


CONSTRUCTION PLANS FOR M.R. TAFOYA OFFICE BUILDING

WATER AND SANITARY
SEWER IMPROVEMENTS

INDEX TO DRAWINGS



1. COVER SHEET - VICINITY MAP AND
GENERAL NOTES
2. WATER AND SANITARY SEWER
PLAN AND PROFILE

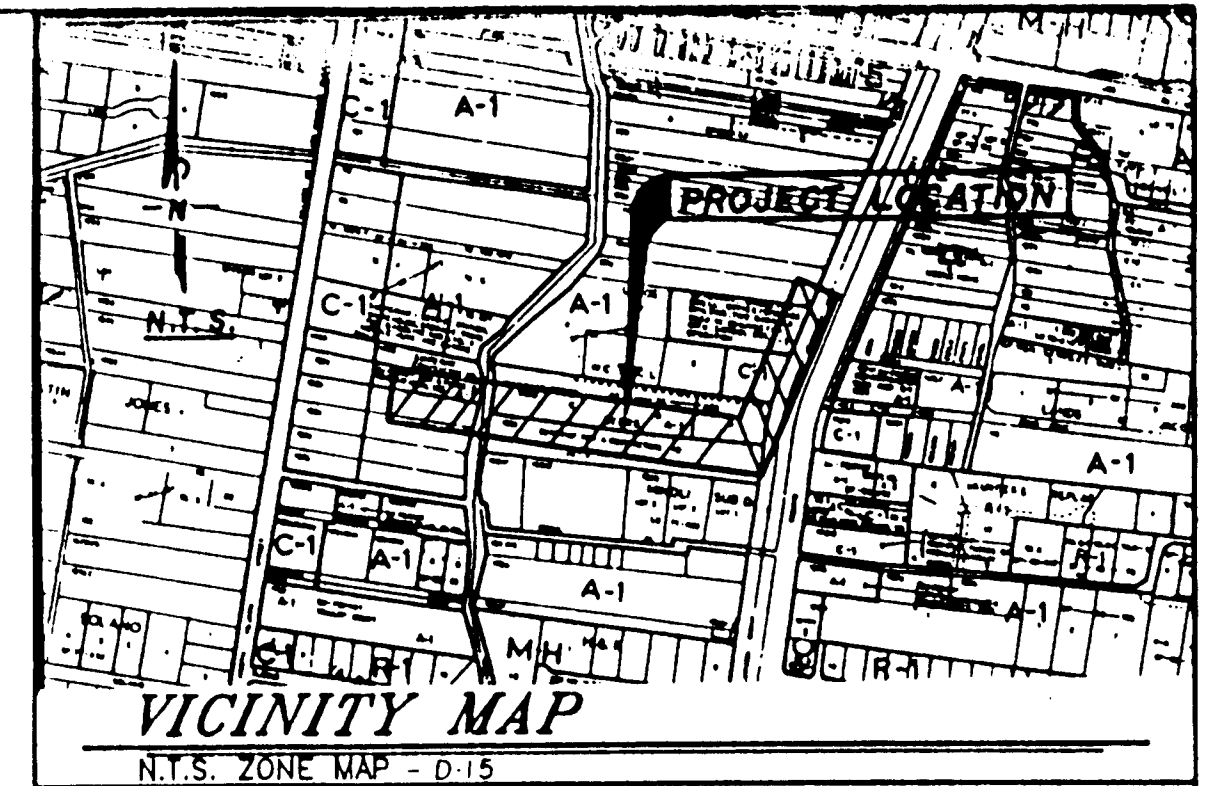

GENERAL NOTES

1. ALL WORK DETAILED IN THESE PLANS TO BE PERFORMED UNDER CONTRACT SHALL, EXCEPT AS OTHERWISE STATED OR PROVIDED FOR HEREON, BE CONSTRUCTED IN ACCORDANCE WITH THE CITY OF ALBUQUERQUE STANDARD SPECIFICATIONS, 1986 EDITION (REFERRED TO HEREIN AS THE STANDARD SPECIFICATIONS).
2. ALL WORK PERFORMED ON THIS PROJECT SHALL BE PERFORMED IN ACCORDANCE WITH APPLICABLE FEDERAL, STATE, AND LOCAL LAWS, RULES AND REGULATIONS CONCERNING CONSTRUCTION SAFETY AND HEALTH.
3. CONTRACTOR SHALL NOTIFY AND COORDINATE ALL CONSTRUCTION TWO WEEKS PRIOR TO START WITH THE FOLLOWING UTILITIES: US WEST COMMUNICATIONS, PUBLIC SERVICE COMPANY OF NEW MEXICO, AND THE GAS CO. OF NEW MEXICO.
4. CONTRACTOR SHALL MAINTAIN ACCESS TO ADJACENT PROPERTIES DURING CONSTRUCTION.
5. TWO (2) WORKING DAYS PRIOR TO ANY EXCAVATION, CONTRACTOR MUST CONTACT LINE LOCATING SERVICE, 260-1990, FOR LOCATION OF EXISTING UTILITIES.
6. PRIOR TO CONSTRUCTION, THE CONTRACTOR SHALL EXCAVATE AND VERIFY THE HORIZONTAL AND VERTICAL LOCATIONS OF ALL OBSTRUCTIONS. SHOULD A CONFLICT EXIST, THE CONTRACTOR SHALL NOTIFY THE ENGINEER OR SURVEYOR SO THAT THE CONFLICT CAN BE RESOLVED WITH MINIMUM AMOUNT OF DELAY.
7. BACKFILL COMPACTION SHALL BE ACCORDING TO SPECIFIED STREET USE.
8. BACKFILL COMPACTION SHALL BE ACCORDING TO SPECIFIED STREET USE.
9. THREE (3) WORKING DAYS PRIOR TO BEGINNING CONSTRUCTION, THE CONTRACTOR SHALL SUBMIT TO THE COORDINATION DIVISION A DETAILED CONSTRUCTION SCHEDULE REGARDING TRAFFIC CONTROL. TWO (2) WORKING DAYS PRIOR TO CONSTRUCTION, THE CONTRACTOR SHALL OBTAIN A BARRICADE PERMIT FROM THE CONSTRUCTION COORDINATION DIVISION. CONTRACTOR SHALL NOTIFY BARRICADE ENGINEER (768-2551) PRIOR TO OCCUPYING AN INTERSECTION. SEE SECTION 19 OF THE SPECIFICATIONS.


As-Built Dwg. 3/1/96

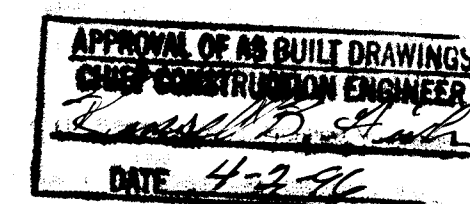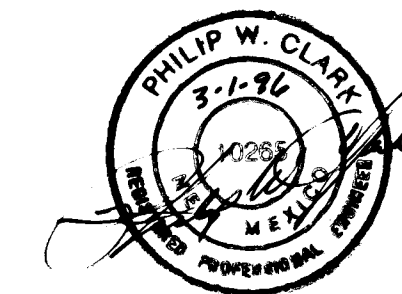

1 2 3 4 5 6 7 8 9 10 11 12 13 14 15
24-4690.90 01/96

REV	SHEETS	CITY	ENG.	DATE	USER	DEPT.	DATE	USER	DEPT.	DATE
APPROVAL OF REVISIONS										

SCANNED BY
BY: 1802

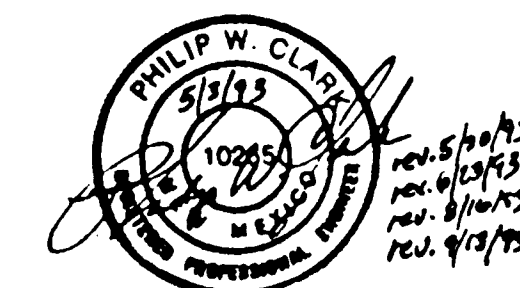



TMS and Associates, Inc.
Engineers, Architects, Surveyors
200 North 1st St., Suite 111
Albuquerque, New Mexico 87102
(505) 263-1111 FAX (505) 263-1117



Robert B. St. John
9/24/92
R. St. John

DWG. No. 4690.90

SHEET 1 OF 2

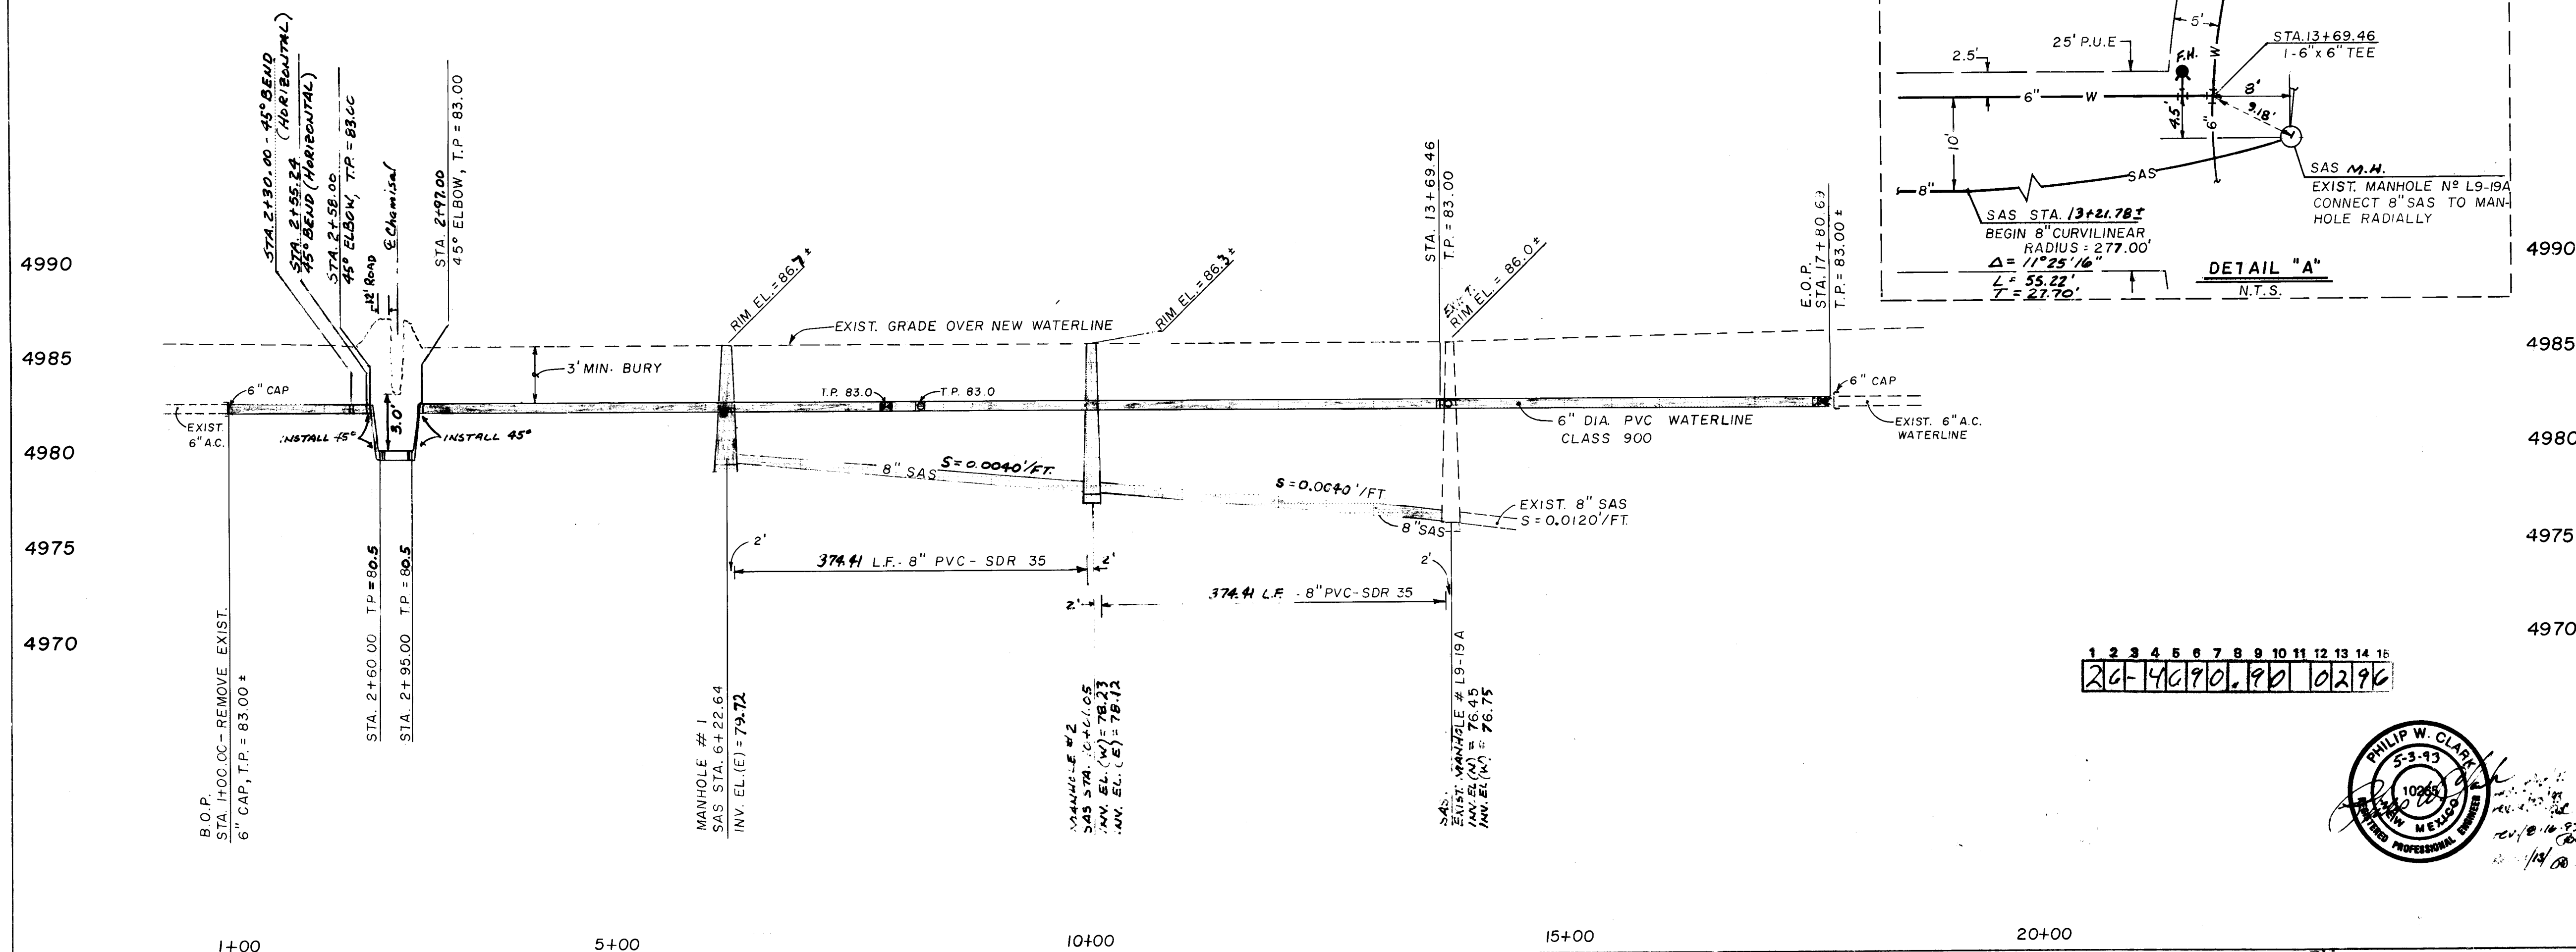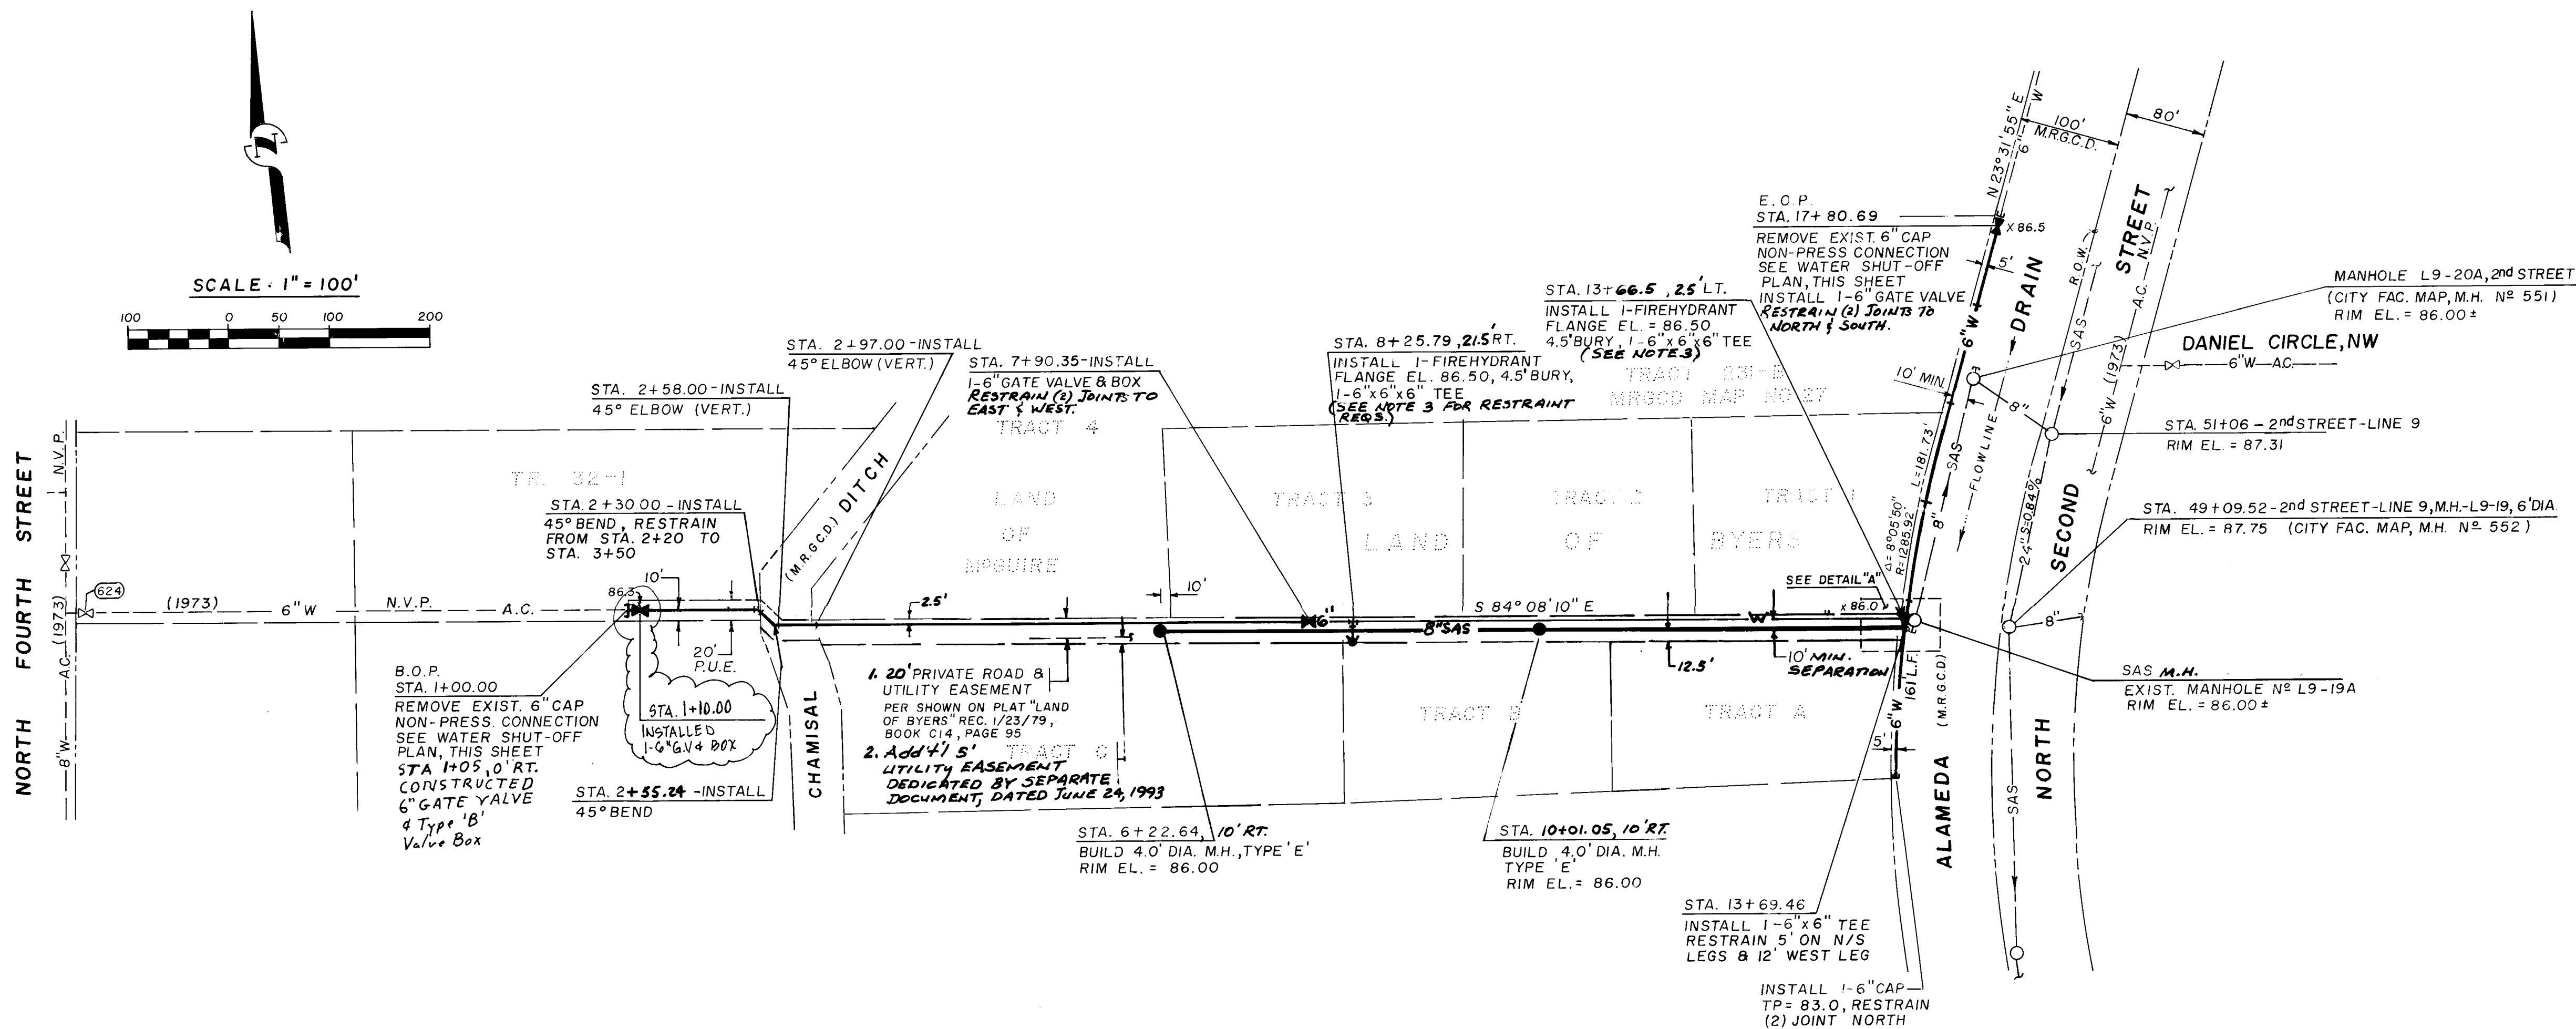

SCANNED BY
BY LASON