

CONTRACTOR SHALL COORDINATE WITH THE WATER SYSTEM DIVISION AT 857-8200 FOR THE EXECUTION OF THE VALVE #522 SHUT OFF NOT LESS THAN THREE (3) WORKING DAYS IN ADVANCE OF ANY WORK THAT MAY AFFECT THE EXISTING PUBLIC WATER UTILITIES. ONLY WATER SYSTEM DIVISION PERSONNEL SHALL OPERATE EXISTING VALVES.

GENERAL NOTES

NOTICE TO CONTRACTORS


- CITY OF ALBUQUERQUE SPECIFICATIONS FOR PUBLIC WORKS CONSTRUCTION, 1986 EDITION AS AMENDED THROUGH UPDATE 4, WILL BE REFERRED TO HEREIN AS THE "STANDARD SPECIFICATIONS".
- TWO WORKING DAYS PRIOR TO ANY EXCAVATION, CONTRACTOR MUST CONTACT NEW MEXICO ONE CALL SYSTEM (260-1990) AND DETERMINE LOCATION OF EXISTING UTILITIES.
- PRIOR TO ANY CONSTRUCTION, THE CONTRACTOR SHALL EXCAVATE AND VERIFY THE HORIZONTAL AND VERTICAL LOCATIONS OF ALL OBSTRUCTIONS. SHOULD A CONFLICT EXIST, THE CONTRACTOR SHALL NOTIFY THE ENGINEER OR THE SURVEYOR SO THAT THE CONFLICT CAN BE RESOLVED WITHOUT DELAY.
- ALL EXISTING SIGNS, MARKERS, DELINEATORS, ETC., WITHIN THE CONSTRUCTION LIMITS SHALL BE REMOVED, STORED AND RE-SET BY THE CONTRACTOR.
- THREE (3) WORKING DAYS PRIOR TO BEGINNING CONSTRUCTION THE CONTRACTOR SHALL SUBMIT TO THE CONSTRUCTION CO-ORDINATION DIVISION A DETAILED CONSTRUCTION SCHEDULE. TWO (2) WORKING DAYS PRIOR TO CONSTRUCTION THE CONTRACTOR SHALL OBTAIN A BARRICADING PERMIT FROM THE CONSTRUCTION CO-ORDINATION DIVISION. CONTRACTOR SHALL NOTIFY BARRICADE ENGINEER (768-2551) PRIOR TO OCCUPYING AN INTERSECTION.

THE FOLLOWING NOTES ALSO APPLY WHEN CHECKED

- ☐ ALL UTILITIES AND UTILITY SERVICE LINES SHALL BE INSTALLED PRIOR TO PAVING.
- ☒ BACKFILL COMPACTION SHALL BE ACCORDING TO SPECIFIED STREET USE.
- ☐ TACK COAT REQUIREMENTS SHALL BE DETERMINED BY THE CITY ENGINEER.
- ☐ SIDEWALK AND WHEELCHAIR RAMPS WITHIN THE CURB RETURNS SHALL BE CONSTRUCTED WHEREVER A NEW CURB RETURN IS CONSTRUCTED.
- ☐ IF CURB IS DEPRESSED FOR A DRIVEPAD, THE DRIVEPAD SHALL BE CONSTRUCTED PRIOR TO ACCEPTANCE OF CURB AND GUTTER.
- ☐ ALL STORM DRAINAGE FACILITIES SHALL BE COMPLETED PRIOR TO FINAL ACCEPTANCE.
- ☒ THE REQUESTOR OR DEVELOPER SHALL BE RESPONSIBLE FOR REPAIR OR REPLACEMENT OF ALL CURB AND GUTTER OR SIDEWALK DAMAGE AFTER APPROVAL BY THE CITY ENGINEER OR WORK COMPLETED BY THE CONTRACTOR.

SUPPLEMENTAL NOTE


THIS PLAN IS INTENDED ONLY TO DISPLAY RELOCATION OF THE EXISTING FIRE HYDRANT & DROP INLET FOR DRC APPROVAL. IT IS NOT SUBMITTED TO OBTAIN APPROVAL FOR OTHER UNRELATED IMPROVEMENTS THAT WOULD OTHERWISE BE SOUGHT VIA THE NORMAL BUILDING PERMIT PROCESS.

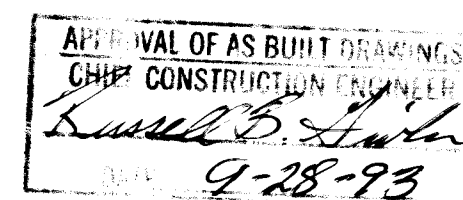

RECORD DRAWING

I hereby certify that the information contained on this drawing has been revised in accordance with information furnished by the Contractor, Sundance Mechanical and by the Surveyor, D. Mark Goodwin and Associates, P.A. and reflects the construction as actually accomplished. This plan as constructed is in close compliance with the Approved Plan.

Mark Goodwin 6/25/93  
Mark Goodwin, NMPE 8548

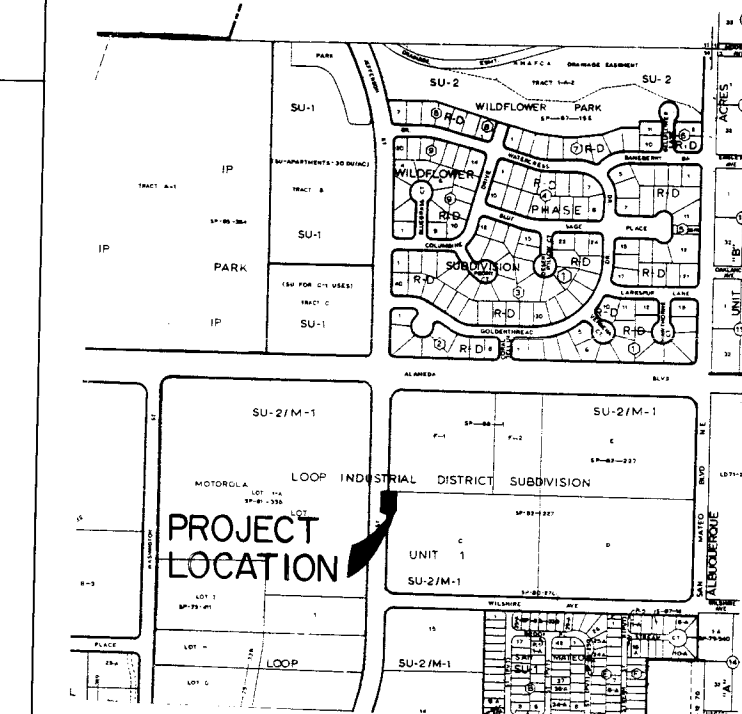

VICINITY MAP ZONE ATLAS: C-17-Z

AS BUILT INFORMATION			
CONTRACTOR	Sundance Mech.	DATE	6/10/93
WORK	RELOCATE EXIST. INLET	DATE	6/10/93
INSPECTED BY	AS	DATE	6/10/93
ACCEPTANCE BY	AS	DATE	6/10/93
FIELD VERIFICATION BY	AS	DATE	6/10/93
DRAWINGS CORRECTED BY	AS	DATE	6/10/93
MICRO-FILM INFORMATION			
RECORDED BY	NO.	DATE	

THE ACS STATION IS LOCATED AT RICHFIELD ROAD BRIDGE OVER THE ANAFCA NORTH DIVERSION CHANNEL. STATION IS ANAFCA BRASS TABLET STAMPED "NOC 1" SET ON A CONCRETE POST PROTECTING 0.3 FEET ABOVE GROUND. X=394,094.08 Y=1,522,635.84 Z=5062.60

BENCH MARKS	
NO.	DATE

SURVEY INFORMATION	
FIELD NOTES	NO.
BY	

ENGINEER'S SEAL	
NO.	DATE
10/10/93	
REVISIONS	
NO.	DATE
1	5/93
2	5/93
3	5/93

John McMartin 6/10/93  
HYDROLOGY APPROVAL FOR INLET RELOCATION

Ricardo R. Lopez 6/10/93  
APPROVED FOR CONSTRUCTION DATE

dmg  
D. MARK GOODWIN & ASSOCIATES, P.A.  
CONSULTING ENGINEERS & SURVEYORS  
P.O. BOX 90606  
ALBUQUERQUE, NEW MEXICO 87199  
(505) 828-2200

CITY OF ALBUQUERQUE  
PUBLIC WORKS DEPARTMENT  
ENGINEERING GROUP

TITLES:					
AMTECH FIRE HYDRANT RELOCATION					
APPROVALS	ENGINEER	DATE	APPROVALS	ENGINEER	DATE
DRC CHAIRMAN	S. P. Amodeo	5-14-93	WATER	R. W. Kane	5-12-93
TRANSPORTATION	W. A. R. H. D.	5-14-93	WASTE WATER	R. W. Kane	5-12-93
HYDROLOGY	W. A. R. H. D.	5-14-93			

PROJECT NO.	4697.90	MAP NO.	C17	SHEET	OF
				1	1