

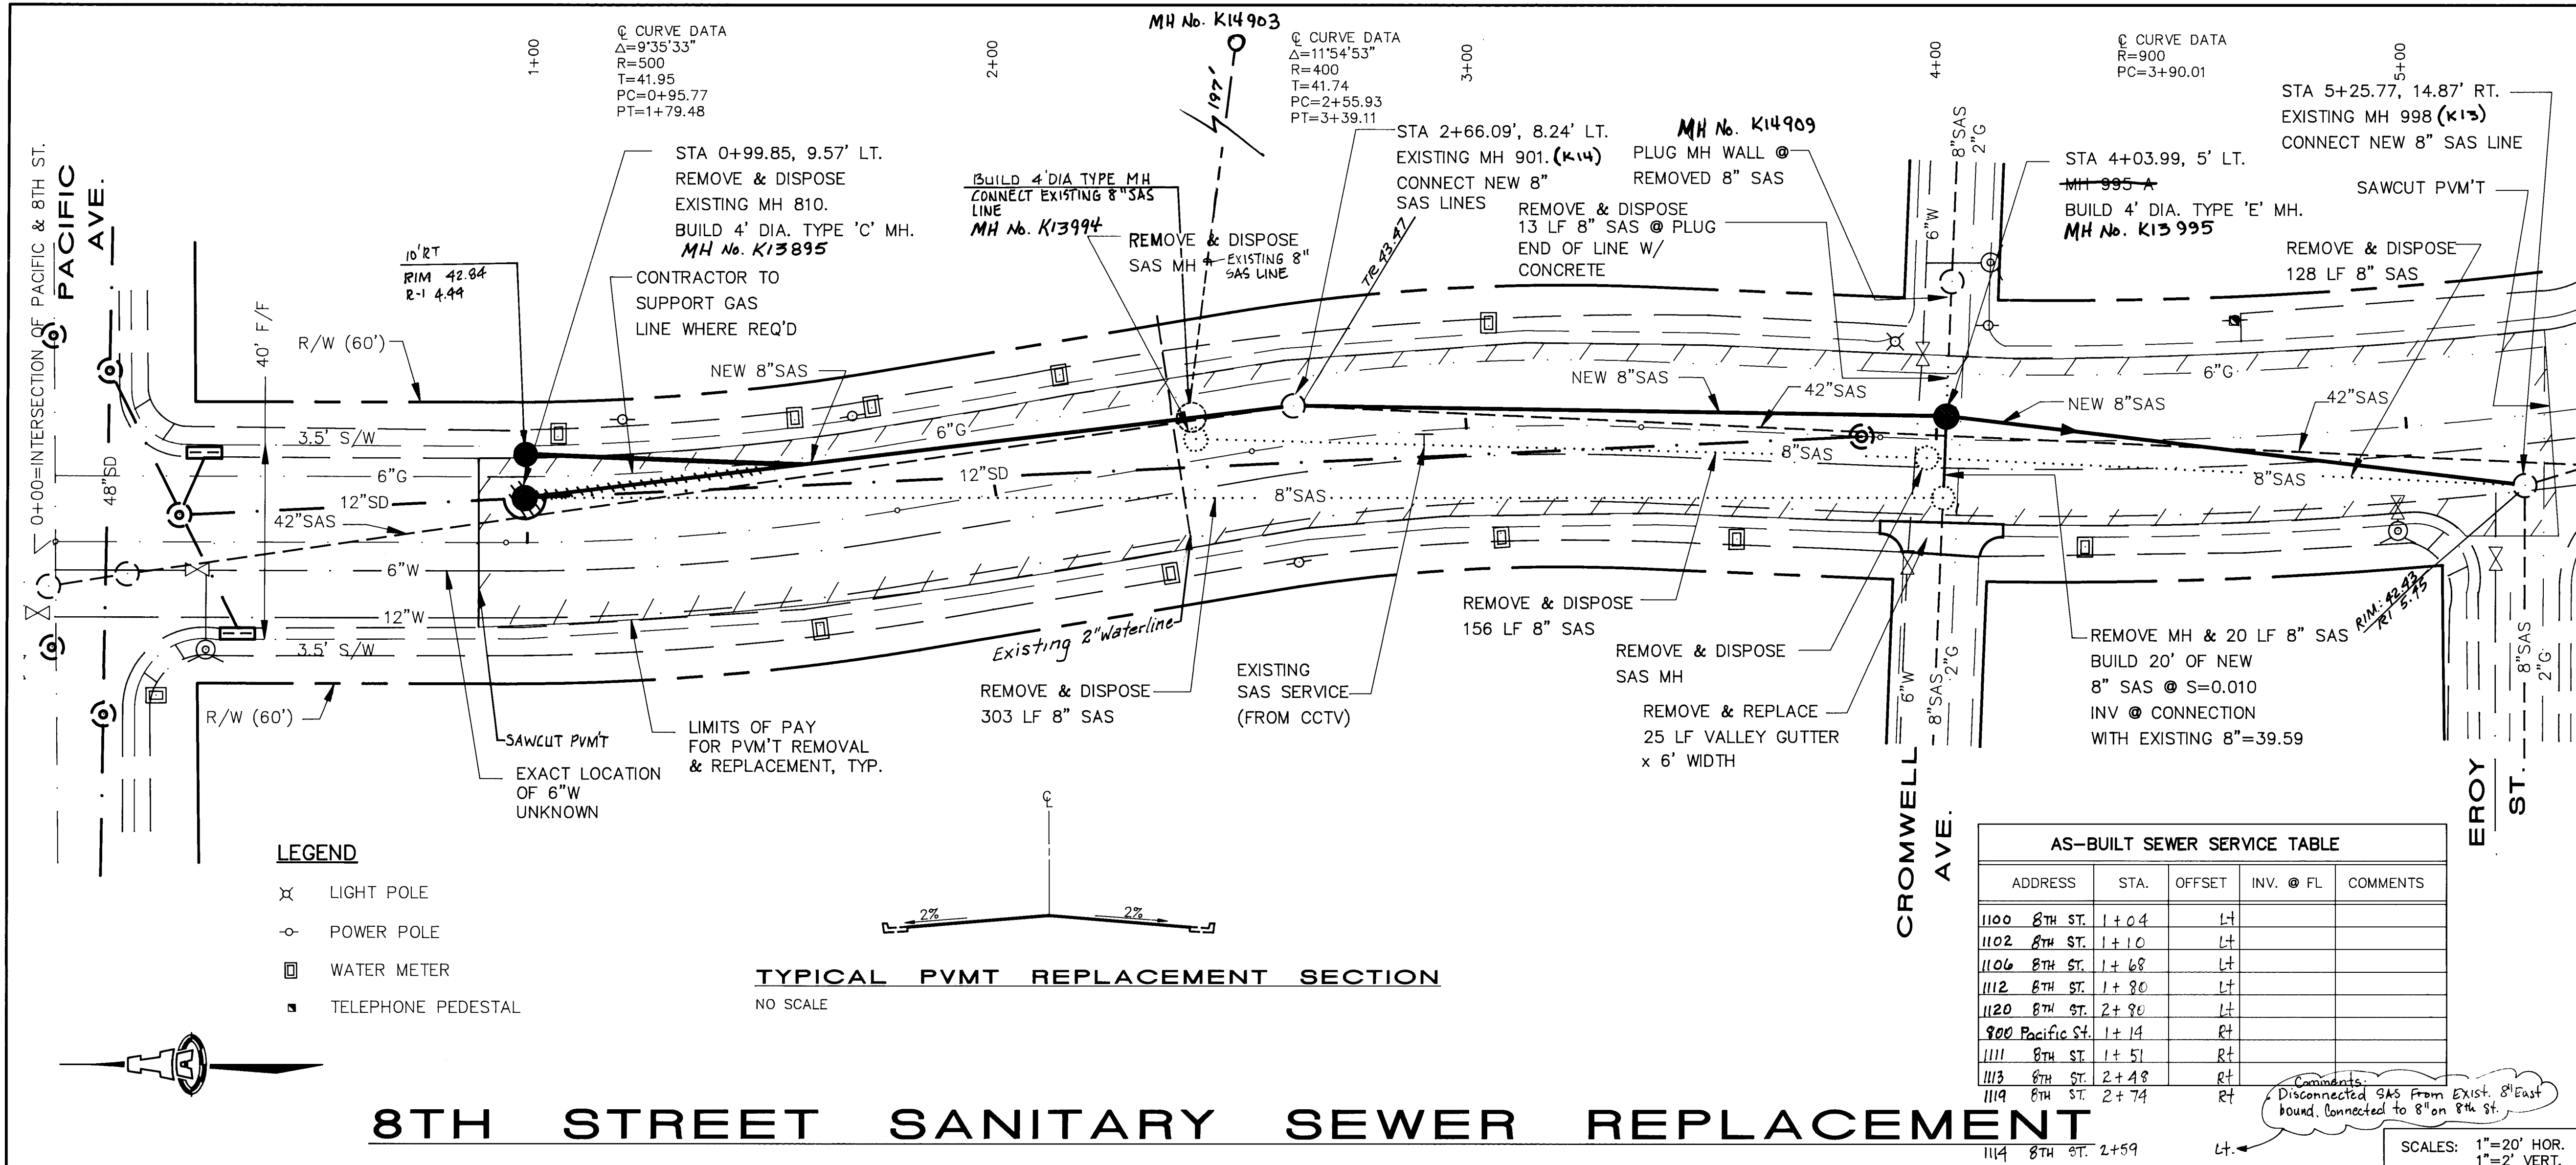


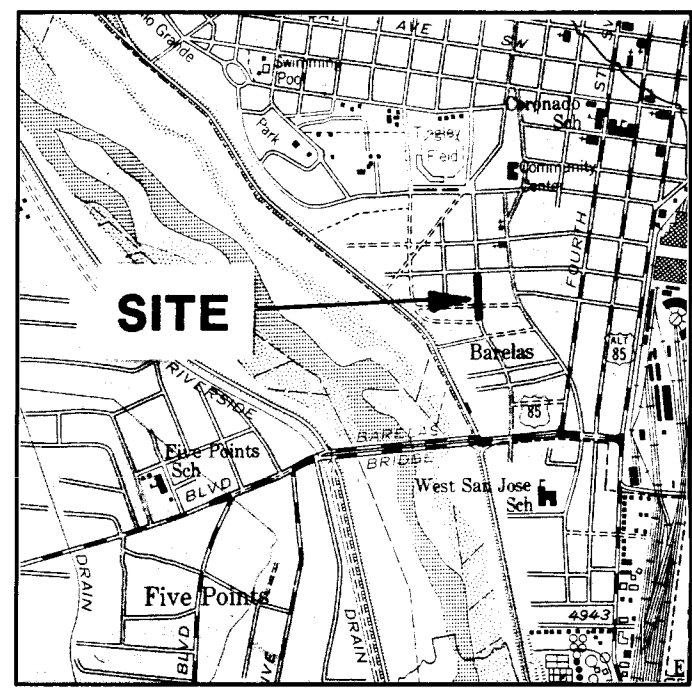

8TH STREET SANITARY SEWER REPLACEMENT

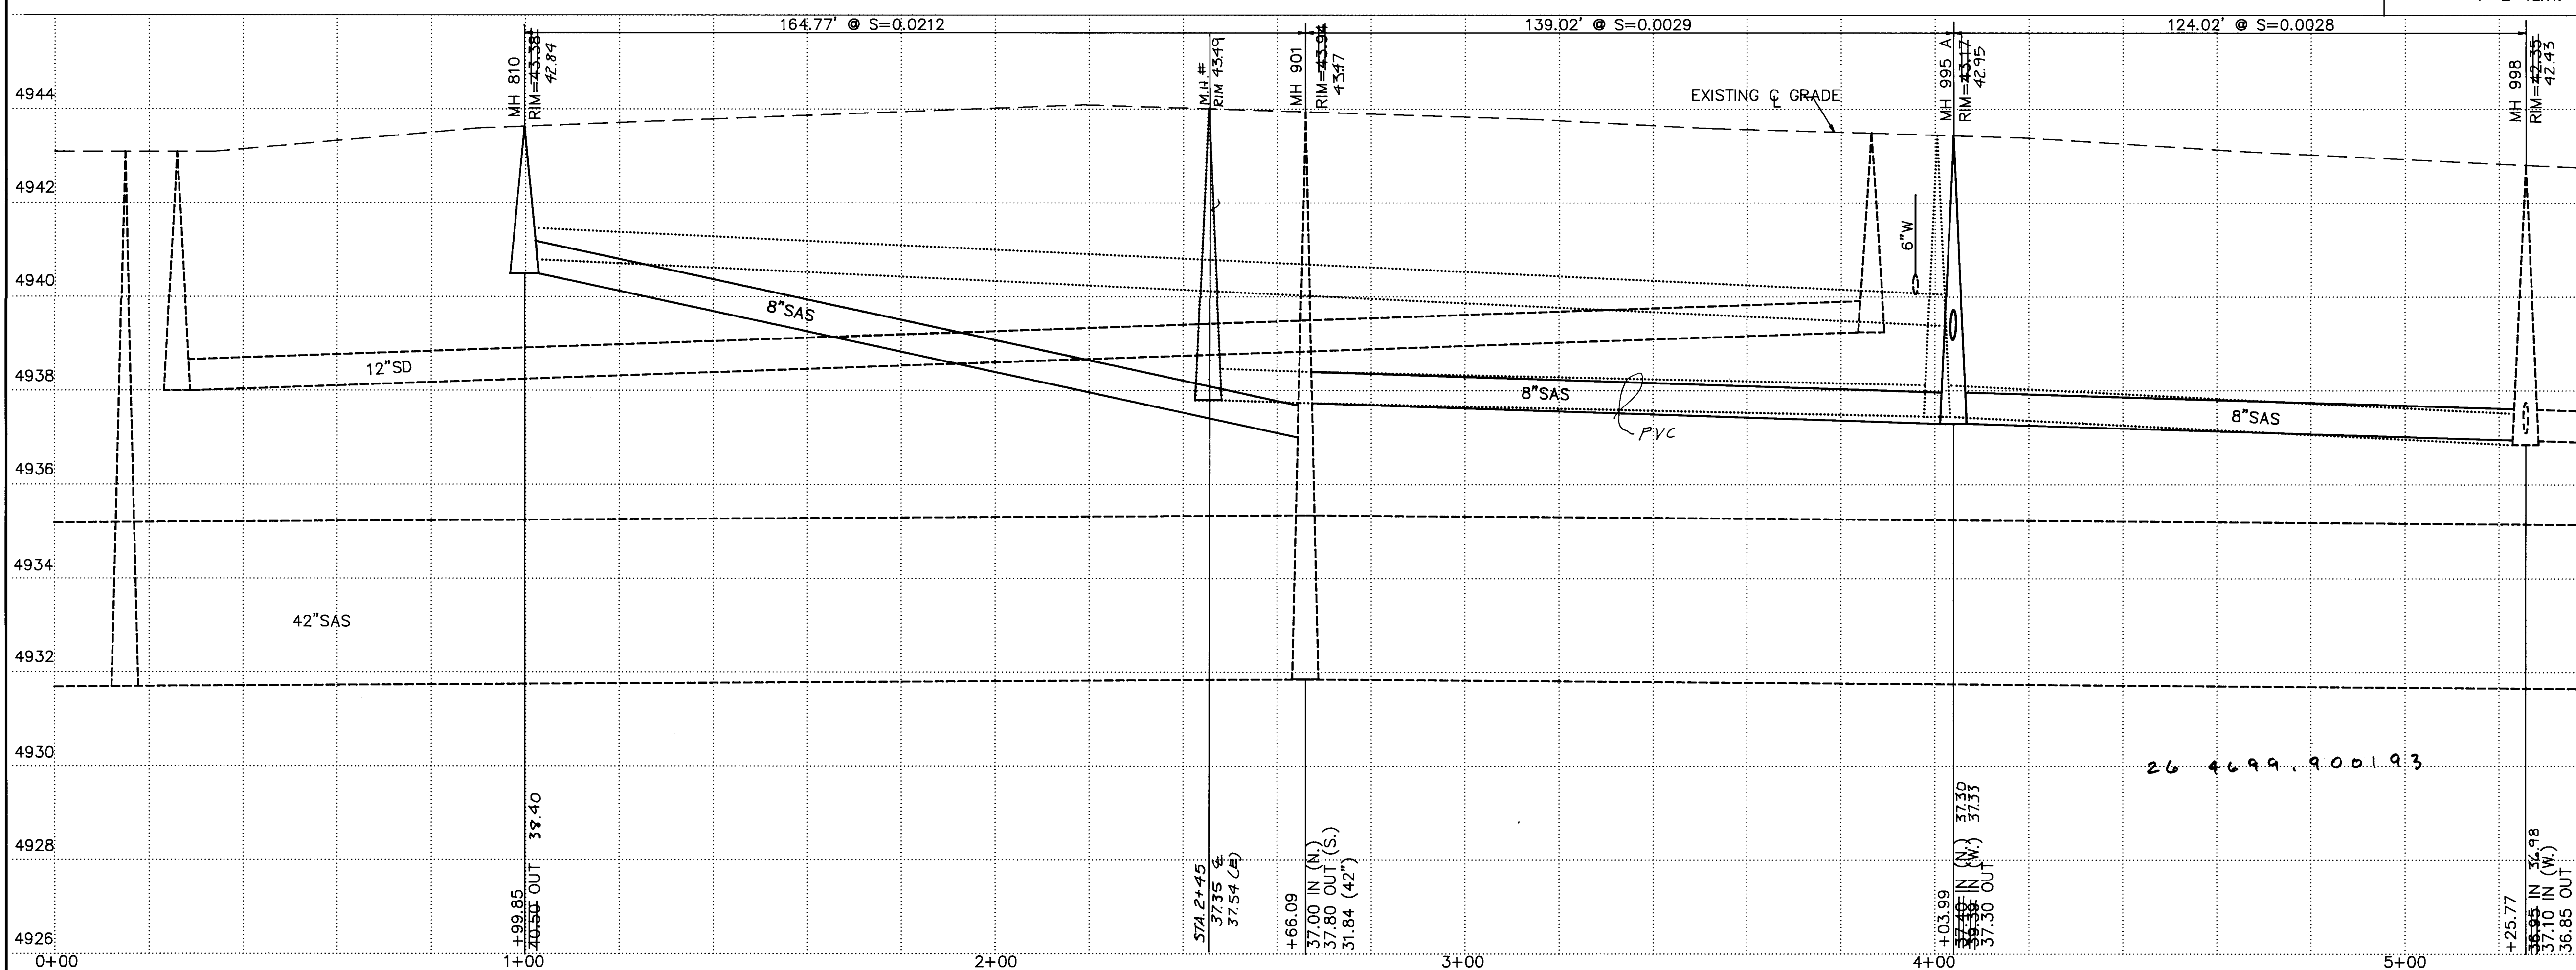

VICINITY MAP
ZONE ATLAS MAP K-13

GENERAL NOTES

- CONTRACTOR SHALL SUBMIT A CONSTRUCTION SIGNING AND BARRICADING PLAN TO THE CITY CONSTRUCTION COORDINATOR, AND RECEIVE A BARRICADING PERMIT PRIOR TO BEGINNING THE JOB.
- TWO WORKING DAYS PRIOR TO ANY EXCAVATION, THE CONTRACTOR MUST CONTACT LINE LOCATING SERVICE (260-1990) FOR LOCATION OF EXISTING UTILITIES.
- PAVEMENT REPLACEMENT SHALL CONFORM TO STANDARD DRWG NO. 2407 WITH THE FOLLOWING PROVISIONS:
1) 6" ASPHALT TREATED BASE IS DELETED, AND 2) THE PAVING SECTION SHALL CONSIST OF 3 1/2" ASPHALTIC CONCRETE BASE COURSE (1800# WITH MACHINE LAYDOWN), AND 1 1/2" ASPHALTIC CONCRETE SURFACE COURSE (1800# WITH MACHINE LAYDOWN).
- TRAFFIC CONTROL: THREE (3) WORKING DAYS PRIOR TO BEGINNING CONSTRUCTION THE CONTRACTOR SHALL SUBMIT TO THE CONSTRUCTION COORDINATION DIVISION A DETAILED CONSTRUCTION SCHEDULE. TWO (2) WORKING DAYS PRIOR TO CONSTRUCTION THE CONTRACTOR SHALL OBTAIN A BARRICADING PERMIT FROM THE CONSTRUCTION COORDINATION DIVISION. CONTRACTOR SHALL NOTIFY BARRICADE ENGINEER (768-2551) PRIOR TO OCCUPYING AN INTERSECTION. SEE SECTION 19 OF THE SPECIFICATIONS. ALL STREET STRIPING ALTERED OR DESTROYED SHALL BE REPLACED BY CONTRACTOR TO LOCATION AND IN KIND AS EXISTING AT NO ADDITIONAL COST TO THE OWNER.
- CONTRACTOR SHALL EXTEND EXISTING SEWER SERVICES AND CONNECT TO NEW 8" SAS MAIN PER STANDARD DRAWING 2134.
- CONTRACTOR TO INSCRIBE AN "S" IN TOP OF CURB OVER ALL SERVICE STUBOUTS.

APPROVAL OF AS-BUILT DRAWING
CHIEF CONSTRUCTION ENGINEER
[Signature]
DATE 12-29-95

APPROVED FOR CONSTRUCTION
[Signature]
CITY ENGINEER

5/28/93
DATE

ISAACSON & ARFMAN, P.A.
Consulting Engineering Associates
128 Monroe Street, N.E.
Albuquerque, New Mexico
74404SWR.DWG 5/27/93

CITY OF ALBUQUERQUE
PUBLIC WORKS DEPARTMENT
ENGINEERING GROUP

TITLE: FY 93 SMALL DIAMETER WATER & SEWER LINES REPLACEMENT
8TH STREET SAS REPLACEMENT

APPROVALS	ENGINEER	DATE	APPROVALS	ENGINEER	DATE
DRC CHAIRMAN	B. J. [Signature]	5-28-93	WATER	R. [Signature]	5/28/93
TRANSPORTATION	[Signature]	5-29-93	WASTE WATER	"	"
HYDROLOGY	[Signature]	5/20/93			

PROJECT NO. 4699.90
MAP NO. K-13
SHEET 1 OF 1

AS-BUILT INFORMATION				BENCH MARKS				SURVEY INFORMATION			
CONTRACTOR	MARK	STATION	DATE	CONTRACTOR	MARK	STATION	DATE	NO.	BY	DATE	NO.
CONDORE	BY CITY	1-K13	7/93	CONDORE	BY CITY	1-K13	7/93	1.	S. GUTIERREZ	5/93	1.
DATE 7/93	DATE 7/93	DATE 7/93	DATE 7/93	DATE 7/93	DATE 7/93	DATE 7/93	DATE 7/93				

ENGINEER'S SEAL				REVISIONS			
				NO.	DATE	TOI	BY

DESIGNED BY	TOI	DATE	CHECKED BY	TOI	DATE
		5/12/93			5/12/93
		5/12/93			5/12/93