


JUSTO WATERLINE

Note: Contractor shall construct Joint Restraints:
From To:
Sta. 10+00 Sta. 10+28
Sta. 11+24 Sta. 11+55
Sta. 12+73 Sta. 13+07
Sta. 15+40.53 Fire Hydrant

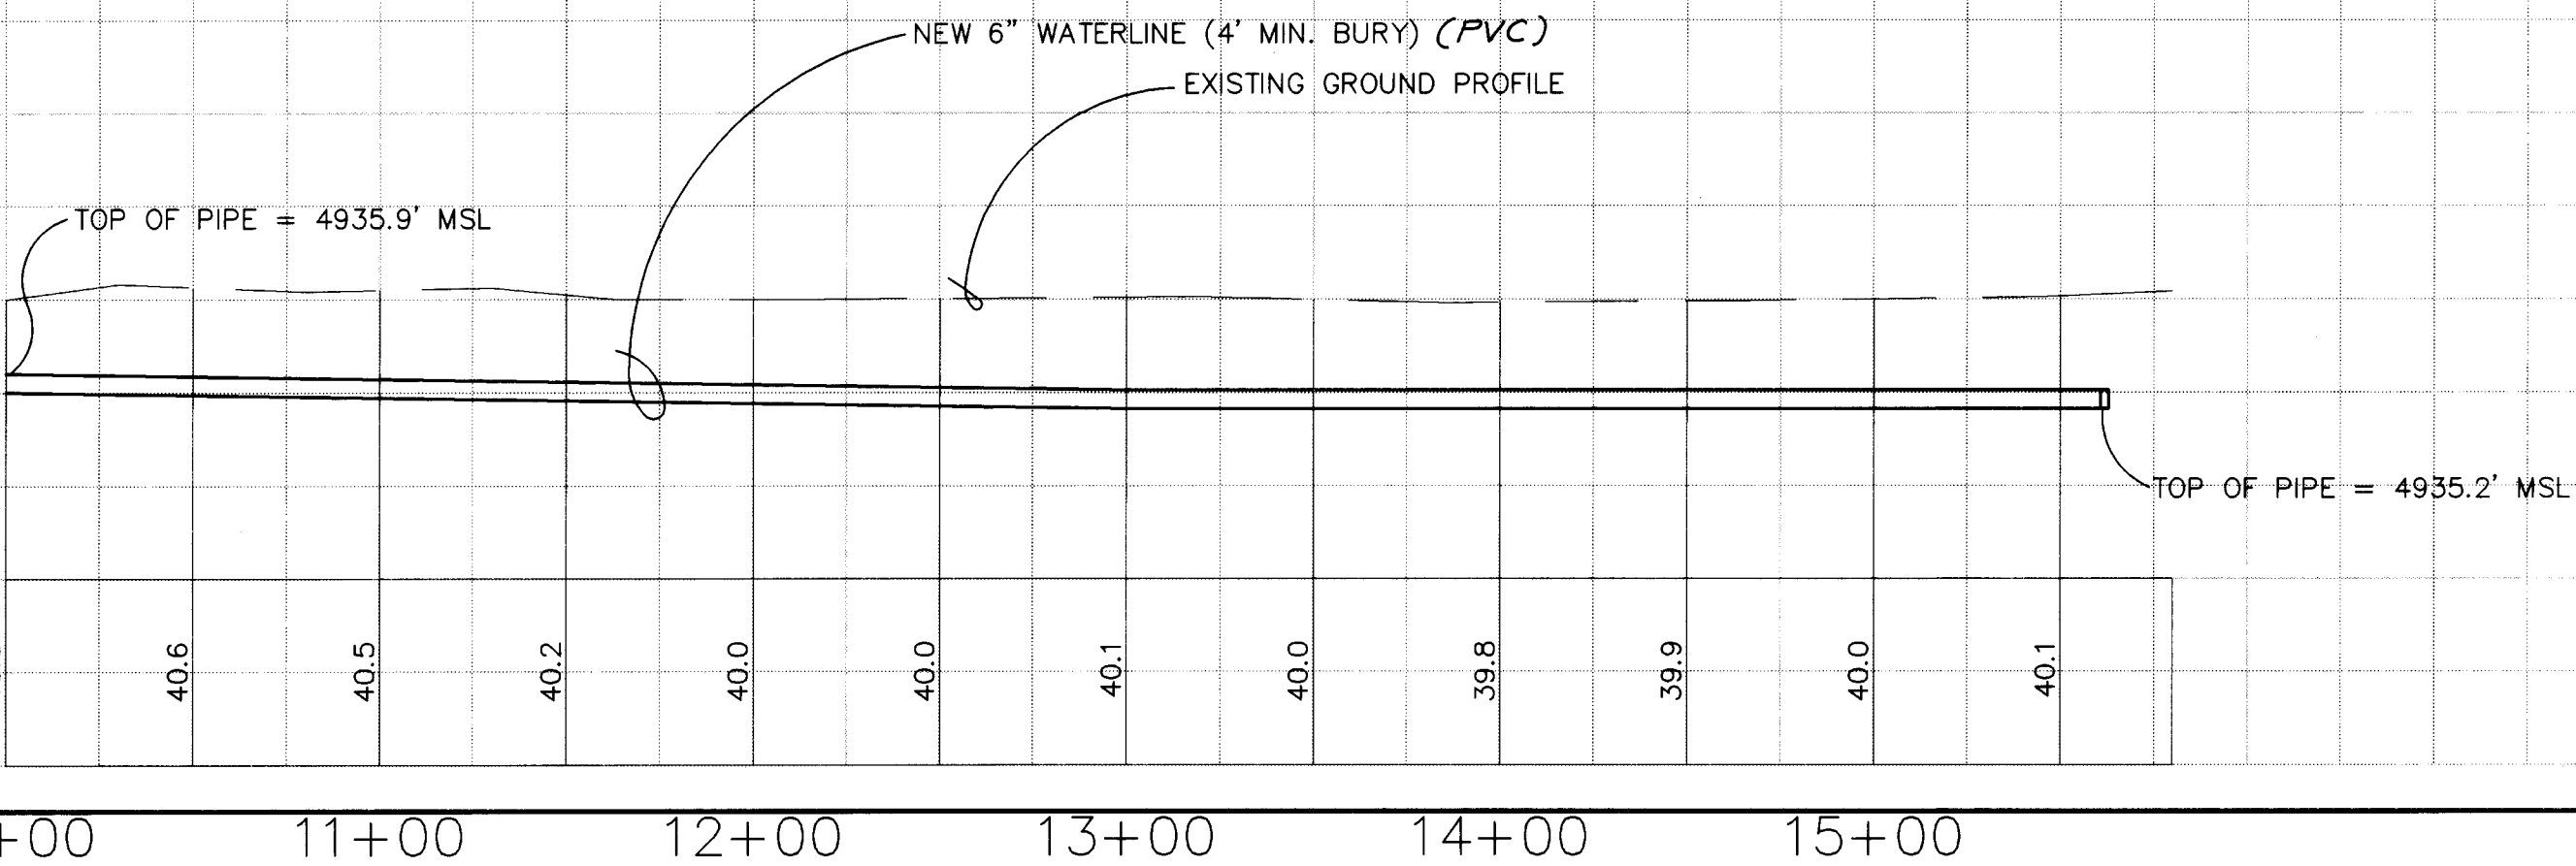

- GENERAL NOTES:
- NOTICE TO CONTRACTORS
- ALL WORK DETAILED ON THESE PLANS TO BE PERFORMED UNDER CONTRACT SHALL, EXCEPT AS OTHERWISE STATED OR PROVIDED FOR HEREON, BE CONSTRUCTED IN ACCORDANCE WITH CITY OF ALBUQUERQUE STANDARD SPECIFICATIONS FOR PUBLIC WORKS CONSTRUCTION, 1986 EDITION WITH UPDATE NO. 4.
 - TWO WORKING DAYS PRIOR TO ANY EXCAVATION, CONTRACTOR MUST CONTACT LINE LOCATING SERVICE, 260-1990 FOR LOCATION OF EXISTING UTILITIES.
 - PRIOR TO CONSTRUCTION, THE CONTRACTOR SHALL EXCAVATE AND VERIFY THE HORIZONTAL AND VERTICAL LOCATIONS OF ALL OBSTRUCTIONS. SHOULD A CONFLICT EXIST, THE CONTRACTOR SHALL NOTIFY THE ENGINEER OR SURVEYOR SO THAT THE CONFLICT CAN BE RESOLVED WITH A MINIMUM AMOUNT OF DELAY.
 - TRAFFIC CONTROL - THREE (3) WORKING DAYS PRIOR TO BEGINNING CONSTRUCTION THE CONTRACTOR SHALL SUBMIT TO CONSTRUCTION COORDINATION DIVISION A DETAILED CONSTRUCTION SCHEDULE. TWO (2) WORKING DAYS PRIOR TO CONSTRUCTION THE CONTRACTOR SHALL OBTAIN A BARRICADING PERMIT FROM THE CONSTRUCTION COORDINATION DIVISION. CONTRACTOR SHALL NOTIFY BARRICADING ENGINEER (768-2551) PRIOR TO OCCUPYING AND INTERSECTION.

- THE FOLLOWING NOTES APPLY WHEN CHECKED:
- ☐ ALL UTILITIES AND UTILITY SERVICE LINES SHALL BE INSTALLED PRIOR TO PAVING.
 - ☒ BACKFILL COMPACTION SHALL BE ACCORDING TO SPECIFIED STREET USE.
 - ☐ TACK COAT REQUIREMENTS SHALL BE DETERMINED BY THE CITY ENGINEER.
 - ☐ SIDEWALKS AND WHEELCHAIR RAMPS WITHIN THE CURB RETURNS SHALL BE CONSTRUCTED WHEREVER A NEW CURB RETURN IS CONSTRUCTED.
 - ☐ IF CURB IS DEPRESSIONED FOR A DRIVEPAD, THE DRIVEPAD SHALL BE CONSTRUCTED PRIOR TO ACCEPTANCE OF CURB AND GUTTER.
 - ☐ ALL STORM DRAINAGE FACILITIES SHALL BE COMPLETED PRIOR TO FINAL ACCEPTANCE.
 - ☐ THE REQUESTOR OR DEVELOPER SHALL BE RESPONSIBLE FOR REPAIR OR REPLACEMENT OF ALL CURB AND GUTTER OR SIDEWALK DAMAGED AFTER APPROVAL BY THE CITY ENGINEER OF WORK COMPLETED BY THE CONTRACTOR.

THE FOLLOWING STANDARD CITY OF ALBUQUERQUE DRAWING NUMBERS APPLY:

PIPE TRENCH - DWG. #2315
BLOCKING - DWG. #2320
VALVE BOX - DWG. #2325
VALVE RING/COVER - DWG. #2328
FIRE HYDRANT - DWG. #2340
METER BOXES - DWG. #2360 & #2361
SERVICE LINE - DWG. #2362

WHERE A WATER LINE PASSES BENEATH OF LESS THAN 18" ABOVE AN EXISTING SEWER LINE, THE SEWER LINE SHALL BE ENCASED IN CONCRETE 6" THICK AS DETAILED (CITY OF ALBUQUERQUE STD. DRAWING #2140) FOR AT LEAST 10 FEET ON EACH SIDE OF THE WATER LINE, OR THE SEWER LINE SHALL BE D.I. OR C.I. PIPE WITH PRESSURE-TYPE JOINTS FOR AT LEAST 10 FEET ON EACH SIDE OF THE WATER LINE. THIS SHALL ALSO APPLY WHERE A PARALLEL WATER LINE IS LESS THAN 10 FEET HORIZONTALLY AND LESS THAN 2 FEET ABOVE THE SEWER LINE.

TJB
Terry O. Brown, P.E.
P. O. Box 92051
Albuquerque, NM 87199
(505) 883-8807

APPROVAL OF AS BUILT DRAWINGS
CHIEF CONSTRUCTION ENGINEER
Terry O. Brown
DATE *6-28-94*

APPROVED FOR CONSTRUCTION
Ricardo B. Lopez
CITY ENGINEER
DATE *4/23/94*

CITY OF ALBUQUERQUE PUBLIC WORKS DEPARTMENT ENGINEERING GROUP					
TITLE: JUSTO WATERLINE PROJECT					
APPROVALS	ENGINEER	DATE	APPROVALS	ENGINEER	DATE
DRC CHAIRMAN	<i>8-16-93</i>		WATER		
TRANSPORTATION	<i>8-16-93</i>		WASTE WATER	<i>8-24-93</i>	
HYDROLOGY	<i>NA</i>	<i>8/1/93</i>			
PROJECT NO.	4707.90	MAP NO.	L-11	SHEET	OF
				1	1