

RECORD DRAWING

ECORD DRAWING , Jeffrey G. Mortensen, Registered Professional Engineer in the State of New Mexico, do hereby certify that this "as-built" information was obtained by me or under my supervision and represents the "asbuilt" conditions of this project, and is true and correct to the best of my knowledge and belief. All vertical and horizontal dimensions should be field verified prior to use on future projects.

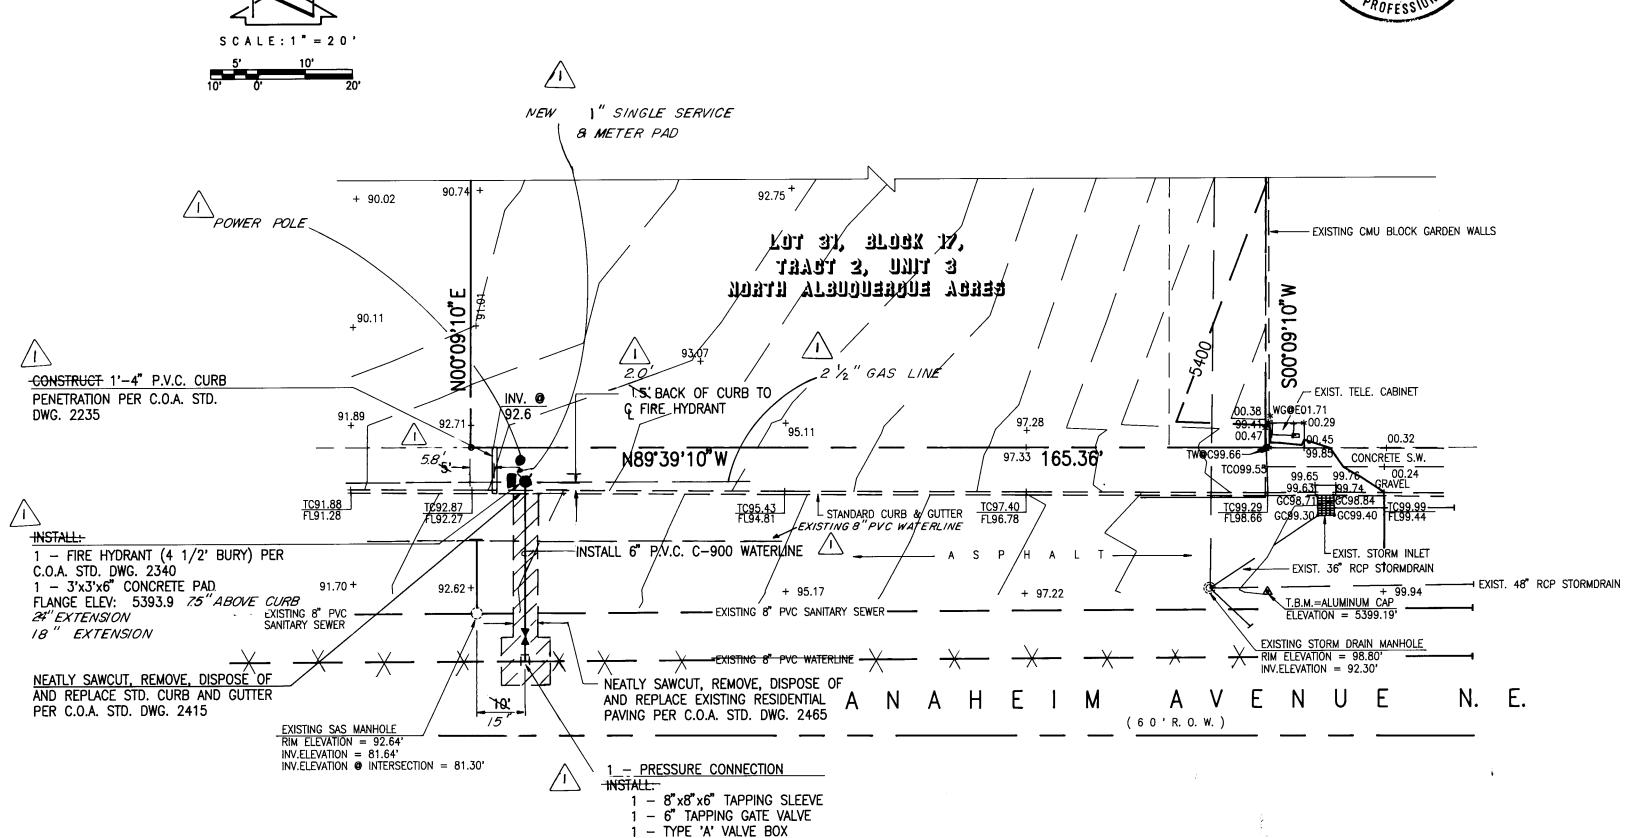

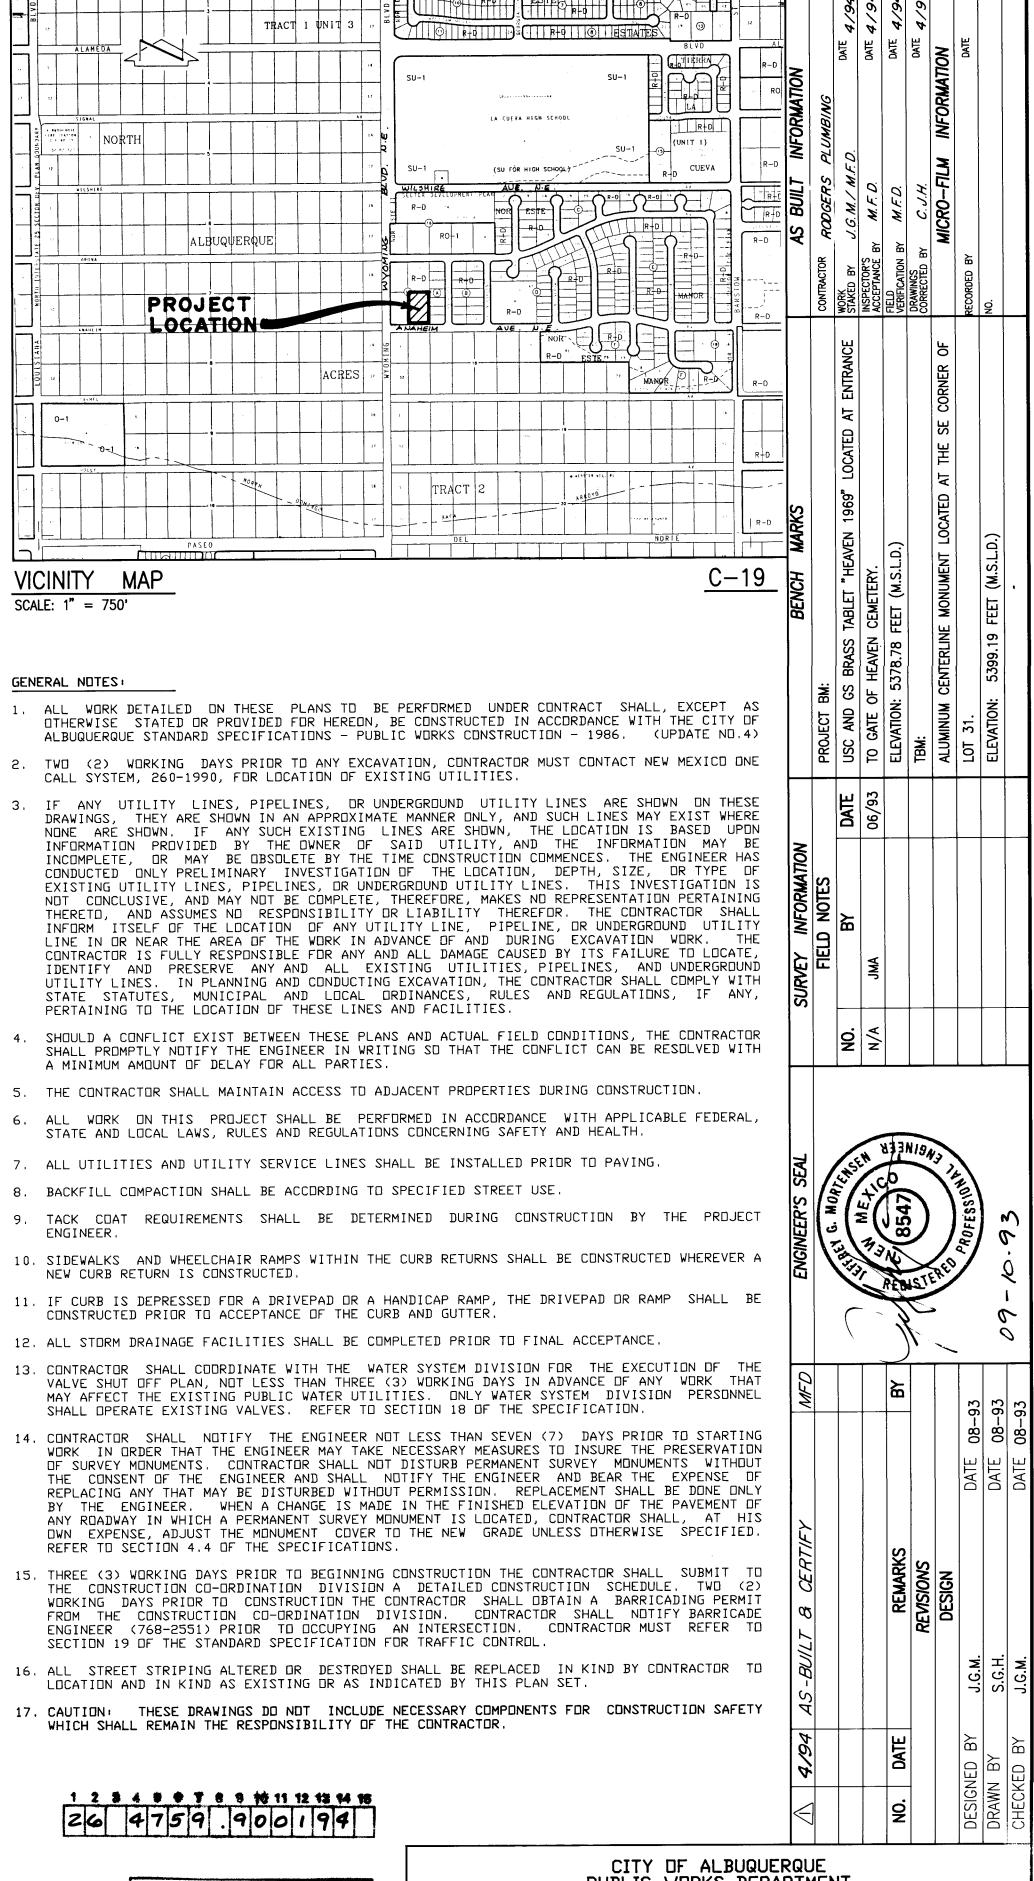

APPROVAL OF AS BUILT DRAWINGS
CHIEF CONSTRUCTION ENGINEES

APPROVED FOR -CONSTRUCTION

PUBLIC WORKS DEPARTMENT ENGINEERING GROUP

TITLE BRIGHT BEGINNINGS - WYOMING FIRE HYDRANT INSTALLATION

JEFF MORTENSEN & ASSOCIATES, INC. 6010-B MIDWAY PARK BLVD. N.E. ALBUQUERQUE | NEW MEXICO 87109 ENGINEERS | SURVEYORS (505) 345-4250

930454

SCHMMED R

BY LASON

DRC CHAIRMAN TRANSPORTATI HYDROLOGY PROJECT

APPROVALS ENGINEER DATE DATE APPROVALS TON Elsent 9.23.93 WATER

ON Elsent 9.23.93 WASTE WATER

B. Marga 193193 R.W. Kane 9-21-9 R.W. Kano 9-21-4 SHEET DF N□, C-19 4759.90