
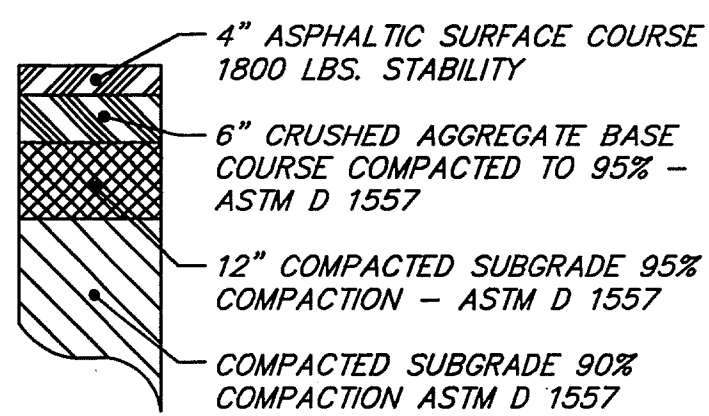


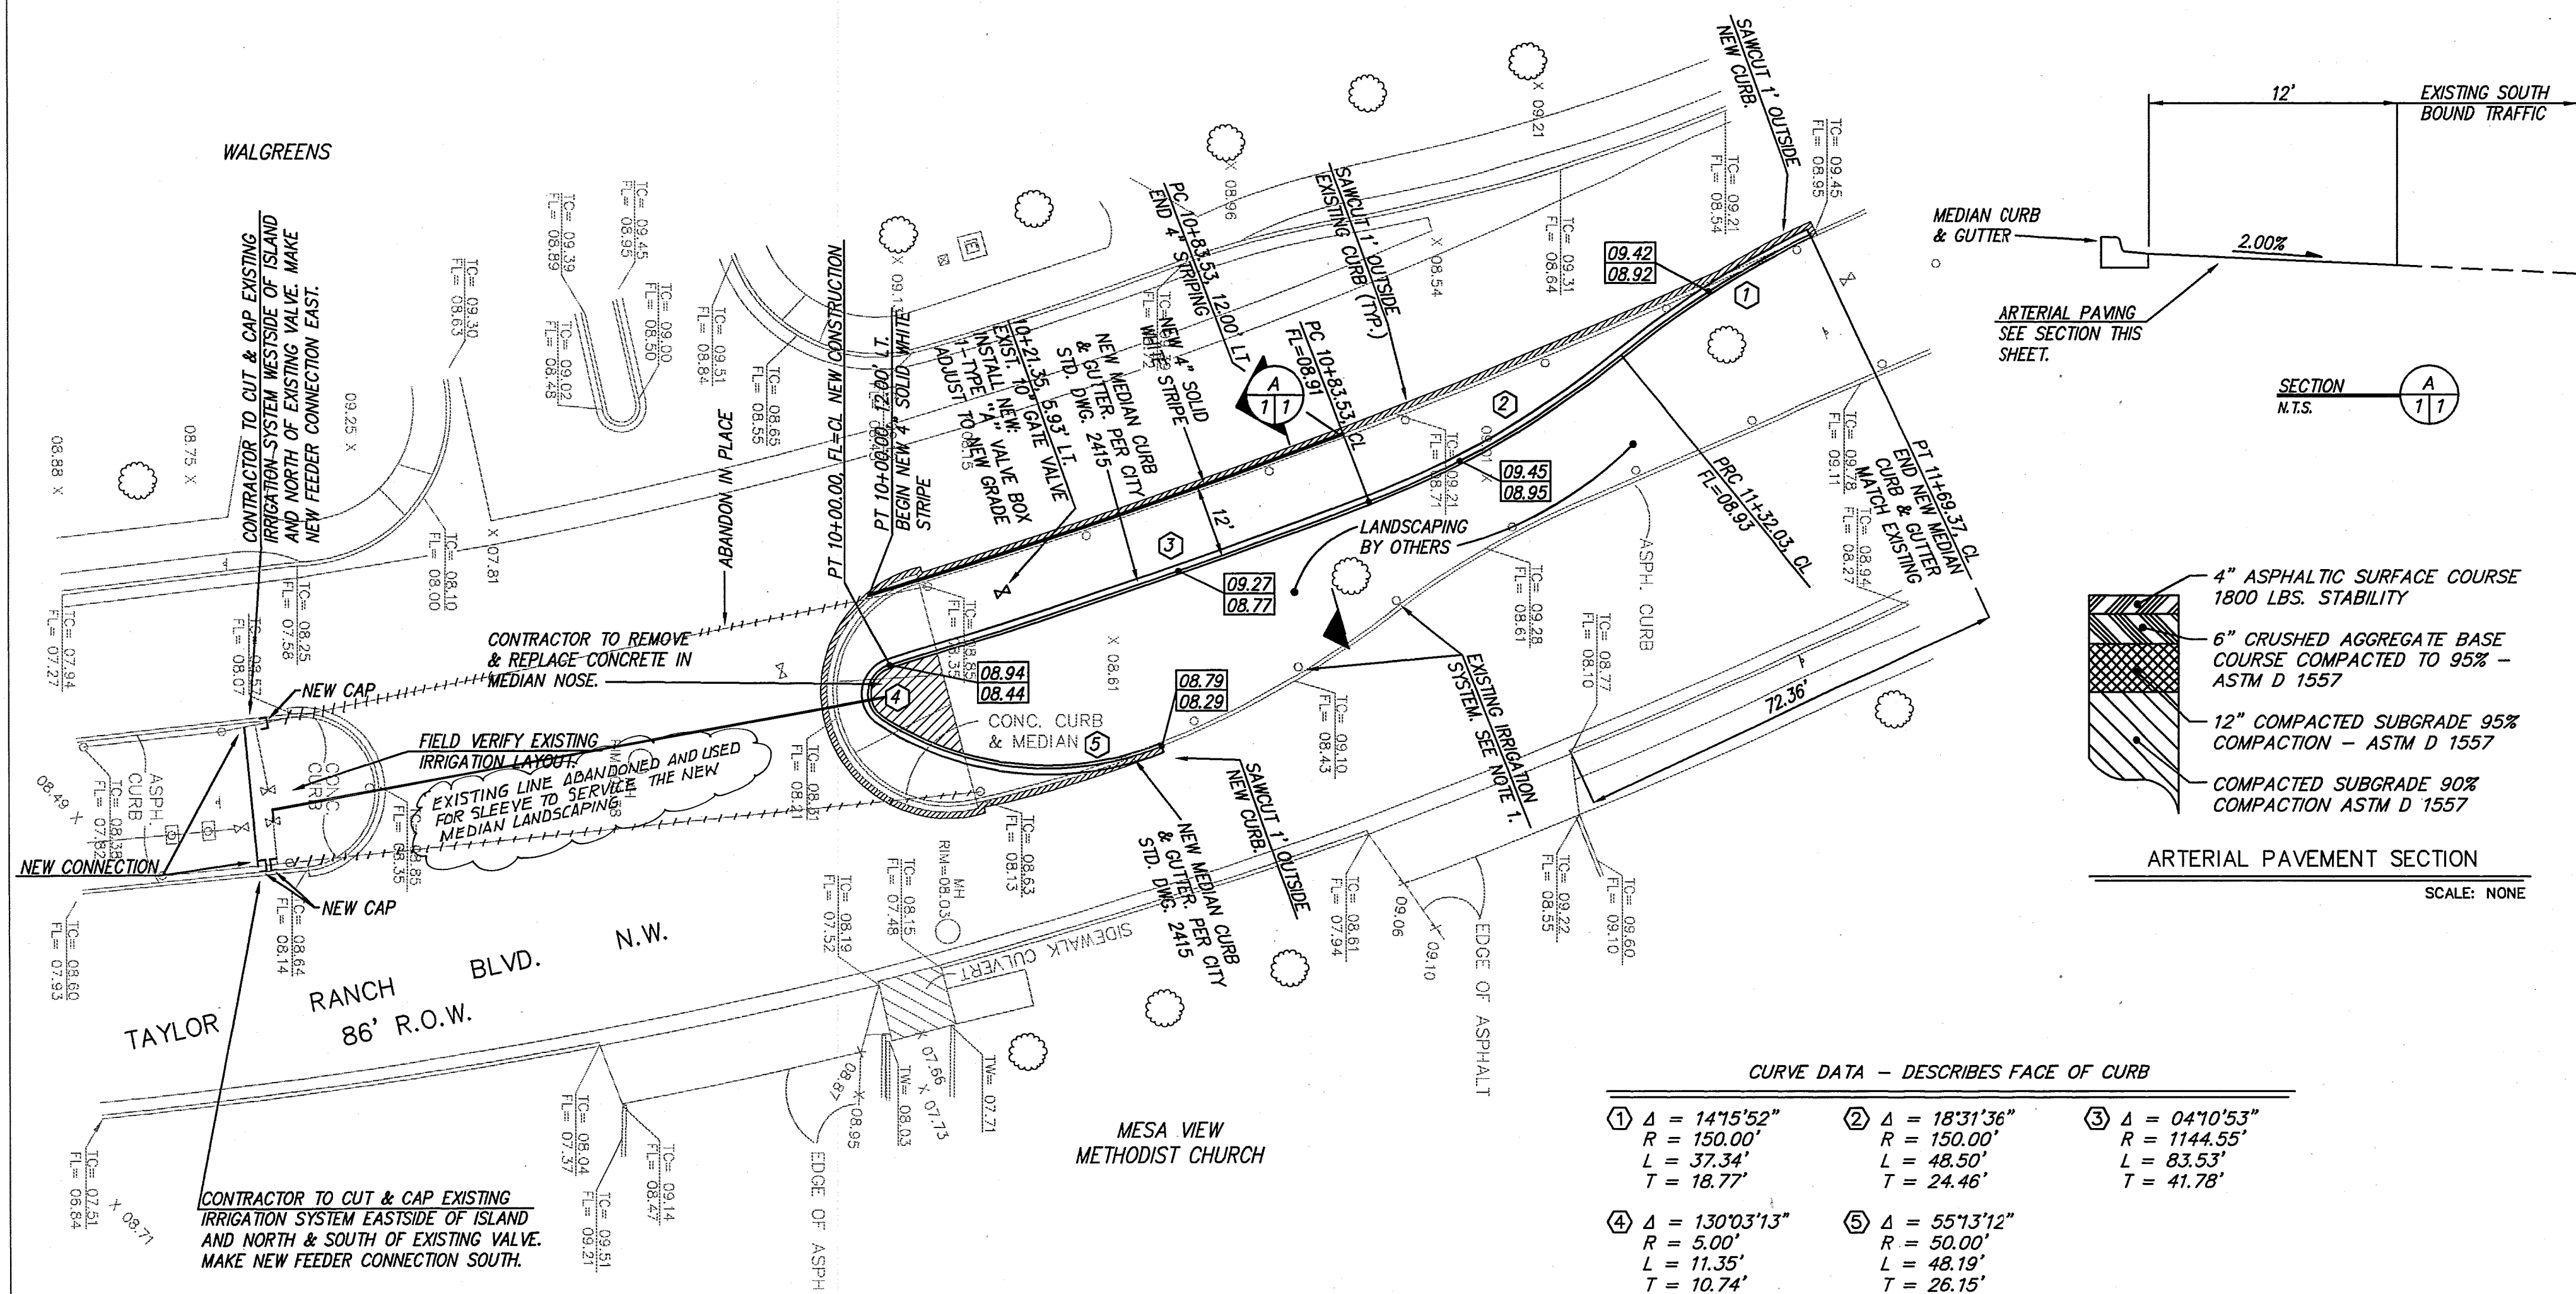


- GENERAL NOTES**
- NOTICE TO CONTRACTORS**
1. CITY OF ALBUQUERQUE SPECIFICATIONS FOR PUBLIC WORKS CONSTRUCTION, 1986 EDITION AS AMENDED THROUGH UPDATE 4, WILL BE REFERRED TO HEREIN AS THE "STANDARD SPECIFICATIONS".
 2. TWO WORKING DAYS PRIOR TO ANY EXCAVATION, CONTRACTOR MUST CONTACT NEW MEXICO ONE CALL SYSTEM (280-1990) AND DETERMINE LOCATION OF EXISTING UTILITIES.
 3. PRIOR TO ANY CONSTRUCTION, THE CONTRACTOR SHALL EXCAVATE AND VERIFY THE HORIZONTAL AND VERTICAL LOCATIONS OF ALL OBSTRUCTIONS. SHOULD A CONFLICT EXIST, THE CONTRACTOR SHALL NOTIFY THE ENGINEER OR THE SURVEYOR SO THAT THE CONFLICT CAN BE RESOLVED WITHOUT DELAY.
 4. THREE (3) WORKING DAYS PRIOR TO BEGINNING CONSTRUCTION THE CONTRACTOR SHALL SUBMIT TO THE CONSTRUCTION CO-ORDINATION DIVISION A DETAILED CONSTRUCTION SCHEDULE. TWO (2) WORKING DAYS PRIOR TO CONSTRUCTION THE CONTRACTOR SHALL OBTAIN A BARRICADING PERMIT FROM THE CONSTRUCTION CO-ORDINATION DIVISION. CONTRACTOR SHALL NOTIFY BARRICADE ENGINEER (788-2551) PRIOR TO OCCUPYING AN INTERSECTION. SEE SECTION 19 OF THE SPECIFICATIONS. ALL STREET STRIPING ALTERED OR DESTROYED SHALL BE REPLACED IN KIND BY CONTRACTOR TO LOCATION AND IN KIND AS EXISTING OR AS INDICATED BY THIS SET.
 5. ALL EXISTING SIGNS, MARKERS, DELINEATORS ETC. WITHIN THE CONSTRUCTION LIMITS SHALL BE REMOVED, STORED AND RE-SET BY THE CONTRACTOR.
- THE FOLLOWING NOTES ALSO APPLY WHEN CHECKED**
- ☐ ALL UTILITIES AND UTILITY SERVICE LINES SHALL BE INSTALLED PRIOR TO PAVING.
 - ☒ BACKFILL COMPACTION SHALL BE ACCORDING TO SPECIFIED STREET USE.
 - ☐ TACK COAT REQUIREMENTS SHALL BE DETERMINED BY THE CITY ENGINEER.
 - ☐ SIDEWALK AND WHEELCHAIR RAMPS WITHIN THE CURB RETURNS SHALL BE CONSTRUCTED WHEREVER A NEW CURB RETURN IS CONSTRUCTED.
 - ☐ IF CURB IS DEEPRESSED FOR A DRIVEPAD, THE DRIVEPAD SHALL BE CONSTRUCTED PRIOR TO ACCEPTANCE OF CURB AND GUTTER.
 - ☐ ALL STORM DRAINAGE FACILITIES SHALL BE COMPLETED PRIOR TO FINAL ACCEPTANCE.
 - ☒ THE REQUESTOR OR DEVELOPER SHALL BE RESPONSIBLE FOR REPAIR OR REPLACEMENT OF ALL CURB AND GUTTER OR SIDEWALK DAMAGE AFTER APPROVAL BY THE CITY ENGINEER OR WORK COMPLETED BY THE CONTRACTOR.

CURVE DATA - DESCRIBES FACE OF CURB

① Δ = 141°52" R = 150.00' L = 37.34' T = 18.77'	② Δ = 18°31'36" R = 150.00' L = 48.50' T = 24.46'	③ Δ = 04°10'53" R = 1144.55' L = 83.53' T = 41.78'
④ Δ = 130°03'13" R = 5.00' L = 11.35' T = 10.74'	⑤ Δ = 55°13'12" R = 50.00' L = 48.19' T = 26.15'	

NEW LEFT TURN BAY
STA. P.C. 10+00.00 TO STA. P.T. 11+69.37
SCALE: HORIZ. 1"=20'
VERT. 1"=5'

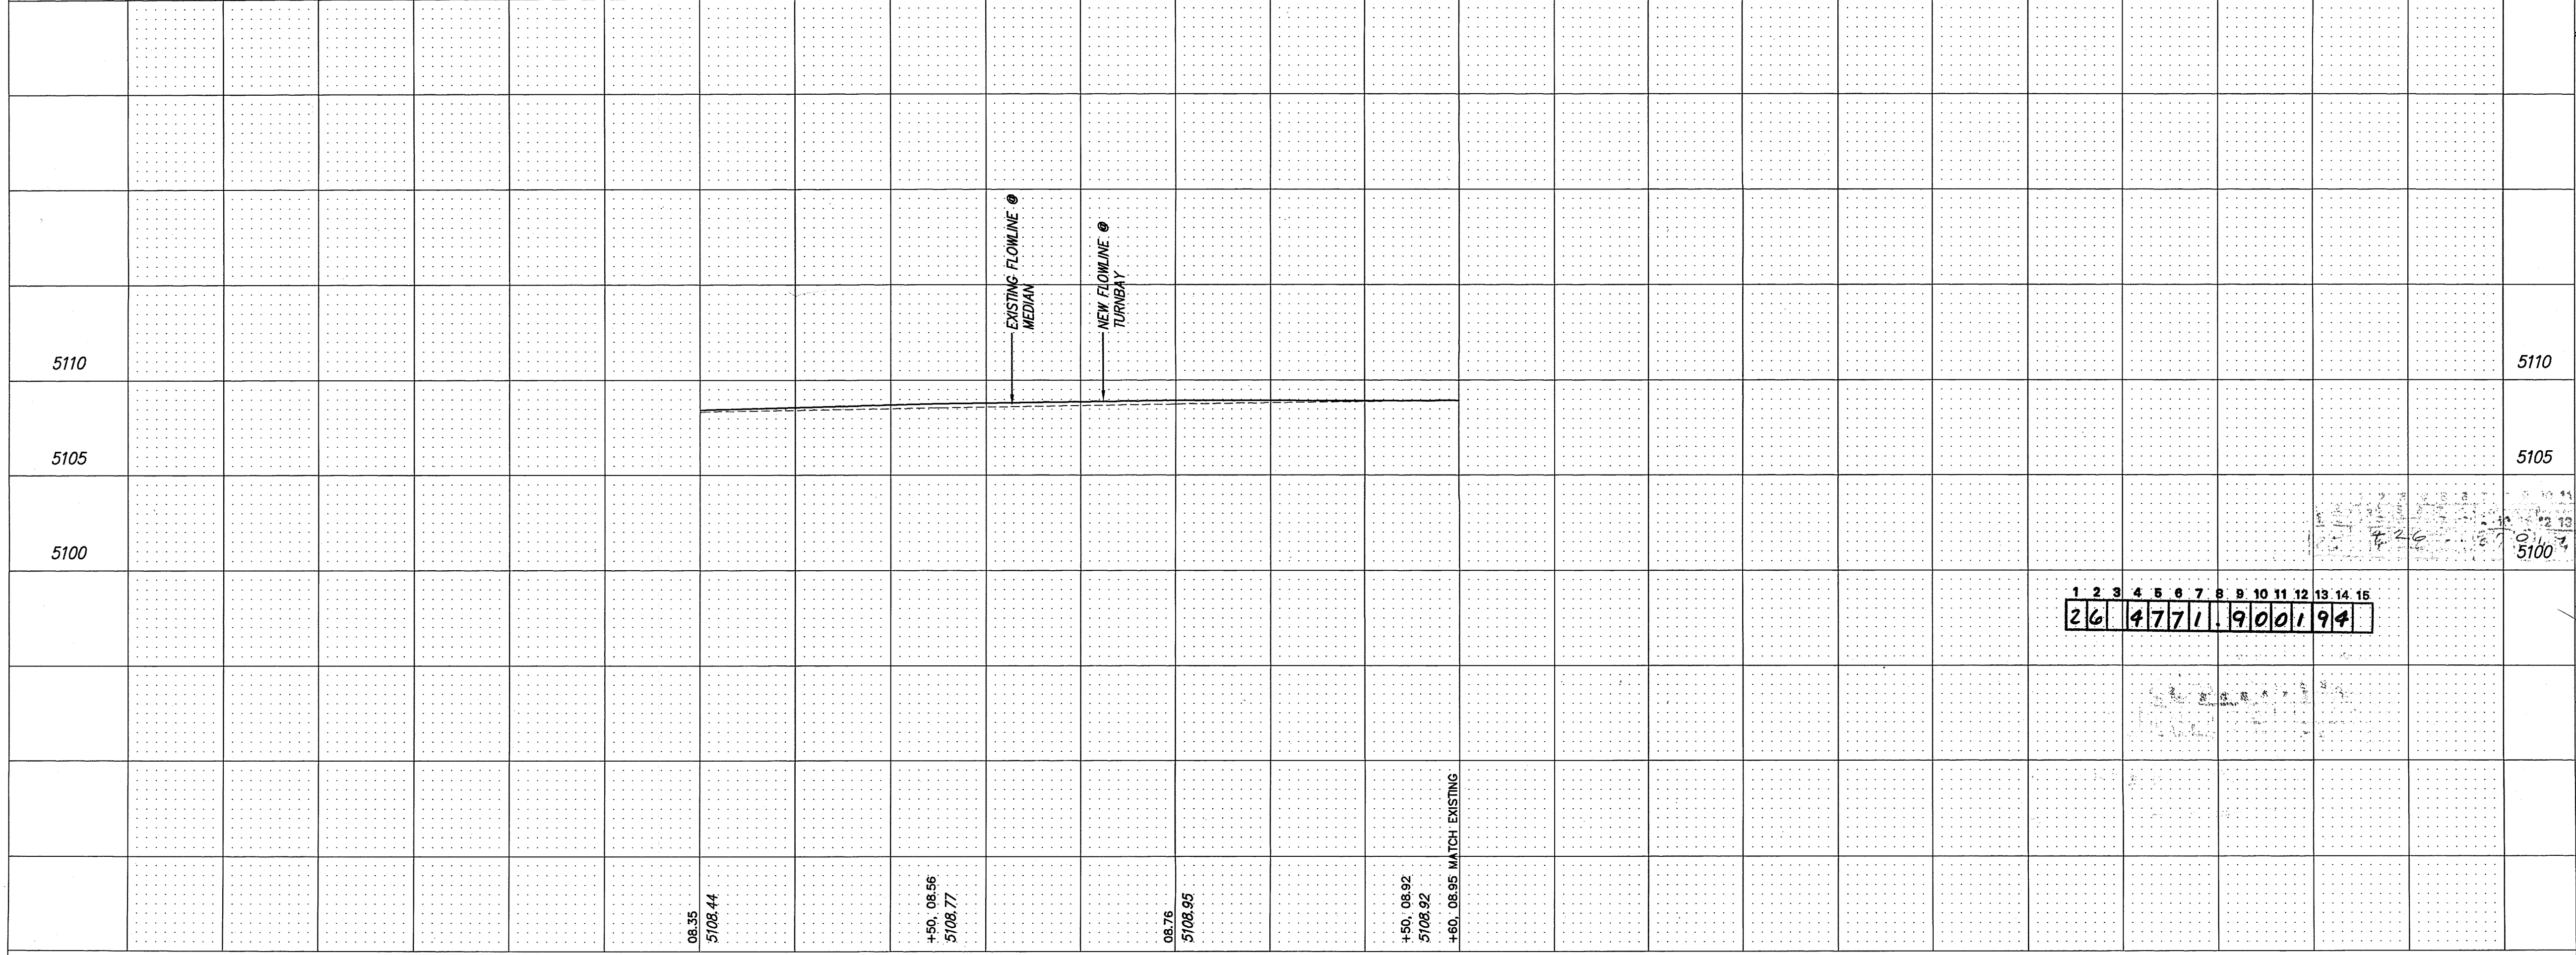

VICINITY MAP

NOTE

1. CONTRACTOR IS TO COORDINATE ALL WORK INVOLVING LANDSCAPE REMOVALS AND MODIFICATIONS TO THE EXISTING IRRIGATION SYSTEM WITH MR. MIKE MARTINEZ, PARKS MANAGEMENT, 857-8650, 3 WORKING DAYS BEFORE CONSTRUCTION BEGINS.
2. LANDSCAPE IMPROVEMENTS PER DESIGN PROVIDED BY HILLTOP.

AS BUILT INFORMATION

CONTRACTOR: STAR PAVING
WORK: PAVING
DATE: 11-08-93
ACCEPTANCE BY: RAY BACA
DATE: 11-08-93
DRAWINGS: 11-08-93
CORRECTED BY: RAY BACA
DATE: 11-08-93
MICRO-FILM INFORMATION
RECORDED BY: NO.
DATE:

BEVCH MARKS

THE STATION IS A 3 1/4" ALUMINUM TABLET SET IN A DRILL HOLE
FLUSH WITH THE CONCRETE MEDIAN NOSE. THE STATION IS STAMPED
"NM 448-4171984"
TO REACH THE STATION FROM CENTRAL AVE., TRAVEL NORTH ON
COORS BLVD. 5.25 MILES TO MONTANO RD.
X=389,804.62 Y=1510,014.99 Z=5006.41

SURVEY INFORMATION

FIELD NOTES
DATE: 11-08-93
BY: [Signature]
NO.:

ENGINEER'S SEAL

APPROVAL OF AS BUILT DRAWINGS
CHIEF CONSTRUCTION ENGINEER
[Signature]
DATE: 5-18-94

APPROVED FOR CONSTRUCTION

[Signature]
CITY ENGINEER
DATE: 11-08-93

LEGEND

- NEW SPOT ELEVATION
- EXISTING SPOT ELEVATION
- NEW MEDIAN CURB & GUTTER
- EXISTING TREE/LANDSCAPE
- EXISTING WATER METER

DESIGNED BY JMB
DRAWN BY JMB
CHECKED BY DMG

REVISIONS

NO.	DATE	REMARKS
1	11-08-93	DESIGN
2	11-08-93	DESIGN
3	11-08-93	DESIGN

CITY OF ALBUQUERQUE
PUBLIC WORKS DEPARTMENT
ENGINEERING GROUP

TITLE: TAYLOR RANCH TURN BAY
PAVING IMPROVEMENTS
STA. P.C. 10+00.00 TO STA. P.T. 11+69.37

APPROVALS	ENGINEER	DATE	APPROVALS	ENGINEER	DATE
DRG CHAIRMAN	[Signature]	11-08-93	WATER	N/A	11-08-93
TRANSPORTATION	[Signature]	11-08-93	WASTE WATER	N/A	11-08-93
HYDROLOGY	N/A	11-08-93	PARKS	[Signature]	11-08-93

PROJECT NO. 4771.90
MAP NO. E11
SHEET 1
OF 1