

CONSTRUCTION DOCUMENTS CLASS I CONSTRUCTION


NOVEMBER 20, 1995

SALIDA DEL SOL PARK

4419 DRIFTWOOD DRIVE N.W.

Albuquerque, New Mexico

CITY OF ALBUQUERQUE
PARKS & GENERAL SERVICES DEPARTMENT
DESIGN & DEVELOPMENT DIVISION

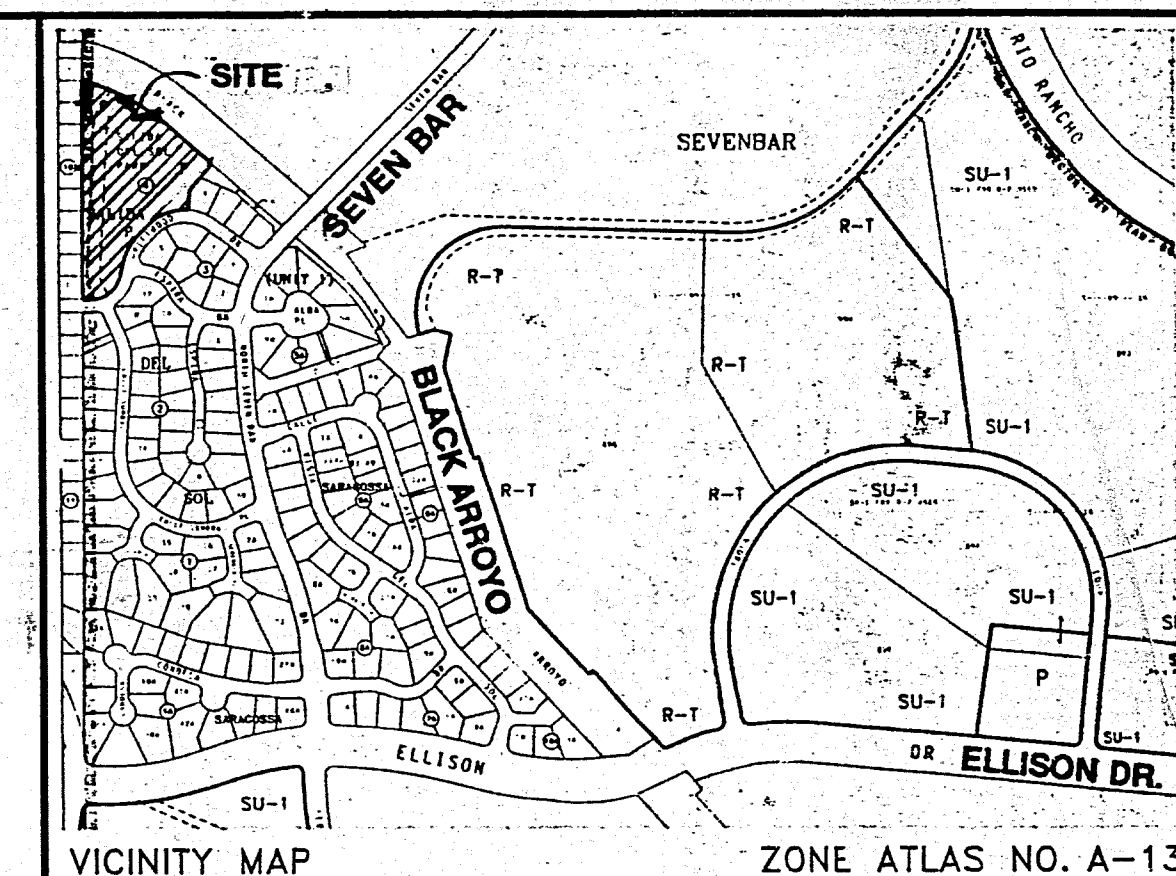

NOTICE TO CONTRACTORS

- All work detailed on these plans to be performed under contract shall, except as otherwise stated or provided for herein, be constructed in accordance with City of Albuquerque Standard Specifications, Public Works Construction - 1986 Edition, as amended through UPDATE #6.
- Two (2) working days prior to any excavation, contractor must contact Line Locating Service, 260-1990 for location of existing utilities.
- Prior to construction, the contractor shall verify the horizontal and vertical locations of all obstructions. Should a conflict exist, the contractor shall notify the engineer or surveyor so that the conflict can be resolved with a minimum amount of delay.
- Any work affecting an arterial roadway requires twenty-four (24) hour construction.

THE FOLLOWING ALSO APPLY WHEN CHECKED

- ☐ All utilities and utility service lines shall be installed prior to paving.
- ☐ Backfill compaction shall be according to specified street use.
- ☐ Tack coat requirements shall be determined by the city engineer.
- ☐ Sidewalks and wheelchair ramps within the curb returns shall be constructed wherever a new curb return is constructed.
- ☐ If curb is depressed for a driveway or ramp, it shall be constructed prior to acceptance of the curb and gutter.
- ☐ All storm drainage facilities shall be completed prior to final acceptance.

SHEET TITLE SHEET NUMBER

COVER SHEET	1 of 14
SITE SURVEY	2 of 14
LAYOUT AND REFERENCE PLAN	3 of 14
GRADING AND DRAINAGE PLAN	4 of 14
BASE BID PLAY AREA PLAN	5 of 14
ADD ALTERNATE NO. 2 PLAY AREA PLAN	6 of 14
ADD ALTERNATE NOS 1 & 3 LAYOUT PLANS	7 of 14
CONSTRUCTION DETAILS	8 of 14
CONSTRUCTION DETAILS	9 of 14
PLAY EQUIPMENT LAYOUT PLAN	10 of 14
ELECTRICAL SERVICE SCHEMATIC PLAN	11 of 14
IRRIGATION PLAN	12 of 14
PLANTING PLAN	13 of 14
IRRIGATION AND PLANTING DETAILS	14 of 14



200' 320' / 1000'

1 2 3 4 5 6 7 8 9 10 11 12 13 14 15
26-4777-91 0197




PDS Southwest, Ltd.
Planning & Design Solutions
Land Planning ■ Landscape Architecture ■ Environmental Services
121 Tijeras Avenue NE Suite 2200 (505) 764-8446
Albuquerque, NM 87102-3400 FAX (505) 764-8262

39

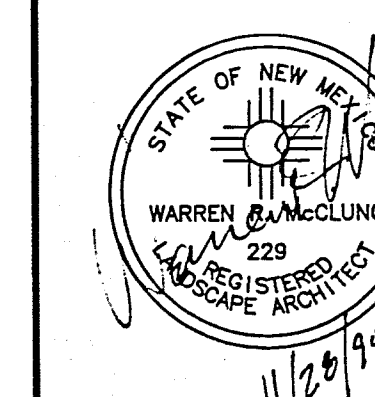
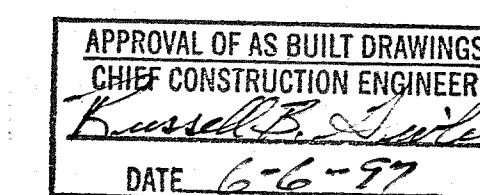


REV.	SHEETS	CITY ENGINEER	DATE	USER DEPARTMENT	DATE	USER DEPARTMENT	DATE
ENGINEERS STAMP & SIGNATURE	APPROVALS	ENGINEER	DATE	APPROVED FOR CONSTRUCTION			
	DRC Chairman	Billy B. Bradley	11-30-95				
	Transportation	R. B. B.	11-30-95				
	Water/Wastewater	R.W. Kane	11-30-95				
	Hydrology	C. Montoya	11-30-95				
	Parks	E. Montoya	11-30-95				
	AMAFCA	J. Kelly	11-30-95				
	NM Utilities		11-29-95				
	City Project No.	4777.91					
	Sheet	1					
	Of	14					

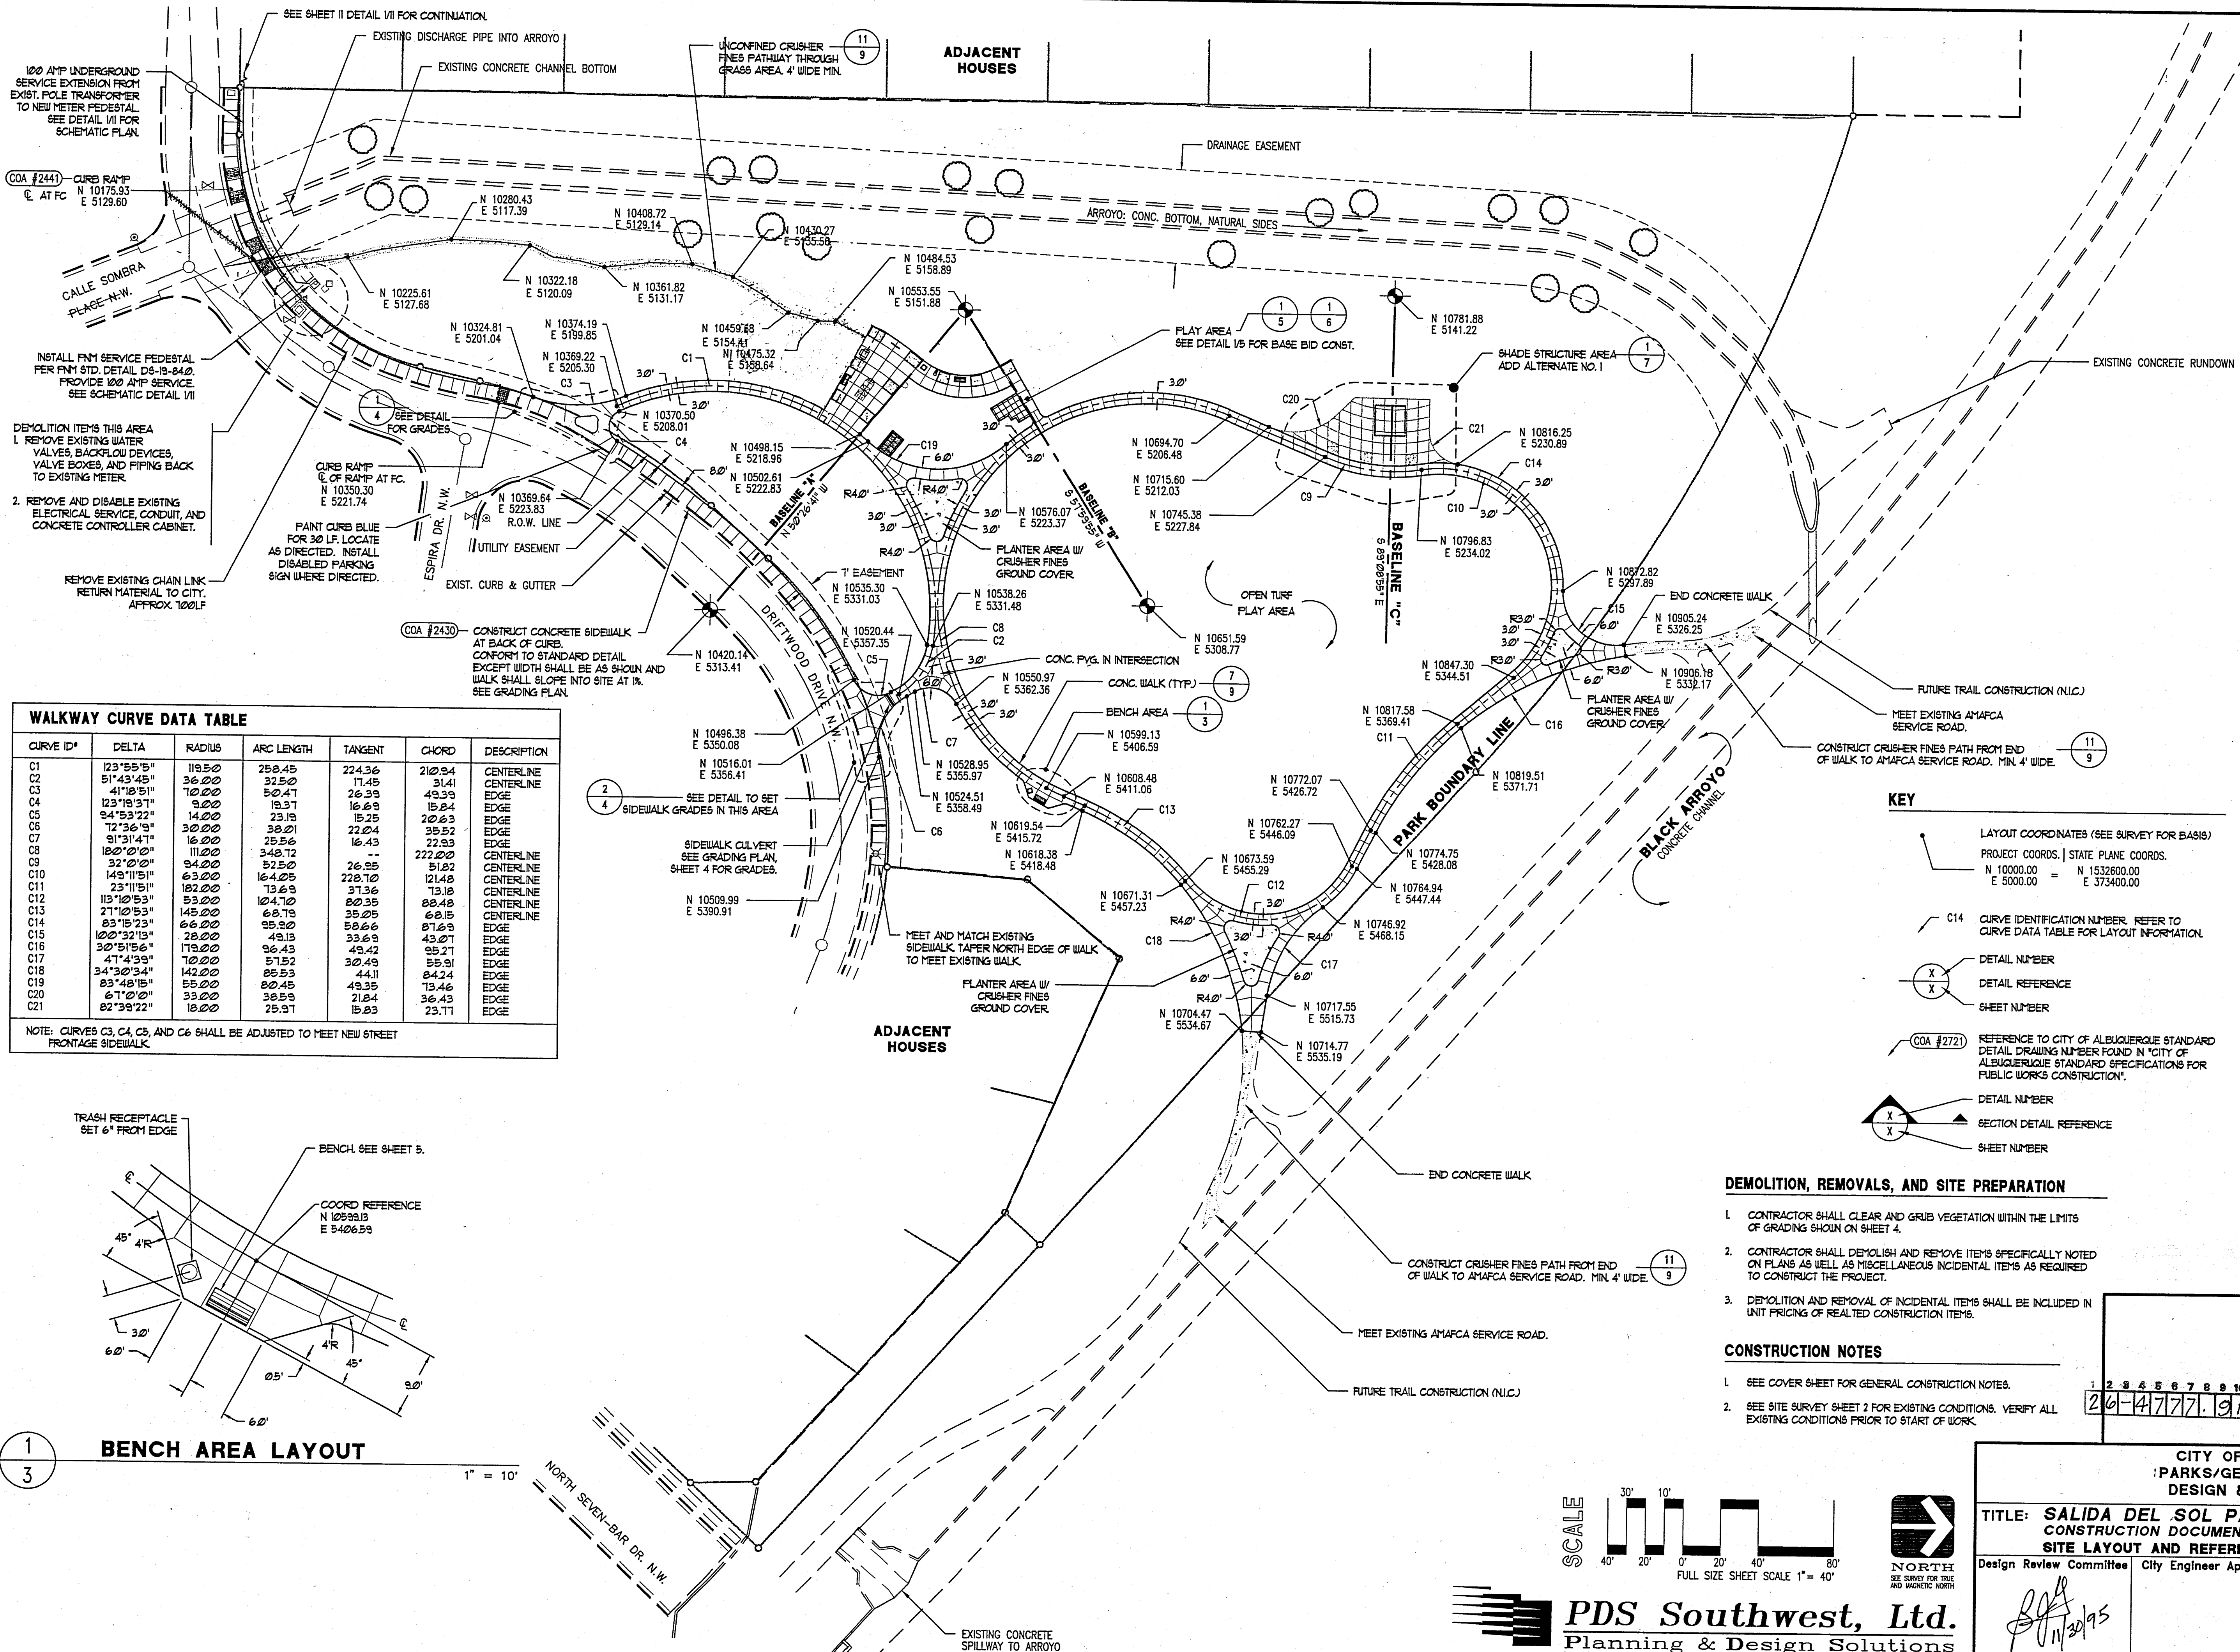

WALKWAY CURVE DATA TABLE						
CURVE ID	DELTA	RADIUS	ARC LENGTH	TANGENT	CHORD	DESCRIPTION
C1	123°55'55"	119.50	258.45	224.36	210.94	CENTERLINE
C2	51°43'45"	36.00	32.50	17.45	31.41	CENTERLINE
C3	41°18'51"	10.00	50.47	26.39	49.39	EDGE
C4	123°19'31"	9.00	19.37	16.69	15.84	EDGE
C5	94°53'22"	14.00	23.19	15.25	20.63	EDGE
C6	12°36'19"	30.00	38.01	22.04	35.52	EDGE
C7	91°51'47"	16.00	25.56	16.43	22.93	EDGE
C8	180°0'0"	11.00	3.48	11.00	22.00	CENTERLINE
C9	32°0'0"	94.00	52.50	26.95	51.82	CENTERLINE
C10	149°11'51"	63.00	164.05	228.10	121.48	CENTERLINE
C11	23°11'51"	182.00	13.69	37.36	13.18	CENTERLINE
C12	113°10'53"	53.00	104.10	80.35	88.48	CENTERLINE
C13	21°10'53"	145.00	68.19	35.05	68.15	CENTERLINE
C14	83°15'23"	66.00	49.13	33.69	43.07	EDGE
C15	100°32'13"	29.00	49.42	33.69	43.07	EDGE
C16	30°51'56"	179.00	96.43	30.49	55.91	EDGE
C17	47°4'39"	10.00	57.52	30.49	55.91	EDGE
C18	34°30'34"	142.00	85.53	44.11	84.24	EDGE
C19	83°48'15"	55.00	80.45	49.35	73.46	EDGE
C20	67°10'0"	33.00	38.59	21.84	36.43	EDGE
C21	82°59'22"	18.00	25.91	15.83	23.71	EDGE

NOTE: CURVES C3, C4, C5, AND C6 SHALL BE ADJUSTED TO MEET NEW STREET FRONTAGE SIDEWALK.

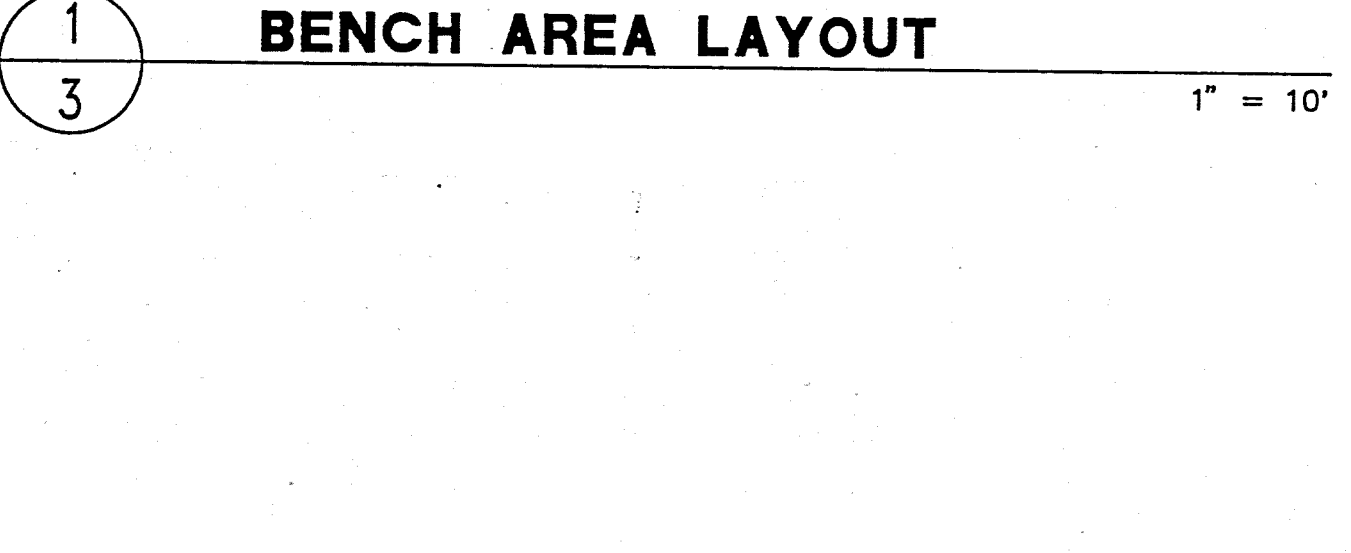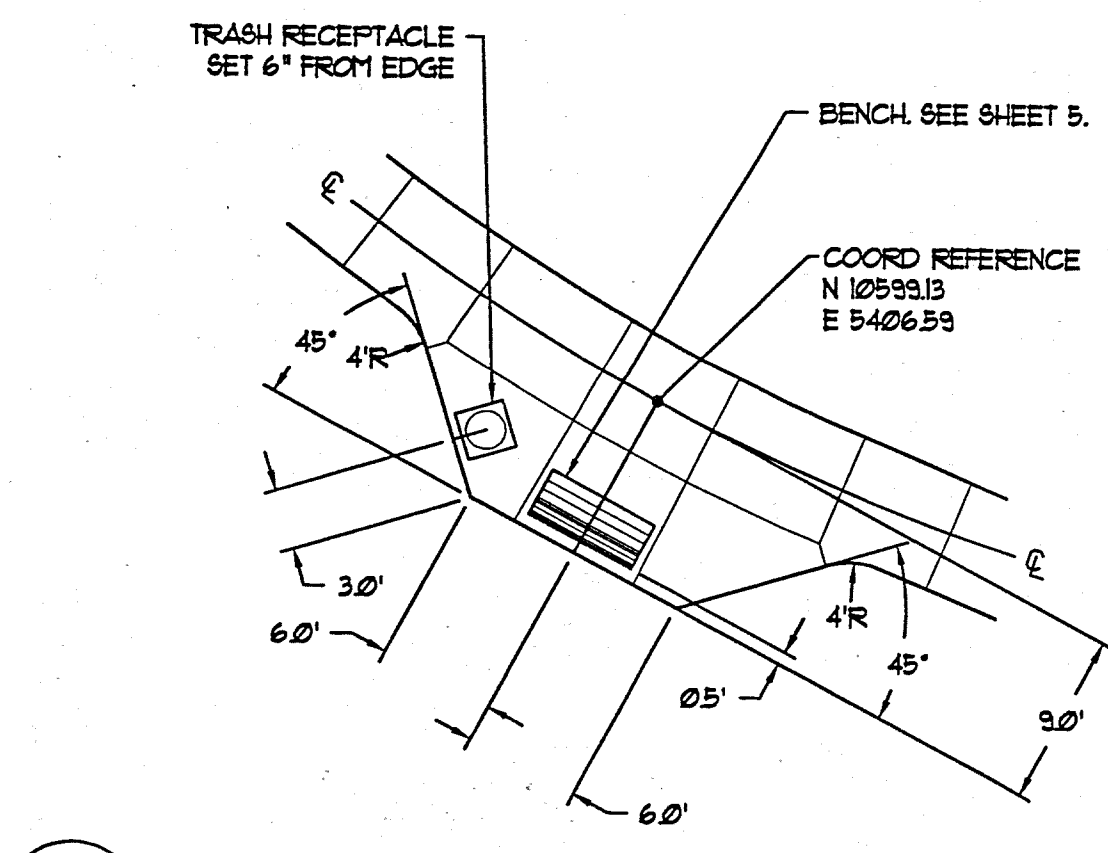


DEMOLITION, REMOVALS, AND SITE PREPARATION

- CONTRACTOR SHALL CLEAR AND GRUB VEGETATION WITHIN THE LIMITS OF GRADING SHOWN ON SHEET 4.
- CONTRACTOR SHALL DEMOLISH AND REMOVE ITEMS SPECIFICALLY NOTED ON PLANS AS WELL AS MISCELLANEOUS INCIDENTAL ITEMS AS REQUIRED TO CONSTRUCT THE PROJECT.
- DEMOLITION AND REMOVAL OF INCIDENTAL ITEMS SHALL BE INCLUDED IN UNIT PRICING OF RELATED CONSTRUCTION ITEMS.

CONSTRUCTION NOTES

- SEE COVER SHEET FOR GENERAL CONSTRUCTION NOTES.
- SEE SITE SURVEY SHEET 2 FOR EXISTING CONDITIONS. VERIFY ALL EXISTING CONDITIONS PRIOR TO START OF WORK.

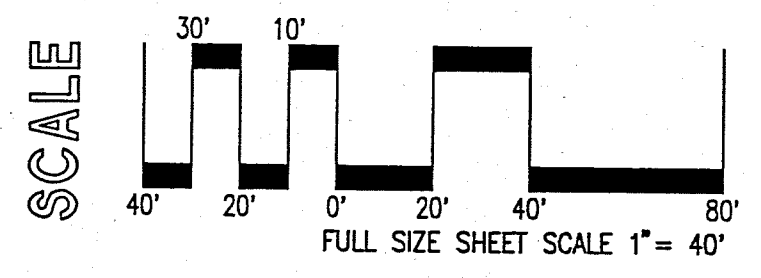

PDS Southwest, Ltd.
Planning & Design Solutions
Land Planning • Landscape Architecture • Environmental Services
121 Tijeras Avenue NE Suite 2200 Albuquerque, NM 87102-3400
(505) 764-8446 FAX (505) 764-8262

CITY OF ALBUQUERQUE
PARKS/GENERAL SERVICES
DESIGN & DEVELOPMENT


TITLE: **SALIDA DEL SOL PARK**
CONSTRUCTION DOCUMENTS
SITE LAYOUT AND REFERENCE PLAN


NOV. 20, 1995

DESIGNED BY: PDS SOUTHWEST, LTD. DATE: NOV. 20, 1995
DRAWN BY: PDS SOUTHWEST, LTD. DATE: NOV. 20, 1995
CHECKED BY: PDS SOUTHWEST, LTD. DATE: NOV. 20, 1995

City Project No. **4777.91** Zone Map No. **A-13** Sheet **3** Of **14**

AS BUILT INFORMATION		BENCHMARK		SURVEY INFORMATION		FIELD NOTES		SEAL		REVISIONS / REMARKS	
CONTRACTOR	LEE LANDSCAPES	DATE	5-97	ELEVATIONS SHOWN ARE OLD BENCHMARK ELEVATIONS BASED ON ALBUQUERQUE BENCHMARK 4-AUT, ELEVATION = 5195.93	DATE	2-97	NO.	DATE	NO.	DATE	NO.
WORK STAKED BY	CONTRACTOR	DATE	2-97	INSPECTOR'S APPROVAL	DATE	5-97	NO.	DATE	NO.	DATE	NO.
FIELD VERIFICATION BY	LEE LANDSCAPES	DATE	5-97	DRAWING CORRECTED BY	DATE	5-97	NO.	DATE	NO.	DATE	NO.
DRAWING CORRECTED BY	LEE LANDSCAPES	DATE	5-97	MICRO-FILM INFORMATION	DATE		NO.	DATE	NO.	DATE	NO.

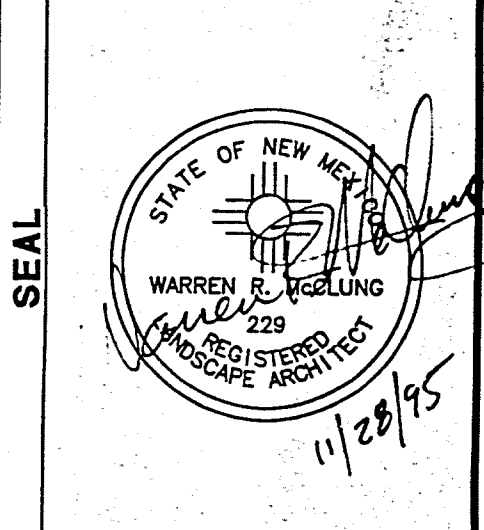

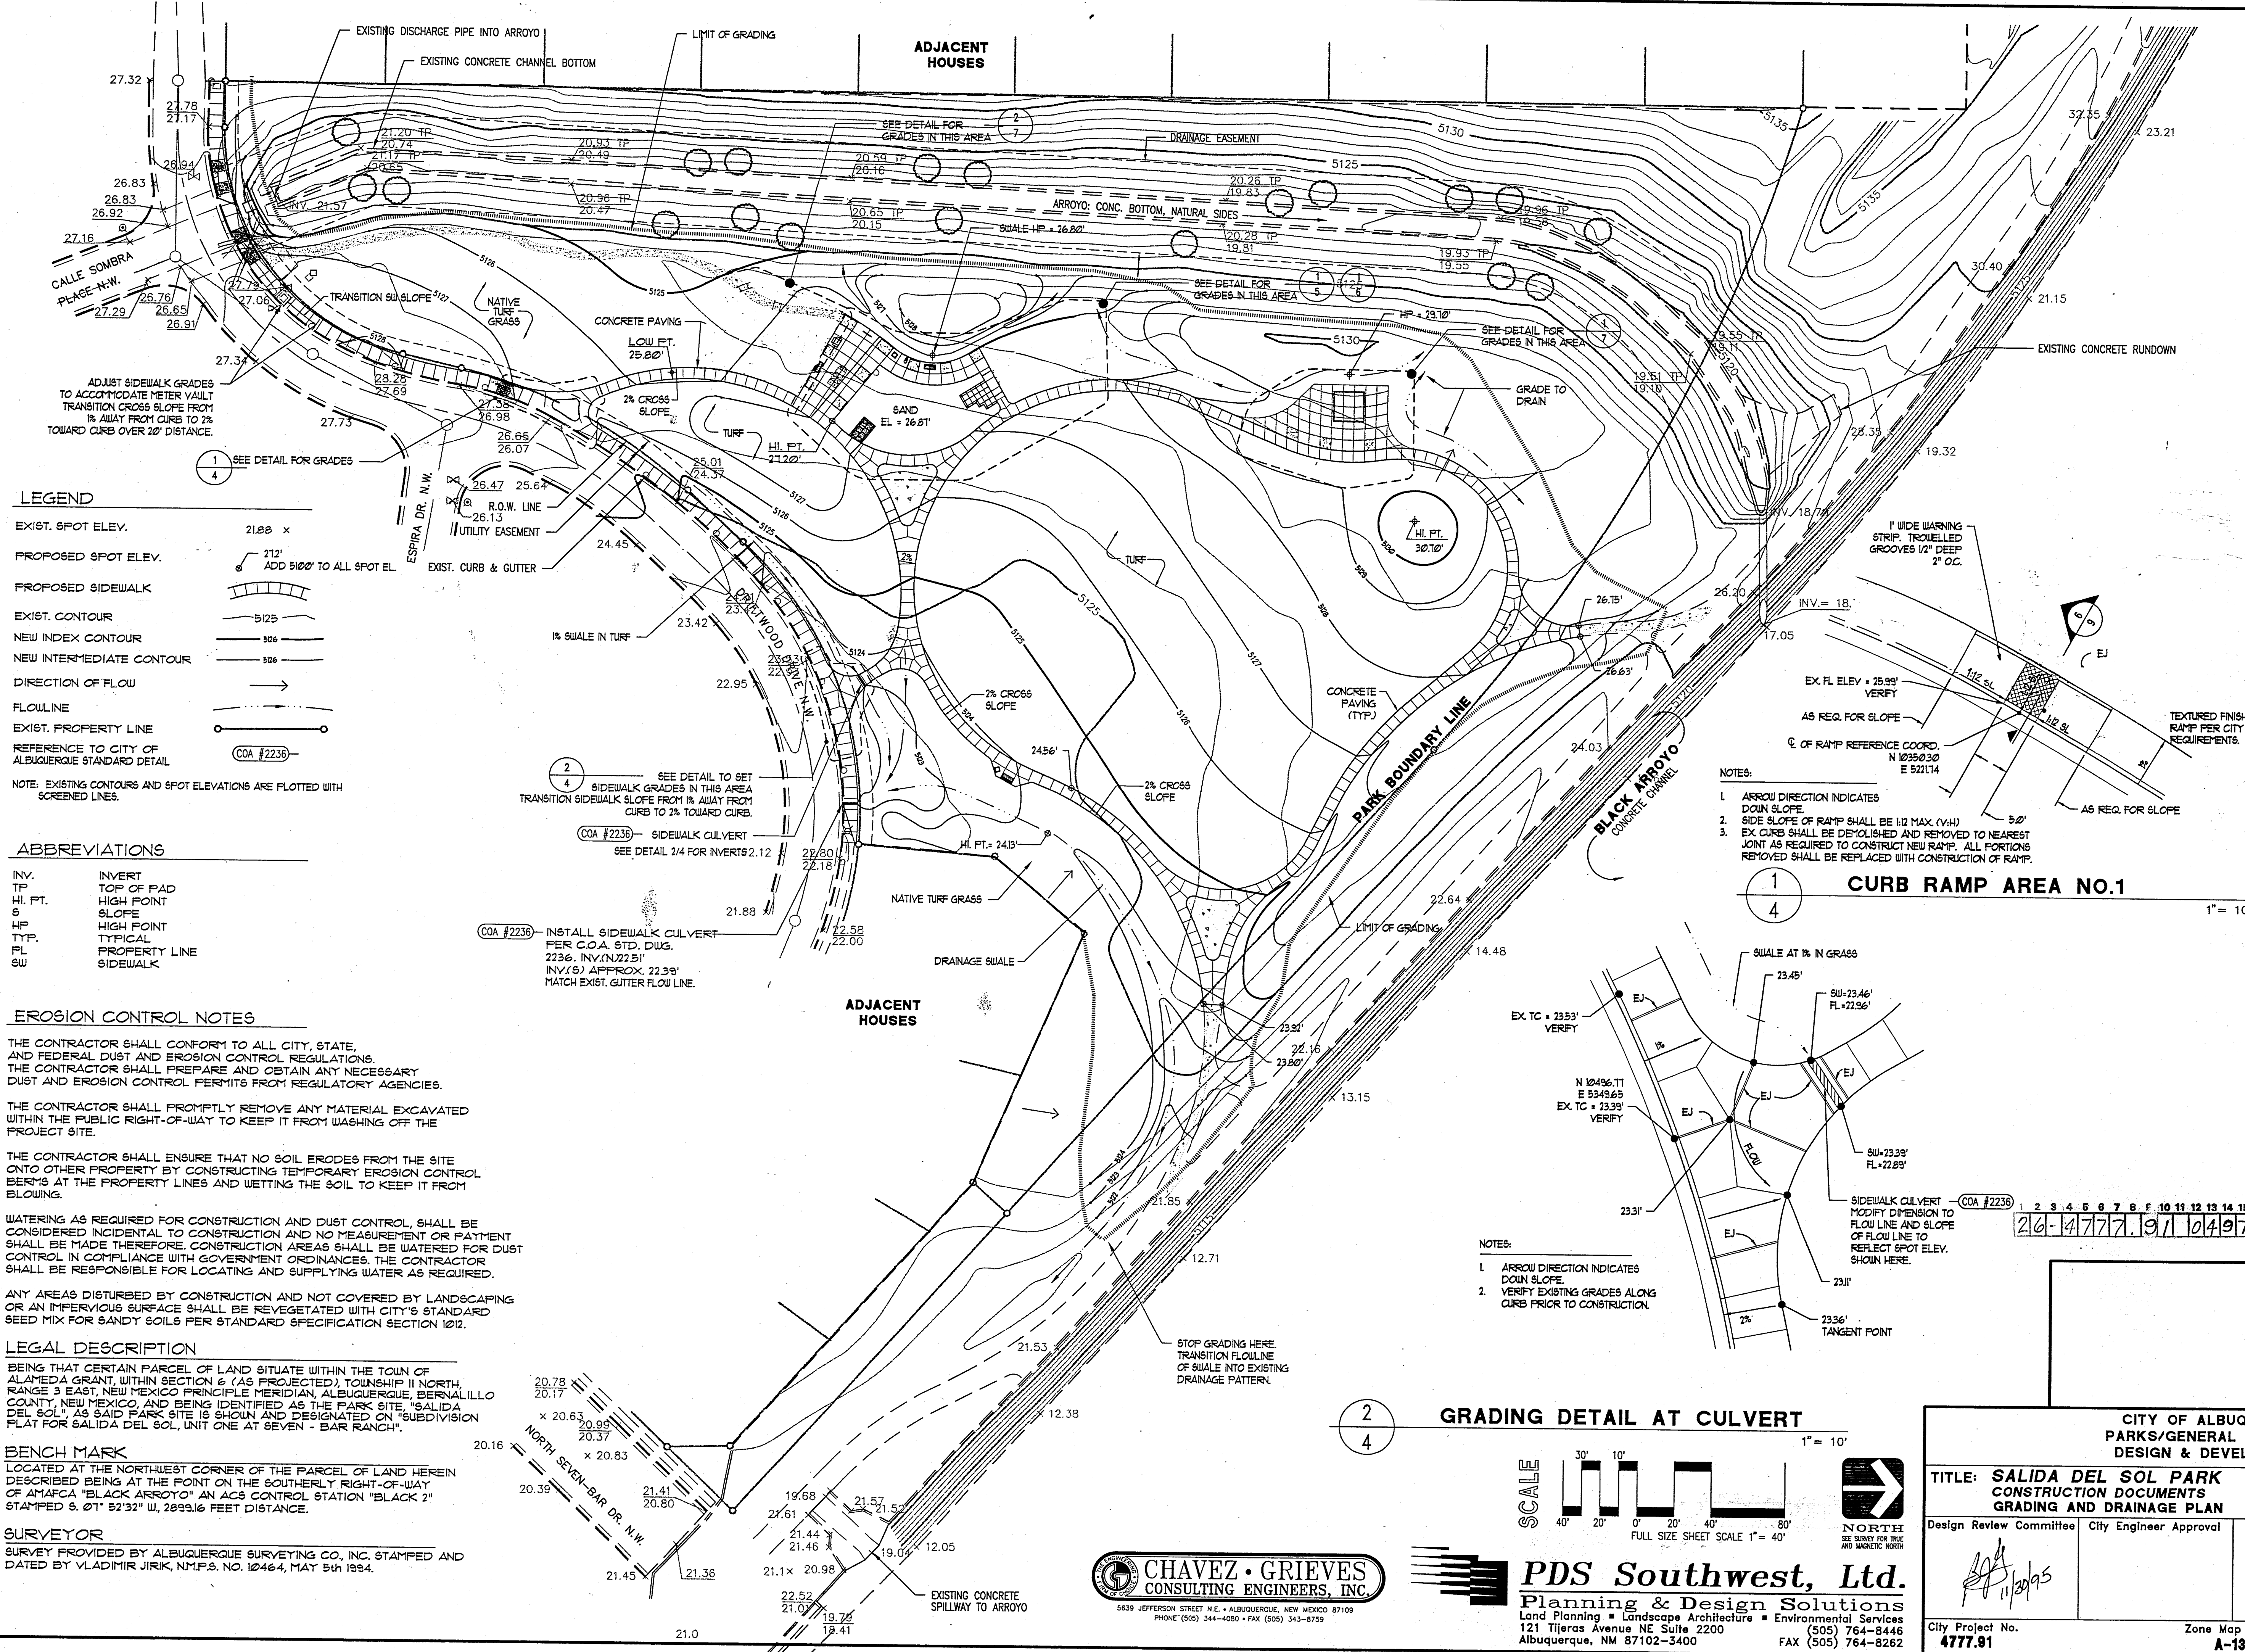

LEGEND

EXIST. SPOT ELEV. 21.28 x

PROPOSED SPOT ELEV. 21.21 x

PROPOSED SIDEWALK

EXIST. CONTOUR 5125

NEW INDEX CONTOUR 506

NEW INTERMEDIATE CONTOUR 506

DIRECTION OF FLOW

FLOWLINE

EXIST. PROPERTY LINE

REFERENCE TO CITY OF ALBUQUERQUE STANDARD DETAIL

NOTE: EXISTING CONTOURS AND SPOT ELEVATIONS ARE PLOTTED WITH SCREENED LINES.

ABBREVIATIONS

INV. INVERT

TP. TOP OF PAD

HI. PT. HIGH POINT

S. SLOPE

HP. HIGH POINT

TYP. TYPICAL

PL. PROPERTY LINE

SU. SIDEWALK

EROSION CONTROL NOTES

THE CONTRACTOR SHALL CONFORM TO ALL CITY, STATE, AND FEDERAL DUST AND EROSION CONTROL REGULATIONS. THE CONTRACTOR SHALL PREPARE AND OBTAIN ANY NECESSARY DUST AND EROSION CONTROL PERMITS FROM REGULATORY AGENCIES.

THE CONTRACTOR SHALL PROMPTLY REMOVE ANY MATERIAL EXCAVATED WITHIN THE PUBLIC RIGHT-OF-WAY TO KEEP IT FROM WASHING OFF THE PROJECT SITE.

THE CONTRACTOR SHALL ENSURE THAT NO SOIL ERODES FROM THE SITE ONTO OTHER PROPERTY BY CONSTRUCTING TEMPORARY EROSION CONTROL BARRIERS AT THE PROPERTY LINES AND WETTING THE SOIL TO KEEP IT FROM BLOWING.

WATERING AS REQUIRED FOR CONSTRUCTION AND DUST CONTROL, SHALL BE CONSIDERED INCIDENTAL TO CONSTRUCTION AND NO MEASUREMENT OR PAYMENT SHALL BE MADE THEREFOR. CONSTRUCTION AREAS SHALL BE WATERED FOR DUST CONTROL IN COMPLIANCE WITH GOVERNMENT ORDINANCES. THE CONTRACTOR SHALL BE RESPONSIBLE FOR LOCATING AND SUPPLYING WATER AS REQUIRED.

ANY AREAS DISTURBED BY CONSTRUCTION AND NOT COVERED BY LANDSCAPING OR AN INTERVIOUS SURFACE SHALL BE REVEGETATED WITH CITY'S STANDARD SEED MIX FOR SANDY SOILS PER STANDARD SPECIFICATION SECTION 1012.

LEGAL DESCRIPTION

BEING THAT CERTAIN PARCEL OF LAND SITUATE WITHIN THE TOWN OF ALAMEDA GRANT, WITHIN SECTION 6 (AS PROJECTED), TOWNSHIP 11 NORTH, RANGE 3 EAST, NEW MEXICO PRINCIPLE MERIDIAN, ALBUQUERQUE, BERNALILLO COUNTY, NEW MEXICO, AND BEING IDENTIFIED AS THE PARK SITE, "SALIDA DEL SOL", AS SAID PARK SITE IS SHOWN AND DESIGNATED ON "SUBDIVISION PLAT FOR SALIDA DEL SOL, UNIT ONE AT SEVEN - BAR RANCH".

BENCH MARK

LOCATED AT THE NORTHWEST CORNER OF THE PARCEL OF LAND HEREIN DESCRIBED BEING AT THE POINT ON THE SOUTHERLY RIGHT-OF-WAY OF AMAPCA "BLACK ARROYO" AN ACS CONTROL STATION "BLACK 2" STAMPED S. 01° 52' 32" W., 2899.16 FEET DISTANCE.

SURVEYOR

SURVEY PROVIDED BY ALBUQUERQUE SURVEYING CO., INC. STAMPED AND DATED BY VLADIMIR JIRIK, N.M.P.S. NO. 10464, MAY 5th 1994.

NOTES:

1. ARROW DIRECTION INDICATES DOWN SLOPE.
2. SIDE SLOPE OF RAMP SHALL BE 1/2 MAX. (V/H).
3. EX. CURBS SHALL BE DEMOLISHED AND REMOVED TO NEAREST JOINT AS REQUIRED TO CONSTRUCT NEW RAMP. ALL PORTIONS REMOVED SHALL BE REPLACED WITH CONSTRUCTION OF RAMP.

CURB RAMP AREA NO.1


1"=10'

NOTES:

1. ARROW DIRECTION INDICATES DOWN SLOPE.
2. VERIFY EXISTING GRADES ALONG CURB PRIOR TO CONSTRUCTION.

GRADING DETAIL AT CULVERT

1"=10'





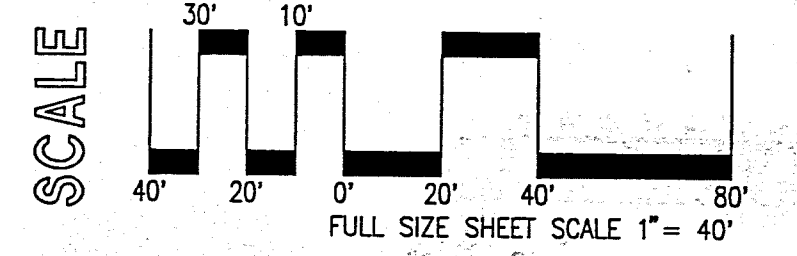


CHAVEZ • GRIEVES
CONSULTING ENGINEERS, INC.
5639 JEFFERSON STREET N.E. • ALBUQUERQUE, NEW MEXICO 87109
PHONE (505) 344-4080 • FAX (505) 343-8759

PDS Southwest, Ltd.
Planning & Design Solutions
Land Planning • Landscape Architecture • Environmental Services
121 Tijeras Avenue NE Suite 2200 Albuquerque, NM 87102-3400
(505) 764-8446 FAX (505) 764-8262

CITY OF ALBUQUERQUE PARKS/GENERAL SERVICES DESIGN & DEVELOPMENT			
TITLE: SALIDA DEL SOL PARK CONSTRUCTION DOCUMENTS GRADING AND DRAINAGE PLAN			
Design Review Committee		City Engineer Approval	
Last Design Update		Date	
City Project No. 4777.91		Zone Map No. A-13	
Sheet 4		Of 14	

AS BUILT INFORMATION		BENCHMARK		SURVEY INFORMATION		SEAL		BY		REVISIONS / REMARKS		NO. DATE		DESIGNED BY:		DRAWN BY:		CHECKED BY:	
CONTRACTOR'S LABEL	DATE: 5-97	ELEVATIONS SHOWN ARE OLD 1993 ELEVATIONS BASED ON ALBUQUERQUE BENCHMARK 447.427 ELEVATION = 5193.53	DATE: 5-97	FIELD NOTES	DATE	NO.	BY	NO.	DATE	NO.	DATE	NO.	DATE	NO.	DATE	NO.	DATE	NO.	DATE
WORK STAMPED BY	DATE: 5-97	INSPECTOR'S APPROVAL	DATE: 5-97	NO.	DATE	NO.	BY	NO.	DATE	NO.	DATE	NO.	DATE	NO.	DATE	NO.	DATE	NO.	DATE
FIELD VERIFICATION BY	DATE: 5-97	DRAWING CORRECTED BY	DATE: 5-97	NO.	DATE	NO.	BY	NO.	DATE	NO.	DATE	NO.	DATE	NO.	DATE	NO.	DATE	NO.	DATE
MICRO-FILM INFORMATION	DATE	RECORDED BY	DATE	NO.	DATE	NO.	BY	NO.	DATE	NO.	DATE	NO.	DATE	NO.	DATE	NO.	DATE	NO.	DATE

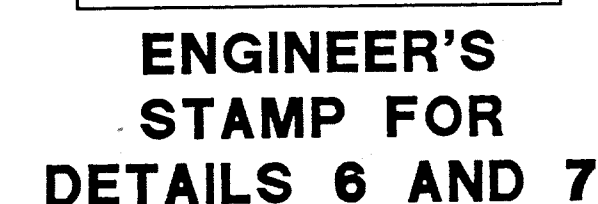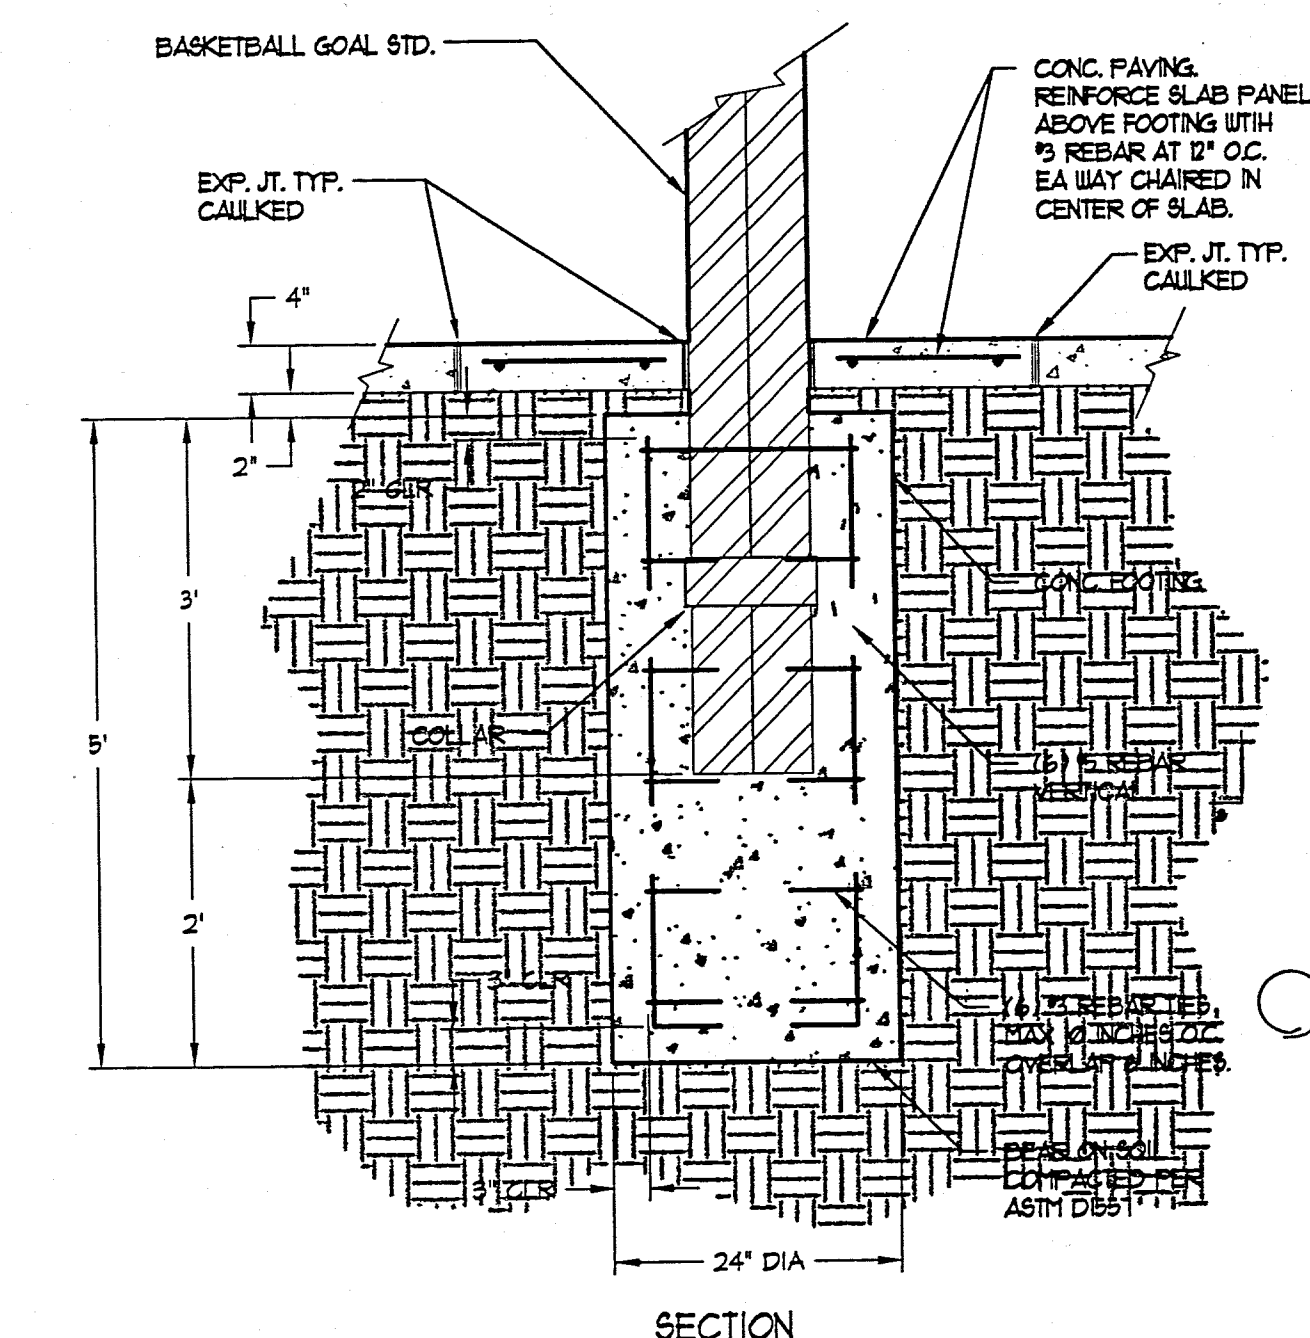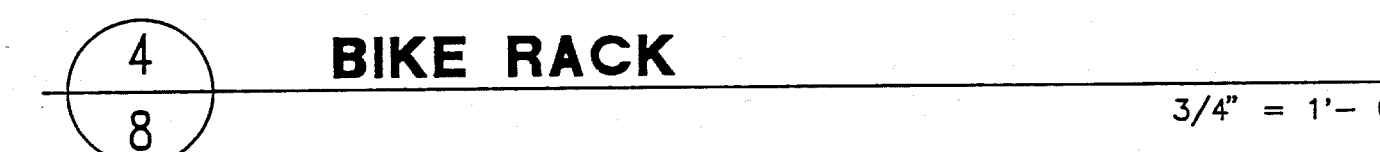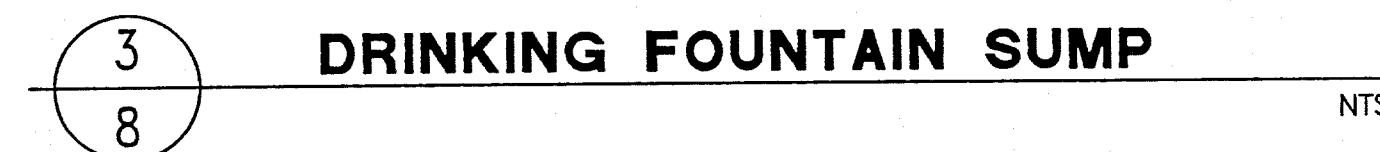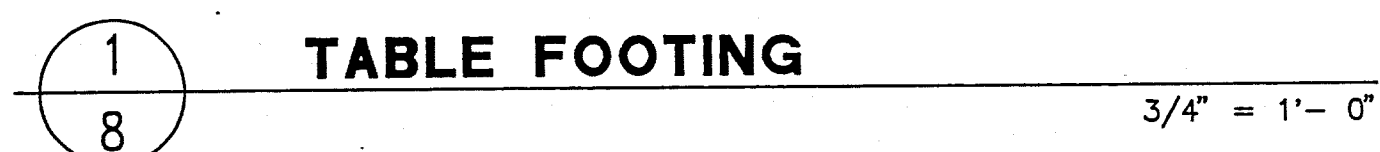

1	2	3	4	5	6	7	8	9	10	11	12	13	14	15	
2	6	-	4	7	7	7	.	9	1			0	8	9	7

NO.		DATE	REVISIONS / REMARKS	BY	SEAL	SURVEY INFORMATION		BENCHMARK	AS BUILT INFORMATION	
						FIELD NOTES				
						NO.	BY			DATE
									CONTRACTOR L&E LANDSCAPES DATE: 5-97	
									WORK STATED BY: <u>Warren Wiering</u> DATE: 1-97	
									INSPECTOR'S APPROVAL DATE: 6-5-97	
									FIELD VERIFICATION BY: <u>Warren Wiering</u> DATE: 5/15/97	
									DRAWING CORRECTED BY: <u>Warren Wiering</u> DATE: 5-97	
									MICRO-FILM INFORMATION	
									RECORDED BY DATE:	
									NO.	

DESIGNED BY: PIS SOUTHWEST, LTD. DATE: NOV. 20, 1995

DRAWN BY: PIS SOUTHWEST, LTD. DATE: NOV. 20, 1995

City Project No.	Zone
------------------	------


	ML/DAY/YR.
--	------------

--	--

[illegible]


Of

14

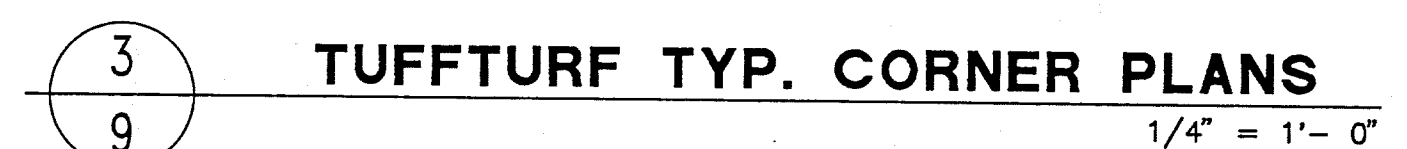


PDS Southwest, Ltd.
Planning & Design Solutions
 Land Planning ■ Landscape Architecture ■ Environmental Services
 21 Tijeras Avenue NE Suite 2200 (505) 764-8446
 Albuquerque, NM 87102-3400 FAX (505) 764-8262


CITY OF ALBUQUERQUE PARKS/GENERAL SERVICES DESIGN & DEVELOPMENT			
TITLE: SALIDA DEL SOL CONSTRUCTION DOCUMENTS CONSTRUCTION DETAILS		NOV. 20, 1995	
Design Review Committee	City Engineer Approval	Last Design Update	NOV20/95
 11/30/95			
City Project No. 4777-91	Zone Map No. A-13	Sheet 9	Of 14

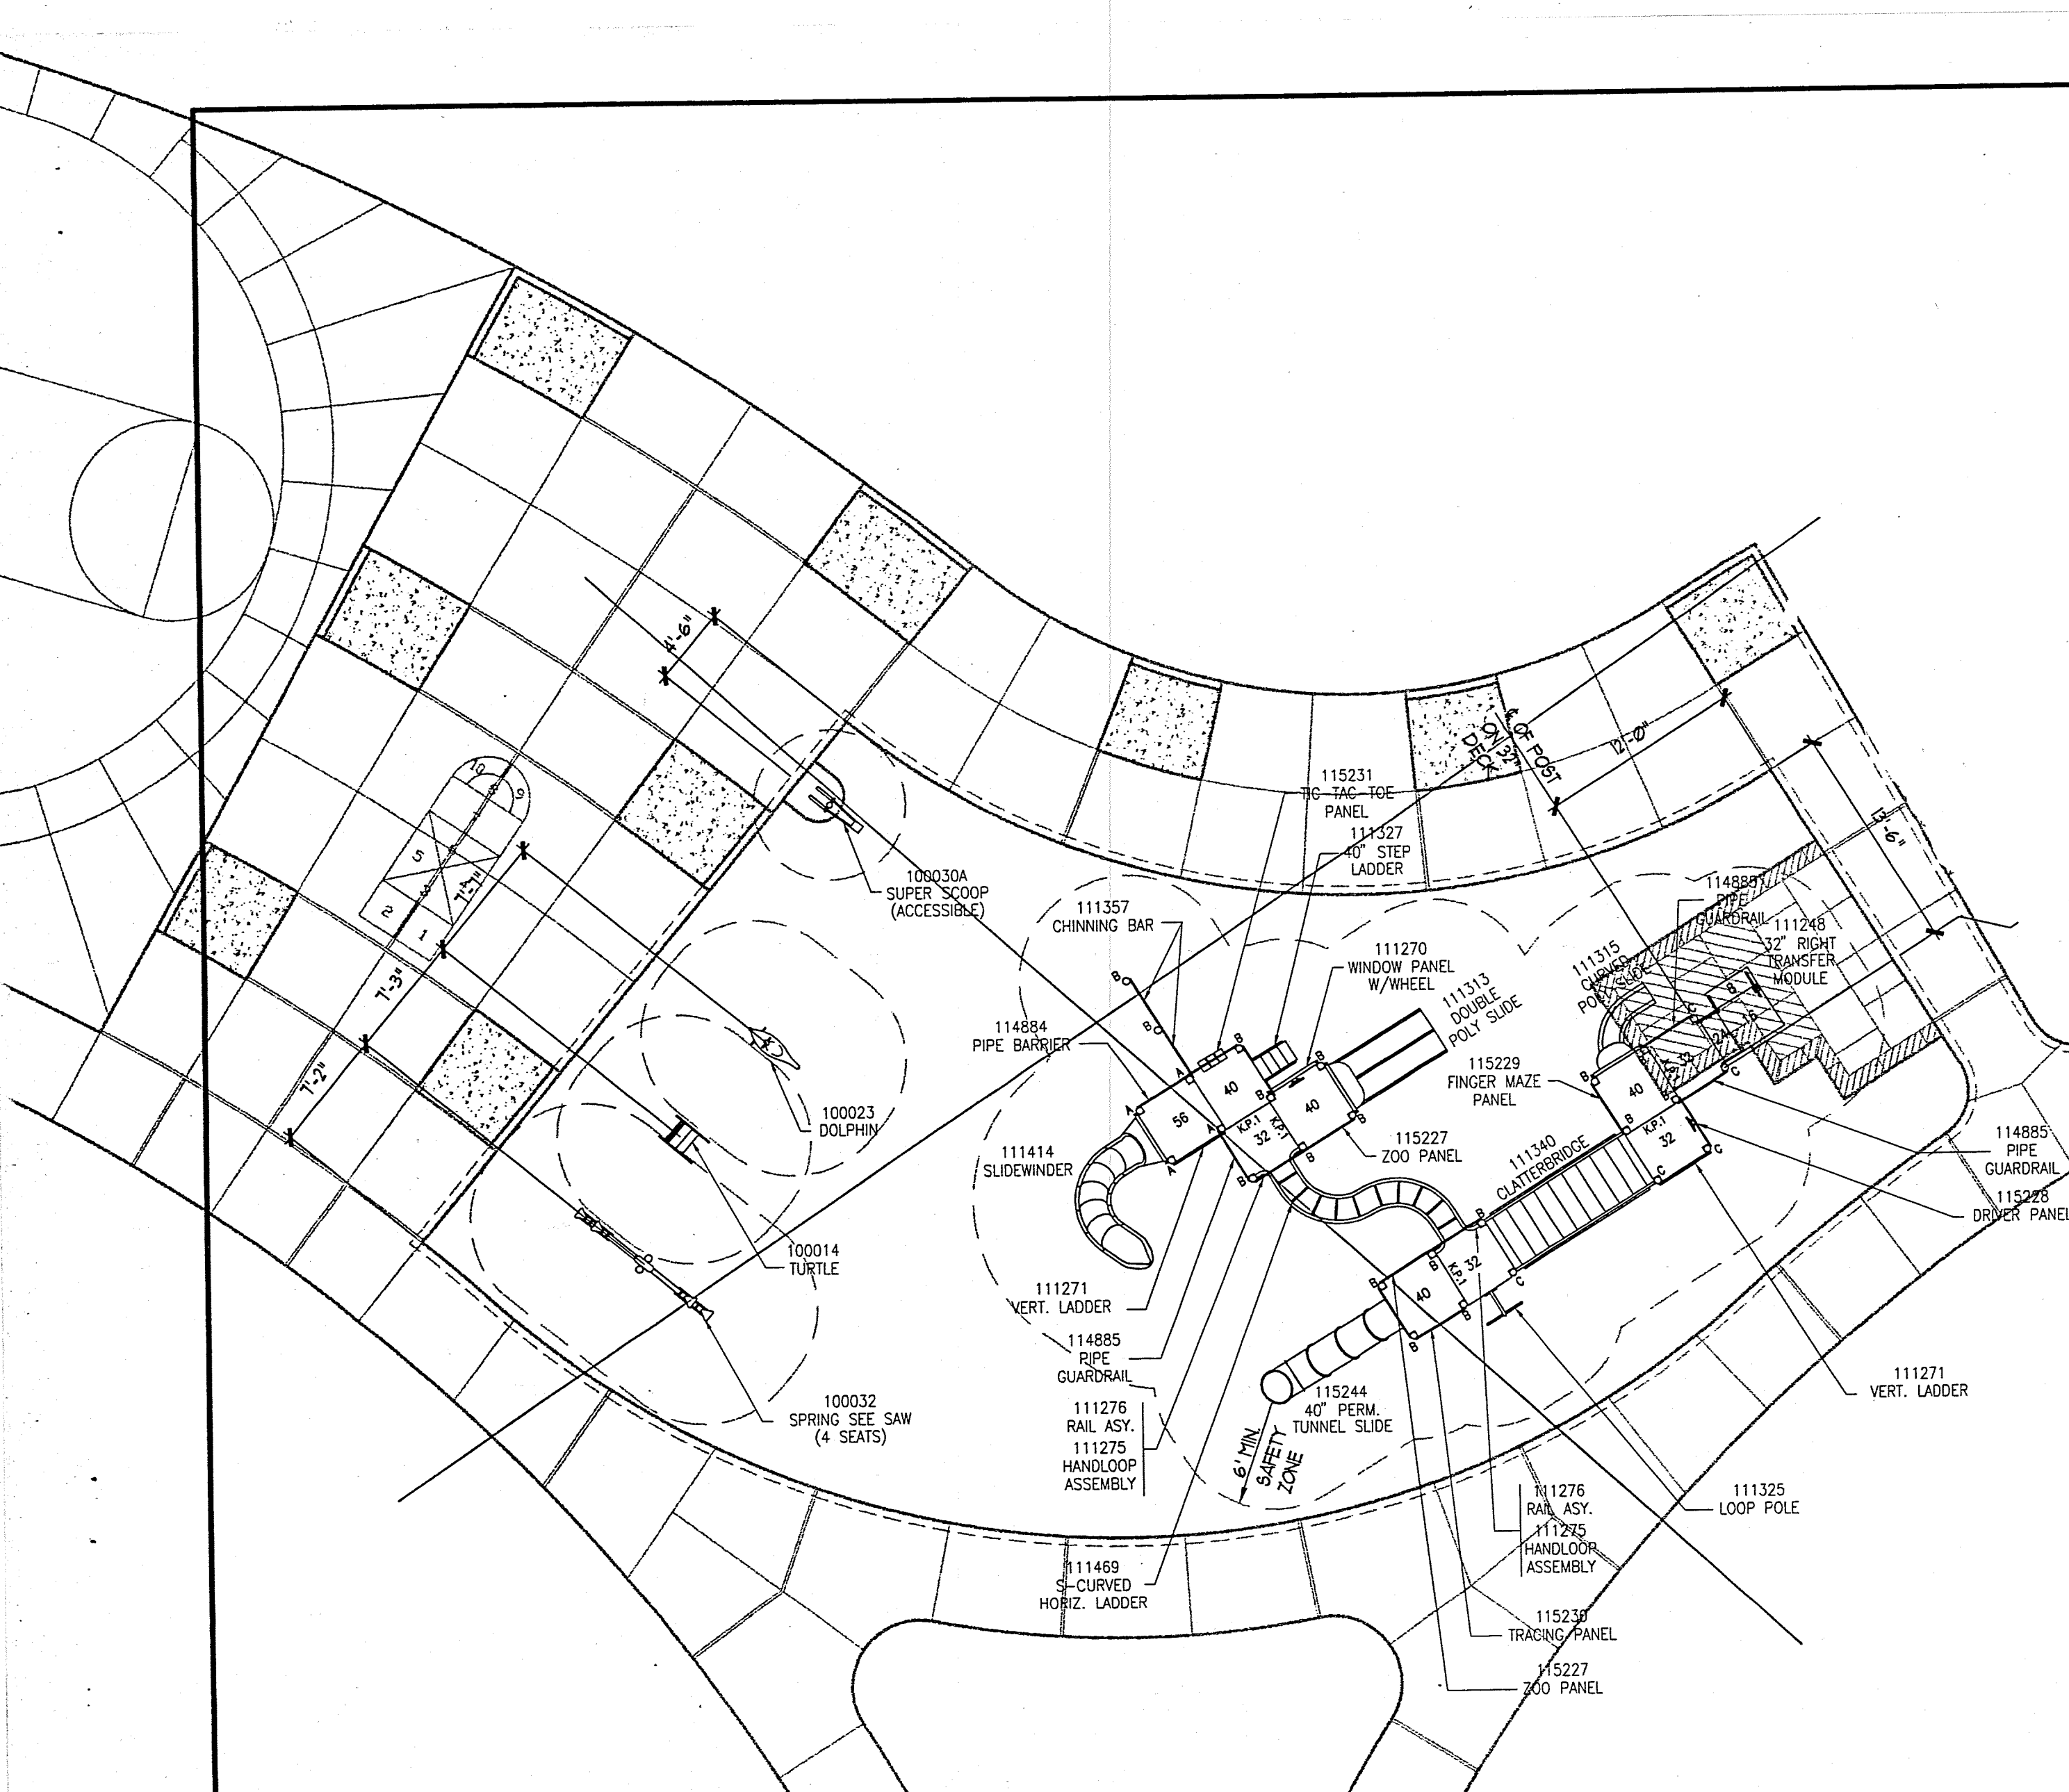

PLAY EQUIPMENT SCHEDULE - ADD ALTERNATE NO. 2		
NOTE: EQUIPMENT IN THIS LIST IS REFERRING TO PRODUCTS BY LANDSCAPE STRUCTURES, INC AVAILABLE FROM EXERPLAY, INC. (505) 281-0151		
PART QTY. NUMBER DESCRIPTION	PART QTY. NUMBER DESCRIPTION	
POSTS	SLIDES	
4 111404 132" ALUM. POST	1 111315 CURVED POLY SLIDE 40" DECK	
17 111404 116" ALUM. POST	1 111313 DOUBLE POLY SLIDE 40" DECK	
5 111404 108" ALUM. POST	1 111414 SLIDEWINDER 56" DECK	
DECKS	1 115244 TUNNEL SLIDE(PERMALENE) 40" DECK	
5 111253 KICK PLATE FOR 8" RISE	ATTACHMENTS/CONNECTORS	
9 111228 SQUARE TENDERDECK	1 111469 2" S' HORIZONTAL LADDER	
1 111248 TRANSFER MODULE, RIGHT 32" DECK	2 111357 CHINNING BAR	
ENCLOSURES	1 111340 CLATTERBRIDGE	
2 111275 HANDLOOP ASSEMBLY	1 111325 LOOP POLE 32" DECK	
1 114884 PIPE BARRIER	1 111327 STEP LADDER 40" DECK	
3 114885 PIPE GUARDRAIL	INDEPENDENT ITEMS	
2 111276 RAIL ASSEMBLY	1 100032 4-SEAT SPRING SEE SAW	
1 111271 VERTICAL LADDER 32" DECK	1 100014 TUFFRIDER TURTLE	
1 111271 VERTICAL LADDER 56" DECK	1 100023 TUFFRIDER DOLPHIN	
1 111270 WINDOW PANEL W/WHEEL	1 100030 WHEELCHAIR ACCESSIBLE SUPER SCOOP	
PERMALENE PANELS	SWINGS	
1 115228 DRIVER PANEL	1 100048 2" ARCH SWING	
1 115229 FINGER MAZE PANEL	1 100050 ARCH BELT SWING	
1 115231 TIC-TAC-TOE PANEL		
1 115230 TRACING PANEL		
2 115227 ZOO PANEL		

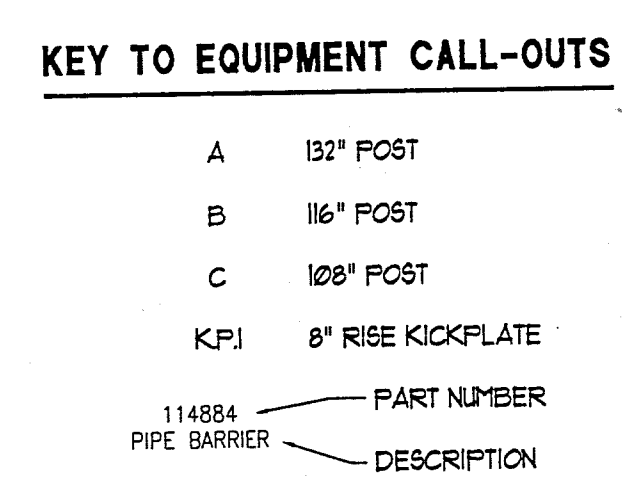

- CONSTRUCTION NOTES - BASE BID AND ADD-ALTERNATE NO. 2**
- COORDINATE EQUIPMENT FOOTING INSTALLATIONS WITH CONSTRUCTION OF RESILIENT SURFACING CONCRETE BASE.
 - FIELD VERIFY DIMENSIONS OF PLAY AREA PRIOR TO INSTALLATION OF ANY EQUIPMENT.
 - STAKE LOCATIONS OF ALL EQUIPMENT AND VERIFY THAT SAFETY ZONE CLEARANCES ARE MET PRIOR TO INSTALLATION OF ANY EQUIPMENT.

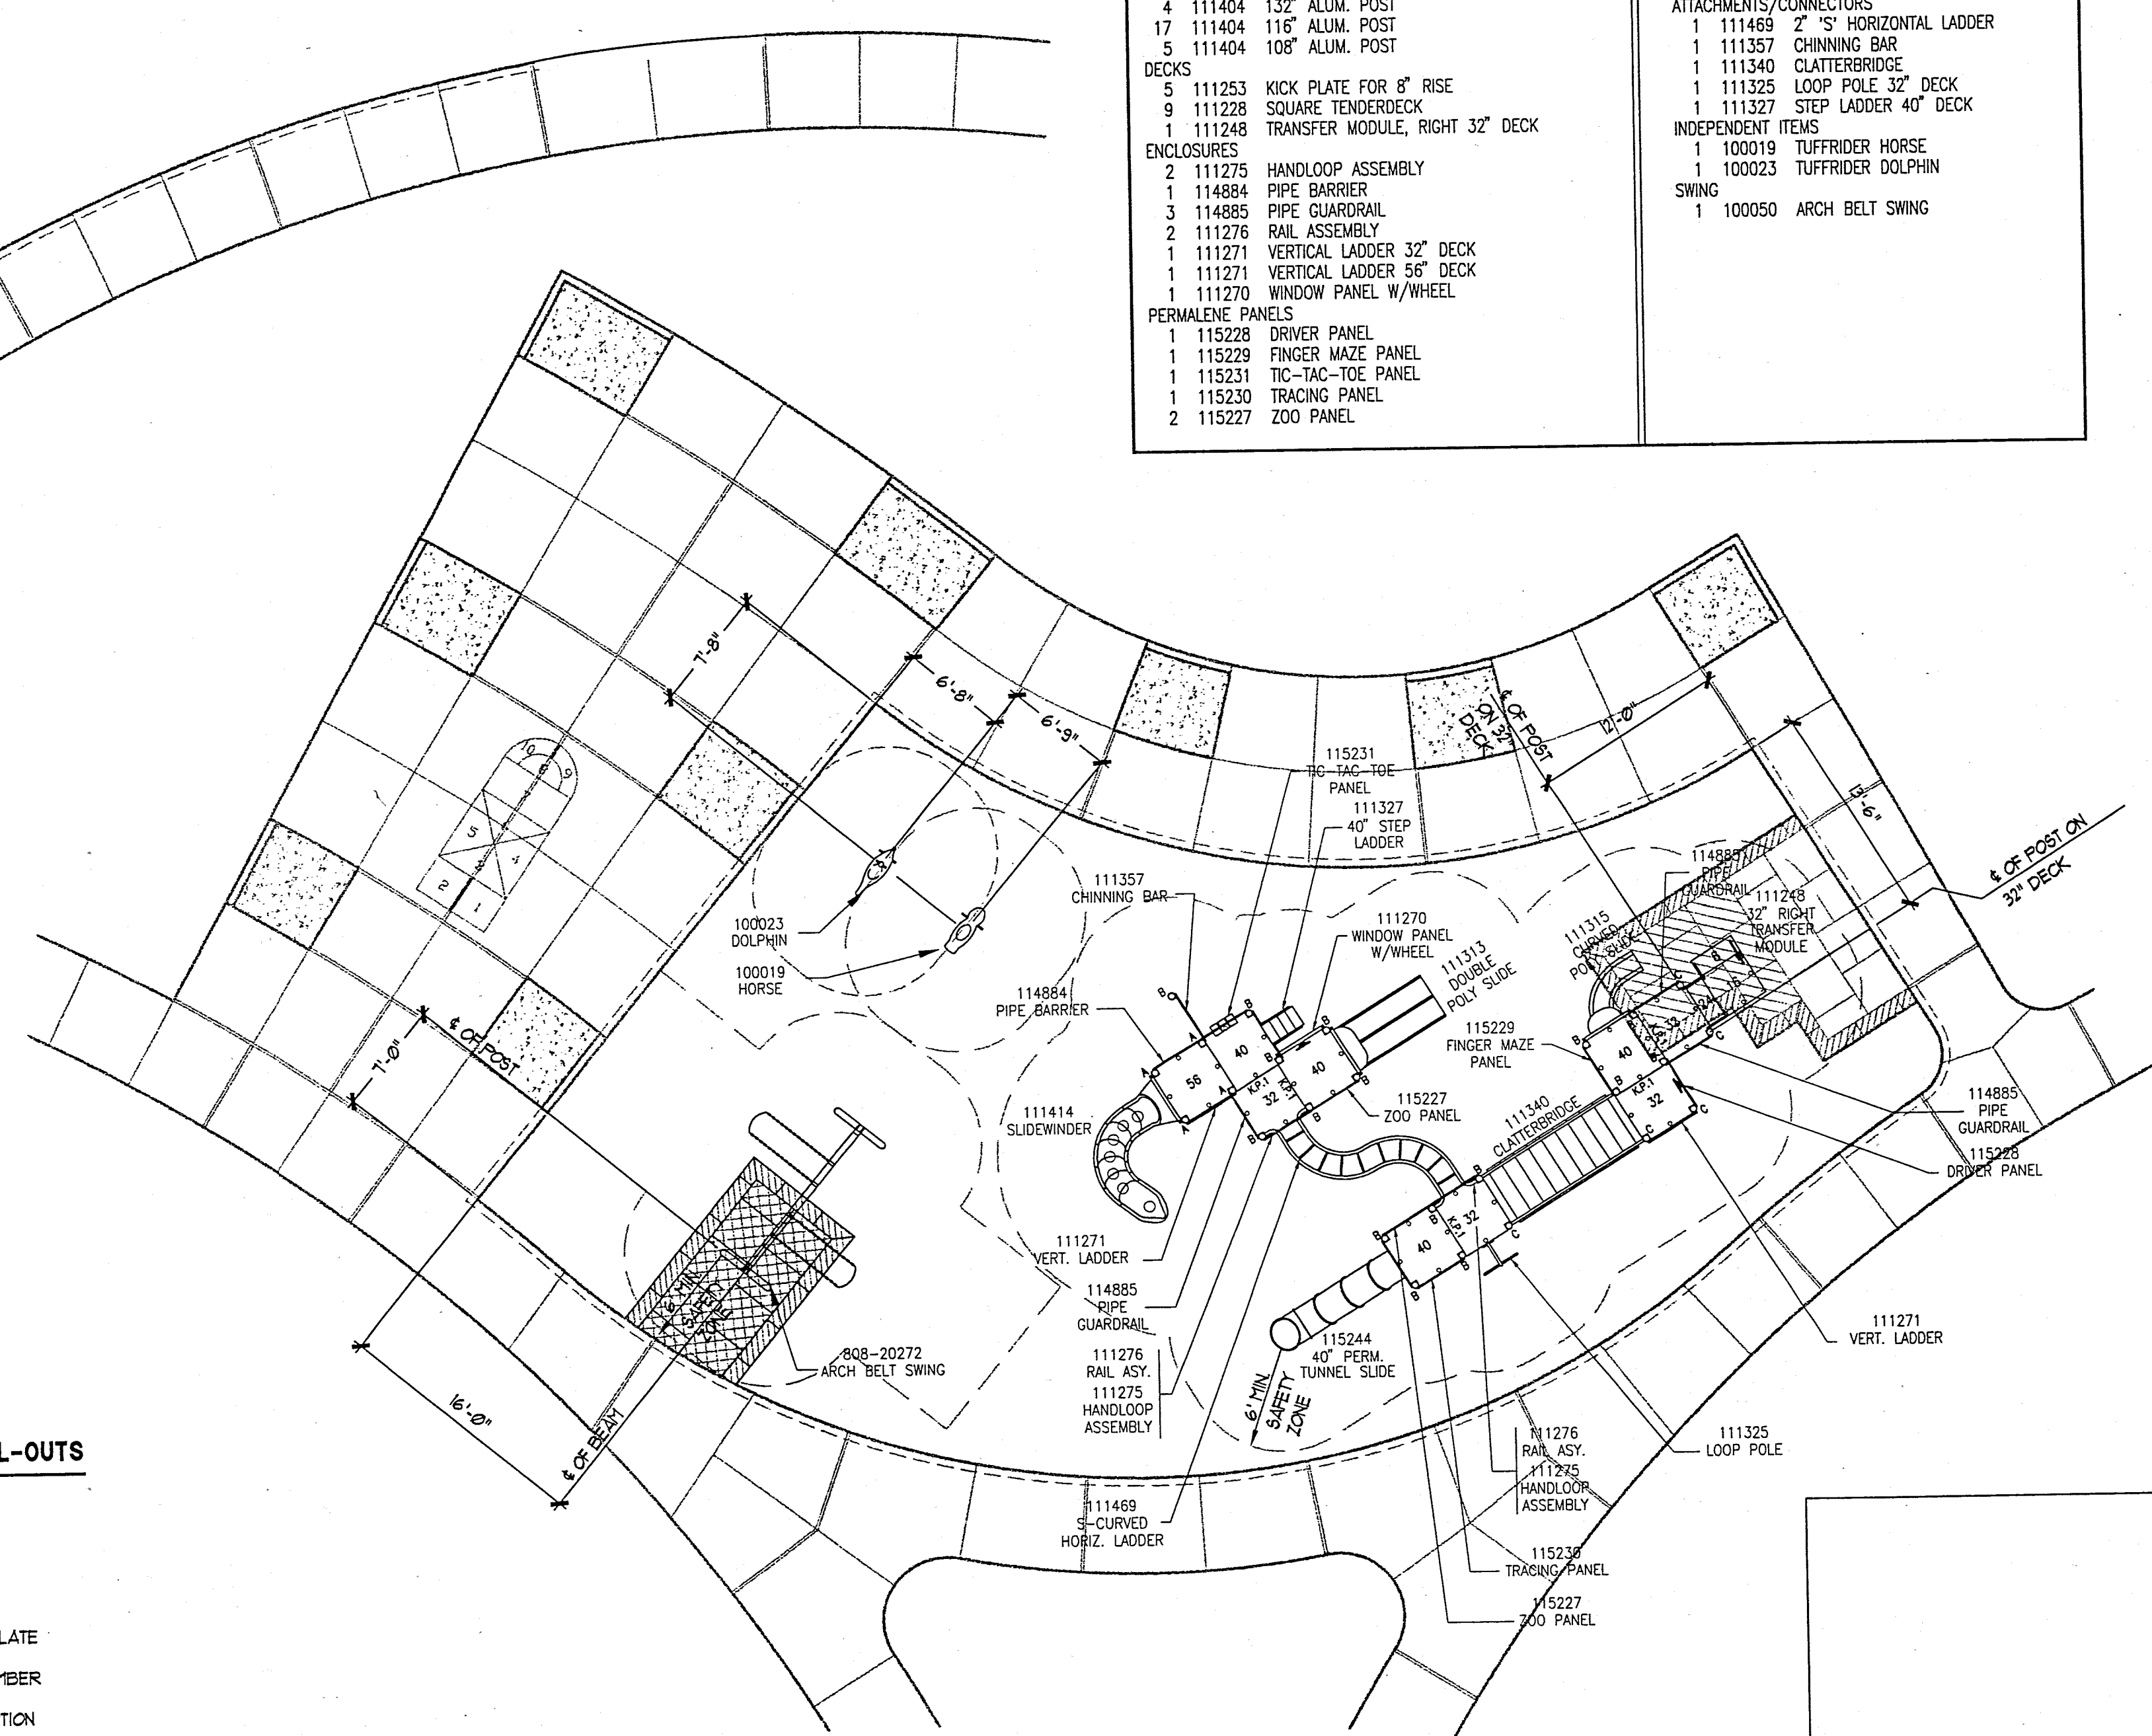

PLAY EQUIPMENT SCHEDULE - BASE BID		
NOTE: EQUIPMENT IN THIS LIST IS REFERRING TO PRODUCTS BY LANDSCAPE STRUCTURES, INC AVAILABLE FROM EXERPLAY, INC. (505) 281-0151		
PART QTY. NUMBER DESCRIPTION	PART QTY. NUMBER DESCRIPTION	
POSTS	SLIDES	
4 111404 132" ALUM. POST	1 111315 CURVED POLY SLIDE 40" DECK	
17 111404 116" ALUM. POST	1 111313 DOUBLE POLY SLIDE 40" DECK	
5 111404 108" ALUM. POST	1 111414 SLIDEWINDER 56" DECK	
DECKS	1 115244 TUNNEL SLIDE(PERMALENE) 40" DECK	
5 111253 KICK PLATE FOR 8" RISE	ATTACHMENTS/CONNECTORS	
9 111228 SQUARE TENDERDECK	1 111469 2" S' HORIZONTAL LADDER	
1 111248 TRANSFER MODULE, RIGHT 32" DECK	2 111357 CHINNING BAR	
ENCLOSURES	1 111340 CLATTERBRIDGE	
2 111275 HANDLOOP ASSEMBLY	1 111325 LOOP POLE 32" DECK	
1 114884 PIPE BARRIER	1 111327 STEP LADDER 40" DECK	
3 114885 PIPE GUARDRAIL	INDEPENDENT ITEMS	
2 111276 RAIL ASSEMBLY	1 100019 TUFFRIDER HORSE	
1 111271 VERTICAL LADDER 32" DECK	1 100023 TUFFRIDER DOLPHIN	
1 111271 VERTICAL LADDER 56" DECK	SWING	
1 111270 WINDOW PANEL W/WHEEL	1 100050 ARCH BELT SWING	
PERMALENE PANELS		
1 115228 DRIVER PANEL		
1 115229 FINGER MAZE PANEL		
1 115231 TIC-TAC-TOE PANEL		
1 115230 TRACING PANEL		
2 115227 ZOO PANEL		

AS BUILT INFORMATION		
CONTRACTOR: LANDSCAPES DATE: 5-97		
WORK STATED BY: LANDSCAPES DATE: 5-97		
INSPECTOR'S APPROVAL: [Signature] DATE: 6-5-97		
FIELD VERIFICATION BY: [Signature] DATE: 5-16-97		
DRAWING CORRECTED BY: [Signature] DATE: 5-97		
MICRO-FILM INFORMATION		
RECORDED BY: [Signature] DATE: [Signature]		
NO.		

BENCHMARK		
ELEVATIONS SHOWN ARE SLD 1929 ELEVATIONS BASED ON ALBUQUERQUE BENCHMARK 4-112, ELEVATION = 5199.53'		

SURVEY INFORMATION		
FIELD NOTES		
NO.	BY	DATE

SEAL		

NO. DATE REVISIONS / REMARKS		
BY	DATE	REVISIONS / REMARKS

DESIGNED BY: PDS SOUTHWEST, LTD. DATE: NOV. 20, 1995
DRAWN BY: PDS SOUTHWEST, LTD. DATE: NOV. 20, 1995
CHECKED BY: PDS SOUTHWEST, LTD. DATE: NOV. 20, 1995

2
10
PLAY EQUIPMENT LAYOUT
ADD-ALTERNATE NO. 2
1/8" = 1'-0"

NOTE: THIS DETAIL REPLACES DETAIL 140 IF ADD-ALTERNATE NUMBER 2 IS PART OF CONTRACT.

1
10
PLAY EQUIPMENT LAYOUT
BASE BID INSTALLATION
1/8" = 1'-0"


PDS Southwest, Ltd.
Planning & Design Solutions
Land Planning ■ Landscape Architecture ■ Environmental Services
121 Tijeras Avenue NE Suite 2200 Albuquerque, NM 87102-3400
(505) 764-8446 FAX (505) 764-8262

CITY OF ALBUQUERQUE
PARKS/GENERAL SERVICES
DESIGN & DEVELOPMENT

TITLE: **SALIDA DEL SOL PARK**
CONSTRUCTION DOCUMENTS
PLAY EQUIPMENT LAYOUT PLAN
NOV. 20, 1995

Design Review Committee City Engineer Approval

City Project No. **4777.91** Zone Map No. **A-13** Sheet **10** Of **14**

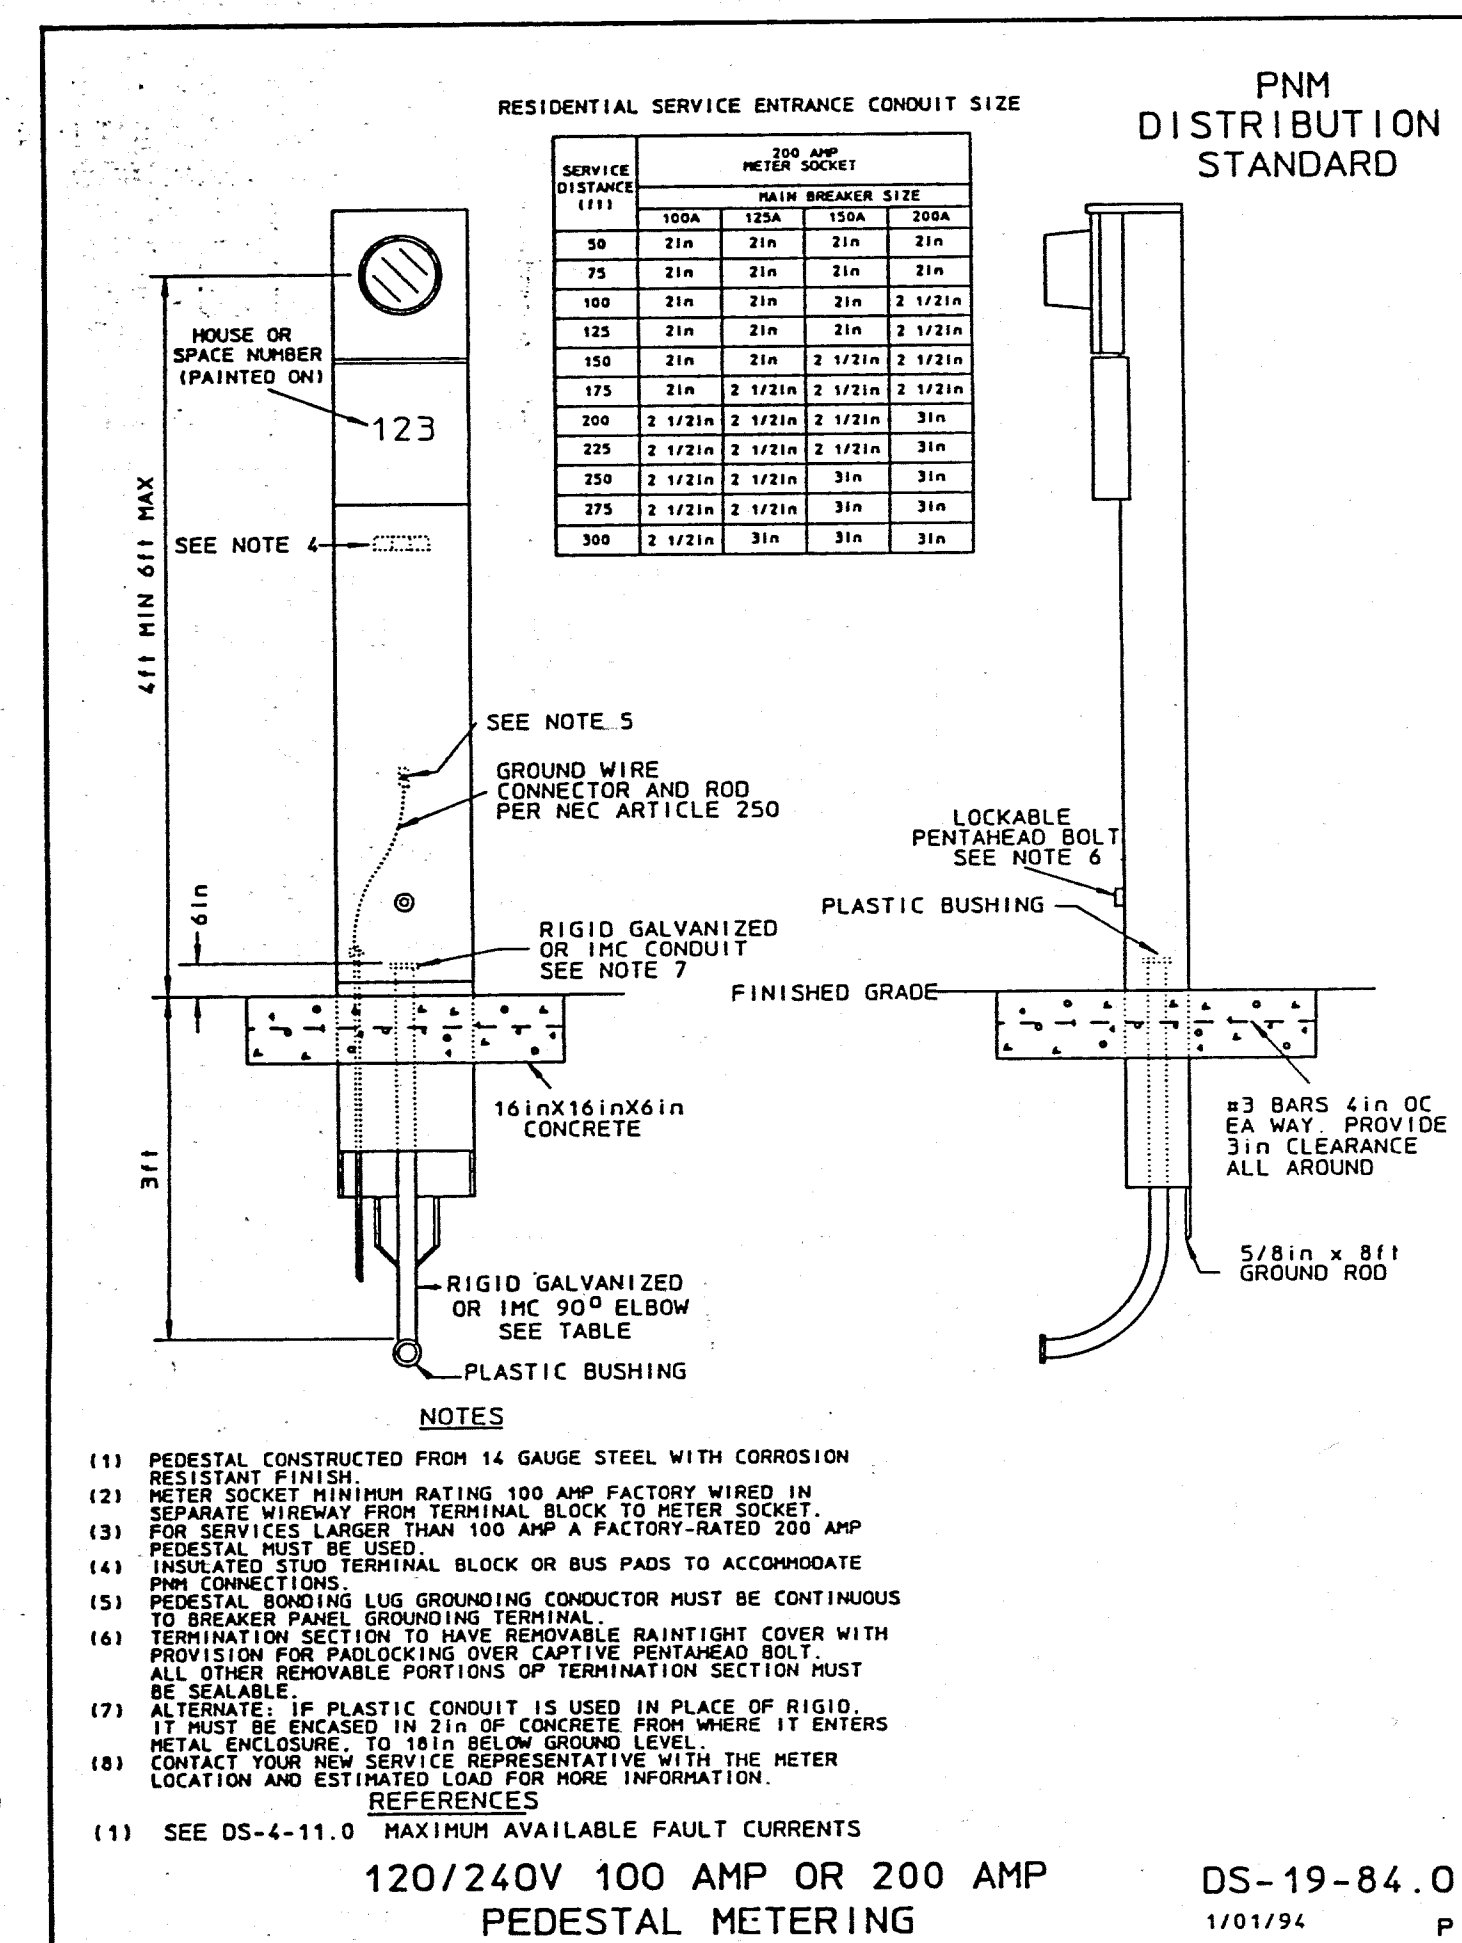



- | | | | | | | | | | | | | | | |
|---|---|---|---|---|---|---|---|---|----|----|----|----|----|----|
| 1 | 2 | 3 | 4 | 5 | 6 | 7 | 8 | 9 | 10 | 11 | 12 | 13 | 14 | 15 |
| 2 | 6 | - | 4 | 7 | 7 | 7 | . | 9 | 1 | | | 1 | 1 | 9 |



PDS Southwest, Ltd.
Planning & Design Solutions
 Land Planning ■ Landscape Architecture ■ Environmental Services
 121 Tijeras Avenue NE Suite 2200 (505) 764-8446
 Albuquerque, NM 87102-3400 FAX (505) 764-8262

[illegible]

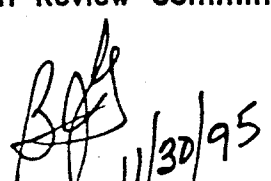CITY OF ALBUQUERQUE PARKS/GENERAL SERVICES DESIGN & DEVELOPMENT					
TITLE: SALIDA DEL SOL PARK		NOV. 20, 1995			
CONSTRUCTION DOCUMENTS					
ELECTRICAL SERVICE SCHEMATIC PLAN					
Design	Review	Committee	City Engineer Approval		
			Last Design Update		
				RD / DAY / YR	RD / DAY / YR
City Project No.		Zone Map No.	Sheet		
4777.91		A-13	Of 14		

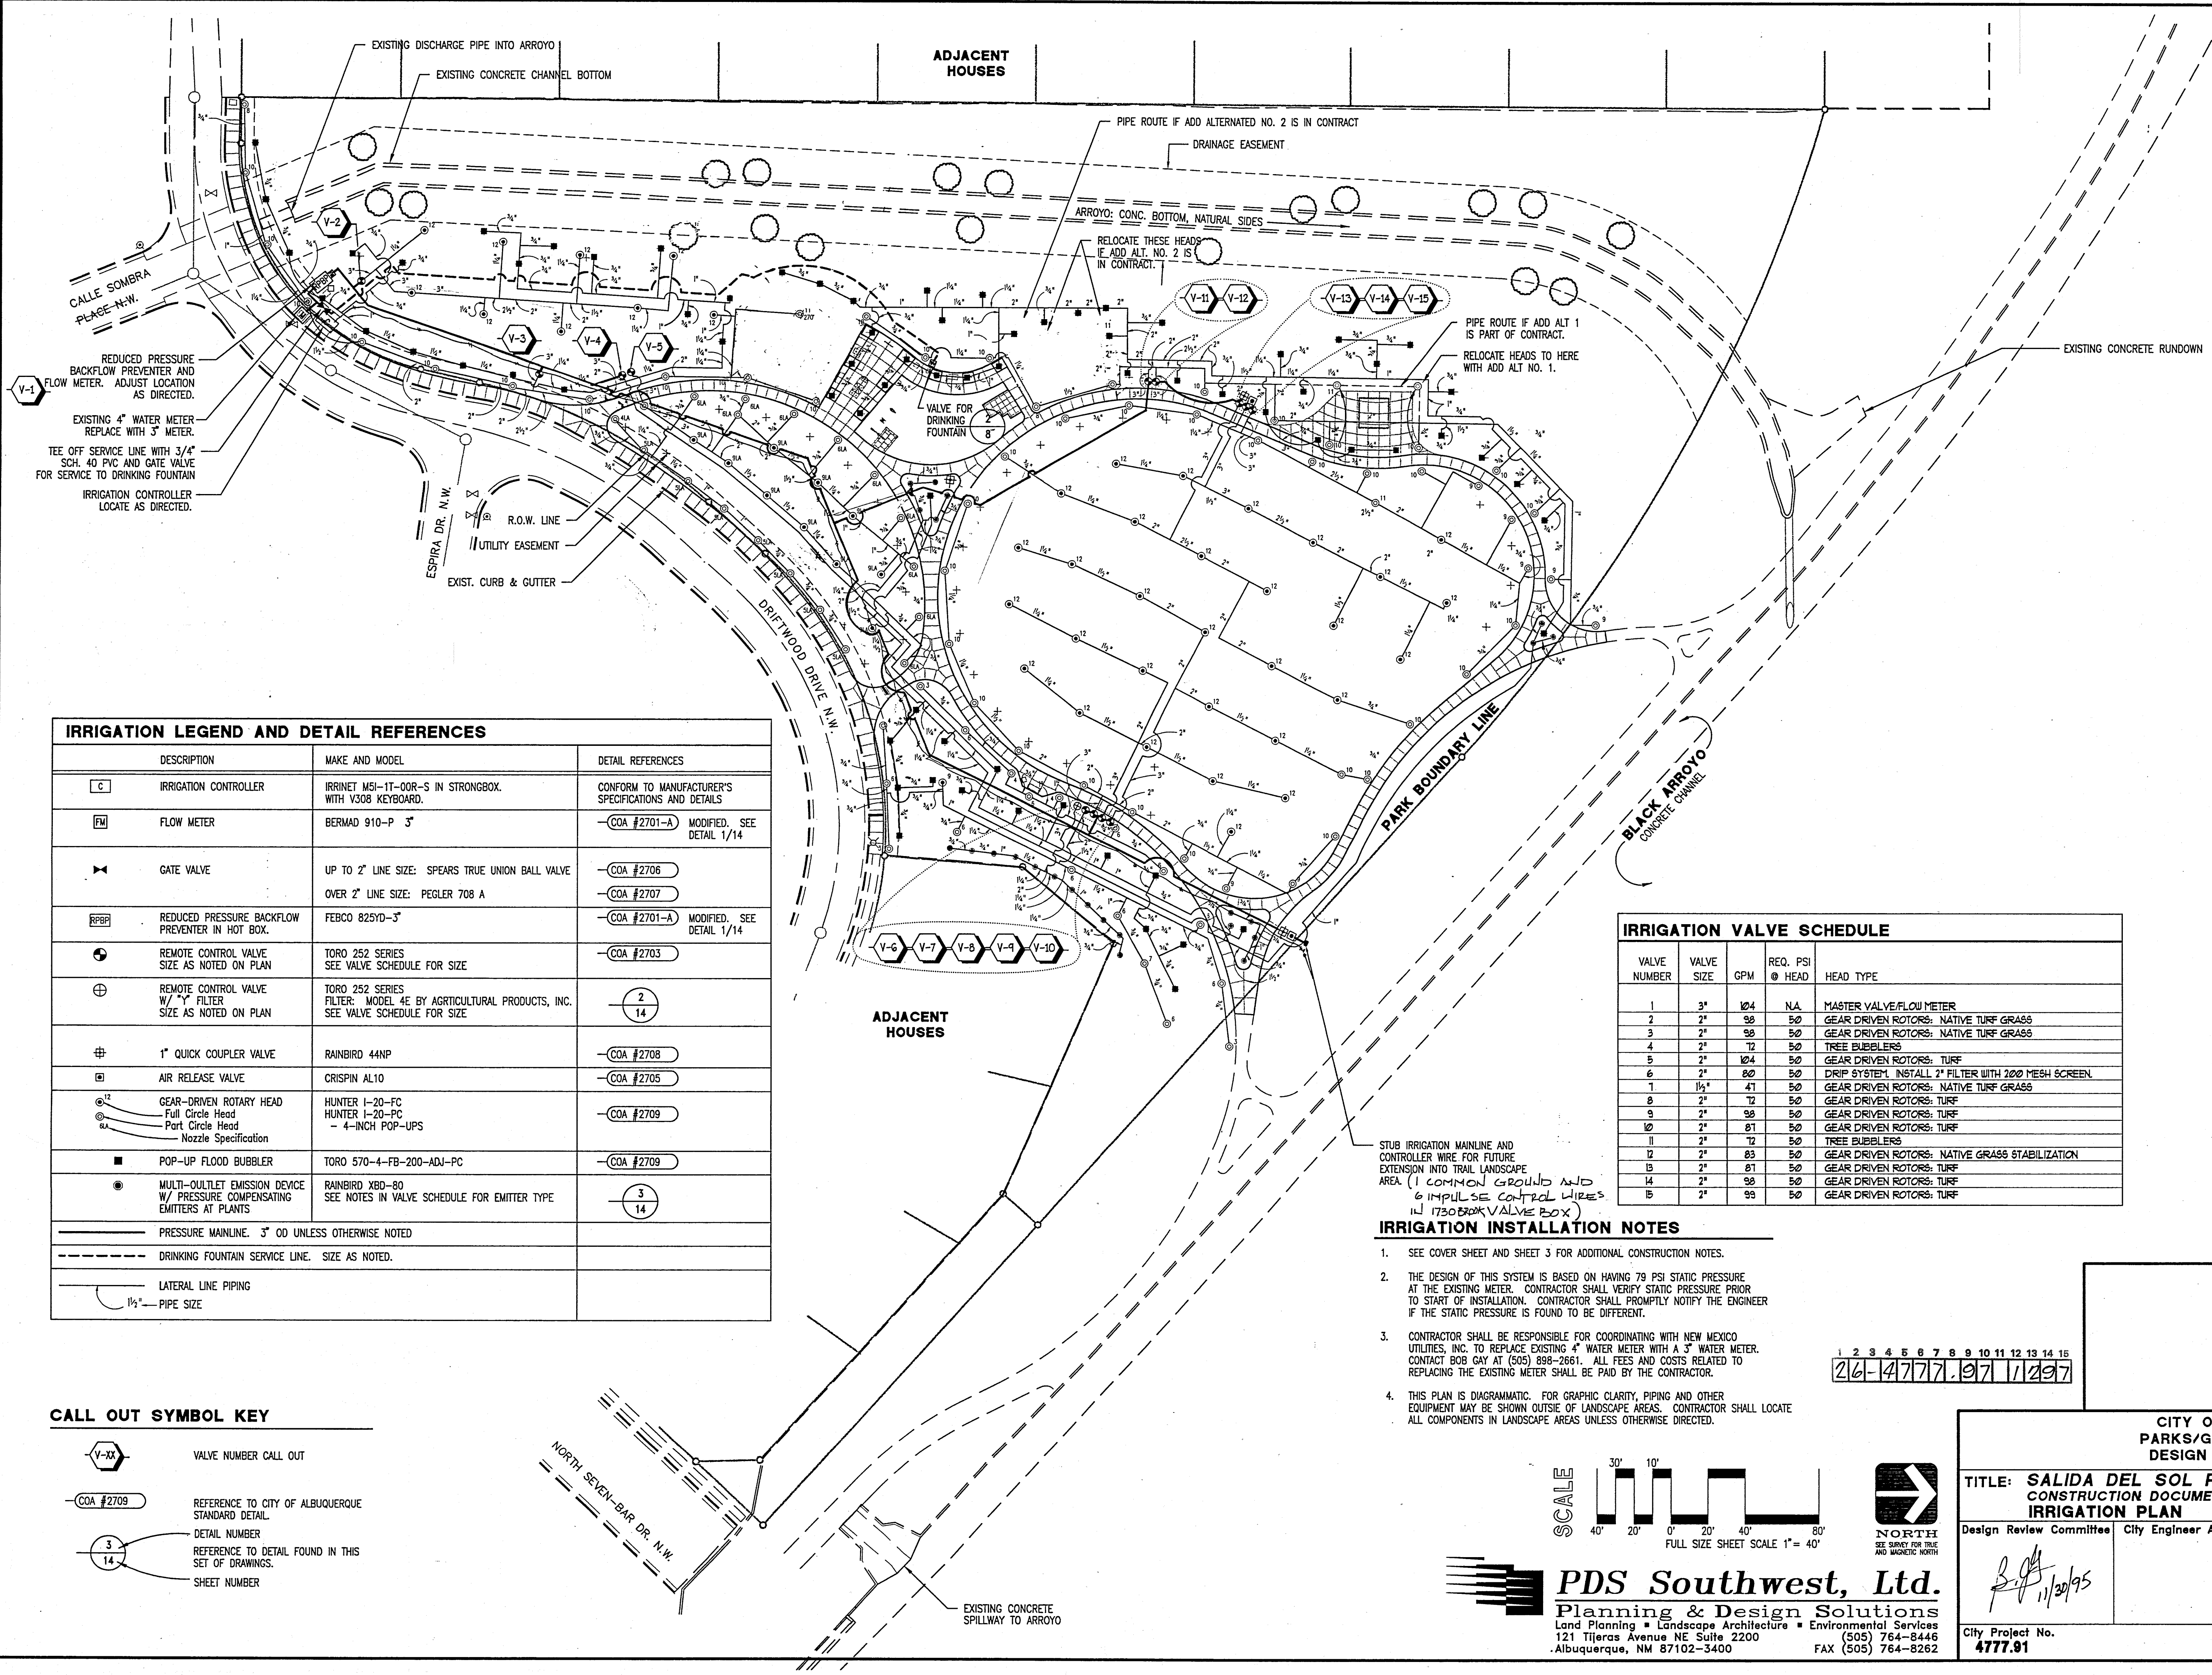


IRRIGATION LEGEND AND DETAIL REFERENCES		
DESCRIPTION	MAKE AND MODEL	DETAIL REFERENCES
IRRIGATION CONTROLLER	IRRINET MSI-1T-00R-S IN STRONGBOX WITH V308 KEYBOARD.	CONFORM TO MANUFACTURER'S SPECIFICATIONS AND DETAILS
FLOW METER	BERMAD 910-P 3"	-COA #2701-A MODIFIED, SEE DETAIL 1/14
GATE VALVE	UP TO 2" LINE SIZE: SPEARS TRUE UNION BALL VALVE OVER 2" LINE SIZE: PEGLER 708 A	-COA #2706 -COA #2707
REDUCED PRESSURE BACKFLOW PREVENTER IN HOT BOX.	FEBCO 825YD-3"	-COA #2701-A MODIFIED, SEE DETAIL 1/14
REMOTE CONTROL VALVE SIZE AS NOTED ON PLAN	TORO 252 SERIES SEE VALVE SCHEDULE FOR SIZE	-COA #2703
REMOTE CONTROL VALVE W/ "Y" FILTER SIZE AS NOTED ON PLAN	TORO 252 SERIES MODEL 4E BY AGRICULTURAL PRODUCTS, INC. SEE VALVE SCHEDULE FOR SIZE	
1" QUICK COUPLER VALVE	RAINBIRD 44NP	-COA #2708
AIR RELEASE VALVE	CRISPIN AL10	-COA #2705
GEAR-DRIVEN ROTARY HEAD Full Circle Head Part Circle Head Nozzle Specification	HUNTER I-20-FC HUNTER I-20-PC - 4-INCH POP-UPS	-COA #2709
POP-UP FLOOD BUBBLER	TORO 570-4-FB-200-ADJ-PC	-COA #2709
MULTI-OUTLET EMISSION DEVICE W/ PRESSURE COMPENSATING EMITTERS AT PLANTS	RAINBIRD XBD-80 SEE NOTES IN VALVE SCHEDULE FOR EMITTER TYPE	
PRESSURE MAINLINE. 3" OD UNLESS OTHERWISE NOTED		
DRINKING FOUNTAIN SERVICE LINE. SIZE AS NOTED.		
LATERAL LINE PIPING		
1/2" PIPE SIZE		

CALL OUT SYMBOL KEY	
	VALVE NUMBER CALL OUT
	REFERENCE TO CITY OF ALBUQUERQUE STANDARD DETAIL.
	DETAIL NUMBER
	REFERENCE TO DETAIL FOUND IN THIS SET OF DRAWINGS.
	SHEET NUMBER

IRRIGATION VALVE SCHEDULE				
VALVE NUMBER	VALVE SIZE	GPM	REQ. PSI @ HEAD	HEAD TYPE
1	3"	104	N.A.	MASTER VALVE/FLOW METER
2	2"	98	50	GEAR DRIVEN ROTORS: NATIVE TURF GRASS
3	2"	98	50	GEAR DRIVEN ROTORS: NATIVE TURF GRASS
4	2"	12	50	TREE BUBBLERS
5	2"	104	50	GEAR DRIVEN ROTORS: TURF
6	2"	80	50	DRIP SYSTEM. INSTALL 2" FILTER WITH 200 MESH SCREEN.
7	1 1/2"	41	50	GEAR DRIVEN ROTORS: NATIVE TURF GRASS
8	2"	12	50	GEAR DRIVEN ROTORS: TURF
9	2"	98	50	GEAR DRIVEN ROTORS: TURF
10	2"	81	50	GEAR DRIVEN ROTORS: TURF
11	2"	12	50	TREE BUBBLERS
12	2"	83	50	GEAR DRIVEN ROTORS: NATIVE GRASS STABILIZATION
13	2"	81	50	GEAR DRIVEN ROTORS: TURF
14	2"	98	50	GEAR DRIVEN ROTORS: TURF
15	2"	98	50	GEAR DRIVEN ROTORS: TURF

- STUB IRRIGATION MAINLINE AND CONTROLLER WIRE FOR FUTURE EXTENSION INTO TRAIL LANDSCAPE AREA (1 COMMON GROUND AND 6 INDIVIDUAL CONTROL WIRES IN 1750BRAIN VALVE BOX)
- IRRIGATION INSTALLATION NOTES**
- SEE COVER SHEET AND SHEET 3 FOR ADDITIONAL CONSTRUCTION NOTES.
 - THE DESIGN OF THIS SYSTEM IS BASED ON HAVING 79 PSI STATIC PRESSURE AT THE EXISTING METER. CONTRACTOR SHALL VERIFY STATIC PRESSURE PRIOR TO START OF INSTALLATION. CONTRACTOR SHALL PROMPTLY NOTIFY THE ENGINEER IF THE STATIC PRESSURE IS FOUND TO BE DIFFERENT.
 - CONTRACTOR SHALL BE RESPONSIBLE FOR COORDINATING WITH NEW MEXICO UTILITIES, INC. TO REPLACE EXISTING 4" WATER METER WITH A 3" WATER METER. CONTACT BOB GAY AT (505) 898-2861. ALL FEES AND COSTS RELATED TO REPLACING THE EXISTING METER SHALL BE PAID BY THE CONTRACTOR.
 - THIS PLAN IS DIAGRAMMATIC. FOR GRAPHIC CLARITY, PIPING AND OTHER EQUIPMENT MAY BE SHOWN OUTSIDE OF LANDSCAPE AREAS. CONTRACTOR SHALL LOCATE ALL COMPONENTS IN LANDSCAPE AREAS UNLESS OTHERWISE DIRECTED.

1 2 3 4 5 6 7 8 9 10 11 12 13 14 15
26-47777.97 11/29/97

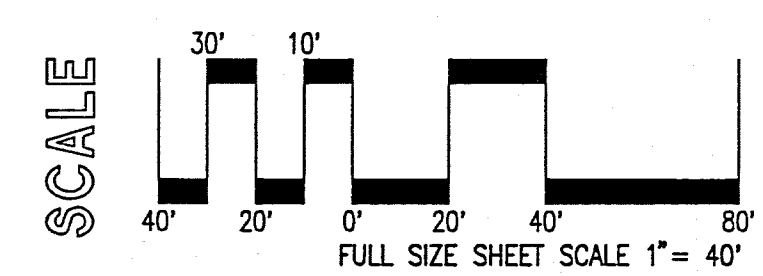

PDS Southwest, Ltd.
Planning & Design Solutions
Land Planning • Landscape Architecture • Environmental Services
121 Tijeras Avenue NE Suite 2200
Albuquerque, NM 87102-3400
(505) 764-8446
FAX (505) 764-8262


CITY OF ALBUQUERQUE
PARKS/GENERAL SERVICES
DESIGN & DEVELOPMENT

TITLE: **SALIDA DEL SOL PARK**
CONSTRUCTION DOCUMENTS
IRRIGATION PLAN

DESIGNED BY: PDS SOUTHWEST LTD. DATE: NOV. 20, 1995
DRAWN BY: PDS SOUTHWEST LTD. DATE: NOV. 20, 1995
CHECKED BY: PDS SOUTHWEST LTD. DATE: NOV. 20, 1995

City Project No. **4777.91** Zone Map No. **A-13** Sheet **12** Of **14**

SURVEY INFORMATION		BENCHMARK		AS BUILT INFORMATION	
NO.	FIELD NOTES BY DATE	NO.	DATE	CONTRACTOR'S FIELD INFORMATION DATE: 5-97	WORK STAKED BY DATE: 2-97
				INSPECTOR'S APPROVAL DATE: 6-97	FIELD VERIFICATION BY DATE: 6-97
				DRAWING CORRECTED BY DATE: 5-97	MICRO-FILM INFORMATION
				RECORDED BY	NO.

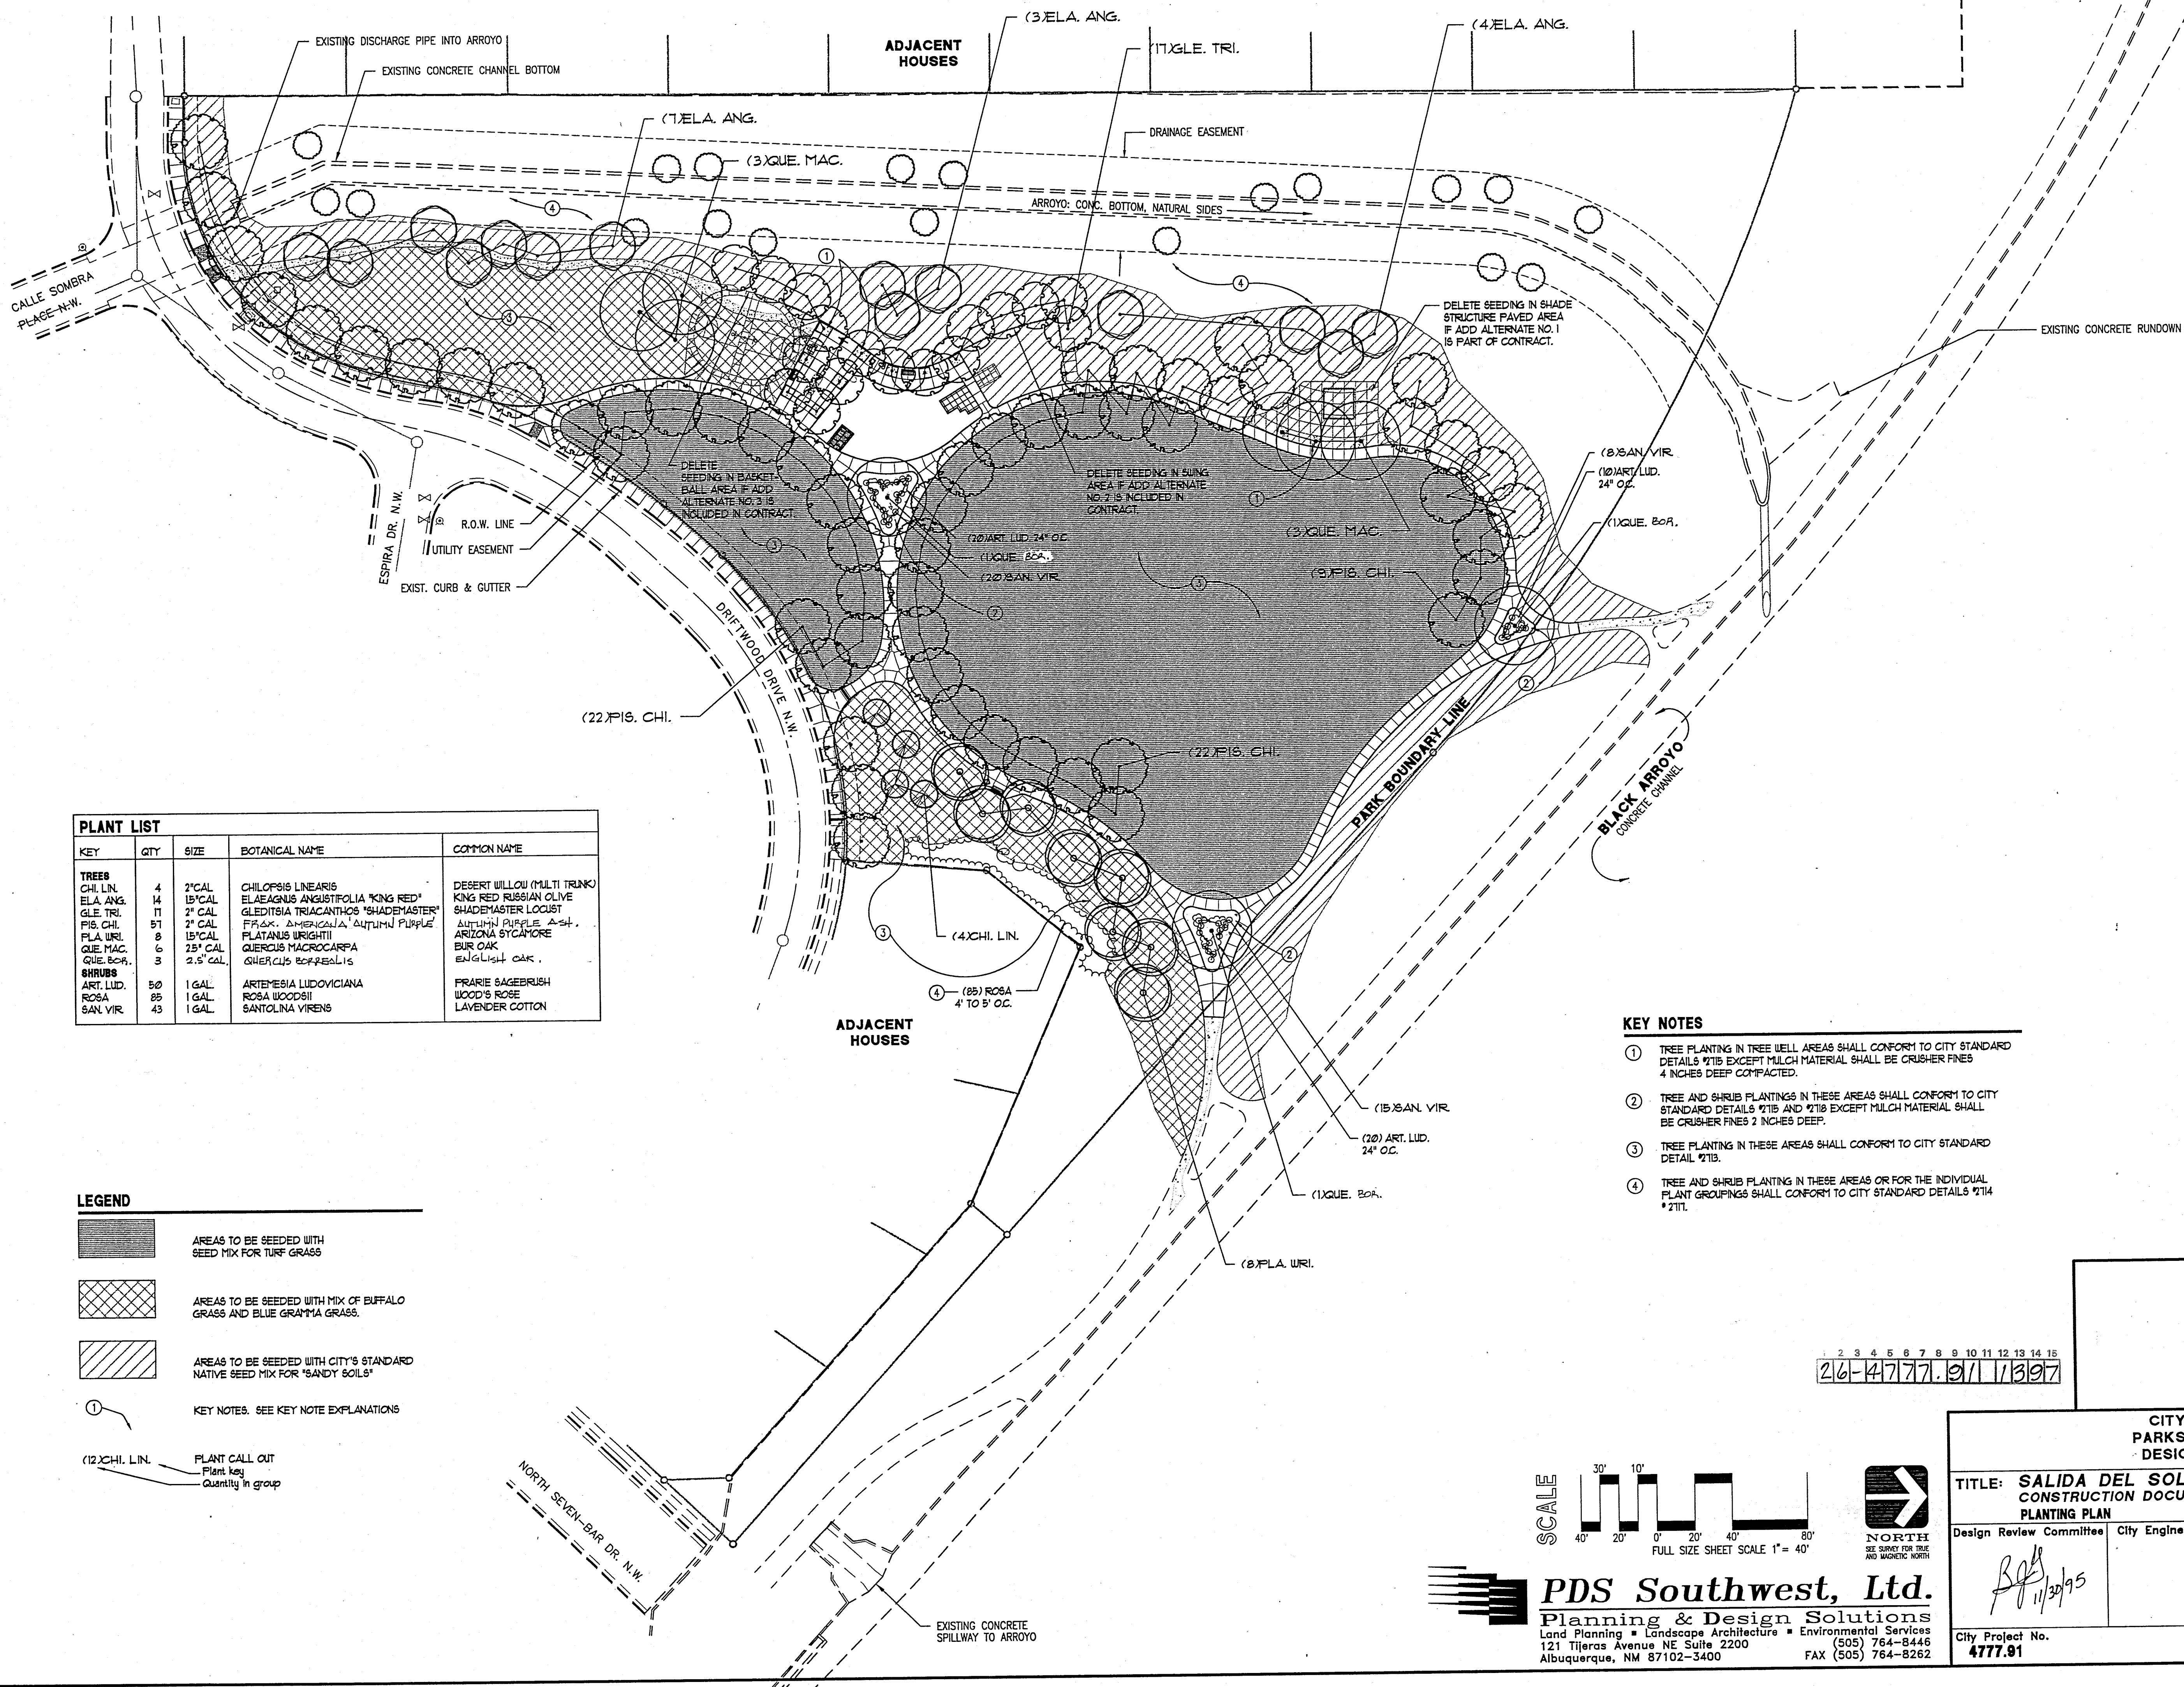


PLANT LIST				
KEY	QTY	SIZE	BOTANICAL NAME	COMMON NAME
TREES				
CHI. LIN.	4	2" CAL.	CHILOPSIS LINEARIS	DESERT WILLOW (MULTI TRUNK)
ELA. ANG.	14	15" CAL.	ELAEAGNUS ANGUSTIFOLIA 'KING RED'	KING RED RUSSIAN OLIVE
GLE. TRI.	11	2" CAL.	GLEDITSIA TRIACANTHOS 'SHADEMASTER'	SHADEMASTER LOCUST
PIS. CHI.	51	2" CAL.	FRAX. AMERICANA 'AUTUMN PURPLE'	AUTUMN PURPLE ASH
PLA. URI.	8	15" CAL.	PLATANUS URWIGHTII	ARIZONA SYCAMORE
QUE. MAC.	6	25" CAL.	QUERCUS MACROCARPA	BUR OAK
QUE. BOA.	3	2.5" CAL.	QUERCUS BOYDII	ENGLISH OAK
SHRUBS				
ART. LUD.	50	1 GAL.	ARTEMESIA LUDOVICIANA	PRAIRIE SAGEBRUSH
ROSA	25	1 GAL.	ROSA WOODSII	WOOD'S ROSE
SAN. VIR.	43	1 GAL.	SANTOLINA VIRENS	LAVENDER COTTON

LEGEND	
	AREAS TO BE SEEDDED WITH SEED MIX FOR TURF GRASS
	AREAS TO BE SEEDDED WITH MIX OF BUFFALO GRASS AND BLUE GRAMA GRASS
	AREAS TO BE SEEDDED WITH CITY'S STANDARD NATIVE SEED MIX FOR "SANDY SOILS"
①	KEY NOTES. SEE KEY NOTE EXPLANATIONS
(12) CHI. LIN.	PLANT CALL OUT Plant key Quantity in group

- KEY NOTES**
- TREE PLANTING IN TREE WELL AREAS SHALL CONFORM TO CITY STANDARD DETAILS #215 EXCEPT MULCH MATERIAL SHALL BE CRUSHER FINES 4 INCHES DEEP CONTRACTED.
 - TREE AND SHRUB PLANTINGS IN THESE AREAS SHALL CONFORM TO CITY STANDARD DETAILS #215 AND #218 EXCEPT MULCH MATERIAL SHALL BE CRUSHER FINES 2 INCHES DEEP.
 - TREE PLANTING IN THESE AREAS SHALL CONFORM TO CITY STANDARD DETAIL #215.
 - TREE AND SHRUB PLANTING IN THESE AREAS OR FOR THE INDIVIDUAL PLANT GROUPINGS SHALL CONFORM TO CITY STANDARD DETAILS #214 & #217.

26-47777.9/11/3/97

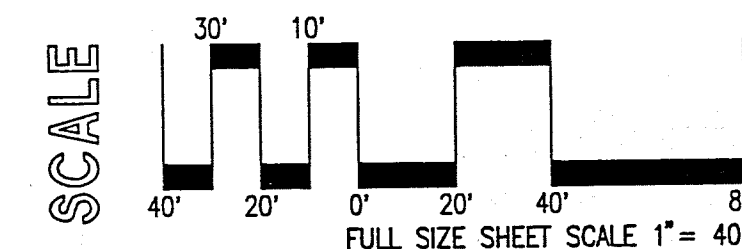


PDS Southwest, Ltd.
Planning & Design Solutions
Land Planning • Landscape Architecture • Environmental Services
121 Tijeras Avenue NE Suite 2200 (505) 764-8446
Albuquerque, NM 87102-3400 FAX (505) 764-8262

CITY OF ALBUQUERQUE PARKS/GENERAL SERVICES DESIGN & DEVELOPMENT	
TITLE: SALIDA DEL SOL PARK CONSTRUCTION DOCUMENTS PLANTING PLAN	
Design Review Committee	City Engineer Approval
City Project No. 4777.91	Zone Map No. A-13
Sheet 13	Of 14

DESIGNED BY: PDS SOUTHWEST, LTD. DATE: NOV. 20, 1995
 DRAWN BY: PDS SOUTHWEST, LTD. DATE: NOV. 20, 1995
 CHECKED BY: PDS SOUTHWEST, LTD. DATE: NOV. 20, 1995

NO.		DATE		REVISIONS / REMARKS		BY		SEAL		SURVEY INFORMATION		BENCHMARK		AS BUILT INFORMATION	
										FIELD NOTES				CONTRACTOR/LANDSCAPES	
										DATE				DATE: 6-97	
										NO.				WORK STAKED BY	
														DATE: 2-97	
														INSPECTOR'S APPROVAL	
														DATE: 4-97	
														FIELD VERIFICATION BY	
														DATE: 5/15/97	
														DRAWING CORRECTED BY	
														DATE: 10-97	
														MICRO-FILM INFORMATION	
														RECORDED BY	
														DATE:	
														NO.	

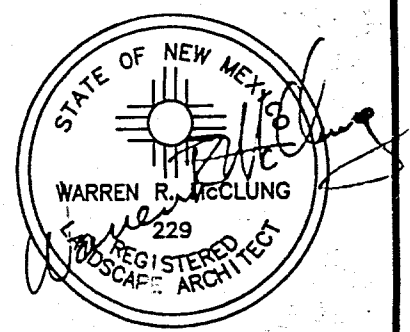




DESIGNED BY: PDS SOUTHWEST, LTD.	DATE: NOV. 20, 1995
DRAWN BY: PDS SOUTHWEST, LTD.	DATE: NOV. 20, 1995

**CITY OF ALBUQUERQUE
PARKS/GENERAL SERVICES
DESIGN & DEVELOPMENT**

TITLE: **SALIDA DEL SOL**
CONSTRUCTION DOCUMENTS
IRRIGATION AND PLANTING DETAILS

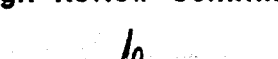Design Review Committee	City Engineer Approval	Last Design Update	MM/DD/YYYY	MM/DD/YYYY
				
City Project No. 4777.91	Zone Map No. A-13		Sheet 14	Of 14

1	2	3	4	5	6	7	8	9	10	11	12	13	14	15
2	6	-	4	7	7	7	.	9	1			1	4	9



PDS Southwest, Ltd.
Planning & Design Solutions
 Land Planning ■ Landscape Architecture ■ Environmental Services
 121 Tijeras Avenue NE Suite 2200 (505) 764-8446
 Albuquerque, NM 87102-3400 FAX (505) 764-8262