



CITY OF ALBUQUERQUE, NEW MEXICO


CONSTRUCTION PLANS FOR

INTEL SANITARY SEWER WESTERN TRAIL (PHASE III)

FROM COORS BLVD. TO
LIFT STATION #24

TABLE OF CONTENTS

SHT. NO.	TITLE
1	COVER SHEET
2	OVERALL PLAN
3	STA. B.O.P. TO STA. 43+00 - PLAN & PROFILE
4	STA. 43+00 TO STA. 54+00 - PLAN & PROFILE
5	STA. 54+00 TO STA. 65+00 - PLAN & PROFILE
6	STA. 65+00 TO STA. 74+00 - PLAN & PROFILE
7	STA. 74+00 TO E.O.P. - PLAN & PROFILE
8	MISCELLANEOUS DETAILS
9	OVERALL TRAFFIC CONTROL MAP, SIGN FACE DETAILS & SEQUENCE OF CONSTRUCTION
10-11	TRAFFIC CONTROL PLAN - PHASE I
12	TRAFFIC CONTROL PLAN - PHASE II
13	SIGNING AND CONSTRUCTION TRAFFIC CONTROL STANDARDS
14	TYPICAL TRAFFIC CONTROL & SIGNING EXAMPLES (REF. M.U.T.C.D.)

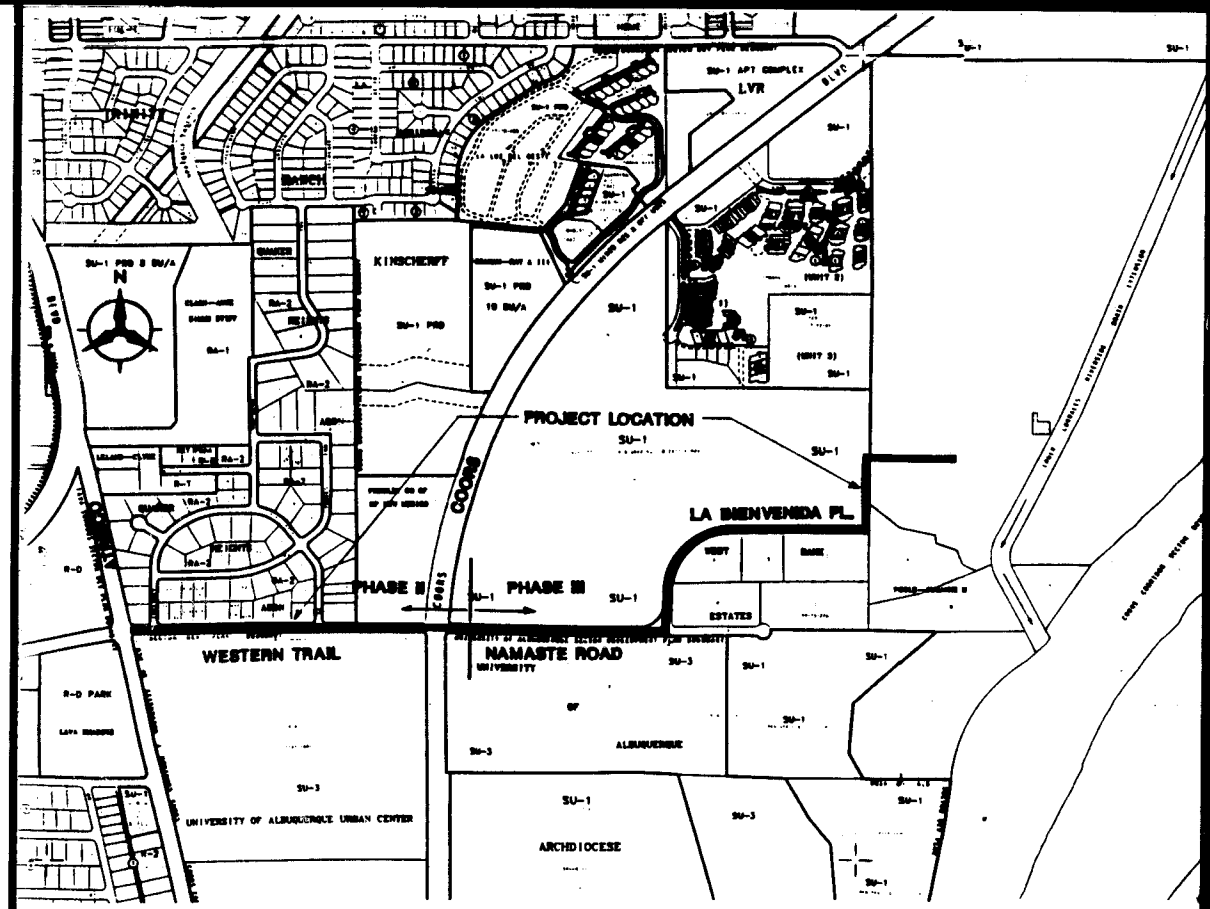

VICINITY MAP

NOT TO SCALE
F-11, F-12

NOTICE TO CONTRACTORS

- ALL WORK DETAILED ON THESE PLANS TO BE PERFORMED UNDER CONTRACT SHALL, EXCEPT AS OTHERWISE STATED OR PROVIDED FOR HEREON, BE CONSTRUCTED IN ACCORDANCE WITH THE CITY OF ALBUQUERQUE STANDARD SPECIFICATIONS FOR PUBLIC WORKS CONSTRUCTION, 1986 EDITION, WITH CURRENT UPDATES (NO. 5).
- TWO WORKING DAYS PRIOR TO ANY EXCAVATION, THE CONTRACTOR MUST CONTACT NEW MEXICO ONE CALL SYSTEM (260-1990) FOR LOCATION OF EXISTING UTILITIES.
- PRIOR TO CONSTRUCTION, THE CONTRACTOR SHALL EXCAVATE AND VERIFY THE HORIZONTAL AND VERTICAL LOCATIONS OF ALL OBSTRUCTIONS. SHOULD A CONFLICT EXIST, THE CONTRACTOR SHALL NOTIFY THE ENGINEER OR SURVEYOR IMMEDIATELY SO THAT THE CONFLICT CAN BE RESOLVED WITH A MINIMUM AMOUNT OF DELAY.
- THREE (3) WORKING DAYS PRIOR TO BEGINNING CONSTRUCTION, THE CONTRACTOR SHALL SUBMIT TO CONSTRUCTION COORDINATION DIVISION A DETAILED CONSTRUCTION SCHEDULE. TWO (2) WORKING DAYS PRIOR TO CONSTRUCTION, THE CONTRACTOR SHALL OBTAIN A BARRICADING PERMIT FROM THE CONST. COORDINATION DIVISION. CONTRACTOR SHALL NOTIFY BARRICADE ENGINEER (768-2551) PRIOR TO OCCUPYING AN INTERSECTION. REFER TO SECTION 19 OF THE GENERAL CONDITIONS OF THE STANDARD SPECIFICATIONS.
- ALL STREET STRIPING ALTERED OR DESTROYED SHALL BE REPLACED IN KIND BY CONTRACTOR TO LOCATION AND IN KIND AS EXISTING OR AS INDICATED BY THIS PLAN SET.
- CONTRACTOR SHALL NOTIFY THE ENGINEER NOT LESS THAN SEVEN (7) DAYS PRIOR TO STARTING WORK IN ORDER THAT THE ENGINEER MAY TAKE NECESSARY MEASURES TO INSURE THE PRESERVATION OF SURVEY MONUMENTS. CONTRACTOR SHALL NOT DISTURB PERMANENT SURVEY MONUMENTS WITHOUT THE CONSENT OF THE ENGINEER AND SHALL NOTIFY THE ENGINEER AND BEAR THE EXPENSE OF REPLACING ANY THAT MAY BE DISTURBED WITHOUT PERMISSION. REPLACEMENT SHALL BE DONE ONLY BY CITY SURVEY SECTION. WHEN A CHANGE IS MADE IN THE FINISHED ELEVATIONS OF THE PAVEMENT OF ANY ROADWAY IN WHICH A PERMANENT SURVEY MONUMENT IS LOCATED, CONTRACTOR SHALL, AT HIS OWN EXPENSE, ADJUST THE MONUMENT COVER TO THE NEW GRADE UNLESS OTHERWISE SPECIFIED. REFER TO SECTION 4.4 OF THE GENERAL CONDITIONS OF THE STANDARD SPECIFICATIONS.

THE FOLLOWING NOTES ALSO APPLY WHEN CHECKED

- ☒ ALL UTILITIES AND UTILITY SERVICE LINES SHALL BE INSTALLED PRIOR TO PAVING.
- ☒ BACKFILL COMPACTION SHALL BE ACCORDING TO SPECIFIED STREET USE.
- ☐ TACK COAT REQUIREMENTS SHALL BE DETERMINED BY THE CITY ENGINEER.
- ☐ SIDEWALKS AND WHEELCHAIR RAMPS WITHIN THE CURB RETURNS SHALL BE CONSTRUCTED WHEREVER A NEW CURB RETURN IS CONSTRUCTED.
- ☐ IF CURB IS DEPRESSED FOR A DRIVEPAD, THE DRIVEPAD SHALL BE CONSTRUCTED PRIOR TO ACCEPTANCE OF CURB AND GUTTER.
- ☐ ALL STORM DRAINAGE FACILITIES SHALL BE COMPLETED PRIOR TO FINAL ACCEPTANCE.
- ☐ THE REQUESTOR OR DEVELOPER SHALL BE RESPONSIBLE FOR REPAIR OR REPLACEMENT OF ALL CURB AND GUTTER OR SIDEWALK DAMAGED AFTER APPROVAL BY THE CITY ENGINEER OF WORK COMPLETED BY THE CONTRACTOR.

2 6 1 4 7 9 9 4 0 1 9 7

REV	SHEETS	CITY ENGINEER	DATE	USER DEPARTMENT	DATE	USER DEPARTMENT	DATE

APPROVAL OF REVISIONS

 3/31/95 SCANNED BY BY LASON	 BOHANNAN HUSTON INC. ALBUQUERQUE, NEW MEXICO ENGINEERS PLANNERS PHOTOGRAMMETRISTS	APPROVED FOR CONSTRUCTION 3/12/95 C.E.
	PROJECT NUMBER 4779.94	SHEET 1 OF 14


APPROVAL OF AS BUILT DRAWINGS
CHIEF CONSTRUCTION ENGINEER

DATE 1-5-97

BHI JOB NO. 93252.21



TABLE 1	
RESTRAINED JOINT LENGTH @	
STATION & FITTING *	LENGTH (EACH SIDE OF FITTING)
31+16 45° BEND (exist.)	13 FEET
31+41.07 45° BEND	13 FEET
44+37.51 45° BEND	12 FEET
45+52.14 45° BEND	11 FEET
48+23.16 22.5° BEND	8 FEET
49+93.68 22.5° BEND	9 FEET
51+13.31 22.5° BEND	9 FEET
52+59.03 22.5° BEND	9 FEET
53+00.57 24"x24" TEE	ENTIRE BRANCH
53+21.20 45° BEND	18 FEET
53+47.28 45° BEND	18 FEET
62+84.72 45° BEND	13 FEET
62+89.67 45° BEND	13 FEET
71+84.66 45° BEND	7 FEET
72+32.32 45° BEND	7 FEET
83+10.68 24"x24" TEE	ENTIRE BRANCH
* ALL FITTING JOINTS MUST BE RESTRAINED.	

@ ALL VALVES SHALL BE RESTRAINED PER THE
DETAIL ON SHEET 8.

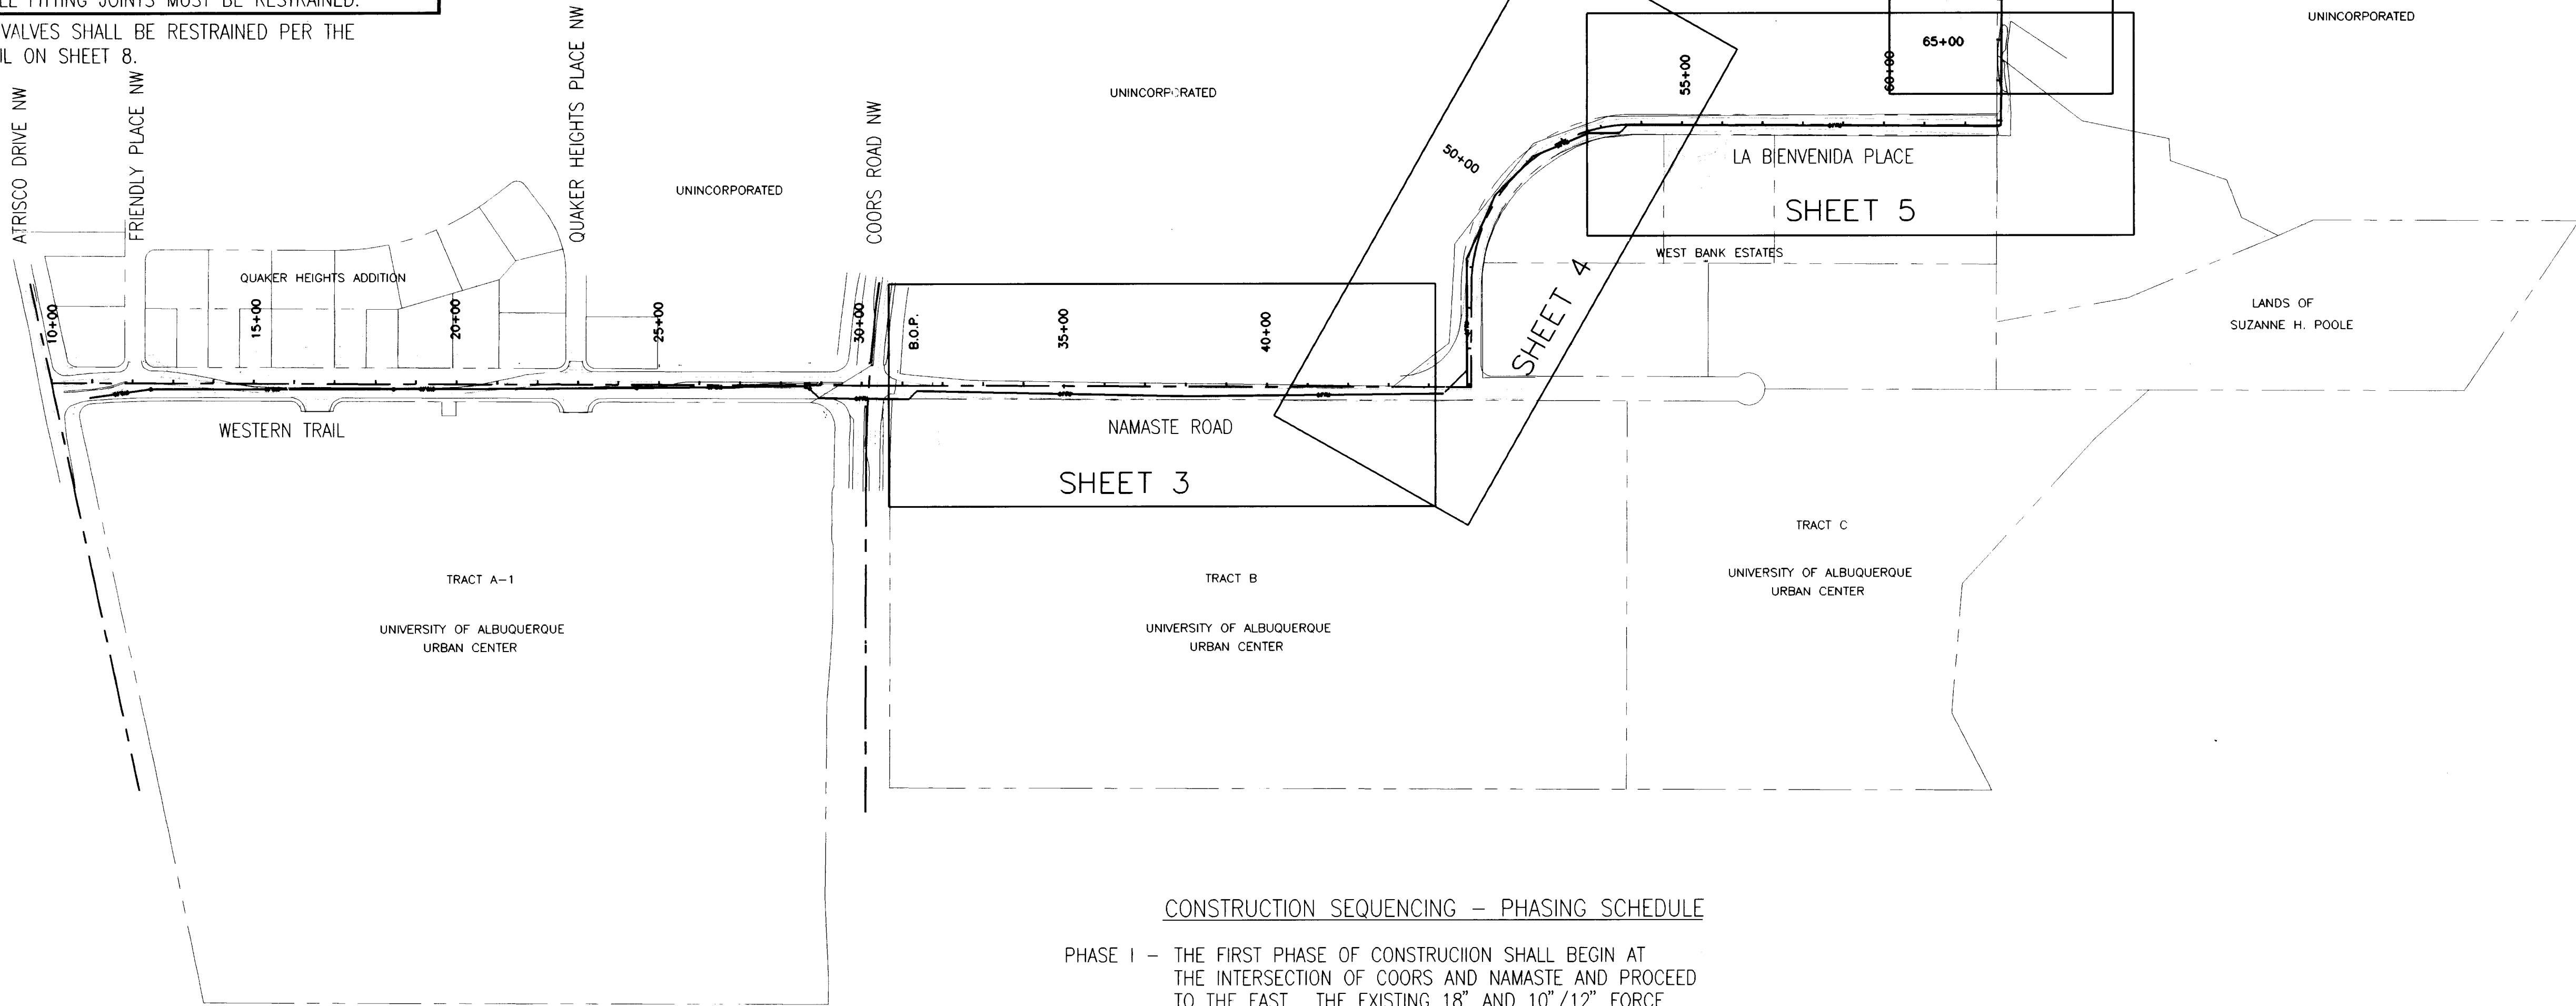



CONSTRUCTION SEQUENCING - PHASING SCHEDULE



- PHASE I - THE FIRST PHASE OF CONSTRUCTION SHALL BEGIN AT THE INTERSECTION OF COORS AND NAMASTE AND PROCEED TO THE EAST. THE EXISTING 18" AND 10"/12" FORCE MAINS SHALL REMAIN IN SERVICE THROUGHOUT THIS PHASE. UPON INSTALLATION OF THE VALVE AT STA. 53+00.57 (See Sheet 4) AND CONNECTION TO THE EXISTING STUB OUT FROM THE 18" FORCE MAIN, THE 10"/12" LINE SHALL BE TAKEN OUT OF SERVICE AND THE NEW 24" PIPE PUT INTO SERVICE. ALL TESTING AND ACCEPTANCE BY THE CITY OF THE 24" PIPE SHALL BE COMPLETED PRIOR TO PLACING THE LINE INTO SERVICE. ALL REROUTING OF FORCE MAIN FLOWS SHALL BE CLOSELY COORDINATED WITH CITY PERSONNEL.
- PHASE II - AFTER THE 10"/12" FORCE MAIN HAS BEEN TAKEN OUT OF SERVICE THE SECOND PHASE OF CONSTRUCTION CAN BEGIN. THIS PHASE SHALL BEGIN AT THE VALVE AT STA. 53+00.57 INSTALLED IN THE FIRST PHASE AND PROCEED TO THE END OF THE PROJECT. UPON COMPLETION OF PHASE II OPEN VALVE AT STA. 53+00.57.

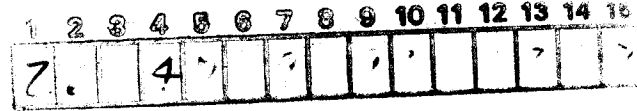
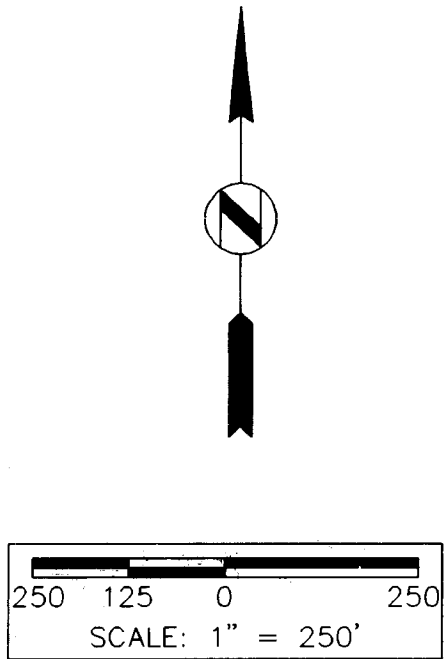


CITY OF ALBUQUERQUE PUBLIC WORKS DEPARTMENT ENGINEERING					
INTEL SANITARY SEWER - WESTERN TRAIL (PHASE III) OVERALL PLAN					
APPROVALS	ENGINEER	DATE	APPROVALS	ENGINEER	DATE
DRC CHAIRMAN	<i>[Signature]</i>	5/13/95	WATER	<i>[Signature]</i>	5/13/95
TRANSPORTATION	<i>[Signature]</i>	5-02-95	WASTE WATER	"	"
HYDROLOGY	<i>[Signature]</i>	5-1-95			
DRAWING NO. 4779.94		MAP NO. F-11,12		SHEET: 2 OF 14	

ENGINEER'S SEAL		SURVEY INFORMATION		BENCH MARKS		AS-BUILT INFORMATION	
		FIELD NOTES		THE BENCH MARK IS A 3-1/4" ALUMINUM CAP SET FLUSH ON THE MEDIAN AND IS STAMPED "ACS NM4448-NSB 1986". THE BENCH MARK IS LOCATED AT THE INTERSECTION OF WESTERN TRAIL/ NAMASTE RD. AND COORS RD. NW ON THE NORTH ISLAND OF COORS RD.		CONTRACTOR <i>New Concepts Inc.</i>	
		BY		INSPECTOR'S ACCEPTANCE BY <i>B. SMITH</i> DATE <i>1/1/96</i>		DRAWINGS CORRECTED BY <i>P. GREEN</i> DATE <i>12/16</i>	
		REMARKS		MICRO-FILM INFORMATION		RECORDED BY	
		DESIGNED BY		NO.		DATE	
		DRAWN BY					
		CHECKED BY					

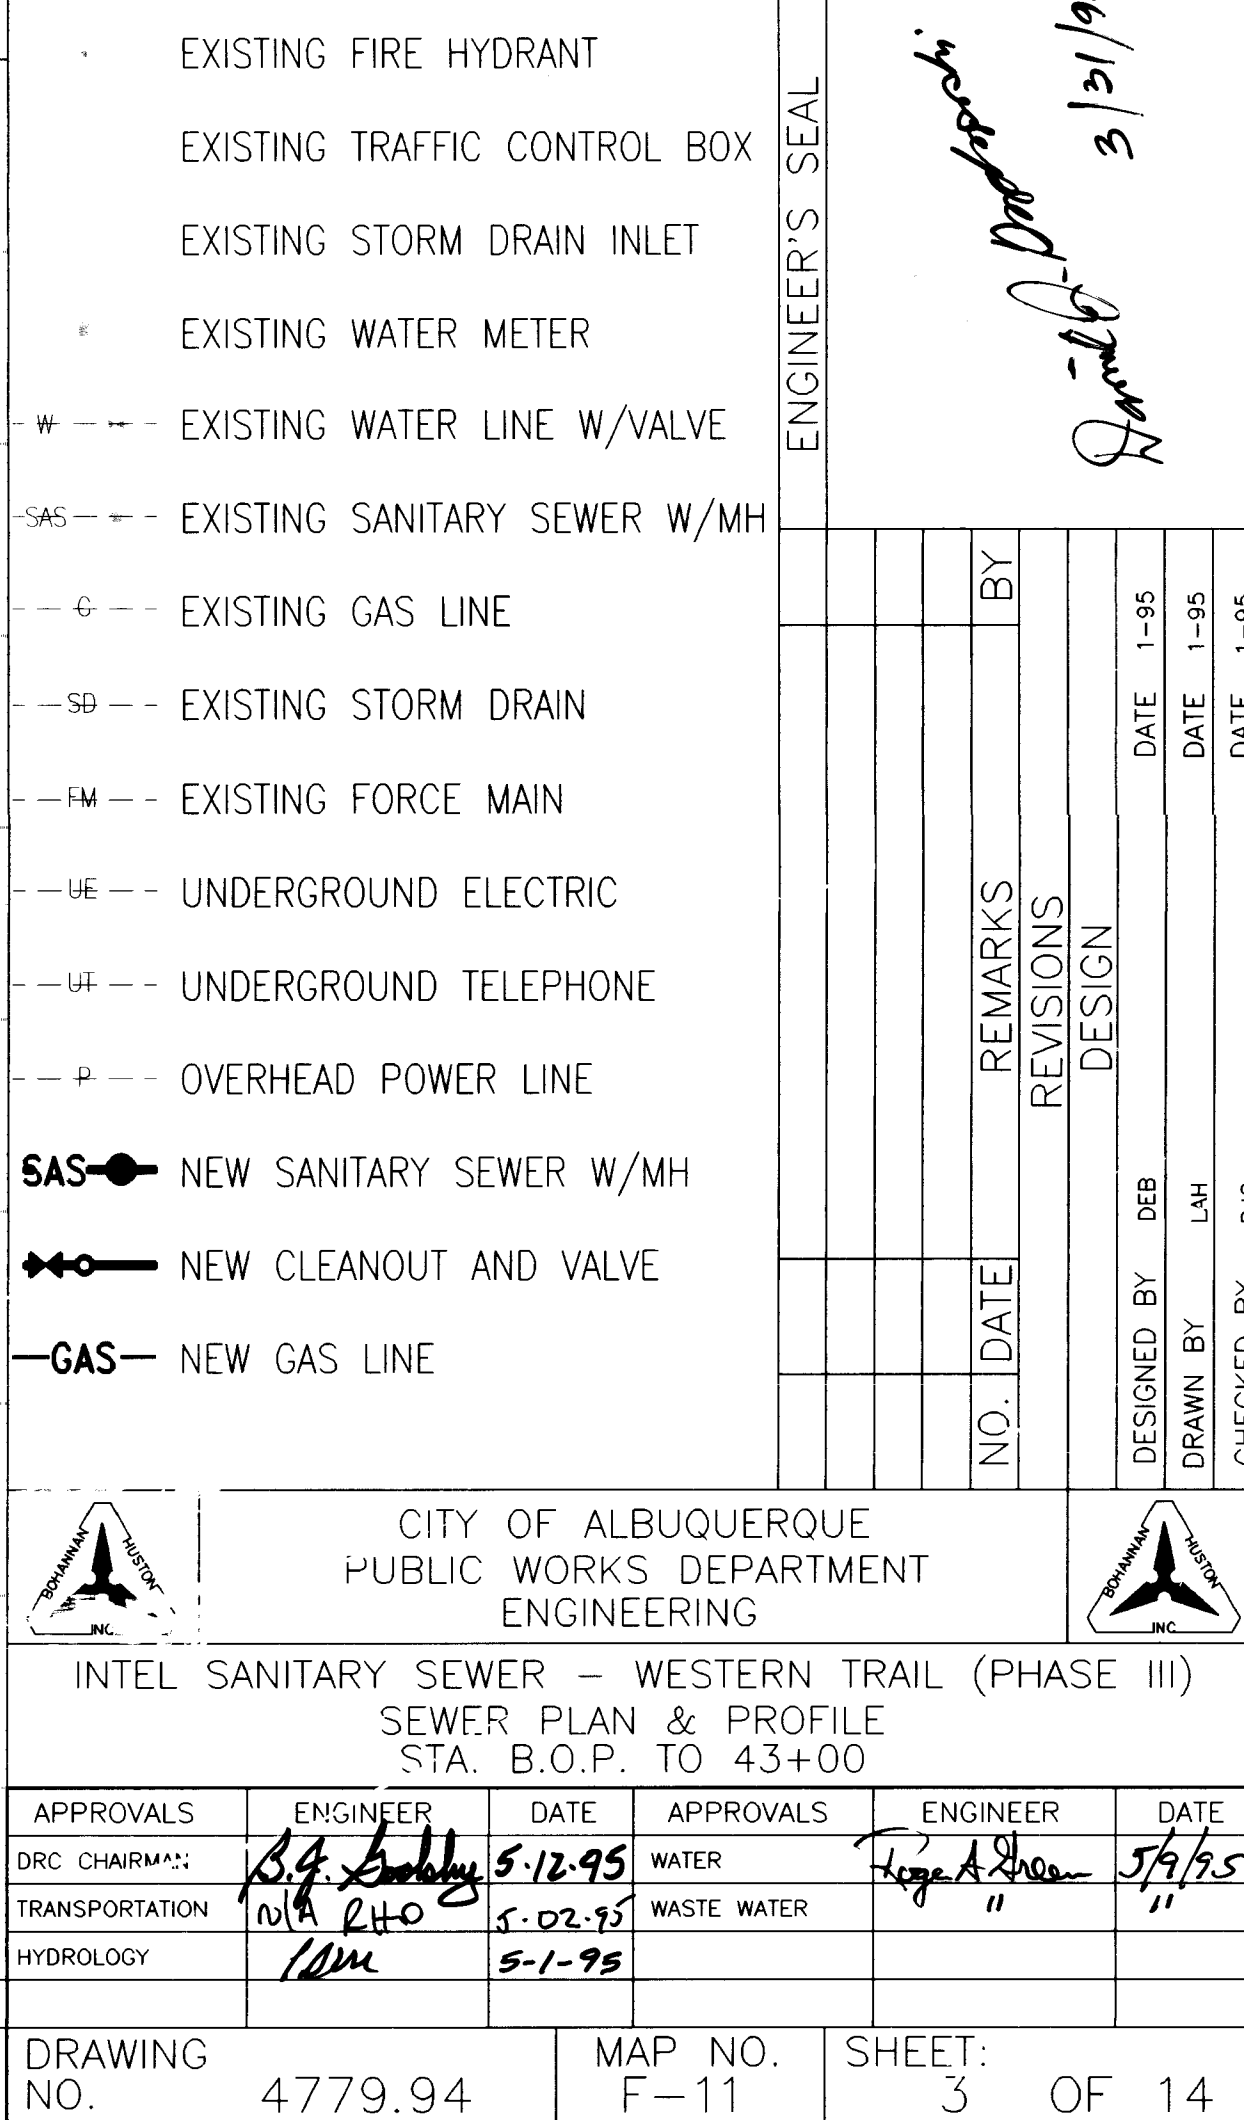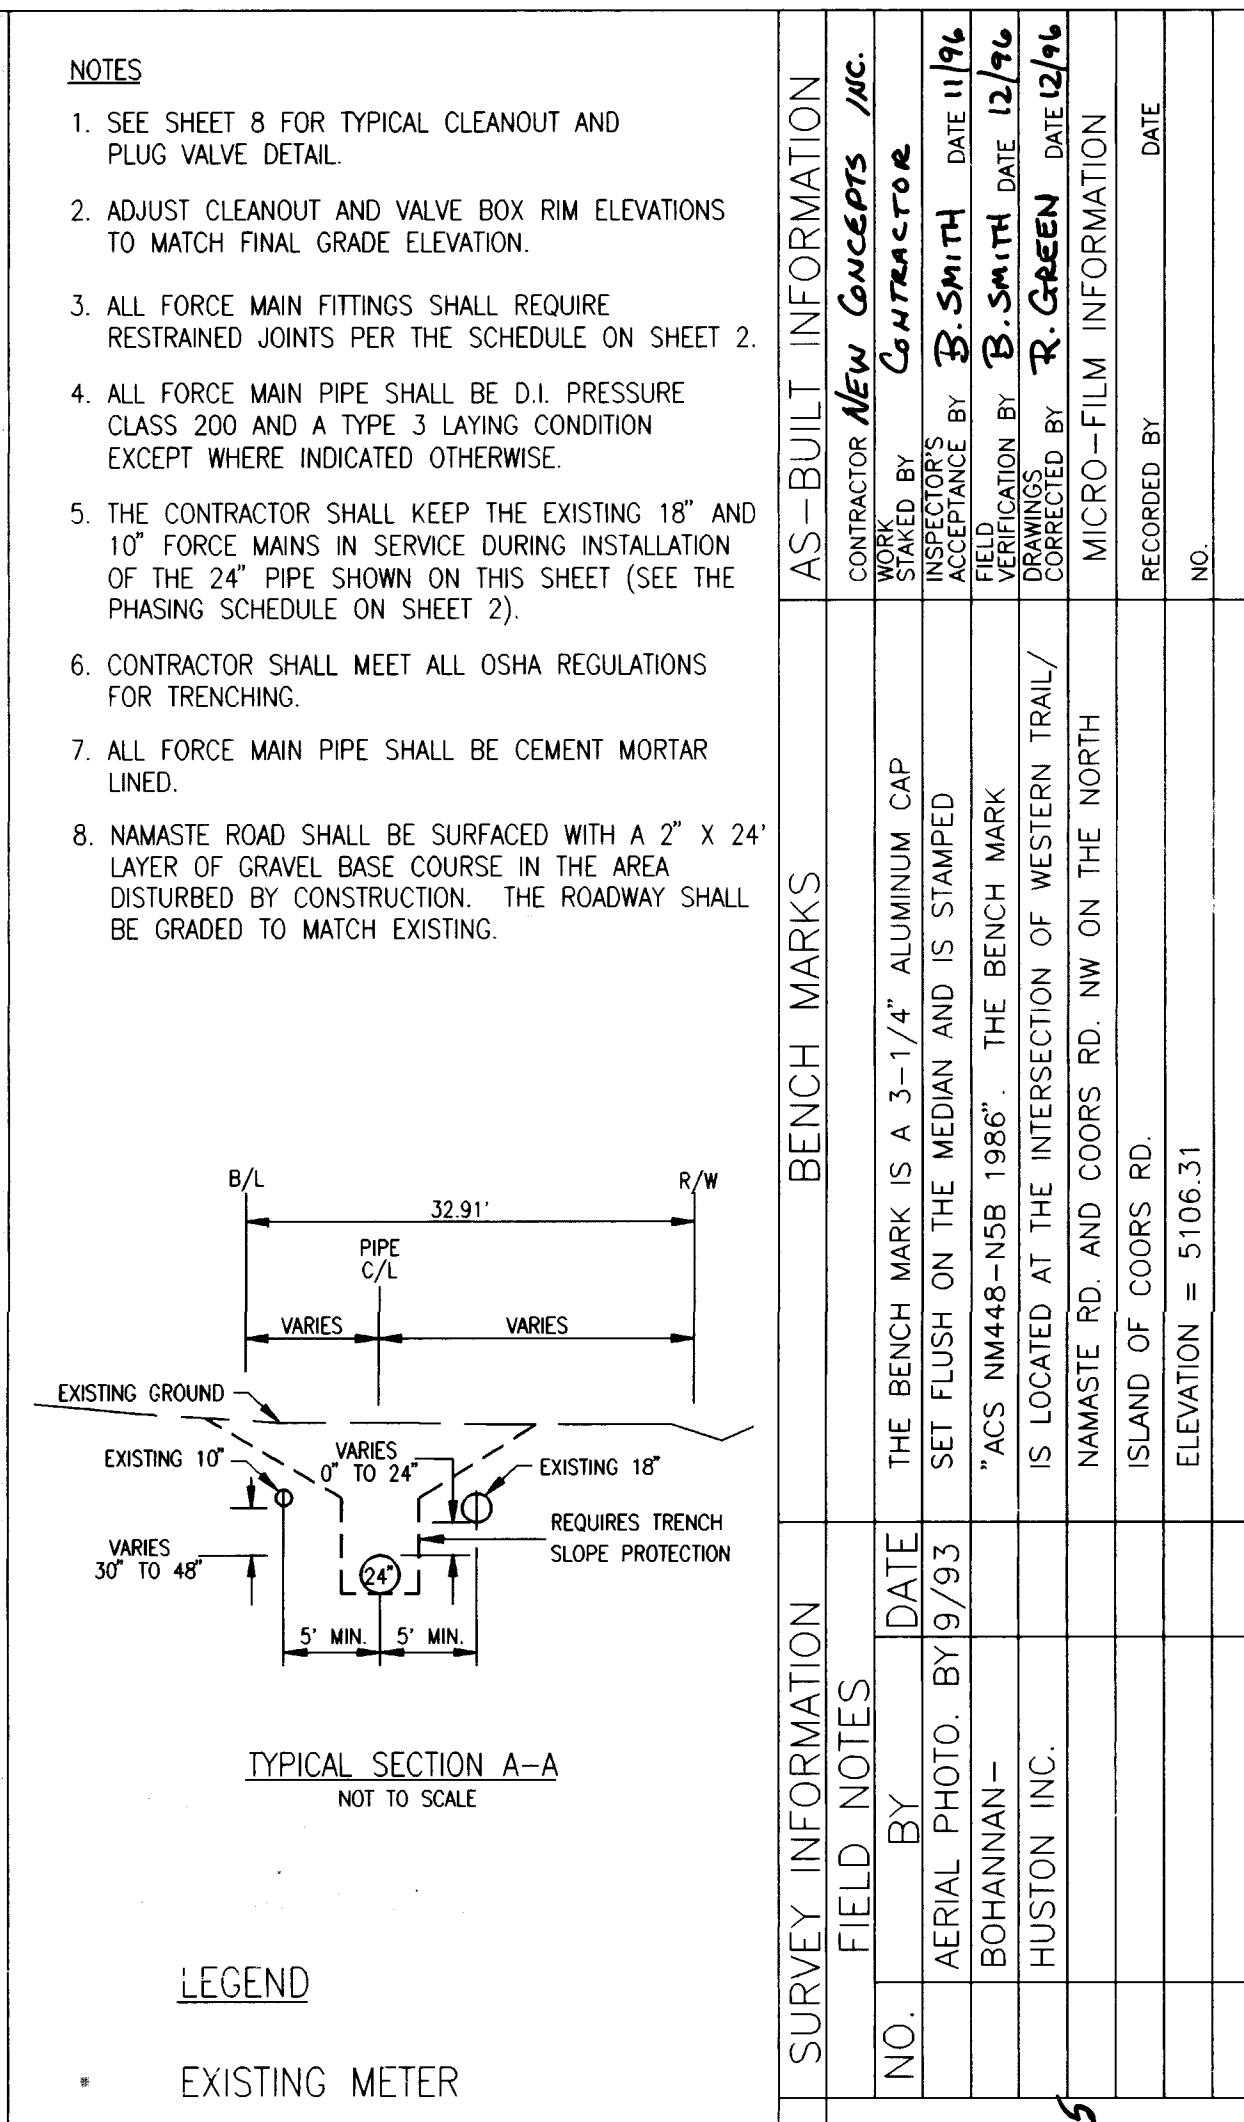

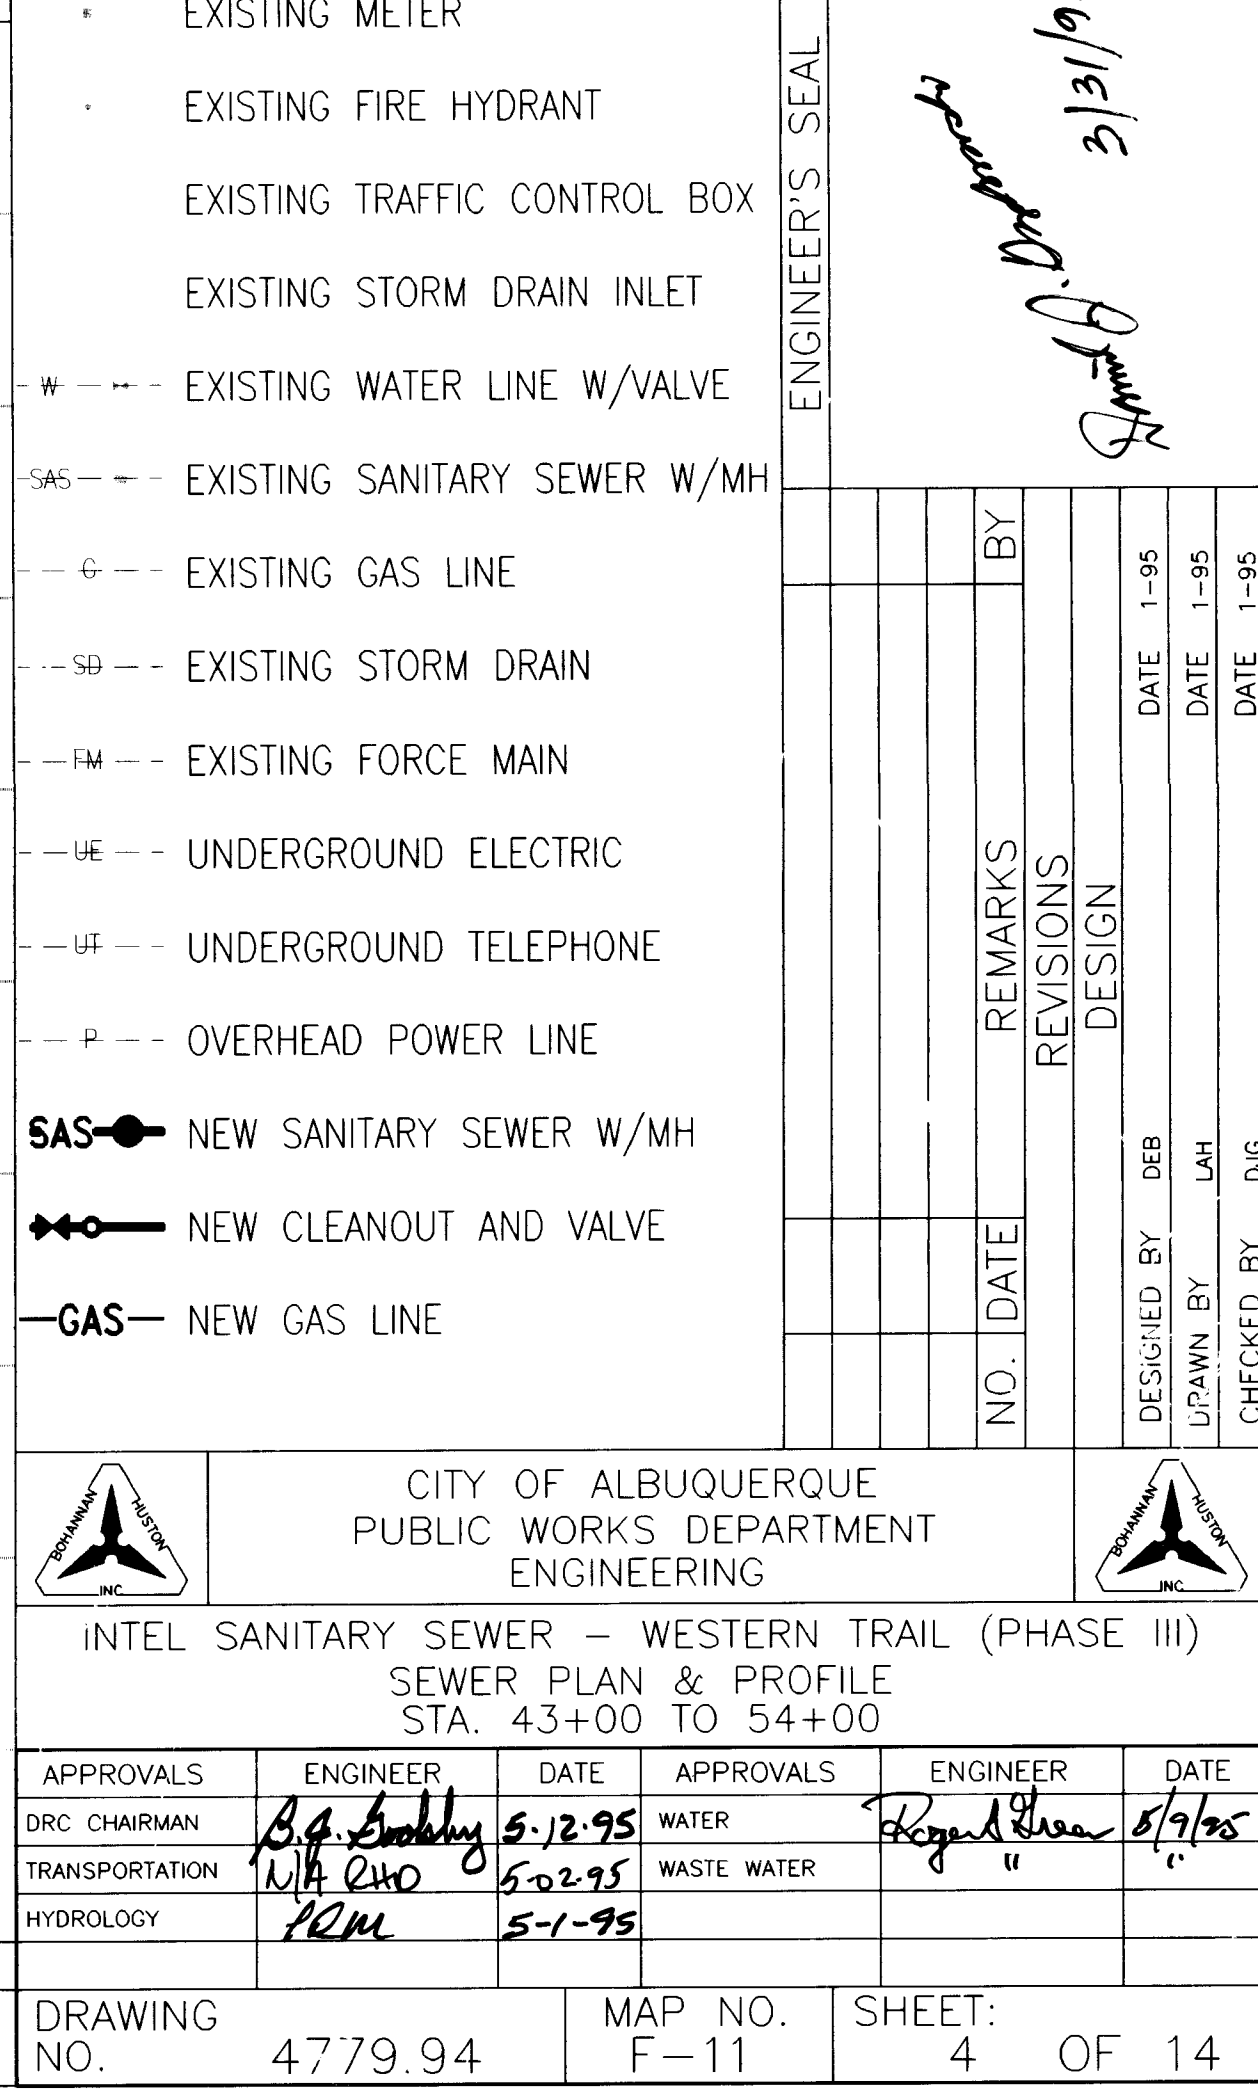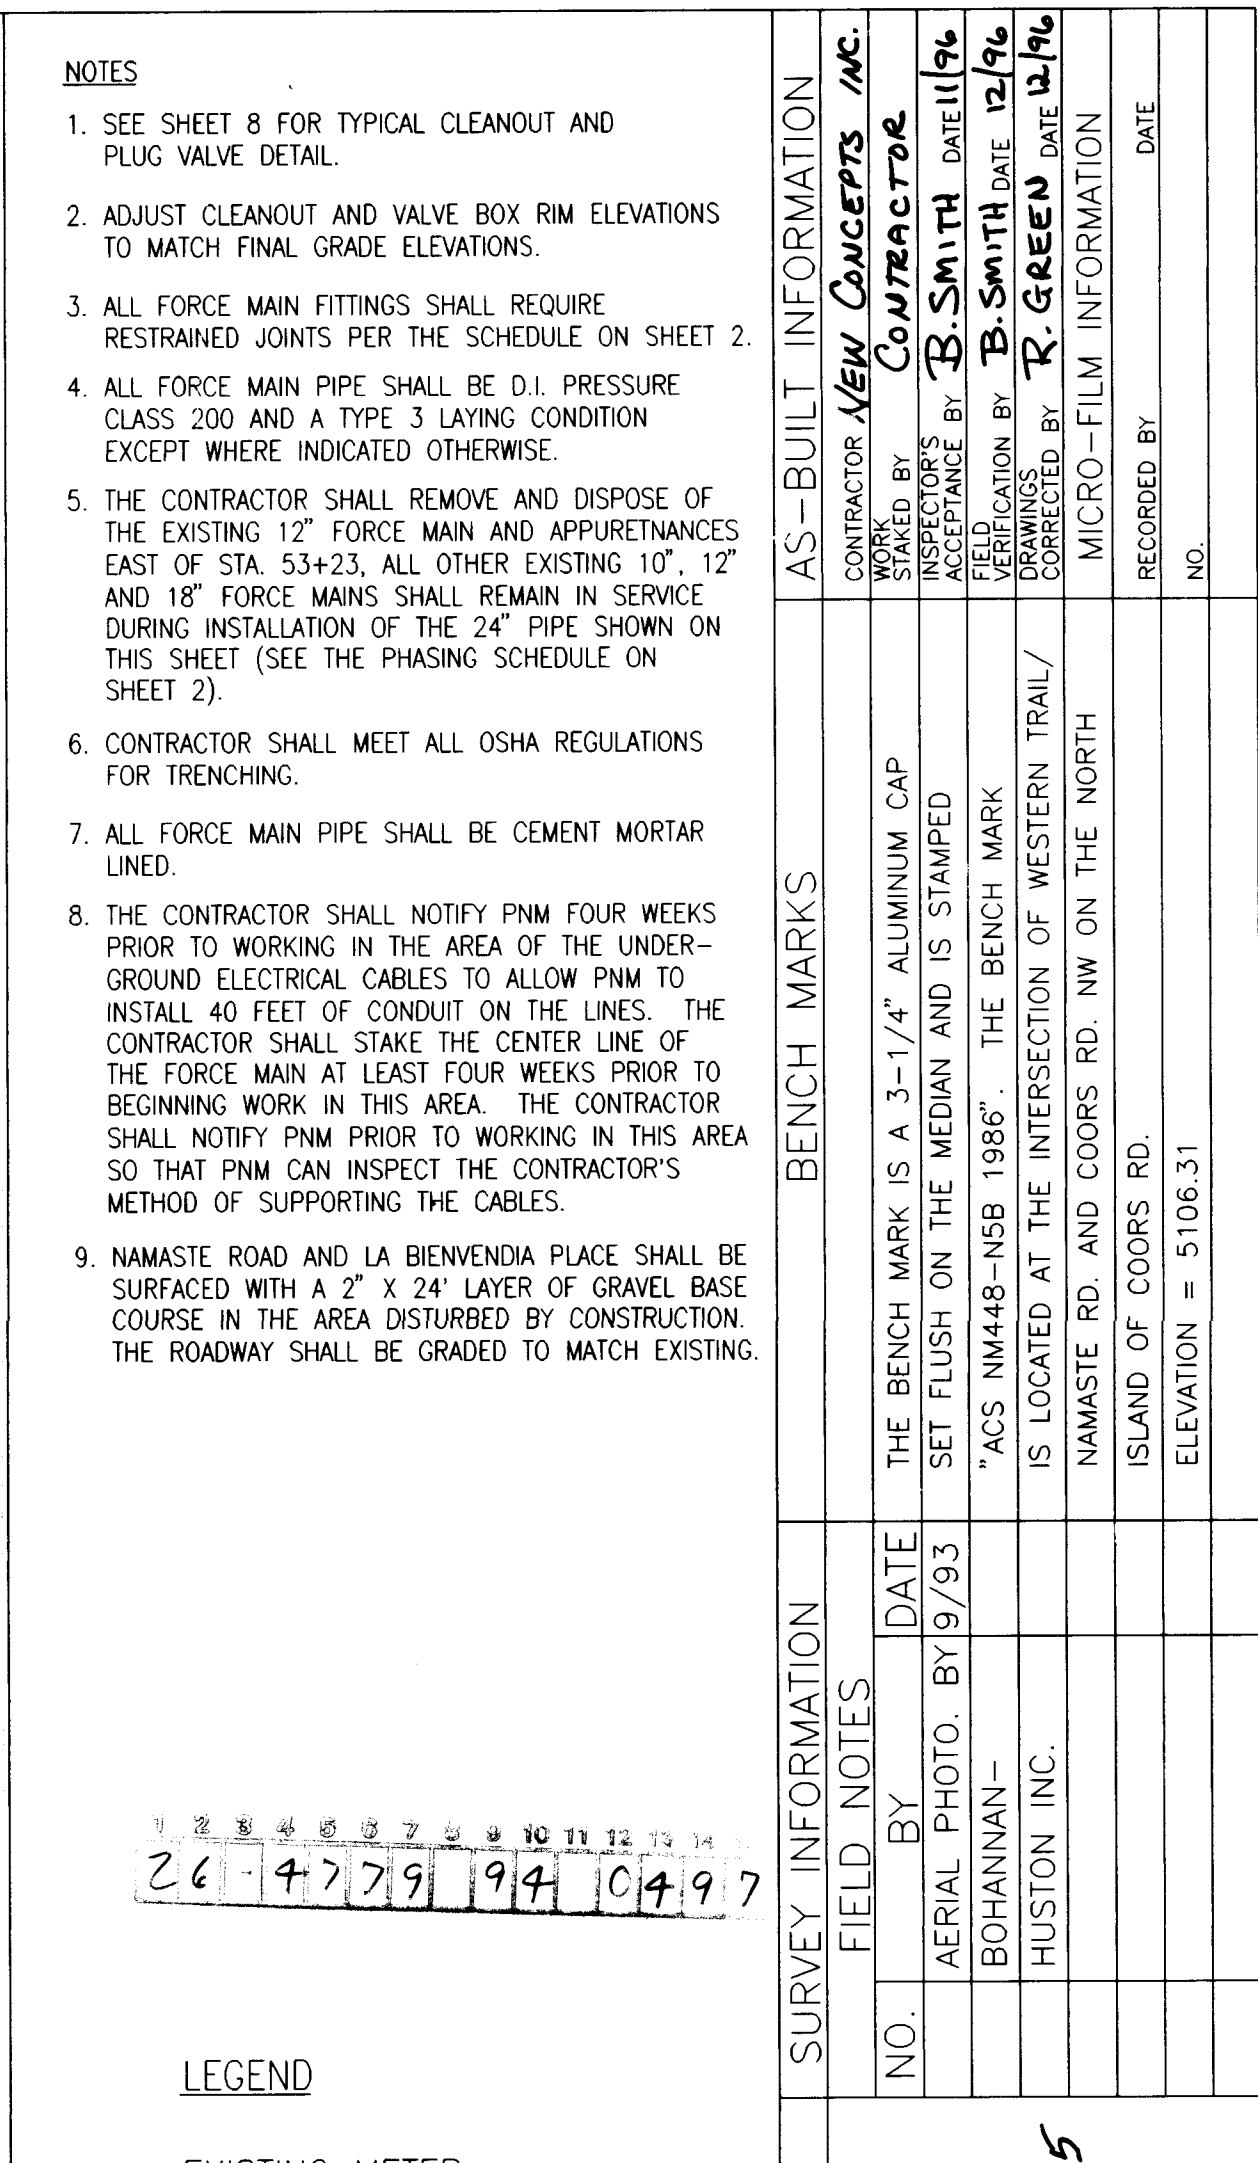

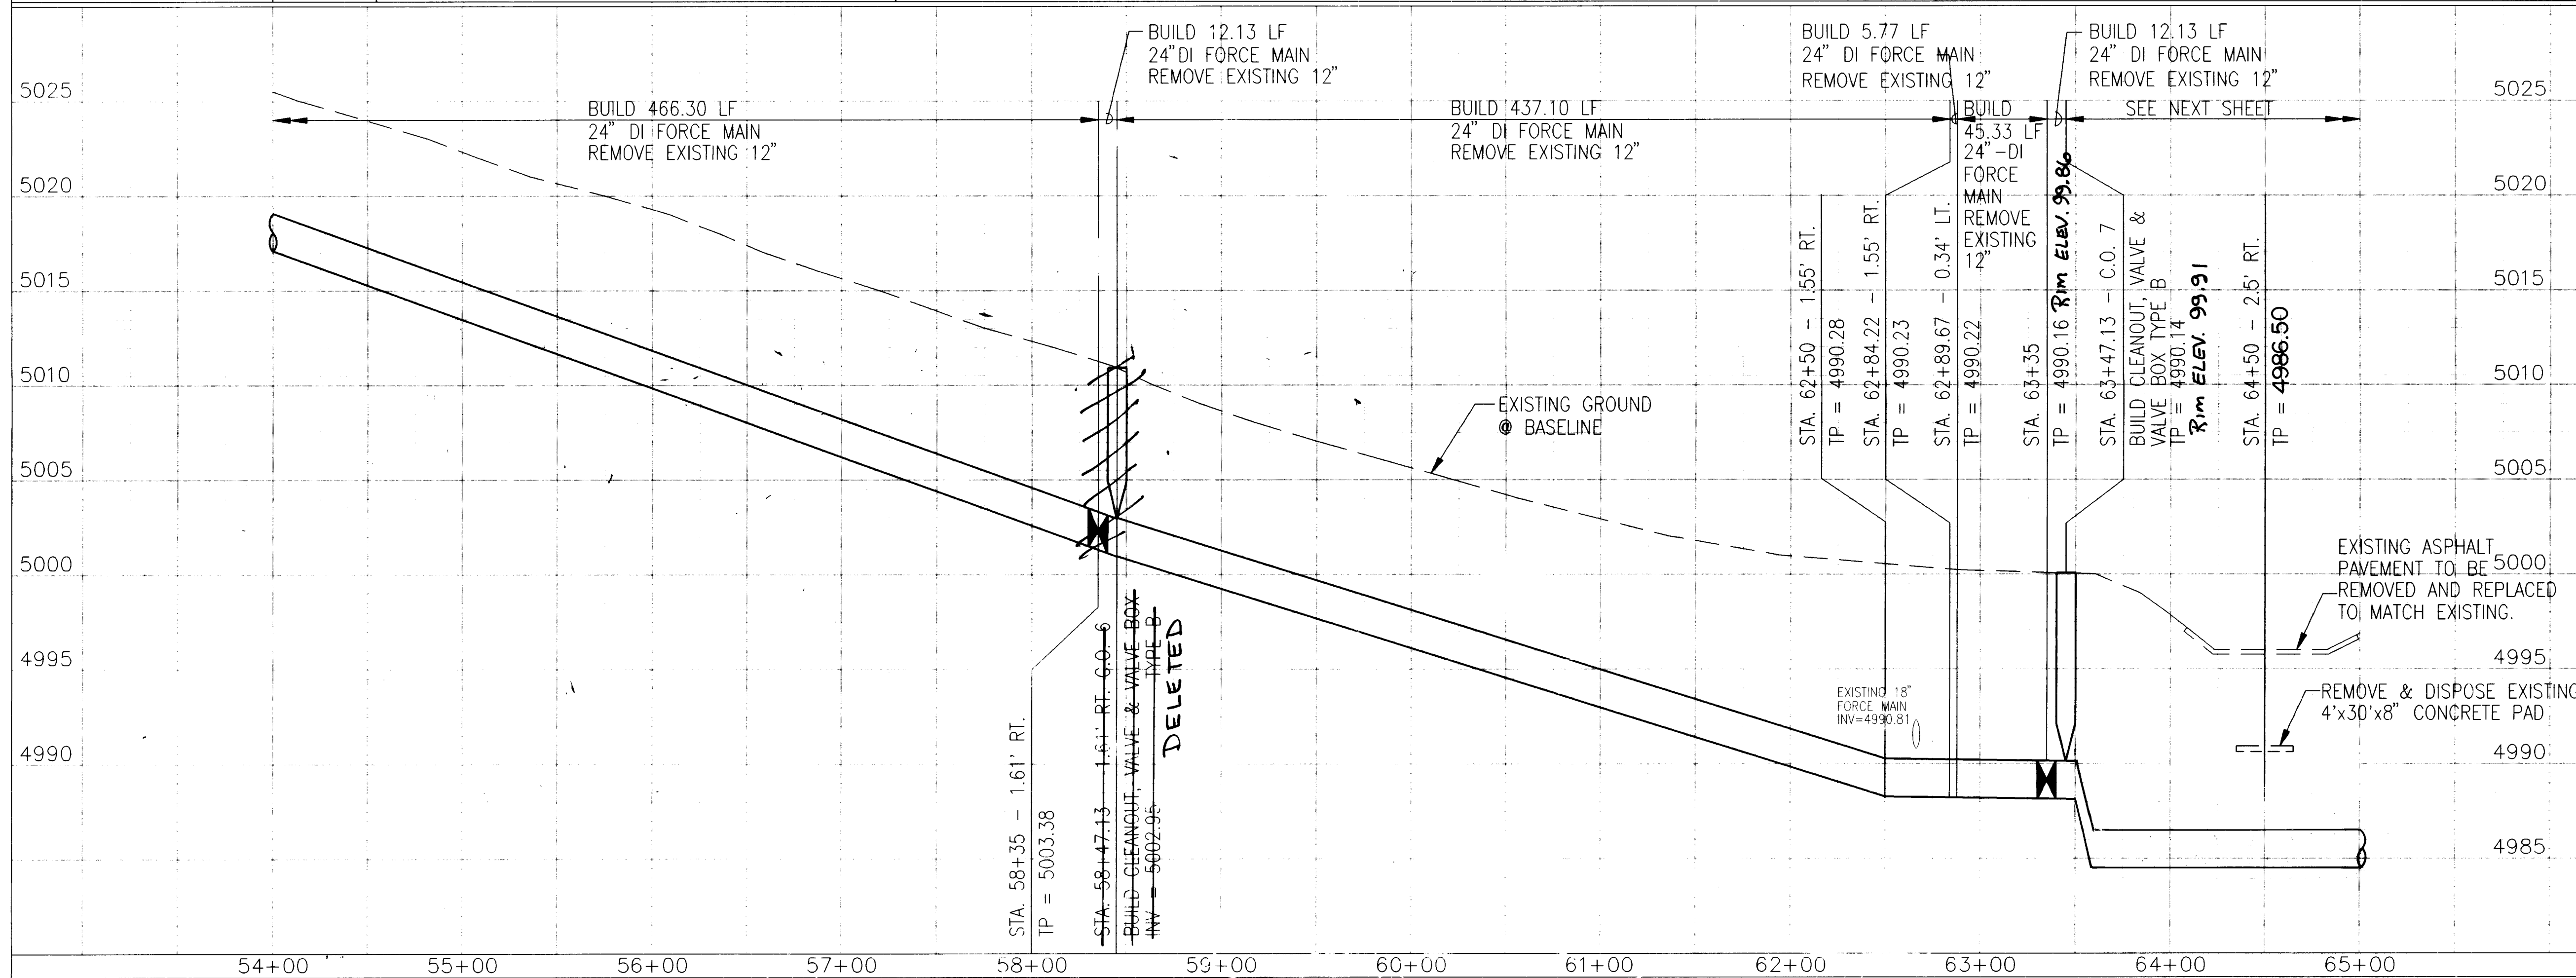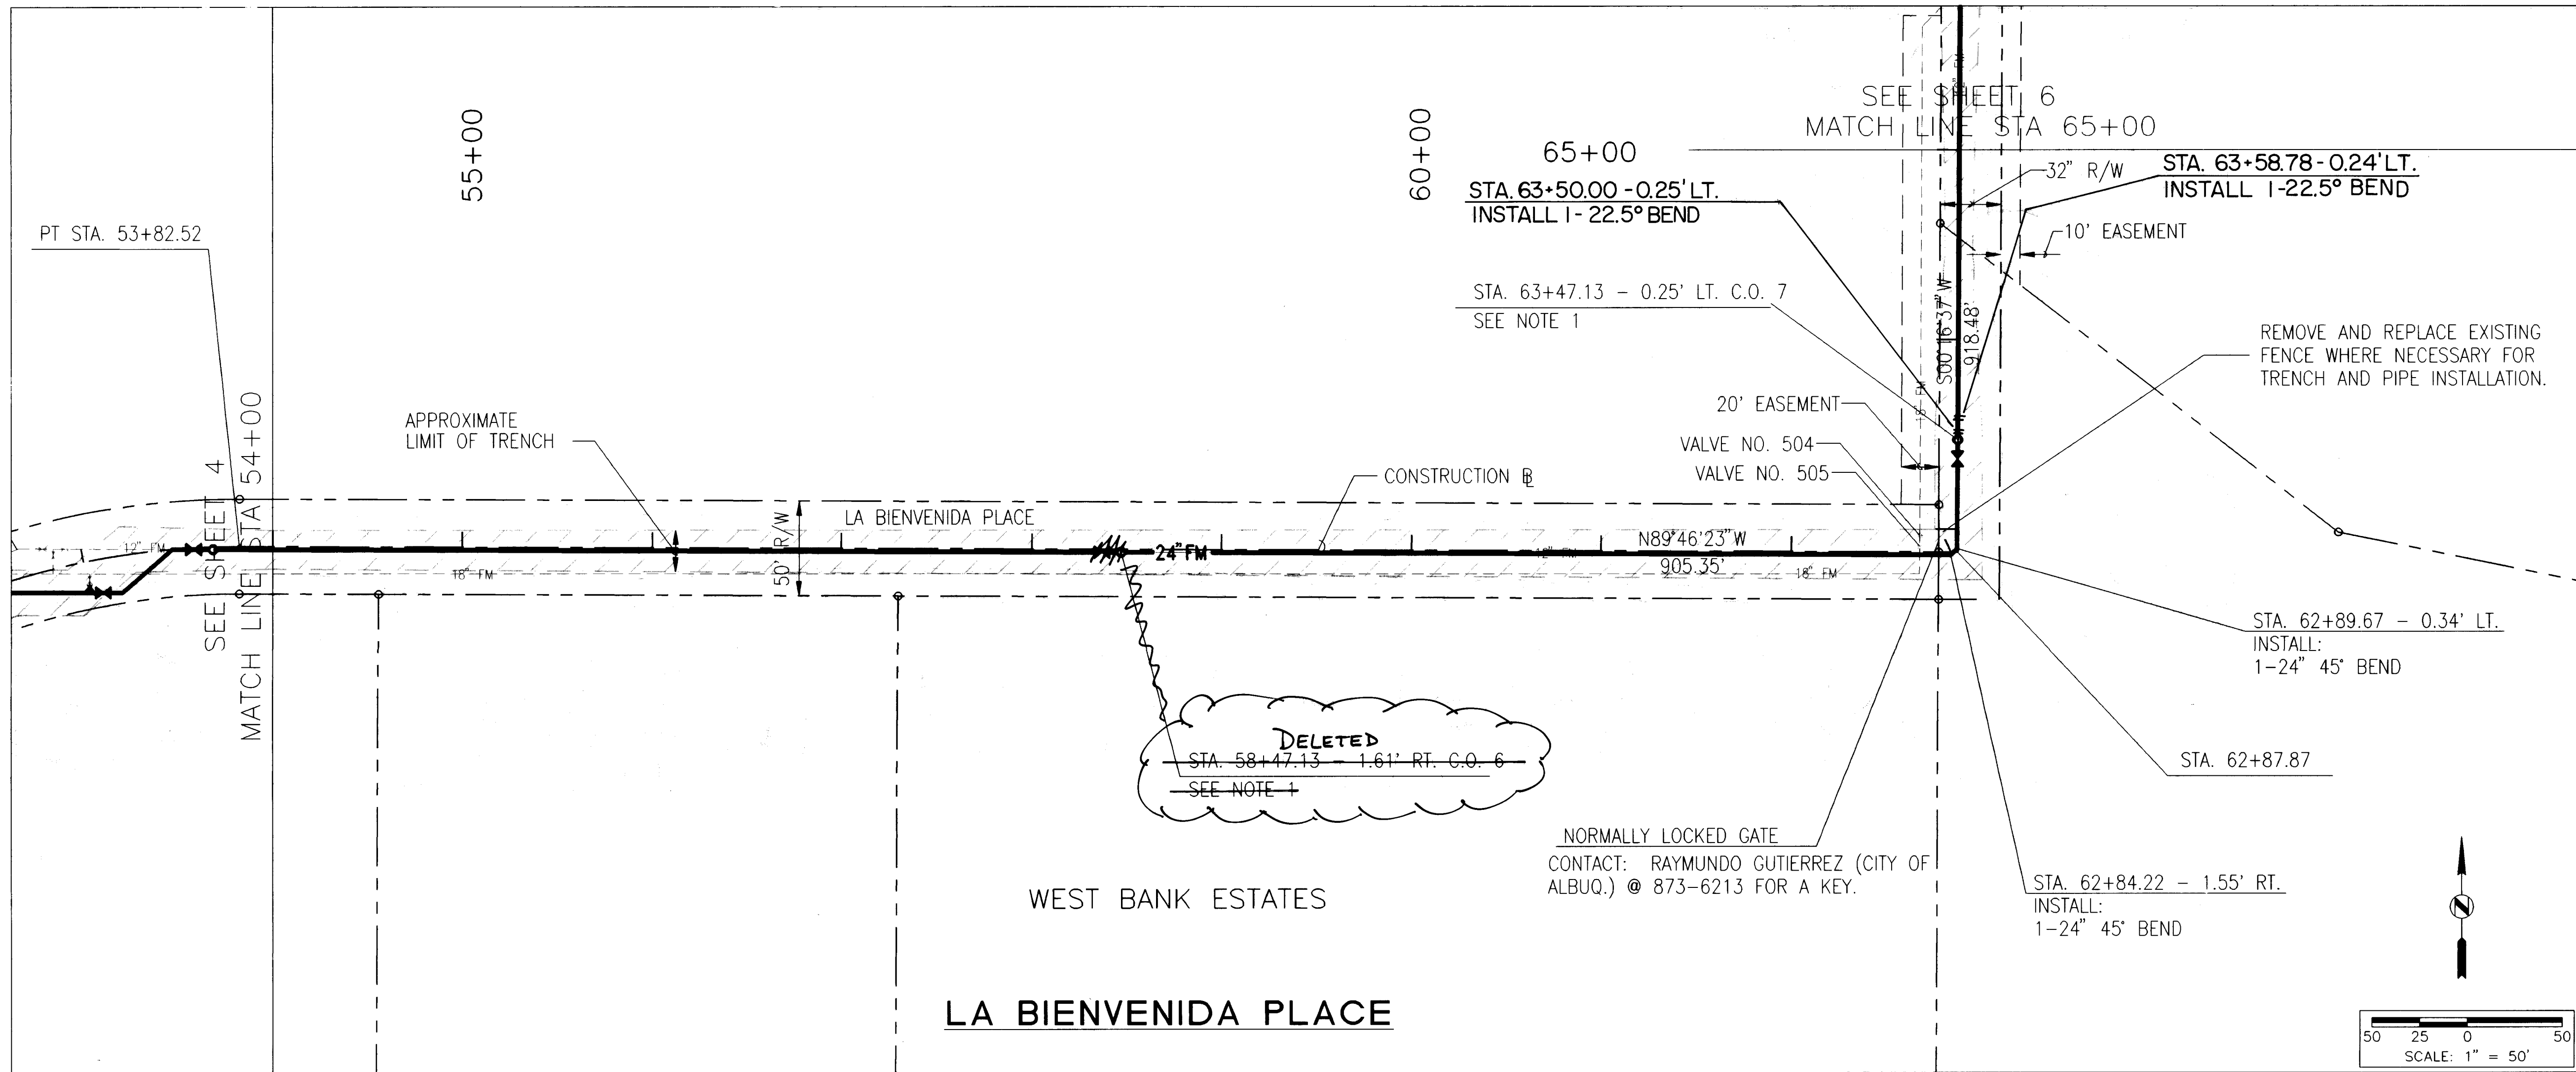

NOTES

- SEE SHEET 8 FOR TYPICAL CLEANOUT AND PLUG VALVE DETAIL.
- ADJUST CLEANOUT AND VALVE RIM ELEVATIONS TO MATCH FINAL GRADE ELEVATIONS.
- ALL FORCE MAIN FITTINGS SHALL REQUIRE RESTRAINED JOINTS PER THE SCHEDULE ON SHEET 2.
- ALL FORCE MAIN PIPE SHALL BE D.I. PRESSURE CLASS 200 AND A TYPE 3 LAYING CONDITION EXCEPT WHERE INDICATED OTHERWISE.
- THE CONTRACTOR SHALL REMOVE AND DISPOSE OF THE EXISTING 12" FORCE MAIN AND APPURTENANCES.
- CONTRACTOR SHALL MEET ALL OSHA REGULATIONS FOR TRENCHING.
- ALL FORCE MAIN PIPE SHALL BE CEMENT MORTAR LINED.
- LA BIENVENIDA PLACE SHALL BE SURFACED WITH A 2" X 24" LAYER OF GRAVEL BASE COURSE IN THE AREA DISTURBED BY CONSTRUCTION. THE ACCESS ROAD EAST OF THE GATE AT THE END OF LA BIENVENIDA PLACE SHALL BE SURFACED WITH A 2" X 15" LAYER OF GRAVEL BASE COURSE IN THE AREA DISTURBED BY CONSTRUCTION. THE ROADWAYS SHALL BE GRADED TO MATCH EXISTING.

LEGEND

- EXISTING METER
- EXISTING FIRE HYDRANT
- EXISTING TRAFFIC CONTROL BOX
- EXISTING STORM DRAIN INLET
- EXISTING WATER LINE W/VALVE
- EXISTING SANITARY SEWER W/MH
- EXISTING GAS LINE
- EXISTING STORM DRAIN
- EXISTING FORCE MAIN
- UNDERGROUND ELECTRIC
- UNDERGROUND TELEPHONE
- OVERHEAD POWER LINE
- SAS** NEW SANITARY SEWER W/MH
- NEW CLEANOUT AND VALVE
- GAS** NEW GAS LINE

AS-BUILT INFORMATION

CONTRACTOR	NEW CONCEPTS INC.
WORK BY	CONTRACTOR
SUPERVISOR'S ACCEPTANCE BY	B. SMITH DATE 11/94
VERIFICATION BY	B. SMITH DATE 11/94
DRAWINGS CORRECTED BY	R. GREEN DATE 12/96
MICRO-FILM INFORMATION	
RECORDED BY	
NO.	

SURVEY INFORMATION

FIELD NOTES	DATE
BY	9/9/93
AERIAL PHOTO. BY	9/9/93
BOHANNAN -	
HUSTON INC.	
NAMASTE RD. AND COORS RD. NW ON THE NORTH ISLAND OF COORS RD.	
ELEVATION = 5106.31	

ENGINEER'S SEAL

[Signature] 3/19/95



NO.	DATE	REMARKS	DESIGNED BY	DATE
			DEB	1-95
			LAM	1-95
			DUG	1-95

CITY OF ALBUQUERQUE
PUBLIC WORKS DEPARTMENT
ENGINEERING

INTEL SANITARY SEWER - WESTERN TRAIL (PHASE III)
SEWER PLAN & PROFILE
STA. 54+00 TO 65+00

APPROVALS	ENGINEER	DATE	APPROVALS	ENGINEER	DATE
DRC CHAIRMAN	B. Smith	5-12-95	WATER	R. Green	5/9/95
TRANSPORTATION	M. LHO	5-01-95	WASTE WATER		
HYDROLOGY	R. Green	5-1-95			
AMAFCA	J. M. 5-1-95				

DRAWING NO. 4779.94 MAP NO. F-11 SHEET: 5 OF 14

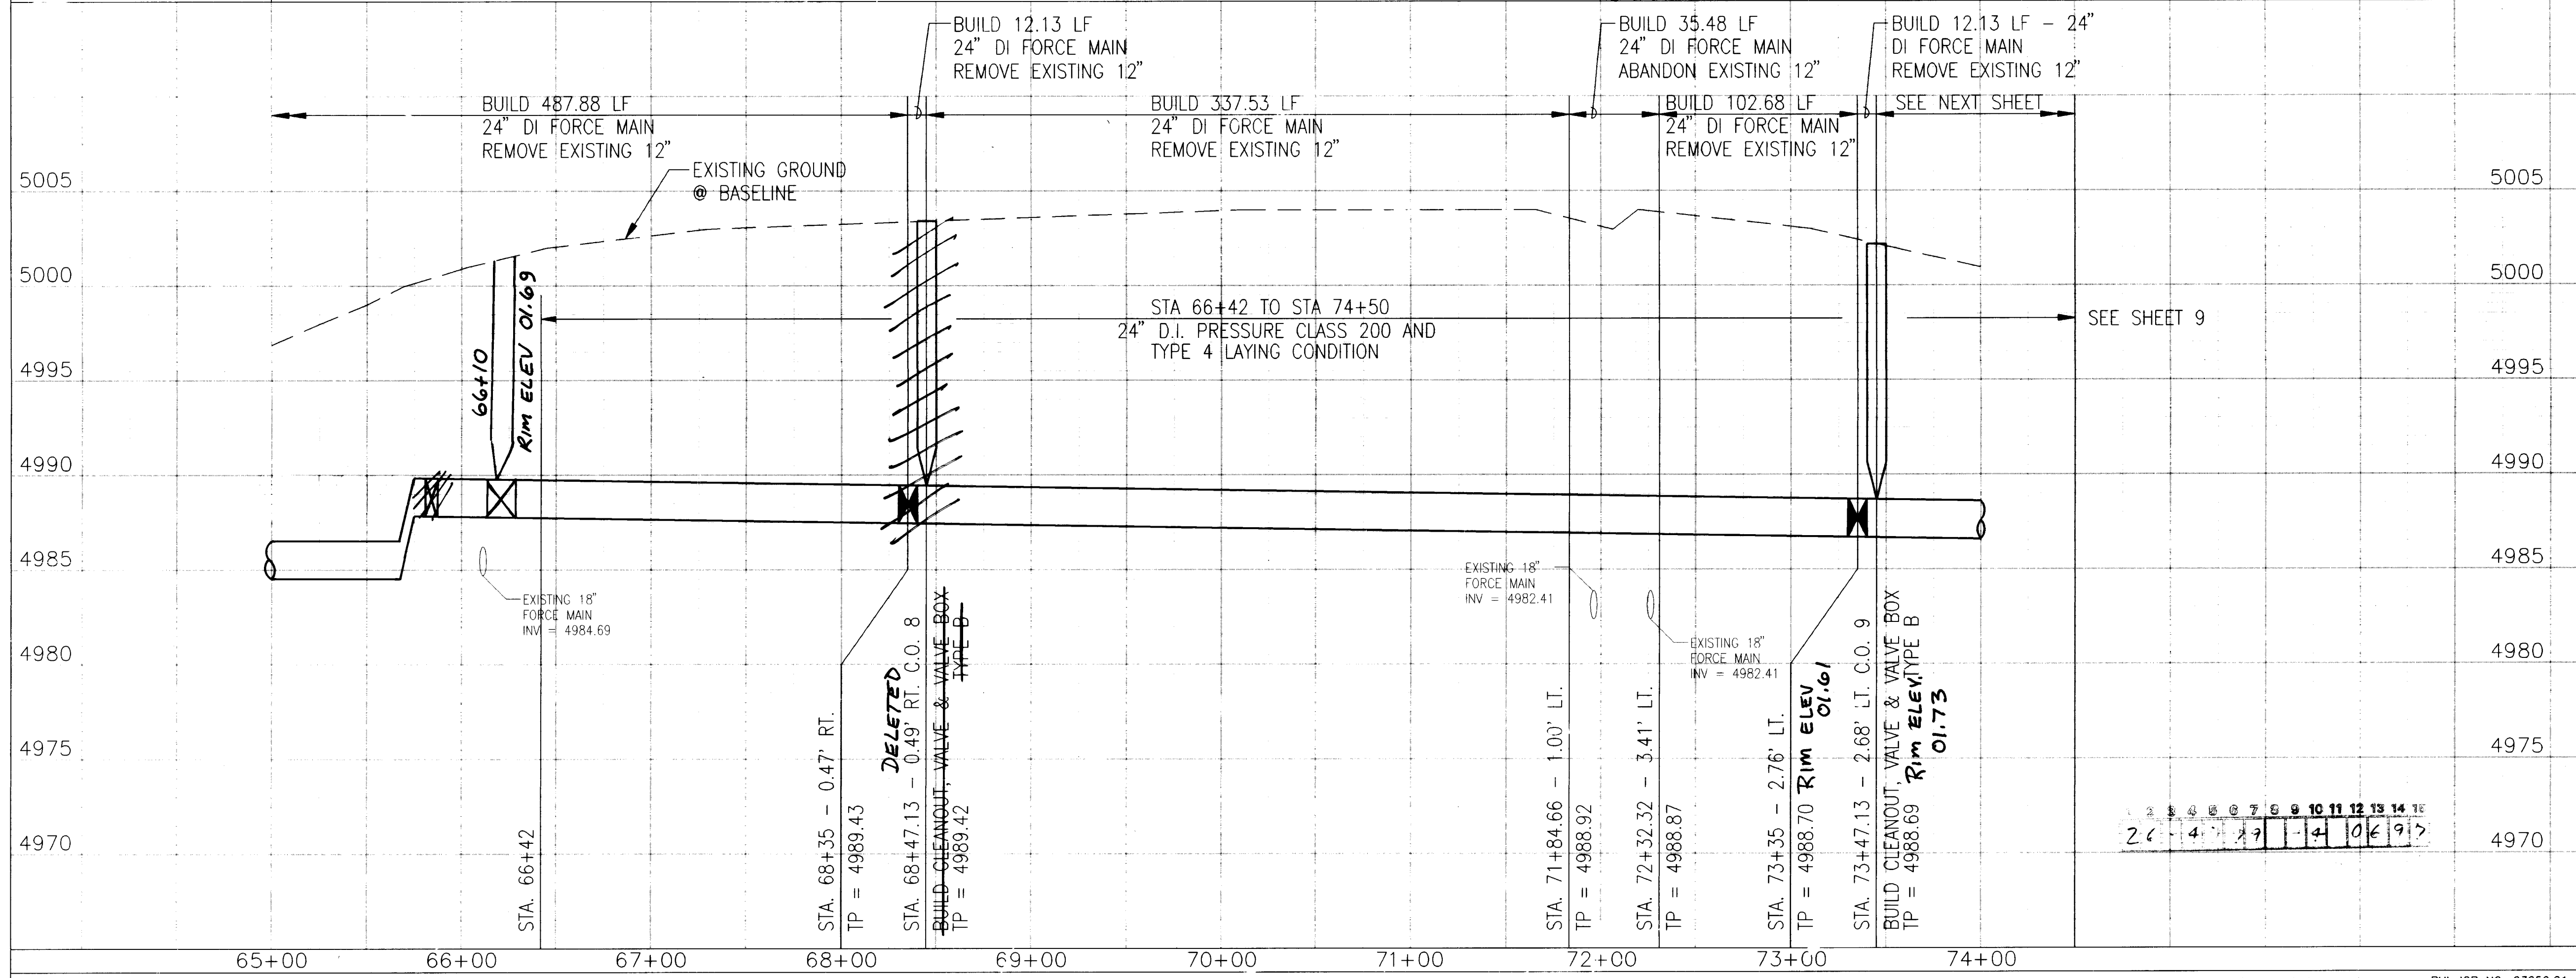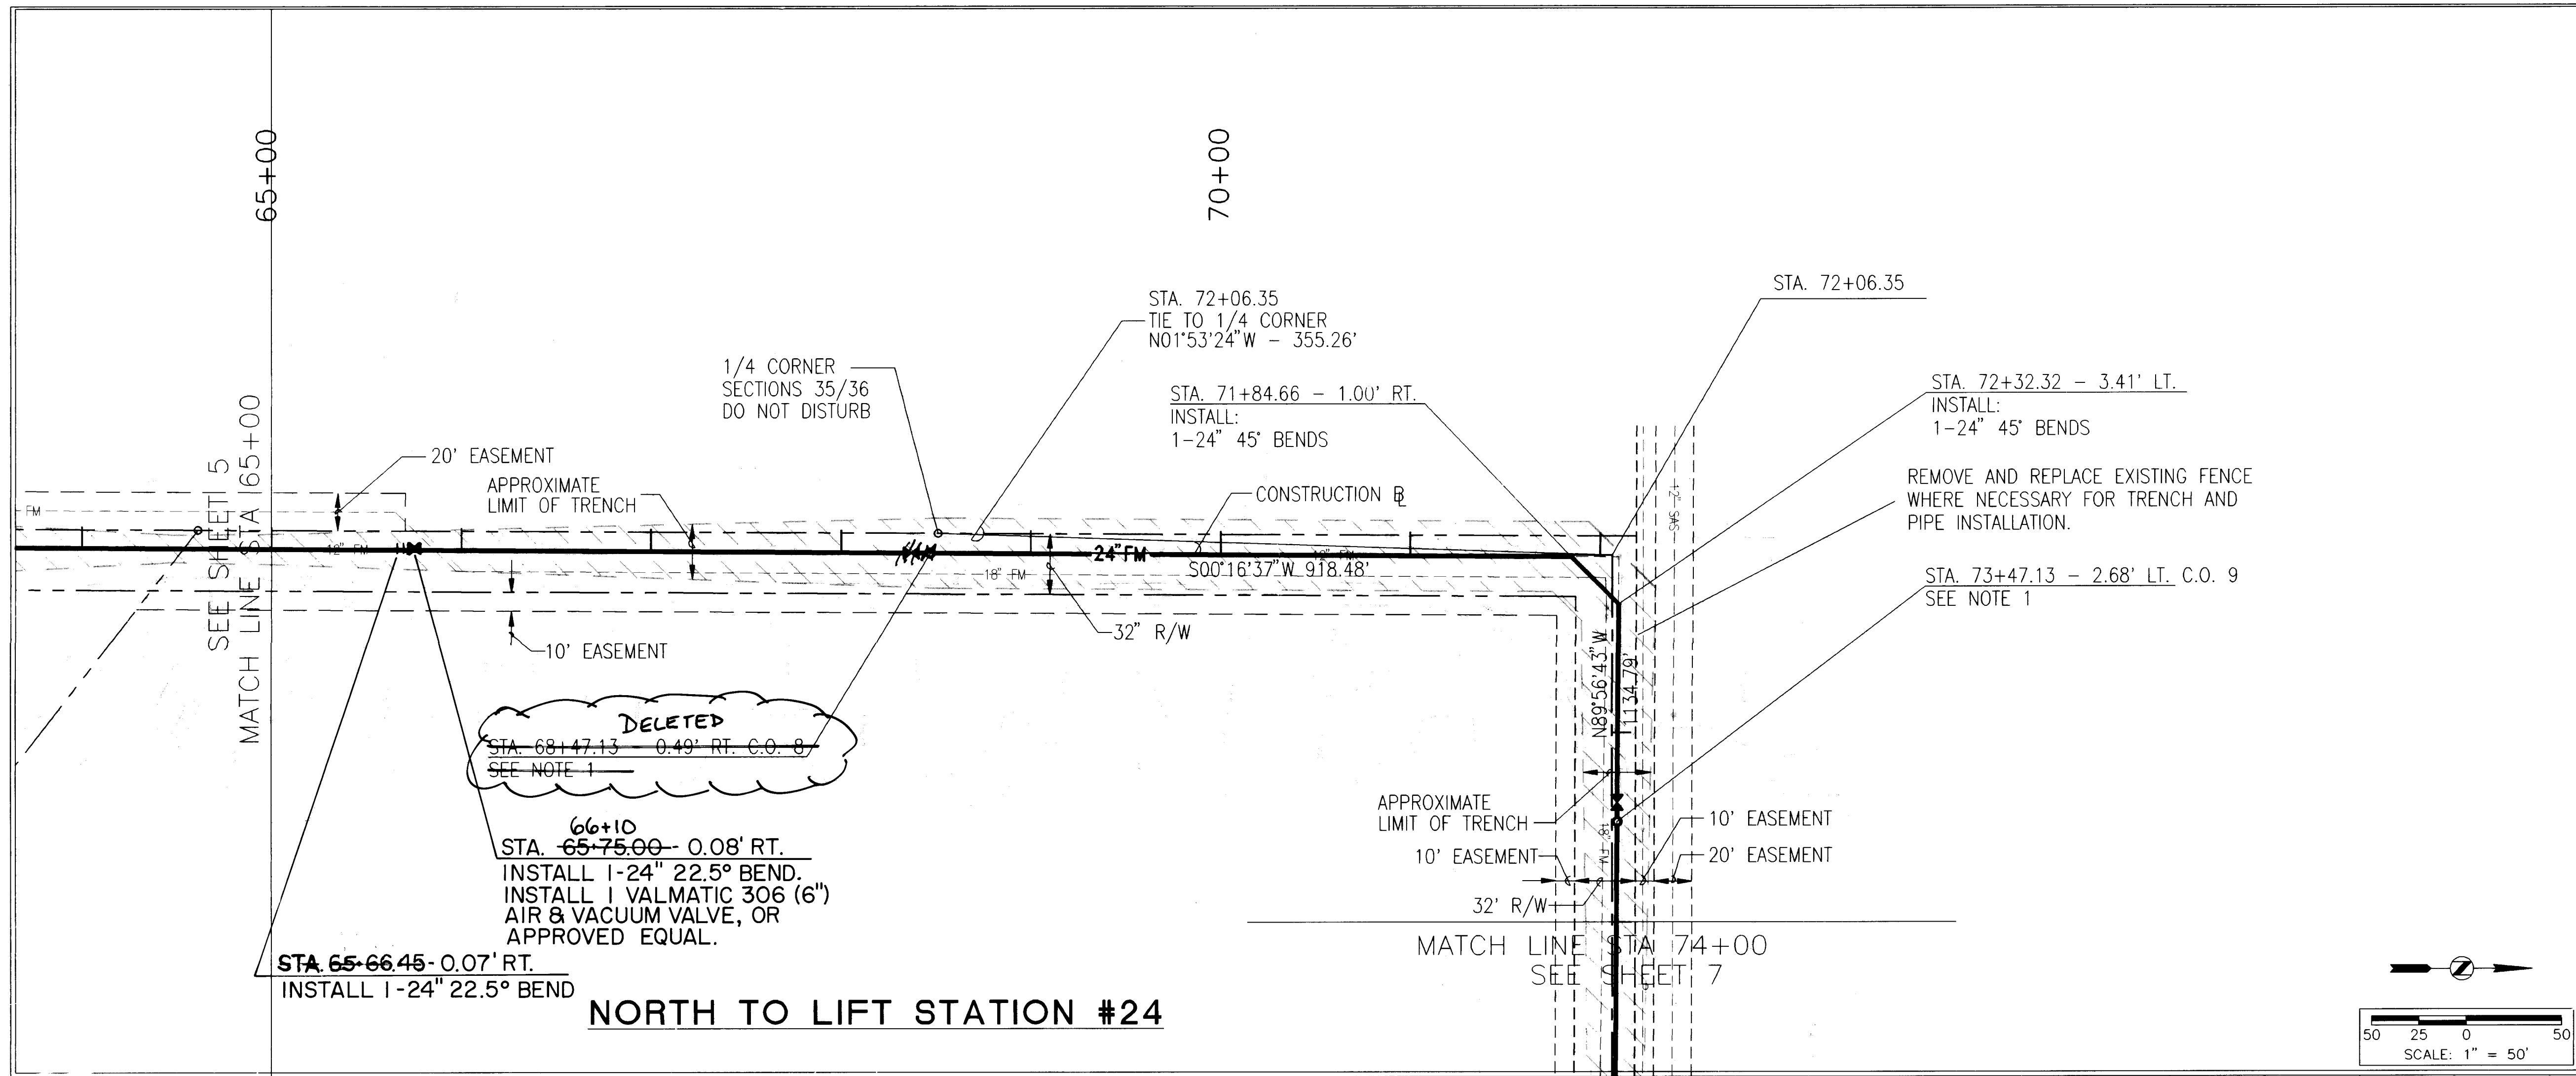

NOTES

- SEE SHEET 8 FOR TYPICAL CLEANOUT AND PLUG VALVE DETAIL.
- ADJUST CLEANOUT AND VALVE BOX RIM ELEVATIONS TO MATCH FINAL GRADE ELEVATION.
- ALL FORCE MAIN FITTINGS SHALL REQUIRE RESTRAINED JOINTS PER THE SCHEDULE ON SHEET 2.
- ALL FORCE MAIN PIPE SHALL BE D.I. PRESSURE CLASS 200 AND A TYPE 3 LAYING CONDITION EXCEPT WHERE INDICATED OTHERWISE.
- THE CONTRACTOR SHALL REMOVE AND DISPOSE OF THE EXISTING 12" FORCE MAIN AND APPURTENANCES.
- CONTRACTOR SHALL MEET ALL OSHA REGULATIONS FOR TRENCHING.
- ALL FORCE MAIN PIPE SHALL BE CEMENT MORTAR LINED.
- THE ACCESS ROAD SHALL BE SURFACED WITH A 2" X 15' LAYER OF GRAVEL BASE COURSE IN THE AREA DISTURBED BY CONSTRUCTION. THE ROADWAY SHALL BE GRADED TO MATCH EXISTING.

LEGEND

- EXISTING METER
- EXISTING FIRE HYDRANT
- EXISTING TRAFFIC CONTROL BOX
- EXISTING STORM DRAIN INLET
- EXISTING WATER LINE W/VALVE
- EXISTING SANITARY SEWER W/MH
- EXISTING GAS LINE
- EXISTING STORM DRAIN
- EXISTING FORCE MAIN
- UNDERGROUND ELECTRIC
- UNDERGROUND TELEPHONE
- OVERHEAD POWER LINE
- NEW SANITARY SEWER W/MH
- NEW CLEANOUT AND VALVE
- NEW GAS LINE



AS-BUILT INFORMATION		BENCH MARKS		SURVEY INFORMATION		ENGINEER'S SEAL							
CONTRACTOR	NEW CONCEPTS INC.	THE BENCH MARK IS A 3-1/4" ALUMINUM CAP SET FLUSH ON THE MEDIAN AND IS STAMPED "ACS NM448-NSB 1986". THE BENCH MARK IS LOCATED AT THE INTERSECTION OF WESTERN TRAIL/	NO.	DATE	BY	REMARKS	DESIGNED BY	DATE	DRAWN BY	DATE	CHECKED BY	DATE	
WORKED BY	CONTRACTOR	BOHANNAN - HUSTON INC.	NO.	DATE	BY								
ACCEPTANCE BY	B. SMITH	DATE	NO.	DATE	BY								
VERIFICATION BY	B. SMITH	DATE	NO.	DATE	BY	REVISIONS	DESIGN	DESIGNED BY	DATE	DRAWN BY	DATE	CHECKED BY	DATE
DRAWINGS	R. GREEN	DATE	NO.	DATE	BY	DESIGNED BY	DATE	DRAWN BY	DATE	CHECKED BY	DATE		
CORRECTIONS			NO.	DATE	BY								
MICRO-FILM			NO.	DATE	BY								
INFORMATION			NO.	DATE	BY								
RECORDED BY			NO.	DATE	BY								
NO.			NO.	DATE	BY								

CITY OF ALBUQUERQUE
PUBLIC WORKS DEPARTMENT
ENGINEERING

INTEL SANITARY SEWER - WESTERN TRAIL (PHASE III)
SEWER PLAN & PROFILE
STA. 65+00 TO 74+00

APPROVALS	ENGINEER	DATE	APPROVALS	ENGINEER	DATE
DRC CHAIRMAN	<i>[Signature]</i>	5.12.95	WATER	<i>[Signature]</i>	5/9/95
TRANSPORTATION	<i>[Signature]</i>	5.02.95	WASTE WATER		
HYDROLOGY	<i>[Signature]</i>	5-1-95			
AMAFCA	<i>[Signature]</i>	5-12-95			

DRAWING NO.	4779.94	MAP NO.	F-11,12	SHEET:	6 OF 14
-------------	---------	---------	---------	--------	---------

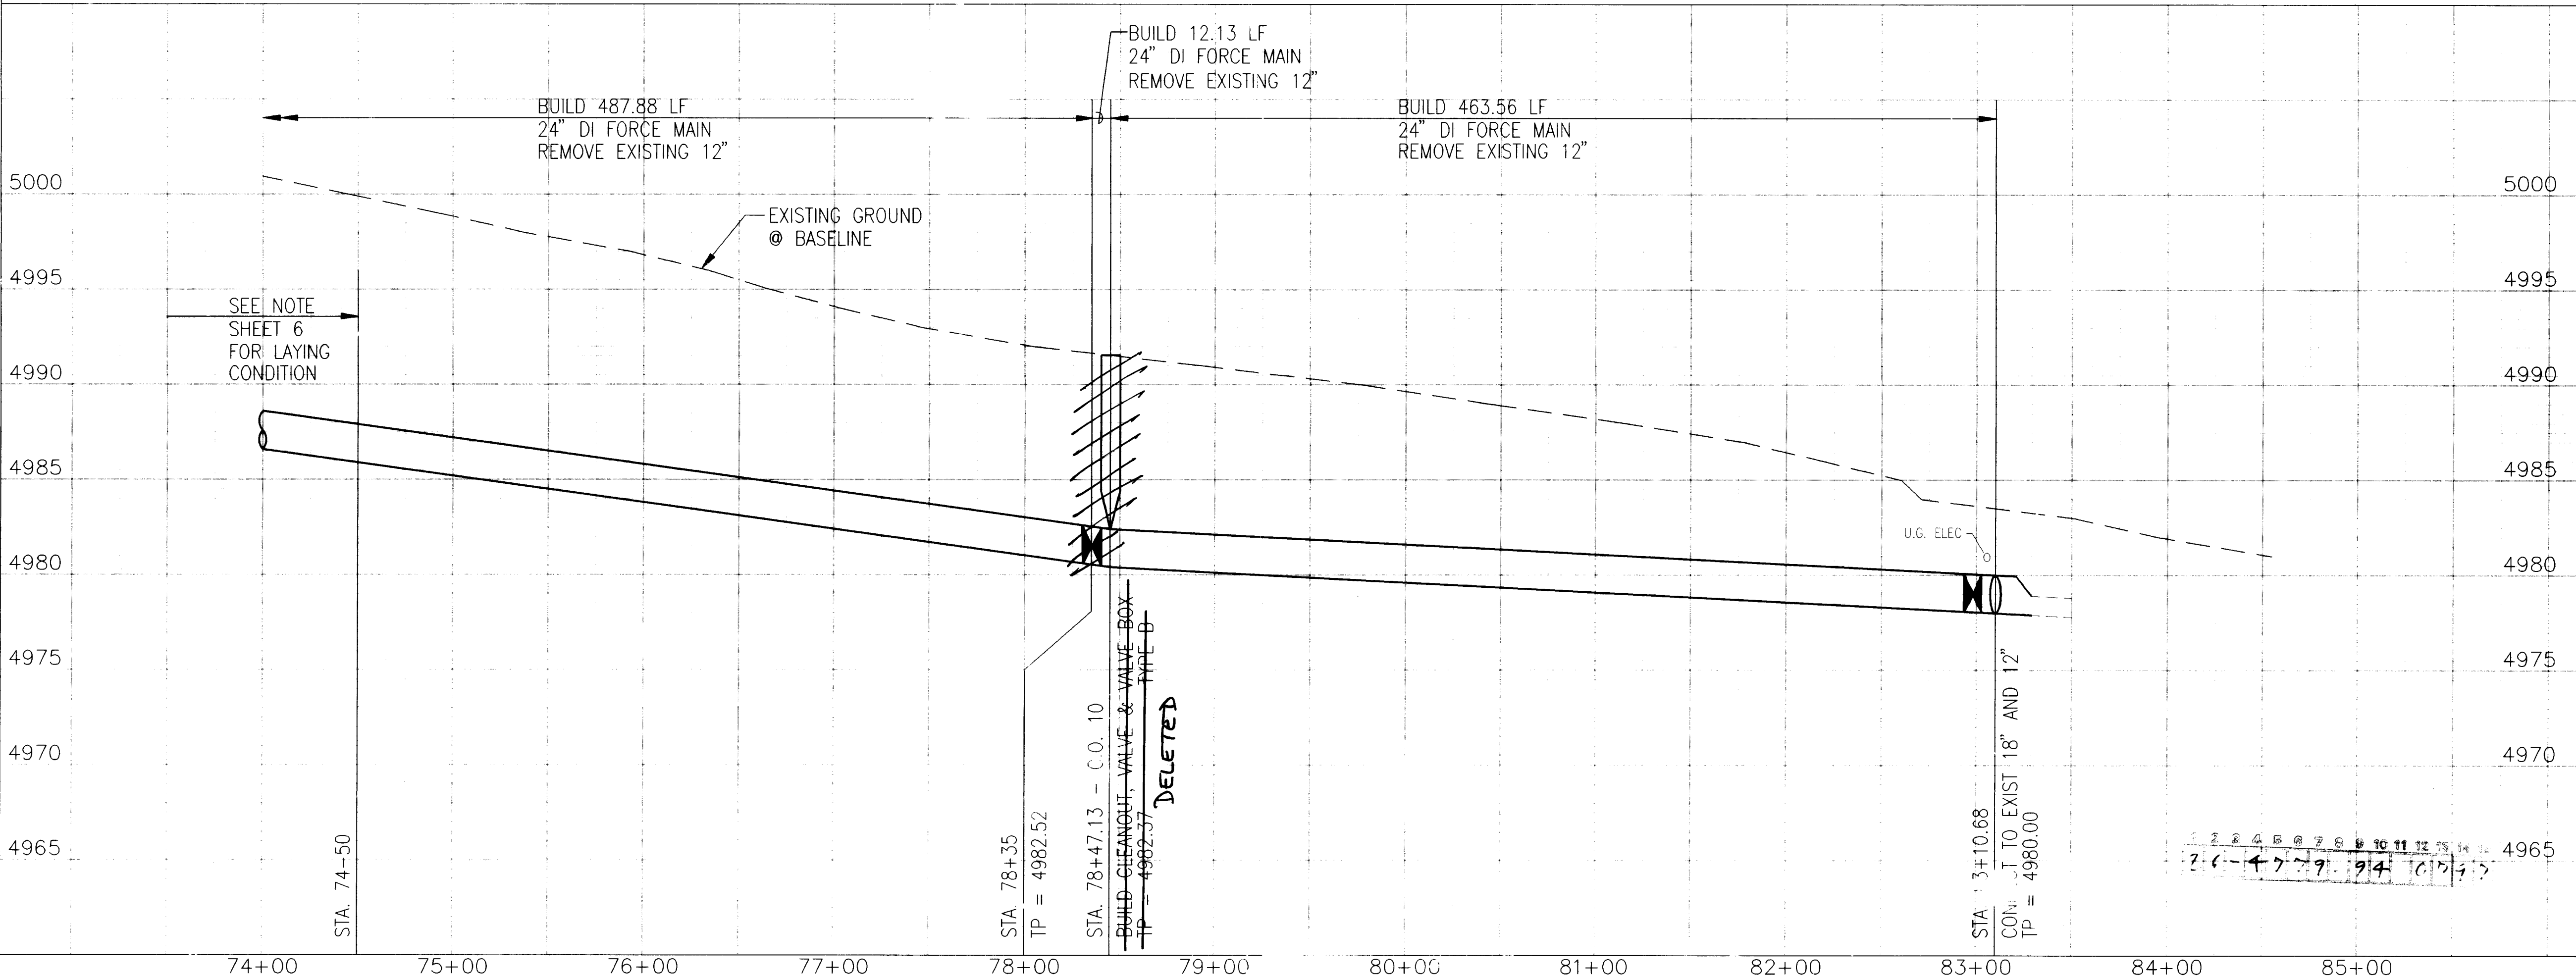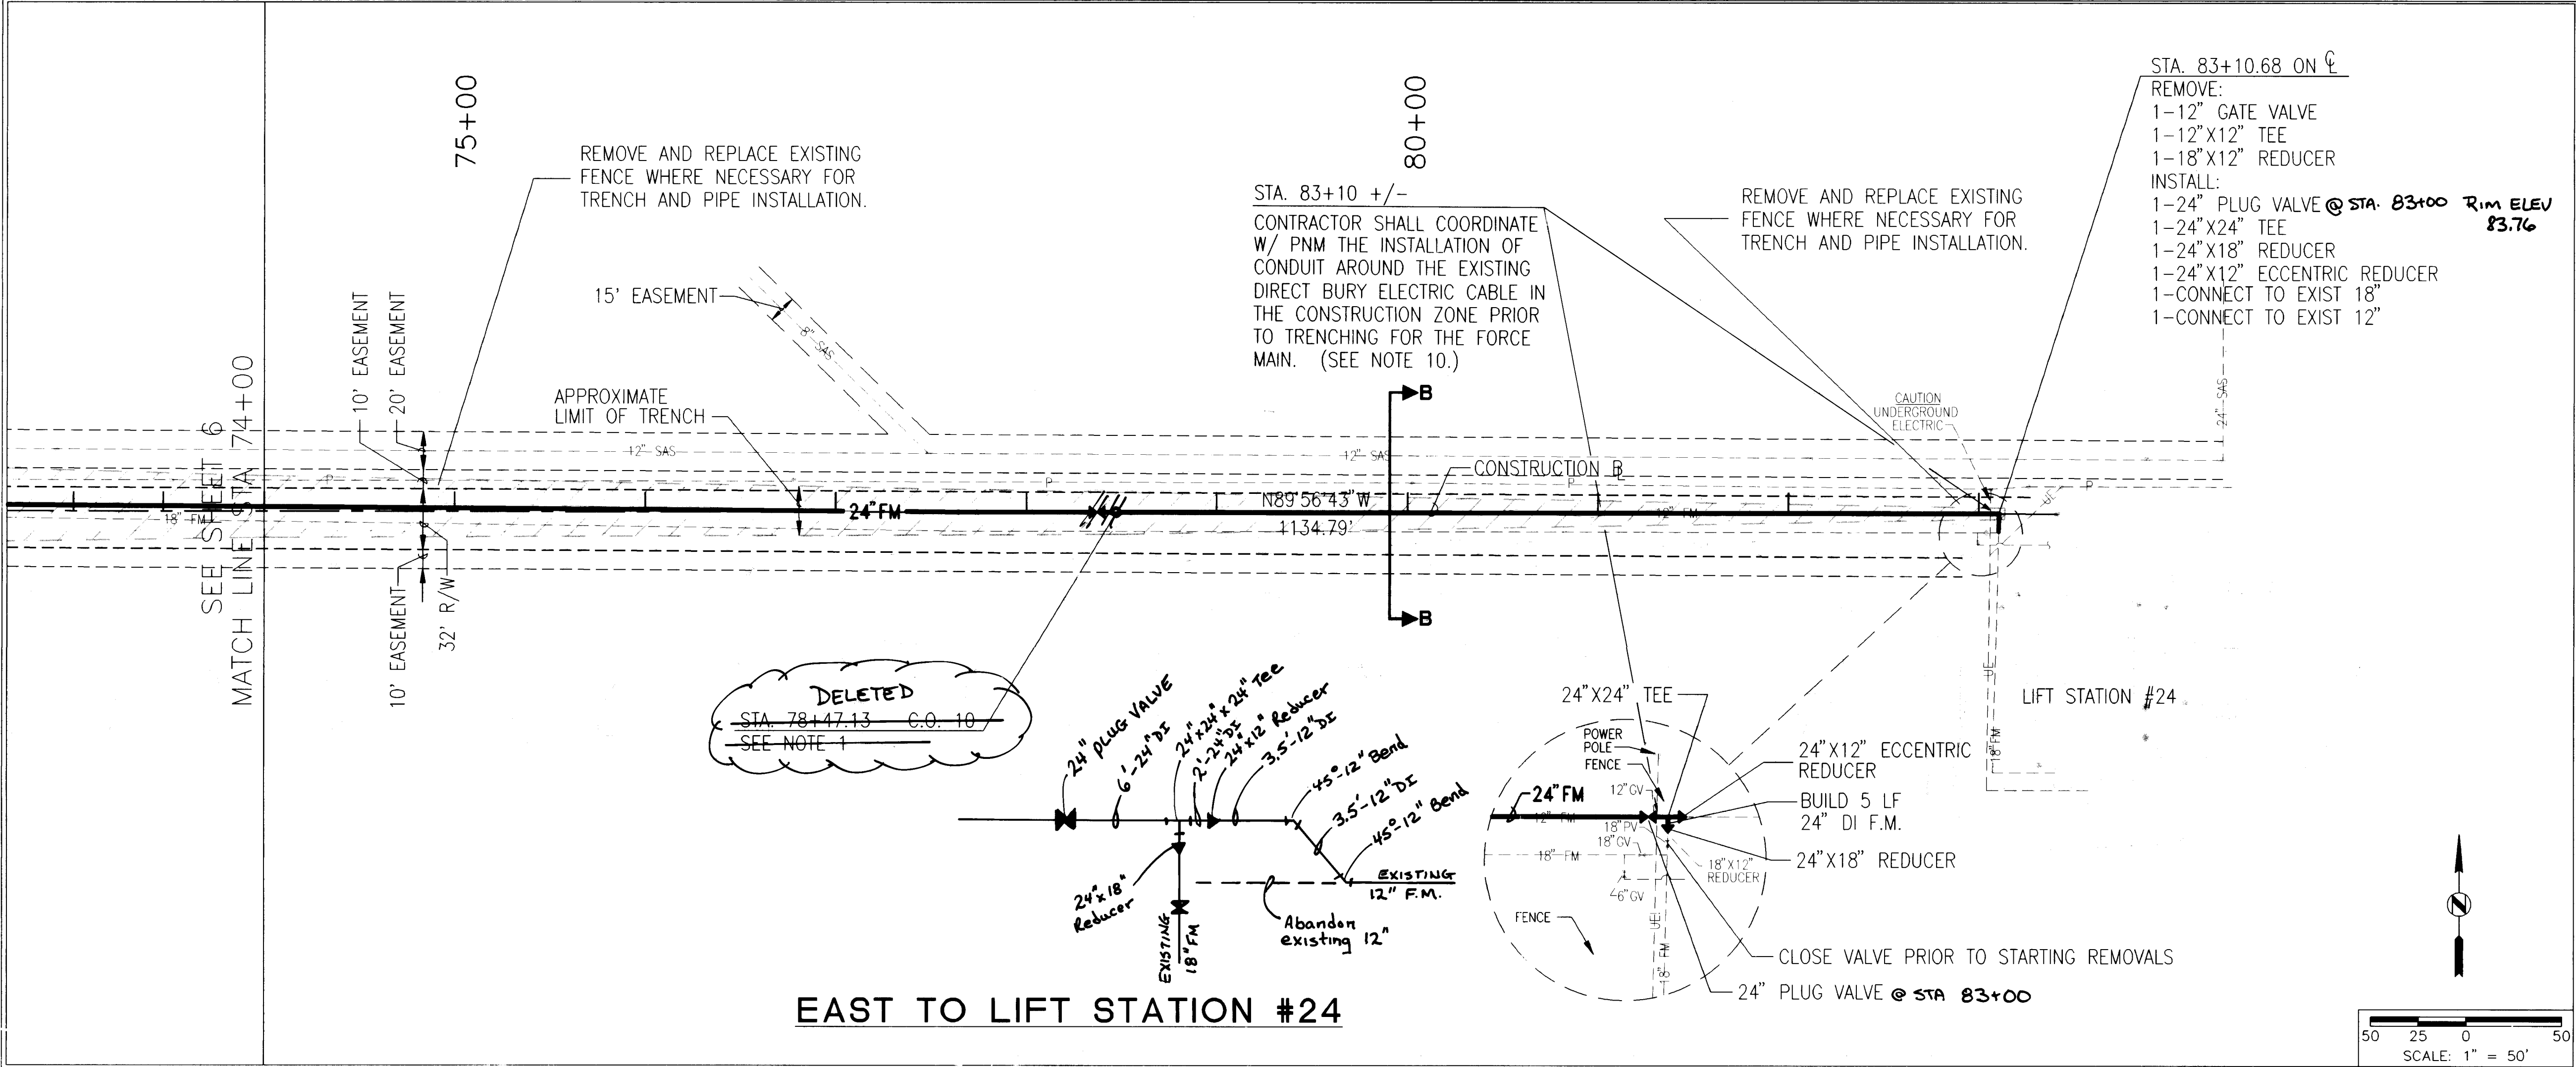

NOTES

- SEE SHEET 8 FOR TYPICAL CLEANOUT AND PLUG VALVE DETAIL.
- ADJUST CLEANOUT AND VALVE BOX RIM ELEVATION TO MATCH FINAL GRADE ELEVATION.
- ALL FORCE MAIN FITTINGS SHALL REQUIRE RESTRAINED JOINTS PER THE SCHEDULE ON SHEET 2.
- ALL FORCE MAIN PIPE SHALL BE D.I. PRESSURE CLASS 200 AND A TYPE 3 LAYING CONDITION EXCEPT WHERE INDICATED OTHERWISE.
- THE CONTRACTOR SHALL REMOVE AND DISPOSE OF THE EXISTING 12" FORCE MAIN AND APPURTENANCES.
- THE CONTRACTOR SHALL COORDINATE THE CONNECTION TO THE 18" LINE WITH CITY LIFT STATION PERSONNEL.
- CONTRACTOR SHALL MEET ALL OSHA REGULATIONS FOR TRENCHING.
- ALL FORCE MAIN PIPE SHALL BE CEMENT MORTAR LINED.
- THE ACCESS ROAD SHALL BE SURFACED WITH A 2" X 15" LAYER OF GRAVEL BASE COURSE IN THE AREA DISTURBED BY CONSTRUCTION. THE ROADWAY SHALL BE GRADED TO MATCH EXISTING.
- THE CONTRACTOR SHALL NOTIFY PNM FOUR WEEKS PRIOR TO WORKING IN THE AREA OF THE UNDERGROUND ELECTRICAL CABLE TO ALLOW PNM TO INSTALL CONDUIT ON THE LINE. THE CONTRACTOR SHALL STAKE THE CENTER LINE OF THE FORCE MAIN AT LEAST FOUR WEEKS PRIOR TO BEGINNING WORK IN THIS AREA. THE CONTRACTOR SHALL NOTIFY PNM PRIOR TO WORKING IN THIS AREA SO THAT PNM CAN INSPECT THE CONTRACTOR'S METHOD OF SUPPORTING THE CABLE.

LEGEND

- EXISTING METER
- EXISTING FIRE HYDRANT
- EXISTING TRAFFIC CONTROL BOX
- EXISTING STORM DRAIN INLET
- EXISTING WATER LINE W/VALVE
- EXISTING SANITARY SEWER W/MH
- EXISTING GAS LINE
- EXISTING STORM DRAIN
- EXISTING FORCE MAIN
- UNDERGROUND ELECTRIC
- UNDERGROUND TELEPHONE
- OVERHEAD POWER LINE
- NEW SANITARY SEWER W/MH
- NEW CLEANOUT AND VALVE
- NEW GAS LINE

CONTRACTOR INFORMATION

CONTRACTOR: **NEW CONCEPTS INC.**
WORK: **SEWER**
SUBMITTER: **CONTRACTOR**
ACCEPTANCE: **B. SMITH** DATE: **11/19/95**
FIELD: **B. SMITH** DATE: **12/19/95**
DRAWING: **R. GREEN** DATE: **12/19/95**
MICRO-FILM INFORMATION
RECORDED BY: **NO.** DATE: **NO.**

ENGINEER'S SEAL

DESIGNED BY: **DEB** DATE: **1-95**
DRAWN BY: **LAM** DATE: **1-95**
CHECKED BY: **DUG** DATE: **1-95**


CITY OF ALBUQUERQUE
PUBLIC WORKS DEPARTMENT
ENGINEERING

INTEL SANITARY SEWER - WESTERN TRAIL (PHASE III)
SEWER PLAN & PROFILE
STA. 74+00 TO E.O.P.


APPROVALS	ENGINEER	DATE	APPROVALS	ENGINEER	DATE
DRC CHAIRMAN	<i>B. G. Bailey</i>	5-12-95	WATER	<i>Harold R. R...</i>	5/9/95
TRANSPORTATION	<i>M. H. R...</i>	5-12-95	WASTE WATER		
HYDROLOGY	<i>Ken</i>	5-1-95			

DRAWING NO. **4779.94** MAP NO. **F-12** SHEET: **7** OF **14**

TYPE 3 - PIPE BEDDED IN 4-IN. MINIMUM NATIVE SOIL EXCAVATED FROM THE TRENCH, FREE OF ROCKS, FOREIGN MATERIAL, AND FROZEN EARTH. BACKFILL LIGHTLY CONSOLIDATED TO TOP OF PIPE.

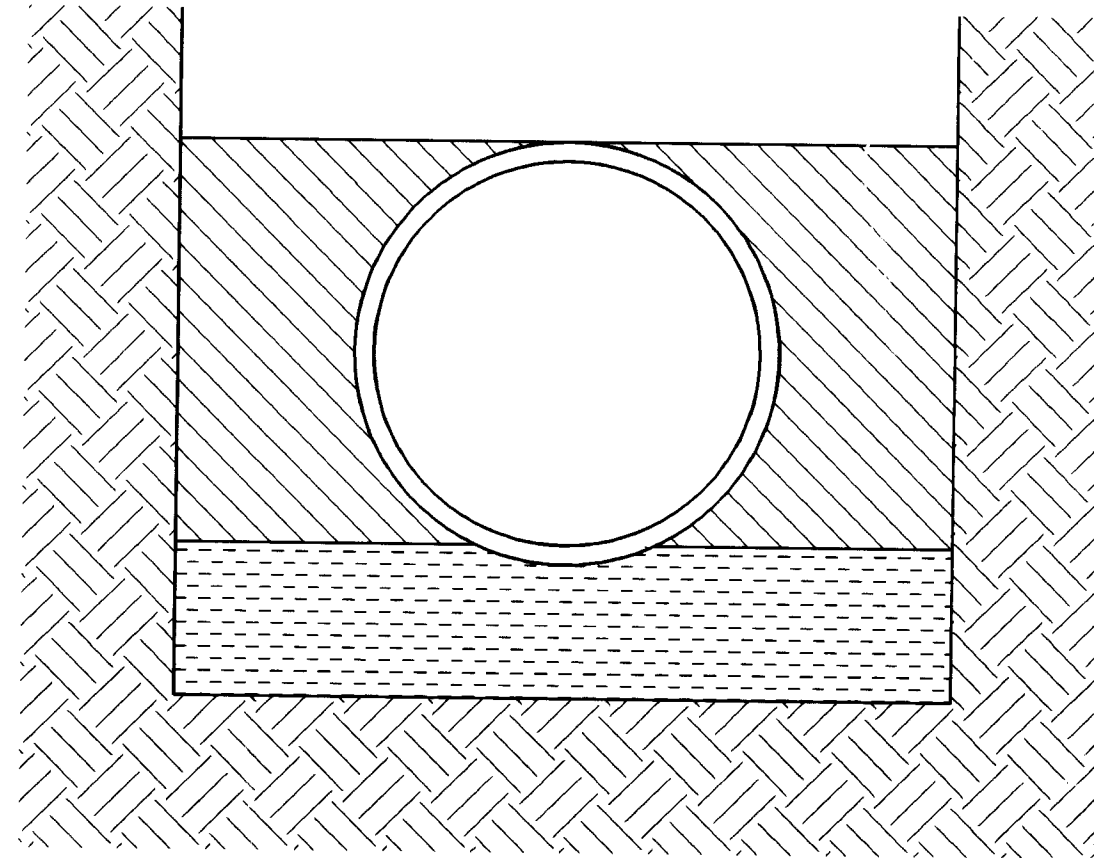

TYPE 4 - PIPE BEDDED IN SAND, GRAVEL, OR CRUSHED STONE TO DEPTH OF 1/8 PIPE DIAMETER, 4-IN. MINIMUM. BACKFILL COMPACTED TO TOP OF PIPE. (APPROXIMATELY 80 PERCENT STANDARD PROCTOR, AASHTO T-99)

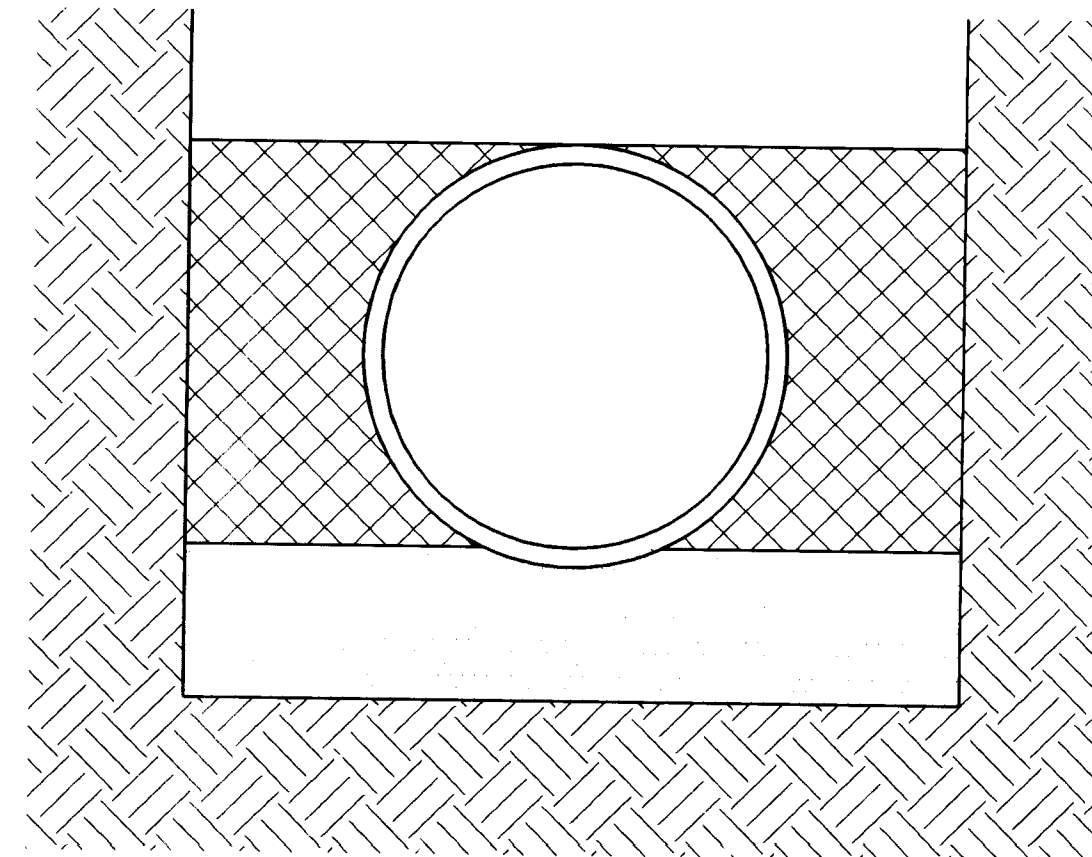

PIPE INSTALLATION SHALL MEET THE REQUIREMENTS OF SECTIONS 129, 701 AND 801 OF THE SPECIFICATIONS.




1. SIDES OF CONC. PAD TO BE PARALLEL AND PERPENDICULAR TO THE NORMAL STREET TRAFFIC FLOW.
2. USE THIS TYPE VALVE BOX FOR LOCATION IN UNPAVED STREETS OR ALLEYS AND IN NON-TRAFFIC EASEMENTS.

CONSTRUCTION NOTES:

- A. RUMB.
- B. COVER.
- C. PORTLAND CEMENT CONC. 3000 PS I.
- D. COMPACTED EARTH FILL, 95% OF MAX. DENSITY AS DETERMINED BY A.S.T.M. D 1557
- E. 12" DIA. CORRUGATED GALV. CURTMENT PIV. GA. DRIPPED IN COAL TAR ENAMEL OR COATED WITH POLYMERIC COATING 3 MILS THICK MIN. MEETING REQUIREMENTS SET BY A.A.S.H.T.O. M 246.
- F. GROUND LEVEL.
- G. NO. 4 BARS AT 12" O.C. EACH WAY.
- H. NO. 4 BARS 1' - 6" LONG.
- J. 2" - 0" MAX. USE STEEL EXTENSION AS NECESSARY, SEE DWG. 2330, 2331.
- K. NEW OR EXISTING VALVE.
- L. SCRIBE IN THE FRESH CONCRETE THE SIZE OF THE VALVE.


- * 10" DIAMETER CORRUGATED OR RIBBED PVC OR PE PIPE WITH A SMOOTH INTERIOR WALL MAY BE SUBSTITUTED FOR 12" DIAMETER CMP. TRIM PIPE RIBS OR CORRUGATIONS IF NECESSARY TO RECEIVE VALVE BOX RING AND COVER.

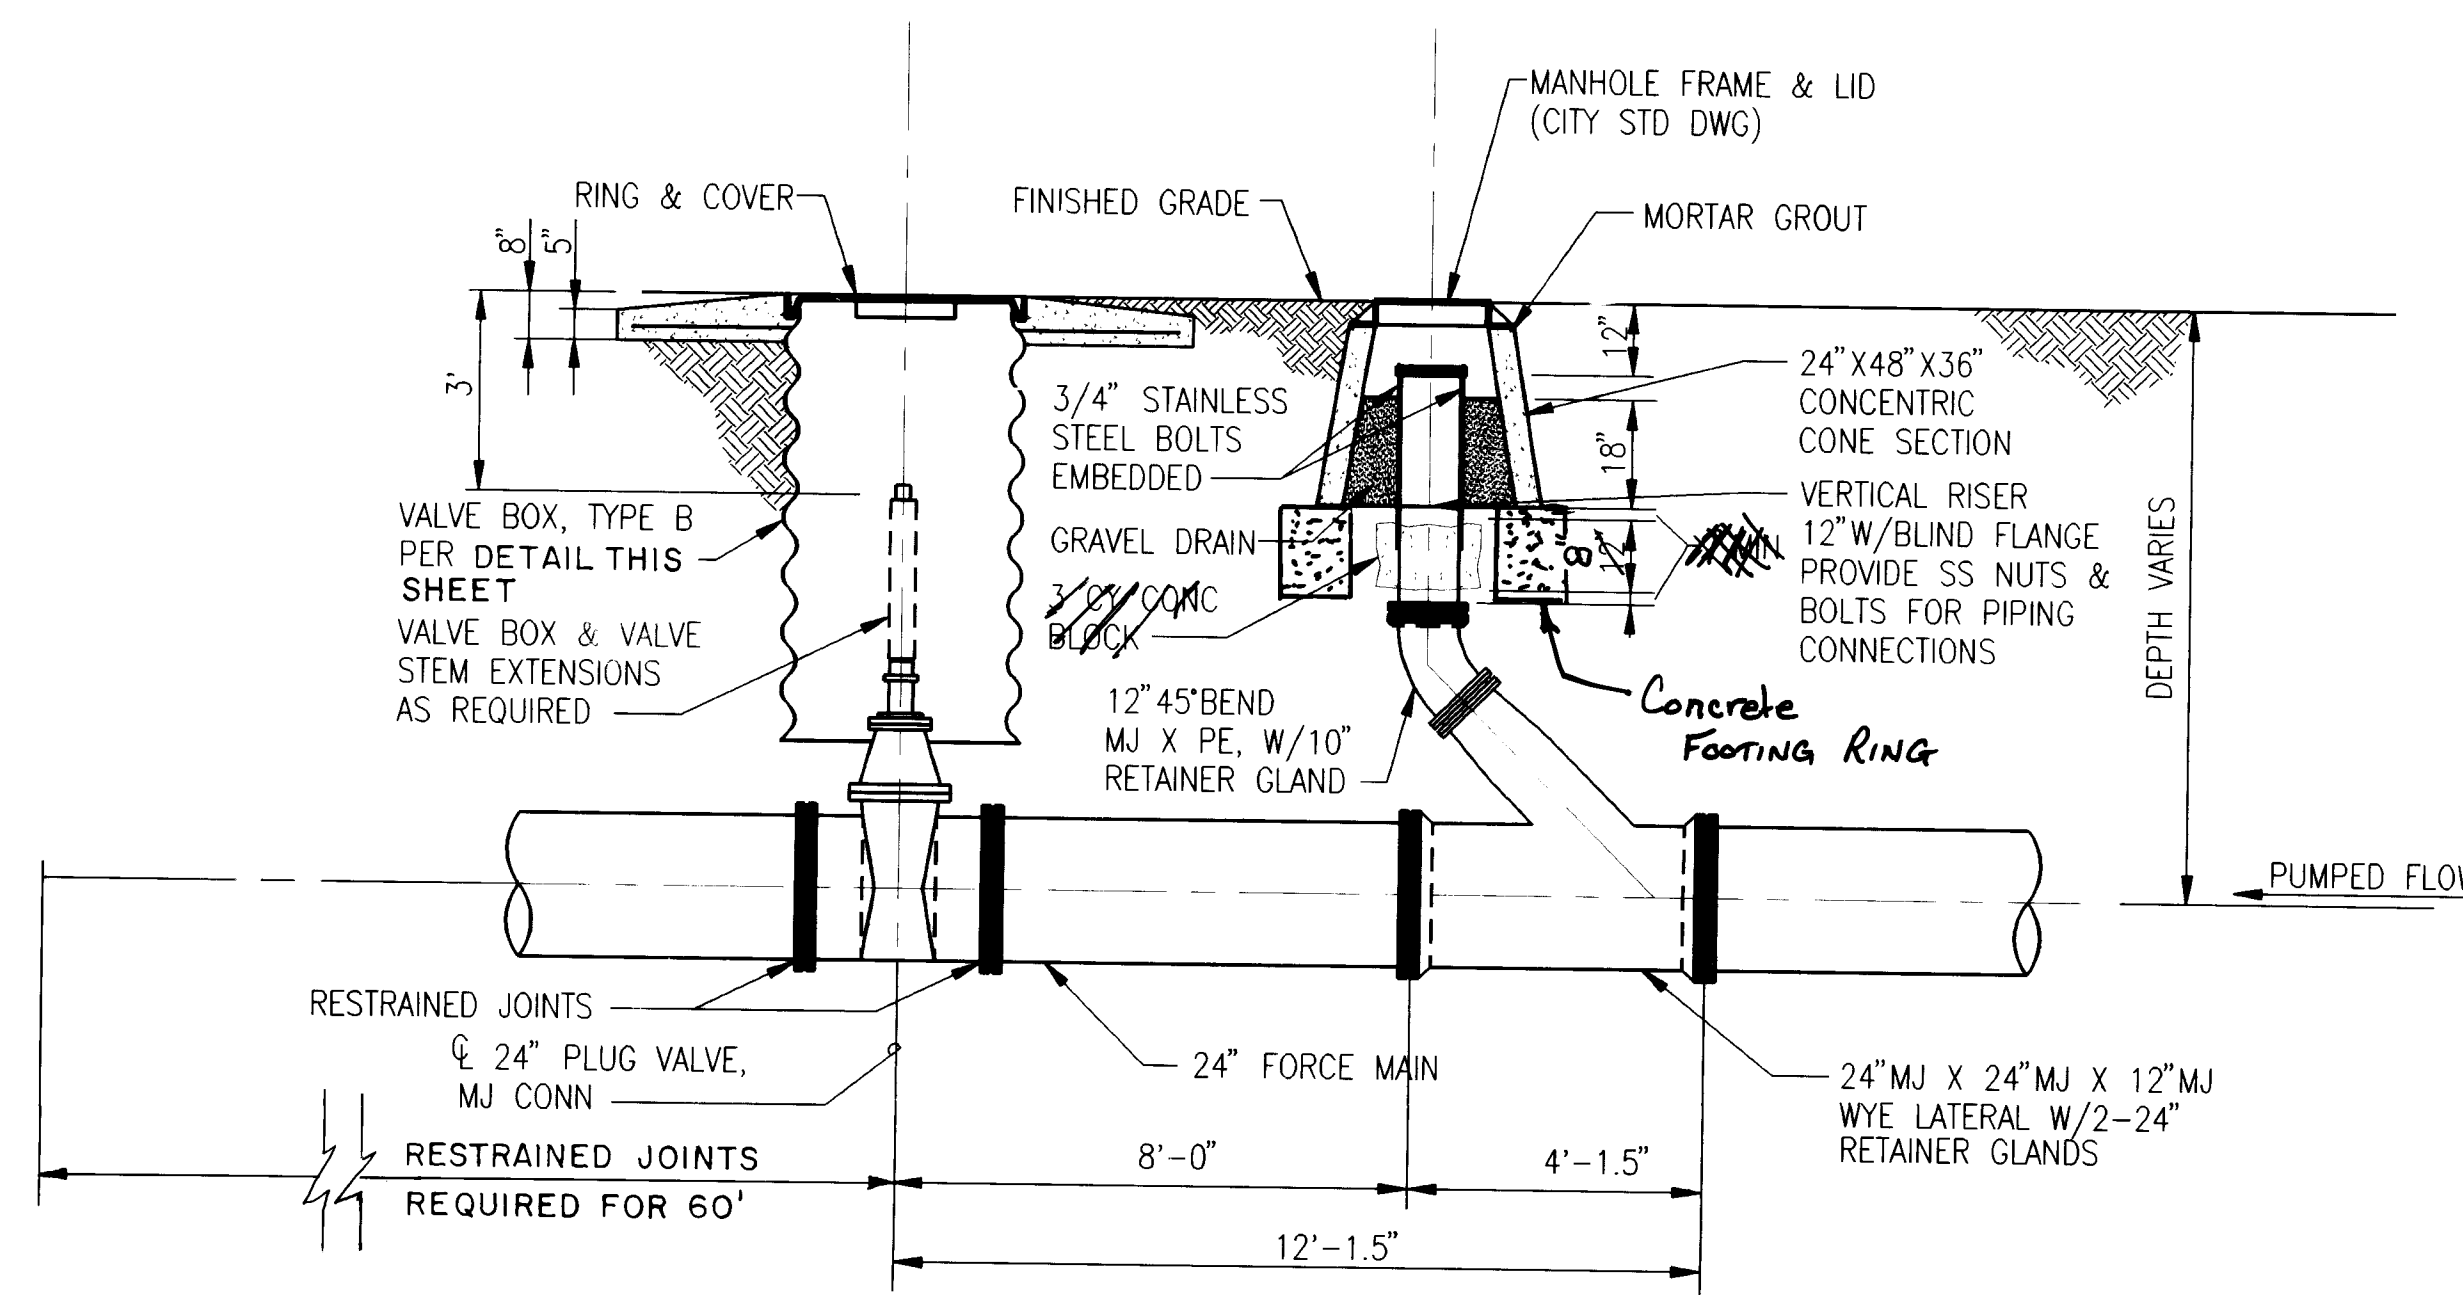


VALVE BOX TYPE "B"

NOTES:

1. FOR CLEANOUT, PROVIDE REMOVABLE "T" HANDLE BAR LOCKING STYLE MH LID, NEENAH TYPE J OR EQUAL.

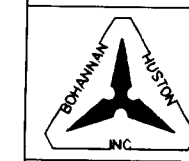[illegible]


CITY OF ALBUQUERQUE
PUBLIC WORKS DEPARTMENT
ENGINEERING

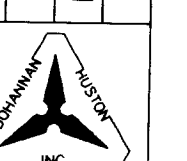

INTEL SANITARY SEWER - WESTERN TRAIL (PHASE III)
MISCELLANEOUS DETAILS

APPROVALS	ENGINEER	DATE	APPROVALS	ENGINEER	DATE
DRC CHAIRMAN	<i>B.G. Smalley</i>	<i>5-12-95</i>	WATER	<i>Ronald Sheen</i>	<i>5/9/95</i>
TRANSPORTATION	<i>N/A RHD</i>	<i>5-02-95</i>	WASTE WATER	<i>"</i>	<i>"</i>
HYDROLOGY	<i>PLM</i>	<i>5-1-95</i>			

DRAWING NO.	4779.94	MAP NO. F-11,12	SHEET: 8 OF 14
----------------	---------	--------------------	-------------------

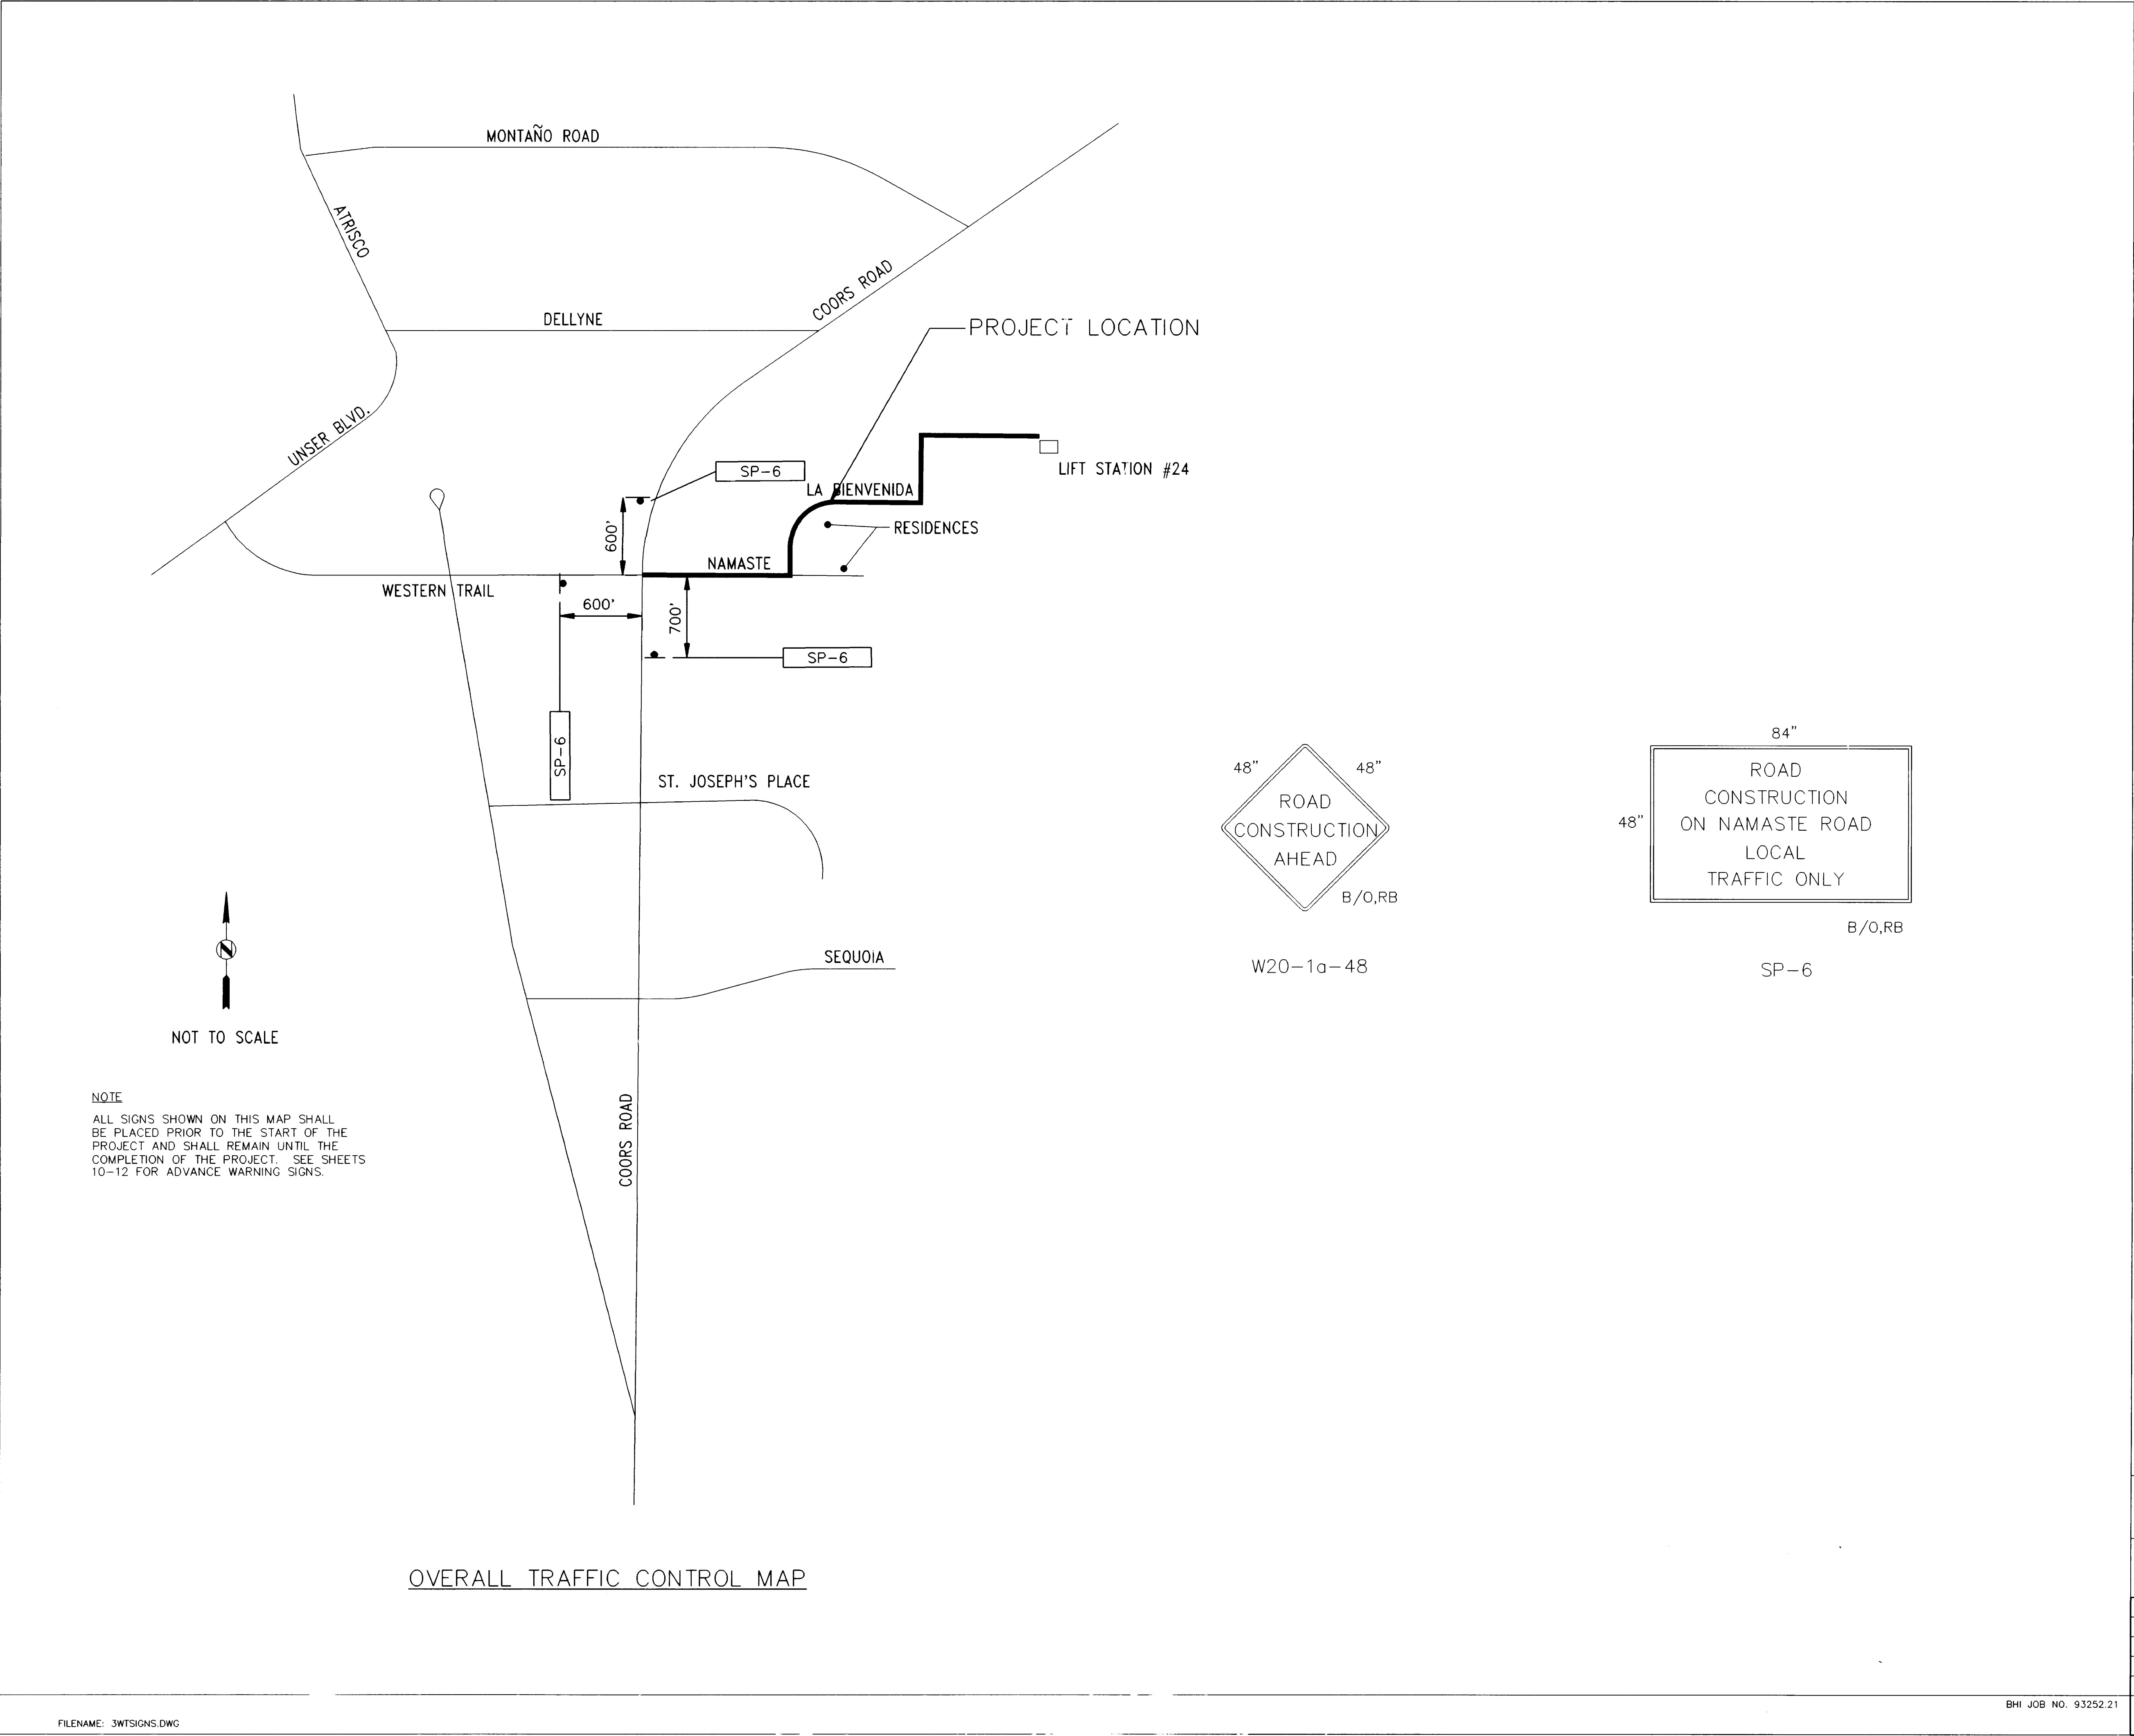

SEQUENCE OF CONSTRUCTION

PHASE I
1. CLOSE NORTH SIDE OF NAMASTE ROAD AND THE WEST SIDE OF LA BIENVENIDA PLACE.
BUILD NEW SAS IN NAMASTE ROAD AND LA BIENVENIDA PLACE.

2. SEE SHEETS 10 FOR DETAILS.

PHASE II
1. CLOSE NORTH SIDE OF LA BIENVENIDA PLACE.
BUILD NEW SAS LINES IN LA BIENVENDIA PLACE.

GENERAL NOTES

1. ACCESS SHALL BE MAINTAINED AT ALL TIMES TO THE RESIDENT ON NAMASTE ROAD & THE RESIDENT ON LA BIENVENIDA PLACE.

ENGINEER'S SEAL		SURVEY INFORMATION		BENCH MARKS		AS-BUILT INFORMATION	
		FIELD NOTES				CONTRACTOR	
		NO.	BY	DATE	WORKS BY		NO.
					THE BENCH MARK IS A 3-1/4" ALUMINUM CAP SET FLUSH ON THE MEDIAN AND IS STAMPED "ACS NM448-NB 1986". THE BENCH MARK IS LOCATED AT THE INTERSECTION OF WESTERN TRAIL/ NAMASTE RD. AND COORS RD. NW ON THE NORTH ISLAND OF COORS RD.		RECORDED BY
					ELEVATION = 5106.31		DATE
DESIGNED BY		DATE		DESIGNED BY		DATE	
DRAWN BY		DATE		DRAWN BY		DATE	
CHECKED BY		DATE		CHECKED BY		DATE	

CITY OF ALBUQUERQUE
PUBLIC WORKS DEPARTMENT
ENGINEERING

INTEL SANITARY SEWER - WESTERN TRAIL (PHASE III)
OVERALL TRAFFIC CONTROL MAP, SIGN FACE DETAILS
AND SEQUENCE OF CONSTRUCTION

APPROVALS	ENGINEER	DATE	APPROVALS	ENGINEER	DATE
DRC CHAIRMAN	<i>Bob Kelly</i>	5-12-95	WATER	<i>Robert Shaw</i>	5/9/95
TRANSPORTATION	<i>Mike RHO</i>	5-02-95	WASTE WATER		
HYDROLOGY	<i>TRU</i>	5-1-95			

DRAWING NO. 4779.94

MAP NO. F-11,12

SHEET: 9 OF 14


26-4779-94

10 11 12 13 14 15

9 1 10 11 12 13 14 15

2-14-95

SCANNED BY LASON

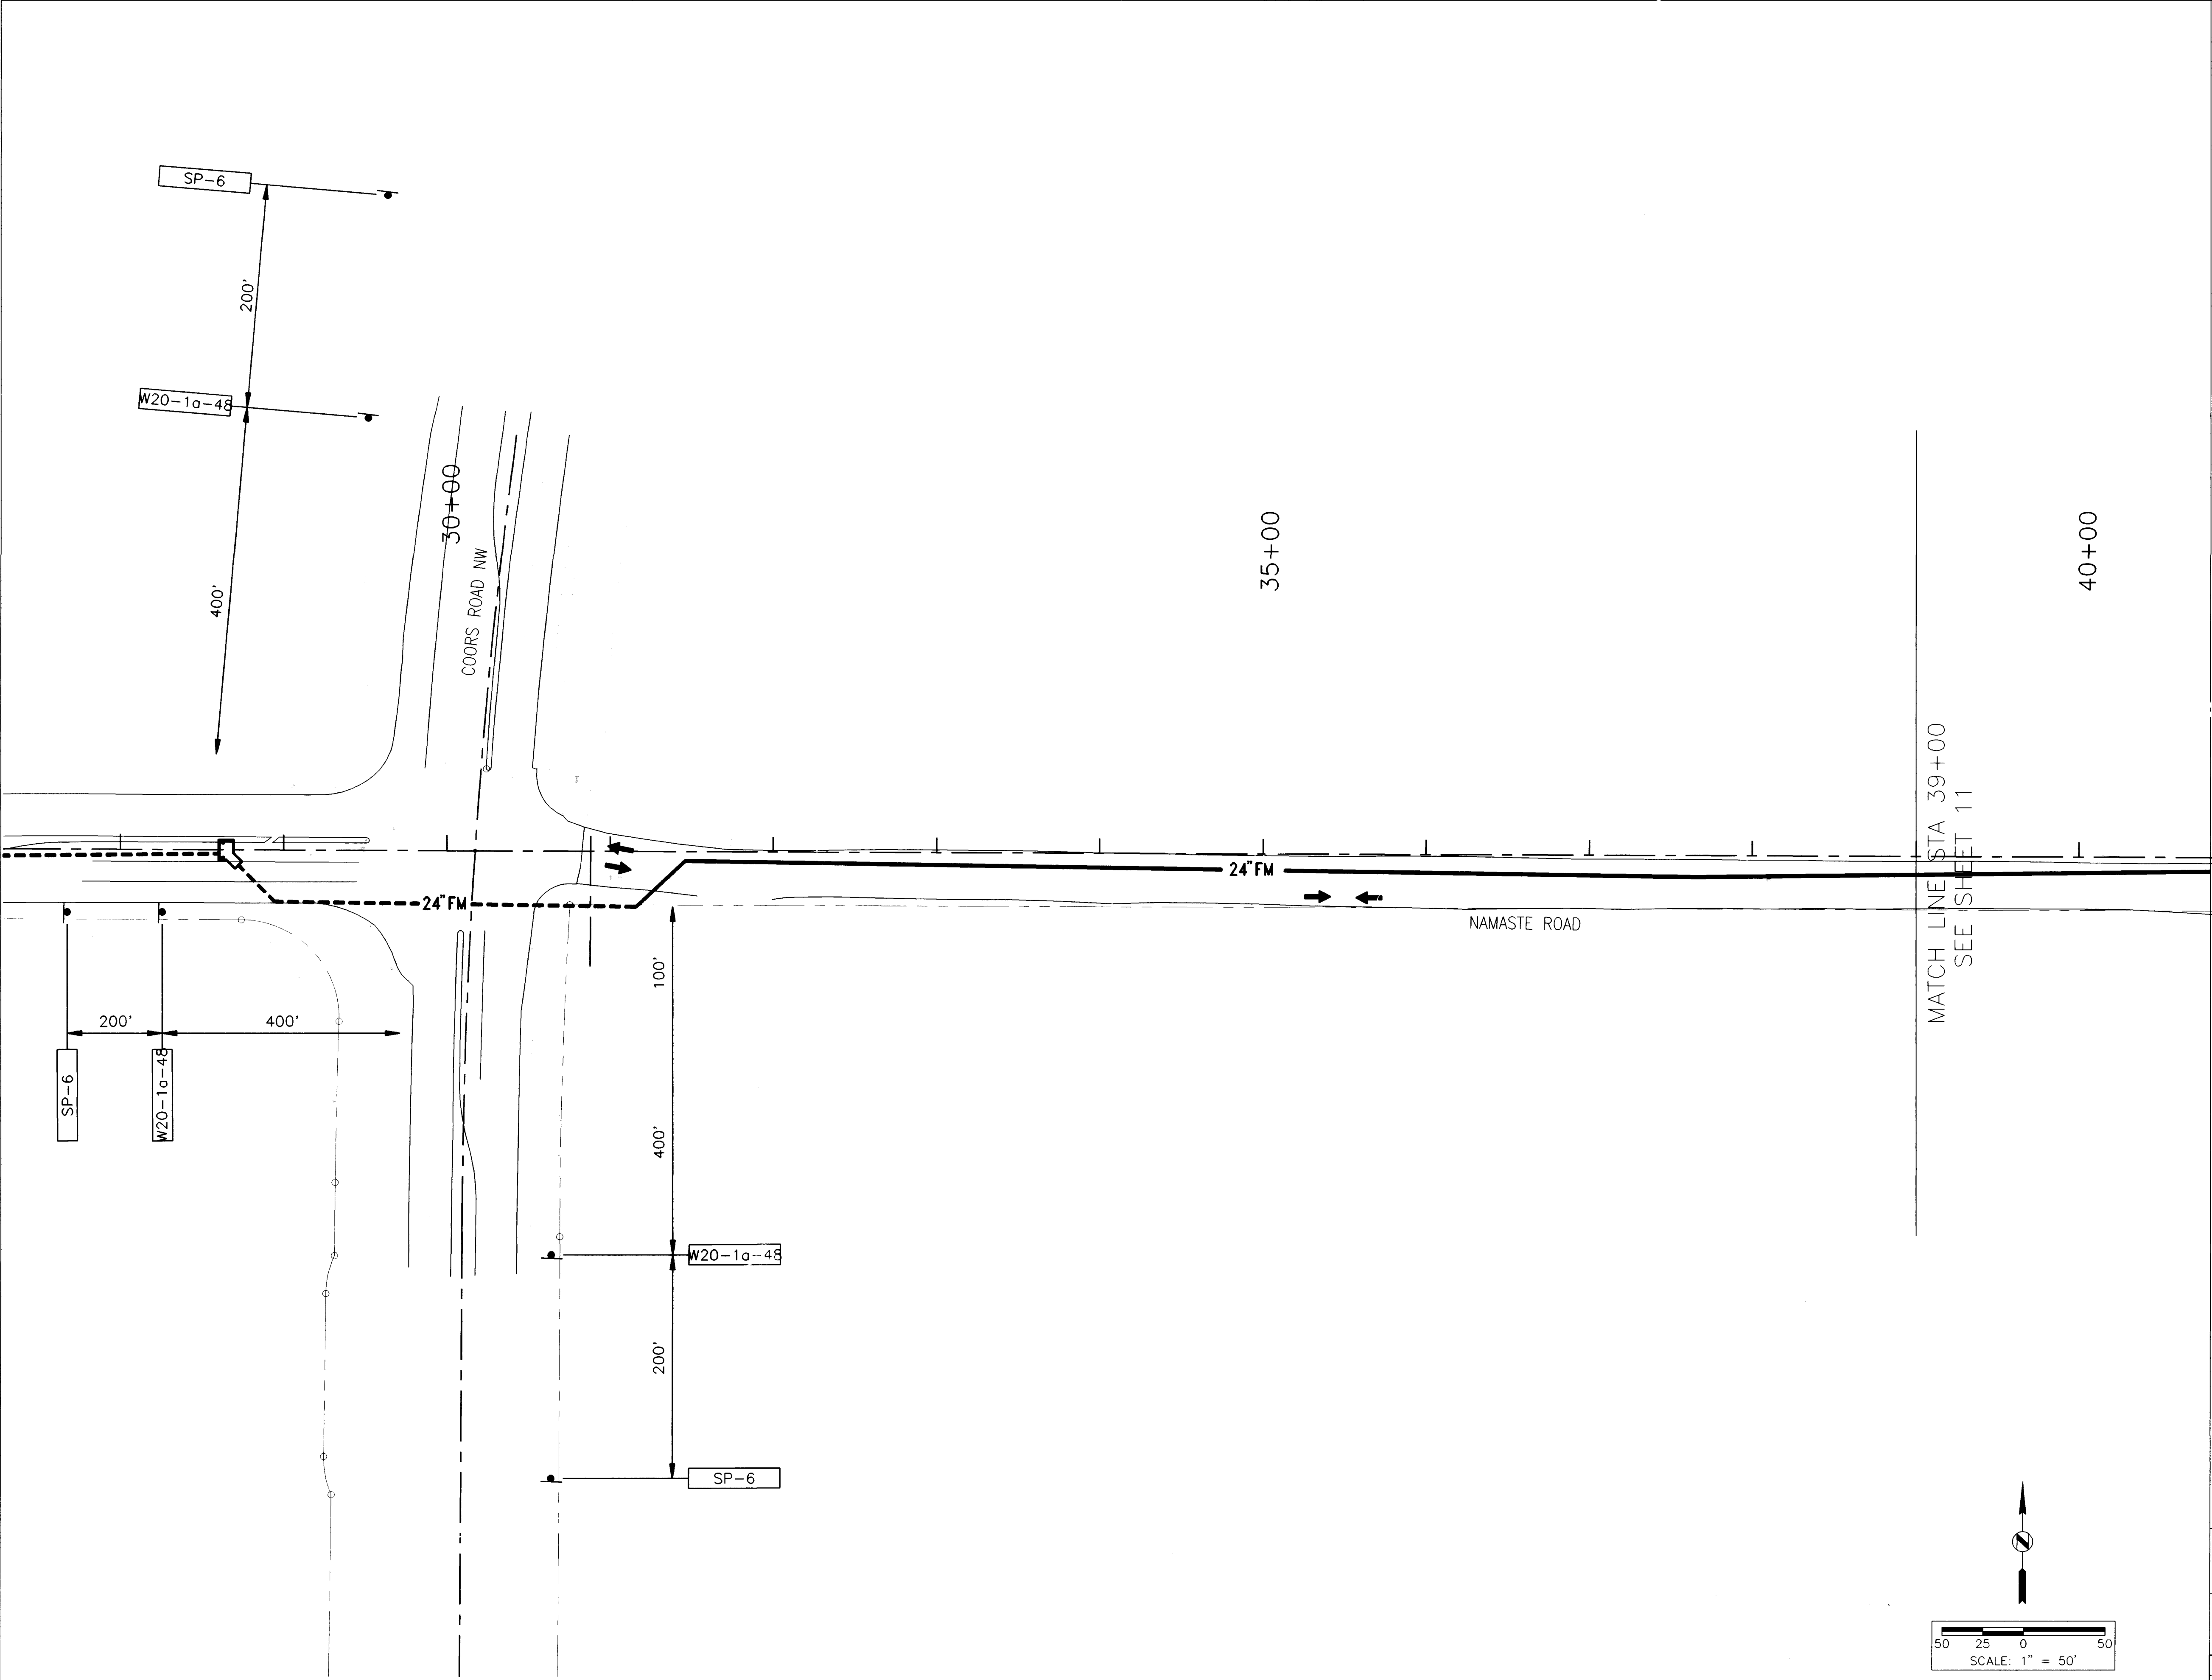

PHASE III NOTES

1. ACCESS SHALL BE MAINTAINED AT ALL TIMES TO THE RESIDENT ON NAMASTE ROAD AND THE RESIDENT ON BIENVENIDA PLACE.

26-4779.94 1097

LEGEND

- CONSTRUCTION SIGN
- ① BARREL (TYPE H)
- ② TYPE III BARRICADE (8 FT)
- ③ VERTICAL PANEL (BACK TO BACK)
- DIRECTION OF TRAFFIC
- ATTENUATORS (SAND BARRELS)
- CONCRETE WALL BARRIER



CITY OF ALBUQUERQUE
PUBLIC WORKS DEPARTMENT
ENGINEERING



INTEL SANITARY SEWER - WESTERN TRAIL (PHASE III)
TRAFFIC CONTROL PLAN
PHASE I

APPROVALS	ENGINEER	DATE	APPROVALS	ENGINEER	DATE
DRC CHAIRMAN	<i>B. G. Gentry</i>	5-12-95	WATER	<i>Rogelio Arana</i>	5/9/95
TRANSPORTATION	<i>N. H. LHO</i>	5-12-95	WASTE WATER		
HYDROLOGY	<i>Rum</i>	5-1-95			

DRAWING NO.	4779.94	MAP NO.	F-11,12	SHEET:	10 OF 14
-------------	---------	---------	---------	--------	----------

SURVEY INFORMATION		BENCH MARKS		AS-BUILT INFORMATION	
FIELD NOTES					
NO.	BY	DATE	THE BENCH MARK IS A 3-1/4" ALUMINUM CAP SET FLUSH ON THE MEDIAN AND IS STAMPED "ACS NM448-NB 1986". THE BENCH MARK IS LOCATED AT THE INTERSECTION OF WESTERN TRAIL/ NAMASTE RD. AND COORS RD. NW ON THE NORTH ISLAND OF COORS RD.	CONTRACTOR	WORK BY
					INSPECTOR'S ACCEPTANCE BY
					VERIFICATION BY
					DRAWINGS CORRECTED BY
					MICRO-FILM INFORMATION
					RECORDED BY
					NO
					ELEVATION = 5106.31

James H. Anderson
3/31/95

DESIGNED BY	DATE	1-95
DRAWN BY	DATE	1-95
CHECKED BY	DATE	1-95


CONSTRUCTION TRAFFIC CONTROL GENERAL NOTES

- CONTRACTOR MUST OBTAIN FROM CONSTRUCTION COORDINATION AN EXCAVATION/BARRICADING PERMIT BEFORE ENGAGING IN ANY CONSTRUCTION, MAINTENANCE OR REPAIR WORK IN ANY OF THE CITY OF ALBUQUERQUE'S RIGHTS-OF-WAY. EMERGENCY WORK THAT WOULD PRESERVE LIFE OR PROPERTY IS EXCLUDED WITH THE UNDERSTANDING, THAT A PERMIT SHALL BE OBTAINED WITHIN 24 TO 48 HOURS.
- CONTRACTOR SHALL AT THE TIME OF PERMIT REQUEST, SUBMIT FOR APPROVAL BY CONSTRUCTION COORDINATION, A TRAFFIC CONTROL PLAN DETAILING ALL EXISTING TOPOGRAPHY SUCH AS LANE WIDTHS, DRIVEWAYS, AND BUSINESS/RESIDENTIAL ACCESSES. THE TRAFFIC CONTROL PLAN SHALL INCLUDE ALL PHASES OF WORK AND SCHEDULES INVOLVED IN THE CONSTRUCTION PROJECT. ANY SEPARATE PHASES OF A CONSTRUCTION PROJECT SHALL BE GIVEN AN INDIVIDUAL PERMIT EACH. BLANKET PERMITS WILL NOT BE ISSUED.
- THESE TYPICAL TRAFFIC CONTROL PLANS DO NOT REFLECT THE EXISTING TOPOGRAPHY SUCH AS DRIVEWAYS, LANE WIDTHS, AND BUSINESS/RESIDENTIAL ACCESSES. EVERY LOCATION THAT REQUIRES CONSTRUCTION TRAFFIC CONTROL SHALL HAVE A DETAILED TRAFFIC CONTROL PLAN SHOWING ALL EXISTING TOPOGRAPHY.
- CONSTRUCTION SHALL NOT BEGIN UNLESS A TRAFFIC CONTROL PLAN HAS BEEN APPROVED AND VERIFIED BY CONSTRUCTION COORDINATION.
- CONSTRUCTION COORDINATION SHALL BE NOTIFIED 48 HOURS PRIOR TO ANY TRAFFIC CONTROL CHANGES NEEDED BY CONTRACTOR, THAT WERE NOT PREVIOUSLY APPROVED. THESE TRAFFIC CONTROL CHANGES SHALL BE REQUESTED IN WRITING ACCOMPANIED WITH A TRAFFIC CONTROL PLAN REFLECTING SUCH CHANGES.
- ALL CONSTRUCTION TRAFFIC CONTROL DEVICES SHALL COMPLY TO THE MANUAL ON UNIFORM TRAFFIC CONTROL DEVICES (MUTCD), LATEST EDITION. IT IS THE RESPONSIBILITY OF THE CONTRACTOR TO INSTALL, SERVICE AND MAINTAIN ALL TRAFFIC CONTROL DEVICES. TRAFFIC CONTROL DEVICES SHALL NOT BE REMOVED OR ALTERED IN ANY WAY WITHOUT THE APPROVAL OF CONSTRUCTION COORDINATION, PER SECTION 6A-4 OF THE MUTCD, LATEST EDITION.
- THE CONSTRUCTION TRAFFIC CONTROL INITIAL SET-UP SHALL BE BY AN AMERICAN TRAFFIC SAFETY SERVICES ASSOCIATION (ATSSA) CERTIFIED WORKSITE TRAFFIC SUPERVISOR. THE MAINTENANCE AND SERVICING SHALL ALSO BE DONE BY AN ATSSA CERTIFIED WORKSITE TRAFFIC SUPERVISOR OR EQUIVALENT.
- CONTRACTOR IS RESPONSIBLE TO MAINTAIN AND SERVICE ALL TRAFFIC CONTROL DEVICES 24 HOURS A DAY, 7 DAYS A WEEK THROUGHOUT LENGTH OF PROJECT. CONTRACTOR IS RESPONSIBLE THAT ALL TRAFFIC CONTROL DEVICES COMPLY WITH THE MUTCD, LATEST EDITION.
- ALL ADVANCE WARNING SIGNS SHALL BE DOUBLE INDICATED WHENEVER THERE ARE MULTI-LANE TRAFFIC IN ANY ONE GIVEN DIRECTION AND THERE IS SUFFICIENT MEDIAN SPACE.
- ALL BARRICADES IN ALL TAPERS AND TANGENTS SHALL BE PLACED APART, A DISTANCE MEASURED IN FEET, EQUAL TO THAT OF THE POSTED SPEED LIMIT. NO EXCEPTIONS UNLESS APPROVED BY CONSTRUCTION COORDINATION PER MUTCD SECTION 6A-4.
- CONTRACTOR SHALL NOT BEGIN WORK BEFORE 8:30 A.M. OR END WORK AFTER 4:00 P.M. WITHOUT THE APPROVAL OF CONSTRUCTION COORDINATION.
- CONTRACTOR IS RESPONSIBLE TO PROVIDE CONSTRUCTION COORDINATION, A WEEKLY LOG OF DAILY INSPECTIONS OF BARRICADE AND MAINTENANCE SCHEDULES ON PROJECTS THAT ARE OVER ONE WEEK DURATION.
- EQUIPMENT OR MATERIALS SHALL NOT BE STORED WITHIN 15 FEET OF A TRAVELLED TRAFFIC LANE DURING NON-WORKING HOURS WITHOUT THE APPROVAL OF CONSTRUCTION COORDINATION.
- CONTRACTOR SHALL PROVIDE AND MAINTAIN A SAFE AND ADEQUATE MEANS OF CHANNELIZING PEDESTRIAN TRAFFIC AROUND AND THROUGH THE CONSTRUCTION AREA.
- CONTRACTOR IS RESPONSIBLE FOR OBLITERATION OF ANY CONFLICTING STRIPING AND RESPONSIBLE FOR ALL TEMPORARY STRIPING.
- CONTRACTOR SHALL MAINTAIN ACCESS TO ALL FACILITIES, BUSINESSES AND/OR RESIDENTS AT ALL TIMES.
- CONTRACTOR SHALL PROVIDE ACCESS SIGNS FOR BUSINESSES LOCATED WITHIN THE CONSTRUCTION AREA UNDER THE SUPERVISION OF CONSTRUCTION COORDINATION. EACH ACCESS SIGN SHALL HAVE 5 INCH, WHITE OPAQUE LETTERING ON BLUE REFLECTORIZED BACKGROUND. ACCESS SIGNS SHALL BE CONSIDERED INCIDENTAL TO THE BID AND NOT PART OF THE CONTRACT UNLESS OTHERWISE STATED. NO MORE THAN 3 BUSINESSES SHALL BE LISTED ON A ACCESS SIGN. SHOPPING CENTERS AND MALLS SHALL BE LISTED AS SUCH.
- ALL ADVANCE WARNING SIGNS SHALL MEET THE MINIMUM REFLECTIVE INTENSITY REQUIREMENTS SET FORTH BY THE CITY OF ALBUQUERQUE. CONSTRUCTION COORDINATION SHALL DETERMINE ALL REQUIREMENTS AND APPROVE OR DISAPPROVE ANY ADVANCE WARNING SIGN PER SECTION 6A-4 OF THE MUTCD, LATEST EDITION.
- 24 HOURS PRIOR TO OCCUPYING OR CLOSING OF A RIGHT-OF-WAY, CONTRACTOR SHALL NOTIFY: POLICE, FIRE DEPARTMENT, SCHOOLS, HOSPITALS, TRANSIT AUTHORITY, BUSINESSES AND/OR RESIDENTS THAT WILL BE AFFECTED BY THE CONSTRUCTION.
- ANY FIELD ADJUSTMENTS SHALL BE APPROVED BY CONSTRUCTION COORDINATION.


- EXCAVATIONS SHALL BE PLATED, TEMPORARILY PATCHED OR RESURFACED PRIOR TO OPENING OF TRAFFIC. A MINIMUM OF 11 FEET SHALL BE PROVIDED FOR TRAFFIC IN ANY GIVEN DIRECTION. CONTRACTOR IS RESPONSIBLE FOR ANY WORK INVOLVED IN SATISFYING THESE REQUIREMENTS.
- CONTRACTOR SHALL AT ALL TIMES COMPLY WITH THE FOLLOWING:
 - STANDARDS AND REQUIREMENTS SET FORTH IN THE MANUAL ON UNIFORM TRAFFIC CONTROL DEVICES, LATEST EDITION.
 - THE CITY OF ALBUQUERQUE TRAFFIC CODE, LATEST EDITION.
 - SECTION 19 OF THE CITY OF ALBUQUERQUE'S STANDARD SPECIFICATIONS FOR PUBLIC WORK CONSTRUCTION, AS WELL AS OTHER SECTIONS.
- FAILURE TO COMPLY WITH ANY OF THE ABOVE MENTIONED, WILL BE ADEQUATE CAUSE TO CEASE ALL WORK ON ANY CONSTRUCTION PROJECT. WORK WILL NOT RESUME UNTIL ALL REQUIREMENTS ARE ADDRESSED AND APPROVED BY CONSTRUCTION COORDINATION.
- ALL TRAFFIC CONTROL DEVICES SHALL BE KEPT IN NEW-CLEAN CONDITION. WASHING OF EQUIPMENT IS INCIDENTAL TO ITS PLACEMENT AND MAINTENANCE.

25. TRAFFIC CONTROL STANDARDS APPLY ONLY WHERE THE CONSTRUCTION TRAFFIC CONTROL PLANS ARE NOT SPECIFIC.

26. Advanced Warning Signs may be 36x24" if Super Engineering grade retro-reflective sheeting is used.

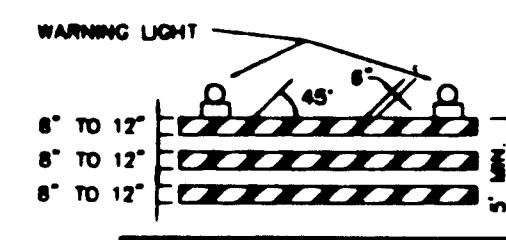


TYPE II BARRICADE

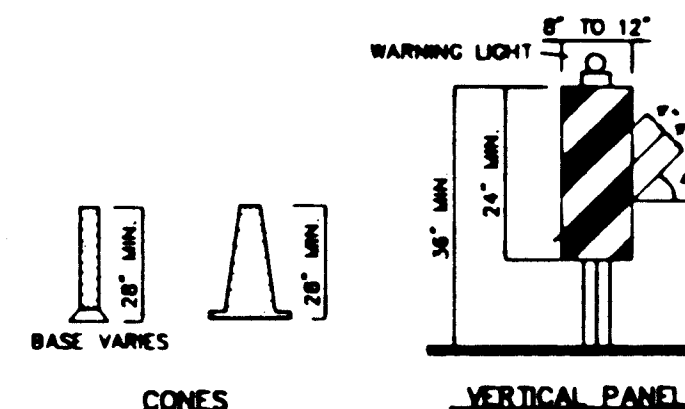


CONES

VERTICAL PANEL


HIGH LEVEL WARNING DEVICE

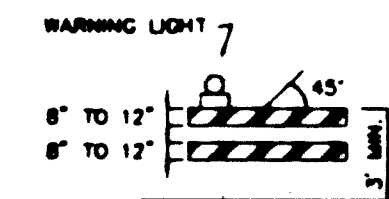


TYPE II BARRICADE COLLAPSIBLE

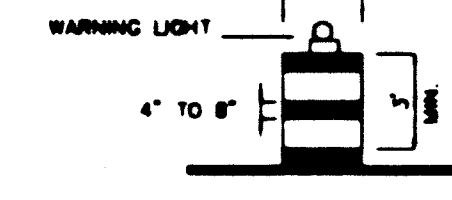

BARREL

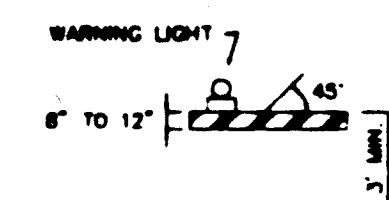

TYPE I BARRICADE COLLAPSIBLE

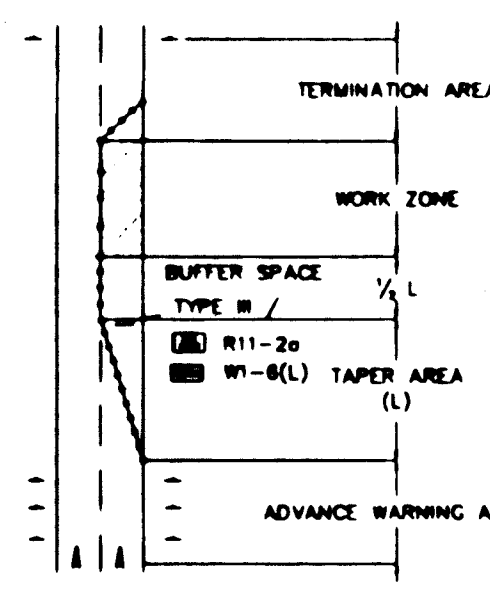

TRAFFIC CONTROL ELEMENTS

LEGEND

- WORK AREA
- BARRICADE - TYPE I, TYPE II OR BARREL
- BARRICADE - TYPE III
- VERTICAL PANEL
- WARNING SIGN
- DISTANCE BETWEEN SIGNS - A DISTANCE MEASURED IN FEET EQUAL TO A VALUE OF TEN TIMES THE SPEED LIMIT OF THE STREET
- FLAGMAN POSITION
- SPACING BETWEEN BARRICADES - A DISTANCE MEASURED IN FEET EQUAL TO THE SPEED LIMIT OF THE STREET
- TAPER LENGTH - SEE CHART BELOW
- THE TANGENT LENGTH IS EQUAL TO THE TAPER LENGTH FOR A GIVEN STREET.

TAPER REQUIREMENTS

SPEED LIMIT (MPH)	TAPER LENGTH (FEET)			MINIMUM NUMBER OF DEVICES FOR TAPER	MAXIMUM DEVICE SPACING IN FEET	
	10' LANE	11' LANE	12' LANE		BEFORE TAPER	AFTER TAPER
20	70	75	80	5	20	20
25	105	115	125	6	25	25
30	150	165	180	7	30	30
35	205	225	245	8	35	35
40	270	295	320	9	40	40
45	450	495	540	13	45	45
50	500	550	600	13	50	50
55	550	605	660	13	55	55

RECOMMENDED SIGN SPACING FOR ADVANCE WARNING SIGN SERIES

MILES PER HOUR	MINIMUM DISTANCE IN FEET	
	BETWEEN SIGNS	FROM LAST SIGN TO TAPER
0-20	10 X SPEED LIMIT	10 X SPEED LIMIT
25-30	10 X SPEED LIMIT	10 X SPEED LIMIT
30-35	10 X SPEED LIMIT	10 X SPEED LIMIT
40-45	10 X SPEED LIMIT	10 X SPEED LIMIT
50-60	10 X SPEED LIMIT	10 X SPEED LIMIT


TAPER CRITERIA

TYPE OF TAPER	TAPER LENGTH
UPSTREAM TAPER:	
MERGING TAPER	L MINIMUM
SHIFTER TAPER	1/2 L MINIMUM
SHOULDER TAPER	1/2 L MINIMUM
TWO-WAY TRAFFIC TAPER	100 FEET MAXIMUM
DOWNSTREAM TAPERS	100 FEET PER LANE

TAPER LENGTH COMPUTATION

SPEED LIMIT	
40 MPH OR LESS	$L = \frac{WS^2}{60}$
45 MPH OR GREATER	$L = W \times S$
L = TAPER LENGTH	
W = WIDTH OF OFFSET IN FEET	
S = POSTED SPEED OR OFF-PEAK 85-PERCENTILE SPEED IN MPH	

SIGN FACE DETAILS

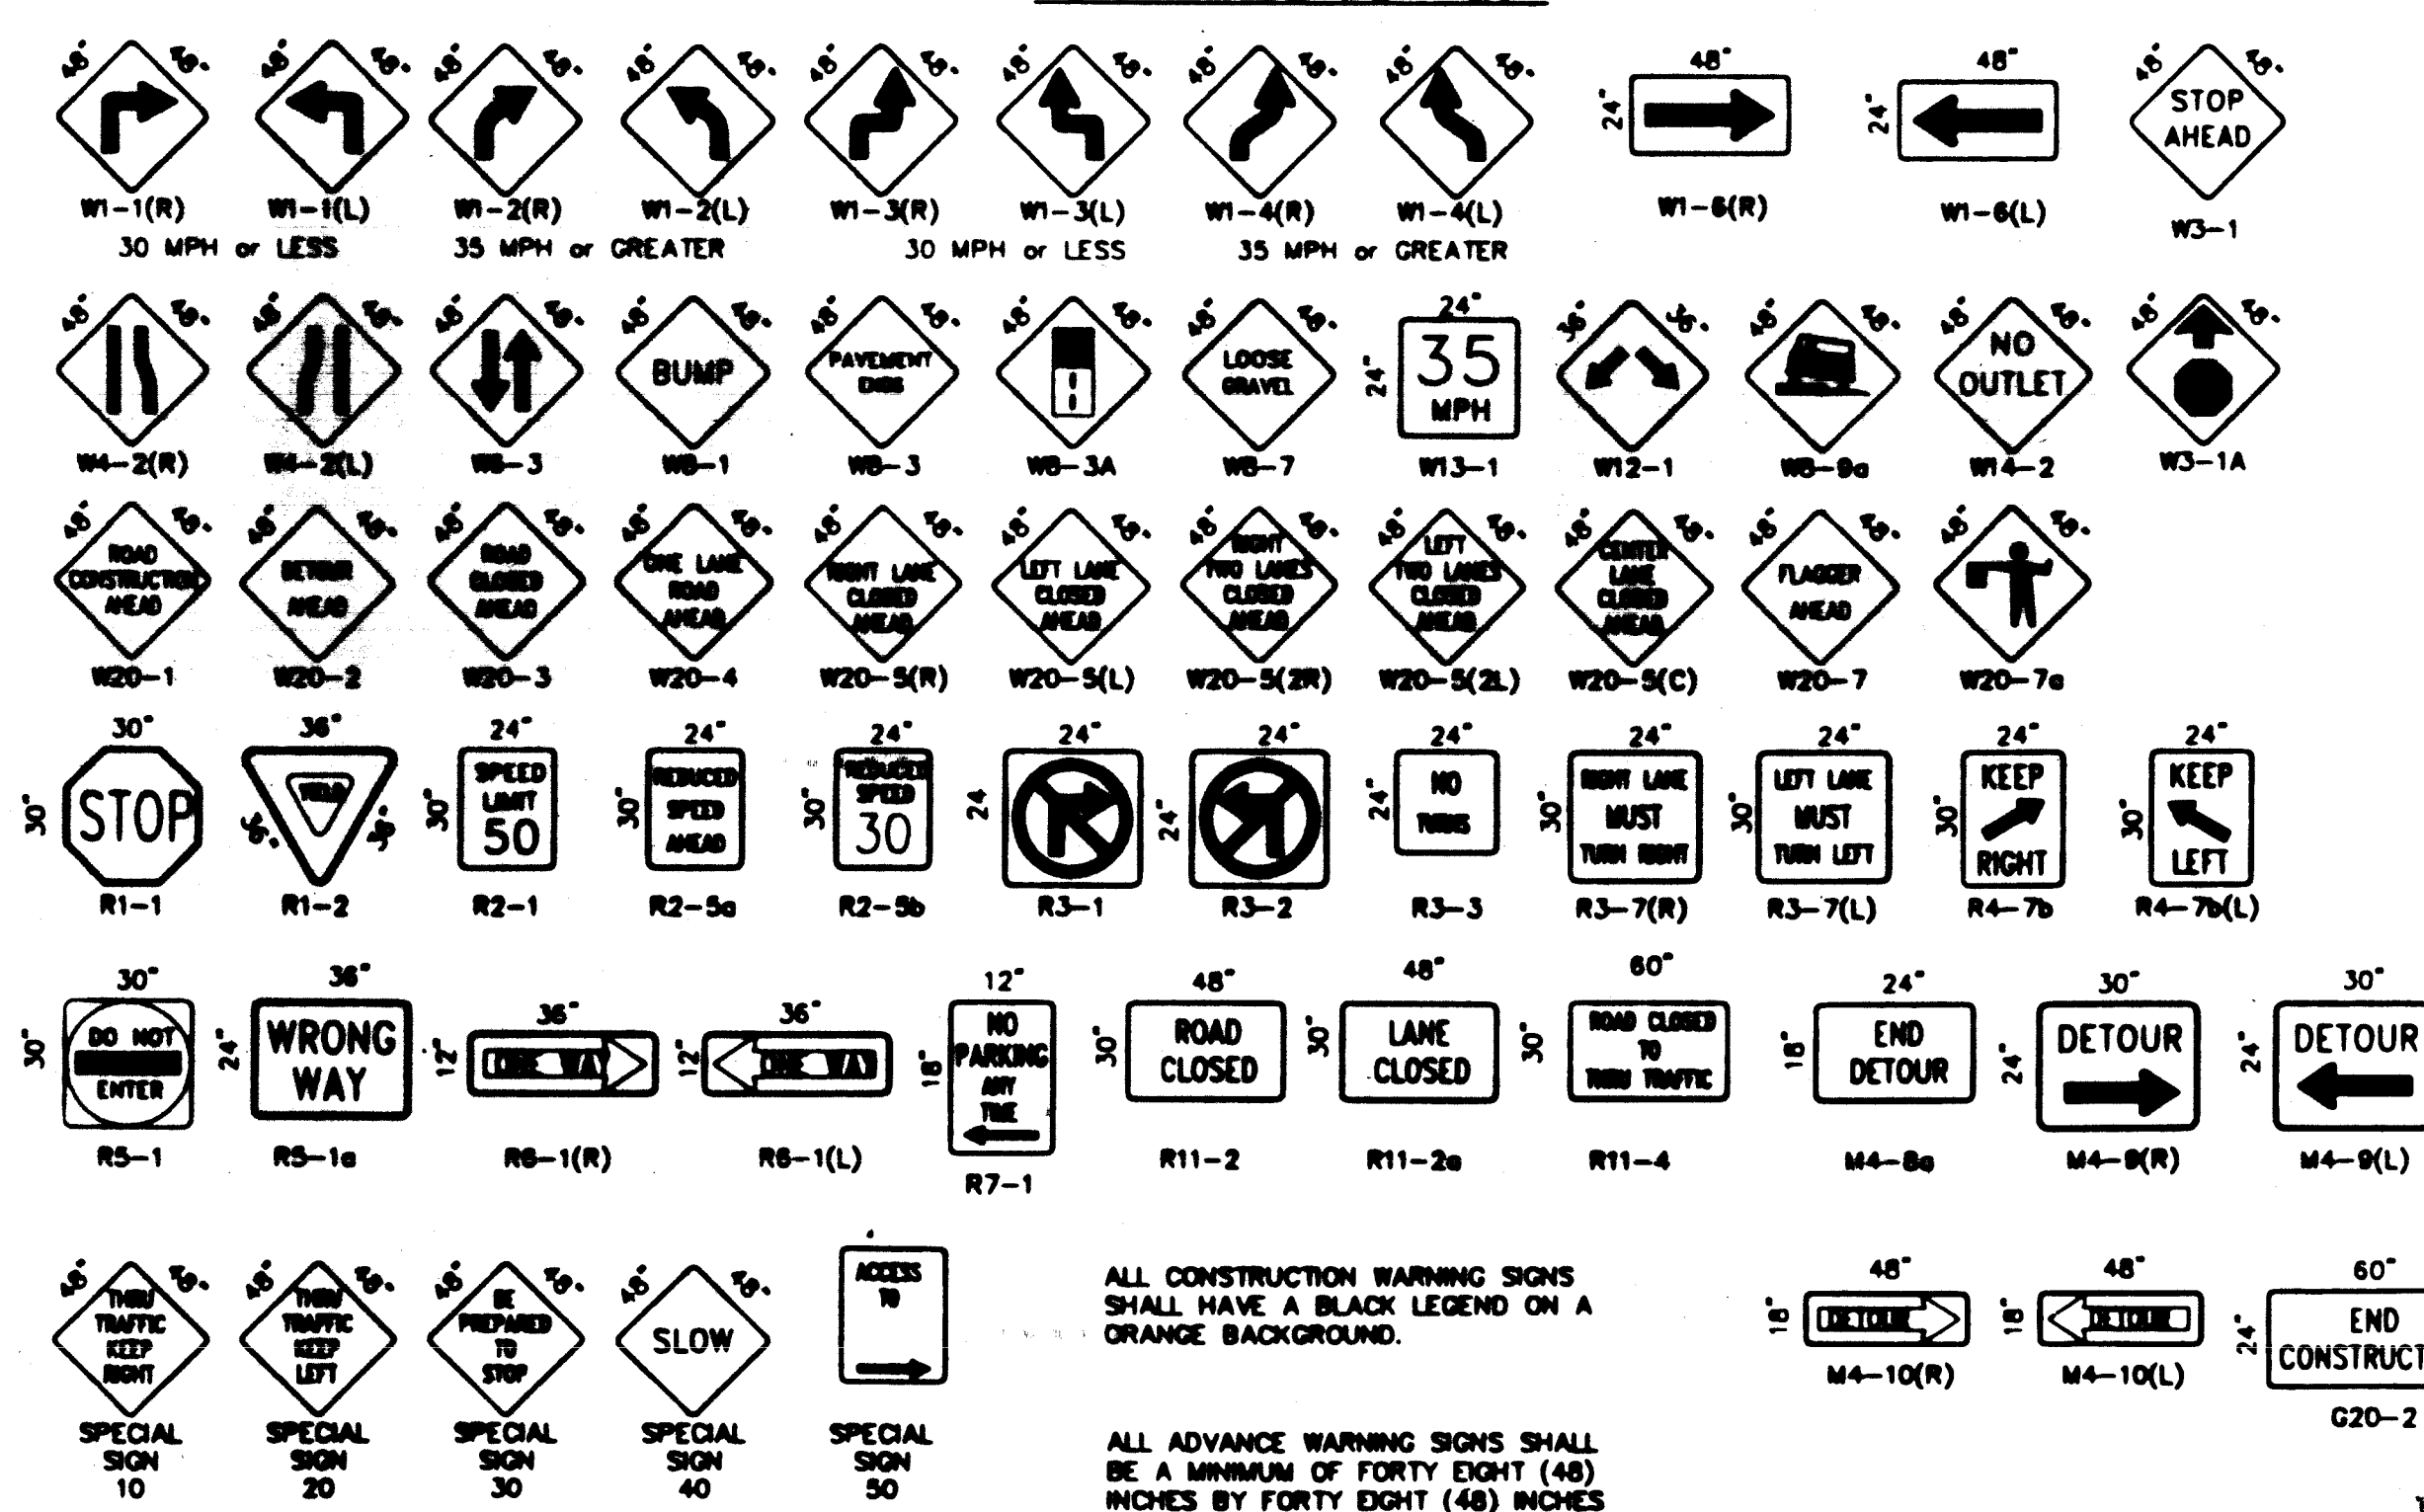

ALL CONSTRUCTION WARNING SIGNS SHALL HAVE A BLACK LEGEND ON A ORANGE BACKGROUND.

ALL ADVANCE WARNING SIGNS SHALL BE A MINIMUM OF FORTY EIGHT (48) INCHES BY FORTY EIGHT (48) INCHES IN SIZE AND SHALL HAVE ONE WARNING LIGHT.

AS-BUILT INFORMATION			
CONTRACTOR	DATE	BY	DATE
DESIGNED BY	DATE	BY	DATE
CHECKED BY	DATE	BY	DATE
REVISIONS	DATE	BY	DATE
MICRO-FILM INFORMATION			
RECORDED BY	DATE	BY	DATE

CITY OF ALBUQUERQUE PUBLIC WORKS DEPARTMENT ENGINEERING GROUP					
TITLE: SIGNING AND CONSTRUCTION TRAFFIC CONTROL STANDARDS					
APPROVALS	ENGINEER	DATE	APPROVALS	ENGINEER	DATE
DRG CHAIRMAN	5/12/99		WATER		
TRANSPORTATION	WLB BHD	5/12/99	WASTE WATER		
HYDROLOGY	12/1/99				
PROJECT NO.	4779.94	MAP NO.		SHEET 13 OF 14	

