


• L E G E N D •


MATERIALS

CONCRETE
RIP-RAP

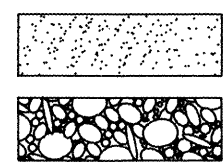


LINES

SUBDIVISION BOUNDARY
PROPERTY LINE (PLAN)
PROPERTY LINE (SECTION)
CENTERLINE
EASEMENT LINE
MATCH LINE
SECTION CUT LINE

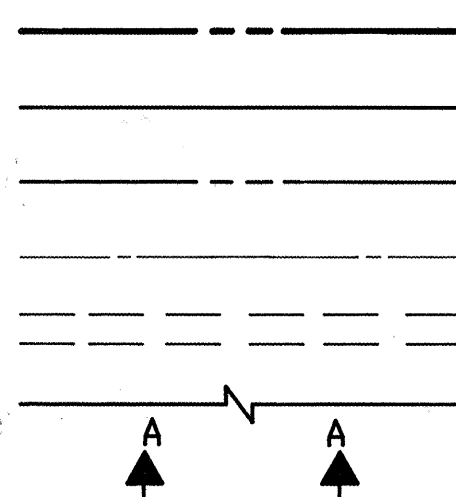


EARTHWORK

CONTOUR LINE
SPOT ELEVATION
PROJECT / PHASE BOUNDARY
FLOWLINE
DIRECTION OF FLOW

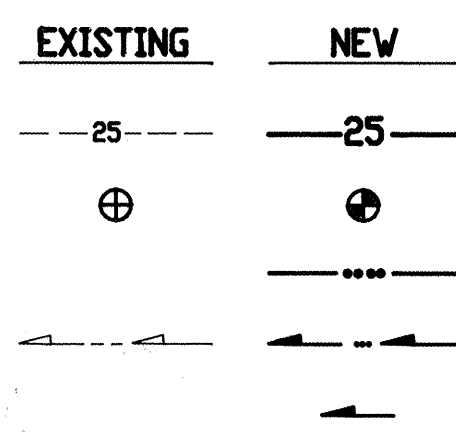


MISCELLANEOUS UTILITIES

GAS LINE
UNDERGROUND TELEPHONE
UNDERGROUND ELECTRICAL
STORM DRAIN
STORM DRAIN MANHOLE
STORM DRAIN INLET

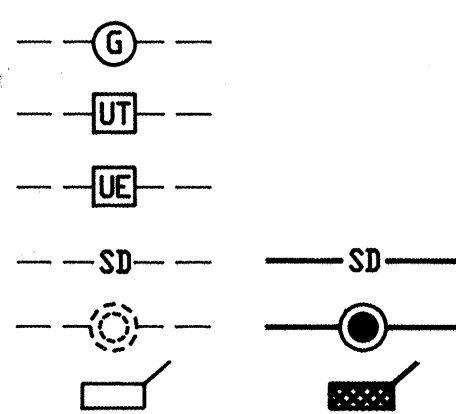


SANITARY SEWER

SANITARY SEWER LINE
SANITARY SEWER MANHOLE
SAS SERVICE CONNECTIONS
SAS CAP OR PLUG
ENCASEMENT

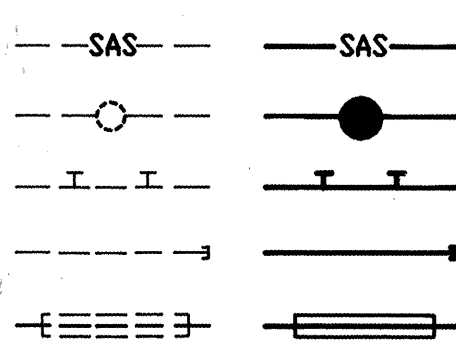


WATER

WATER LINE
WATER SERVICE CONNECTIONS
GATE VALVE
FIRE HYDRANT
BUTTERFLY VALVE
REDUCER
WATER PRESSURE ZONE BOUNDARY

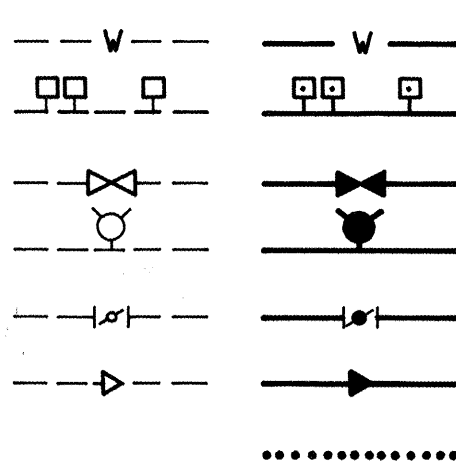


WATER FITTINGS

CAPS AND PLUGS
ELBOW
CROSS
TEE

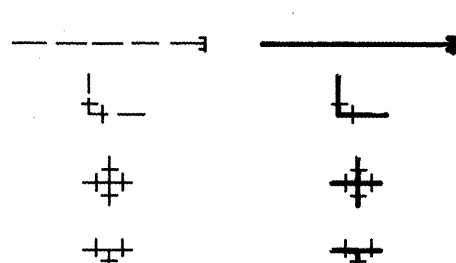

MISCELLANEOUS

CHAINLINK FENCE
FIELD FENCE
COMMON YARD WALL
RETAINING WALL
POWER OR TELEPHONE POLE

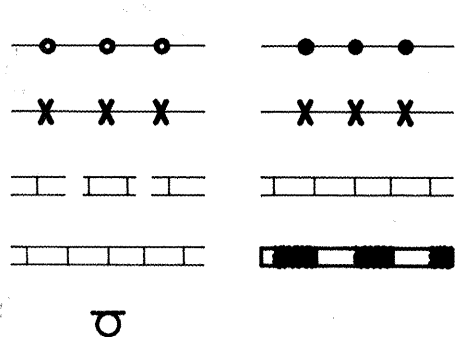

CONSTRUCTION PLANS for WILSON MIDDLE SCHOOL STORM DRAIN AND WATERLINE EXTENSIONS ALBUQUERQUE, NEW MEXICO OCTOBER, 1993

RECORD DRAWING

INDEX OF DRAWINGS

SHEET	DESCRIPTION
1	COVER SHEET, VICINITY MAP, GENERAL NOTES, LEGEND, INDEX OF DRAWINGS
2	EASEMENT SURVEY
3	GRADING AND DRAINAGE PLAN - PH.1
4	GRADING AND DRAINAGE PLAN - PH.1
5	WATER AND STORM DRAIN EXTENSIONS PLAN AND PROFILE
6	STA. 10+00.00 TO STA. 16+00.00
7	WATER AND STORM DRAIN IMPROVEMENTS
8	SECTIONS AND DETAILS, PAVEMENT SECTIONS AND DETAILS
9	SIGNING AND CONSTRUCTION TRAFFIC CONTROL STANDARDS
10	TYPICAL TRAFFIC CONTROL AND SIGNING EXAMPLES

RECORD DRAWING
I, Jeffrey G. Mortensen, Registered Professional Engineer in the State of New Mexico, do hereby certify that this "as-built" information was obtained by me or under my supervision and represents the "as-built" conditions of this project, and is true and correct to the best of my knowledge and belief. All vertical and horizontal dimensions should be field verified prior to use on future projects.
Jeffrey G. Mortensen
NMPE No. 12547
Date 02-22-94
NEW MEXICO
REGISTERED PROFESSIONAL ENGINEER


FOR INFORMATION ONLY

APPROVAL OF DRAWINGS
CHIEF CONSTRUCTION ENGINEER
Date 9/15/93

REV.	SHEETS	CITY ENGINEER	DATE	USER DEPARTMENT	DATE	USER DEPARTMENT	DATE


APPROVAL OF REVISIONS

		APPROVED FOR CONSTRUCTION DATE 9/15/93
10-27-93	PROJECT NO. 478990	SHEET 1 OF 8

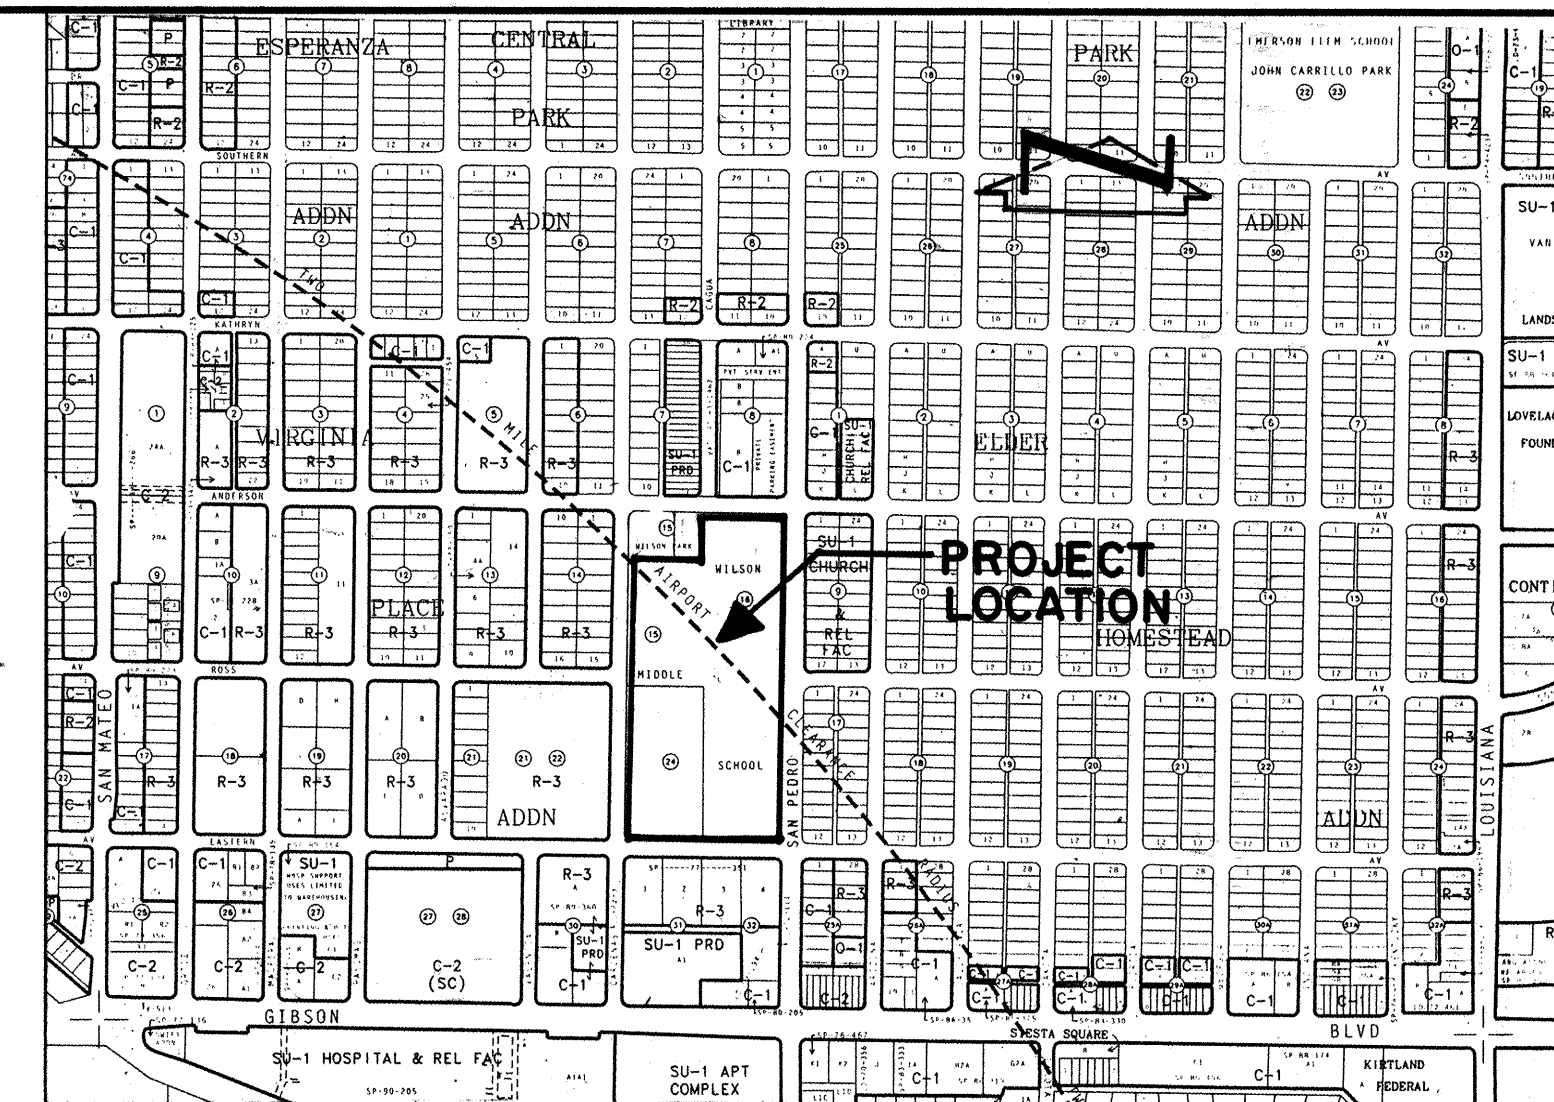

VICINITY MAP
SCALE: 1" = 750' (APPROX.)

- GENERAL NOTES:
- ALL WORK DETAILED ON THESE PLANS TO BE PERFORMED UNDER CONTRACT SHALL, EXCEPT AS OTHERWISE STATED OR PROVIDED FOR HEREON, BE CONSTRUCTED IN ACCORDANCE WITH THE CITY OF ALBUQUERQUE STANDARD SPECIFICATIONS - PUBLIC WORKS CONSTRUCTION - 1986. (UPDATE NO. 4)
 - TWO (2) WORKING DAYS PRIOR TO ANY EXCAVATION, CONTRACTOR MUST CONTACT NEW MEXICO ONE CALL SYSTEM, 260-1990, FOR LOCATION OF EXISTING UTILITIES. FOR ON-SITE LOCATIONS OF EXISTING UTILITIES CONTACT KEITH RUTHERFORD OF APS AT 765-5950 OR BILL BENNETT OF BRADBURY & STAMM AT 1-252-0956.
 - IF ANY UTILITY LINES, PIPELINES, OR UNDERGROUND UTILITY LINES ARE SHOWN ON THESE DRAWINGS, THEY ARE SHOWN IN AN APPROXIMATE MANNER ONLY, AND SUCH LINES MAY EXIST WHERE NONE ARE SHOWN. IF ANY SUCH EXISTING LINES ARE SHOWN, THE LOCATION IS BASED UPON INFORMATION PROVIDED BY THE OWNER OF SAID UTILITY, AND THE INFORMATION MAY BE INCOMPLETE, OR MAY BE OBSOLETE BY THE TIME CONSTRUCTION COMMENCES. THE ENGINEER HAS CONDUCTED ONLY PRELIMINARY INVESTIGATION OF THE LOCATION, DEPTH, SIZE, OR TYPE OF EXISTING UTILITY LINES, PIPELINES, OR UNDERGROUND UTILITY LINES. THIS INVESTIGATION IS NOT CONCLUSIVE, AND MAY NOT BE COMPLETE. THEREFORE, MAKES NO REPRESENTATION PERTAINING THERETO, AND ASSUMES NO RESPONSIBILITY OR LIABILITY THEREFOR. THE CONTRACTOR SHALL INFORM ITSELF OF THE LOCATION OF ANY UTILITY LINE, PIPELINE, OR UNDERGROUND UTILITY LINE IN OR NEAR THE AREA OF THE WORK IN ADVANCE OF AND DURING EXCAVATION WORK. THE CONTRACTOR IS FULLY RESPONSIBLE FOR ANY AND ALL DAMAGE CAUSED BY ITS FAILURE TO LOCATE, IDENTIFY AND PRESERVE ANY AND ALL EXISTING UTILITIES, PIPELINES, AND UNDERGROUND UTILITY LINES. IN PLANNING AND CONDUCTING EXCAVATION, THE CONTRACTOR SHALL COMPLY WITH STATE, MUNICIPAL, AND LOCAL ORDINANCES, RULES AND REGULATIONS, IF ANY, PERTAINING TO THE LOCATION OF THESE LINES AND FACILITIES.
 - SHOULD A CONFLICT EXIST BETWEEN THESE PLANS AND ACTUAL FIELD CONDITIONS, THE CONTRACTOR SHALL PROMPTLY NOTIFY THE ENGINEER IN WRITING SO THAT THE CONFLICT CAN BE RESOLVED WITH A MINIMUM AMOUNT OF DELAY FOR ALL PARTIES.
 - THE CONTRACTOR SHALL MAINTAIN ACCESS TO ADJACENT PROPERTIES DURING CONSTRUCTION.
 - ALL WORK ON THIS PROJECT SHALL BE PERFORMED IN ACCORDANCE WITH APPLICABLE FEDERAL, STATE AND LOCAL LAWS, RULES AND REGULATIONS CONCERNING SAFETY AND HEALTH.
 - ALL UTILITIES AND UTILITY SERVICE LINES SHALL BE INSTALLED PRIOR TO PAVING.
 - BACKFILL COMPACTION SHALL BE ACCORDING TO SPECIFIED STREET USE.
 - TACK COAT REQUIREMENTS SHALL BE DETERMINED DURING CONSTRUCTION BY THE PROJECT ENGINEER.
 - SIDEWALKS AND WHEELCHAIR RAMPS WITHIN THE CURB RETURNS SHALL BE CONSTRUCTED WHEREVER A NEW CURB RETURN IS CONSTRUCTED.
 - IF CURB IS DEEPENED FOR A DRIVEPAD OR A HANDICAP RAMP, THE DRIVEPAD OR RAMP SHALL BE CONSTRUCTED PRIOR TO ACCEPTANCE OF THE CURB AND GUTTER.
 - ALL STORM DRAINAGE FACILITIES SHALL BE COMPLETED PRIOR TO FINAL ACCEPTANCE.
 - CONTRACTOR SHALL COORDINATE WITH THE WATER SYSTEM DIVISION FOR THE EXECUTION OF THE VALVE SHUT OFF PLAN, NOT LESS THAN THREE (3) WORKING DAYS IN ADVANCE OF ANY WORK THAT MAY AFFECT THE EXISTING PUBLIC WATER UTILITIES. ONLY WATER SYSTEM DIVISION PERSONNEL SHALL OPERATE EXISTING VALVES. REFER TO SECTION 18 OF THE SPECIFICATION.
 - CONTRACTOR SHALL NOTIFY THE ENGINEER NOT LESS THAN SEVEN (7) DAYS PRIOR TO STARTING WORK IN ORDER THAT THE ENGINEER MAY TAKE NECESSARY MEASURES TO INSURE THE PRESERVATION OF SURVEY MONUMENTS. CONTRACTOR SHALL NOT DISTURB PERMANENT SURVEY MONUMENTS WITHOUT THE CONSENT OF THE ENGINEER AND SHALL NOTIFY THE ENGINEER AND BEAR THE EXPENSE OF REPLACING ANY THAT MAY BE DISTURBED WITHOUT PERMISSION. REPLACEMENT SHALL BE DONE ONLY BY THE ENGINEER. WHEN A CHANGE IS MADE IN THE FINISHED ELEVATION OF THE PAVEMENT OF ANY ROADWAY IN WHICH A PERMANENT SURVEY MONUMENT IS LOCATED, CONTRACTOR SHALL AT HIS OWN EXPENSE, ADJUST THE MONUMENT COVER TO THE NEW GRADE UNLESS OTHERWISE SPECIFIED. REFER TO SECTION 4.4 OF THE SPECIFICATIONS.
 - THREE (3) WORKING DAYS PRIOR TO BEGINNING CONSTRUCTION THE CONTRACTOR SHALL SUBMIT TO THE CONSTRUCTION CO-ORDINATION DIVISION A DETAILED CONSTRUCTION SCHEDULE. TWO (2) WORKING DAYS PRIOR TO CONSTRUCTION THE CONTRACTOR SHALL OBTAIN A BARRICADE PERMIT FROM THE CONSTRUCTION CO-ORDINATION DIVISION. CONTRACTOR SHALL NOTIFY BARRICADE ENGINEER (768-2551) PRIOR TO OCCUPYING AN INTERSECTION. CONTRACTOR MUST REFER TO SECTION 19 OF THE STANDARD SPECIFICATION FOR TRAFFIC CONTROL.
 - ALL STREET STRIPING ALTERED OR DESTROYED SHALL BE REPLACED IN KIND BY CONTRACTOR TO LOCATION AND IN KIND AS EXISTING OR AS INDICATED BY THIS PLAN SET.
 - CAUTION: THESE DRAWINGS DO NOT INCLUDE NECESSARY COMPONENTS FOR CONSTRUCTION SAFETY WHICH SHALL REMAIN THE RESPONSIBILITY OF THE CONTRACTOR.

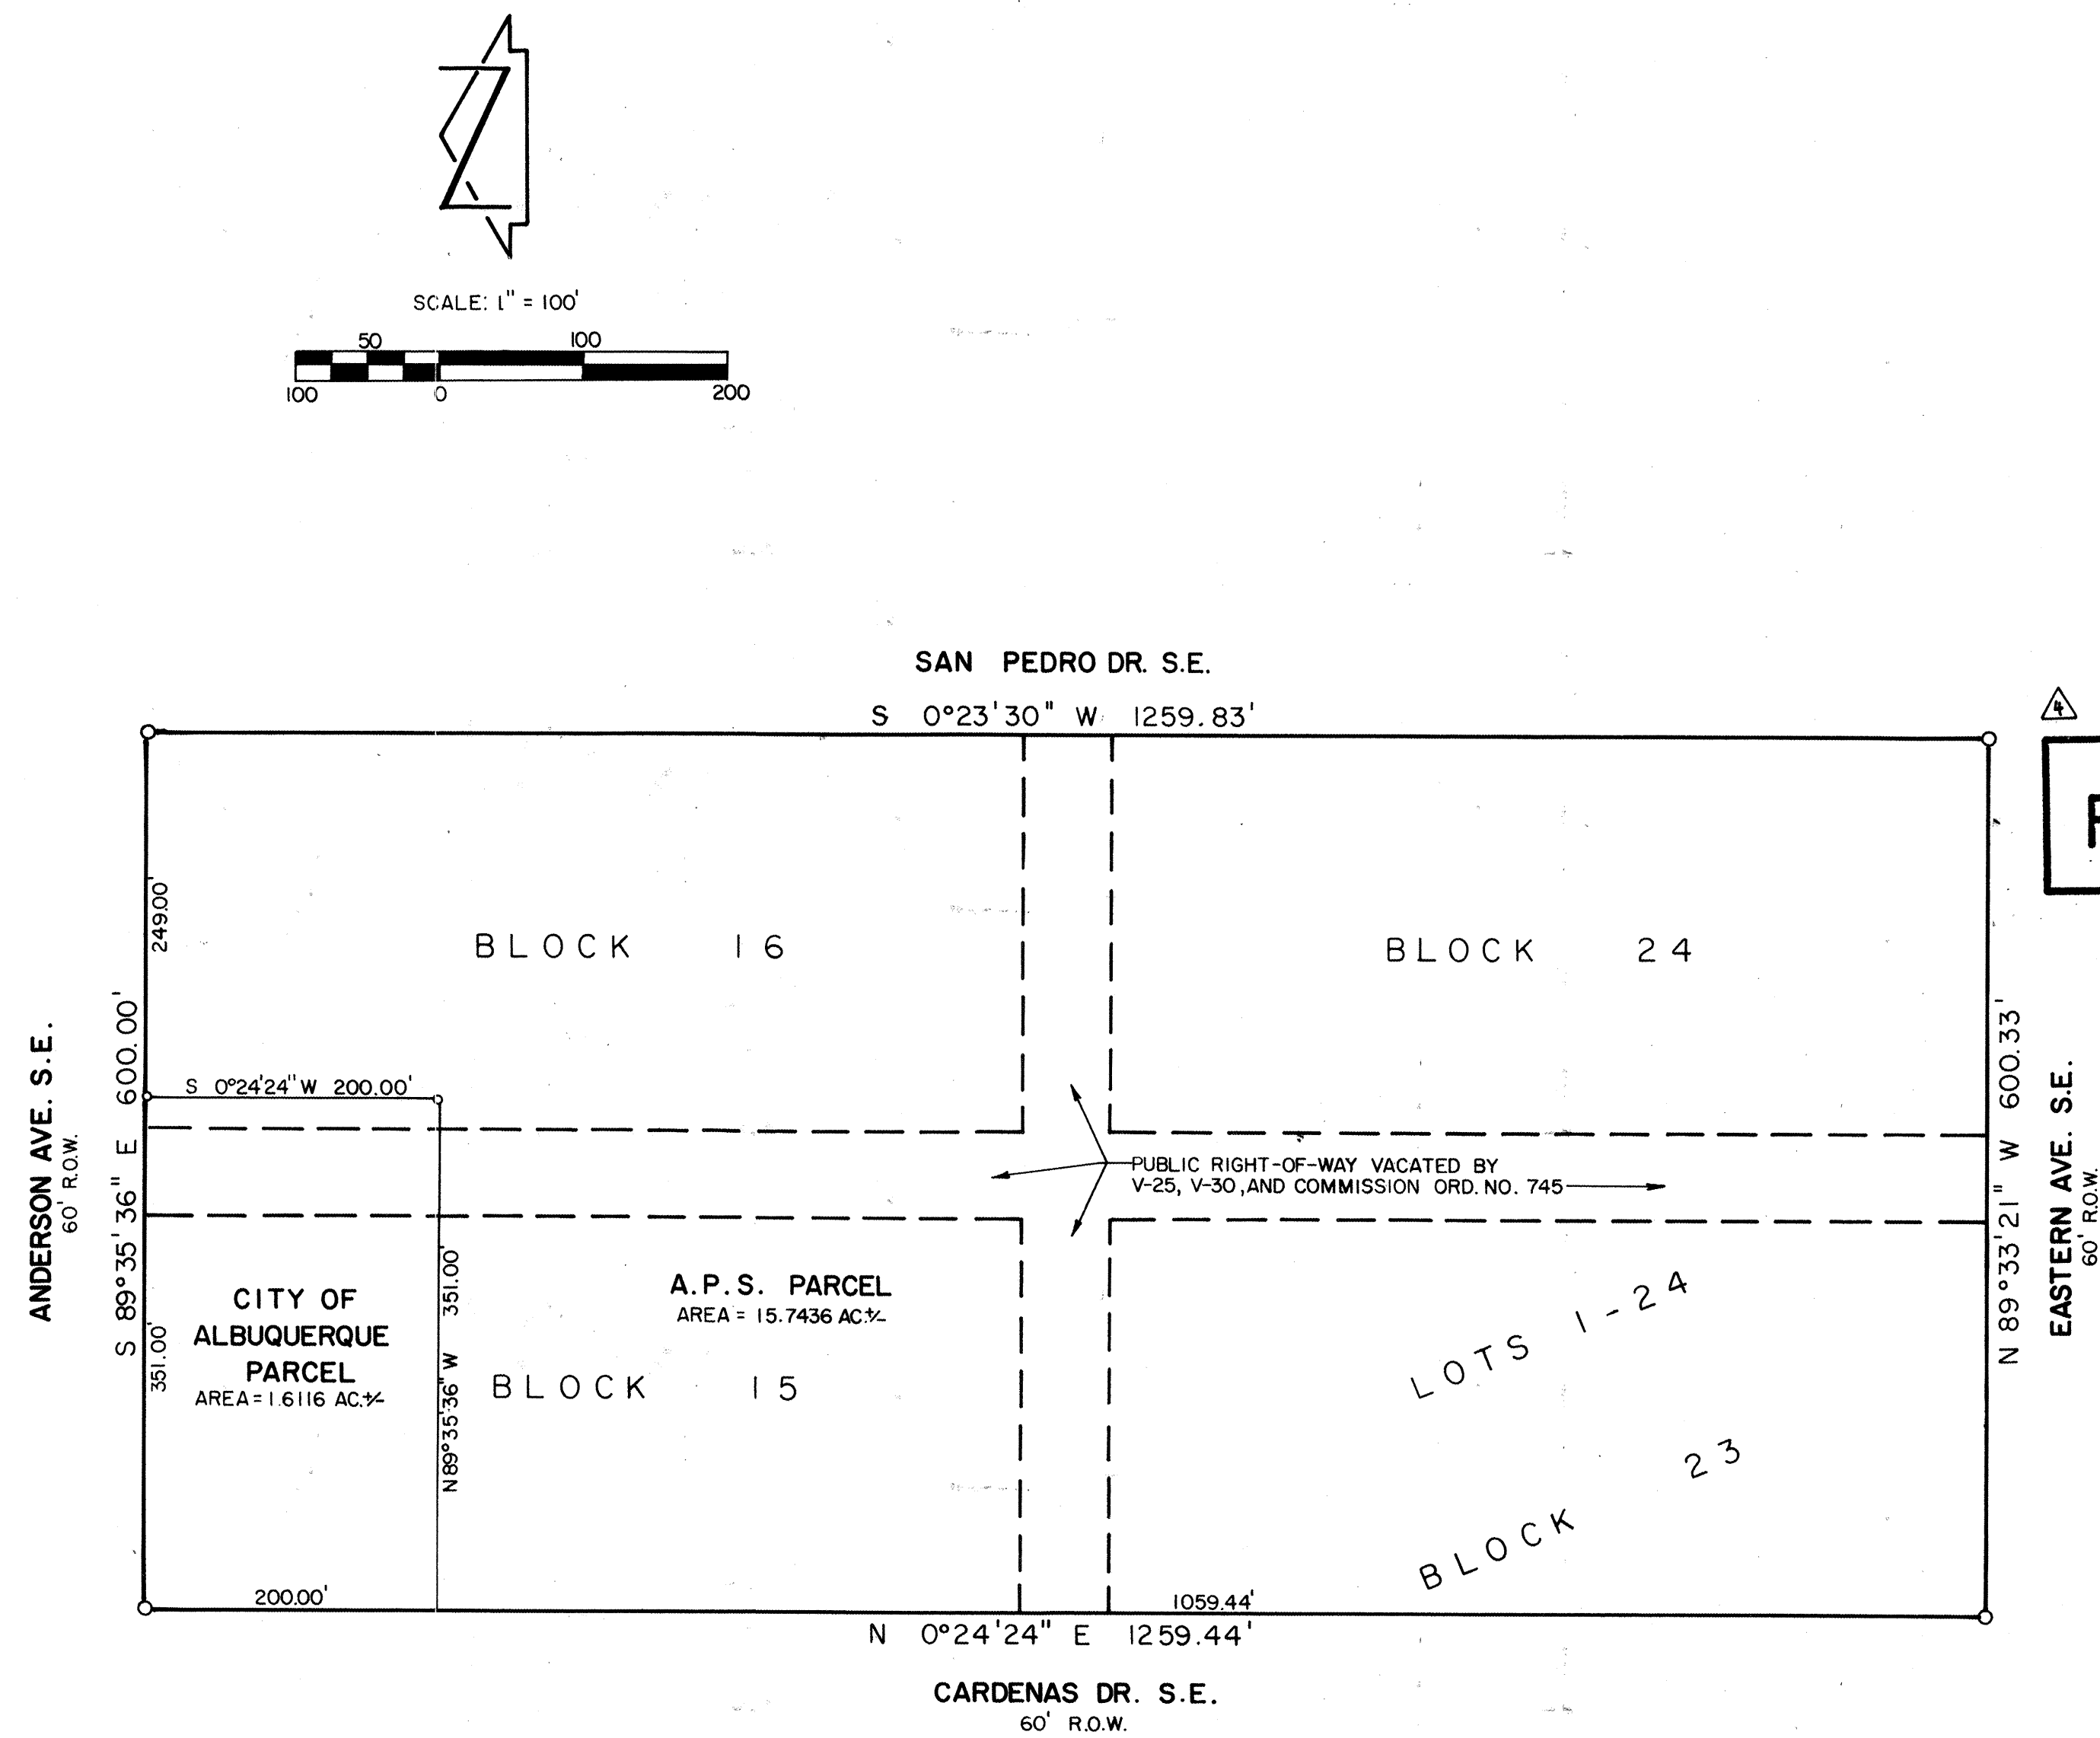


RECORD DRAWING

910993

CITY OF ALBUQUERQUE PUBLIC WORKS DEPARTMENT ENGINEERING GROUP					
TITLE: WILSON MIDDLE SCHOOL EASEMENT SURVEY					
APPROVALS	ENGINEER	DATE	APPROVALS	ENGINEER	DATE
DRC CHAIRMAN	<i>B. J. A.</i>	<i>12/12/93</i>	WATER	<i>NA GSA</i>	<i>12/12/93</i>
TRANSPORTATION			WASTE WATER		
HYDROLOGY	<i>B. Montoya</i>	<i>12/12/93</i>			
PROJECT NO.		MAP NO.	SHEET		OF
4789.90		L18	2		8

SURVEY INFORMATION		BENCH MARKS		AS BUILT INFORMATION	
NO.	FIELD NOTES	DATE	CONTRACTOR	WORKED BY	DATE
	BY				
N/A	W.P. PETTIT	07/91		INSPECTOR'S	DATE
				ACCEPTANCE BY	DATE
				VERIFICATION BY	DATE
				DRAWINGS	DATE
				BY	DATE
				MICRO-FILM INFORMATION	
				RECORDED BY	DATE
				NO.	

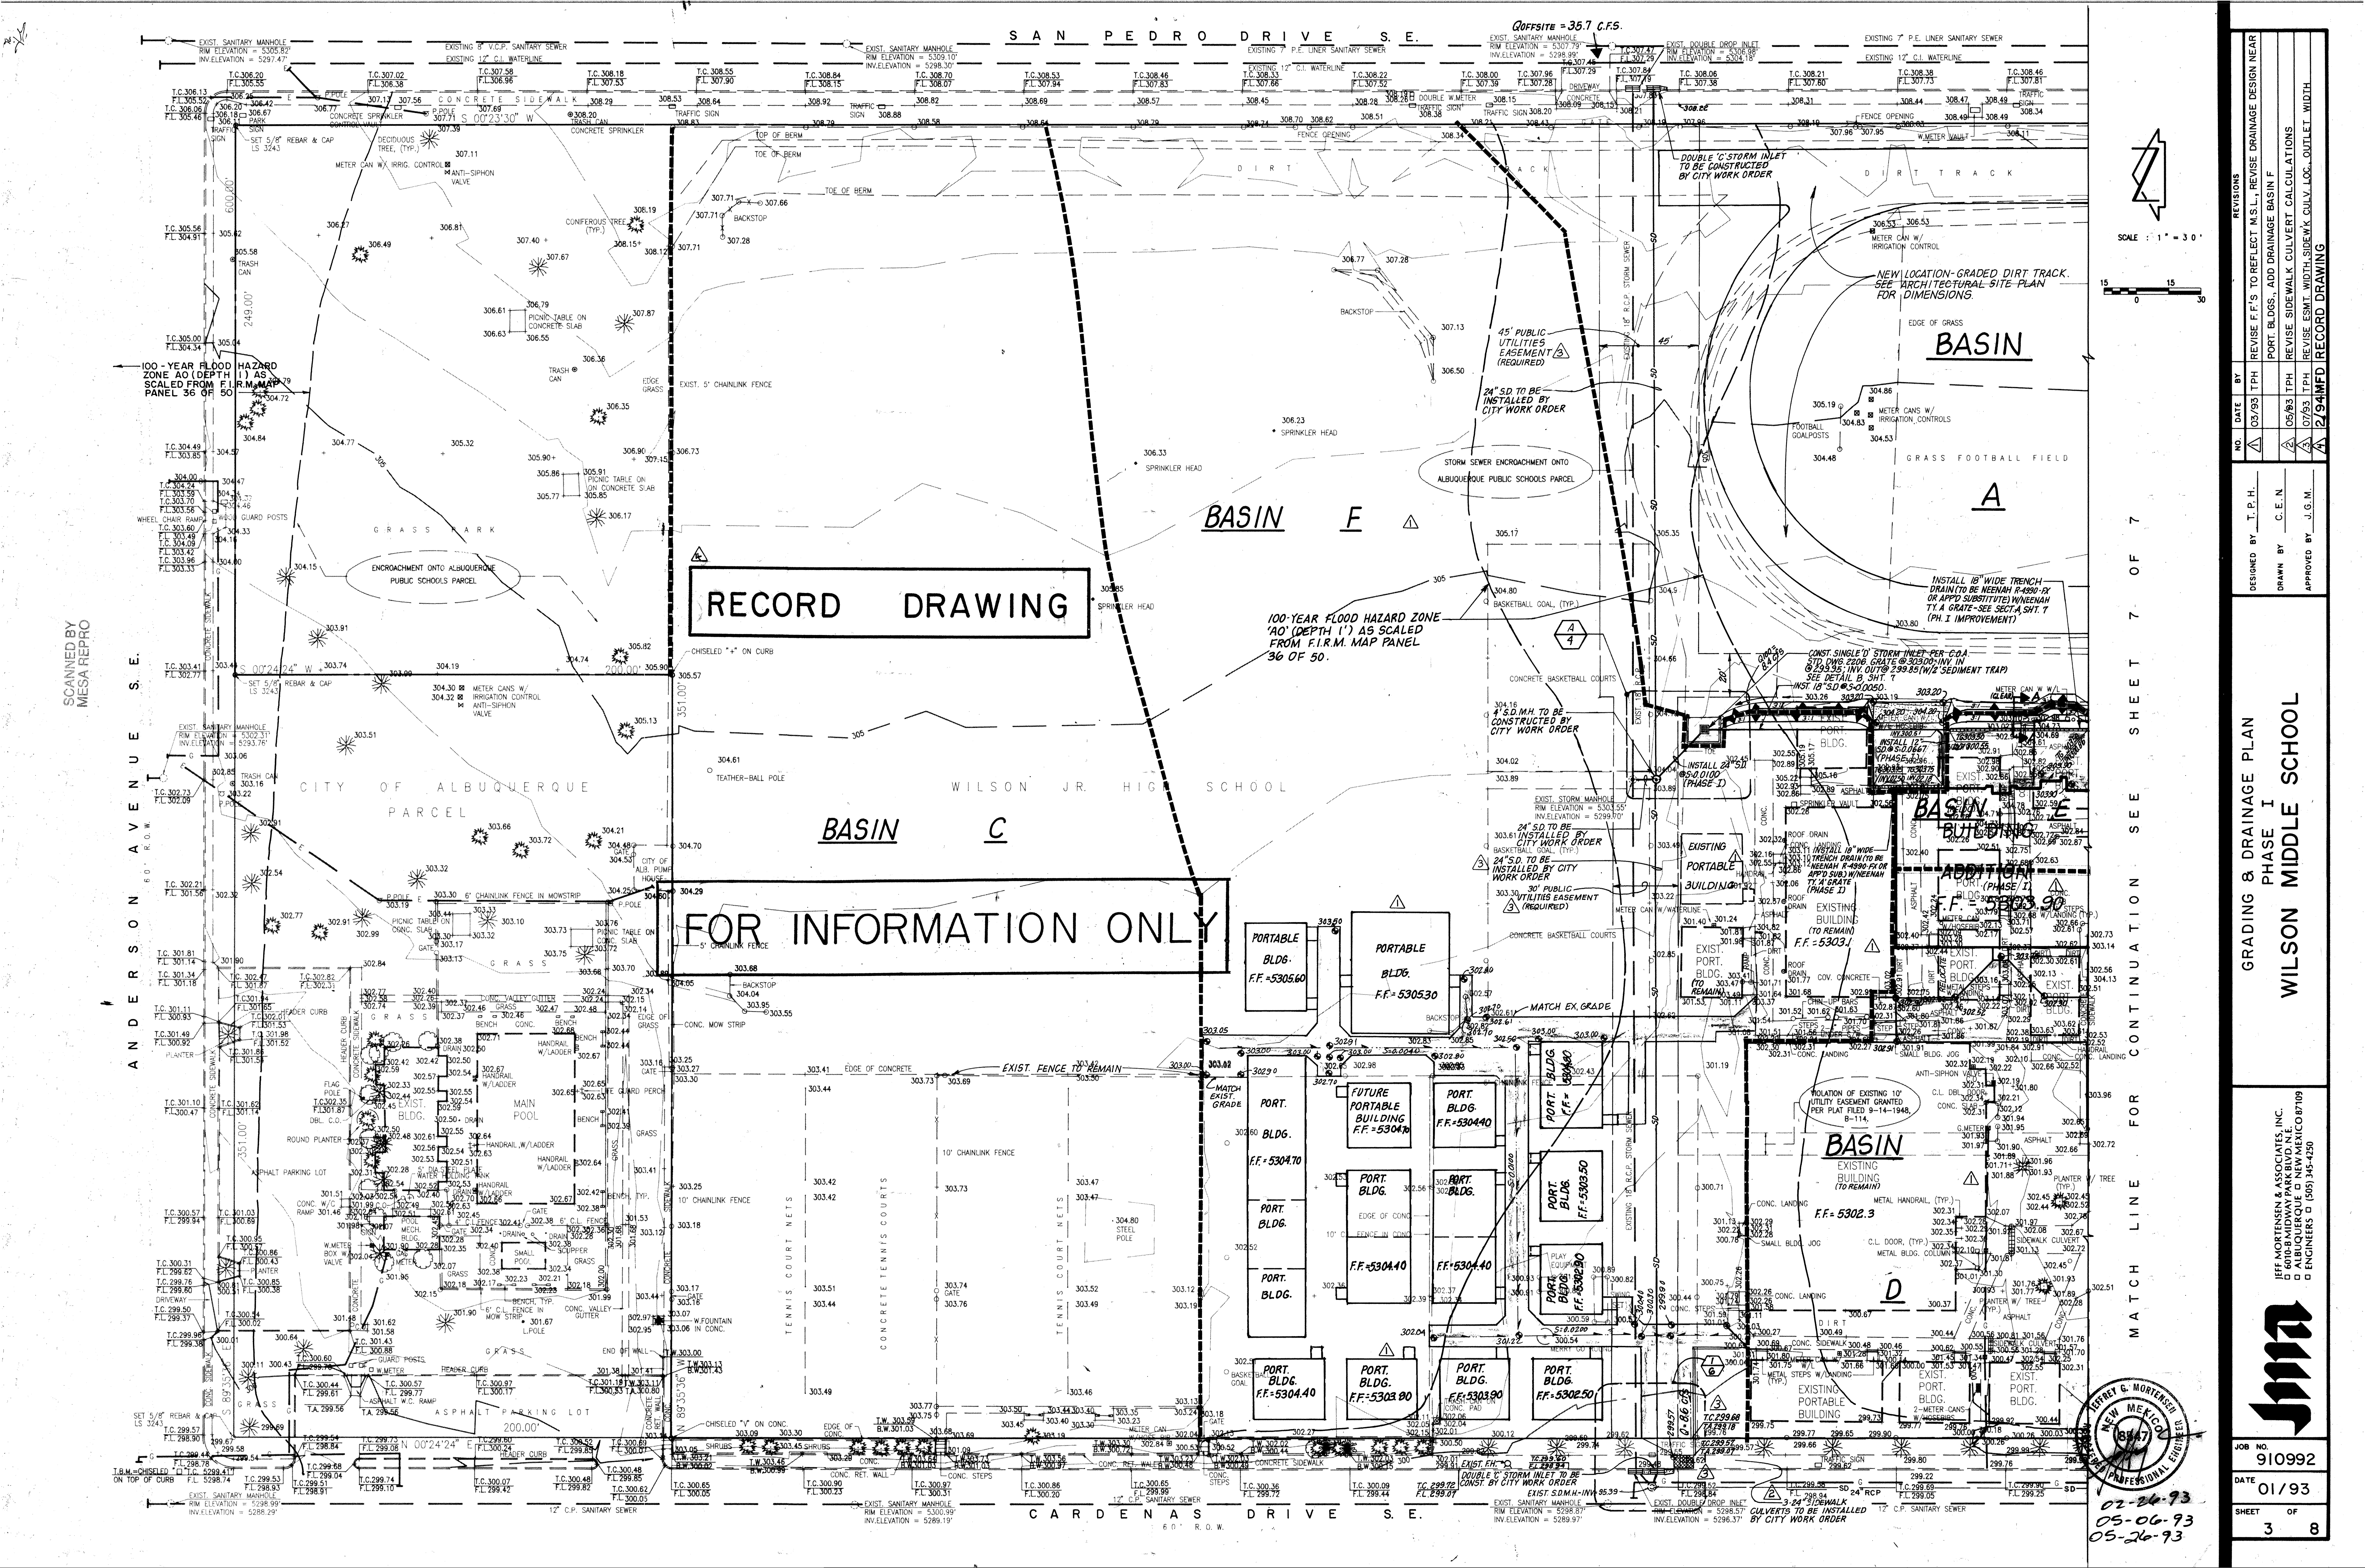

REVISIONS	
NO.	DATE
1	02/93
2	05/93
3	07/93
4	12/94

DESIGNED BY	DATE
T.P.H.	02/93

DRAWN BY	DATE
C.E.N.	05/93

APPROVED BY	DATE
J.G.M.	07/93



REVISIONS
1. REVISE F.F.'S TO REFLECT M.S.L. REVISE DRAINAGE DESIGN NEAR
2. PORT. BLDGS. ADD DRAINAGE BASIN F
3. REVISE SIDEWALK CULVERT CALCULATIONS
4. REVISE SIDEWALK CULVERT LOC. OUTLET WIDTH

GRADING & DRAINAGE PLAN PHASE I
WILSON MIDDLE SCHOOL


JEFF MORTENSEN & ASSOCIATES, INC.
600 B MIDWAY PARK BLVD N.E.
ALBUQUERQUE, N.M. 87109
ENGINEERS (505) 445-4250

J.M. ENGINEERS
NEW MEXICO
1997

JOB NO. 910992
DATE 01/93
SHEET 3 OF 8

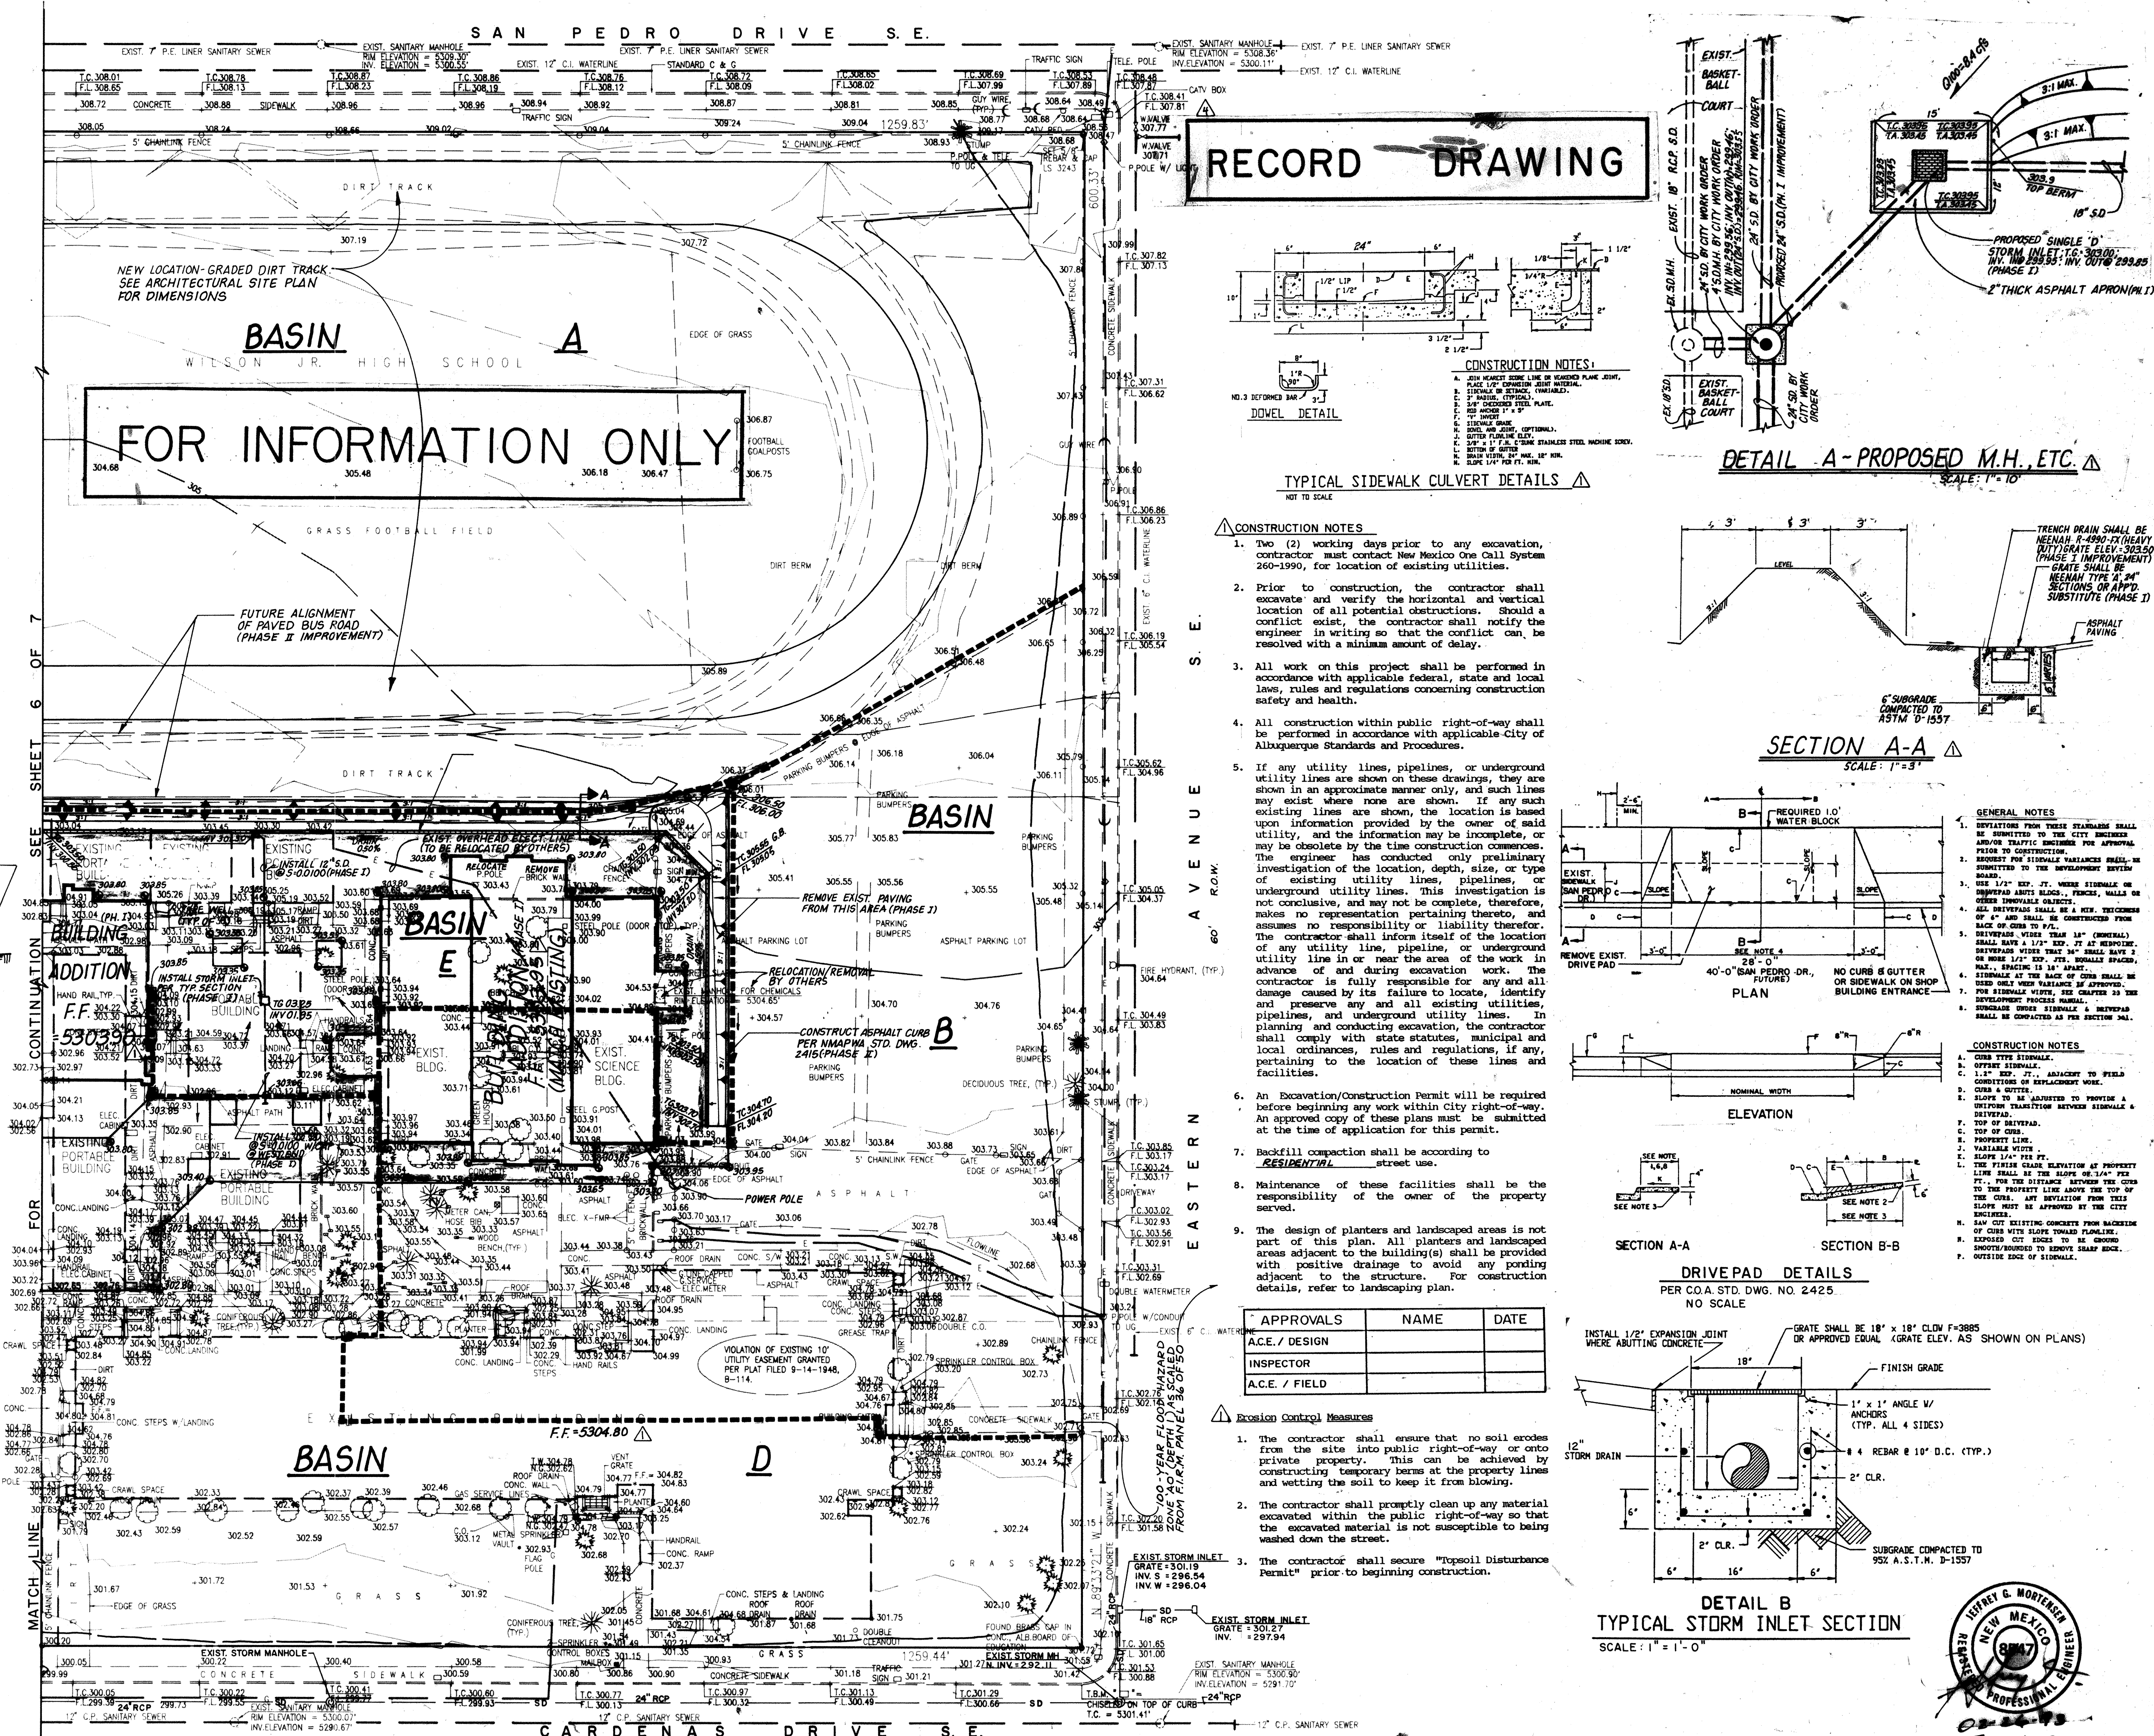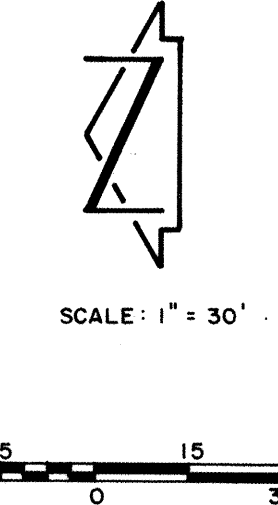


RECORD DRAWING

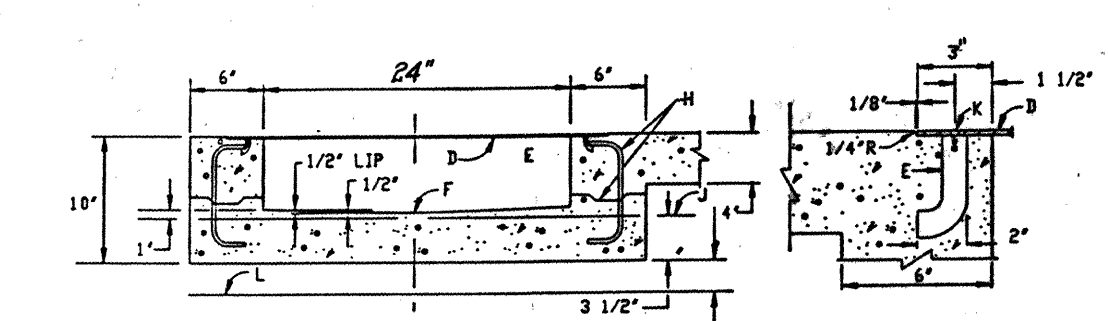


- ### CONSTRUCTION NOTES
- Two (2) working days prior to any excavation, contractor must contact New Mexico One Call System 260-1990, for location of existing utilities.
 - Prior to construction, the contractor shall excavate and verify the horizontal and vertical location of all potential obstructions. Should a conflict exist, the contractor shall notify the engineer in writing so that the conflict can be resolved with a minimum amount of delay.
 - All work on this project shall be performed in accordance with applicable federal, state and local laws, rules and regulations concerning construction safety and health.
 - All construction within public right-of-way shall be performed in accordance with applicable City of Albuquerque Standards and Procedures.
 - If any utility lines, pipelines, or underground utility lines are shown on these drawings, they are shown in an approximate manner only, and such lines may exist where none are shown. If any such existing lines are shown, the location is based upon information provided by the owner of said utility, and the information may be incomplete, or may be obsolete by the time construction commences. The engineer has conducted only preliminary investigation of the location, depth, and type of existing utility lines, pipelines, or underground utility lines. This investigation is not conclusive, and may not be complete, therefore, makes no representation pertaining thereto, and assumes no responsibility or liability therefor. The contractor shall inform itself of the location of any utility line, pipeline, or underground utility line in or near the area of the work in advance of and during excavation work. The contractor is fully responsible for any and all damage caused by its failure to locate, identify and preserve any and all existing utilities, pipelines, and underground utility lines. In planning and conducting excavation, the contractor shall comply with state statutes, municipal and local ordinances, rules and regulations, if any, pertaining to the location of these lines and facilities.
 - An Excavation/Construction Permit will be required before beginning any work within city right-of-way. An approved copy of these plans must be submitted at the time of application for this permit.
 - Backfill compaction shall be according to RESIDENTIAL street use.
 - Maintenance of these facilities shall be the responsibility of the owner of the property served.
 - The design of planters and landscaped areas is not part of this plan. All planters and landscaped areas adjacent to the building(s) shall be provided with positive drainage to avoid any ponding adjacent to the structure. For construction details, refer to landscaping plan.


TYPICAL SIDEWALK CULVERT DETAILS

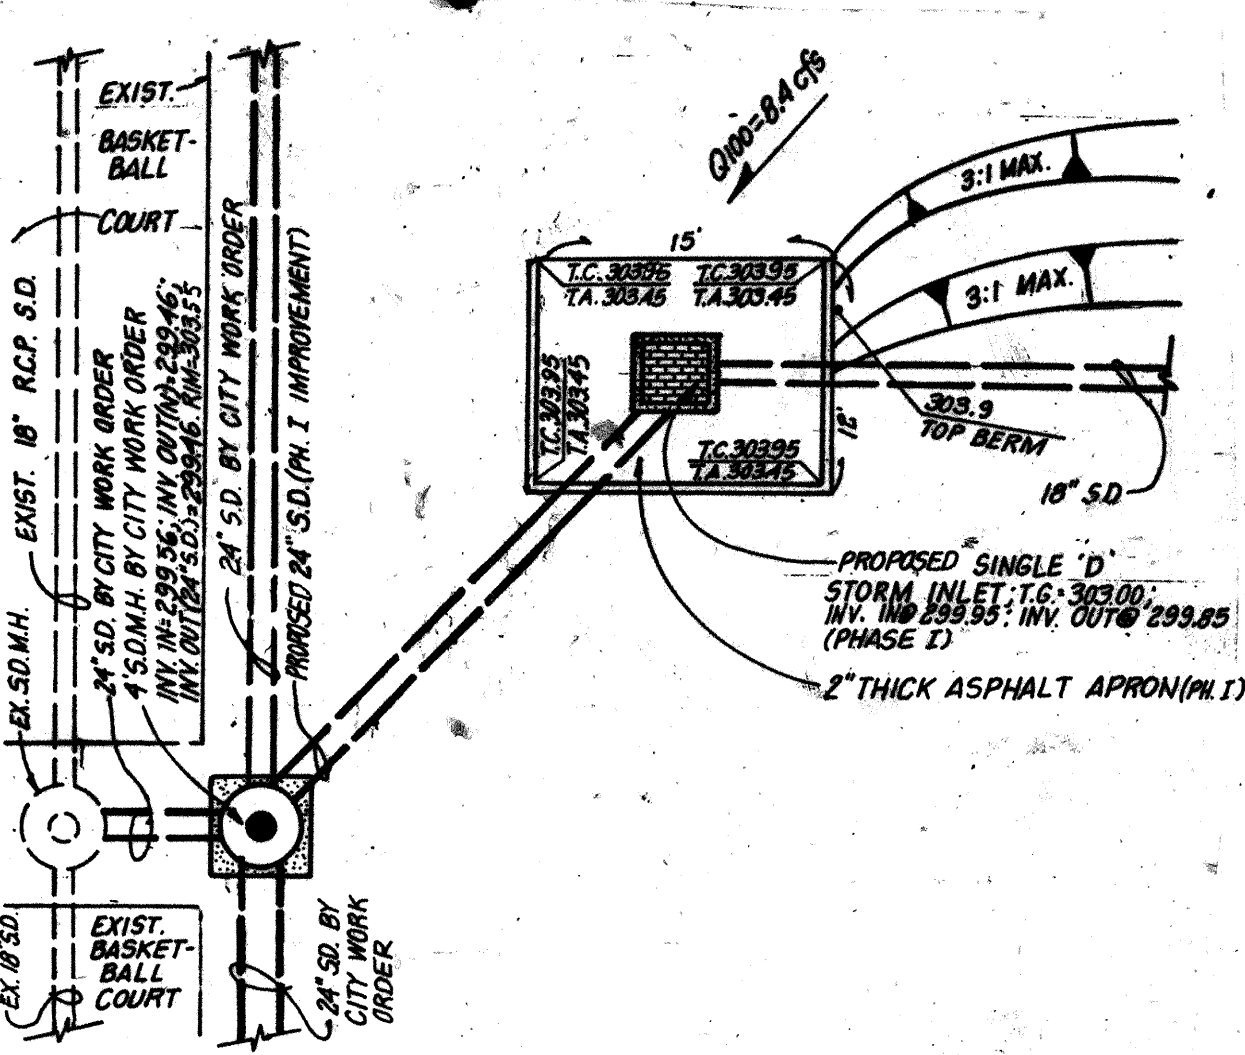


DETAIL A - PROPOSED M.H., ETC.

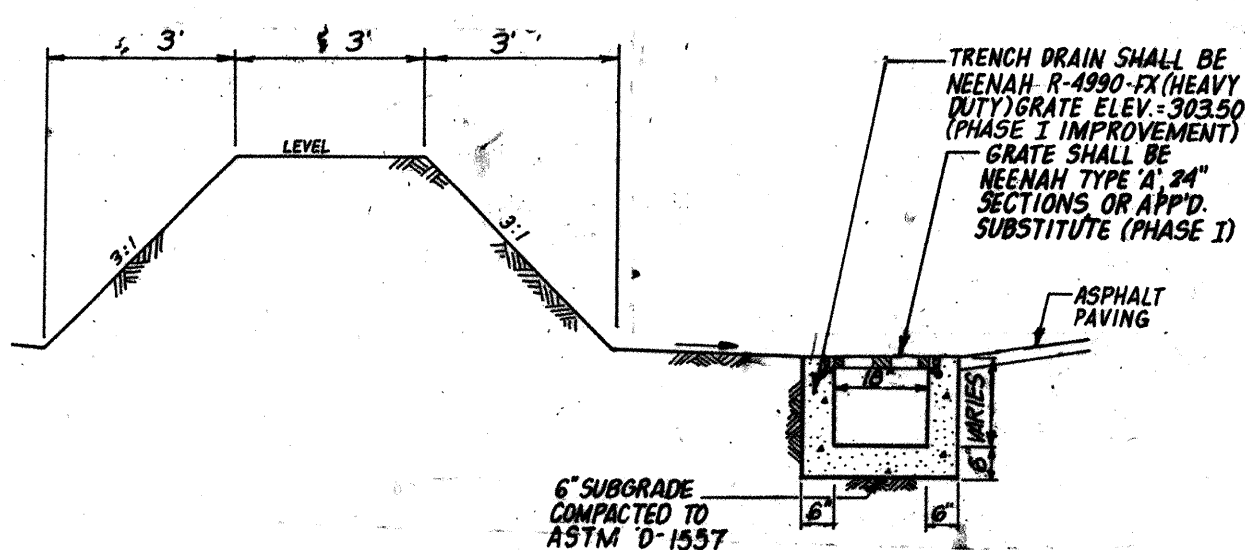


SECTION A-A

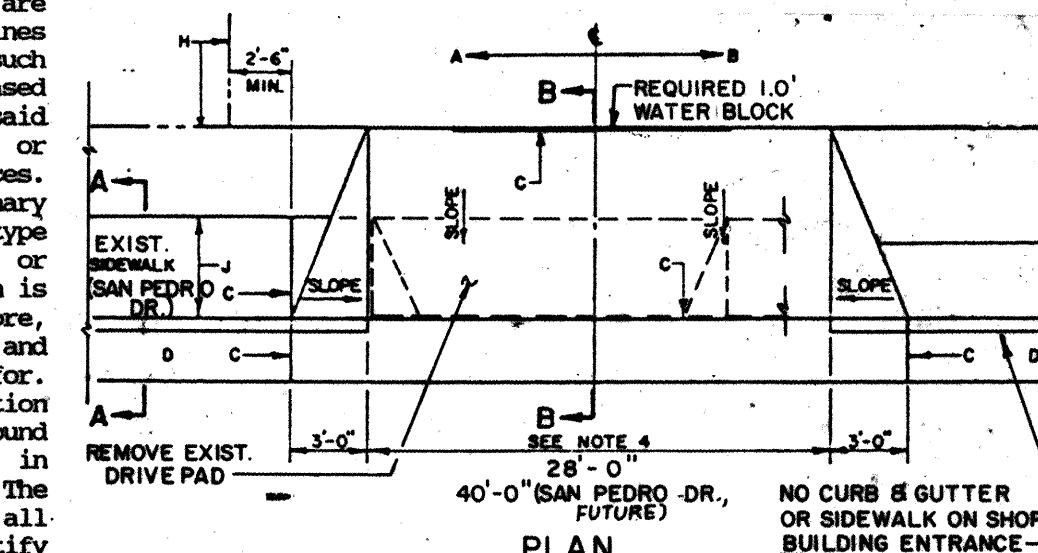

PLAN

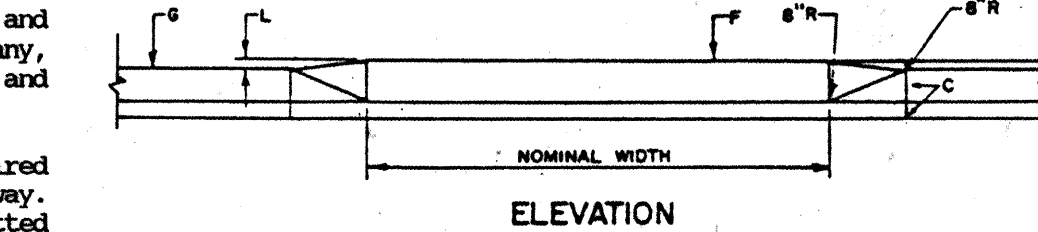

ELEVATION

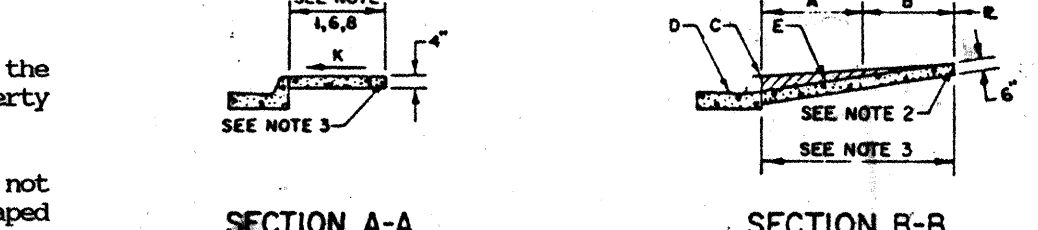


SECTION A-A

SECTION B-B

DRIVEPAD DETAILS

PER C.O.A. STD. DWG. NO. 2425
NO SCALE

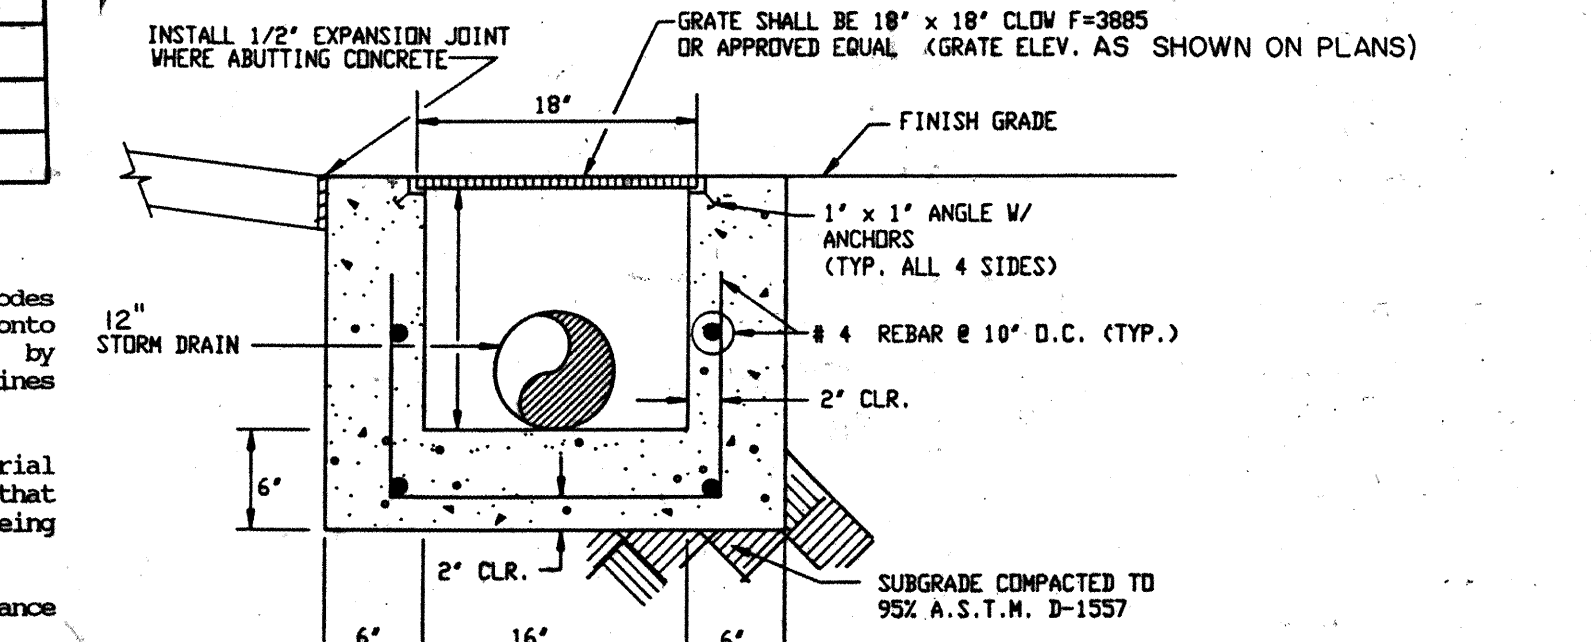

DETAIL B
TYPICAL STORM INLET SECTION

SCALE: 1" = 1'-0"

APPROVALS	NAME	DATE
A.C.E. / DESIGN		
INSPECTOR		
A.C.E. / FIELD		

Erosion Control Measures

- The contractor shall ensure that no soil erodes from the site into public right-of-way or onto private property. This can be achieved by constructing temporary berms at the property lines and wetting the soil to keep it from blowing.
- The contractor shall promptly clean up any material excavated within the public right-of-way so that the excavated material is not susceptible to being washed down the street.
- The contractor shall secure "Topsell Disturbance Permit" prior to beginning construction.

REVISIONS

NO.	DATE	BY	DESCRIPTION
1	03/93	TPH	ADD DETAIL A TO SHEET, ADD INLET & M.H. INV. ELEVATIONS, ADD SIDEWALK CULVERT DETAIL & SECTIONS A-A THRU E-E TO SHEET, ADD CONSTRUCTION NOTES, SIGN-OFF & EROSION CONTROL MEAS.
2	07/93	TPH	REVISE F.F.'S TO REFLECT M.S.L.
3	07/93	TPH	REVISE OUTLET WIDTH (SECTION 2/94 MFD RECORD DRAWING)


DESIGNED BY: T.P.H.
DRAWN BY: C.E.N.
APPROVED BY: J.G.M.

GRADING & DRAINAGE PLAN
PHASE I
WILSON MIDDLE SCHOOL

JEFF MORTENSEN & ASSOCIATES, INC.
4400 MIDWAY PARK BLVD. N.E.
ALBUQUERQUE, N.M. 87109
TEL: 505-263-4250

JM
JEFF MORTENSEN
REGISTERED PROFESSIONAL ENGINEER
NEW MEXICO
05-06-93

JOB NO. 910992
DATE 01/93
SHEET 4 OF 8

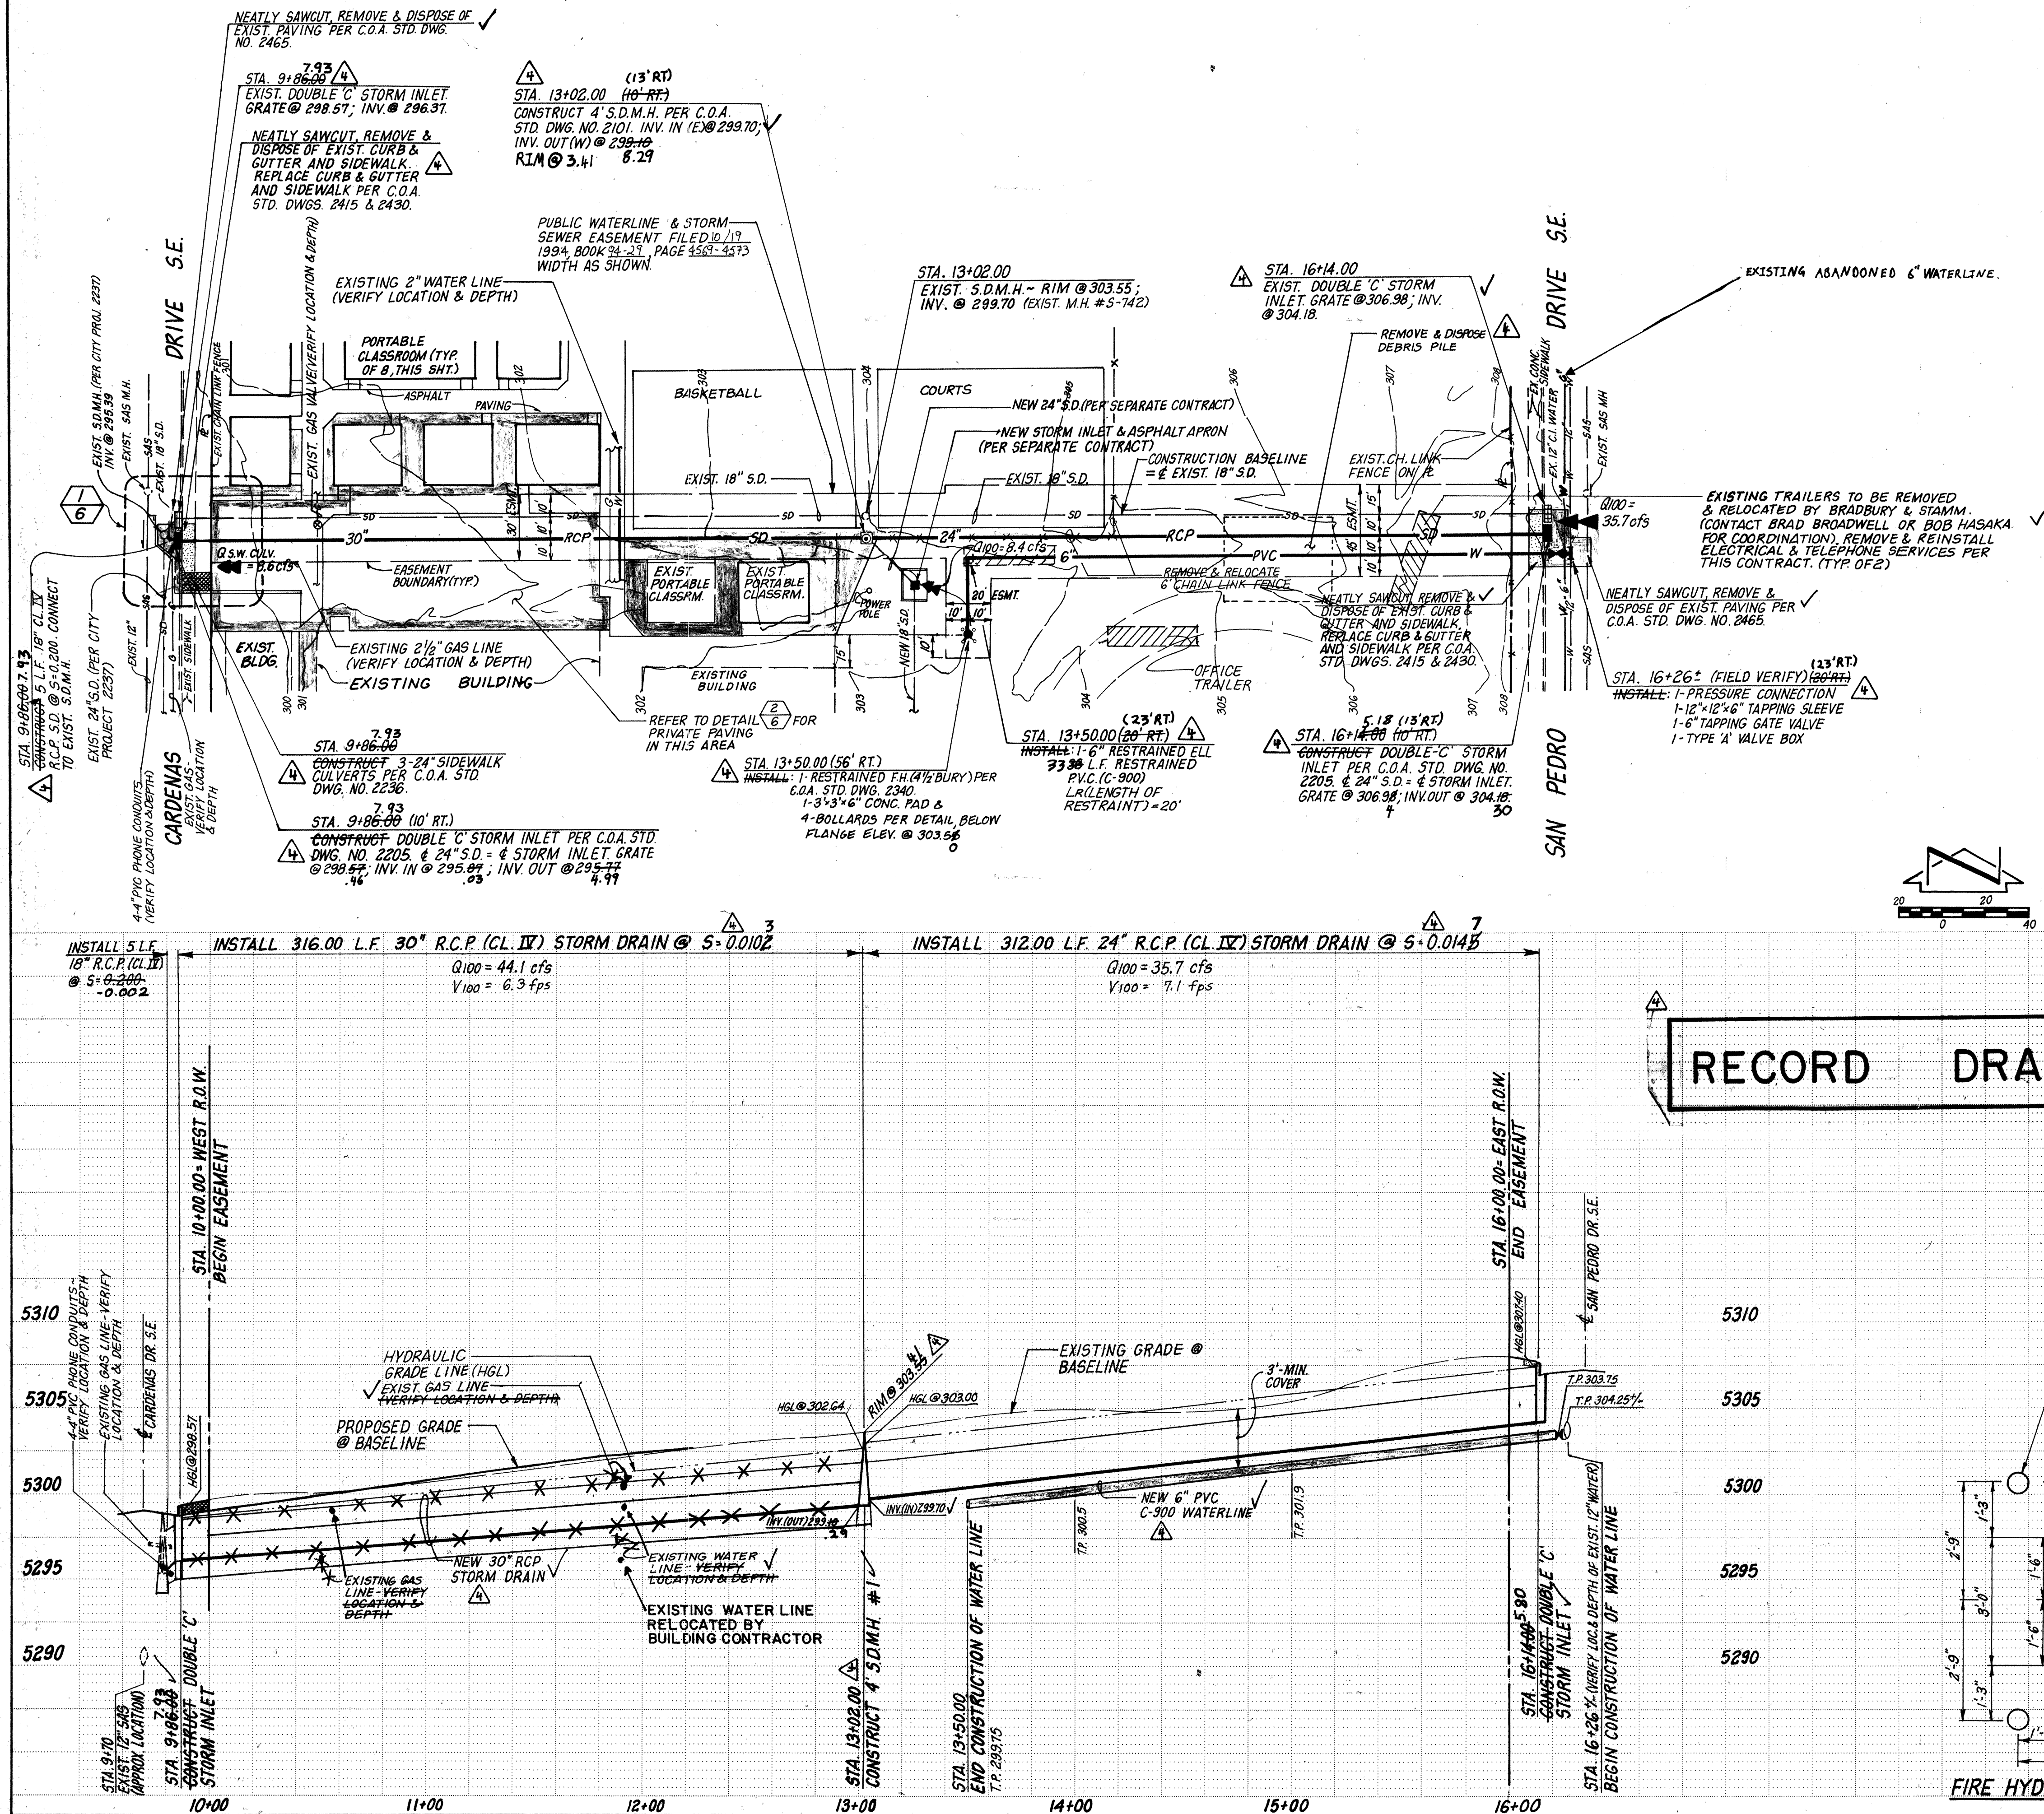

FIRE HYDRANT BOLLARD DETAIL
SCALE: 1" = 2'-0"

RECORD DRAWING

WATERLINE NOTES:

1. ALL STATIONING IS BASED ON EXISTING 18" STORM DRAIN.
2. FOR ALL LINES 12" AND SMALLER, WATER MAIN SHALL BE PVC C-900 PIPE OR AS APPROVED BY THE CITY OF ALBUQUERQUE CITY ENGINEER. DUCTILE IRON IS AN ACCEPTABLE PIPE MATERIAL IN LIEU OF PVC.
3. WATER LINE SHALL HAVE A MINIMUM COVER OF 3'-0" (FINISHED GRADE TO TOP OF PIPE). EXTRA DEPTH TRENCHING, IF REQUIRED, SHALL BE CONSIDERED INCIDENTAL TO CONSTRUCTION, THEREFORE, NO SEPARATE PAYMENT WILL BE MADE.
4. ELECTRONIC MARKER DISCS (EMD) SHALL BE INSTALLED IN ACCORDANCE WITH THE STANDARD SPECIFICATION.
5. IN ACCORDANCE WITH SECTION 801 OF THE "STANDARD SPECIFICATIONS," METALLIZED DETECTABLE WARNING TAPE SHALL BE INSTALLED 18" ABOVE ALL PVC PIPE INSTALLED ON THIS PROJECT.
6. VALVE STEM AND FIRE HYDRANT EXTENSIONS SHALL BE PROVIDED IN ACCORDANCE WITH THE STANDARD SPECIFICATIONS. THE COST OF THESE EXTENSIONS SHALL BE CONSIDERED INCIDENTAL TO CONSTRUCTION THEREFORE NO SEPARATE PAYMENT WILL BE MADE.
7. THE CONTRACTOR SHALL BE RESPONSIBLE FOR PROTECTING, SUPPORTING AND REPLACING, IF DAMAGED, ALL OTHER UTILITIES ENCOUNTERED DURING CONSTRUCTION. THIS SHALL BE CONSIDERED INCIDENTAL TO TRENCHING, THEREFORE, NO SEPARATE PAYMENT WILL BE MADE.
8. THE REMOVAL AND DISPOSAL OF ALL CONFLICTING TREES AND OTHER VEGETATION SHALL BE CONSIDERED INCIDENTAL TO CONSTRUCTION THEREFORE NO SEPARATE PAYMENT WILL BE MADE.
9. JOINT RESTRAINT SHALL BE CONSIDERED INCIDENTAL TO CONSTRUCTION THEREFORE NO SEPARATE PAYMENT WILL BE MADE.

STORM DRAIN NOTES:

1. ALL STATIONING IS BASED ON EXISTING 18" STORM DRAIN.
2. WHERE REMOVAL OF EXISTING CURB AND GUTTER, SIDEWALK OR PAVEMENT IS REQUIRED, THE CONTRACTOR SHALL SAWCUT AND/OR REMOVE TO THE NEAREST JOINT. CURB AND GUTTER SHOWN AS EXISTING AND NOT TO BE REMOVED UNDER THIS CONTRACT WHICH IS DAMAGED OR DISPLACED BY THE CONTRACTOR SHALL BE REMOVED AND REPLACED BY THE CONTRACTOR AT THE CONTRACTOR'S EXPENSE.
3. ALL STORM DRAINPIPE SHALL BE OF RCP CLASS IV.
4. THE CONTRACTOR SHALL BE RESPONSIBLE FOR PROTECTING, SUPPORTING & REPLACING, IF DAMAGED, ALL OTHER UTILITIES ENCOUNTERED DURING CONSTRUCTION. THIS SHALL BE CONSIDERED INCIDENTAL TO TRENCHING, THEREFORE NO SEPARATE PAYMENT WILL BE MADE.

RECORD DRAWING

I, Jeffrey C. Mortensen, Registered Professional Engineer in the State of New Mexico, do hereby certify that this "as-built" information was obtained by me or under my supervision and represents the "as-built" conditions of this project, and is true and correct to the best of my knowledge and belief. All vertical and horizontal dimensions should be verified prior to use on future projects.

Jeffrey C. Mortensen, Registered Professional Engineer
New Mexico State Board of Engineers
No. 12227
Date 12-22-94


CITY OF ALBUQUERQUE
PUBLIC WORKS DEPARTMENT
ENGINEERING GROUP


TITLE: WILSON MIDDLE SCHOOL
WATER & STORM DRAIN EXTENSIONS
PLAN & PROFILE
STA. 10+00 TO STA. 16+00

APPROVALS	ENGINEER	DATE	APPROVALS	ENGINEER	DATE
DRG CHAIRMAN	B. G. Boudry	12-13-93	WATER	G. S. Reedy	12-13-93
TRANSPORTATION	B. G. Boudry	11-03-93	WASTE WATER		
HYDROLOGY	B. G. Boudry	11-03-93			

PROJECT NO.	4789.90	MAP NO.	L-18	SHEET	5	OF	8
-------------	---------	---------	------	-------	---	----	---

AS BUILT INFORMATION		BENCH MARKS		FIELD NOTES		SURVEY INFORMATION		ENGINEER'S SEAL	
CONTRACTOR	DATE	STAKE	DATE	NO.	BY	NO.	BY	NO.	BY
TRIAD BUILDERS	12/93	JMA	12/93						
INSPECTORS									
FIELD CHANGE BY									
VERIFICATION BY									
DATE									
DATE									
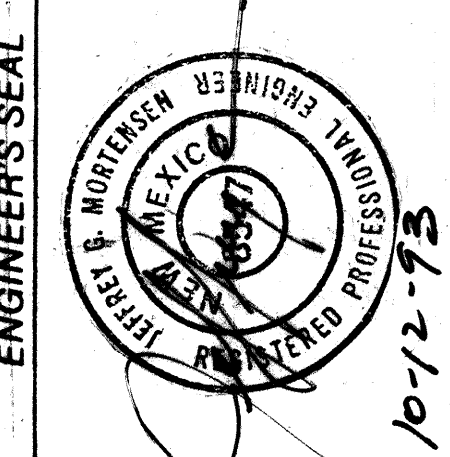


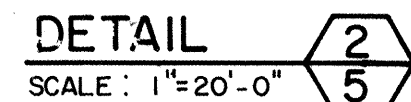






1. *Journal of the American Medical Association*, 1997; 278: 1039-1044.

AS BUILT & CERTIFY		ENGINEER'S SEAL	SURVEY INFORMATION		BENCH MARKS	AS BUILT INFORMATION
2/94		MFD	FIELD NOTES		A SQUARE "A" CHISELED ON THE TOP OF CURB AT THE NNE RETURN LOCATED AT THE INTERSECTION OF SAN PEDRO DRIVE SE TO ROSS AVENUE SE.	CONTRACTOR TRIAD BUILDERS
			NO.	DATE		WORK ORDER NO. JMA DATE 12-93
						INSPECTED BY MFD DATE 12-93
						FIELD ACCEPTANCE BY JMA DATE 12-93
						DRAWINGS CORRECTED BY MFD DATE 12-93
REVISIONS					ELEVATION = 5308.43 (MSLD)	MICRO-FILM INFORMATION
DESIGN						RECORDED BY DATE
DESIGNED BY	T.P.H./MFD.	DATE 7/93				NO
DRAWN BY	T.P.H.	DATE 7/93				
CHECKED BY	J.G.M.	DATE 7/93				

10-12-93

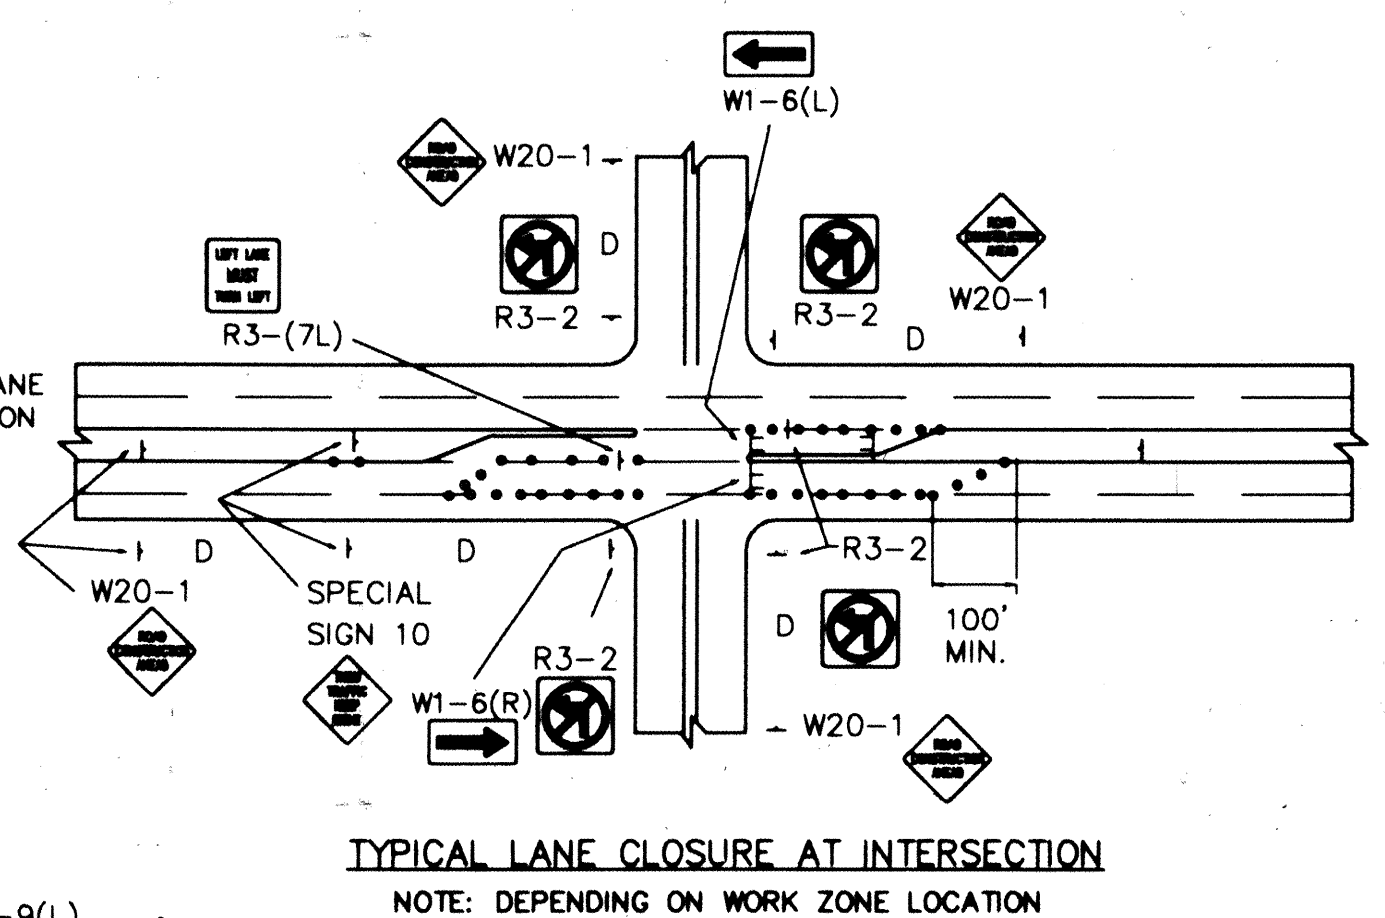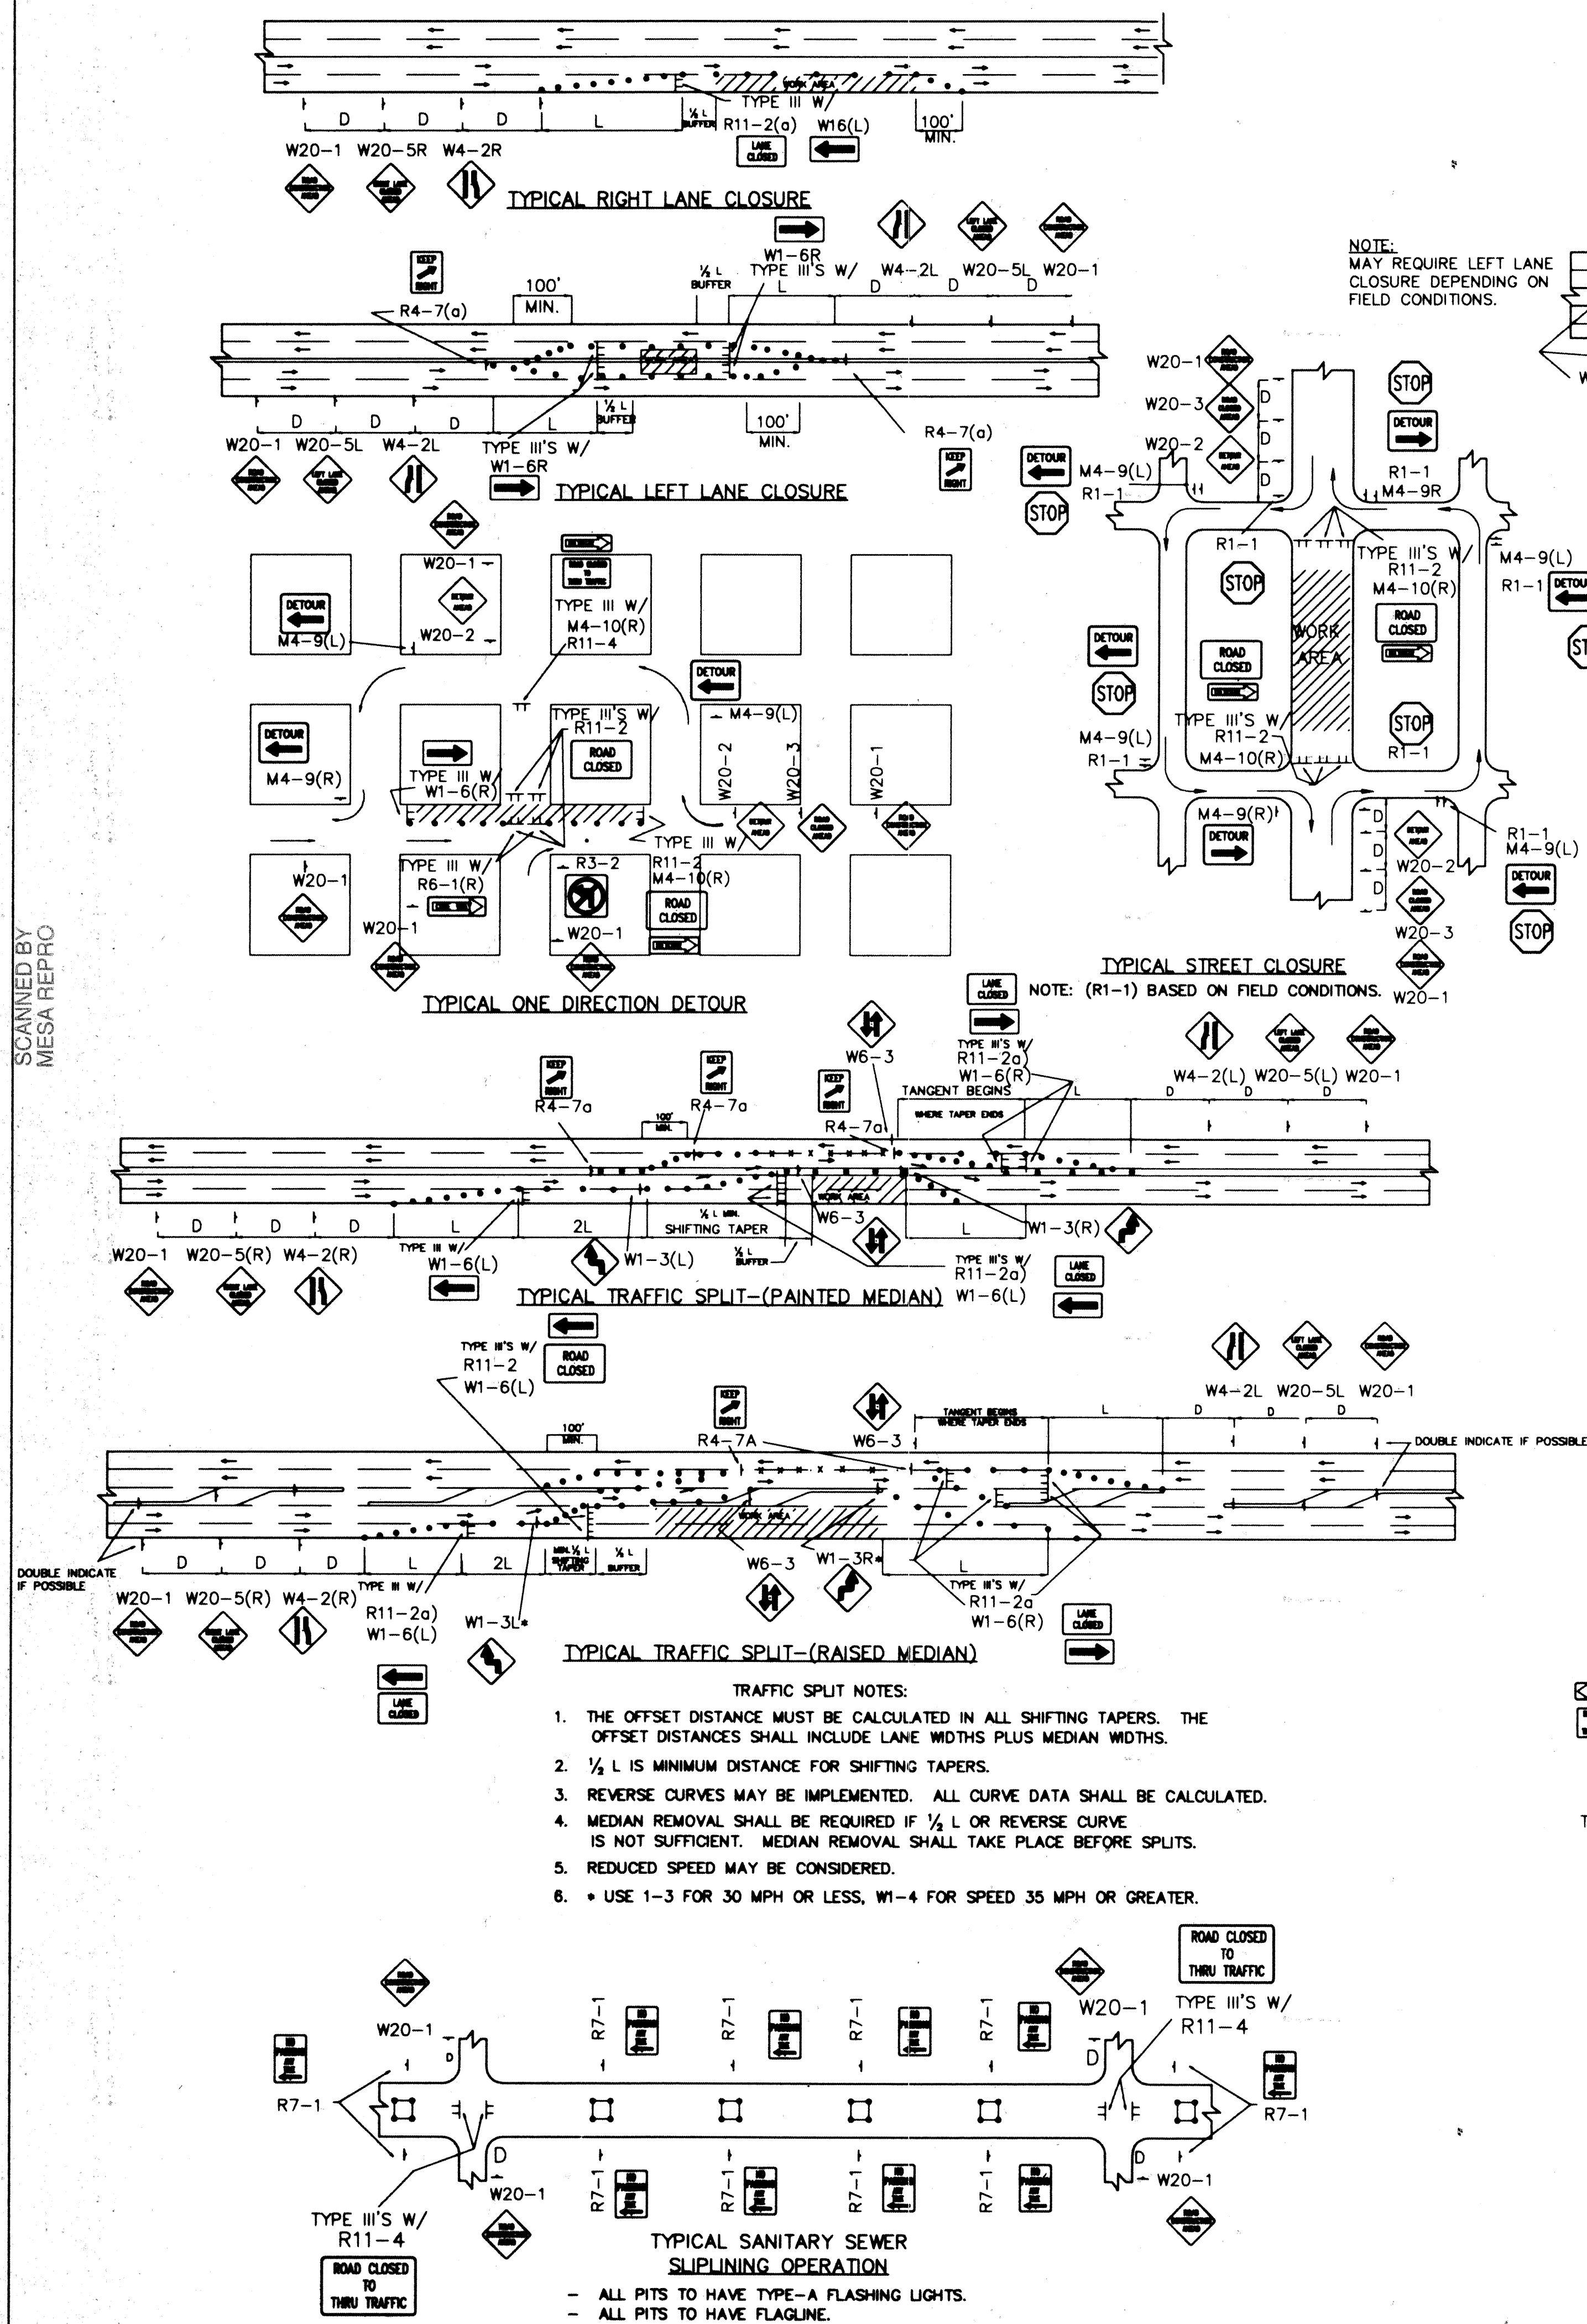

RECORD DRAWING

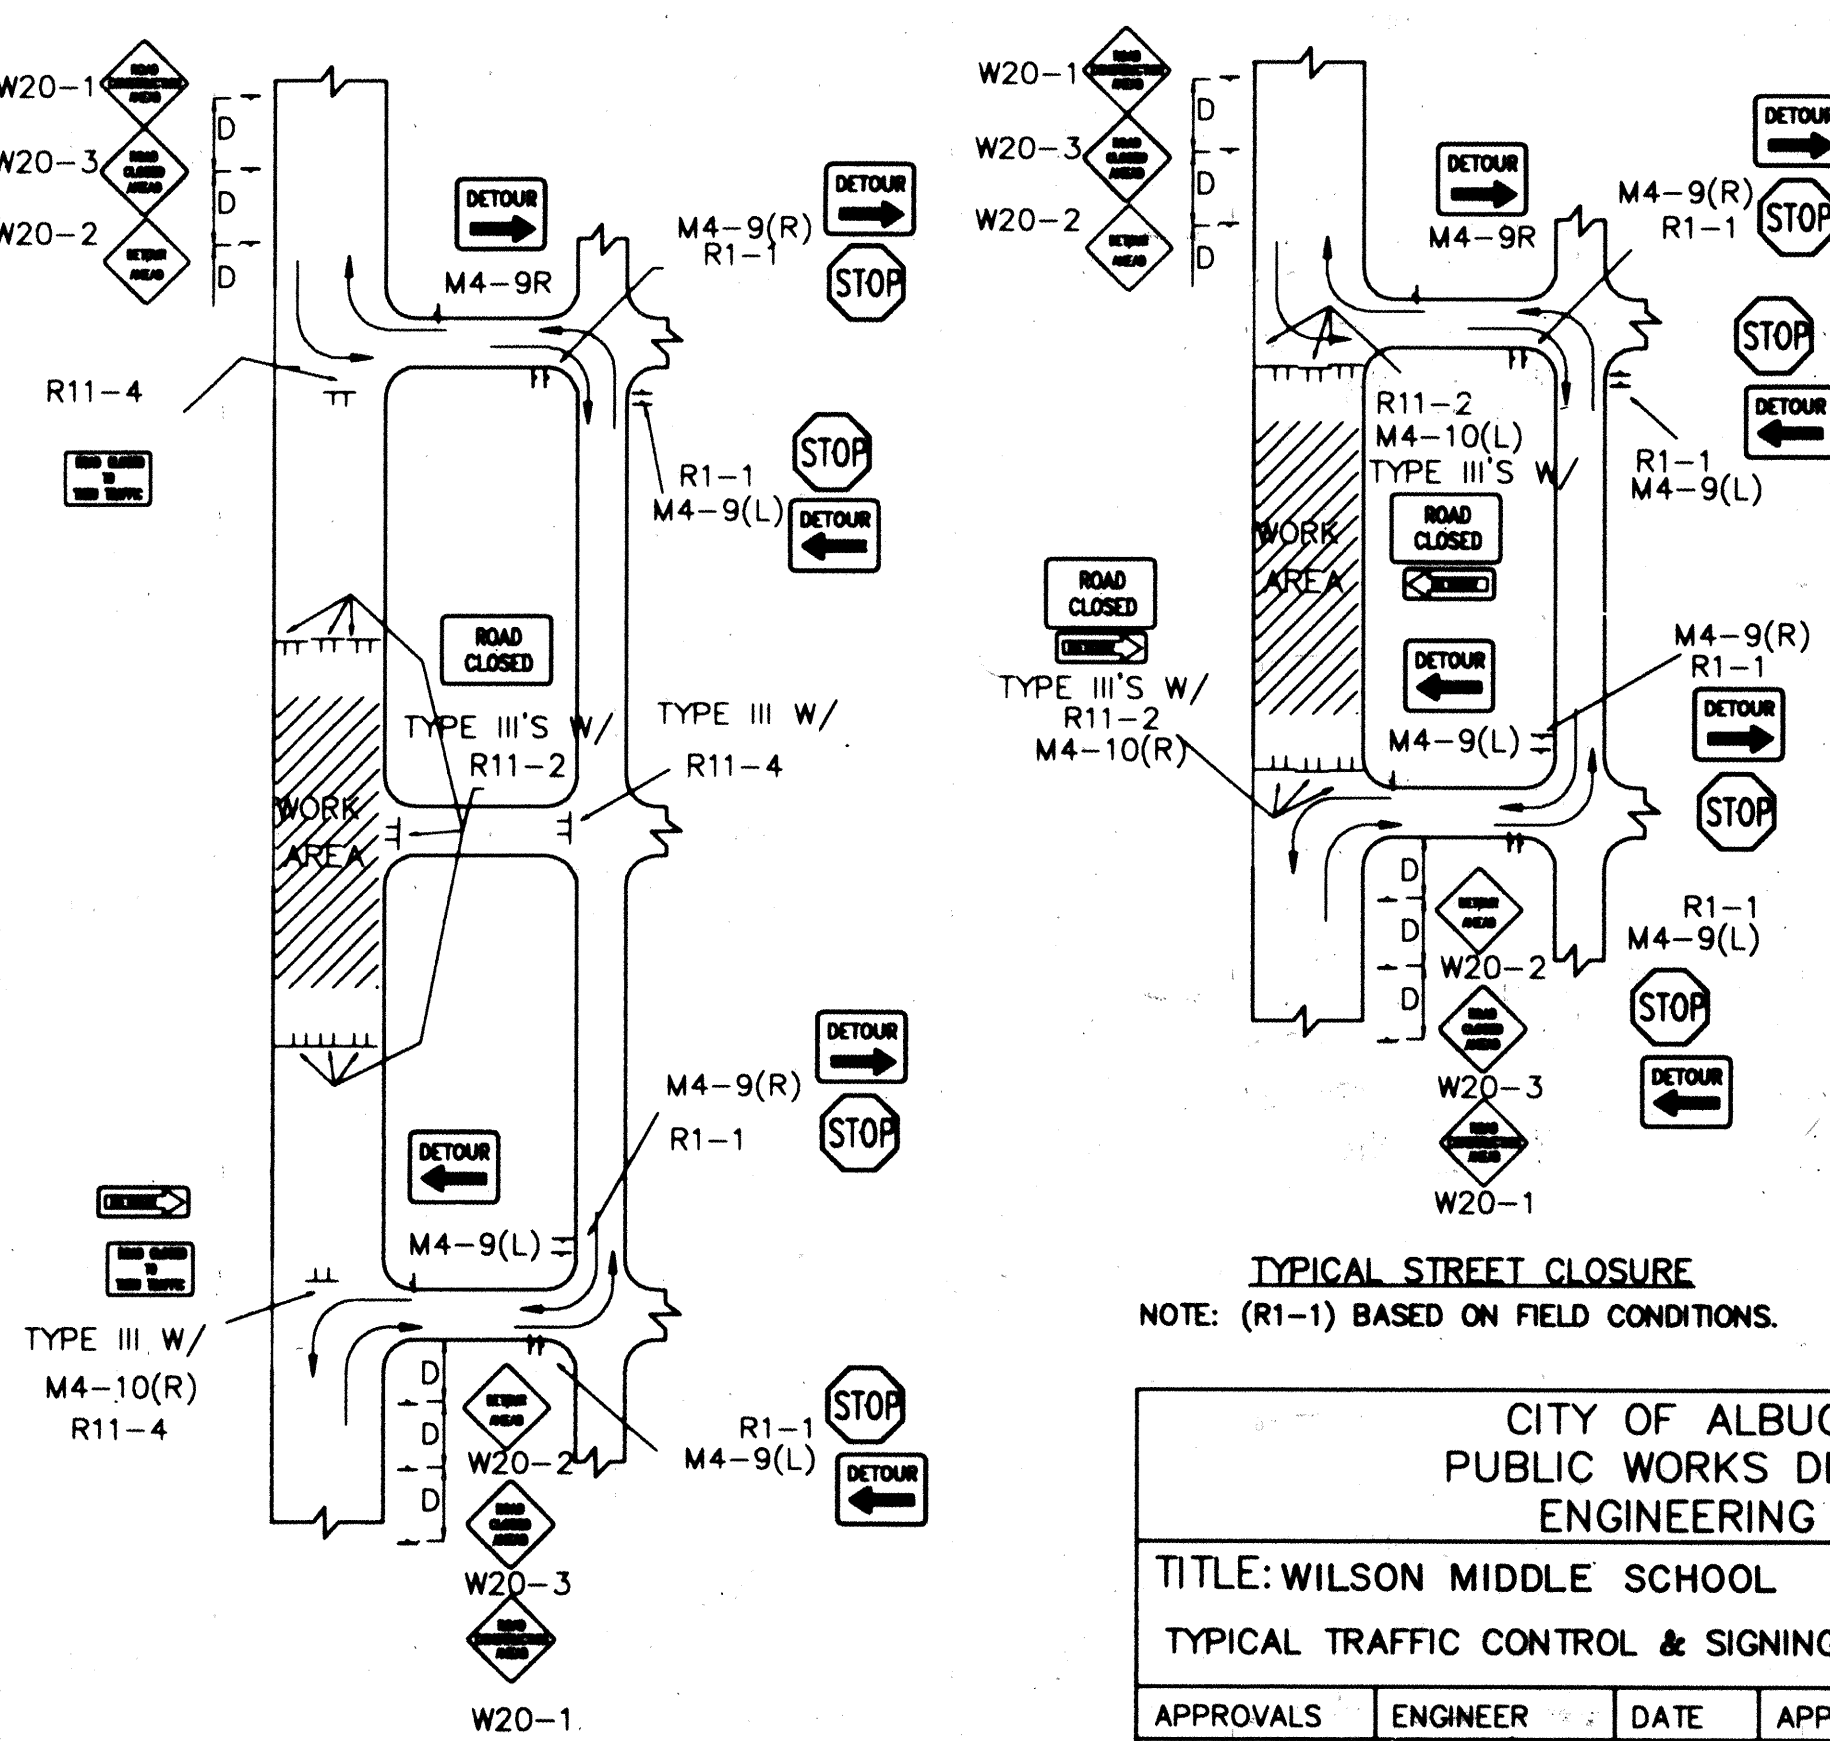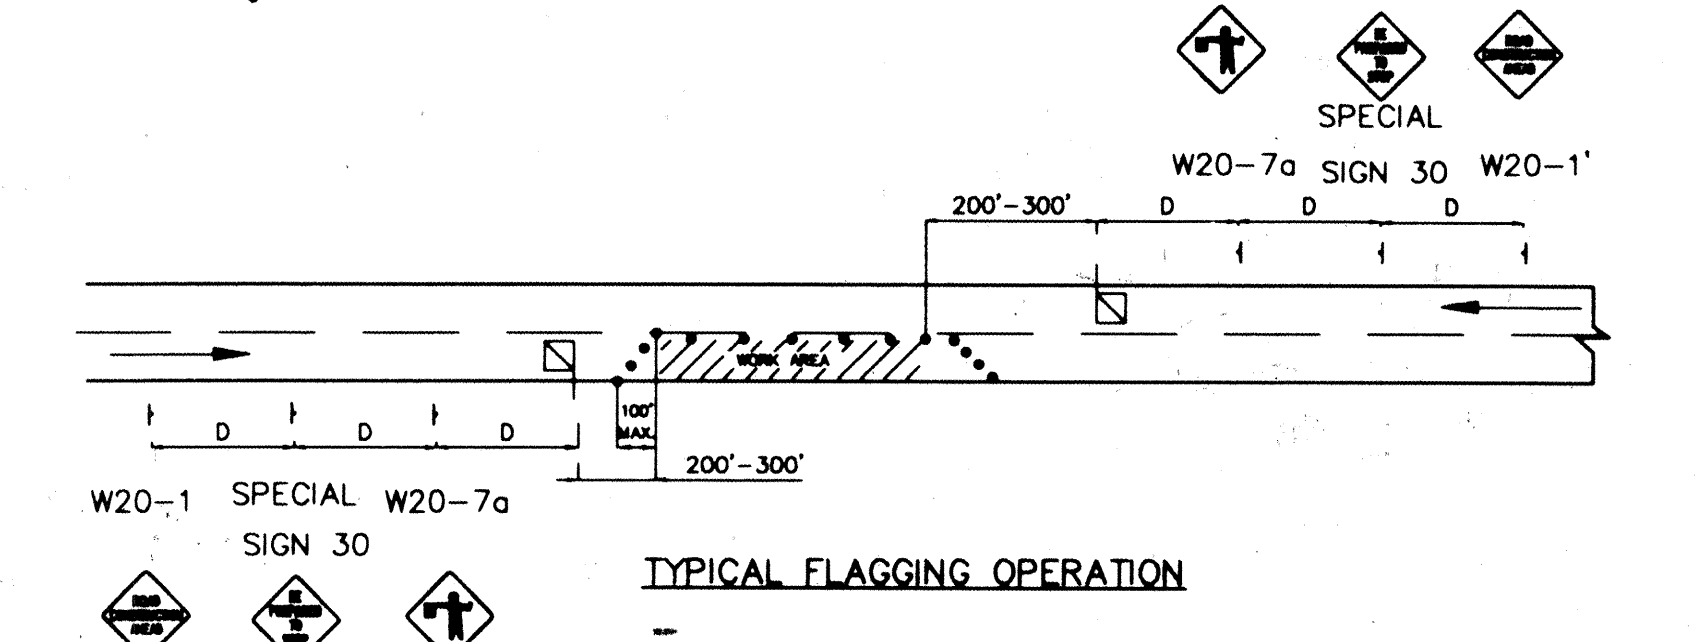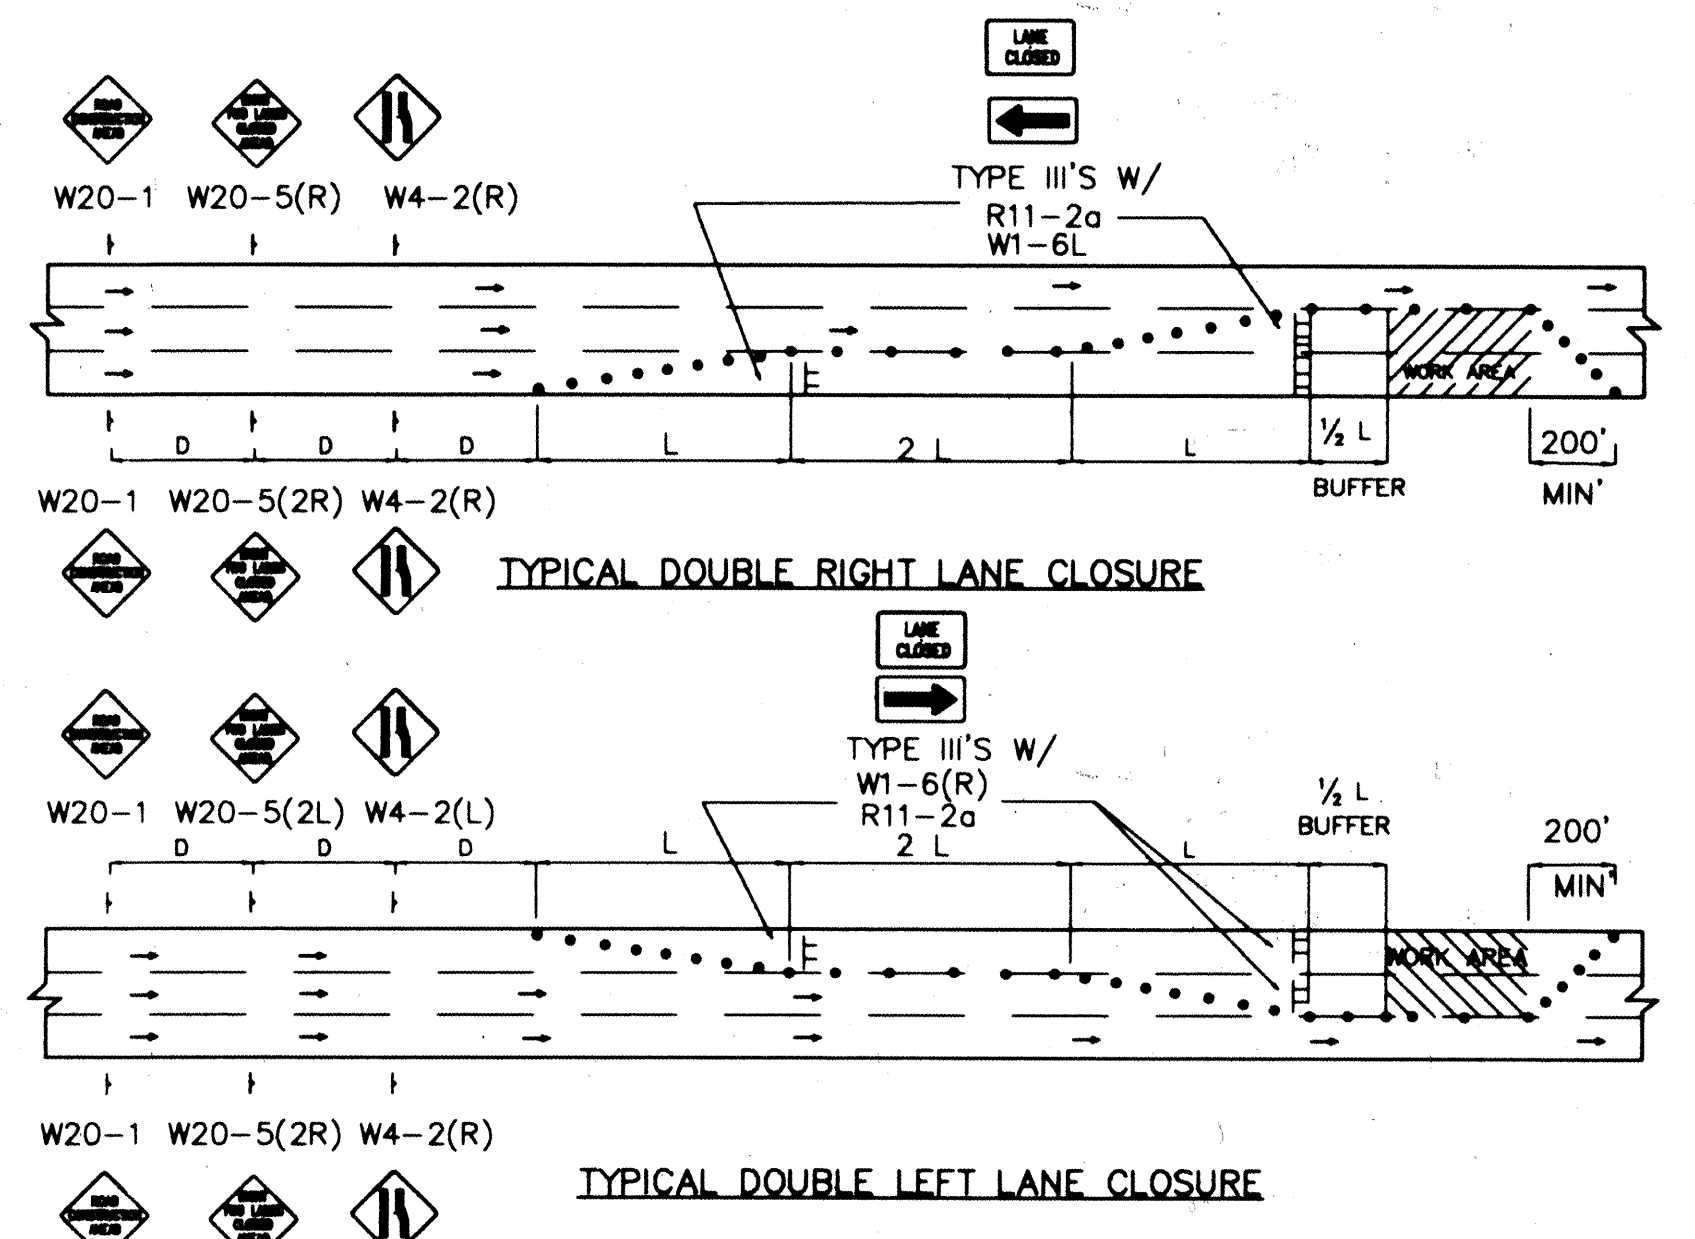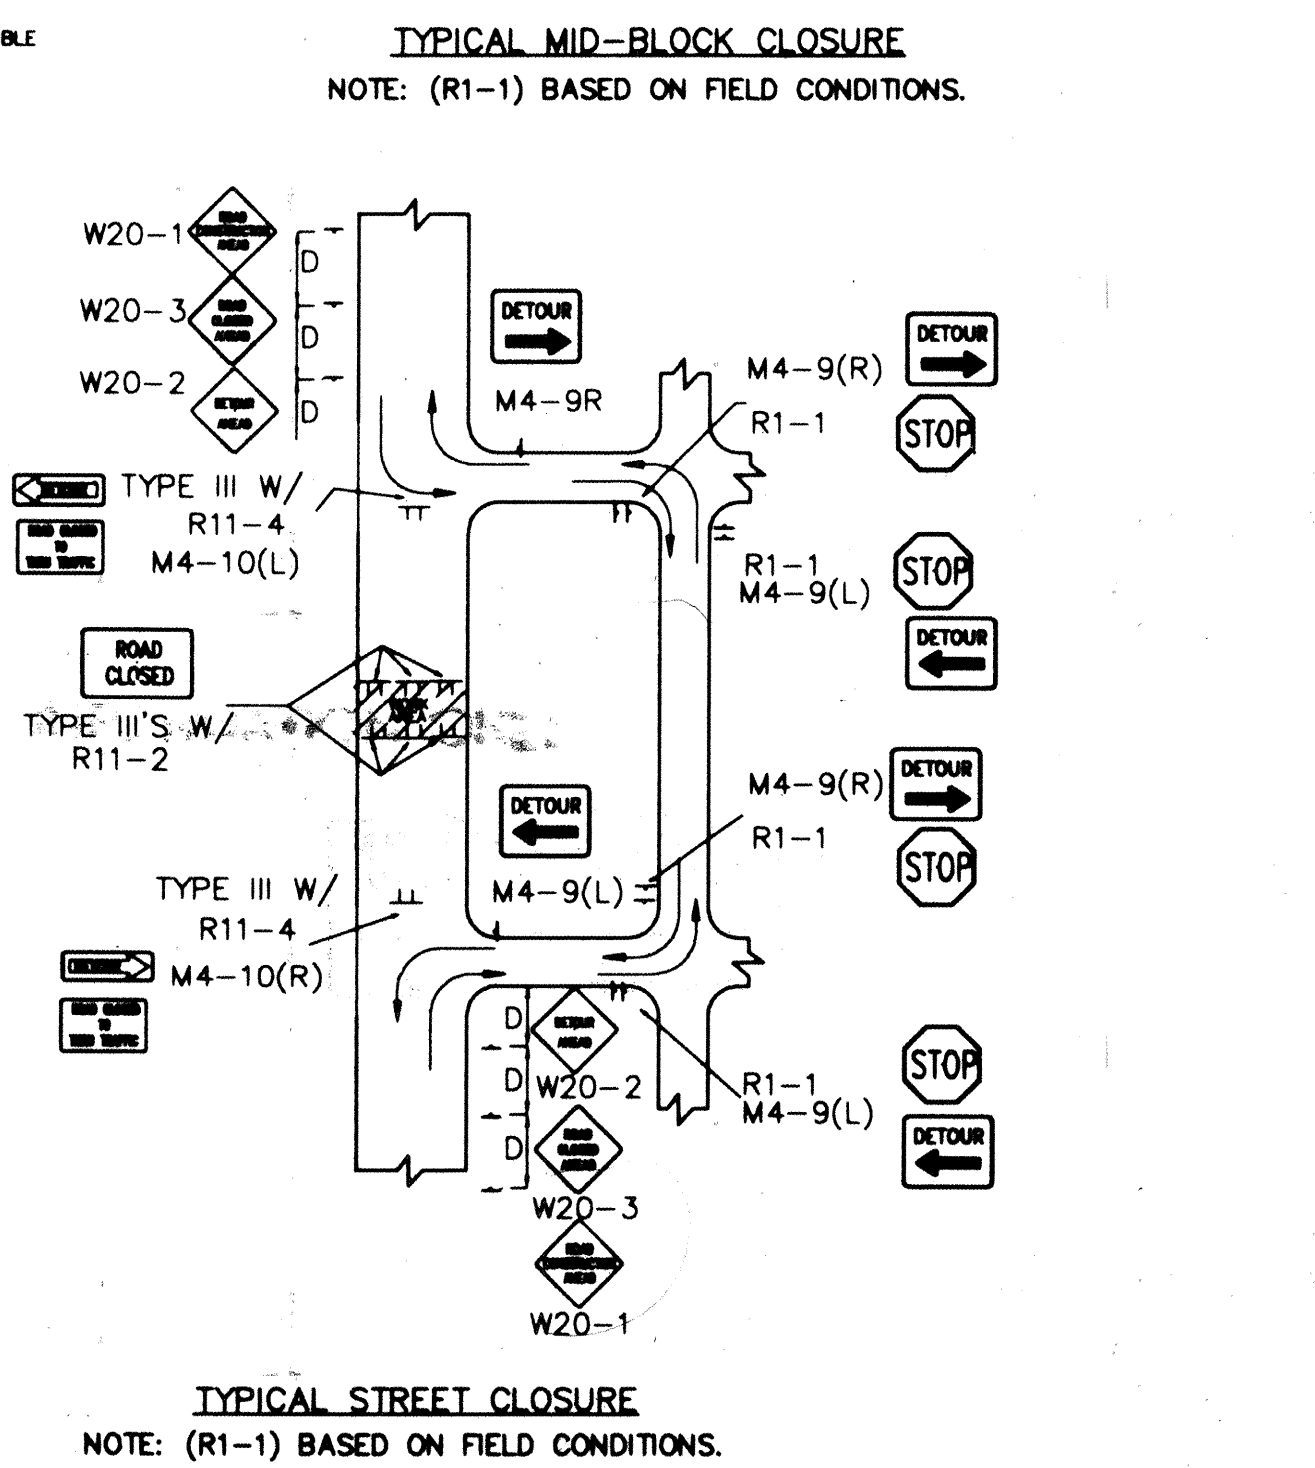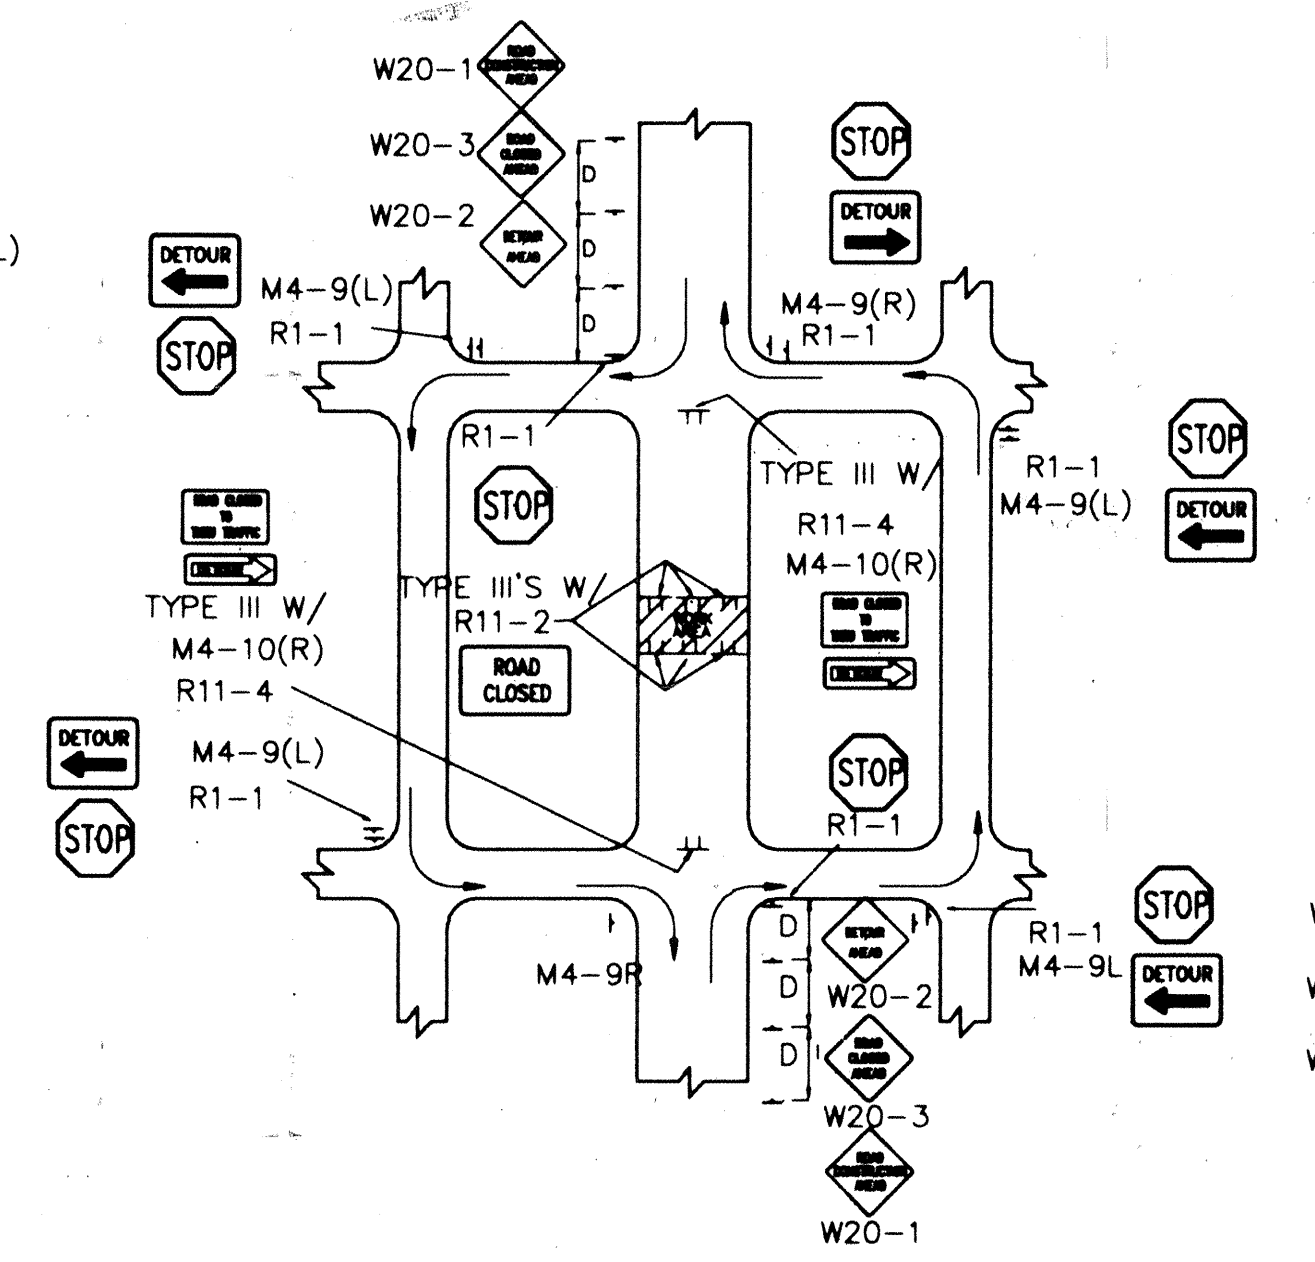

CITY OF ALBUQUERQUE PUBLIC WORKS DEPARTMENT ENGINEERING GROUP			
TITLE: WILSON MIDDLE SCHOOL TYPICAL TRAFFIC CONTROL & SIGNING EXAMPLES (REF. M.U.T.C.D.)			
APPROVALS	ENGINEER	DATE	APPROVALS
DRC CHAIRMAN	29.4	12-13-93	WATER
TRANSPORTATION	NA	11-03-93	WASTE WATER
HYDROLOGY	NA	11-03-93	
PROJECT NO.	4789.90	MAP NO.	L-18
SHEET		OF	
8		8	