



CITY OF ALBUQUERQUE DIVERSE DRAINAGE IMPROVEMENTS LOMAS AND NAKOMIS STORM DRAIN

MAY 1997

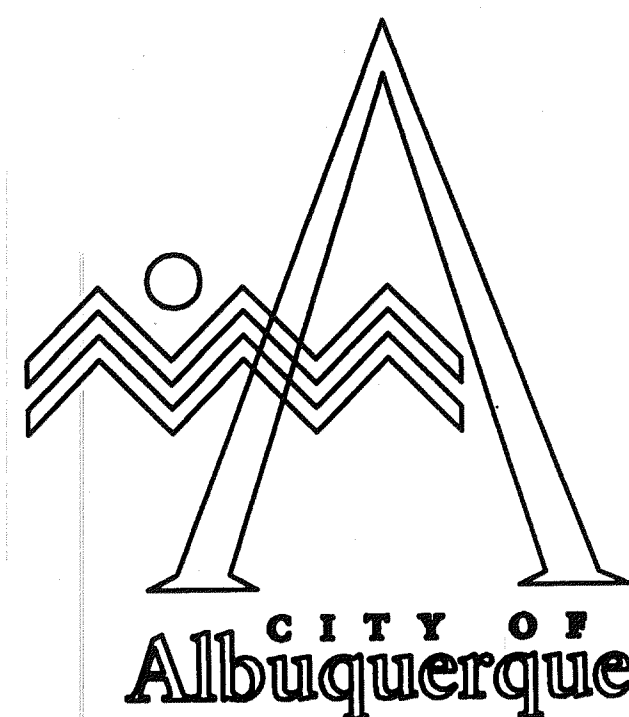

INDEX OF DRAWINGS

SHEET NO.	DESCRIPTION
1	COVER SHEET, INDEX OF DRAWINGS AND LOCATION MAP
2	LEGEND, ABBREVIATIONS AND GENERAL NOTES
PART A	
3	LOMAS/NAKOMIS AND LOMAS/TRAMWAY SURVEY CONTROL SHEET
4	LOMAS PLAN AND PROFILE STA 1+00 TO STA 5+00
5	LOMAS PLAN AND PROFILE STA 5+00 TO STA 9+40
6	LOMAS PLAN AND PROFILE STA 9+40 TO STA 13+60
7	NAKOMIS PLAN AND PROFILE STA 13+60 TO STA 16+54.59
8	LOMAS/TRAMWAY PLAN AND PROFILE STA 1+28 TO STA 3+08
9	FURRS - LOMAS BLVD AND TRAMWAY BLVD OFFSITE TURN LANE IMPROVEMENTS
10	LOMAS AND NAKOMIS STORM DRAIN PHASE I TRAFFIC CONTROL PLAN
11	LOMAS AND NAKOMIS STORM DRAIN PHASE I TRAFFIC CONTROL PLAN
12	LOMAS AND NAKOMIS STORM DRAIN PHASE I TRAFFIC CONTROL PLAN
13	LOMAS AND NAKOMIS STORM DRAIN PHASE III TRAFFIC CONTROL PLAN
14	LOMAS AND NAKOMIS STORM DRAIN PHASE III TRAFFIC CONTROL PLAN
15	LOMAS AND NAKOMIS STORM DRAIN PHASE I TRAFFIC CONTROL PLAN
16	LOMAS AND TRAMWAY PHASE II TRAFFIC CONTROL PLAN
17	LOMAS AND TRAMWAY PHASE II TRAFFIC CONTROL PLAN
PART B	
18	NAKOMIS DRIVE NE STA 16+54.59 TO STA 18+00 (NIC)
19	NAKOMIS DRIVE NE STA 18+00 TO STA 22+40 (NIC)
20	NAKOMIS DRIVE NE STORM SEWER PLAN AND PROFILE STA 22+40 TO STA 25+09.59 (NIC)
PART A AND B	
21	TYPICAL TRAFFIC CONTROL & SIGNING EXAMPLES (REF M.U.T.C.D.)
22	SIGNING AND CONSTRUCTION TRAFFIC CONTROL STANDARDS
23	WATER SHUTOFF PLAN
24	DETAILS

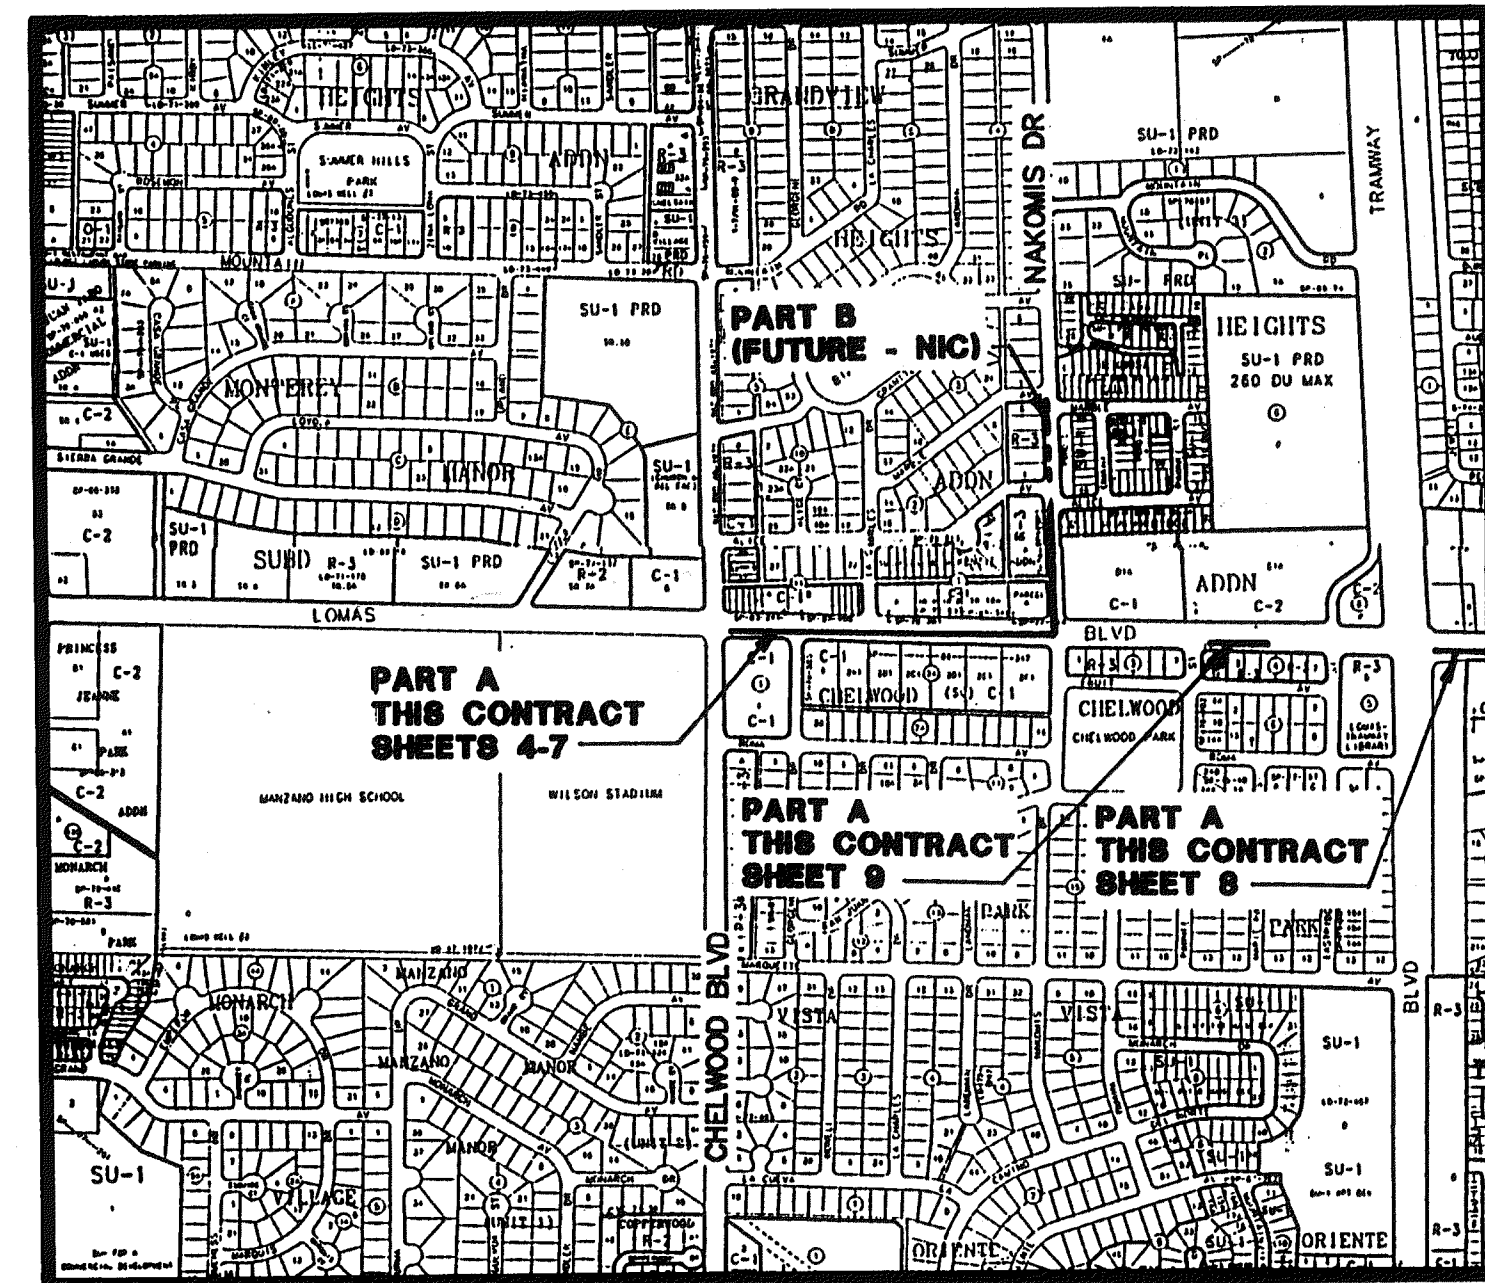

LOCATION MAP

1" = 350'
(ZONE ATLAS MAPS NO J22, J23, K22, K23)
ADDRESS: ALBUQUERQUE, NEW MEXICO


NOTE: EXTENDED WORK HOURS
THIS PROJECT SUBJECT TO
EXTENDED WORK HOURS--
7:00 AM TO 10:00 PM
MONDAY THROUGH SATURDAY
SEE SPECIFICATIONS

LEEDSHILL-HERKENHOFF, INC
500 Copper Avenue NW
P.O. Box 1217
Albuquerque, NM 87103
(505)247-0294

REV.	SHEET	CITY ENGINEER	DATE	USER DEPARTMENT	DATE	USER DEPARTMENT	DATE
ENGINEERS STAMP & SIGNATURE		APPROVALS		ENGINEER	DATE	*****	
		DRC Chairman		<i>Billy G. Arshady</i>	6-19-97	APPROVED FOR CONSTRUCTION	
		Transportation		<i>John B. Arshady</i>	6-19-97		
		Water/Wastewater		<i>John B. Arshady</i>	5/27/97		
		Hydrology		<i>John B. Arshady</i>	6/12/97		
		Const. Mngmt.		<i>David L. Cates</i>	6/14/97		
City Project No.		4880.92		Sheet 1 Of 24			

RECORD DRAWING

Date JAN 1998
These drawings have been revised based on the construction records of the owner. While the accuracy is guaranteed by the Owner, the Engineer will not be responsible for the accuracy of this information nor for errors.

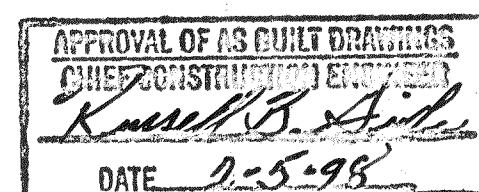

LEGEND

PROPOSED	EXISTING	DESCRIPTION
		SANITARY SEWER MANHOLE
		STORM DRAIN MANHOLE
NA	NA	WATER MANHOLE
NA		TELEPHONE MANHOLE
SAS 8" CP	SAS 8" CP	SANITARY SEWER LINE WITH SIZE AND TYPE
SD 48" RCP	SD 48" RCP	STORM DRAIN LINE WITH SIZE AND TYPE
W 6" CI	W 6" CI	WATER LINE WITH SIZE AND TYPE
NA		OVERHEAD ELECTRICAL LINE
NA		UNDERGROUND ELECTRICAL/TRAFFIC CONTROL
NA		UNDERGROUND TELEPHONE
NA		GAS LINE WITH SIZE AND TYPE
NA		CABLE TELEVISION LINE
		ENCASEMENT
		STORM DRAIN INLET SEE GENERAL NOTE RR, THIS SHEET
NA		GATE VALVE
NA		BUTTERFLY VALVE
		FIRE HYDRANT
NA		REDUCER
NA		SANITARY SEWER SERVICE CONNECTION
NA		WATER SERVICE CONNECTION
NA		TEE
NA		CROSS
NA		BEND
NA		CAP AND PLUG
NA		WATER METER
O		VALVE BOX
NA		POWER POLE
NA		LIGHT POLE
O		TRAFFIC LIGHT
		TRAFFIC CONTROL BOX
		PULL BOX
NA		TELEPHONE BOOTH
		PCC CURB AND GUTTER
NA		AC CURB
NA		SIDEWALK
NA		BLOCK WALL
NA		CHAIN LINK FENCE
NA		FIELD FENCE
0.83		SPOT ELEVATION
NA		EDGE OF AC PAVEMENT
NA		RIGHT OF WAY LINES
NA		PROPERTY LINE (SIDE)
NA		PUBLIC EASEMENT LINE
	NA	LIGHT POLE BASE
	EXISTING	RESIDENTIAL PAVING
	EXISTING	ARTERIAL PAVING
	EXISTING	CONCRETE PAVING
	EXISTING	TEMPORARY PAVING
		WHEELCHAIR RAMP
		SWALE
		CONTOURS
NA		REMOVE ITEM
	NA	MAXIMUM ANTICIPATED LIMITS OF CONSTRUCTION AND PAYMENT AREA


GENERAL NOTES

- A ALL WORK DETAILED ON THESE PLANS TO BE PERFORMED UNDER THIS CONTRACT SHALL, EXCEPT AS OTHERWISE STATED OR PROVIDED FOR HEREON, BE CONSTRUCTED IN ACCORDANCE WITH THE CITY OF ALBUQUERQUE STANDARD SPECIFICATIONS FOR PUBLIC WORKS CONSTRUCTION, 1986, AS AMENDED, THROUGH UPDATE #6 (REFERRED TO HEREINAFTER AS THE STANDARD SPECIFICATIONS). THE STANDARD SPECIFICATIONS CONTAIN THE CITY STANDARD DRAWINGS.
- B CONSTRUCTION WILL LIKELY BE OCCURRING DURING STORM EVENTS. CONTRACTOR MUST MAKE PROVISIONS TO PROTECT EXISTING STORM DRAIN FACILITIES AS WELL AS TO PROTECT NEW CONSTRUCTION DURING STORMS.
- C CONTRACTOR SHALL FIELD VERIFY HORIZONTAL AND VERTICAL LOCATIONS OF UTILITIES TO BE RELOCATED AS SHOWN ON THESE CONSTRUCTION DRAWINGS. THE CONTRACTOR SHALL NOTIFY THE ENGINEER IF THE UTILITY IS FOUND TO BE DIFFERENT BY MORE THAN (ONE) FOOT VERTICALLY OR 3(THREE) FEET HORIZONTALLY, THAN SHOWN ON THESE DRAWINGS. THE CONTRACTOR SHALL NOTIFY THE ENGINEER SO THAT THE CONFLICT CAN BE RESOLVED WITH A MINIMUM AMOUNT OF DELAY. IN ADDITION, PRIOR TO THE REMOVAL OF ANY PAVEMENT, CURB AND GUTTER OR OTHER SURFACE REMOVAL, THE ROADWAY SHALL BE SURVEYED TO ENSURE THE RESTORATION OF PROPER GRADES, GEOMETRY AND ELEVATIONS.
- D THE LIMITS OF CONSTRUCTION SHOWN ON THE PLANS ARE AN APPROXIMATION TO SHOW AREAS OF ANTICIPATED PAVEMENT, CURB AND GUTTER AND/OR OTHER SURFACE REMOVAL. THE LIMITS OF CONSTRUCTION SHOWN ON THE PLANS SHALL GOVERN FOR PAYMENT PURPOSES.
- E ALL EXCAVATED MATERIAL THAT IS NOT REQUIRED TO BE REUSED MUST BE REMOVED FROM THE PROJECT AREA WITHIN FOUR DAYS OF EXCAVATION. SPOIL PILES WILL BE ALLOWED ONLY AS DIRECTED BY THE ENGINEER.
- F THE CONTRACTOR SHALL BE RESPONSIBLE FOR REMOVAL AND DISPOSAL OF ALL DEMOLITION DEBRIS. ANY MATERIAL TO BE SALVAGED SHALL BE IDENTIFIED BY THE ENGINEER. WORK MATERIALS SHALL BE DISPOSED OF IN CITY APPROVED WASTE AREAS SECURED BY, AND AT THE EXPENSE OF, THE CONTRACTOR. THE CONTRACTOR SHALL COORDINATE WEEKLY REFUSE REMOVAL WITH THE CITY SOLID WASTE DEPARTMENT, AS NECESSARY.
- G EQUIPMENT AND MATERIALS ARE NOT TO BE STORED WITHIN THE STREET RIGHT OF WAY OR WITHIN 15 FEET OF A TRAFFIC LANE DURING NON-WORKING HOURS.
- H THREE (3) WORKING DAYS PRIOR TO BEGINNING CONSTRUCTION THE CONTRACTOR SHALL SUBMIT TO THE CONSTRUCTION CO-ORDINATION DIVISION A DETAILED CONSTRUCTION SCHEDULE. TWO (2) WORKING DAYS PRIOR TO CONSTRUCTION THE CONTRACTOR SHALL OBTAIN A BARRICADING PERMIT FROM THE CONSTRUCTION CO-ORDINATION DIVISION. CONTRACTOR SHALL NOTIFY BARRICADE ENGINEER (768-2551) PRIOR TO OCCUPYING AN INTERSECTION. SEE SECTION 19 OF THE SPECIFICATIONS.
- J ALL STREET STRIPING ALTERED OR DESTROYED SHALL BE REPLACED WITH PLASTIC REFLECTORIZED PAVEMENT MARKING BY CONTRACTOR TO LOCATION AS EXISTING OR AS INDICATED BY THIS PLAN SET.
- K ONE WEEK PRIOR TO THE COMMENCEMENT OF EACH PHASE OF CONSTRUCTION, THE CONTRACTOR SHALL OBTAIN A BARRICADING PERMIT FOR THE NEXT PHASE FROM THE CONSTRUCTION COORDINATION DIVISION, CITY OF ALBUQUERQUE (768-2551), AND FROM THE TRAFFIC CONTROL DEPARTMENT OF BERNALILLO COUNTY FOR WORK IN COUNTY AREAS (848-1500).
- L THE CONTRACTORS OPERATIONS MAY MOVE AHEAD ONLY IF THE PREVIOUS SECTION OF ROADWAY IN THAT WORK ZONE IS IN THE PROCESS OF BEING PAVED. AT NO TIME SHALL THERE BE MORE THAN 800 FEET OF BACKFILL WITHOUT AN "ALL-WEATHER" SURFACE BEHIND OR IN ADVANCE OF THE PIPE INSTALLATION IN A GIVEN WORK ZONE. A MAXIMUM OF TWO WORK ZONES WILL BE ALLOWED WITH PRIOR APPROVAL FROM THE ENGINEER.
- M ALL TRAFFIC SIGNS REMOVED SHALL BE REPLACED IN KIND BY CONTRACTOR TO LOCATIONS AND IN KIND AS EXISTING OR AS INDICATED BY THIS PLAN SET.
- N THE CONTRACTOR SHALL ASSUME RESPONSIBILITY FOR ANY DAMAGE TO EXISTING PAVING, CURB AND GUTTER, SIDEWALK, WHEELCHAIR RAMPS, ETC. DURING CONSTRUCTION, APART FROM THOSE SECTIONS INDICATED FOR REMOVAL ON THE PLANS, AND SHALL REPAIR OR REPLACE SAME AT HIS OWN EXPENSE. THE CONTRACTOR SHALL SUITABLY PROTECT THE CURB AND GUTTER FROM INCIDENTAL SPLASHING DURING THE TACK COAT APPLICATION AND SHALL BE RESPONSIBLE FOR CLEANING SAME AT HIS OWN COST SHOULD SPLASHING OCCUR.
- P WHEN ABUTTING NEW PAVEMENT TO EXISTING, CONTRACTOR SHALL SAW CUT EXISTING PAVEMENT TO A STRAIGHT LINE, AS REQUIRED, TO REMOVE ANY BROKEN OR CRACKED PAVEMENT AND TO MATCH NEW TO EXISTING.
- Q ALL NEW STREET PAVING, DRIVEWAYS, SIDEWALKS, AND CURBS AND GUTTERS ABUTTING EXISTING AREAS SHALL MATCH THE ELEVATION OF THOSE AREAS.
- R ASPHALT PAVEMENT REPLACEMENT SHALL BE IN ACCORDANCE WITH THESE PLANS.
- S TACK COAT FOR SURFACE COURSE REQUIREMENTS SHALL BE DETERMINED BY THE ENGINEER.
- T ALL EXISTING MANHOLES AND VALVE BOXES WITHIN THE CONSTRUCTION LIMITS SHALL BE ADJUSTED TO THE NEW FINISH GRADE AS PART OF THE PAVING OPERATIONS.
- U THE RELOCATION OF THE EXISTING UTILITIES AND THE INSTALLATION OF NEW UTILITY LINES SHALL BE COMPLETED IN ADVANCE OF STARTING THE PAVEMENT WORK. TEMPORARY PAVEMENT SHALL BE PLACED AS REQUIRED IN THOSE AREAS THAT MUST MAINTAIN TRAFFIC UNTIL THE PERMANENT PAVEMENT WORK STARTS IN THAT AREA. TEMPORARY STRIPING SHALL BE THE CONTRACTORS RESPONSIBILITY.
- V ALL REFERENCE TO CURB AND GUTTER IS TO STANDARD CURB AND GUTTER UNLESS OTHERWISE NOTED.
- W TWO (2) WORKING DAYS PRIOR TO ANY EXCAVATION, CONTRACTOR MUST CONTACT LINE LOCATION SERVICE, 260-1990, FOR LOCATION OF EXISTING UTILITIES.
- X EXCAVATIONS SHALL BE CONSTRUCTED, BRACED AND SHEETED TO PROVIDE COMPLETE SAFETY TO PERSONS WORKING THEREIN. CONSTRUCTION AND BRACING SHALL COMPLY WITH ALL OSHA AND OTHER APPLICABLE STATE AND LOCAL LAWS AND ORDINANCES.
- Y THE CONTRACTOR SHALL EXERCISE CARE TO AVOID DISTURBING EXISTING UNDERGROUND UTILITIES. IT SHALL BE HIS RESPONSIBILITY TO COORDINATE WITH THE UTILITY COMPANIES IN ORDER TO PREVENT ANY SERVICE DISRUPTION.
- Z ALL UTILITY LINES, TO INCLUDE TRAFFIC SIGNAL CONDUITS AND PULL BOXES, WHICH ARE NOT SPECIFICALLY DESIGNATED TO BE REMOVED AND REPLACED ON THE PLANS SHALL BE MAINTAINED IN SERVICE. SHORING, SHEETING, AND OTHER MEANS OF SUPPORT SHALL BE EMPLOYED BY THE CONTRACTOR TO PREVENT DAMAGE OR LOSS OF THESE EXISTING UTILITIES. BEAM AND CABLE OR OTHER ADEQUATE SUPPORTS SHALL BE USED FOR TEMPORARY SUPPORT OF ALL UTILITY LINES WHICH CROSS THE TRENCH. ANY DAMAGE TO EXISTING UTILITIES SHALL PROMPTLY BE REPAIRED AT THE CONTRACTORS EXPENSE. THE ENGINEER WILL BE IMMEDIATELY NOTIFIED OF ANY SIGNIFICANT DEVIATION OF EXPOSED UTILITIES FROM THE LOCATIONS SHOWN ON THE PLANS SO THAT CONFLICTS CAN BE RESOLVED IN A TIMELY MANNER.
- AA THE CONTRACTOR SHALL COORDINATE HIS CONSTRUCTION ACTIVITIES WITH ALL OTHER CONTRACTORS AND UTILITY COMPANIES WORKING IN THE SAME AREA. CONTRACTOR SHALL BE RESPONSIBLE FOR COORDINATING UTILITY RELOCATIONS WITH APPROPRIATE PRIVATE UTILITY COMPANIES, AS FOLLOWS:
PNM - (505)848-3451
GAS COMPANY OF NEW MEXICO - (505)761-7775
US WEST - (505)245-6694
CABLE TV - (505)761-6235
CITY WATER - (505)857-8200
CITY SANITARY SEWER - (505)873-6200
THE CONTRACTOR MAY BE REQUIRED TO RESCHEDULE HIS ACTIVITIES TO ALLOW UTILITY CREWS TO PERFORM THEIR REQUIRED WORK. NO ADDITIONAL COMPENSATION WILL BE ALLOWED FOR DELAYS OR INCONVENIENCE CAUSED BY UTILITY COMPANY WORK CREWS.
THE CONTRACTOR SHALL COORDINATE ALL CONSTRUCTION ALONG NEW POST OFFICE FRONTAGE (NE CORNER OF LOMAS BLVD/NAKOMIS DRIVE) AND INVOLVING THE EASTBOUND LEFT TURN BAY ON LOMAS BLVD AT NAKOMIS DRIVE WITH FLITCO CONTRACTORS - (505) 262-1888.
- BB ALL ABANDONED UTILITY LINES WHICH ARE EXPOSED AS A RESULT OF CONSTRUCTION SHALL BE REMOVED AND DISPOSED OF BY THE CONTRACTOR. REFER TO SECTION 18 OF THE SPECIFICATIONS.
- CC THE CONTRACTOR SHALL COORDINATE SHUT DOWN OF WATER SYSTEM ELEMENTS WITH CITY WATER SYSTEMS DIVISION IN ACCORDANCE WITH SECTION 18 OF THE GENERAL CONDITIONS.
- DD THE CONTRACTOR SHALL FIELD VERIFY ALL WATERLINE CONNECTIONS TO EXISTING FACILITIES SUFFICIENTLY IN ADVANCE OF CONSTRUCTION TO ALLOW OBTAINING CORRECT ADAPTERS AND OTHER FITTINGS.
- EE TEMPORARY WATER SERVICES ARE TO BE PROVIDED FOR ANY RESIDENCE OR BUSINESS WHICH WILL BE OUT OF SERVICE MORE THAN FOUR HOURS.
- FF ALL WATER CONNECTIONS ARE NON PRESSURIZED CONNECTIONS UNLESS OTHERWISE NOTED ON THE PLANS.
- GG ALL WATER SERVICE LINES WHICH ARE TO BE EXTENDED OR REPLACED SHALL BE THE SAME SIZE AS THE METER.
- HH THE CONTRACTOR SHALL NOTIFY WATER SYSTEMS DIVISIONS OF PUBLIC WORKS (PH. 857-8200). AT LEAST FIVE WORKING DAYS IN ADVANCE OF ANY WORK REQUIRING A WATER SHUTOFF REFER TO SECTION 18 OF THE GENERAL CONDITIONS.
- JJ CONTRACTOR SHALL UTILIZE MECHANICALLY-RESTRAINED JOINTS IN LIEU OF BLOCKING FOR WATER LINES.
- KK THE HYDRAULIC GRADE LINE SHOWN ON THE PLANS DEPICTS THAT OF ULTIMATE DEVELOPMENT CONDITIONS WITHIN THE WATERSHED.
- LL MAXIMUM ANTICIPATED LIMITS OF CONSTRUCTION AND PAYMENT LIMIT IS SHOWN ONLY FOR THOSE AREAS WHICH HAVE MAJOR IMPACT ON TRAFFIC CONTROL. IN OTHER AREAS THE CONTRACTOR SHALL USE HIS OWN JUDGMENT OF CONSTRUCTION LIMITS AND RECEIVE PRIOR APPROVAL FROM ENGINEER. LIMITS MUST NOT CROSS THE RIGHT-OF-WAY.
- MM PRIOR TO THE REMOVAL OF ANY PAVEMENT, CURB AND GUTTER, ETC., THE ROADWAY SHALL BE SURVEYED TO ENSURE RESTORATION OF PROPER GRADES, CROWN AND ELEVATIONS. THE CONTRACTOR SHALL REMOVE AND REPLACE SHORT (LESS THAN 6') EXISTING SECTIONS OF PAVEMENT AND CURB AND GUTTER REMAINING AFTER PRIMARY REMOVALS ARE COMPLETED.
- NN MEDIAN NOSES ON LOMAS BLVD SHALL BE PAINTED YELLOW AFTER CONSTRUCTION HAS BEEN COMPLETED. (INCIDENTAL TO CONTRACT)

- PP THE CONTRACTOR IS ADVISED THAT HE MUST CONTACT THE ALBUQUERQUE CITY SURVEYOR FOURTEEN (14) DAYS IN ADVANCE OF CONSTRUCTION WHICH MAY DAMAGE SURVEY MONUMENTS WITHIN FIFTY (50) FEET OF CONSTRUCTION. CONTACT DANNY MONTANO AT 768-3612, IF THE MONUMENT IS DESTROYED BY THE CONTRACTORS CONSTRUCTION ACTIVITIES PRIOR TO NOTIFICATION, THE COST OF RESETTling THE MONUMENT SHALL BE AT THE EXPENSE OF THE CONTRACTOR.
- QQ "AC" INLET DESIGNATION REFERS TO AN "A" TYPE INLET CONSTRUCTED WITH TWO GRATES SIMILAR TO A "DOUBLE C" INLET. SEE COA DWG 2201, 2202, AND 2205.
- RR "PROJECTED FL" ELEVATION GIVEN IN PLANS IS EXTENDED FLOW LINE. "GRATE EL" ELEVATION GIVEN IN PLANS IS AT EDGE OF GRATE, SEE COA DWG 2207, CONSTRUCTION NOTE H
- SS RIGHT OF WAY SHOWN IS FOR INFORMATION ONLY BASED ON RECORD DISTANCES, NOT ON A PROPERTY SURVEY.
- TT EXTENDED WORK HOURS-CONTRACTOR IS REQUIRED TO PROVIDE CONSTRUCTION PERSONNEL ON THE PROJECT FOR EXTENDED WORK HOURS: MONDAY THROUGH SATURDAY, 7:00AM TO 10:00 PM EACH WORK DAY. SEE SPECIFICATIONS.
- UU CONTACT TRAFFIC OPERATIONS AT 857-8000 THREE (3) WORKING DAYS PRIOR TO CONSTRUCTION WHERE SIGNALS MAY BE IMPACTED.

ABBREVIATIONS

AC	ASPHALTIC CONCRETE	NO	NUMBER
APPROX	APPROXIMATELY	OD	OUTSIDE DIAMETER
CATV	CABLE TELEVISION	OPP	OPPOSITE
CB	STORM CATCH BASIN / INLET	PC	POINT OF CURVE
CCY	CONCRETE CYLINDER PIPE	PED	PEDESTAL
CFS	CUBIC FEET PER SECOND	PI	POINT OF INTERSECTION
CL	CENTER LINE	PL	PLATE
CONST	CENTER LINE OF CONSTRUCTION	PNM	PUBLIC SERVICE COMPANY OF NEW MEXICO
CLR	CLEAR	PT	POINT OF TANGENCY
COA	CITY OF ALBUQUERQUE	PVC	POLYVINYL CHLORIDE
DIA	DIAMETER	Q	FLOW RATE
DWG	DRAWING	RCP	REINFORCED CONCRETE
E	EAST	PIPE	PIPE
EG	EXISTING GRADE	ROW	RIGHT-OF-WAY
EL	ELEVATION	RT	RIGHT
ELEC	ELECTRIC	S	SLOPE/SOUTH
EP	EDGE OF PAVEMENT	SAS	SANITARY SEWER
FL	FLOW LINE ELEVATION / FLANGE	SD	STORM DRAIN
FPS	FEET PER SECOND	SE	SOUTHEAST
HGL	HYDRAULIC GRADE LINE	STA	STATION
HORIZ	HORIZONTAL	STD	STANDARD
HP	HIGH PRESSURE	TAN	TANGENT
INV	INVERT	TC	TOP OF CURB
L	LENGTH/ANGLE	TELE	TELEPHONE
LB	POUND	TG	TOP OF GRAVEL
LLV	LONG LEG VERTICAL	TOS	TOP OF SLAB
LF	LINEAR FOOT	TYP	TYPICAL
LT	LEFT	UE	UNDERGROUND ELECTRIC
MH	MANHOLE	V	VELOCITY
N	NORTH	VERT	VERTICAL
NIC	NOT IN CONTRACT	W	WEST
		W or WL	WATER LINE

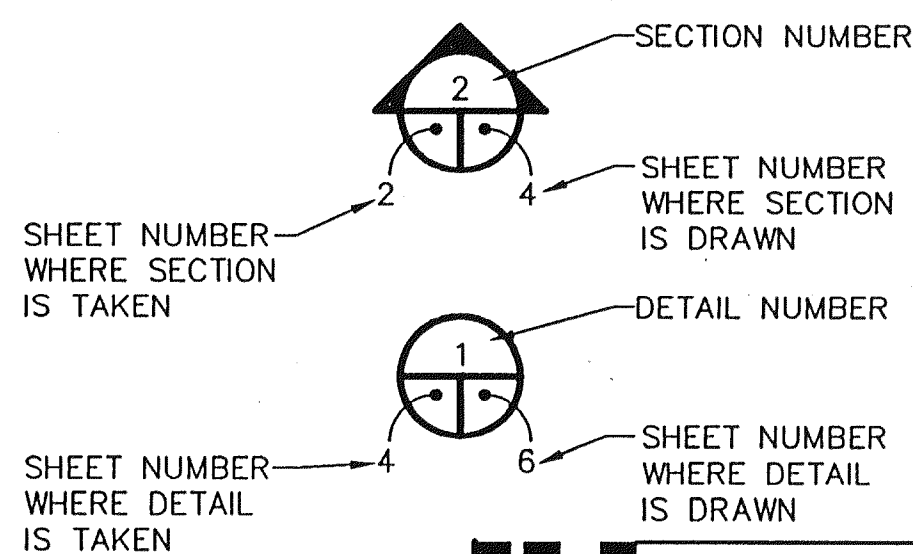


LEEDSHILL-HERKENHOFF, INC.
500 Copper Avenue NW
P.O. Box 1217
Albuquerque, NM 87103
(505)247-0294

RECORD DRAWING

JAN 1998
These drawings have been revised based on the construction records of the owner. While the information submitted by the Owner will be assumed to be reliable, the Engineer will not be responsible for the accuracy of this information nor for errors or omissions which may appear in the drawings as a result thereof.

CITY OF ALBUQUERQUE PUBLIC WORKS DEPARTMENT ENGINEERING DEVELOPMENT GROUP	
TITLE: DIVERSE DRAINAGE IMPROVEMENTS LOMAS AND NAKOMIS STORM DRAIN LEGEND, ABBREVIATIONS AND GENERAL NOTES	
APPROVED DESIGN REVIEW COMMITTEE	APPROVED CITY ENGINEER
City Project No. 4880.92	Zone Map No. -
Sheet 2	Of 24

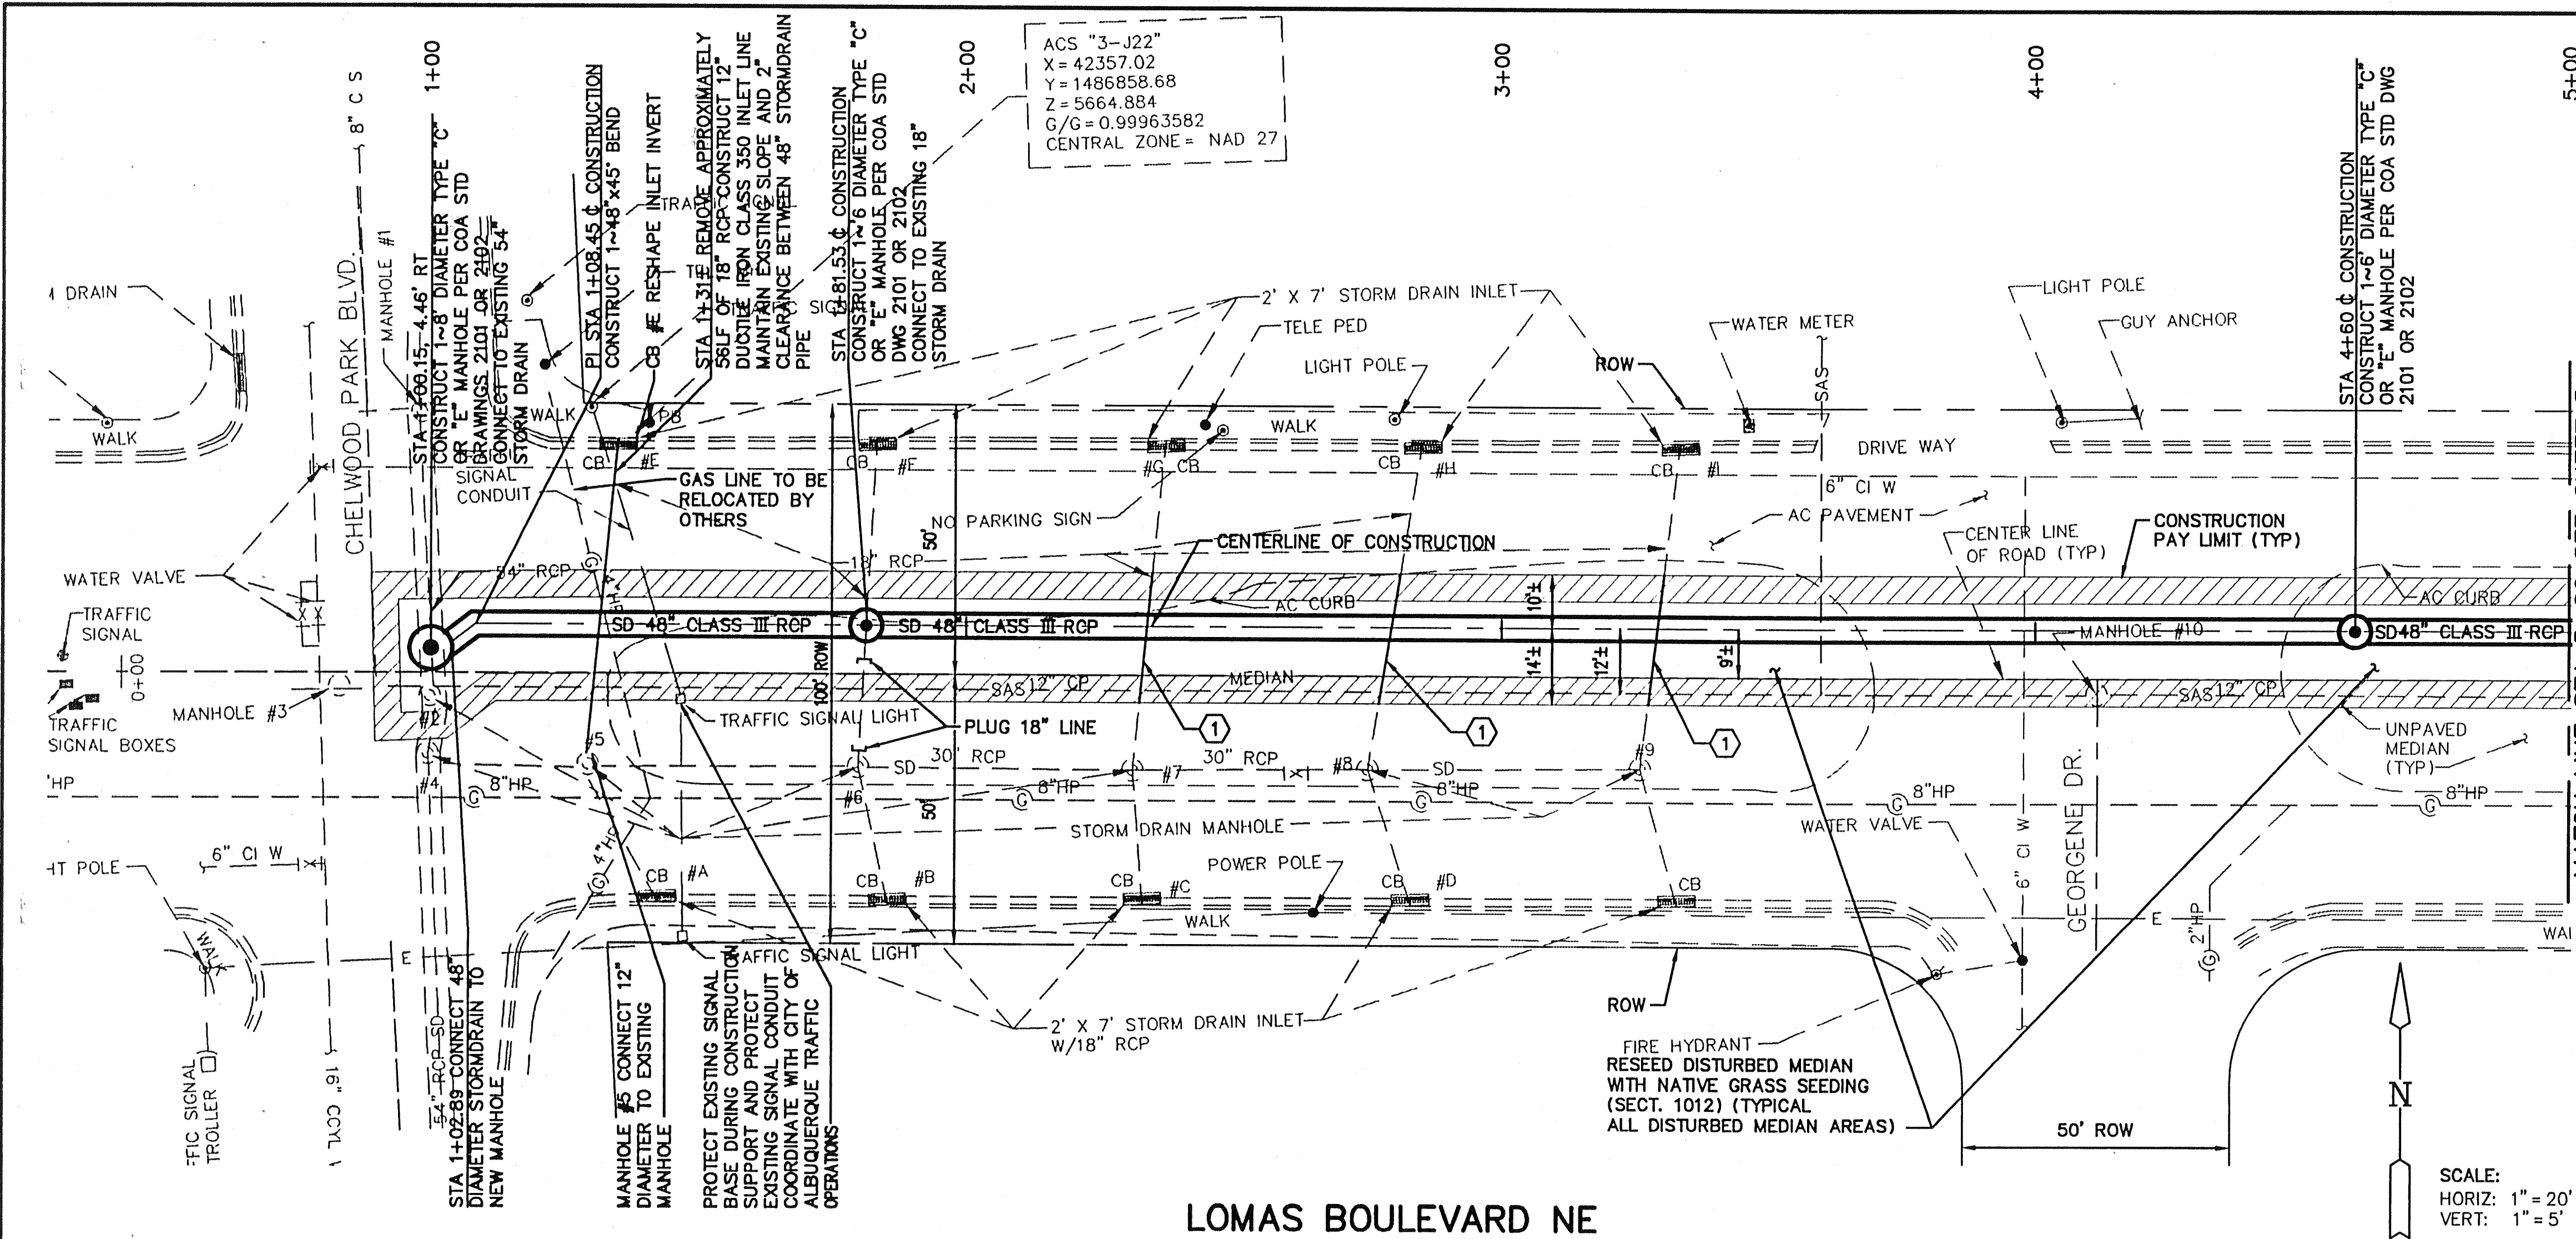


NOTES

- FOR SURVEY CONTROL SEE SHEET 3.
- ALL WATER LINE RELOCATION SHALL EMPLOY EXCLUSIVELY MECHANICAL RESTRAINT ON BENDS.
- IF A PAVEMENT DROP-OFF IS CREATED DURING CONSTRUCTION THE CONTRACTOR SHALL INITIATE PROTECTIVE ACTION IN ACCORDANCE WITH THE NEW MEXICO STATE HIGHWAY AND TRANSPORTATION DEPARTMENTS CURRENT DROP-OFF POLICY. THIS WORK SHALL BE INCIDENTAL TO THE PROJECT.
- PROVIDE SHORING OR TRENCH PROTECTION TO PROTECT EXISTING AC CURB ON LOMAS AS SHOWN. DAMAGE TO AC CURB OUTSIDE THE CONSTRUCTION PAY LIMITS MUST BE REPAIRED AT CONTRACTORS EXPENSE. SEE SHEET 24, DETAIL 2.
- FOR PAVEMENT SECTION, SEE SHEET 24, DETAIL 2.
- MEDIAN CURB REMOVED DURING CONSTRUCTION TO BE REPLACED WITH STANDARD ASPHALT CURB IN ACCORDANCE WITH COA STD DWG 2415.

KEYED NOTES

- REMOVE AND RE-INSTALL OR REPLACE EXISTING STORMDRAIN LATERALS INCLUDING FIELD CONNECTIONS IF REQUIRED. (INCIDENTAL TO TRENCH AND BACKFILL FOR NEW STORM DRAIN) SEE SHEET 6, DETAIL 9.


EXISTING MANHOLE DATA					
MH	RIM ELEV	NORTH INV 1	SOUTH INV 2	EAST INV 3	WEST INV 4
1	5663.14	5654.61	5654.59		5662.72
2	5663.95	5654.75	5654.25		5654.25
3	5663.41	5654.16		5653.27	5653.22
4	5663.55	5654.15	5654.05	5654.26	
5	5664.57	5658.57		5656.87	5656.07
6	5666.97	5659.77	5660.27	5659.07	5658.87
7	5669.32	5662.42	5661.52	5661.17	5661.17
8	5670.69	5663.95	5664.35	5663.17	5662.97
9	5672.87	5665.87	5666.37	5665.37	5665.27
10	5676.44			5666.94	5666.84
11	5687.90			5678.25	5678.15
12	5703.10			5693.20	5693.05
13	5716.80	5708.65		5707.95	5707.95
14	5716.13	5709.28	5709.18		
15	5718.90	5713.25	5713.15		
16	5723.00	5716.65			5716.65
17	5726.41	5720.41	5720.31	5720.51	
18	5727.01	5721.01	5720.96	5721.31	5721.01
19	5729.39	5723.54	5723.39	5723.49	
20	5768.75	5757.00		5756.95	5756.75
21	5771.87	5762.25	5761.75	5761.65	5761.55
22	5772.86	5767.16	5764.76		5764.86
23	5779.72	5770.12		5770.02	5770.02
24	5794.56	5786.57		5786.57	5786.47
25	5795.18		5787.18	5787.18	5787.08

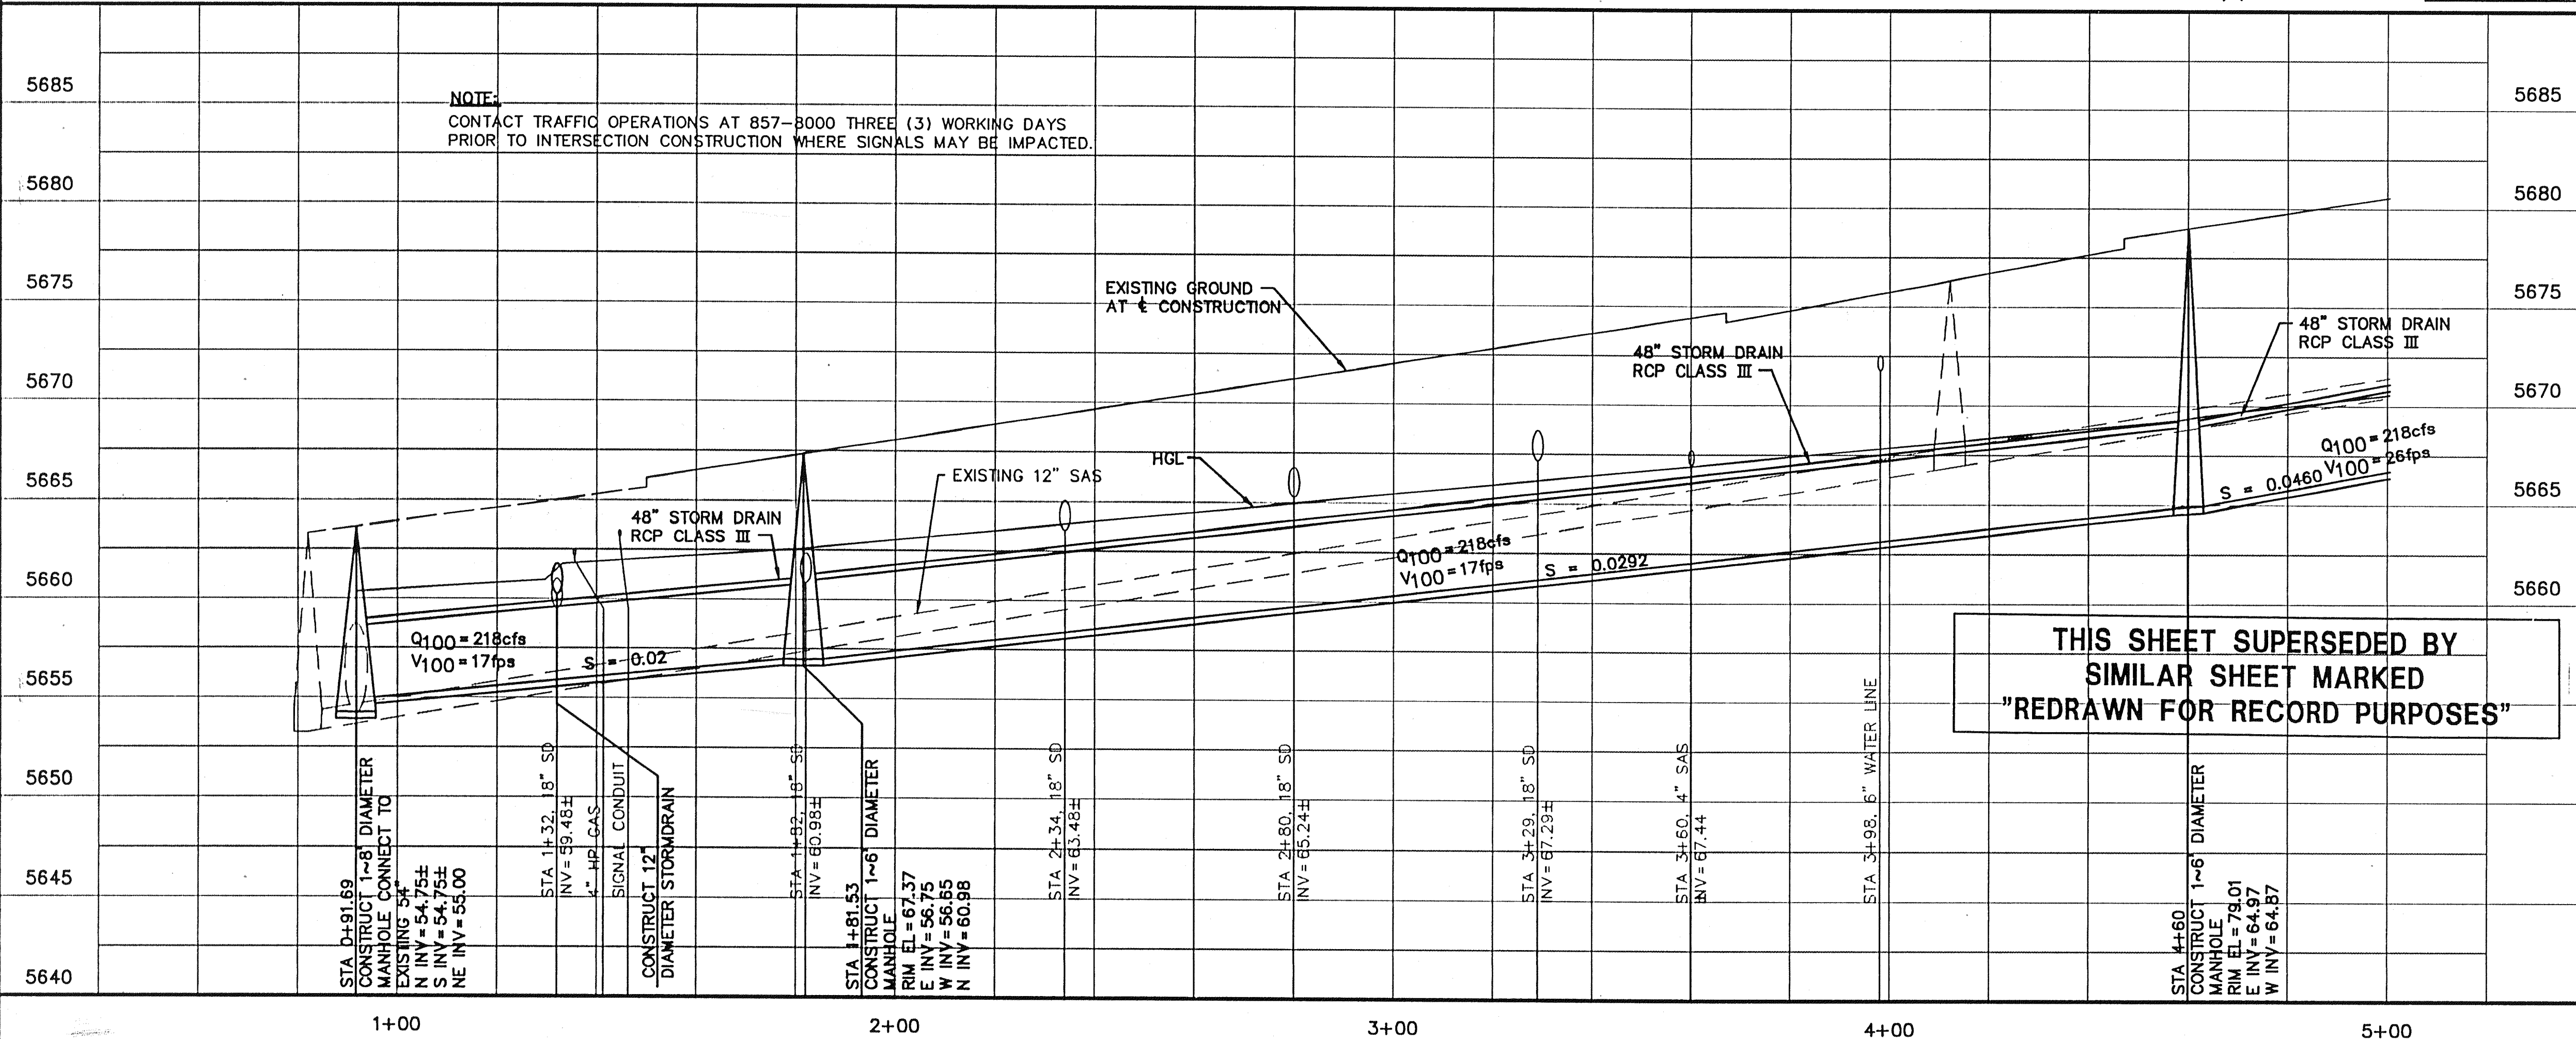

EXISTING STORM DRAIN INLETS	GRATE ELEVATION	INVERT ELEVATION
A	5663.77	5660.77
B	5667.48	5664.48
C	5669.43	5666.43
D	5671.53	5668.53
E	5663.59	5660.59
F	5665.45	5662.45
G	5667.69	5664.69
H	5669.71	5666.71
I	5671.69	5668.96
J	5773.37	5770.37
K	5774.47	5771.43
L	5779.89	5776.89
M	5781.34	5778.34
N	5772.89	5769.89

LEEDSHILL-HERKENHOFF, INC.
500 Copper Avenue NW
P.O. Box 1217
Albuquerque, NM 87103
(505)247-0294


CITY OF ALBUQUERQUE PUBLIC WORKS DEPARTMENT ENGINEERING DEVELOPMENT GROUP	
TITLE: DIVERSE DRAINAGE IMPROVEMENTS LOMAS PLAN AND PROFILE STA 1+00 TO STA 5+00	
DESIGN REVIEW COMMITTEE APPROVED JUL 19 1997	CITY ENGINEER APPROVAL APPROVED JAN 19 1997
City Project No. 4880-92	Zone Map No. J.K-22,23
Sheet 4	Of 24

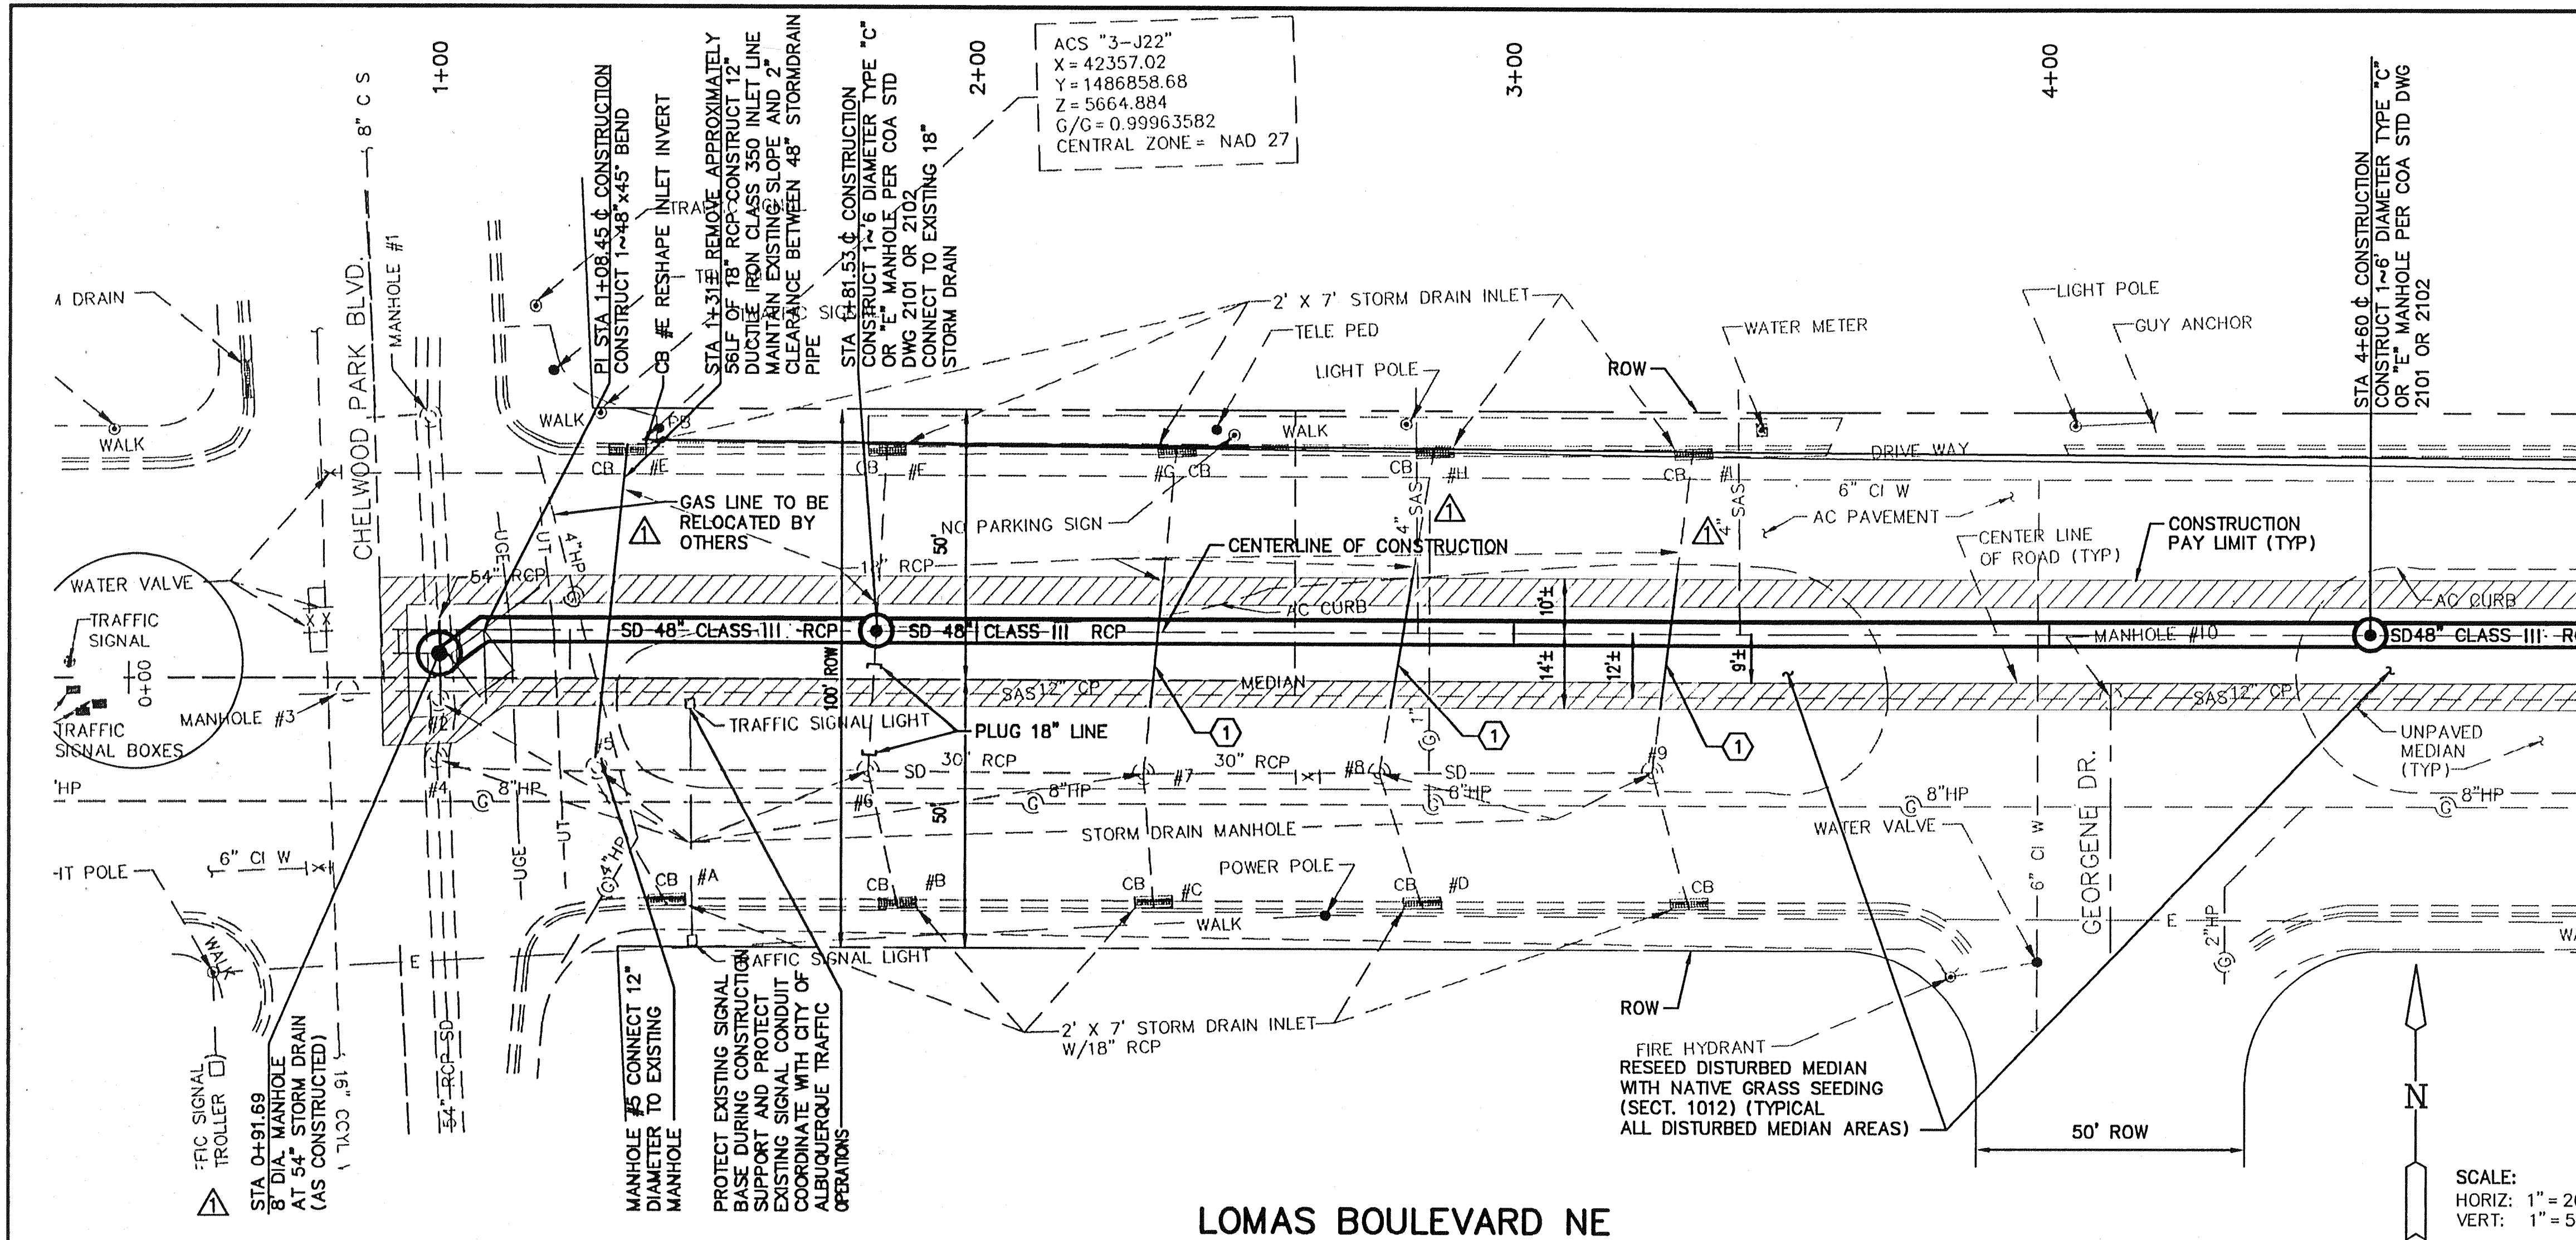

- NOTES**
- A FOR SURVEY CONTROL SEE SHEET 3.
- B ALL WATER LINE RELOCATION SHALL EMPLOY EXCLUSIVELY MECHANICAL RESTRAINT ON BENDS.
- C IF A PAVEMENT DROP-OFF IS CREATED DURING CONSTRUCTION THE CONTRACTOR SHALL INITIATE PROTECTIVE ACTION IN ACCORDANCE WITH THE NEW MEXICO STATE HIGHWAY AND TRANSPORTATION DEPARTMENT'S CURRENT DROP-OFF POLICY. THIS WORK SHALL BE INCIDENTAL TO THE PROJECT.
- D PROVIDE SHORING OR TRENCH PROTECTION TO PROTECT EXISTING AC CURB ON LOMAS AS SHOWN. DAMAGE TO AC CURB OUTSIDE THE CONSTRUCTION PAY LIMITS MUST BE REPAIRED AT CONTRACTORS EXPENSE. SEE SHEET 24, DETAIL 2.
- E FOR PAVEMENT SECTION, SEE SHEET 24, DETAIL 2.
- F MEDIAN CURB REMOVED DURING CONSTRUCTION TO BE REPLACED WITH STANDARD ASPHALT CURB IN ACCORDANCE WITH COA STD DWG 2415.

- KEYED NOTES**
- 1 REMOVE AND RE-INSTALL OR REPLACE EXISTING STORMDRAIN LATERALS INCLUDING FIELD CONNECTIONS IF REQUIRED. (INCIDENTAL TO TRENCH AND BACKFILL FOR NEW STORM DRAIN) SEE SHEET 6, DETAIL 9.

EXISTING MANHOLE DATA						
MH	RIM ELEV	NORTH INV 1	SOUTH INV 2	EAST INV 3	WEST INV 4	COA GIS NUMBER
1	5663.14	5654.61	5654.59		5662.72	S942
2	5663.95	5654.75	5654.25		5654.25	NO NUMBER
3	5663.41	5654.16			5653.22	944
4	5663.55	5654.15	5654.05	5653.27		S43
5	5664.57	5658.57		5656.87	5656.07	S56
6	5666.97	5659.77	5660.27	5659.07	5658.87	S55
7	5669.32	5662.42	5662.82	5661.52	5661.17	S54
8	5670.69	5663.95	5664.35	5663.17	5662.97	S53
9	5672.87	5665.87	5666.37	5665.37	5665.27	S52
10	5676.44			5666.94	5666.84	NO NUMBER
11	5687.90			5678.25	5678.15	
12	5703.10			5693.20	5693.05	964
13	5716.80	5708.65		5707.95	5707.95	972
14	5716.13	5709.28	5709.18			NO NUMBER
15	5718.90	5713.25	5713.15			971
16	5723.00	5716.65			5716.65	873
17	5726.41	5720.41	5720.31	5720.51		875
18	5727.01	5721.01	5720.96	5721.31	5721.01	871
19	5729.39	5723.54	5723.39	5723.49		NO NUMBER
20	5768.75	5757.00		5756.95	5756.75	903
21	5771.87	5762.25	5761.75	5761.65	5761.55	NO NUMBER
22	5772.86	5767.16	5764.76		5764.86	S902
23	5779.72	5770.12		5770.02	5770.02	S903
24	5794.56	5786.57		5786.57	5786.47	
25	5795.18		5787.18	5787.18	5787.08	

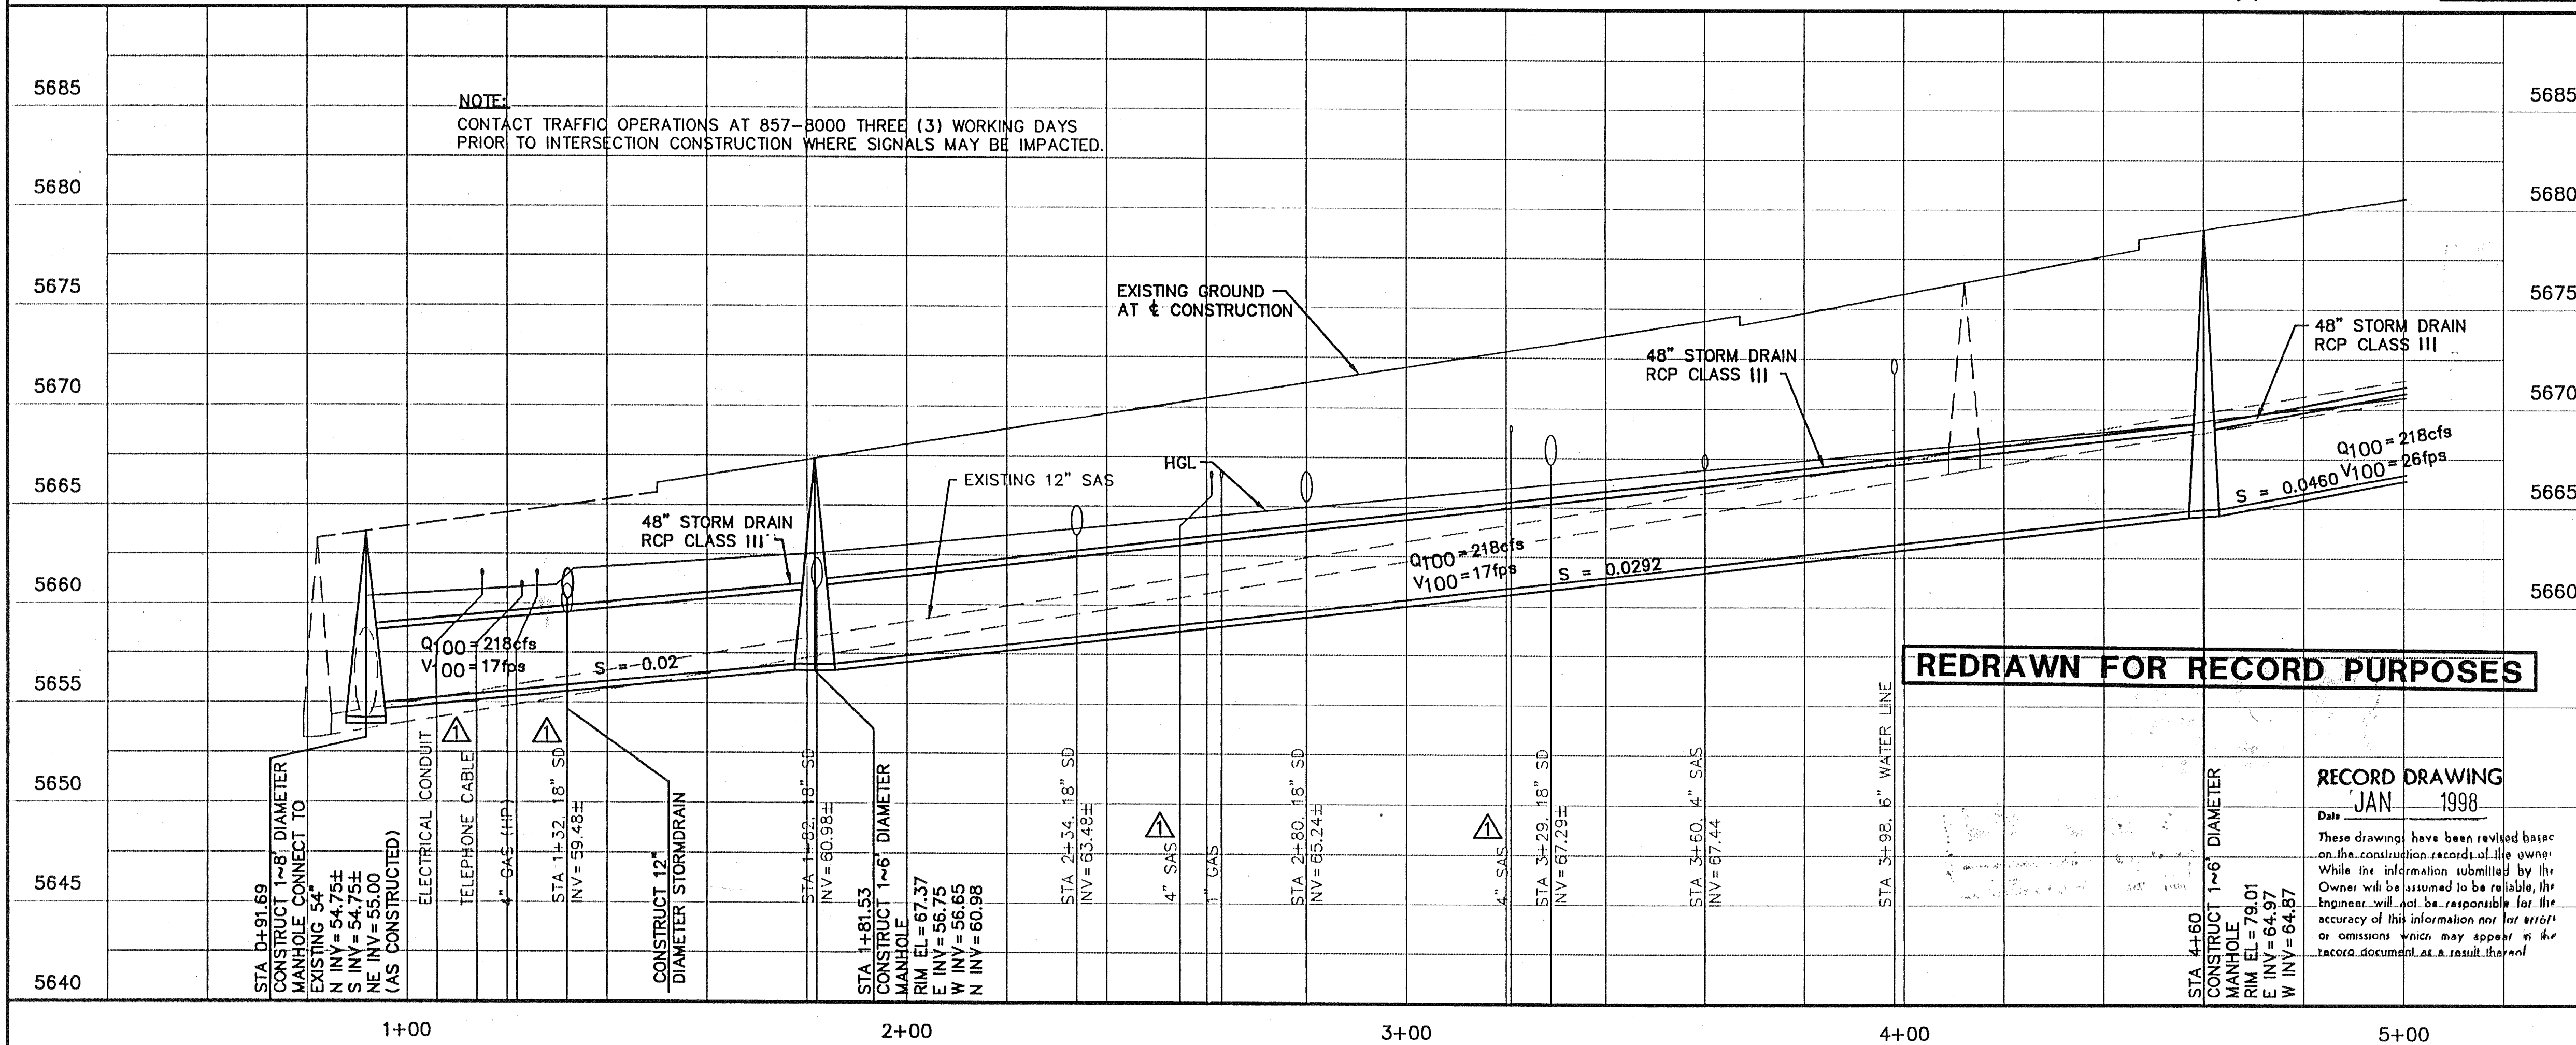

EXISTING STORM DRAIN INLETS	GRATE ELEVATION	INVERT ELEVATION
A	5663.77	5660.77
B	5667.48	5664.48
C	5669.43	5666.43
D	5671.53	5668.53
E	5663.59	5660.59
F	5665.45	5662.45
G	5667.69	5664.69
H	5669.71	5666.71
I	5671.69	5668.96
J	5773.37	5770.37
K	5774.47	5771.43
L	5779.89	5776.89
M	5781.34	5778.34
N	5772.89	5769.89

REVISIONS

NO.	DATE	REMARKS
1	1/98	CHANGES AS PER RECORD DWG. LUS

LEEDSHILL-HERKENHOFF, INC.
500 Copper Avenue NW
P.O. Box 1217
Albuquerque, NM 87103
(505)247-0294

CITY OF ALBUQUERQUE
PUBLIC WORKS DEPARTMENT
ENGINEERING DEVELOPMENT GROUP

TITLE: DIVERSE DRAINAGE IMPROVEMENTS
LOMAS PLAN AND PROFILE
STA 1+00 TO STA 5+00

Design Review Committee: City Engineer Approval

City Project No. 4880-92, Zone Map No. JK-22,23, Sheet 4A of 24

AS BUILT INFORMATION

CONTRACTOR: JR. HALE, INC.
WORK ORDER: 1997
DATE: 1997

BENCH MARKS

THE STATION IS A STANDARD ACS BRASS TABLET STAMPED "3-122 1979" SET FLUSH WITH THE GROUND AND LOCATED AT THE NORTHEAST CORNER OF LOMAS BLVD AND CHELWOOD PARK BLVD NE. ELEV = 5664.88 (SLD 1929)


SURVEY INFORMATION

FIELD NOTES: NO. BY DATE

ENGINEER'S SEAL


1/98 CHANGES AS PER RECORD DWG. LUS
NO. DATE REMARKS

LEEDSHILL-HERKENHOFF, INC.
DESIGNED BY: RAS/TM/KO
DRAWN BY: C ROMERO
CHECKED BY: C DODGE
DATE: JAN 1996
DATE: JAN 1996
DATE: JAN 1996

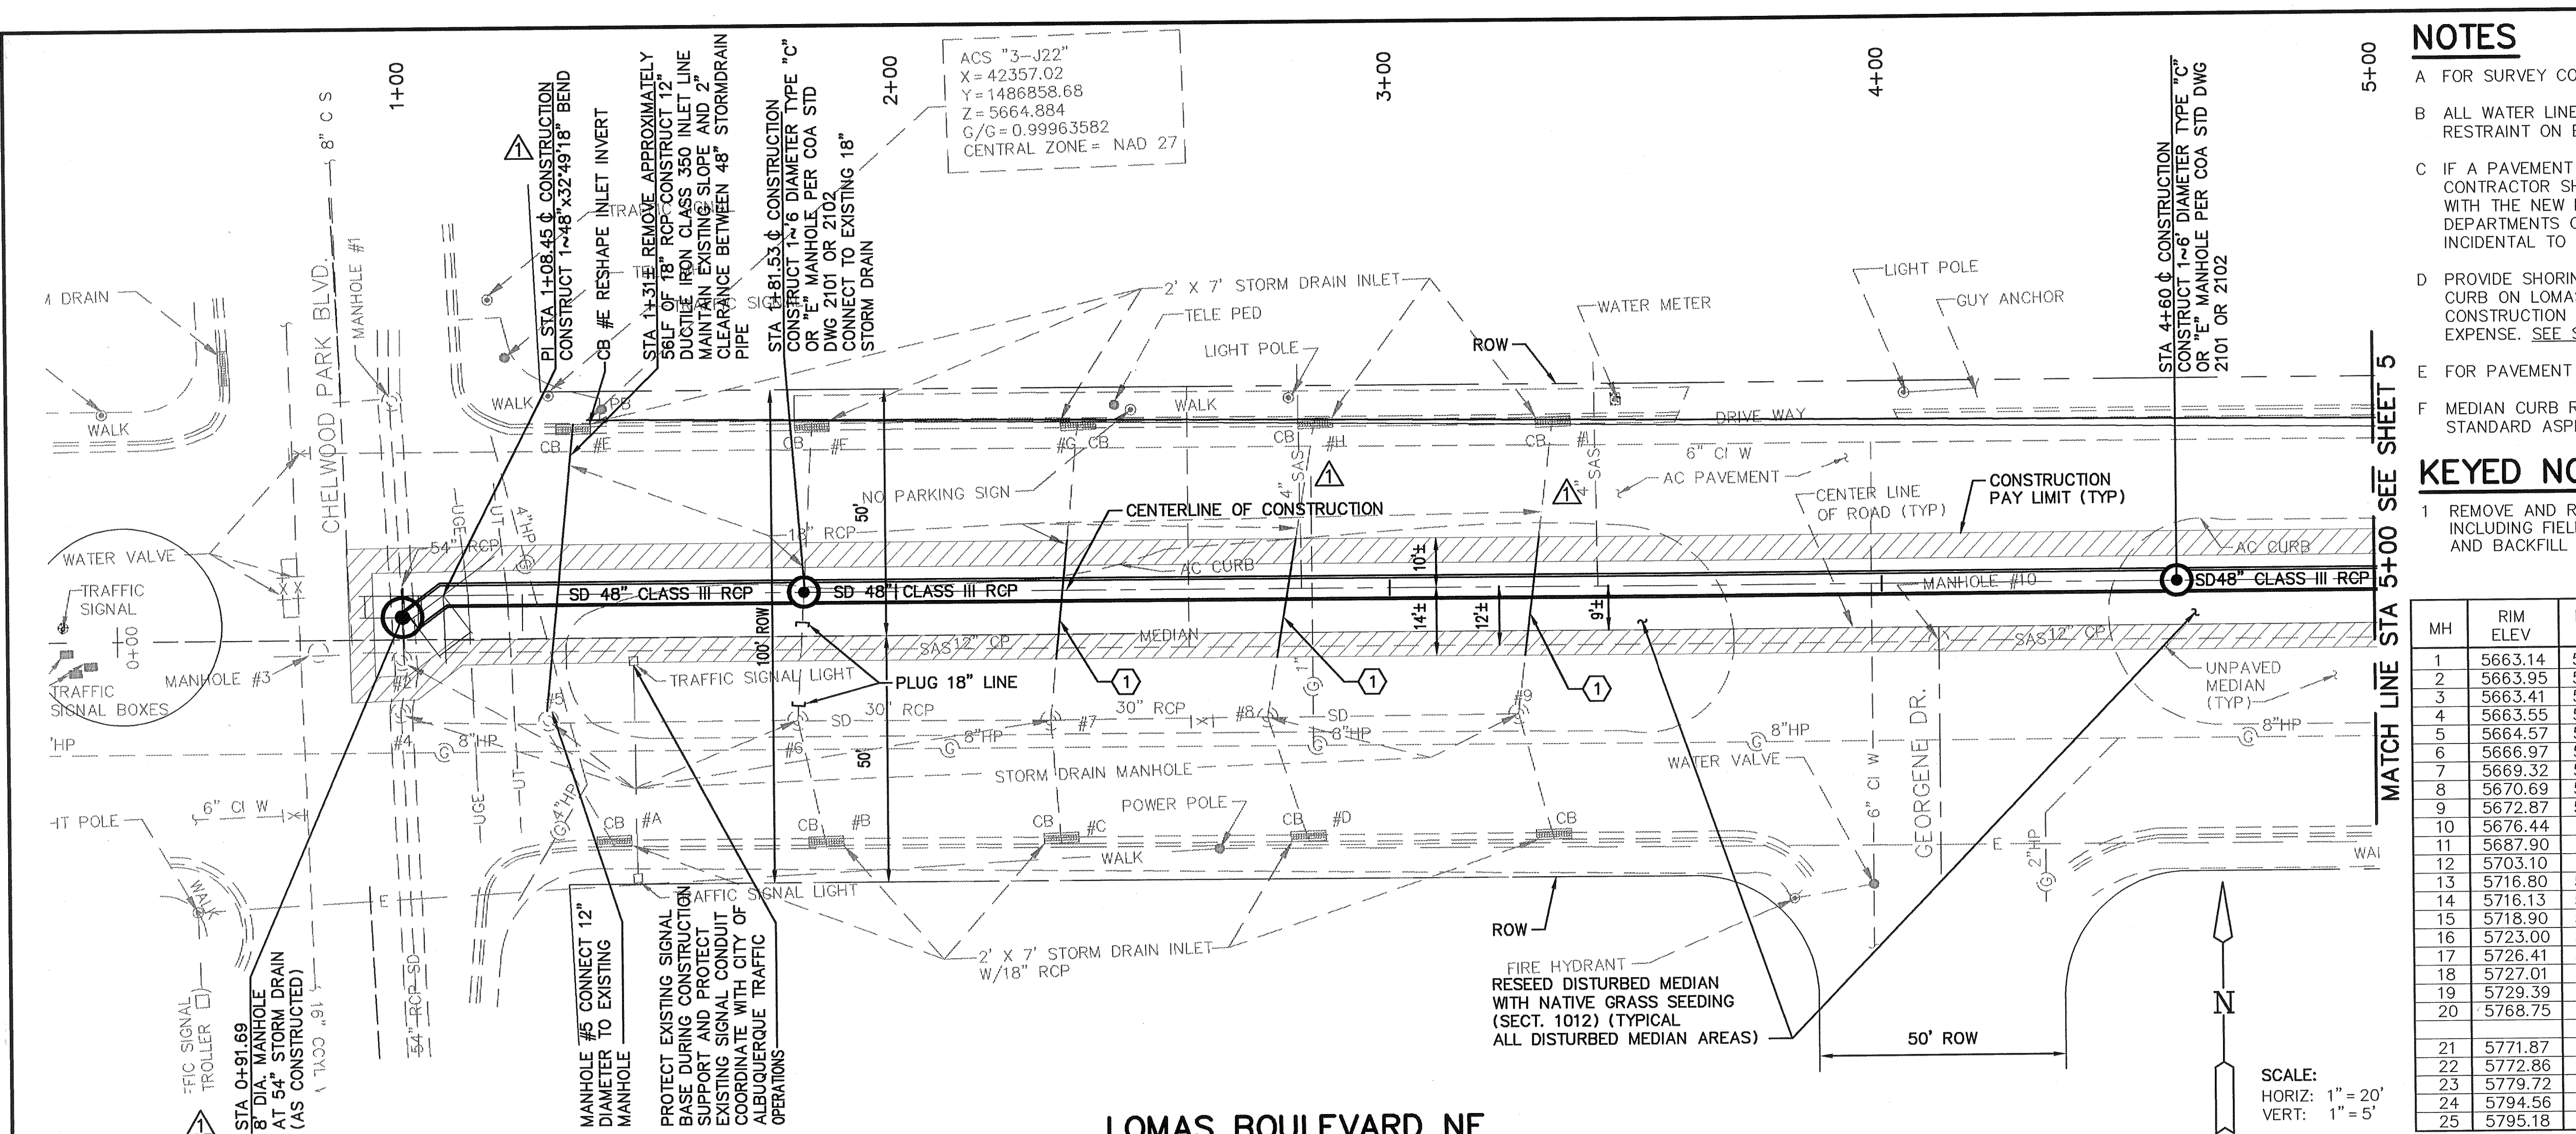

- NOTES**
- A FOR SURVEY CONTROL SEE SHEET 3.
 - B ALL WATER LINE RELOCATION SHALL EMPLOY EXCLUSIVELY MECHANICAL RESTRAINT ON BENDS.
 - C IF A PAVEMENT DROP-OFF IS CREATED DURING CONSTRUCTION THE CONTRACTOR SHALL INITIATE PROTECTIVE ACTION IN ACCORDANCE WITH THE NEW MEXICO STATE HIGHWAY AND TRANSPORTATION DEPARTMENTS CURRENT DROP-OFF POLICY. THIS WORK SHALL BE INCIDENTAL TO THE PROJECT.
 - D PROVIDE SHORING OR TRENCH PROTECTION TO PROTECT EXISTING AC CURB ON LOMAS AS SHOWN. DAMAGE TO AC CURB OUTSIDE THE CONSTRUCTION PAY LIMITS MUST BE REPAIRED AT CONTRACTORS EXPENSE. SEE SHEET 24, DETAIL 2.
 - E FOR PAVEMENT SECTION, SEE SHEET 24, DETAIL 2.
 - F MEDIAN CURB REMOVED DURING CONSTRUCTION TO BE REPLACED WITH STANDARD ASPHALT CURB IN ACCORDANCE WITH COA STD DWG 2415.
- KEYED NOTES**
- 1 REMOVE AND RE-INSTALL OR REPLACE EXISTING STORMDRAIN LATERALS INCLUDING FIELD CONNECTIONS IF REQUIRED. (INCIDENTAL TO TRENCH AND BACKFILL FOR NEW STORM DRAIN) SEE SHEET 6, DETAIL 9.

EXISTING MANHOLE DATA						
MH	RIM ELEV	NORTH INV 1	SOUTH INV 2	EAST INV 3	WEST INV 4	COA GIS NUMBER
1	5663.14	5654.61	5654.59		5662.72	S942
2	5663.95	5654.75	5654.25		5654.25	NO NUMBER
3	5663.41	5654.16		5653.27	5653.22	944
4	5663.55	5654.15	5654.05	5654.26		S43
5	5664.57	5658.57		5656.87	5656.07	S56
6	5666.97	5659.77	5660.27	5659.07	5658.87	S55
7	5669.32	5662.42	5662.82	5661.52	5661.17	S54
8	5670.69	5663.95	5664.35	5663.17	5662.97	S53
9	5672.87	5665.87	5666.37	5665.37	5665.27	S52
10	5676.44			5666.94	5666.84	NO NUMBER
11	5687.90			5678.25	5678.15	
12	5703.10			5693.20	5693.05	964
13	5716.80	5708.65		5707.95	5707.95	972
14	5716.13	5709.28	5709.18			NO NUMBER
15	5718.90	5713.25	5713.15			971
16	5723.00	5716.65			5716.65	873
17	5726.41	5720.41	5720.31	5720.51		875
18	5727.01	5721.01	5720.96	5721.31	5721.01	871
19	5729.39	5723.54	5723.39	5723.49		NO NUMBER
20	5768.75	5757.00		5756.95	5756.75	903
21	5771.87	5762.25	5761.75	5761.65	5761.55	NO NUMBER
22	5772.86	5767.16	5764.76		5764.86	S902
23	5779.72	5770.12		5770.02	5770.02	S903
24	5794.56	5786.57		5786.57	5786.47	
25	5795.18			5787.18	5787.08	

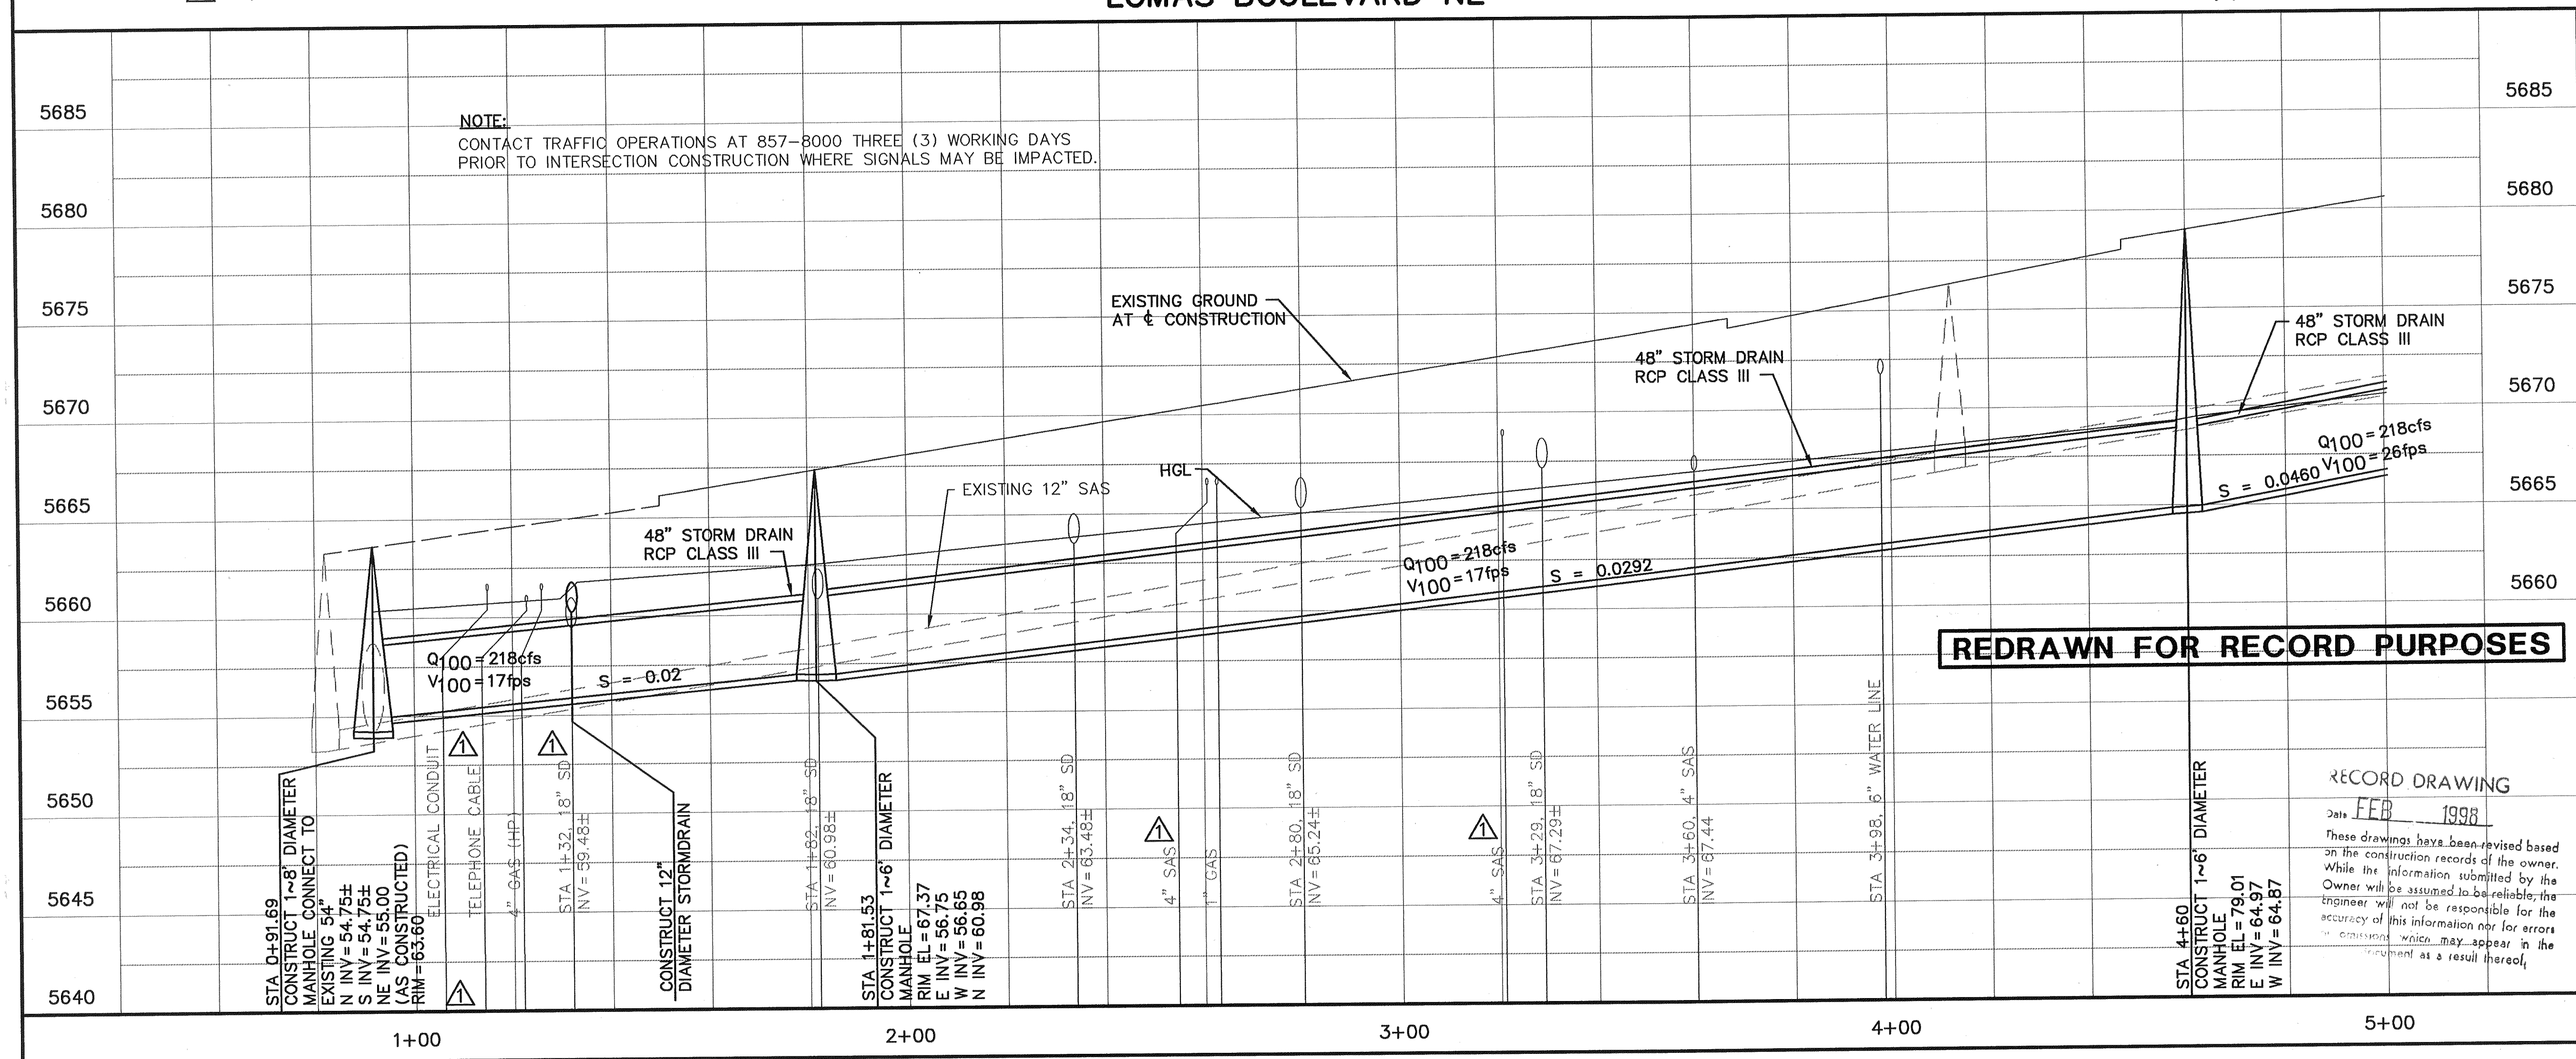

EXISTING STORM DRAIN INLETS	GRATE ELEVATION	INVERT ELEVATION
A	5663.77	5660.77
B	5667.48	5664.48
C	5669.43	5666.43
D	5671.53	5668.53
E	5663.59	5660.59
F	5665.45	5662.45
G	5667.69	5664.69
H	5669.71	5666.71
I	5671.69	5668.96
J	5773.37	5770.37
K	5774.47	5771.43
L	5779.89	5776.89
M	5781.34	5778.34
N	5772.89	5769.89

REVISIONS

NO.	DATE	REMARKS
1	1/98	CHANGES AS PER RECORD DWG. LJS


LEEDSHILL-HERKENHOFF, INC.
500 Copper Avenue NW
P.O. Box 1217
Albuquerque, NM 87103
(505)247-0294

CITY OF ALBUQUERQUE
PUBLIC WORKS DEPARTMENT
ENGINEERING DEVELOPMENT GROUP

TITLE: DIVERSE DRAINAGE IMPROVEMENTS
LOMAS PLAN AND PROFILE
STA 1+00 TO STA 5+00

Design Review Committee: City Engineer Approval

City Project No. 4880-92 Zone Map No. J,K-22,23 Sheet 4B of 24

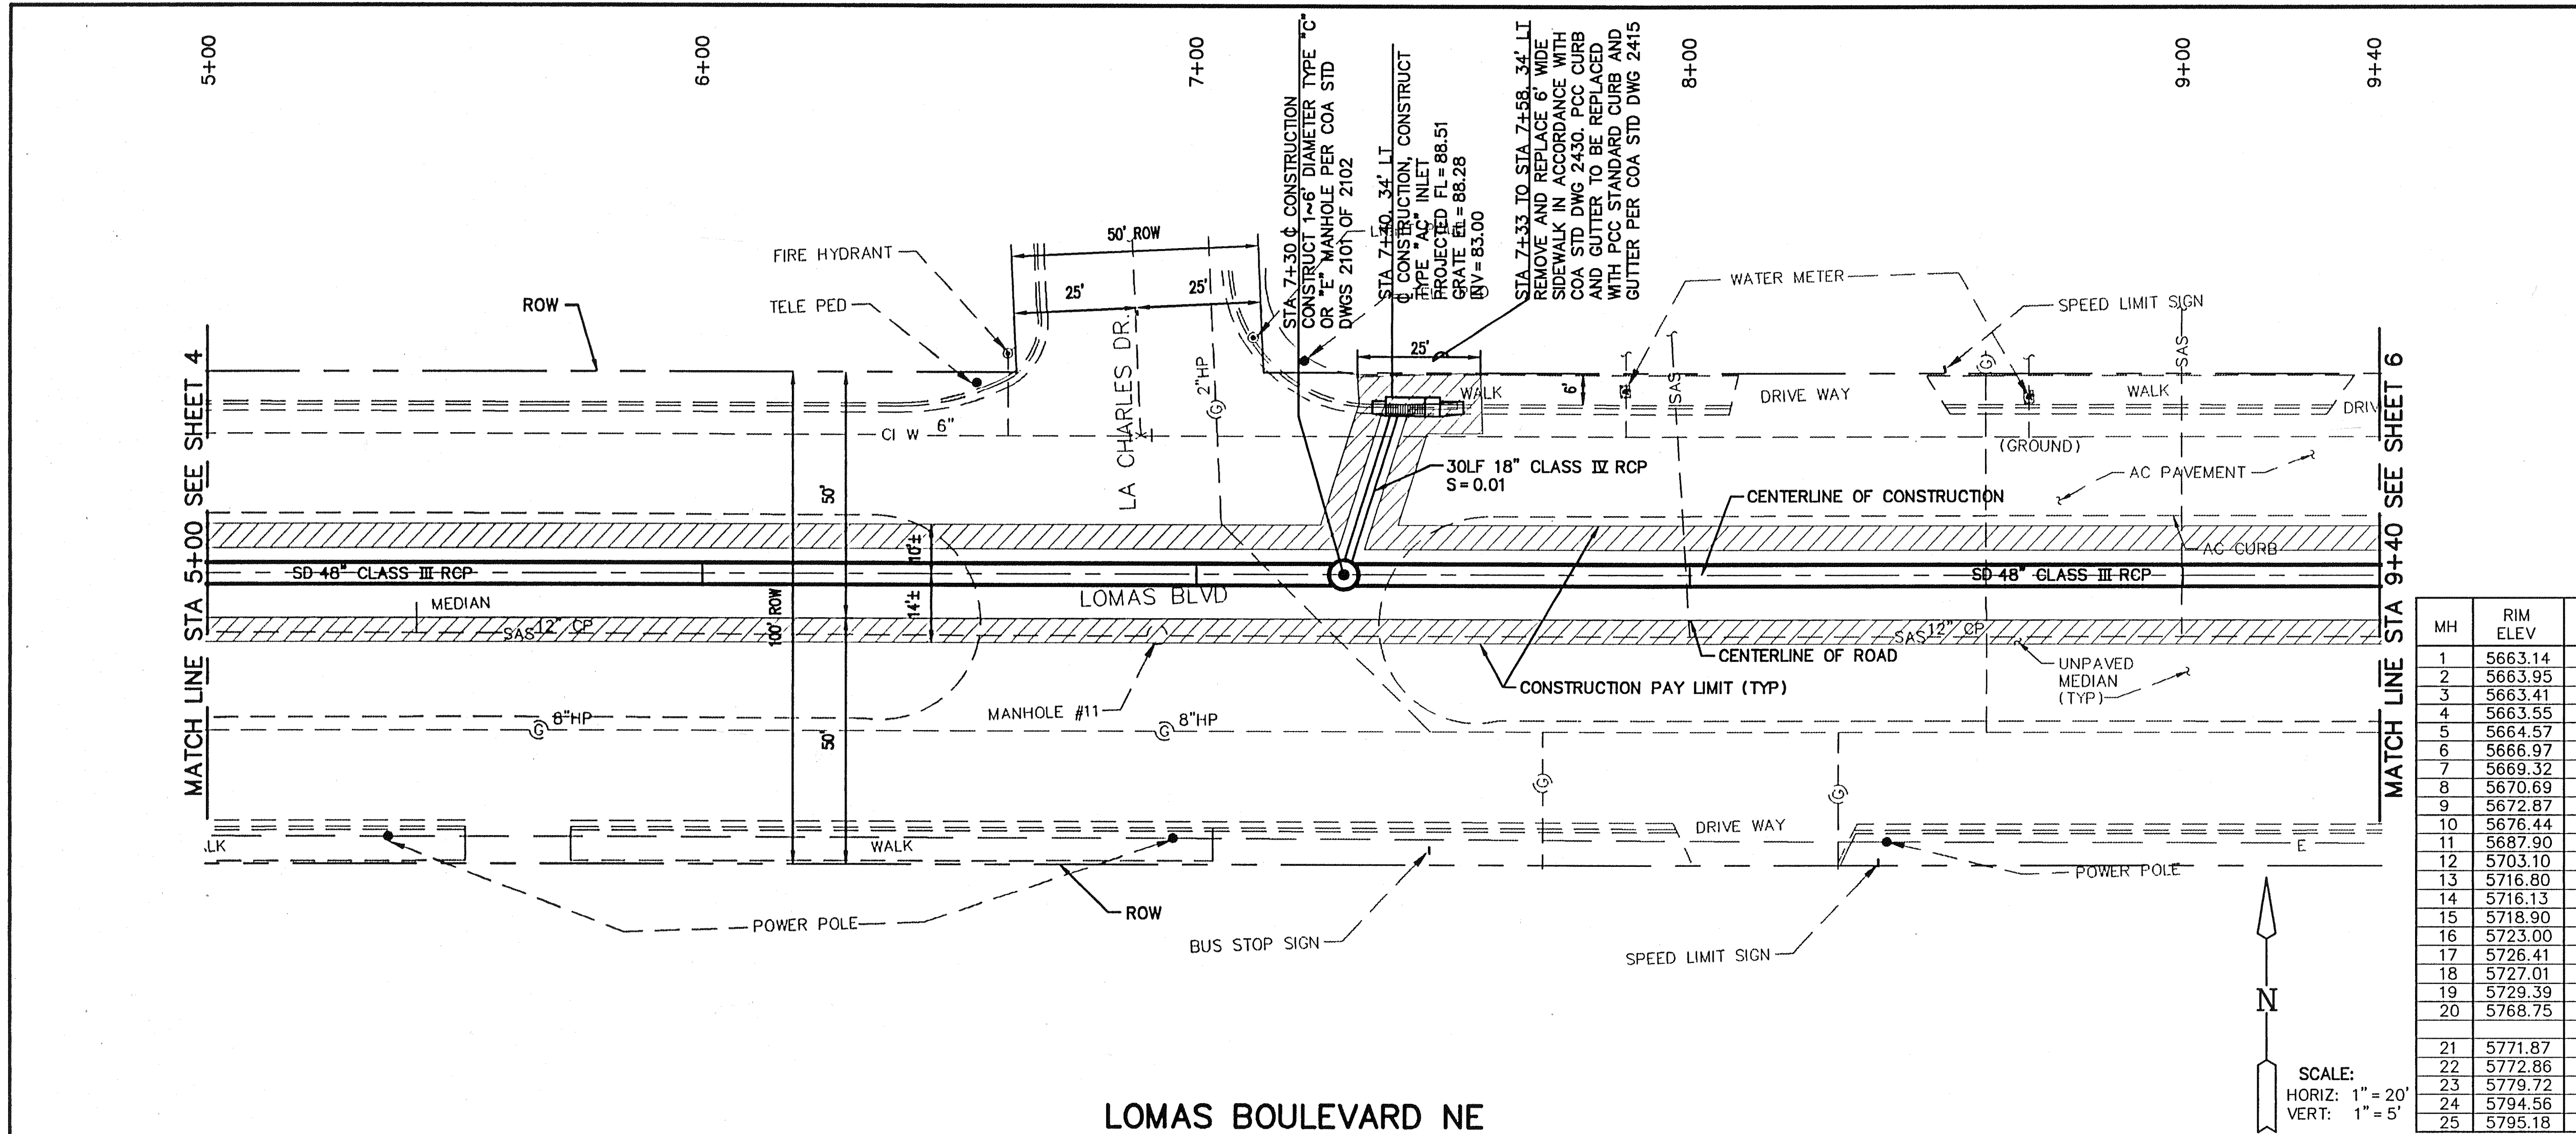


NOTES

- FOR SURVEY CONTROL SEE SHEET 3.
- ALL WATER LINE RELOCATION SHALL EMPLOY EXCLUSIVELY MECHANICAL RESTRAINT ON BENDS.
- IF A PAVEMENT DROP-OFF IS CREATED DURING CONSTRUCTION THE CONTRACTOR SHALL INITIATE PROTECTIVE ACTION IN ACCORDANCE WITH THE NEW MEXICO STATE HIGHWAY AND TRANSPORTATION DEPARTMENTS CURRENT DROP-OFF POLICY. THIS WORK SHALL BE INCIDENTAL TO THE PROJECT.
- PROVIDE SHORING OR TRENCH PROTECTION TO PROTECT EXISTING AC CURB ON LOMAS AS SHOWN. DAMAGE TO AC CURB OUTSIDE THE CONSTRUCTION PAY LIMITS MUST BE REPAIRED AT CONTRACTORS EXPENSE. SEE SHEET 24, DETAIL 2.
- FOR PAVEMENT SECTION, SEE SHEET 24, DETAIL 2.
- MEDIAN CURB REMOVED DURING CONSTRUCTION TO BE REPLACED WITH STANDARD ASPHALT CURB IN ACCORDANCE WITH COA STD DWG 2415.

EXISTING MANHOLE DATA

MH	RIM ELEV	NORTH INV 1	SOUTH INV 2	EAST INV 3	WEST INV 4	COA GIS NUMBER
1	5663.14	5654.61	5654.59		5662.72	S942
2	5663.95	5654.75	5654.25		5654.25	NO NUMBER
3	5663.41	5654.16		5653.27	5653.22	944
4	5663.55	5654.15	5654.05	5654.26		S43
5	5664.57	5658.57		5656.87	5656.07	S56
6	5666.97	5659.77	5660.27	5659.07	5658.87	S55
7	5669.32	5662.42	5662.82	5661.52	5661.17	S54
8	5670.69	5663.95	5664.35	5663.17	5662.97	S53
9	5672.87	5665.87	5666.37	5665.37	5665.27	S52
10	5676.44			5666.94	5666.84	NO NUMBER
11	5687.90			5678.25	5678.15	972
12	5703.10			5693.20	5693.05	964
13	5716.80	5708.65		5707.95	5707.95	971
14	5716.13	5709.28	5709.18			NO NUMBER
15	5718.90	5713.25	5713.15			971
16	5723.00	5716.65			5716.65	873
17	5726.41	5720.41	5720.31	5720.51		875
18	5727.01	5721.01	5720.96	5721.31	5721.01	871
19	5729.39	5723.54	5723.39	5723.49		NO NUMBER
20	5768.75	5757.00		5756.95	5756.75	903
21	5771.87	5762.25	5761.75	5761.65	5761.55	NO NUMBER
22	5772.86	5767.16	5764.76		5764.86	S902
23	5779.72	5770.12		5770.02	5770.02	S903
24	5794.56	5786.57		5786.57	5786.47	
25	5795.18			5787.18	5787.08	

LOMAS BOULEVARD NE

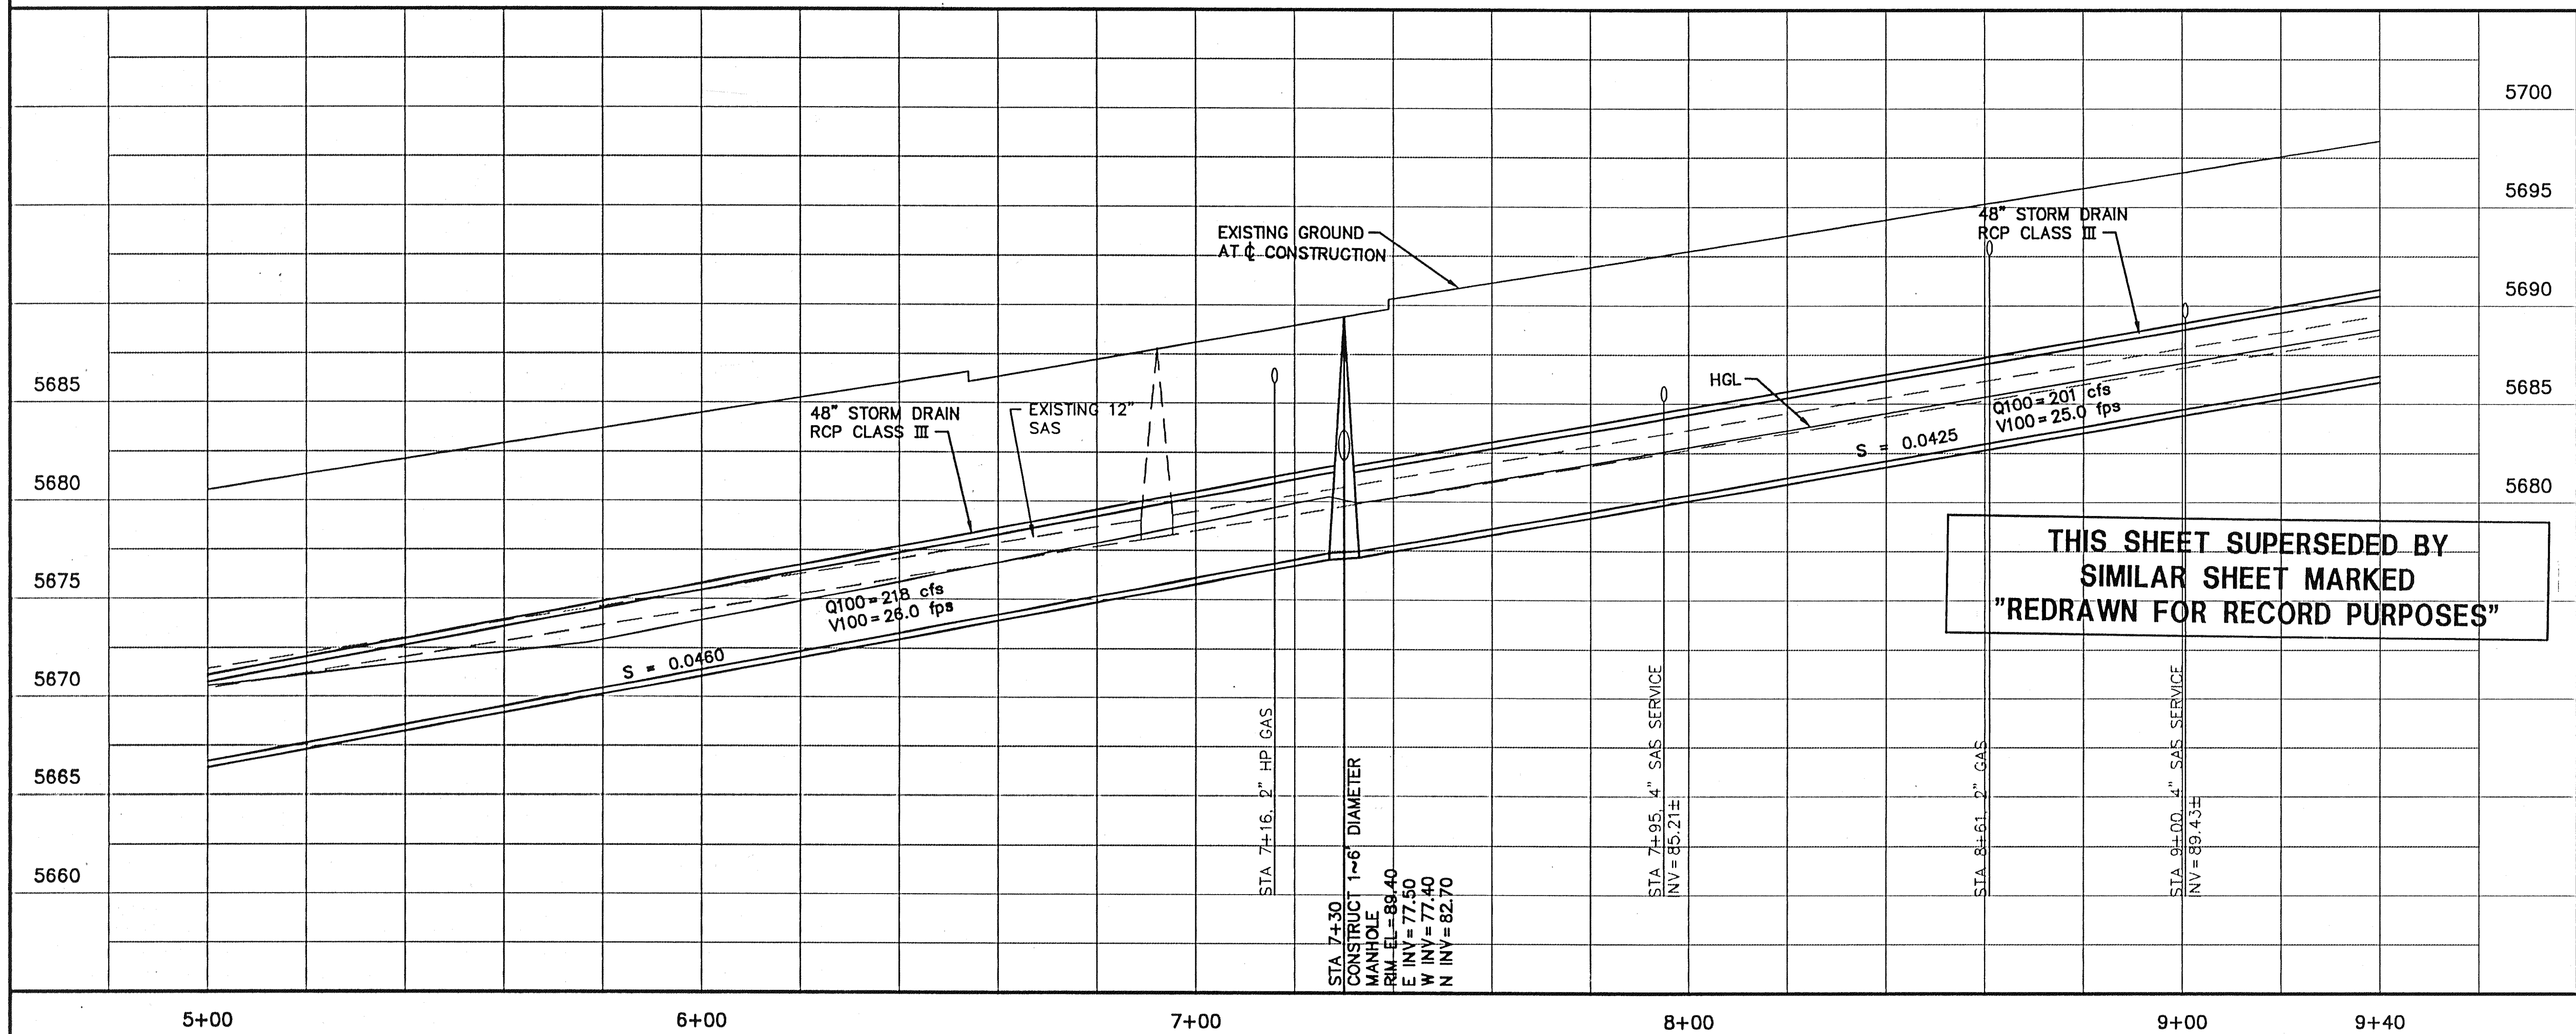

EXISTING STORM DRAIN INLETS	GRATE ELEVATION	INVERT ELEVATION
A	5663.77	5660.77
B	5667.48	5664.48
C	5669.43	5666.43
D	5671.53	5668.53
E	5663.59	5660.59
F	5665.45	5662.45
G	5667.69	5664.69
H	5669.71	5666.71
I	5671.69	5668.96
J	5773.37	5770.37
K	5774.47	5771.43
L	5779.89	5776.89
M	5781.34	5778.34
N	5772.89	5769.89

LEEDSHILL-HERKENHOFF, INC.
500 Copper Avenue NW
P.O. Box 1217
Albuquerque, NM 87103
(505)247-0294

CITY OF ALBUQUERQUE
PUBLIC WORKS DEPARTMENT
ENGINEERING DEVELOPMENT GROUP


TITLE: DIVERSE DRAINAGE IMPROVEMENTS
LOMAS PLAN AND PROFILE
STA 5+00 TO STA 9+40

DESIGN REVIEW COMMITTEE
APPROVED
JUN 19 1997
DESIGN REVIEW COMMITTEE

CITY ENGINEER
APPROVED
JUN 19 1997
CITY ENGINEER


City Project No. 4880-92
Zone Map No. J.K-22,23
Sheet 5 of 24

20/94036_31/DWG/C/LOM-NAK1/5-12-97/BGC

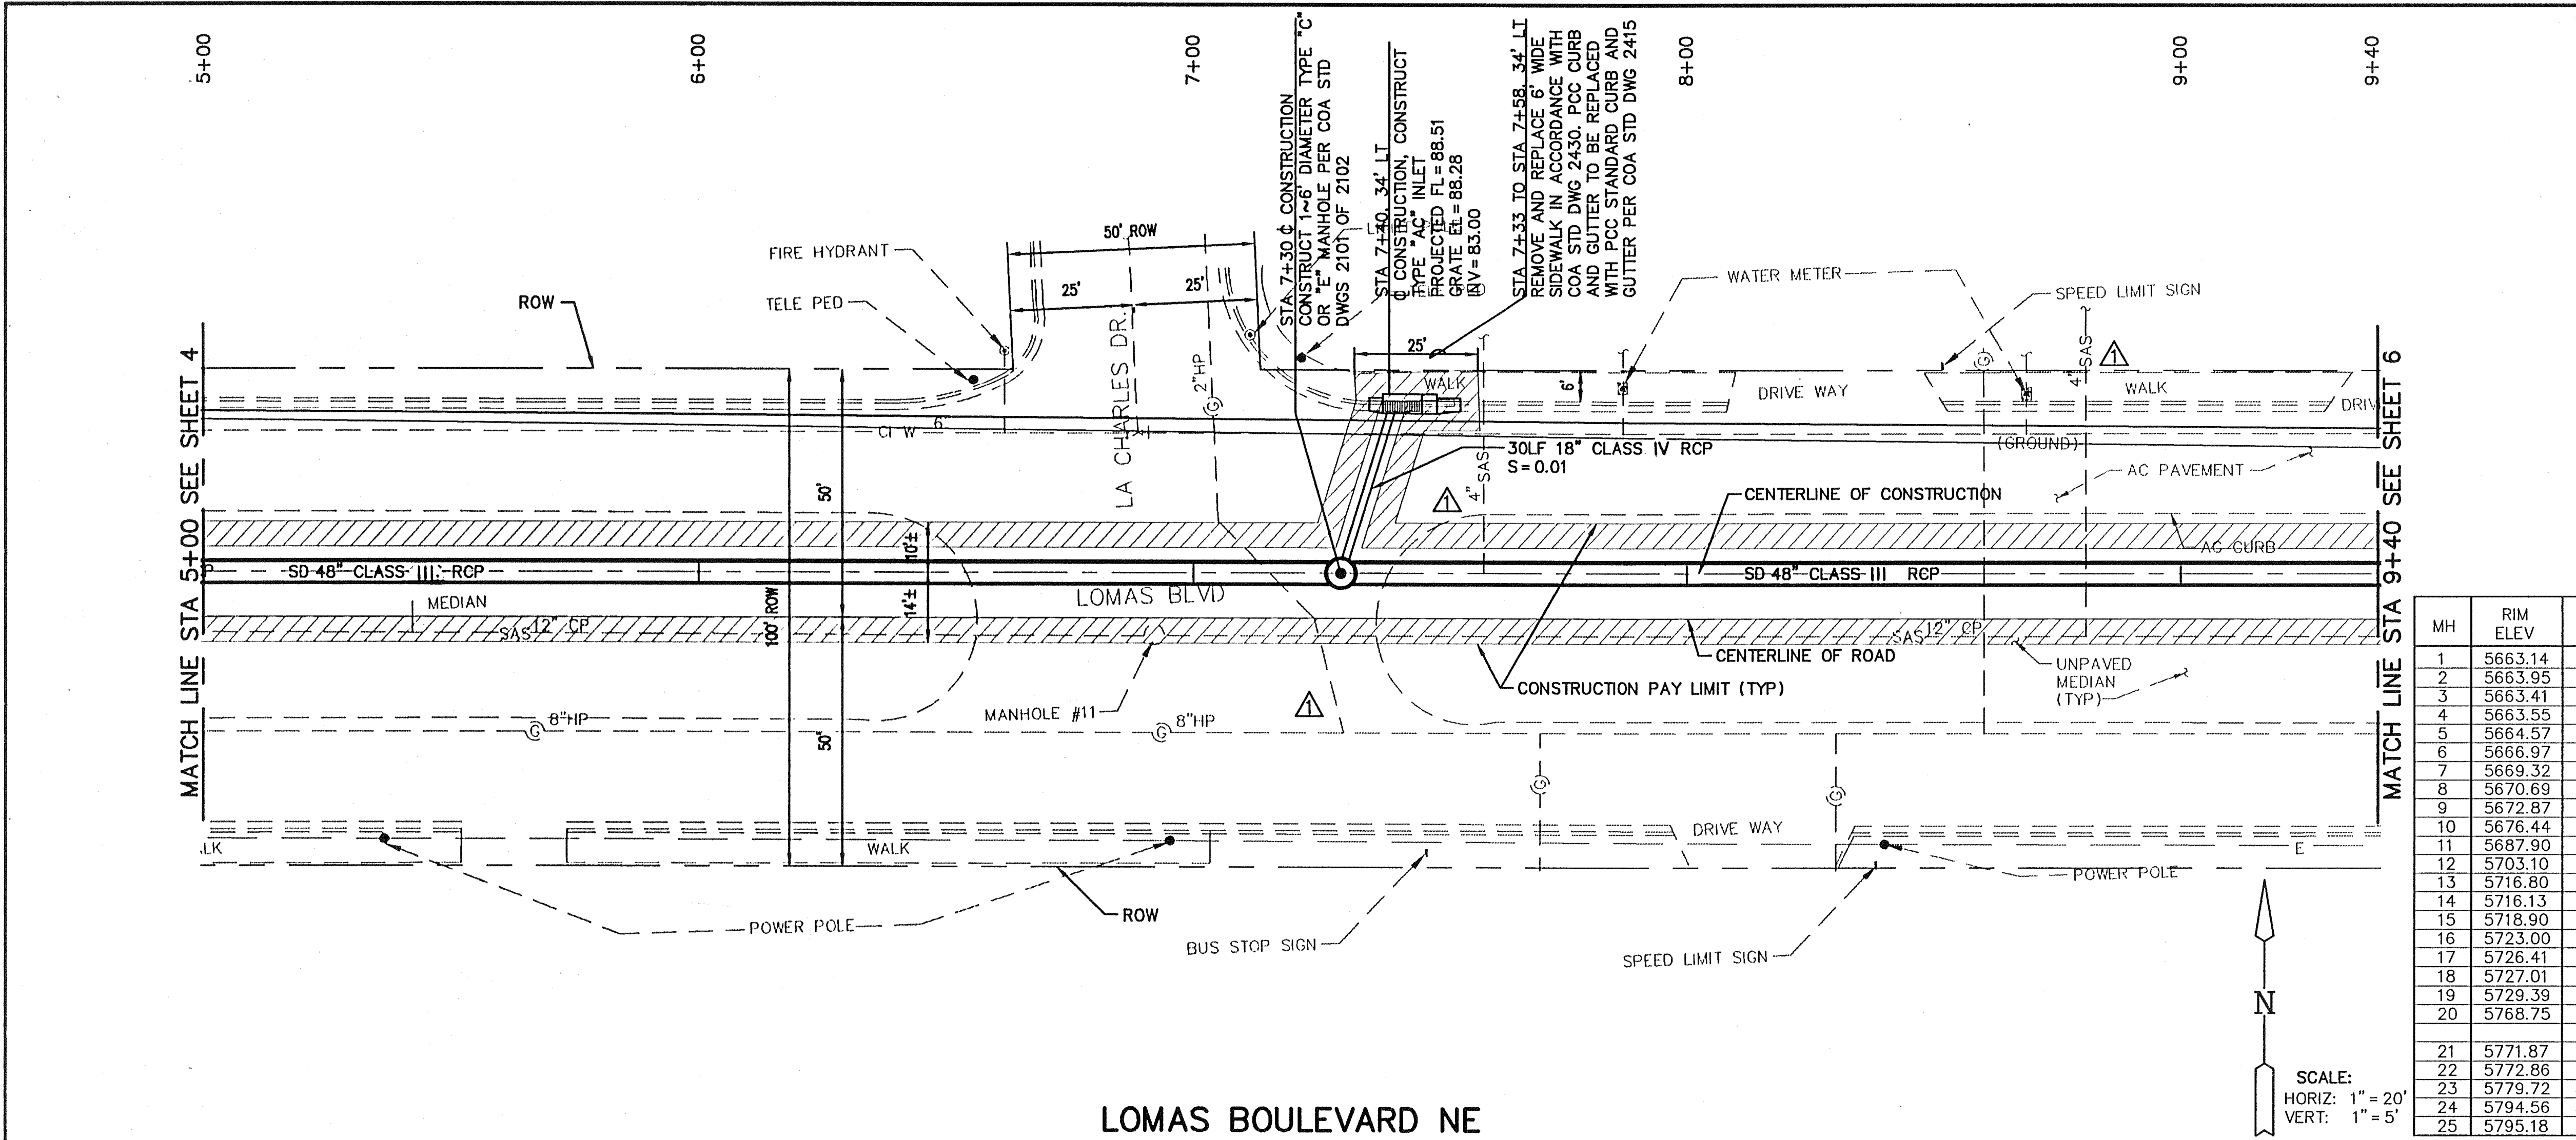

- NOTES**
- A FOR SURVEY CONTROL SEE SHEET 3.
 - B ALL WATER LINE RELOCATION SHALL EMPLOY EXCLUSIVELY MECHANICAL RESTRAINT ON BENDS.
 - C IF A PAVEMENT DROP-OFF IS CREATED DURING CONSTRUCTION THE CONTRACTOR SHALL INITIATE PROTECTIVE ACTION IN ACCORDANCE WITH THE NEW MEXICO STATE HIGHWAY AND TRANSPORTATION DEPARTMENTS CURRENT DROP-OFF POLICY. THIS WORK SHALL BE INCIDENTAL TO THE PROJECT.
 - D PROVIDE SHORING OR TRENCH PROTECTION TO PROTECT EXISTING AC CURB ON LOMAS AS SHOWN. DAMAGE TO AC CURB OUTSIDE THE CONSTRUCTION PAY LIMITS MUST BE REPAIRED AT CONTRACTORS EXPENSE. SEE SHEET 24, DETAIL 2.
 - E FOR PAVEMENT SECTION, SEE SHEET 24, DETAIL 2.
 - F MEDIAN CURB REMOVED DURING CONSTRUCTION TO BE REPLACED WITH STANDARD ASPHALT CURB IN ACCORDANCE WITH COA STD DWG 2415.

EXISTING MANHOLE DATA					
MH	RIM ELEV	NORTH INV 1	SOUTH INV 2	EAST INV 3	WEST INV 4
1	5663.14	5654.61	5654.59		5662.72
2	5663.95	5654.75	5654.25		5654.25
3	5663.41	5654.16		5653.27	5653.22
4	5663.55	5654.15	5654.05	5654.26	
5	5664.57	5658.57		5656.87	5656.07
6	5666.97	5659.77	5660.27	5659.07	5658.87
7	5669.32	5662.42	5662.82	5661.52	5661.17
8	5670.69	5663.95	5664.35	5663.17	5662.97
9	5672.87	5665.87	5666.37	5665.37	5665.27
10	5676.44			5666.94	5666.84
11	5687.90			5678.25	5678.15
12	5703.10			5693.20	5693.05
13	5716.80	5708.65		5707.95	5707.95
14	5716.13	5709.28	5709.18		
15	5718.90	5713.25	5713.15		
16	5723.00	5716.65		5716.65	
17	5726.41	5720.41	5720.31	5720.51	
18	5727.01	5721.01	5720.96	5721.31	5721.01
19	5729.39	5723.54	5723.39	5723.49	
20	5768.75	5757.00		5756.95	5756.75
21	5771.87	5762.25	5761.75	5761.65	5761.55
22	5772.86	5767.16	5764.76		5764.86
23	5779.72	5770.12		5770.02	5770.02
24	5794.56	5786.57		5786.57	5786.47
25	5795.18				

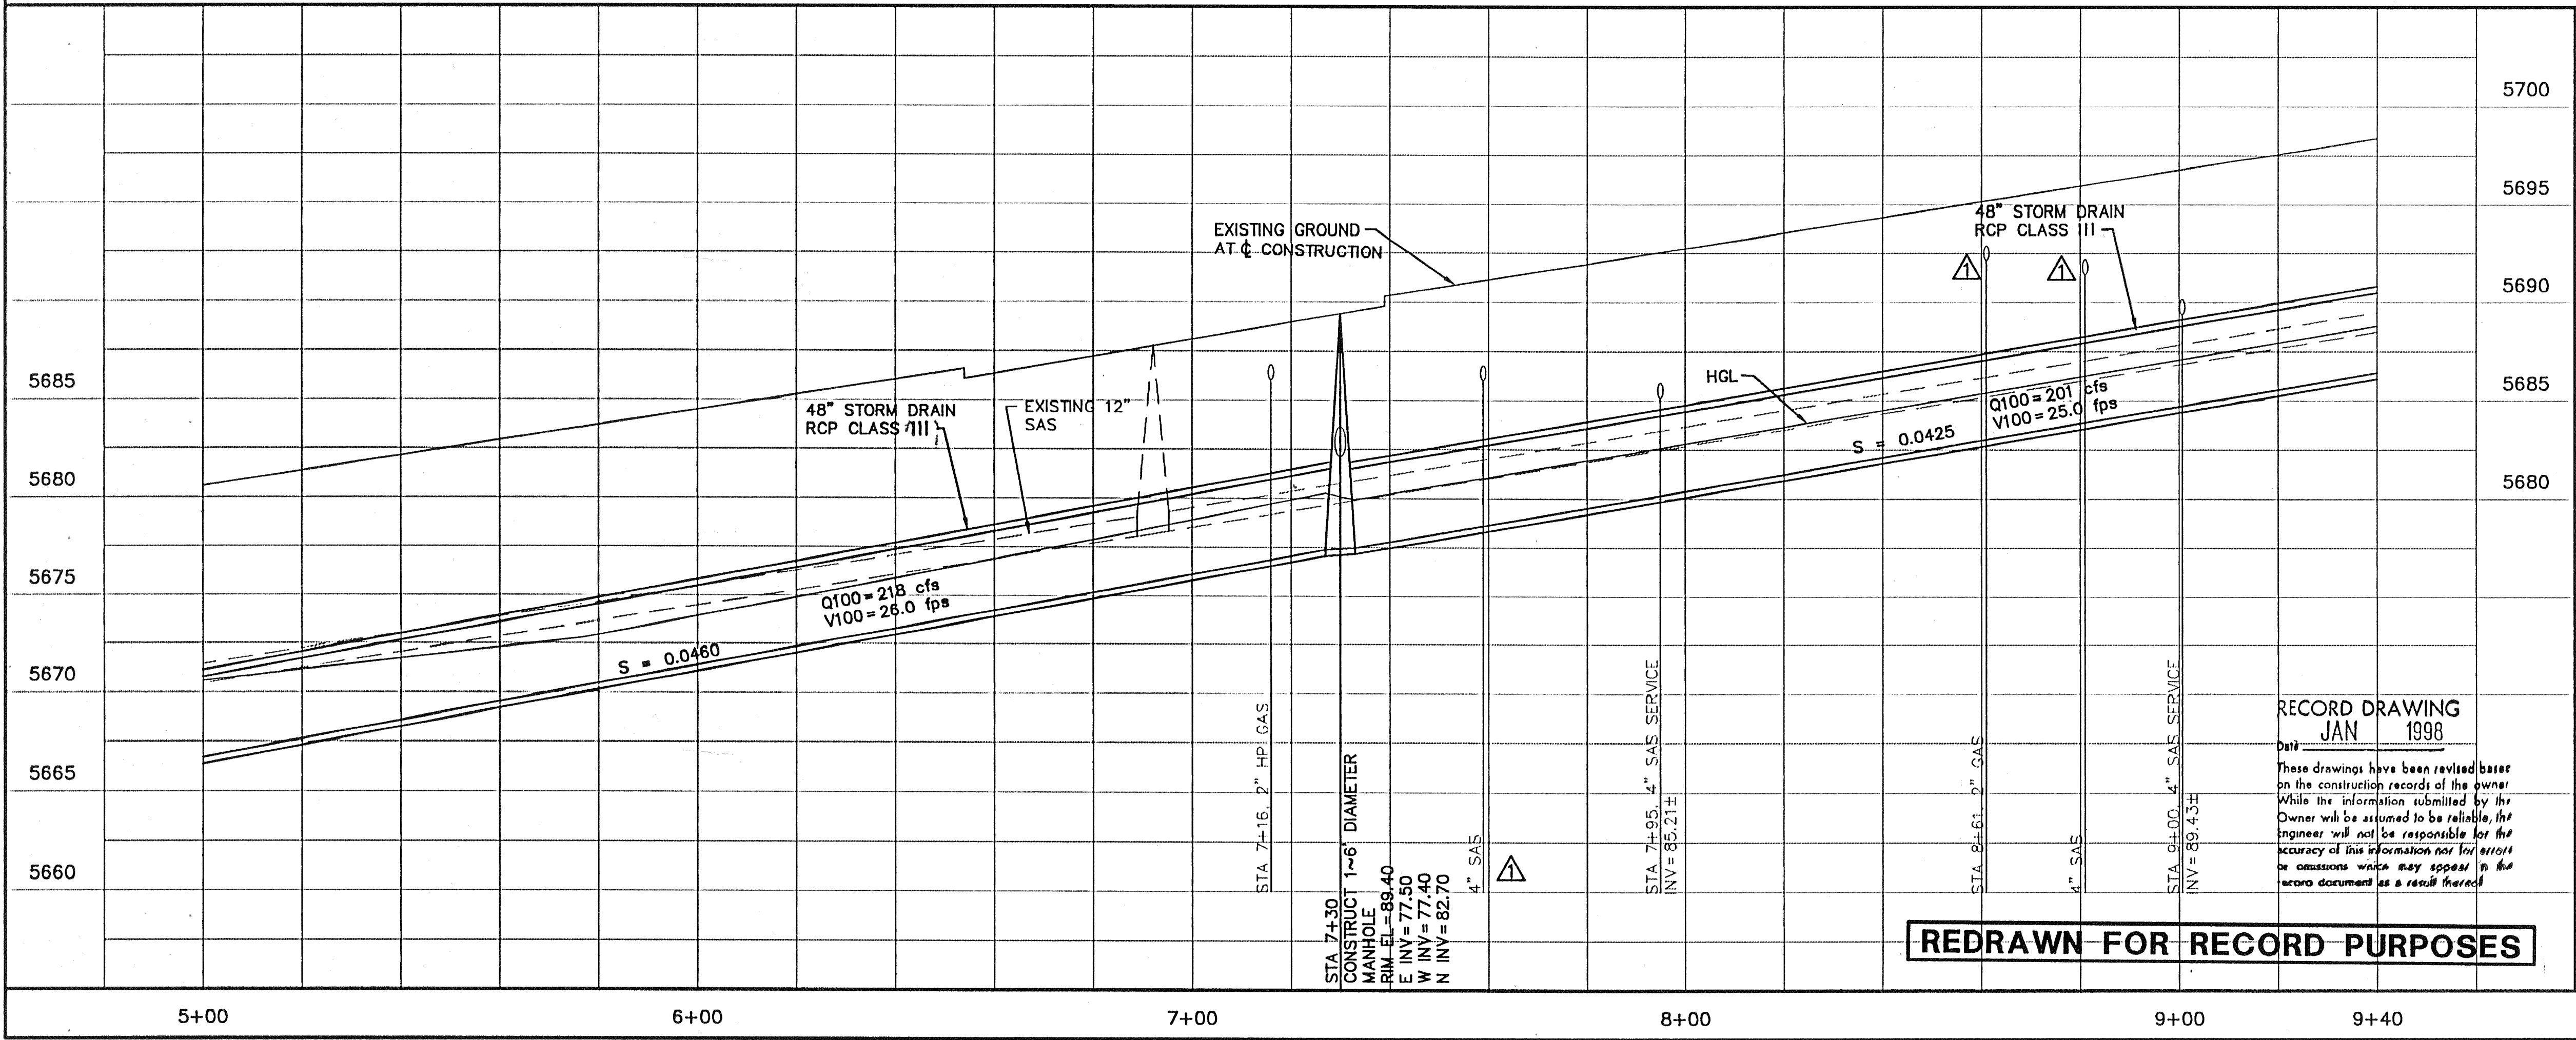

EXISTING STORM DRAIN INLETS	GRATE ELEVATION	INVERT ELEVATION
A	5663.77	5660.77
B	5667.48	5664.48
C	5669.43	5666.43
D	5671.53	5668.53
E	5663.59	5660.59
F	5665.45	5662.45
G	5667.69	5664.69
H	5669.71	5666.71
I	5671.69	5668.96
J	5773.37	5770.37
K	5774.47	5771.43
L	5779.89	5776.89
M	5781.34	5778.34
N	5772.89	5769.89

LEEDSHILL-HERKENHOFF, INC
500 Copper Avenue NW
P.O. Box 1217
Albuquerque, NM 87103
(505)247-0294

CITY OF ALBUQUERQUE
PUBLIC WORKS DEPARTMENT
ENGINEERING DEVELOPMENT GROUP

TITLE: DIVERSE DRAINAGE IMPROVEMENTS
LOMAS PLAN AND PROFILE
STA 5+00 TO STA 9+40

Design Review Committee: City Engineer Approval

Zone Map No. 4880-92, J,K-22,23

Sheet 5A of 24

AS BUILT INFORMATION

CONTRACTOR: JR. HALE, INC.
WORK STARTED BY: CONTRACTOR
DATE: 1997

BENCH MARKS

THE STATION IS A STANDARD ACS BRASS TABLET STAMPED
"3-J22 1979" SET IN CONCRETE AT THE NORTHEAST CORNER OF LOMAS BLVD AND
CHELWOOD PARK BLVD. NE.
ELEV = 5664.88 (SLD 1929)

FIELD NOTES

NO. BY DATE

ENGINEER'S SEAL

NO. DATE

1/98 CHANGES AS PER RECORD DWG. LUS

REMARKS BY

REVISIONS

LEEDSHILL-HERKENHOFF, INC.

DESIGNED BY: RAS/TM/KD DATE: JAN 1997


DRAWN BY: C. ROMERO DATE: JAN 1997

CHECKED BY: C. DODGE DATE: JAN 1997

REDRAWN FOR RECORD PURPOSES

RECORD DRAWING
JAN 1998

These drawings have been revised based on the construction records of the owner. While the information submitted by the Owner will be assumed to be reliable, the engineer will not be responsible for the accuracy of this information nor for errors or omissions which may appear in the record documents as a result thereof.

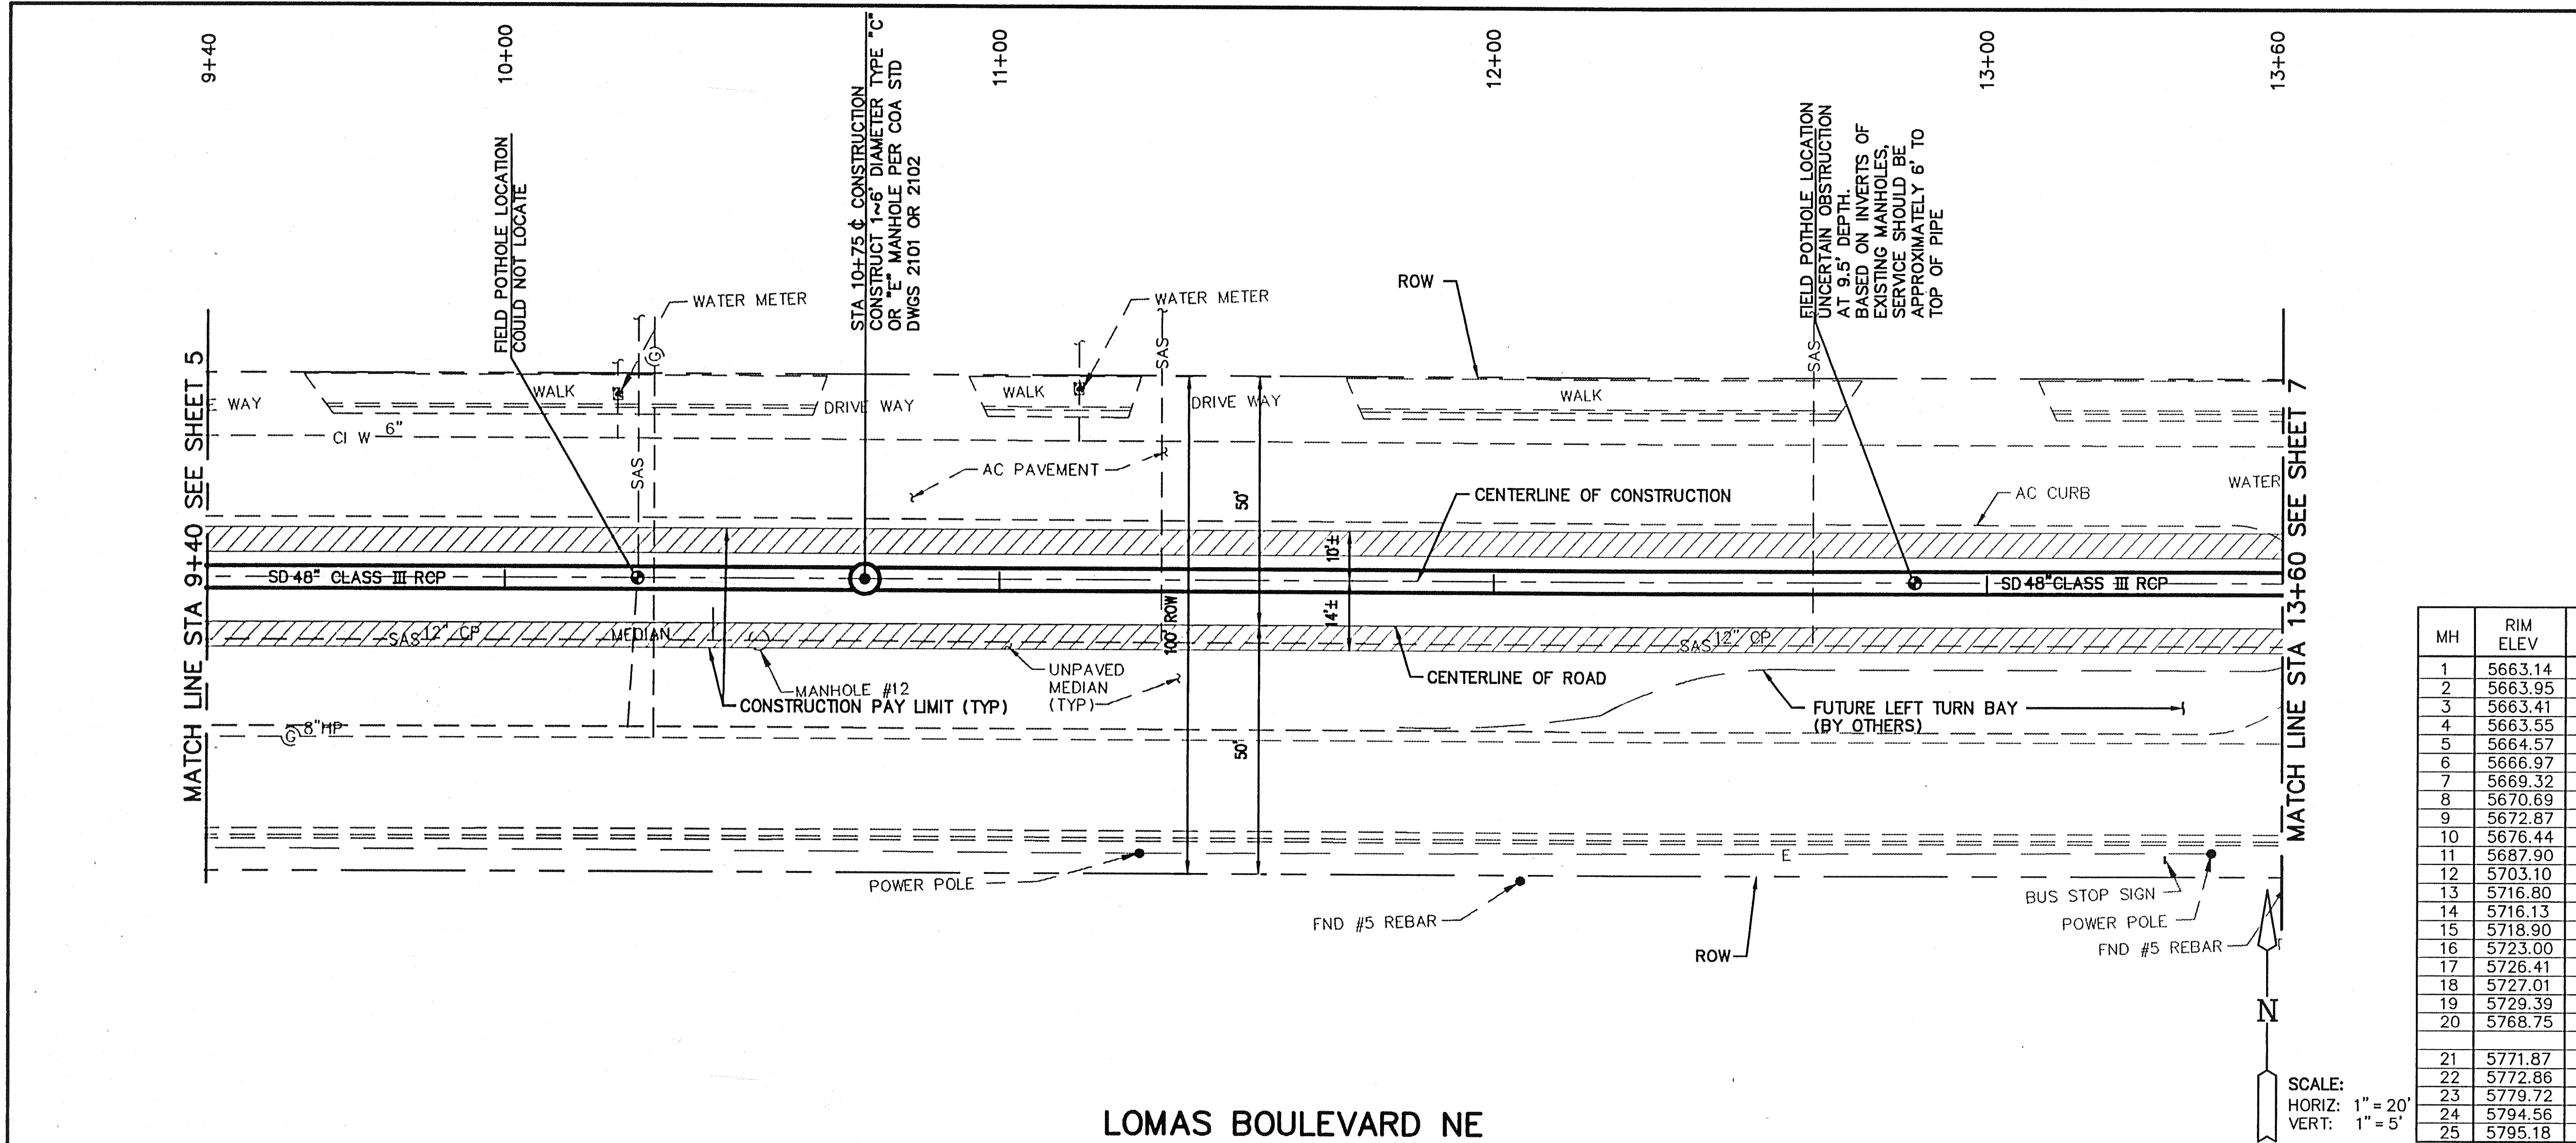

NOTES


- A FOR SURVEY CONTROL SEE SHEET 3.
- B ALL WATER LINE RELOCATION SHALL EMPLOY EXCLUSIVELY MECHANICAL RESTRAINT ON BENDS.
- C IF A PAVEMENT DROP-OFF IS CREATED DURING CONSTRUCTION THE CONTRACTOR SHALL INITIATE PROTECTIVE ACTION IN ACCORDANCE WITH THE NEW MEXICO STATE HIGHWAY AND TRANSPORTATION DEPARTMENTS CURRENT DROP-OFF POLICY. THIS WORK SHALL BE INCIDENTAL TO THE PROJECT.
- D PROVIDE SHORING OR TRENCH PROTECTION TO PROTECT EXISTING AC CURB ON LOMAS AS SHOWN. DAMAGE TO AC CURB OUTSIDE THE CONSTRUCTION PAY LIMITS MUST BE REPAIRED AT CONTRACTORS EXPENSE. SEE SHEET 24, DETAIL 2.
- E FOR PAVEMENT SECTION, SEE SHEET 24, DETAIL 2.
- F MEDIAN CURB REMOVED DURING CONSTRUCTION TO BE REPLACED WITH STANDARD ASPHALT CURB IN ACCORDANCE WITH COA STD DWG 2415.

EXISTING MANHOLE DATA

MH	RIM ELEV	NORTH INV 1	SOUTH INV 2	EAST INV 3	WEST INV 4	COA GIS NUMBER
1	5663.14	5654.61	5654.59		5662.72	S942
2	5663.95	5654.75	5654.25		5654.25	NO NUMBER
3	5663.41	5654.16		5653.27	5653.22	944
4	5663.55	5654.15	5654.05	5654.26		S43
5	5664.57	5658.57		5656.87	5656.07	S56
6	5666.97	5659.77	5660.27	5659.07	5658.87	S55
7	5669.32	5662.42	5662.82	5661.52	5661.17	S54
8	5670.69	5663.95	5664.35	5663.17	5662.97	S53
9	5672.87	5665.87		5665.37	5665.27	S52
10	5676.44			5666.94	5666.84	NO NUMBER
11	5687.90			5678.25	5678.15	
12	5703.10			5693.20	5693.05	964
13	5716.80	5708.65		5707.95	5707.95	972
14	5716.13	5709.28	5709.18			NO NUMBER
15	5718.90	5713.25	5713.15			971
16	5723.00	5716.65			5716.65	873
17	5726.41	5720.41	5720.31	5720.51		875
18	5727.01	5721.01	5720.96	5721.31	5721.01	871
19	5729.39	5723.54	5723.39	5723.49		NO NUMBER
20	5768.75	5757.00		5756.95	5756.75	903
21	5771.87	5762.25	5761.75	5761.65	5761.55	NO NUMBER
22	5772.86	5767.16	5764.76		5764.86	S902
23	5779.72	5770.12		5770.02	5770.02	S903
24	5794.56	5786.57		5786.57	5786.47	
25	5795.18			5787.18	5787.08	

SCALE:
HORIZ: 1" = 20'
VERT: 1" = 5'

LOMAS BOULEVARD NE

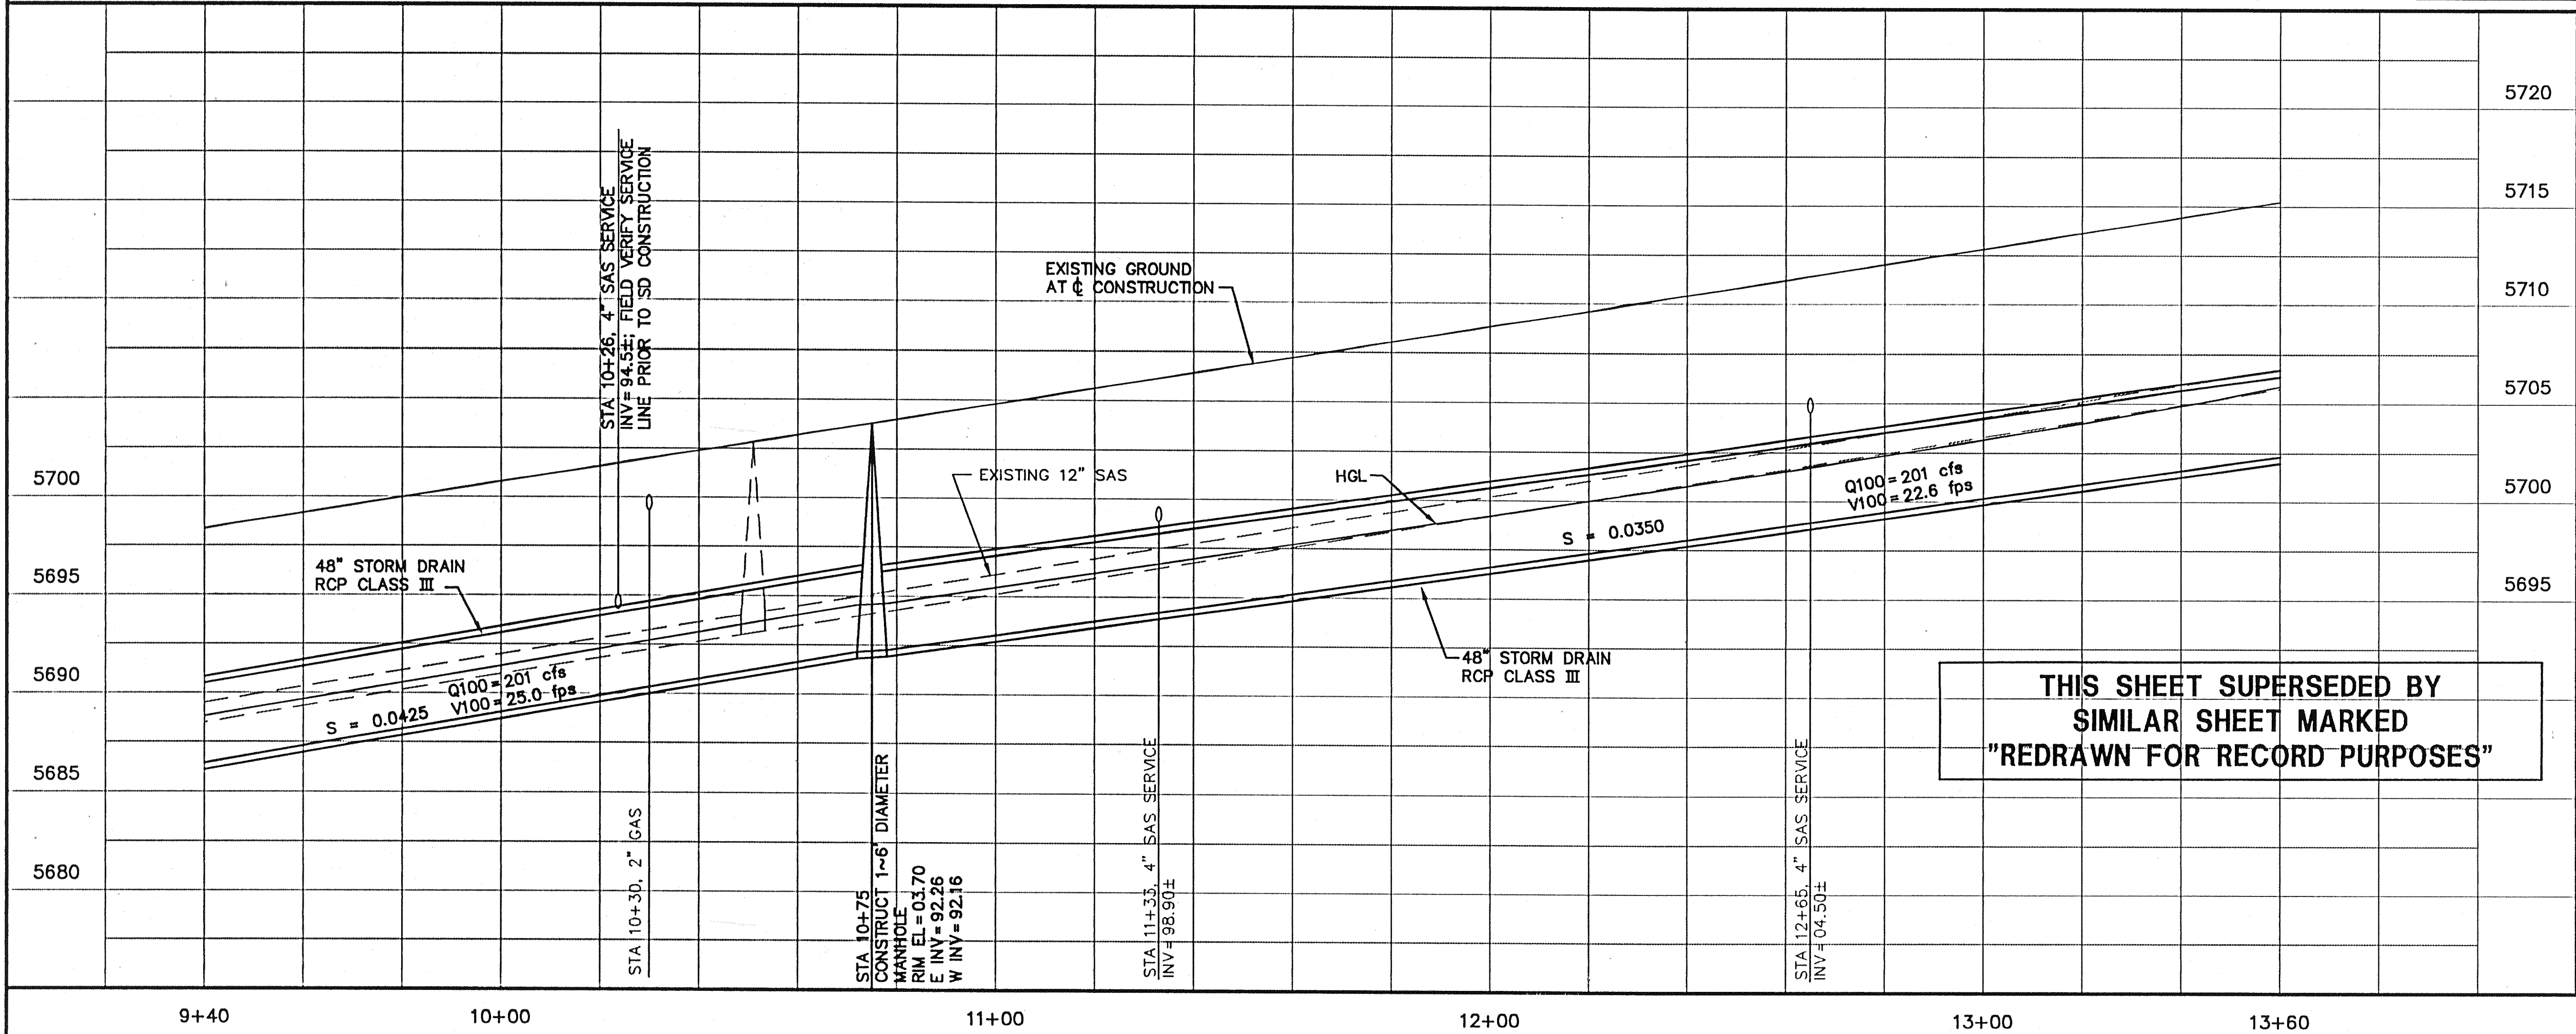


EXISTING STORM DRAIN INLETS	GRATE ELEVATION	INVERT ELEVATION
A	5663.77	5660.77
B	5667.48	5664.48
C	5669.43	5666.43
D	5671.53	5668.53
E	5663.59	5660.59
F	5665.45	5662.45
G	5667.69	5664.69
H	5669.71	5666.71
I	5671.69	5668.96
J	5773.37	5770.37
K	5774.47	5771.43
L	5779.89	5776.89
M	5781.34	5778.34
N	5772.89	5769.89


THIS SHEET SUPERSEDED BY
SIMILAR SHEET MARKED
"REDRAWN FOR RECORD PURPOSES"

LEEDSHILL-HERKENHOFF, INC
500 Copper Avenue NW
P.O. Box 1217
Albuquerque, NM 87103
(505)247-0294

CITY OF ALBUQUERQUE PUBLIC WORKS DEPARTMENT ENGINEERING DEVELOPMENT GROUP	
TITLE: DIVERSE DRAINAGE IMPROVEMENTS LOMAS PLAN AND PROFILE STA 9+40 TO STA 13+60	
Design Review Committee APPROVED JUN 19 1997	City Engineer Approval APPROVED JUN 19 1997
City Project No. 4880-92	Zone Map No. J,K-22,23
Sheet 6	Of 24

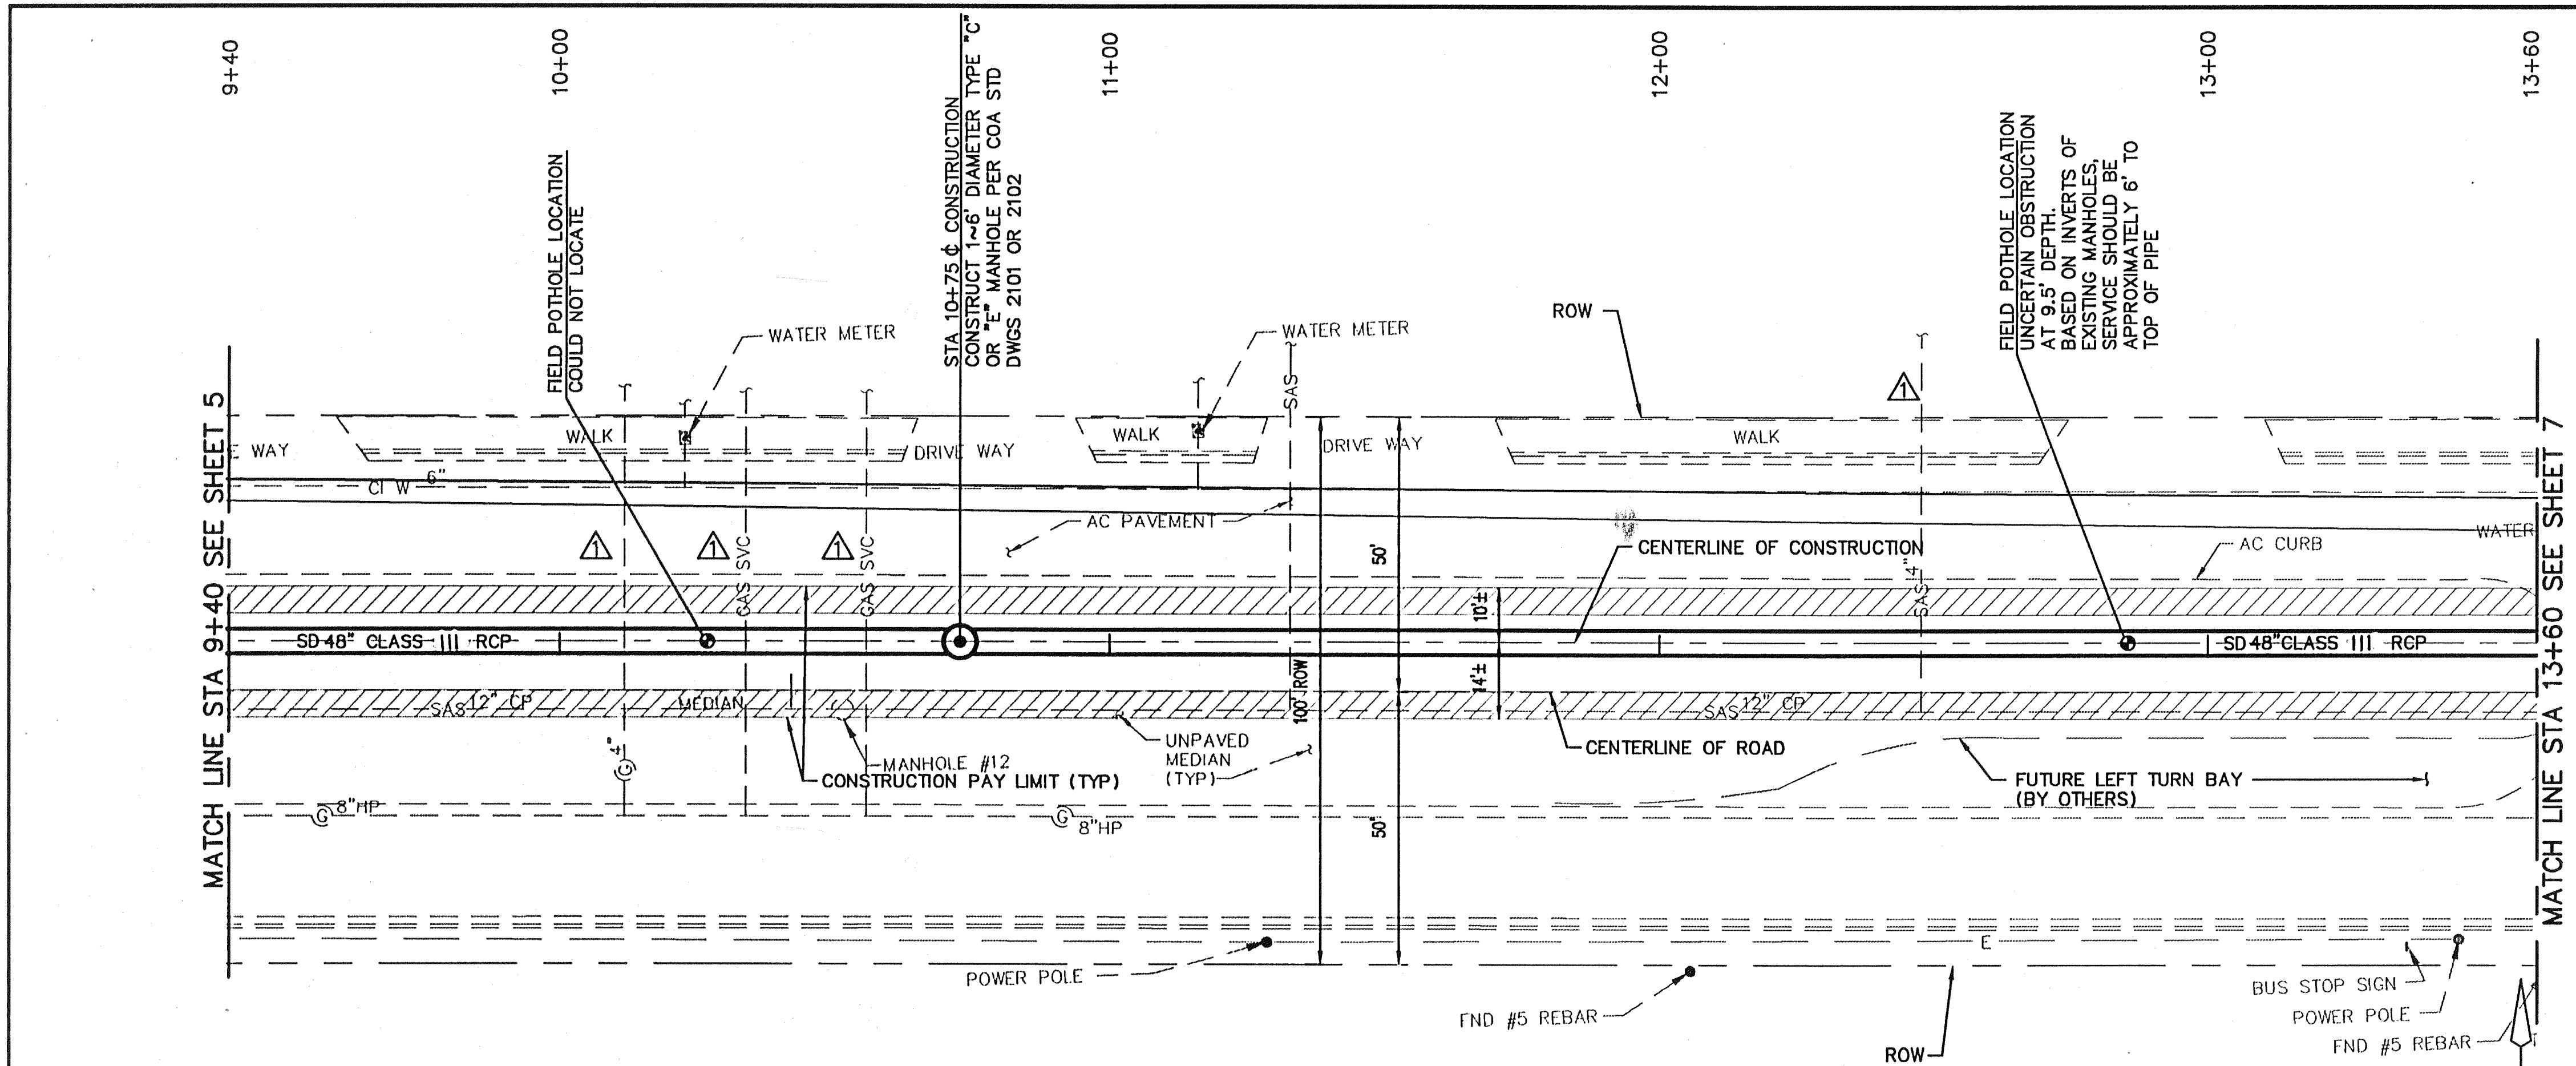

LOMAS BOULEVARD NE

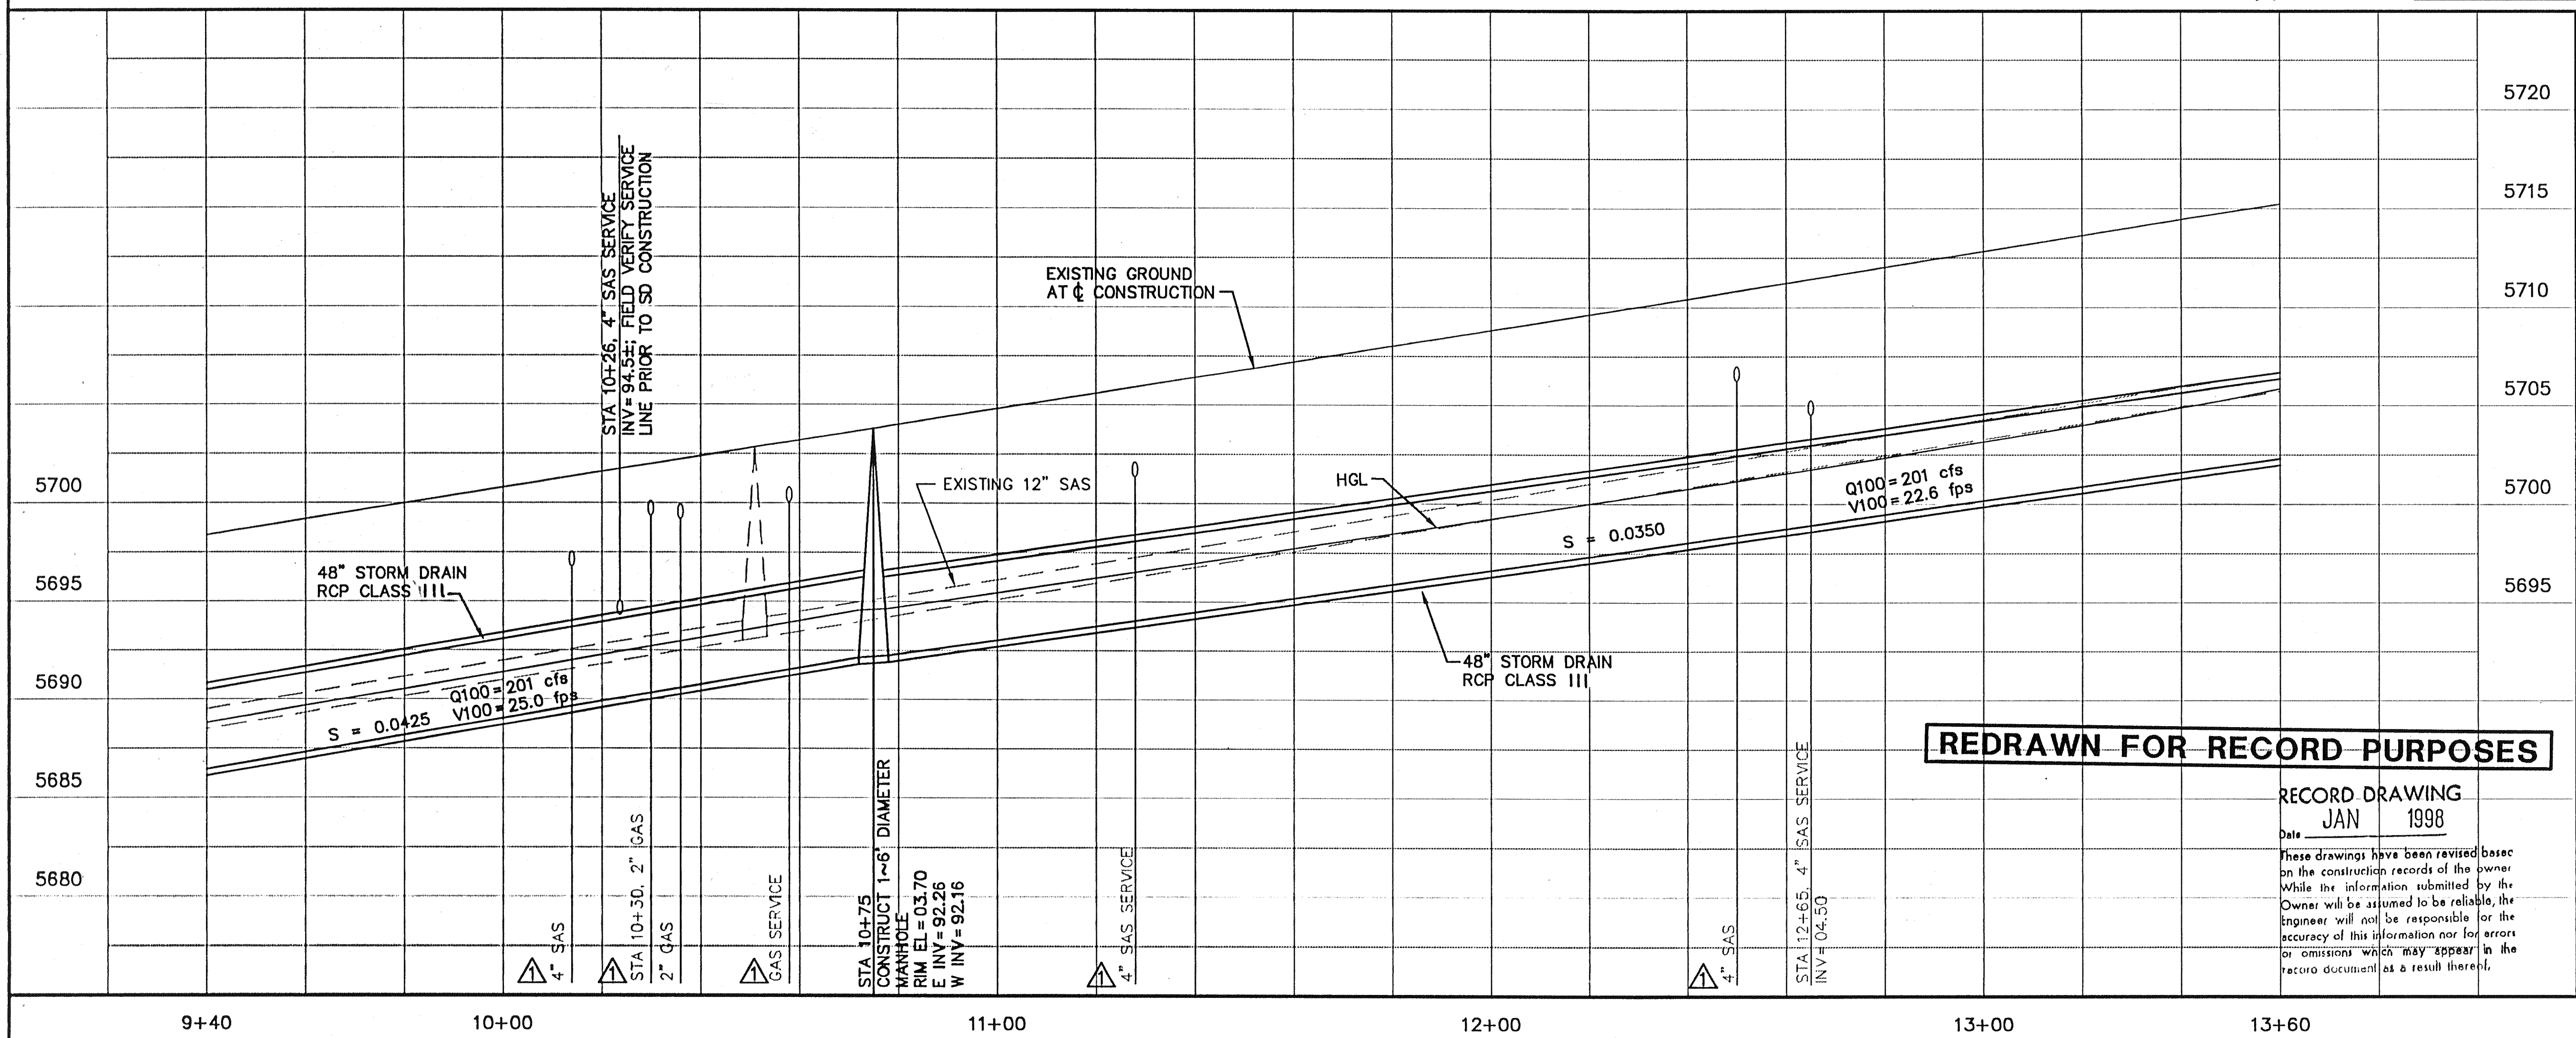

NOTES

- FOR SURVEY CONTROL SEE SHEET 3.
- ALL WATER LINE RELOCATION SHALL EMPLOY EXCLUSIVELY MECHANICAL RESTRAINT ON BENDS.
- IF A PAVEMENT DROP-OFF IS CREATED DURING CONSTRUCTION THE CONTRACTOR SHALL INITIATE PROTECTIVE ACTION IN ACCORDANCE WITH THE NEW MEXICO STATE HIGHWAY AND TRANSPORTATION DEPARTMENTS CURRENT DROP-OFF POLICY. THIS WORK SHALL BE INCIDENTAL TO THE PROJECT.
- PROVIDE SHORING OR TRENCH PROTECTION TO PROTECT EXISTING AC CURB ON LOMAS AS SHOWN. DAMAGE TO AC CURB OUTSIDE THE CONSTRUCTION PAY LIMITS MUST BE REPAIRED AT CONTRACTORS EXPENSE. SEE SHEET 24, DETAIL 2
- FOR PAVEMENT SECTION, SEE SHEET 24, DETAIL 2.
- MEDIAN CURB REMOVED DURING CONSTRUCTION TO BE REPLACED WITH STANDARD ASPHALT CURB IN ACCORDANCE WITH COA STD DWG 2415.

EXISTING MANHOLE DATA

MH	RIM ELEV	NORTH INV 1	SOUTH INV 2	EAST INV 3	WEST INV 4	COA GIS NUMBER
1	5663.14	5654.61	5654.59		5662.72	S942
2	5663.95	5654.75	5654.25		5654.25	NO NUMBER
3	5663.41	5654.16		5653.27	5653.22	944
4	5663.55	5654.15	5654.05	5654.26		S43
5	5664.57	5658.57		5656.87	5656.07	S56
6	5666.97	5659.77	5660.27	5659.07	5658.87	S55
7	5669.32	5662.42	5662.82	5661.52	5661.17	S54
8	5670.69	5663.95	5664.35	5663.17	5662.97	S53
9	5672.87	5665.87	5666.37	5665.37	5665.27	S52
10	5676.44			5666.94	5666.84	NO NUMBER
11	5687.90			5678.25	5678.15	
12	5703.10			5693.20	5693.05	964
13	5716.80	5708.65		5707.95	5707.95	972
14	5716.13	5709.28	5709.18			NO NUMBER
15	5718.90	5713.25	5713.15			971
16	5723.00	5716.65			5716.65	873
17	5726.41	5720.41	5720.31	5720.51		875
18	5727.01	5721.01	5720.96	5721.31	5721.01	871
19	5729.39	5723.54	5723.39			NO NUMBER
20	5768.75	5757.00		5756.95	5756.75	903
21	5771.87	5762.25	5761.75	5761.65	5761.55	NO NUMBER
22	5772.86	5767.16	5764.76		5764.86	S902
23	5779.72	5770.12		5770.02	5770.02	S903
24	5794.56			5786.57	5786.47	
25	5795.18			5787.18	5787.08	


EXISTING STORM DRAIN INLETS

	GRATE ELEVATION	INVERT ELEVATION
A	5663.77	5660.77
B	5667.48	5664.48
C	5669.43	5668.43
D	5671.53	5668.53
E	5663.59	5660.59
F	5665.45	5662.45
G	5667.69	5664.69
H	5669.71	5666.71
I	5671.69	5668.96
J	5773.37	5770.37
K	5774.47	5771.43
L	5779.89	5776.89
M	5781.34	5778.34
N	5772.89	5769.89

AS BUILT INFORMATION	
CONTRACTOR	JR. HALE, INC.
DATE	1997
INSPECTOR'S ACCEPTANCE BY	C.O.A.
DATE	1997
VERIFICATION BY	C.O.A.
DATE	1997
DRAWN BY	L.H. INC.
DATE	1/7/98
MICRO-FILM INFORMATION	
RECORDED BY	
DATE	
NO.	
BENCH MARKS	
THE STATION IS A STANDARD ACS BRASS TABLET STAMPED	
"3-122 1979" SET FLUSH WITH THE GROUND AND LOCATED	
AT THE NORTHEAST CORNER OF LOMAS BLVD. AND	
CHELWOOD PARK BLVD NE.	
ELEV = 5664.88 (SLD 1929)	
FIELD NOTES	
NO.	DATE
BY	
ENGINEER'S SEAL	
1/98 CHANGES AS PER RECORD DWG. LUS	
NO.	DATE
REVISIONS	BY
LEEDSHILL-HERKENHOFF, INC.	
DESIGNED BY	RAS/TM/KD
DRAWN BY	C. ROMERO
CHECKED BY	C. DODGE
DATE	JAN 1997
DATE	JAN 1997
DATE	JAN 1997

LEEDSHILL-HERKENHOFF, INC.
500 Copper Avenue NW
P.O. Box 1217
Albuquerque, NM 87103
(505)247-0294

CITY OF ALBUQUERQUE PUBLIC WORKS DEPARTMENT ENGINEERING DEVELOPMENT GROUP	
TITLE: DIVERSE DRAINAGE IMPROVEMENTS LOMAS PLAN AND PROFILE STA 9+40 TO STA 13+60	
Design Review Committee	City Engineer Approval
Mo./Day/Yr.	Mo./Day/Yr.
City Project No.	Zone Map No.
4880-92	J,K-22,23
Sheet	Of
6A	24

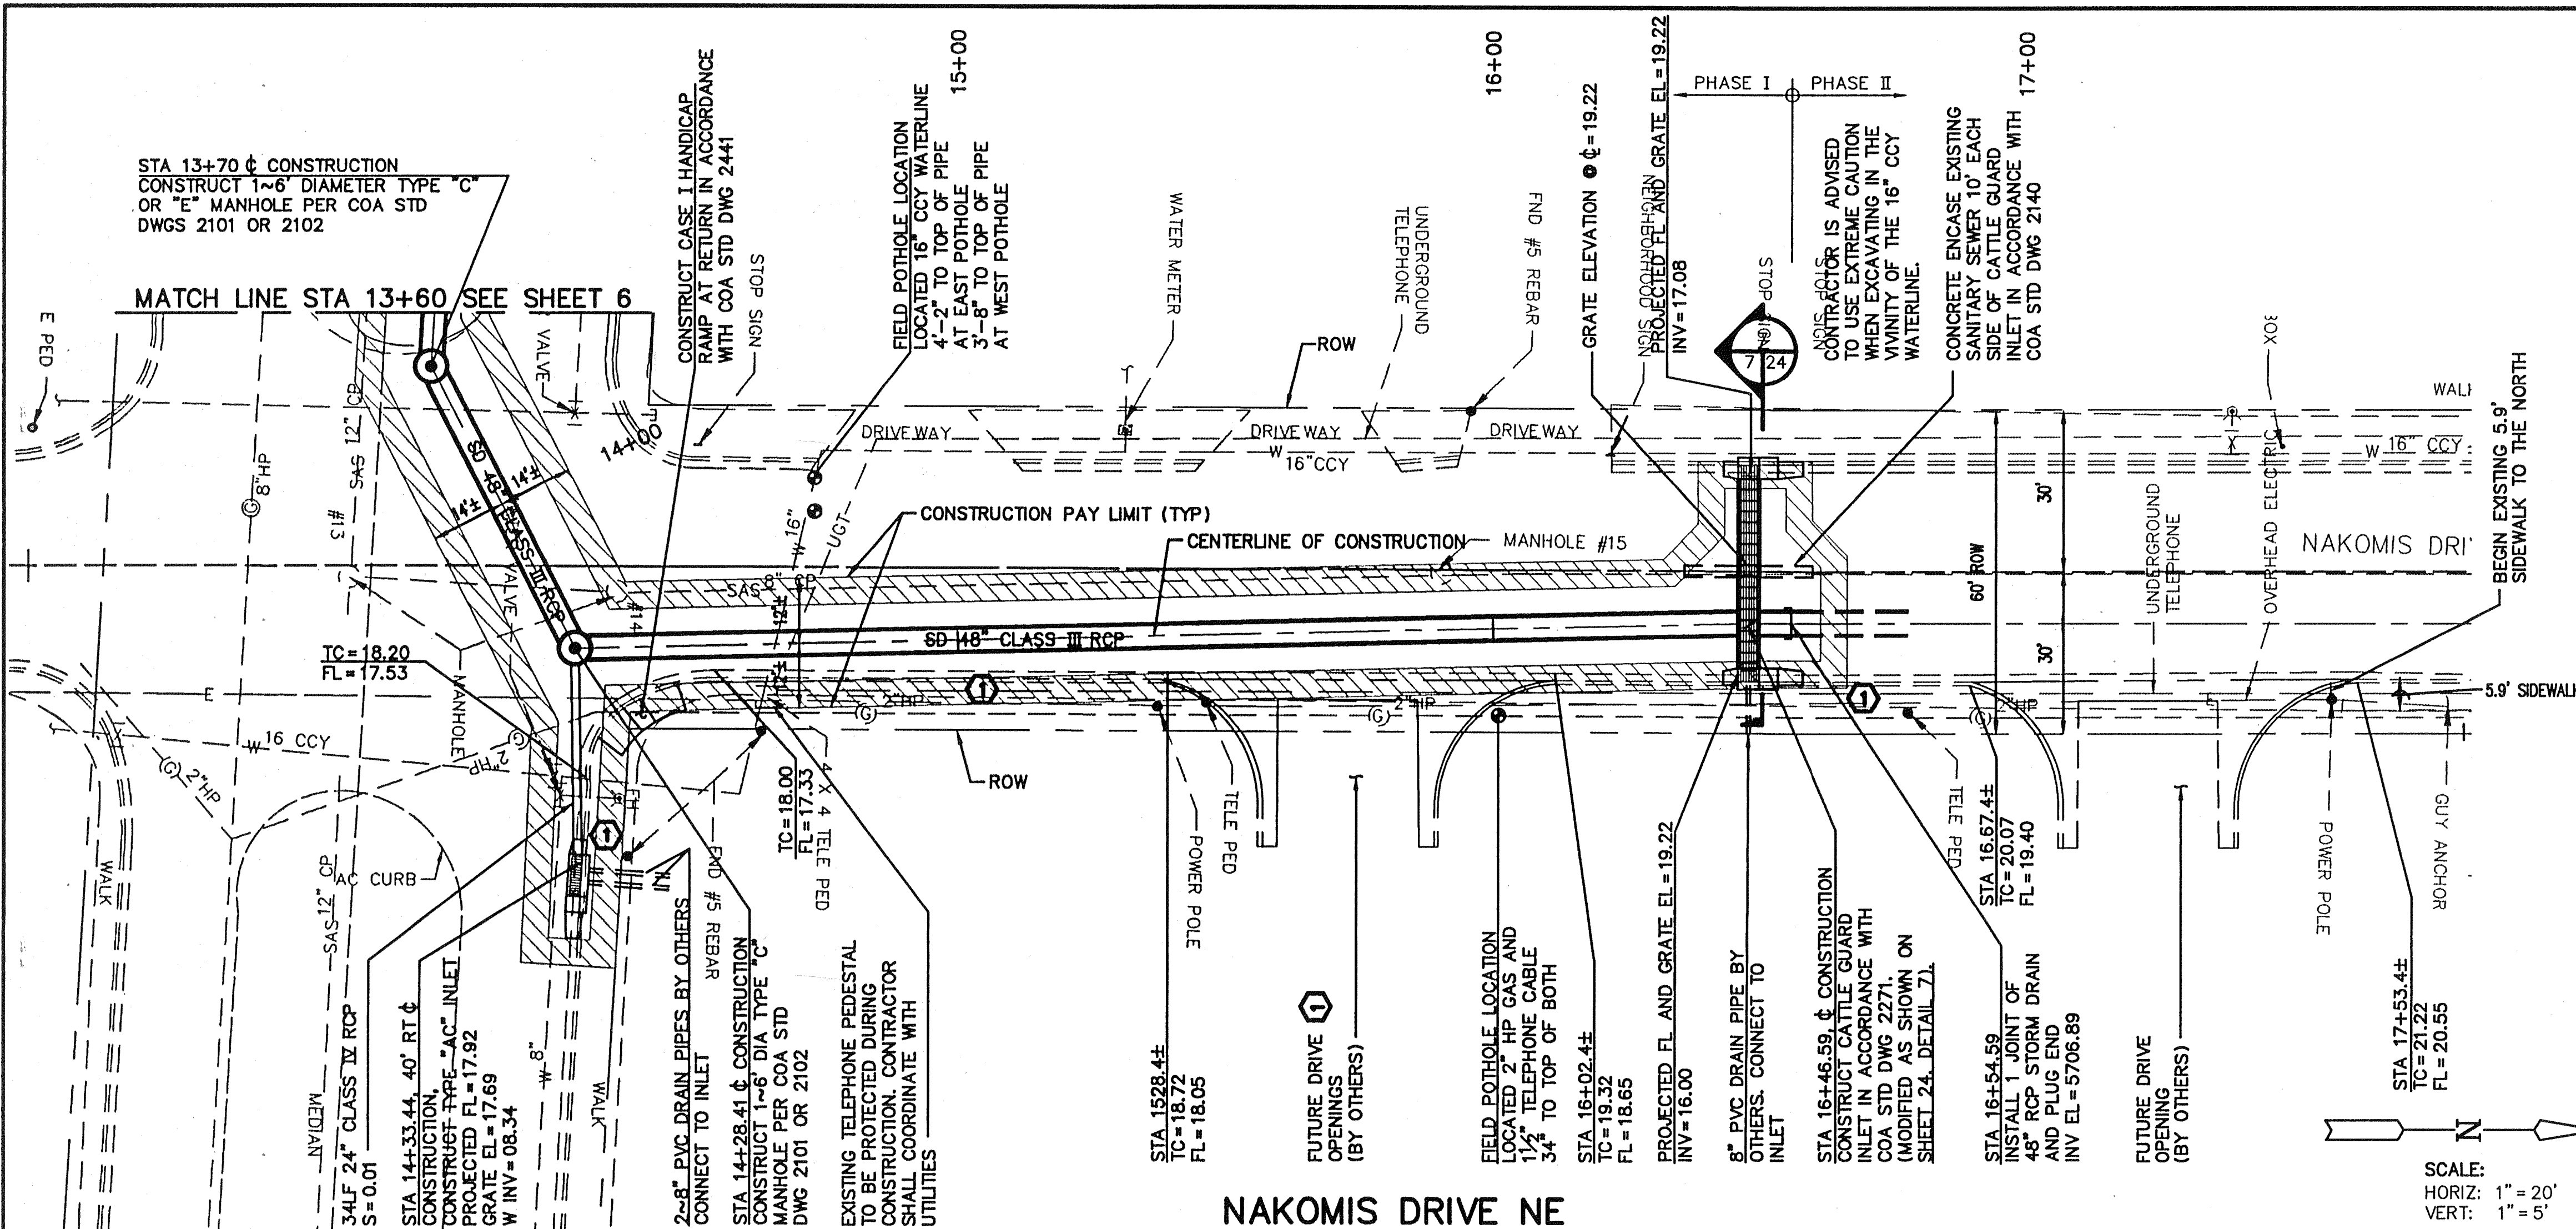

NOTES


- A FOR SURVEY CONTROL SEE SHEET 3.
- B ALL WATER LINE RELOCATION SHALL EMPLOY EXCLUSIVELY MECHANICAL RESTRAINT ON BENDS.
- C IF A PAVEMENT DROP-OFF IS CREATED DURING CONSTRUCTION THE CONTRACTOR SHALL INITIATE PROTECTIVE ACTION IN ACCORDANCE WITH THE NEW MEXICO STATE HIGHWAY AND TRANSPORTATION DEPARTMENTS CURRENT DROP-OFF POLICY. THIS WORK SHALL BE INCIDENTAL TO THE PROJECT.
- D PROVIDE SHORING OR TRENCH PROTECTION TO PROTECT EXISTING AC CURB ON LOMAS AS SHOWN. DAMAGE TO AC CURB OUTSIDE THE CONSTRUCTION PAY LIMITS MUST BE REPAIRED AT CONTRACTORS EXPENSE. SEE SHEET 24, DETAIL 2
- E PAVEMENT REPLACEMENT SECTION FOR NAKOMIS SHALL BE IN ACCORDANCE WITH COA STD DWG 2405 FOR FLEXIBLE PAVEMENT.
- F CURB AND GUTTER REMOVED DURING CONSTRUCTION TO BE REPLACED WITH PCC STANDARD CURB AND GUTTER IN ACCORDANCE WITH COA STD DWG 2415.

KEYED NOTES

- 1 SIDEWALK, DRIVE ENTRANCES AND OTHER SITE MODIFICATIONS MAY PRECEDE OR BE CONCURRENT WITH THIS PROJECT. REMOVAL AND REPLACEMENT QUANTITIES MAY BE AFFECTED.

EXISTING MANHOLE DATA						
MH	RIM ELEV	NORTH INV 1	SOUTH INV 2	EAST INV 3	WEST INV 4	COA GIS NUMBER
1	5663.14	5654.61	5654.59		5662.72	S942
2	5663.95	5654.75	5654.25		5654.25	NO NUMBER
3	5663.41	5654.16		5653.27	5653.22	944
4	5663.55	5654.15	5654.05	5654.26		S43
5	5664.57	5658.57		5656.87	5656.07	S56
6	5666.97	5659.77	5660.27	5659.07	5658.87	S55
7	5669.32	5662.42	5662.82	5661.52	5661.17	S54
8	5670.69	5663.95	5664.35	5663.17	5662.97	S53
9	5672.87	5665.87	5666.37	5665.37	5665.27	S52
10	5676.44		5666.94	5666.84		NO NUMBER
11	5687.90		5678.25	5678.15		972
12	5703.10		5693.20	5693.05		964
13	5716.80	5708.65		5707.95	5707.95	972
14	5716.13	5709.28	5709.18			NO NUMBER
15	5718.90	5713.25	5713.15			971
16	5723.00	5716.65			5716.65	873
17	5726.41	5720.41	5720.31	5720.51		875
18	5727.01	5721.01	5720.96	5721.31	5721.01	871
19	5729.39	5723.54	5723.39			NO NUMBER
20	5768.75	5757.00		5756.95	5756.75	903
		5761.15				
21	5771.87	5762.25	5761.75	5761.65	5761.55	NO NUMBER
22	5772.86	5767.16	5764.76		5764.86	S902
23	5779.72	5770.12		5770.02	5770.02	S903
24	5794.56	5786.57		5786.57	5786.47	
25	5795.18		5787.18	5787.18	5787.08	

EXISTING STORM DRAIN INLETS	GRATE ELEVATION	INVERT ELEVATION
A	5663.77	5660.77
B	5667.48	5664.48
C	5669.43	5666.43
D	5671.53	5668.53
E	5663.59	5660.59
F	5665.45	5662.45
G	5667.69	5664.69
H	5669.71	5666.71
I	5671.69	5668.96
J	5773.37	5770.37
K	5774.47	5771.43
L	5779.89	5776.89
M	5781.34	5778.34
N	5772.89	5769.89

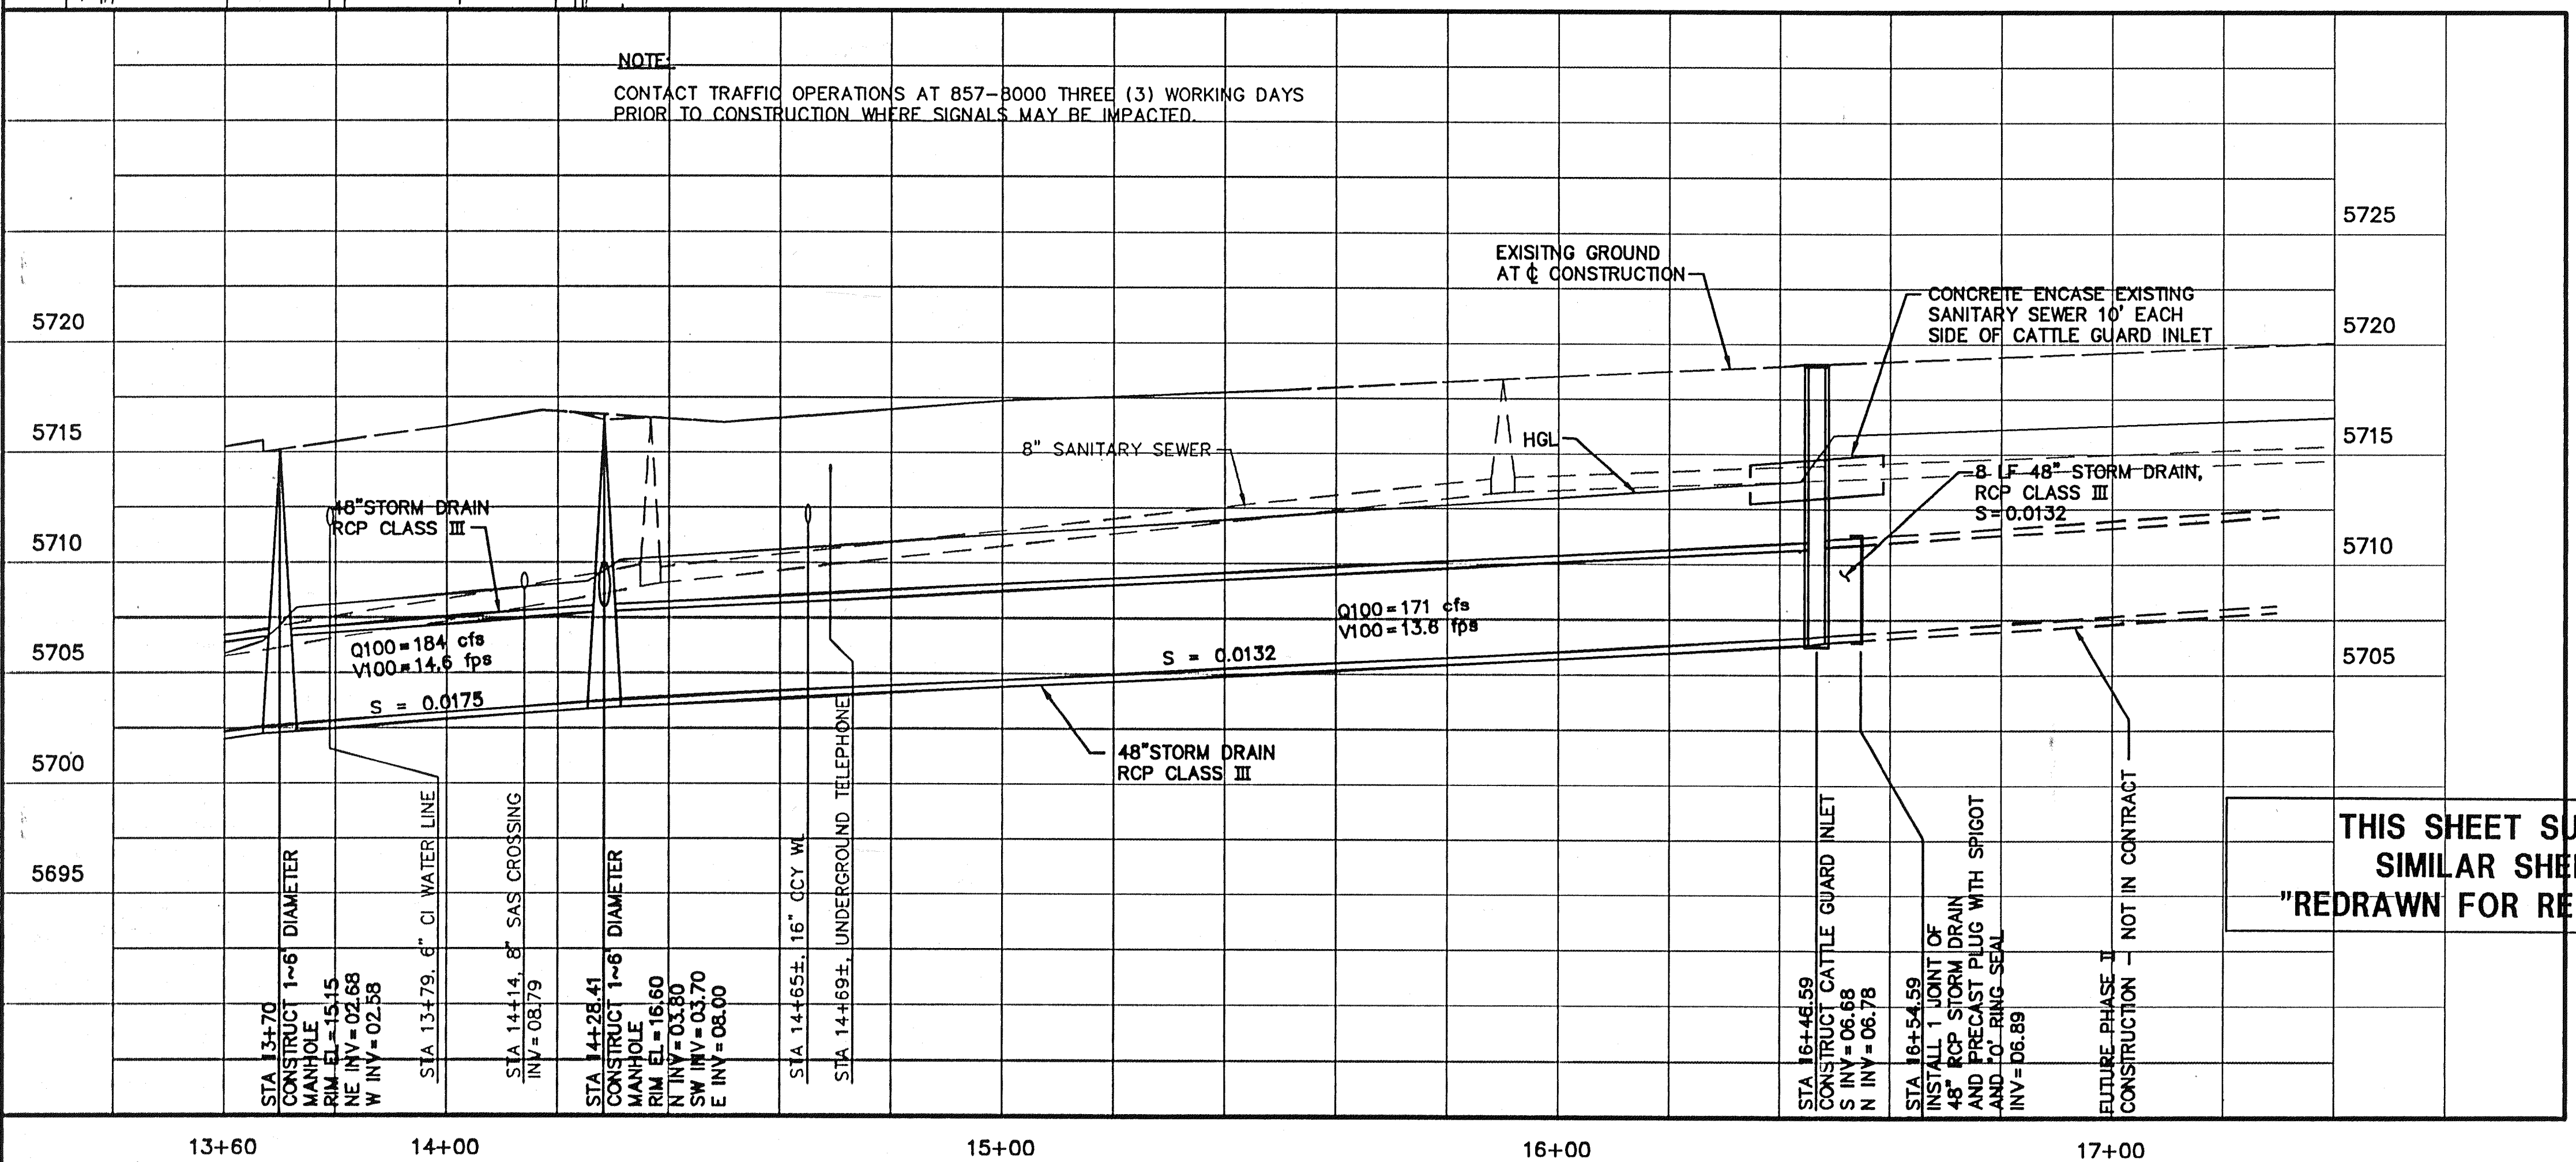

THIS SHEET SUPERSEDED BY
SIMILAR SHEET MARKED
"REDRAWN FOR RECORD PURPOSES"

LEEDSHILL-HERKENHOFF, INC.
500 Copper Avenue NW
P.O. Box 1217
Albuquerque, NM 87103
(505)247-0294

CITY OF ALBUQUERQUE
PUBLIC WORKS DEPARTMENT
ENGINEERING DEVELOPMENT GROUP

TITLE: DIVERSE DRAINAGE IMPROVEMENTS
NAKOMIS PLAN AND PROFILE
STA 13+60 TO STA 16+54.59


DESIGN REVIEW COMMITTEE
JUN 19 1997

CITY ENGINEER
JUN 19 1997

Mo./Day/Yr.
Mo./Day/Yr.

City Project No. 4880-92 Zone Map No. J,K-22,23 Sheet 7 Of 24

NO. DATE REMARKS BY
LEEDSHILL-HERKENHOFF, INC.
DESIGNED BY RAS/TM/KO DATE JAN 1997
DRAWN BY C ROMERO DATE JAN 1997
CHECKED BY C DODGE DATE JAN 1997

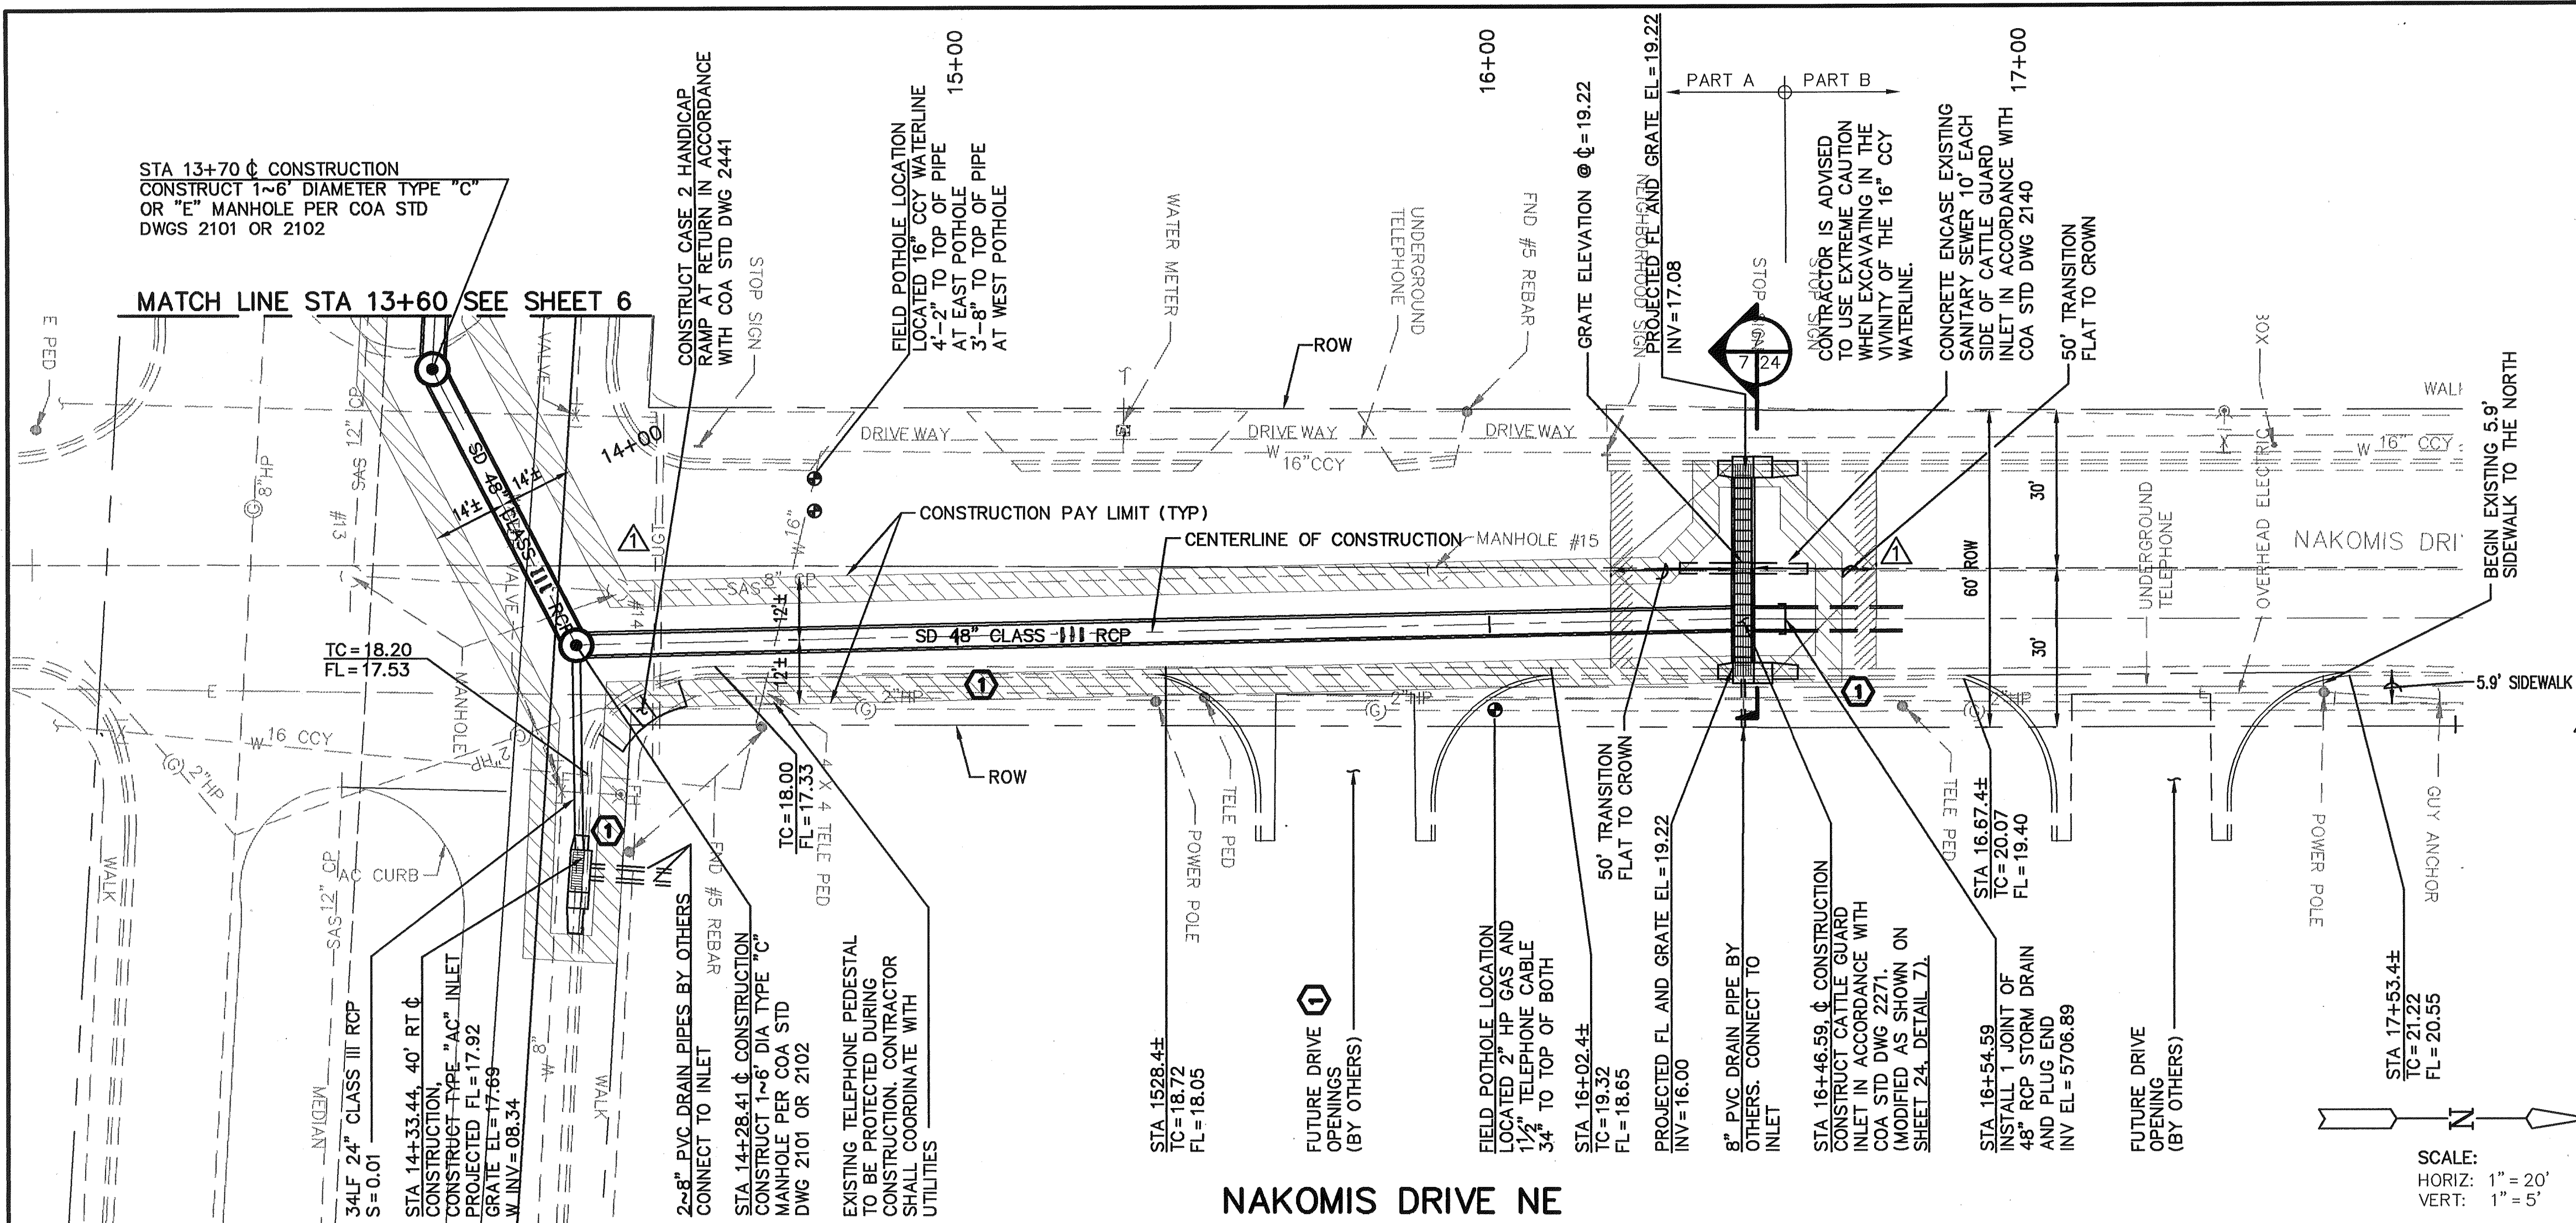

NOTES

- FOR SURVEY CONTROL SEE SHEET 3.
- ALL WATER LINE RELOCATION SHALL EMPLOY EXCLUSIVELY MECHANICAL RESTRAINT ON BENDS.
- IF A PAVEMENT DROP-OFF IS CREATED DURING CONSTRUCTION THE CONTRACTOR SHALL INITIATE PROTECTIVE ACTION IN ACCORDANCE WITH THE NEW MEXICO STATE HIGHWAY AND TRANSPORTATION DEPARTMENTS CURRENT DROP-OFF POLICY. THIS WORK SHALL BE INCIDENTAL TO THE PROJECT.
- PROVIDE SHORING OR TRENCH PROTECTION TO PROTECT EXISTING AC CURB ON LOMAS AS SHOWN. DAMAGE TO AC CURB OUTSIDE THE CONSTRUCTION PAY LIMITS MUST BE REPAIRED AT CONTRACTORS EXPENSE. SEE SHEET 24, DETAIL 2.
- PAVEMENT REPLACEMENT SECTION FOR NAKOMIS SHALL BE IN ACCORDANCE WITH COA STD DWG 2405 FOR FLEXIBLE PAVEMENT.
- CURB AND GUTTER REMOVED DURING CONSTRUCTION TO BE REPLACED WITH PCC STANDARD CURB AND GUTTER IN ACCORDANCE WITH COA STD DWG 2415.


KEYED NOTES

- SIDEWALK, DRIVE ENTRANCES AND OTHER SITE MODIFICATIONS MAY PRECEDE OR BE CONCURRENT WITH THIS PROJECT. REMOVAL AND REPLACEMENT QUANTITIES MAY BE AFFECTED.
- EXISTING UNDERGROUND TELEPHONE CABLE 22' RT. OF CL AT CATTLE GUARD.

EXISTING MANHOLE DATA

MH	RIM ELEV	NORTH INV 1	SOUTH INV 2	EAST INV 3	WEST INV 4	COA GIS NUMBER
1	5663.14	5654.61	5654.59		5662.72	S942
2	5663.95	5654.75	5654.25		5654.25	NO NUMBER
3	5663.41	5654.16		5653.27	5653.22	944
4	5663.55	5654.15	5654.05	5654.26		S43
5	5664.57	5658.57		5656.87	5656.07	S56
6	5666.97	5659.77	5660.27	5659.07	5658.87	S55
7	5669.32	5662.42	5662.82	5661.52	5661.17	S54
8	5670.69	5663.95	5664.35	5663.17	5662.97	S53
9	5672.87	5665.87	5666.37	5665.37	5665.27	S52
10	5676.44			5666.94	5666.84	NO NUMBER
11	5687.90			5678.25	5678.15	
12	5703.10			5693.20	5693.05	964
13	5716.80	5708.65		5707.95	5707.95	972
14	5716.13	5709.28	5709.18			NO NUMBER
15	5718.90	5713.25	5713.15			971
16	5723.00	5716.65			5716.65	873
17	5726.41	5720.41	5720.31	5720.51		875
18	5727.01	5721.01	5720.96	5721.31	5721.01	871
19	5729.39	5723.54	5723.39	5723.49		NO NUMBER
20	5768.75	5757.00		5756.95	5756.75	903
21	5771.87	5762.25	5761.75	5761.65	5761.55	NO NUMBER
22	5772.86	5767.16	5764.76		5764.86	S902
23	5779.72	5770.12		5770.02	5770.02	S903
24	5794.56	5786.57		5786.57	5786.47	
25	5795.18		5787.18		5787.08	

EXISTING STORM DRAIN INLETS	GRATE ELEVATION	INVERT ELEVATION
A	5663.77	5660.77
B	5667.48	5664.48
C	5669.43	5666.43
D	5671.53	5668.53
E	5663.59	5660.59
F	5665.45	5662.45
G	5667.69	5664.69
H	5669.71	5666.71
I	5671.69	5668.96
J	5773.37	5770.37
K	5774.47	5771.43
L	5779.89	5776.89
M	5781.34	5778.34
N	5772.89	5769.89

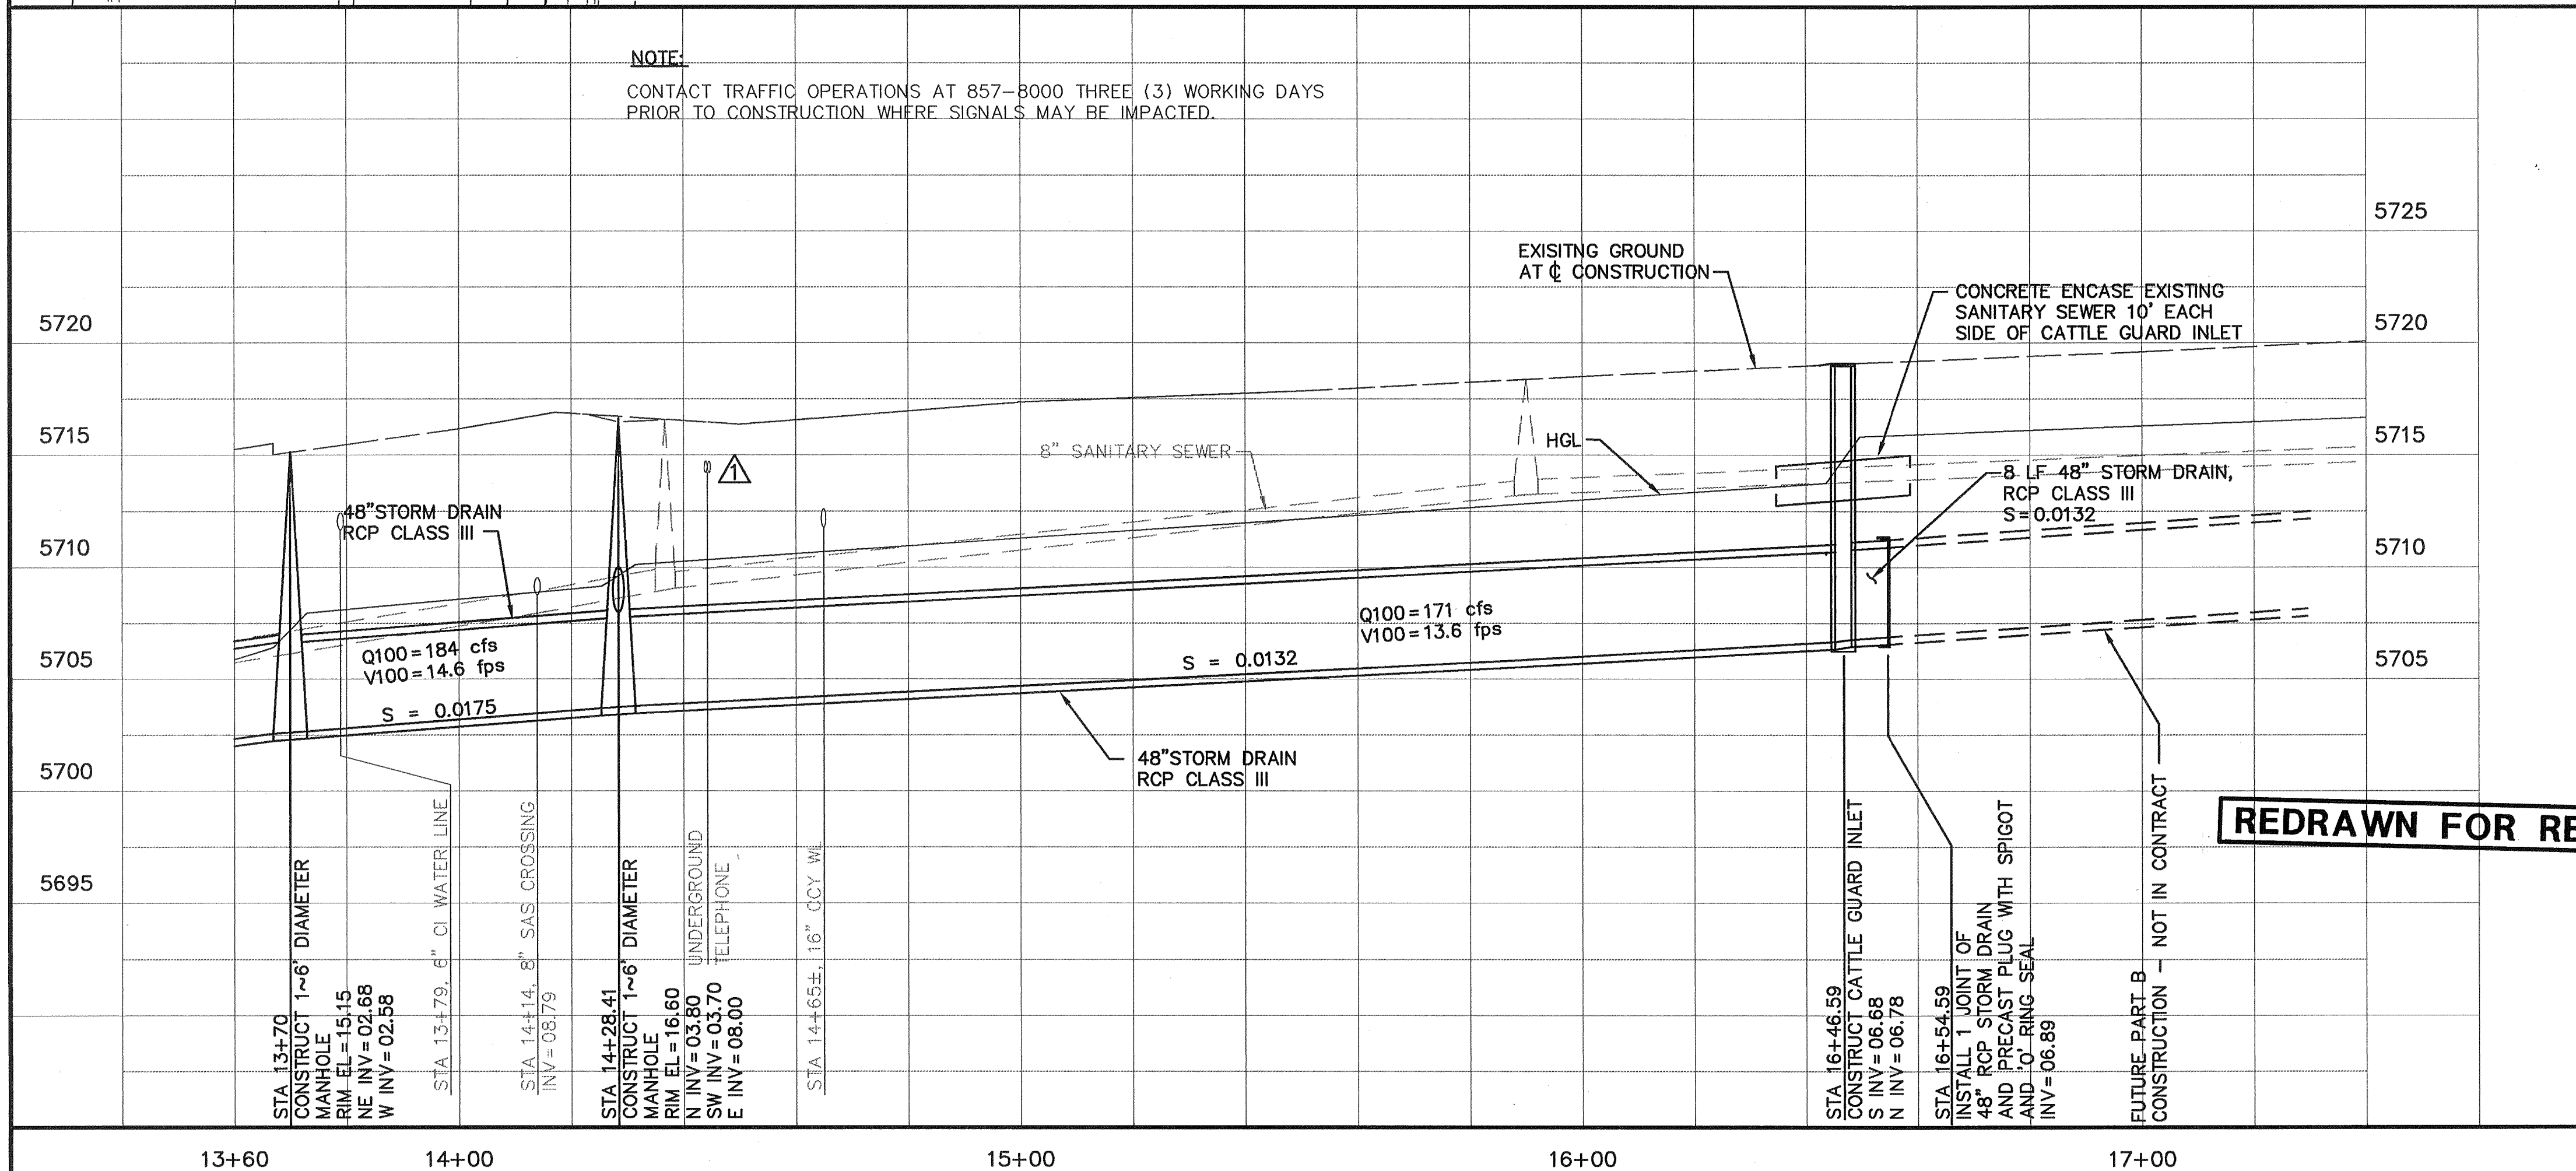

REDRAWN FOR RECORD PURPOSES

RECORD DRAWING
FEB 1998


These drawings have been revised based on the construction records of the owner. While the information submitted by the Owner will be assumed to be reliable, the engineer will not be responsible for the accuracy of this information nor for error or omissions which may appear in the record document as a result thereof.

LEEDSHILL-HERKENHOFF, INC.
500 Copper Avenue NW
P.O. Box 1217
Albuquerque, NM 87103
(505)247-0294

CITY OF ALBUQUERQUE
PUBLIC WORKS DEPARTMENT
ENGINEERING DEVELOPMENT GROUP

TITLE: DIVERSE DRAINAGE IMPROVEMENTS
NAKOMIS PLAN AND PROFILE
STA 13+60 TO STA 16+54.59

Design Review Committee	City Engineer Approval	Mo./Day/Yr.	Mo./Day/Yr.
Last Design Update			
City Project No.	Zone Map No.	Sheet	Of
4880-92	J,K-22,23	7B	24

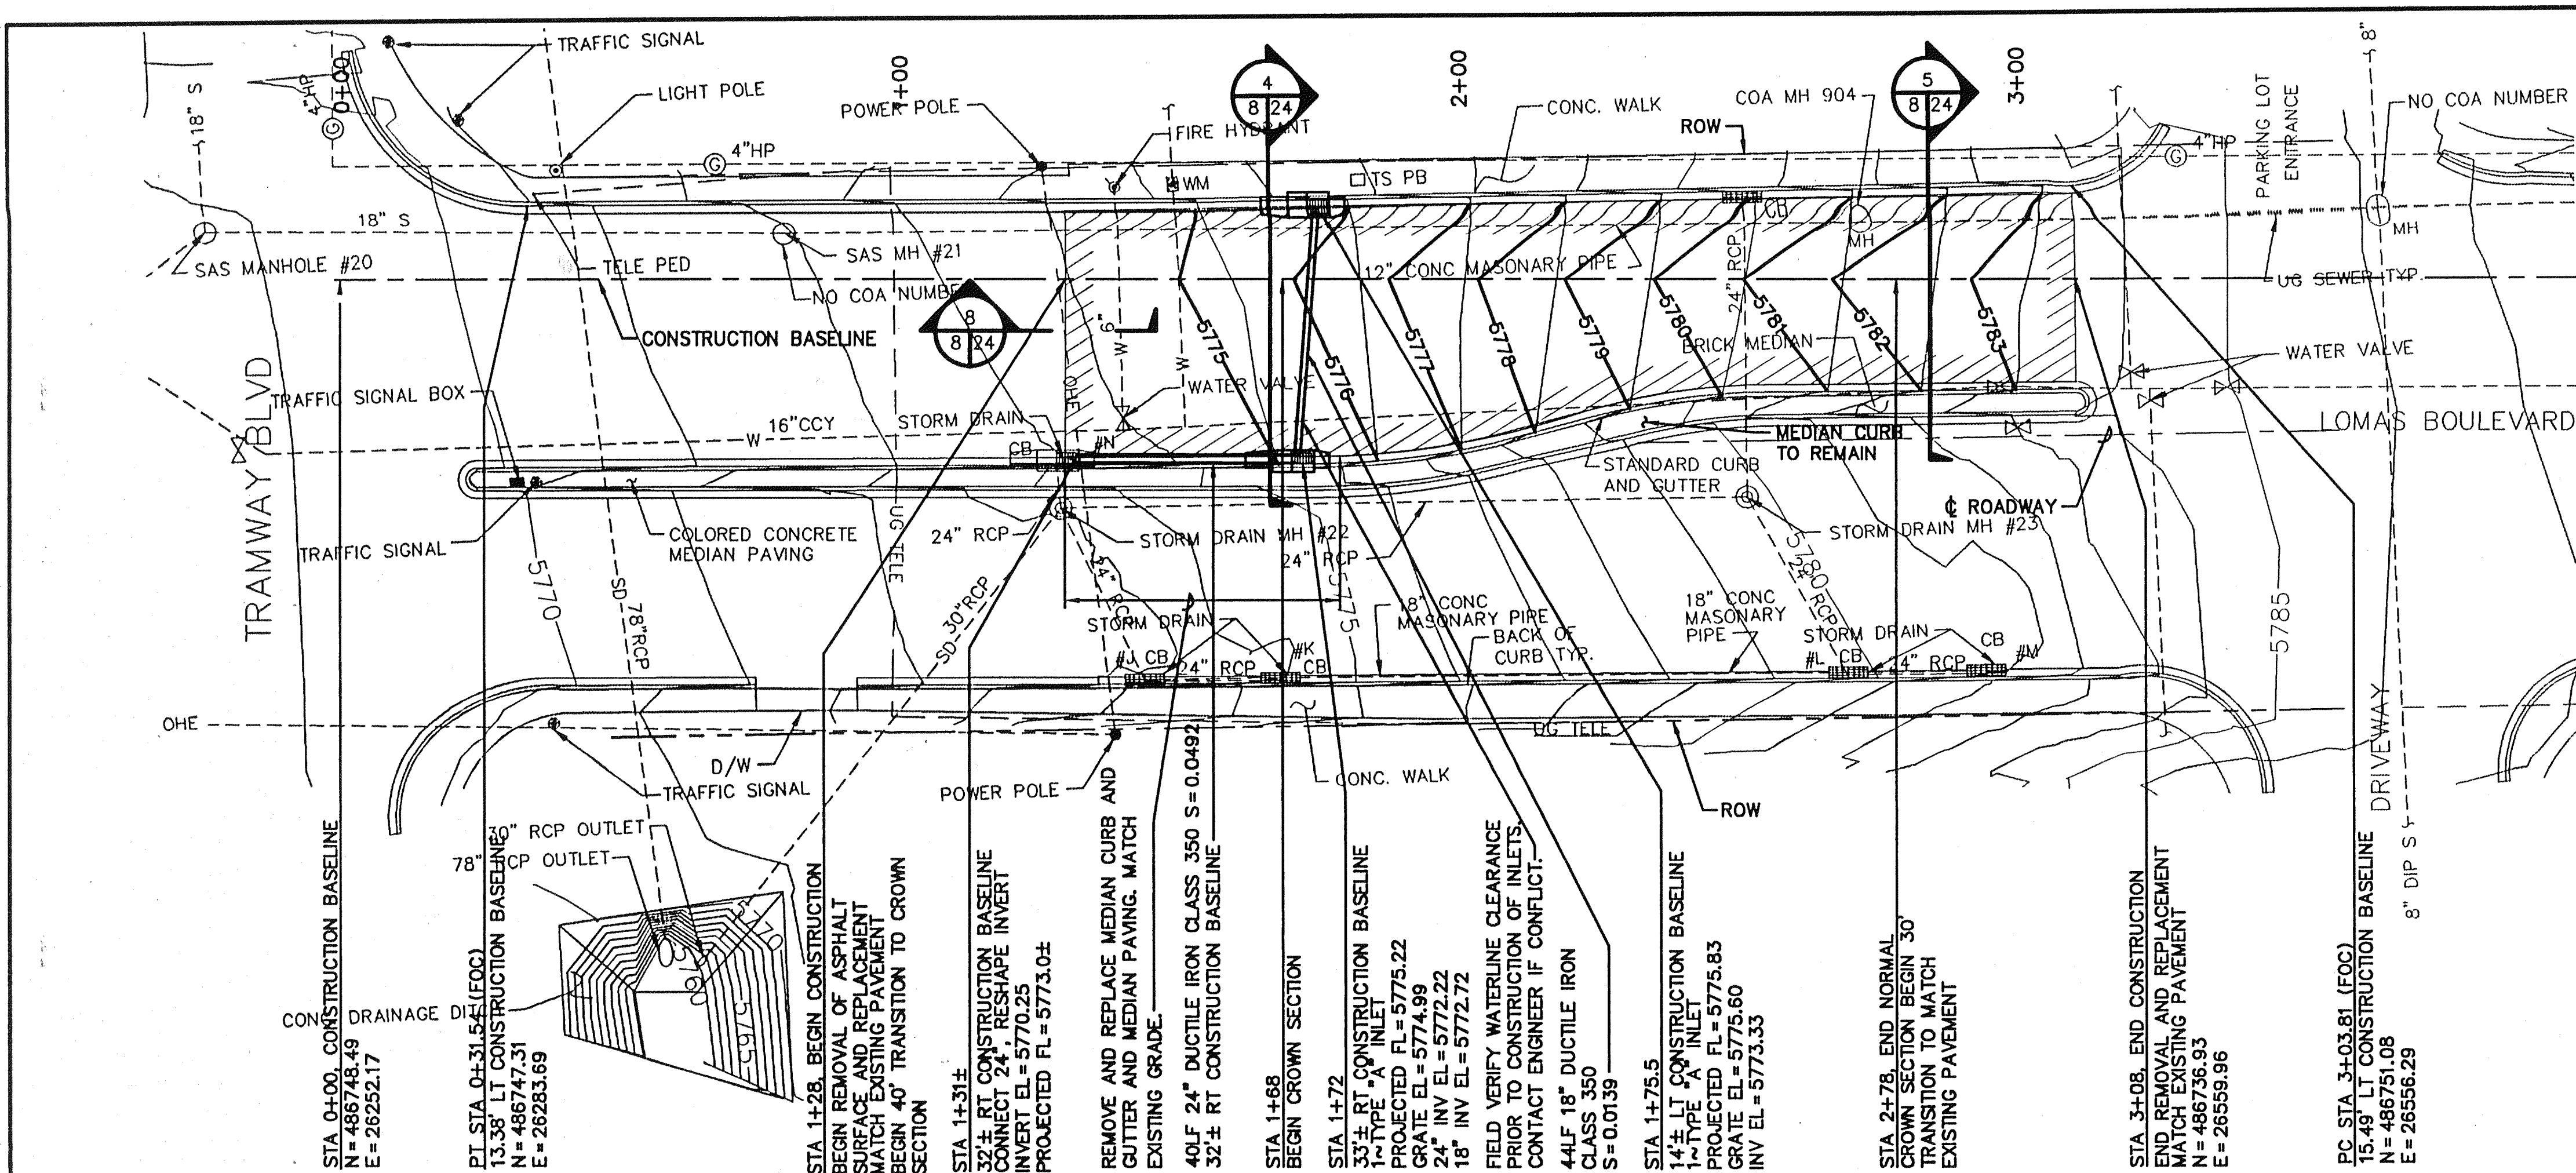


NOTES

- A FOR SURVEY CONTROL SEE SHEET 3.
- B ALL WATER LINE RELOCATION SHALL EMPLOY EXCLUSIVELY MECHANICAL RESTRAINT ON BENDS.
- C IF A PAVEMENT DROP-OFF IS CREATED DURING CONSTRUCTION THE CONTRACTOR SHALL INITIATE PROTECTIVE ACTION IN ACCORDANCE WITH THE NEW MEXICO STATE HIGHWAY AND TRANSPORTATION DEPARTMENTS CURRENT DROP-OFF POLICY. THIS WORK SHALL BE INCIDENTAL TO THE PROJECT.
- D FOR PAVEMENT SECTION SEE SHEET 24, DETAIL 3.
- E CURB AND GUTTER WHICH IS REMOVED FOR STORM DRAIN CONSTRUCTION SHALL BE REPLACED WITH MEDIAN CURB AND GUTTER AND/OR STANDARD CURB AND GUTTER TO MATCH EXISTING.

EXISTING MANHOLE DATA						
MH	RIM ELEV	NORTH INV 1	SOUTH INV 2	EAST INV 3	WEST INV 4	COA GIS NUMBER
1	5663.14	5654.61	5654.59		5662.72	S942
2	5663.95	5654.75	5654.25		5654.25	NO NUMBER
3	5663.41	5654.16		5653.27	5653.22	944
4	5663.55	5654.15	5654.05	5654.26		543
5	5664.57	5658.57		5656.87	5656.07	S56
6	5666.97	5659.77	5660.27	5659.07	5658.87	S55
7	5669.32	5662.42	5662.82	5661.52	5661.17	S54
8	5670.69	5663.95	5664.35	5663.17	5662.97	S53
9	5672.87	5665.87	5666.37	5665.37	5665.27	S52
10	5676.44			5666.94	5666.84	NO NUMBER
11	5687.90			5678.25	5678.15	
12	5703.10			5693.20	5693.05	964
13	5716.80	5708.65		5707.95	5707.95	972
14	5716.13	5709.28	5709.18			NO NUMBER
15	5718.90	5713.25	5713.15			971
16	5723.00	5716.65			5716.65	873
17	5726.41	5720.41	5720.31	5720.51		875
18	5727.01	5721.01	5720.96	5721.31	5721.01	871
19	5729.39	5723.54	5723.39	5723.49		NO NUMBER
20	5768.75	5757.00		5756.95	5756.75	903
		5761.15				
21	5771.87	5762.25	5761.75	5761.65	5761.55	NO NUMBER
22	5772.86	5767.16	5764.76		5764.86	S902
23	5779.72	5770.12		5770.02	5770.02	S903
24	5794.56	5786.57		5786.57	5786.47	
25	5795.18		5787.18	5787.18	5787.08	

SCALE:
HORIZ: 1" = 20'
VERT: 1" = 5'

LOMAS BOULEVARD NE

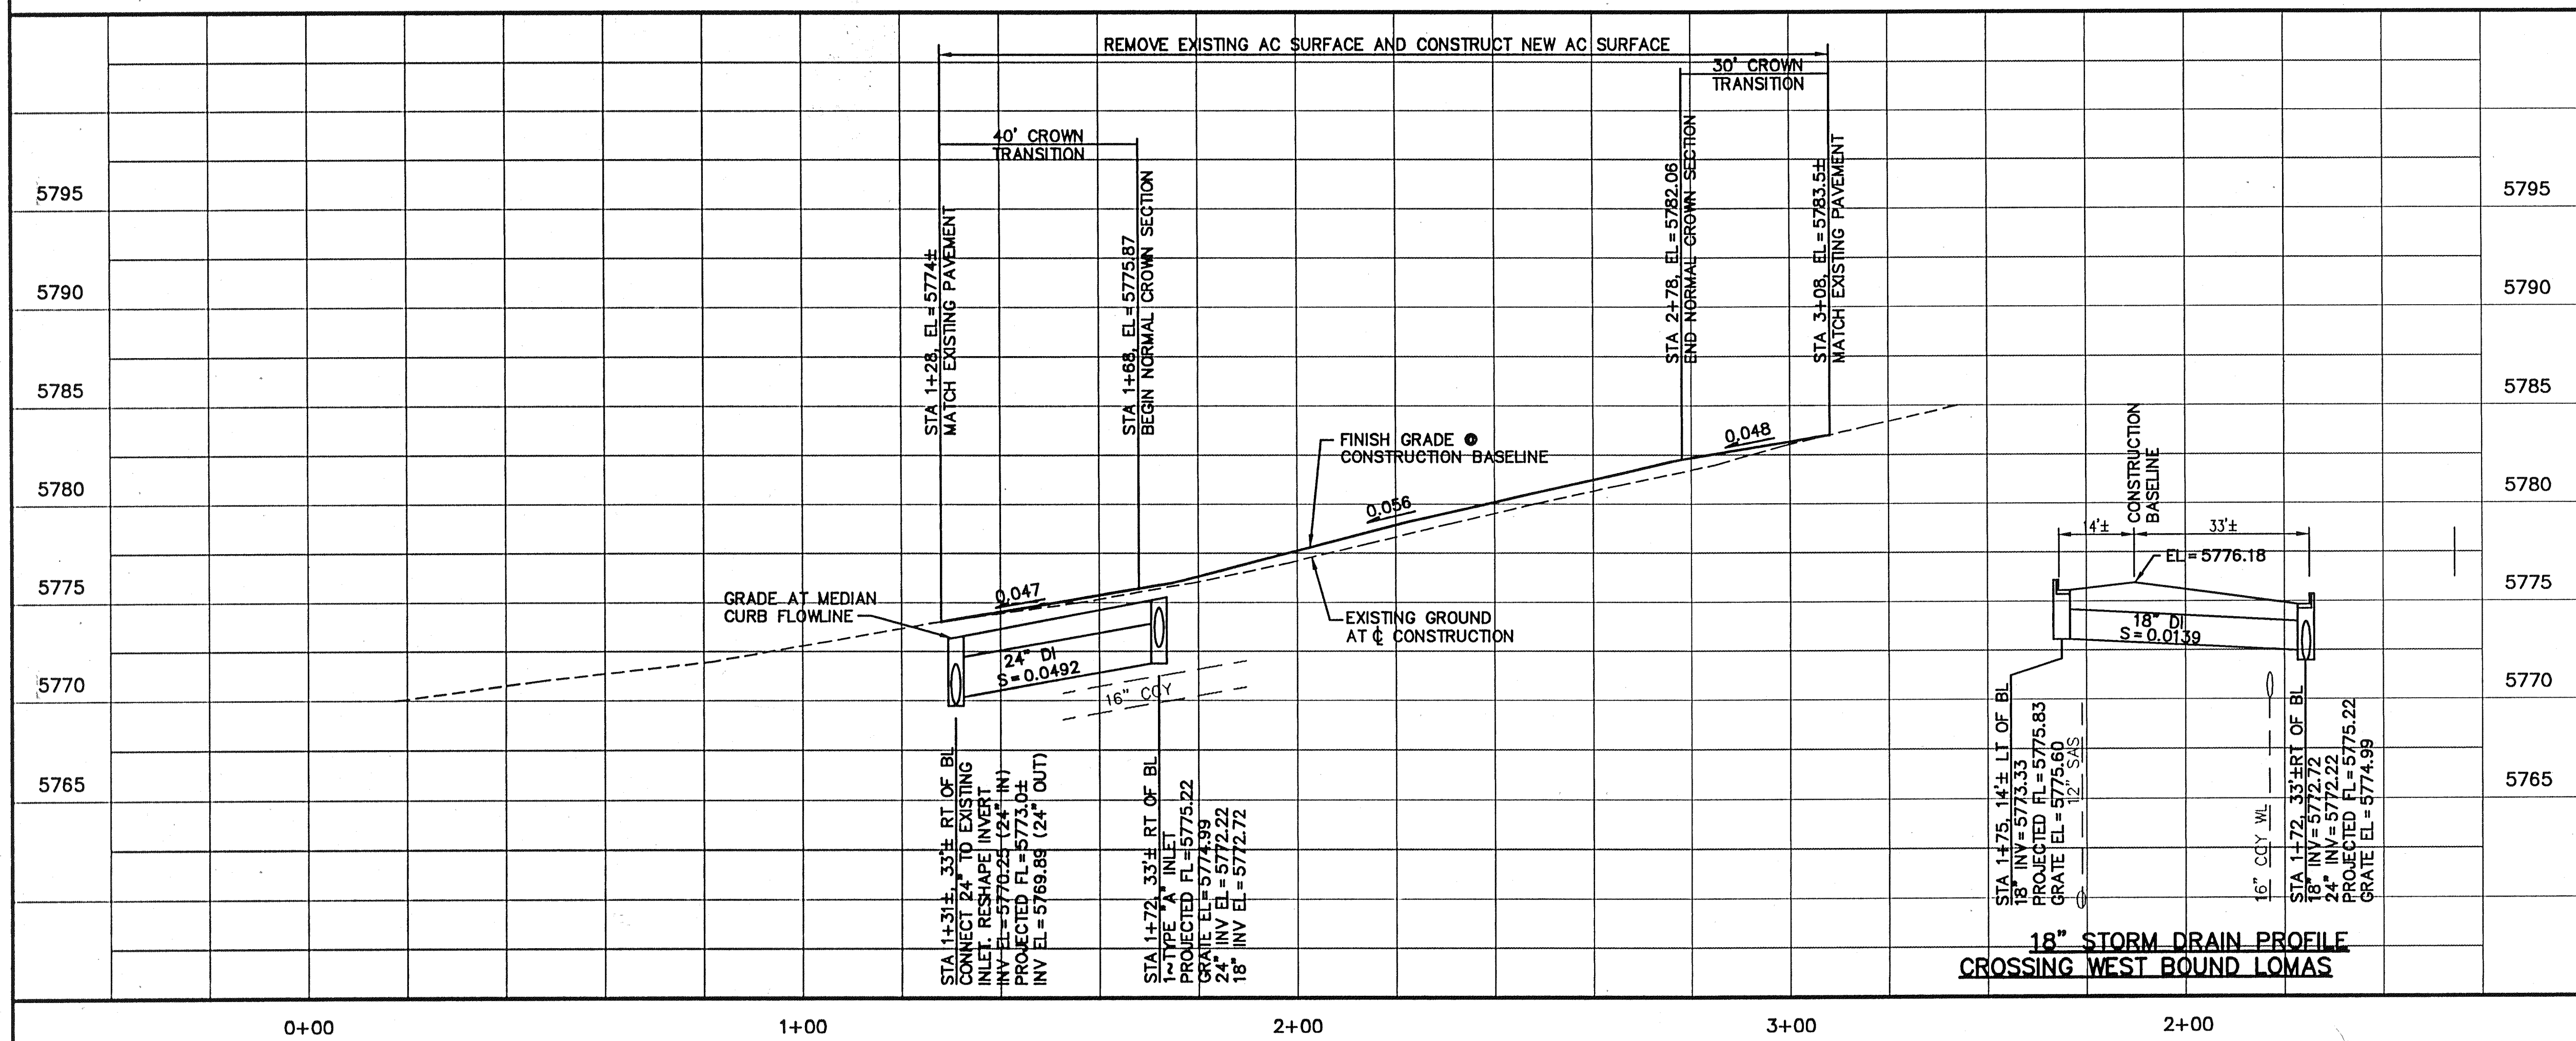

EXISTING STORM DRAIN INLETS	GRATE ELEVATION	INVERT ELEVATION
A	5663.77	5660.77
B	5667.48	5664.48
C	5669.43	5666.43
D	5671.53	5668.53
E	5663.59	5660.59
F	5665.45	5662.45
G	5667.69	5664.69
H	5669.71	5666.71
I	5671.69	5668.96
J	5773.37	5770.37
K	5774.47	5771.43
L	5779.89	5776.89
M	5781.34	5778.34
N	5772.89	5769.89

RECORD DRAWING
JAN 1998

These drawings have been revised based on the construction records of the owner. While the information submitted by the Owner will be assumed to be reliable, the Engineer will not be responsible for the accuracy of this information nor for errors or omissions which may appear in the drawings as a result thereof.

LEEDSHILL-HERKENHOFF, INC
500 Copper Avenue NW
P.O. Box 1217
Albuquerque, NM 87103
(505)247-0294

CITY OF ALBUQUERQUE
PUBLIC WORKS DEPARTMENT
ENGINEERING DEVELOPMENT GROUP
TITLE: DIVERSE DRAINAGE IMPROVEMENTS
LOMAS/TRAMWAY PLAN AND PROFILE
STA 1+28 TO STA 3+08

APPROVE
DESIGN REVIEW COMMITTEE
JUN 1998

APPROVE
CITY ENGINEER
JUN 1998


City Project No. 4880.92 Zone Map No. K-22.23 Sheet 8 Of 24
1/94036.31/DWG/C/LOMAS/6-5-97/MDJ

KEYED NOTES

- SAWCUT REMOVE & DISPOSE OF ALL EXISTING ASPHALT CURB OUTSIDE OF NEW EXTRUDED CONCRETE CURB.
- NEW ASPHALT PAVEMENT PER STD. DWG. 2408. SEE PAVEMENT SECTION THIS SHEET.
- 4" SOLID WHITE STRIPE OFFSET 12" FROM NEW MEDIAN FACE OF CURB.
- PAINT NEW MEDIAN NOSE SOLID YELLOW FROM P.C. TO P.C.
- REMOVE EXISTING CONCRETE SIDEWALK WITHIN NEW CONSTRUCTION.
- NEW WHEEL CHAIR-RAMP PER STD. DWG. 2426.
- NEW 4" THICK GREY CONCRETE OVER 90% COMPACTED SUBGRADE.
- MATCH EXISTING FILLET AND VALLEY GUTTER.
- SAWCUT REMOVE & DISPOSE OF ALL EXISTING STANDARD CURB & GUTTER WITHIN NEW CONSTRUCTION.
- ADJUST EXISTING WATER VALVE AS NECESSARY.

LEGEND

- NEW STANDARD CURB & GUTTER
- NEW EXTRUDED CONC. CURB
- KEYED NOTES DESIGNATOR
- PROPERTY LINE
- EXIST. CONTOUR
- EXIST. SPOT ELEVATION
- EXIST. CURB
- NOT IN CONTRACT

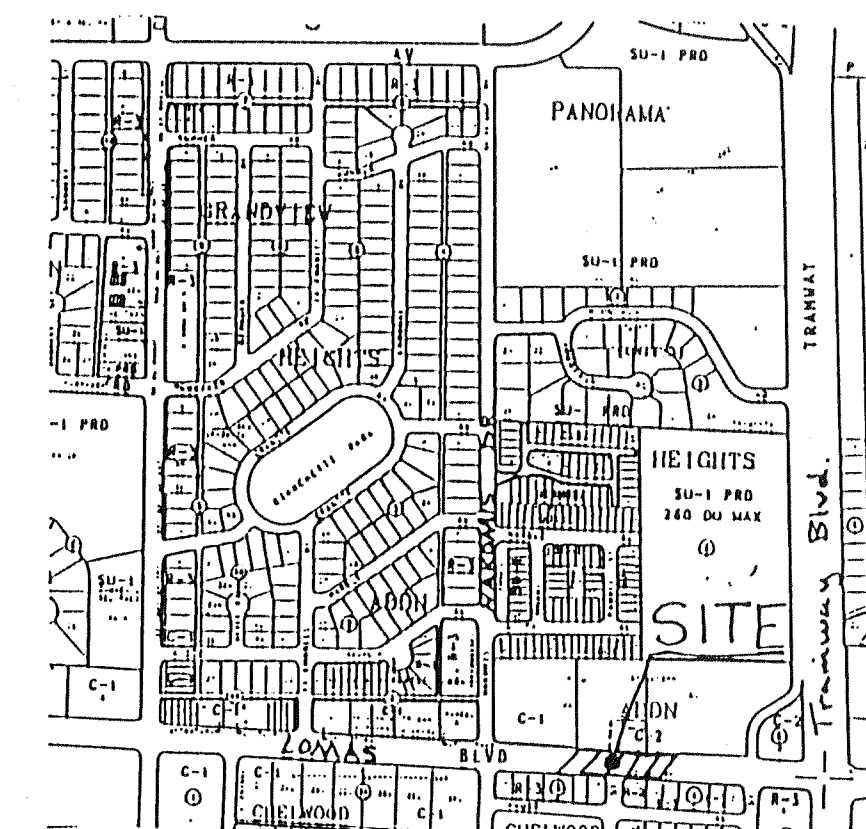

VICINITY MAP ZONE ATLAS J-22-Z
SCALE: NONE

GENERAL NOTES

NOTICE TO CONTRACTORS

- CITY OF ALBUQUERQUE SPECIFICATIONS FOR PUBLIC WORKS CONSTRUCTION, 1986 EDITION AS AMENDED THROUGH UPDATE 6, WILL BE REFERRED TO HEREIN AS THE "STANDARD SPECIFICATIONS".
- TWO WORKING DAYS PRIOR TO ANY EXCAVATION, CONTRACTOR MUST CONTACT NEW MEXICO ONE CALL SYSTEM (280-1990) AND DETERMINE LOCATION OF EXISTING UTILITIES.
- PRIOR TO ANY CONSTRUCTION, THE CONTRACTOR SHALL EXCAVATE AND VERIFY THE HORIZONTAL AND VERTICAL LOCATIONS OF ALL OBSTRUCTIONS. SHOULD A CONFLICT EXIST, THE CONTRACTOR SHALL NOTIFY THE ENGINEER OR THE SURVEYOR SO THAT THE CONFLICT CAN BE RESOLVED WITHOUT DELAY.
- ALL EXISTING SIGNS, MARKERS, DELINEATORS, ETC., WITHIN THE CONSTRUCTION LIMITS SHALL BE REMOVED, STORED AND RE-SET BY THE CONTRACTOR.
- THE CONTRACTOR SHALL NOTIFY THE ENGINEER NOT LESS THAN SEVEN (7) DAYS PRIOR TO STARTING WORK IN ORDER THAT THE ENGINEER MAY TAKE NECESSARY MEASURES TO INSURE THE PRESERVATION OF SURVEY MONUMENTS. CONTRACTOR SHALL NOT DISTURB PERMANENT SURVEY MONUMENTS WITHOUT THE CONSENT OF THE ENGINEER AND SHALL NOTIFY THE ENGINEER AND BEAR THE EXPENSE OF REPLACING ANY THAT MAY BE DISTURBED WITHOUT PERMISSION. WHEN A CHANGE IS MADE IN THE FINISHED ELEVATIONS OF THE PAVEMENT OF ANY ROADWAY IN WHICH A PERMANENT SURVEY MONUMENT IS LOCATED, CONTRACTOR SHALL, AT HIS OWN EXPENSE, ADJUST THE MONUMENT COVER TO THE NEW GRADE UNLESS OTHERWISE SPECIFIED. REFER TO SECTION 4.4 OF THE GENERAL CONDITIONS OF THE STANDARD SPECIFICATIONS.
- THREE (3) WORKING DAYS PRIOR TO BEGINNING CONSTRUCTION THE CONTRACTOR SHALL SUBMIT TO THE CONSTRUCTION CO-ORDINATION DIVISION A DETAILED CONSTRUCTION SCHEDULE. TWO (2) WORKING DAYS PRIOR TO CONSTRUCTION THE CONTRACTOR SHALL OBTAIN A BARRICADING PERMIT FROM THE CONSTRUCTION CO-ORDINATION DIVISION. CONTRACTOR SHALL NOTIFY BARRICADE ENGINEER (788-2551) PRIOR TO OCCUPANCY AN INTERSECTION.
- ANY WORK OCCURRING WITHIN AN ARTERIAL ROADWAY REQUIRES 24 HOURS CONSTRUCTION.

THE FOLLOWING NOTES ALSO APPLY WHEN CHECKED


- ☐ ALL UTILITIES AND UTILITY SERVICE LINES SHALL BE INSTALLED PRIOR TO PAVING.
- ☒ BACKFILL COMPACTION SHALL BE ACCORDING TO SPECIFIED STREET USE.
- ☐ TACK COAT REQUIREMENTS SHALL BE DETERMINED BY THE CITY ENGINEER.
- ☐ SIDEWALK AND WHEELCHAIR RAMPS WITHIN THE CURB RETURNS SHALL BE CONSTRUCTED WHEREVER A NEW CURB RETURN IS CONSTRUCTED.
- ☐ IF CURB IS DEEPRESSED FOR A DRIVEPAD, THE DRIVEPAD SHALL BE CONSTRUCTED PRIOR TO ACCEPTANCE OF CURB AND GUTTER.
- ☐ ALL STORM DRAINAGE FACILITIES SHALL BE COMPLETED PRIOR TO FINAL ACCEPTANCE.
- ☒ THE REQUESTOR OR DEVELOPER SHALL BE RESPONSIBLE FOR REPAIR OR REPLACEMENT OF ALL EXISTING CURB AND GUTTER, SIDEWALK OR DRIVEPAD DAMAGE CAUSED BY NEW CONSTRUCTION.

dmg D. MARK GOODWIN & ASSOCIATES, P.A.
CONSULTING ENGINEERS & SURVEYORS
P. O. BOX 90608
ALBUQUERQUE, NEW MEXICO 87199
(505) 345-2010


CITY OF ALBUQUERQUE
PUBLIC WORKS DEPARTMENT
ENGINEERING DEVELOPMENT GROUP

TITLE: FURRS - LOMAS BLVD. & TRAMWAY BLVD.
OFFSITE TURN LANE IMPROVEMENTS


REV.	SHEETS	CITY ENGINEER	DATE	USER DEPARTMENT	DATE	USER DEPARTMENT	DATE
1	1	APPROVED FOR CONSTRUCTION					
2	2	APPROVED FOR CONSTRUCTION					
3	3	APPROVED FOR CONSTRUCTION					
100	100	APPROVED FOR CONSTRUCTION					

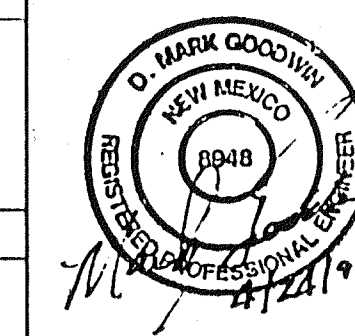


CITY PROJECT NO. 4880.92 5392
SHEET 9 OF 24

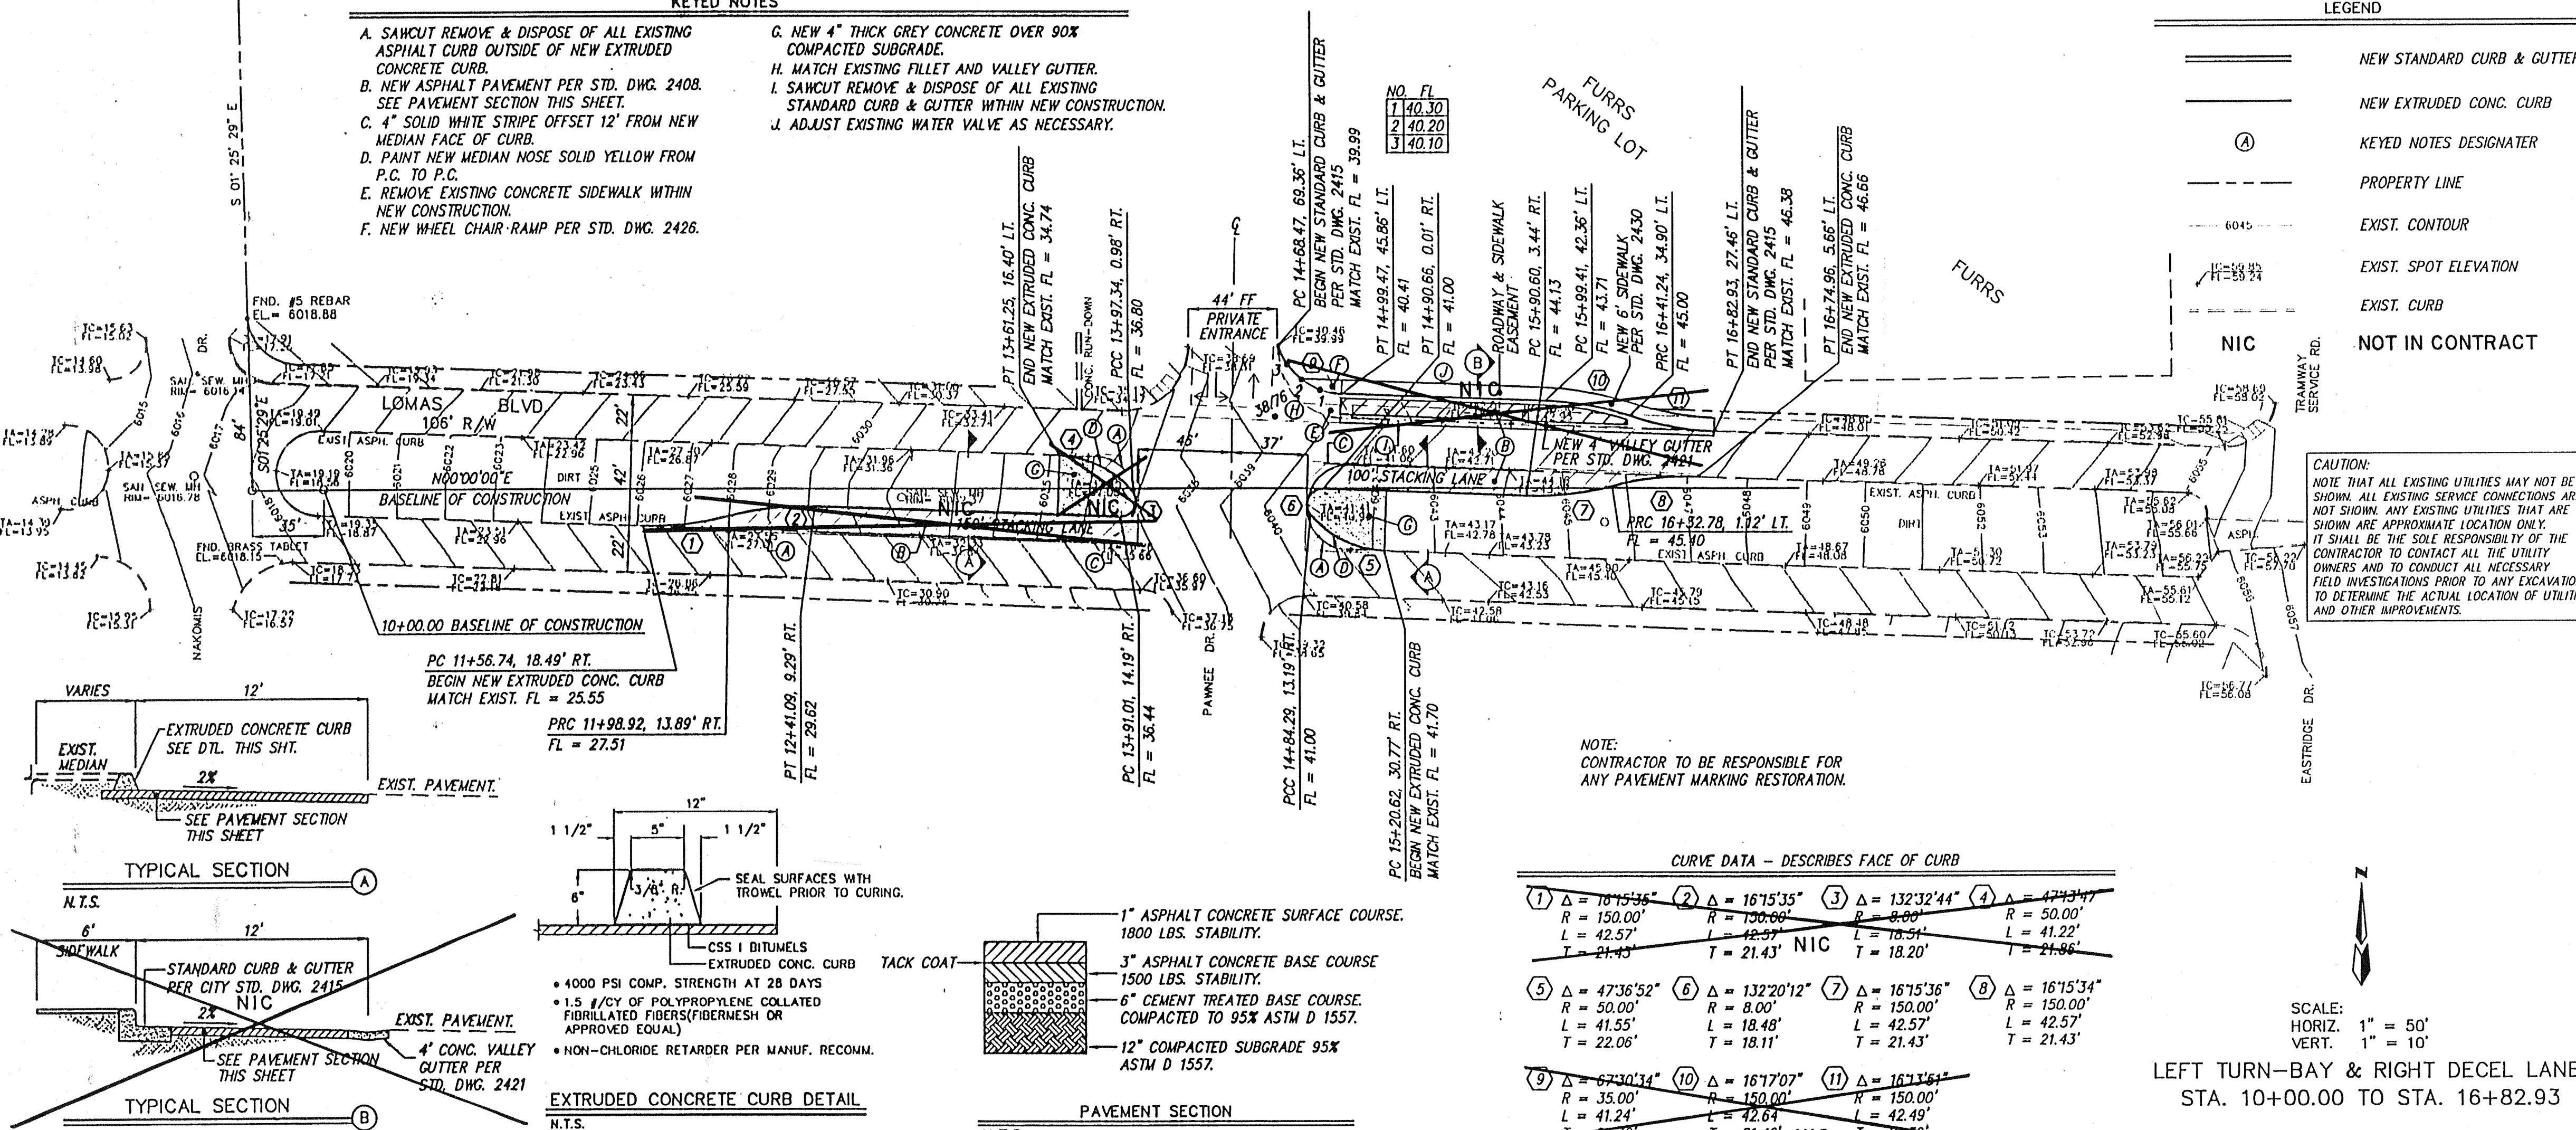

																																																																																																																																																																																																																																																																																																																																																																																																																																																																																																																																																																																																																																																																																																																																																																																																																																																																																																																																																																																																																																																																																																																																																																																																																																																																																																																																																																																																																					</
--	--	----

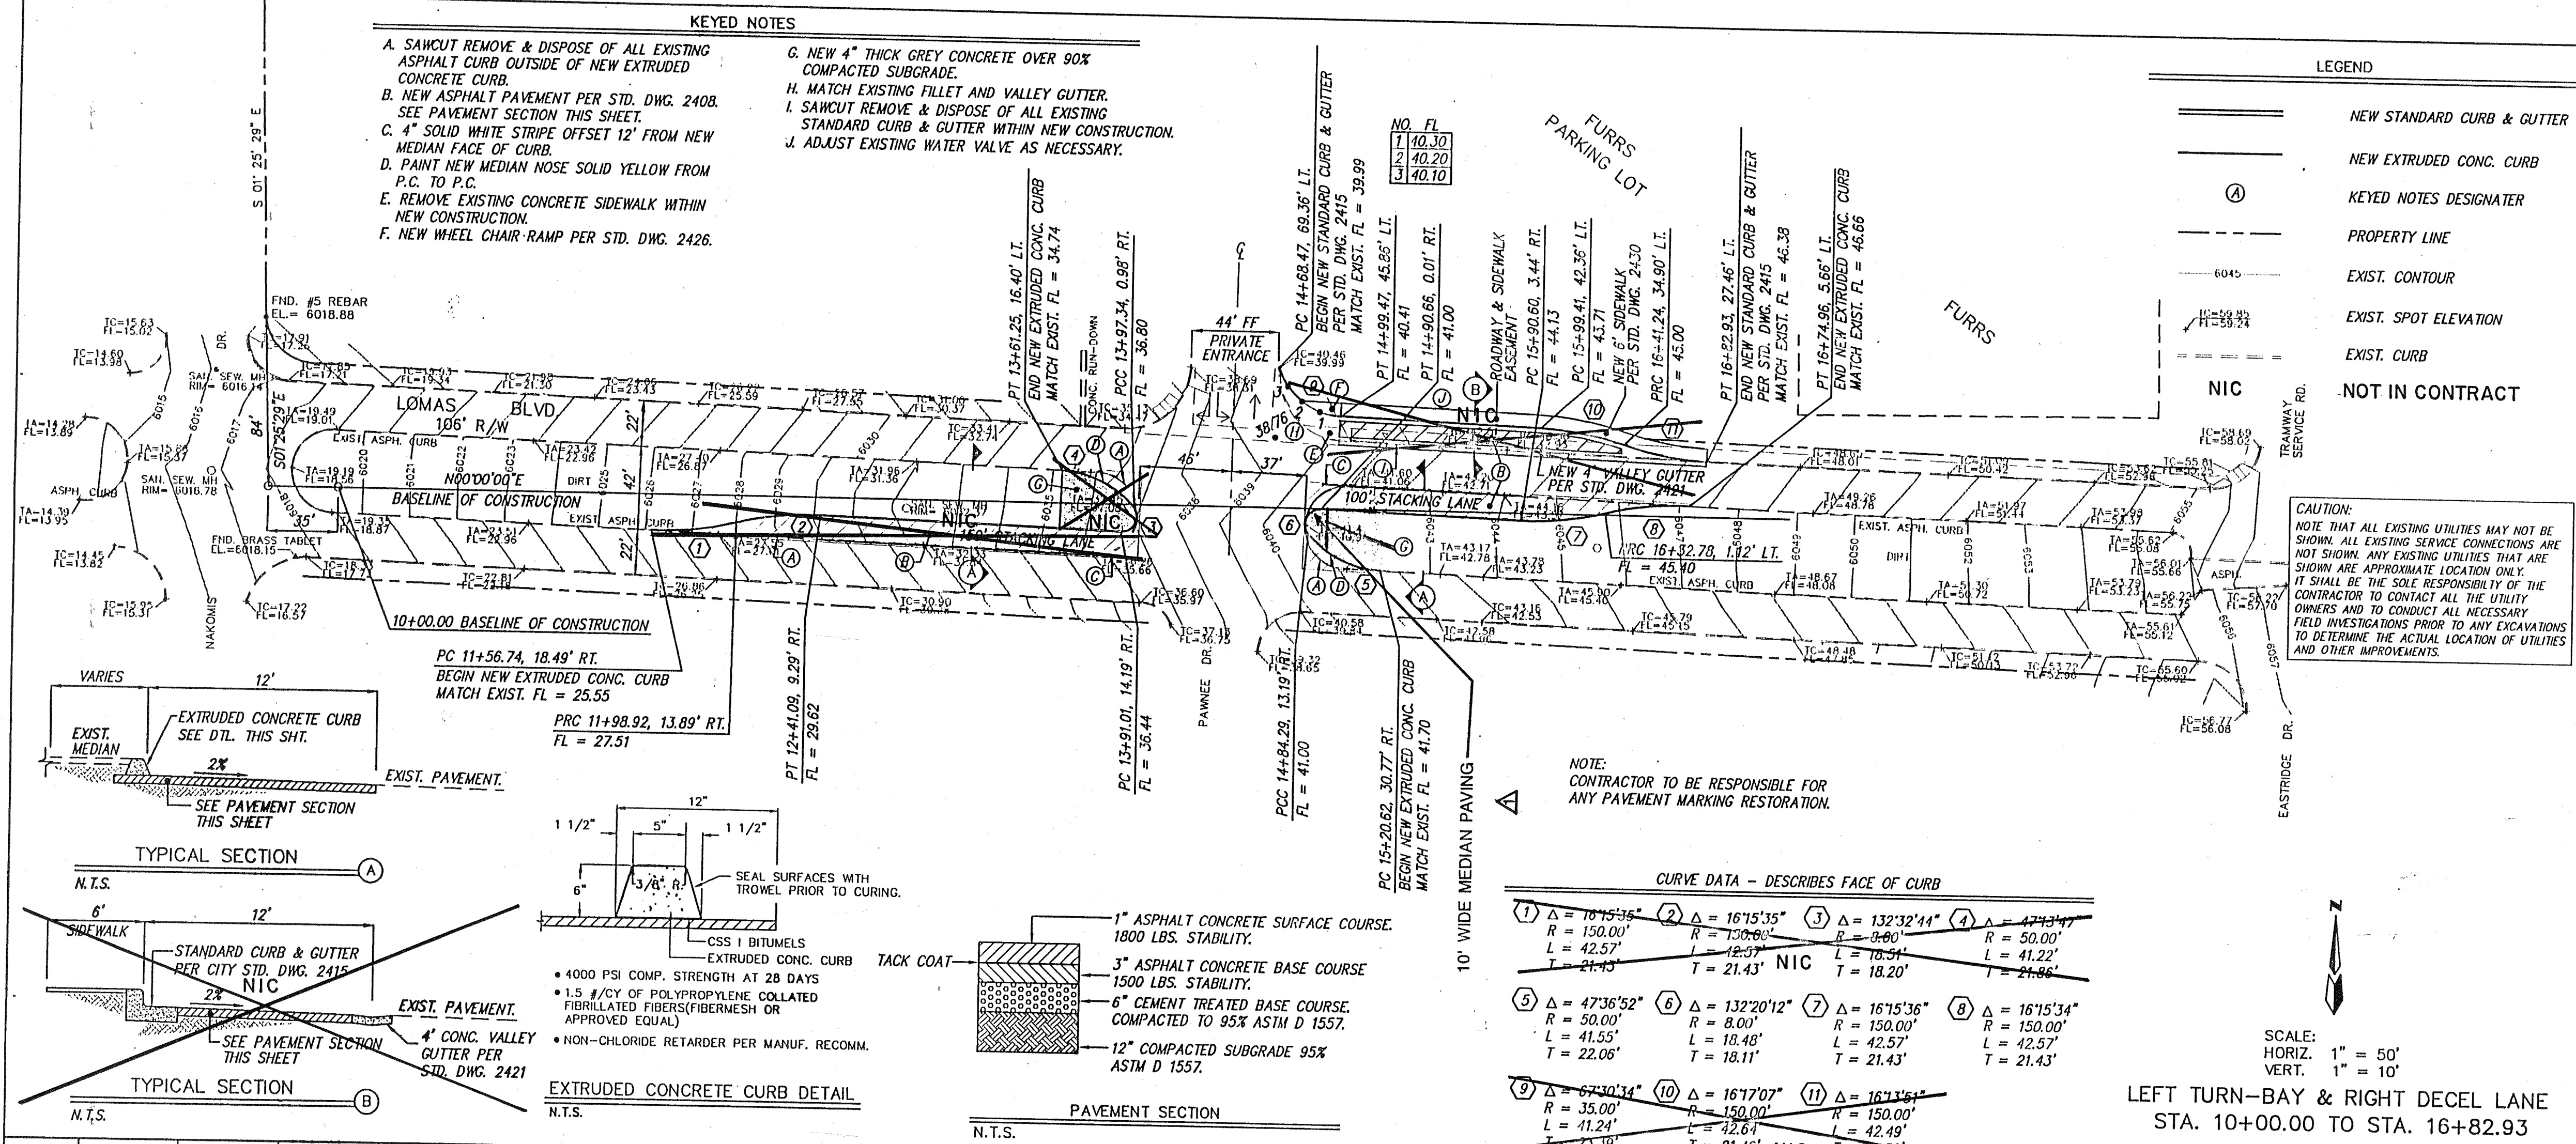

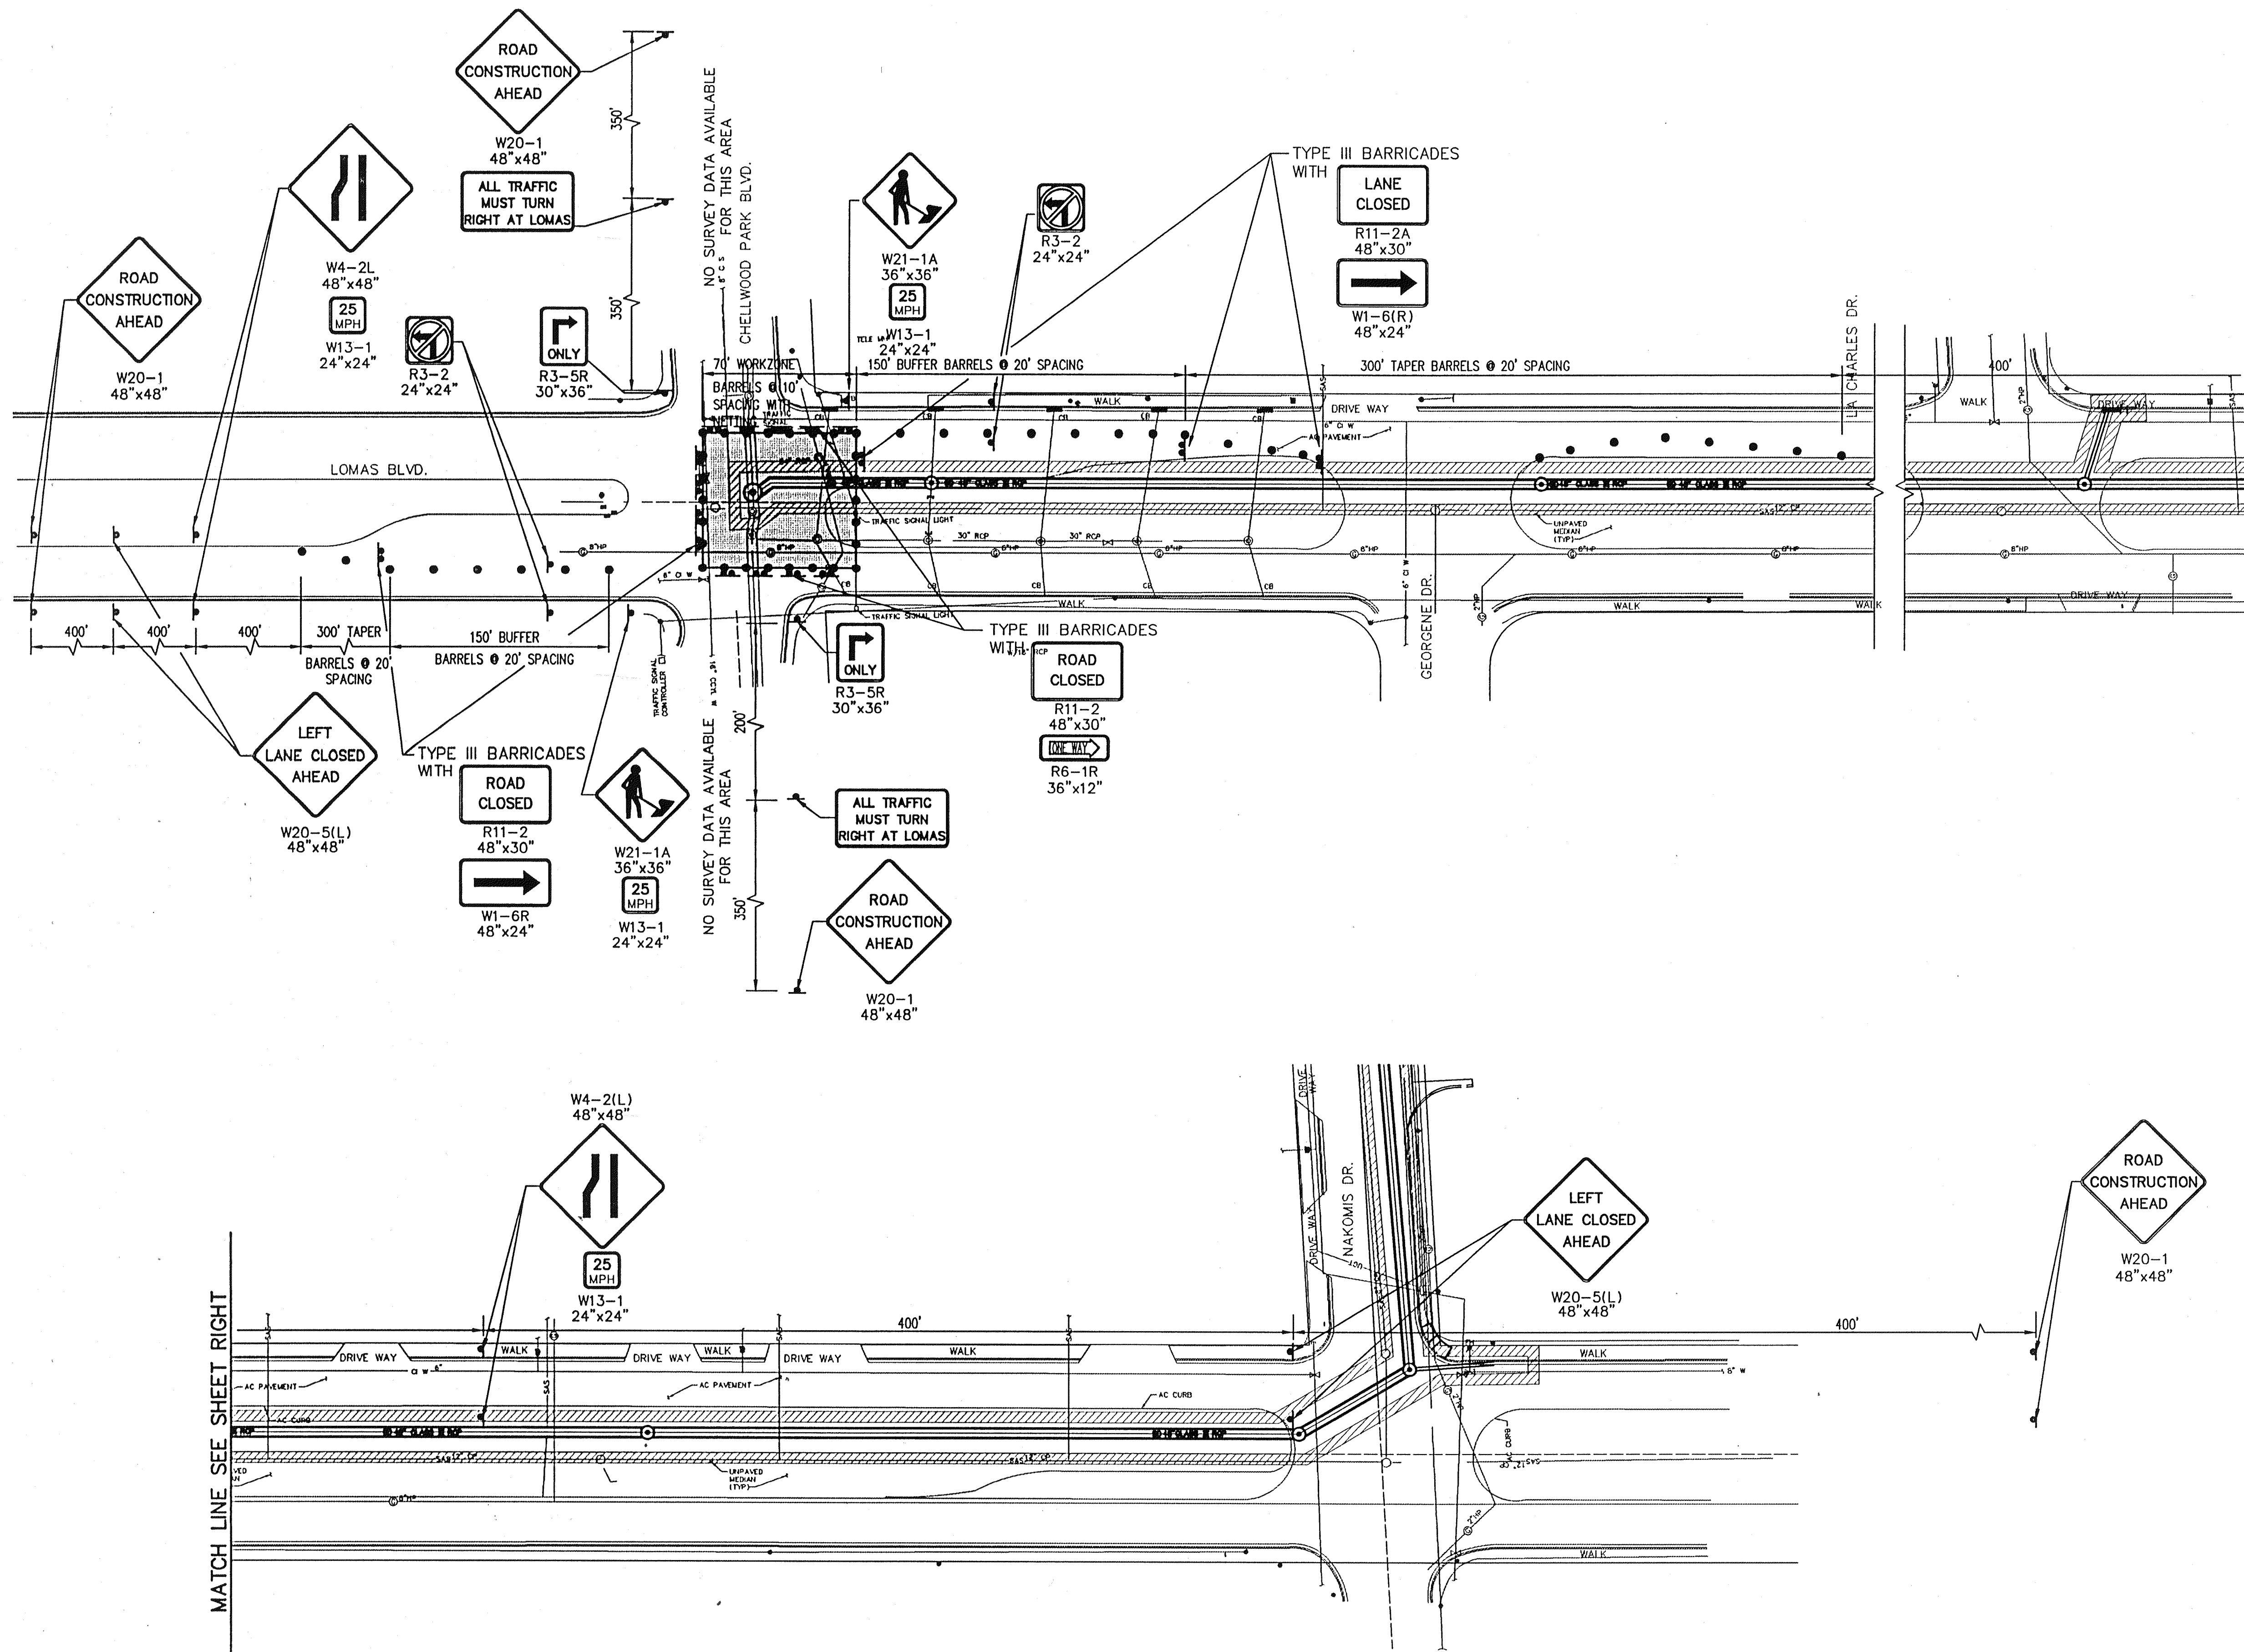

NOTES

- A BASED ON 11' LANE CLOSURE WITH POSTED SPEED LIMIT OF 40 MPH ON LOMAS BOULEVARD; 35 MPH POSTED SPEED LIMIT ON CHELWOOD PARK BOULEVARD.
- B MAINTAIN 12' CLEARANCE FOR OPEN DRIVING LANE.
- C CONTACT CITY OF ALBUQUERQUE TRAFFIC OPERATIONS BEFORE DISTURBING SIGNALS.


TRAFFIC LEGEND

- WORK ZONE OR COMBINED WORK AND BUFFER ZONE (SEE PLAN)
- BARRICADE TYPE I, TYPE II, OR BARREL
- R11-2 BARRICADE, TYPE III AND SIGN TYPE
- VERTICAL PANEL
- W6-3 TRAFFIC SIGN AND SIGN TYPE
- DOUBLE INDICATING SIGNS AND SIGN TYPE

TRAFFIC CONTROL PHASES

(REFER TO CONTRACT DOCUMENTS)

- PART A
 - PHASE I LOMAS BLVD WEST OF TRAMWAY
 - PHASE II LOMAS BLVD EAST OF TRAMWAY
 - PHASE III NAKOMIS DR
- PART B FUTURE

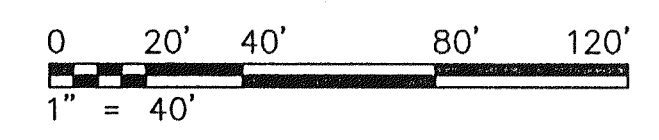

LEEDSHILL-HERKENHOFF, INC
500 Copper Avenue NW
P.O. Box 1217
Albuquerque, NM 87103
(505)247-0294

CITY OF ALBUQUERQUE
PUBLIC WORKS DEPARTMENT
ENGINEERING DEVELOPMENT GROUP

TITLE:
DIVERSE DRAINAGE IMPROVEMENTS
LOMAS AND NAKOMIS STORM DRAIN
PHASE I TRAFFIC CONTROL PLAN

Design Review Committee	City Engineer Approval	Mo./Day/Yr.	Mo./Day/Yr.
APPROVED	APPROVED		
JUN 19 1997	JUN 19 1997		
DESIGN REVIEW COMMITTEE	CITY ENGINEER		
City Project No.	Zone Map No.	Sheet	Of

4880.92 - 10 24

RECORD DRAWING
JAN 1998


These drawings have been revised based on the construction records of the owner while the information submitted by the Owner will be assumed to be reliable, the Engineer will not be responsible for the accuracy of this information nor for errors or omissions which may appear in the drawings as a result thereof.

LEFT LANE CLOSURE - LOMAS BOULEVARD AT CHELWOOD PARK BOULEVARD

AS BUILT INFORMATION		BENCH MARKS		SURVEY INFORMATION		ENGINEER'S SEAL		REVISIONS	
CONTRACTOR	DATE	NO.	BY	NO.	DATE	NO.	DATE	NO.	DATE
WORK STARTED BY	DATE								
ACCEPTANCE BY	DATE								
FIELD CATCH BY	DATE								
DRAWINGS CORRECTED BY	DATE								
RECORDED BY	DATE								
NO.									

DESIGNED BY	DATE	DESIGNED BY	DATE
T. MARTINI	JAN 1997	T. MARTINI	JAN 1997
DRAWN BY	DATE	DRAWN BY	DATE
M. JENSEN	JAN 1997	M. JENSEN	JAN 1997
CHECKED BY	DATE	CHECKED BY	DATE
C. DODGE	JAN 1997	C. DODGE	JAN 1997

RIGHT LANE CLOSURE - LOMAS BOULEVARD AND PART ONE OF MOVING ROAD CLOSURE - NAKOMIS DRIVE

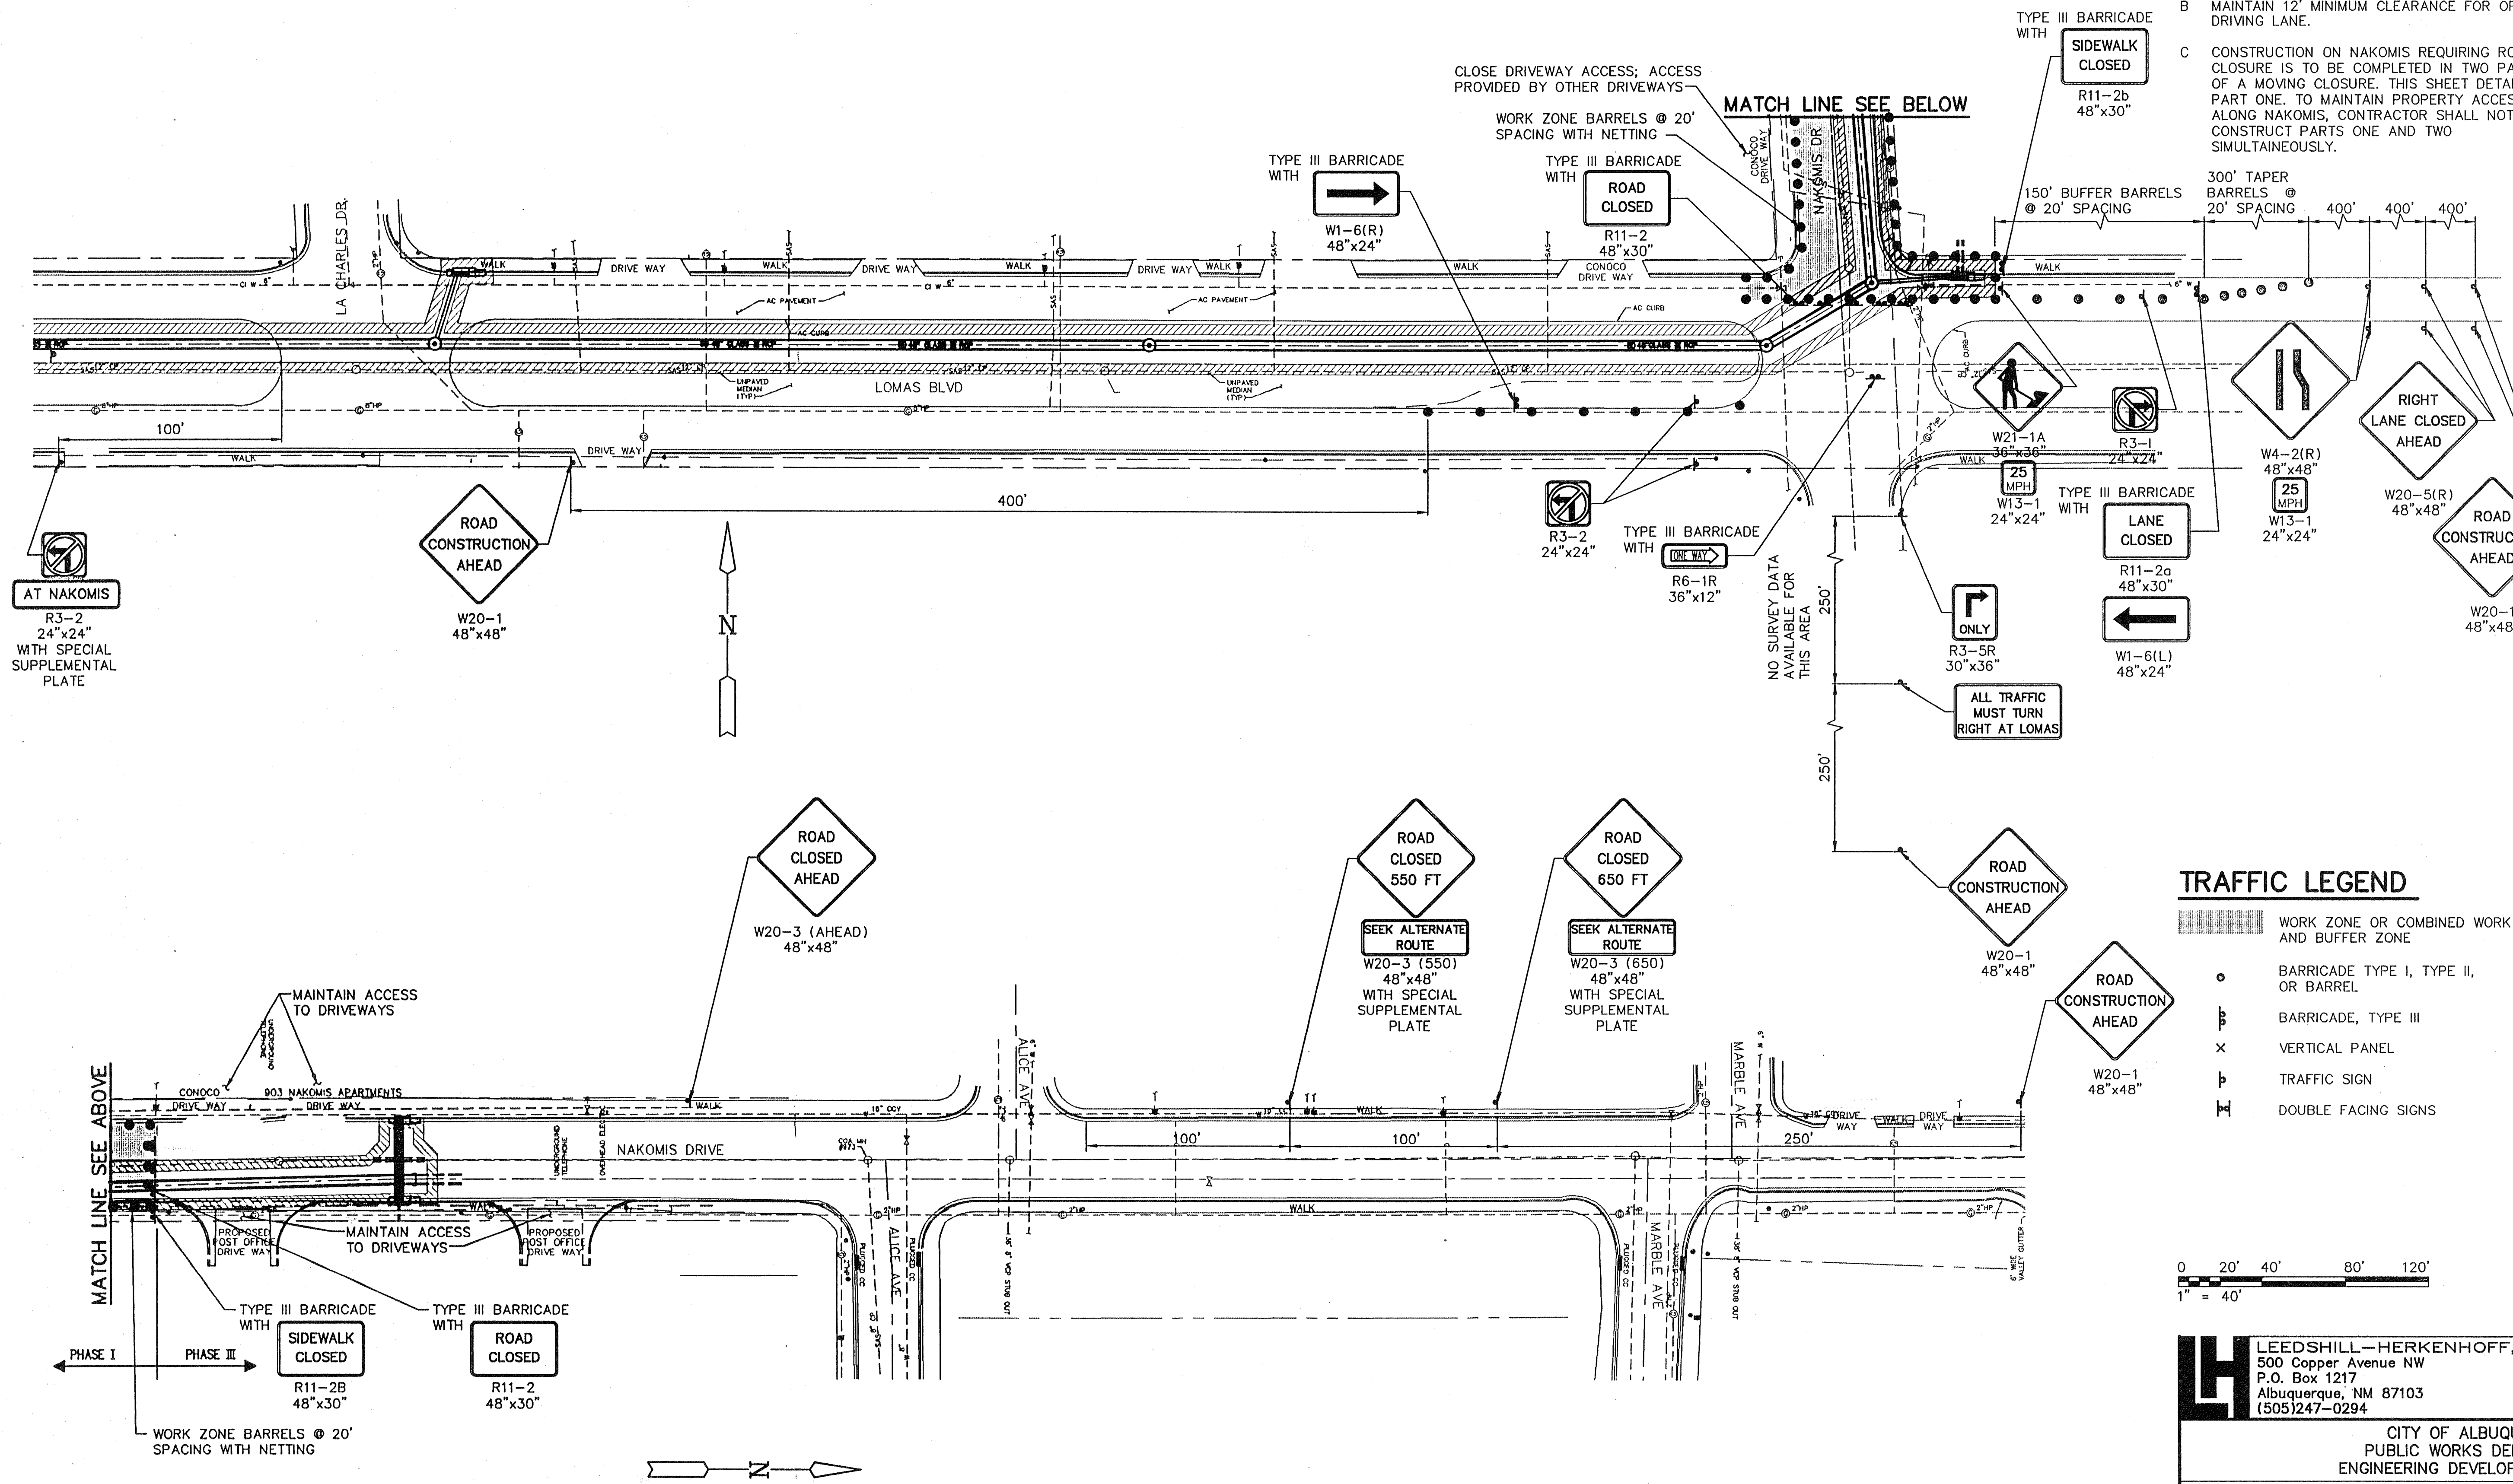


NOTES

- BASED ON 11' LANE CLOSURE WITH POSTED SPEED LIMIT OF 40 MPH ON LOMAS BLVD; 25 MPH POSTED SPEED LIMIT ON NAKOMIS DRIVE.
- MAINTAIN 12' MINIMUM CLEARANCE FOR OPEN DRIVING LANE.
- CONSTRUCTION ON NAKOMIS REQUIRING ROAD CLOSURE IS TO BE COMPLETED IN TWO PARTS OF A MOVING CLOSURE. THIS SHEET DETAILS PART ONE. TO MAINTAIN PROPERTY ACCESS ALONG NAKOMIS, CONTRACTOR SHALL NOT CONSTRUCT PARTS ONE AND TWO SIMULTANEOUSLY.

TRAFFIC LEGEND

- WORK ZONE OR COMBINED WORK AND BUFFER ZONE
- BARRICADE TYPE I, TYPE II, OR BARREL
- BARRICADE, TYPE III
- VERTICAL PANEL
- TRAFFIC SIGN
- DOUBLE FACING SIGNS

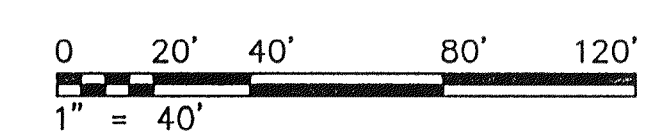

LEEDSHILL-HERKENHOFF, INC
500 Copper Avenue NW
P.O. Box 1217
Albuquerque, NM 87103
(505)247-0294

CITY OF ALBUQUERQUE
PUBLIC WORKS DEPARTMENT
ENGINEERING DEVELOPMENT GROUP

TITLE: DIVERSE DRAINAGE IMPROVEMENTS
LOMAS AND NAKOMIS STORM DRAIN
PHASE I TRAFFIC CONTROL PLAN

DESIGN REVIEW COMMITTEE APPROVED JUN 19 1997
CITY ENGINEER APPROVED JUN 19 1997

City Project No. 4880.92 Zone Map No. Sheet 12 Of 24

RECORD DRAWING
Date: JAN 1998


These drawings have been revised based on the construction records of the owner. While the information submitted by the Owner will be assumed to be reliable, the Engineer will not be responsible for the accuracy of this information nor for any omissions which may appear in the record document as a result thereof.

AS BUILT INFORMATION		BENCH MARKS		SURVEY INFORMATION	
CONTRACTOR	DATE	NO.	BY	DATE	NO.

ENGINEER'S SEAL		REVISIONS	
		NO.	DATE

DESIGNED BY	T MARTINI	DATE	OCT 96
DRAWN BY	M JENSEN	DATE	OCT 96
CHECKED BY	C DODGE	DATE	OCT 96



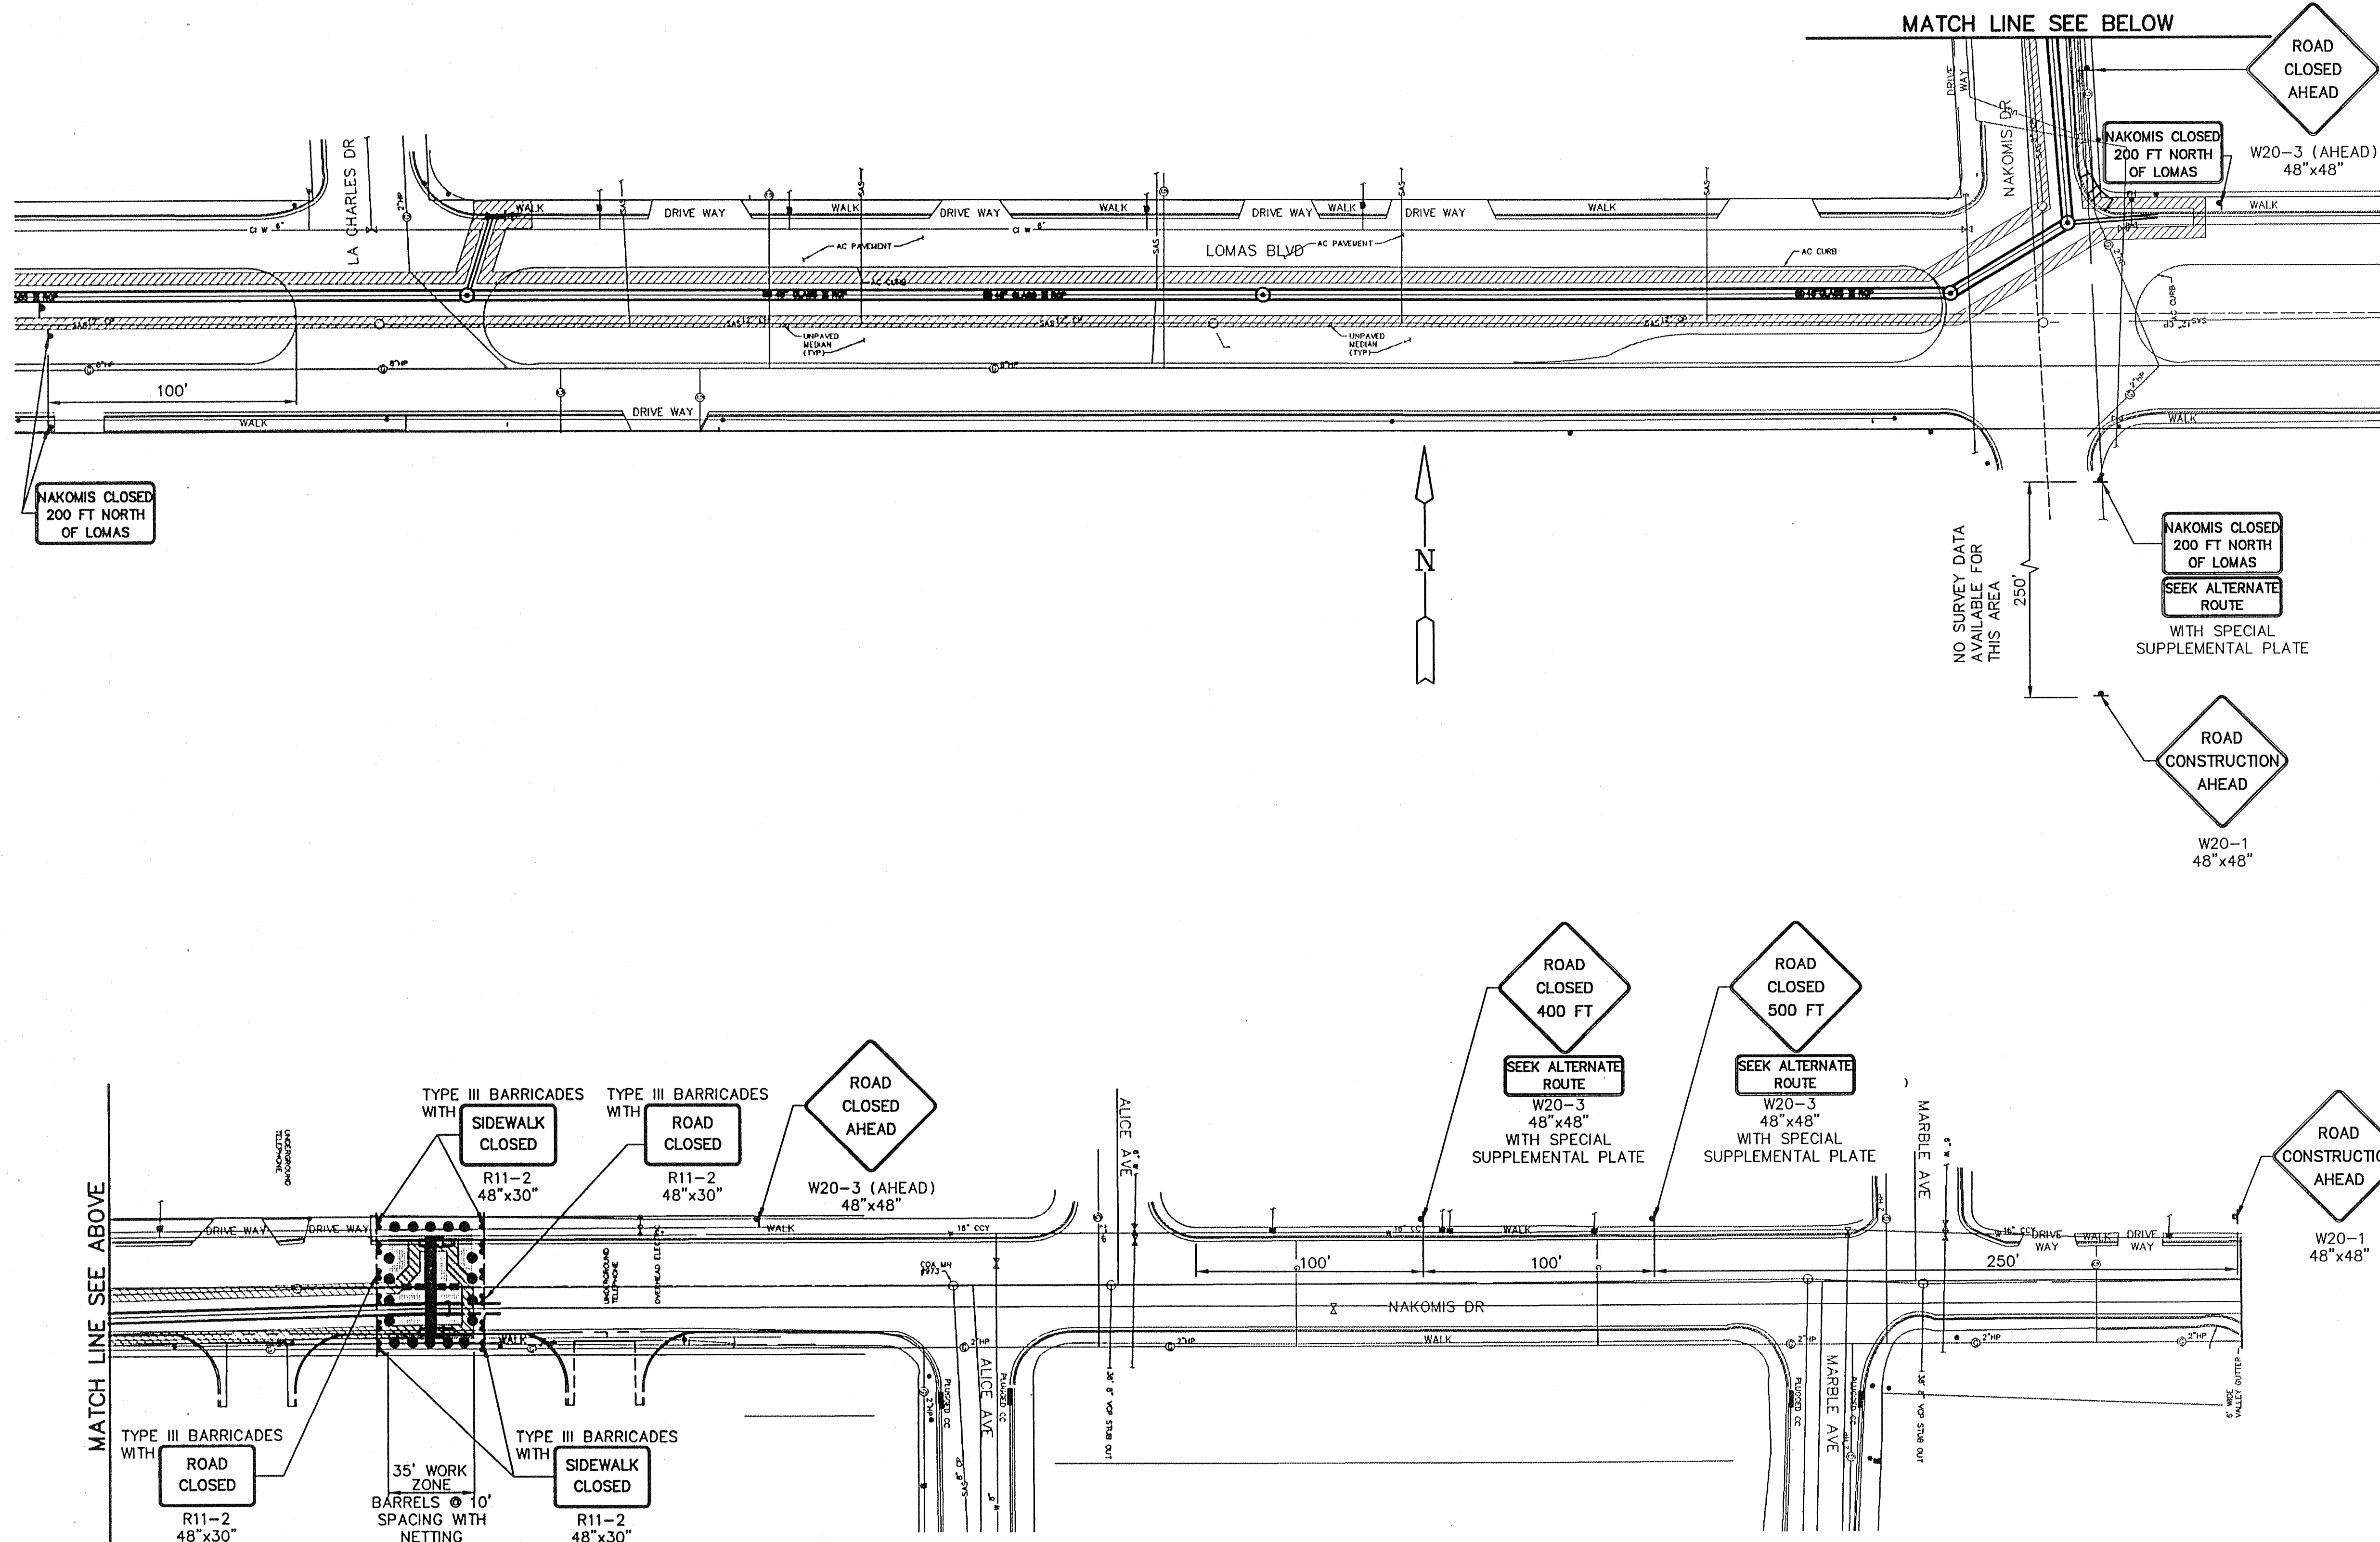


NOTES

A BASED ON 25 MPH POSTED SPEED LIMIT ON NAKOMIS DRIVE.

TRAFFIC LEGEND

- WORK ZONE OR COMBINED WORK AND BUFFER ZONE
- BARRICADE TYPE I, TYPE II, OR BARREL
- BARRICADE, TYPE III
- VERTICAL PANEL
- TRAFFIC SIGN
- DOUBLE FACING SIGNS

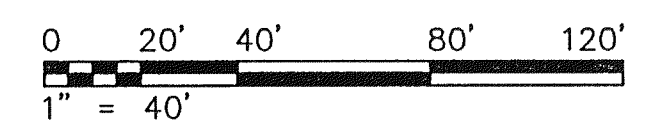

LEEDSHILL-HERKENHOFF, INC.
500 Copper Avenue NW
P.O. Box 1217
Albuquerque, NM 87103
(505)247-0294

CITY OF ALBUQUERQUE
PUBLIC WORKS DEPARTMENT
ENGINEERING DEVELOPMENT GROUP

TITLE:
DIVERSE DRAINAGE IMPROVEMENTS
LOMAS AND NAKOMIS STORM DRAIN
PHASE III TRAFFIC CONTROL PLAN

Design-Review Committee APPROVE JUN 19 1997 DESIGN REVIEW COMMITTEE	City Engineer Approval APPROVE JUN 19 1997 CITY ENGINEER	Mo./Day/Yr. ____/____/____	Mo./Day/Yr. ____/____/____
City Project No. 4880.92		Sheet 14 Of 24	

RECORD DRAWING

Date **JAN 1998**

These drawings have been revised based on the construction records of the owner. While the information submitted by the Owner will be assumed to be reliable, the engineer will not be responsible for the accuracy of this information nor for errors or omissions which may appear in the record document as a result thereof.

ROAD CLOSURE-NAKOMIS DRIVE

AS BUILT INFORMATION	
CONTRACTOR	DATE
WORKED BY	DATE
INSPECTOR'S ACCEPTANCE BY	DATE
VERIFICATION BY	DATE
DRAWN BY	DATE
CHECKED BY	DATE
MICRO-FILM INFORMATION	
RECORDED BY	DATE
NO.	

BENCH MARKS	
NO.	DATE


SURVEY INFORMATION	
FIELD NOTES	DATE
NO.	BY

ENGINEER'S SEAL	
NO.	DATE

REVISIONS	
NO.	DATE

REVISIONS	
NO.	DATE

REVISIONS	
NO.	DATE

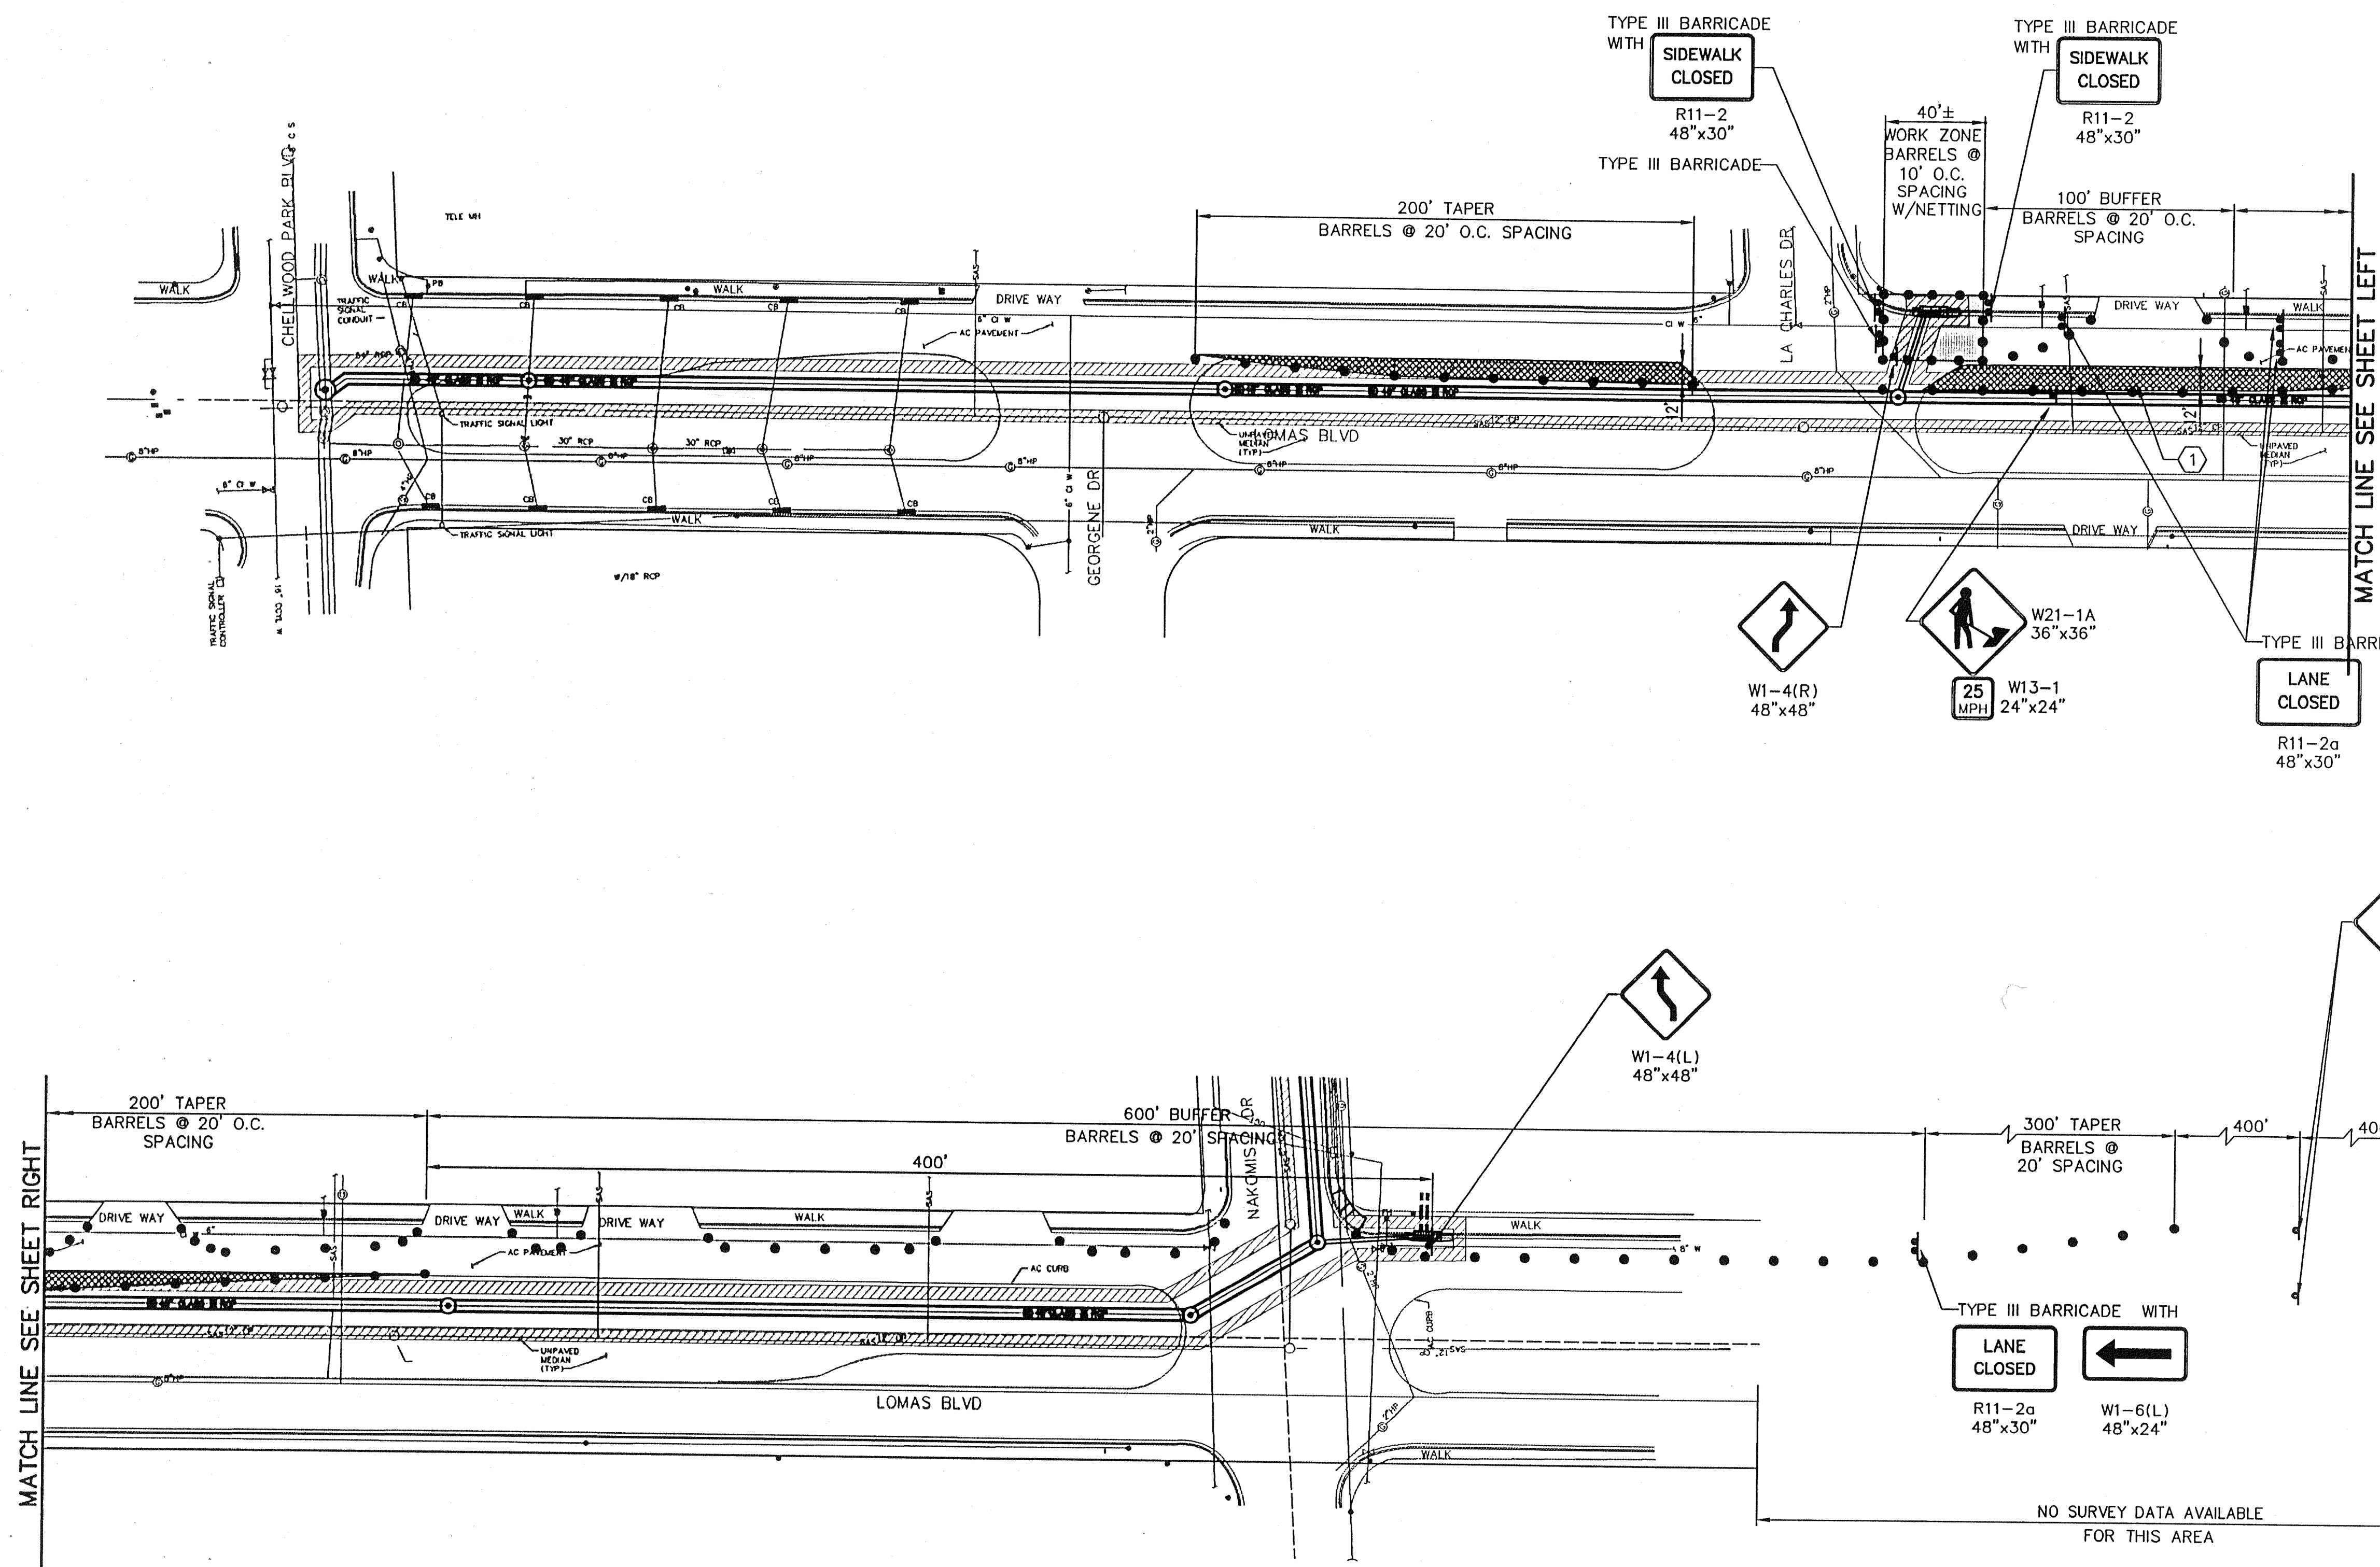

NOTES

- BASED ON 11' LANE CLOSURE AND 7' SHIFT WITH POSTED SPEED LIMIT OF 40 MPH ON LOMAS BLVD.
- MAINTAIN 12' MINIMUM CLEARANCE FOR OPEN DRIVING LANE.

KEYED NOTES

- REMOVE EXISTING ASPHALT MEDIAN CURB. GRADE, SHAPE AND COMPACT 6" SUBGRADE 95%. INSTALL 4" TEMPORARY ASPHALT DETOUR PAVING PRIOR TO CONSTRUCTION OF AC CURB.

TRAFFIC LEGEND

- WORK ZONE OR COMBINED WORK AND BUFFER ZONE
- BARRICADE TYPE I, TYPE II, OR BARREL
- BARRICADE, TYPE III
- VERTICAL PANEL
- TRAFFIC SIGN
- DOUBLE FACING SIGNS
- TEMPORARY DETOUR PAVING

RIGHT LANE CLOSURE-LOMAS BOULEVARD

RECORD DRAWING

Date JAN 1998

These drawings have been revised based on the construction records of the owner. While the information submitted by the engineer will not be responsible for the accuracy of this information nor the error or omissions which may appear in the record document as a result thereof.

LEEDSHILL-HERKENHOFF, INC.
500 Copper Avenue NW
P.O. Box 1217
Albuquerque, NM 87103
(505)247-0294

CITY OF ALBUQUERQUE
PUBLIC WORKS DEPARTMENT
ENGINEERING DEVELOPMENT GROUP

TITLE: DIVERSE DRAINAGE IMPROVEMENTS
LOMAS AND NAKOMIS STORM DRAIN
PHASE I TRAFFIC CONTROL PLAN

DESIGN REVIEW COMMITTEE
APPROVED
JUN 19 1997

CITY ENGINEER
APPROVED
JUN 19 1997

City Project No.

4880.92

Zone Map No.

Sheet

Of

15 24

1/P: 94036-16/DWG/C/TRAFCON2/5-12-97/BGC


AS BUILT INFORMATION

ENGINEER'S SEAL

REVISIONS
NO. DATE REMARKS BY
LEEDSHILL-HERKENHOFF, INC.
DESIGNED BY T MARTINI DATE OCT 96
DRAWN BY M JENSEN DATE OCT 96
CHECKED BY C DODGE DATE OCT 96

CONTRACTOR
WORK STARTED BY DATE
INSPECTION BY DATE
FIELD VERIFICATION BY DATE
CORRECTED BY DATE
MICRO-FILM INFORMATION
RECORDED BY DATE
NO.

- A BASED ON 22' LANE CLOSURE WITH POSTED SPEED LIMIT OF 35 MPH ON LOMAS BLVD.
- B MAINTAIN 12' MINIMUM CLEARANCE FOR OPEN DRIVING LANE.

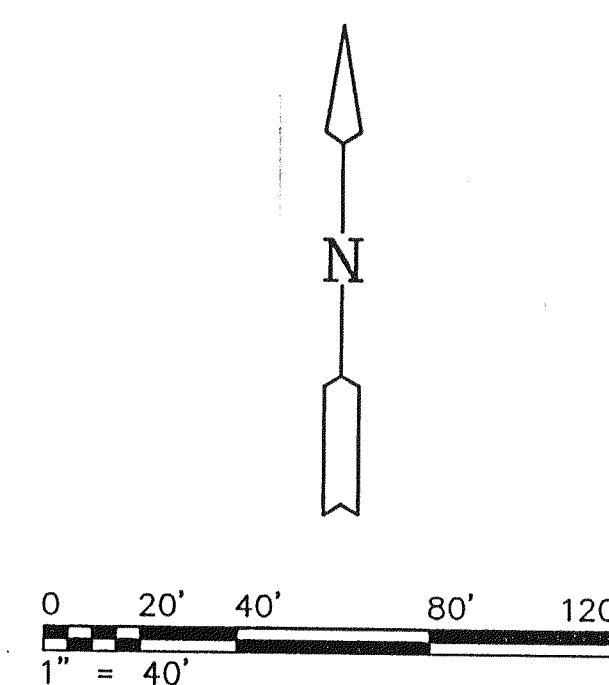

RECORD DRAWING
Date JAN 1998

These drawings have been revised based on the construction records of the owner. While the information submitted by the Owner will be assumed to be reliable, the Engineer will not be responsible for the accuracy of this information nor for error or omissions which may appear in the record document as a result thereof.

LEEDSHILL—HERKENHOFF, INC
500 Copper Avenue NW
P.O. Box 1217
Albuquerque, NM 87103
(505)247-0294

CITY OF ALBUQUERQUE PUBLIC WORKS DEPARTMENT ENGINEERING DEVELOPMENT GROUP	
TITLE:	DIVERSE DRAINAGE IMPROVEMENTS LOMAS/TRAMWAY PHASE II TRAFFIC CONTROL PLAN

APPROVED
JUN 19 1997
DESIGN
REVIEW COMMITTEE

City Engineer Approval
APPROVE
JUN 19 1997
CITY ENGINEER


City Project No.	4880.92	Zone Map No.	-	Sheet	16	Of	24
------------------	---------	--------------	---	-------	----	----	----

1/94036_16/DWG/C/TRAFCON6/5-12-97/BGC

[illegible]

NOTES

- A BASED ON 22' LANE CLOSURE WITH POSTED SPEED LIMIT OF 35 MPH ON LOMAS BLVD.
- B MAINTAIN 12' MINIMUM CLEARANCE FOR OPEN DRIVING LANE.

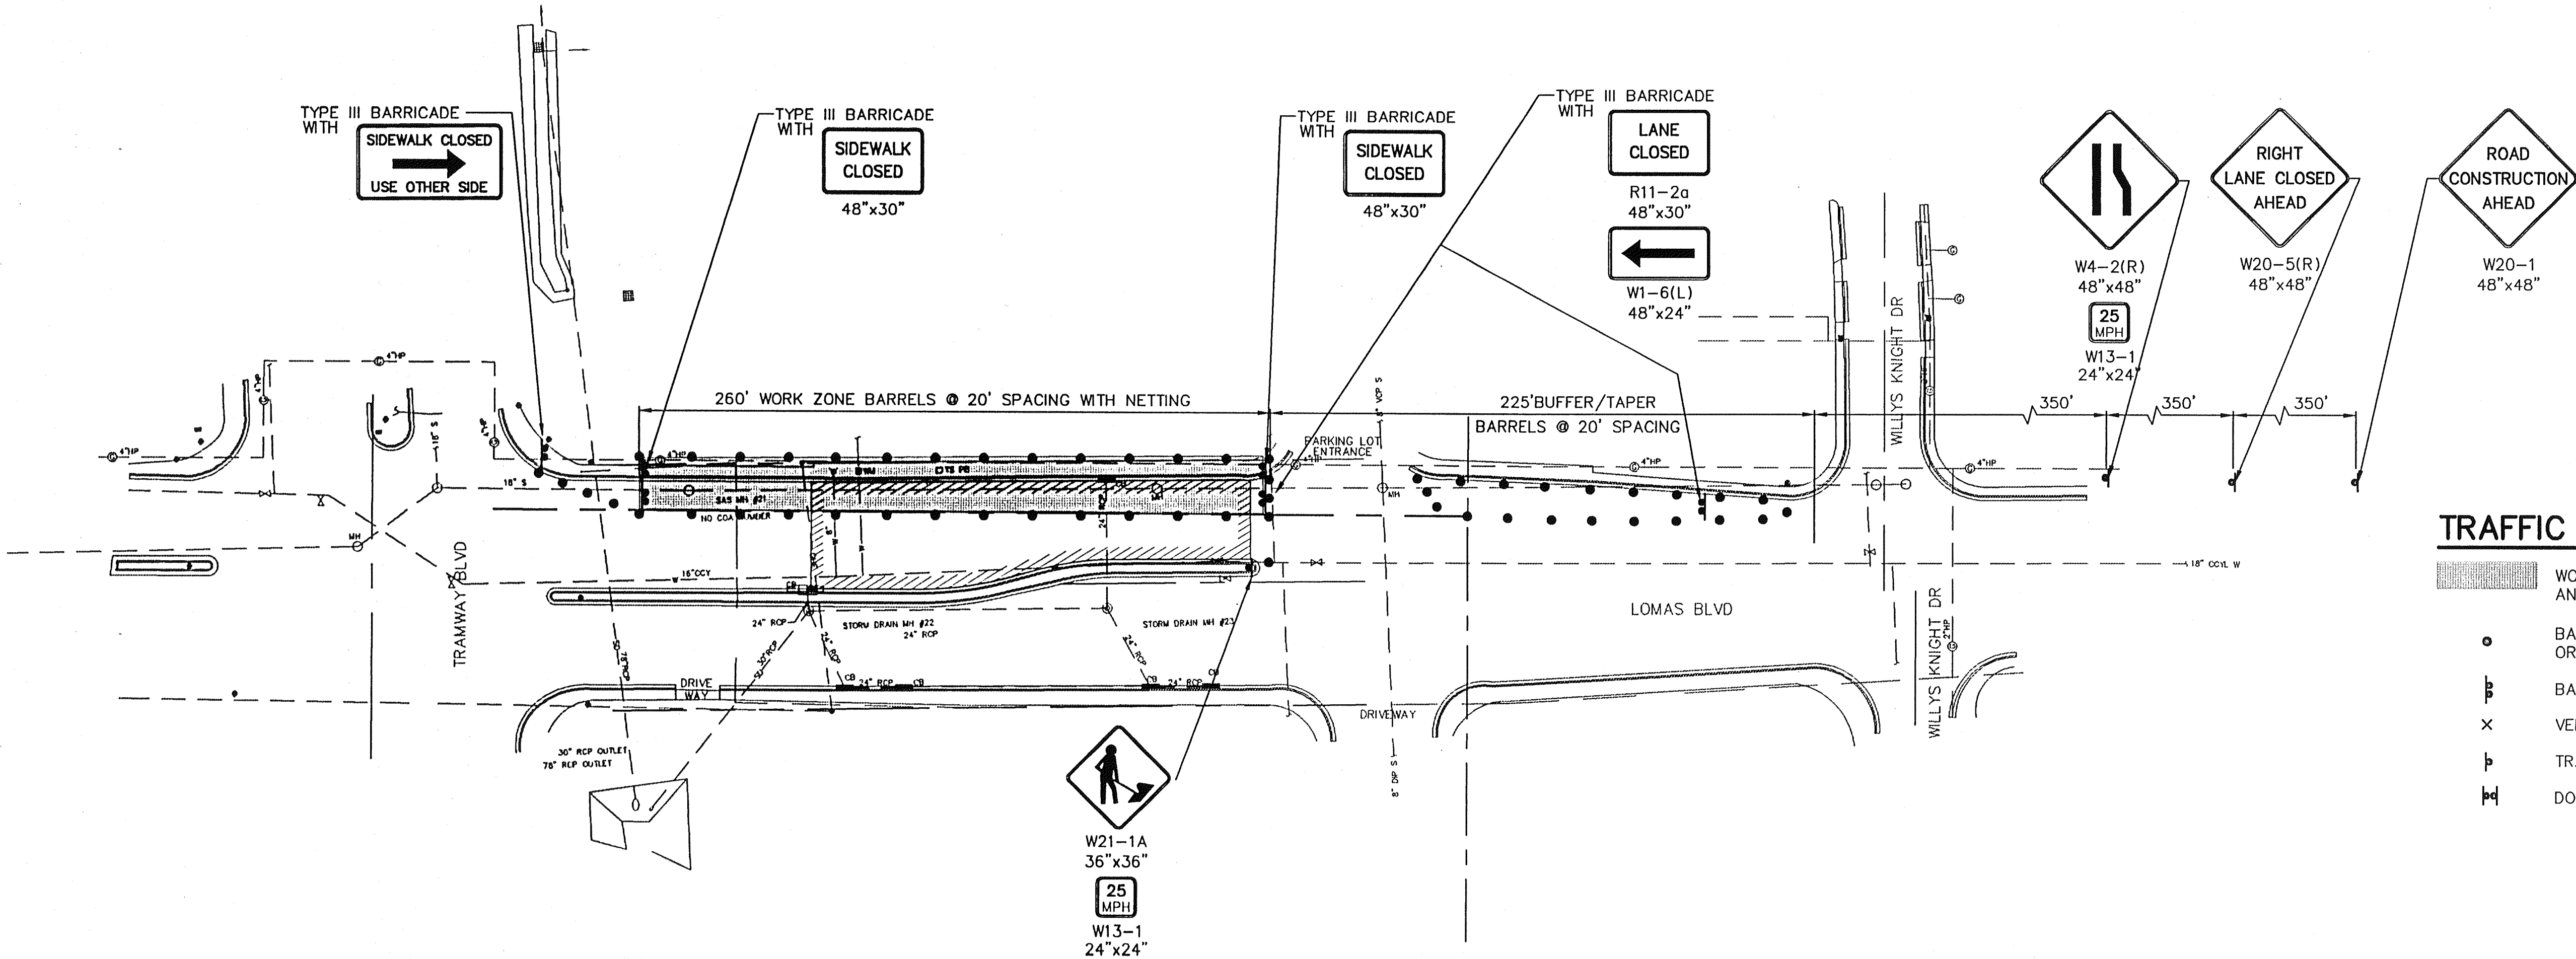

TRAFFIC LEGEND

- WORK ZONE OR COMBINED WORK AND BUFFER ZONE
- BARRICADE TYPE I, TYPE II, OR BARREL
- BARRICADE, TYPE III
- VERTICAL PANEL
- TRAFFIC SIGN
- DOUBLE FACING SIGNS

RIGHT LANE CLOSURE—LOMAS BOULEVARD EAST OF TRAMWAY

RECORD DRAWING
Date JAN 1998

These drawings have been revised based on the construction records of the owner. While the information submitted by the engineer will not be responsible for the accuracy of this information nor for error or omissions which may appear in the record document as a result thereof.

LEEDSHILL—HERKENHOFF, INC
500 Copper Avenue NW
P.O. Box 1217
Albuquerque, NM 87103
(505)247-0294


CITY OF ALBUQUERQUE
PUBLIC WORKS DEPARTMENT
ENGINEERING DEVELOPMENT GROUP

TITLE: DIVERSE DRAINAGE IMPROVEMENTS
LOMAS/TRAMWAY
PHASE II TRAFFIC CONTROL PLAN

APPROVED
JUN 19 1997
DESIGN REVIEW COMMITTEE

APPROVED
JUN 19 1997
CITY ENGINEER

City Project No. 4880.92 Zone Map No. Sheet 17 Of 24

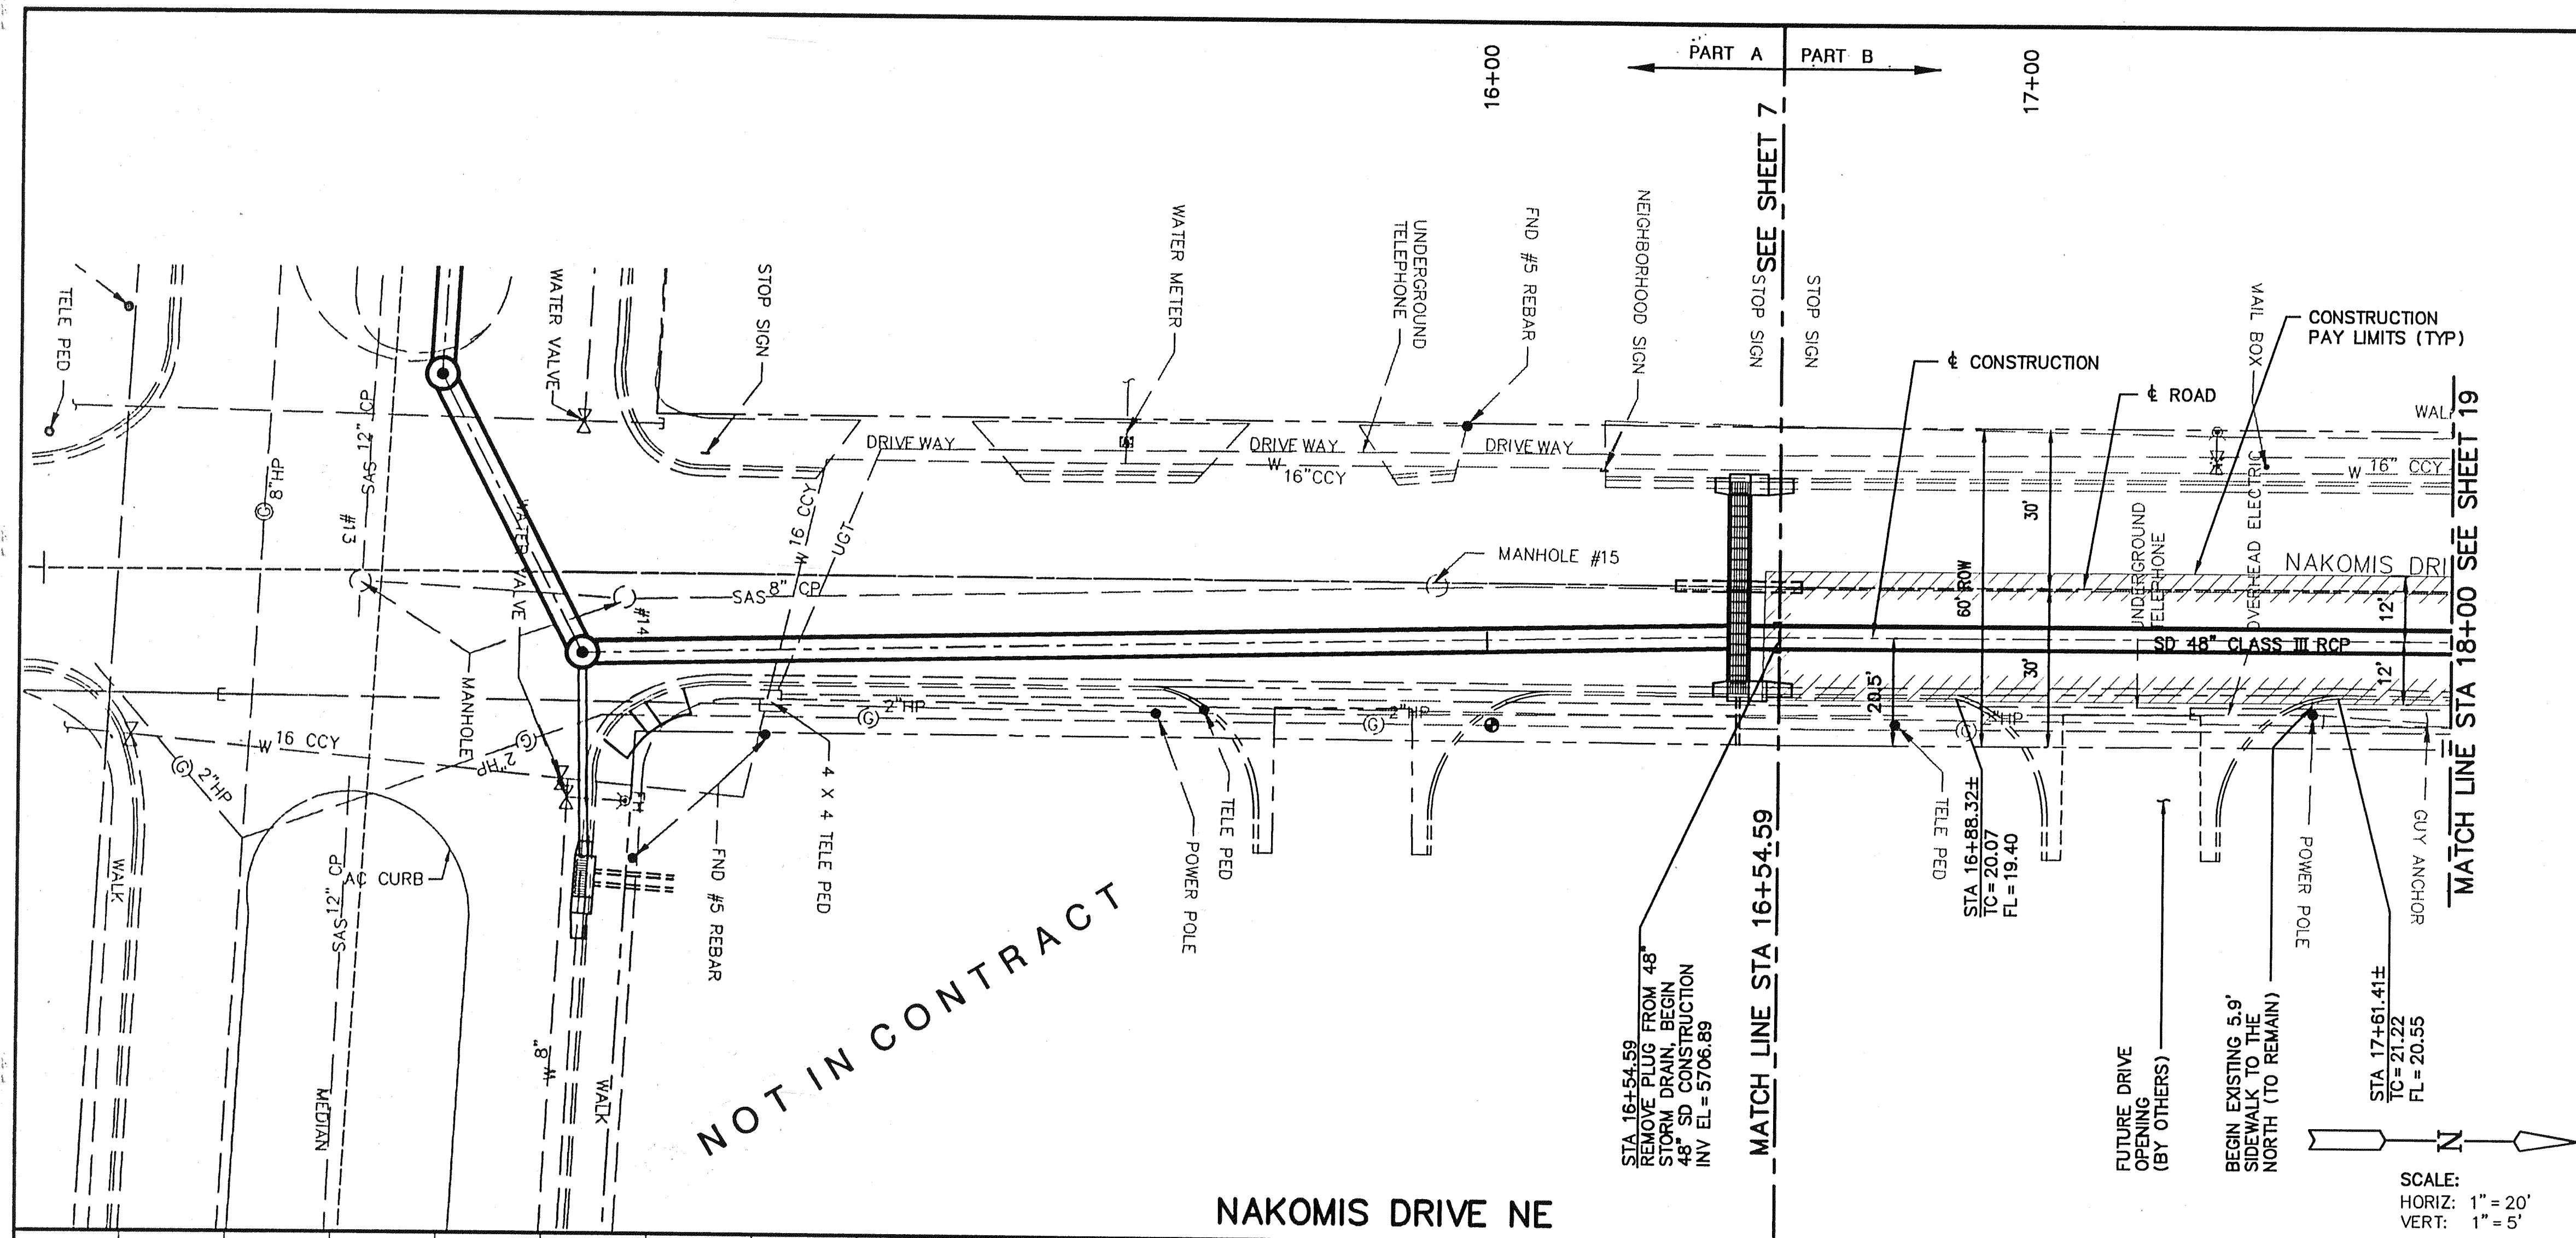


NOTES

- A FOR SURVEY CONTROL SEE SHEET 3.
- B ALL WATER LINE RELOCATION SHALL EMPLOY EXCLUSIVELY MECHANICAL RESTRAINT ON BENDS.
- C IF A PAVEMENT DROP-OFF IS CREATED DURING CONSTRUCTION THE CONTRACTOR SHALL INITIATE PROTECTIVE ACTION IN ACCORDANCE WITH THE NEW MEXICO STATE HIGHWAY AND TRANSPORTATION DEPARTMENTS CURRENT DROP-OFF POLICY. THIS WORK SHALL BE INCIDENTAL TO THE PROJECT.
- D PROVIDE SHORING OR TRENCH PROTECTION TO PROTECT EXISTING AC CURB ON LOMAS AS SHOWN. DAMAGE TO AC CURB OUTSIDE THE CONSTRUCTION PAY LIMITS MUST BE REPAIRED AT CONTRACTORS EXPENSE.
- E PAVEMENT REPLACEMENT SECTION FOR NAKOMIS SHALL BE IN ACCORDANCE WITH COA STD DWG 2405 FOR FLEXIBLE PAVEMENT.
- F CURB AND GUTTER REMOVED DURING CONSTRUCTION TO BE REPLACED WITH PCC STANDARD CURB AND GUTTER IN ACCORDANCE WITH COA STD DWG 2415.
- G EXISTING SIDEWALK WHICH MAY BE DAMAGED OR REMOVED DURING CONSTRUCTION TO BE REPLACED IN ACCORDANCE WITH COA STD DWG 2430 AND MATCH EXISTING WIDTH.

EXISTING MANHOLE DATA

MH	RIM ELEV	NORTH INV 1	SOUTH INV 2	EAST INV 3	WEST INV 4	COA GIS NUMBER
1	5663.14	5654.61	5654.59		5662.72	S942
2	5663.95	5654.75	5654.25		5654.25	NO NUMBER
3	5663.41	5654.16		5653.27	5653.22	944
4	5663.55	5654.15	5654.05	5654.26		S43
5	5664.57	5658.57		5656.87	5656.07	S56
6	5666.97	5659.77	5660.27	5659.07	5658.87	S55
7	5669.32	5662.42	5662.82	5661.52	5661.17	S54
8	5670.69	5663.95	5664.35	5663.17	5662.97	S53
9	5672.87	5665.87	5666.37	5665.37	5665.27	S52
10	5676.44			5666.94	5666.84	NO NUMBER
11	5687.90			5678.25	5678.15	
12	5703.10			5693.20	5693.05	964
13	5716.80	5708.65		5707.95	5707.95	972
14	5716.13	5709.28	5709.18			NO NUMBER
15	5718.90	5713.25	5713.15			971
16	5723.00	5716.65		5716.65		873
17	5726.41	5720.41	5720.31	5720.51		875
18	5727.01	5721.01	5720.96	5721.31	5721.01	871
19	5729.39	5723.54	5723.39	5723.49		NO NUMBER
20	5768.75	5757.00		5756.95	5756.75	903
21	5771.87	5762.25	5761.75	5761.65	5761.55	NO NUMBER
22	5772.86	5767.16	5764.76		5764.86	S902
23	5779.72	5770.12		5770.02	5770.02	S903
24	5794.56	5786.57		5786.57	5786.47	
25	5795.18		5787.18	5787.18	5787.08	

EXISTING STORM DRAIN INLETS	GRATE ELEVATION	INVERT ELEVATION
A	5663.77	5660.77
B	5667.48	5664.48
C	5669.43	5666.43
D	5671.53	5668.53
E	5663.59	5660.59
F	5665.45	5662.45
G	5667.69	5664.69
H	5669.71	5666.71
I	5671.69	5668.96
J	5773.37	5770.37
K	5774.47	5771.43
L	5779.89	5776.89
M	5781.34	5778.34
N	5772.89	5769.89

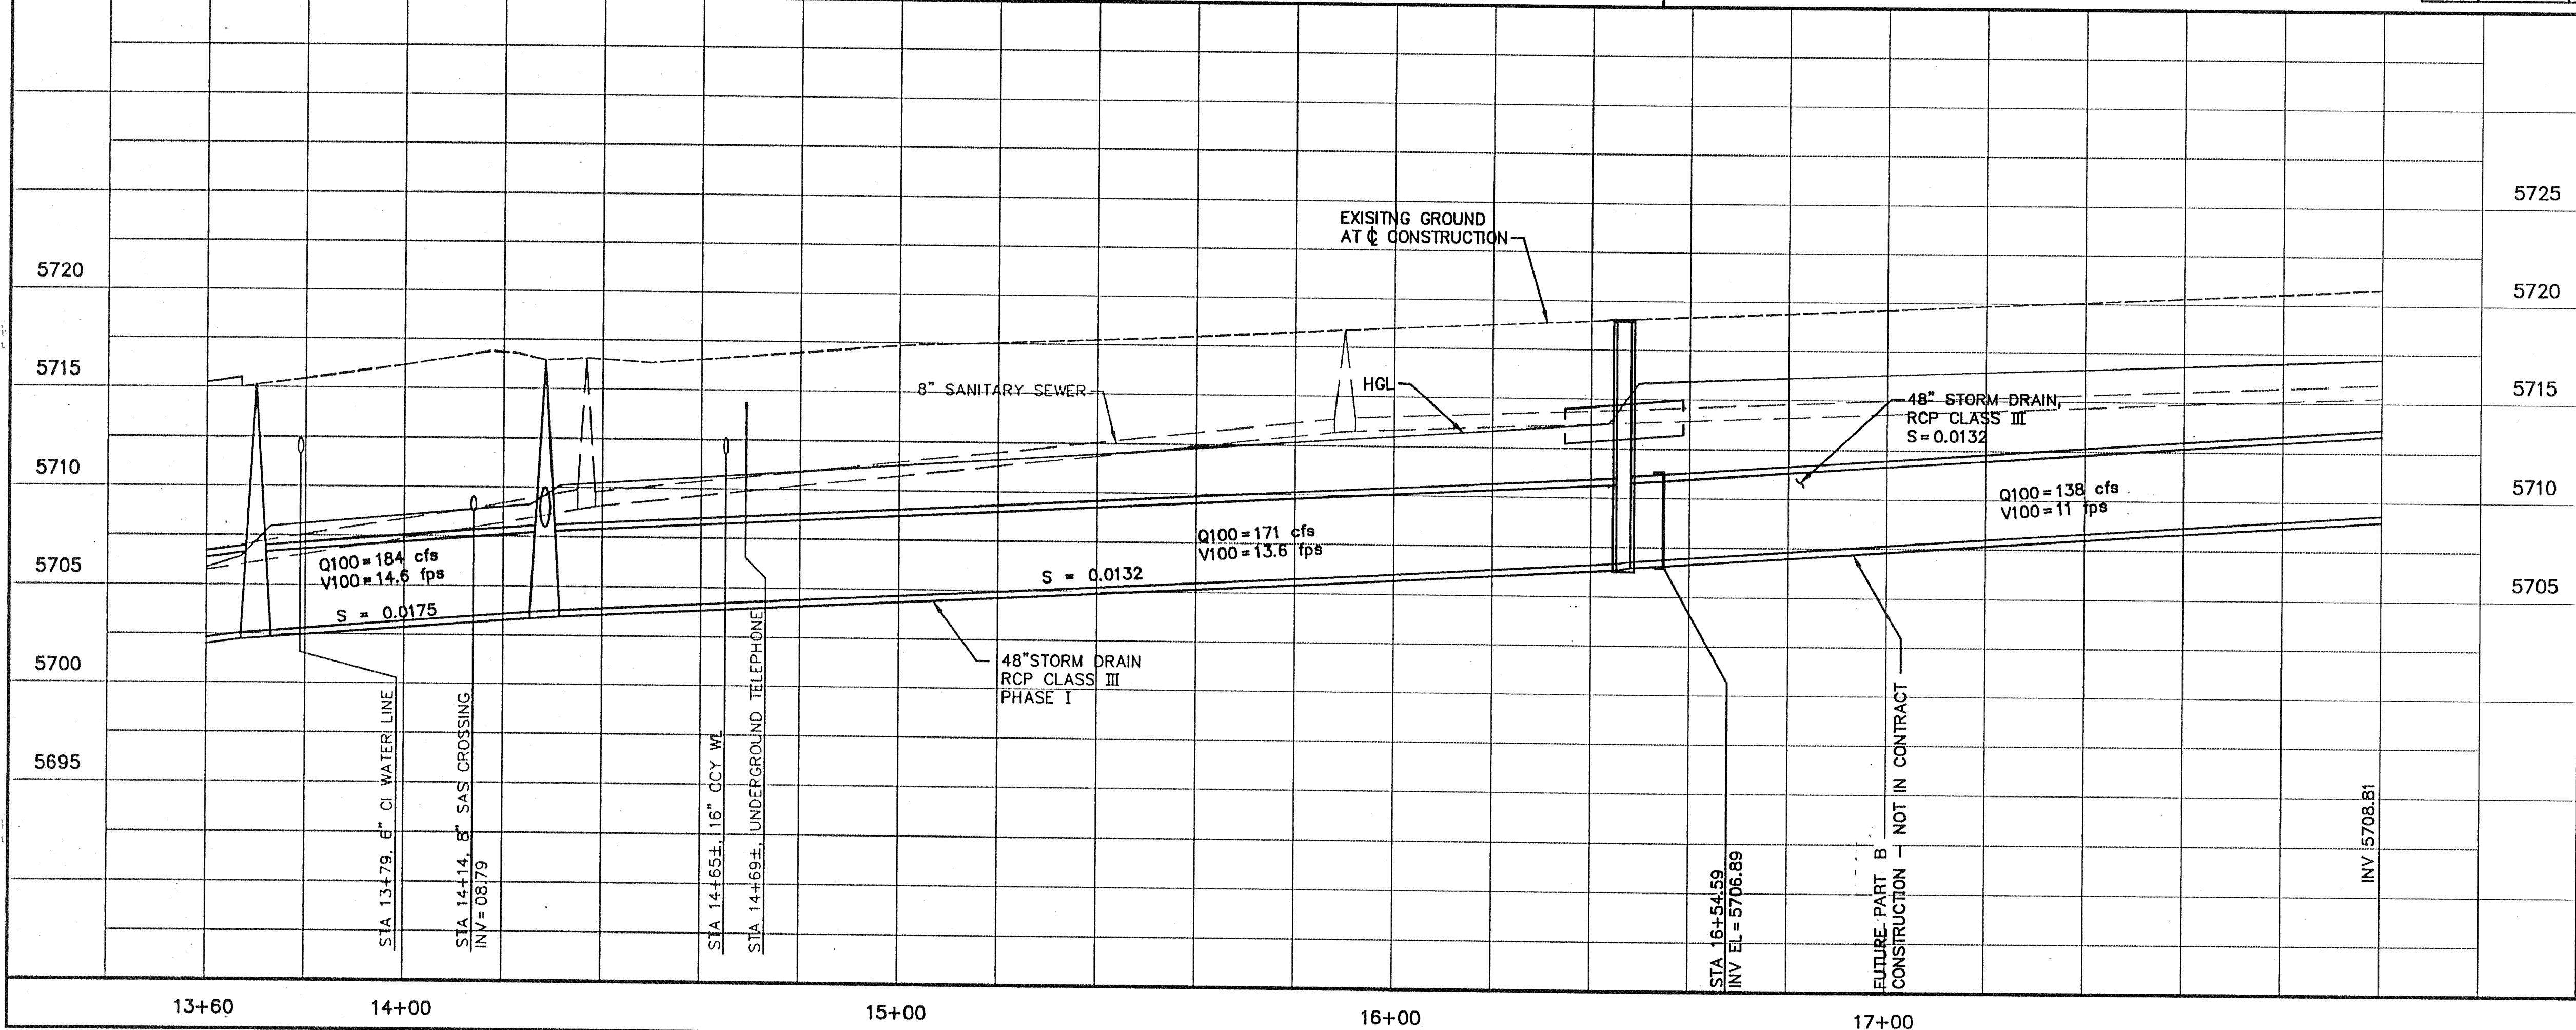

LEEDSHILL—HERKENHOFF, INC
500 Copper Avenue NW
P.O. Box 1217
Albuquerque, NM 87103
(505)247-0294


CITY OF ALBUQUERQUE
PUBLIC WORKS DEPARTMENT
ENGINEERING DEVELOPMENT GROUP

TITLE: DIVERSE DRAINAGE IMPROVEMENTS
NAKOMIS DRIVE NE - PART B - STORM SEWER
PLAN AND PROFILE STA 16+54.59 TO STA 18+00

DESIGN REVIEW COMMITTEE
APPROVE
JUN 19 1997

CITY ENGINEER
APPROVE
JUN 19 1997

City Project No. 4880-92 JK-22,23 Sheet 18 Of 24

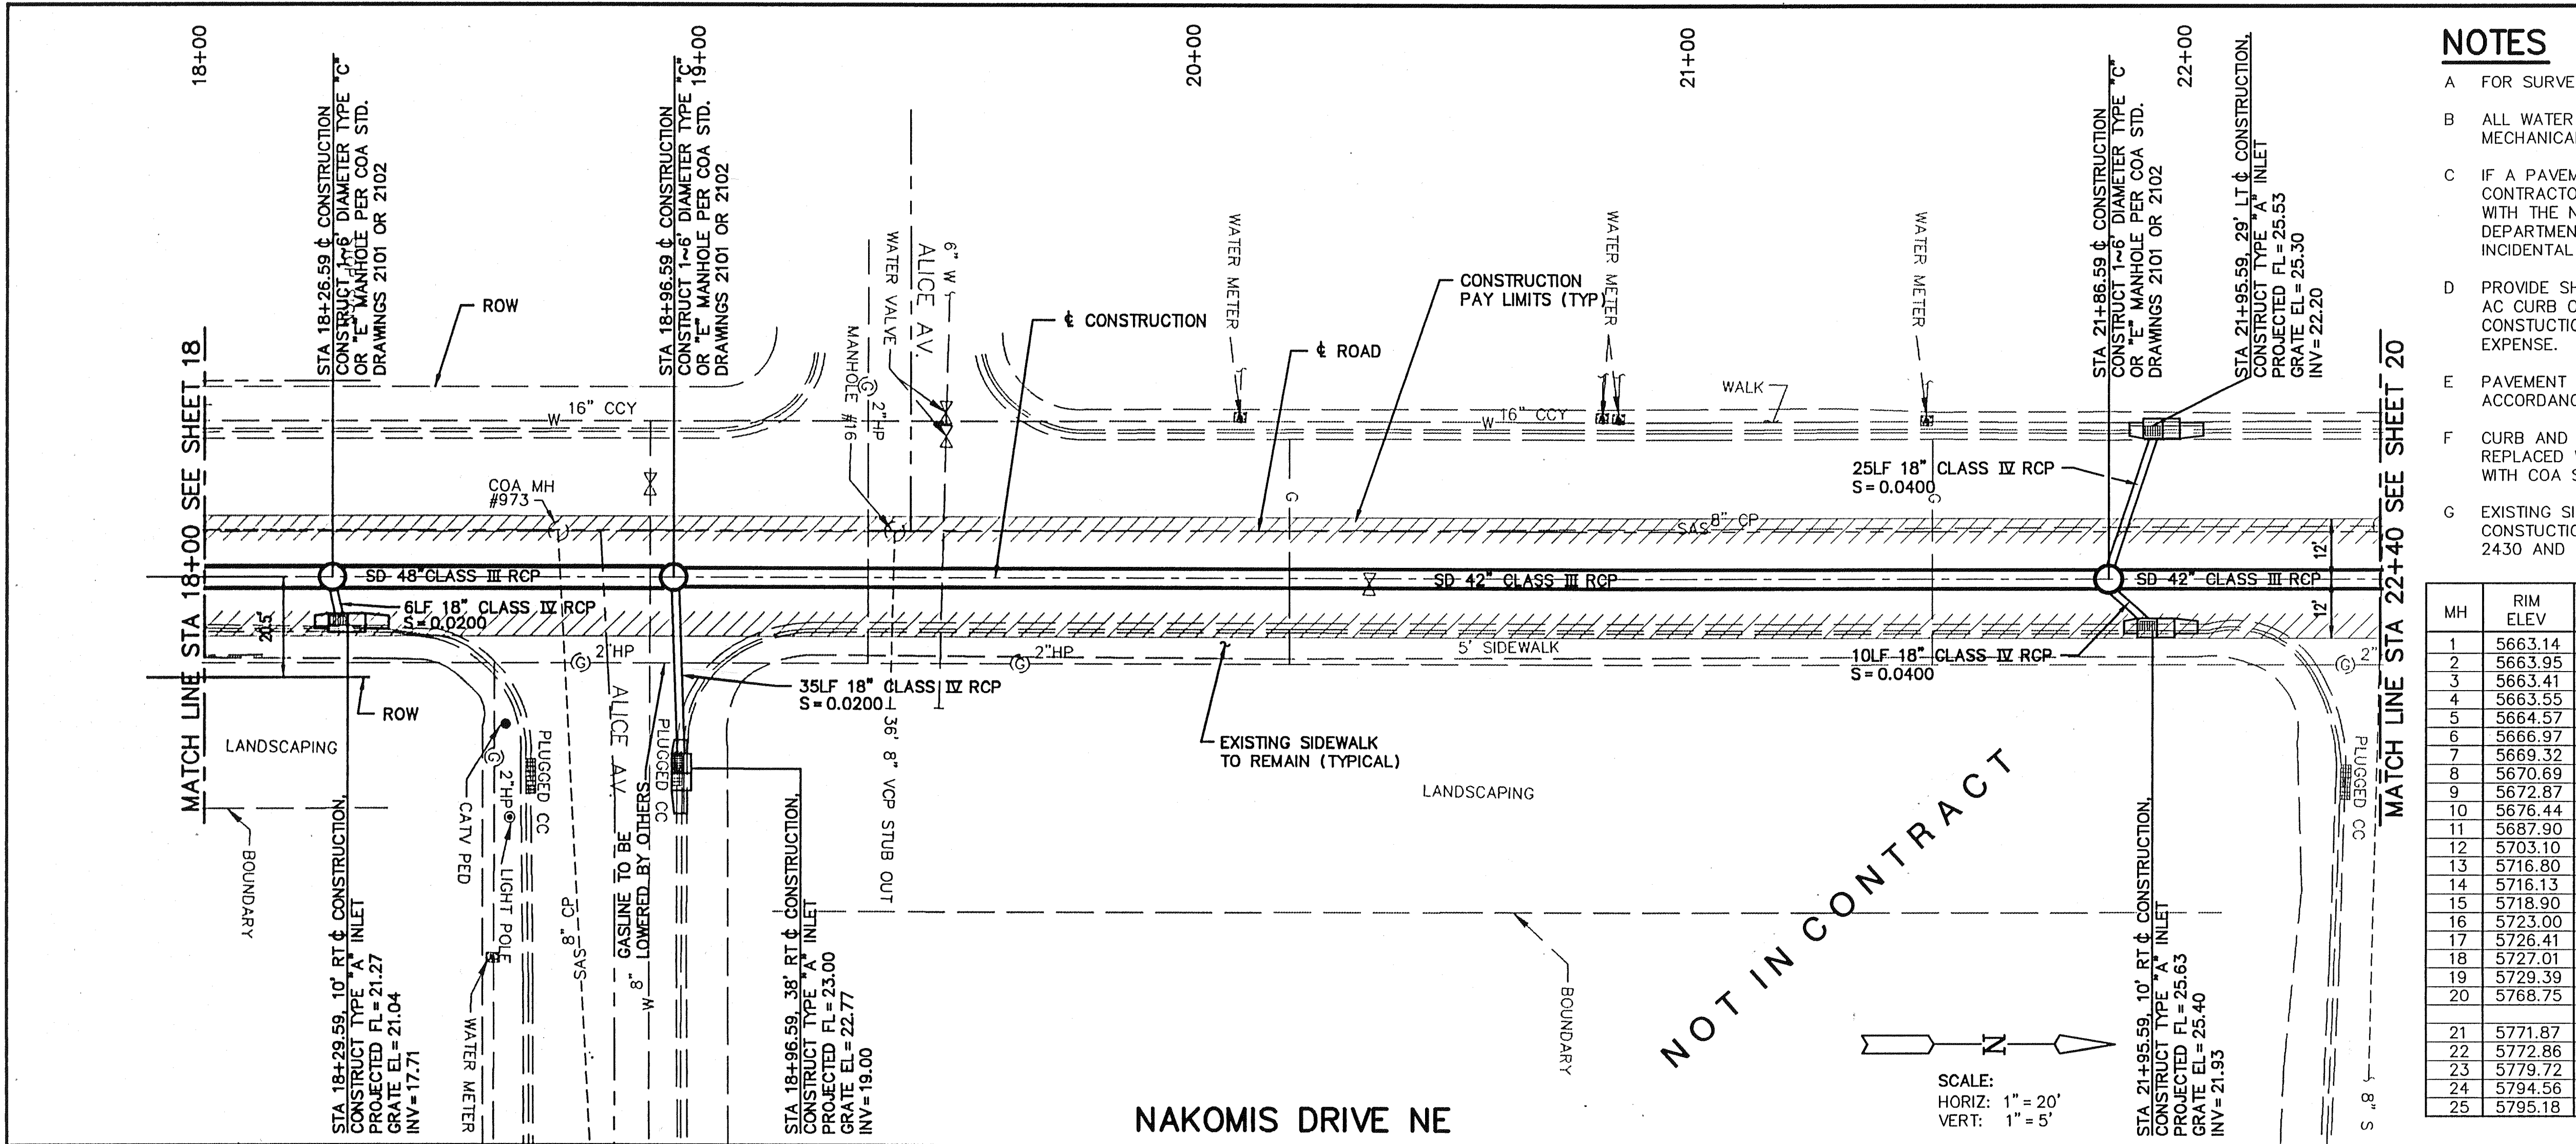


NOTES

- FOR SURVEY CONTROL SEE SHEET 3.
- ALL WATER LINE RELOCATION SHALL EMPLOY EXCLUSIVELY MECHANICAL RESTRAINT ON BENDS.
- IF A PAVEMENT DROP-OFF IS CREATED DURING CONSTRUCTION THE CONTRACTOR SHALL INITIATE PROTECTIVE ACTION IN ACCORDANCE WITH THE NEW MEXICO STATE HIGHWAY AND TRANSPORTATION DEPARTMENTS CURRENT DROP-OFF POLICY. THIS WORK SHALL BE INCIDENTAL TO THE PROJECT.
- PROVIDE SHORING OR TRENCH PROTECTION TO PROTECT EXISTING AC CURB ON LOMAS AS SHOWN. DAMAGE TO AC CURB OUTSIDE THE CONSTRUCTION PAY LIMITS MUST BE REPAIRED AT CONTRACTORS EXPENSE.
- PAVEMENT REPLACEMENT SECTION FOR NAKOMIS SHALL BE IN ACCORDANCE WITH COA STD DWG 2405 FOR FLEXIBLE PAVEMENT.
- CURB AND GUTTER REMOVED DURING CONSTRUCTION TO BE REPLACED WITH PCC STANDARD CURB AND GUTTER IN ACCORDANCE WITH COA STD DWG 2415.
- EXISTING SIDEWALK WHICH MAY BE DAMAGED OR REMOVED DURING CONSTRUCTION TO BE REPLACED IN ACCORDANCE WITH COA STD DWG 2430 AND MATCH EXISTING WIDTH.

EXISTING MANHOLE DATA

MH	RIM ELEV	NORTH INV 1	SOUTH INV 2	EAST INV 3	WEST INV 4	COA GIS NUMBER
1	5663.14	5654.61	5654.59		5662.72	S942
2	5663.95	5654.75	5654.25		5654.25	NO NUMBER
3	5663.41	5654.16		5653.27	5653.22	944
4	5663.55	5654.15	5654.05		5654.26	S43
5	5664.57	5658.57		5656.87	5656.07	S56
6	5666.97	5659.77	5660.27		5659.07	S55
7	5669.32	5662.42	5662.82	5661.52	5661.17	S54
8	5670.69	5663.95	5664.35	5663.17	5662.97	S53
9	5672.87	5665.87	5666.37	5665.37	5665.27	S52
10	5676.44			5666.94	5666.84	NO NUMBER
11	5687.90			5678.25	5678.15	
12	5703.10			5693.20	5693.05	964
13	5716.80	5708.65		5707.95	5707.95	972
14	5716.13	5709.28	5709.18			NO NUMBER
15	5718.90	5713.25	5713.15			971
16	5723.00	5716.65			5716.65	873
17	5726.41	5720.41	5720.31	5720.51		875
18	5727.01	5721.01	5720.96	5721.31	5721.01	871
19	5729.39	5723.54	5723.39	5723.49		NO NUMBER
20	5768.75	5757.00		5756.95	5756.75	903
		5761.15				
21	5771.87	5762.25	5761.75	5761.65	5761.55	NO NUMBER
22	5772.86	5767.16	5764.76		5764.86	S902
23	5779.72	5770.12		5770.02	5770.02	S903
24	5794.56	5786.57		5786.57	5786.47	
25	5795.18		5787.18	5787.18	5787.08	

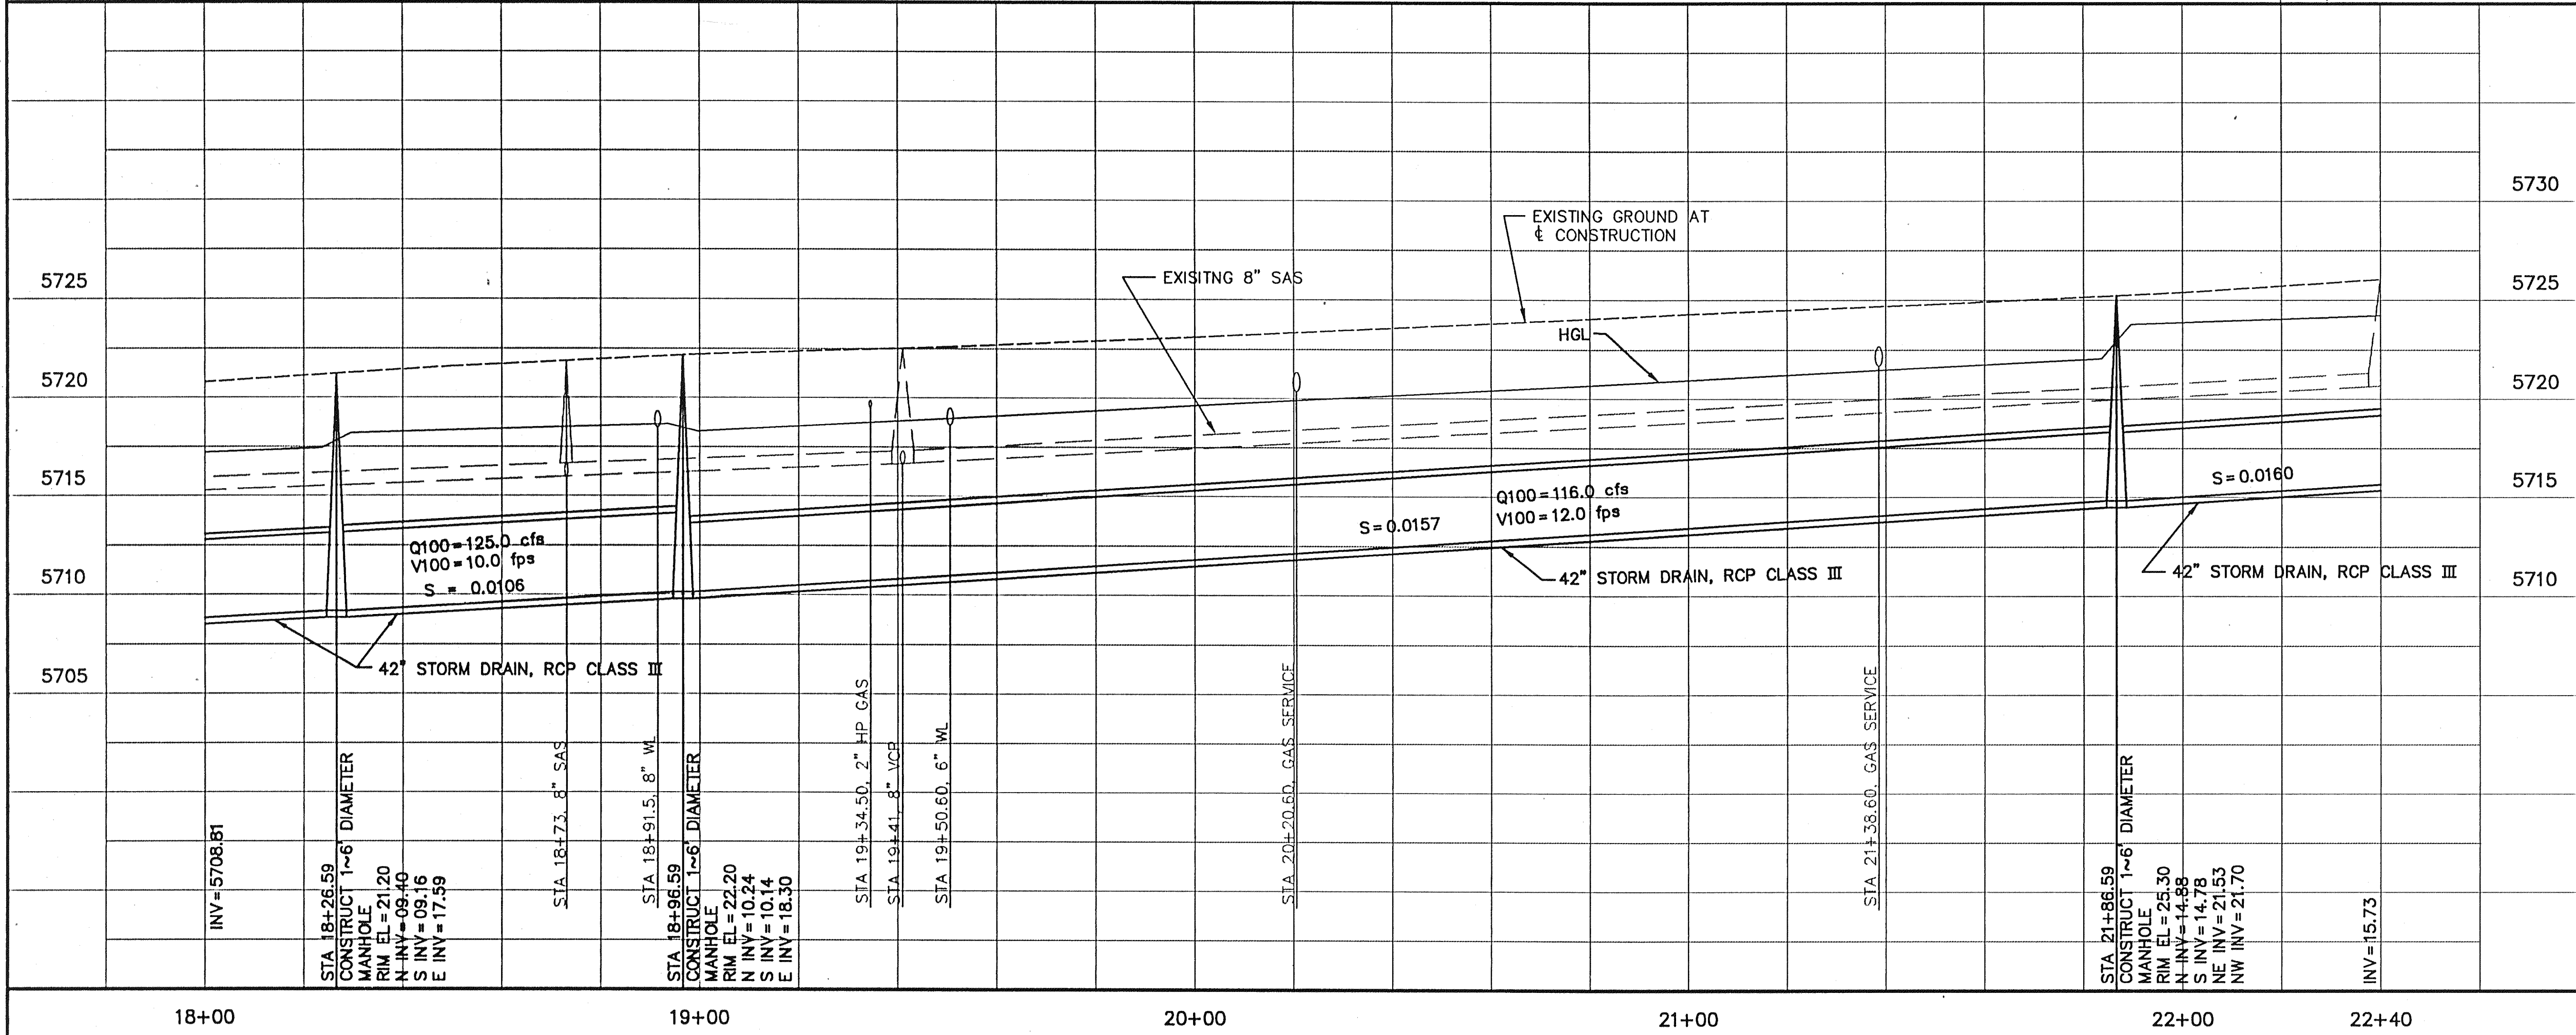

EXISTING STORM DRAIN INLETS	GRATE ELEVATION	INVERT ELEVATION
A	5663.77	5660.77
B	5667.48	5664.48
C	5669.43	5666.43
D	5671.53	5668.53
E	5663.59	5660.59
F	5665.45	5662.45
G	5667.69	5664.69
H	5669.71	5666.71
I	5671.69	5668.96
J	5773.37	5770.37
K	5774.47	5771.43
L	5779.89	5776.89
M	5781.34	5778.34
N	5772.89	5769.89

LEEDSHILL-HERKENHOFF, INC.
500 Copper Avenue NW
P.O. Box 1217
Albuquerque, NM 87103
(505)247-0294

CITY OF ALBUQUERQUE
PUBLIC WORKS DEPARTMENT
ENGINEERING DEVELOPMENT GROUP

TITLE: DIVERSE DRAINAGE IMPROVEMENTS
NAKOMIS DRIVE NE - PART B - STORM SEWER
PLAN AND PROFILE STA 18+00 TO STA 22+40

DESIGN REVIEW COMMITTEE
APPROVED
JUN 19 1997

CITY ENGINEER
APPROVED
JUN 19 1997

City Project No.

Zone, Map No.


4880-92 JK-22,23

Sheet

Of

19 24



20/94036.31/DWG/C/LOM-NAK2/5-12-97/BCC

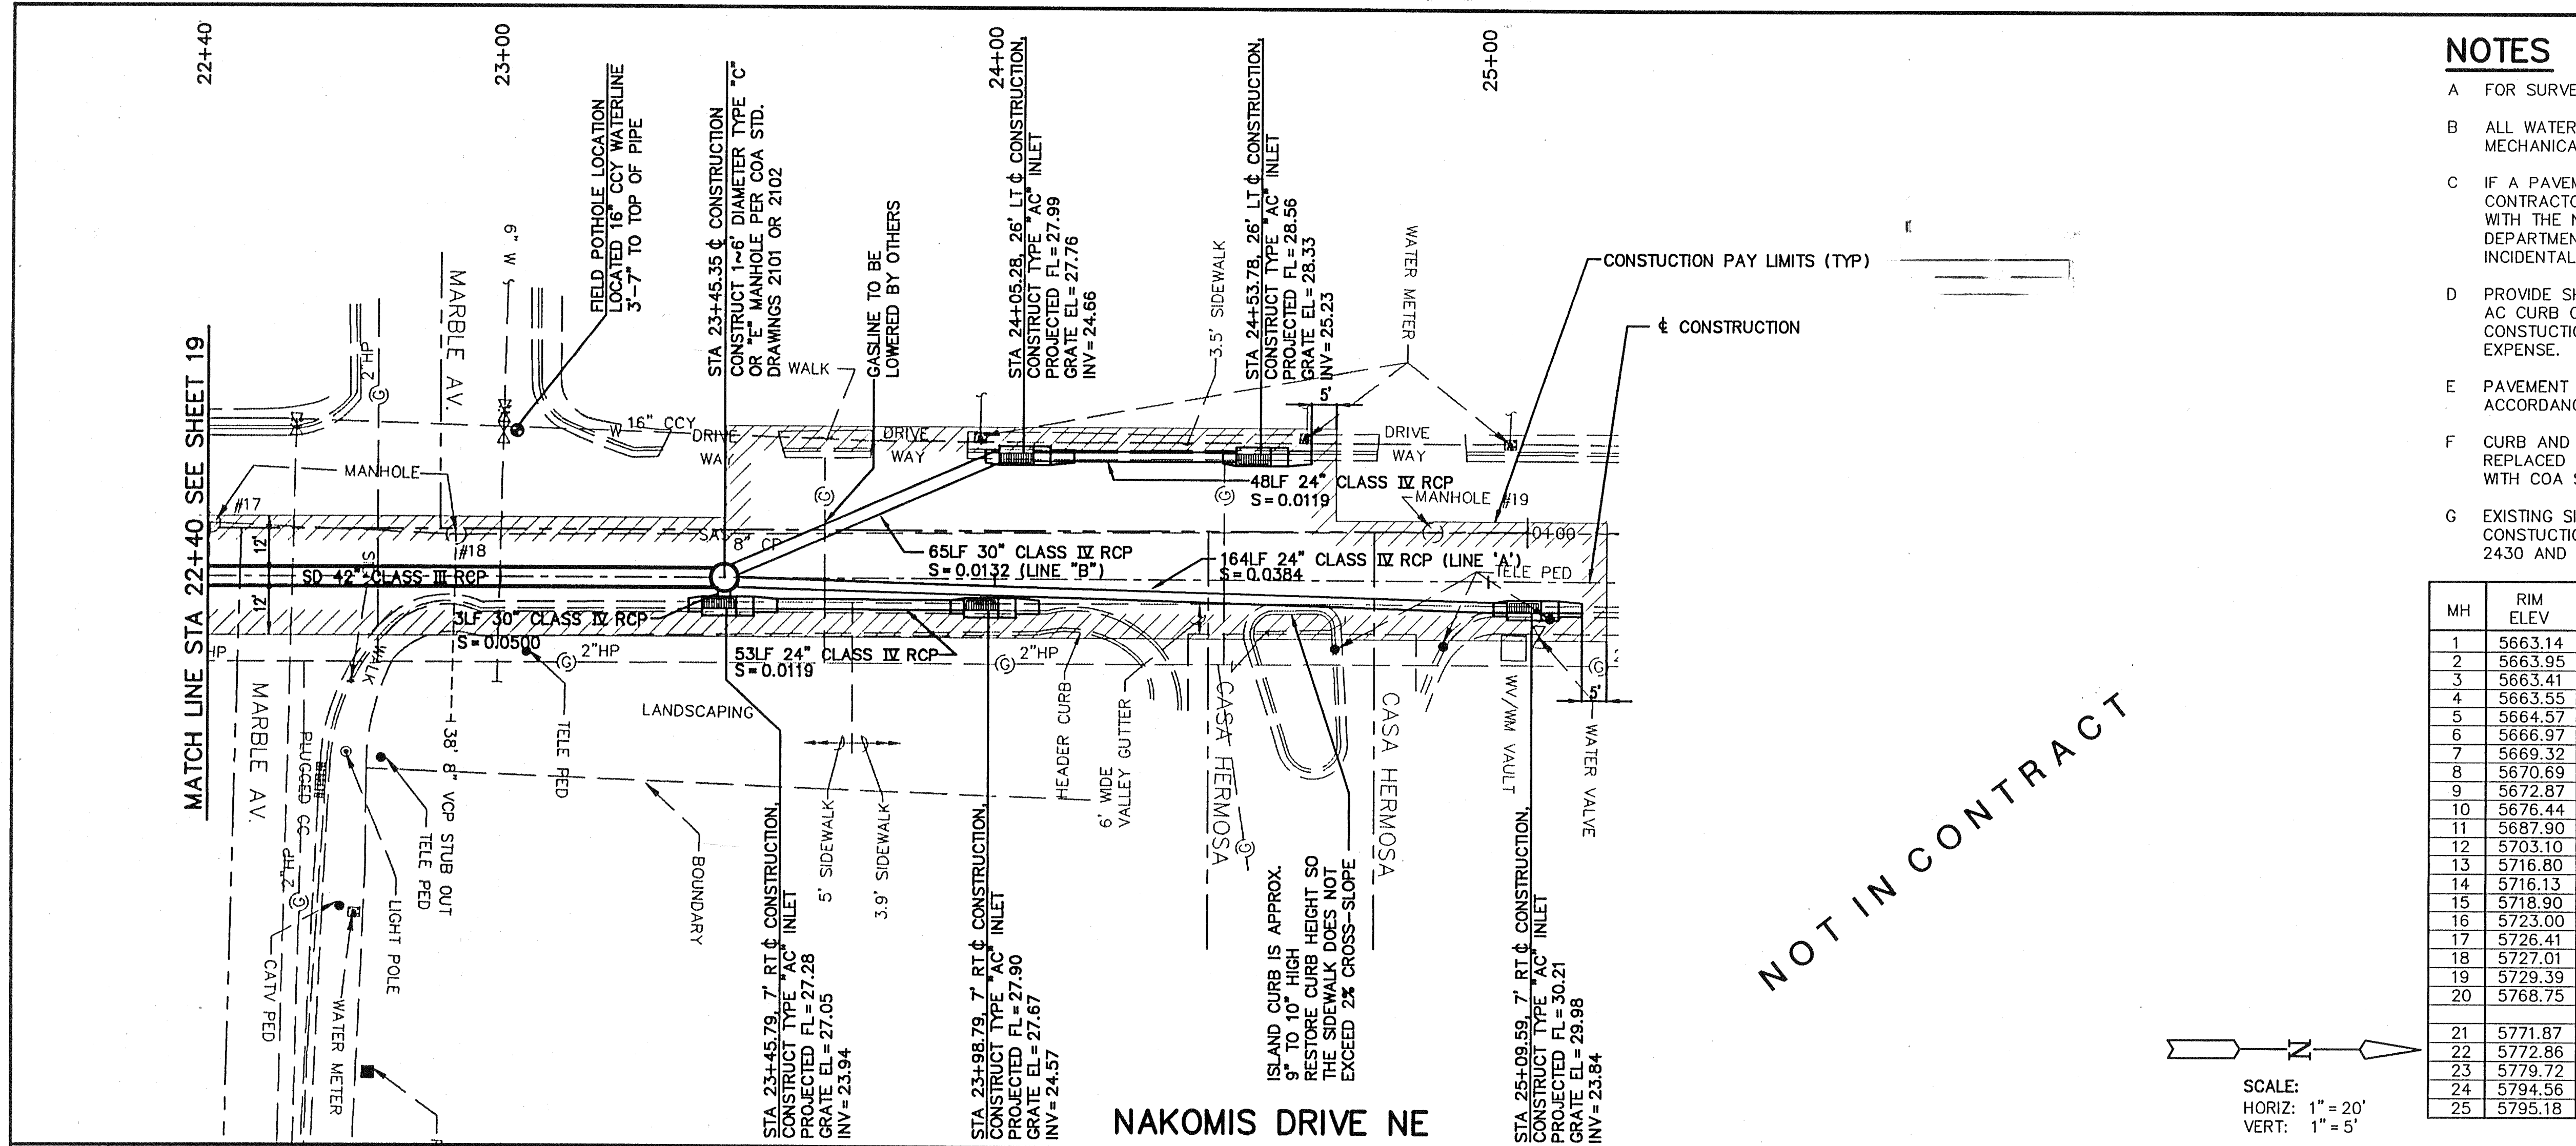

NOTES

- A FOR SURVEY CONTROL SEE SHEET 3.
- B ALL WATER LINE RELOCATION SHALL EMPLOY EXCLUSIVELY MECHANICAL RESTRAINT ON BENDS.
- C IF A PAVEMENT DROP-OFF IS CREATED DURING CONSTRUCTION THE CONTRACTOR SHALL INITIATE PROTECTIVE ACTION IN ACCORDANCE WITH THE NEW MEXICO STATE HIGHWAY AND TRANSPORTATION DEPARTMENTS CURRENT DROP-OFF POLICY. THIS WORK SHALL BE INCIDENTAL TO THE PROJECT.
- D PROVIDE SHORING OR TRENCH PROTECTION TO PROTECT EXISTING AC CURB ON LOMAS AS SHOWN. DAMAGE TO AC CURB OUTSIDE THE CONSTRUCTION PAY LIMITS MUST BE REPAIRED AT CONTRACTORS EXPENSE.
- E PAVEMENT REPLACEMENT SECTION FOR NAKOMIS SHALL BE IN ACCORDANCE WITH COA STD DWG 2405 FOR FLEXIBLE PAVEMENT.
- F CURB AND GUTTER REMOVED DURING CONSTRUCTION TO BE REPLACED WITH PCC STANDARD CURB AND GUTTER IN ACCORDANCE WITH COA STD DWG 2415.
- G EXISTING SIDEWALK WHICH MAY BE DAMAGED OR REMOVED DURING CONSTRUCTION TO BE REPLACED IN ACCORDANCE WITH COA STD DWG 2430 AND MATCH EXISTING WIDTH.

EXISTING MANHOLE DATA						
MH	RIM ELEV	NORTH INV 1	SOUTH INV 2	EAST INV 3	WEST INV 4	COA GIS NUMBER
1	5663.14	5654.61	5654.59		5662.72	S942
2	5663.95	5654.75	5654.25		5654.25	NO NUMBER
3	5663.41	5654.16		5653.27	5653.22	944
4	5663.55	5654.15	5654.05	5654.26		S43
5	5664.57	5658.57		5656.87	5656.07	S56
6	5666.97	5659.77	5660.27	5659.07	5658.87	S55
7	5669.32	5662.42	5662.82	5661.52	5661.17	S54
8	5670.69	5663.95	5664.35	5663.17	5662.97	S53
9	5672.87	5665.87	5666.37	5665.37	5665.27	S52
10	5676.44			5666.94	5666.84	NO NUMBER
11	5687.90			5678.25	5678.15	
12	5703.10			5693.20	5693.05	964
13	5716.80	5708.65		5707.95	5707.95	972
14	5716.13	5709.28	5709.18			NO NUMBER
15	5718.90	5713.25	5713.15			971
16	5723.00	5716.65			5716.65	873
17	5726.41	5720.41	5720.31	5720.51		875
18	5727.01	5721.01	5720.96	5721.31	5721.01	871
19	5729.39	5723.54	5723.39	5723.49		NO NUMBER
20	5768.75	5757.00		5756.95	5756.75	903
		5761.15				
21	5771.87	5762.25	5761.75	5761.65	5761.55	NO NUMBER
22	5772.86	5767.16	5764.76		5764.86	S902
23	5779.72	5770.12		5770.02	5770.02	S903
24	5794.56	5786.57		5786.57	5786.47	
25	5795.18		5787.18	5787.18	5787.08	

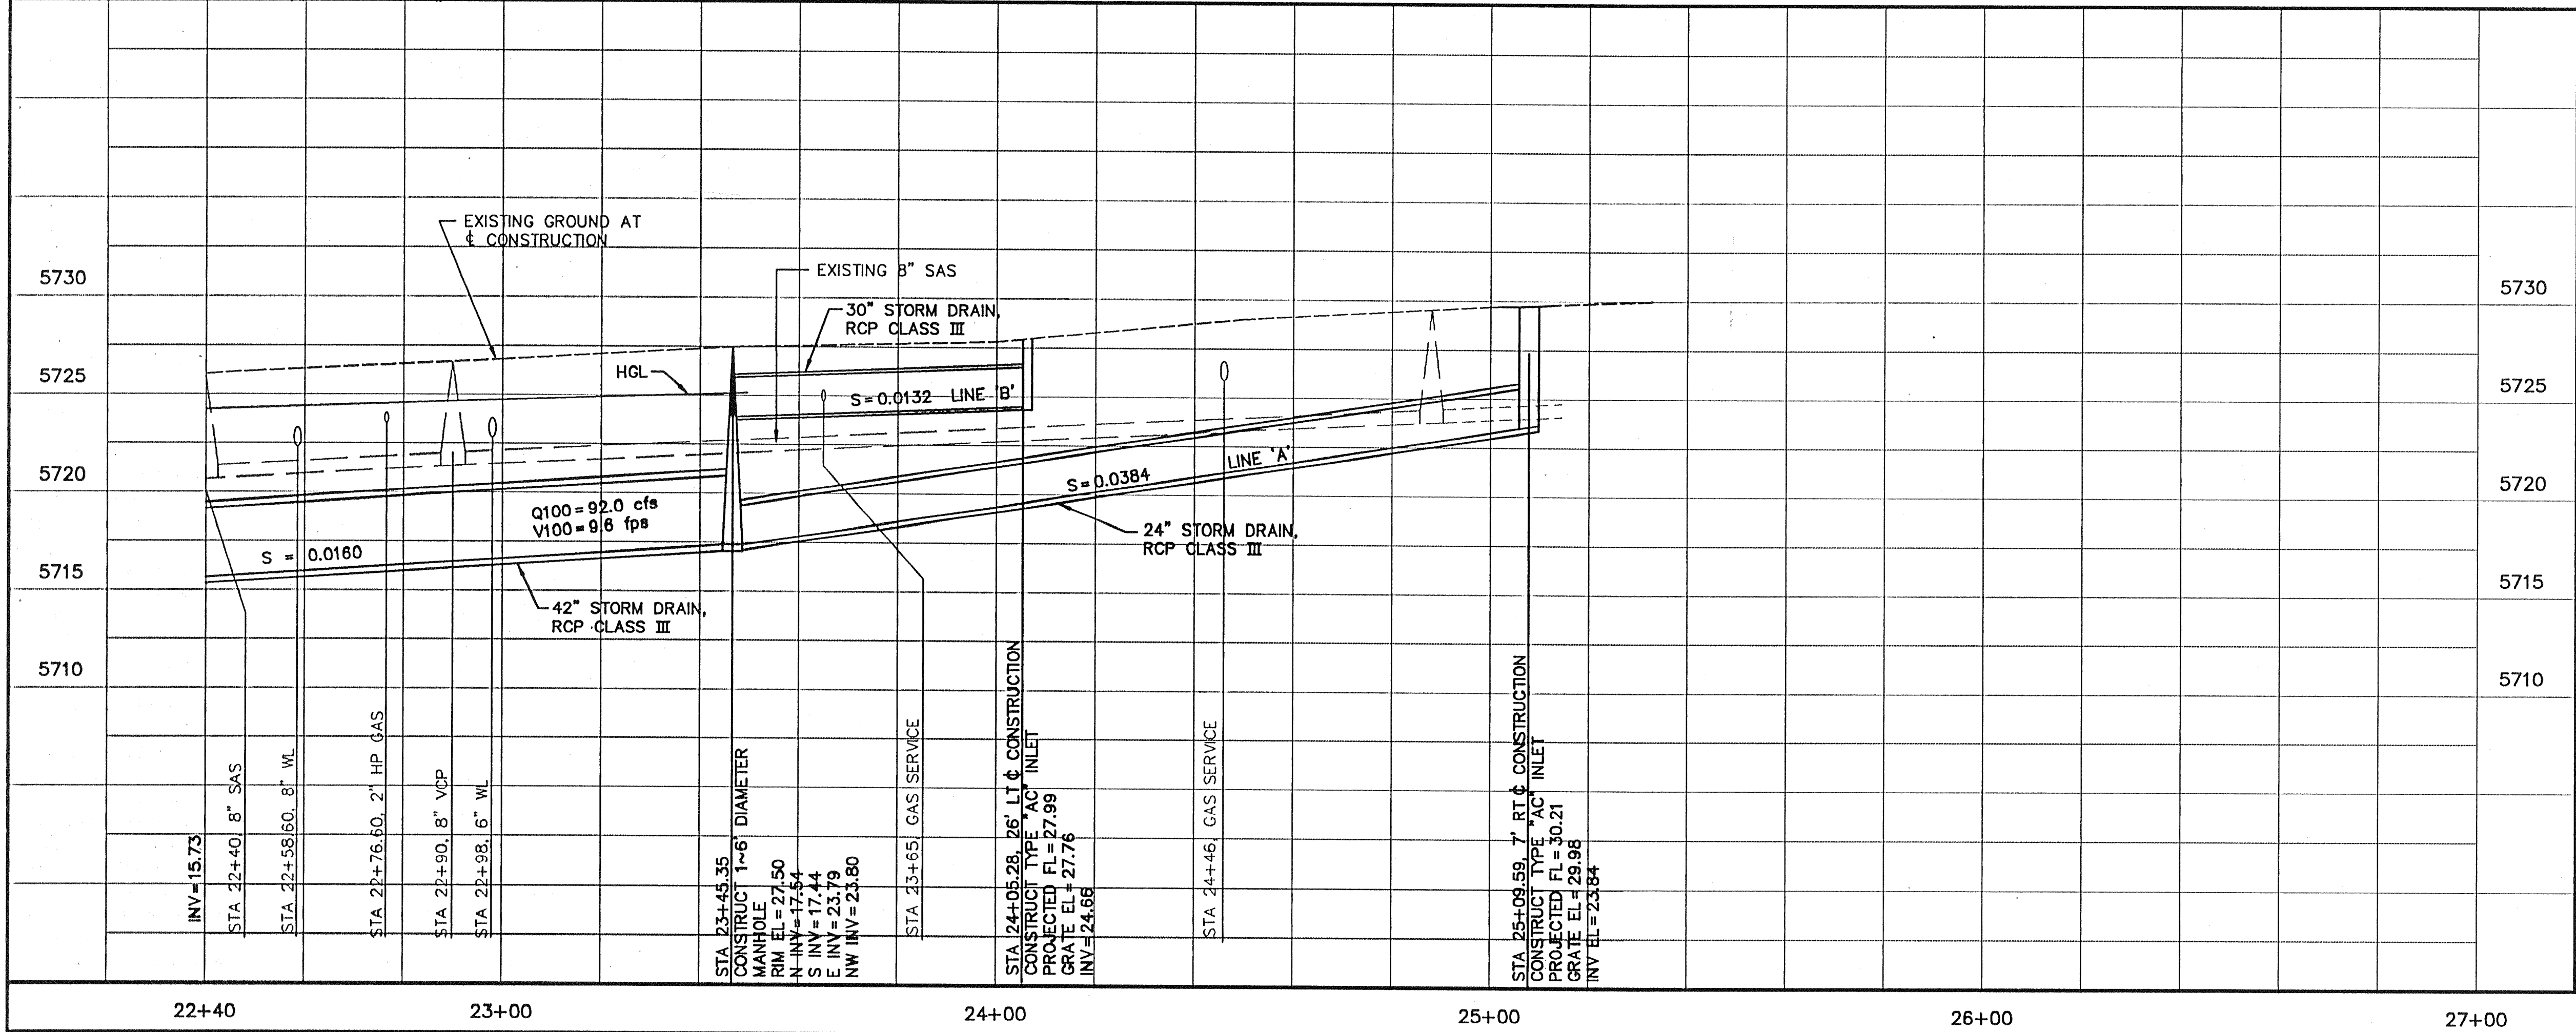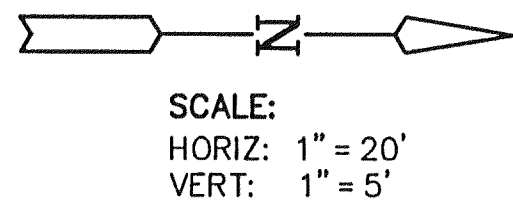

EXISTING STORM DRAIN INLETS	GRATE ELEVATION	INVERT ELEVATION
A	5663.77	5660.77
B	5667.48	5664.48
C	5669.43	5666.43
D	5671.53	5668.53
E	5663.59	5660.59
F	5665.45	5662.45
G	5667.69	5664.69
H	5669.71	5666.71
I	5671.69	5668.96
J	5773.37	5770.37
K	5774.47	5771.43
L	5779.89	5776.89
M	5781.34	5778.34
N	5772.89	5769.89

LEEDSHILL-HERKENHOFF, INC.
500 Copper Avenue NW
P.O. Box 1217
Albuquerque, NM 87103
(505)247-0294

CITY OF ALBUQUERQUE
PUBLIC WORKS DEPARTMENT
ENGINEERING DEVELOPMENT GROUP

TITLE:
DIVERSE DRAINAGE IMPROVEMENTS
NAKOMIS DRIVE NE - PART B - STORM SEWER
PLAN AND PROFILE STA 22+40 TO STA 25+09.59


DESIGN REVIEW COMMITTEE	CITY ENGINEER
APPROVED JUN 19 1997	APPROVED JUN 19 1997


AS BUILT INFORMATION	
CONTRACTOR	DATE
WORK STARTED BY	DATE
FIELD ACCEPTANCE BY	DATE
FIELD CORRECTION BY	DATE
RECORDED BY	DATE

BENCH MARKS	
THE ACS MONUMENTS ARE MARKED "3-102" AND "23-102"	
AND ARE STANDARD BRASS TABLET STAMP AND A 1/4"	
ALUMINUM CAP, RESPECTIVELY. SEE ALBUQUERQUE CITY	
SURVEY MONUMENTATION LOGS FOR EXACT LOCATION.	

SURVEY INFORMATION	
FIELD NOTES	
NO.	DATE
BY	

ENGINEER'S SEAL	REVISIONS
	NO. DATE
	BY
	REMARKS
	LEEDSHILL-HERKENHOFF, INC.
	DESIGNED BY RAS/TM/KO DATE JUNE 96
	DRAWN BY C ROMERO DATE JUNE 96
	CHECKED BY C DODGE DATE JUNE 96

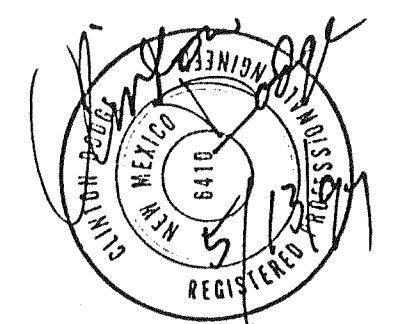

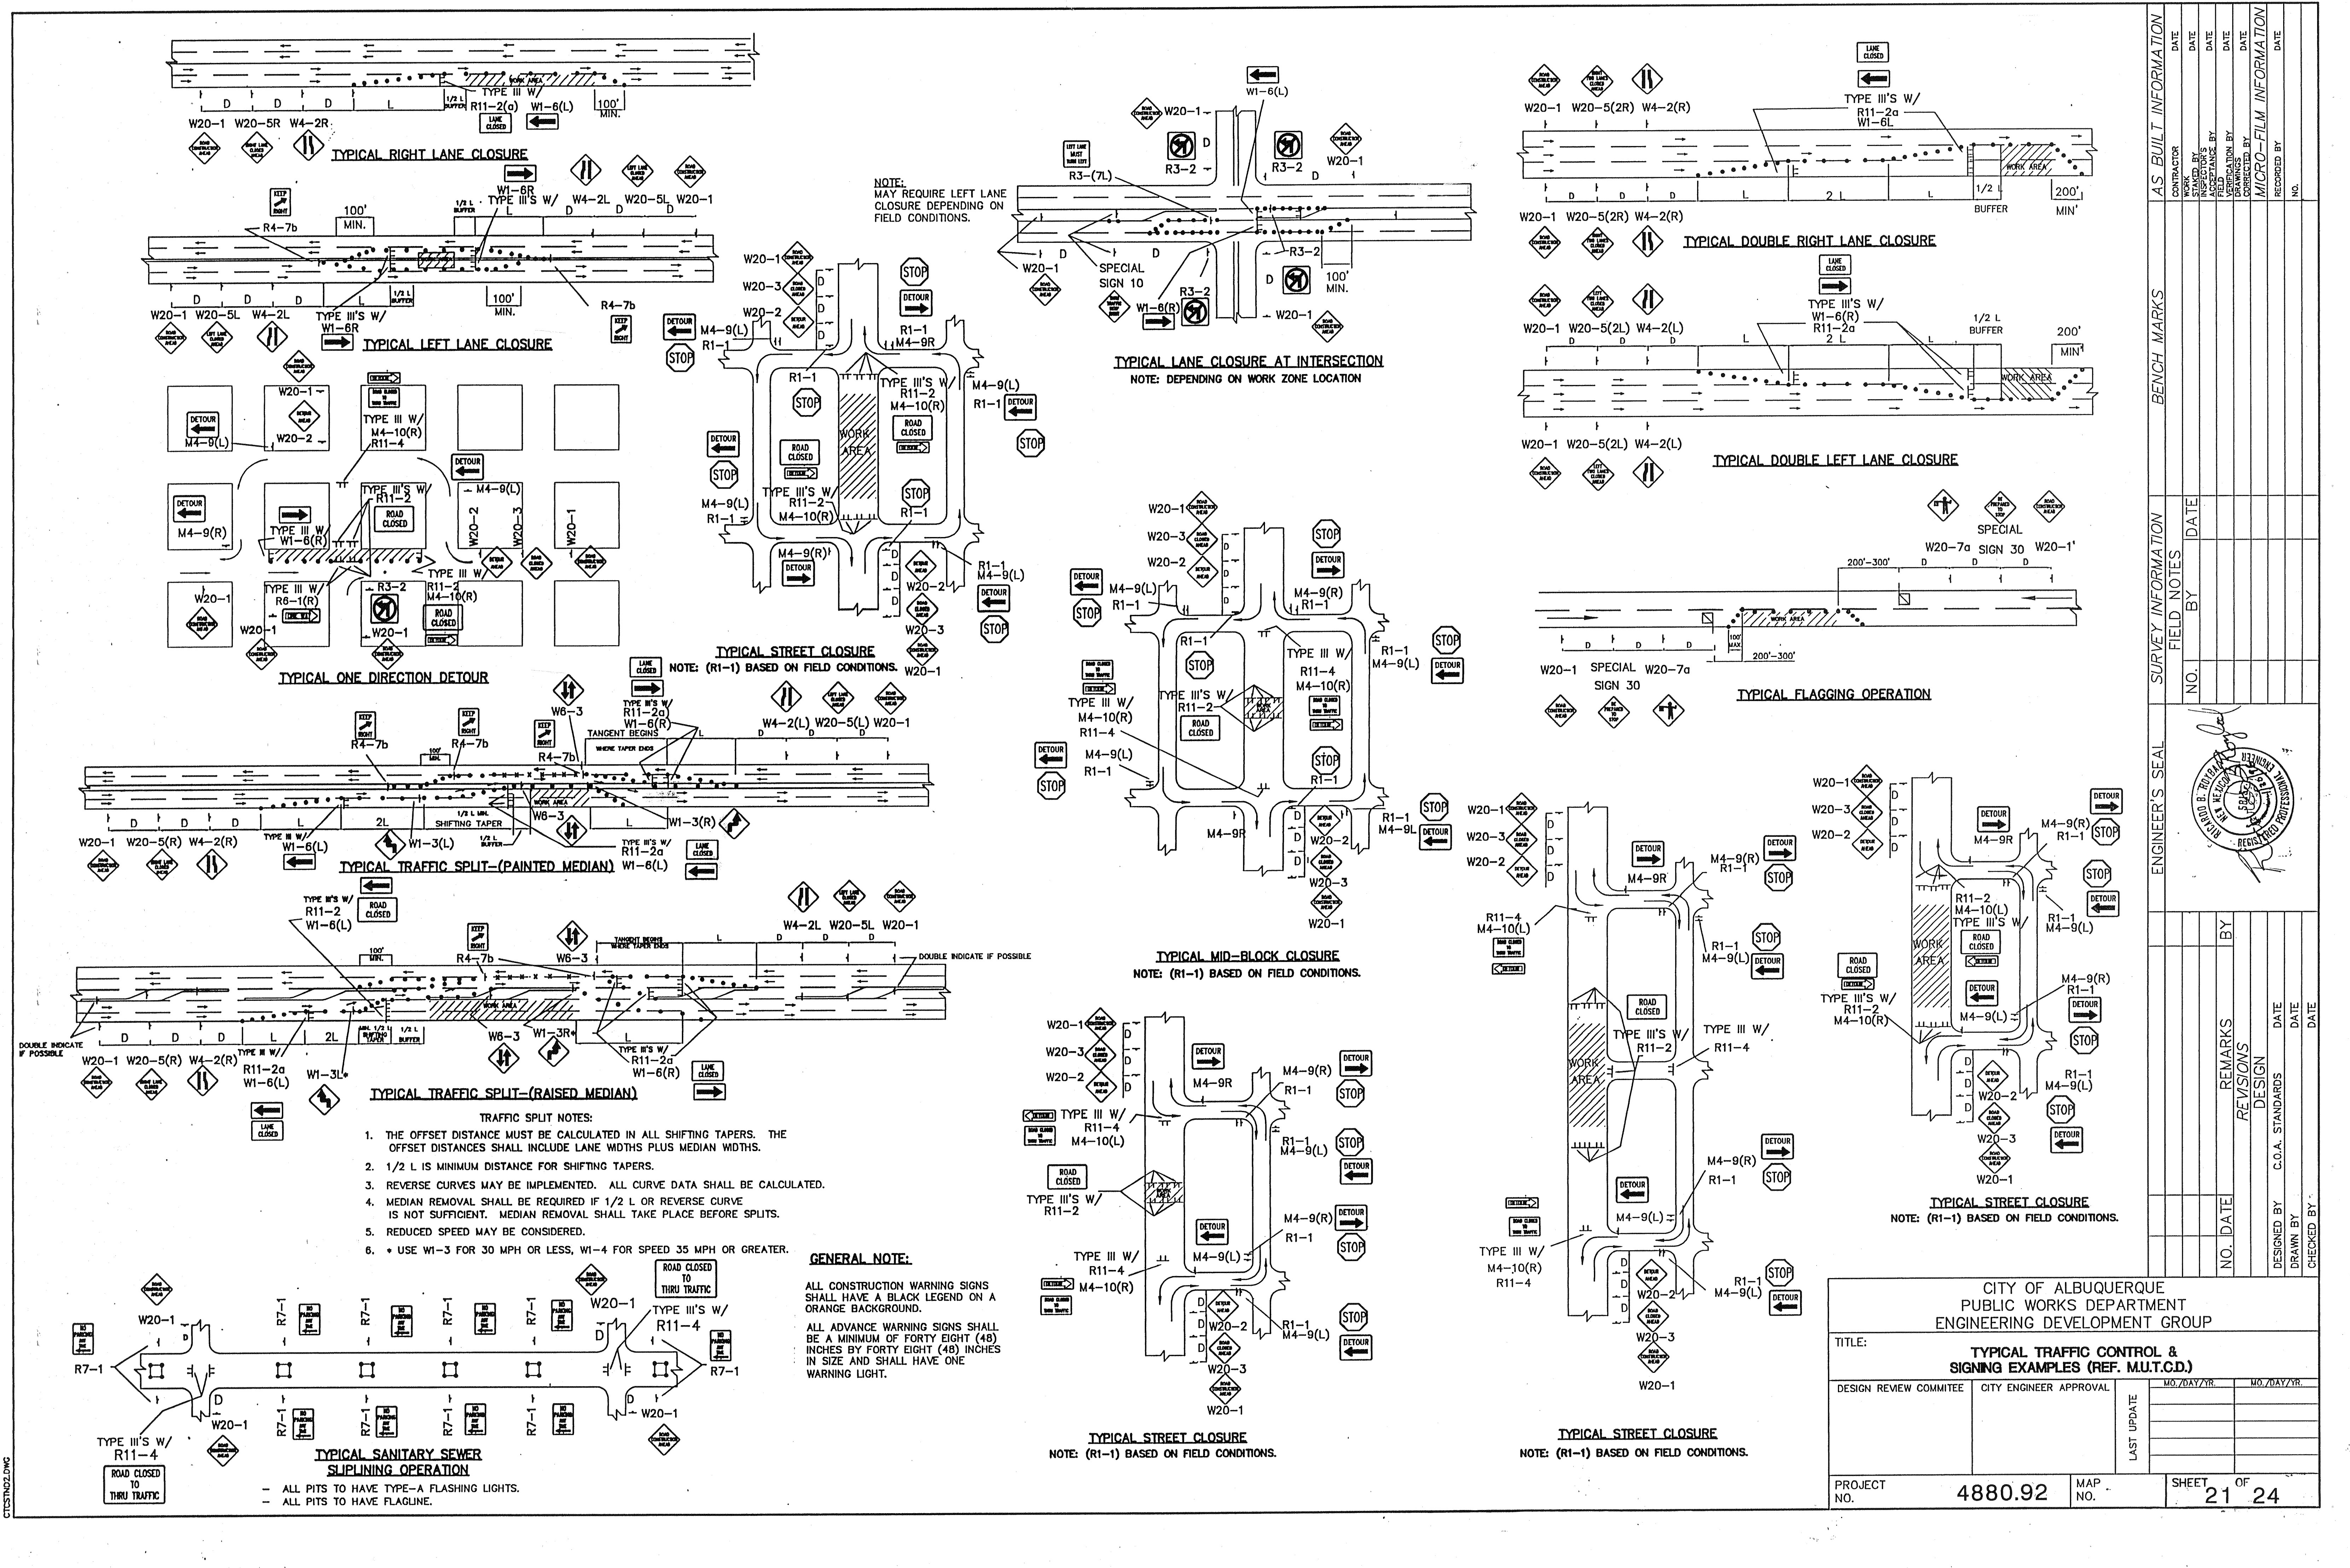

- TRAFFIC SPLIT NOTES:**
1. THE OFFSET DISTANCE MUST BE CALCULATED IN ALL SHIFTING TAPERS. THE OFFSET DISTANCES SHALL INCLUDE LANE WIDTHS PLUS MEDIAN WIDTHS.
 2. 1/2 L IS MINIMUM DISTANCE FOR SHIFTING TAPERS.
 3. REVERSE CURVES MAY BE IMPLEMENTED. ALL CURVE DATA SHALL BE CALCULATED.
 4. MEDIAN REMOVAL SHALL BE REQUIRED IF 1/2 L OR REVERSE CURVE IS NOT SUFFICIENT. MEDIAN REMOVAL SHALL TAKE PLACE BEFORE SPLITS.
 5. REDUCED SPEED MAY BE CONSIDERED.
 6. * USE W1-3 FOR 30 MPH OR LESS, W1-4 FOR SPEED 35 MPH OR GREATER.

GENERAL NOTE:

ALL CONSTRUCTION WARNING SIGNS SHALL HAVE A BLACK LEGEND ON A ORANGE BACKGROUND.


ALL ADVANCE WARNING SIGNS SHALL BE A MINIMUM OF FORTY EIGHT (48) INCHES BY FORTY EIGHT (48) INCHES IN SIZE AND SHALL HAVE ONE WARNING LIGHT.

CITY OF ALBUQUERQUE PUBLIC WORKS DEPARTMENT ENGINEERING DEVELOPMENT GROUP			
TITLE: TYPICAL TRAFFIC CONTROL & SIGNING EXAMPLES (REF. MUT.C.D.)			
DESIGN REVIEW COMMITTEE	CITY ENGINEER APPROVAL	MO./DAY/YR.	
LAST UPDATE		MO./DAY/YR.	
PROJECT NO.	4880.92	MAP NO.	SHEET 21 OF 24

CONSTRUCTION TRAFFIC CONTROL GENERAL NOTES

1. CONTRACTOR MUST OBTAIN FROM CONSTRUCTION COORDINATION AN EXCAVATION/BARRICADING PERMIT BEFORE ENGAGING IN ANY CONSTRUCTION, MAINTENANCE OR REPAIR WORK IN ANY OF THE CITY OF ALBUQUERQUE'S RIGHTS-OF-WAY. EMERGENCY WORK THAT WOULD PRESERVE LIFE OR PROPERTY IS EXCLUDED WITH THE UNDERSTANDING, THAT A PERMIT SHALL BE OBTAINED WITHIN 24 TO 48 HOURS.
2. CONTRACTOR SHALL AT THE TIME OF PERMIT REQUEST, SUBMIT FOR APPROVAL BY CONSTRUCTION COORDINATION, A TRAFFIC CONTROL PLAN DETAILING ALL EXISTING TOPOGRAPHY SUCH AS LANE WIDTHS, DRIVEWAYS, AND BUSINESS/RESIDENTIAL ACCESSES. THE TRAFFIC CONTROL PLAN SHALL INCLUDE ALL PHASES OF WORK AND SCHEDULES INVOLVED IN THE CONSTRUCTION PROJECT. ANY SEPARATE PHASES OF A CONSTRUCTION PROJECT SHALL BE GIVEN AN INDIVIDUAL PERMIT EACH. BLANKET PERMITS WILL NOT BE ISSUED.
3. THESE TYPICAL TRAFFIC CONTROL PLANS DO NOT REFLECT THE EXISTING TOPOGRAPHY SUCH AS DRIVEWAYS, LANE WIDTHS, AND BUSINESS/RESIDENTIAL ACCESSES. EVERY LOCATION THAT REQUIRES CONSTRUCTION TRAFFIC CONTROL SHALL HAVE A DETAILED TRAFFIC CONTROL PLAN SHOWING ALL EXISTING TOPOGRAPHY.
4. CONSTRUCTION SHALL NOT BEGIN UNLESS A TRAFFIC CONTROL PLAN HAS BEEN APPROVED AND VERIFIED BY CONSTRUCTION COORDINATION.
5. CONSTRUCTION COORDINATION SHALL BE NOTIFIED 48 HOURS PRIOR TO ANY TRAFFIC CONTROL CHANGES NEEDED BY CONTRACTOR, THAT WERE NOT PREVIOUSLY APPROVED. THESE TRAFFIC CONTROL CHANGES SHALL BE REQUESTED IN WRITING ACCOMPANIED WITH A TRAFFIC CONTROL PLAN REFLECTING SUCH CHANGES.
6. ALL CONSTRUCTION TRAFFIC CONTROL DEVICES SHALL COMPLY TO THE MANUAL ON UNIFORM TRAFFIC CONTROL DEVICES (MUTCD), LATEST EDITION. IT IS THE RESPONSIBILITY OF THE CONTRACTOR TO INSTALL, SERVICE AND MAINTAIN ALL TRAFFIC CONTROL DEVICES. TRAFFIC CONTROL DEVICES SHALL NOT BE REMOVED OR ALTERED IN ANY WAY WITHOUT THE APPROVAL OF CONSTRUCTION COORDINATION, PER SECTION 6A-4 OF THE MUTCD, LATEST EDITION.
7. THE CONSTRUCTION TRAFFIC CONTROL INITIAL SET-UP SHALL BE BY AN AMERICAN TRAFFIC SAFETY SERVICES ASSOCIATION (ATSSA) CERTIFIED WORKSITE TRAFFIC SUPERVISOR. THE MAINTENANCE AND SERVICING SHALL ALSO BE DONE BY AN ATSSA CERTIFIED WORKSITE TRAFFIC SUPERVISOR OR EQUIVALENT.
8. CONTRACTOR IS RESPONSIBLE TO MAINTAIN AND SERVICE ALL TRAFFIC CONTROL DEVICES 24 HOURS A DAY, 7 DAYS A WEEK THROUGHOUT LENGTH OF PROJECT. CONTRACTOR IS RESPONSIBLE THAT ALL TRAFFIC CONTROL DEVICES COMPLY WITH THE MUTCD, LATEST EDITION.
9. ALL ADVANCE WARNING SIGNS SHALL BE DOUBLE INDICATED WHENEVER THERE ARE MULTI-LANE TRAFFIC IN ANY ONE GIVEN DIRECTION AND THERE IS SUFFICIENT MEDIAN SPACE.
10. ALL BARRICADES IN ALL TAPERS AND TANGENTS SHALL BE PLACED APART, A DISTANCE MEASURED IN FEET, EQUAL TO THAT OF THE POSTED SPEED LIMIT. NO EXCEPTIONS UNLESS APPROVED BY CONSTRUCTION COORDINATION PER MUTCD SECTION 6A-4.
11. CONTRACTOR SHALL NOT BEGIN WORK BEFORE 7:00 A.M. OR END WORK AFTER 7:00 P.M. WITHOUT THE APPROVAL OF CONSTRUCTION COORDINATION.
12. CONTRACTOR IS RESPONSIBLE TO PROVIDE CONSTRUCTION COORDINATION, A WEEKLY LOG OF DAILY INSPECTIONS OF BARRICADE AND MAINTENANCE SCHEDULES ON PROJECTS THAT ARE OVER ONE WEEK DURATION.
13. EQUIPMENT OR MATERIALS SHALL NOT BE STORED WITHIN 15 FEET OF A TRAVELLED TRAFFIC LANE DURING NON-WORKING HOURS WITHOUT THE APPROVAL OF CONSTRUCTION COORDINATION.
14. CONTRACTOR SHALL PROVIDE AND MAINTAIN A SAFE AND ADEQUATE MEANS OF CHANNELIZING PEDESTRIAN TRAFFIC AROUND AND THROUGH THE CONSTRUCTION AREA.
15. CONTRACTOR IS RESPONSIBLE FOR OBLITERATION OF ANY CONFLICTING STRIPING AND RESPONSIBLE FOR ALL TEMPORARY STRIPING.
16. CONTRACTOR SHALL MAINTAIN ACCESS TO ALL FACILITIES, BUSINESSES AND/OR RESIDENTS AT ALL TIMES.
17. CONTRACTOR SHALL PROVIDE ACCESS SIGNS FOR BUSINESSES LOCATED WITHIN THE CONSTRUCTION AREA UNDER THE SUPERVISION OF CONSTRUCTION COORDINATION. EACH ACCESS SIGN SHALL HAVE 5 INCH, WHITE OPAQUE LETTERING ON BLUE REFLECTORIZED BACKGROUND. ACCESS SIGNS SHALL BE CONSIDERED INCIDENTAL TO THE BID AND NOT PART OF THE CONTRACT UNLESS OTHERWISE STATED. NO MORE THAN 3 BUSINESSES SHALL BE LISTED ON A ACCESS SIGN. SHOPPING CENTERS AND MALLS SHALL BE LISTED AS SUCH.
18. ALL ADVANCE WARNING SIGNS SHALL MEET THE MINIMUM REFLECTIVE INTENSITY REQUIREMENTS SET FORTH BY THE CITY OF ALBUQUERQUE. CONSTRUCTION COORDINATION SHALL DETERMINE ALL REQUIREMENTS AND APPROVE OR DISAPPROVE ANY ADVANCE WARNING SIGN PER SECTION 6A-4 OF THE MUTCD, LATEST EDITION.
19. 24 HOURS PRIOR TO OCCUPYING OR CLOSING OF A RIGHT-OF-WAY, CONTRACTOR SHALL NOTIFY: POLICE, FIRE DEPARTMENT, SCHOOLS, HOSPITALS, TRANSIT AUTHORITY, BUSINESSES AND/OR RESIDENTS THAT WILL BE AFFECTED BY THE CONSTRUCTION.
20. ANY FIELD ADJUSTMENTS SHALL BE APPROVED BY CONSTRUCTION COORDINATION.

21. EXCAVATIONS SHALL BE PLATED, TEMPORARILY PATCHED OR RESURFACED PRIOR TO OPENING OF TRAFFIC. A MINIMUM OF 11 FEET SHALL BE PROVIDED FOR TRAFFIC IN ANY GIVEN DIRECTION. CONTRACTOR IS RESPONSIBLE FOR ANY WORK INVOLVED IN SATISFYING THESE REQUIREMENTS.
22. CONTRACTOR SHALL AT ALL TIMES COMPLY WITH THE FOLLOWING:
- STANDARDS AND REQUIREMENTS SET FORTH IN THE MANUAL ON UNIFORM TRAFFIC CONTROL DEVICES, LATEST EDITION.
 - THE CITY OF ALBUQUERQUE TRAFFIC CODE, LATEST EDITION.
 - SECTION 19 OF THE CITY OF ALBUQUERQUE'S STANDARD SPECIFICATIONS FOR PUBLIC WORK CONSTRUCTION, AS WELL AS OTHER SECTIONS.
23. FAILURE TO COMPLY WITH ANY OF THE ABOVE MENTIONED, WILL BE ADEQUATE CAUSE TO CEASE ALL WORK ON ANY CONSTRUCTION PROJECT. WORK WILL NOT RESUME UNTIL ALL REQUIREMENTS ARE ADDRESSED AND APPROVED BY CONSTRUCTION COORDINATION.
24. ALL TRAFFIC CONTROL DEVICES SHALL BE KEPT IN NEW-CLEAN CONDITION. WASHING OF EQUIPMENT IS INCIDENTAL TO IT'S PLACEMENT AND MAINTENANCE.
25. TRAFFIC CONTROL STANDARDS APPLY ONLY WHERE THE CONSTRUCTION TRAFFIC CONTROL PLANS ARE NOT SPECIFIC.
26. ADVANCE WARNING SIGNS SHALL BE 36"x36" WITH SUPER ENGINEERING GRADE SHEETING OR BETTER.

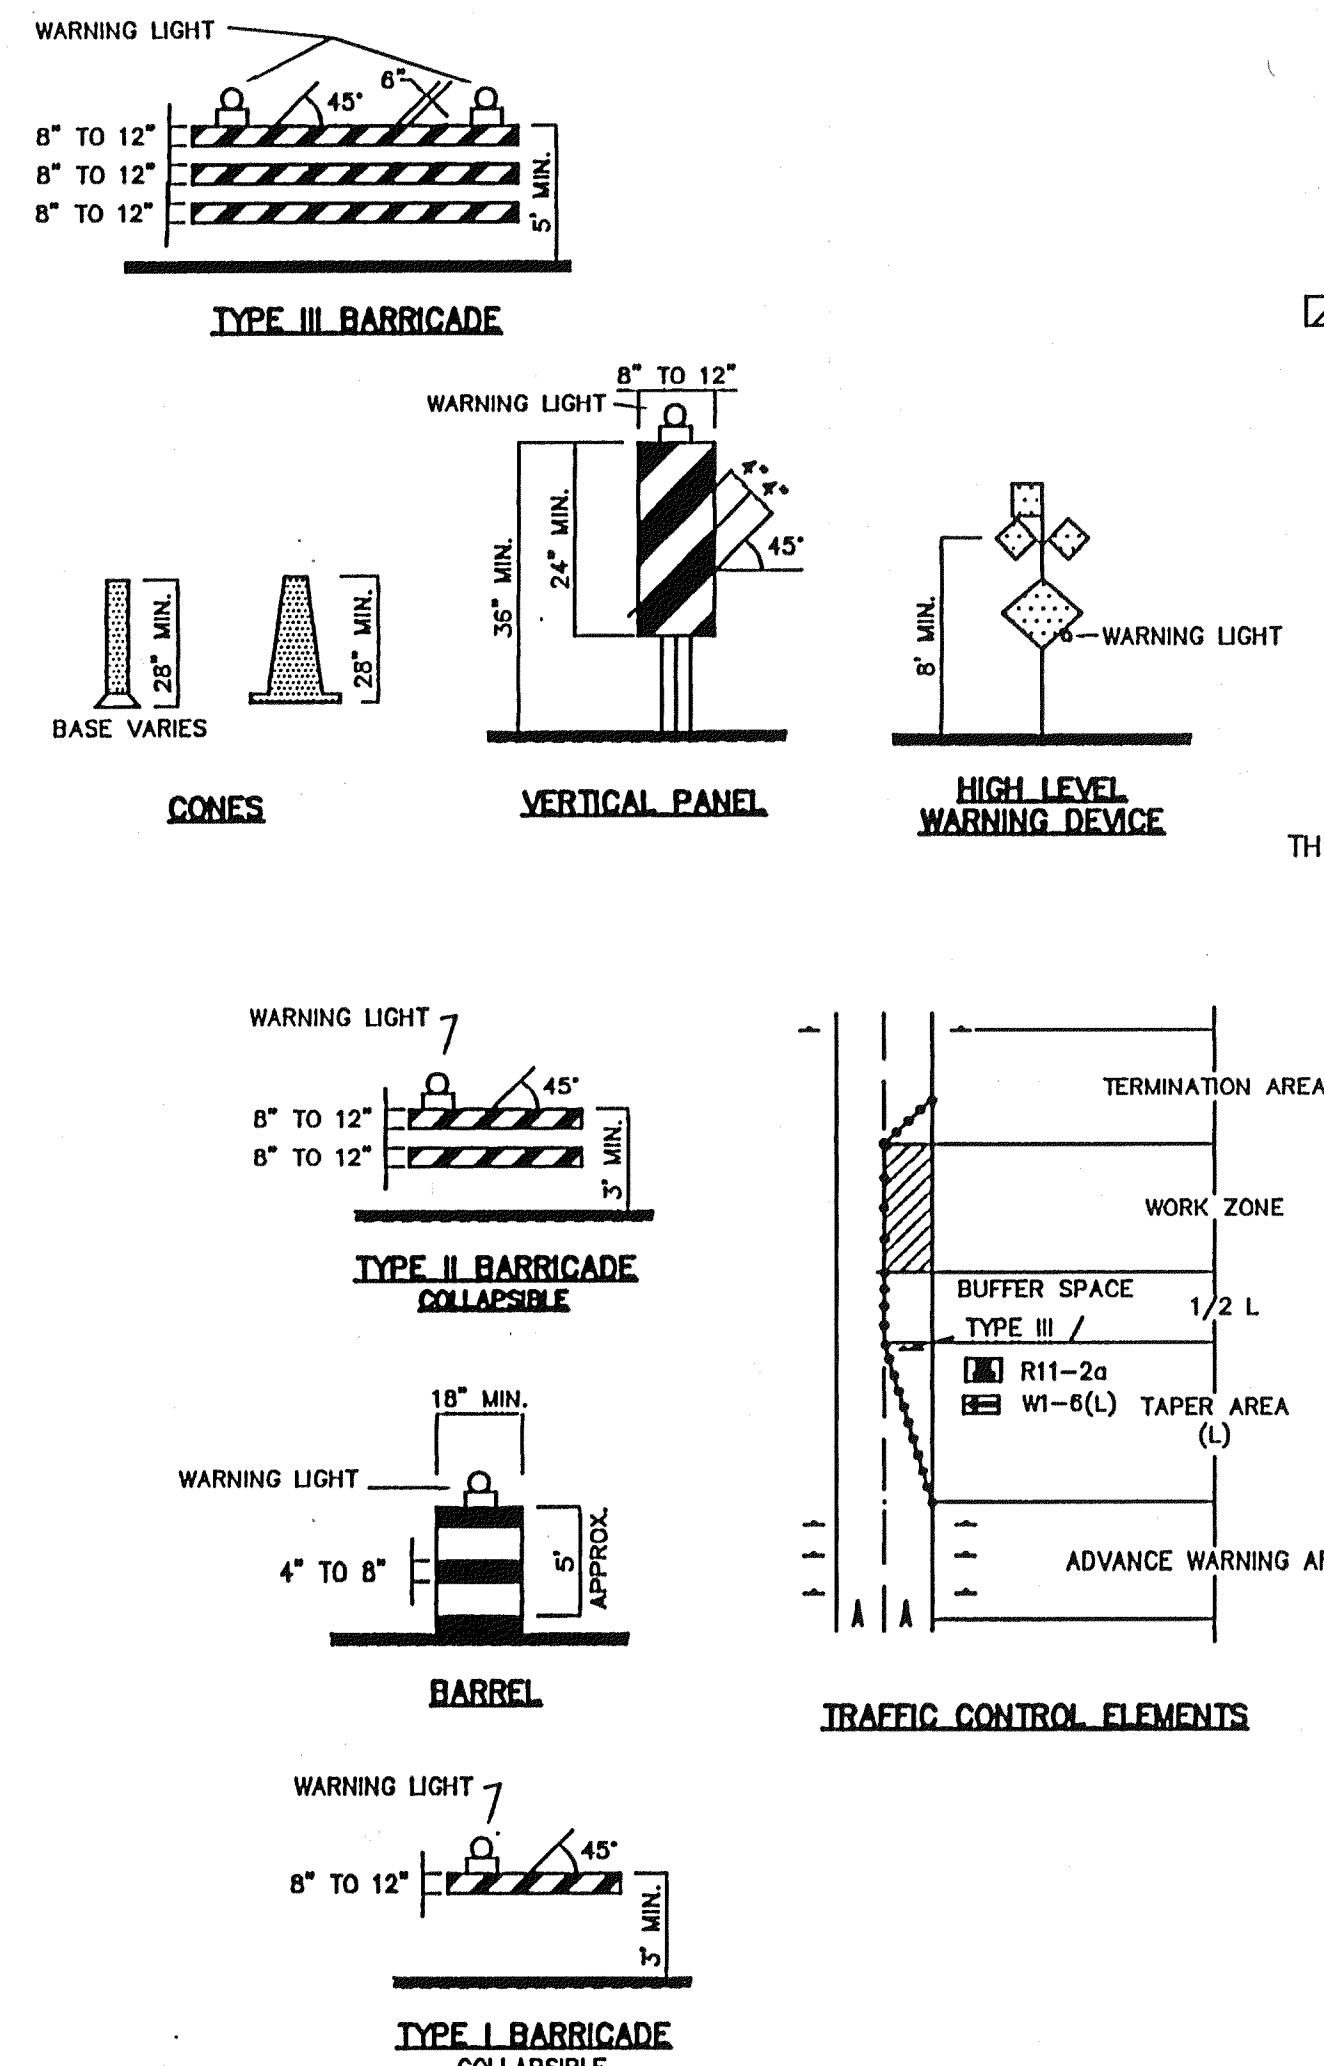

LEGEND

- WORK AREA
BARRICADE - TYPE I, TYPE II, OR BARREL
BARRICADE - TYPE III
VERTICAL PANEL
WARNING SIGN
DISTANCE BETWEEN SIGNS - A DISTANCE MEASURED IN FEET EQUAL TO A VALUE OF TEN TIMES THE SPEED LIMIT OF THE STREET
FLAGMAN POSITION
SPACING BETWEEN BARRICADES- A DISTANCE MEASURED IN FEET EQUAL TO THE SPEED LIMIT OF THE STREET
TAPER LENGTH - SEE CHART BELOW
THE TANGENT LENGTH IS EQUAL TO THE TAPER LENGTH FOR A GIVEN STREET.

TAPER REQUIREMENTS

SPEED LIMIT (MPH)	TAPER LENGTH (L) (FEET)			MINIMUM NUMBER OF DEVICES FOR TAPER	MAXIMUM DEVICE SPACING IN FEET	
	10' LANE	11' LANE	12' LANE		ALONG TAPER	AFTER TAPER
20	70	75	80	5	20	20
25	105	115	125	6	25	25
30	150	165	180	7	30	30
35	205	225	245	8	35	35
40	270	295	320	9	40	40
45	450	495	540	13	45	45
50	500	550	600	13	50	50
55	550	605	660	13	55	55

RECOMMENDED SIGN SPACING(D) FOR ADVANCE WARNING SIGN SERIES

SPEED MILES PER HOUR	MINIMUM DISTANCE IN FEET	
	BETWEEN SIGNS	FROM LAST SIGN TO TAPER
0-20	10 X SPEED LIMIT	10 X SPEED LIMIT
25-30	10 X SPEED LIMIT	10 X SPEED LIMIT
30-35	10 X SPEED LIMIT	10 X SPEED LIMIT
40-45	10 X SPEED LIMIT	10 X SPEED LIMIT
50-60	10 X SPEED LIMIT	10 X SPEED LIMIT


TAPER CRITERIA

TYPE OF TAPER	TAPER LENGTH
UPSTREAM TAPER:	
MERCING TAPER	L MINIMUM
SHIFTING TAPER	1/2 L MINIMUM
SHOULDER TAPER	1/2 L MINIMUM
TWO-WAY TRAFFIC TAPER	100 FEET MAXIMUM
DOWNSTREAM TAPERS	100 FEET PER LANE

TAPER LENGTH COMPUTATION

SPEED LIMIT	
40 MPH OR LESS	$L = \frac{WS^2}{60}$
45 MPH OR GREATER	$L = W \times S$
L = TAPER LENGTH W = WIDTH OF OFFSET IN FEET S = POSTED SPEED OR OFF-PEAK 85-PERCENTILE SPEED IN MPH	

SIGN FACE DETAILS

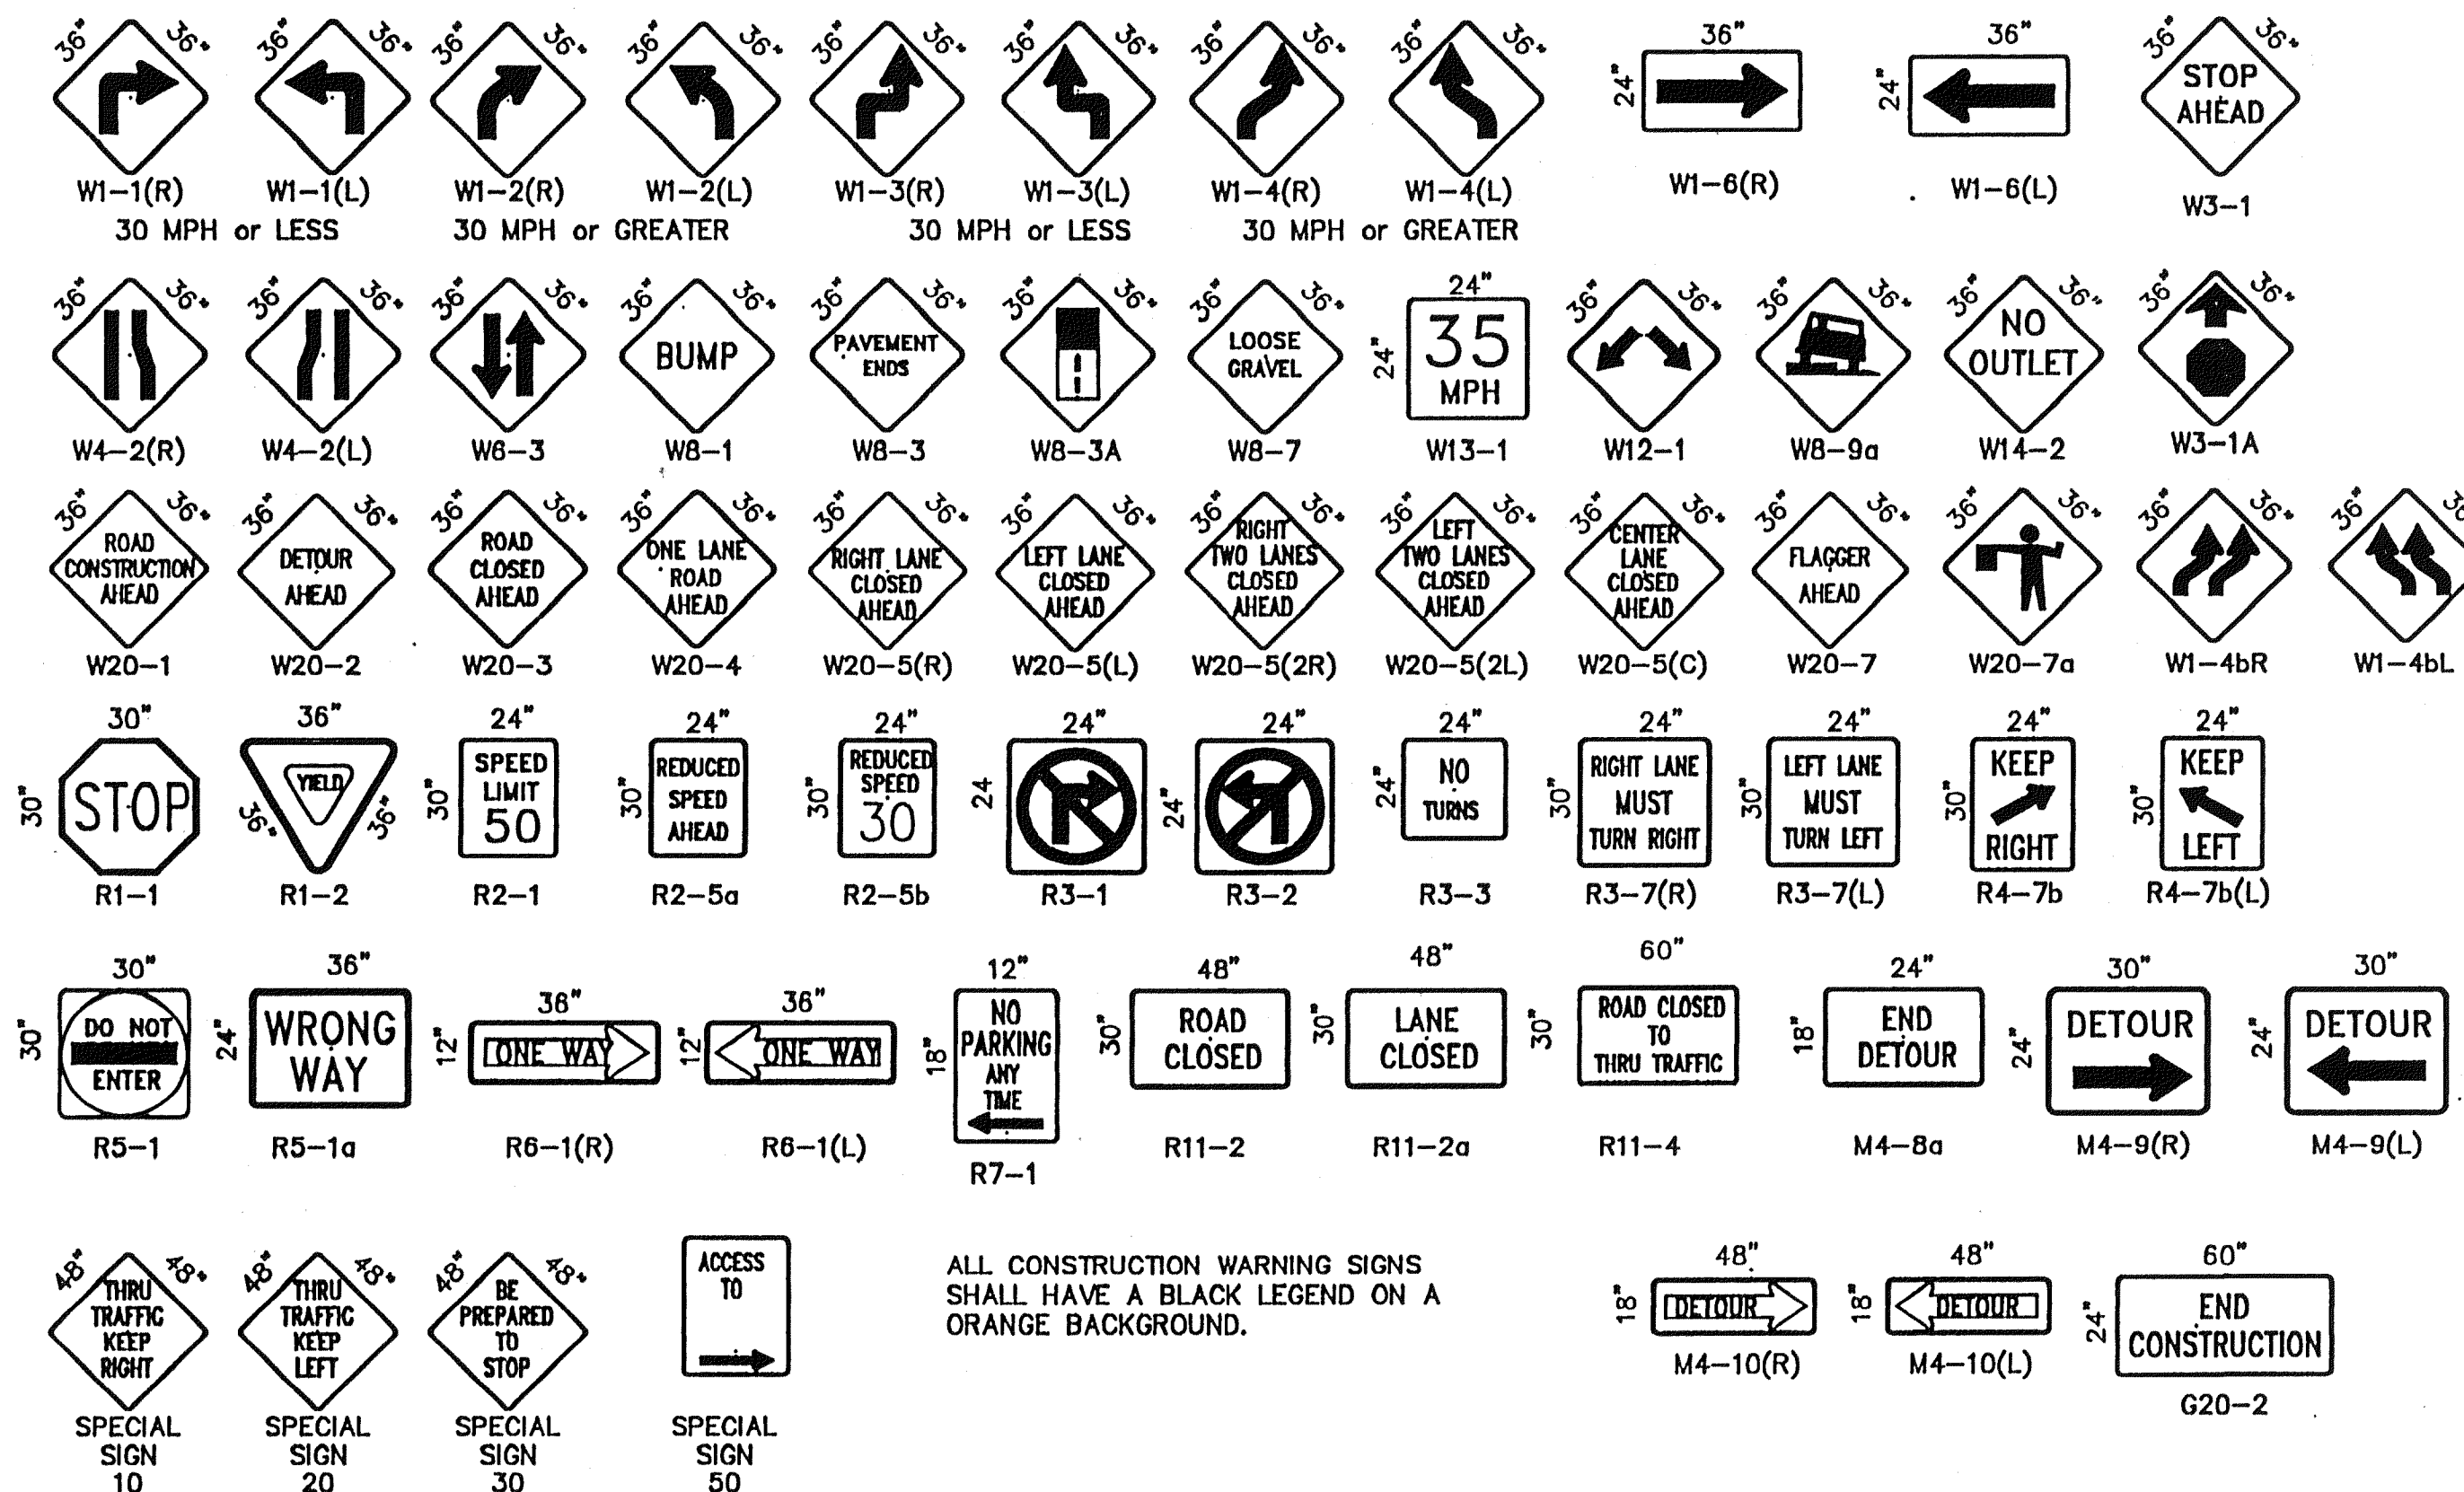

ALL CONSTRUCTION WARNING SIGNS SHALL HAVE A BLACK LEGEND ON A ORANGE BACKGROUND.

AS BUILT INFORMATION

CONTRACTOR	DATE
DESIGNED BY	DATE
CHECKED BY	DATE
REVIEWED BY	DATE
APPROVED BY	DATE
RECORDED BY	DATE

BENCH MARKS

NO.	DATE
-----	------

SURVEY INFORMATION

NO.	DATE
-----	------

ENGINEER'S SEAL

Seal of the City of Albuquerque, New Mexico, Professional Engineer, License No. 10000, signed by Robert J. [Signature]

REVISIONS

NO.	DATE	REVISIONS


DESIGNED BY: [] DATE: []
DRAWN BY: [] C.O.A. STANDARDS: []
CHECKED BY: []

CITY OF ALBUQUERQUE
PUBLIC WORKS DEPARTMENT
ENGINEERING DEVELOPMENT GROUP

TITLE: **SIGNING AND CONSTRUCTION TRAFFIC CONTROL STANDARDS**

DESIGN REVIEW COMMITTEE	CITY ENGINEER APPROVAL	MO. DAY/YR.	MO. DAY/YR.

PROJECT NO. **4880.92** MAP NO. **22** OF **24**

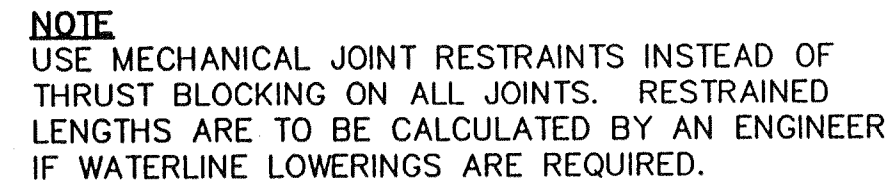

NOT TO SCALE

Date JAN 1998

These drawings have been revised based on the construction records of the owner. While the information submitted by the Owner will be assumed to be reliable, the Engineer will not be responsible for the accuracy of this information nor for errors or omissions which may appear in the record document as a result thereof.

- A WATER SHUT-OFF PLANS SHOWN WERE PREPARED USING THE CITY OF ALBUQUERQUE WATER RECORD MAPS AND ARE PROVIDED FOR THE PURPOSE OF COORDINATING WATER VALVE CLOSURES WITHIN CONSTRUCTION AREAS.
- B OPERATION OF THE EXISTING WATER SYSTEM SHALL BE IN ACCORDANCE WITH SECTION 18 OF THE GENERAL CONDITIONS, CITY OF ALBUQUERQUE STANDARD SPECIFICATIONS FOR PUBLIC WORKS CONSTRUCTION, 1986, WHICH SHALL TAKE PRECEDENCE OVER THESE PLANS.
- C WATER SHUT-OFF HOURS DURING ANY ONE DAY WILL BE DETERMINED BY THE PROJECT ENGINEER.
- D THE CONTRACTOR SHALL APPLY FOR A WATER SHUT-OFF PERMIT FROM THE WATER UTILITIES DIVISION AT LEAST FIVE (5) DAYS BEFORE THE DATE OF THE ACTUAL SHUT-OFF.
- E THE CONTRACTOR SHALL CONTACT CITY LINE MAINTENANCE AND THE FIRE DEPARTMENT PRIOR TO ANY AND ALL WATERLINE SHUT-OFF. THE CONTRACTOR MAY BE REQUIRED TO MAKE WATERLINE CONNECTIONS AND FIRE HYDRANT RELOCATIONS DURING NON-BUSINESS HOURS.
- F WATER SHUT-OFF FOR CONNECTIONS SHALL NOT EXCEED FOUR (4) HOURS.
- G CONTRACTOR SHALL PROVIDE TEMPORARY WATER SERVICE FOR SERVICE INTERRUPTIONS LONGER THAN FOUR (4) HOURS. THE COST FOR TEMPORARY SERVICE SHALL BE INCLUDED IN THE PAY ITEMS FOR THE WORK CAUSING THE OUTAGE.
- H CONTRACTOR SHALL BE PAID FROM UTILITY RELOCATION ALLOWANCE FOR LOWERING OR RELOCATING EXISTING WATER LINES WHICH WILL INCLUDE ALL MATERIALS AND LABOR INCLUDING TRENCH AND BACKFILL, FITTING, RESTRAINED JOINTS AND CONNECTIONS TO EXISTING LINES.

1126 STORM DRAIN CONSTRUCTION
WATER VALVE NO.

LEEDSHILL—HERKENHOFF, INC
500 Copper Avenue NW
P.O. Box 1217
Albuquerque, NM 87103
(505)247-0294

CITY OF ALBUQUERQUE
PUBLIC WORKS DEPARTMENT
ENGINEERING DEVELOPMENT GROUP

TITLE: DIVERSE DRAINAGE IMPROVEMENTS
LOMAS AND NAKOMIS STORM DRAIN
WATER SHUT-OFF PLAN

DESIGN REVIEW COMMITTEE

APPROVE

JUN 19 1997

DESIGN
REVIEW COMMITTEE


City Engineer Approval

APPROVED

JUN 19 1997


CITY ENGINEER

City Project No.	4880.92	Zone Map No.	J-K22	Sheet	23	Of	24
------------------	---------	--------------	-------	-------	----	----	----

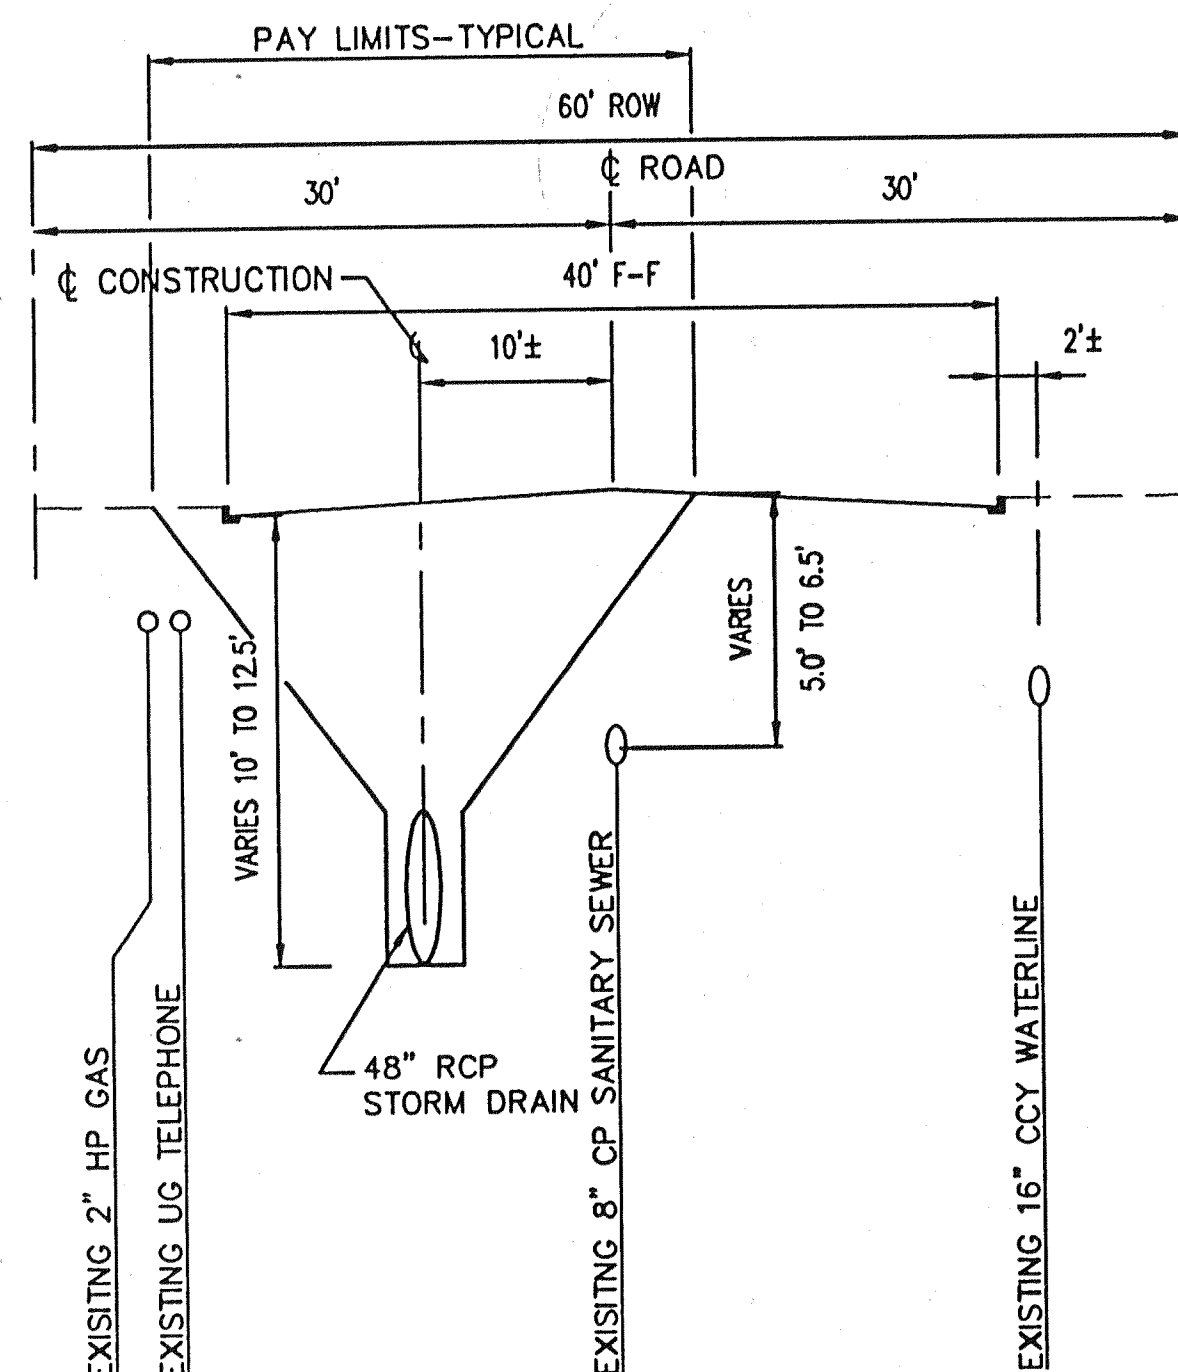


NOTE: 1 FOR ILLUSTRATION PURPOSES ONLY
2 EXCAVATE TRENCH IN ACCORDANCE WITH OSHA CRITERIA

TYPICAL TRENCH PRISM NAKOMIS DRIVE

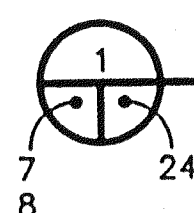


NOT TO SCALE

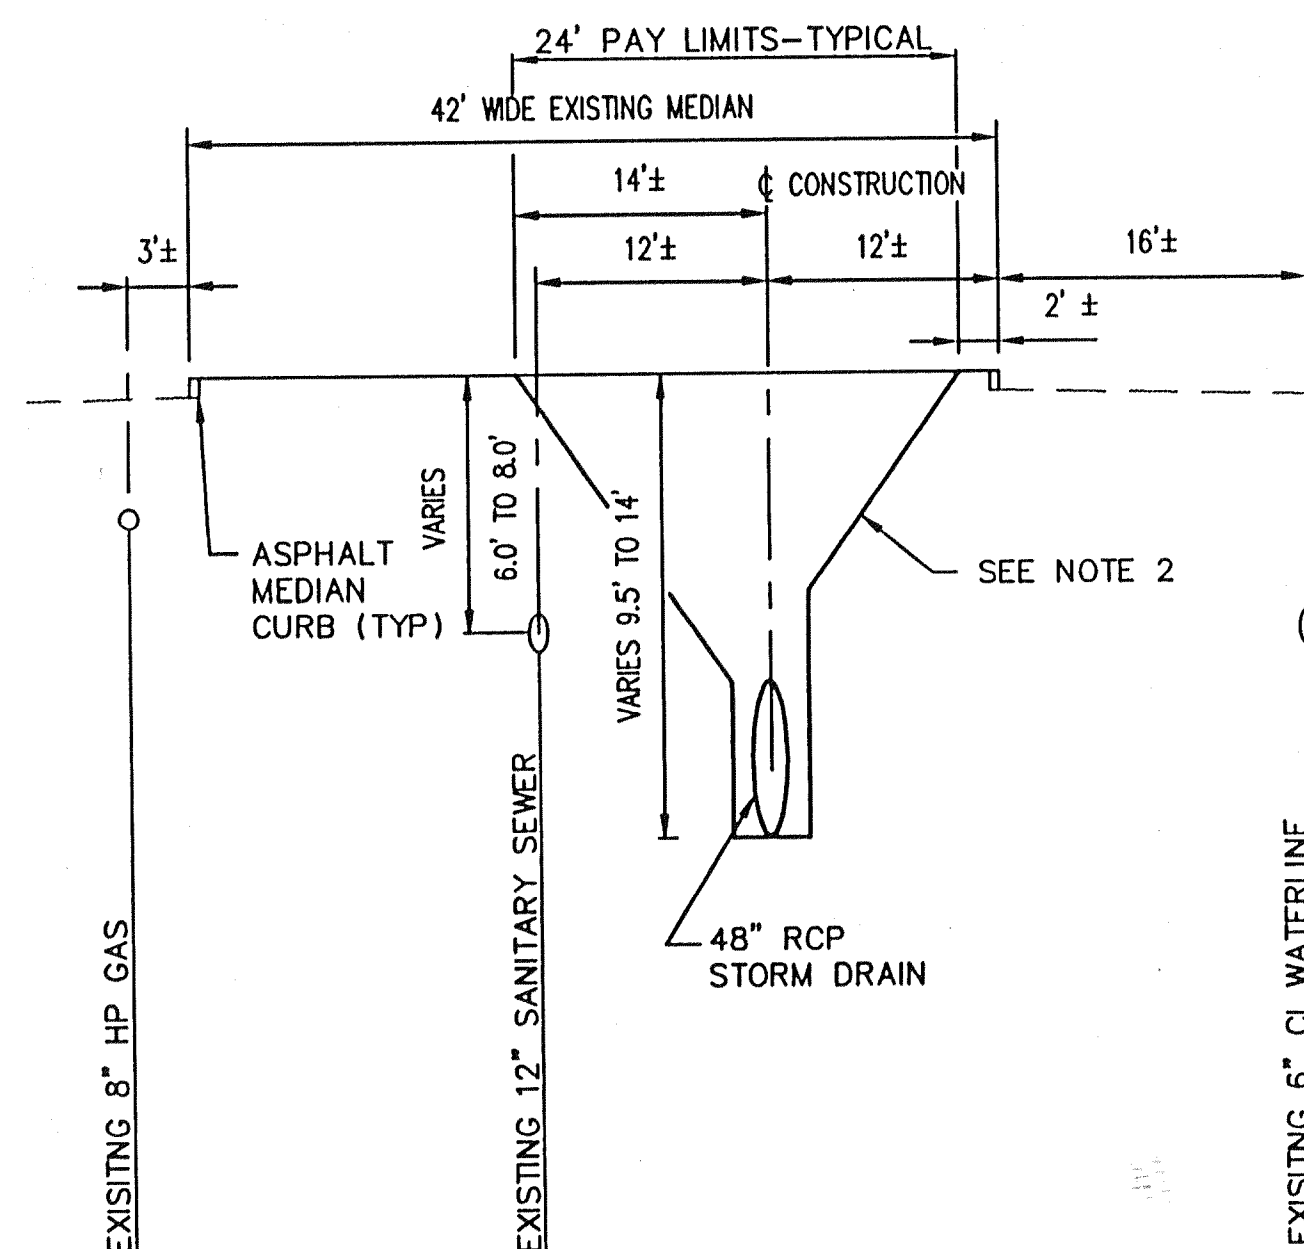


NOTES: 1 FOR ILLUSTRATION PURPOSES ONLY
2 EXCAVATE TRENCH IN ACCORDANCE WITH OSHA CRITERIA
3 PROVIDE SHORING OR TRENCH PROTECTION TO PROTECT EXISTING AC CURB ON LOMAS AS SHOWN. DAMAGE TO AC CURB OUTSIDE THE CONSTRUCTION PAY LIMITS MUST BE REPAIRED AT CONTRACTORS EXPENSE.


TYPICAL TRENCH PRISM LOMAS BLVD (100' ROW)

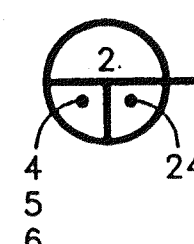


NOT TO SCALE

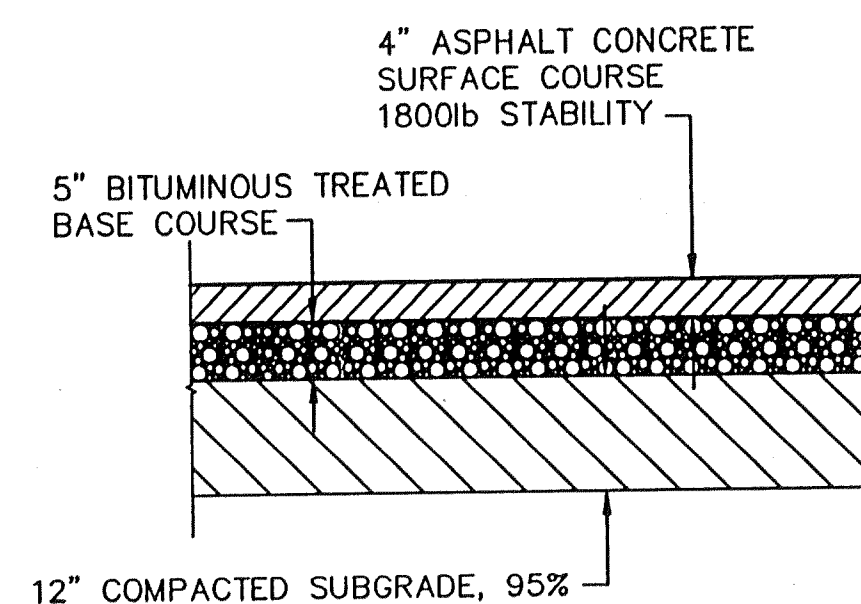

TYPICAL PAVEMENT SECTION - LOMAS BLVD

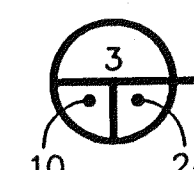


NOT TO SCALE

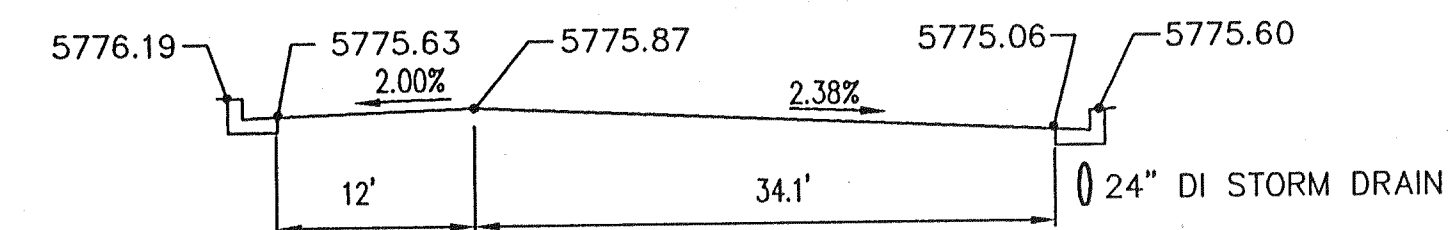

STA 1+68

LOMAS, EAST OF TRAMWAY SECTION


SCALE: 1\"/>

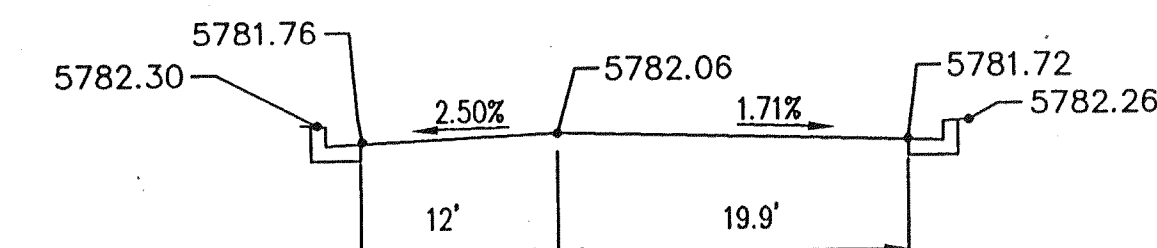


STA 2+78

LOMAS, EAST OF TRAMWAY SECTION


SCALE: 1\"/>

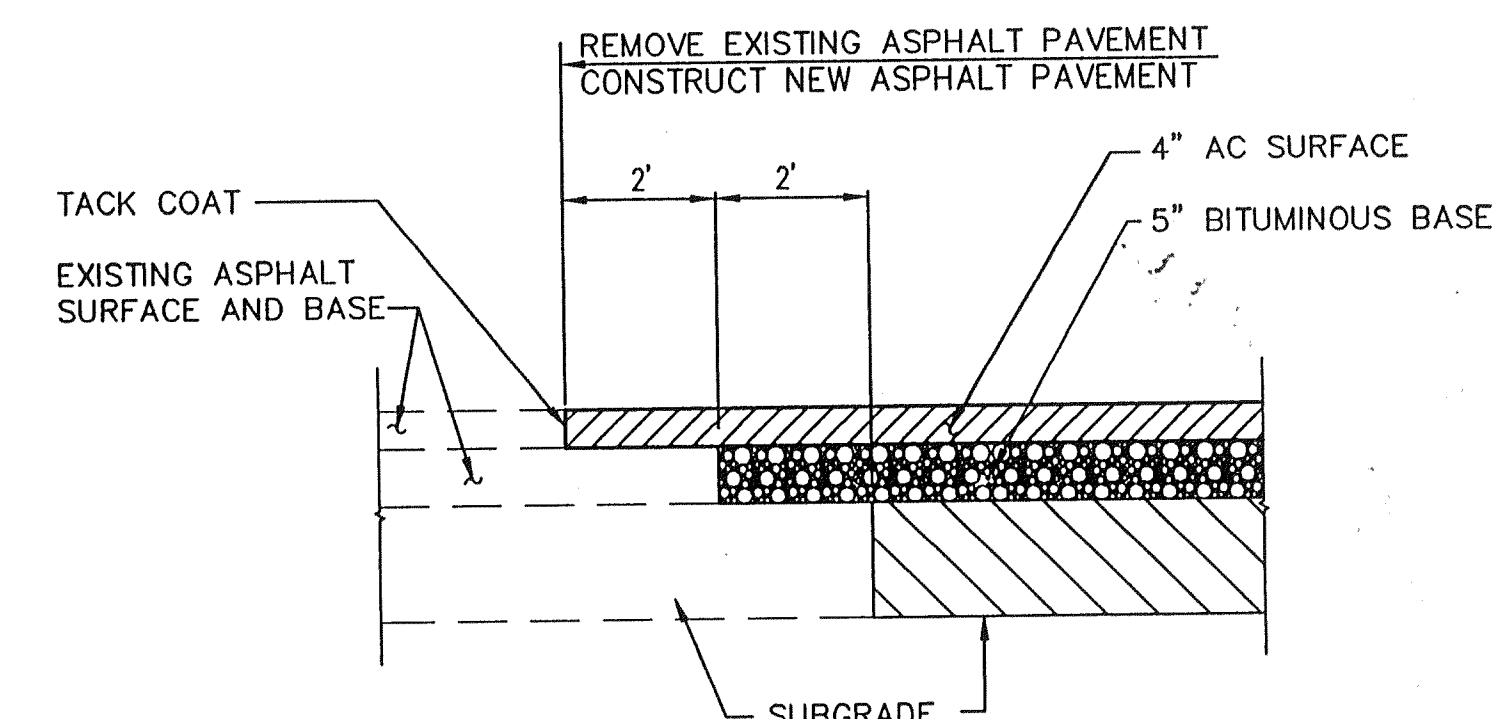

TYPICAL PAVEMENT CONNECTION DETAIL


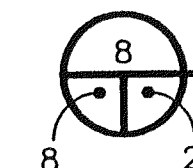


NOT TO SCALE

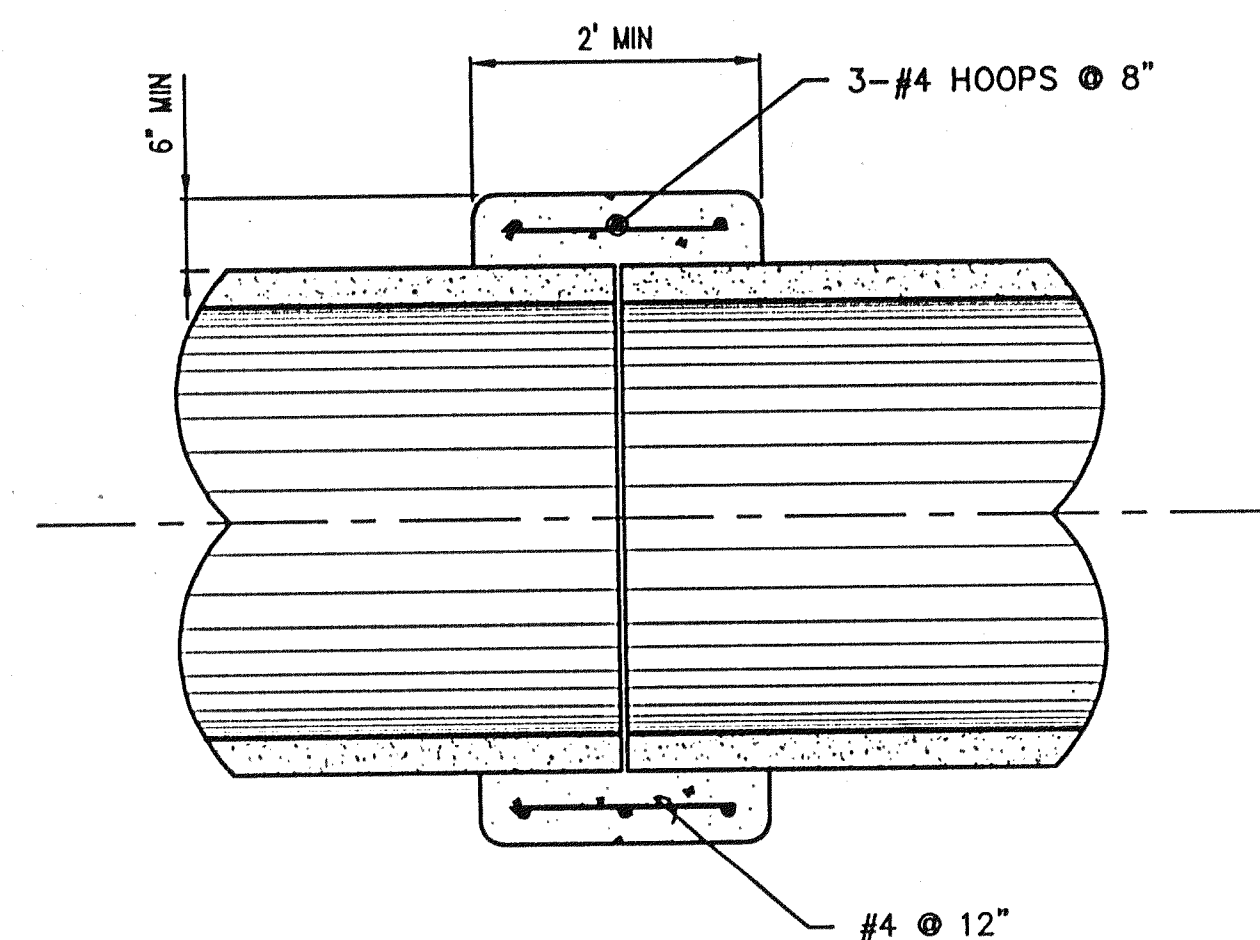


FIELD STORM DRAIN CONNECTION

SCALE: 3/4\"/>

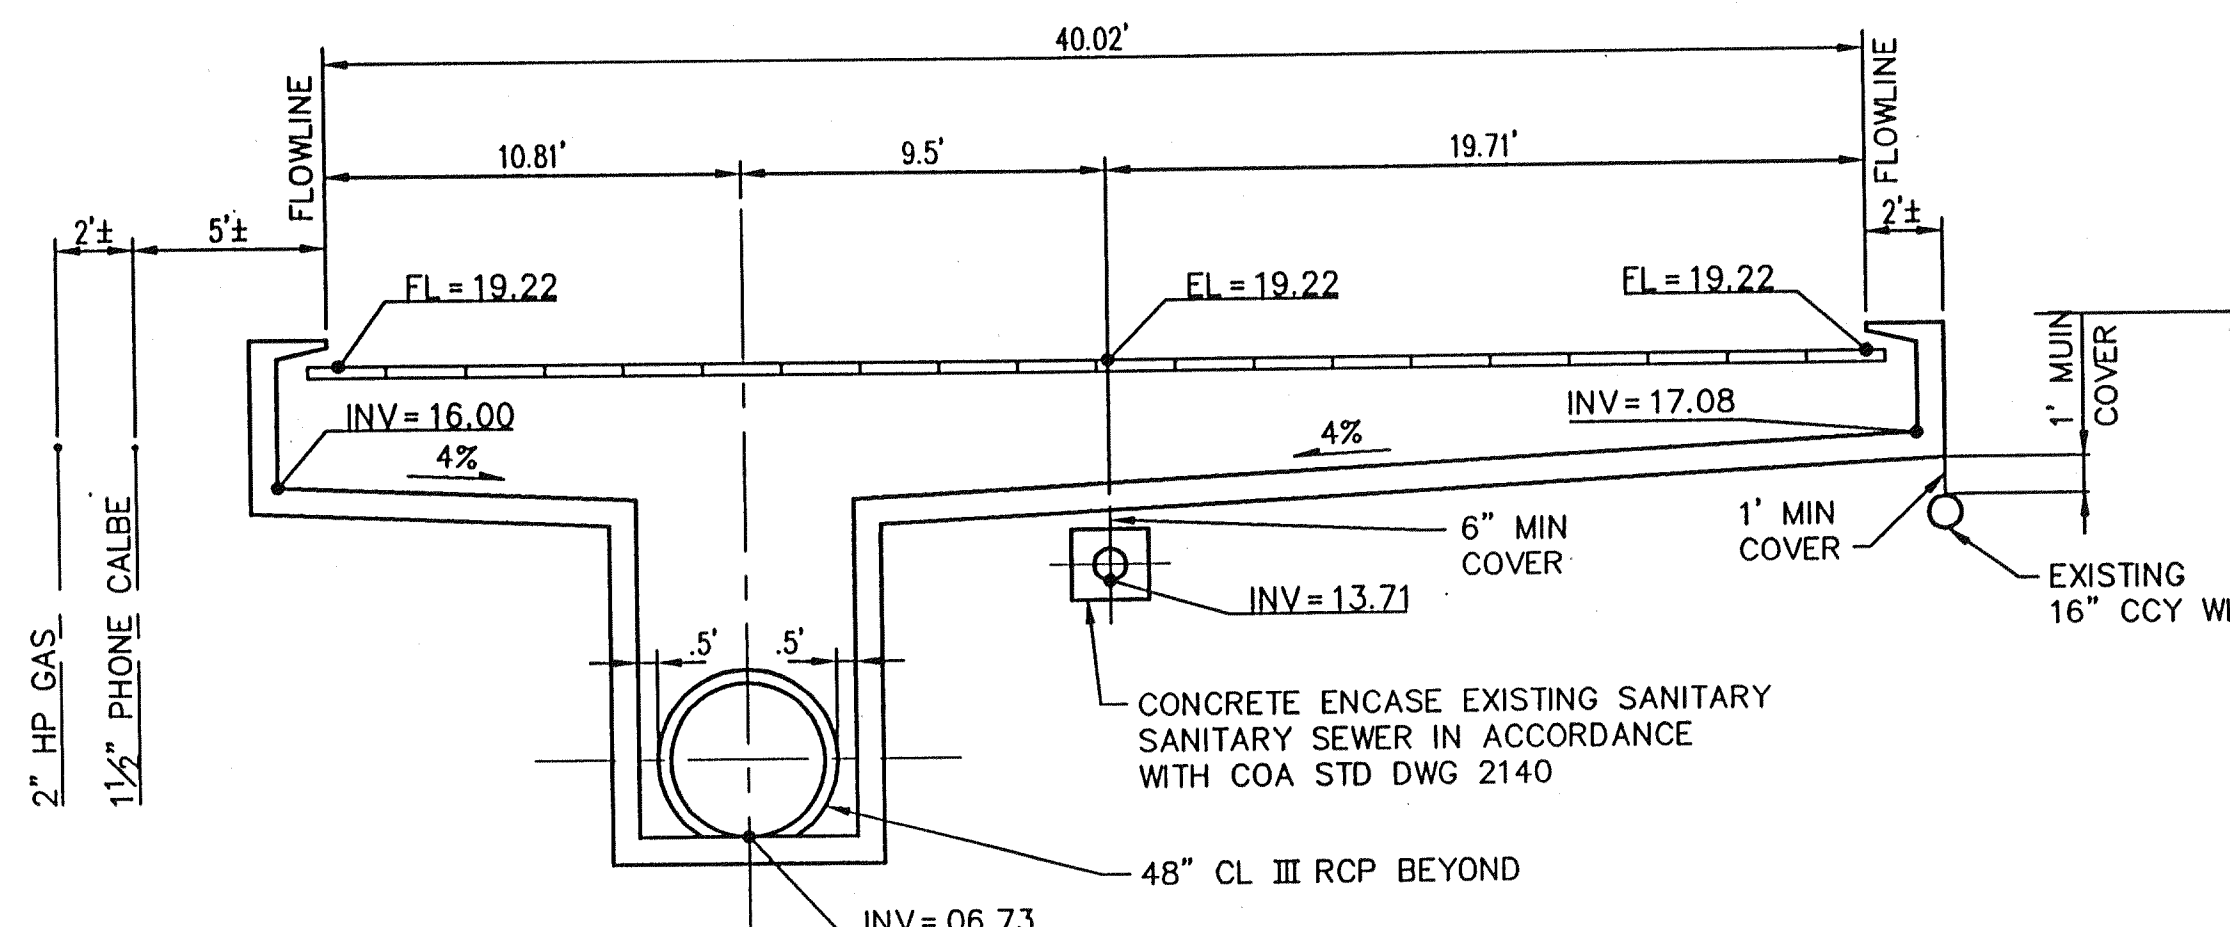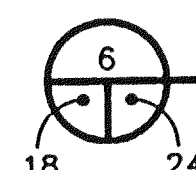

CATTLE GUARD INLET SECTION

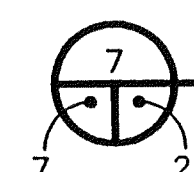

1\"/>

RECORD DRAWING

Date: JAN 1998

These drawings have been revised based on the construction records of the owner. While the information submitted by the Owner will be assumed to be reliable, the Engineer will not be responsible for the accuracy of this information nor for error or omissions which may appear in the record document as a result thereof.

LEEDSHILL-HERKENHOFF, INC
500 Copper Avenue NW
P.O. Box 1217
Albuquerque, NM 87103
(505)247-0294

CITY OF ALBUQUERQUE
PUBLIC WORKS DEPARTMENT
ENGINEERING DEVELOPMENT GROUP

TITLE: DIVERSE DRAINAGE IMPROVEMENTS
DETAILS

Design Review Committee	City Engineer Approval	Mo./Day/Yr.	Mo./Day/Yr.
APPROVE JUN 19 1997 DESIGN REVIEW COMMITTEE	APPROVE JUN 19 1997 CITY ENGINEER		
City Project No. 4880.92	Zone Map No. -	Sheet 24	Of 24