

RECORD DRAWING

PARKWEST SUBDIVISION - UNIT 1

CITY OF ALBUQUERQUE, BERNALILLO COUNTY, NEW MEXICO
IMPROVEMENTS FOR
GRADING, PAVING AND UTILITIES

INDEX TO DRAWINGS

SHEET NO.	DESCRIPTION
1	COVER SHEET AND INDEX TO DRAWINGS
2-3	PLAT OF GEOMETRY
4-5	GRADING AND EROSION CONTROL PLANS
	PAVING PLAN AND PROFILES
6	COMPOSITE PAVING PLAN
7	MEADOWBROOK AVE NW PARKWEST DR NW WINDWARD DR NW
8	STONEHAVEN DR NW BROOKSTONE DR NW STONECREEK AVE NW SUNSTONE DR NW NW SPUR NE SPUR
9	SUNSTONE DR NW FIELDSTONE AVE NW BROOKSTONE DR NW SE SPUR SW SPUR
10	98TH ST NW MEDIAN MODIFICATION PLAN
	UTILITY PLAN AND PROFILES
11	COMPOSITE UTILITY PLAN
12	MEADOWBROOK AVE NW PARKWEST DR NW WINDWARD DR NW
13	STONEHAVEN DR NW BROOKSTONE DR NW STONECREEK AVE NW SUNSTONE DR NW NW SPUR NE SPUR
14	SUNSTONE DR NW FIELDSTONE AVE NW BROOKSTONE DR NW SE SPUR SW SPUR
15	STORM DRAIN DETAILS

WARNING - EXISTING UTILITY LINE LOCATIONS ARE SHOWN IN AN APPROXIMATE MANNER ONLY, AND SUCH LINES MAY EXIST WHERE NONE ARE SHOWN. THE LOCATION OF ANY SUCH EXISTING LINES IS BASED UPON INFORMATION PROVIDED BY THE UTILITY COMPANY, THE OWNER, OR BY OTHERS, AND THE INFORMATION MAY BE INCOMPLETE OR MAY BE OBSOLETE BY THE TIME CONSTRUCTION COMMENCES.

THE ENGINEER HAS UNDERTAKEN LIMITED FIELD VERIFICATION OF THE LOCATION, DEPTH, SIZE, OR TYPE OF EXISTING UNDERGROUND UTILITY LINES, MAKES NO REPRESENTATION PERTAINING THERETO AND ASSUMES NO RESPONSIBILITY OR LIABILITY THEREFOR. THE CONTRACTOR SHALL INFORM ITSELF OF THE LOCATION OF ANY UTILITY LINE IN OR NEAR THE AREA OF THE WORK IN ADVANCE OF AND DURING EXCAVATION WORK. THE CONTRACTOR IS FULLY RESPONSIBLE FOR ANY AND ALL DAMAGE CAUSED BY ITS FAILURE TO LOCATE, IDENTIFY, AND PRESERVE ANY AND ALL EXISTING UTILITIES. THE CONTRACTOR SHALL COMPLY WITH STATE STATUTES, MUNICIPAL AND LOCAL ORDINANCES, RULES AND REGULATIONS PERTAINING TO THE LOCATION OF THESE LINES AND FACILITIES IN PLANNING AND CONDUCTING EXCAVATION, WHETHER BY CALLING OR NOTIFYING THE UTILITIES, COMPLYING WITH "BLUE STAKES" PROCEDURES, OR OTHERWISE.

RECORD DRAWING


"I, Kent M. Whitman, a duly Registered Professional Engineer in the State of New Mexico, (registration number 6170), do hereby certify that this Record Drawing was prepared at my direction and under my supervision, and that it is true and correct to the best of my knowledge and belief. The information contained herein is not based upon construction observation conducted under my supervision, but on interviews with supervisory personnel employed by the General Contractor and interviews with field survey personnel who staked the infrastructure for construction.

Kent M. Whitman 12/3/97
Kent M. Whitman, P.E. No. 6170 Date




26-14886.91-101197

REV.	SHEETS	CITY ENGINEER	DATE	USER	DEPARTMENT	DATE	USER	DEPARTMENT	DATE

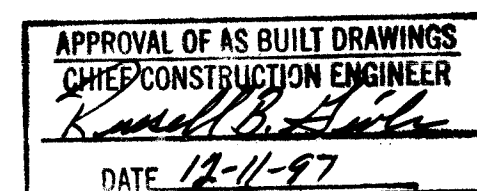

ENGINEER'S SEAL 	DATE: MARCH, 1994 SCALE: AS SHOWN DESIGNED: B.O.W. DRAWN: C.E.N. JOB NO.: 143-22-040 LAND PLANNING: P.O. Box 1328 ENGINEERING: Corrales, N.M. 87048 SURVEYING: Corrales, N.M. 87048	APPROVED FOR CONSTRUCTION CITY ENGINEER <u>James D. Hinkle</u> 9/1/97 DATE
PROJECT NO. 4886.91	SHEET 1 OF 15	

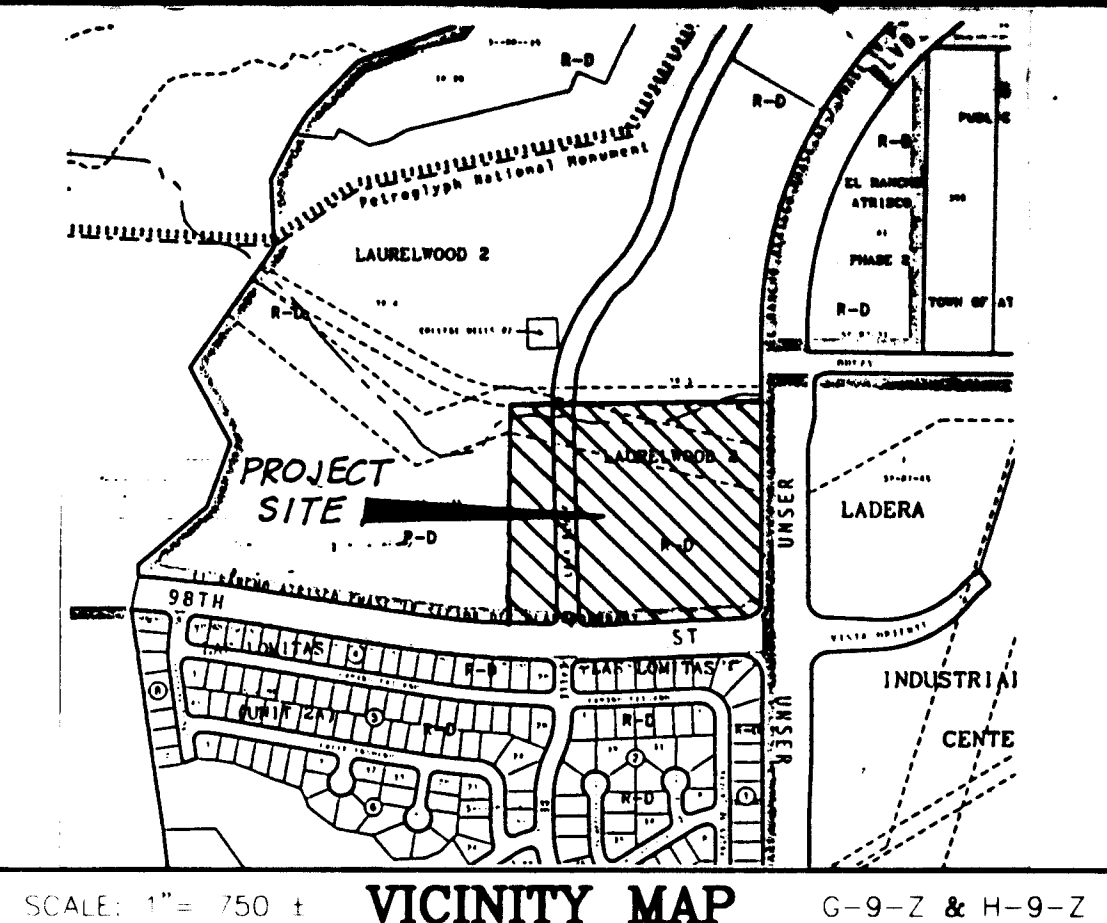

- GENERAL NOTES:
- ALL WORK DETAILED ON THESE PLANS TO BE PERFORMED UNDER CONTRACT SHALL, EXCEPT AS OTHERWISE STATED OR PROVIDED FROM HEREON, BE CONSTRUCTED IN ACCORDANCE WITH THE CITY OF ALBUQUERQUE STANDARD SPECIFICATIONS FOR PUBLIC WORKS CONSTRUCTION, 1986 EDITION AS AMENDED WITH UPDATE NO. 4.
 - TWO (2) WORKING DAYS PRIOR TO ANY EXCAVATION, CONTRACTOR MUST CONTACT LINE LOCATING SERVICE, (280-1990) FOR LOCATION OF EXISTING UTILITIES.
 - PRIOR TO CONSTRUCTION, THE CONTRACTOR SHALL EXCAVATE AND VERIFY THE HORIZONTAL AND VERTICAL LOCATIONS OF ALL OBSTRUCTIONS AND EXISTING PAVEMENT. SHOULD A CONFLICT EXIST, THE CONTRACTOR SHALL NOTIFY THE ENGINEER OR SURVEYOR SO THAT THE CONFLICT CAN BE RESOLVED WITH MINIMUM AMOUNT OF DELAY.
 - THE CONTRACTOR SHALL FURNISH EMD'S ON ALL WATER AND SEWER SERVICE STUBS, CAPS AND PLUGS.
 - CONTRACTOR SHALL NOTIFY THE PROJECT ENGINEER NOT LESS THAN SEVEN (7) DAYS PRIOR TO STARTING WORK IN ORDER THAT THE ENGINEER MAY TAKE NECESSARY MEASURES TO INSURE THE PRESERVATION OF SURVEY MONUMENTS. CONTRACTOR SHALL NOT DISTURB PERMANENT SURVEY MONUMENTS WITHOUT THE CONSENT OF THE ENGINEER AND BEAR THE EXPENSE OF REPLACING ANY THAT MAY BE DISTURBED WITHOUT PERMISSION. REPLACEMENT SHALL BE DONE ONLY BY THE CITY SURVEY SECTION. WHEN A CHANGE IS MADE IN ANY ROADWAY IN WHICH A PERMANENT SURVEY MONUMENT IS LOCATED, CONTRACTOR SHALL, AT HIS OWN EXPENSE, ADJUST THE MONUMENT COVER TO THE NEW GRADE UNLESS OTHERWISE SPECIFIED. REFER TO SECTION 4.4 OF GENERAL CONDITIONS OF THE CITY OF ALBUQUERQUE STANDARD SPECIFICATIONS FOR PUBLIC WORKS CONSTRUCTION.
 - RESTRAINED JOINTS ARE REQUIRED AT ALL WATER LINE BENDS, TEES, CAPS AND GATE VALVES.
 - THE PUBLIC WATER LINE MUST BE A MINIMUM OF 18" ABOVE THE SEWER LINE AT ALL CROSSINGS.
 - THE CONTRACTOR SHALL CONTACT WATER SYSTEMS DIVISION (857-8200) THREE (3) WORKING DAYS PRIOR TO NEEDING SHUT-OFF OR TURN-ON OF VALVES. ONLY CITY WATER SYSTEMS PERSONNEL ARE AUTHORIZED TO OPERATE VALVE.
 - THREE (3) WORKING DAYS PRIOR TO BEGINNING CONSTRUCTION, THE CONTRACTOR SHALL SUBMIT TO THE CONSTRUCTION COORDINATION DIVISION A DETAILED CONSTRUCTION SCHEDULE. TWO (2) WORKING DAYS PRIOR TO CONSTRUCTION, THE CONTRACTOR SHALL OBTAIN A BARRICADE PERMIT FROM THE CONSTRUCTION COORDINATION DIVISION. CONTRACTOR SHALL NOTIFY BARRICADE ENGINEER (768-2551) PRIOR TO OCCUPYING AN INTERSECTION. SEE SECTION 19 OF THE SPECIFICATIONS.
 - ALL STREET STRIPING ALTERED OR DESTROYED SHALL BE REPLACED IN KIND BY CONTRACTOR TO LOCATION AND IN KIND AS EXISTING OR AS INDICATED BY THIS PLAN SET. ALL NEW STRIPING SHALL BE PLASTIC AS PER CITY STANDARDS.

VACATION AND REPLAT
COMPRISED OF
ALL OF TRACTS I, III
AND PORTIONS OF TRACTS II-B AND IV
LAURELWOOD II SUBDIVISION
TOGETHER WITH
ALL OF LAVA BLUFF DRIVE RIGHT-OF-WAY

TO
PARKWEST UNIT 1

SITUATE WITHIN
THE TOWN OF ATRISCO GRANT
"PROJECTED" SECTIONS 4 & 9, T10N, R2E, N.M.P.M.
CITY OF ALBUQUERQUE, BERNALILLO COUNTY, NEW MEXICO
JUNE, 1994

NOTES:

- THE PURPOSE OF THIS PLAT IS TO VACATE EXISTING LAVA BLUFF 72' RIGHT-OF-WAY AND SUBDIVIDE TRACTS I AND III WITH PORTIONS OF TRACT II-B AND IV LAURELWOOD II SUBDIVISION AND CONTAINING 83.2783 ACRES INTO 75 RESIDENTIAL LOTS, ADJOINING STREETS, TWO TRACTS, AND A 1/4 A.C. RIGHT-OF-WAY.
- ALL BEARING SHOWN HEREON ARE GRID BEARINGS BASED ON THE NEW MEXICO STATE PLANE COORDINATE SYSTEM, CENTRAL ZONE, MEAN DELTA ALPHA -00°16'22" ALL DISTANCES ARE GROUND DISTANCES.
- BEARINGS AND DISTANCES SHOWN IN PARENTHESES ARE FROM RECORD PLATS.
- ALL DIMENSIONS PUBLISHED ALONG CURVED LINES ARE ARC DISTANCES. LOT LINES MARKED N/A ARE NON-RADIAL.
- BENCHMARK FOR THIS PLAT IS THE CITY OF ALBUQUERQUE ALL ALU. BASS TABLE STAMPED "2-G9" SET IN A 2" IRON PIPE 1 FT. ABOVE GROUND, LOCATED ON TOP OF A VOLCANIC OUTCROP, TO REACH THE STATION FROM THE INTERSECTION OF COORS RD. AND URAY RD. NW GO WEST ON URAY RD. ABOUT 0.7 MI. TO THE END OF PAVEMENT. CONTINUE WEST ON THE DIRT RD. TO THE TOP OF THE DETENTION DAM, ALONG THE N. BANK OF LAKE 0.6 MI. TO A DIRT CROSS ROAD. TURN RIGHT, GO N ON THE DIRT ROAD 0.5 MI. TO 1929 ELEVATION = 5334.50 A.L.
- UNLESS OTHERWISE NOTED, ALL CORNERS ARE EVIDENCED BY A #5 REBAR WITH ALUMINUM CAP STAMPED "C.S. 4972".
- CENTERLINE (IN LIEU OF R/W) MONUMENTATION TO BE INSTALLED AT ALL CENTERLINE POINTS, ITS ANGLE POINTS AND STREET INTERSECTIONS PRIOR TO ACCEPTANCE OF SUBDIVISION STREET IMPROVEMENTS AND WILL CONSIST OF A FOUR INCH ALUMINUM ALLOY CAP STAMPED "CITY OF ALBUQUERQUE CENTERLINE MONUMENTATION SURVEY MARKER DO NOT DISTURB P.L.S. 4972". DENOTES CENTERLINE MONUMENT.
- PUBLIC UTILITY EASEMENTS (P.U.E.) SHOWN ON THIS PLAT ARE TEN (10) FEET WIDE AND ARE GRANTED FOR THE COMMON AND JOINT USE OF:
 - THE PUBLIC SERVICE COMPANY OF NEW MEXICO FOR THE INSTALLATION, MAINTENANCE, AND SERVICE OF UNDERGROUND ELECTRICAL LINES, TRANSFORMERS, POLES AND ANY OTHER EQUIPMENT, FIXTURES, STRUCTURES AND RELATED FACILITIES REASONABLY NECESSARY TO PROVIDE ELECTRICAL SERVICE.
 - THE GAS COMPANY OF NEW MEXICO FOR INSTALLATION, MAINTENANCE, AND SERVICE OF NATURAL GAS LINES, VALVES AND OTHER EQUIPMENT AND FACILITIES REASONABLY NECESSARY TO PROVIDE NATURAL GAS.
 - U.S. WEST FOR THE INSTALLATION, MAINTENANCE AND SERVICE OF ALL BURIED COMMUNICATION LINES AND OTHER RELATED EQUIPMENT AND FACILITIES REASONABLY NECESSARY TO PROVIDE COMMUNICATION SERVICES, INCLUDING BUT NOT LIMITED TO ABOVE GROUND PEDESTALS AND CLOSURES.
 - JONES INTERCABLE FOR THE INSTALLATION, MAINTENANCE, AND SERVICE OF SUCH UNDERGROUND LINES, CABLE, AND OTHER RELATED EQUIPMENT AND FACILITIES REASONABLY NECESSARY TO PROVIDE CABLE TV SERVICE.

(NOTE CONTINUE ON SHEET 8)

CURVE TABLE					
CURVE	RADIUS	ARC	DELTA	TANGENT	CHORD BRG
C1	70.15	109.18	089-10-44	69.15	S26-10-05E 98.49
C2	1322.07	741.87	032-09-04	380.98	S34-29-49W 732.17
C3	1477.55	1310.12	050-48-12	701.65	N25-10-15E 1267.62
C4	60.00	91.91	087-45-53	57.70	S43-40-06W 83.18
C5	3749.16	780.87	011-56-01	391.85	N86-28-57W 779.46
C6	4644.34	442.14	005-27-16	221.24	S83-14-35E 441.97
C7	625.00	345.29	031-39-12	177.11	N60-40-35E 340.91
C8	584.13	278.87	028-42-23	142.5	S42-20-29W 278.87
C9	2175.00	873.54	023-00-42	442.7	N36-40-59E 867.00
C10	491.49	106.17	012-22-38	53.29	N39-58-36W 105.97
C11	487.33	559.04	065-43-35	314.82	N76-23-36E 528.88

C16	2470.00	142.02	003-17-3	71.03	N69-41-11W 142.00
C17	300.00	43.25	008-15-35	21.66	N02-54-24E 43.22
C18	570.00	218.37	029-59-29	152.69	N75-13-47W 294.97
C19	630.00	329.77	029-59-29	168.76	N75-13-48W 326.92
C20	75.00	119.12	090-59-53	76.32	N44-16-32E 106.99
C21	75.00	59.51	045-30-13	31.45	N21-31-41E 58.01
C22	75.00	59.55	045-29-40	31.45	N67-01-38E 58.00
C23	120.00	93.95	044-51-24	49.53	N23-39-07W 91.57
C24	75.00	116.50	089-00-07	73.70	S45-43-28E 105.14
C25	75.00	67.66	011-38-36	36.29	S64-24-14E 65.34
C26	75.00	48.90	037-21-31	25.36	S19-54-10E 48.04
C27	120.00	80.33	038-21-24	41.74	N70-35-46E 78.84
C28	75.00	116.21	088-46-27	73.41	S43-09-49W 104.93
C29	75.00	62.25	047-33-29	33.05	S22-33-20W 60.48
C30	75.00	53.95	041-12-58	32.20	S66-56-33W 52.80
C31	120.00	91.61	043-44-25	48.17	N69-21-13W 89.40
C32	75.00	119.41	091-13-33	76.62	N46-50-11W 107.19
C33	75.00	59.78	045-40-16	31.58	N69-36-49W 58.21
C34	75.00	59.63	045-33-16	31.49	N24-00-03W 58.07
C35	120.00	90.21	043-04-25	47.36	S67-14-22W 87.10
C36	2432.00	64.49	001-28-58	32.25	N88-54-07W 6.49
C37	3747.16	10.16	000-09-19	5.08	N88-23-20W 10.16
C38	3747.16	67.62	001-02-02	33.81	N67-47-39W 67.62
C39	2492.00	23.82	000-32-52	11.91	N99-55-02W 23.82
C40	20.00	31.08	088-58-03	19.64	S45-42-26E 28.03
C41	35.00	56.66	092-45-26	36.73	S45-09-18W 50.67
C42	20.00	31.77	091-01-16	20.36	S44-17-13W 28.54
C43	2448.00	97.72	002-17-14	48.87	N89-03-32W 97.71
C44	20.00	30.95	088-40-23	19.54	S45-53-21E 27.95
C45	20.00	31.54	090-20-30	20.12	S44-36-13W 28.37
C46	328.00	39.97	006-58-53	20.01	N02-55-25E 39.94
C47	272.00	42.79	009-00-47	21.44	N03-16-58E 42.74
C48	20.00	31.30	089-40-16	19.89	N46-23-17W 28.20
C49	20.00	31.42	090-00-00	20.00	S43-46-35W 28.28
C50	97.00	9.17	005-25-01	4.59	N01-29-06E 9.17
C51	97.00	42.78	025-16-14	21.74	N16-49-44E 42.44
C52	20.00	10.16	029-05-54	5.19	S14-54-54W 10.05
C53	20.00	11.20	032-05-38	5.75	S15-40-52E 11.06

CURVE TABLE					
CURVE	RADIUS	ARC	DELTA	TANGENT	CHORD BRG
C54	134.50	42.40	018-03-42	21.38	N22-41-50W 42.22
C55	134.50	29.21	012-26-34	14.66	N07-26-42W 29.15
C56	105.50	39.23	021-18-10	19.84	N11-52-30W 39.00
C57	20.00	32.28	092-28-00	20.88	N68-45-36W 28.89
C58	97.00	24.65	014-33-42	12.39	N72-17-15E 24.59
C59	97.00	17.28	010-12-22	8.66	N84-40-17E 17.27
C60	97.00	18.92	011-10-22	9.41	S84-38-21E 18.86
C61	97.00	40.93	024-10-43	20.78	S66-57-49E 40.63
C62	20.00	13.44	038-30-23	6.99	N74-07-39W 13.19
C63	20.00	9.34	026-45-03	4.76	S73-14-38W 9.25
C64	134.50	44.11	018-47-26	22.22	N69-15-50E 43.91
C65	134.50	26.09	011-06-55	13.06	N84-13-00E 26.05
C66	105.50	44.03	023-54-35	22.34	N77-49-11E 44.71
C67	20.00	29.99	085-54-22	18.62	N22-54-42E 27.26
C68	97.00	25.85	015-16-18	13.00	S12-24-20E 25.78
C69	97.00	6.00	003-32-46	3.00	S02-59-48E 6.00
C70	97.00	19.28	011-23-09	9.67	S04-28-10W 19.24
C71	97.00	21.16	013-40-55	11.66	S17-00-12W 23.11
C72	20.00	33.59	096-14-05	22.30	N24-16-23W 29.78
C73	105.50	34.68	018-49-59	17.50	N81-48-25W 34.52
C74	134.50	51.47	021-55-27	26.05	N80-15-41W 51.15
C75	134.50	18.87	008-02-20	9.45	N65-16-48W 18.86
C76	20.00	20.52	058-47-30	11.27	N89-20-37E 19.63
C77	97.00	14.81	008-45-03	7.47	S64-19-24W 14.81
C78	97.00	31.92	018-51-07	16.10	S78-07-29W 31.77
C79	97.00	4.63	002-44-11	2.32	S88-55-08W 4.63
C80	97.00	48.99	028-56-19	25.03	N75-14-37W 48.47
C81	20.00	4.11	011-46-50	2.06	S66-39-53E 4.10
C82	20.00	16.68	047-47-06	8.86	N83-33-09E 16.20
C83	134.50	36.16	015-24-17	18.19	S67-21-45W 36.05
C84	134.50	32.19	013-42-41	16.17	S81-55-14W 32.11
C85	105.50	34.27	018-36-43	17.29	S79-28-13W 34.12
C86	20.00	33.17	095-01-40	21.84	S22-39-02W 29.50
C87	97.00	23.56	013-54-50	11.84	N17-54-23W 23.50
C88	97.00	16.47	009-43-33	8.25	N06-05-12W 16.45
C89	20.00	31.42	090-00-00	20.00	S46-13-25E 28.28
C90	20.00	31.42	090-00-00	20.00	N44-46-35E 28.28
C91	35.00	54.52	089-15-02	34.55	N45-50-56W 49.17
C92	3747.16	63.46	000-58-13	31.73	S89-02-27W 63.46
C93	3747.16	62.93	000-57-44	31.46	S88-04-28W 62.92
C94	3747.16	2.80	000-02-34	1.40	S87-34-20W 2.80
C95	60.00	91.91	087-45-53	57.70	S43-40-06W 83.18
C96	53.00	82.33	089-00-07	52.08	S45-43-28E 74.30
C97	53.00	82.12	088-46-27	51.88	S43-09-49W 74.15
C98	53.00	84.39	091-13-33	54.15	N46-50-11W 75.75
C99	53.00	84.18	090-59-53	53.93	N44-16-32E 75.80
C100	3747.16	442.19	006-45-41	221.35	N83-53-47W 441.93
C101	4646.34	442.42	005-27-20	221.38	S83-14-37E 442.25

SURVEYOR'S CERTIFICATION:

I, C. A. SPIROCK, HEREBY AFFIRM THAT I AM A DULY QUALIFIED REGISTERED PROFESSIONAL SURVEYOR UNDER THE LAWS OF THE STATE OF NEW MEXICO AND DO CERTIFY THAT THIS PLAT WAS PREPARED BY ME OR UNDER MY DIRECT SUPERVISION; SHOWS ACCURATE DIMENSIONS, AND LAND AREAS; SHOWS ALL EASEMENTS AND RESTRICTIONS AS SHOWN ON THE PLAT OF RECORD OR MADE KNOWN TO ME BY THE OWNERS AND/OR PROPRIETORS OF THE SUBDIVISION SHOWN HEREON, TITLE COMPANIES, UTILITY COMPANIES OR OTHER PARTIES EXPRESSING AN INTEREST. I FURTHER CERTIFY THAT THIS PLAT MEETS THE MINIMUM REQUIREMENTS FOR MONUMENTATION AND SURVEYS OF THE ALBUQUERQUE SUBDIVISION ORDINANCE, MEETS THE "MINIMUM STANDARDS FOR LAND SURVEYS" SET FORTH BY THE STATE OF NEW MEXICO AND IS TRUE AND CORRECT TO THE BEST OF MY KNOWLEDGE AND BELIEF.

C. A. SPIROCK, N.M.P.S. #4972

7/10/94
DATE

SHEET 7 OF 8

DATE	JUNE, 1994
SCALE	AS SHOWN
DESIGNED	BOM
DRAWN	SPS
COR NO.	143-22-025

community
sciences
corporation

LAND PLANNING
P.O. Box 1328
ENGINEERING
CORP., N.M. 87048




SCANNED BY
BY TASON

VACATION AND REPLAT
COMPRISED OF
ALL OF TRACTS I, III
AND PORTIONS OF TRACTS II-B AND IV
LAURELWOOD II SUBDIVISION
TOGETHER WITH
ALL OF LAVA BLUFF DRIVE RIGHT-OF-WAY

TO
PARKWEST UNIT 1

SITUATE WITHIN
THE TOWN OF ATRISCO GRANT
"PROJECTED" SECTIONS 4 & 9, T10N, R2E, N.M.P.M.
CITY OF ALBUQUERQUE, BERNALILLO COUNTY, NEW MEXICO
JUNE, 1994

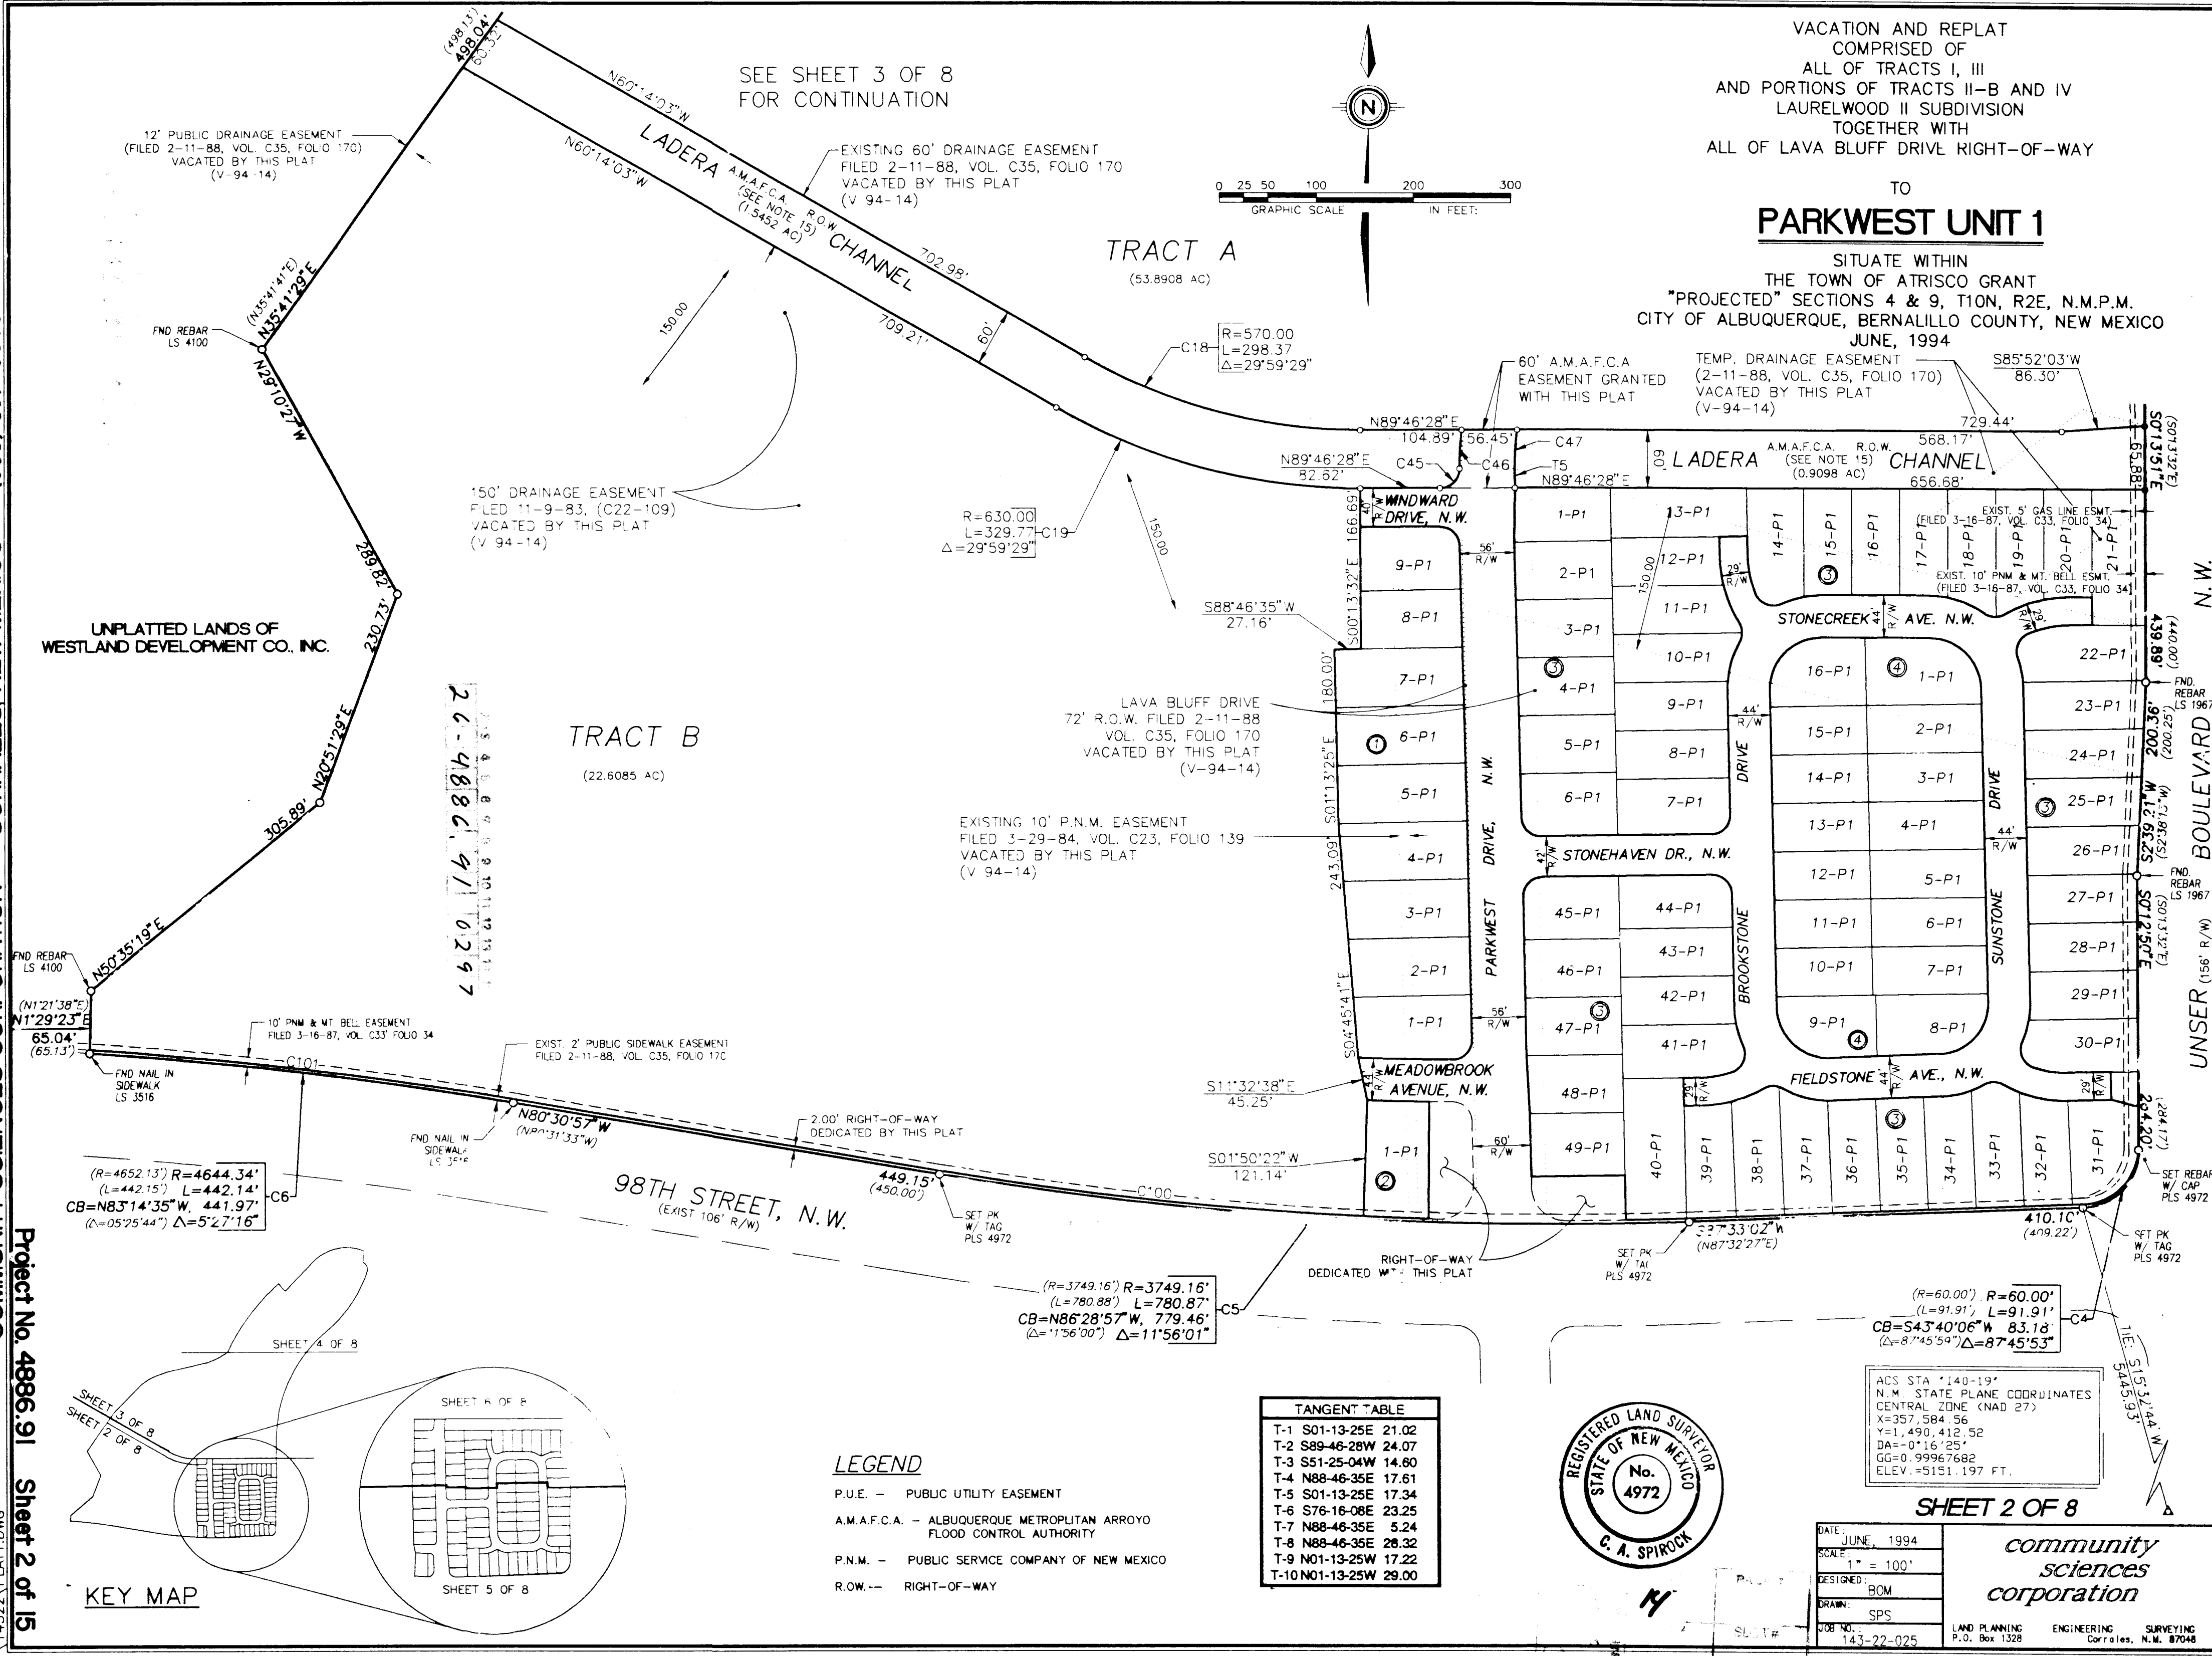

LEGEND

- P.U.E. - PUBLIC UTILITY EASEMENT
A.M.A.F.C.A. - ALBUQUERQUE METROPOLITAN ARROYO FLOOD CONTROL AUTHORITY
P.N.M. - PUBLIC SERVICE COMPANY OF NEW MEXICO
R.O.W. - RIGHT-OF-WAY

TANGENT TABLE	
T-1	S01-13-25E 21.02
T-2	S89-46-28W 24.07
T-3	S51-25-04W 14.80
T-4	N88-40-35E 17.51
T-5	S01-13-25E 17.34
T-6	S76-16-08E 23.25
T-7	N88-46-35E 5.24
T-8	N88-46-35E 28.32
T-9	N01-13-25W 17.22
T-10	N01-13-25W 29.00



SHEET 2 OF 8

DATE	JUNE, 1994
SCALE	1" = 100'
DESIGNED	BOM
DRAWN	SPS
COR NO.	143-22-025

community
sciences
corporation

LAND PLANNING
P.O. Box 1328
ENGINEERING
CORP., N.M. 87048

KEY MAP

COMMUNITY SCIENCES CORPORATION - CORRALES, NEW MEXICO - (505) 897-0000

Project No. 4896.91 Sheet 2 of 15


14322 PLAT.DWG

VACATION AND REPLAT
COMPRISED OF
ALL OF TRACTS I, III
AND PORTIONS OF TRACTS II-B AND IV
LAURELWOOD II SUBDIVISION
TOGETHER WITH
ALL OF LAVA BLUFF DRIVE RIGHT-OF-WAY


TO
PARKWEST UNIT 1

SITUATE WITHIN
THE TOWN OF ATRISCO GRANT
"PROJECTED" SECTIONS 4 & 9, T10N, R2E, N.M.P.M.
CITY OF ALBUQUERQUE, BERNALILLO COUNTY, NEW MEXICO
JUNE, 1994

TANGENT TABLE	
T-1	S01-13-25E 21.02
T-2	S89-46-28W 24.07
T-3	S51-25-04W 14.60
T-4	N88-46-35E 17.61
T-5	S01-13-25E 17.34
T-6	S76-16-08E 23.25
T-7	N88-46-35E 5.24
T-8	N88-46-35E 28.32
T-9	N01-13-25W 17.22
T-10	N01-13-25W 29.00

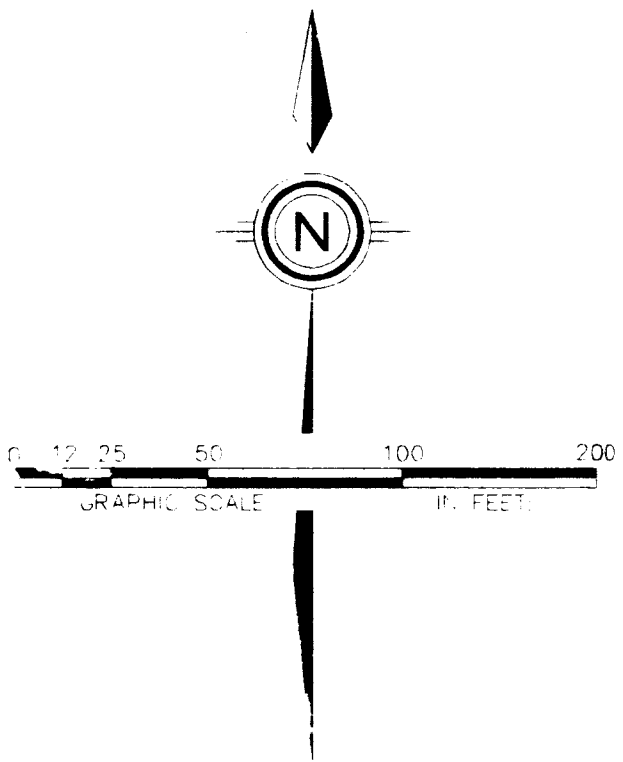

KEY MAP

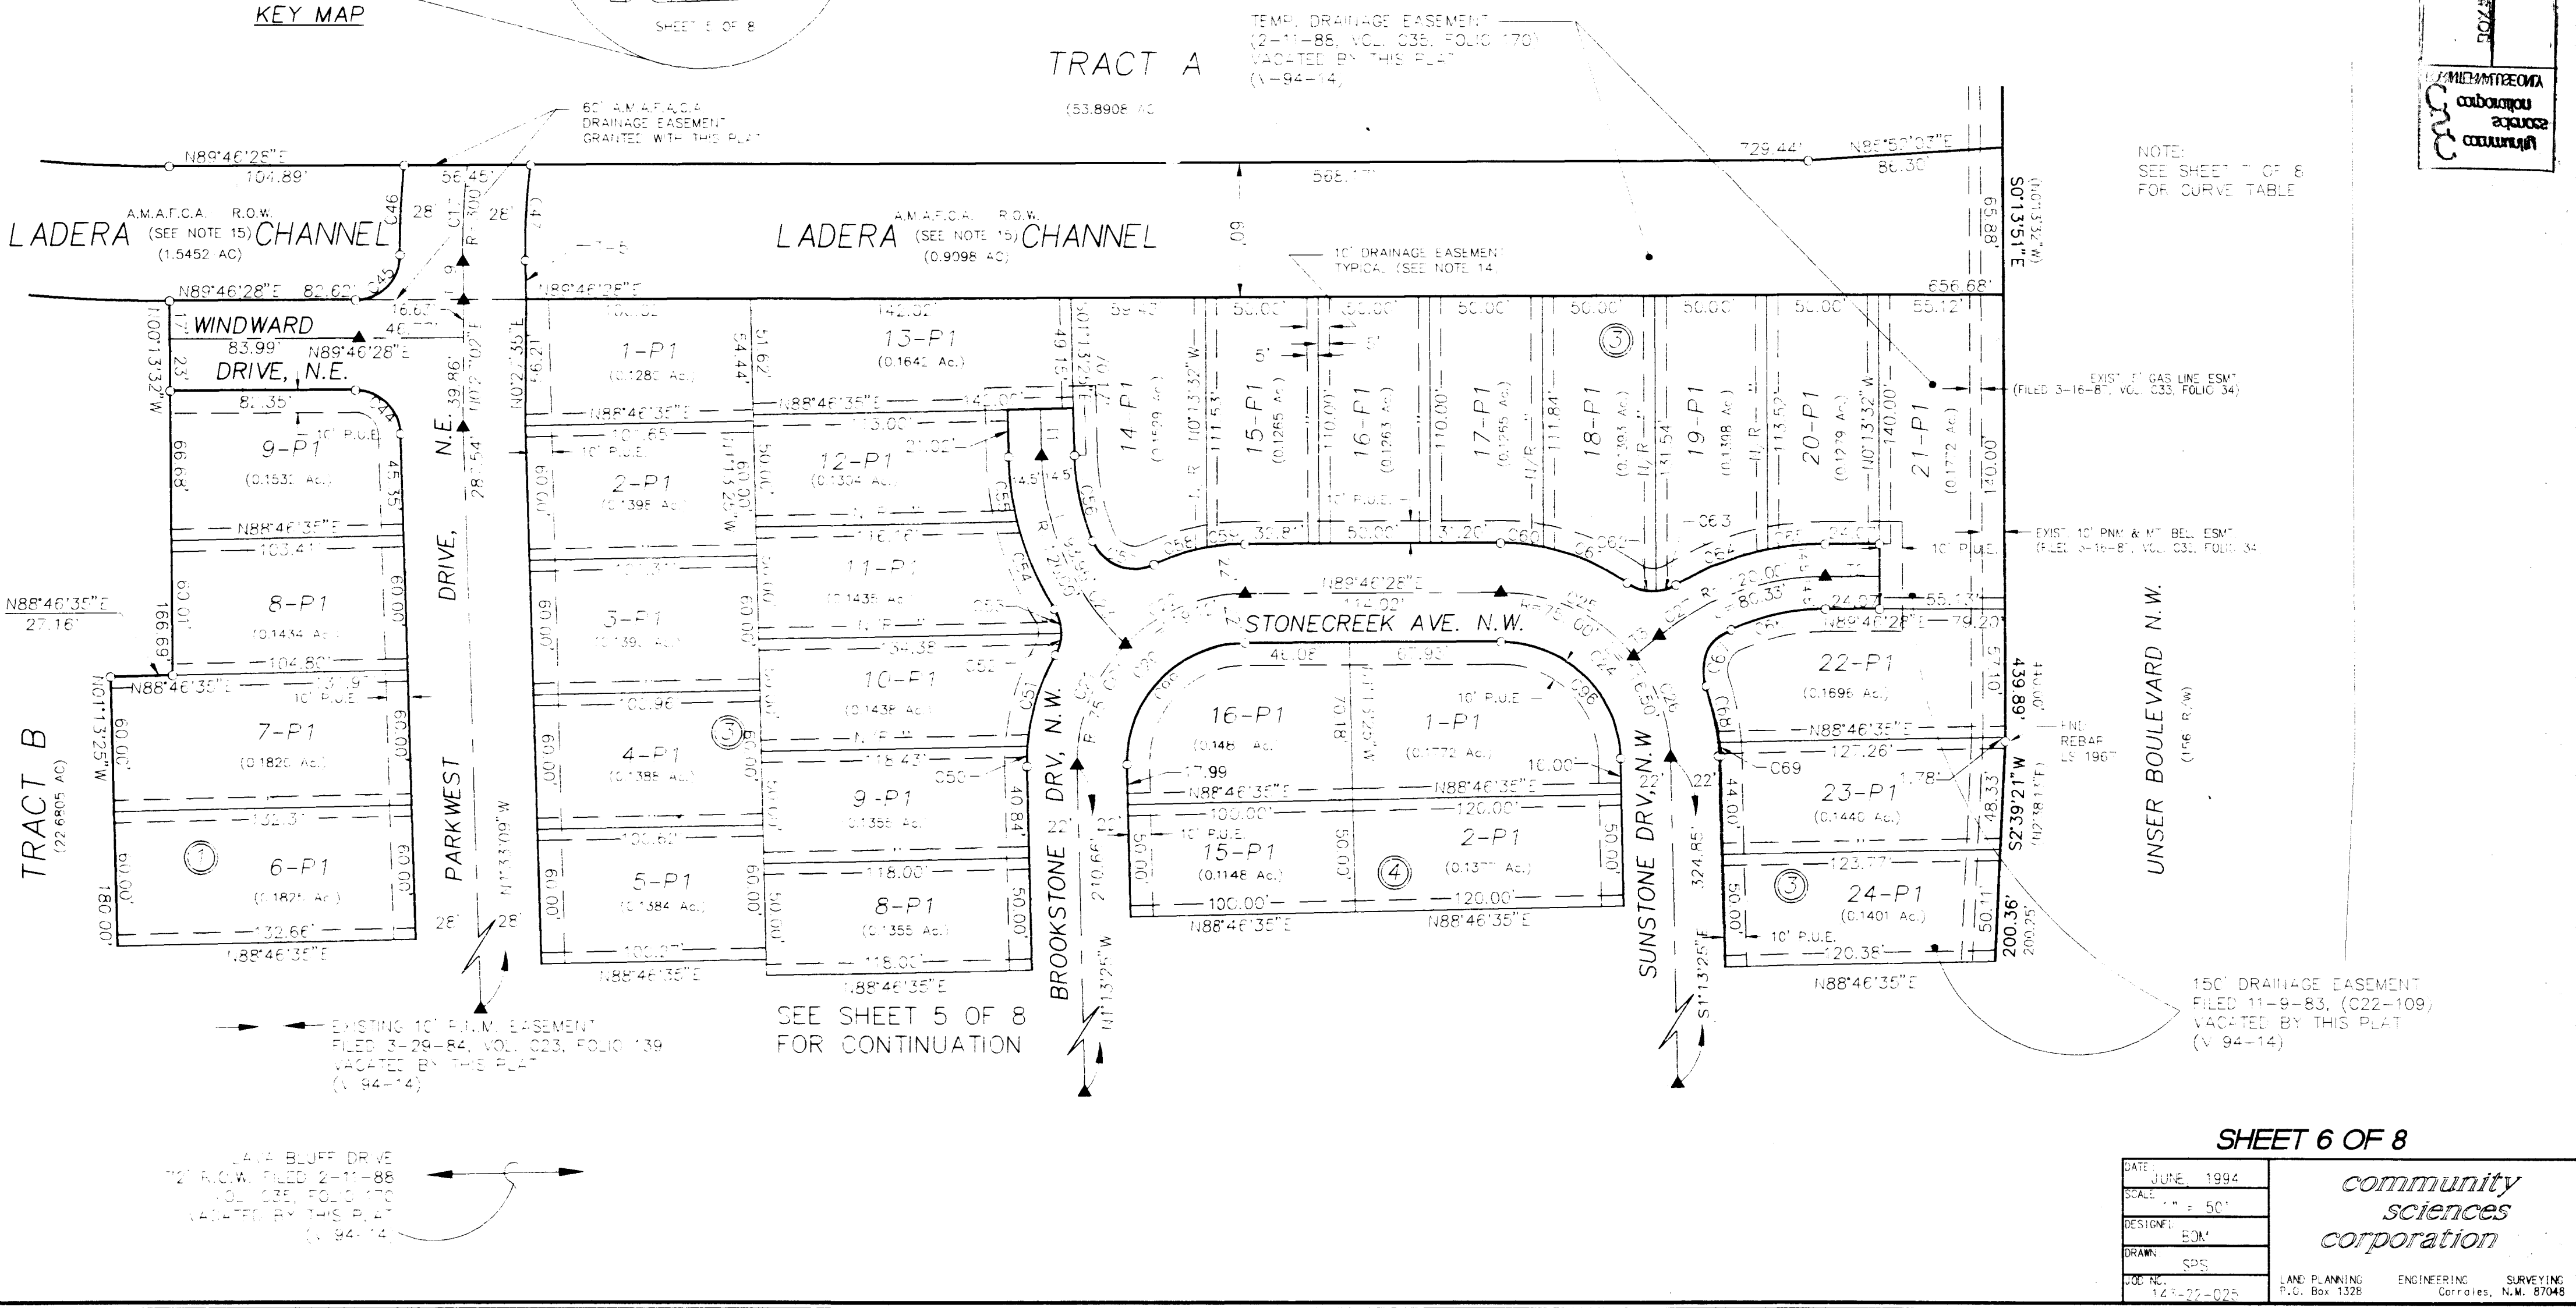

SHEET 6 OF 8

DATE	JUNE, 1994	<i>community sciences corporation</i>		
SCALE	1" = 50'			
DESIGN	EDM			
DRAWN	SPS			
FILE NO.	143-22-025	LAND PLANNING	ENGINEERING	SURVEYING
		P.O. Box 1328	Corrales, N.M. 87048	


SCANNED BY
BY LASON

VACATION AND REPLAT
COMPRISED OF
ALL OF TRACTS I, III
AND PORTIONS OF TRACTS II-B AND IV
LAURELWOOD II SUBDIVISION
TOGETHER WITH
ALL OF LAVA BLUFF DRIVE RIGHT-OF-WAY


TO
PARKWEST UNIT 1

SITUATE WITHIN
THE TOWN OF ATRISCO GRANT
"PROJECTED" SECTIONS 4 & 9, T10N, R2E, N.M.P.M.
CITY OF ALBUQUERQUE, BERNALILLO COUNTY, NEW MEXICO
JUNE, 1994

TANGENT TABLE	
T-1	S01-13-25E 21.02
T-2	S89-46-28W 24.07
T-3	S51-25-04W 14.60
T-4	N88-46-35E 17.61
T-5	S01-13-25E 17.34
T-6	S76-16-08E 23.25
T-7	N88-46-35E 5.24
T-8	N88-46-35E 28.32
T-9	N01-13-25W 17.22
T-10	N01-13-25W 29.00

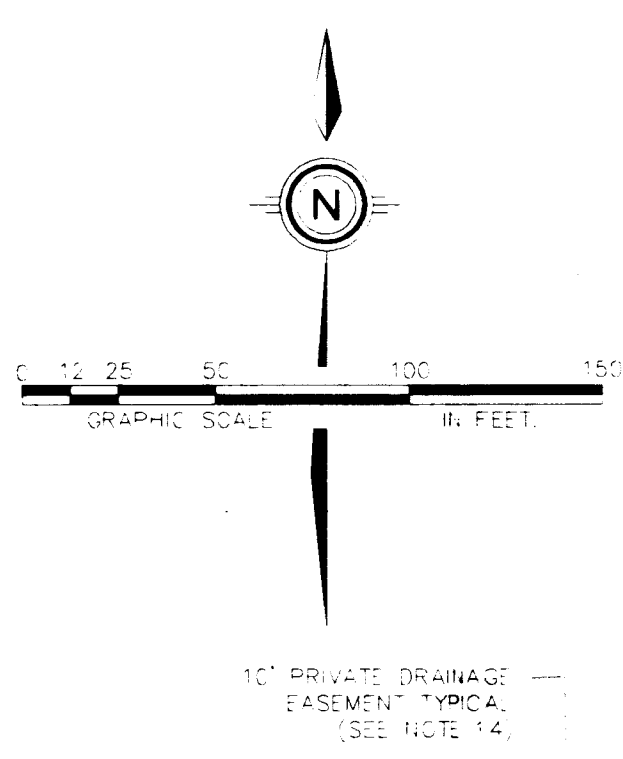


KEY MAP

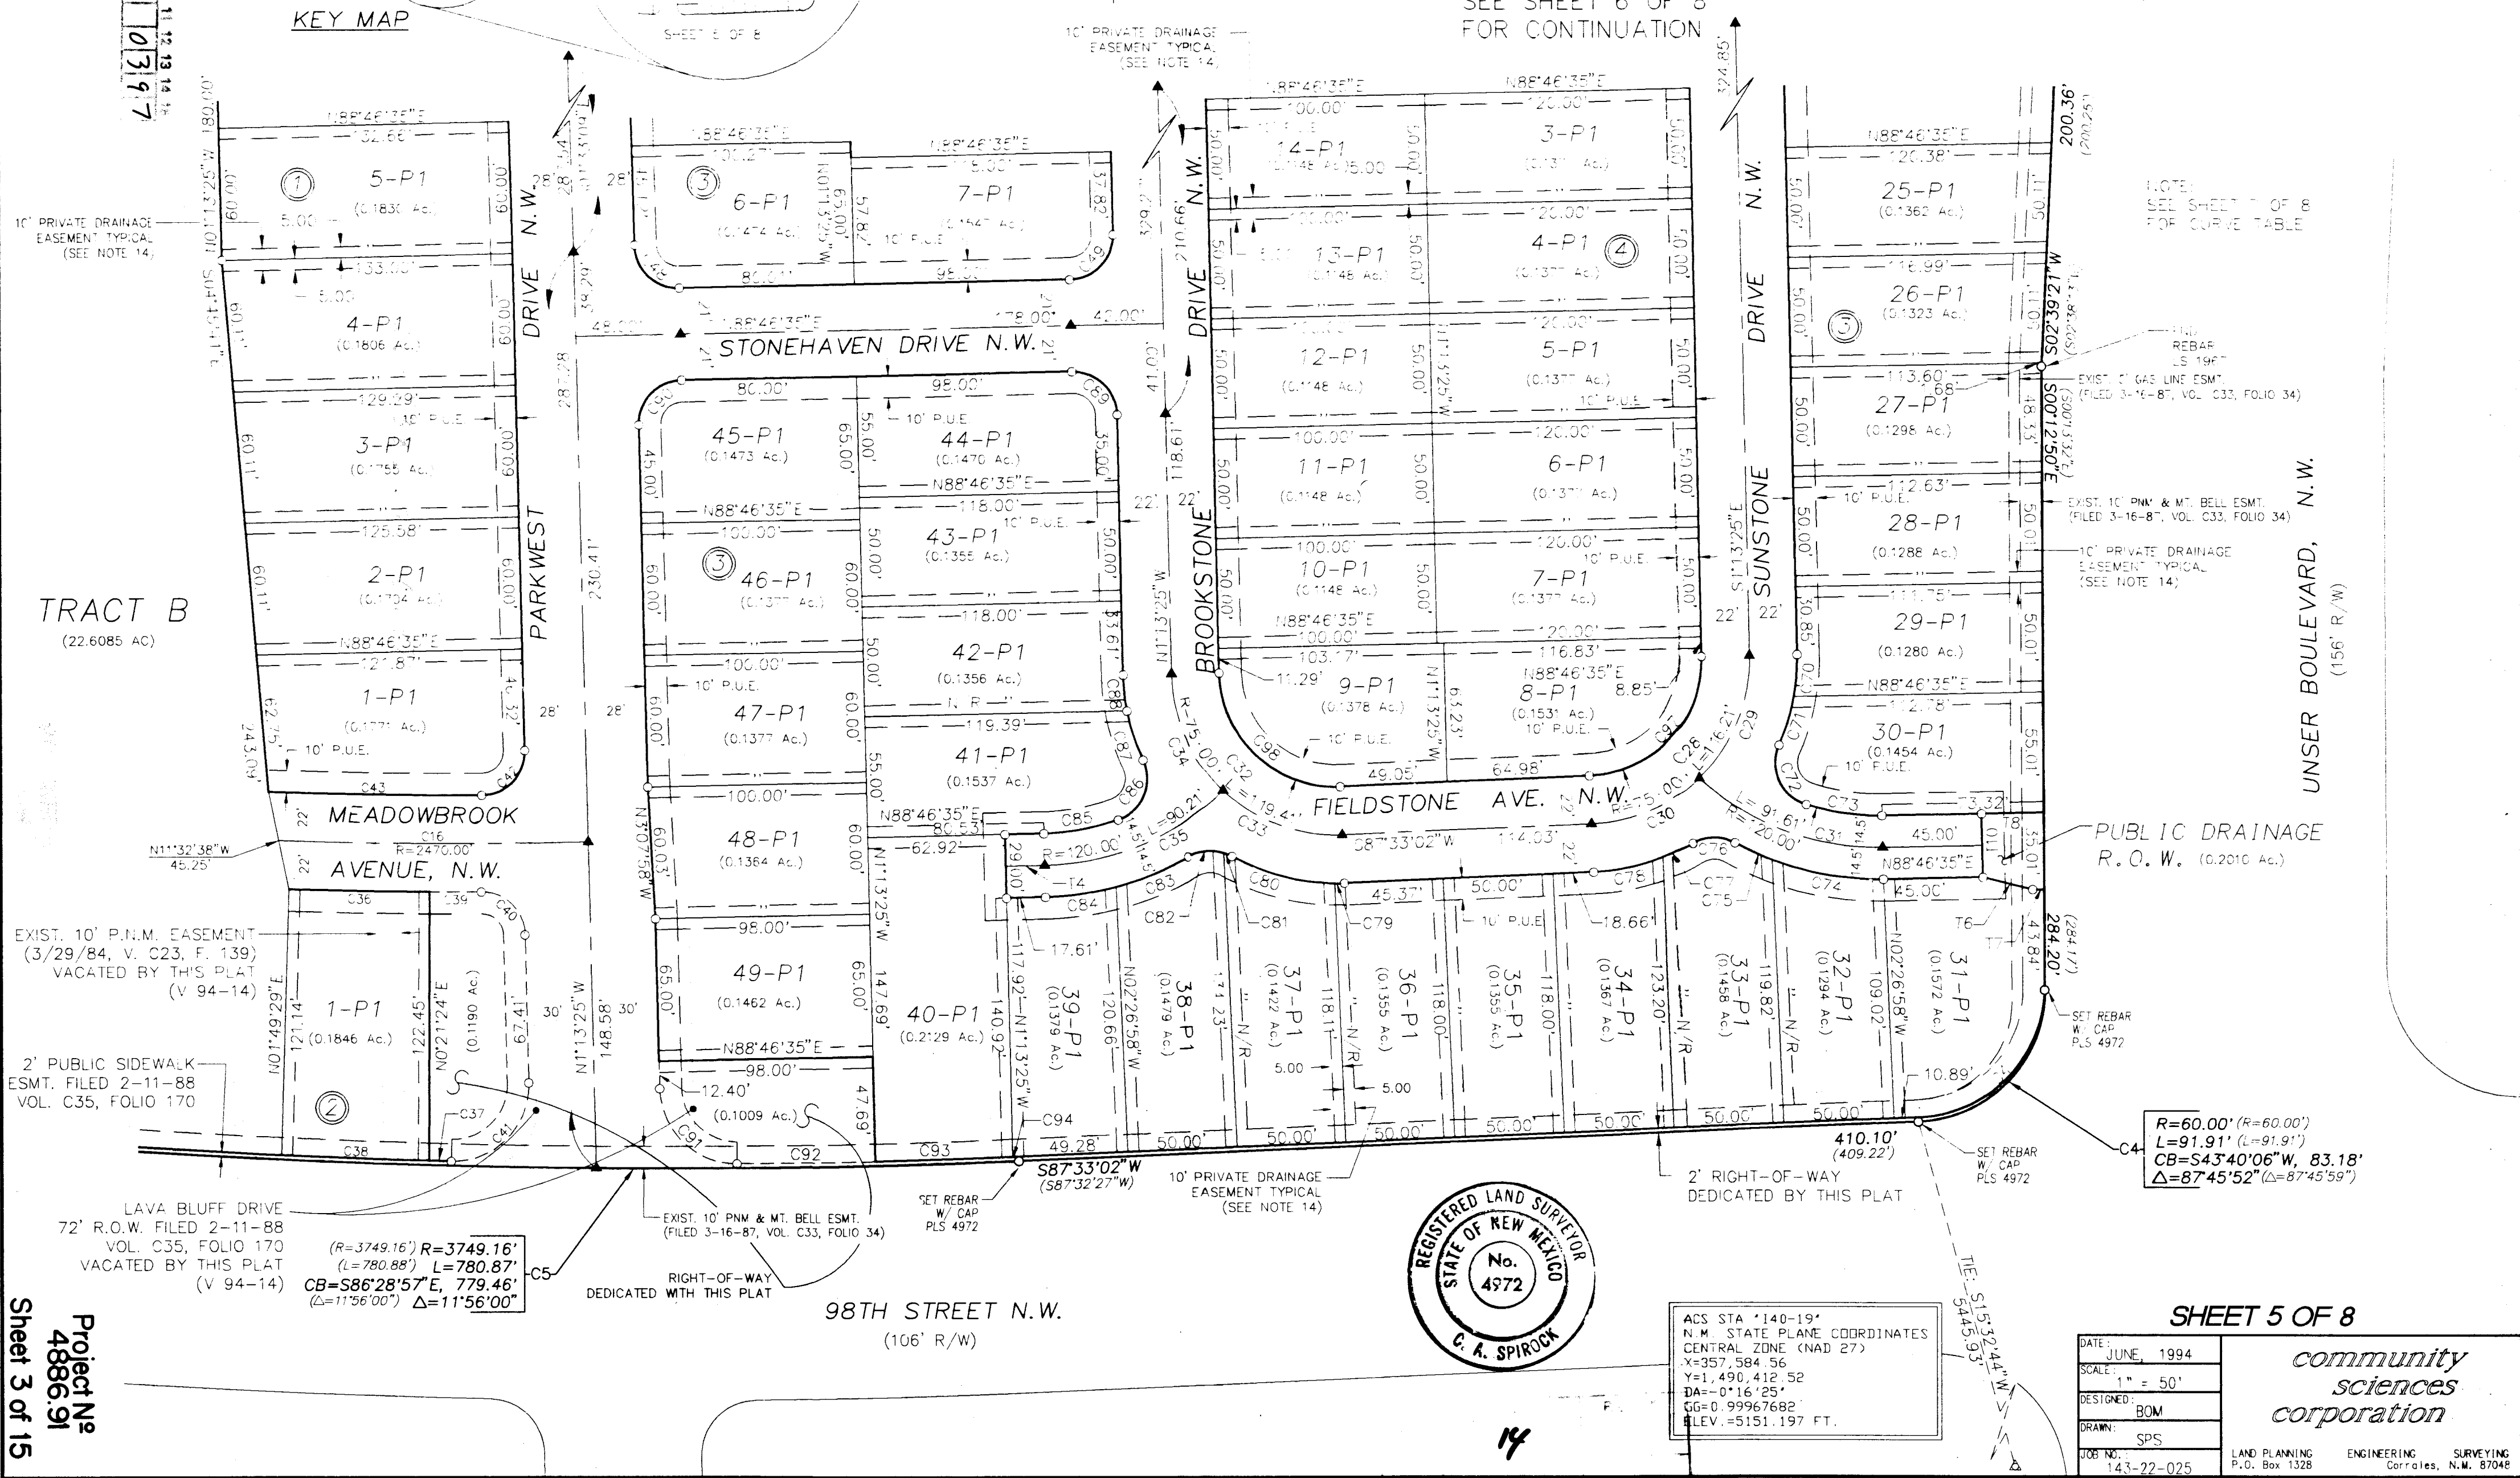

SHEET 5 OF 8

DATE:	JUNE, 1994	<i>community sciences corporation</i>		
SCALE:	1" = 50'			
DESIGNED:	BOM			
DRAWN:	SPS			
JOB NO.	143-22-025	LAND PLANNING	ENGINEERING	SURVEYING
		P.O. Box 1328	Corrales, N.M. 87048	

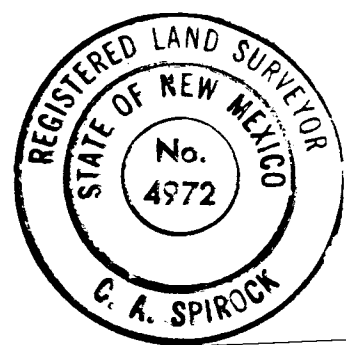

ACS STA "140-19"	
N.M. STATE PLANE COORDINATES	
CENTRAL ZONE (NAD 27)	
X=357,584.56	
Y=1,490,412.52	
DA=011625	
SG=0.99967682	
ELEV.=5151.197 FT.	

Project No.
4886-91
Sheet 3 of 15

[illegible]

THE
H
P

WA
C.A.
9

WA
C.A.
9

WA
C.A.
9

WA
C.A.
9



WA
C.A.
9

WA
C.A.
9

WA
C.A.
9

1000

Q.

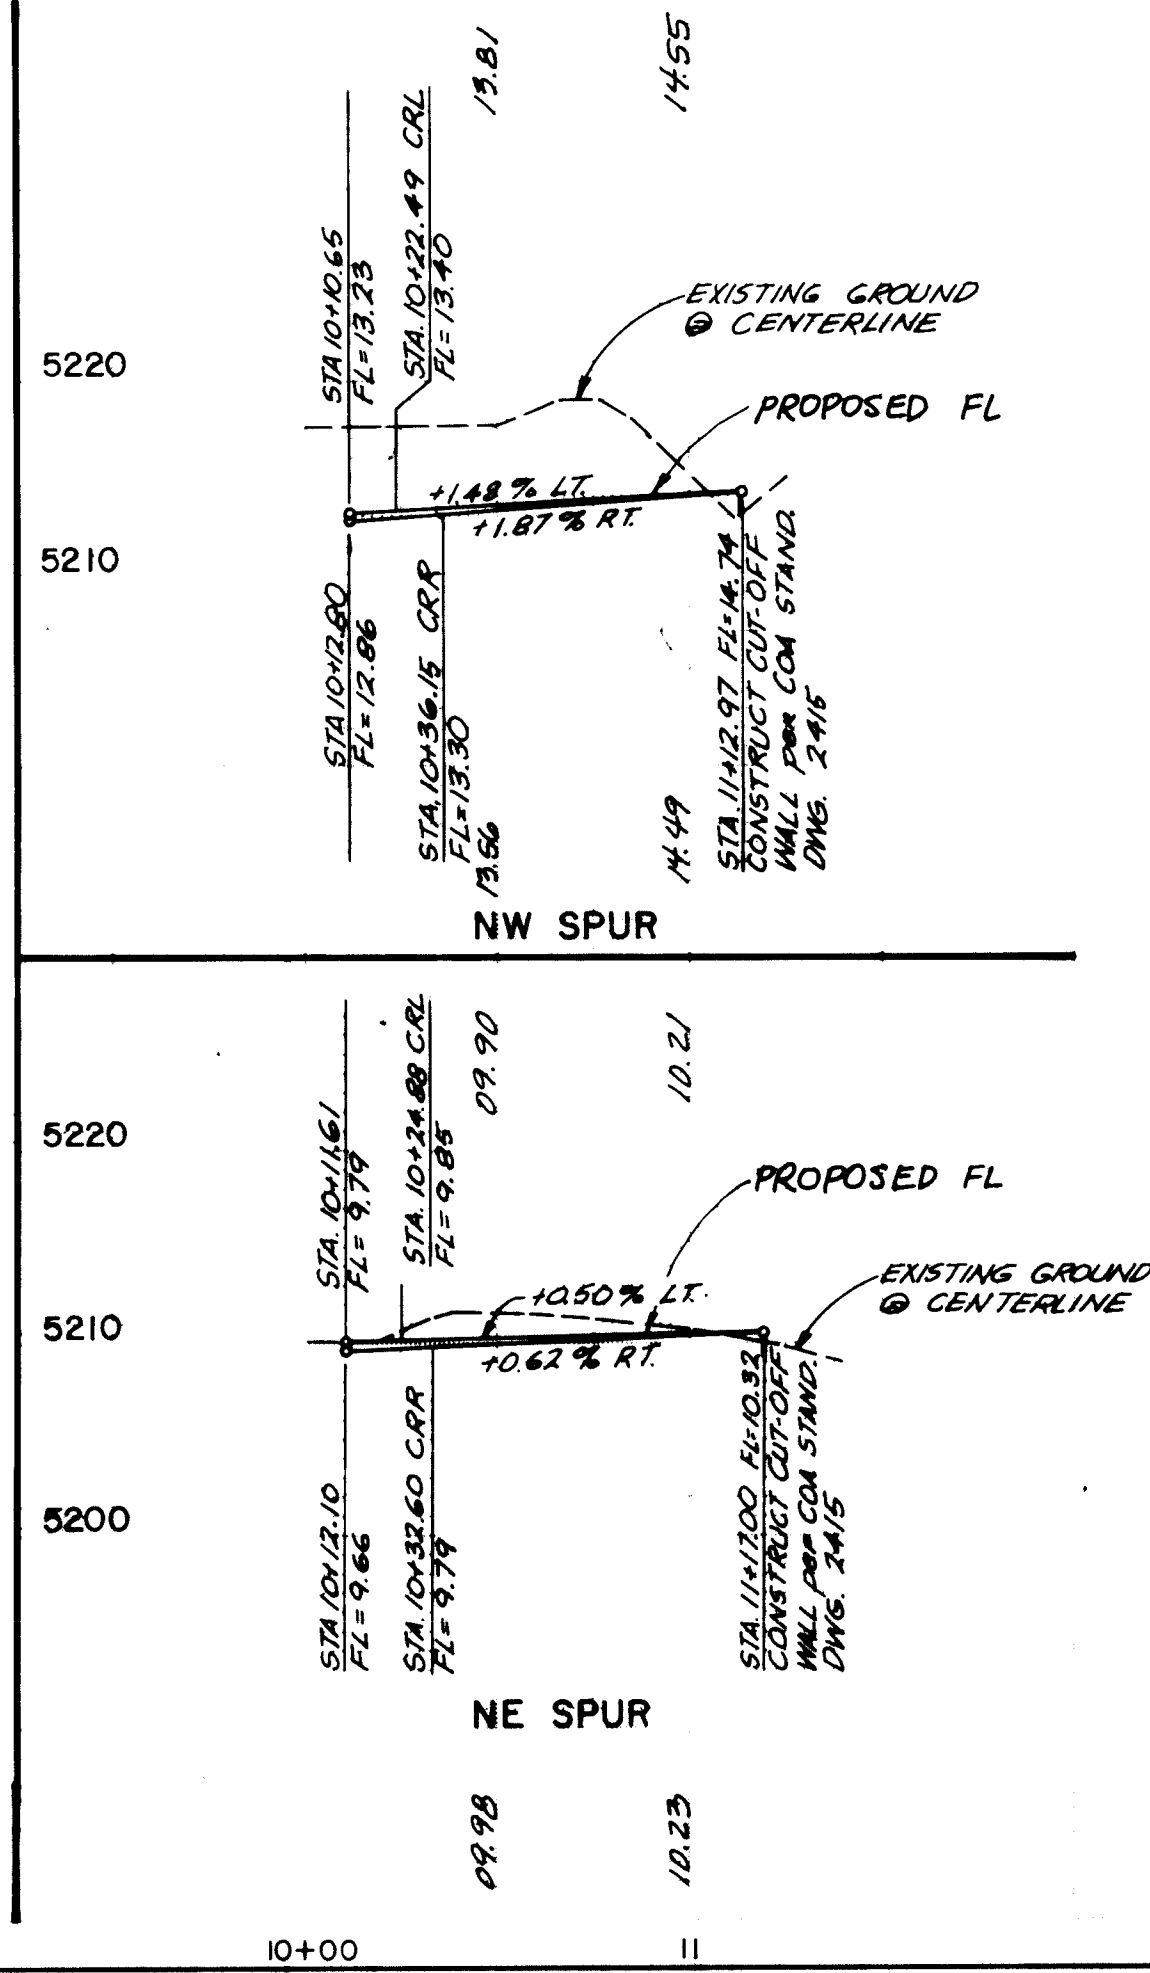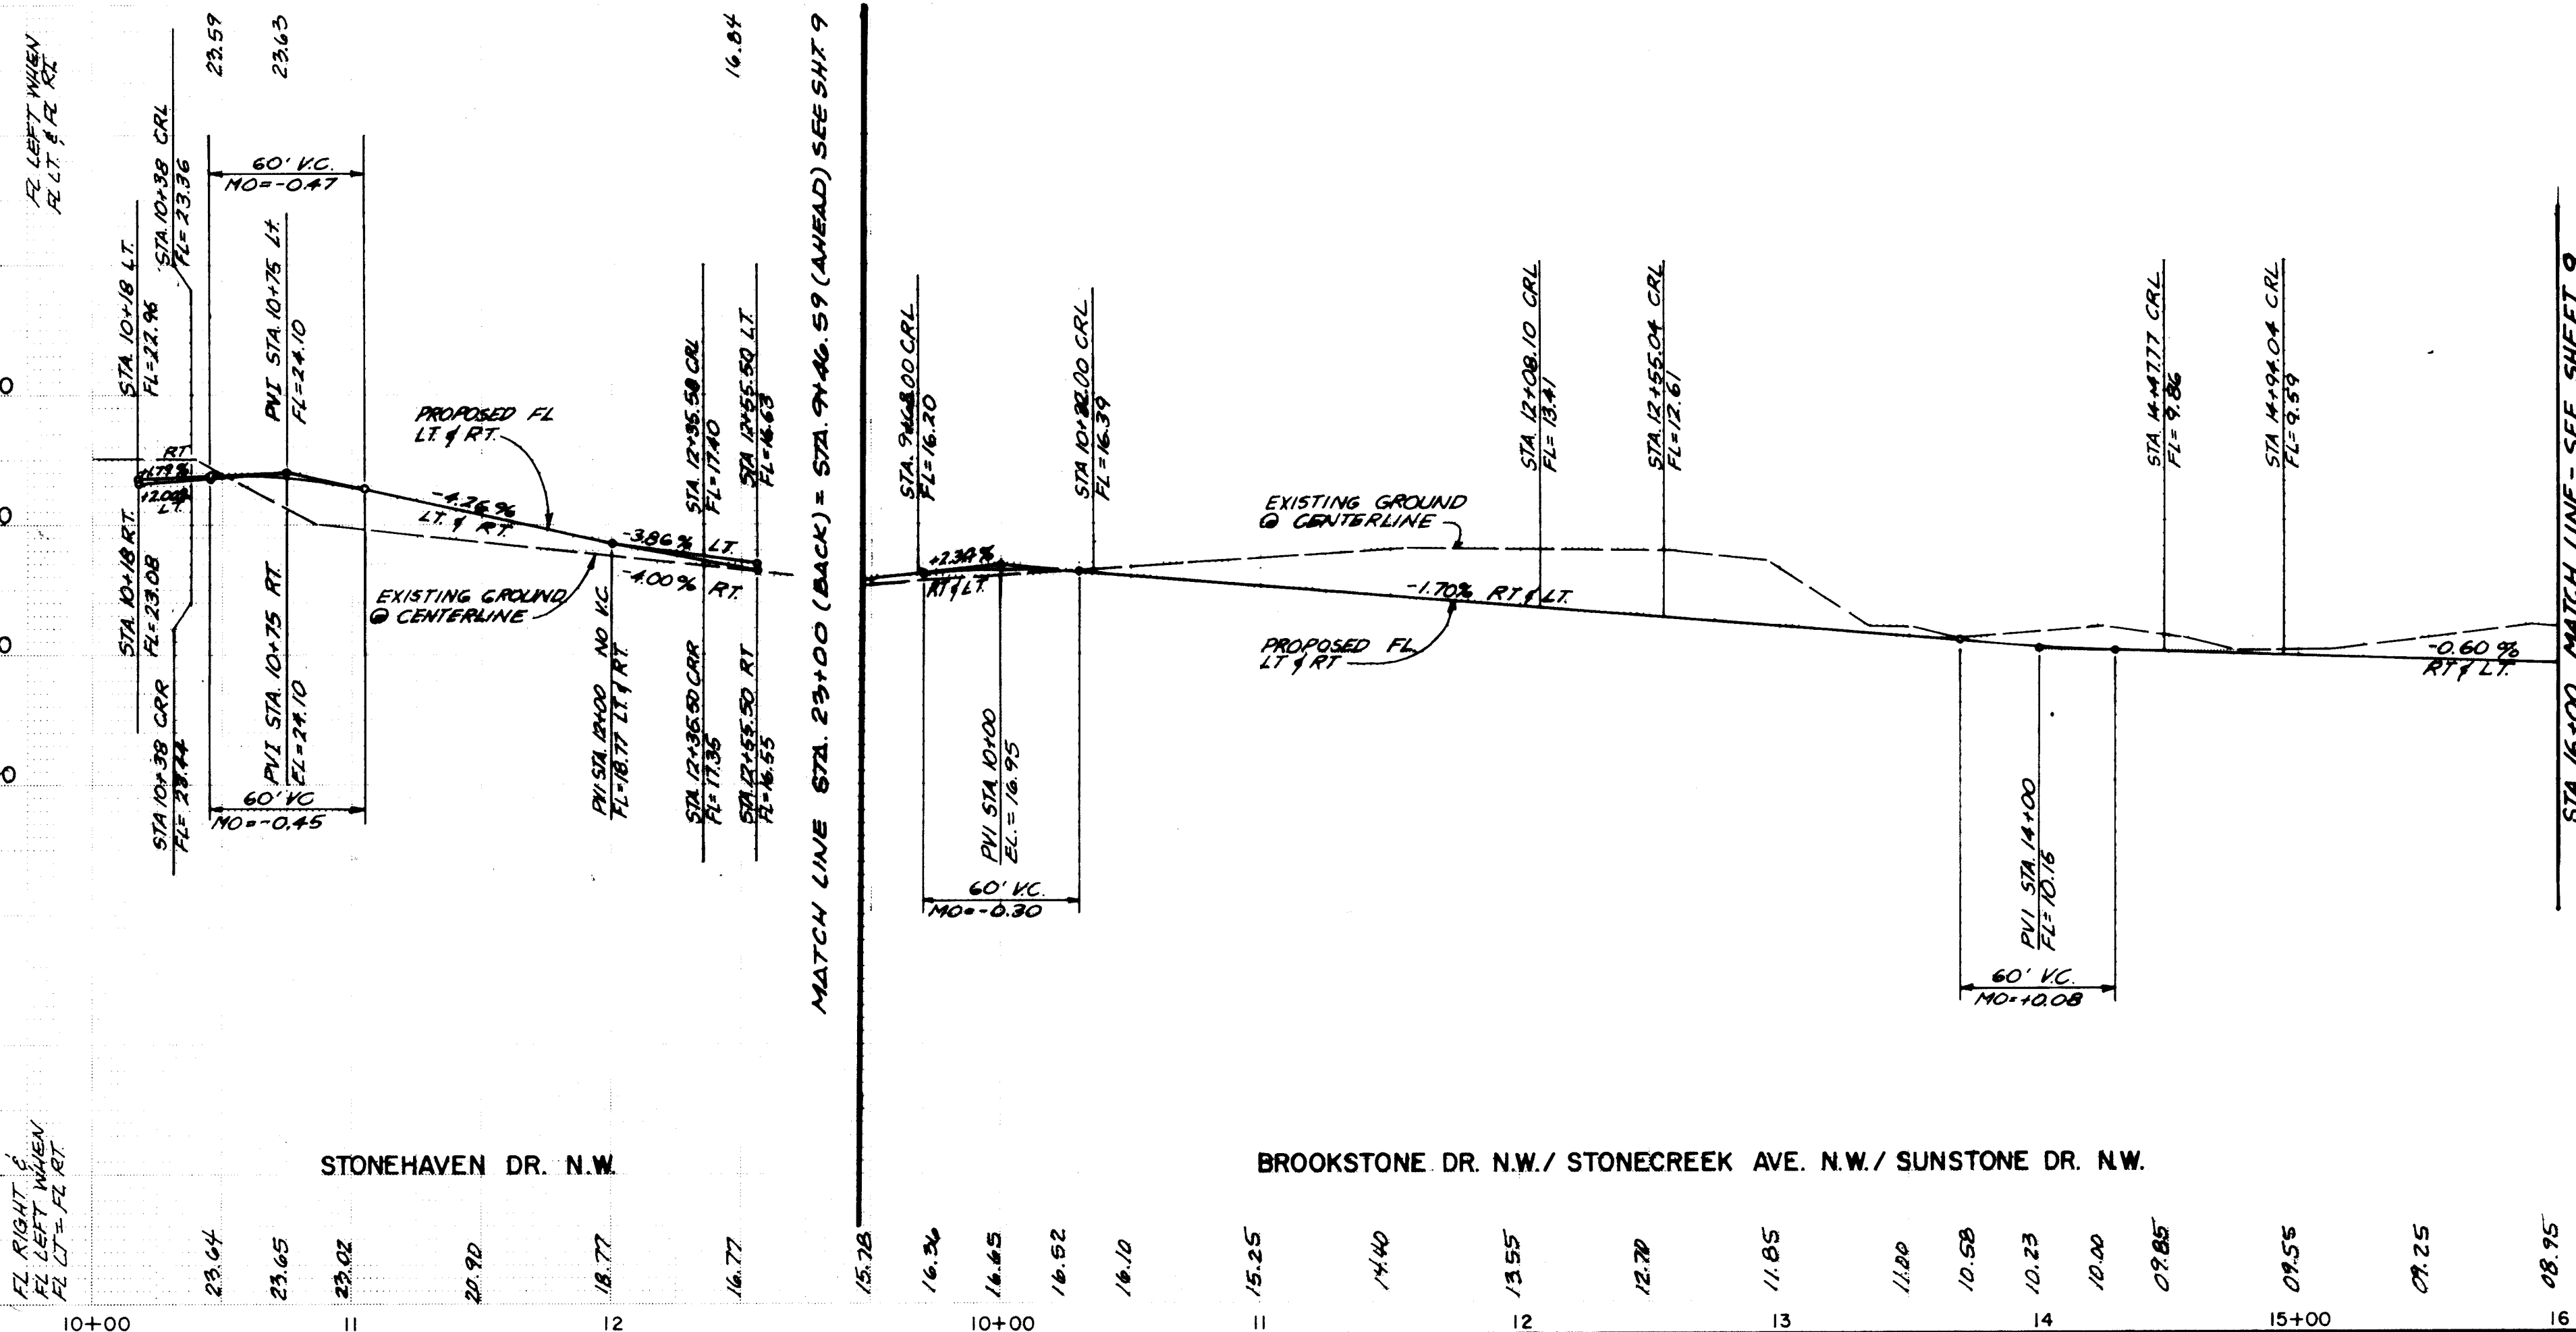

Curve	Radius	Arc	Delta	Chord	Chord
Iden				Brg	
K	20.00	31.42	090-00-00	28.28	S46-13-25E
L	20.00	31.42	090-00-00	28.28	S43-46-35W
M	87.50	44.74	029-17-41	44.25	N13-25-26E
N	20.00	22.14	063-24-46	21.02	S03-38-07E
O	132.50	78.90	034-07-05	77.74	N18-16-57W
P	107.50	51.77	027-35-40	51.27	N15-01-15W
Q	20.00	30.43	087-10-47	27.58	N72-24-28W
R	87.50	39.36	025-46-19	39.03	N76-53-18E
S	62.50	99.26	090-59-53	89.15	N44-16-32E
T	87.50	52.47	034-21-30	51.69	S73-02-47E
U	20.00	23.67	067-48-24	22.31	N89-46-13W
V	132.50	77.35	033-26-53	76.26	N73-03-01E
W	107.50	55.83	029-45-30	55.21	N74-53-43E
X	20.00	28.11	080-32-14	25.85	N19-44-51E
Y	88.00	29.64	019-17-51	29.50	S10-52-20E
Z	62.51	97.10	089-00-07	87.63	S45-43-28E



Legend
FL=74.11 PROPOSED CURB FLOWLINE ELEVATION
73.6 • EXISTING SPOT ELEVATION (GRND & TC)
PROPOSED VALLEY GUTTER/ SIDEWALK
EXISTING CURB & GUTTER
PROPOSED MOUNTABLE CURB & GUTTER
PROPOSED STANDARD CURB & GUTTER
FLOW ARROW
CROWN TRANSITION

- KEYNOTES**
- WHEEL CHAIR RAMP PER COA STD. DWG. 2441 CASE I
 - WHEEL CHAIR RAMP PER COA STD. DWG. 2441 CASE II
 - MOUNTABLE TO STANDARD CURB TRANSITION PER COA STD. DWG. 2418
 - CONC. VALLEY GUTTER PER COA STD. DWG. 2420
 - SPECIAL CONC. VALLEY GUTTER PER COA STD. DWG. 2422
 - FUTURE 4' SIDEWALK, BY OTHERS
 - 50' CROWN TRANSITION PER COA STD. DWG. 2401

RECORD DRAWING
12-3-87

CITY OF ALBUQUERQUE PUBLIC WORKS DEPARTMENT ENGINEERING GROUP					
TITLE: PARKWEST SUBDIVISION - UNIT 1 PAVING PLAN & PROFILE STONEHAVEN DR. N.W./BROOKSTONE DR. N.W./STONECREEK AVE. N.W./SUNSTONE DR. N.W./NW SPUR					
APPROVALS	ENGINEER	DATE	APPROVALS	ENGINEER	DATE
DR. CHAIRMAN	8-27-94	8-27-94	WATER	N/A	8-18-94
TRANSPORTATION	8-18-94	8-18-94	WASTE WATER	N/A	8-18-94
HYDROLOGY	N/A	8-18-94	A.M.A.F.C.A.	N/A	8-18-94
DESIGNED BY	SLC/BOM	DATE	DESIGNED BY	SLC/BOM	DATE
DRAWN BY	CEN	DATE	DRAWN BY	CEN	DATE
CHECKED BY	JDH	DATE	CHECKED BY	JDH	DATE
PROJECT NO.	4886.91	MAP NO.	H-9	SHEET	8 OF 15

SUNSTONE DR. N.W./FIELDSTONE AVE. N.W./BROOKSTONE DR. N.W./S.E. SPUR/S.W. SPUR

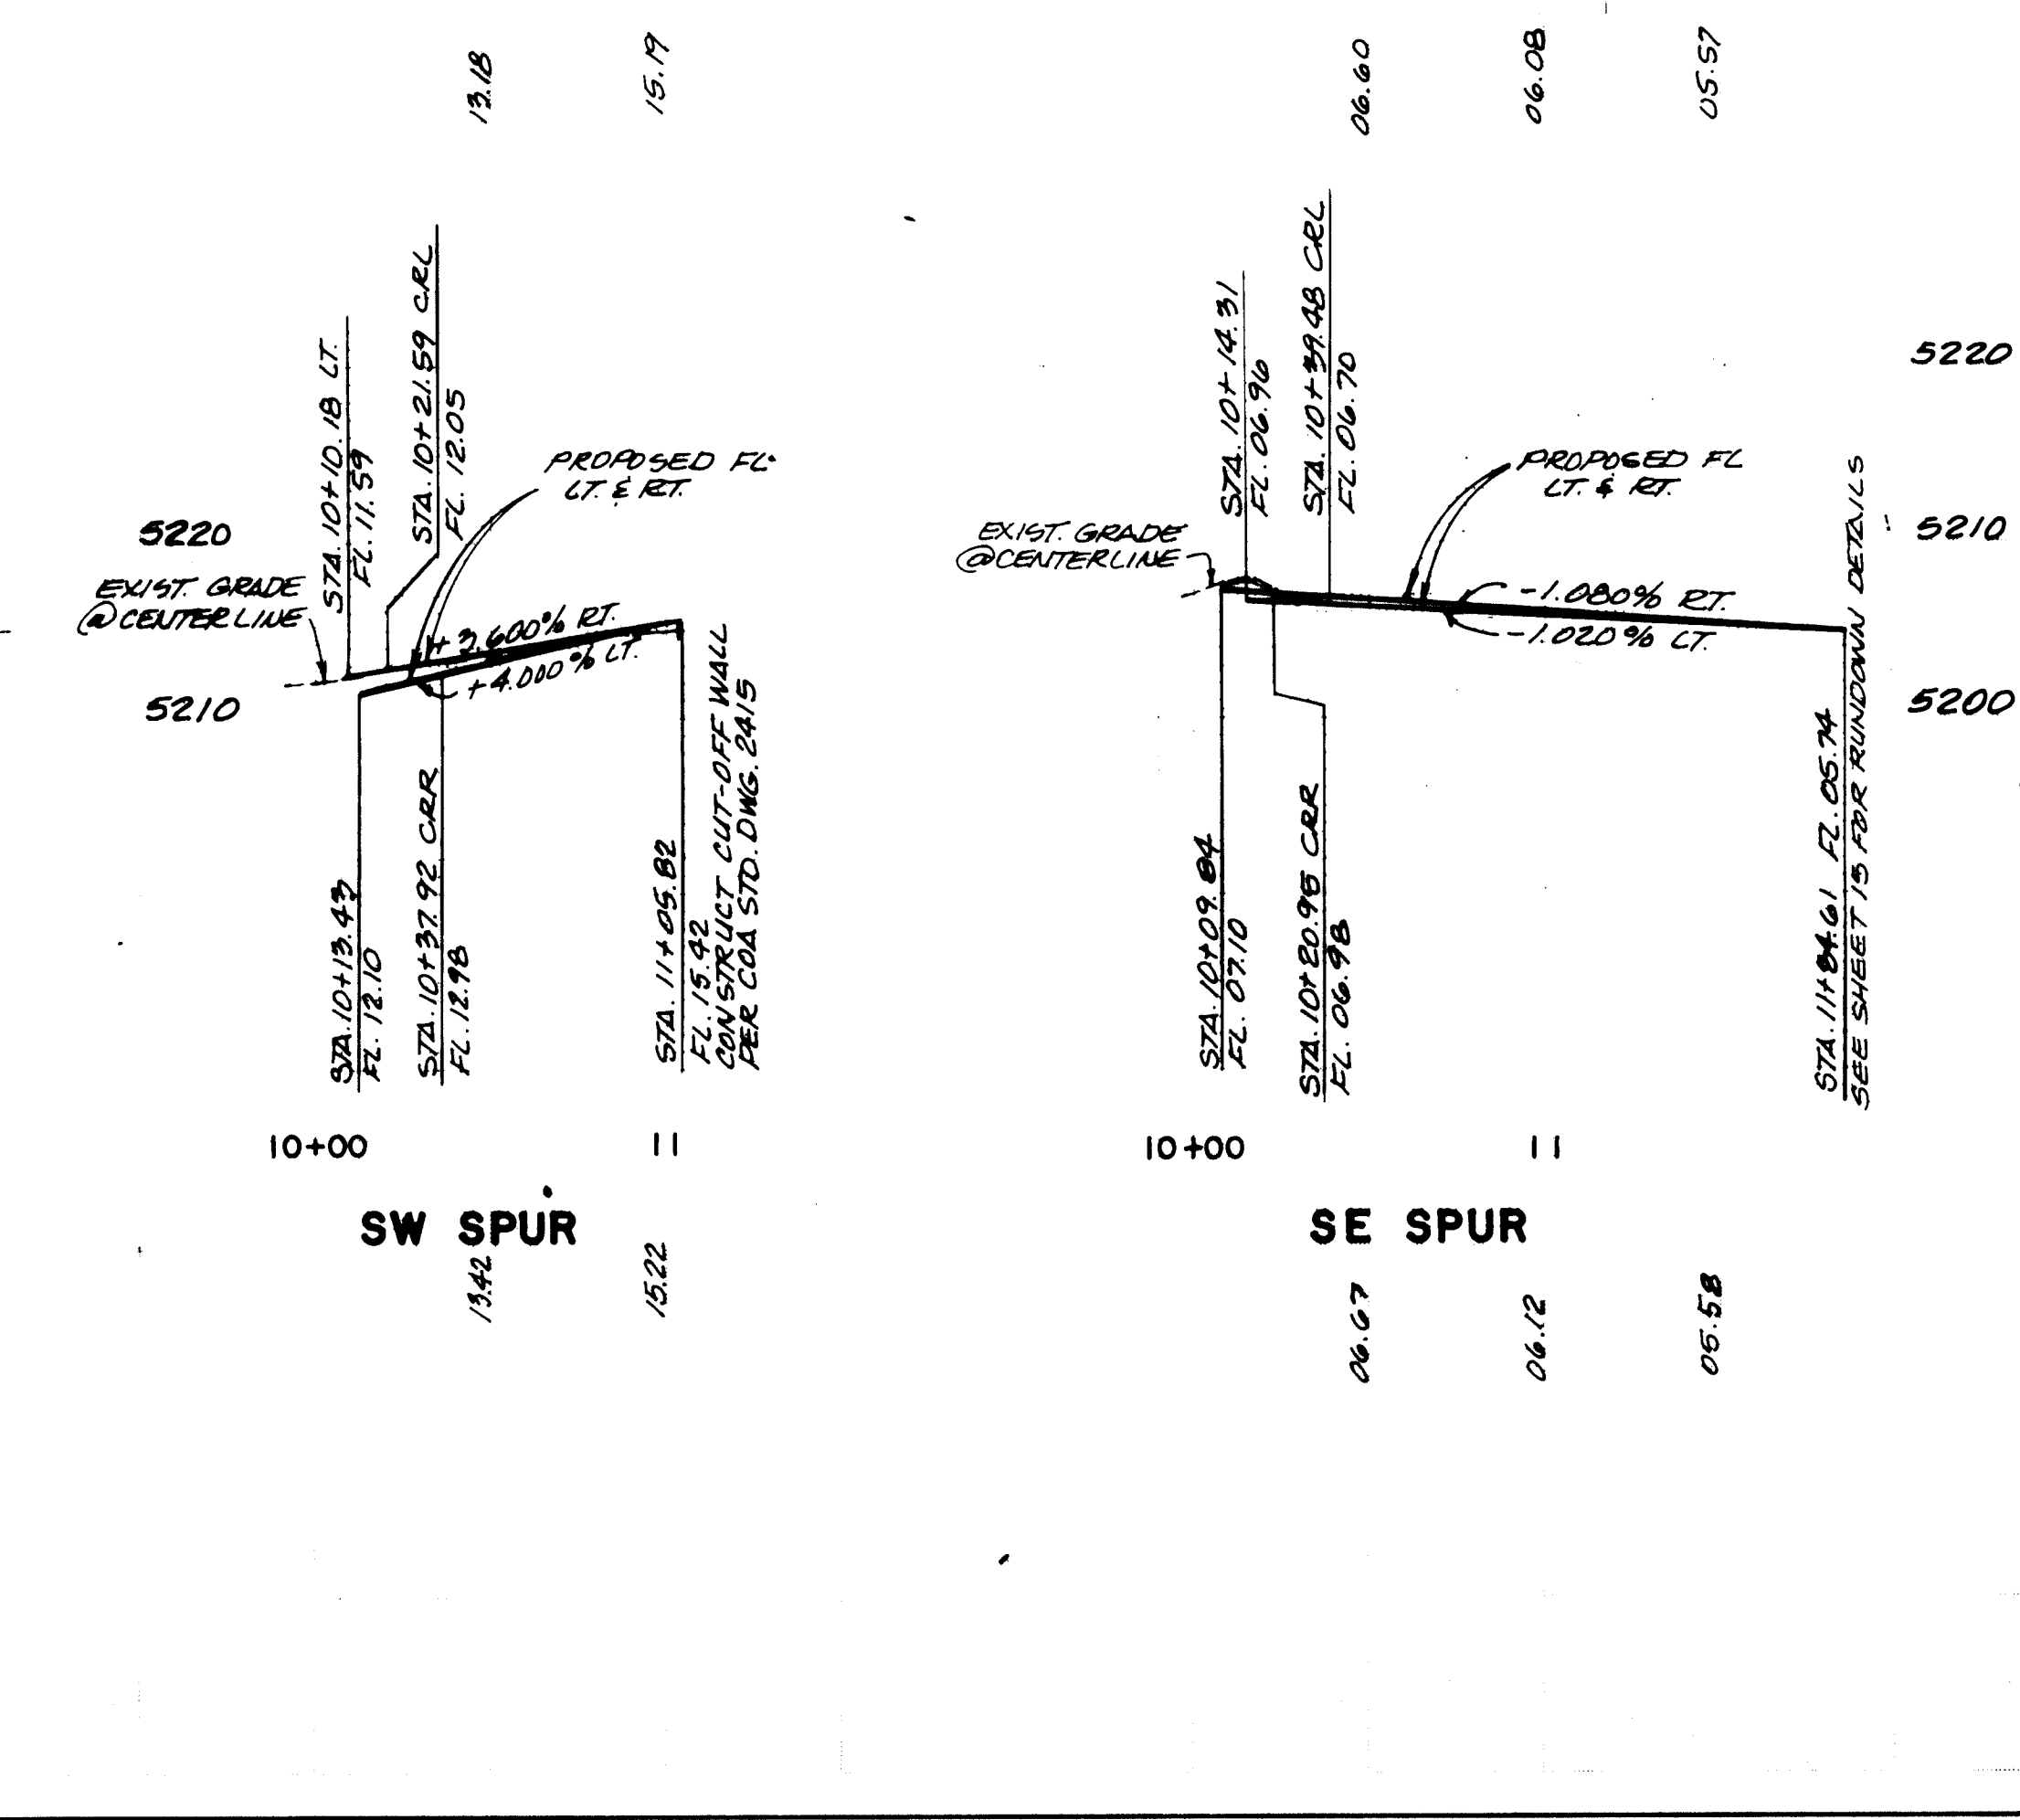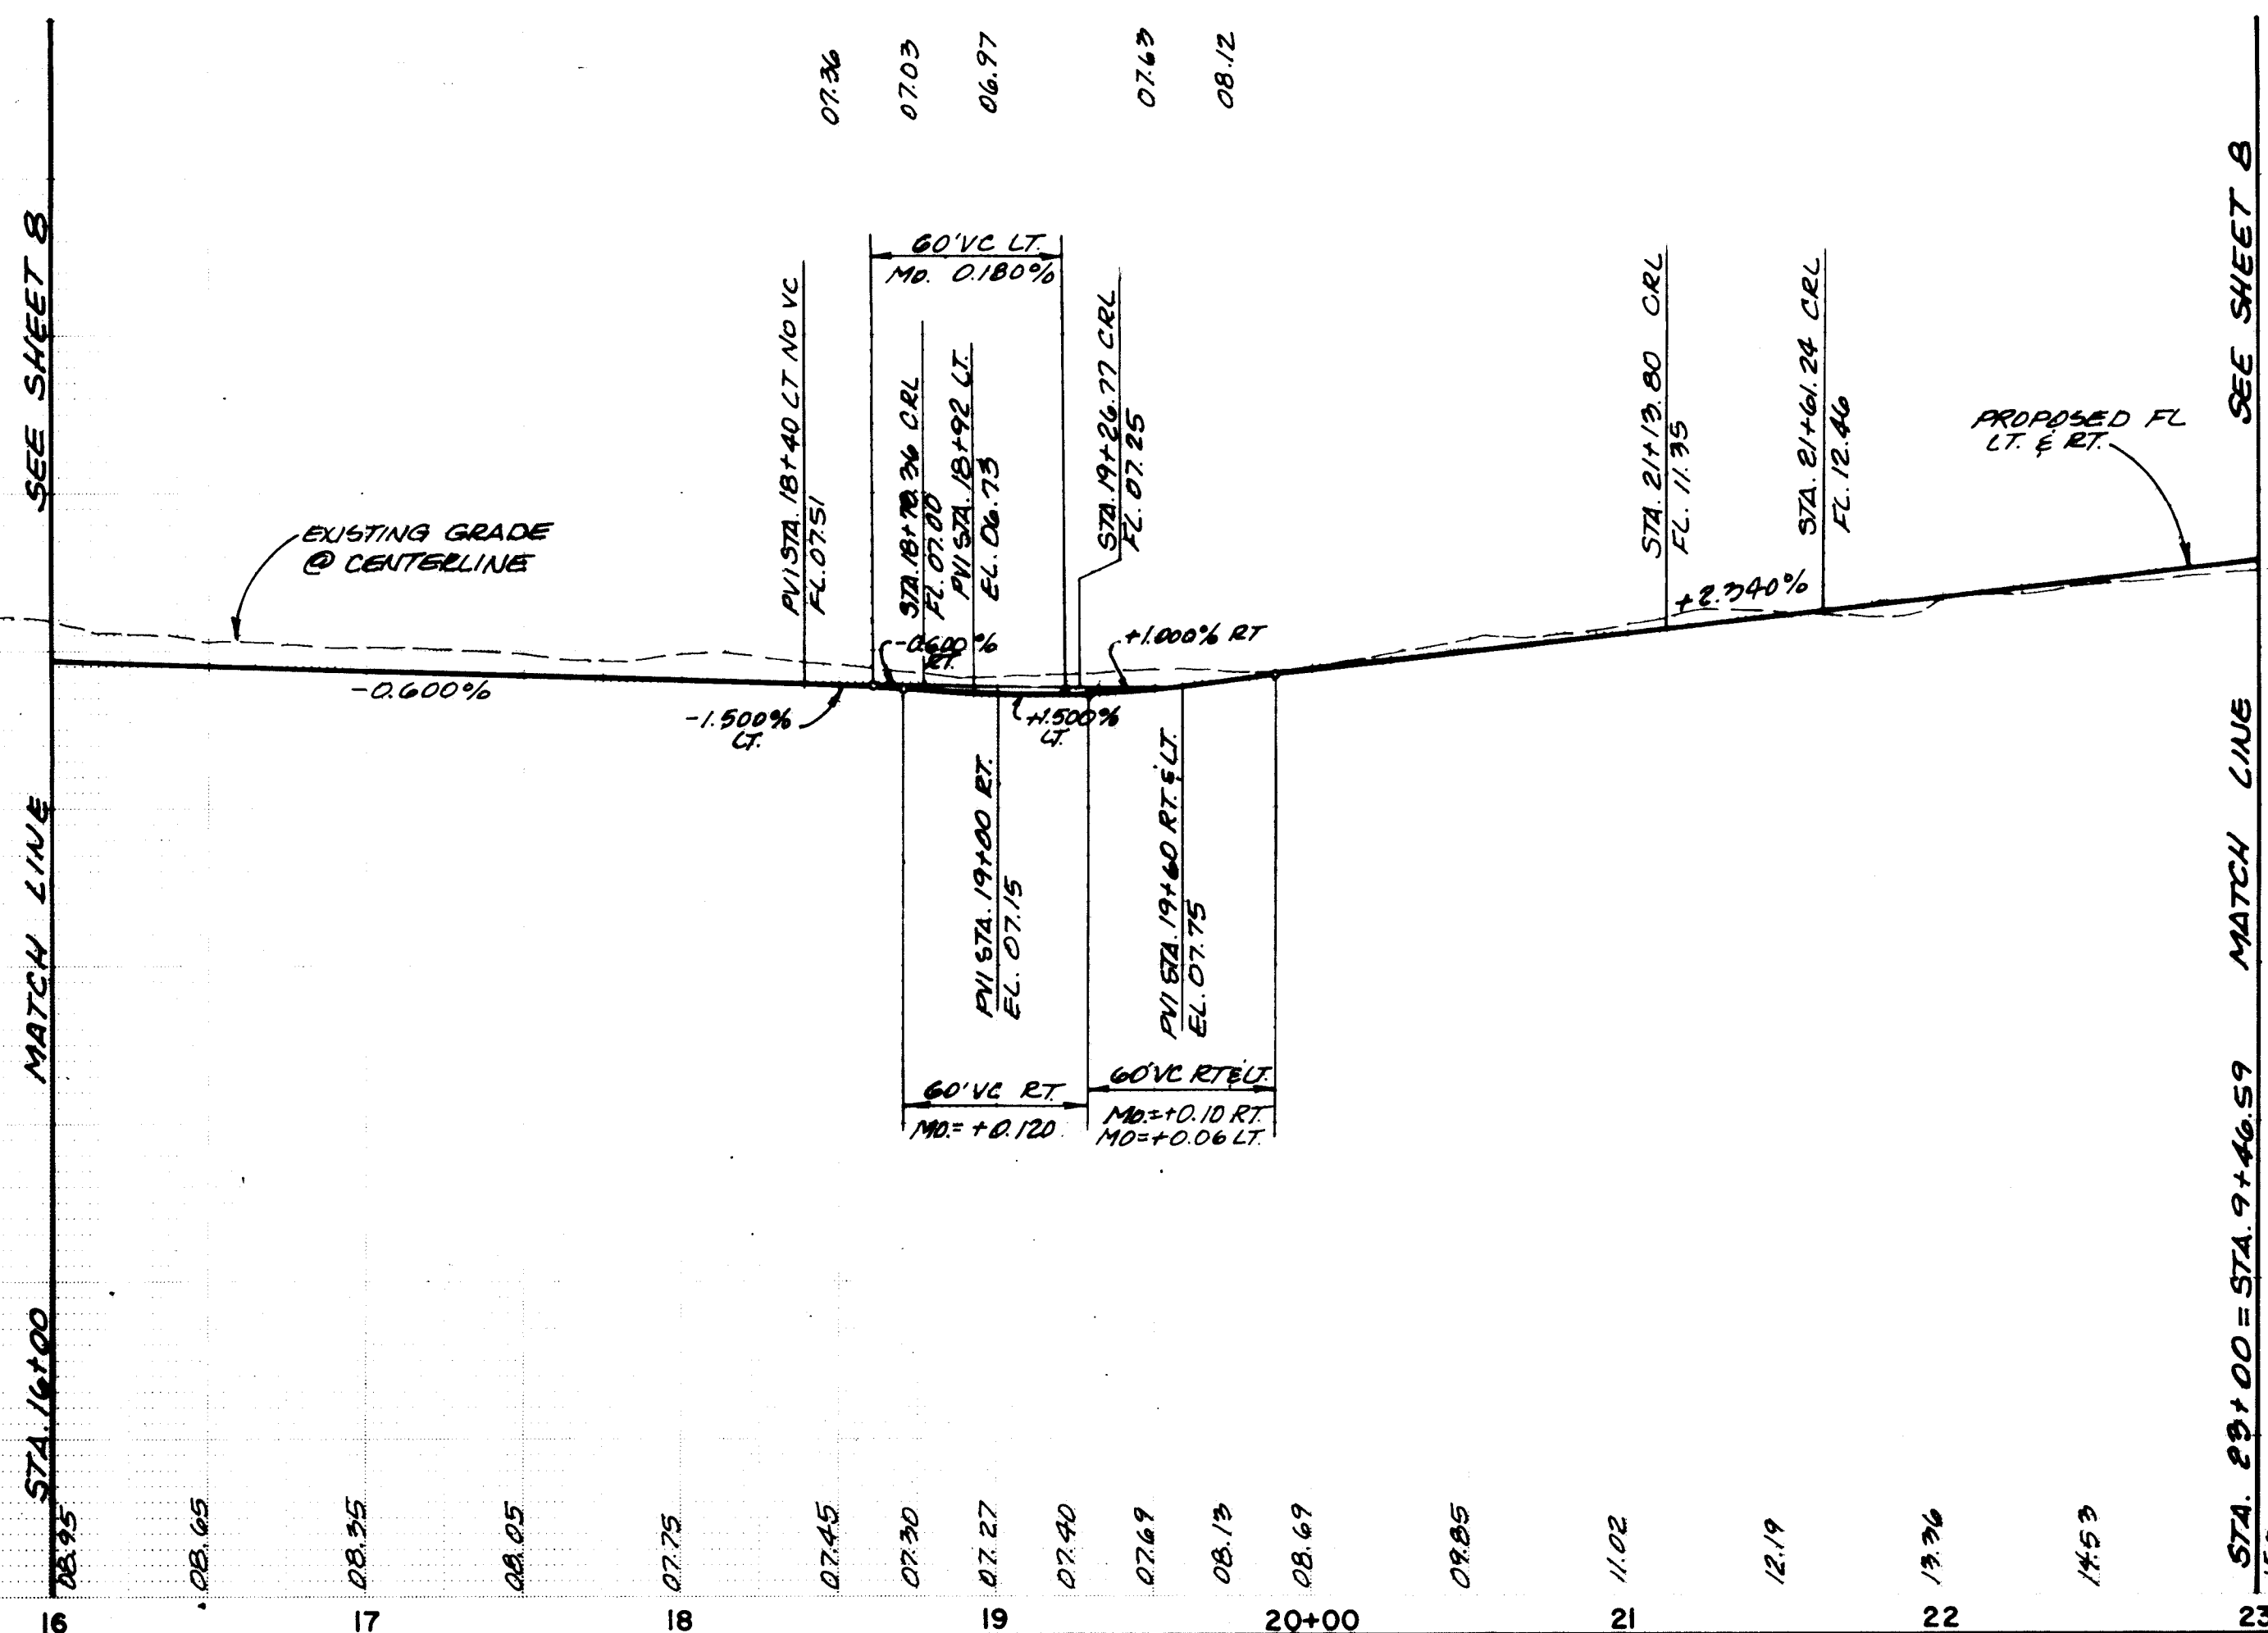

CURB CURVE DATA					
Curve	Radius	Arc	Delta	Chord	Chord
Iden					Sta
AA	82.51	96.85	088-46-27	87.45	S43-08-49W
BB	88.00	40.54	026-23-49	40.19	S11-58-30W
CC	20.00	31.94	091-29-50	28.85	N20-34-30W
DD	107.50	46.72	024-54-00	46.36	N78-46-25W
EE	132.50	77.78	033-37-54	76.66	N74-24-28W
FF	20.00	21.23	060-49-10	20.25	S88-00-05E
GG	87.50	39.65	025-57-43	39.31	S74-34-11W
HH	87.50	45.99	030-06-54	45.46	N77-23-30W
II	20.00	21.52	061-39-20	20.50	N86-50-17E
JJ	132.50	75.77	032-45-58	74.75	S72-23-36W
KK	107.50	46.85	024-58-13	46.48	S76-17-29W
LL	20.00	31.38	089-53-54	28.26	S18-51-25W
MM	87.50	37.98	024-52-07	37.68	N13-39-28W
NN	62.50	99.51	091-13-33	89.33	N46-50-11W

LEGEND

FL=74.11 PROPOSED CURB FLOWLINE ELEVATION
73.6 • EXISTING SPOT ELEVATION (GRND & TC)
--- PROPOSED VALLEY GUTTER / SIDEWALK
--- EXISTING CURB & GUTTER
--- PROPOSED MOUNTABLE CURB & GUTTER
--- PROPOSED STANDARD CURB & GUTTER
--- FLOW ARROW
--- CROWN TRANSITION

KEYNOTES

- WHEELCHAIR RAMP PER COA STD. DWG. 2441 CASE I.
- WHEELCHAIR RAMP PER COA STD. DWG. 2441 CASE II.
- MOUNTABLE TO STANDARD CURB TRANSITION PER COA STD. DWG. 2418.
- CONC. VALLEY GUTTER PER COA STD. DWG. 2420.
- SPECIAL CONC. VALLEY GUTTER PER COA STD. DWG. 2422.
- FUTURE 4' SIDEWALK, BY OTHERS.
- 50' CROWN TRANSITION PER COA STD. DWG. 2401.

RECORD DRAWING
12-3-97



CITY OF ALBUQUERQUE
PUBLIC WORKS DEPARTMENT
ENGINEERING GROUP

TITLE: PARKWEST SUBDIVISION - UNIT 1
PAVING PLAN & PROFILE
SUNSTONE DR. N.W./FIELDSTONE AVE. N.W./BROOKSTONE DR. N.W./S.E. SPUR/S.W. SPUR


APPROVALS	ENGINEER	DATE	APPROVALS	ENGINEER	DATE
URC CHAIRMAN	8-22-94	8-22-94	WATER	N/A	8-18-94
TRANSPORTATION	8-11-94	8-11-94	WASTE WATER	N/A	8-18-94
HYDROLOGY	8-11-94	8-11-94	AMAFCA	N/A	8-18-94

PROJECT NO. 4886.91 MAP NO. H-9 SHEET 9 OF 15

SCANNED BY LASON

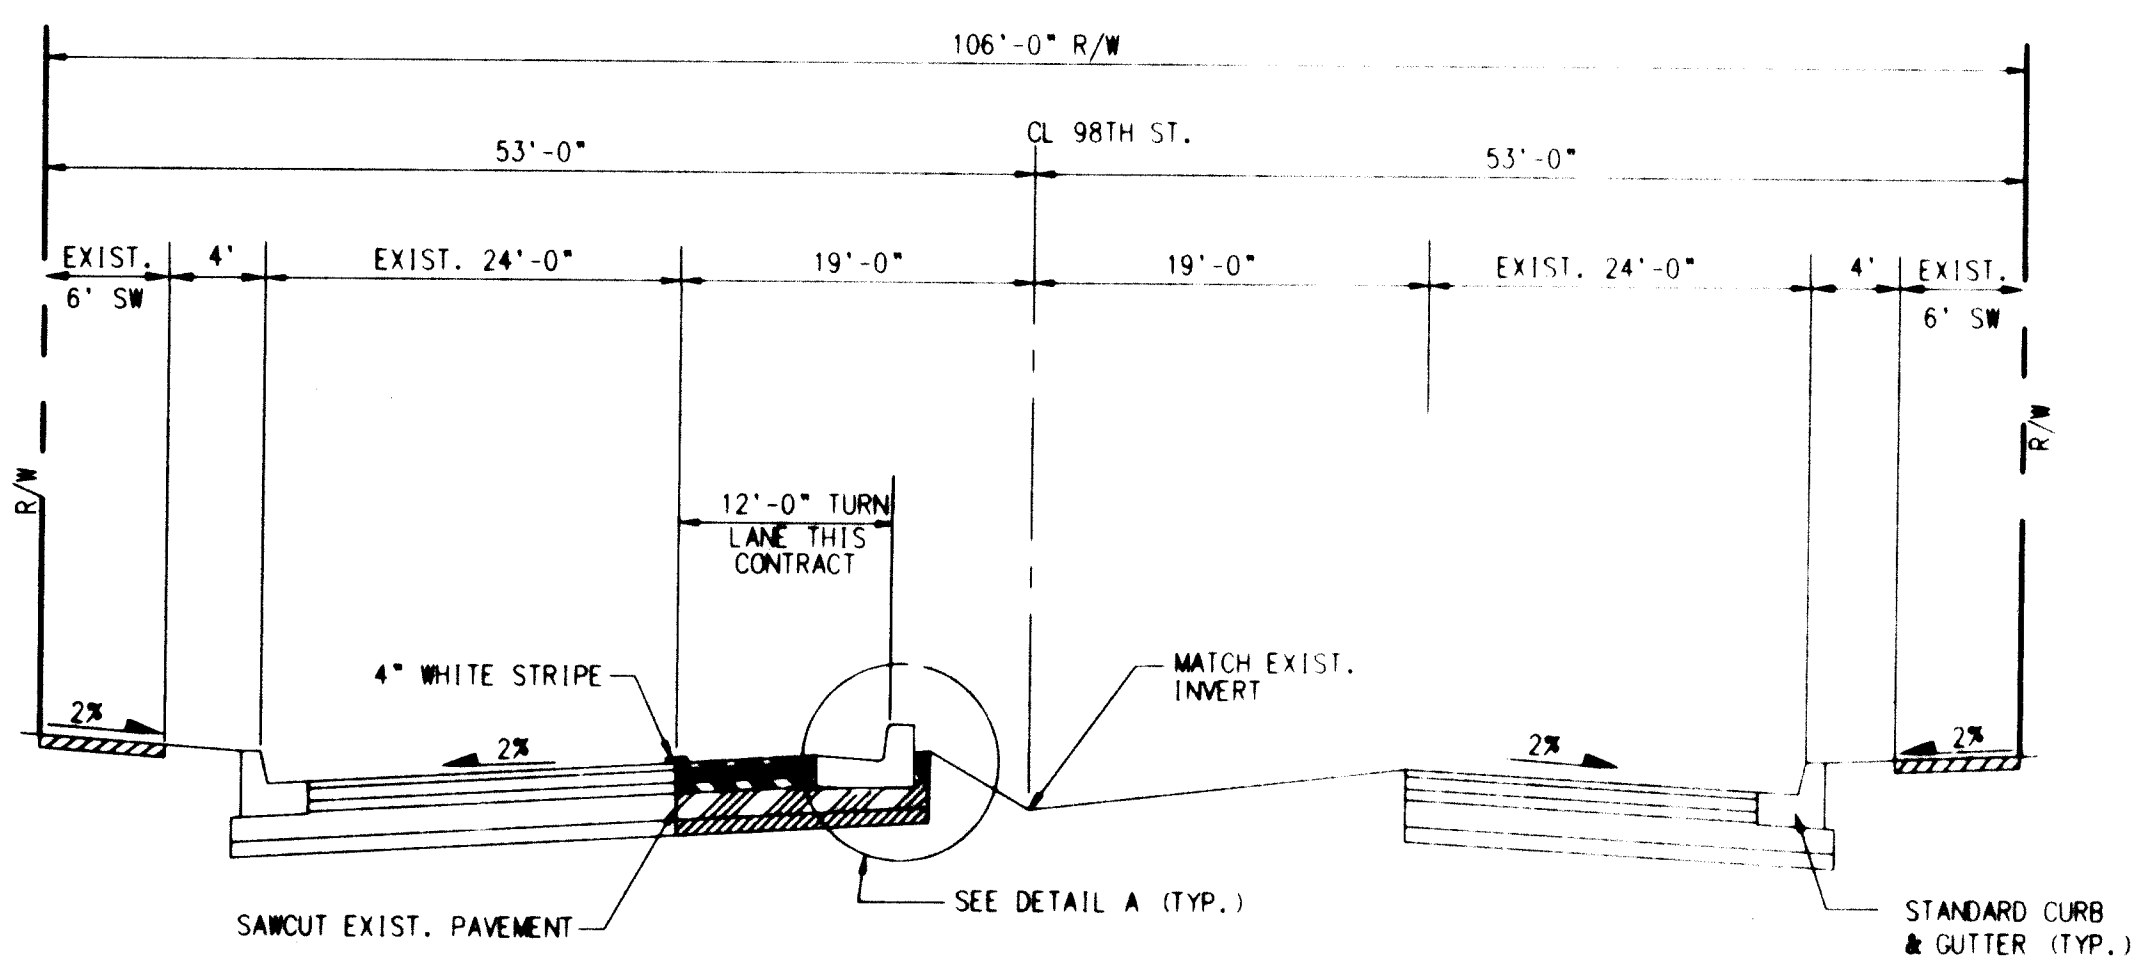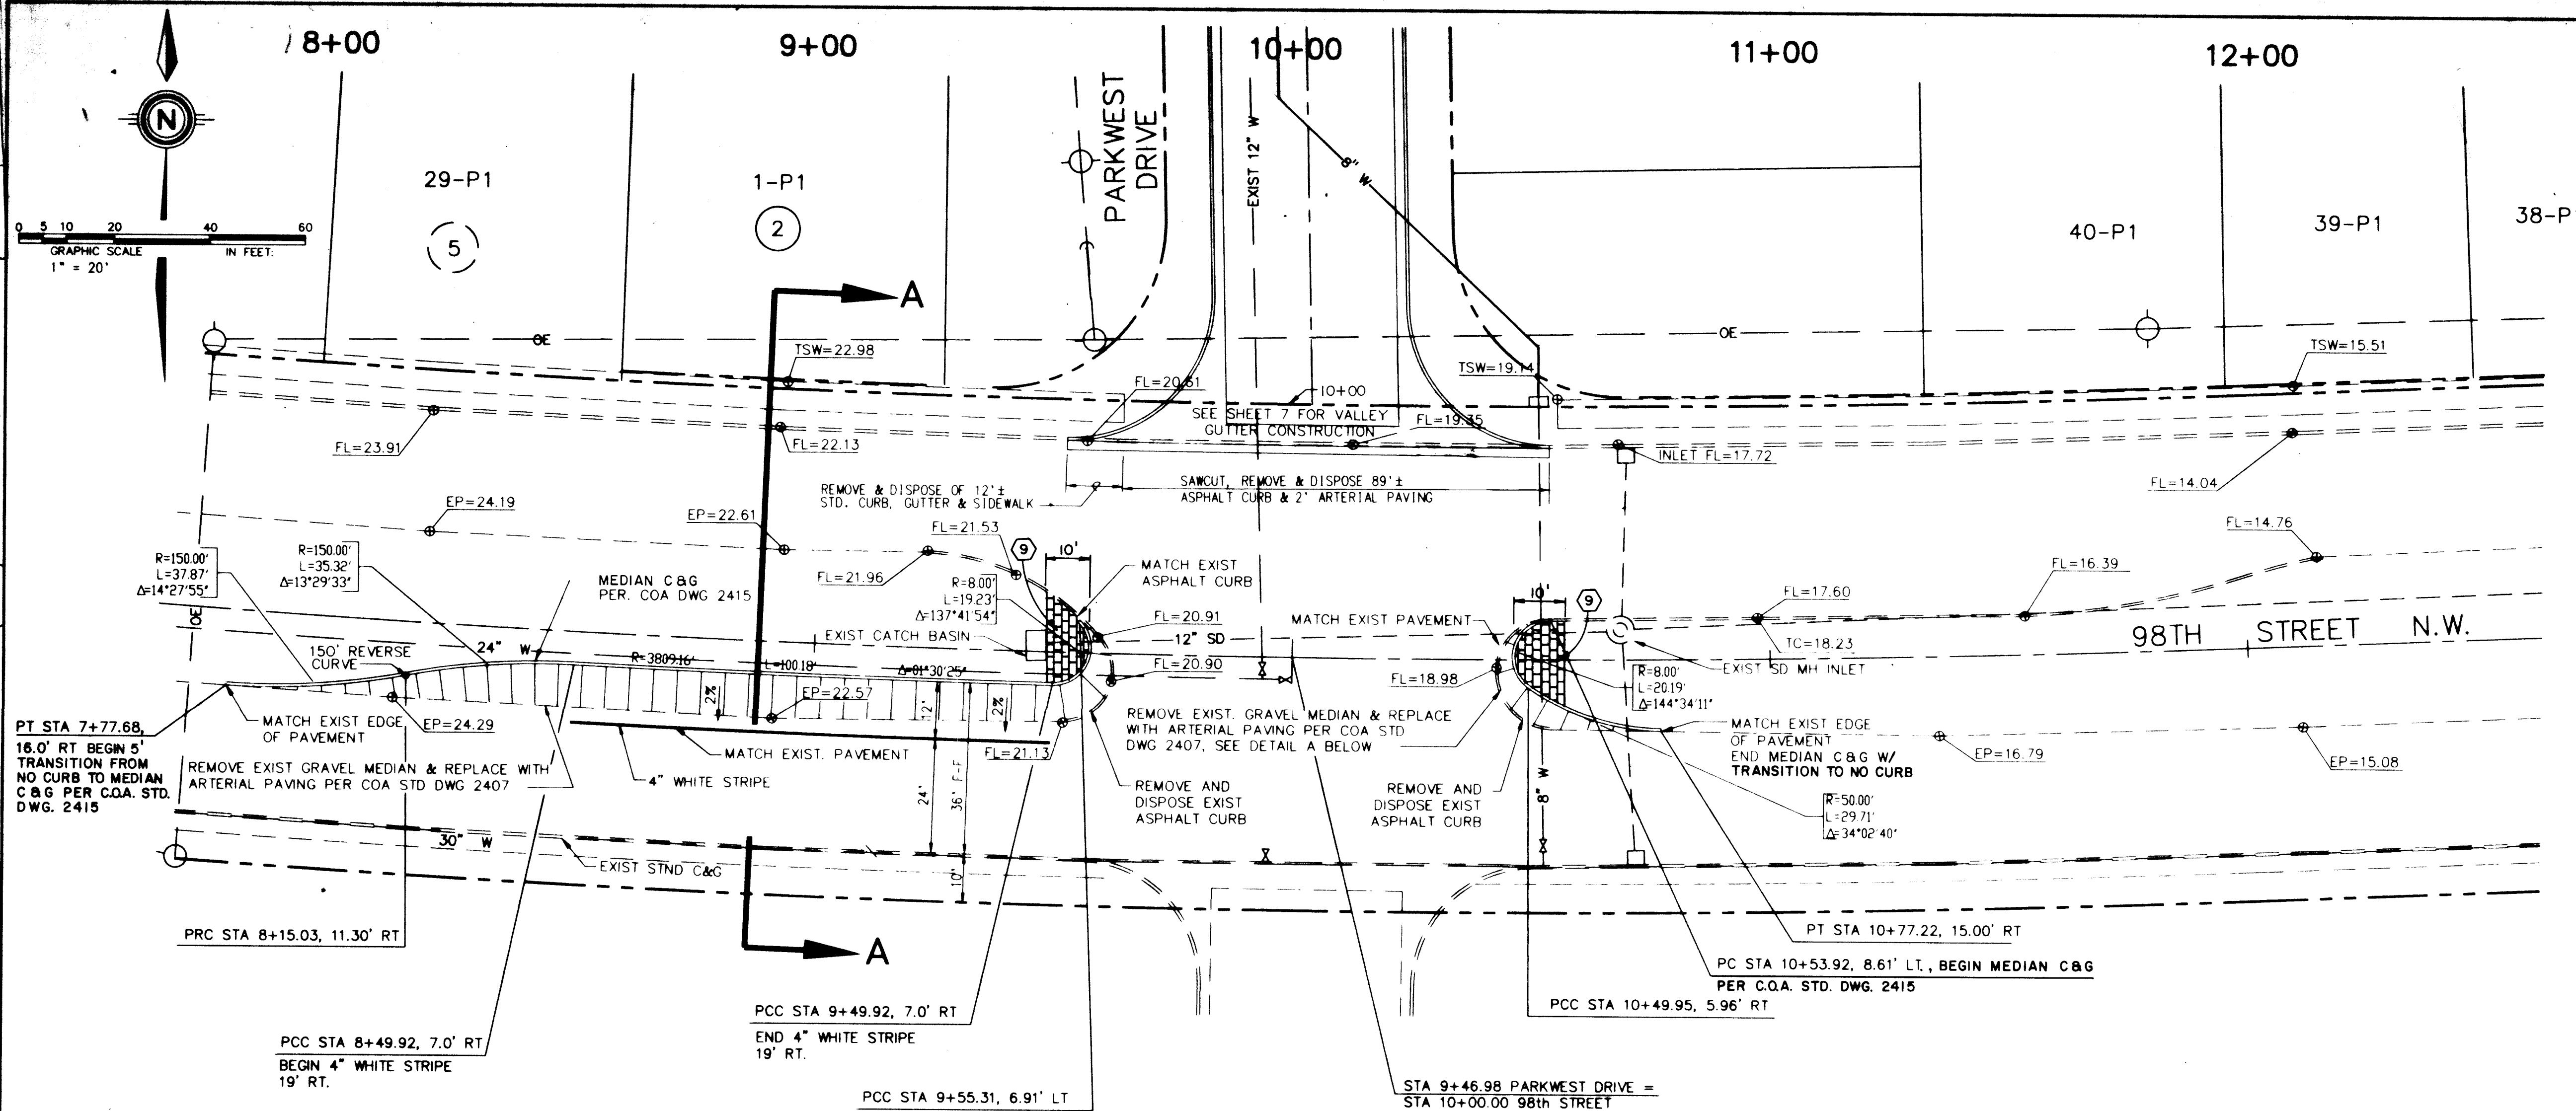

SECTION A-A
N.T.S.

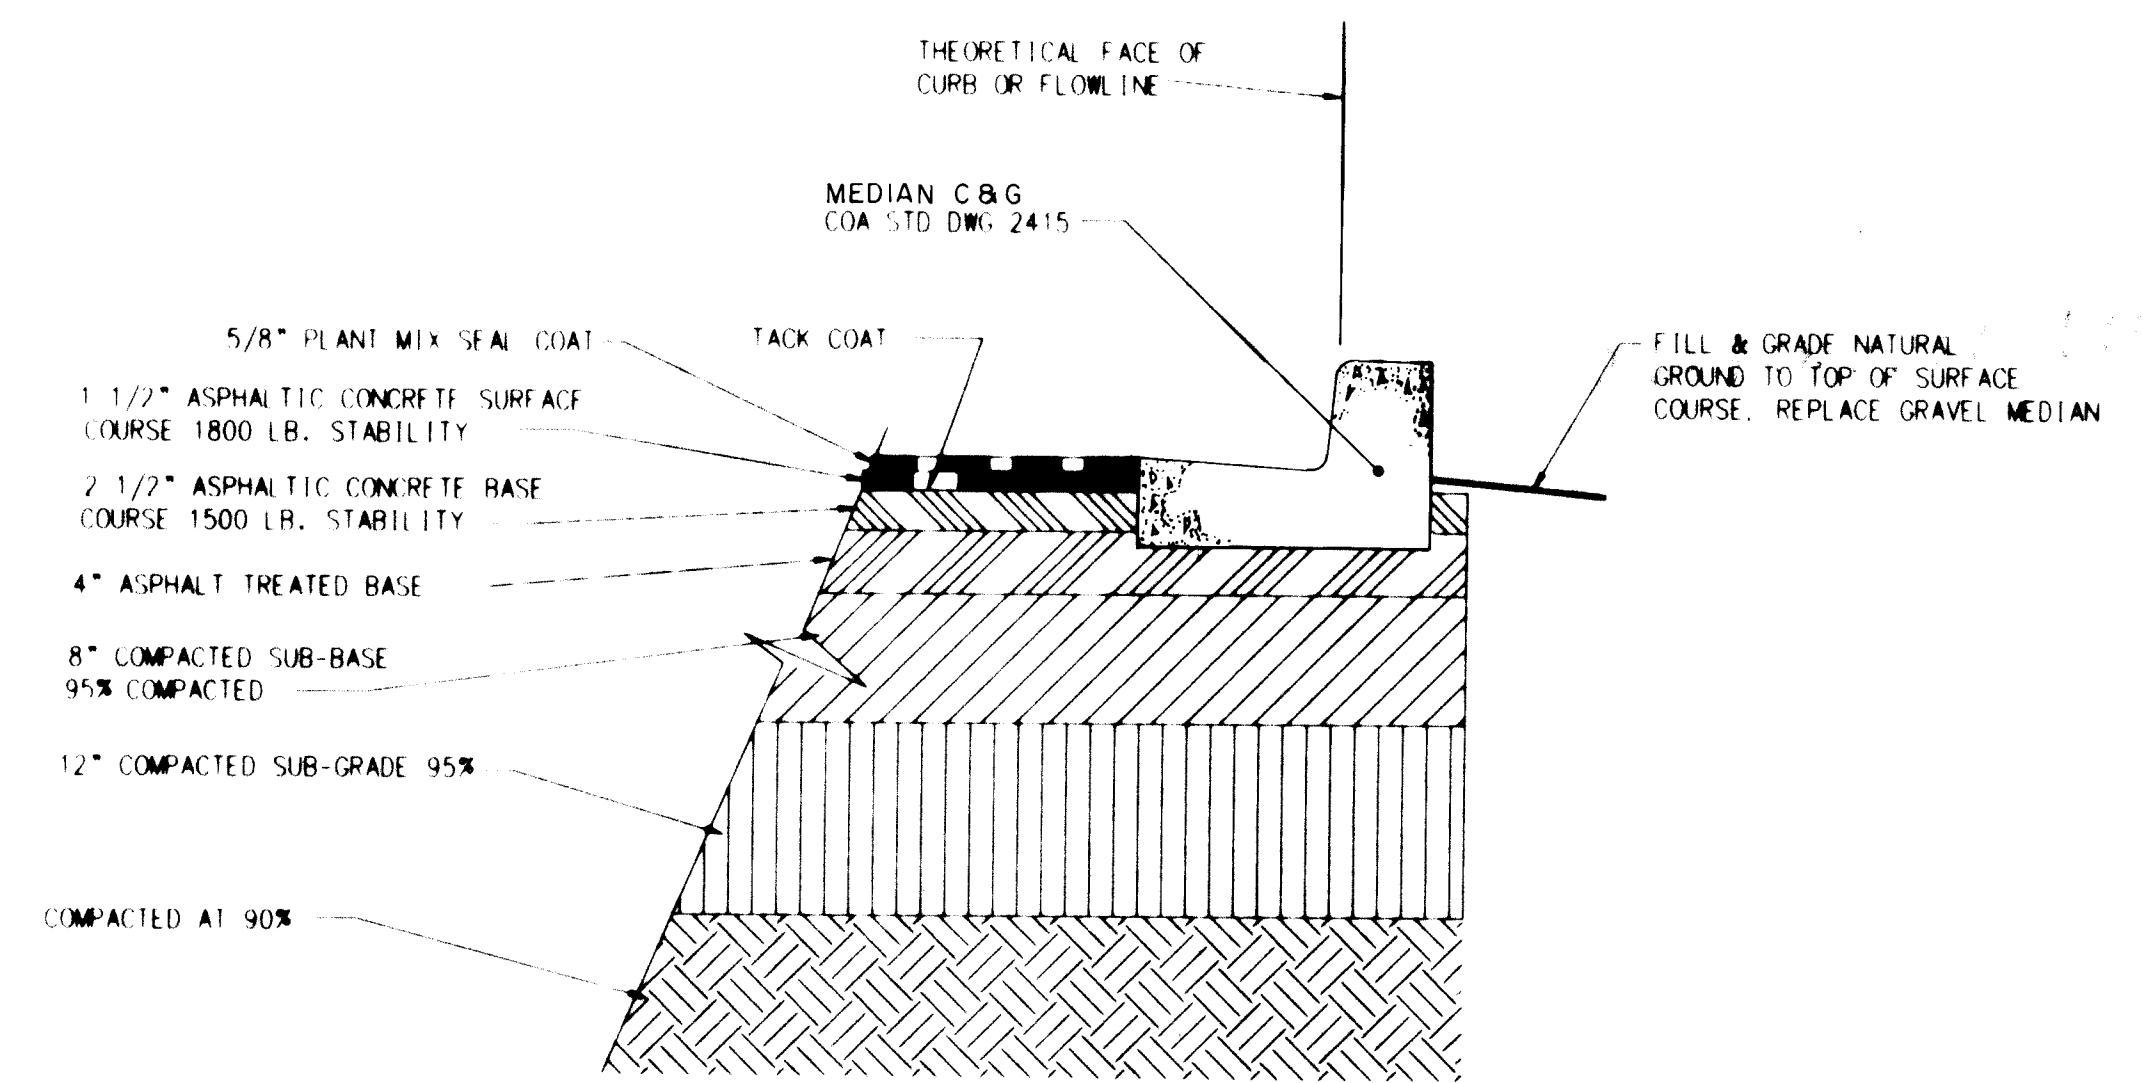

DETAIL A
SCALE: 1"=1'

4" PORTLAND CEMENT PATTERNED CONC. SIDEWALK (3/16" PATTERNED DEPTH.)

AS BUILT INFORMATION		BENCH MARKS		SURVEY INFORMATION		ENGINEER'S SEAL		REVISIONS		DESIGN	
NO.	DATE	NO.	DATE	NO.	DATE	NO.	DATE	NO.	DATE	NO.	DATE
1	6/15/94	1	6/15/94	1	6/15/94	1	6/15/94	1	6/15/94	1	6/15/94
THE STATION IS A STANDARD A.C.S. BRASS TABLET STAMPED "2.08" SET IN A 2" IRON PIPE 1" ABOVE THE GROUND. STATION IS LOCATED ON TOP OF VOLCANIC OUTCROP. TO REACH THIS SITE BEGIN AT 1-40 & COORS RD., PROCEED NORTH ON COORS 0.4 MI. TO OURAY RD., THEN WEST ON OURAY RD. 0.7 MI. TO END OF PAVEMENT, CONTINUE WEST ON DIRT RD. TO TOP OF DIRT, THEN ALONG NORTH BANK 0.6 MI. TO DIRT CROSS RD. THEN NORTH ON DIRT RD. 0.5 MI. THE STATION IS ABOUT 600' WEST OF THIS POINT. ELEVATION = 5334.50 FEET.		THE STATION IS A STANDARD A.C.S. BRASS TABLET STAMPED "2.08" SET IN A 2" IRON PIPE 1" ABOVE THE GROUND. STATION IS LOCATED ON TOP OF VOLCANIC OUTCROP. TO REACH THIS SITE BEGIN AT 1-40 & COORS RD., PROCEED NORTH ON COORS 0.4 MI. TO OURAY RD., THEN WEST ON OURAY RD. 0.7 MI. TO END OF PAVEMENT, CONTINUE WEST ON DIRT RD. TO TOP OF DIRT, THEN ALONG NORTH BANK 0.6 MI. TO DIRT CROSS RD. THEN NORTH ON DIRT RD. 0.5 MI. THE STATION IS ABOUT 600' WEST OF THIS POINT. ELEVATION = 5334.50 FEET.		THE STATION IS A STANDARD A.C.S. BRASS TABLET STAMPED "2.08" SET IN A 2" IRON PIPE 1" ABOVE THE GROUND. STATION IS LOCATED ON TOP OF VOLCANIC OUTCROP. TO REACH THIS SITE BEGIN AT 1-40 & COORS RD., PROCEED NORTH ON COORS 0.4 MI. TO OURAY RD., THEN WEST ON OURAY RD. 0.7 MI. TO END OF PAVEMENT, CONTINUE WEST ON DIRT RD. TO TOP OF DIRT, THEN ALONG NORTH BANK 0.6 MI. TO DIRT CROSS RD. THEN NORTH ON DIRT RD. 0.5 MI. THE STATION IS ABOUT 600' WEST OF THIS POINT. ELEVATION = 5334.50 FEET.		THE STATION IS A STANDARD A.C.S. BRASS TABLET STAMPED "2.08" SET IN A 2" IRON PIPE 1" ABOVE THE GROUND. STATION IS LOCATED ON TOP OF VOLCANIC OUTCROP. TO REACH THIS SITE BEGIN AT 1-40 & COORS RD., PROCEED NORTH ON COORS 0.4 MI. TO OURAY RD., THEN WEST ON OURAY RD. 0.7 MI. TO END OF PAVEMENT, CONTINUE WEST ON DIRT RD. TO TOP OF DIRT, THEN ALONG NORTH BANK 0.6 MI. TO DIRT CROSS RD. THEN NORTH ON DIRT RD. 0.5 MI. THE STATION IS ABOUT 600' WEST OF THIS POINT. ELEVATION = 5334.50 FEET.		THE STATION IS A STANDARD A.C.S. BRASS TABLET STAMPED "2.08" SET IN A 2" IRON PIPE 1" ABOVE THE GROUND. STATION IS LOCATED ON TOP OF VOLCANIC OUTCROP. TO REACH THIS SITE BEGIN AT 1-40 & COORS RD., PROCEED NORTH ON COORS 0.4 MI. TO OURAY RD., THEN WEST ON OURAY RD. 0.7 MI. TO END OF PAVEMENT, CONTINUE WEST ON DIRT RD. TO TOP OF DIRT, THEN ALONG NORTH BANK 0.6 MI. TO DIRT CROSS RD. THEN NORTH ON DIRT RD. 0.5 MI. THE STATION IS ABOUT 600' WEST OF THIS POINT. ELEVATION = 5334.50 FEET.		THE STATION IS A STANDARD A.C.S. BRASS TABLET STAMPED "2.08" SET IN A 2" IRON PIPE 1" ABOVE THE GROUND. STATION IS LOCATED ON TOP OF VOLCANIC OUTCROP. TO REACH THIS SITE BEGIN AT 1-40 & COORS RD., PROCEED NORTH ON COORS 0.4 MI. TO OURAY RD., THEN WEST ON OURAY RD. 0.7 MI. TO END OF PAVEMENT, CONTINUE WEST ON DIRT RD. TO TOP OF DIRT, THEN ALONG NORTH BANK 0.6 MI. TO DIRT CROSS RD. THEN NORTH ON DIRT RD. 0.5 MI. THE STATION IS ABOUT 600' WEST OF THIS POINT. ELEVATION = 5334.50 FEET.	

RECORD DRAWING
12-3-97


community sciences corporation

CITY OF ALBUQUERQUE
PUBLIC WORKS DEPARTMENT
ENGINEERING GROUP

TITLE: PARKWEST SUBDIVISION - UNIT 1
PAVING PLAN
98TH STREET MEDIAN MODIFICATION


APPROVALS	ENGINEER	DATE	APPROVALS	ENGINEER	DATE
DR. CHAIRMAN	8/22/94	8/22/94	WATER	N/A	8/22/94
TRANSPORTATION	8/22/94	8/22/94	WASTE WATER	N/A	8/22/94
HYDROLOGY	8/22/94	8/22/94	A.M.A.F.C.A.	N/A	8/22/94

PROJECT NO. 4886.91 MAP NO. H-9 SHEET 10 OF 15

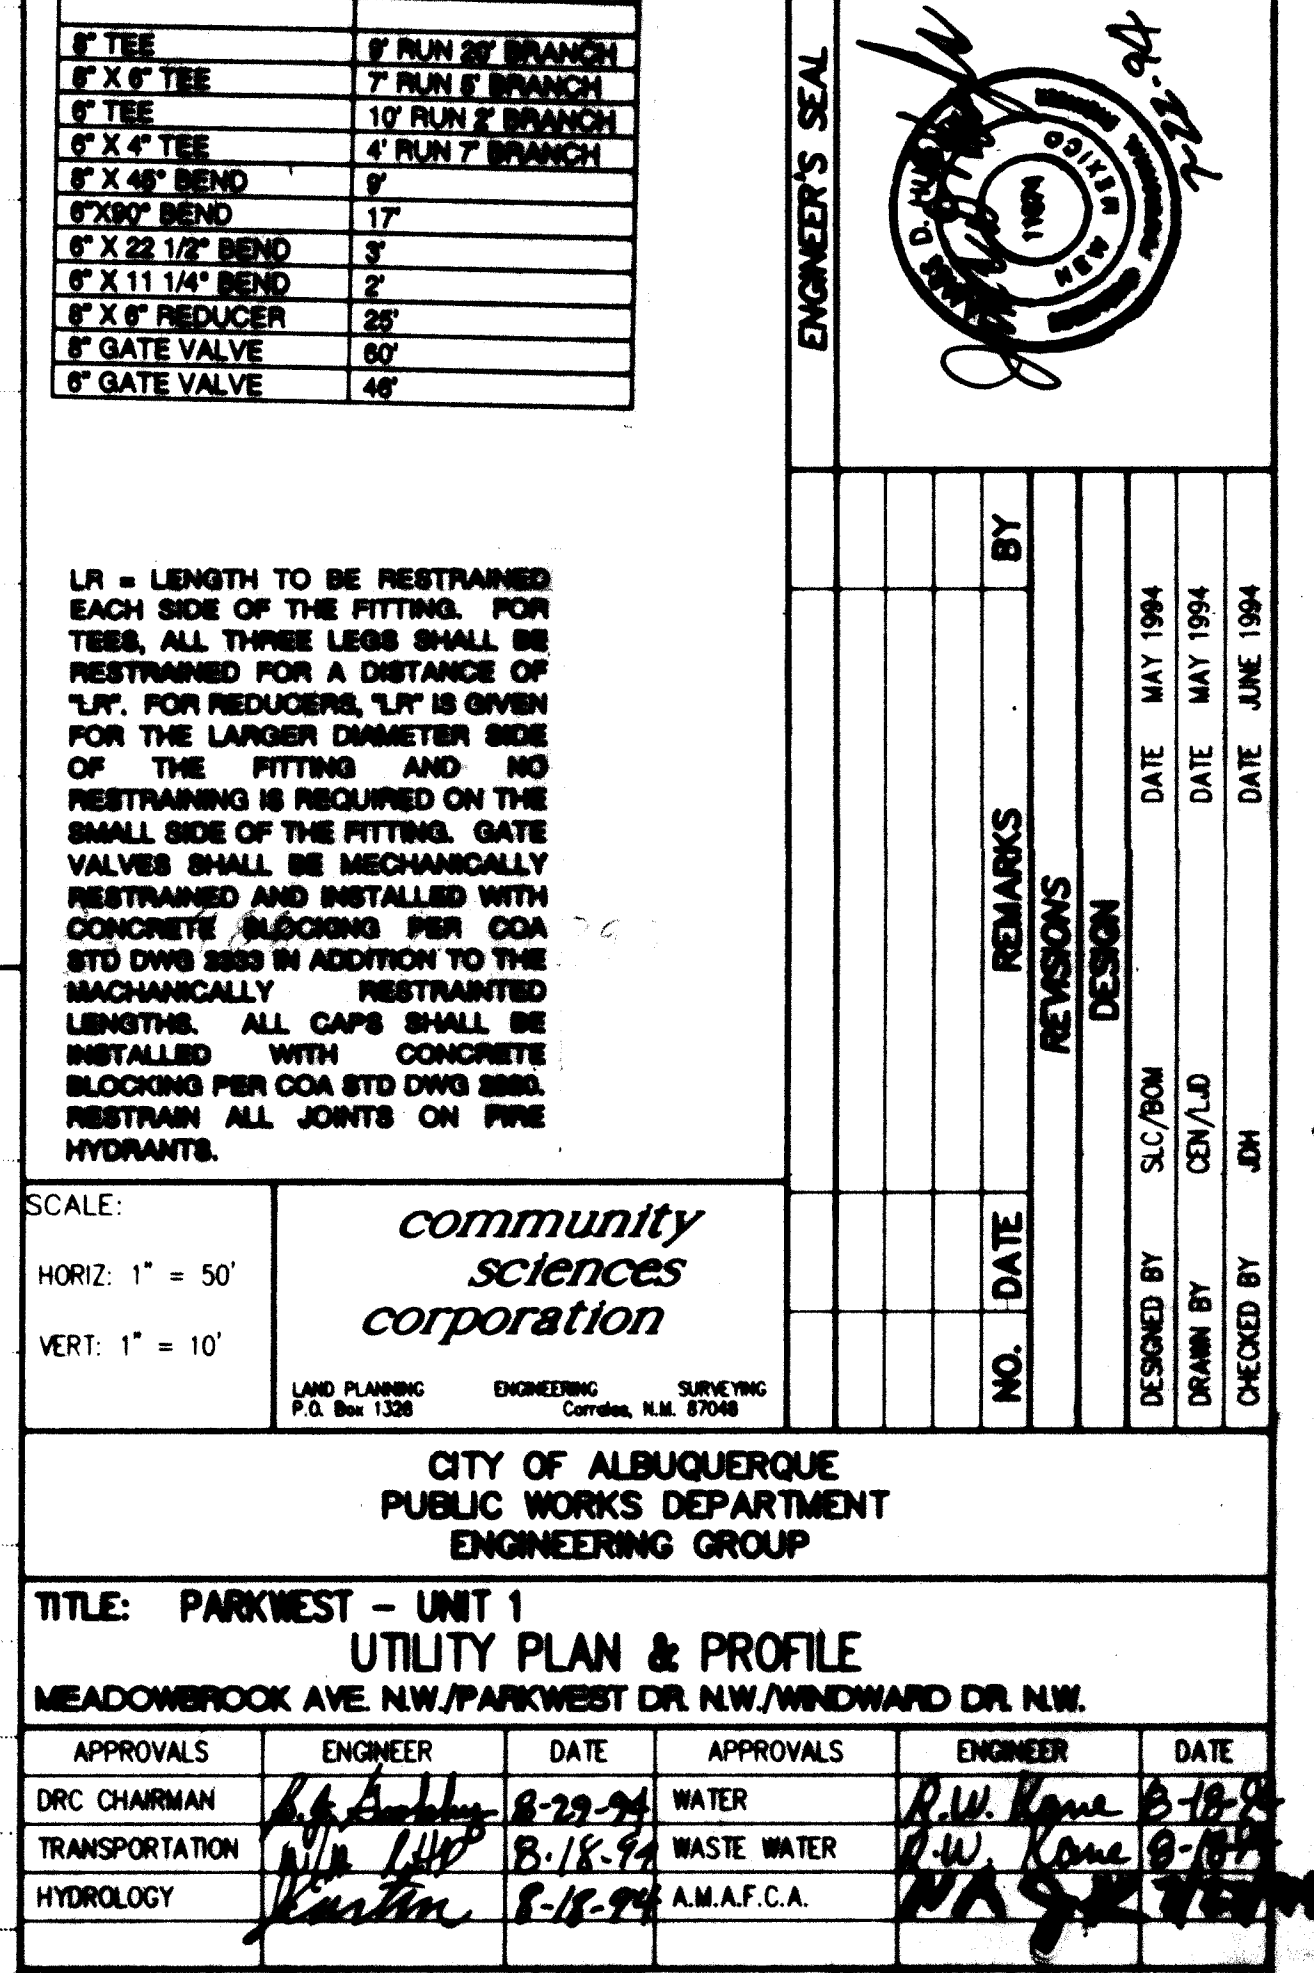


6" TEE 6" X 6" TEE 6" TEE 6" X 4" BEND 6" X 6" BEND 6" X 22 1/2" BEND 6" X 11 1/4" BEND 6" X 6" REDUCER 6" GATE VALVE 6" GATE VALVE	8" RUN 8" BRANCH 7" RUN 6" BRANCH 10" RUN 6" BRANCH 4" RUN 7" BRANCH 17 2 2 22 50 48
LR = LENGTH TO BE RESTRAINED EACH SIDE OF THE FITTING. FOR TEES, ALL THREE LEGS SHALL BE RESTRAINED FOR A DISTANCE OF "LR". FOR REDUCERS, "LR" IS GIVEN FOR THE LARGER DIAMETER SIDE OF THE FITTING AND NO RESTRAINING IS REQUIRED ON THE SMALL SIDE OF THE FITTING. GATE VALVES SHALL BE MECHANICALLY RESTRAINED AND INSTALLED WITH CONCRETE BLOCKING PER COA STD DWG 3889 IN ADDITION TO THE MECHANICALLY RESTRAINED LINGHTS. ALL CAPS SHALL BE INSTALLED WITH CONCRETE BLOCKING PER COA STD DWG 3889. RESTRAIN ALL JOINTS ON FIRE HYDRANTS.	
SCALE: HORIZ: 1" = 50' VERT: 1" = 10'	<i>community sciences corporation</i> LAND PLANNING ENGINEERING SURVEYING P.O. Box 1308 Corralito, N.M. 87008
CITY OF ALBUQUERQUE PUBLIC WORKS DEPARTMENT ENGINEERING GROUP	
TITLE: PARKWEST - UNIT 1 UTILITY PLAN & PROFILE MEADOWBROOK AVE. N.W./PARKWEST DR. N.W./MINIOWARD DR. N.W.	
APPROVALS DRC CHAIRMAN TRANSPORTATION HYDROLOGY	ENGINEER DATE APPROVALS ENGINEER DATE
WATER WASTE WATER A.M.A.F.C.A.	DESIGNED BY DRAWN BY CHECKED BY
NO. DATE	REMARKS REVISIONS DESIGN S.L.C./BOM CEN./J.D J.M
BY	DATE DATE DATE

PROJECT NO.	4886.91	MAP NO.	H-9	SHEET	12 OF 15
SCANNED BY BY LASON			DATE SOURCE AUTHORITY	RACK	PAGE
				14	

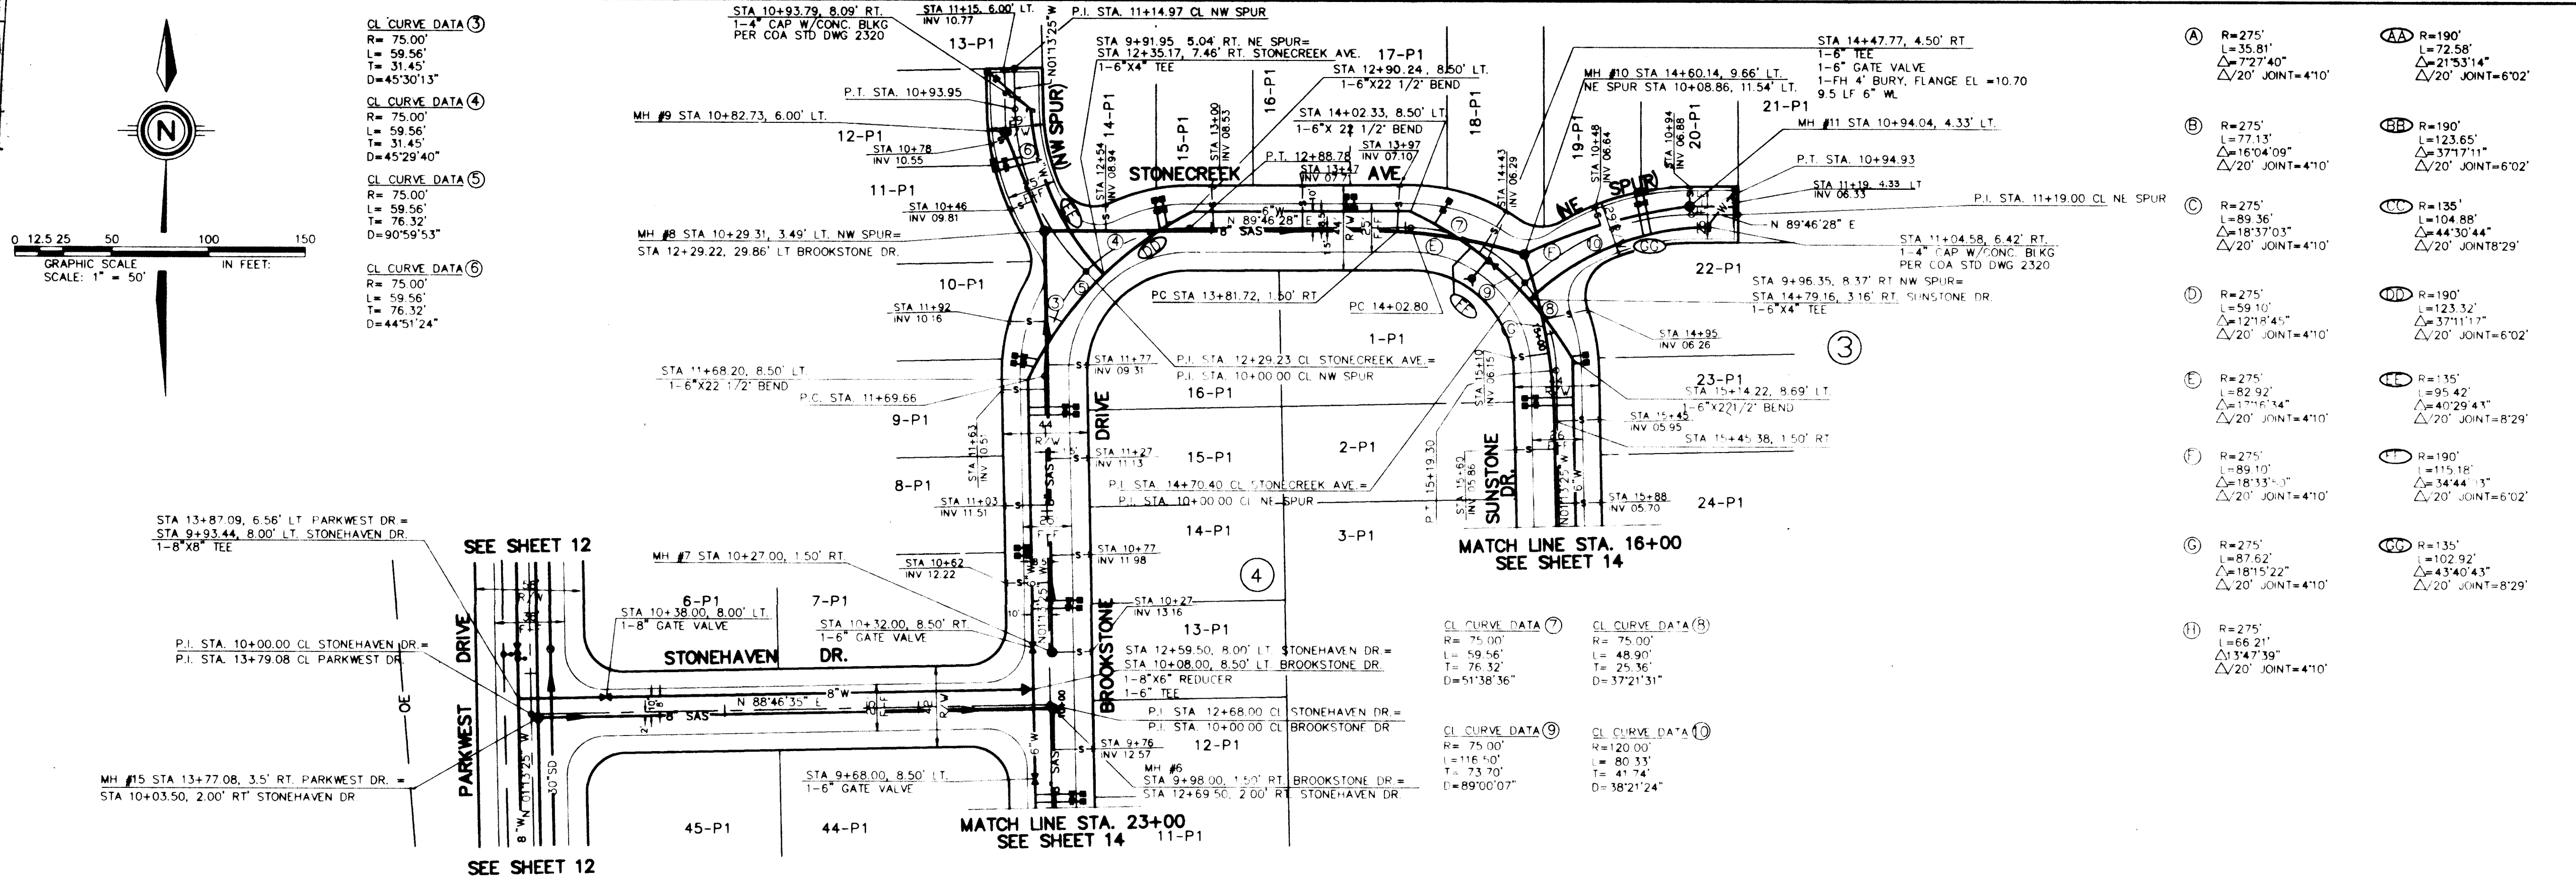

STONEHAVEN DR. N.W./BROOKSTONE DR. N.W./STONECREEK AVE. N.W./ SUNSTONE DR. N.W./NW SPUR/NE SPUR

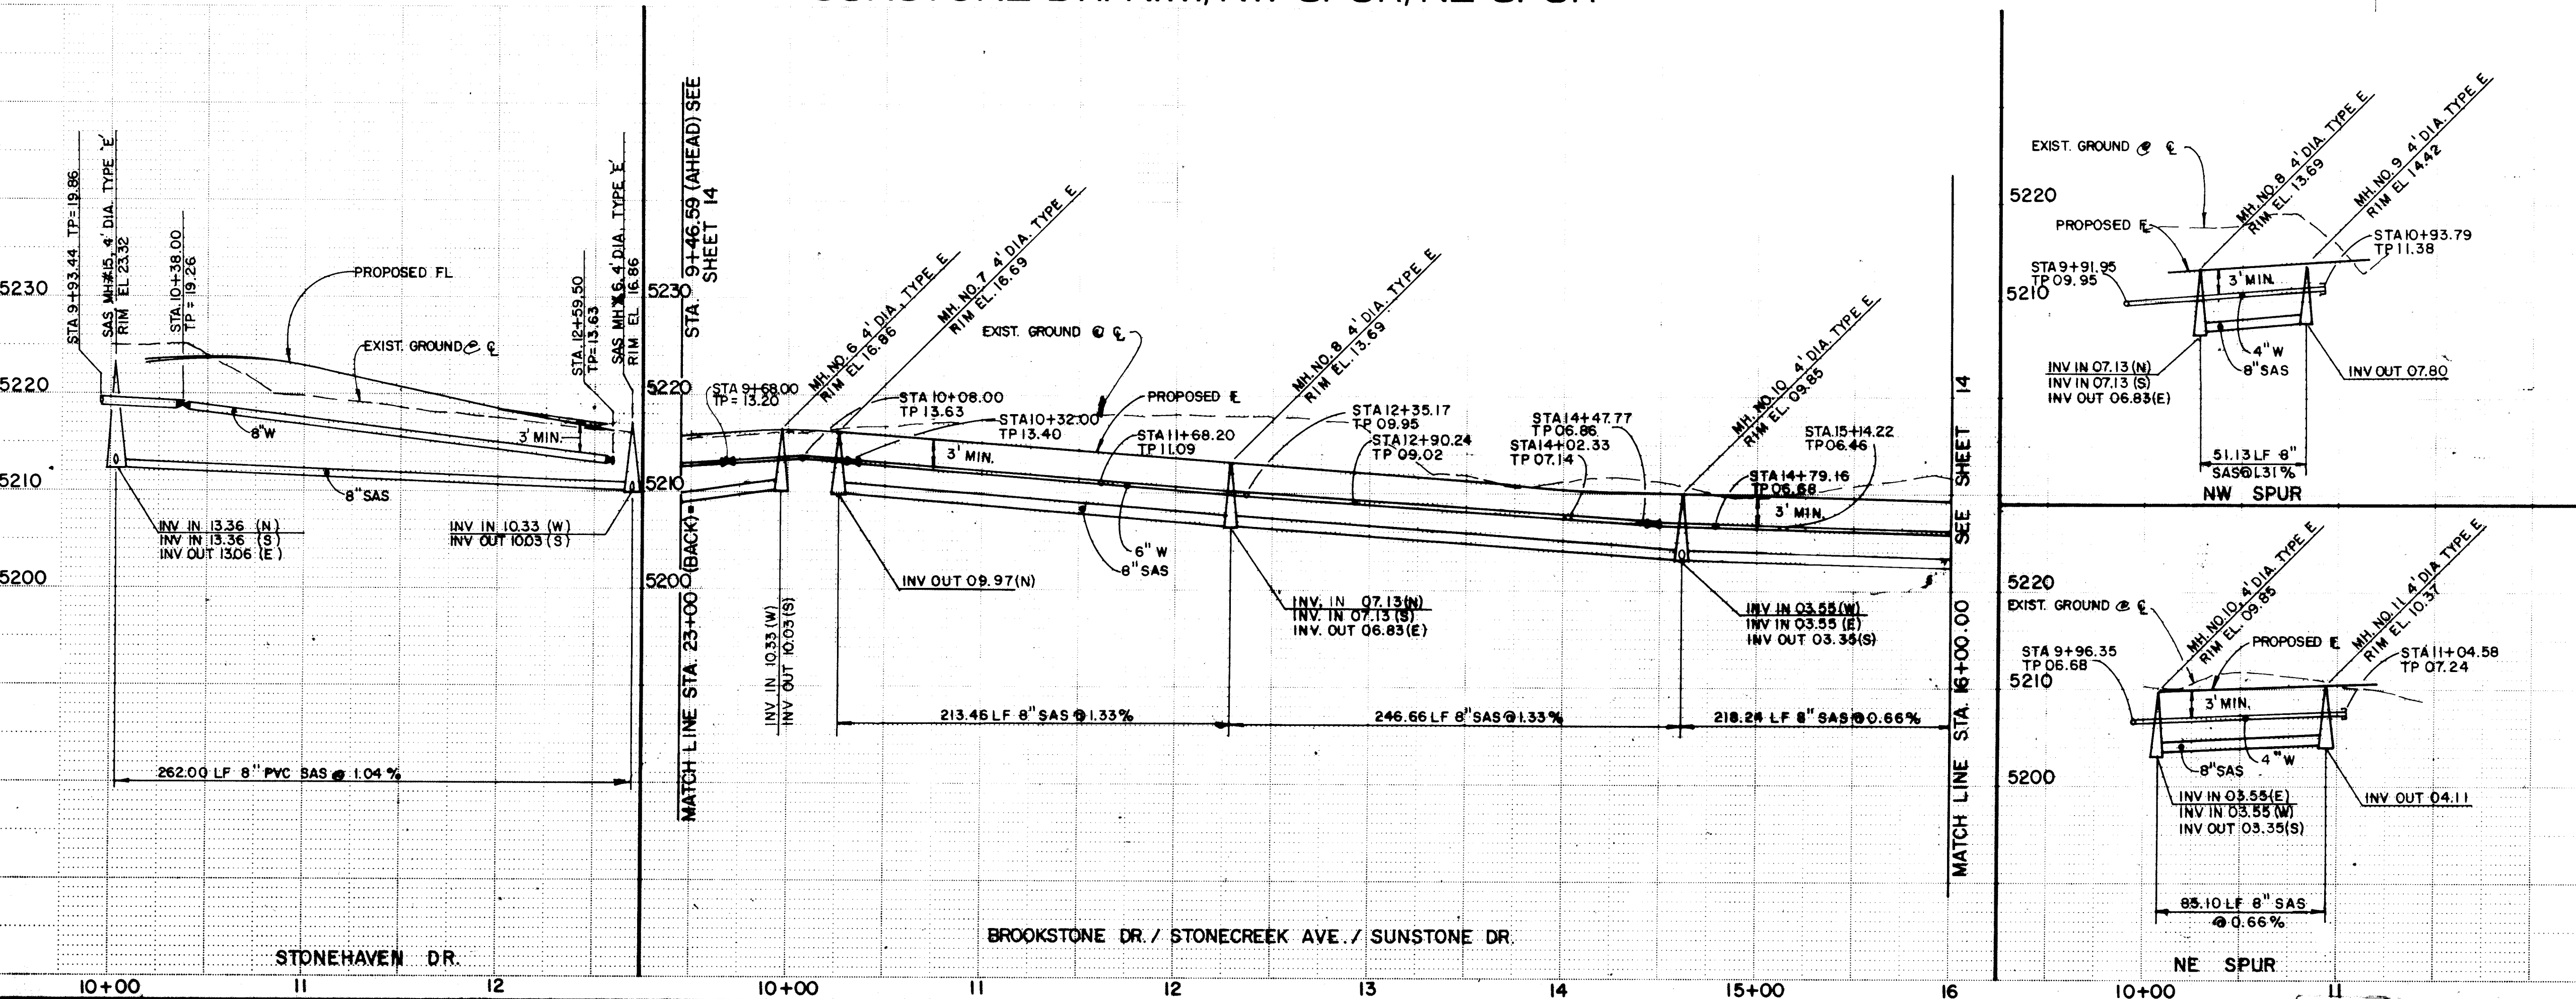

UTILITY LEGEND

DESCRIPTION	PROPOSED	EXISTING
SANITARY SEWER LINE		
ENCASEMENT		
SANITARY SEWER MANHOLE		
SAS SERVICE CONNECTION		
STORM DRAIN LINE		
STORM DRAIN MANHOLE		
WATER LINE		
GATE VALVE		
BUTTERFLY VALVE		
FIRE HYDRANTS		
REDUCERS		
WATER SERVICE/ METER		
TEES		
CROSSES		
BENDS		
CAPS & PLUGS		
GAS LINES		
OVERHEAD ELECTRICAL LINE		
UNDERGROUND ELECTRICAL		
OVERHEAD TELEPHONE		
UNDERGROUND TELEPHONE		
CABLE TELEVISION		
POWER OR TELEPHONE POLE		

RESTRAINING LENGTHS

FITTING	LR
8" TEE	9' RUN 20' BRANCH
8" X 6" TEE	7' RUN 8' BRANCH
6" TEE	10' RUN 2' BRANCH
6" X 4" TEE	4' RUN 7' BRANCH
8" X 45" BEND	9'
6" X 90" BEND	17'
6" X 22 1/2" BEND	3'
6" X 11 1/4" BEND	2'
8" X 6" REDUCER	25'
8" GATE VALVE	60'
6" GATE VALVE	46'

LR = LENGTH TO BE RESTRAINED EACH SIDE OF THE FITTING. FOR TEES, ALL THREE LEGS SHALL BE RESTRAINED FOR A DISTANCE OF "LR". FOR REDUCERS, "LR" IS GIVEN FOR THE LARGER DIAMETER SIDE OF THE FITTING AND NO RESTRAINING IS REQUIRED ON THE SMALL SIDE OF THE FITTING. GATE VALVES SHALL BE MECHANICALLY RESTRAINED AND INSTALLED WITH CONCRETE BLOCKING PER COA STD DWG 2333 IN ADDITION TO THE MECHANICALLY RESTRAINED LENGTHS. ALL CAPS SHALL BE INSTALLED WITH CONCRETE BLOCKING PER COA STD DWG 2320. RESTRAIN ALL JOINTS ON FIRE HYDRANTS.

RECORD DRAWING

24-4886.91 1139.7

SCALE: 1" = 50' HORIZ.
1" = 10' VERT.


community sciences corporation

CITY OF ALBUQUERQUE
PUBLIC WORKS DEPARTMENT
ENGINEERING GROUP

TITLE: PARKWEST - UNIT 1
UTILITY PLAN & PROFILE
STONEHAVEN DR. N.W./BROOKSTONE DR. N.W./STONECREEK AVE. N.W./SUNSTONE DR. N.W./NW SPUR/NE SPUR

APPROVALS	ENGINEER	DATE	APPROVALS	ENGINEER	DATE
DRG CHAIRMAN	B.G. Kelly	8-29-94	WATER	R.W. Kane	8-18-94
TRANSPORTATION	W.R. HED	8-18-94	WASTE WATER	R.W. Kane	8-18-94
HYDROLOGY	N/A JPC	8-18-94	A.M.A.F.C.A.	N/A G.R.	9-14-94

PROJECT NO. 4886.91 MAP NO. H-9 SHEET 13 OF 15

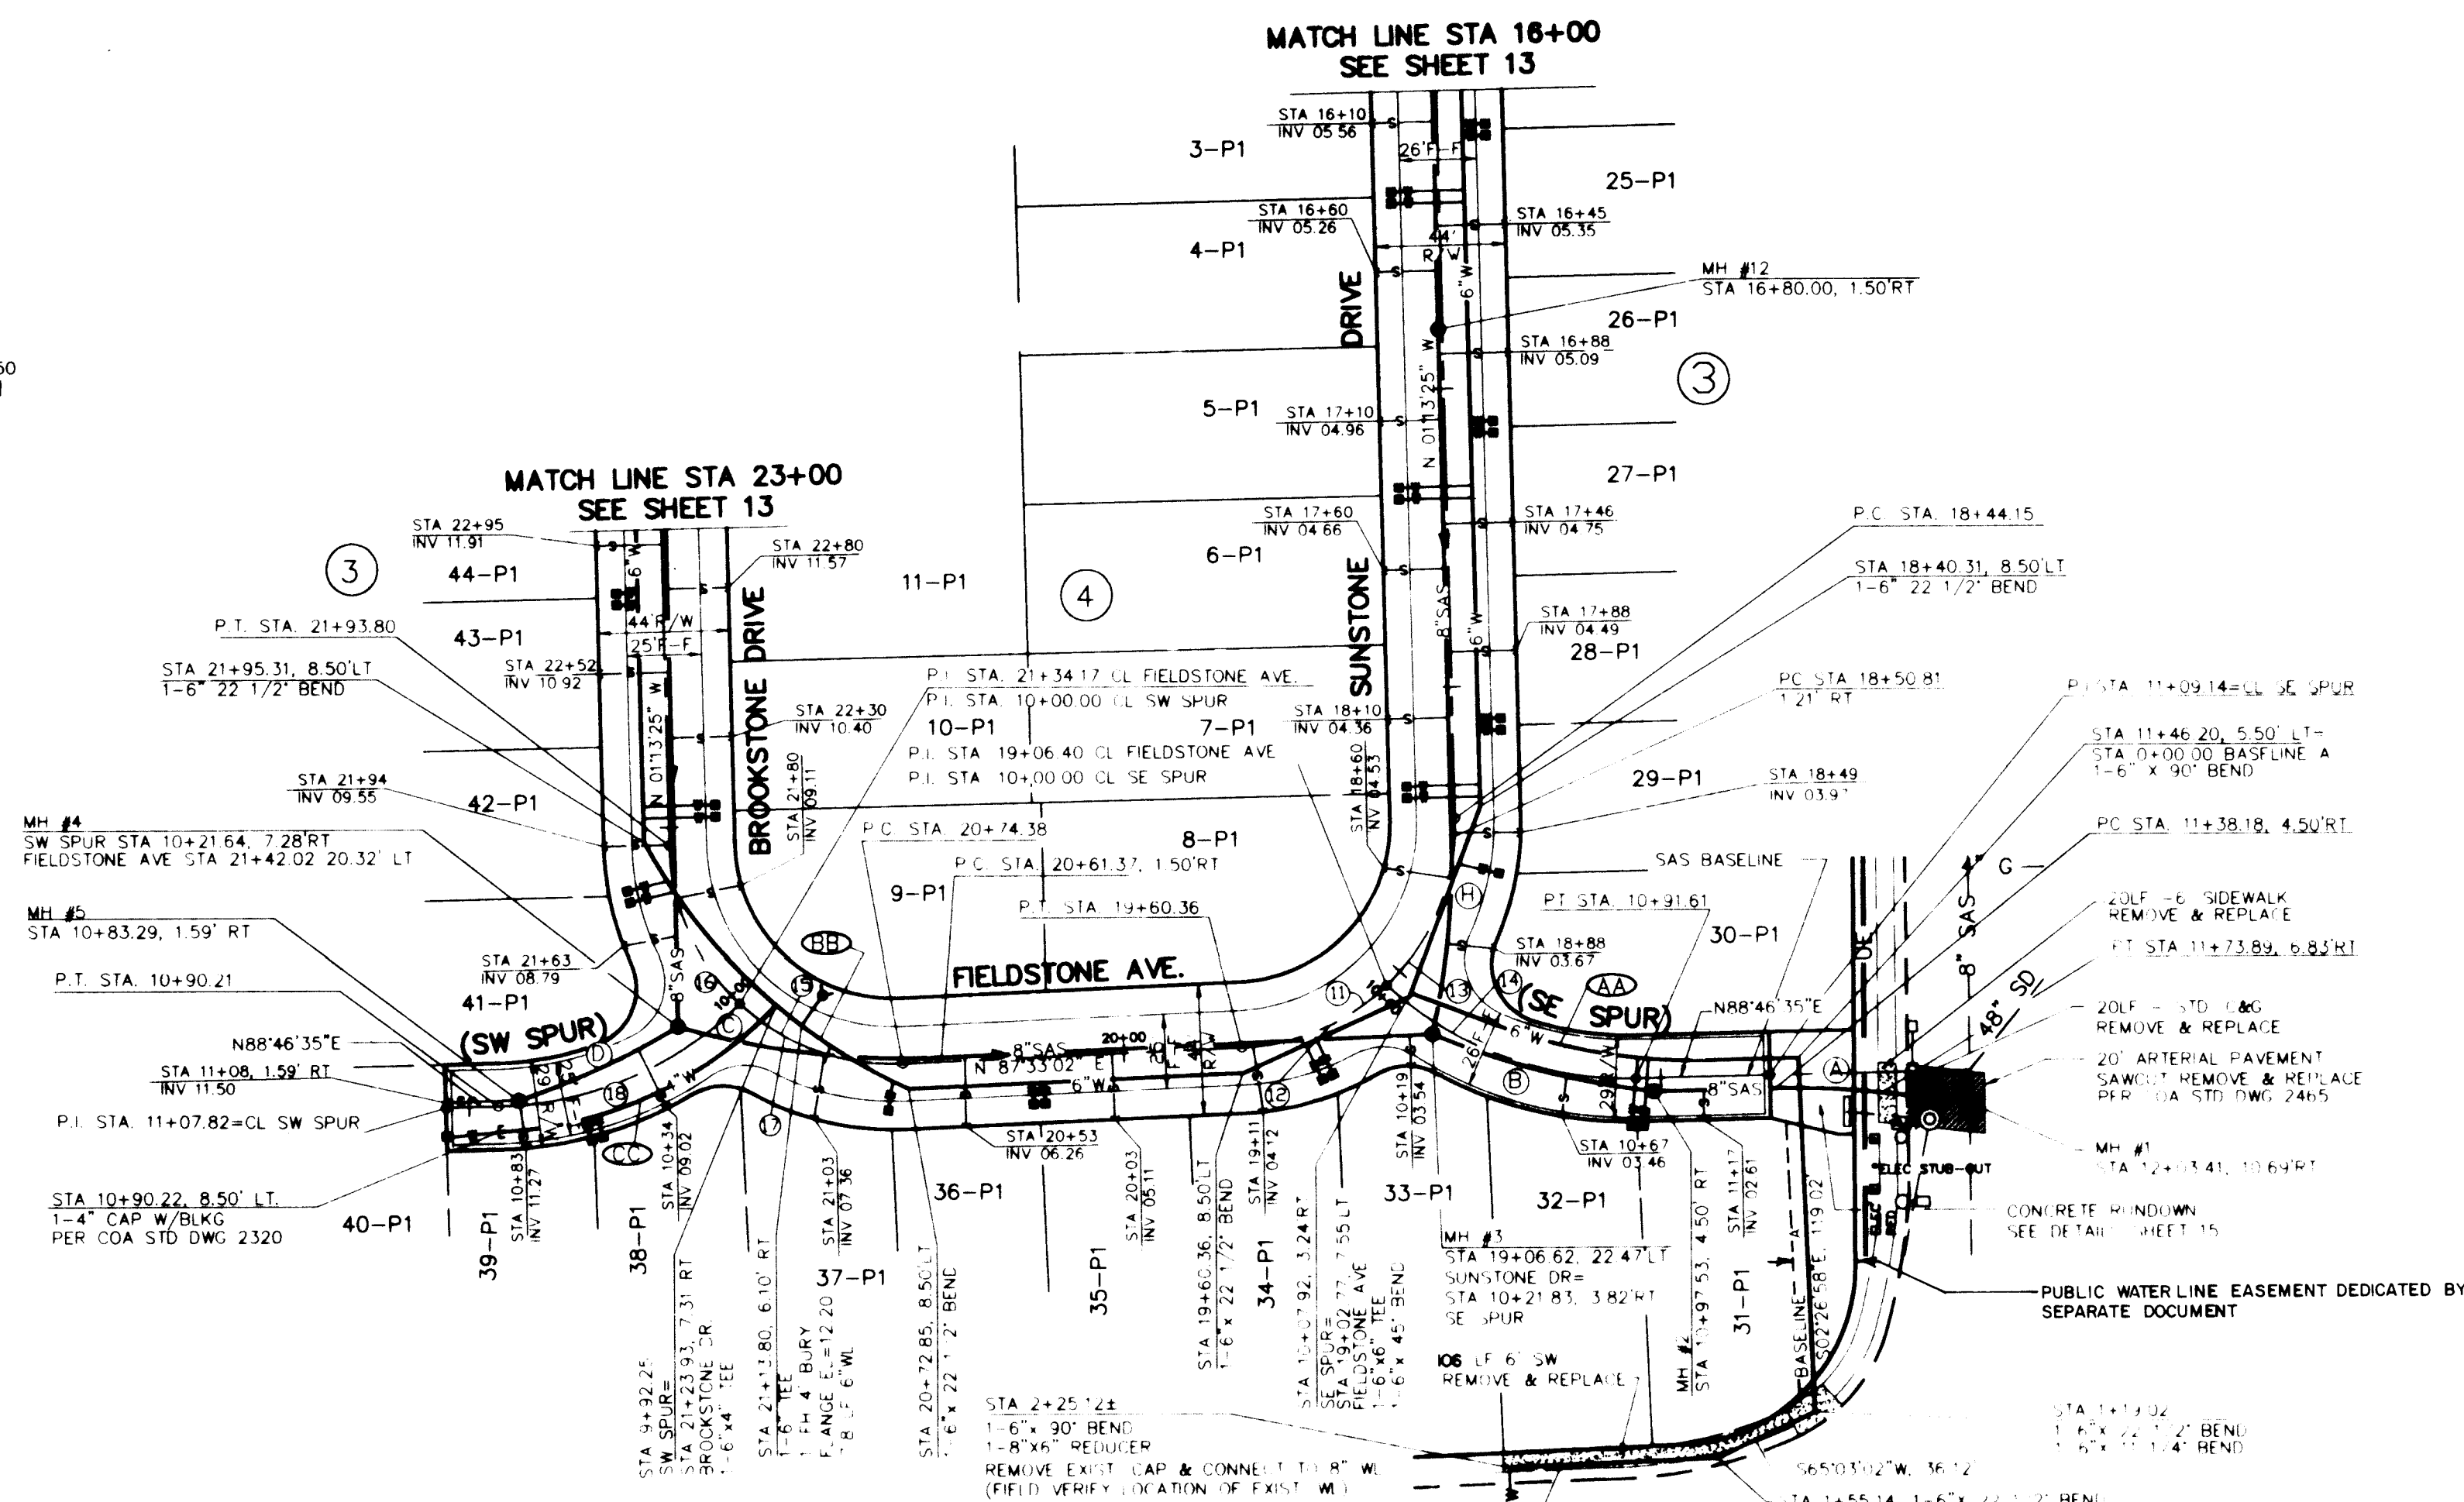

(A) $R=275'$
 $L=35.81'$
 $\Delta=72^{\circ}7'40''$
 $\Delta/20' \text{ JOINT}=47'10''$

(B) $R=275'$
 $L=77.13'$
 $\Delta=16^{\circ}04'08''$
 $\Delta/20' \text{ JOINT}=47'10''$

(C) $R=275'$
 $L=89.36'$
 $\Delta=18^{\circ}37'03''$
 $\Delta/20' \text{ JOINT}=47'10''$

(D) $R=59.10'$
 $L=27.15'$
 $\Delta=12^{\circ}18'45''$
 $\Delta/20' \text{ JOINT}=47'10''$

(E) $R=275'$
 $L=82.92'$
 $\Delta=17^{\circ}16'34''$
 $\Delta/20' \text{ JOINT}=47'10''$

(F) $R=275'$
 $L=89.10'$
 $\Delta=18^{\circ}37'50''$
 $\Delta/20' \text{ JOINT}=47'10''$

(G) $R=275'$
 $L=91.62'$
 $\Delta=18^{\circ}15'22''$
 $\Delta/20' \text{ JOINT}=47'10''$

(H) $R=275'$
 $L=66.21'$
 $\Delta=24^{\circ}34'39''$
 $\Delta/20' \text{ JOINT}=47'10''$

(I) $R=190'$
 $L=72.58'$
 $\Delta=21^{\circ}53'14''$
 $\Delta/20' \text{ JOINT}=67'02''$

(J) $R=190'$
 $L=123.65'$
 $\Delta=37^{\circ}17'11''$
 $\Delta/20' \text{ JOINT}=67'02''$

(K) $R=135'$
 $L=104.88'$
 $\Delta=44^{\circ}30'44''$
 $\Delta/20' \text{ JOINT}=82'29''$

(L) $R=190'$
 $L=123.32'$
 $\Delta=37^{\circ}11'17''$
 $\Delta/20' \text{ JOINT}=67'02''$

(M) $R=135'$
 $L=95.42'$
 $\Delta=40^{\circ}29'43''$
 $\Delta/20' \text{ JOINT}=82'29''$

(N) $R=190'$
 $L=115.18'$
 $\Delta=34^{\circ}44'03''$
 $\Delta/20' \text{ JOINT}=67'02''$

(O) $R=135'$
 $L=102.92'$
 $\Delta=43^{\circ}40'43''$
 $\Delta/20' \text{ JOINT}=82'29''$

(P) $R=75.00'$
 $L=75.00'$
 $\Delta=90^{\circ}$
 $\Delta/20' \text{ JOINT}=90^{\circ}$

(Q) $R=75.00'$
 $L=75.00'$
 $\Delta=90^{\circ}$
 $\Delta/20' \text{ JOINT}=90^{\circ}$

(R) $R=75.00'$
 $L=75.00'$
 $\Delta=90^{\circ}$
 $\Delta/20' \text{ JOINT}=90^{\circ}$

(S) $R=75.00'$
 $L=75.00'$
 $\Delta=90^{\circ}$
 $\Delta/20' \text{ JOINT}=90^{\circ}$

(T) $R=75.00'$
 $L=75.00'$
 $\Delta=90^{\circ}$
 $\Delta/20' \text{ JOINT}=90^{\circ}$

(U) $R=75.00'$
 $L=75.00'$
 $\Delta=90^{\circ}$
 $\Delta/20' \text{ JOINT}=90^{\circ}$

(V) $R=75.00'$
 $L=75.00'$
 $\Delta=90^{\circ}$
 $\Delta/20' \text{ JOINT}=90^{\circ}$

(W) $R=75.00'$
 $L=75.00'$
 $\Delta=90^{\circ}$
 $\Delta/20' \text{ JOINT}=90^{\circ}$

(X) $R=75.00'$
 $L=75.00'$
 $\Delta=90^{\circ}$
 $\Delta/20' \text{ JOINT}=90^{\circ}$


(Y) $R=75.00'$
 $L=75.00'$
 $\Delta=90^{\circ}$
 $\Delta/20' \text{ JOINT}=90^{\circ}$

(Z) $R=75.00'$
 $L=75.00'$
 $\Delta=90^{\circ}$
 $\Delta/20' \text{ JOINT}=90^{\circ}$

UTILITY LEGEND			
DESCRIPTION	PROPOSED	EXISTING	
SANITARY SEWER LINE			
ENCASEMENT			
SANITARY SEWER MANHOLE			
SAS SERVICE CONNECTION			
STORM DRAIN LINE			
STORM DRAIN MANHOLE			
STORM DRAIN INLETS			
WATER LINE			
GATE VALVE			
BUTTERFLY VALVE			
FIRE HYDRANTS			
REDUCERS			
WATER SERVICE/ METER			
TEES			
CROSSES			
BENDS			
CAPS & PLUGS	N/A		
GAS LINES	N/A		
OVERHEAD ELECTRICAL LINE	N/A		
UNDERGROUND ELECTRICAL	N/A		
OVERHEAD TELEPHONE	N/A		
UNDERGROUND TELEPHONE	N/A		
CABLE TELEVISION	N/A		
POWER OR TELEPHONE POLE	N/A		

FITTING	LR
8" TEE	9' RUN 20' BRANCH
8" X 6" TEE	7' RUN 8" BRANCH
6" TEE	10' RUN 2' BRANCH
6" X 4" TEE	4' RUN 7" BRANCH
8" X 45° BEND	9'
6"X90° BEND	17'
6" X 22 1/2" BEND	3'
6" X 11 1/4" BEND	2'
8" X 6" REDUCER	25'
8" GATE VALVE	60'
6" GATE VALVE	46'

LR = LENGTH TO BE RESTRAINED
EACH SIDE OF THE FITTING. FOR
TEES, ALL THREE LEGS SHALL BE
RESTRAINED FOR A DISTANCE OF
"LR". FOR REDUCERS, "LR" IS GIVEN
FOR THE LARGER DIAMETER SIDE OF
THE FITTING AND NO
RESTRAINING IS REQUIRED ON THE
SMALL SIDE OF THE FITTING. GATE
VALVES SHALL BE MECHANICALLY
RESTRAINED AND INSTALLED WITH
CONCRETE BLOCKING PER COA
STD DWG 2333 IN ADDITION TO THE
MECHANICALLY RESTRAINED
CAPS. ALL CAPS SHALL BE
INSTALLED WITH CONCRETE
BLOCKING PER COA STD DWG 2320.
RESTRAIN ALL JOINTS ON FIRE
HYDRANTS.

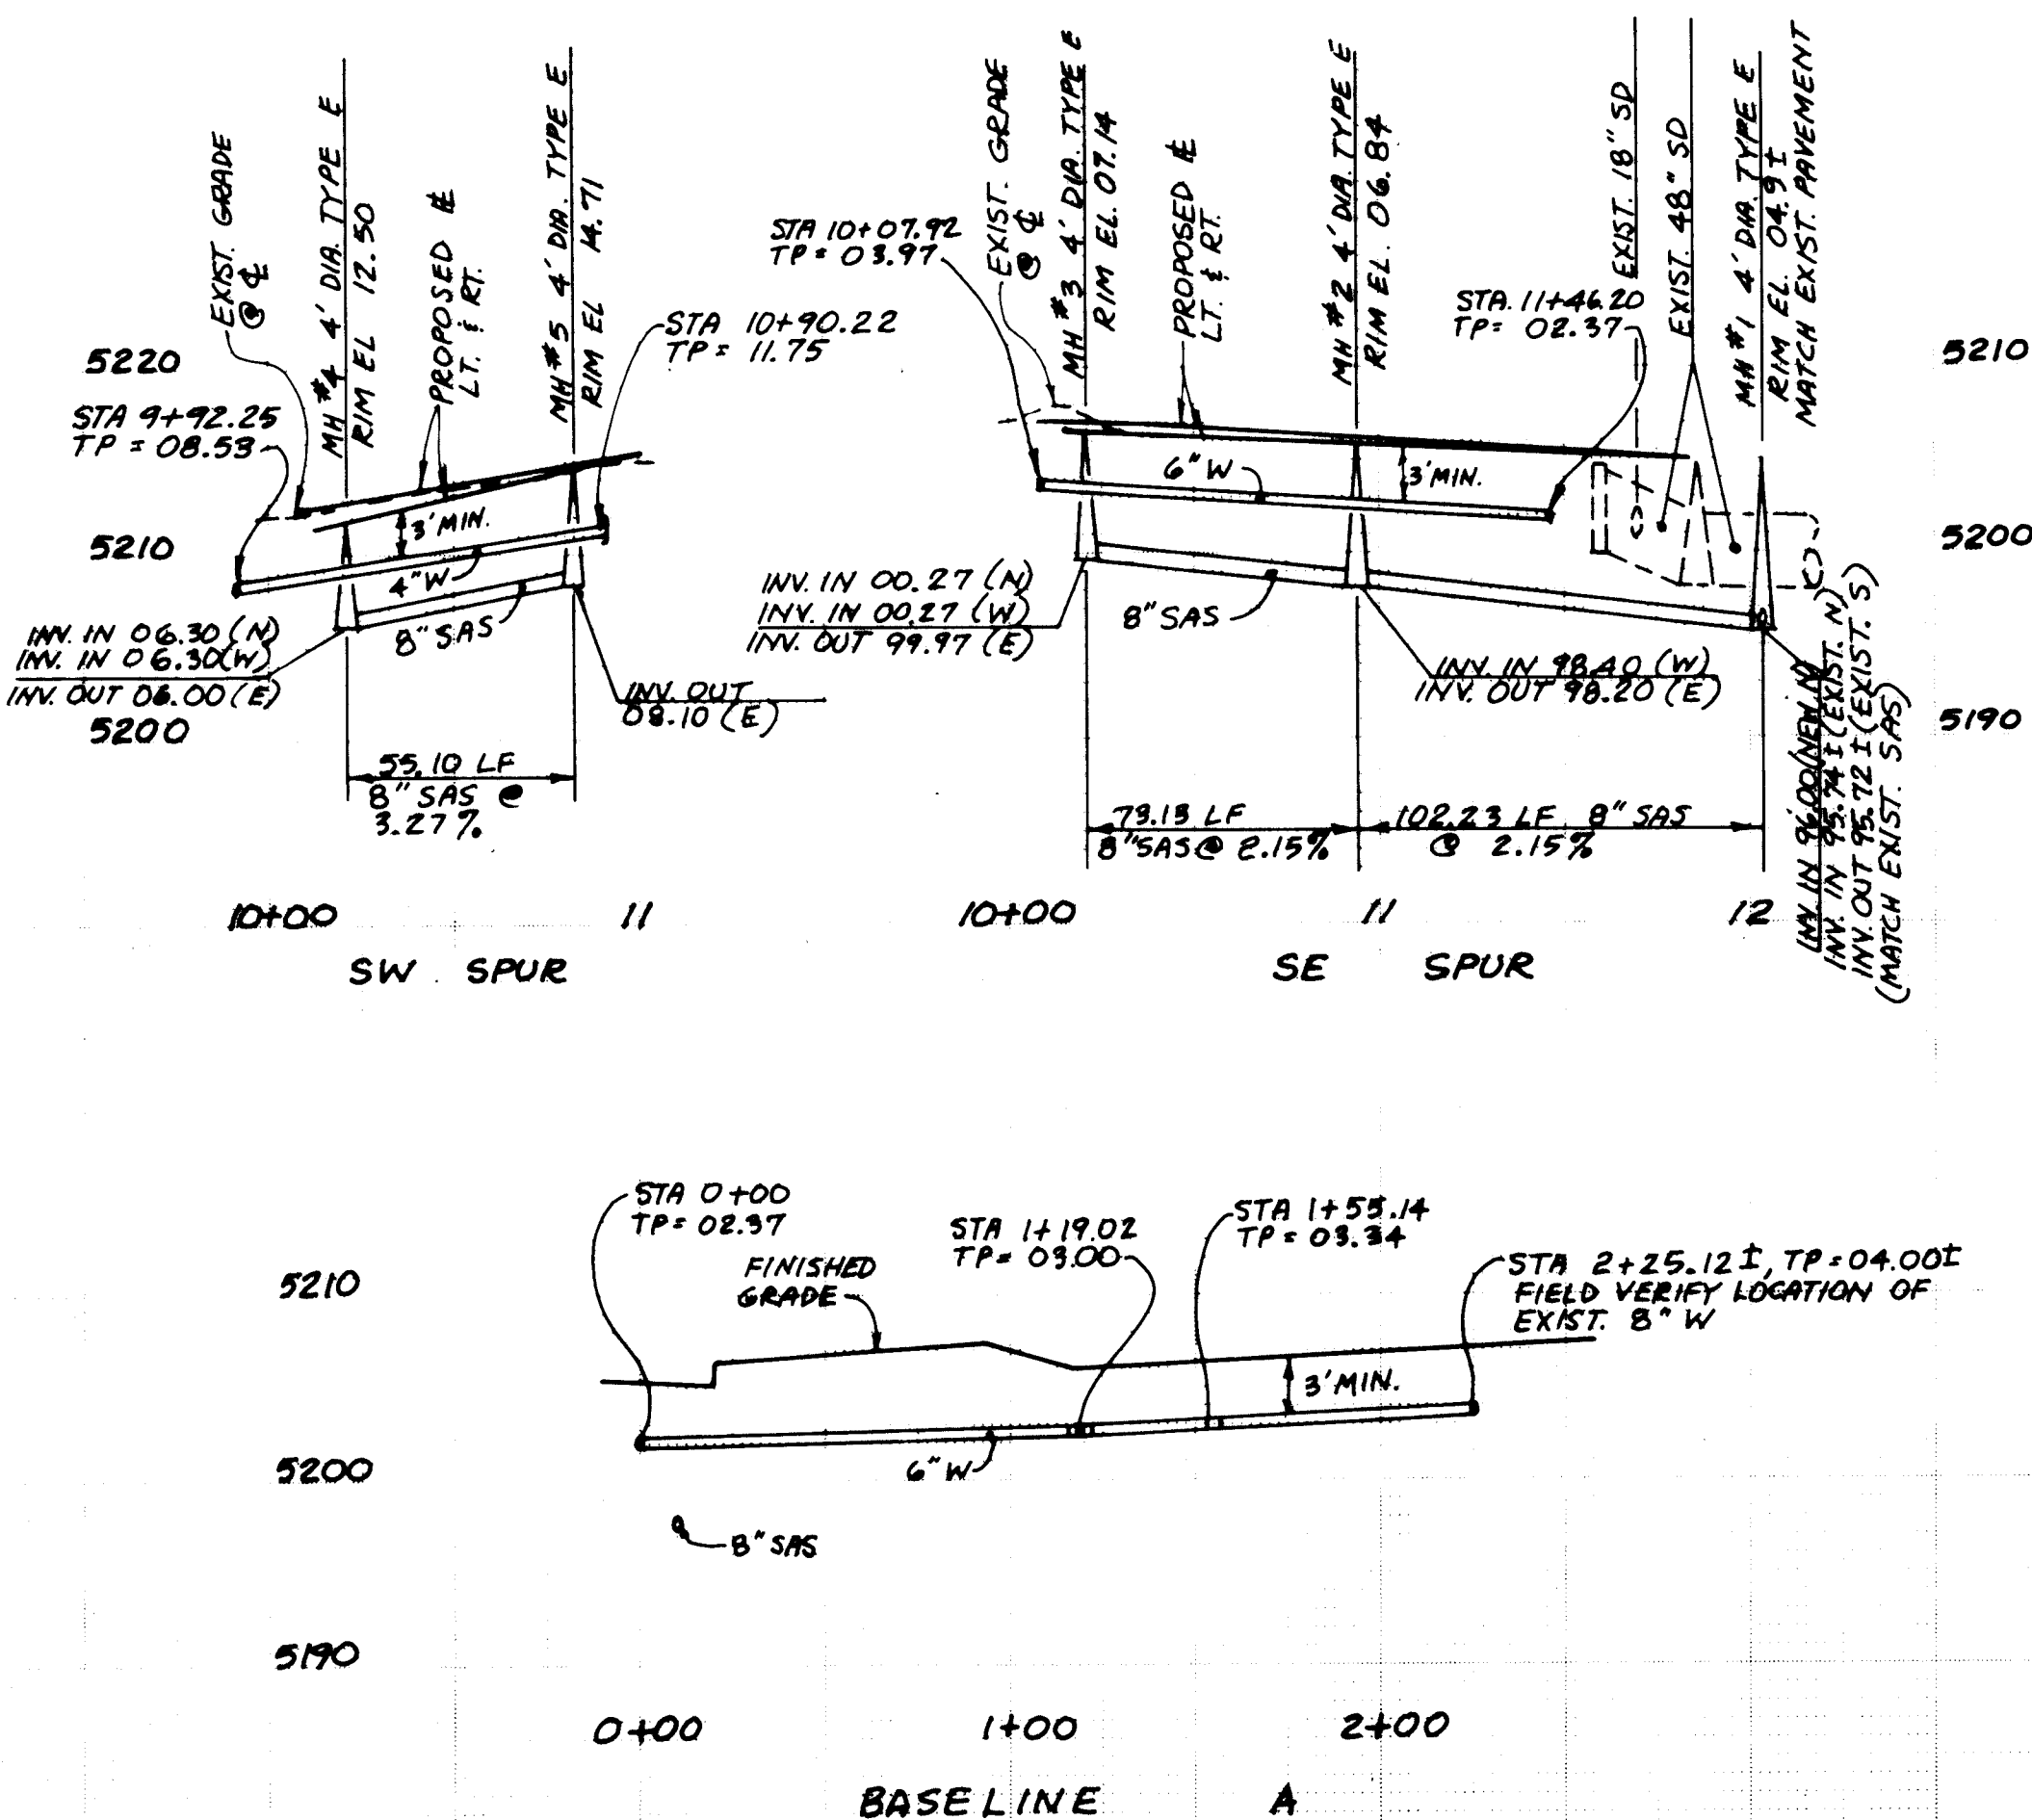

26-4886.91 1497

RECORD DRAWING

12-3-97

SCALE

HORIZ: 1" = 50'

VERT. $1 = 10$

CITY OF ALBUQUERQUE
PUBLIC WORKS DEPARTMENT
ENGINEERING GROUP




TITLE: PARKWEST - UNIT 1
UTILITY PLAN & PROFILE
SUNSTONE DR. N.W./FIELDSTONE AVE. N.W./BROOKSTONE DR. N.W./S.E. SPUR/S.W. SPUR

APPROVALS	ENGINEER	DATE	APPROVALS	ENGINEER	DATE
DRC CHAIRMAN	<i>S.G. Sordley</i>	<i>8-29-94</i>	WATER	<i>R.W. Kane</i>	<i>9-18-94</i>
TRANSPORTATION	<i>N/A RHO</i>	<i>3-18-94</i>	WASTE WATER	<i>R.W. Kane</i>	<i>9-18-94</i>
HYDROLOGY	<i>N/A APC</i>	<i>5-18-94</i>	A.M.A.F.C.A.	<i>NA GK</i>	<i>9-18-94</i>

PROJECT NO.	4886.91	MAP NO.	H-9	SHEET	14	OF	15
-------------	---------	---------	-----	-------	----	----	----

SCANNED BY
BY LASON

14 BOX #	PAGE #
14 BOX #	SLOT #

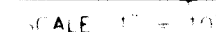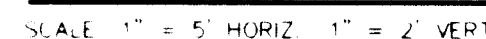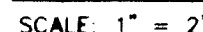

BY	REMARKS	DATE	NO.
REVISIONS			
DESIGN			
DATE	JUNE 1994	DESIGNED BY	SLC/BOM
DATE	JUNE 1994	DRAWN BY	CEN
DATE	JUNE 1994	CHECKED BY	JDH

PROJECT NO.	4886.91	MAP NO.	H-9	SHEET	15 ^{OF}	15
-------------	---------	---------	-----	-------	------------------	----

PACK #	PAGE #
14	
BOX #	SLOT #