

RECORD DRAWING

PARKWEST SUBDIVISION- UNIT 5

CITY OF ALBUQUERQUE, BERNALILLO COUNTY, NEW MEXICO

IMPROVEMENTS FOR
GRADING, PAVING AND UTILITIES

INDEX TO DRAWINGS

SHEET NO.	DESCRIPTION	SHEET NO.	DESCRIPTION
1	COVER SHEET, VICINITY MAP AND INDEX TO DRAWINGS		<u>PAVING PLAN & PROFILES (CONTINUED)</u>
2-3	PLATS OF GEOMETRY	23	SADDLEBROOK AVENUE AND STONEWOOD DRIVE N.W.
	<u>GRADING AND EROSION CONTROL PLANS</u>	24	LAVA BLUFF DRIVE N.W.
4	COMPOSITE GRADING PLAN		<u>UTILITY PLAN & PROFILES</u>
5-6	GRADING AND EROSION CONTROL PLANS (ONSITE)	25	COMPOSITE UTILITY PLAN (ONSITE)
7	GRADING DETAILS	26	COMPOSITE UTILITY PLAN (OFFSITE)
8-9	OFFSITE GRADING (LAVA BLUFF DRIVE N.W.)	27	PARKWEST DRIVE N.W.
10	OFFSITE GRADING (PETROGLYPH AVENUE, MONUMENT DRIVE)	28	WESTBROOK DRIVE, CASCADE PARK AVENUE, AND OAKBROOK DRIVE N.W.
11	OFFSITE GRADING (BASALT AVENUE)	29	CREEKWOOD AVENUE AND CREEKWOOD LOOP N.W.
12	OFFSITE GRADING (MONUMENT DRIVE)	30	CREEKWOOD AVENUE N.W.
13-14	CHANNEL PLAN AND PROFILES	31	SMOKERISE AVENUE N.W.
15	POND AND POND DETAILS	32	SADDLEBROOK AVENUE AND STONEWOOD DRIVE N.W.
16	DRAINAGE STRUCTURE DETAILS	33	LAVA BLUFF DRIVE N.W.
	<u>PAVING PLAN & PROFILES</u>	34-35	OFFSITE UTILITIES (LAVA BLUFF DRIVE N.W.)
17	COMPOSITE PAVING PLAN	36	OFFSITE UTILITIES (PETROGLYPH AND MONUMENT DRIVE)
18	PARKWEST DRIVE N.W.	37	OFFSITE UTILITIES (BASALT AVENUE N.W.)
19	WESTBROOK DRIVE, CASCADE PARK AVENUE, AND OAKBROOK DRIVE N.W.	38	OFFSITE UTILITIES (MONUMENT DRIVE N.W.)
20	CREEKWOOD AVENUE AND CREEKWOOD LOOP N.W.	39	MISC. STRUCTURAL AND DRAINAGE DETAILS
21	CREEKWOOD AVENUE N.W.		
22	SMOKERISE AVENUE N.W.		

WARNING - EXISTING UTILITY LINE LOCATIONS ARE SHOWN IN APPROXIMATE MANNER ONLY, AND SUCH LINES MAY EXIST WHERE NONE ARE SHOWN. THE LOCATION OF ANY SUCH EXISTING LINES IS BASED UPON INFORMATION PROVIDED BY THE UTILITY COMPANY, THE OWNER, OR BY OTHERS, AND THE INFORMATION MAY BE INCOMPLETE OR MAY BE OBSOLETE BY THE TIME CONSTRUCTION COMMENCES.



THE ENGINEER HAS UNDERTAKEN LIMITED FIELD VERIFICATION OF THE LOCATION, DEPTH, SIZE, OR TYPE OF EXISTING UNDERGROUND UTILITY LINES. MAKES NO REPRESENTATION PERTAINING THERETO AND ASSUMES NO RESPONSIBILITY OR LIABILITY THEREFOR. THE CONTRACTOR SHALL INFORM ITSELF OF THE LOCATION OF ANY UTILITY LINE IN OR NEAR THE AREA OF THE WORK IN ADVANCE OF AND DURING EXCAVATION WORK. THE CONTRACTOR IS FULLY RESPONSIBLE FOR ANY AND ALL DAMAGE CAUSED BY ITS FAILURE TO LOCATE, IDENTIFY, AND PRESERVE ANY AND ALL EXISTING UTILITIES. THE CONTRACTOR SHALL COMPLY WITH STATE STATUTES, MUNICIPAL AND LOCAL ORDINANCES, RULES AND REGULATIONS PERTAINING TO THE LOCATION OF THESE LINES AND FACILITIES, IN PLANNING AND CONDUCTING EXCAVATION, WHETHER BY CALLING OR NOTIFYING THE UTILITIES, COMPLYING WITH "BLUE STAKES" PROCEDURES, OR OTHERWISE.

RECORD DRAWING

"I, Kent M. Whitman, a duly Registered Professional Engineer in the State of New Mexico, (registration number 6170), do hereby certify that this Record Drawing was prepared at my direction and under my supervision; and that it is true and correct to the best of my knowledge and belief. The information contained herein is not based upon construction observation conducted under my supervision, but on interviews with supervisory personnel employed by the General Contractor and interviews with field survey personnel who staked the infrastructure for construction.

Kent M. Whitman, P.E. No. 6170

12/3/99 Date

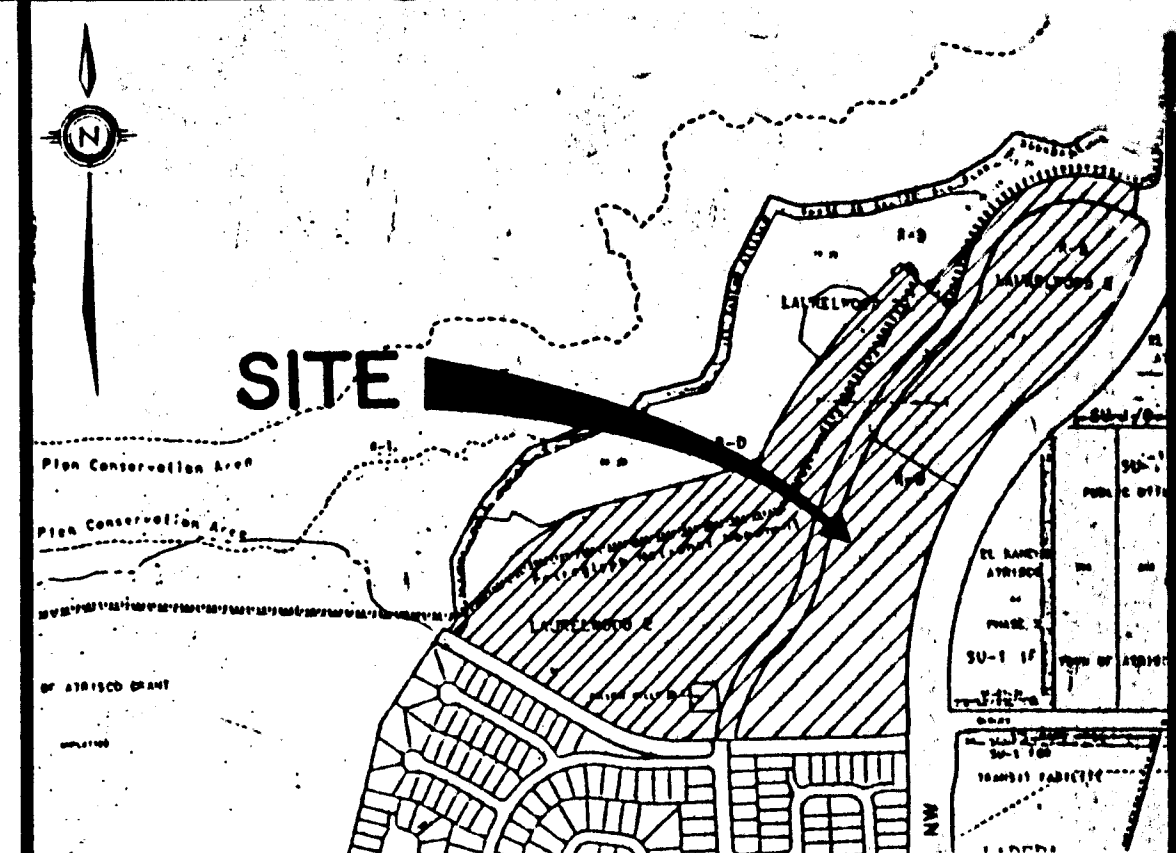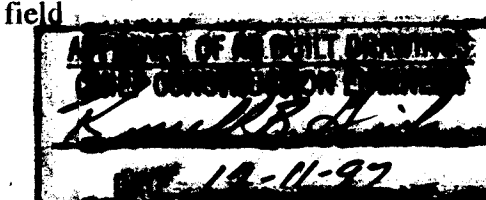

SCALE: 1" = 750 ± VICINITY MAP G-9, H-9-2

GENERAL NOTES



- ALL WORK DETAILED ON THESE PLANS TO BE PERFORMED UNDER CONTRACT SHALL, EXCEPT AS OTHERWISE STATED OR PROVIDED FROM HEREON, BE CONSTRUCTED IN ACCORDANCE WITH THE CITY OF ALBUQUERQUE STANDARD SPECIFICATIONS FOR PUBLIC WORKS CONSTRUCTION, 1986 EDITION AS AMENDED WITH UPDATE NO. 5.
- TWO (2) WORKING DAYS PRIOR TO ANY EXCAVATION, CONTRACTOR MUST CONTACT LINE LOCATING SERVICE, (260-1990) FOR LOCATION OF EXISTING UTILITIES.
- PRIOR TO CONSTRUCTION, THE CONTRACTOR SHALL EXCAVATE AND VERIFY THE HORIZONTAL AND VERTICAL LOCATIONS OF ALL OBSTRUCTIONS AND EXISTING PAVEMENT. SHOULD A CONFLICT EXIST, THE CONTRACTOR SHALL NOTIFY THE ENGINEER OR SURVEYOR SO THAT THE CONFLICT CAN BE RESOLVED WITH MINIMUM AMOUNT OF DELAY.
- THE CONTRACTOR SHALL FURNISH EMD'S ON ALL WATER AND SEWER SERVICE STUBS, CAPS AND PLUGS.
- CONTRACTOR SHALL NOTIFY THE PROJECT ENGINEER NOT LESS THAN SEVEN (7) DAYS PRIOR TO STARTING WORK IN ORDER THAT THE ENGINEER MAY TAKE NECESSARY MEASURES TO INSURE THE PRESERVATION OF SURVEY MONUMENTS. CONTRACTOR SHALL NOT DISTURB PERMANENT SURVEY MONUMENTS WITHOUT THE CONSENT OF THE ENGINEER AND BEAR THE EXPENSE OF REPLACING ANY THAT MAY BE DISTURBED WITHOUT PERMISSION. REPLACEMENT SHALL BE DONE ONLY BY THE CITY SURVEY SECTION. WHEN A CHANGE IS MADE IN ANY ROADWAY IN WHICH A PERMANENT SURVEY MONUMENT IS LOCATED, CONTRACTOR SHALL, AT HIS OWN EXPENSE, ADJUST THE MONUMENT COVER TO THE NEW GRADE UNLESS OTHERWISE SPECIFIED. REFER TO SECTION 4.4 OF GENERAL CONDITIONS OF THE CITY OF ALBUQUERQUE STANDARD SPECIFICATIONS FOR PUBLIC WORKS CONSTRUCTION.
- RESTRAINED JOINTS ARE REQUIRED AT ALL WATER LINE BENDS, TEES, CAPS AND GATE VALVES.
- THE PUBLIC WATER LINE MUST BE A MINIMUM OF 18" ABOVE THE SEWER LINE AT ALL CROSSINGS.
- THE CONTRACTOR SHALL CONTACT WATER SYSTEMS DIVISION (857-8200) THREE (3) WORKING DAYS PRIOR TO NEEDING SHUT-OFF OR TURN-ON OF VALVES. ONLY CITY WATER SYSTEMS PERSONNEL ARE AUTHORIZED TO OPERATE VALVE.
- THREE (3) WORKING DAYS PRIOR TO BEGINNING CONSTRUCTION, THE CONTRACTOR SHALL SUBMIT TO THE CONSTRUCTION COORDINATION DIVISION A DETAILED CONSTRUCTION SCHEDULE. TWO (2) WORKING DAYS PRIOR TO CONSTRUCTION, THE CONTRACTOR SHALL OBTAIN A BARRICADING PERMIT FROM THE CONSTRUCTION COORDINATION DIVISION. CONTRACTOR SHALL NOTIFY BARRICADE ENGINEER (788-2551) PRIOR TO OCCUPYING AN INTERSECTION. SEE SECTION 19 OF THE SPECIFICATIONS.
- ALL STREET STRIPING ALTERED OR DESTROYED SHALL BE REPLACED IN KIND BY CONTRACTOR TO LOCATION AND IN KIND AS EXISTING OR AS INDICATED BY THIS PLAN SET. ALL NEW STRIPING SHALL BE PLASTIC AS PER CITY STANDARDS.

26-4886.94 0177

REV.	SHEETS	CITY ENGINEER	DATE	USER DEPARTMENT	DATE	USER DEPARTMENT	DATE
1							

ENGINEER'S SEAL	DATE: MARCH, 1995 SCALE: AS SHOWN EXSOSER: S.R.L. DRAWE: A.M. JOB NO.: 14326-PRE PROJECT NO. 4886.94	community sciences corporation	APPROVED FOR CONSTRUCTION CITY ENGINEER DATE
		LAND PLANNING P.O. Box 1326 ENGINEERING Corrales, N.M. 87048 SURVEYING	


SCANNED BY
BY LASON

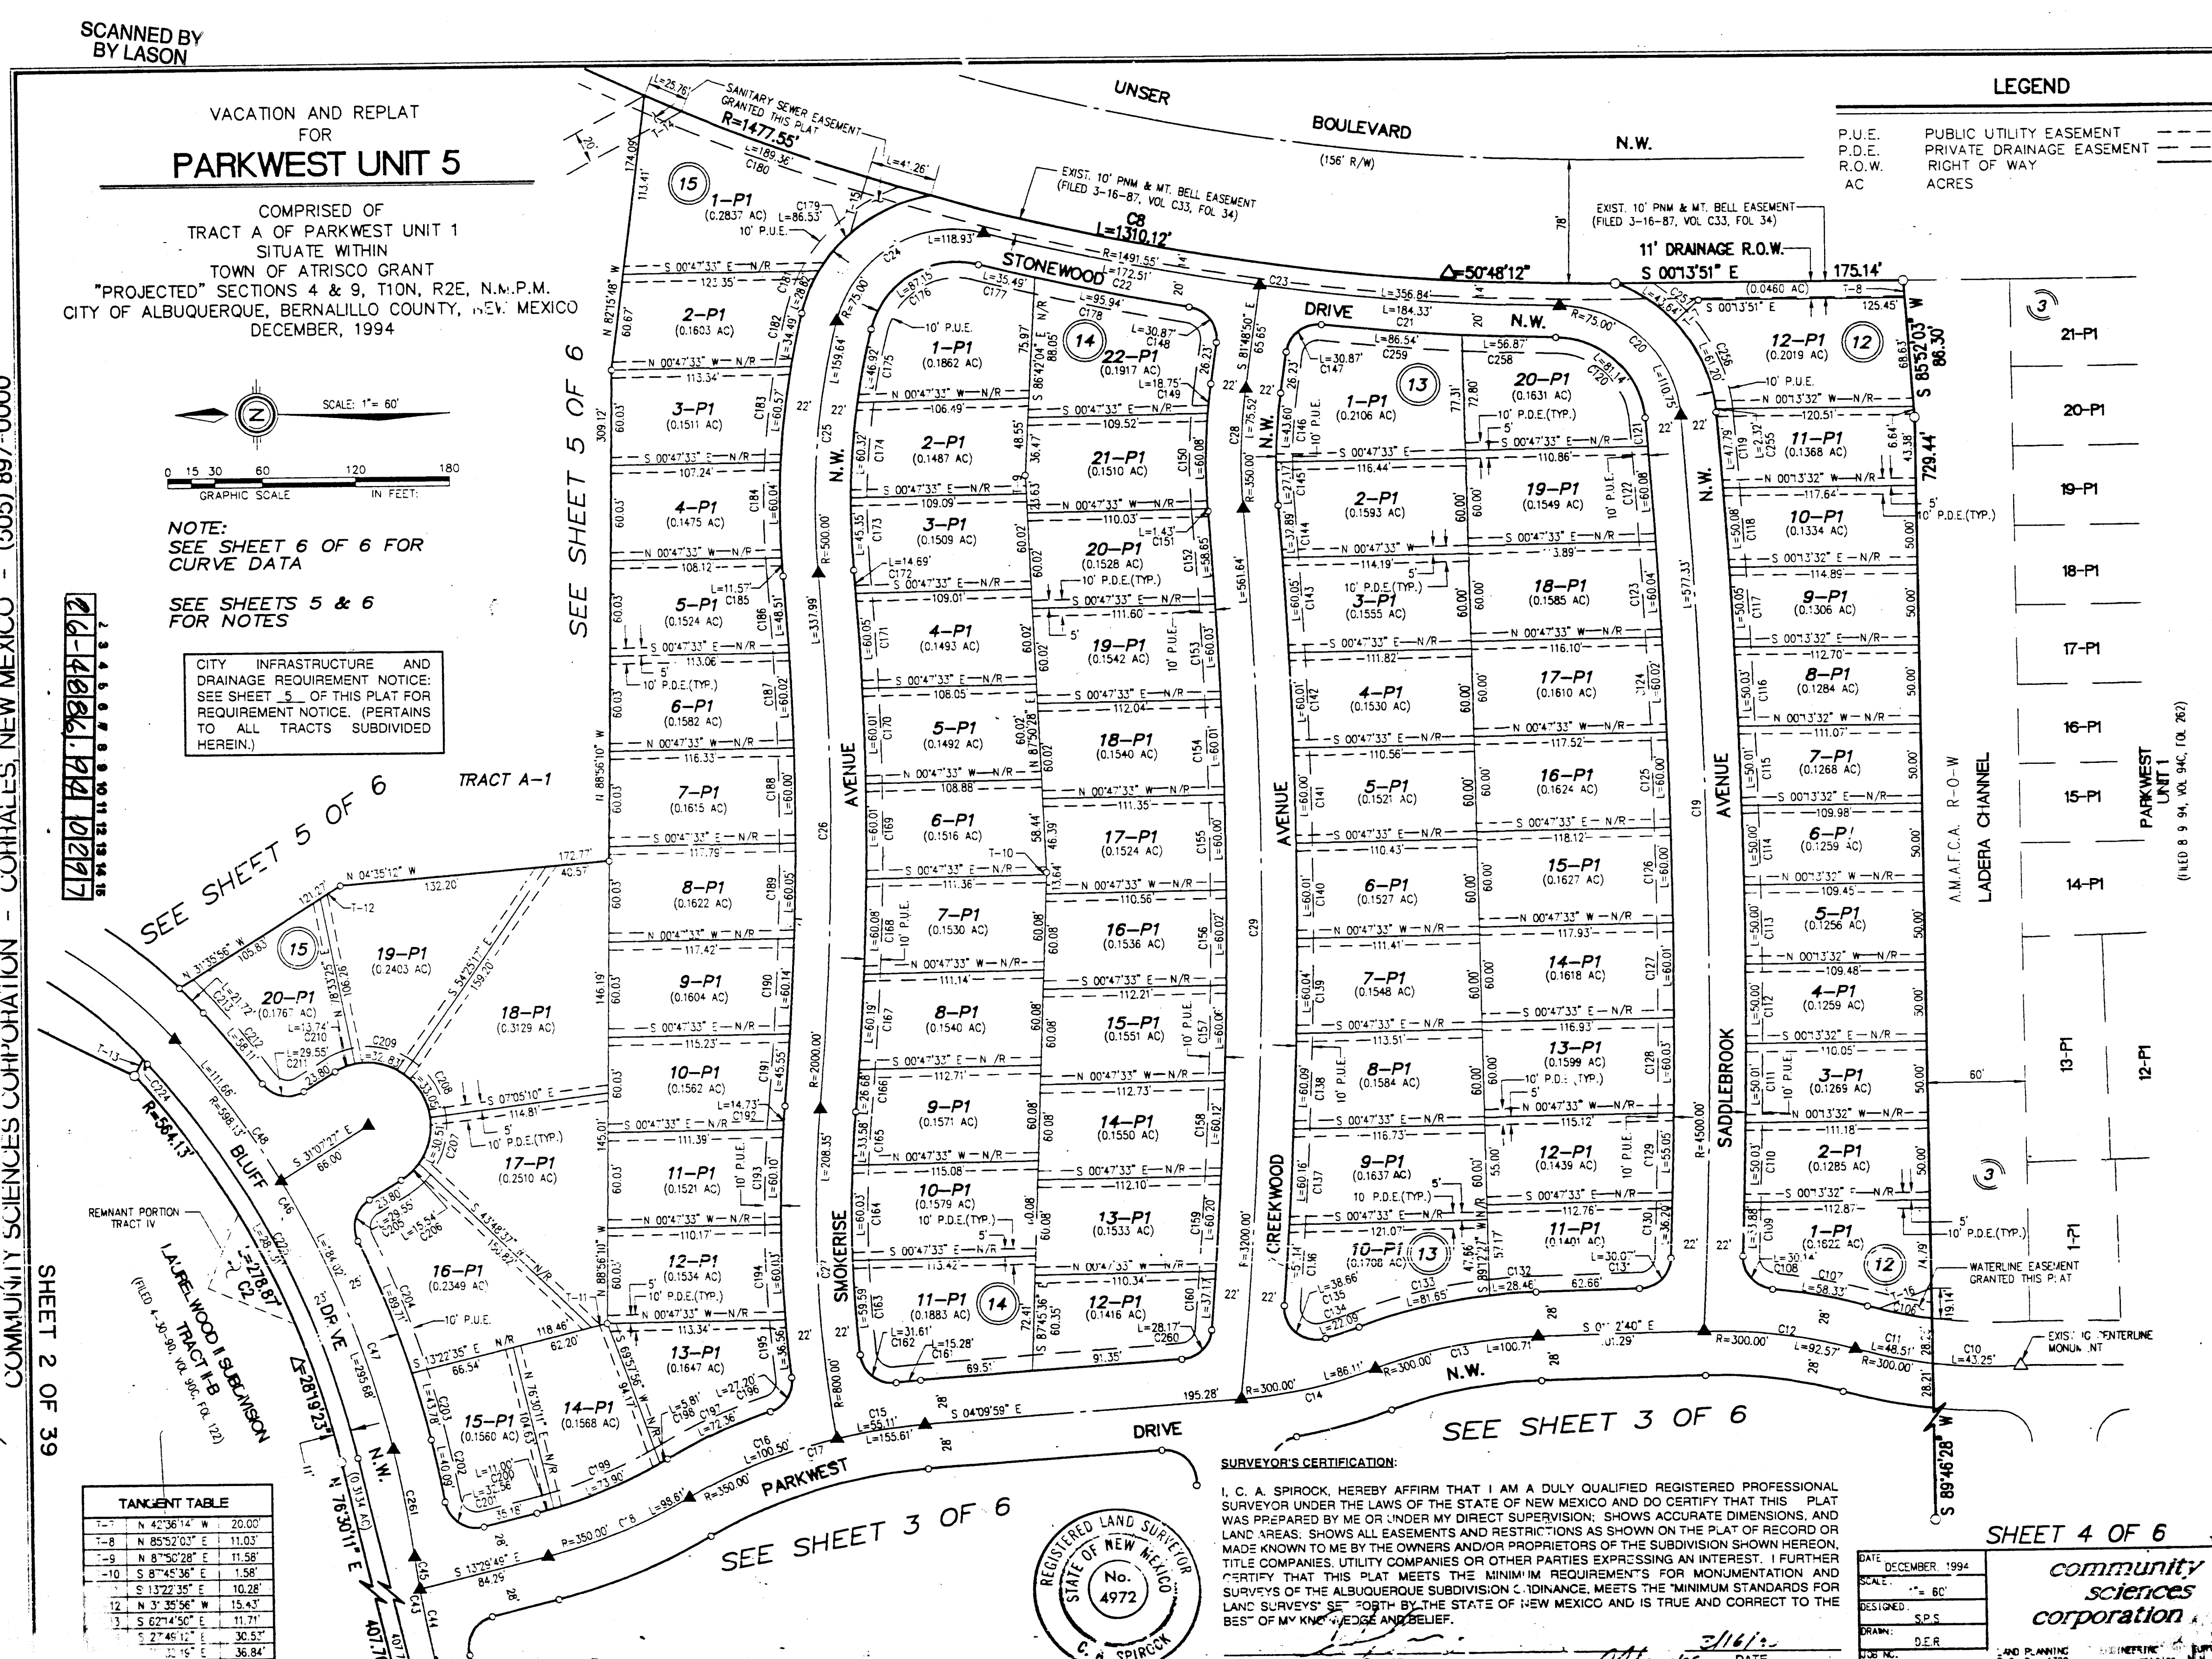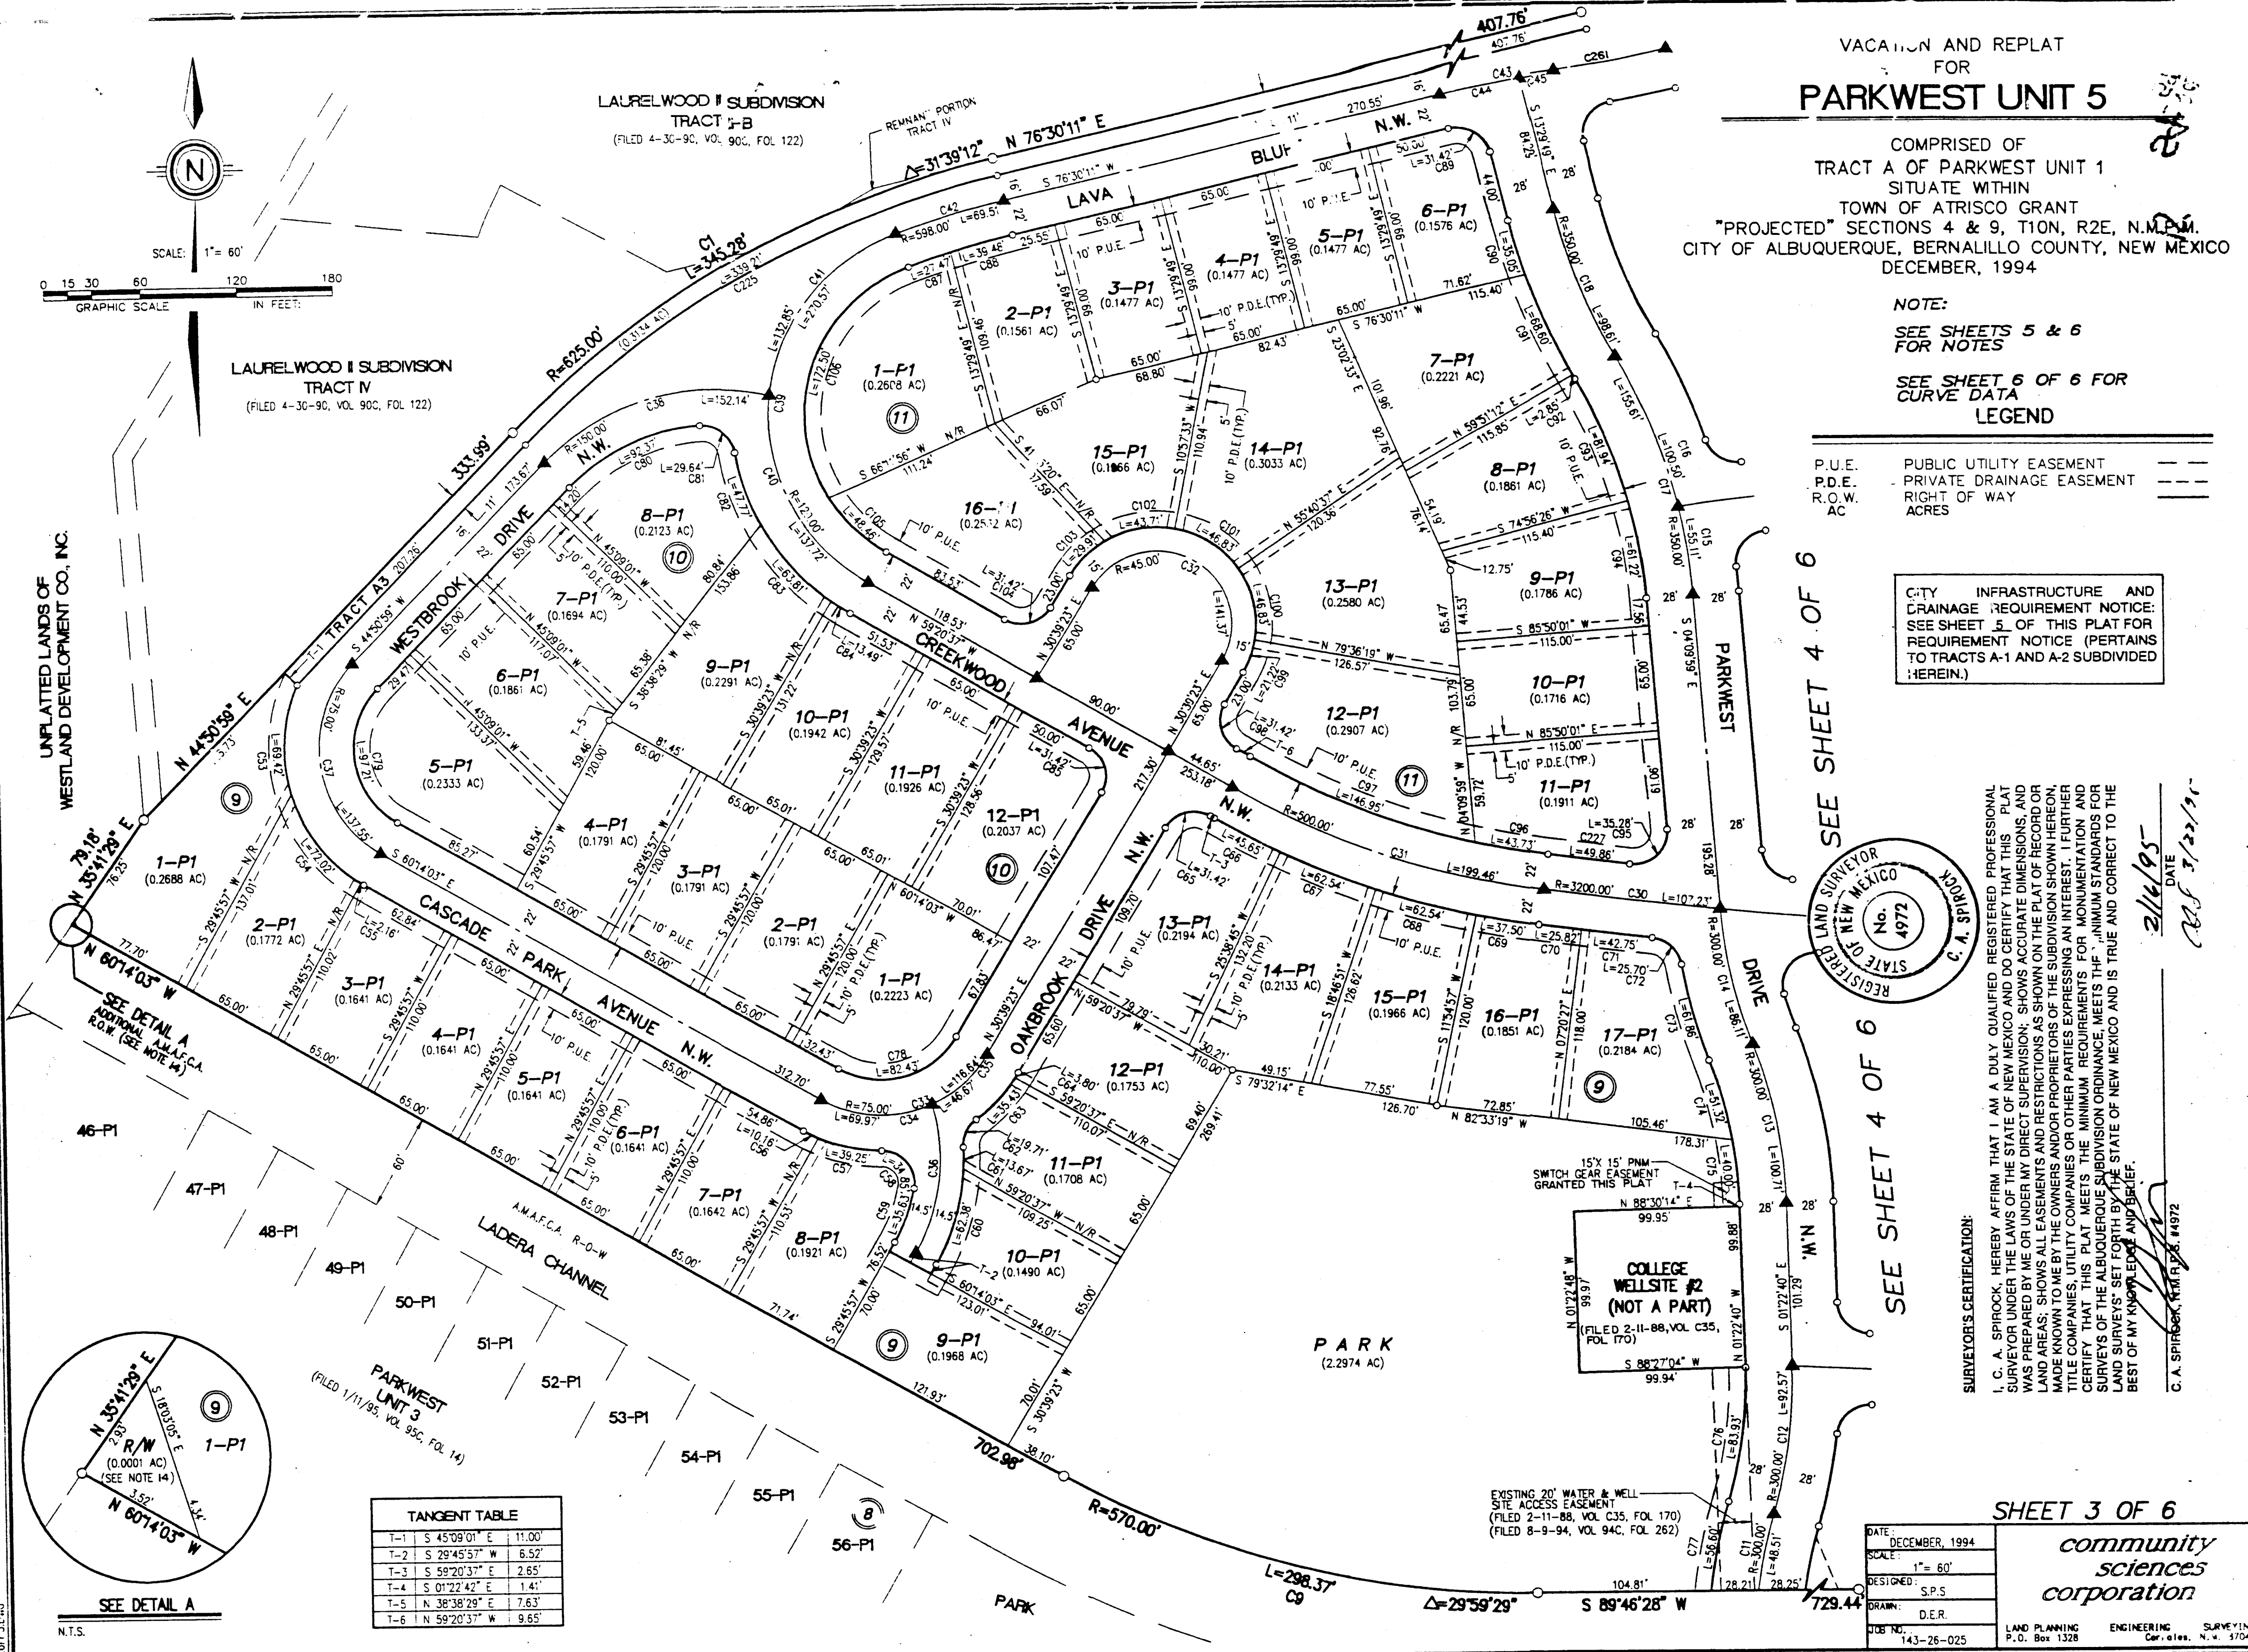





100

100

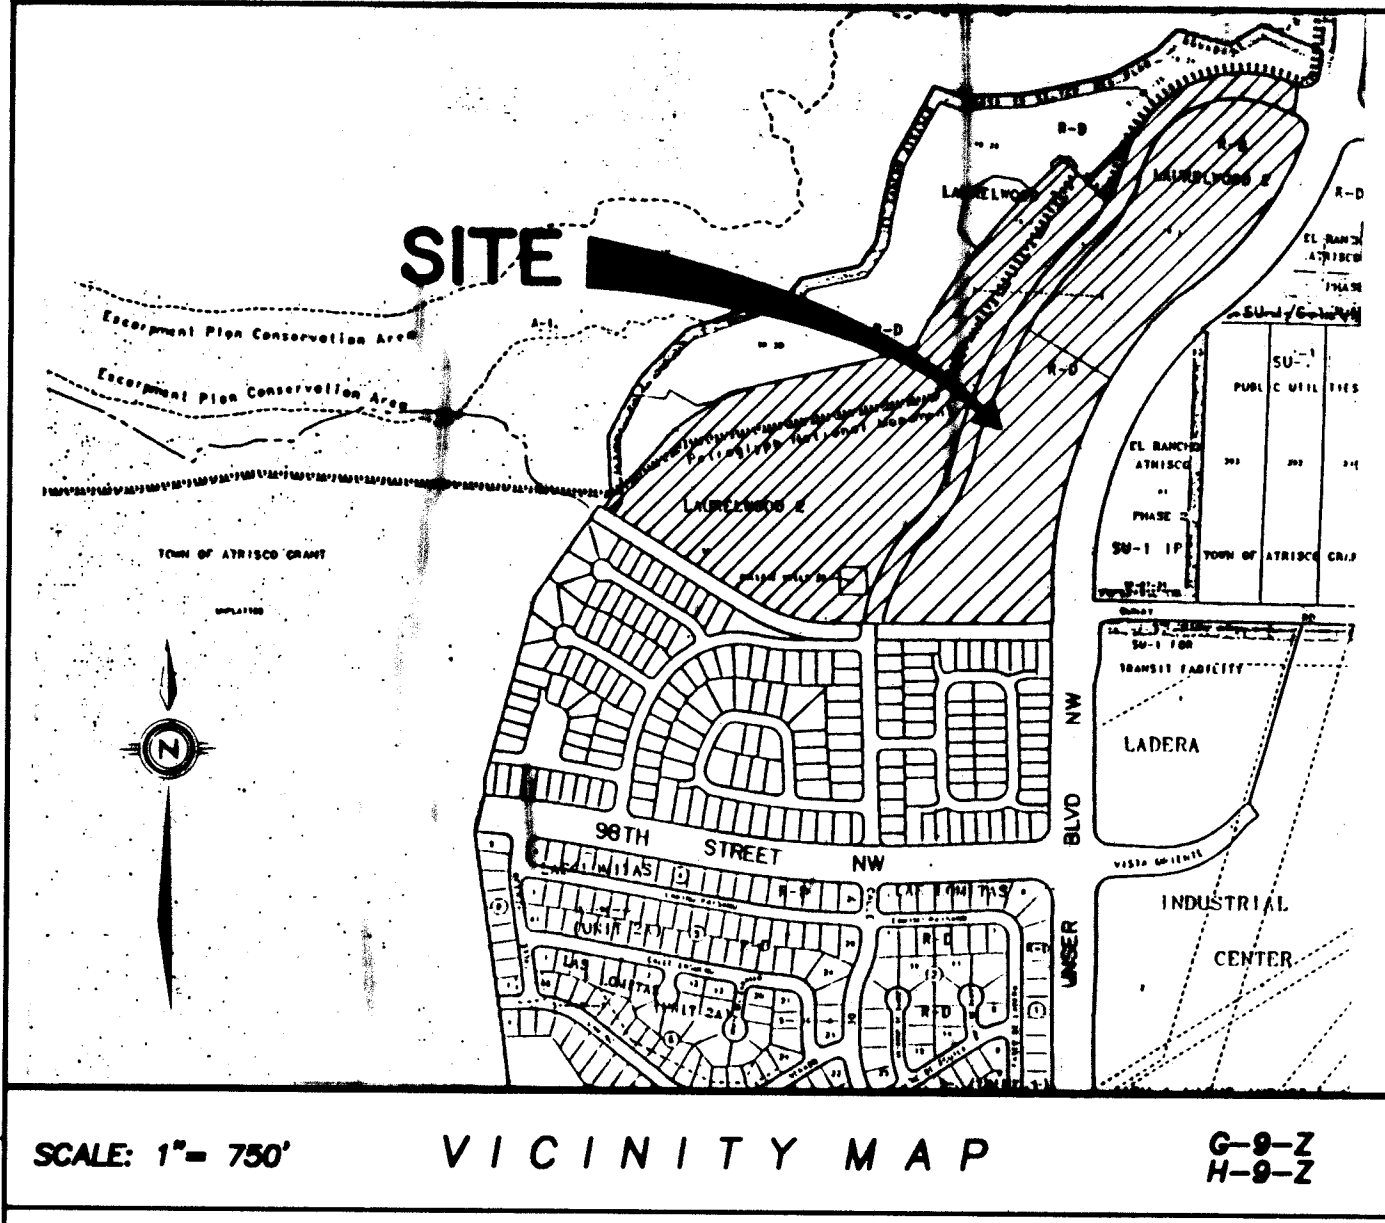


**PARK WEST SUBDIVISION
UNIT 5**
COMPRISED OF
TRACT A
PARK WEST UNIT 1
SITUATE WITHIN
THE TOWN OF ATRISCO GRANT
"PROJECTED" SECTIONS 4 AND 9, T10N, R2E, NMP.M.
CITY OF ALBUQUERQUE, BERNALILLO COUNTY, NEW MEXICO
MARCH, 1995
DRB-93-303

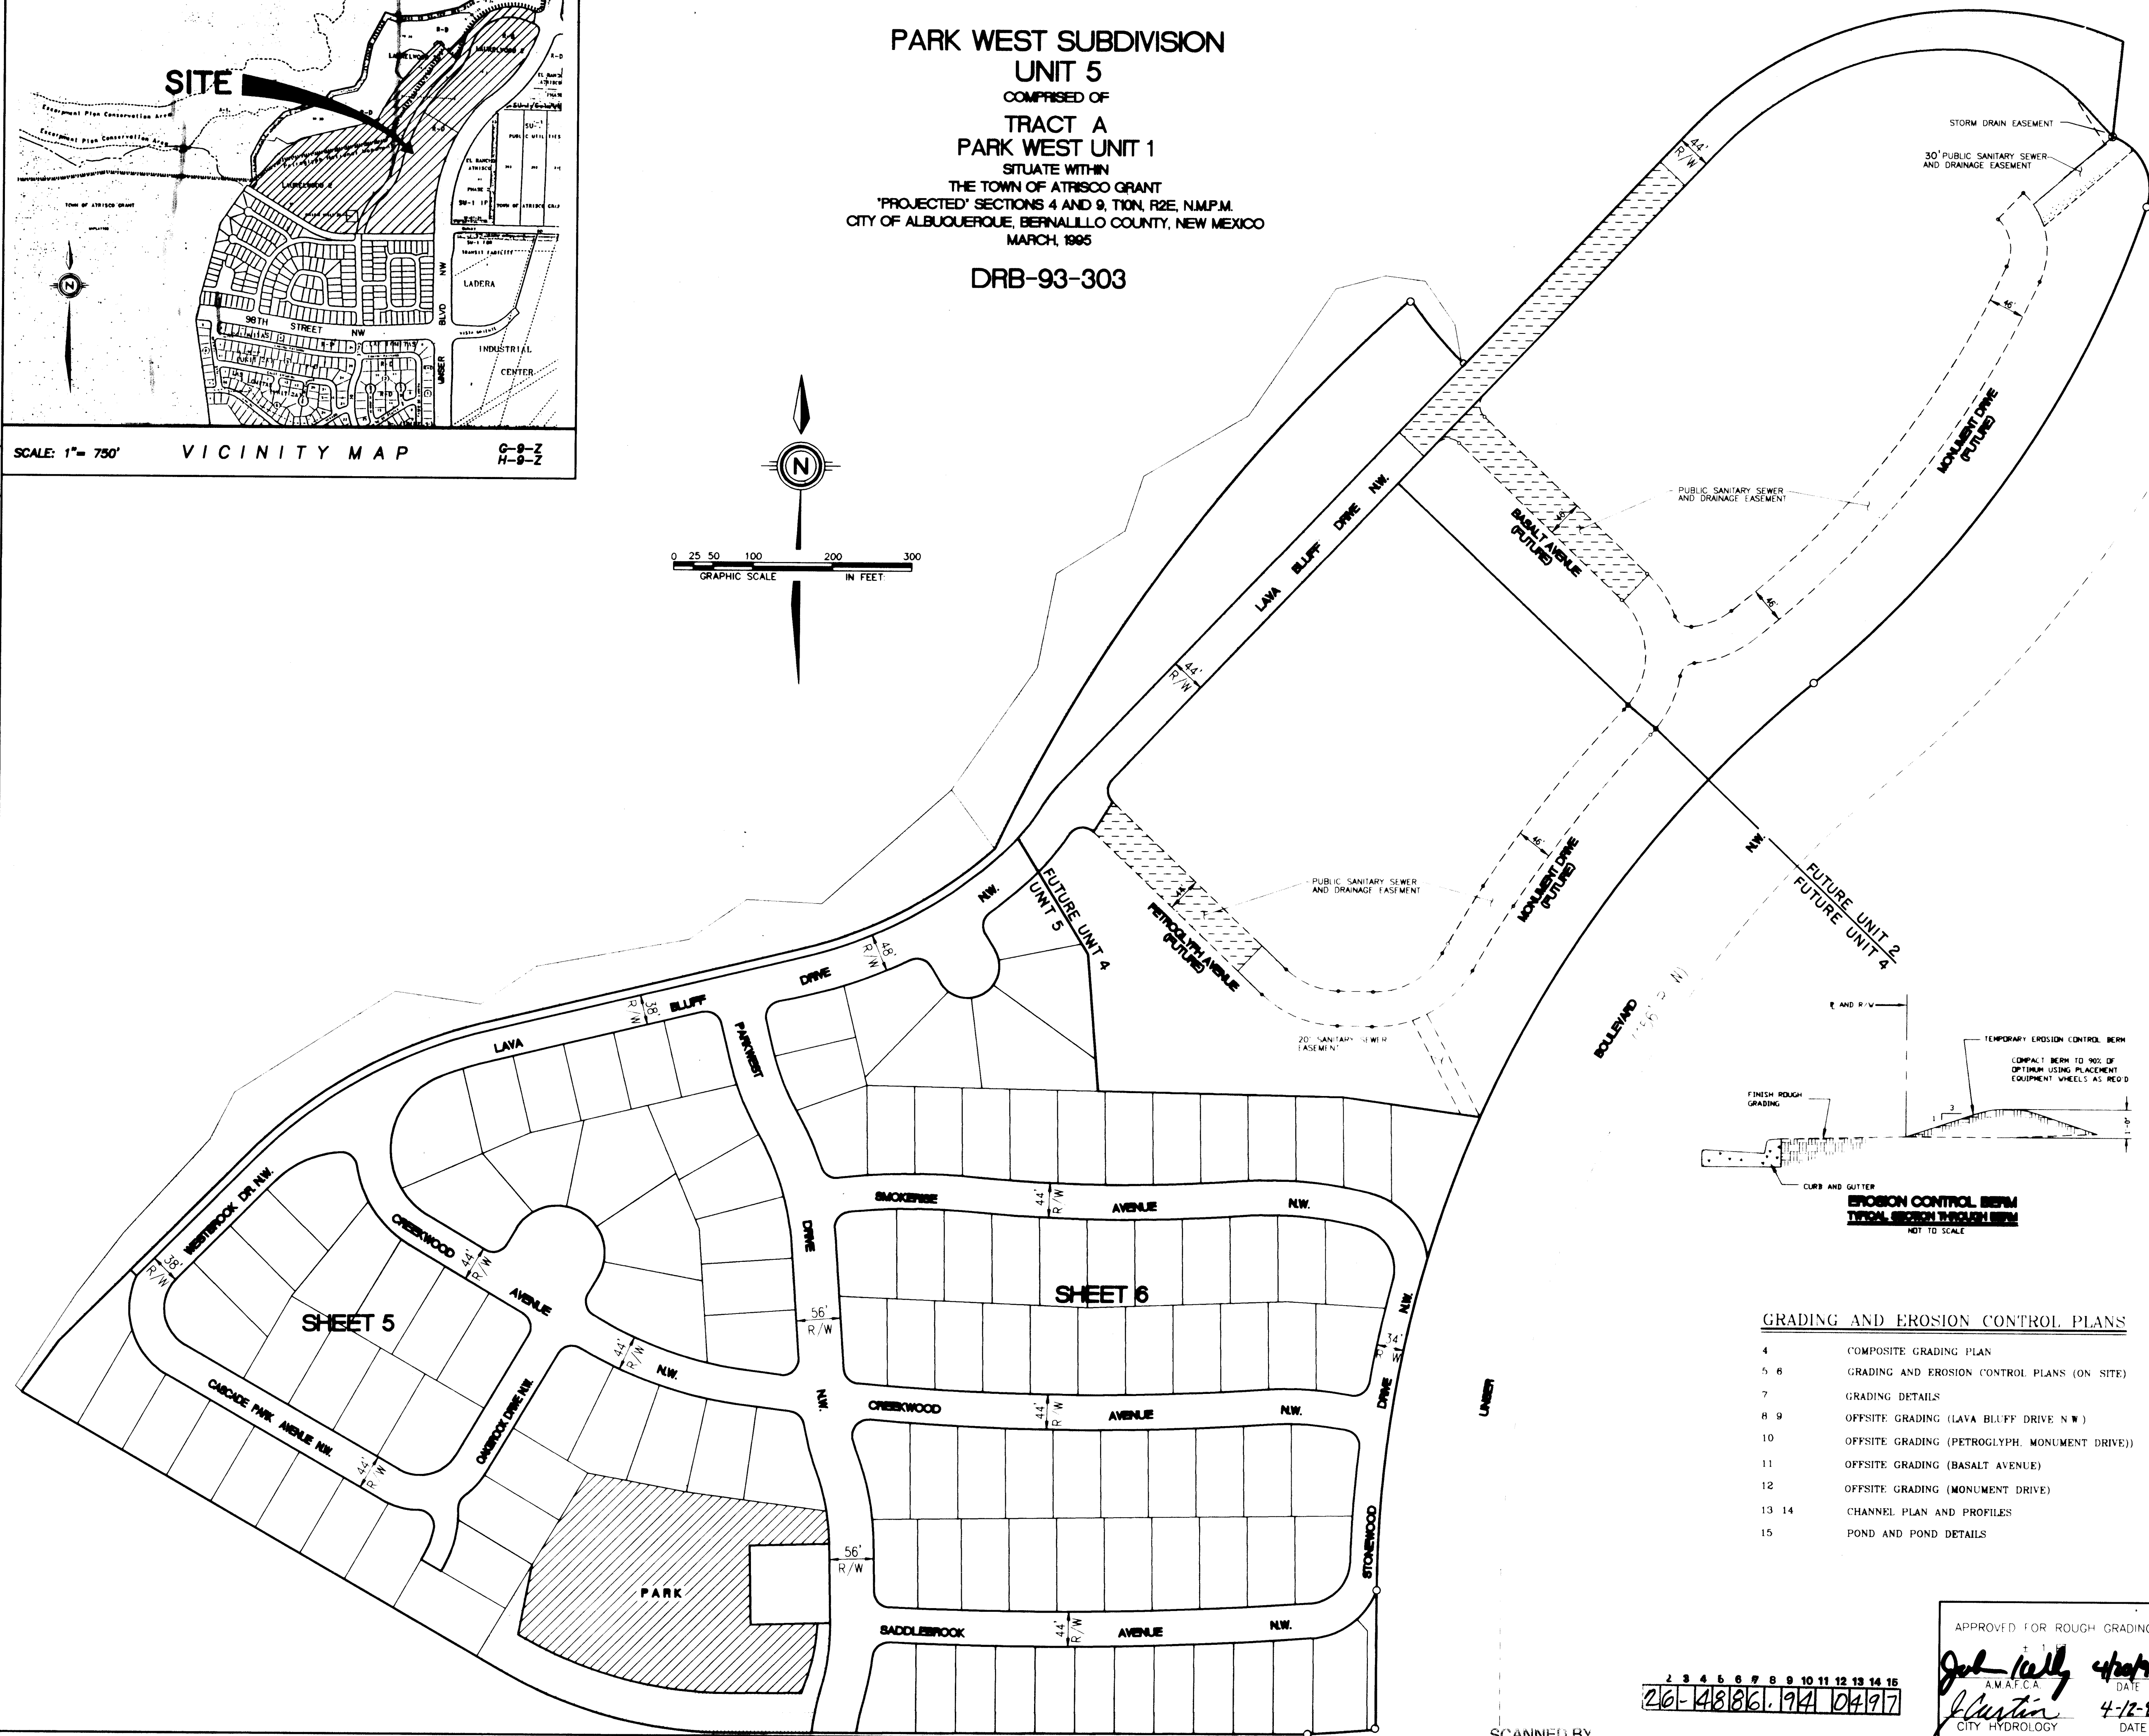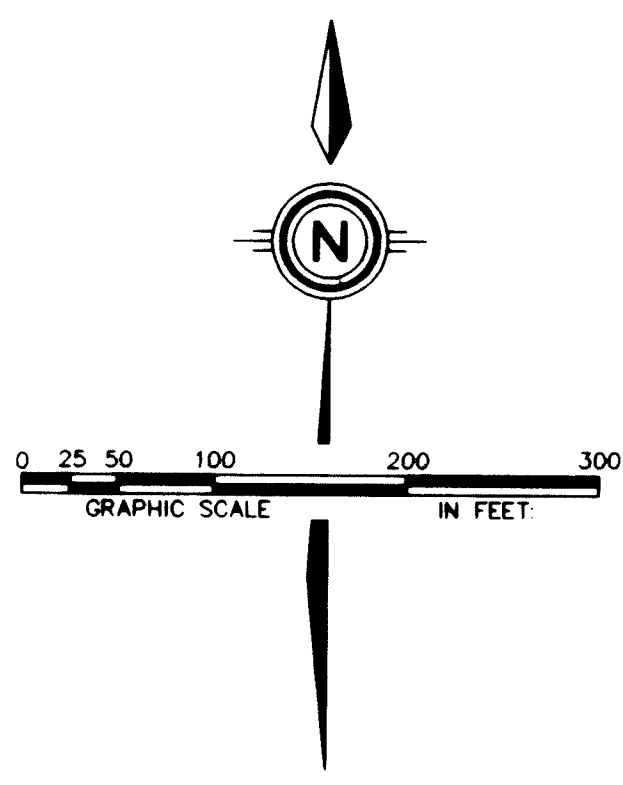

GRADING AND EROSION CONTROL PLANS

- 4 COMPOSITE GRADING PLAN
- 5 6 GRADING AND EROSION CONTROL PLANS (ON SITE)
- 7 GRADING DETAILS
- 8 9 OFFSITE GRADING (LAVA BLUFF DRIVE N.W.)
- 10 OFFSITE GRADING (PETROGLYPH MONUMENT DRIVE)
- 11 OFFSITE GRADING (BASALT AVENUE)
- 12 OFFSITE GRADING (MONUMENT DRIVE)
- 13 14 CHANNEL PLAN AND PROFILES
- 15 POND AND POND DETAILS

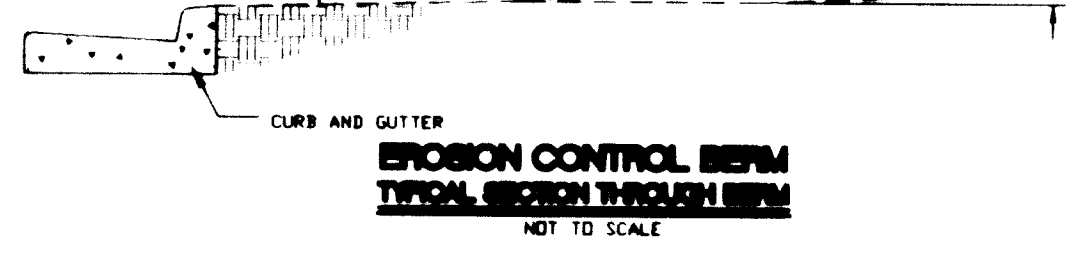

LEGEND

CUT

FILL

NO GRADING
(DO NOT DISTURB)

NOTE: ALL DISTURBED AREAS INDICATED ON THIS SHEET AS EITHER CUT OR FILL SHALL BE REVEGETATED PER C.O.A. STANDARD SPECIFICATIONS FOR PUBLIC WORKS CONSTRUCTION SECTION 1012.

- LOT GRADING SPECIFICATIONS:**
1. CROSS LOT DRAINAGE WILL NOT BE PERMITTED. IF LOCAL CONDITIONS SHOULD DICTATE A RELAXATION OF THIS RULE, THEN THE APPROPRIATE PUBLIC OR PRIVATE DRAINAGE EASEMENTS WILL BE DEDICATED ON THE PLAT.
 2. CRITERIA FOR SETTING LOT ELEVATION CONTROL GRADES SHALL INCLUDE THE FOLLOWING:
 - A. ALL DRAINAGE SWALES AND YARD AREAS SHALL HAVE MINIMUM SLOPES OF 1% AND MAXIMUM SLOPES OF 3 HORIZONTAL TO 1 VERTICAL.
 - B. BUILDING PADS SHALL BE SET AT LEAST 0.3' ABOVE THE HIGHEST ELEVATION OF ADJACENT SWALES.
 - C. PAD ELEVATIONS WILL BE ASSUMED TO BE EQUAL TO FINISHED FLOOR OF GARAGE. LONGITUDINAL GRADIENT OF DRIVEWAY SHALL NOT BE LESS THAN ONE PERCENT (1%), IF DRIVEWAY ALSO IS USED AS A REQUIRED WALK. IF USED ONLY AS A DRIVEWAY, THE LONGITUDINAL GRADIENT SHALL NOT EXCEED 14% (1 IN 7).
 - D. USABLE YARD AREAS SHALL HAVE MINIMUM DIMENSIONS OF 30' X 15'.
 3. WHERE YARD GRADES OF ADJACENT LOTS AT PROPERTY LINES CANNOT BE MATCHED USING THE ABOVE CRITERIA, RETAINING WALL SHALL BE PROVIDED TO ACCOMMODATE GRADE DIFFERENTIALS.

- EROSION CONTROL NOTES:**
1. CONTRACTOR SHALL OBTAIN A TOP SOIL DISTURBANCE PERMIT PRIOR TO GRADING.
 2. DISTURBED AREAS WILL BE RESEDED PER C.O.A. DPM SECTION 1012, WHERE INDICATED BY SHADING, THIS PLAN.
 3. PROTECTION OF ADJACENT RIGHT-OF-WAY AND PRIVATE PROPERTY FROM SEDIMENT, WILL BE ACCOMPLISHED BY THE EROSION

community sciences corporation

LAND PLANNING ENGINEERING SURVEYING
P.O. Box 1328 Corrales, N.M. 87048

CITY OF ALBUQUERQUE
PUBLIC WORKS DEPARTMENT
ENGINEERING GROUP

**TITLE: PARKWEST- UNIT 5
COMPOSITE GRADING PLAN**

APPROVALS	ENGINEER	DATE	APPROVALS	ENGINEER	DATE
DRG CHAIRMAN			WATER	N/A RWK	6-5-95
TRANSPORTATION	N/A LHO	6-02-95	WASTE WATER	N/A RWK	6-5-95
HYDROLOGY	J. Curtin	9-19-95	A.M.A.F.C.A.		
PARKS AND REC.					
PROJECT NO.	4886.94	MAP NO. G, H9	SHEET	4	OF 39

APPROVED FOR ROUGH GRADING
J. Curtin
CITY HYDROLOGY
DATE 4-12-95


26-4886.94 04/97

SCANNED BY
BY LASON

BENCH MARKS		SURVEY INFORMATION		ENGINEER'S SEAL		REVISIONS		DESIGN	
CONTRACTOR	DATE	FIELD NOTES	DATE	NO.	BY	NO.	DATE	NO.	DATE
ACS BRASS TABLET SET IN A 2" IRON PIPE 1 FT. ABOVE GROUND LOCATED ON TOP OF A VOLCANIC OUTCROP TO REACH THE STATION FROM THE INTERSECTION OF COORS RD. & QUARRY RD. NW. GO WEST ON QUARRY RD. ABOUT 0.7 MI. TO THE END OF PAVEMENT. CONTINUE WEST ON THE DIRT RD. TO THE TOP OF THE DETENTION DAM. ALONG THE NORTH BANK OF THE DAM 0.6 MI. TO A DIRT CROSS RD., TURN RIGHT, GO NORTH ON THE DIRT RD. 0.5 MI.		COMMUNITY SCIENCES							
S.D. 1929 ELEVATION = 5334.50 FEET									

Rev 5-26-95
J. Curtin
CITY OF ALBUQUERQUE
PUBLIC WORKS DEPARTMENT
ENGINEERING GROUP

SEE SHEET 13 FOR
GRADING IN THIS
AREA

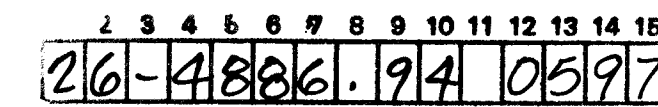

APPROVED FOR ROUGH GRADING (+ 1.1.1.1)	
<i>John Kelly</i> C.M.A.A.F.C.A.	4/24/95 DATE
<i>J. Austin</i> CITY HYDROLOGY	4-12-95 DATE
<i>B. Barber</i> PLANS & GEN. SERVICES	4-17-95 DATE

DRB-93-303

VALUES TABULATED REPRESENT IN PLACE
CONDITIONS WITH C/F 1.35 AND THE NET EXPORT
EQUAL TO THE DEFICIT FILL NEEDED FOR FUTURE
UNITS 2 AND 4

**community
sciences
corporation**

APPROVAL	ENGINEER	DATE	APPROVALS	ENGINEER	DATE
DRC CHAIRMAN			WATER	N/A RWK	6-5-95
TRANSPORTATION	N/A LHO	6-8-95	WASTE WATER	N/A RWK	6-5-95
HYDROLOGY	Clarison	7-19-95	A.M.F. C.C.A.		
PARKS & REC.					
PROJECT NO.	4886.94	MAP NO.	G, H9	SHEET	5 OF 39


NO.		DATE	REMARKS	BY
REVISIONS				
DESIGN				
DESIGNED BY		S. R. L.	DATE	MARCH 1995
DRAWN BY		A. M.	DATE	MARCH 1995
CHECKED BY		J. D. H.	DATE	MARCH 1995


DIRT RD. 0.5 MI.	
SLD 1929 ELEVATION = 5334.50 FEET	

CONTRACTOR IS NOT TO DISTURB THIS OFF-SITE AREA UNTIL A SPECIAL USE PERMIT IS ISSUED BY THE NATIONAL PARKS SERVICE PERMITTING GRADING ON NATIONAL MONUMENT PROPERTY


NATIONAL MONUMENT PROPERTY

SEE SHEET 5

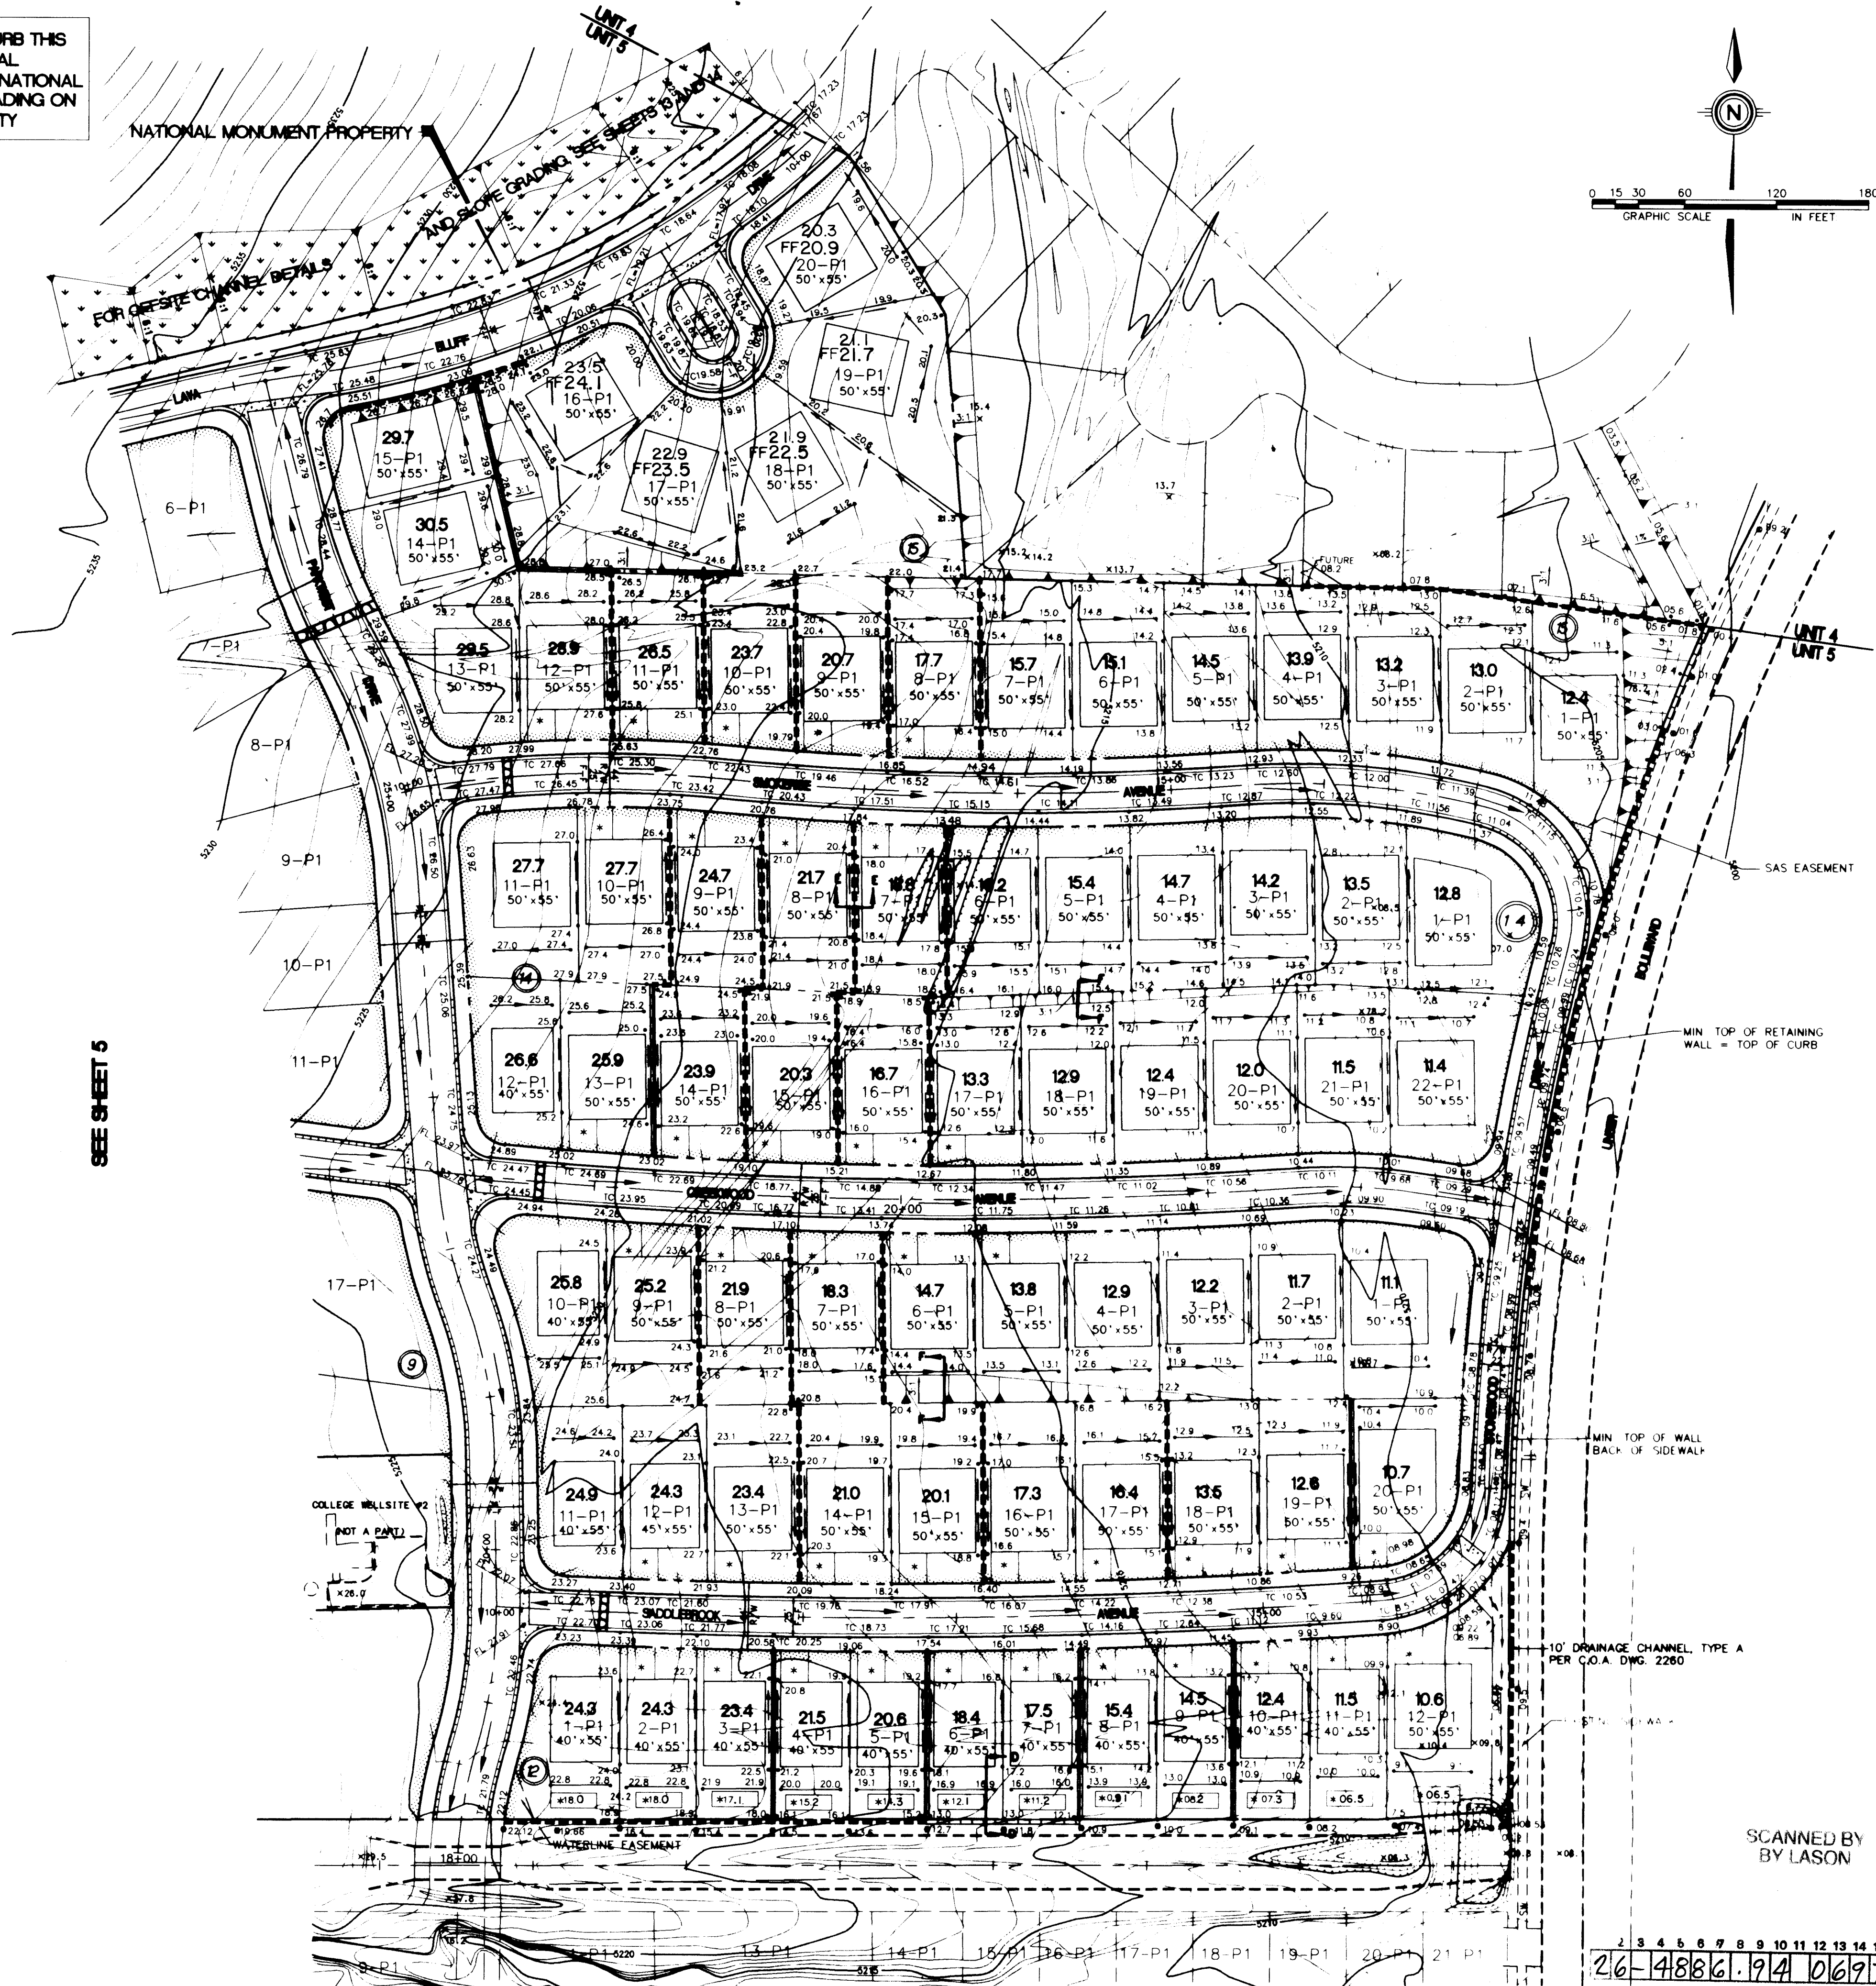


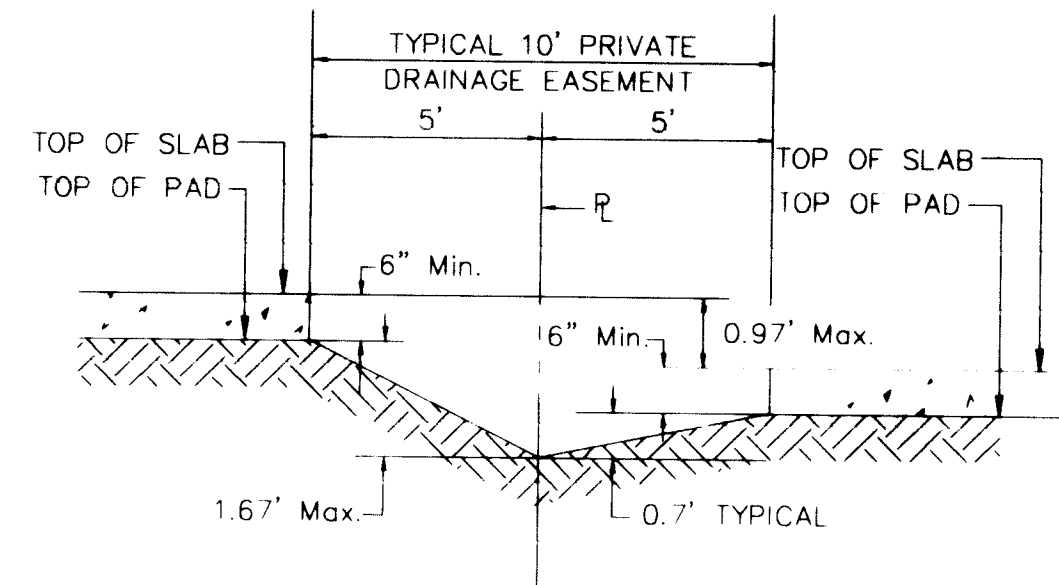


TYPICAL SECTION A - A
N.T.S.
NOTE: FENCES ARE ALLOWED ON THE PROPERTY LINE WITHIN THE PRIVATE DRAINAGE EASEMENT.

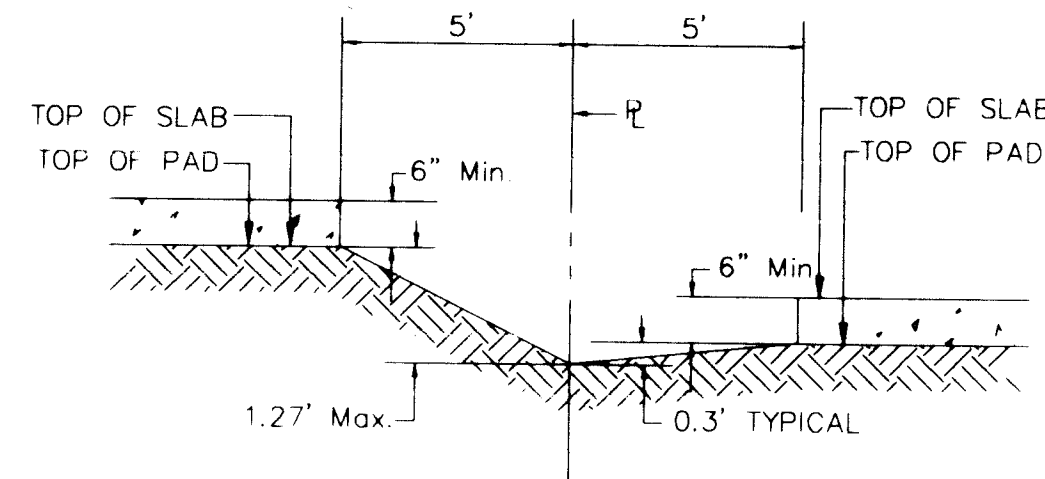


TYPICAL SECTION B - B
N.T.S.

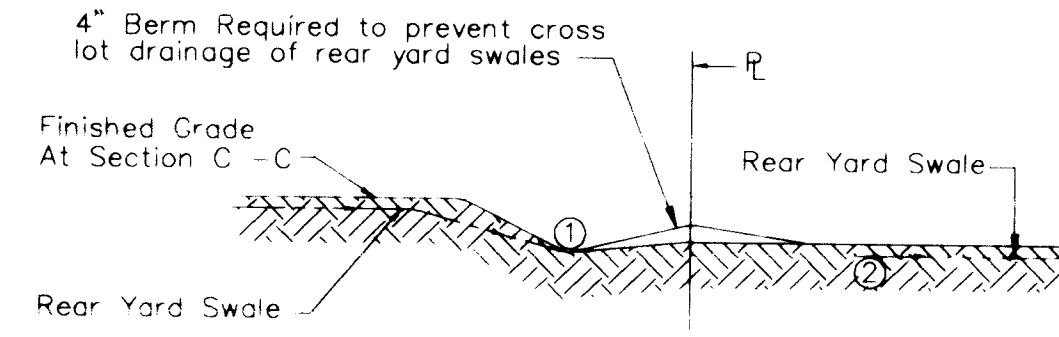


TYPICAL SECTION C - C
N.T.S.

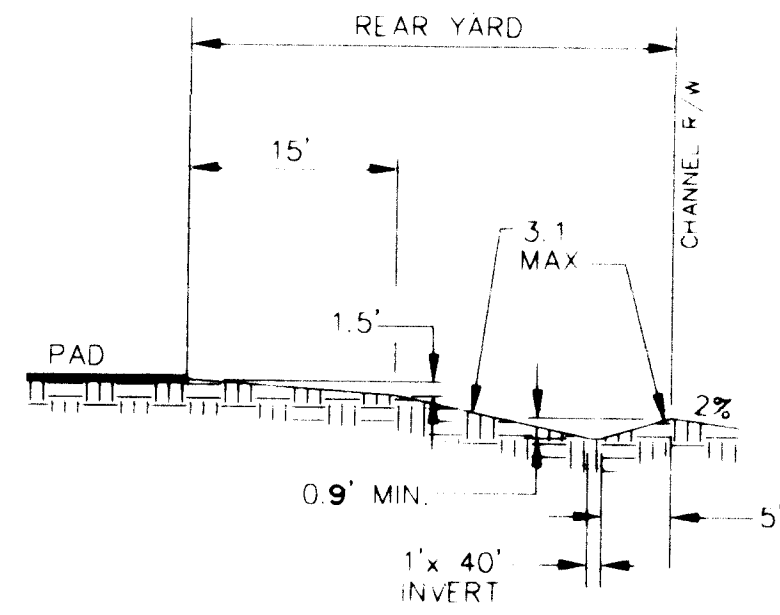


SECTION D - D
N.T.S.
TYPICAL REAR YARD WITH POND

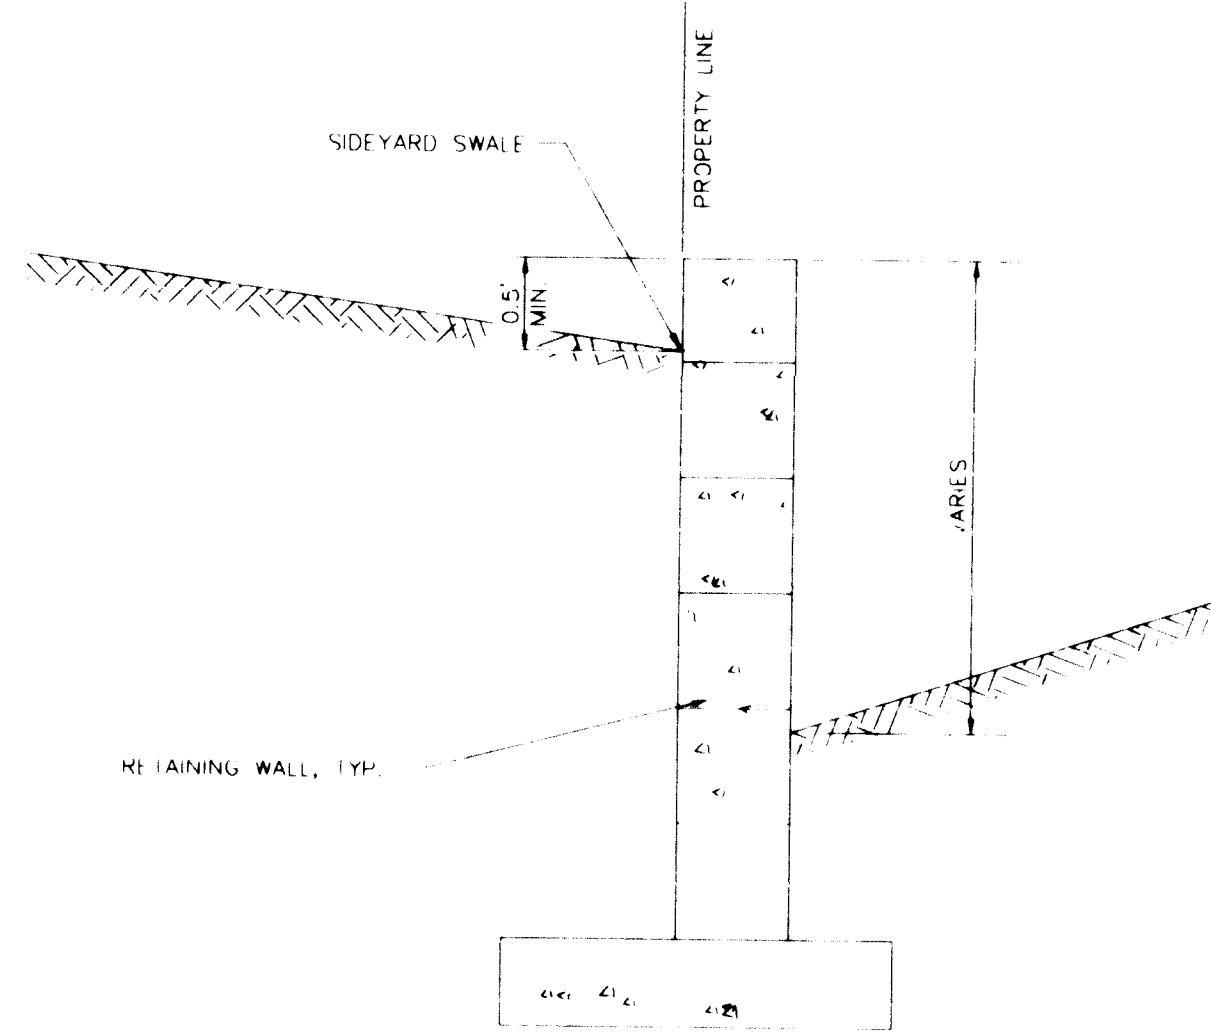


SECTION E - E
TYPICAL RETAINING WALL WITH ADJACENT SWALE
N.T.S.
NOTE: CROSS LOT DRAINAGE SHALL BE PREVENTED BY 0.5' MIN HEIGHT FROM TOP OF RETAINING WALL TO THE INVERT OF THE SWALE

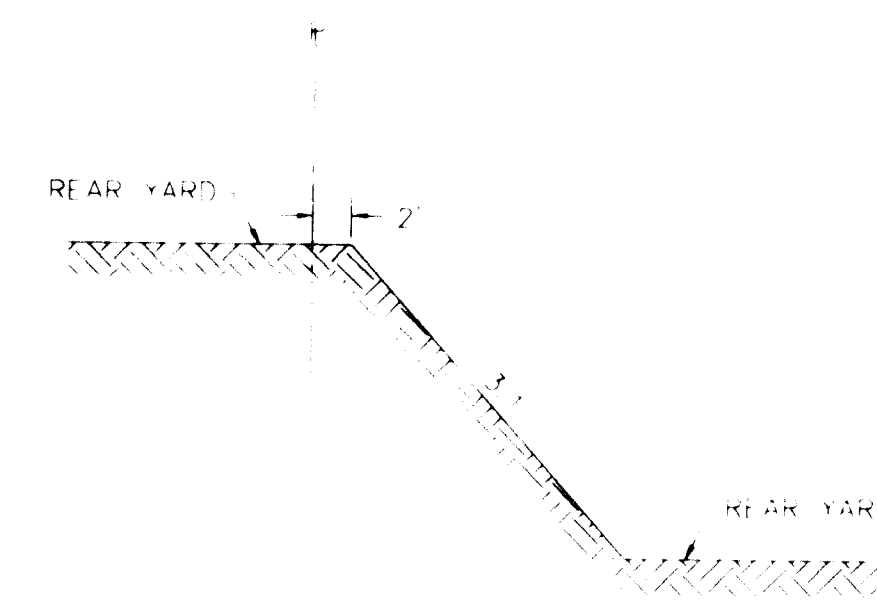


TYPICAL SECTION F - F
REAR PROPERTY LINE GRADING DETAIL
N.T.S.

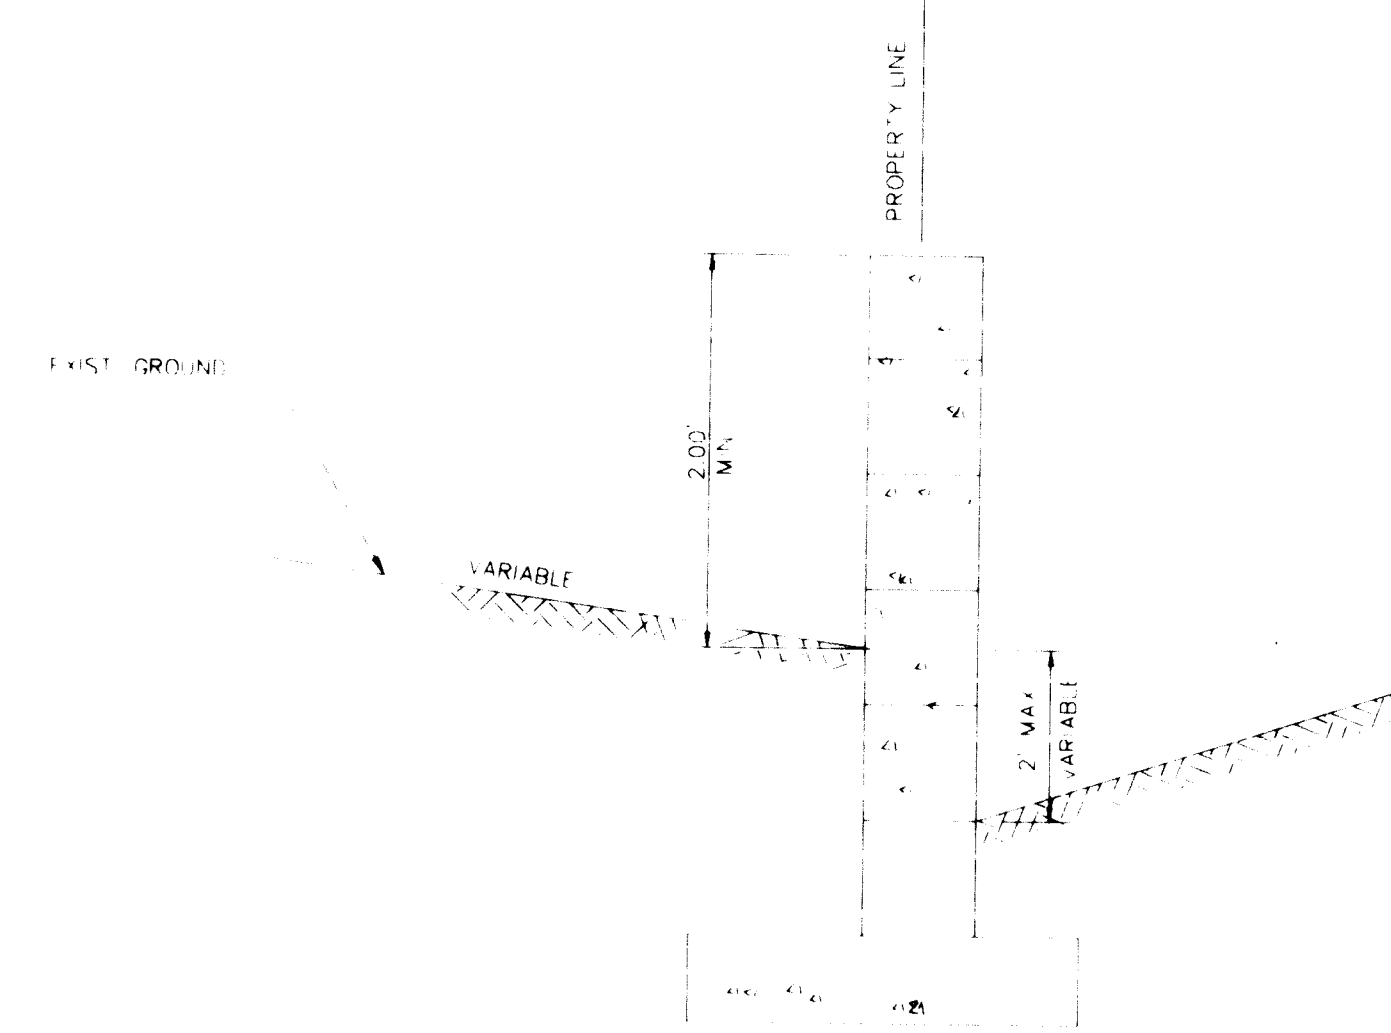


SECTION G - G
N.T.S.

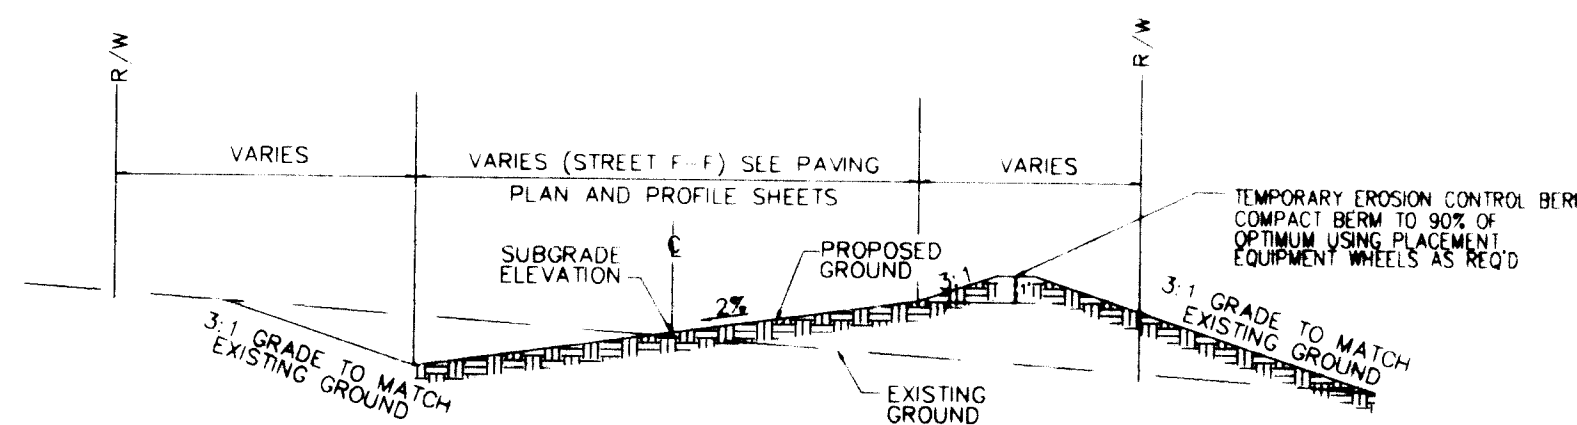


SECTION H - H
TYPICAL OFF-SITE PRELIMINARY STREET GRADING
N.T.S.

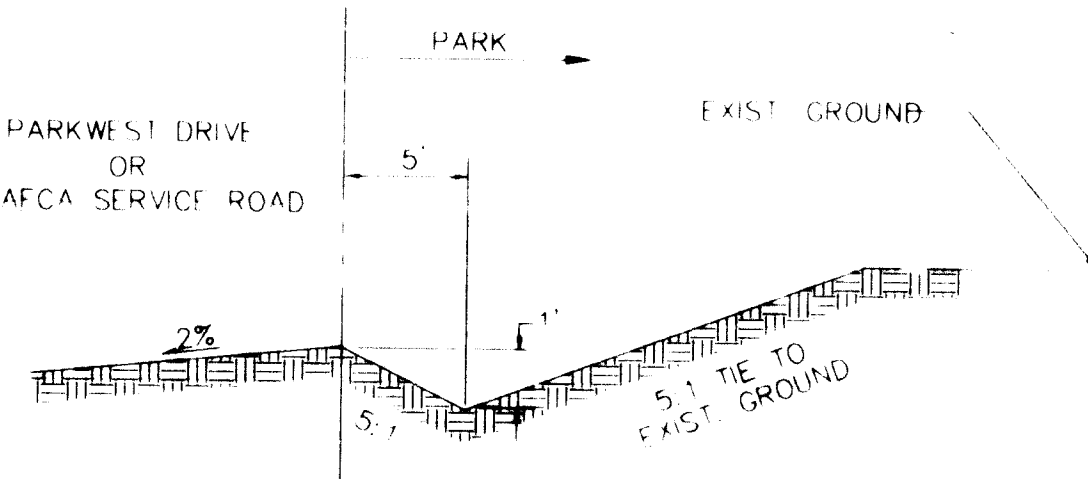


SECTION I - I
TYPICAL PARK SWALE
N.T.S.

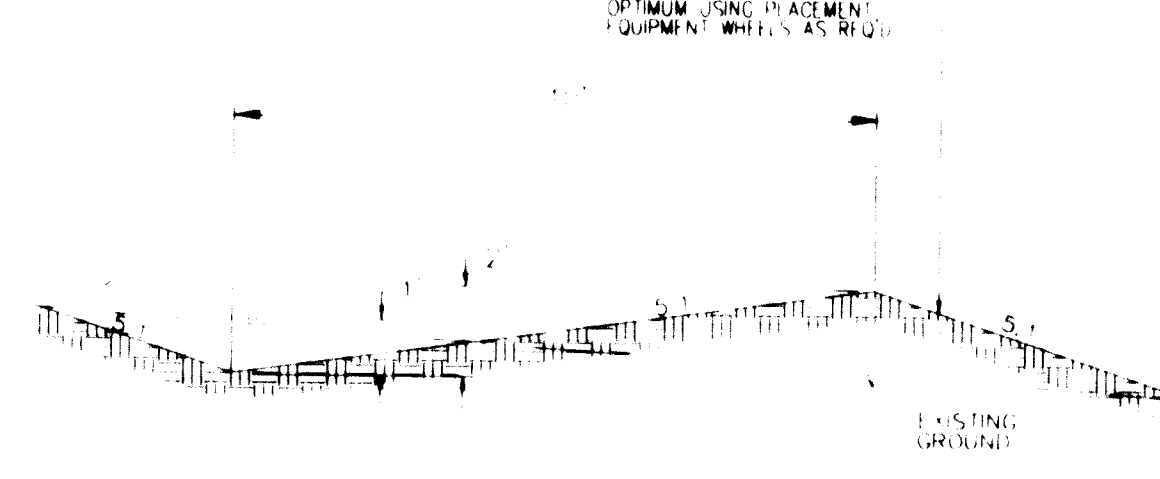

SECTION J - J
TYPICAL PARK DIVERSION BERM
N.T.S.

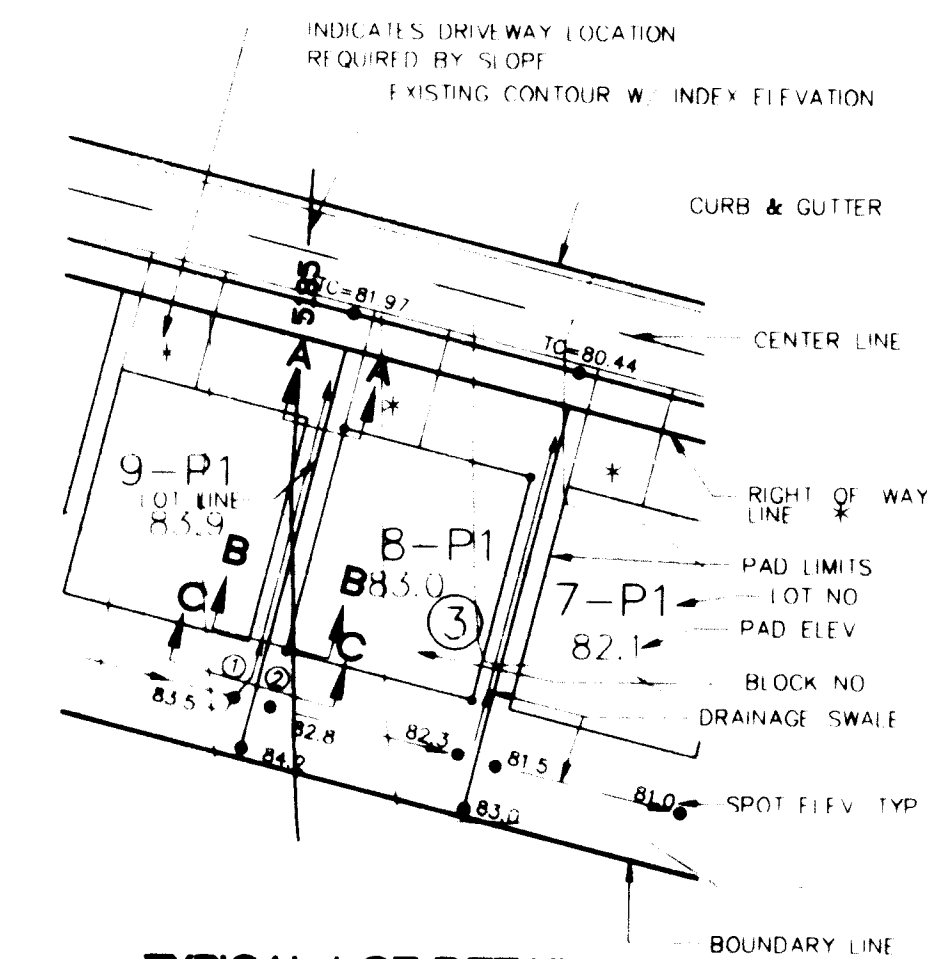

TYPICAL LOT DETAIL
N.T.S.
• FINISHED GRADE AROUND PERIMETER OF HOUSE SHALL BE A MINIMUM OF 6\"/>

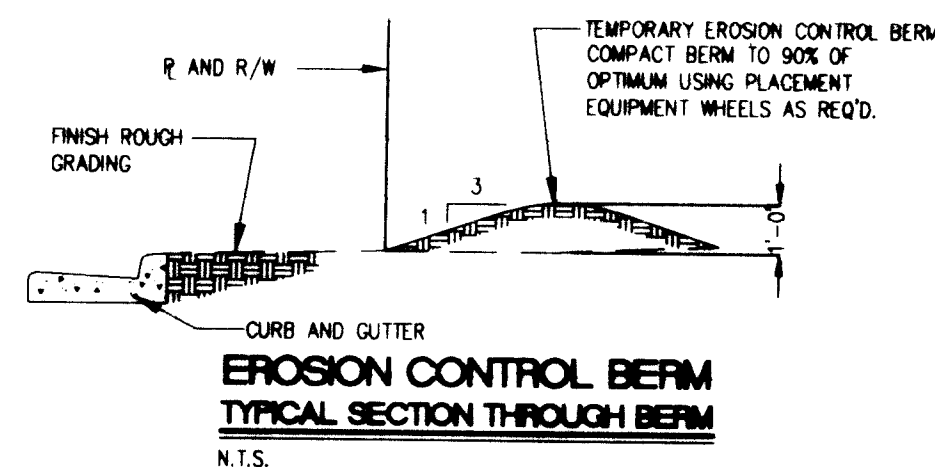

EROSION CONTROL BERM
TYPICAL SECTION THROUGH BERM
N.T.S.


- CONTRACTOR SHALL OBTAIN A TOP SOIL DISTURBANCE PERMIT PRIOR TO GRADING
- DISTURBED AREAS WILL BE RESEDED PER C.O.A. DPM SECTION 1012, WHERE INDICATED BY SHADING, THIS PLAN.
- PROTECTION OF ADJACENT RIGHT-OF-WAY AND PRIVATE PROPERTY FROM SEDIMENT WILL BE ACCOMPLISHED BY THE EROSION CONTROL BERM SHOWN HERE ON.

PARK WEST SUBDIVISION
UNIT 5
COMPRISED OF
TRACT A
PARK WEST UNIT 1
SITUATE WITHIN
THE TOWN OF ATRISCO GRANT
"PROJECTED" SECTIONS 4 AND 9, T10N, R2E, N1/4M.
CITY OF ALBUQUERQUE, BERNALILLO COUNTY, NEW MEXICO
MARCH, 1995

DRB-93-303

AS BUILT INFORMATION			
CONTRACTOR	DATE	BY	DATE
INSPECTOR'S	DATE	BY	DATE
VERIFICATION BY	DATE	BY	DATE
RECORDED BY	DATE	BY	DATE
MICRO-FILM INFORMATION			
NO.	DATE	BY	DATE

FIELD NOTES	
NO.	DATE
1	COMMUNITY SCIENCES 1/93

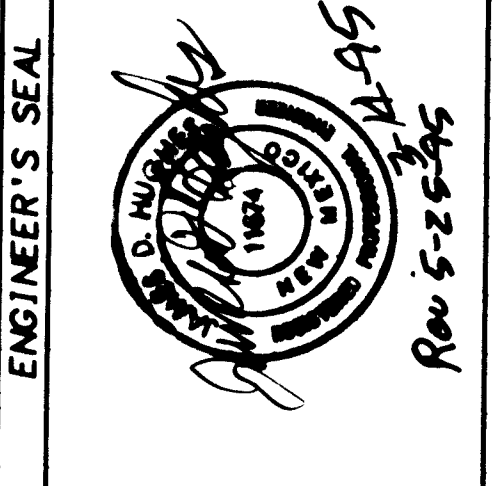

REVISIONS	
NO.	DATE
1	DESIGN
2	REVISIONS
3	REVISIONS
DATE	MARCH, 1995
SCALE	AS SHOWN
DESIGNED BY	AM, M.V.
DRAWN BY	AM, M.V.
CHECKED BY	AM, M.V.

community sciences corporation
LAND PLANNING
P.O. Box 1328
Corrales, N.M. 87046

CITY OF ALBUQUERQUE
PUBLIC WORKS DEPARTMENT
ENGINEERING GROUP

TITLE: PARKWEST- UNIT 5
GRADING AND EROSION CONTROL PLAN
GRADING DETAILS

APPROVALS	ENGINEER	DATE	APPROVALS	ENGINEER	DATE
DRG. CHAIRMAN	DATE	DATE	WATER	DATE	DATE
TRANSPORTATION	DATE	DATE	WASTE WATER	DATE	DATE
HYDROLOGY	DATE	DATE		DATE	DATE
PARKS & REC.	DATE	DATE		DATE	DATE
PROJECT NO.	4886.94		MAP NO.	G, H9	
SHEET	7		OF	39	

26-4886.194 0797

APPROVED FOR ROUGH GRADING
(E.T.)
DATE 4-12-95
DATE 4-17-95
DATE 4-17-95
DATE 4-17-95



SCANNED BY
BY LASON

UNITS 3, 4, 5, 99, 100

33 C CURVE DATA
R = 300.00'
L = 76.78'
Δ = 014°39'52"
CH = 76.57'
CH BEARING = N38°26'50"E

34 C CURVE DATA
R = 300.00'
L = 76.78'
Δ = 007°15'46"
CH = 38.00'
CH BEARING = N34°44'47"E

35 C CURVE DATA
R = 300.00'
L = 76.78'
Δ = 005°09'08"
CH = 26.97'
CH BEARING = N40°57'14"E

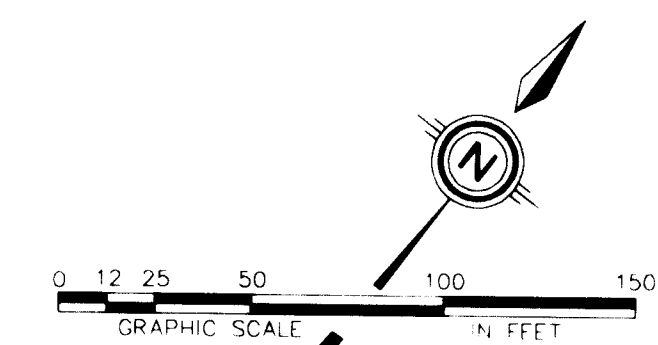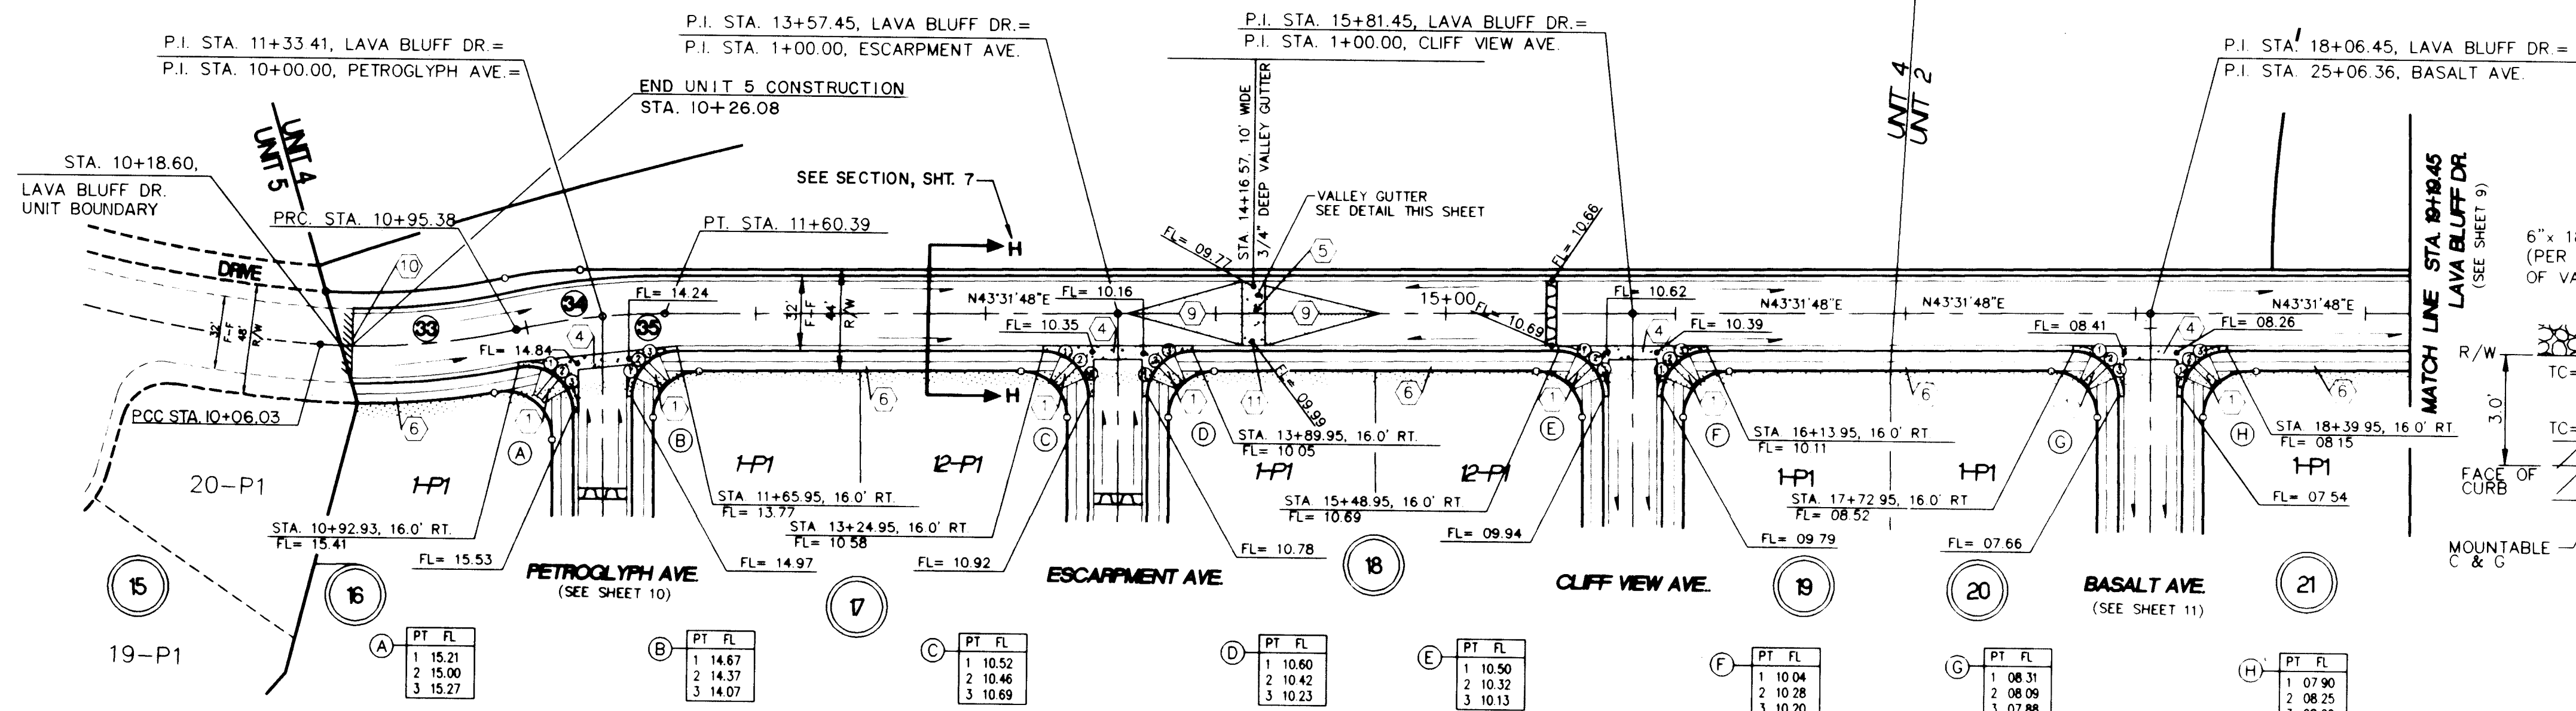

- LEGEND
- FL=74.11 PROPOSED CURB FLOWLINE ELEVATION
 - 73.6 EXISTING SPOT ELEVATION (GRND & TC)
 - PROPOSED VALLEY GUTTER / SIDEWALK
 - EXISTING CURB & GUTTER
 - PROPOSED MOUNTABLE CURB & GUTTER
 - PROPOSED STANDARD CURB & GUTTER
 - CROWN TRANSITION
 - WATER BLOCK (HIGH POINT)
 - TEMPORARY EROSION CONTROL BERM
 - PROPOSED SLOPE
 - FLOW ARROW

- KEYNOTES
- WHEELCHAIR RAMP PER COA STD. DWG. 2441 CASE II
 - WHEELCHAIR RAMP PER COA STD. DWG. 2441 CASE I
 - MOUNTABLE 10" STANDARD CURB TRANSITION PER COA STD. DWG. 2418
 - CONC. VALLEY GUTTER PER COA STD. DWG. 2420
 - SPECIAL CONC. VALLEY GUTTER PER COA STD. DWG. 2422
 - FUTURE 4' SIDEWALK, BY OTHERS
 - PROPOSED 4' SIDEWALK, THIS CONTRACT
 - PROPOSED 6' SIDEWALK, THIS CONTRACT
 - 50' CROWN TRANSITION PER COA STD. DWG. 2401
 - CUT-OFF WALL (FULL STREET WIDTH, 24" DEEP x 8" THICK) PER COA STD. DWG. NO. 2415
 - DEPRESS GUTTER TO MATCH VALLEY GUTTER FROM STA 14+11.57 TO STA 14+21.57

~~NOTE: NOT FOR CONSTRUCTION FOR GRADING AND EROSION CONTROL ONLY~~

LAVA BLUFF DRIVE N.W.
MOUNTABLE CURB & GUTTER W/ RESIDENTIAL PAVING
(SEE SHEET 7 FOR STREET SECTION)

PARKWEST UNIT 2 CURVE TABLE

CURVE IDEN	RADIUS	ARC	DELTA
A	107.50	168.23	089-39-58
B	20.00	27.85	079-47-14
C	20.00	25.29	072-27-24
D	20.00	31.42	090-00-00
E	20.00	31.42	090-00-00
F	20.00	31.42	090-00-00
G	20.00	32.42	090-00-00
H	20.00	32.07	091-52-46
I	20.00	31.87	091-17-25
J	20.00	28.25	090-55-09
K	20.00	35.71	102-18-24
L	20.00	31.42	090-00-00
M	20.00	32.14	092-03-52
N	20.00	32.13	092-03-19
O	20.00	34.37	098-27-52
P	60.76	75.36	071-04-01
Q	89.24	110.39	071-04-01

PARKWEST UNIT 4 CURVE TABLE

CURVE IDEN	RADIUS	ARC	DELTA
A	20.00	35.59	101-56-49
B	20.00	31.42	090-00-00
C	20.00	31.42	090-00-00
D	20.00	31.42	090-00-00
E	20.00	31.42	090-00-00
F	20.00	31.42	090-00-00
G	20.00	32.42	092-52-03
H	20.00	29.62	084-50-32
I	20.00	35.19	100-48-11
J	20.00	26.83	078-50-57
K	20.00	30.62	087-43-13
L	20.00	31.42	090-00-00
M	20.00	21.99	036-00-00

APPROVED FOR ROUGH GRADING
(11.11)
J. Austin 4-12-95
DATE

community sciences corporation

CITY OF ALBUQUERQUE
PUBLIC WORKS DEPARTMENT
ENGINEERING GROUP


TITLE: PARKWEST-UNIT 5 (OFFSITE GRADING)
GRADING & EROSION CONTROL PLAN
LAVA BLUFF DRIVE N.W.

APPROVALS	ENGINEER	DATE	APPROVALS	ENGINEER	DATE
DRC CHAIRMAN			WATER		
TRANSPORTATION	N/A RWP	6-22-95	WASTE WATER	N/A RWP	6-5-95
HYDROLOGY	N/A RWP	7-19-95	A.M.A.F.C.A.		
PARKS & REC.					

PROJECT NO. 4886.94 MAP NO. G,H-9 SHEET 8 OF 39

SCANNED BY
BY LASON

26-4886.94 0897

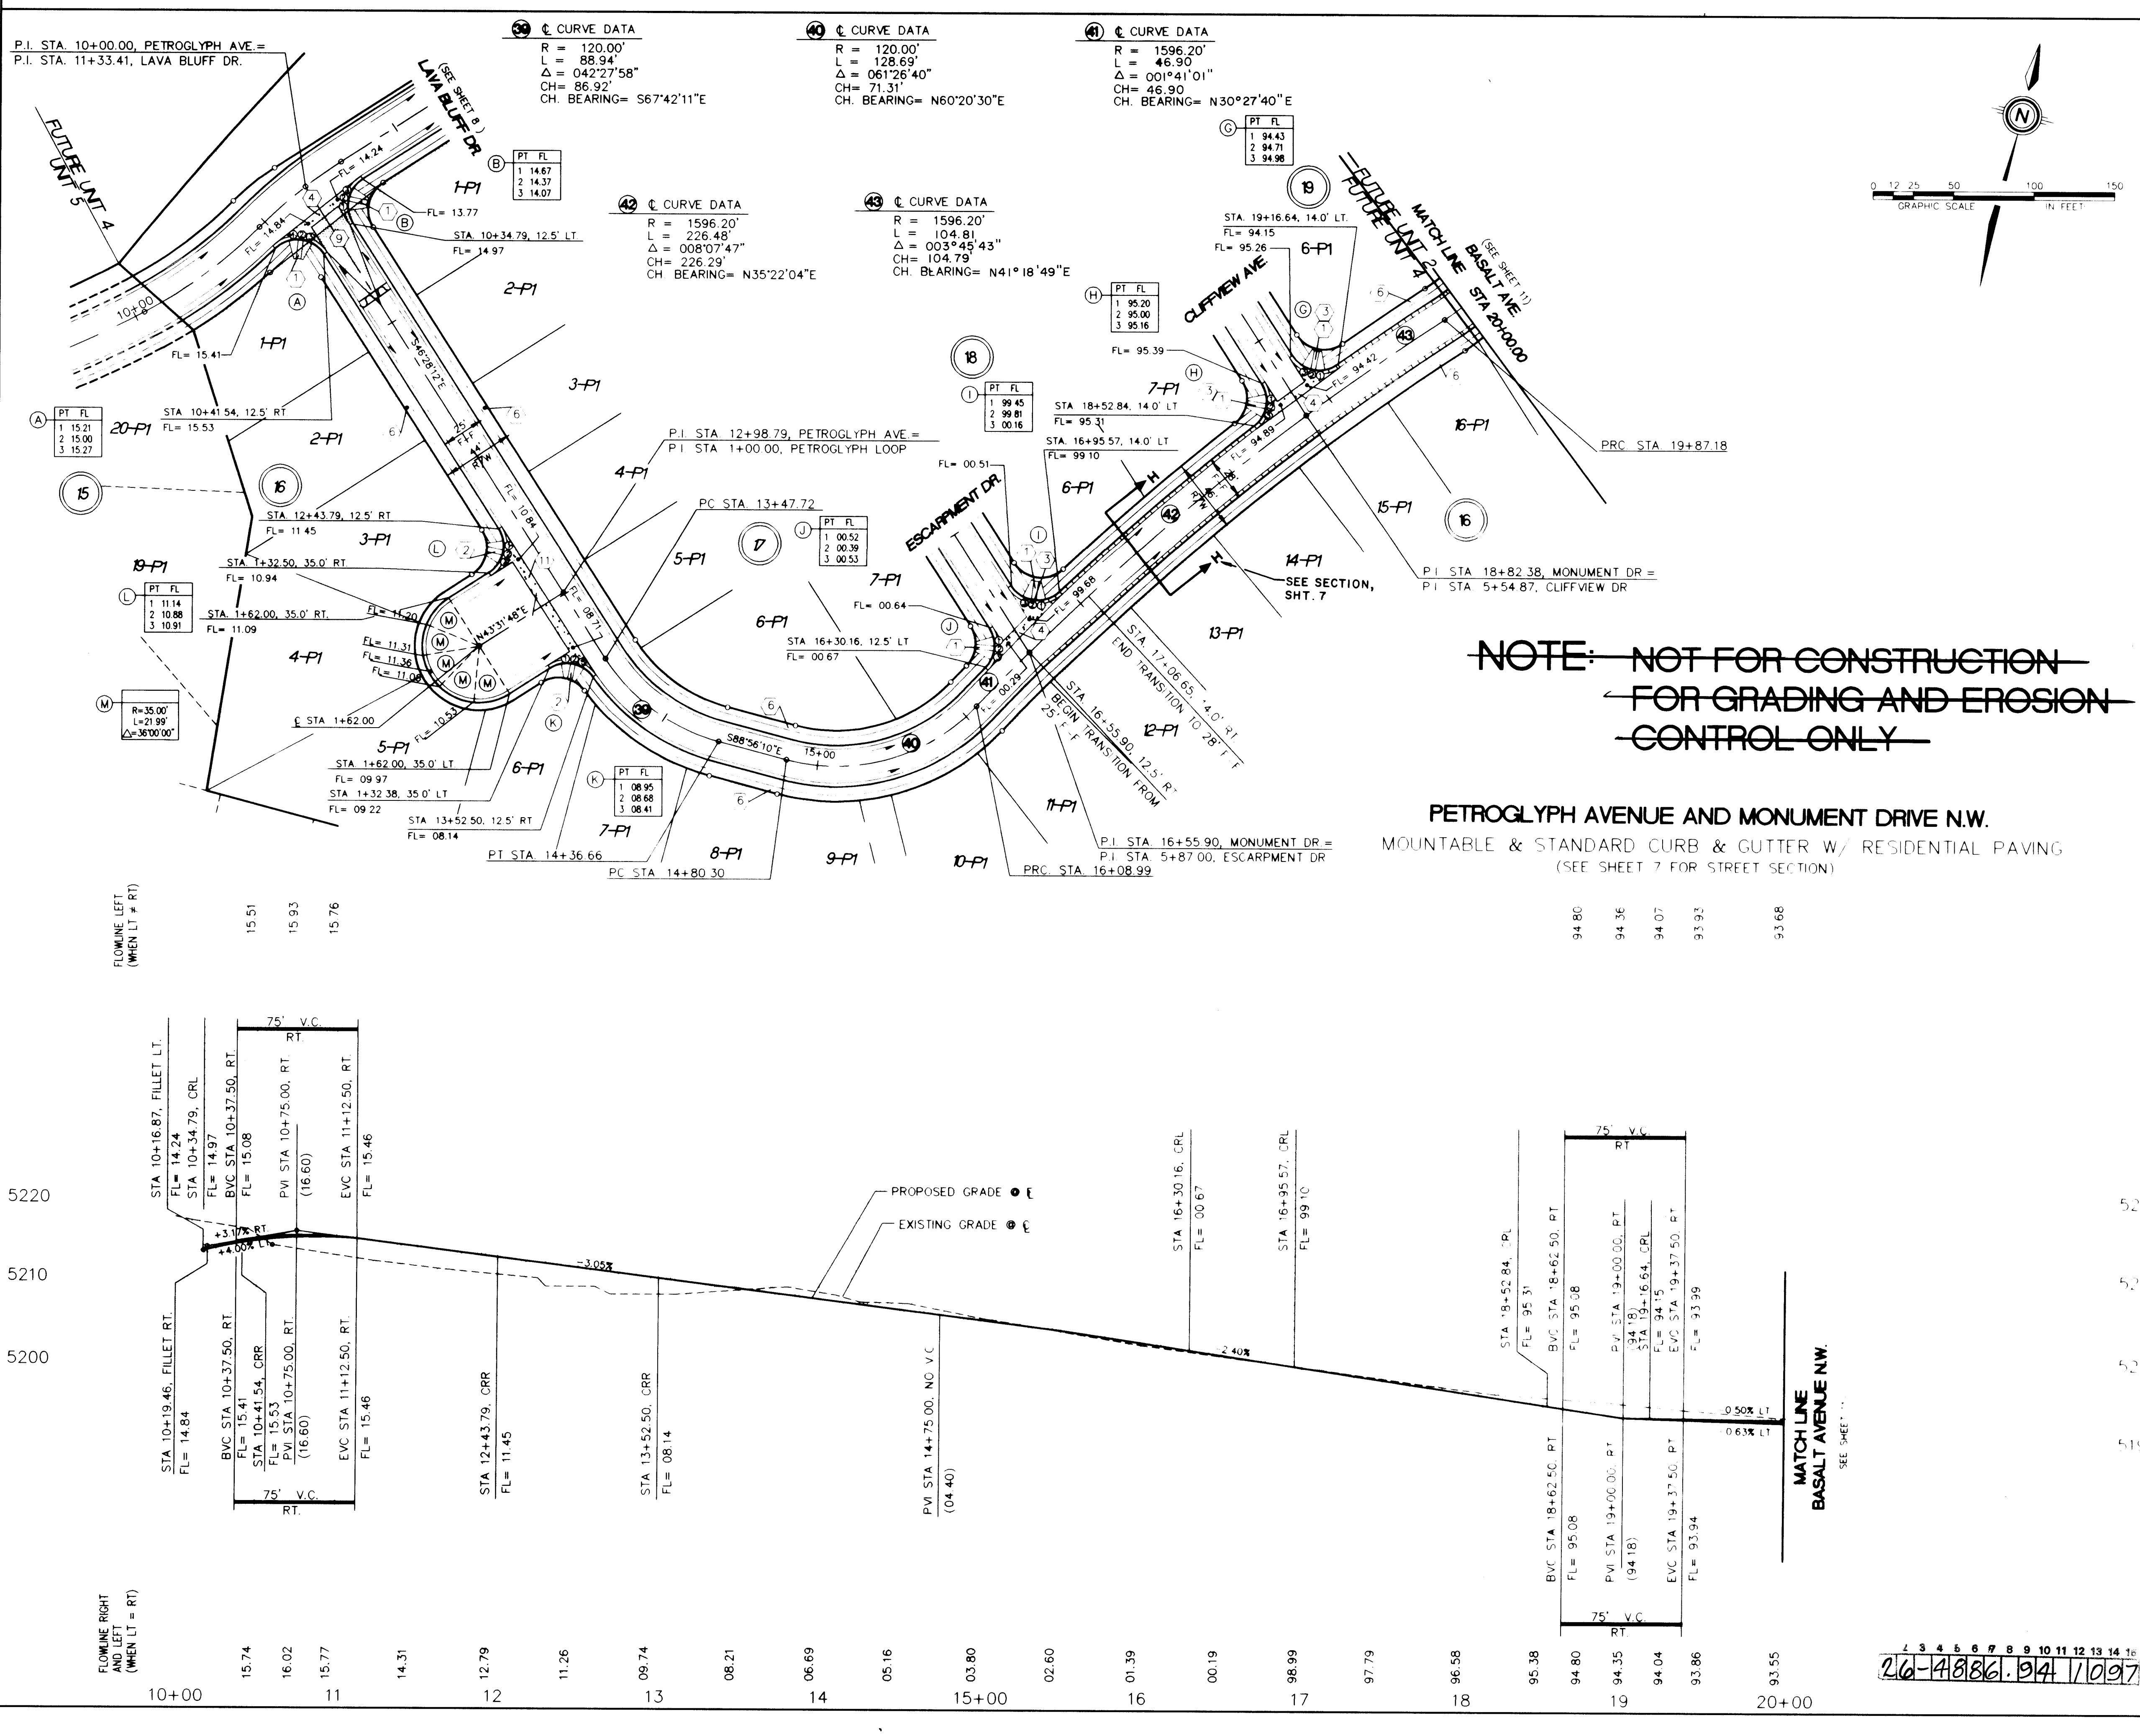

LEGEND

- FL=74.11 PROPOSED CURB FLOWLINE ELEVATION
- 73.6 EXISTING SPOT ELEVATION (GRND & TO)
- PROPOSED VALLEY GUTTER / SIDEWALK
- EXISTING CURB & GUTTER
- PROPOSED MOUNTABLE CURB & GUTTER
- PROPOSED STANDARD CURB & GUTTER
- CROWN TRANSITION
- WATER BLOCK (HIGH POINT)
- TEMPORARY EROSION CONTROL BERM
- PROPOSED SLOPE
- FLOW ARROW

KEYNOTES

- WHEELCHAIR RAMP PER COA STD. DWG. 2441 CASE 1
- WHEELCHAIR RAMP PER COA STD. DWG. 2441 CASE 1
- MOUNTABLE TO STANDARD CURB TRANSITION PER COA STD. DWG. 2418
- CONC. VALLEY GUTTER PER COA STD. DWG. 2420
- SPECIAL CONC. VALLEY GUTTER PER COA STD. DWG. 2422
- FUTURE 4' SIDEWALK, BY OTHERS
- PROPOSED 4' SIDEWALK, THIS CONTRACT
- PROPOSED 6' SIDEWALK, THIS CONTRACT
- NO CROWN TRANSITION PER COA STD. DWG. 2401
- CUT-OFF WALL (FULL STREET WIDTH, 24" DEEP x 8" THICK) PER COA STD. DWG. NO. 2415
- CONC. VALLEY GUTTER PER COA STD. DWG. 2421

PARKWEST UNIT 4 CURVE TABLE

CURVE IDEN	RADIUS	ARC	DELTA
A	20.00	35.59	101-56-49
B	20.00	31.42	090-00-00
C	20.00	31.42	090-00-00
D	20.00	31.42	090-00-00
E	20.00	31.42	090-00-00
F	20.00	31.42	090-00-00
G	20.00	32.42	092-52-03
H	20.00	29.62	084-50-32
I	20.00	35.19	100-48-11
J	20.00	26.83	076-50-57
K	20.00	30.62	087-43-13
L	20.00	31.42	090-00-00
M	20.00	21.99	036-00-00

ENGINEER'S SEAL

APPROVED FOR ROUGH GRADING (1:1)

community sciences corporation

4-12-95

CITY OF ALBUQUERQUE PUBLIC WORKS DEPARTMENT ENGINEERING GROUP


TITLE: PARKWEST-UNIT 5 (OFFSITE GRADING) GRADING & EROSION CONTROL PLAN PETROGLYPH AVE. & MONUMENT DRIVE

APPROVALS	ENGINEER	DATE	APPROVALS	ENGINEER	DATE
DR. CHAIRMAN			WATER	NIA	RWL 6-5-95
TRANSPORTATION	NIA	6-02-95	WASTE WATER	NIA	RWL 6-5-95
HYDROLOGY	NIA	9-19-95	A.M.A.F.C.A.		
MARKS & REC.					

PROJECT NO. 4886.94 MAP NO. G,H-9 SHEET 10 OF 39



44 C CURVE DATA
R = 121.00'
L = 102.74'
Δ = 048°39'03"
CH = 99.68'
CH BEARING = N18°52'09"E

45 C CURVE DATA
R = 121.00'
L = 86.61'
Δ = 041°00'50"
CH = 84.78'
CH BEARING = S25°57'47"E

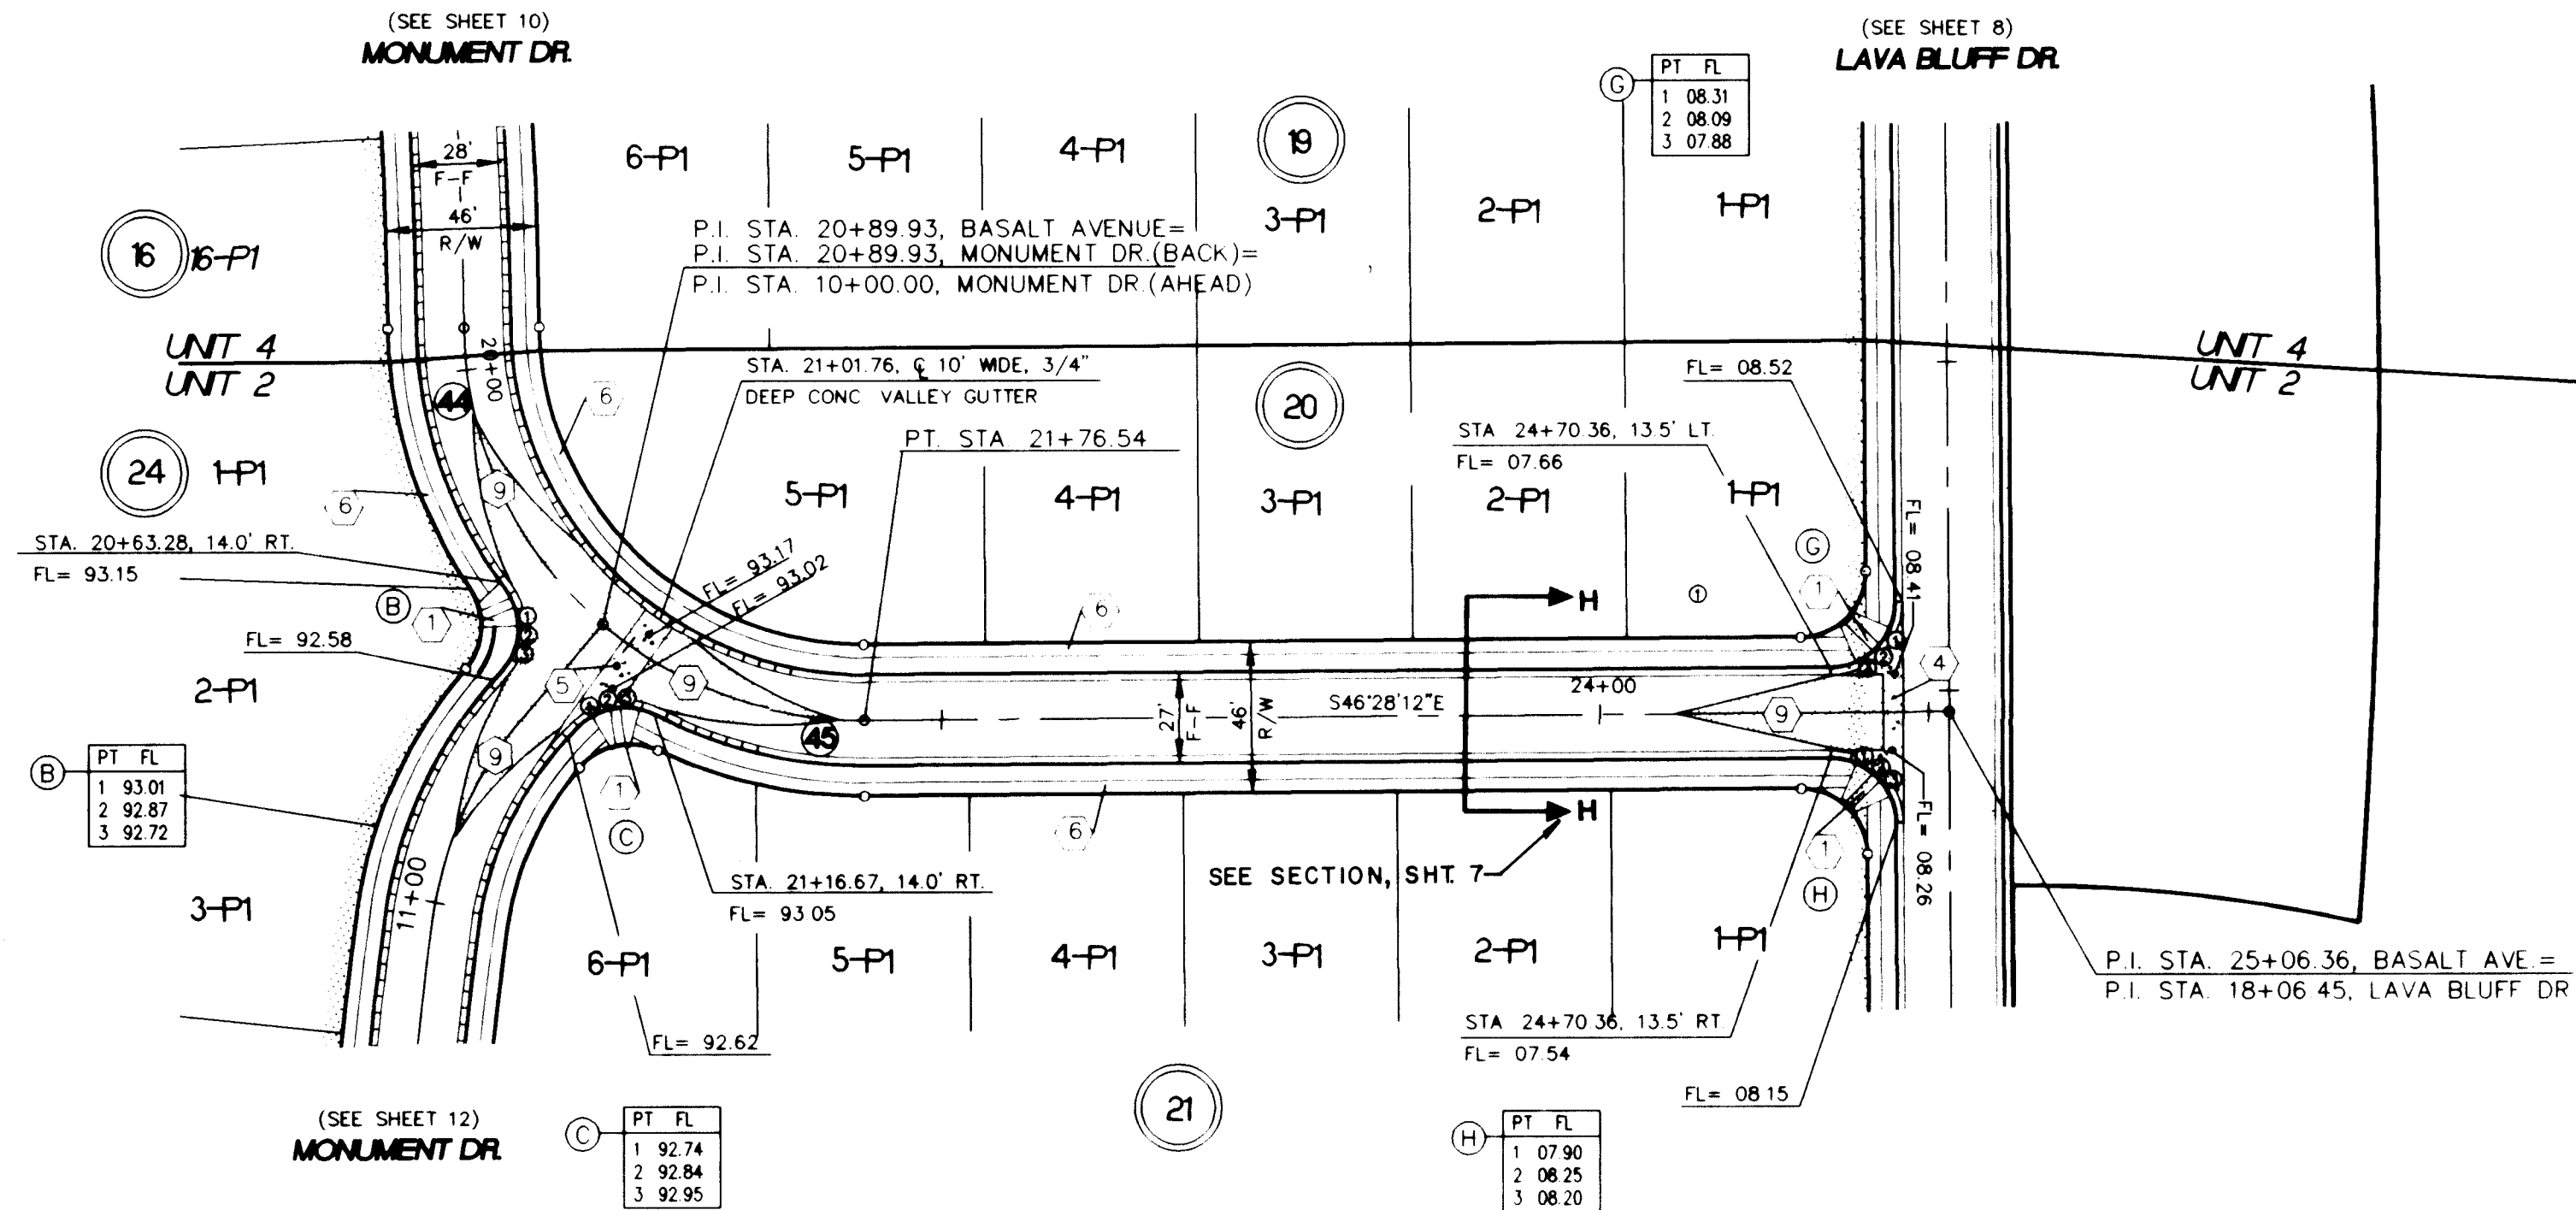

BASALT AVENUE N.W.

MOUNTABLE CURB & GUTTER W/ RESIDENTIAL PAVING
(SEE SHEET 7 FOR STREET SECTION)

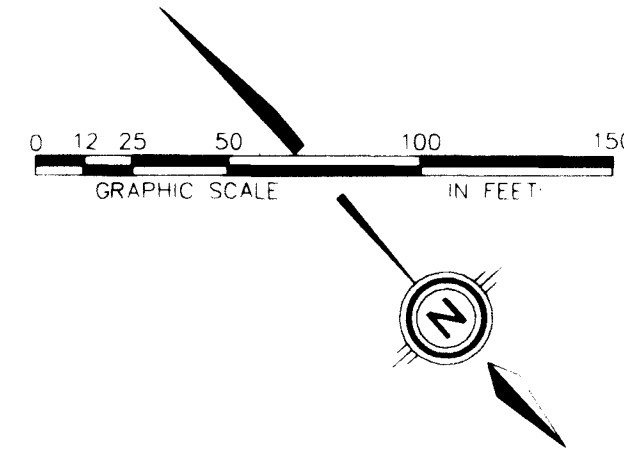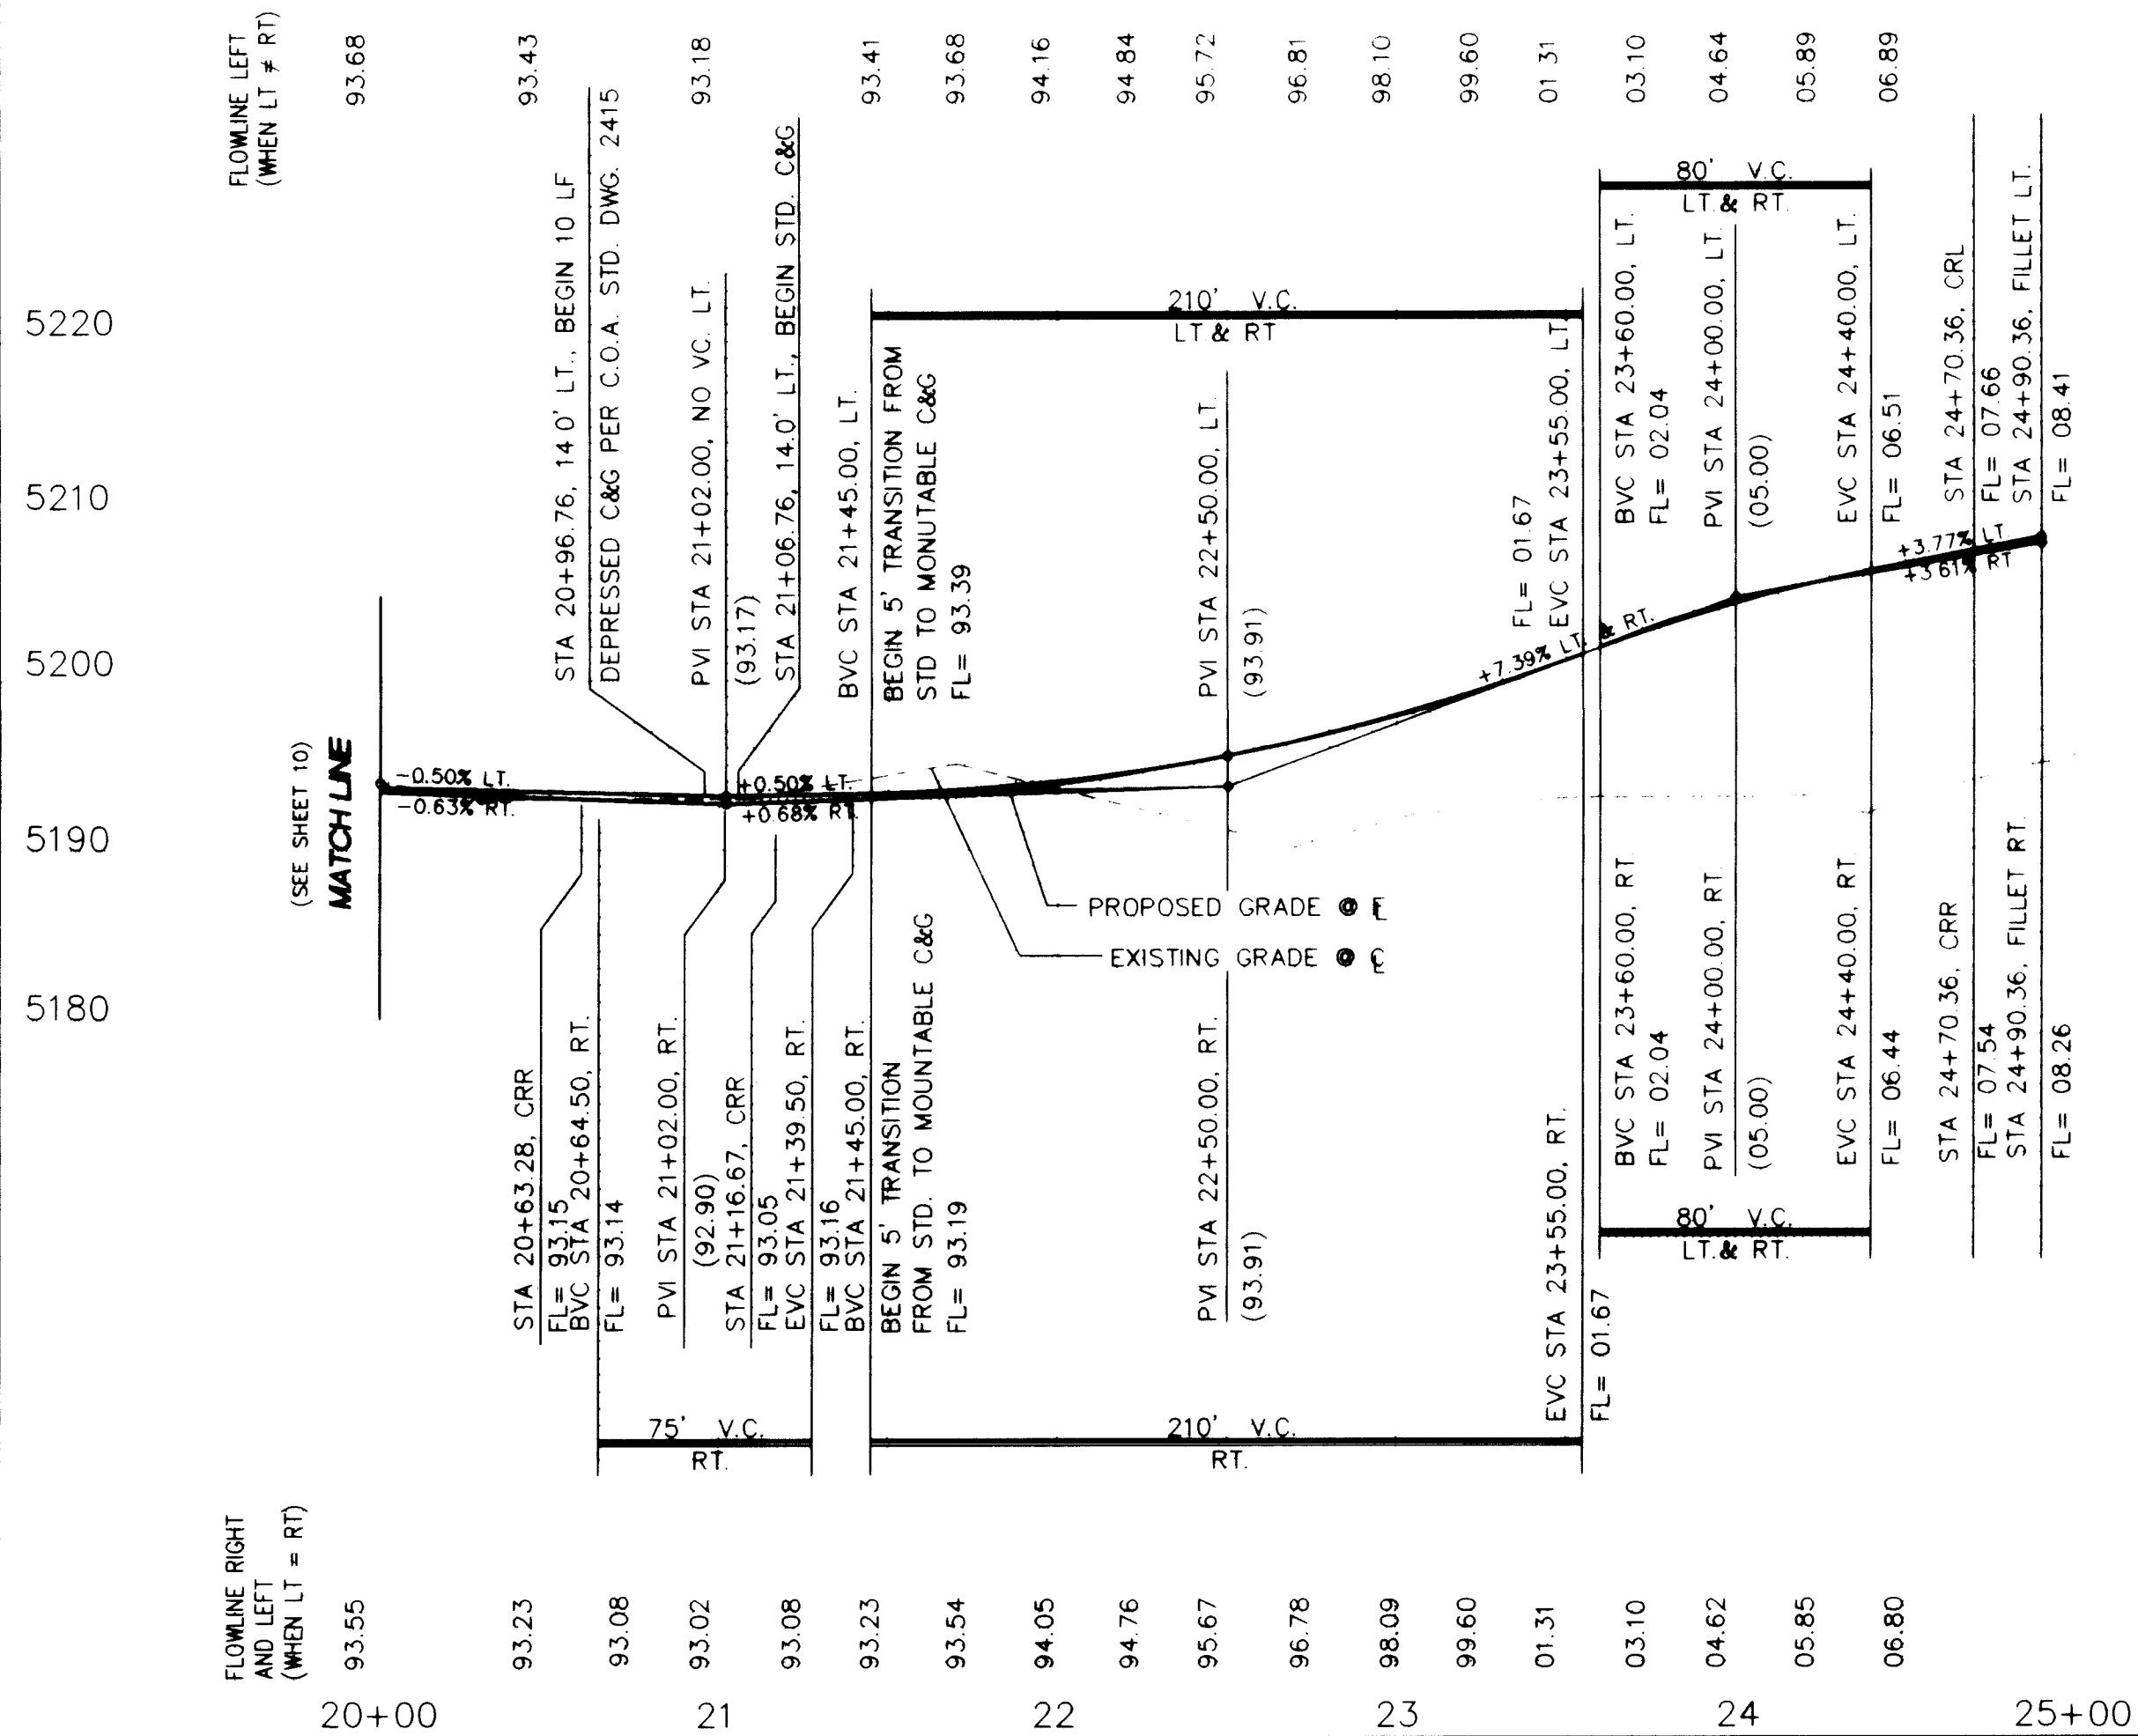

**NOTE: NOT FOR CONSTRUCTION
FOR GRADING AND EROSION
CONTROL ONLY**

LEGEND

- FL=74.11 PROPOSED CURB FLOWLINE ELEVATION
- 73.6 EXISTING SPOT ELEVATION (GRND & TC)
- PROPOSED VALLEY GUTTER/ SIDEWALK
- EXISTING CURB & GUTTER
- PROPOSED MOUNTABLE CURB & GUTTER
- PROPOSED STANDARD CURB & GUTTER
- CROWN TRANSITION

KEYNOTES

- WHEELCHAIR RAMP PER COA STD DWG 2441 CASE 11
- WHEELCHAIR RAMP PER COA STD DWG 2441 CASE 11
- MOUNTABLE TO STANDARD CURB TRANSITION PER COA STD DWG 2418
- CONC. VALLEY GUTTER PER COA STD DWG 2420
- SPECIAL CONC. VALLEY GUTTER PER COA STD DWG 2422
- FUTURE 4' SIDEWALK, BY OTHERS
- PROPOSED 4' SIDEWALK, THIS CONTRACT
- PROPOSED 6' SIDEWALK, THIS CONTRACT
- 50' GROWTH TRANSITION PER COA STD DWG 2401
- CUT OFF WALL (FULL STREET WIDTH, 24' DEEP x 4' THICK) PER COA STD DWG 2415

PARKWEST UNIT 2 CURVE TABLE

CURVE IDEN	RADIUS	ARC	DELTA
A	107.50	168.23	089-39-58
B	20.00	27.85	079-47-14
C	20.00	25.29	072-27-24
D	20.00	31.42	090-00-00
E	20.00	31.42	090-00-00
F	20.00	31.42	090-00-00
G	20.00	32.42	090-00-00
H	20.00	32.07	091-52-46
I	20.00	31.87	091-17-25
J	20.00	28.25	080-55-09
K	20.00	35.71	102-18-24
L	20.00	31.42	090-00-00
M	20.00	32.14	092-03-52
N	20.00	32.13	092-03-19
O	20.00	34.37	098-27-52
P	80.78	75.36	071-04-01
Q	88.24	110.39	071-04-01

APPROVED FOR REVISION GRADING
(DATE)

Valentin 4-12-96

**community
sciences
corporation**

CITY OF ALBUQUERQUE
PUBLIC WORKS DEPARTMENT
ENGINEERING GROUP

TITLE: PARKWEST-UNIT 5 (OFFSITE GRADING)
GRADING & EROSION CONTROL PLAN
BASALT AVENUE N.W.

APPROVALS	ENGINEER	DATE	APPROVALS	ENGINEER	DATE
TRANSPORTATION	N/A RHP	6-02-95	WATER	N/A RWE	6-5-95
HYDROLOGY	9-19-95		WASTE WATER	N/A RWE	6-5-95
PARKS & REC			A.M.A.F.C.A.		

PROJECT NO.	4886.94	MAP NO.	G,H-9	SHEET	11 OF 39
-------------	---------	---------	-------	-------	----------

SCANNED BY
BY LASON

46 C CURVE DATA
R = 120.00'
L = 68.84'
Δ = 032°52'11"
CH = 67.90'
CH BEARING = N68°06'32"E


47 C CURVE DATA
R = 1209.07'
L = 165.82'
Δ = 007°51'28"
CH = 165.69'
CH BEARING = N47°44'43"E

48 C CURVE DATA
R = 1209.07'
L = 225.20'
Δ = 010°40'18"
CH = 224.87'
CH BEARING = N38°28'49"E

49 C CURVE DATA
R = 1209.07'
L = 180.37'
Δ = 008°32'50"
CH = 180.20'
CH BEARING = N28°52'15"E

**NOTE: NOT FOR CONSTRUCTION
FOR GRADING AND EROSION
CONTROL ONLY**

P.I. STA. 10+00.00, MONUMENT DR. (AHEAD)=
P.I. STA. 20+89.93, MONUMENT DR. (BACK)=
P.I. STA. 20+89.93, BASALT AVE.

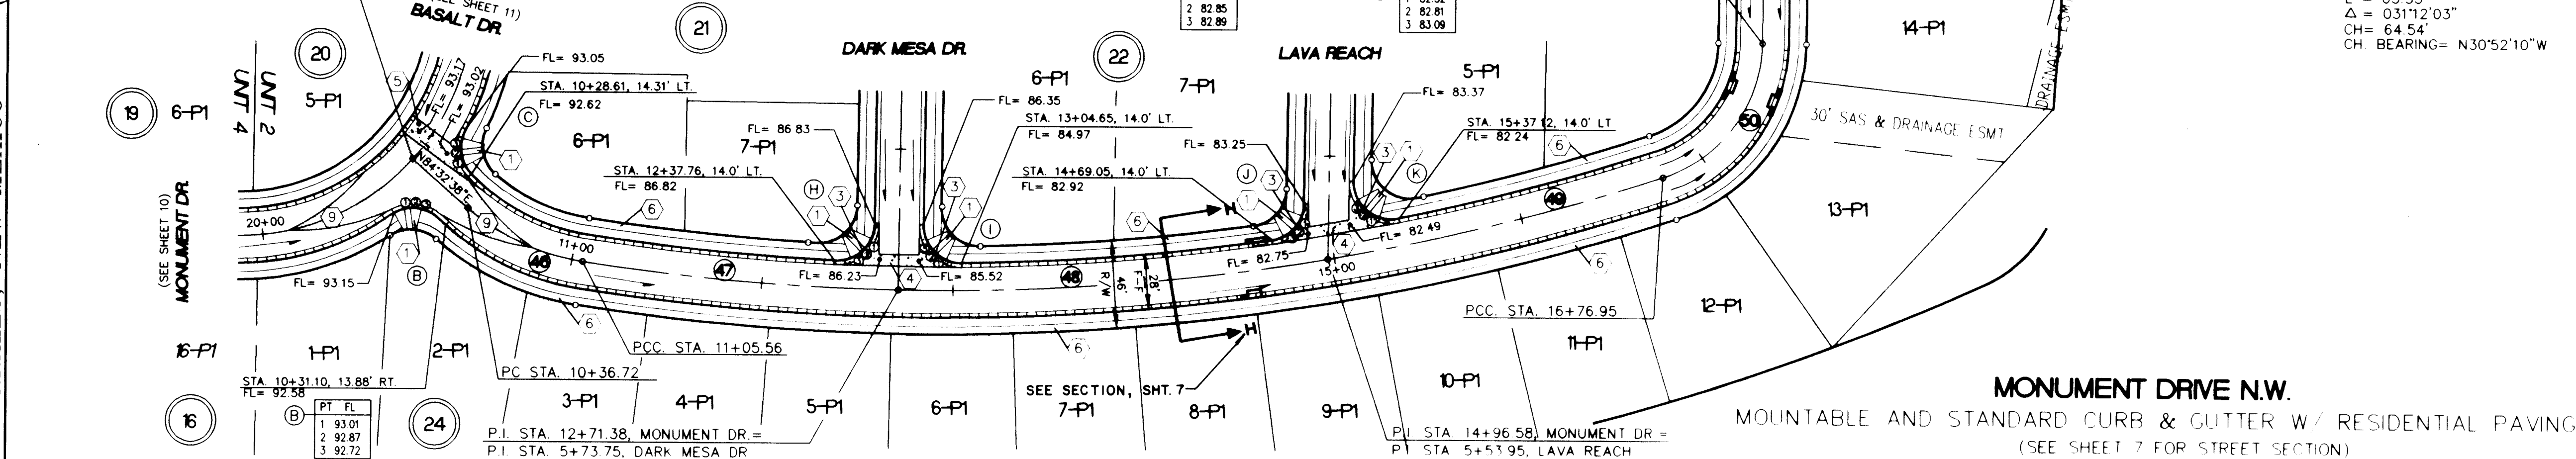

LEGEND

- FL=74.11 PROPOSED CURB FLOWLINE ELEVATION
- 73.6 EXISTING SPOT ELEVATION (GRND & TC)
- PROPOSED VALLEY GUTTER/ SIDEWALK
- EXISTING CURB & GUTTER
- PROPOSED MOUNTABLE CURB & GUTTER
- PROPOSED STANDARD CURB & GUTTER
- CROWN TRANSITION
- WATER BLOCK (HIGH POINT)
- TEMPORARY EROSION CONTROL BERM
- PROPOSED SLOPE
- FLOW ARROW

- KEYNOTES:**
- WHEELCHAIR RAMP PER COA STD. DWG. 2441 CASE II
 - WHEELCHAIR RAMP PER COA STD. DWG. 2441 CASE I
 - MOUNTABLE TO STANDARD CURB TRANSITION PER COA STD. DWG. 2418
 - CONC. VALLEY GUTTER PER COA STD. DWG. 2420
 - SPECIAL CONC. VALLEY GUTTER PER COA STD. DWG. 2422
 - FUTURE 4' SIDEWALK, BY OTHERS
 - PROPOSED 4' SIDEWALK, THIS CONTRACT
 - PROPOSED 6' SIDEWALK, THIS CONTRACT
 - 50' CROWN TRANSITION PER COA STD. DWG. 2401
 - CUT OFF WALL (FULL STREET WIDTH, 24" DEEP, 2' THICK) PER COA STD. DWG. 2415

PARKWEST UNIT 2 CURVE TABLE

CURVE IDEN	RADIUS	ARC	DELTA
A	107.50	168.23	089-39-58
B	20.00	27.85	079-47-14
C	20.00	25.29	072-27-24
D	20.00	31.42	090-00-00
E	20.00	31.42	090-00-00
F	20.00	31.42	090-00-00
G	20.00	32.42	090-00-00
H	20.00	32.07	091-52-46
I	20.00	31.87	091-17-25
J	20.00	28.25	080-55-09
K	20.00	35.71	102-18-24
L	20.00	31.42	090-00-00
M	20.00	32.14	092-03-52
N	20.00	32.13	092-03-16
O	20.00	34.37	098-27-52
P	60.78	75.36	071-04-01
Q	89.24	110.39	071-04-01

APPROVED FOR ROUGH GRADING (1:1)

4-12-95

community sciences corporation

CITY OF ALBUQUERQUE
PUBLIC WORKS DEPARTMENT
ENGINEERING GROUP


TITLE: PARKWEST-UNIT 5 (OFFSITE GRADING)
GRADING & EROSION CONTROL PLAN
MONUMENT DRIVE N.W.

APPROVALS	ENGINEER	DATE	APPROVALS	ENGINEER	DATE
DR. CHAIRMAN			WATER		
TRANSPORTATION			WASTE WATER		
HYDROLOGY			A.M.A.F.C.A.		
PAVING & REC.					


PROJECT NO. 4886.94 MAP NO. G,H-9 SHEET 12 OF 39

SCANNED BY LASON

80 CURVE DATA
R = 598.00'
L = 260.86'
Δ = 024°59'36"
CH = 258.79'
CH BEARING = N57°20'47"E

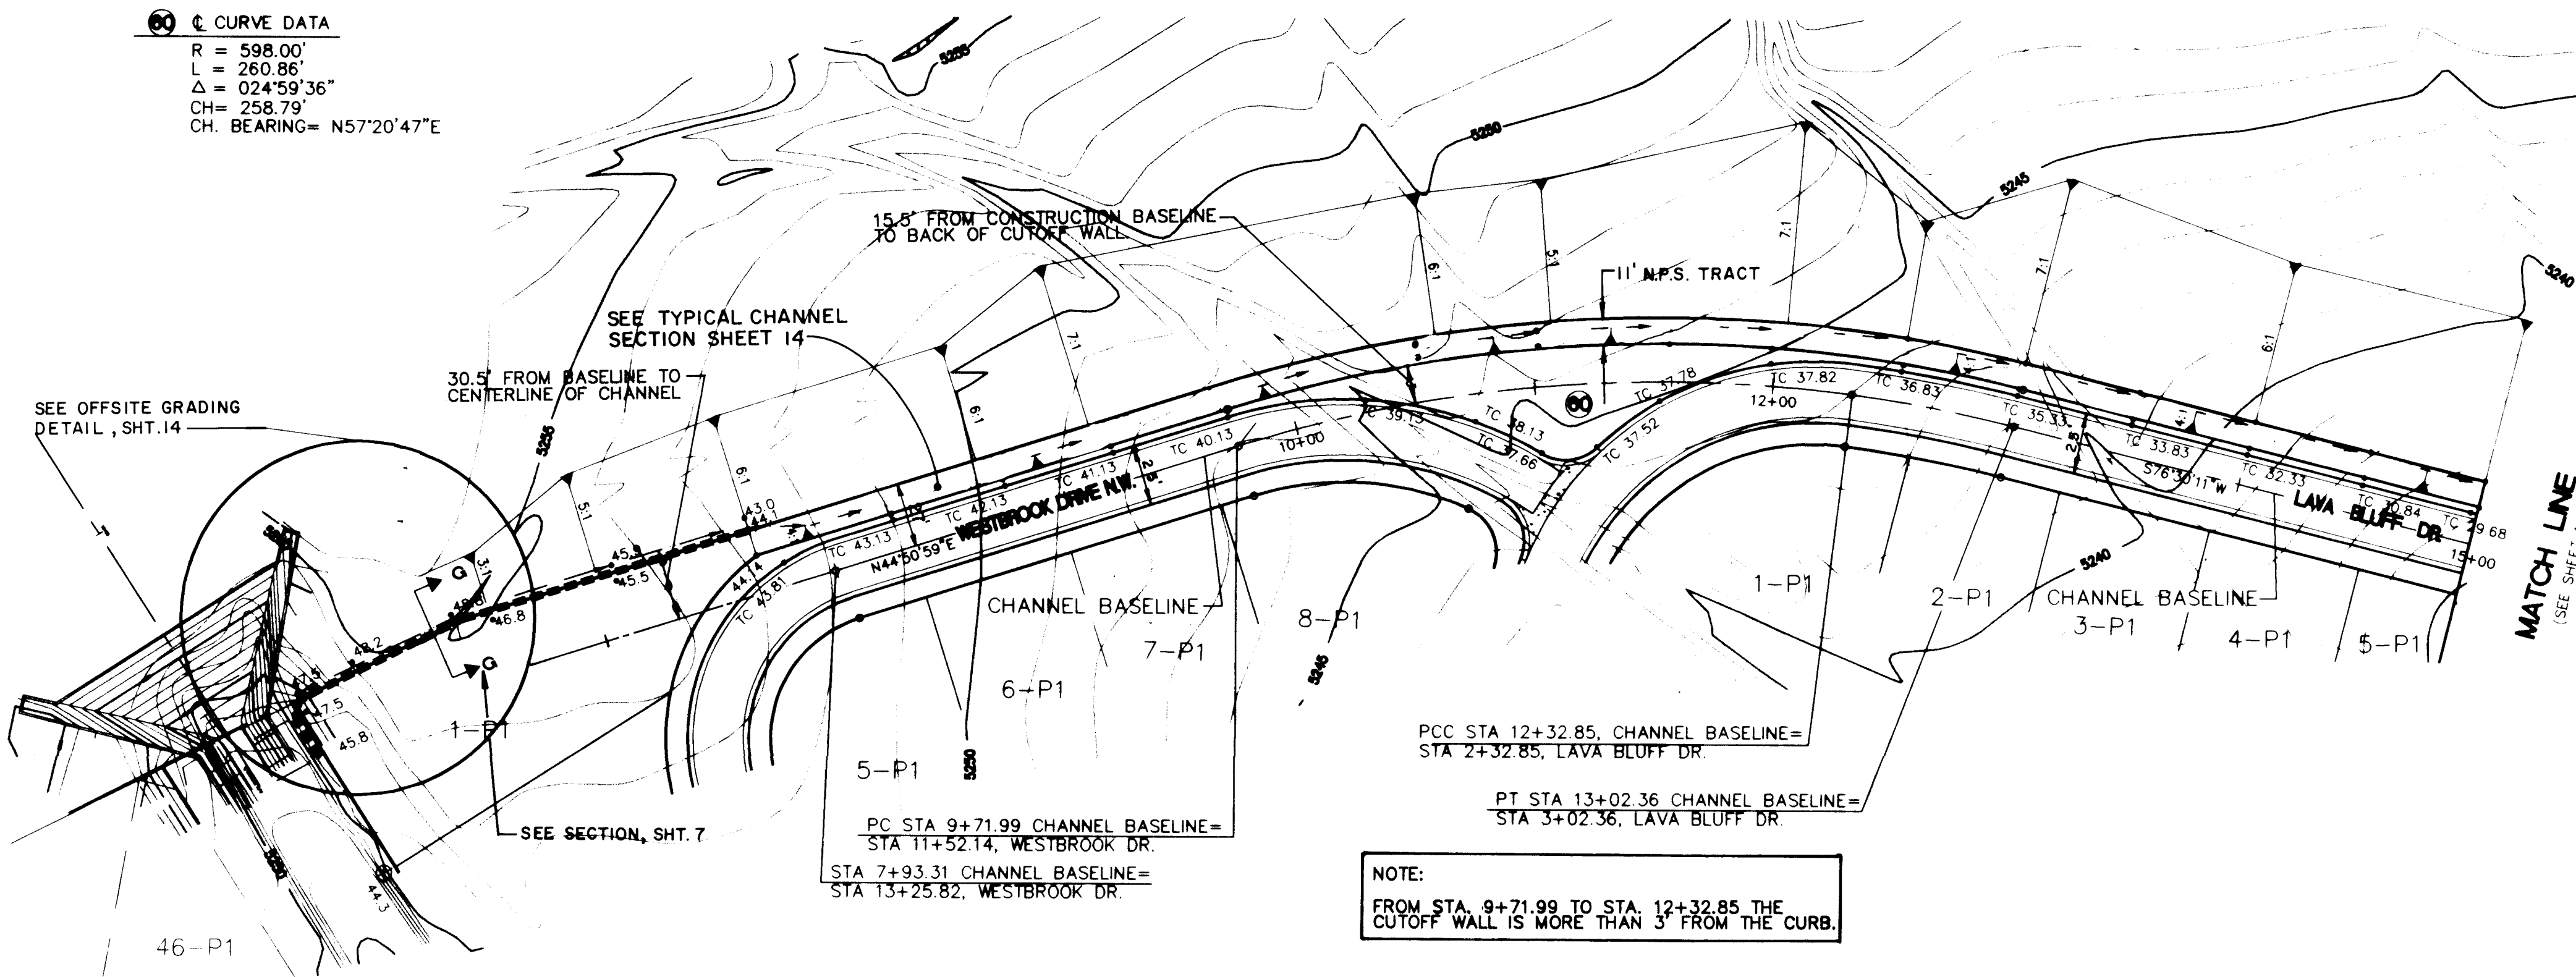

CHANNEL ALONG WESTBROOK DR. AND LAVA BLUFF DR.
(SEE SHEET 14 FOR TYPICAL CROSS SECTION)

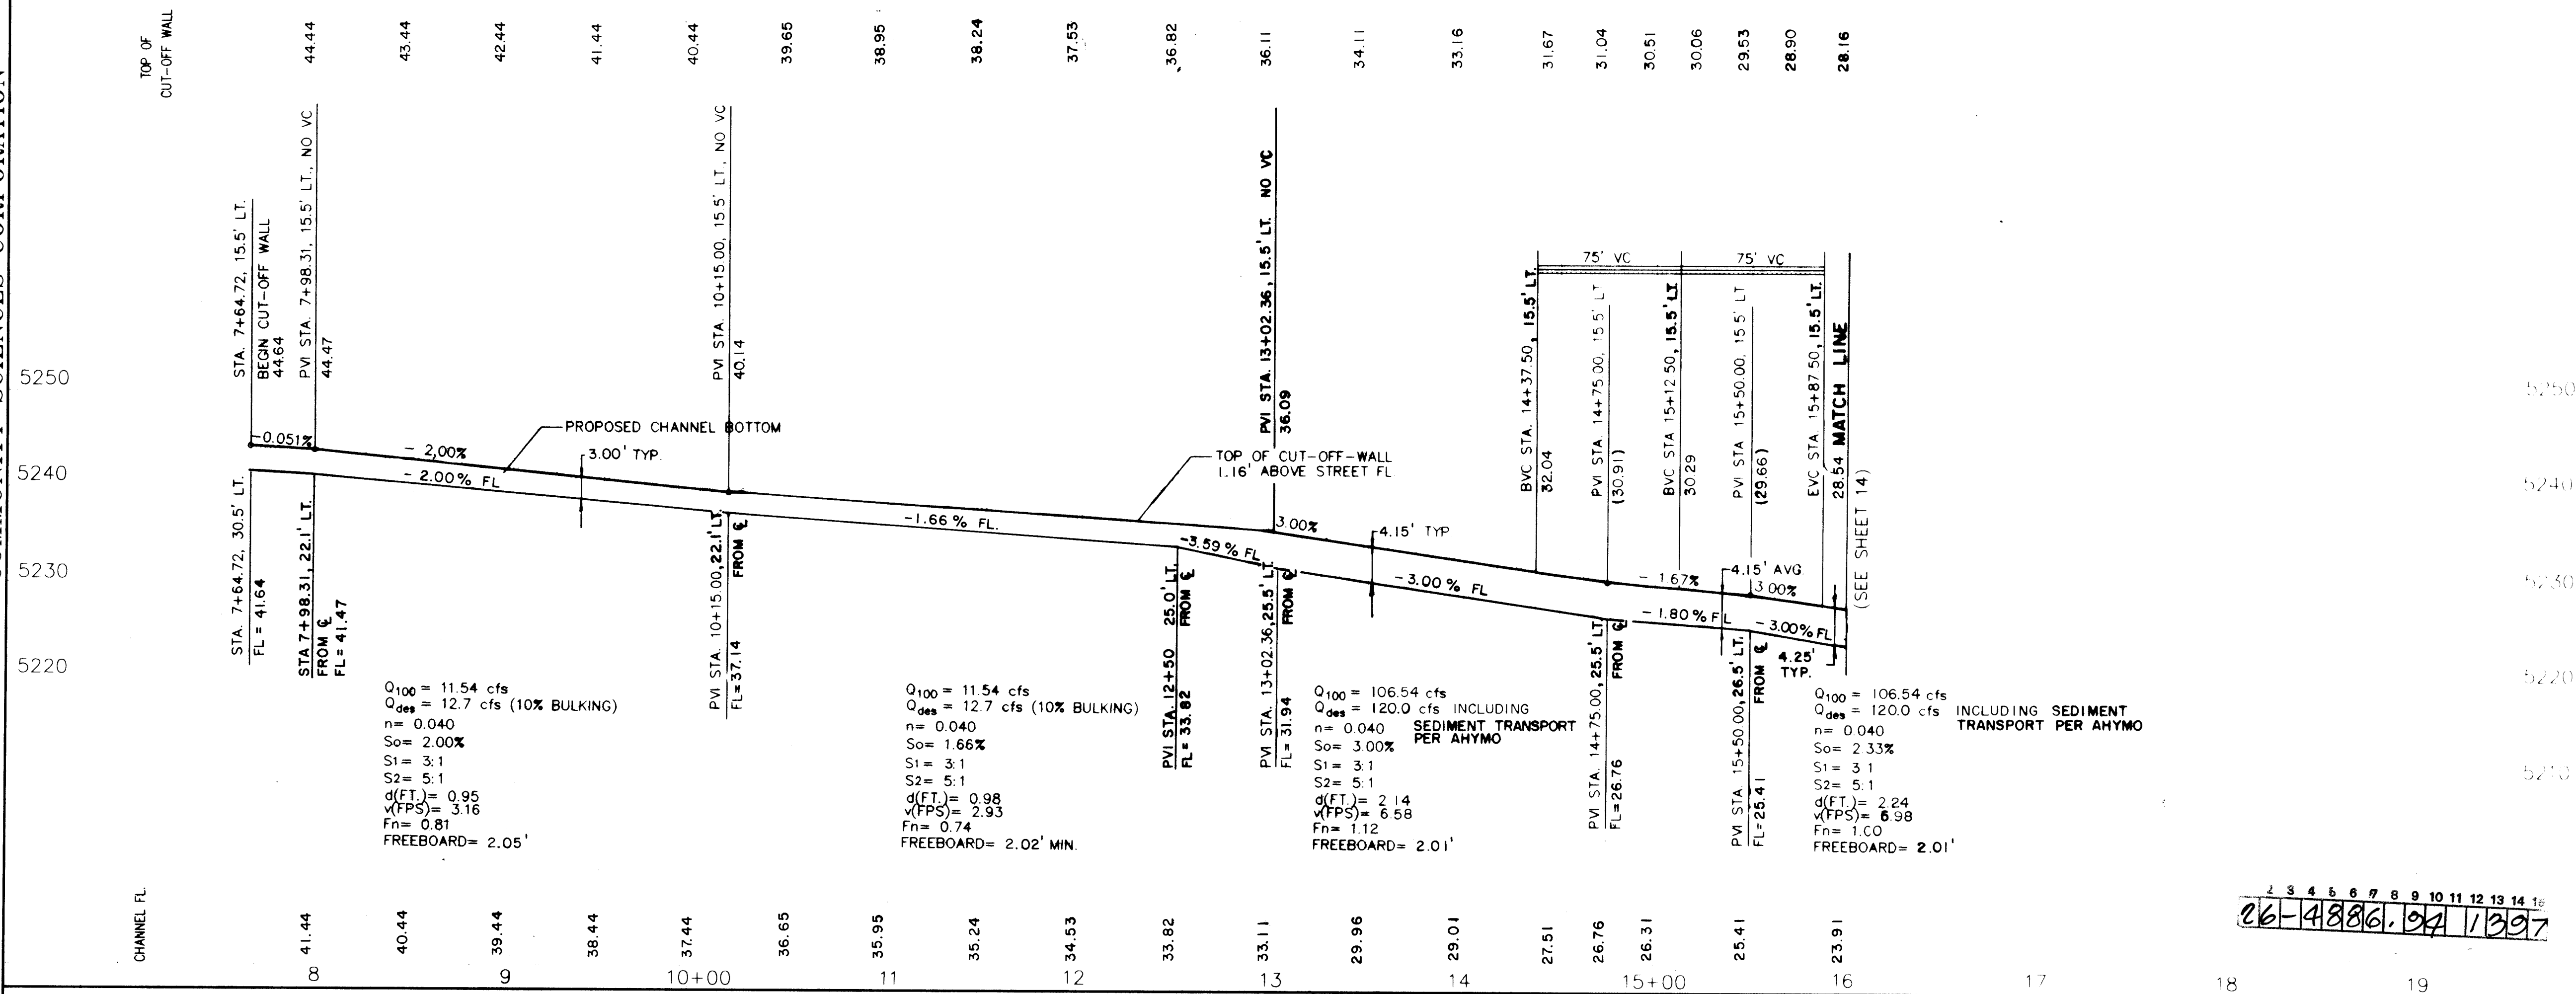

26-4886.94 1/397

SCANNED BY
BY LASON

LEGEND

- TC 98.43 PROPOSED TOP OF CURB ELEVATION
- 99.0 PROPOSED SPOT ELEVATION
- 09.0 EXISTING SPOT ELEVATION (GRND & TC)
- ▬ TEMPORARY EROSION CONTROL BERM
- ▬ PROPOSED CONCRETE VALLEY GUTTER
- ▬ EXISTING CURB & GUTTER
- ▬ PROPOSED MOUNTABLE CURB & GUTTER
- ▬ PROPOSED STANDARD CURB & GUTTER
- ▬ 49.73 EXISTING CONTOUR W/ INDEX ELEVATION
- ▬ PROPOSED SLOPE
- ▬ DRAINAGE BASIN DIVIDE
- ▬ UNIT BOUNDARY
- ▬ SWALE
- ▬ FLOW ARROW
- ▬ PROPOSED RETAINING WALL
- ▬ EXISTING STORM DRAIN
- ▬ 30" SD PROPOSED STORM DRAIN
- ▬ WATER BLOCK (HIGH POINT)

GRAPHIC SCALE
0 25 50 100 150
IN FEET

SURVEY INFORMATION		BENCH MARKS		AS BUILT INFORMATION	
NO.	DATE	NO.	DATE	NO.	DATE
1	COMMUNITY SCIENCES	1	COMMUNITY SCIENCES	1	COMMUNITY SCIENCES
2	DATE	2	DATE	2	DATE
3	DATE	3	DATE	3	DATE
4	DATE	4	DATE	4	DATE
60	DATE	60	DATE	60	DATE

ENGINEER'S SEAL
Rev 5-25-95 3-14-95

APPROVED FOR ROUGH GRADING
(+ 1 FT.)
4-12-95
DATE

SCALE
1" = 50' HOR.
1" = 10' VER.

community
sciences
corporation

DRAWN BY
14326 (04)

LAND PLANNING
P.O. Box 1328

ENGINEERING
Corrales, N.M. 87048

SURVEYING

DATE

DATE

CITY OF ALBUQUERQUE
PUBLIC WORKS DEPARTMENT
ENGINEERING GROUP

TITLE: PARKWEST-UNIT 5
CHANNEL PLAN & PROFILE
GRADING AND EROSION CONTROL PLAN

APPROVALS	ENGINEER	DATE	APPROVALS	ENGINEER	DATE
DRC CHAIRMAN			WATER		
TRANSPORTATION			WASTE WATER		
HYDROLOGY			A.M.A.F.C.A.		
PARKS & REC.					

PROJECT NO.

MAP

SHEET

13

OF


39

4886.94


NO. G,H-9

13


39

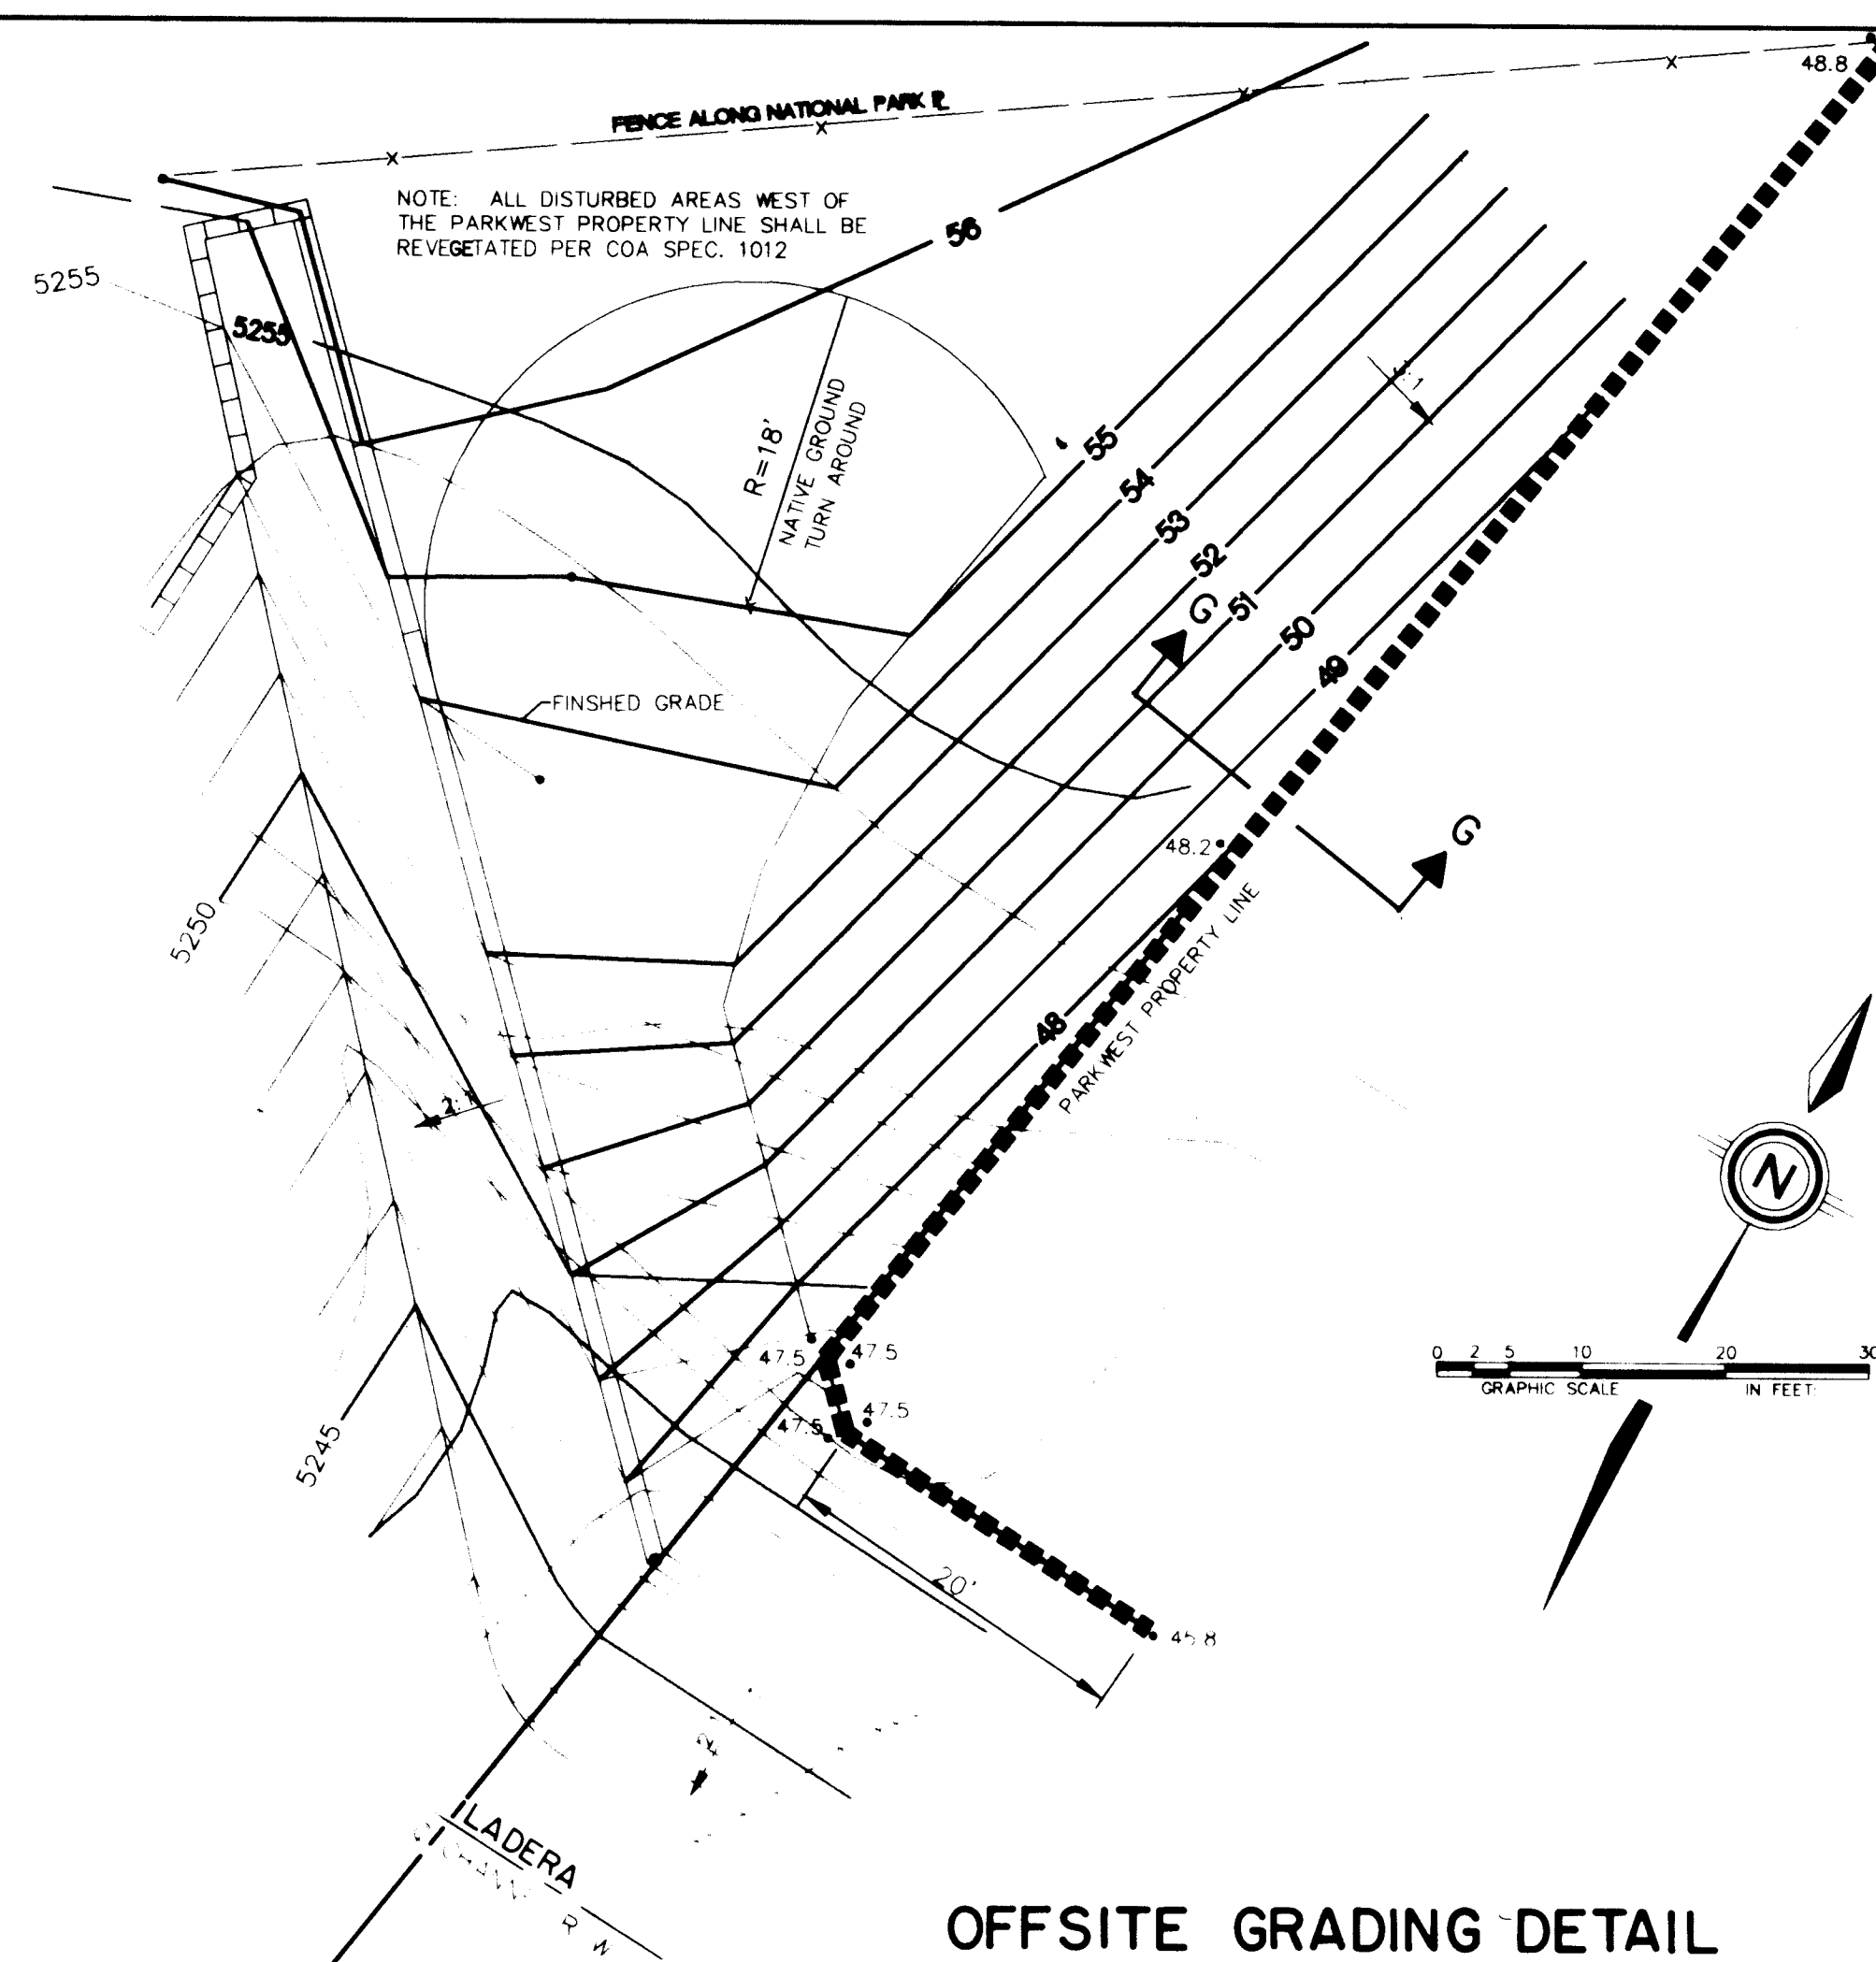

OFFSITE GRADING DETAIL

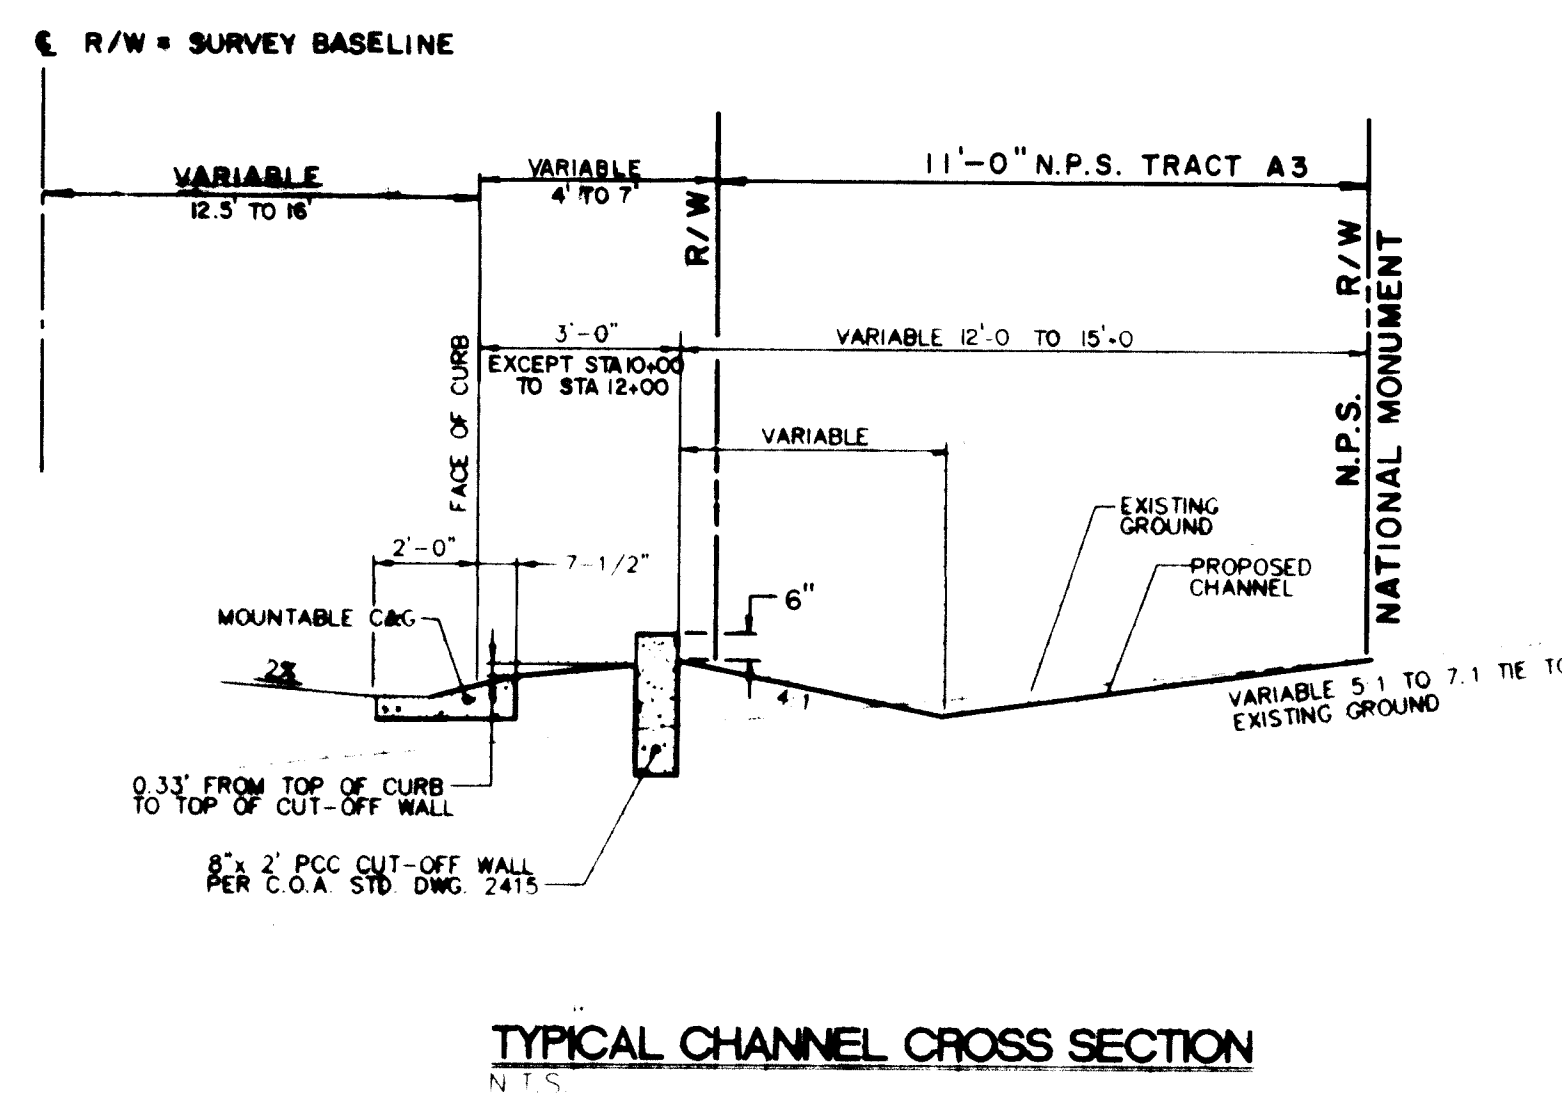

TYPICAL CHANNEL CROSS SECTION
N.T.S.

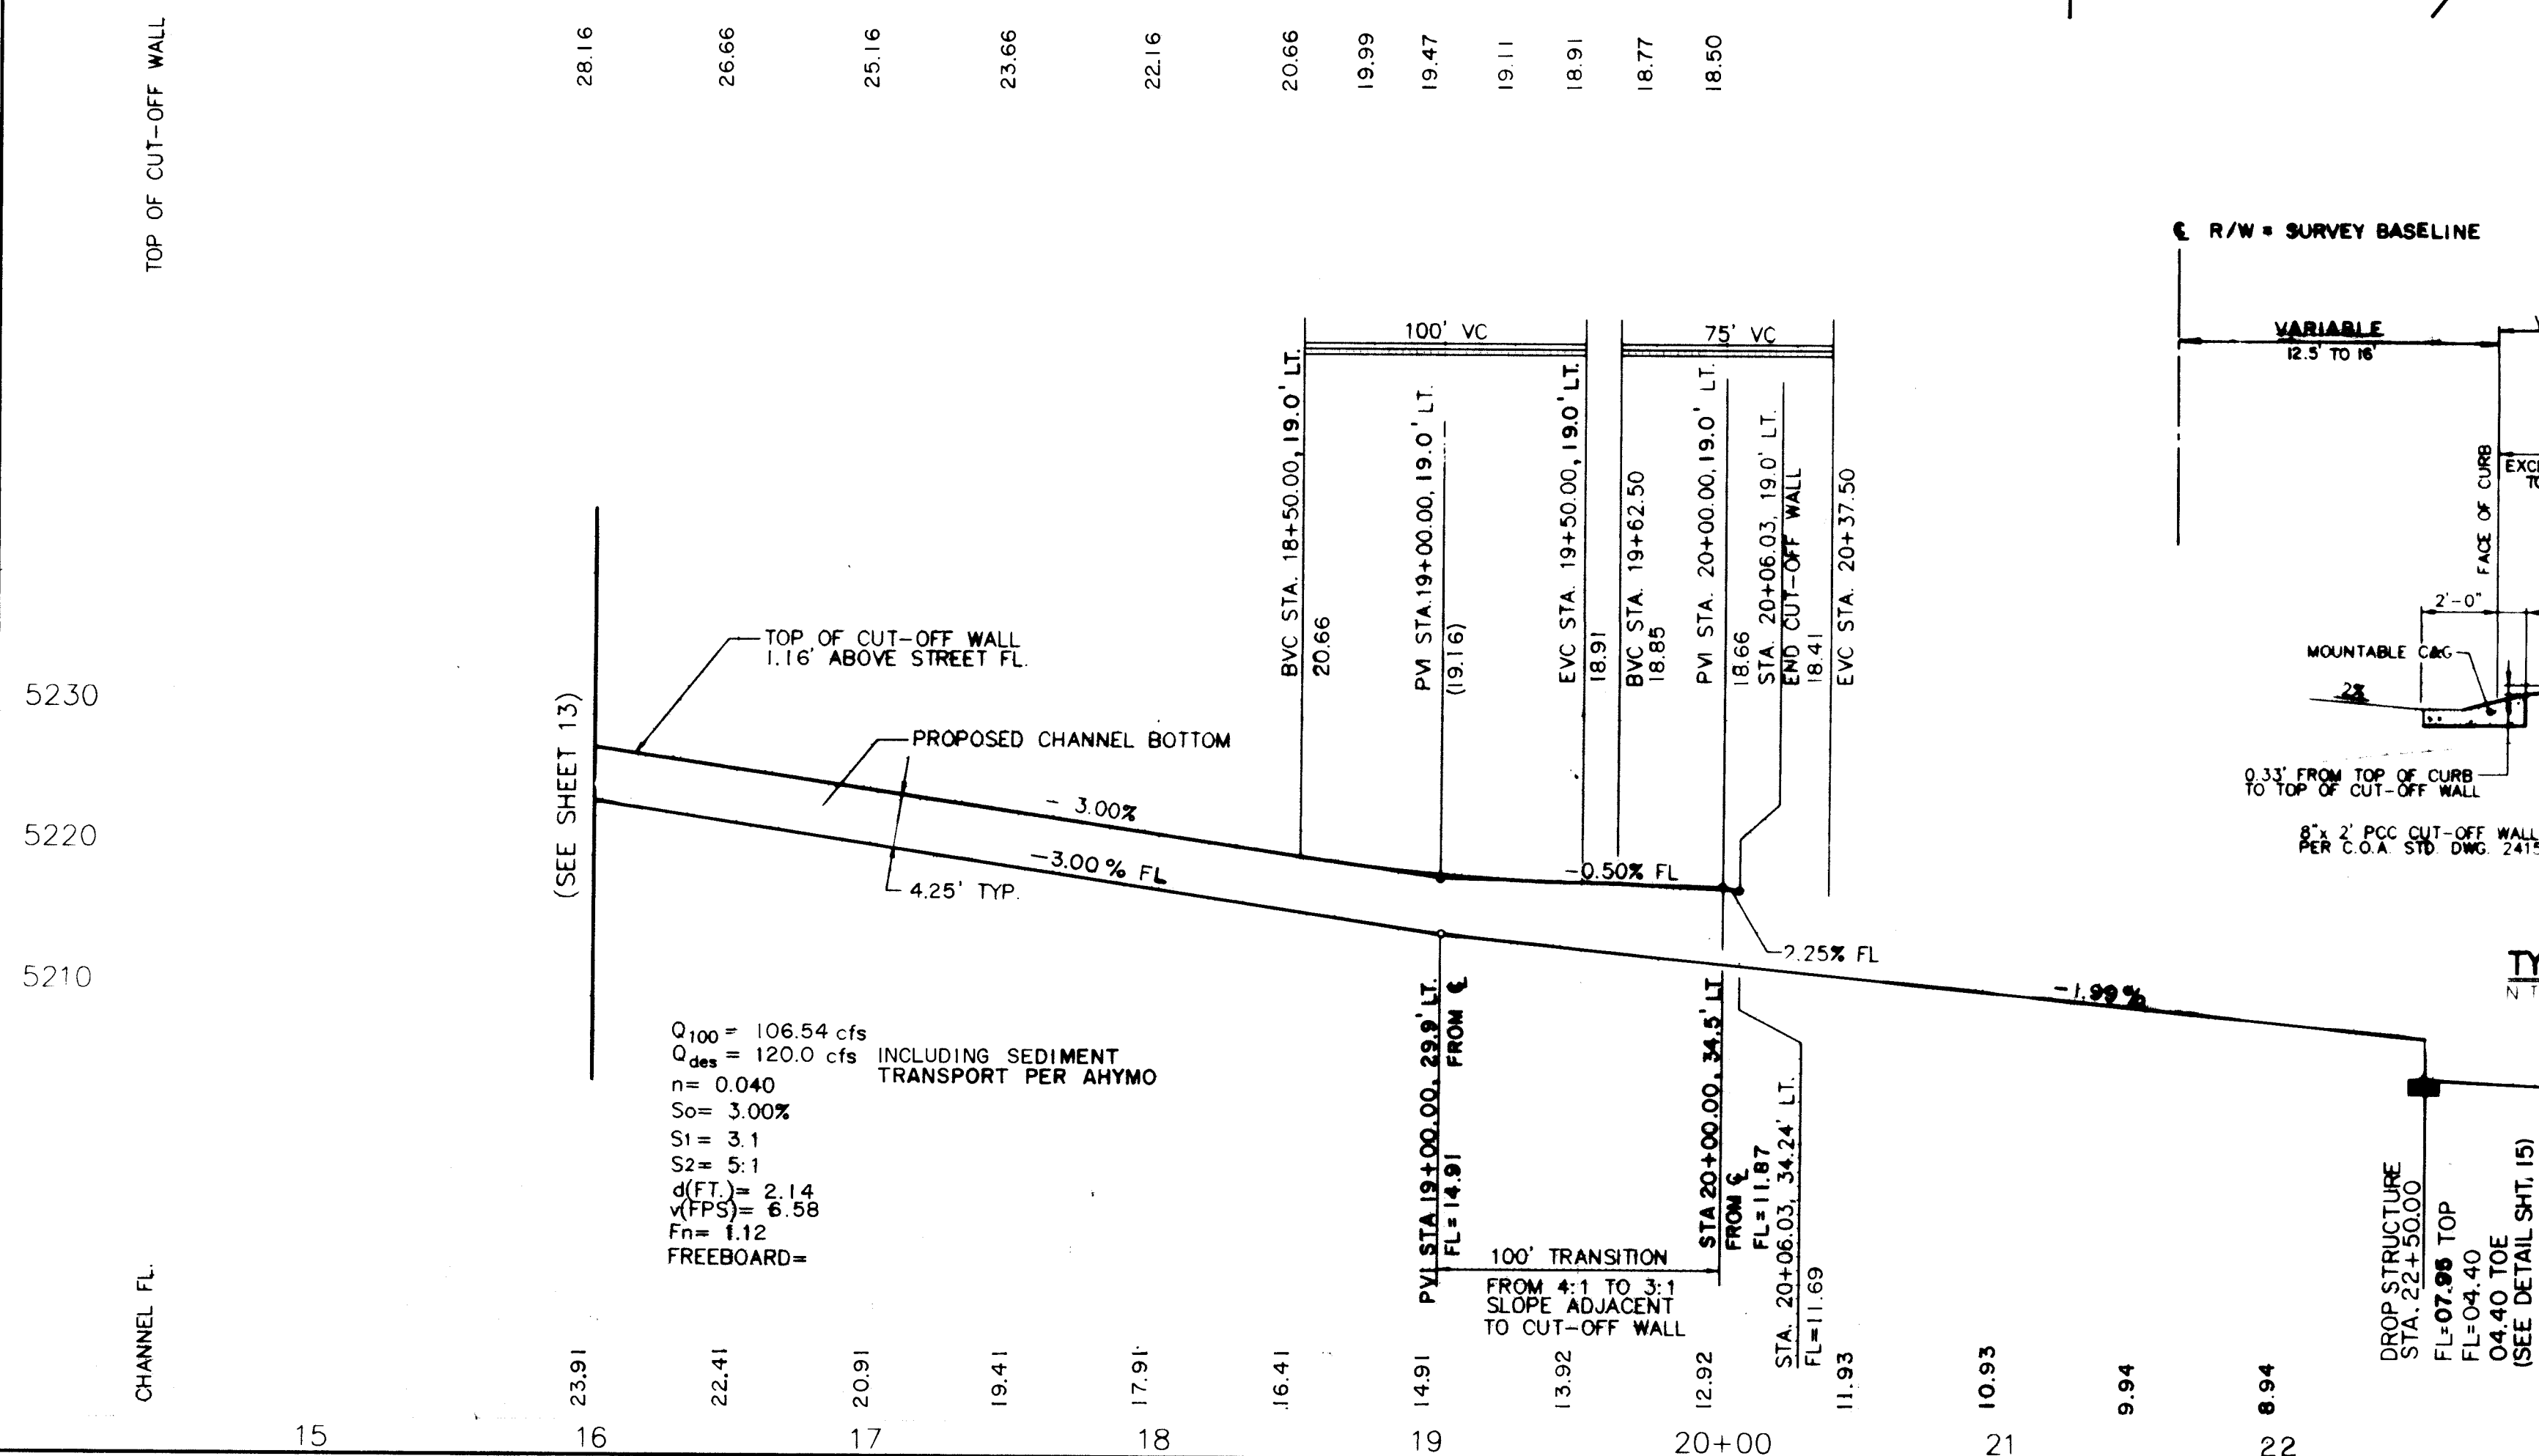

SCANNED BY
BY LASON

● TC 98.43	PROPOSED TOP OF CURB ELEVATION
● 99.0	PROPOSED SPOT ELEVATION
○ 99.0	EXISTING SPOT ELEVATION (GRND. & TC)
	TEMPORARY EROSION CONTROL BERM
	PROPOSED CONCRETE VALLEY GUTTER
	EXISTING CURB & GUTTER
	PROPOSED MOUNTABLE CURB & GUTTER
	PROPOSED STANDARD CURB & GUTTER
497.3	EXISTING CONTOUR W/ INDEX ELEVATION
	PROPOSED SLOPE
	DRAINAGE BASIN DIVIDE
	UNIT BOUNDARY
	SWALE
	FLOW ARROW
	PROPOSED RETAINING WALL
-- 30" SD --	EXISTING STORM DRAIN
-- 30" SD --	PROPOSED STORM DRAIN
	WATER BLOCK (HIGH POINT)
	CUT OFF WALL

SURVEY INFORMATION		BENCH MARKS		AS BUILT INFORMATION	
NO.	FIELD NOTES	BY	DATE	CONTRACTOR	DATE
1	COMMUNITY SCIENCES			INSPECTOR'S	DATE
				SET BY	DATE
				CERTIFICATION BY	DATE
				DRAWINGS	DATE
				CORRECTED BY	DATE
				DATE	DATE
				NO.	DATE
				NO.	DATE

ENGINEER'S SEAL

3-14-95
Rev 5-25-95

	9-6-95	General Revisions		DLM
NO.	DATE	REMARKS	BY	
DESIGN REVISIONS				
DESIGNED BY S.R.L.				
DRAWN BY A.M.	DATE MARCH, 1995			
CHECKED BY J.D.H.	DATE MARCH, 1995			

APPROVED FOR ROUGH GRADING
(± 1 FT.)

J. Austin
CITY HYDROLOGY

4-12-93
DATE

SCALE
1" = 50', HORIZ.
1" = 10', VERT.

**community
sciences
corporation**

JOB NO 14326-041	LAND PLANNING P.O. Box 1328	ENGINEERING Corrales, N.M. 87048	SURVEYING
---------------------	--------------------------------	-------------------------------------	-----------

CITY OF ALBUQUERQUE
PUBLIC WORKS DEPARTMENT
ENGINEERING GROUP



TITLE: PARKWEST-UNIT 5
CHANNEL PLAN & PROFILE
GRADING AND EROSION CONTROL PLAN

APPROVALS	ENGINEER	DATE	APPROVALS	ENGINEER	DATE
DRC CHAIRMAN			WATER	N/A RWF	6-5-95
TRANSPORTATION	N/A RHD	6-02-95	WASTE WATER	N/A RWF	6-5-95
HYDROLOGY			A.M.A.F.C.A.		
PARKS & REC					

PROJECT NO.	MAP NO.	SHEET
4886.94	G,H-9	14 OF 39

LEGEND

- TC 98.43 PROPOSED TOP OF CURB ELEVATION
- 99.0 PROPOSED SPOT ELEVATION
- 09.0 EXISTING SPOT ELEVATION (GRND & TC)
- ▬ TEMPORARY EROSION CONTROL BERM
- ▬ PROPOSED CONCRETE VALLEY GUTTER
- ▬ EXISTING CURB & GUTTER
- ▬ PROPOSED MOUNTABLE CURB & GUTTER
- ▬ PROPOSED STANDARD CURB & GUTTER
- 49.73 EXISTING CONTOUR W/ INDEX ELEVATION
- ▬ PROPOSED SLOPE
- ▬ DRAINAGE BASIN DIVIDE
- ▬ UNIT BOUNDARY
- ▬ SWALE
- ▬ FLOW ARROW
- ▬ PROPOSED RETAINING WALL
- 30" SD EXISTING STORM DRAIN
- 30" SD PROPOSED STORM DRAIN
- ▬ WATER BLOCK (HIGH POINT)

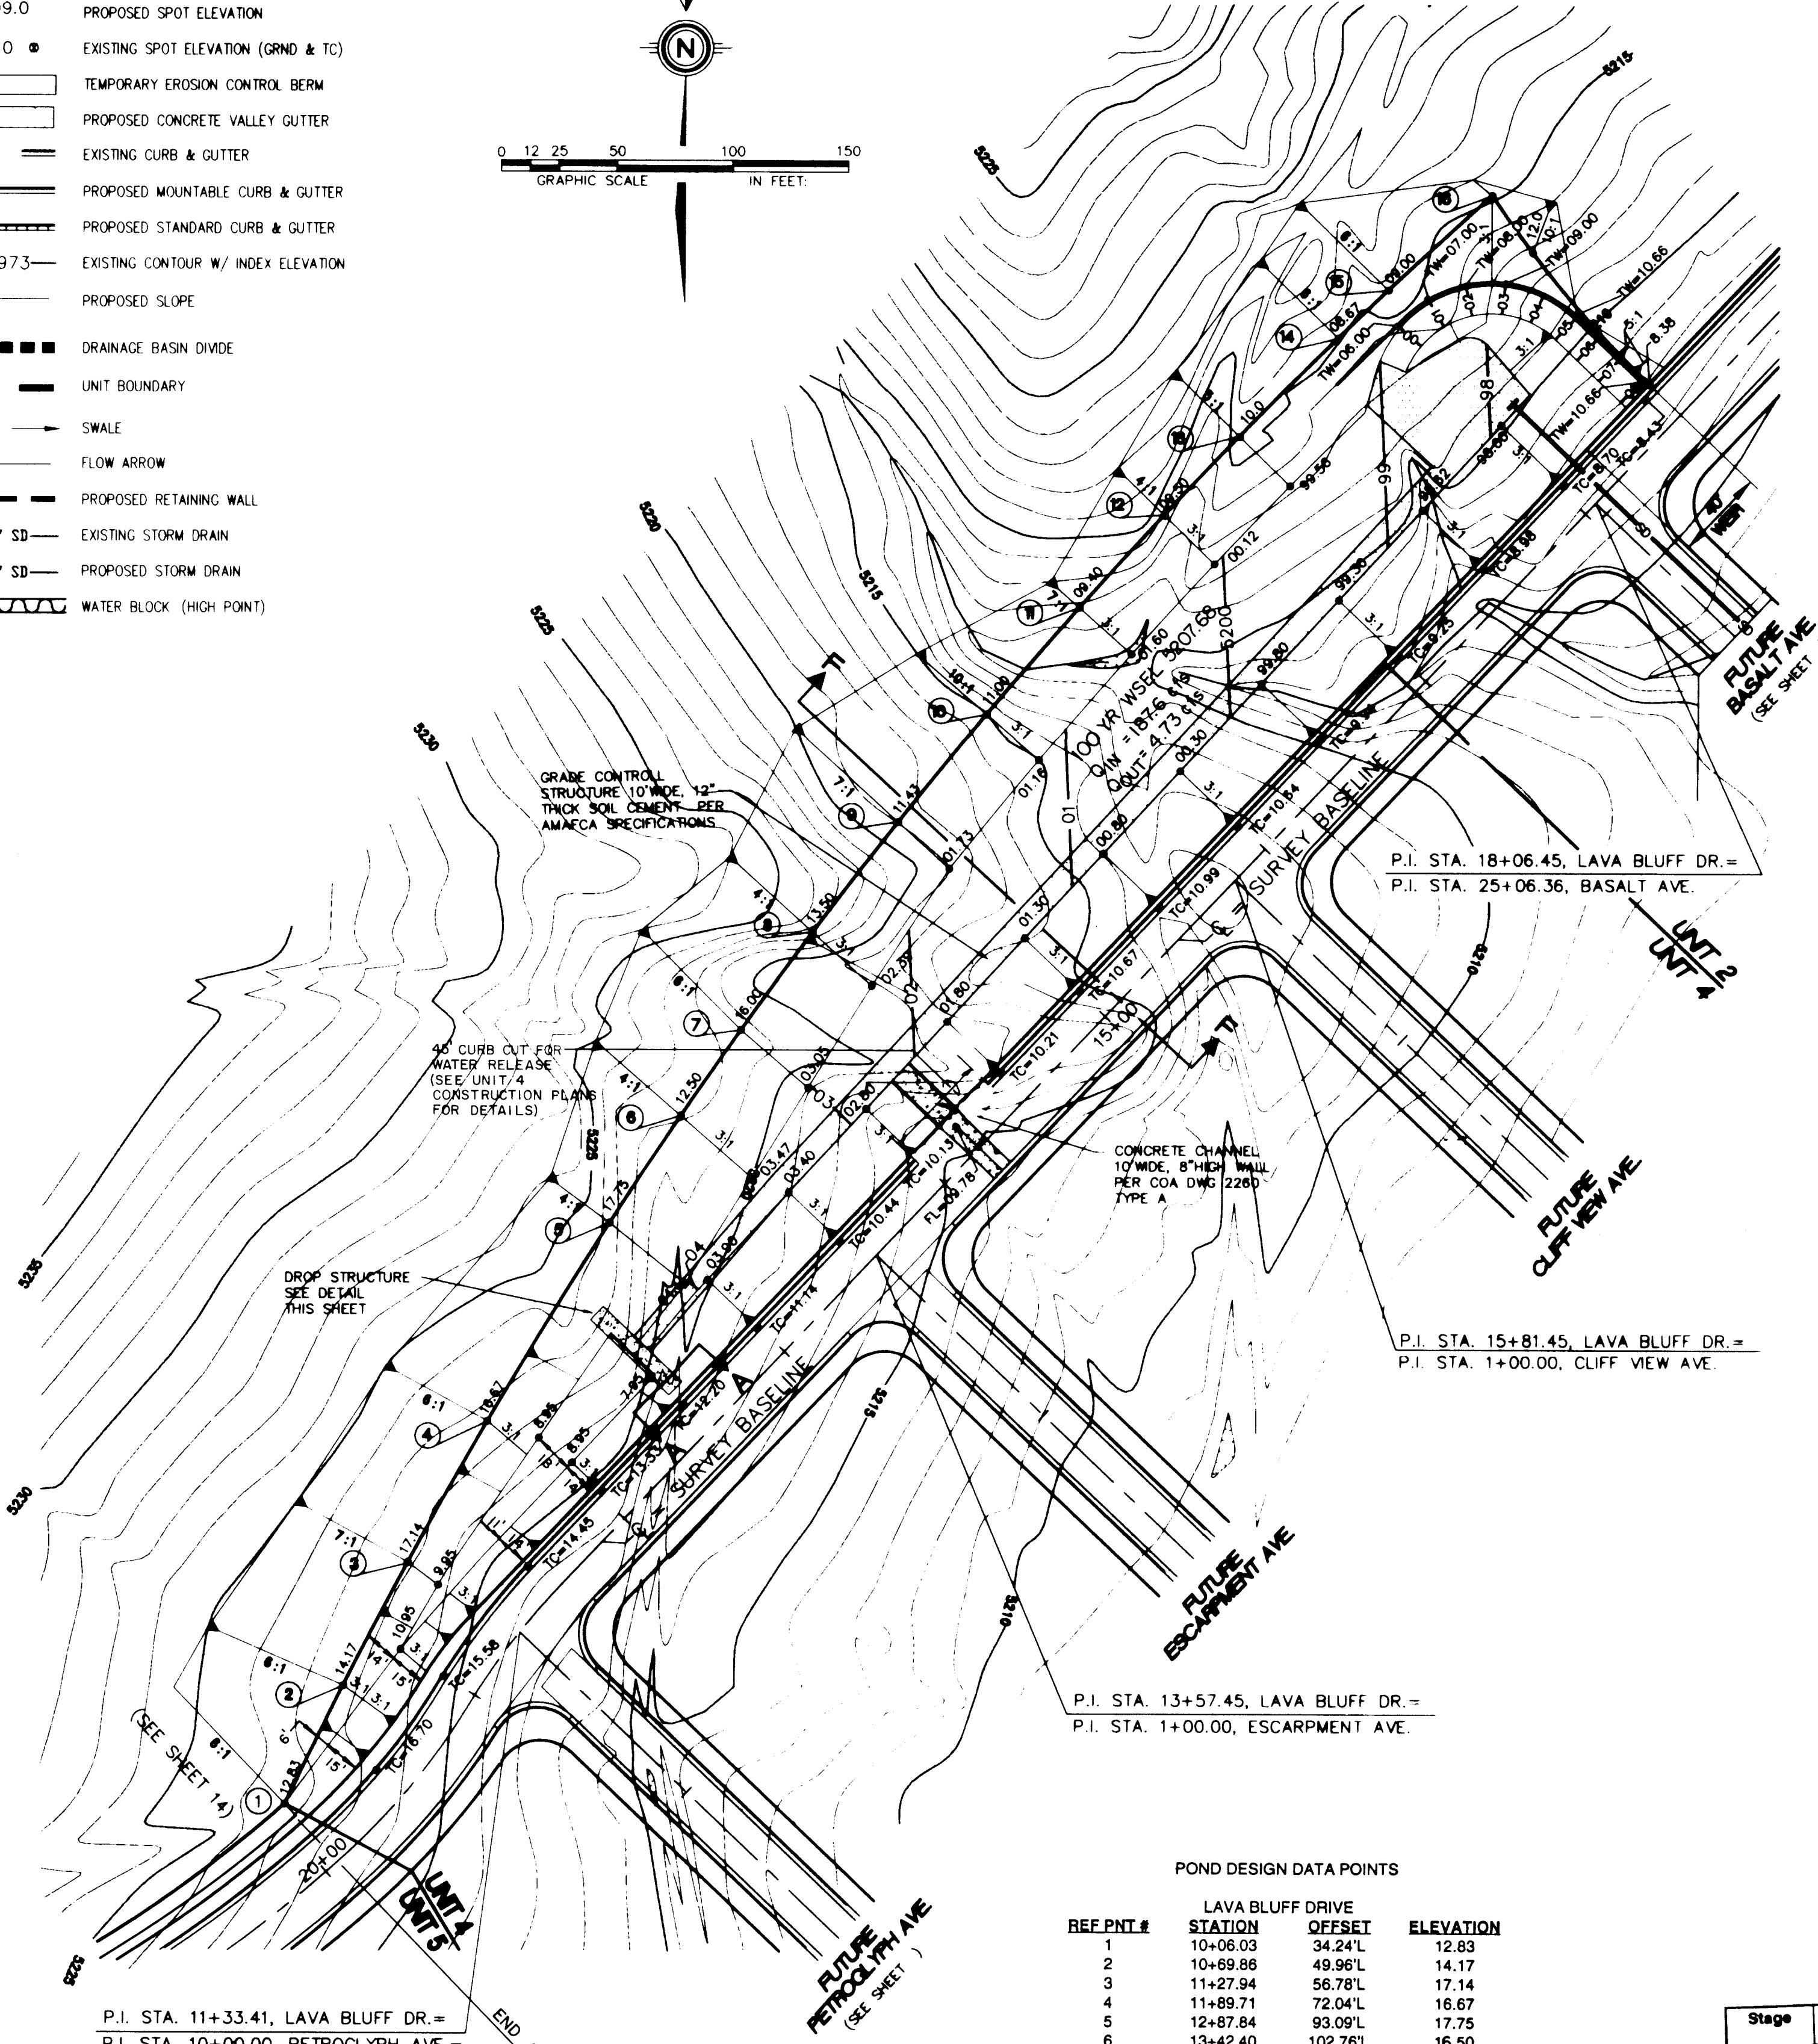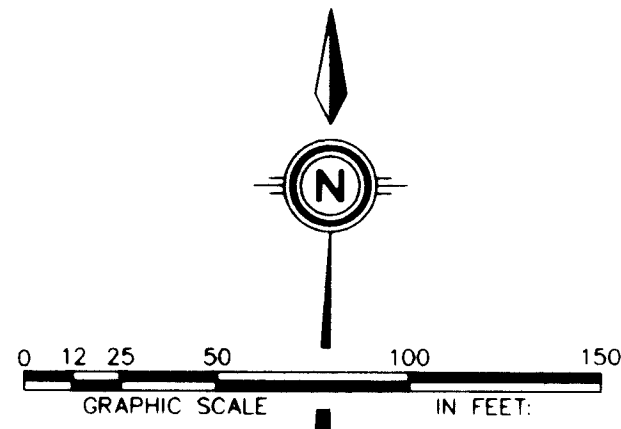

AHYMO Reservoir Routing
W/Max Sediment Loading

*S Route Hydrograph Thru Parkwest Pond
Route Reservoir ID=12 HYD NO=133.50 INFLOW ID=11
CODE=5

OUTFLOW (CFS)	SOTRAGE (AC FT)	ELEV (FT)
0.0	0.00	5201.60
0.9	0.11	5201.84
1.4	0.25	5202.10
1.9	0.53	5202.60
2.4	0.83	5203.10
3.1	1.16	5203.60
3.4	1.51	5204.10
3.6	1.89	5204.60
3.9	2.29	5205.10
4.1	2.72	5205.60
4.3	3.17	5206.10
4.5	3.65	5206.60
4.7	4.14	5207.10
4.9	4.66	5207.60
5.1	5.20	5208.10
5.1	5.58	5208.43

Peak Discharge= 4.732 - Peak Occurs at Hour 2.45
Maximum Water Surface Elevation= 5207.680
Maximum Storage= 4.7466 AC FT
Incremental Time = .050000hrs

RESERVOIR OUTLET
MODELING BY POND2

Structure No. 1
(Input Data)

INLET BOX
Weir & Orifice defined by length and area

E1 elev.(ft)?	201.6
E2 elev.(ft)?	208.45
Invert elev.(ft)?	201.6
Weir length (ft)?	2.438
Orifice area (sq.ft)?	.371
Orifice coefficient?	.65
Start transition elev. (ft) @ ?	201.84
Transition height (ft)?	.24

ELEVATION (ft)	OUTFLOW (cfs)	STORAGE (ac-ft)
200.80	0.0	0.41
201.60	0.0	0.72
201.84	0.9	0.83
202.10	1.4	0.97
202.60	1.9	1.25
203.10	2.4	1.55
203.60	2.7	1.88
204.10	3.1	2.23
204.60	3.4	2.61
205.10	3.6	3.01
205.60	3.9	3.44
206.10	4.1	3.89
206.60	4.3	4.37
207.10	4.5	4.86
207.60	4.7	5.38
208.10	4.9	5.92
208.43	5.1	6.30
208.43	5.1	6.30




Peak Inflow = 187.6 cfs
Peak Outflow = 4.6 cfs
Peak Elevation = 207.40 ft

RESERVOIR VOLUME

Pond Bottom el = 5198.00
Emergency Overflow el 5208.43

Stage	V (ac-ft)	*Sediment V (ac-ft)	**Clear Water V (ac-ft)
0.0	0.0	0.0	0.0
2.0	0.19	0.19	0.0
3.6	0.72	0.72	0.0
4.0	0.92	0.72	0.20
6.0	2.16	0.72	1.44
8.0	3.80	0.72	3.08
10.0	5.81	0.72	5.09
10.43	6.30	0.72	5.58
11.0	6.99	0.72	6.27

* Max Sediment at el. 5201.6 = .072 ac-ft
** With Max sediment Load

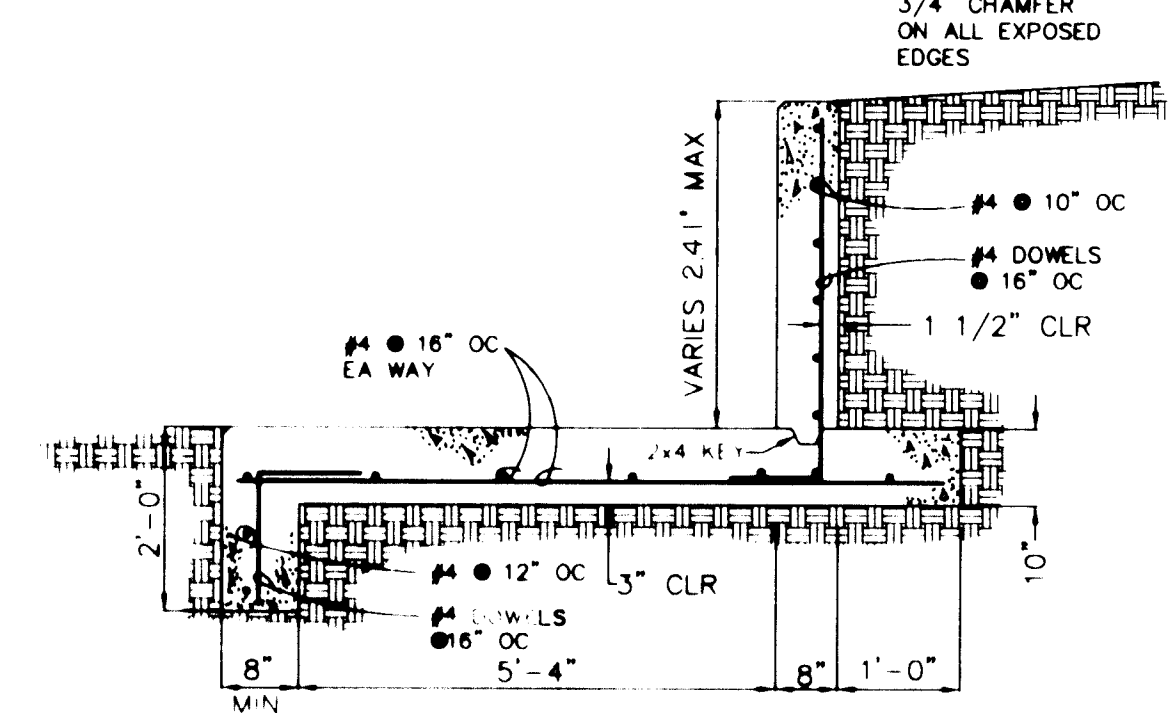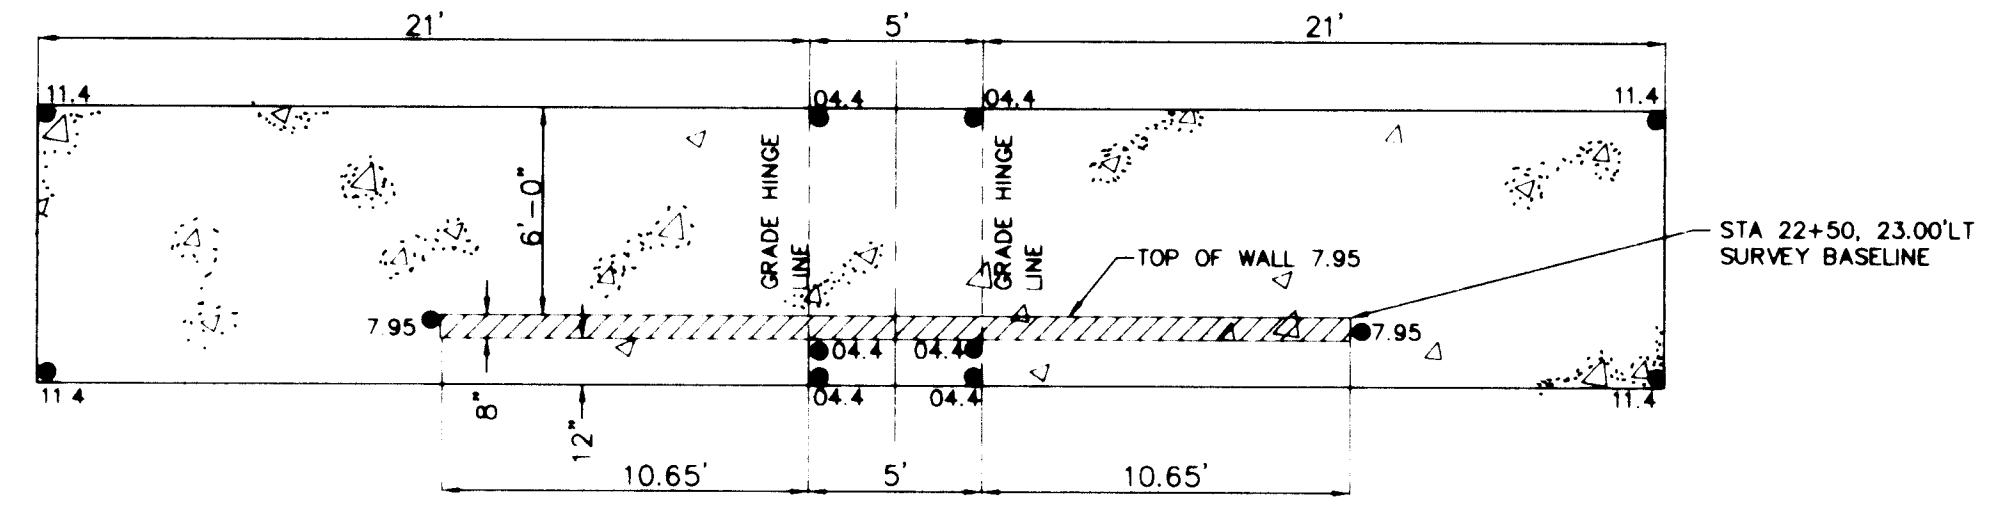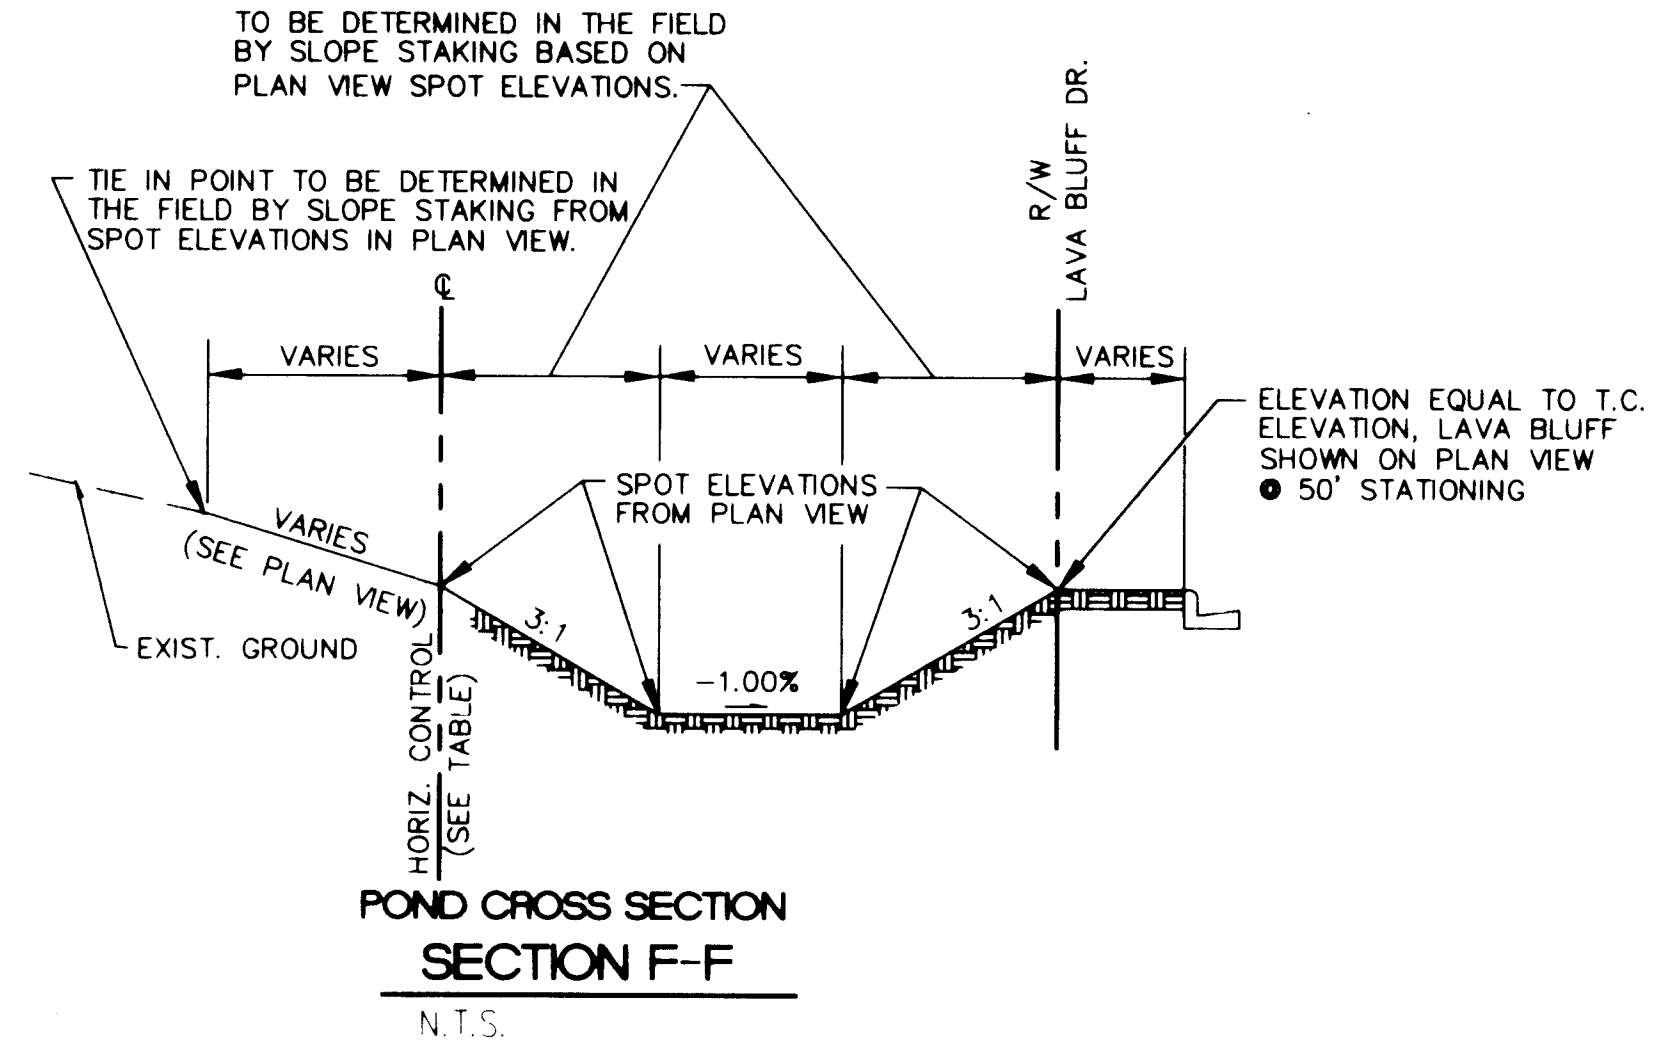


DROP STRUCTURE
SECTION A-A


APPROVED FOR ROUGH GRADING
(± 1 FT.)

CITY HYDROLOGY

JUNE, 1995		community sciences corporation	
AS SHOWN		CITY OF ALBUQUERQUE PUBLIC WORKS DEPARTMENT ENGINEERING GROUP	
TITLE: PARKWEST- UNIT 5 GRADING AND EROSION CONTROL PLAN POND AND POND DETAILS			
APPROVALS	ENGINEER	DATE	APPROVALS
DRC CHAIRMAN	WATER	7-28-95	ENGINEER
TRANSPORTATION	WASTE WATER	7-28-95	DATE
HYDROLOGY	A.M.A.F.C.A.	7-19-95	DATE
PARKS & REC.			DATE
PROJECT NO.	4886.94	MAP NO.	G, H9
SHEET		15 OF 39	

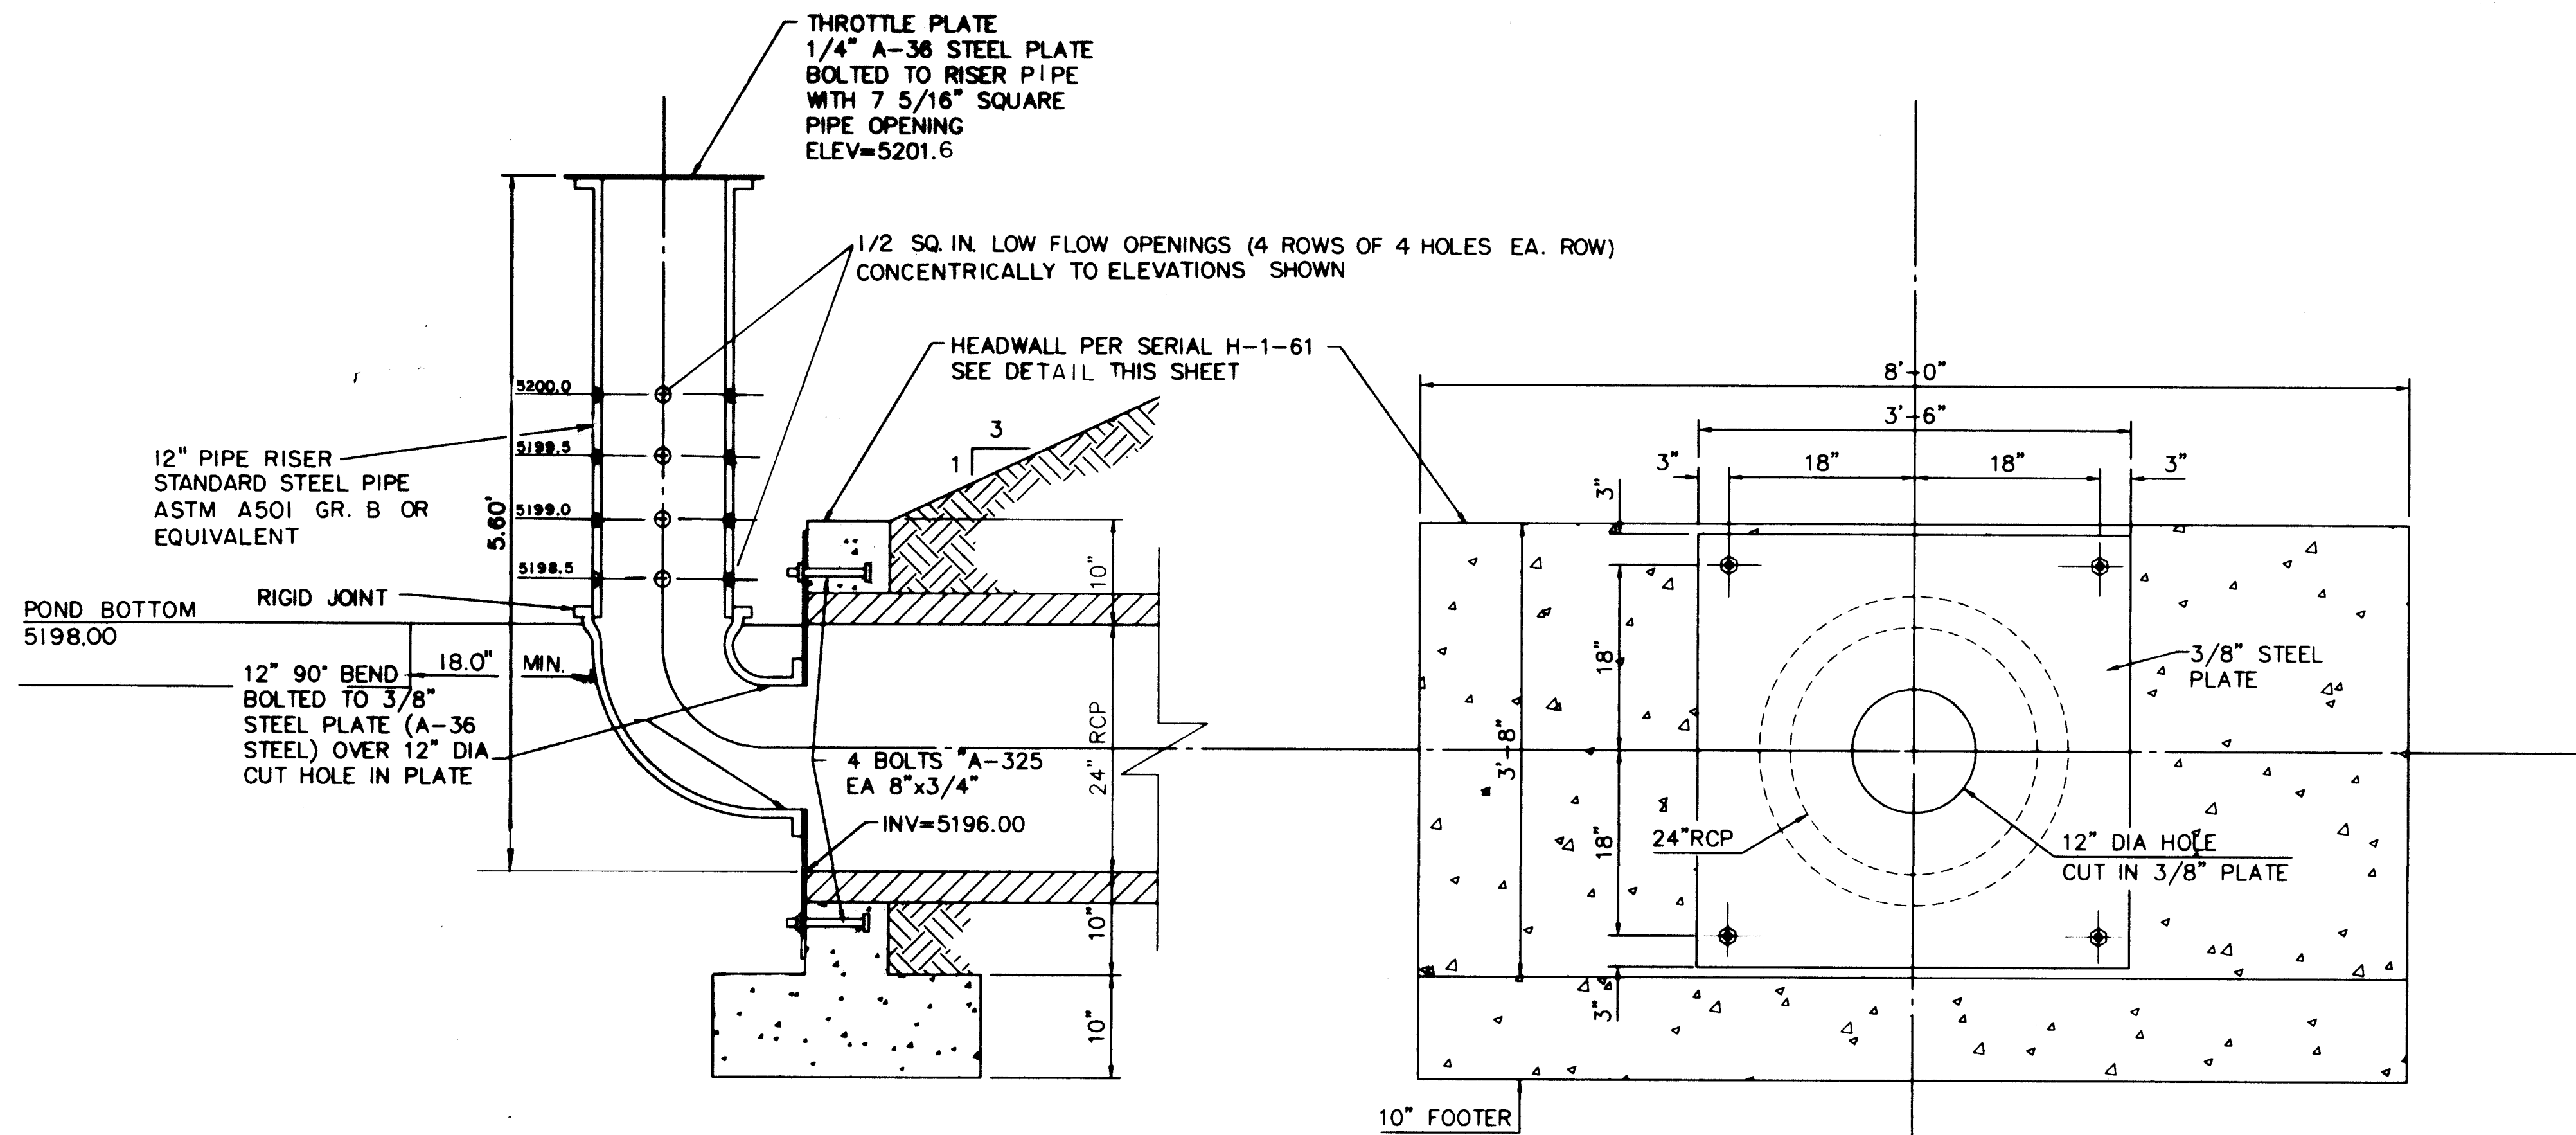

NOTE: ALL EXPOSED METAL TO BE HOT DIP GALVANIZED
POND OUTFALL CONTROL STRUCTURE DETAILS
 NTS

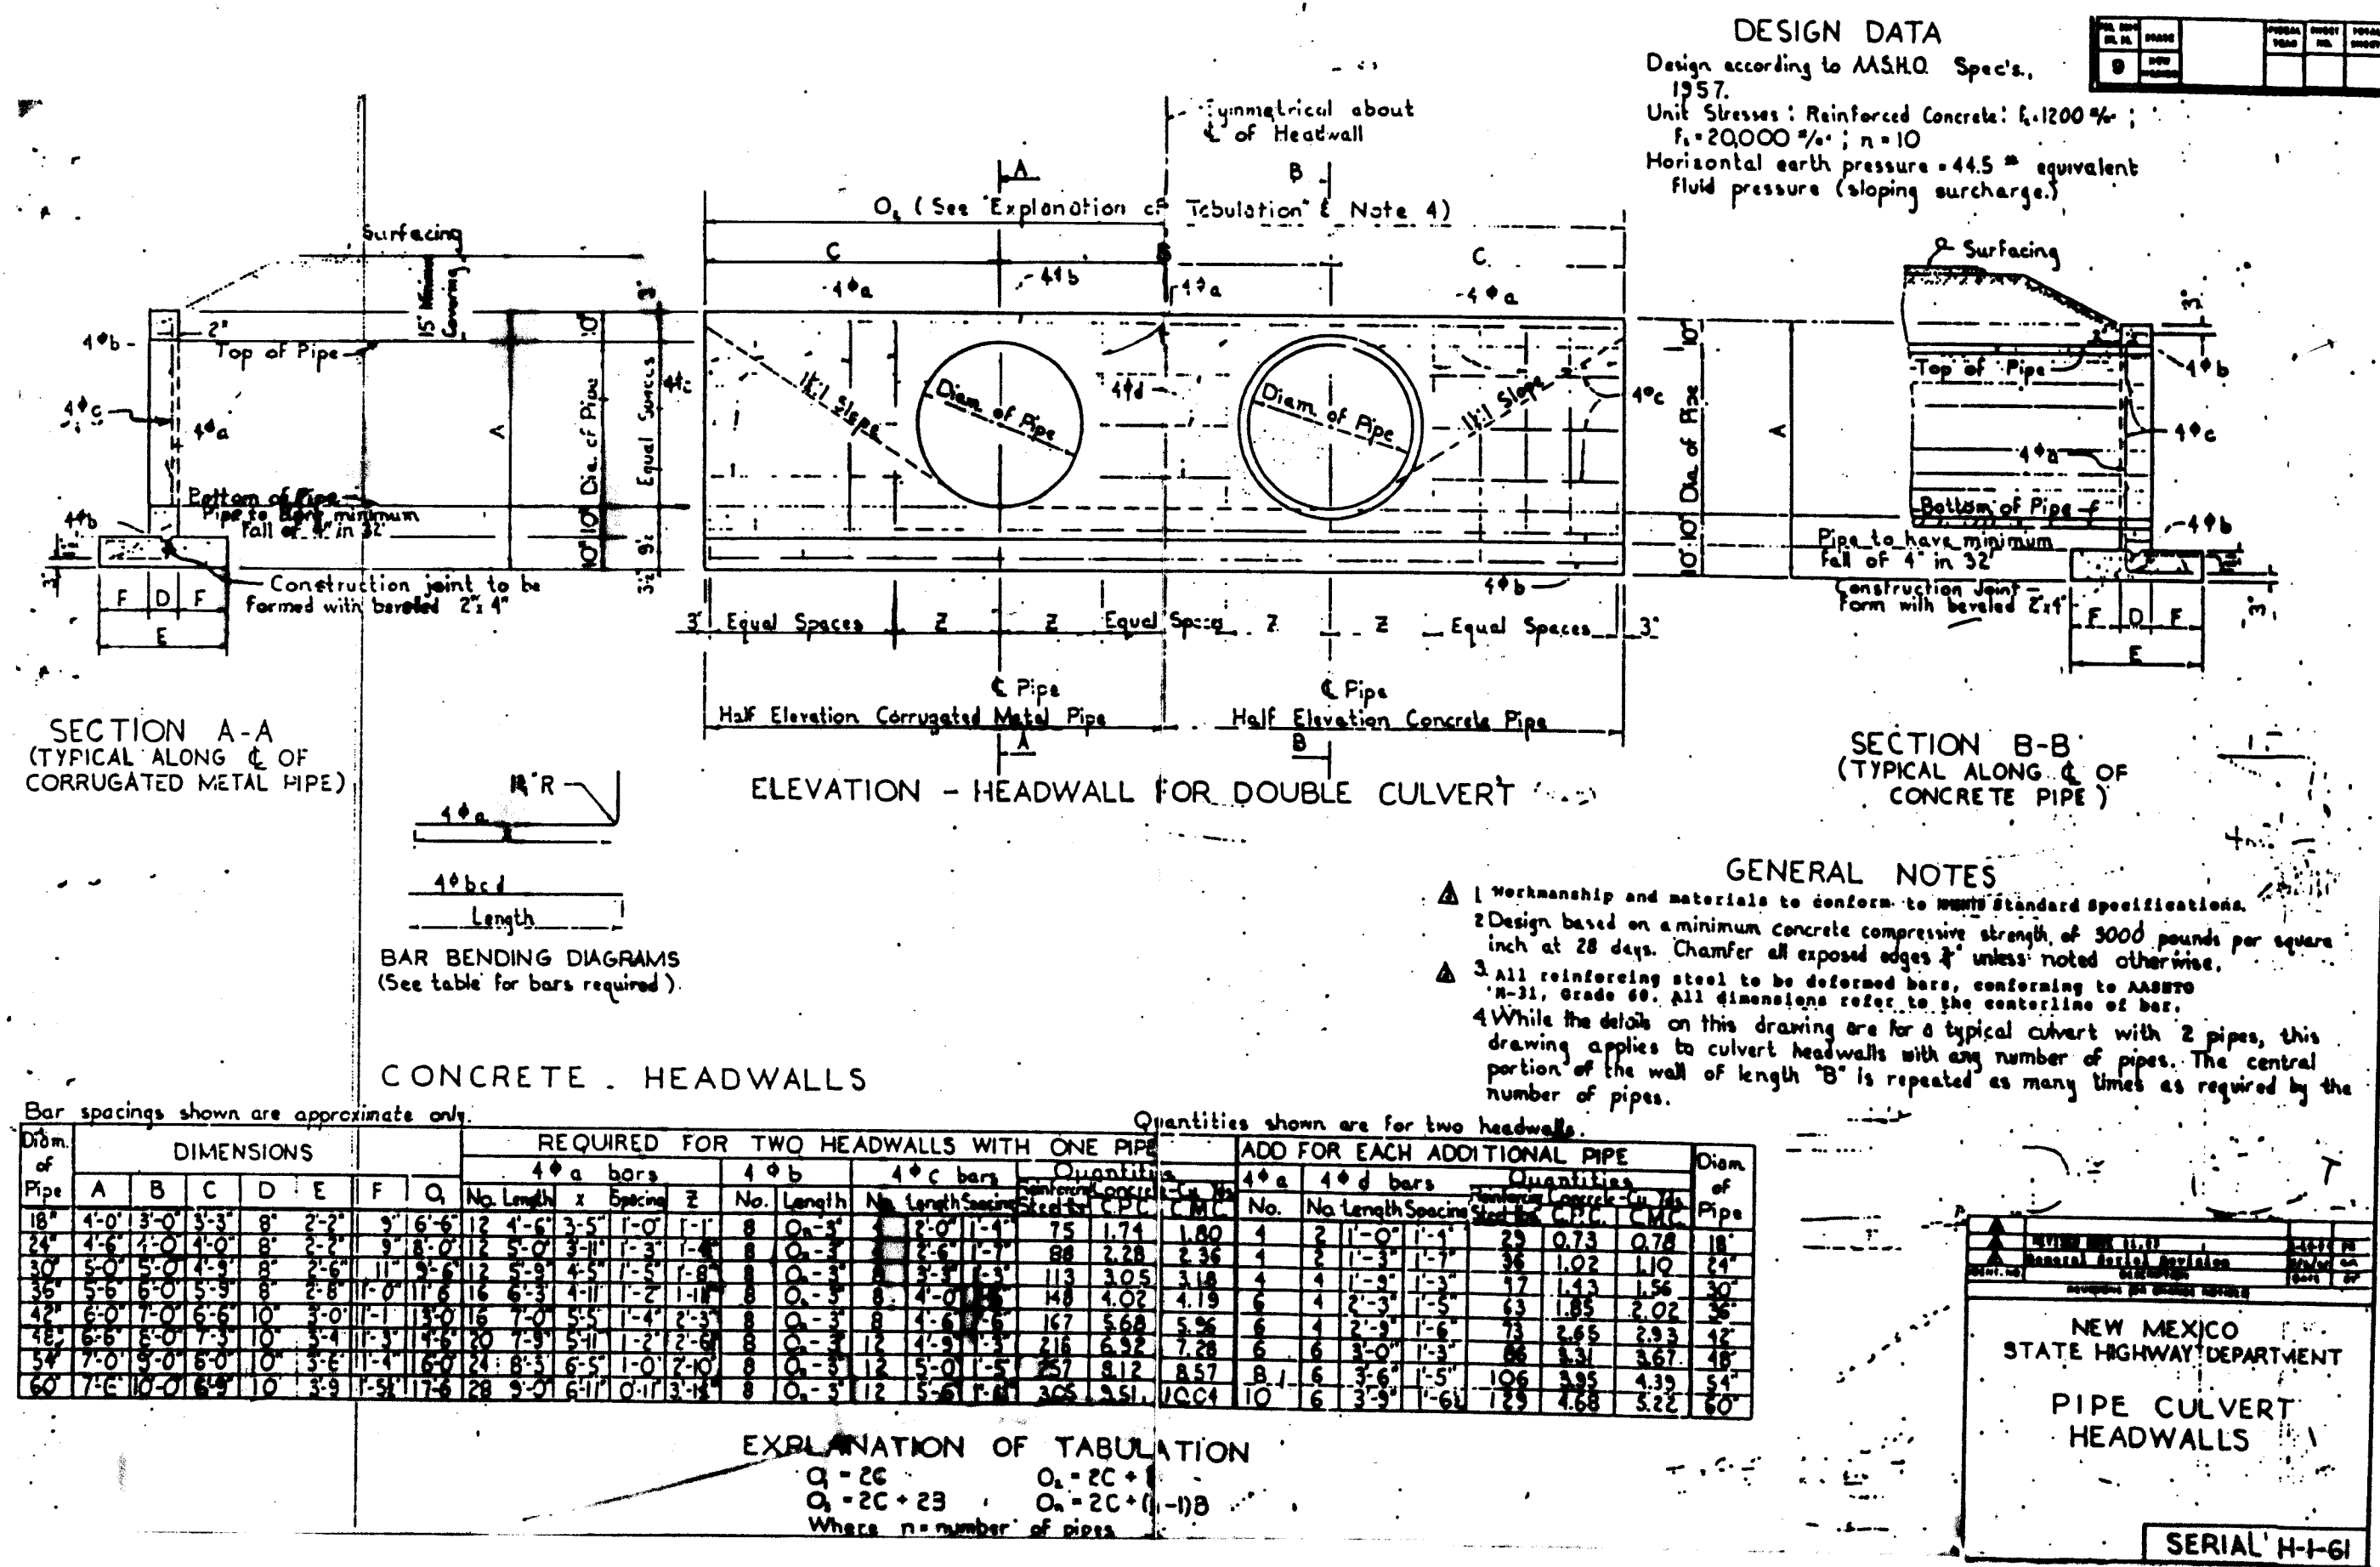

DATE JUNE 1995
 SCALE AS SHOWN
 DESIGNED SMB
 DRAWN BY K.C.D.
 CHECKED BY R.A.C.
 PROJECT NO. 4886.94
 MAP NO. G, H9
 SHEET 16 OF 39

community sciences corporation


CITY OF ALBUQUERQUE
PUBLIC WORKS DEPARTMENT
ENGINEERING GROUP

TITLE: PARKWEST UNIT 5
GRADING AND EROSION CONTROL PLAN
DRAINAGE STRUCTURE DETAILS


APPROVALS	ENGINEER	DATE	APPROVALS	ENGINEER	DATE
DRC CHAIRMAN			WATER		
TRANSPORTATION	N/A RHP	7-28-95	WASTE WATER		
HYDROLOGY	W. H. HARTON	9-19-95	A.M.A.F.C.A.		

DESIGNED BY K.C.D. DATE MARCH 1995
 DRAWN BY R.A.C. DATE MARCH 1995
 CHECKED BY DATE

CONTRACTOR		BENCH MARKS		SURVEY INFORMATION	
NO.	DATE	NO.	DATE	NO.	DATE
1	COMMUNITY SCIENCES	1	COMMUNITY SCIENCES	1	COMMUNITY SCIENCES
MICRO-FILM INFORMATION		MICRO-FILM INFORMATION		MICRO-FILM INFORMATION	
NO.	DATE	NO.	DATE	NO.	DATE
1	COMMUNITY SCIENCES	1	COMMUNITY SCIENCES	1	COMMUNITY SCIENCES

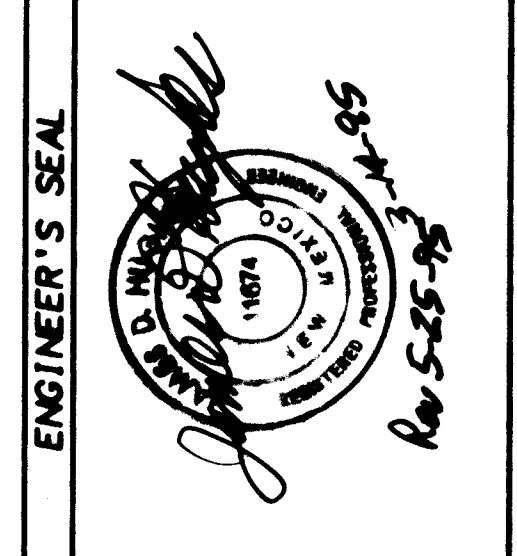

SCANNED BY
 BY LASON

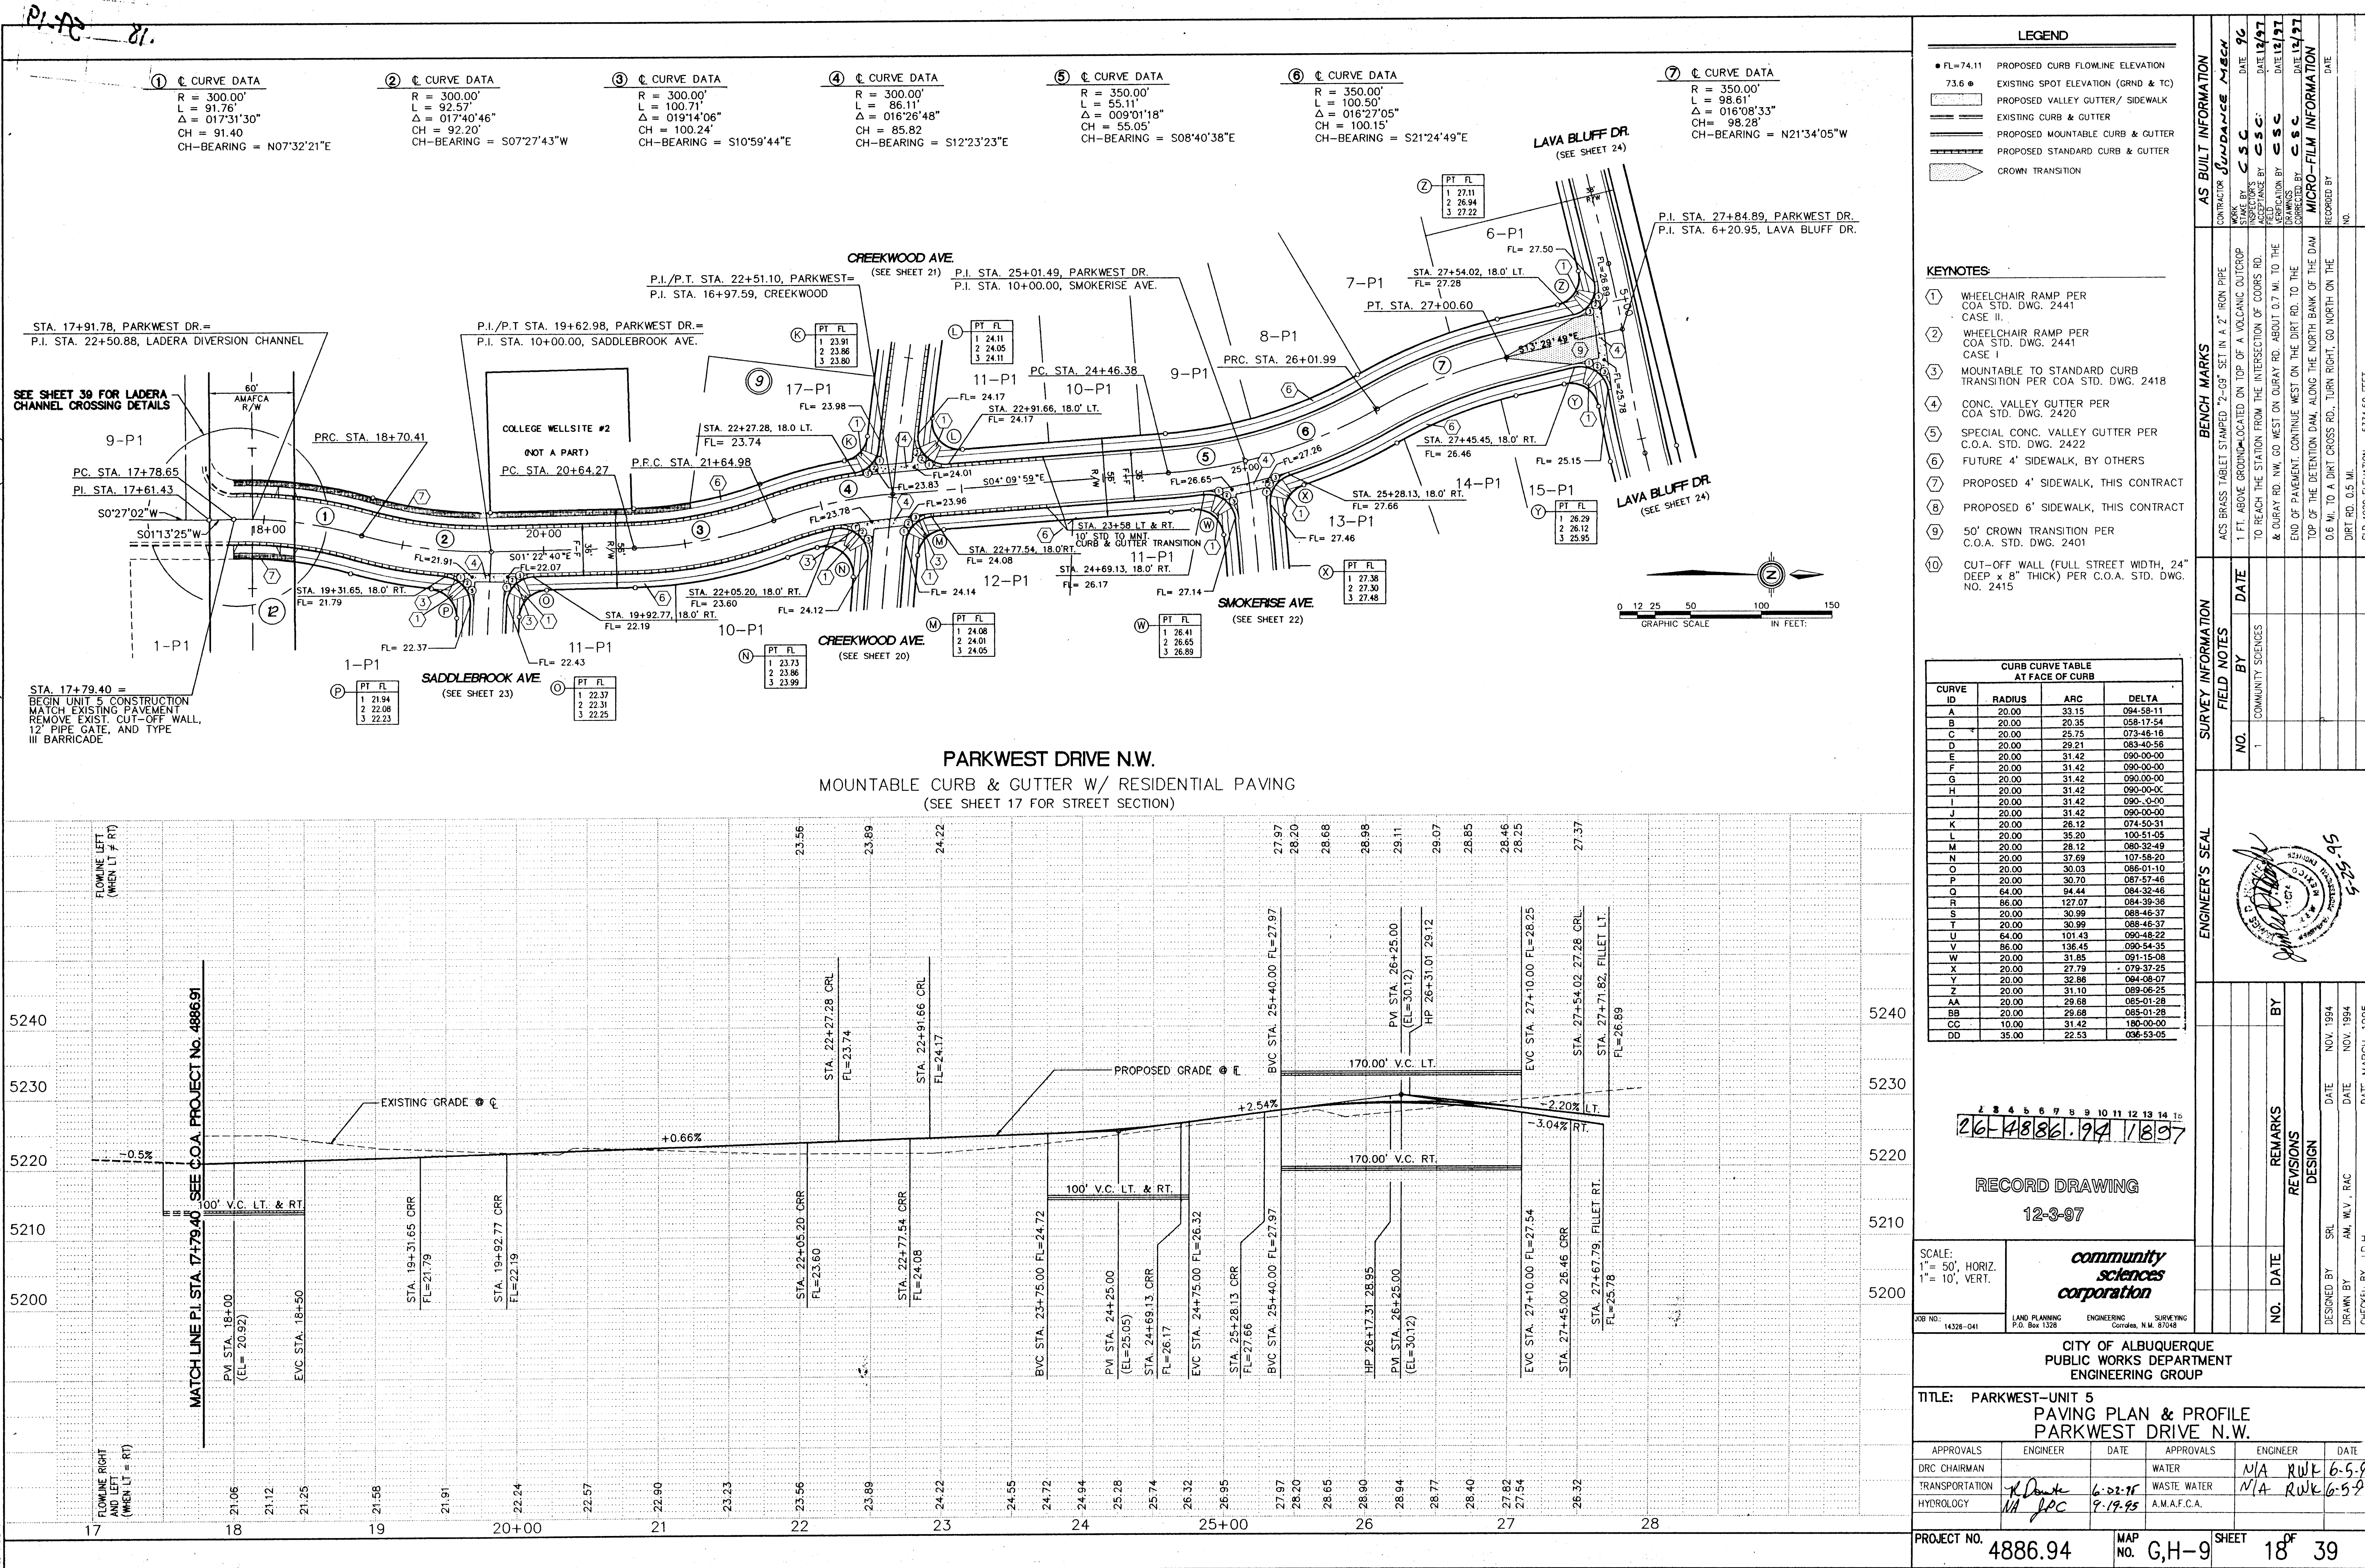

LEGEND

- FL=74.11 PROPOSED CURB FLOWLINE ELEVATION
- 73.6 EXISTING SPOT ELEVATION (GRND & TC)
- PROPOSED VALLEY GUTTER/ SIDEWALK
- EXISTING CURB & GUTTER
- PROPOSED MOUNTABLE CURB & GUTTER
- PROPOSED STANDARD CURB & GUTTER
- CROWN TRANSITION

KEYNOTES

- WHEELCHAIR RAMP PER COA STD. DWG. 2441 CASE II
- WHEELCHAIR RAMP PER COA STD. DWG. 2441 CASE I
- MOUNTABLE TO STANDARD CURB TRANSITION PER COA STD. DWG. 2418
- CONC. VALLEY GUTTER PER COA STD. DWG. 2420
- SPECIAL CONC. VALLEY GUTTER PER COA STD. DWG. 2422
- FUTURE 4' SIDEWALK, BY OTHERS
- PROPOSED 4' SIDEWALK, THIS CONTRACT
- PROPOSED 6' SIDEWALK, THIS CONTRACT
- 50' CROWN TRANSITION PER COA STD. DWG. 2401
- CUT-OFF WALL (FULL STREET WIDTH, 24" DEEP x 8" THICK) PER COA STD. DWG. NO. 2415

CURB CURVE TABLE AT FACE OF CURB

CURVE ID	RADIUS	ARC	DELTA
A	20.00	33.15	894-58-11
B	20.00	20.35	558-17-54
C	20.00	25.75	073-46-18
D	20.00	29.21	083-40-58
E	20.00	31.42	090-00-00
F	20.00	31.42	090-00-00
G	20.00	31.42	090-00-00
H	20.00	31.42	090-00-00
I	20.00	31.42	090-00-00
J	20.00	31.42	090-00-00
K	20.00	28.12	074-50-31
L	20.00	35.20	100-51-05
M	20.00	28.12	080-32-49
N	20.00	37.69	107-58-20
O	20.00	30.03	085-01-10
P	20.00	30.70	087-57-48
Q	64.00	94.44	084-32-46
R	86.00	127.07	084-39-38
S	20.00	30.99	088-46-37
T	20.00	30.99	088-46-37
U	64.00	101.43	090-45-22
V	86.00	136.45	090-54-35
W	20.00	31.85	091-15-08
X	20.00	27.79	079-37-25
Y	20.00	32.88	084-08-07
Z	20.00	31.10	089-06-25
AA	20.00	29.68	085-01-28
BB	20.00	29.68	085-01-28
CC	10.00	31.42	180-00-00
DD	35.00	22.53	036-53-05

RECORD DRAWING

12-3-97

SCALE: 1" = 50', HORIZ. 1" = 10', VERT.

community sciences corporation

JOB NO. 14328-041 LAND PLANNING P.O. Box 1328 ENGINEERING Corrales, N.M. 87048 SURVEYING

CITY OF ALBUQUERQUE PUBLIC WORKS DEPARTMENT ENGINEERING GROUP

TITLE: PARKWEST-UNIT 5 PAVING PLAN & PROFILE PARKWEST DRIVE N.W.

APPROVALS	ENGINEER	DATE	APPROVALS	ENGINEER	DATE
DRC CHAIRMAN			WATER	N/A	RWK 6-5-99
TRANSPORTATION	K. D. D.	6-22-97	WASTE WATER	N/A	RWK 6-5-99
HYDROLOGY	J. P. C.	9-19-95	A.M.A.F.C.A.		

PROJECT NO. 4886.94 MAP NO. G,H-9 SHEET 18 OF 39

AS BUILT INFORMATION

CONTRACTOR: J. D. D. DATE: 9/96

BENCH MARKS

ACS BRASS TABLE STAMPED "2-C9" SET IN A 2" IRON PIPE 1 FT. ABOVE GROUND LOCATED ON TOP OF A VOLCANIC OUTCROP TO REACH THE STATION FROM THE INTERSECTION OF CORRS RD. & DUNAY RD. NW. GO WEST ON DUNAY RD. ABOUT 0.7 MI. TO THE END OF PAVEMENT. CONTINUE WEST ON THE DIRT RD. TO THE TOP OF THE DETENTION DAM. ALONG THE NORTH BANK OF THE DAM 0.6 MI. TO A DIRT CROSS RD. TURN RIGHT, GO NORTH ON THE DIRT RD. 0.5 MI. S.D. 1929 ELEVATION = 5334.50 FEET




SURVEY INFORMATION

FIELD NOTES

NO.	DATE	BY
1	COMMUNITY SCIENCES	

ENGINEER'S SEAL

DESIGNED BY: SRL DATE: NOV. 1994
DRAWN BY: AM, W.V., RAC DATE: NOV. 1994
CHECKED BY: J.C.H. DATE: MARCH, 1996

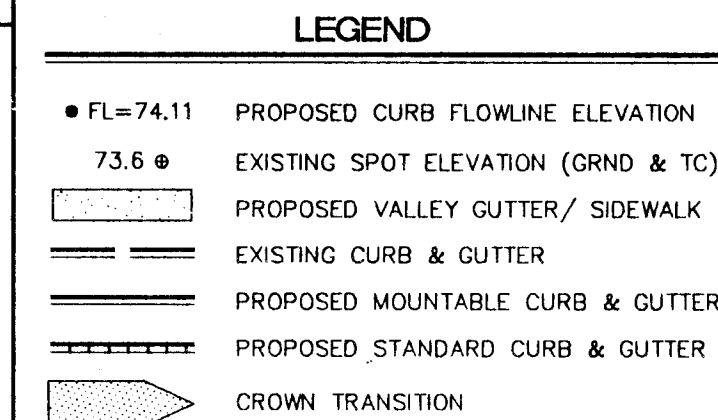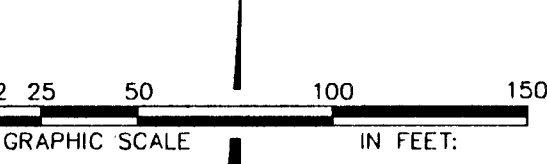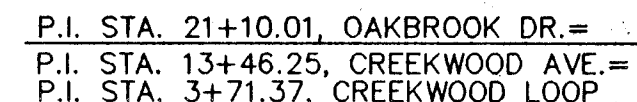

KEYNOTES:

- ① WHEELCHAIR RAMP PER
COA STD. DWG. 2441
CASE II.
- ② WHEELCHAIR RAMP PER
COA STD. DWG. 2441
CASE I
- ③ MOUNTABLE TO STANDARD CURB
TRANSITION PER COA STD. DWG. 2418
- ④ CONC. VALLEY GUTTER PER
COA STD. DWG. 2420
- ⑤ SPECIAL CONC. VALLEY GUTTER PER
C.O.A. STD. DWG. 2422
- ⑥ FUTURE 4' SIDEWALK, BY OTHERS
- ⑦ PROPOSED 4' SIDEWALK, THIS CONTRACT
- ⑧ PROPOSED 6' SIDEWALK, THIS CONTRACT
- ⑨ 50' CROWN TRANSITION PER
C.O.A. STD. DWG. 2401
- ⑩ CUT-OFF WALL (FULL STREET WIDTH, 24"
DEEP x 8" THICK) PER C.O.A. STD. DWG.
NO. 2415

CURB CURVE TABLE AT FACE OF CURB			
CURB CURVE ID	RADIUS	ARC	DELTA
A	20.00	33.15	094-58-11
B	20.00	20.35	058-17-55
C	20.00	25.75	073-46-16
D	20.00	29.21	083-40-56
E	20.00	31.42	090-00-00
F	20.00	31.42	090-00-00
G	20.00	31.42	090-00-00
H	20.00	31.42	090-00-00
I	20.00	31.42	090-00-00
J	20.00	31.42	090-00-00
K	20.00	26.12	074-50-31
L	20.00	35.20	100-51-05
M	20.00	29.12	080-32-49
N	20.00	37.89	107-00-00
O	20.00	30.03	086-01-10
P	20.00	30.70	087-57-46
Q	64.00	94.44	084-32-46
R	86.00	127.07	084-39-36
S	20.00	30.99	088-46-37
T	20.00	30.99	088-46-37
U	64.00	101.43	090-48-22
V	20.00	136.45	090-55-55
W	20.00	31.85	091-15-08
X	20.00	27.79	079-37-25
Y	20.00	32.86	064-08-07
Z	20.00	31.10	089-06-25
AA	20.00	29.68	085-01-28
BB	20.00	29.68	085-01-28
CC	10.00	31.42	180-00-00
CD	35.00	22.53	093-53-05

	3	4	5	6	7	8	9	10	11	12	13	14	1
26	-	4	8	8	6	.	9	4			1	9	9

RECORD DRAWING
12-3-97

SCALE:
1" = 50', HORIZ
1" = 10', VERT.

*community
sciences
corporation*

JOB NO.:

LAND PLANNING
D. D. D. 130

ENGINEERING SURVEYING

CITY OF ALBUQUERQUE
PUBLIC WORKS DEPARTMENT
ENGINEERING GROUP

TITLE: PARKWEST-UNIT 5
PAVING PLAN & PROFILE
WESTBROOK, CASCADE PARK AND OAKBROOK

APPROVALS	ENGINEER	DATE	APPROVALS	ENGINEER	DATE
DRC CHAIRMAN			WATER	N/A RWK	6-5
TRANSPORTATION	<i>TKD</i>	6-02-95	WASTE WATER	N/A RWK	6-5
HYDROLOGY	N/A RPS	7-10-95	A.M.A.F.C.A.		

PROJECT NO.

4886.94



MAP

G.H-S

SHEE

19^{OF} 39

~~SCANNED BY~~
BY LASON

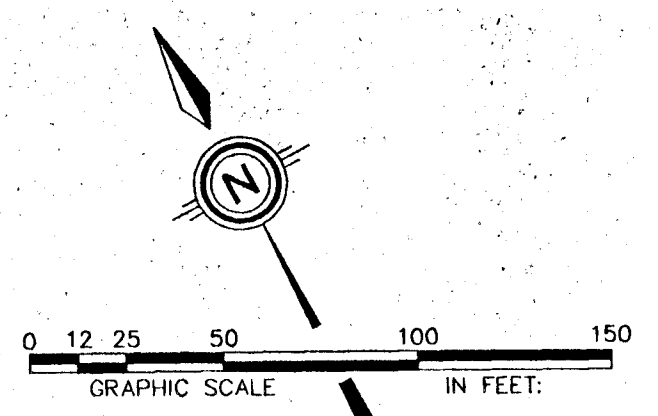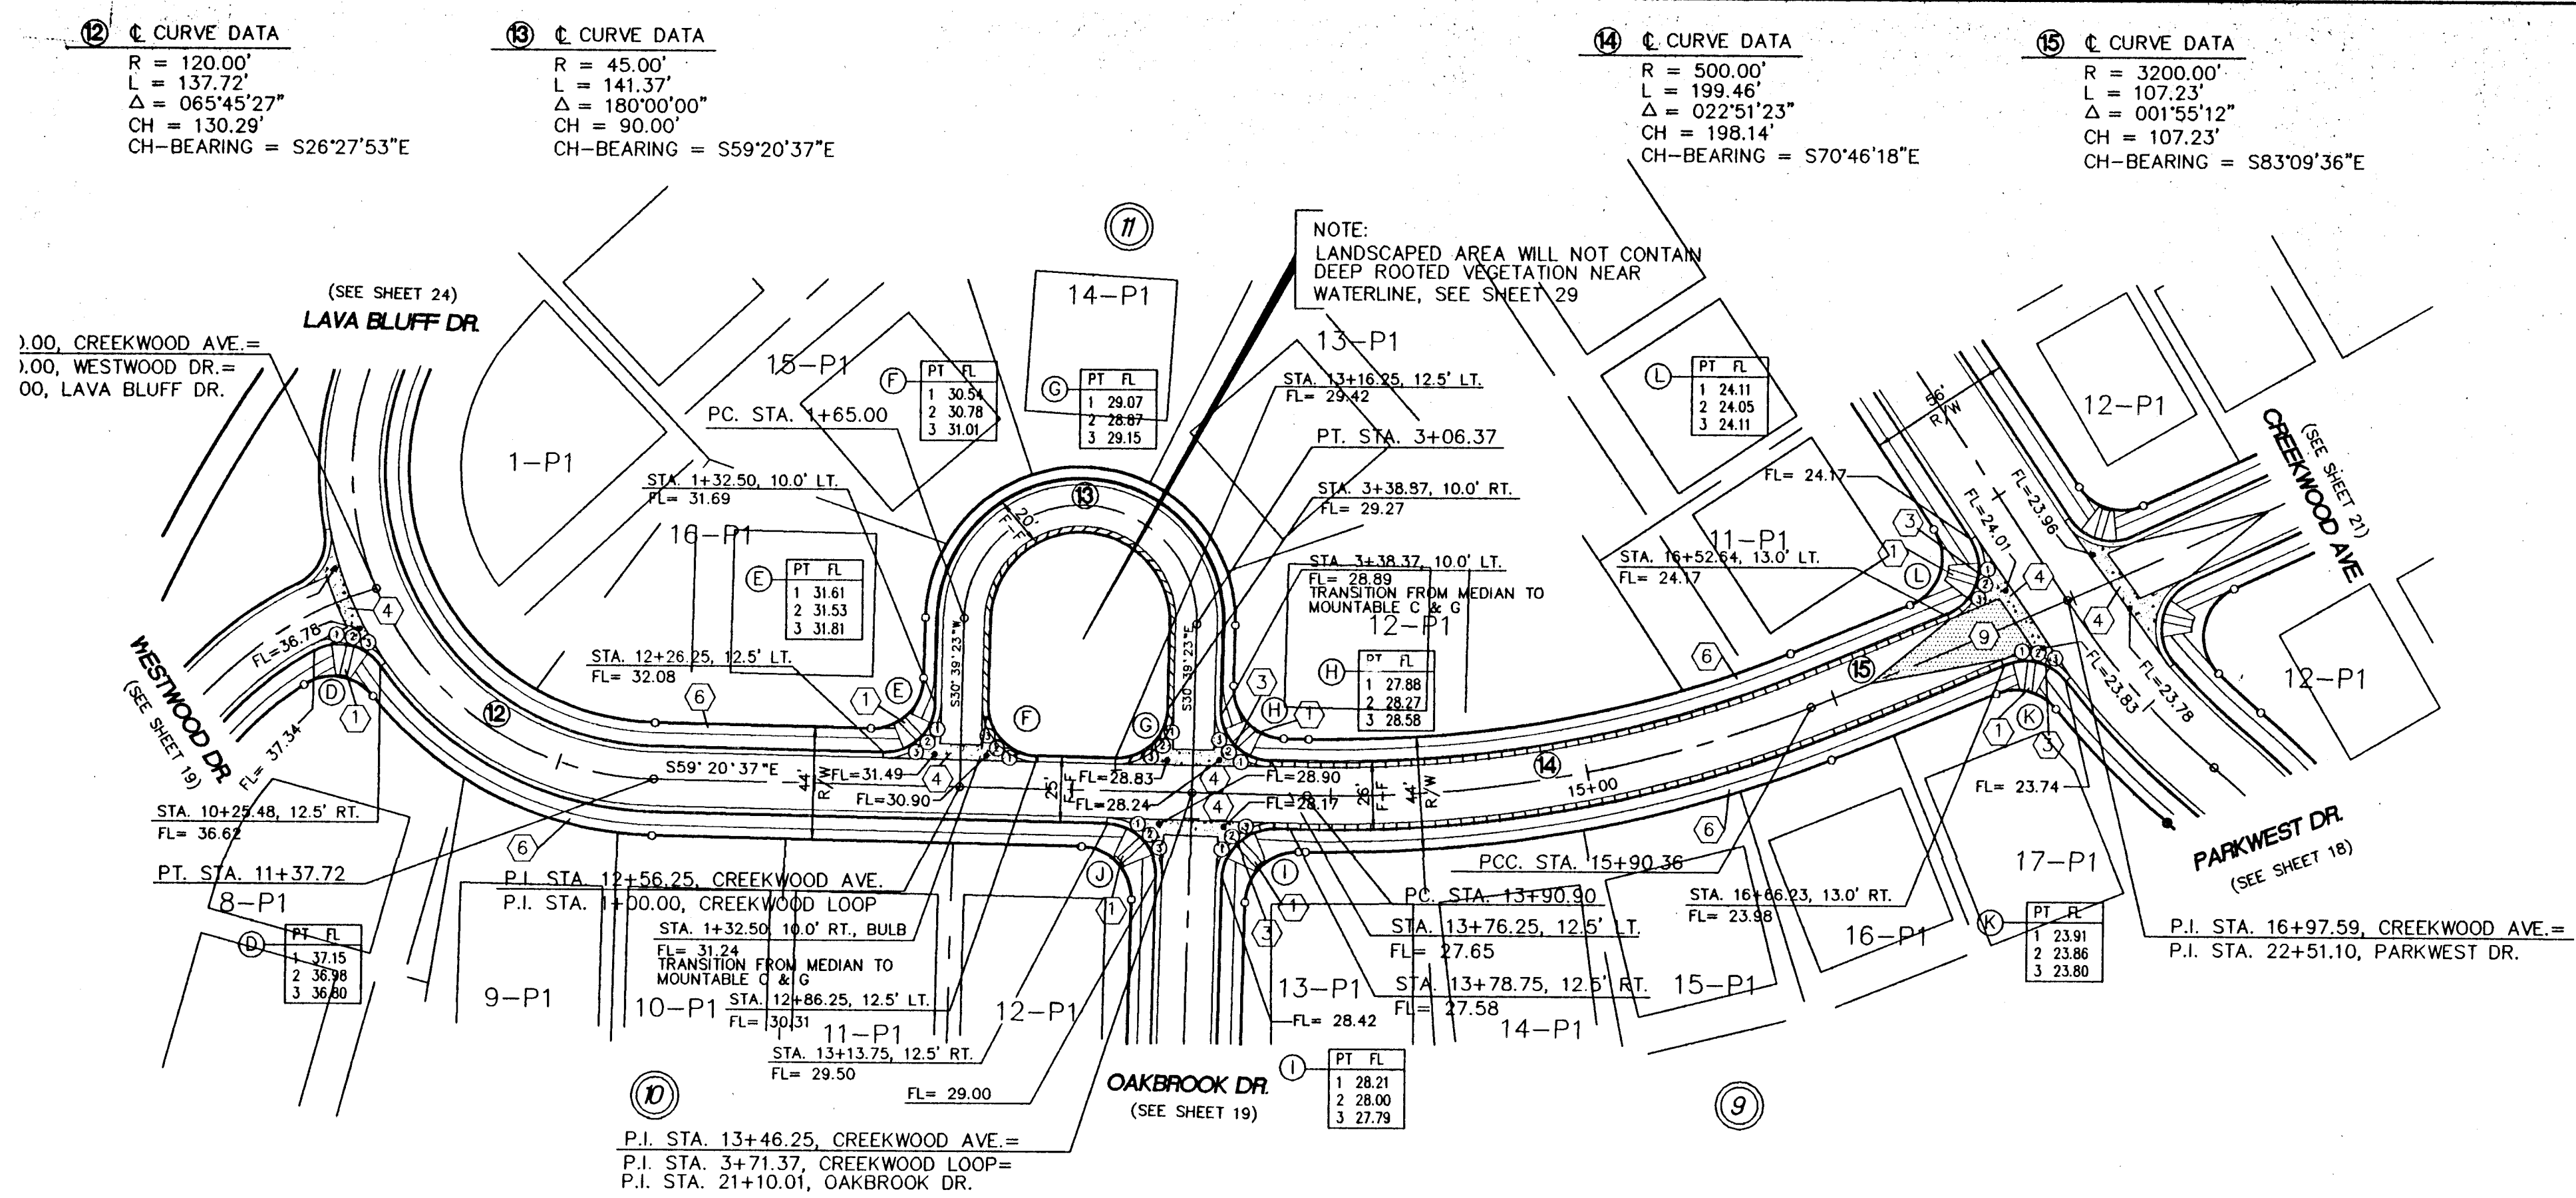


LEGEND

FL=74.11	PROPOSED CURB FLOWLINE ELEVATION
73.6	EXISTING SPOT ELEVATION (GRND & TC)
[Symbol]	PROPOSED VALLEY GUTTER/ SIDEWALK
[Symbol]	EXISTING CURB & GUTTER
[Symbol]	PROPOSED MOUNTABLE CURB & GUTTER
[Symbol]	PROPOSED STANDARD CURB & GUTTER
[Symbol]	CROWN TRANSITION
[Symbol]	PROPOSED MEDIAN CURB & GUTTER

- KEYNOTES**
- 1 WHEELCHAIR RAMP PER COA STD. DWG. 2441 CASE II
 - 2 WHEELCHAIR RAMP PER COA STD. DWG. 2441 CASE I
 - 3 MOUNTABLE TO STANDARD CURB TRANSITION PER COA STD. DWG. 2418
 - 4 CONC. VALLEY GUTTER PER COA STD. DWG. 2420
 - 5 SPECIAL CONC. VALLEY GUTTER PER C.O.A. STD. DWG. 2422
 - 6 FUTURE 4' SIDEWALK, BY OTHERS
 - 7 PROPOSED 4' SIDEWALK, THIS CONTRACT
 - 8 PROPOSED 6' SIDEWALK, THIS CONTRACT
 - 9 50' CROWN TRANSITION PER C.O.A. STD. DWG. 2401
 - 10 CUT-OFF WALL (FULL STREET WIDTH, 24" DEEP x 8" THICK) PER C.O.A. STD. DWG. NO. 2415

CURB CURVE TABLE AT FACE OF CURB

CURVE ID	RADIUS	ARC	DELTA
A	20.00	23.15	094-58-11
B	20.00	20.35	058-17-54
C	20.00	25.75	073-46-16
D	20.00	29.21	083-40-56
E	20.00	31.42	090-00-00
F	20.00	31.42	090-00-00
G	20.00	31.42	090-00-00
H	20.00	31.42	090-00-00
I	20.00	31.42	090-00-00
J	20.00	31.42	090-00-00
K	20.00	26.12	074-50-31
L	20.00	35.20	100-51-05
M	20.00	28.12	080-32-49
N	20.00	37.69	107-58-20
O	20.00	30.03	086-01-10
P	20.00	30.70	087-57-46
Q	64.00	94.44	084-32-48
R	86.00	127.07	084-39-36
S	20.00	30.99	088-46-37
T	20.00	30.99	088-46-37
U	64.00	101.43	090-48-22
V	86.00	136.45	090-54-35
W	20.00	31.85	091-15-08
X	20.00	27.79	079-37-25
Y	20.00	32.86	094-08-07
Z	20.00	31.10	089-06-25
AA	20.00	29.68	085-01-28
BB	20.00	29.68	085-01-28
CC	20.00	180-00-00	
DD	35.00	22.53	036-53-05

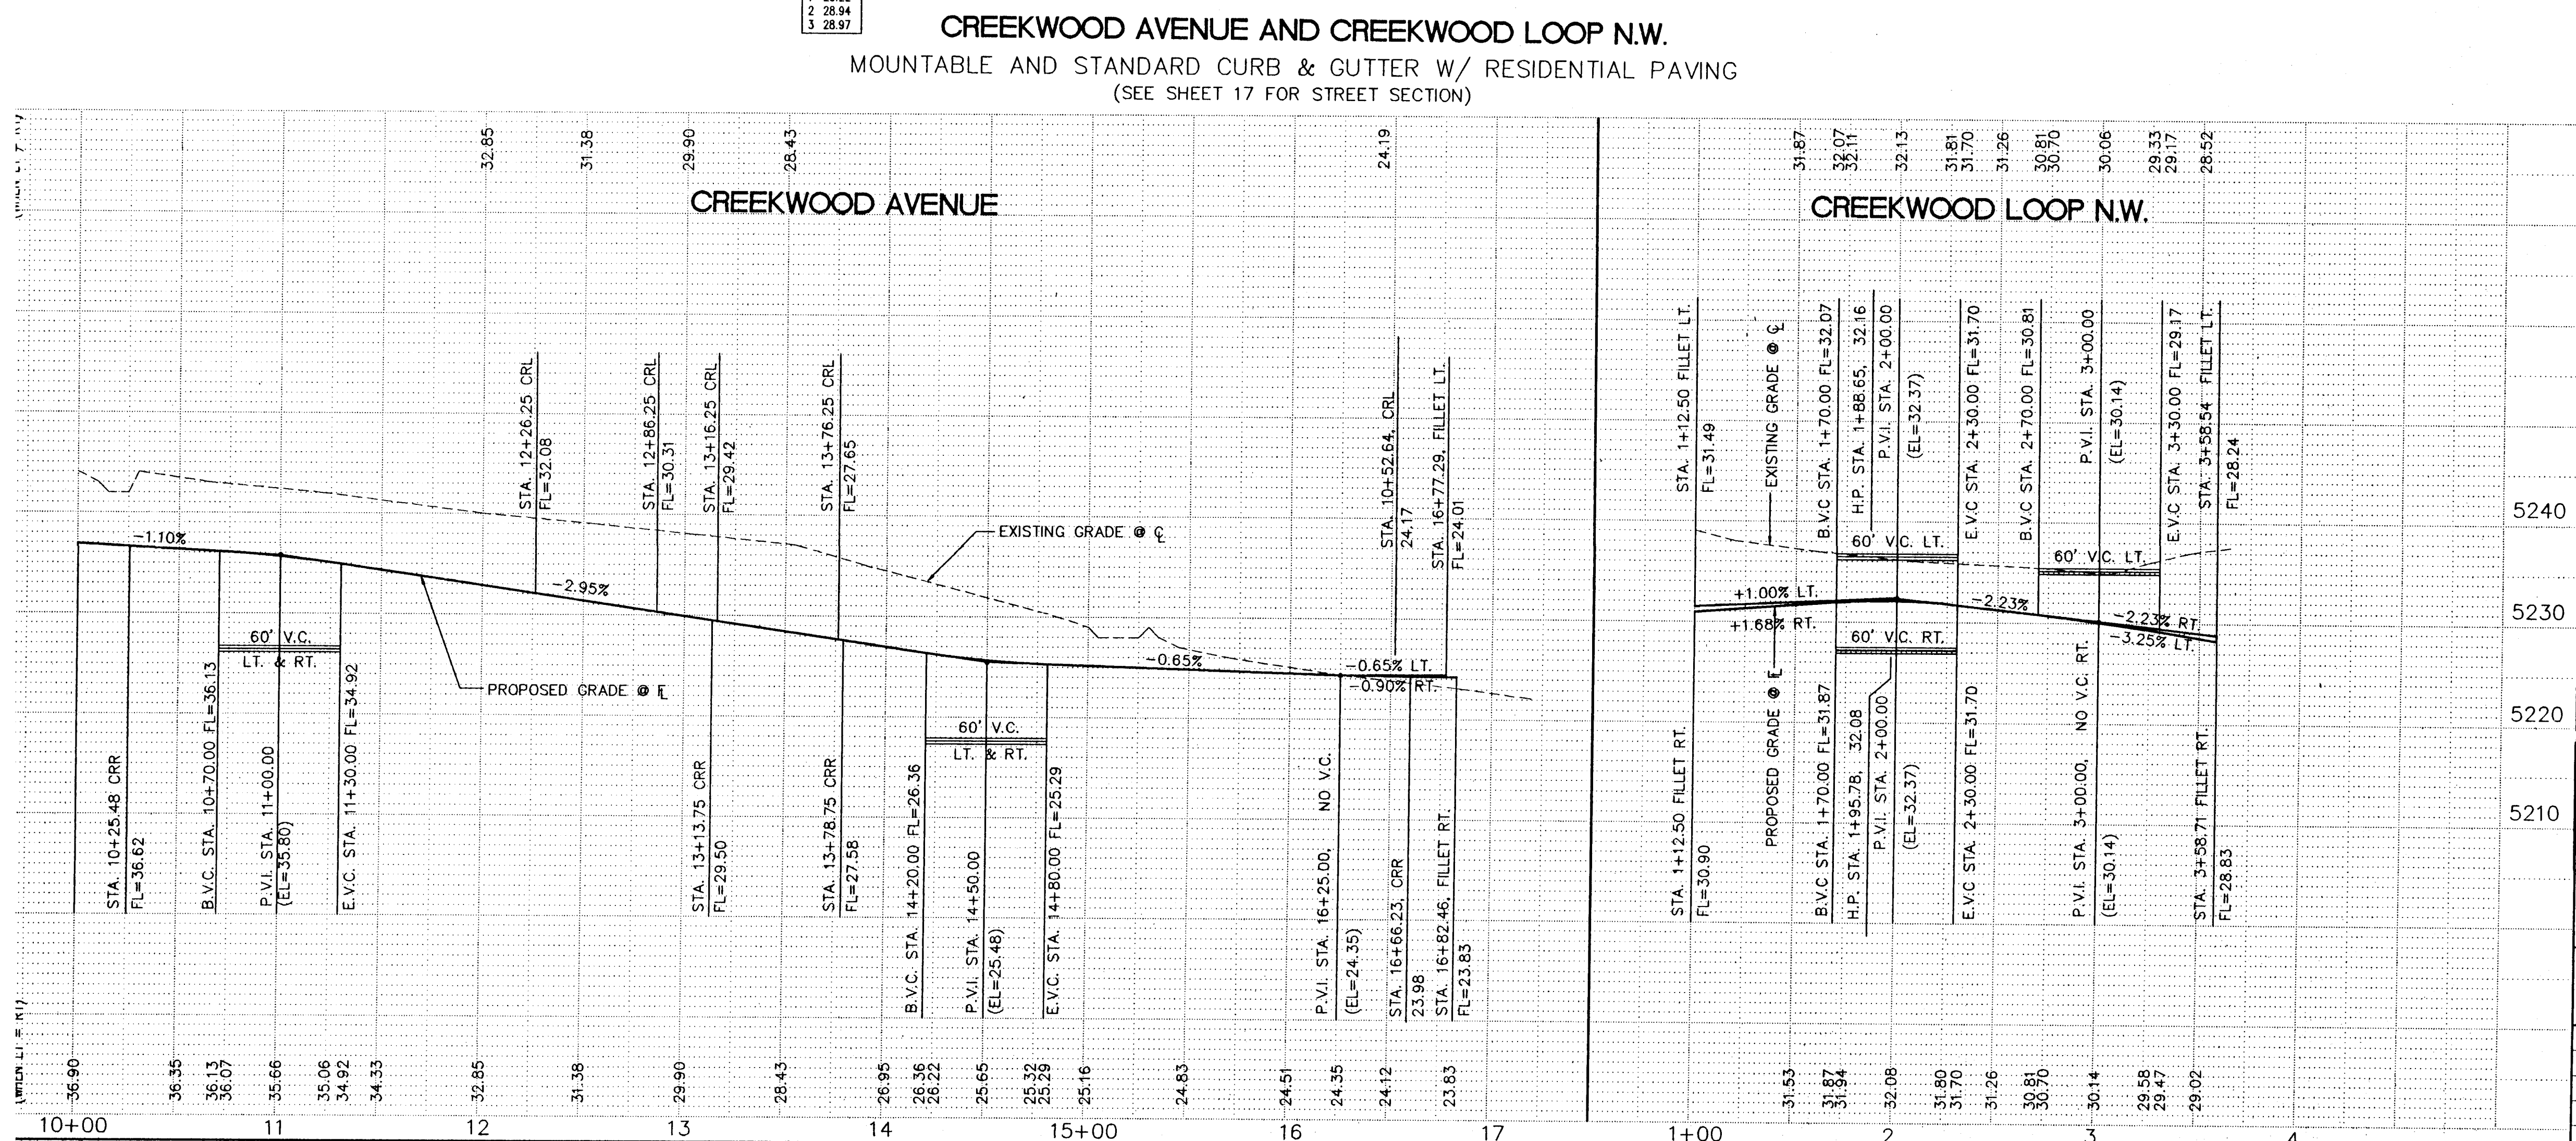

26-4886.94 12-3-97

RECORD DRAWING
12-3-97

SCALE:
1" = 50', HORIZ.
1" = 10', VERT.

community sciences corporation

CITY OF ALBUQUERQUE
PUBLIC WORKS DEPARTMENT
ENGINEERING GROUP

**TITLE: PARKWEST-UNIT 5
PAVING PLAN & PROFILE
CREEKWOOD AVE. & CREEKWOOD LOOP N.W.**

APPROVALS	ENGINEER	DATE	APPROVALS	ENGINEER	DATE
DRC CHAIRMAN			WATER	N/A RWK	6-5-95
TRANSPORTATION	R. Pank	6-02-95	WASTE WATER	N/A RWK	6-5-95
HYDROLOGY	NA JPC	9-19-95	A.M.A.F.C.A.		

PROJECT NO. 4886.94
MAP NO. G,H-9
SHEET 20 OF 39

AS BUILT INFORMATION

CONTRACTOR: *community sciences*
DATE: *9-12-95*
INSPECTOR'S NAME: *CSC*
DATE: *12-3-97*
APPROVED BY: *CSC*
DATE: *12-3-97*
DRAWN BY: *CSC*
DATE: *12-3-97*
RECORDED BY: *CSC*
DATE: *12-3-97*

BENCH MARKS

ACS BRASS TABLE STAMPED "2-68" SET IN A 2" IRON PIPE
1 FT. ABOVE GROUND LOCATED ON TOP OF A VOLCANIC OUTCROP
TO REACH THE STATION FROM THE INTERSECTION OF CREEKWOOD
& CREEKWOOD AVE. GO WEST ON CREEKWOOD ABOUT 0.7 MI. TO THE
END OF PAVEMENT. CONTINUE WEST ON THE DIRT ROAD TO THE
TOP OF THE DETENTION DAM ALONG THE NORTH BANK OF THE DAM
0.6 MI. TO A DIRT CROSS ROAD, TURN RIGHT GO NORTH ON THE
DIRT ROAD 0.5 MI.
S.D. 1929 ELEVATION = 5334.50 FEET


ENGINEER'S SEAL

[Signature]
5-25-97


REVISIONS

NO.	DATE	REMARKS
1		DESIGN

DESIGNED BY: S.R.L. DATE: MARCH, 1995
DRAWN BY: A.M. DATE: MARCH, 1995
CHECKED BY: J.D.H. DATE: MARCH, 1995

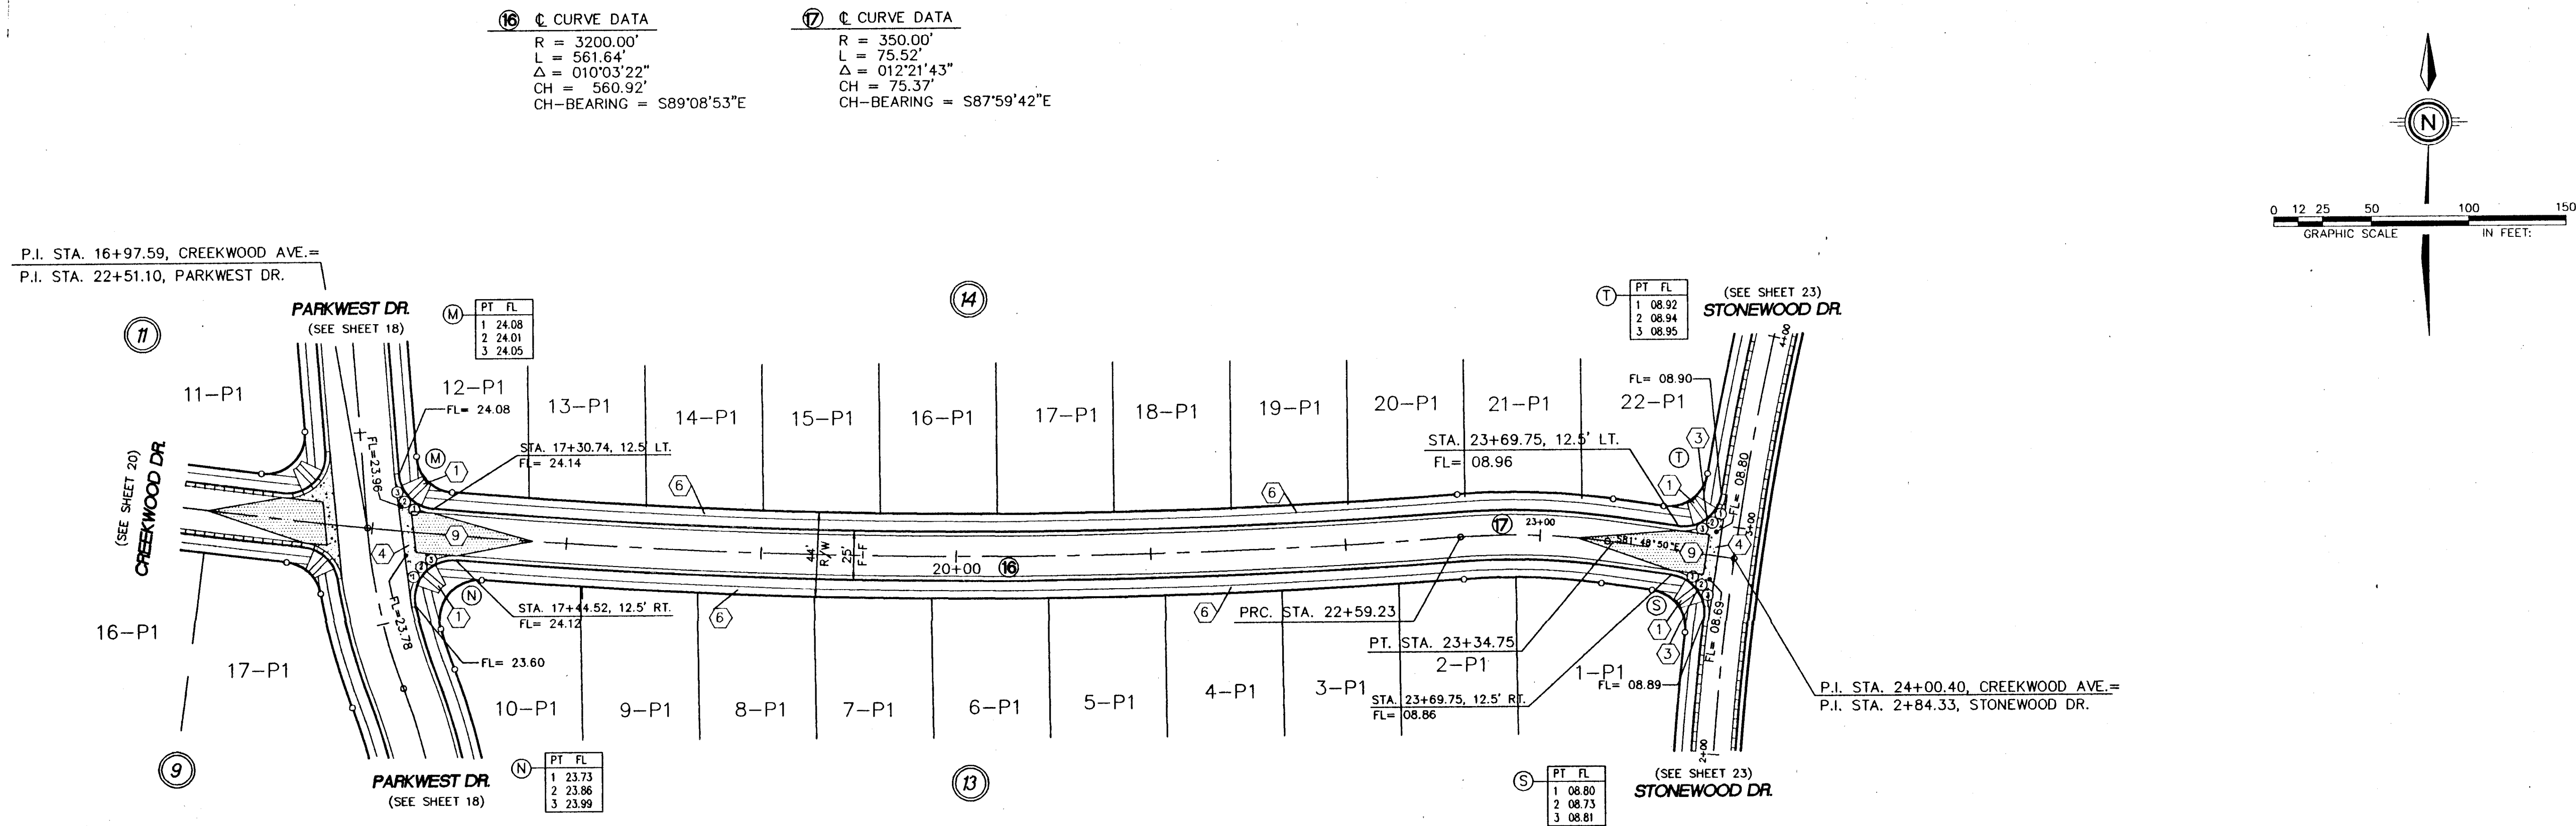

CREEKWOOD AVE. N.W.
MOUNTABLE CURB & GUTTER W/ RESIDENTIAL PAVING
(SEE SHEET 17 FOR STREET SECTION)

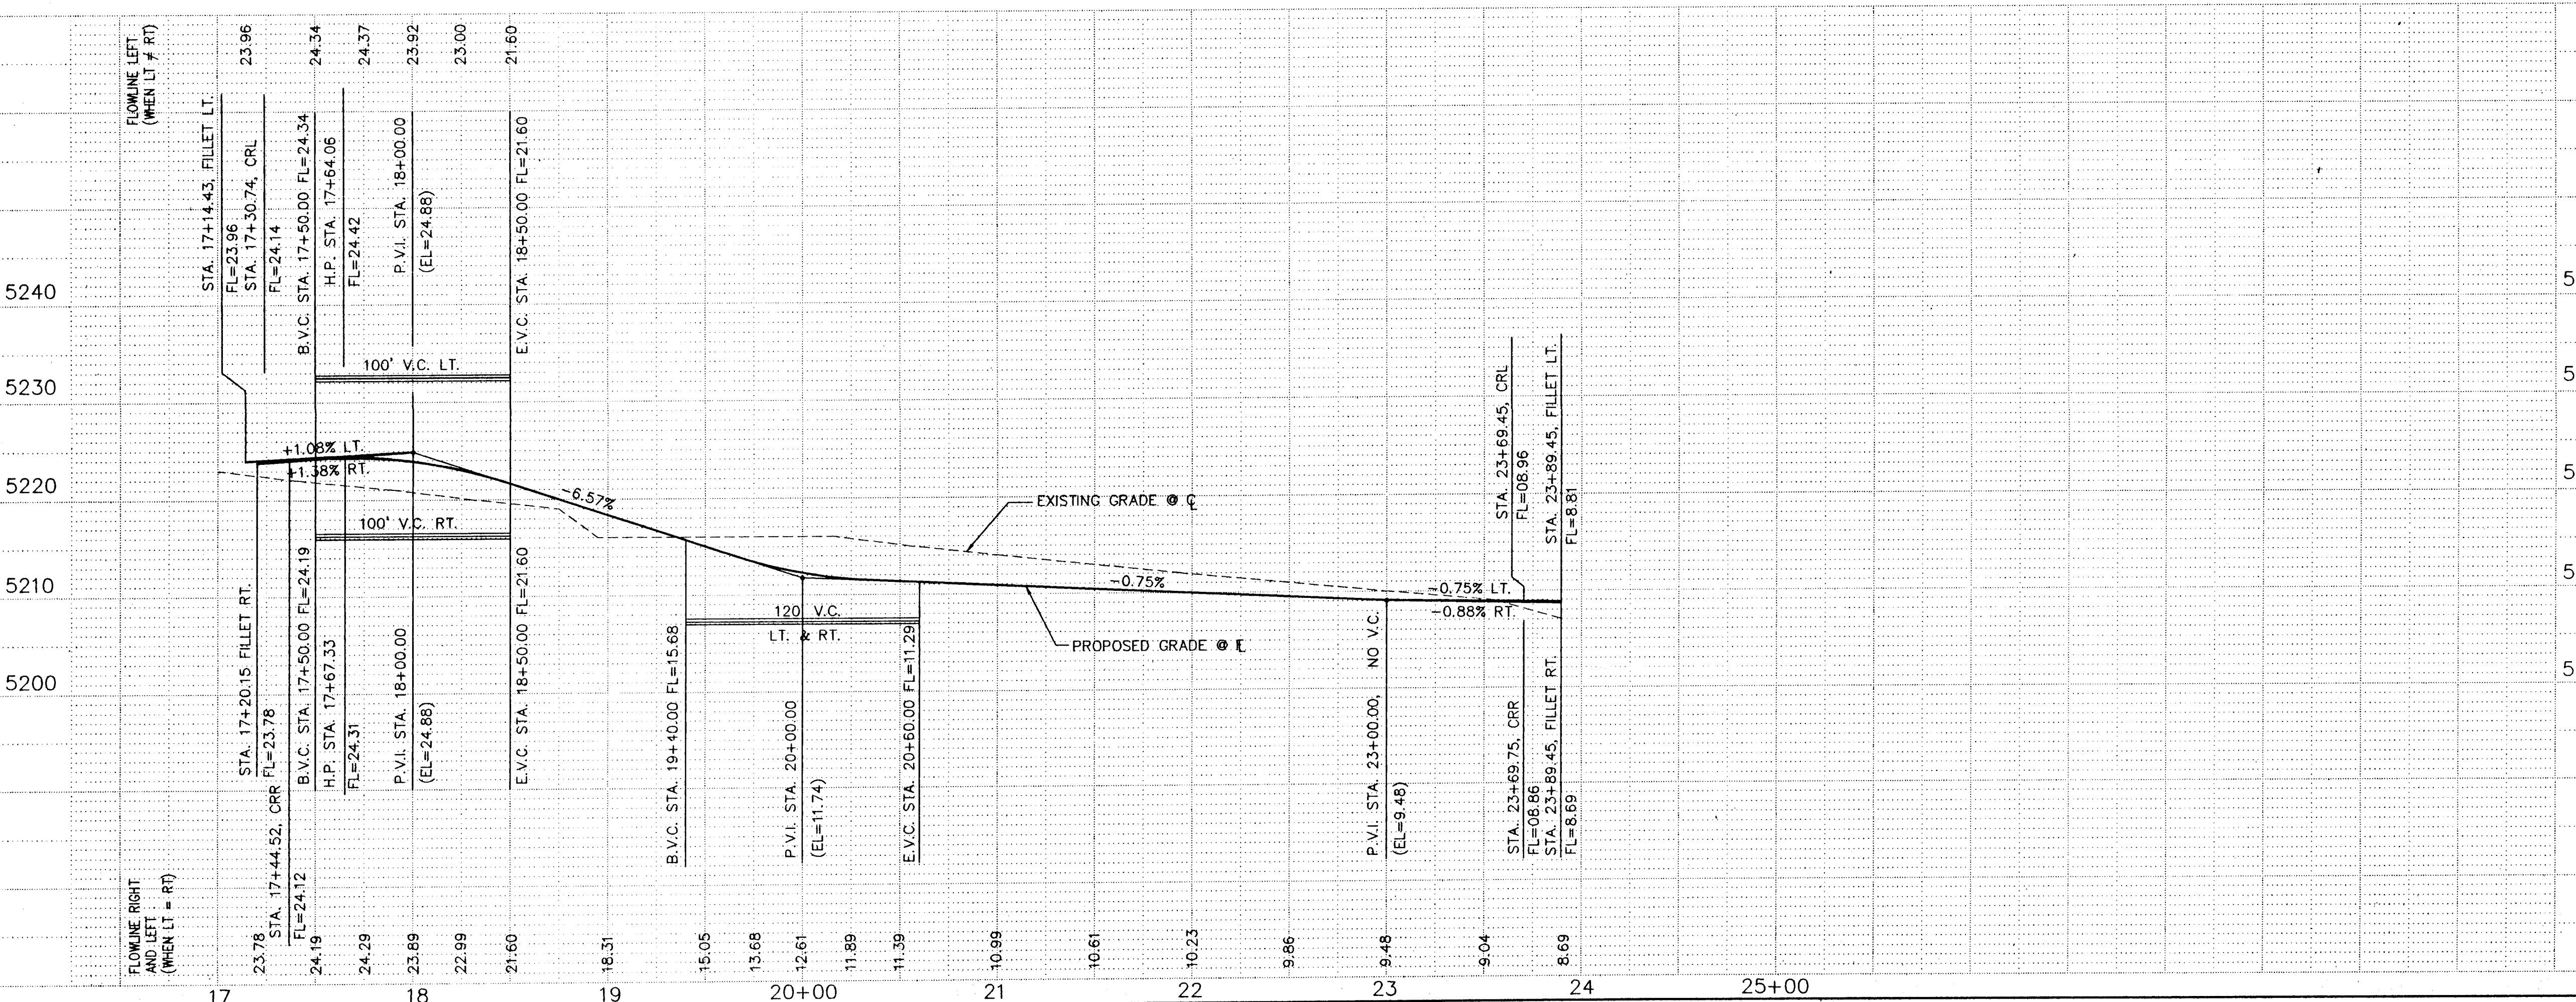

CURB CURVE TABLE AT FACE OF CURB			
CURVE ID	RADIUS	ARC	DELTA
A	20.00	33.15	084-58-11
B	20.00	20.35	058-17-54
C	20.00	25.75	073-46-16
D	20.00	29.21	083-40-56
E	20.00	31.42	090-00-00
F	20.00	31.42	090-00-00
G	20.00	31.42	090-00-00
H	20.00	31.42	090-00-00
I	20.00	31.42	090-00-00
J	20.00	31.42	090-00-00
K	20.00	26.12	074-50-31
L	20.00	35.20	100-51-05
M	20.00	28.12	080-32-49
N	20.00	37.69	107-58-20
O	20.00	30.03	086-01-10
P	20.00	30.70	087-57-48
Q	64.00	94.44	084-32-46
R	86.00	127.07	084-39-36
S	20.00	30.99	088-46-37
T	20.00	30.99	088-46-37
U	64.00	101.43	090-48-22
V	86.00	136.45	090-54-35
W	20.00	31.85	091-15-08
X	20.00	27.79	079-37-25
Y	20.00	32.86	094-08-07
Z	20.00	31.10	089-06-25
AA	20.00	29.68	085-01-28
BB	20.00	29.68	085-01-28
CC	10.30	31.42	180-00-00
DD	35.00	22.53	036-53-05

26-4886.94 21-97

RECORD DRAWING
12-3-97

SCALE:
1" = 50', HORIZ.
1" = 10', VERT.

community
sciences
corporation

CITY OF ALBUQUERQUE
PUBLIC WORKS DEPARTMENT
ENGINEERING GROUP

TITLE: PARKWEST-UNIT 5
PAVING PLAN & PROFILE
CREEKWOOD AVENUE N.W.

APPROVALS	ENGINEER	DATE	APPROVALS	ENGINEER	DATE
DRC CHAIRMAN			WATER	N/A RWK	6-5-99
TRANSPORTATION			WASTE WATER	N/A RWK	6-5-99
HYDROLOGY			A.M.A.F.C.A.		

PROJECT NO. 4886.94 MAP NO. G,H-9 SHEET 21 OF 39


SCANNED BY
BY LASON

16) C CURVE DATA
R = 800.00'
L = 208.35'
Δ = 014°55'19"
CH = 207.76'
CH-BEARING = N87°52'57"E

19) C CURVE DATA
R = 2000.00'
L = 337.99'
Δ = 009°40'58"
CH = 337.59'
CH-BEARING = S89°29'52"E

20) C CURVE DATA
R = 500.00'
L = 159.64'
Δ = 018°17'38"
CH = 158.97'
CH-BEARING = S85°11'32"E


21) C CURVE DATA
R = 75.00'
L = 118.93'
Δ = 090°51'29"
CH = 106.86'
CH-BEARING = S30°36'59"E

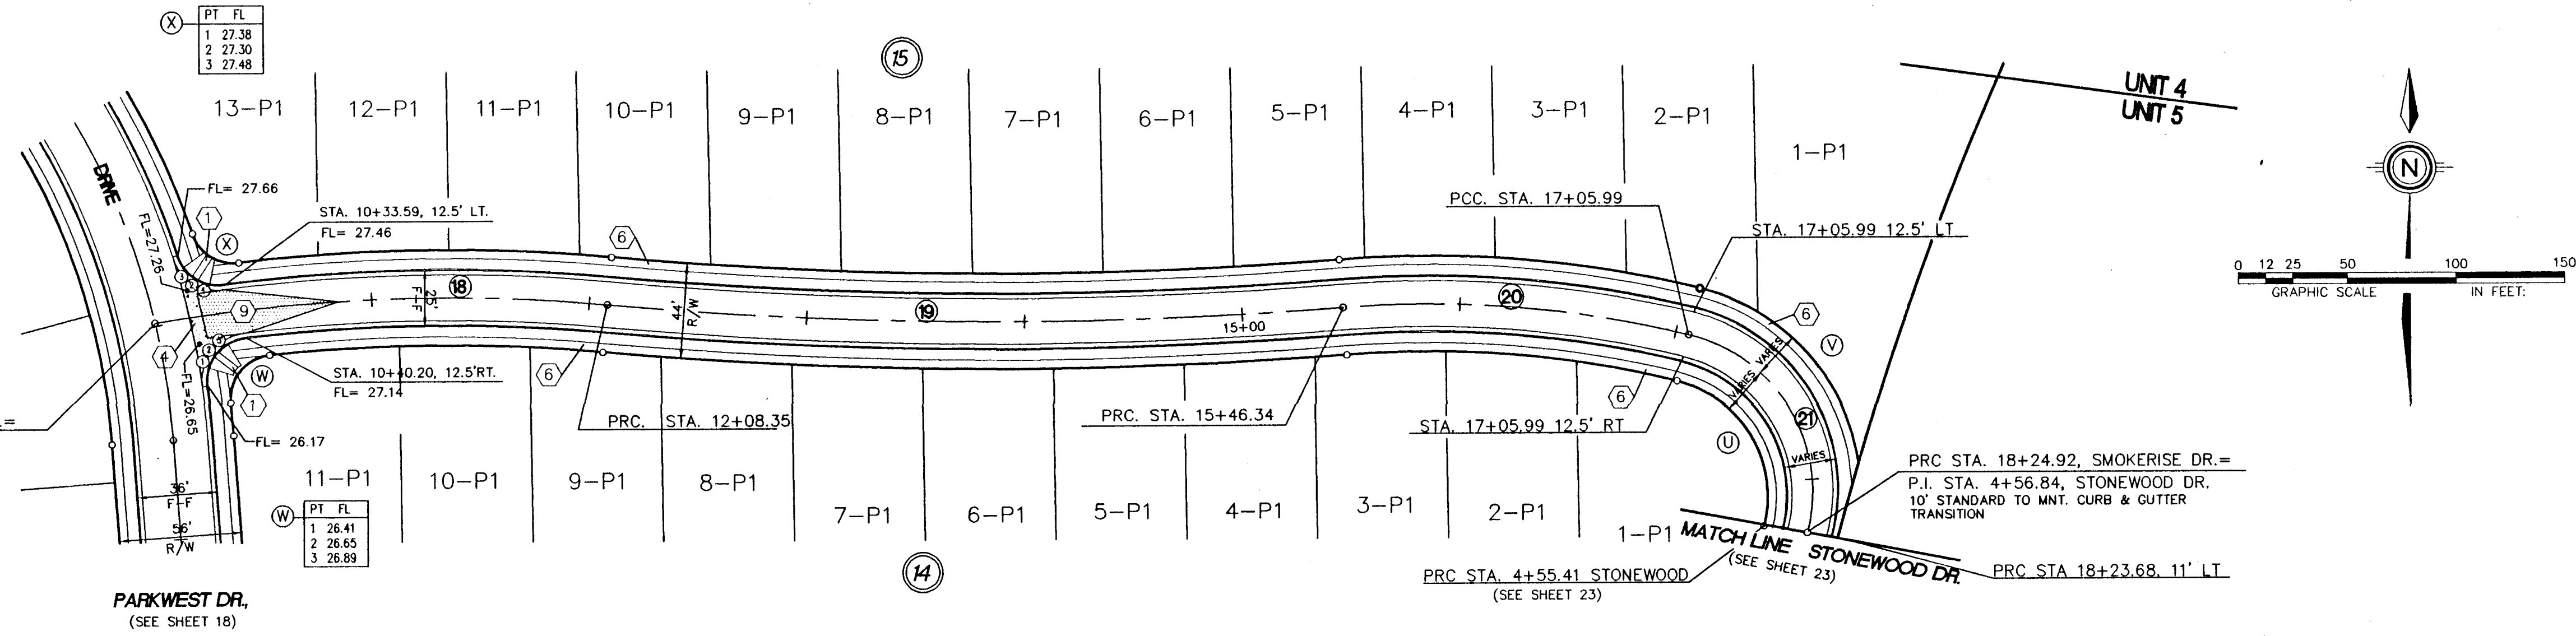

SMOKERISE AVENUE N.W.
MOUNTABLE CURB & GUTTER W/ RESIDENTIAL PAVING
(SEE SHEET 17 FOR STREET SECTION)

FLOWLINE LEFT
(WHEN LT = RT)

FLOWLINE RIGHT
AND LEFT
(WHEN LT = RT)

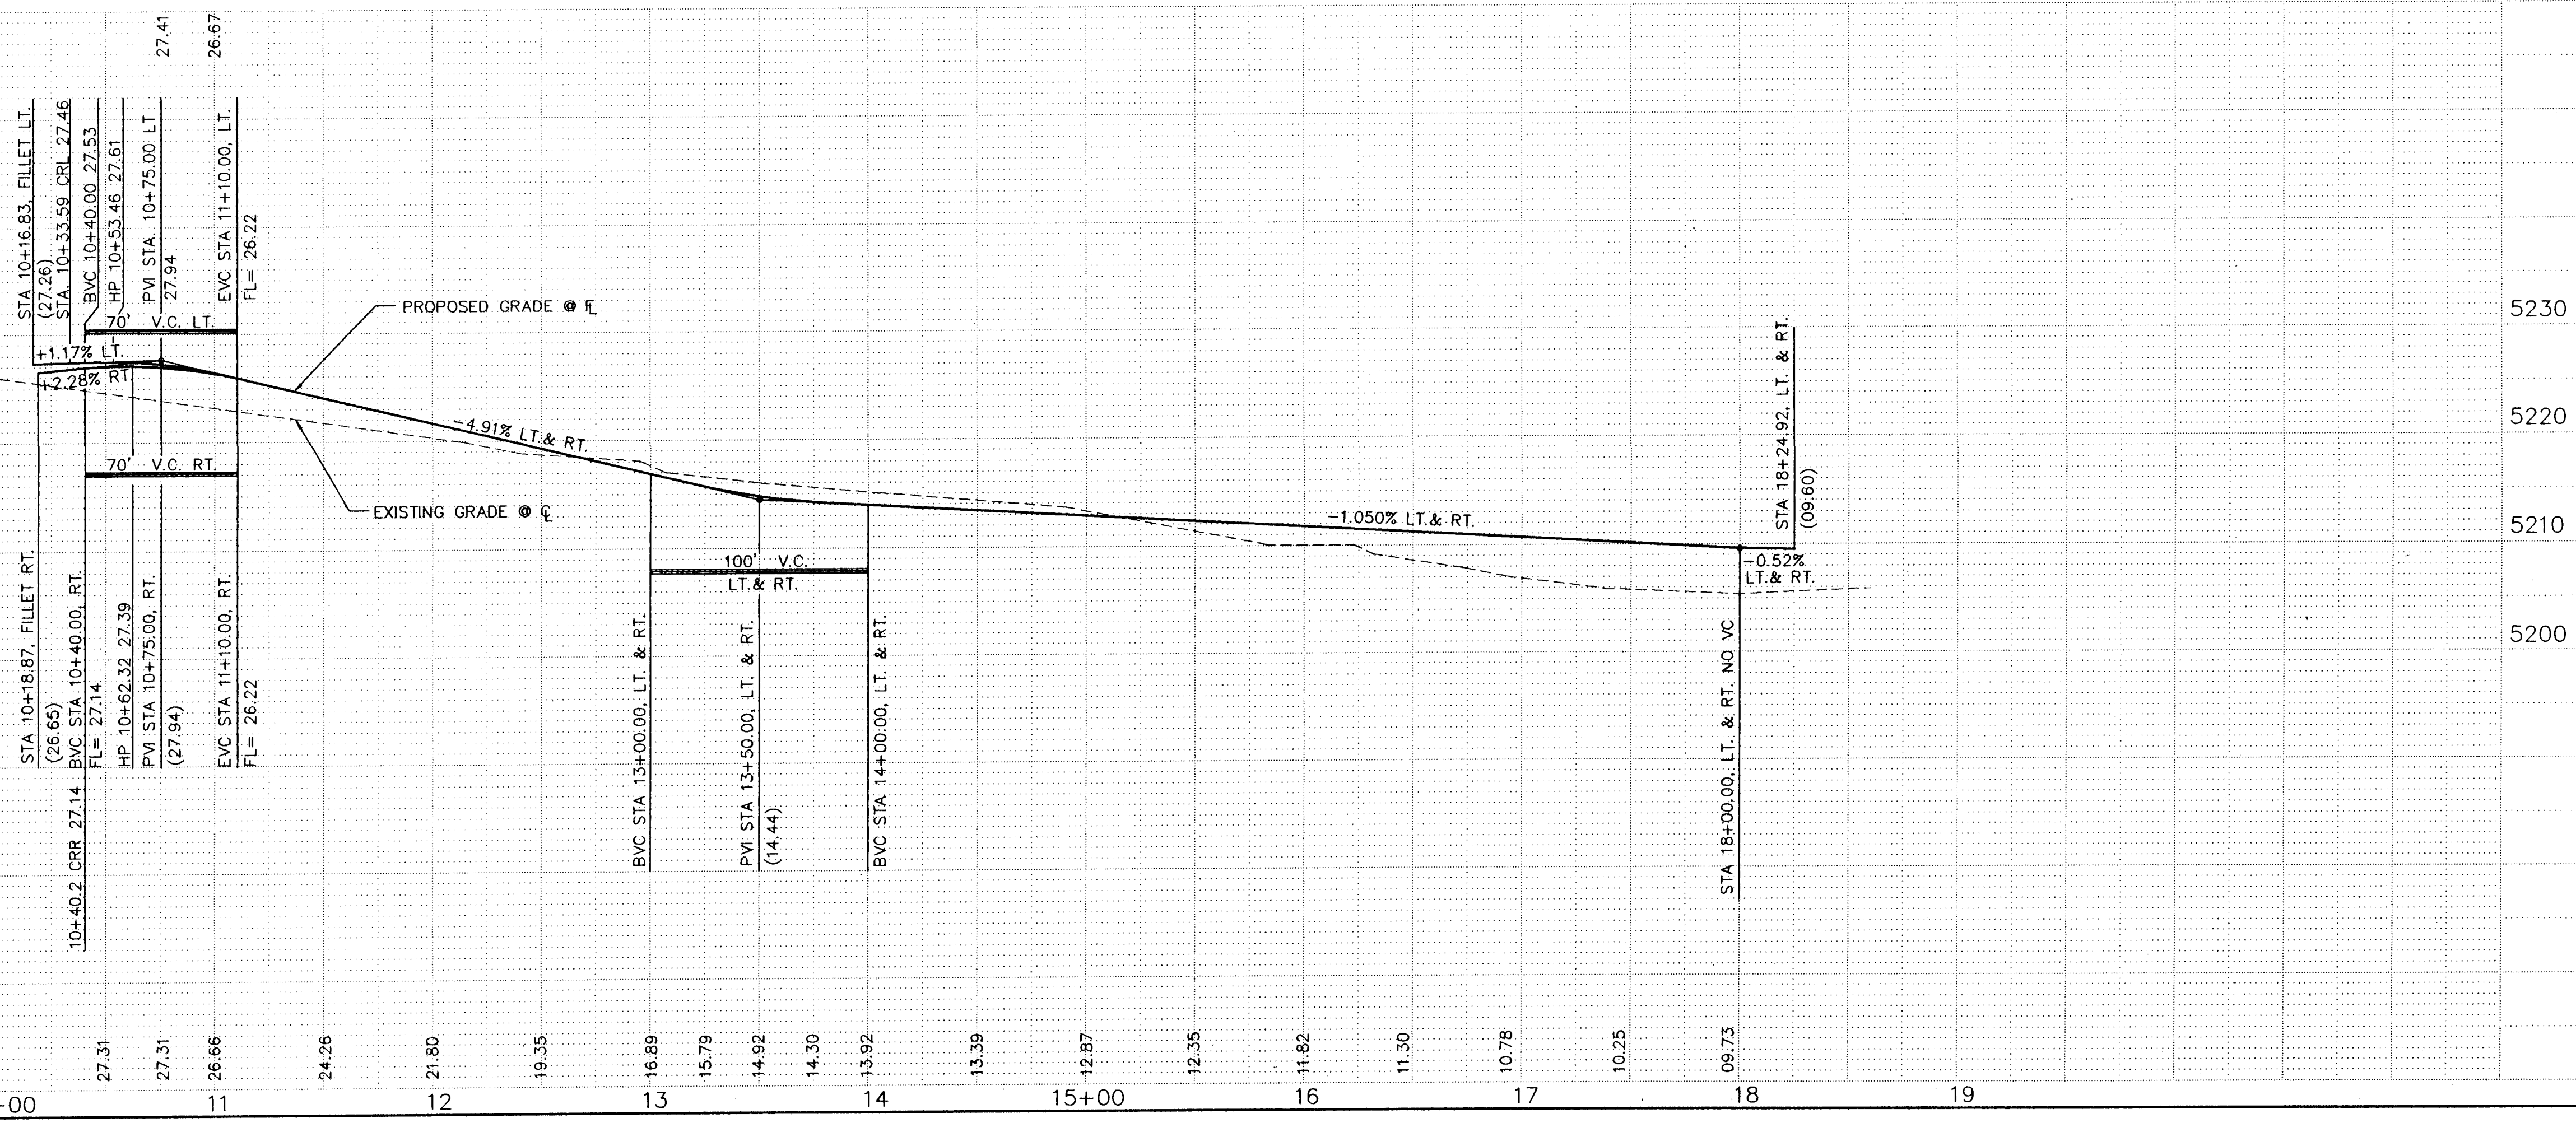

- LEGEND
- FL=74.11 PROPOSED CURB FLOWLINE ELEVATION
 - 73.6 ● EXISTING SPOT ELEVATION (GRND & TO)
 - PROPOSED VALLEY GUTTER/ SIDEWALK
 - EXISTING CURB & GUTTER
 - PROPOSED MOUNTABLE CURB & GUTTER
 - PROPOSED STANDARD CURB & GUTTER
 - CROWN TRANSITION

KEYNOTES:

- WHEELCHAIR RAMP PER COA STD. DWG. 2441 CASE II.
- WHEELCHAIR RAMP PER COA STD. DWG. 2441 CASE I.
- MOUNTABLE TO STANDARD CURB TRANSITION PER COA STD. DWG. 2418
- CONC. VALLEY GUTTER PER COA STD. DWG. 2420
- SPECIAL CONC. VALLEY GUTTER PER COA STD. DWG. 2422
- FUTURE 4' SIDEWALK, BY OTHERS
- PROPOSED 4' SIDEWALK, THIS CONTRACT
- PROPOSED 6' SIDEWALK, THIS CONTRACT
- 50' CROWN TRANSITION PER COA STD. DWG. 2401
- CUT-OFF WALL (FULL STREET WIDTH, 24" DEEP x 8" THICK) PER COA STD. DWG. NO. 2415

CURB CURVE TABLE AT FACE OF CURB			
CURVE ID	RADIUS	ARC	DELTA
A	20.00	33.15	094-58-11
B	20.00	20.35	058-17-54
C	20.00	25.75	073-46-18
D	20.00	29.21	083-40-56
E	20.00	31.42	090-00-00
F	20.00	31.42	090-00-00
G	20.00	31.42	090-00-00
H	20.00	31.42	090-00-00
I	20.00	31.42	090-00-00
J	20.00	31.42	090-00-00
K	20.00	26.12	074-50-31
L	20.00	35.20	100-51-05
M	20.00	28.12	080-32-49
N	20.00	37.69	107-58-20
O	20.00	30.03	088-01-10
P	20.00	30.70	087-57-46
Q	64.00	94.44	084-32-46
R	86.00	127.07	084-39-36
S	20.00	30.99	088-46-57
T	20.00	30.99	088-46-57
U	64.00	101.43	090-48-22
V	86.00	136.45	090-54-35
W	20.00	31.85	091-15-08
X	20.00	27.79	079-37-25
Y	20.00	32.86	094-08-07
Z	20.00	31.10	089-06-25
AA	20.00	29.68	085-01-28
BB	20.00	29.68	085-01-28
CC	10.00	31.42	180-00-00
DD	35.00	22.53	036-53-05

26-4886.94 2297

RECORD DRAWING

12-3-87

SCALE:
1" = 50', HORIZ.
1" = 10', VERT.

community
sciences
corporation

JOB NO.

14326-041

LAND PLANNING

P.O. Box 1328

ENGINEERING

Corrales, N.M. 87048

SURVEYING

Corrales, N.M. 87048

CITY OF ALBUQUERQUE
PUBLIC WORKS DEPARTMENT
ENGINEERING GROUP

TITLE: PARKWEST-UNIT 5
PAVING PLAN & PROFILE
SMOKERISE AVENUE N.W.

APPROVALS	ENGINEER	DATE	APPROVALS	ENGINEER	DATE
DRC CHAIRMAN			WATER	N/A RWK	6-3-95
TRANSPORTATION	R. Dwyer	6-2-95	WASTE WATER	N/A RWK	6-3-95
HYDROLOGY	N/A RDC	7-19-95	A.M.A.F.C.A.		

PROJECT NO.

4886.94

MAP NO.

G,H-9

SHEET

22 OF

39



SCANNED BY
BY LASON

22 C CURVE DATA
 R = 4500.00'
 L = 577.33'
 Δ = 007°21'03"
 CH = 576.93'
 CH-BEARING = N89°23'01"E

23 C CURVE DATA
 R = 75.00'
 L = 110.75'
 Δ = 084°36'11"
 CH = 100.95'
 CH-BEARING = S43°24'24"W

24 C CURVE DATA
 R = 1491.55'
 L = 184.33'
 Δ = 007°04'51"
 CH = 184.21'
 CH-BEARING = S04°38'44"W

25 C CURVE DATA
 R = 1491.55'
 L = 172.51'
 Δ = 006°37'36"
 CH = 172.41'
 CH-BEARING = S11°29'58"W

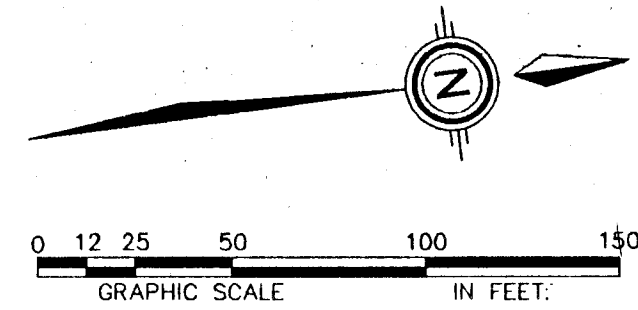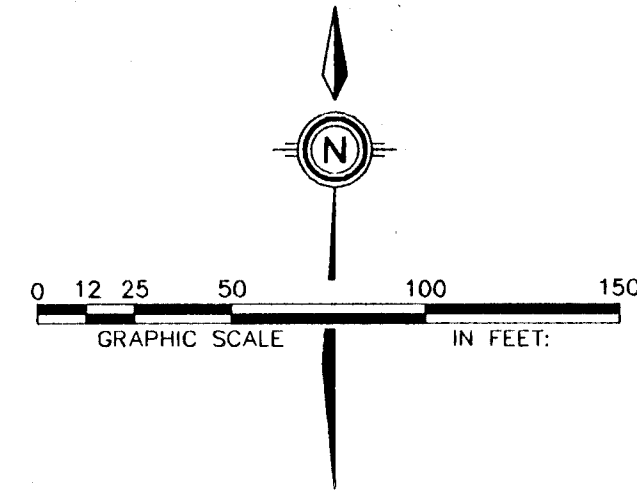

LEGEND

- FL=74.11 PROPOSED CURB FLOWLINE ELEVATION
- 73.6 EXISTING SPOT ELEVATION (GRND & TC)
- PROPOSED VALLEY GUTTER/ SIDEWALK
- EXISTING CURB & GUTTER
- PROPOSED MOUNTABLE CURB & GUTTER
- PROPOSED STANDARD CURB & GUTTER
- CROWN TRANSITION

KEYNOTES

- WHEELCHAIR RAMP PER COA STD. DWG. 2441 CASE II.
- WHEELCHAIR RAMP PER COA STD. DWG. 2441 CASE I.
- MOUNTABLE TO STANDARD CURB TRANSITION PER COA STD. DWG. 2418
- CONC. VALLEY GUTTER PER COA STD. DWG. 2420
- SPECIAL CONC. VALLEY CUTTER PER C.O.A. STD. DWG. 2422
- FUTURE 4' SIDEWALK, BY OTHERS
- PROPOSED 4' SIDEWALK, THIS CONTRACT
- PROPOSED 6' SIDEWALK, THIS CONTRACT
- 50' CROWN TRANSITION PER C.O.A. STD. DWG. 2401
- CUT-OFF WALL (FULL STREET WIDTH, 24" DEEP x 8" THICK) PER C.O.A. STD. DWG. NO. 2415

CURB CURVE TABLE AT FACE OF CURB

CURVE ID	RADIUS	ARC	DELTA
A	20.00	33.15	094-58-11
B	20.00	20.35	058-17-54
C	20.00	28.75	073-46-16
D	20.00	29.21	083-40-56
E	20.00	31.42	090-00-00
F	20.00	31.42	090-00-00
G	20.00	31.42	090-00-00
H	20.00	31.42	090-00-00
I	20.00	31.42	090-00-00
J	20.00	31.42	090-00-00
K	20.00	26.12	074-50-31
L	20.00	35.20	100-51-05
M	20.00	28.12	080-32-49
N	20.00	37.69	107-58-20
O	20.00	30.03	086-01-10
P	20.00	30.70	087-57-46
Q	64.00	94.44	084-32-46
R	86.00	127.07	084-39-36
S	20.00	30.99	088-46-37
T	20.00	30.99	088-46-37
U	64.00	101.43	090-48-22
V	86.00	136.45	090-54-35
W	20.00	31.65	091-15-08
X	20.00	27.79	079-37-25
Y	20.00	32.86	094-08-07
Z	20.00	31.10	089-06-25
AA	20.00	29.68	085-01-28
BB	20.00	29.68	085-01-28
CC	10.00	31.42	180-00-00
DD	35.00	22.53	036-53-05

26-4886.94 12327

RECORD DRAWING
12-3-97

SCALE:
1" = 50', HORIZ.
1" = 10', VERT.

community sciences corporation

JOB NO.: 14328-041

LAND PLANNING
P.O. Box 1328


ENGINEERING
Corrales, N.M. 87046

**CITY OF ALBUQUERQUE
PUBLIC WORKS DEPARTMENT
ENGINEERING GROUP**


**TITLE: PARKWEST-UNIT 5
PAVING PLAN & PROFILE
SADDLEBROOK AVE & STONEWOOD DRIVE N.W.**

APPROVALS	ENGINEER	DATE	APPROVALS	ENGINEER	DATE
DRC CHAIRMAN			WATER	N/A RWK	6-5-95
TRANSPORTATION	NA PRC	6-02-95	WASTE WATER	N/A RWK	6-5-95
HYDROLOGY		9-19-95	A.M.A.F.C.A.		



PROJECT NO. 4886.94 MAP NO. G,H9 SHEET 23 OF 39

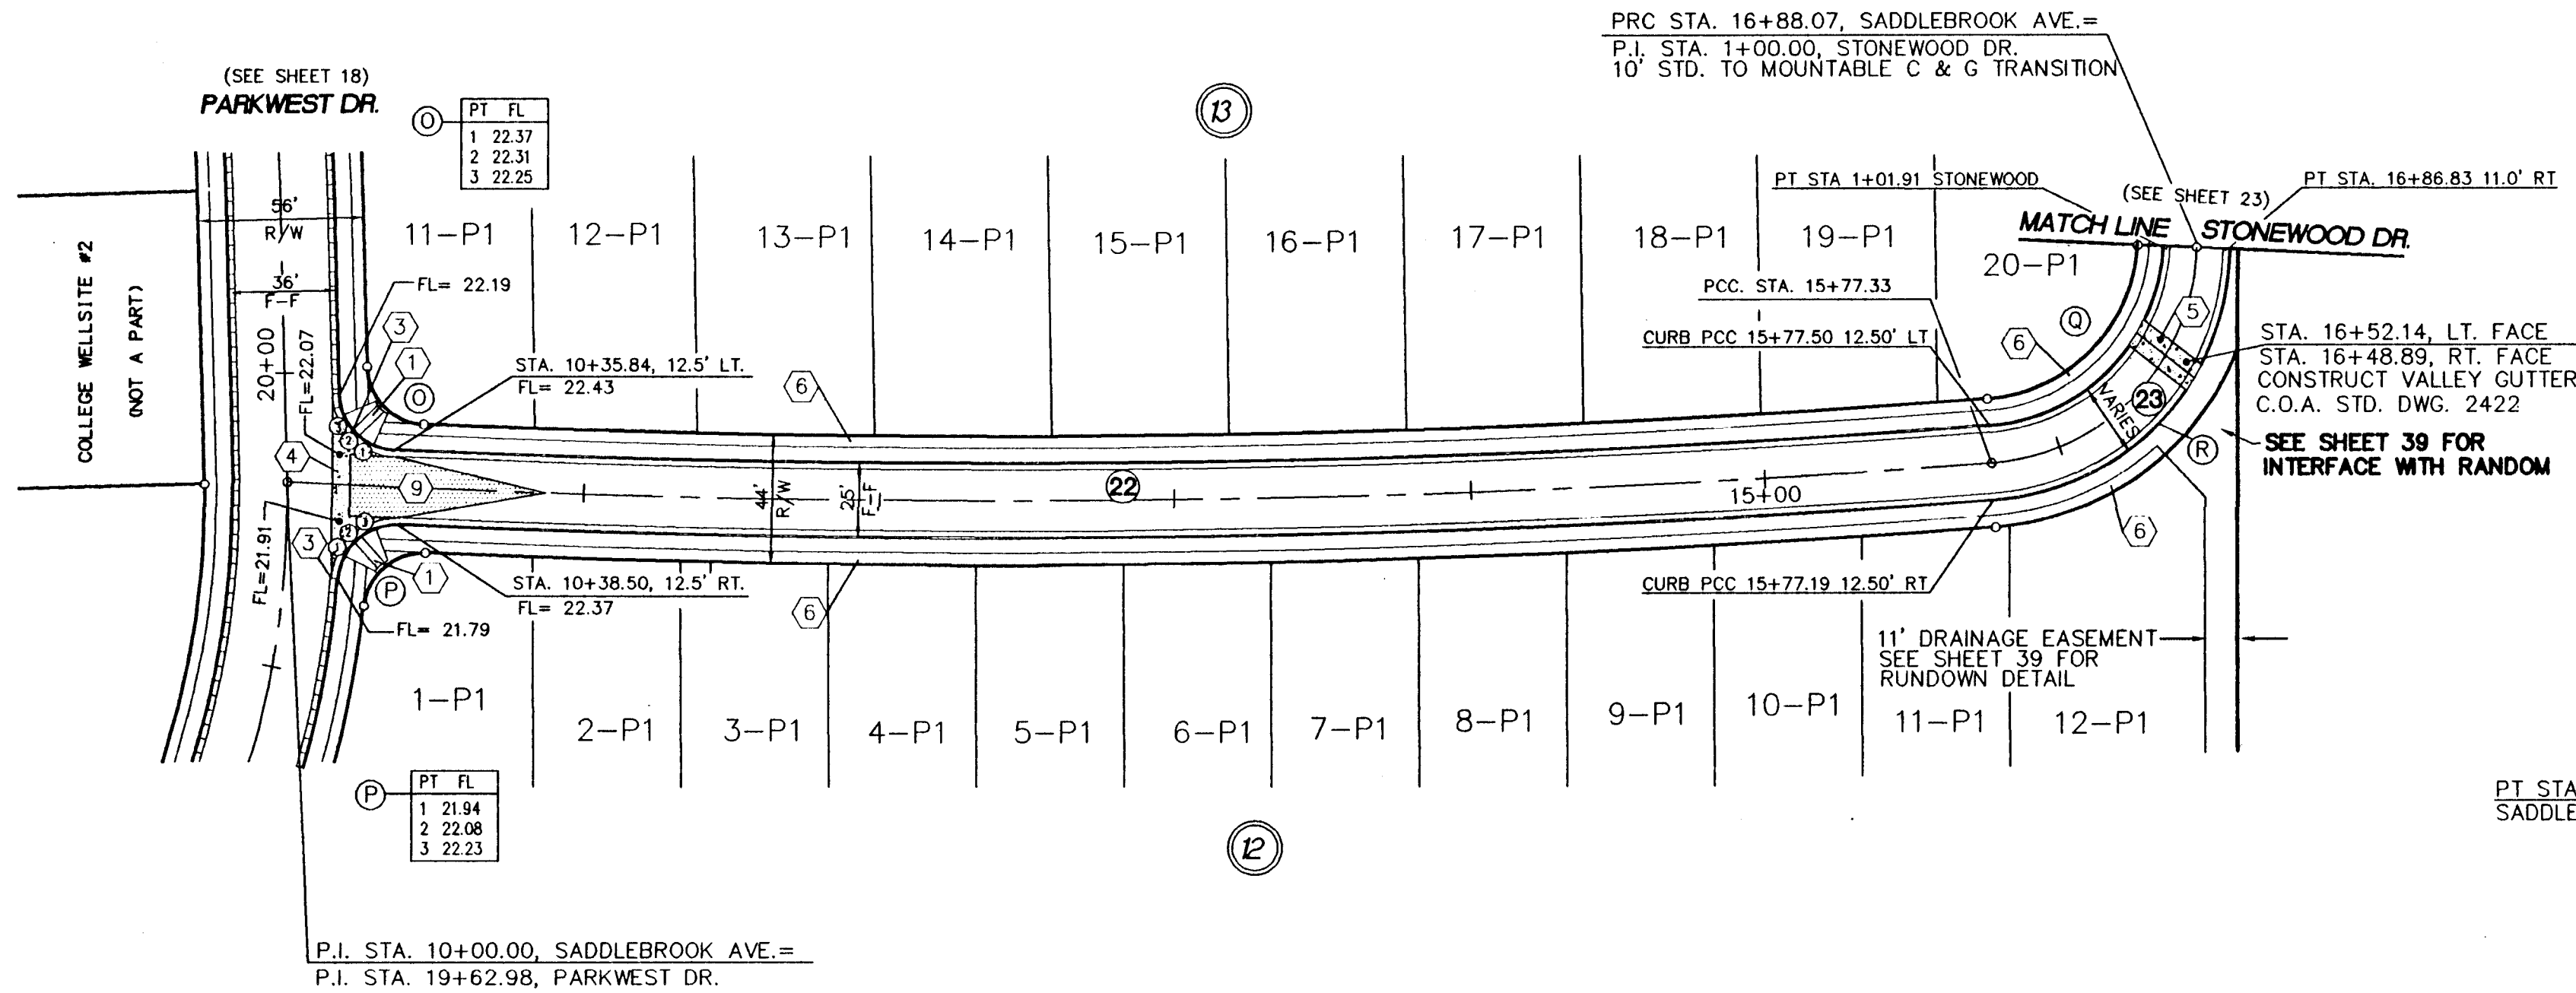

SADDLEBROOK AVENUE N.W.
 MOUNTABLE CURB & GUTTER W/ RESIDENTIAL PAVING
 (SEE SHEET 17 FOR STREET SECTION)

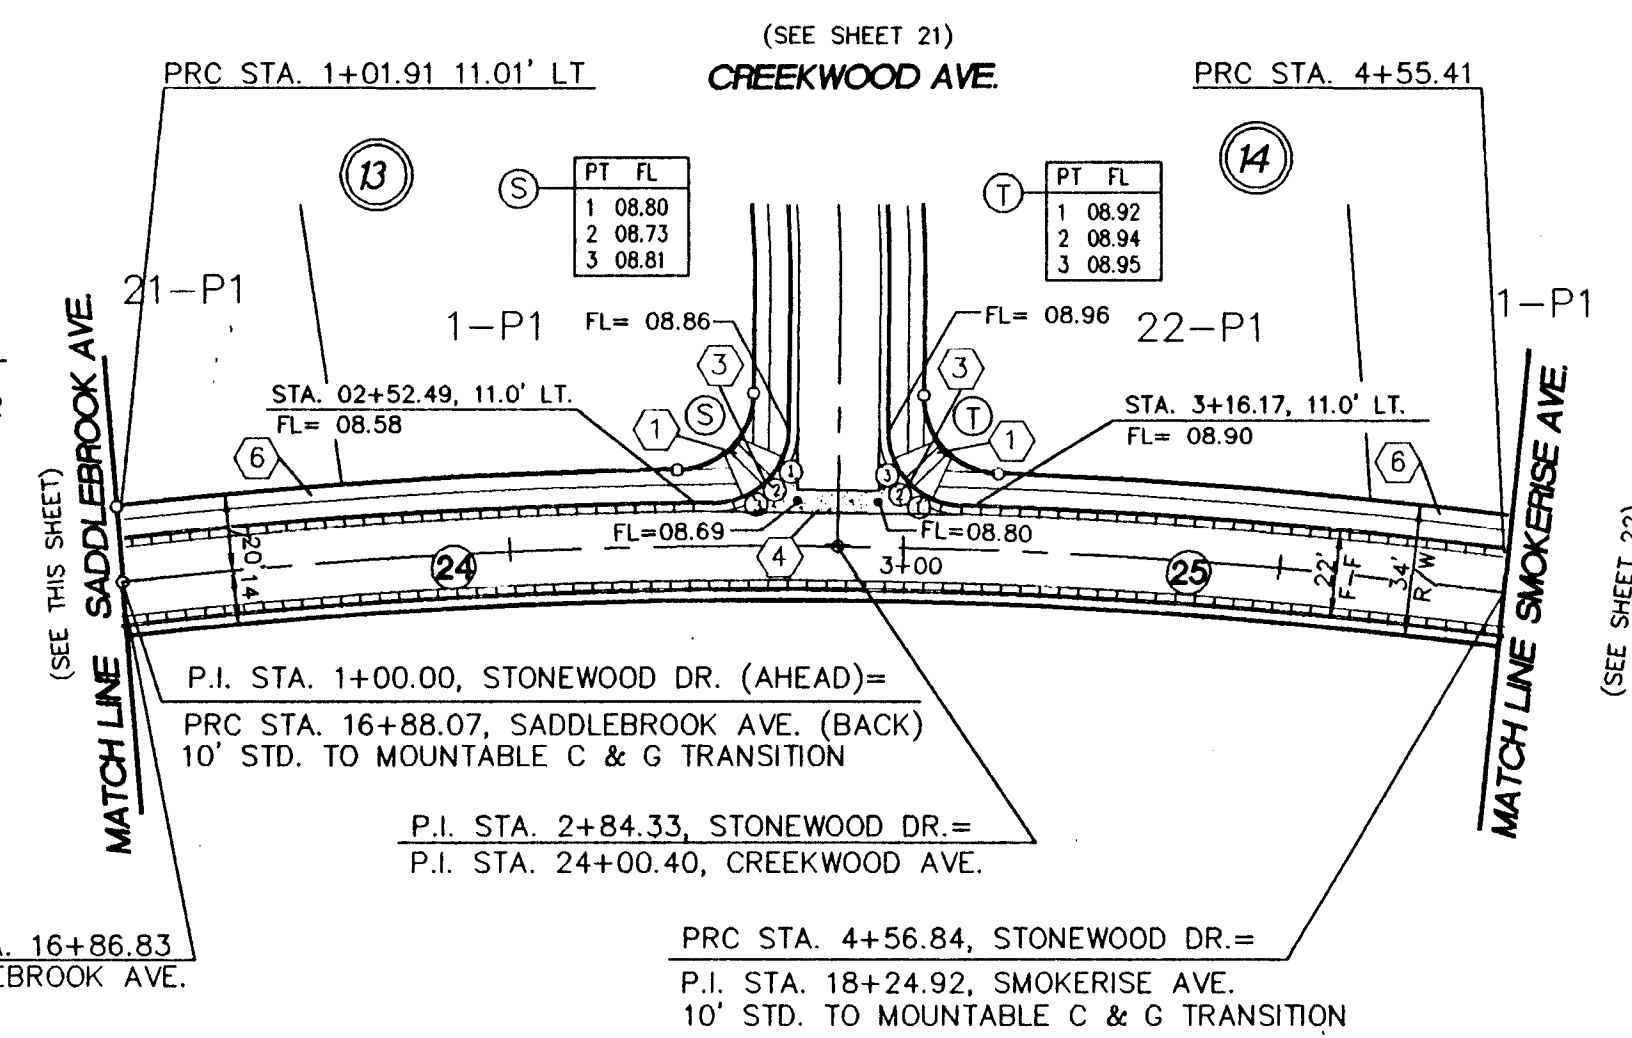

STONEWOOD DRIVE N.W.
 STANDARD CURB & GUTTER W/ RESIDENTIAL PAVING
 (SEE SHEET 17 FOR STREET SECTION)

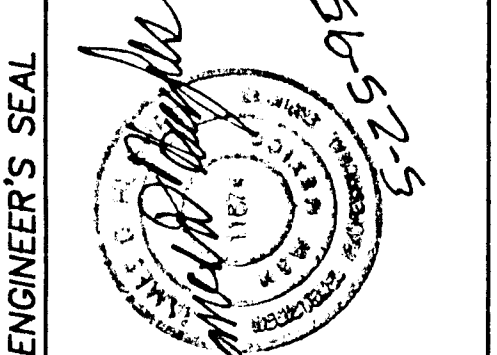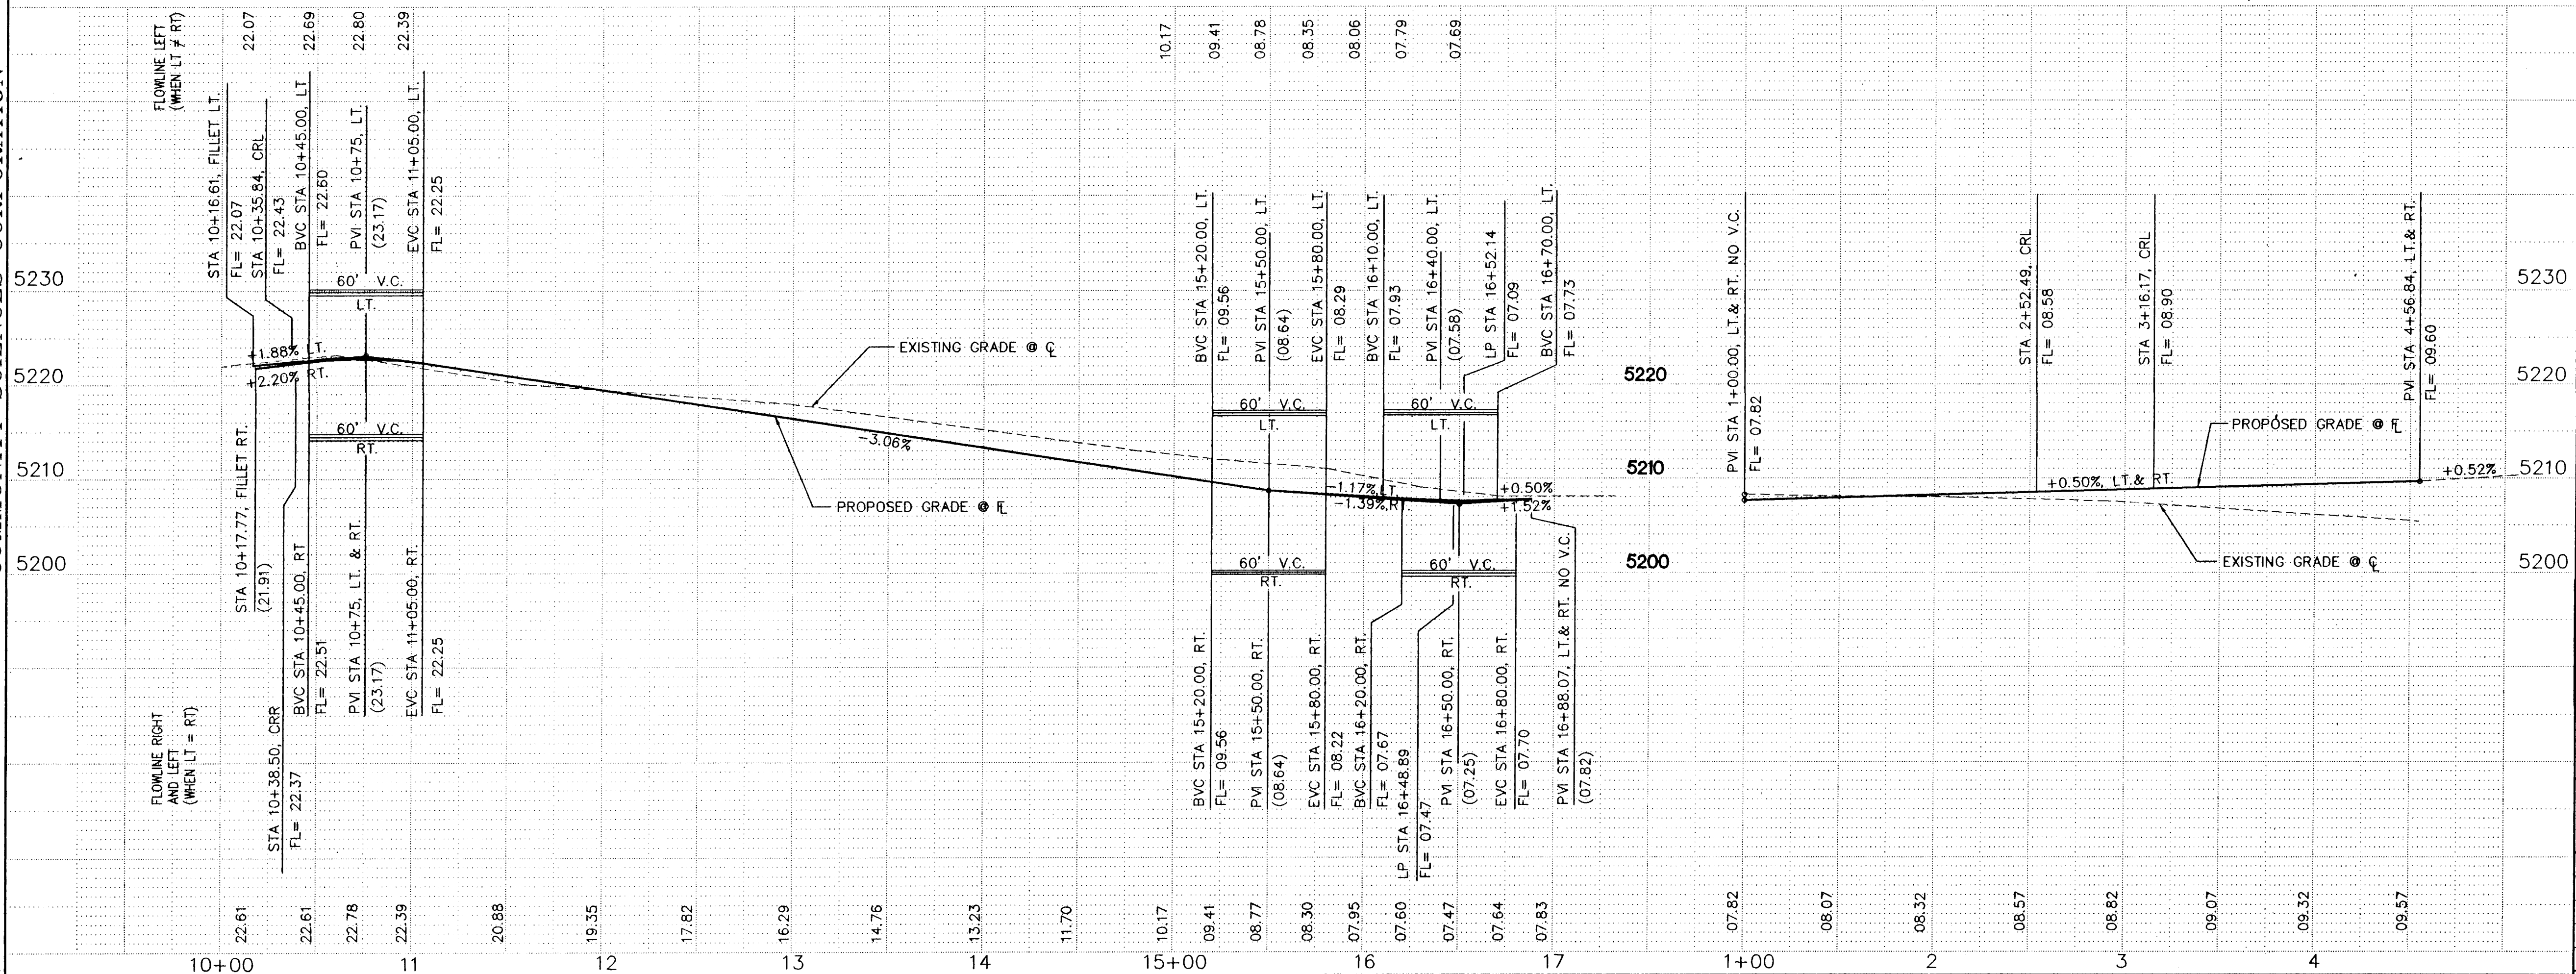

ENGINEER'S SEAL

NO.	DATE	REVISIONS	BY
		DESIGN	
DESIGNED BY	S.R.L.	DATE	MARCH, 1995
DRAWN BY	A.M.	DATE	MARCH, 1995
CHECKED BY	J.D.H.	DATE	MARCH, 1995

1 CURVE DATA
R = 120.00'
L = 132.85'
Δ = 06°32'45"
CH = 126.17'
CH-BEARING = S38°07'43"W

27 CURVE DATA
R = 598.00'
L = 69.51'
Δ = 006°39'36"
CH = 69.47'
CH-BEARING = S73°10'23"W

28 CURVE DATA
R = 674.13'
L = 48.04'
Δ = 004°04'59"
CH = 48.03'
CH-BEARING = S78°32'41"W



29 CURVE DATA
R = 674.13'
L = 20.68'
Δ = 001°45'29"
CH = 20.68'
CH-BEARING = S81°27'55"W

30 CURVE DATA
R = 674.13'
L = 68.72'
Δ = 005°50'28"
CH = 68.69'
CH-BEARING = S79°25'25"W


31 CURVE DATA
R = 598.13'
L = 184.02'
Δ = 017°37'38"
CH = 183.29'
CH-BEARING = S67°41'22"W

32 CURVE DATA
R = 598.13'
L = 111.50'
Δ = 010°41'45"
CH = 111.50'
CH-BEARING = S53°31'40"W

33 CURVE DATA
R = 300.00'
L = 89.35'
Δ = 017°03'53"
CH = 89.02'
CH-BEARING = N39°38'51"E

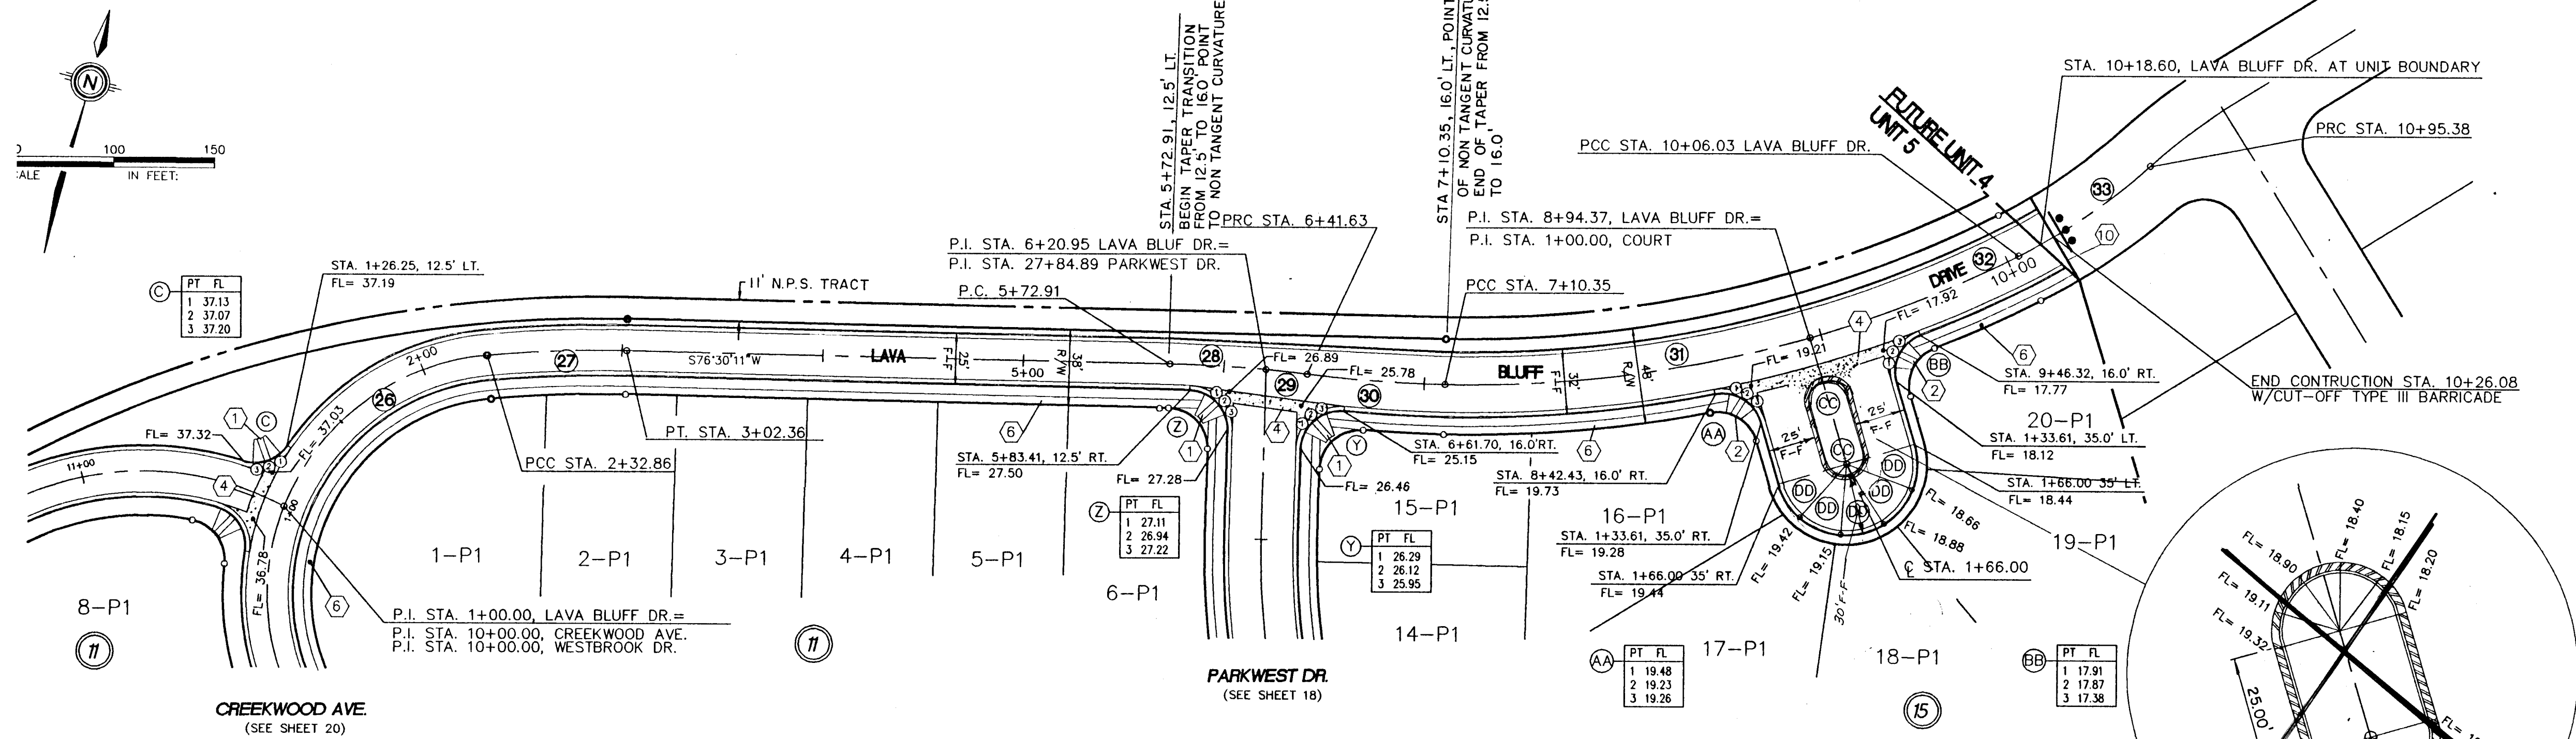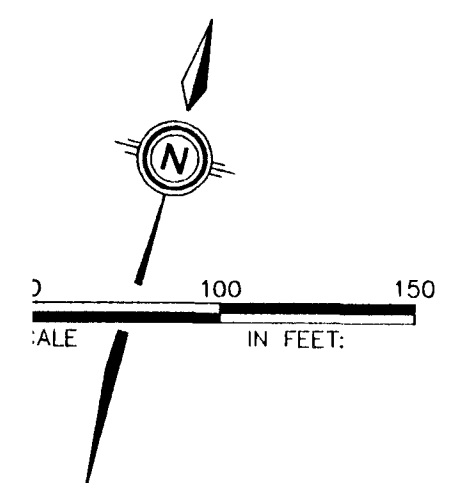

LAVA BLUFF DRIVE N.W.
MOUNTABLE CURB & GUTTER W/ RESIDENTIAL PAVING
(SEE SHEET 17 FOR STREET SECTION)

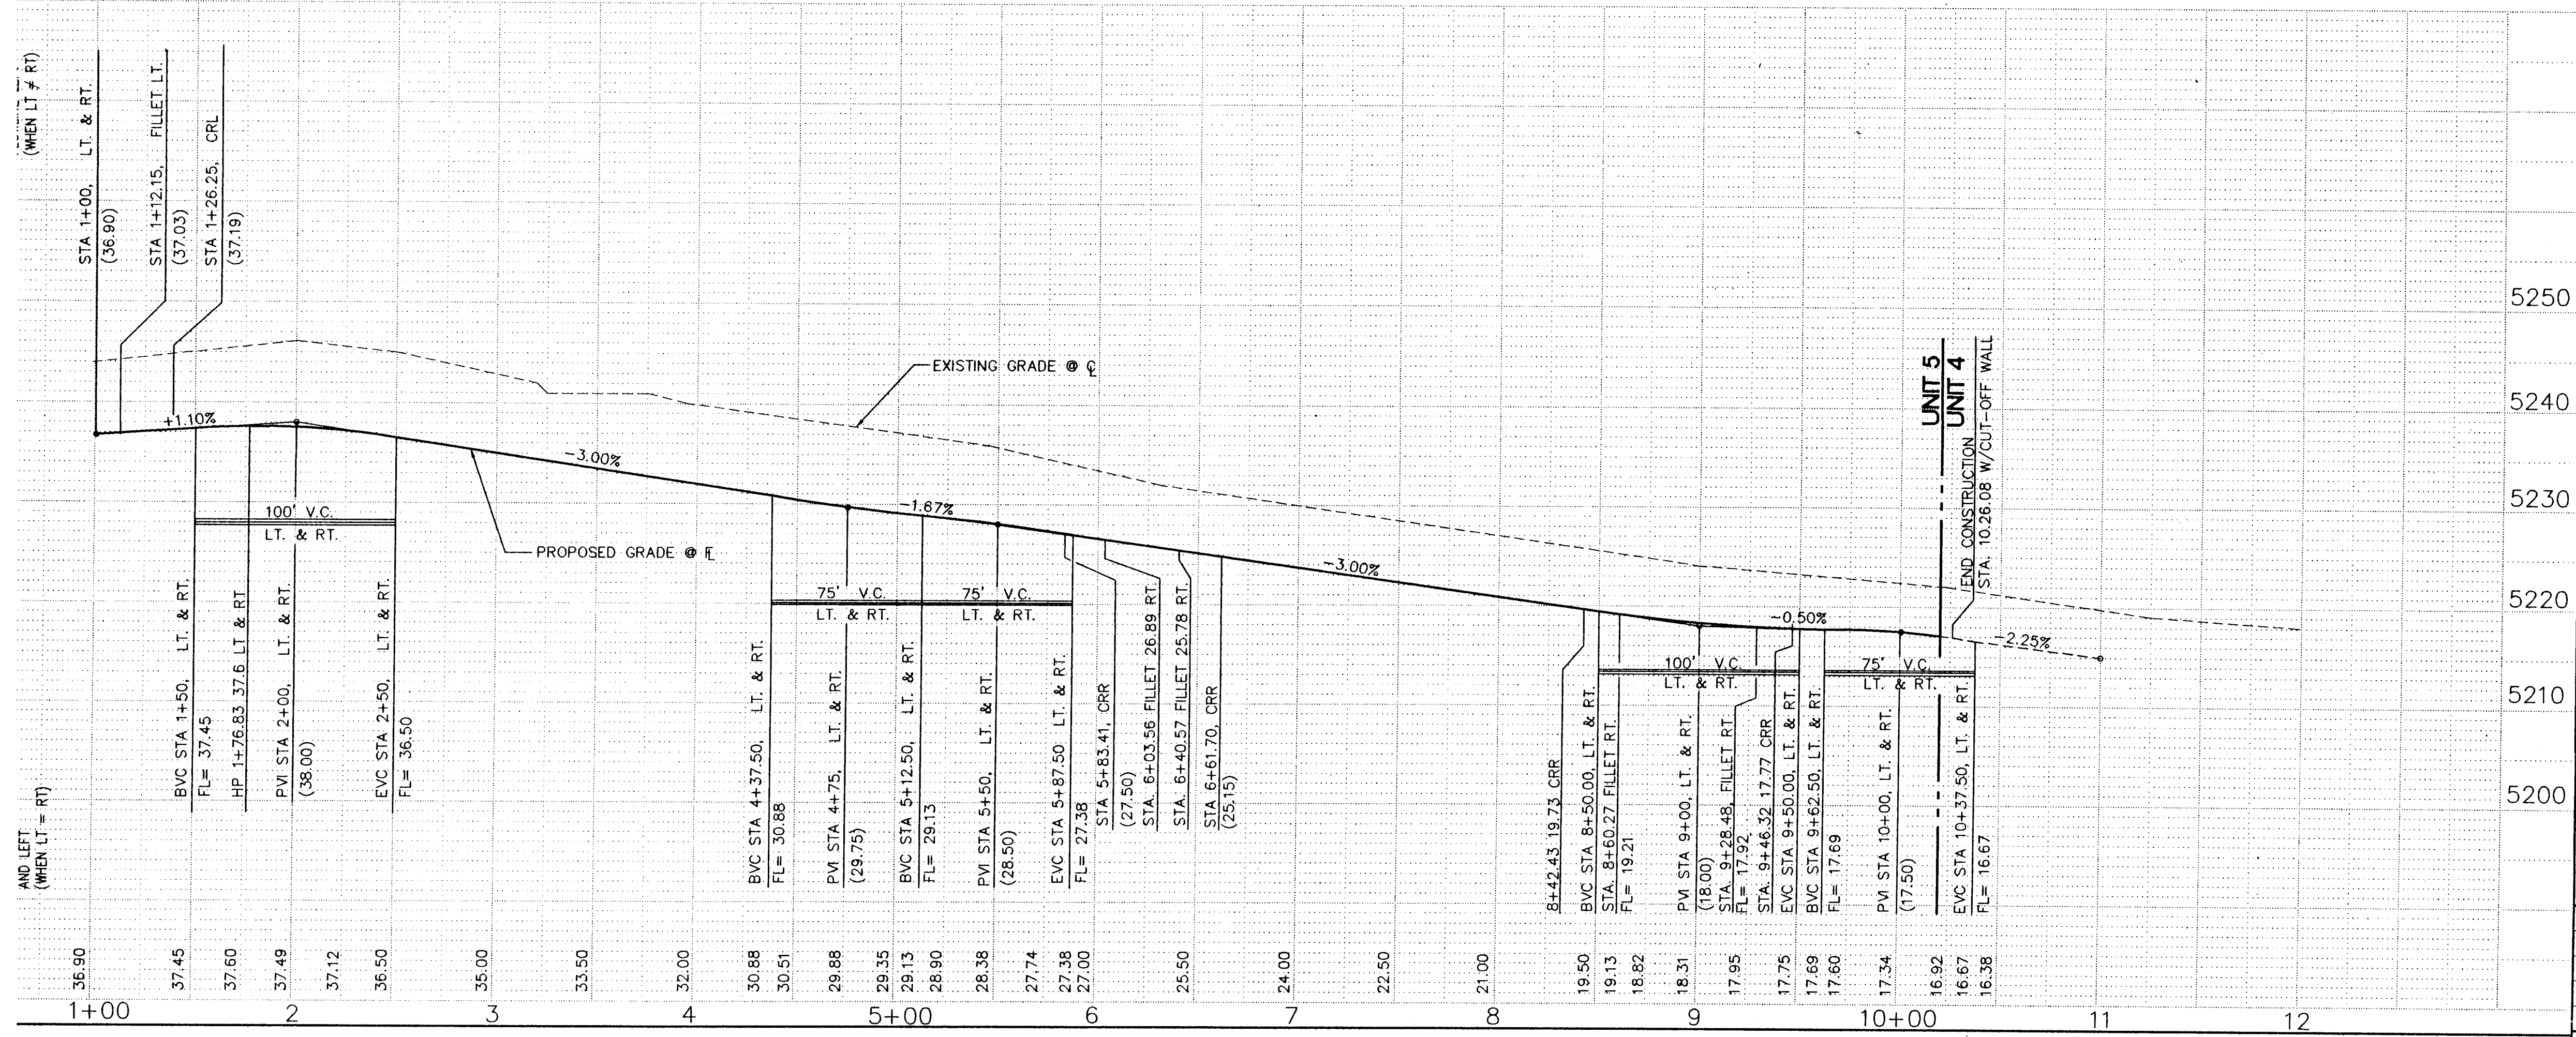

LEGEND

FL=74.11	PROPOSED CURB FLOWLINE ELEVATION
73.6	EXISTING SPOT ELEVATION (GRND & TC)
[Symbol]	PROPOSED VALLEY GUTTER/ SIDEWALK
[Symbol]	EXISTING CURB & GUTTER
[Symbol]	PROPOSED MOUNTABLE CURB & GUTTER
[Symbol]	PROPOSED STANDARD CURB & GUTTER
[Symbol]	CROWN TRANSITION
[Symbol]	PROPOSED MEDIAN CURB & GUTTER

- KEYNOTES
- WHEELCHAIR RAMP PER COA STD. DWG. 2441 CASE II.
 - WHEELCHAIR RAMP PER COA STD. DWG. 2441 CASE I.
 - MOUNTABLE TO STANDARD CURB TRANSITION PER COA STD. DWG. 2418
 - CONC. VALLEY GUTTER PER COA STD. DWG. 2420
 - SPECIAL CONC. VALLEY GUTTER PER C.O.A. STD. DWG. 2422
 - FUTURE 4' SIDEWALK, BY OTHERS
 - PROPOSED 4' SIDEWALK, THIS CONTRACT
 - PROPOSED 6' SIDEWALK, THIS CONTRACT
 - 50' CROWN TRANSITION PER C.O.A. STD. DWG. 2401
 - CUT-OFF WALL (FULL STREET WIDTH, 24" DEEP x 8" THICK) PER C.O.A. STD. DWG. NO. 2415

CURB CURVE TABLE
AT FACE OF CURB

CURVE ID	RADIUS	ARC	DELTA
A	20.00	33.15	094-58-11
B	20.00	20.35	058-17-54
C	20.00	25.75	073-46-16
D	20.00	29.21	083-40-56
E	20.00	31.42	090-00-00
F	20.00	31.42	090-00-00
G	20.00	31.42	090-00-00
H	20.00	31.42	090-00-00
I	20.00	31.42	090-00-00
J	20.00	31.42	090-00-00
K	20.00	26.12	074-50-31
L	20.00	35.20	100-51-05
M	20.00	28.12	065-32-49
N	20.00	37.69	107-58-20
O	20.00	30.03	089-01-10
P	20.00	30.70	087-57-46
Q	64.00	94.44	084-32-46
R	86.00	127.07	084-39-36
S	20.00	30.99	088-46-37
T	20.00	30.99	088-46-37
U	64.00	101.43	090-48-22
V	86.00	136.45	090-54-35
W	20.00	31.85	091-15-08
X	20.00	27.79	079-37-25
Y	20.00	32.86	094-08-07
Z	20.00	31.10	089-06-25
AA	20.00	29.88	085-01-28
BB	20.00	29.68	085-01-28
CC	10.00	31.42	160-00-00
DD	35.00	22.53	036-53-05

26-4886.94 12497

RECORD DRAWING
12-3-97

SCALE:
1" = 50', HORIZ.
1" = 10', VERT.

community sciences corporation

CITY OF ALBUQUERQUE
PUBLIC WORKS DEPARTMENT
ENGINEERING GROUP

TITLE: PARKWEST-UNIT 5
PAVING PLAN & PROFILE
LAVA BLUFF DRIVE N.W.

APPROVALS	ENGINEER	DATE	APPROVALS	ENGINEER	DATE
DRC CHAIRMAN			WATER	N/A RWE	6-5-95
TRANSPORTATION	R. Rude	6-2-95	WASTE WATER	N/A RWE	6-5-95
HYDROLOGY	N/A JPC	7-19-95	A.M.A.F.C.A.		

PROJECT NO. 4886.94
MAP NO. G,H-9
SHEET 24 OF 39

AS BUILT INFORMATION

CONTRACTOR: SURVANCE INC. DATE: 9/6/97

INSPECTOR'S NAME: C.S.C. DATE: 12/1/97

FIELD NAME: C.S.C. DATE: 12/1/97

VERIFICATION BY: C.S.C. DATE: 12/1/97

DESIGNED BY: S.R.L. DATE: MARCH, 1995

DRAWN BY: A.M. DATE: MARCH, 1995



CHECKED BY: J.S.L. DATE: MARCH, 1995

REVISIONS

NO.	DATE	REMARKS
1		COMMUNITY SCIENCES

ENGINEER'S SEAL

26-4886.94 12497

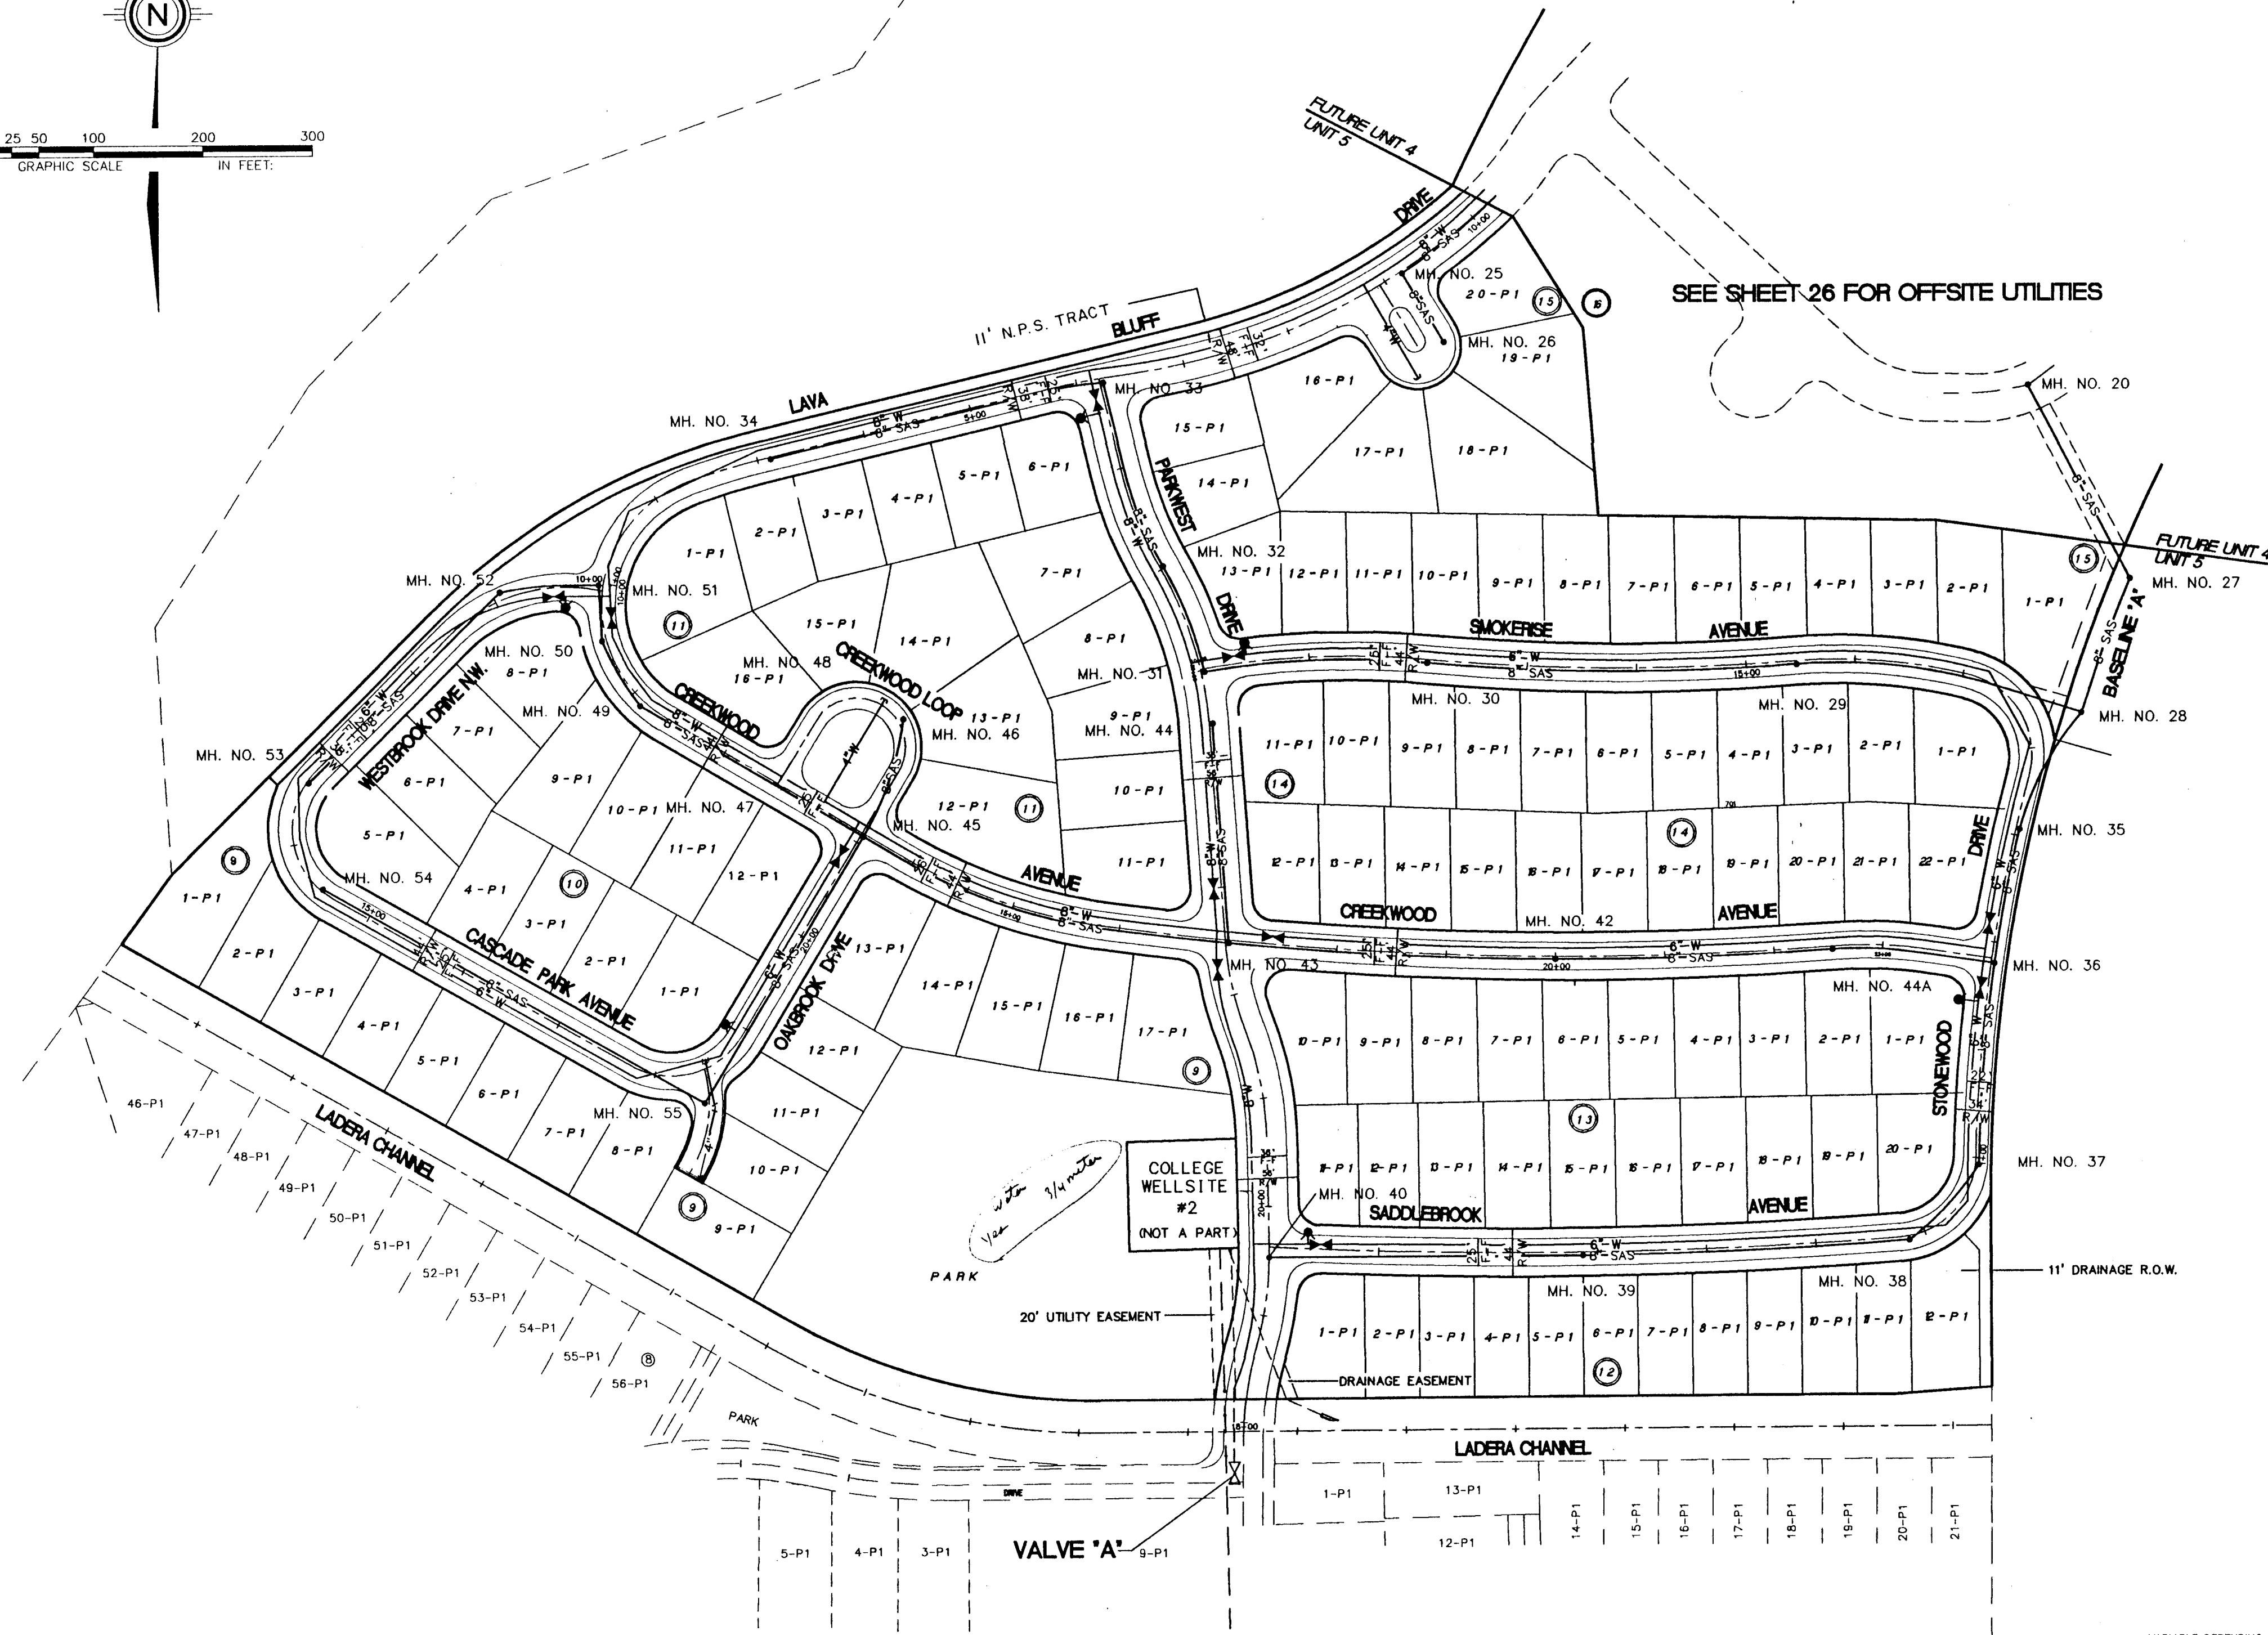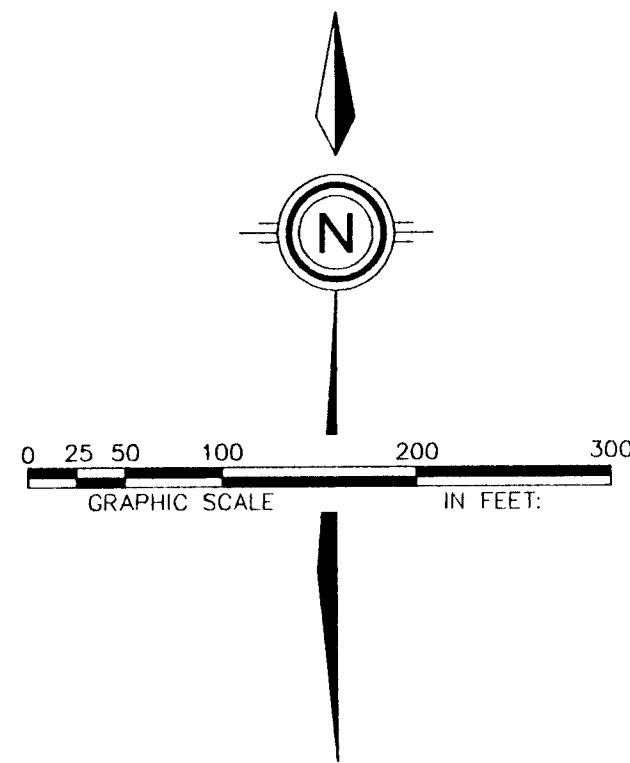

SEE SHEET 26 FOR OFFSITE UTILITIES

UTILITY LEGEND		
DESCRIPTION	PROPOSED	EXISTING
SANITARY SEWER LINE	8" SAS	8" SAS
ENCASEMENT		
SANITARY SEWER MANHOLE		
SAS SERVICE CONNECTION	S	S
STORM DRAIN LINE	SD-30"	SD-30"
STORM DRAIN MANHOLE		
STORM DRAIN INLETS		
WATER LINE	W-6"	W-6"
GATE VALVE		
BUTTERFLY VALVE		
FIRE HYDRANTS		
REDUCERS		
WATER SERVICE/ METER		
TEES		
CROSSES		
BENDS		
CAPS & PLUGS		
GAS LINES	N/A	N/A
OVERHEAD ELECTRICAL LINE	N/A	N/A
UNDERGROUND ELECTRICAL	N/A	N/A
OVERHEAD TELEPHONE	N/A	N/A
UNDERGROUND TELEPHONE	N/A	N/A
CABLE TELEVISION	N/A	N/A
POWER OR TELEPHONE POLE	N/A	N/A

UTILITY NOTES:


1. RESTRAINED JOINTS SUCH AS MEGA-LUG EQUIVALENT BRANDS ACCEPTABLE TO THE ENGINEER, SHALL BE USED ON ALL TEES, BENDS, CROSSES & CAPS IN LIEU OF CONCRETE THRUST BLOCKING. RESTRAINED JOINTS SHALL BE CONSIDERED INCIDENTAL TO THIS CONTRACT AND NO ADDITIONAL COMPENSATION, MEASUREMENT OR PAYMENT WILL BE MADE THEREFOR.
2. LR= LENGTH TO BE RESTRAINED EACH SIDE OF THE FITTINGS.
3. ALL FIRE HYDRANTS & FITTINGS ETC. SHALL BE BUILT IN ACCORDANCE WITH C.O.A. STD. DWGS. 2301 THRU 2380 INCLUSIVE.
4. FOR MH. #'s 29,30,31,32,43,45 & 47 SEE SPECIAL MH. DETAIL ON SHEET 39.

WATER SHUT-OFF PLAN

1. VALVES NO. 1 AND 203 SHALL BE SHUT-OFF SO NON-PRESSURE CONNECTIONS CAN BE MADE.
2. CONTRACTOR SHALL CONTACT WATER SYSTEMS DIVISION (857-8200) THREE (3) WORKING DAYS PRIOR TO VALVE SHUT-OFF. ONLY WATER SYSTEMS PERSONNEL ARE AUTHORIZED TO OPERATE VALVES.

26-4886.94 12507

RECORD DRAWING
12-3-97

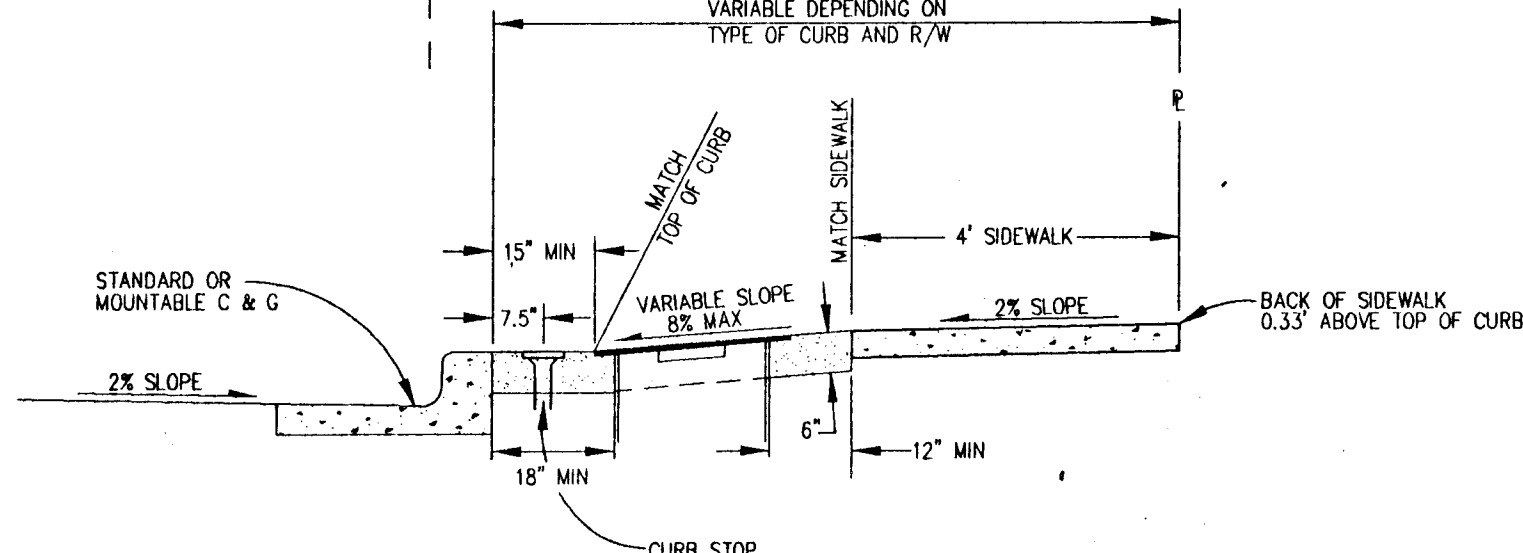

WATER METER BOX INSTALLATION
NOT TO SCALE
NOTE: INSTALL WATER METER PER C.O.A. STD. DWG. 2362

DATE: MAR. 1995		community sciences corporation	
SCALE: 1" = 100'			
DESIGNED BY: B.O.M.			
DRAWN BY: A.B.M.			
JOB NO.: 14326-PRE		LAND PLANNING P.O. Box 1328	
		ENGINEERING Corrales, N.M. 87048	
		SURVEYING	
CITY OF ALBUQUERQUE PUBLIC WORKS DEPARTMENT ENGINEERING GROUP			
TITLE: PARKWEST- UNIT 5 COMPOSITE UTILITY PLAN ON-SITE UTILITIES			
APPROVALS	ENGINEER	DATE	APPROVALS
DRC CHAIRMAN			WATER
TRANSPORTATION	N/A LHO	6-02-95	WASTE WATER
HYDROLOGY	N/A JOC	9-19-95	A.M.A.F.C.A.
DESIGNED BY	B.O.M.	DATE	MARCH 1995
DRAWN BY	A.B.M.	DATE	MARCH 1995
CHECKED BY	J.D.H.	DATE	MARCH 1995
PROJECT NO. 4886.94		MAP NO. G, H9	SHEET 25 OF 39


BENCH MARKS

AS BRASS TABLET STAMPED "2-89" SET IN A 2" ROR PIPE
1 FT. ABOVE GROUND LOCATED ON TOP OF A VOLCANIC OUTCROP
TO REACH THE STATION FROM THE INTERSECTION OF COORS RD.
& OURAY RD. NW. GO WEST ON OURAY RD. ABOUT 0.7 MI. TO THE
END OF PAVEMENT. CONTINUE WEST ON THE DIRT RD. TO THE
TOP OF THE DETENTION DAM ALONG THE NORTH BANK OF THE DAM
0.6 MI. TO A DIRT CROSS RD., TURN RIGHT, GO NORTH ON THE
DIRT RD. 0.5 MI.
S.D. 1428 ELEVATION = 5334.50 FEET

SURVEY INFORMATION

FIELD NOTES	DATE
NO. 1	COMMUNITY SCIENCES



ENGINEER'S SEAL

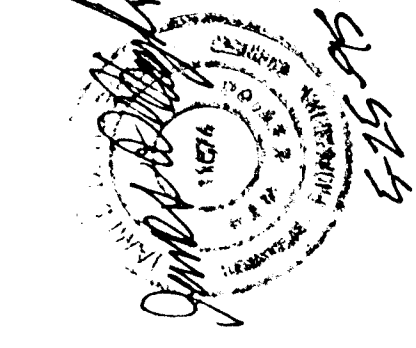

REVISIONS

NO.	DATE	REMARKS	BY
1		DESIGN	

05-23 81

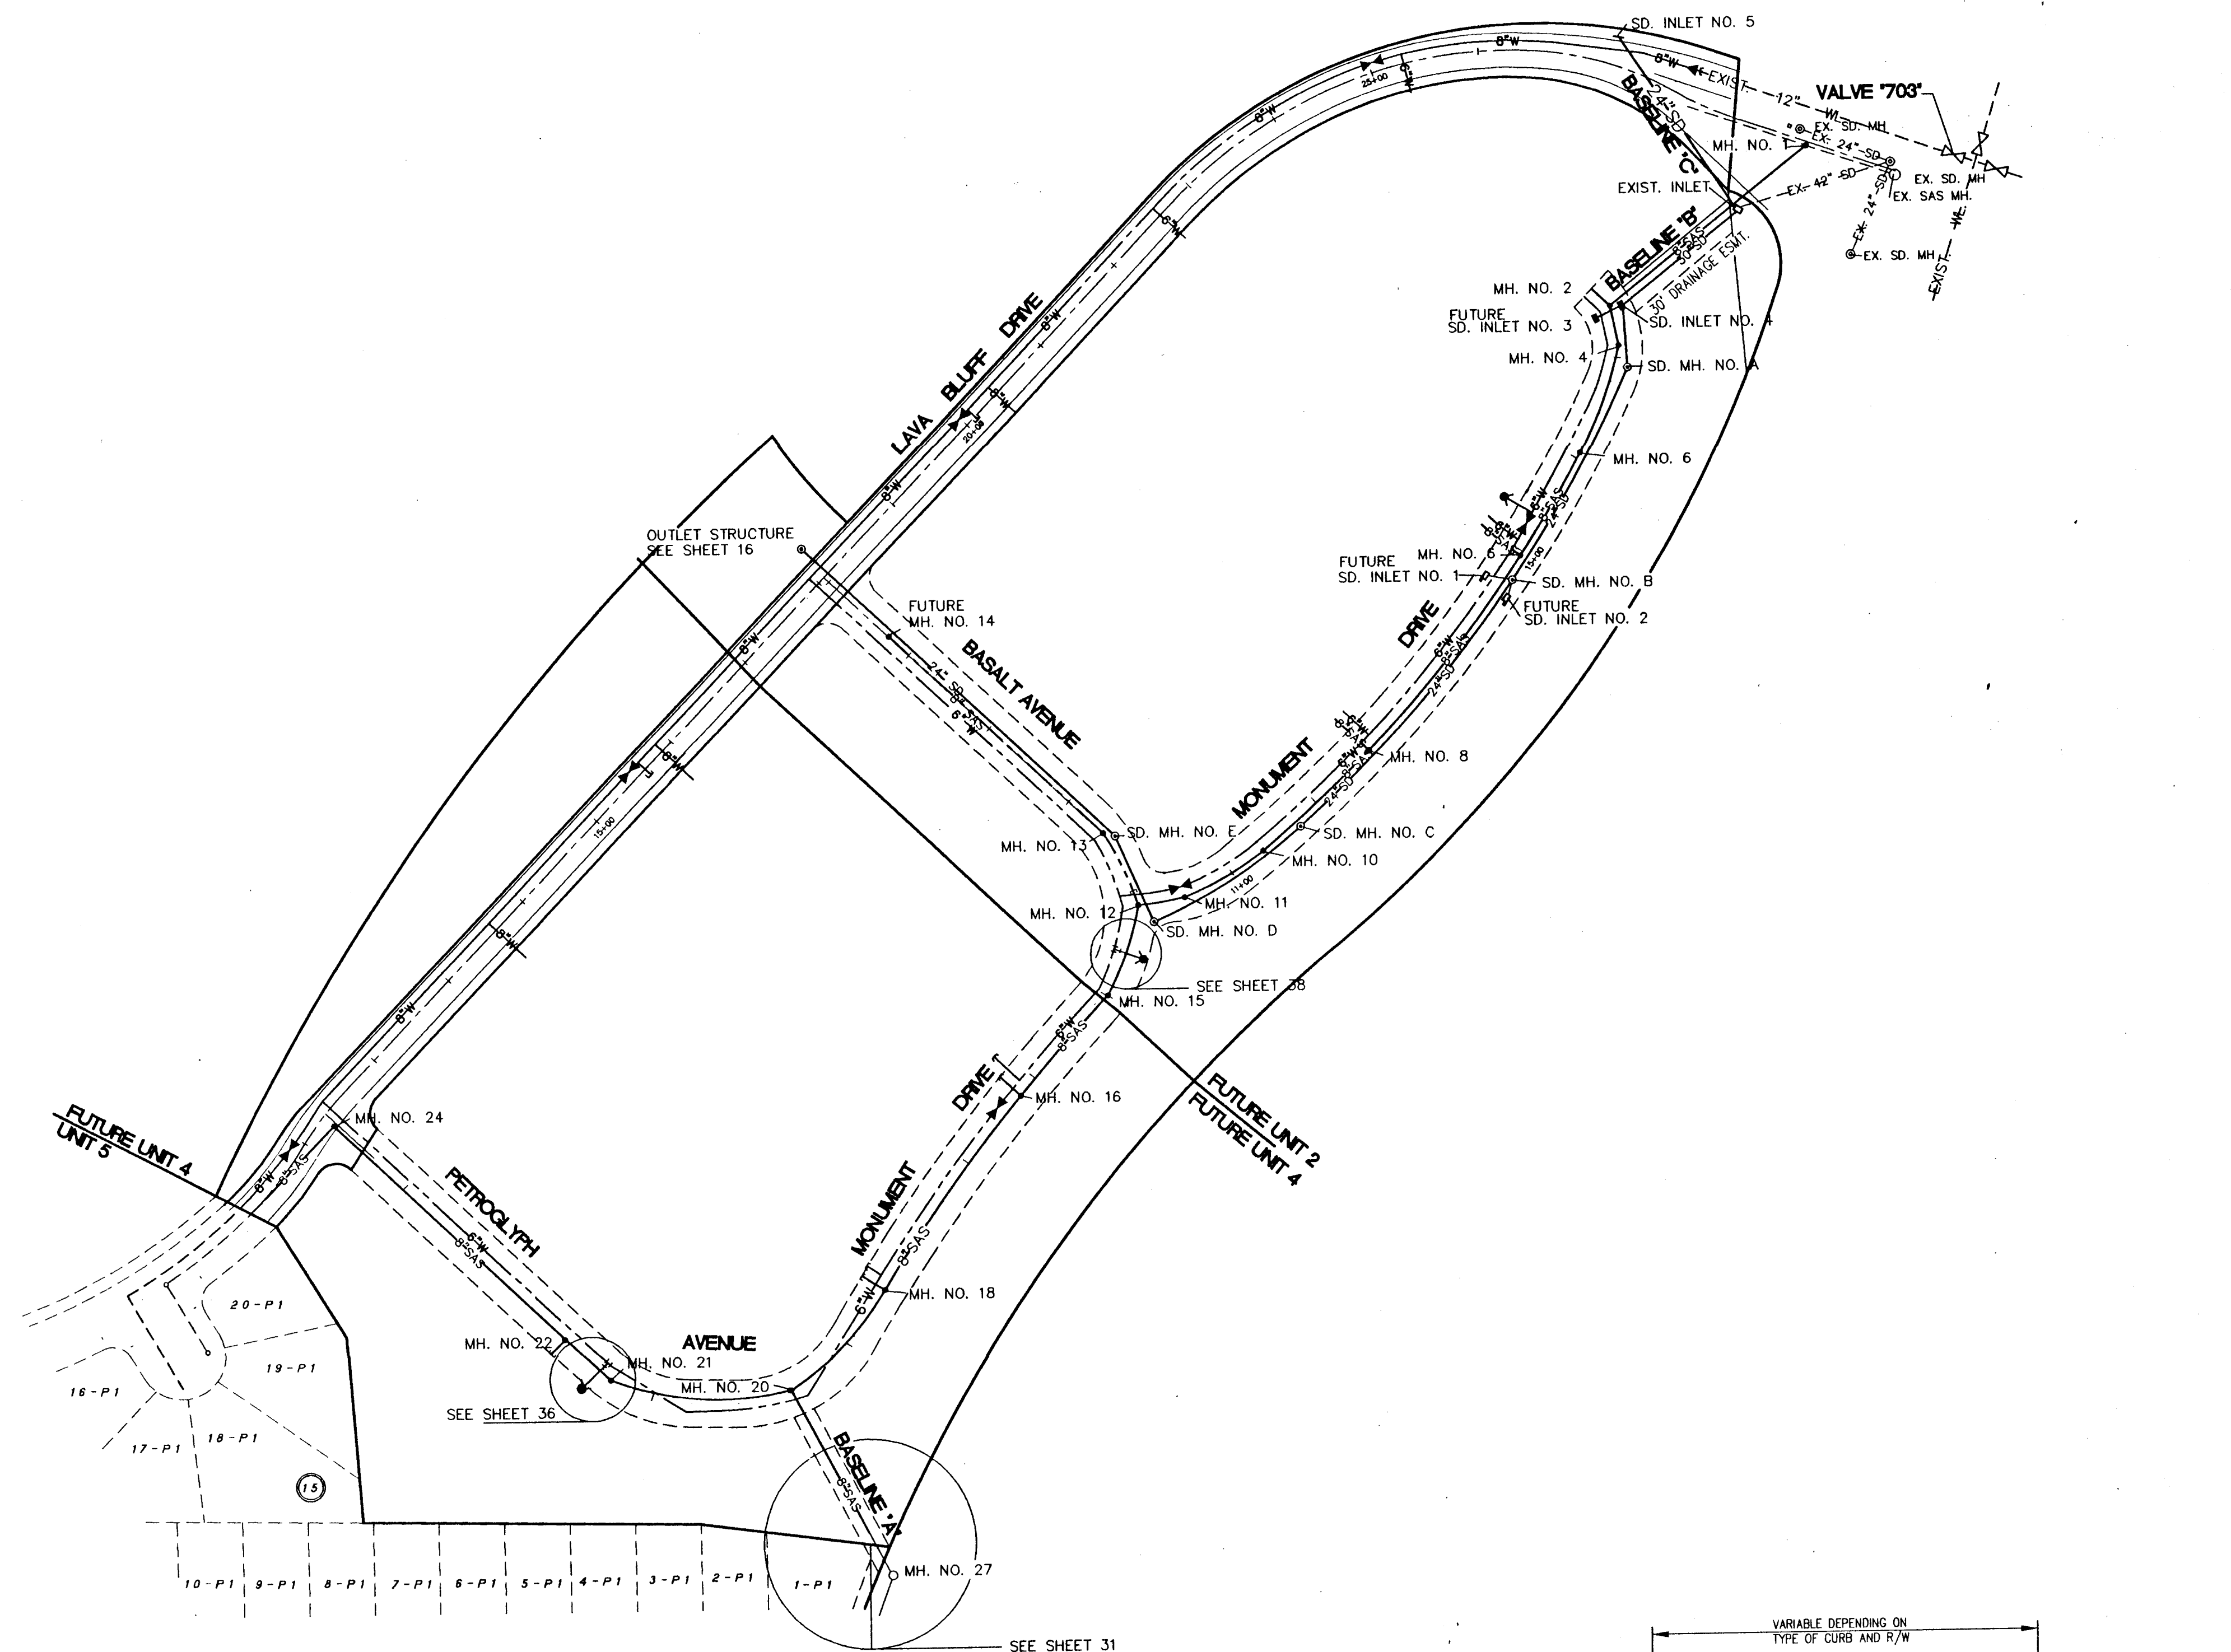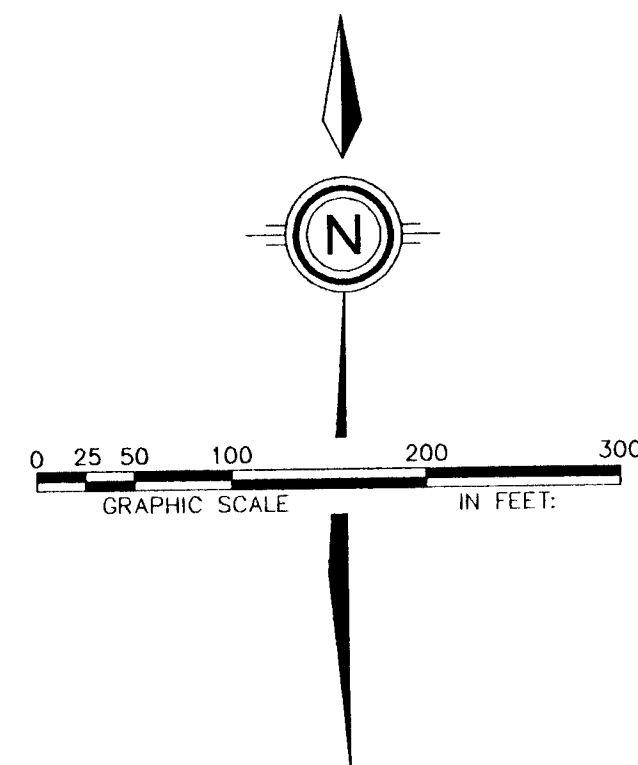

UTILITY LEGEND		
DESCRIPTION	PROPOSED	EXISTING
SANITARY SEWER LINE	8" SAS	8" SAS
ENCASEMENT		
SANITARY SEWER MANHOLE		
SAS SERVICE CONNECTION		
STORM DRAIN LINE	SD-30"	SD-30"
STORM DRAIN MANHOLE		
STORM DRAIN INLETS		
WATER LINE	W-6"	W-6"
GATE VALVE		
BUTTERFLY VALVE		
FIRE HYDRANTS		
REDUCERS		
WATER SERVICE/ METER		
TEES		
CROSSES		
BENDS		
CAPS & PLUGS		
WATERLINE (FUTURE)	6" W	

UTILITY NOTES:


1. RESTRAINED JOINTS SUCH AS MEGA-LUG EQUIVALENT BRANDS ACCEPTABLE TO THE ENGINEER, SHALL BE USED ON ALL TEES, BENDS, CROSSES & CAPS IN LIEU OF CONCRETE THRUST BLOCKING, RESTRAINED JOINTS SHALL BE CONSIDERED INCIDENTAL TO THIS CONTRACT AND NO ADDITIONAL COMPENSATION, MEASUREMENT OR PAYMENT WILL BE MADE THEREFORE.
2. LR SHALL BE THE LENGTH OF WATER MAIN THAT REQUIRED JOINTS ON EACH SIDE OF THE FITTINGS.
3. ALL FIRE HYDRANTS & FITTINGS ETC. SHALL BE BUILT IN ACCORDANCE WITH C.O.A. STD. DWGS. 2301 THRU 2380 INCLUSIVE.

WATER SHUT-OFF PLAN

1. VALVES NO. A AND 703 SHALL BE SHUT-OFF SO NON-PRESSURE CONNECTIONS CAN BE MADE.
2. CONTRACTOR SHALL CONTACT WATER SYSTEMS DIVISION (857-8200) THREE (3) WORKING DAYS PRIOR TO VALVE SHUT-OFF ONLY WATER SYSTEMS PERSONNEL ARE AUTHORIZED TO OPERATE VALVES.

26-4886.94 21627

RECORD DRAWING
12-3-97

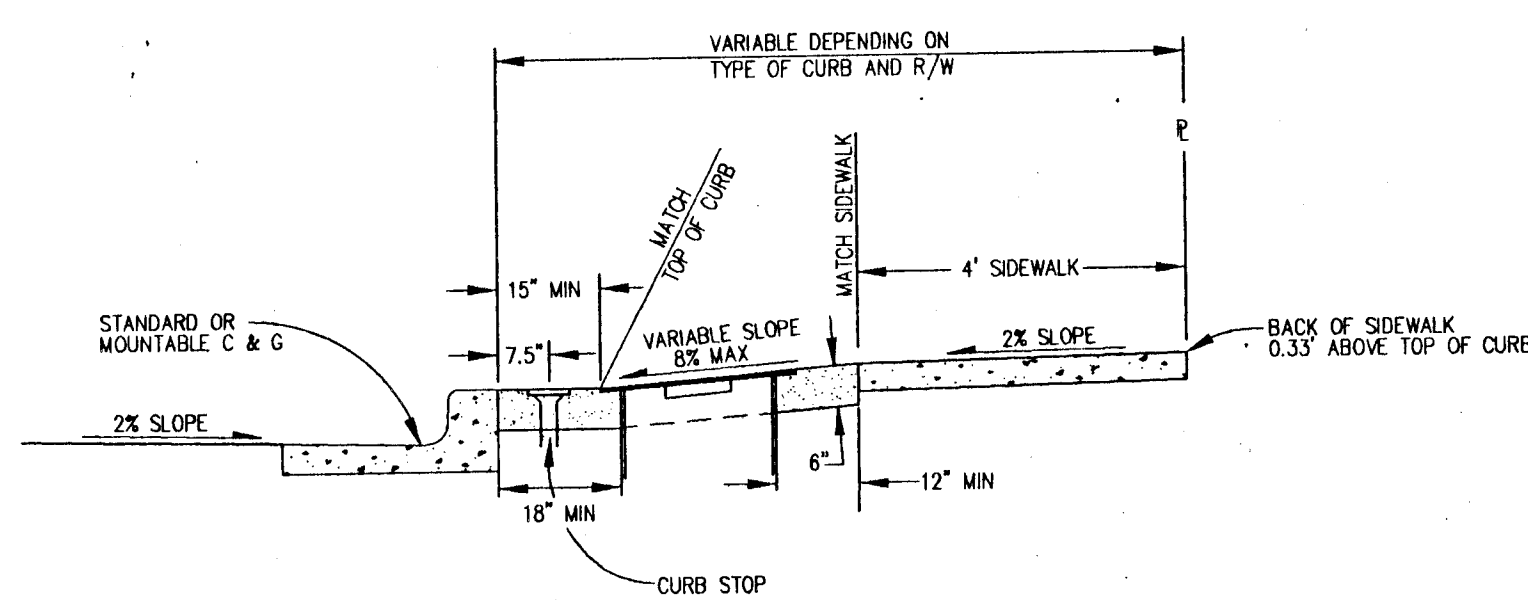

WATER METER BOX INSTALLATION
NOT TO SCALE
NOTE: INSTALL WATER METER PER C.O.A. STD. DWG. 2362

CONTRACTOR SUNDANCE MECH. DATE 12/97		ENGINEER'S SEAL 																	
WORK BY SUNDANCE MECH. DATE 12/97		REVISIONS <table border="1"> <tr> <th>NO.</th> <th>DATE</th> <th>BY</th> <th>REMARKS</th> </tr> <tr> <td>1</td> <td>MARCH 1995</td> <td>B.O.M.</td> <td>DESIGN</td> </tr> <tr> <td>2</td> <td>MARCH 1995</td> <td>A.M.</td> <td></td> </tr> <tr> <td>3</td> <td>MARCH 1995</td> <td>J.D.H.</td> <td></td> </tr> </table>		NO.	DATE	BY	REMARKS	1	MARCH 1995	B.O.M.	DESIGN	2	MARCH 1995	A.M.		3	MARCH 1995	J.D.H.	
NO.	DATE	BY	REMARKS																
1	MARCH 1995	B.O.M.	DESIGN																
2	MARCH 1995	A.M.																	
3	MARCH 1995	J.D.H.																	
CITY OF ALBUQUERQUE PUBLIC WORKS DEPARTMENT ENGINEERING GROUP																			
TITLE: PARKWEST- UNIT 5 COMPOSITE UTILITY PLAN OFFSITE UTILITIES																			
APPROVALS	ENGINEER	DATE	APPROVALS																
DRG CHAIRMAN	R.W. Kane	6-5-95	WATER																
TRANSPORTATION	n/p RHP	6-2-95	WASTE WATER																
HYDROLOGY																			
PROJECT NO. 4886.94		SHEET 26 OF 30																	

① CURVE DATA
R = 300.00'
L = 48.51'
Δ = 009°15'52"
CH = 48.46
CH-BEARING = N11°40'10"E

② CURVE DATA
R = 300.00'
L = 92.57'
Δ = 017°40'46"
CH = 92.20'
CH-BEARING = S07°27'43"W

③ CURVE DATA
R = 300.00'
L = 100.71'
Δ = 019°14'06"
CH = 100.24'
CH-BEARING = S88°37'20"W

④ CURVE DATA
R = 300.00'
L = 88.11'
Δ = 016°26'48"
CH = 85.82'
CH-BEARING = S12°23'23"E

⑤ CURVE DATA
R = 350.00'
L = 55.11'
Δ = 009°01'18"
CH = 55.05'
CH-BEARING = S08°40'38"E

⑥ CURVE DATA
R = 350.00'
L = 100.50'
Δ = 016°27'05"
CH = 100.15'
CH-BEARING = S21°24'49"E


⑦ CURVE DATA
R = 350.00'
L = 98.61'
Δ = 016°08'33"
CH = 98.28'
CH-BEARING = N 21°34'05" W


⑧ CURVE DATA
R = 350.00'
L = 100.50'
Δ = 016°27'05"
CH = 100.15'
CH-BEARING = S21°24'49"E

⑨ CURVE DATA
R = 350.00'
L = 98.61'
Δ = 016°08'33"
CH = 98.28'
CH-BEARING = N 21°34'05" W

⑩ CURVE DATA
R = 350.00'
L = 100.50'
Δ = 016°27'05"
CH = 100.15'
CH-BEARING = S21°24'49"E


⑪ CURVE DATA
R = 350.00'
L = 98.61'
Δ = 016°08'33"
CH = 98.28'
CH-BEARING = N 21°34'05" W

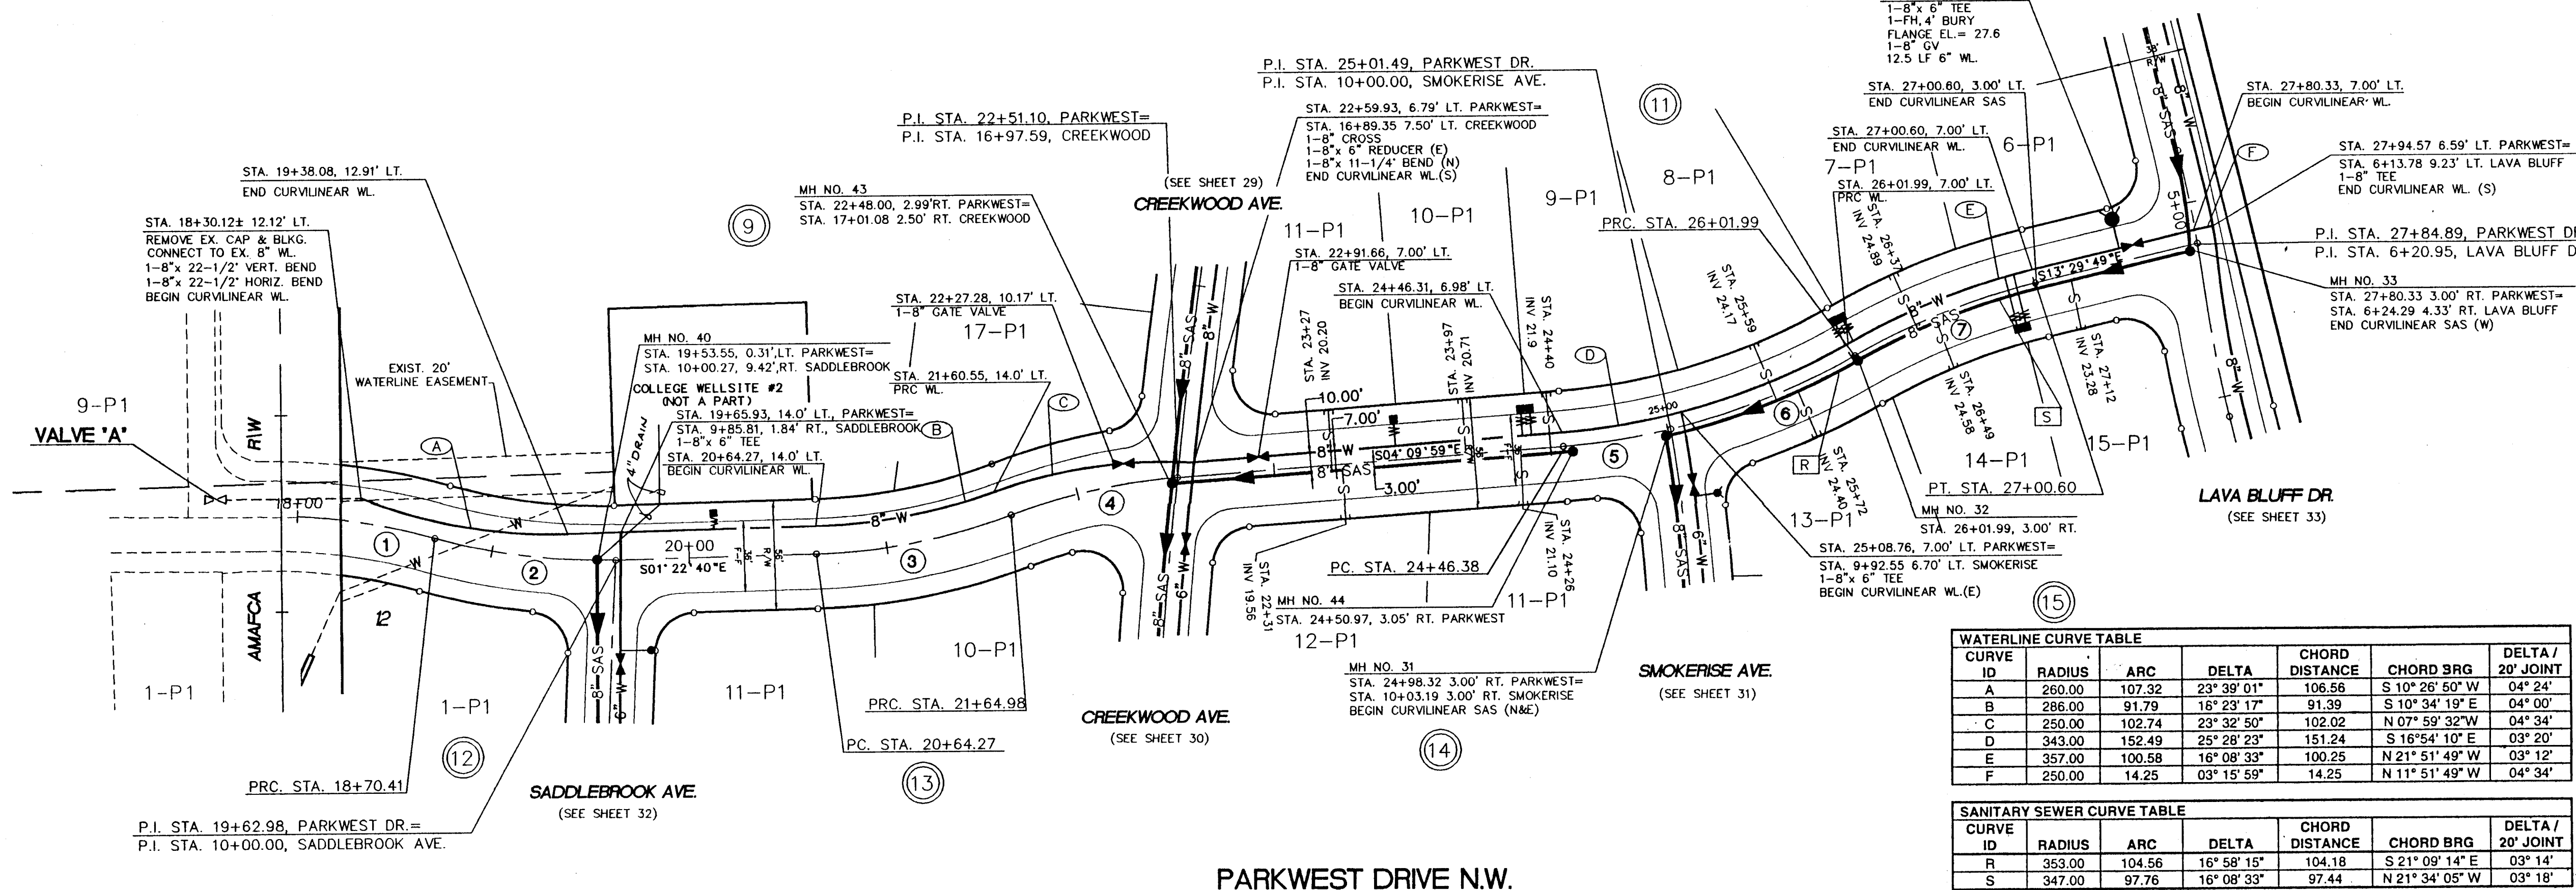

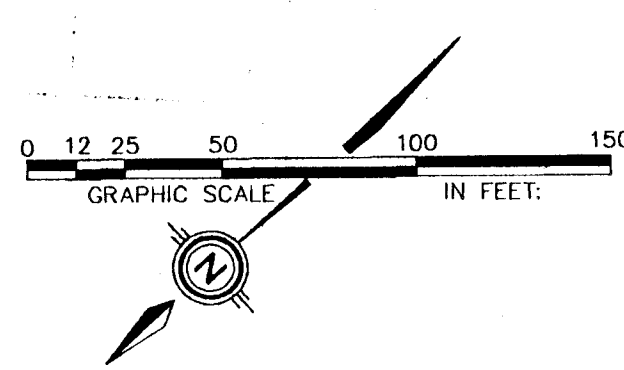

⑧ CURVE DATA
R = 150.00'
L = 152.14'
Δ = 058°06'49"
CH = 145.70'
CH-BEARING = S73°54'24"W

⑨ CURVE DATA
R = 75.00'
L = 137.55'
Δ = 105°05'02"
CH = 119.07'
CH-BEARING = S07°41'32"E

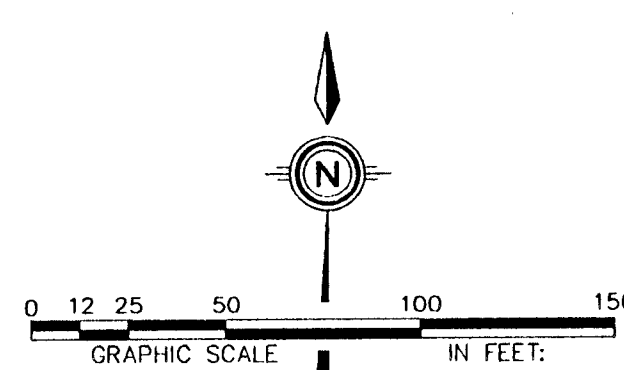

⑩ CURVE DATA
R = 75.00'
L = 116.64'
Δ = 089°06'34"
CH = 105.24'
CH-BEARING = N75°12'40"E

⑪ CURVE DATA
R = 120.00'
L = 95.62'
Δ = 045°39'26"
CH = 93.11'
CH-BEARING = S06°56'14"W

P.I. STA. 21+10.01, OAKBROOK DR. =
P.I. STA. 13+46.25, CREEKWOOD AVE. =
P.I. STA. 3+71.37, CREEKWOOD LOOP

UTILITY LEGEND		
DESCRIPTION	PROPOSED	EXISTING
SANITARY SEWER LINE	8" SAS	8" SAS
ENCASEMENT		
SANITARY SEWER MANHOLE		
SAS SERVICE CONNECTION	S	S
STORM DRAIN LINE	SD-30"	SD-30"
STORM DRAIN MANHOLE		
STORM DRAIN INLETS		
WATER LINE	W-6"	W-6"
GATE VALVE		
BUTTERFLY VALVE		
FIRE HYDRANTS		
REDUCERS		
WATER SERVICE/ METER		
TEES		
CROSSES		
BENDS		
CAPS & PLUGS		
GAS LINES	N/A	N/A
OVERHEAD ELECTRICAL LINE	N/A	N/A
UNDERGROUND ELECTRICAL	N/A	N/A
OVERHEAD TELEPHONE	N/A	N/A
UNDERGROUND TELEPHONE	N/A	N/A
CABLE TELEVISION	N/A	N/A
POWER OR TELEPHONE POLE	N/A	N/A
WATERLINE CURVILINEAR I.D.		
SANITARY SEWER CURVILINEAR I.D.		
STORM DRAINAGE CURVILINEAR I.D.		

RESTRAINING LENGTHS	
FITTING	LR (FT)
6"-11 1/4" Bend	2
6"-22 1/2" Bend	3
6"-45" Bend	7
8"-11 1/4" Bend	2
8"-22 1/2" Bend	4
6" GV	46
8" GV	60
8x6 Reducers	25 L/33 S
8x8 Tee	9 Run/20 Branch
8x6 Tee	5 Run/17 Branch
8" Cross	9
8x6x4 Tee	5/17
6" Dead Ends	46
8" Dead Ends	60
12x8 Reducers	45 Run/68 Branch

LR = LENGTH TO BE RESTRAINED EACH SIDE OF THE FITTING. FOR TEES, ALL THREE LEGS SHALL BE RESTRAINED FOR A DISTANCE OF "LR". FOR REDUCERS, "LR" IS GIVEN FOR THE LARGER DIAMETER SIDE OF THE FITTING AND NO RESTRAINING IS REQUIRED ON THE SMALL SIDE OF THE FITTING. GATE VALVES SHALL BE MECHANICALLY RESTRAINED AND INSTALLED WITH CONCRETE BLOCKING PER COA STD DWG 2333 IN ADDITION TO THE MECHANICALLY RESTRAINED LENGTHS. ALL CAPS SHALL BE INSTALLED WITH CONCRETE BLOCKING PER COA STD DWG 2320. RESTRAIN ALL JOINTS ON FIRE HYDRANTS.

26-4886-174 2807

RECORD DRAWING
12-3-97

SCALE:
1" = 50', HORIZ.
1" = 10', VERT.

community sciences corporation


JOB NO. 14326-041 LAND PLANNING P.O. Box 1328 ENGINEERING Corrales, N.M. 87048 SURVEYING

CITY OF ALBUQUERQUE
PUBLIC WORKS DEPARTMENT
ENGINEERING GROUP



TITLE: PARKWEST-UNIT 5
UTILITY PLAN & PROFILE
WESTBROOK, CASCADE PARK & OAKBROOK DR.

APPROVALS	ENGINEER	DATE	APPROVALS	ENGINEER	DATE
DRC CHAIRMAN			WATER	R.W. Kane	6-5-95
TRANSPORTATION	N/A RHD	6-22-95	WASTE WATER	R.W. Kane	6-5-95
HYDROLOGY	N/A JPC	9-19-95	A.M.A.F.C.A.		

PROJECT NO. 4886.94 MAP NO. G,H-9 SHEET 28 OF 39

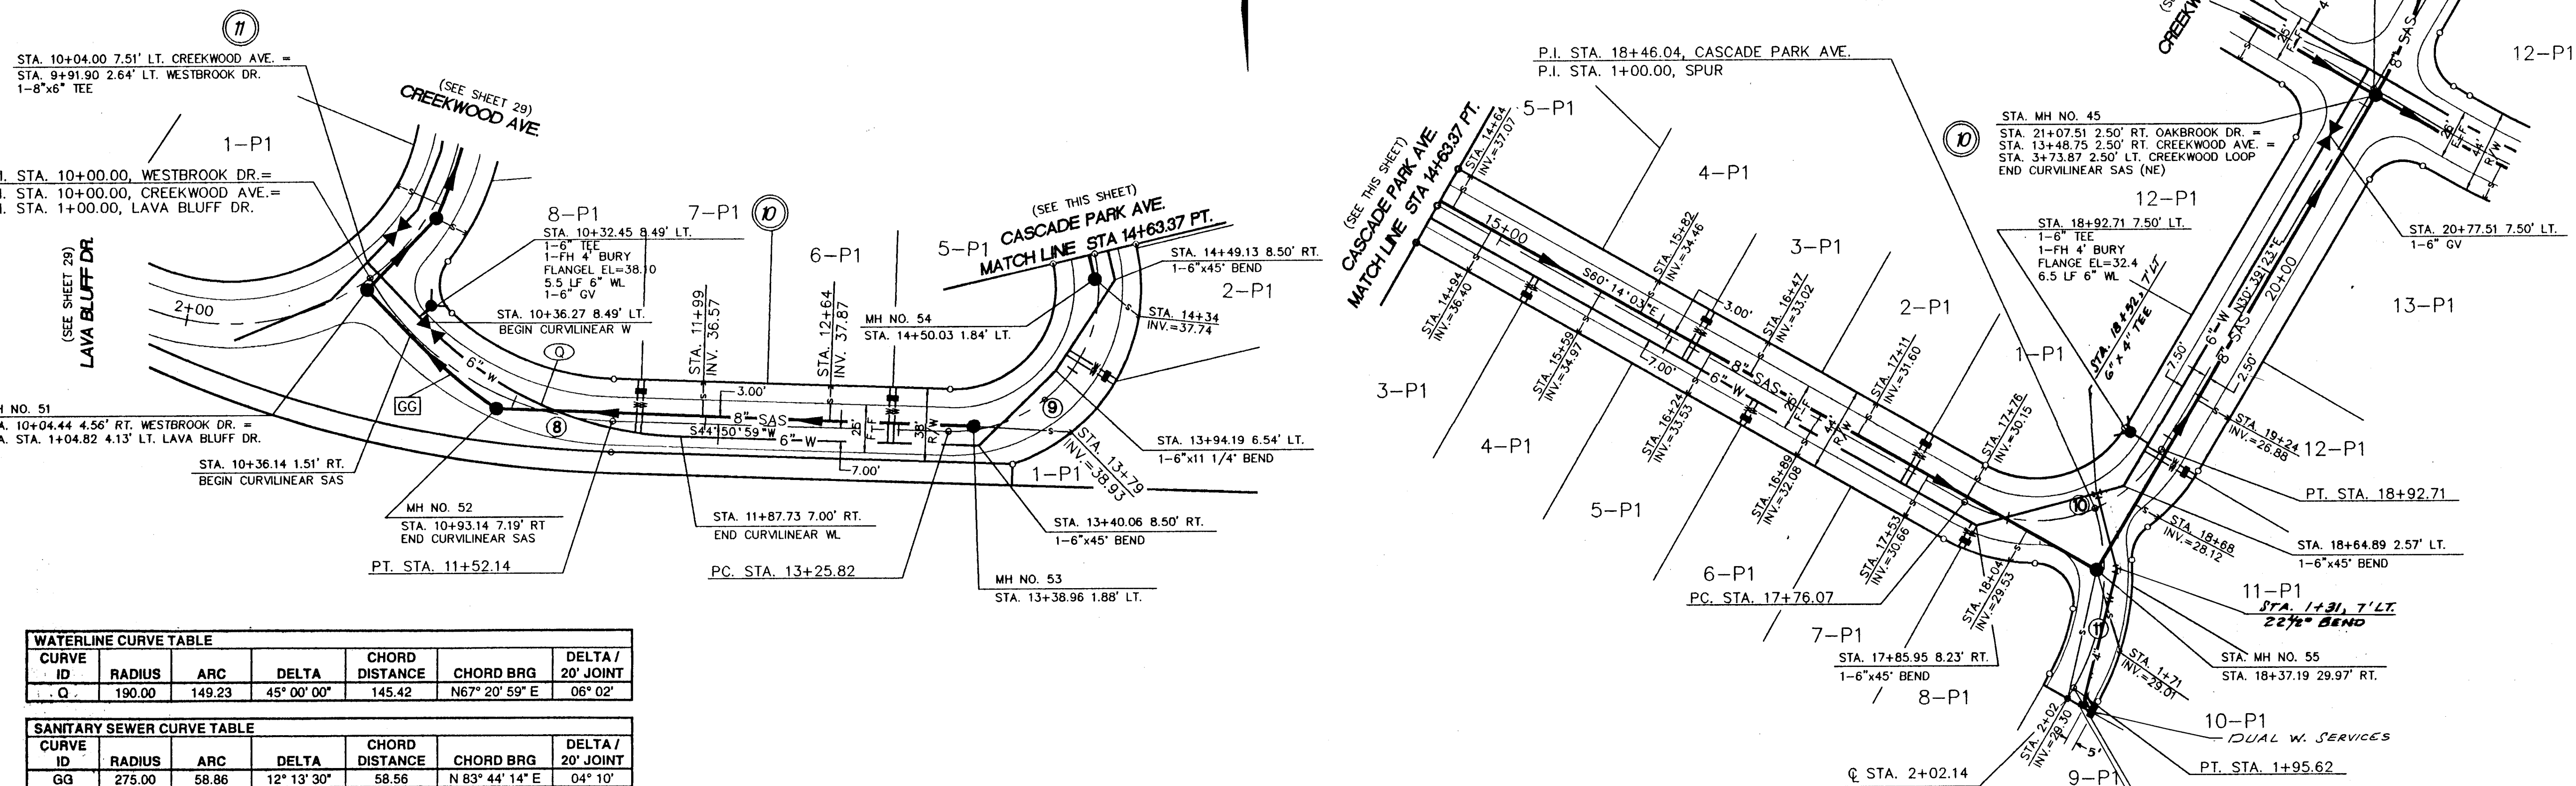


WESTBROOK DR., CASCADE PARK AVE. AND OAKBROOK DR. N.W.

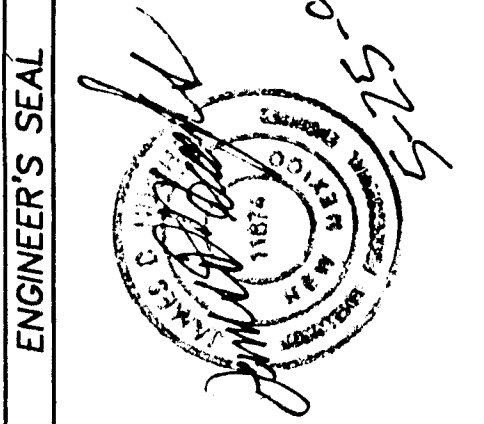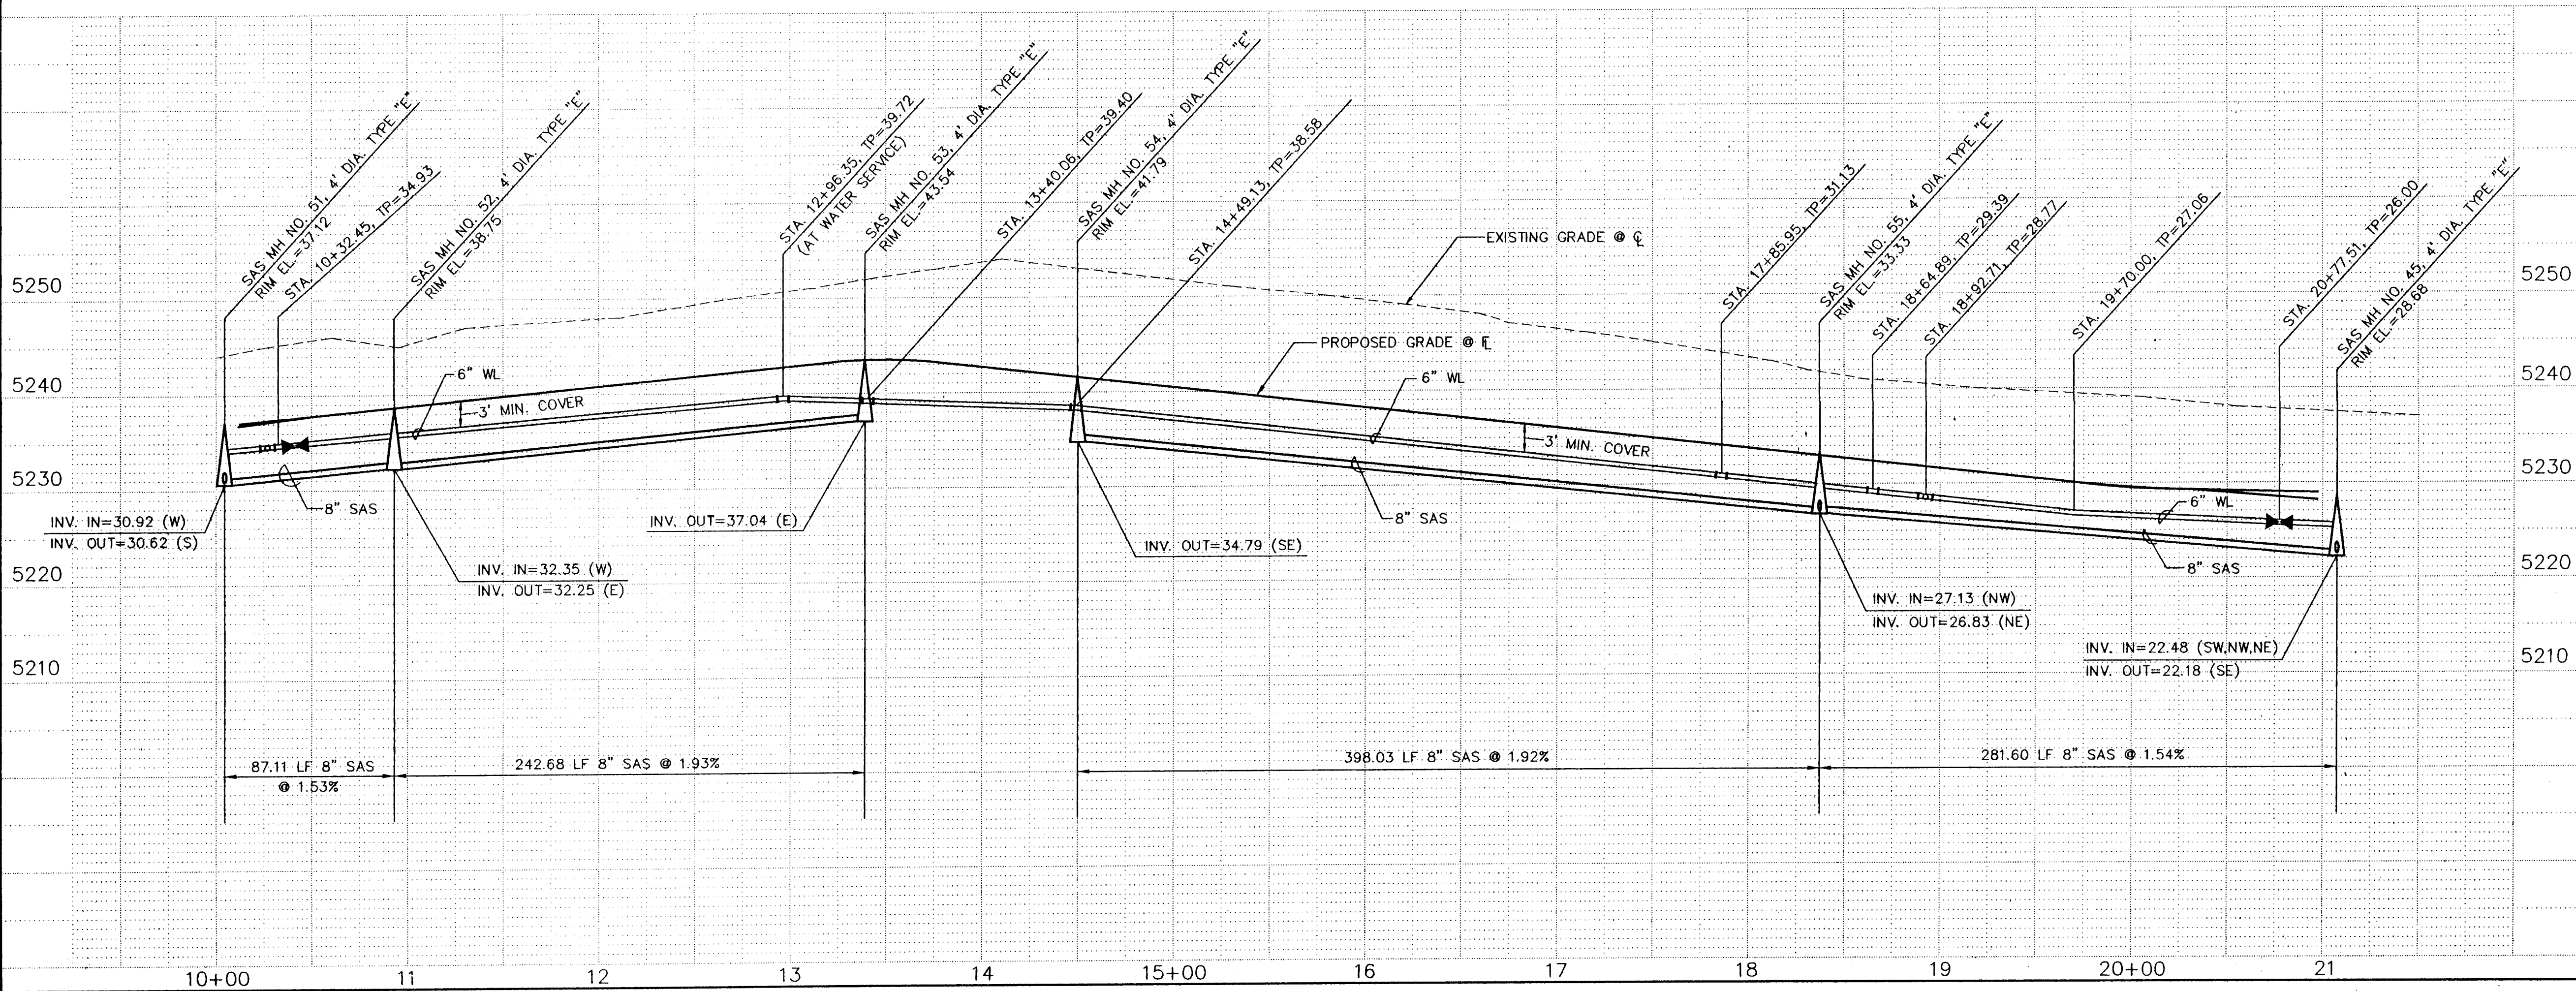

REVISIONS		DATE	BY
NO.	DATE	REMARKS	BY
1	6-5-95	DESIGN	JDH


SCANNED BY
BY LASON

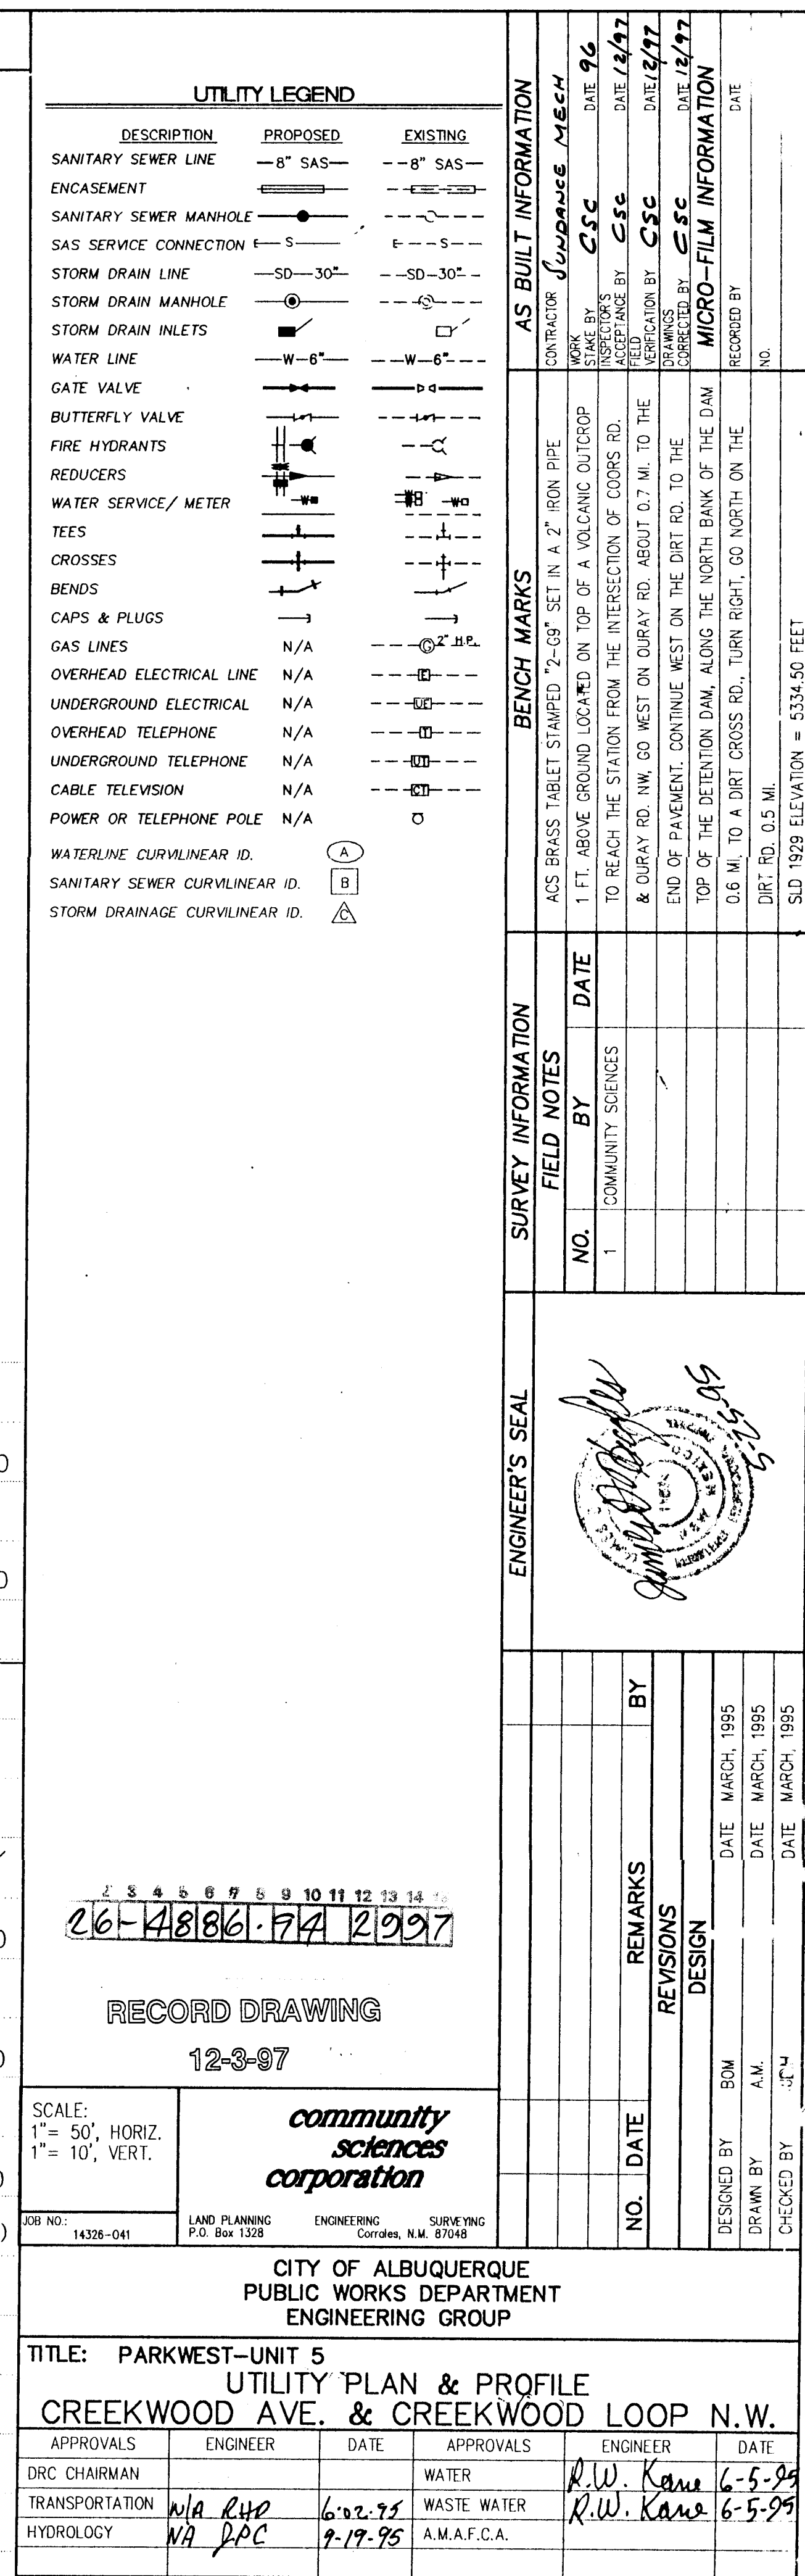

18-42 81

COMMUNITY SCIENCES CORPORATION - CORRALES, NEW MEXICO - (505) 897-0000

18) C CURVE DATA R = 800.00' L = 208.35' Δ = 014°55'19" CH = 207.76' CH-BEARING = N87°52'57"E	19) C CURVE DATA R = 2000.00' L = 337.99' Δ = 009°40'58" CH = 338.59' CH-BEARING = S89°29'52"E	20) C CURVE DATA R = 500.00' L = 159.64' Δ = 018°17'38" CH = 158.97' CH-BEARING = S85°11'32"E	21) C CURVE DATA R = 75.00' L = 118.93' Δ = 090°51'29" CH = 106.86' CH-BEARING = S30°36'59"E
--	---	--	---

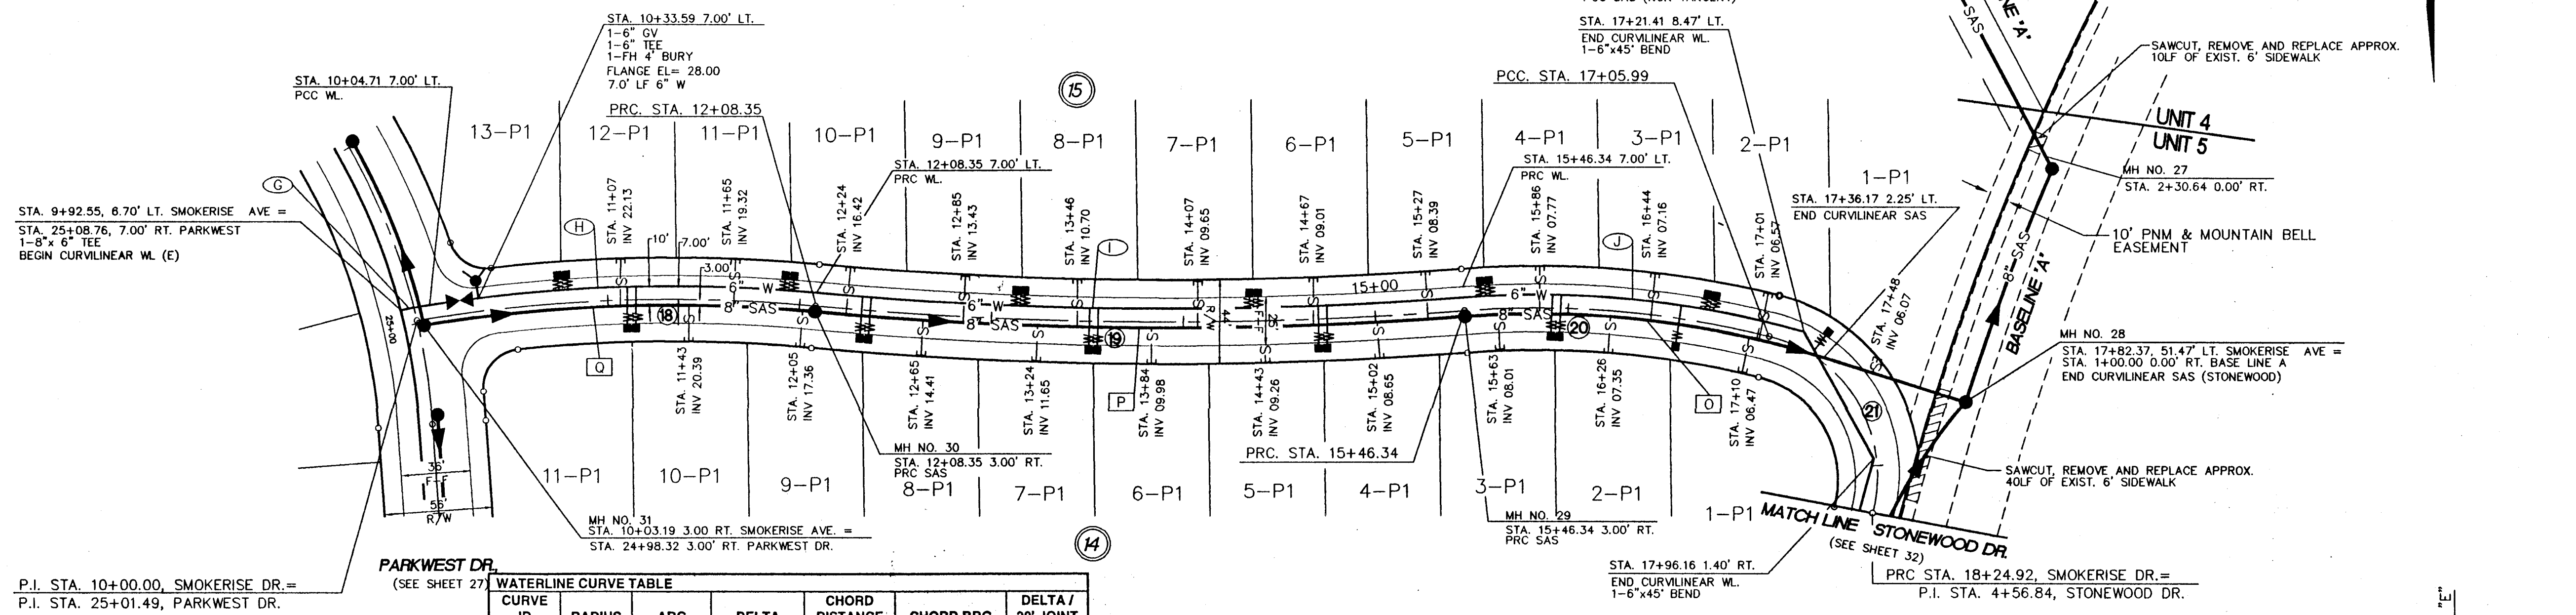

WATERLINE CURVE TABLE						
CURVE ID	RADIUS	ARC	DELTA	CHORD DISTANCE	CHORD BRG	DELTA / 20° JOINT
G	190.00	12.27	03° 42' 01"	12.27	N 78° 54' 33" E	08° 02'
H	807.00	205.42	14° 35' 04"	204.86	N 89° 03' 05" E	18° 25'
I	1993.00	336.81	09° 40' 58"	336.41	N 89° 29' 52" W	03° 34'
J	507.00	178.93	20° 13' 15"	178.00	S 84° 13' 44" E	02° 15'

SANITARY SEWER CURVE TABLE						
CURVE ID	RADIUS	ARC	DELTA	CHORD DISTANCE	CHORD BRG	DELTA / 20° JOINT
O	497.00	188.97	21° 47' 04"	187.83	S 83° 26' 49" E	02° 18'
P	2003.00	338.50	09° 40' 58"	338.10	N 89° 29' 52" W	03° 42'
Q	797.00	204.39	14° 41' 36"	204.39	N 87° 59' 49" E	01° 26'

SMOKERISE AVENUE N.W.

UTILITY LEGEND		
DESCRIPTION	PROPOSED	EXISTING
SANITARY SEWER LINE	— 8" SAS —	— 8" SAS —
ENCASEMENT	— 8" SAS —	— 8" SAS —
SANITARY SEWER MANHOLE	— S —	— S —
SAS SERVICE CONNECTION	— S —	— S —
STORM DRAIN LINE	— SD — 30" —	— SD — 30" —
STORM DRAIN MANHOLE	— S —	— S —
STORM DRAIN INLETS	— S —	— S —
WATER LINE	— W — 6" —	— W — 6" —
GATE VALVE	— G —	— G —
BUTTERFLY VALVE	— B —	— B —
FIRE HYDRANTS	— F —	— F —
REDUCERS	— R —	— R —
WATER SERVICE/ METER	— W —	— W —
TEES	— T —	— T —
CROSSES	— C —	— C —
BENDS	— B —	— B —
CAPS & PLUGS	— C —	— C —
GAS LINES	N/A	— G — 2" B.S.
OVERHEAD ELECTRICAL LINE	N/A	— E —
UNDERGROUND ELECTRICAL	N/A	— E —
OVERHEAD TELEPHONE	N/A	— T —
UNDERGROUND TELEPHONE	N/A	— T —
CABLE TELEVISION	N/A	— C —
POWER OR TELEPHONE POLE	N/A	— P —
WATERLINE CURVILINEAR ID.	(A)	(A)
SANITARY SEWER CURVILINEAR ID.	(B)	(B)
STORM DRAINAGE CURVILINEAR ID.	(C)	(C)

RESTRAINING LENGTHS	
FITTING	LR (FT)
6"-11 1/2" Bend	2
6"-22 1/2" Bend	3
6"-45" Bend	7
8"-11 1/2" Bend	2
8"-22 1/2" Bend	4
8" GV	46
8" Tee	60
8x6 Reducers	25 L/33 S
8x8 Tee	9 Run/20 Branch
8x6 Tee	5 Run/17 Branch
8" Cross	9
8x8x4 Tee	5/17
6x6x6 Tee	6/20
6" Dead Ends	46
8" Dead Ends	60
12x8 Reducers	45 Run/68 Branch

LR = LENGTH TO BE RESTRAINED EACH SIDE OF THE FITTING. FOR TEES, ALL THREE LEGS SHALL BE RESTRAINED FOR A DISTANCE OF "LR". FOR REDUCERS, "LR" IS GIVEN FOR THE LARGER DIAMETER SIDE OF THE FITTING AND NO RESTRAINING IS REQUIRED ON THE SMALL SIDE OF THE FITTING. GATE VALVES SHALL BE MECHANICALLY RESTRAINED AND INSTALLED WITH CONCRETE BLOCKING PER COA STD DWG 2333 IN ADDITION TO THE MECHANICALLY RESTRAINED LENGTHS. ALL CAPS SHALL BE INSTALLED WITH CONCRETE BLOCKING PER COA STD DWG 2320. RESTRAIN ALL JOINTS ON FIRE HYDRANTS.

RECORD DRAWING
12-3-87

SCALE:
1" = 50', HORIZ.
1" = 10', VERT.

community sciences corporation

14328-041 LAND PLANNING P.O. Box 1328 ENGINEERING Corrales, N.M. 87048 SURVEYING


CITY OF ALBUQUERQUE
PUBLIC WORKS DEPARTMENT
ENGINEERING GROUP

TITLE: PARKWEST-UNIT 5
UTILITY PLAN & PROFILE
SMOKERISE AVENUE N.W.

APPROVALS	ENGINEER	DATE	APPROVALS	ENGINEER	DATE
DRC CHAIRMAN			WATER	R.W. Kane	6-5-89
TRANSPORTATION	W.A. GAO	6-12-85	WASTE WATER	R.W. Kane	6-5-89
HYDROLOGY	W.A. GAO	9-19-85	A.M.A.F.C.A.		

PROJECT NO. 4886.94 MAP NO. G,H-9 SHEET 31 OF 39

AS BUILT INFORMATION		
CONTRACTOR	Community Sciences	DATE 9/6
WORK	1 FT. ABOVE GROUND LOCATED ON TOP OF A VOLCANIC OUTCROP	DATE 12/17
STATE BY	1 FT. ABOVE GROUND LOCATED ON TOP OF A VOLCANIC OUTCROP	DATE 12/17
DATE	1 FT. ABOVE GROUND LOCATED ON TOP OF A VOLCANIC OUTCROP	DATE 12/17
DATE	1 FT. ABOVE GROUND LOCATED ON TOP OF A VOLCANIC OUTCROP	DATE 12/17
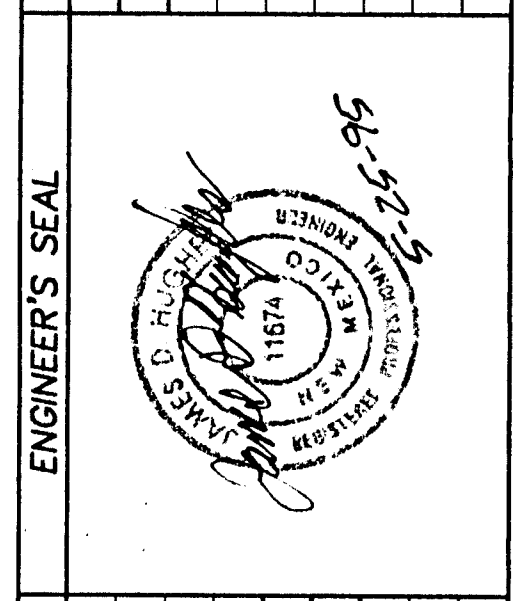

REVISIONS	
NO.	DATE
1	6-5-89
2	6-5-89
SCANNED BY
BY LASON





26-4886.94 131917

22 C CURVE DATA
R = 4500.00'
L = 577.33'
Δ = 007°21'03"
CH = 576.93'
CH-BEARING = N89°23'01"E

23 C CURVE DATA
R = 75.00'
L = 110.75'
Δ = 084°36'11"
CH = 100.95'
CH-BEARING = S43°24'24"W

24 C CURVE DATA
R = 1491.55'
L = 184.33'
Δ = 007°04'51"
CH = 184.21'
CH-BEARING = S04°38'44"W

25 C CURVE DATA
R = 1491.55'
L = 172.51'
Δ = 006°37'36"
CH = 172.41'
CH-BEARING = S11°29'58"W

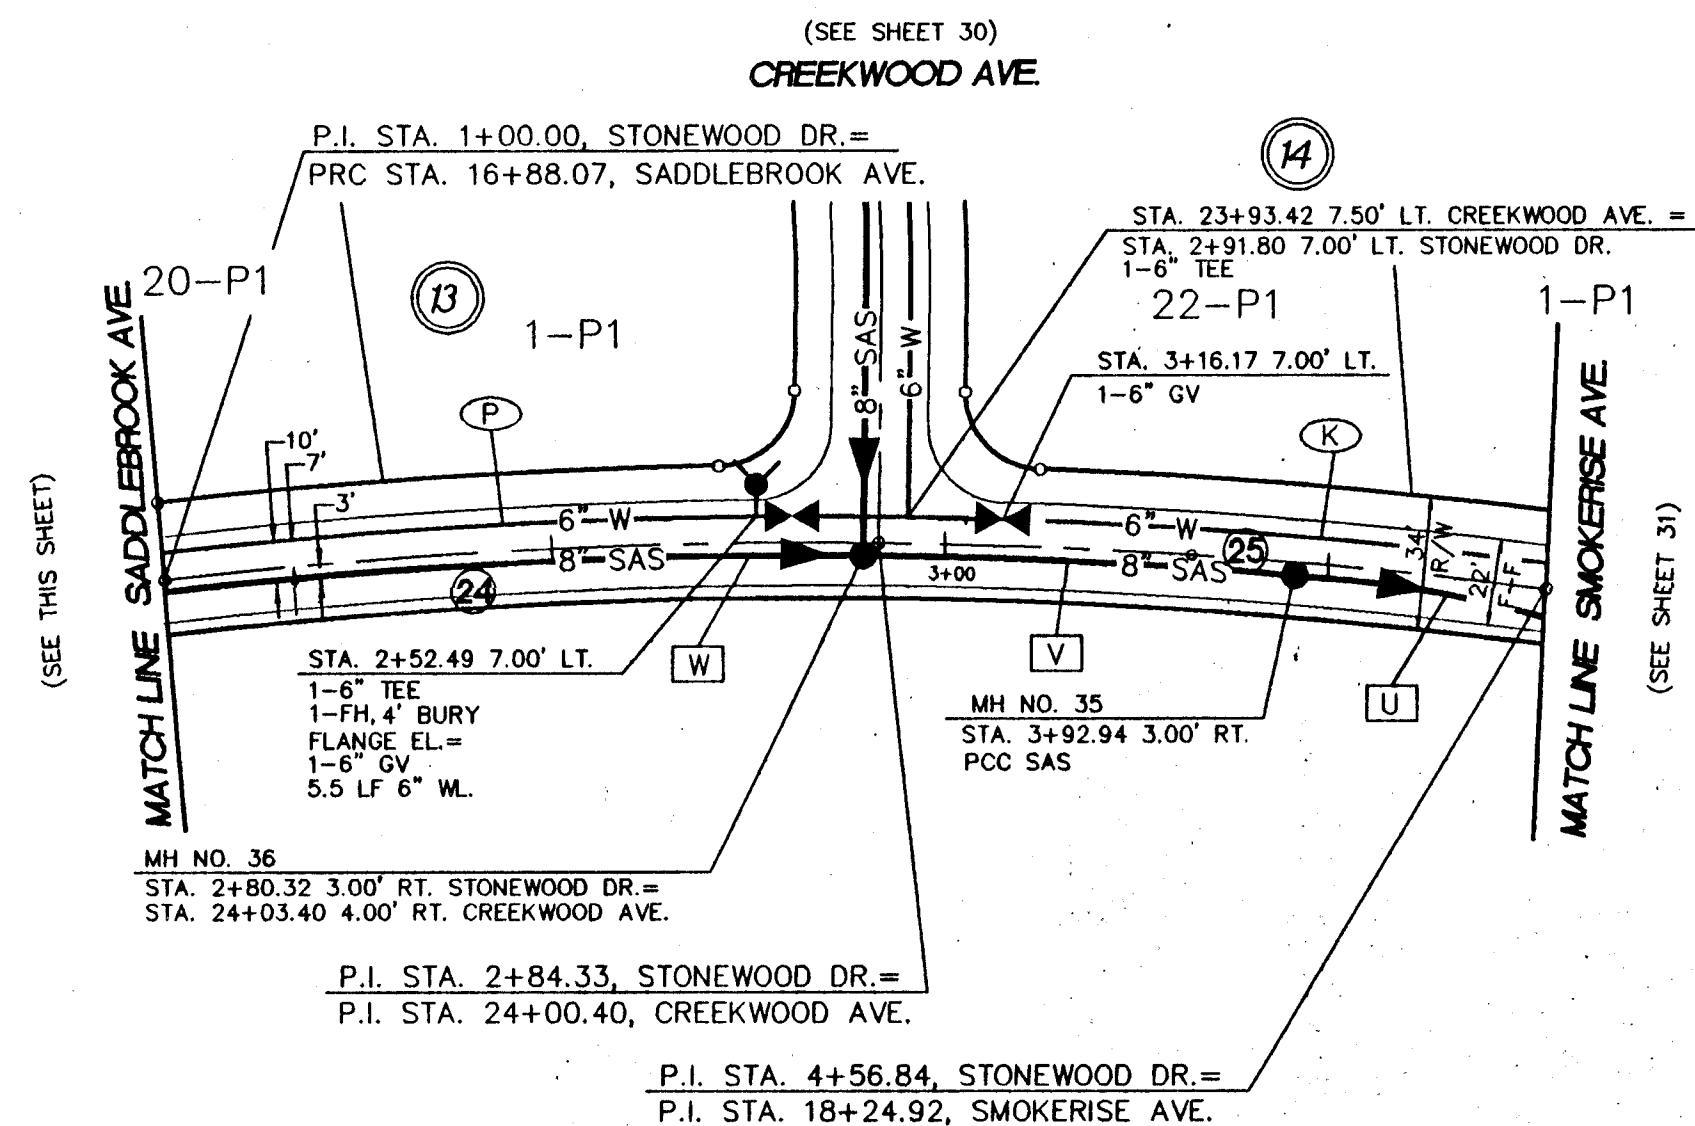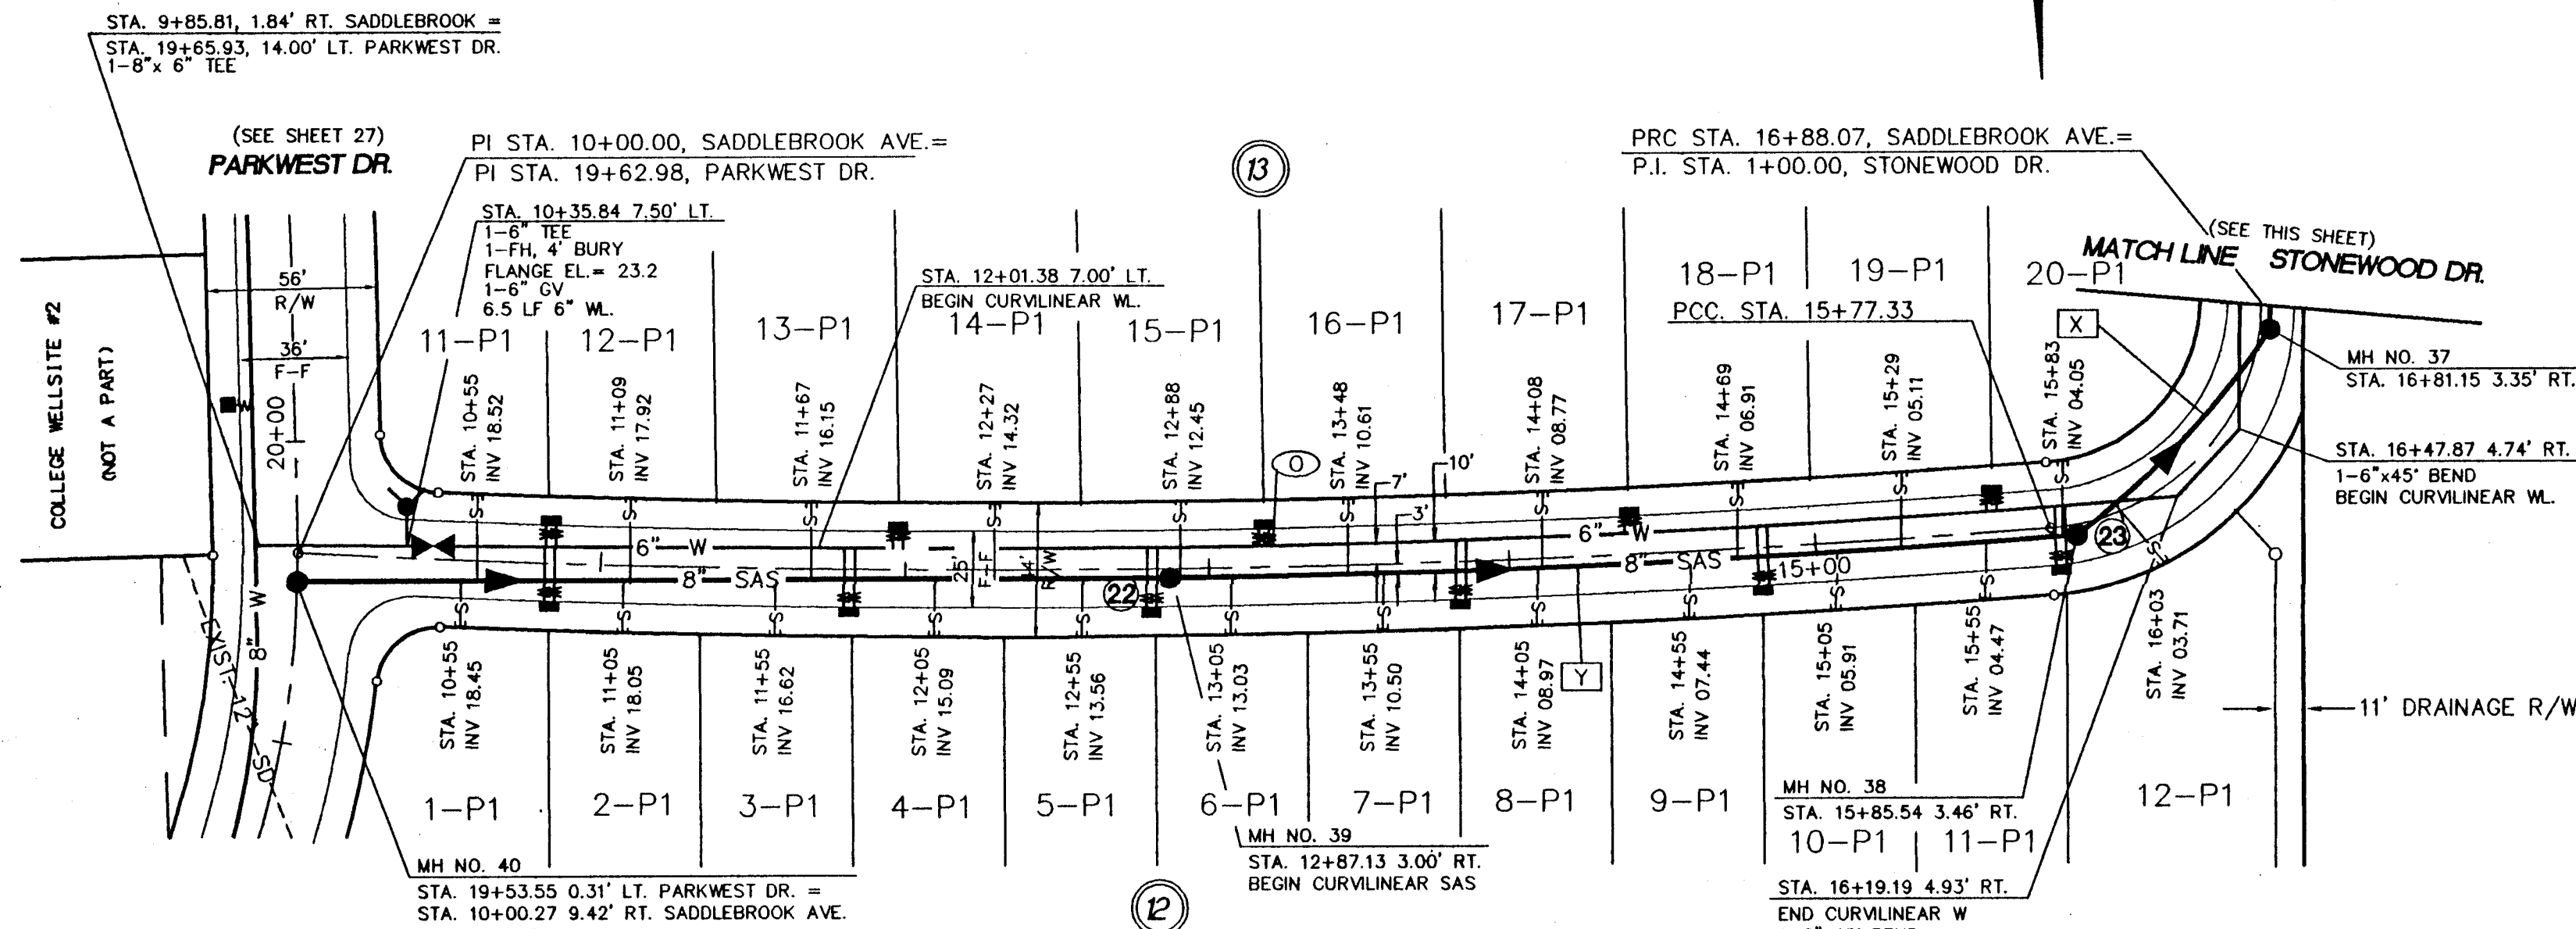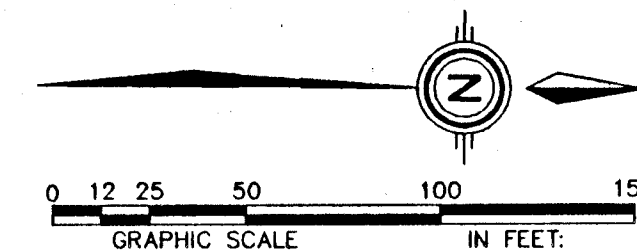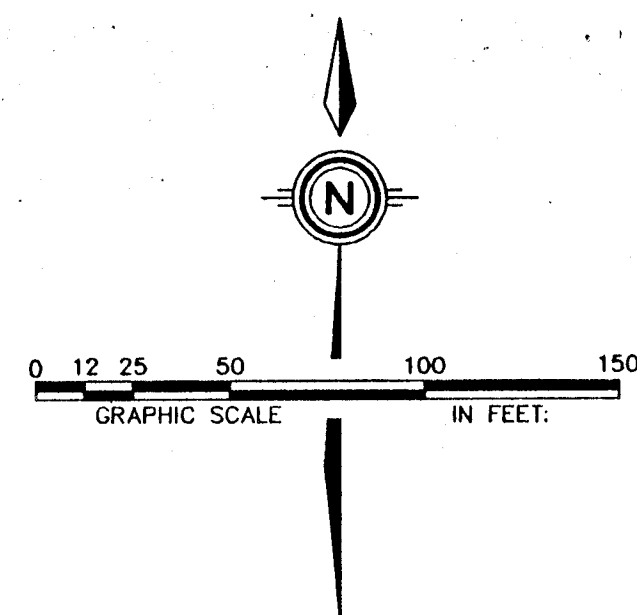

UTILITY LEGEND		
DESCRIPTION	PROPOSED	EXISTING
SANITARY SEWER LINE	8" SAS	8" SAS
ENCASEMENT		
SANITARY SEWER MANHOLE		
SAS SERVICE CONNECTION		
STORM DRAIN LINE	30" SD	30" SD
STORM DRAIN MANHOLE		
STORM DRAIN INLETS		
WATER LINE	W-6"	W-6"
GATE VALVE		
BUTTERFLY VALVE		
FIRE HYDRANTS		
REDUCERS		
WATER SERVICE/ METER		
TEES		
CROSSES		
BENDS		
CAPS & PLUGS		
GAS LINES	N/A	N/A
OVERHEAD ELECTRICAL LINE	N/A	N/A
UNDERGROUND ELECTRICAL	N/A	N/A
OVERHEAD TELEPHONE	N/A	N/A
UNDERGROUND TELEPHONE	N/A	N/A
CABLE TELEVISION	N/A	N/A
POWER OR TELEPHONE POLE	N/A	N/A
WATERLINE CURVILINEAR ID.		
SANITARY SEWER CURVILINEAR ID.		
STORM DRAINAGE CURVILINEAR ID.		

SADDLEBROOK AVENUE N.W.

STONEWOOD DRIVE N.W.

WATERLINE CURVE TABLE						
CURVE ID	RADIUS	ARC	DELTA	CHORD DISTANCE	CHORD BRG	DELTA / 20' JOINT
O	4493.00	417.70	05° 19' 38"	417.55	S 87° 49' 54" E	00° 15'
P	1498.55	233.43	08° 55' 30"	233.19	N 04° 00' 37" E	00° 46'
K	1498.00	193.35	07° 29' 34"	193.22	N 12° 10' 09" E	00° 46'

SANITARY SEWER CURVE TABLE						
CURVE ID	RADIUS	ARC	DELTA	CHORD DISTANCE	CHORD BRG	DELTA / 20' JOINT
U	275.00	135.92	28° 19' 08"	134.54	N 26° 30' 59" E	04° 10'
V	1488.55	112.36	04° 19' 29"	112.33	N 10° 11' 40" E	00° 48'
W	1488.55	187.18	07° 12' 18"	187.06	N 04° 25' 47" E	00° 48'
X	275.00	93.77	19° 22' 14"	93.82	S 42° 51' 34" W	04° 10'
Y	4503.00	298.97	03° 48' 15"	298.92	S 87° 30' 04" W	00° 15'

RESTRAINING LENGTHS	
FITTING	LR (FT)
6" 11 1/2" Bend	2
6" 22 1/2" Bend	3
6" 45" Bend	7
8" 11 1/2" Bend	2
8" 22 1/2" Bend	4
6" GV	46
8" GV	60
8X6 Reducers	25 L/33 S
8X8 Tee	9 Run/20 Branch
8X6 Tee	5 Run/17 Branch
8" Cross	9
8X8 Tee	5/17
6X6 Tee	6/20
6" Dead Ends	46
8" Dead Ends	60
12x8 Reducers	45 Run/58 Branch

LR = LENGTH TO BE RESTRAINED EACH SIDE OF THE FITTING. FOR TEES, ALL THREE LEGS SHALL BE RESTRAINED FOR A DISTANCE OF "LR". FOR REDUCERS, "LR" IS GIVEN FOR THE LARGER DIAMETER SIDE OF THE FITTING AND NO RESTRAINING IS REQUIRED ON THE SMALL SIDE OF THE FITTING. GATE VALVES SHALL BE MECHANICALLY RESTRAINED AND INSTALLED WITH CONCRETE BLOCKING PER COA STD DWG 2333 IN ADDITION TO THE MECHANICALLY RESTRAINED LENGTHS. ALL CAPS SHALL BE INSTALLED WITH CONCRETE BLOCKING PER COA STD DWG 2320. RESTRAIN ALL JOINTS ON FIRE HYDRANTS.

RECORD DRAWING
12-3-87

SCALE:
1" = 50' HORIZ.
1" = 10' VERT.


community sciences corporation

CITY OF ALBUQUERQUE
PUBLIC WORKS DEPARTMENT
ENGINEERING GROUP

TITLE: PARKWEST-UNIT 5
UTILITY PLAN & PROFILE
SADDLEBROOK AVE. & STONEWOOD DR. N.W.

APPROVALS	ENGINEER	DATE	APPROVALS	ENGINEER	DATE
DRC CHAIRMAN			WATER	R.W. Kane	6-5-95
TRANSPORTATION	W.A. RHO	6-02-95	WASTE WATER	R.W. Kane	6-5-95
HYDROLOGY	W.A. RHO	7-19-95	A.M.A.F.C.A.		

PROJECT NO. 4886.94
MA NC. G,H-9
SHEET 32 OF 39

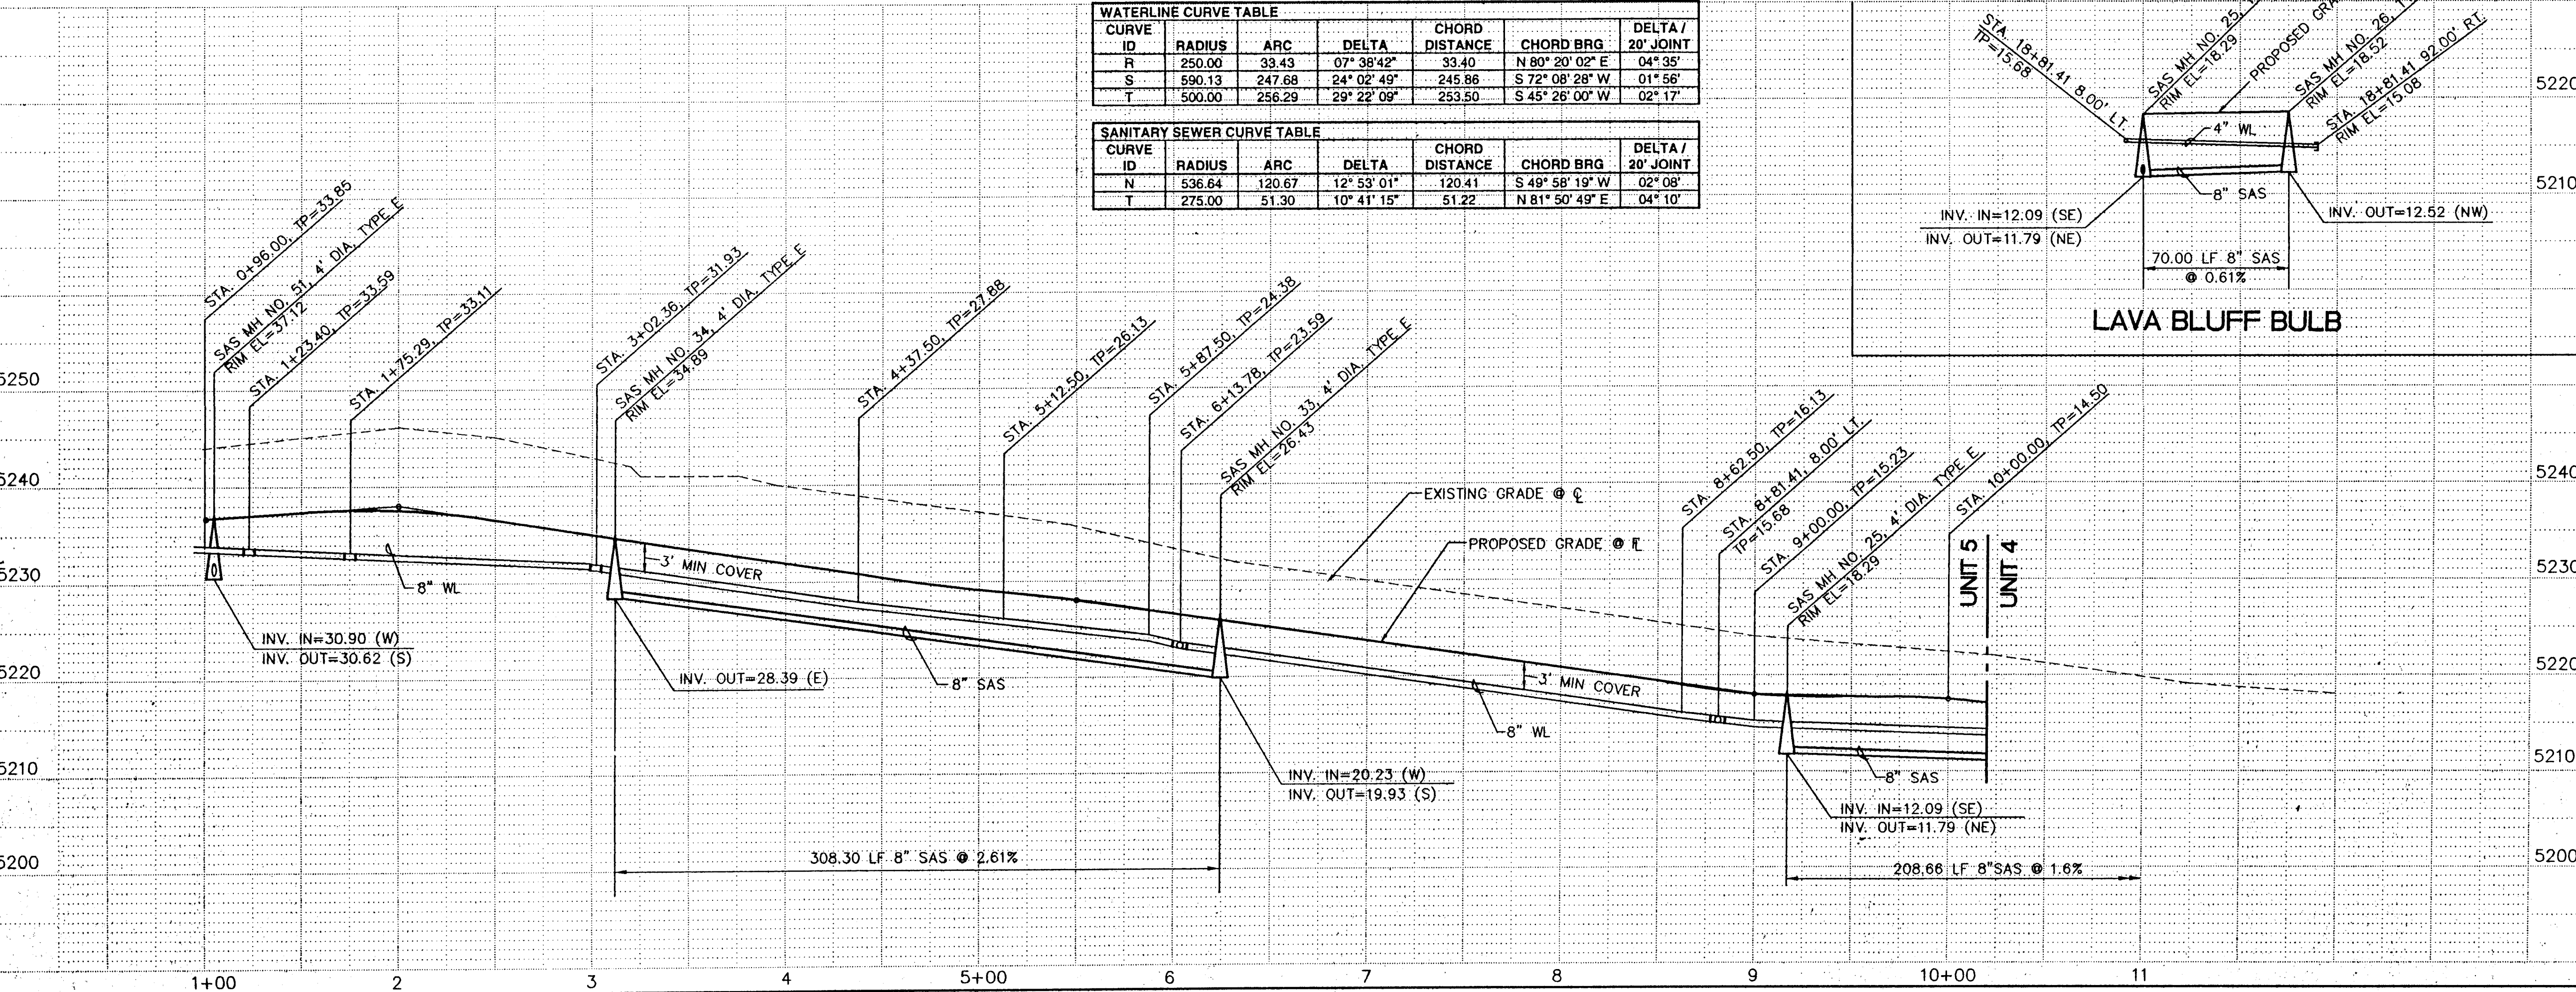

RESTRAINING LENGTHS	
FITTING	LR (FT)
6"-11½" Bend	2
6"-22½" Bend	3
6"-45" Bend	7
8"-11½" Bend	2
8"-22½" Bend	4
6" GV	46
8" GV	60
8X6 Reducers	25 L/33 S
8X8 Tee	9 Run/20 Branch
8X8 Tee	5 Run/17 Branch
8" Cross	9
8X8X4 Tee	5/17
6X6X6 Tee	6/20
6" Dead Ends	46
8" Dead Ends	60
12x8 Reducers	45 Run/68 Branch

"L.R." LENGTH TO BE RESTRAINED
 EACH SIDE OF THE FITTING. FOR
 TEES, ALL THREE LEGS SHALL BE
 RESTRAINED FOR A DISTANCE OF
 "L.R." FOR REDUCERS, "L.R." IS GIVEN
 FOR THE LARGER DIAMETER SIDE
 OF THE FITTING AND NO
 RESTRAINING IS REQUIRED ON THE
 SMALL SIDE OF THE FITTING. GATE
 VALVES SHALL BE MECHANICALLY
 RESTRAINED AND INSTALLED WITH
 CONCRETE BLOCKING PER COA
 STD DWG 2333 IN ADDITION TO THE
 MECHANICALLY RESTRAINED
 LENGTHS. ALL CAPS SHALL BE
 INSTALLED WITH CONCRETE
 BLOCKING PER COA STD DWG 2320.
 RESTRAIN ALL JOINTS ON FIRE
 HYDRANTS.

RECORD DRAWING
12-3-97

SCALE: 1" = 50', HORIZ. 1" = 10', VERT.	<i>community sciences corporation</i>	
JOB NO.: 14328-041	LAND PLANNING P.O. Box 1328	ENGINEERING SURVEY Corrales, N.M. 87048

CITY OF ALBUQUERQUE
PUBLIC WORKS DEPARTMENT
ENGINEERING GROUP

TITLE: PARKWEST-UNIT 5
UTILITY PLAN &
LAVA BLUFF

APPROVALS	ENGINEER	DATE	APPROVAL
DRC CHAIRMAN			WATER
TRANSPORTATION	N/A <i>END</i>	6-02-95	WASTE
HYDROLOGY	NA <i>JPC</i>	9-19-95	A.M.A.

PROJECT NO.	4886.94	MAP NO.	G,H
-------------	---------	---------	-----



2	3	4	5	6	7	8	9	10	11	12	13	14	15
26	-	48	86	.	74					33	97		

[illegible]

33 C CURVE DATA
R = 300.00'
L = 76.78'
Δ = 014°39'52"
CH = 76.57'
CH. BEARING = N38°26'50"E

34 C CURVE DATA
R = 300.00'
L = 38.03'
Δ = 007°15'46"
CH = 38.00'
CH. BEARING = N34°44'47"E

35 C CURVE DATA
R = 300.00'
L = 26.98'
Δ = 005°09'08"
CH = 26.97'
CH. BEARING = N40°57'14"E

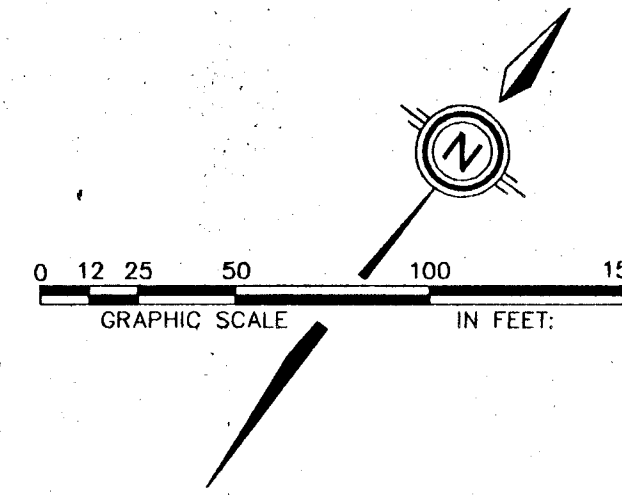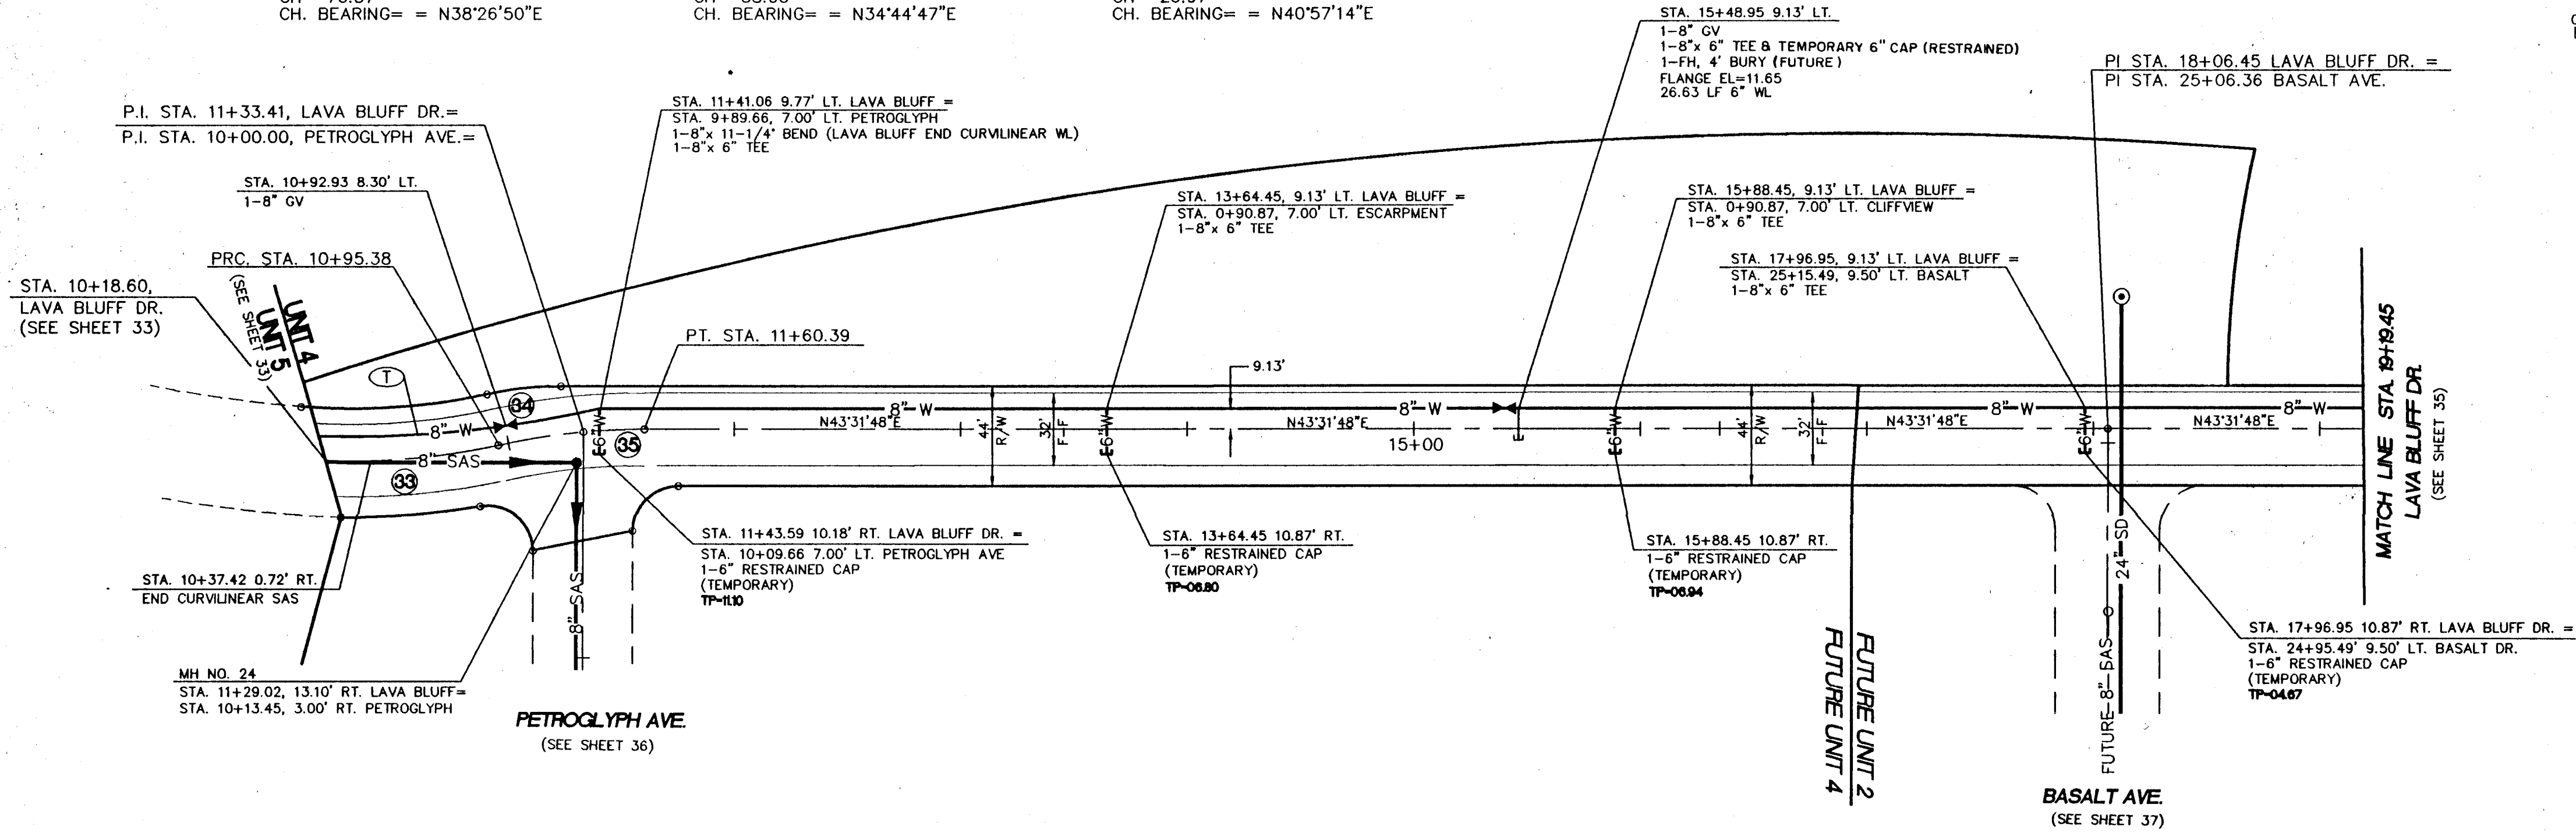

LAVA BLUFF DRIVE N.W.

WATERLINE CURVE TABLE					
CURVE	R	L	DELTA	CHORD DISTANCE	CHORD BRG
T	500.00	256.29	29° 22' 09"	253.50	S 45° 26' 00" W
					02° 17'

RESTRAINING LENGTHS	
FITTING	LR (FT)
6"-11 1/4" Bend	2
6"-22 1/4" Bend	3
6"-45" Bend	7
8"-11 1/4" Bend	2
8"-22 1/4" Bend	4
6" GV	46
8" GV	60
8x6 Reducers	25 L/33 S
8x6 Tee	9 Run/20 Branch
8x6 Tee	5 Run/17 Branch
8" Cross	9
8x8x4 Tee	5/17
6x6x6 Tee	6/20
6" Dead Ends	46
8" Dead Ends	60
12x8 Reducers	45 Run/68 Branch

LR = LENGTH TO BE RESTRAINED EACH SIDE OF THE FITTING. FOR TEES, ALL THREE LEGS SHALL BE RESTRAINED FOR A DISTANCE OF "LR". FOR REDUCERS, "LR" IS GIVEN FOR THE LARGER DIAMETER SIDE OF THE FITTING AND NO RESTRAINING IS REQUIRED ON THE SMALL SIDE OF THE FITTING. GATE VALVES SHALL BE MECHANICALLY RESTRAINED AND INSTALLED WITH CONCRETE BLOCKING PER COA STD DWG 2333 IN ADDITION TO THE MECHANICALLY RESTRAINED LENGTHS. ALL CAPS SHALL BE INSTALLED WITH CONCRETE BLOCKING PER COA STD DWG 2320. RESTRAIN ALL JOINTS ON FIRE HYDRANTS.

RECORD DRAWING
12-3-97

SCALE:
HORIZ: 1" = 50'
VERT: 1" = 10'

community sciences corporation

LAND PLANNING ENGINEERING SURVEYING
P.O. Box 1328 Corrales, N.M. 87048

CITY OF ALBUQUERQUE
PUBLIC WORKS DEPARTMENT
ENGINEERING GROUP

TITLE: PARKWEST - UNIT 5
OFFSITE UTILITY PLAN & PROFILE
LAVA BLUFF DRIVE N.W.

APPROVALS	ENGINEER	DATE	APPROVALS	ENGINEER	DATE
DRC CHAIRMAN			WATER	R.W. Kame	6-5-95
TRANSPORTATION	N/A EHO	6-02-95	WASTE WATER	R.W. Kame	6-5-95
HYDROLOGY	N/A RJC	2-19-95	A.M.A.F.C.A.		

PROJECT NO. 4886.94 MAP NO. G, H9 SHEET 34 OF 39

SURVEY INFORMATION		BENCH MARKS		AS BUILT INFORMATION	
NO.	BY	DATE	NO.	DATE	NO.
1	COMMUNITY SCIENCES				

ENGINEER'S SEAL
J. W. Kame
Professional Engineer
No. 1664
New Mexico
1984

NO.	DATE	REMARKS	BY
		DESIGN	
		REVISIONS	
DESIGNED BY	DATE	DATE	DATE
DRAWN BY	DATE	DATE	DATE
CHECKED BY	DATE	DATE	DATE

26-42

81

COMMUNITY SCIENCES CORPORATION - CORRALES, NEW MEXICO - (505) 897-0000

(SEE SHEET 34)

LAVA BLUFF DR. STA 19+49.45

MATCH LINE - STA 19+49.45

STA. 00+90.87 7.00' LT. DARK MESA AVE. =
STA. 20+38.45 9.13' LT. LAVA BLUFF DR.
1-8"x6" TEE

STA. 19+98.95 9.13' LT.
1-8" GV
1-8"x6" TEE & TEMPORARY 6" CAP (RESTRAINED)
1-FH 4" BURY (FUTURE)
FLANGE EL=8.10
26.63 LF 6" WL

STA. 22+62.45 9.13' LT. LAVA BLUFF DR. =
STA. 00+90.87 7.00' LT. LAVA REACH AVE.
1-8"x6" TEE

STA. 20+38.45 10.87' RT.
1-6" RESTRAINED CAP (TEMPORARY)
TP-314

STA. 22+62.45 10.87' RT.
1-6" RESTRAINED CAP (TEMPORARY)
TP-65.82

PC. STA. 22+72.37

STA. 22+72.37 9.13' LT.
BEGIN CURVILINEAR WL

9.13'

8"-W

9.13'

8"-W


9.13'

8"-W

36 CURVE DATA
R = 468.33'
L = 182.47'
Δ = 022°19'24"
CH = 181.32'
CH BEARING = N54°41'30"E

38 CURVE DATA
R = 402.00'
L = 247.83'
Δ = 035°19'19"
CH = 243.92'
CH BEARING = S84°42'12"E

37 CURVE DATA
R = 402.00'
L = 82.67'
Δ = 011°46'57"
CH = 82.52'
CH BEARING = N71°44'40"E

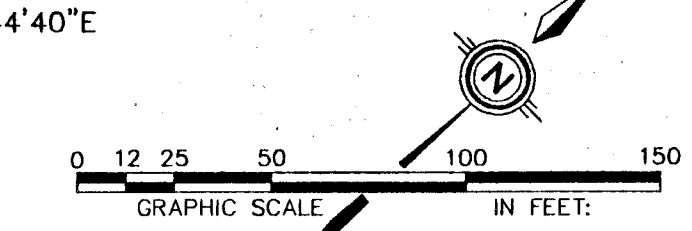

WATERLINE CURVE TABLE						
CURVE	R	L	DELTA	CHORD DISTANCE	CHORD BRG	DELTA 20' JOINT
U	477.46	186.02	22° 19' 24"	184.85	N 54° 41' 30" E	02° 24'
V	411.13	230.79	32° 09' 46"	227.77	N 81° 58' 05" E	02° 47'

LAVA BLUFF DRIVE N.W.

STA. 24+66.72 BASELINE B =
STA. 2+79.78 BASELINE C

STA. 27+28.32 21.94' LT. LAVA BLUFF =
STA. 1+00.00 BASELINE C

STA. 25+30.38 10.87' RT.
1-6" RESTRAINED CAP (TEMPORARY)
TP-78.26

STA. 25+02.71 9.13' LT.
1-8" GV

STA. 24+54.84 9.13' LT.
PCC W

STA. 24+54.84

STA. 25+30.38 9.13' LT. LAVA BLUFF DR. =
STA. 20+52.90 6.82' LT. MONUMENT DR.
1-8"x6" TEE

STA. 26+80.18 9.74' LT.
END CURVILINEAR WL

STA. 27+99.33± 27.84± LT.
1-12"x8" REDUCER
CONNECT TO EXISTING 12" WL
(FIELD VERIFY END OF EXISTING 12" WL.)

PRC STA. 27+88.72

1-8"x11 1/4" BEND

STA. 1+00.00 0.00 RT. BASELINE C
SEE SECTION DETAIL SHEET 39

STA. 27+47.54 20.01' LT.
1-8"x11 1/4" BEND

STA. 27+47.54 20.01' LT.
1-8"x11 1/4" BEND

SEE C.O.O.A. PROJECT NO. 2803

STA. 27+47.54 20.01' LT.
1-8"x11 1/4" BEND

STA. 27+47.54 20.01' LT.
1-8"x11 1/4" BEND


STA. 27+47.54 20.01' LT.
1-8"x11 1/4" BEND

STA. 27+47.54 20.01' LT.
1-8"x11 1/4" BEND

STA. 27+47.54 20.01' LT.
1-8"x11 1/4" BEND

STA. 27+47.54 20.01' LT.
1-8"x11 1/4" BEND


STA. 27+47.54 20

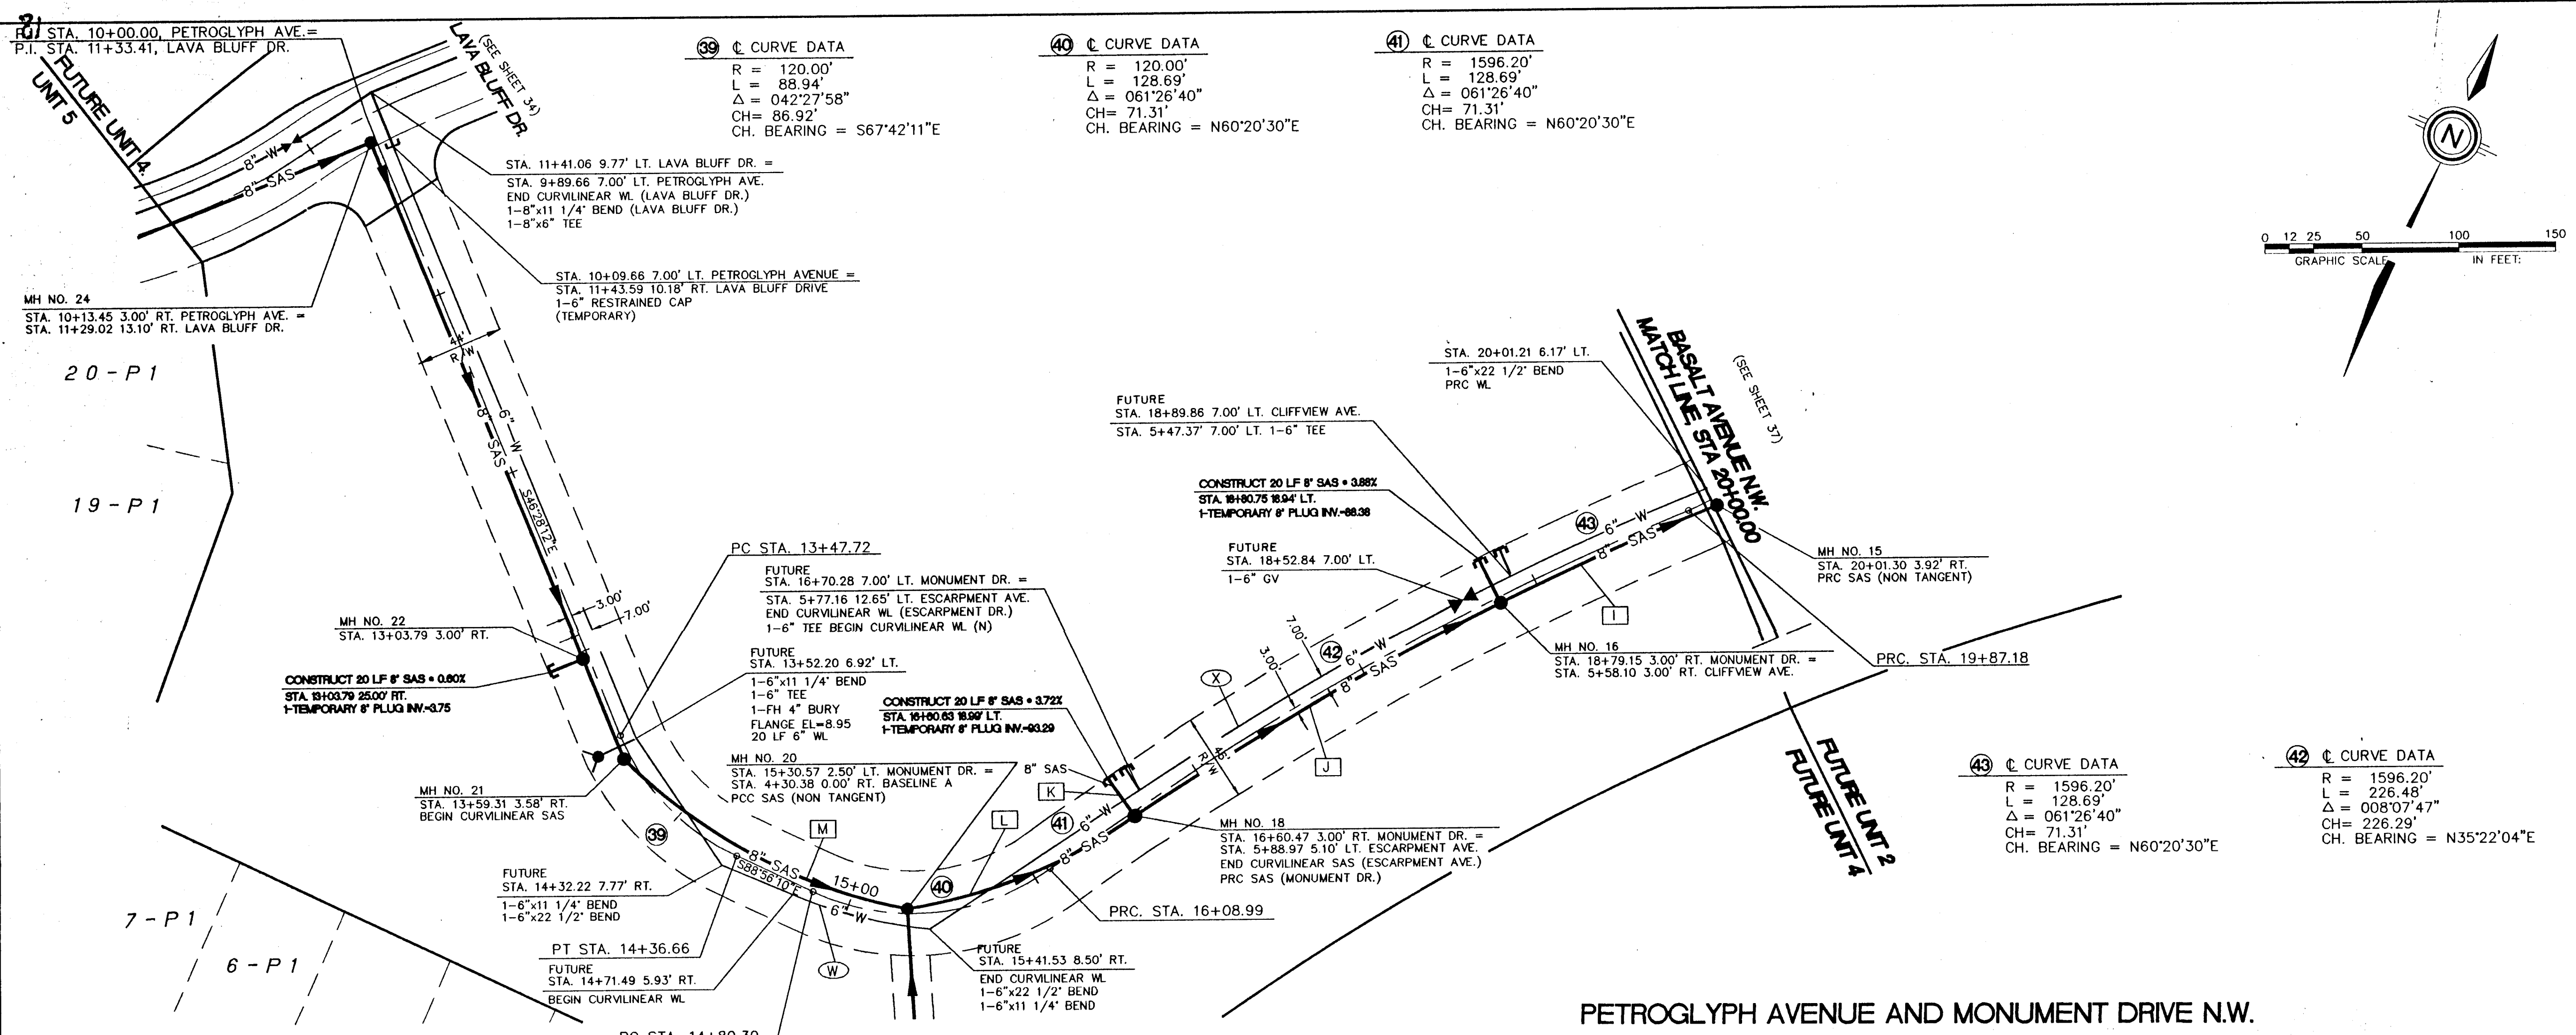

PETROGLYPH AVENUE AND MONUMENT DRIVE N.W.

WATERLINE CURVE TABLE						
CURVE	R	L	DELTA	CHORD DISTANCE	CHORD BRG	DELTA 20' JOINT
W	250.00	73.14	16° 45' 48"	72.88	S 80° 08' 54" W	04° 35'
X	1603.20	331.57	11° 51' 00"	330.98	N 37° 44' 39" E	00° 43'

SANITARY SEWER CURVE TABLE						
CURVE	R	L	DELTA	CHORD DISTANCE	CHORD BRG	DELTA 20' JOINT
I	1593.20	120.25	04° 19' 28"	120.22	N 41° 33' 19" E	00° 43'
J	1593.20	220.40	07° 55' 34"	220.22	N 35° 25' 49" E	00° 43'
K	275.00	86.89	13° 56' 13"	66.73	N 53° 26' 18" W	04° 10'
L	275.00	127.69	26° 36' 15"	126.55	S 43° 35' 02" W	04° 10'
M	275.00	168.54	35° 06' 52"	165.91	N 85° 58' 37" W	04° 10'

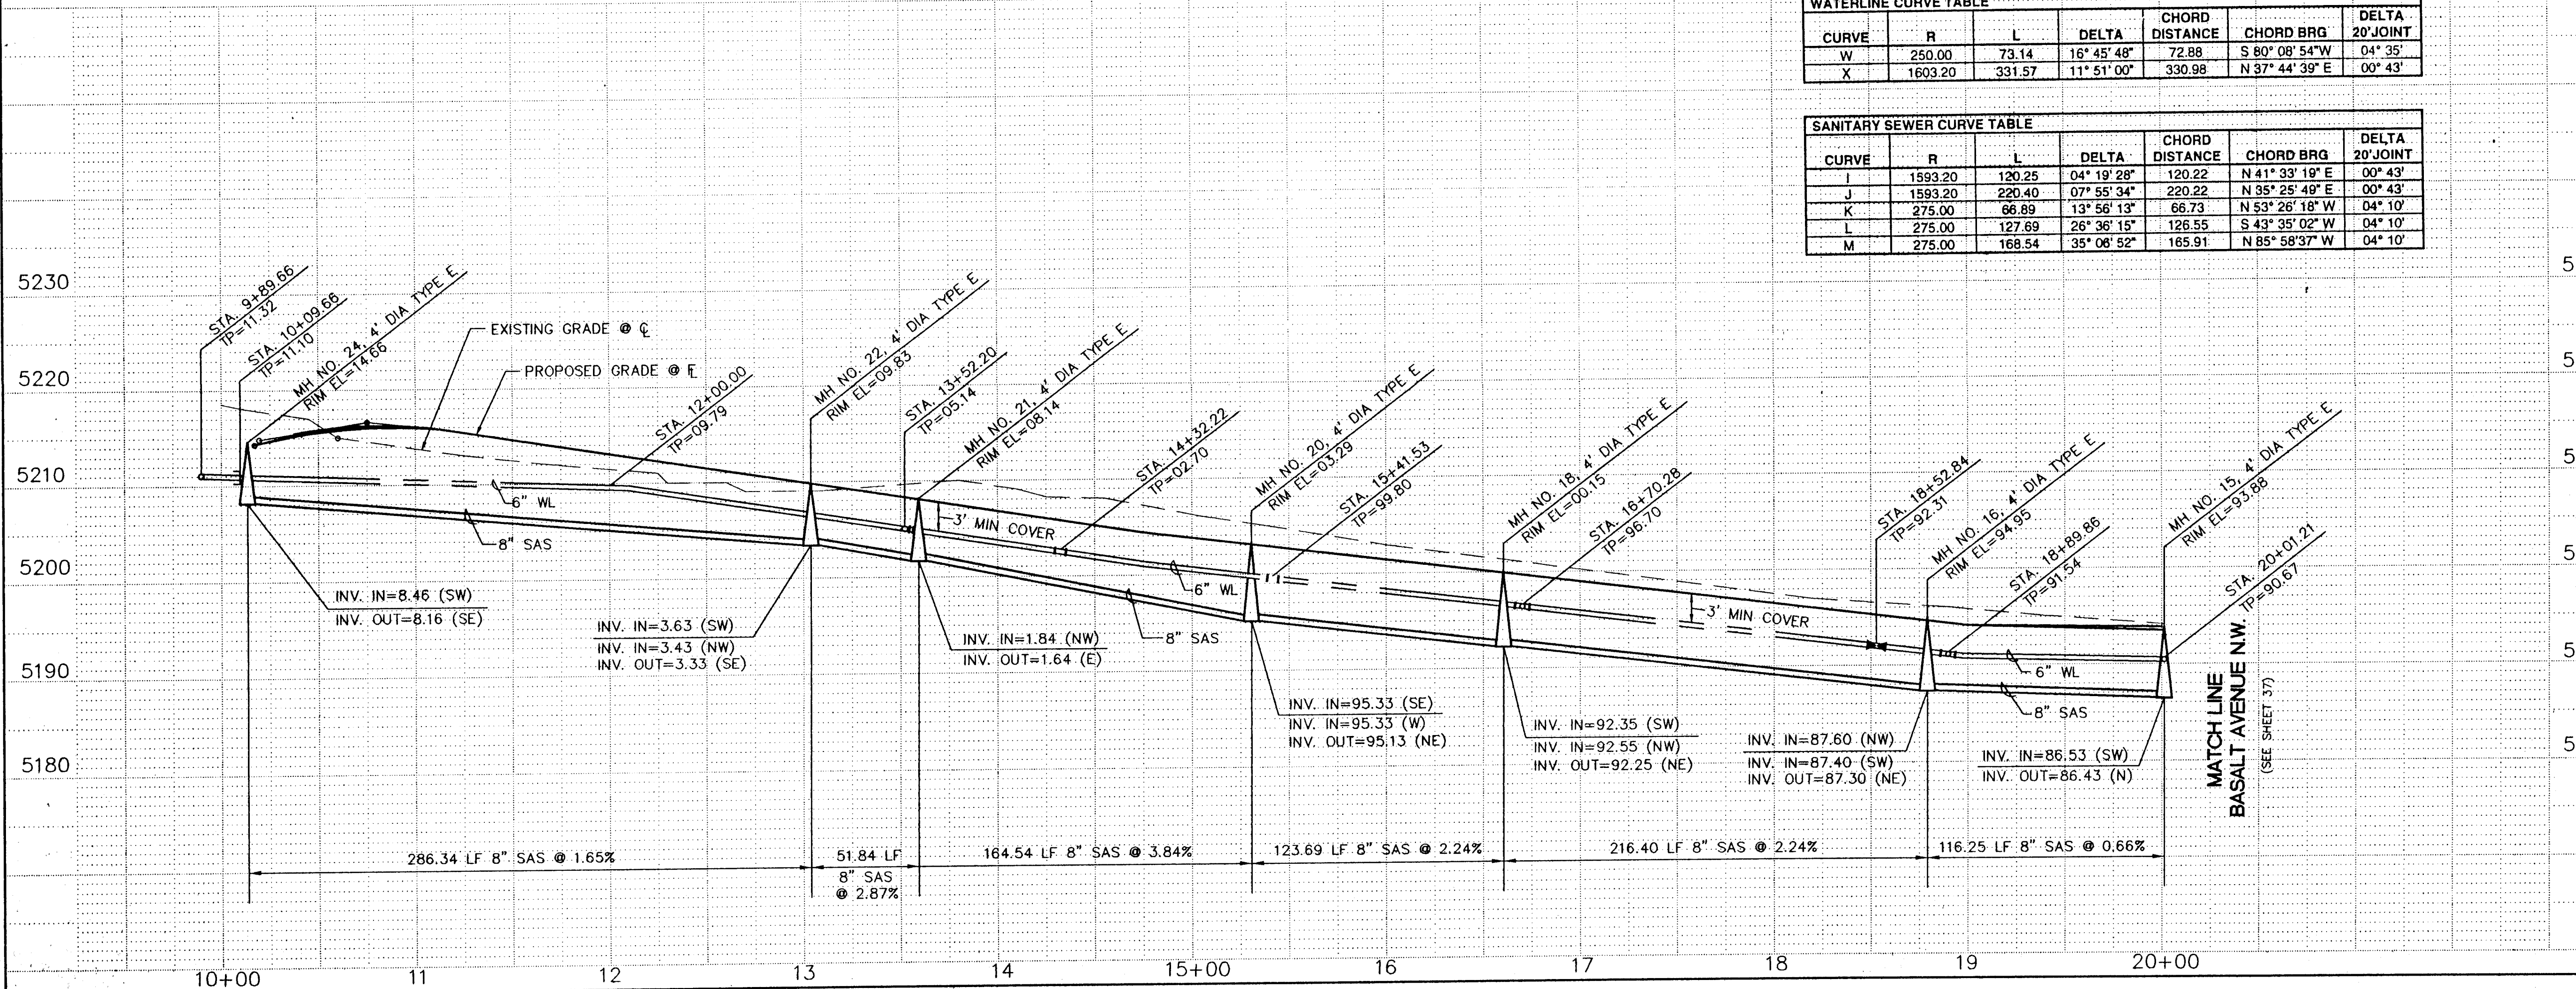

MATCH LINE
BASALT AVENUE N.W.
(SEE SHEET 37)

UTILITY LEGEND		
DESCRIPTION	PROPOSED	EXISTING
SEWER LINE	8" SAS	8" SAS
ENCASEMENT		
SANITARY SEWER MANHOLE		
SAS SERVICE CONNECTION		
STORM DRAIN LINE	SD-30"	SD-30"
STORM DRAIN MANHOLE		
STORM DRAIN INLETS		
WATER LINE	W-6"	W-6"
GATE VALVE		
BUTTERFLY VALVE		
FIRE HYDRANTS		
REDUCERS		
WATER SERVICE/ METER		
TEES		
CROSSES		
BENDS		
CAPS & PLUGS		
GAS LINES	N/A	6" HP
OVERHEAD ELECTRICAL LINE	N/A	
UNDERGROUND ELECTRICAL	N/A	
OVERHEAD TELEPHONE	N/A	
UNDERGROUND TELEPHONE	N/A	
CABLE TELEVISION	N/A	
FUTURE 6" WL		
POWER OR TELEPHONE POLE	N/A	
WATERLINE CURVILINEAR ID	(W)	
SANITARY SEWER CURVILINEAR ID	(K)	

RESTRAINING LENGTHS	
FITTING	LR (FT)
6"-11 1/4" Bend	2
6"-22 1/2" Bend	3
6"-45" Bend	7
8"-11 1/4" Bend	2
8"-22 1/2" Bend	4
6" GV	46
8" GV	60
8X6 Reducers	25 L/33 S
8X8 Tee	9 Run/20 Branch
8X6 Tee	5 Run/17 Branch
8" Cross	9
8X8 Tee	5/17
6X8 Tee	6/20
6" Dead Ends	46
8" Dead Ends	60
12x8 Reducers	45 Run/68 Branch

LR = LENGTH TO BE RESTRAINED EACH SIDE OF THE FITTING. FOR TEES, ALL THREE LEGS SHALL BE RESTRAINED FOR A DISTANCE OF "LR". FOR REDUCERS, "LR" IS GIVEN FOR THE LARGER DIAMETER SIDE OF THE FITTING AND NO RESTRAINING IS REQUIRED ON THE SMALL SIDE OF THE FITTING. GATE VALVES SHALL BE MECHANICALLY RESTRAINED AND INSTALLED WITH CONCRETE BLOCKING PER COA STD DWG 2333 IN ADDITION TO THE MECHANICALLY RESTRAINED LENGTHS. ALL CAPS SHALL BE INSTALLED WITH CONCRETE BLOCKING PER COA STD DWG 2320. RESTRAIN ALL JOINTS ON FIRE HYDRANTS.

RECORD DRAWING
12-3-97

SCALE:	community sciences corporation	
HORIZ: 1" = 50'	LAND PLANNING P.O. Box 1328	
VERT: 1" = 10'	ENGINEERING CORRALES, N.M. 87048	
CITY OF ALBUQUERQUE PUBLIC WORKS DEPARTMENT ENGINEERING GROUP		
TITLE: PARKWEST - UNIT 5 OFFSITE UTILITY PLAN & PROFILE PETROGLYPH AVENUE & MONUMENT DRIVE N.W.		
APPROVALS	ENGINEER	DATE
DRC CHAIRMAN	WATER	6-5-95
TRANSPORTATION	WASTE WATER	6-5-95
HYDROLOGY	A.M.A.F.C.A.	
PROJECT NO.	MAP NO.	SHEET
4886.94	G, H9	36 OF 39

CANNED BY LASON

26-4886.94 3697

71

44 C CURVE DATA

R = 121.00'
L = 102.74'
Δ = 048°39'03"
CH = 99.68'
CH BEARING = N18°52'09"E

45 C CURVE DATA

R = 121.00'
L = 86.61'
Δ = 041°00'50"
CH = 84.78'
CH BEARING = S25°57'47"E

FUTURE
STA. 20+65.37, 8.91' LT.
1-6" TEE
1-FH, 4" BURY
FLANGE EL. = 94.3
24.5 LF. 6" WL.

FUTURE
STA. 20+86.76, 5.89' LT.
1-6" x 22-1/2" BEND

P.I. STA. 20+89.93, BASALT AVENUE=
P.I. STA. 20+89.93, MONUMENT DR.(BACK)=
P.I. STA. 10+00.00, MONUMENT DR.(AHEAD)

FUTURE
STA. 9+92.31(AHEAD) 6.48' LT. MONUMENT=
STA. 20+96.83, 7.50' LT. BASALT
1-6" TEE
1-6" x 11-1/4" BEND (N)

FUTURE
STA. 21+56.96, 8.02' LT.
END CURVILINEAR WL
1-6" x 22-1/2" BEND

FUTURE
MH NO. 13
STA. 21+57.40 2.04' RT. BASALT
END CURVILINEAR SAS

SD, MH NO. E
STA. 21+49.08, 9.34' RT. BASALT

STA. 21+06.85, 4.24' RT.
1-8" TEMPORARY CAP

FUTURE
MH NO. 14
STA. 24+25.36, 0.50' RT. BASALT

(SEE SHEET 35)
LAVA BLUFF DR.

FUTURE UNIT 2
FUTURE UNIT 4




STA. 24+95.49, 9.50' LT. BASALT=
STA. 17+96.95, 10.87' RT. LAVA BLUFF
1-6" RESTRAINED CAP (TEMPORARY)

STA. 25+15.49, 9.50' LT. BASALT=
STA. 17+96.95, 9.13' LT. LAVA BLUFF
1-8" x 6" TEE

OUTLET STRUCTURE
STA. 25+67.21 6.00' RT. BASALT



P.I. STA. 25+06.36, BASALT AVE.=
P.I. STA. 18+06.45, LAVA BLUFF DR.

BASALT AVENUE N.W.

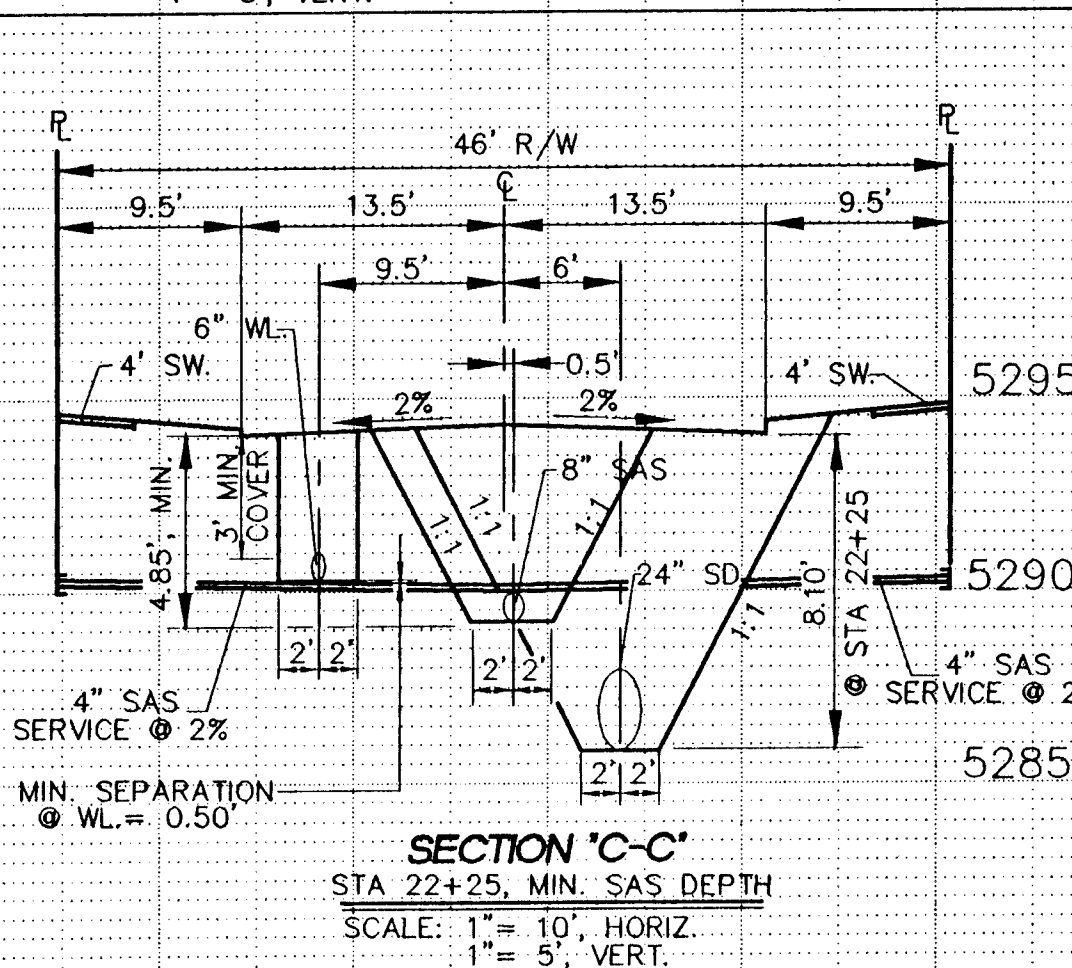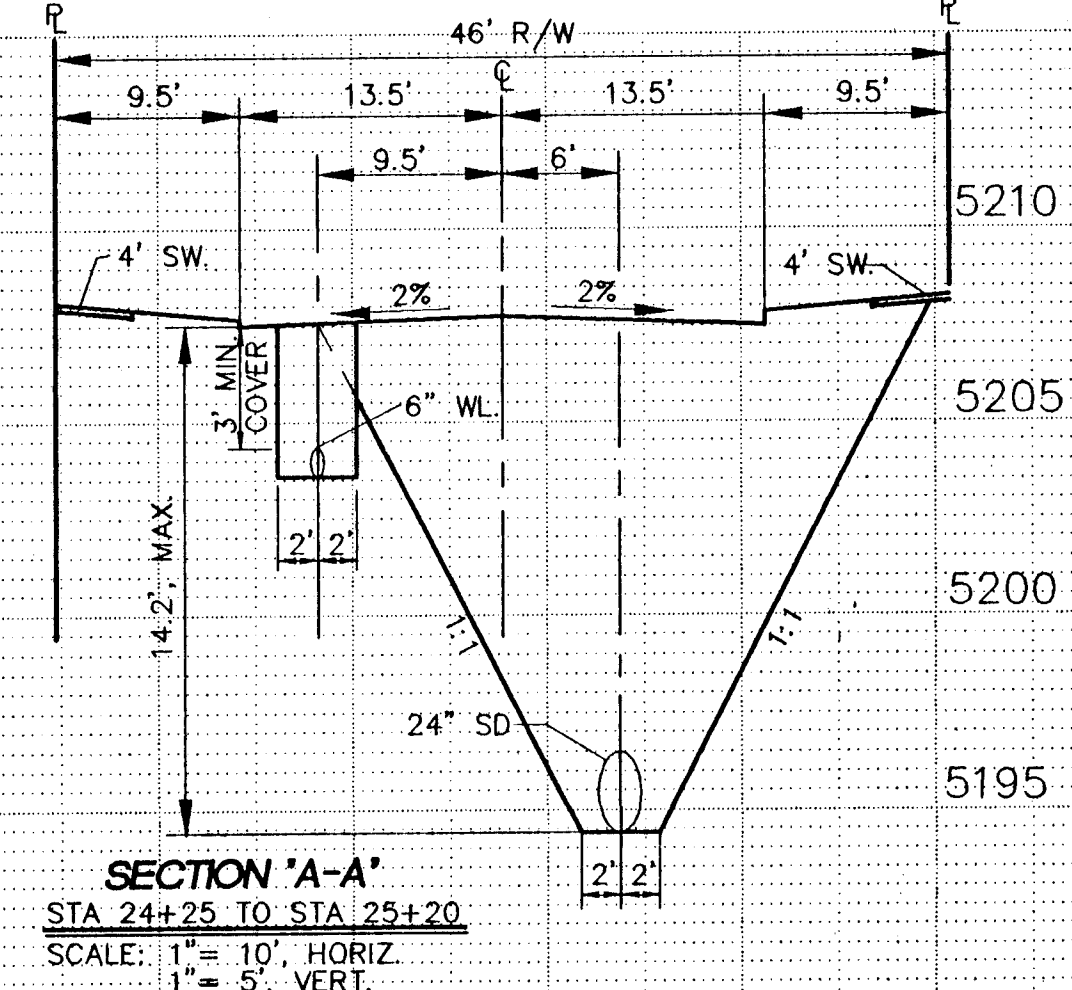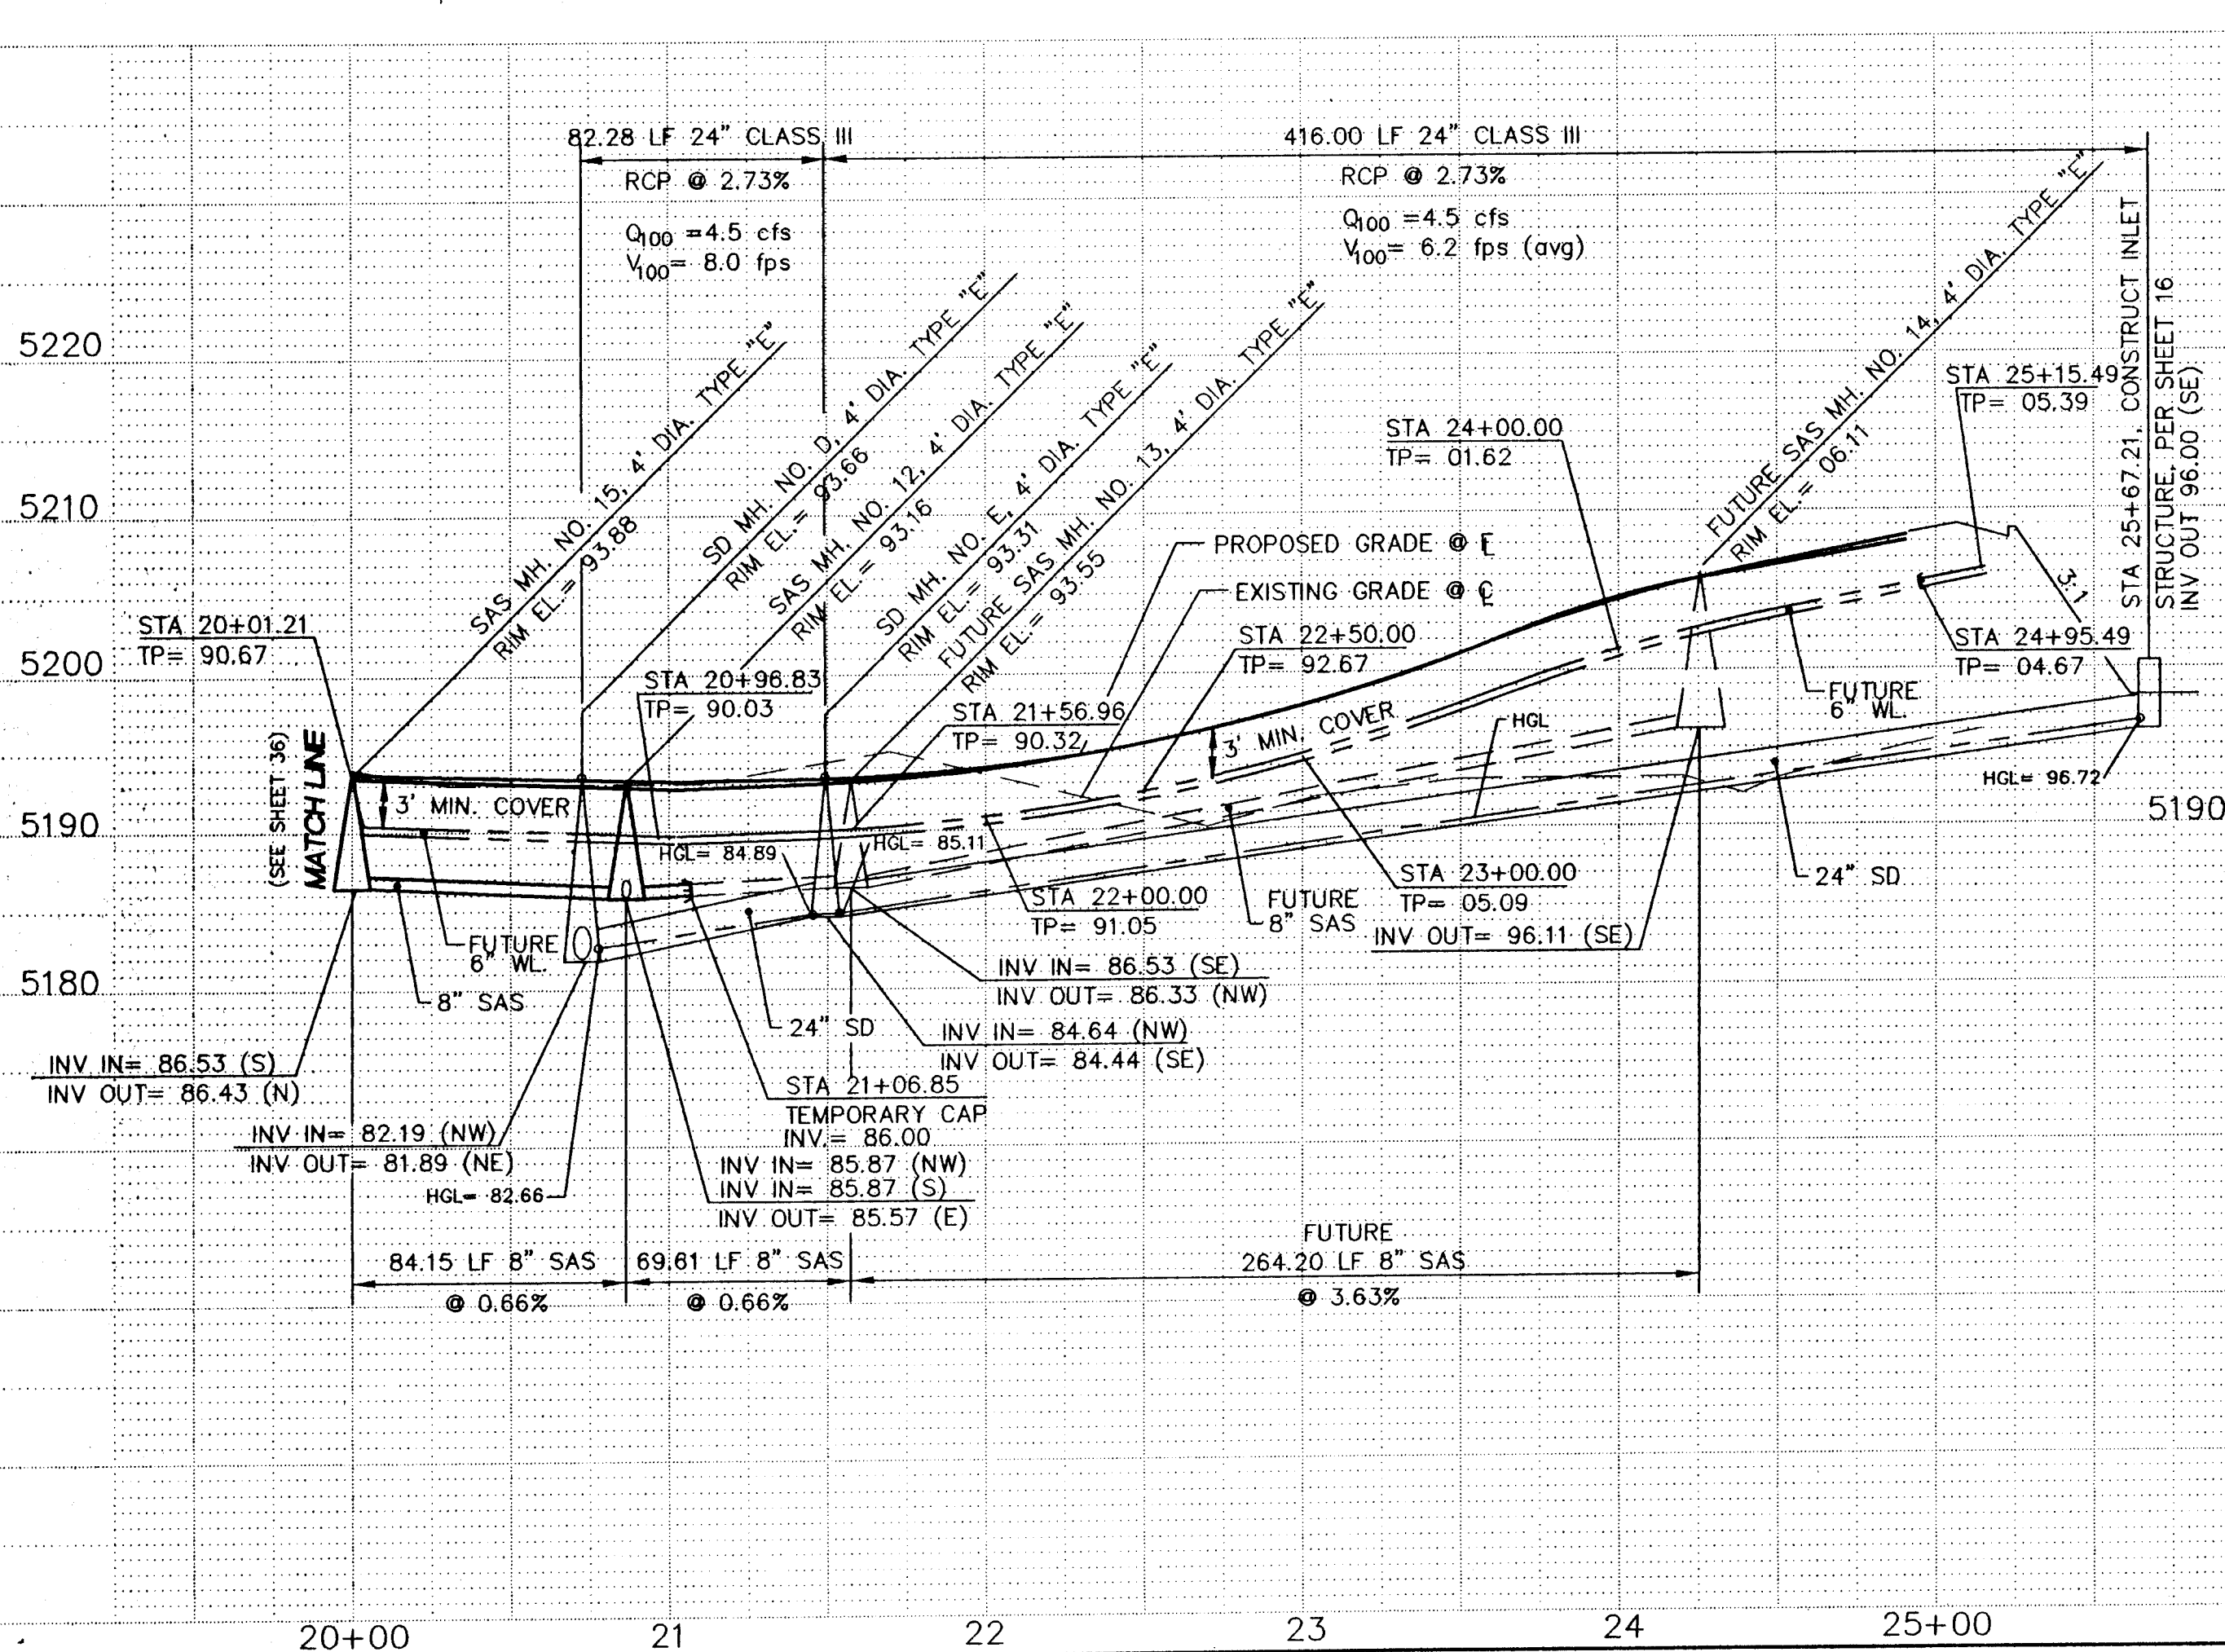

WATERLINE CURVE TABLE						
CURVE	R	L	DELTA	CHORD DISTANCE	CHORD BRG	DELTA 20' JOINT
Y	250.00	79.95	18° 19' 20"	79.61	S 16° 29' 36" W	04° 35'
Z	250.00	65.46	15° 00' 07"	65.27	S 22° 22' 28" E	04° 35'

SANITARY SEWER CURVE TABLE						
CURVE	R	L	DELTA	CHORD DISTANCE	CHORD BRG	DELTA 20' JOINT
G	275.00	73.61	15° 20' 14"	73.39	S 25° 33' 00" E	04° 10'
H	275.00	88.15	18° 21' 55"	87.77	S 19° 16' 57" W	04° 10'

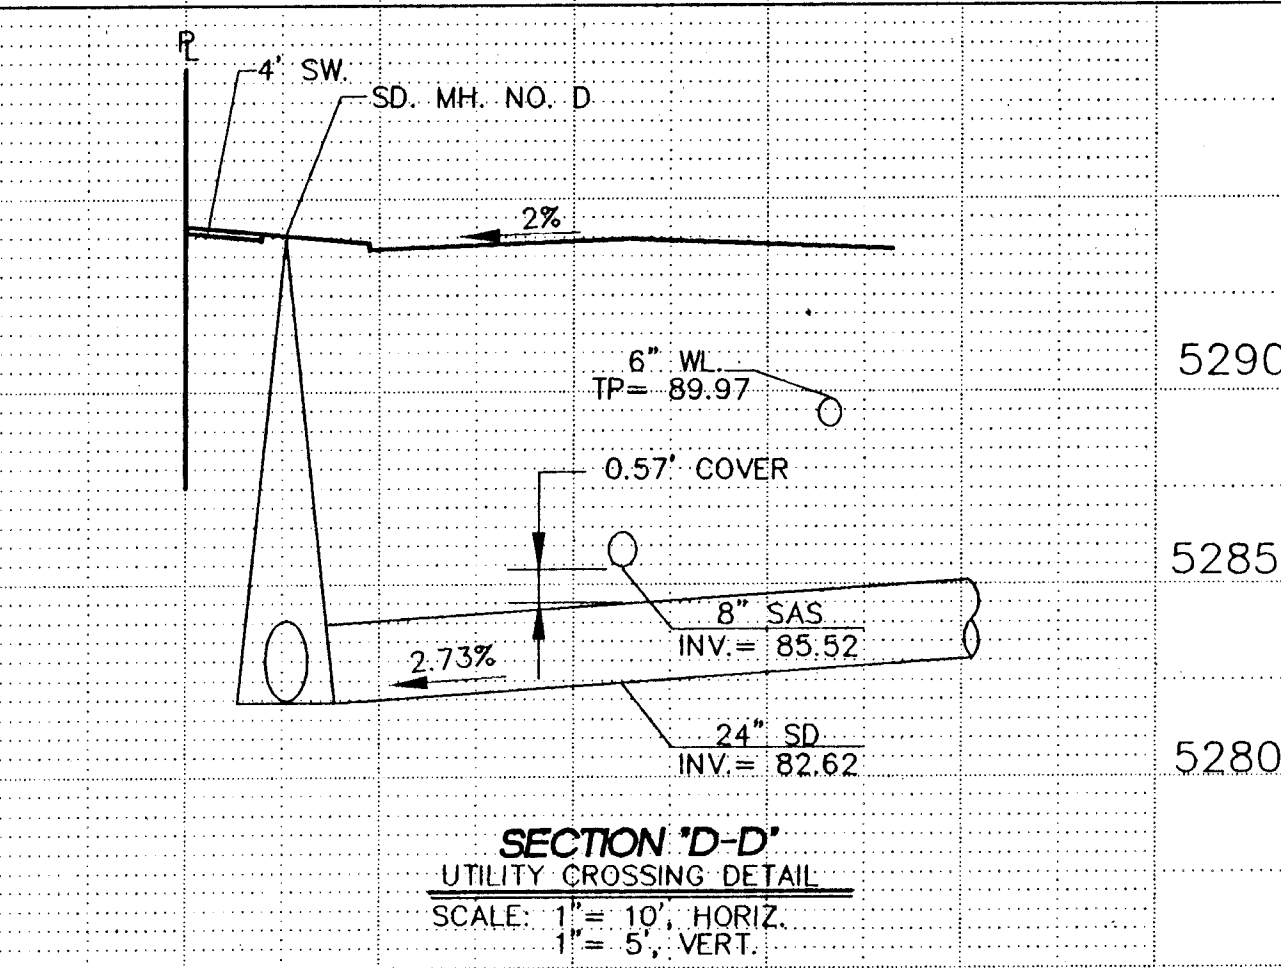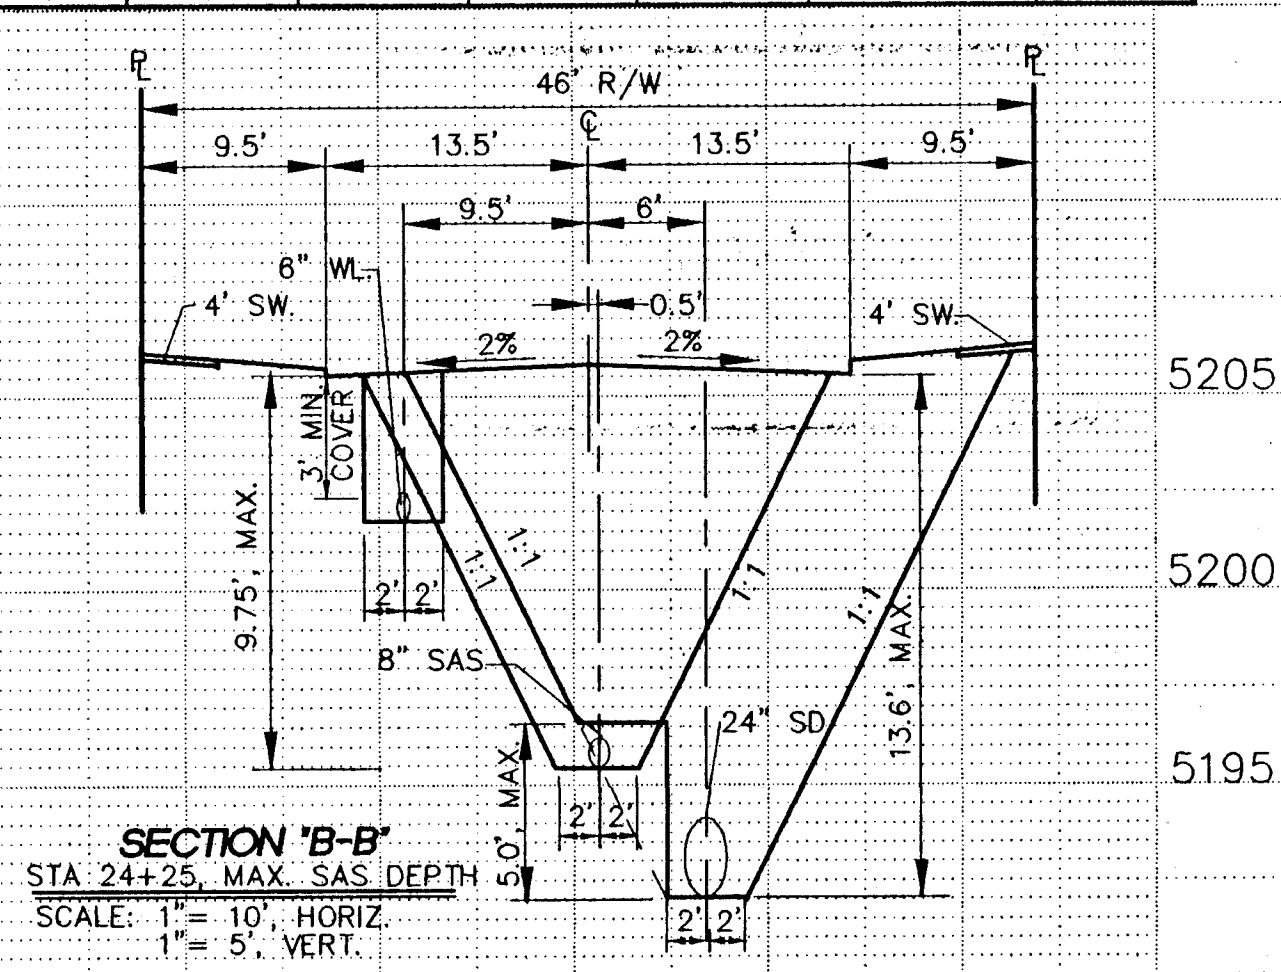

UTILITY LEGEND		
DESCRIPTION	PROPOSED	EXISTING
SANITARY SEWER LINE	8" SAS	8" SAS
ENCASEMENT		
SANITARY SEWER MANHOLE		
SAS SERVICE CONNECTION	S	S
STORM DRAIN LINE	SD-30"	SD-30"
STORM DRAIN MANHOLE		
STORM DRAIN INLETS		
WATER LINE	W-6"	W-6"
GATE VALVE		
BUTTERFLY VALVE		
FIRE HYDRANTS		
REDUCERS		
WATER SERVICE/ METER		
TEES		
CROSSES		
BENDS		
CAPS & PLUGS		
FUTURE FIRE HYDRANT		
FUTURE WATER		
FUTURE MANHOLE		
GAS LINES	N/A	N/A
OVERHEAD ELECTRICAL LINE	N/A	N/A
UNDERGROUND ELECTRICAL	N/A	N/A
OVERHEAD TELEPHONE	N/A	N/A
UNDERGROUND TELEPHONE	N/A	N/A
CABLE TELEVISION	N/A	N/A
POWER OR TELEPHONE POLE	N/A	N/A
WATERLINE CURVILINEAR ID.		
SANITARY SEWER CURVILINEAR ID.		
STORM DRAINAGE CURVILINEAR ID.		

RESTRAINING LENGTHS

FITTING	LR (FT)
6"-11 1/2" Bend	2
6"-22 1/2" Bend	3
6"-45" Bend	7
8"-11 1/2" Bend	2
8"-22 1/2" Bend	4
8" GV	46
8" GV	60
8X6 Reducers	25 L/33 S
8X8 Tee	9 Run/20 Branch
8X6 Tee	5 Run/17 Branch
8" Cross	9
8X8X4 Tee	5/17
6X6X6 Tee	6/20
6" Dead Ends	46
8" Dead Ends	60
12x8 Reducers	45 Run/68 Branch

LR = LENGTH TO BE RESTRAINED EACH SIDE OF THE FITTING. FOR TEES, ALL THREE LEGS SHALL BE RESTRAINED FOR A DISTANCE OF "LR". FOR REDUCERS, "LR" IS GIVEN FOR THE LARGER DIAMETER SIDE OF THE FITTING AND NO RESTRAINING IS REQUIRED ON THE SMALL SIDE OF THE FITTING. GATE VALVES SHALL BE MECHANICALLY RESTRAINED AND INSTALLED WITH CONCRETE BLOCKING PER COA STD DWG 2333 IN ADDITION TO THE MECHANICAL RESTRAINING LENGTHS. ALL CAPS SHALL BE INSTALLED WITH CONCRETE BLOCKING PER COA STD DWG 2330. RESTRAIN ALL JOINTS ON FIRE HYDRANTS.

RECORD DRAWING

12-3-97

SCALE:
HORIZ: 1" = 50'
VERT: 1" = 10'

community sciences corporation
LAND PLANNING P.O. Box 1328 ENGINEERING Corrales, N.M. 87048 SURVEYING

CITY OF ALBUQUERQUE
PUBLIC WORKS DEPARTMENT
ENGINEERING GROUP



TITLE: PARKWEST - UNIT 5
OFFSITE UTILITY PLAN & PROFILE
BASALT AVENUE N.W.

APPROVALS	ENGINEER	DATE	APPROVALS	ENGINEER	DATE
DRG CHAIRMAN			WATER	R.W. Kane	6-5-99
TRANSPORTATION	N/A, R40	6-02-95	WASTE WATER	R.W. Kane	6-5-99
HYDROLOGY	J. Martin	9-19-95	A.M.A.F.C.A.		

PROJECT NO. 4886.94 MAP NO. G, H9 SHEET 37 OF 39

SCANNED BY
BY LASON

26-4886.94 3797

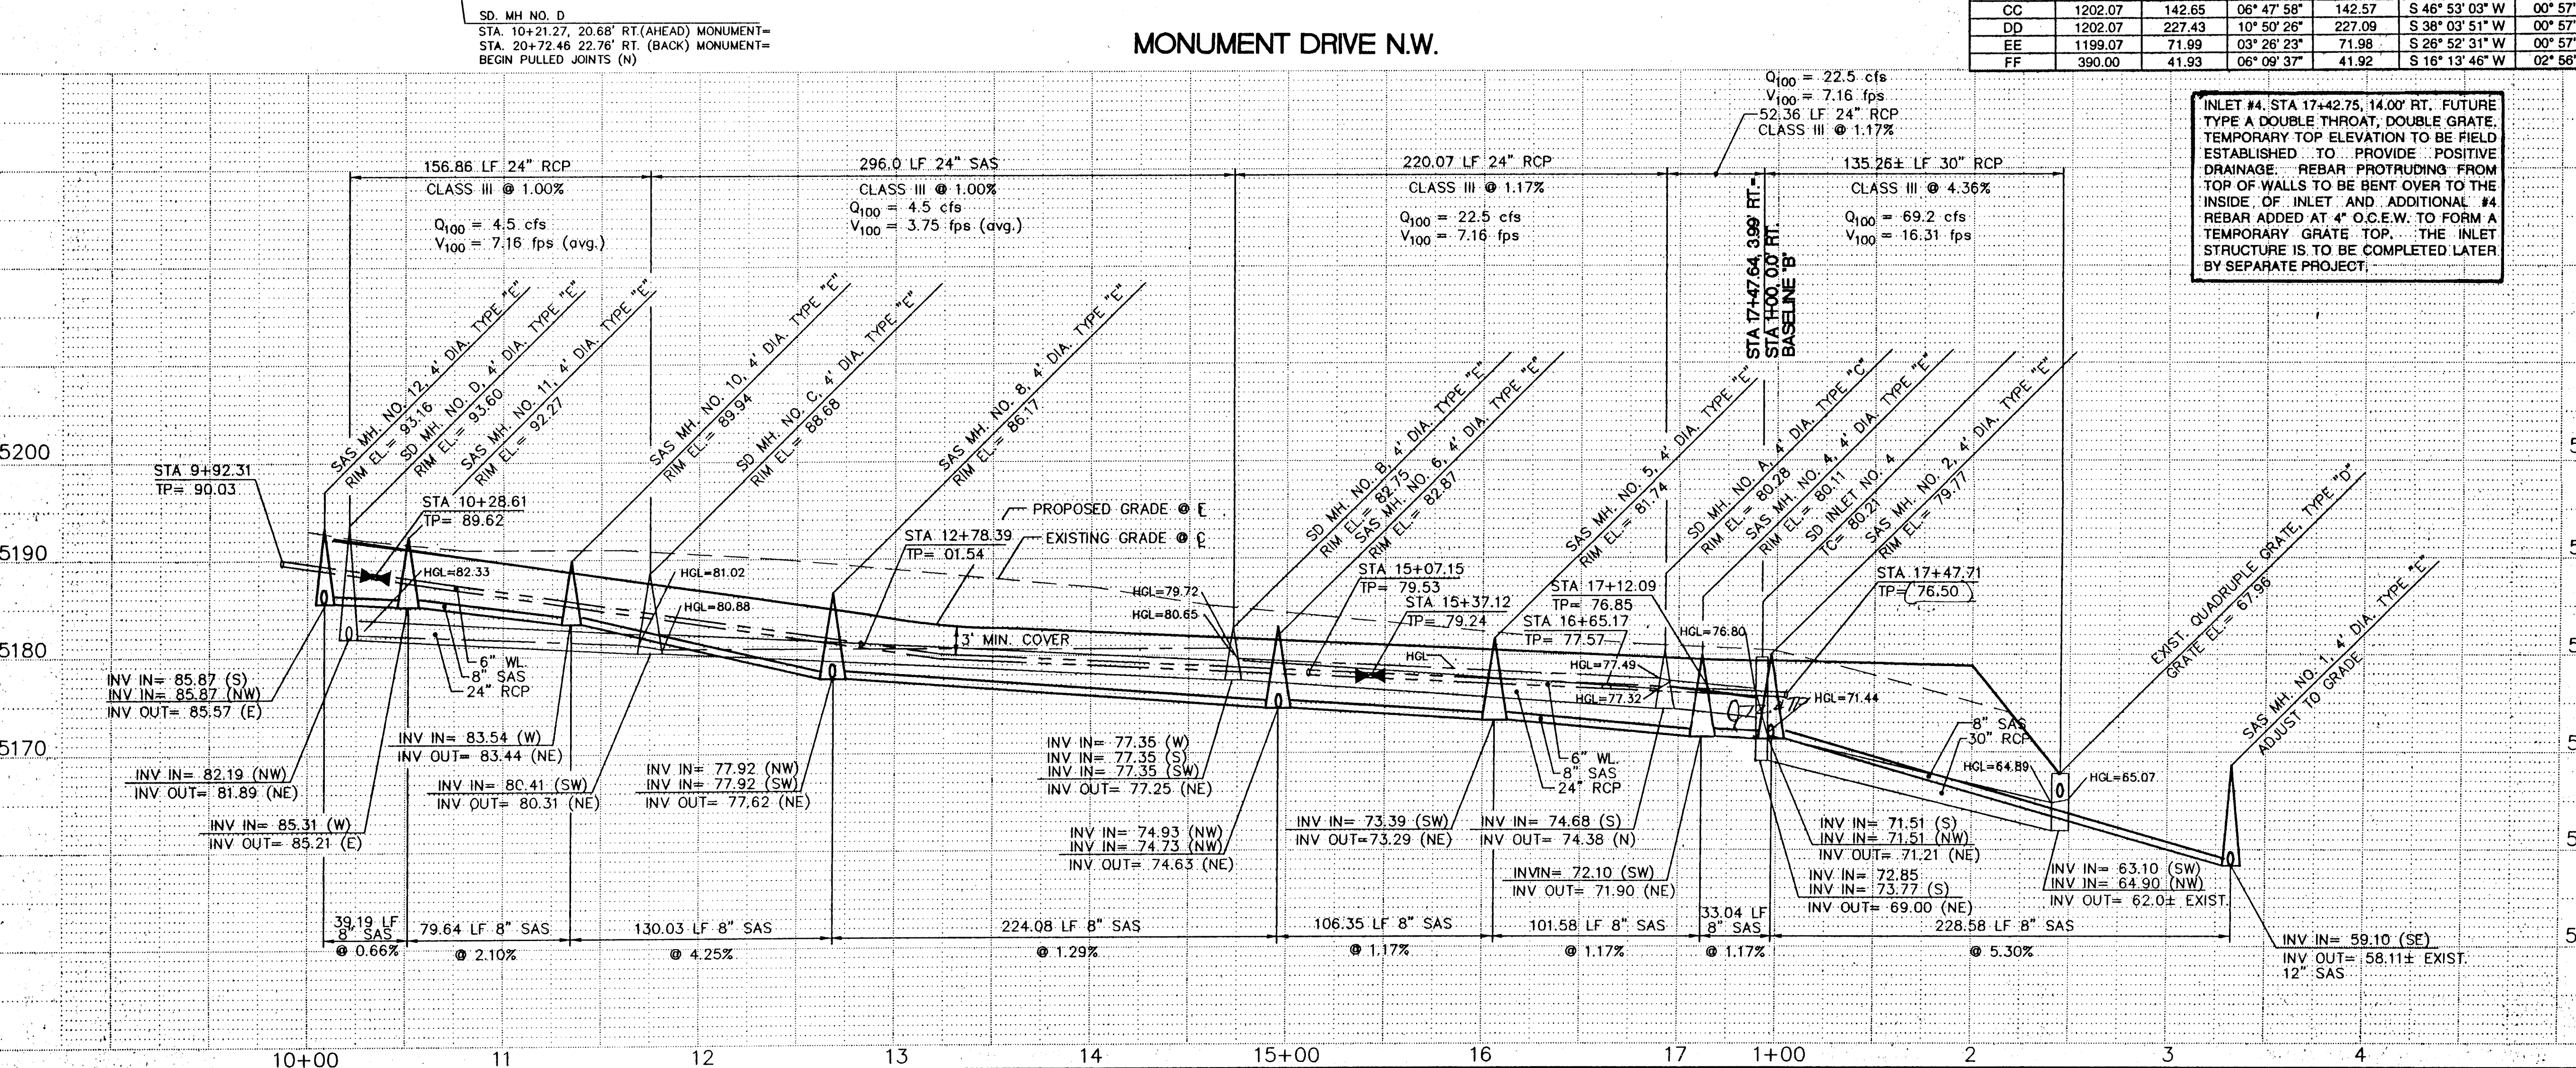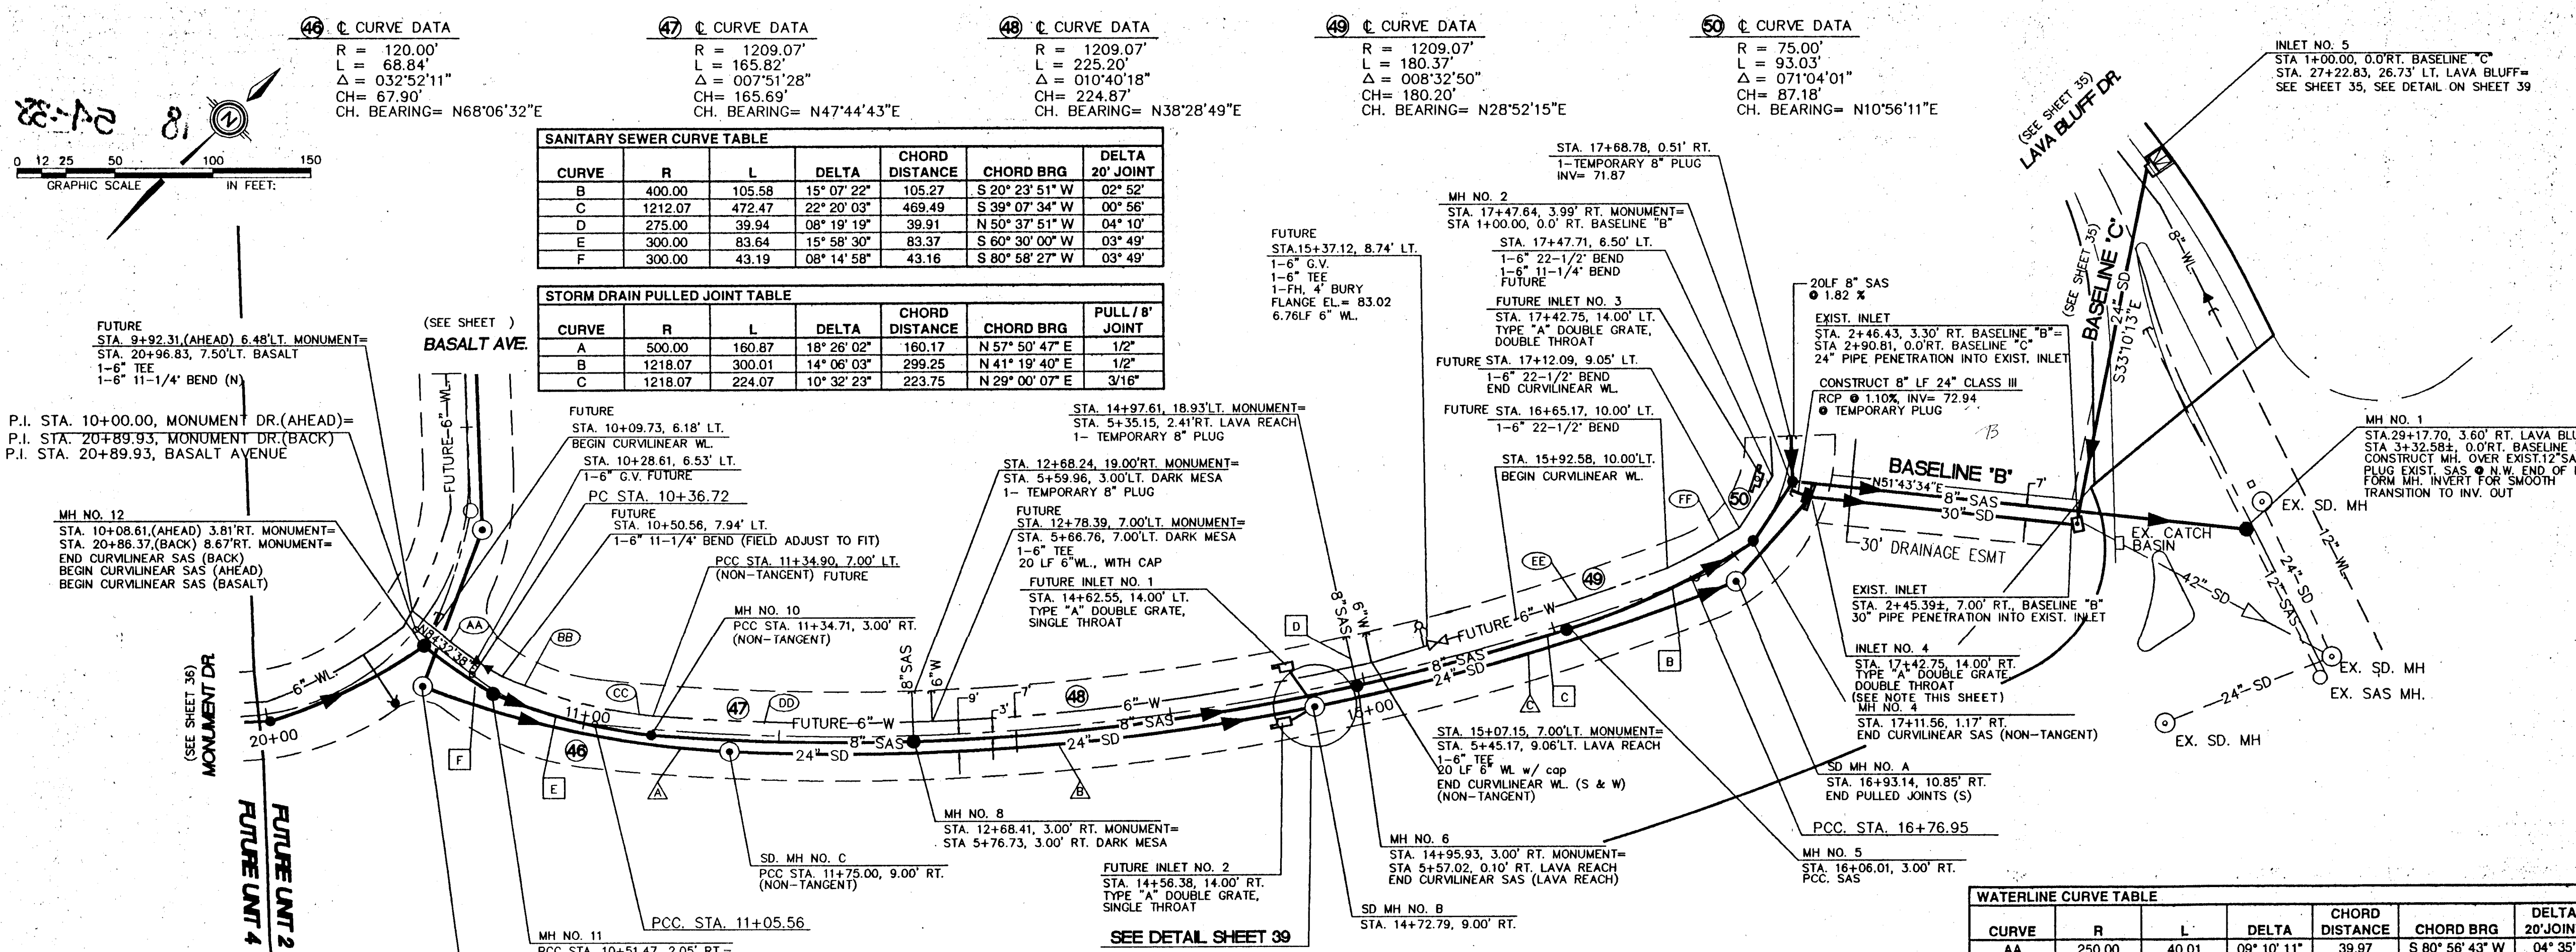

UTILITY LEGEND

DESCRIPTION	PROPOSED	EXISTING
SANITARY SEWER LINE	8" SAS	8" SAS
ENCASEMENT		
SANITARY SEWER MANHOLE		
SAS SERVICE CONNECTION		
STORM DRAIN LINE	SD 30"	SD 30"
STORM DRAIN MANHOLE		
STORM DRAIN INLETS		
WATER LINE	W 8"	W 8"
GATE VALVE		
BUTTERFLY VALVE		
FIRE HYDRANTS		
REDUCERS		
WATER SERVICE/ METER		
TEES		
CROSSES		
BENDS		
CAPS & PLUGS		
FUTURE FIRE HYDRANT		
FUTURE WATER		
FUTURE MANHOLE		
GAS LINES	N/A	N/A
OVERHEAD ELECTRICAL LINE	N/A	N/A
OVERHEAD ELECTRICAL	N/A	N/A
OVERHEAD TELEPHONE	N/A	N/A
UNDERGROUND TELEPHONE	N/A	N/A
CABLE TELEVISION	N/A	N/A
POWER OR TELEPHONE POLE	N/A	N/A

RECORD DRAWING
 12-3-97

community sciences corporation

**CITY OF ALBUQUERQUE
 PUBLIC WORKS DEPARTMENT
 ENGINEERING GROUP**

**TITLE: PARKWEST - UNIT 5
 MONUMENT DRIVE N.W.**

APPROVALS	ENGINEER	DATE	APPROVALS	ENGINEER	DATE
DRC CHAIRMAN			WATER		
TRANSPORTATION	M.A. RHP	6-22-95	WASTE WATER	R.W. Kane	6-5-95
HYDROLOGY	J. Carter	9-19-95	A.M.A.F.C.A.		

PROJECT NO. 4886.94

MAP NO. G, H9

SHEET 38 OF 39

EQUIPMENT GROUP		
MAINTENANCE DETAILS		
EQUIPMENT NO.	ENGINEER	DATE
WATER	N/A RWE	6-5-9
F.C.A.	N/A RWE	6-5-9
9	SHEET	39 ^{OF} 39