

RECORD DRAWING

PARKWEST SUBDIVISION- UNIT 2

CITY OF ALBUQUERQUE, BERNALILLO COUNTY, NEW MEXICO

IMPROVEMENTS FOR GRADING, PAVING AND UTILITIES

INDEX TO DRAWINGS

SHEET NO.	DESCRIPTION
1	COVER SHEET, VICINITY MAP AND INDEX TO DRAWINGS
2-3	PLATS OF GEOMETRY
4	GRADING AND EROSION CONTROL PLAN
5	GRADING DETAILS AND SECTIONS
PAVING PLAN & PROFILES	
6	COMPOSITE PAVING PLAN
7	LAVA BLUFF DRIVE N.W.
8	MONUMENT DRIVE & BASALT DRIVE N.W.
9	MONUMENT DRIVE N.W.
10	DARK MESA AVENUE & LAVA REACH AVENUE N.W.
UTILITY PLAN & PROFILES	
11	COMPOSITE UTILITY PLAN
12	LAVA BLUFF DRIVE N.W.
13	MONUMENT DRIVE & BASALT DRIVE N.W.
14	MONUMENT DRIVE N.W.
15	DARK MESA AVENUE & LAVA REACH AVENUE N.W.

WARNING - EXISTING UTILITY LINE LOCATIONS ARE SHOWN IN AN APPROXIMATE MANNER ONLY, AND SUCH LINES MAY EXIST WHERE NONE ARE SHOWN. THE LOCATION OF ANY SUCH EXISTING LINES IS BASED UPON INFORMATION PROVIDED BY THE UTILITY COMPANY, THE OWNER, OR BY OTHERS, AND THE INFORMATION MAY BE INCOMPLETE OR MAY BE OBSOLETE BY THE TIME CONSTRUCTION COMMENCES.



THE ENGINEER HAS UNDERTAKEN LIMITED FIELD VERIFICATION OF THE LOCATION, DEPTH, SIZE, OR TYPE OF EXISTING UNDERGROUND UTILITY LINES. MAKES NO REPRESENTATION PERTAINING THERETO AND ASSUMES NO RESPONSIBILITY OR LIABILITY THEREFORE. THE CONTRACTOR SHALL INFORM ITSELF OF THE LOCATION OF ANY UTILITY LINE IN OR NEAR THE AREA OF THE WORK IN ADVANCE OF AND DURING EXCAVATION WORK. THE CONTRACTOR IS FULLY RESPONSIBLE FOR ANY AND ALL DAMAGE CAUSED BY ITS FAILURE TO LOCATE, IDENTIFY, AND PRESERVE ANY AND ALL EXISTING UTILITIES. THE CONTRACTOR SHALL COMPLY WITH STATE STATUTES, MUNICIPAL AND LOCAL ORDINANCES, RULES AND REGULATIONS PERTAINING TO THE LOCATION OF THESE LINES AND FACILITIES IN PLANNING AND CONDUCTING EXCAVATION, WHETHER BY CALLING OR NOTIFYING THE UTILITIES, COMPLYING WITH (BLUE STAKES) PROCEDURES, OR OTHERWISE.

SURVEYOR'S CERTIFICATION:

"I, Robert C. Miller, a duly qualified Registered Professional Land Surveyor under the laws of the State of New Mexico, do hereby certify that the 'as-built' information shown on these drawings was obtained from field construction and 'as-built' surveys performed by me or under my supervision, and that this 'as-built' information is true and correct to the best of my knowledge and belief and that I am not responsible for any of the design concepts, calculations, engineering, or intent of the record drawings."

Robert C. Miller
Robert C. Miller, N.M.F.P.S. #3794

11/14/96
Date

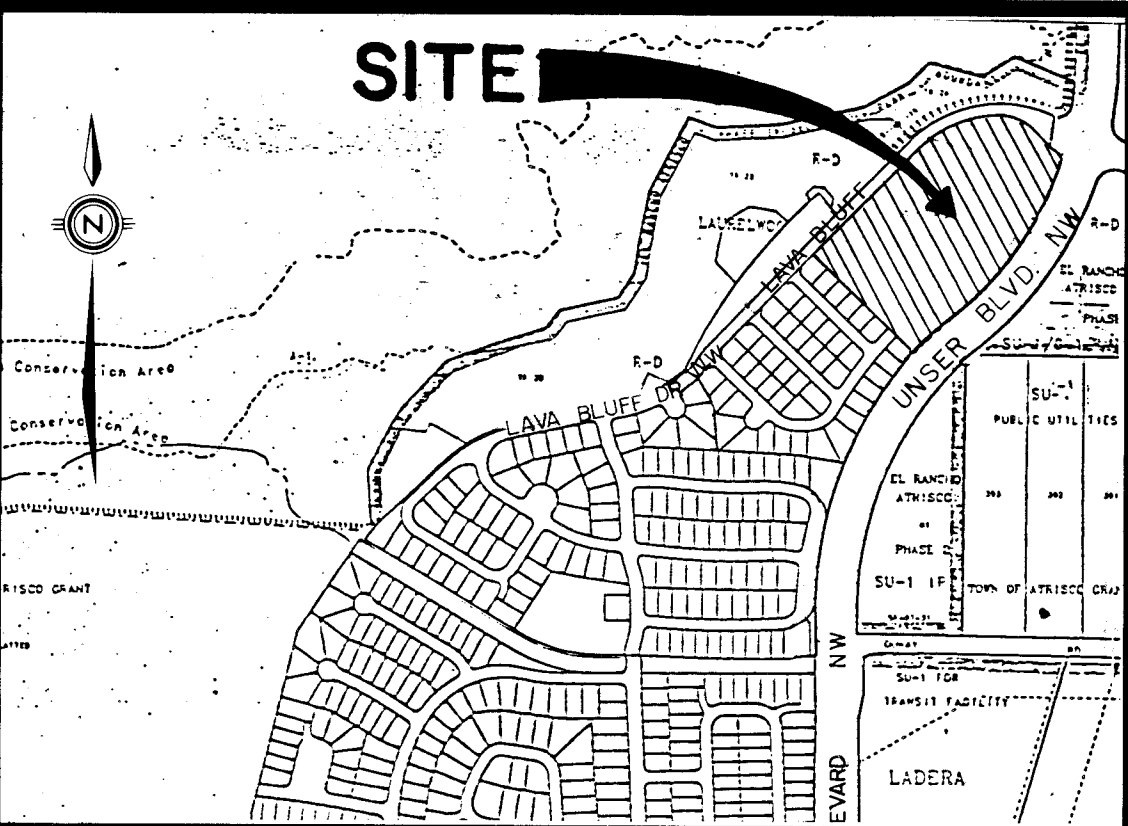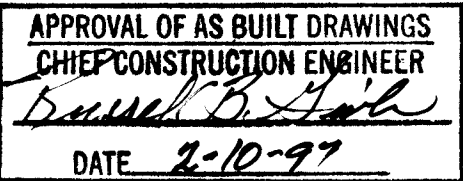

SCALE: 1" = 750 ± VICINITY MAP G-9, H-9-Z

GENERAL NOTES:

- ALL WORK DETAILED ON THESE PLANS TO BE PERFORMED UNDER CONTRACT SHALL, EXCEPT AS OTHERWISE STATED OR PROVIDED FROM HEREON, BE CONSTRUCTED IN ACCORDANCE WITH THE CITY OF ALBUQUERQUE STANDARD SPECIFICATIONS FOR PUBLIC WORKS CONSTRUCTION, 1986 EDITION AS AMENDED WITH UPDATE NO. 6.
- TWO (2) WORKING DAYS PRIOR TO ANY EXCAVATION, CONTRACTOR MUST CONTACT LINE LOCATING SERVICE, (260-1990) FOR LOCATION OF EXISTING UTILITIES.
- PRIOR TO CONSTRUCTION, THE CONTRACTOR SHALL EXCAVATE AND VERIFY THE HORIZONTAL AND VERTICAL LOCATIONS OF ALL OBSTRUCTIONS AND EXISTING PAVEMENT. SHOULD A CONFLICT EXIST, THE CONTRACTOR SHALL NOTIFY THE ENGINEER OR SURVEYOR SO THAT THE CONFLICT CAN BE RESOLVED WITH MINIMUM AMOUNT OF DELAY.
- THE CONTRACTOR SHALL FURNISH EMD'S ON ALL WATER AND SEWER SERVICE STUBS, CAPS AND PLUGS.
- CONTRACTOR SHALL NOTIFY THE PROJECT ENGINEER NOT LESS THAN SEVEN (7) DAYS PRIOR TO STARTING WORK IN ORDER THAT THE ENGINEER MAY TAKE NECESSARY MEASURES TO ENSURE THE PRESERVATION OF SURVEY MONUMENTS. CONTRACTOR SHALL NOT DISTURB PERMANENT SURVEY MONUMENTS WITHOUT THE CONSENT OF THE ENGINEER AND BEAR THE EXPENSE OF REPLACING ANY THAT MAY BE DISTURBED WITHOUT PERMISSION. REPLACEMENT SHALL BE DONE ONLY BY THE CITY SURVEY SECTION. WHEN A CHANGE IS MADE IN ANY ROADWAY IN WHICH A PERMANENT SURVEY MONUMENT IS LOCATED, CONTRACTOR SHALL, AT HIS OWN EXPENSE, ADJUST THE MONUMENT COVER TO THE NEW GRADE UNLESS OTHERWISE SPECIFIED. REFER TO SECTION 4.4 OF GENERAL CONDITIONS OF THE CITY OF ALBUQUERQUE STANDARD SPECIFICATIONS FOR PUBLIC WORKS CONSTRUCTION.
- RESTRAINED JOINTS ARE REQUIRED AT ALL WATER LINE BENDS, TEES, CAPS AND GATE VALVES.
- THE PUBLIC WATER LINE MUST BE A MINIMUM OF 18" ABOVE THE SEWER LINE AT ALL CROSSINGS.
- THE CONTRACTOR SHALL CONTACT WATER SYSTEMS DIVISION (857-8200) FIVE (5) WORKING DAYS PRIOR TO NEEDING SHUT-OFF OR TURN-ON OF VALVES. ONLY CITY WATER SYSTEMS PERSONNEL ARE AUTHORIZED TO OPERATE VALVE.
- THREE (3) WORKING DAYS PRIOR TO BEGINNING CONSTRUCTION, THE CONTRACTOR SHALL SUBMIT TO THE CONSTRUCTION COORDINATION DIVISION A DETAILED CONSTRUCTION SCHEDULE. TWO (2) WORKING DAYS PRIOR TO CONSTRUCTION, THE CONTRACTOR SHALL OBTAIN A BARRICADE PERMIT FROM THE CONSTRUCTION COORDINATION DIVISION. CONTRACTOR SHALL NOTIFY BARRICADE ENGINEER (768-2551) PRIOR TO OCCUPYING AN INTERSECTION. SEE SECTION 19 OF THE SPECIFICATIONS.
- ALL STREET STRIPING ALTERED OR DESTROYED SHALL BE REPLACED IN KIND BY CONTRACTOR TO LOCATION AND IN KIND AS EXISTING OR AS INDICATED BY THIS PLAN SET. ALL NEW STRIPING SHALL BE PLASTIC AS PER CITY STANDARDS.
- ANY WORK AFFECTING AN ARTERIAL ROADWAY REQUIRES TWENTY-FOUR HOUR CONSTRUCTION.
- ALL HANDICAP RAMPS WILL MEET ADA STANDARDS.

SCANNED BY
BY LASON

1 2 3 4 5 6 7 8 9 10 11 12 13 14 15
26-4886.96-96 01/97

1	REV.	SHEETS	CITY ENGINEER	DATE	USER DEPARTMENT	DATE	USER DEPARTMENT	DATE
---	------	--------	---------------	------	-----------------	------	-----------------	------

ENGINEER'S SEAL <i>James D. Haggler</i> 12-27-95	DATE: MAY 1995 SCALE: AS SHOWN DESIGNED: S.R.L. DRAWN: A.M. JOB NO.: 14323-PRE PROJECT NO.: 4886.96	community sciences corporation LAND PLANNING P.O. Box 1328 ENGINEERING Corrales, N.M. 87048 SURVEYING APPROVED FOR CONSTRUCTION <i>John Costello</i> CITY ENGINEER 7/23/96 DATE	SHEET 1 OF 15
--	--	---	---------------




THE SUBDIVISION SHOWN HEREON IS WITH THE FREE CONSENT AND IN ACCORDANCE WITH THE DESIRES OF THE UNDERSIGNED OWNER(S) AND/OR PROPRIETOR(S) THEREOF AND SAID OWNER(S) AND/OR PROPRIETOR(S) DO HEREBY DEDICATE ALL STREETS AND PUBLIC RIGHTS-OF-WAY SHOWN HEREON TO THE PUBLIC AND TO THE CITY OF LOS ANGELES, CALIFORNIA, AND TO THE PEOPLE THEREOF, HEREBY GRANT: ALL ACCESS, UTILITY AND DRAINAGE EASEMENTS SHOWN HEREON INCLUDING THE RIGHT TO CONSTRUCT, OPERATE, INSPECT, AND MAINTAIN FACILITIES THEREIN; AND ALL PUBLIC EASEMENTS SHOWN HEREON FOR THE COMMON AND JOINT USE OF GAS, ELECTRICAL, POWER AND WATER LINES, AND ALL OTHER UTILITIES SHOWN HEREON; AND THE RIGHT TO ENTER FOR UNDERGROUND UTILITIES WHERE SHOWN OR INDICATED, AND INCLUDING THE RIGHT OF INGRESS AND EGRESS FOR CONSTRUCTION AND MAINTENANCE, AND THE RIGHT TO TRIM INTERFERING TREES AND SHRUBS (SEE NOTE 8). SAID OWNER(S) AND/OR PROPRIETOR(S) DO HEREBY CERTIFY AND WARRANT THAT THE FOREGOING AND DO HEREBY CERTIFY THAT THIS SUBDIVISION IS THEIR FREE ACT AND DEED.

STATE OF NEW MEXICO)
COUNTY OF BERNALILLO) SS

THIS INSTRUMENT WAS ACKNOWLEDGED BEFORE ME ON December 28, 1995
BY GEORGE F. PHILLIPSON, VICE PRESIDENT, ON BEHALF OF SAID CORPORATION.


MY COMMISSION EXPIRES:

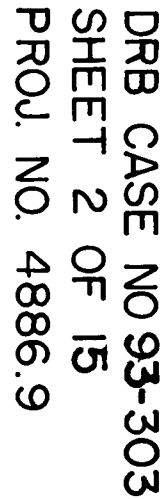

LAND PLANNING ENGINEERING SURVEYING
P.O. Box 1328 Corrales, N.M. 87048

REPLAT FOR PARKWEST UNIT 2

COMPRISED OF TRACT A-2 OF PARKWEST UNIT 5 SITUATE WITHIN TOWN OF ATRISCO GRANT "PROJECTED" SECTIONS 4 & 9, T10N, R2E, N.M.P.M. CITY OF ALBUQUERQUE, BERNALILLO COUNTY, NEW MEXICO APRIL, 1995

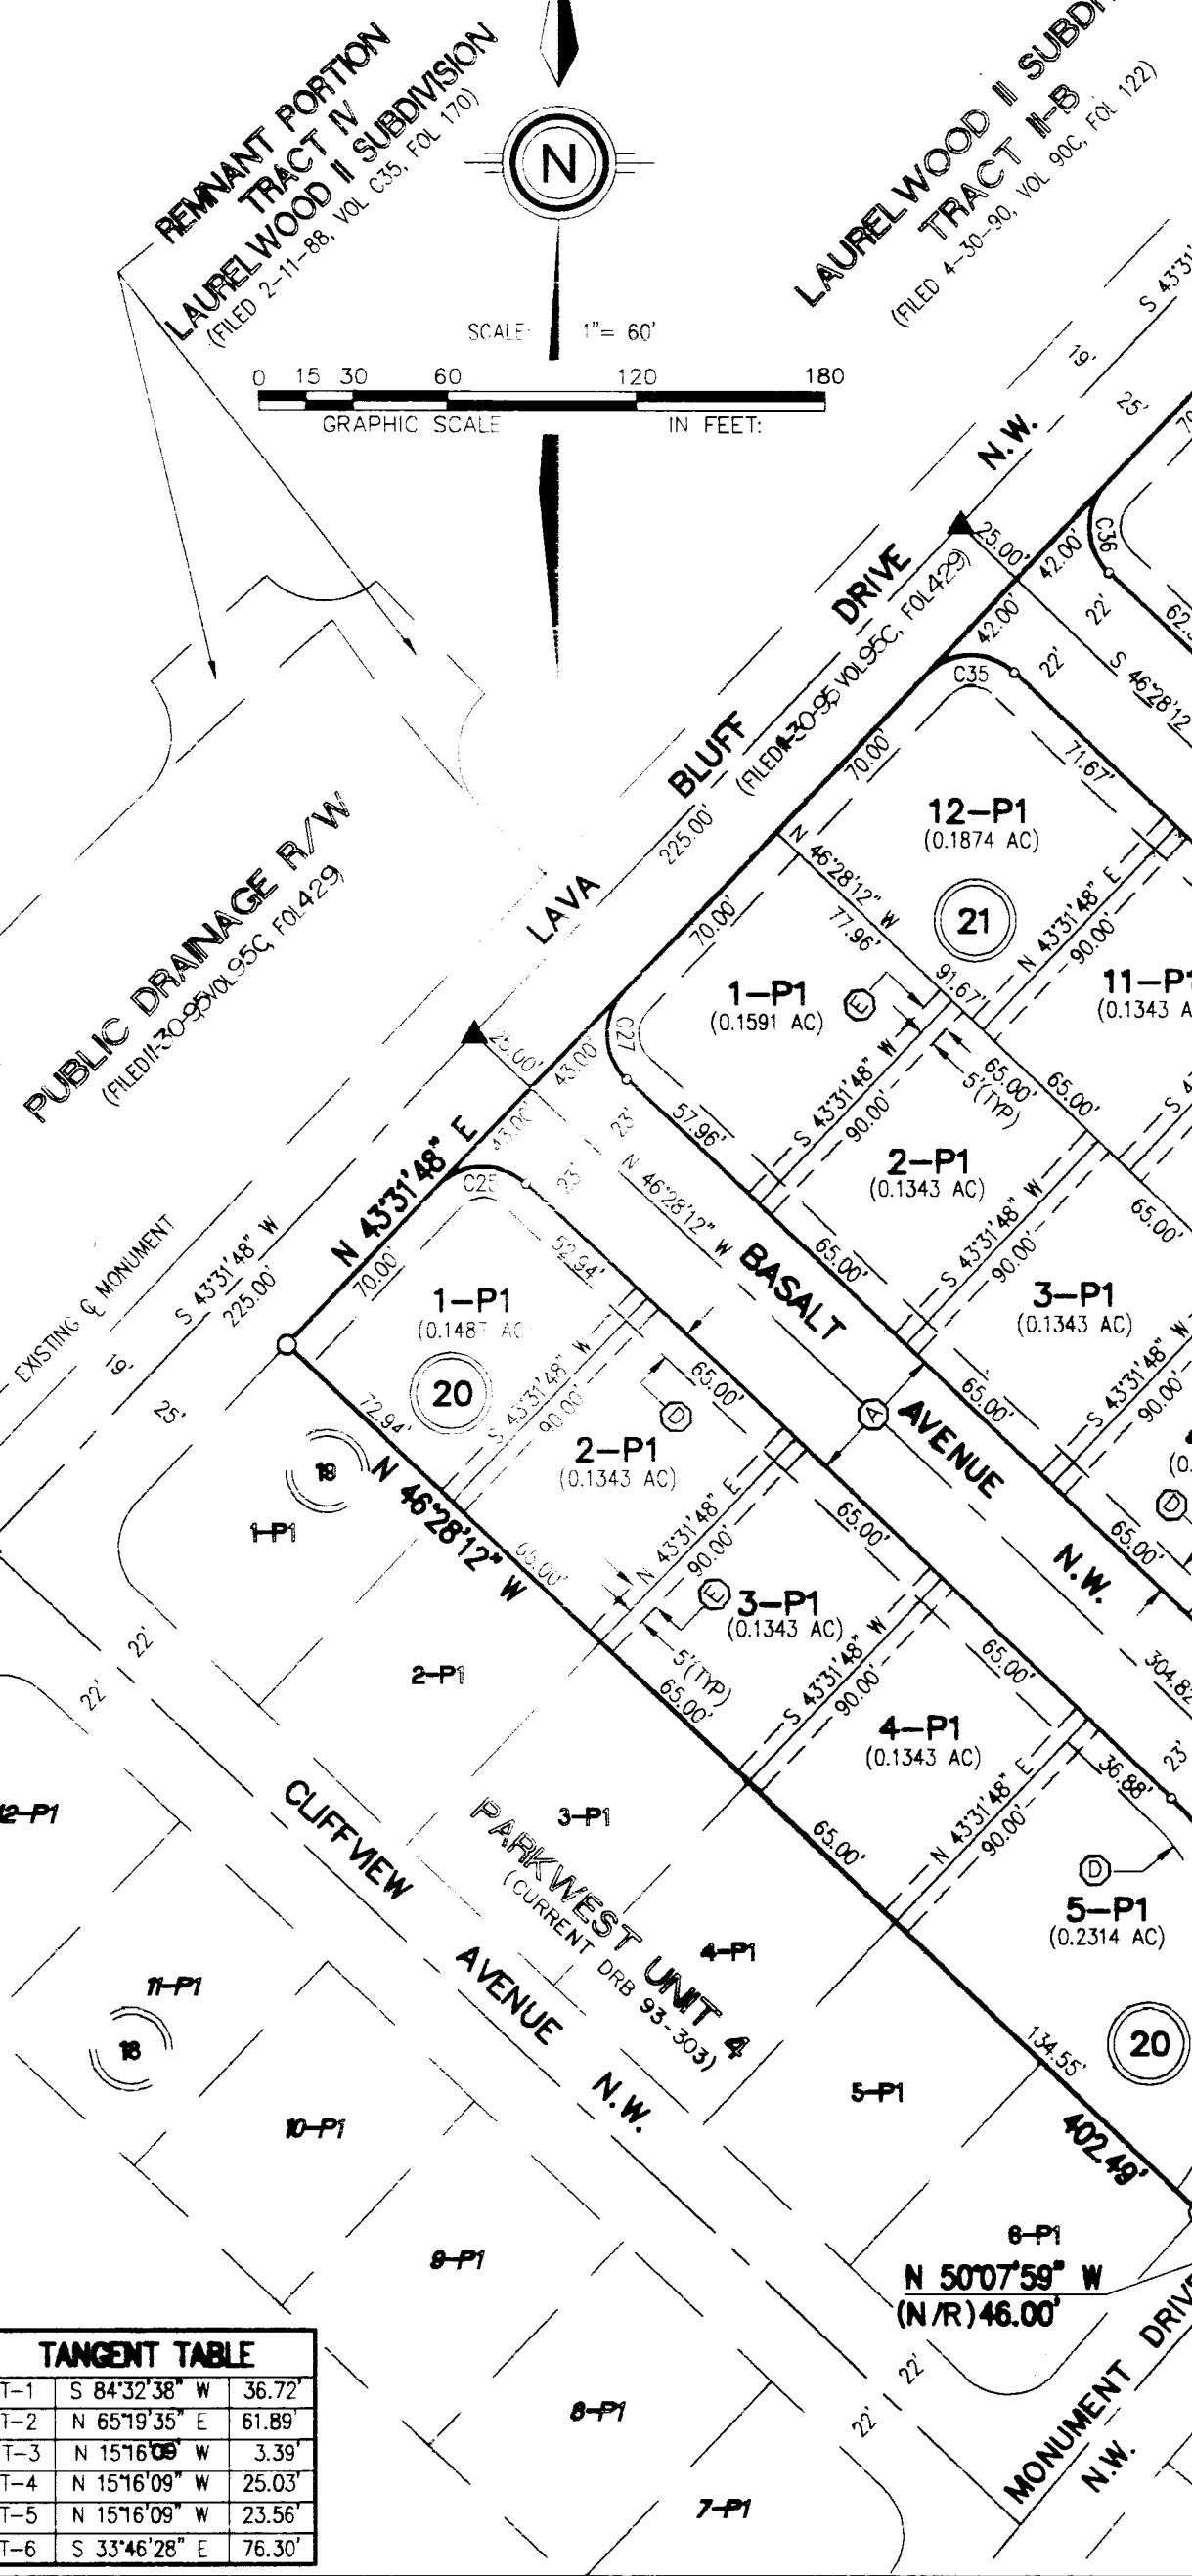

LAURELWOOD II SUBDIVISION TRACT I-A (FILED 4-30-90, VOL. 90C, FOL. 122)

S 35°37'11" E, 719.17' (GRND) TIE TO CITY OF ALBUQUERQUE ACS MONUMENT "2-G9" N.M. STATE PLANE COORDINATES (CENTRAL ZONE) NAD 27 X=356,680.72 Y=1,499,064.48 DELTA ALPHA = -0°01'33" G-G=0.9996684 ELEVATION = 5334.50

NOTE: SEE SHEET 3 FOR NOTES CURVE DATA

LEGEND

- FND #5 REBAR W/ CAP STAMPED "4972"
- PRIVATE DRAINAGE EASEMENT (P.D.E.)
- PUBLIC UTILITY EASEMENT (P.U.E.)
- AC ACRES
- ▲ EXISTING CENTERLINE MONUMENT
- ▲ CENTERLINE MONUMENT TO BE SET

KEYED NOTES

- EXISTING PUBLIC SANITARY SEWER & DRAINAGE EASEMENT (FILED 3-30-95, VOL. 95C, FOL. 429)
- EXISTING DRAINAGE EASEMENT (FILED 3-30-95, VOL. 95C, FOL. 429)
- EXISTING 10' PNM & MT. BELL EASEMENT (FILED 3-16-87, VOL. C33, FOL. 34)
- 10' PUBLIC UTILITY EASEMENT GRANTED WITH THIS PLAT
- 10' PRIVATE DRAINAGE EASEMENT GRANTED WITH THIS PLAT
- EXISTING PUBLIC DRAINAGE EASEMENT (FILED 3-30-95, VOL. 95C, FOL. 429)

SURVEYOR'S CERTIFICATION:

I, C. A. SPIROCK, HEREBY AFFIRM THAT I AM A DULY QUALIFIED REGISTERED PROFESSIONAL SURVEYOR UNDER THE LAWS OF THE STATE OF NEW MEXICO AND DO CERTIFY THAT THIS PLAT WAS PREPARED BY ME OR UNDER MY DIRECT SUPERVISION; SHOWS ACCURATE DIMENSIONS, AND LAND AREAS; SHOWS ALL EASEMENTS AND RESTRICTIONS AS SHOWN ON THE PLAT OF RECORD OR MADE KNOWN TO ME BY THE OWNERS AND/OR PROPRIETORS OF THE SUBDIVISION SHOWN HEREON. TITLE COMPANIES, UTILITY COMPANIES OR OTHER PARTIES EXPRESSING AN INTEREST. I FURTHER CERTIFY THAT THIS PLAT MEETS THE MINIMUM REQUIREMENTS FOR MONUMENTATION AND SURVEYS OF THE ALBUQUERQUE SUBDIVISION ORDINANCE, MEETS THE "MINIMUM STANDARDS FOR LAND SURVEYS" SET FORTH BY THE STATE OF NEW MEXICO AND IS TRUE AND CORRECT TO THE BEST OF MY KNOWLEDGE AND BELIEF.

C. A. SPIROCK, N.M.P.S. #4972

1/5/96 DATE

SHEET 2 OF 3

community sciences corporation

DATE:	APRIL, 1995
SCALE:	1" = 60'
DESIGNED:	S.P.S.
DRAWN:	D.E.R.
CHECKED:	D.E.R.
DATE:	143-23-025
LAND PLANNING:	P.O. Box 1328
ENGINEERING:	Corrales, N.M. 87048
SURVEYING:	

T	1	S	84°32'38"	W	36.72'
T	2	N	65°19'35"	E	61.89'
T	3	N	15°16'08"	W	3.39'
T	4	N	15°16'09"	W	25.03'
T	5	N	15°16'09"	W	23.56'
T	6	S	33°46'28"	E	76.30'

N 07°45'11" W, 732.316' (GRND) TIE TO CITY OF ALBUQUERQUE ACS MONUMENT "140-19" N.M. STATE PLANE COORDINATES (CENTRAL ZONE) NAD 27 X=357,584.56 Y=1,490,412.52 DELTA ALPHA = -0°01'25" G-G=0.99967682 ELEVATION = 5151.067



NOTES:


- THE PURPOSE OF THIS PLAT IS TO SUBDIVIDE TRACT A-2 PARKWEST UNIT 5 CONTAINING 10.9054 ACRES INTO 54 RESIDENTIAL LOTS AND ADJOINING STREETS.
- ALL BEARINGS SHOWN HEREON ARE GRID BEARINGS BASED ON THE NEW MEXICO STATE PLANE COORDINATE SYSTEM, CENTRAL ZONE, MEAN DELTA ALPHA -0°01'32". ALL DISTANCES ARE GROUND DISTANCES.
- BEARINGS AND DISTANCES SHOWN ARE BOTH RECORD AND MEASURED.
- ALL DIMENSIONS PUBLISHED ALONG CURVED LINES ARE ARC DISTANCES. LOT LINES MARKED N/R ARE NON-RADIAL.
- BENCHMARK FOR THIS PLAT IS THE CITY OF ALBUQUERQUE ACS BRASS TABLET STAMPED "2-G9" SET IN A 2" IRON PIPE 1 FT. ABOVE GROUND, LOCATED ON TOP OF A VOLCANIC OUTCROP TO REACH THE STATION FROM THE INTERSECTION OF COORS RD. AND DURAY RD. GO WEST ON DURAY RD. ABOUT 0.7 MI. TO THE END OF PAVEMENT, CONTINUE WEST ON THE DIRT RD. TO THE TOP OF THE DETENTION DAM, ALONG THE N. BANK OF DAM, 0.6 MI. TO A DIRT CROSS ROAD. TURN RIGHT, GO N. ON THE DIRT ROAD 0.5 MI. SLD ELEVATION = 5334.50.
- UNLESS OTHERWISE NOTED, ALL CORNERS ARE EVIDENCED BY A #5 REBAR WITH ALUMINUM CAP STAMPED "P.S. #4972".
- CENTERLINE (IN LIEU OF R/W) MONUMENTATION TO BE INSTALLED AT ALL CENTERLINE P.O.S, P.T'S, ANGLE POINTS AND STREET INTERSECTIONS PRIOR TO ACCEPTANCE OF SUBDIVISION STREET IMPROVEMENTS AND WILL CONSIST OF A FOUR INCH ALUMINUM ALLOY CAP STAMPED "CITY OF ALBUQUERQUE CENTERLINE MONUMENTATION SURVEY MARKER DO NOT DISTURB P.L.S. 4972". ▲ DENOTES CENTERLINE MONUMENT
- PUBLIC UTILITY EASEMENTS (P.U.E.) SHOWN ON THIS PLAT ARE GRANTED FOR THE COMMON AND JOINT USE OF:
 - THE PUBLIC SERVICE COMPANY OF NEW MEXICO FOR THE INSTALLATION, MAINTENANCE, REPAIR, REPLACEMENT, AND SERVICE OF UNDERGROUND ELECTRICAL LINES, TRANSFORMERS, POLES AND ANY OTHER EQUIPMENT, FIXTURES, STRUCTURES AND RELATED FACILITIES REASONABLY NECESSARY TO PROVIDE ELECTRICAL SERVICE.
 - THE GAS COMPANY OF NEW MEXICO FOR INSTALLATION, MAINTENANCE, AND SERVICE OF NATURAL GAS LINES, VALVES AND OTHER EQUIPMENT AND FACILITIES REASONABLY NECESSARY TO PROVIDE NATURAL GAS.
 - U.S. WEST FOR THE INSTALLATION, MAINTENANCE AND SERVICE OF ALL BURIED COMMUNICATION LINES AND OTHER RELATED EQUIPMENT AND FACILITIES REASONABLY NECESSARY TO PROVIDE COMMUNICATION SERVICES, INCLUDING BUT NOT LIMITED TO ABOVE GROUND PEDESTALS AND CLOSURES.
 - JONES INTERCABLE FOR THE INSTALLATION, MAINTENANCE, AND SERVICE OF SUCH UNDERGROUND LINES, CABLE, AND OTHER RELATED EQUIPMENT AND FACILITIES REASONABLY NECESSARY TO PROVIDE CABLE TV SERVICE.
- INCLUDED IS THE RIGHT TO BUILD, REBUILD, CONSTRUCT, RECONSTRUCT, LOCATE, RELOCATE, CHANGE, REMOVE, MODIFY, RENEW, OPERATE, AND MAINTAIN FACILITIES FOR THE PURPOSES DESCRIBED ABOVE, TOGETHER WITH FREE ACCESS TO, FROM, AND OVER SAID EASEMENTS, INCLUDING SUFFICIENT WORKING AREA SPACE FOR ELECTRIC TRANSFORMERS, WITH THE RIGHT AND PRIVILEGE TO TRIM AND REMOVE TREES, SHRUBS OR BUSHES WHICH INTERFERE WITH THE PURPOSES SET FORTH HEREIN. NO BUILDING, SIGN, POOL, (ABOVE GROUND OR SUBSURFACE), HOT TUB, CONCRETE OR WOOD POOL DECKING, OR OTHER STRUCTURE SHALL BE ERECTED OR CONSTRUCTED ON SAID EASEMENTS, NOR SHALL ANY WELL BE DRILLED OR OPERATED THEREON. PROPERTY OWNERS SHALL BE SOLELY RESPONSIBLE FOR CORRECTING ANY VIOLATIONS OF NATIONAL ELECTRICAL SAFETY CODE CAUSED BY CONSTRUCTION OR POOLS, DECKING, OR ANY STRUCTURES ADJACENT TO OR NEAR EASEMENTS SHOWN ON THIS PLAT.
- CITY OF ALBUQUERQUE WATER AND SEWER SERVICE TO THESE LOTS MUST BE VERIFIED AND COORDINATED WITH THE PUBLIC WORKS DEPARTMENT, CITY OF ALBUQUERQUE.
- THE P1 SUFFIX TO LOT NUMBERS DESIGNATES SPECIAL ON-SITE PARKING CRITERIA WHICH JUSTIFIED THE CITY ALLOWING REDUCED STREET WIDTHS IN THIS SUBDIVISION. SPECIFICALLY, THE PARKING DENSITY CATEGORY OF "INTERMITTENT" IS MET BY EACH LOT PROVIDING 4 PARKING SPACES (INCLUDING THE GARAGE) FOR 3-4 BEDROOMS. ALL DWELLINGS WILL HAVE 2-4 BEDROOMS AND 2-CAR ATTACHED GARAGES WITH 2-CAR WIDTH DRIVEWAYS.
- THE FOLLOWING MINIMUM DWELLING SETBACKS ARE BASED UPON AN APPROVED SITE DEVELOPMENT PLAN:
 - 20' FRONT YARD TO GARAGE; 15' TO DWELLING
 - 5' SIDE YARD
 - 15' REAR YARD
 - 10' SIDE YARD AT ALL CORNER LOTS REGARDLESS OF LOT ORIENTATION
 THERE ARE NO SOLAR SETBACK REQUIREMENTS.
- NO DIRECT DRIVEWAY ACCESS WILL BE ALLOWED TO UNSER BOULEVARD N.W. FROM ANY ADJACENT LOT.
- THERE IS A TEN FOOT (10') WIDE PRIVATE DRAINAGE EASEMENT CENTERED ON COMMON SIDE LOT LINES IN THIS SUBDIVISION (5' ON EACH SIDE). THIS EASEMENT DOES NOT APPLY TO THE COMMON LOT LINE BETWEEN LOTS 13-P1 AND 14-P1, BLOCK 24, NOR TO SIDE LOT LINES ADJACENT TO STREET RIGHT-OF-WAYS.

SURVEYOR'S CERTIFICATION:

I, C. A. SPIROCK, HEREBY AFFIRM THAT I AM A DULY QUALIFIED REGISTERED PROFESSIONAL SURVEYOR UNDER THE LAWS OF THE STATE OF NEW MEXICO AND DO CERTIFY THAT THIS PLAT WAS PREPARED BY ME OR UNDER MY DIRECT SUPERVISION; SHOWS ACCURATE DIMENSIONS, AND LAND AREAS; SHOWS ALL EASEMENTS AND RESTRICTIONS AS SHOWN ON THE PLAT OF RECORD OR MADE KNOWN TO ME BY THE OWNERS AND/OR PROPRIETORS OF THE SUBDIVISION SHOWN HEREON. TITLE COMPANIES, UTILITY COMPANIES OR OTHER PARTIES EXPRESSING AN INTEREST. I FURTHER CERTIFY THAT THIS PLAT MEETS THE MINIMUM REQUIREMENTS FOR MONUMENTATION AND SURVEYS OF THE ALBUQUERQUE SUBDIVISION ORDINANCE, MEETS THE "MINIMUM STANDARDS FOR LAND SURVEYS" SET FORTH BY THE STATE OF NEW MEXICO AND IS TRUE AND CORRECT TO THE BEST OF MY KNOWLEDGE AND BELIEF.

C. A. SPIROCK, N.M.P.S. #4972

1/5/96 DATE

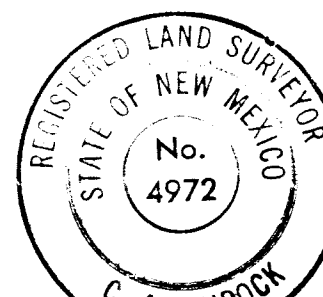

SHEET 3 OF 3

community sciences corporation

DATE:	APRIL, 1995
SCALE:	1" = 60'
DESIGNED:	S.P.S.
DRAWN:	D.E.R.
CHECKED:	D.E.R.
DATE:	143-23-025
LAND PLANNING:	P.O. Box 1328
ENGINEERING:	Corrales, N.M. 87048
SURVEYING:	

CURVE DATA							
CURVE	IDEN	RADIUS	ARC	DELTA	TANGENT	CHORD	CHORD BRG
CURVE	C1	443.33	172.73	022-19-24	87.47	171.64	N54-41-30E
CURVE	C2	377.00	175.66	026-42-00	89.47	174.10	N79-12-12E
CURVE	C3	220.31	170.74	044-24-19	89.92	166.50	S65-14-39E
CURVE	C4	70.15	109.18	089-10-44	69.15	98.49	S26-10-05E
CURVE	C5	1322.07	741.87	032-09-04	380.98	732.17	S34-29-49W
CURVE	C6	1477.55	179.52	006-57-40	89.87	179.41	S47-05-31W
CURVE	C7	468.33	182.47	022-19-24	92.41	181.32	N54-41-30E
CURVE	C8	402.00	82.67	011-46-57	41.48	82.52	N71-44-40E
CURVE	C9	402.00	104.66	014-55-03	52.63	104.37	N85-05-40E
CURVE	C10	300.00	146.55	027-59-20	74.77	145.10	S73-27-08E
CURVE	C11	300.00	58.91	011-15-03	29.55	58.81	N65-04-59W
CURVE	C12	121.00	180.59	085-30-41	111.87	164.29	S03-42-51E
CURVE	C13	121.00	86.61	041-00-50	45.26	84.78	S25-57-47E
CURVE	C14	121.00	93.97	044-29-51	49.50	91.63	S16-47-34W
CURVE	C15	120.00	68.84	032-52-11	35.40	67.90	S68-06-32W
CURVE	C16	1209.07	165.82	007-51-28	83.04	165.69	S47-44-43W
CURVE	C17	1209.07	230.07	010-40-18	124.93	224.87	S38-26-49W
CURVE	C18	1209.07	180.37	006-32-50	90.35	180.20	S28-52-15W
CURVE	C19	1209.07	571.39	027-04-37	291.13	566.08	S38-06-08W
CURVE	C20	75.00	93.03	071-04-01	53.56	87.18	S10-56-11E
CURVE	C21	120.00	65.35	031-12-03	33.51	64.54	N30-52-10W
CURVE	C22	377.00	46.91	007-07-48	23.49	46.88	N81-23-37E
CURVE	C23	377.00	44.29	006-43-54	22.17	44.27	N74-27-46E
CURVE	C24	443.33	26.27	003-23-44	13.14	26.27	N45-13-40E
CURVE	C25	20.00	31.42	090-00-00	20.00	28.28	N88-31-48E
CURVE	C26	98.00	145.93	085-19-03	90.30	132.82	S03-48-40E
CURVE	C27	20.00	31.42	090-00-00	20.00	28.28	N01-26-12W
CURVE	C28	144.00	33.44	013-18-20	16.80	33.37	S30-49-01E
CURVE	C29	144.00	31.43	012-30-26	15.78	31.37	S26-54-39E
CURVE	C30	20.00	26.25	075-12-01	15.40	24.41	N58-15-26W
CURVE	C31	97.00	54.97	032-26-06	28.24	54.24	S67-54-30W
CURVE	C32	1186.07	50.35	002-25-57	25.18	50.35	S50-27-28W
CURVE	C33	1186.07	69.36	003-21-02	34.69	69.35	S47-33-59W
CURVE	C34	20.00	32.24	092-21-40	20.84	28.86	S00-17-22E
CURVE	C35	20.00	31.42	090-00-00	20.00	28.28	N88-31-48E
CURVE	C36	20.00	31.42	090-00-00	20.00	28.28	N01-26-12W
CURVE	C37	20.00	32.03	091-46-02	20.63	28.72	S87-38-47W
CURVE	C38	1186.07	69.52	003-21-30	34.77	69.51	S40-05-01W
CURVE	C39	1186.07	73.56	003-33-13	36.79	73.55	S36-37-40W
CURVE	C40	20.00	28.39	081-19-15	17.18	26.06	S05-48-34E
CURVE	C41	20.00	31.42	090-00-00	20.00	28.28	N88-31-48E
CURVE	C42	20.00	32.60	093-23-44	21.22	28.11	N09-13-40E
CURVE	C43	20.00	35.91	102-52-54	25.09	31.28	S82-05-21W
CURVE	C44	1186.07	67.71	003-16-16	33.87	67.70	S29-00-47W
CURVE	C45	1186.07	57.55	002-46-49	28.78	57.55	S25-59-14W
CURVE	C46	52.00	64.50	071-04-01	37.14	60.44	S10-56-11E
CURVE	C47	143.00	33.98	013-36-55	17.07	33.90	N39-39-44W
CURVE	C48	143.00	43.89	017-35-08	22.12	43.72	N24-03-43W
CURVE	C49	20.00	32.68	093-38-02	21.31	29.17	S62-05-10E
CURVE	C50	377.00	34.50	005-14-37	17.26	34.49	N68-26-31E
CURVE	C51	443.33	76.91	009-56-23	38.55	76.81	N60-53-00E
CURVE	C52	443.33	69.54	008-59-16	34.84	69.47	N51-25-10E
CURVE	C53	144.00	73.96	029-25-46	37.82	73.15	S24-27-31W
CURVE	C54	20.00	26.04	074-36-36	15.24	24.24	N47-02-56E
CURVE	C55	143.00	55.25	022-08-10	27.97	54.91	S73-17-09W
CURVE	C56	143.00	26.32	010-32-37	13.19	26.28	S66-56-45W
CURVE	C57	1232.07	37.74	001-45-17	18.87	37.73	S00-47-48W
CURVE	C58	1232.07	63.95	002-58-26	31.98	63.94	S48-25-56W
CURVE	C59	1232.07	63.95	002-58-26	31.98	63.94	S45-27-30W
CURVE	C60	1232.07	63.95	002-58-26	31.98	63.94	S42-29-04W
CURVE	C61	1232.07	63.95	002-58-26	31.98	63.94	S39-30-38W
CURVE	C62	1232.07	63.95	002-58-26	31.98	63.94	S36-32-12W
CURVE	C63	1232.07	63.95	002-58-26	31.98	63.94	S33-33-46W
CURVE	C64	1232.07	63.95	002-58-26	31.98	63.94	S30-35-20W
CURVE	C65	1232.07	66.36	003-05-13	33.20	66.37	S27-33-30W
CURVE	C66	1232.07	30.49	001-25-04	15.24	30.49	S26-18-22W
CURVE	C67	98.00	28.95	016-55-31	14.58	28.84	S16-08-04W
CURVE	C68	98.00	73.53	042-59-15	38.59	71.81	S13-49-18E
CURVE	C69	98.00	19.08	011-09-16	9.57	19.05	N40-53-34E
CURVE	C70	97.00	50.85	030-02-19	26.03	50.27	N31-27-02W
CURVE	C71	20.00	35.39	011-23-23	24.43	30.95	N34-15-49E
CURVE	C72	377.00	49.97	007-35-41	25.02	49.94	N88-45-21E
CURVE	C73	220.31	80.12	020-90-12	40.51	79.68	S77-01-42E
CURVE	C74	220.31	66.58	017-18-57	33.55	66.33	S57-57-07E
CURVE	C75	220.31	24.04	006-15-09	12.03	24.03	S46-10-04E
CURVE	C76	1322.07	85.65	003-42-42	42.84	85.63	S20-16-38W
CURVE	C77	1322.07	89.57	003-52-55	44.80	89.55	S24-04-27W
CURVE	C78	1322.07	71.23	003-05-13	35.62	71.22	S27-33-30W
CURVE	C79	1322.07	66.62	002-58-26	34.32	66.61	S30-35-20W
CURVE	C80	1322.07	66.62	002-58-26	34.32	66.61	S33-33-46W
CURVE	C81	1322.07	66.62	002-58-26	34.32	66.61	S36-32-12W
CURVE	C82	1322.07	66.62	002-58-26	34.32	66.61	S39-30-38W
CURVE	C83	1322.07	66.62	002-58-26	34.32	66.61	S42-29-04W
CURVE	C84	1322.07	66.62	002-58-26	34.32	66.61	S45-27-30W
CURVE	C85	1322.07	66.62	002-58-26	34.32	66.61	S48-25-56W
CURVE	C86	1322.07	15.07	000-39-12	7.54	15.07	S50-14-45W
CURVE	C87	1477.55	55.03	002-04-47	26.82	53.63	N49-31-58E
CURVE	C88	1477.55	61.83	002-23-52	30.92	61.83	N47-17-39E
CURVE	C89	1477.55	64.06	002-29-02	32.03	64.05	N44-51-12E

PARKWEST SUBDIVISION
UNIT 2



COMPRISED OF

TRACT A-2
PARKWEST UNIT 2

SITUATE WITHIN
THE TOWN OF ATRISCO GRANT

'PROJECTED' SECTIONS 4 AND 9, T10N, R2E, N.M.P.M.
CITY OF ALBUQUERQUE, BERNALILLO COUNTY, NEW MEXICO
JUNE, 1995


DRB-93-303

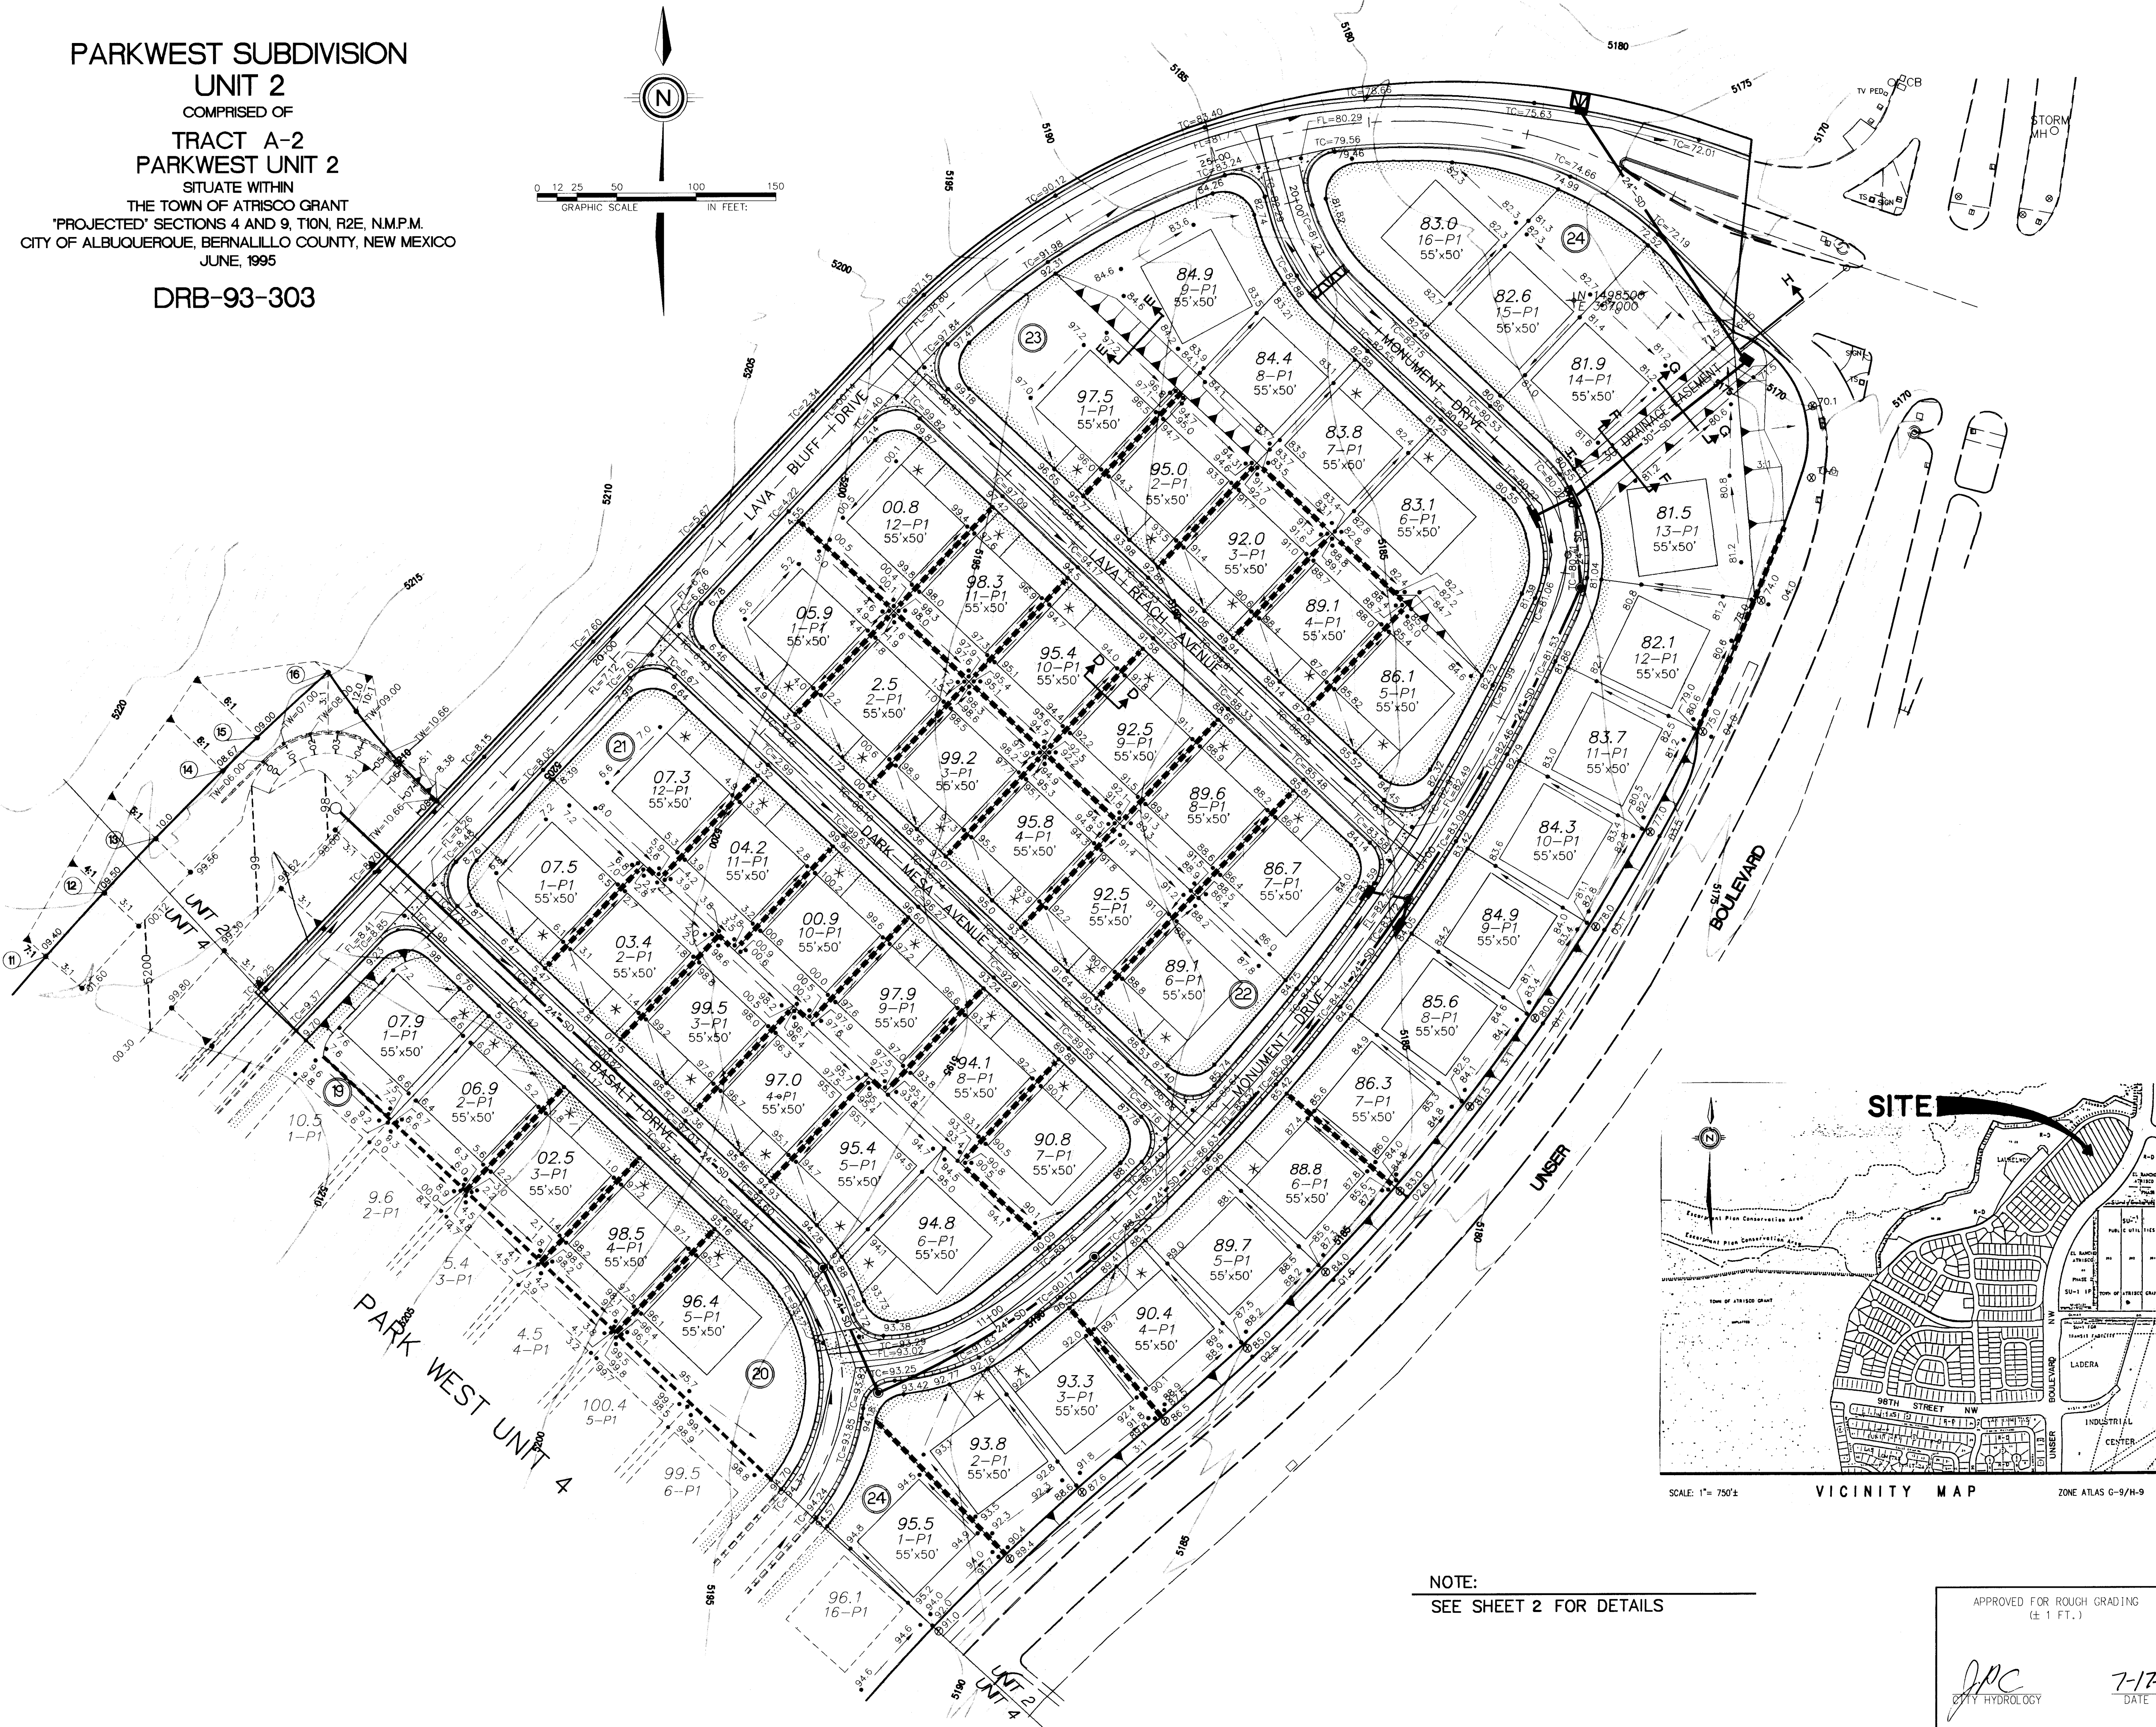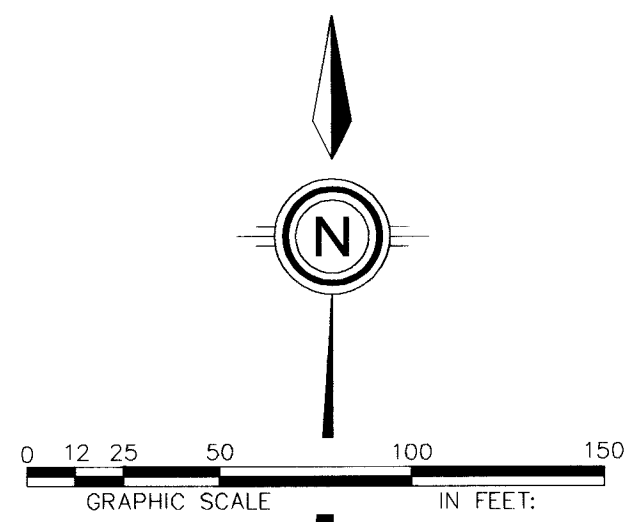

NOTE:
SEE SHEET 2 FOR DETAILS

LEGEND

- TC=98.43 PROPOSED TOP OF CURB ELEVATION
- 99.0 PROPOSED SPOT ELEVATION
- 09.0 EXISTING SPOT ELEVATION (GRND & TC)
- ▬ EROSION CONTROL BERM
- ▬ PROPOSED CONCRETE VALLEY GUTTER
- ▬ EXISTING SIDEWALK
- ▬ PROPOSED MOUNTABLE CURB & GUTTER
- ▬ PROPOSED STANDARD CURB & GUTTER
- ▬ 497.3 EXISTING CONTOUR W/ INDEX ELEVATION
- ▬ PROPOSED SLOPE
- ▬ SWALE
- ▬ FLOW ARROW
- ▬ PROPOSED RETAINING WALL
- ▬ PROPOSED FLOOD WALL
- ▬ PROPOSED GARDEN WALL
- ▬ 30" SD EXISTING STORM DRAIN
- ▬ 30" SD PROPOSED STORM DRAIN
- ▬ TEMPORARY DESILTATION POND
- ▬ POND=08.8 REAR YARD POND W/ ELEVATION
- ▬ WATER BLOCK
- ▬ AREA TO BE RESEED
- ▬ NO GRADING (DO NOT DISTURB)

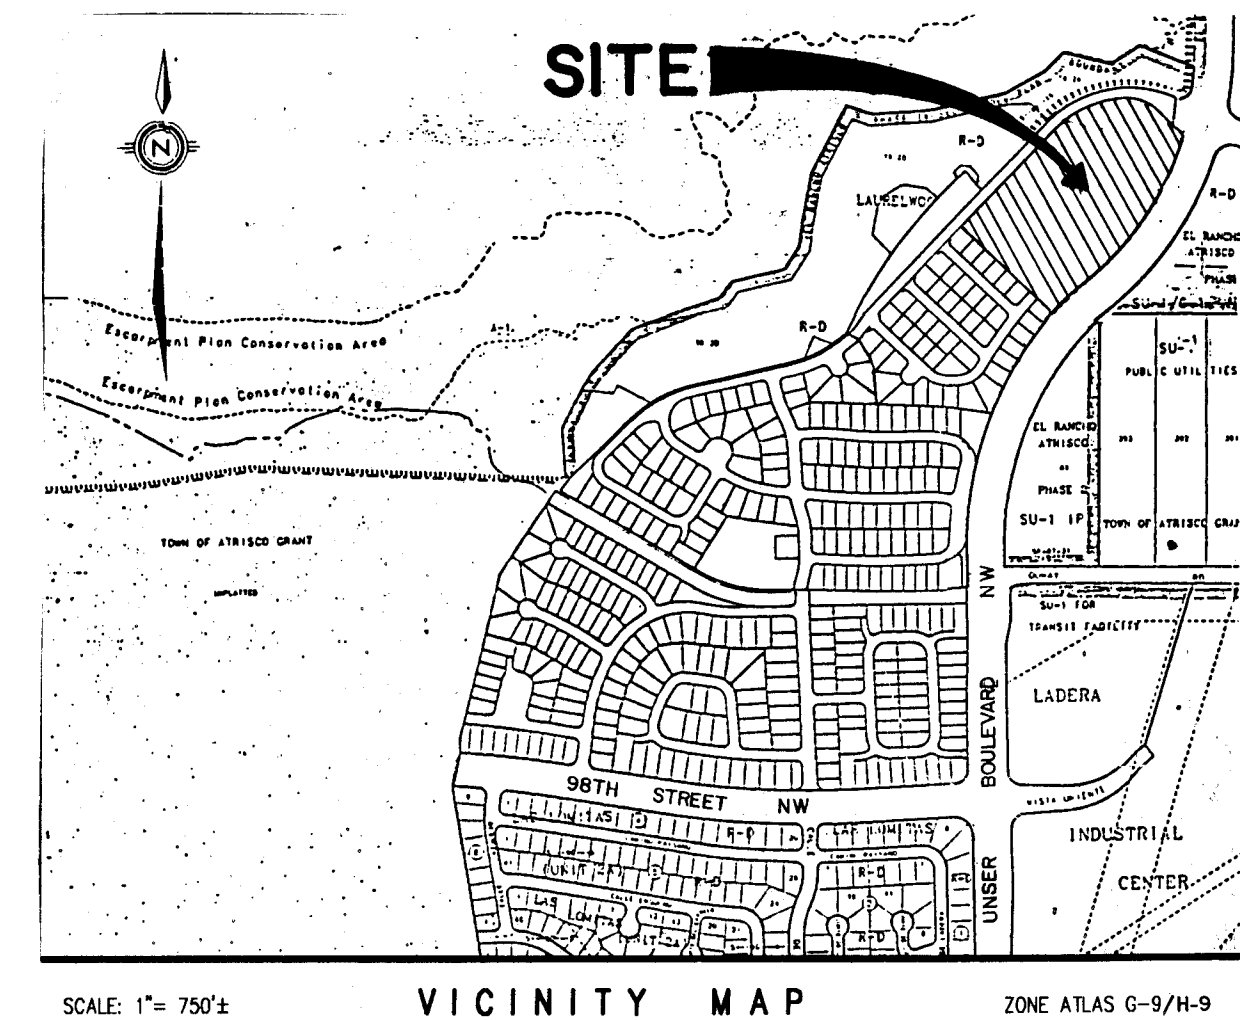

26-4886.96 0497

DATE: JUNE, 1995
SCALE: 1"= 50'
DESIGNED: SRL
DRAWN: M.V.
JOB NO. 14325-043
LAND PLANNING
P.O. Box 1328
ENGINEERING
Corrales, N.M. 87048
SURVEYING


community
sciences
corporation

CITY OF ALBUQUERQUE
PUBLIC WORKS DEPARTMENT
ENGINEERING GROUP

TITLE: PARKWEST - UNIT 2
GRADING & EROSION CONTROL PLAN


APPROVALS	ENGINEER	DATE	APPROVALS	ENGINEER	DATE
DRG. CHAIRMAN			WATER		
T. FOR			HYDROLOGY		
PROJECT NO.	4886.96	MAP NO. G, H9	SHEET	4	OF 15

FOR INFORMATION ONLY

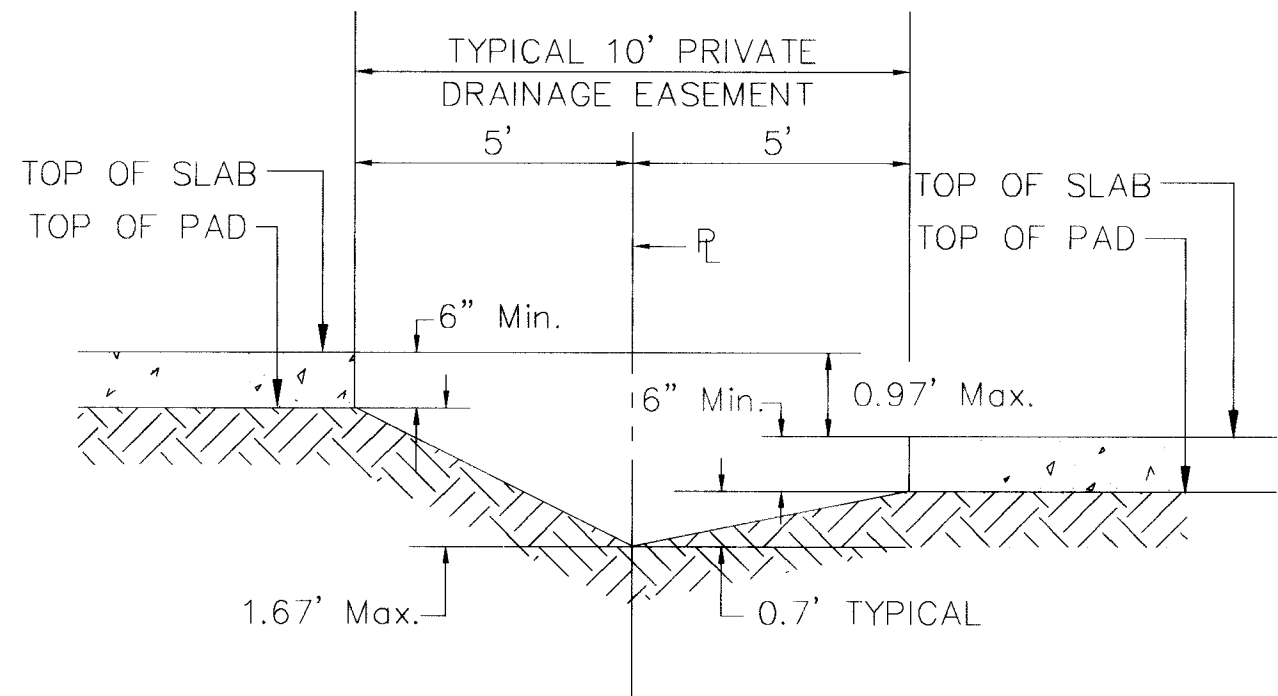


TYPICAL SECTION A - A

N.T.S.
NOTE: FENCES ARE ALLOWED ON THE PROPERTY LINE WITHIN THE PRIVATE DRAINAGE EASEMENT.

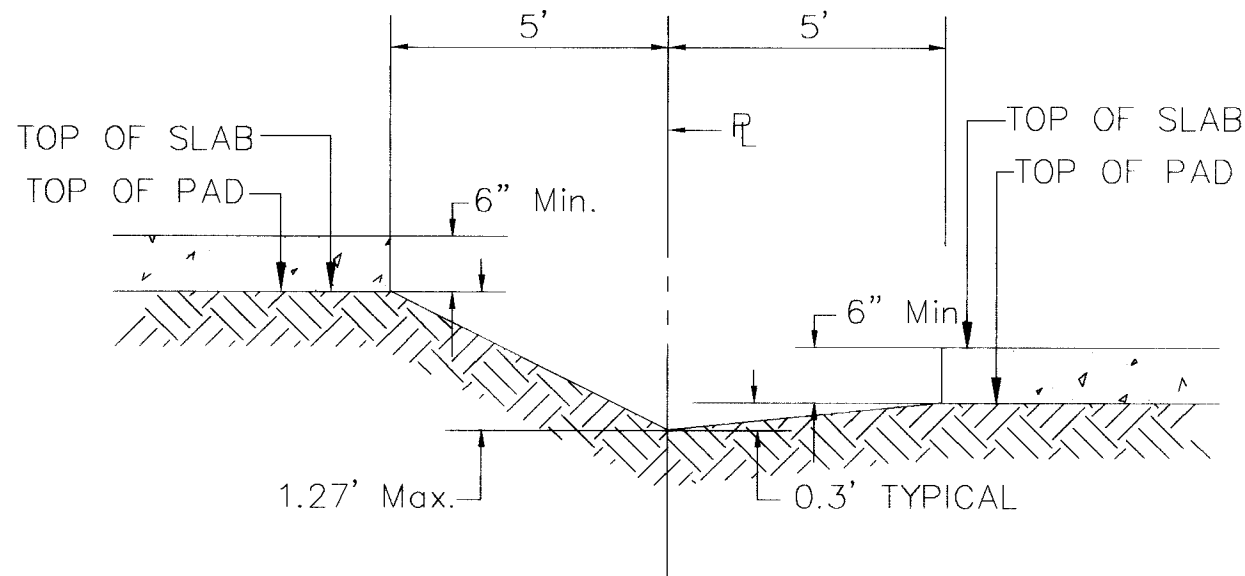


TYPICAL SECTION B - B

N.T.S.

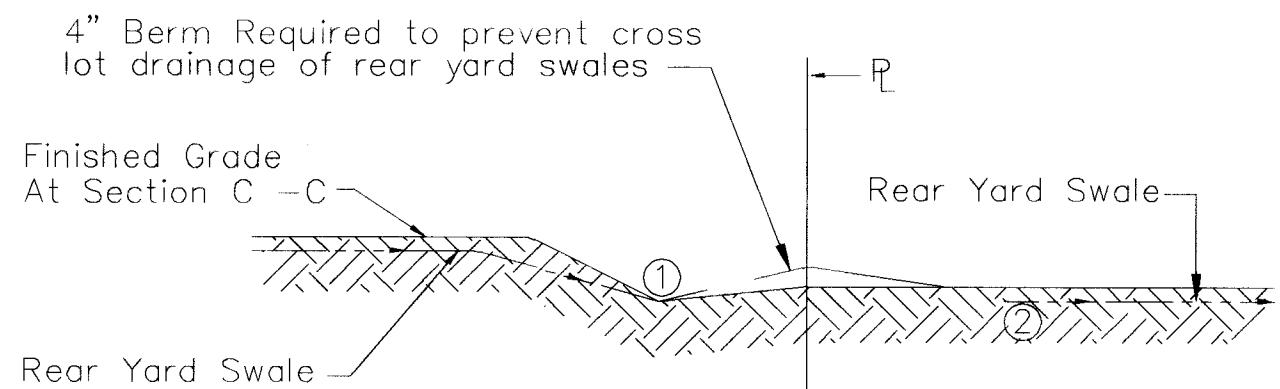

TYPICAL SECTION C - C


N.T.S.

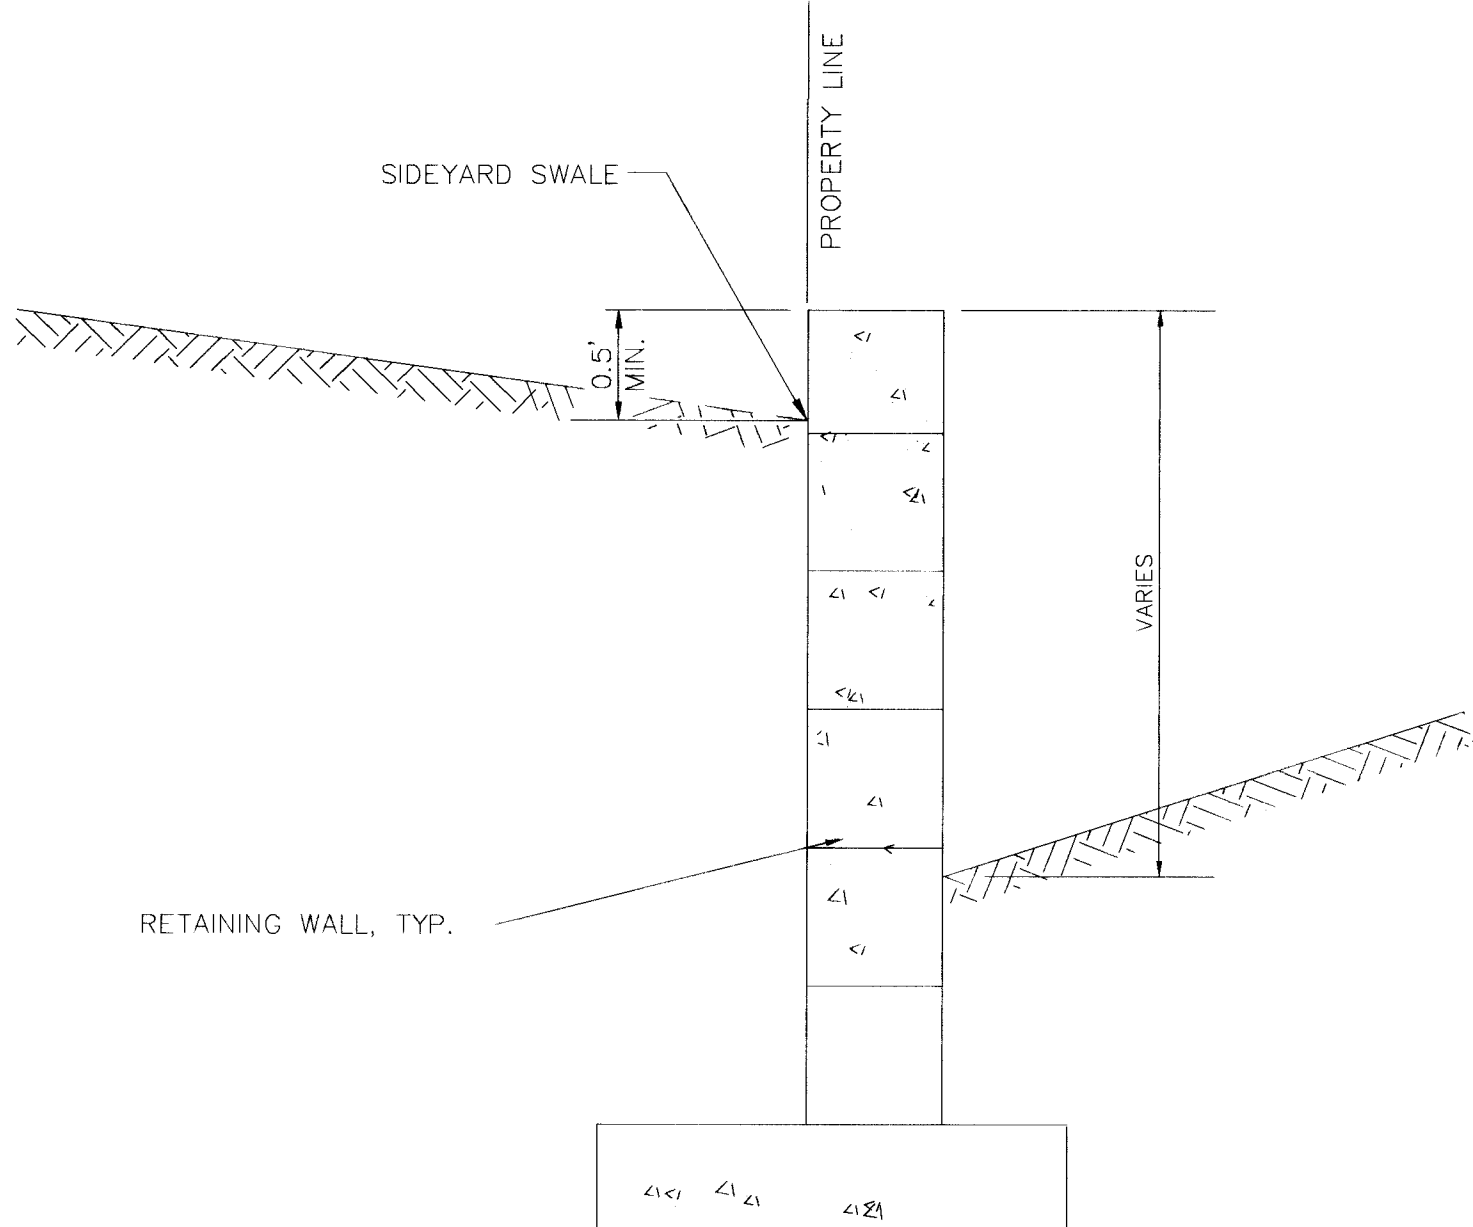

SECTION D - D


TYPICAL RETAINING WALL WITH ADJACENT SWALE

N.T.S.
NOTE: CROSS LOT DRAINAGE SHALL BE PREVENTED BY 0.5' MIN. HEIGHT FROM TOP OF RETAINING WALL TO THE INVERT OF THE SWALE

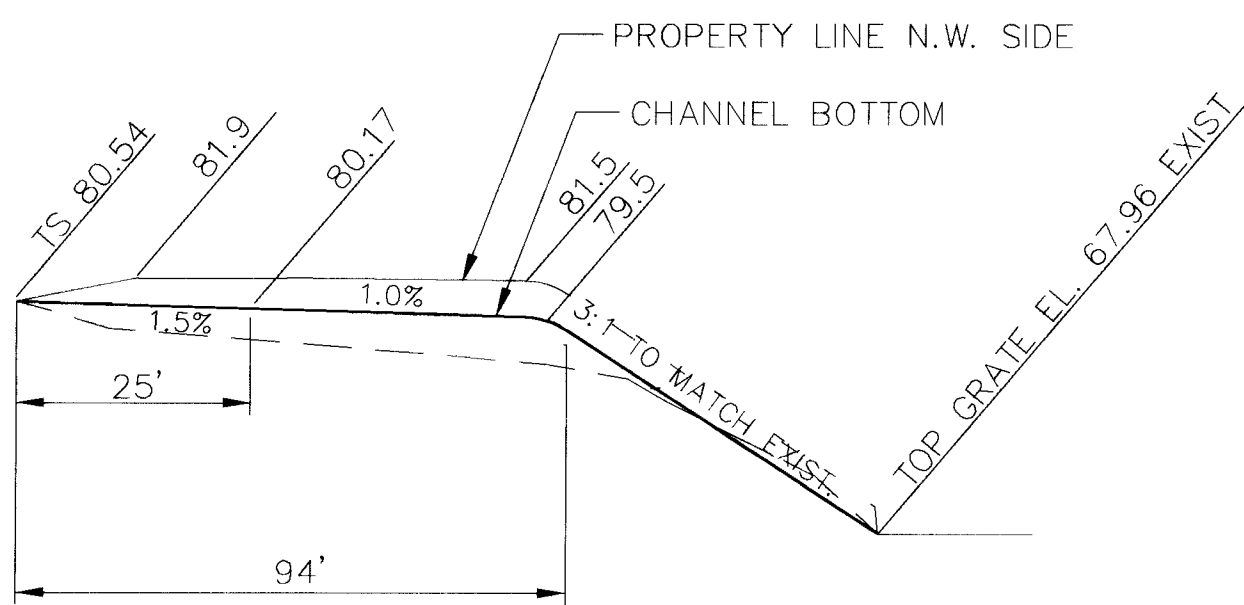


EMERGENCY OVER FLOW TYPICAL SECTION H - H

N.T.S.

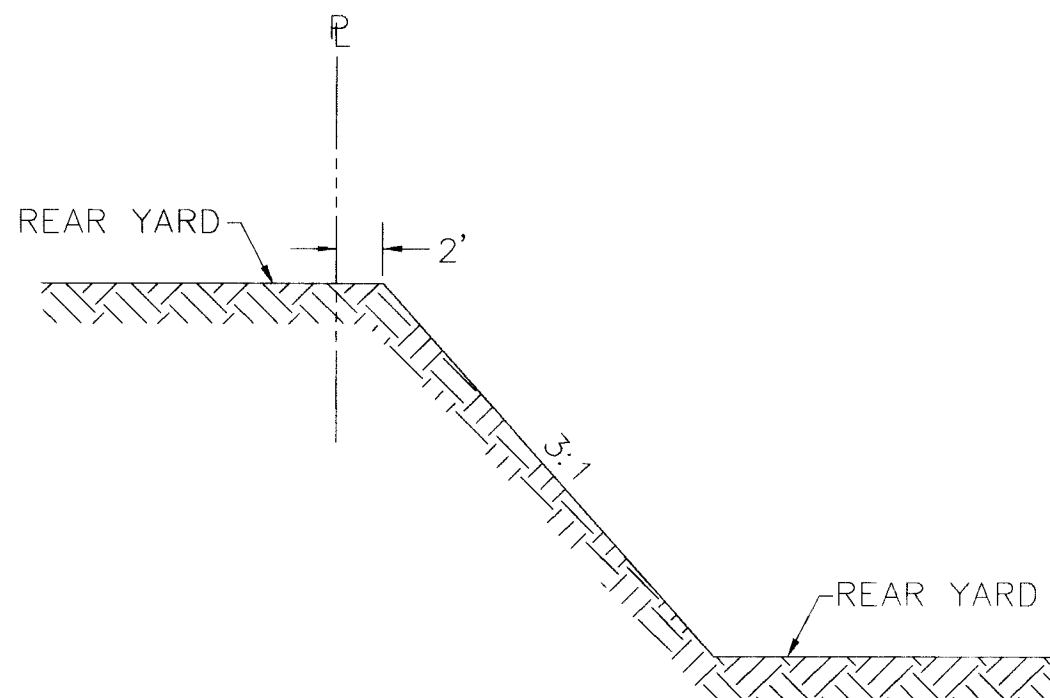

TYPICAL SECTION E - E
REAR PROPERTY LINE GRADING DETAIL


N.T.S.

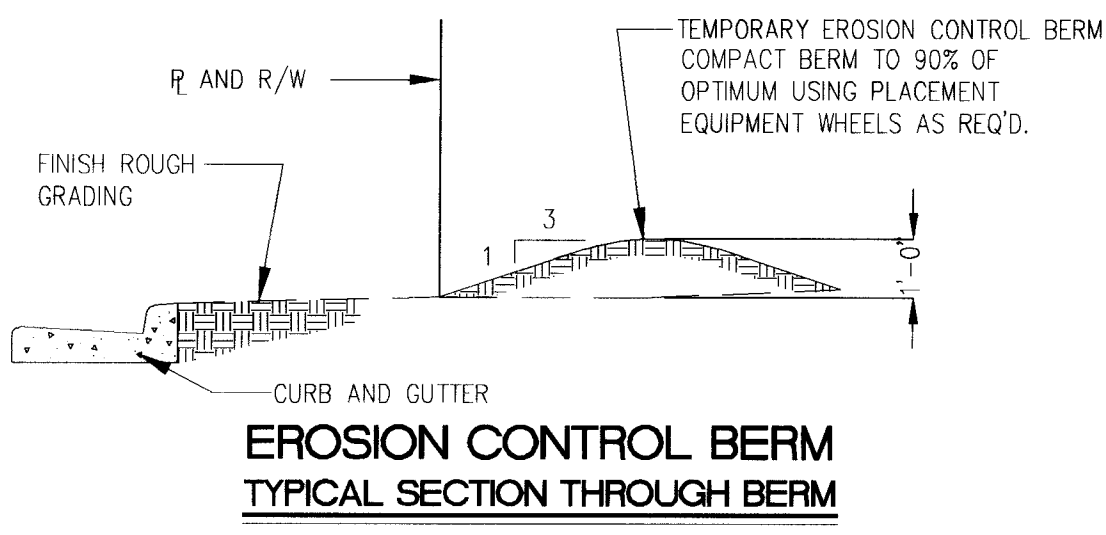

EROSION CONTROL BERM
TYPICAL SECTION THROUGH BERM

N.T.S.


- CONTRACTOR SHALL OBTAIN A TOP SOIL DISTURBANCE PERMIT PRIOR TO GRADING
- DISTURBED AREAS WILL BE RESEED PER C.O.A. DPM SECTION 1012, WHERE INDICATED BY SHADING, THIS PLAN.
- PROTECTION OF ADJACENT RIGHT-OF-WAY AND PRIVATE PROPERTY FROM SEDIMENT, WILL BE ACCOMPLISHED BY THE EROSION CONTROL BERM SHOWN HERE ON.

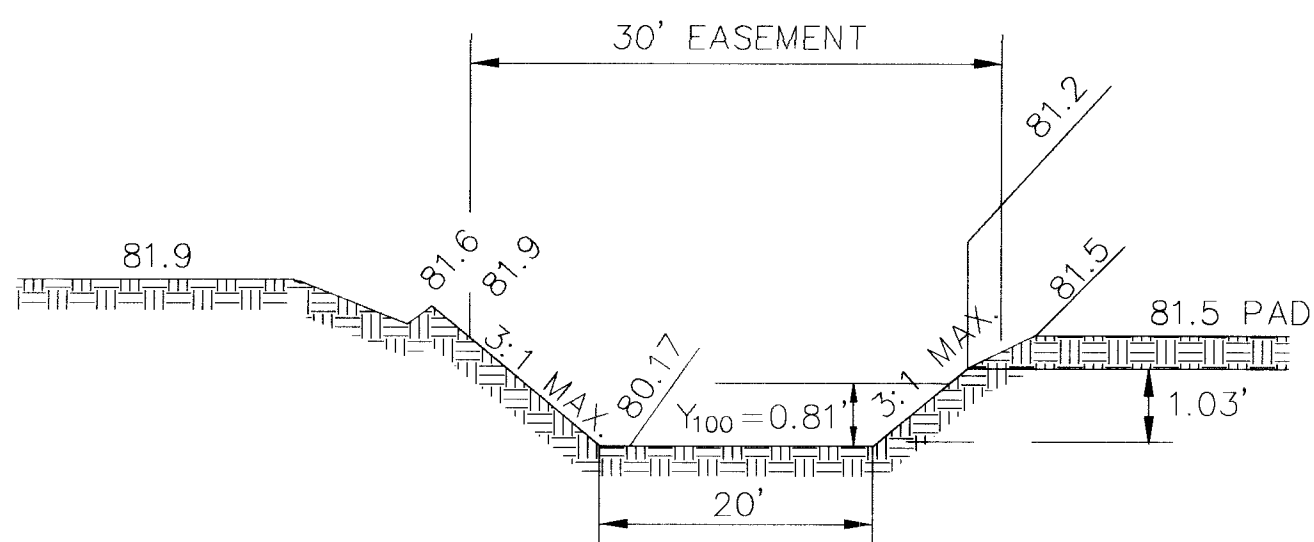

CHANNEL; S=.015 N=.04
Q₁₀₀=67 cfs V₁₀₀=3.60 fps
Y₁₀₀=0.81' A=18.11 P=24.86
Q_{MAX}=100.8 cfs V_{MAX}=4.23 fps
Y_{MAX}=1.03' A=23.78 P=26.51

EMERGENCY OVERFLOW
SECTION F - F


N.T.S.

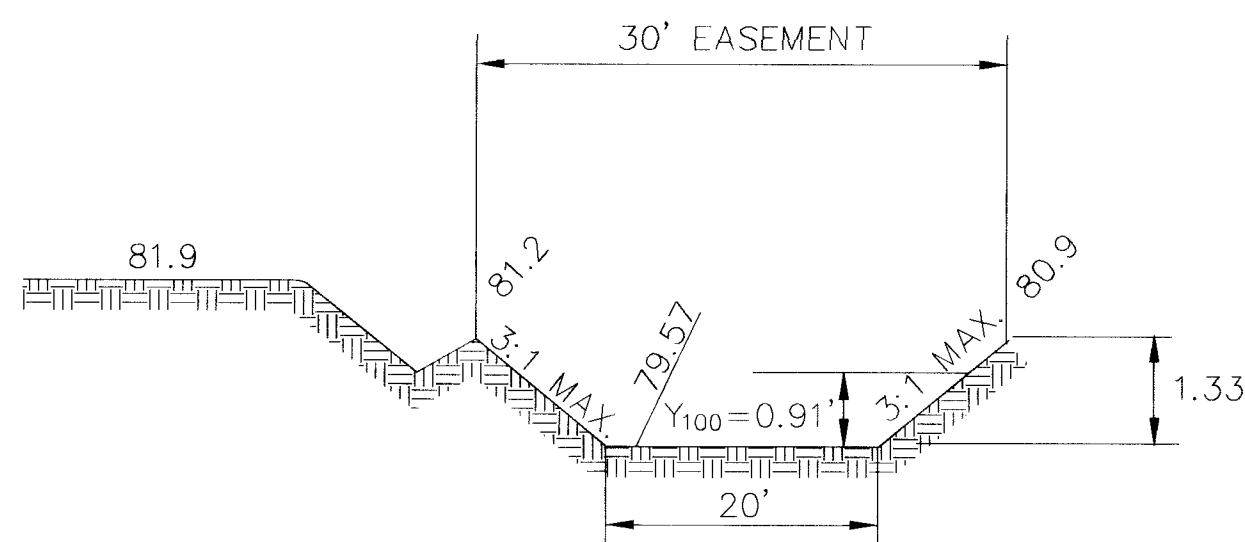

CHANNEL; S=.01 N=.04
Q₁₀₀=67 cfs V₁₀₀=3.22 fps
Y₁₀₀=0.91' A=20.66 P=25.76
Q_{MAX}=128.42 cfs V_{MAX}=4.02 fps
Y_{MAX}=1.33' A=31.91 P=28.41

EMERGENCY OVERFLOW
SECTION G - G

N.T.S.

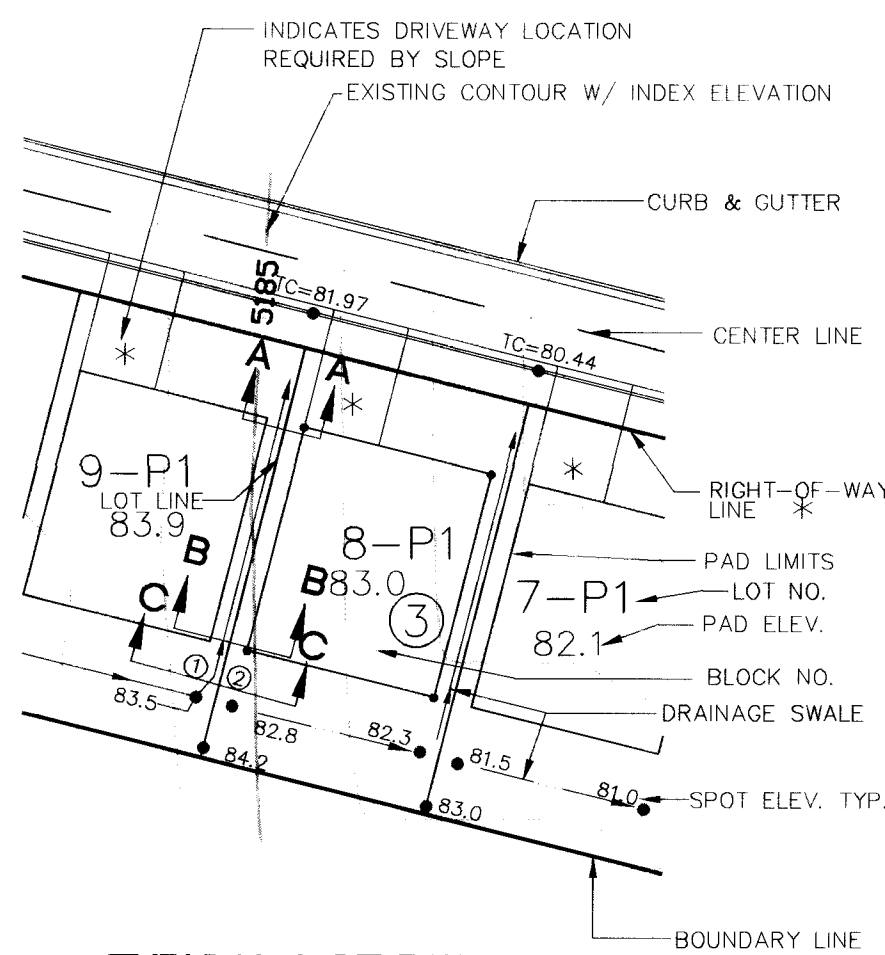

TYPICAL LOT DETAIL

N.T.S.
• FINISHED GRADE AROUND PERIMETER OF HOUSE SHALL BE A MINIMUM OF 6" BELOW TOP OF CONCRETE SLAB. (SEE SECTIONS THIS SHEET)

PARKWEST SUBDIVISION
UNIT 2
COMPRISED OF
TRACT A-2
PARKWEST UNIT 2
SITUATE WITHIN
THE TOWN OF ATRISCO GRANT
'PROJECTED' SECTIONS 4 AND 9, T10N, R2E, N.M.P.M.
CITY OF ALBUQUERQUE, BERNALILLO COUNTY, NEW MEXICO
JUNE, 1995

DRB-93-303

AS BUILT INFORMATION		BENCH MARKS		SURVEY INFORMATION		ENGINEER'S SEAL		REVISIONS		DESIGN	
CONTRACTOR	WORK BY	AS BUILT	DATE	NO.	BY	DATE	DATE	NO.	DATE	DATE	DATE
1. FT. ABOVE GROUND LOCATED ON TOP OF A VOLCANIC OUTCROP TO REACH THE STATION FROM THE INTERSECTION OF COORS RD. & OURAY RD. NW. GO WEST ON OURAY RD. ABOUT 0.7 MI. TO THE END OF PAVEMENT. CONTINUE WEST ON THE DIRT RD. TO THE TOP OF THE DETENTION DAM. ALONG THE NORTH BANK OF THE DAM 0.6 MI. TO A DIRT CROSS RD., TURN RIGHT, GO NORTH ON THE DIRT RD. 0.5 MI.	1. FT. ABOVE GROUND LOCATED ON TOP OF A VOLCANIC OUTCROP TO REACH THE STATION FROM THE INTERSECTION OF COORS RD. & OURAY RD. NW. GO WEST ON OURAY RD. ABOUT 0.7 MI. TO THE END OF PAVEMENT. CONTINUE WEST ON THE DIRT RD. TO THE TOP OF THE DETENTION DAM. ALONG THE NORTH BANK OF THE DAM 0.6 MI. TO A DIRT CROSS RD., TURN RIGHT, GO NORTH ON THE DIRT RD. 0.5 MI.	1. FT. ABOVE GROUND LOCATED ON TOP OF A VOLCANIC OUTCROP TO REACH THE STATION FROM THE INTERSECTION OF COORS RD. & OURAY RD. NW. GO WEST ON OURAY RD. ABOUT 0.7 MI. TO THE END OF PAVEMENT. CONTINUE WEST ON THE DIRT RD. TO THE TOP OF THE DETENTION DAM. ALONG THE NORTH BANK OF THE DAM 0.6 MI. TO A DIRT CROSS RD., TURN RIGHT, GO NORTH ON THE DIRT RD. 0.5 MI.	1. FT. ABOVE GROUND LOCATED ON TOP OF A VOLCANIC OUTCROP TO REACH THE STATION FROM THE INTERSECTION OF COORS RD. & OURAY RD. NW. GO WEST ON OURAY RD. ABOUT 0.7 MI. TO THE END OF PAVEMENT. CONTINUE WEST ON THE DIRT RD. TO THE TOP OF THE DETENTION DAM. ALONG THE NORTH BANK OF THE DAM 0.6 MI. TO A DIRT CROSS RD., TURN RIGHT, GO NORTH ON THE DIRT RD. 0.5 MI.	1. FT. ABOVE GROUND LOCATED ON TOP OF A VOLCANIC OUTCROP TO REACH THE STATION FROM THE INTERSECTION OF COORS RD. & OURAY RD. NW. GO WEST ON OURAY RD. ABOUT 0.7 MI. TO THE END OF PAVEMENT. CONTINUE WEST ON THE DIRT RD. TO THE TOP OF THE DETENTION DAM. ALONG THE NORTH BANK OF THE DAM 0.6 MI. TO A DIRT CROSS RD., TURN RIGHT, GO NORTH ON THE DIRT RD. 0.5 MI.	1. FT. ABOVE GROUND LOCATED ON TOP OF A VOLCANIC OUTCROP TO REACH THE STATION FROM THE INTERSECTION OF COORS RD. & OURAY RD. NW. GO WEST ON OURAY RD. ABOUT 0.7 MI. TO THE END OF PAVEMENT. CONTINUE WEST ON THE DIRT RD. TO THE TOP OF THE DETENTION DAM. ALONG THE NORTH BANK OF THE DAM 0.6 MI. TO A DIRT CROSS RD., TURN RIGHT, GO NORTH ON THE DIRT RD. 0.5 MI.	1. FT. ABOVE GROUND LOCATED ON TOP OF A VOLCANIC OUTCROP TO REACH THE STATION FROM THE INTERSECTION OF COORS RD. & OURAY RD. NW. GO WEST ON OURAY RD. ABOUT 0.7 MI. TO THE END OF PAVEMENT. CONTINUE WEST ON THE DIRT RD. TO THE TOP OF THE DETENTION DAM. ALONG THE NORTH BANK OF THE DAM 0.6 MI. TO A DIRT CROSS RD., TURN RIGHT, GO NORTH ON THE DIRT RD. 0.5 MI.	1. FT. ABOVE GROUND LOCATED ON TOP OF A VOLCANIC OUTCROP TO REACH THE STATION FROM THE INTERSECTION OF COORS RD. & OURAY RD. NW. GO WEST ON OURAY RD. ABOUT 0.7 MI. TO THE END OF PAVEMENT. CONTINUE WEST ON THE DIRT RD. TO THE TOP OF THE DETENTION DAM. ALONG THE NORTH BANK OF THE DAM 0.6 MI. TO A DIRT CROSS RD., TURN RIGHT, GO NORTH ON THE DIRT RD. 0.5 MI.	1. FT. ABOVE GROUND LOCATED ON TOP OF A VOLCANIC OUTCROP TO REACH THE STATION FROM THE INTERSECTION OF COORS RD. & OURAY RD. NW. GO WEST ON OURAY RD. ABOUT 0.7 MI. TO THE END OF PAVEMENT. CONTINUE WEST ON THE DIRT RD. TO THE TOP OF THE DETENTION DAM. ALONG THE NORTH BANK OF THE DAM 0.6 MI. TO A DIRT CROSS RD., TURN RIGHT, GO NORTH ON THE DIRT RD. 0.5 MI.	1. FT. ABOVE GROUND LOCATED ON TOP OF A VOLCANIC OUTCROP TO REACH THE STATION FROM THE INTERSECTION OF COORS RD. & OURAY RD. NW. GO WEST ON OURAY RD. ABOUT 0.7 MI. TO THE END OF PAVEMENT. CONTINUE WEST ON THE DIRT RD. TO THE TOP OF THE DETENTION DAM. ALONG THE NORTH BANK OF THE DAM 0.6 MI. TO A DIRT CROSS RD., TURN RIGHT, GO NORTH ON THE DIRT RD. 0.5 MI.	1. FT. ABOVE GROUND LOCATED ON TOP OF A VOLCANIC OUTCROP TO REACH THE STATION FROM THE INTERSECTION OF COORS RD. & OURAY RD. NW. GO WEST ON OURAY RD. ABOUT 0.7 MI. TO THE END OF PAVEMENT. CONTINUE WEST ON THE DIRT RD. TO THE TOP OF THE DETENTION DAM. ALONG THE NORTH BANK OF THE DAM 0.6 MI. TO A DIRT CROSS RD., TURN RIGHT, GO NORTH ON THE DIRT RD. 0.5 MI.	1. FT. ABOVE GROUND LOCATED ON TOP OF A VOLCANIC OUTCROP TO REACH THE STATION FROM THE INTERSECTION OF COORS RD. & OURAY RD. NW. GO WEST ON OURAY RD. ABOUT 0.7 MI. TO THE END OF PAVEMENT. CONTINUE WEST ON THE DIRT RD. TO THE TOP OF THE DETENTION DAM. ALONG THE NORTH BANK OF THE DAM 0.6 MI. TO A DIRT CROSS RD., TURN RIGHT, GO NORTH ON THE DIRT RD. 0.5 MI.

DATE: MAY, 1995
SCALE: AS SHOWN
JOB NO.: 14323-043

community
sciences
corporation

LAND PLANNING ENGINEERING SURVEYING
P.O. Box 1328 Santa Fe, N.M. 87506

CITY OF ALBUQUERQUE
PUBLIC WORKS DEPARTMENT
ENGINEERING GROUP




TITLE: PARKWEST - UNIT 2
GRADING AND EROSION CONTROL PLAN
SECTIONS AND DETAILS

APPROVALS	ENGINEER	DATE	APPROVALS	ENGINEER	DATE
DRC CHAIRMAN			WATER		
TRANSPORTATION			HYDROLOGY		
FOR INFORMATION ONLY					
PROJECT NO.	4886.96	MAP NO.	G, H9	SHEET	5 OF 15

APPROVED FOR ROUGH GRADING
(± 1 FT.)

JPC
CITY HYDROLOGY

7-17-95
DATE

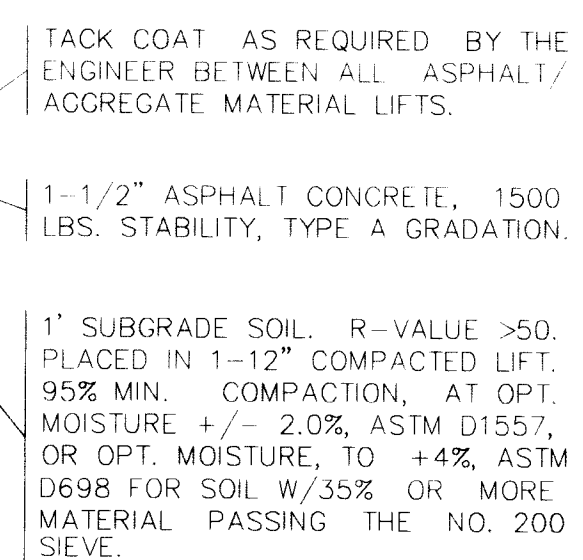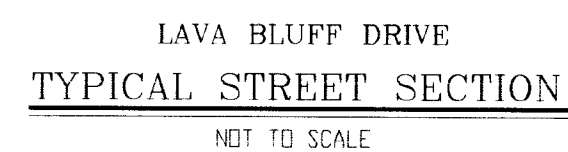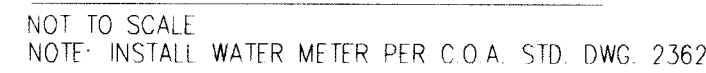


- ## KEYNOTES

- | | | |
|--------------|---|-------------------------------------|
| X FL = 74.11 | | PROPOSED CURB FLOWLINE ELEVATION |
| 73.6 @ |  | EXISTING SPOT ELEVATION (GRND & TC) |
| |  | PROPOSED VALLEY GUTTER/ SIDEWALK |
| |  | EXISTING CURB & GUTTER |
| |  | PROPOSED MOUNTABLE CURB & GUTTER |
| |  | PROPOSED STANDARD CURB & GUTTER |
| |  | EXISTING SIDEWALK |
| |  | FLOW ARROW |
| |  | EXISTING SANITARY SEWER MANHOLE |
| |  | PROPOSED SANITARY SEWER MANHOLE |
| |  | EXISTING STORM MANHOLE |
| |  | PROPOSED STORM MANHOLE |
| |  | EXISTING GATE VALVE |
| |  | PROPOSED GATE VALVE |
| |  | EXISTING AIR RELEASE VALVE |
| |  | PROPOSED AIR RELEASE VALVE |
| |  | CROWN TRANSITION |
| |  | PROPOSED STORM SEWER CATCH BASIN |
| |  | EXISTING STORM SEWER CATCH BASIN |
| |  | REMOVE & REPLACE ARTERIAL PAVEMENT |
| |  | PROPOSED STREET LIGHT |

DESIGNED BY		H.O.M.		DATE		MAY, 1995	
DRAWN BY		A.M.		DATE		MAY, 1995	
CHECKED BY		J.D.H.		DATE		MAY, 1995	
APPROVALS		ENGINEER		DATE			
WATER		N/A		RWF		1-3-96	
C.C.A.							
SHEET 6 OF 15							

ENGINEER'S SEAL		SURVEY INFORMATION		BENCH MARKS		AS BUILT INFORMATION	
		FIELD NOTES		ACS BRASS TABLET STAMPED "92-39" SET IN A 2" IRON PIPE 1 FT. ABOVE GROUND LOCATED ON TOP OF A VOLCANIC OUTCROP TO REACH THE STATION FROM THE INTERSECTION OF COORS RD. & QURAY RD. NW, GO WEST ON QURAY RD. ABOUT 0.7 MI. TO THE END OF PAVEMENT. CONTINUE WEST ON THE DIRT RD. TO THE TOP OF THE DETENTION DAM, ALONG THE NORTH BANK OF THE DAM 0.6 MI. TO A DIRT CROSS RD., TURN RIGHT, GO NORTH ON THE DIRT RD. 0.5 MI. SLD 1928 ELEVATION = 9334.50 FEET		92-427-09 Sundance Mechanical DESIGNED BY: C.S.C. DATE 9/96 CHECKED BY: C.O.A. DATE 9/96 FIELD ASST: A.B. DATE 9/96 CORRECTED BY: C.S.C. DATE 10/96 MICRO-FILM INFORMATION RECORDED BY: DATE NO.	
		NO. BY DATE 1 COMMUNITY SCIENCES					
NO. DATE		REMARKS		BY			
		REVISIONS					
		DESIGN					

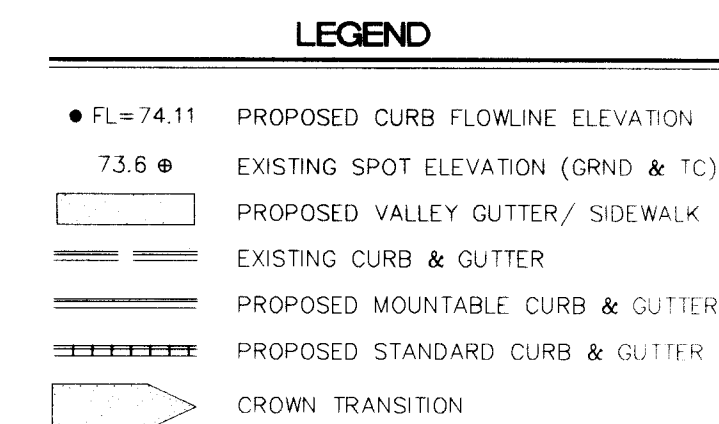

- KEYNOTES:**
-
- (1) WHEELCHAIR RAMP PER
COA STD. DWG. 2441
CASE II.
 - (2) WHEELCHAIR RAMP PER
COA STD. DWG. 2441
CASE I.
 - (3) MOUNTABLE TO STANDARD CURB
TRANSITION PER COA STD. DWG. 2418
 - (4) CONC. VALLEY GUTTER PER
COA STD. DWG. 2420
 - (5) SPECIAL CONC. VALLEY GUTTER PER
C.O.A. STD. DWG. 2422
 - (6) FUTURE 4' SIDEWALK, BY OTHERS
 - (7) PROPOSED 4' SIDEWALK, THIS CONTRACT
 - (8) PROPOSED 6' SIDEWALK, THIS CONTRACT
 - (9) 50' CROWN TRANSITION PER
C.O.A. STD. DWG. 2401
 - (10) CUT-OFF WALL (FULL STREET WIDTH, 24"
DEEP x 8" THICK) PER C.O.A. STD. DWG.
NO. 2415

PARKWEST UNIT
CURVE TABLE

CURVE IDEN	RADIUS	ARC	DELTA
A	107.50	168.23	089-39-58
B	20.00	27.85	079-47-14
C	20.00	25.29	072-27-24
D	20.00	31.42	090-00-00
E	20.00	31.42	090-00-00
F	20.00	31.42	090-00-00
G	20.00	32.42	090-00-00
H	20.00	32.07	091-52-46
I	20.00	31.87	091-17-25
J	20.00	28.25	080-55-09
K	20.00	35.71	102-18-24
L	20.00	31.42	090-00-00
M	20.00	32.14	093-03-52
N	20.00	32.13	093-03-19
O	20.00	34.37	098-27-52
P	60.76	75.36	071-04-01
Q	89.24	110.39	071-04-01

SCALE:
1" = 50', HORIZ
1" = 10', VERT.

**community
sciences
corporation**

JOB NO.: 14323- 041	LAND PLANNING P.O. Box 1328	ENGINEERING Corrales, N.M. 87048	SURVEYING
------------------------	--------------------------------	-------------------------------------	-----------

CITY OF ALBUQUERQUE
PUBLIC WORKS DEPARTMENT
ENGINEERING GROUP

TITLE: PARKWEST-UNIT 2
PAVING PLAN AND PROFILE
LAVA BLUFF DRIVE N.W.



LAWYER DEPT DRIVE N.W.					
APPROVALS	ENGINEER	DATE	APPROVALS	ENGINEER	DATE
DRC CHAIRMAN	<i>B.G. Bookley</i>	2-7-96	WATER	N/A RWK	1-3-00
TRANSPORTATION	<i>John B. ...</i>	1-29-96	WASTE WATER		
HYDROLOGY	<i>RFC</i>	1-10-96	A.M.A.F.C.A.		

PROJECT NO.	4886.96	MAP NO.	G.H9	SHEET	7	OF	15
-------------	---------	---------	------	-------	---	----	----

SCANNED BY
BY LASON



44 CURVE DATA
R = 121.00'
L = 102.74'
Δ = 048°39'03"
CH = 99.68'
CH BEARING = N18°52'09"E

45 CURVE DATA
R = 121.00'
L = 86.61'
Δ = 041°00'50"
CH = 84.78'
CH BEARING = S25°57'47"E

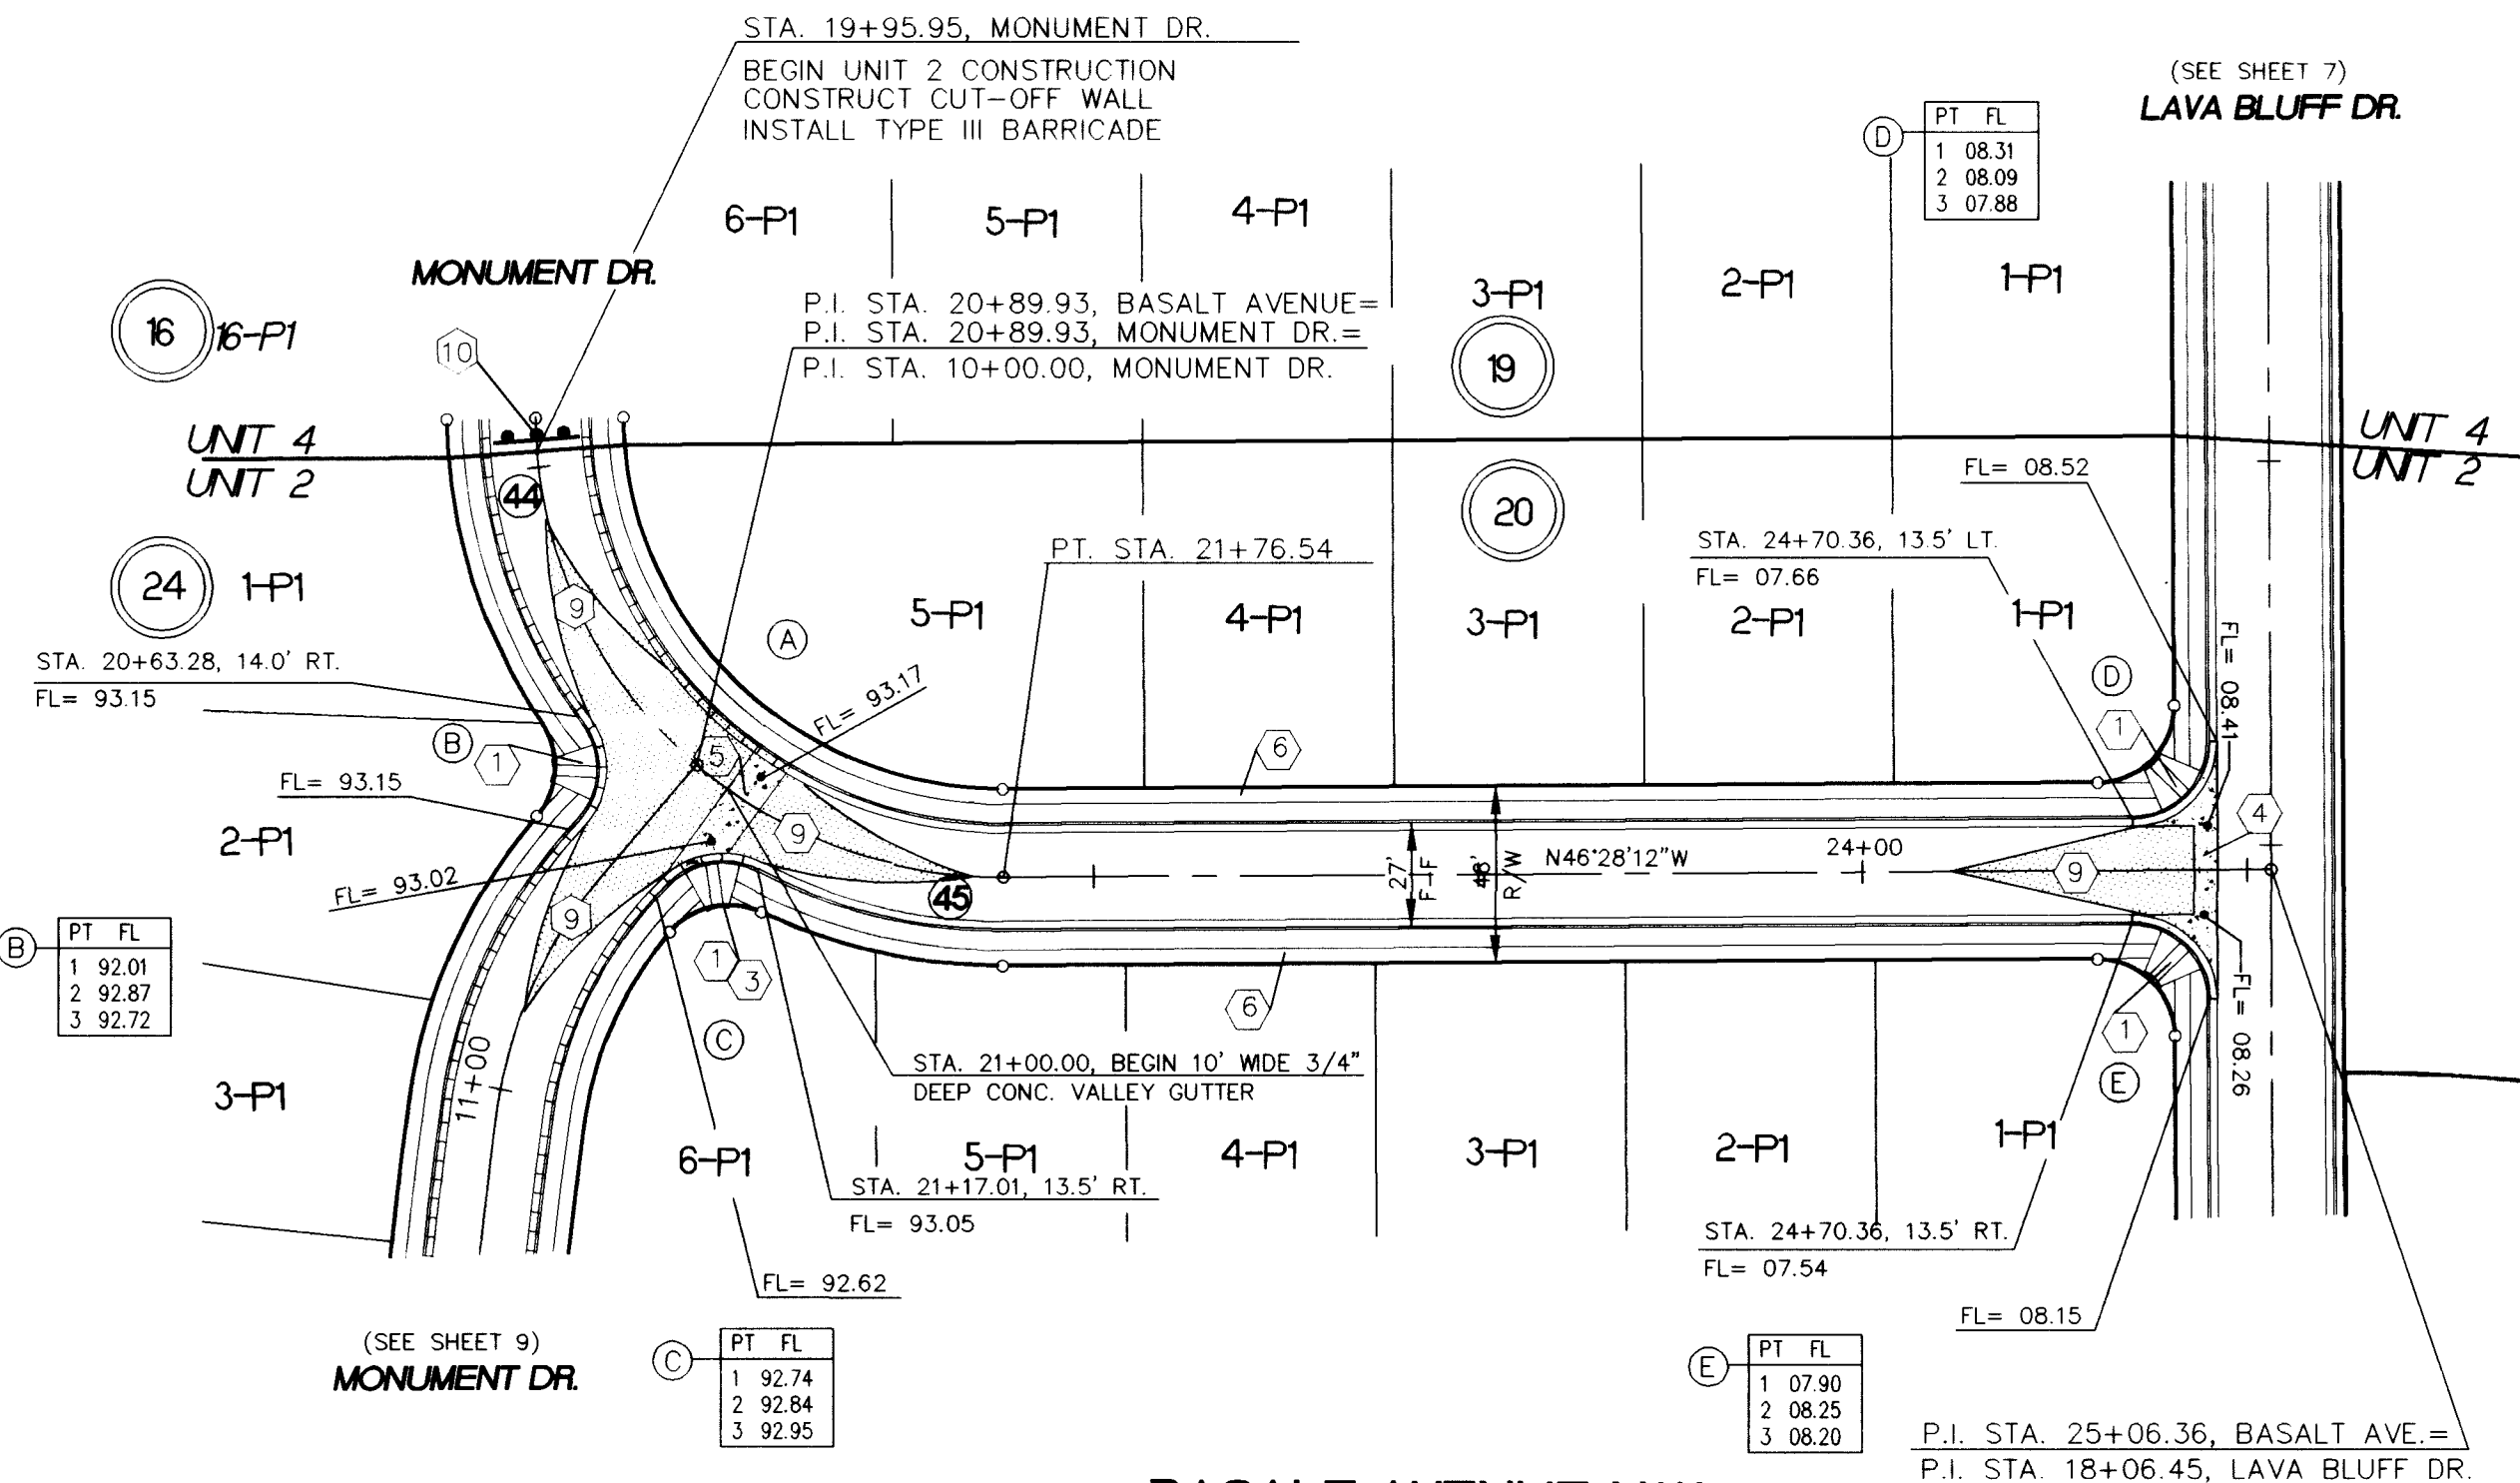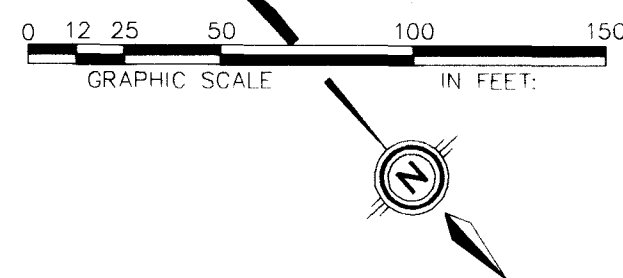

BASALT AVENUE N.W.

MOUNTABLE CURB & GUTTER W/ RESIDENTIAL PAVING
(SEE SHEET 6 FOR STREET SECTION)

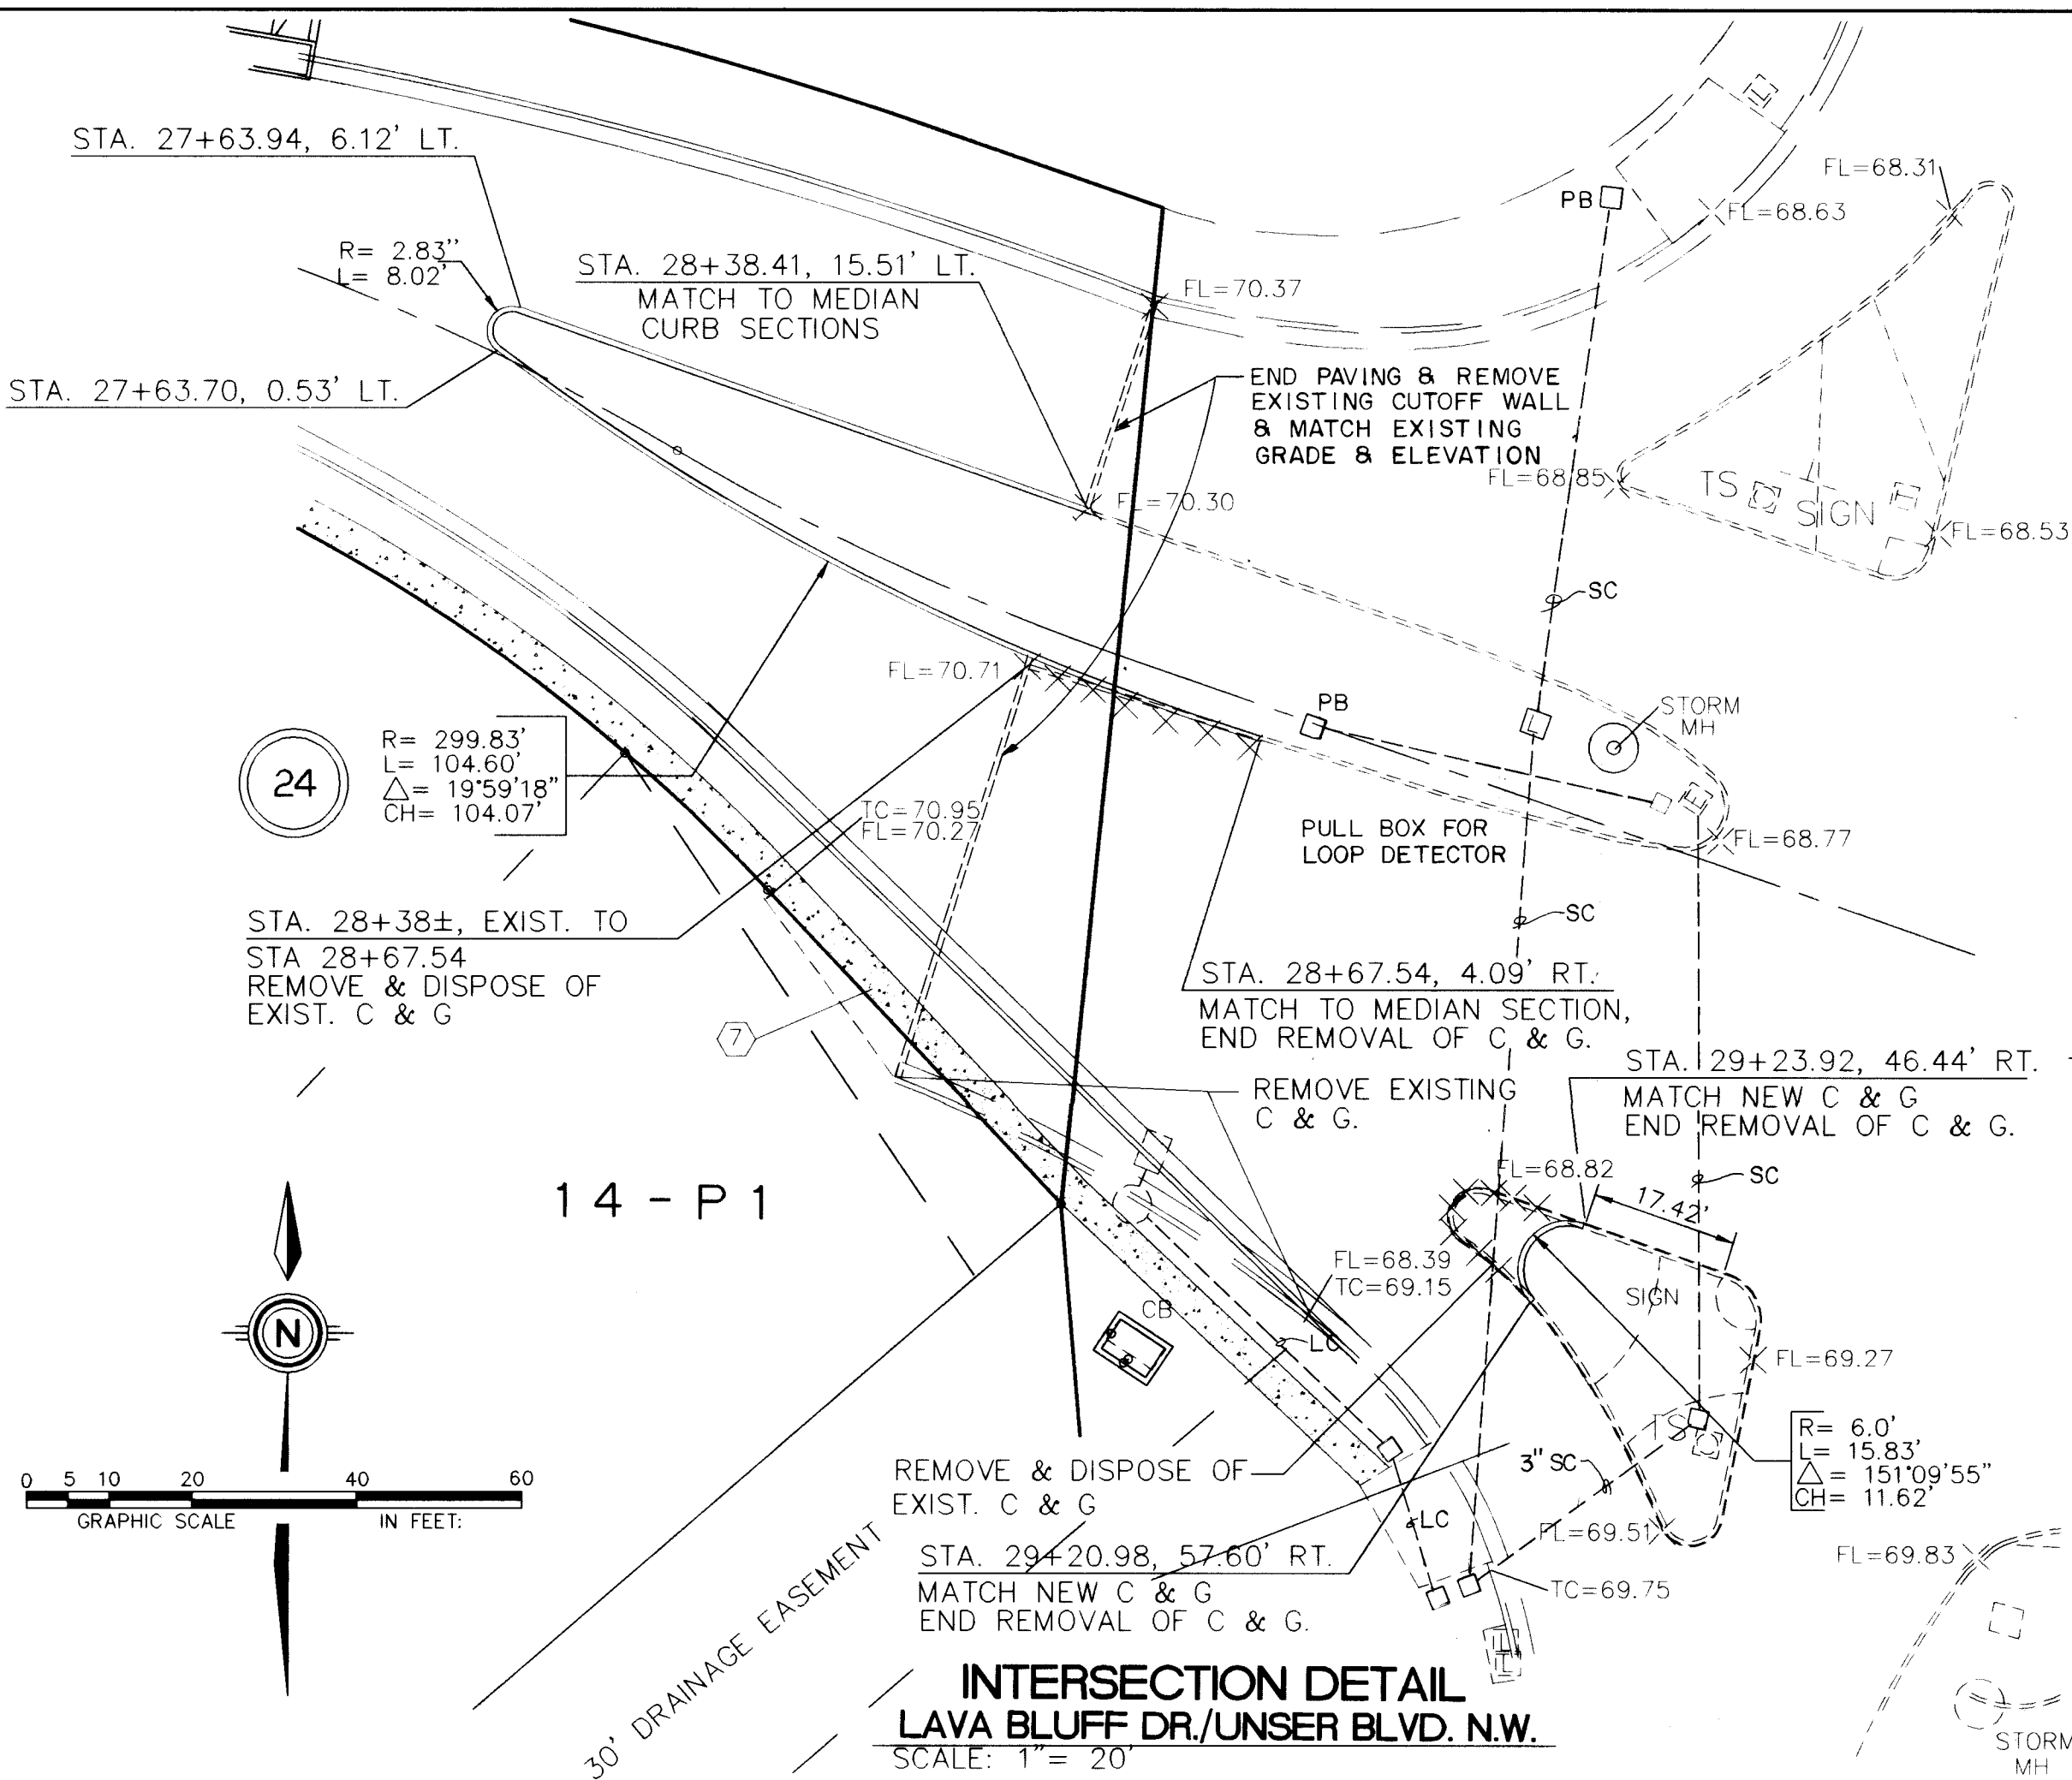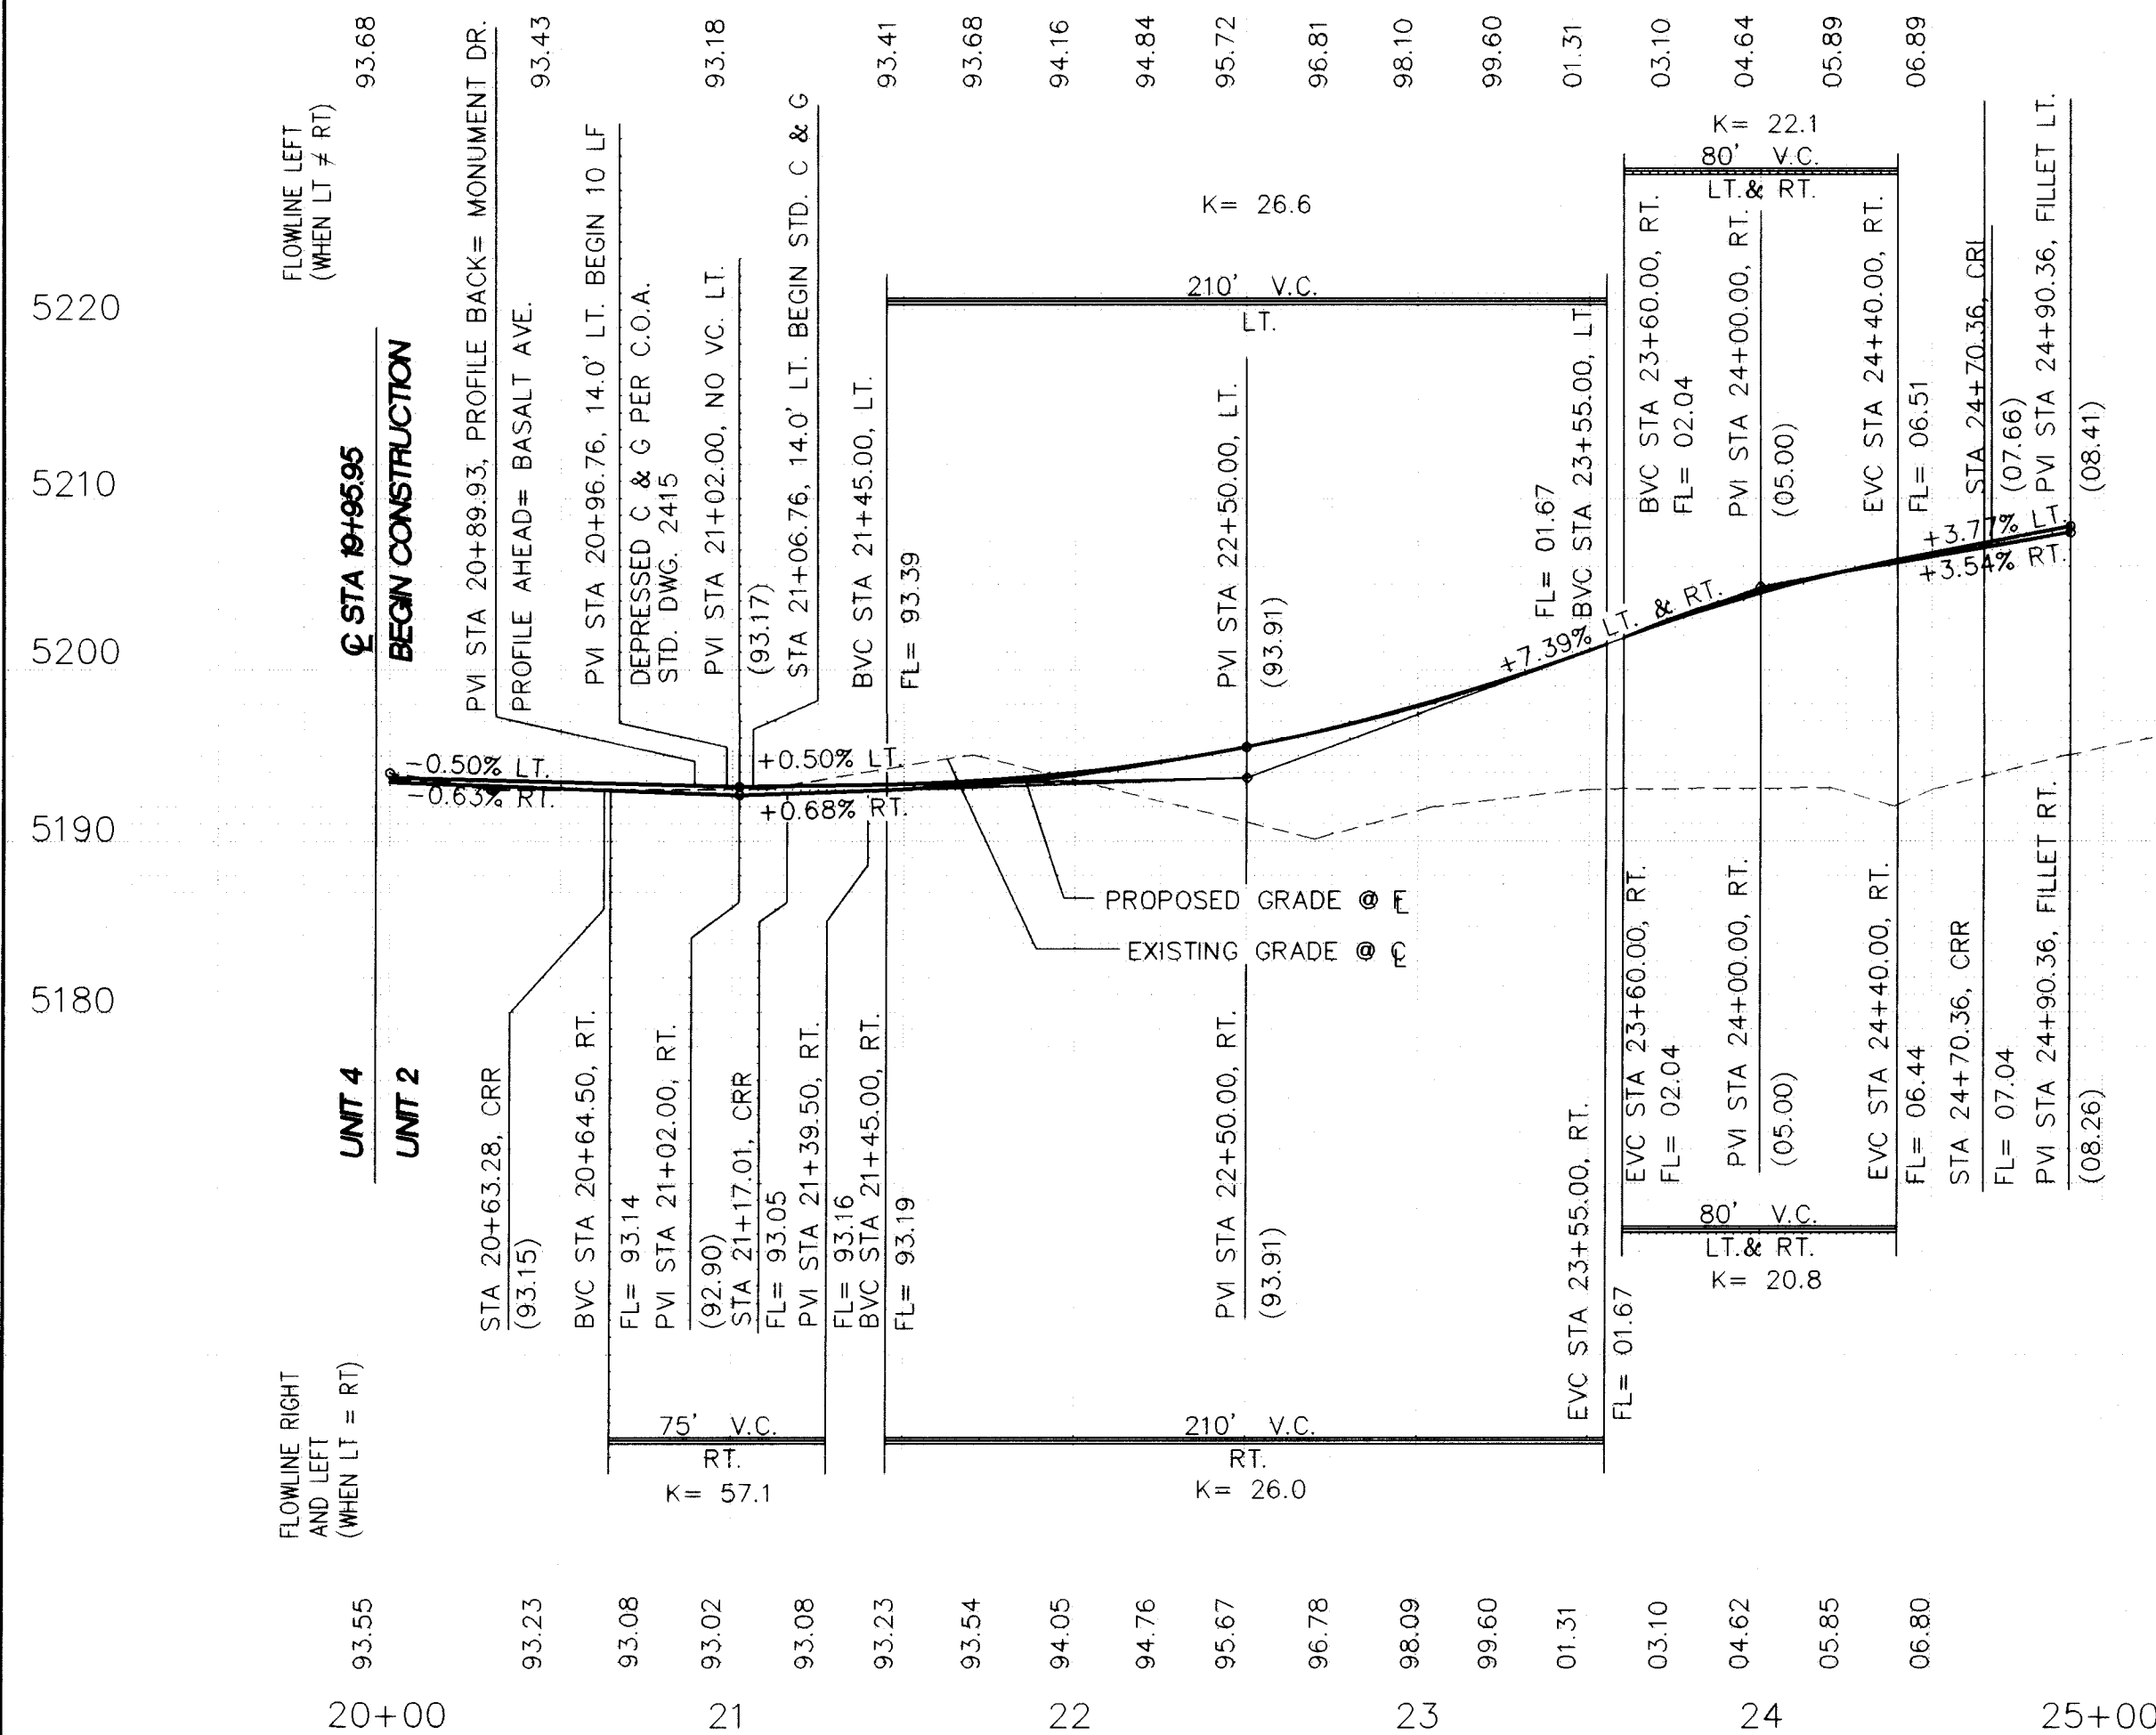

**INTERSECTION DETAIL
LAVA BLUFF DR./UNSER BLVD. N.W.**

CONTRACTOR IS TO REPLACE AND RESTORE OPERATION OF THE LOOP DETECTORS AND CONDUITS FOR BOTH THE TRAFFIC SIGNALS AND STREET LIGHTS IN ACCORDANCE WITH CITY OF ALBUQUERQUE'S 3RD DRAFT OF INTERIM STANDARDS FOR SIGNAL CONSTRUCTION. CONTRACTOR IS TO CONTACT TRAFFIC OPERATIONS TO DETERMINE EXACT FIELD LOCATIONS.

LEGEND

- FL=74.11 PROPOSED CURB FLOWLINE ELEVATION
- 73.6 ● EXISTING SPOT ELEVATION (GRND & TC)
- PROPOSED VALLEY GUTTER/ SIDEWALK
- EXISTING CURB & GUTTER
- PROPOSED MOUNTABLE CURB & GUTTER
- PROPOSED STANDARD CURB & GUTTER
- CROWN TRANSITION

KEYNOTES:

- WHEELCHAIR RAMP PER COA STD. DWG. 2441 CASE II.
- WHEELCHAIR RAMP PER COA STD. DWG. 2441 CASE I.
- MOUNTABLE TO STANDARD CURB TRANSITION PER COA STD. DWG. 2418
- CONC. VALLEY GUTTER PER COA STD. DWG. 2420
- SPECIAL CONC. VALLEY GUTTER PER COA STD. DWG. 2422
- FUTURE 4' SIDEWALK, BY OTHERS
- PROPOSED 4' SIDEWALK, THIS CONTRACT
- PROPOSED 6' SIDEWALK, THIS CONTRACT
- 50' CROWN TRANSITION PER COA STD. DWG. 2401
- CUT-OFF WALL (FULL STREET WIDTH, 24\"/>

**PARKWEST UNIT 2
CURVE TABLE**

CURVE IDEN	RADIUS	ARC	DELTA
A	107.50	168.23	089-39-58
B	20.00	27.85	079-47-14
C	20.00	25.29	072-27-24
D	20.00	31.42	090-00-00
E	20.00	31.42	090-00-00
F	20.00	31.42	090-00-00
G	20.00	32.42	090-00-00
H	20.00	32.07	091-52-46
I	20.00	31.87	091-17-25
J	20.00	28.25	080-55-09
K	20.00	35.71	102-18-24
L	20.00	31.42	090-00-00
M	20.00	32.14	092-03-52
N	20.00	32.13	092-03-19
O	20.00	34.37	098-27-52
P	60.78	75.36	071-04-01
Q	89.24	110.39	071-04-01

SCALE:
1" = 50' HORIZ.
1" = 10' VERT.

**community
sciences
corporation**

JOB NO: 14323- 041 LAND PLANNING ENGINEERING SURVEYING
P.O. Box 1328 Corrales, N.M. 80748


**CITY OF ALBUQUERQUE
PUBLIC WORKS DEPARTMENT
ENGINEERING GROUP**

**TITLE: PARKWEST-UNIT 2
PAVING PLAN AND PROFILE
MONUMENT DR. & BASALT DR. N.W.**


APPROVALS	ENGINEER	DATE	APPROVALS	ENGINEER	DATE
DRC CHAIRMAN	2-7-96	2-7-96	WATER		
TRANSPORTATION	1-29-96	1-29-96	WASTE WATER		
HYDROLOGY	1-10-96	1-10-96	A.M.A.F.C.A.		

PROJECT NO. 4886.96 MAP NO. G,H9 SHEET 8 OF 15



SCANNED BY
BY LASON

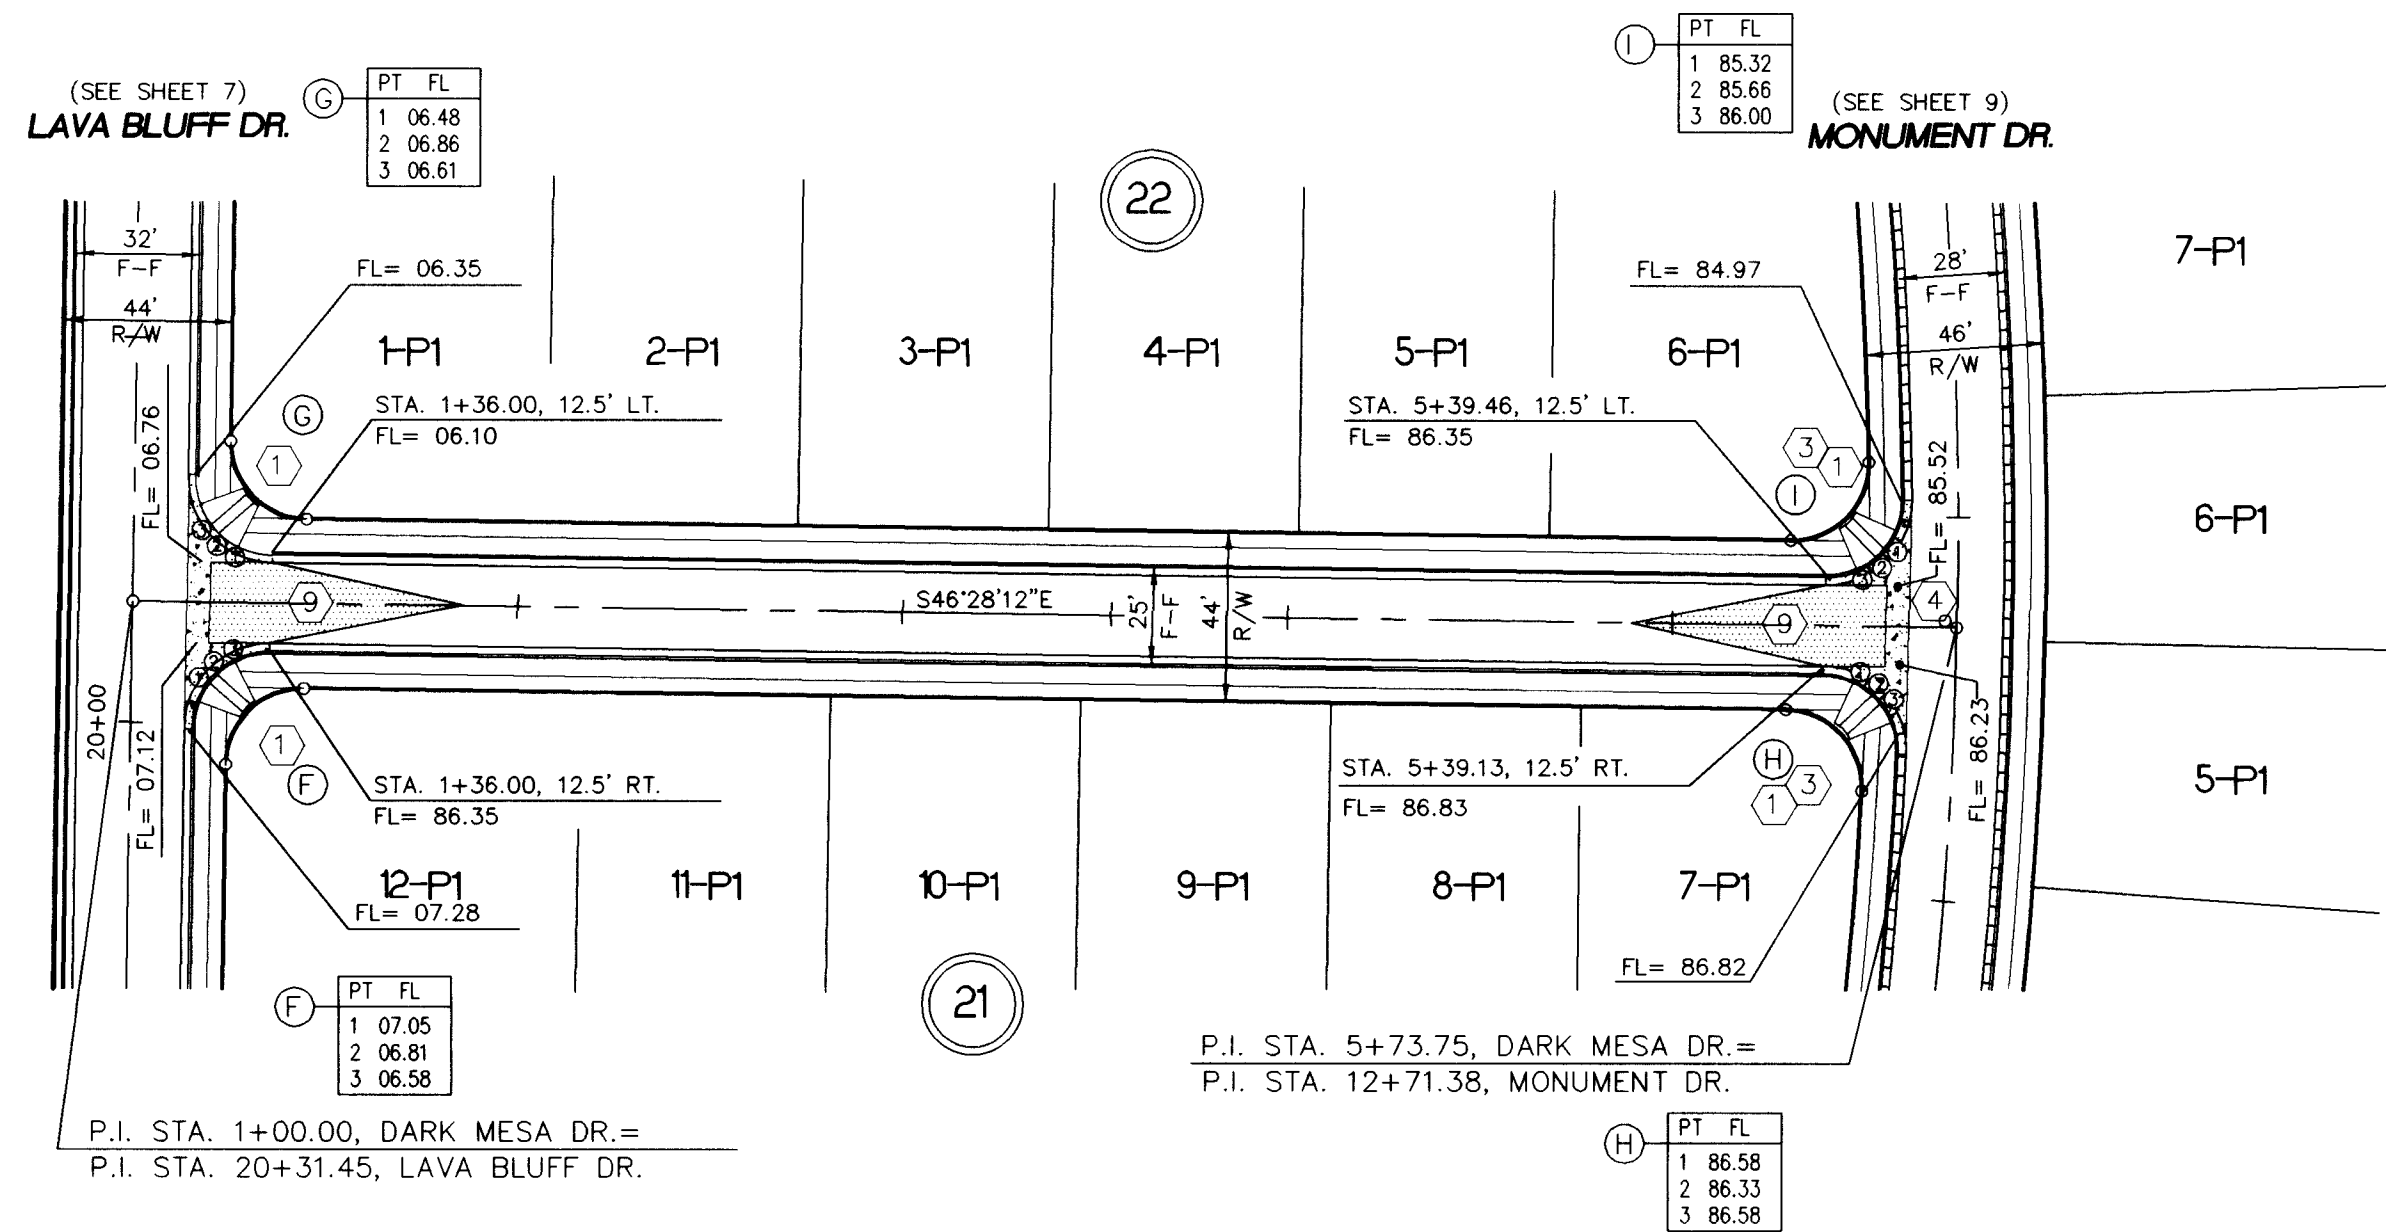

DARK MESA AVENUE N.W.
MOUNTABLE CURB & GUTTER W/ RESIDENTIAL PAVING
(SEE SHEET 6 FOR STREET SECTION)

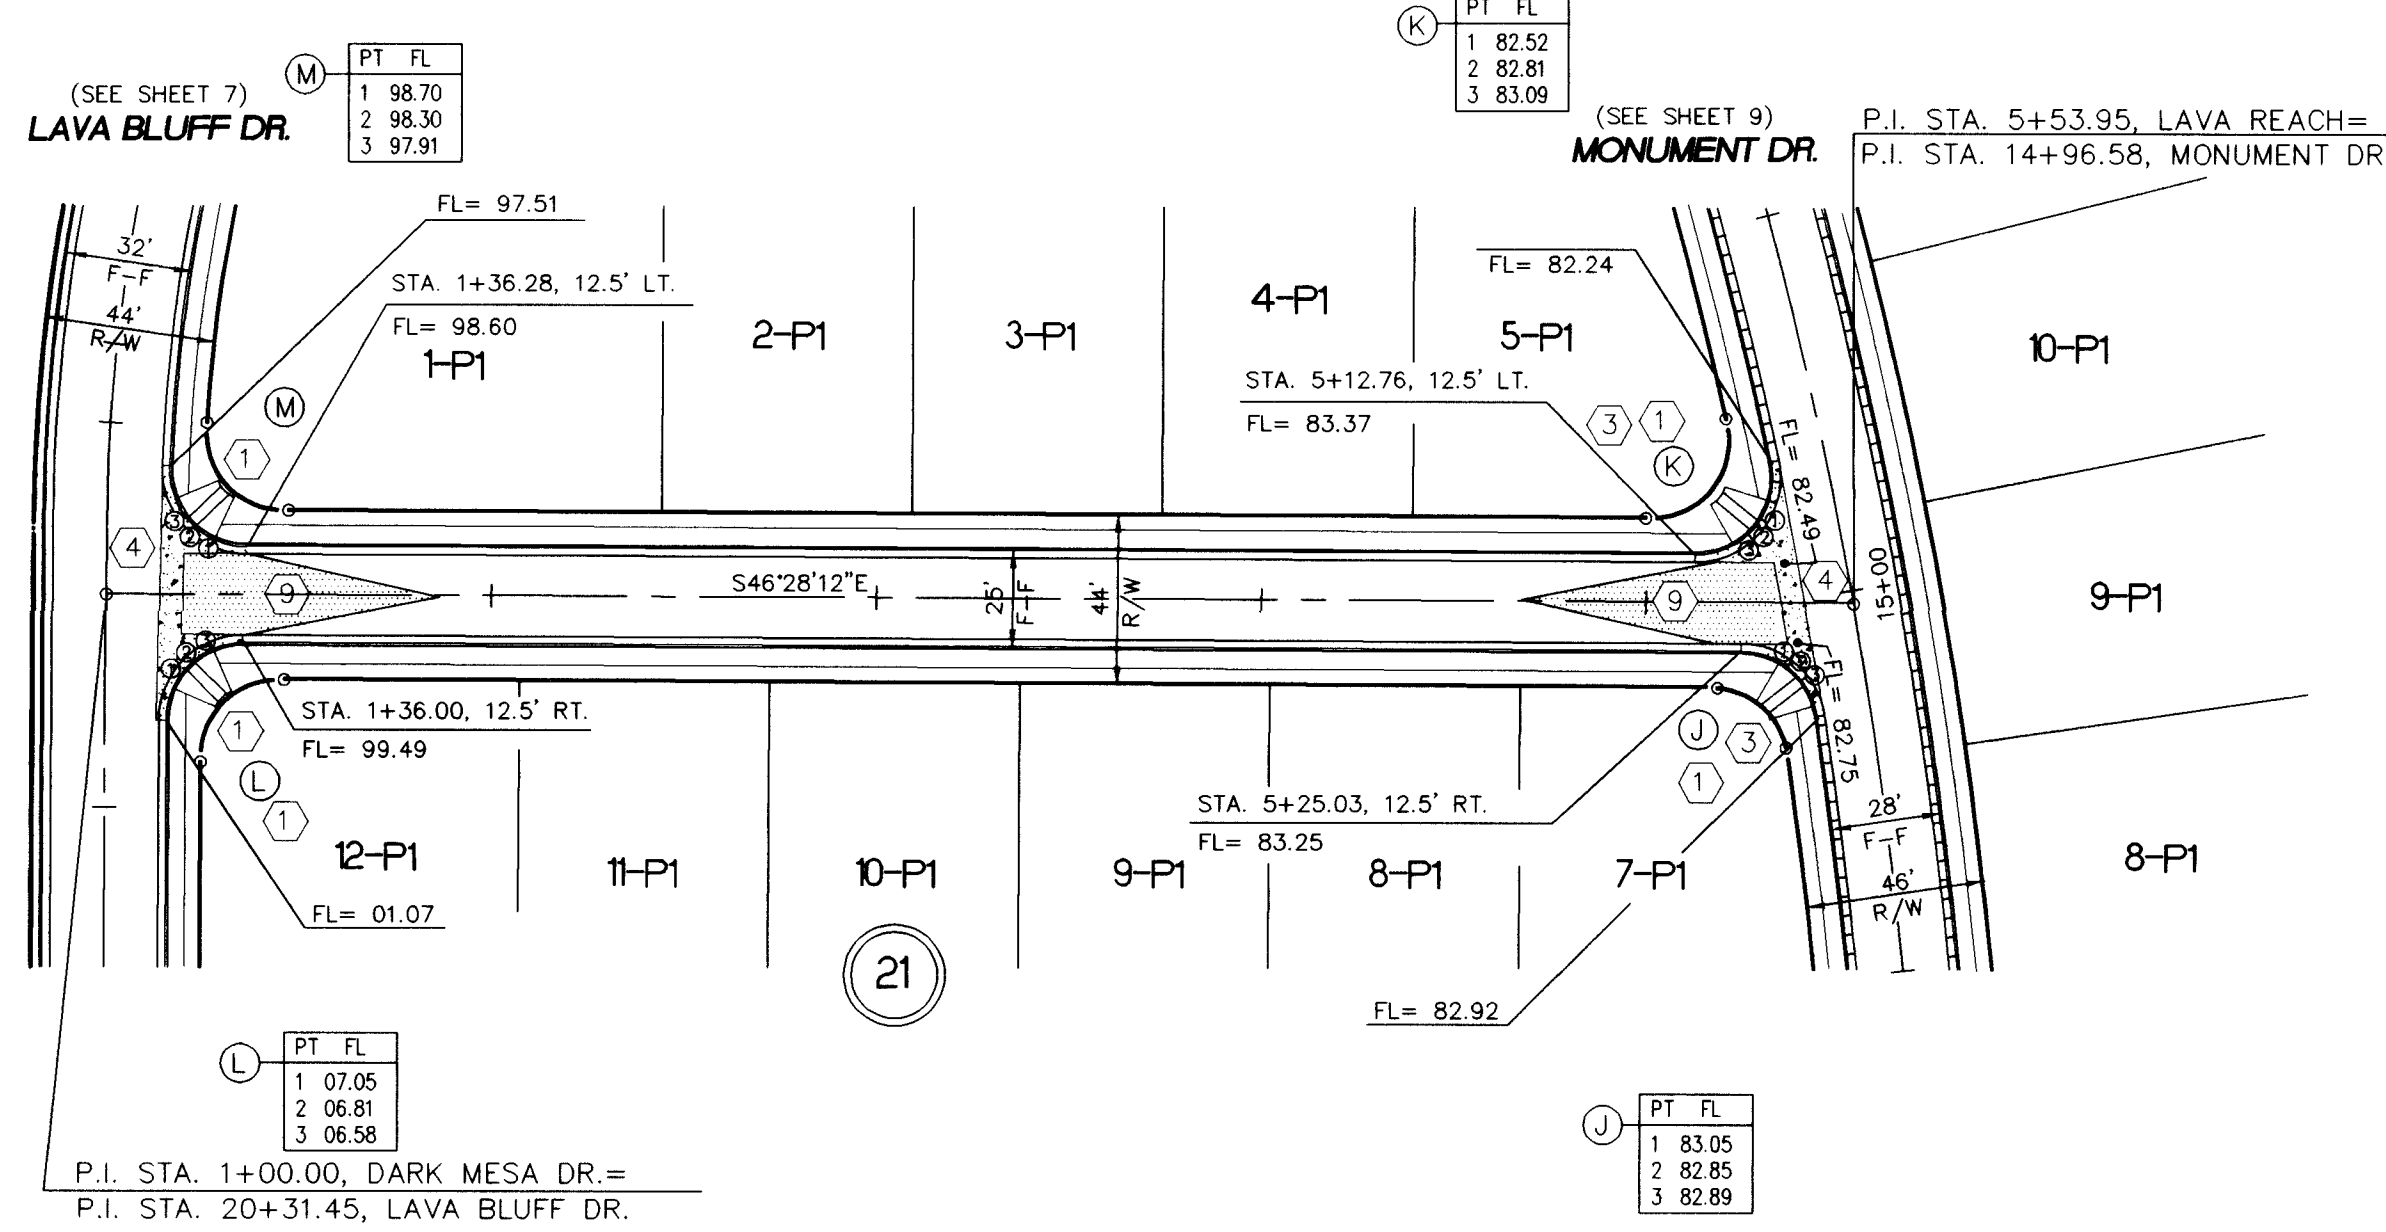

LAVA REACH AVENUE N.W.
MOUNTABLE CURB & GUTTER W/ RESIDENTIAL PAVING
(SEE SHEET 6 FOR STREET SECTION)

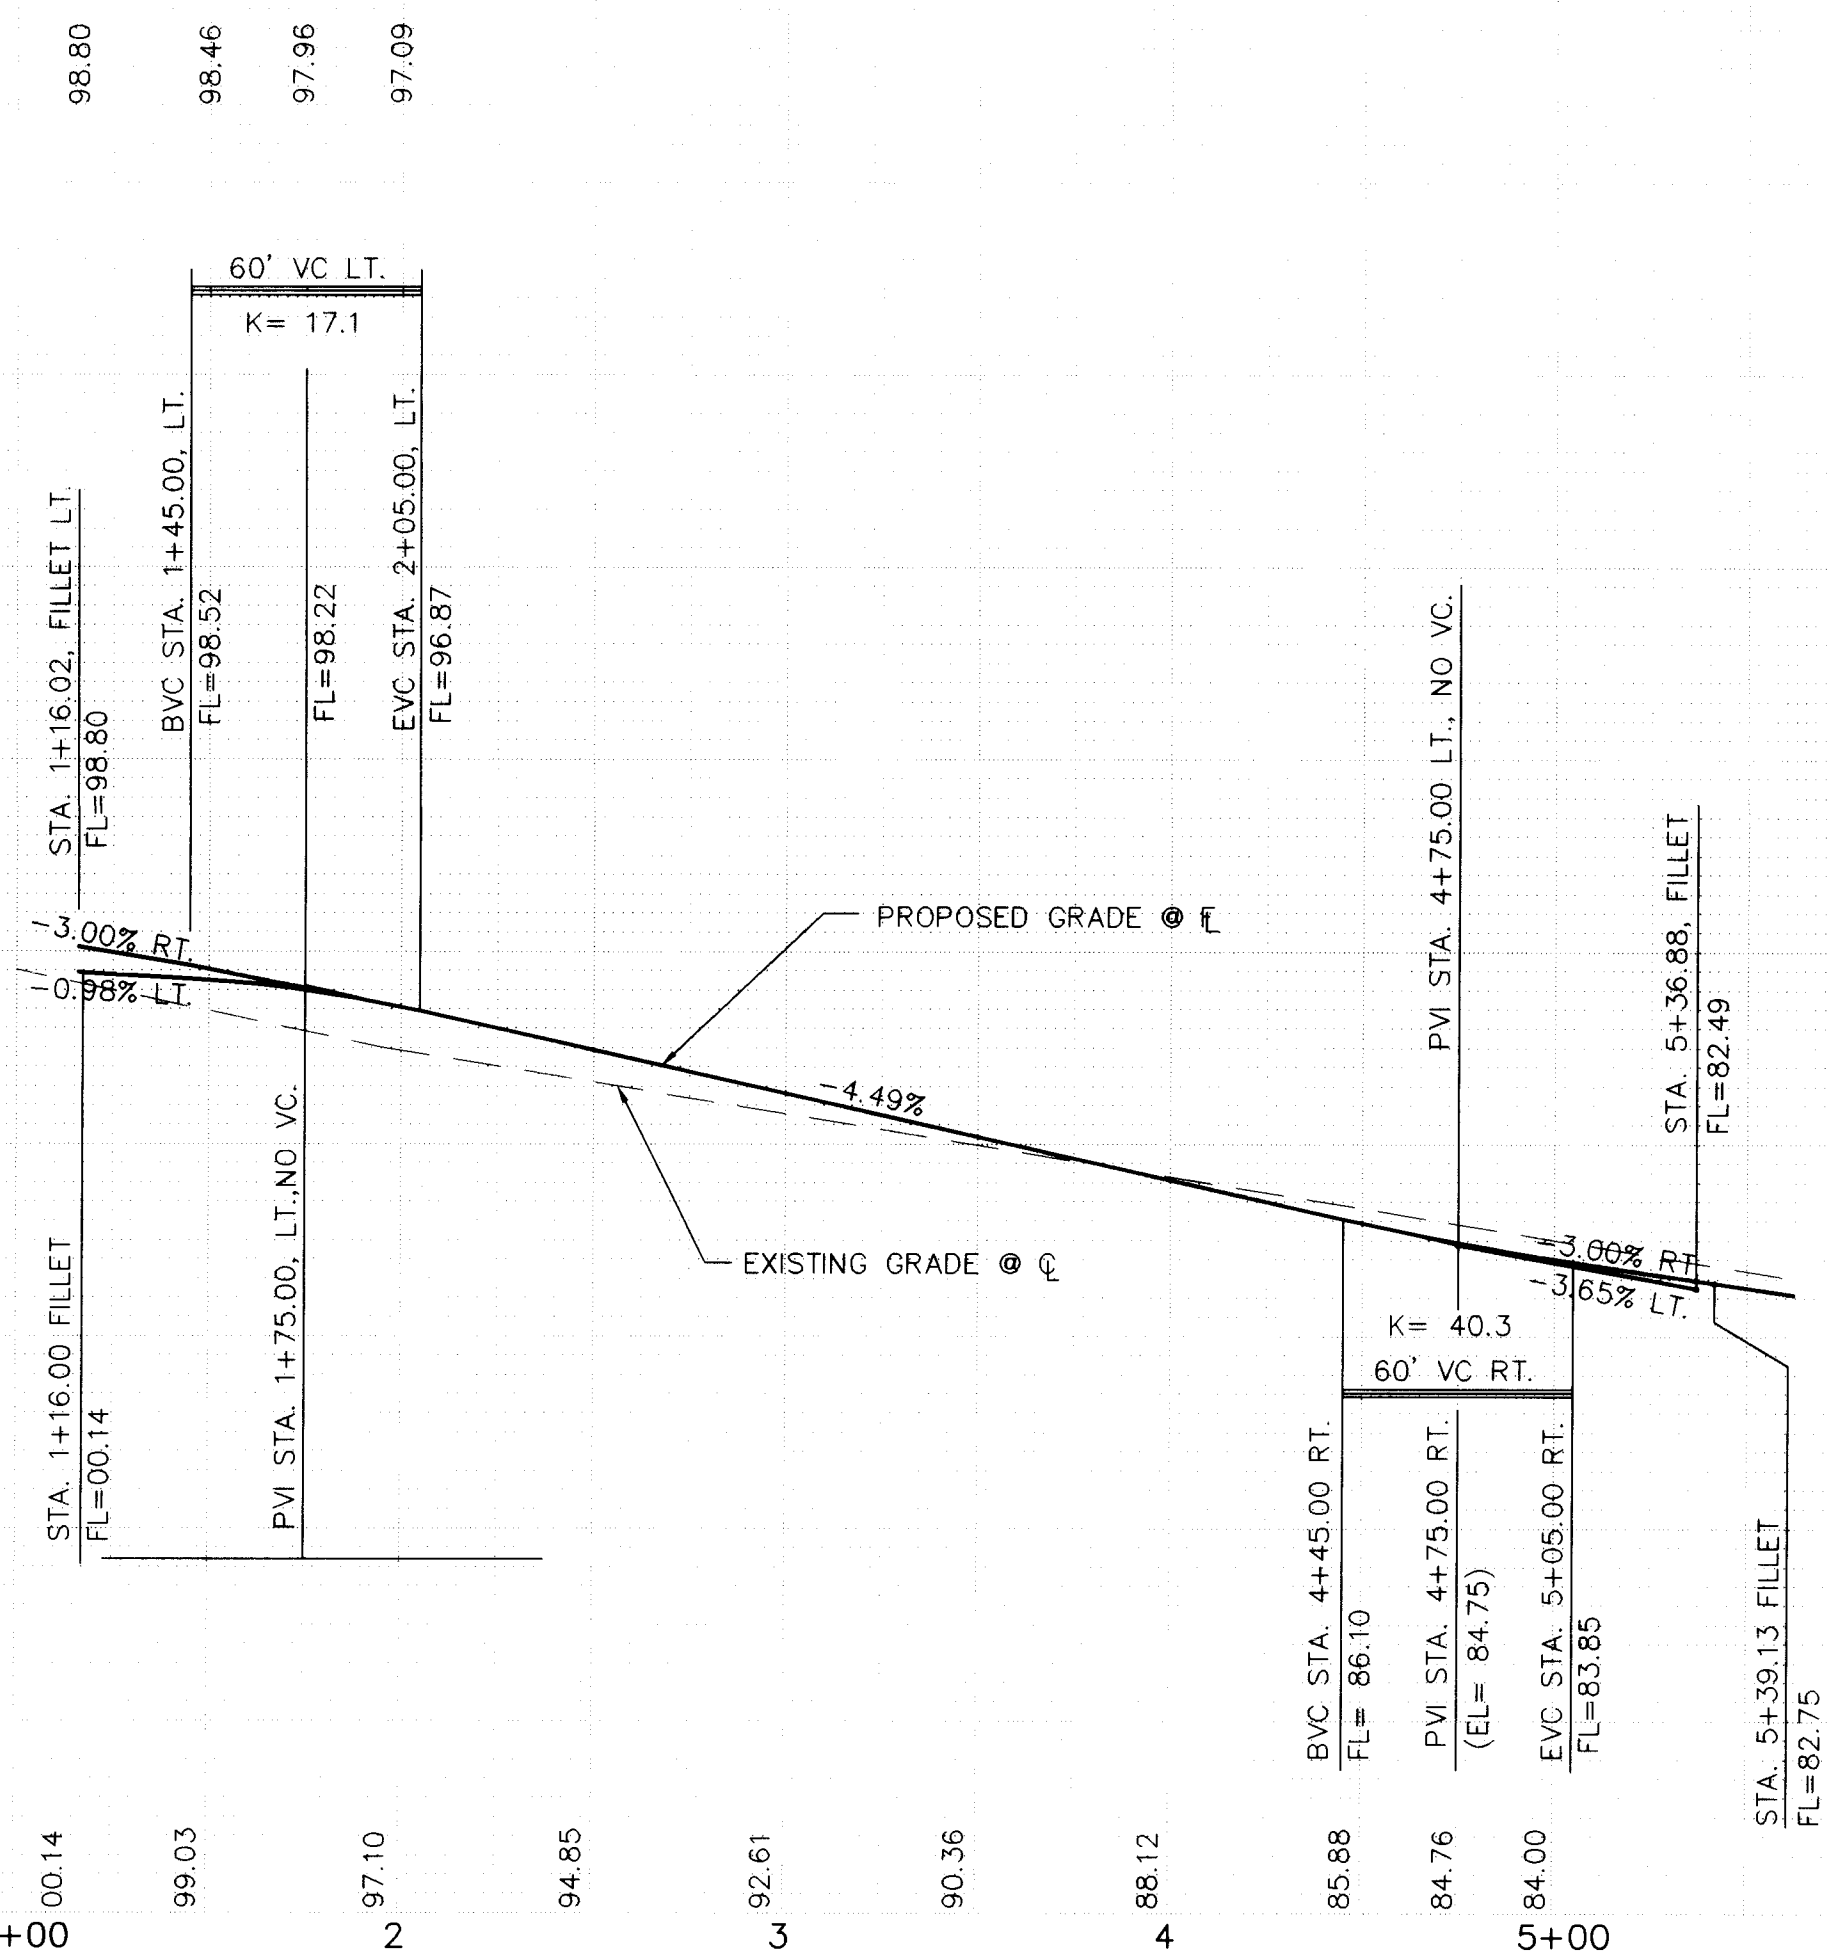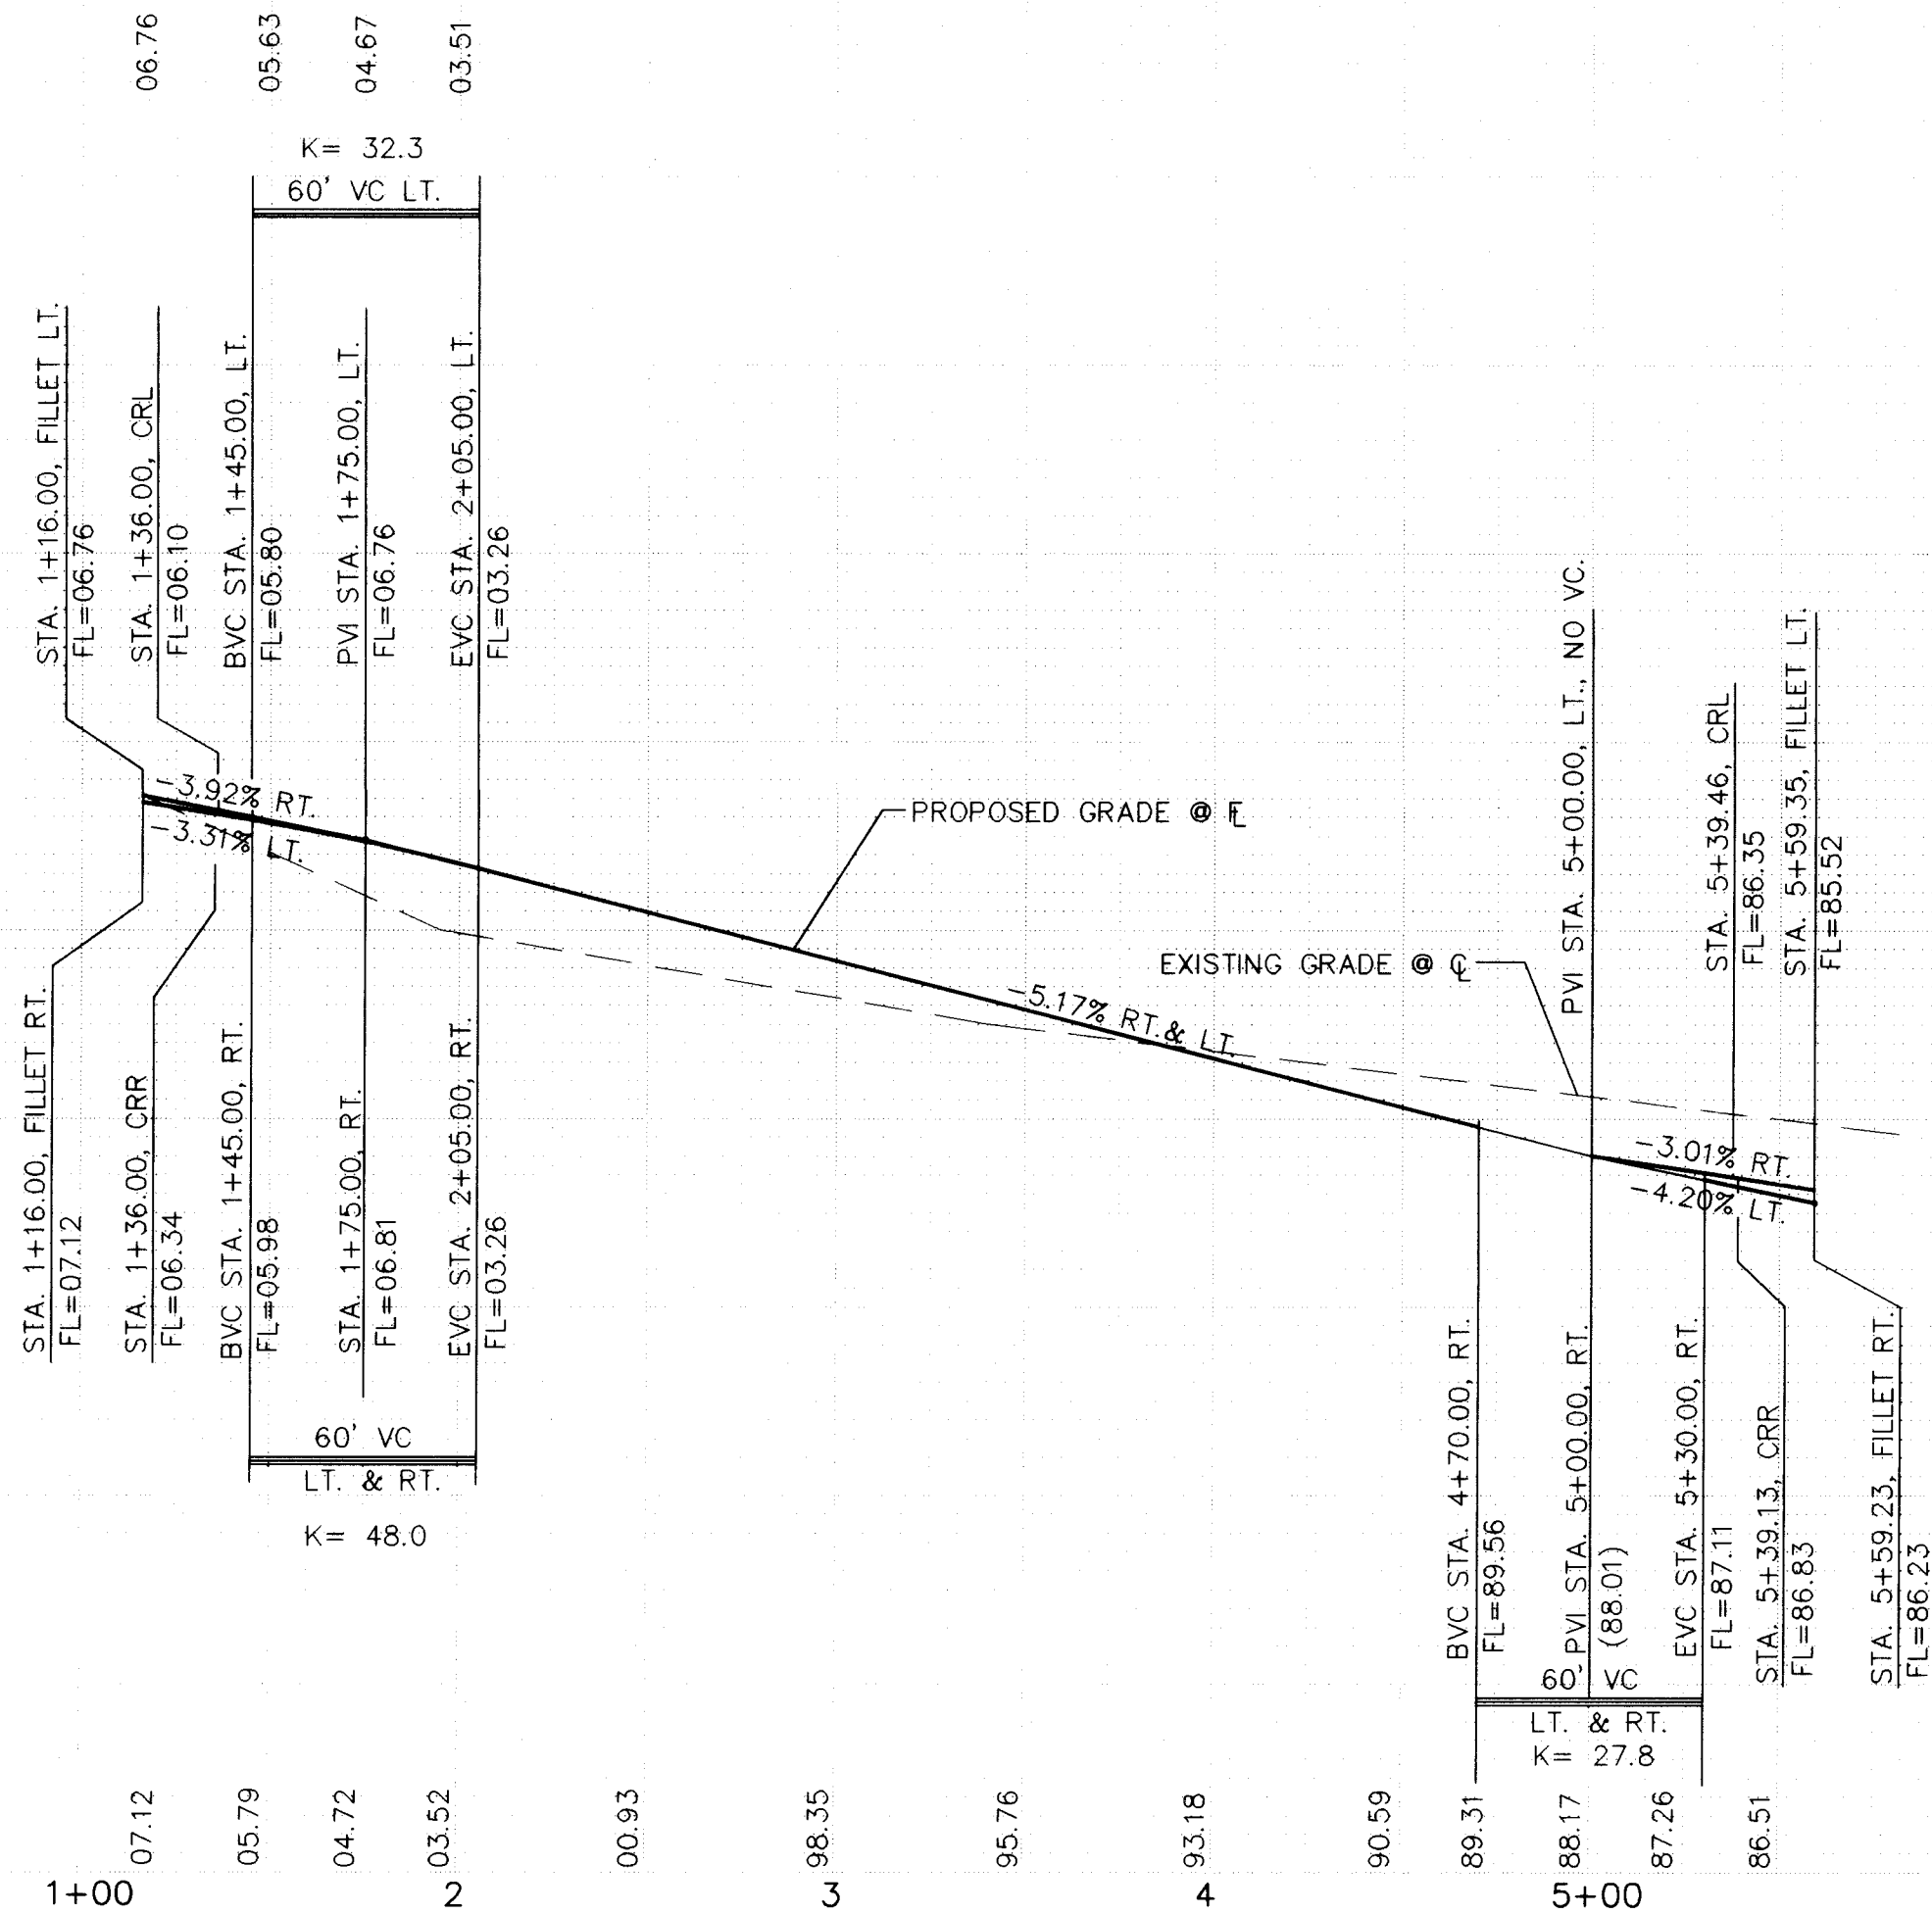

LEGEND	
● FL=74.11	PROPOSED CURB FLOWLINE ELEVATION
73.6 ●	EXISTING SPOT ELEVATION (GRND & TC)
—	PROPOSED VALLEY GUTTER/ SIDEWALK
—	EXISTING CURB & GUTTER
—	PROPOSED MOUNTABLE CURB & GUTTER
—	PROPOSED STANDARD CURB & GUTTER
—	CROWN TRANSITION

- KEYNOTES:**
- WHEELCHAIR RAMP PER COA STD. DWG. 2441 CASE II.
 - WHEELCHAIR RAMP PER COA STD. DWG. 2441 CASE I.
 - MOUNTABLE TO STANDARD CURB TRANSITION PER COA STD. DWG. 2418
 - CONC. VALLEY GUTTER PER COA STD. DWG. 2420
 - SPECIAL CONC. VALLEY GUTTER PER C.O.A. STD. DWG. 2422
 - FUTURE 4' SIDEWALK, BY OTHERS
 - PROPOSED 4' SIDEWALK, THIS CONTRACT
 - PROPOSED 6' SIDEWALK, THIS CONTRACT
 - 50' CROWN TRANSITION PER C.O.A. STD. DWG. 2401
 - CUT-OFF WALL (FULL STREET WIDTH, 24" DEEP x 8" THICK) PER C.O.A. STD. DWG. NO. 2415

PARKWEST UNIT 2
CURVE TABLE

CURVE IDEN	RADIUS	ARC	DELTA
A	107.50	168.23	089-39-58
B	20.00	27.85	079-47-14
C	20.00	25.29	072-27-24
D	20.00	31.42	090-00-00
E	20.00	31.42	090-00-00
F	20.00	31.42	090-00-00
G	20.00	32.42	090-00-00
H	20.00	32.07	091-52-46
I	20.00	31.87	091-17-25
J	20.00	28.25	080-55-09
K	20.00	35.71	102-16-24
L	20.00	31.42	090-00-00
M	20.00	32.14	092-03-52
N	20.00	32.13	092-03-19
O	20.00	34.37	098-27-52
P	60.76	75.36	071-04-01
Q	89.24	110.39	071-04-01

SCALE:
1"= 50', HORIZ.
1"= 10', VERT.

community sciences corporation



JOB NO. 14323 - 041 LAND PLANNING ENGINEERING SURVEYING
P.O. Box 1328 Corrales, N.M. 87049

CITY OF ALBUQUERQUE
PUBLIC WORKS DEPARTMENT
ENGINEERING GROUP


TITLE: PARKWEST-UNIT 2 PAVING PLAN AND PROFILE DARK MESA AVE. & LAVA REACH AVE. N.W.				
APPROVALS	ENGINEER	DATE	APPROVALS	ENGINEER
DRC CHAIRMAN	B. J. Smith	2-7-96	WATER	W/A RWT
TRANSPORTATION	W. J. Smith	1-24-96	WASTE WATER	1-3-96
HYDROLOGY	J. P. Smith	1-10-96	A.M.A.F.C.A.	

PROJECT NO. 4886.96 MAP NO. G,H-9 SHEET 10 OF 15

SCANNED BY
BY LASON

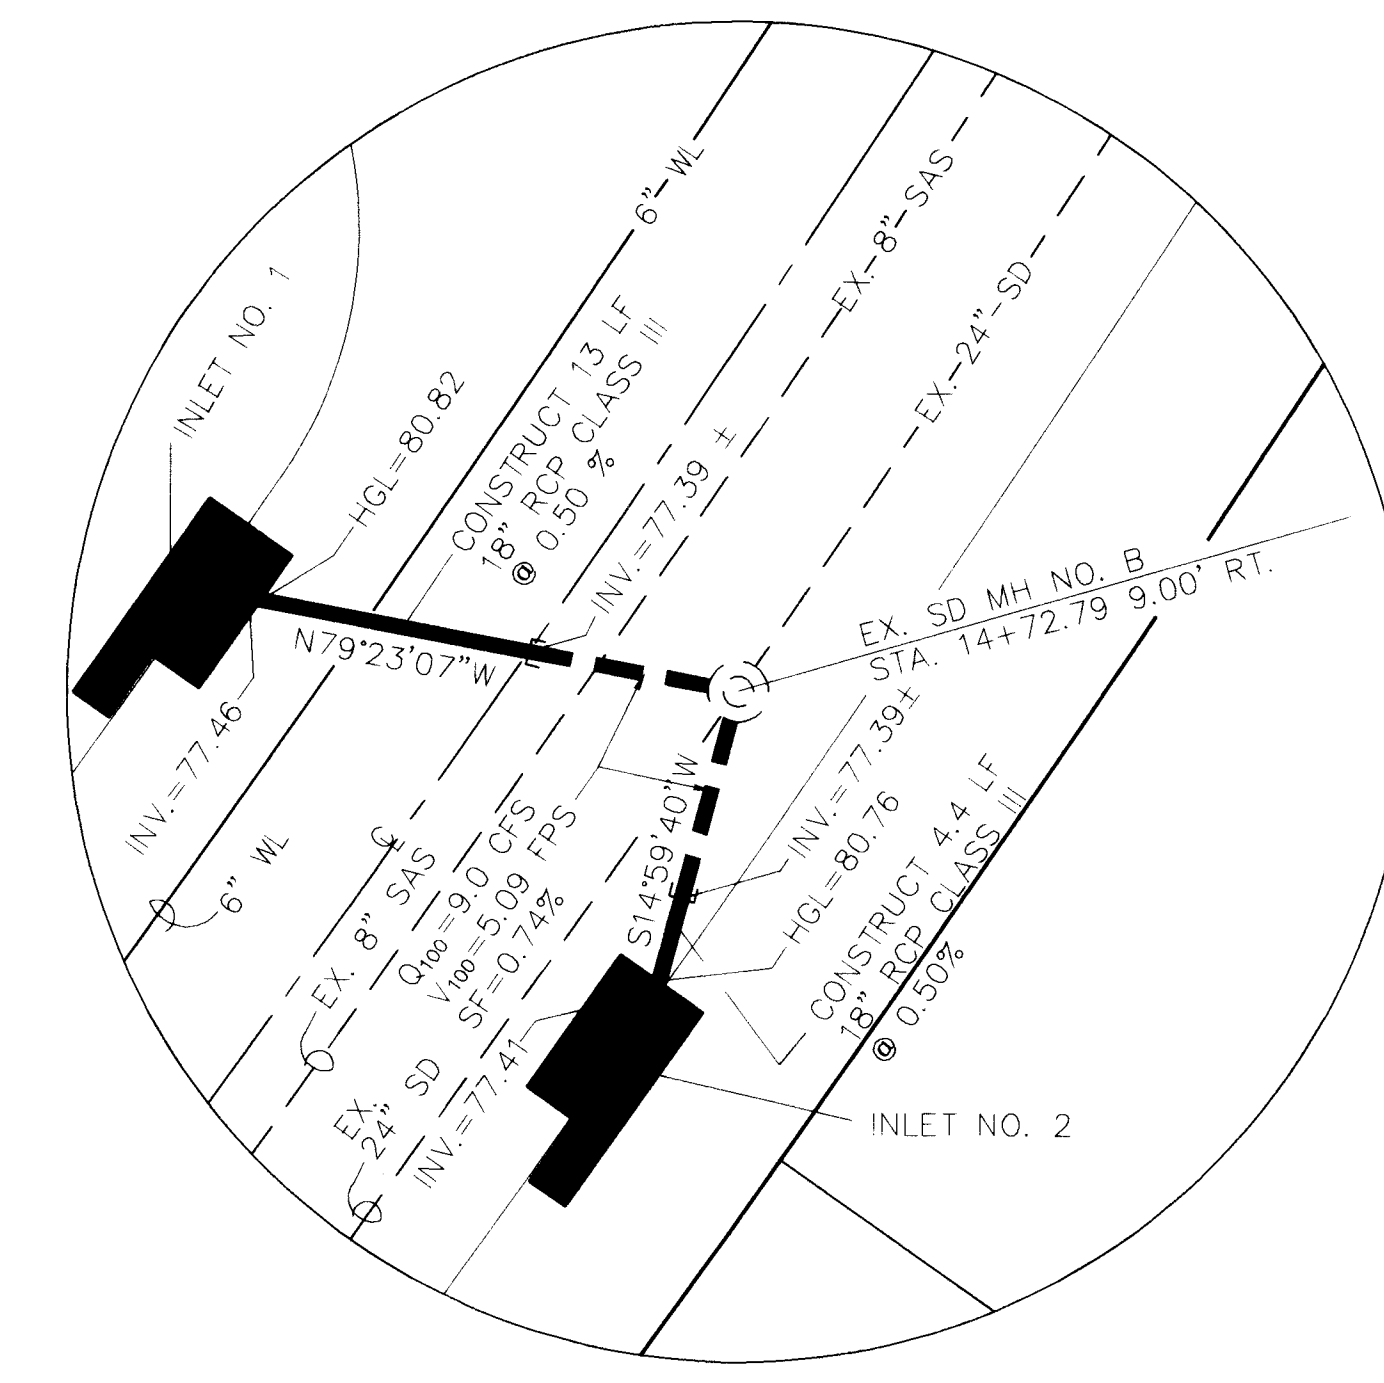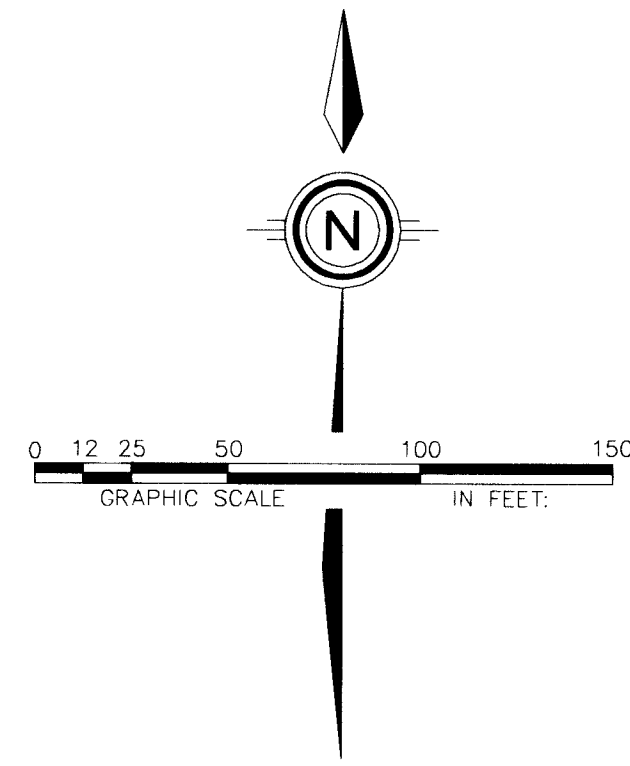


NOTE:
FOR EXISTING UTILITIES
SEE COA PROJECT NO.
4886.94

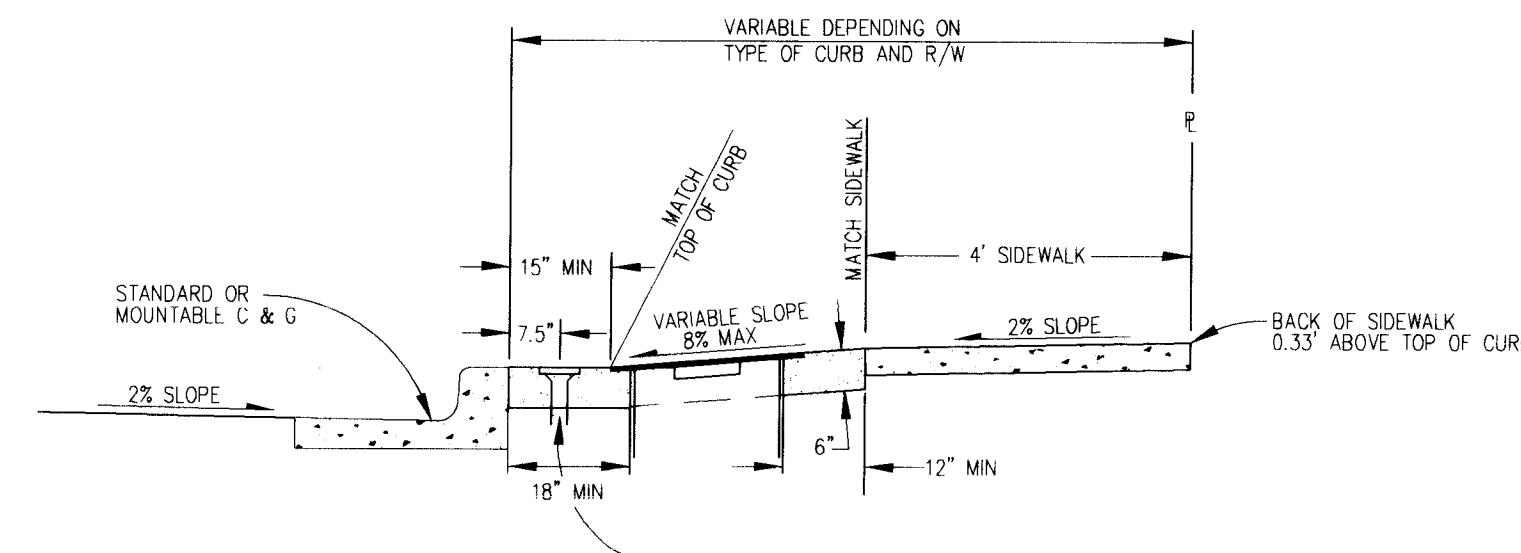


WATER METER BOX INSTALLATION
NOT TO SCALE
NOTE: INSTALL WATER METER PER C.O.A. STD. DWG. 236

- UTILITY NOTES**
1. RESTRAINED JOINTS, SUCH AS MEGA-LUG EQUIVALENT BRANDS, ACCEPTABLE TO THE ENGINEER, SHALL BE USED ON ALL TEES, BENDS, CROSSES & CAPS IN LIEU OF CONCRETE THRUST BLOCKING. RESTRAINED JOINTS SHALL BE CONSIDERED INCIDENTAL TO THIS CONTRACT AND NO ADDITIONAL COMPENSATION, MEASUREMENT, OR PAYMENT WILL BE MADE THEREFORE.
 2. LR SHALL BE THE LENGTH OF WATER MAIN THAT REQUIRED JOINTS ON EACH SIDE OF THE FITTINGS.
 3. ALL FIRE HYDRANTS & FITTINGS ETC. SHALL BE BUILT IN ACCORDANCE WITH/COA STD. DWG'S 2301 THRU 2380 INCLUSIVE.
- WATER SHUT-OFF PLAN**
1. VALVES NO. 703 AND EXISTING VALVE 2574 SOUTHWEST OF THE INTERSECTION AT BASALT AVENUE AND LAVA BLUFF DRIVE SHALL BE SHUT-OFF SO NON-PRESSURE CONNECTIONS CAN BE MADE.
 2. CONTRACTOR SHALL CONTACT WATER SYSTEMS DIVISION (857-8200) FIVE (5) WORKING DAYS PRIOR TO VALVE SHUT-OFF ONLY WATER SYSTEMS PERSONNEL ARE AUTHORIZED TO OPERATE VALVES.

ENGINEER'S SEAL		SURVEY INFORMATION		BENCH MARKS		AS BUILT INFORMATION	
		FIELD NOTES		DATE		CONTRACTOR <i>Sundance Mechanical</i>	
		NO.	BY			WORK SINK BY INSPECTOR'S FIELD DATE BY VERIFICATION BY DRAWN BY CHECKED BY	DATE DATE DATE DATE DATE DATE DATE
REMARKS		1		COMMUNITY SCIENCES		C.S.C.	
REVISITONS						GOA A-D	
DESIGN						C.S.C.	
DESIGNED BY B.O.M.		DATE MAY, 1995				C.S.C.	
DRAWN BY A.M., W.L.V.		DATE MAY, 1995				C.S.C.	
CHECKED BY J.D.H.		DATE MAY, 1995				C.S.C.	
MICRO-FILM INFORMATION TOP OF THE DEFENTION DAM, ALONG THE NORTH BANK OF THE DAM 0.6 MI. TO A DIRT CROSS RD., TURN RIGHT, GO NORTH ON THE DIRT RD. 0.5 MI. RECORDED BY NO.							
S/D 1929 ELEVATION = 5334.50 FEET							

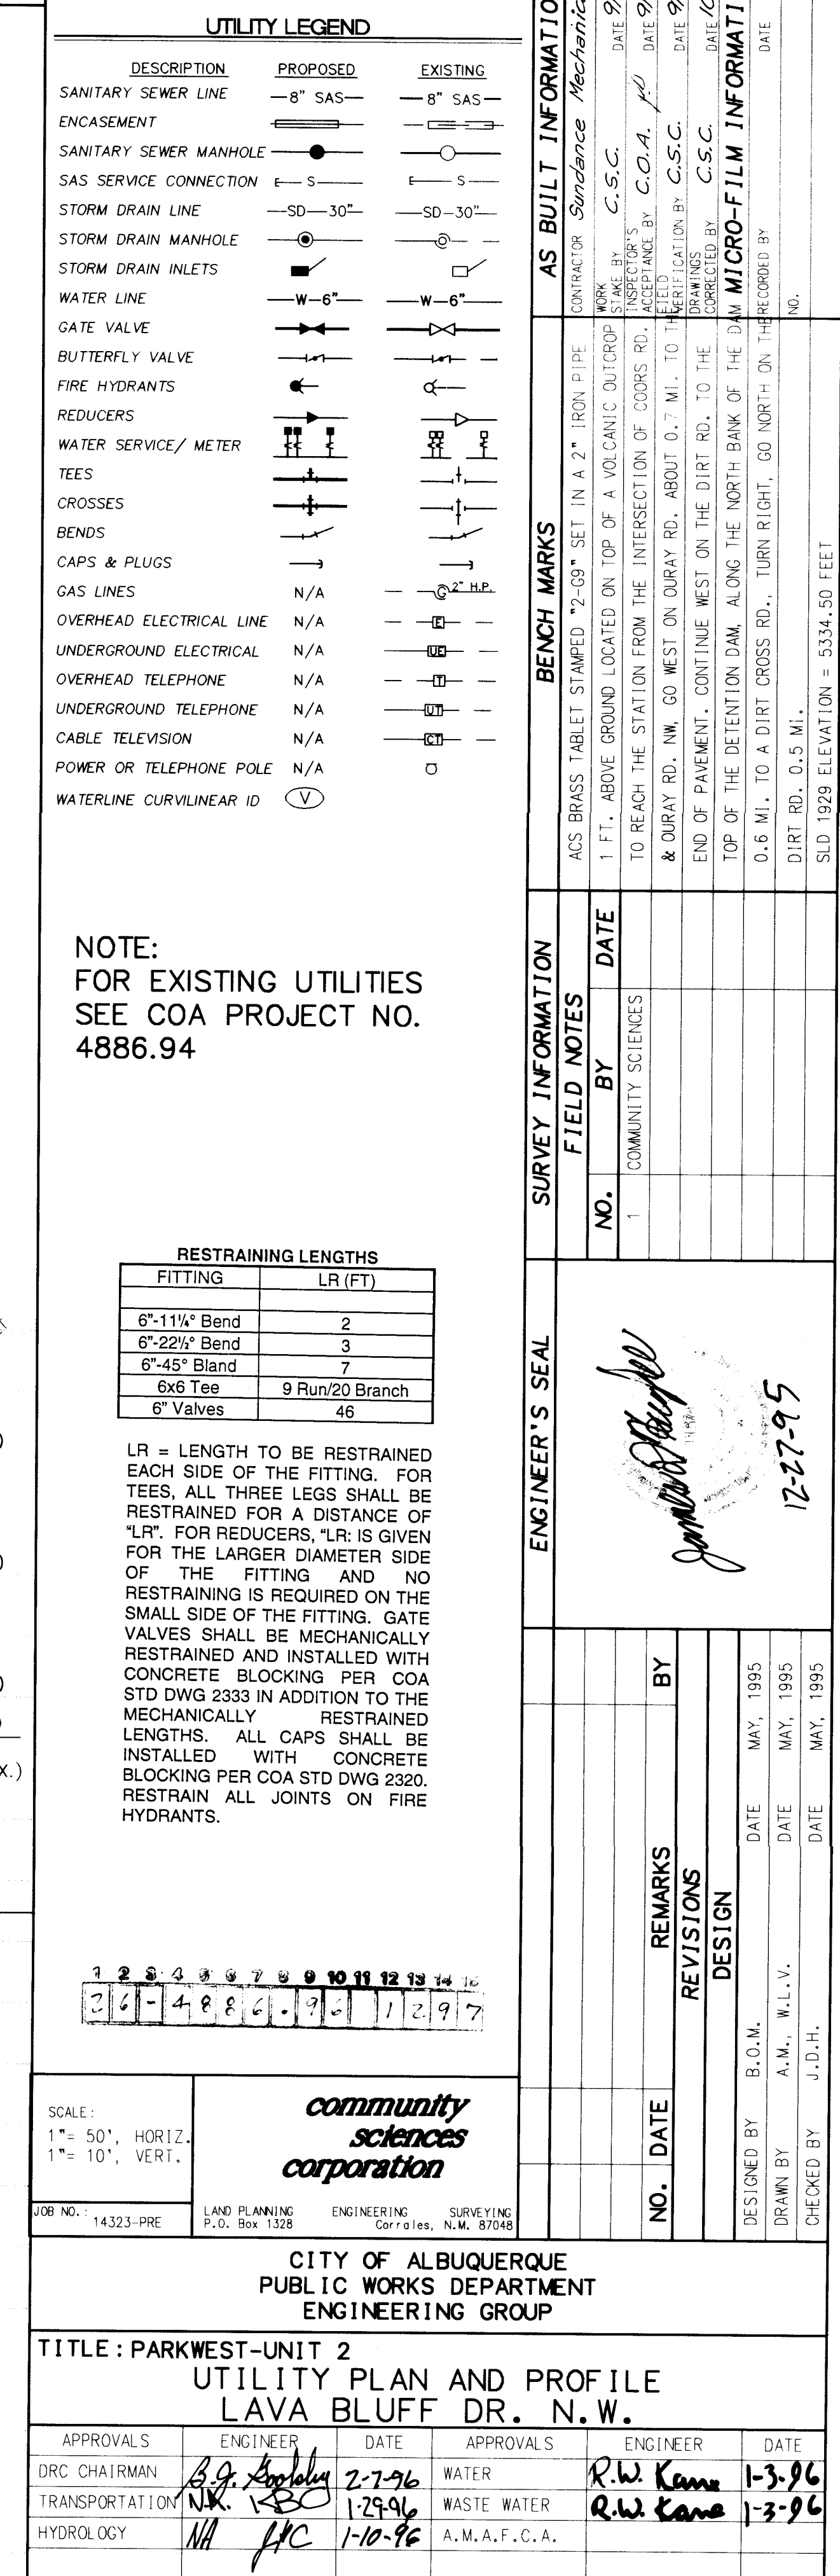

SCANNED BY
BY LASON

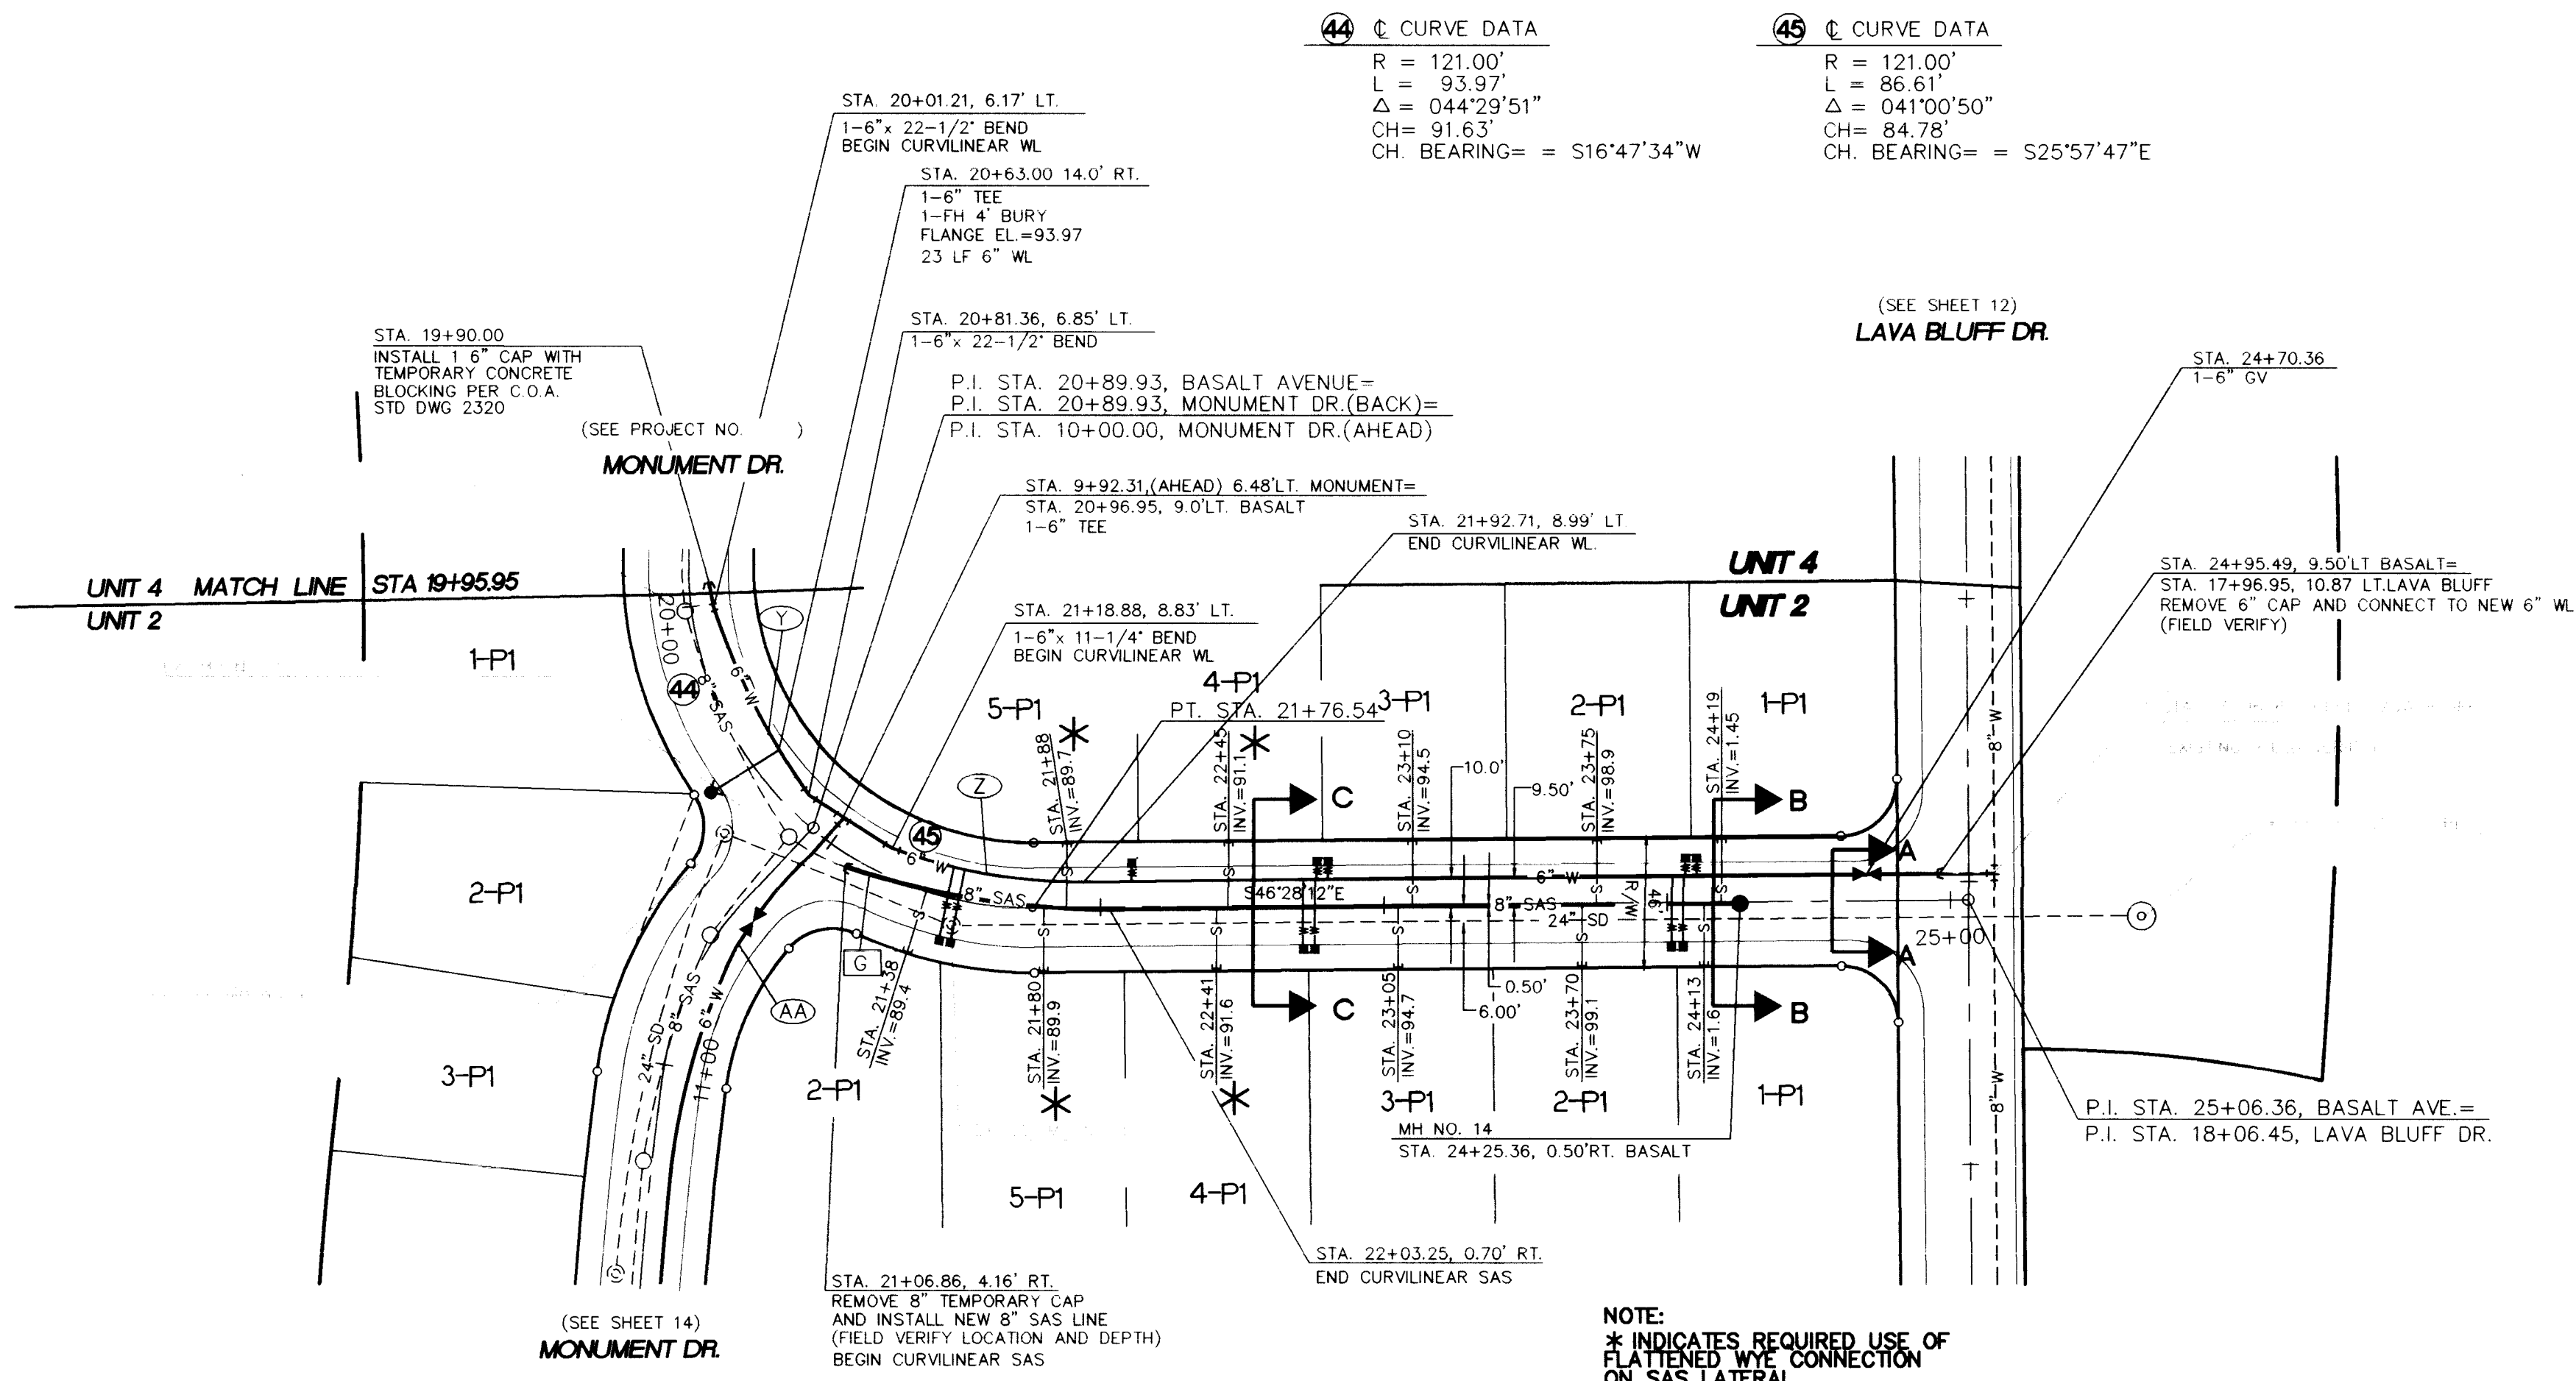

WATERLINE CURVE TABLE						
CURVE	R	L	DELTA	CHORD DISTANCE	CHORD BRG	DELTA 20' JOINT
Y	250.00	74.74	17°07'43"	74.46	S 17°85'25" W	4.58'
Z	190.00	69.12	20°10'39"	68.74	S 36°08'15" E	6.03'

SANITARY SEWER CURVE TABLE						
CURVE	R	L	DELTA	CHORD DISTANCE	CHORD BRG	DELTA 20' JOINT
G	275.00	96.81	20°10'13"	96.31	S36°28'15"E	4.17'

UTILITY LEGEND		
DESCRIPTION	PROPOSED	EXISTING
SANITARY SEWER LINE	— 8" SAS —	— 8" SAS —
ENCASEMENT	— SD — 30" —	— SD — 30" —
SANITARY SEWER MANHOLE	— 8" SAS —	— 8" SAS —
SAS SERVICE CONNECTION	— S —	— S —
STORM DRAIN LINE	— SD — 30" —	— SD — 30" —
STORM DRAIN MANHOLE	— SD — 30" —	— SD — 30" —
STORM DRAIN INLETS	— SD — 30" —	— SD — 30" —
WATER LINE	— W — 6" —	— W — 6" —
GATE VALVE	— G —	— G —
BUTTERFLY VALVE	— B —	— B —
FIRE HYDRANTS	— F —	— F —
REDUCERS	— R —	— R —
TEES	— T —	— T —
CROSSES	— C —	— C —
BENDS	— B —	— B —
CAPS & PLUGS	— P —	— P —
GAS LINES	N/A	— G — 2" B.P.
OVERHEAD ELECTRICAL LINE	N/A	— O —
UNDERGROUND ELECTRICAL	N/A	— U —
OVERHEAD TELEPHONE	N/A	— O —
UNDERGROUND TELEPHONE	N/A	— U —
CABLE TELEVISION	N/A	— C —
POWER OR TELEPHONE POLE	N/A	— P —

WATERLINE CURVILINEAR ID. (A)
SANITARY SEWER CURVILINEAR ID. (B)
STORM DRAINAGE CURVILINEAR ID. (C)

RESTRAINING LENGTHS	
FITTING	LR (FT)
6"-11/4" Bend	2
6"-22/4" Bend	3
6"-45" Bend	7
6x6 Tee	9 Run/20 Branch
6" Valves	46

LR = LENGTH TO BE RESTRAINED EACH SIDE OF THE FITTING. FOR TEES, ALL THREE LEGS SHALL BE RESTRAINED FOR A DISTANCE OF "LR". FOR REDUCERS, "LR" IS GIVEN FOR THE LARGER DIAMETER SIDE OF THE FITTING AND NO RESTRAINING IS REQUIRED ON THE SMALL SIDE OF THE FITTING. GATE VALVES SHALL BE MECHANICALLY RESTRAINED AND INSTALLED WITH CONCRETE BLOCKING PER COA STD DWG 2333 IN ADDITION TO THE MECHANICALLY RESTRAINED LENGTHS. ALL CAPS SHALL BE INSTALLED WITH CONCRETE BLOCKING PER COA STD DWG 2320. RESTRAIN ALL JOINTS ON FIRE HYDRANTS.

1	2	3	4	5	6	7	8	9	10	11	12	13	14	15
2	3	4	5	6	7	8	9	10	11	12	13	14	15	16

SCALE:
HORIZ: 1" = 50'
VERT: 1" = 10'

community sciences corporation


LAND PLANNING: P.O. Box 1328
ENGINEERING: Corrales, N.M. 87048
SURVEYING: Corrales, N.M. 87048

CITY OF ALBUQUERQUE
PUBLIC WORKS DEPARTMENT
ENGINEERING GROUP

TITLE: PARKWEST - UNIT 2
UTILITY PLAN & PROFILE
MONUMENT DR. & BASALT AVE. N.W.

APPROVALS	ENGINEER	DATE	APPROVALS	ENGINEER	DATE
DRC CHAIRMAN	B.G. Lohdy	2-2-96	WATER	R.W. Kane	1-3-96
TRANSPORTATION	NA	1-29-96	WASTE WATER	R.W. Kane	1-3-96
HYDROLOGY	NA	1-10-96	A.M.A.F.C.A.		

PROJECT NO.	4886.96	MAP NO.	G, H9	SHEET	13 OF 15
-------------	---------	---------	-------	-------	----------

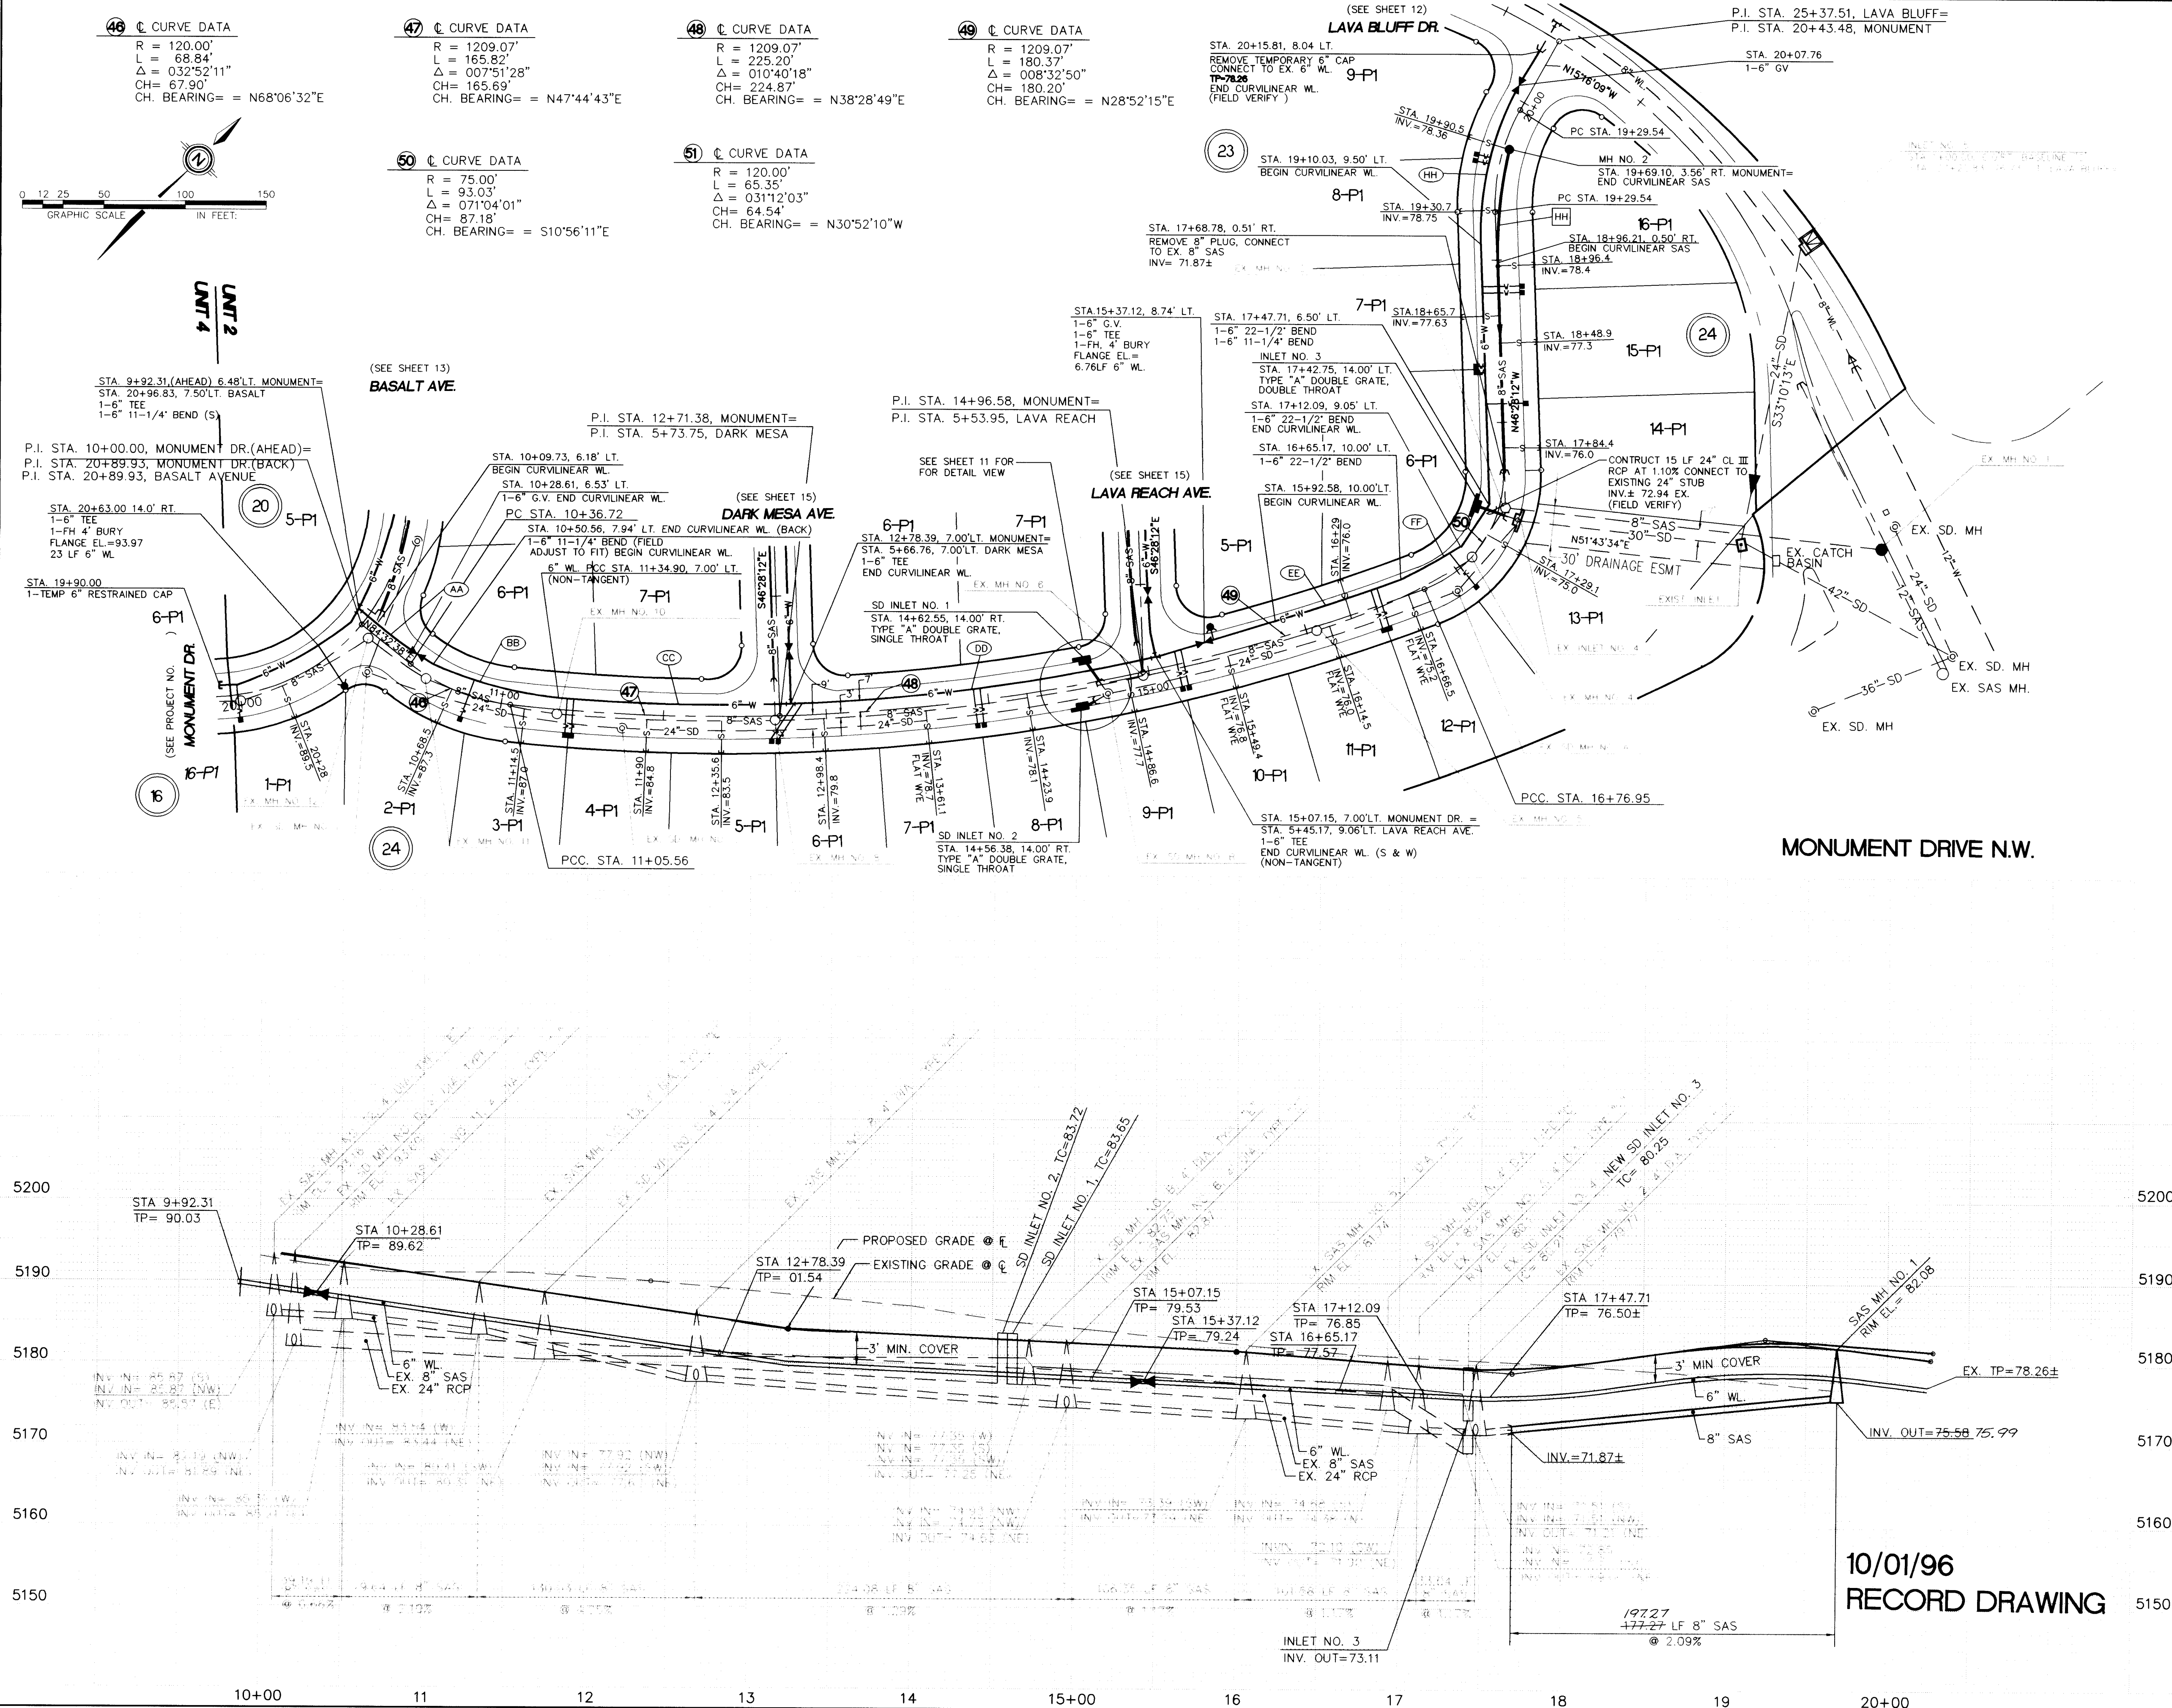

AS BUILT INFORMATION				BENCH MARKS				SURVEY INFORMATION				ENGINEER'S SEAL			
CONTRACTOR	DATE	INSPECTOR	DATE	CONTRACTOR	DATE	INSPECTOR	DATE	NO.	BY	DATE	NO.	BY	DATE	NO.	BY
Community Sciences Corporation	10/01/96	R.W. Kume	10/01/96	Community Sciences Corporation	10/01/96	R.W. Kume	10/01/96	1	BY	DATE	1	BY	DATE	1	BY

REMARKS

DESIGNED BY: B.O.M. DATE: MAY, 1995
 DRAWN BY: A.M., W.L.V. DATE: MAY, 1995
 CHECKED BY: J.D.H. DATE: MAY, 1995


community sciences corporation

CITY OF ALBUQUERQUE
 PUBLIC WORKS DEPARTMENT
 ENGINEERING GROUP

**TITLE: PARKWEST-UNIT 2
 UTILITY PLAN AND PROFILE
 MONUMENT DRIVE N.W.**



APPROVALS	ENGINEER	DATE	APPROVALS	ENGINEER	DATE
DRC CHAIRMAN	R.W. Kume	10/01/96	WATER	R.W. Kume	10/01/96
TRANSPORTATION	R.W. Kume	10/01/96	WASTE WATER	R.W. Kume	10/01/96
HYDROLOGY	R.W. Kume	10/01/96	A.M.A.F.C.A.		

PROJECT NO. 4886.96 MAP NO. G, H9 SHEET 14 OF 15

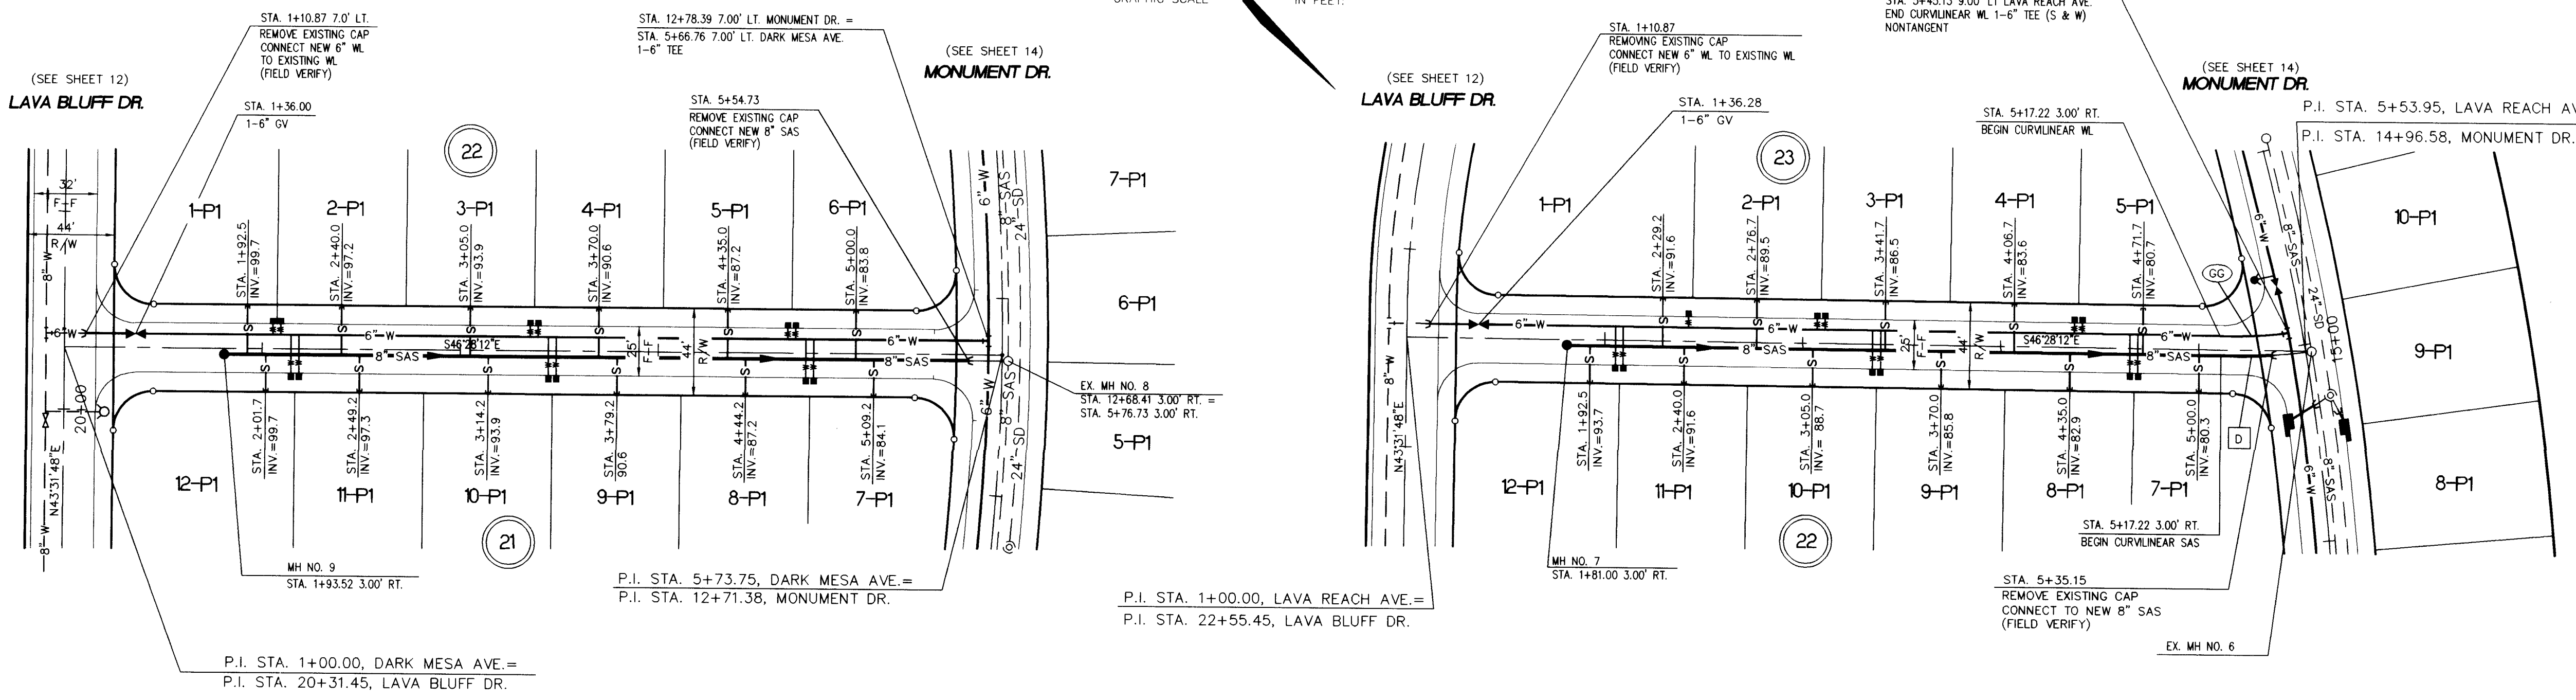

DARK MESA AVENUE N.W.

LAVA REACH AVENUE N.W.

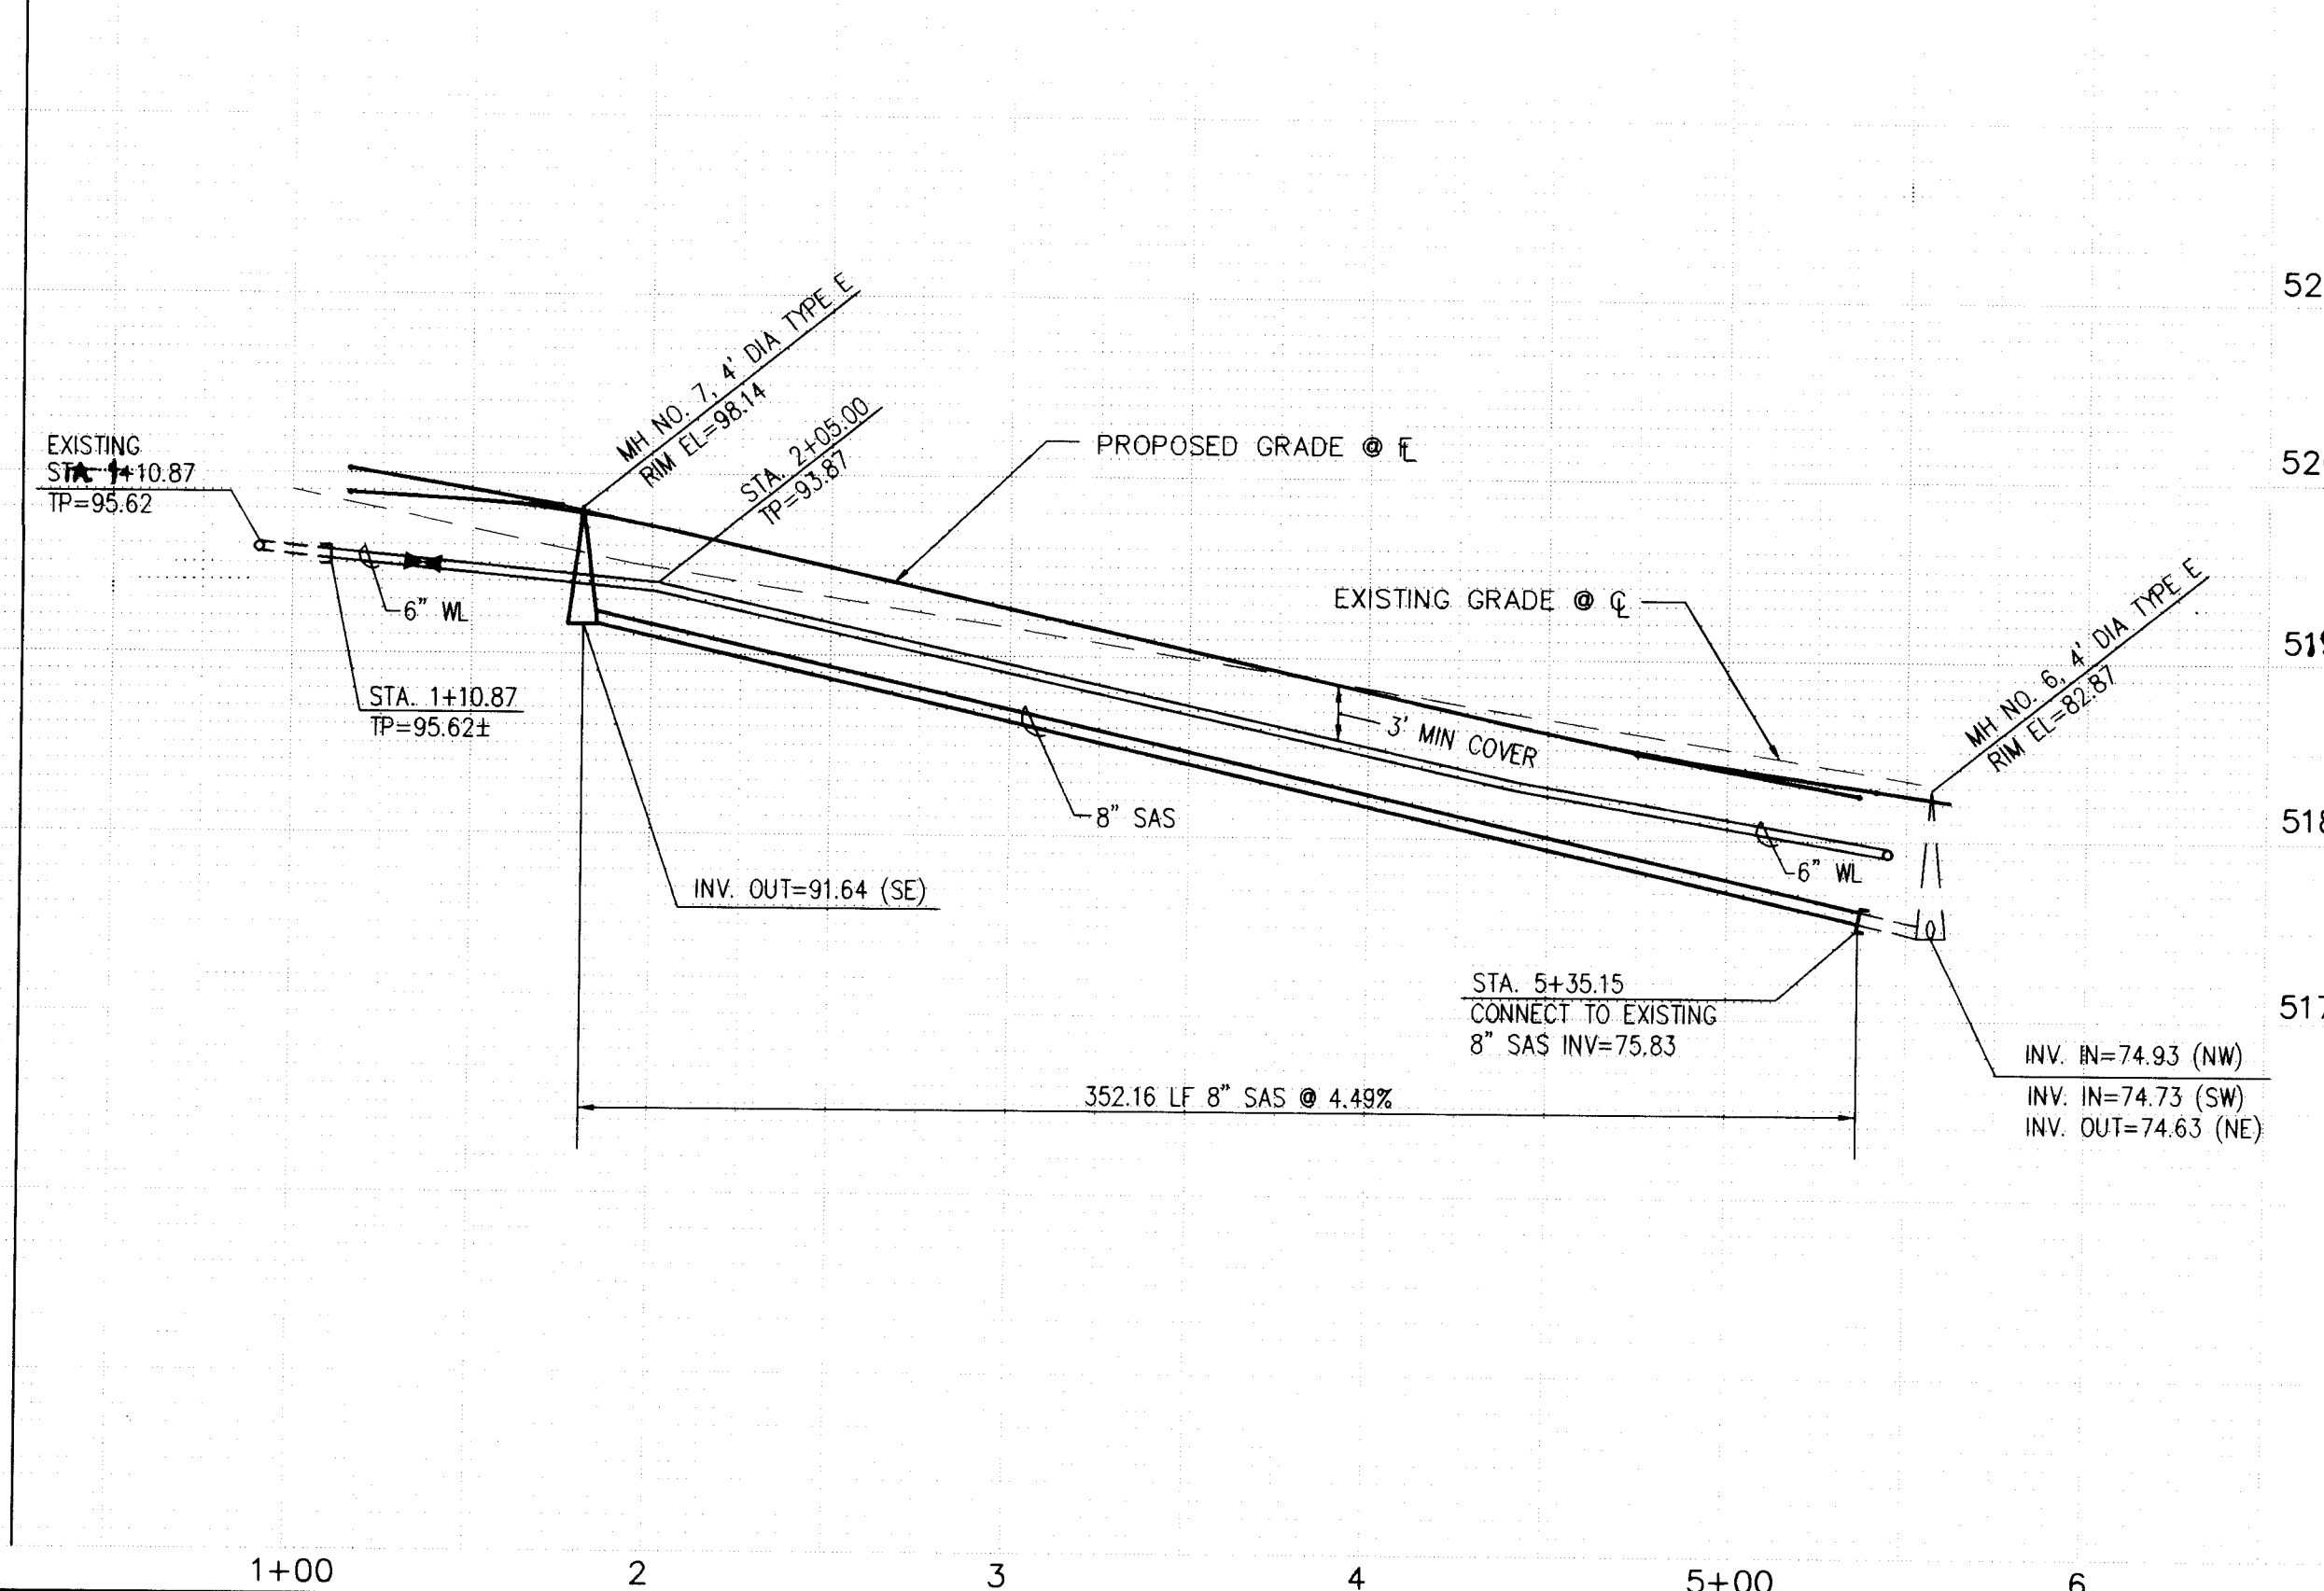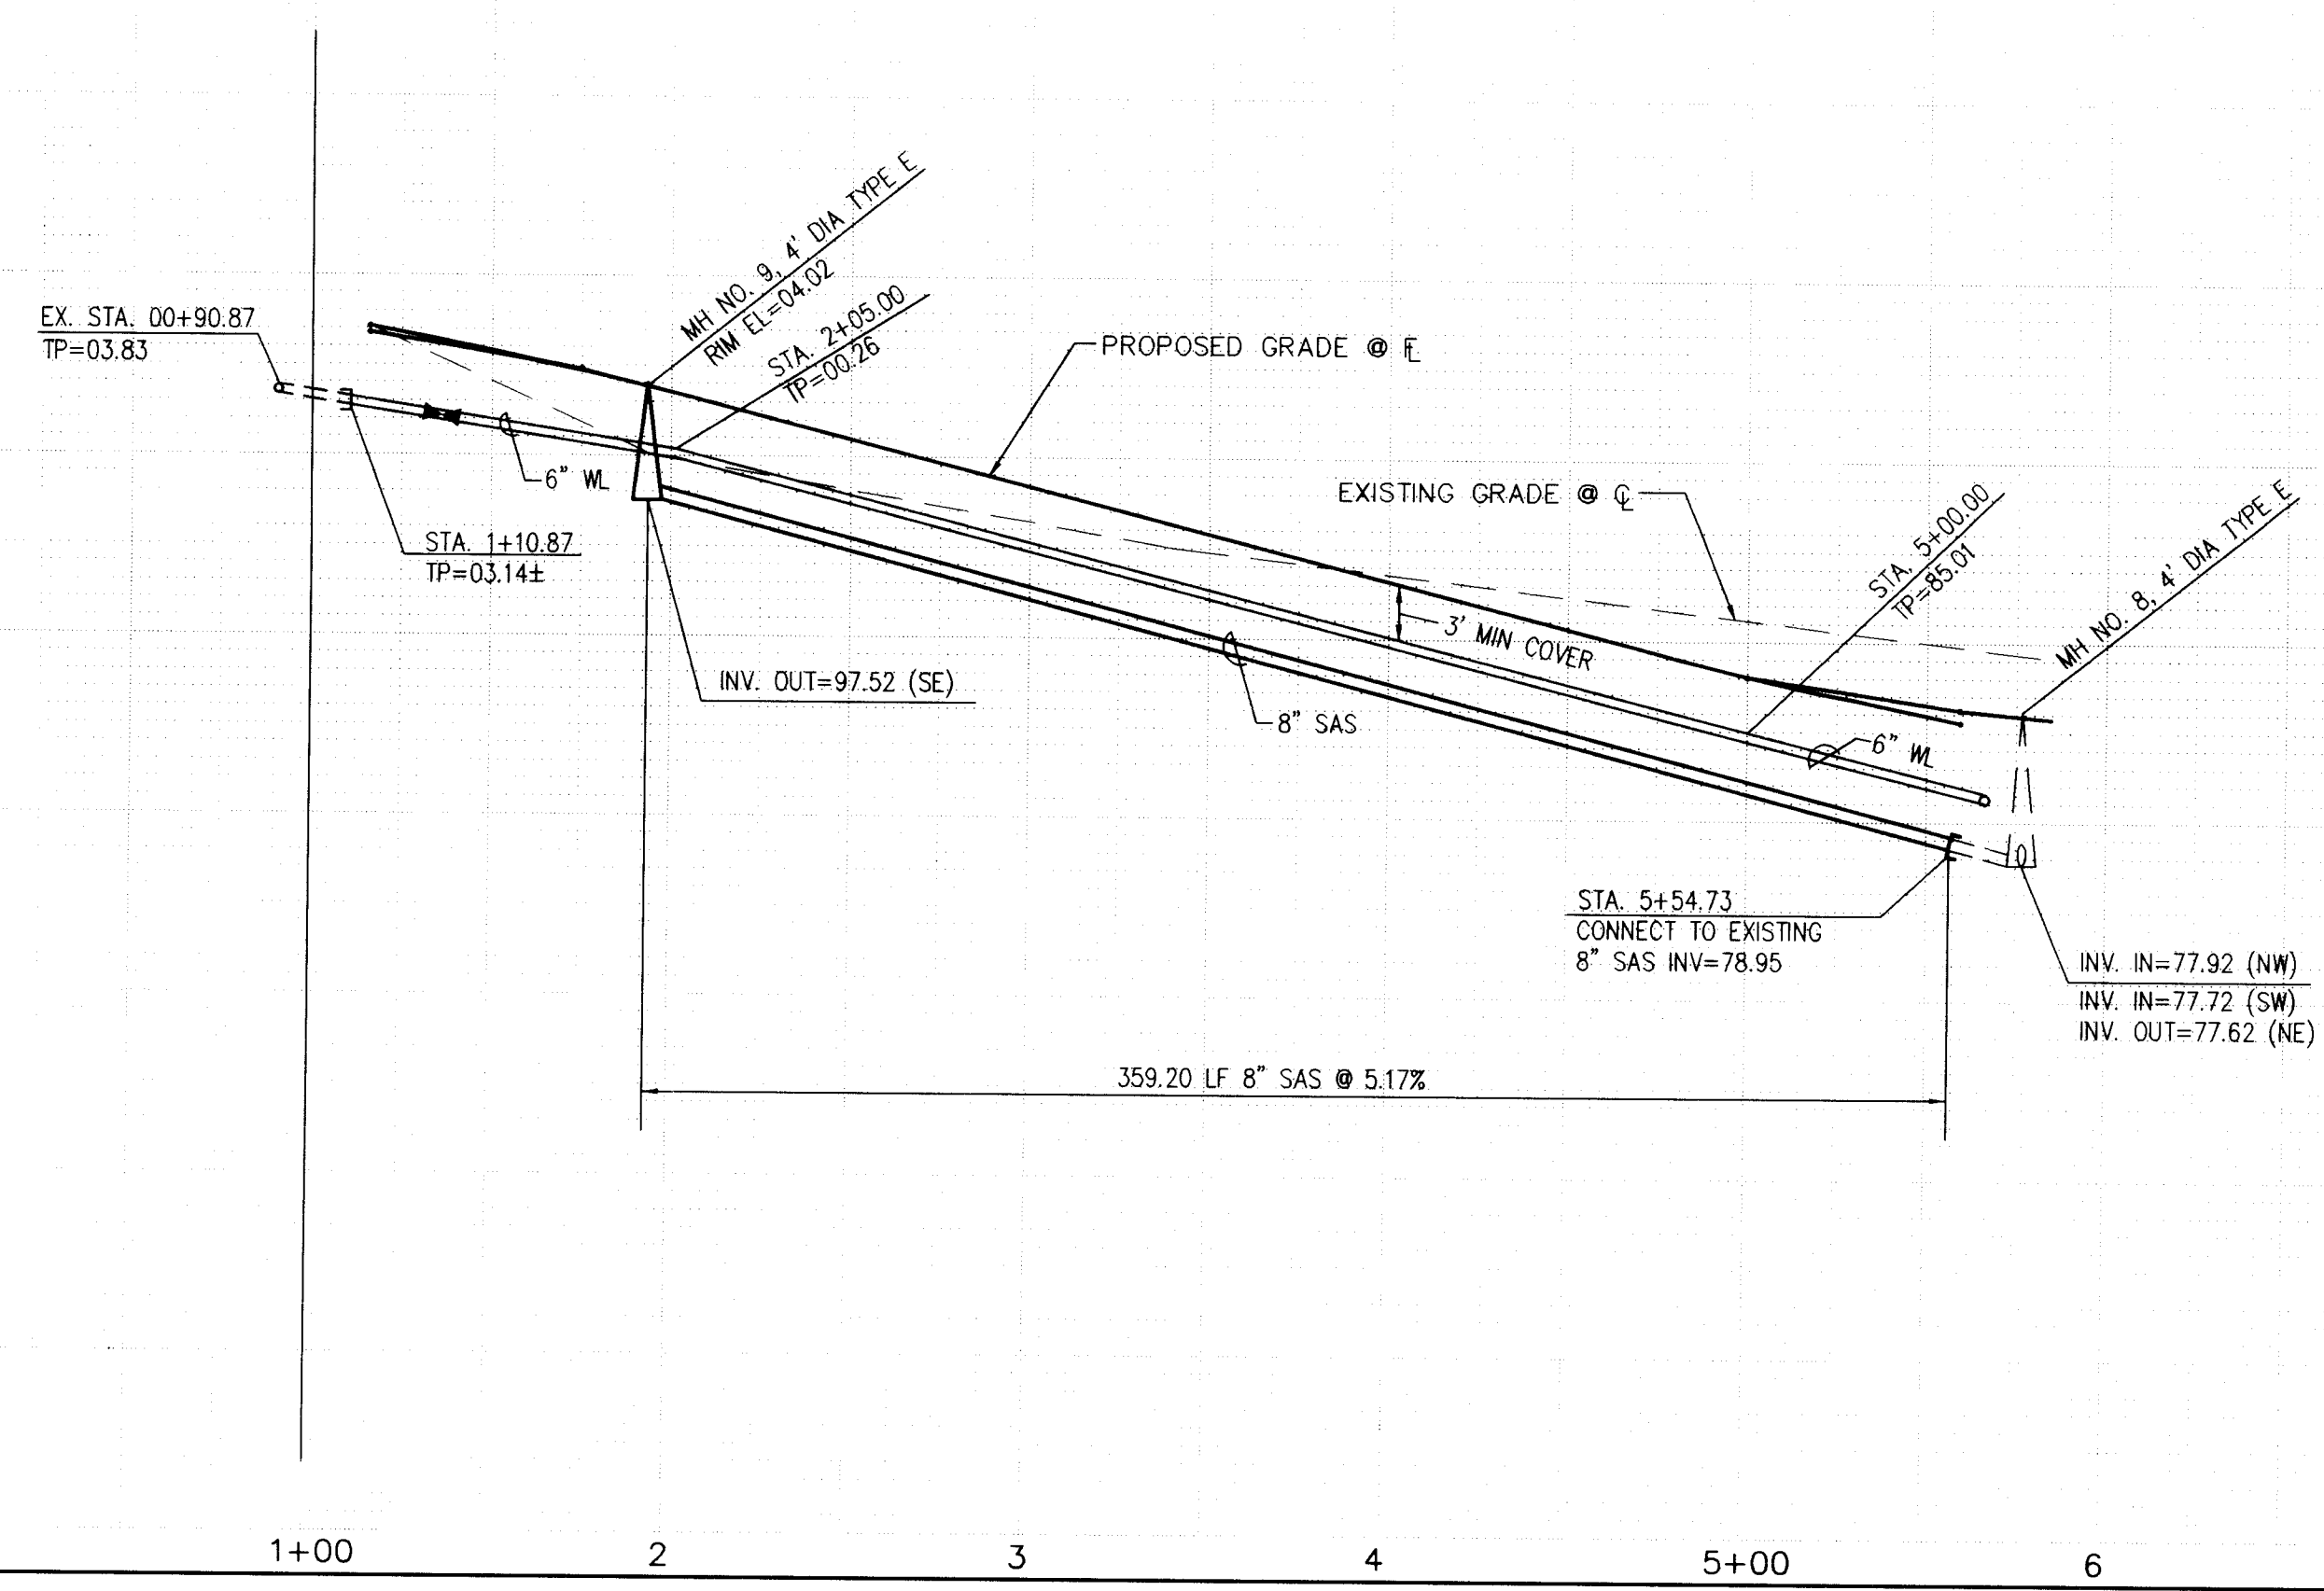

UTILITY LEGEND

DESCRIPTION	PROPOSED	EXISTING
SANITARY SEWER LINE	8" SAS	8" SAS
ENCASEMENT		
SANITARY SEWER MANHOLE		
SAS SERVICE CONNECTION	S	S
STORM DRAIN LINE	SD-30"	SD-30"
STORM DRAIN MANHOLE		
STORM DRAIN INLETS		
WATER LINE	W-6"	W-6"
GATE VALVE		
BUTTERFLY VALVE		
FIRE HYDRANTS		
REDUCERS		
WATER SERVICE/ METER		
TEES		
CROSSES		
BENDS		
CAPS & PLUGS		
OVERHEAD ELECTRICAL LINE	N/A	N/A
UNDERGROUND ELECTRICAL	N/A	N/A
OVERHEAD TELEPHONE	N/A	N/A
UNDERGROUND TELEPHONE	N/A	N/A
CABLE TELEVISION	N/A	N/A
POWER OR TELEPHONE POLE	N/A	N/A
WATERLINE CURVILINEAR ID.	A	A
SANITARY SEWER CURVILINEAR ID.	B	B
STORM DRAINAGE CURVILINEAR ID.	C	C

RESTRAINING LENGTHS

FITTING	LR (FT)
6"-11 1/2" Bend	2
6"-22 1/2" Bend	3
6"-45" Bend	7
6x6 Tee	9 Run/20 Branch
6" Valves	46

LR = LENGTH TO BE RESTRAINED EACH SIDE OF THE FITTING. FOR TEES, ALL THREE LEGS SHALL BE RESTRAINED FOR A DISTANCE OF "LR". FOR REDUCERS, "LR" IS GIVEN FOR THE LARGER DIAMETER SIDE OF THE FITTING AND NO RESTRAINED IS REQUIRED ON THE SMALL SIDE OF THE FITTING. GATE VALVES SHALL BE MECHANICALLY RESTRAINED AND INSTALLED WITH CONCRETE BLOCKING PER COA STD DWG 2333 IN ADDITION TO THE MECHANICALLY RESTRAINED LENGTHS. ALL CAPS SHALL BE INSTALLED WITH CONCRETE BLOCKING PER COA STD DWG 2320. RESTRAIN ALL JOINTS ON FIRE HYDRANTS.

REVISIONS

NO.	DATE	REMARKS	BY
1	12-27-95	DESIGN	J. W. Kane

ENGINEER'S SEAL

12-27-95

COMMUNITY SCIENCES CORPORATION

LAND PLANNING P.O. Box 1328 CORRALES, N.M. 87048

ENGINEERING SURVEYING

CITY OF ALBUQUERQUE

PUBLIC WORKS DEPARTMENT

ENGINEERING GROUP

TITLE: PARKWEST-UNIT 2

UTILITY PLAN AND PROFILE

DARK MESA AVE. & LAVA REACH AVE. N.W.

APPROVALS	ENGINEER	DATE	APPROVALS	ENGINEER	DATE
DRC CHAIRMAN	J. W. Kane	1-3-96	WATER	J. W. Kane	1-3-96
TRANSPORTATION	J. W. Kane	1-3-96	WASTE WATER	J. W. Kane	1-3-96
HYDROLOGY	J. W. Kane	1-3-96	A.M.A.F.C.A.	J. W. Kane	1-3-96

PROJECT NO. 4886.96

MAP NO. G,H-9

SHEET 15 OF 15



CITY OF ALBUQUERQUE



CONSTRUCTION PLANS FOR

WESTERN SKIES DRIVE DRAINAGE IMPROVEMENTS AND SANITARY SEWER REPLACEMENT

DECEMBER 1995


INDEX of SHEETS

Sheet No.	Sheet Title
1	TITLE SHEET, GENERAL NOTES & VICINITY MAP
2	PLAN & PROFILE, STA. 9+80.12 TO STA. 14+00
3	PLAN & PROFILE, STA. 14+00 TO STA. 16+90.39
4	MISCELLANEOUS DETAILS & TRAFFIC CONTROL PLAN - WESTERN SKIES DRIVE
5	SIGNING AND CONSTRUCTION TRAFFIC CONTROL STANDARDS
6	TYPICAL TRAFFIC CONTROL & SIGNING EXAMPLES (REF. M.U.T.C.D.)

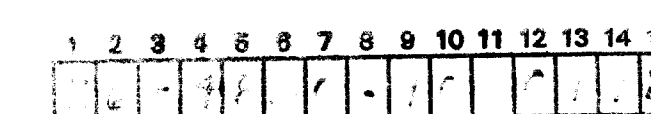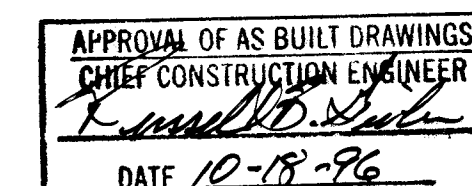

RECORD DRAWING
THIS IS A RECORD DRAWING OF THE FACILITIES IDENTIFIED IN THE TITLE BLOCK ONLY AND HAS BEEN PREPARED IN PART ON THE BASIS OF INFORMATION COMPILED AND FURNISHED BY OTHERS. THE ENGINEER/ARCHITECT AND OTHER (S) WILL NOT BE RESPONSIBLE FOR THE ACCURACY OF THE INFORMATION WHICH HAS BEEN USED. THE ENGINEER/ARCHITECT AND OTHER (S) WILL NOT BE RESPONSIBLE FOR THE ACCURACY OF THE INFORMATION WHICH HAS BEEN USED. THE ENGINEER/ARCHITECT AND OTHER (S) WILL NOT BE RESPONSIBLE FOR THE ACCURACY OF THE INFORMATION WHICH HAS BEEN USED.

REV.	SHEETS	CITY ENGINEER	DATE	USER DEPARTMENT	DATE	USER DEPARTMENT	DATE
ENGINEERS STAMP & SIGNATURE		APPROVALS		ENGINEER		DATE	
		DRC Chairman		Billy G. Anderson		12/26/95	
		Transportation		[Signature]		12/23/95	
		Water/Wastewater		[Signature]		12/23/95	
		Hydrology		[Signature]		12/23/95	
		Parks		[Signature]		12/23/95	
Constr. Mngmt.							
City Project No.				Sheet Of			
PROJECT NO. : 4830.90				SHEET 1 of 6			

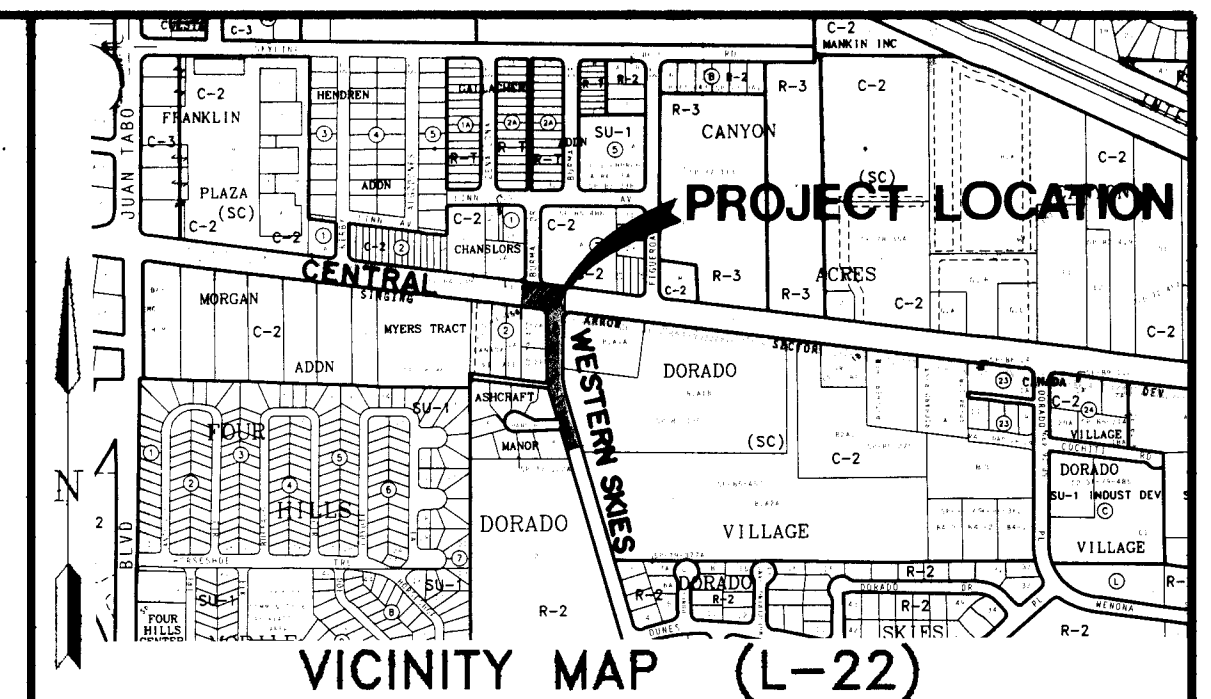


VICINITY MAP (L-22)

NOT TO SCALE

GENERAL NOTES

- TWO WORKING DAYS PRIOR TO ANY EXCAVATION, CONTRACTOR MUST CONTACT N.M. ONE-CALL SYSTEM, INC., 260-1990. FOR LOCATION OF EXISTING UTILITIES.
- ALL WORK DETAILED ON THESE PLANS TO BE PERFORMED UNDER CONTRACT SHALL, EXCEPT AS OTHERWISE STATED OR PROVIDED FOR HEREON, BE CONSTRUCTED IN ACCORDANCE WITH THE CITY OF ALBUQUERQUE STANDARD SPECIFICATIONS FOR PUBLIC WORKS CONSTRUCTION, 1986 AS AMENDED THROUGH UPDATE #6. REFERENCED TO HEREIN AS THE "STANDARD SPECIFICATIONS".
- THE CONTRACTOR IS RESPONSIBLE FOR ANY DAMAGE CAUSED TO EXISTING VALVE BOXES, SIDEWALKS, ELECTRIC CONDUIT, MANHOLES, AND CURB & GUTTER DURING CONSTRUCTION AND SHALL REPAIR OR REPLACE SAME AT CONTRACTOR'S EXPENSE.
- THE LOCATION OF EXISTING UNDERGROUND UTILITIES HAS BEEN DETERMINED BY INFORMATION PROVIDED BY OTHERS, AND SHALL BE CONSIDERED APPROXIMATE ONLY. THE CONTRACTOR SHALL DETERMINE THE EXACT LOCATION AND SIZE OF ALL EXISTING UTILITY LINES PRIOR TO CONSTRUCTION AND SHALL BE RESPONSIBLE FOR ANY AND ALL DAMAGES RESULTING FROM FAILURE TO LOCATE ANY AND ALL UTILITIES.
- QUANTITIES SHOWN FOR THE VARIOUS BID ITEMS ARE FOR THE CONTRACTOR'S INFORMATION ONLY. PAYMENT SHALL BE BASED ON ACTUAL QUANTITIES AS CONSTRUCTED.
- THE CONTRACTOR IS RESPONSIBLE FOR REMOVAL AND DISPOSAL OF ALL DEMOLITION DEBRIS IN AN ENVIRONMENTALLY ACCEPTABLE MANNER AT A LOCATION APPROVED BY THE PROJECT ENGINEER. ALL SALVAGED MATERIALS SHALL BECOME THE PROPERTY OF THE CONTRACTOR.
- THE CONTRACTOR SHALL SUPPORT AND MAINTAIN OPERATIONAL ALL UTILITIES EXPOSED DURING TRENCHING AND OTHER CONSTRUCTION OPERATIONS. ALL CONSTRUCTION ACTIVITIES INVOLVING GAS, POWER, WATER, FIBER OPTIC, AND/OR OTHER UTILITY LINES SHALL BE COORDINATED WITH THE OWNER OF THE UTILITY PRIOR TO ANY DISTURBANCE. NO UTILITY SERVICE SHALL BE DISRUPTED WITHOUT FIRST NOTIFYING ALL AFFECTED PARTIES 48 HOURS IN ADVANCE.
- EXISTING SANITARY SEWER MANHOLES WITH LIGHT-WEIGHT, VENTED, MULTIHOLED MANHOLE COVERS SHALL BE UPGRADED PER STANDARD SPECIFICATION SECTION 920 WHEN ENCOUNTERED IN THE CONSTRUCTION AREA. THIS WORK INCLUDES REPLACING THE EXISTING MANHOLE FRAME AND COVER, PLACING A CONCRETE PAD AROUND THE EXISTING MANHOLE, AND REPLACING ADJOINING ASPHALT PAVEMENT.
- ALL WATER VALVE BOXES AND SEWER MANHOLES WITHIN THE NEW PAVEMENT ARE TO BE ADJUSTED TO FINISH GRADE PER COA STANDARD DETAILS.
- STREET CENTERLINE GRADES SHALL BE RESTORED BY THE CONTRACTOR TO THE EXISTING CENTERLINE GRADES UNLESS OTHERWISE DIRECTED BY THE ENGINEER. SMOOTH TRANSITIONS SHALL BE MADE BETWEEN EXISTING PAVEMENT WHICH REMAINS IN PLACE AND PAVEMENT WHICH IS BEING REPLACED. REPLACE PAVEMENT TO MATCH EXISTING.
- THREE (3) WORKING DAYS PRIOR TO BEGINNING CONSTRUCTION, THE CONTRACTOR SHALL SUBMIT TO CONSTRUCTION COORDINATION DIVISION A DETAILED CONSTRUCTION SCHEDULE TWO (2) WORKING DAYS PRIOR TO CONSTRUCTION. THE CONTRACTOR SHALL OBTAIN A BARRICADING PERMIT FROM THE CONSTRUCTION COORDINATION DIVISION. CONTRACTOR SHALL NOTIFY BARRICADE ENGINEER (768-2551) PRIOR TO OCCUPYING AN INTERSECTION. REFER TO SECTION 19 OF THE GENERAL CONDITIONS OF THE STANDARD SPECIFICATIONS.
- WHERE STORM DRAIN IMPROVEMENTS ARE SHOWN ALONG WITH SANITARY SEWER REPLACEMENT, THE ENTIRE STREET WIDTH PAVEMENT SHALL BE REMOVED AND REPLACED PER PAVEMENT SECTION SHOWN ON PLANS.



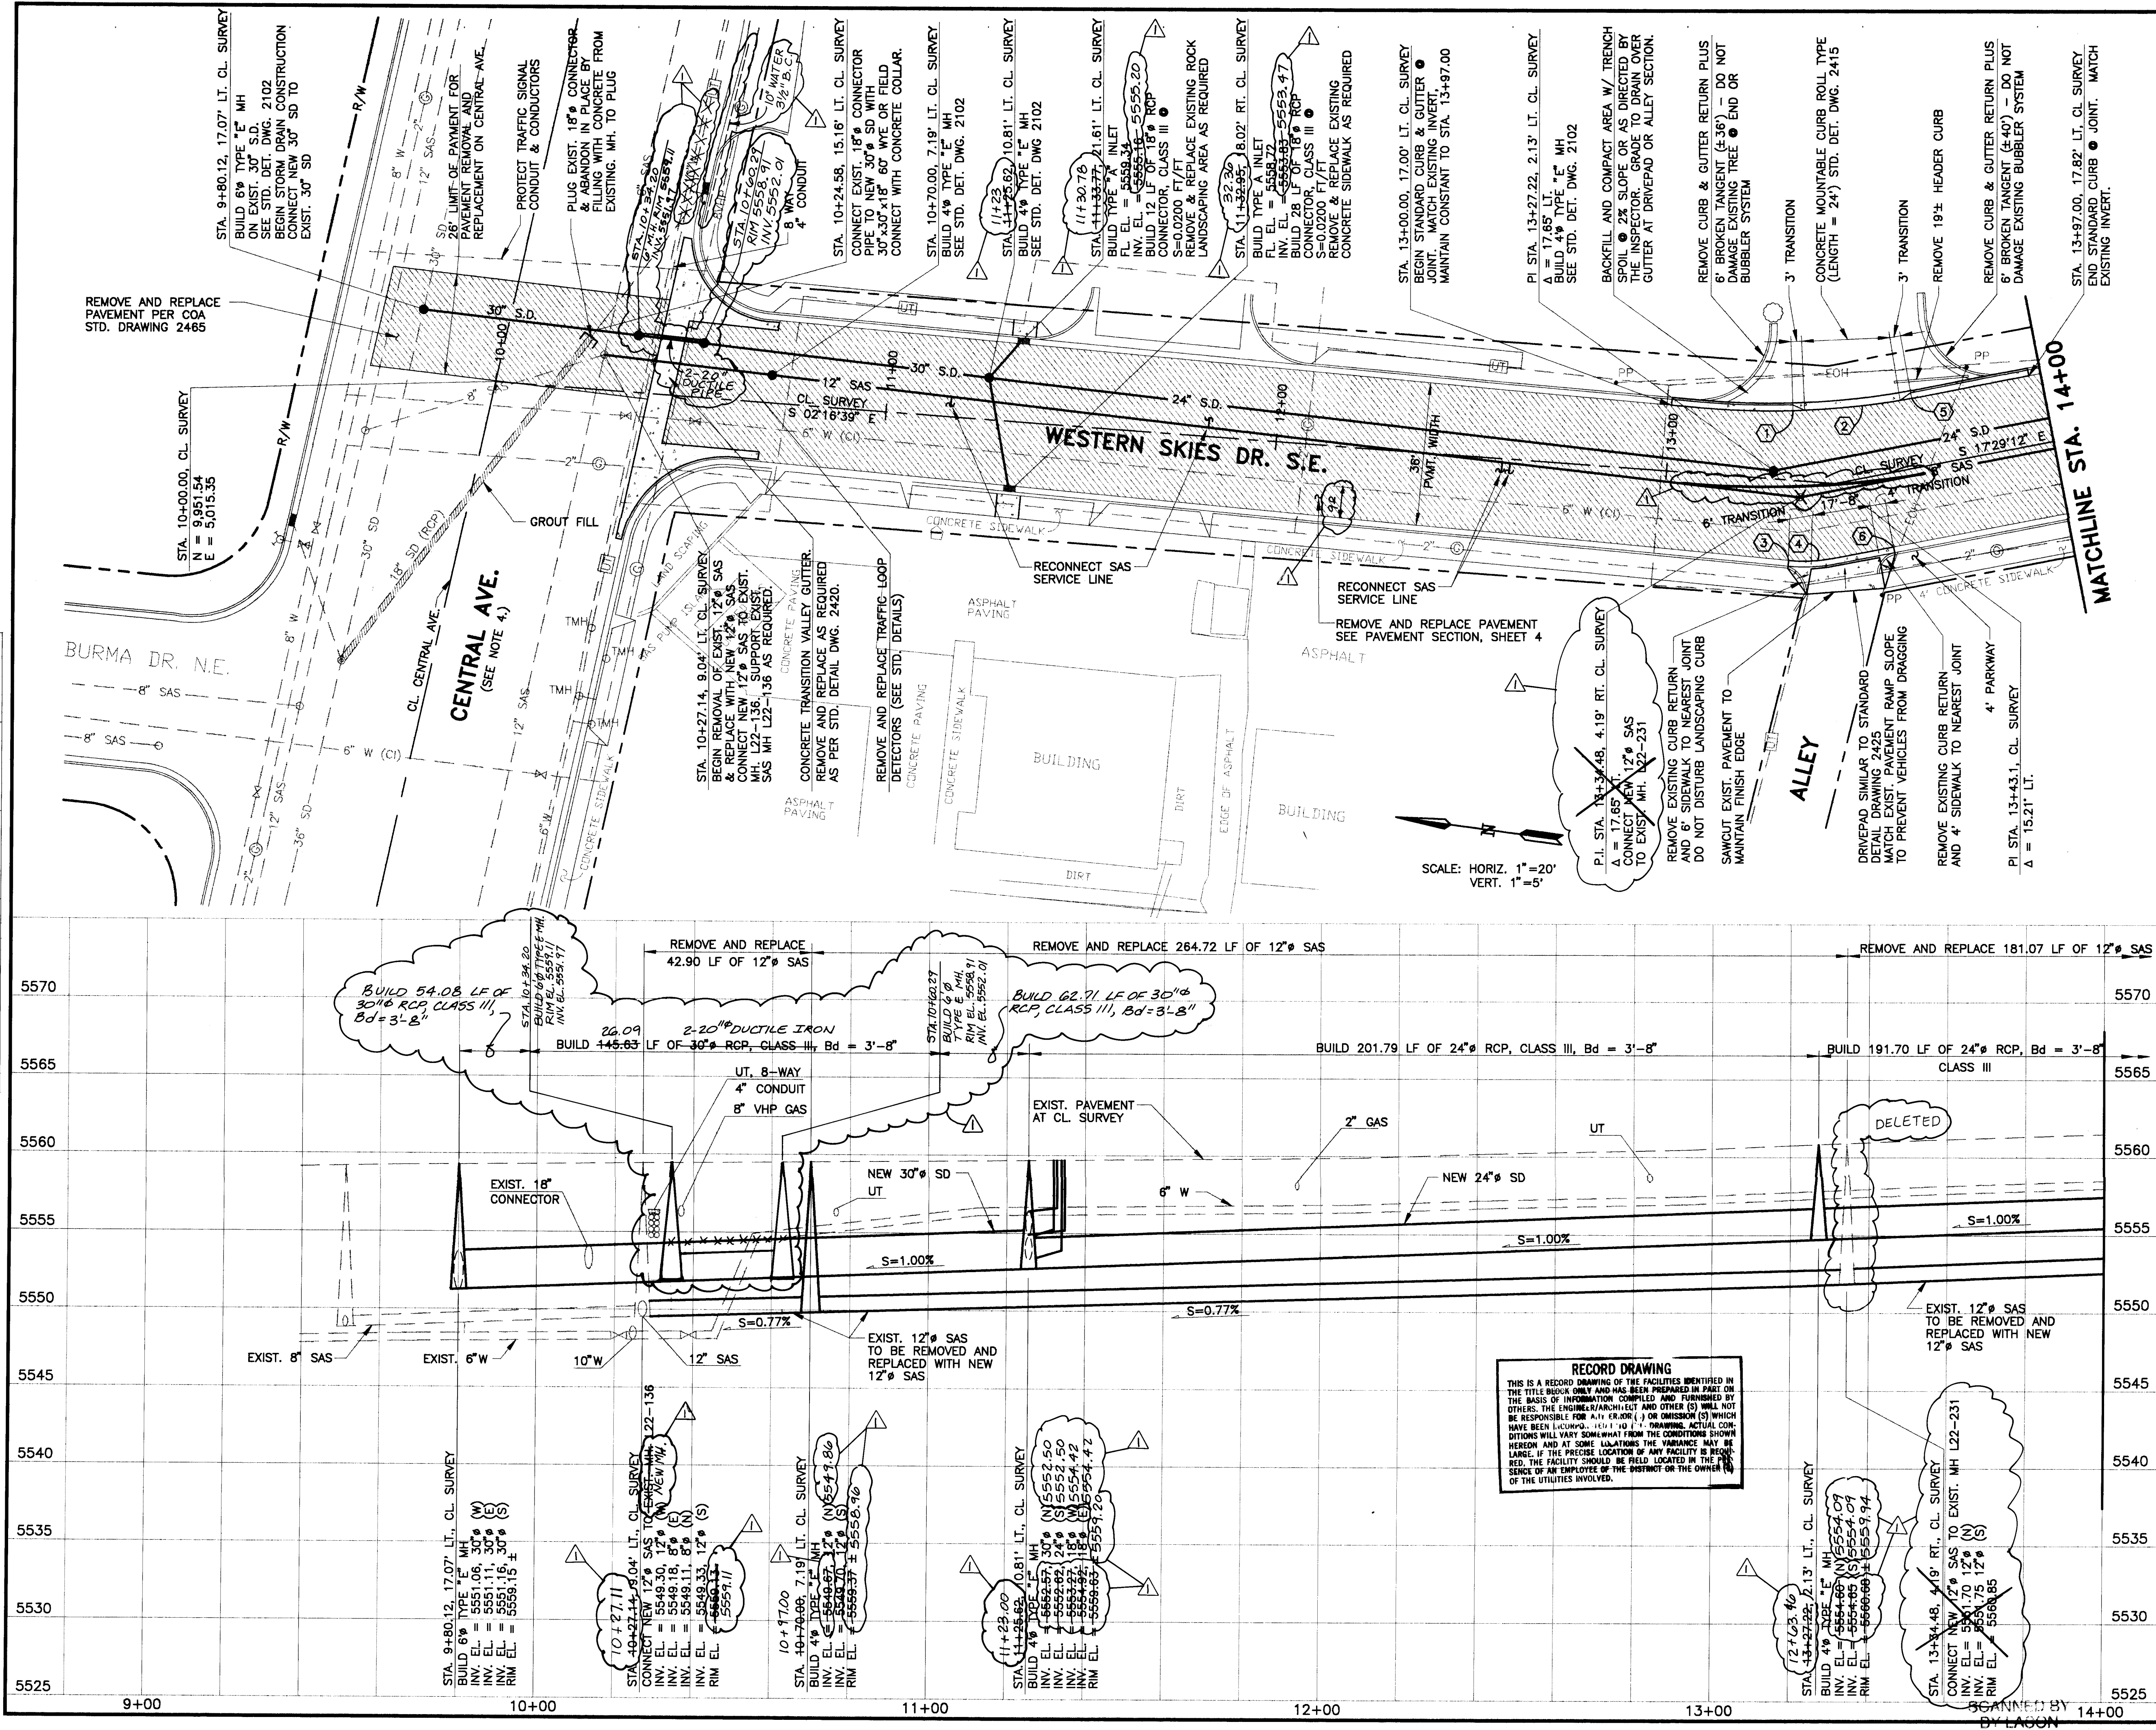

- GENERAL NOTES:**
- NO HYDROLOGY WAS PERFORMED FOR THIS DESIGN, THEREFORE THE STORM DRAIN CAPACITY AND HYDRAULIC GRADELINE HAVE BEEN OMITTED. EXISTING DOWNSIDE SYSTEM IN CENTRAL AVE. IS LIMITED. NUMBER OF CATCH BASINS AND PIPE SIZES AS DIRECTED BY THE CITY.
 - PAVEMENT REMOVAL AND REPLACEMENT SHALL BE IN ACCORDANCE WITH THE PAVEMENT REPLACEMENT SECTION, SHEET 4.
 - CONTRACTOR SHALL BYPASS FLOW MH TO MH, REMOVING EXISTING 12" SAS, & REPLACING WITH NEW 12" SAS AT SAME GRADE. SANITARY SEWER SERVICE RECONNECTIONS SHALL BE PER STD. SPEC. SECTION 905.
 - WORK IN CENTRAL AVENUE SHALL BE PHASED. SEE SPECIAL PROVISIONS IN SPECIFICATIONS.
 - A CCTV INSPECTION WAS PERFORMED IN MARCH 1995 FOR THE SEGMENT OF 12" SAS FROM MANHOLE 122-136 TO MANHOLE 122-231. NO CCTV INSPECTION WAS PERFORMED ON THE 12" SAS BETWEEN MANHOLE 122-231 AND MANHOLE 122-333. CONTRACTOR SHALL VERIFY AND RECONNECT ALL THE SAS SERVICE LINES ON THE 12" SAS SCHEDULED TO BE REPLACED.
 - STATIONING FOR SAS & SD REFER TO CENTERLINE SURVEY STATIONING, NOT PIPE STATIONING. PROFILE BUILD LENGTHS ARE ACTUAL PIPE LENGTHS.
 - REPLACE WESTERN SKIES STRIPING TO MATCH EXISTING: SOLID DOUBLE YELLOW 20' SOUTH OF INTERSECTION; SOLID SINGLE WHITE NORTHBOUND RIGHT TURN 100'; AND CROSSWALK ON WESTERN SKIES DRIVE.

- KEYED NOTES:**
- STA. 13+31.00, 17.89' LT. CL. SURVEY END STANDARD CURB & GUTTER. BEGIN 3' TRANSITION TO MOUNTABLE CURB ROLL TYPE, COA STD. DET. 2415.
 - CURVE DATA @ EDGE OF PAVEMENT
A 16'14"16"
D 28'38"52"
R 200.00'
T 28.53'
L 56.68'
 - STA. 13+32.98, 20.64' RT. CL. SURVEY BEGIN TRANSITION TO CONCRETE DRIVEPAD SIMILAR TO STD. DET. 2425.
 - CURVE DATA @ EDGE OF PAVEMENT
A 16'35"03"
D 14'14"22"
R 40.00'
T 5.83'
L 11.58'
 - STA. 13+66.58, 17.78' LT. CL. SURVEY END 3' TRANSITION FROM MOUNTABLE CURB ROLL TYPE. BEGIN STANDARD CURB & GUTTER.
 - STA. 13+54.87, 18.91' RT. CL. SURVEY END TRANSITION TO CONCRETE DRIVEPAD SIMILAR TO STD. DET. 2425.

LEGEND

PAVEMENT REMOVAL AND REPLACEMENT


NEW SIDEWALK

CITY OF ALBUQUERQUE
PUBLIC WORKS DEPARTMENT
ENGINEERING GROUP

TITLE: **WESTERN SKIES PLAN & PROFILE
STA. 9+80.12 TO STA. 14+00**

APPROVALS	ENGINEER	DATE	APPROVALS	ENGINEER	DATE
DRC CHAIRMAN			WATER		
TRANSPORTATION			WASTE WATER		
HYDROLOGY					

PROJECT NO. **4830.90** MAP NO. **L-22** SHEET **2** OF **6**

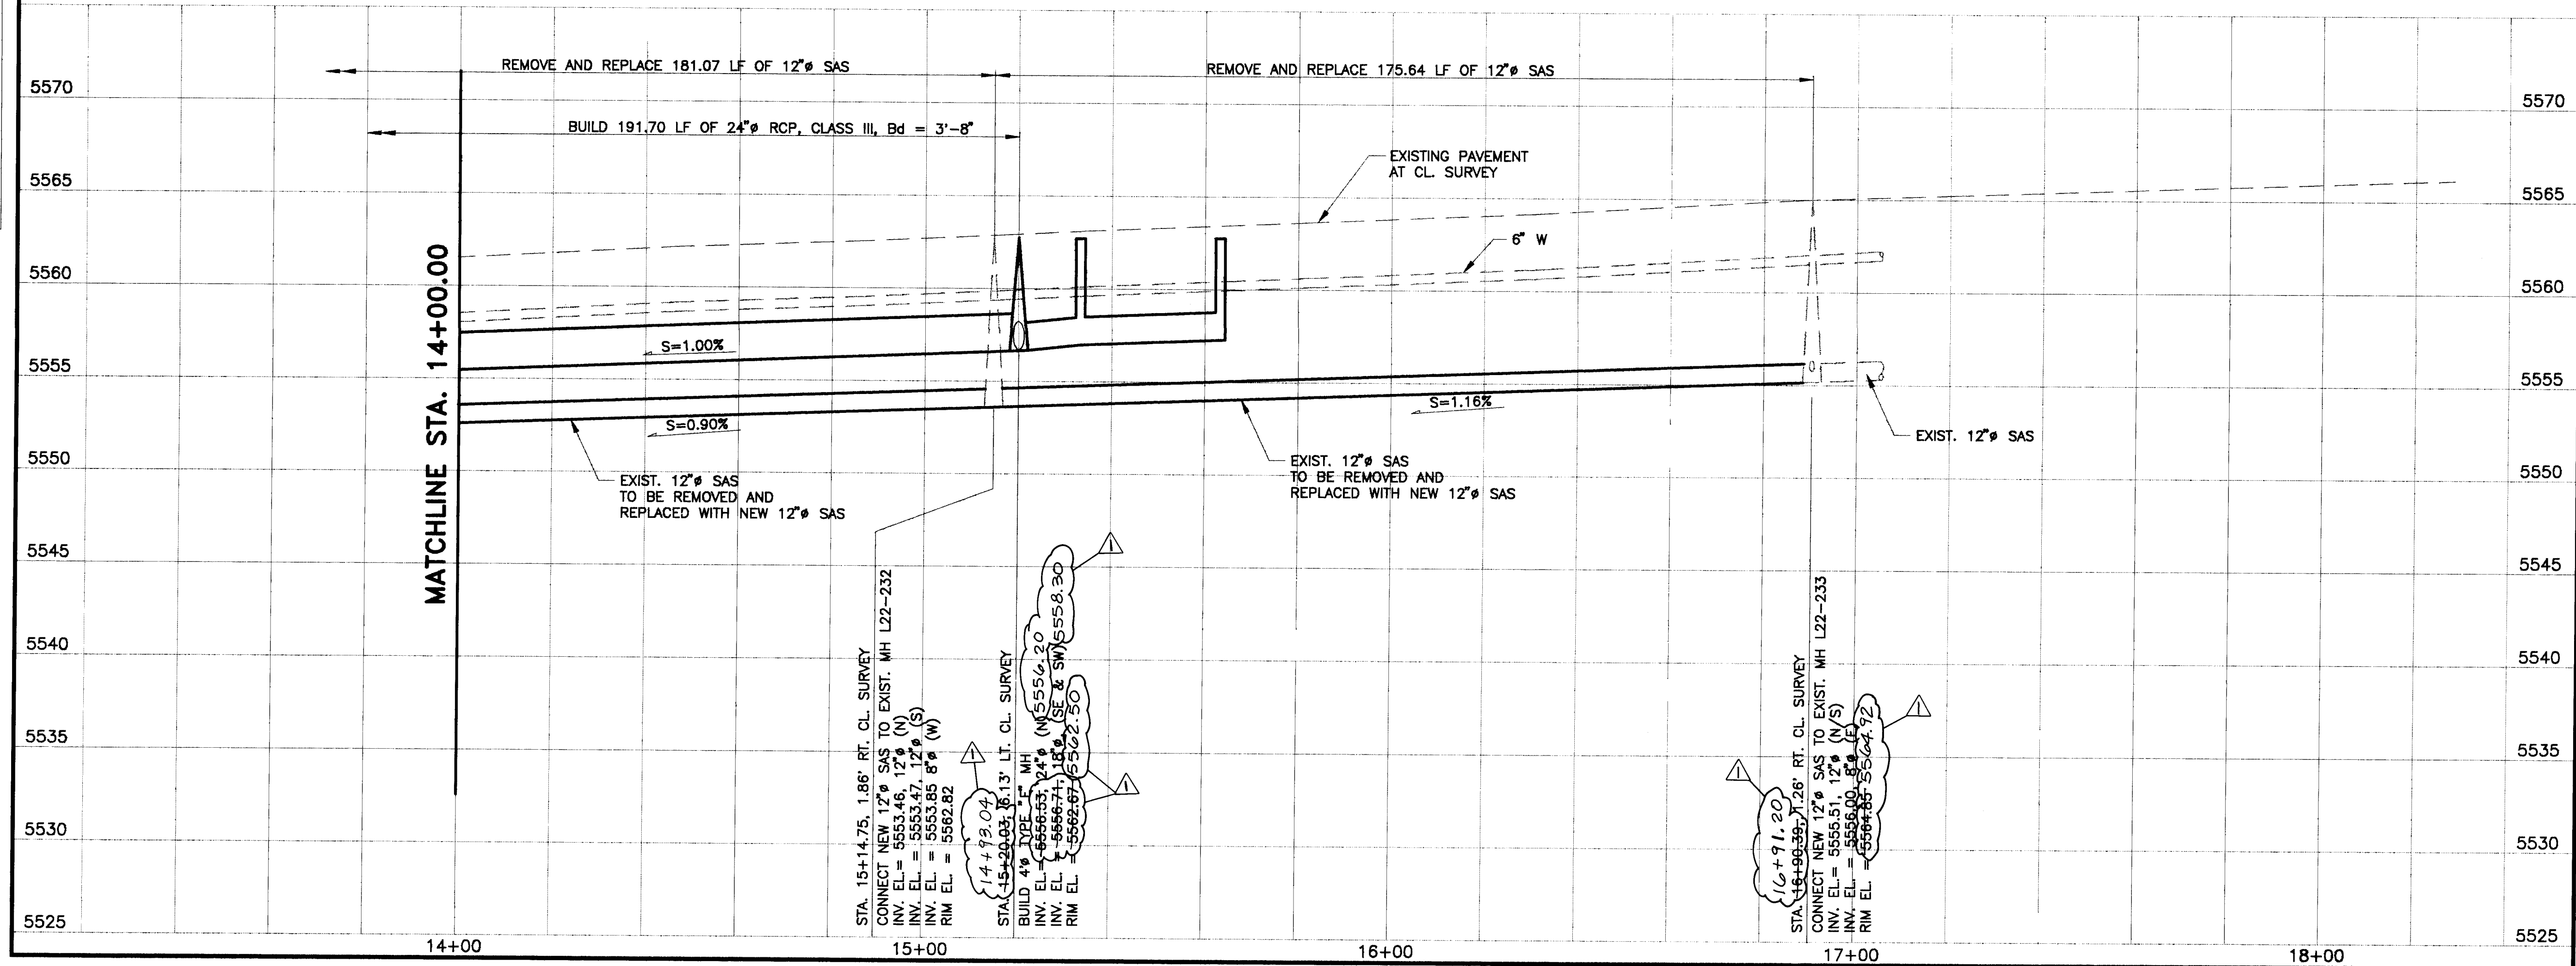

GENERAL NOTES:

- NO HYDROLOGY WAS PERFORMED FOR THIS DESIGN. THEREFORE THE STORM DRAIN CAPACITY AND HYDRAULIC GRADELINE HAVE BEEN OMITTED. EXISTING DOWNSIDE SYSTEM IN CENTRAL AVE. IS LIMITED, NUMBER OF CATCH BASINS AND PIPE SIZES AS DIRECTED BY THE CITY.
- PAVEMENT REMOVAL AND REPLACEMENT SHALL BE IN ACCORDANCE WITH THE PAVEMENT REPLACEMENT SECTION, SHEET 4.
- CONTRACTOR SHALL BY PASS FLOW MH TO MH, REMOVE EXIST. 12" SAS, AND REPLACE WITH NEW 12" SAS AT SAME GRADE. SANITARY SEWER SERVICE RECONNECTIONS SHALL BE PER STD. SPEC. SEC. 905.
- A CCTV INSPECTION WAS PERFORMED IN MARCH 1993 FOR THE SEGMENT OF 12" SAS FROM MANHOLE L22-136 TO MANHOLE L22-231. NO CCTV INSPECTION WAS PERFORMED ON THE 12" SAS BETWEEN MANHOLE L22-231 AND MANHOLE L22-333. CONTRACTOR SHALL VERIFY AND RECONNECT ALL THE SAS SERVICE LINES ON THE 12" SAS SCHEDULED TO BE REPLACED.
- STATIONING FOR SAS & SD REFER TO CENTERLINE SURVEY STATIONING, NOT PIPE STATIONING. PROFILE BUILD LENGTHS ARE ACTUAL PIPE LENGTHS.

AS BUILT INFORMATION

HORIZONTAL & VERTICAL CONTROL STATION (4-L22) IS A 3 1/4" ALUMINUM CAP SET FLUSH IN THE CURB AND IS STAMPED, "4-L22, 1986". STATION IS LOCATED ON THE SOUTHWEST CORNER OF CENTRAL AVE. & WHISPERING SANDS ACCESS RD., APPROX. 800' EAST OF THE INTERSECTION OF CENTRAL AVE. & WESTERN SKIES DR. (ELEV. 5583.83)

CONTRACTOR
STAMPED BY
INSPECTORS
FIELD VERIFICATION BY
COMPILED BY
RECORDED BY
NO.

ENGINEER'S SEAL

DATE
9-95
DATE
9-95
DATE
9-95

DESIGNED BY
KWW
CHECKED BY
KWW

CITY OF ALBUQUERQUE
PUBLIC WORKS DEPARTMENT
ENGINEERING GROUP

TITLE:
WESTERN SKIES DRIVE PLAN & PROFILE
STA. 14+00 TO STA. 16+90.39

APPROVALS	ENGINEER	DATE	APPROVALS	ENGINEER	DATE
DRC CHAIRMAN			WATER		
TRANSPORTATION			WASTE WATER		
HYDROLOGY					

PROJECT NO. **4830.90** MAP NO. **L-22** SHEET **3** OF **6**



WESTERN SKIES DRIVE CONSTRUCTION TRAFFIC CONTROL GENERAL NOTES:

- [illegible]

GENERAL NOTES:

- CONSTRUCTION NOTES:

- ## WESTERN SKIES DRIVE

LEGEND



CONSTRUCTION AREA

TYPE III BARRICADE

CONSTRUCTION WARNING SIGN

GENERAL NOTES:

1. ACCESS FOR APARTMENT RESIDENTS ON WESTERN SKIES DR. SHALL BE TO THE SOUTH VIA SINGING ARROW AVE.
2. CENTRAL AVENUE PAVEMENT REPLACEMENT SHALL MATCH EXISTING SECTION PLUS 2" AC PAVEMENT. SEE COA STD. DWG. 2465.


[illegible]

RECORD DRAWING

THIS IS A RECORD DRAWING OF THE FACILITIES IDENTIFIED IN THE TITLE BLOCK ONLY AND HAS BEEN PREPARED IN PART ON THE BASIS OF INFORMATION COMPILED BY FOLLOWING UP OTHERS. THE ENGINEER, ARCHITECT AND OTHER (S) WILL NOT BE RESPONSIBLE FOR ANY ERROR (S) OR OMISSION (S) WHICH HAVE BEEN INCORPORATED INTO THIS DRAWING. ACTUAL CONDITIONS WILL VARY SOMEWHAT FROM THE CONDITIONS SHOWN HEREON AND AT SOME LOCATIONS THE VARIANCE MAY BE LARGE. IF THE FACILITY SHOULD BE FIELD LOCATED IN THE PRESENCE OF AN EMPLOYEE OF THE DISTRICT OR THE OWNER (S) OF THE UTILITIES INVOLVED.

CITY OF ALBUQUERQUE
PUBLIC WORKS DEPARTMENT
ENGINEERING GROUP

TITLE: MISCELLANEOUS DETAILS & TRAFFIC
CONTROL PLAN - WESTERN SKIES

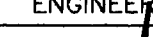APPROVALS	ENGINEER	DATE	APPROVALS	ENGINEER	DATE
DRC CHAIRMAN	 		WATER		
TRANSPORTATION			WASTE WATER		
HYDROLOGY					
PROJECT NO.	4830.90		MAP NO.	L-22	
			SHEET 4 OF 6		

SCANNED @
BY LASON

