


• L E G E N D •


MATERIALS

CONCRETE
RIP-RAP

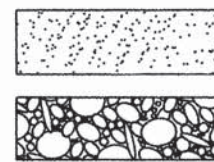


LINES

SUBDIVISION BOUNDARY
PROPERTY LINE (PLAN)
PROPERTY LINE (SECTION)
CENTERLINE
EASEMENT LINE
MATCH LINE
SECTION CUT LINE

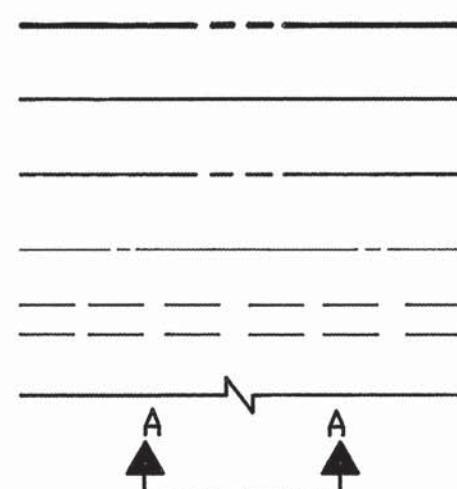


EARTHWORK

CONTOUR LINE
SPOT ELEVATION
PROJECT / PHASE BOUNDARY
FLOWLINE
DIRECTION OF FLOW

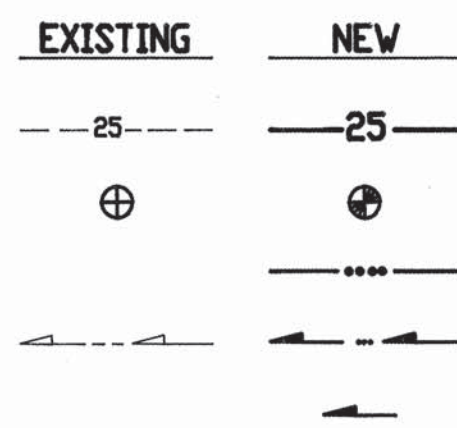


MISCELLANEOUS UTILITIES

GAS LINE
UNDERGROUND TELEPHONE
UNDERGROUND ELECTRICAL
STORM DRAIN
STORM DRAIN MANHOLE
STORM DRAIN INLET

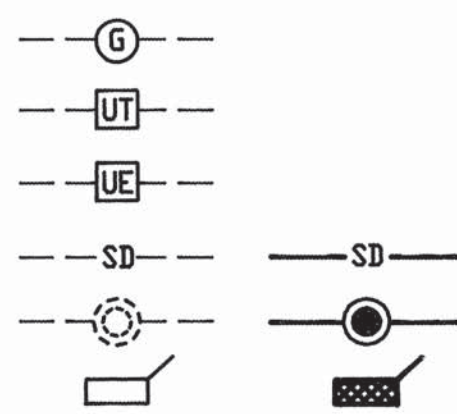


SANITARY SEWER

SANITARY SEWER LINE
SANITARY SEWER MANHOLE
SAS SERVICE CONNECTIONS
SAS CAP OR PLUG
ENCASEMENT

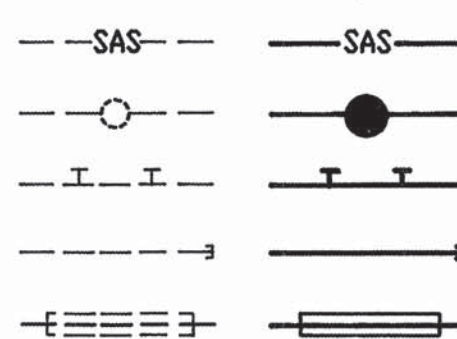


WATER

WATER LINE
WATER SERVICE CONNECTIONS
GATE VALVE
FIRE HYDRANT
BUTTERFLY VALVE
REDUCER
WATER PRESSURE ZONE BOUNDARY

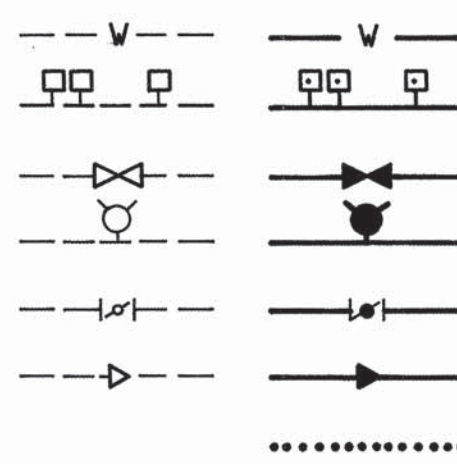


WATER FITTINGS

CAPS AND PLUGS
ELBOW
CROSS
TEE

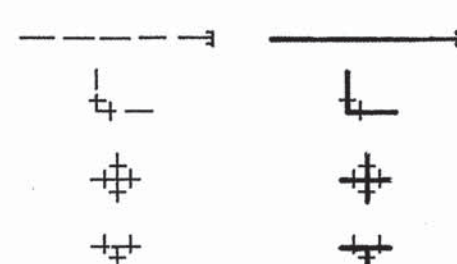

MISCELLANEOUS

CHAINLINK FENCE
FIELD FENCE
COMMON YARD WALL
RETAINING WALL
POWER OR TELEPHONE POLE

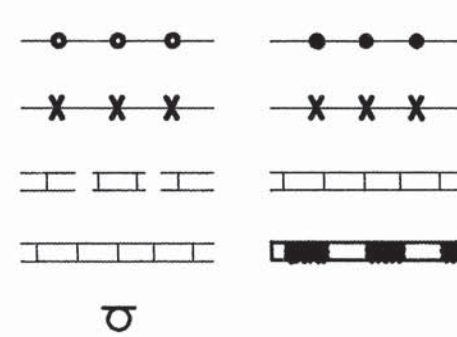


CONSTRUCTION PLANS

for

BONA TERRA FARMS

BERNALILLO COUNTY, NEW MEXICO


APRIL, 1994

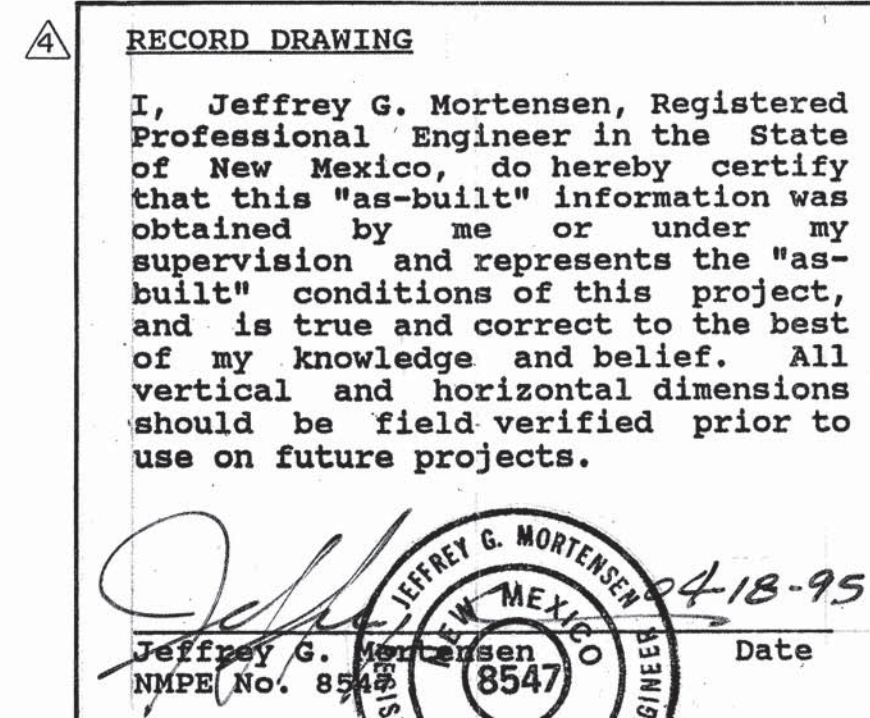

INDEX OF DRAWINGS

SHEET	DESCRIPTION
1	COVER SHEET, VICINITY MAP, GENERAL NOTES, LEGEND, INDEX OF DRAWINGS
2	SUBDIVISION PLAN
3	GRADING PLAN (EAST)
4	GRADING PLAN (WEST)
5	DRAINAGE PLAN AND CALCULATIONS, GRADING NOTES, SECTIONS AND DETAILS
6	ROAD SECTIONS AND DETAILS
7	SITE PLAN
8	LANES END WATERLINE AND PAVING IMPROVEMENTS PLAN AND PROFILE
9	LINE 'A' WATERLINE IMPROVEMENTS PLAN AND PROFILE
10	BONA TERRA LOOP (LINE 'A') WATERLINE AND PAVING IMPROVEMENTS PLAN AND PROFILE
11	ALAMEDA BOULEVARD WATERLINE EXTENSION PLAN AND PROFILE
12	BONA TERRA LOOP (LINE 'B') WATERLINE AND PAVING IMPROVEMENTS PLAN AND PROFILE
13	BONA TERRA LOOP (LINE 'B') WATERLINE AND PAVING IMPROVEMENTS PLAN AND PROFILE
14	STA. 15+67.16 TO STA. 20+93.60
15	WATER VALVE SHUTOFF PLAN AND LANE LATERAL CROSSING
16	SIGNING AND CONSTRUCTION TRAFFIC CONTROL STANDARDS TYPICAL TRAFFIC CONTROL AND SIGNING EXAMPLES

RECORD DRAWING

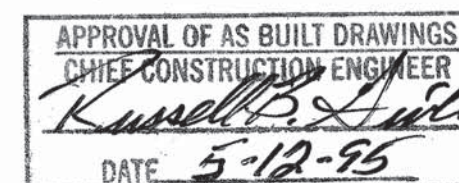

VICINITY MAP
SCALE: 1" = 750' (APPROX.)

GENERAL NOTES:


- ALL WORK DETAILED ON THESE PLANS TO BE PERFORMED UNDER CONTRACT SHALL, EXCEPT AS OTHERWISE STATED OR PROVIDED FOR HEREON, BE CONSTRUCTED IN ACCORDANCE WITH THE CITY OF ALBUQUERQUE STANDARD SPECIFICATIONS - PUBLIC WORKS CONSTRUCTION - 1986. (UPDATE NO.4) OR BERNALILLO COUNTY STANDARDS, WHICHEVER ARE MORE STRINGENT.
- TWO (2) WORKING DAYS PRIOR TO ANY EXCAVATION, CONTRACTOR MUST CONTACT NEW MEXICO ONE CALL SYSTEM, 260-1990, FOR LOCATION OF EXISTING UTILITIES.
- IF ANY UTILITY LINES, PIPELINES, OR UNDERGROUND UTILITY LINES ARE SHOWN ON THESE DRAWINGS, THEY ARE SHOWN IN AN APPROXIMATE MANNER ONLY, AND SUCH LINES MAY EXIST WHERE NONE ARE SHOWN. IF ANY SUCH EXISTING LINES ARE SHOWN, THE LOCATION IS BASED UPON INFORMATION PROVIDED BY THE OWNER OF SAID UTILITY, AND THE INFORMATION MAY BE INCOMPLETE OR MAY BE OBSOLETE BY THE TIME CONSTRUCTION COMMENCES. THE ENGINEER HAS CONDUCTED ONLY PRELIMINARY INVESTIGATION OF THE LOCATION, DEPTH, SIZE, OR TYPE OF EXISTING UTILITY LINES, PIPELINES, OR UNDERGROUND UTILITY LINES. THIS INVESTIGATION IS NOT CONCLUSIVE, AND MAY NOT BE COMPLETE, THEREFORE, MAKES NO REPRESENTATION PERTAINING THERETO, AND ASSUMES NO RESPONSIBILITY OR LIABILITY THEREFOR. THE CONTRACTOR SHALL INFORM ITSELF OF THE LOCATION OF ANY UTILITY LINE, PIPELINE, OR UNDERGROUND UTILITY LINE IN OR NEAR THE AREA OF THE WORK IN ADVANCE OF AND DURING EXCAVATION WORK. THE CONTRACTOR IS FULLY RESPONSIBLE FOR ANY AND ALL DAMAGE CAUSED BY ITS FAILURE TO LOCATE, IDENTIFY AND PRESERVE ANY AND ALL EXISTING UTILITIES, PIPELINES, AND UNDERGROUND UTILITY LINES. IN PLANNING AND CONDUCTING EXCAVATION, THE CONTRACTOR SHALL COMPLY WITH STATE STATUTES, MUNICIPAL AND LOCAL ORDINANCES, RULES AND REGULATIONS, IF ANY, PERTAINING TO THE LOCATION OF THESE LINES AND FACILITIES.
- SHOULD A CONFLICT EXIST BETWEEN THESE PLANS AND ACTUAL FIELD CONDITIONS, THE CONTRACTOR SHALL PROMPTLY NOTIFY THE ENGINEER IN WRITING SO THAT THE CONFLICT CAN BE RESOLVED WITH A MINIMUM AMOUNT OF DELAY FOR ALL PARTIES.
- THE CONTRACTOR SHALL MAINTAIN ACCESS TO ADJACENT PROPERTIES DURING CONSTRUCTION.
- ALL WORK ON THIS PROJECT SHALL BE PERFORMED IN ACCORDANCE WITH APPLICABLE FEDERAL, STATE AND LOCAL LAWS, RULES AND REGULATIONS CONCERNING SAFETY AND HEALTH.
- ALL UTILITIES AND UTILITY SERVICE LINES SHALL BE INSTALLED PRIOR TO PAVING.
- BACKFILL COMPACTION SHALL BE ACCORDING TO SPECIFIED STREET USE, (REFER TO NOTE 18).
- TACK COAT REQUIREMENTS SHALL BE DETERMINED DURING CONSTRUCTION BY THE PROJECT ENGINEER.
- SIDEWALKS AND WHEELCHAIR RAMPS WITHIN THE CURB RETURNS SHALL BE CONSTRUCTED WHEREVER A NEW CURB RETURN IS CONSTRUCTED.
- IF CURB IS DEEPENED FOR A DRIVEPAD OR A HANDICAP RAMP, THE DRIVEPAD OR RAMP SHALL BE CONSTRUCTED PRIOR TO ACCEPTANCE OF THE CURB AND GUTTER.
- ALL STORM DRAINAGE FACILITIES SHALL BE COMPLETED PRIOR TO FINAL ACCEPTANCE.
- CONTRACTOR SHALL COORDINATE WITH THE WATER SYSTEM DIVISION FOR THE EXECUTION OF THE VALVE SHUT OFF PLAN, NOT LESS THAN THREE (3) WORKING DAYS IN ADVANCE OF ANY WORK THAT MAY AFFECT THE EXISTING PUBLIC WATER UTILITIES. ONLY WATER SYSTEM DIVISION PERSONNEL SHALL OPERATE EXISTING VALVES. REFER TO SECTION 18 OF THE SPECIFICATION.
- CONTRACTOR SHALL NOTIFY THE CITY SURVEYOR NOT LESS THAN SEVEN (7) DAYS PRIOR TO STARTING WORK IN ORDER THAT THE CITY SURVEYOR MAY TAKE NECESSARY MEASURES TO INSURE THE PRESERVATION OF SURVEY MONUMENTS. CONTRACTOR SHALL NOT DISTURB PERMANENT SURVEY MONUMENTS WITHOUT THE CONSENT OF THE CITY SURVEYOR AND SHALL NOTIFY THE CITY SURVEYOR AND BEAR THE EXPENSE OF REPLACING ANY THAT MAY BE DISTURBED WITHOUT PERMISSION. REPLACEMENT SHALL BE DONE ONLY BY THE CITY SURVEYOR. WHEN A CHANGE IS MADE IN THE FINISHED ELEVATION OF THE PAVEMENT OF ANY ROADWAY IN WHICH A PERMANENT SURVEY MONUMENT IS LOCATED, CONTRACTOR SHALL, AT HIS OWN EXPENSE, ADJUST THE MONUMENT COVER TO THE NEW GRADE UNLESS OTHERWISE SPECIFIED. REFER TO SECTION 4.4 OF THE SPECIFICATIONS.
- CONTRACTOR SHALL COORDINATE ALL CONSTRUCTION ACTIVITIES AND SCHEDULES WITH THE NEW MEXICO STATE HIGHWAY AND TRANSPORTATION DEPT. (NMSHTD) AND THE BERNALILLO COUNTY PUBLIC WORKS DEPT. (BCPWD).
- ALL STREET STRIPING ALTERED OR DESTROYED SHALL BE REPLACED IN KIND BY CONTRACTOR TO LOCATION AND IN KIND AS EXISTING OR AS INDICATED BY THIS PLAN SET.
- CONTRACTOR SHALL SECURE AND PROTECT ALL EXISTING UTILITIES DURING CONSTRUCTION. THIS SHALL BE CONSIDERED INCIDENTAL TO CONSTRUCTION, THEREFORE NO SEPARATE PAYMENT WILL BE MADE.
- ALL BACKFILL AND COMPACTION WITHIN COUNTY RIGHT-OF-WAY AND/OR EASEMENT SHALL BE 95% ASTM D-1557 FOR THE FULL DEPTH OF TRENCH PER COUNTY STANDARD DRAWING 2465.
- THIS PROJECT IS TO BE CONSTRUCTED UNDER, AND IS SUBJECT TO THE TERMS AND CONDITIONS OF THE MASTER UTILITY EASEMENT AND RIGHT-OF-WAY AGREEMENT ENTERED INTO BETWEEN THE COUNTY OF BERNALILLO AND THE CITY OF ALBUQUERQUE, EFFECTIVE DATE 8/20/90.

REV.	SHEETS	CITY ENGINEER	DATE	USER	DEPARTMENT	DATE	USER	DEPARTMENT	DATE
1-16			04/95						
APPROVAL OF REVISIONS									

	APPROVED FOR CONSTRUCTION	
PROJECT NO. 4910.90		SHEET 1 OF 16

1 2 3 4 5 6 7 8 9 10 11 12 13 14 15
26 4910.900195

930824

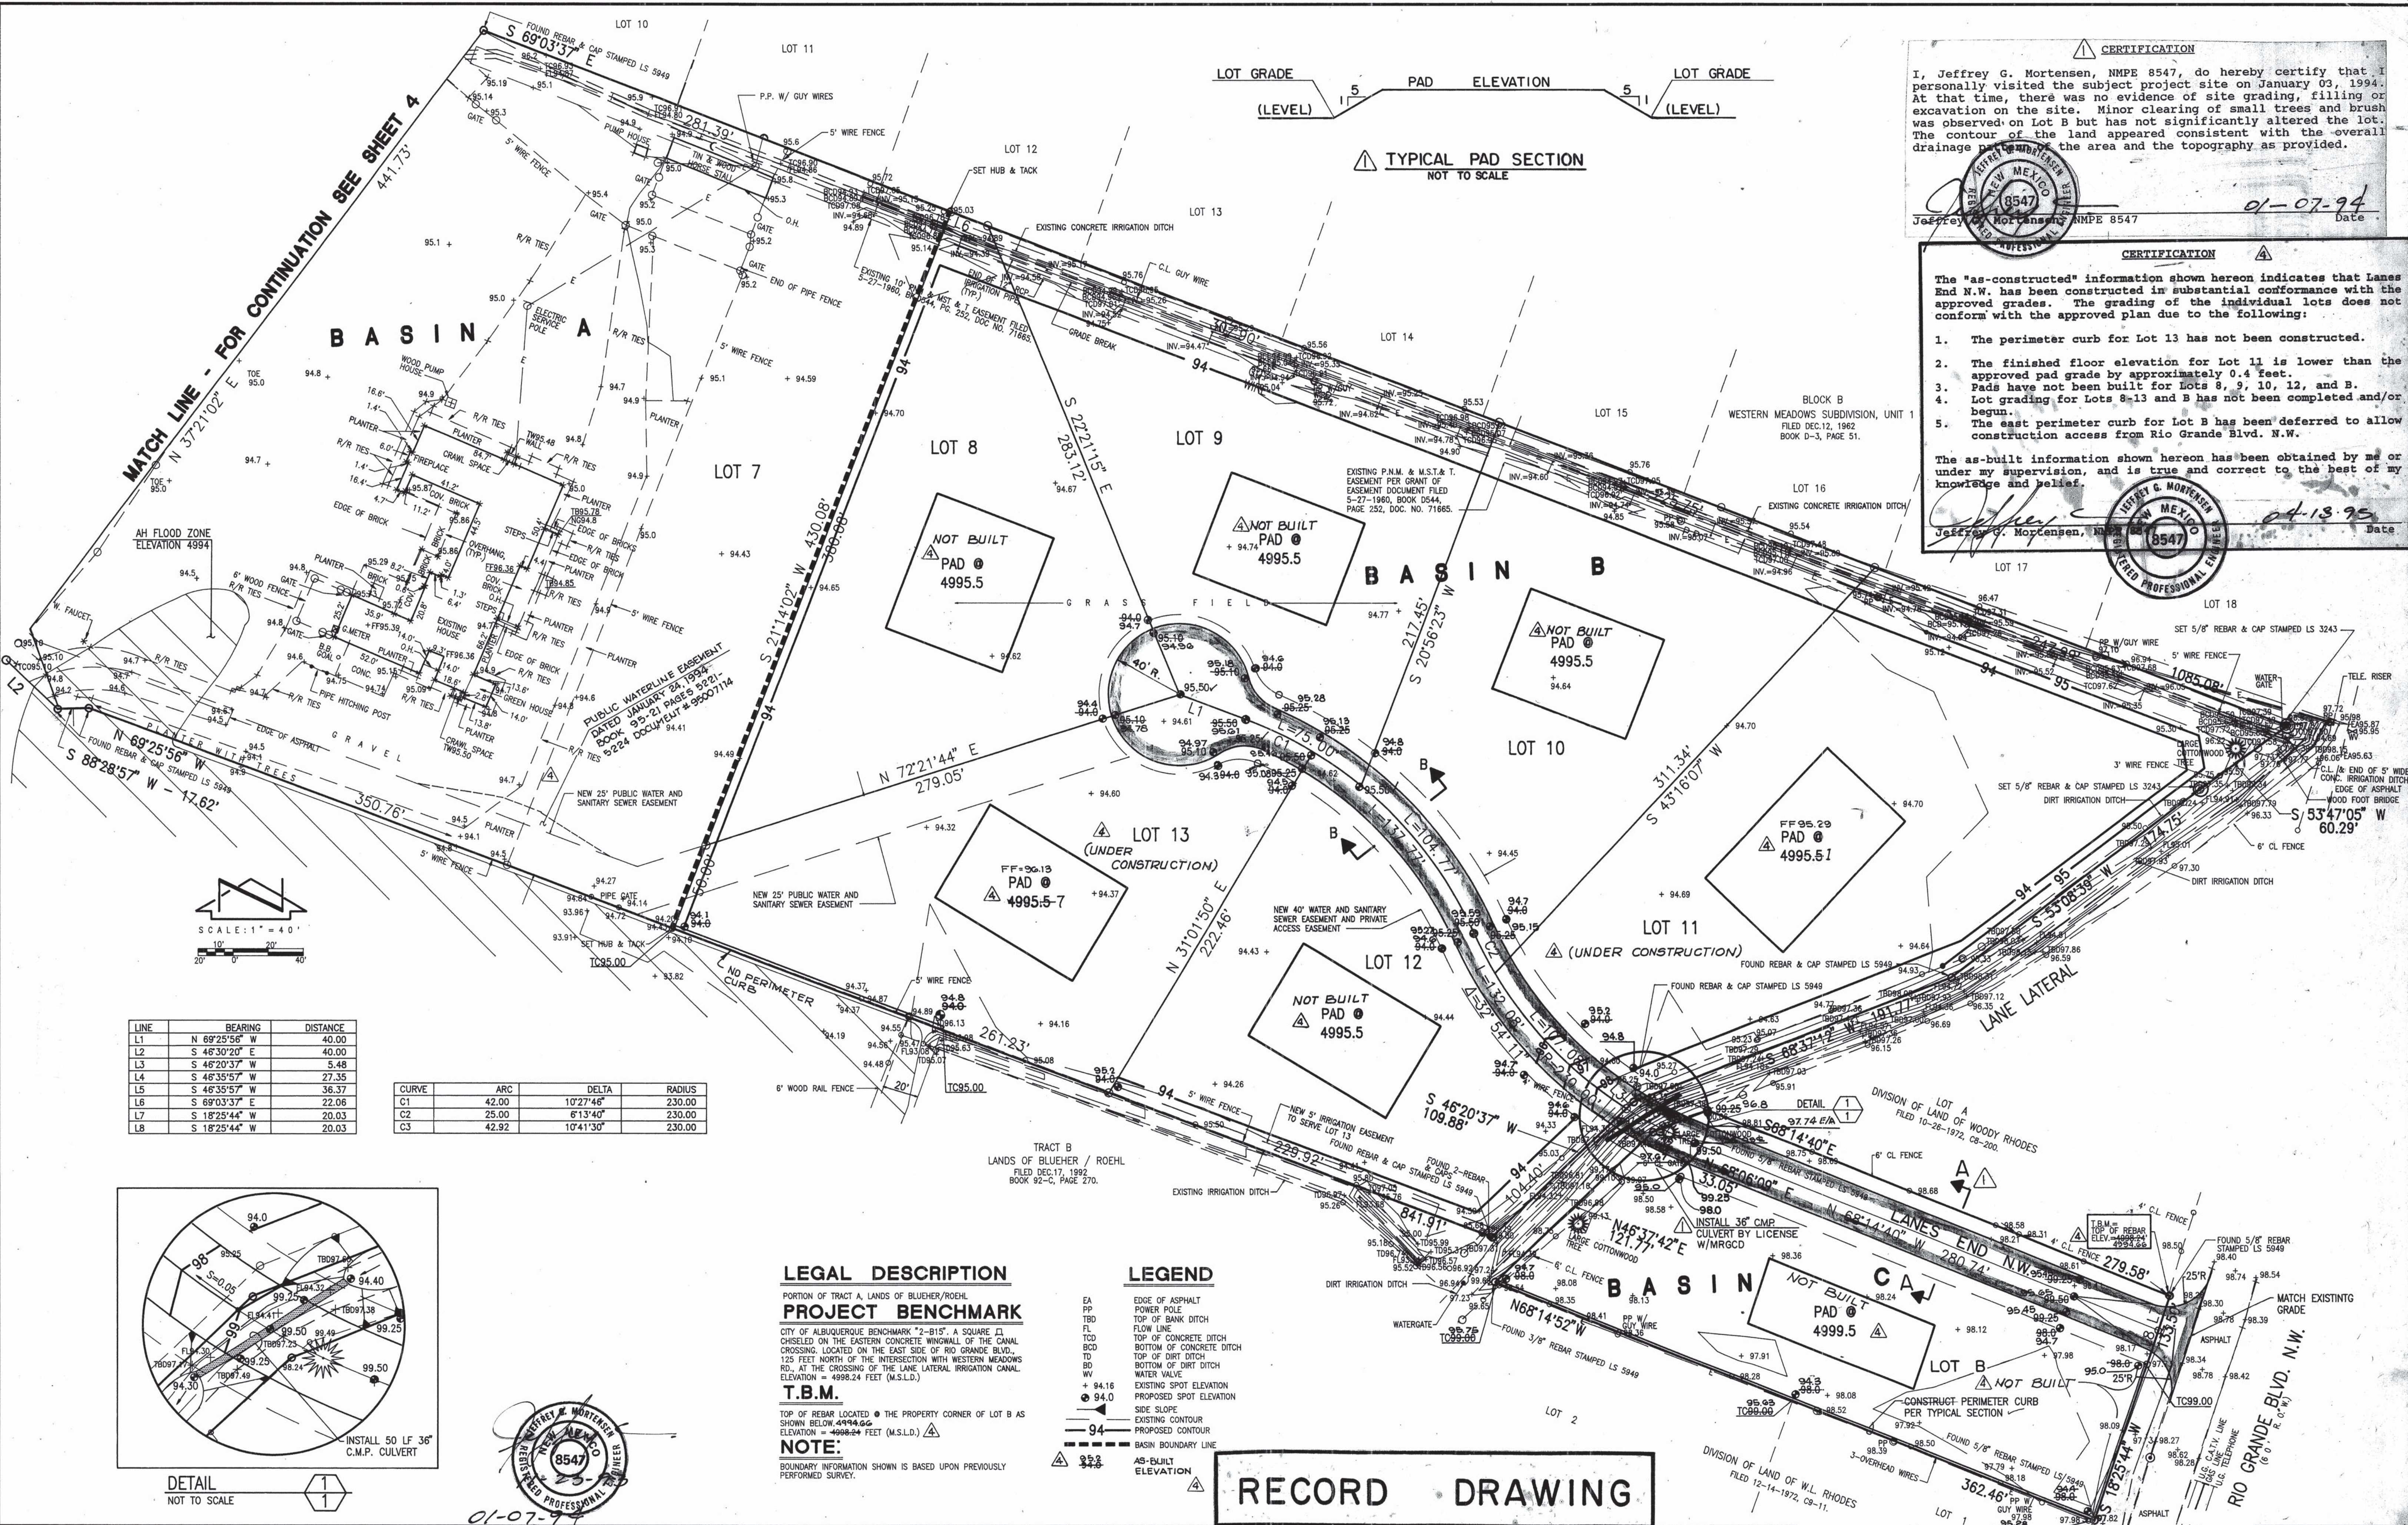

CERTIFICATION
I, Jeffrey G. Mortensen, NMPE 8547, do hereby certify that I personally visited the subject project site on January 03, 1994. At that time, there was no evidence of site grading, filling or excavation on the site. Minor clearing of small trees and brush was observed on Lot B but has not significantly altered the lot. The contour of the land appeared consistent with the overall drainage pattern of the area and the topography as provided.

CERTIFICATION
The "as-constructed" information shown hereon indicates that Lanes End N.W. has been constructed in substantial conformance with the approved grades. The grading of the individual lots does not conform with the approved plan due to the following:

1. The perimeter curb for Lot 13 has not been constructed.
2. The finished floor elevation for Lot 11 is lower than the approved pad grade by approximately 0.4 feet.
3. Pads have not been built for Lots 8, 9, 10, 12, and B.
4. Lot grading for Lots 8-13 and B has not been completed and/or begun.
5. The east perimeter curb for Lot B has been deferred to allow construction access from Rio Grande Blvd. N.W.


The as-built information shown hereon has been obtained by me or under my supervision, and is true and correct to the best of my knowledge and belief.

LINE	BEARING	DISTANCE
L1	N 69°25'56" W	40.00
L2	S 46°30'20" E	40.00
L3	S 46°20'37" W	27.48
L4	S 46°35'57" W	27.35
L5	S 46°35'57" W	36.37
L6	S 69°03'37" E	22.06
L7	S 18°25'44" W	20.03
L8	S 18°25'44" W	20.03


CURVE	ARC	DELTA	RADIUS
C1	42.00	10°27'46"	230.00
C2	25.00	6°13'40"	230.00
C3	42.92	10°41'30"	230.00

LEGAL DESCRIPTION
PORTION OF TRACT A, LANDS OF BLUETTER/ROEHL
PROJECT BENCHMARK
CITY OF ALBUQUERQUE BENCHMARK "2-B15", A SQUARE IRON CHISEL ON THE EASTERN CONCRETE WALL OF THE CANAL CROSSING, LOCATED ON THE EAST SIDE OF RIO GRANDE BLVD., 125 FEET NORTH OF THE INTERSECTION WITH WESTERN MEADOWS RD., AT THE CROSSING OF THE LANE LATERAL IRRIGATION CANAL. ELEVATION = 4998.24 FEET (M.S.L.D.)
T.B.M.
TOP OF REBAR LOCATED AT THE PROPERTY CORNER OF LOT B AS SHOWN BELOW 4994.60
NOTE:
BOUNDARY INFORMATION SHOWN IS BASED UPON PREVIOUSLY PERFORMED SURVEY.

- LEGEND**
- EA EDGE OF ASPHALT
 - PP POWER POLE
 - TBD TOP OF BANK DITCH
 - FL FLOW LINE
 - TCB TOP OF CONCRETE DITCH
 - BCD BOTTOM OF CONCRETE DITCH
 - TD TOP OF DIRT DITCH
 - BD BOTTOM OF DIRT DITCH
 - WV WATER VALVE
 - SE EXISTING SPOT ELEVATION
 - PS PROPOSED SPOT ELEVATION
 - SS SIDE SLOPE
 - EX EXISTING CONTOUR
 - PR PROPOSED CONTOUR
 - BL BASIN BOUNDARY LINE
 - AS AS-BUILT ELEVATION

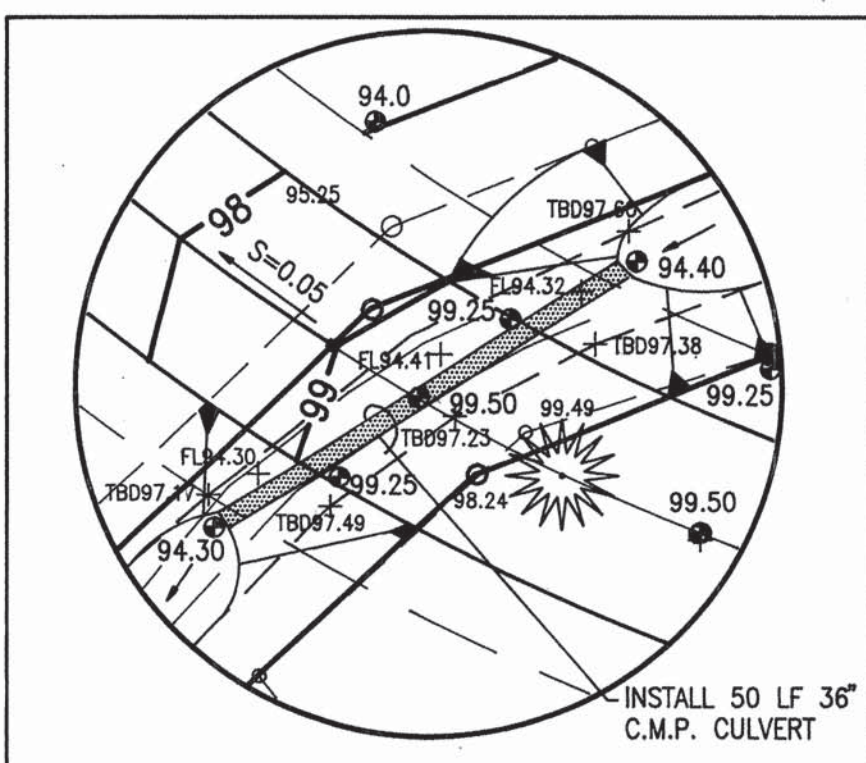

RECORD DRAWING

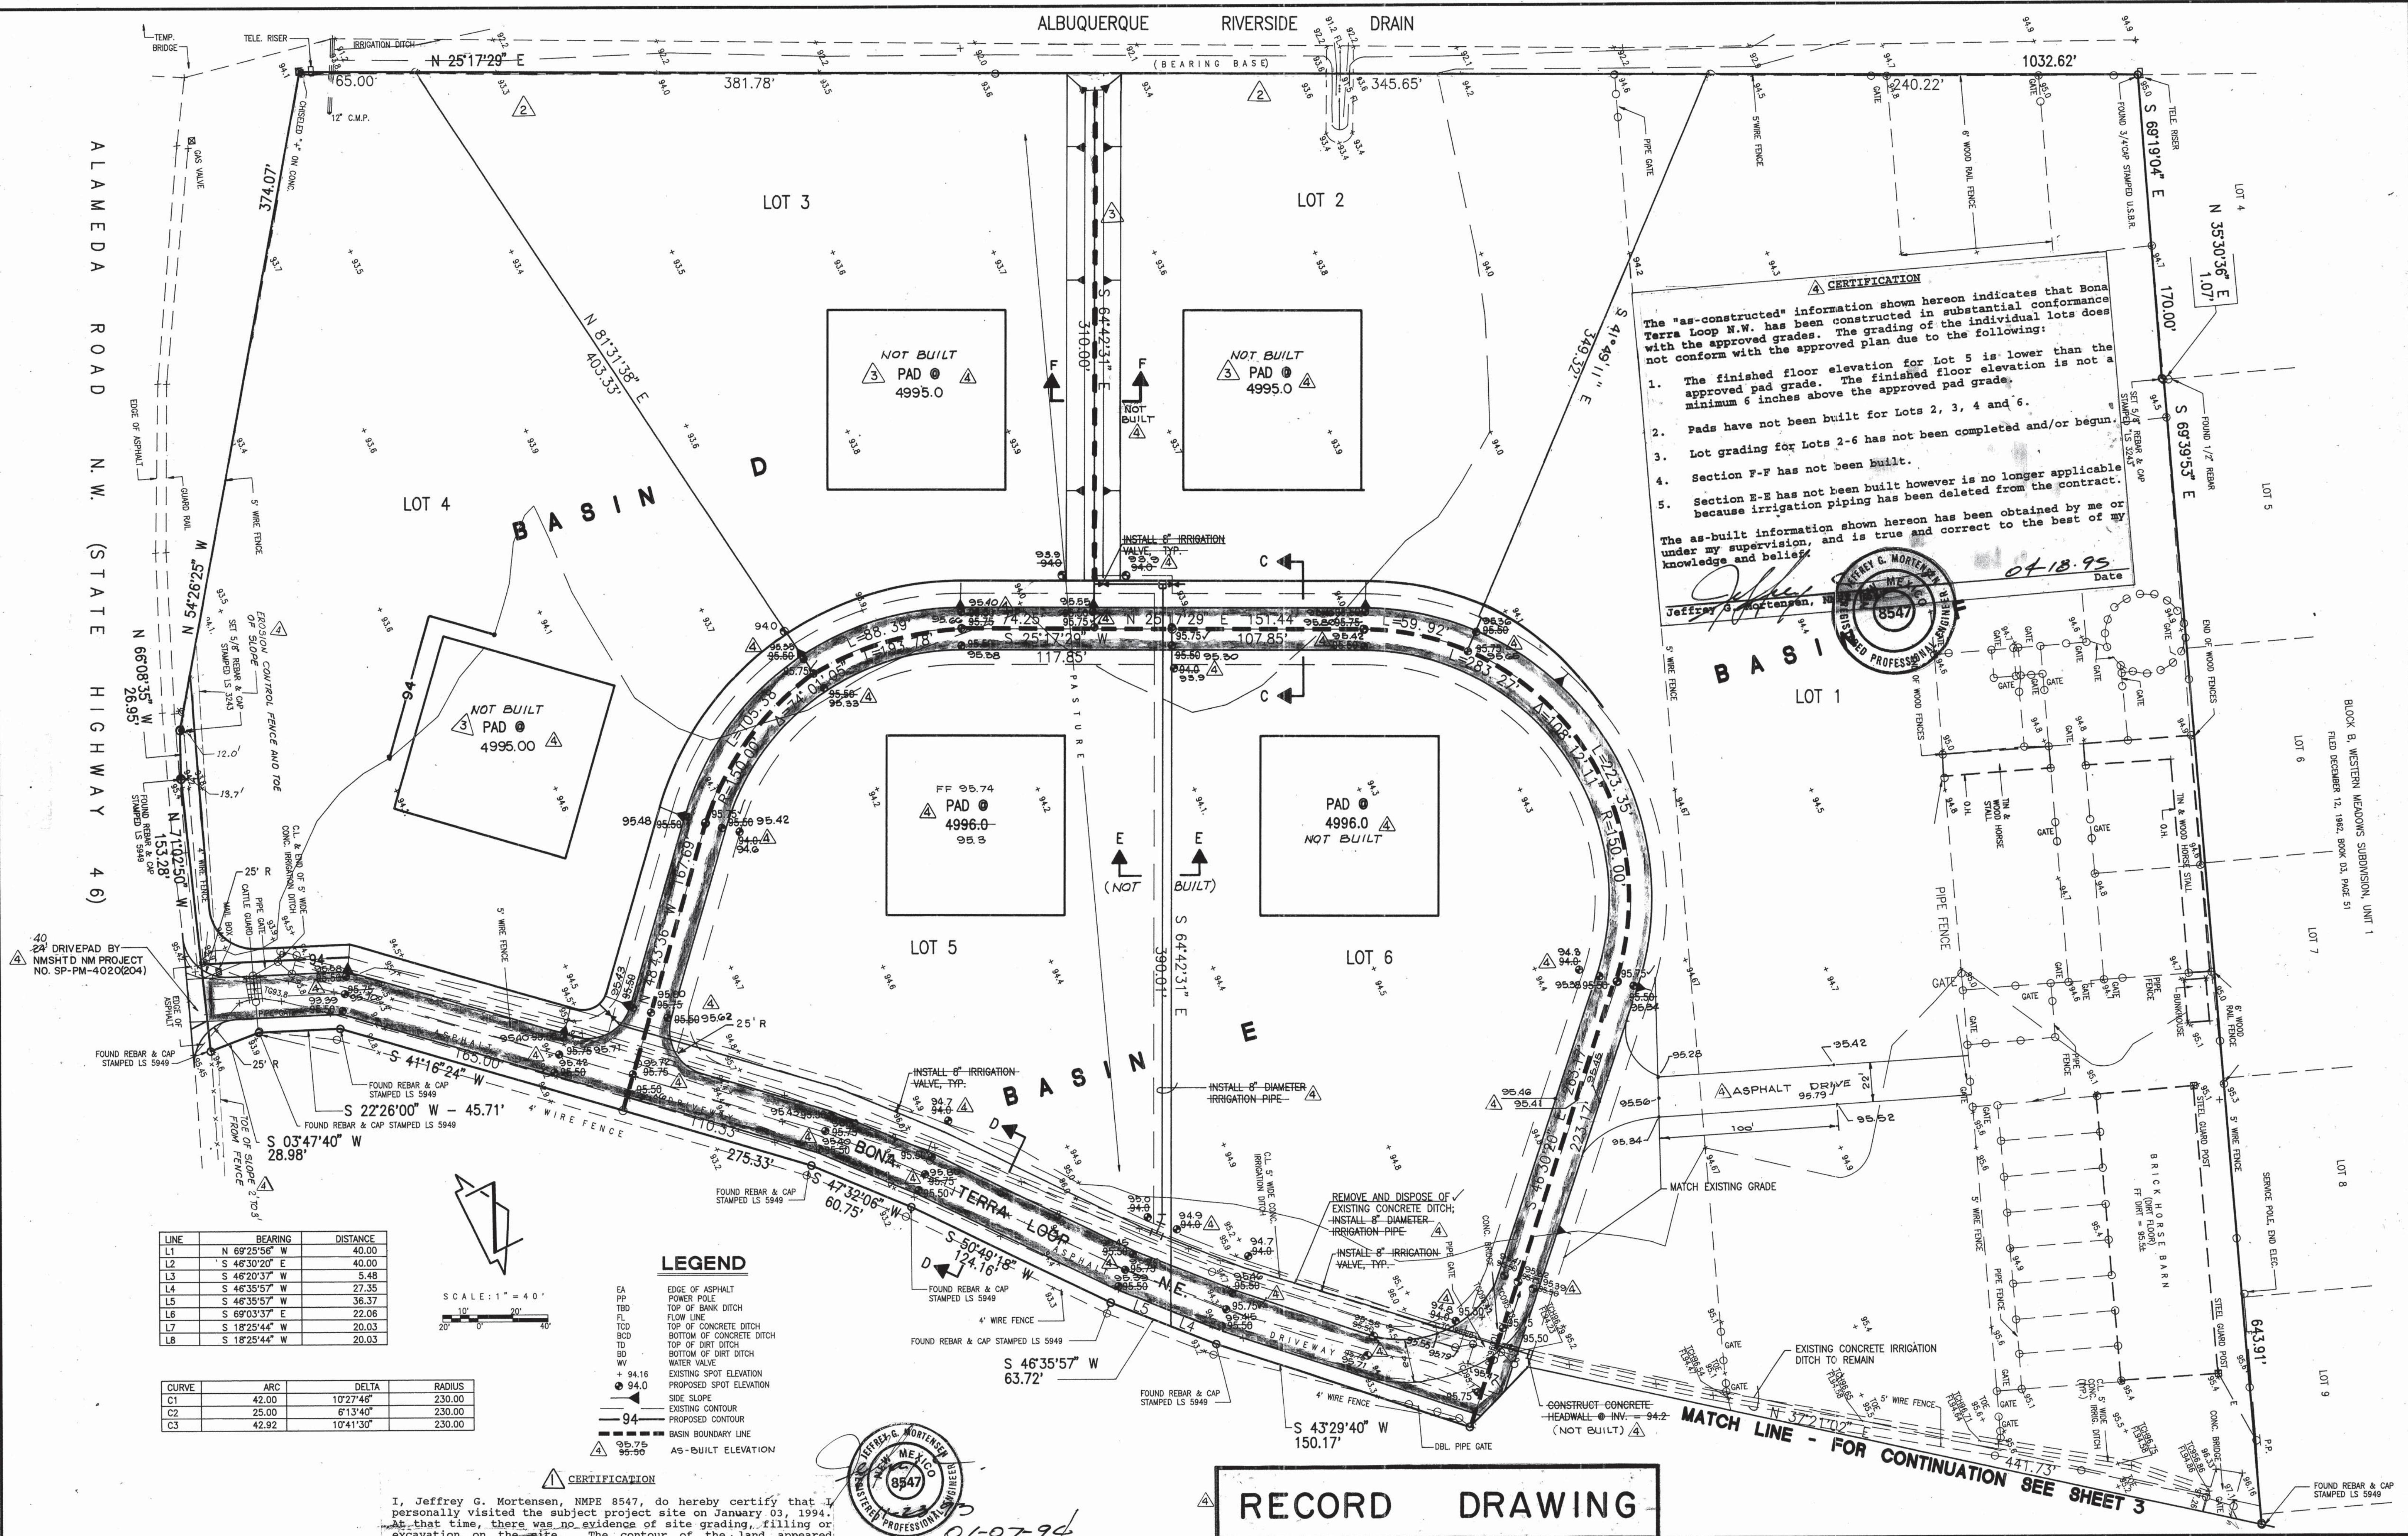

CERTIFICATION

The "as-constructed" information shown hereon indicates that Bona Terra Loop N.W. has been constructed in substantial conformance with the approved grades. The grading of the individual lots does not conform with the approved plan due to the following:

1. The finished floor elevation for Lot 5 is lower than the approved pad grade. The finished floor elevation is not a minimum 6 inches above the approved pad grade.
2. Pads have not been built for Lots 2, 3, 4 and 6.
3. Lot grading for Lots 2-6 has not been completed and/or begun.
4. Section F-F has not been built.
5. Section E-E has not been built however is no longer applicable because irrigation piping has been deleted from the contract.

The as-built information shown hereon has been obtained by me or under my supervision, and is true and correct to the best of my knowledge and belief.

Jeffrey G. Mortensen, N.M.P.E. 8547
Date: 01-18-95

LINE	BEARING	DISTANCE
L1	N 69°25'56" W	40.00
L2	S 46°30'20" E	40.00
L3	S 46°20'37" W	5.48
L4	S 46°35'57" W	27.35
L5	S 46°35'57" W	36.37
L6	S 60°03'37" E	22.06
L7	S 18°25'44" W	20.03
L8	S 18°25'44" W	20.03

CURVE	ARC	DELTA	RADIUS
C1	42.00	10°27'46"	230.00
C2	25.00	6°13'40"	230.00
C3	42.92	10°41'30"	230.00

LEGEND

- EA EDGE OF ASPHALT
- PP POWER POLE
- TBD TOP OF BANK DITCH
- FL FLOW LINE
- TCO TOP OF CONCRETE DITCH
- BCD BOTTOM OF CONCRETE DITCH
- TD TOP OF DIRT DITCH
- BD BOTTOM OF DIRT DITCH
- WV WATER VALVE
- + 94.16 EXISTING SPOT ELEVATION
- + 94.0 PROPOSED SPOT ELEVATION
- 94 SIDE SLOPE
- 94 EXISTING CONTOUR
- 94 PROPOSED CONTOUR
- 94 BASIN BOUNDARY LINE
- 94 AS-BUILT ELEVATION

I, Jeffrey G. Mortensen, NMPE 8547, do hereby certify that I personally visited the subject project site on January 03, 1994. At that time, there was no evidence of site grading, filling or excavation on the site. The contour of the land appeared consistent with the drainage pattern of the area and the topography as shown on this plan.

Jeffrey G. Mortensen, N.M.P.E. 8547
Date: 01-07-94
REVISED 05-12-94




**GRADING PLAN
BONA TERRA FARMS
(WEST)**

RECORD DRAWING


1 2 3 4 5 6 7 8 9 10 11 12 13 14 15
26 49 10.90 0495

DESIGNED BY	DATE	BY	REVISIONS	JOB NO.
J.G.M.	01/94	J.G.M.	ADD DRIVEPAD & CERTIFICATION	930823
ACAD	04/94	J.G.M.	DELETE WEST PERIMETER CURB FOR LOTS 2, 3, & 4	DATE 11-1993
J.G.M.	05/94	J.G.M.	REVISE LOTS 2, 3, & 4	SHEET 4 OF 16
J.G.M.	01/95	J.M.A.	RECORD DRAWING	

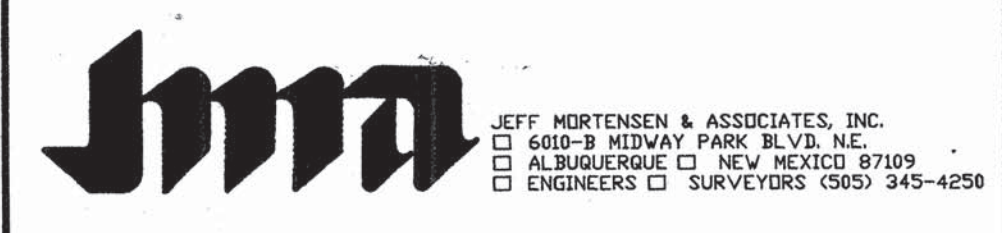




VICINITY MAP
SCALE: 1"=750' (APPROX.)

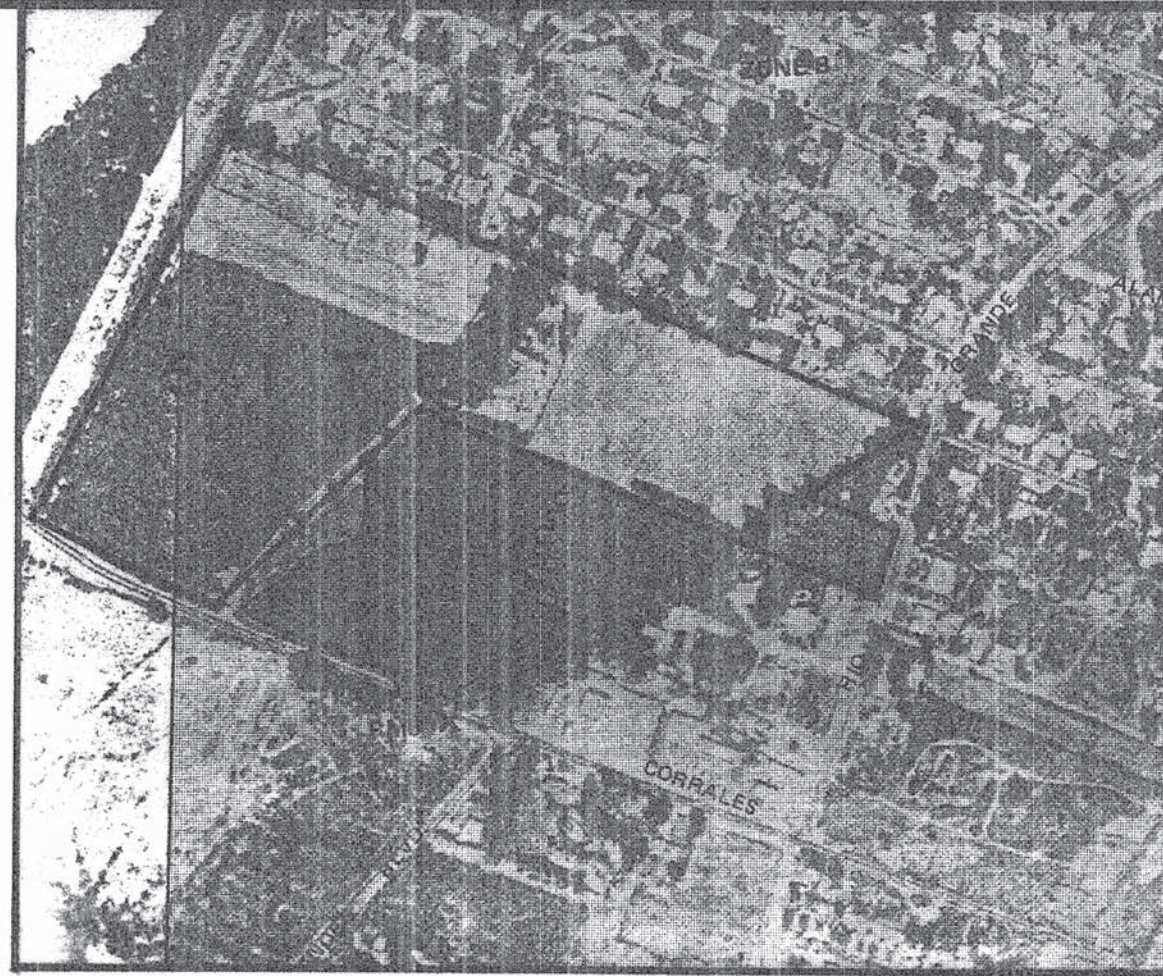

FLOODPLAIN MAP
SCALE: 1"=500'

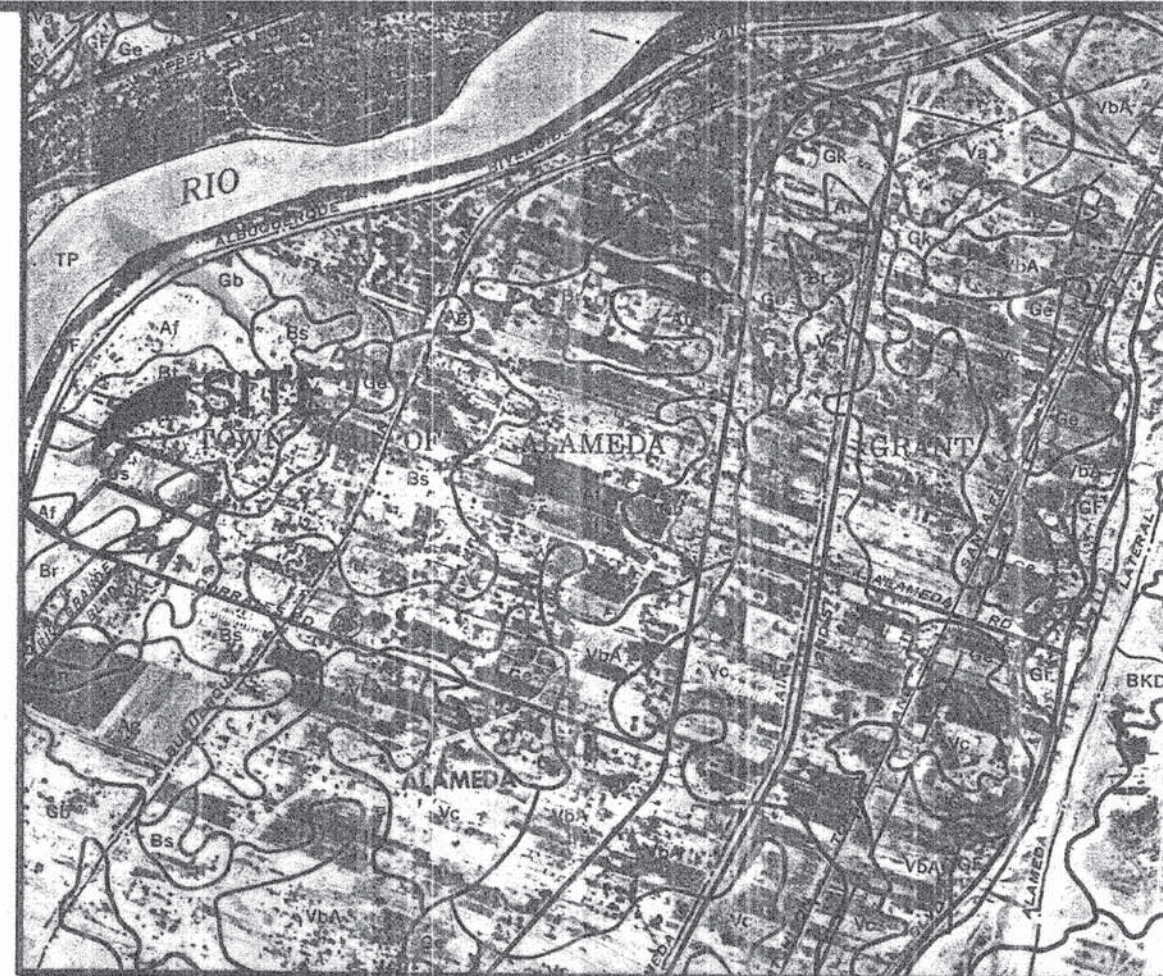

SOILS MAP ~ BERNALILLO CTY. SCS SHEET NO. 11
SCALE: 1"=2000'

DRAINAGE PLAN

The following items concerning the Bona Terra Farms Drainage Plan are contained hereon:

1. Vicinity Map
2. FIRM Map
3. Soils Map
4. Grading Plan
5. Typical Road Sections
6. Calculations

As shown by the Vicinity Map, the site is located north of Alameda Blvd., east of the Rio Grande. The site is described as a Tract A, Lands of Blueher/Roehl and Lot B Lands of W.L. Rhodes.

As shown by Panel 3 of 50 of the National Flood Insurance Rate Maps (FIRM) dated October 14, 1983, the site lies adjacent to a flood hazard zone designated as AH the AH zone does encroach upon Lot 7 which contains an existing single family residence.

The Grading Plan shows 1) existing grades indicated by spot elevations and contours at 1'0" intervals, 2) proposed grades indicated by contours at 1'0" intervals, 3) the limit and character of the existing improvements, 4) the limit and character of the proposed improvements, and 5) continuity between existing and proposed grades. As shown by this plan, the proposed development consists of single family residences and associated private roads. The topography of the site is flat with very little relief. No lots have slopes greater than 1.0%. The site will require minimal grading to construct the new road, build house pads and develop the flat grading scheme. The "flat" grading scheme will effect a zero discharge concept for managing stormwater runoff. Each lot, with the exception of the pad, will be graded "flat." This will contain the runoff generated within each respective basin. The "flat" grading will prohibit runoff from migrating from one lot to another which could create an excessive burden on the lowest lot. With each lot within the respective basin being graded at the same base elevation, this will not occur. Lots 1, 2, 3 and 4 will deviate from this scheme slightly and will discharge excess runoff in its historic pattern to the Albuquerque Riverside Drain. A net decrease in runoff discharging to the Drain is noted in the Comparison hereon. In addition, Offsite flows will not be blocked by the development. Offsite flows are discussed in more detail elsewhere on this page.

The Calculations which appear hereon analyze both the existing and developed conditions for the 100-year, 6-hour rainfall event. The Procedure for 40-acre and Smaller Basins, as set forth in the Revision of Section 22.2, Hydrology of the Development Process Manual, Volume 2, Design Criteria, dated January, 1993, has been used to quantify the peak rate of discharge and volume of runoff generated. As shown by these calculations, a minor increase in runoff is anticipated due to the proposed development. The 10-day developed runoff volume (V_{10-day}) has also been calculated along with the associated water surface elevation (depth).

CALCULATIONS

Site Characteristics

1. Precipitation Zone 2
2. $P_{6,100} = P_{360} = 2.35$ in
3. Total Area (A_T) 28.05 Acres
4. Existing Land Treatment

Basin A	148,110/3.4	100
Treatment	Area (sf/ac)	%
A	114,570/2.63	77
B	12,200/0.28	08
C	8,710/0.20	06
D	12,630/0.29	09
Basin B	277,480/6.37	100
A	271,820/6.24	98
D	5,660/0.13	02
Basin C	43,560/1.00	100
A	43,560/1.00	100
Basin D	216,240/5.01	100
A	212,320/4.92	98
D	3,920/0.09	02
Basin E	180,770/4.15	100
A	172,490/3.96	95
D	8,280/0.19	05
Basin F	353,710/8.12	100
A	291,420/6.69	82
C	48,790/1.12	14
D	13,500/0.31	4

5. Developed Land Treatment

Basin A	148,110/3.4	100
Treatment	Area (sf/ac)	%
A	114,570/2.63	77
B	12,200/0.28	08
C	8,710/0.20	06
D	12,630/0.29	09
Basin B	277,480/6.37	100
A	216,930/4.98	78
D	60,550/1.39	22
Basin C	43,560/1.00	100
A	29,190/0.67	67
D	14,370/0.33	33
Basin D	218,240/5.01	100
A	186,740/4.29	86
D	31,500/0.72	14
Basin E	180,770/4.15	100
A	140,260/3.22	78
D	40,510/0.93	22
Basin F	353,710/8.12	100
A	274,050/6.29	77
C	48,790/1.12	14
D	30,870/0.71	09

Existing Condition

A. Basin A

1. Volume
 $E_W = (E_A A_A + E_B A_B + E_C A_C + E_D A_D) / A_T$
 $E_W = [(0.53)(2.63) + (0.78)(0.28) + (1.13)(0.20) + (2.12)(0.29)] / 3.4 = 0.72$ in.
 $V_{100} = (E_W / 12) A_T$
 $V_{100} = (0.72 / 12) 3.4 = 0.2044$ ac.ft.; 8,900 cf
 $V_{10 \text{ Day}} = V_{360} + A_p * (P_{10 \text{ Days}} - P_{360}) / (12 \text{ in/ft})$
 $V_{10 \text{ Day}} = 0.2044 + 0.29 * (3.95 - 2.35) / (12 \text{ in/ft})$
 $V_{10 \text{ Day}} = 0.2044 + 0.0387 = 0.2431$ ac.ft.; 10,590 cf
2. Peak Discharge
 $Q_p = Q_{PA} A_A + Q_{PB} A_B + Q_{PC} A_C + Q_{PD} A_D$
 $Q_p = Q_{100} = (1.56)(2.63) + (2.28)(0.28) + (3.14)(0.20) + (4.70)(0.29) = 6.7$ cfs

B. Basin B

1. Volume
 $E_W = (E_A A_A + E_B A_B + E_C A_C + E_D A_D) / A_T$
 $E_W = [(0.53)(6.24) + (2.12)(0.13)] / 6.37 = 0.56$ in.
 $V_{100} = (E_W / 12) A_T$
 $V_{100} = (0.56 / 12) 6.37 = 0.2973$ ac.ft.; 12,950 cf
 $V_{10 \text{ Day}} = V_{360} + A_p * (P_{10 \text{ Days}} - P_{360}) / (12 \text{ in/ft})$
 $V_{10 \text{ Day}} = 0.2973 + 0.13 * (3.95 - 2.35) / 12$
 $V_{10 \text{ Day}} = 0.3146$ ac.ft.; 13,700 cf
2. Peak Discharge
 $Q_p = Q_{PA} A_A + Q_{PB} A_B + Q_{PC} A_C + Q_{PD} A_D$
 $Q_p = Q_{100} = (1.56)(6.24) + (4.70)(0.13) = 10.3$ cfs

C. Basin C

1. Volume
 $E_W = (E_A A_A + E_B A_B + E_C A_C + E_D A_D) / A_T$
 $E_W = [(0.53)(1.00)] / 1.00 = 0.53$ in.
 $V_{100} = (E_W / 12) A_T$
 $V_{100} = (0.53 / 12) 1.00 = 0.0442$ ac.ft.; 1,925 cf
 $V_{10 \text{ Day}} = V_{360} + A_p * (P_{10 \text{ Days}} - P_{360}) / (12 \text{ in/ft})$
 $V_{10 \text{ Day}} = 0.0442 + 0 = 0.0442$ ac.ft.; 1,925 cf
2. Peak Discharge
 $Q_p = Q_{PA} A_A + Q_{PB} A_B + Q_{PC} A_C + Q_{PD} A_D$
 $Q_p = Q_{100} = (1.56)(1.00) = 1.6$ cfs

3.D. Basin D

1. Volume
 $E_W = (E_A A_A + E_B A_B + E_C A_C + E_D A_D) / A_T$
 $E_W = [(0.53)(4.92) + (2.12)(0.09)] / 5.01 = 0.56$ in.
 $V_{100} = (E_W / 12) A_T$
 $V_{100} = (0.56 / 12) 5.01 = 0.2332$ ac.ft.; 10,160 cf
2. Peak Discharge
 $Q_p = Q_{PA} A_A + Q_{PB} A_B + Q_{PC} A_C + Q_{PD} A_D$
 $Q_p = Q_{100} = (1.56)(4.92) + (4.70)(0.09) = 8.1$ cfs

E. Basin E

1. Volume
 $E_W = (E_A A_A + E_B A_B + E_C A_C + E_D A_D) / A_T$
 $E_W = [(0.53)(3.96) + (2.12)(0.19)] / 4.15 = 0.60$ in.
 $V_{100} = (E_W / 12) A_T$
 $V_{100} = (0.60 / 12) 4.15 = 0.2085$ ac.ft.; 9,080 cf
 $V_{10 \text{ Day}} = V_{360} + A_p * (P_{10 \text{ Days}} - P_{360}) / (12 \text{ in/ft})$
 $V_{10 \text{ Day}} = 0.2085 + 0.19(3.95 - 2.35) / 12$
 $V_{10 \text{ Day}} = 0.2338$ ac.ft.; 10,190 cf
2. Peak Discharge
 $Q_p = Q_{PA} A_A + Q_{PB} A_B + Q_{PC} A_C + Q_{PD} A_D$
 $Q_p = Q_{100} = (1.56)(3.96) + (4.70)(0.19) = 7.1$ cfs

3.F. Basin F

1. Volume
 $E_W = (E_A A_A + E_B A_B + E_C A_C + E_D A_D) / A_T$
 $E_W = [(0.53)(6.69) + (1.13)(1.12) + (2.12)(0.31)] / 8.12 = 0.67$ in.
 $V_{100} = (E_W / 12) A_T$
 $V_{100} = (0.67 / 12) 8.12 = 0.4557$ ac.ft.; 19,850 cf
2. Peak Discharge
 $Q_p = Q_{PA} A_A + Q_{PB} A_B + Q_{PC} A_C + Q_{PD} A_D$
 $Q_p = Q_{100} = (1.56)(6.69) + (3.14)(1.12) + (4.70)(0.31) = 15.4$ cfs

4. Developed Condition

A. Basin A

1. Volume
(No Change)
 $V_{10 \text{ Day}}$ (No Change)
- 10-Day Water Surface Elevation
10,590 cf / (148,110 - 12,630) sf = 0.08 ft
2. Peak Discharge
(No Change)

B. Basin B


1. Volume
 $E_W = [(0.53)(4.98) + (2.12)(1.39)] / 6.37 = 0.88$ in.
 $V_{100} = (0.88 / 12) 6.37 = 0.4671$ ac.ft.; 20,350 cf
 $V_{10 \text{ Day}} = 0.4671 + 1.39(3.95 - 2.35) / 12$
 $V_{10 \text{ Day}} = 0.6524$ ac.ft.; 28,420 cf
- 10-Day Water Surface Elevation
28,420 cf / (277,480 - 60,550) sf = 0.13 ft
2. Peak Discharge
 $Q_p = Q_{100} = (1.56)(4.98) + (4.70)(1.39) = 14.3$ cfs

C. Basin C

1. Volume
 $E_W = [(0.53)(0.67) + (2.12)(0.33)] / 1.00 = 1.05$ in.
 $V_{100} = (1.05 / 12) 1.00 = 0.0879$ ac.ft.; 3,830 cf
 $V_{10 \text{ Day}} = 0.0879 + 0.33(3.95 - 2.35) / 12$
 $V_{10 \text{ Day}} = 0.1319$ ac.ft.; 5,750 cf
- 10-Day Water Surface Elevation
5,750 cf / (43,560 - 14,370) sf = 0.20 ft
2. Peak Discharge
 $Q_p = Q_{100} = (1.56)(0.67) + (4.70)(0.33) = 2.6$ cfs


3.D. Basin D

1. Volume
 $E_W = [(0.53)(4.29) + (2.12)(0.72)] / 5.01 = 0.76$ in.
 $V_{100} = (0.76 / 12) 5.01 = 0.3164$ ac.ft.; 13,780 cf

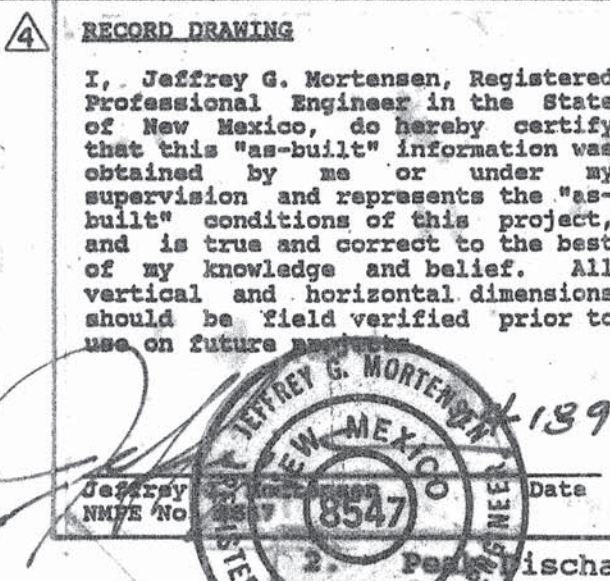

GRADING NOTES:

1. ALL FILL SHALL BE COMPACTED TO A MINIMUM OF 90% ASTM D-1557; HOUSE PADS SHALL BE COMPACTED AT 95% ASTM D-1557; ROADWAYS SHALL BE COMPACTED AT 95% ASTM D-1557.
2. THE PAD ELEVATIONS SHOWN HEREON ARE FOR ROUGH GRADING PURPOSES.
3. PAD LOCATIONS ARE APPROXIMATE IN HORIZONTAL PLACEMENT AND SIZE; LOCATIONS SHOWN ARE FOR ILLUSTRATION PURPOSES. INDIVIDUAL GRADING & DRAINAGE PLANS ARE REQUIRED FOR EACH LOT AS A CONDITION FOR BUILDING PERMIT APPROVAL.
4. FINISHED FLOOR ELEVATIONS MAY VARY FROM THE PAD ELEVATIONS AND WILL BE DETERMINED AS A FUNCTION OF INDIVIDUAL HOUSE DESIGN. (SEE NOTE 5).
5. FINISHED FLOOR ELEVATIONS SHOULD BE ESTABLISHED AT A MINIMUM OF 6 INCHES ABOVE PAD ELEVATIONS; DEVIATIONS FROM THESE GUIDELINES MUST BE BASED ON THE RECOMMENDATIONS AND/OR DESIGN OF A COMPETENT DESIGN PROFESSIONAL.
6. OFFSITE FLOWS SHALL NOT BE BLOCKED.
7. THE PAD ELEVATIONS SHOWN HEREON ARE MINIMUM ELEVATIONS; DEVIATIONS MUST BE BASED UPON THE RECOMMENDATIONS AND/OR DESIGN OF A COMPETENT DESIGN PROFESSIONAL.
8. TWO (2) WORKING DAYS PRIOR TO ANY EXCAVATION, CONTRACTOR MUST CONTACT NEW MEXICO ONE CALL SYSTEM, 260-1990, FOR LOCATION FOR EXISTING UTILITIES.
9. IF ANY UTILITY LINES, PIPELINES, OR UNDERGROUND UTILITY LINES ARE SHOWN ON THESE DRAWINGS, THEY ARE SHOWN IN AN APPROXIMATE MANNER ONLY, AND SUCH LINES MAY EXIST WHERE NONE ARE SHOWN. IF ANY SUCH EXISTING LINES ARE SHOWN, THE LOCATION IS BASED UPON INFORMATION PROVIDED BY THE OWNER OF SAID UTILITY, AND THE INFORMATION MAY BE INCOMPLETE, OR MAY BE OBSOLETE BY THE TIME CONSTRUCTION COMMENCES. THE ENGINEER HAS CONDUCTED ONLY PRELIMINARY INVESTIGATION OF THE LOCATION, DEPTH, SIZE, OR TYPE OF EXISTING UTILITY LINES, PIPELINES, OR UNDERGROUND UTILITY LINES. THIS INVESTIGATION IS NOT CONCLUSIVE, AND MAY NOT BE COMPLETE, THEREFORE, MAKES NO REPRESENTATION PERTAINING THERETO, AND ASSUMES NO RESPONSIBILITY OR LIABILITY THEREFOR. THE CONTRACTOR SHALL INFORM ITSELF OF THE LOCATION OF ANY UTILITY LINE, PIPELINE, OR UNDERGROUND UTILITY LINE IN OR NEAR THE AREA OF THE WORK IN ADVANCE OF AND DURING EXCAVATION WORK. THE CONTRACTOR IS FULLY RESPONSIBLE FOR ANY AND ALL DAMAGE CAUSED BY ITS FAILURE TO LOCATE, IDENTIFY AND PRESERVE ANY AND ALL EXISTING UTILITIES, PIPELINES, AND UNDERGROUND UTILITY LINES. IN PLANNING AND CONDUCTING EXCAVATION, THE CONTRACTOR SHALL COMPLY WITH STATE STATUTES, MUNICIPAL AND LOCAL ORDINANCES, RULES AND REGULATIONS, IF ANY, PERTAINING TO THE LOCATION OF THESE LINES AND FACILITIES.
10. THE CONTRACTOR SHALL ENSURE THAT NO SOIL ERODES FROM THE SITE INTO PUBLIC RIGHT-OF-WAY OR ONTO PRIVATE PROPERTY.
11. THE CONTRACTOR SHALL PROMPTLY CLEAN UP ANY MATERIAL EXCAVATED WITHIN THE PUBLIC RIGHT-OF-WAY SO THAT THE EXCAVATED MATERIAL IS NOT SUSCEPTIBLE TO BEING WASHED DOWN THE STREET OR ONTO PRIVATE PROPERTY.
12. THE CONTRACTOR SHALL SECURE "TOPSOIL DISTURBANCE PERMIT" PRIOR TO BEGINNING CONSTRUCTION. AN EXCAVATION PERMIT IS REQUIRED FOR ALL WORK WITHIN PUBLIC RIGHT-OF-WAY.
13. THE LANE LATERAL CROSSING WILL BE ACCOMPLISHED BY LICENSE WITH THE MRCD. THE MRCD WILL EVALUATE IF THE 36" CMP IS SIZED ADEQUATELY, A REVISED PLAN WILL BE SUBMITTED TO SHOW A DIFFERENT SIZE CROSSING IF REQUIRED BY THE MRCD.

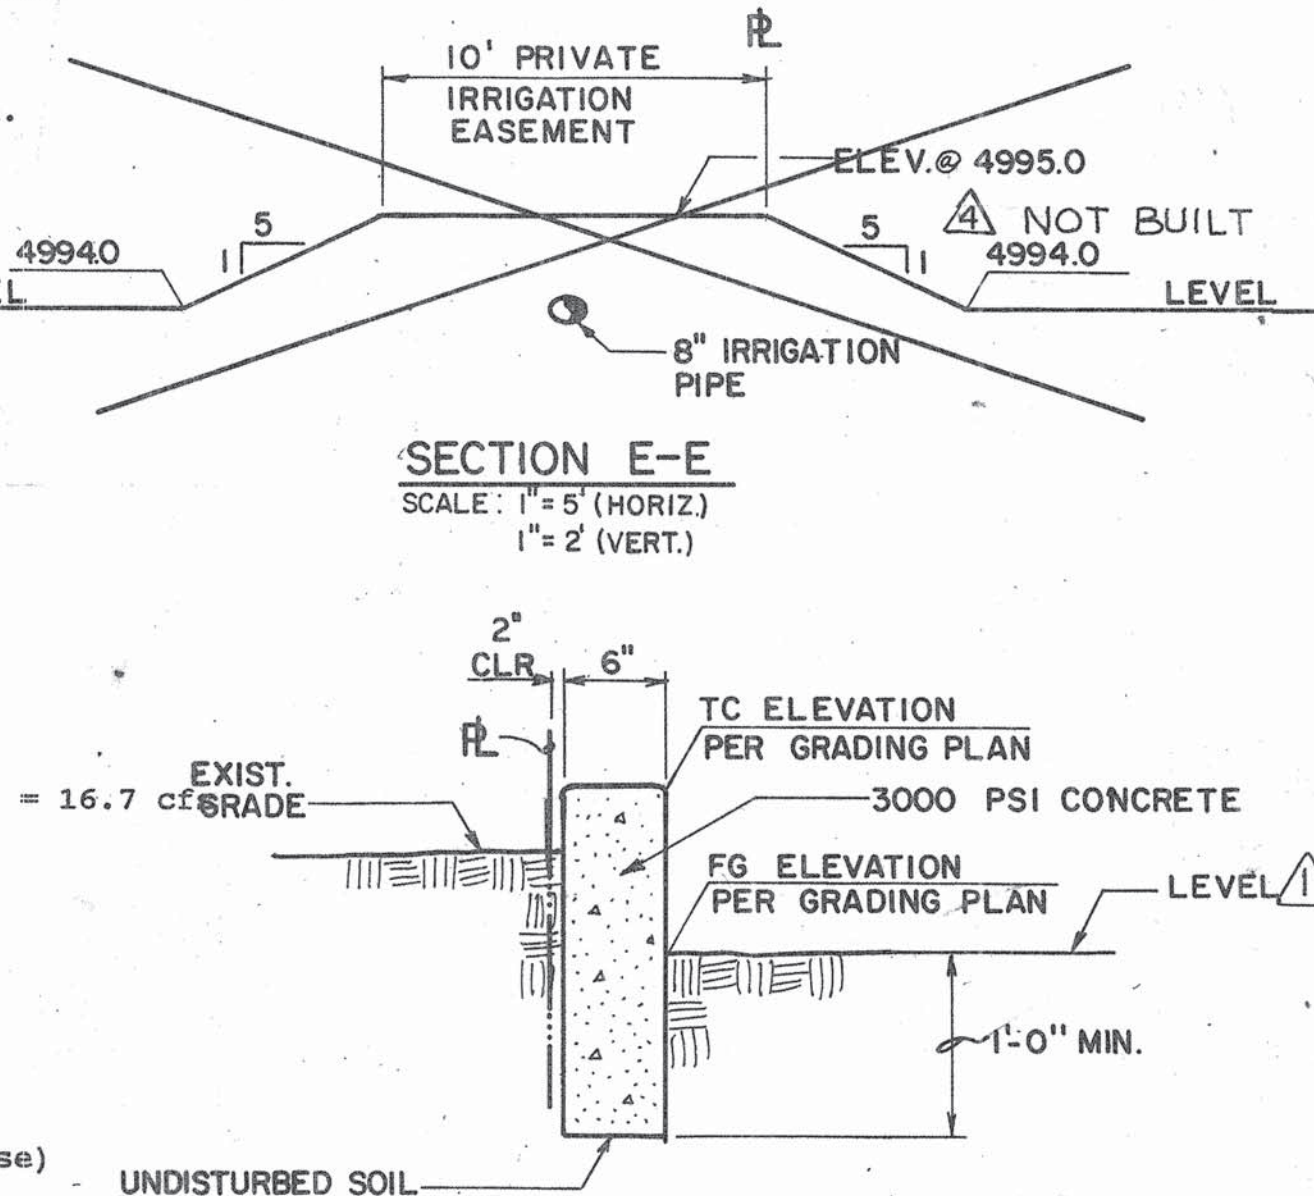

TYPICAL PERIMETER CURB SECTION







SCALE: 1"=1'-0"

OFFSITE FLOWS

Review of City of Albuquerque Orthotops Plate B15, existing onsite conditions and the topography shown hereon indicates that offsite flows do not presently enter the project site from adjacent properties. The existing concrete irrigation ditch, which lies along the north edge of Basins A & B blocks offsite flows which could potentially be generated on the properties which lie to the north. The land which lies to the south of Basins A & B is topographically lower hence does not contribute runoff to the property. Basins B & C are separated by the Lane Lateral which is an elevated unlined irrigation ditch. The elevated ditch serves as a physical barrier to block flows from the runoff generated on the respective properties. The land which lies to the east of Basin D is bounded on the south by Alameda Blvd. N.W. which is currently under construction. The construction plans include curb and gutter which will block potential offsite flows which could enter the site from the south. The Albuquerque Riverside Drain lies to the west of Basin D & F. The Albuquerque Riverside Drain is topographically lower than the site hence does not contribute runoff. The Western Meadows Subdivision consists of developed residential lots which affectively contain the runoff. The runoff from the properties which lie to the east of the site, Basins D & E is topographically lower than the site hence does not contribute to runoff. As demonstrated above, offsite flows do not enter the site. The perimeter curbs will tend to contain runoff generated by this project and prevent those flows from exiting onto the neighboring properties. The above conclusions are based upon careful examination of available mapping as well as onsite reconnaissance.

Note: Retaining Basin E runoff and allowing Basins D and F to drain historically, will result in an overall decrease in runoff discharging from the site to the Albuquerque Riverside Drain.



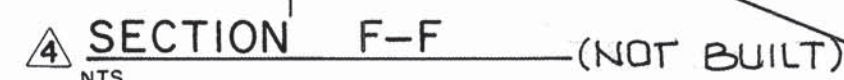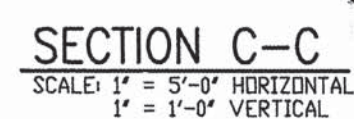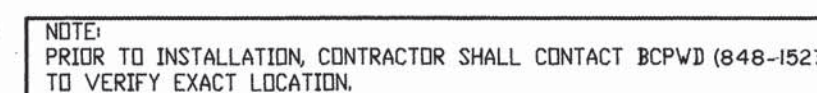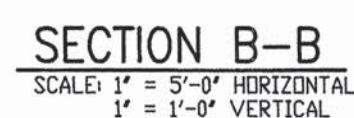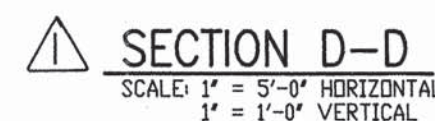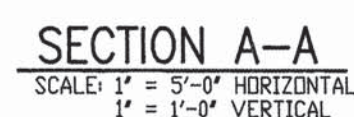

RECORD DRAWING

930823

DESIGNED BY		J.G.M.		DATE		11-93		ENGINEER'S SEAL		SURVEY INFORMATION			BENCH MARKS		AS BUILT INFORMATION	
DRAWN BY		S.C.H.		DATE		11-93				FIELD NOTES						
REVISIONS		NO.		DATE		BY		DATE								
RECORD DRAWING		01/95				J.M.A.										
REVISE SECTION D-D		01/94				J.G.M.										
REMARKS		NO.		DATE		BY		DATE								
DESIGN		NO.		DATE		BY		DATE								
DESIGNED BY		J.G.M.		DATE		11-93										
DRAWN BY		S.C.H.		DATE		11-93										

RECORD DRAWING

I, Jeffrey G. Mortensen, Registered Professional Engineer in the State of New Mexico, do hereby certify that this "as-built" information was obtained by me under my supervision and represents the "as-built" conditions of this project, and is true and correct to the best of my knowledge and belief. All vertical and horizontal dimensions should be field verified prior to use on future projects.



Jeffrey G. Mortensen
New Mexico
1895
Date _____
NMPPE No. 8547

CITY OF ALBUQUERQUE
PUBLIC WORKS DEPARTMENT
ENGINEERING GROUP

TITLE: BONA TERRA FARMS
ROAD SECTIONS AND DETAILS

APPROVALS	ENGINEER	DATE	APPROVALS	ENGINEER	DATE
DRC CHAIRMAN	<i>B.G. Goshaly</i>	6-28-94	WATER	<i>R.W. Kane</i>	6-3-94
TRANSPORTATION	<i>M.A. El-Hay</i>	6-03-94	WASTE WATER	<i>R.W. Kane</i>	6-3-94
HYDROLOGY	<i>HA 3A</i>	6-13-94	BCPWD	<i>James Palmer</i>	5-31-94

PROJECT NO.	4910.90	MAP NO.	B-15	SHEET	OF
				6	16

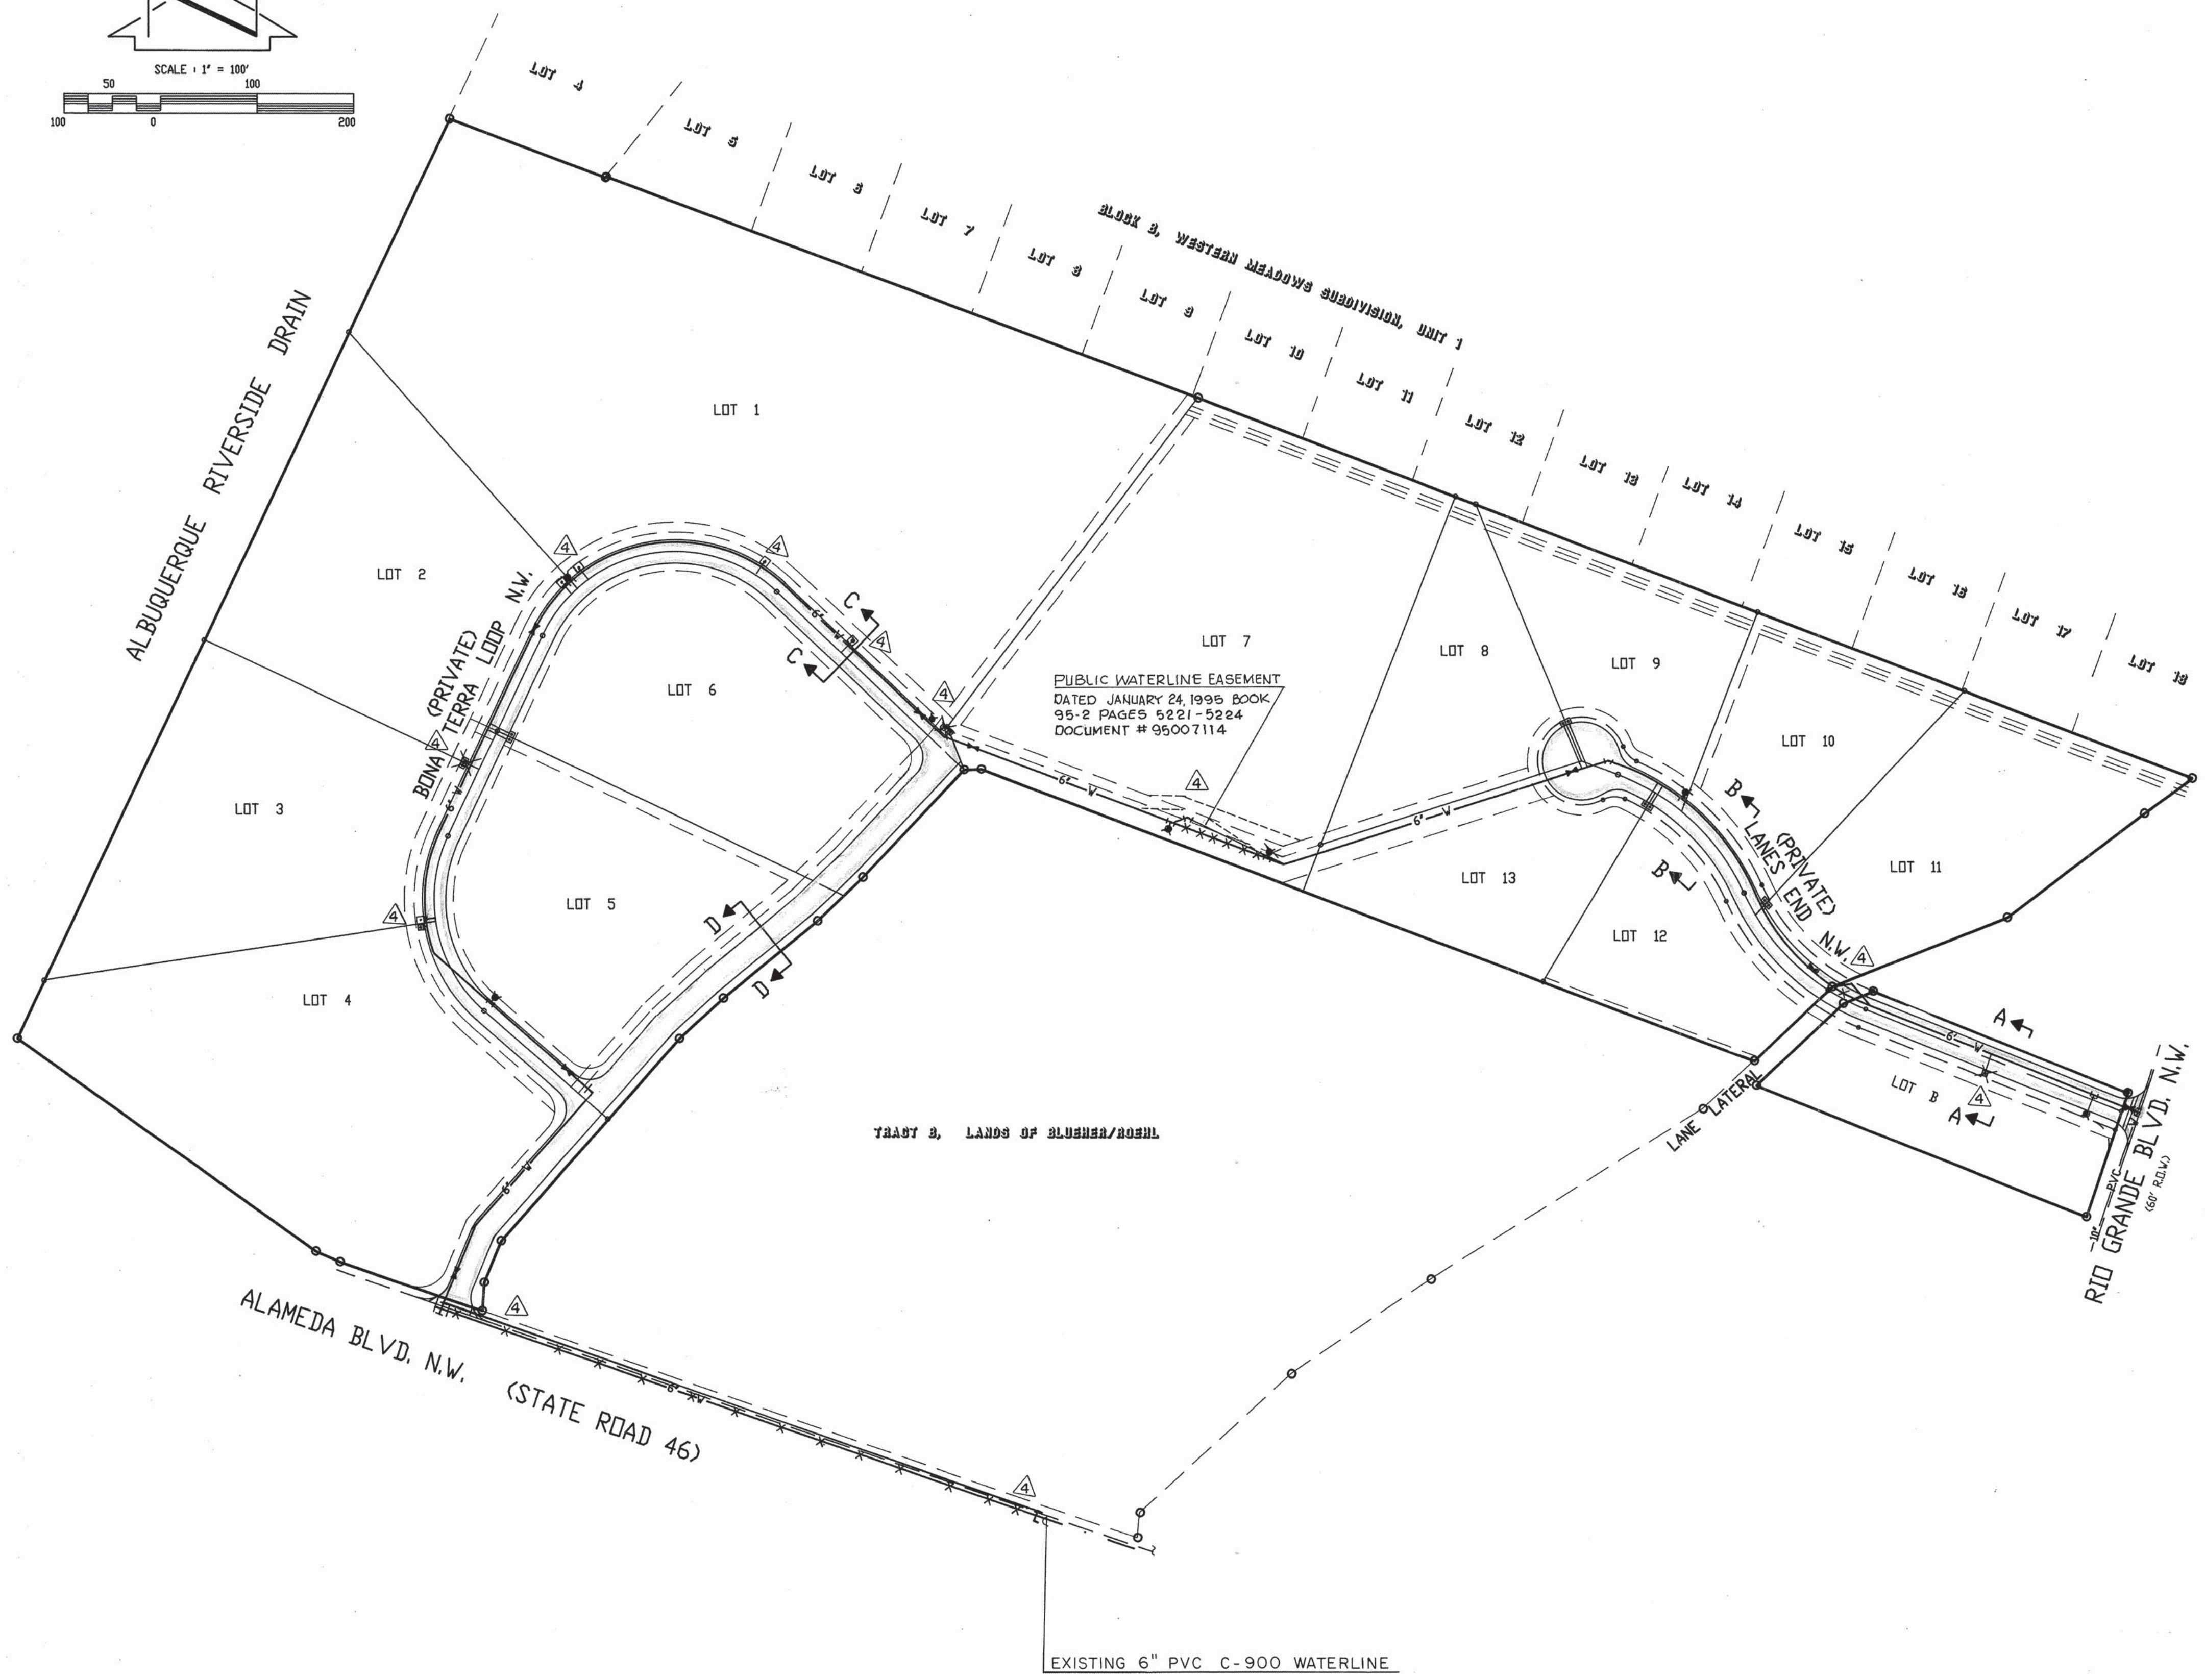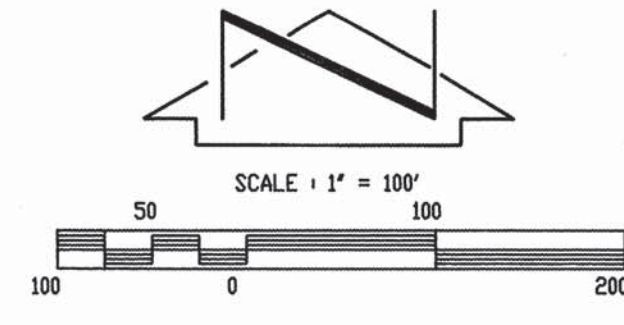

RECORD DRAWING

1 2 3 4 5 6 7 8 9 10 11 12 13 14 15
26 4910.90 10 10 795

9308224

RECORD DRAWING

I, Jeffrey G. Mortensen, Registered Professional Engineer in the State of New Mexico, do hereby certify that this "as-built" information was obtained by me or under my supervision and represents the "as-built" conditions of this project, and is true and correct to the best of my knowledge and belief. All vertical and horizontal dimensions should be field verified prior to use on future projects.


Jeffrey G. Mortensen
JEFFREY G. MORTENSEN
NEW MEXICO
REGISTERED PROFESSIONAL ENGINEER
EXPIRATION DATE 04-13-95
N.M.P.E. No. 8547

CITY OF ALBUQUERQUE PUBLIC WORKS DEPARTMENT ENGINEERING GROUP					
TITLE: BONA TERRA FARMS SITE PLAN					
APPROVALS	ENGINEER	DATE	APPROVALS	ENGINEER	DATE
DRC CHAIRMAN	<i>B.G. Carls</i>	6-28-94	WATER	<i>R.W. Kane</i>	6-3-94
TRANSPORTATION	<i>W.A. Cho</i>	6-03-94	WASTE WATER	<i>R.W. Kane</i>	6-3-94
HYDROLOGY	<i>W.A. Cho</i>	6-03-94	BCPWD	<i>W.A. Cho</i>	5-31-94
PROJECT NO.	4910.90	MAP NO.	B-15	SHEET	7 OF 16

SURVEY INFORMATION			BENCH MARKS		AS BUILT INFORMATION	
FIELD NOTES					HYDRO SYSTEMS	
NO.	BY	DATE			CONTRACTOR	DATE
			C.D.A. BENCHMARK "2-BIG" A SQUARE, ' ', CHISELED ON THE EASTERN CONCRETE		APPROVED BY	DATE
			VINGWALL OF THE CANAL CROSSING LOCATED ON THE EAST SIDE OF RIO GRANDE		INSPECTOR'S	DATE
			BLVD, 125 FEET NORTH OF THE INTERSECTION WITH WESTERN MEADOWS RD. AT		ACCEPTANCE BY	DATE
			THE CROSSING OF THE LAKE LATERAL IRRIGATION CANAL.		VERIFICATION BY	DATE
			ELEVATION = 4998.24 FEET (M.S.L.D.)		PROCESSED BY	DATE
					MICRO-FILM INFORMATION	
					RECORDED BY	DATE
					NO.	


ENGINEER'S SEAL

Jeffrey G. Mortensen
JEFFREY G. MORTENSEN
NEW MEXICO
REGISTERED PROFESSIONAL ENGINEER
EXPIRATION DATE 04-13-95
N.M.P.E. No. 8547

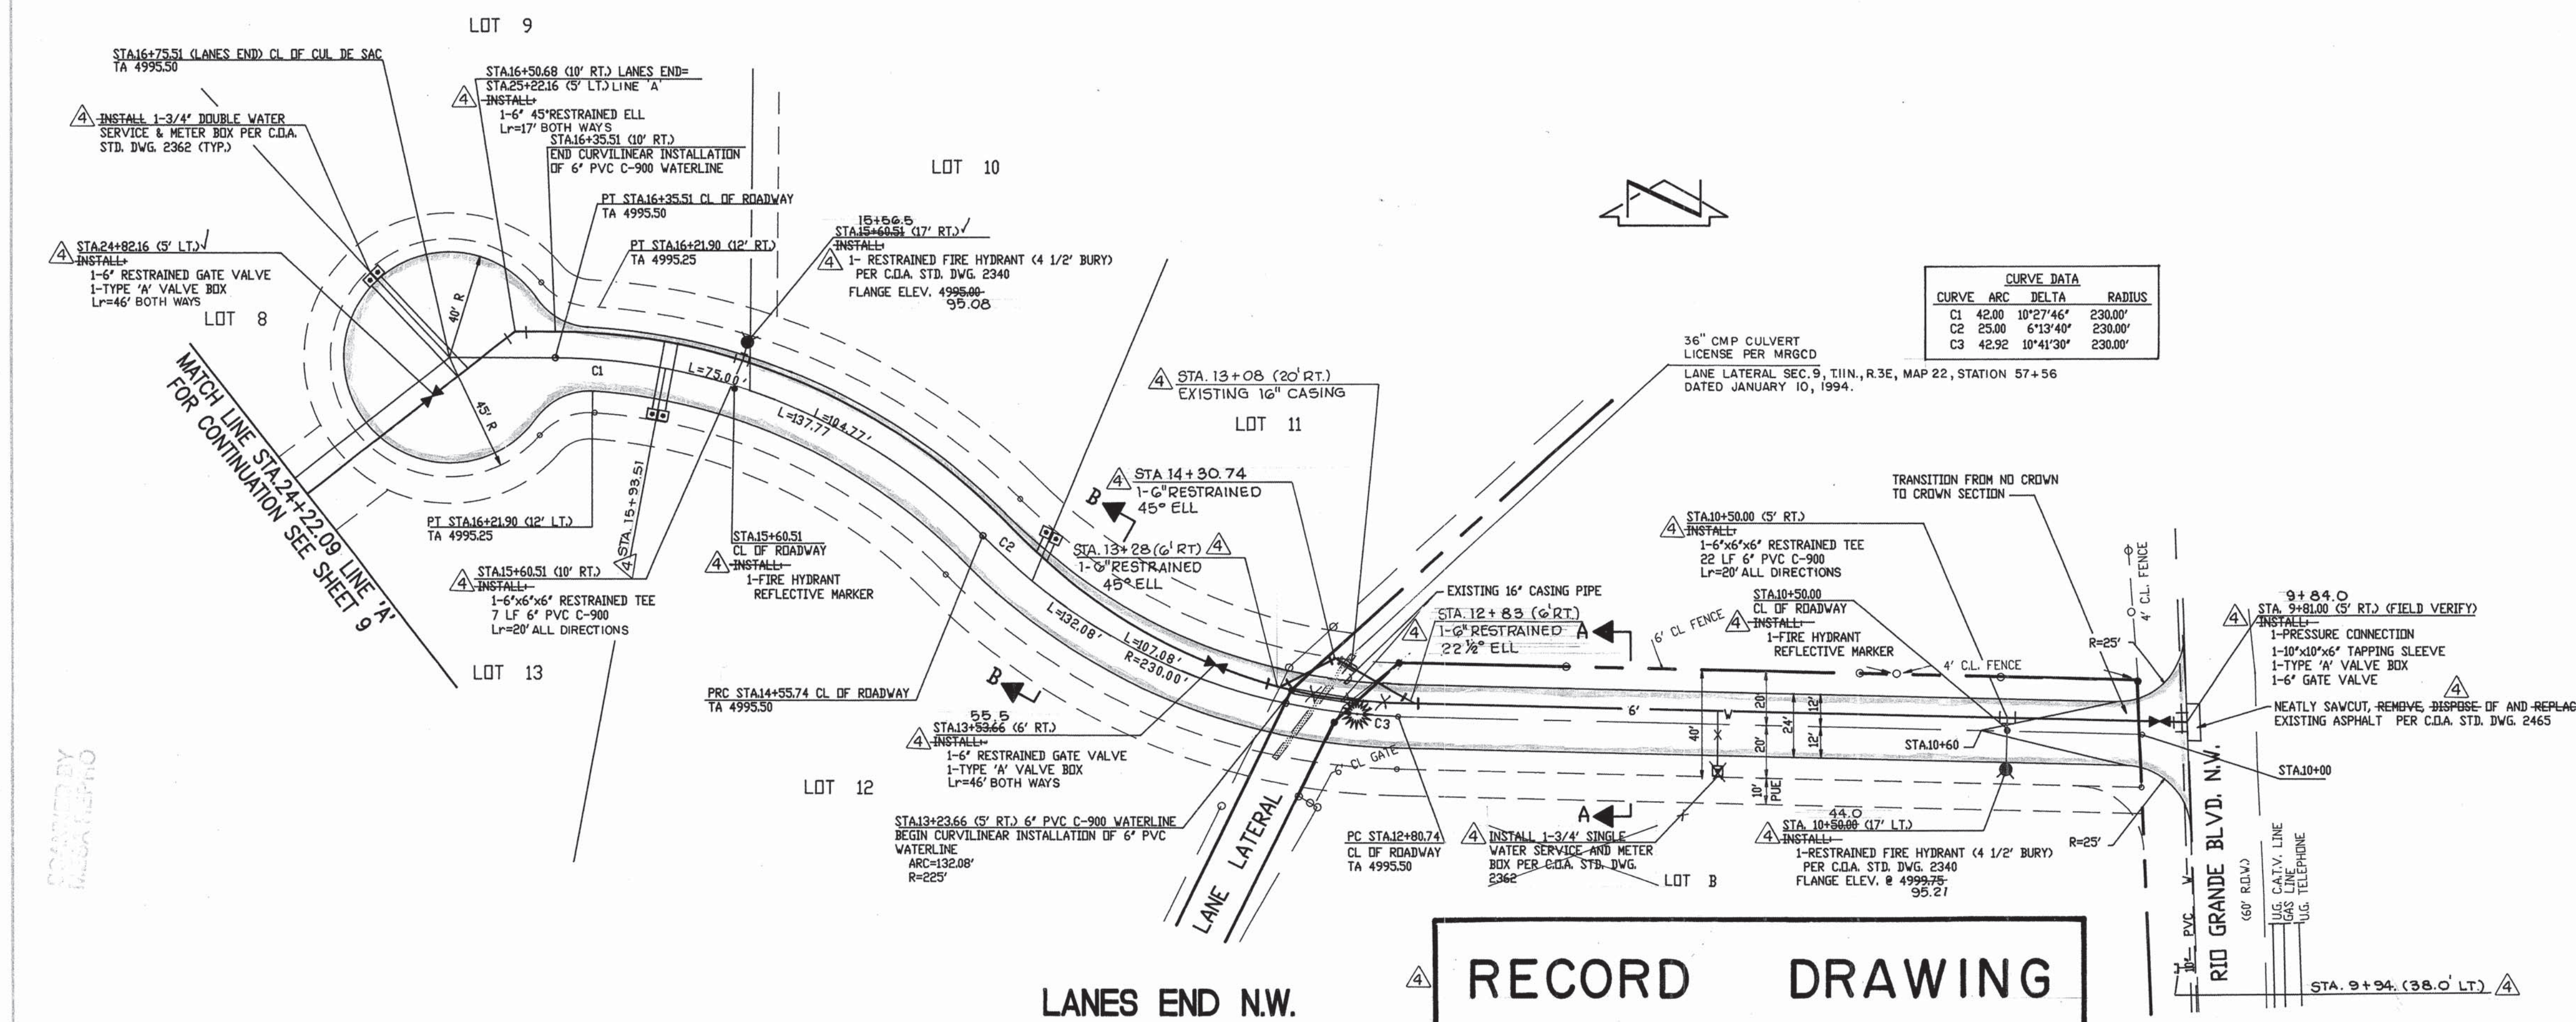

RECORD DRAWING

SCALE:
HORIZONTAL 1" = 40'
VERTICAL 1" = 5'

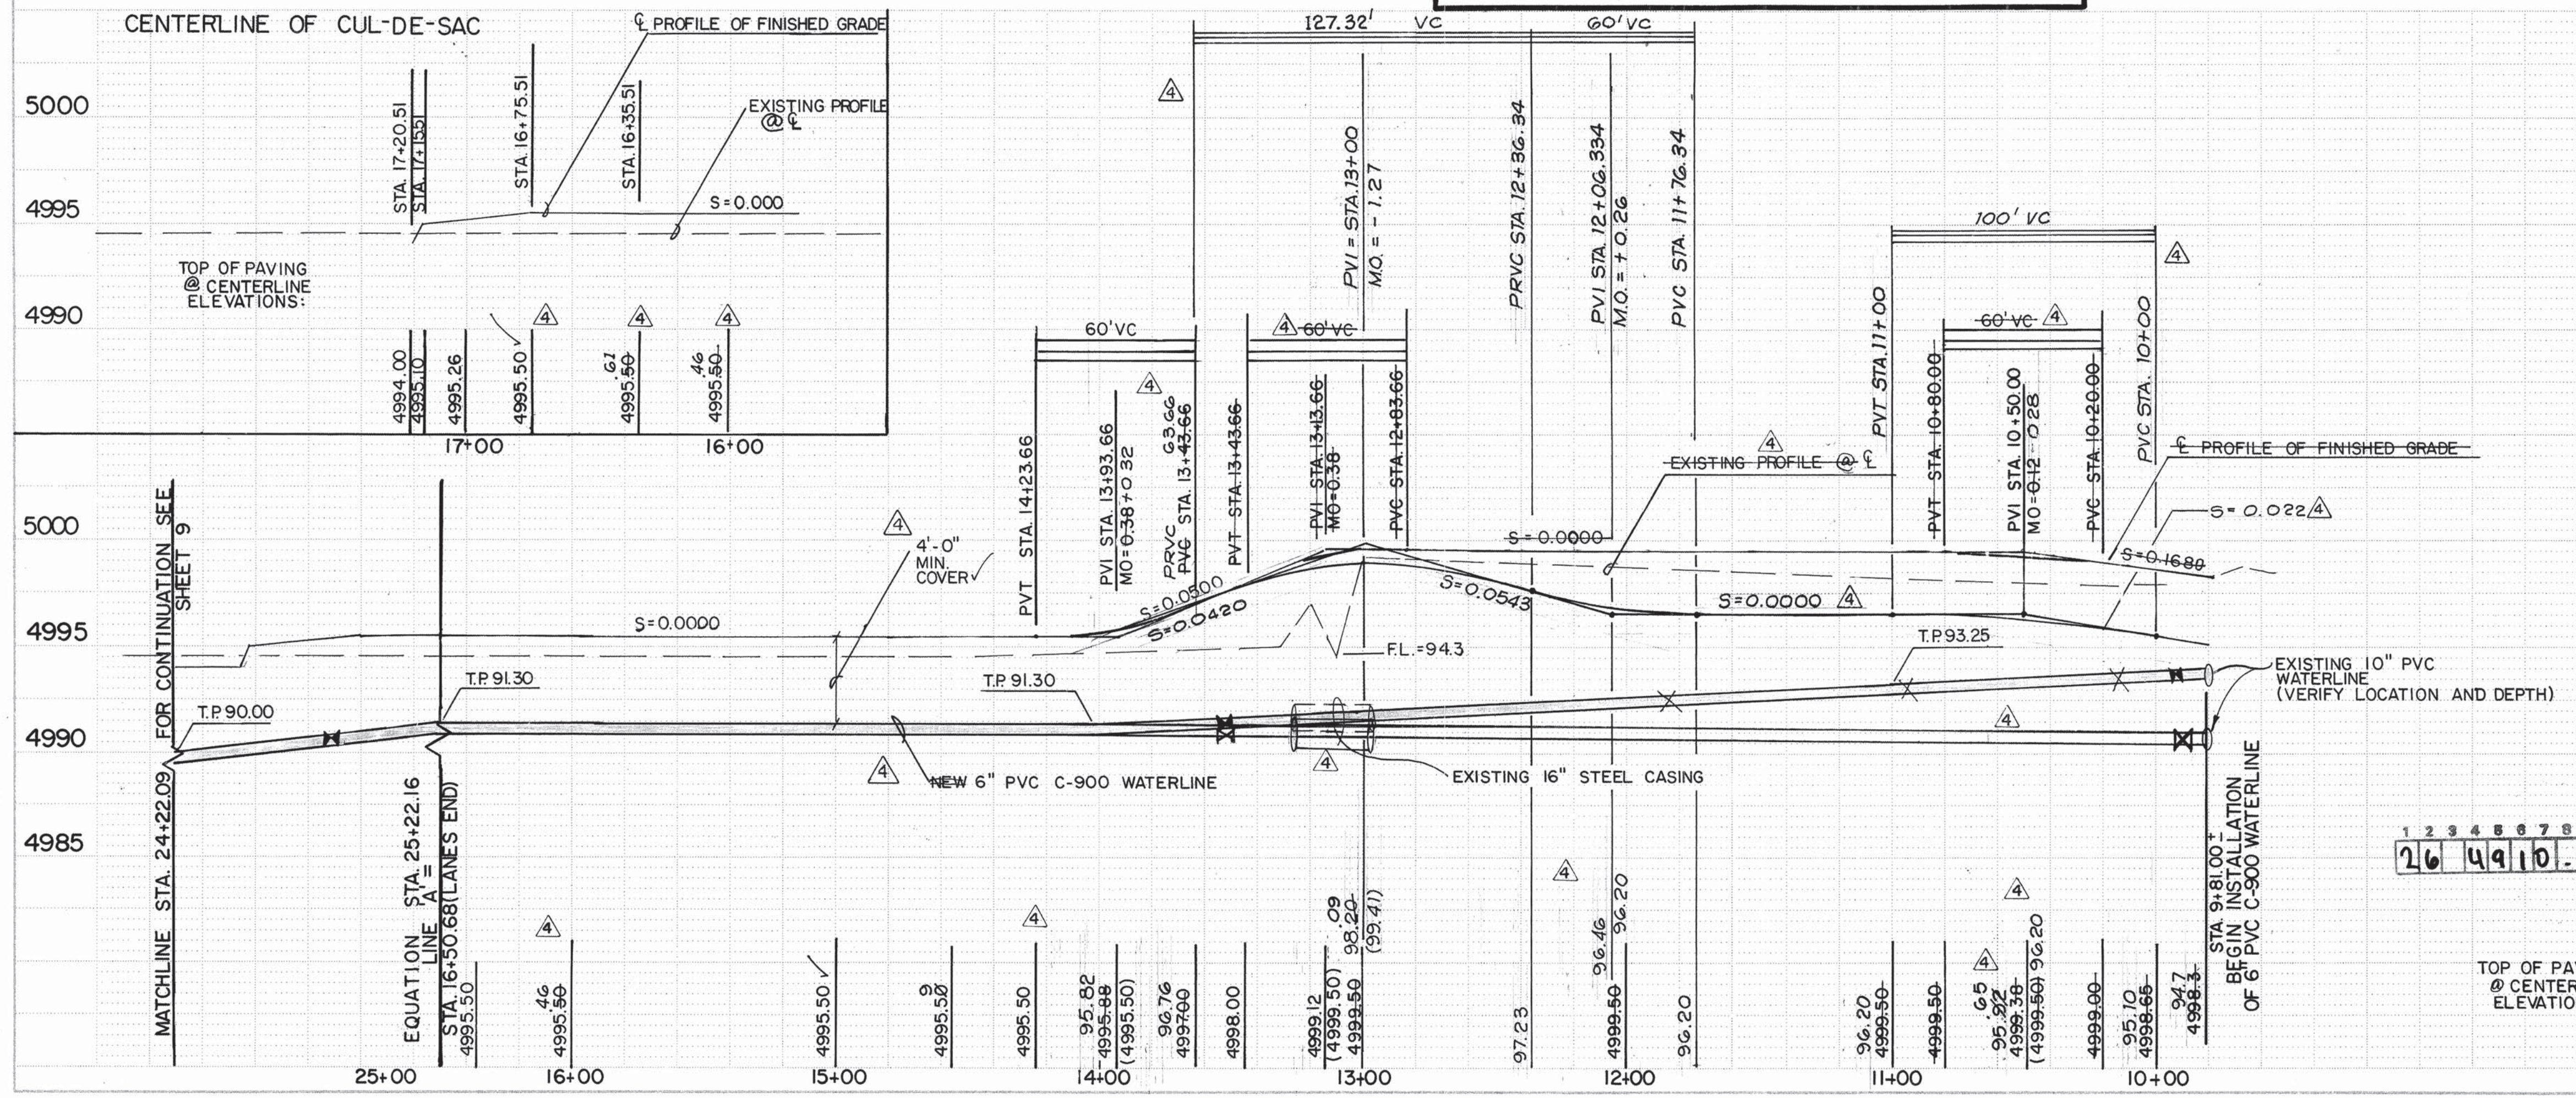

- WATERLINE CONSTRUCTION NOTES:**
- ALL STATIONING IS BASED ON STREET CENTERLINE UNLESS INDICATED OTHERWISE.
 - FOR ALL LINES 12" AND SMALLER, WATER MAIN SHALL BE PVC C-900 PIPE OR AS APPROVED BY THE CITY OF ALBUQUERQUE CITY ENGINEER. FOR ALL LINES 12" AND LARGER, WATER MAIN SHALL BE CONCRETE CYLINDER OR AS APPROVED BY THE CITY OF ALBUQUERQUE CITY ENGINEER. DUCTILE IRON IS AN ACCEPTABLE PIPE MATERIAL IN LIEU OF PVC AND CONCRETE CYLINDER.
 - WATERLINE SHALL HAVE A MINIMUM COVER OF 4'-0" (FINISHED GRADE TO TOP OF PIPE). EXTRA DEPTH TRENCHING, IF REQUIRED, SHALL BE CONSIDERED INCIDENTAL TO CONSTRUCTION, THEREFORE NO SEPARATE PAYMENT WILL BE MADE.
 - ELECTRONIC MARKER DISCS (EMD) SHALL BE INSTALLED IN ACCORDANCE WITH THE STANDARD SPECIFICATION.
 - IN ACCORDANCE WITH SECTION 801 OF THE STANDARD SPECIFICATIONS, METALLIZED DETECTABLE WARNING TAPE SHALL BE INSTALLED 18" ABOVE ALL PVC PIPE INSTALLED ON THIS PROJECT.
 - VALVE STEM AND FIRE HYDRANT EXTENSIONS SHALL BE PROVIDED IN ACCORDANCE WITH THE STANDARD SPECIFICATIONS. THE COST OF EACH EXTENSION SHALL BE CONSIDERED INCIDENTAL TO CONSTRUCTION THEREFORE NO SEPARATE PAYMENT WILL BE MADE.
 - JOINT RESTRAINT SHALL BE CONSIDERED INCIDENTAL TO WATERLINE CONSTRUCTION THEREFORE NO SEPARATE PAYMENT WILL BE MADE.
- STREET PAVING IMPROVEMENTS:**
- ALL SLOPES AS SHOWN ON PROFILES ARE BASED ON STREET CENTERLINE STATIONING EXCEPT CUL-DE-SACS WHERE STATIONING IS ALONG FACE-OF-CURB.
 - WHERE REMOVAL OF EXISTING CURB AND GUTTER, SIDEWALK OR PAVEMENT IS REQUIRED, THE CONTRACTOR SHALL SAWCUT AND/OR REMOVE TO THE NEAREST JOINT. CURB AND GUTTER SHOWN AS EXISTING AND NOT TO BE REMOVED UNDER THIS CONTRACT WHICH IS DAMAGED OR DISPLACED BY THE CONTRACTOR SHALL BE REMOVED AND REPLACED BY THE CONTRACTOR AT THE CONTRACTOR'S EXPENSE.
 - ALL DIMENSIONS OF PAVING AND RETURNS ARE SHOWN TO EDGE OF PAVING.


WATER SERVICE SCHEDULE			
Lot	Station	Type	Size
10/11	14+30.74	Double	3/4"
8/9	As Shown	Double	3/4"
13/12	15+93.51	Double	3/4"
B	161.83	Single	3/4"

RECORD DRAWING

I, Jeffrey G. Mortensen, Registered Professional Engineer in the State of New Mexico, do hereby certify that this "as-built" information was obtained by me or under my supervision and represents the "as-built" conditions of this project, and is true and correct to the best of my knowledge and belief. All vertical and horizontal dimensions should be field verified prior to use on future projects.


Jeffrey G. Mortensen
N.M.P.E. No. 8547
04-18-95

CITY OF ALBUQUERQUE PUBLIC WORKS DEPARTMENT ENGINEERING GROUP			
TITLE	APPROVALS	ENGINEER	DATE
BONA TERRA FARMS LANES END WATERLINE AND PAVING IMPROVEMENTS PLAN AND PROFILE	DRG CHAIRMAN	B.G. Soderberg	6-28-94
	TRANSPORTATION	N.A. RHO	6-03-94
	HYDROLOGY	N.A. RHO	6-03-94
		BCPWD	
		John Calogian	5-31-94

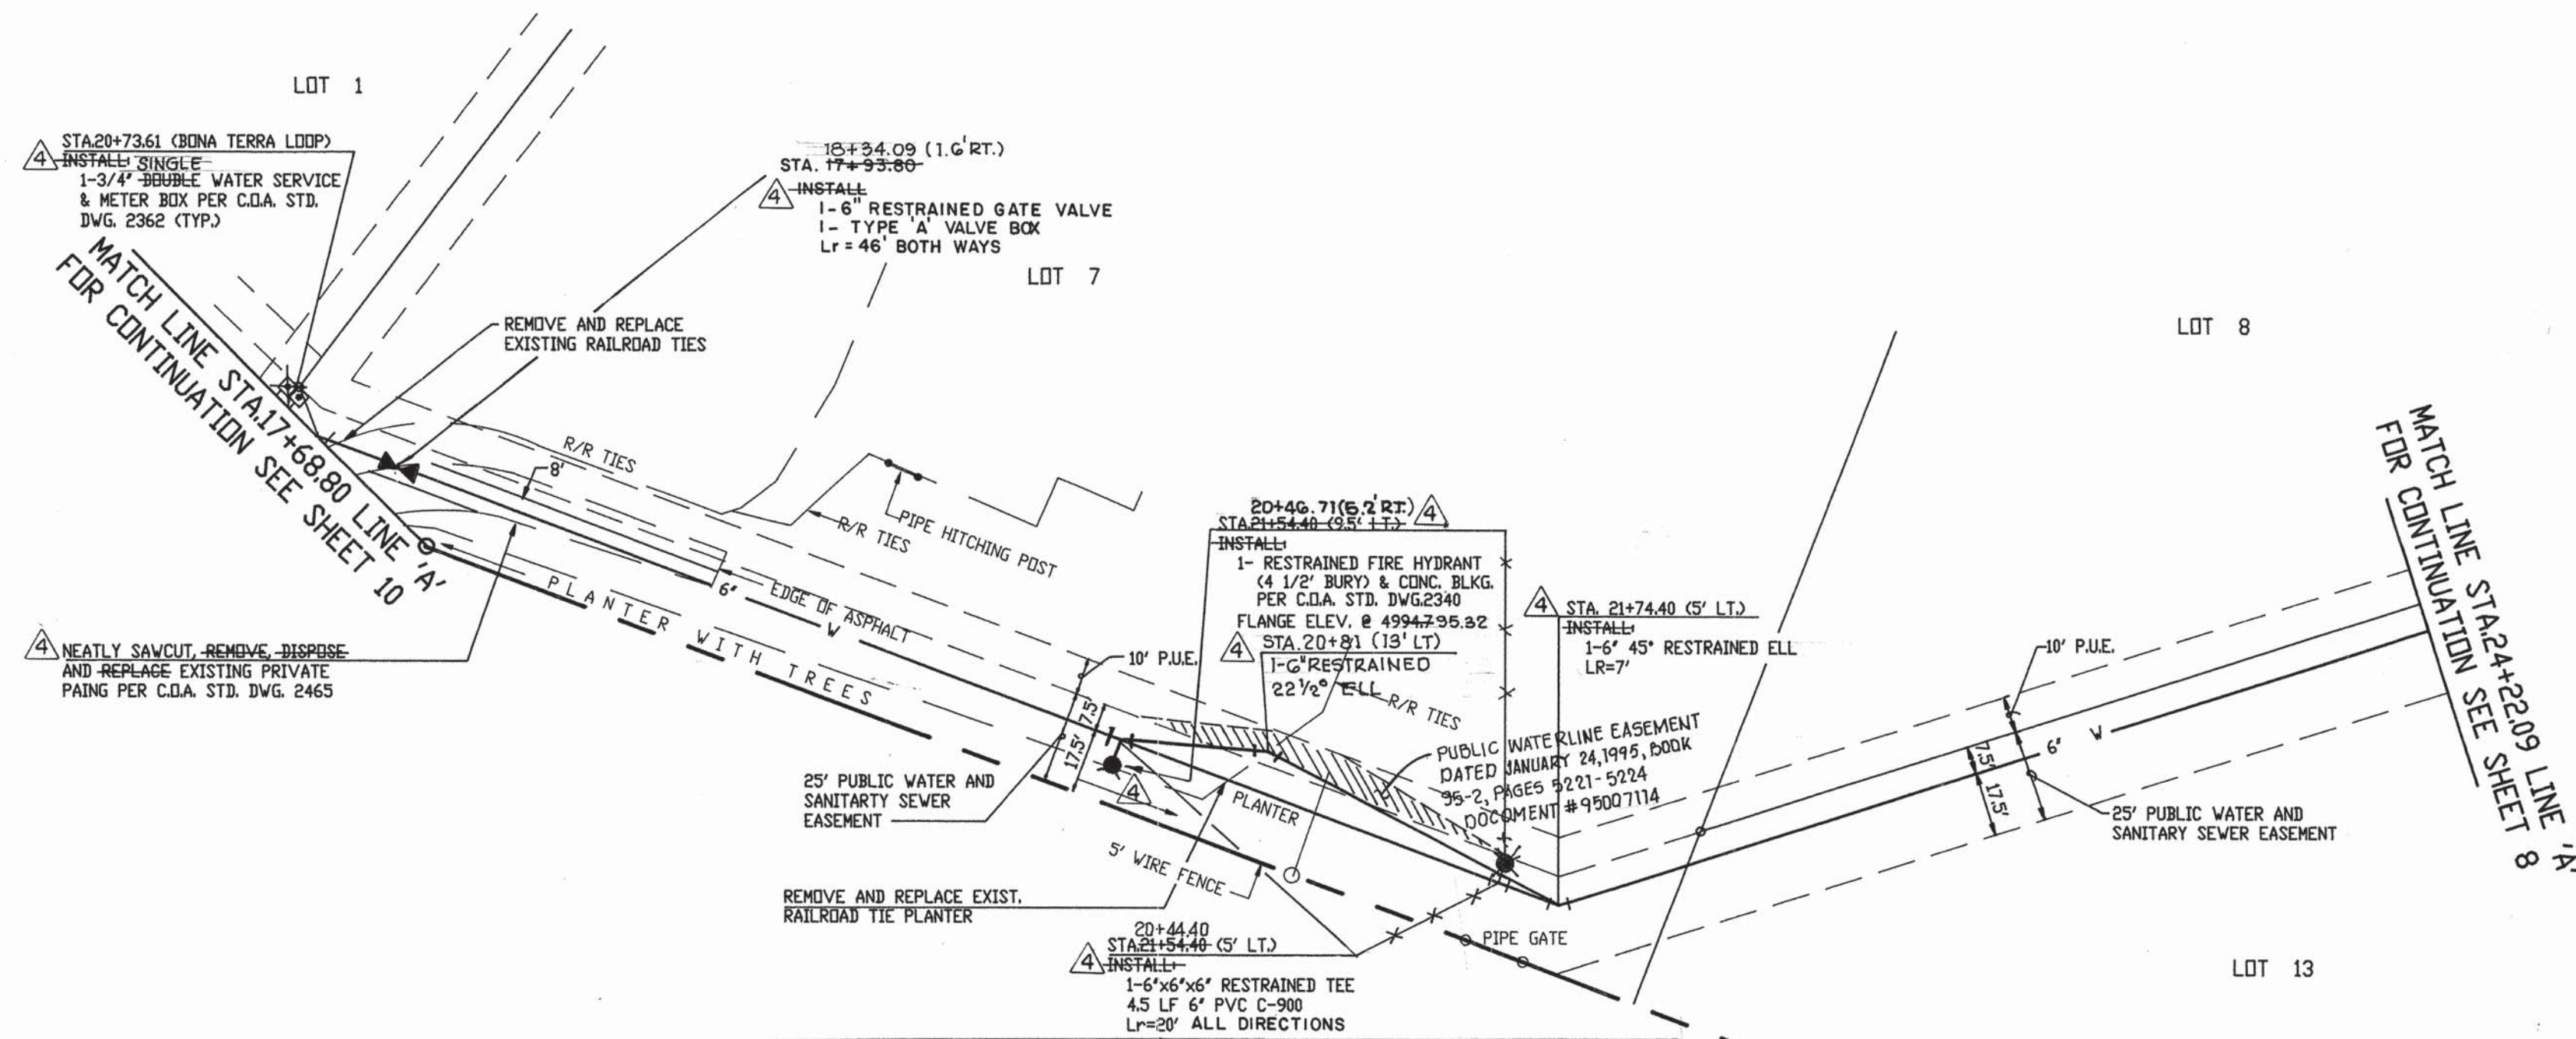

RECORD DRAWING
LINE 'A'

SCALE:
HORIZONTAL 1" = 40'
VERTICAL 1" = 5'

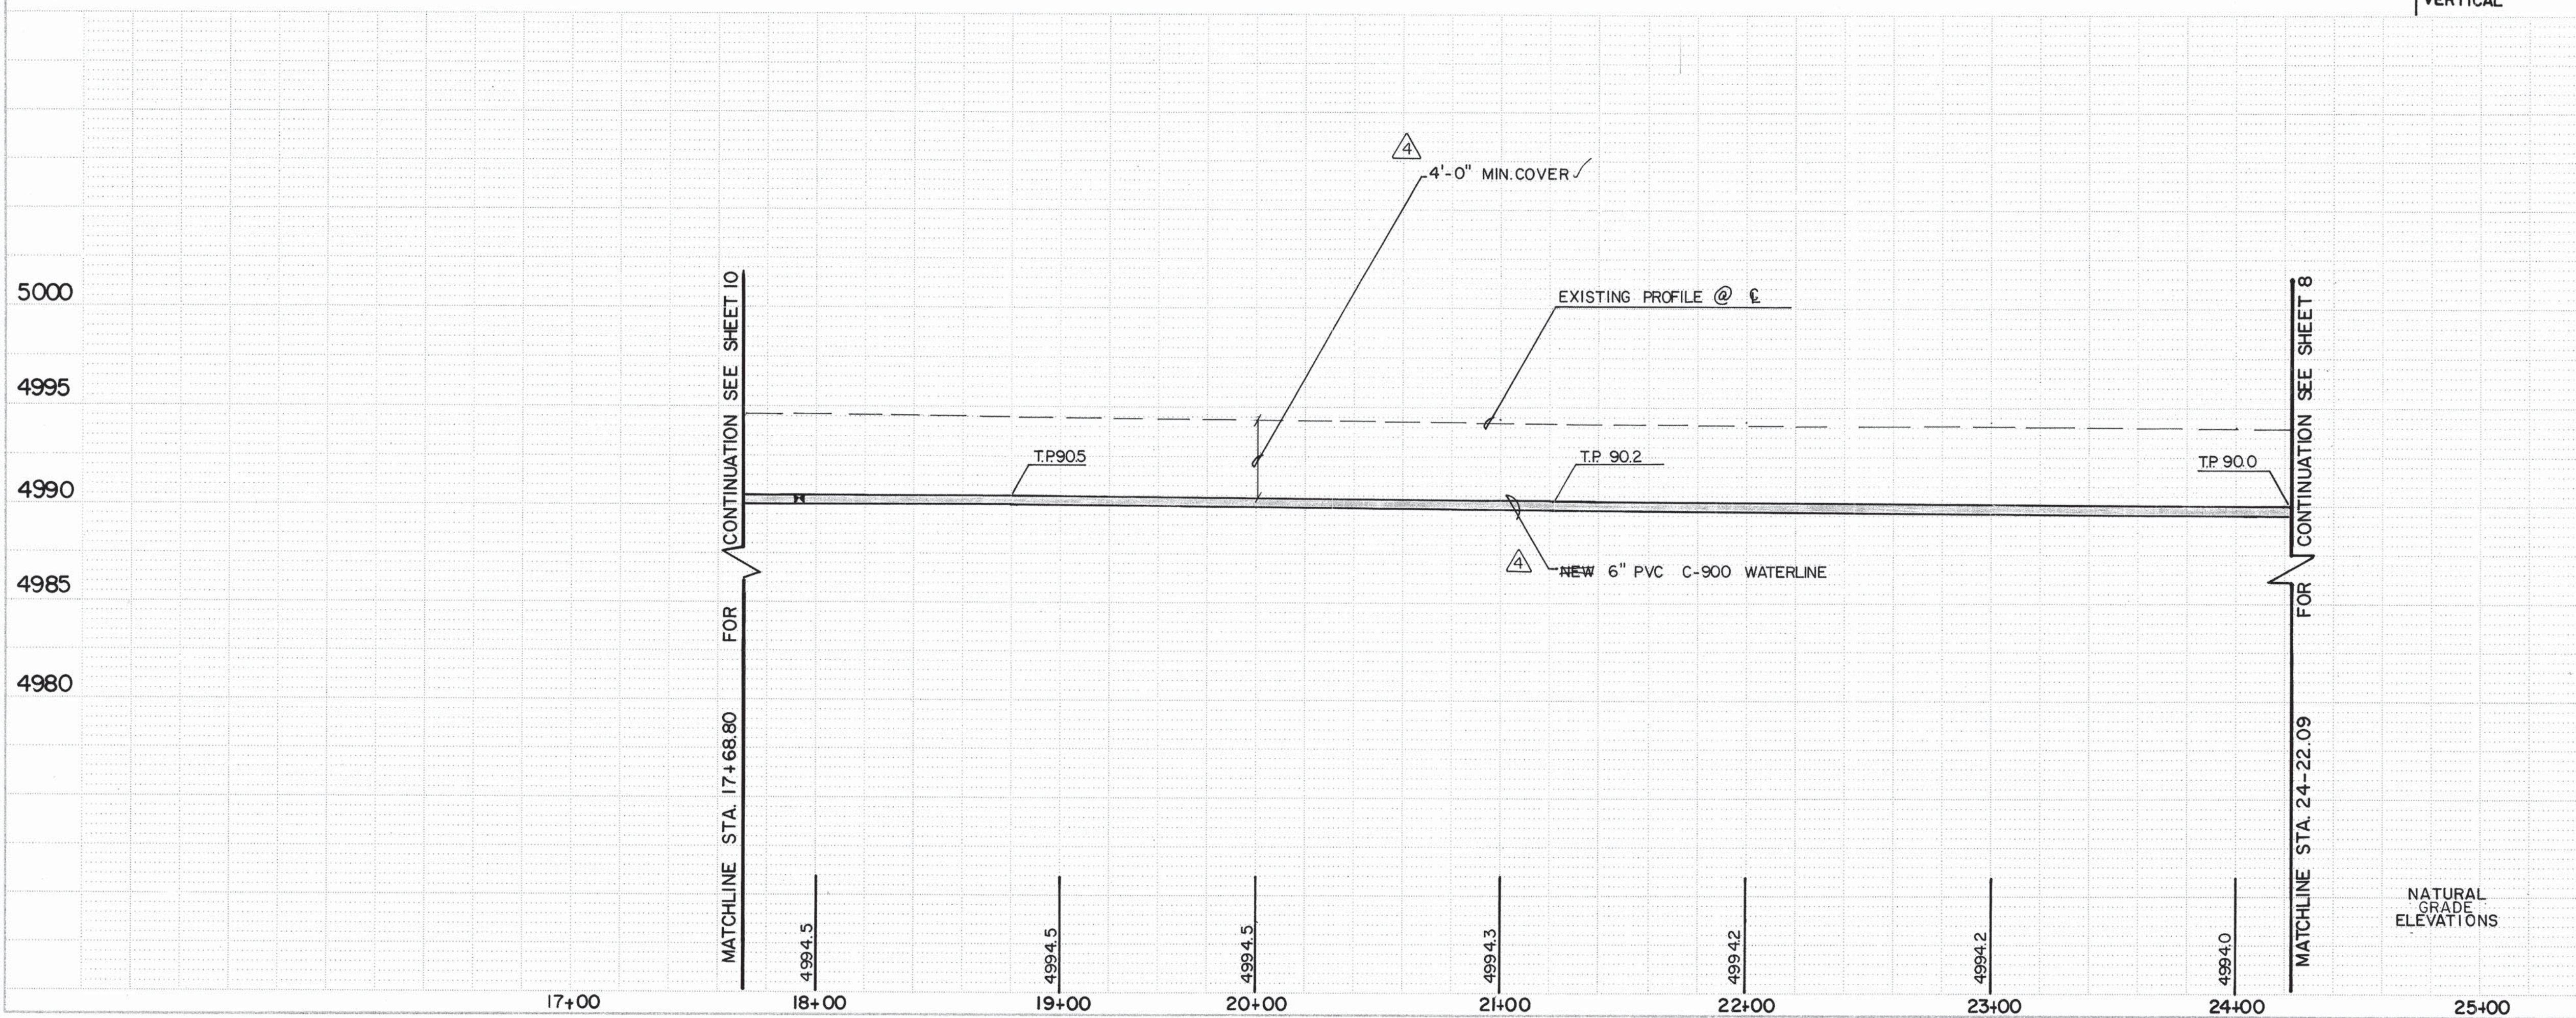

- WATERLINE CONSTRUCTION NOTES:**
1. ALL STATIONING IS BASED ON STREET CENTERLINE UNLESS INDICATED OTHERWISE.
 2. FOR ALL LINES 12" AND SMALLER, WATER MAIN SHALL BE PVC C-900 PIPE OR AS APPROVED BY THE CITY OF ALBUQUERQUE CITY ENGINEER. FOR ALL LINES 12" AND LARGER, WATER MAIN SHALL BE CONCRETE CYLINDER OR AS APPROVED BY THE CITY OF ALBUQUERQUE CITY ENGINEER. DUCTILE IRON IS AN ACCEPTABLE PIPE MATERIAL IN LIEU OF PVC AND CONCRETE CYLINDER.
 3. WATERLINE SHALL HAVE A MINIMUM COVER OF 4'-0" (FINISHED GRADE TO TOP OF PIPE). EXTRA DEPTH TRENCHING, IF REQUIRED, SHALL BE CONSIDERED INCIDENTAL TO CONSTRUCTION, THEREFORE, NO SEPARATE PAYMENT WILL BE MADE.
 4. ELECTRONIC MARKER DISCS (EMD) SHALL BE INSTALLED IN ACCORDANCE WITH THE STANDARD SPECIFICATION.
 5. IN ACCORDANCE WITH SECTION 801 OF THE STANDARD SPECIFICATIONS, METALIZED DETECTABLE WARNING TAPE SHALL BE INSTALLED 18" ABOVE ALL PVC PIPE INSTALLED ON THIS PROJECT.
 6. VALVE STEM AND FIRE HYDRANT EXTENSIONS SHALL BE PROVIDED IN ACCORDANCE WITH THE STANDARD SPECIFICATIONS. THE COST OF EACH EXTENSION SHALL BE CONSIDERED INCIDENTAL TO CONSTRUCTION THEREFORE NO SEPARATE PAYMENT WILL BE MADE.
 7. JOINT RESTRAINT SHALL BE CONSIDERED INCIDENTAL TO WATERLINE CONSTRUCTION THEREFORE NO SEPARATE PAYMENT WILL BE MADE.
- STREET PAVING IMPROVEMENTS:**
1. ALL SLOPES AS SHOWN ON PROFILES ARE BASED ON STREET CENTERLINE STATIONING EXCEPT CUL-DE-SACS WHERE STATIONING IS ALONG FACE-OF-CURB.
 2. WHERE REMOVAL OF EXISTING CURB AND GUTTER, SIDEWALK OR PAVEMENT IS REQUIRED, THE CONTRACTOR SHALL SAVICUT AND/OR REMOVE TO THE NEAREST JOINT. CURB AND GUTTER SHOWN AS EXISTING AND NOT TO BE REMOVED UNDER THIS CONTRACT WHICH IS DAMAGED OR DISPLACED BY THE CONTRACTOR SHALL BE REMOVED AND REPLACED BY THE CONTRACTOR AT THE CONTRACTOR'S EXPENSE.
 3. ALL DIMENSIONS OF PAVING AND RETURNS ARE SHOWN TO EDGE OF PAVING.

WATER SERVICE SCHEDULE			
Lot	Station	Type	Size
7/1	As Shown	Double	3/4"

1 2 3 4 5 6 7 8 9 10 11 12 13 14 15
26 49110.900995

RECORD DRAWING

I, Jeffrey G. Mortensen, Registered Professional Engineer in the State of New Mexico, do hereby certify that this "as-built" information was obtained by me or under my supervision and represents the "as-built" conditions of this project, and is true and correct to the best of my knowledge and belief. All vertical and horizontal dimensions should be field verified prior to use on future projects.

Jeffrey G. Mortensen
Professional Engineer
No. 8547


CITY OF ALBUQUERQUE
PUBLIC WORKS DEPARTMENT
ENGINEERING GROUP

TITLE: BONA TERRA FARMS
LINE 'A' WATERLINE IMPROVEMENTS PLAN AND PROFILE

APPROVALS	ENGINEER	DATE	APPROVALS	ENGINEER	DATE
DRC CHAIRMAN	B.G. Bookley	6-28-94	WATER	R.W. Kane	6-3-94
TRANSPORTATION	M.B. RHO	6-03-94	WASTE WATER	R.W. Kane	6-3-94
HYDROLOGY	J.P. NA	6-03-94	BCPWD	Ann Colapinto	5-31-94


PROJECT NO. 4910.90
MAP NO. B-15
SHEET 9 OF 16

AS BUILT INFORMATION		BENCH MARKS		SURVEY INFORMATION		ENGINEER'S SEAL	
CONTRACTOR	HYDRO	CONTRACTOR	CHISELED	NO.	DATE	ENGINEER'S SEAL	ENGINEER'S SEAL
WORK BY	INSPECTOR'S	ON THE EASTERN CONCRETE WINGWALL OF THE	DATE	BY	DATE	ENGINEER'S SEAL	ENGINEER'S SEAL
DATE	DATE	CANAL CROSSING LOCATED ON THE EAST SIDE OF	DATE	DATE	DATE	ENGINEER'S SEAL	ENGINEER'S SEAL
DATE	DATE	RIO GRANDE BLVD. 125 FEET NORTH OF THE	DATE	DATE	DATE	ENGINEER'S SEAL	ENGINEER'S SEAL
DATE	DATE	INTERSECTION WITH WESTERN MEADOWS RD. AT	DATE	DATE	DATE	ENGINEER'S SEAL	ENGINEER'S SEAL
DATE	DATE	THE CROSSING OF THE LANE LATERAL IRRIGATION	DATE	DATE	DATE	ENGINEER'S SEAL	ENGINEER'S SEAL
DATE	DATE	CANAL	DATE	DATE	DATE	ENGINEER'S SEAL	ENGINEER'S SEAL
DATE	DATE	ELEVATION = 4998.24 FEET (MSLD)	DATE	DATE	DATE	ENGINEER'S SEAL	ENGINEER'S SEAL

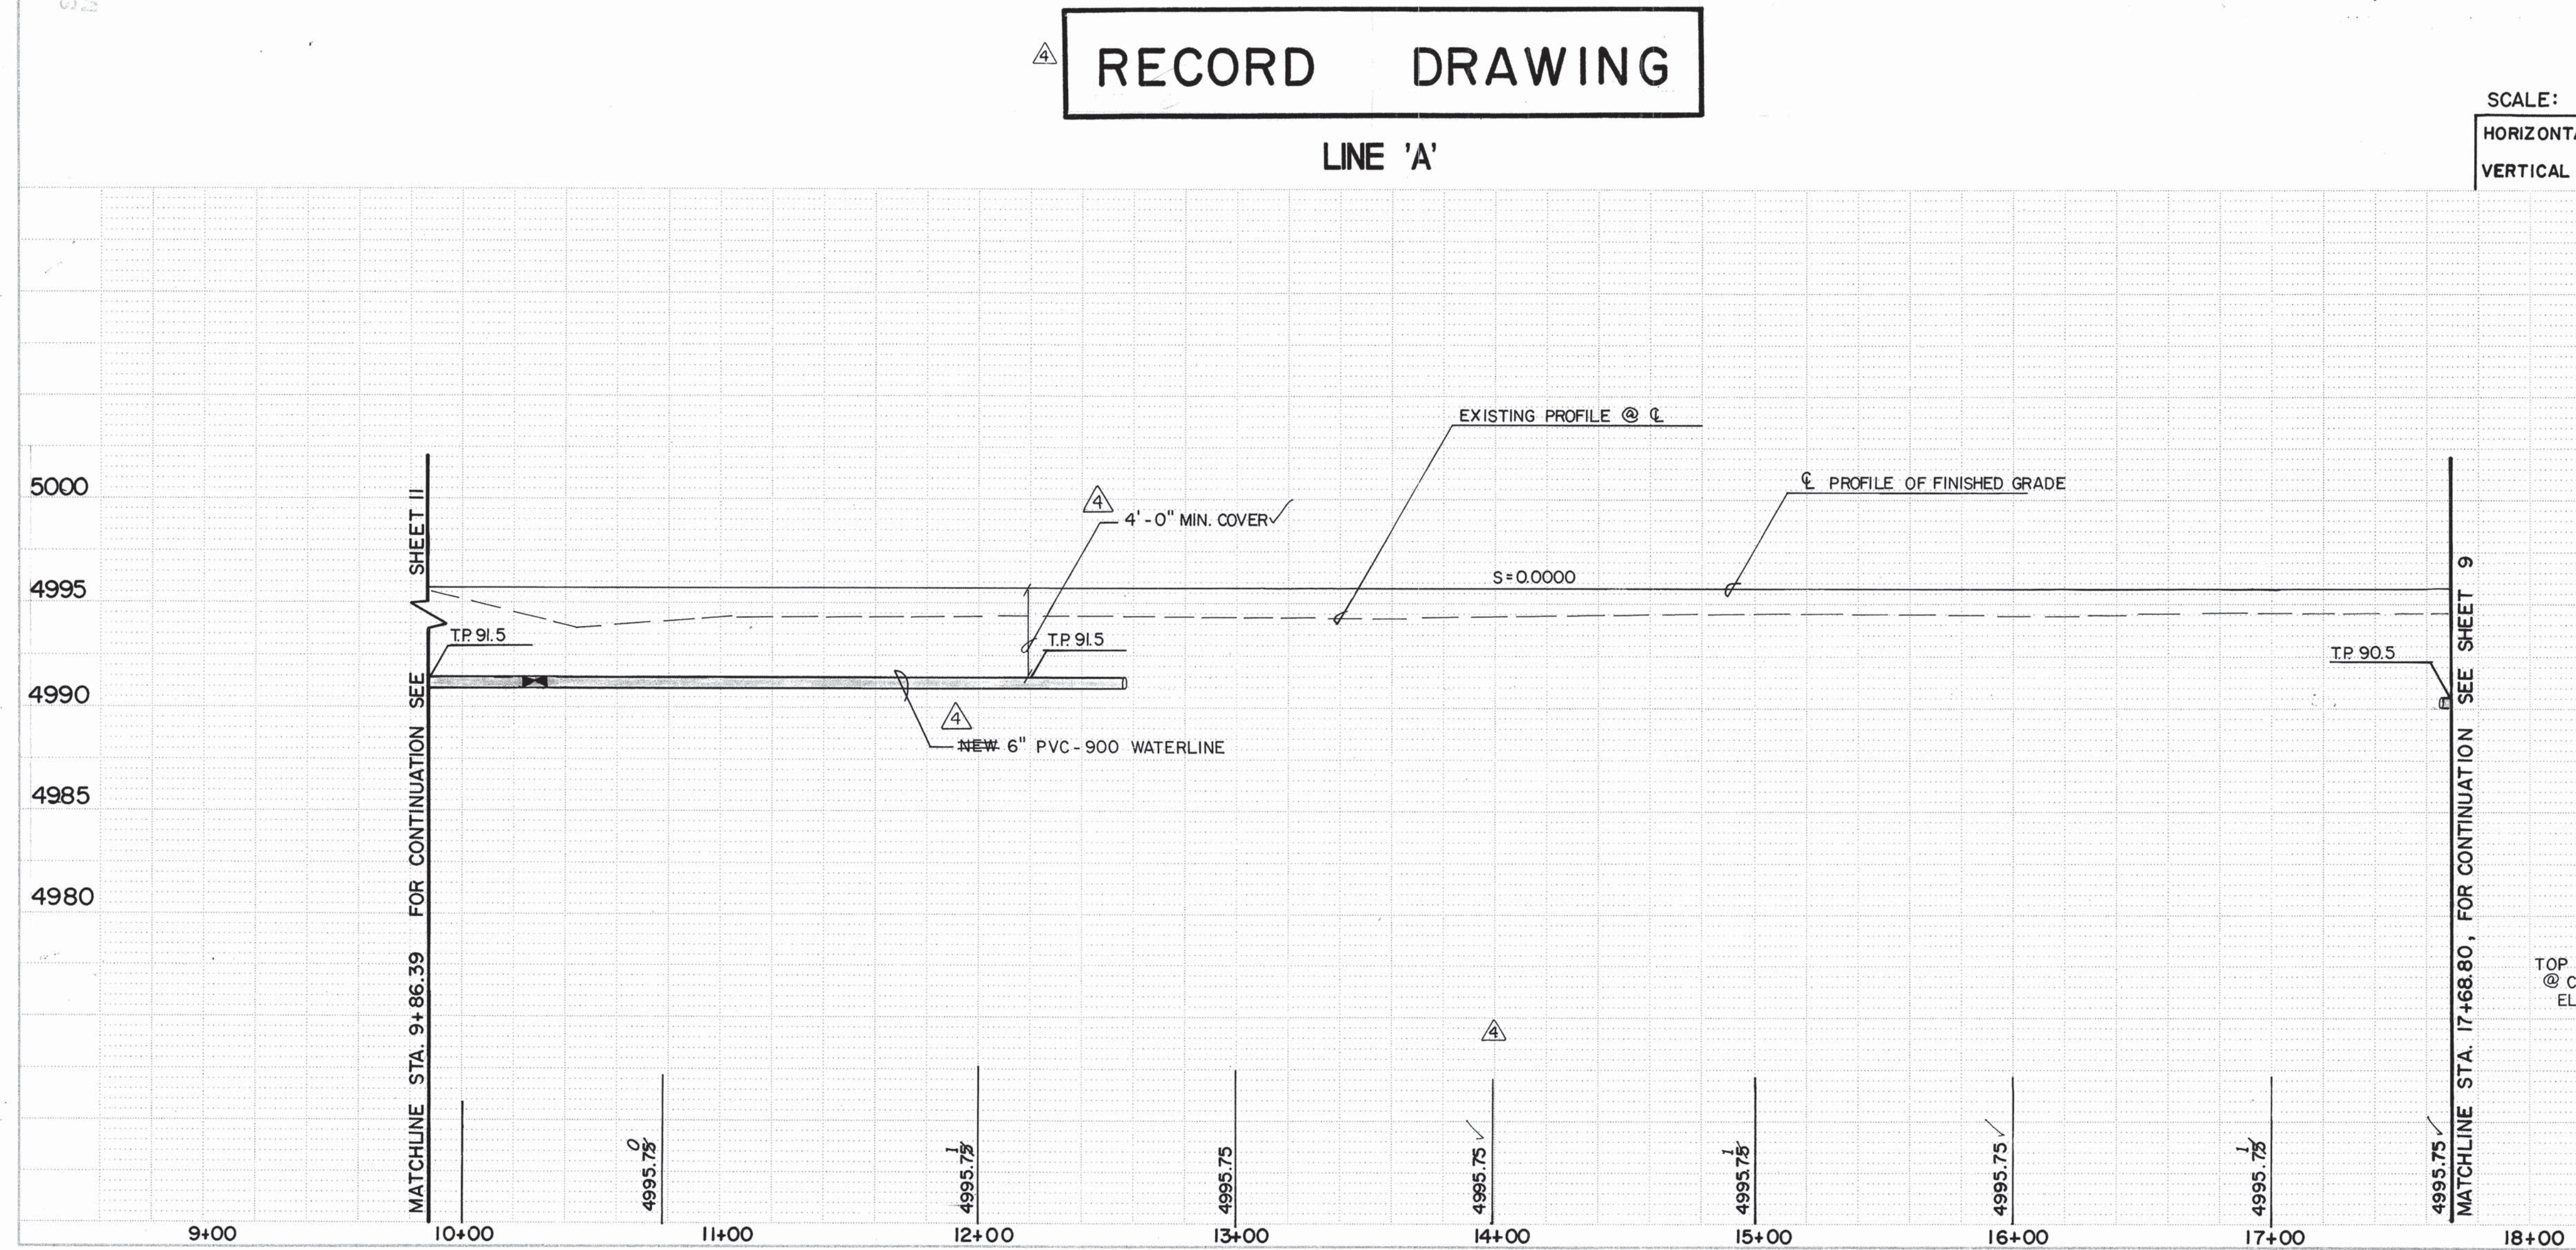

1. ALL SLOPES AS SHOWN ON PROFILES ARE BASED ON STREET CENTERLINE STATIONING EXCEPT CUL-DE-SACS WHERE STATIONING IS ALONG FACE-OF-CURB.
2. WHERE REMOVAL OF EXISTING CURB AND GUTTER, SIDEWALK OR PAVEMENT IS REQUIRED, THE CONTRACTOR SHALL REMOVE SAWCUT AND/OR REMOVE TO THE NEAREST JOINT. CURB AND GUTTER REMOVED AS EXISTING AND NOT TO BE REMOVED UNDER THIS CONTRACT WHICH IS DAMAGED OR DISPLACED BY THE CONTRACTOR SHALL BE REMOVED AND REPLACED BY THE CONTRACTOR AT THE CONTRACTOR'S EXPENSE.
3. ALL DIMENSIONS OF PAVING AND RETURNS ARE SHOWN TO EDGE OF PAVING.

HORIZONTAL	1" = 40'
VERTICAL	1" = 5'

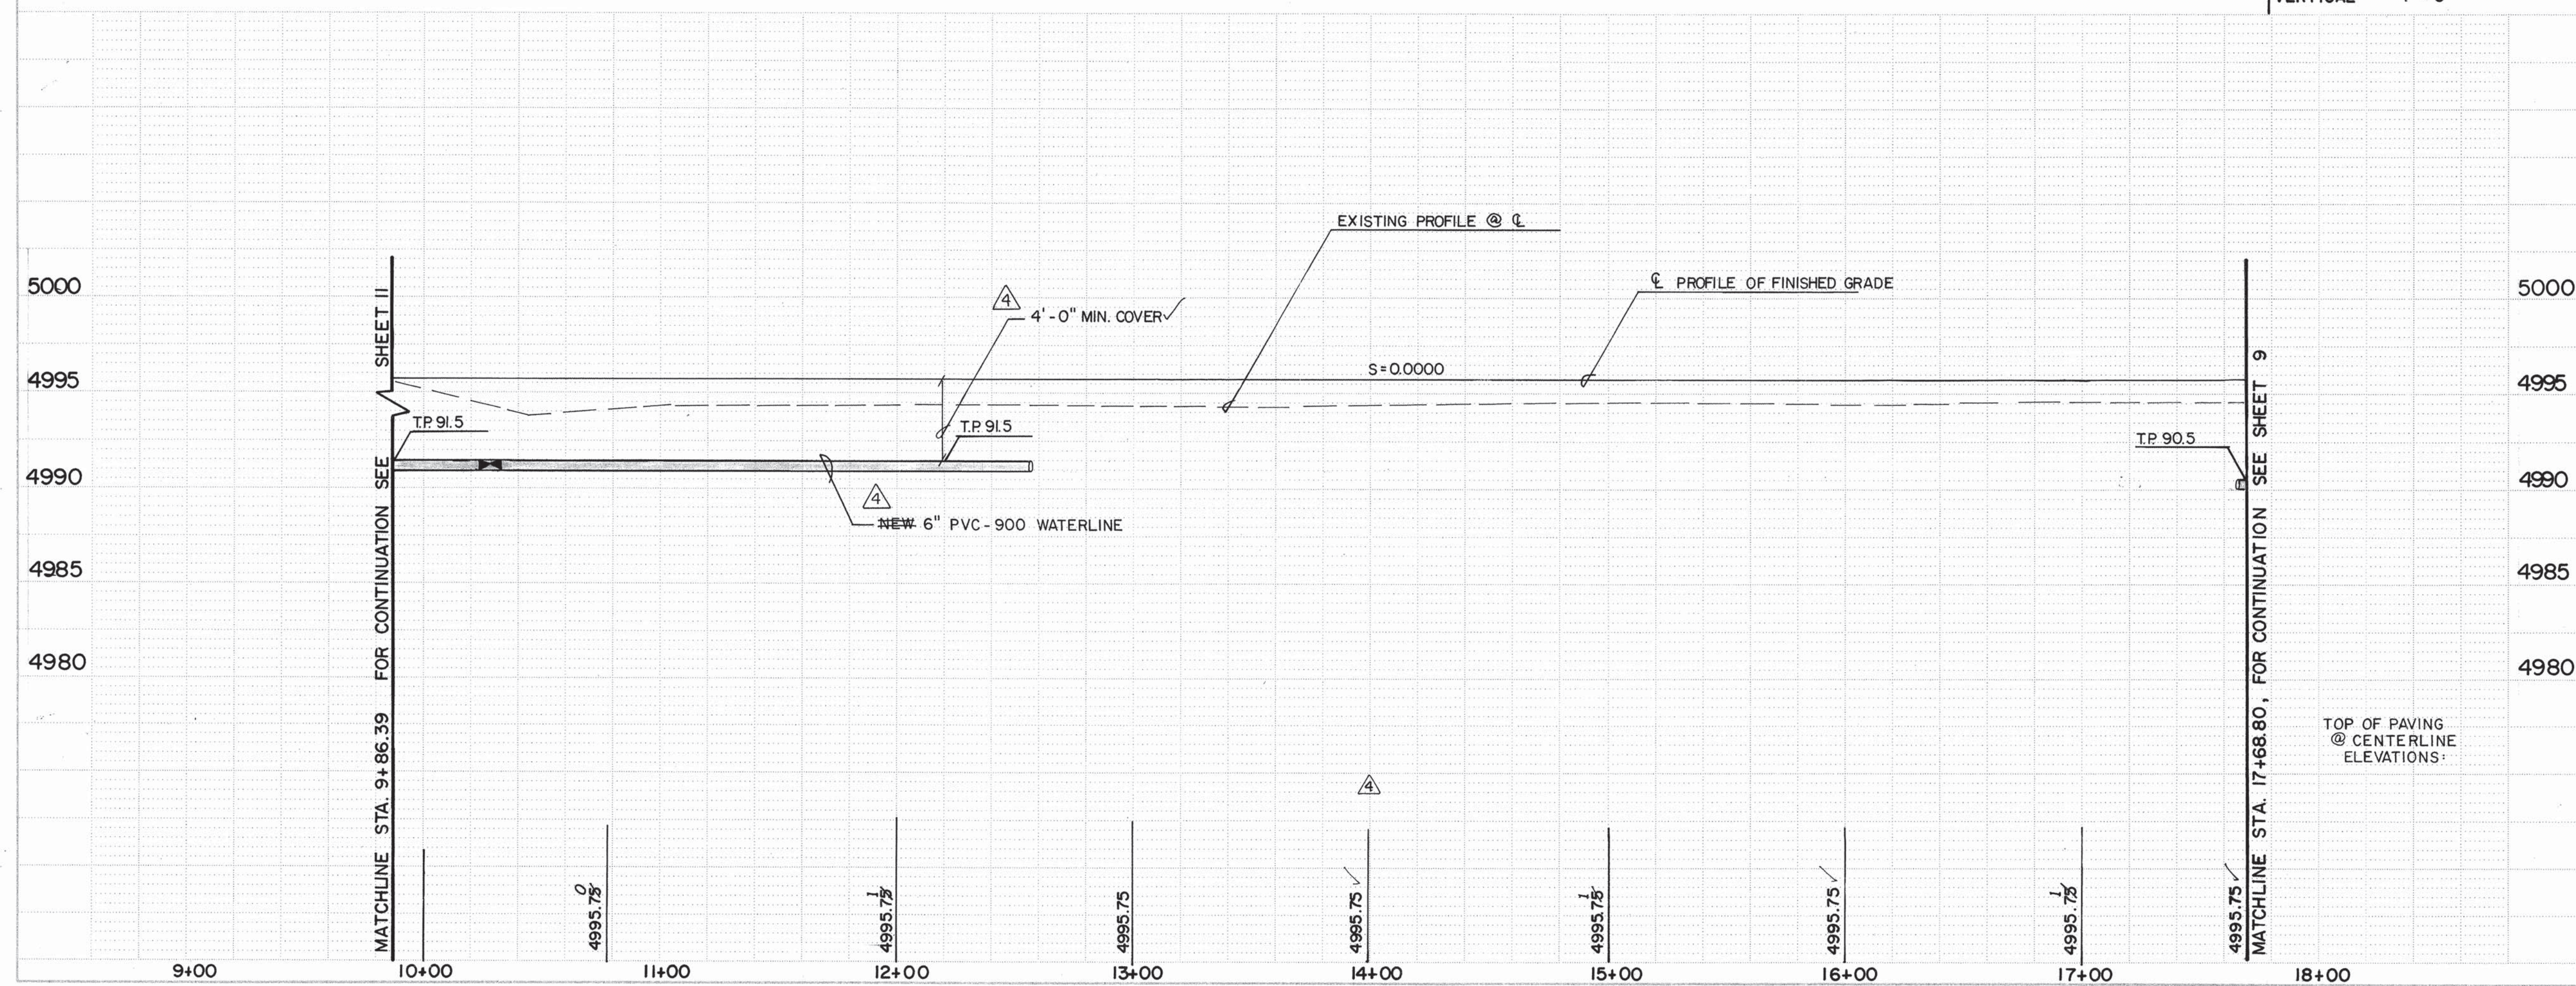


Jeffrey G. Mortensen 04-18-95
NMPK No. 1357
Professional Engineer
State of New Mexico
8547

APPROVALS	ENGINEER	DATE	APPROVALS	ENGINEER	DATE
DRC CHAIRMAN	<i>B.G. Goshaly</i>	<i>6-28-94</i>	WATER	<i>R.W. Kame</i>	<i>6-3-94</i>
TRANSPORTATION	<i>RHA RHO</i>	<i>6-03-94</i>	WASTE WATER	<i>R.W. Kame</i>	<i>6-3-94</i>
HYDROLOGY	<i>RA 2/2</i>	<i>6-13-94</i>	BCWPD	<i>Joson Coleman</i>	<i>5-27-94</i>


PROJECT NO.	4910.90	MAP NO.	B-15	SHEET	10	OF	16
-------------	---------	---------	------	-------	----	----	----

DATE		ENGINEER'S SEAL		SURVEY INFORMATION		BENCH MARKS		AS BUILT INFORMATION	
NO.	DATE	NO.	BY	FIELD	NOTES	NO.	DATE	CONTRACTOR	HYDRO SYSTEMS
AS-BUILT	CERTIFY	J.M.A.	BY					INSPECTORS STATED BY	J.M.A.
NO.	DATE							FIELD CHANGE BY	M.F.D.
REVISIONS								VERIFICATION BY	J.M.A.
DESIGN								CORRECTED BY	M.F.D.
DESIGNED BY	M.F.D.	DATE	3/94					MICRO-FILM INFORMATION	
DRAWN BY	C.J.H./S.G.H.	DATE	4/94					RECORDED BY	DATE
CHECKED BY	J.G.M.	DATE	4/94					NO.	
								C.O.A. BENCHMARK "2-B15". A SQUARE □, CHISELED ON THE EASTERN CONCRETE WINGWALL OF THE CANAL CROSSING. LOCATED ON THE EAST SIDE OF RIO GRANDE BLVD. 125 FEET NORTH OF THE INTERSECTION WITH WESTERN MEADOWS RD. AT THE CROSSING OF THE LANE LATERAL IRRIGATION CANAL.	
								ELEVATION = 4998.24 FEET (MSLD)	

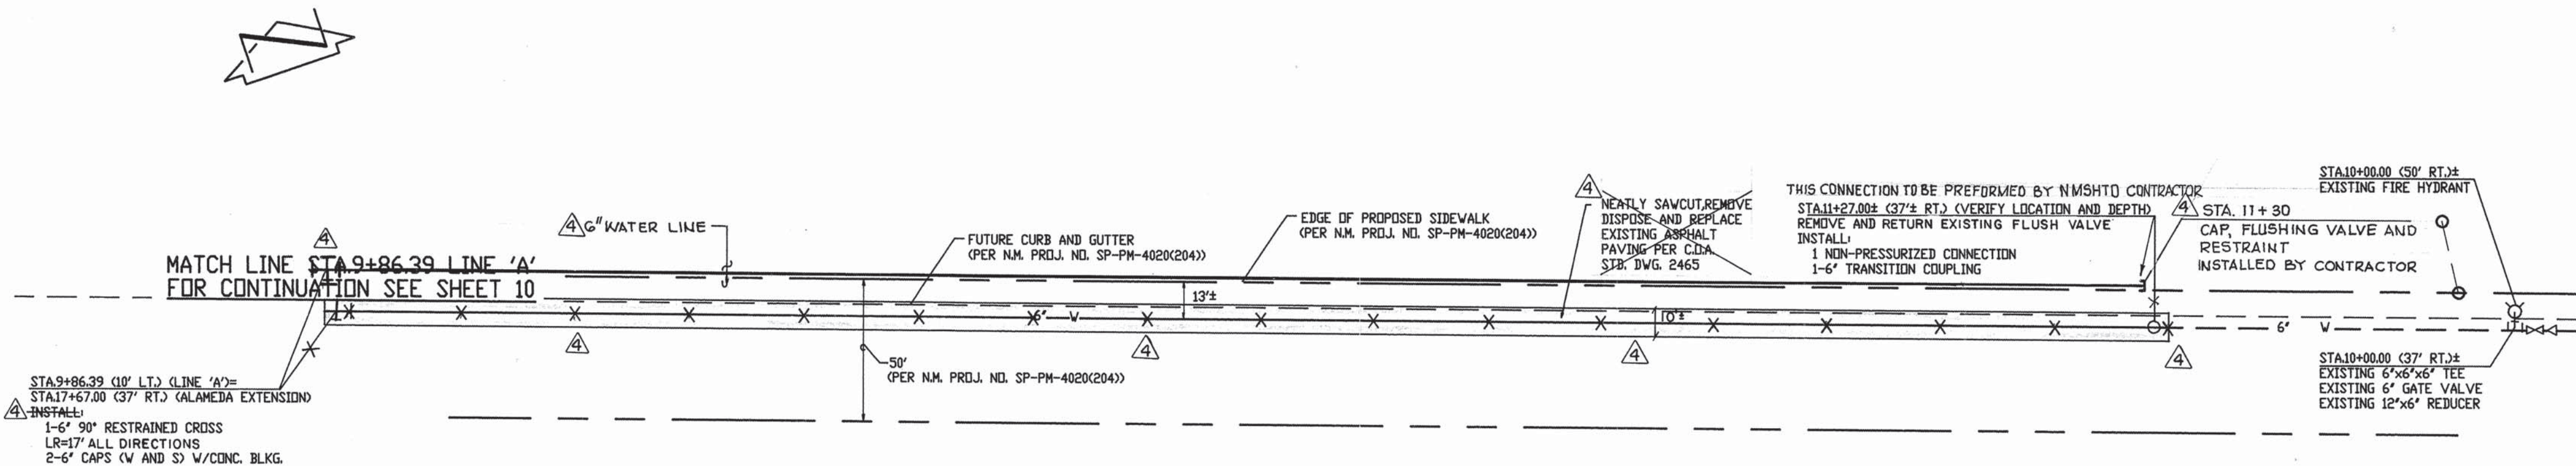

RECORD DRAWING
ALAMEDA BOULEVARD N.W. (STATE ROAD 46)

SCALE:
HORIZONTAL 1" = 40'
VERTICAL 1" = 5'

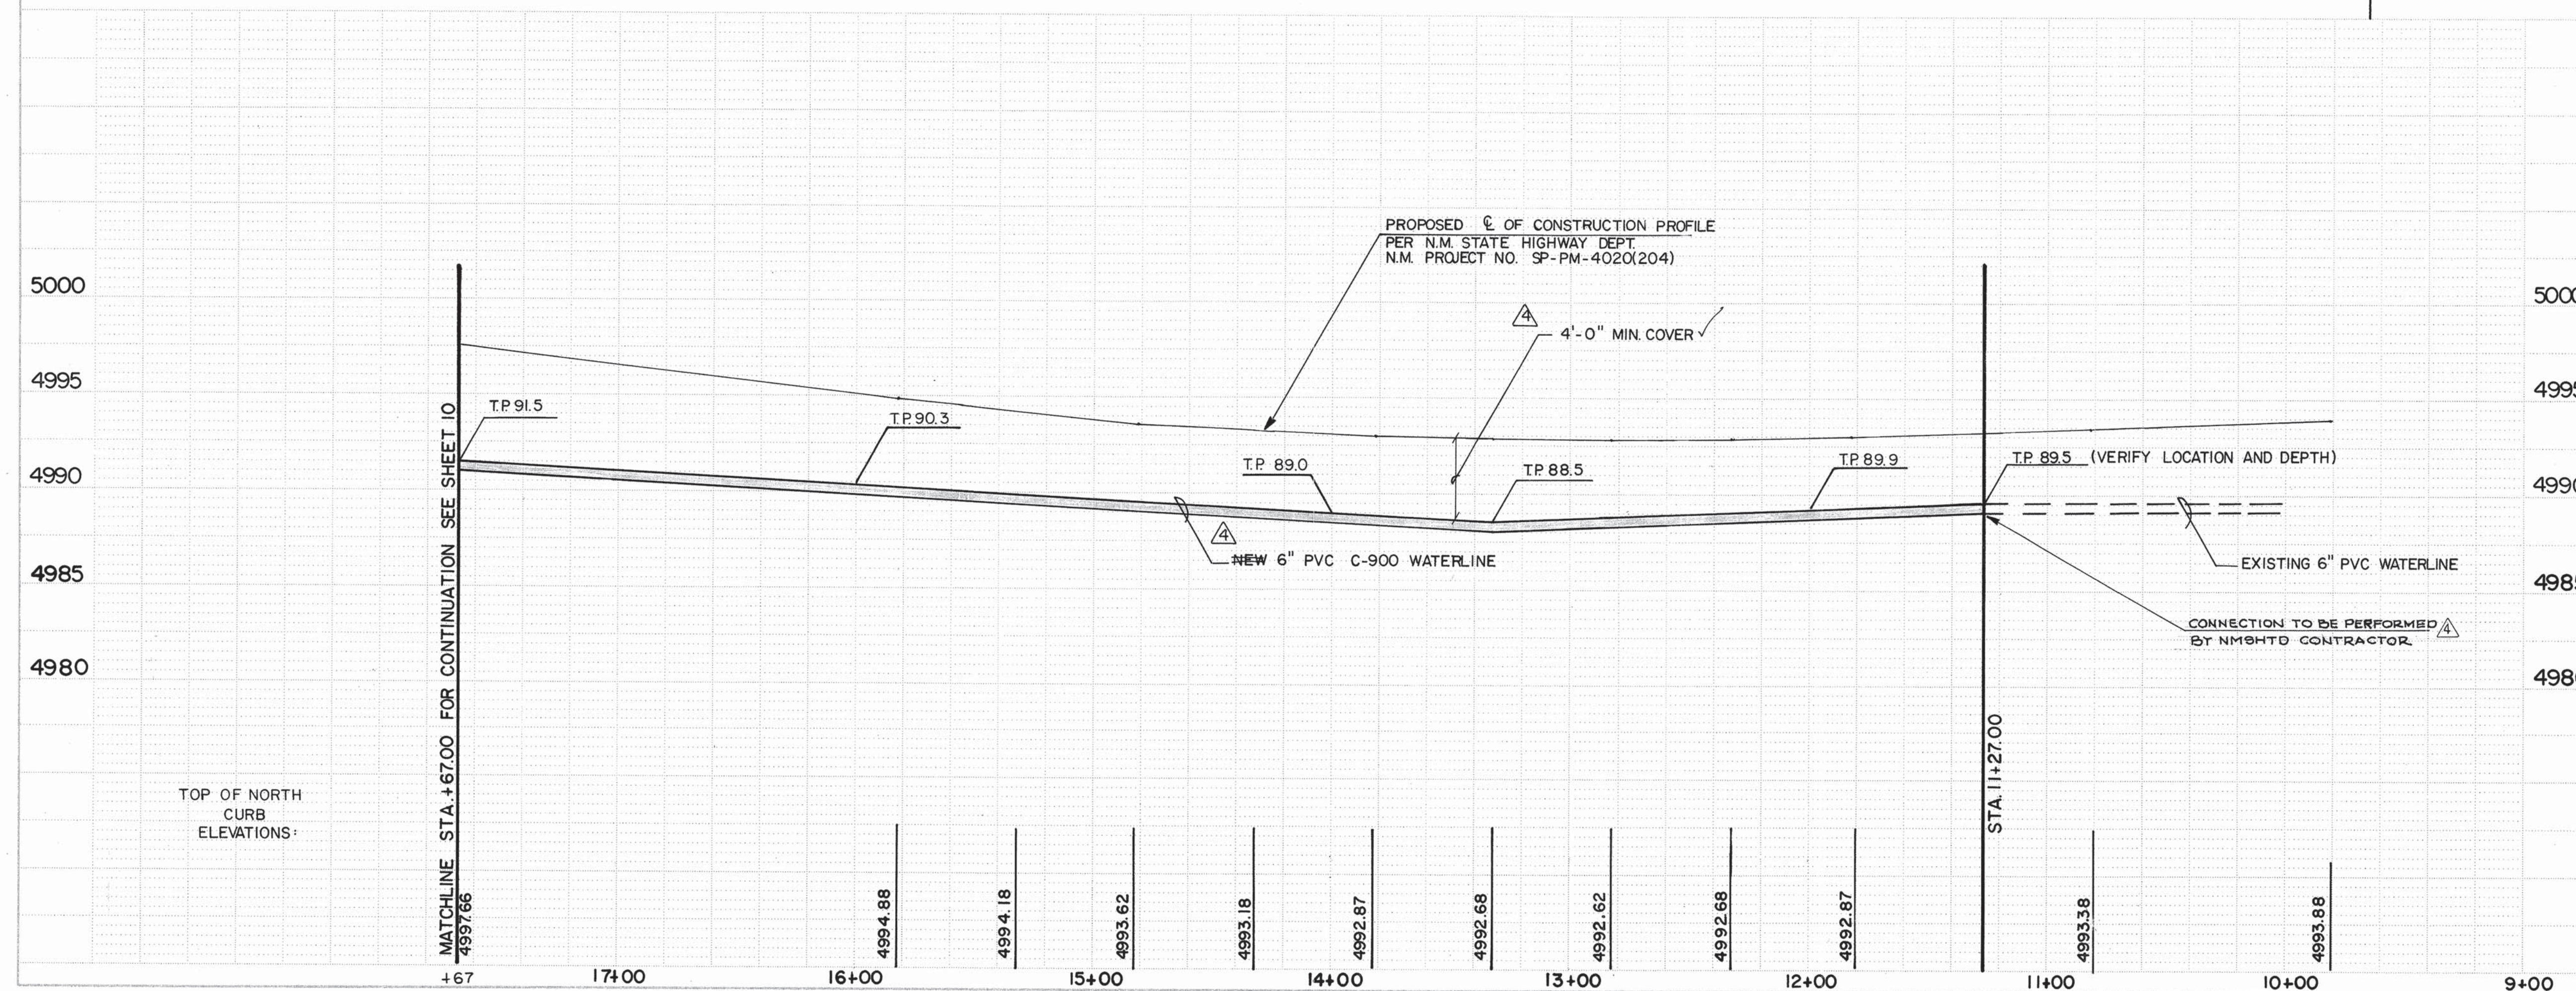

- WATERLINE CONSTRUCTION NOTES:
- ALL STATIONING IS BASED ON STREET CENTERLINE UNLESS INDICATED OTHERWISE.
 - FOR ALL LINES 12" AND SMALLER, WATER MAIN SHALL BE PVC C-900 PIPE OR AS APPROVED BY THE CITY OF ALBUQUERQUE CITY ENGINEER. FOR ALL LINES 12" AND LARGER, WATER MAIN SHALL BE CONCRETE CYLINDER OR AS APPROVED BY THE CITY OF ALBUQUERQUE CITY ENGINEER. DUCTILE IRON IS AN ACCEPTABLE PIPE MATERIAL IN LIEU OF PVC AND CONCRETE CYLINDER.
 - WATERLINE SHALL HAVE A MINIMUM COVER OF 4'-0" (FINISHED GRADE TO TOP OF PIPE) EXTRA DEPTH TRENCHING, IF REQUIRED, SHALL BE CONSIDERED INCIDENTAL TO CONSTRUCTION. THEREFORE, NO SEPARATE PAYMENT WILL BE MADE.
 - ELECTRONIC MARKER DISCS (EMD) SHALL BE INSTALLED IN ACCORDANCE WITH THE STANDARD SPECIFICATION.
 - IN ACCORDANCE WITH SECTION 801 OF THE "STANDARD SPECIFICATIONS", METALIZED DETECTABLE WARNING TAPE SHALL BE INSTALLED 18" ABOVE ALL PVC PIPE INSTALLED ON THIS PROJECT.
 - VALVE STEM AND FIRE HYDRANT EXTENSIONS SHALL BE PROVIDED IN ACCORDANCE WITH THE STANDARD SPECIFICATIONS. THE COST OF EACH EXTENSION SHALL BE CONSIDERED INCIDENTAL TO CONSTRUCTION THEREFORE NO SEPARATE PAYMENT WILL BE MADE.
 - JOINT RESTRAINT SHALL BE CONSIDERED INCIDENTAL TO WATERLINE CONSTRUCTION THEREFORE NO SEPARATE PAYMENT WILL BE MADE.

- STREET PAVING IMPROVEMENTS:
- ALL SLOPES AS SHOWN ON PROFILES ARE BASED ON STREET CENTERLINE STATIONING EXCEPT CUL-DE-SACS WHERE STATIONING IS ALONG FACE-OF-CURB.
 - WHERE REMOVAL OF EXISTING CURB AND GUTTER, SIDEWALK OR PAVEMENT IS REQUIRED, THE CONTRACTOR SHALL SAWCUT AND/OR REMOVE TO THE NEAREST JOINT. CURB AND GUTTER SHOWN AS EXISTING AND NOT TO BE REMOVED UNDER THIS CONTRACT WHICH IS DAMAGED OR DISPLACED BY THE CONTRACTOR SHALL BE REMOVED AND REPLACED BY THE CONTRACTOR AT THE CONTRACTOR'S EXPENSE.
 - ALL DIMENSIONS OF PAVING AND RETURNS ARE SHOWN TO EDGE OF PAVING.

1 2 3 4 5 6 7 8 9 10 11 12 13 14 15
26 49 10 40 11 95

RECORD DRAWING
I, Jeffrey G. Mortensen, Registered Professional Engineer in the State of New Mexico, do hereby certify that this "as-built" information was obtained by me or under my supervision and represents the "as-built" conditions of this project, and is true and correct to the best of my knowledge and belief. All vertical and horizontal dimensions should be field verified prior to use on future projects.

Jeffrey G. Mortensen
Professional Engineer
New Mexico
No. 8547
05-18-95

CITY OF ALBUQUERQUE PUBLIC WORKS DEPARTMENT ENGINEERING GROUP					
TITLE: BONA TERRA FARMS ALAMEDA BLVD WATERLINE EXTENSION PLAN AND PROFILE					
APPROVALS	ENGINEER	DATE	APPROVALS	ENGINEER	DATE
DRC CHAIRMAN	B. J. Borek	6-28-94	WATER	R. W. Kane	6-3-94
TRANSPORTATION	NIA RHO	6-03-94	WASTE WATER	R. W. Kane	6-3-94
HYDROLOGY	J. J. MA	6-03-94	BCPWD	John Calogian	5-31-94
PROJECT NO.	4910.90		MAP NO.	B-15	
SHEET 11			OF 16		

MATCH LINE STA.15+67.60 BONA TERRA LOOP
FOR CONTINUATION SEE SHEET 13

LOT 6

LOT 2

INSTALL 1 DOUBLE 3/4" WATER
SERVICE AND METER BOX PER
C.O.A. STD. DWG. 2362
(TYP.)

STA.13+41.47 (10' LT.)
END CURVILINEAR INSTALLATION
OF 6" PVC C-900 WATERLINE

LOT 3

INSTALL 1 DOUBLE 3/4" WATER
SERVICE AND METER BOX PER C.O.A.
STD. DWG. 2362
(TYP.)

STA.12+23.49 (10' LT.)
INSTALL 1-6" 45° RESTRAINED ELL
LR=7' BOTH WAYS
BEGIN CURVILINEAR INSTALLATION
OF 6" PVC C-900 WATERLINE
R=233'
ARC=117.98'

BONA TERRA LOOP N.W.

LOT 5

STA.11+47.69 (12' LT.)
INSTALL 1-RESTRAINED FIRE HYDRANT
(4 1/2" BURY) PER
C.O.A. STD. DWG. 2340
FLANGE ELEV. @ 4995.50-
95.75

LOT 4

PC STA.11+47.69
CL OF ROADWAY
TA 4995.75
INSTALL 1-RESTRAINED GATE VALVE
1-TYPE "A" VALVE BOX
LR=46' BOTH WAYS

LOT 4

INSTALL 1-FIRE HYDRANT
REFLECTIVE MARKER

PT STA.10+37 (12' LT.)
TRANSITION FROM NO CROWN
TO CROWN

FOR CONTINUATION
SEE SHEET 10

STA. 10+10.00 (10' RT) BONA TERRA LOOP
STA.12+46.59 (10' LT) LINE 'A'
1-6" 90° RESTRAINED ELL

STA. 9+80.00 BONA TERRA LOOP
STA.12+46.59 (20' RT) LINE 'A'

STA. 10+00.00 BONA TERRA LOOP
STA.12+46.59 LINE 'A'

STA.10+37.00 (10' RT.)
INSTALL 1-RESTRAINED GATE VALVE
1-TYPE "A" VALVE BOX
LR=46' BOTH WAYS

CURVE DATA		
CURVE	ARC	RADIUS
C6	193.78°	74°01'05" 150.00'

RECORD DRAWING

SCALE:

HORIZONTAL 1"=40'
VERTICAL 1"=5'

WATERLINE CONSTRUCTION NOTES:

- ALL STATIONING IS BASED ON STREET CENTERLINE UNLESS INDICATED OTHERWISE.
- FOR ALL LINES 12" AND SMALLER, WATER MAIN SHALL BE PVC C-900 PIPE OR AS APPROVED BY THE CITY OF ALBUQUERQUE CITY ENGINEER. FOR ALL LINES 12" AND LARGER, WATER MAIN SHALL BE CONCRETE CYLINDER OR AS APPROVED BY THE CITY OF ALBUQUERQUE CITY ENGINEER. DUCTILE IRON IS AN ACCEPTABLE PIPE MATERIAL IN LIEU OF PVC AND CONCRETE CYLINDER.
- WATERLINE SHALL HAVE A MINIMUM COVER OF 4'-0" (FINISHED GRADE TO TOP OF PIPE). EXTRA DEPTH TRENCHING, REQUIRED, SHALL BE CONSIDERED INCIDENTAL TO CONSTRUCTION THEREFORE, NO SEPARATE PAYMENT WILL BE MADE.
- ELECTRONIC MARKER DISCS (EMD) SHALL BE INSTALLED IN ACCORDANCE WITH THE STANDARD SPECIFICATION.
- IN ACCORDANCE WITH SECTION 801 OF THE "STANDARD SPECIFICATIONS", METALIZED DETECTABLE WARNING TAPE SHALL BE INSTALLED 18" ABOVE ALL PVC PIPE INSTALLED ON THIS PROJECT.
- VALVE STEM AND FIRE HYDRANT EXTENSIONS SHALL BE PROVIDED IN ACCORDANCE WITH THE STANDARD SPECIFICATIONS. THE COST OF EACH EXTENSION SHALL BE CONSIDERED INCIDENTAL TO CONSTRUCTION THEREFORE NO SEPARATE PAYMENT WILL BE MADE.
- JOINT RESTRAINT SHALL BE CONSIDERED INCIDENTAL TO WATERLINE CONSTRUCTION THEREFORE NO SEPARATE PAYMENT WILL BE MADE.

STREET PAVING IMPROVEMENTS:

- ALL SLOPES AS SHOWN ON PROFILES ARE BASED ON STREET CENTERLINE STATIONING EXCEPT CUL-DE-SACS WHERE STATIONING IS ALONG FACE-OF-CURB.
- WHERE REMOVAL OF EXISTING CURB AND GUTTER, SIDEWALK OR PAVEMENT IS REQUIRED, THE CONTRACTOR SHALL SAWCUT AND/OR REMOVE TO THE NEAREST JOINT. CURB AND GUTTER SHOWN AS EXISTING AND NOT TO BE REMOVED UNDER THIS CONTRACT WHICH IS DAMAGED OR DISPLACED BY THE CONTRACTOR SHALL BE REMOVED AND REPLACED BY THE CONTRACTOR AT THE CONTRACTOR'S EXPENSE.
- ALL DIMENSIONS OF PAVING AND RETURNS ARE SHOWN TO EDGE OF PAVING.

WATER SERVICE SCHEDULE			
Lot	Station	Type	Size
2/3	14+13.71	Double	3/4"
4	12+51.07	Single	3/4"
6/5	14+57.31	Double	3/4"

26 4910.90 1012265

RECORD DRAWING 4

I, Jeffrey G. Mortensen, Registered Professional Engineer in the State of New Mexico, do hereby certify that this "as-built" information was obtained by me or under my supervision and represents the "as-built" conditions of this project, and is true and correct to the best of my knowledge and belief. All vertical and horizontal dimensions should be field verified prior to use on future projects.

JEFFREY G. MORTENSEN
REGISTERED PROFESSIONAL ENGINEER
NEW MEXICO
18547
04.18.95


CITY OF ALBUQUERQUE
PUBLIC WORKS DEPARTMENT
ENGINEERING GROUP

TITLE: BONA TERRA FARMS
BONA TERRA LOOP (LINE 'B') WATERLINE AND PAVING IMPROVEMENTS
PLAN AND PROFILE

APPROVALS		ENGINEER	DATE	APPROVALS	ENGINEER	DATE
DRG CHAIRMAN		B.G. Soolahy	6-28-94	WATER		R.W. Kane 6-3-94
TRANSPORTATION		N.H. RHD	6-23-94	WASTE WATER		R.W. Kane 6-3-94
HYDROLOGY		J.P. ...	...	BCPWD		...

PROJECT NO. 4910.90 MAP NO. B-15 SHEET 12 OF 16


CURVE DATA		
CURVE	ARC	DELTA
C5	283.27'	108°12'11"
		150.00'

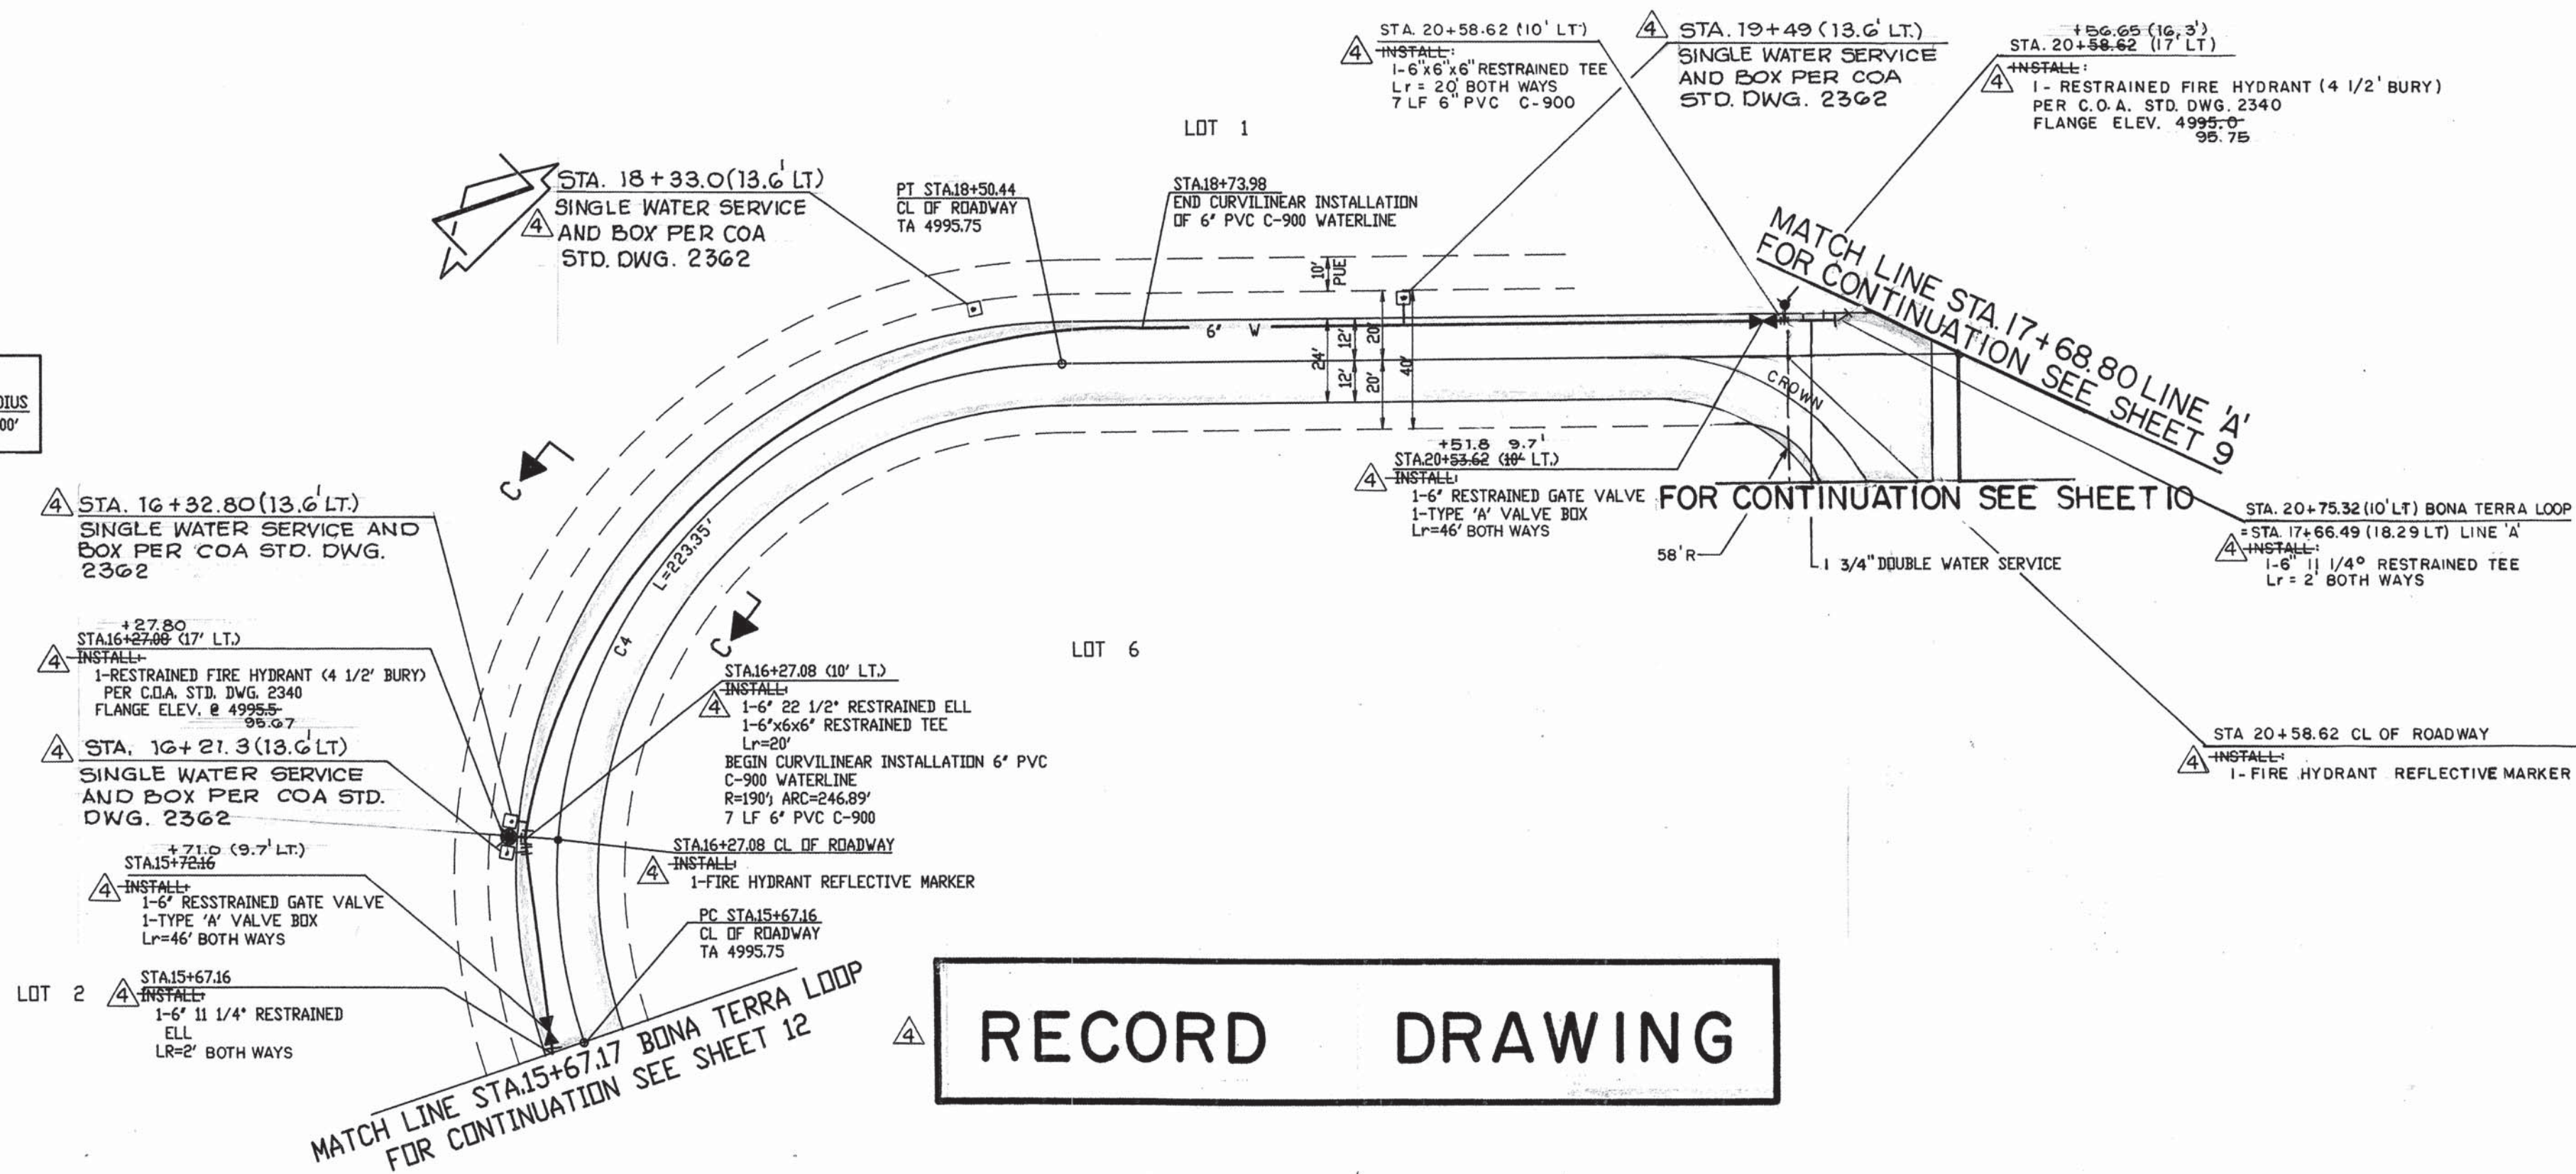

RECORD DRAWING

BONA TERRA LOOP N.W.

SCALE:
HORIZONTAL 1"= 40'
VERTICAL 1"= 5'

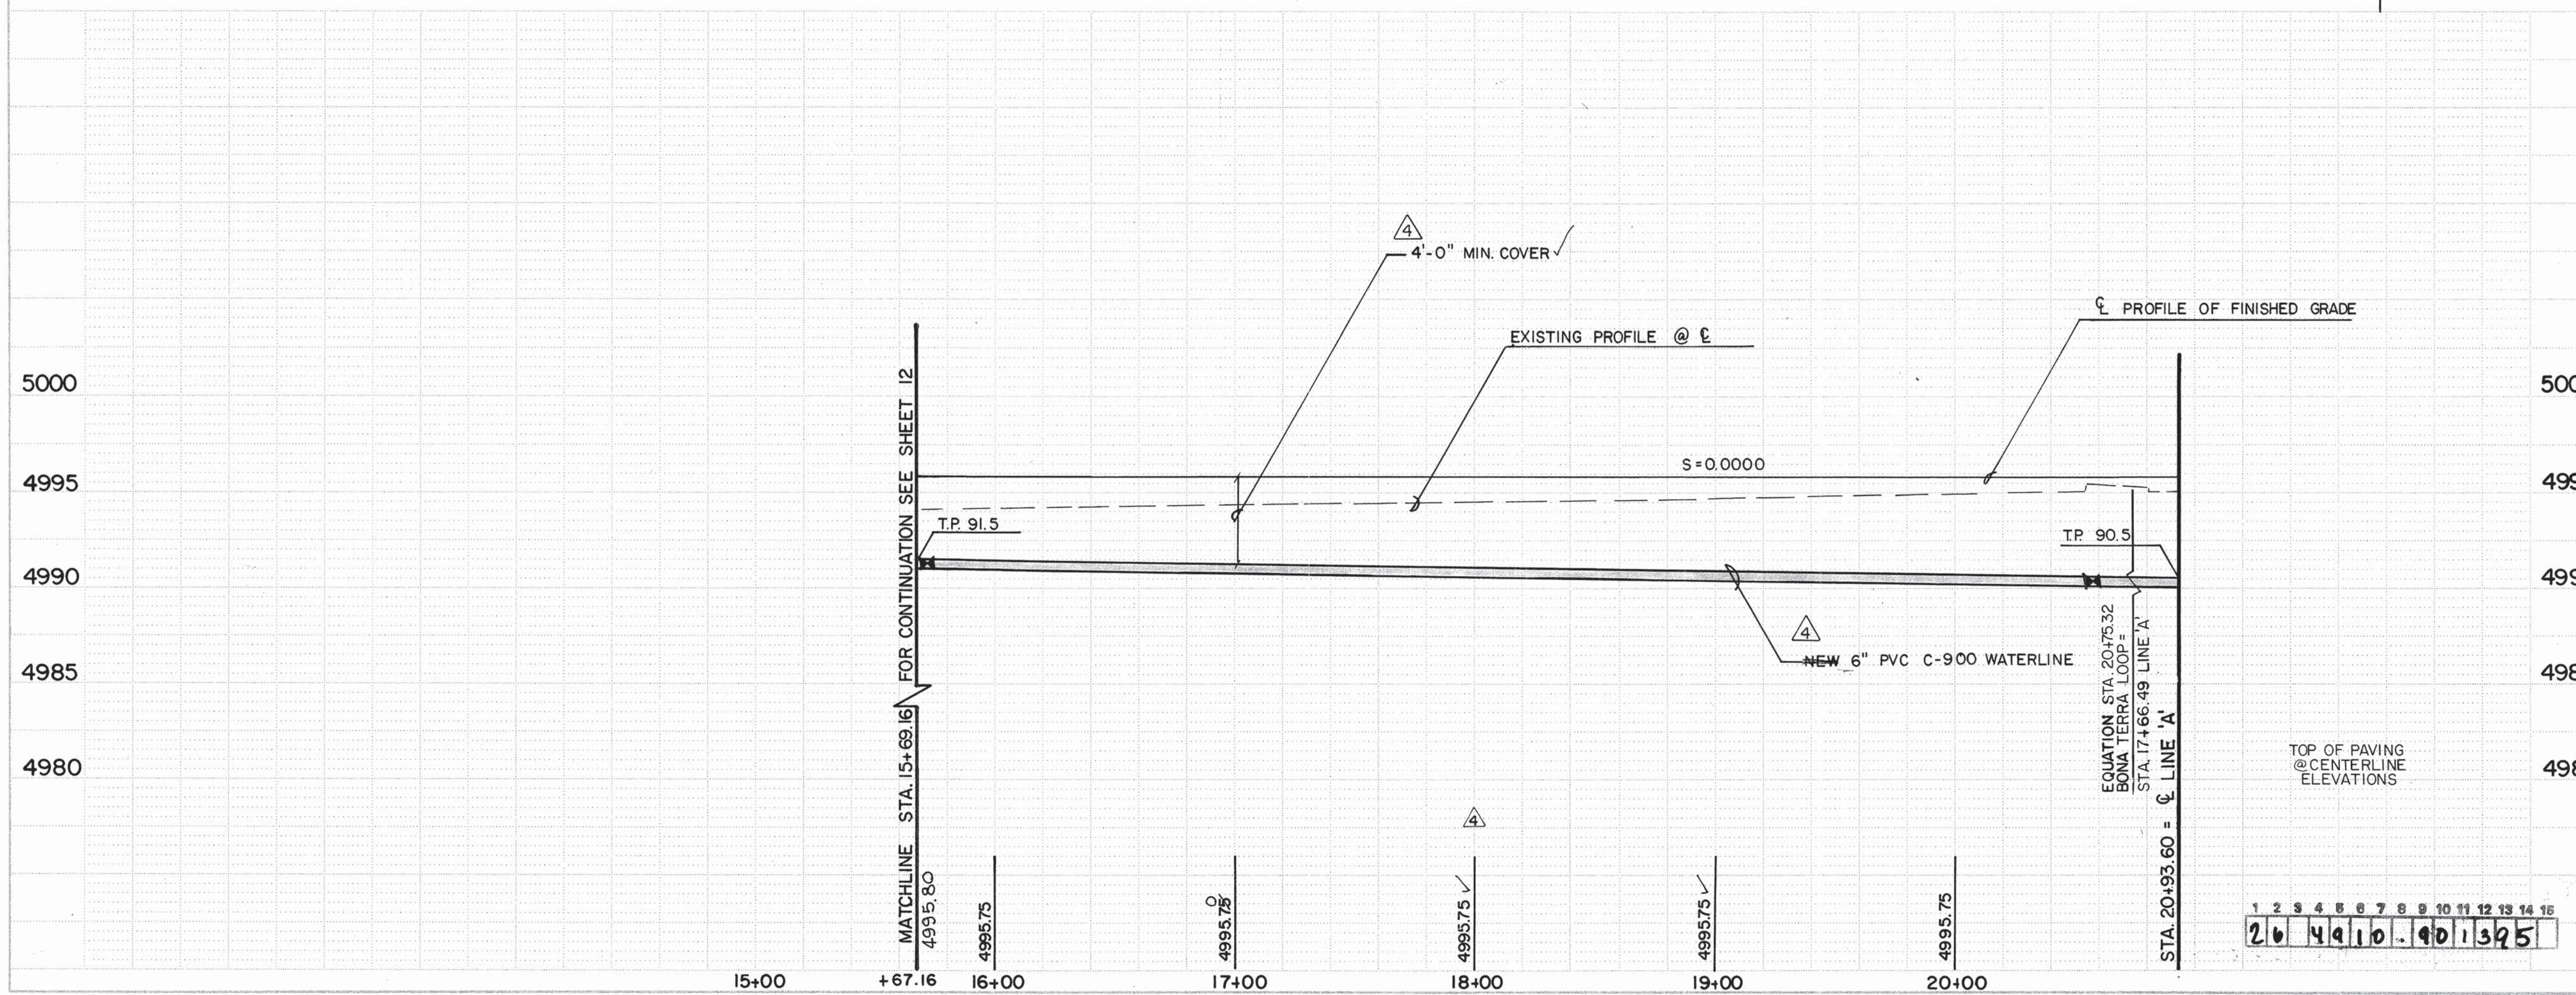

- WATERLINE CONSTRUCTION NOTES:**
- ALL STATIONING IS BASED ON STREET CENTERLINE UNLESS OTHERWISE INDICATED.
 - FOR ALL LINES 12" AND SMALLER, WATER MAIN SHALL BE PVC C-900 PIPE OR AS APPROVED BY THE CITY OF ALBUQUERQUE CITY ENGINEER. FOR ALL LINES 12" AND LARGER, WATER MAIN SHALL BE CONCRETE CYLINDER OR AS APPROVED BY THE CITY OF ALBUQUERQUE CITY ENGINEER. DUCTILE IRON IS AN ACCEPTABLE PIPE MATERIAL IN LIEU OF PVC AND CONCRETE CYLINDER.
 - WATERLINE SHALL HAVE A MINIMUM COVER OF 4'-0" (FINISHED GRADE TO TOP OF PIPE). EXTRA DEPTH TRENCHING, IF REQUIRED, SHALL BE CONSIDERED INCIDENTAL TO CONSTRUCTION THEREFORE NO SEPARATE PAYMENT WILL BE MADE.
 - ELECTRONIC MARKER DISCS (EMD) SHALL BE INSTALLED IN ACCORDANCE WITH THE STANDARD SPECIFICATION.
 - IN ACCORDANCE WITH SECTION 801 OF THE "STANDARD SPECIFICATIONS", METALIZED DETECTABLE WARNING TAPE SHALL BE INSTALLED 18" ABOVE ALL PVC PIPE INSTALLED ON THIS PROJECT.
 - VALVE STEM AND FIRE HYDRANT EXTENSIONS SHALL BE PROVIDED IN ACCORDANCE WITH THE STANDARD SPECIFICATIONS. THE COST OF EACH EXTENSION SHALL BE CONSIDERED INCIDENTAL TO CONSTRUCTION THEREFORE NO SEPARATE PAYMENT WILL BE MADE.
 - JOINT RESTRAINT SHALL BE CONSIDERED INCIDENTAL TO WATERLINE CONSTRUCTION THEREFORE NO SEPARATE PAYMENT WILL BE MADE.

- STREET PAVING IMPROVEMENTS:**
- ALL SLOPES AS SHOWN ON PROFILES ARE BASED ON STREET CENTERLINE STATIONING EXCEPT CUL-DE-SACS WHERE STATIONING IS ALONG FACE-OF-CURB.
 - WHERE REMOVAL OF EXISTING CURB AND GUTTER, SIDEWALK OR PAVEMENT IS REQUIRED, THE CONTRACTOR SHALL SAWCUT AND/OR REMOVE TO THE NEAREST ADJ. CURB AND GUTTER SHOWN AS EXISTING AND NOT TO BE REMOVED UNDER THIS CONTRACT WHICH IS DAMAGED OR DISPLACED BY THE CONTRACTOR SHALL BE REMOVED AND REPLACED BY THE CONTRACTOR AT THE CONTRACTOR'S EXPENSE.
 - ALL DIMENSIONS OF PAVING AND RETURNS ARE SHOWN TO EDGE OF PAVING.

WATER SERVICE SCHEDULE			
Lot	Station	Type	Size
7/1	20+73.61	Double	3/4"

RECORD DRAWING

I, Jeffrey G. Mortensen, Registered Professional Engineer in the State of New Mexico do hereby certify that this "as-built" information was obtained by me or under my supervision and represents the "as-built" conditions of this project, and is true and correct to the best of my knowledge and belief. All vertical and horizontal dimensions should be field verified prior to use on future projects.

Jeffrey G. Mortensen, P.E.
N.M.P.E. No. 8547
05-18-94

STATE OF ALBUQUERQUE
PUBLIC WORKS DEPARTMENT
ENGINEERING GROUP

TITLE: BONA TERRA FARMS
BONA TERRA LOOP (LINE 'B') WATERLINE AND PAVING IMPROVEMENTS
PLAN AND PROFILE
STA. 15+67 TO STA. 20+93.60

APPROVALS	ENGINEER	DATE	APPROVALS	ENGINEER	DATE
DRC CHAIRMAN	B.G. Sweeney	6-28-94	WATER	R.W. Kane	6-3-94
TRANSPORTATION	N.A. XHD	6-03-94	WASTE WATER	R.W. Kane	6-3-94
HYDROLOGY	Tyler	6-13-94	BCPWD	Jason Coleman	5-21-94

PROJECT NO. 4910.90
MAP NO. B-15
SHEET 13 OF 16

AS BUILT INFORMATION		BENCH MARKS		SURVEY INFORMATION		ENGINEER'S SEAL	
CONTRACTOR	WORK	C.O.A. BENCHMARK	DATE	NO.	DATE	NO.	DATE
INSPECTED BY	INSPECTION	ON THE EASTERN CONCRETE WINGWALL OF THE	DATE	NO.	DATE	NO.	DATE
ACCEPTANCE BY	ACCEPTANCE	CANAL CROSSING LOCATED ON THE EAST SIDE OF	DATE	NO.	DATE	NO.	DATE
DESIGNED BY	DESIGN	RIO GRANDE BLVD, 125 FEET NORTH OF THE	DATE	NO.	DATE	NO.	DATE
DRAWN BY	DRAWING	INTERSECTION WITH WESTERN MEADOWS RD. AT	DATE	NO.	DATE	NO.	DATE
CHECKED BY	CHECKING	THE CROSSING OF THE LANE LATERAL IRRIGATION	DATE	NO.	DATE	NO.	DATE
RECORDED BY	RECORDING	CANAL	DATE	NO.	DATE	NO.	DATE
NO.	NO.	ELEVATION = 4998.24 FEET (MSLD)	DATE	NO.	DATE	NO.	DATE

CONSTRUCTION TRAFFIC CONTROL GENERAL NOTES

1. CONTRACTOR MUST OBTAIN FROM CONSTRUCTION COORDINATION AN EXCAVATION/BARRICADING PERMIT BEFORE ENGAGING IN ANY CONSTRUCTION, MAINTENANCE OR REPAIR WORK IN ANY OF THE CITY OF ALBUQUERQUE'S RIGHTS-OF-WAY. EMERGENCY WORK THAT WOULD PRESERVE LIFE OR PROPERTY IS EXCLUDED WITH THE UNDERSTANDING, THAT A PERMIT SHALL BE OBTAINED WITHIN 24 TO 48 HOURS.

2. CONTRACTOR SHALL AT THE TIME OF PERMIT REQUEST, SUBMIT FOR APPROVAL BY CONSTRUCTION COORDINATION, A TRAFFIC CONTROL PLAN DETAILING ALL EXISTING TOPOGRAPHY SUCH AS LANE WIDTHS, DRIVEWAYS, AND BUSINESS/RESIDENTIAL ACCESSES. THE TRAFFIC CONTROL PLAN SHALL INCLUDE ALL PHASES OF WORK AND SCHEDULES INVOLVED IN THE CONSTRUCTION PROJECT. ANY SEPARATE PHASES OF A CONSTRUCTION PROJECT SHALL BE GIVEN AN INDIVIDUAL PERMIT EACH. BLANKET PERMITS WILL NOT BE ISSUED.

3. THESE TYPICAL TRAFFIC CONTROL PLANS DO NOT REFLECT THE EXISTING TOPOGRAPHY SUCH AS DRIVEWAYS, LANE WIDTHS, AND BUSINESS/RESIDENTIAL ACCESSES. EVERY LOCATION THAT REQUIRES CONSTRUCTION TRAFFIC CONTROL SHALL HAVE A DETAILED TRAFFIC CONTROL PLAN SHOWING ALL EXISTING TOPOGRAPHY.

4. CONSTRUCTION SHALL NOT BEGIN UNLESS A TRAFFIC CONTROL PLAN HAS BEEN APPROVED AND VERIFIED BY CONSTRUCTION COORDINATION.

5. CONSTRUCTION COORDINATION SHALL BE NOTIFIED 48 HOURS PRIOR TO ANY TRAFFIC CONTROL CHANGES NEEDED BY CONTRACTOR, THAT WERE NOT PREVIOUSLY APPROVED. THESE TRAFFIC CONTROL CHANGES SHALL BE REQUESTED IN WRITING ACCOMPANIED WITH A TRAFFIC CONTROL PLAN REFLECTING SUCH CHANGES.

6. ALL CONSTRUCTION TRAFFIC CONTROL DEVICES SHALL COMPLY TO THE MANUAL ON UNIFORM TRAFFIC CONTROL DEVICES (MUTCD), LATEST EDITION. IT IS THE RESPONSIBILITY OF THE CONTRACTOR TO INSTALL, SERVICE AND MAINTAIN ALL TRAFFIC CONTROL DEVICES. TRAFFIC CONTROL DEVICES SHALL NOT BE REMOVED OR ALTERED IN ANY WAY WITHOUT THE APPROVAL OF CONSTRUCTION COORDINATION, PER SECTION 6A-4 OF THE MUTCD, LATEST EDITION.

7. THE CONSTRUCTION TRAFFIC CONTROL INITIAL SET-UP SHALL BE BY AN AMERICAN TRAFFIC SAFETY SERVICES ASSOCIATION (ATSSA) CERTIFIED WORKSITE TRAFFIC SUPERVISOR. THE MAINTENANCE AND SERVICING SHALL ALSO BE DONE BY AN ATSSA CERTIFIED WORKSITE TRAFFIC SUPERVISOR OR EQUIVALENT.

8. CONTRACTOR IS RESPONSIBLE TO MAINTAIN AND SERVICE ALL TRAFFIC CONTROL DEVICES 24 HOURS A DAY, 7 DAYS A WEEK THROUGHOUT LENGTH OF PROJECT. CONTRACTOR IS RESPONSIBLE THAT ALL TRAFFIC CONTROL DEVICES COMPLY WITH THE MUTCD, LATEST EDITION.

9. ALL ADVANCE WARNING SIGNS SHALL BE DOUBLE INDICATED WHENEVER THERE ARE MULTI-LANE TRAFFIC IN ANY ONE GIVEN DIRECTION AND THERE IS SUFFICIENT MEDIAN SPACE.

10. ALL BARRICADES IN ALL TAPERS AND TANGENTS SHALL BE PLACED APART, A DISTANCE MEASURED IN FEET, EQUAL TO THAT OF THE POSTED SPEED LIMIT. NO EXCEPTIONS UNLESS APPROVED BY CONSTRUCTION COORDINATION PER MUTCD SECTION 6A-4.

11. CONTRACTOR SHALL NOT BEGIN WORK BEFORE 8:30 A.M. OR END WORK AFTER 4:00 P.M. WITHOUT THE APPROVAL OF CONSTRUCTION COORDINATION.

12. CONTRACTOR IS RESPONSIBLE TO PROVIDE CONSTRUCTION COORDINATION, A WEEKLY LOG OF DAILY INSPECTIONS OF BARRICADE AND MAINTENANCE SCHEDULES ON PROJECTS THAT ARE OVER ONE WEEK DURATION.

13. EQUIPMENT OR MATERIALS SHALL NOT BE STORED WITHIN 15 FEET OF A TRAVELLED TRAFFIC LANE DURING NON-WORKING HOURS WITHOUT THE APPROVAL OF CONSTRUCTION COORDINATION.

14. CONTRACTOR SHALL PROVIDE AND MAINTAIN A SAFE AND ADEQUATE MEANS OF CHANNELIZING PEDESTRIAN TRAFFIC AROUND AND THROUGH THE CONSTRUCTION AREA.

15. CONTRACTOR IS RESPONSIBLE FOR OBLITERATION OF ANY CONFLICTING STRIPING AND RESPONSIBLE FOR ALL TEMPORARY STRIPING.

16. CONTRACTOR SHALL MAINTAIN ACCESS TO ALL FACILITIES, BUSINESSES AND/OR RESIDENTS AT ALL TIMES.

17. CONTRACTOR SHALL PROVIDE ACCESS SIGNS FOR BUSINESSES LOCATED WITHIN THE CONSTRUCTION AREA UNDER THE SUPERVISION OF CONSTRUCTION COORDINATION. EACH ACCESS SIGN SHALL HAVE 5 INCH, WHITE OPAQUE LETTERING ON BLUE REFLECTORIZED BACKGROUND. ACCESS SIGNS SHALL BE CONSIDERED INCIDENTAL TO THE BID AND NOT PART OF THE CONTRACT UNLESS OTHERWISE STATED. NO MORE THAN 3 BUSINESSES SHALL BE LISTED ON A ACCESS SIGN. SHOPPING CENTERS AND MALLS SHALL BE LISTED AS SUCH.

18. ALL ADVANCE WARNING SIGNS SHALL MEET THE MINIMUM REFLECTIVE INTENSITY REQUIREMENTS SET FORTH BY BERNALILLO COUNTY. CONSTRUCTION COORDINATION SHALL DETERMINE ALL REQUIREMENTS AND APPROVE OR DISAPPROVE ANY ADVANCE WARNING SIGN PER SECTION 6A-4 OF THE MUTCD, LATEST EDITION.

19. 24 HOURS PRIOR TO OCCUPYING OR CLOSING OF A RIGHT-OF-WAY, CONTRACTOR SHALL NOTIFY: POLICE, FIRE DEPARTMENT, SCHOOLS, HOSPITALS, TRANSIT AUTHORITY, BUSINESSES AND/OR RESIDENTS THAT WILL BE AFFECTED BY THE CONSTRUCTION.

20. ANY FIELD ADJUSTMENTS SHALL BE APPROVED BY CONSTRUCTION COORDINATION.

21. EXCAVATIONS SHALL BE PLATED, TEMPORARILY PATCHED OR RESURFACED PRIOR TO OPENING OF TRAFFIC. A MINIMUM OF 11 FEET SHALL BE PROVIDED FOR TRAFFIC IN ANY GIVEN DIRECTION. CONTRACTOR IS RESPONSIBLE FOR ANY WORK INVOLVED IN SATISFYING THESE REQUIREMENTS.

22. CONTRACTOR SHALL AT ALL TIMES COMPLY WITH THE FOLLOWING:
1. STANDARDS AND REQUIREMENTS SET FORTH IN THE MANUAL ON UNIFORM TRAFFIC CONTROL DEVICES, LATEST EDITION.
2. THE CITY OF ALBUQUERQUE TRAFFIC CODE, LATEST EDITION.
3. SECTION 19 OF THE CITY OF ALBUQUERQUE'S STANDARD SPECIFICATIONS FOR PUBLIC WORK CONSTRUCTION, AS WELL AS OTHER SECTIONS.

23. FAILURE TO COMPLY WITH ANY OF THE ABOVE MENTIONED, WILL BE ADEQUATE CAUSE TO CEASE ALL WORK ON ANY CONSTRUCTION PROJECT. WORK WILL NOT RESUME UNTIL ALL REQUIREMENTS ARE ADDRESSED AND APPROVED BY CONSTRUCTION COORDINATION.

24. ALL TRAFFIC CONTROL DEVICES SHALL BE KEPT IN NEW-CLEAN CONDITION. WASHING OF EQUIPMENT IS INCIDENTAL TO ITS PLACEMENT AND MAINTENANCE.


25. TRAFFIC CONTROL STANDARDS APPLY ONLY WHERE THE CONSTRUCTION TRAFFIC CONTROL PLANS ARE NOT SPECIFIC.

PROJECT CONSTRUCTION TRAFFIC CONTROL GENERAL NOTES

- NO CONSTRUCTION WITHIN THE PUBLIC RIGHT-OF-WAY CAN OCCUR WITHOUT AN APPROVED TRAFFIC CONTROL PLAN. THE CONTRACTOR MUST SUBMIT A TRAFFIC CONTROL PLAN TO THE BERNALILLO COUNTY PUBLIC WORKS DEPARTMENT A MINIMUM OF FOUR (4) WORKING DAYS PRIOR TO COMMENCEMENT OF ANY CONSTRUCTION WITHIN PUBLIC RIGHT-OF-WAY.
- FOR THE PURPOSES OF THIS PROJECT, "CONSTRUCTION COORDINATION" SHALL BE REPLACED WITH "TRAFFIC CONTROL MANAGER, TRAFFIC CONTROL DIVISION, BERNALILLO COUNTY PUBLIC WORKS DEPARTMENT". CONTACT MARTIN J. GARCIA, P.E., (843-6120), 2400 BROADWAY S.E. 843-1593
- THE PARKING OF CONSTRUCTION EQUIPMENT OR VEHICLES WITHIN PUBLIC RIGHT-OF-WAY SHALL NOT BE PERMITTED.




SIGN FACE DETAILS

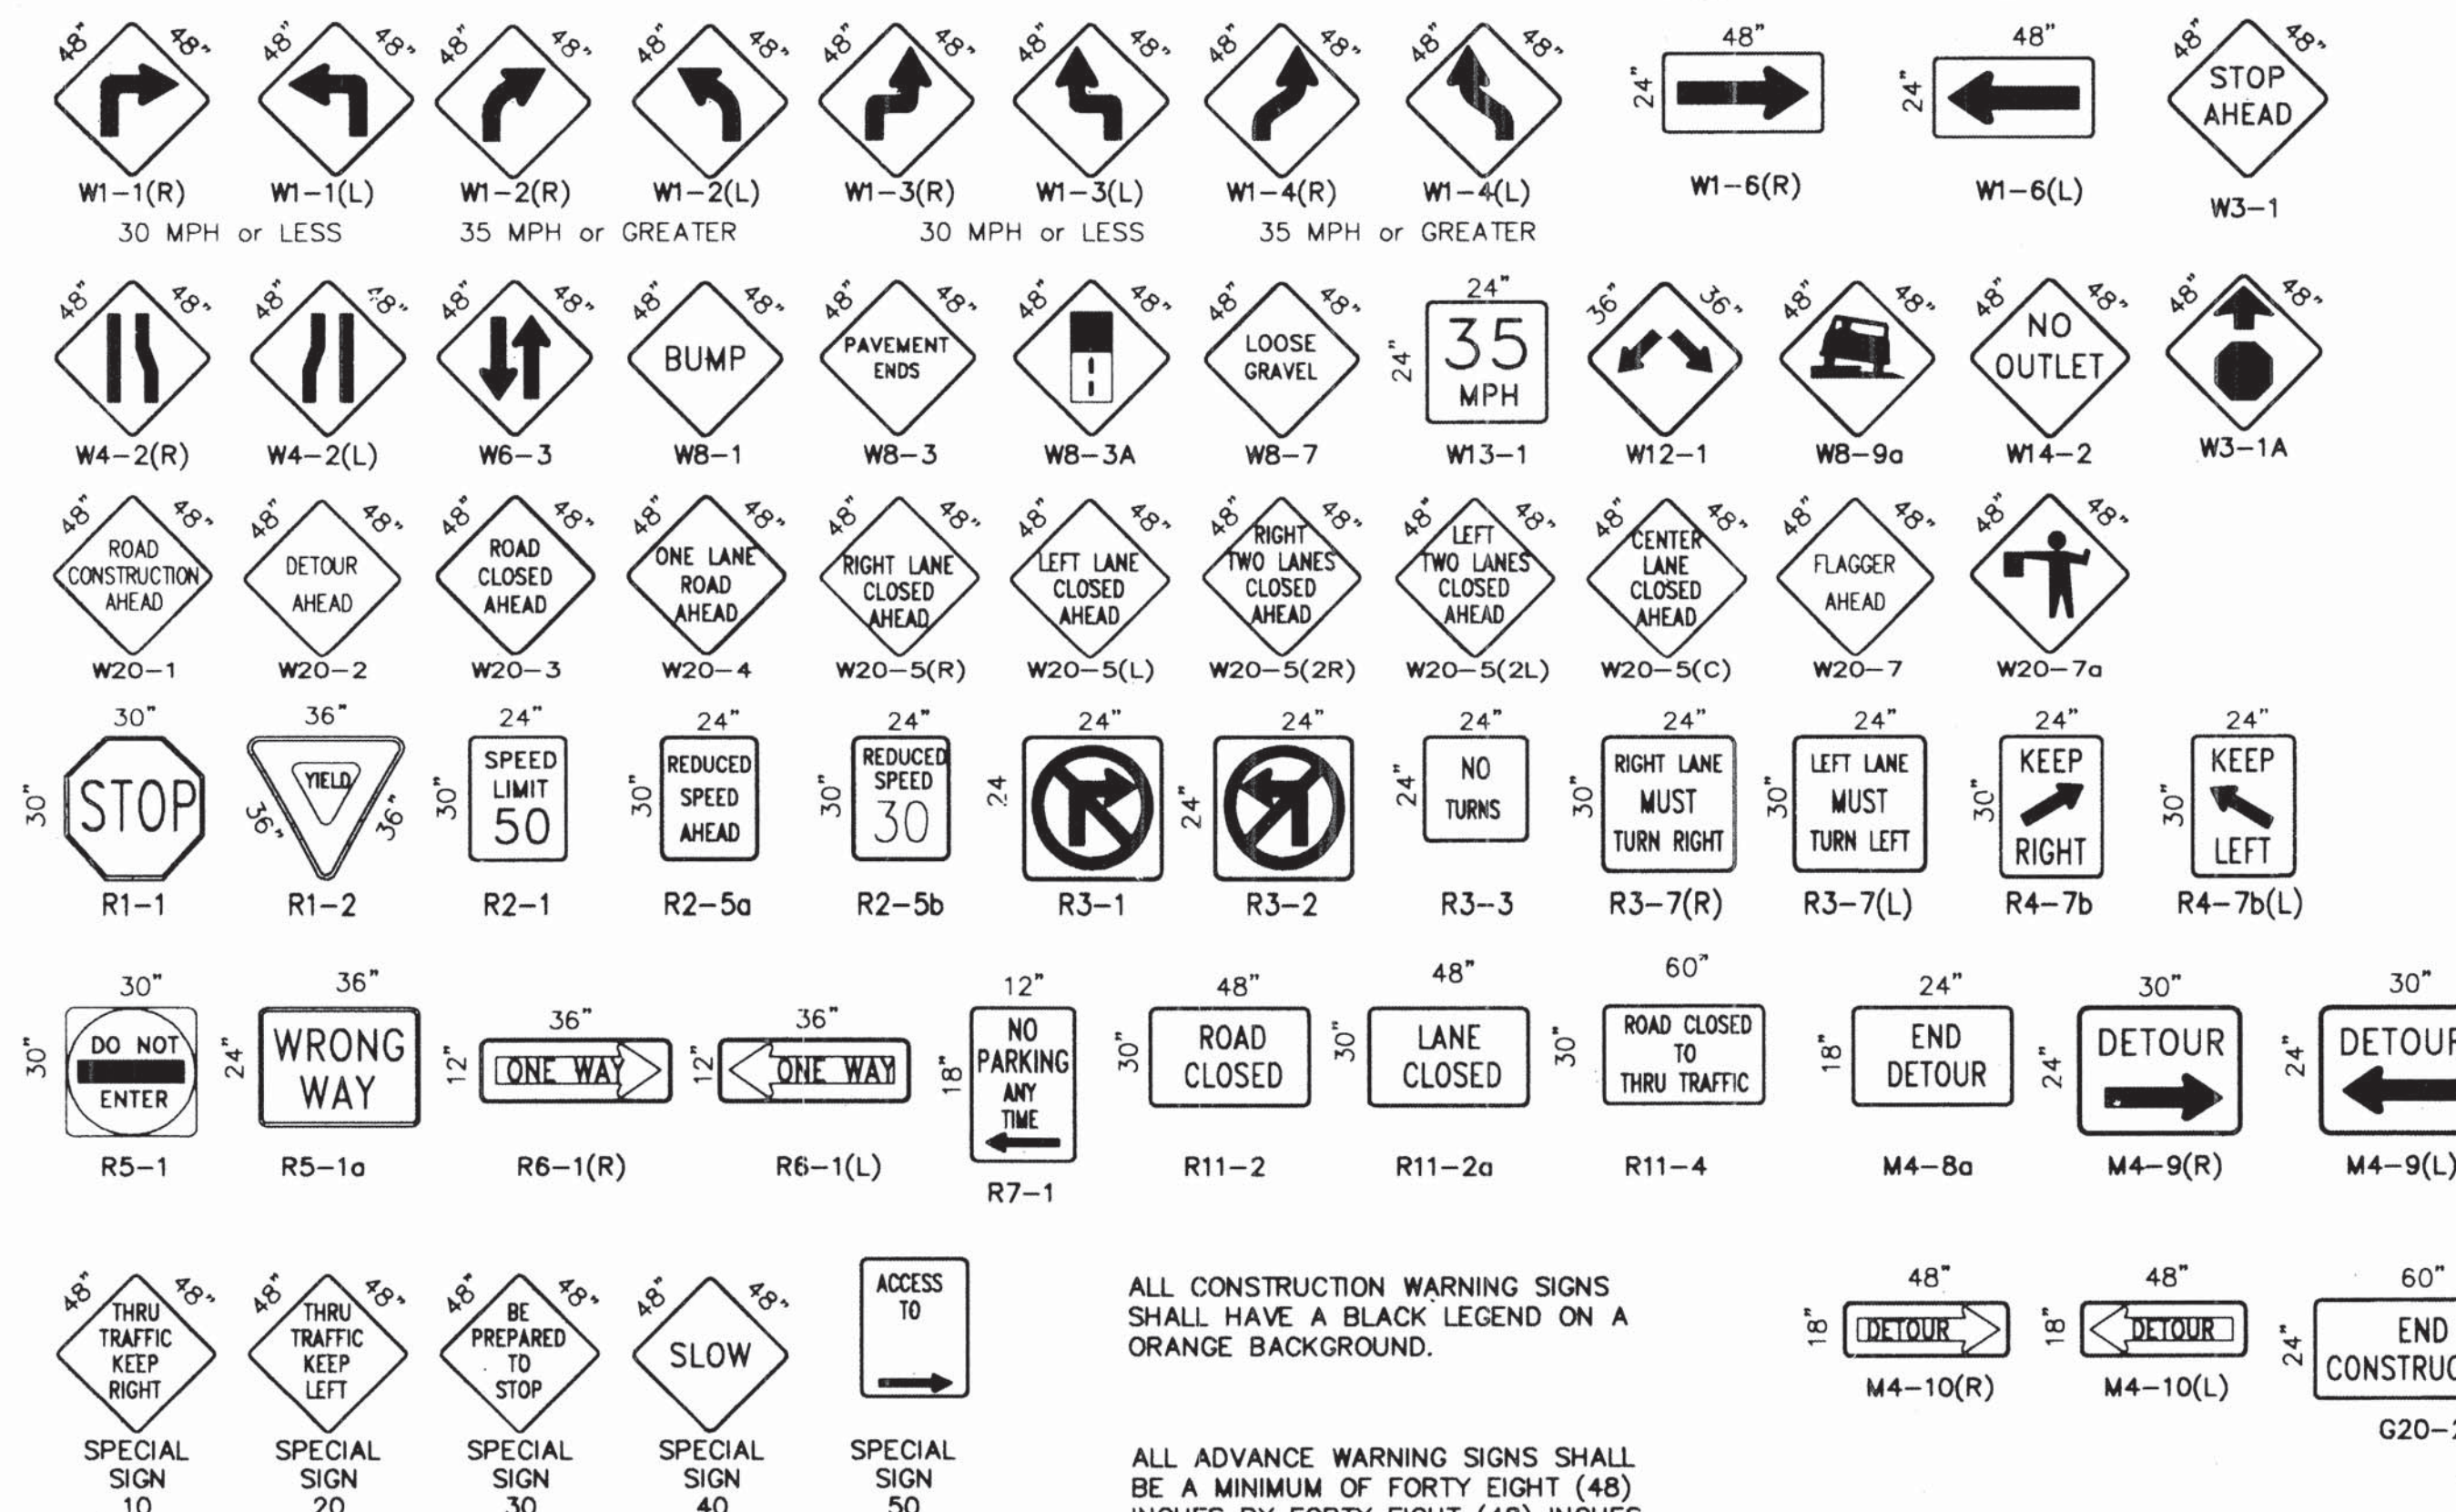

ALL CONSTRUCTION WARNING SIGNS SHALL HAVE A BLACK LEGEND ON A ORANGE BACKGROUND.

ALL ADVANCE WARNING SIGNS SHALL BE A MINIMUM OF FORTY EIGHT (48) INCHES BY FORTY EIGHT (48) INCHES IN SIZE AND SHALL HAVE ONE WARNING LIGHT.

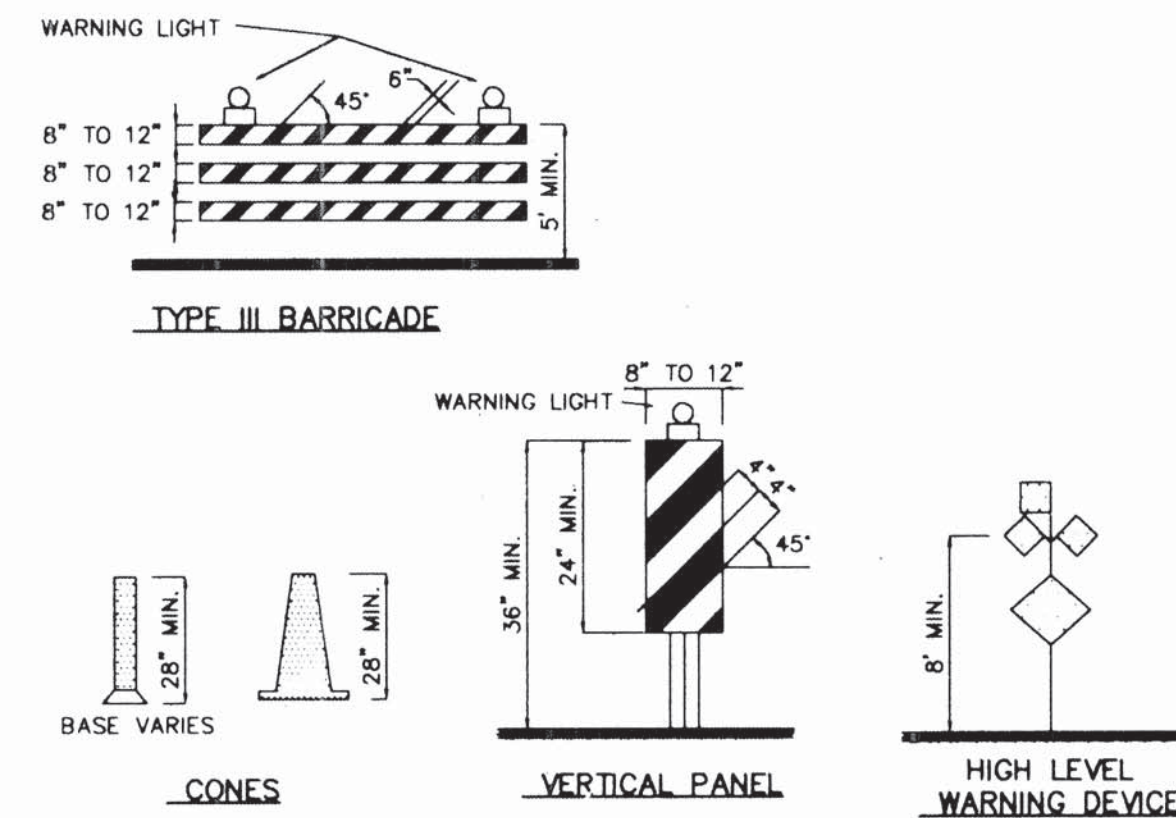

LEGEND

WORK AREA
BARRICADE - TYPE I, TYPE II, OR BARREL
BARRICADE - TYPE III
VERTICAL PANEL
WARNING SIGN
DISTANCE BETWEEN SIGNS - A DISTANCE MEASURED IN FEET EQUAL TO A VALUE OF TEN TIMES THE SPEED LIMIT OF THE STREET
FLAGMAN POSITION
SPACING BETWEEN BARRICADES- A DISTANCE MEASURED IN FEET EQUAL TO THE SPEED LIMIT OF THE STREET
TAPER LENGTH - SEE CHART BELOW
THE TANGENT LENGTH IS EQUAL TO THE TAPER LENGTH FOR A GIVEN STREET.

TAPER REQUIREMENTS

SPEED LIMIT (MPH)	TAPER LENGTH (FEET)			MINIMUM NUMBER OF DEVICES FOR TAPER	MAXIMUM DEVICE SPACING IN FEET	
	10' LANE	11' LANE	12' LANE		ALONG TAPER	AFTER TAPER
20	70	75	80	5	20	20
25	105	115	125	6	25	25
30	150	165	180	7	30	30
35	205	225	245	8	35	35
40	270	295	320	9	40	40
45	450	495	540	13	45	45
50	500	550	600	13	50	50
55	550	605	660	13	55	55

RECOMMENDED SIGN SPACING FOR ADVANCE WARNING SIGN SERIES

SPEED PER HOUR	MINIMUM DISTANCE IN FEET	
	BETWEEN SIGNS	FROM LAST SIGN TO TAPER
0-20	10 X SPEED LIMIT	10 X SPEED LIMIT
25-30	10 X SPEED LIMIT	10 X SPEED LIMIT
30-35	10 X SPEED LIMIT	10 X SPEED LIMIT
40-45	10 X SPEED LIMIT	10 X SPEED LIMIT
50-60	10 X SPEED LIMIT	10 X SPEED LIMIT

TAPER CRITERIA

TYPE OF TAPER	TAPER LENGTH
UPSTREAM TAPER:	
MERGING TAPER	L MINIMUM
SHIFTER TAPER	1/2 L MINIMUM
SHOULDER TAPER	1/2 L MINIMUM
TWO-WAY TRAFFIC TAPER	100 FEET MAXIMUM
DOWNSTREAM TAPERS	100 FEET PER LANE

TAPER LENGTH COMPUTATION

SPEED LIMIT	L =
40 MPH OR LESS	$L = \frac{WS^2}{60}$
45 MPH OR GREATER	$L = W \times S$

L = TAPER LENGTH
W = WIDTH OF OFFSET IN FEET
S = POSTED SPEED OR OFF-PEAK 85-PERCENTILE SPEED IN MPH

26 4910.90 1595

CITY OF ALBUQUERQUE
PUBLIC WORKS DEPARTMENT
ENGINEERING GROUP

TITLE: BONA TERRA FARMS
SIGNING AND CONSTRUCTION TRAFFIC CONTROL STANDARDS

APPROVALS	ENGINEER	DATE	APPROVALS	ENGINEER	DATE
DRC CHAIRMAN	B.G. Soolby	6-28-94	WATER	R.W. Kano	6-3-94
TRANSPORTATION	N/A	6-23-94	WASTE WATER	R.W. Kano	6-3-94
HYDROLOGY	B.G. Soolby	6-28-94	BCPWD	M.H. Soolby	5-11-94

PROJECT NO. 4910.90
MAP NO. B15
SHEET 15 OF 16

