

CONSTRUCTION DOCUMENTS

FOURTH STREET STREETScape

BARELAS NEIGHBORHOOD, ALBUQUERQUE, NEW MEXICO

INDEX TO SHEETS:

SURVEY:

S-1	CONTROL AND DESIGN SURVEY	0+00	TO	6+00
S-2	CONTROL AND DESIGN SURVEY	6+00	TO	12+00
S-3	CONTROL AND DESIGN SURVEY	12+00	TO	18+00
S-4	CONTROL AND DESIGN SURVEY	18+00	TO	24+00
S-5	CONTROL AND DESIGN SURVEY	24+00	TO	30+10
S-6	CONTROL AND DESIGN SURVEY	30+10	TO	36+20
S-7	CONTROL AND DESIGN SURVEY	36+20	TO	41+07.95
S-8	CONTROL AND DESIGN SURVEY			

CIVIL:

C-1	PAVING: B.O.P.	0+00	TO	6+00
C-2	PAVING:	6+00	TO	12+00
C-3	PAVING:	12+00	TO	18+00
C-4	PAVING AND STORM DRAINAGE:	18+00	TO	24+00
C-5	PAVING AND STORM DRAINAGE:	24+00	TO	30+10
C-6	PAVING:	30+10	TO	36+20
C-7	PAVING:	36+20	TO	41+07.95
C-8	BARELAS INTERSECTION AND RAMP DETAILS			
C-9	PACIFIC AVE. INTERSECTION			
C-10	ATLANTIC AVE. INTERSECTION			

PAVEMENT STRIPING:

ST-1	PAVEMENT STRIPING PLAN	0+00	TO	6+00
ST-2	PAVEMENT STRIPING PLAN	6+00	TO	12+00
ST-3	PAVEMENT STRIPING PLAN	12+00	TO	18+00
ST-4	PAVEMENT STRIPING PLAN	18+00	TO	24+00
ST-5	PAVEMENT STRIPING PLAN	24+00	TO	30+10
ST-6	PAVEMENT STRIPING PLAN	30+10	TO	36+20
ST-7	PAVEMENT STRIPING PLAN	36+20	TO	41+07.95

ARCHITECTURAL:

A-1	STREETSCAPE PLAN : 1" = 20'
A-2	STREETSCAPE PLAN : 1" = 20'
A-3	STREETSCAPE PLAN : 1" = 20'
A-4	STREETSCAPE PLAN : 1" = 20'
A-5	STREETSCAPE PLAN : 1" = 20'
A-6	STREETSCAPE PLAN : 1" = 20'
A-7	STREETSCAPE PLAN : 1" = 20'
A-8	ENLARGED PLANS
A-9	ENLARGED PLANS
A-10	ENLARGED PLANS
A-11	DETAILS
A-12	DETAILS
A-13	TILE PATTERNS

LANDSCAPE:


L1	IRRIGATION PLAN : 1" = 20'
L2	IRRIGATION PLAN : 1" = 20'
L3	IRRIGATION PLAN : 1" = 20'
L4	IRRIGATION PLAN : 1" = 20'
L5	IRRIGATION PLAN : 1" = 20'
L6	IRRIGATION PLAN : 1" = 20'
L7	IRRIGATION PLAN : 1" = 20'
L8	ENLARGED TRIANGLE PLAZUELA
L9	LANDSCAPE LEGEND
L10	PLANTING PLAN
L11	PLANTING PLAN
L12	PLANTING PLAN
L13	PLANTING PLAN
L14	PLANTING PLAN
L15	PLANTING PLAN
L16	PLANTING PLAN
L17	LEGENDS AND SCHEDULES
L18	IRRIGATION DETAILS
L19	DETAILS

ELECTRICAL:

E1	ELECTRICAL PLAN : 1" = 20'
E2	ELECTRICAL PLAN : 1" = 20'
E3	ELECTRICAL PLAN : 1" = 20'
E4	ELECTRICAL PLAN : 1" = 20'
E5	ELECTRICAL PLAN : 1" = 20'
E6	ELECTRICAL PLAN : 1" = 20'
E7	ELECTRICAL PLAN : 1" = 20'


TRAFFIC CONTROL:

TC 1	TRAFFIC CONTROL - GENERAL NOTES
TC 2	TYPICAL TRAFFIC CONTROL AND SIGNING EXAMPLES
TC 3	SIGNING AND TRAFFIC CONTROL STANDARDS
TC 4	TRAFFIC CONTROL SIGN DETAILS
TC 5	TRAFFIC CONTROL - PHASE 1, PHASE 2
TC 6	TRAFFIC CONTROL - PHASE 3, PHASE 4
TC 7	TRAFFIC CONTROL - PHASE 5
TC 8	TRAFFIC CONTROL - PHASE 6, PHASE 7
TC 9	TRAFFIC CONTROL - PHASE 8, PHASE 9
TC 10	TRAFFIC CONTROL - PHASE 10

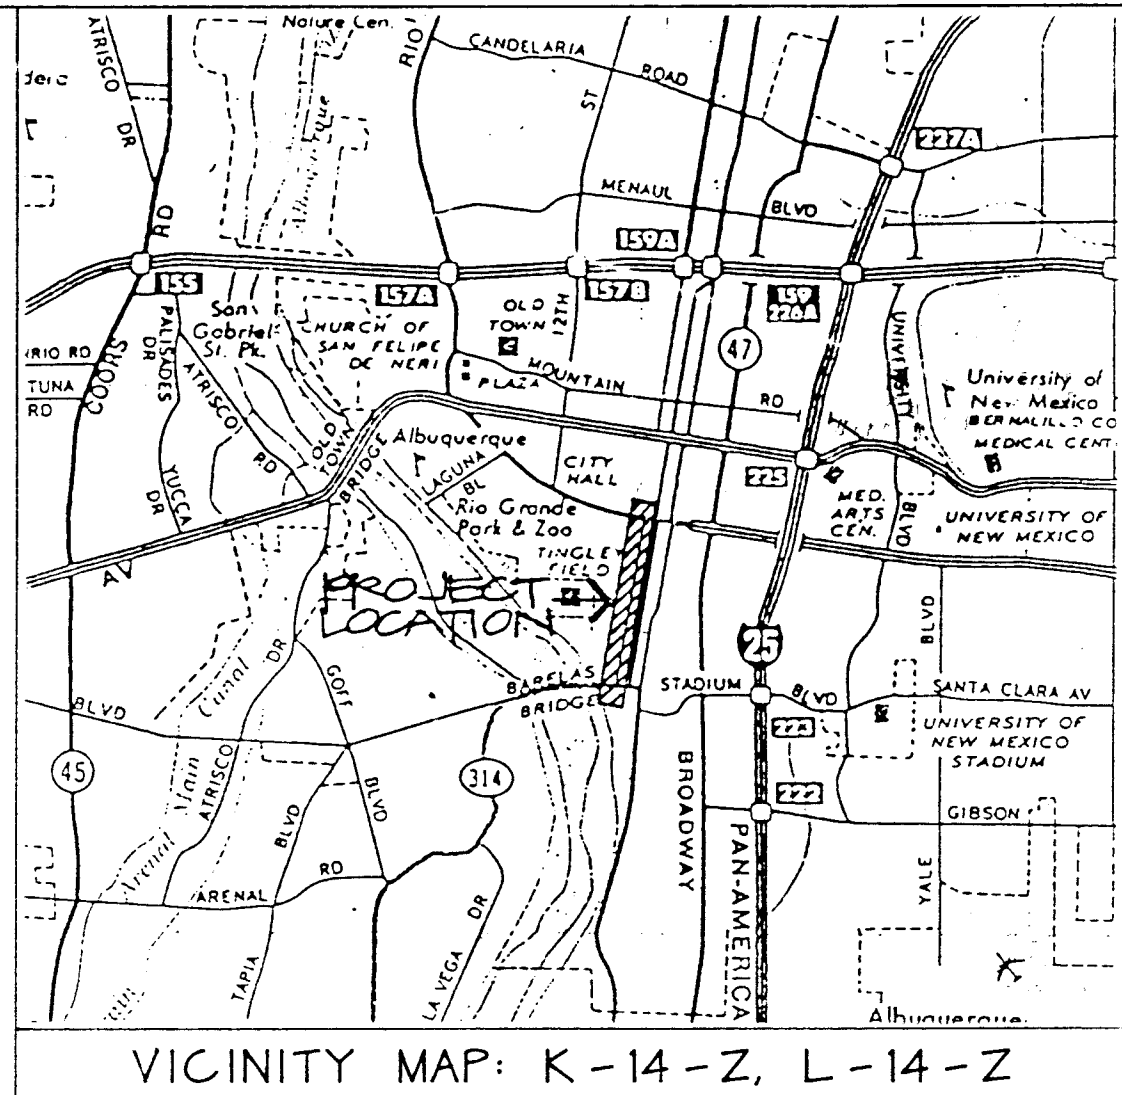

VICINITY MAP: K-14-Z, L-14-Z

- ALL WORK TO BE IN ACCORDANCE WITH CITY OF ALBUQUERQUE STANDARD SPECIFICATIONS, 1986 EDITION (AS UPDATED WITH REVISION #5) OR PER ATTACHED SPECIFICATIONS.
- (1) THREE WORKING DAYS PRIOR TO BEGINNING CONSTRUCTION, CONTRACTOR SHALL SUBMIT TO THE CONSTRUCTION COORDINATION DIVISION A DETAILED CONSTRUCTION SCHEDULE, REFER TO SECTION 19 OF THE CITY OF ALBUQUERQUE STANDARD SPECIFICATIONS.
- THE WATER SYSTEMS DIVISION (857-8300) SHALL BE NOTIFIED (5) FIVE WORKING DAYS IN ADVANCE OF ANY WORK WHICH MAY AFFECT EXISTING PUBLIC WATER FACILITIES. THE CONTRACTOR SHALL ALSO COORDINATE FOR VALVE OPERATION FOR WATER SHUTOFF.
- (1) THREE WORKING DAYS PRIOR TO CONSTRUCTION THE CONTRACTOR SHALL OBTAIN A BARRICADE PERMIT FROM THE CONSTRUCTION COORDINATION DIVISION. CONTRACTOR SHALL NOTIFY PARKING ENGINEER (768-2551) PRIOR TO OCCUPYING AN INTERSECTION. SEE SECTION 19 OF THE SPECIFICATIONS.
- ALL STREET STRIPING ALTERED OR DESTROYED SHALL BE REPLACED IN KIND BY CONTRACTOR TO LOCATION AND IN KIND AS EXISTING OR AS INDICATED BY THIS PLAN SET.
- THE CONTRACTOR SHALL CONTACT NEW MEXICO ONE CALL SYSTEM PHONE: 260-1950, TO LOCATE UNDERGROUND UTILITIES 2 WORK DAYS PRIOR TO BEGINNING EXCAVATION.
- THE CONTRACTOR SHALL CONTACT TRAFFIC ENGINEERING OPERATIONS AT 764-1544 FOR REMOVAL AND REPLACEMENT OF TRAFFIC SIGNS.
- THE CONTRACTOR SHALL RETAIN AND PROTECT ALL EXISTING UTILITIES, UNLESS NOTED OTHERWISE, ANY DAMAGE TO EXISTING UTILITIES SHALL BE REPAIRED AT THE CONTRACTOR'S EXPENSE.
- ALL EXISTING IMPROVEMENTS ARE TO REMAIN UNLESS SPECIFICALLY NOTED TO BE REMOVED. CONTRACTOR SHALL REPAIR ANY CONTRACTOR-CAUSED DAMAGE, AS DETERMINED BY THE ENGINEER TO EXISTING IMPROVEMENTS TO THE SATISFACTION OF THE OWNER AT THE CONTRACTOR'S EXPENSE.
- PRIOR TO CONSTRUCTION, THE CONTRACTOR SHALL CHECK ALL DIMENSIONS, HORIZONTAL AND VERTICAL, AND SHALL EXCAVATE AND VERIFY THE HORIZONTAL AND VERTICAL LOCATIONS OF ALL OBSTRUCTIONS. SHOULD A CONFLICT EXIST, THE CONTRACTOR SHALL NOTIFY THE ENGINEER PRIOR TO CONSTRUCTION SO THAT CONFLICT CAN BE RESOLVED WITH THE MINIMUM AMOUNT OF DELAY.
- FOR PURPOSES OF THIS PROJECT THE TERM ENGINEER SHALL REFER TO EITHER THE OWNER'S EMPLOYEE OR THE LANDSCAPE ARCHITECT RESPONSIBLE FOR CONSTRUCTION INSPECTION OF THE PROJECT.
- ALL REFERENCES TO COMPACTED BACKFILL OR COMPACTED SUBGRADE SHALL MEAN SOIL COMPACTED TO 95% OF MAXIMUM DENSITY AS DETERMINED BY ASTM D-1557 UNLESS OTHERWISE NOTED.
- CONTRACTOR SHALL NOTIFY THE ENGINEER NOT LESS THAN SEVEN (7) DAYS PRIOR TO STARTING WORK. IN ORDER THAT THE ENGINEER MAY TAKE NECESSARY MEASURES TO INSURE THE PRESERVATION OF SURVEY MONUMENTS, CONTRACTOR SHALL NOT DISTURB PERMANENT SURVEY MONUMENTS WITHOUT THE CONSENT OF THE ENGINEER AND SHALL NOTIFY THE ENGINEER AND BEAR THE EXPENSE OF REPLACING ANY THAT MAY BE DISTURBED WITHOUT PERMISSION. REPLACEMENT SHALL BE DONE ONLY BY THE CITY OF ALBUQUERQUE SURVEY SECTION. WHEN A CHANGE IS MADE IN THE FINISH ELEVATION OF THE PAVEMENT OF ANY ROADWAY IN WHICH A PERMANENT SURVEY MONUMENT IS LOCATED, CONTRACTOR SHALL AT HIS OWN EXPENSE, ADJUST THE MONUMENT COVER TO NEW GRADE, UNLESS OTHERWISE SPECIFIED.

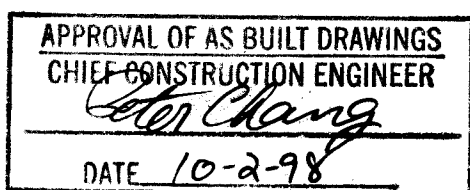

RECORD SET


May 1, 1997

G. Smith

REV.	SHEETS	CITY ENGINEER	DATE	USER	DEPARTMENT	DATE	USER	DEPARTMENT	DATE
ENGINEERS STAMP & SIGNATURE		APPROVALS		ENGINEER		DATE	*****		
		DRC Chairman		<i>John S. Bodeley</i>		12-21-95	APPROVED FOR CONSTRUCTION		
		Transportation		<i>John S. Bodeley</i>		12-21-95			
		Water/Wastewater		<i>John S. Bodeley</i>		12-21-95			
		Hydrology		<i>John S. Bodeley</i>		12-21-95			
		Parks		<i>John S. Bodeley</i>		12-21-95			
Constr. Mngmt.		<i>John S. Bodeley</i>		12-21-95	City Engineer			Date	
Traffic Eng.		<i>John S. Bodeley</i>		12-21-95					
City Project No.		4917.90		Sheet		1	Of		1

SCANNED BY
ASON

Total: 74 Sheets

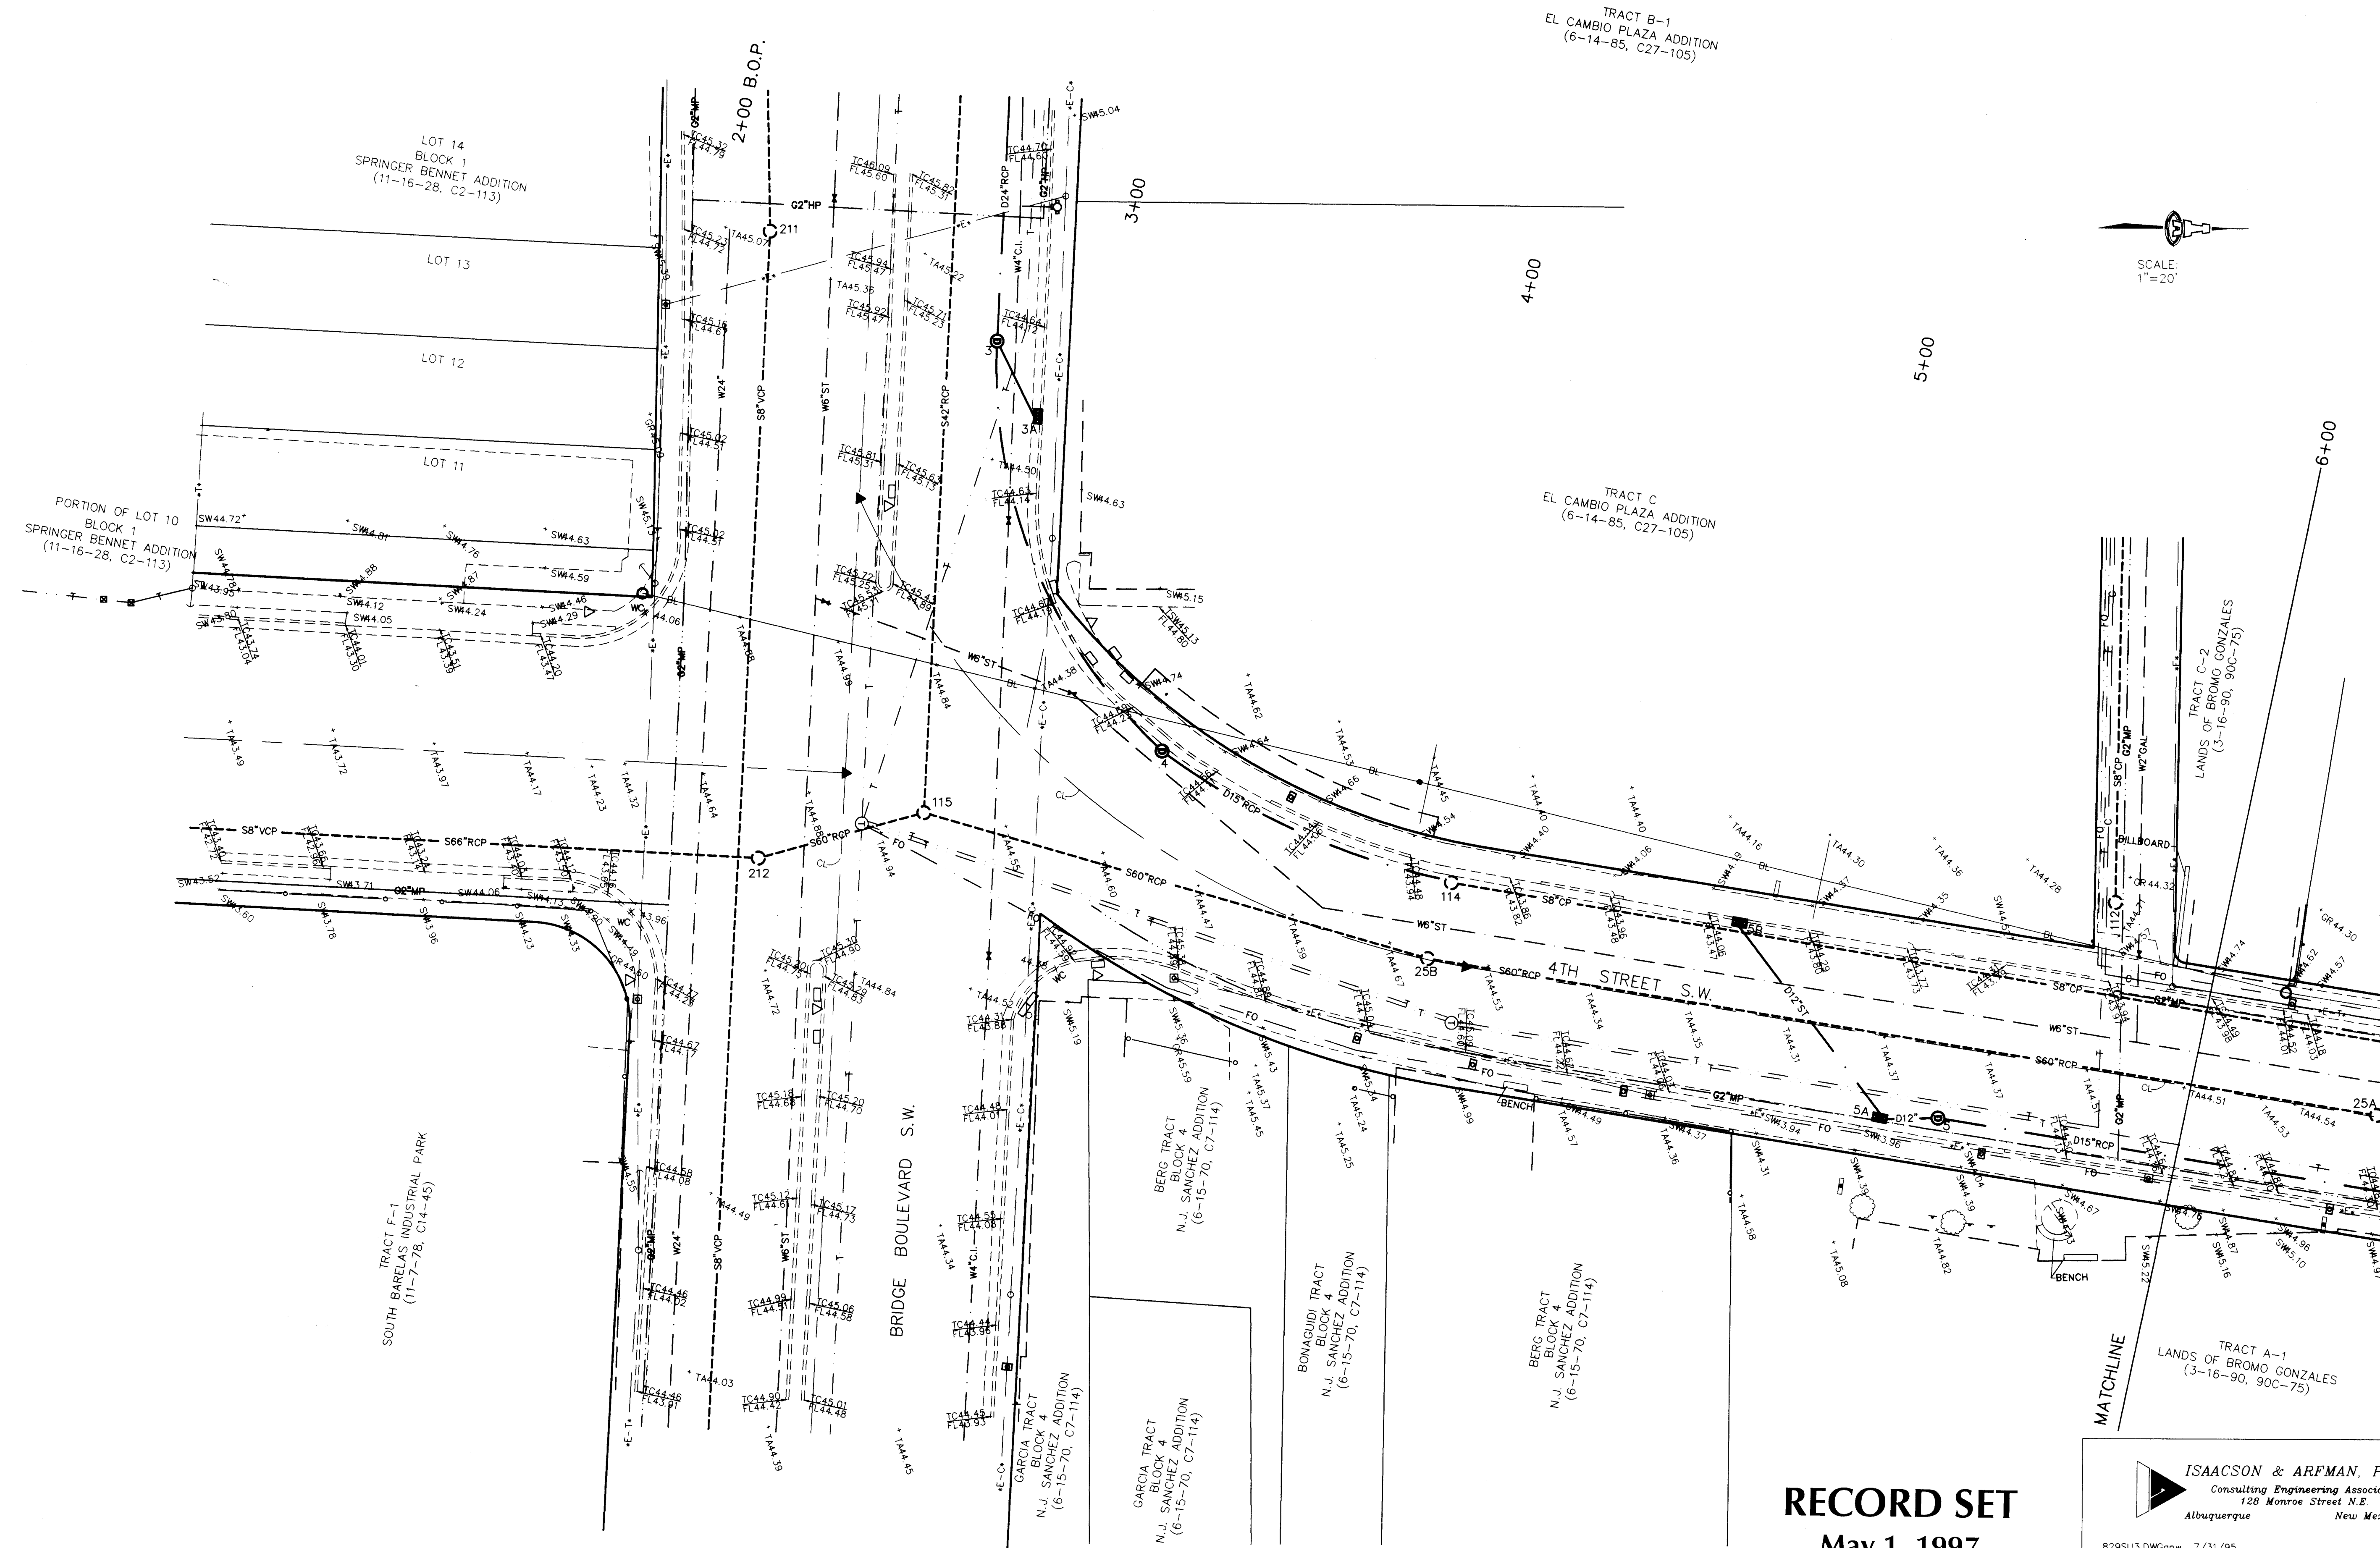

SANITARY SEWER MANHOLE DATA

MH. NO.	RIM ELEVATION	INVERT
211	45.24	35.56 (E&W)
212	44.77	COULDN'T OPEN
115	44.91	COULDN'T OPEN
25B	44.62	38.11 (N&S)
114	44.09	COULDN'T OPEN
112	44.18	36.64 (W)
25A	44.46	36.46 (N&S)

STORM DRAIN MANHOLE/DROP INLET DATA

MH/D.I. NO.	RIM/GRATE ELEVATION	INVERT
3	44.65	29.97 (W&E)
3A	43.75	42.02
4	44.27	41.17 (N&S)
5	44.20	39.47 (N)
5A	43.99	41.37
5B	43.28	42.35



RECORD SET
May 1, 1997

26 49 17 70
Continued

Timothy Adair
09-11-95

ISAACSON & ARFMAN, P.A. Consulting Engineering Associates 128 Monroe Street N.E. Albuquerque New Mexico	
829SU3.DWG 7/31/95	
CITY OF ALBUQUERQUE PUBLIC WORKS DEPARTMENT ENGINEERING GROUP	
TITLE: SOUTH 4th STREET STREETSCAPE CONTROL & DESIGN SURVEY STA 0+00 TO STA 6+00	
Design Review Committee	City Engineer Approval
10/6/95	10/6/95
City Project No. 4917.90	Zone Map No. L-14
Sheet S-1	Of 8

AS-BUILT INFORMATION		BENCH MARKS		SURVEY INFORMATION	
CONTRACTOR	ALBINO, ULLIBRECHT & ASSOCIATES	NO.	DATE	FIELD	NOTES
STARTED BY	ALBINO, ULLIBRECHT & ASSOCIATES	NO.	DATE	BY	DATE
INSPECTOR'S	ALBINO, ULLIBRECHT & ASSOCIATES	NO.	DATE	ALS	DATE
FIELD	ALBINO, ULLIBRECHT & ASSOCIATES	NO.	DATE	NO.	DATE
VERIFIED BY	ALBINO, ULLIBRECHT & ASSOCIATES	NO.	DATE	NO.	DATE
CORRECTED BY	ALBINO, ULLIBRECHT & ASSOCIATES	NO.	DATE	NO.	DATE
RECORDED BY	ALBINO, ULLIBRECHT & ASSOCIATES	NO.	DATE	NO.	DATE

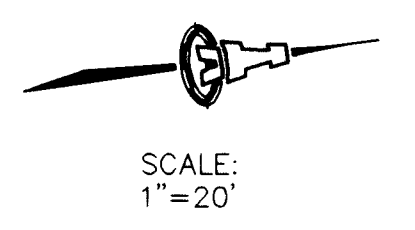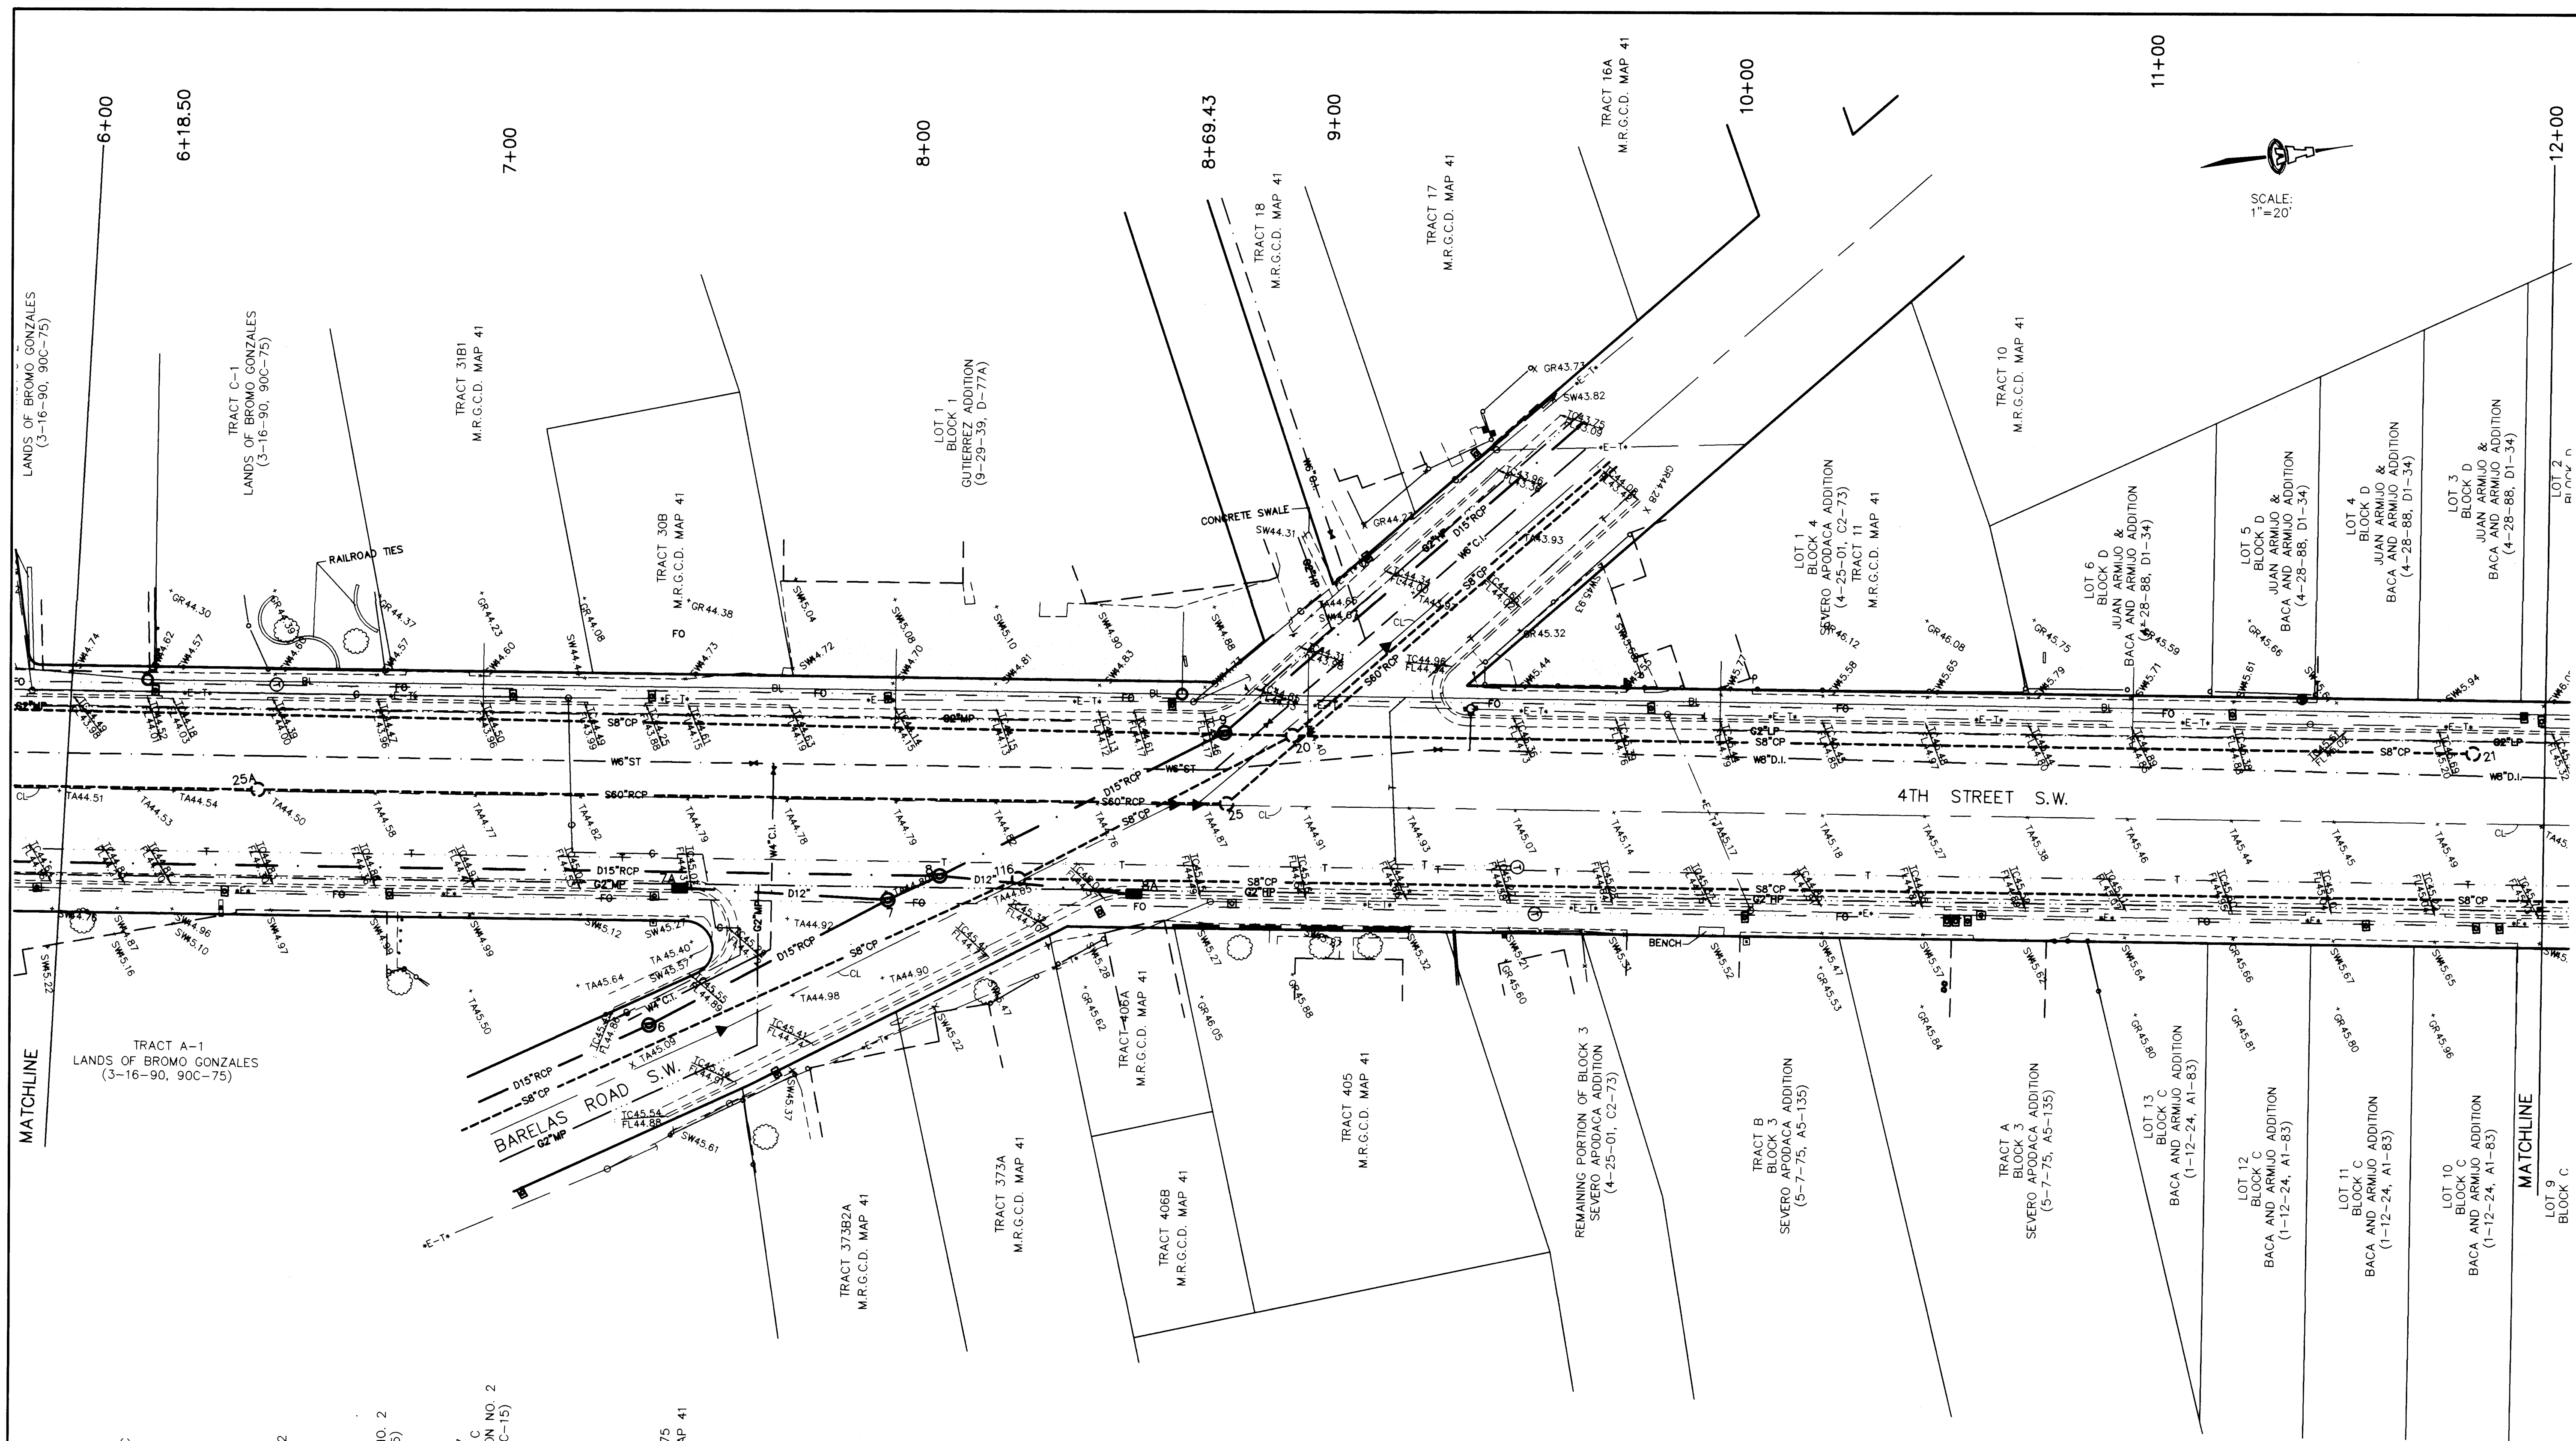

SCALE:
1"=20'

REMAINING PORTION OF BLOCK C
SIMPIER ADDITION NO. 2
(3-23-15, C-15)

LOT 5
BLOCK C
SIMPIER ADDITION NO. 2
(3-23-15, C-15)

LOT 6
BLOCK C
SIMPIER ADDITION NO. 2
(3-23-15, C-15)

LOT 7
BLOCK C
SIMPIER ADDITION NO. 2
(3-23-15, C-15)

TRACT 375
M.R.G.C.D. MAP 41

MH NO.	RIM ELEVATION	INVERT
112	44.18	36.64 (W)
25A	44.46	36.46 (N&S)
116	44.80	36.36 (N,NW&SE)
25	44.87	25.97 (S&NW)
20	44.58	35.56 (NE&SW)
21	45.36	COULDN'T OPEN
22	45.41	COULDN'T OPEN

MH/D.I. NO.	RIM/GRATE ELEVATION	INVERT
6	45.01	37.66 (NW&SE)
7	44.86	COULDN'T OPEN
7A	45.15	42.25
8	44.82	37.02 (S,NW&SE)
8A	44.16	42.19
9	44.45	36.17 (NW&SE)

RECORD SET
May 1, 1997




 Consulting Engineering Associates 128 Monroe Street N.E. Albuquerque New Mexico	
B29SU4.DWGrev 7/31/95	
CITY OF ALBUQUERQUE PUBLIC WORKS DEPARTMENT ENGINEERING GROUP	
TITLE: SOUTH 4th STREET STREETSCAPE CONTROL & DESIGN SURVEY STA 6+00 TO STA 12+00	
Design Review Committee	City Engineer Approval
City Project No. 4917.90	Zone Map No. L-14
Sheet S-2 Of 8	

AS-BUILT INFORMATION	
CONTRACTOR	DATE
STATED BY	DATE
ACCEPTANCE BY	DATE
FIELD	DATE
DRAWN BY	DATE
CORRECTED BY	DATE
RECORDED BY	DATE
MICRO-FILM INFORMATION	
NO.	

SURVEY INFORMATION	
NO.	DATE
BY	DATE
ALS	DATE
ELEV: 4951.924	
T.B.M. BASELINE STA 8+69.43 (CROSS IN SIDEWALK)	
S.W. QUADRANT OF 4TH ST. AND BARELAS RD. S.W.	
ELEV: 4944.77	

BENCH MARKS	
ACS "10-114" ALONG THE SOUTHERLY R.O.W. OF BRIDGE	
BLVD. SW APPROX. 500' EAST OF 4TH ST. SW	
ELEV: 4951.924	

ENGINEER'S SEAL	
REVISIONS	
NO.	DATE
REMARKS	
BY	
DESIGN	
DESIGNED BY	DATE
DRAWN BY	DATE
CHECKED BY	DATE

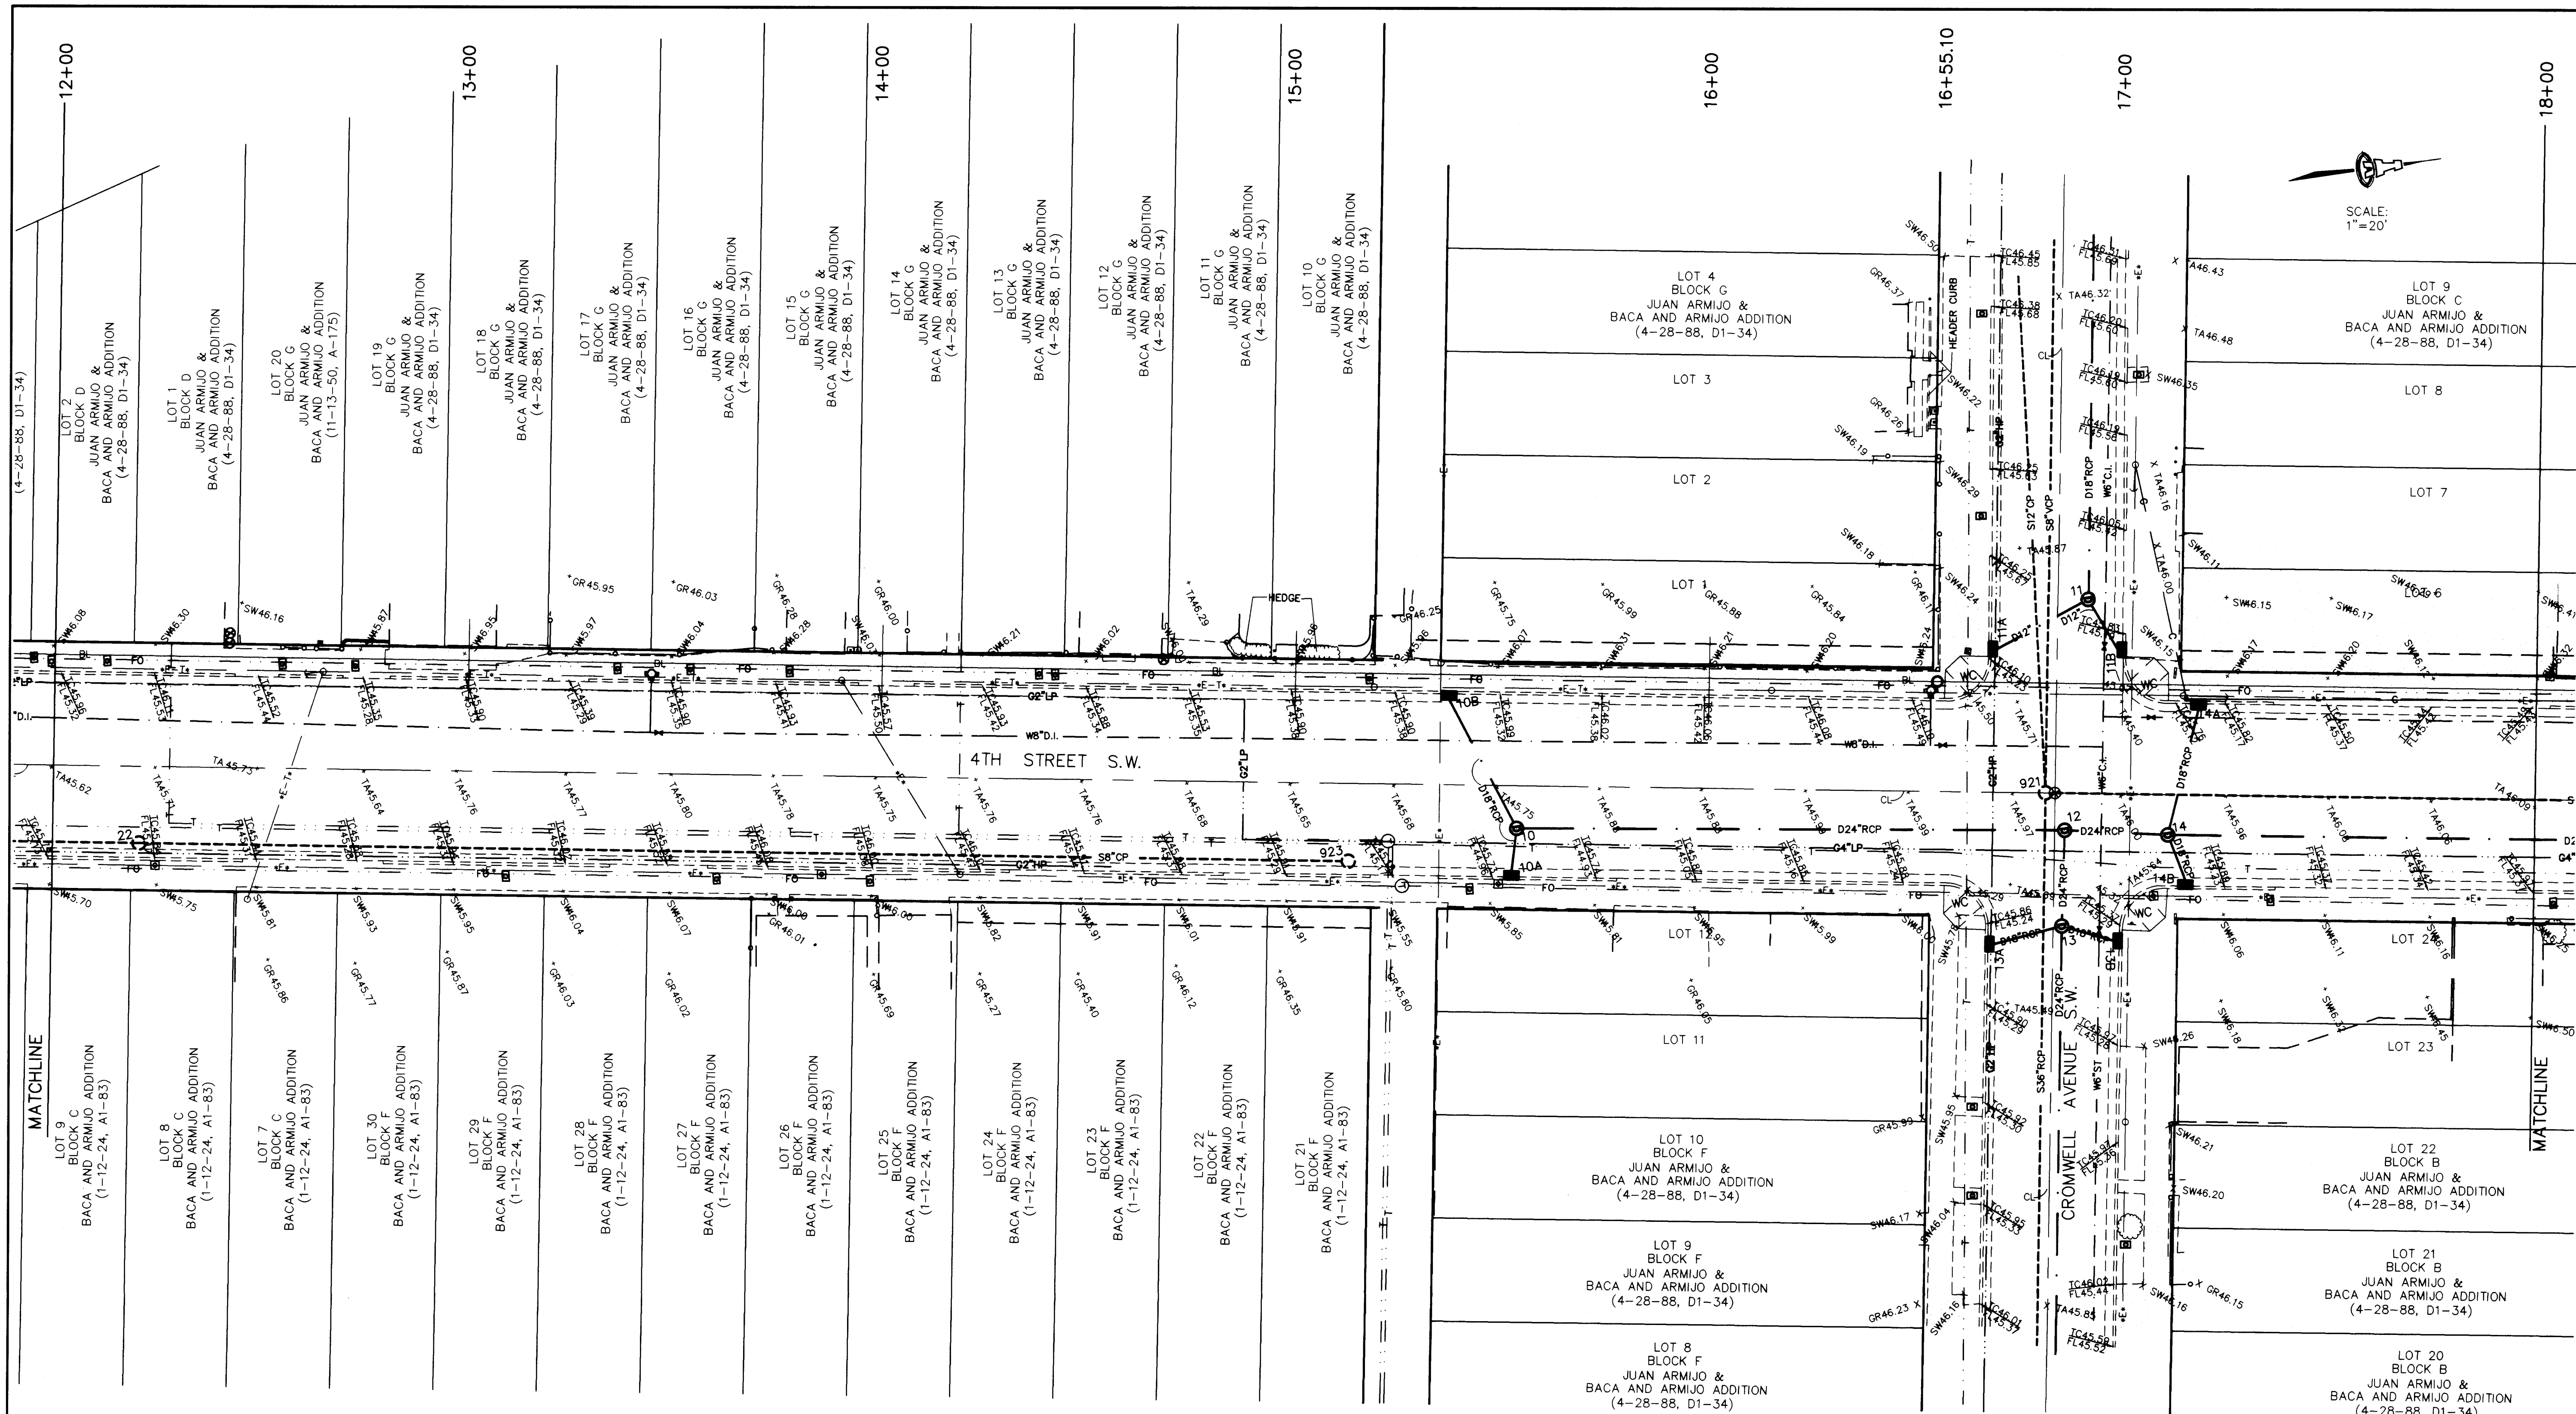

SANITARY SEWER MANHOLE DATA		
MH. NO.	RIM ELEVATION	INVERT
921	46.02	32.72 (N,E&W)
923	45.35	38.26 (S)
22	45.41	COULDN'T OPEN
21	45.36	COULDN'T OPEN

STORM DRAIN MANHOLE/DROP INLET DATA		
MH/D.I. NO.	RIM/GRATE ELEVATION	INVERT
10	45.40	COULDN'T OPEN
10A	44.86	39.29
10B	45.15	39.32
11	45.70	41.57 (W)
11A	45.24	43.49
11B	45.00	42.95
12	46.00	38.11 (N,S&E)
13	45.67	38.28 (E&W)
13A	45.15	40.37
13B	45.32	40.59
14	45.88	37.90 (N&S)
14A	44.98	42.08
14B	45.13	COULDN'T OPEN

RECORD SET
May 1, 1997




ISAACSON & ARFMAN, P.A. Consulting Engineering Associates 128 Monroe Street N.E. Albuquerque New Mexico	
829SU5.DWG on 7/31/95	
CITY OF ALBUQUERQUE PUBLIC WORKS DEPARTMENT ENGINEERING GROUP	
TITLE: SOUTH 4th STREET STREETSCAPE CONTROL & DESIGN SURVEY STA 12+00 TO STA 18+00	
Design Review Committee	City Engineer Approval
12/21/95	CE 12/21/95
City Project No. 4917.90	Zone Map No. L-14
Sheet S-3	Of 8




AS-BUILT INFORMATION	
CONTRACTOR	ALBUQUERQUE ENGINEERING INC.
STAMPED BY	ALBUQUERQUE ENGINEERING INC.
DATE	4/97
ACCEPTANCE BY	ALBUQUERQUE ENGINEERING INC.
DATE	4/97
REVISIONS	
NO.	DATE
1	4/97
2	4/97
3	4/97
ENGINEER'S SEAL	
NO.	DATE
1	4/97
2	4/97
3	4/97
SURVEY INFORMATION	
NO.	DATE
1	4/97
2	4/97
3	4/97
BENCH MARKS	
NO.	DATE
1	4/97
2	4/97
3	4/97
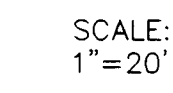

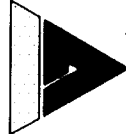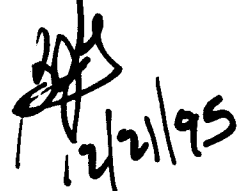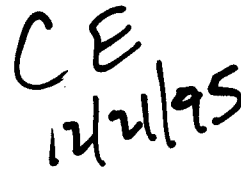 ISAACSON & ARFMAN, P.A. Consulting Engineering Associates 128 Monroe Street N.E. Albuquerque New Mexico	NO. DATE 6/18/95		ISS.	DESIGNED BY	AL	DRAWN BY	128	CHECKED BY
B29SU6.DWGonw 7/31/95								
CITY OF ALBUQUERQUE PUBLIC WORKS DEPARTMENT ENGINEERING GROUP								
TITLE: SOUTH 4th STREET STREETSCAPE CONTROL & DESIGN SURVEY STA 18+00 TO STA 24+00								
Design Review Committee  12/21/95		City Engineer Approval  CE 12/21/95		Last Design Update Mo./day/Yr. 10/6/95		Mo./day/Yr.		
City Project No. 4917.90		Zone Map No. K-14		Sheet S-4 Of 8				

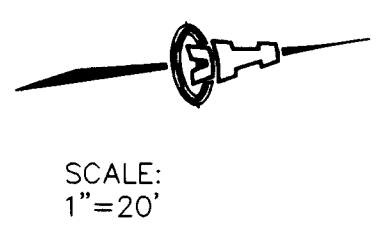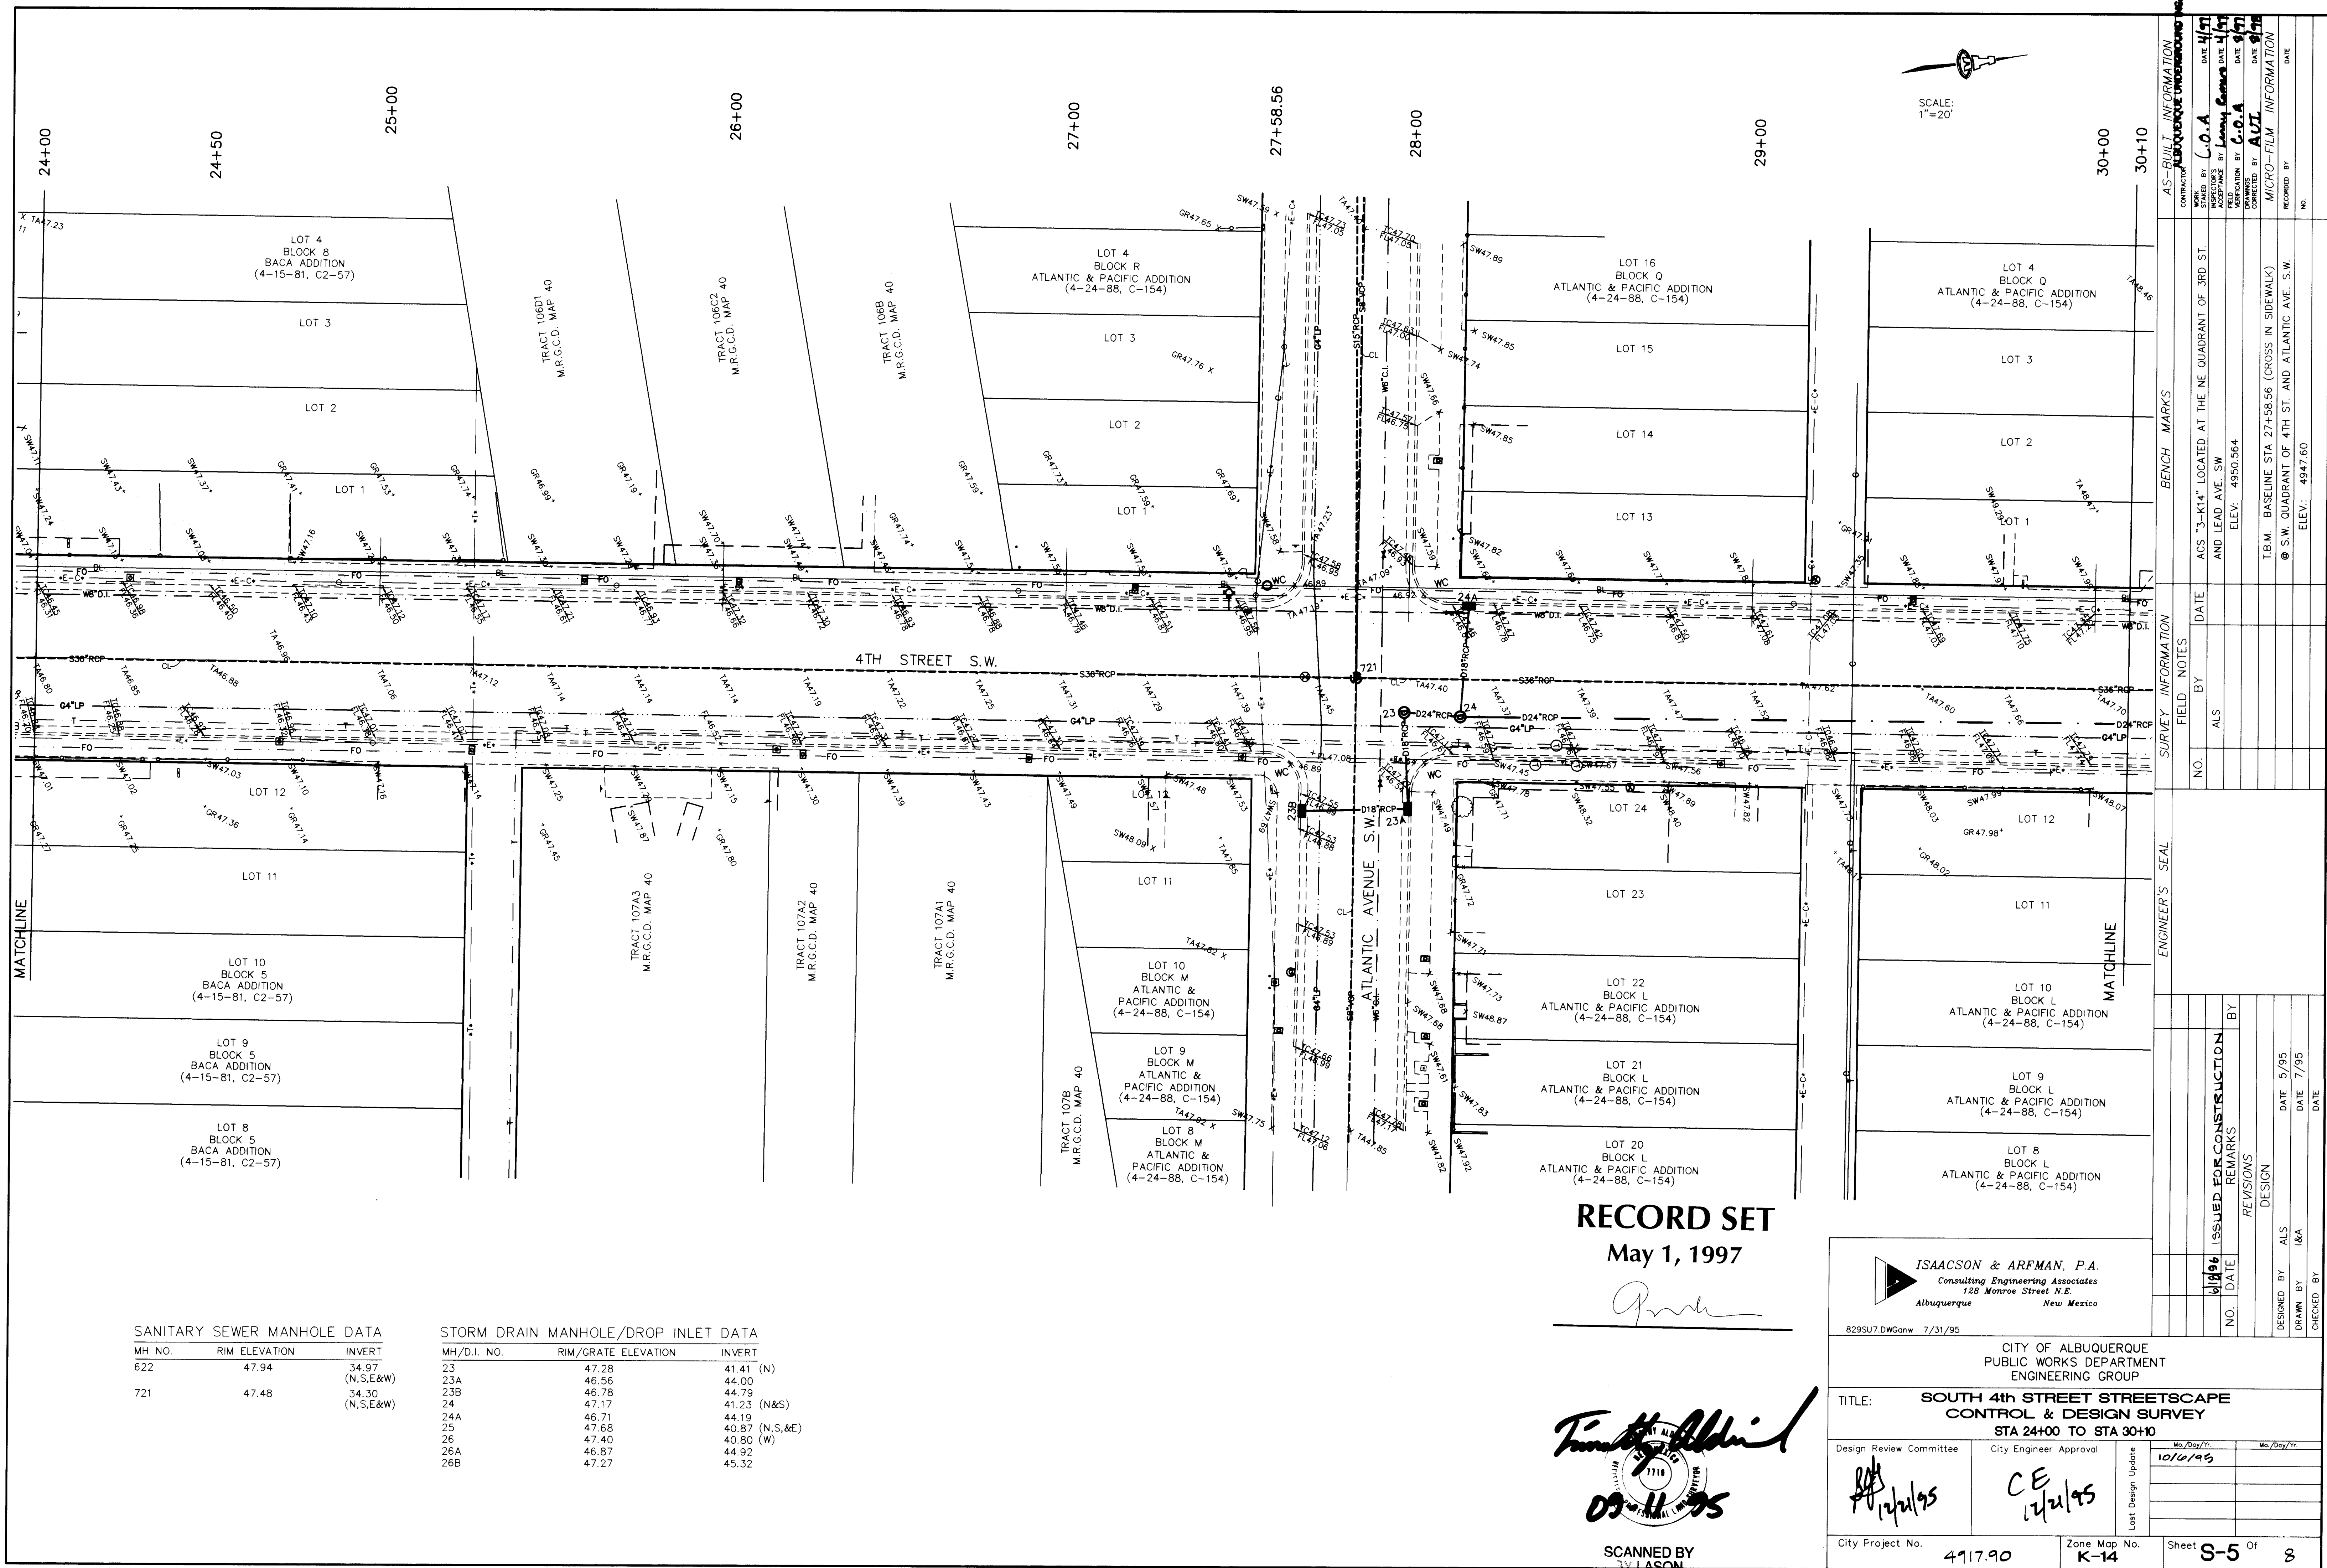

SCALE:
1"=20'

RECORD SET
May 1, 1997

Timothy J. Allen
02-11-95

SCANNED BY
JY LASON

ISAACSON & ARFMAN, P.A. Consulting Engineering Associates 128 Monroe Street N.E. Albuquerque New Mexico	
829SU7.DWGanw 7/31/95	
CITY OF ALBUQUERQUE PUBLIC WORKS DEPARTMENT ENGINEERING GROUP	
TITLE: SOUTH 4th STREET STREETSCAPE CONTROL & DESIGN SURVEY STA 24+00 TO STA 30+10	
Design Review Committee <i>SAH</i> 12/21/95	City Engineer Approval <i>CE</i> 12/21/95
Last Design Update 10/16/95	
City Project No. 4917.90	Zone Map No. K-14
Sheet S-5 Of 8	

SANITARY SEWER MANHOLE DATA

MH NO.	RIM ELEVATION	INVERT
622	47.94	34.97 (N,S,E&W)
721	47.48	34.30 (N,S,E&W)

STORM DRAIN MANHOLE/DROP INLET DATA


MH/D.I. NO.	RIM/GRATE ELEVATION	INVERT
23	47.28	41.41 (N)
23A	46.56	44.00
23B	46.78	44.79
24	47.17	41.23 (N&S)
24A	46.71	44.19
25	47.68	40.87 (N,S,&E)
26	47.40	40.80 (W)
26A	46.87	44.92
26B	47.27	45.32

AS-BUILT INFORMATION	
CONTRACTOR ISAACSON & ARFMAN, P.A.	DATE 4/97
STARTED BY C.O.A.	DATE 4/97
INSPECTOR'S FIELD VERIFICATION BY C.O.A.	DATE 9/97
CORRECTED BY AUT	DATE 9/97
MICRO-FILM INFORMATION	
RECORDED BY	DATE
NO.	DATE

BENCH MARKS	
ACS "3-K14" LOCATED AT THE NE QUADRANT OF 3RD ST. AND LEAD AVE. SW	ELEV: 4950.564
T.B.M. BASELINE STA 27+58.56 (CROSS IN SIDEWALK)	
SW. QUADRANT OF 4TH ST. AND ATLANTIC AVE. S.W.	ELEV: 4947.60

SURVEY INFORMATION	
NO.	DATE
BY	ALS
NO.	DATE
BY	ALS

ENGINEER'S SEAL	
ISSUED FOR CONSTRUCTION	
NO.	DATE
REMARKS	BY
DESIGN	
DESIGNED BY ALS	DATE 5/95
DRAWN BY ISA	DATE 7/95
CHECKED BY	DATE

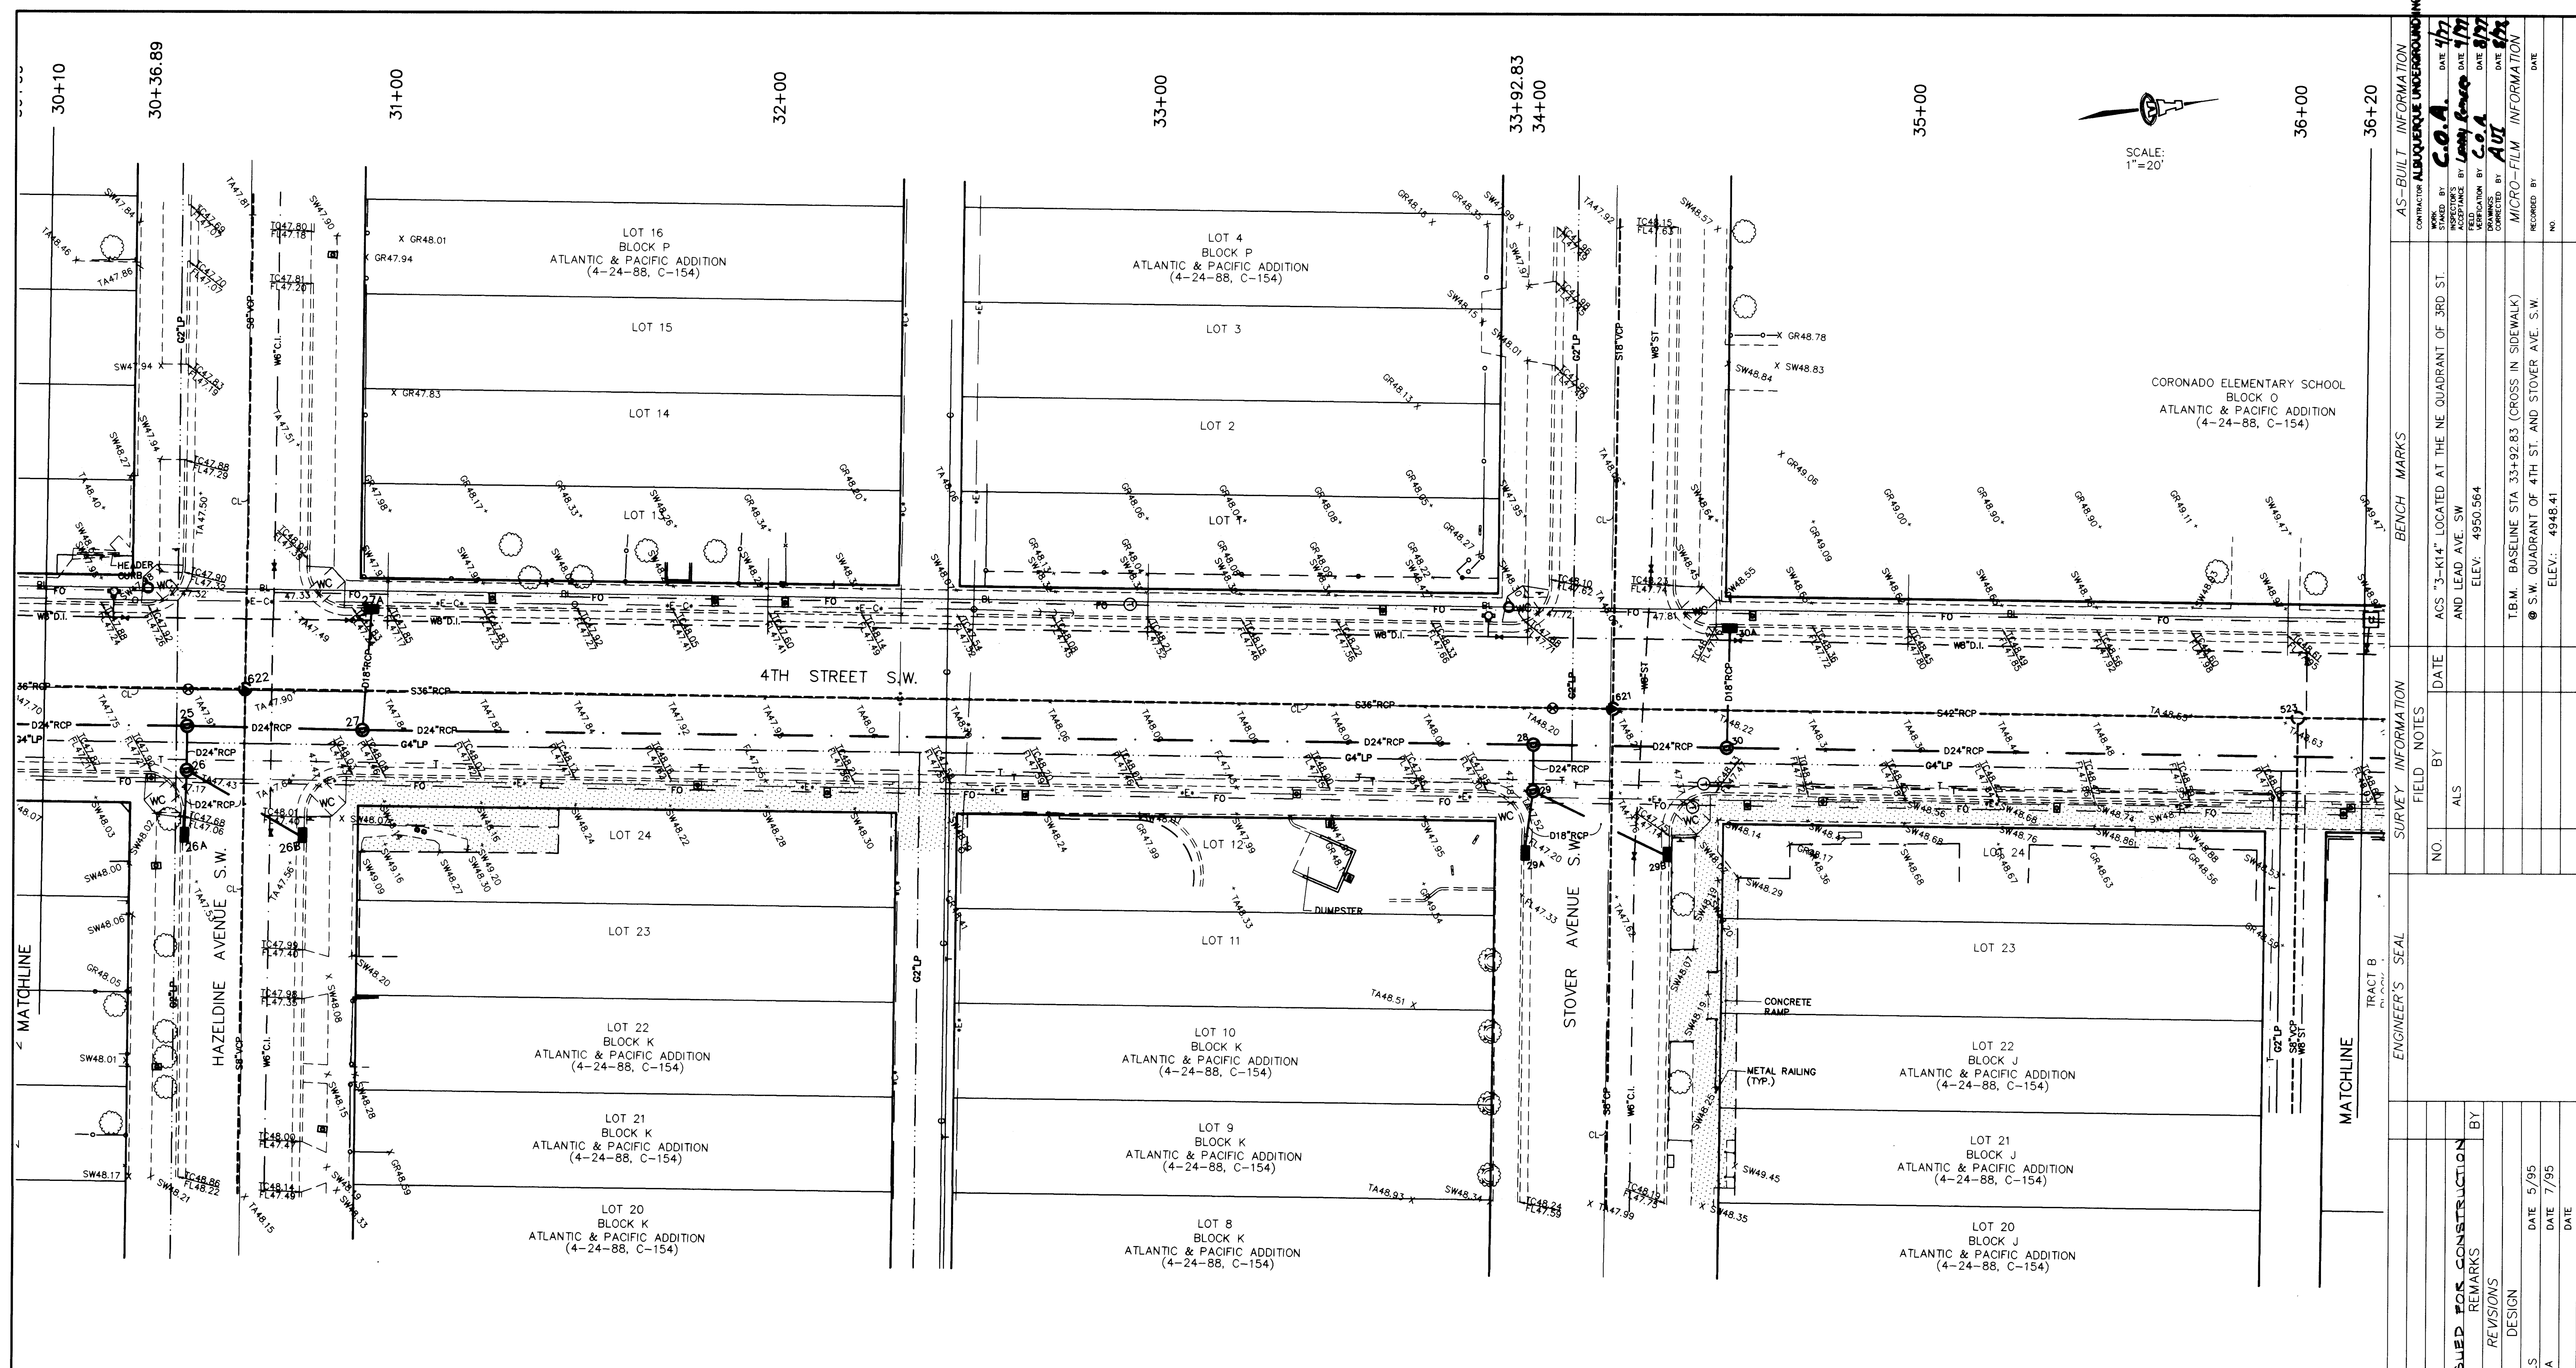


RECORD SET
May 1, 1997

Qu



SCANNED BY
BY LASON

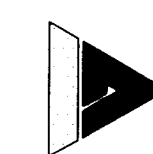

ISAACSON & ARFMAN, P.A.
Consulting Engineering Associates
128 Monroe Street N.E.
Albuquerque New Mexico

829SU8.DWGanw 7/31/95

CITY OF ALBUQUERQUE
PUBLIC WORKS DEPARTMENT
ENGINEERING GROUP

TITLE: **SOUTH 4th STREET STREETSCAPE
CONTROL & DESIGN SURVEY
STA 30+10 TO STA 36+20**

Design Review Committee	City Engineer Approval	Mo./Day/Yr.	Mo./Day/Yr.
-------------------------	------------------------	-------------	-------------

[illegible]

City Project No.	4917.90	Zone Map No.	K-14	Sheet	S-6	Of	8
------------------	---------	--------------	------	-------	-----	----	---

LEGEND

SW 00.00 X TOP SIDEWALK\TOP CONCRETE

TA 00.00 X TOP ASPHALT

TC=FL= TOP OF CURB FLOWLINE

GR 00.00 X GROUND

CURB AND GUTTER

CONCRETE/SIDEWALK

WALL OR HEAD WALL

BOLLARD

SIGN

CHAIN LINK FENCE

WOOD FENCE

TREE

SANITARY SEWER MANHOLE

CLEANOUT

WATER VALVE

FIRE HYDRANT

WATER METER

SPRINKLER CONTROL

ELECTRIC TRANSFORMER

OVERHEAD ELECTRIC LINE

POWER POLE

ANCHOR

STREET LIGHT

TRAFFIC LIGHT

SIGNAL PULLBOX

UTILITY BOX

TELEPHONE MANHOLE

CABLE T.V. PEDESTAL

TELEPHONE PEDESTAL

PAY PHONE

GAS LINE

GAS VALVE

GAS METER

STORM DRAIN MANHOLE

DROP INLET (2.0'X2.5')

DROP INLET (2.0'X3.5')

WHEELCHAIR RAMP

POSTAL\MAILBOX

HOME\MAILBOX

BUSINESS SIGN\BILLBOARD

PARKING METER

EXISTING BUILDING

S8"VCP SANITARY SEWER 8" VITRIFIED CLAY PIPE

S8"RCP SANITARY SEWER 8" REINFORCED CONCRETE PIPE

S8"CP SANITARY SEWER 8" CONCRETE PIPE

S8"PVC SANITARY SEWER 8" PVC PIPE

D24"RCP STORM DRAIN 24" REINFORCED CONCRETE PIPE

D12"CP STORM DRAIN 12" CONCRETE PIPE

D12"ST STORM DRAIN 12" STEEL PIPE

D53"X35"RCPSTORM DRAIN 53"X35" CONCRETE ARCH PIPE

D12" STORM DRAIN 12" PIPE (UNKNOWN TYPE)

W6"DI WATER 6" DUCTILE IRON PIPE

W6"PVC WATER 6" PVC PIPE

W6"CI WATER 6" CAST IRON PIPE

W6"ST WATER 6" STEEL PIPE

W6"GAL WATER 6" GALVANIZED PIPE

W6" WATER 6" PIPE (UNKNOWN TYPE)

G4"LP GAS 4" LOW PRESSURE

G4"MP GAS 4" MEDIUM PRESSURE

G4"HP GAS 4" HIGH PRESSURE

FO FIBER OPTIC TELEPHONE LINE (UNDERGROUND)

T TELEPHONE LINE (UNDERGROUND)

T TELEPHONE LINE (OVERHEAD)

C CABLE TELEVISION LINE (UNDERGROUND)

C CABLE TELEVISION LINE (OVERHEAD)

E ELECTRIC LINE (UNDERGROUND)

E ELECTRIC LINE (OVERHEAD)


CL CENTERLINE OF RIGHT-OF-WAY

▲ CENTERLINE INTERSECTION

⊙ CENTERLINE REFERENCE MONUMENT (IN VALVE BOX)

BL SURVEY BASELINE

○ SURVEY BASELINE MONUMENT (CROSS ON SIDEWALK)

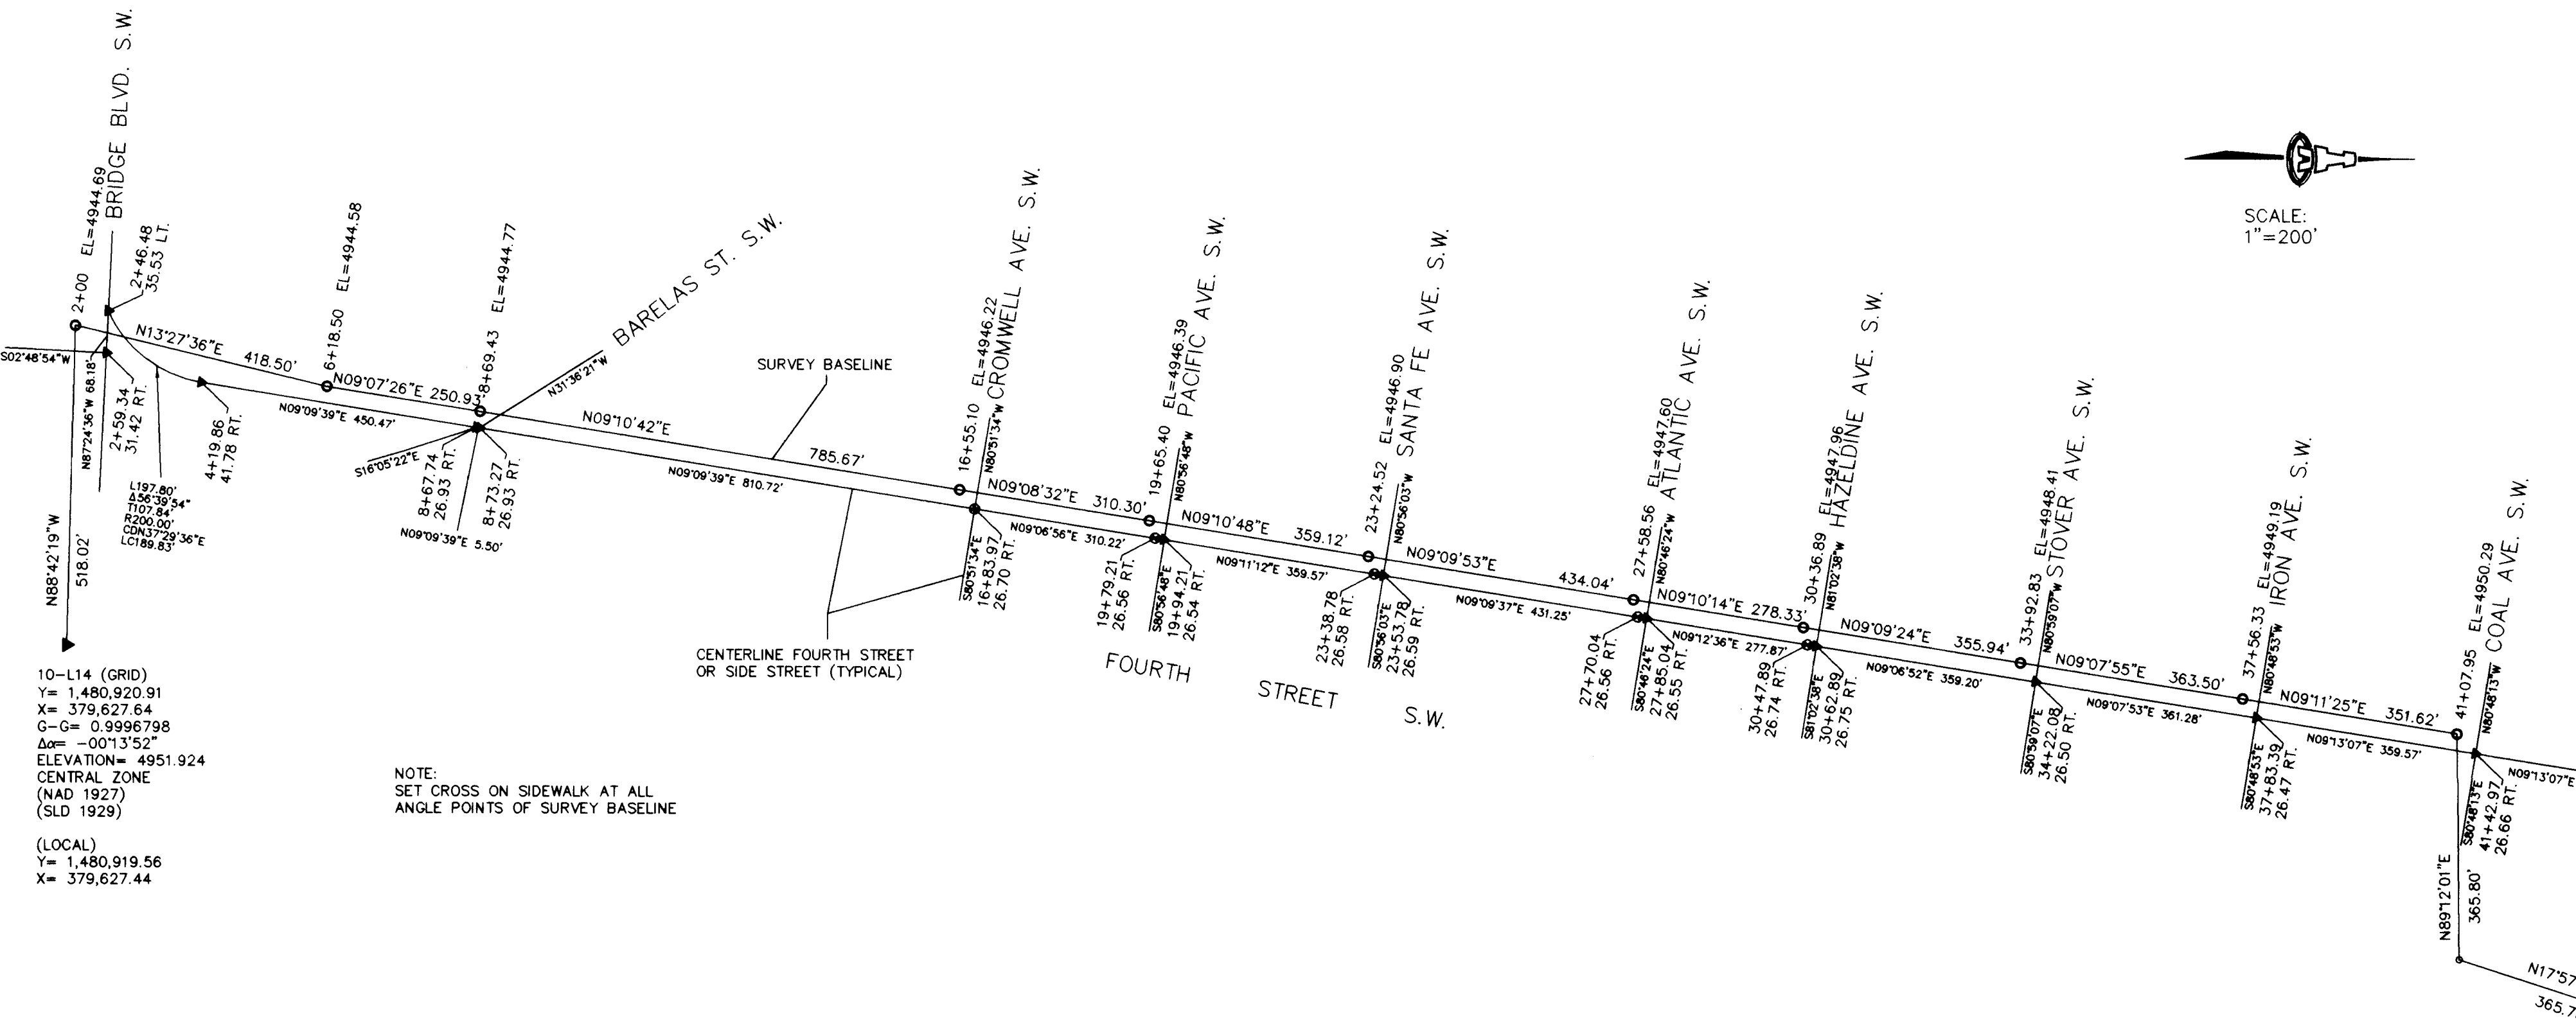

SCALE:
1"=200'

RECORD SET
May 1, 1997

[Signature]

ISAACSON & ARFMAN, P.A.
Consulting Engineering Associates
128 Monroe Street N.E.
Albuquerque New Mexico

829SH72.DWGanw 10/6/95

CITY OF ALBUQUERQUE
PUBLIC WORKS DEPARTMENT
ENGINEERING GROUP

TITLE: SOUTH 4th STREET STREETSCAPE
CONTROL & DESIGN SURVEY

Design Review Committee	City Engineer Approval	Last Design Update	Mo./Day/Yr.	Mo./Day/Yr.
<i>[Signature]</i>	<i>[Signature]</i>	10/6/95		
City Project No. 4917.90	Zone Map No. K-14/L-14	Sheet S-8	Of 8	



SCANNED BY
BY LASON

AS-BUILT INFORMATION		BENCH MARKS		SURVEY INFORMATION		ENGINEER'S SEAL	
CONTRACTOR	ALBUQUERQUE UNDERGROUND INC.	NO.	DATE	NO.	DATE		
STAKED BY	C.B.A.						
NO. OF STAKES	477						
FIELD OBSERVATION BY	C.B.A.						
REVISION BY	C.B.A.						
CORRECTED BY	AUT						
MICRO-FILM INFORMATION							
RECORDED BY							
NO.							

ACS "3-K14" LOCATED AT THE NE QUADRANT OF 3RD ST. AND LEAD AVE. SW	DATE	BY	NO.
ELEV: 4950.564		ALS	


ISSUED FOR CONSTRUCTION	REMARKS	BY	DATE
DESIGNED BY	ALS	DATE	5/95
CHECKED BY	I&A	DATE	7/95

LEGEND

- SW 00.00 X TOP SIDEWALK\TOP CONCRETE
TA 00.00 X TOP ASPHALT
TC= TOP OF CURB
FL= FLOWLINE
GR 00.0 X GROUND
CURB AND GUTTER
CONCRETE/SIDEWALK
WALL OR HEAD WALL
BOLLARD
SIGN
CHAIN LINK FENCE
WOOD FENCE
TREE
SANITARY SEWER MANHOLE
CLEANOUT
WATER VALVE
FIRE HYDRANT
WATER METER
SPRINKLER CONTROL
ELECTRIC TRANSFORMER
OVERHEAD ELECTRIC LINE
POWER POLE

- ANCHOR
STREET LIGHT
TRAFFIC LIGHT
SIGNAL PULLBOX
UTILITY BOX
TELEPHONE MANHOLE
CABLE T.V. PEDESTAL
TELEPHONE PEDESTAL
PAY PHONE
GAS LINE
GAS VALVE
GAS METER
STORM DRAIN MANHOLE
DROP INLET (2.0'X2.5')
DROP INLET (2.0'X3.5')
WHEELCHAIR RAMP
POSTAL\MAILBOX
HOME\MAILBOX
BUSINESS SIGN\BILLBOARD
PARKING METER
EXISTING BUILDING
S8"VCP SANITARY SEWER 8" VITRIFIED CLAY PIPE
S8"RCP SANITARY SEWER 8" REINFORCED CONCRETE PIPE
S8"CP SANITARY SEWER 8" CONCRETE PIPE

- S8"PVC SANITARY SEWER 8" PVC PIPE
D24"RCP STORM DRAIN 24" REINFORCED CONCRETE PIPE
D12"CP STORM DRAIN 12" CONCRETE PIPE
D12"ST STORM DRAIN 12" STEEL PIPE
D53"X35"RCPSTORM DRAIN 53"X35" CONCRETE ARCH PIPE
D12" STORM DRAIN 12" PIPE (UNKNOWN TYPE)
W6"DI WATER 6" DUCTILE IRON PIPE
W6"PVC WATER 6" PVC PIPE
W6"CI WATER 6" CAST IRON PIPE
W6"ST WATER 6" STEEL PIPE
W6"GAL WATER 6" GALVANIZED PIPE
W6" WATER 6" PIPE (UNKNOWN TYPE)
G4"LP GAS 4" LOW PRESSURE
G4"MP GAS 4" MEDIUM PRESSURE
G4"HP GAS 4" HIGH PRESSURE
FO FIBER OPTIC TELEPHONE LINE (UNDERGROUND)
T TELEPHONE LINE (UNDERGROUND)
T TELEPHONE LINE (OVERHEAD)
C CABLE TELEVISION LINE (UNDERGROUND)
C CABLE TELEVISION LINE (OVERHEAD)
E ELECTRIC LINE (UNDERGROUND)
E ELECTRIC LINE (OVERHEAD)
CL CENTERLINE OF RIGHT-OF-WAY
▲ CENTERLINE INTERSECTION
⊙ CENTERLINE REFERENCE MONUMENT (IN VALVE BOX)
BL SURVEY BASELINE
○ SURVEY BASELINE MONUMENT (CROSS ON SIDEWALK)

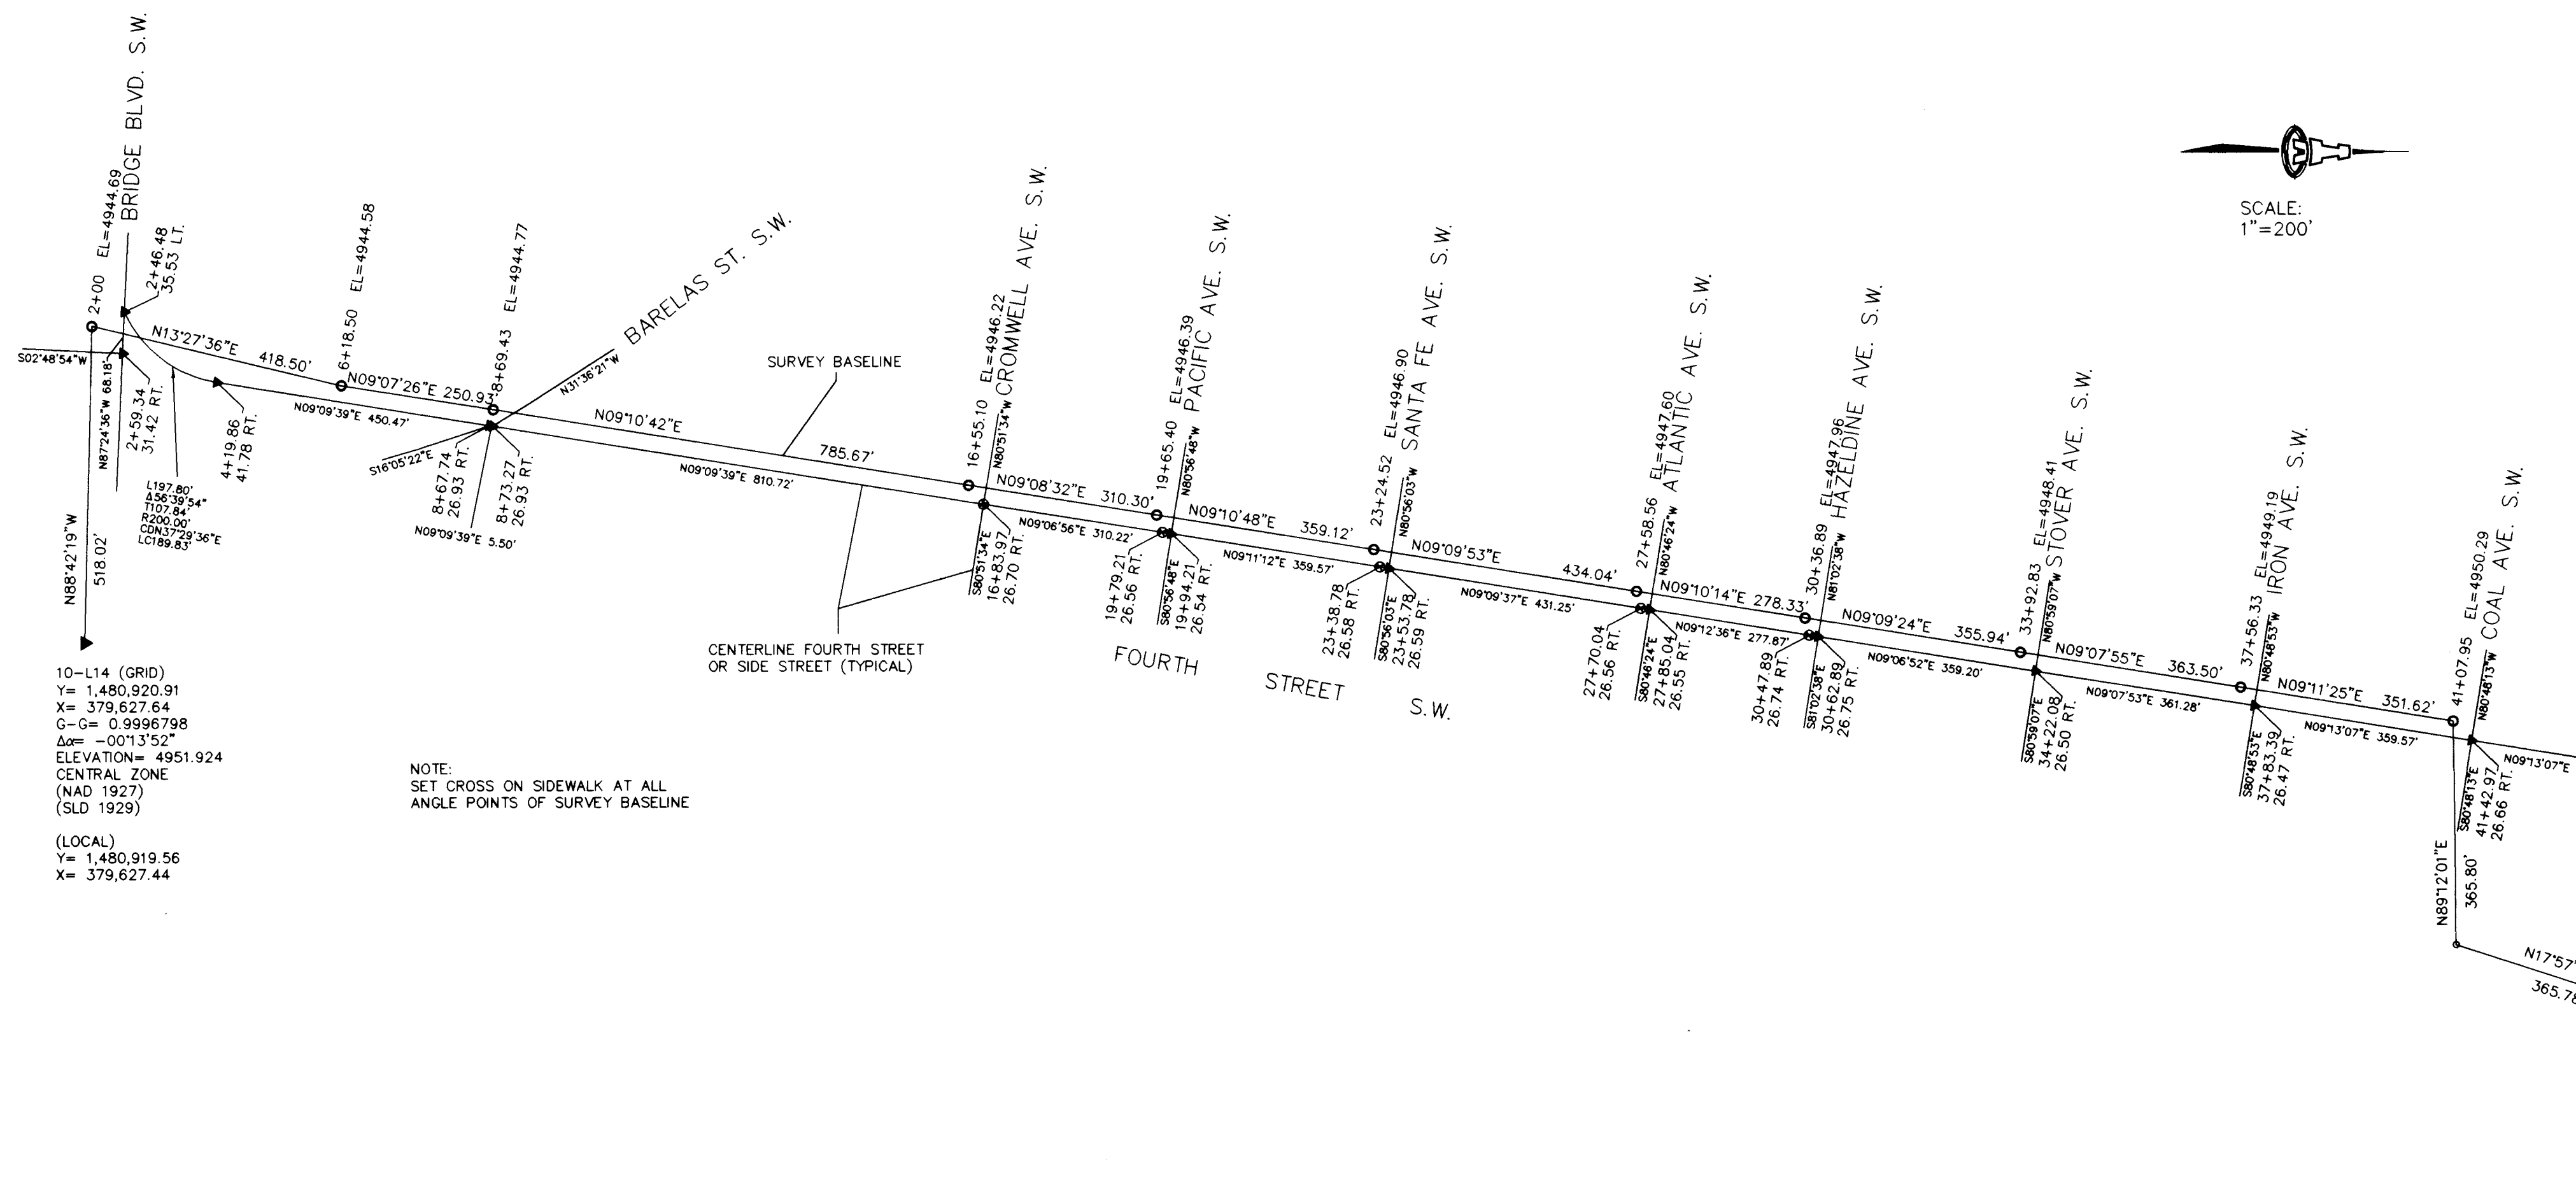

RECORD SET
May 1, 1997

ISAACSON & ARFMAN, P.A.
Consulting Engineering Associates
128 Monroe Street N.E.
Albuquerque New Mexico

829SH2.DWGonw 7/31/95


CITY OF ALBUQUERQUE
PUBLIC WORKS DEPARTMENT
ENGINEERING GROUP

TITLE: SOUTH 4th STREET STREETSCAPE
CONTROL & DESIGN SURVEY

Design Review Committee	City Engineer Approval	Last Design Update	Mo./Day/Yr.	Mo./Day/Yr.

City Project No. Zone Map No. K-14/L-14 Sheet S-8A Of 8

AS-BUILT INFORMATION		BENCH MARKS		SURVEY INFORMATION		ENGINEER'S SEAL		REVISIONS		DESIGN		CHECKED BY		DATE	
CONTRACTOR	ALBUQUERQUE UNDERGROUND INC.	NO.	DATE	NO.	DATE			NO.	DATE	DESIGNED BY	DATE	DRAWN BY	DATE	CHECKED BY	DATE
STAMPED BY	C.O.A.			BY	ALS					ALS	5/95				
ACCEPTANCE	LEAHY ENGINEERS														
VERIFICATION	C.O.A.														
DRAWINGS	ADDI														
CORRECTED BY	MICRO-FILM														
RECORDED BY															
NO.															

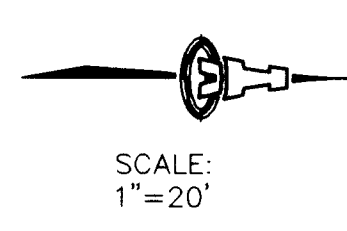

POTHOLING LOG

LOCATION OF MARKER ONE (M1)	STORM DRAIN SOUTH OF POTHOLES
LOCATION OF MARKER TWO (M2)	WATER VALVE COVER SOUTH OF POTHOLES
LOCATION OF MARKER THREE (M3)	POWER POLE NORTH OF POTHOLES

POT HOLE #	UTILITY	TYPE	DIAMETER	DEPTH TO TOP	DEPTH TO BOTTOM	DISTANCE TO M1	DISTANCE TO M2	DISTANCE TO M3	PAVEMENT
15	CATV	PVC	2"	24"	NR	38.0'	48.0'	32.6'	8"
16	WATER	STEEL	12"	45"	NR	38.0'	48.0'	32.6'	8"


NR=NOT REQUIRED

POTHOLING LOG

LOCATION OF MARKER ONE (M1)	STORM DRAIN SOUTH OF POTHOLES
LOCATION OF MARKER TWO (M2)	STORM DRAIN SOUTHEAST OF POTHOLES
LOCATION OF MARKER THREE (M3)	MANHOLE SOUTHWEST OF POTHOLES

POT HOLE #	UTILITY	TYPE	DIAMETER	DEPTH TO TOP	DEPTH TO BOTTOM	DISTANCE TO M1	DISTANCE TO M2	DISTANCE TO M3	PAVEMENT
13	TELE	CON CAP	NR	57"	77"	8.4'	26.7'	17.5'	0
14	TELE	CON CAP	NR	31"	60"	43.0'	63.0'	47.2'	8"
14A	GAS	STEEL	4"	30"	NR	43.0'	63.0'	47.2'	8"

NR=NOT REQUIRED

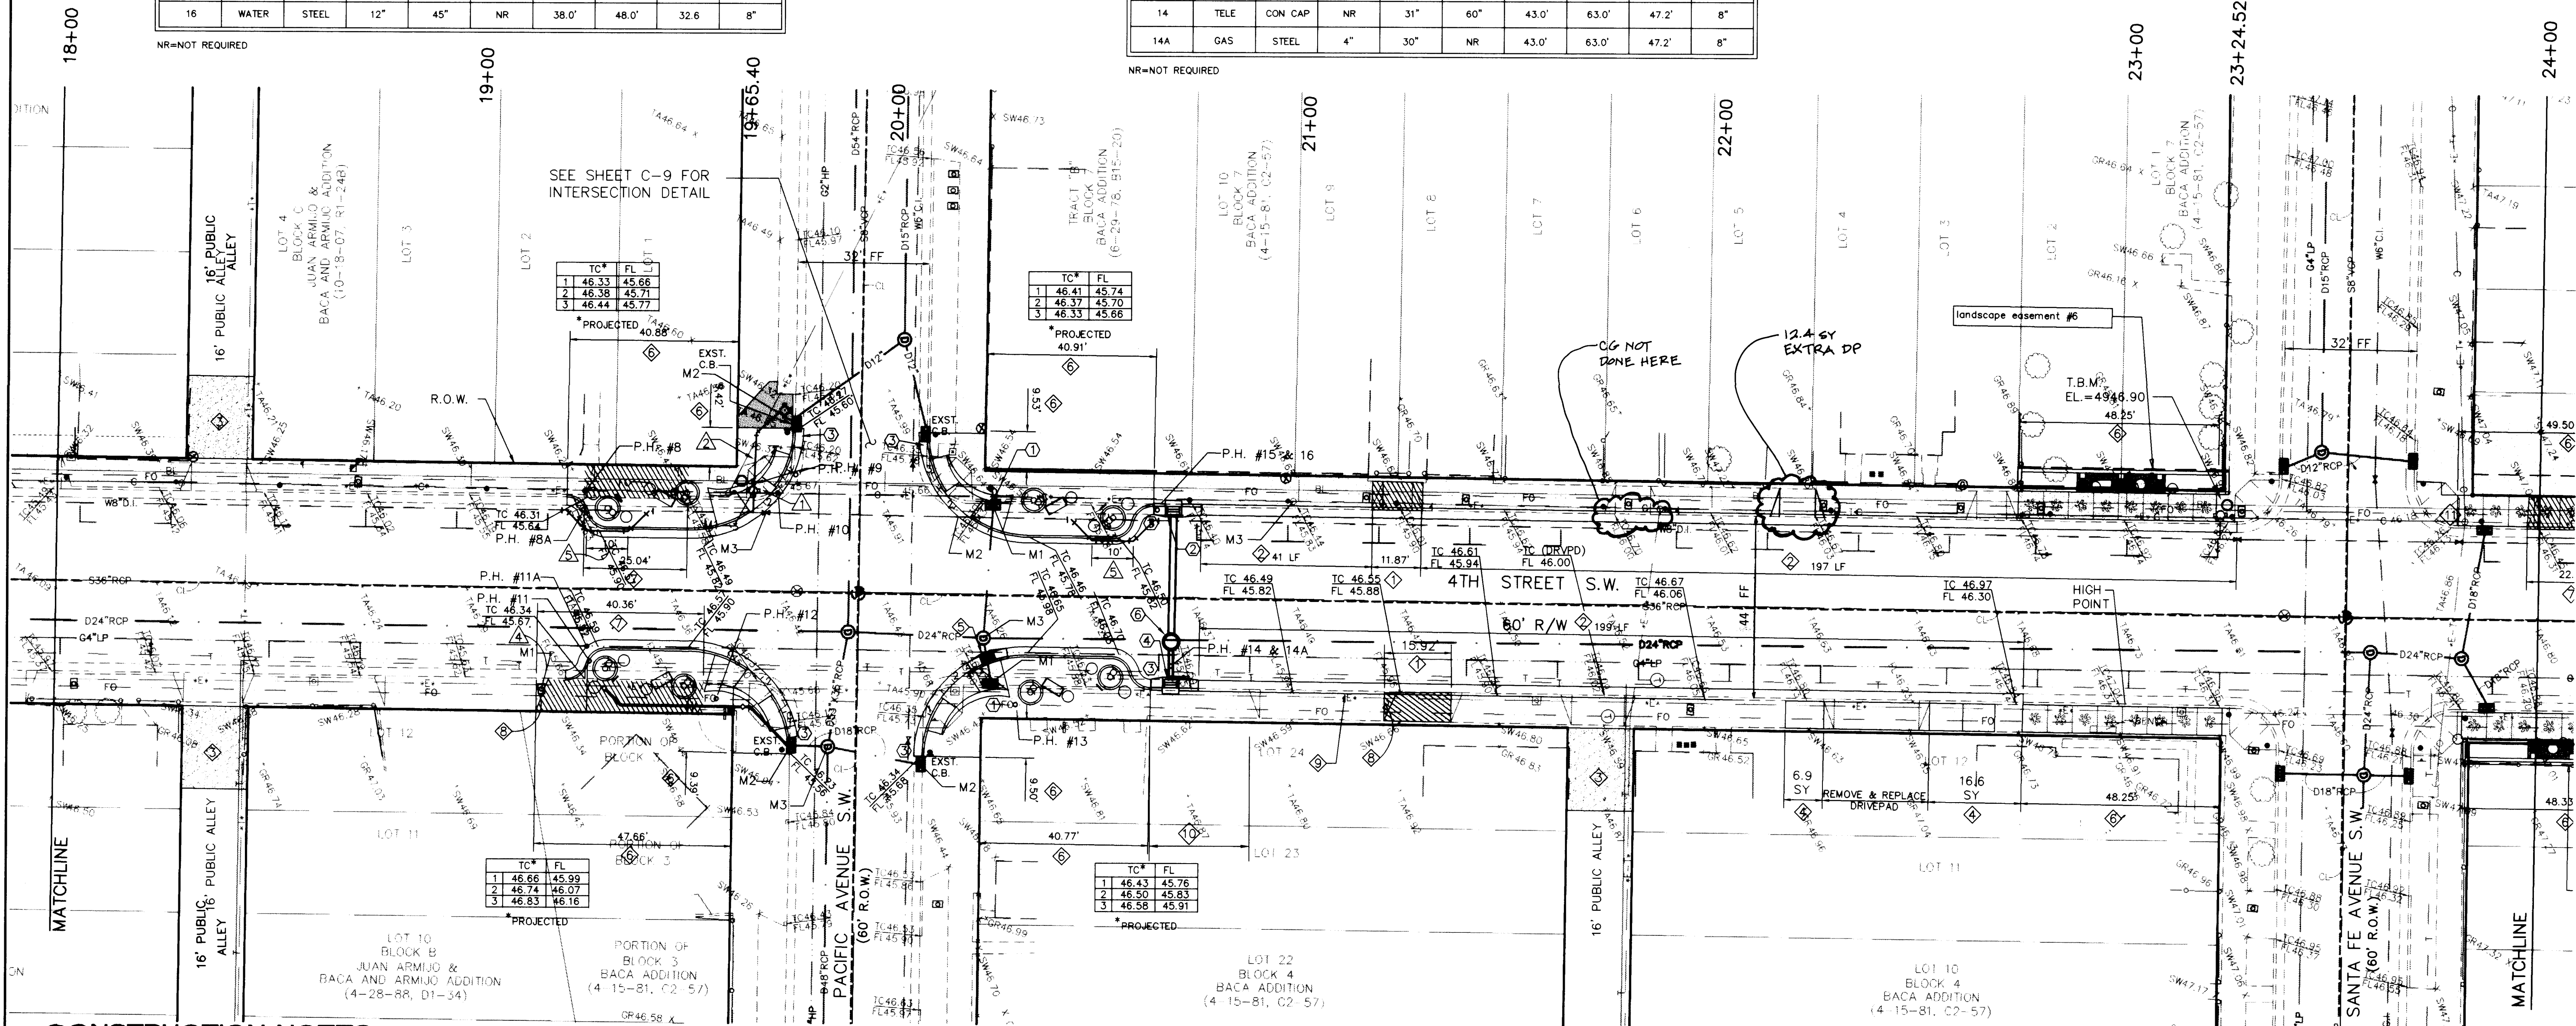

CONSTRUCTION NOTES

PAVING: KEYED

- REMOVE AND DISPOSE EXISTING P.C.C. DRIVEPADS AS INDICATED AT EACH DIMENSIONED LOCATION. CONSTRUCT STD. CURB & GUTTER AS A STRAIGHT GRADE FLOWLINE BETWEEN EDGES. CONSTRUCT P.C.C. SIDEWALK TO MATCH REMOVED AREA.
- REMOVE, DISPOSE AND REPLACE STD. P.C.C. CURB STONES AS INDICATED ON THESE PLANS OR AS FIELD MARKED BY THE CITY STREET MAINTENANCE DEPT.
- 2" ACSC OVER 12" COMPACTED SUBGRADE. PLACE TO CONFORM TO PERIMETER GRADES AND EXISTING DRAINAGE PATTERNS.
- REMOVE AND DISPOSE EXISTING P.C.C. SIDEWALK AS INDICATED AT EACH DIMENSIONED LOCATION. CONSTRUCT STD. 4" THICK P.C.C. SIDEWALK @ 2% CROSS-SLOPE BETWEEN BACK OF CURB EXTENDING 6 FT TOWARD R.O.W. LINE.
- THE FOLLOWING PAVEMENT REMOVALS & DISPOSALS APPLY IN EACH QUADRANT OF THE PACIFIC AVE. INTERSECTION.
 - 62 LF OF STD. CURB & GUTTER. NOTE - REMOVE ENTIRE CURB STONE AT EACH END OF NEW CURBING.
 - 40 SY OF ASPHALTIC PAVING.
- REMOVE P.C.C. SIDEWALK AND REPLACE PER ARCHITECTURAL PLAN DETAILS.

- REMOVE & DISPOSE EXISTING P.C.C. DRIVEPAD. REPLACE CURB & GUTTER MATCHING FLOWLINE GRADE. REPLACE P.C.C. SIDEWALK PER ARCHITECTURAL PLAN DETAILS.
- CONSTRUCT DRIVEPAD TRANSITION FLARE (MAX. 1:10 SLOPE).
- SAWCUT ALONG BACK OF CURB LINE.
- REMOVE AND REPLACE P.C.C. SIDEWALK AS NECESSARY TO MATCH TOP OF CURB.
- REMOVE GUY WIRE ANCHOR.

A.D.A. NOTE:

ALL RECONSTRUCTED DRIVEPADS AND HANDICAP RAMPS SHALL BE IN ACCORDANCE WITH THE A.D.A. SLOPE STANDARDS.

POTHOLING LOG

LOCATION OF MARKER ONE (M1)	FIRE HYDRANT
LOCATION OF MARKER TWO (M2)	STORM GRATE
LOCATION OF MARKER THREE (M3)	WATER VALVE COVER

POT HOLE #	UTILITY	TYPE	DIAMETER	DEPTH TO TOP	DEPTH TO BOTTOM	DISTANCE TO M1	DISTANCE TO M2	DISTANCE TO M3	PAVEMENT
8	CATV	PVC	2"	17"	NR	41.0'	56.6'	44.0'	8"
8A	WATER	STEEL	4"	48"	NR	41.9'	56.3'	44.0'	8"
9	TELE F.O.	PVC	4"	39"	NR	11.0'	12.3'	12.0'	8"
10	NO LOCATE---CLEAR TO 5 FT.								

NR=NOT REQUIRED

STORM DRAINAGE: KEYED

- MODIFY EXISTING CATCH BASIN TO A JUNCTION BOX. REMOVE GRATE, AND CURB OPENING AND SUPPORT STRUCTURE AND RESHAPE TO ACCEPT A MODIFIED TYPE 'C' MANHOLE COVER (TO FIT). SEE DWG. 2107 - PLUS.
- CONSTRUCT SINGLE 'C' INLET PER DWG. 2205. GRATE EL.=45.49 INV.=43.60
- CONSTRUCT 3' GUTTER TRANSITION AT CURB RETURN SIDE PER DWG. 2207.
- CONSTRUCT SINGLE 'C' INLET PER DWG. 2205. GRATE EL.=45.57 INV.=44.30
- CONSTRUCT SINGLE 'C' INLET PER DWG. 2205. GRATE EL.=45.55 INV. (EXIST. PIPE)=39.6
- CONSTRUCT 4" DIA. TYPE C STORM DRAIN MANHOLE OVER EXST. 24" S.D. STA 20+69.82, 37.32' RT. RIM=46.26, INV. (EXST.)=37.03, INV. (W)=42.40, INV. (E)=43.90

UTILITY & MISC.: KEYED

- REMOVE AND RELOCATE EXISTING FIRE HYDRANT IF INSPECTED AND APPROVED FOR REUSE BY U.D.D., C.O.A.
- 28' OF 6" WATERLINE 1-6" (22 1/2") BEND REST. JOINTS
- RELOCATE FH TO STD. LOCATION 9' WEST OF CURB RETURN. DWGS. 2340 & 2347. FL EL.=46.70
- REBUILD WATER METER BOX TO REVISED GRADES.
- REMOVE 20' OF 6" WATERLINE AND INSTALL 24' OF BYPASS 6" WATER LINE WITH 4-6" 45° BEND AND RESTRAINTS. 10' SECTION OF BYPASS LINE OFFSET 5 FEET RIGHT.

POTHOLING LOG

LOCATION OF MARKER ONE (M1)	WATER METER SOUTH OF POTHOLES
LOCATION OF MARKER TWO (M2)	STORM DRAIN NORTH OF POTHOLES
LOCATION OF MARKER THREE (M3)	MANHOLE NORTH OF POTHOLES

POT HOLE #	UTILITY	TYPE	DIAMETER	DEPTH TO TOP	DEPTH TO BOTTOM	DISTANCE TO M1	DISTANCE TO M2	DISTANCE TO M3	PAVEMENT
11	TELE	CON CAP	N/R	34"	52"	13.4'	55.0'	61.3'	8"
11A	GAS	STEEL	4"	30"	NR	14.9'	56.3'	62.3'	8"
12	TELE	CON CAP	NR	51"	70"	42.5'	21.3'	27.3'	0

NR=NOT REQUIRED

LEGEND (SEE SHT. S-8 FOR COMPLETE LEGEND)

SW 00.00 X TOP SIDEWALK/ TOP CONCRETE

TA 00.00 X TOP ASPHALT

TC= TOP OF CURB FLOWLINE

== CURB AND GUTTER (EXISTING)

== CURB AND GUTTER (PROPOSED)

CONCRETE/SIDEWALK

DRIVEPAD (PROPOSED/EXISTING)

○ SANITARY SEWER MANHOLE

○ WATER VALVE

○ FIRE HYDRANT

○ WATER METER

○ POWER POLE

○ TELEPHONE MANHOLE

○ GAS METER

○ STORM DRAIN MANHOLE

○ DROP INLET

S8" SANITARY SEWER 8"

D24" STORM DRAIN 24"

W6" WATER 6"

G4" GAS 4"

FO FIBER OPTIC TELEPHONE LINE (UNDERGROUND)

● LIGHT FIXTURE (PROPOSED)

RECORD SET May 1, 1997

[Signature]

ISAACSON & ARFMAN, P.A.
Consulting Engineering Associates
128 Monroe Street N.E.
Albuquerque New Mexico

829SH16.DwgGaw 12/20/95

CITY OF ALBUQUERQUE
PUBLIC WORKS DEPARTMENT
ENGINEERING GROUP

TITLE: **SOUTH 4th STREET STREETSCAPE
PAVING & DRAINAGE PLAN
STA 18+00 TO STA 24+00**

Design Review Committee City Engineer Approval

[Signature] *[Signature]*

Mo./Day/Yr. 10/6/95

Mo./Day/Yr. 10/6/95

City Project No. 4917.90

Zone Map No. K-14

Sheet C-4 Of 10

AS-BUILT INFORMATION		SURVEY INFORMATION		ENGINEER'S SEAL	
CONTRACTOR	ALBUQUERQUE UNDERGROUND INC.	NO.	DATE	NO.	DATE
STATIONED BY	C.O.A.	BY	DATE	SEAL	DATE
INSPECTED BY	C.O.A.	ALS	DATE		DATE
FIELD CHECKED BY	C.O.A.	DATE	DATE		
REVISIONS	C.O.A.	DATE	DATE		
MICRO-FILM INFORMATION		T.B.M. BASELINE STA 23+24.57 (CROSS IN SIDEWALK)		DESIGNED BY FCA	
RECORDED BY		S.W. QUADRANT OF 4TH ST. AND SANTA FE AVE. S.W.		DRAWN BY ANW	
DATE		ELEV.: 4946.90		CHECKED BY RKA	
NO.				DATE 10/95	
				DATE 10/95	

POTHOLING LOG

LOCATION OF MARKER ONE (M1)	POWER POLE SOUTH OF POTHLES
LOCATION OF MARKER TWO (M2)	WATER METER EAST OF POTHLES
LOCATION OF MARKER THREE (M3)	FIRE HYDRANT NORTH OF POTHLES



POT HOLE #	UTILITY	TYPE	DIAMETER	DEPTH TO TOP	DEPTH TO BOTTOM	DISTANCE TO M1	DISTANCE TO M2	DISTANCE TO M3	PAVEMENT
17	TELE	CON CAP	NR	27"	48"	47.7'	0.4'	76.4'	0
18	GAS	STEEL	4"	36"	NR	40.4'	8.4'	70.0'	8"
19	TELE	CON CAP	NR	46"	68"	38.8'	10.0'	69.0'	8"
20	WATER	STEEL	12"	45"	NR	8.9'	45.0'	54.0'	8"

NR=NOT REQUIRED

LOCATION OF MARKER ONE (M1)	POWER POLE #225 NORTH OF POTHOLE #24
LOCATION OF MARKER TWO (M2)	STORM GRATE SOUTH OF POTHOLE #24
LOCATION OF MARKER THREE (M3)	TELEPHONE MANHOLE COVER, CENTER OF

POTHOLE #	UTILITY	TYPE	DIAMETER	DEPTH TO TOP	DEPTH TO BOTTOM	DISTANCE TO M1	DISTANCE TO M2	DISTANCE TO M3	PAVEMENT
21	TELE	CON CAP	NR	53"	75"	59.6'	73.4'	31.0'	6" CONC
22	TELE	CON CAP	NR	35"	58"	35.6'	68.4'	31.0'	10" ASP
23	GAS	STEEL	4"	16"	NR	53.1'	66.0'	31.0'	10" ASP
24	TELE F.O.	PVC	2"	41"	NR	37.0'	48.0'	56.7'	10" ASP

NR=NOT REQUIRED

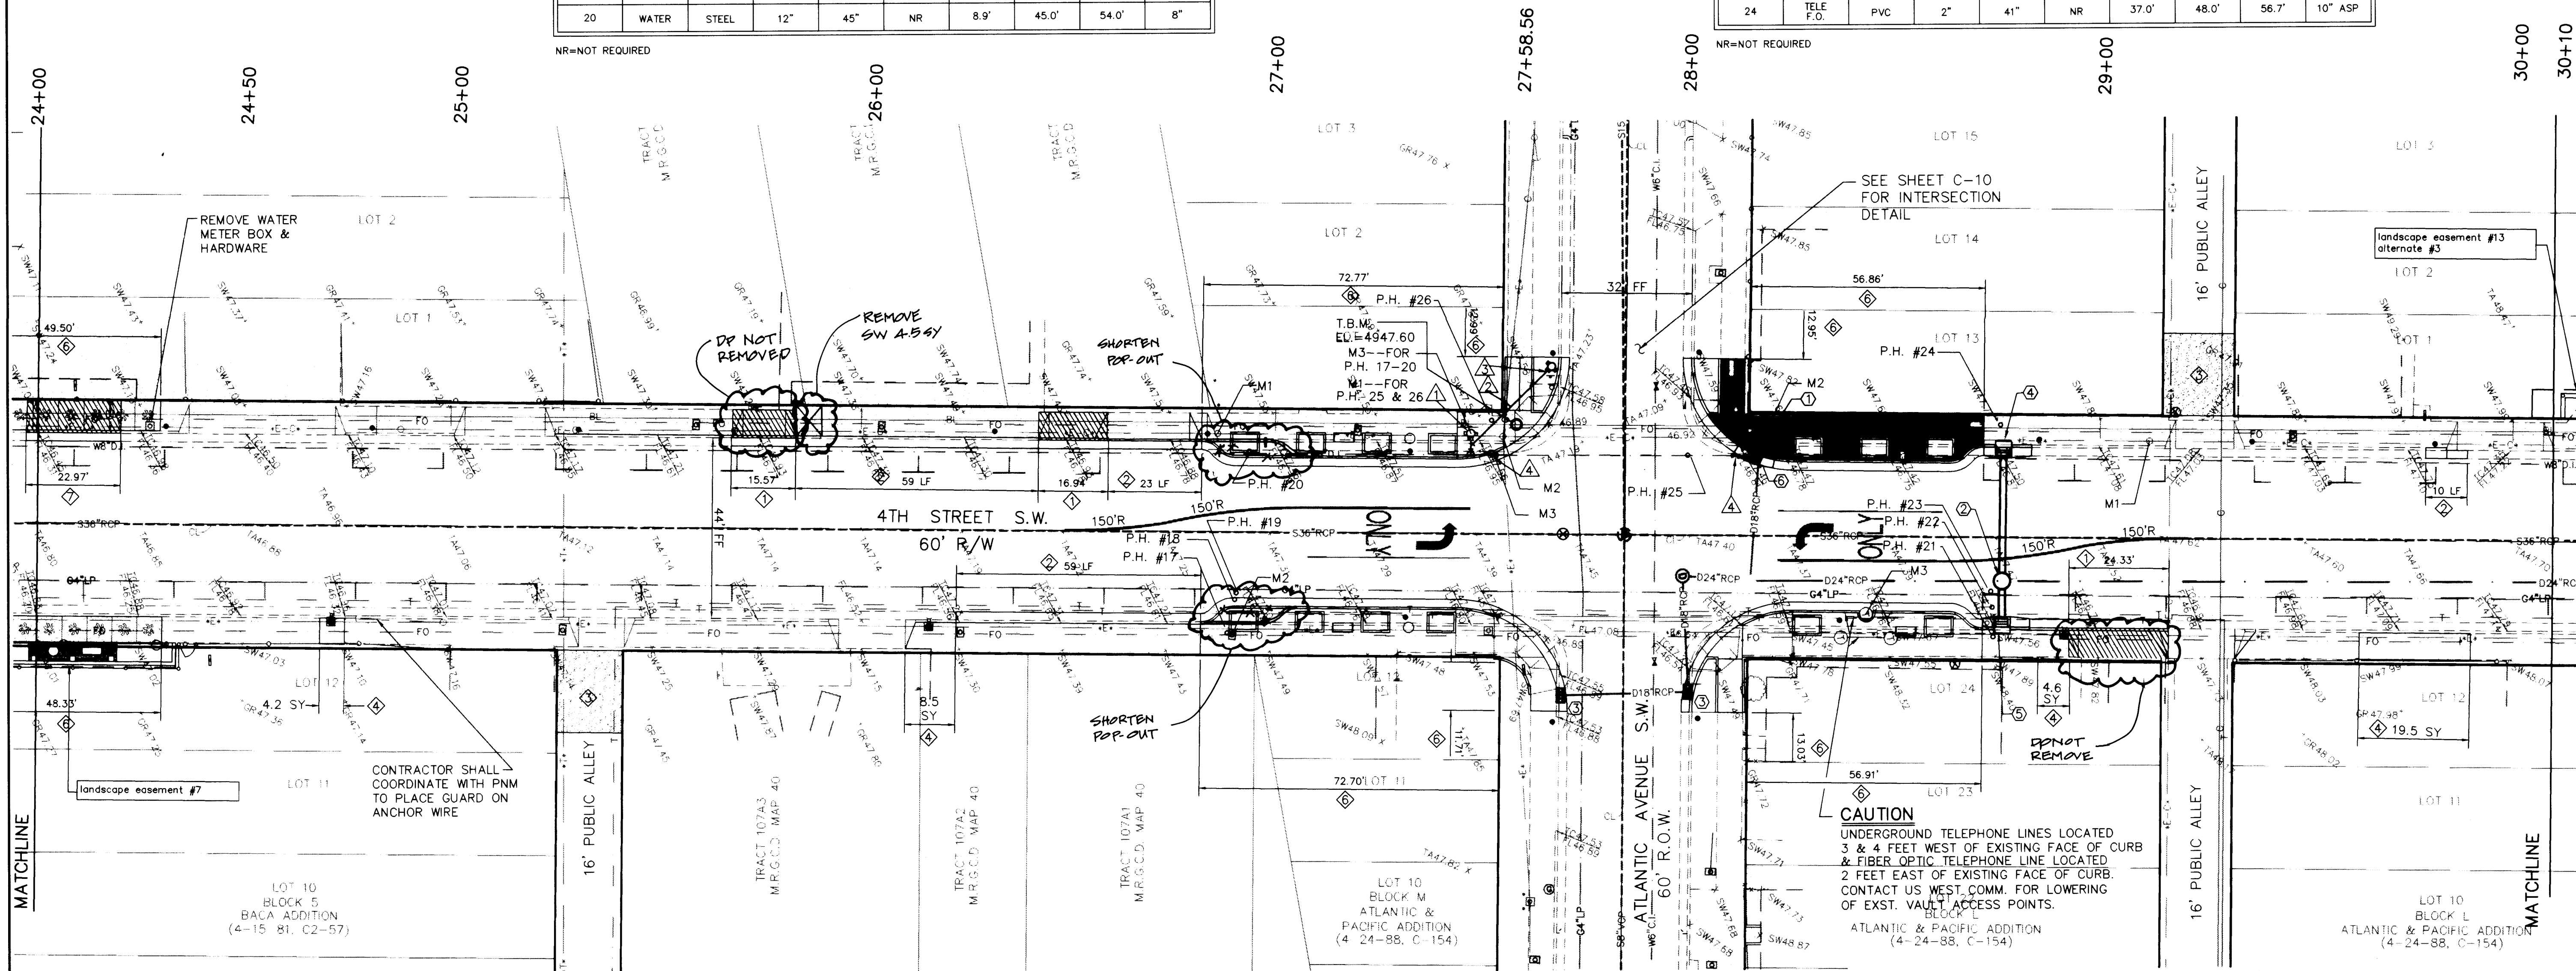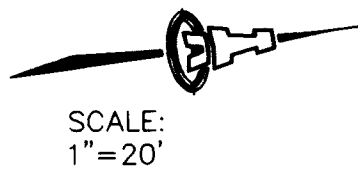PAVING: KEYED

1. REMOVE AND DISPOSE EXISTING P.C.C. DRIVEPADS AS INDICATED AT EACH DIMENSIONED LOCATION. CONSTRUCT STD. CURB & GUTTER AS A STRAIGHT GRADE FLOWLINE BETWEEN EDGES. CONSTRUCT P.C.C. SIDEWALK TO MATCH REMOVED AREA.
2. REMOVE, DISPOSE AND REPLACE STD. P.C.C. CURB STONES AS INDICATED ON THESE PLANS OR AS FIELD MARKED BY THE CITY STREET MAINTENANCE DEPT.
3. 2" ACSC OVER 12" COMPACTED SUBGRADE. PLACE TO CONFORM TO PERIMETER GRADES AND EXISTING DRAINAGE PATTERNS.
4. REMOVE AND DISPOSE EXISTING P.C.C. SIDEWALK AS INDICATED AT EACH DIMENSIONED LOCATION. CONSTRUCT STD. 4" THICK P.C.C. SIDEWALK @ 2% CROSS-SLOPE BETWEEN BACK OF CURB EXTENDING 6 FT TOWARD R.O.W. LINE.
5. THE FOLLOWING PAVEMENT REMOVALS & DISPOSALS APPLY IN EACH QUADRANT OF THE ATLANTIC AVE. INTERSECTION.
 - A. 62 LF OF STD. CURB & GUTTER.
NOTE - REMOVE ENTIRE CURB STONE AT EACH END OF NEW CURBING.
 - B. 40 SY OF ASPHALTIC PAVING.
6. REMOVE P.C.C. SIDEWALK AND REPLACE PER ARCHITECTURAL PLAN DETAILS.
7. REMOVE & DISPOSE EXISTING P.C.C. DRIVEPAD. REPLACE CURB & GUTTER MATCHING FLOWLINE GRADE. REPLACE P.C.C. SIDEWALK PER ARCHITECTURAL PLAN DETAILS.

STORM DRAINAGE: KEYED

1. MODIFY EXISTING CATCH BASIN TO A JUNCTION BOX. REMOVE GRATE AND CURB OPENING SUPPORT STRUCTURE AND RESHAPE TO ACCEPT A MODIFIED TYPE 'C' MANHOLE COVER (TO FIT). SEE GENERAL RECURSEMENTS, DWG. 2107.
2. 4" DIA. TYPE 'E' MANHOLE OVER EXST. 24" RCP STORM DRAIN.
RIM EL.=47.22 INV. (EXST.)=41.14
INV. (E)=43.10 INV. (W)=43.10
3. CONSTRUCT 3' GUTTER TRANSITION AT CURB RETURN SIDE PER DWG. 2207.
4. CONSTRUCT SINGLE 'C' INLET PER DWG. 2205.
GRATE EL.=46.68 INV. =44.30
5. CONSTRUCT SINGLE 'C' INLET PER DWG. 2205.
GRATE EL.=46.46 INV. =44.75
6. CONSTRUCT SINGLE 'D' INLET PER DWG. 2206.
GRATE EL.=46.60 INV. =44.17

UTILITY & MISC.: KEYED

1. REMOVE AND RELOCATE EXISTING FIRE HYDRANT IF INSPECTED AND APPROVED FOR REUSE BY U.D.D., C.O.A.
2. 24" OF 6" WATERLINE
1-6" (45") BENDS
REST. JOINTS
3. RELOCATE FH TO STD. LOCATION AT CURB RETURN,
DWGS. 2340 & 2347.
FL EL.=48.10
4. ADJUST VALVE BOX COVER TO GRADE WITHIN THE
WHEELCHAIR RAMPS OR TRANSITIONAL FLAIRS.

POTHOLING LOG

LOCATION OF MARKER ONE (M1)	FIRE HYDRANT IN SOUTHWEST CORNER
LOCATION OF MARKER TWO (M2)	POWER POLE 250 IN SOUTHWEST CORNER
LOCATION OF MARKER THREE (M3)	WATER VALVE COVER IN SOUTHWEST CORNER

POTHOLE #	UTILITY	TYPE	DIAMETER	DEPTH TO TOP	DEPTH TO BOTTOM	DISTANCE TO M1	DISTANCE TO M2	DISTANCE TO M3	PAVEMENT
25	TELE F.O.	CON CAP	NR	19"	45"	53.1'	45.0'	47.0'	8"
26	TELE F.O.	PVC	4"	40"	NR	6.0'	4.6'	8.5'	0

NR=NOT REQUIRED

LEGEND (SEE SHT. S-8 FOR COMPLETE LEGEND)

- | | |
|---|--|
| SW 00.00 X | TOP SIDEWALK\TOP CONCRETE |
| TA 00.00 X | TOP ASPHALT |
|  | TOP OF CURB
FLOWLINE |
|  | CURB AND GUTTER (EXISTING) |
|  | CURB AND GUTTER (PROPOSED) |
|  | CONCRETE/SIDEWALK |
|  | DRIVEPAD (PROPOSED/EXISTING) |
|  | SANITARY SEWER MANHOLE |
|  | WATER VALVE |
|  | FIRE HYDRANT |
|  | WATER METER |
|  | POWER POLE |
|  | TELEPHONE MANHOLE |
|  | GAS METER |
|  | STORM DRAIN MANHOLE |
|  | DROP INLET |
| S8" | SANITARY SEWER 8" |
| D24" | STORM DRAIN 24" |
| W6" | WATER 6" |
| G4" | GAS 4" |
| FO | FIBER OPTIC TELEPHONE LINE (UNDERGROUND) |

RECORD SET

May 1, 1997

And



ISAACSON & ARFMAN, P.A.
Consulting Engineering Associates
 128 Monroe Street N.E.
 Albuquerque New Mexico

829SHT7.DWGanw 12/20/95

CITY OF ALBUQUERQUE
PUBLIC WORKS DEPARTMENT
ENGINEERING GROUP

TITLE: **SOUTH 4th STREET STREETSCAPE
PAVING & DRAINAGE PLAN
STA 24+00 TO STA 30+10**

Design Review Committee

City Engineer Approval

~~11~~ 2/2/99


C E 12/21/95

City Project No.

4917.90

Zone Map No.
K-14

Sheet **C-5** Of 10

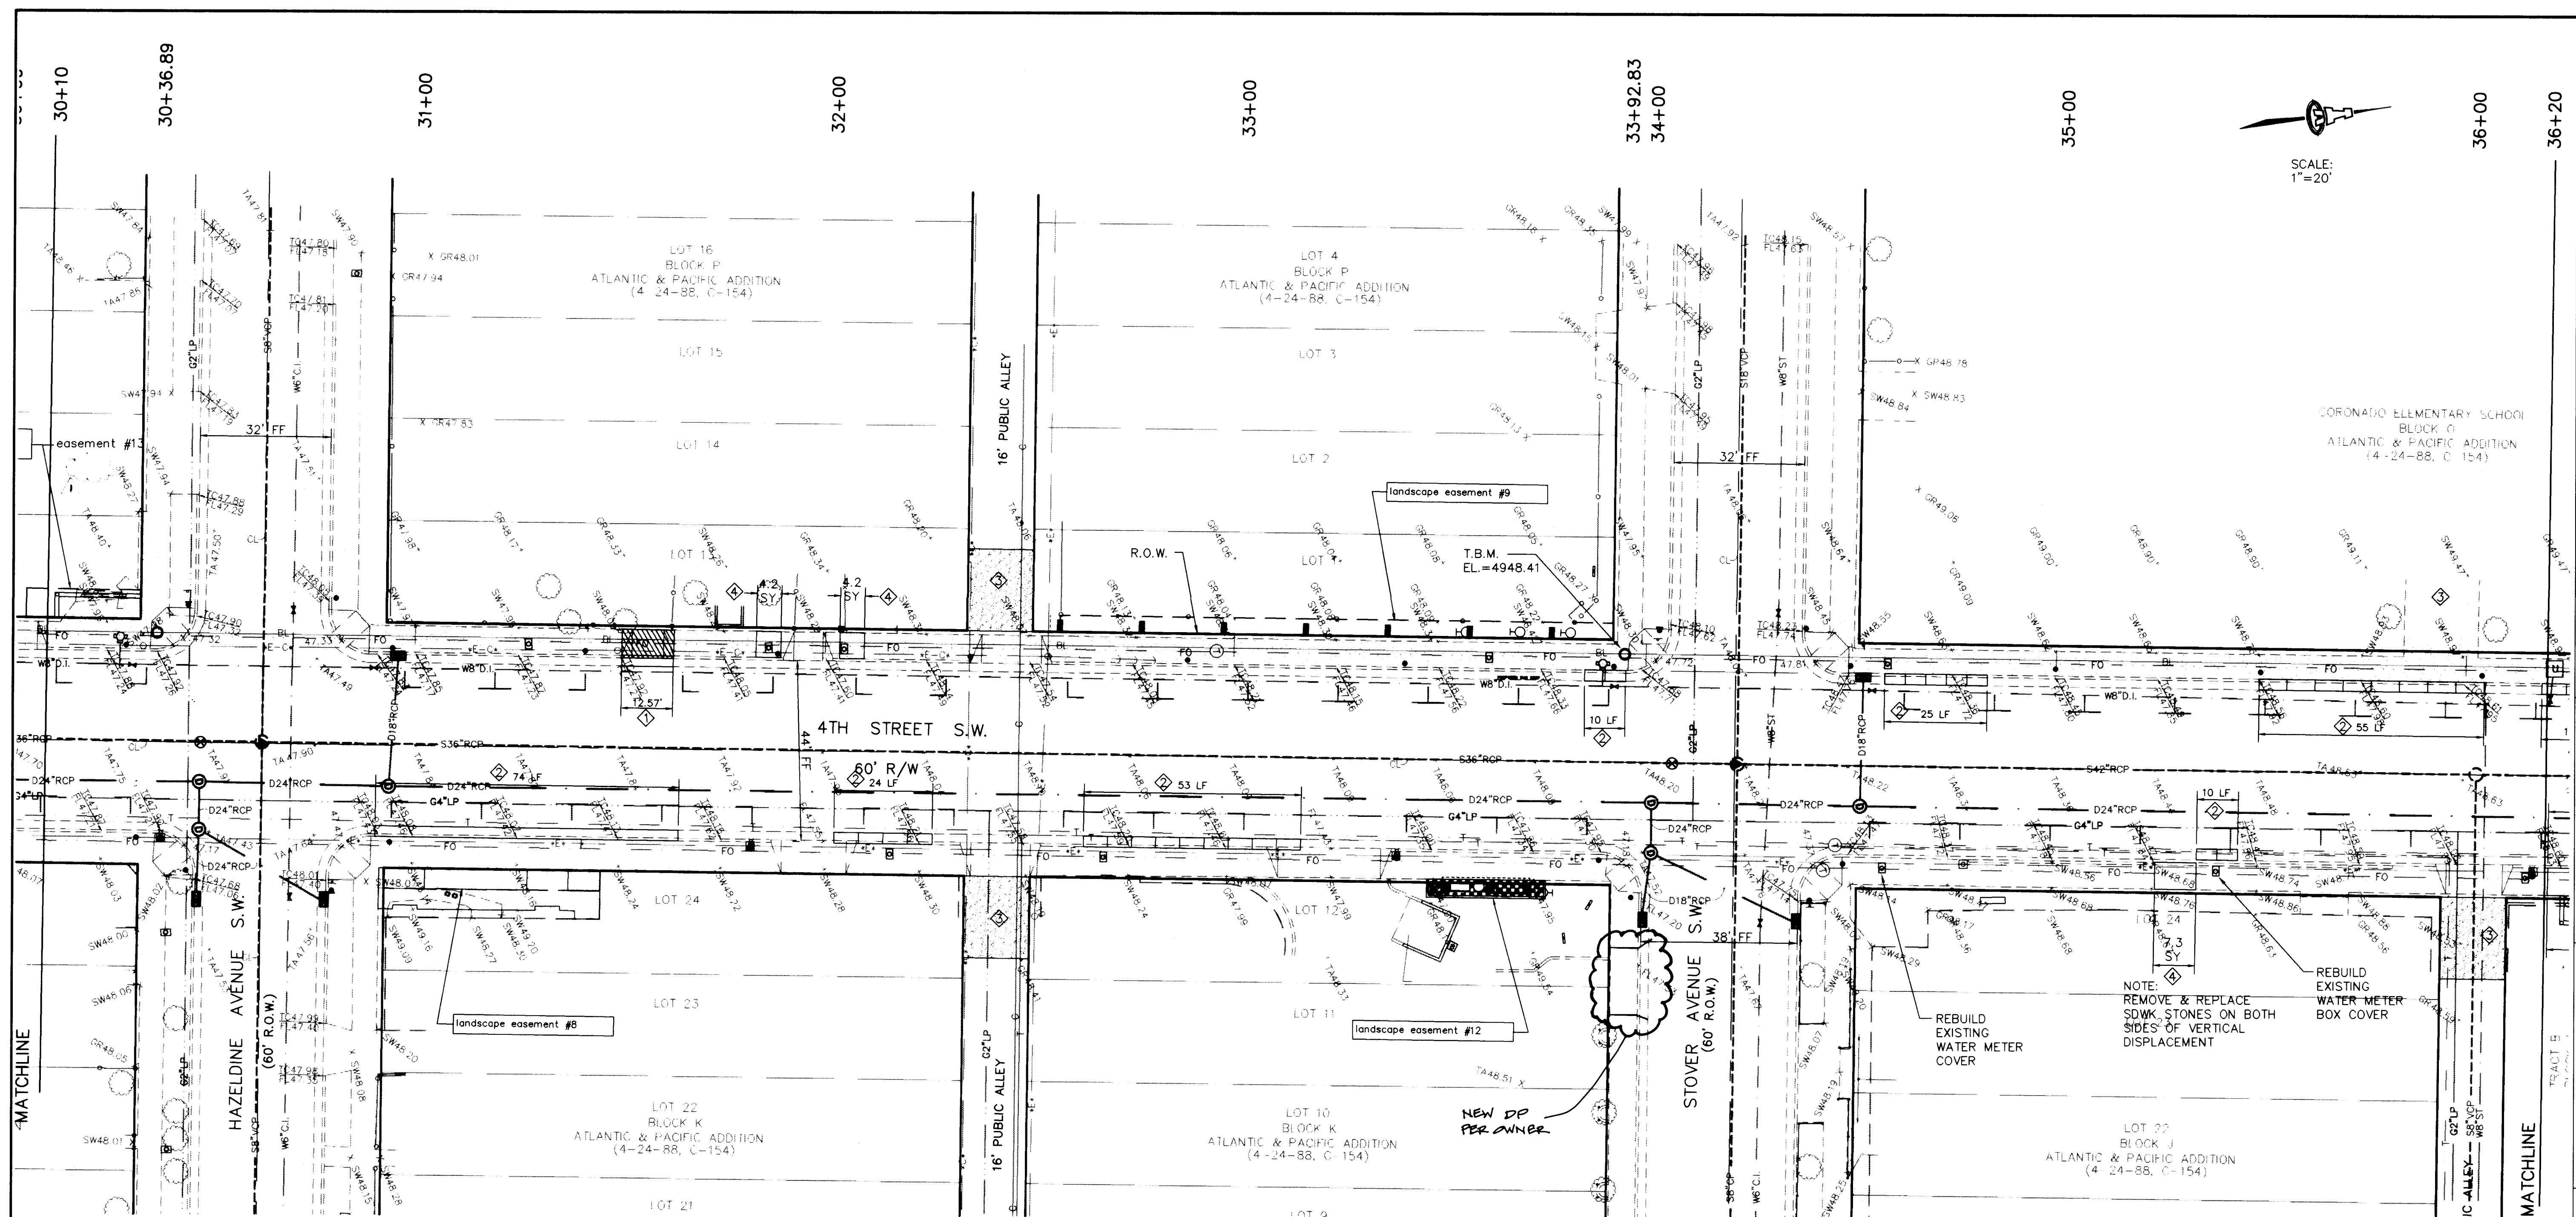

CONSTRUCTION NOTES

PAVING: KEYED

1. REMOVE AND DISPOSE EXISTING P.C.C. DRIVEPADS AS INDICATED AT EACH DIMENSIONED LOCATION. CONSTRUCT STD. CURB & GUTTER AS A STRAIGHT GRADE FLOWLINE BETWEEN EDGES. CONSTRUCT P.C.C. SIDEWALK TO MATCH REMOVED AREA.
2. REMOVE, DISPOSE AND REPLACE STD. P.C.C. CURB STONES AS INDICATED ON THESE PLANS OR AS FIELD MARKED BY THE CITY STREET MAINTENANCE DEPT.
3. 2" ACSC OVER 12" COMPACTED SUBGRADE. PLACE TO CONFORM TO PERIMETER GRADES AND EXISTING DRAINAGE PATTERNS.
4. REMOVE AND DISPOSE EXISTING P.C.C. SIDEWALK AS INDICATED AT EACH DIMENSIONED LOCATION. CONSTRUCT STD. 4" THICK P.C.C. SIDEWALK @ 2% CROSS-SLOPE BETWEEN BACK OF CURB EXTENDING 6 FT TOWARD R.O.W. LINE.

A.D.A. NOTE:

ALL RECONSTRUCTED DRIVEPADS AND HANDICAP RAMPS SHALL BE IN ACCORDANCE WITH THE A.D.A. SLOPE STANDARDS.

LEGEND (SEE SHT. S-8 FOR COMPLETE LEGEND)

- | | |
|--------------|--|
| SW 00.00 X | TOP SIDEWALK/ TOP CONCRETE |
| TA 00.00 X | TOP ASPHALT |
| TC =
FL = | TOP OF CURB
FLOWLINE |
| == | CURB AND GUTTER (EXISTING) |
| == | CURB AND GUTTER (PROPOSED) |
| □ | CONCRETE/SIDEWALK |
| ▨ | DRIVEPAD (PROPOSED/EXISTING) |
| ○ | SANITARY SEWER MANHOLE |
| x | WATER VALVE |
| ⊕ | FIRE HYDRANT |
| ⊙ | WATER METER |
| ○ | POWER POLE |
| ⊙ | TELEPHONE MANHOLE |
| ⊙ | GAS METER |
| ⊙ | STORM DRAIN MANHOLE |
| ⊙ | DROP INLET |
| S8" | SANITARY SEWER 8" |
| D24" | STORM DRAIN 24" |
| W6" | WATER 6" |
| G4" | GAS 4" |
| FO | FIBER OPTIC TELEPHONE LINE (UNDERGROUND) |

RECORD SET May 1, 1997

Signature

 ISAACSON & ARFMAN, P.A. Consulting Engineering Associates 128 Monroe Street N.E. Albuquerque New Mexico	
829SH8.DWG 12/20/95	
CITY OF ALBUQUERQUE PUBLIC WORKS DEPARTMENT ENGINEERING GROUP	
TITLE: SOUTH 4th STREET STREETScape PAVING & DRAINAGE PLAN STA 30+10 TO STA 36+20	
Design Review Committee	City Engineer Approval
 10/6/95	 10/6/95
City Project No. 4917.90	Zone Map No. K-14
Sheet C-6 of 10	

AS-BUILT INFORMATION	
CONTRACTOR: ALBUQUERQUE UNDERGROUND INC.	DATE: 4/97
DESIGNED BY: C. A.	DATE: 4/97
DRAWN BY: LEWIS BROWN	DATE: 4/97
CHECKED BY: C.O.A.	DATE: 4/97
RECORDED BY: ADT	DATE: 4/97
MICRO-FILM INFORMATION	
RECORDED BY:	DATE:


BENCH MARKS	
ACS "3-K14" LOCATED AT THE NE QUADRANT OF 3RD ST. AND LEAD AVE. SW	ELEV: 4950.564
T.B.M. BASELINE STA 33+92.83 (CROSS IN SIDEWALK)	
SW QUADRANT OF 4TH ST. AND STOVER AVE. SW	ELEV: 4948.41

SURVEY INFORMATION	
NO.	DATE
BY	ALS

ENGINEER'S SEAL	

CHANGE ORDER NO. 1	
ISSUED FOR CONSTRUCTION	
NO.	DATE
REVISIONS	DESIGN
DESIGNED BY: FCA	DATE: 10/95
DRAWN BY: ANW	DATE: 10/95
CHECKED BY: RCA	DATE: 10/95

SCANNED BY
-SON

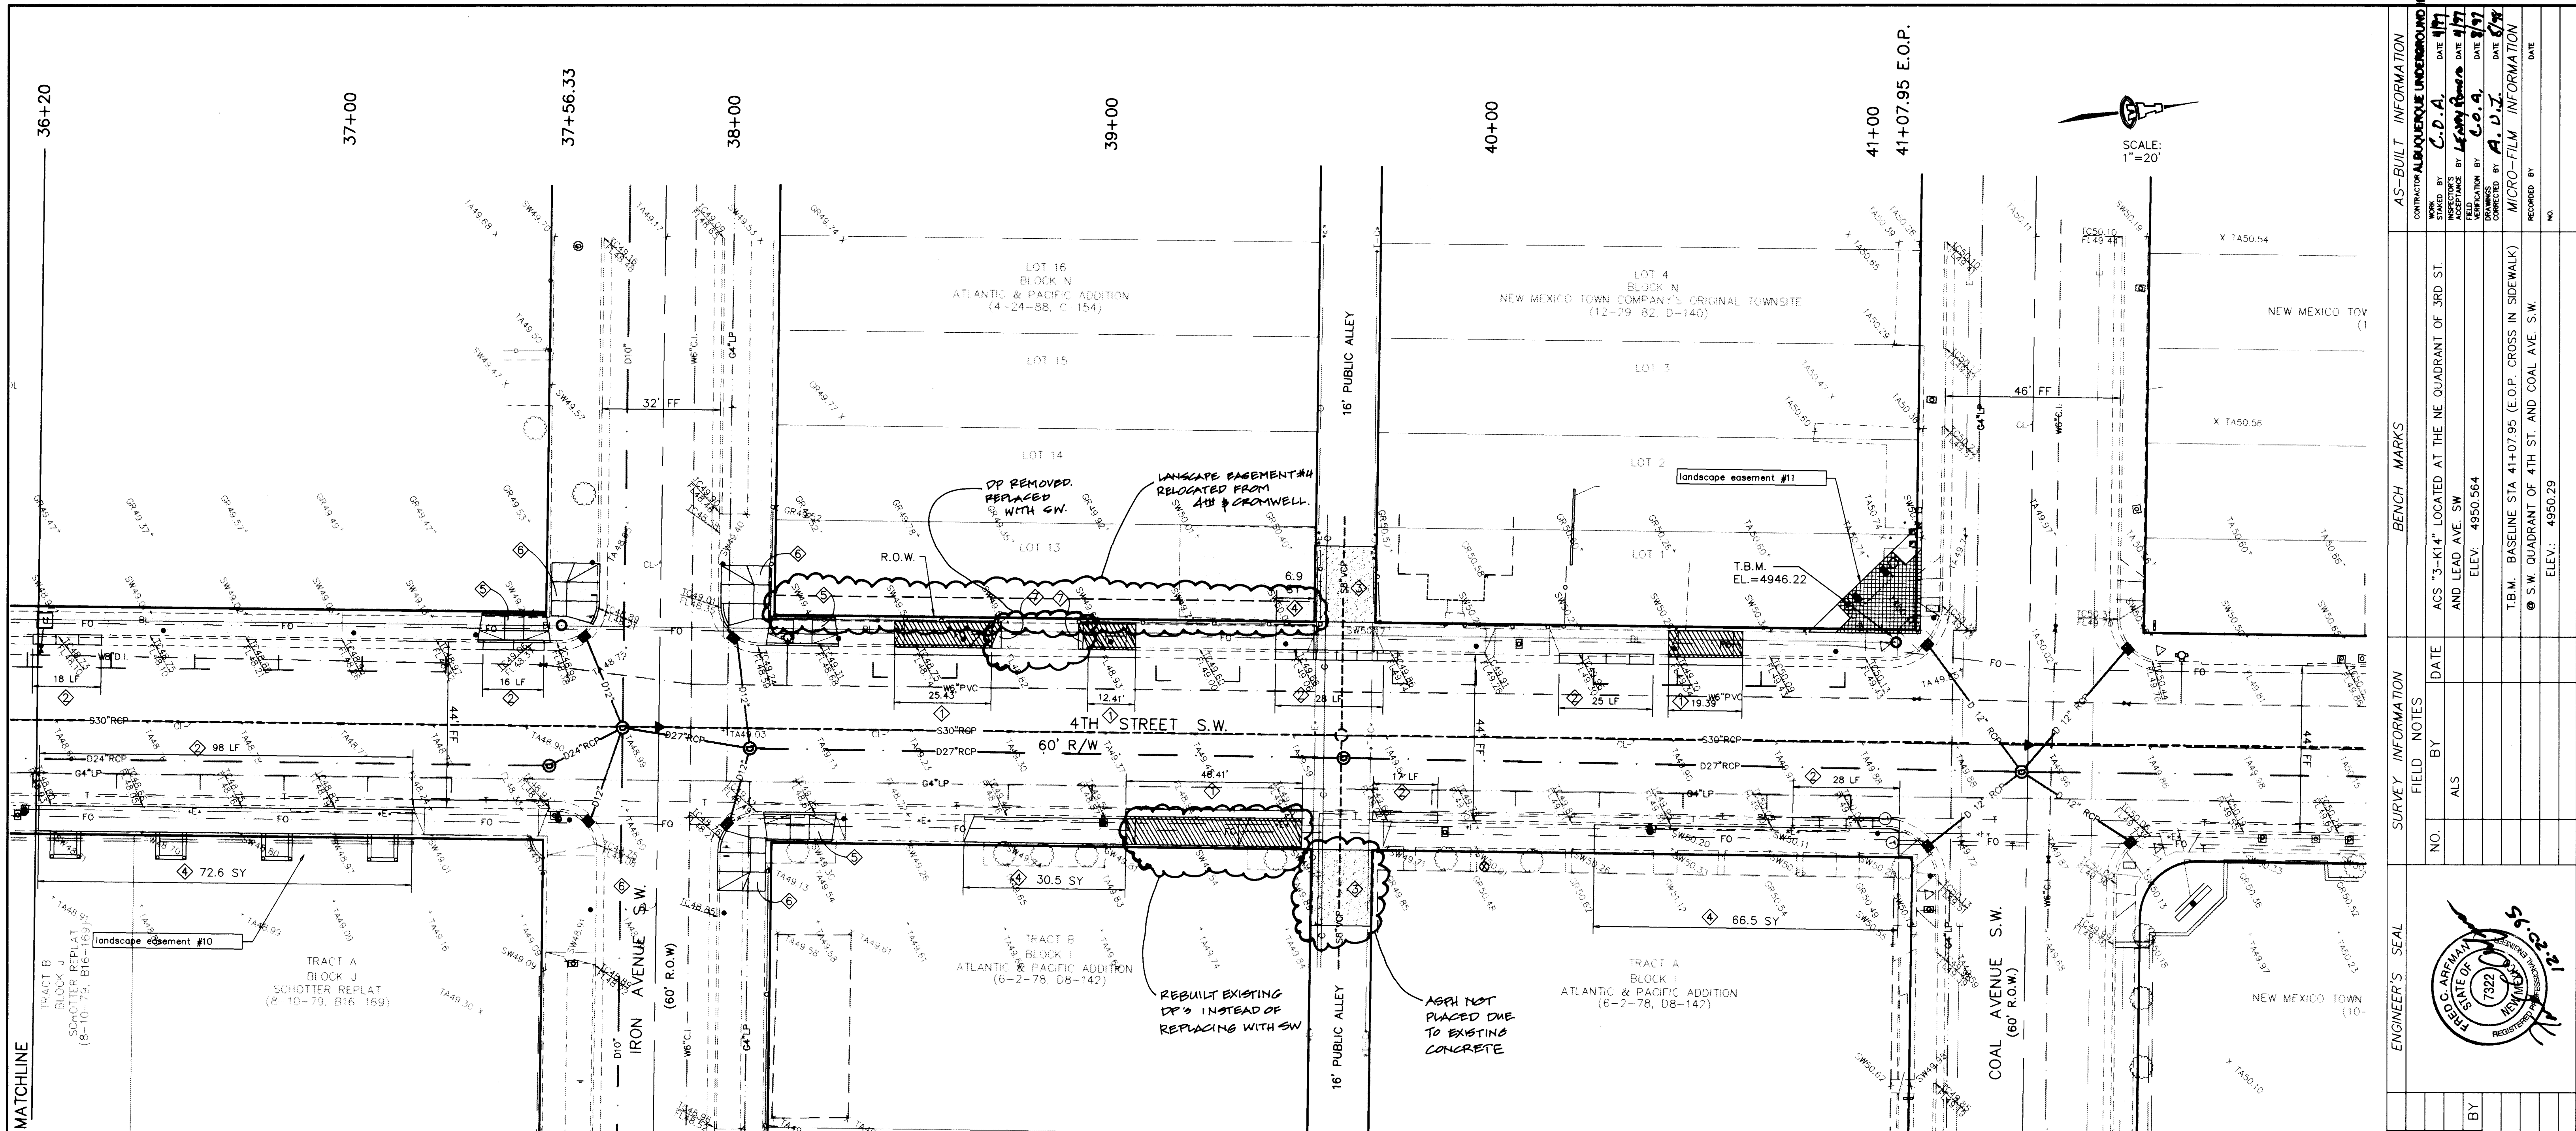

CONSTRUCTION NOTES

PAVING: KEYED

- REMOVE AND DISPOSE EXISTING P.C.C. DRIVEPADS AS INDICATED AT EACH DIMENSIONED LOCATION. CONSTRUCT STD. CURB & GUTTER AS A STRAIGHT GRADE FLOWLINE BETWEEN EDGES. CONSTRUCT P.C.C. SIDEWALK AND/OR HANDICAP ACCESS RAMP TO MATCH REMOVED AREA.
- REMOVE, DISPOSE AND REPLACE STD. P.C.C. CURB STONES AS INDICATED ON THESE PLANS OR AS FIELD MARKED BY THE CITY STREET MAINTENANCE DEPT.
- 2" ACSC OVER 12" COMPACTED SUBGRADE. PLACE TO CONFORM TO PERIMETER GRADES AND EXISTING DRAINAGE PATTERNS.
- REMOVE AND DISPOSE EXISTING P.C.C. SIDEWALK AS INDICATED AT EACH DIMENSIONED LOCATION. CONSTRUCT STD. 4" THICK P.C.C. SIDEWALK 2% CROSS-SLOPE BETWEEN BACK OF CURB EXTENDING 6 FT TOWARD R.O.W. LINE.
- CONSTRUCT HANDICAP ACCESS RAMP TYPE A PER DETAIL, SEE SHEET C-8.
- CONSTRUCT HANDICAP ACCESS RAMP TYPE A PER DETAIL, SEE SHEET C-8.
- CONSTRUCT DRIVEPAD TRANSITION FLARE (MAX 1:10 SLOPE).


A.D.A. NOTE:

ALL RECONSTRUCTED DRIVEPADS AND HANDICAP RAMPS SHALL BE IN ACCORDANCE WITH THE A.D.A. SLOPE STANDARDS.

LEGEND (SEE SHT. S-8 FOR COMPLETE LEGEND)

- SW 00.00 X TOP SIDEWALK\TOP CONCRETE
TA 00.00 X TOP ASPHALT
TC= TOP OF CURB
FL= FLOWLINE
CURB AND GUTTER (EXISTING)
CURB AND GUTTER (PROPOSED)
CONCRETE/SIDEWALK
DRIVEPAD (PROPOSED/EXISTING)
SANITARY SEWER MANHOLE
WATER VALVE
FIRE HYDRANT
WATER METER
POWER POLE
TELEPHONE MANHOLE
GAS METER
STORM DRAIN MANHOLE
DROP INLET
S8" SANITARY SEWER 8"
D24" STORM DRAIN 24"
W6" WATER 6"
G4" GAS 4"
FO FIBER OPTIC TELEPHONE LINE (UNDERGROUND)

RECORD SET
May 1, 1997

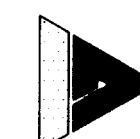

ISAACSON & ARFMAN, P.A.
Consulting Engineering Associates
128 Monroe Street N.E.
Albuquerque New Mexico

829SHT9.DWGonw 12/20/95

CITY OF ALBUQUERQUE
PUBLIC WORKS DEPARTMENT
ENGINEERING GROUP

TITLE: SOUTH 4th STREET STREETScape
PAVING & DRAINAGE PLAN
STA 36+20 TO STA 41+07.95

Design Review Committee City Engineer Approval


10/6/95 10/6/95
10/6/95 10/6/95
10/6/95 10/6/95
10/6/95 10/6/95

City Project No. 4917.90

Zone Map No. K-14

Sheet C-7 Of 10

AS-BUILT INFORMATION		BENCH MARKS		SURVEY INFORMATION		ENGINEER'S SEAL	
CONTRACTOR	ALBUQUERQUE UNDERGROUND, INC.	NO.	DATE	NO.	DATE	NO.	DATE
STANDARD	C.D.A.	NO.	DATE	NO.	DATE	NO.	DATE
INSPECTION	BY C.D.A.	NO.	DATE	NO.	DATE	NO.	DATE
FIELD VERIFICATION	BY C.D.A.	NO.	DATE	NO.	DATE	NO.	DATE
CORRECTION	BY A.D.I.	NO.	DATE	NO.	DATE	NO.	DATE
MICRO-FILM INFORMATION		T.B.M. BASELINE STA 41+07.95 (E.O.P. CROSS IN SIDEWALK)		T.B.M. BASELINE STA 41+07.95 (E.O.P. CROSS IN SIDEWALK)		T.B.M. BASELINE STA 41+07.95 (E.O.P. CROSS IN SIDEWALK)	
RECORDED BY		NO.		NO.		NO.	
DATE		DATE		DATE		DATE	
ELEV.		ELEV.		ELEV.		ELEV.	
4950.29		4950.29		4950.29		4950.29	


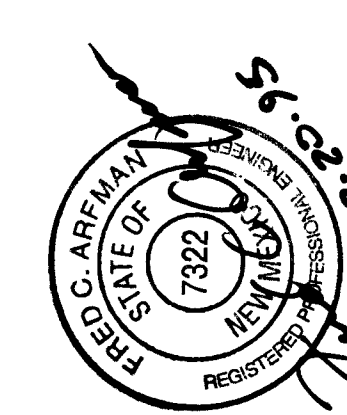


TC*	FL
1 47.68	47.01
2 47.73	47.06
3 47.67	47.00

*PROJECTED TO ELEV.

TC*	FL
1 47.49	46.82
2 47.57	46.90
3 47.65	46.98

*PROJECTED TO ELEV.

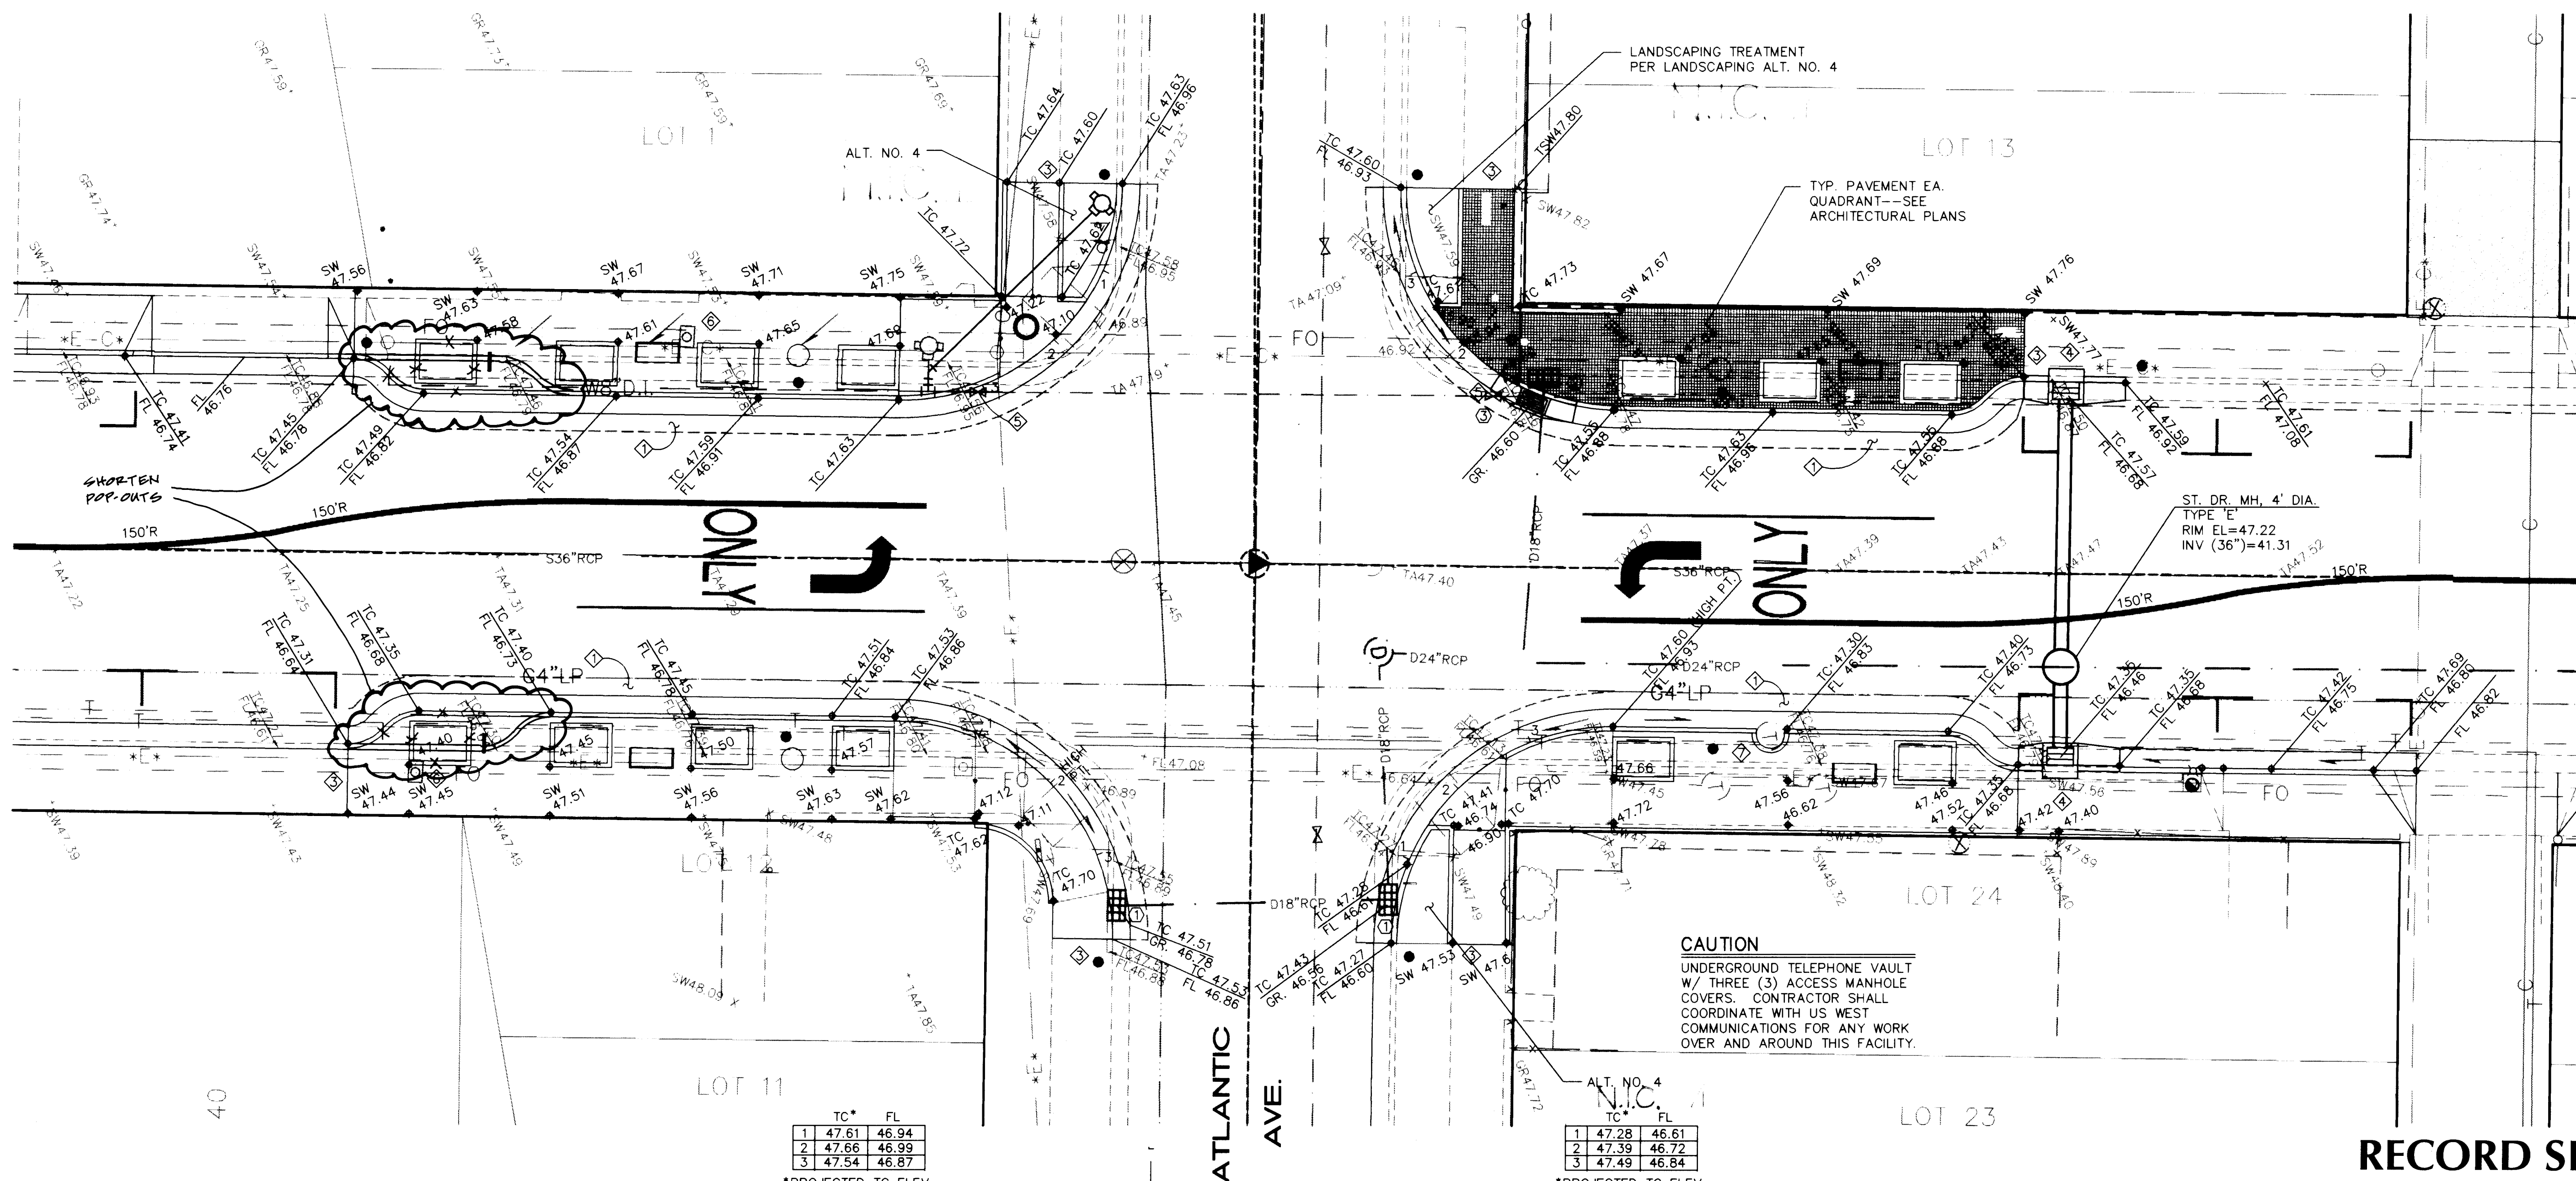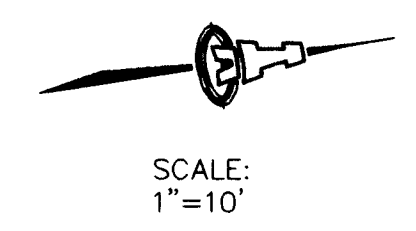


TC*	FL
1 47.61	46.94
2 47.66	46.99
3 47.54	46.87

*PROJECTED TO ELEV.

TC*	FL
1 47.28	46.61
2 47.39	46.72
3 47.49	46.84

*PROJECTED TO ELEV.

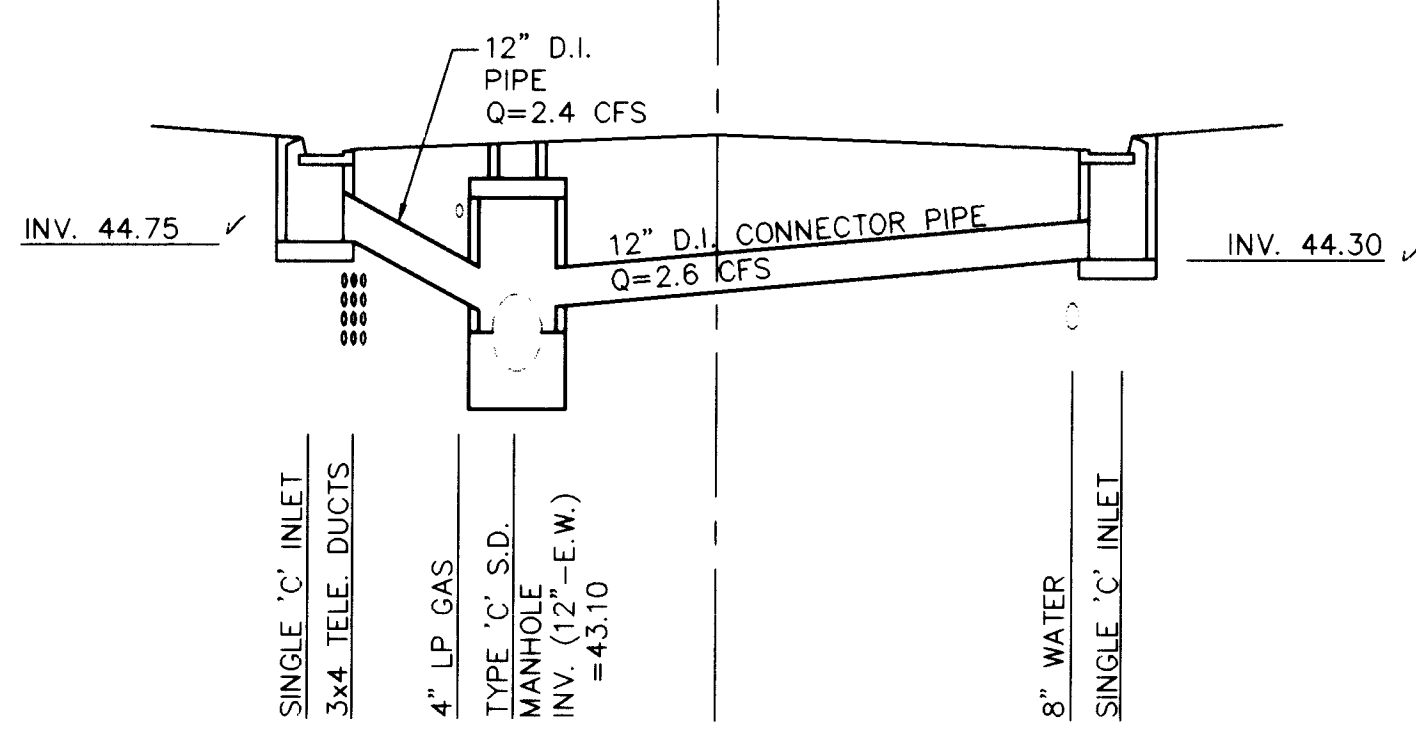

STORM DRAIN CONNECTOR PIPE PROFILE
4TH ST. • ATLANTIC (NORTH)

1"=10' H.
1"=5' V.

INTERSECTION STORM DRAINAGE CONSTRUCTION NOTES

1. RECONSTRUCT TOP OF EXISTING DROP INLETS TO ALIGN WITH 25' FACE OF CURB RADIUS AND TO REVISED GRADES.
2. REMOVE AND DISPOSE EXISTING DROP INLET AND APPROXIMATELY 3 FT. OF 18" RCP CONNECTOR PIPE.
3. CONSTRUCT SINGLE, TYPE 'D' DROP INLET PER STD. DWG. 2206.
GR. EL.: 46.60
INV. 18" RCP: 44.17

INTERSECTION PAVING NOTES

1. REMOVE & REPLACE 2'-0" MIN. STRIP OF ASPHALTIC PAVEMENT. SLOPE TO MATCH NEW TOE OF GUTTER.
2. TRANSITION FROM NEW STD. C & G TO EXISTING DROP INLET. SLOPE GUTTER DOWN TO GRATE GRADE.
3. MATCH EXISTING SIDEWALK GRADE WHERE ABUTTING TO EXISTING PCC SIDEWALKS.
4. REMOVE & REPLACE PCC SIDEWALK AS NECESSARY TO CONSTRUCT DROP INLETS.
5. ADJUST VALVE BOX COVER TO GRADE.
6. RECONSTRUCT METER BOX TO GRADE.
7. US WEST COMMUNICATIONS MANHOLE RIM TO REMAIN AT EXISTING GRADE. CONSTRUCT CURB AROUND ACCESS COVER.

RECORD SET
May 1, 1997


[Signature]

ISAACSON & ARFMAN, P.A. Consulting Engineering Associates 128 Monroe Street N.E. Albuquerque, New Mexico	
CITY OF ALBUQUERQUE PUBLIC WORKS DEPARTMENT ENGINEERING GROUP	
TITLE: SOUTH 4TH STREET STREETSCAPE INTERSECTION PAVING & DRAINAGE PLAN ATLANTIC AVENUE	
Design Review Committee <i>[Signature]</i> 12/21/95	City Engineer Approval <i>[Signature]</i> 12/21/95
City Project No. 4917.90	Zone Map No. K-14
Sheet C-10 of 10	No./Day/Yr. 10/6/95

AS-BUILT INFORMATION	
CONTRACT NO.	ALBUQUERQUE UNDERGROUND
DATE	DATE
BY	BY
DATE	DATE
BY	BY
DATE	DATE

BENCH MARKS	
ACS "3-K14" LOCATED AT THE NE QUADRANT OF 3RD ST. AND LEAD AVE. SW	ELEV.: 4950.564

SURVEY INFORMATION	
DATE	DATE
BY	BY
ALS	ALS

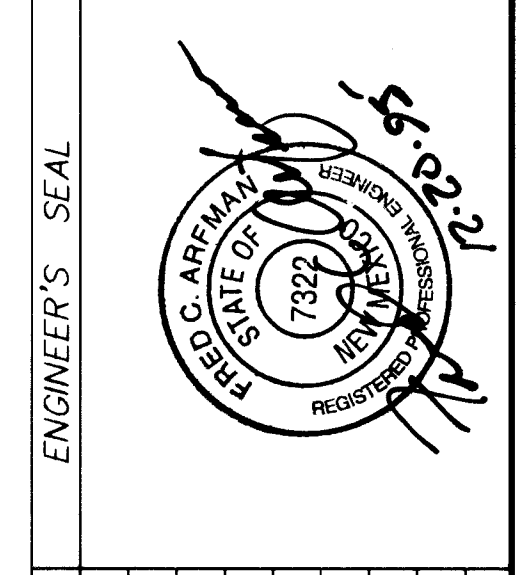


ISSUED FOR CONSTRUCTION	
NO.	DATE
REVISIONS	BY
DESIGN	DATE
DESIGNED BY	DATE
DRAWN BY	DATE
CHECKED BY	DATE

SCANNED BY LASON

STRIPING COORDINATION
CONTRACTOR SHALL NOTIFY CITY OF ALBUQUERQUE, TRAFFIC ENGINEERING, FIELD OPERATIONS (ATTN: FRANK R. JARAMILLO, SIGNS/MARKINGS SUPERVISOR, 857-8000), PRIOR TO STRIPING OPERATION. CITY MUST HAVE REPRESENTATIVE FROM TRAFFIC ENGINEERING, FIELD OPERATIONS, AT ALL TIMES WHILE STRIPING IS PLACED.

STRIPING: KEYED () SEE THIS SHEET FOR DETAIL

1. 4"x4" (L) x4" WIDE WHITE PLASTIC TRAFFIC STRIPING (TYP.)
2. 4"x8" (T) x4" WIDE WHITE PLASTIC TRAFFIC STRIPING.
3. DOUBLE 4" WIDE SOLID YELLOW PLASTIC TRAFFIC STRIPING.

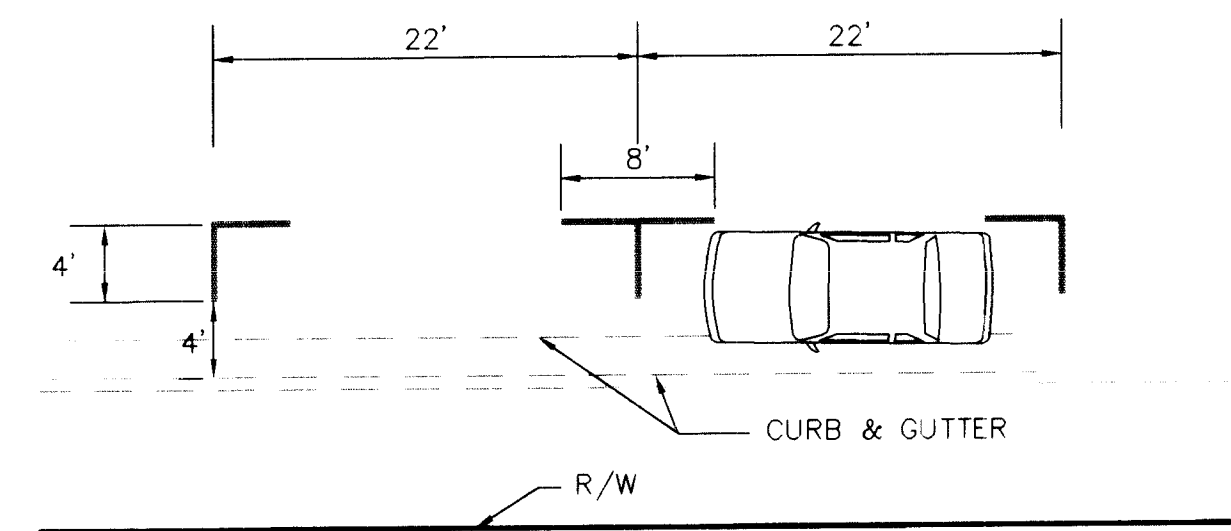

END OF PARKING STRIPING - 'L' & INTERMEDIATE PARKING STRIPING - 'T'
1"=10'

LEGEND (SEE SHT. S-8 FOR COMPLETE LEGEND)

- END OF PARKING STRIPING
- INTERMEDIATE PARKING STRIPING
- CURB AND GUTTER (EXISTING)
- CURB AND GUTTER (PROPOSED)
- CONCRETE/SIDEWALK
- DRIVEPAD (PROPOSED/EXISTING)


RECORD SET
May 1, 1997

SCANNED BY
BY LASON


ISAACSON & ARFMAN, P.A.
Consulting Engineering Associates
28 Monroe Street N.E.
Albuquerque New Mexico


829S3 DWGonw 12/20/95

CITY OF ALBUQUERQUE PUBLIC WORKS DEPARTMENT ENGINEERING GROUP	
TITLE: SOUTH 4th STREET STREETScape STRIPING PLAN	
STA 0+00 TO STA 6+00	
Design Review Committee	City Engineer Approval
<i>[Signature]</i> 12/21/95	<i>[Signature]</i> 12/21/95
City Project No. 4917.90	Zone Map No. L-14
Sheet ST-1	Of 7

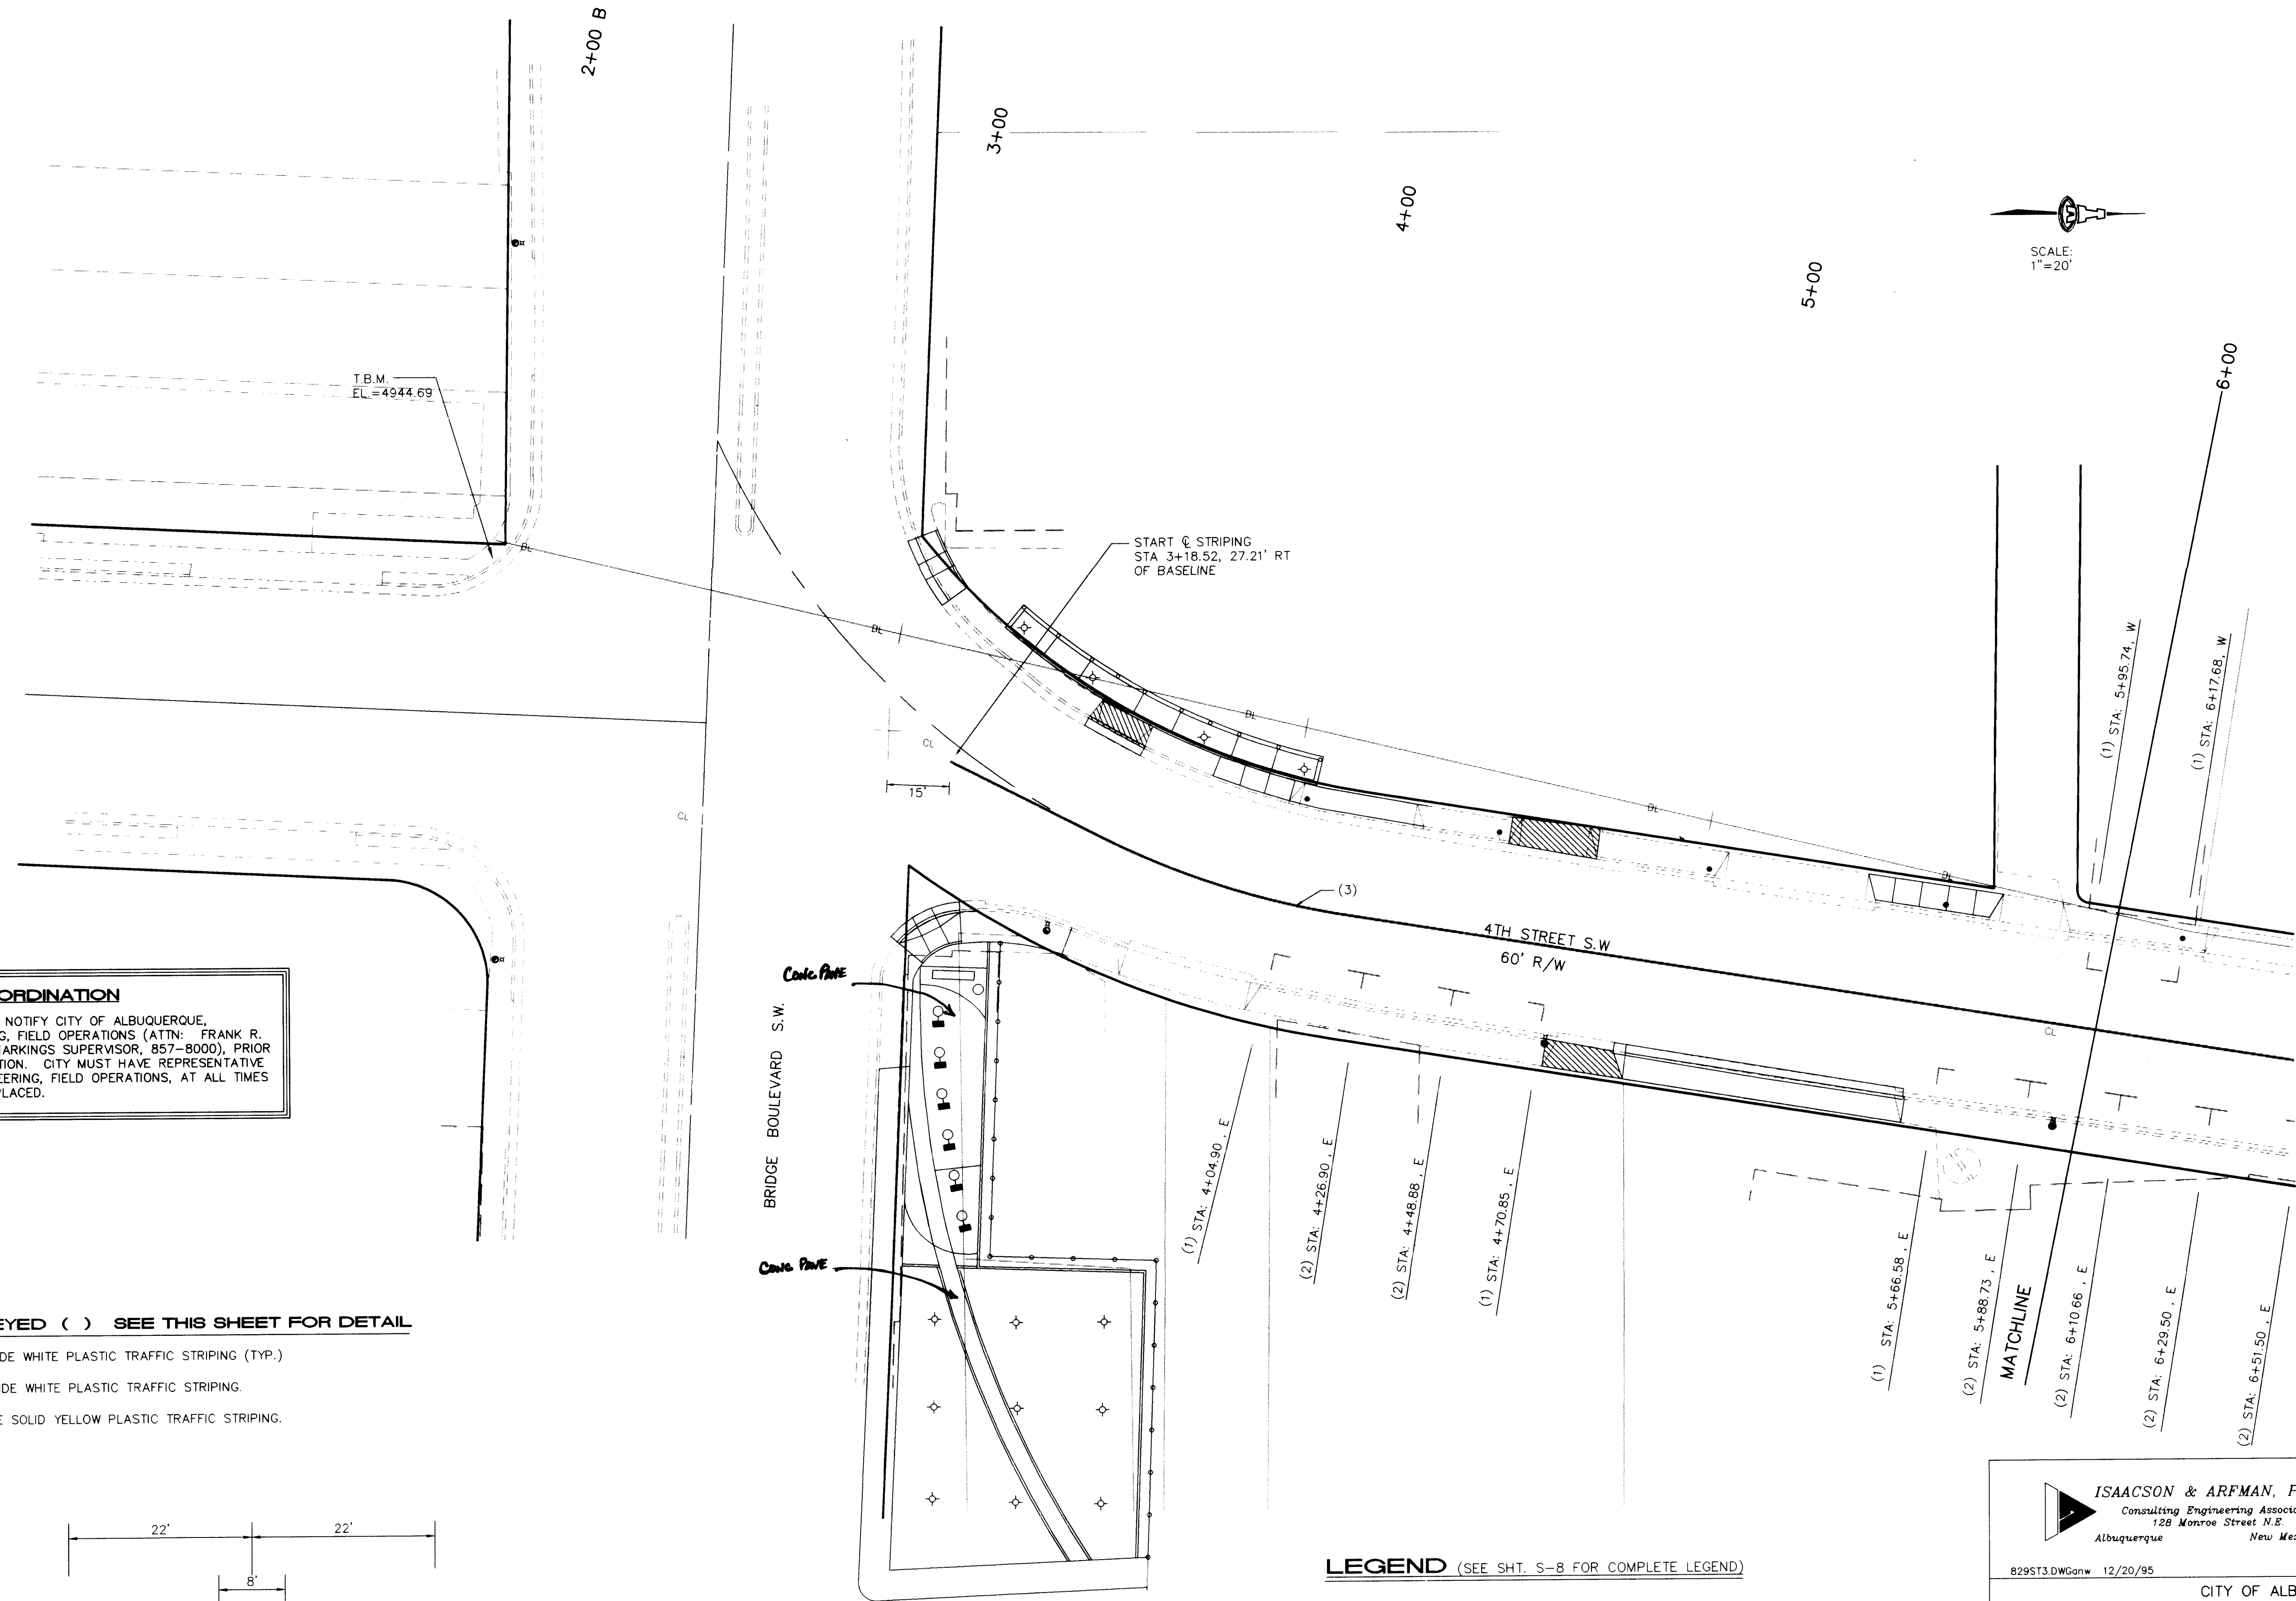

AS-BUILT INFORMATION		BENCH MARKS		SURVEY INFORMATION		ENGINEER'S SEAL	
CONTRACTOR	UNDERGROUND	NO.	DATE	NO.	DATE	NO.	DATE
STATED BY	C.B. A.	ALS	12/21/95	ALS	12/21/95	ALS	12/21/95
ACCEPTANCE BY	Leahy Rocco	NO.	DATE	NO.	DATE	NO.	DATE
FIELD	4/97	NO.	DATE	NO.	DATE	NO.	DATE
DRAWN BY	C.B. A.	NO.	DATE	NO.	DATE	NO.	DATE
CHECKED BY	A. D. J.	NO.	DATE	NO.	DATE	NO.	DATE
RECORDED BY	INFORMATION	NO.	DATE	NO.	DATE	NO.	DATE
NO.	4944.69	NO.	DATE	NO.	DATE	NO.	DATE

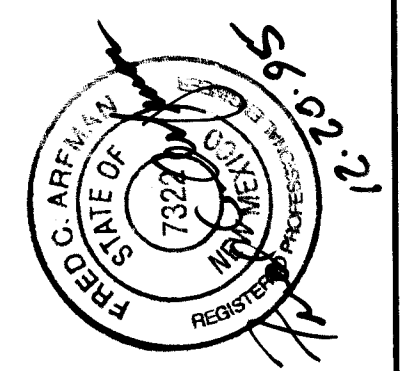

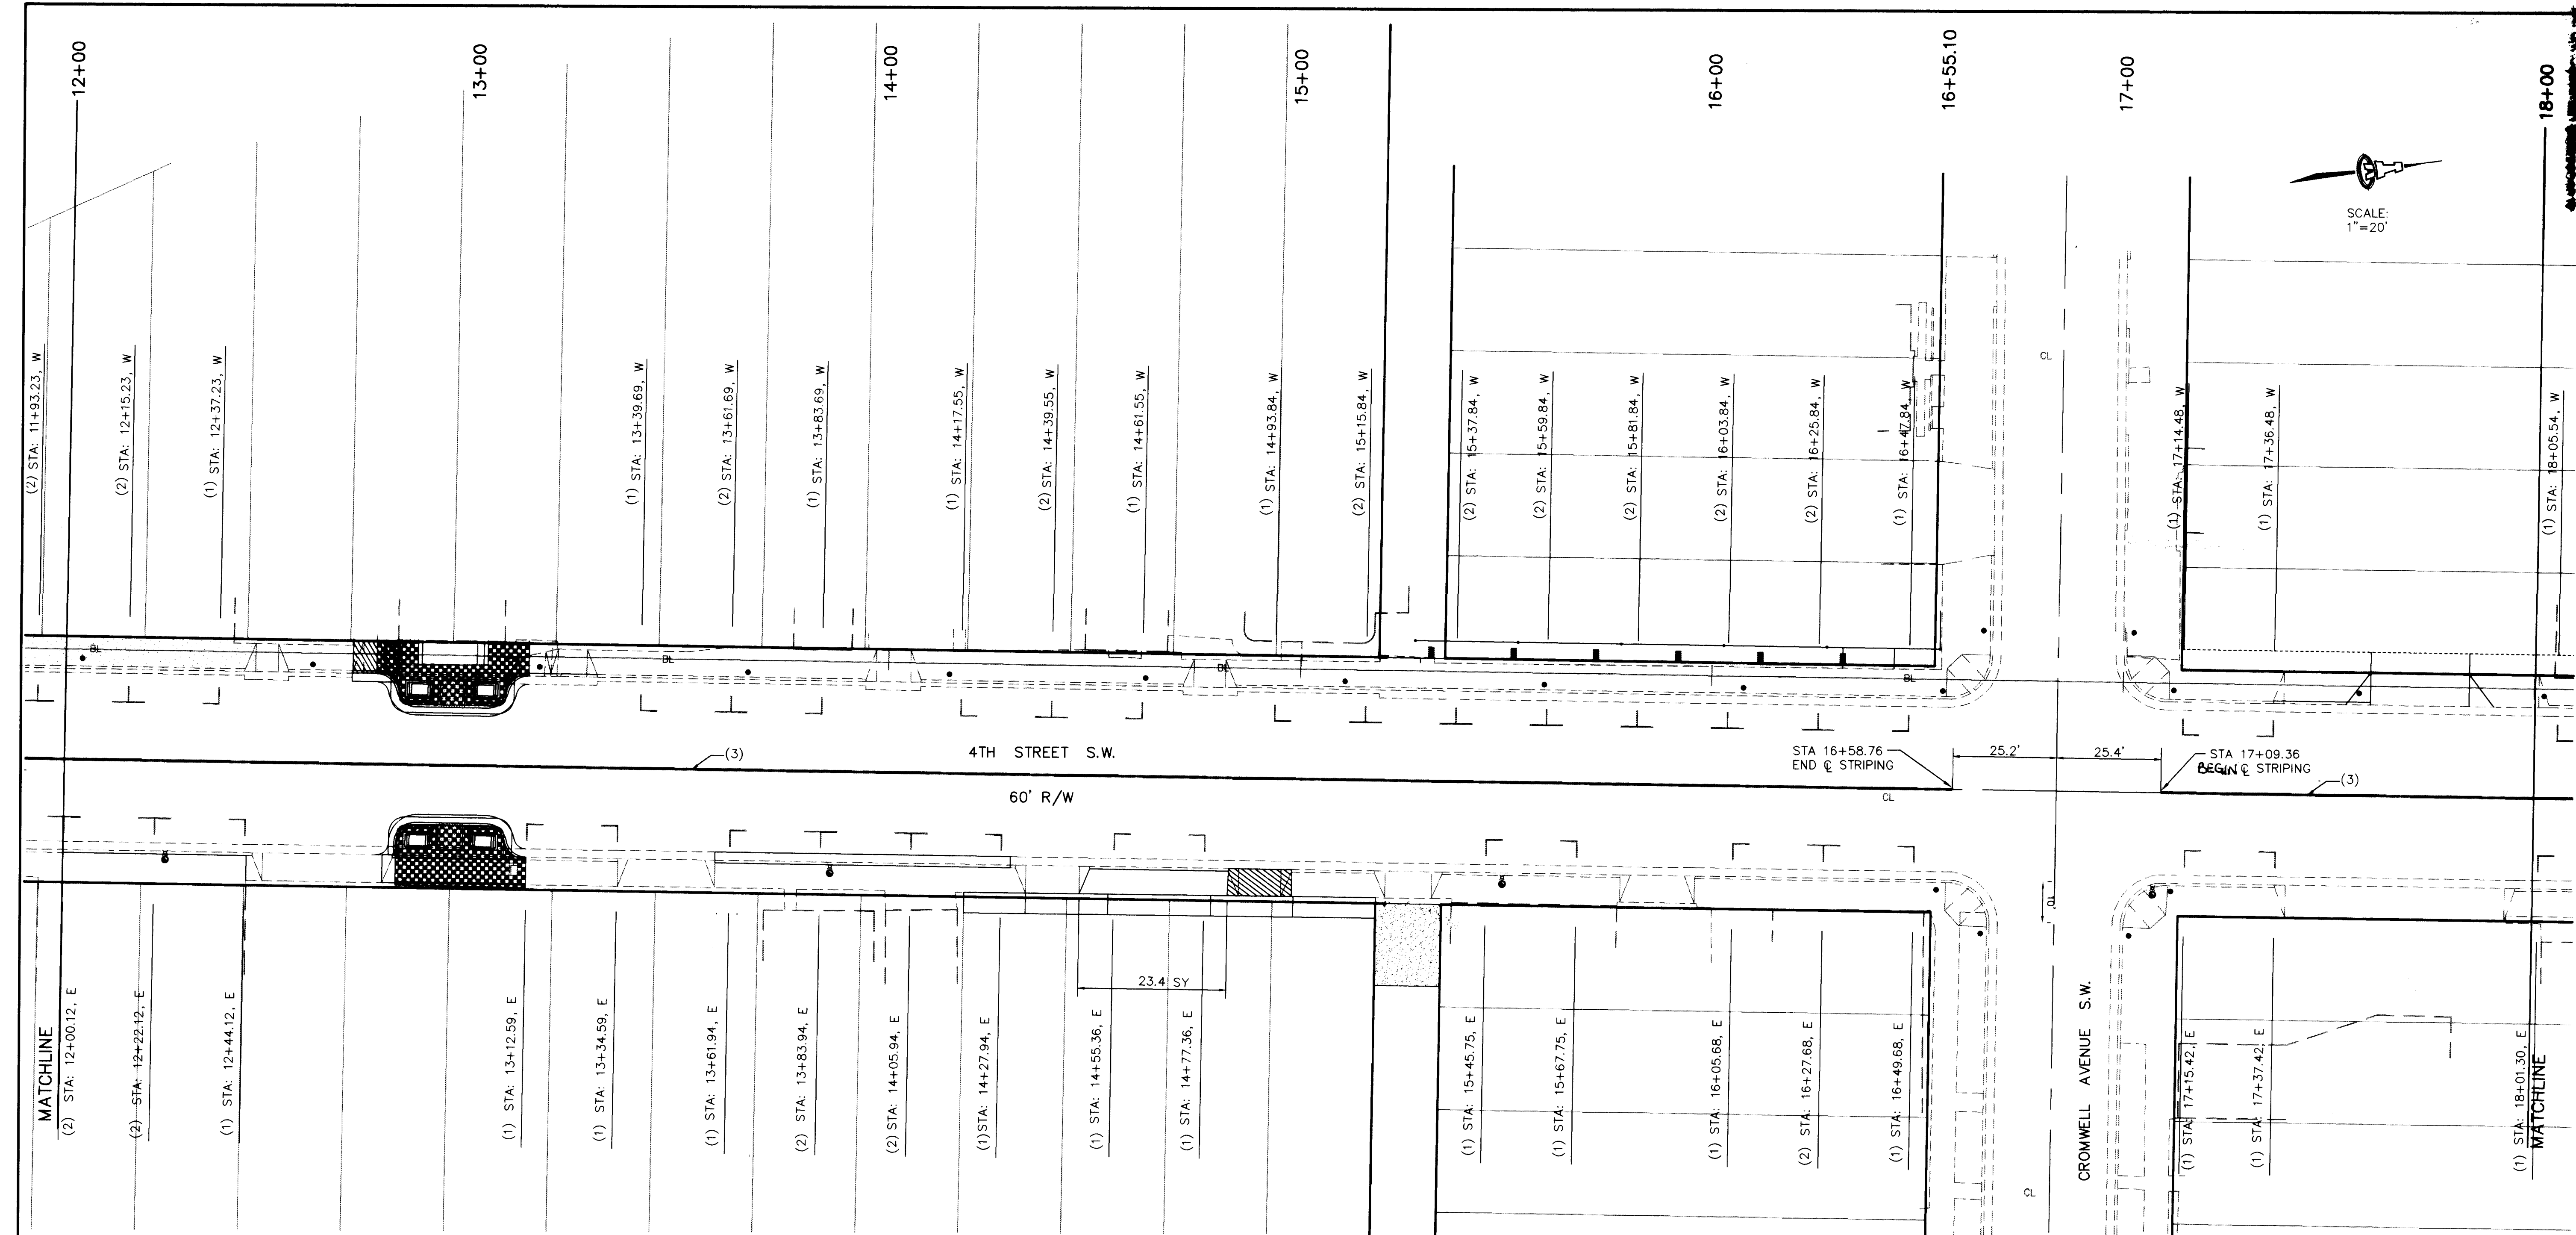

STRIPING: KEYED () SEE SHT ST-1 FOR DETAIL

1. 4'x4' (L) x4" WIDE WHITE PLASTIC TRAFFIC STRIPING (TYP.)
2. 4'x8' (T) x4" WIDE WHITE PLASTIC TRAFFIC STRIPING.
3. DOUBLE 4" WIDE SOLID YELLOW PLASTIC TRAFFIC STRIPING.

LEGEND (SEE SHT. S-8 FOR COMPLETE LEGEND)

- END OF PARKING STRIPING
- INTERMEDIATE PARKING STRIPING
- CURB AND GUTTER (EXISTING)
- CURB AND GUTTER (PROPOSED)
- CONCRETE/SIDEWALK
- DRIVEPAD (PROPOSED/EXISTING)

RECORD SET
May 1, 1997

ISAACSON & ARFMAN, P.A.
Consulting Engineering Associates
128 Monroe Street N.E.
Albuquerque New Mexico

829S75.DWGonw 12/20/95

CITY OF ALBUQUERQUE
PUBLIC WORKS DEPARTMENT
ENGINEERING GROUP

TITLE: **SOUTH 4th STREET STREETSCAPE STRIPING PLAN**
STA 12+00 TO STA 18+00

Design Review Committee	City Engineer Approval	Mo./Day/Yr.	Mo./Day/Yr.
10/6/95	12/21/95		
City Project No.	Zone Map No.	Sheet	Of
4917.90	L-14	ST-3	7

AS-BUILT INFORMATION	
CONTRACTOR	ISAACSON & ARFMAN, P.A.
STAMPED BY	L.O.A.
DATE	4/97
ACCEPTANCE BY	L.O.A.
DATE	4/97
FIELD CHECK BY	L.O.A.
DATE	4/97
REVISIONS	
CORRECTED BY	L.O.A.
DATE	4/97
MICRO-FILM INFORMATION	
RECORDED BY	
NO.	


SURVEY INFORMATION	
NO.	DATE
1	ACS 10-114" ALONG THE SOUTHERLY R.O.W. OF BRIDGE
2	BLVD. SW APPROX. 500' EAST OF 4TH ST. SW.
3	ELEV. 4951.924
4	T.B.M. BASELINE STA 16+55.10 (GROSS IN SIDEWALK)
5	S.W. QUADRANT OF 4TH ST. AND CROWELL AVE. S.W.
6	ELEV. 4946.22


BENCH MARKS	
NO.	DATE
1	ACS 10-114" ALONG THE SOUTHERLY R.O.W. OF BRIDGE
2	BLVD. SW APPROX. 500' EAST OF 4TH ST. SW.
3	ELEV. 4951.924
4	T.B.M. BASELINE STA 16+55.10 (GROSS IN SIDEWALK)
5	S.W. QUADRANT OF 4TH ST. AND CROWELL AVE. S.W.
6	ELEV. 4946.22


ENGINEER'S SEAL
FRED C. AHMAY
STATE OF
NEW MEXICO
7322
NO. 10000
12/21/95


ISSUED FOR CONSTRUCTION	
NO.	DATE
1	10/6/95
REVISIONS	
NO.	DATE
1	10/6/95
DESIGNED BY	FCA
DRAWN BY	ANW
CHECKED BY	IBA
DATE	9/95
DATE	9/95
DATE	9/95

SCANNED BY
BY LASON

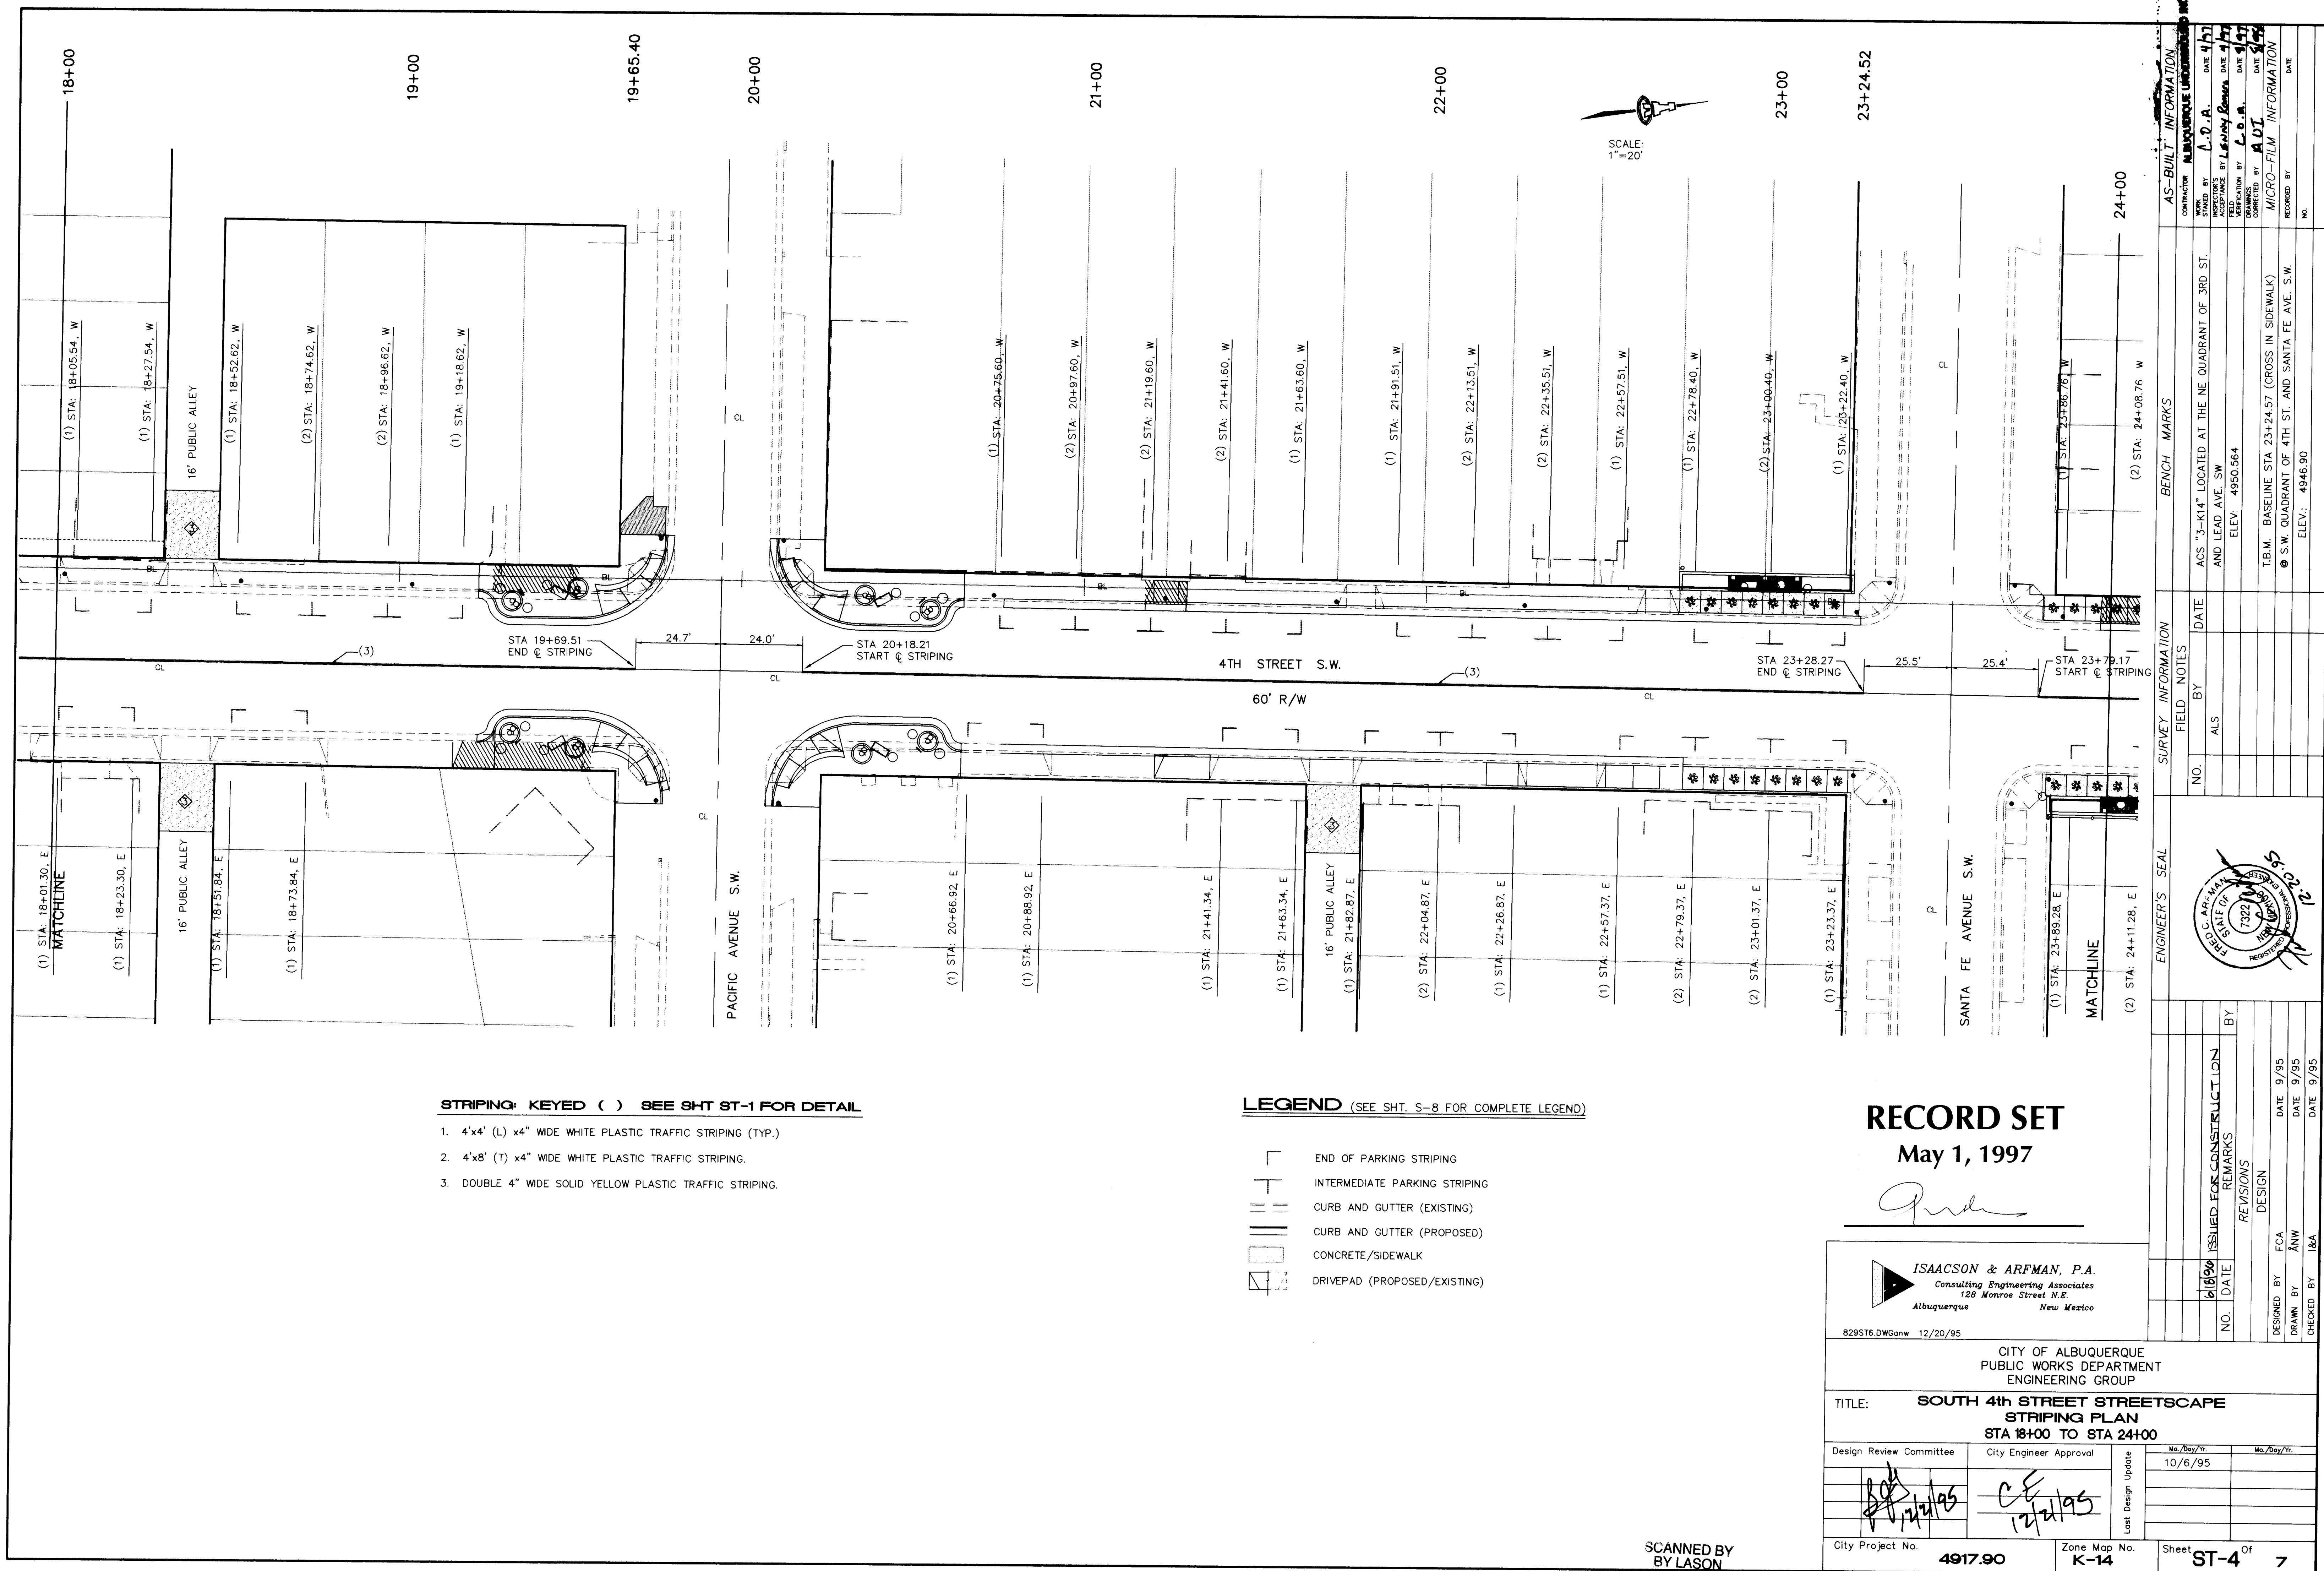


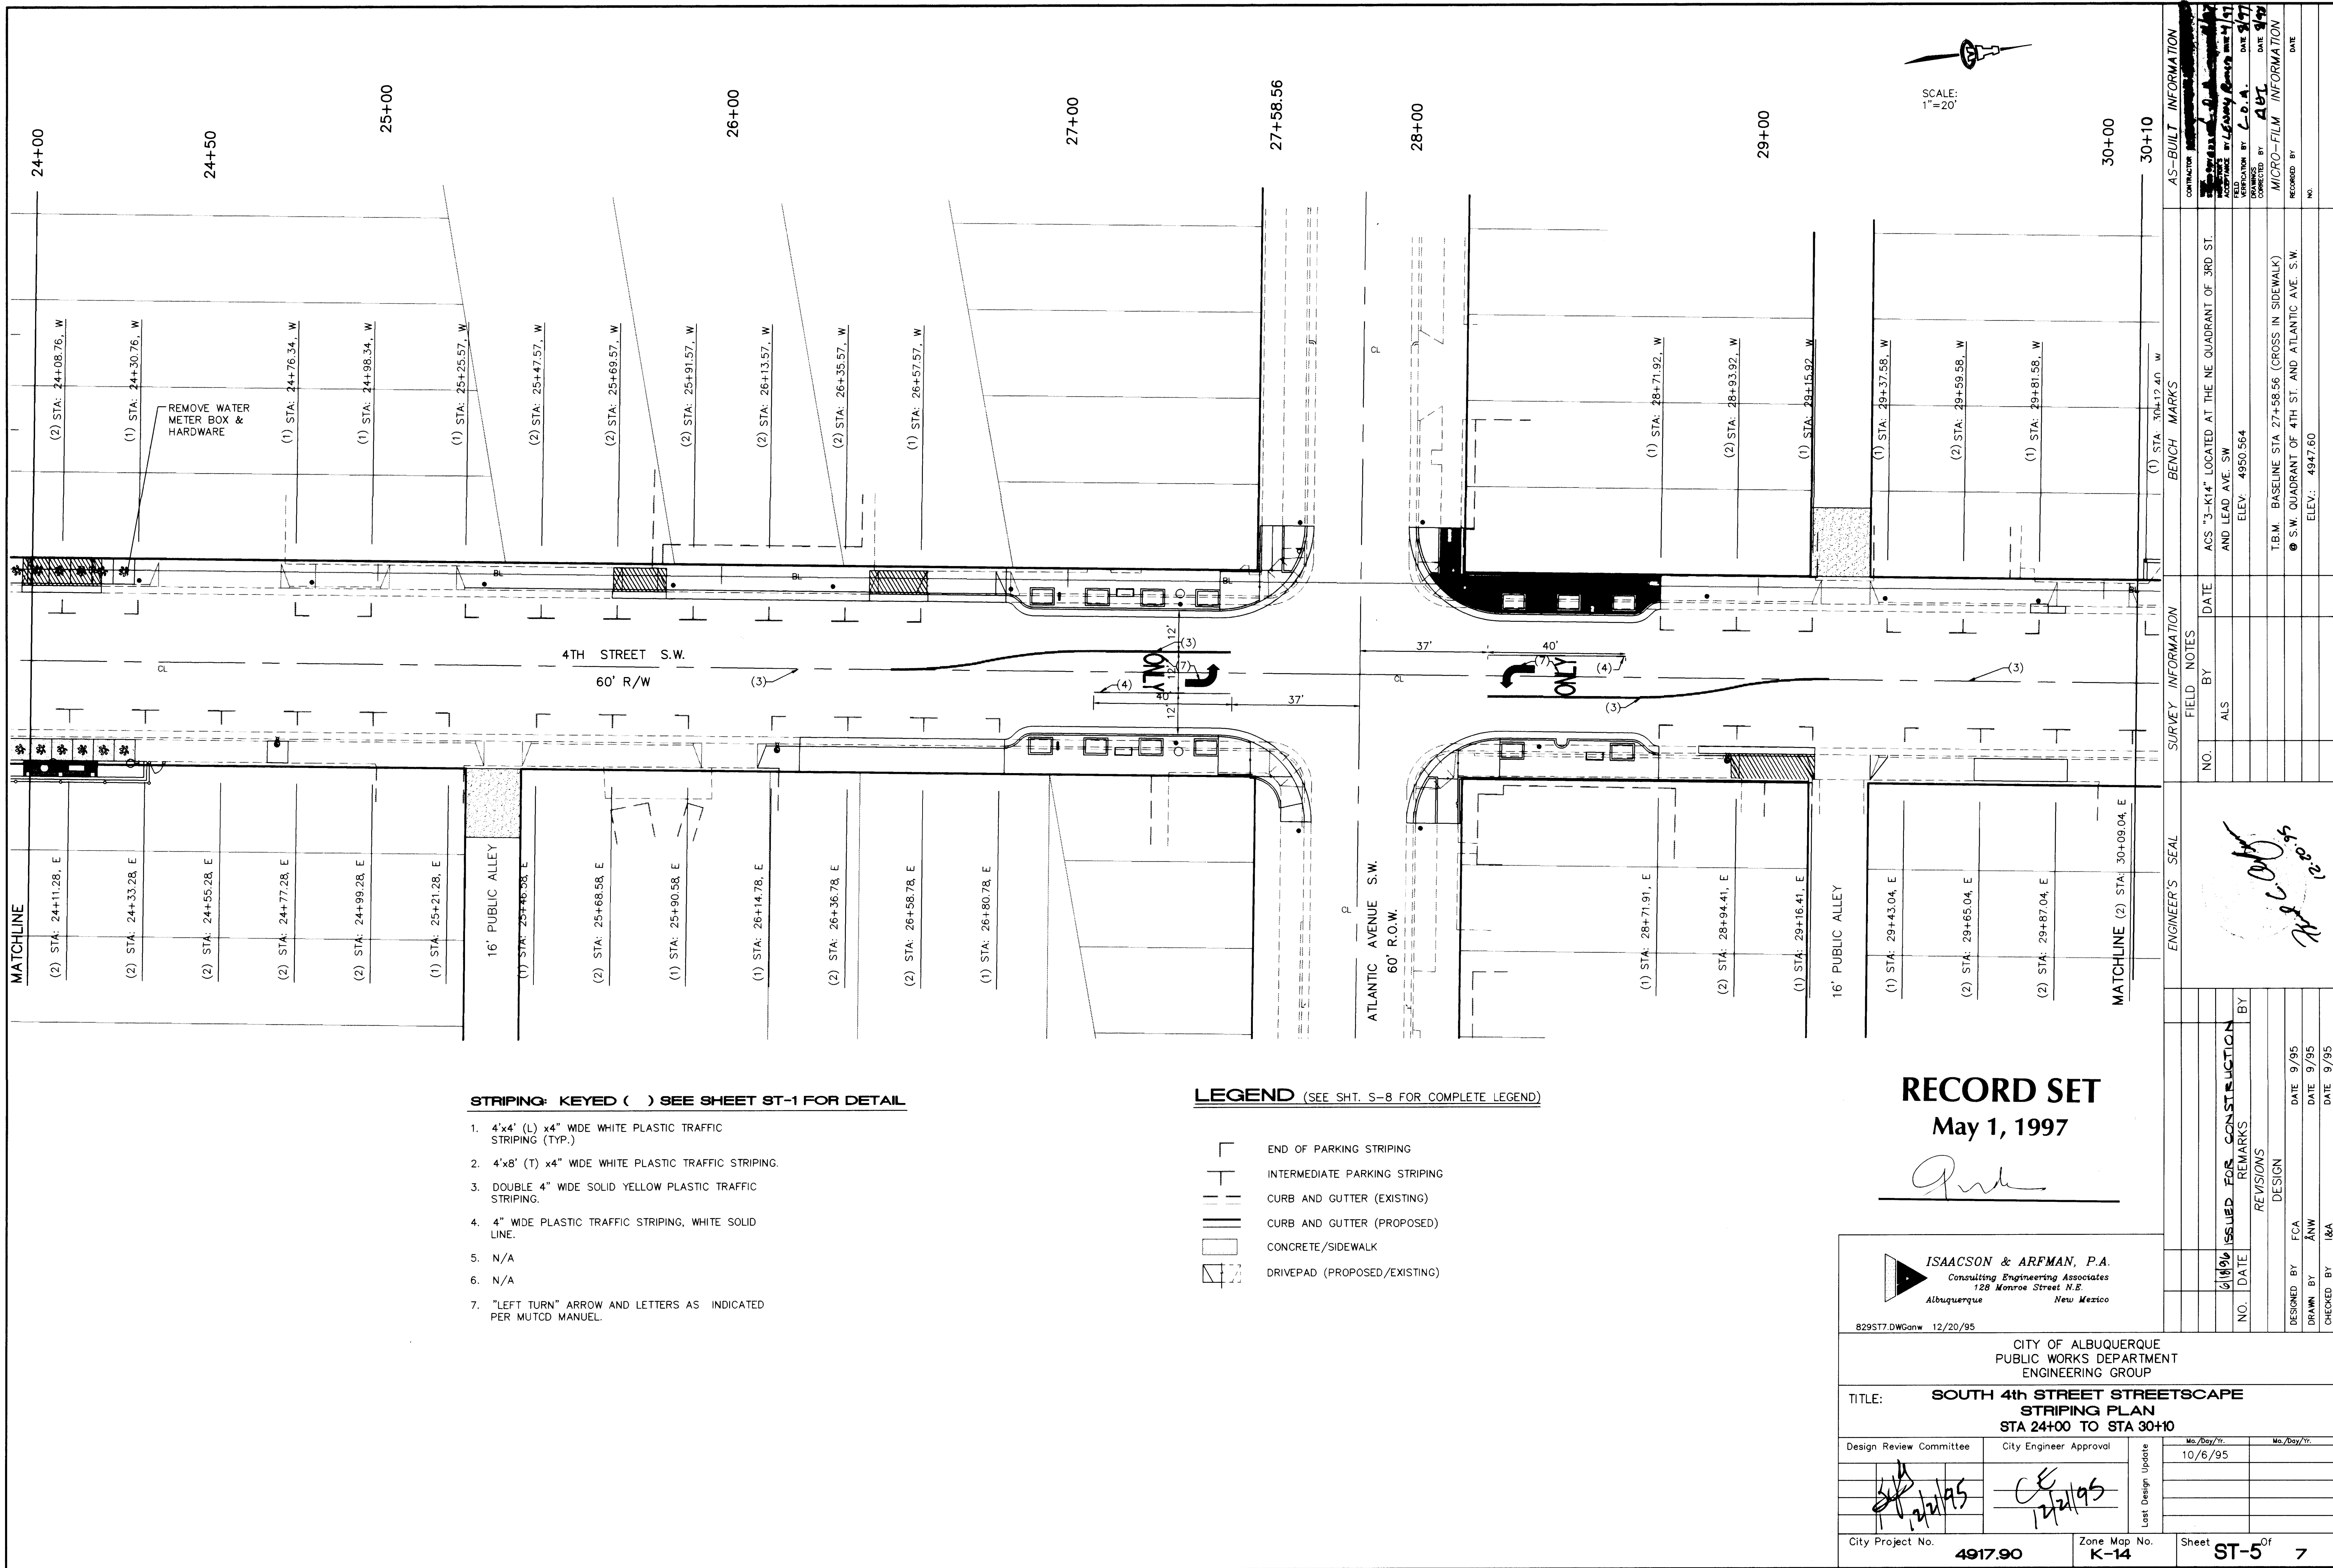


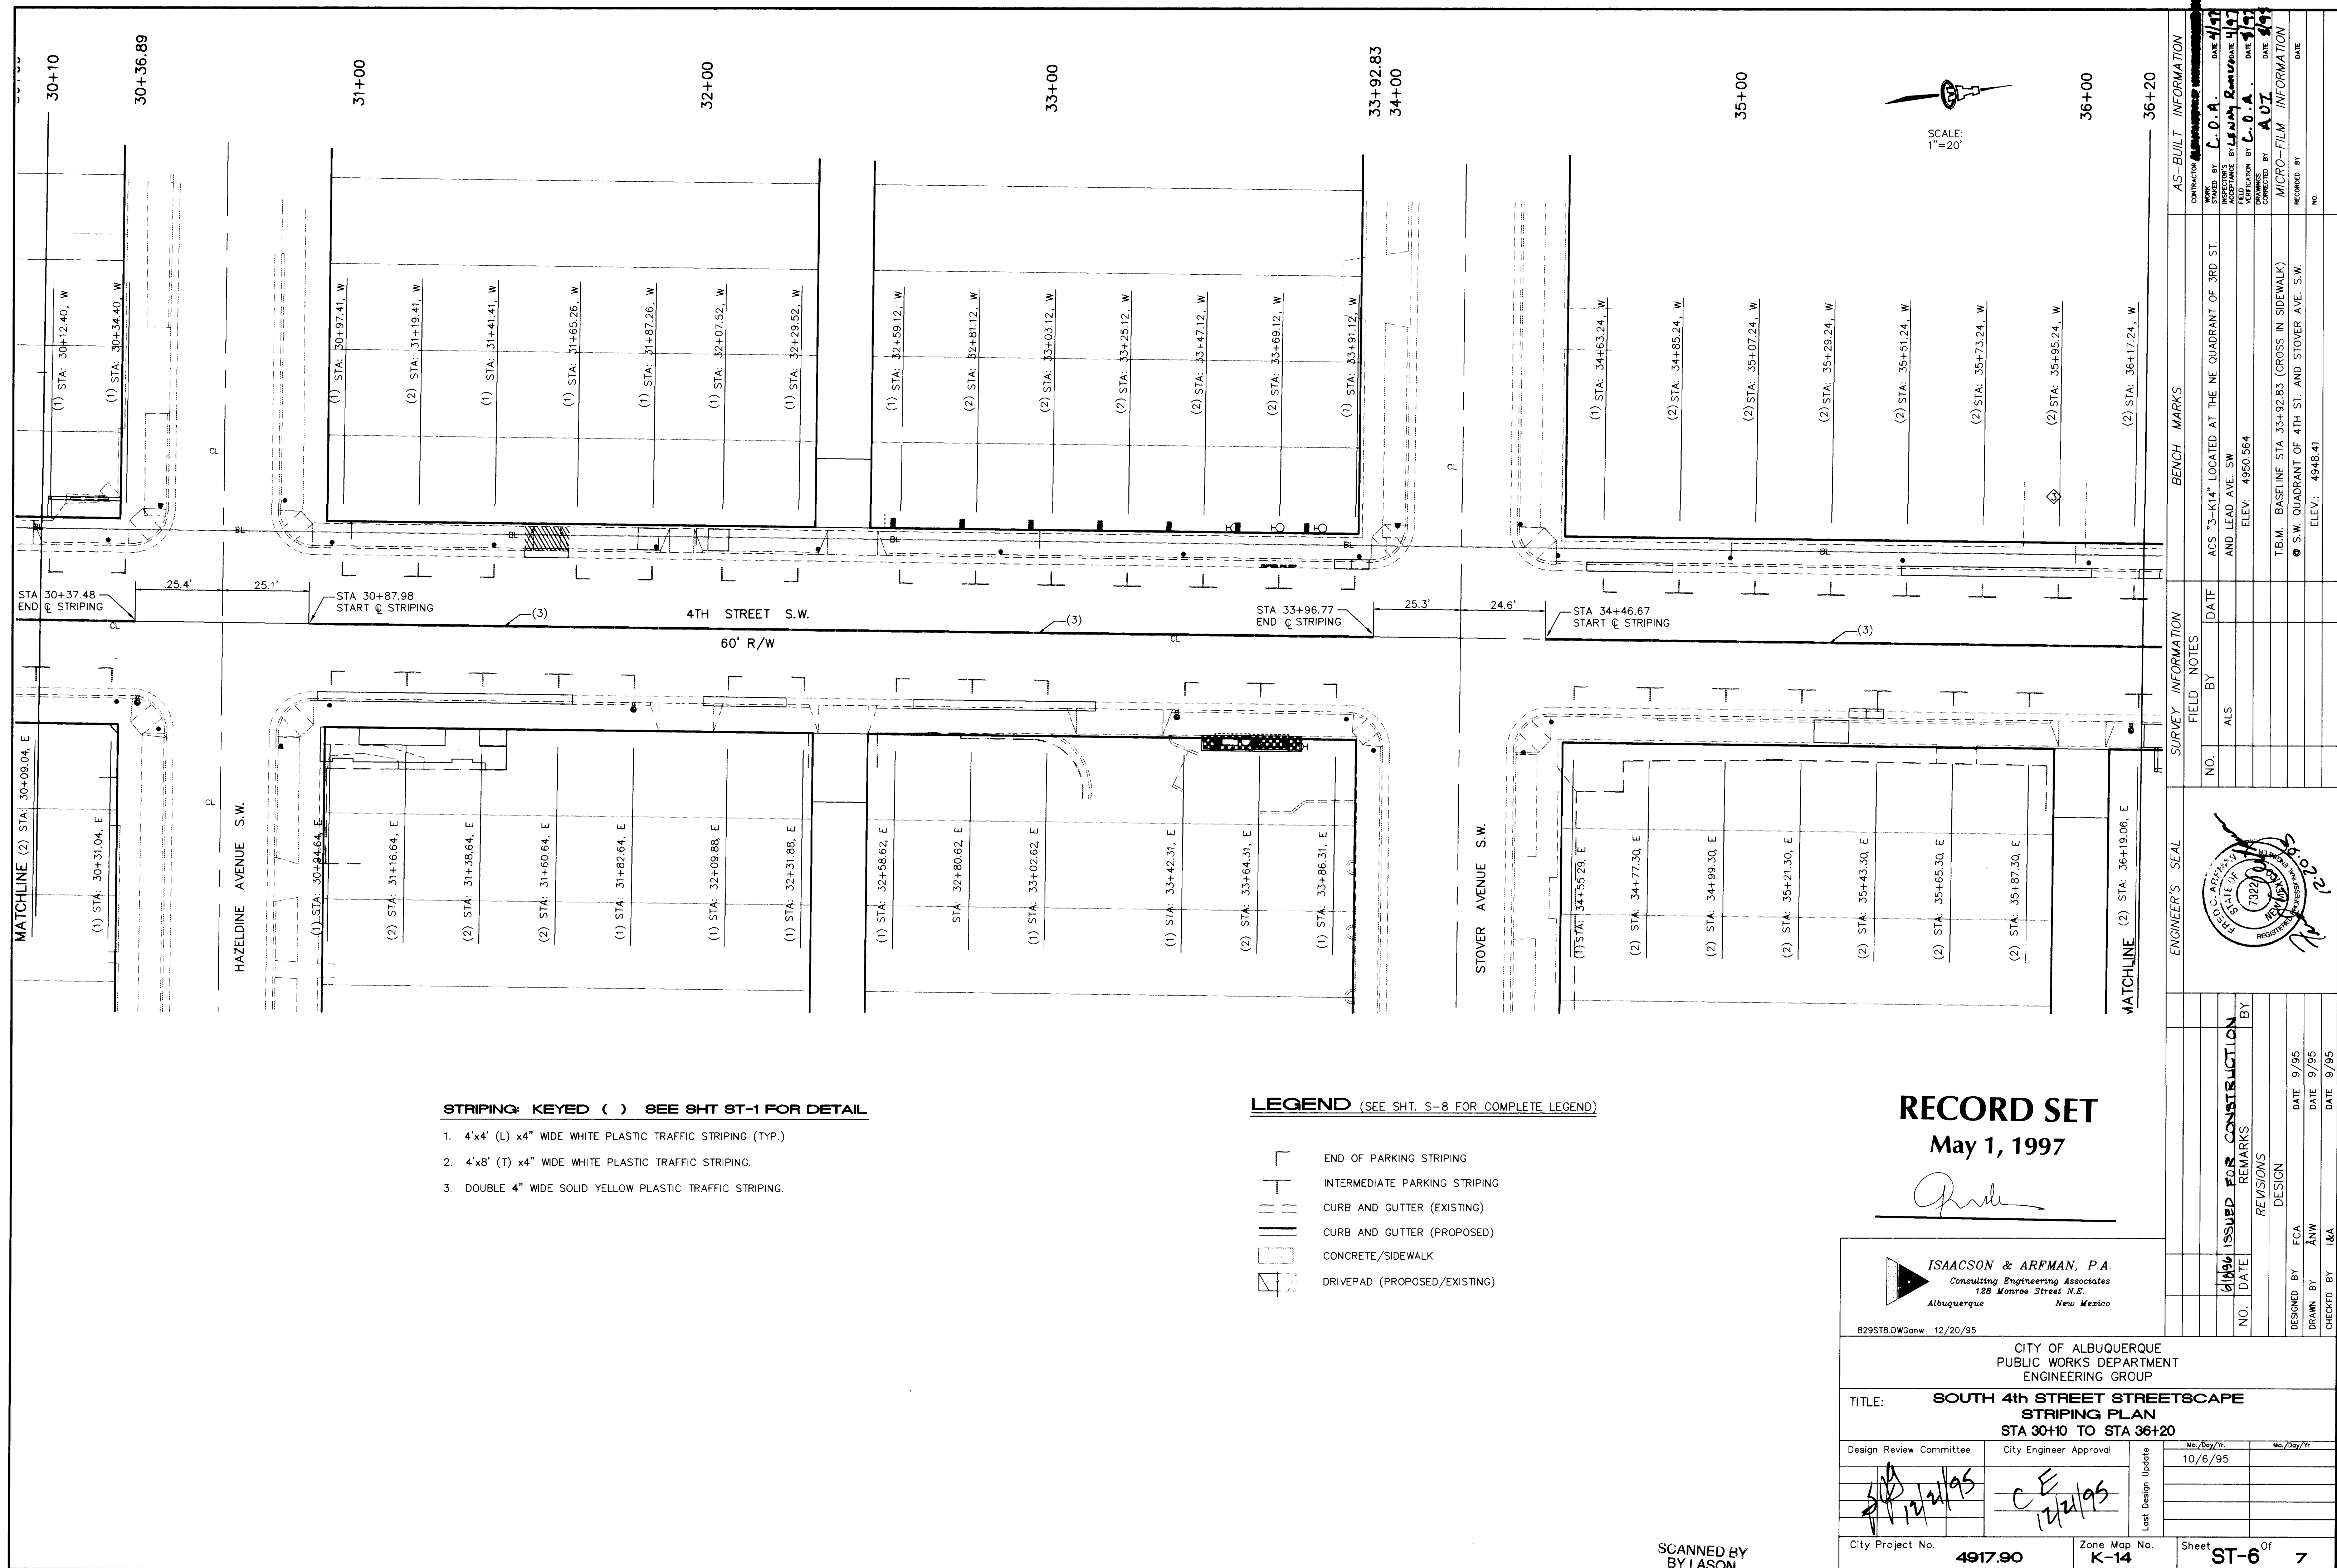

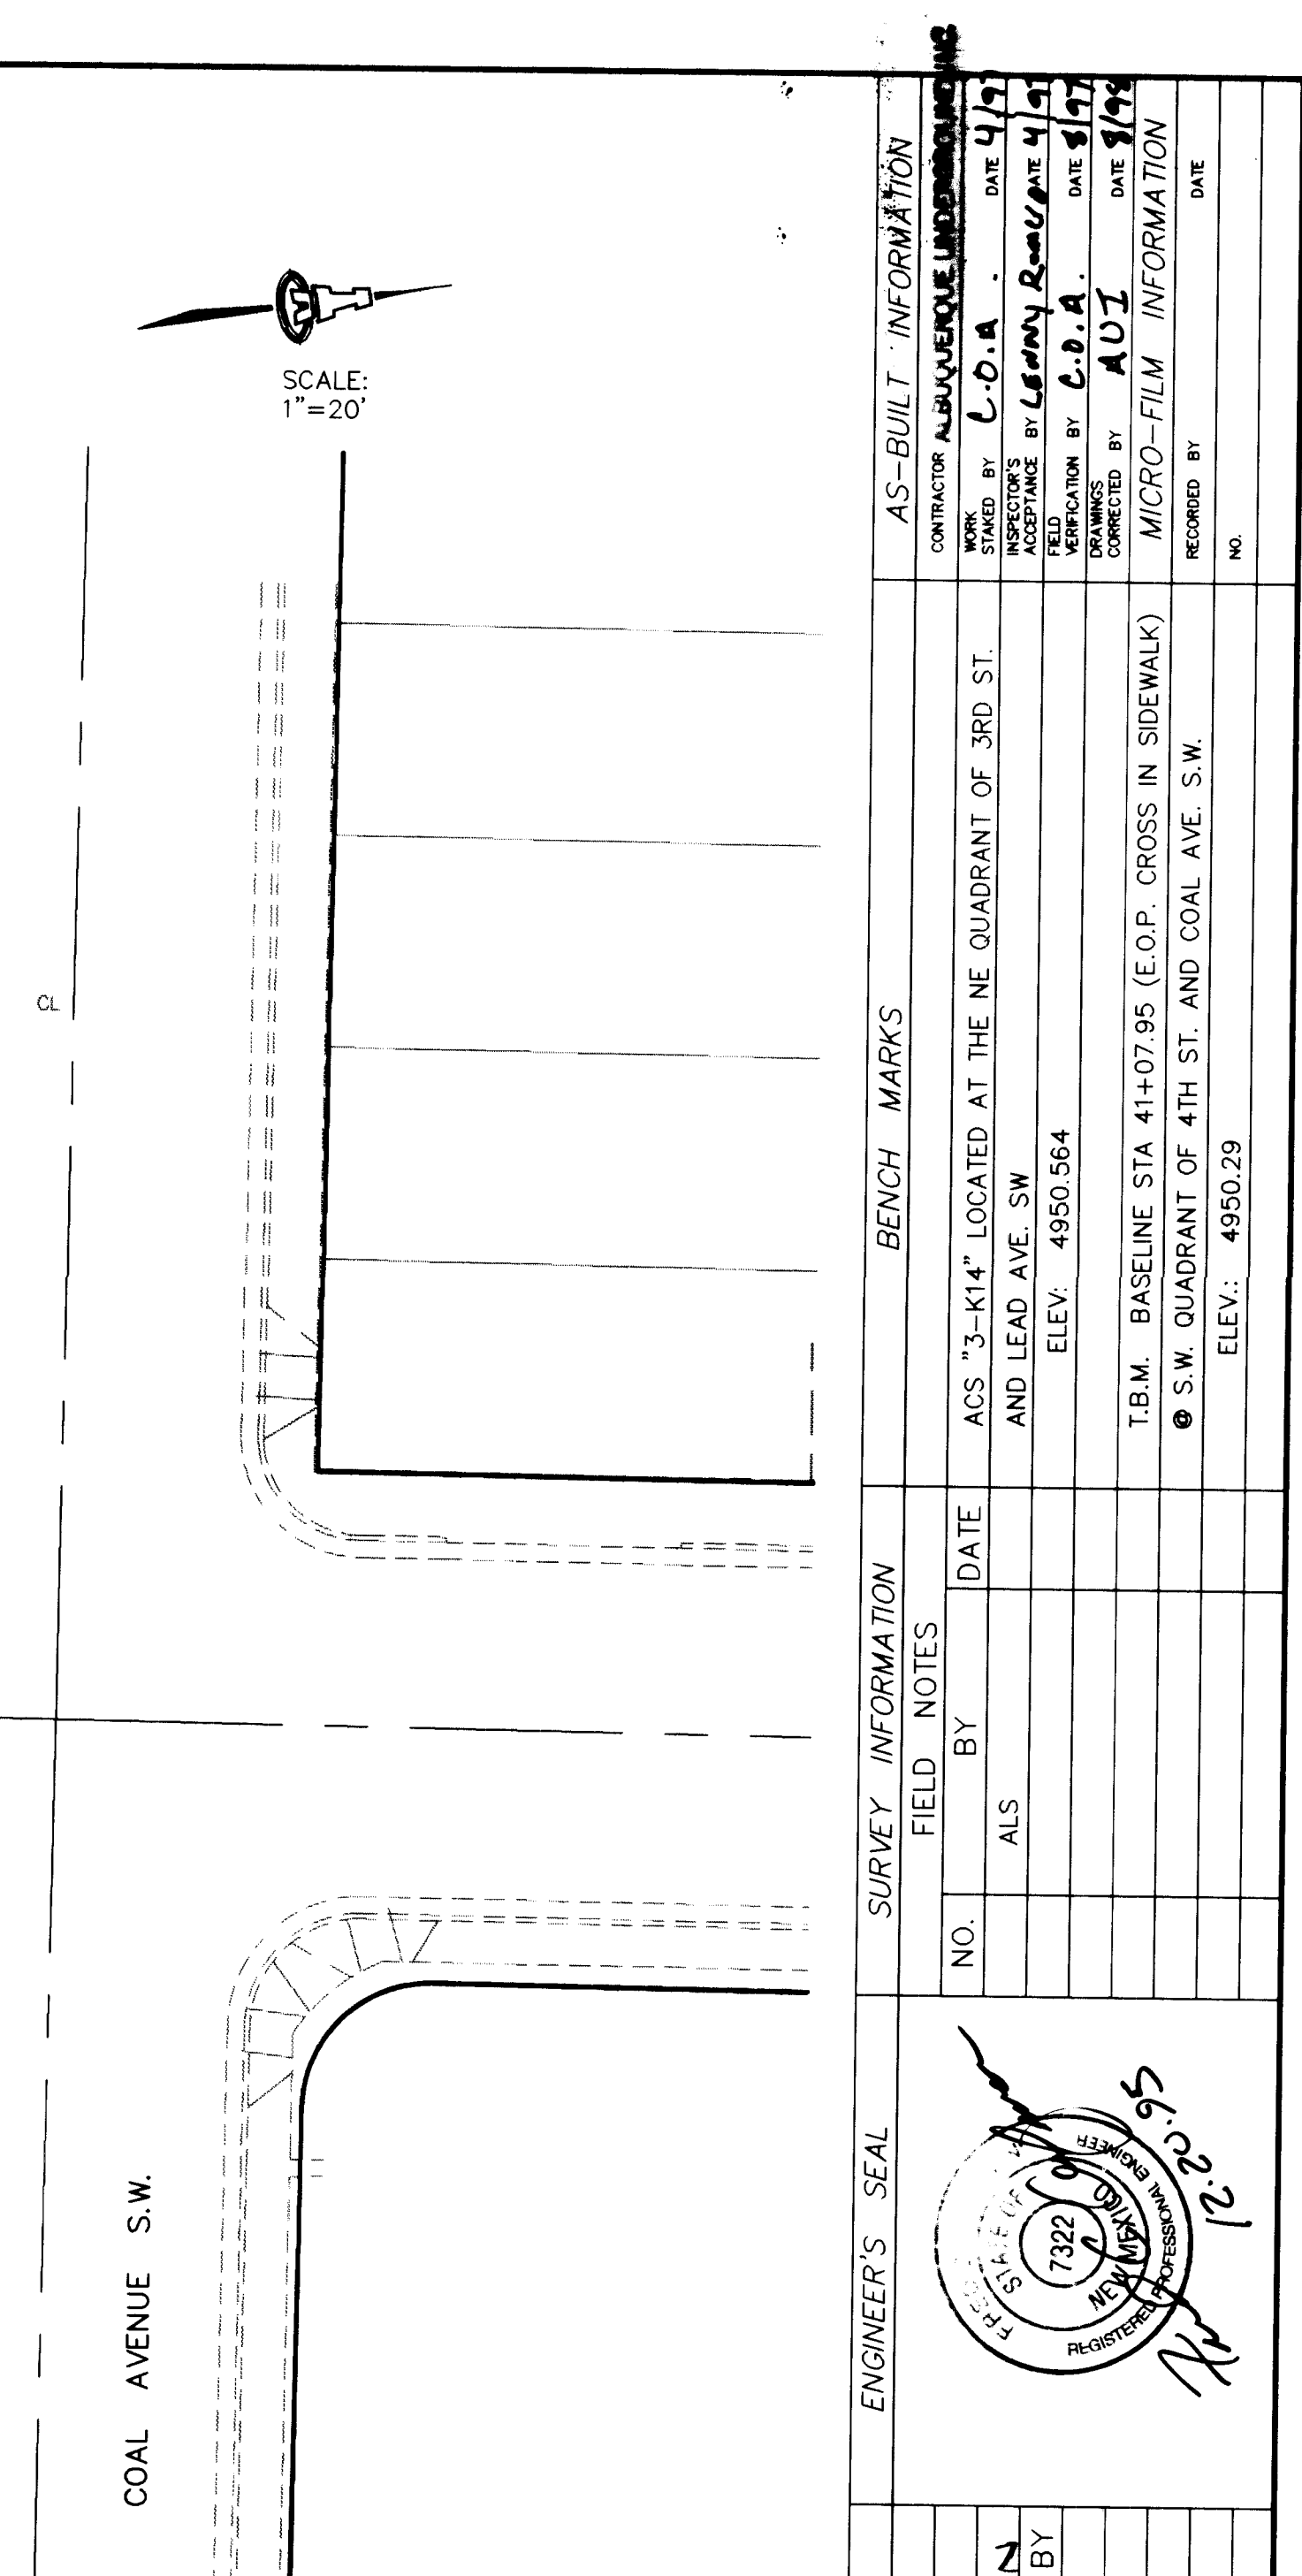

Inde

SCANNED BY
BY LASON

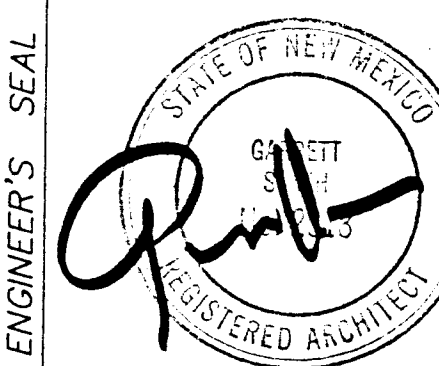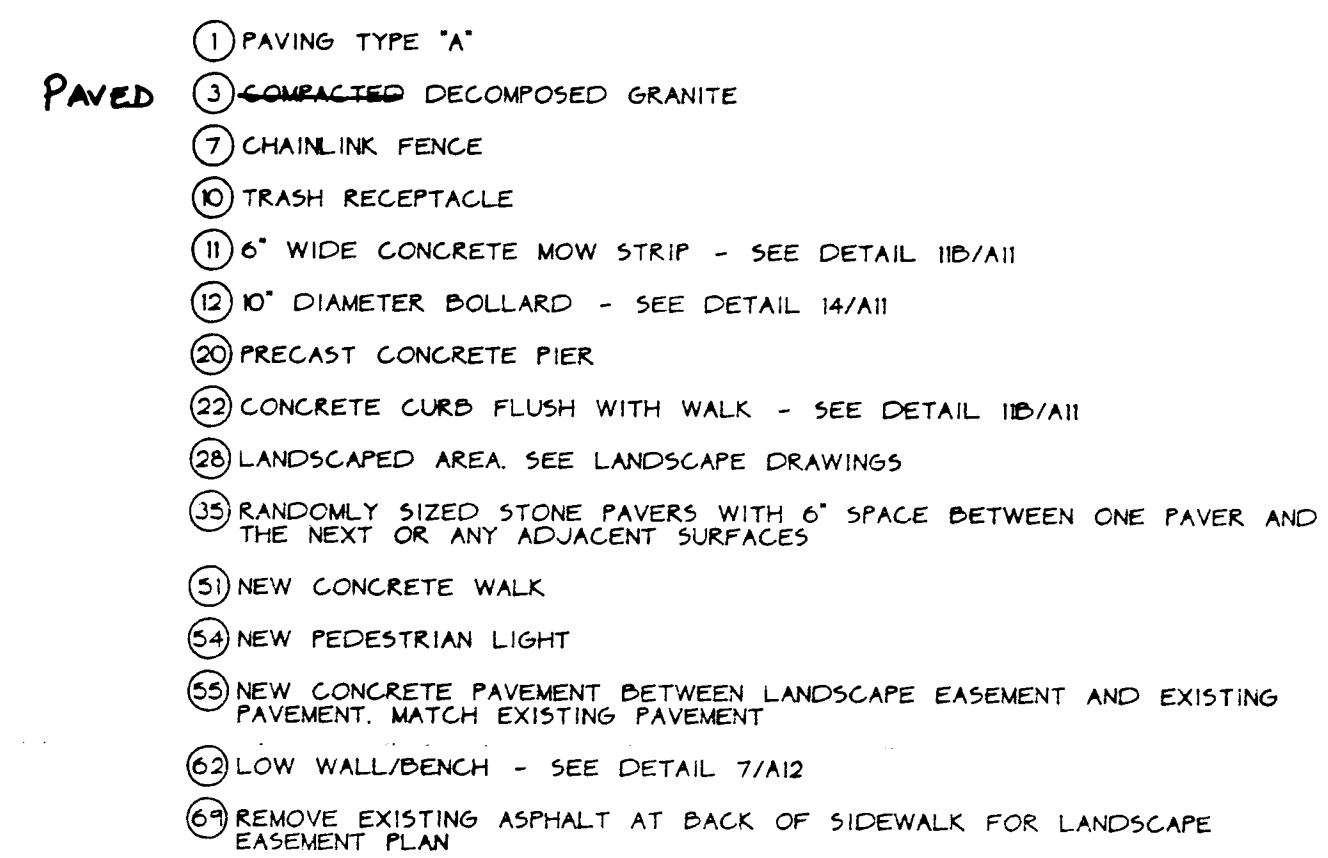

REMARKS		BY
ED FOR CONSTRUCTION		


DESIGNED BY	DATE
DRAWN BY	DATE

GARRETT SMITH LTD
DESIGN ARCHITECTURE & DEVELOPMENT

CITY OF ALBUQUERQUE PUBLIC WORKS DEPARTMENT ENGINEERING GROUP				
TITLE: FOURTH STREET STREETScape BARELAS NEIGHBORHOOD, ALBUQUERQUE, NEW MEXICO				
Design Review Committee	City Engineer Approval	Last Design Update	Mo./Day/Yr.	
			6/16/95	Mo./Day/Yr.
			8/14/95	
			8/15/95	
			8/29/95	
10/6/95				
City Project No. 4917.90	Zone Map No. K14-L14		Sheet A-1	Of 13





1" = 20'

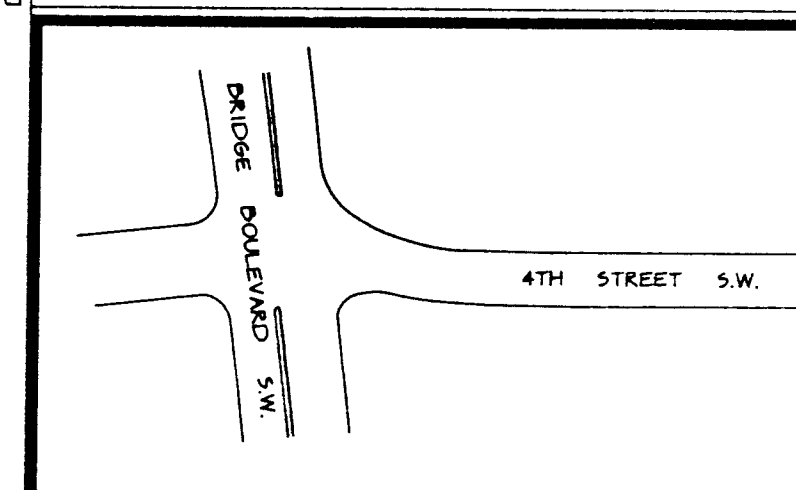


FOURTH STREET STREETSCAPE KEY

SCANNED BY
BY LASON

DWG2 06/24/95 08:06:45

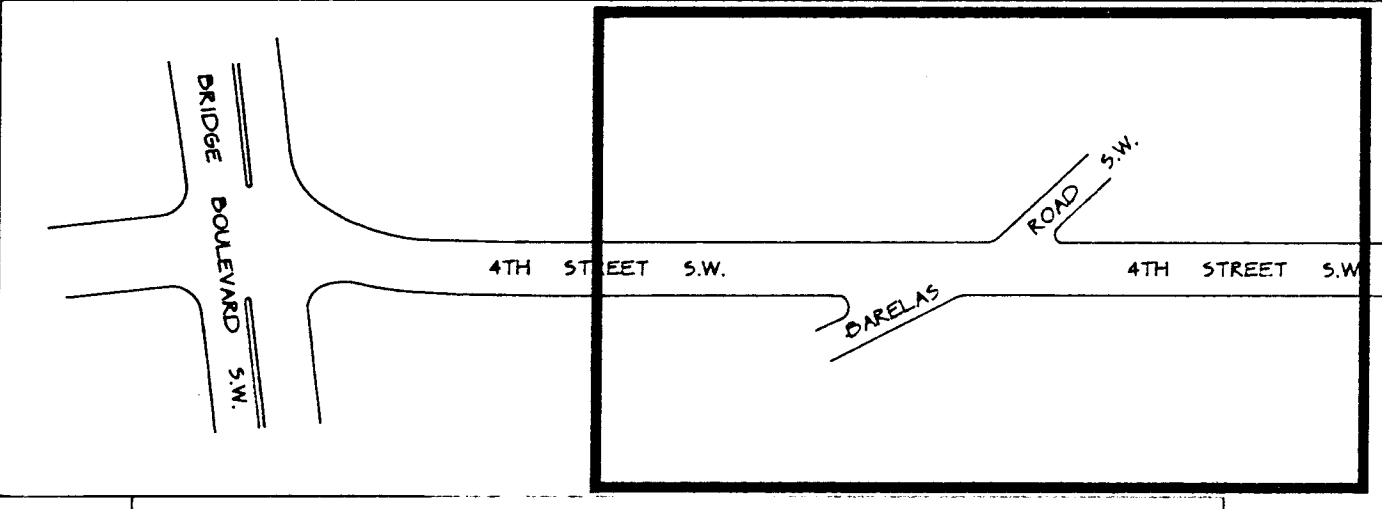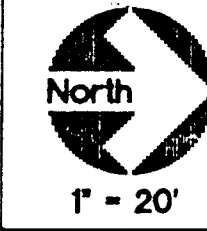

FOURTH STREET STREETSCAPE KEY

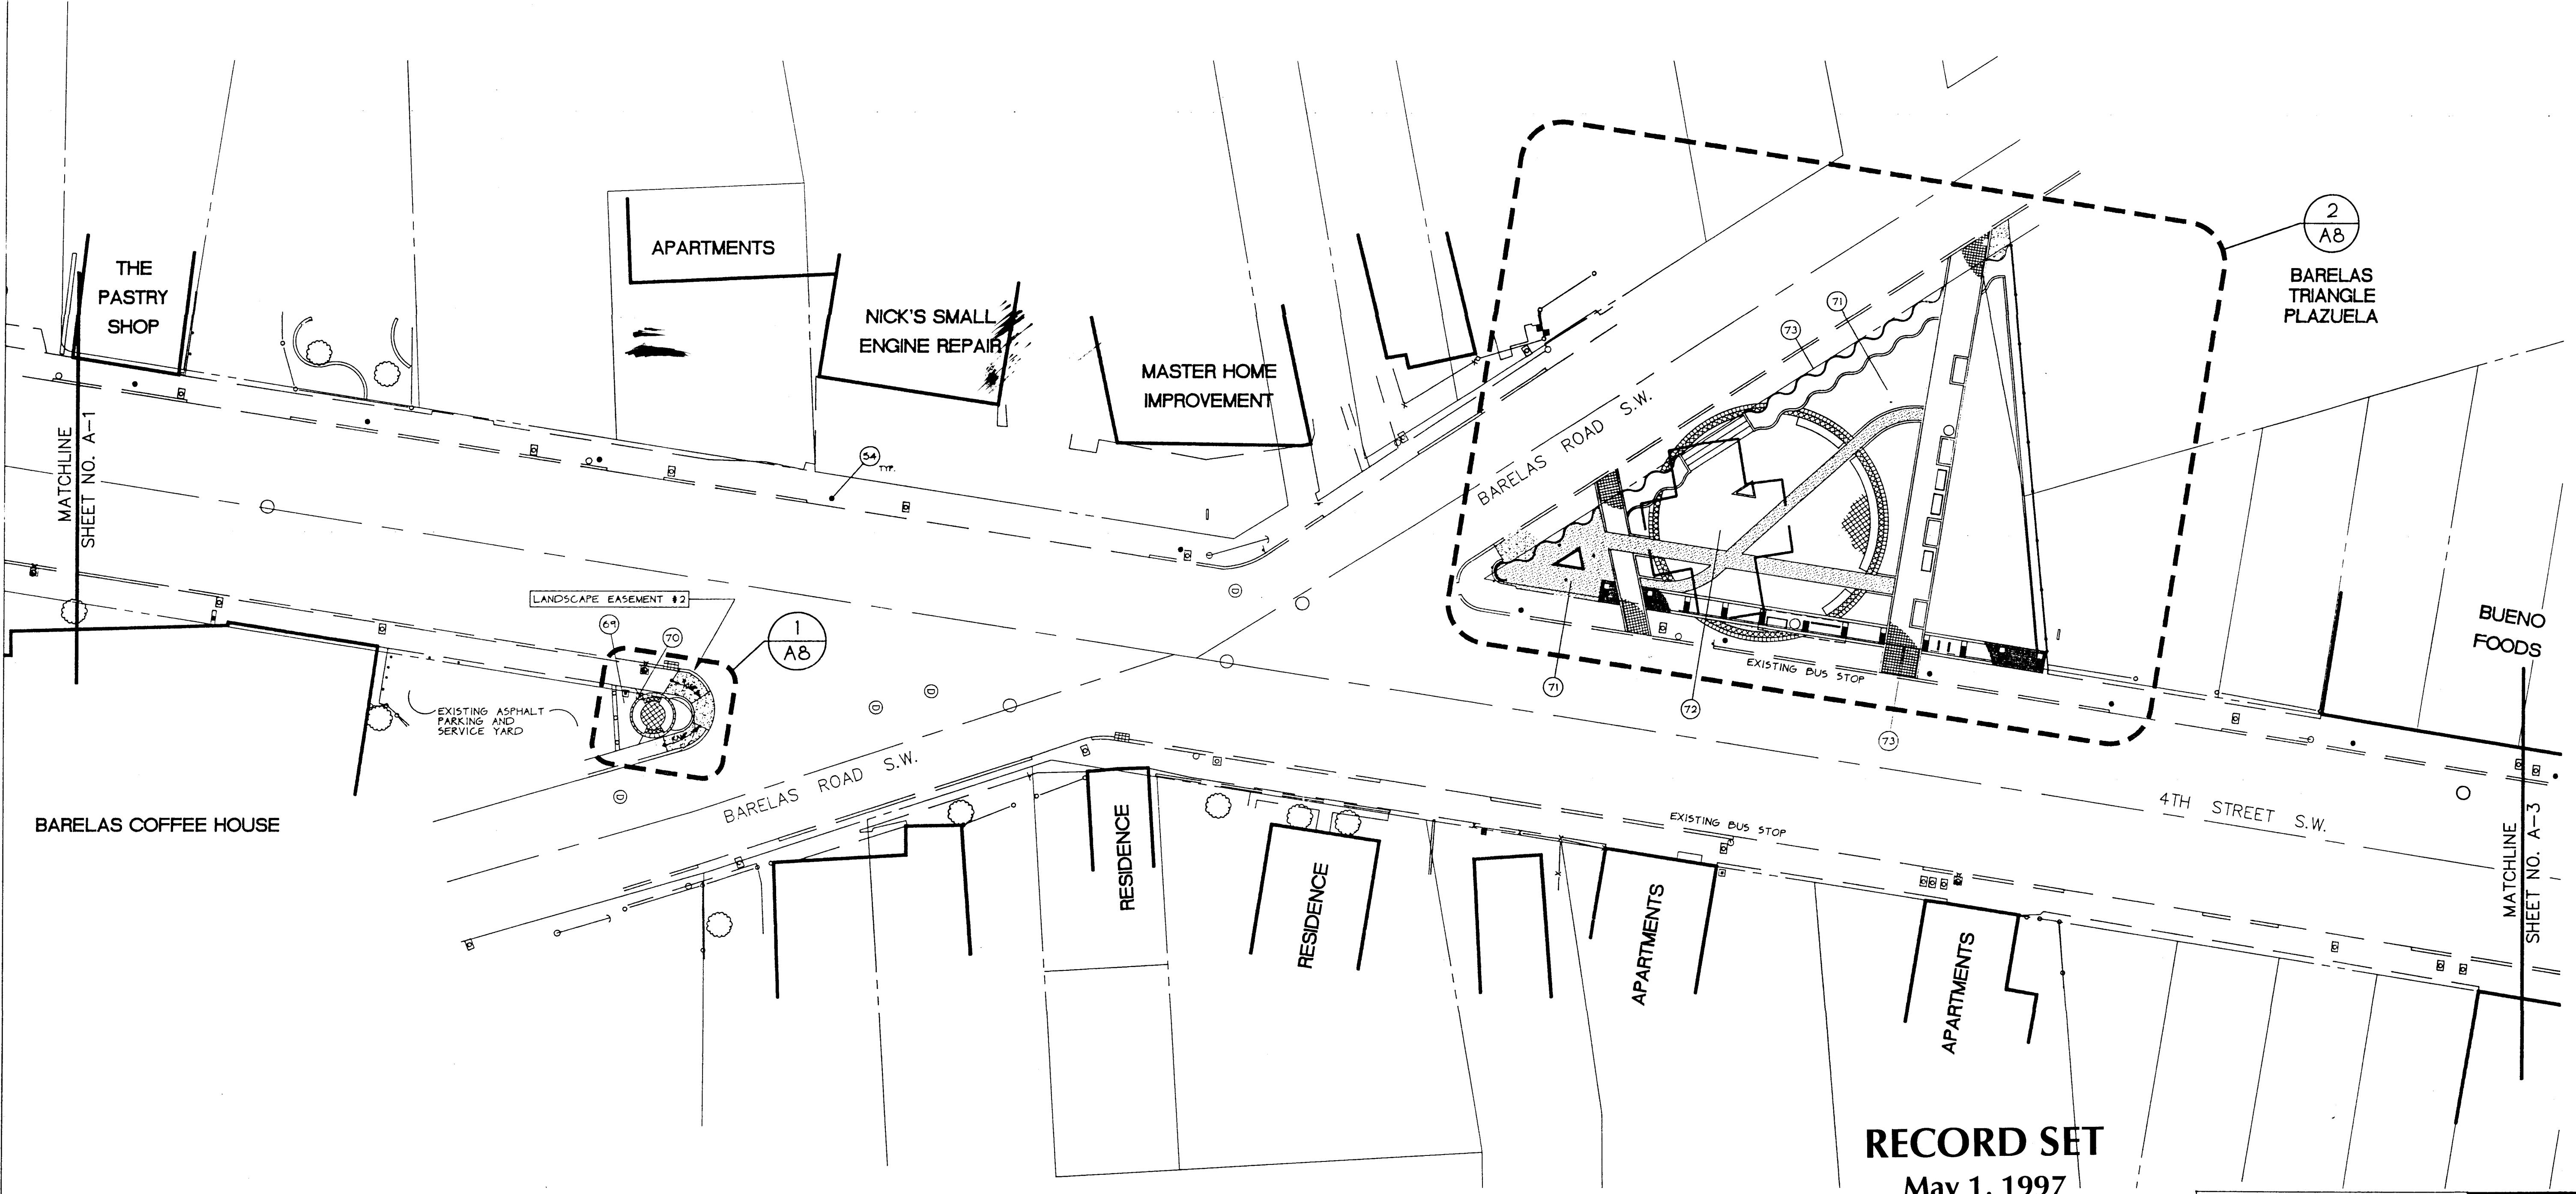



KEYED NOTES

- 64 NEW PEDESTRIAN LIGHT
- 69 REMOVE EXISTING ASPHALT AT BACK OF SIDEWALK FOR LANDSCAPE EASEMENT PLAN
- 70 RELOCATE USPS COLLECTION BOX. SEE DETAIL VAB FOR LOCATION
- 71 REMOVE EXISTING CONCRETE PAVING
- 72 REMOVE EXISTING BUILDING AND FOUNDATIONS
- 73 REMOVE EXISTING CHAIN LINK FENCE POSTS AND FOUNDATIONS ALONG FOURTH STREET AND BARELAS. STORE FOR REUSE

RECORD SET
May 1, 1997


[Signature]

GARRETT SMITH LTD
DESIGN ARCHITECTURE & DEVELOPMENT
514 CENTRAL SW
ALBUQUERQUE
NEW MEXICO
87102
505/766-6968
FAX/243-4508

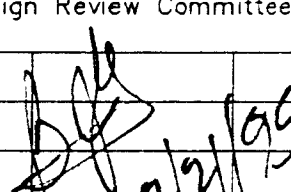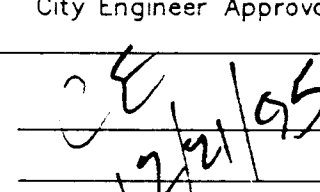CITY OF ALBUQUERQUE PUBLIC WORKS DEPARTMENT ENGINEERING GROUP				
TITLE: FOURTH STREET STREETSCAPE BARELAS NEIGHBORHOOD, ALBUQUERQUE, NEW MEXICO				
Design Review Committee	City Engineer Approval	Last Design Update	Mo./Day/Yr.	
 4/21/95	 12/21/95		6/16/95	
			8/4/95	
			8/15/95	
			8/29/95	
City Project No.	Zone Map No.	Sheet	Of	
4917.90	K14-L14	A-2	13	

ENGINEER'S SEAL		SURVEY INFORMATION		BENCH MARKS		AS-BUILT INFORMATION				
		NO.	BY	DATE		CONTRACTOR	DATE			
ISSUED FOR CONSTRUCTION		REVISIONS		DESIGN		MICRO-FILM INFORMATION				
NO.		DATE		DATE		DATE				
4/18/96										
DESIGNED BY		DRAWN BY		CHECKED BY						


DWG3 08/24/95 10:07:20

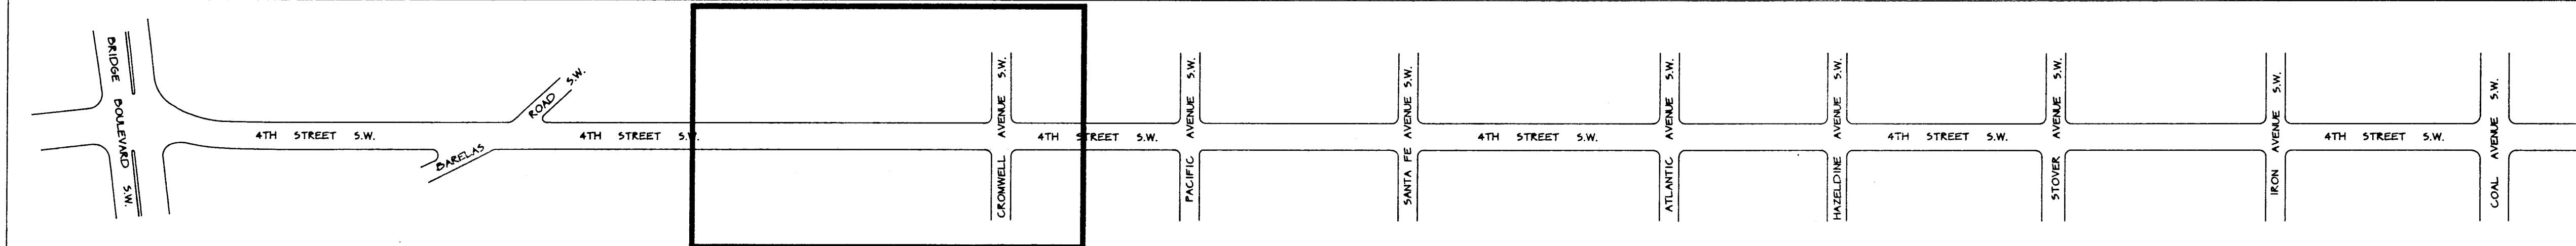

FOURTH STREET STREETSCAPE KEY

KEYED NOTES

- ① PAVING TYPE "A"
- ③ PAVING TYPE "E"
- ⑩ PRECAST CONCRETE PIER
- ⑫ LANDSCAPED AREA. SEE LANDSCAPE DRAWINGS
- ④⑥ RELOCATE EXISTING CHAIN-LINK FENCE. PROVIDE NEW POLES OR CONNECTIONS AS NECESSARY TO CONFIGURE AS SHOWN
- ⑦③ REMOVE EXISTING CHAIN-LINK FENCE POSTS AND FOUNDATIONS ALONG FOURTH STREET AND BARELAS. STORE FOR REUSE
- ⑦④ CLEAR EASEMENT AREA OF DEBRIS, PLANT MATERIAL, CONSTRUCTION MATERIAL, ETC., AS REQUIRED IN PREPARATION FOR NEW CONSTRUCTION
- ⑦⑥ REMOVE SIDEWALK CURB AND GUTTER AS REQUIRED FOR NEW CONSTRUCTION

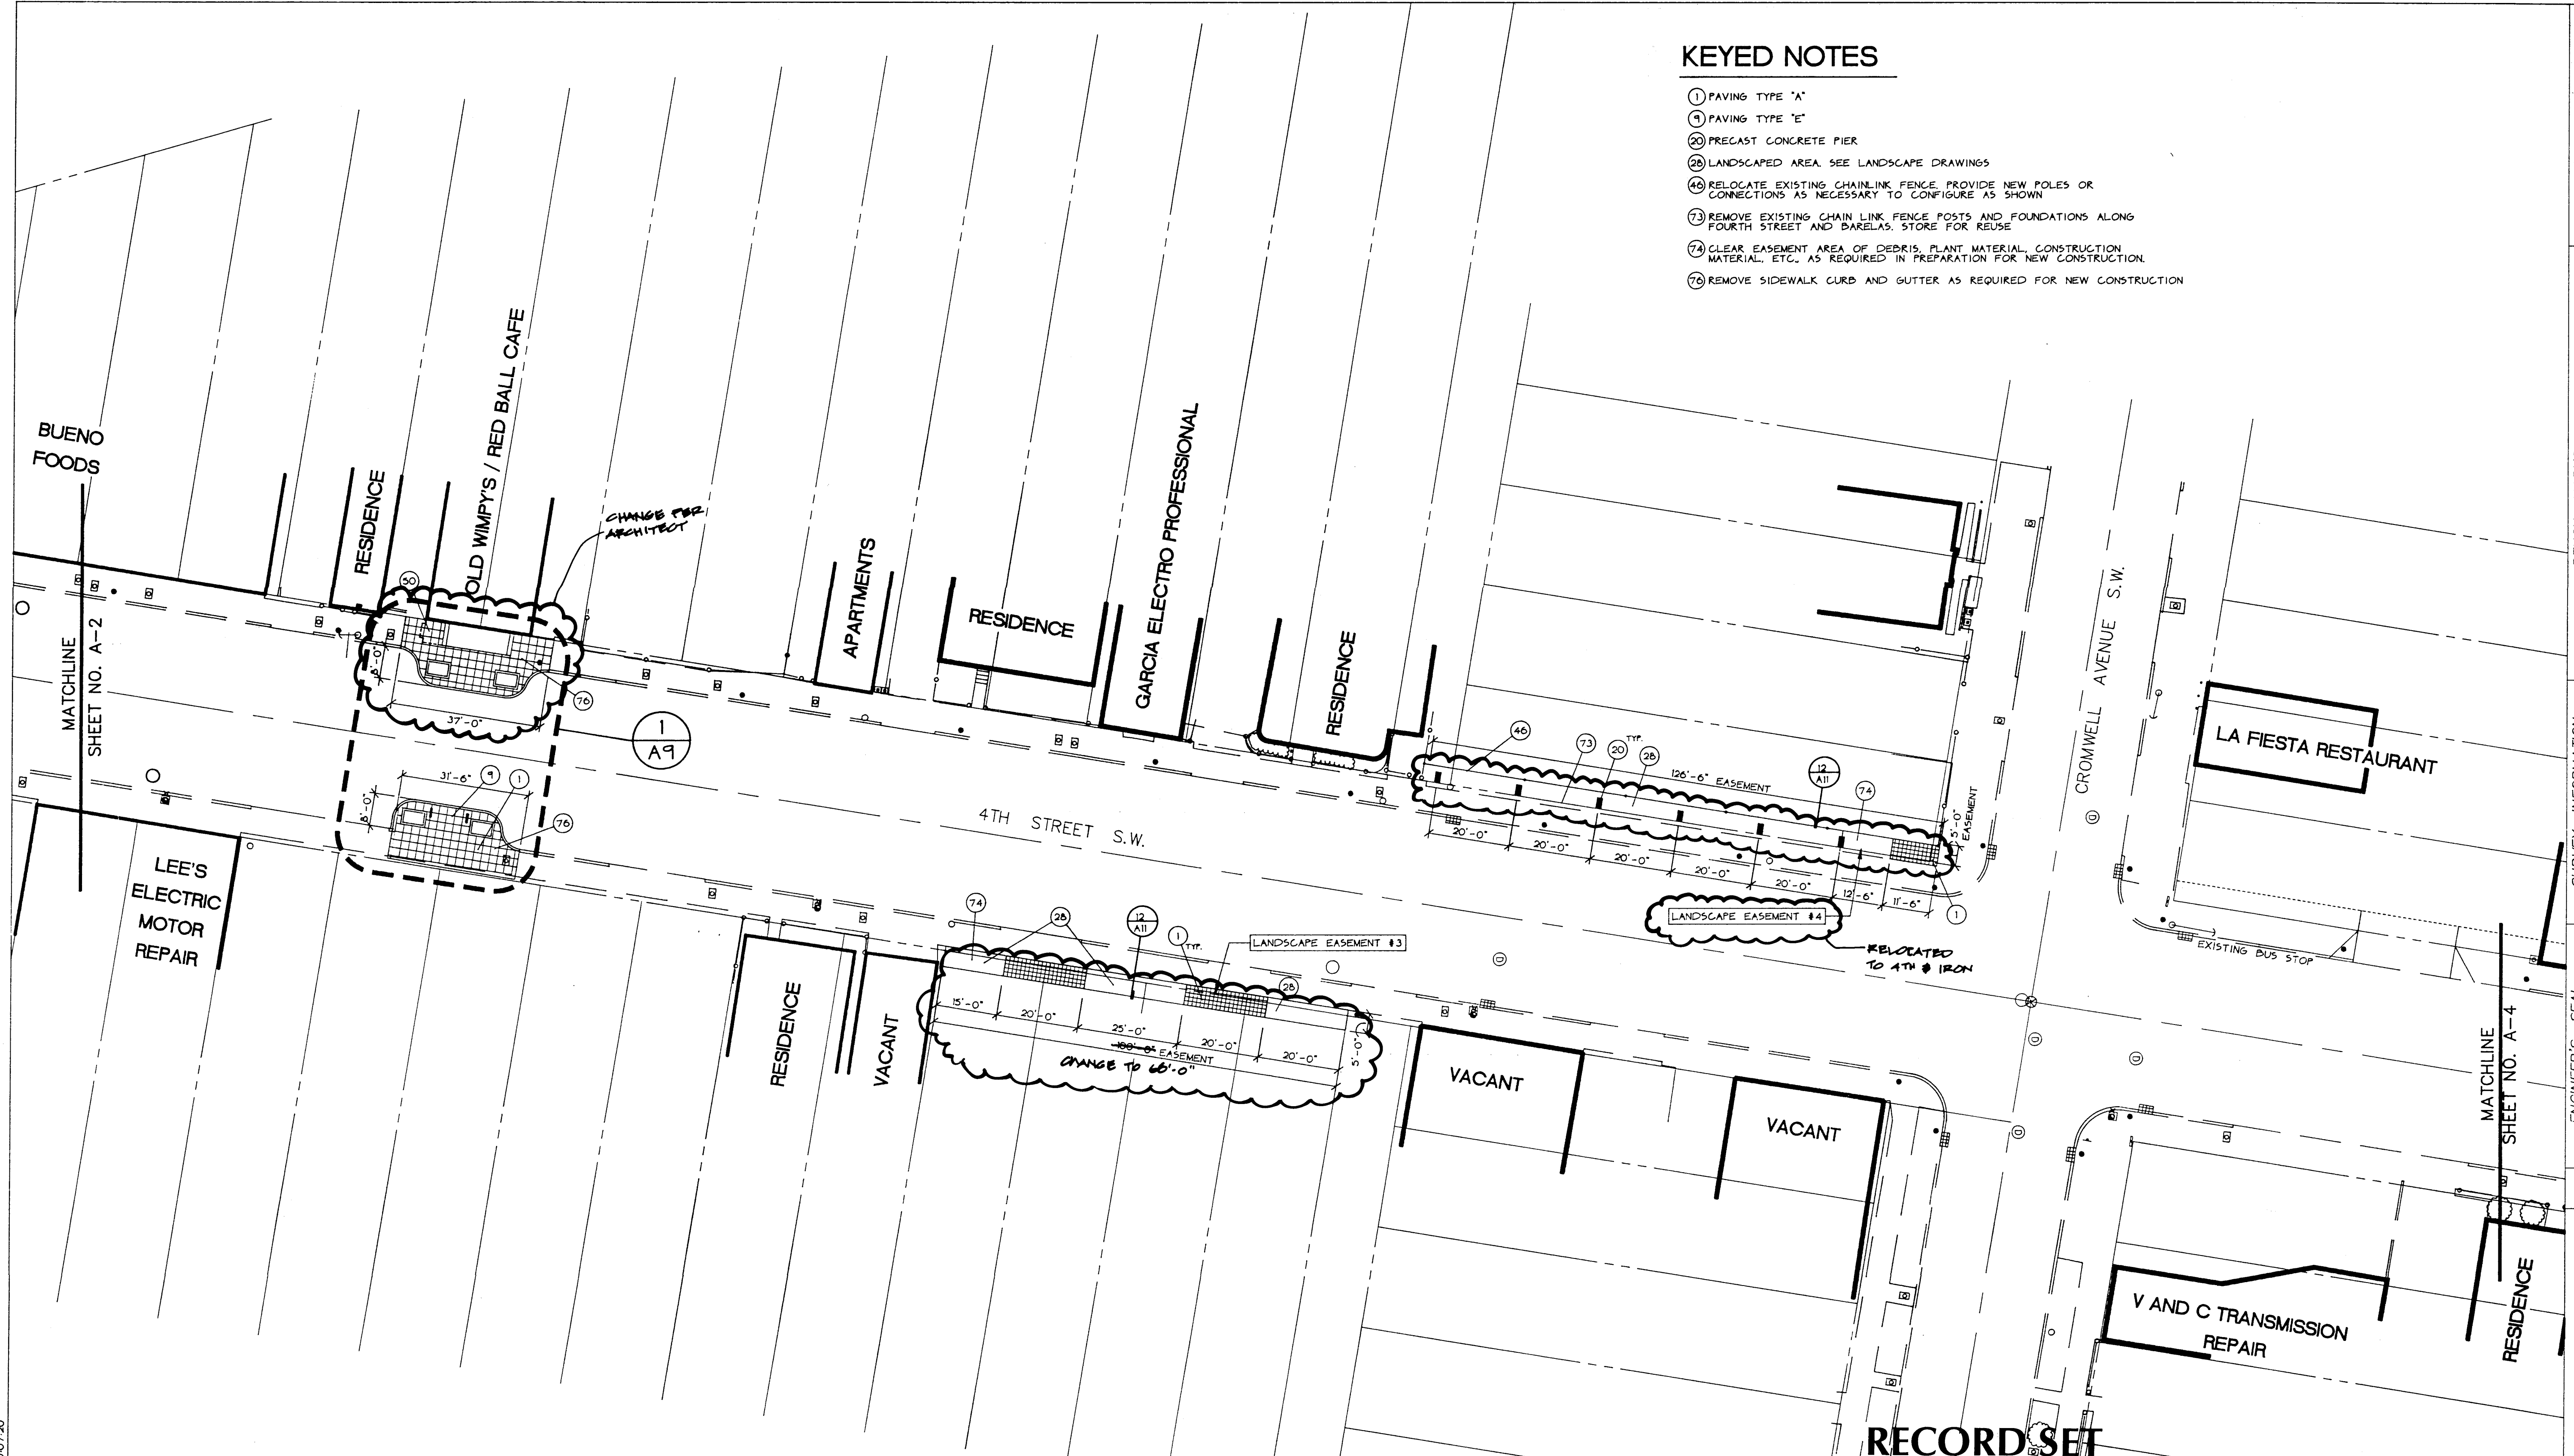

RECORD SET

May 1, 1997

Garrett Smith

GARRETT SMITH LTD.
DESIGN, ARCHITECTURE & DEVELOPMENT
314 CENTRAL SW
ALBUQUERQUE
NEW MEXICO
8 7 1 0 2
505/766-6968
FAX/243-4508

CITY OF ALBUQUERQUE PUBLIC WORKS DEPARTMENT ENGINEERING GROUP			
TITLE: FOURTH STREET STREETSCAPE BARELAS NEIGHBORHOOD, ALBUQUERQUE, NEW MEXICO			
Design Review Committee	City Engineer Approval	Last Design Update	
<i>[Signature]</i> 8/21/95	<i>[Signature]</i> 8/21/95	6/16/95	8/16/95
		8/4/95	8/15/95
		8/15/95	8/29/95
		8/29/95	10/6/95
		10/6/95	
City Project No. 4917.90	Zone Map No. K14-L14	Sheet A-3	Of 13

AS-BUILT - INFORMATION			
CONTRACTOR	WORKS BY	DATE	DATE
INSPECTED BY	ACCEPTANCE BY	DATE	DATE
DESIGNED BY	REVISIONS	DATE	DATE
DRAWN BY	DESIGN	DATE	DATE
CHECKED BY		DATE	DATE
MICRO-FILM INFORMATION			
RECORDED BY	DATE	NO.	







SCANNED BY
BY LASON

[illegible]

DWG# 06/30/95 14:40

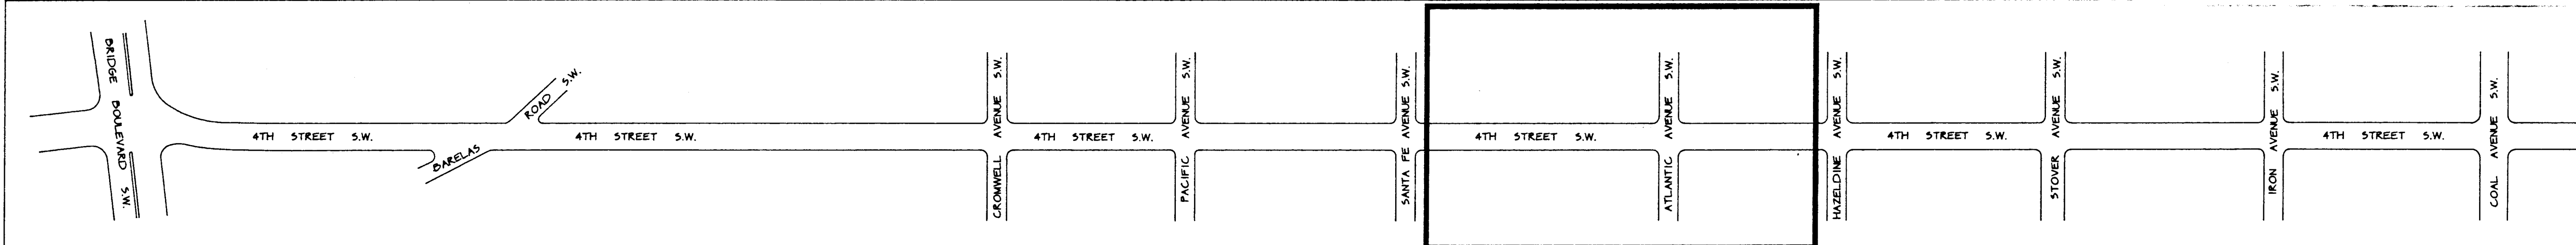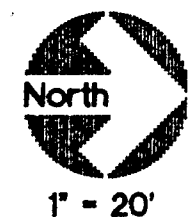


FOURTH STREET STREETSCAPE KEY

KEYED NOTES

- ② PAVING TYPE 'C'
- ④ PAVING TYPE 'D'
- ⑩ TRASH RECEPTACLE
- ⑪ 6" CONCRETE CURB - SEE DETAIL 10/112
- ⑮ 5' WIDE BENCH
- ⑲ BIKE LOOPS - SEE DETAIL 13/111
- ⑳ LANDSCAPED AREA. SEE LANDSCAPE DRAWINGS
- ㉓ RELOCATED EXISTING FIRE HYDRANT - SEE CIVIL DRAWINGS
- ㉔ RELOCATE EXISTING CHAINLINK FENCE. PROVIDE NEW POLES OR CONNECTIONS AS NECESSARY TO CONFIGURE AS SHOWN
- ㉕ ONE GECKO PAVER SHALL BE LOCATED IN THE CENTER OF EACH SIDEWALK STONE, FACING TOWARD THE INTERSECTION. GECKOS WILL BE ROTATED SLIGHTLY TO THE LEFT OR RIGHT IN AN ALTERNATING PATTERN. ARCHITECT SHALL INSPECT LAYOUT OF GECKOS PRIOR TO POURING OF SURROUNDING SIDEWALK.
- ㉖ EXISTING CONCRETE JOINT
- ㉗ RELOCATED EXISTING WATER METER - SEE CIVIL
- ㉘ REMOVE SIDEWALK CURB AND GUTTER AS REQUIRED FOR NEW CONSTRUCTION

N.I.C.

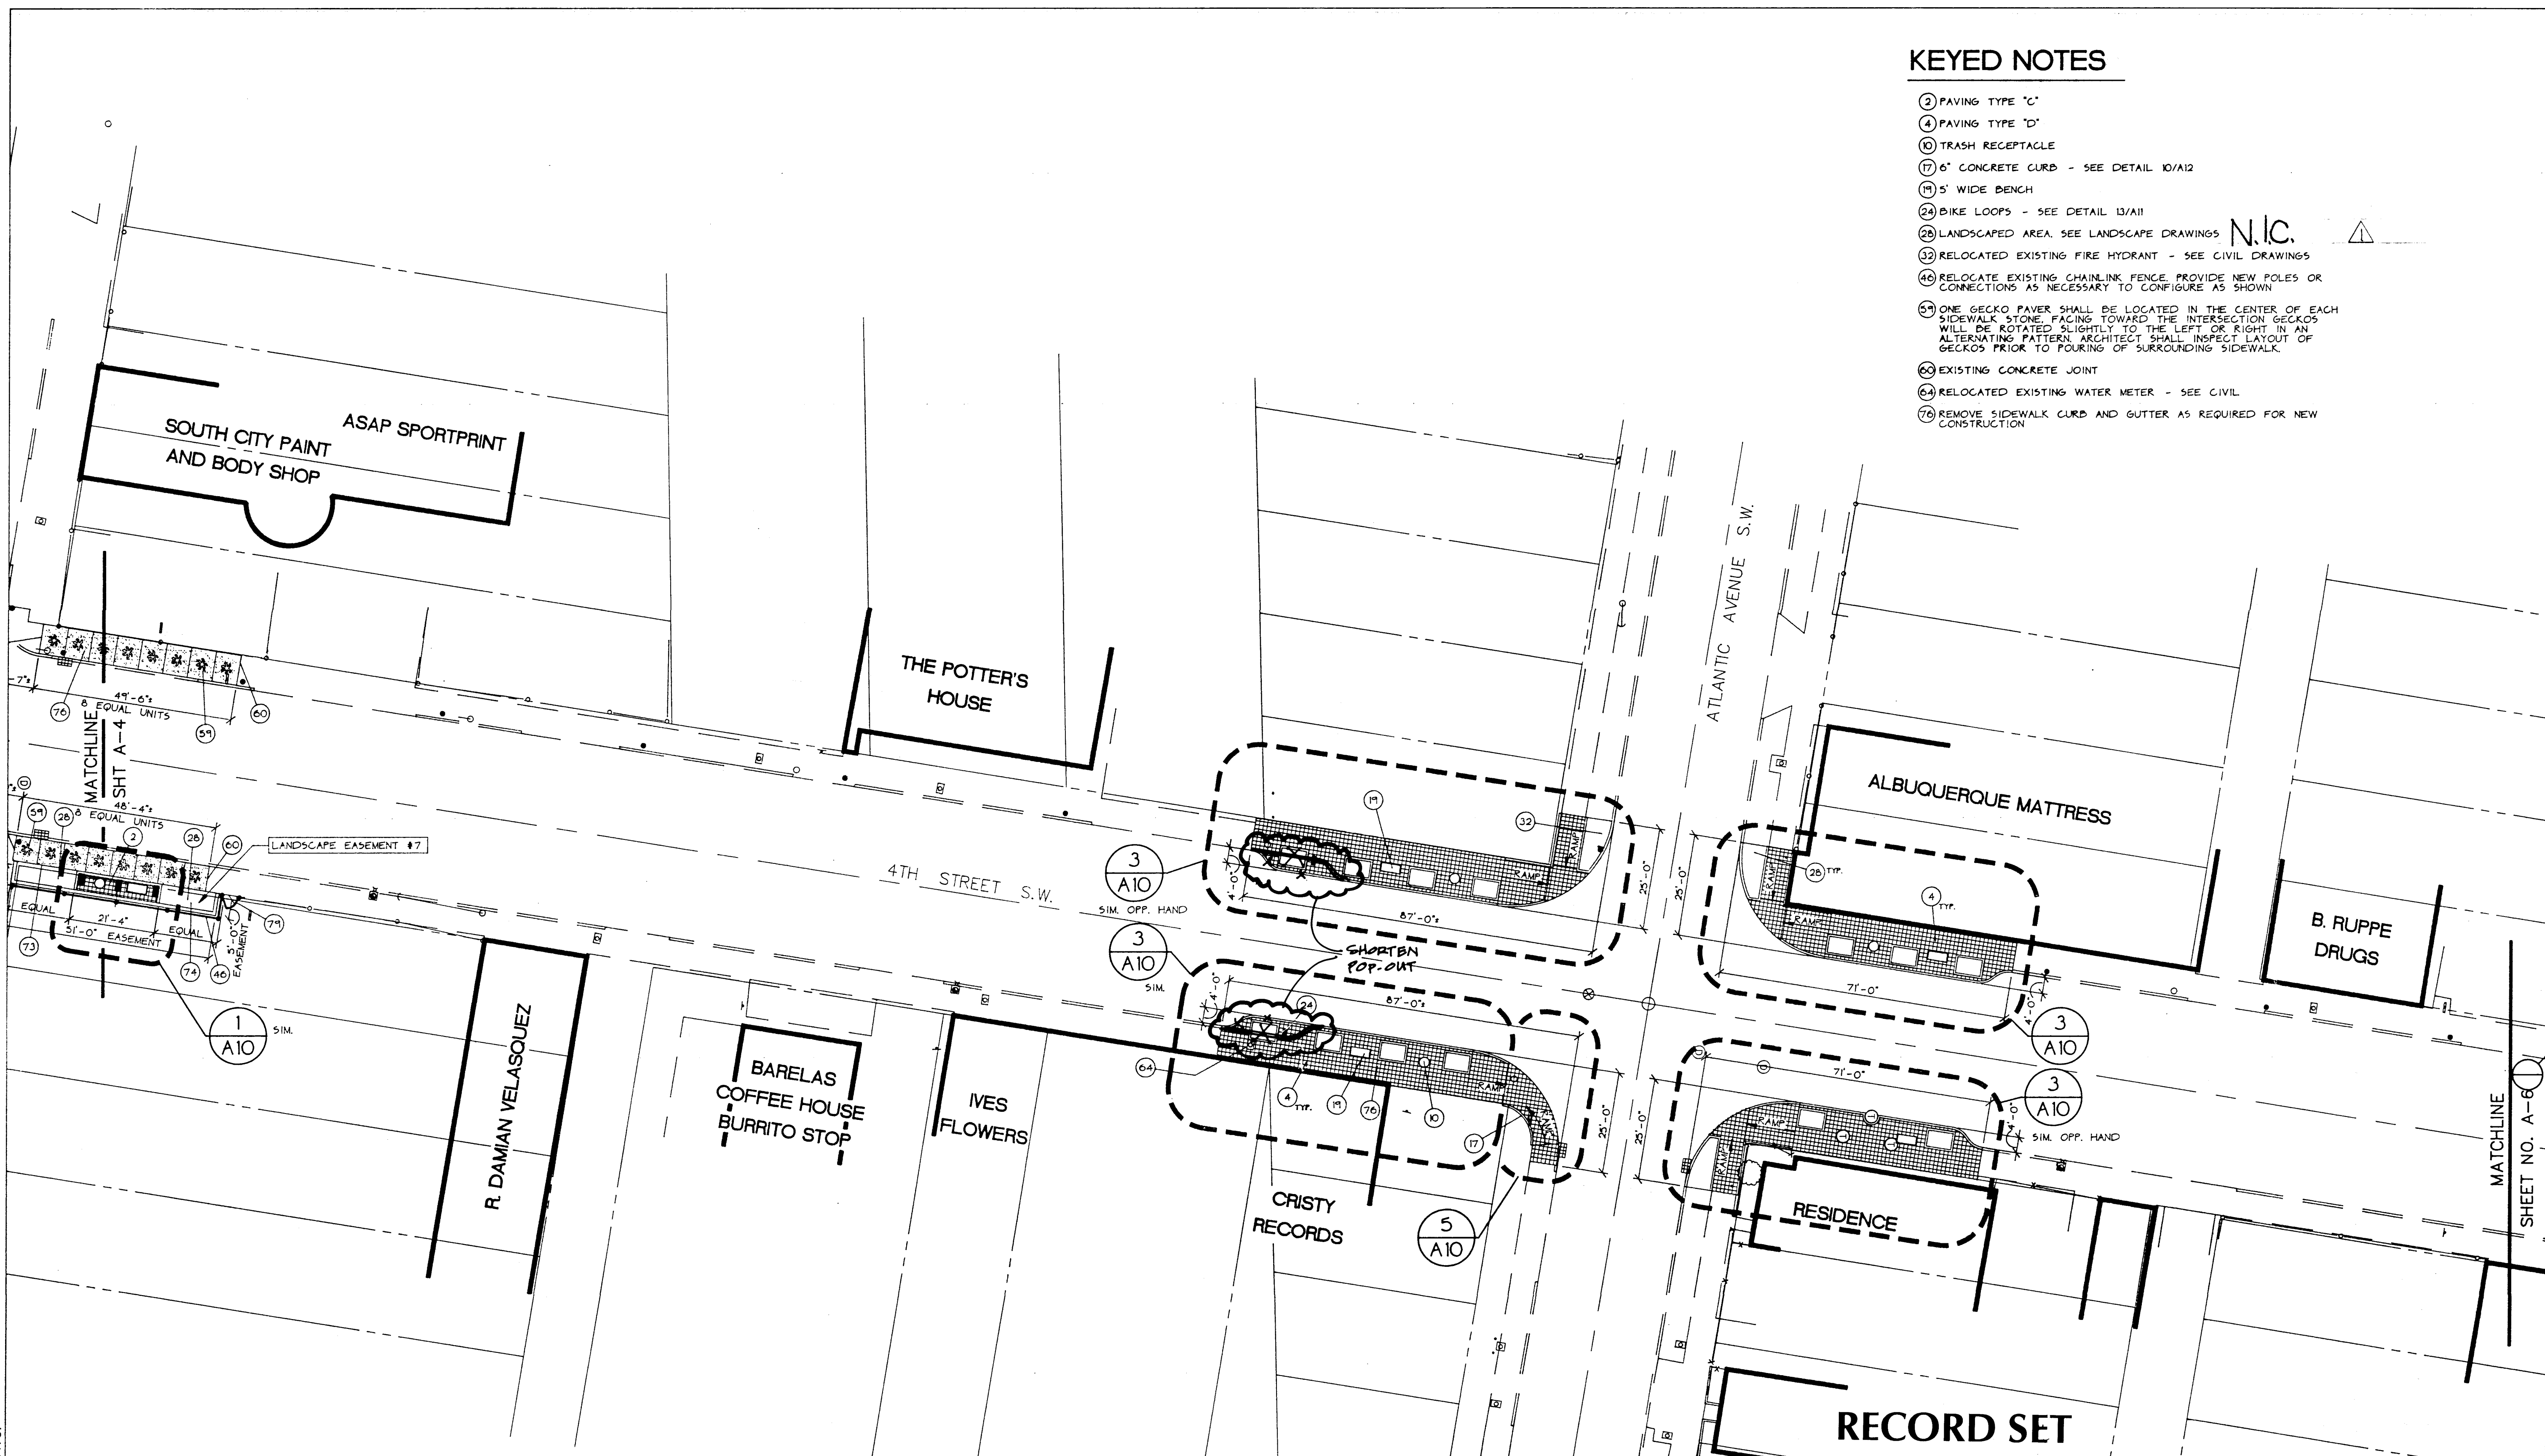

RECORD SET
May 1, 1997

Garrett Smith

GARRETT SMITH LTD.
DESIGN ARCHITECTURE & DEVELOPMENT

514 CENTRAL SW
ALBUQUERQUE
NEW MEXICO
8 7 1' 0 2
505/766-5968
FAX/243-4508

CITY OF ALBUQUERQUE
PUBLIC WORKS DEPARTMENT
ENGINEERING GROUP

TITLE: **FOURTH STREET STREETSCAPE**
BARELAS NEIGHBORHOOD, ALBUQUERQUE, NEW MEXICO


Design Review Committee	City Engineer Approval	Mo./Day/Yr.	Mo./Day/Yr.
<i>[Signature]</i>	<i>[Signature]</i>	6/16/95	
		8/4/95	
		8/15/95	
		8/30/95	
		10/6/95	
City Project No.	Zone Map No.	Sheet	Of
4917.90	K14-L14	A-5	13

AS-BUILT INFORMATION		BENCH MARKS	
CONTRACTOR	DATE	NO.	DATE
WORK BY	DATE		
INSPECTOR	DATE		
ACCEPTANCE BY	DATE		
VERIFICATION BY	DATE		
DRAWINGS BY	DATE		
RECORDS BY	DATE		
MICRO-FILM INFORMATION			
NO.	DATE		



ISSUED FOR CONSTRUCTION		REVISIONS	
NO.	DATE	REVISIONS	DESIGN
1	6/16/95		
DESIGNED BY	DATE	DRAWN BY	DATE
		CHECKED BY	DATE

DWG 65 06/30/95 10:00:06

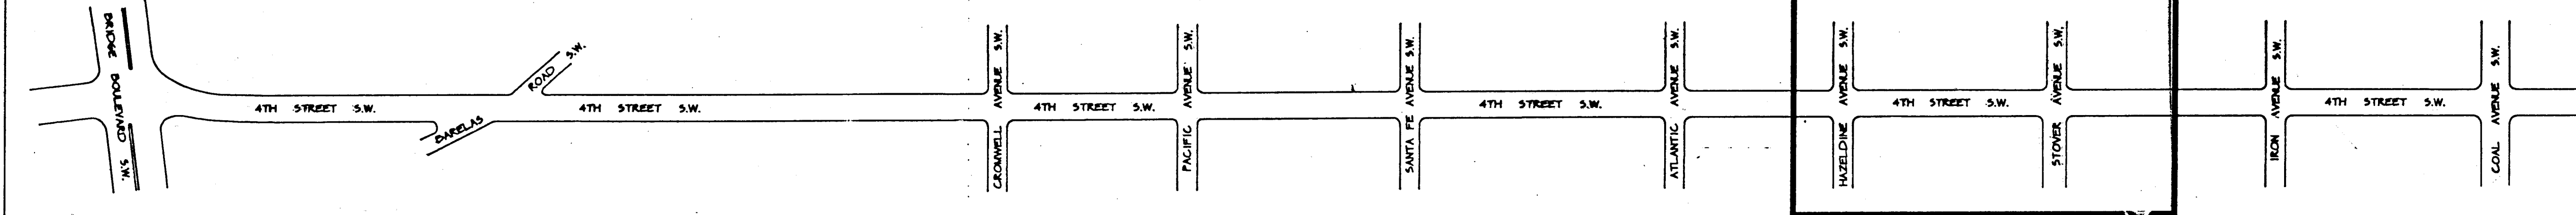

FOURTH STREET STREETScape KEY

KEYED NOTES

- 1) PAVING TYPE "A"
- 2) 10" DIAMETER DOLLARD - SEE DETAIL 14A/11
- 3) CONCRETE PIER
- 4) CONCRETE CURB FLUSH WITH WALK - SEE DETAIL 14B/11
- 5) PAINT CURB FOR NEW BUS STOP. VERIFY WITH CITY TRANSIT DEPARTMENT
- 6) LANDSCAPED AREA SEE LANDSCAPE DRAWINGS
- 7) RELOCATE EXISTING FENCE POLES AND ADJUST LENGTH OF FENCE TO ACCOMMODATE NEW LANDSCAPE EASEMENT.
- 8) PAINT OVER EXISTING BUS-STOP DESIGNATION ON CURB
- 9) CLEAR EASEMENT AREA OF DEBRIS, PLANT MATERIAL, CONSTRUCTION MATERIAL, ETC., AS REQUIRED IN PREPARATION FOR NEW CONSTRUCTION
- 10) 6" CONCRETE CURB - SEE DETAIL 14A/12

RECORD SET
May 1, 1997


[Signature]

CITY OF ALBUQUERQUE
PUBLIC WORKS DEPARTMENT
ENGINEERING GROUP

TITLE: **FOURTH STREET STREETScape**
BARELAS NEIGHBORHOOD, ALBUQUERQUE, NEW MEXICO

Design Review Committee	City Engineer Approval	Ma./Day/Yr.	Ma./Day/Yr.
<i>[Signature]</i>	<i>[Signature]</i>	6/16/95	8/4/95
		8/15/95	8/30/95
		10/6/95	
City Project No. 4917.90	Zone Map No. K14-L14	Sheet A-6	Of 13

DESIGNED BY	DATE	DRAWN BY	DATE	CHECKED BY	DATE
REVISIONS					
NO.	DATE	REMARKS	BY	DESIGN	
1		ISSUED FOR CONSTRUCTION			
2		CHANGE ORDER NO. 1			

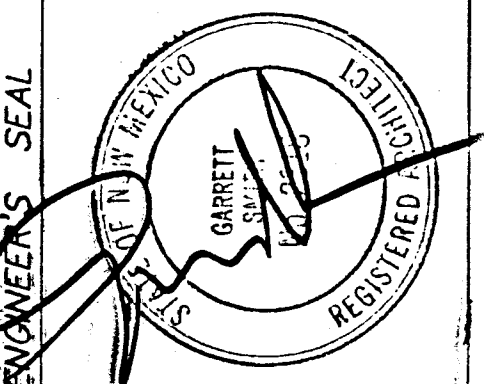

SURVEY INFORMATION		FIELD NOTES	
NO.	DATE	NO.	DATE


BENCH MARKS

AS-BUILT INFORMATION		MICRO-FILM INFORMATION	
CONTRACTOR	DATE	RECORDED BY	DATE
ALBUQUERQUE UNDERGROUND INC.	4/97		
DESIGNED BY	DATE	RECORDED BY	DATE
C.O.A.	4/97		
APPROVED BY	DATE	RECORDED BY	DATE
LEAH R. BARRON	4/97		
VERIFIED BY	DATE	RECORDED BY	DATE
C.O.A.	4/97		
DESIGNED BY	DATE	RECORDED BY	DATE
A. J. T.	4/97		

DWG 08/30/95 17:34:27



FOURTH STREET STREETScape KEY

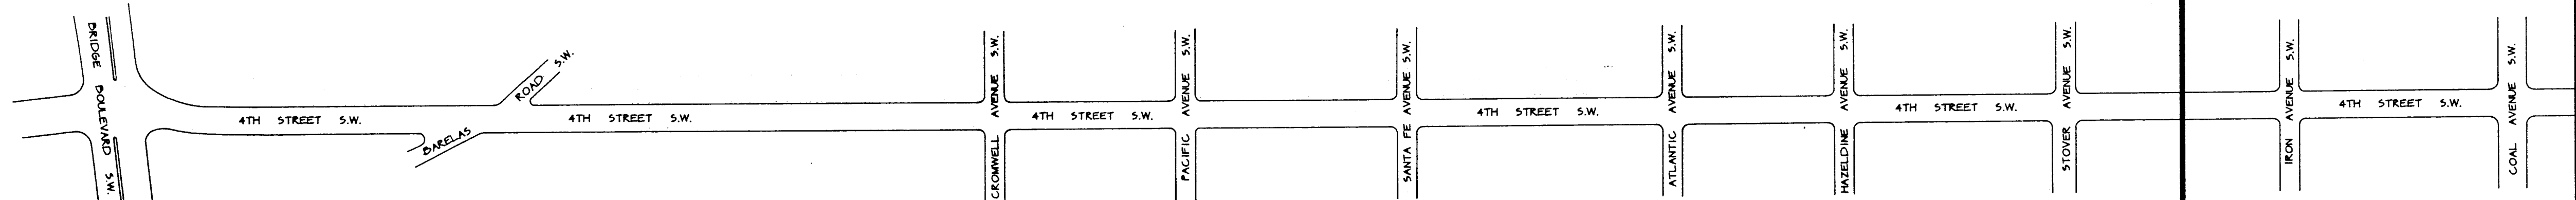

APS SOUTH
REGION OFFICE
CORONADO CENTER

VALLEY
FINANCE

APPLIANCE CITY

LANDSCAPE BASEMENT #A
RELOCATED TO THIS
LOCATION FROM 4TH & CROMWELL

LANDSCAPE EASEMENT #11

LANDSCAPE EASEMENT #10

TYPICAL
FOR 4

4
AIO

PARKING

KEYED NOTES

- 1 PAVING TYPE "A"
- 20 CONCRETE PIER
- 26 LANDSCAPED AREA SEE LANDSCAPE DRAWINGS
- 28 EXISTING 16" SQUARE PEDESTAL AND FENCE SHALL REMAIN
- 67 REMOVE EXISTING ASPHALT AT BACK OF SIDEWALK FOR LANDSCAPE EASEMENT PLAN
- 73 RELOCATE TELEPHONE(S)

RECORD SET
May 1, 1997

GARRETT SMITH LTD
DESIGN ARCHITECTURAL & DEVELOPMENT

514 CENTRAL SW
ALBUQUERQUE
NEW MEXICO
8 7 1 0 2
505/766-6968
FAX/248-4308

CITY OF ALBUQUERQUE
PUBLIC WORKS DEPARTMENT
ENGINEERING GROUP

TITLE: **FOURTH STREET STREETScape**
BARELAS NEIGHBORHOOD, ALBUQUERQUE, NEW MEXICO

Design Review Committee	City Engineer Approval	Mo./Day/Yr.	Mo./Day/Yr.
8/16/95	8/16/95	6/16/95	6/16/95
8/4/95	8/4/95	8/15/95	8/15/95
8/15/95	8/15/95	8/30/95	8/30/95
8/30/95	8/30/95	10/6/95	10/6/95
City Project No. 4917.90	Zone Map No. K14-L14	Sheet A-7	Of 13

NO.

BY

DATE

ENGINEER'S SEAL



ISSUED FOR CONSTRUCTION

REMARKS

BY

NO.

DATE

REVISIONS

DESIGN

DESIGNED BY

DRAWN BY

CHECKED BY

DATE

DATE

DATE

AS-BUILT INFORMATION

CONTRACTOR

WORK

DATE

DATE

DATE

DATE




DATE

DATE

KEYED NOTES

- 1 PAVING TYPE "A"
- 2 PAVING TYPE "E"
- 3 TRASH RECEPTACLE
- 4 5' DIAMETER TREE GRATE
- 5 NEW CONCRETE STEP
- 6 4' X 6' TREE GRATE
- 7 CONCRETE CURB FLUSH WITH WALK - SEE DETAIL 10/A11
- 8 BIKE LOOPS - SEE DETAIL 13/A11
- 9 LOW WALL - SEE DETAIL 4/A12
- 10 PAVING TYPE "B"
- 11 COLORED CONCRETE CURB
- 12 CONCRETE PLANTER
- 13 RAMP DOWN
- 14 DEMOLISH 5' OF EXISTING LANDING

SEE ARCHITECT'S REVISIONS
DRAWING. EXISTING STEPS
DELETED. NEW PAVING
ADDED AND MODIFIED TO
MEET BUILDING.

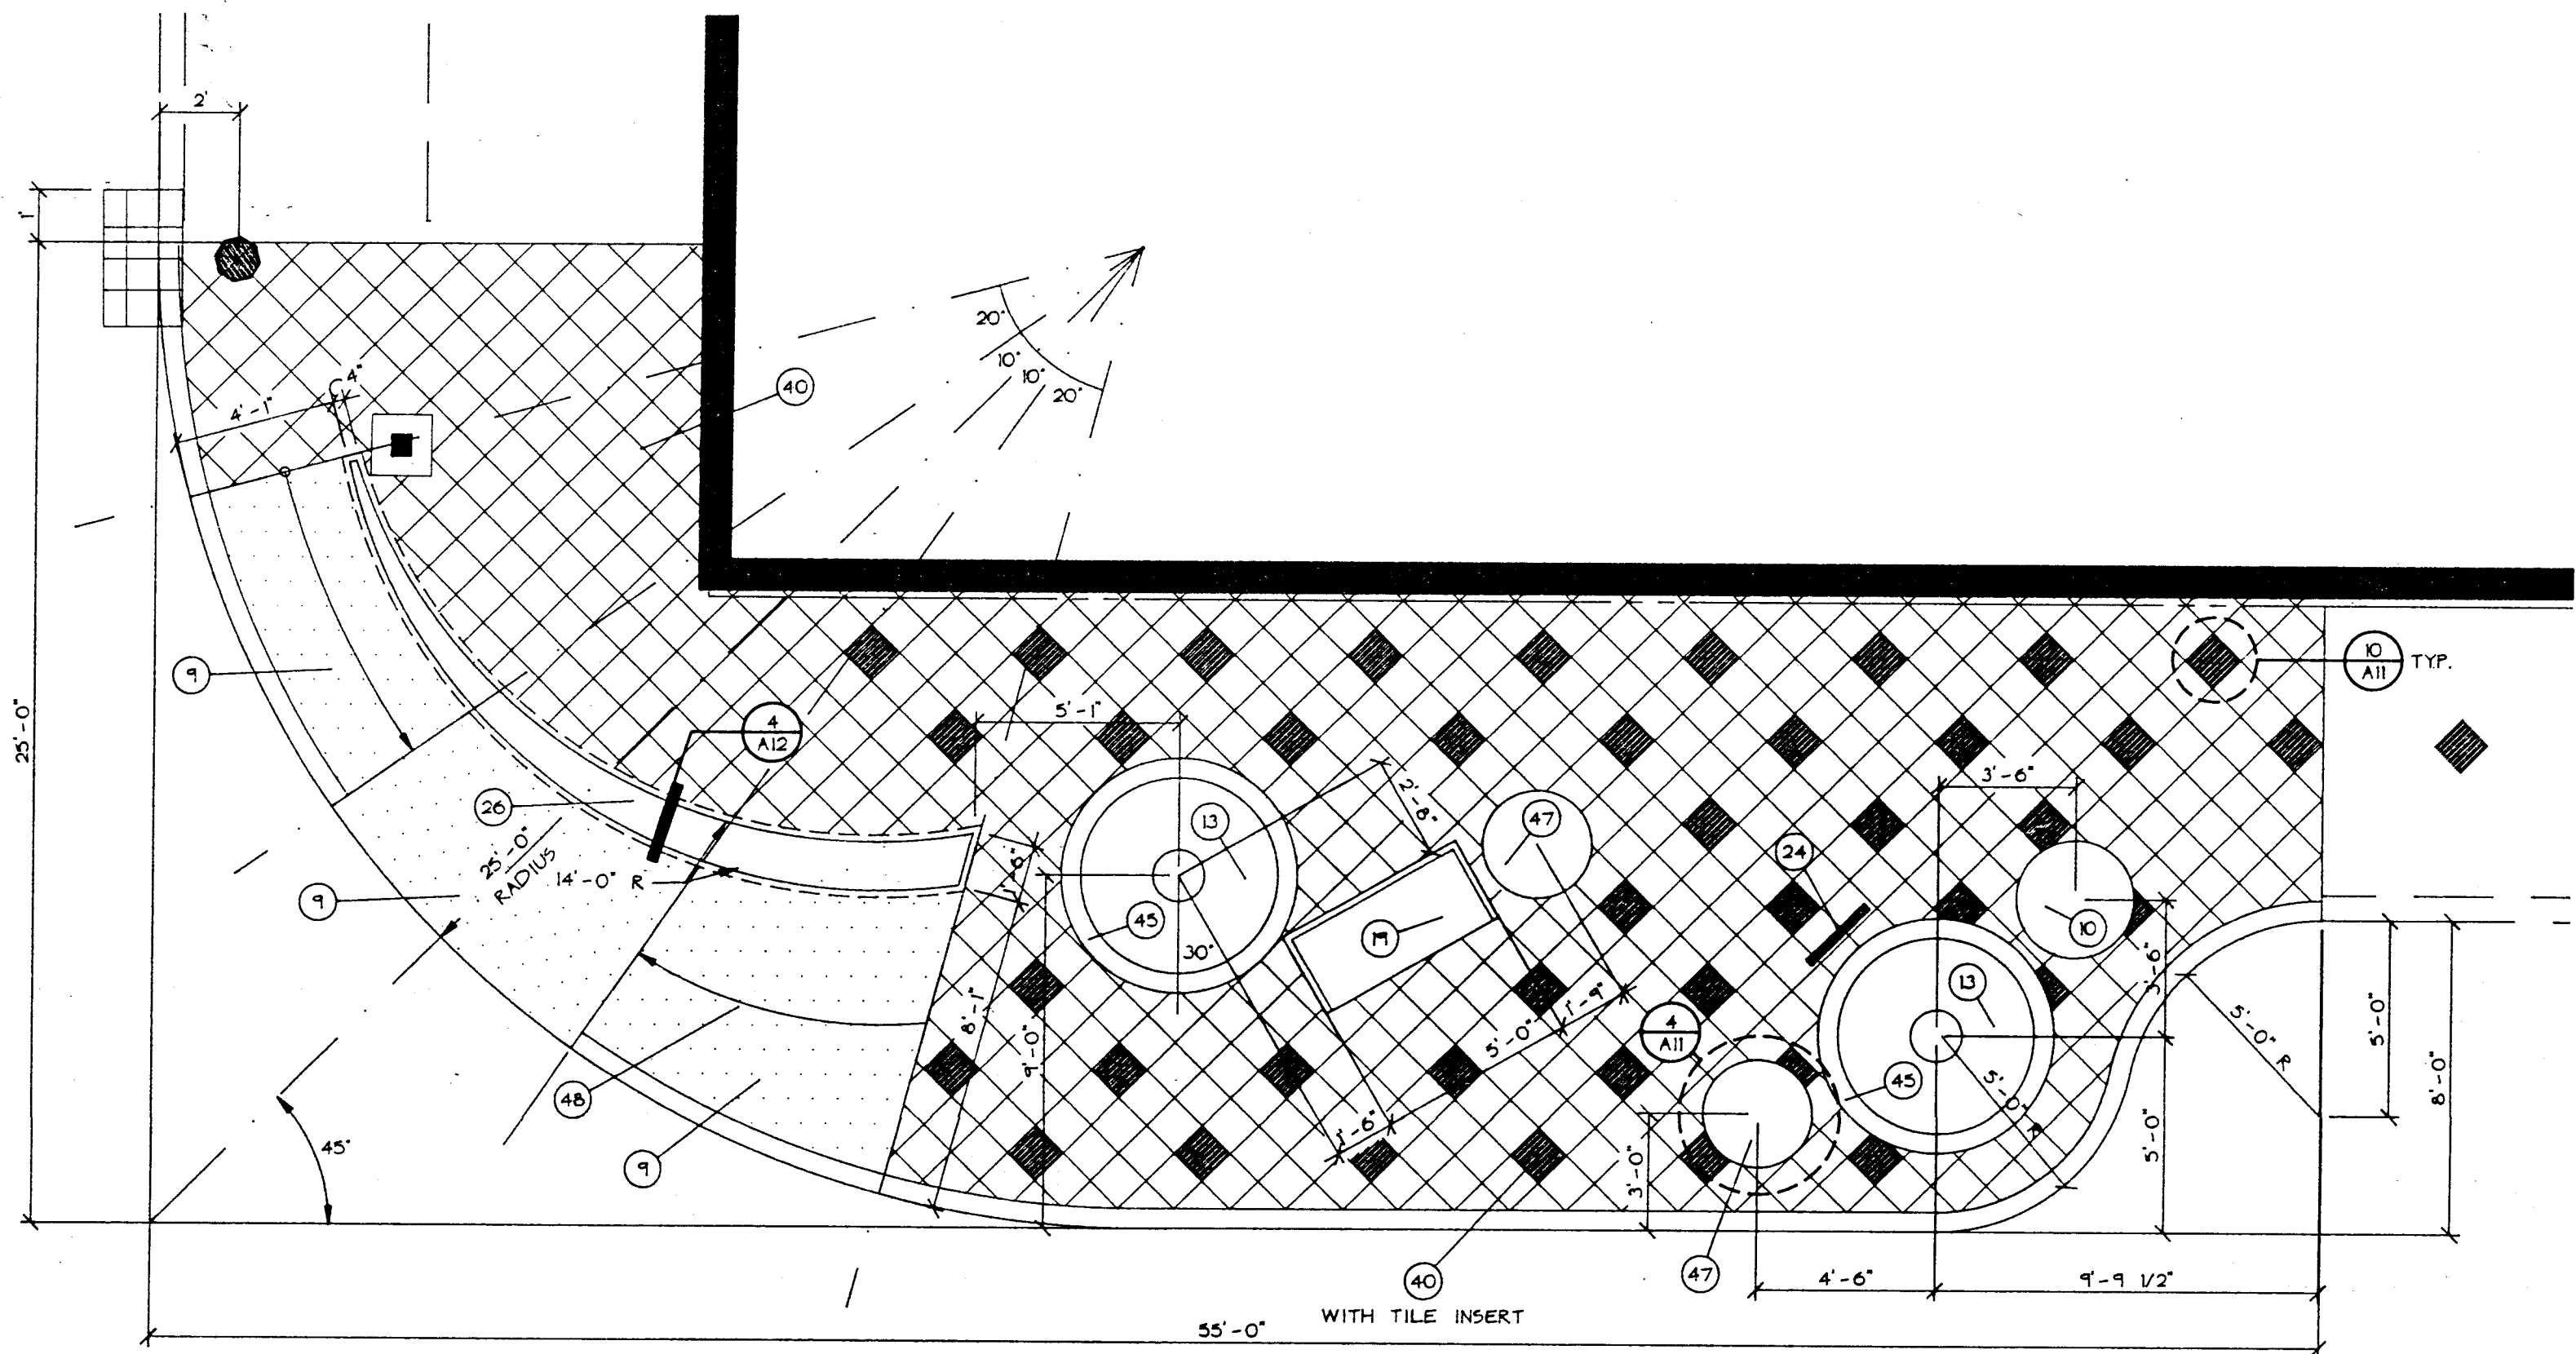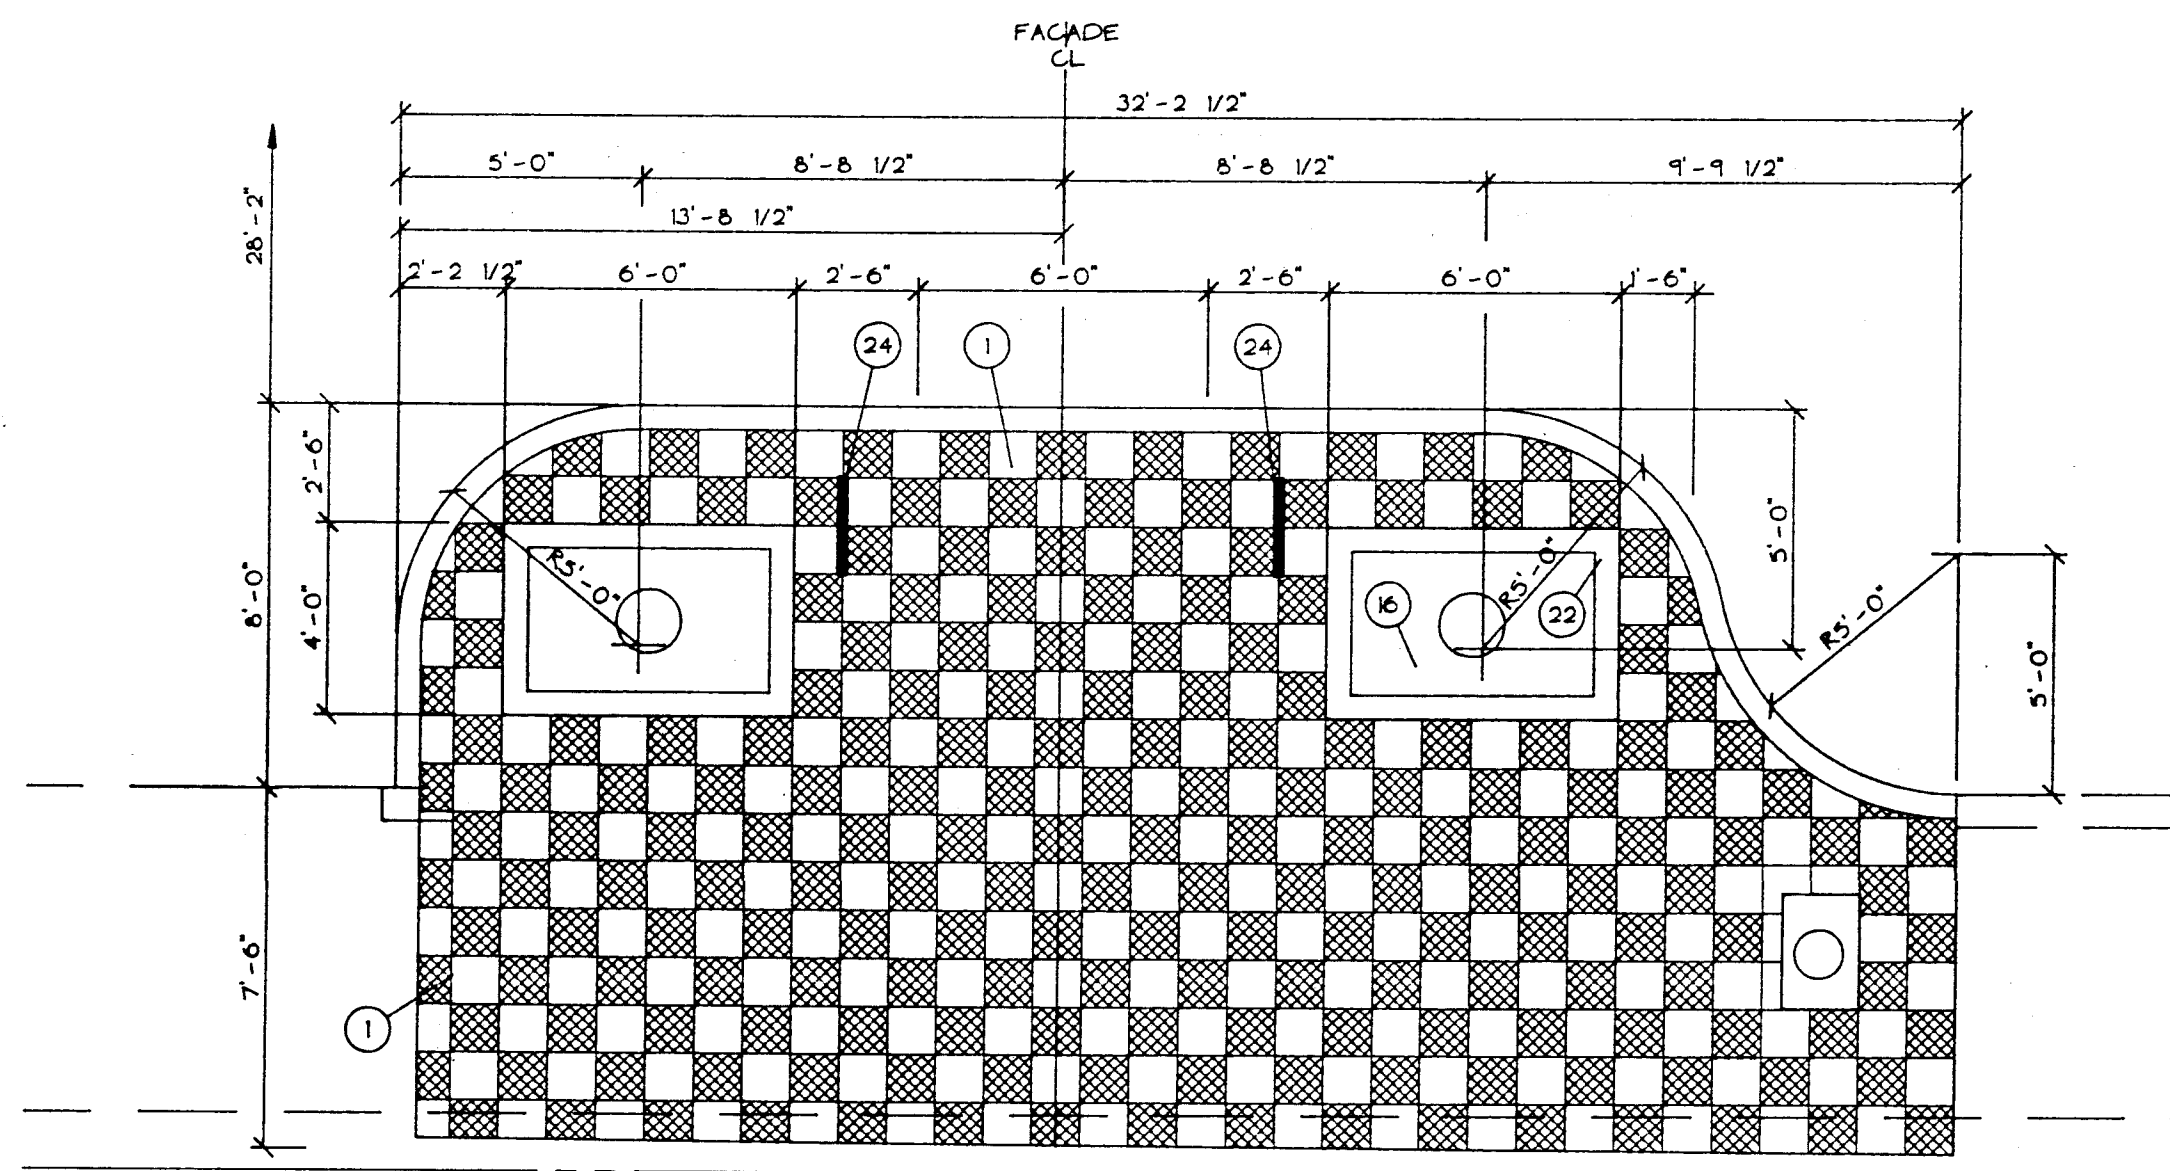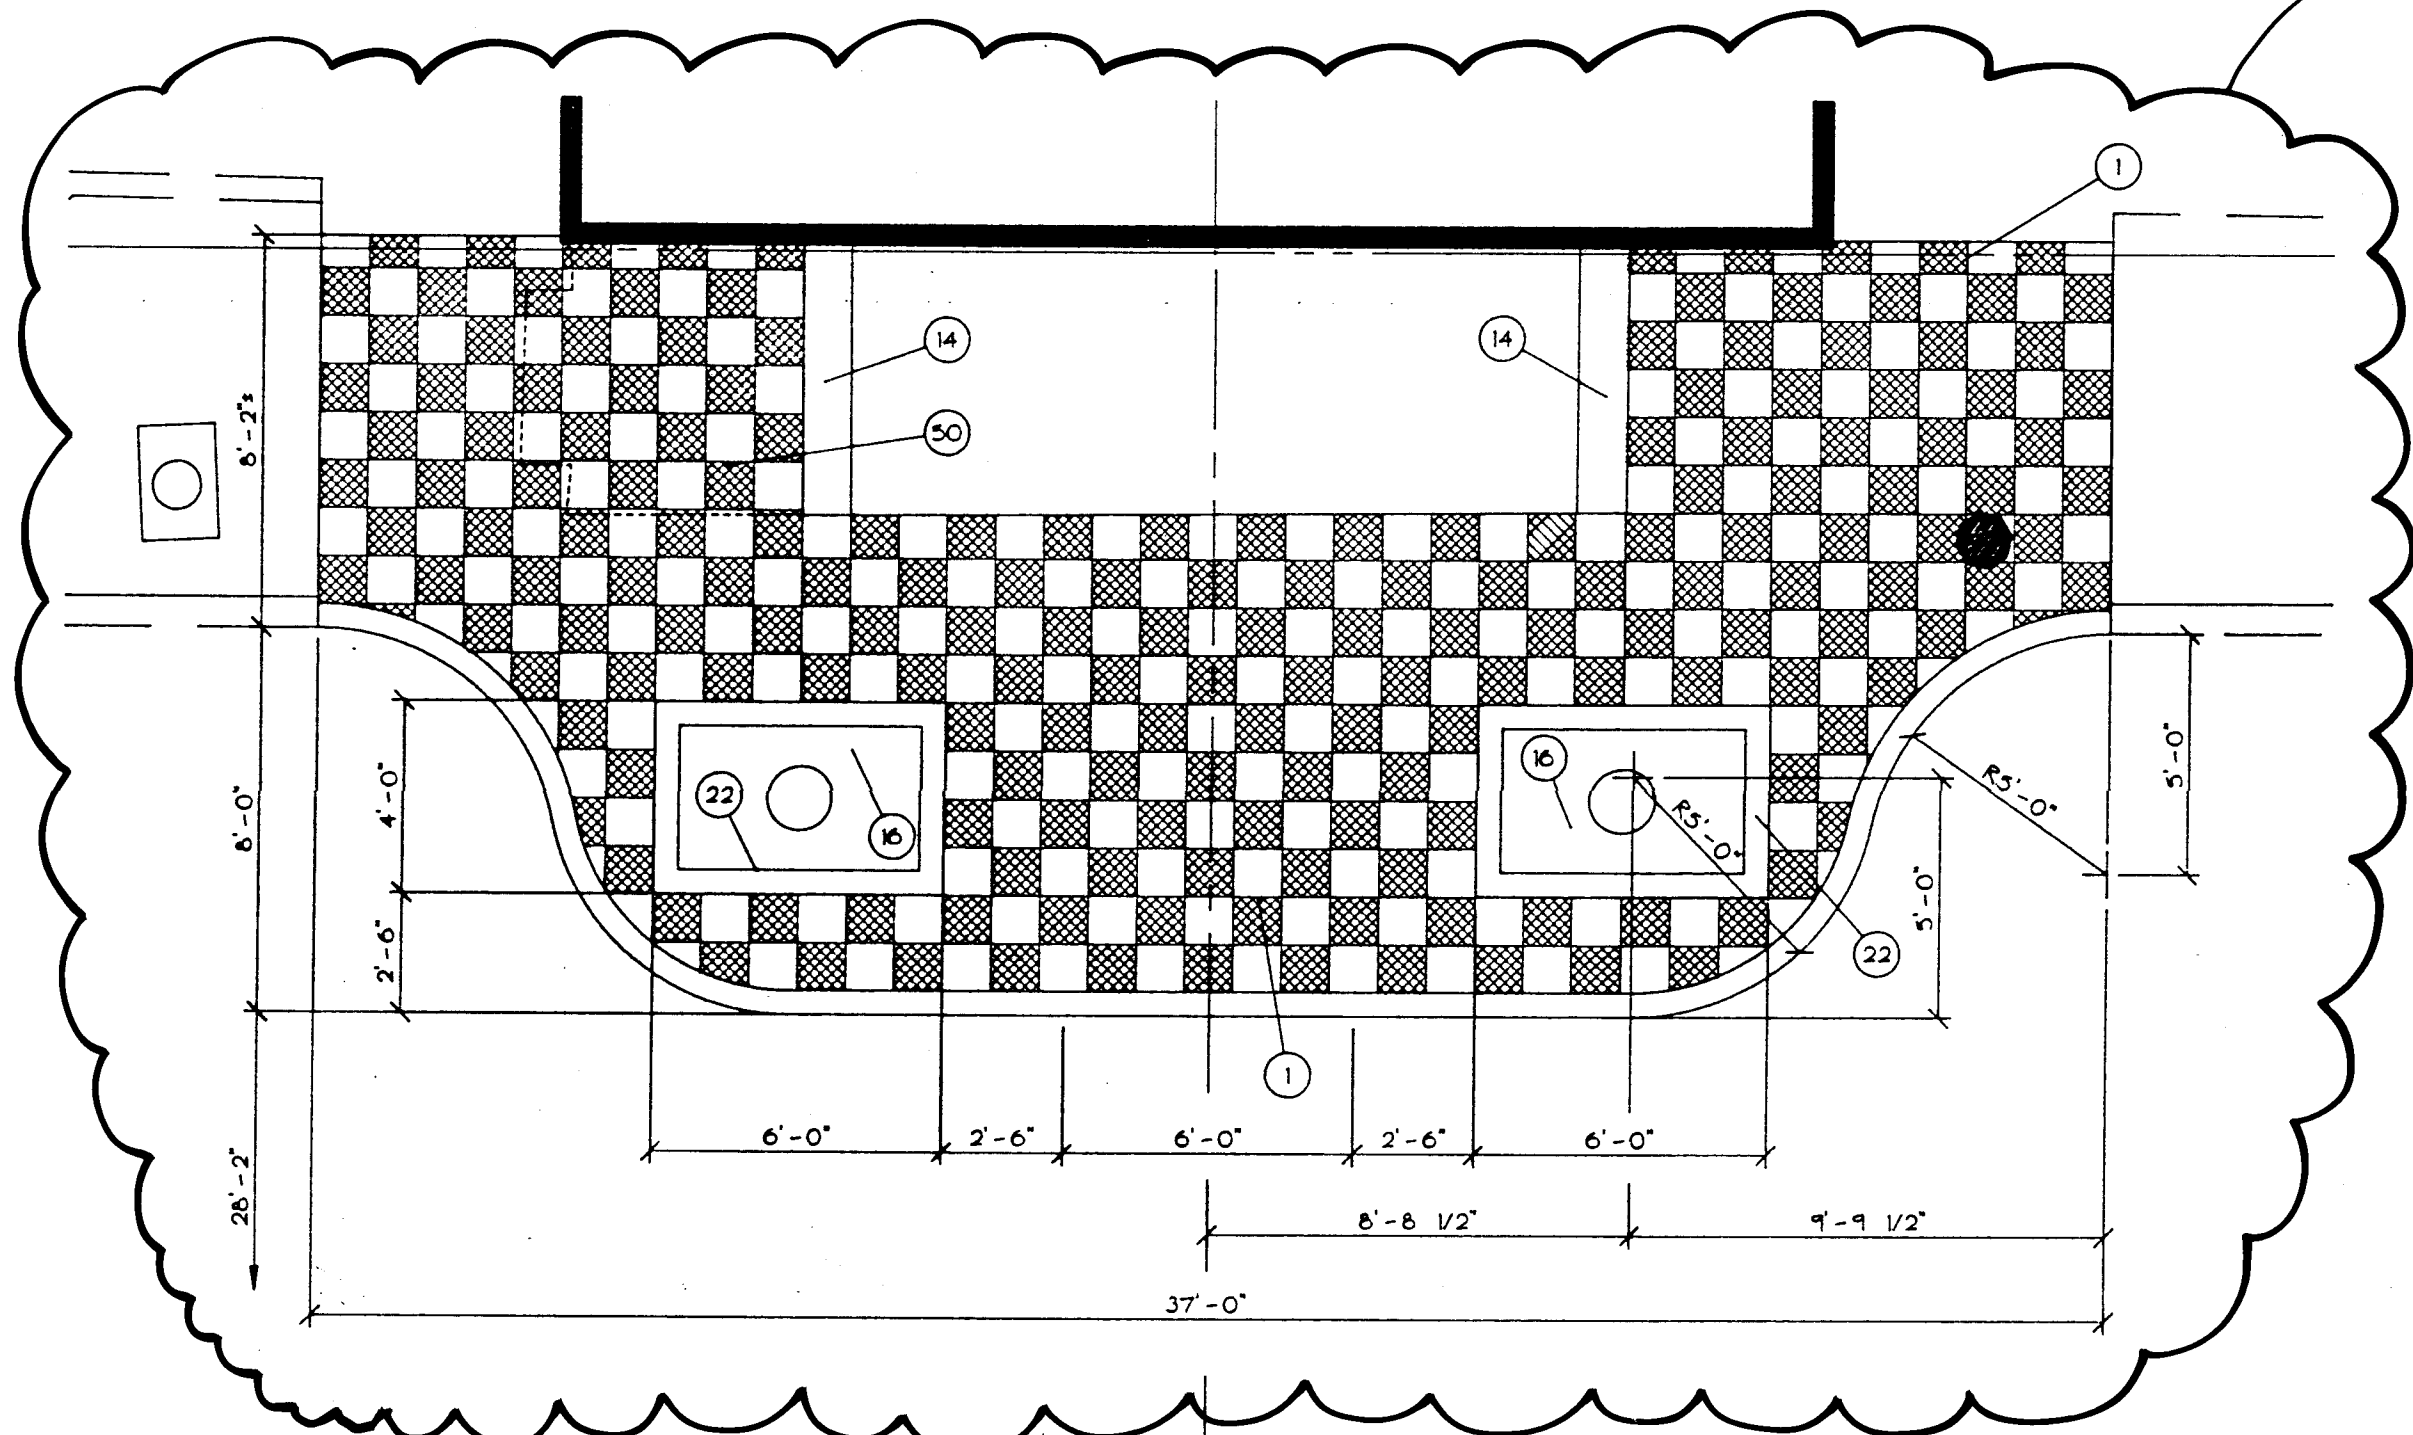

RECORD SET

May 1, 1997

[Signature]

GARRETT SMITH LTD
DESIGN, ARCHITECTURE & DEVELOPMENT

514 CENTRAL SW
ALBUQUERQUE
NEW MEXICO
8 7 1 0 2
505/766-6968
FAX/243-4508

CITY OF ALBUQUERQUE
PUBLIC WORKS DEPARTMENT
ENGINEERING GROUP

TITLE: **FOURTH STREET STREETScape**
BARELAS NEIGHBORHOOD, ALBUQUERQUE, NEW MEXICO

Design Review Committee City Engineer Approval
[Signature] *[Signature]*


Mo./Day/Yr.
6/16/95
8/18/95
8/30/95
10/6/95

City Project No. 4917.90 Zone Map No. K14-L14 Sheet A-9 Of 13




1 Popout At Red Ball Cafe
A9 SCALE 1/4" = 1'-0"

3 Popout At Pacific
A9 SCALE 1/4" = 1'-0"

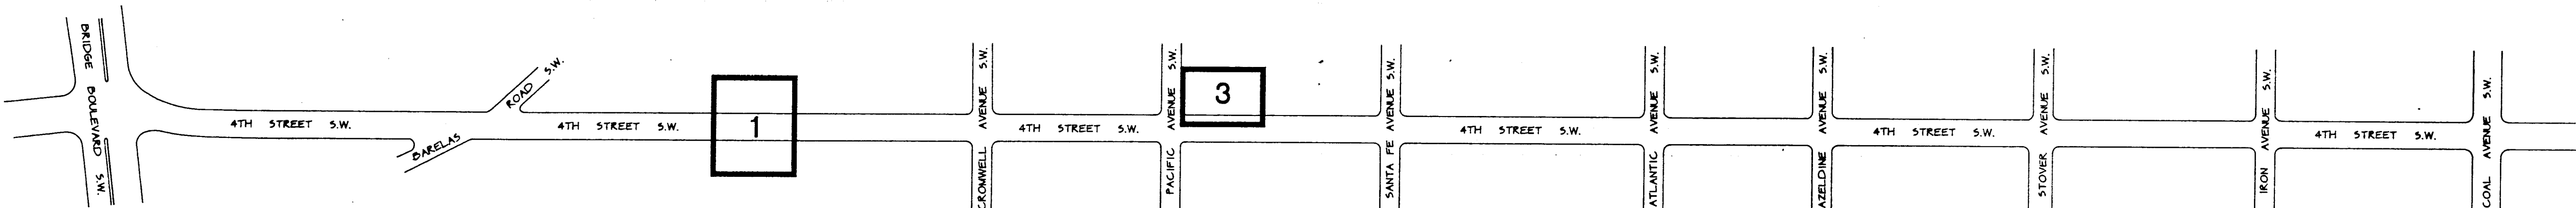


FOURTH STREET STREETScape KEY

SCANNED BY
BY LASON

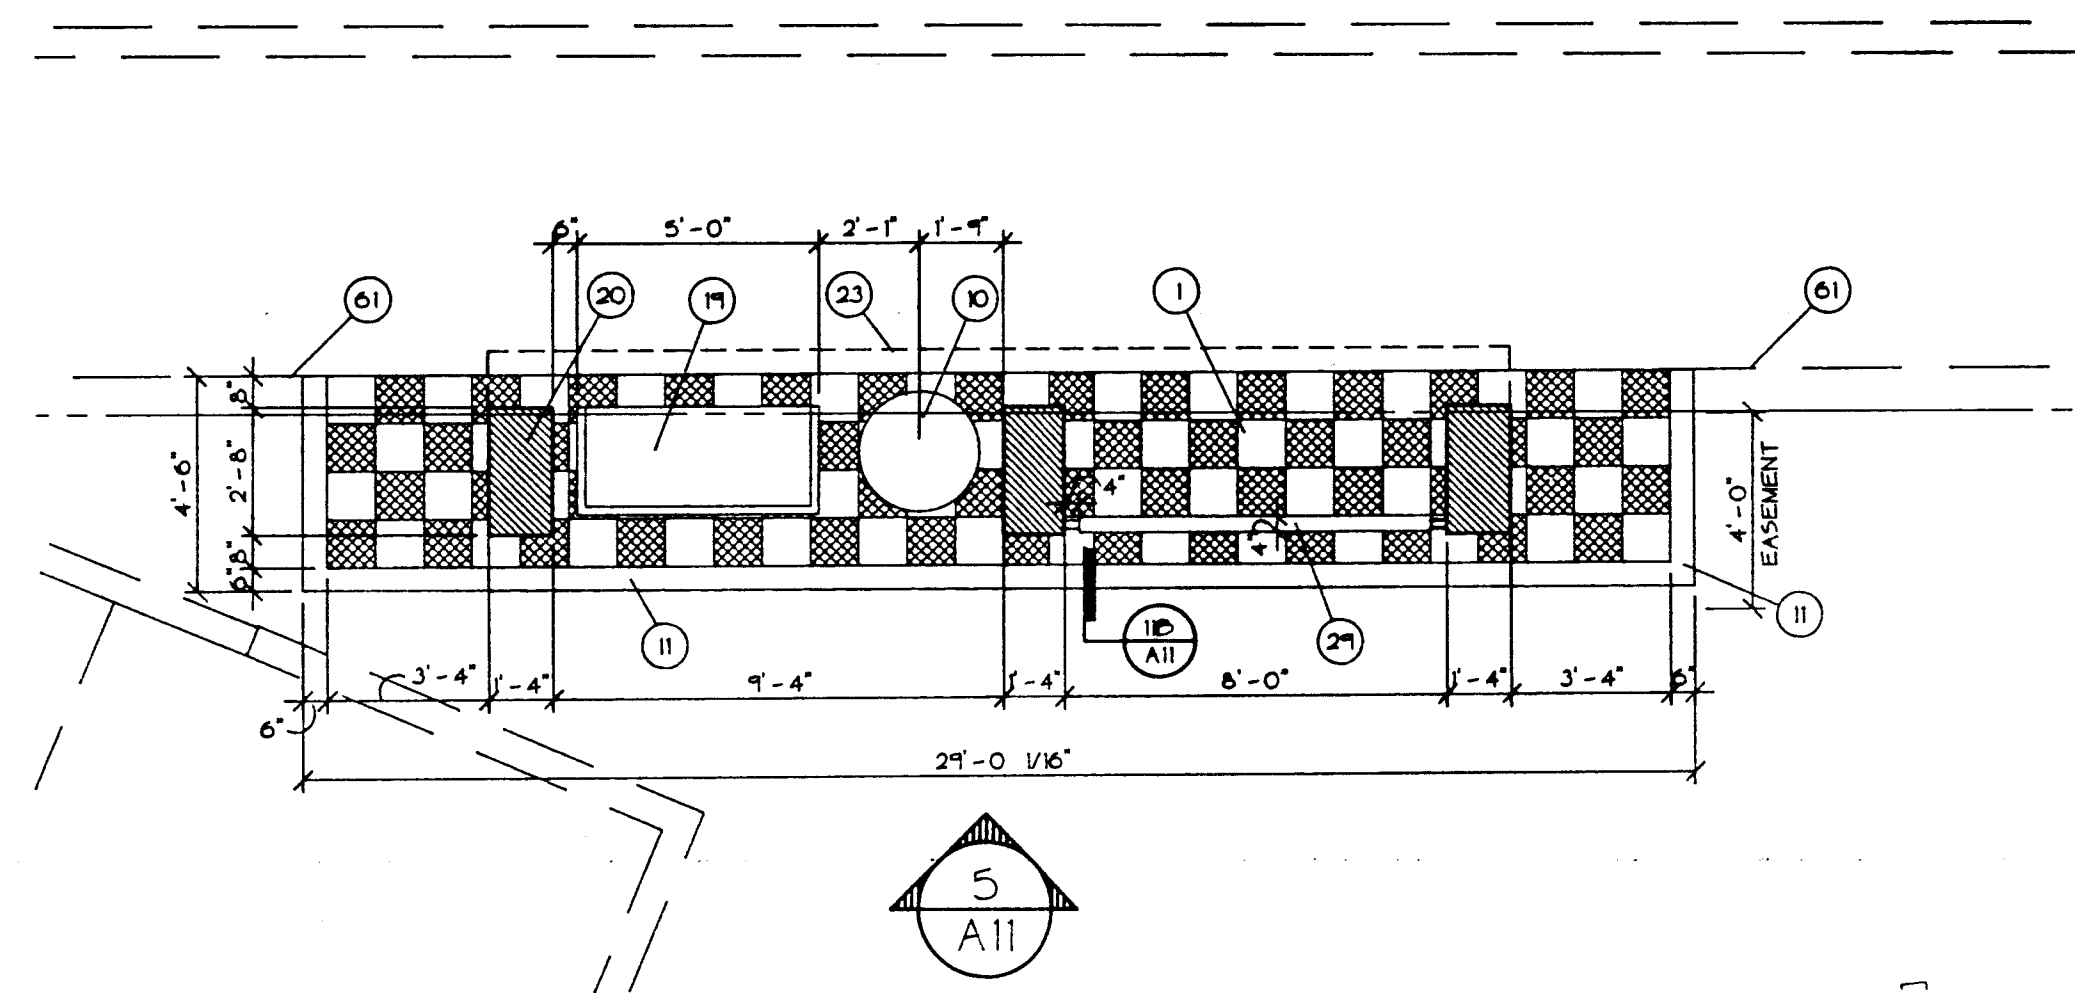


2 Landscape Easement No. 12
A10 SCALE 1/4" = 1'-0"

- 1) PAVING TYPE "A"
- 2) PAVING TYPE "C"
- 3) PAVING TYPE "D"
- 4) BLOCKOUT FOR TREE WELL
- 5) PAVING TYPE "E"
- 6) TRASH RECEPTACLE
- 11) 6" WIDE CONCRETE MOW STRIP - SEE DETAIL 10/A/II
- 12) 10" DIAMETER BOLLARD - SEE DETAIL 14/A/II
- 13) TREE GRATE
- 18) 8" CMU WALL W/ STUCCO BOTH SIDES
- 19) 5" WIDE BENCH
- 20) PRECAST CONCRETE PIER
- 21) CONCRETE GECKO PAVER
- 22) CONCRETE CURB FLUSH WITH WALK
- 23) EDGE OF RAMP ABOVE - SEE DETAIL 8D/A/II
- 24) MURAL PANEL
- 33) EXISTING 16" SQUARE PEDESTAL
- 34) EXISTING FENCE
- 48) RAMP DOWN
- 51) NEW CONCRETE WALK
- 61) LINE OF EXISTING SIDEWALK

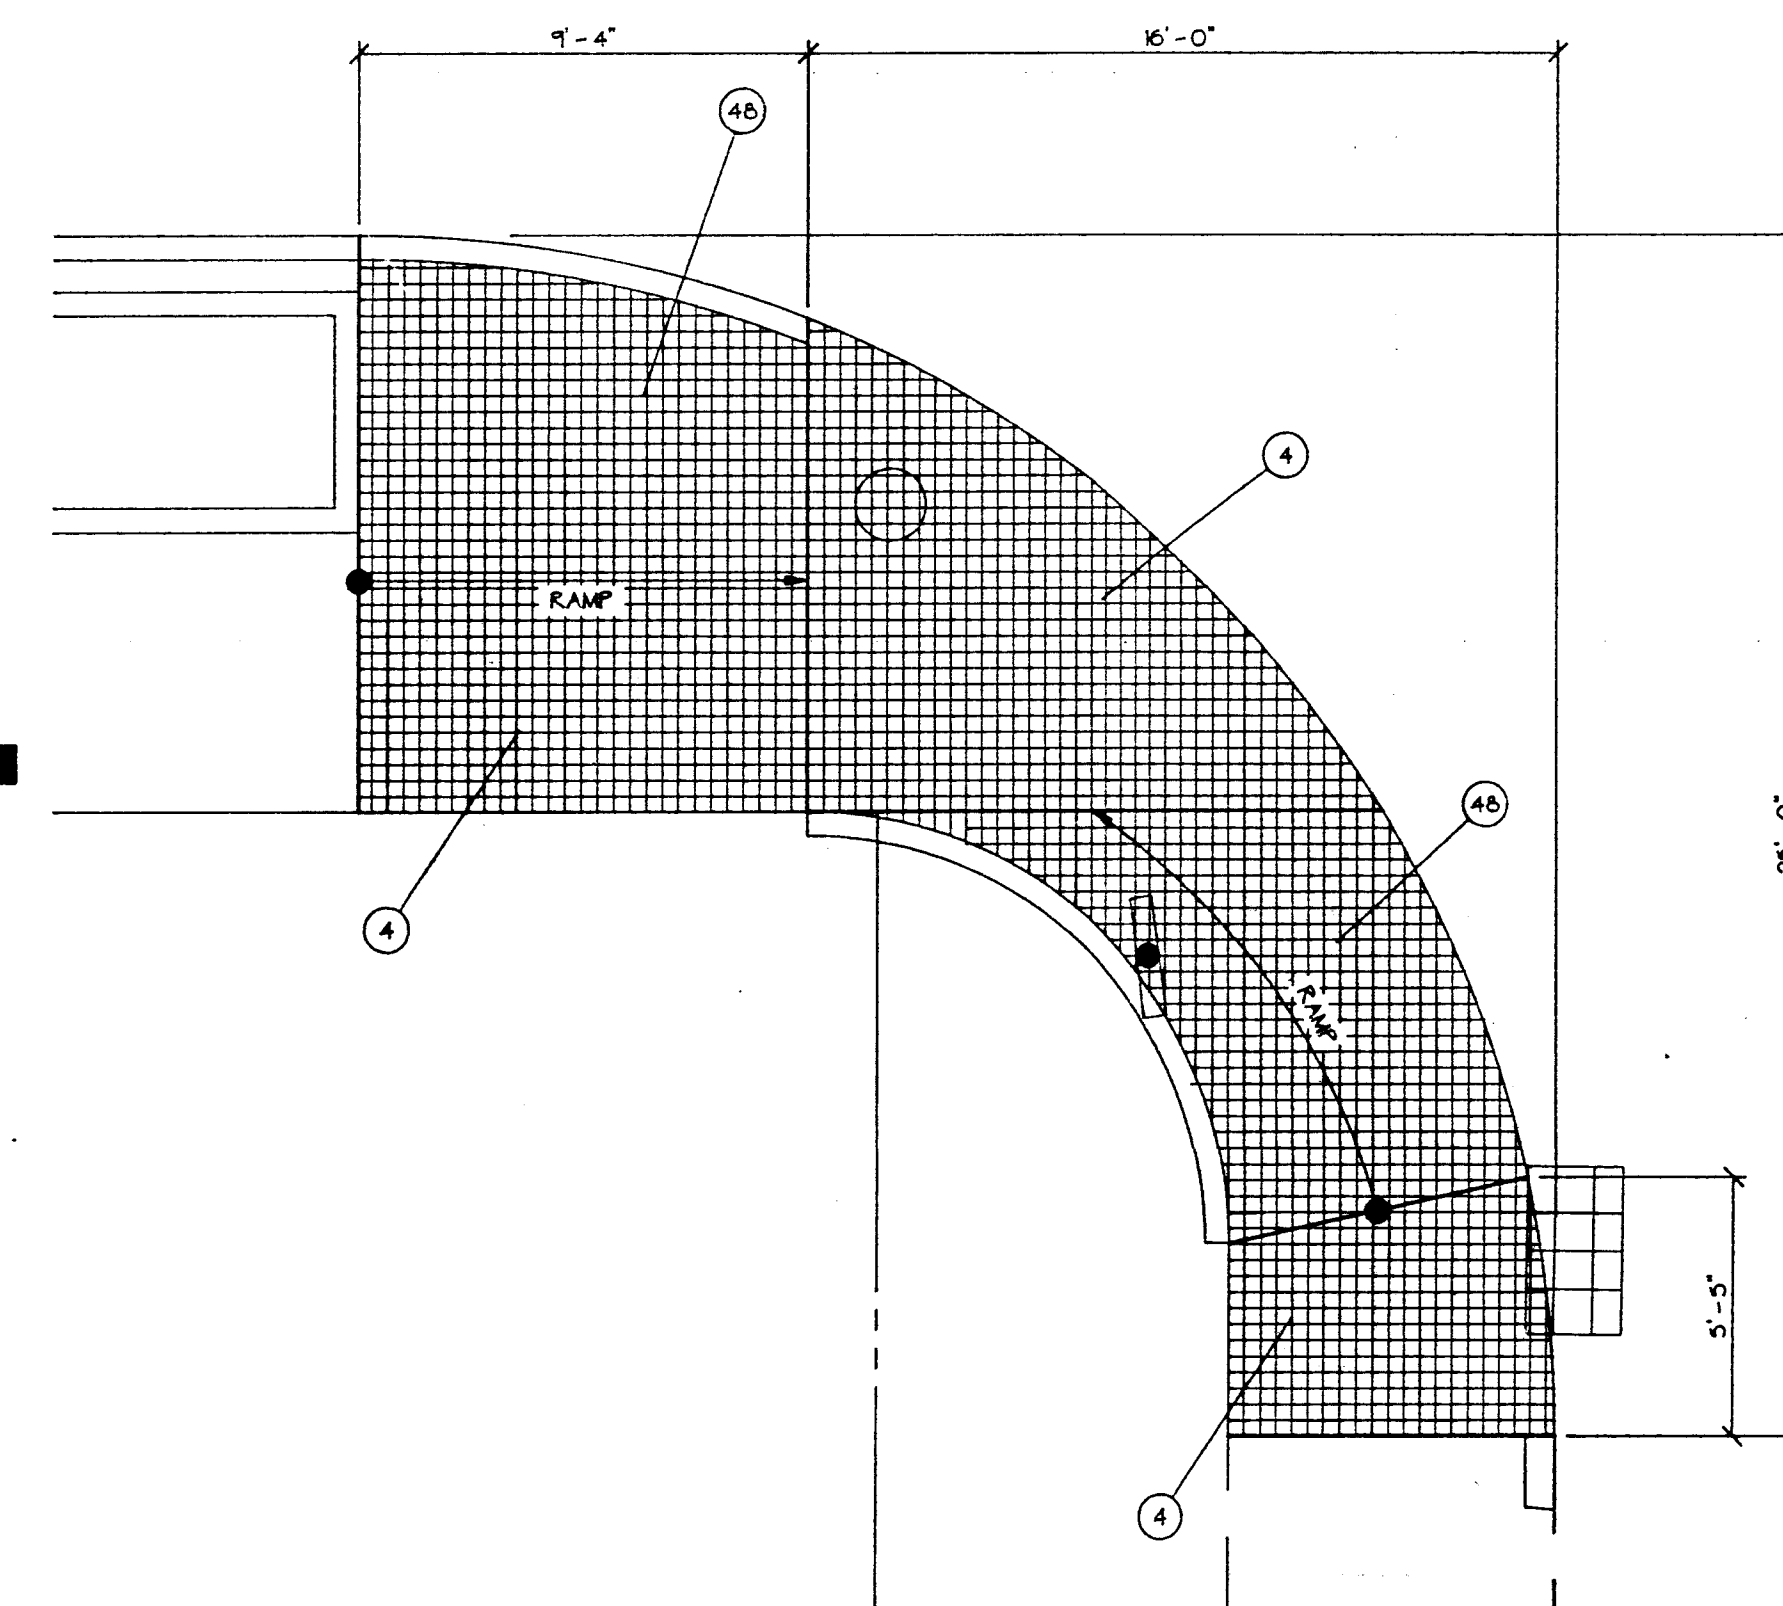



5 RAMP AT ATLANTIC - SE CORNER
A10 SCALE 1/4" = 1'-0"











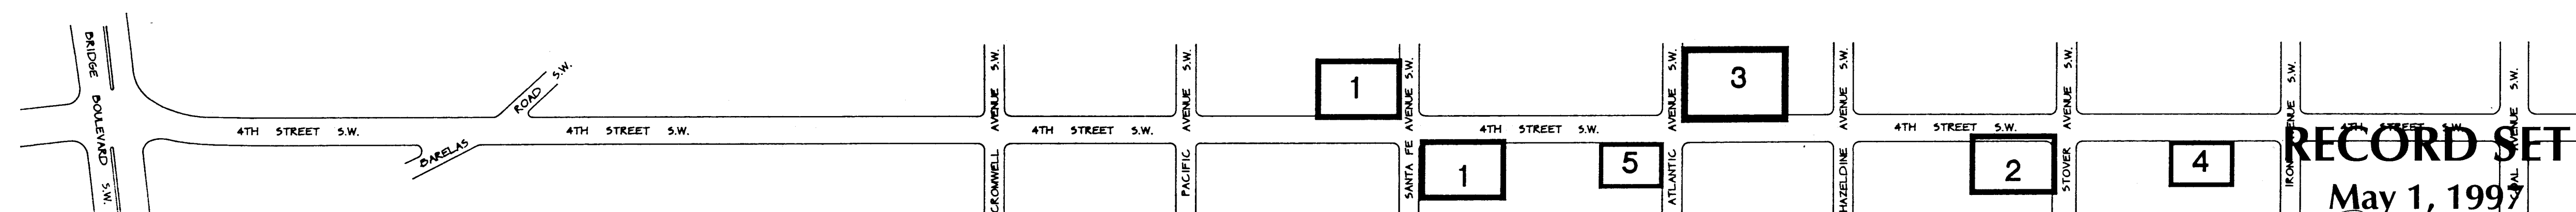


FOURTH STREET STREETScape KEY

FROM THE RECORD SET
May 1, 1997

SCANNED BY
BY LASON

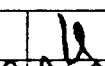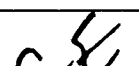
CITY OF ALBUQUERQUE PUBLIC WORKS DEPARTMENT ENGINEERING GROUP				
TITLE: FOURTH STREET STREETScape BARELAS NEIGHBORHOOD, ALBUQUERQUE, NEW MEXICO				
Design Review Committee		City Engineer Approval		Last Design Update
 12/21/95		 12/21/95		
City Project No. 4917.90		Zone Map No. K14-L14		Sheet A-10
				Of 13

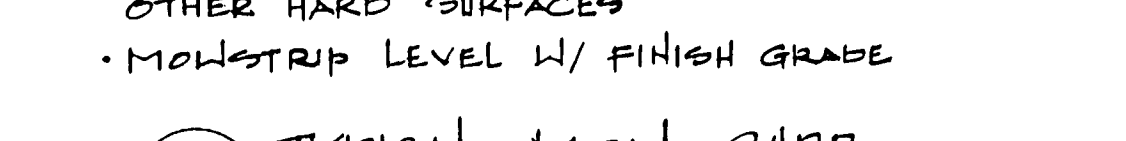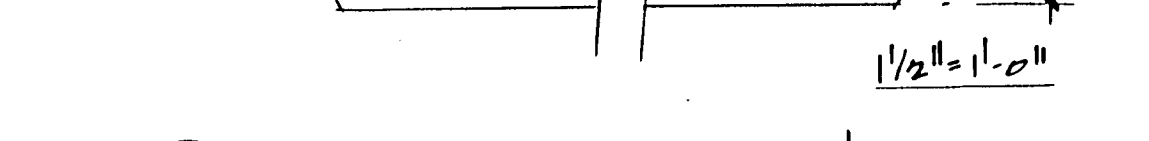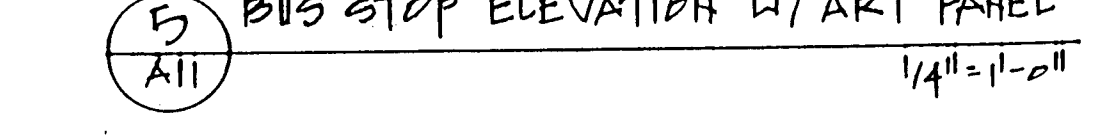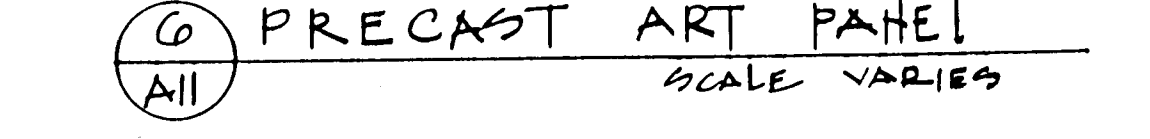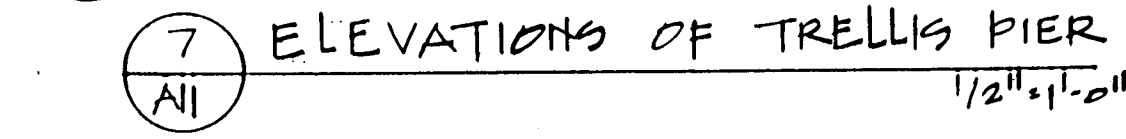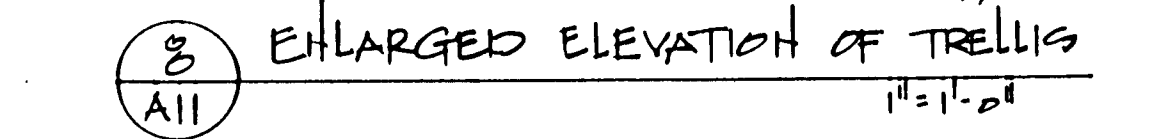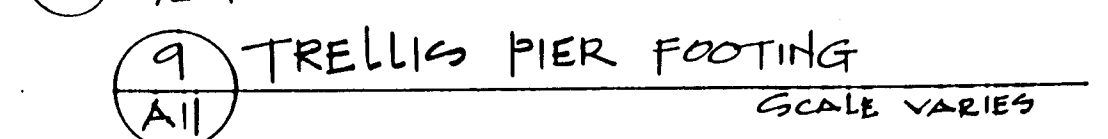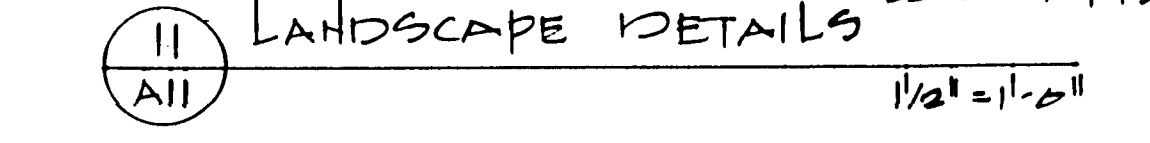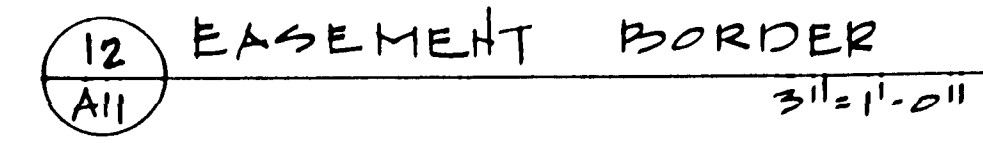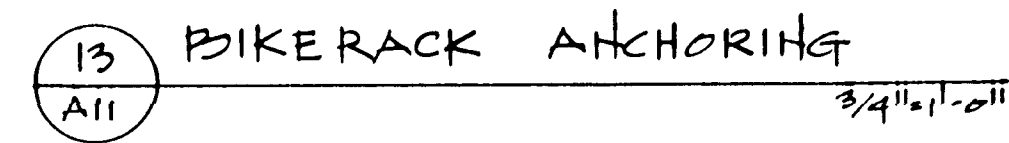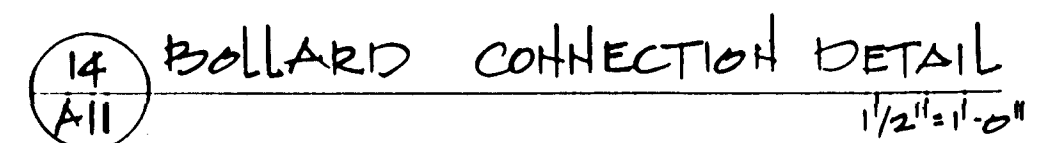


9. msk

CITY OF ALBUQUERQUE
PUBLIC WORKS DEPARTMENT
ENGINEERING GROUP


TITLE: DETAILS

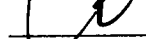Design Review Committee	City Engineer Approval	Last Design Update
  12/2/95	  12/2/95	
City Project No.		Zone Map No.

[illegible]

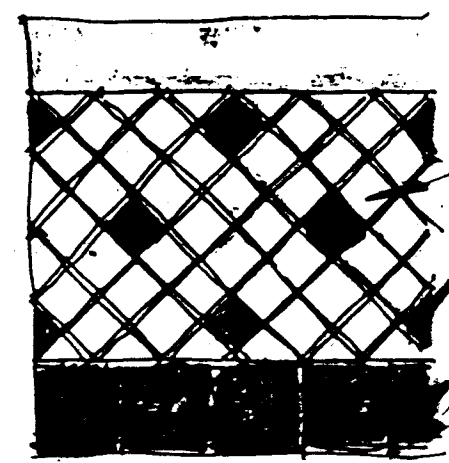

TILE #25
TILE #26
TILE #10
12.B
BENCHES/LOW WALLS
AT EASEMENT #2

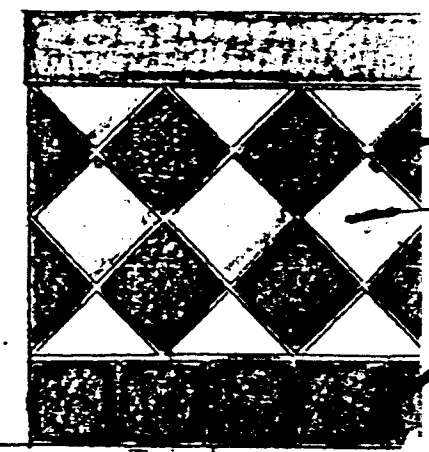


TILE #19
TILE #21
TILE #19
12.A
ALL BENCHES/LOW
WALLS EXCEPT
EASEMENT #2

12 TILE PATTERNS

A12


1/2" = 1'-0"

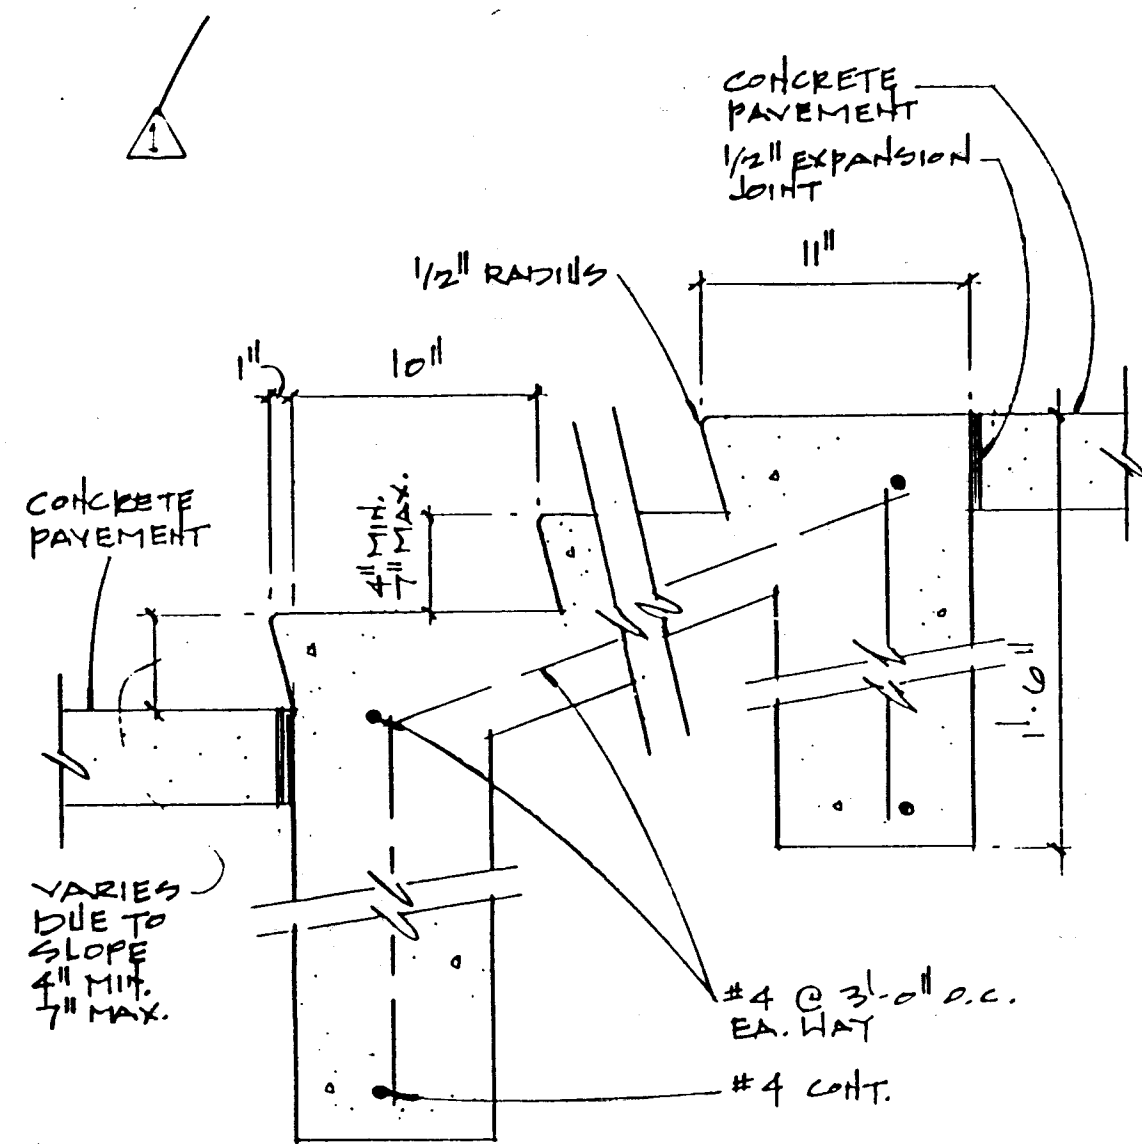

9 STEPS AT PLAZA

A12


1/2" = 1'-0"

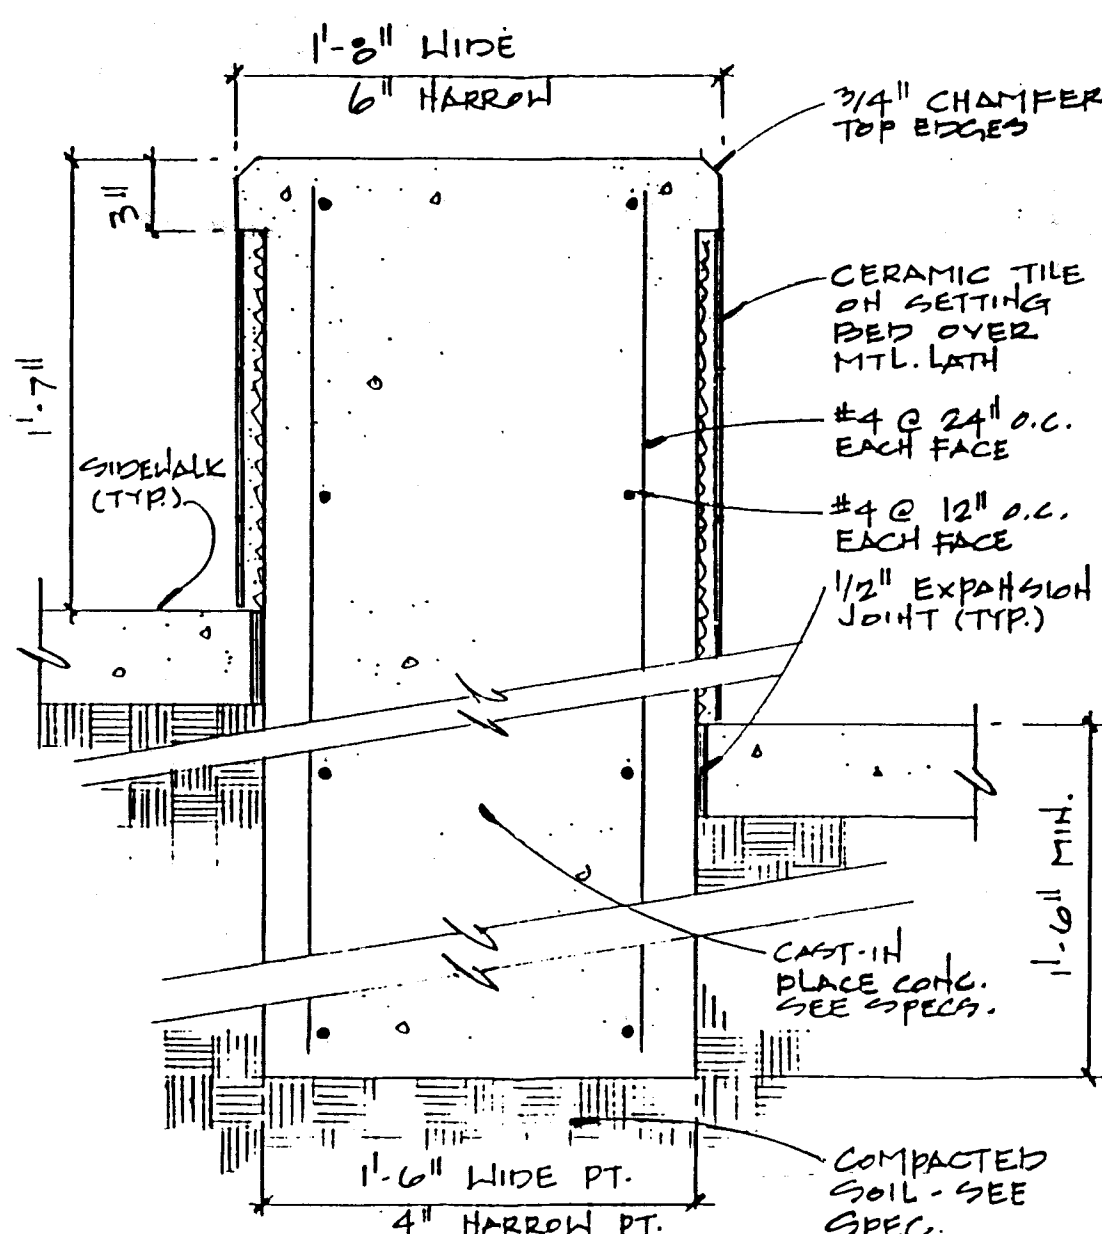

4 DETAIL @ LOW WALL @ PACIFIC POPART


A12

1/2" = 1'-0"

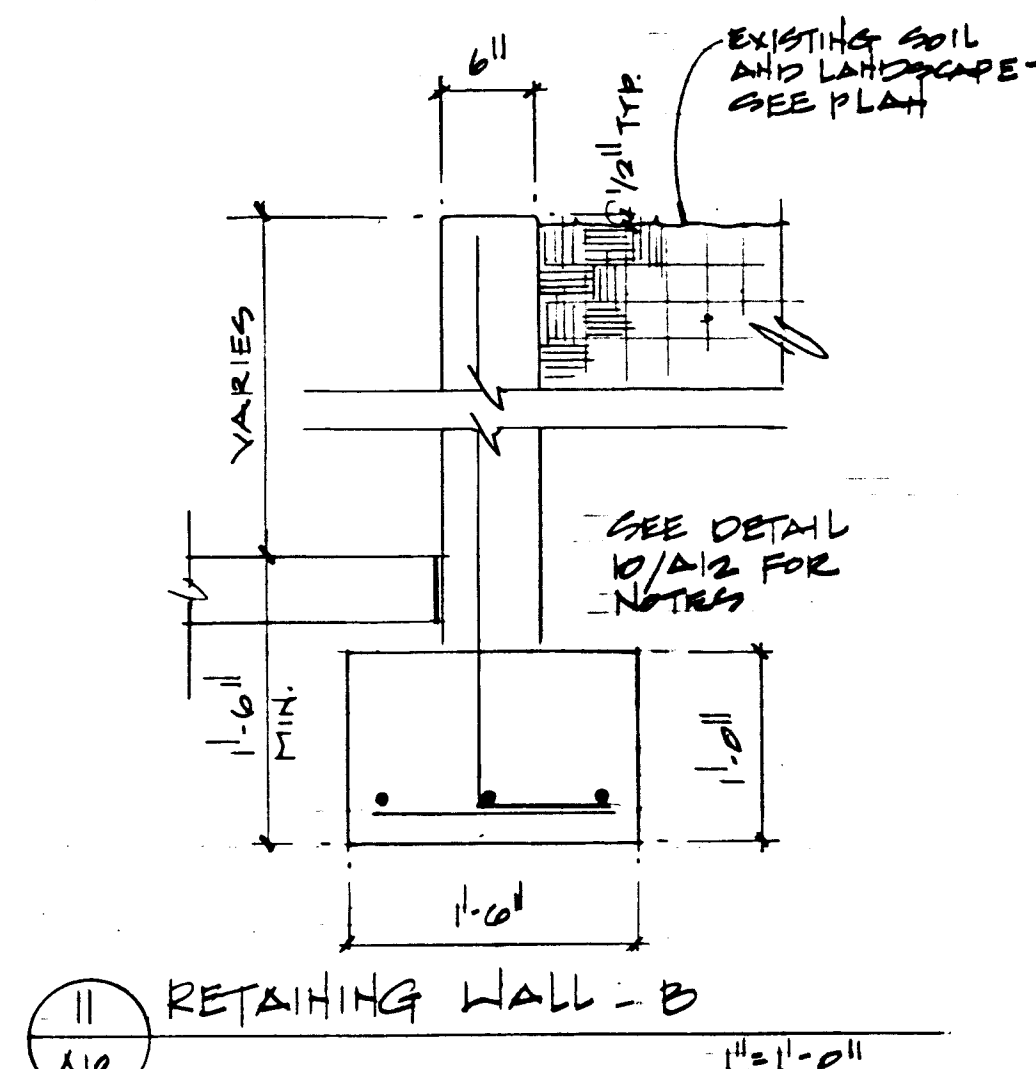

11 RETAINING WALL - B


A12

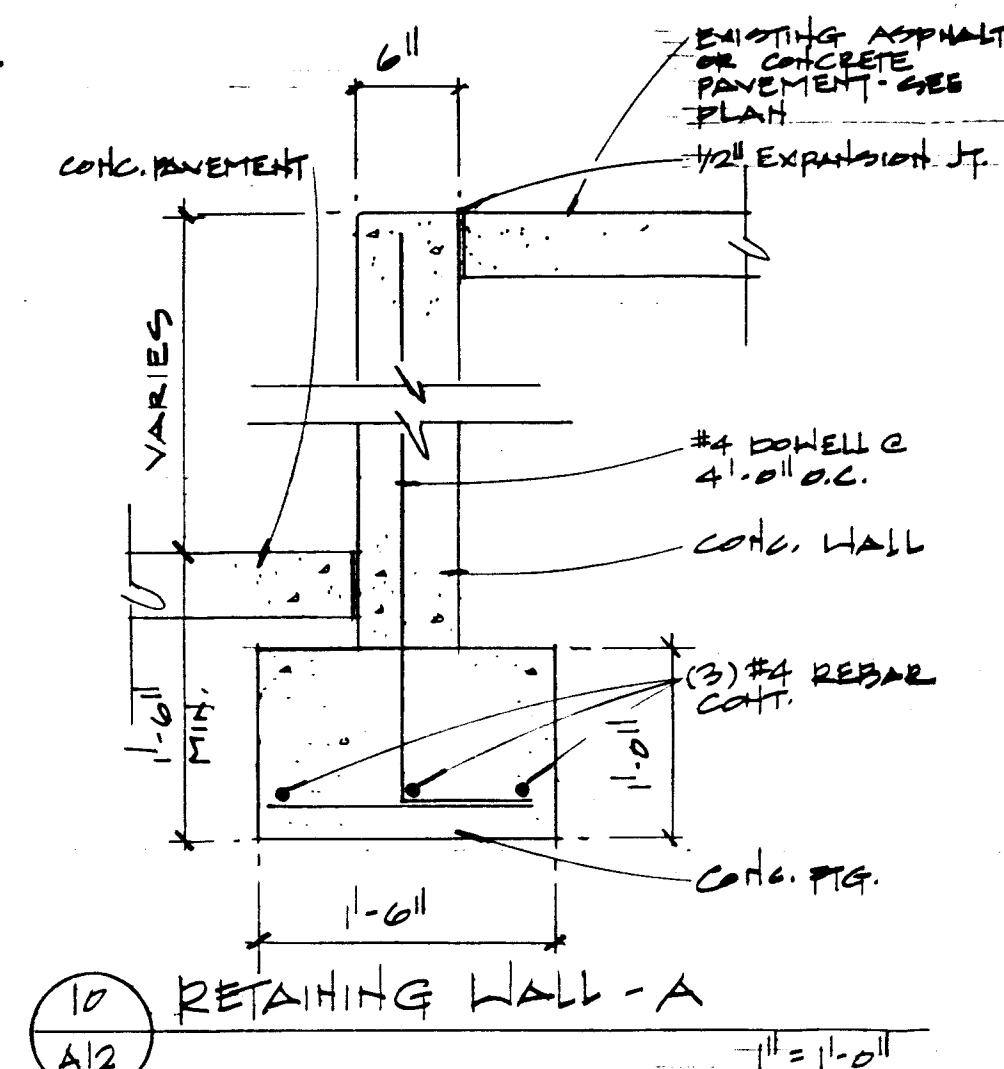

10 RETAINING WALL - A

A12


1/2" = 1'-0"

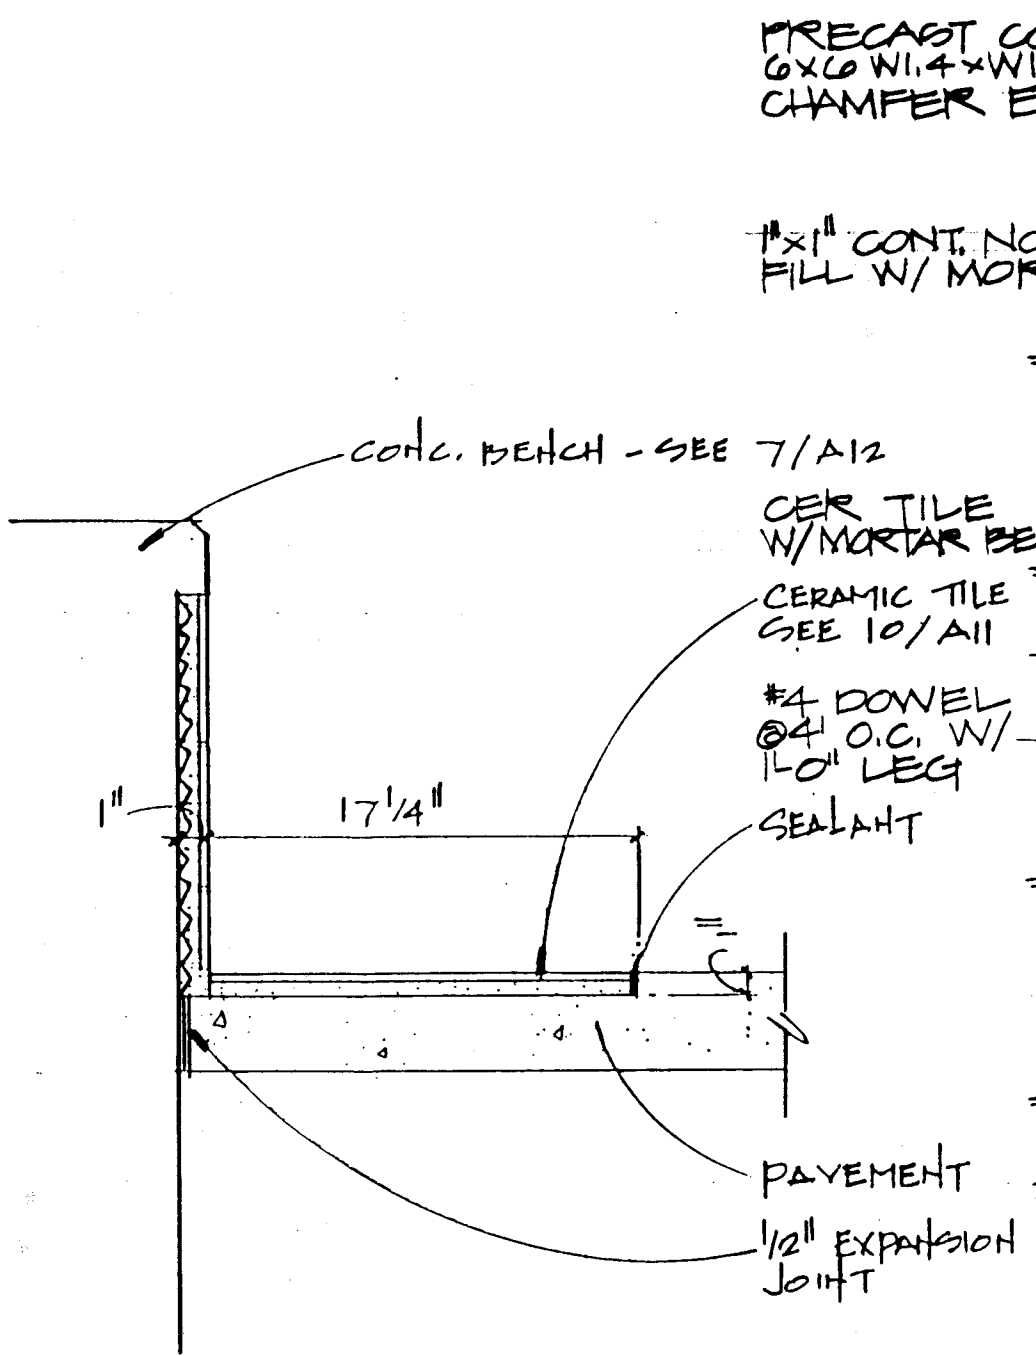

8 TILE @ PLAZA BENCH DETAIL

A12


1/2" = 1'-0"

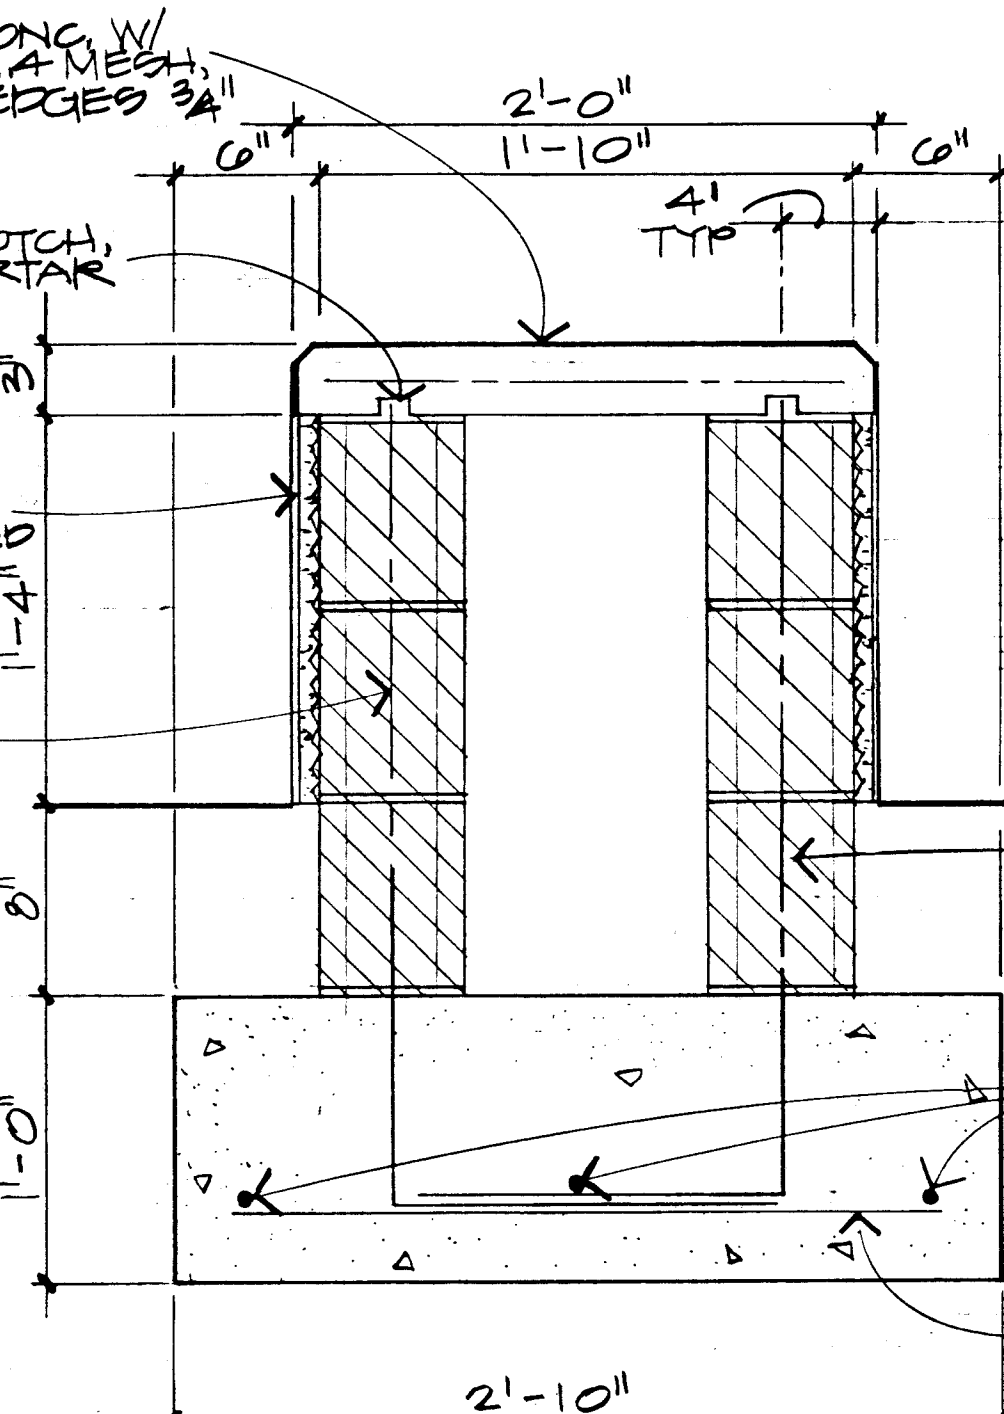

7 LOW WALL/BENCH TYPE A

A12


1/2" = 1'-0"

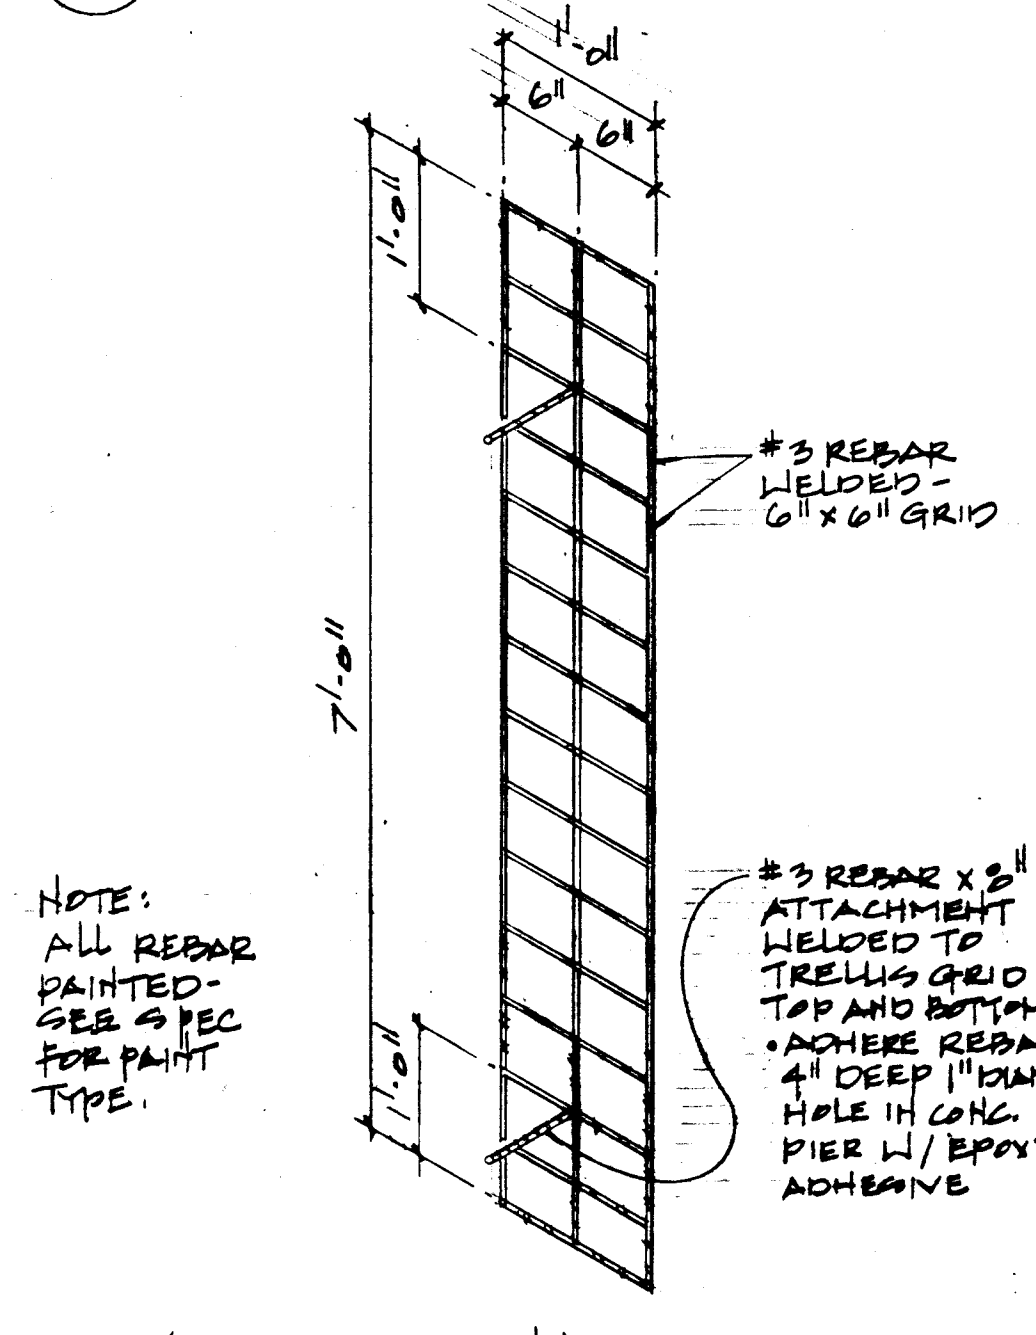

3 VINE TRELLIS

A12


3/4" = 1'-0"

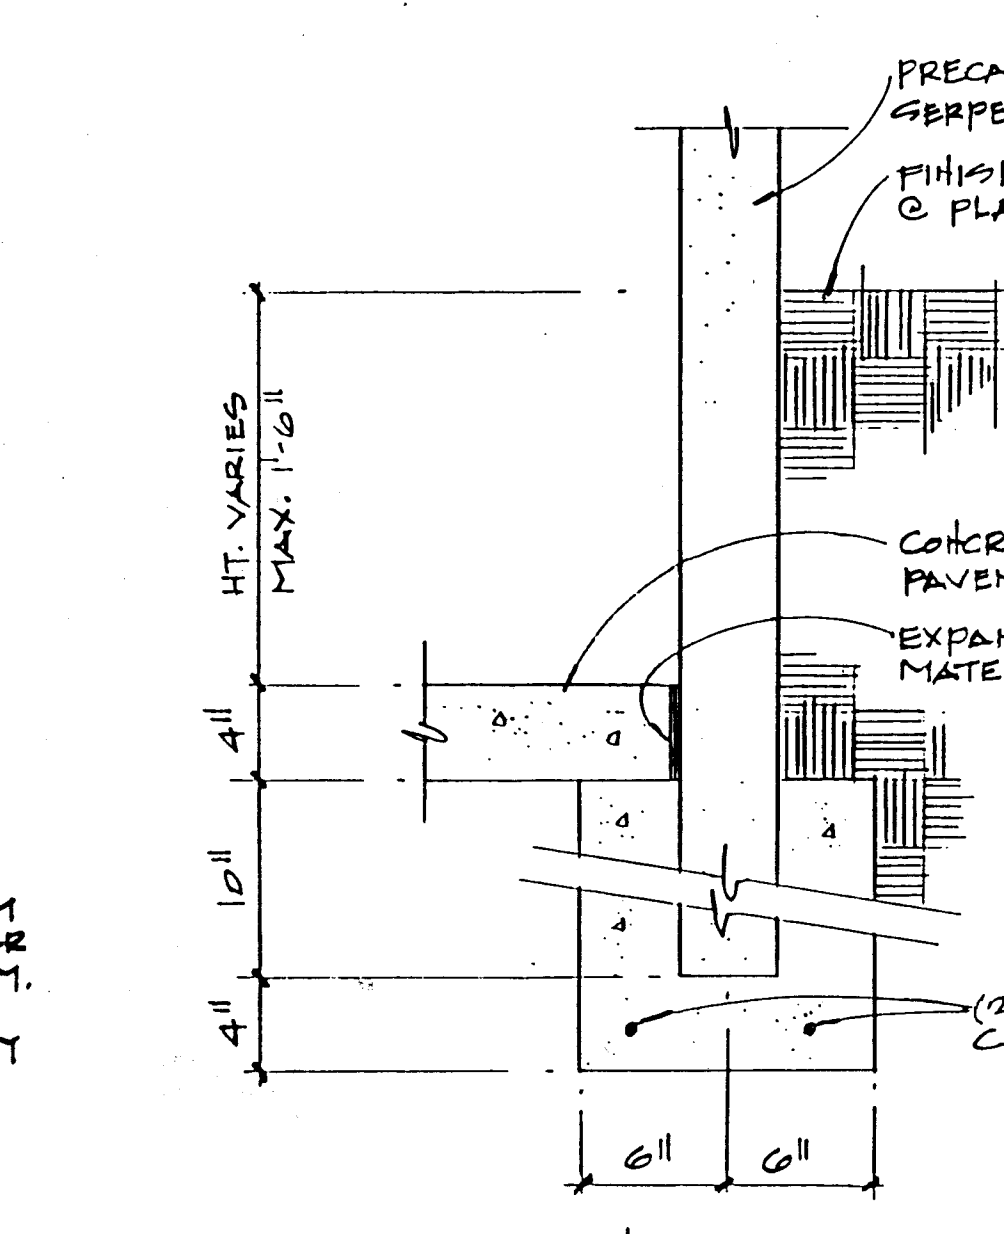

2 SERPENTINE WALL DETAIL

A12

1/2" = 1'-0"

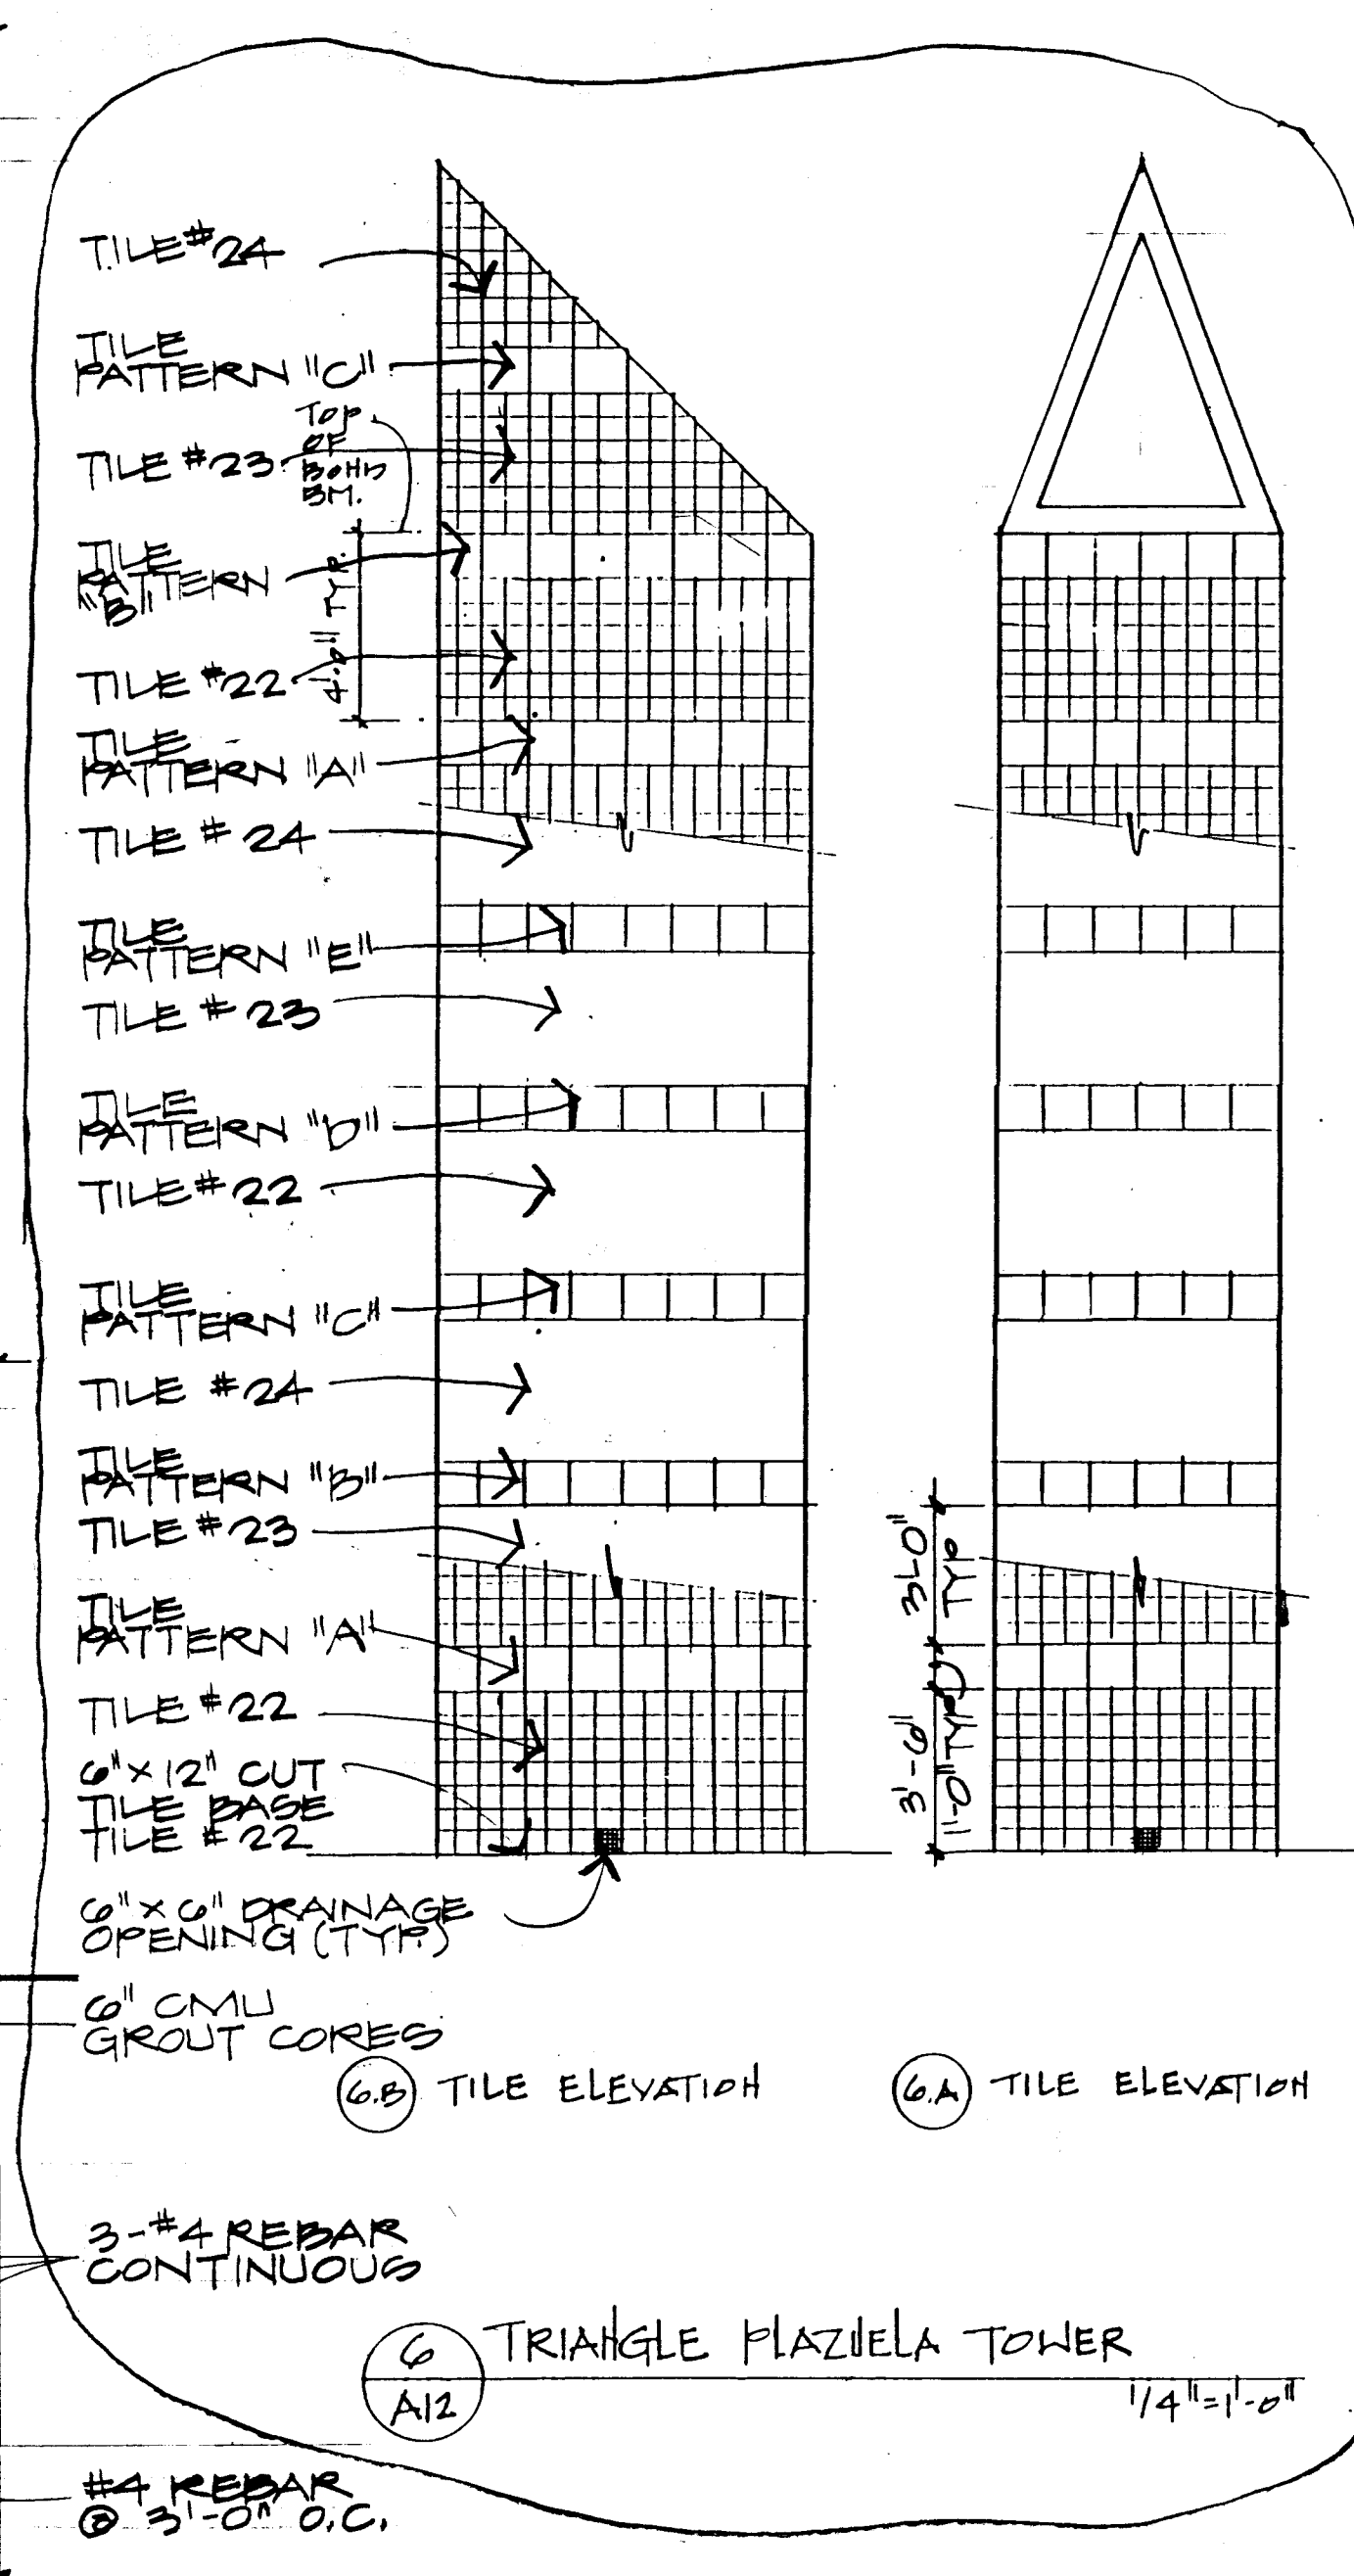

6A TILE ELEVATION

A12


6B TILE ELEVATION

A12

6 TRIANGLE PLAZA TOWER

A12

1/4" = 1'-0"

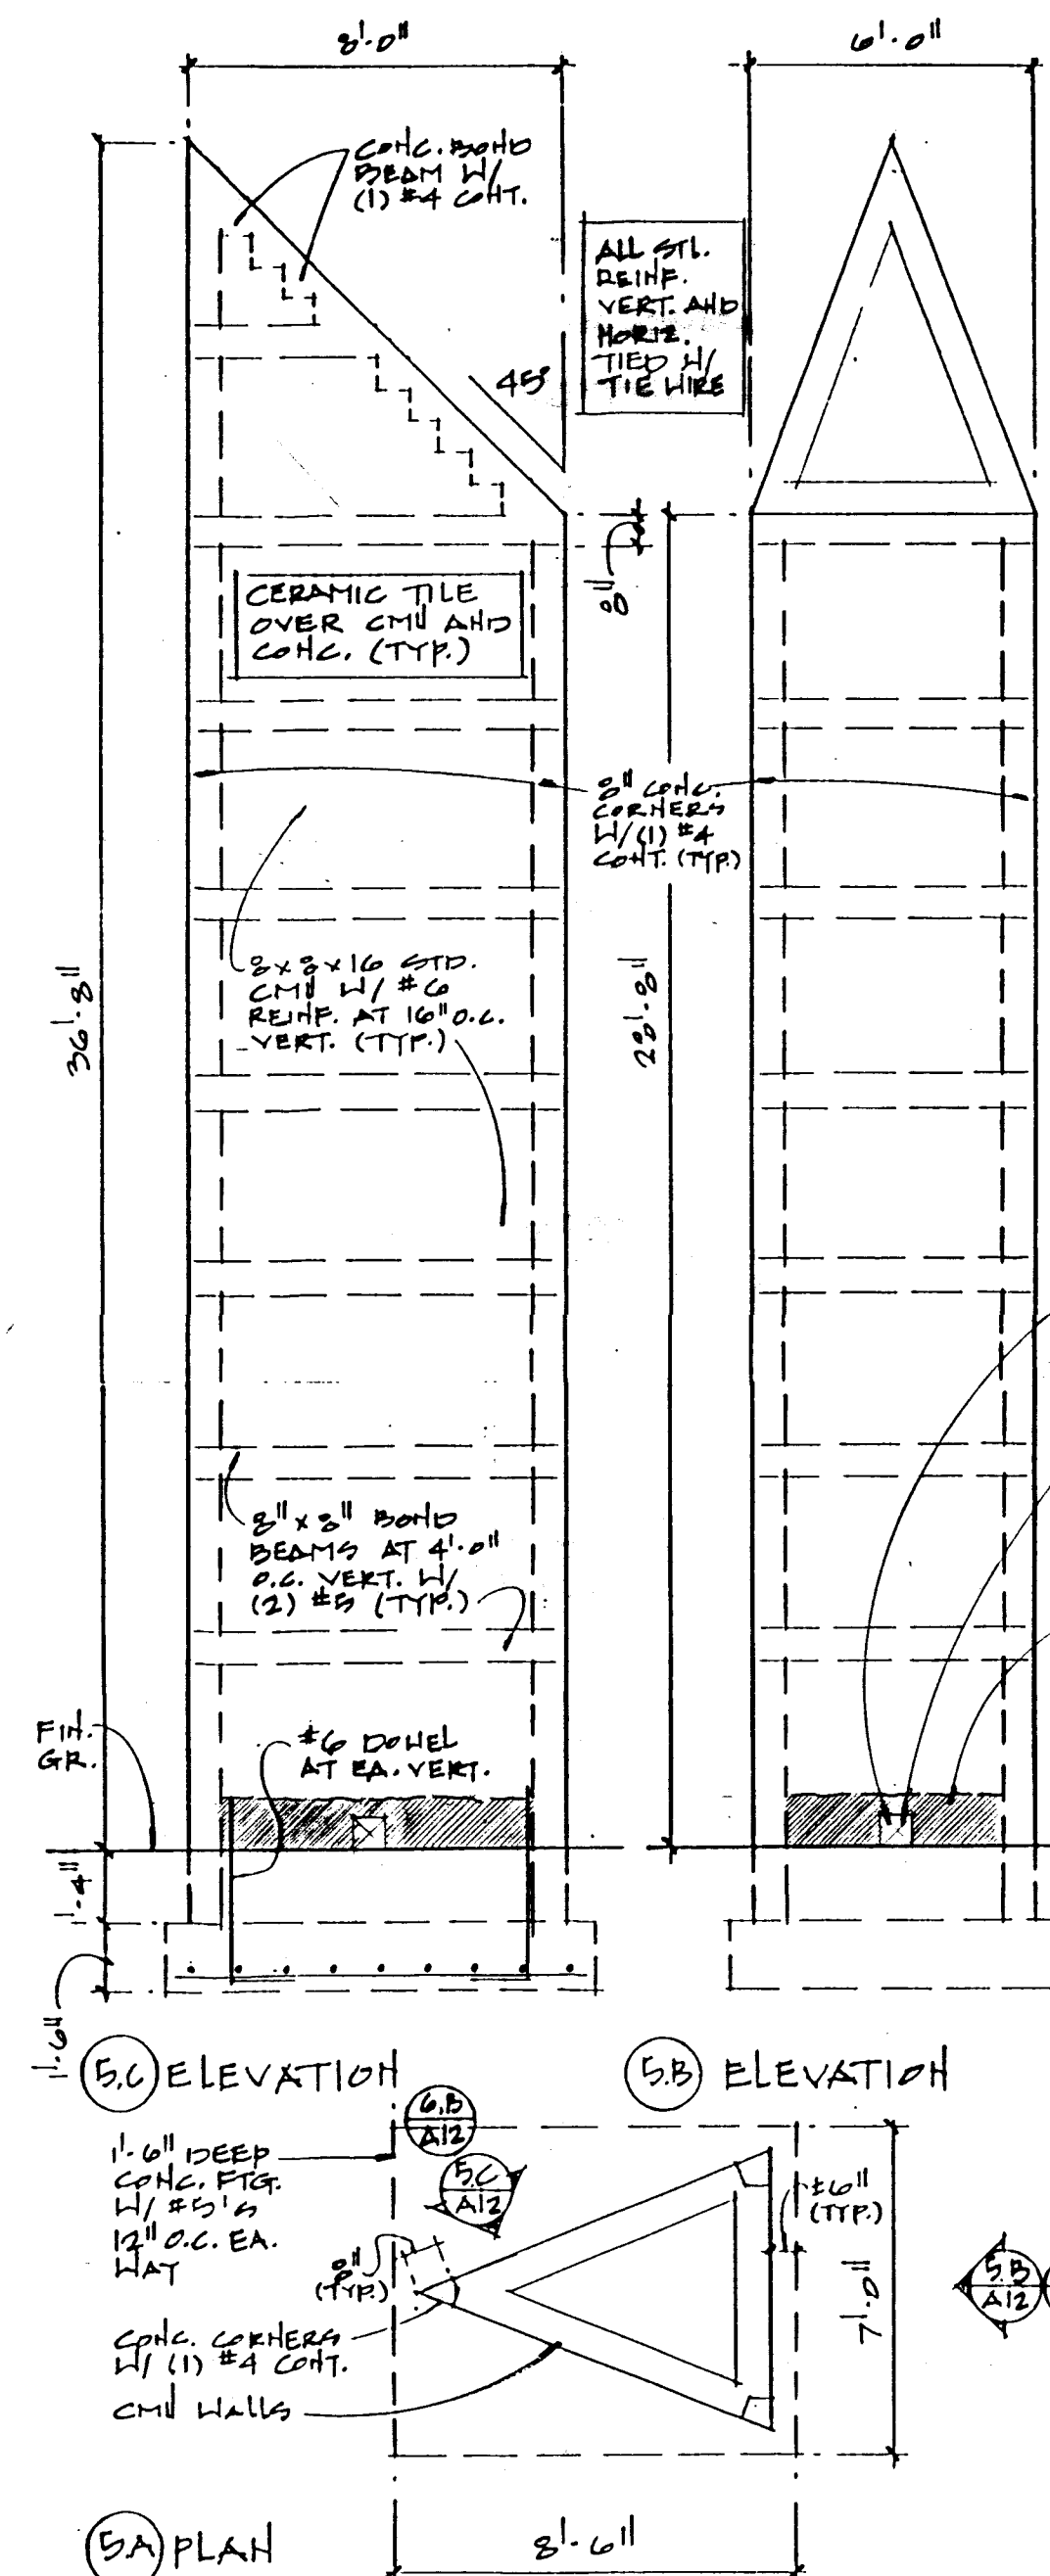

5A ELEVATION

A12

5B ELEVATION

A12

5 TRIANGLE PLAZA TOWER

A12

1/4" = 1'-0"

RECORD SET May 1, 1997

Garrett Smith Ltd

SIX CENTRAL SW
ALBUQUERQUE
NEW MEXICO
87102
505/766-6968
FAX 505/766-4508

CITY OF ALBUQUERQUE
PUBLIC WORKS DEPARTMENT
ENGINEERING GROUP

TITLE: DETAILS

Design Review Committee

City Engineer Approval

City Project No.
4917.90

Zone Map No.
K14-L14


Sheet
A-12

13


SCANNED BY
BY LASON

MAP NOTES






1. MAP AND LABELS - POURED, COLORED CONCRETE
2. ALL LINES ON DRAWINGS REPRESENT SCORE LINES
3. LETTERS IN LABELS TO BE 1" HIGH HELVETICA STYLE LETTERS

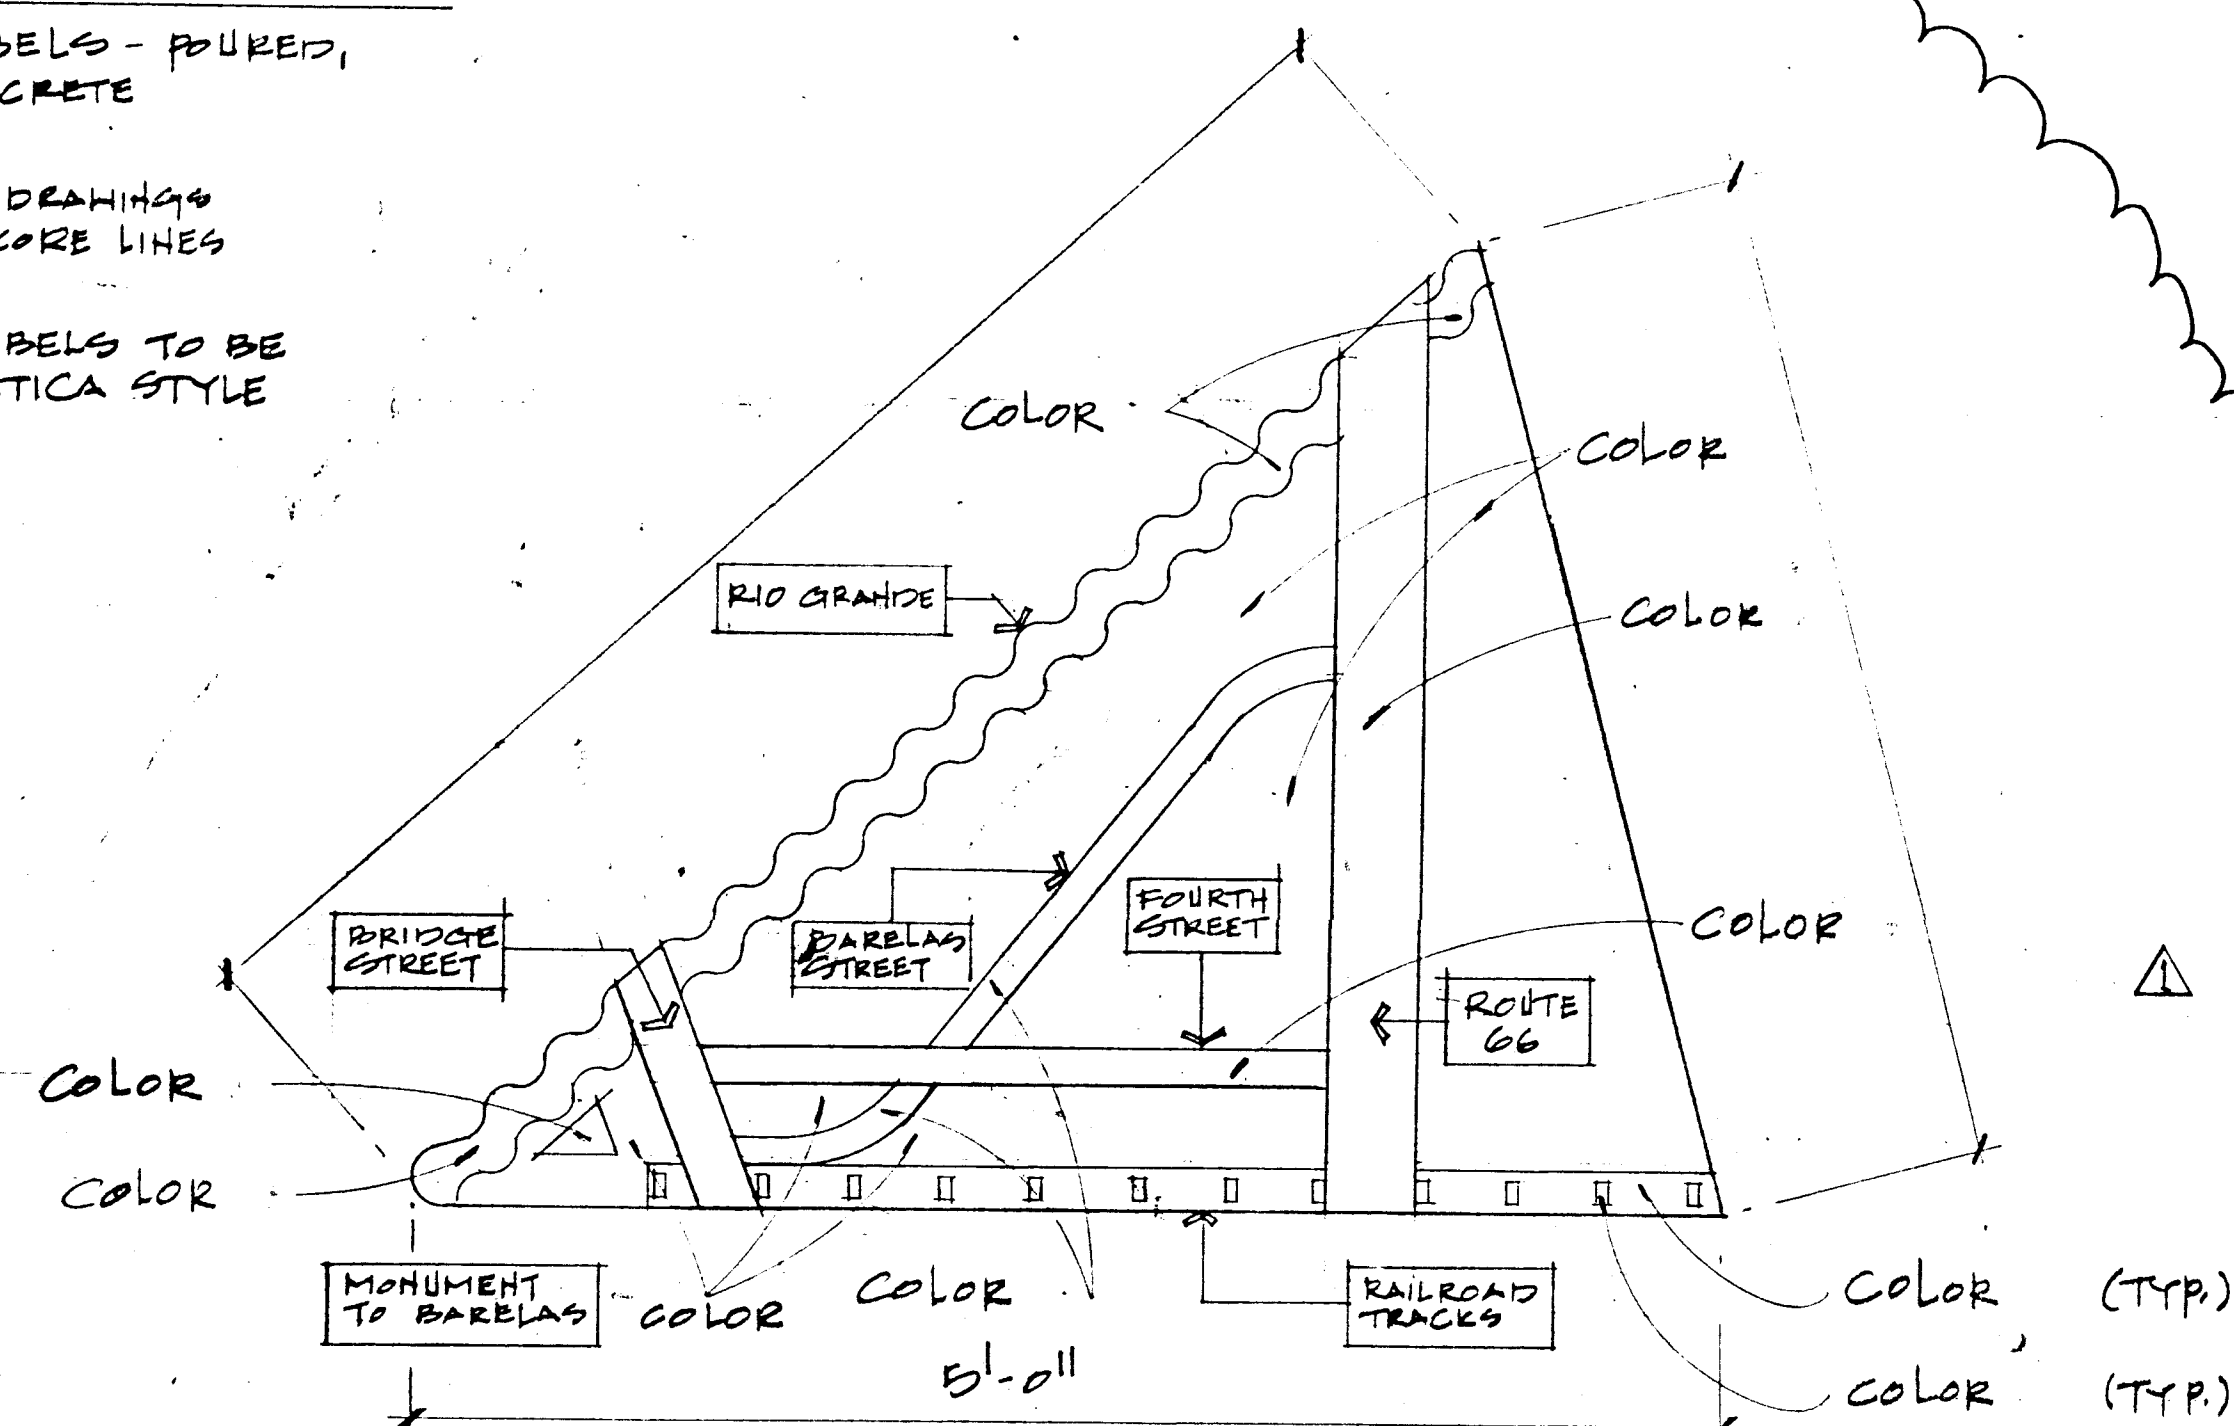

3 PLAZUELA MAP
A13

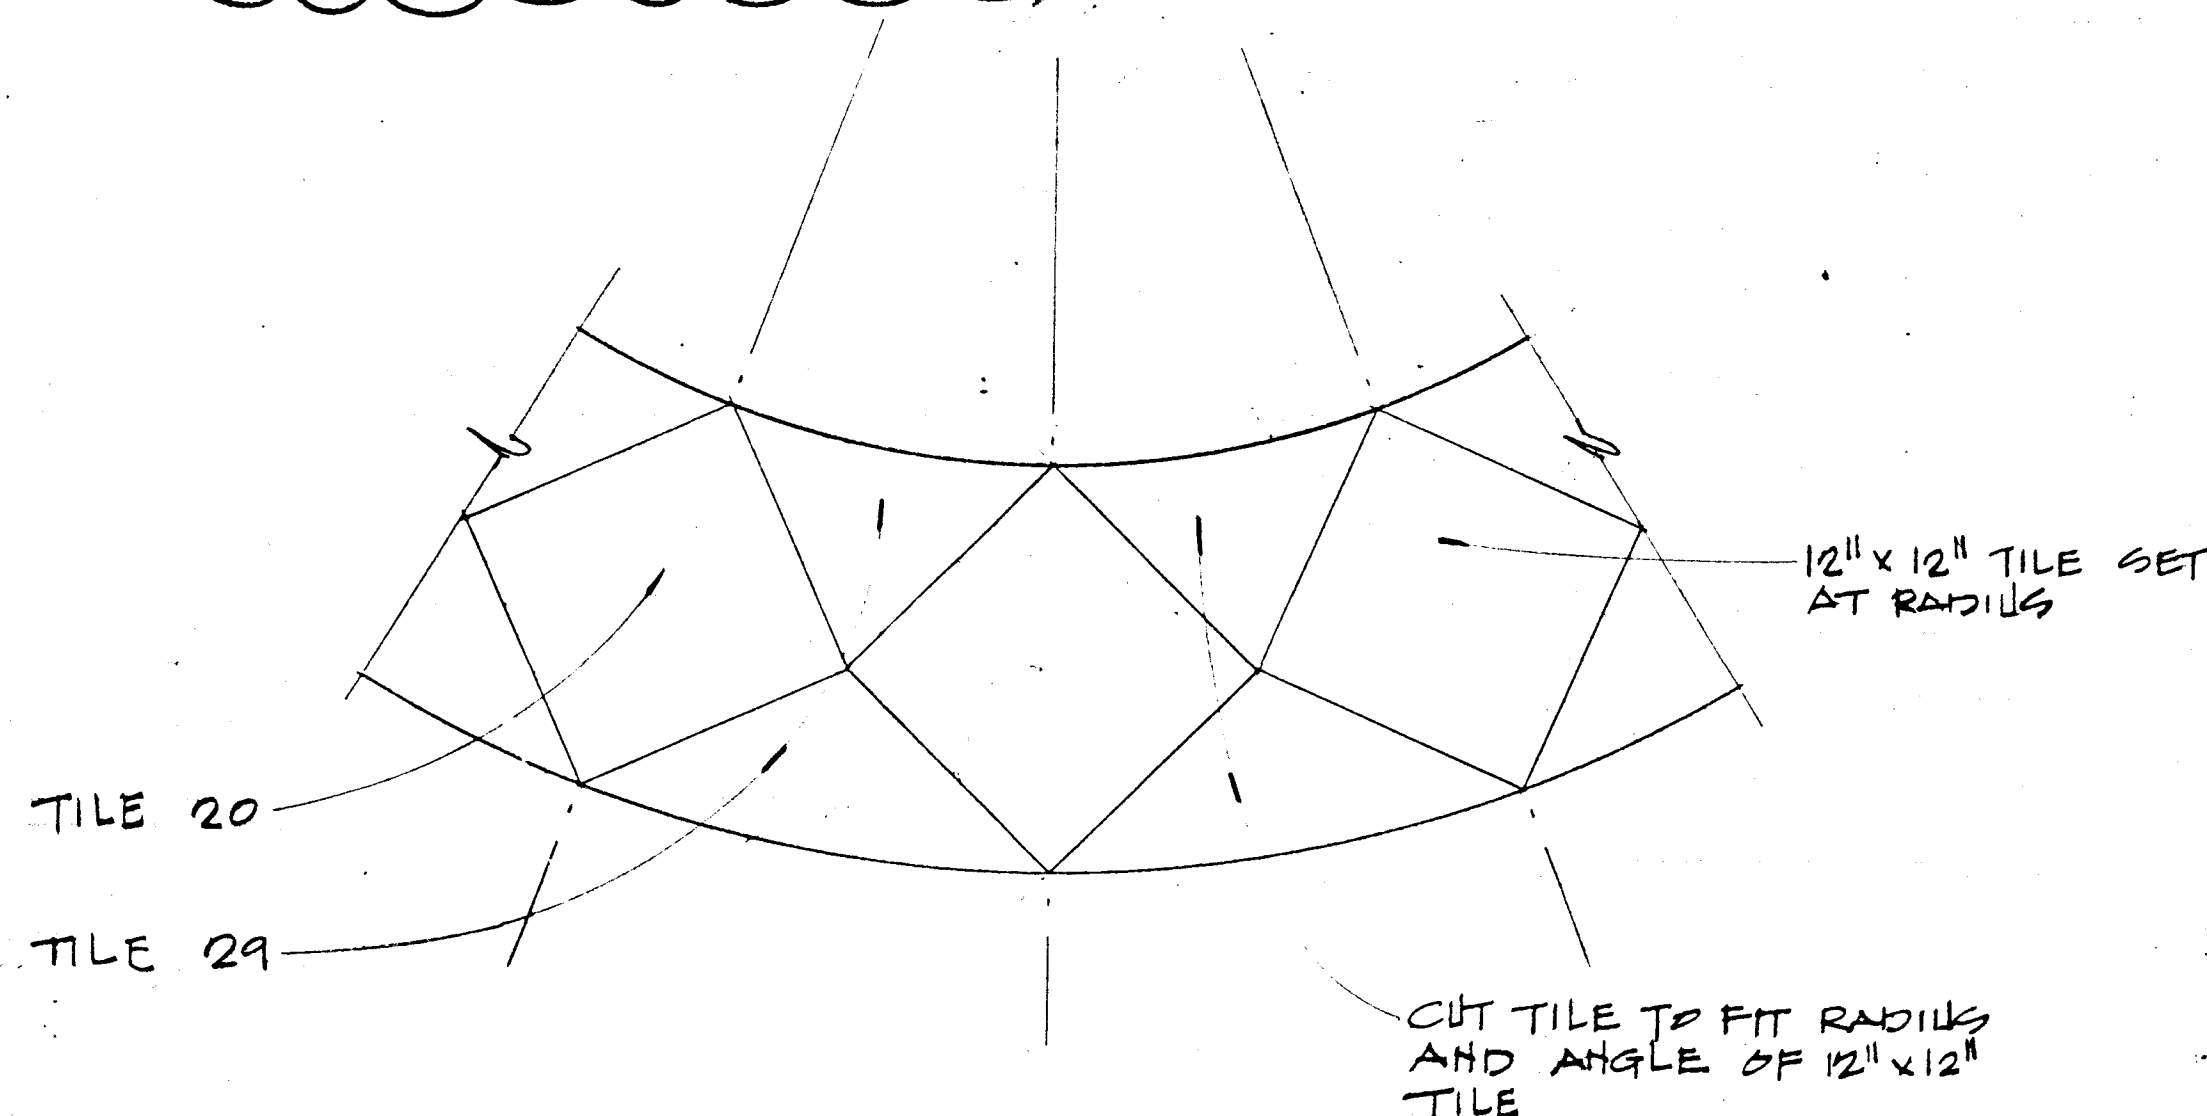

2 CIRCULAR TILE LAY-OUT
A13

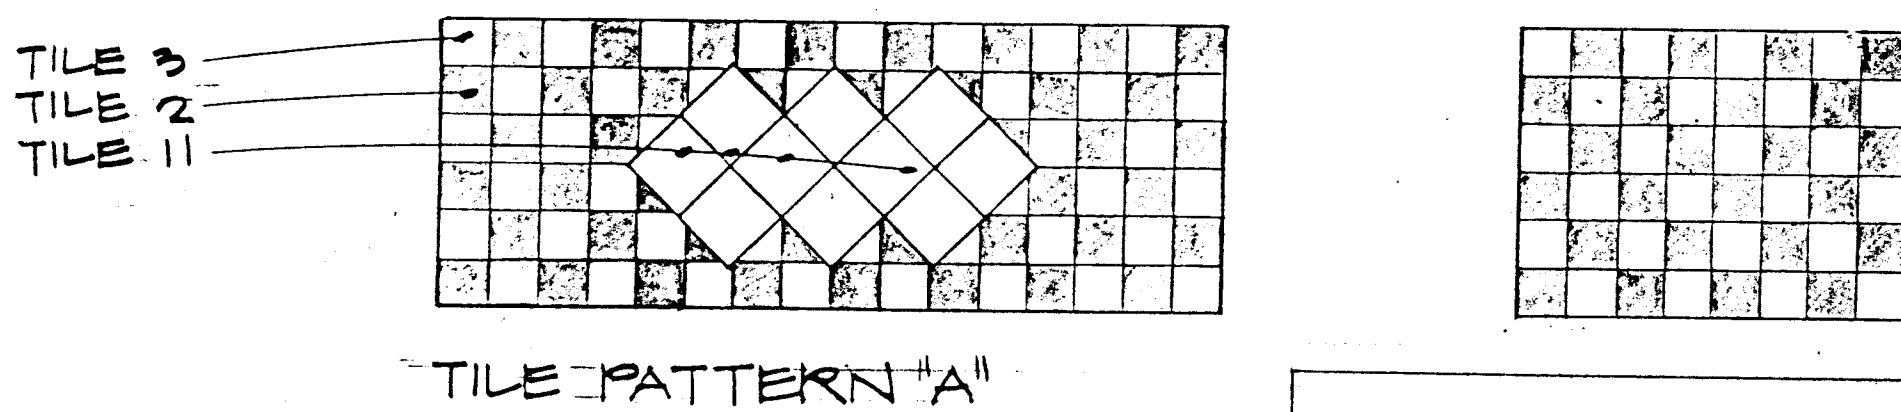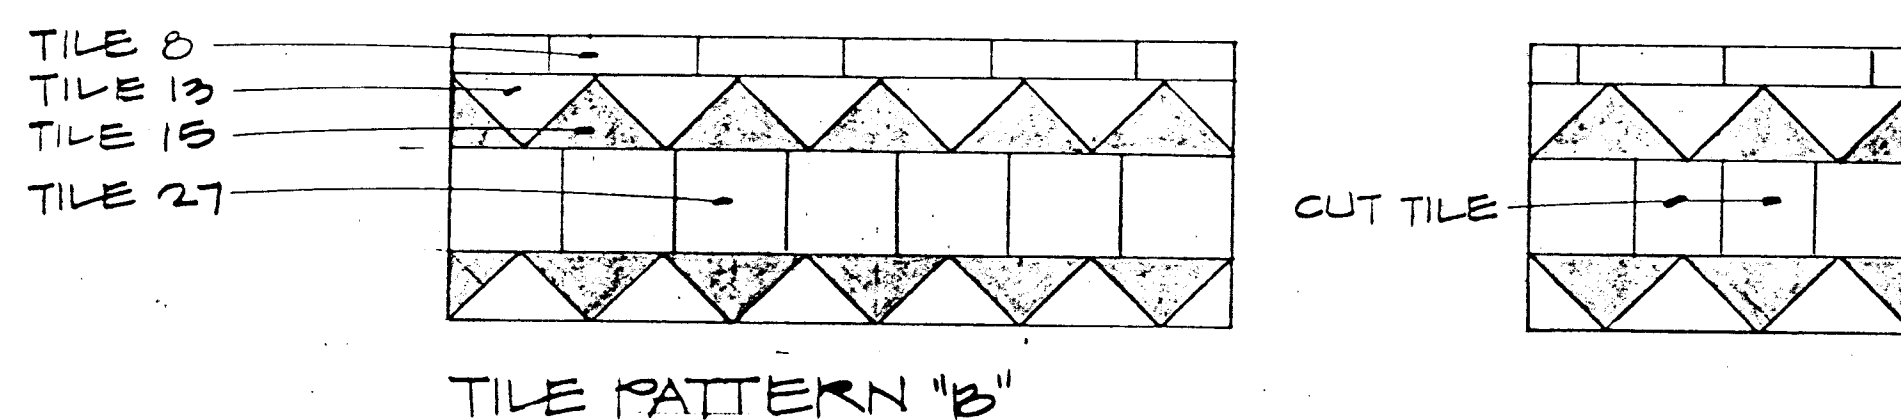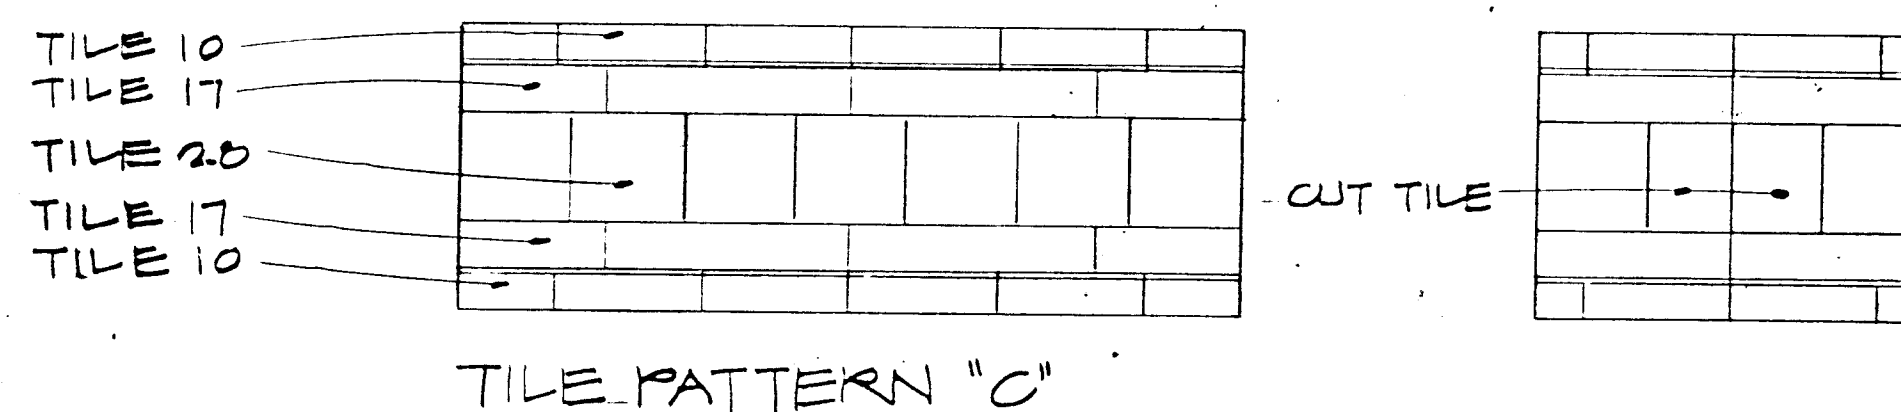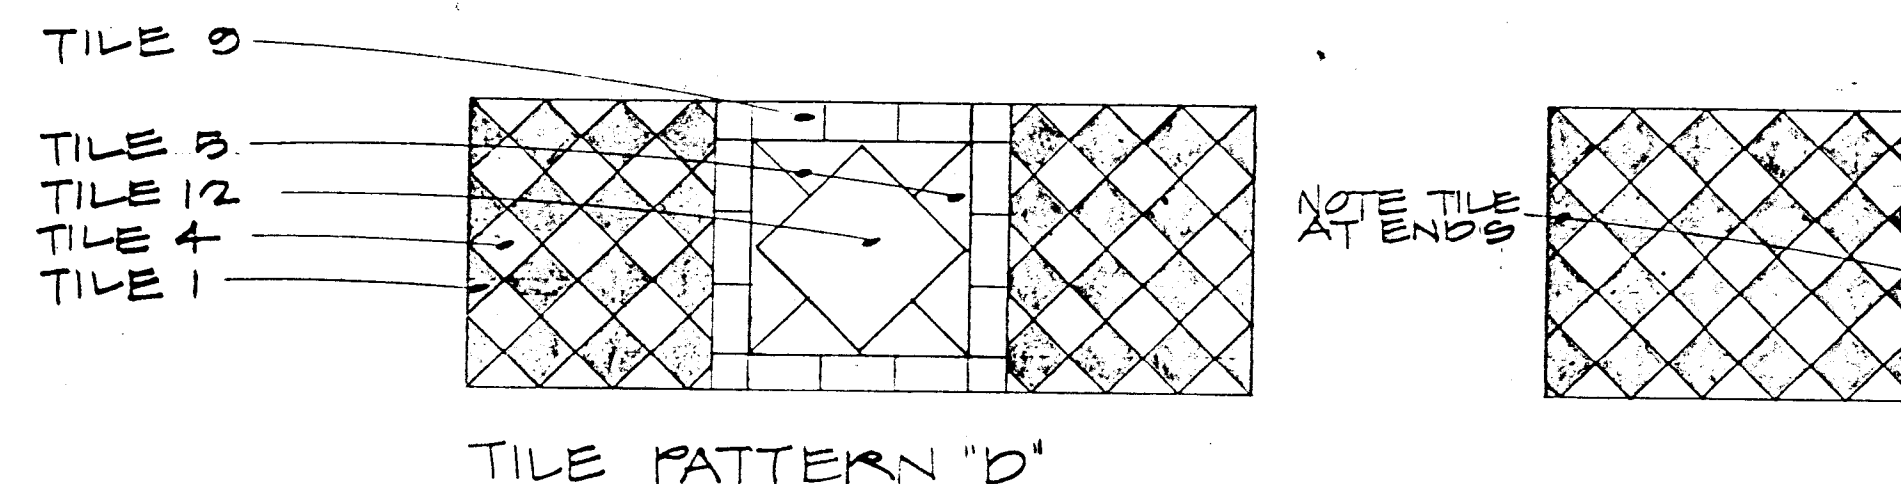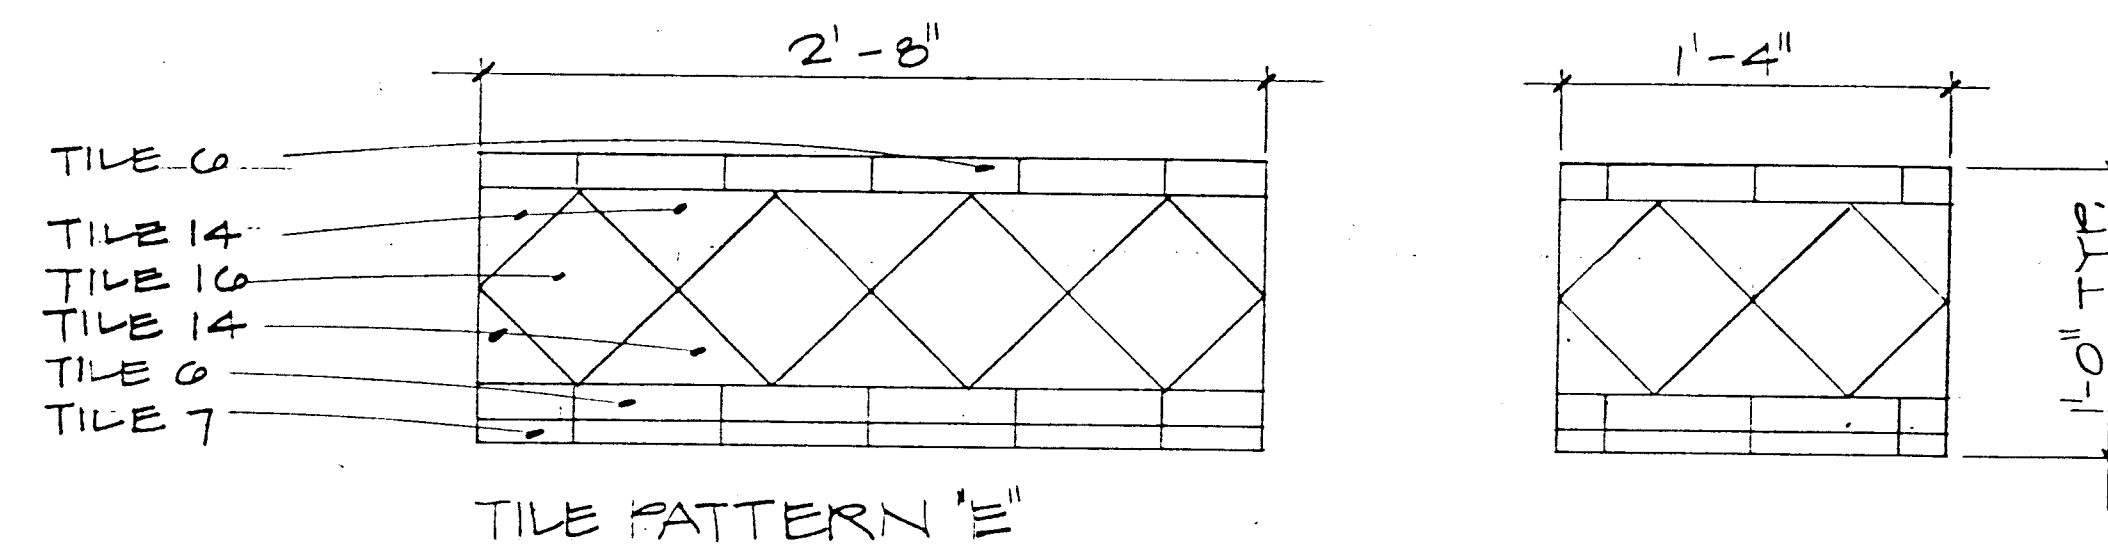

1 PTLOH TILE PATTERNS
A13

RECORD SET
May 1, 1997

[Signature]

SCANNED BY
BY LARON

GARRETT SMITH LTD
DESIGN ARCHITECTURE & ENGINEERING
ALBUQUERQUE
NEW MEXICO
877 100
505/766-6966
FAX/243-4508

CITY OF ALBUQUERQUE
PUBLIC WORKS DEPARTMENT
ENGINEERING GROUP

TITLE: TILE PATTERNS

Design Review Committee	City Engineer Approval	Ms./Day/Yr.	Ms./Day/Yr.
<i>[Signature]</i> 12/1/95	<i>[Signature]</i> 12/1/95		
City Project No. 4917.90	Zone Map No. K14-L14	Sheet A-13	Of 13

AS-BUILT INFORMATION	BENCH MARKS	SURVEY INFORMATION	FIELD NOTES	DATE
CONTRACTOR BY DATE		NO.	BY	
INSPECTOR'S FIELD DATE				
VERIFICATION BY DATE				
CORRECTED BY DATE				
MICRO-FILM INFORMATION				
RECORDED BY				
NO.				

ENGINEER'S SEAL
[Signature]

REVISIONS	DESIGN	DATE	DATE
1. CHANGE ORDER NO. 1			
2. ISSUED FOR CONSTRUCTION			
NO. DATE	BY		
DESIGNED BY	DRAWN BY	CHECKED BY	

[illegible]

NORTH 0 10' 20' 40'
SCALE: 1"=20'-0"

	C	VS	III A	IV A	BO		RE	Z

KEY INFORMATION

LANDSCAPE ARCHITECT'S SEAL

[illegible]

NO.	DATE	ISSUED FOR CONSTRUCTION	REMARKS	BY
△	6/18/96			

REVISIONS

DESIGNED BY	WSP	DATE	8-95
-------------	-----	------	------

DRAWN BY	WBT	DATE	8-95
----------	-----	------	------

CHECKED BY	WSP	DATE
		10-26-95

CITY OF ALBUQUERQUE
PUBLIC WORKS DEPARTMENT
ENGINEERING GROUP


TITLE: **FOURTH STREET STREETSCAPE**
IRRIGATION PLAN

Design Review Committee	City Engineer Approval	8	Mo./Day/Yr.	Mo./Day/Yr.
-------------------------	------------------------	---	-------------	-------------

Design Review Committee	City Engineer Approval	Last Design Update		
<i>[Signature]</i> 12/21/95	<i>[Signature]</i> 12/21/95			


City Project No.	Zone Map No.	Sheet	Of
------------------	--------------	-------	----

SCANNED BY
BY 1202

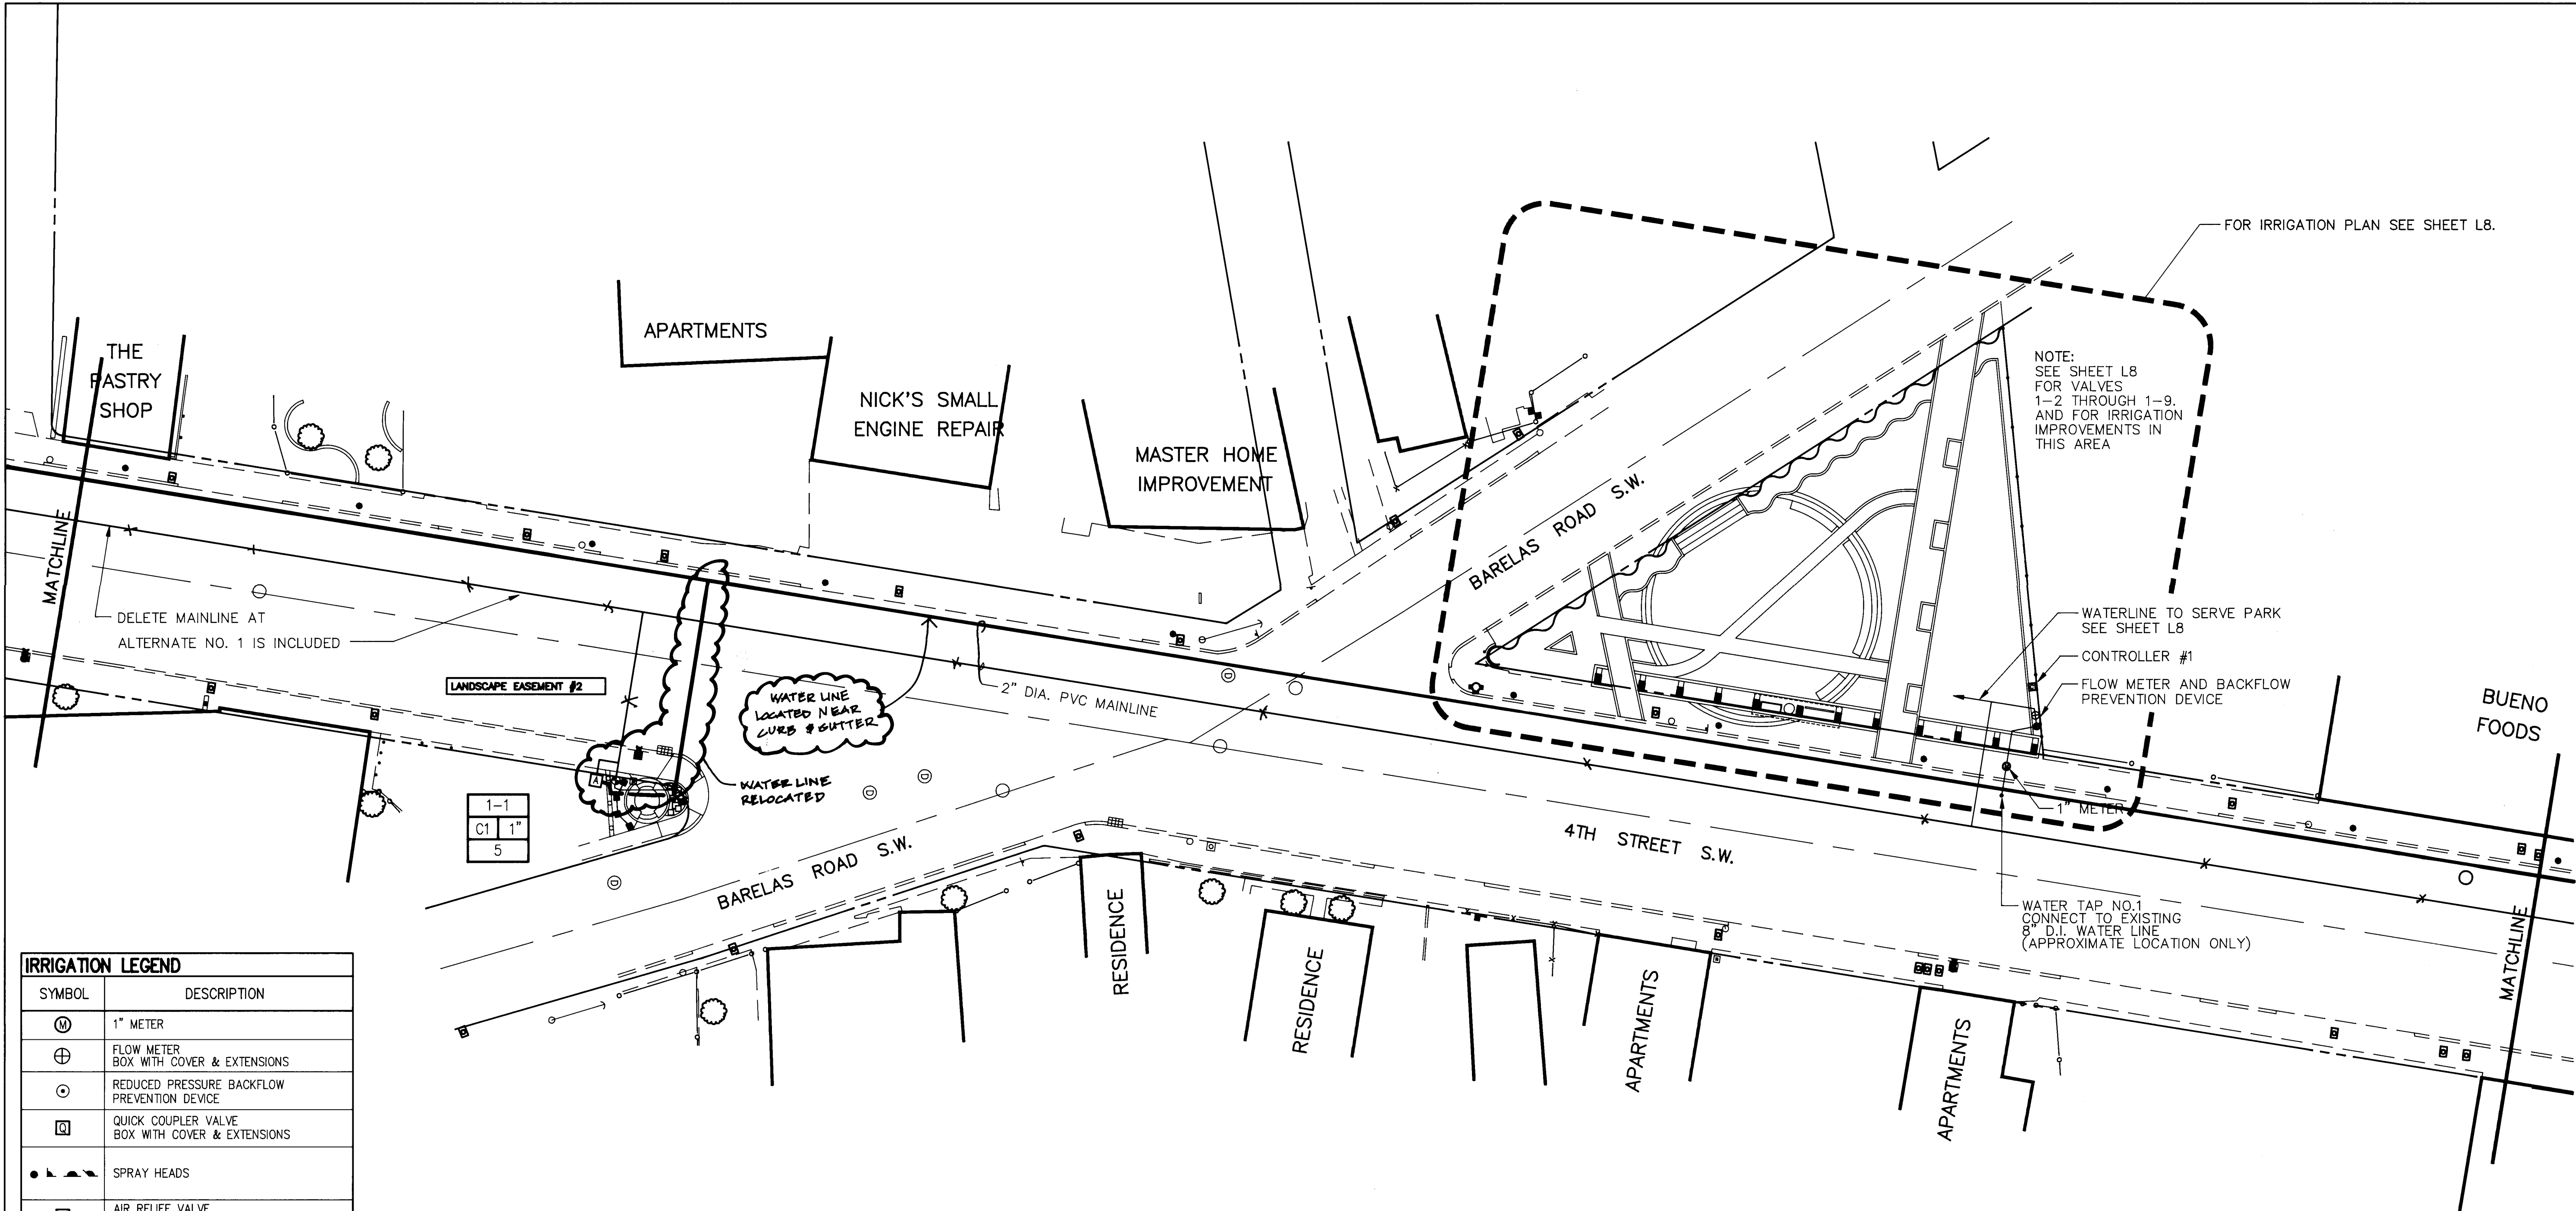

IRRIGATION LEGEND	
SYMBOL	DESCRIPTION
	1" METER
	FLOW METER BOX WITH COVER & EXTENSIONS
	REDUCED PRESSURE BACKFLOW PREVENTION DEVICE
	QUICK COUPLER VALVE BOX WITH COVER & EXTENSIONS
	SPRAY HEADS
	AIR RELIEF VALVE BOX WITH COVER & EXTENSIONS
	REMOTE CONTROL VALVE BOX WITH COVER & EXTENSIONS
	PRESSURE COMPENSATING BUBBLER
	PRESSURE COMPENSATING BUBBLER
	MAIN IRRIGATION LINE
	LATERAL IRRIGATION LINE
	VALVE NUMBER VALVE SIZE CONTROLLER NUMBER GALLONS PER MINUTE
	CONTROLLER-32 STATION SATELLITE
	CONTROLLER-8 STATION REMOTE
	CONTROLLER-8 STATION REMOTE


IRRIGATION LEGEND	
SYMBOL	DESCRIPTION
	SLEEVE
	STREAM BUBBLER ON 12" POP-UP HEAD
	STREAM BUBBLER ON 12" POP-UP HEAD

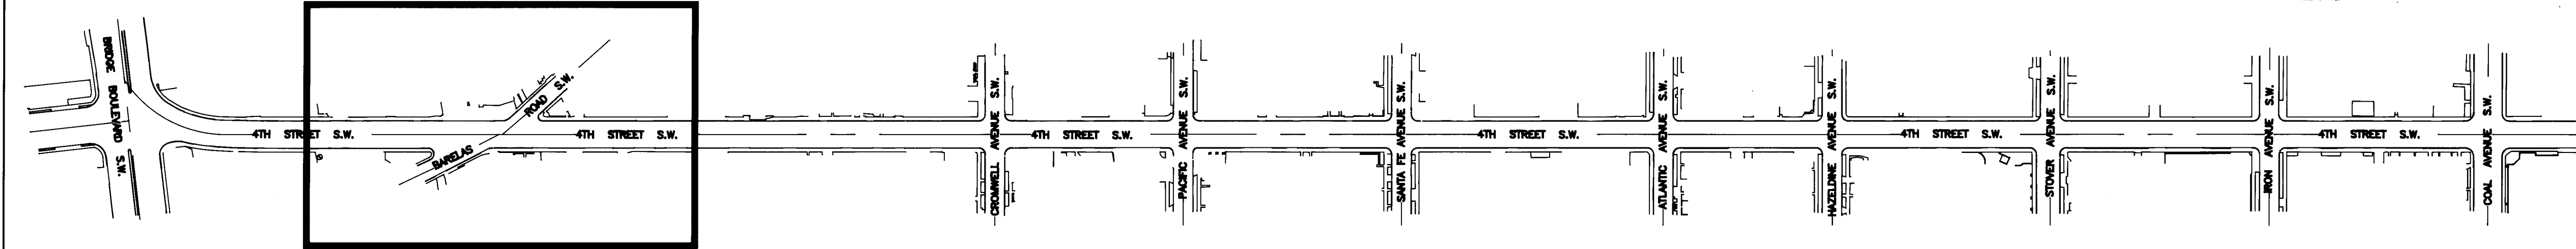


FOURTH STREET STREETSCAPE KEY

RECORD SET
May 1, 1997

[Signature]

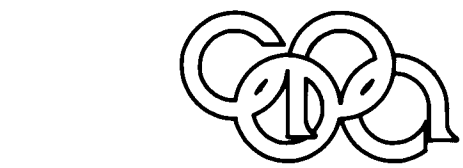

Campbell Okuma Perkins Associates, Inc.
Landscape Architecture and Site Planning
418 Central S.E. Albuquerque, NM 87102
(505) 242-9928

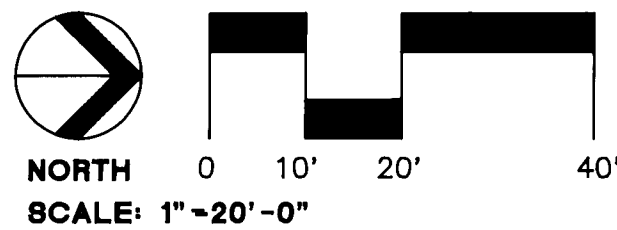


CITY OF ALBUQUERQUE
PUBLIC WORKS DEPARTMENT
ENGINEERING GROUP

TITLE: **FOURTH STREET STREETSCAPE
IRRIGATION PLAN**


Design Review Committee	City Engineer Approval	Mo./Day/Yr.	Mo./Day/Yr.
City Project No.	Zone Map No.	Sheet	Of
4917.90	K14-L14	L2	L19


AS-BUILT INFORMATION		BENCH MARKS		SURVEY INFORMATION		LANDSCAPE ARCHITECT'S SEAL	
CONTRACTOR	DATE			FIELD BY	DATE		
STANDARD	DATE						
INSPECTOR'S	DATE						
FIELD	DATE						
REVISION	DATE						
CONNECTED BY	DATE						
MICRO-FILM	DATE						
INFORMATION	DATE						
RECORDED BY	DATE						
NO.							

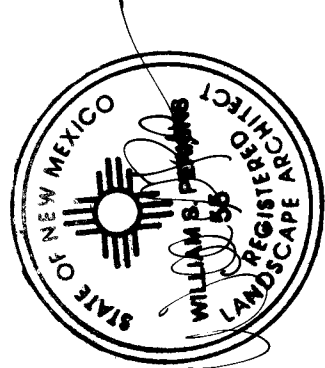

ISSUED FOR CONSTRUCTION		REVISIONS	
NO.	DATE	REMARKS	BY
1	12/1/95	DESIGN	
2	12/1/95	DESIGN	
3	12/1/95	DESIGN	
4	12/1/95	DESIGN	
5	12/1/95	DESIGN	
6	12/1/95	DESIGN	
7	12/1/95	DESIGN	
8	12/1/95	DESIGN	
9	12/1/95	DESIGN	
10	12/1/95	DESIGN	


SCANNED BY
BY LASON

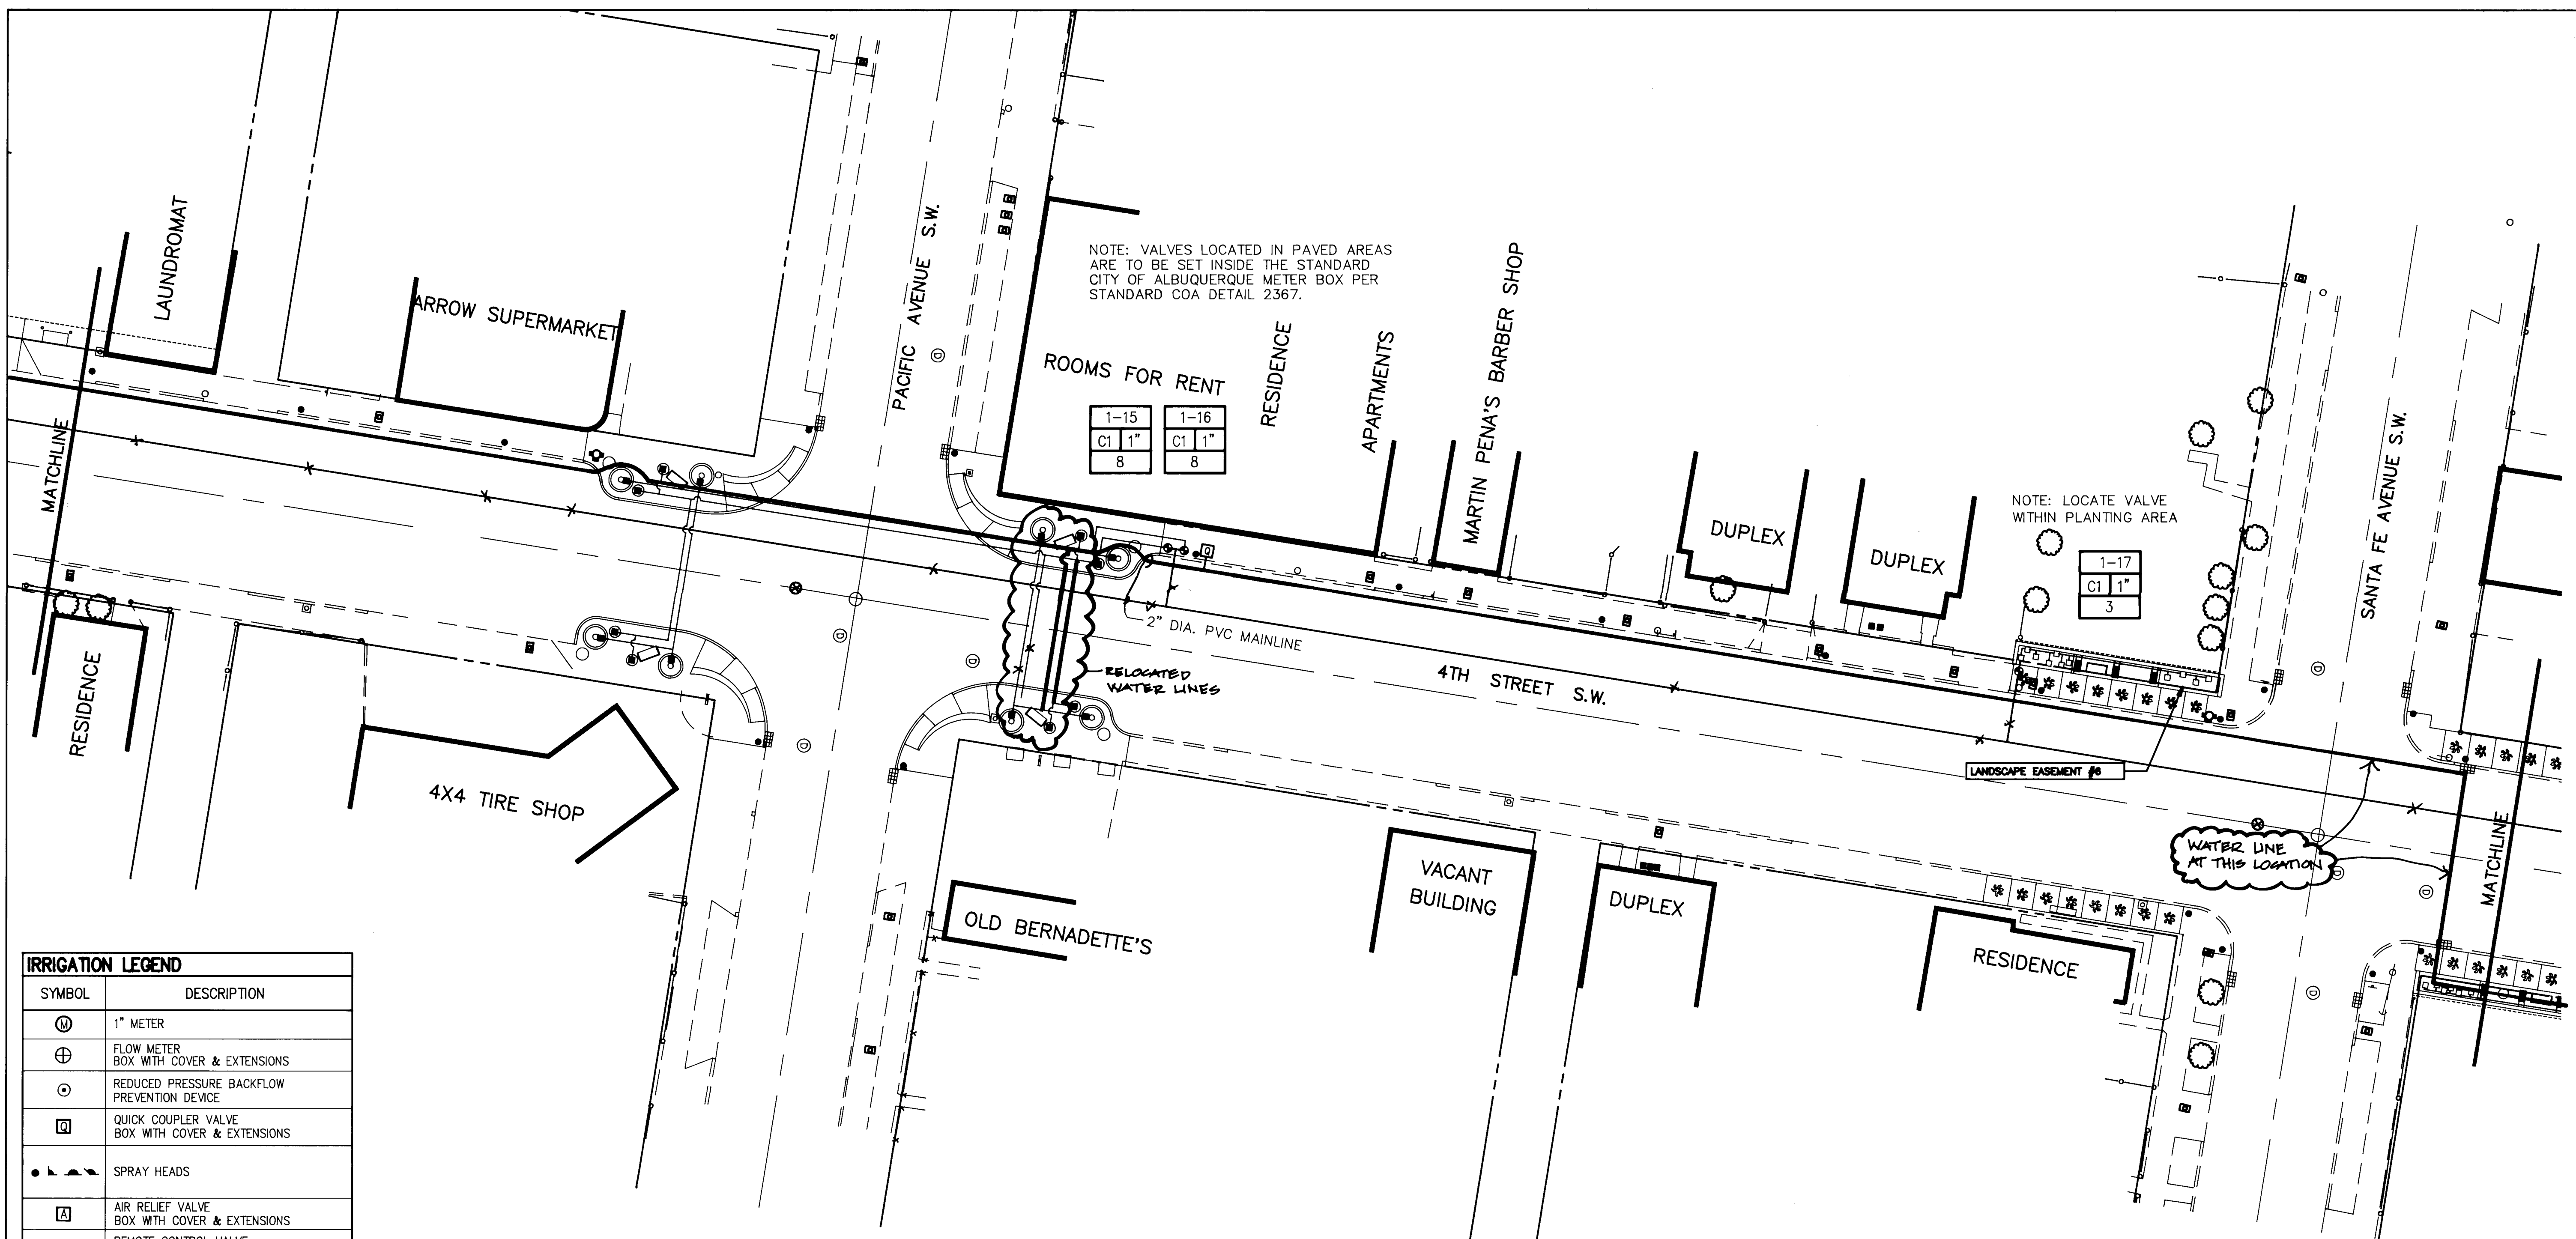

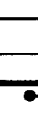IRRIGATION LEGEND	
SYMBOL	DESCRIPTION
	1" METER
	FLOW METER BOX WITH COVER & EXTENSIONS
	REDUCED PRESSURE BACKFLOW PREVENTION DEVICE
	QUICK COUPLER VALVE BOX WITH COVER & EXTENSIONS
	SPRAY HEADS
	AIR RELIEF VALVE BOX WITH COVER & EXTENSIONS
	REMOTE CONTROL VALVE BOX WITH COVER & EXTENSIONS
	PRESSURE REGULATING BUBBLER
	PRESSURE COMPENSATING BUBBLER
	MAIN IRRIGATION LINE
	LATERAL IRRIGATION LINE
	VALVE NUMBER VALVE SIZE CONTROLLER NUMBER GALLONS PER MINUTE
	CONTROLLER-32 STATION SATELLITE
	CONTROLLER-8 STATION REMOTE
	CONTROLLER-8 STATION REMOTE

IRRIGATION LEGEND	
SYMBOL	DESCRIPTION
	SLEEVE
	STREAM BUBBLER ON 12" POP-UP HEAD
	STREAM BUBBLER ON 12" POP-UP HEAD

SEE SHEET L17 FOR COMPLETE IRRIGATION LEGEND.

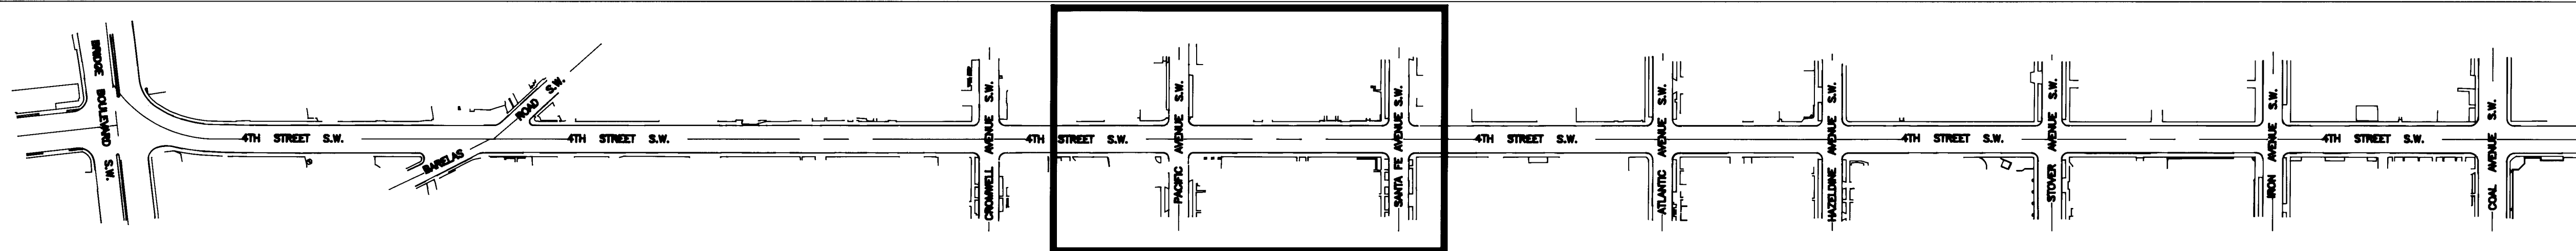


 FOURTH STREET STREETSCAPE KEY

RECORD SET
May 1, 1997



May 1, 1997


Amel

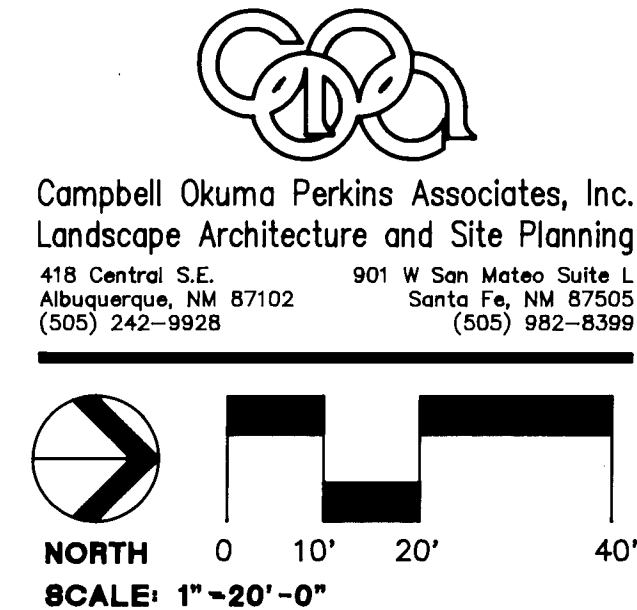

Campbell Okuma Perkins Associates, Inc.
Landscape Architecture and Site Planning
 418 Central S.E. 901 W San Mateo Suite L
 Albuquerque, NM 87102 Santa Fe, NM 87505
 (505) 242-9928 (505) 982-8399


SCANNED BY
BY LASON

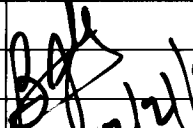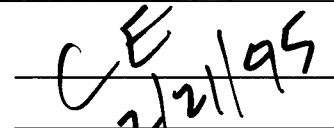CITY OF ALBUQUERQUE PUBLIC WORKS DEPARTMENT ENGINEERING GROUP										
TITLE: FOURTH STREET STREETSCAPE IRRIGATION PLAN										
Design Review Committee			City Engineer Approval			Last Design Update	Mo./Day/Yr.		Mo./Day/Yr.	
										
City Project No.			Zone Map No.			Sheet	Of			
4917.90			K14-L14			L4			L19	

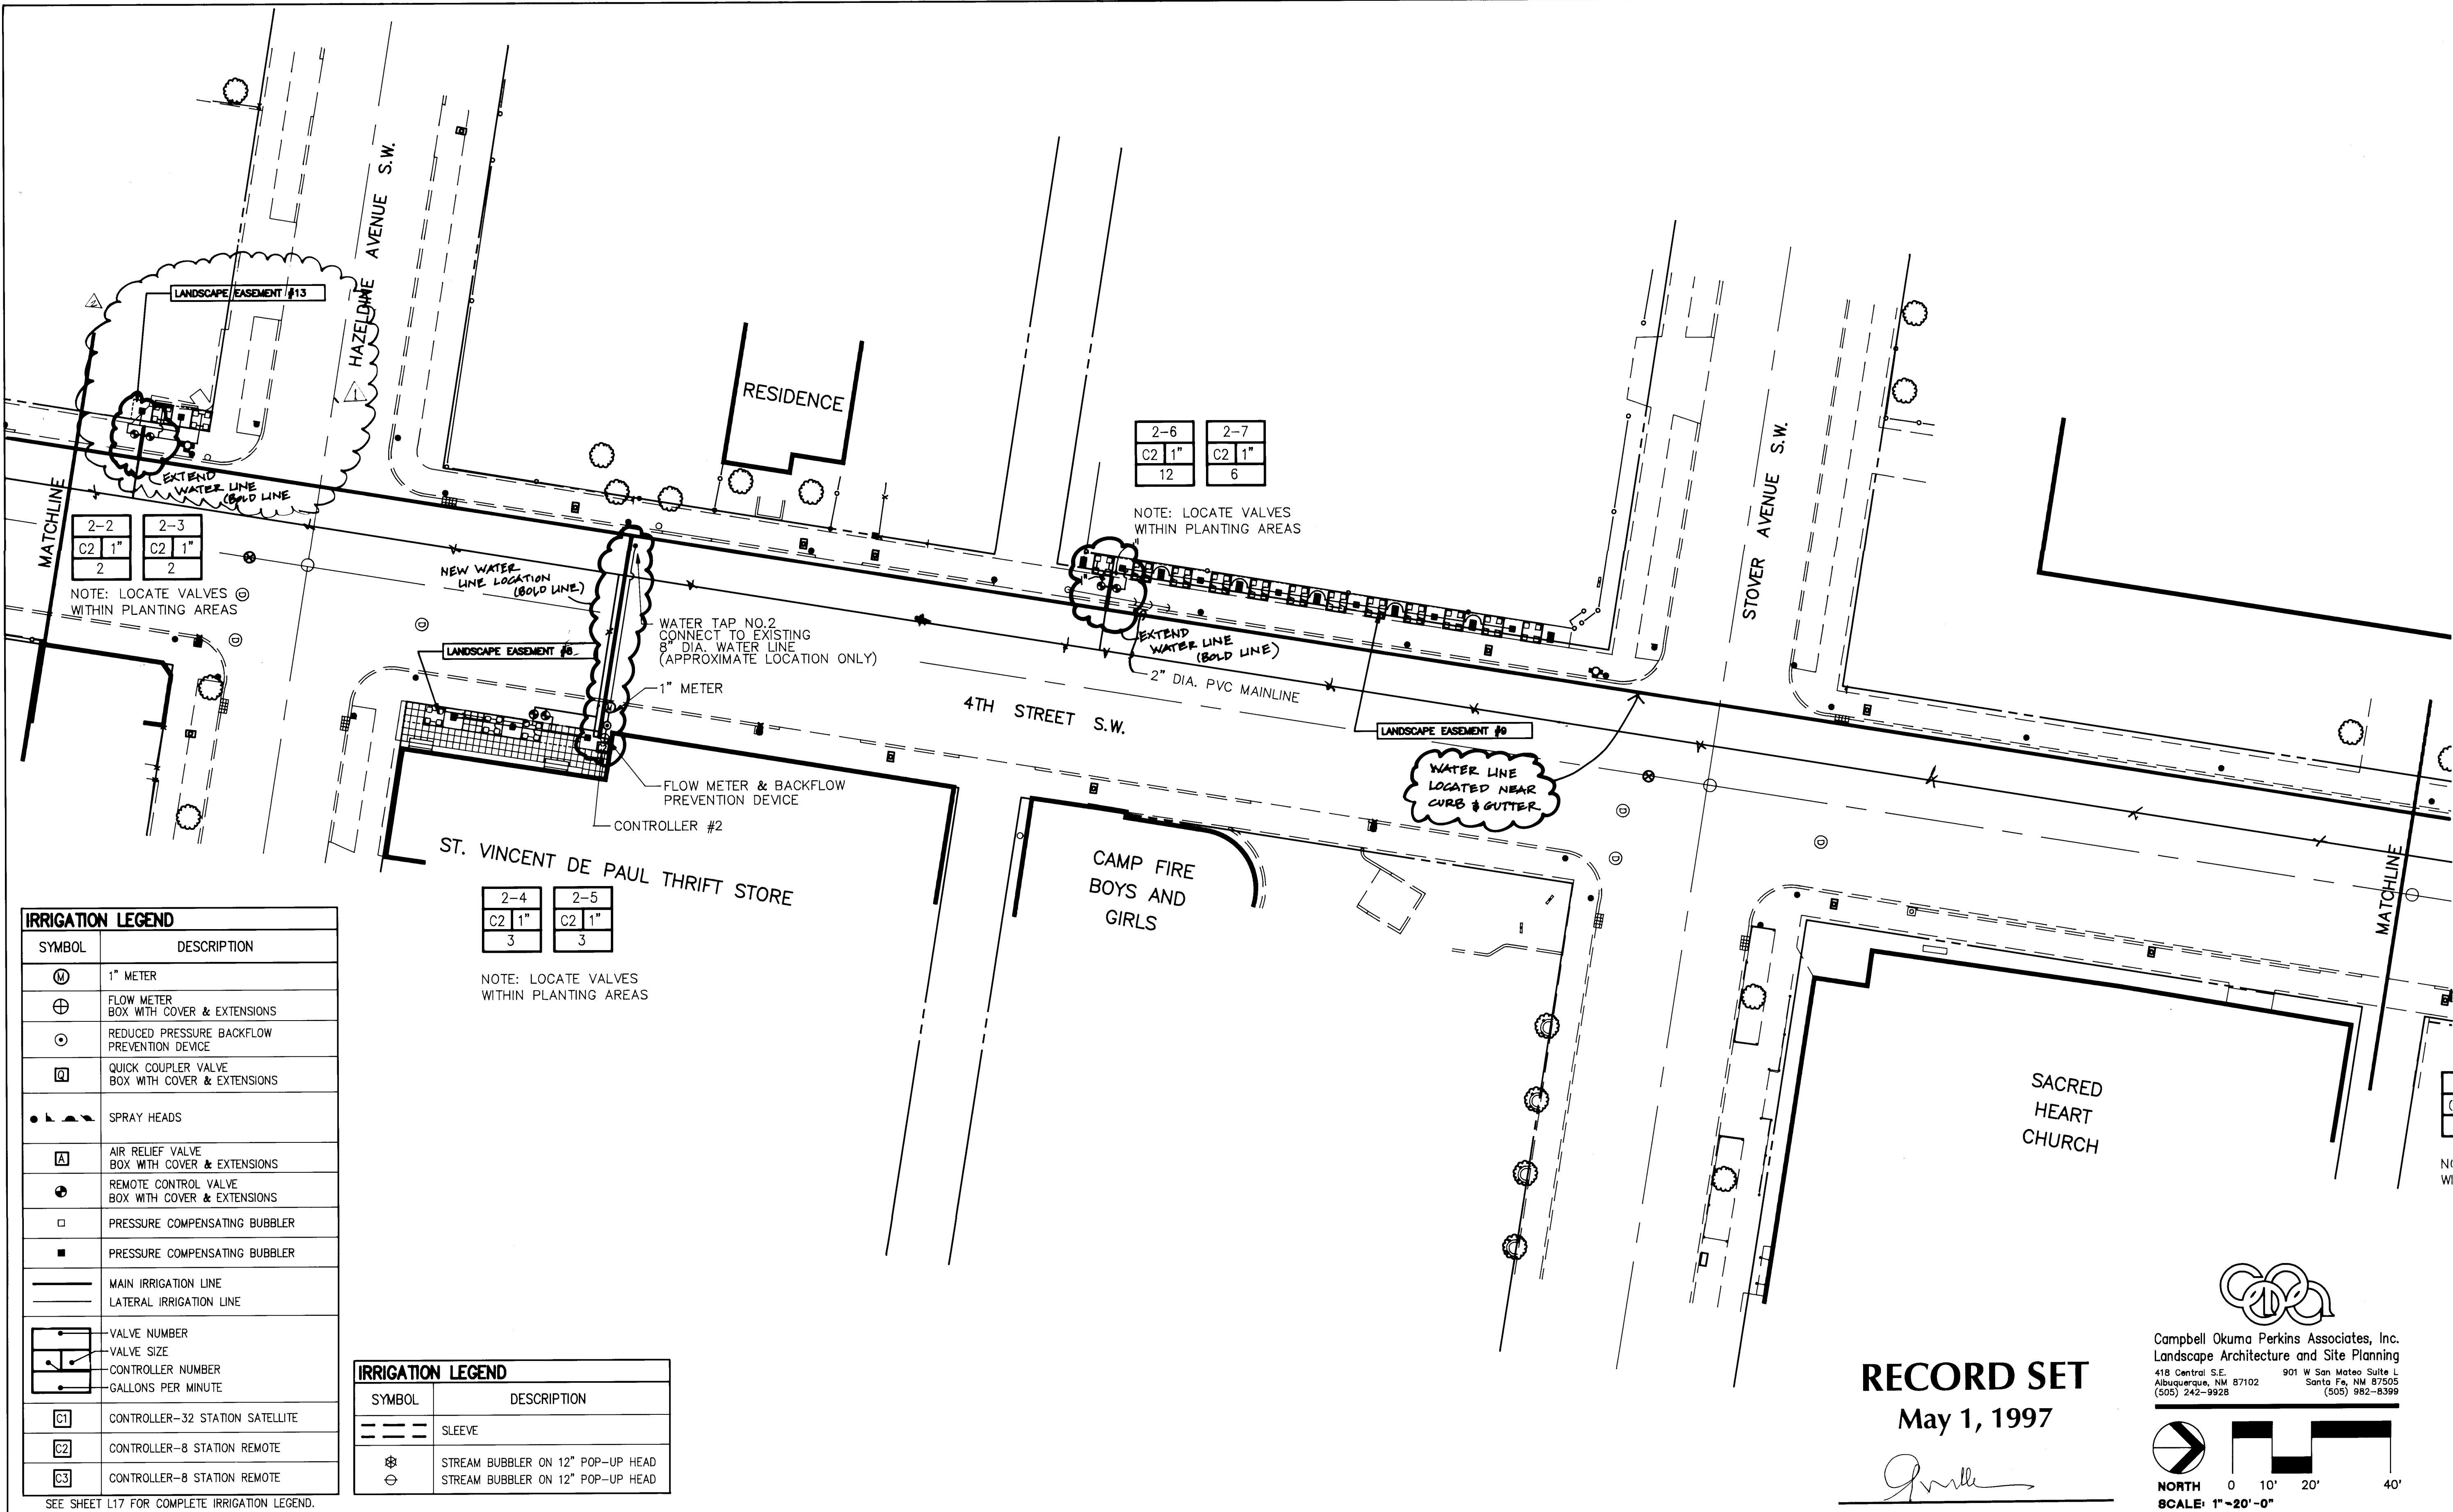

IRRIGATION LEGEND	
SYMBOL	DESCRIPTION
	1" METER
	FLOW METER BOX WITH COVER & EXTENSIONS
	REDUCED PRESSURE BACKFLOW PREVENTION DEVICE
	QUICK COUPLER VALVE BOX WITH COVER & EXTENSIONS
	SPRAY HEADS
	AIR RELIEF VALVE BOX WITH COVER & EXTENSIONS
	REMOTE CONTROL VALVE BOX WITH COVER & EXTENSIONS
	PRESSURE COMPENSATING BUBBLER
	PRESSURE COMPENSATING BUBBLER
	MAIN IRRIGATION LINE
	LATERAL IRRIGATION LINE
	VALVE NUMBER
	VALVE SIZE
	CONTROLLER NUMBER
	GALLONS PER MINUTE
	CONTROLLER-32 STATION SATELLITE
	CONTROLLER-8 STATION REMOTE
	CONTROLLER-8 STATION REMOTE

IRRIGATION LEGEND	
SYMBOL	DESCRIPTION
	SLEEVE
	STREAM BUBBLER ON 12" POP-UP HEAD
	STREAM BUBBLER ON 12" POP-UP HEAD

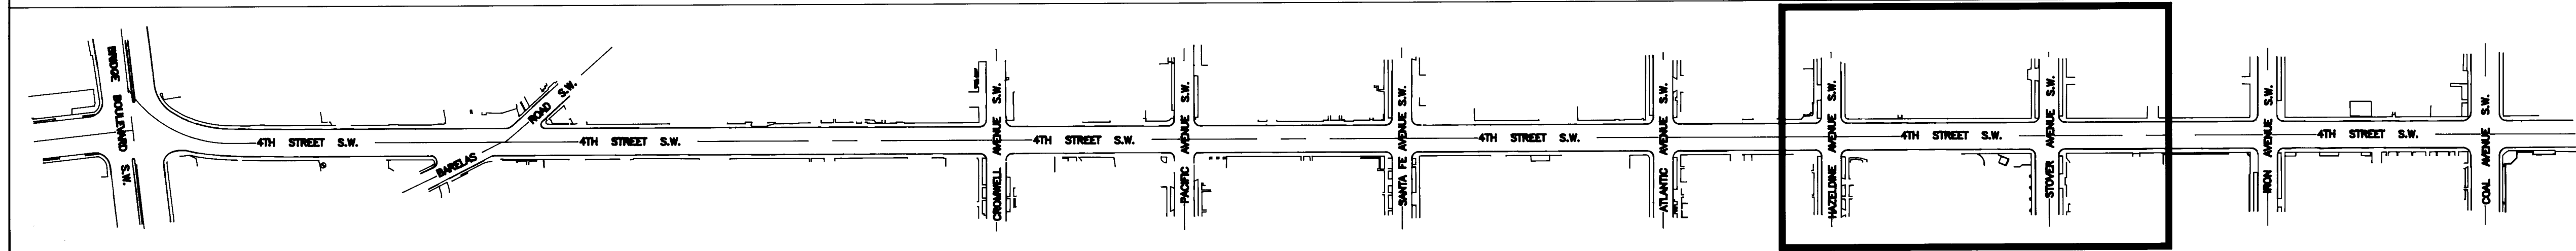

FOURTH STREET STREETSCAPE KEY

RECORD SET
May 1, 1997

Campbell Okuma Perkins Associates, Inc.
Landscape Architecture and Site Planning
418 Central S.E. 901 W. San Mateo Suite 1
Albuquerque, NM 87102 Santa Fe, NM 87505
(505) 242-9928 (505) 982-8399

North arrow and scale bar: 0, 10', 20', 40'.
SCALE: 1"=20'-0"

AS-BUILT INFORMATION		BENCH MARKS		SURVEY INFORMATION		LANDSCAPE ARCHITECT'S SEAL	
CONTRACTOR	DATE	NO.	DATE	NO.	DATE	NO.	DATE
STAMPED BY	DATE						
REVISIONS	DATE						
FIELD	DATE						
REVISIONS	DATE						
CORRECTED BY	DATE						
MICRO-FILM INFORMATION		RECORDED BY		DATE		NO.	

1/22/96 CHANGE ORDER NO. 1
6/18/96 ISSUED FOR CONSTRUCTION
REVISIONS
DESIGN
NO. DATE
DESIGNED BY WSP DATE 8-95
DRAWN BY WBT DATE 8-95
CHECKED BY WSP DATE 10-95-95

SEAL OF NEW MEXICO
LANDSCAPE ARCHITECT
CAMPBELL OKUMA PERKINS ASSOCIATES, INC.

CITY OF ALBUQUERQUE
PUBLIC WORKS DEPARTMENT
ENGINEERING GROUP

TITLE: **FOURTH STREET STREETSCAPE IRRIGATION PLAN**

Design Review Committee	City Engineer Approval	Mo./Day/Yr.	Mo./Day/Yr.
		12/21/95	12/21/95
City Project No.	Zone Map No.	Sheet	Of
4917.90	K14-L14	L6	L19

SCANNED BY BY LASON

SCANNED BY
BY LASON


[illegible]

SEE SHEET L17 FOR COMPLETE PLANT LEGEND.



9 mil



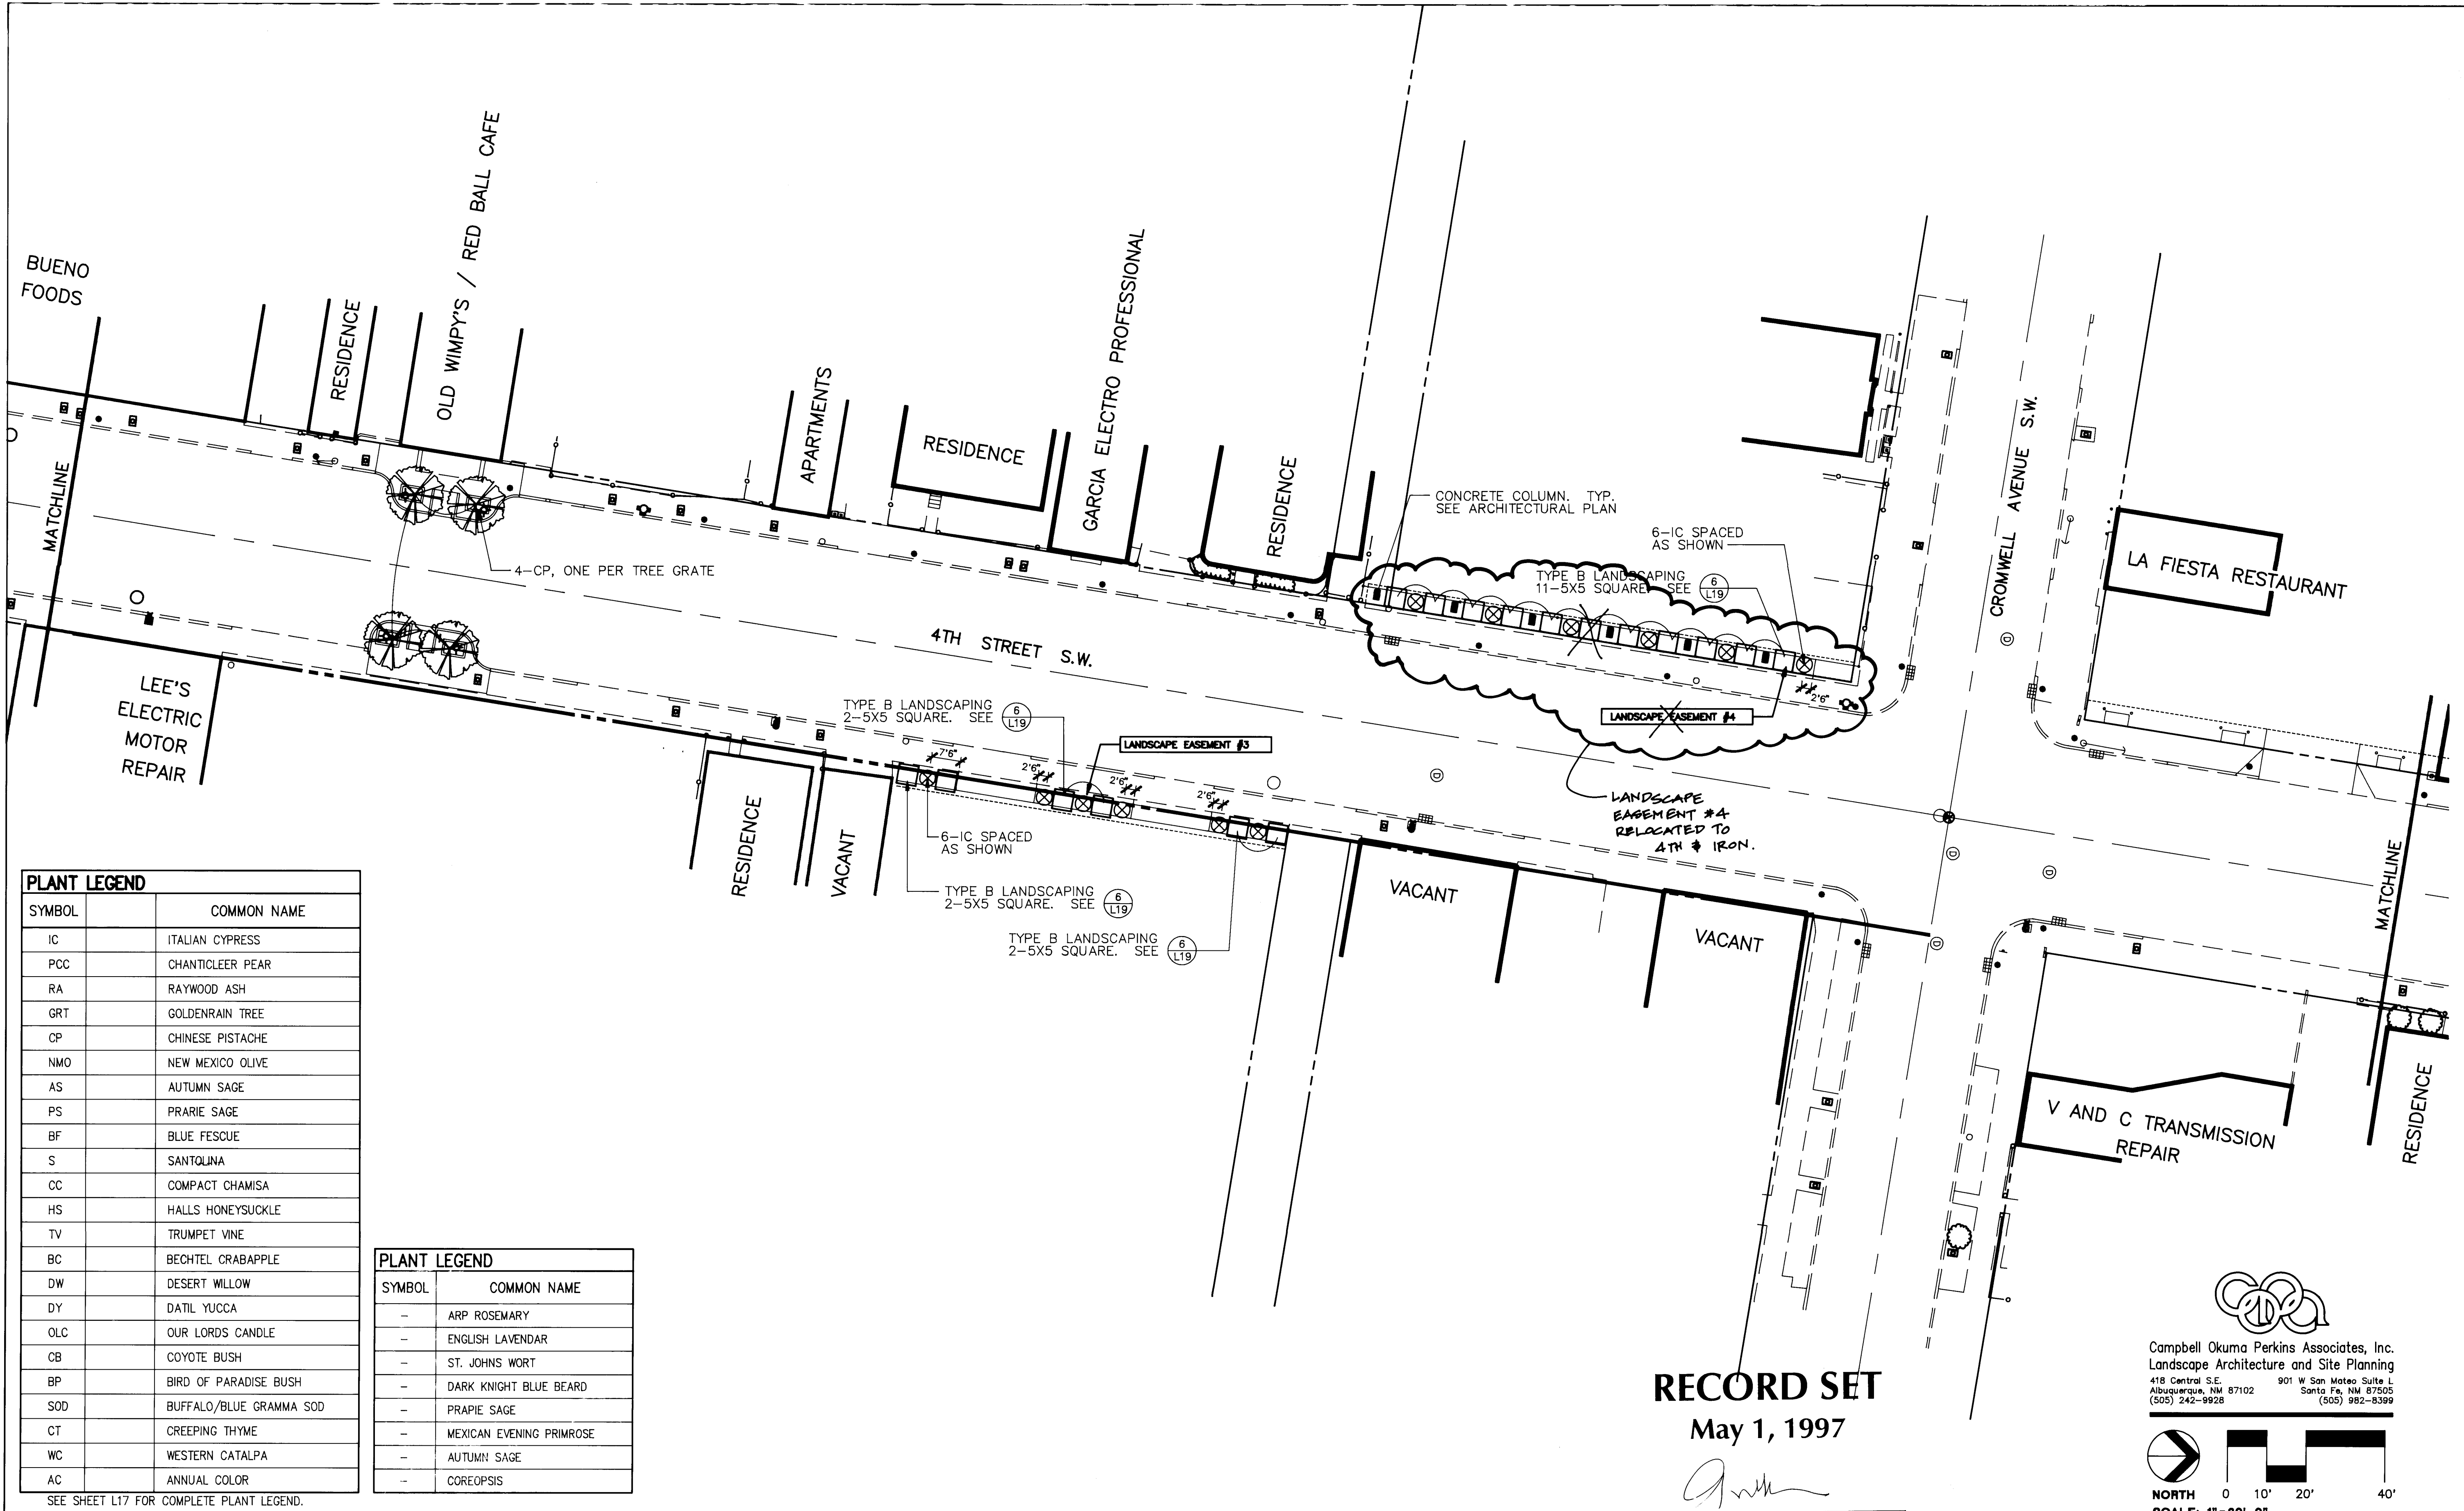

PLANT LEGEND		
SYMBOL		COMMON NAME
IC		ITALIAN CYPRESS
PCC		CHANTICLEER PEAR
RA		RAYWOOD ASH
GRT		GOLDENRAIN TREE
CP		CHINESE PISTACHE
NMO		NEW MEXICO OLIVE
AS		AUTUMN SAGE
PS		PRARIE SAGE
BF		BLUE FESCUE
S		SANTOLINA
CC		COMPACT CHAMISA
HS		HALLS HONEYSUCKLE
TV		TRUMPET VINE
BC		BECHTEL CRABAPPLE
DW		DESERT WILLOW
DY		DATIL YUCCA
OLC		OUR LORDS CANDLE
CB		COYOTE BUSH
BP		BIRD OF PARADISE BUSH
SOD		BUFFALO/BLUE GRAMMA SOD
CT		CREeping THYME
WC		WESTERN CATALPA
AC		ANNUAL COLOR

PLANT LEGEND	
SYMBOL	COMMON NAME
-	ARP ROSEMARY
-	ENGLISH LAVENDAR
-	ST. JOHNS WORT
-	DARK KNIGHT BLUE BEARD
-	PRARIE SAGE
-	MEXICAN EVENING PRIMROSE
-	AUTUMN SAGE
-	COREOPSIS


SEE SHEET L17 FOR COMPLETE PLANT LEGEND.

RECORD SET
May 1, 1997

Campbell Okuma Perkins Associates, Inc.
Landscape Architecture and Site Planning
418 Central S.E. Albuquerque, NM 87102
(505) 242-9928

901 W San Mateo Suite L Santa Fe, NM 87505
(505) 982-8399

NORTH
SCALE: 1"=20'-0"

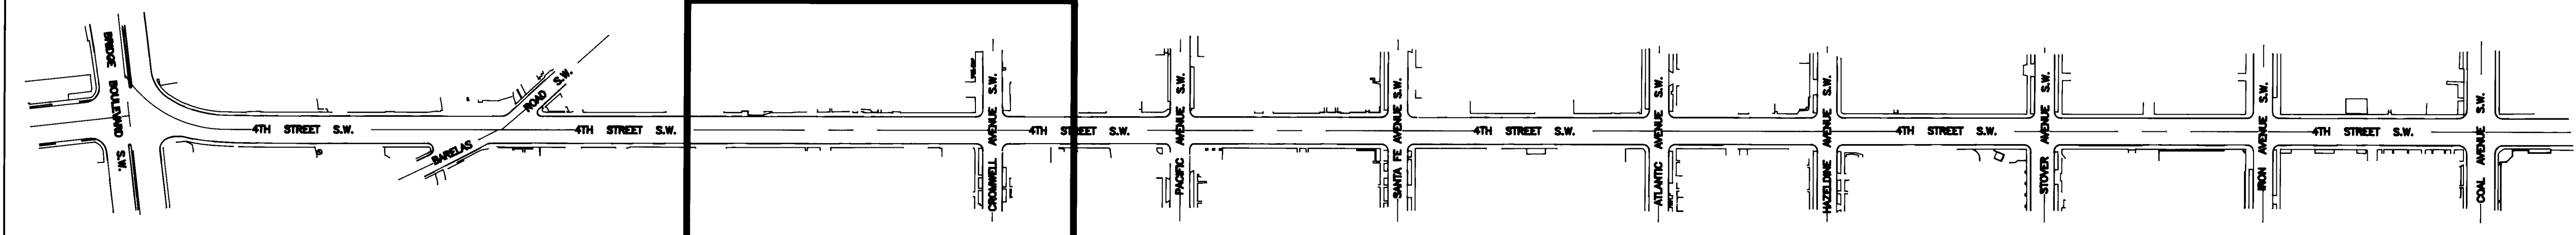

FOURTH STREET STREETSCAPE KEY

CITY OF ALBUQUERQUE PUBLIC WORKS DEPARTMENT ENGINEERING GROUP			
TITLE: FOURTH STREET STREETSCAPE PLANTING PLAN			
Design Review Committee	City Engineer Approval	Mo./Day/Yr.	
City Project No.	Zone Map No.	Sheet	Of
4917.90	K14-L14	L11	L19

AS-BUILT INFORMATION		BENCH MARKS		SURVEY INFORMATION		LANDSCAPE ARCHITECT'S SEAL	
CONTRACTOR	DATE			FIELD NOTES	DATE		
INSPECTOR'S	DATE			BY			
FIELD VERIFICATION	DATE			NO.			
DESIGNED BY	DATE						
DRAWN BY	DATE						
CHECKED BY	DATE						


ISSUED FOR CONSTRUCTION	BY
NO.	DATE
1	12/21/95
REVISIONS	DESIGN
DESIGNED BY	DATE
DRAWN BY	DATE
CHECKED BY	DATE

SCANNED BY
BY LASON

PLANT LEGEND		
SYMBOL		COMMON NAME
IC		ITALIAN CYPRESS
PCC		CHANTICLEER PEAR
RA		RAYWOOD ASH
GRT		GOLDENRAIN TREE
CP		CHINESE PISTACHE
NMO		NEW MEXICO OLIVE
AS		AUTUMN SAGE
PS		PRARIE SAGE
BF		BLUE FESCUE
S		SANTOLINA
CC		COMPACT CHAMISA
HS		HALLS HONEYSUCKLE
TV		TRUMPET VINE
BC		BECHTEL CRABAPPLE
DW		DESERT WILLOW
DY		DATIL YUCCA
OLC		OUR LORDS CANDLE
CB		COYOTE BUSH
BP		BIRD OF PARADISE BUSH
SOD		BUFFALO/BLUE GRAMMA SOD
CT		CREEPING THYME
WC		WESTERN CATALPA
AC		ANNUAL COLOR

SEE SHEET L17 FOR COMPLETE PLANT LEGEND.

PLANT LEGEND	
SYMBOL	COMMON NAME
-	ARP ROSEMARY
-	ENGLISH LAVENDAR
-	ST. JOHNS WORT
-	DARK KNIGHT BLUE BEARD
-	PRARIE SAGE
-	MEXICAN EVENING PRIMROSE
-	AUTUMN SAGE
-	COREOPSIS
-	APACHE PLUME
-	DUSTY MILLER

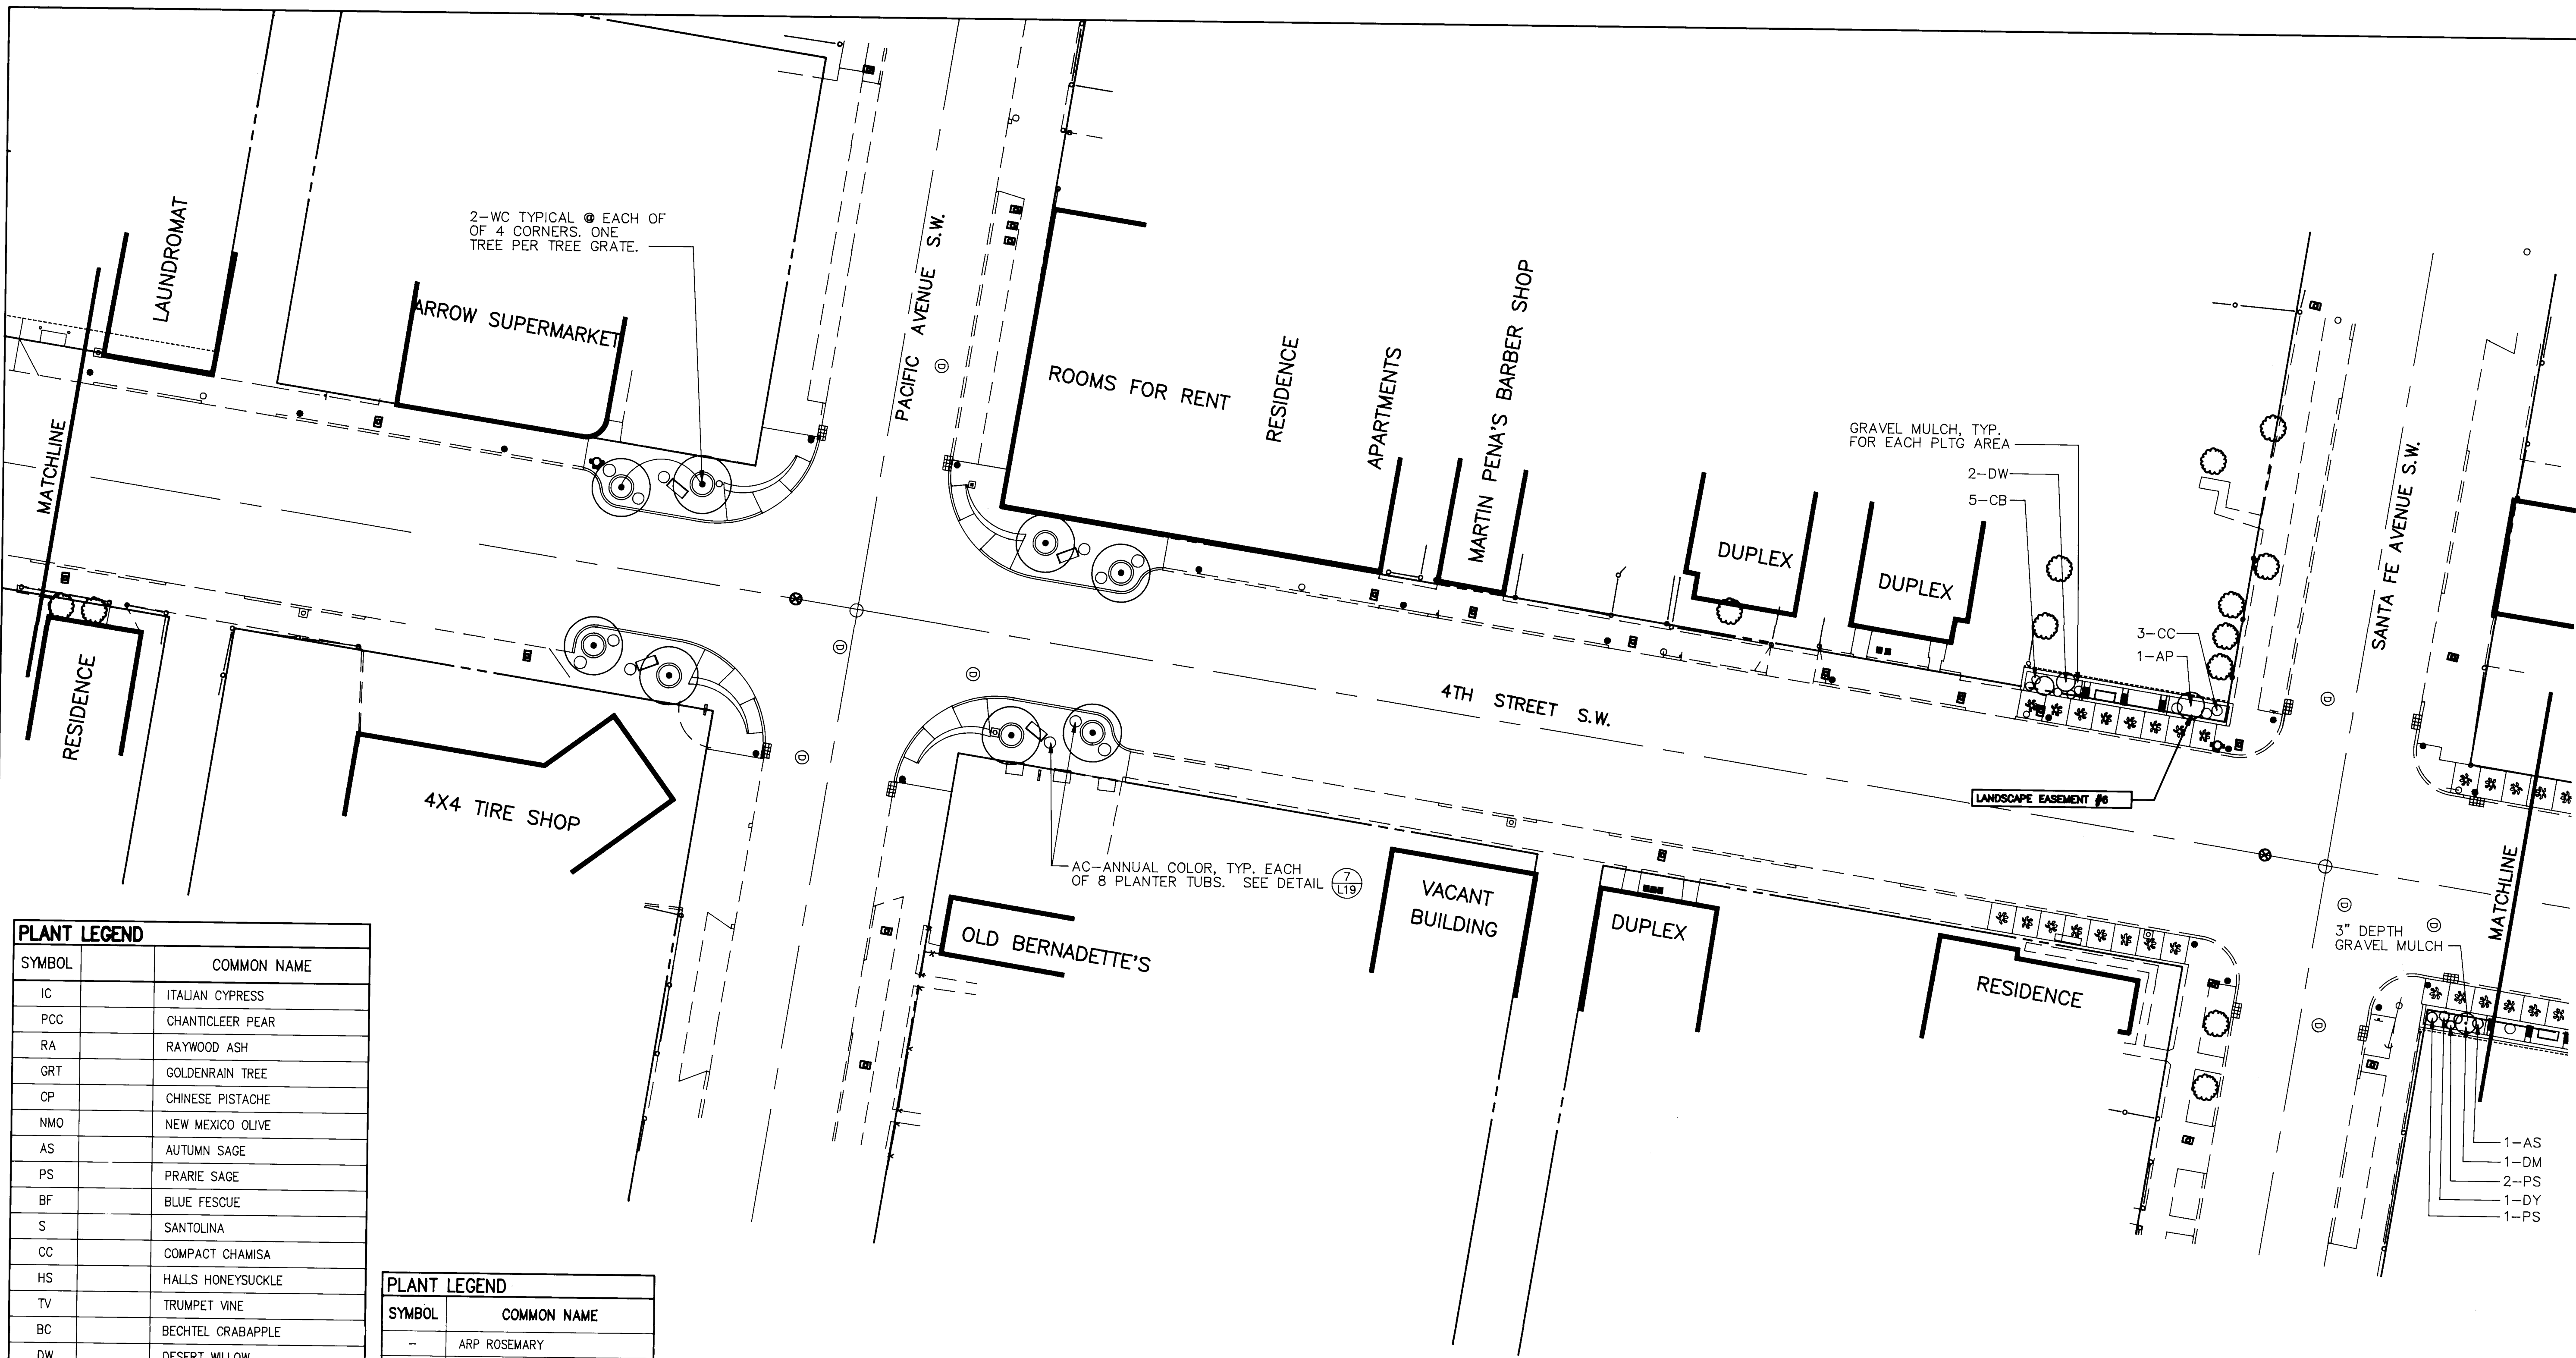


RECORD SET
May 1, 1997

[Signature]

Campbell Okuma Perkins Associates, Inc.
Landscape Architecture and Site Planning
418 Central S.E. Albuquerque, NM 87102 (505) 242-8928
901 W San Mateo Suite L Santa Fe, NM 87505 (505) 982-8399

SCALE: 1"=20'-0"

NORTH

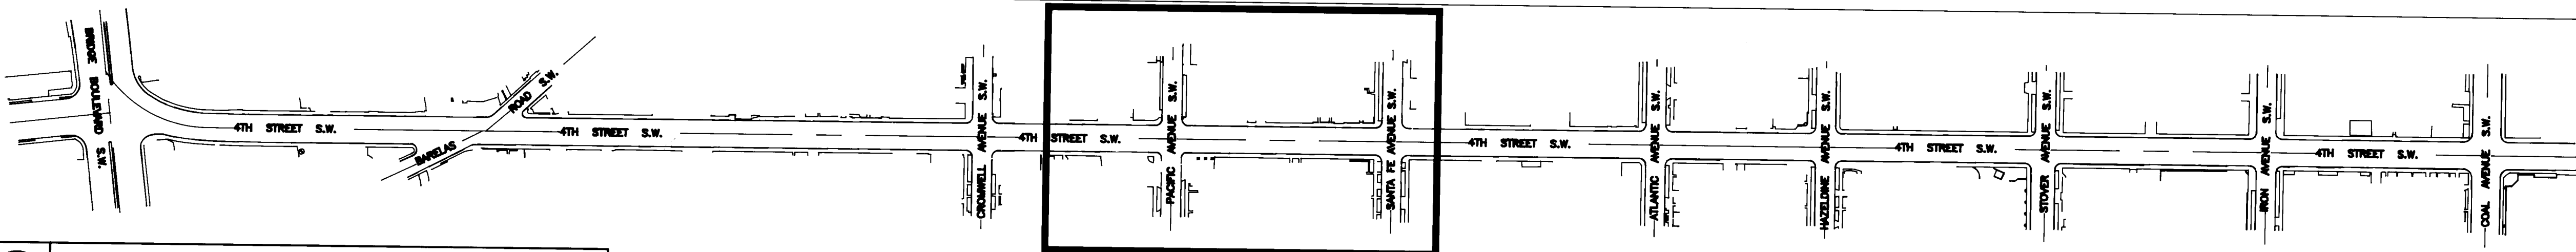

FOURTH STREET STREETScape KEY

**CITY OF ALBUQUERQUE
PUBLIC WORKS DEPARTMENT
ENGINEERING GROUP**


TITLE: FOURTH STREET STREETScape PLANTING PLAN


Design Review Committee	City Engineer Approval	Mo./Day/Yr.	Mo./Day/Yr.
<i>[Signature]</i> 12/21/95	<i>[Signature]</i> 12/21/95		
City Project No. 4917.90	Zone Map No. K14-L14	Sheet L12 Of L19	

DESIGNED BY WSP
DRAWN BY WSP
CHECKED BY WSP

REVISIONS
NO. DATE
1 12/21/95

AS-BUILT INFORMATION		BENCH MARKS		SURVEY INFORMATION		FIELD NOTES		LANDSCAPE ARCHITECT'S SEAL	
CONTRACTOR	DATE	NO.	DATE	NO.	DATE	NO.	DATE	NO.	DATE
WORK BY C.D.A.	DATE 4/92								
DESIGNED BY Lenny Ramirez	DATE 4/97								
FIELD CHECKED BY C.D.A.	DATE 4/97								
REVISIONS	DATE								
CORRECTED BY A.U.	DATE 5/98								
MICRO-FILM INFORMATION									
RECORDED BY	DATE								
NO.									

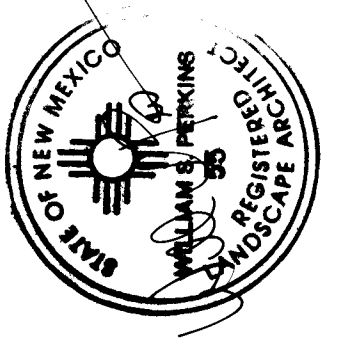

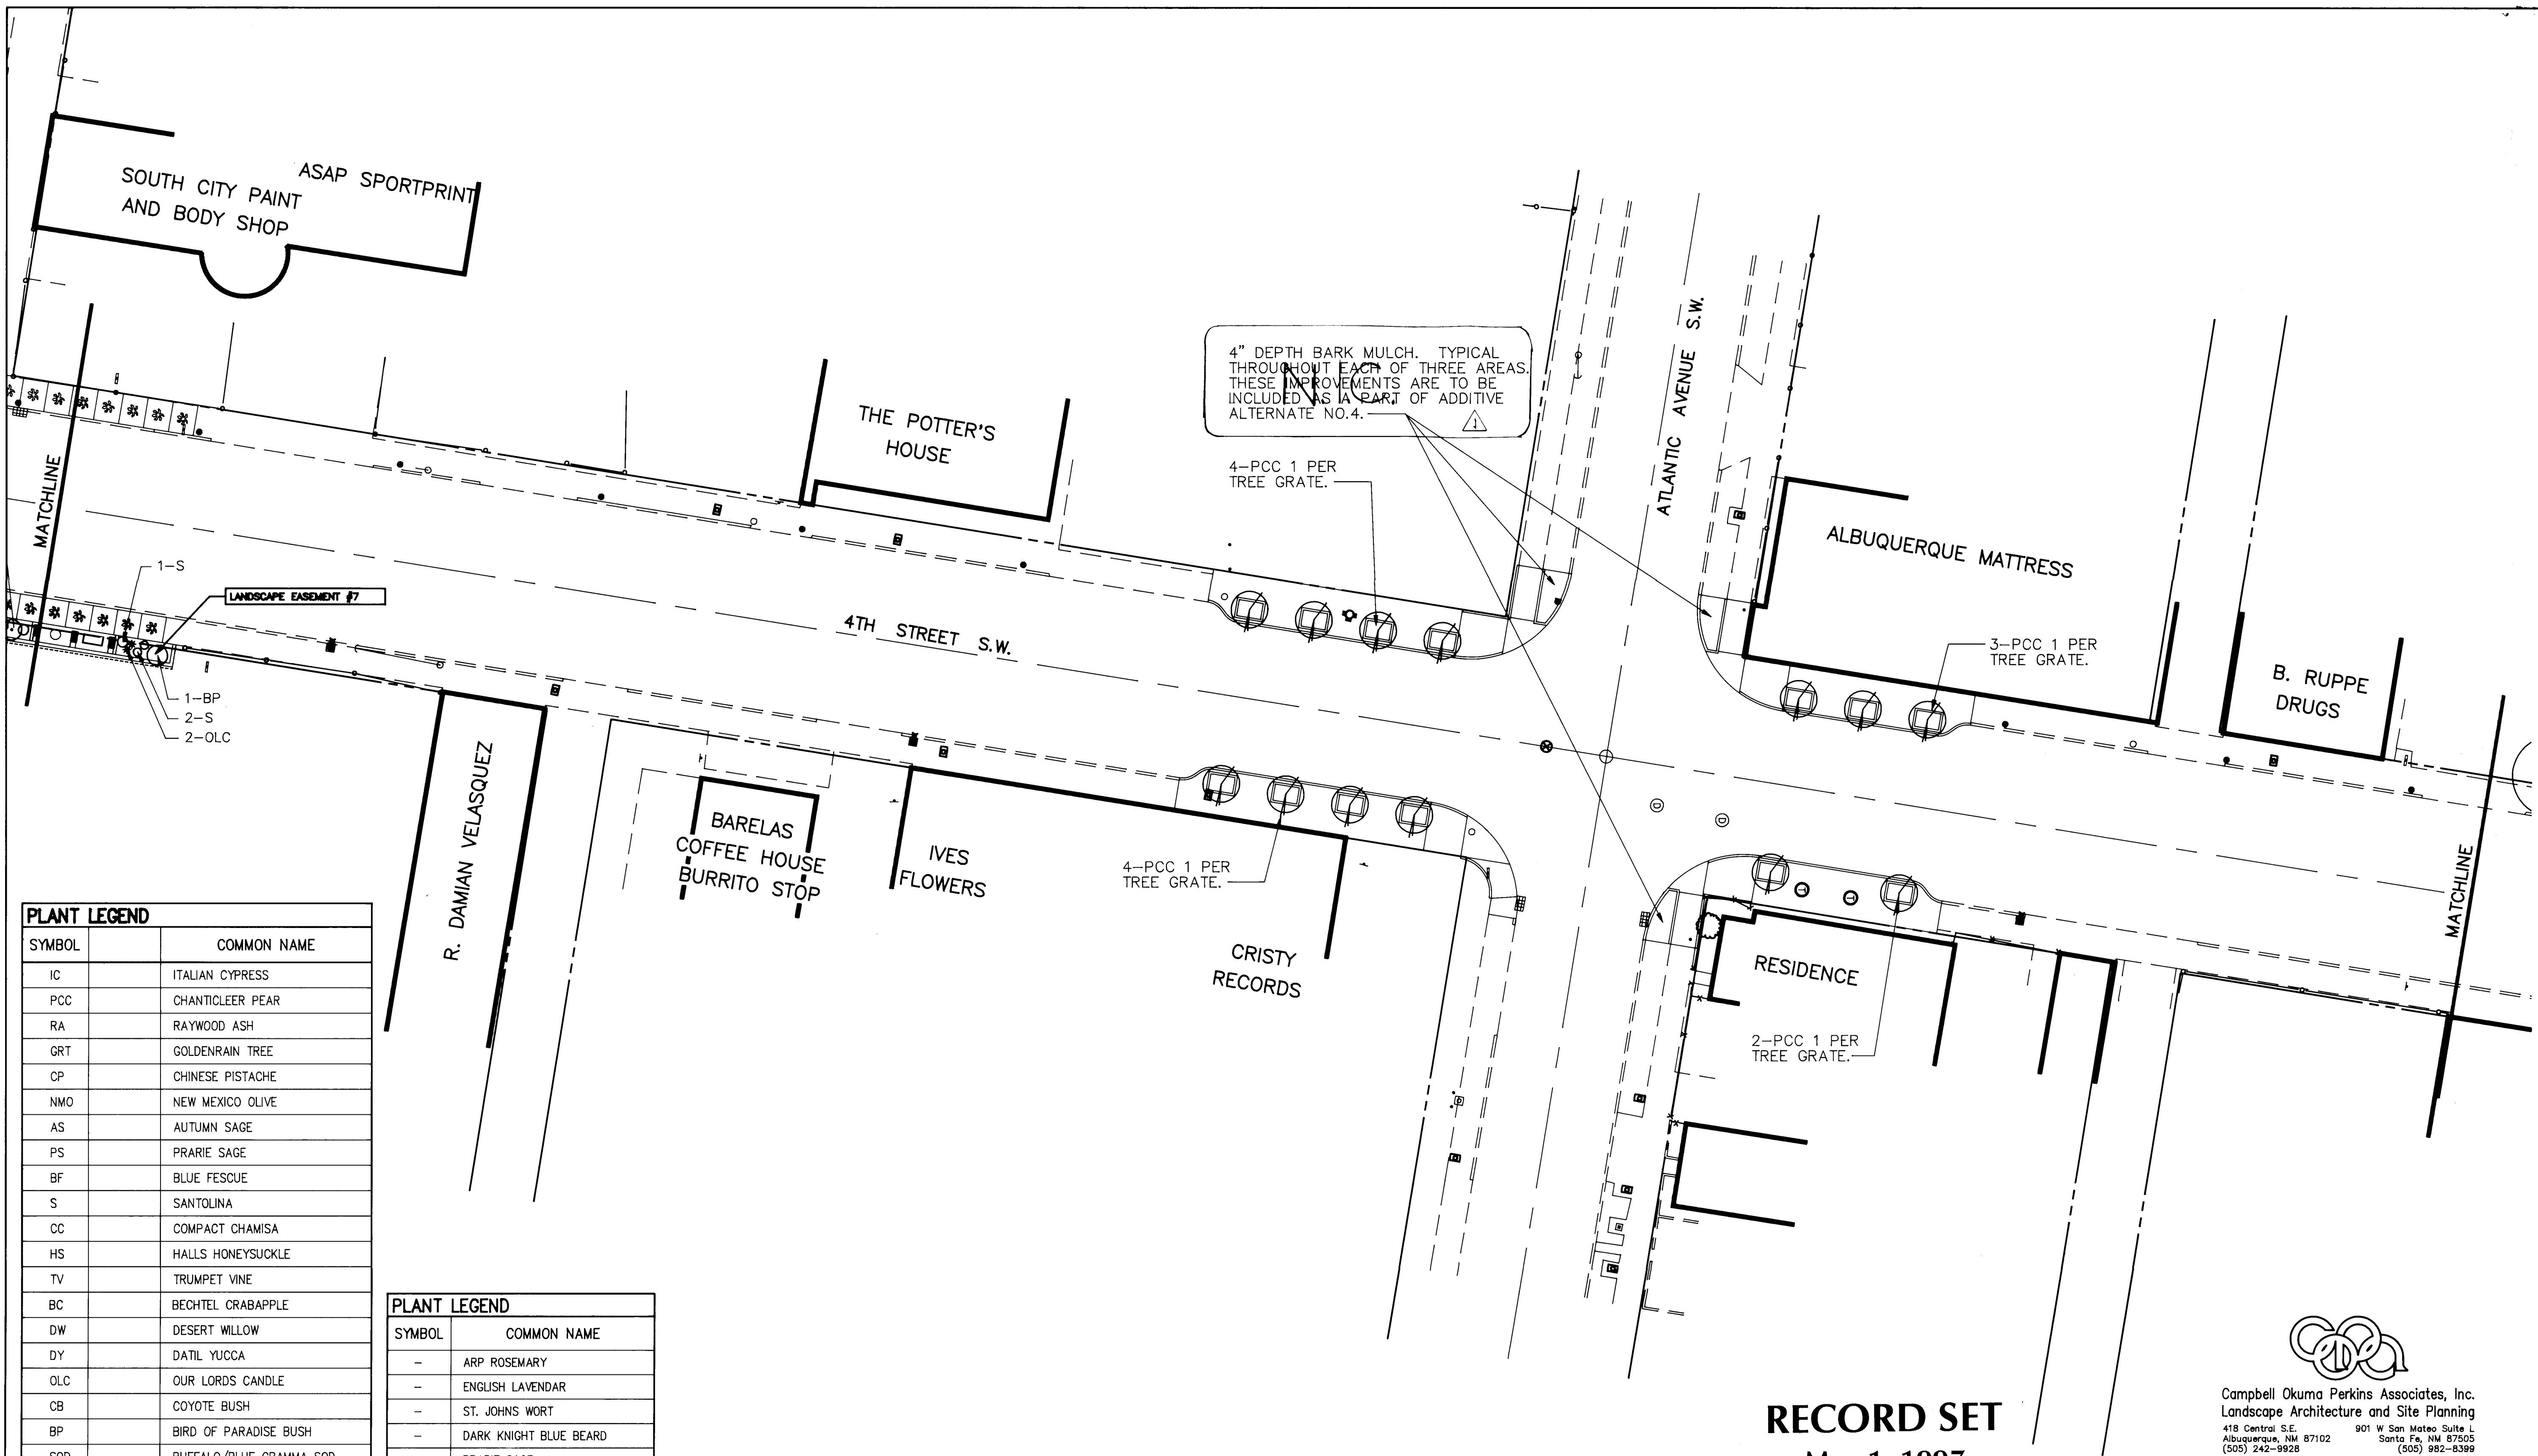


PLANT LEGEND		
SYMBOL		COMMON NAME
IC		ITALIAN CYPRESS
PCC		CHANTICLEER PEAR
RA		RAYWOOD ASH
GRT		GOLDENRAIN TREE
CP		CHINESE PISTACHE
NMO		NEW MEXICO OLIVE
AS		AUTUMN SAGE
PS		PRARIE SAGE
BF		BLUE FESCUE
S		SANTOLINA
CC		COMPACT CHAMISA
HS		HALLS HONEYSUCKLE
TV		TRUMPET VINE
BC		BECHTEL CRABAPPLE
DW		DESERT WILLOW
DY		DATIL YUCCA
OLC		OUR LORDS CANDLE
CB		COYOTE BUSH
BP		BIRD OF PARADISE BUSH
SOD		BUFFALO/BLUE GRAMMA SOD
CT		CREEPING THYME
WC		WESTERN CATALPA
AC		ANNUAL COLOR

PLANT LEGEND	
SYMBOL	COMMON NAME
-	ARP ROSEMARY
-	ENGLISH LAVENDAR
-	ST. JOHNS WORT
-	DARK KNIGHT BLUE BEARD
-	PRARIE SAGE
-	MEXICAN EVENING PRIMROSE
-	AUTUMN SAGE
-	COREOPSIS


SEE SHEET L17 FOR COMPLETE PLANT LEGEND.

RECORD SET
May 1, 1997

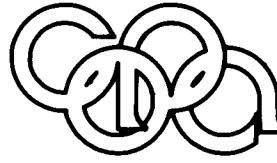


Campbell Okuma Perkins Associates, Inc.
Landscape Architecture and Site Planning
418 Central S.E. Albuquerque, NM 87102
(505) 242-9928

901 W. San Mateo Suite L Santa Fe, NM 87505
(505) 982-8399

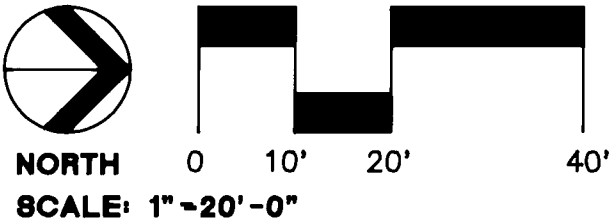


NORTH
SCALE: 1"=20'-0"

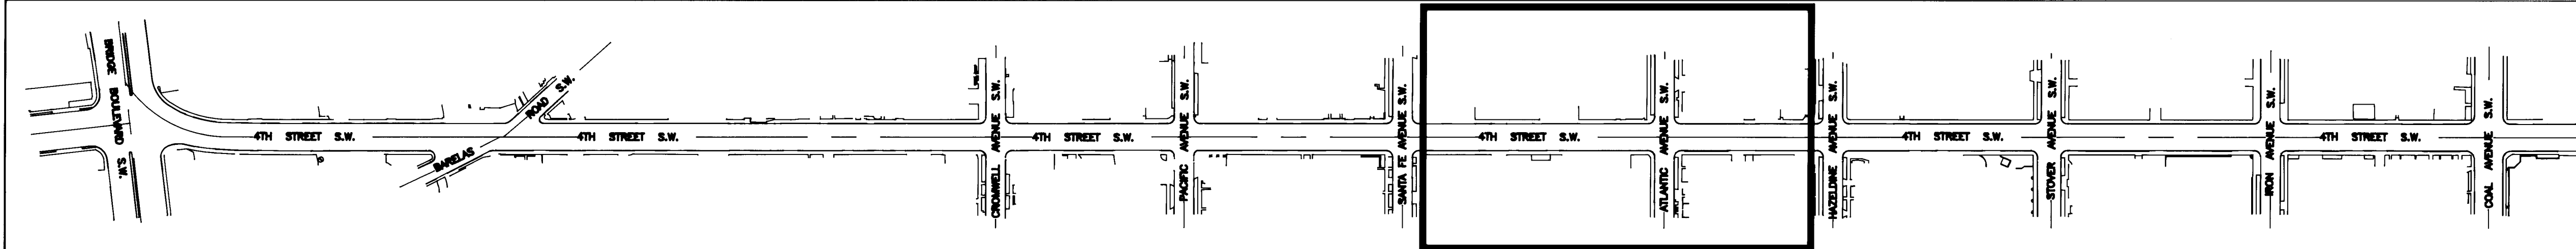

CITY OF ALBUQUERQUE PUBLIC WORKS DEPARTMENT ENGINEERING GROUP			
TITLE: FOURTH STREET STREETScape PLANTING PLAN			
Design Review Committee	City Engineer Approval	Mo./Day/Yr.	
<i>[Signature]</i>	<i>[Signature]</i>		
City Project No.	Zone Map No.	Sheet	Of
4917.90	K14-L14	L13	L19

AS-BUILT INFORMATION		BENCH MARKS		SURVEY INFORMATION		LANDSCAPE ARCHITECT'S SEAL	
CONTRACTOR	DATE	NO.	DATE	NO.	DATE	NO.	DATE
INSPECTOR'S	DATE						
STATIONED BY	DATE						
REVISIONS	DATE						
DESIGNED BY	DATE						
DRAWN BY	DATE						
CHECKED BY	DATE						

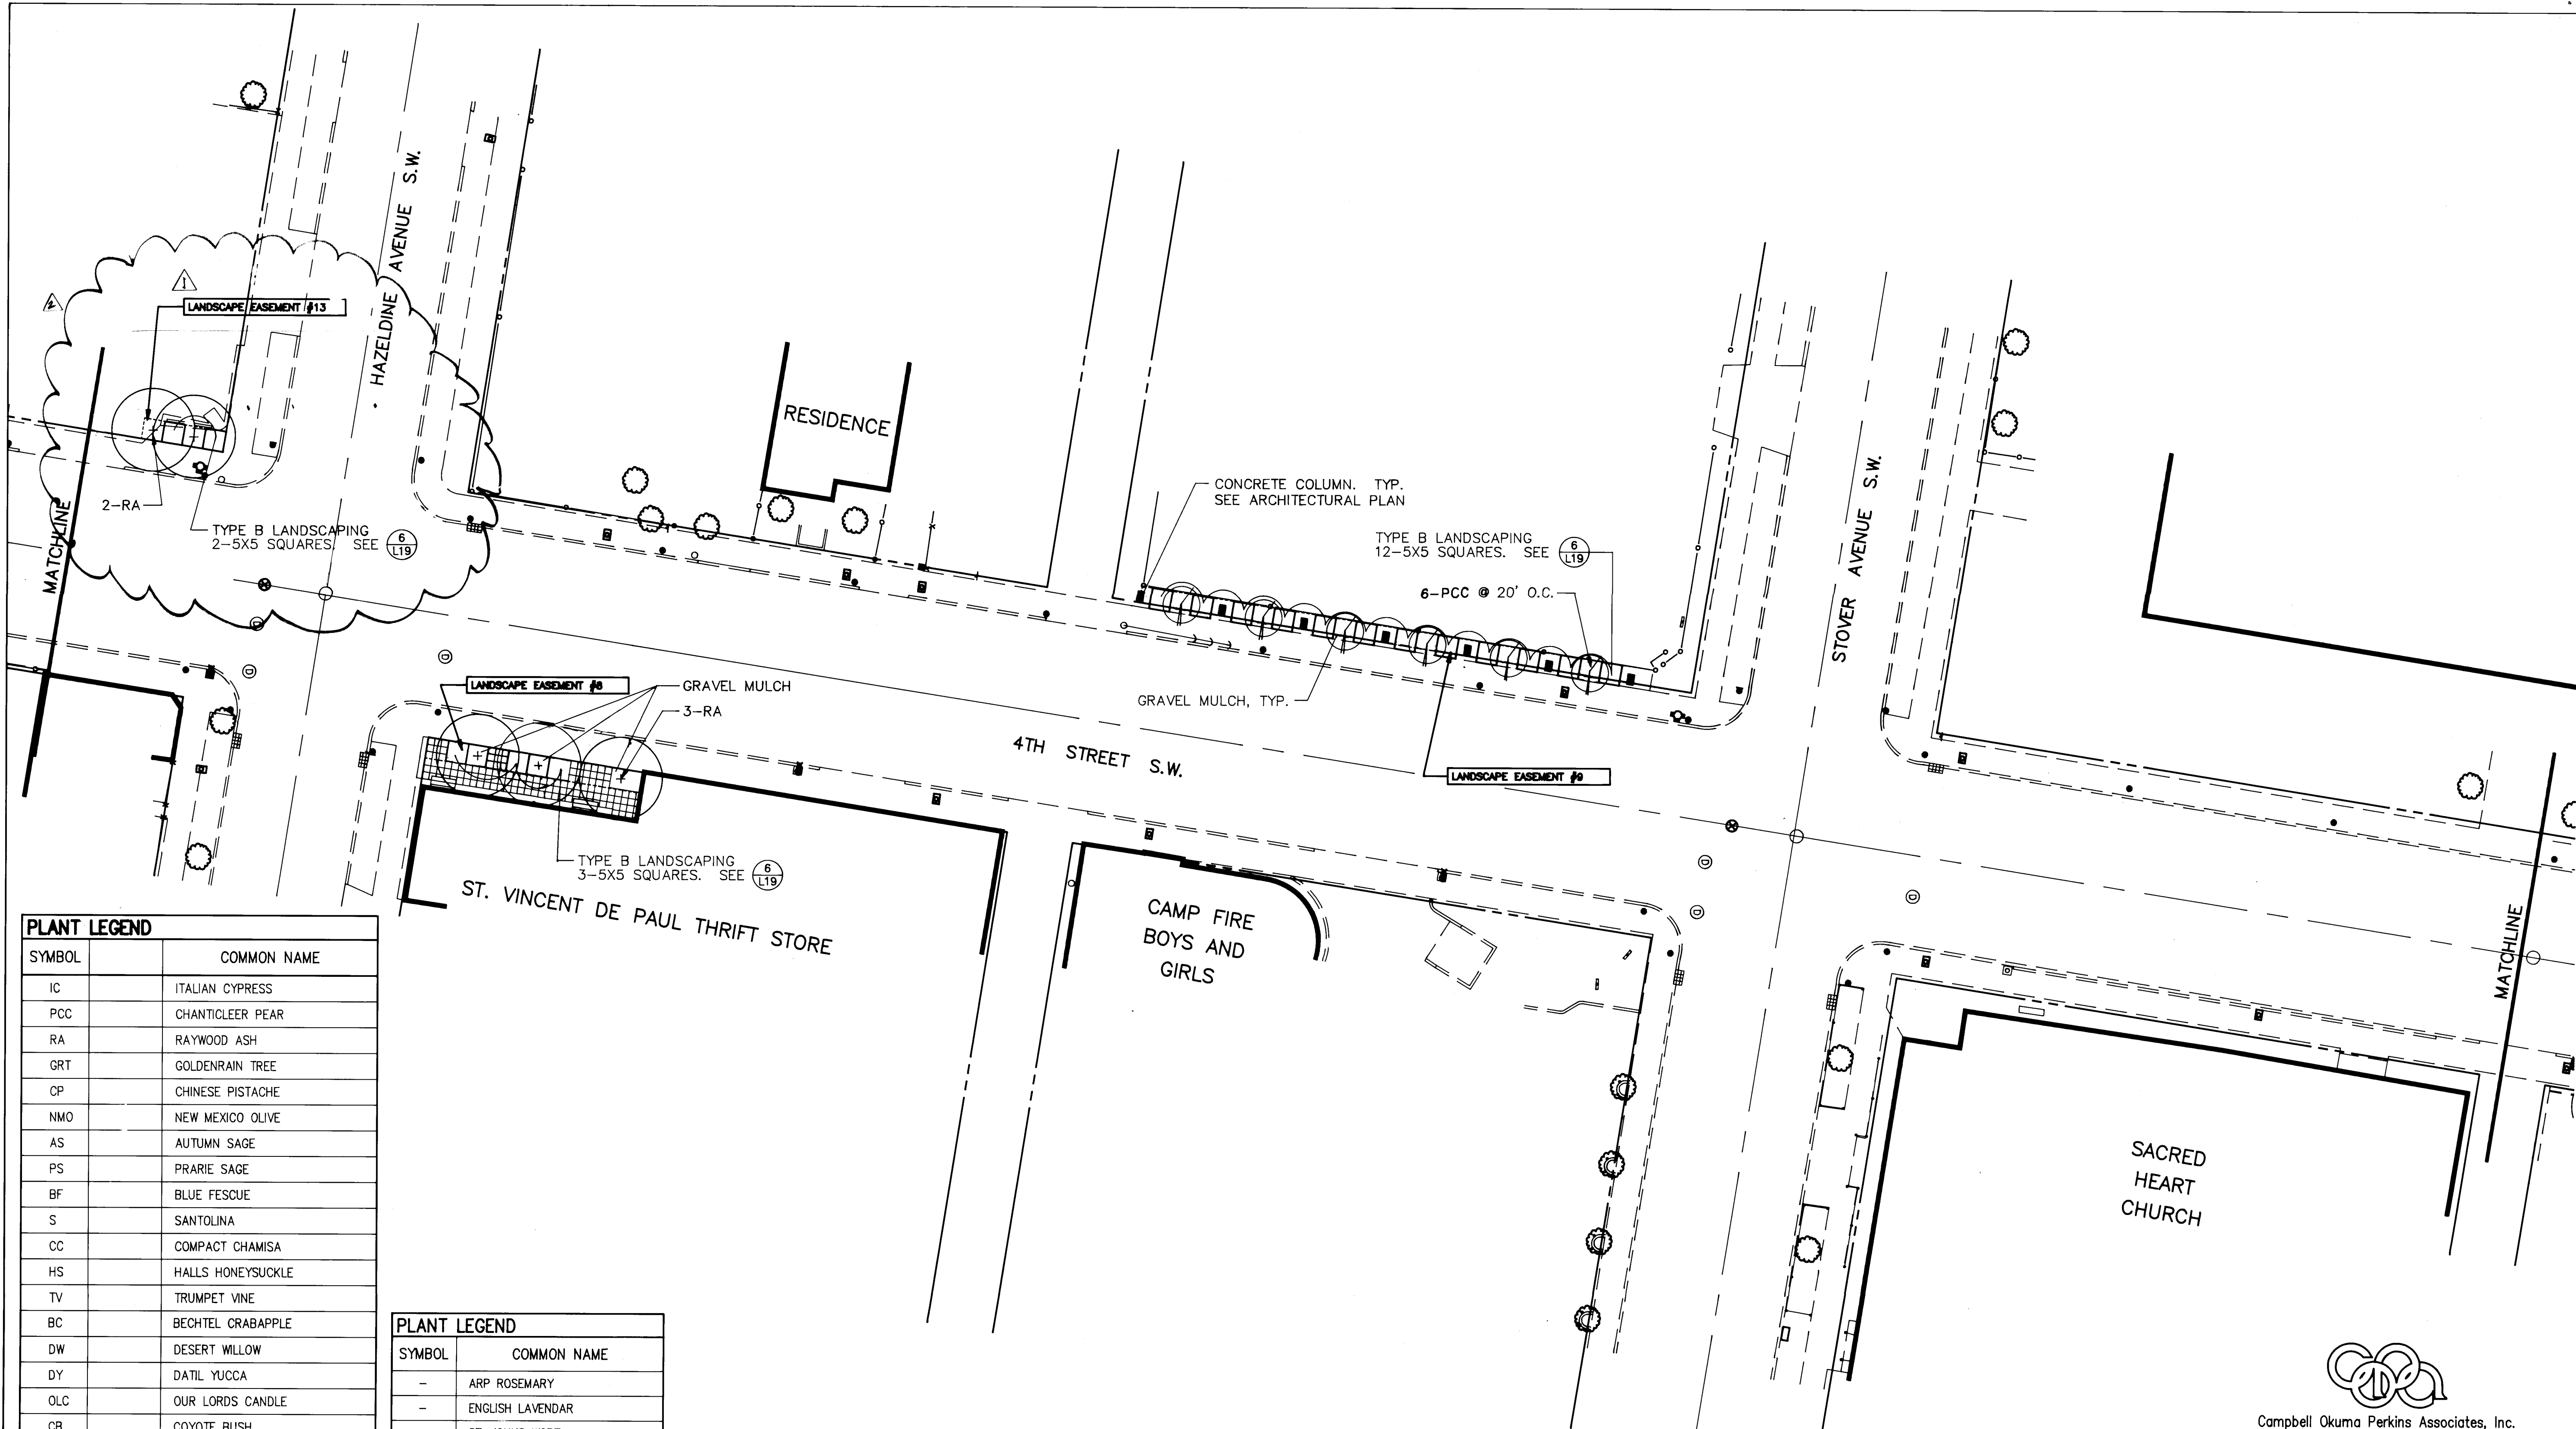


PLANT LEGEND		
SYMBOL		COMMON NAME
IC		ITALIAN CYPRESS
PCC		CHANTICLEER PEAR
RA		RAYWOOD ASH
GRT		GOLDENRAIN TREE
CP		CHINESE PISTACHE
NMO		NEW MEXICO OLIVE
AS		AUTUMN SAGE
PS		PRARIE SAGE
BF		BLUE FESCUE
S		SANTOLINA
CC		COMPACT CHAMISA
HS		HALLS HONEYSUCKLE
TV		TRUMPET VINE
BC		BECHTEL CRABAPPLE
DW		DESERT WILLOW
DY		DATIL YUCCA
OLC		OUR LORDS CANDLE
CB		COYOTE BUSH
BP		BIRD OF PARADISE BUSH
SOD		BUFFALO/BLUE GRAMMA SOD
CT		CREEPING THYME
WC		WESTERN CATALPA
AC		ANNUAL COLOR

PLANT LEGEND	
SYMBOL	COMMON NAME
-	ARP ROSEMARY
-	ENGLISH LAVENDAR
-	ST. JOHNS WORT
-	DARK KNIGHT BLUE BEARD
-	PRARIE SAGE
-	MEXICAN EVENING PRIMROSE
-	AUTUMN SAGE
-	COREOPSIS


SEE SHEET L17 FOR COMPLETE PLANT LEGEND.

RECORD SET
May 1, 1997

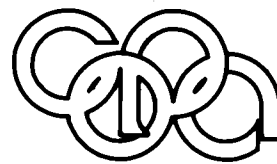

Campbell Okuma Perkins Associates, Inc.
Landscape Architecture and Site Planning
418 Central S.E. Albuquerque, NM 87102
(505) 242-9928


901 W San Mateo Suite L Santa Fe, NM 87505
(505) 982-8399

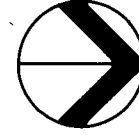

NORTH




SCALE: 1"=20'-0"

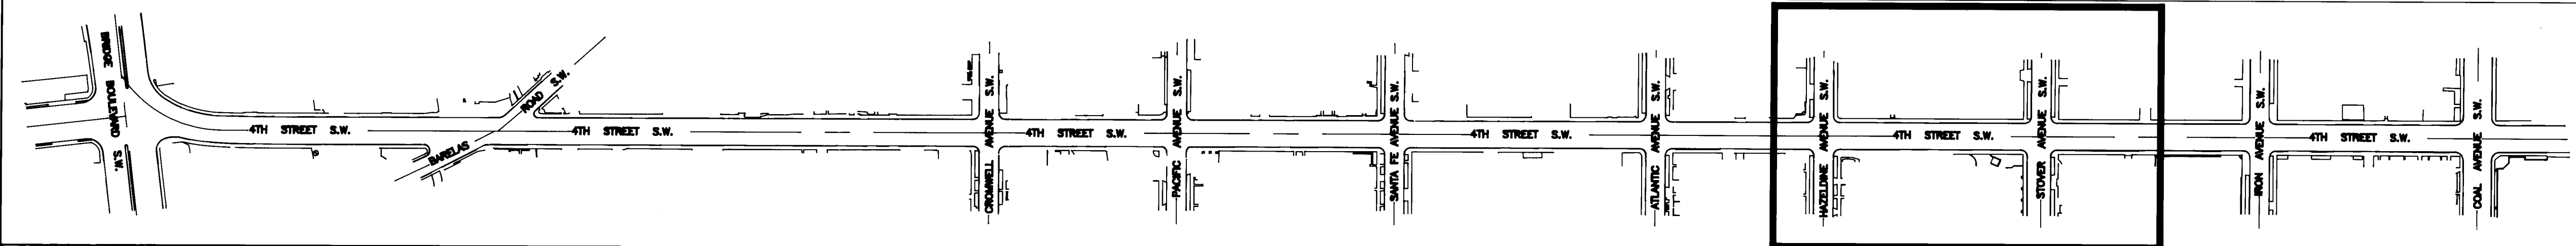

FOURTH STREET STREETSCAPE KEY

SCANNED BY
BY LASON

AS-BUILT INFORMATION		BENCH MARKS		SURVEY INFORMATION		LANDSCAPE ARCHITECT'S SEAL	
CONTRACTOR				FIELD BY	DATE		
WORKS BY	C.O.A.			NO.			
INSPECTED BY	DATE 4/97						
ACCEPTANCE BY	DATE 4/97						
VERIFICATION BY	DATE 4/97						
DRAWING BY	DATE 4/97						
RECORD BY	DATE 4/97						
MICRO-FILM INFORMATION							

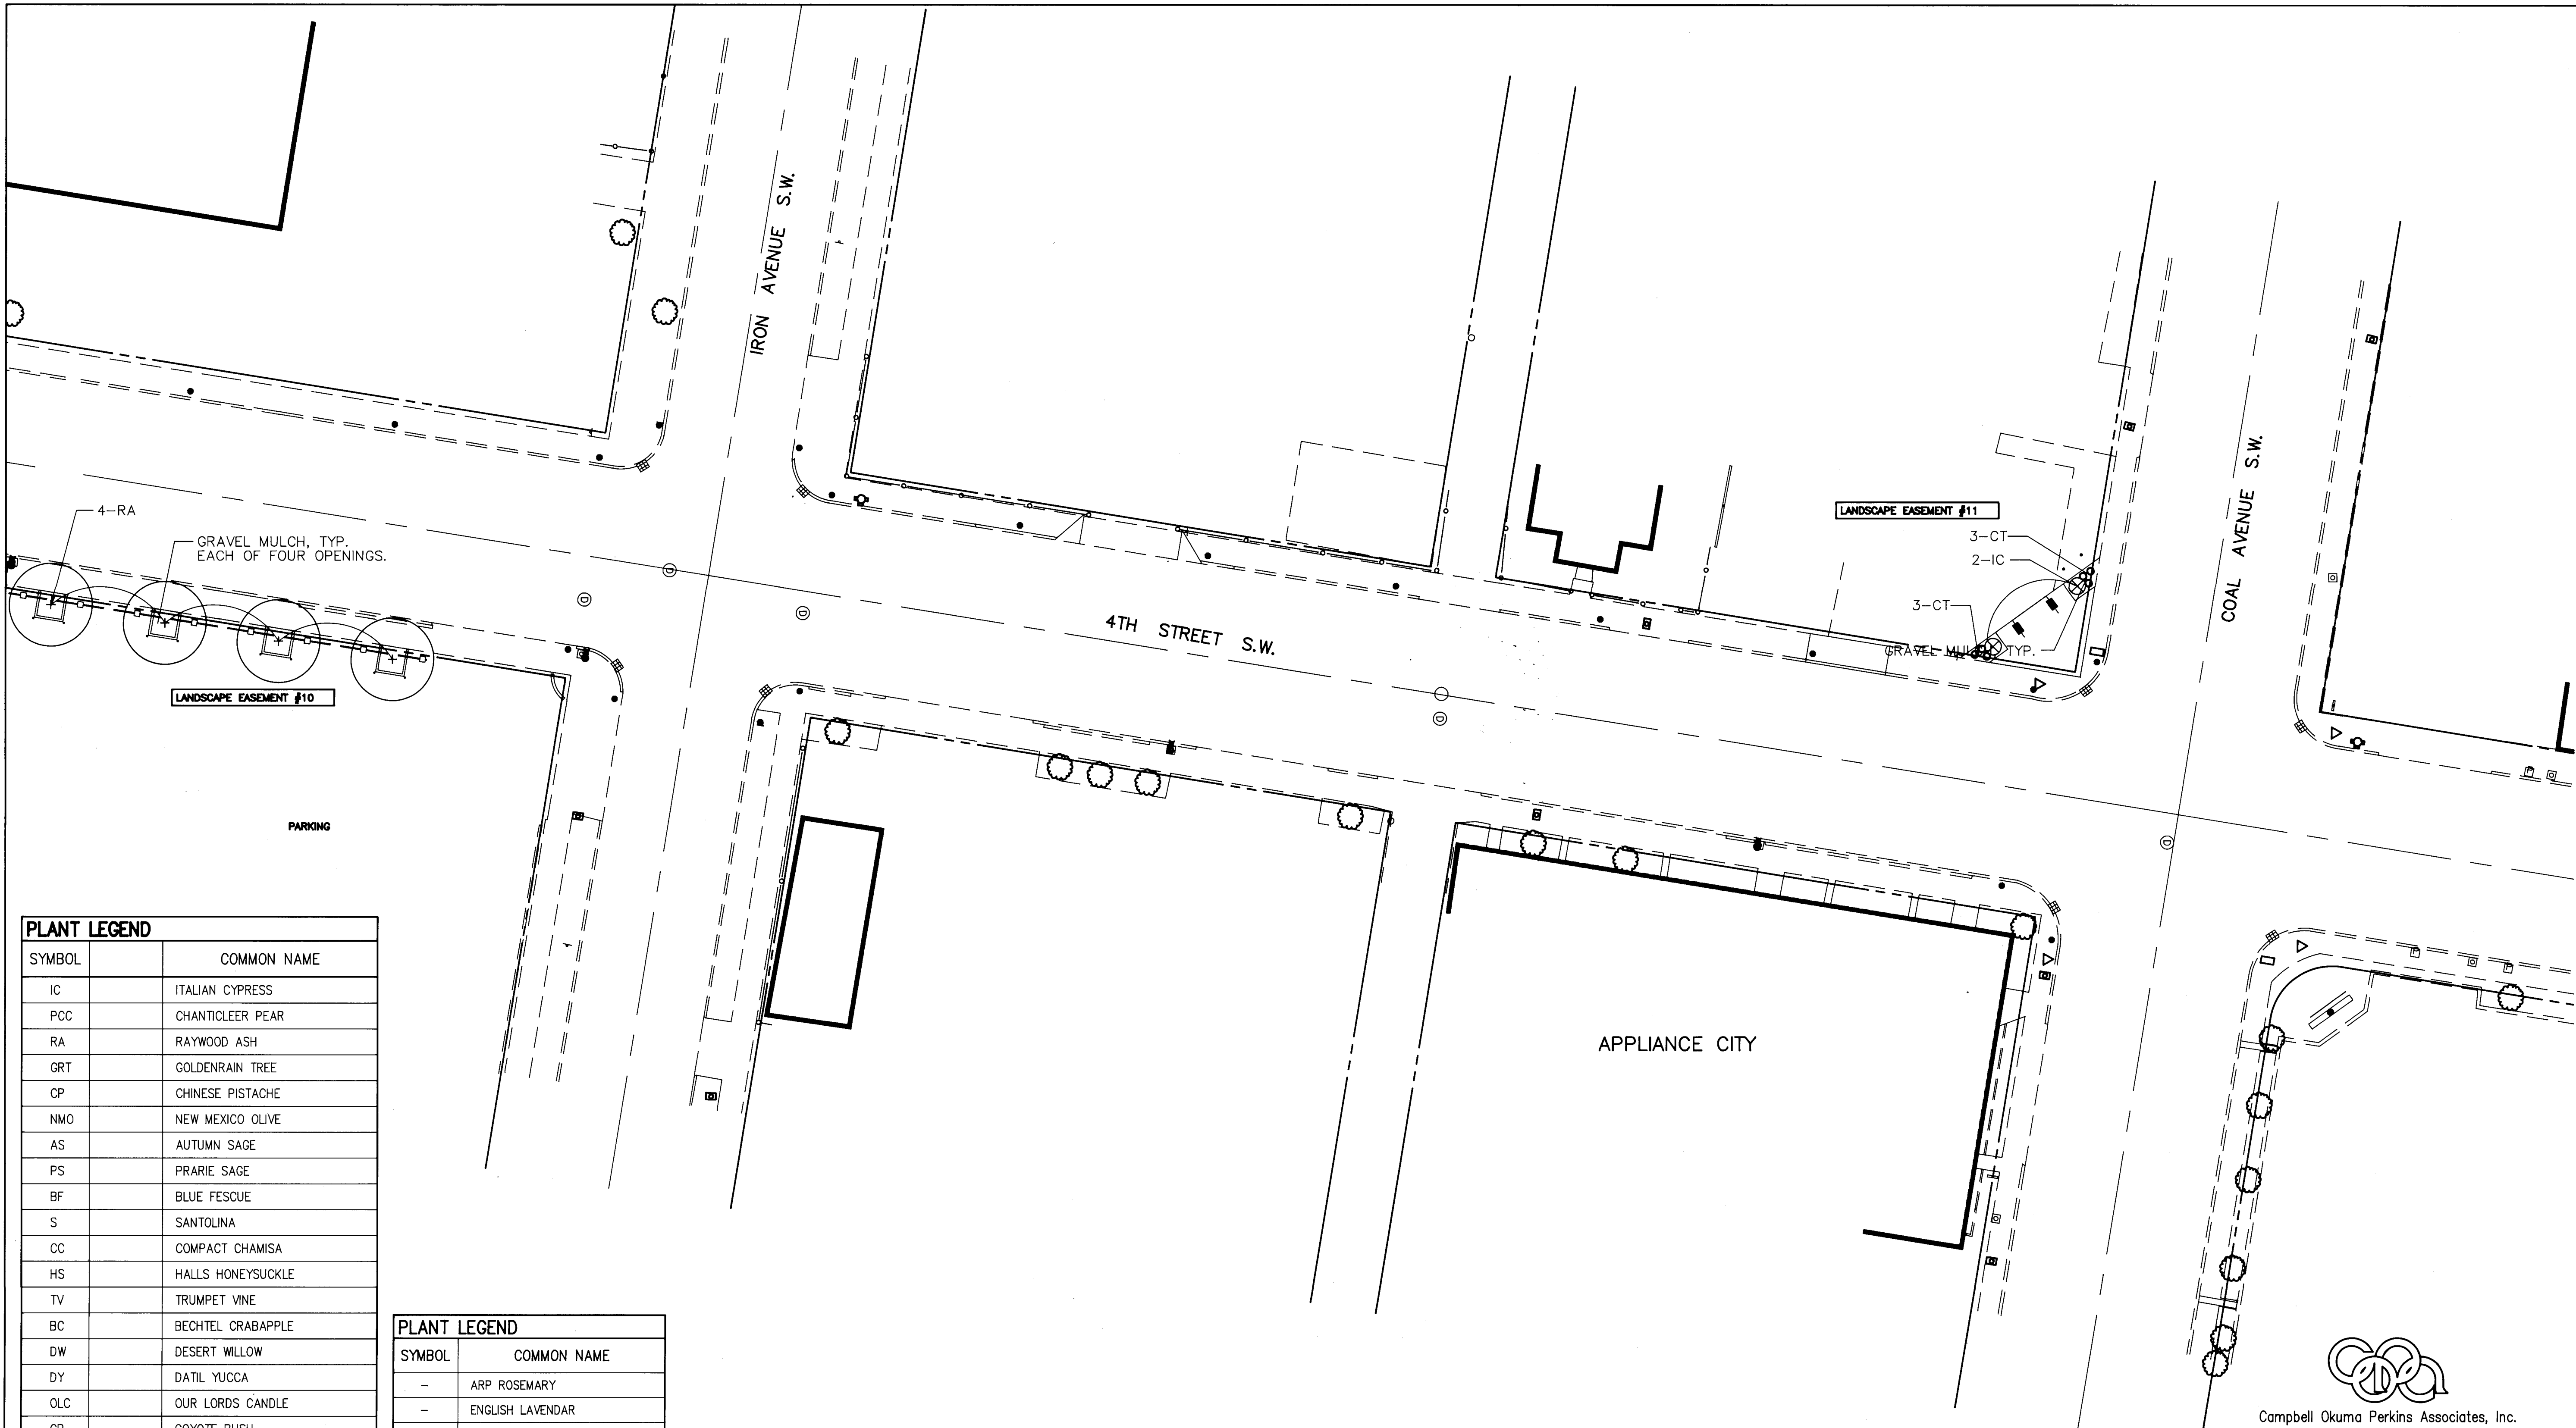

PLANT LEGEND		
SYMBOL		COMMON NAME
IC		ITALIAN CYPRESS
PCC		CHANTICLEER PEAR
RA		RAYWOOD ASH
GRT		GOLDENRAIN TREE
CP		CHINESE PISTACHE
NMO		NEW MEXICO OLIVE
AS		AUTUMN SAGE
PS		PRARIE SAGE
BF		BLUE FESCUE
S		SANTOLINA
CC		COMPACT CHAMISA
HS		HALLS HONEYSUCKLE
TV		TRUMPET VINE
BC		BECHTEL CRABAPPLE
DW		DESERT WILLOW
DY		DATIL YUCCA
OLC		OUR LORDS CANDLE
CB		COYOTE BUSH
BP		BIRD OF PARADISE BUSH
SOD		BUFFALO/BLUE GRAMMA SOD
CT		CREEPING THYME
WC		WESTERN CATALPA
AC		ANNUAL COLOR


PLANT LEGEND	
SYMBOL	COMMON NAME
-	ARP ROSEMARY
-	ENGLISH LAVENDAR
-	ST. JOHNS WORT
-	DARK KNIGHT BLUE BEARD
-	PRAPIE SAGE
-	MEXICAN EVENING PRIMROSE
-	AUTUMN SAGE
-	COREOPSIS

SEE SHEET L17 FOR COMPLETE PLANT LEGEND.

RECORD SET
May 1, 1997

Campbell Okuma Perkins Associates, Inc.
Landscape Architecture and Site Planning
418 Central S.E. Albuquerque, NM 87102
(505) 242-9928

901 W San Mateo Suite L Santa Fe, NM 87505
(505) 982-8399

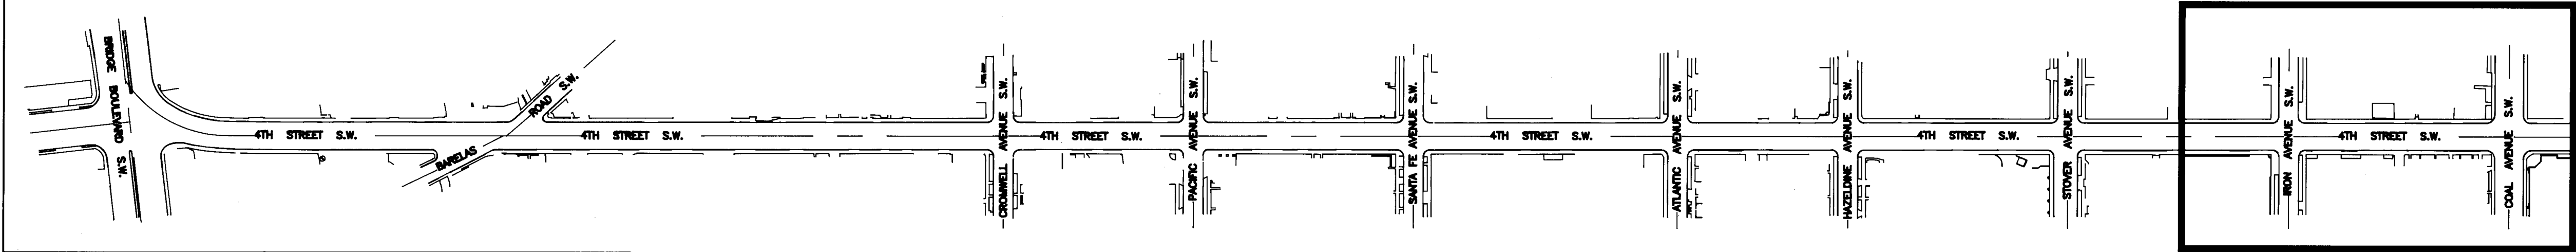


CITY OF ALBUQUERQUE PUBLIC WORKS DEPARTMENT ENGINEERING GROUP			
TITLE: FOURTH STREET STREETSCAPE PLANTING PLAN			
Design Review Committee	City Engineer Approval	Mo./Day/Yr.	
City Project No.	Zone Map No.	Sheet	
4917.90	K14-L14	L15 Of L19	

--	--	
PLANT LEGEND		
SYMBOL		COMMON NAME
IC		ITALIAN CYPRESS
PCC		CHANTICLEER PEAR
RA		RAYWOOD ASH
GRT		GOLDENRAIN TREE
CP		CHINESE PISTACHE
NMO		NEW MEXICO OLIVE
AS		AUTUMN SAGE
PS		PRARIE SAGE
BF		BLUE FESCUE
S		SANTOLINA
CC		COMPACT CHAMISA
HS		HALLS HONEYSUCKLE
TV		TRUMPET VINE
BC		BECHTEL CRABAPPLE
DW		DESERT WILLOW
DY		DATIL YUCCA
OLC		OUR LORDS CANDLE
CB		COYOTE BUSH
BP		BIRD OF PARADISE BUSH
SOD		BUFFALO/BLUE GRAMMA SOD
CT		CREEPING THYME
WC		WESTERN CATALPA
AC		ANNUAL COLOR

SEE SHEET L17 FOR COMPLETE PLANT LEGEND.

PLANT LEGEND	
SYMBOL	COMMON NAME
-	ARP ROSEMARY
-	ENGLISH LAVENDAR
-	ST. JOHNS WORT
-	DARK KNIGHT BLUE BEARD
-	PRARIE SAGE
-	MEXICAN EVENING PRIMROSE
-	AUTUMN SAGE
-	COREOPSIS

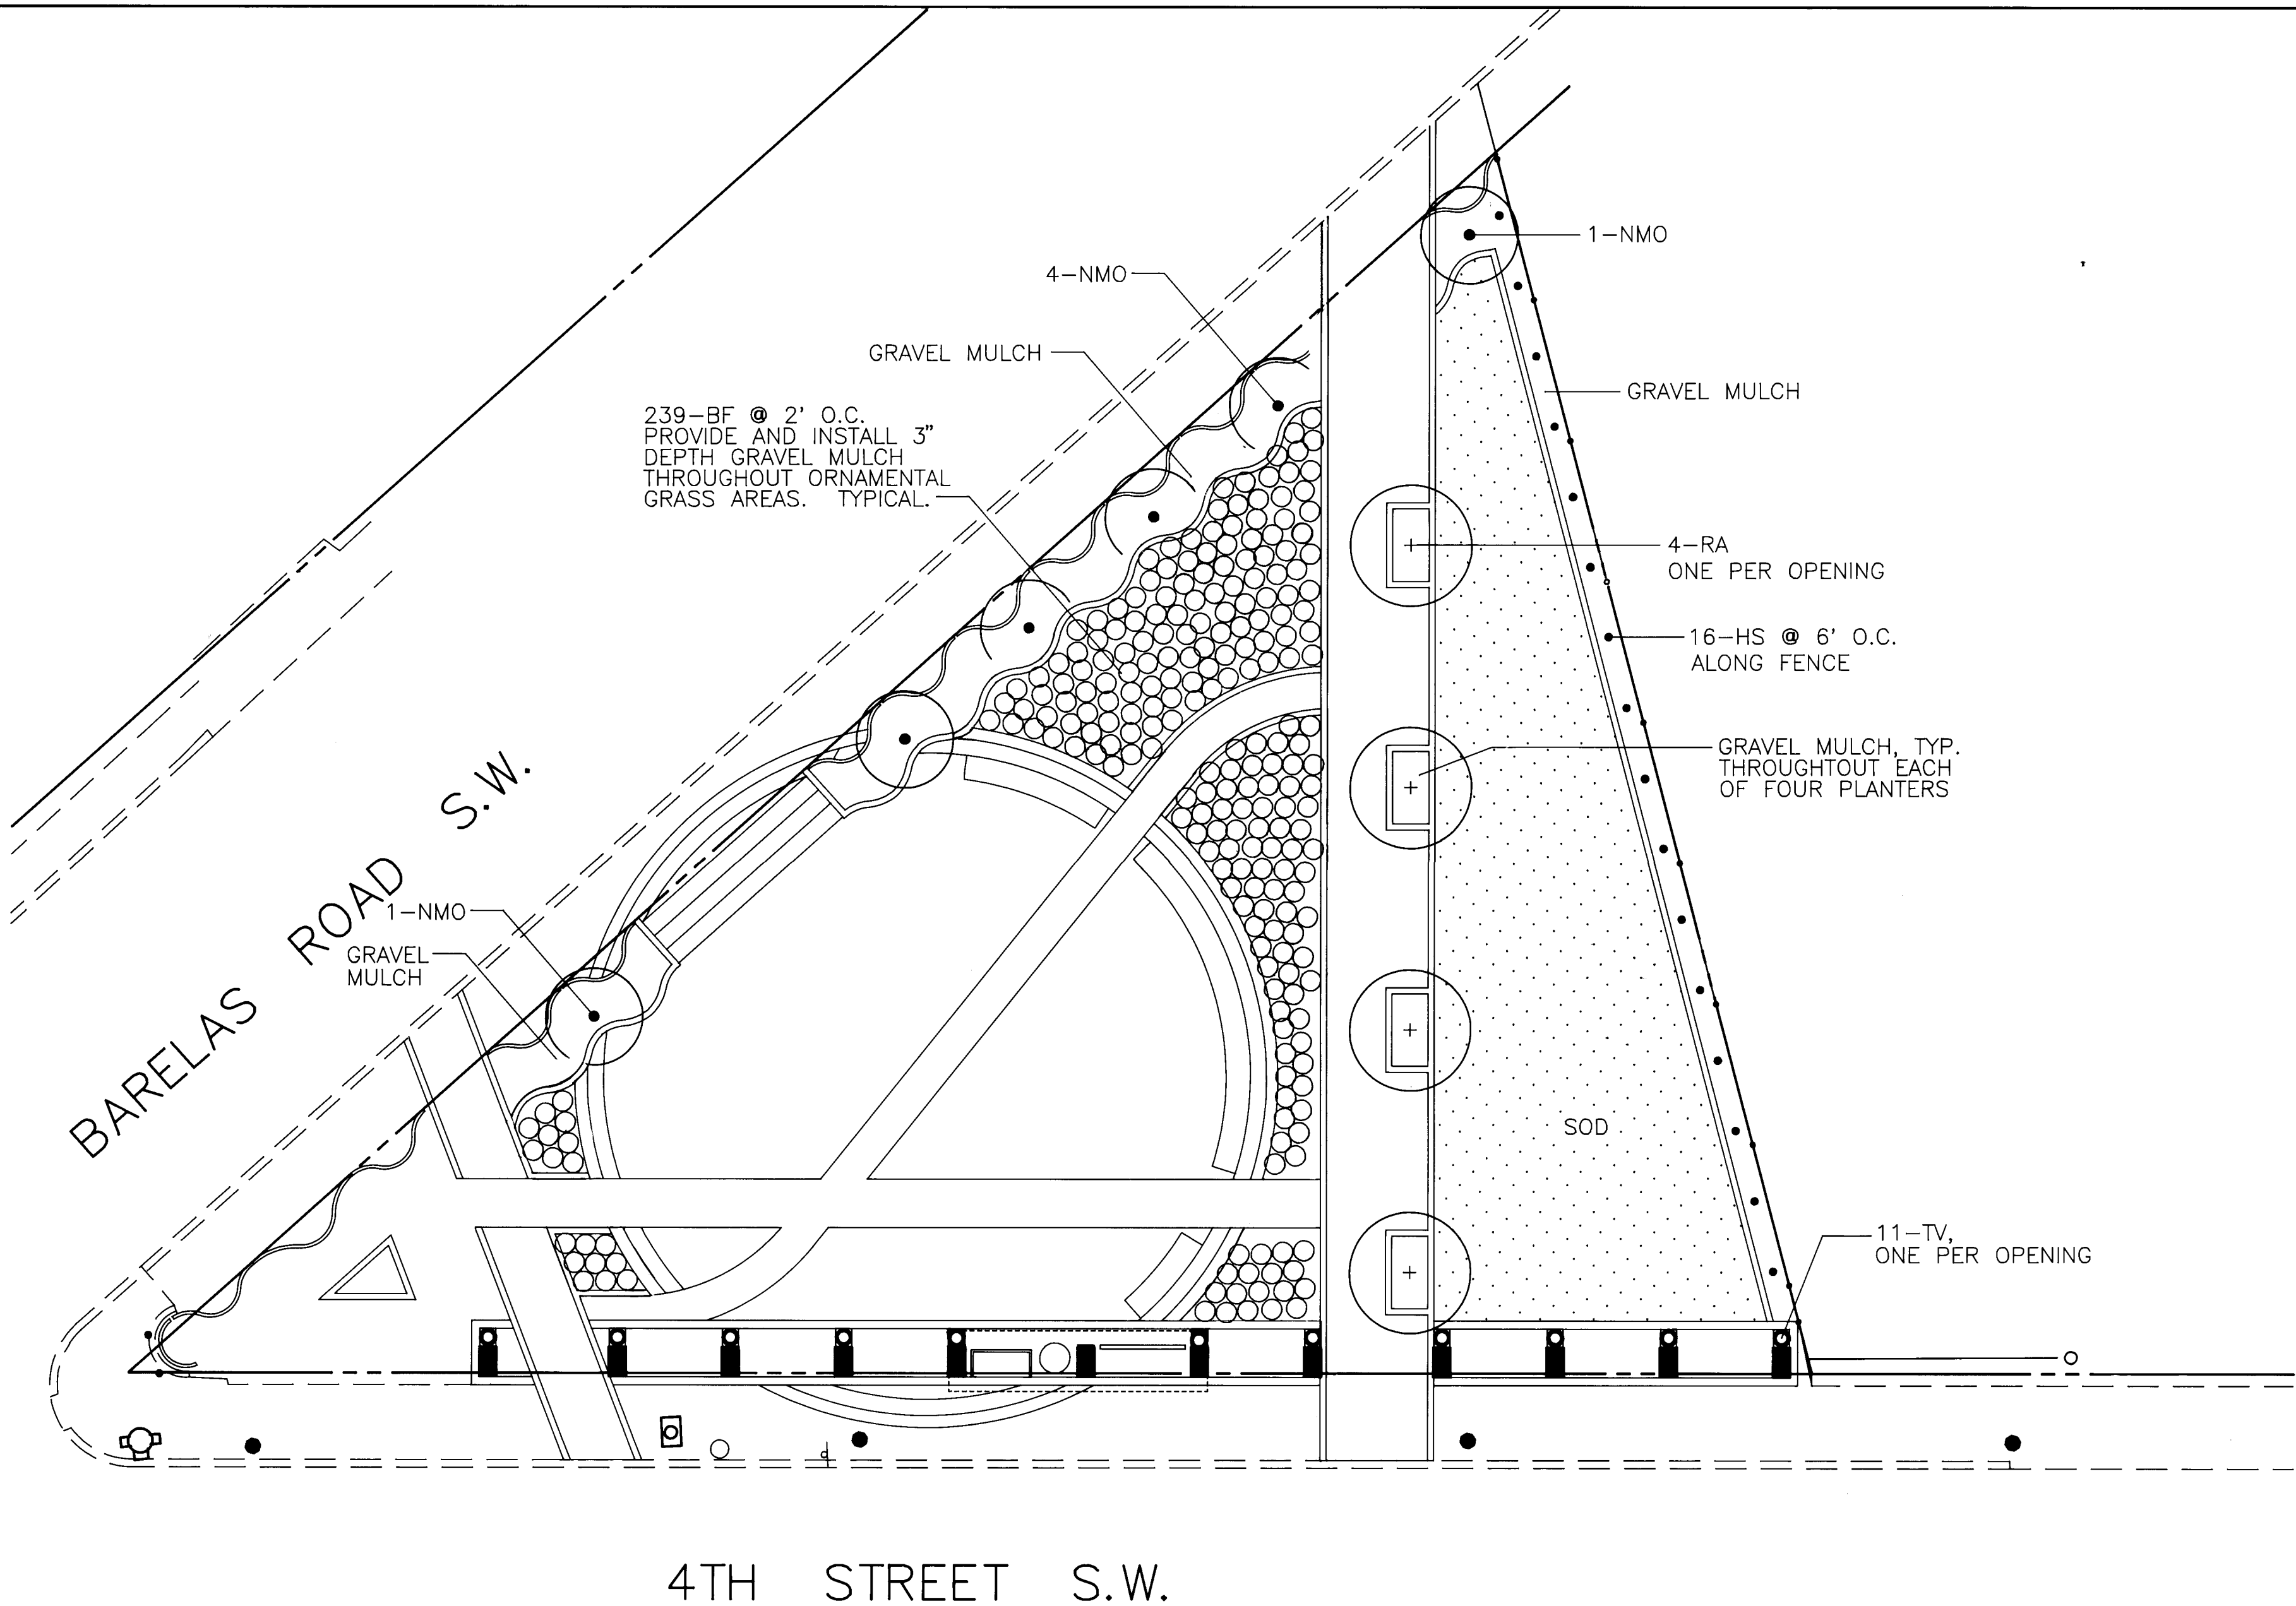


4TH STREET S.W.

RECORD SET
May 1, 1997

Campbell Okuma Perkins Associates, Inc.
Landscape Architecture and Site Planning
418 Central S.E. Albuquerque, NM 87102
(505) 242-9928

901 W San Mateo Suite L Santa Fe, NM 87505
(505) 982-8399

NORTH
SCALE: 1"=10'-0"

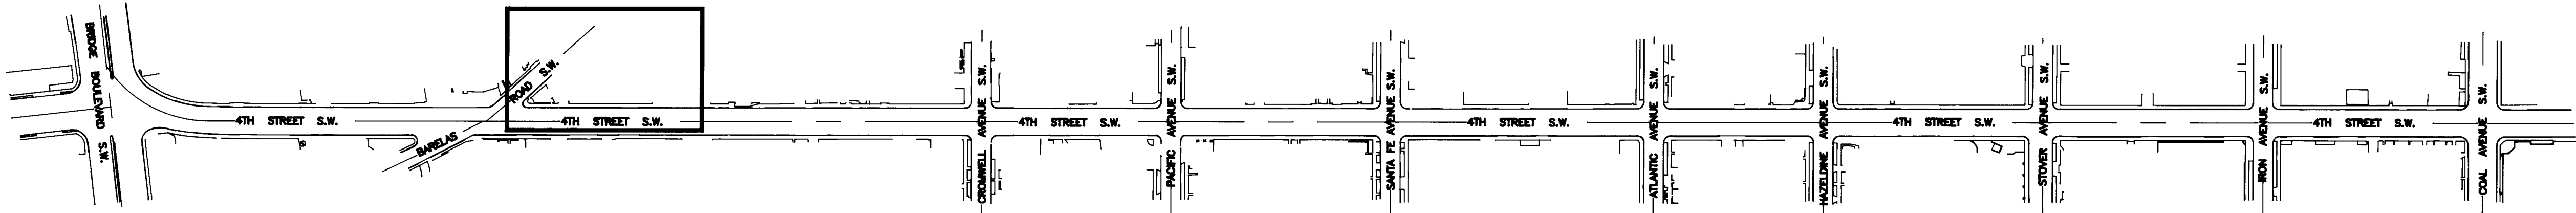

FOURTH STREET STREETScape KEY


CITY OF ALBUQUERQUE
PUBLIC WORKS DEPARTMENT
ENGINEERING GROUP

TITLE: **FOURTH STREET STREETScape
PLANTING PLAN**

Design Review Committee	City Engineer Approval	Mo./Day/Yr.	Mo./Day/Yr.

City Project No.	Zone Map No.	Sheet	Of
4917.90	K14-L14	L16	L19

LANDSCAPE ARCHITECT'S SEAL		SURVEY INFORMATION		BENCH MARKS		AS-BUILT INFORMATION	
	FIELD NOTES						
	NO.	BY	DATE				

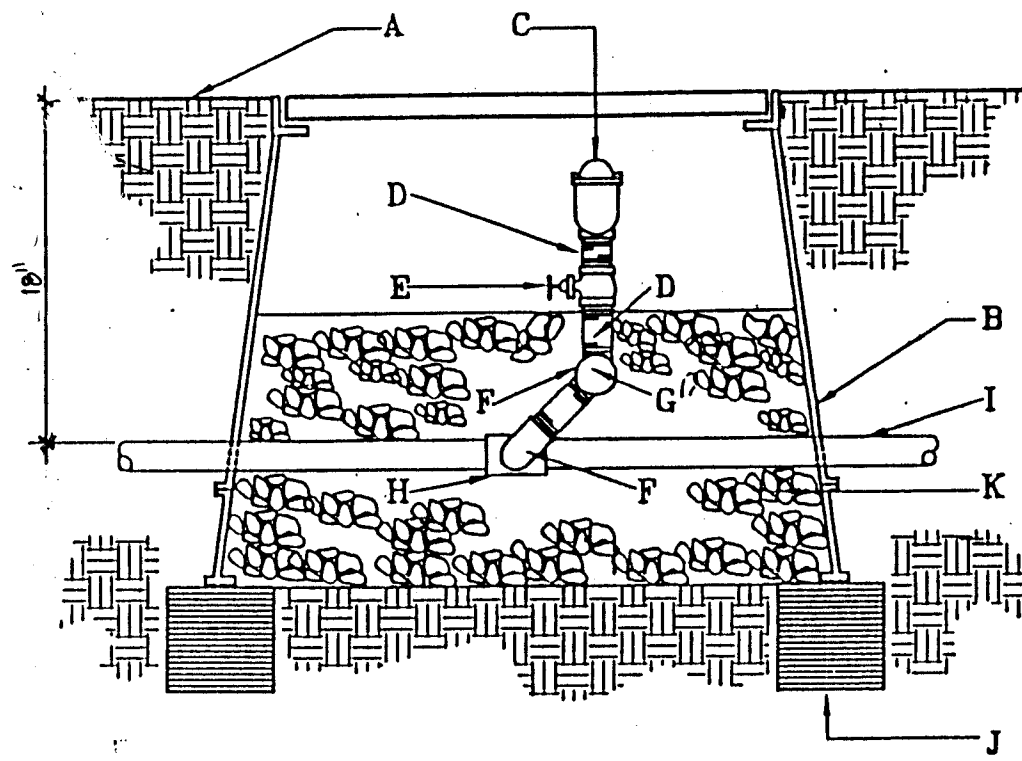


GENERAL NOTES:

1. INSTALL AN 8"x8"x16" SOLID CMU BLOCK AT EACH END OF THE VALVE BOX.
2. WASH ROCK SHALL BE INSTALLED FLUSH WITH BOTTOM OF GATE VALVE.
3. AIR RELIEF VALVE SHALL BE INSTALLED DOWNSTREAM OF THE MASTERVALVE.

CONSTRUCTION NOTES:

- A. FINISH GRADE.
- B. BROOKS PRODUCTS INC., 1730 PB-18 BODY (ABS) VALVE BOX WITH 1730 BOLT DOWN COVER (ABS) AND ONE 8" EXTENSION. WHEN AIR RELIEF VALVE IS INSTALLED IN PLAYING FIELD USE 4" PIPE WITH PLASTIC LID.
- C. AIR RELIEF VALVE (REFERENCE THE DRAWINGS).
- D. SCHEDULE 80 PVC NIPPLE.
- E. GATE VALVE.
- F. SCHEDULE 40 PVC ST. ELL.
- G. SCHEDULE 40 PVC ELL.
- H. IRRIGATION MAINLINE TEE.
- I. IRRIGATION MAINLINE.
- J. 8"x8"x16" SOLID CMU BLOCK.
- K. 1" DIAMETER WASHED ROCK.

1 AIR RELIEF VALVE
L18 DWG. 2705 NTS

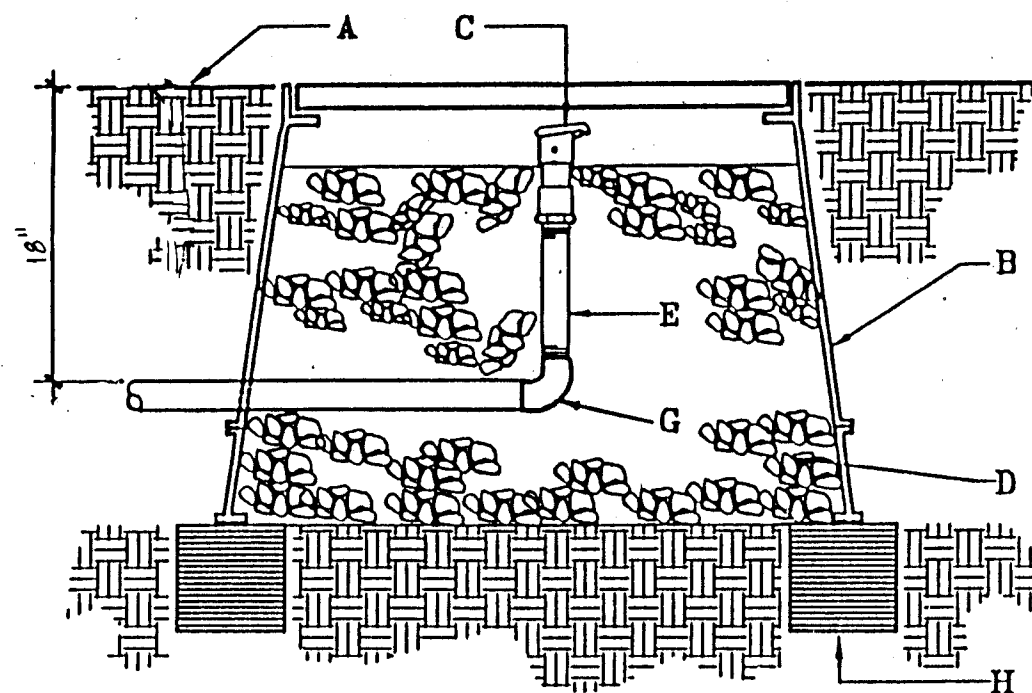


GENERAL NOTES:

1. INSTALL AN 8"x8"x16" SOLID CMU BLOCK AT EACH CORNER OF THE VALVE BOX.
2. INSTALL 1" DIAMETER WASHED ROCK BELOW THE VALVE BOX. EXTEND WASHED ROCK UP TO COLLAR OF QUICK COUPLER VALVE.
3. INSTALL A GATE VALVE IMMEDIATELY UPSTREAM OF QUICK COUPLER VALVE.

CONSTRUCTION NOTES:

- A. FINISH GRADE.
- B. BROOKS PRODUCTS INC., 1730 PB-18 BODY (ABS) VALVE BOX WITH 1730 BOLT DOWN COVER (ABS) AND ONE 8" EXTENSION. WHEN QUICK COUPLER VALVE IS INSTALLED IN PLAYING FIELD USE 4" PIPE WITH PLASTIC LID.
- C. RAINBIRD 33 DRC QUICK COUPLER VALVE.
- D. 1" DIAMETER WASHED ROCK.
- E. 12" SCH. 80 PVC RISER.
- F. IRRIGATION MAINLINE.
- G. SCHEDULE 40 PVC ELL. SXT.
- H. 8"x8"x16" SOLID CMU BLOCK.

2 QUICK COUPLER VALVE
L18 DWG. 2708 NTS

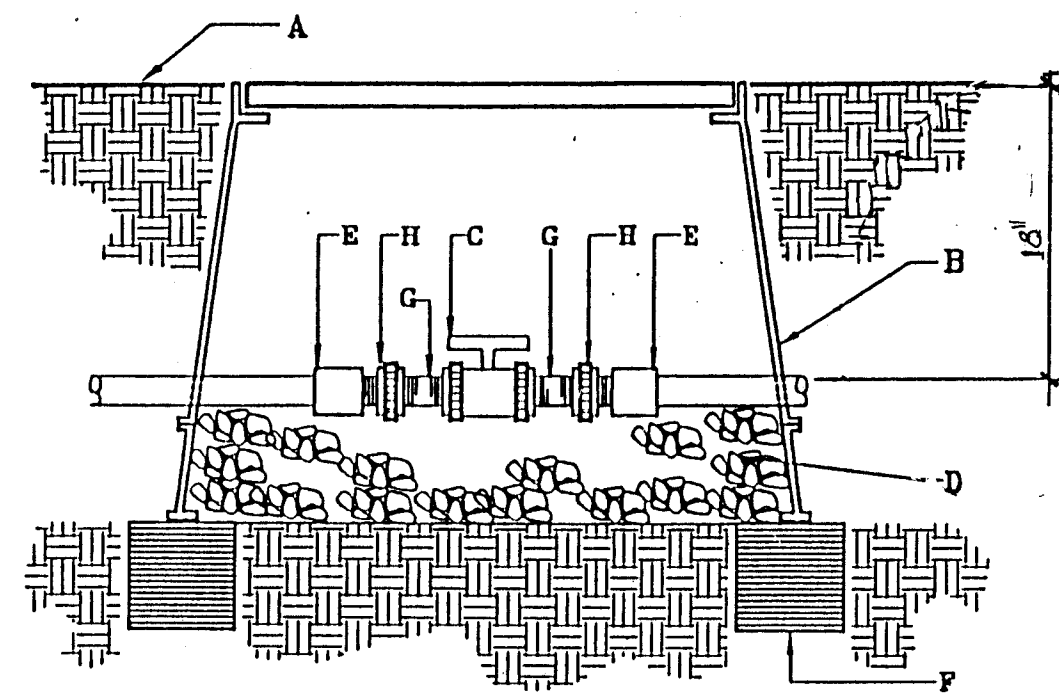


GENERAL NOTES:

1. INSTALL AN 8"x8"x16" SOLID CMU BLOCK AT EACH END OF THE VALVE BOX.
2. WASH ROCK SHALL BE INSTALLED FLUSH WITH BOTTOM OF PIPE AND VALVE.


CONSTRUCTION NOTES:

- A. FINISH GRADE.
- B. BROOKS PRODUCTS INC., 1730 PB-18 BODY (ABS) VALVE BOX WITH 1730 BOLT DOWN COVER (ABS) AND ONE 8" EXTENSION.
- C. SPEARS TRUE UNION SCHEDULED 80 PVC BALL VALVE.
- D. 1" DIAMETER WASHED ROCK.
- E. PVC MIP ADAPTER.
- F. 8"x8"x16" SOLID CMU BLOCK.
- G. SCHEDULE 80 PVC 4" NIPPLE.
- H. SPEARS SCHEDULE 80 PVC UNION.

3 GATE VALVE
L18 DWG. 2706 NTS

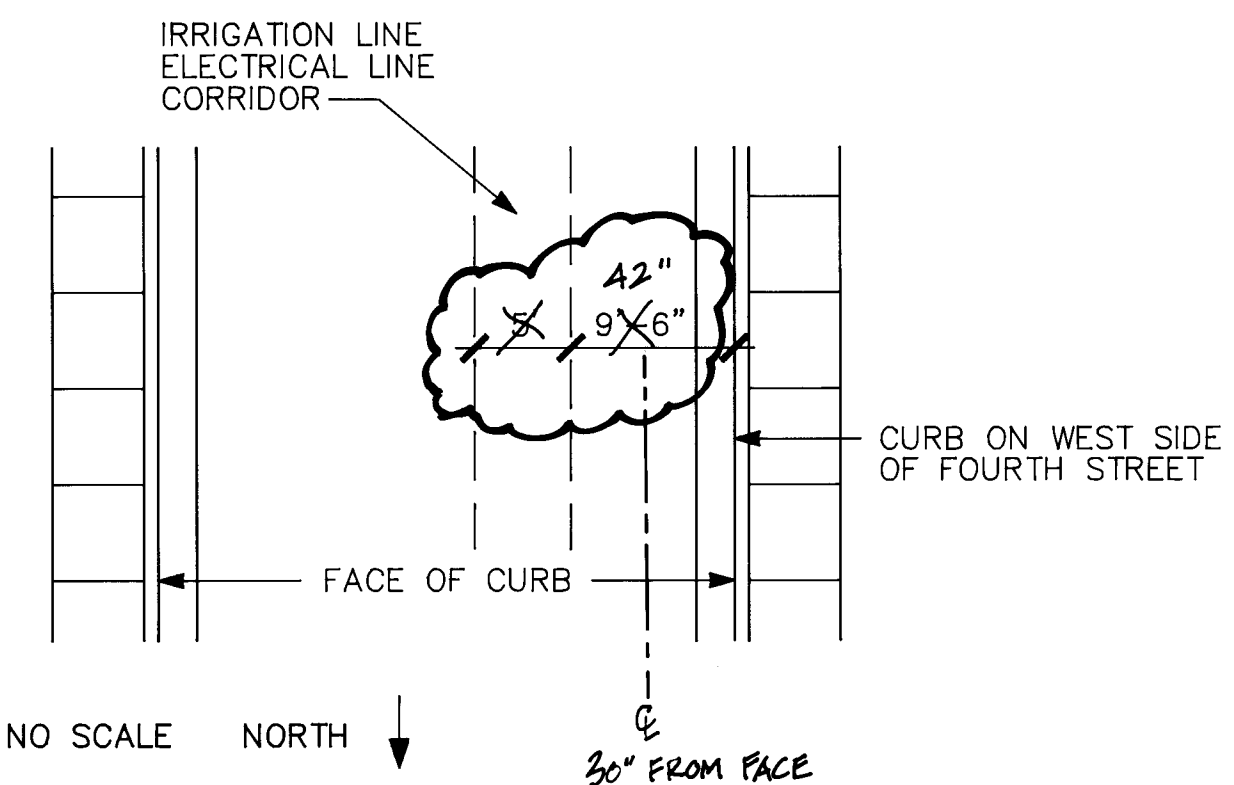


PLAN NO SCALE NORTH

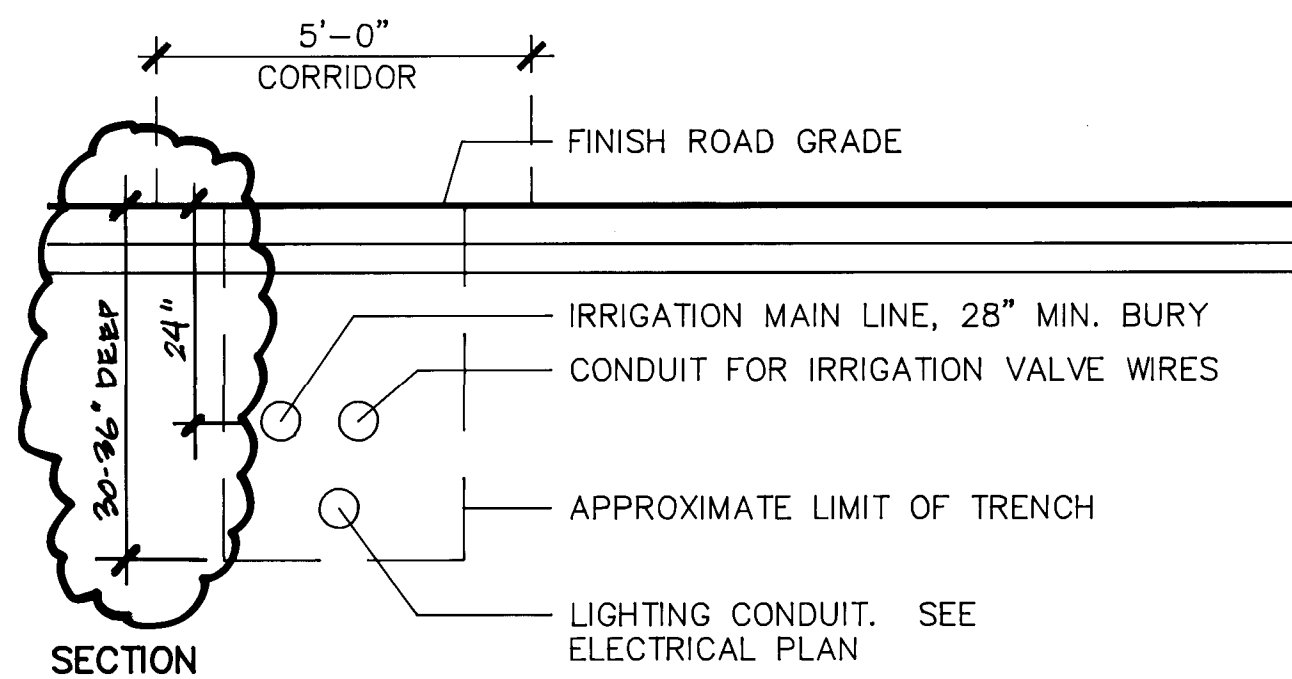

SECTION

4 IRRIGATION LINE PLACEMENT
L18 NTS

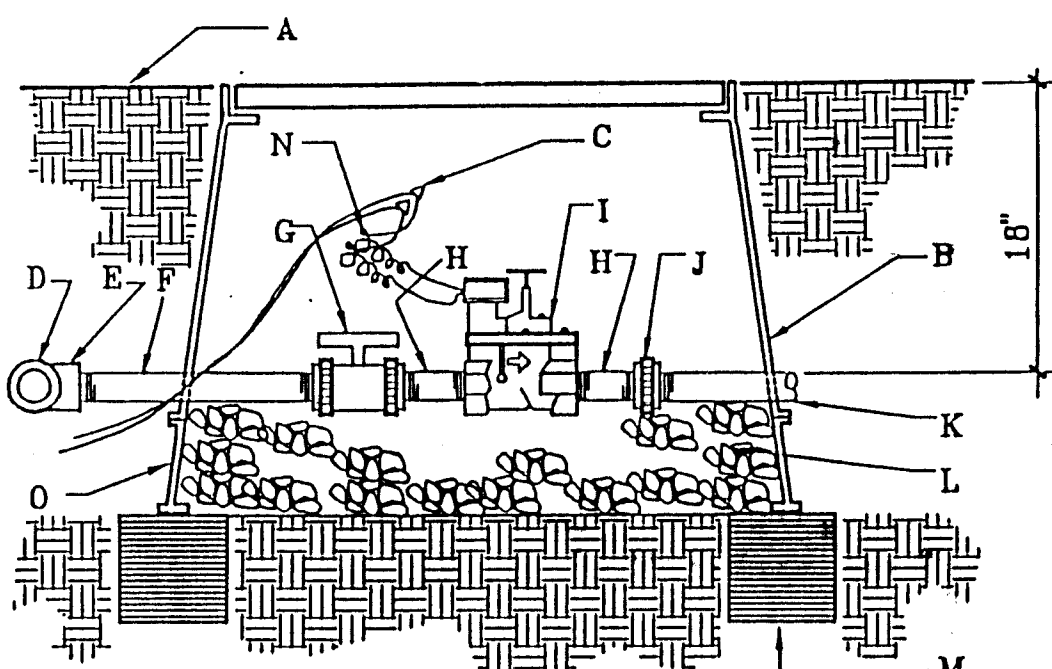


GENERAL NOTES:

1. INSTALL AN 8"x8"x16" SOLID CMU BLOCK AT EACH END OF THE VALVE BOX.
2. WASH ROCK SHALL BE INSTALLED FLUSH WITH BOTTOM OF PIPE AND VALVE.

CONSTRUCTION NOTES:

- A. FINISH GRADE.
- B. BROOKS PRODUCTS INC., 1730 PB-18 BODY (ABS) VALVE BOX WITH 1730 BOLT DOWN COVER (ABS) AND ONE 8" EXTENSION.
- C. 3M SCOTCHLOK CONNECTORS.
- D. IRRIGATION MAINLINE.
- E. IRRIGATION MAINLINE SERVICE TEE OR ELL.
- F. SCHEDULE 80 PVC 12" NIPPLE.
- G. SPEARS TRUE UNION SCHEDULED 80 PVC BALL VALVE.
- H. SCHEDULE 80 PVC 4" NIPPLE.
- I. ELECTRIC VALVE. REFERENCE THE DRAWING FOR SIZE.
- J. SPEARS SCHEDULE 80 PVC UNION.
- K. LATERAL LINE.
- L. 1" DIAMETER WASHED ROCK.
- M. 8"x8"x16" SOLID CMU BLOCK.
- N. 24" WIRE EXPANSION COIL.

5 ELECTRIC VALVE
L18 DWG. 2703 NTS

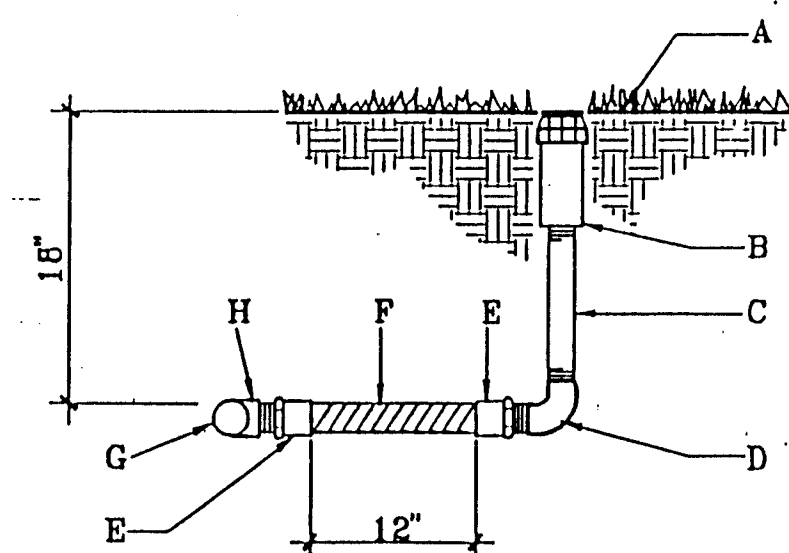


GENERAL NOTES:

1. THIS DETAIL SHALL BE USED FOR POP-UP SHRUB SPRAY, POP-UP LAWN SPRAY, GEAR DRIVEN AND ROTARY SPRINKLER HEADS.
2. LATERAL LINE PRESSURE TESTING SHALL BE COMPLETED PRIOR TO INSTALLATION OF FLEX PIPE ASSEMBLY. LATERAL LINE TESTING SHALL BE ACCOMPLISHED BY INSTALLING A PLUG IN THE OUTLET OF LATERAL LINE TEES AND ELLS.
3. TOP OF SPRINKLER HEAD SHALL BE SET FLUSH WITH FINISH GRADE.

CONSTRUCTION NOTES:

- A. FINISH GRADE.
- B. SPRINKLER HEAD (REFERENCE THE DRAWINGS FOR TYPE).
- C. SCH. 80 PVC NIPPLE. LENGTH VARIES DEPENDING UPON SIZE OF SPRINKLER HEAD.
- D. SCH. 40 PVC THREADED ELL.
- E. SCH. 40 PVC MIP ADAPTER.
- F. PVC FLEXIBLE VINYL PIPE STD. IPS FROM AGRICULTURAL PRODUCTS INC. (818-768-3303).
- G. LATERAL PIPE.
- H. SCH. 40 PVC SXSXT TEE OR SXT ELL.

6 SPRINKLER HEAD W/ FLEX PIPE ASSEMBLY
L18 DWG. 2709 NTS

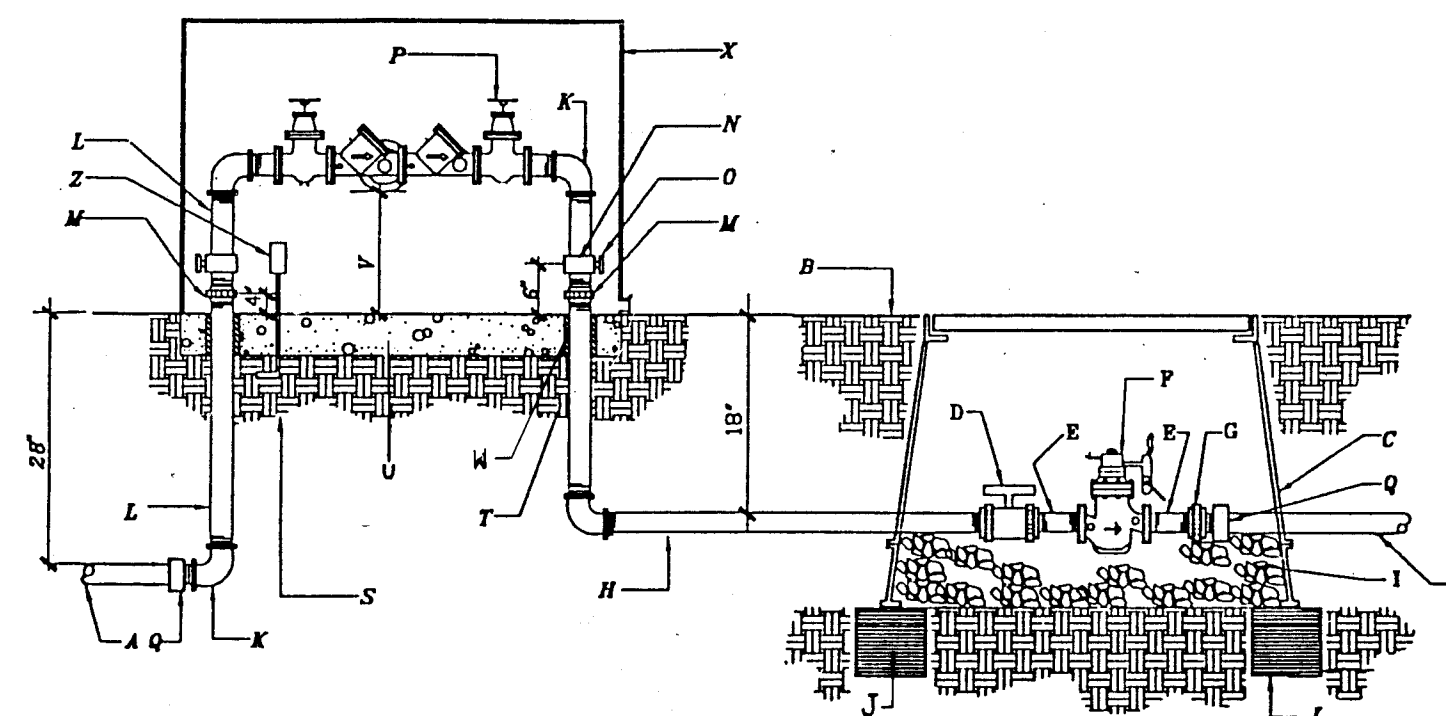

GENERAL NOTES:

1. HORIZONTAL RPBA INSTALLATION REQ'D.
2. ABOVE GRADE RPBA INSTALLATION REQ'D.
3. WATER LINE PRESSURE AND TEMP MUST NOT EXCEED RATED CAPACITY OF RPBA.
4. PROTECT FROM FREEZING WITH POSITIVE HEAT SOURCE AND INSULATION.
5. MIN. RPBA SIZE MUST BE THE BLDG. SERVICE LINE SIZE.
6. DO NOT INSTALL IN FLOOD PRONE AREAS.
7. INSTALL WATER HAMMER ARRESTORS & THERMO EXPANSION PROTECTION AS NECESSARY.
8. METALLIC RISER PIPING REQ'D.
9. JOINTS TO BE ADEQUATELY RESTRAINED.
10. DEVIATION FROM THESE SPECIFICATIONS MUST HAVE PRIOR WRITTEN APPROVAL FROM THE ADMINISTRATIVE AUTHORITY.

CONSTRUCTION NOTES:

- A. SERVICE LINE TO WATER METER, NO OUTLETS ALLOWED.
- B. FINISH GRADE, MATERIAL VARIES REFERENCE PLANS.
- C. BROOKS PRODUCTS INC. 1730 PB-18 BODY (ABS) VALVE BOX W BOLT DOWN COVER (ABS) AND ONE 8" EXTENSION.
- D. SPEARS TRUE UNION SCHEDULED 80 PVC BALL VALVE.
- E. SCHEDULE 80 PVC 4" NIPPLE.
- F. BERMAD FLOWMETER. REFERENCE IRRIGATION LEGEND FOR SIZE.
- G. SPEARS SCHEDULED 80 PVC UNION.
- H. SCHEDULE 80 PVC NIPPLE 3" MIN.
- I. 1" DIAMETER WASHED ROCK.
- J. 8"x8"x16" SOLID CMU BLOCK.
- K. GALVANIZED ELL.
- L. GALVANIZED NIPPLE.
- M. GALVANIZED UNION (MIN. 4" ABOVE GRADE).
- N. GALVANIZED TEE.
- O. BALL BEARING CHAMFER DRIVEN 1/2".
- P. RPBA BACKFLOW PREVENTER (REFERENCE DRAWINGS).
- Q. PVC MIP ADAPTER.
- R. NON-CONSTANT PRESSURE IRRIGATION MAINLINE.
- S. COMPACTED SUBGRADE.
- T. GALVANIZED NIPPLE.
- U. MOUNTING PAD. SIZE AS REQ'D FOR HOT BOX.
- V. 12" W. ADEQUATE SLEEVE AND INSULATION (MIN. 1" THICK).
- X. HOT BOX. MODEL NO. HB-1.5. COLOR: BEIGE.
- Y. NOT USED.
- Z. ELECTRIC OUTLET FOR HEATED PROTECTIVE ENCLOSURE.


7 BERMAD FLOWMETER MASTER VALVE W/ RPBA
L18 DWG. 2701-A NTS


RECORD SET
May 1, 1997

[Signature]

CITY OF ALBUQUERQUE PUBLIC WORKS DEPARTMENT ENGINEERING GROUP			
TITLE: FOURTH STREET STREETSCAPE IRRIGATION DETAILS			
Design Review Committee	City Engineer Approval	Mo./Day/Yr.	Mo./Day/Yr.
<i>[Signature]</i> 12/21/95	<i>[Signature]</i> 12/21/95		
City Project No. 4917.90		Zone Map No.	Sheet L18 Of L19

Campbell Okuma Perkins Associates, Inc.
Landscape Architecture and Site Planning
418 Central S.E. 901 W San Mateo Suite L
Albuquerque, NM 87102 Santa Fe, NM 87505
(505) 242-1822 FAX (505) 882-8399

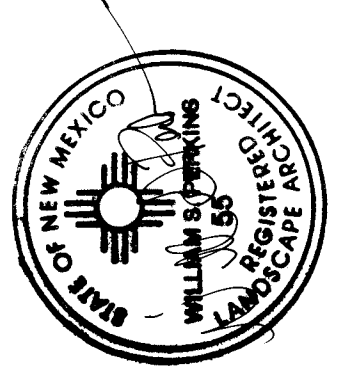

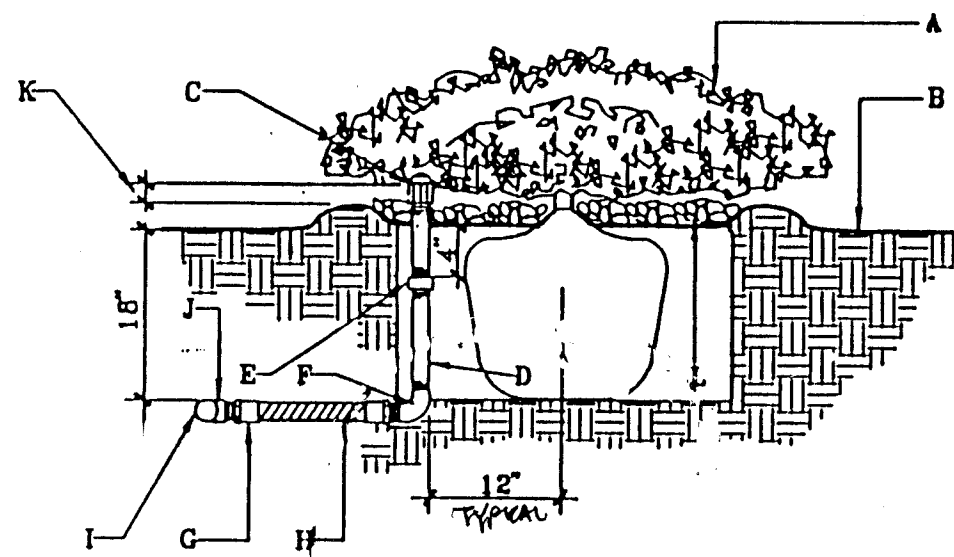


GENERAL NOTES:

1. LATERAL LINE PRESSURE TESTING SHALL BE COMPLETED PRIOR TO INSTALLATION OF FLEX PIPE ASSEMBLY. LATERAL LINE TESTING SHALL BE ACCOMPLISHED BY INSTALLING A PLUG IN THE OUTLET OF LATERAL LINE TEES AND ELLS.
2. BUBBLER SHALL ALWAYS BE INSTALLED ON THE UPHILL SIDE OF THE SHRUB.

CONSTRUCTION NOTES:

- A. SHRUB.
- B. FINISH GRADE.
- C. BUBBLER HEAD (REFERENCE IRRIGATION LEGEND).
- D. SCH. 40 PVC NIPPLE.
- E. SCH. 40 PVC THREADED COUPLER.
- F. SCH. 40 PVC THREADED ELL.
- G. SCH. 40 PVC MIP ADAPTER.
- H. PVC FLEXIBLE VINYL PIPE STD. IPS FROM AGRICULTURAL PRODUCTS INC. (818-768-3303).
- I. LATERAL PIPE.
- J. SCH. 40 PVC SXSXT TEE OR SXT ELL.
- K. TOP OF BUBBLER LEVEL WITH TOP OF BARK MULCH OR MAX. 1" ABOVE TOP OF BARK MULCH.
- L. 4" BARK MULCH.

1 BUBBLER HEAD AT SHRUB
L19 DWG. 2711 NTS

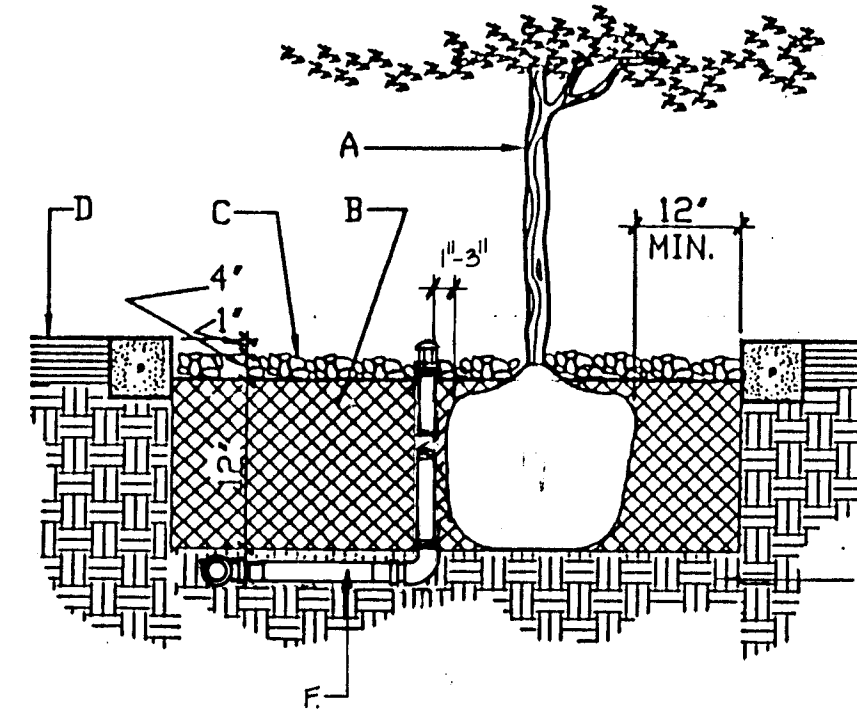

GENERAL NOTES:


1. EXISTING SOIL WITHIN THE SHRUB & TREE PLANTER SHALL BE REMOVED AND REPLACED WITH THE SPECIFIED PLANTING SOIL MIXTURE.
2. ROOTBALL SHALL BE PLACED ON UNDISTURBED SOIL TO PREVENT TREE FROM SETTLING.
3. TOP OF ROOTBALL INDICATES LEVEL AT WHICH TREE WAS GROWN AND DUG; THIS REPRESENTS THE LEVEL AT WHICH THE TREE SHOULD BE INSTALLED; THAT LEVEL MAY BE EXCEEDED BY ONLY A ONE INCH LAYER OF SOIL.
4. PRIOR TO BACKFILLING TREE, ALL WIRE, ROPE AND SYNTHETIC MATERIALS SHALL BE REMOVED FROM THE TREE AND THE PLANTING PIT.
5. PRIOR TO BACKFILLING, ALL BURLAP SHALL BE CUT AWAY EXCEPT FROM BOTTOM OF THE ROOTBALL.

CONSTRUCTION NOTES:

- A. TREE.
- B. PLANTING SOIL MIXTURE. (REFERENCE THE SPECIFICATION).
- C. 4" DEPTH OF BARK MULCH.
- D. MATERIAL VARIES (REFERENCE THE DRAWING).
- E. UNDISTURBED SOIL.
- F. BUBBLER ASSEMBLY PER 1/L-19.

2 TREE IN PLANTER
L19 DWG. 2715 NTS

NOTE: 5'X5' LANDSCAPE SQUARES ARE TO BE MADE UP OF AN EQUAL NUMBER OF SQUARES WITH PLANTS LISTED BELOW AS A,B,C, & D AND SQUARES LISTED BELOW AS A', B', C' & D'. LANDSCAPING SQUARES ARE TO ALTERNATE BETWEEN THE TWO TYPES. LANDSCAPE ARCHITECT IS TO APPROVE FINAL LOCATION OF PLANTS.

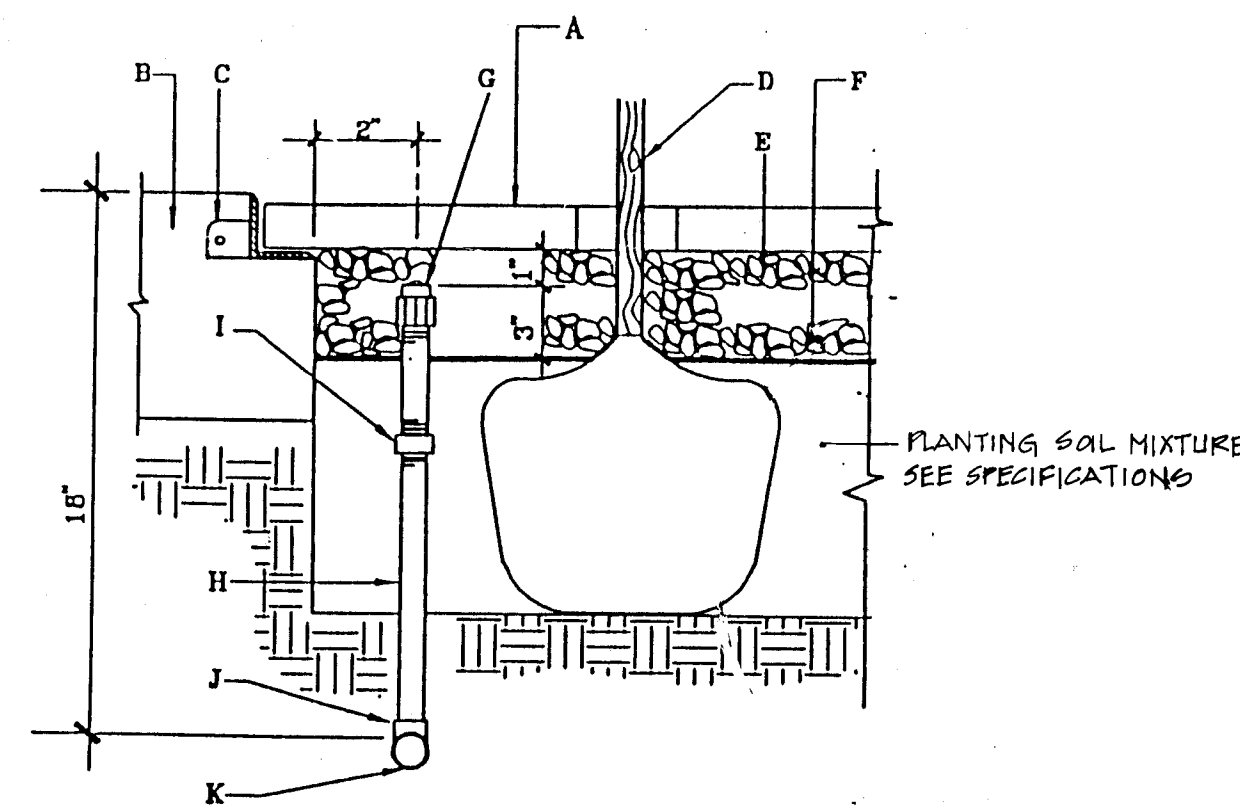


GENERAL NOTES:

1. LATERAL LINE PRESSURE TESTING SHALL BE COMPLETED PRIOR TO INSTALLATION OF FLEX PIPE ASSEMBLY. LATERAL LINE TESTING SHALL BE ACCOMPLISHED BY INSTALLING A PLUG IN THE OUTLET OF LATERAL LINE TEES AND ELLS.
2. BUBBLER SHALL ALWAYS BE INSTALLED ON THE UPHILL SIDE OF THE TREE.
3. PVC PIPE SHALL NOT BE INSTALLED UNDER THE LOCATION OF THE TREE BALL.

CONSTRUCTION NOTES:


- A. TREE GRATE.
- B. 4000 PSI CONCRETE.
- C. TREE GRATE FRAME.
- D. TREE.
- E. 4" BARK MULCH.
- F. FINISH GRADE.
- G. BUBBLER HEAD (REFERENCE IRRIGATION LEGEND).
- H. SCH. 80 PVC NIPPLE.
- I. SCH. 40 PVC THREADED COUPLER.
- J. SCH. 40 PVC SXSXT TEE OR SXT ELL.
- K. LATERAL PIPE.

5 BUBBLER HEAD IN TREE GRATE
L19 DWG. 2712 NTS

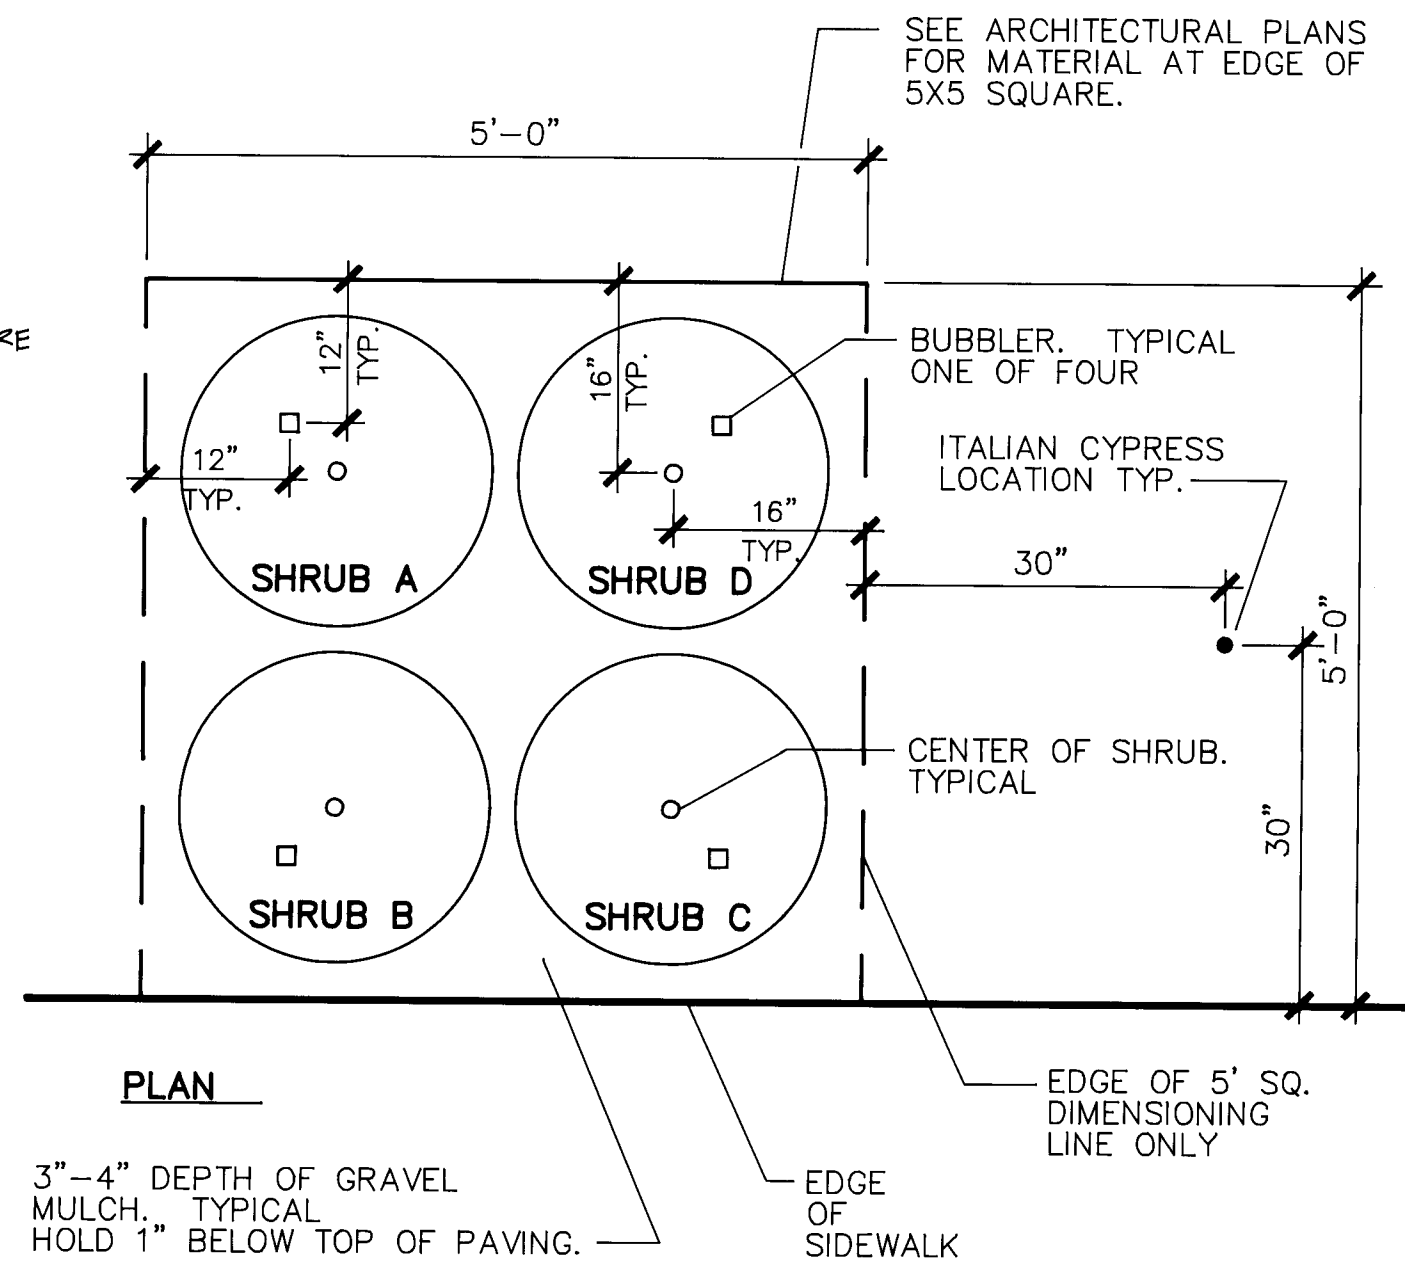

6 TYPE B PLANTING DETAIL
L19 NTS

- A. ARP ROSEMARY / ROSEMARINUS OFFICINALIS / 1 GAL
B. ENGLISH LAVENDER / LAVANDULA ANGUSTILOLIA 'MUNSTED' / 1 GAL
C. ST. JOHNS WORT / HYPERICUM CALYCEUM / 1 GAL
D. DARK KNIGHT BLUE BEARD / CARYOPTERIS X CLANDENSIS / 1 GAL
A. PRARIE SAGE / ARTEMISIA LUDOVICIANA 'ALBULA' / 1 GAL
B. MEXICAN EVENING PRIMROSE / OENTHERA BERLANDIERI / 1 GAL
C. AUTUMN SAGE / SALVIA GREGII / 1 GAL
D. COREOPSIS / COREOPSIS GRANDIFLORA / 1 GAL

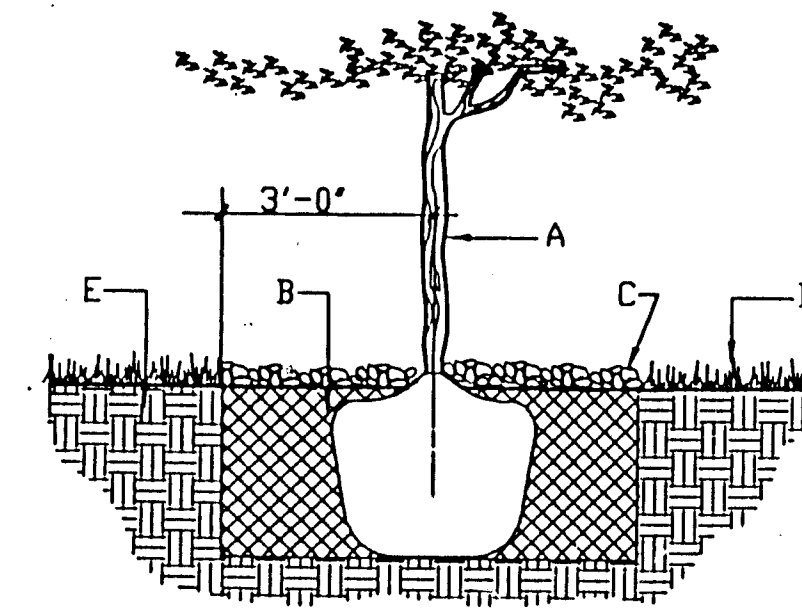


GENERAL NOTES:

1. ROOTBALL SHALL BE PLACED ON UNDISTURBED SOIL TO PREVENT TREE FROM SETTLING.
2. TOP OF ROOTBALL INDICATES LEVEL AT WHICH TREE WAS GROWN AND DUG; THIS REPRESENTS THE LEVEL AT WHICH THE TREE SHOULD BE INSTALLED; THAT LEVEL MAY BE EXCEEDED BY ONLY A ONE INCH LAYER OF SOIL.
3. PRIOR TO BACKFILLING TREE, ALL WIRE, ROPE AND SYNTHETIC MATERIALS SHALL BE REMOVED FROM THE TREE AND THE PLANTING PIT.
4. PRIOR TO BACKFILLING, ALL BURLAP SHALL BE CUT AWAY EXCEPT FROM BOTTOM OF THE ROOTBALL.


CONSTRUCTION NOTES:

- A. TREE.
- B. BACKFILL WITH EXISTING SOIL.
- C. 4" DEPTH OF BARK MULCH.
- D. TURF AT FINISH GRADE.
- E. UNDISTURBED SOIL.

3 TREE PLANTED IN TURF
L19 DWG. 2713 NTS

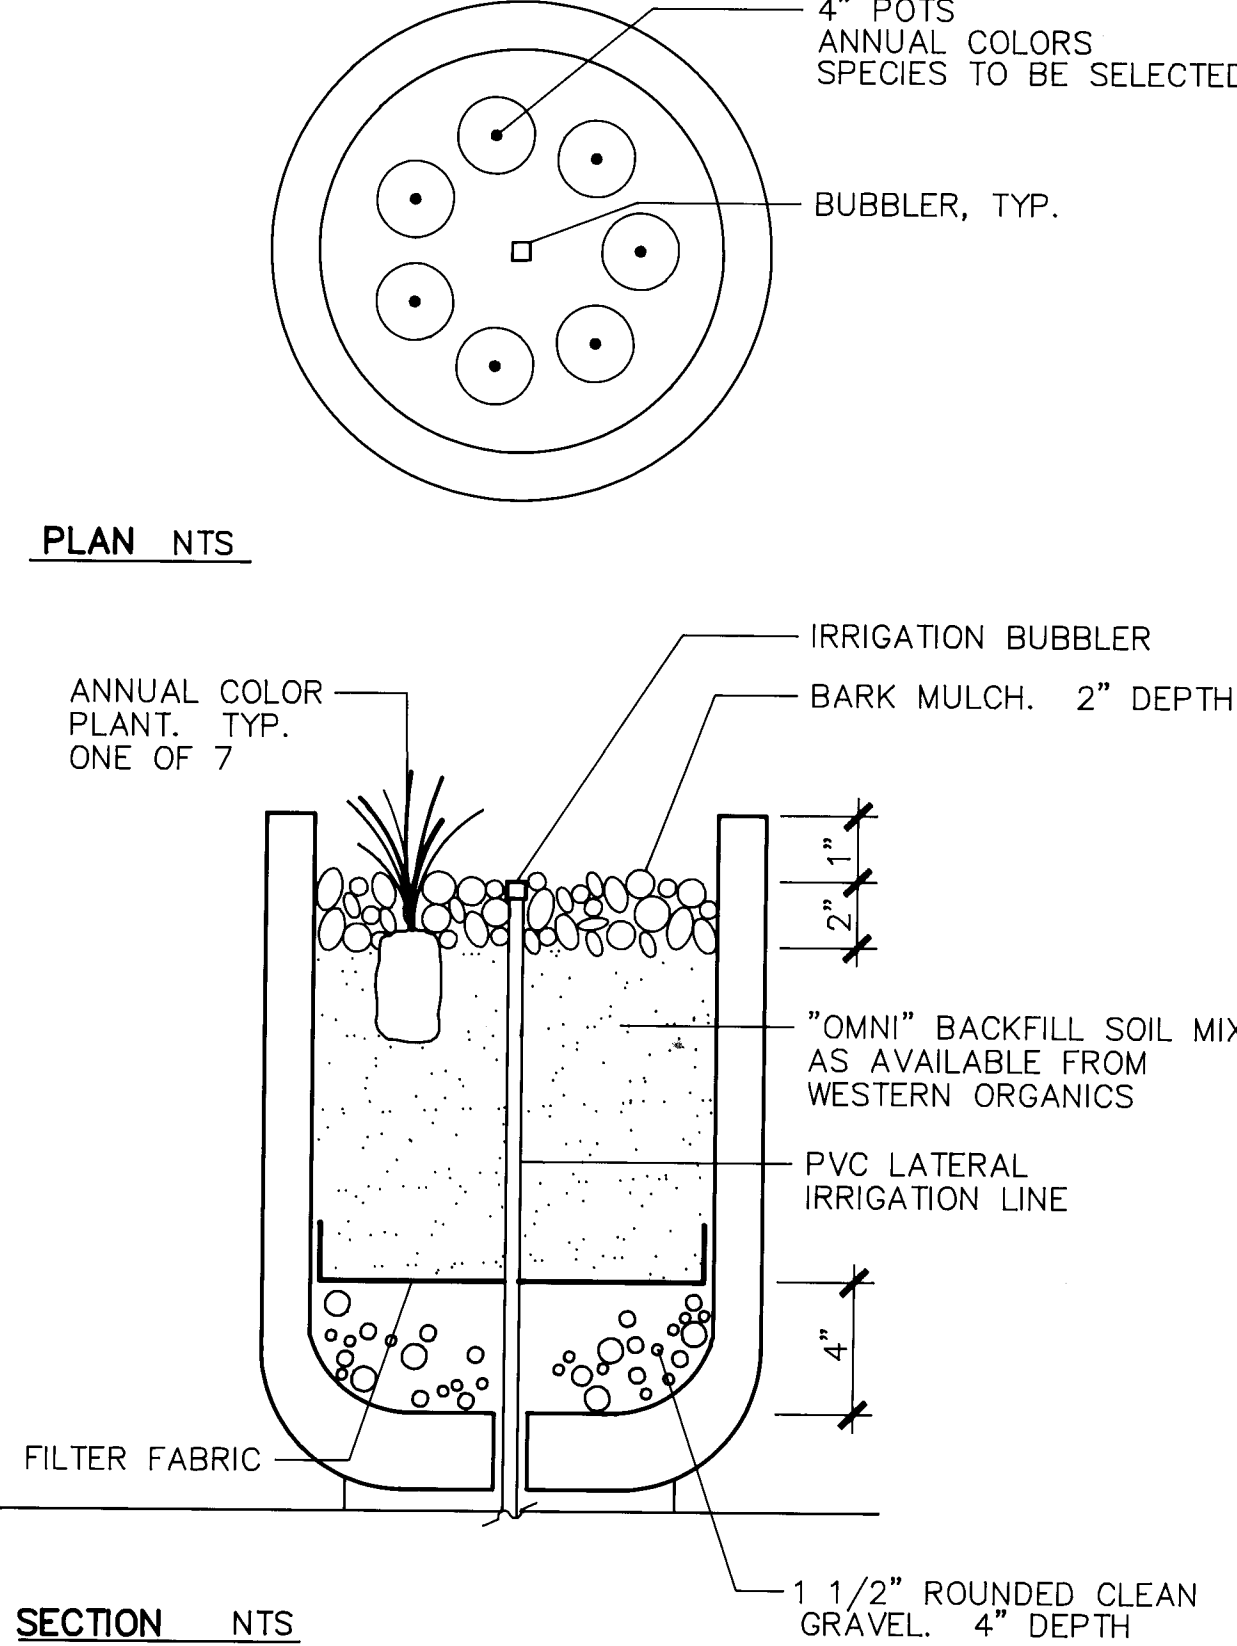

7 PLANTER TUB
L19 NTS

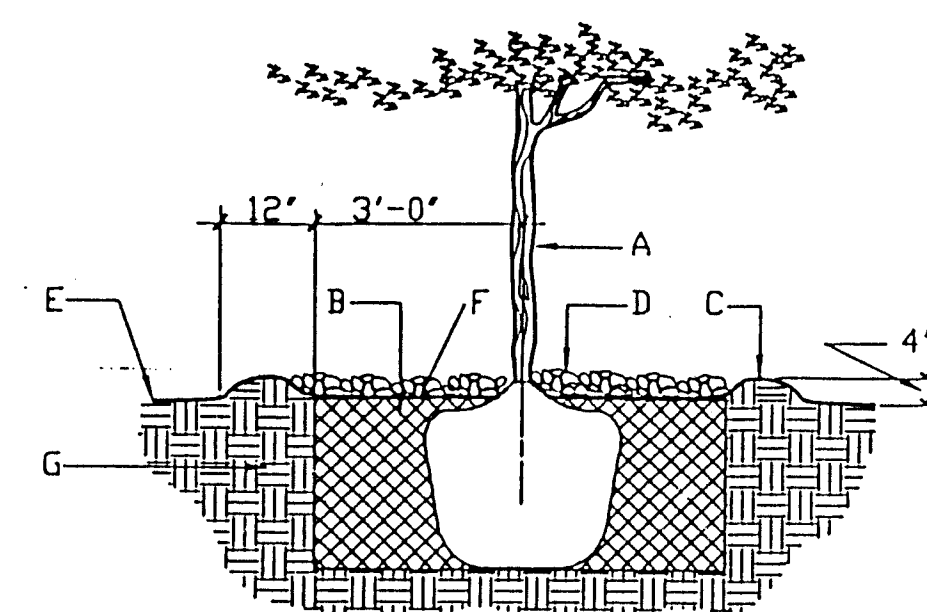


GENERAL NOTES:

1. ROOTBALL SHALL BE PLACED ON UNDISTURBED SOIL TO PREVENT TREE FROM SETTLING.
2. TOP OF ROOTBALL INDICATES LEVEL AT WHICH TREE WAS GROWN AND DUG; THIS REPRESENTS THE LEVEL AT WHICH THE TREE SHOULD BE INSTALLED; THAT LEVEL MAY BE EXCEEDED BY ONLY A ONE INCH LAYER OF SOIL.
3. PRIOR TO BACKFILLING TREE, ALL WIRE, ROPE AND SYNTHETIC MATERIALS SHALL BE REMOVED FROM THE TREE AND THE PLANTING PIT.
4. PRIOR TO BACKFILLING, ALL BURLAP SHALL BE CUT AWAY EXCEPT FROM BOTTOM OF THE ROOTBALL.

CONSTRUCTION NOTES:

- A. TREE.
- B. BACKFILL WITH EXISTING SOIL.
- C. EARTH BERM AROUND WATER RETENTION BASIN.
- D. 4" DEPTH OF BARK MULCH.
- E. FINISH GRADE.
- F. WATER RETENTION BASIN.
- G. UNDISTURBED SOIL.

4 ISOLATED TREE PLANTING
L19 DWG. 2714 NTS

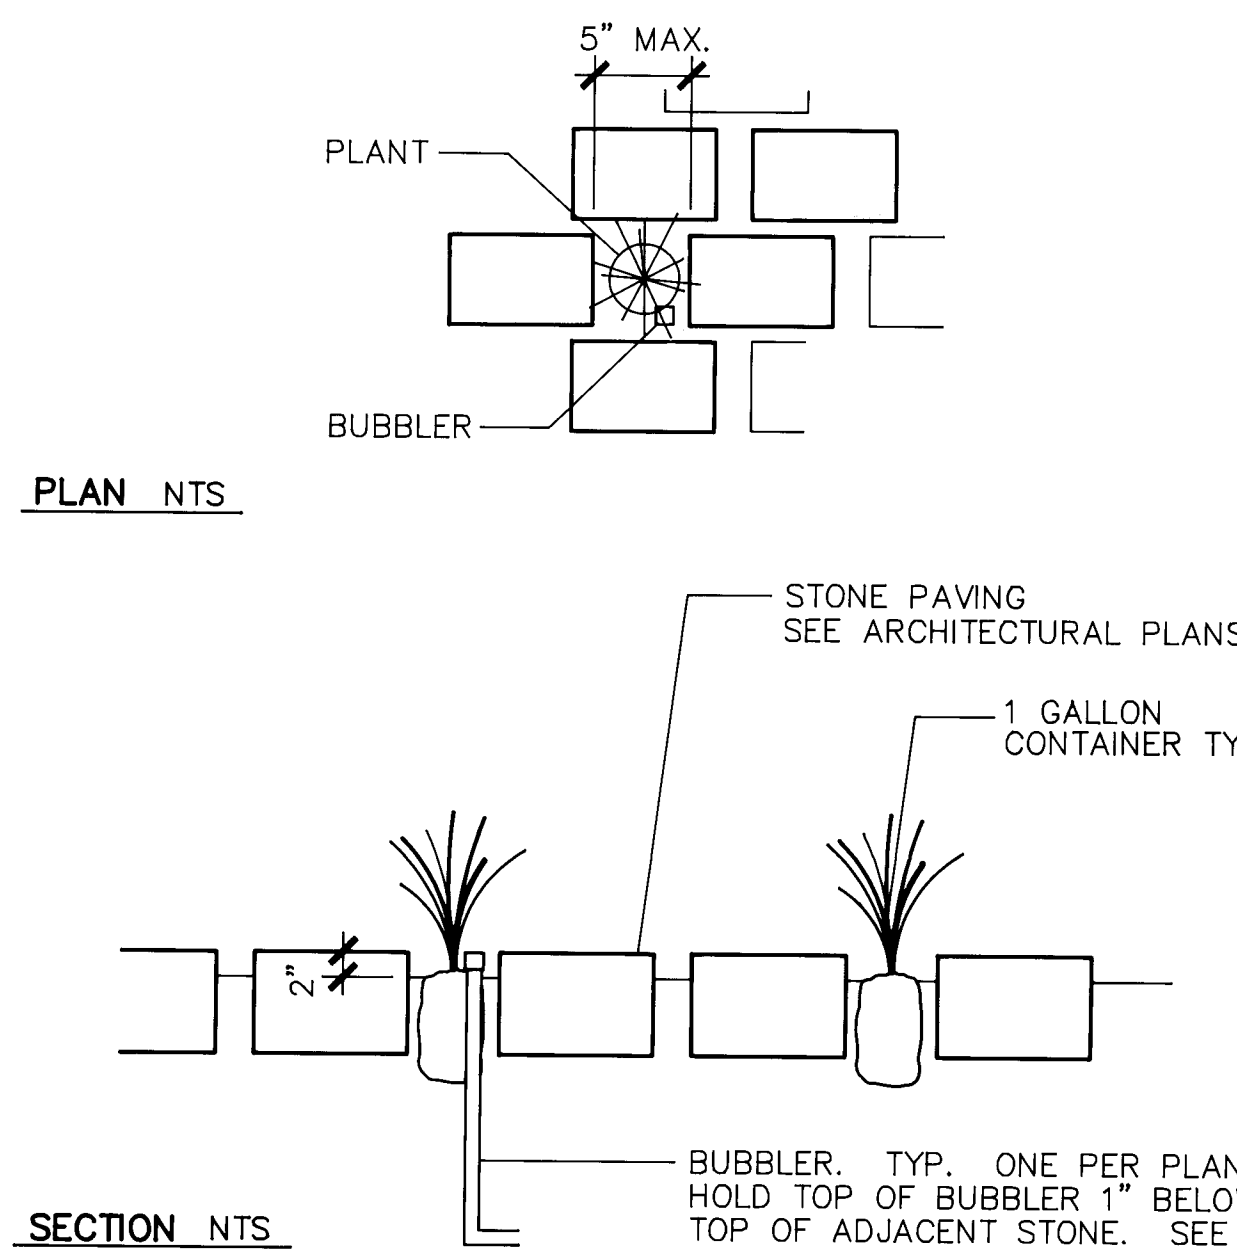

8 TYPE A PLANTING DETAIL
L19 NTS

RECORD SET
May 1, 1997

Campbell Okuma Perkins Associates, Inc.
Landscape Architecture and Site Planning
418 Central S.E. 901 W San Mateo Suite L
Albuquerque, NM 87102 Santa Fe, NM 87505
(505) 242-9828 (505) 982-8399

CITY OF ALBUQUERQUE PUBLIC WORKS DEPARTMENT ENGINEERING GROUP	
TITLE: FOURTH STREET STREETSCAPE DETAILS	
Design Review Committee	City Engineer Approval
Ms./Day/Yr.	Ms./Day/Yr.
City Project No.	Zone Map No.
4917.90	
Sheet	Of
L19	L19


AS-BUILT INFORMATION	
CONTRACTOR	DATE
WORKED BY	DATE
INSPECTED BY	DATE
ACCEPTANCE BY	DATE
VERIFICATION BY	DATE
DRAWING BY	DATE
MICRO-FILM INFORMATION	DATE
RECORDED BY	DATE
NO.	

BENCH MARKS	

SURVEY INFORMATION	
FIELD NOTES	DATE
NO.	

LANDSCAPE ARCHITECT'S SEAL	

ISSUED FOR CONSTRUCTION	
NO.	DATE
REVISIONS	DESIGN
DESIGNED BY	WSP
DRAWN BY	WSP
CHECKED BY	WSP
DATE	8-95
DATE	8-95
DATE	10-95-95

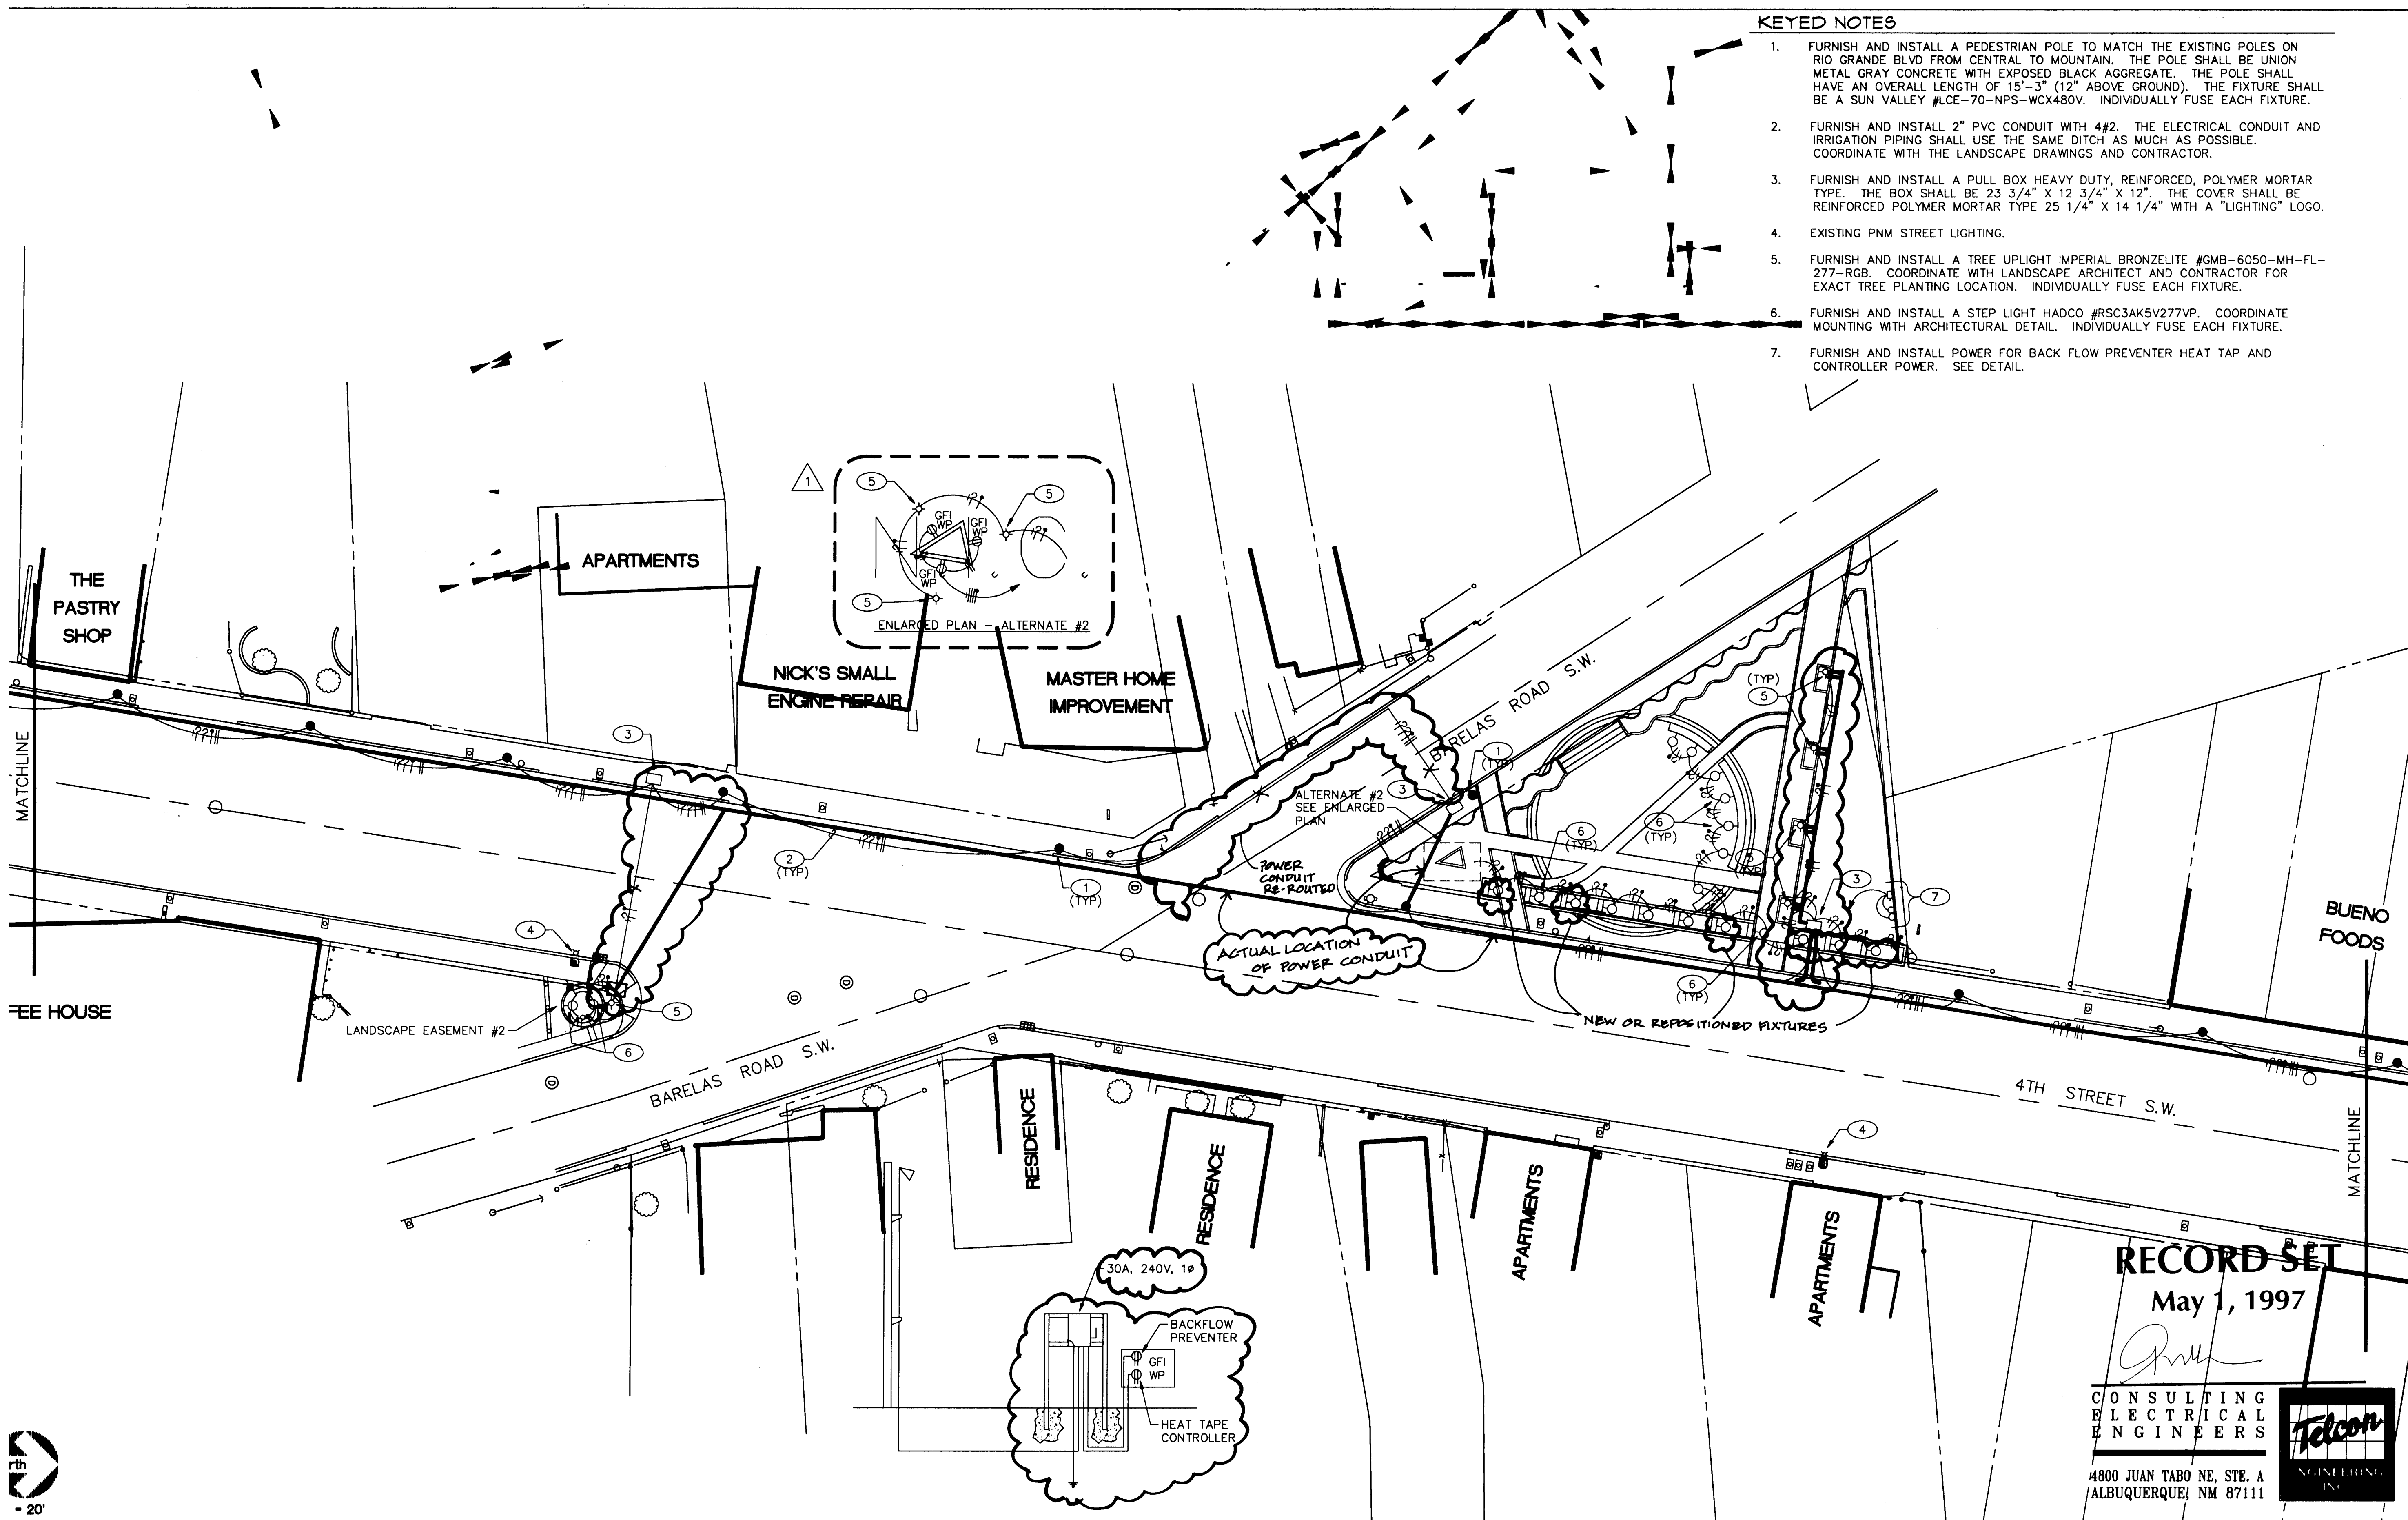


- KEYED NOTES**
1. FURNISH AND INSTALL A PEDESTRIAN POLE TO MATCH THE EXISTING POLES ON RIO GRANDE BLVD FROM CENTRAL TO MOUNTAIN. THE POLE SHALL BE UNION METAL GRAY CONCRETE WITH EXPOSED BLACK AGGREGATE. THE POLE SHALL HAVE AN OVERALL LENGTH OF 15'-3" (12" ABOVE GROUND). THE FIXTURE SHALL BE A SUN VALLEY #LCE-70-NPS-WCX480V. INDIVIDUALLY FUSE EACH FIXTURE.
 2. FURNISH AND INSTALL 2" PVC CONDUIT WITH 4#2. THE ELECTRICAL CONDUIT AND IRRIGATION PIPING SHALL USE THE SAME DITCH AS MUCH AS POSSIBLE. COORDINATE WITH THE LANDSCAPE DRAWINGS AND CONTRACTOR.
 3. FURNISH AND INSTALL A PULL BOX HEAVY DUTY, REINFORCED, POLYMER MORTAR TYPE. THE BOX SHALL BE 23 3/4" X 12 3/4" X 12". THE COVER SHALL BE REINFORCED POLYMER MORTAR TYPE 25 1/4" X 14 1/4" WITH A "LIGHTING" LOGO.
 4. EXISTING PNM STREET LIGHTING.
 5. FURNISH AND INSTALL A TREE UPLIGHT IMPERIAL BRONZELITE #GMB-6050-MH-FL-277-RGB. COORDINATE WITH LANDSCAPE ARCHITECT AND CONTRACTOR FOR EXACT TREE PLANTING LOCATION. INDIVIDUALLY FUSE EACH FIXTURE.
 6. FURNISH AND INSTALL A STEP LIGHT HADCO #RSC3AK5V277VP. COORDINATE MOUNTING WITH ARCHITECTURAL DETAIL. INDIVIDUALLY FUSE EACH FIXTURE.
 7. FURNISH AND INSTALL POWER FOR BACK FLOW PREVENTER HEAT TAP AND CONTROLLER POWER. SEE DETAIL.

RECORD SET
May 1, 1997


CONSULTING ELECTRICAL ENGINEERS


4800 JUAN TABO NE, STE. A
ALBUQUERQUE, NM 87111

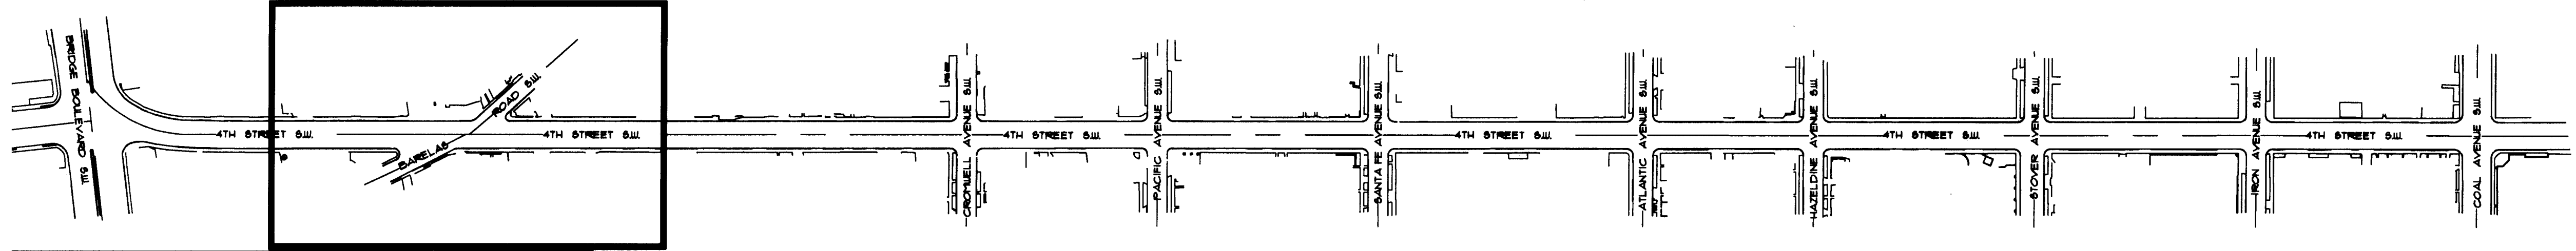

FOURTH STREET STREETScape KEY

CITY OF ALBUQUERQUE PUBLIC WORKS DEPARTMENT ENGINEERING GROUP			
TITLE: FOURTH STREET STREETScape BARELAS NEIGHBORHOOD, ALBUQUERQUE, NEW MEXICO			
Design Review Committee	City Engineer Approval	Ms./Day/yr.	Ms./Day/yr.
8/29/95 10/12/95 8/29/96	8/29/95 10/12/95 8/29/96	Ms./Day/yr.	Ms./Day/yr.
		Ms./Day/yr.	Ms./Day/yr.
		Ms./Day/yr.	Ms./Day/yr.
City Project No.	Zone Map No.	Sheet	Of
4917.90	L-14	E-2	7

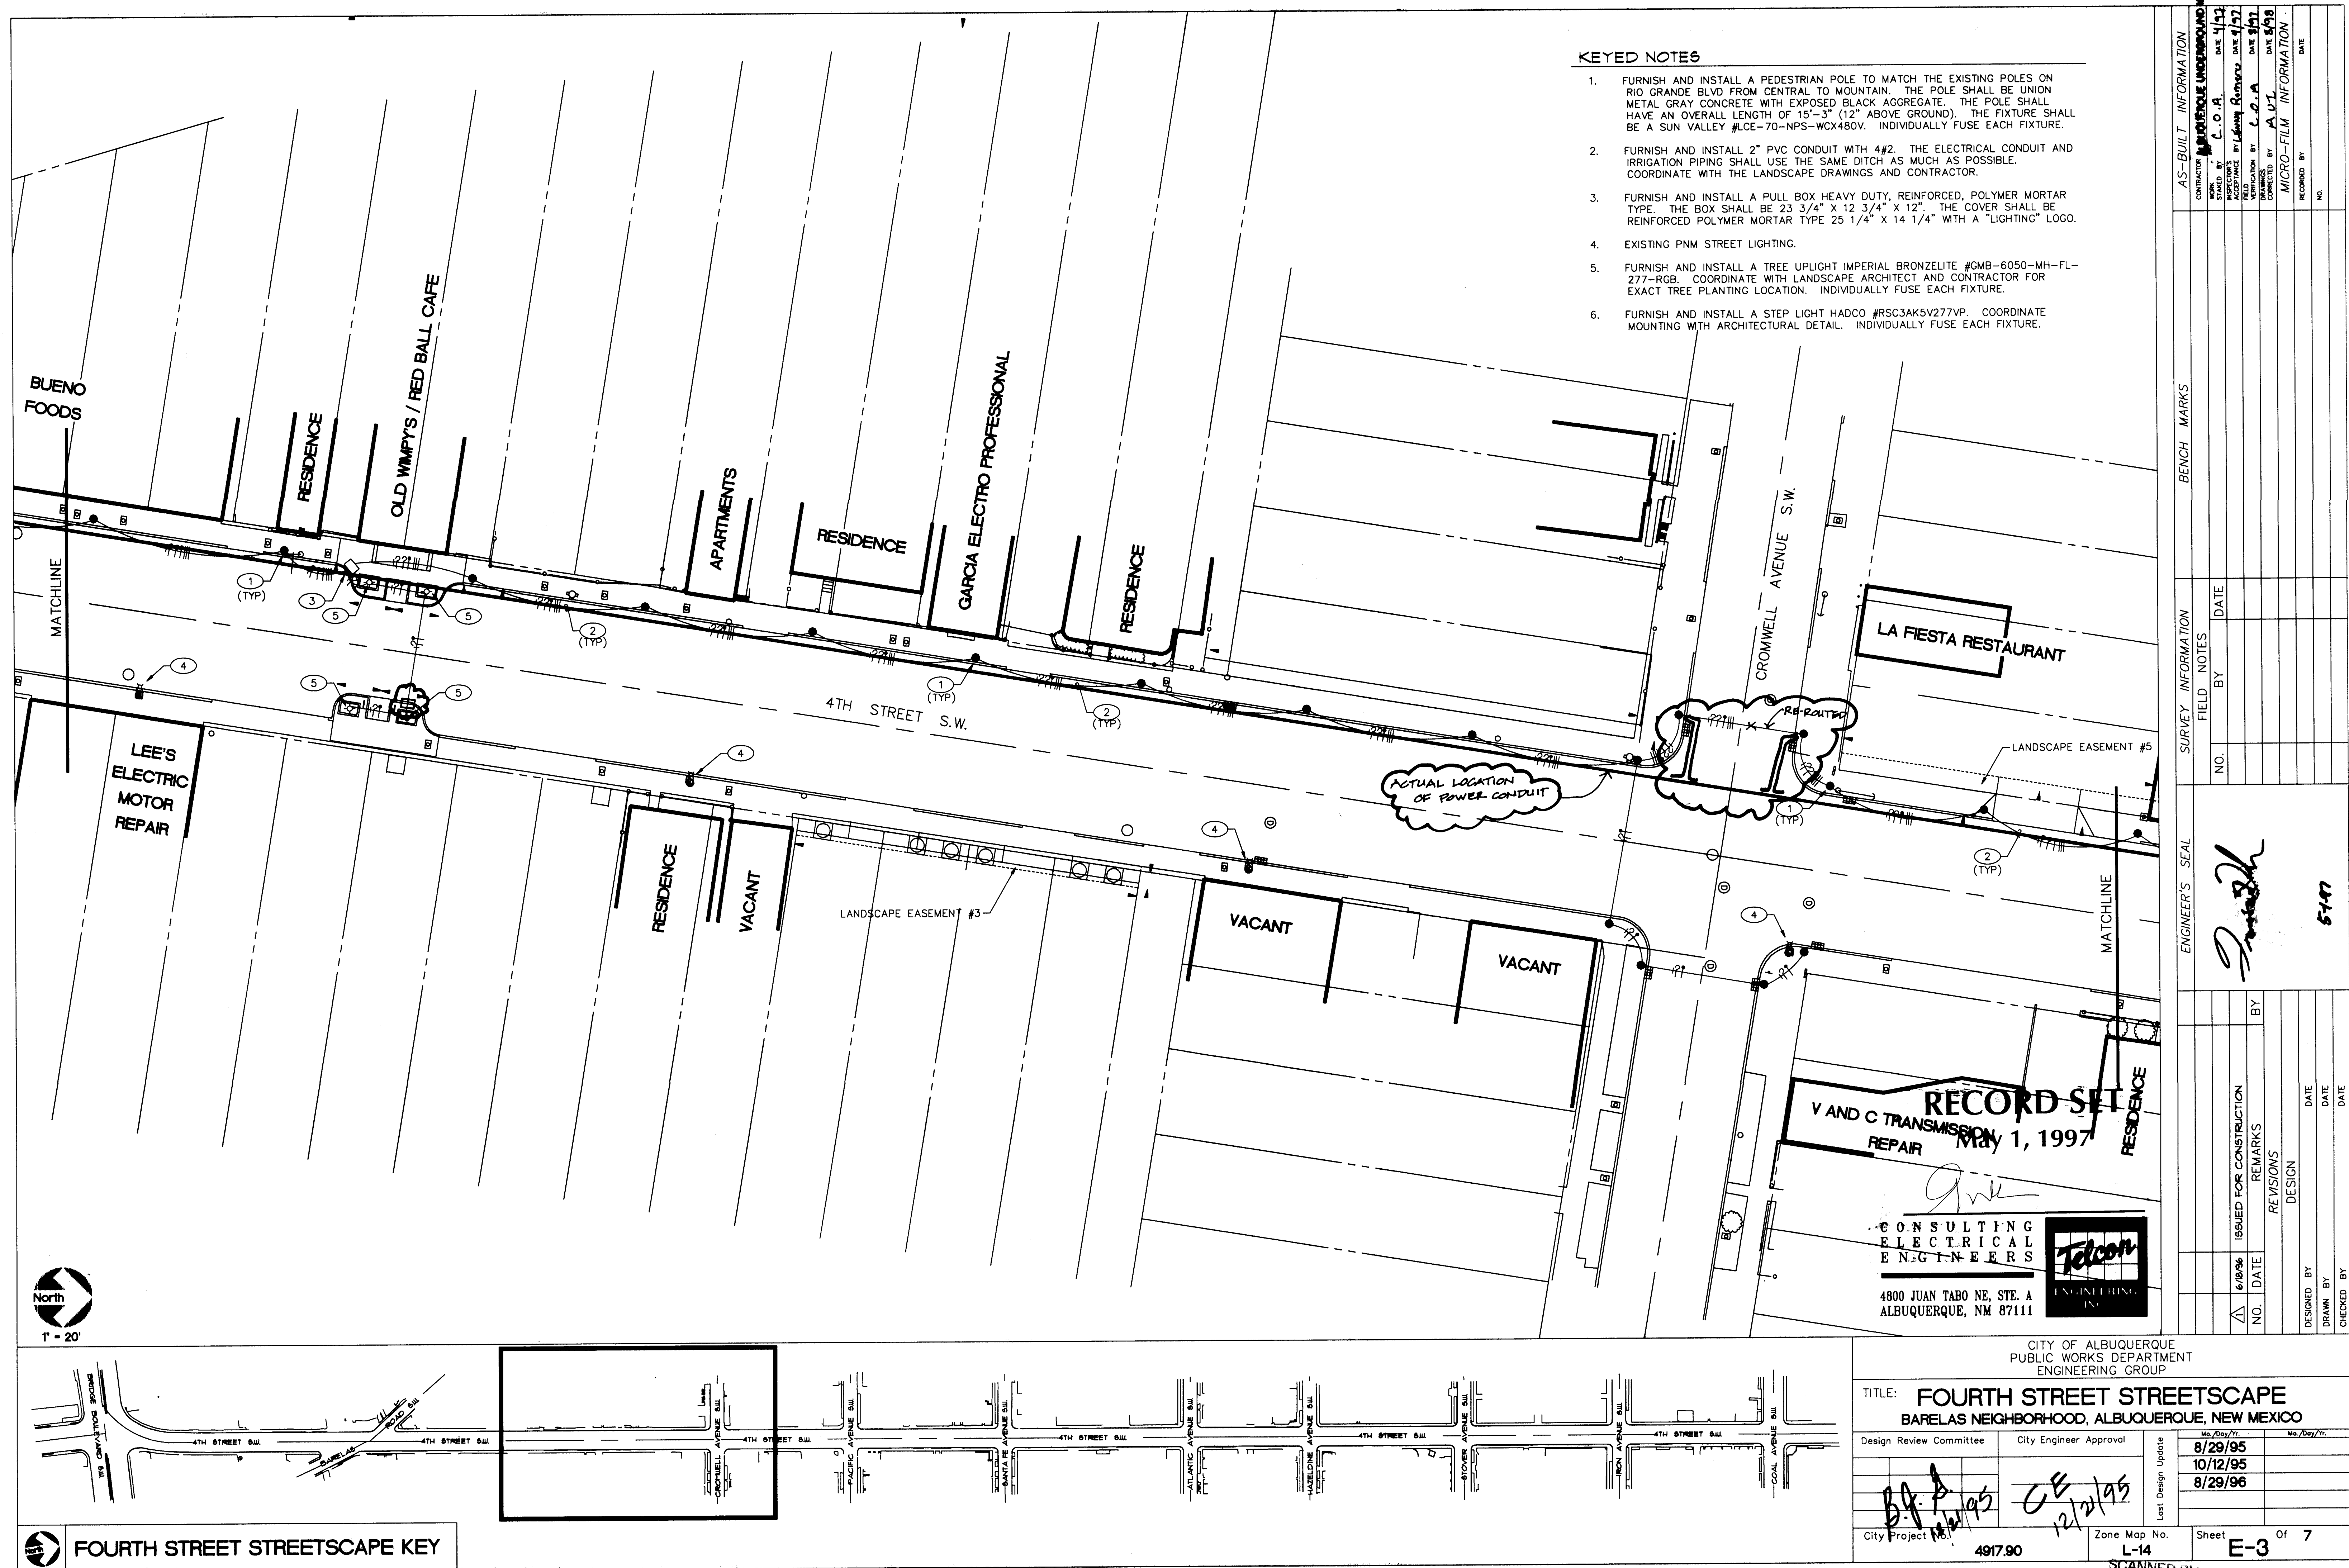


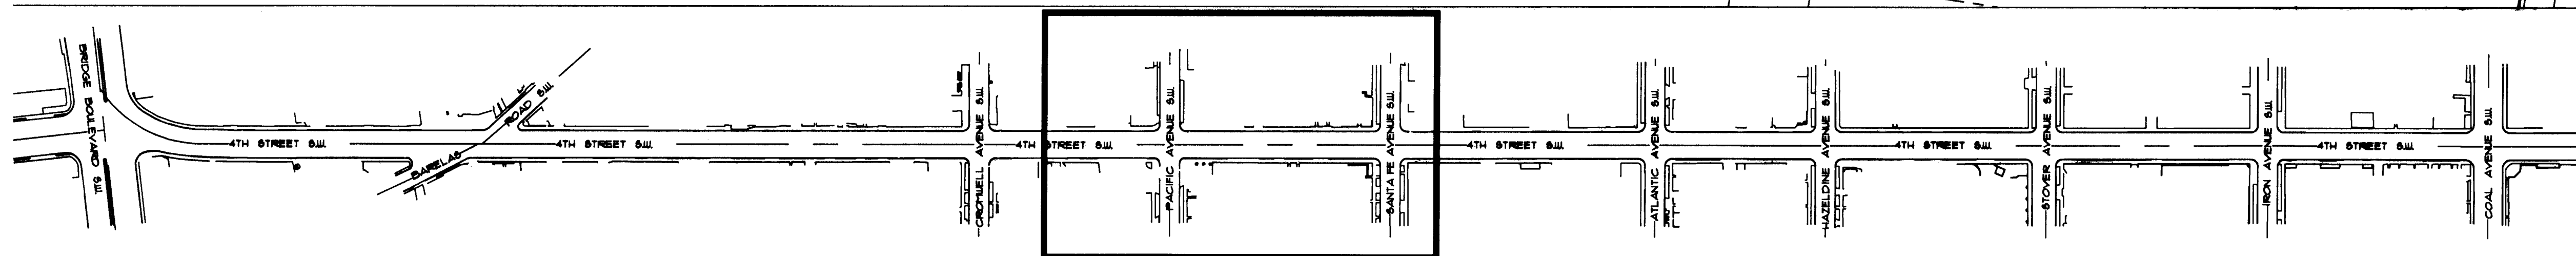

FOURTH STREET STREETScape KEY


KEYED NOTES

1. FURNISH AND INSTALL A PEDESTRIAN POLE TO MATCH THE EXISTING POLES ON RIO GRANDE BLVD FROM CENTRAL TO MOUNTAIN. THE POLE SHALL BE UNION METAL GRAY CONCRETE WITH EXPOSED BLACK AGGREGATE. THE POLE SHALL HAVE AN OVERALL LENGTH OF 15'-3" (12" ABOVE GROUND). THE FIXTURE SHALL BE A SUN VALLEY #LCE-70-NPS-WCX240V. INDIVIDUALLY FUSE EACH FIXTURE.
2. FURNISH AND INSTALL 2" PVC CONDUIT WITH 4#2. THE ELECTRICAL CONDUIT AND IRRIGATION PIPING SHALL USE THE SAME DITCH AS MUCH AS POSSIBLE. COORDINATE WITH THE LANDSCAPE DRAWINGS AND CONTRACTOR.
3. FURNISH AND INSTALL A PULL BOX HEAVY DUTY, REINFORCED, POLYMER MORTAR TYPE. THE BOX SHALL BE 23 3/4" X 12 3/4" X 12". THE COVER SHALL BE REINFORCED POLYMER MORTAR TYPE 25 1/4" X 14 1/4" WITH A "LIGHTING" LOGO.
4. EXISTING PNM STREET LIGHTING.
5. FURNISH AND INSTALL A TREE UPLIGHT IMPERIAL BRONZELITE #GMB-6050-MH-FL-277-RGB. COORDINATE WITH LANDSCAPE ARCHITECT AND CONTRACTOR FOR EXACT TREE PLANTING LOCATION. INDIVIDUALLY FUSE EACH FIXTURE.
6. FURNISH AND INSTALL A STEP LIGHT HADCO #RSC3AK5V277VP. COORDINATE MOUNTING WITH ARCHITECTURAL DETAIL. INDIVIDUALLY FUSE EACH FIXTURE.

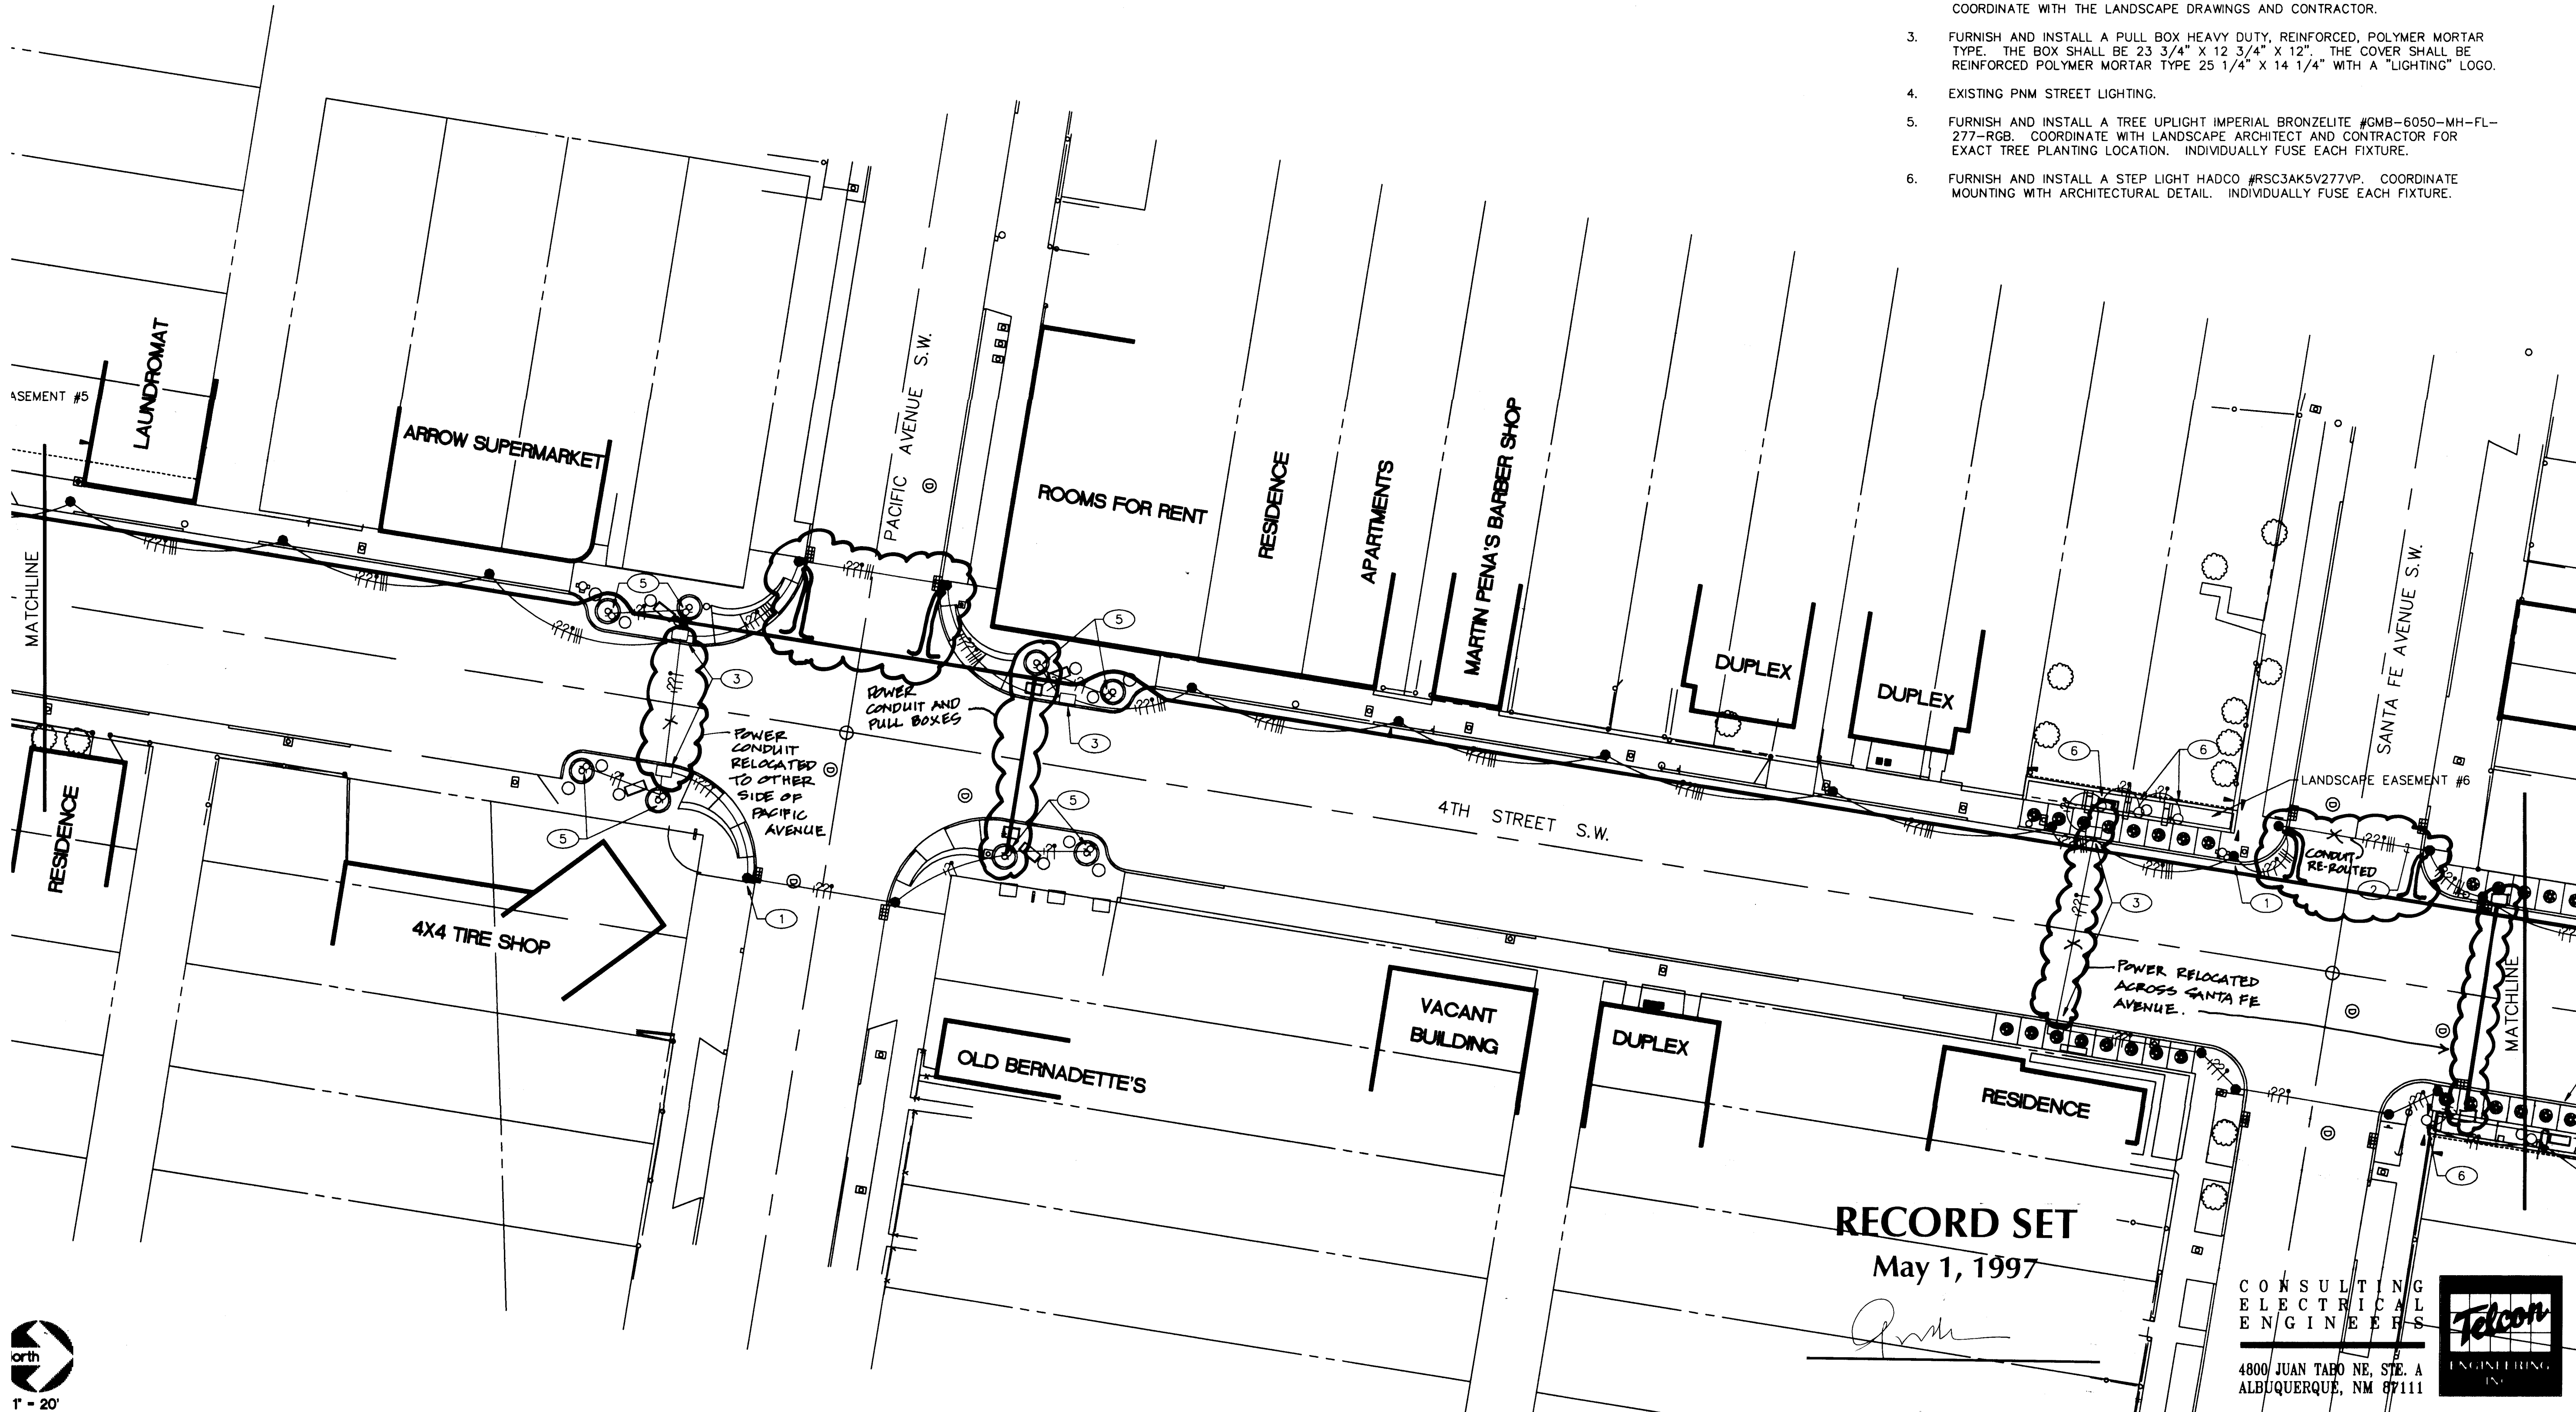

RECORD SET
May 1, 1997


CONSULTING
ELECTRICAL
ENGINEERS
4800 JUAN TABO NE, STE. A
ALBUQUERQUE, NM 87111

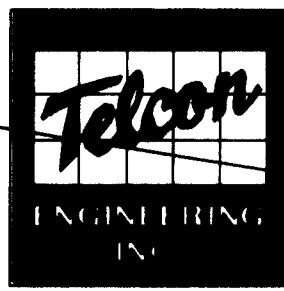

AS-BUILT INFORMATION		BENCH MARKS		SURVEY INFORMATION		ENGINEER'S SEAL		ISSUED FOR CONSTRUCTION		REVISIONS		DESIGNED BY		DRAWN BY		CHECKED BY	
CONTRACTOR	ALBUQUERQUE INFORMATION			FIELD	NOTES			NO.	DATE	NO.	DATE	NO.	DATE	NO.	DATE	NO.	DATE
WORK	DATE																
STARTED BY	C.D.A.																
ACCEPTANCE	DATE																
BY	LEWIS BARR																
DATE	4/97																
REVISIONS	DATE																
BY	C.D.A.																
DATE	8/97																
CORRECTED BY	AUT																
DATE	8/97																
MICRO-FILM	INFORMATION																
RECORDED BY																	
DATE																	
NO.																	

5-1-97

CITY OF ALBUQUERQUE PUBLIC WORKS DEPARTMENT ENGINEERING GROUP		TITLE: FOURTH STREET STREETScape BARELAS NEIGHBORHOOD, ALBUQUERQUE, NEW MEXICO	
Design Review Committee	City Engineer Approval	Mo./Day/Yr.	Mo./Day/Yr.
		8/29/95	
		10/12/95	
		8/29/96	
City Project No.	Zone Map No.	Sheet	Of
491790	L-14	E-4	7

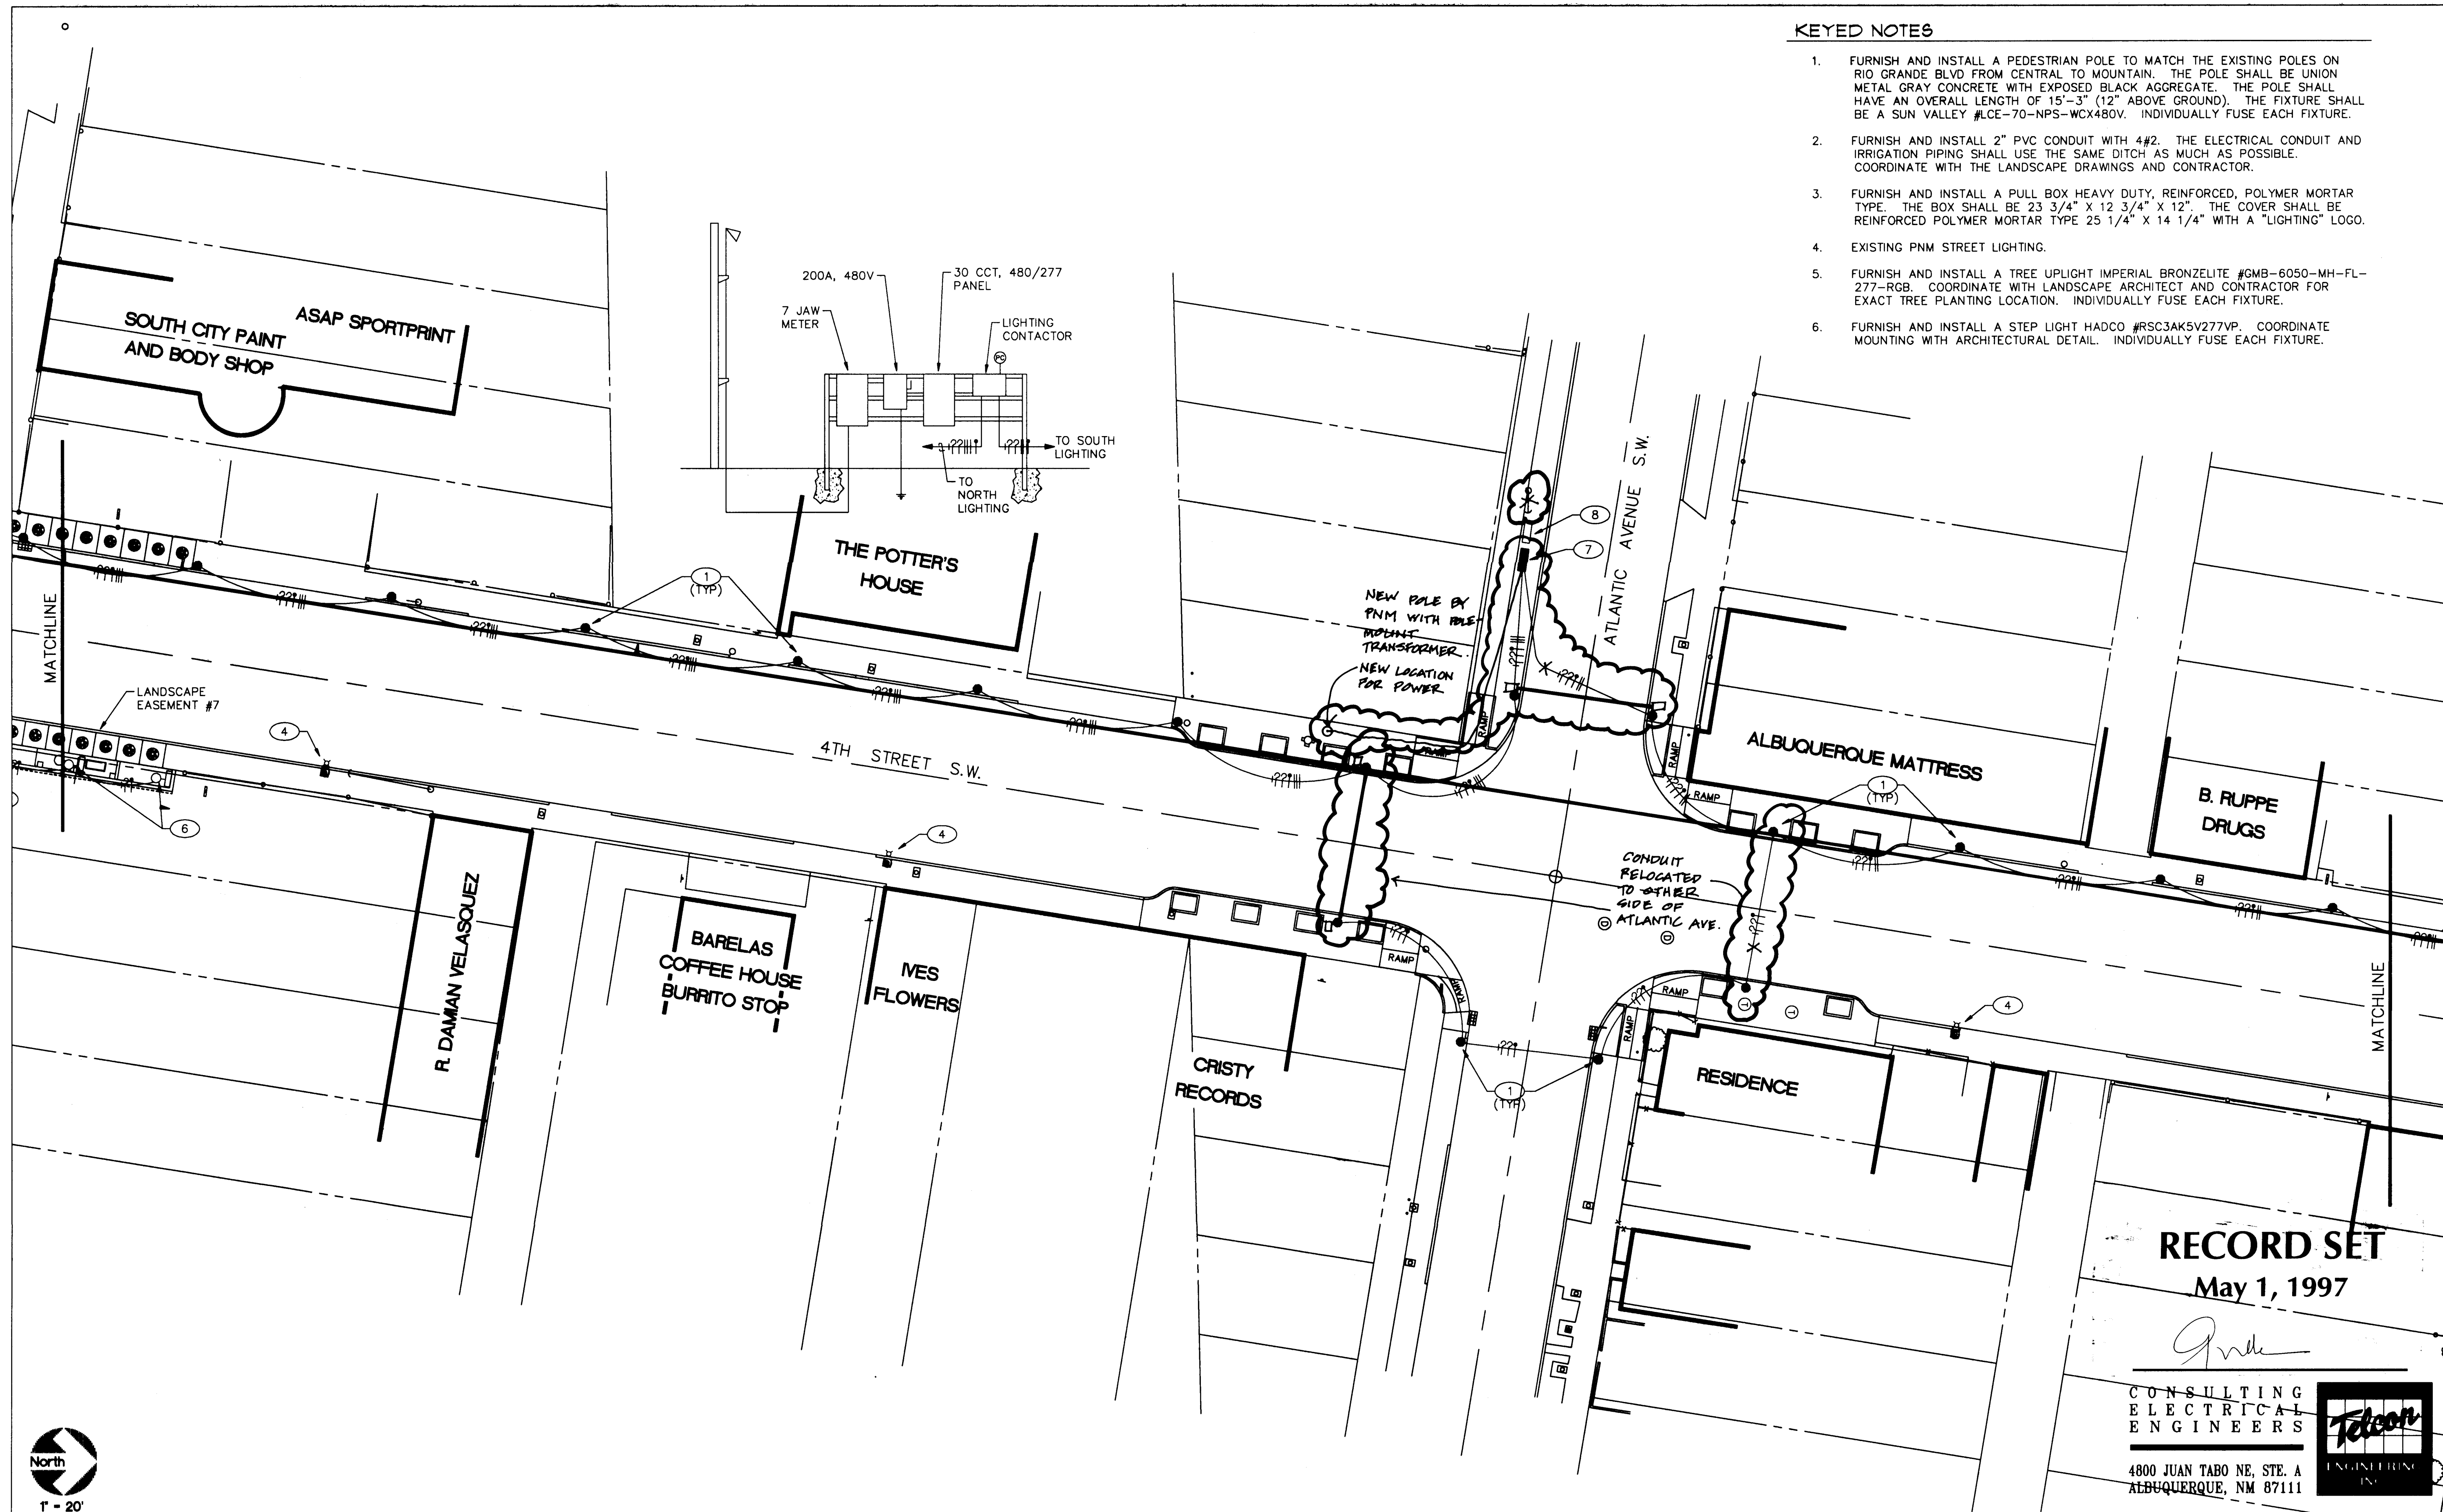

KEYED NOTES

1. FURNISH AND INSTALL A PEDESTRIAN POLE TO MATCH THE EXISTING POLES ON RIO GRANDE BLVD FROM CENTRAL TO MOUNTAIN. THE POLE SHALL BE UNION METAL GRAY CONCRETE WITH EXPOSED BLACK AGGREGATE. THE POLE SHALL HAVE AN OVERALL LENGTH OF 15'-3" (12" ABOVE GROUND). THE FIXTURE SHALL BE A SUN VALLEY #LCE-70-NPS-WCX480V. INDIVIDUALLY FUSE EACH FIXTURE.
2. FURNISH AND INSTALL 2" PVC CONDUIT WITH #42. THE ELECTRICAL CONDUIT AND IRRIGATION PIPING SHALL USE THE SAME DITCH AS MUCH AS POSSIBLE. COORDINATE WITH THE LANDSCAPE DRAWINGS AND CONTRACTOR.
3. FURNISH AND INSTALL A PULL BOX HEAVY DUTY, REINFORCED, POLYMER MORTAR TYPE. THE BOX SHALL BE 23 3/4" X 12 3/4" X 12". THE COVER SHALL BE REINFORCED POLYMER MORTAR TYPE 25 1/4" X 14 1/4" WITH A "LIGHTING" LOGO.
4. EXISTING PNM STREET LIGHTING.
5. FURNISH AND INSTALL A TREE UPLIGHT IMPERIAL BRONZELITE #GMB-6050-MH-FL-277-RGB. COORDINATE WITH LANDSCAPE ARCHITECT AND CONTRACTOR FOR EXACT TREE PLANTING LOCATION. INDIVIDUALLY FUSE EACH FIXTURE.
6. FURNISH AND INSTALL A STEP LIGHT HADCO #RSC3AK5V277VP. COORDINATE MOUNTING WITH ARCHITECTURAL DETAIL. INDIVIDUALLY FUSE EACH FIXTURE.




RECORD SET
May 1, 1997

CONSULTING
ELECTRICAL
ENGINEERS
4800 JUAN TABO NE, STE. A
ALBUQUERQUE, NM 87111




AS-BUILT INFORMATION		BENCH MARKS		SURVEY INFORMATION		ENGINEER'S SEAL	
CONTRACTOR	ALBUQUERQUE UNDERGROUND INC.			FIELD NOTES			
WORK				NO.	DATE		
STARTED BY	C.O.A.						
ACCEPTANCE	By <i>Lenny Camacho</i>						
DATE	4/97						
REVISIONS							
NO.							
DATE							
DESIGNED BY	A.O.T.						
DRAWN BY							
CHECKED BY							
RECORDED BY							
DATE							
NO.							

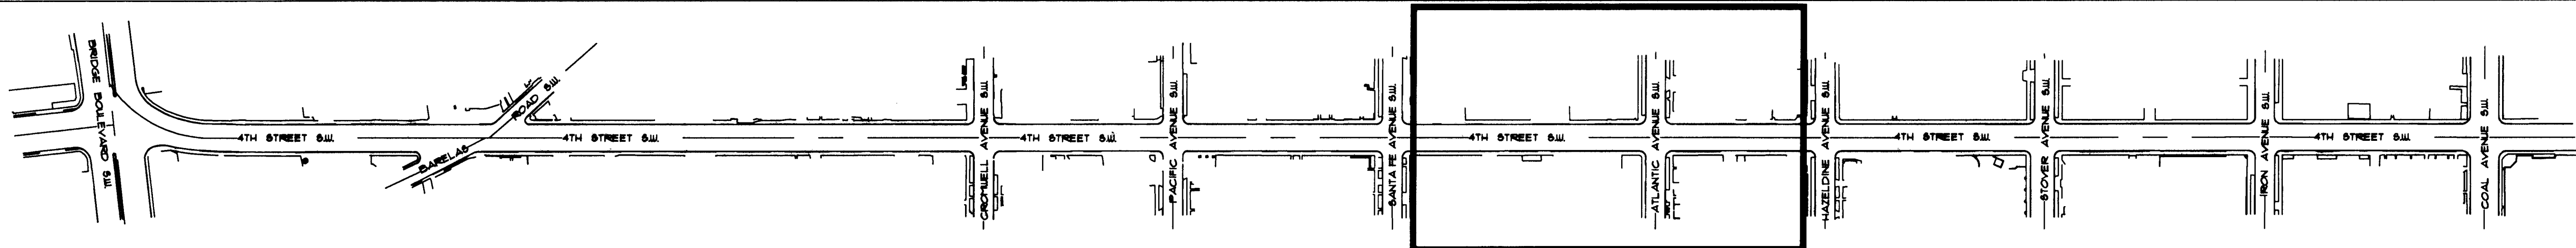

FOURTH STREET STREETScape KEY

CITY OF ALBUQUERQUE PUBLIC WORKS DEPARTMENT ENGINEERING GROUP				
TITLE: FOURTH STREET STREETScape BARELAS NEIGHBORHOOD, ALBUQUERQUE, NEW MEXICO				
Design Review Committee	City Engineer Approval	Last Design Update	Mo./Day/Yr.	
<i>8/29/95</i>	<i>CE 12/2/95</i>		8/29/95	Mo./Day/Yr.
			10/12/95	
			8/29/96	
City Project No.		Zone Map No.	Sheet	Of
4917.90	L-14	E-5	7	


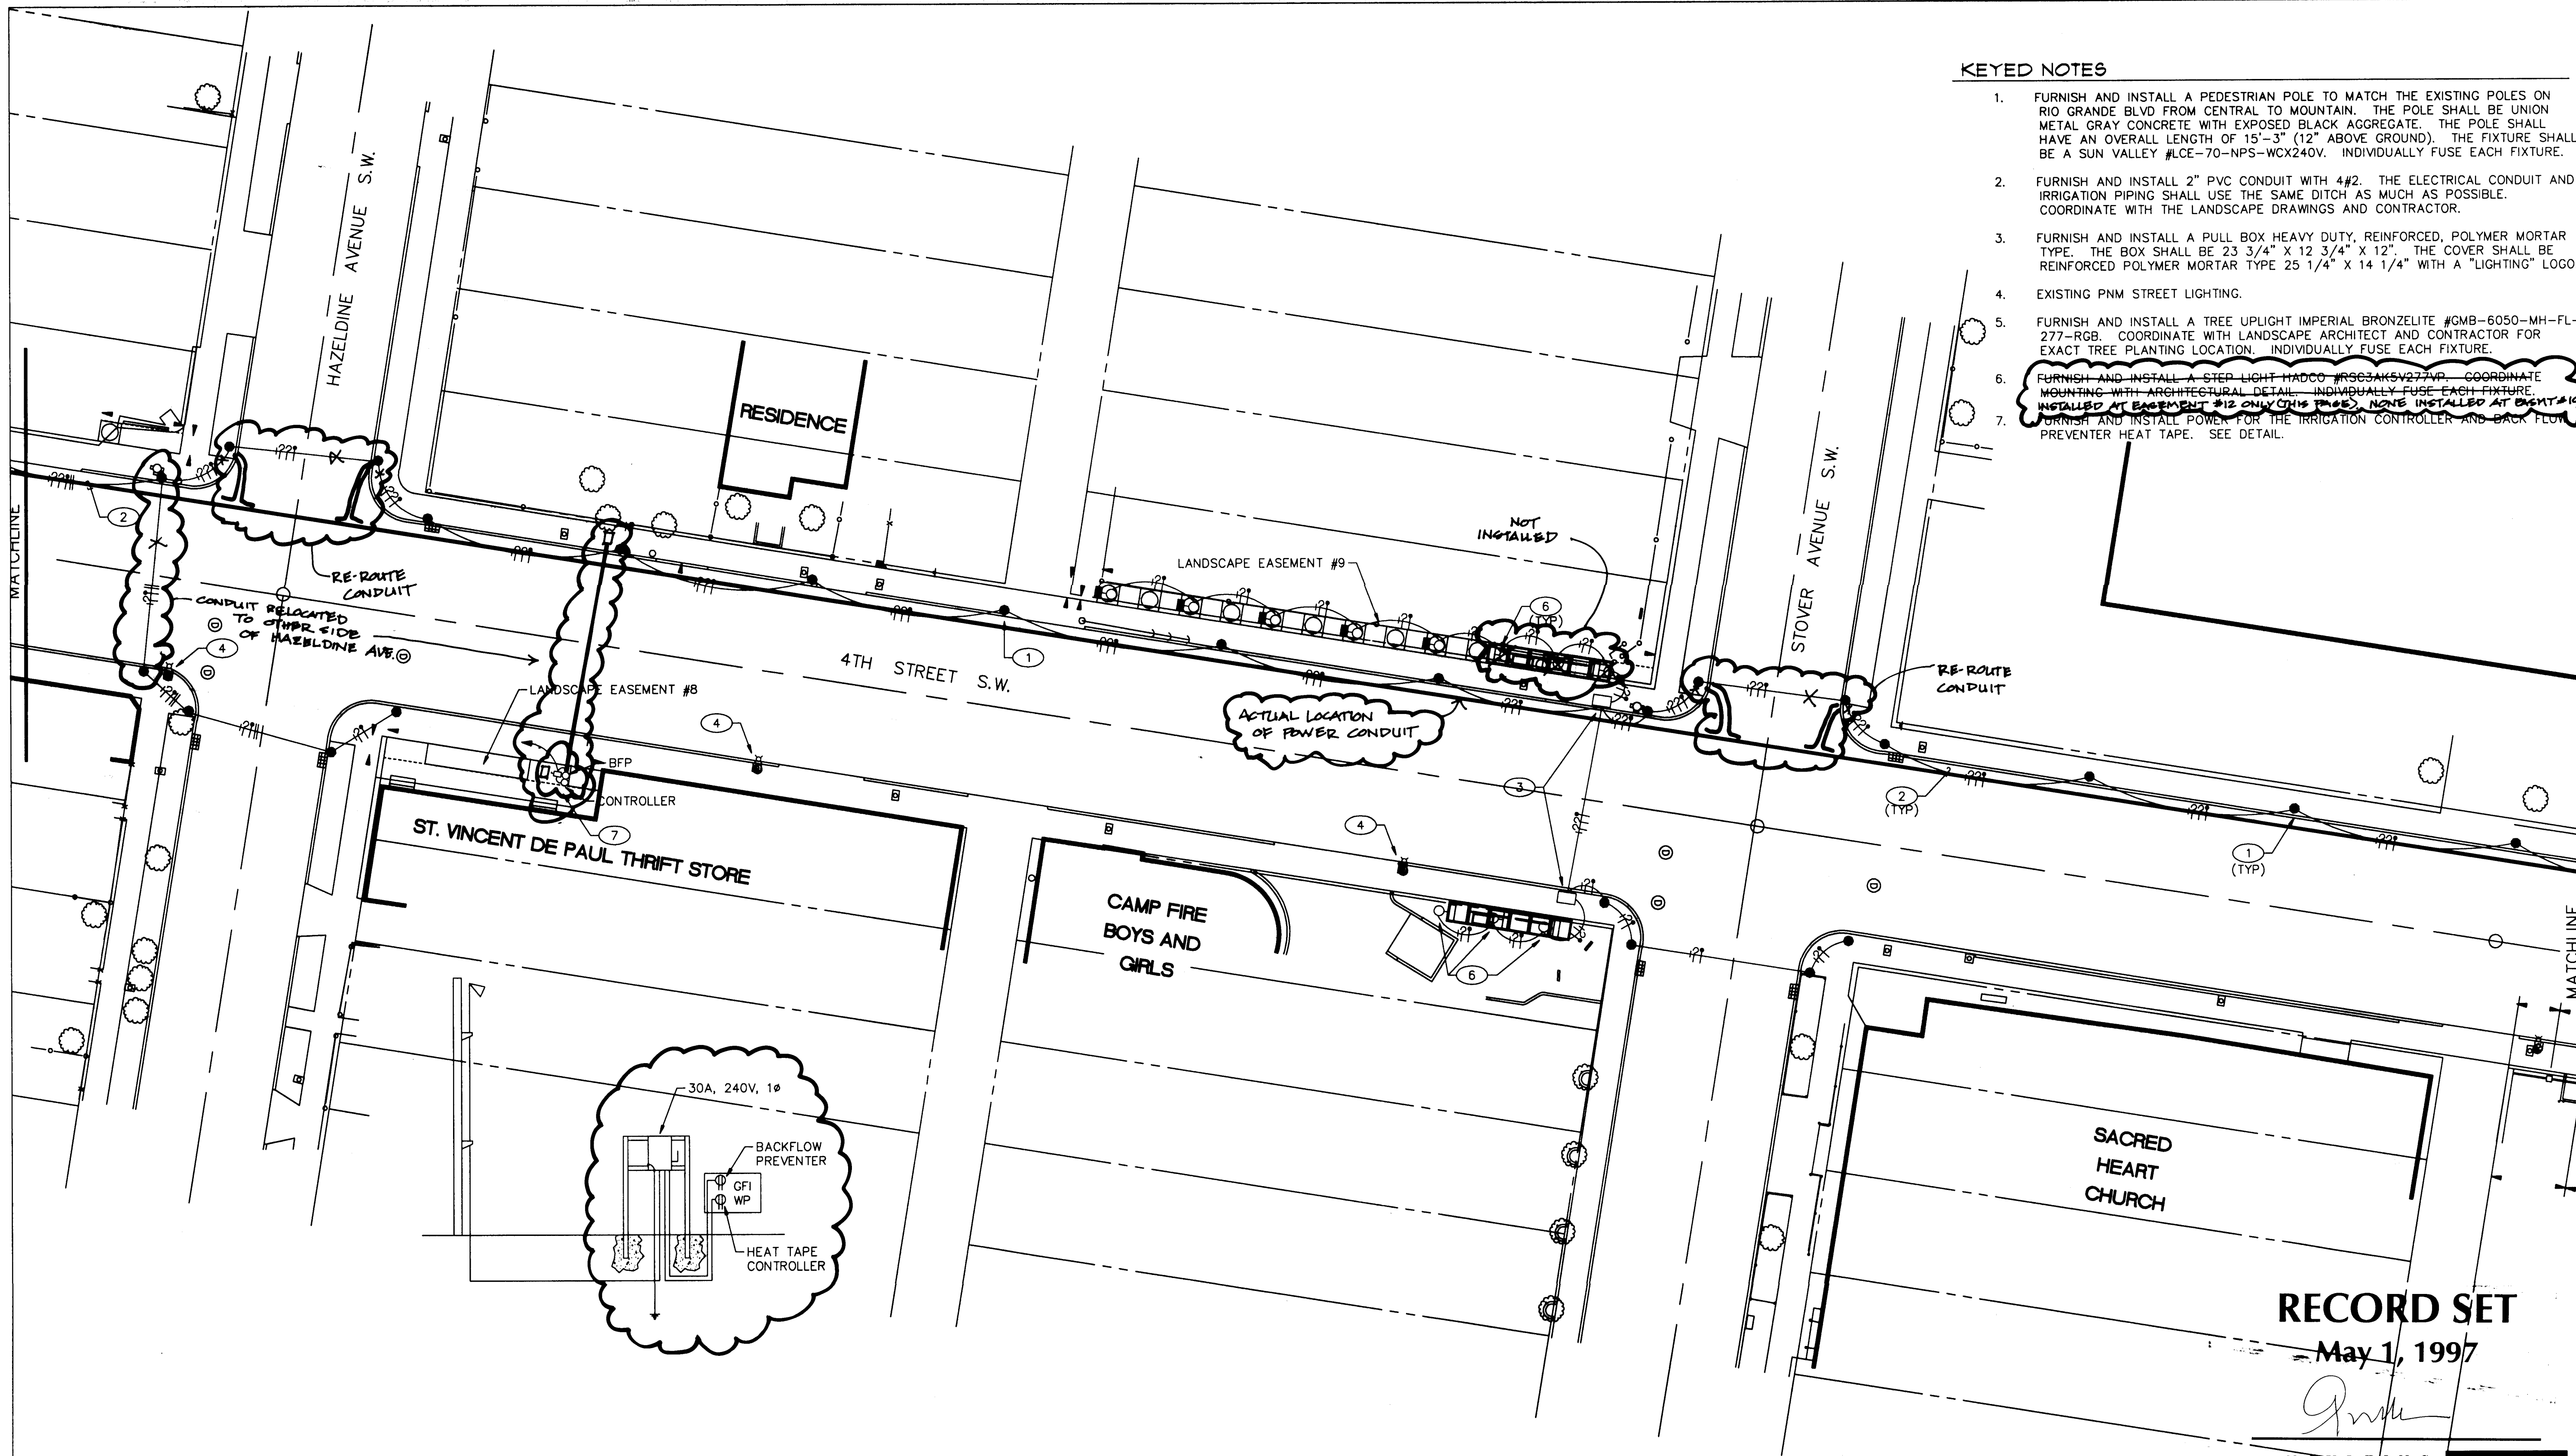


KEYED NOTES

1. FURNISH AND INSTALL A PEDESTRIAN POLE TO MATCH THE EXISTING POLES ON RIO GRANDE BLVD FROM CENTRAL TO MOUNTAIN. THE POLE SHALL BE UNION METAL GRAY CONCRETE WITH EXPOSED BLACK AGGREGATE. THE POLE SHALL HAVE AN OVERALL LENGTH OF 15'-3" (12" ABOVE GROUND). THE FIXTURE SHALL BE A SUN VALLEY #LCE-70-NPS-WCX240V. INDIVIDUALLY FUSE EACH FIXTURE.
2. FURNISH AND INSTALL 2" PVC CONDUIT WITH 4#2. THE ELECTRICAL CONDUIT AND IRRIGATION PIPING SHALL USE THE SAME DITCH AS MUCH AS POSSIBLE. COORDINATE WITH THE LANDSCAPE DRAWINGS AND CONTRACTOR.
3. FURNISH AND INSTALL A PULL BOX HEAVY DUTY, REINFORCED, POLYMER MORTAR TYPE. THE BOX SHALL BE 23 3/4" X 12 3/4" X 12". THE COVER SHALL BE REINFORCED POLYMER MORTAR TYPE 25 1/4" X 14 1/4" WITH A "LIGHTING" LOGO.
4. EXISTING PNM STREET LIGHTING.
5. FURNISH AND INSTALL A TREE UPLIGHT IMPERIAL BRONZELITE #GMB-6050-MH-FL-277-RGB. COORDINATE WITH LANDSCAPE ARCHITECT AND CONTRACTOR FOR EXACT TREE PLANTING LOCATION. INDIVIDUALLY FUSE EACH FIXTURE.
6. FURNISH AND INSTALL A STEP-LIGHT HADCO #R63AK5V277MR. COORDINATE MOUNTING WITH ARCHITECTURAL DETAIL. INDIVIDUALLY FUSE EACH FIXTURE. **INSTALLED AT EASEMENT #12 ONLY THIS POLE, NONE INSTALLED AT EASEMENT #19.**
7. FURNISH AND INSTALL POWER FOR THE IRRIGATION CONTROLLER AND BACK FLOW PREVENTER HEAT TAPE. SEE DETAIL.

RECORD SET
May 1, 1997

CONSULTING
ELECTRICAL
ENGINEERS
4800 JUAN TABO NE, STE. A
ALBUQUERQUE, NM 87111

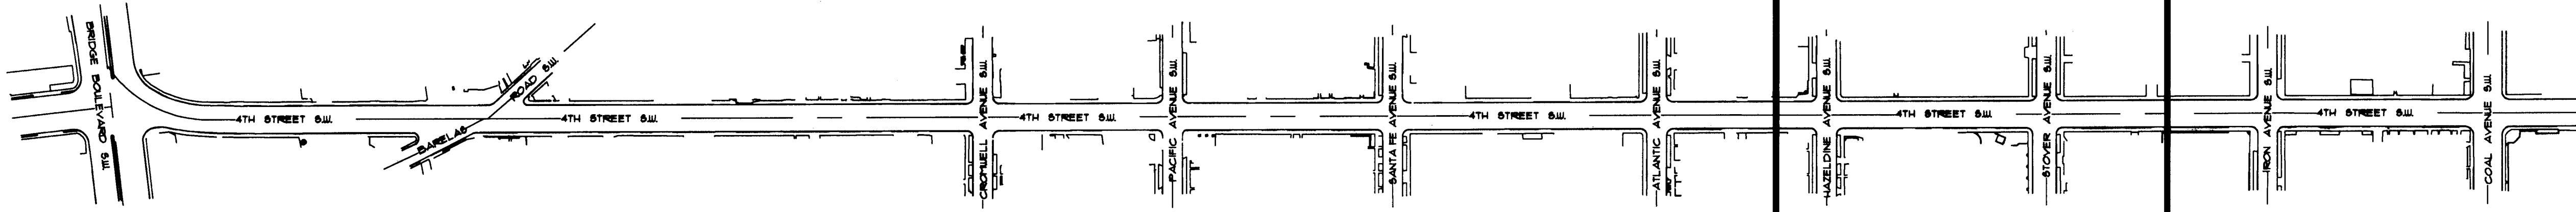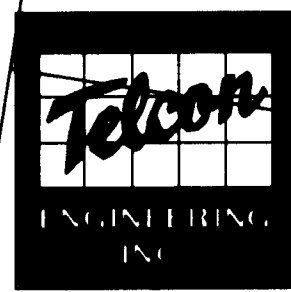

FOURTH STREET STREETScape KEY

AS-BUILT INFORMATION		BENCH MARKS		SURVEY INFORMATION		ENGINEER'S SEAL	
CONTRACTOR	ALBUQUERQUE UNDERGROUND INC.	NO.		NO.			
WORK BY	C.D.A.	DATE	4/97	DATE			
REVISIONS	REVISION	DATE		DATE			
APPROVED BY	C.D.A.	DATE	8/97	DATE			
DESIGNED BY	A.U.T.	DATE	8/97	DATE			
DRAWN BY		DATE		DATE			
CHECKED BY		DATE		DATE			
RECORDED BY		DATE		DATE			

[Signature]
5-197

CITY OF ALBUQUERQUE PUBLIC WORKS DEPARTMENT ENGINEERING GROUP			
TITLE: FOURTH STREET STREETScape BARELAS NEIGHBORHOOD, ALBUQUERQUE, NEW MEXICO			
Design Review Committee	City Engineer Approval	Mo./Day/Yr.	Mo./Day/Yr.
		8/29/95	
		10/12/95	
		8/29/96	
City Project No.	Zone Map No.	Sheet	Of
4917.90	L-14	E-6	7

SCANNED BY
BY LASON


TRAFFIC CONTROL GENERAL NOTES

1. REFER TO SHEETS TC-2 AND TC-3 FOR ADDITIONAL NOTES AND TYPICAL CONSTRUCTION TRAFFIC CONTROL REQUIREMENTS AND STRATEGIES.
2. SEPARATE PERMITS WILL BE REQUIRED FOR EVERY LANE CLOSURE. EACH PERMIT SHALL BE CLEARED BY THE CONSTRUCTION COORDINATION DIVISION OF THE CITY OF ALBUQUERQUE FOR INTERFERENCE WITH OTHER CONSTRUCTION PROJECTS. THE CONTRACTOR SHALL ALLOW ENOUGH TIME BETWEEN THE PERMIT REQUEST AND CONSTRUCTION BEFORE SCHEDULING CREWS AND EQUIPMENT.
3. PROVIDE FLAGGER CONTROL AS NEEDED BETWEEN THE HOURS OF 9:30AM AND 3:30PM ONLY. LANES MUST BE OPEN FOR TRAFFIC OUTSIDE OF THIS TIME.
4. CONTRACTOR SHALL COORDINATE WITH THE CITY'S CONSTRUCTION COORDINATION DIVISION TO INSURE THAT PROJECT MONITORING PERSONNEL ARE ON-DUTY DURING THE PROPOSED WORK SCHEDULE.
5. CONTRACTOR SHALL IMPLEMENT, MAINTAIN AND MANAGE CONSTRUCTION TRAFFIC AND PEDESTRIAN ACCESS CONTROL ON THE PROJECT TO PROVIDE SAFE WORKING CONDITIONS FOR ALL PROJECT PERSONNEL AND SAFE VEHICULAR AND PEDESTRIAN ACCESS THROUGH AND AROUND WORK AREAS AT ALL TIMES.
6. THE CONTRACTOR SHALL REMEDY UNSAFE CONSTRUCTION TRAFFIC CONTROL CONDITIONS IMMEDIATELY UPON DISCOVERY OR NOTIFICATION.
7. WORK AREAS SHALL BE LIMITED TO A MAXIMUM OF 3 INTERSECTIONS AND 3 CONNECTING BLOCKS AT ONE TIME. WORK SHALL BE SCHEDULED TO MINIMIZE DISRUPTION AND CONTINUE OPERATIONS TO A SMALL AREA.
8. TWO WORKING DAYS PRIOR TO THE INITIAL CONSTRUCTION TRAFFIC CONTROL SETUP IN EACH WORK AREA, AND TWO WORKING DAYS PRIOR TO ALL CHANGES IN CONSTRUCTION TRAFFIC CONTROL WHICH INVOLVE STREET OR LANE CLOSURES, THE CONTRACTOR SHALL NOTIFY THE FOLLOWING:
LOCAL BUSINESSES AND/OR LOCAL RESIDENTS
LOCAL NEWS MEDIA
9. THE CONTRACTOR SHALL REVIEW THE OPERATIONAL PRACTICES AND PROCEDURES ON A DAILY BASIS TO EXPEDITE THE WORK AND CLEAR THE RIGHT-OF-WAY AS SOON AS POSSIBLE.
10. TEMPORARY TRAFFIC CONTROL STRIPPING NEED NOT BE PLACED WHERE THE DURATION OF THE TRAFFIC CONTROL STEP IS LESS THAN SEVEN CALENDAR DAYS AND TRAFFIC CONTROL REQUIREMENTS CAN BE CLEARLY DELINEATED BY OTHER MEANS.
11. CONTRACTOR SHALL SWEEP ROADWAY SHOULDERS AND DETOURS FREE OF DEBRIS BEFORE ROUTING TRAFFIC ONTO SHOULDERS AND DETOURS.
12. ALL WARNING SIGNS SHALL BE 36" x 36" MINIMUM WITH SUPER ENGINEERING GRADE OR GREATER AND SHALL HAVE AT LEAST ONE WARNING LIGHT.
13. ALL COST FOR CONSTRUCTION TRAFFIC CONTROL INCLUDING BUT NOT LIMITED TO COORDINATION, PLANNING, SCHEDULING, WORK DURING OFF - HOURS, SETUPS, RESETTING, MAINTENANCE, TAKEDOWNS, FLAGGERS, STRIPPING, STRIPPING REMOVAL, SIGNS, BARRICADES, BARRELS, POST, BASES, TRAFFIC CONTROL, FENCING, CONCRETE BARRIERS, CRASH CUSHIONS, TEMPORARY PAVEMENT, TEMPORARY PAVEMENT REMOVAL AND DISPOSAL, PLATING, PATCHING, ETC., SHALL BE INCLUDED IN THE LUMP SUM BID FOR CONSTRUCTION TRAFFIC CONTROL. PHASE PLANS ARE MINIMUM TRAFFIC CONTROL. FIELD ADJUSTMENTS WILL BE NECESSARY AS PARTICULAR WORK IS DONE. MODIFICATIONS ARE INCLUDED IN THIS BID ITEM.
14. ALL NON-APPLICABLE SIGNING SHALL BE REMOVED OR COVERED COMPLETELY WITH AN OPAQUE NON LIGHT-TRANSMITTING MATERIAL. ALL REMAINING NON-APPLICABLE TRAFFIC CONTROL DEVICES ARE TO BE REMOVED AND STORED AT LOCATIONS DESIGNATED BY THE PROJECT MANAGER.
15. THE CONTRACTOR SHALL PREPARE A DETAILED PATH PROJECT SCHEDULE FOR THE PROJECT BEFORE BEGINNING CONSTRUCTION. THIS SCHEDULE SHALL BE SUBMITTED TO THE CITY'S CONSTRUCTION COORDINATOR FOR REVIEW, COMMENTS, AND APPROVAL. THE SCHEDULE WILL BE USED FOR ESTABLISHING MAJOR CONSTRUCTION OPERATIONS AND FOR DETERMINING THE PROGRESS OF THE WORK. SHOULD IT BECOME APPARENT TO THE PROJECT MANAGER OR THE CONTRACTOR THAT THE CONTRACTOR WILL NOT BE ABLE TO MEET THE REQUIREMENTS OF THE SCHEDULE, THE CONTRACTOR SHALL SUBMIT A REVISED SCHEDULE REFLECTING THE ACTUAL AUTHORIZED TIME LEFT FOR REVIEW AND APPROVAL. REQUEST FOR TIME EXTENSIONS SUBMITTED BY THE CONTRACTOR WILL BE COMPARED TO THE CRITICAL PATH AND APPROVED OR DENIED ON THIS BASIS. THE CONTRACTOR SHALL UPDATE THE SCHEDULE MONTHLY AND SUBMIT WITH THE MONTHLY PAYMENT REQUEST.

RECORD SET

May 1, 1997

[Signature]

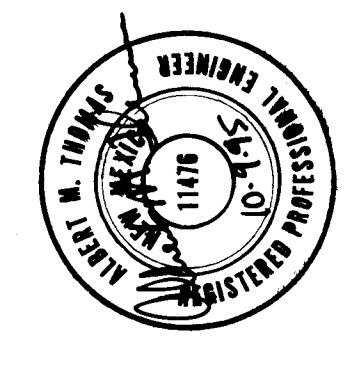AS-BUILT INFORMATION		BENCH MARKS		SURVEY INFORMATION		ENGINEER'S SEAL		REVISIONS		DESIGNED BY		DRAWN BY		CHECKED BY	
CONTRACTOR	DATE	BY	DATE	NO.	BY	DATE		ISSUED FOR CONSTRUCTION	REMARKS	BY	DATE	DESIGNED BY	DRAWN BY	CHECKED BY	
ALBUQUERQUE UNDERGROUND	4/17	C.D.A.	4/17												
INSPECTOR'S	DATE	BY	DATE												
FIELD	4/17	LEAHY, Doreen	4/17												
NOTIFICATION BY	DATE	BY	DATE												
CONNECTED BY	4/17	C.D.A.	4/17												
MICRO-FILM INFORMATION															
RECORDED BY		DATE													
NO.															

 **BOHANNAN-HUSTON INC.**
ENGINEERS • PLANNERS • PHOTOGRAMMETRISTS • SURVEYORS • LANDSCAPE ARCHITECTS
ALBUQUERQUE LAS CRUCES SANTA FE






 **CITY OF ALBUQUERQUE**
PUBLIC WORKS DEPARTMENT
ENGINEERING GROUP

TITLE: SOUTH 4TH STREET STREETSCAPE
TRAFFIC CONTROL - GENERAL NOTES


APPROVALS	ENGINEER	DATE	APPROVALS	ENGINEER	DATE
DRC CHAIRMAN	<i>[Signature]</i>	4/17/97	WATER	<i>[Signature]</i>	4/17/97
TRANSPORTATION	<i>[Signature]</i>	4/17/97	WASTE WATER	<i>[Signature]</i>	4/17/97
HYDROLOGY	<i>[Signature]</i>	4/17/97	TRAF. OPER.	<i>[Signature]</i>	4/17/97

DRAWING NO. 4917.90 MAP NO. SHEET TC-1 OF 10








SCANNED BY
BY LASON

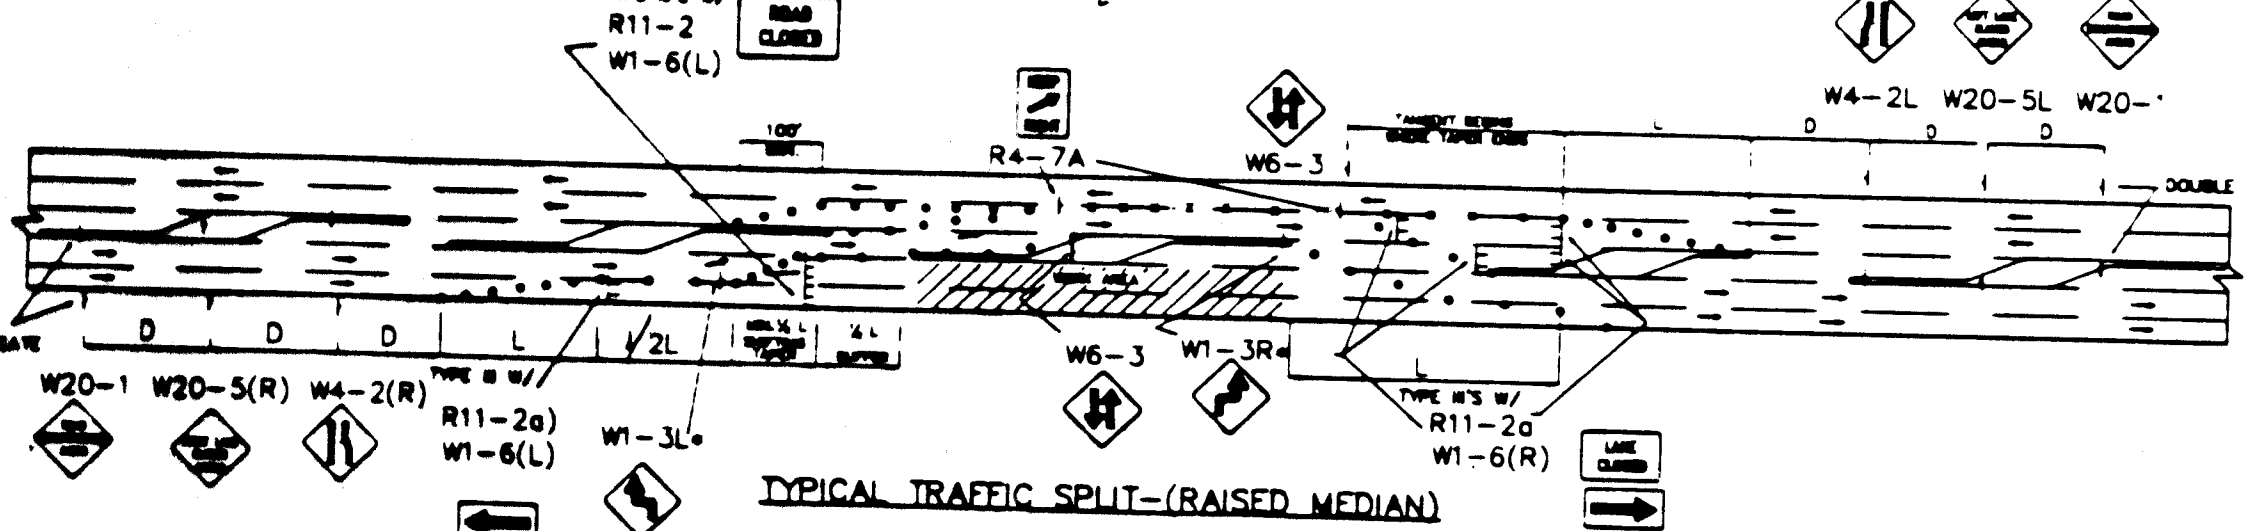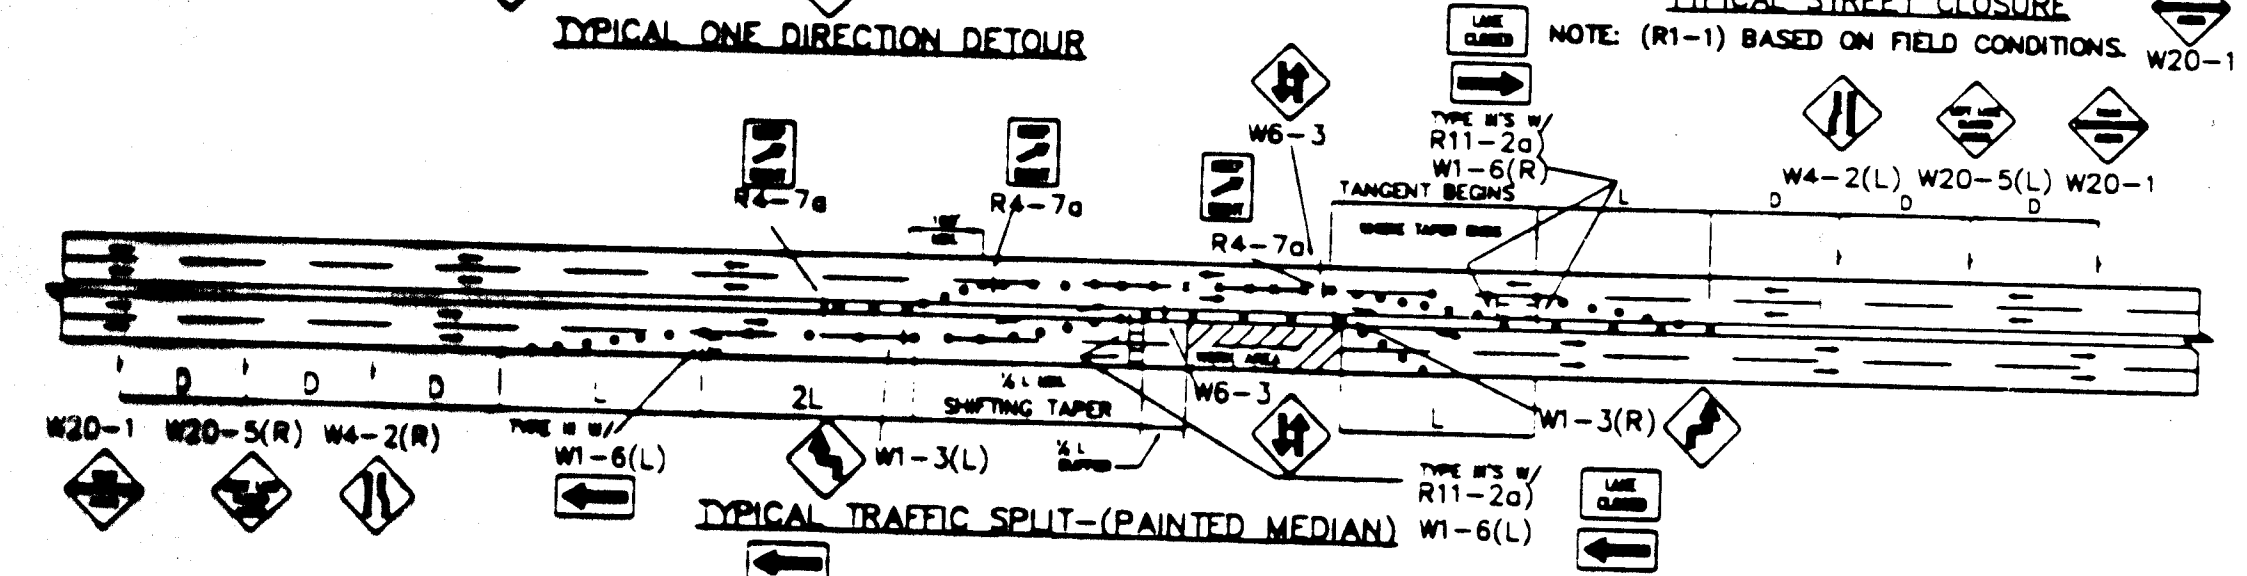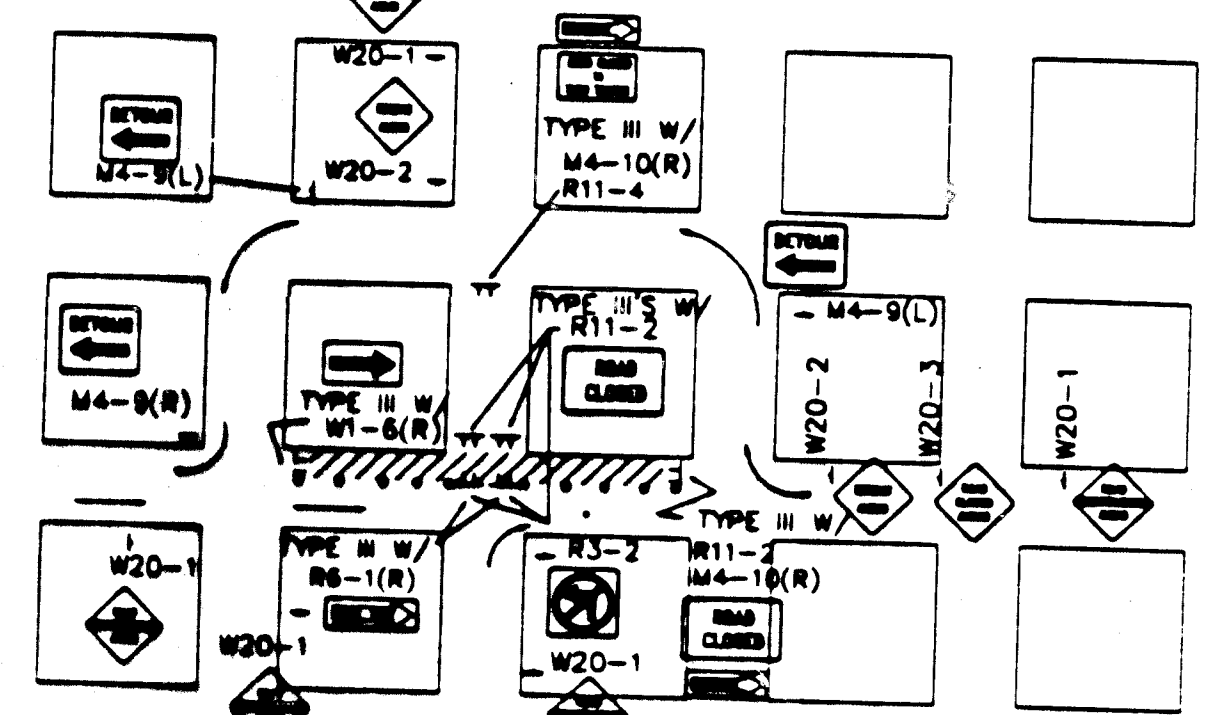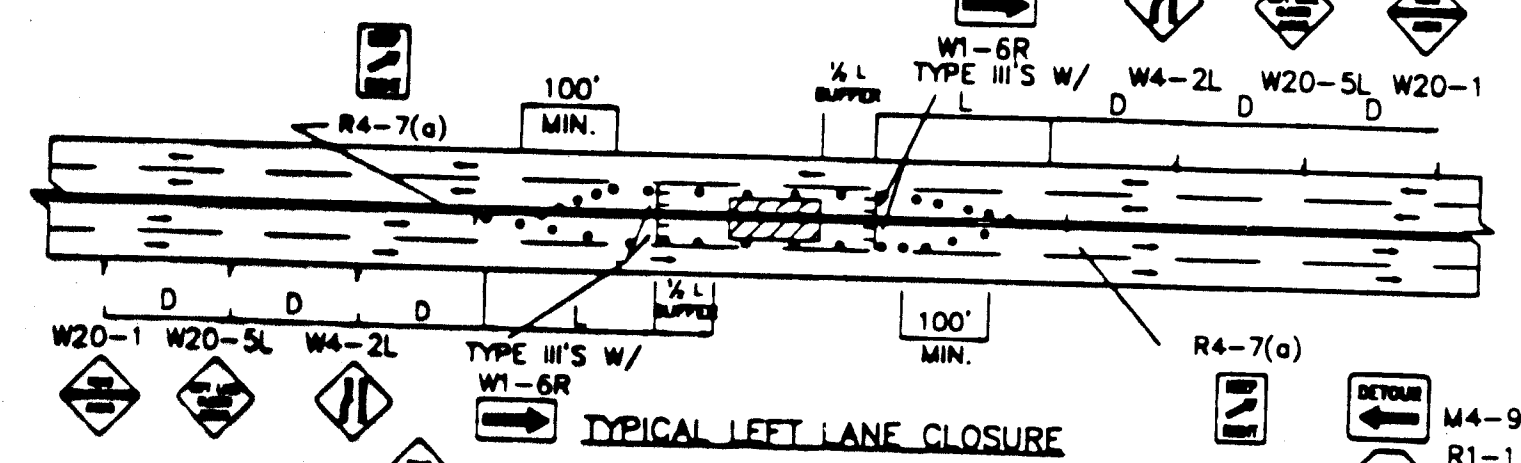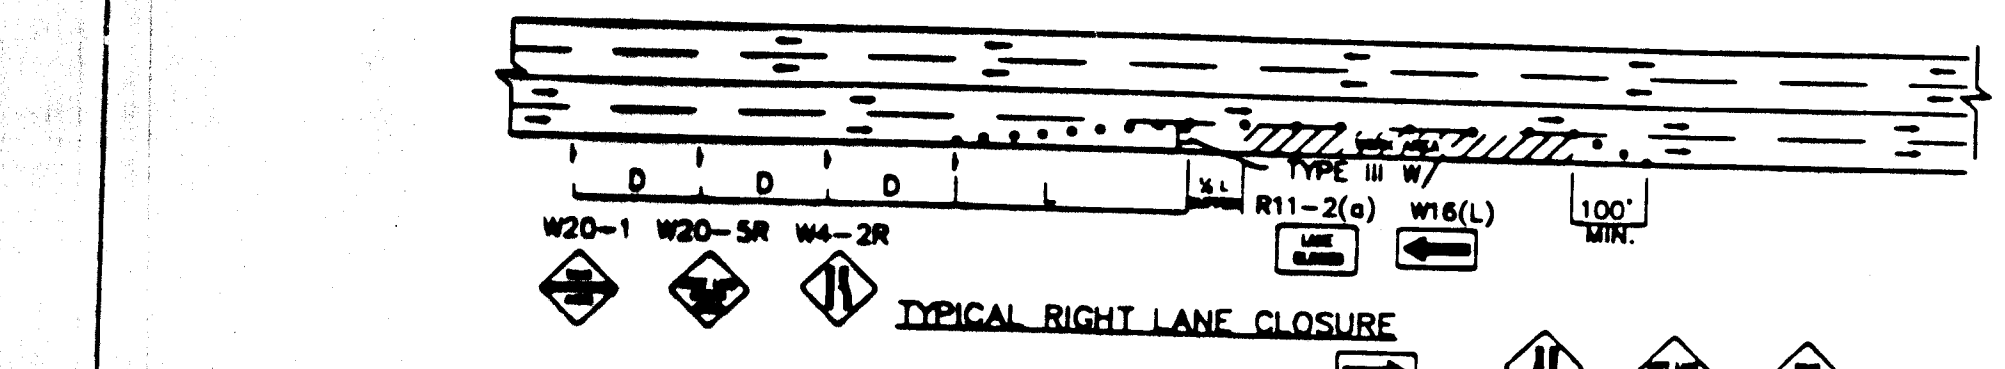

- TRAFFIC SPLIT NOTES:**
1. THE OFFSET DISTANCE MUST BE CALCULATED IN ALL SHIFTING TAPERS. THE OFFSET DISTANCES SHALL INCLUDE LANE WIDTHS PLUS MEDIAN WIDTHS.
 2. 1/4 L IS MINIMUM DISTANCE FOR SHIFTING TAPERS.
 3. REVERSE CURVES MAY BE IMPLEMENTED. ALL CURVE DATA SHALL BE CALCULATED.
 4. MEDIAN REMOVAL SHALL BE REQUIRED IF 1/4 L OR REVERSE CURVE IS NOT SUFFICIENT. MEDIAN REMOVAL SHALL TAKE PLACE BEFORE SPLITS.
 5. REDUCED SPEED MAY BE CONSIDERED.
 6. • USE 1-3 FOR 30 MPH OR LESS, W1-4 FOR SPEED 35 MPH OR GREATER.

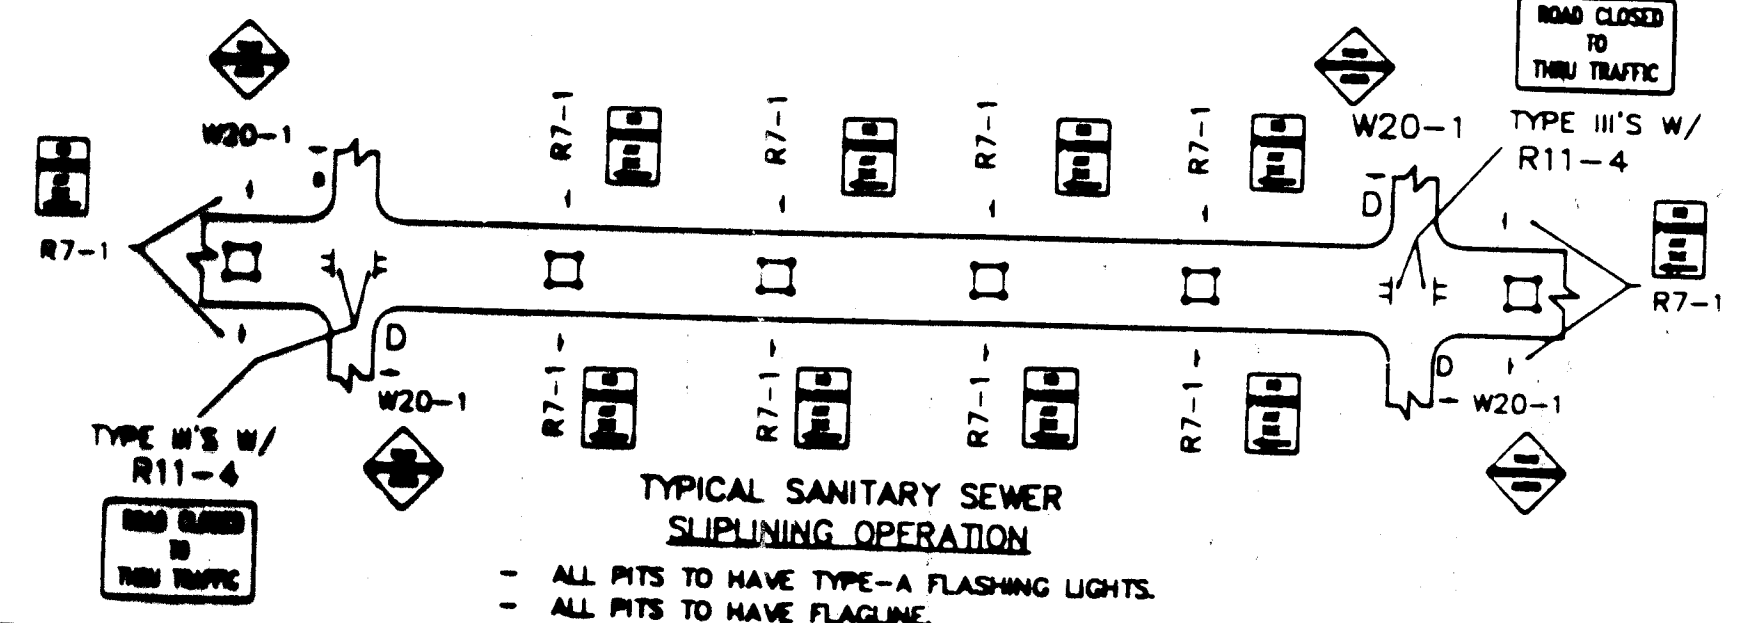

NOTE: MAY REQUIRE LEFT LANE CLOSURE DEPENDING ON FIELD CONDITIONS.

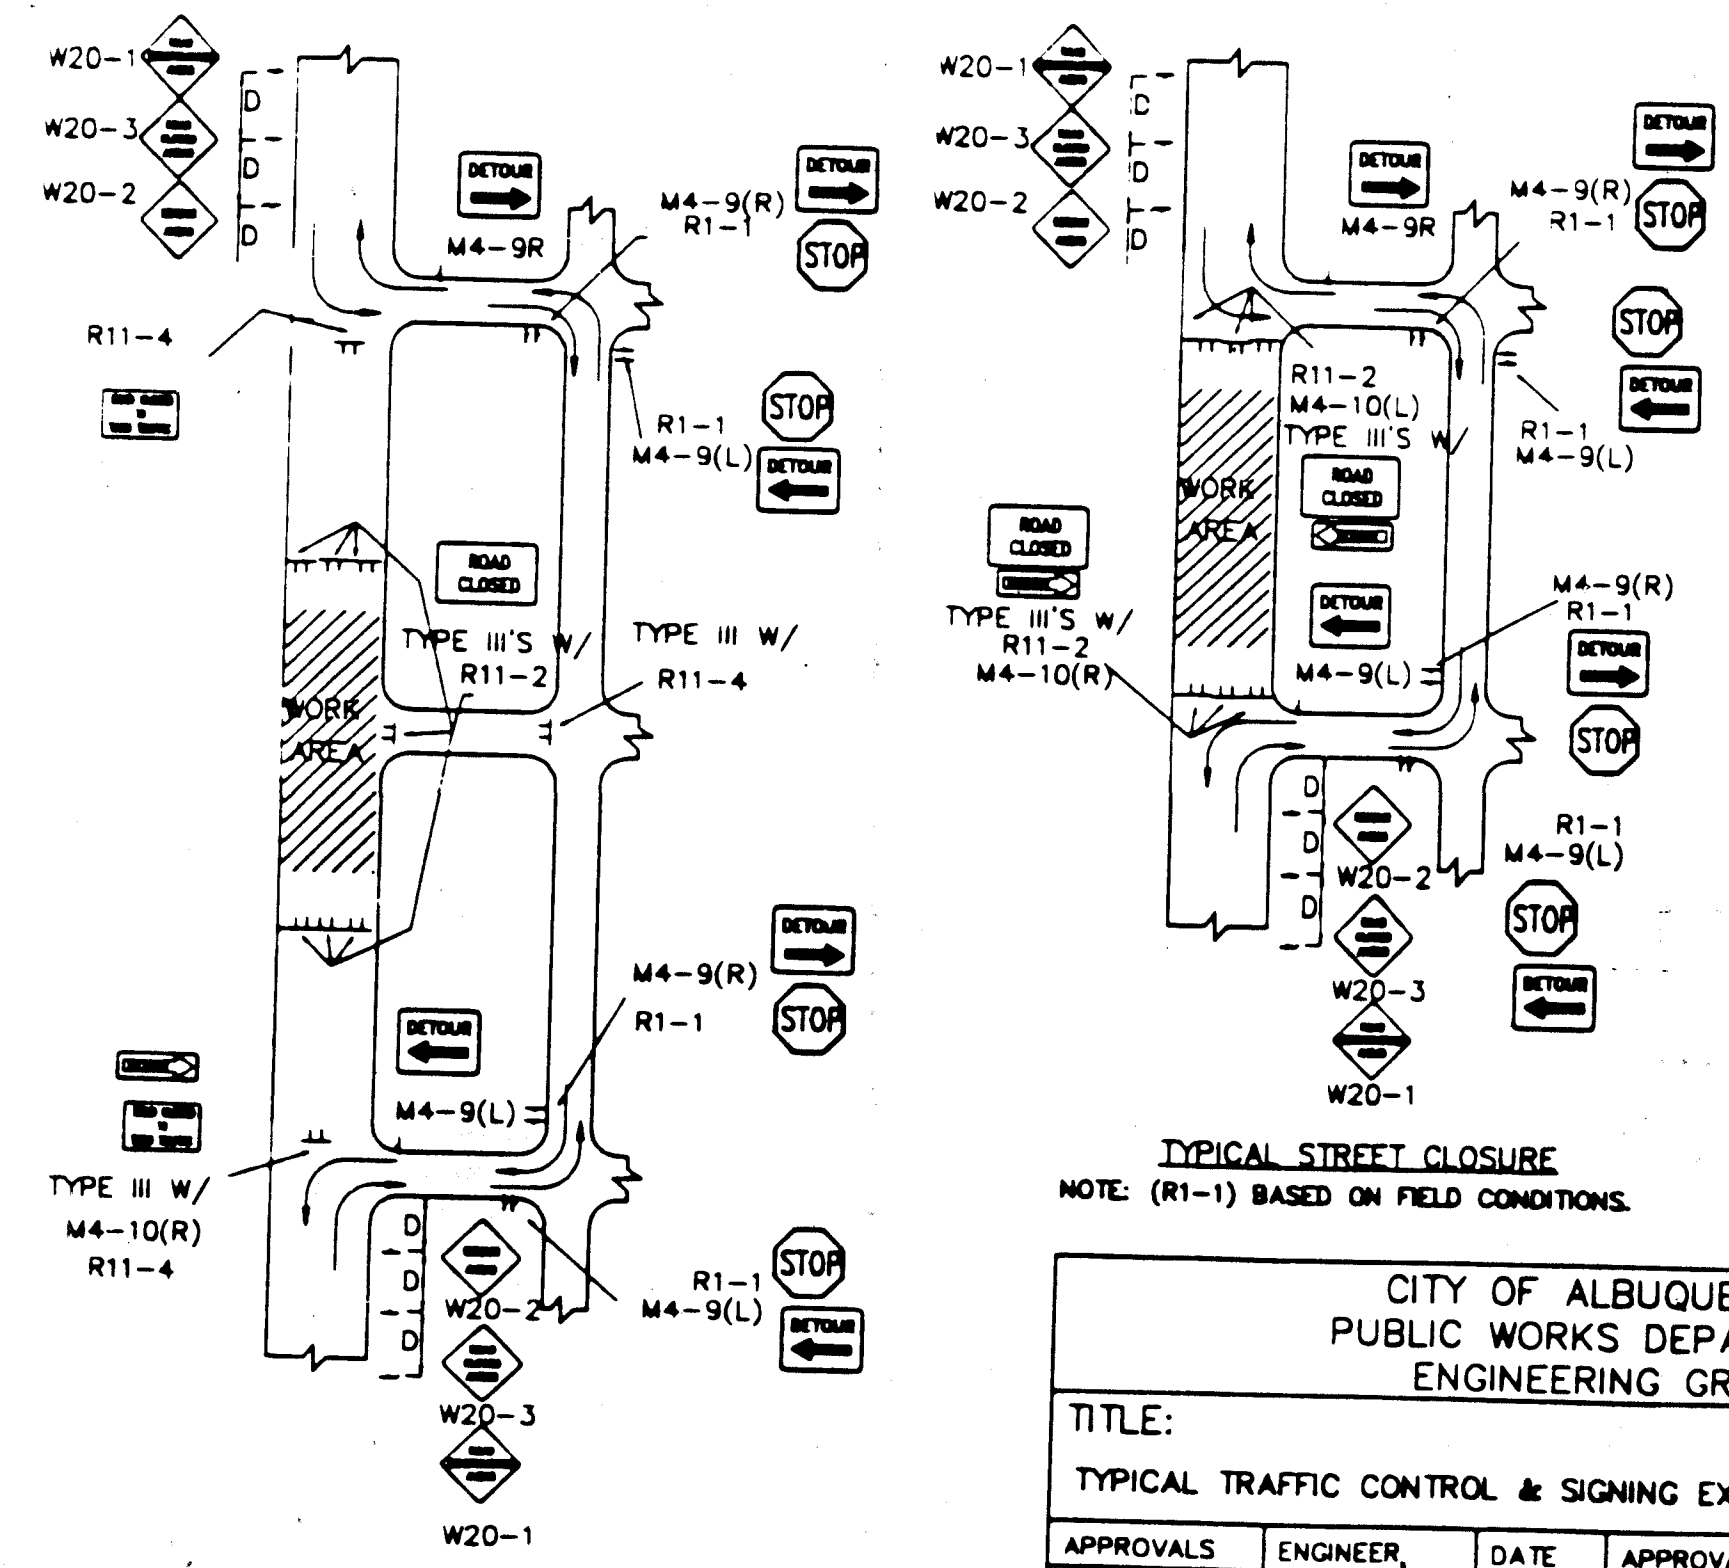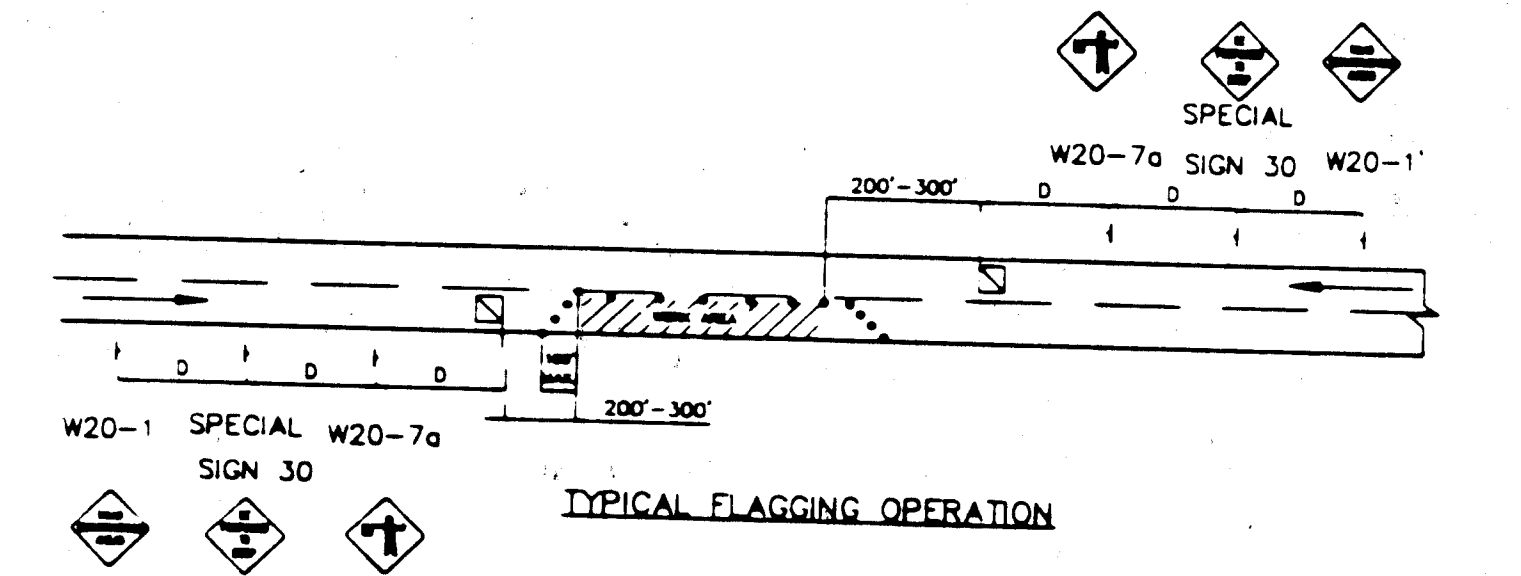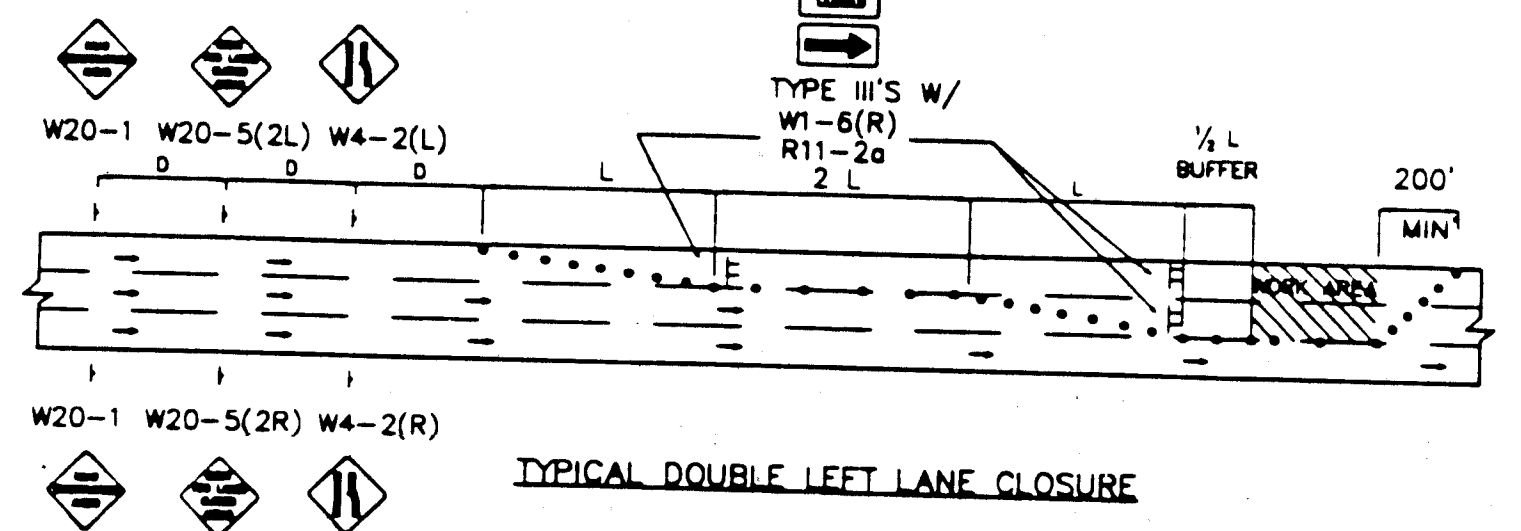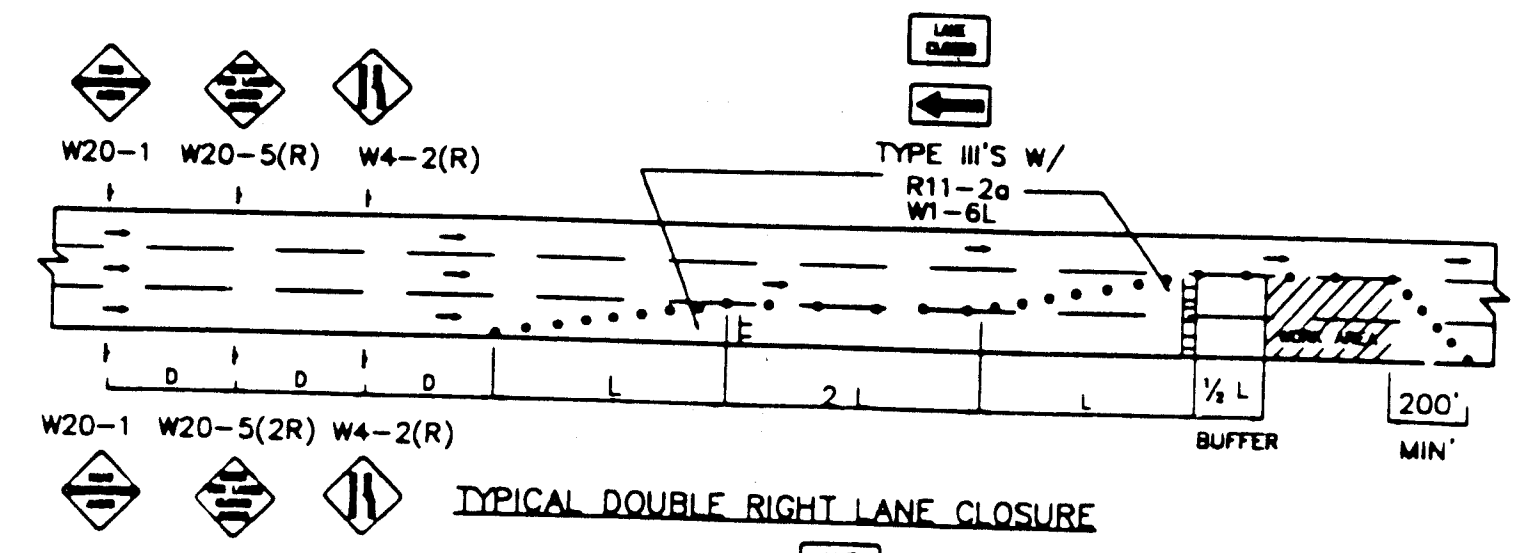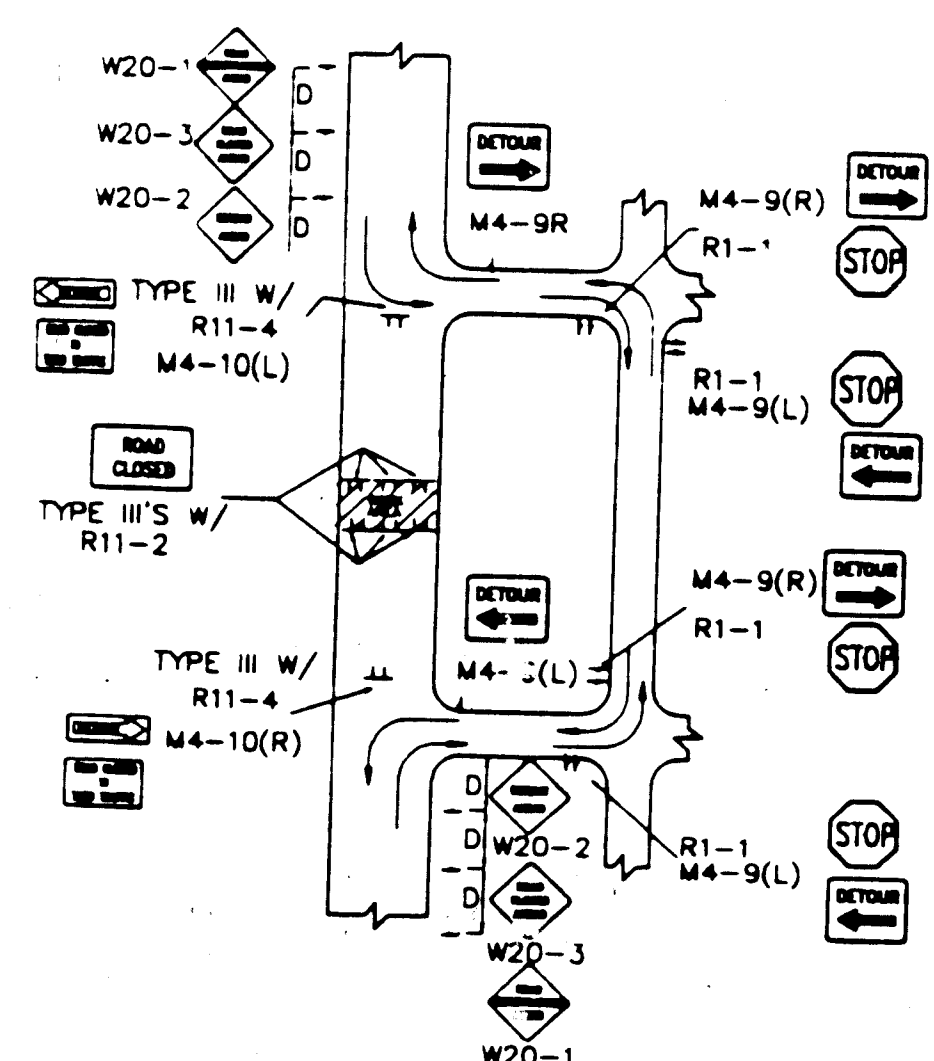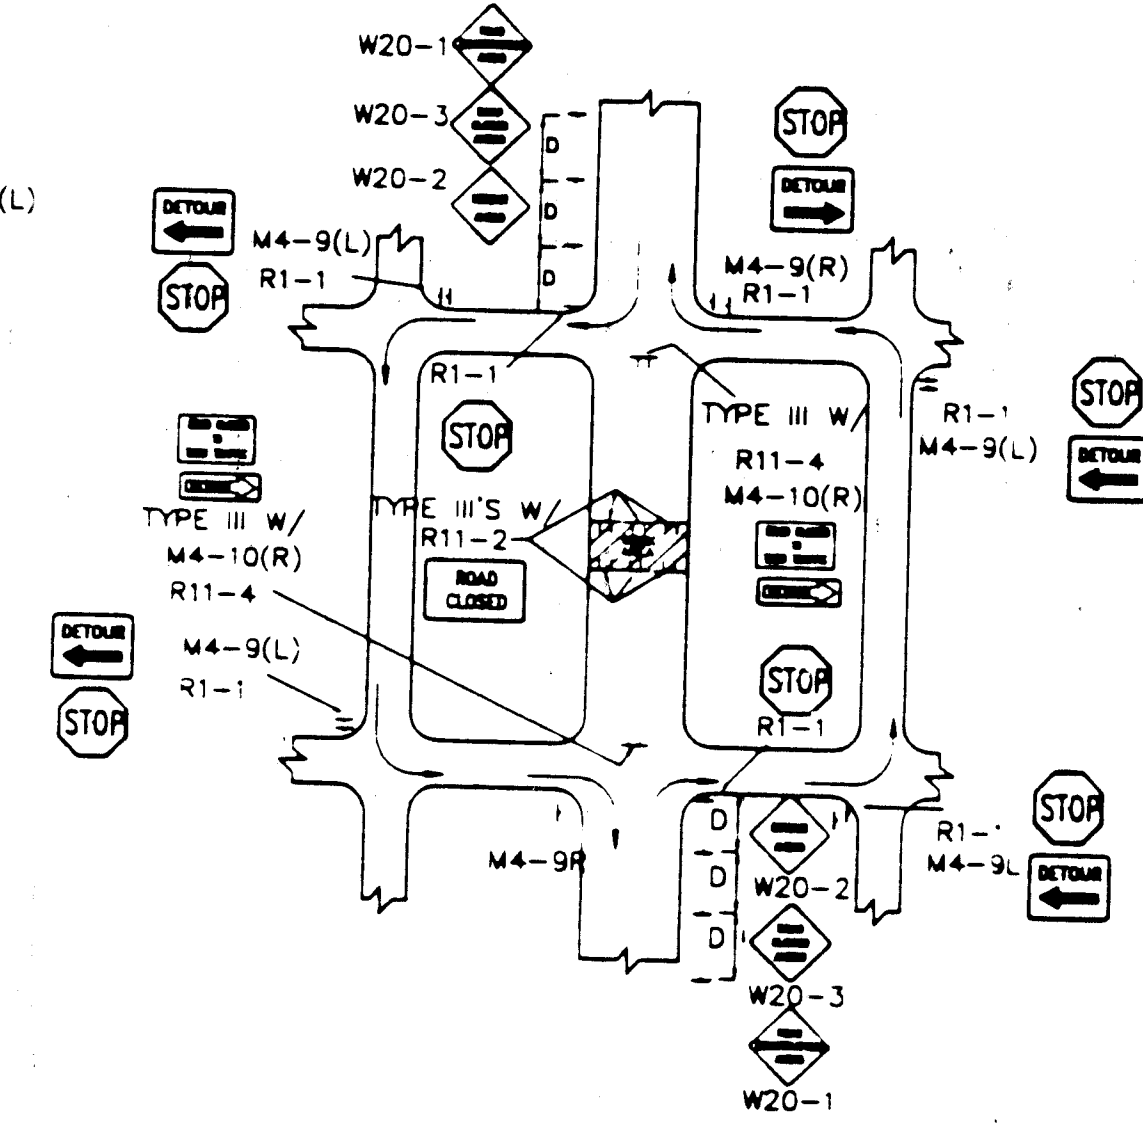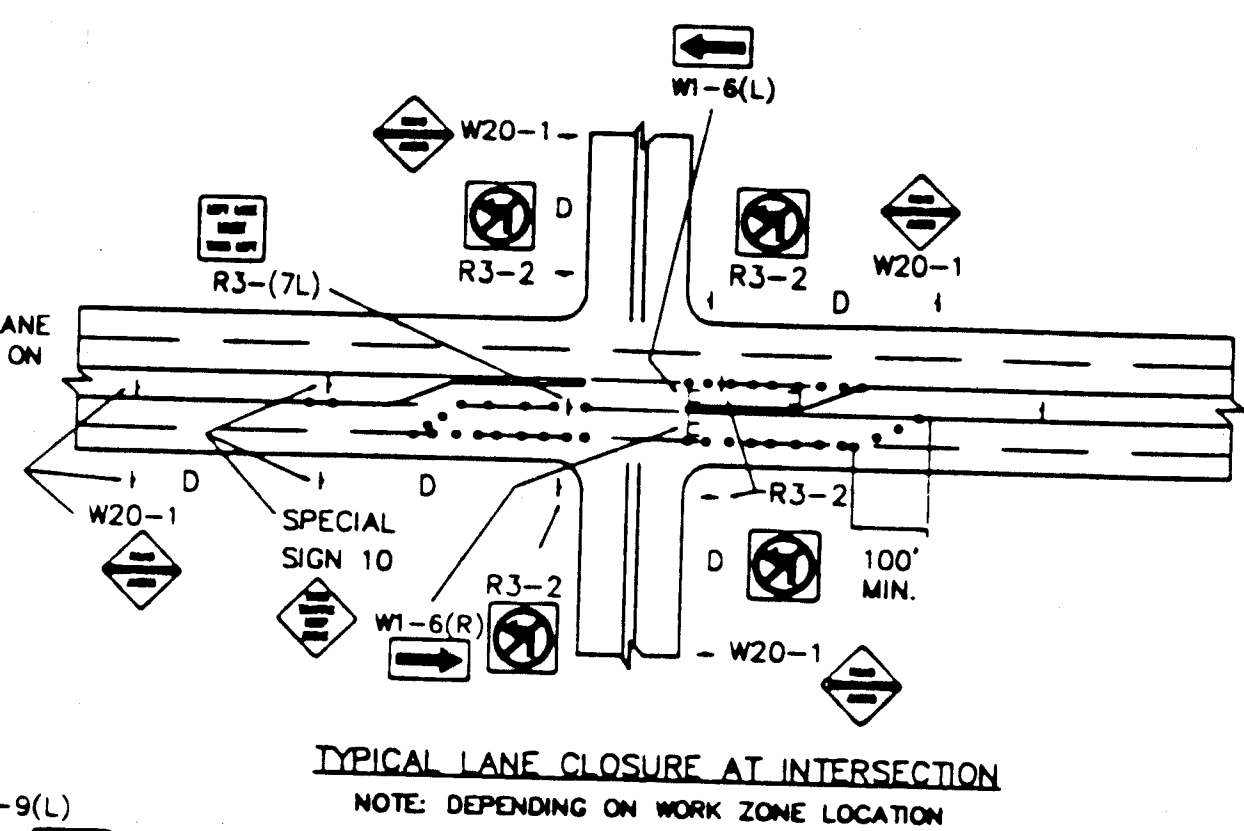

CITY OF ALBUQUERQUE
PUBLIC WORKS DEPARTMENT
ENGINEERING GROUP

TITLE:
TYPICAL TRAFFIC CONTROL & SIGNING EXAMPLES (REF. M.U.T.C.D.)

APPROVALS	ENGINEER	DATE	APPROVALS	ENGINEER	DATE
DRG CHAIRMAN			WATER		
TRANSPORTATION			WASTE WATER		
HYDROLOGY					

PROJECT NO. 9917.90 MAP NO. SHEET OF TC-3 10

AS BUILT INFORMATION

CONTRACTOR: ALBUQUERQUE UNDERGROUND INC.
DATE: 7/97
C.D.A.
APPROVED BY: C.D.A.
DATE: 8/97
CORRECTED BY: A.U.T.
DATE: 8/97
MICRO-FILM INFORMATION
RECORDED BY: NO.
DATE:










ENGINEER'S SEAL

REVISIONS

NO.	DATE	REMARKS	BY
1	NOV 1991	DESIGN	RICARDO ROYAL P.E.
2	NOV 1991	DATE	C.A.D.D./M.L.B./A.F.V.

DESIGNED BY: RICARDO ROYAL P.E.
DRAWN BY: C.A.D.D./M.L.B./A.F.V.
CHECKED BY: DATE

RECORD SET
May 1, 1997

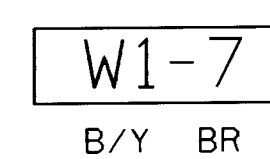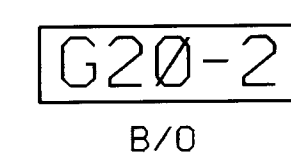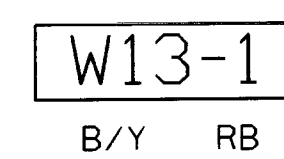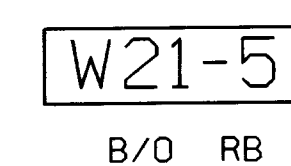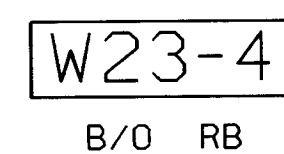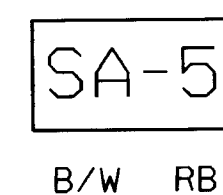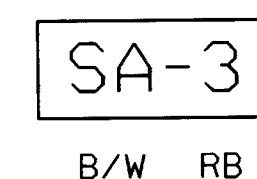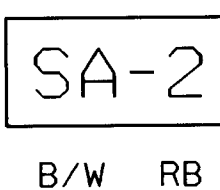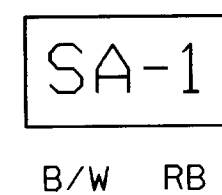

RECORD SET
May 1, 1997

9 mls



TITLE:	SOUTH 4th STREET STREETSCAPE TRAFFIC CONTROL SIGN DETAILS
--------	--



APPROVALS	ENGINEER	DATE	APPROVALS	ENGINEER	DATE
DRC CHAIRMAN	2017/12/19/95		WATER		
TRANSPORTATION			WASTE WATER		
HYDROLOGY			TRAF. OPER.		

DRAWING NO.	4917.90	MAP NO.	SHEET OF
			TC-4 10

[illegible]

DETAIL.DGN

SCANNED BY
BY LASON

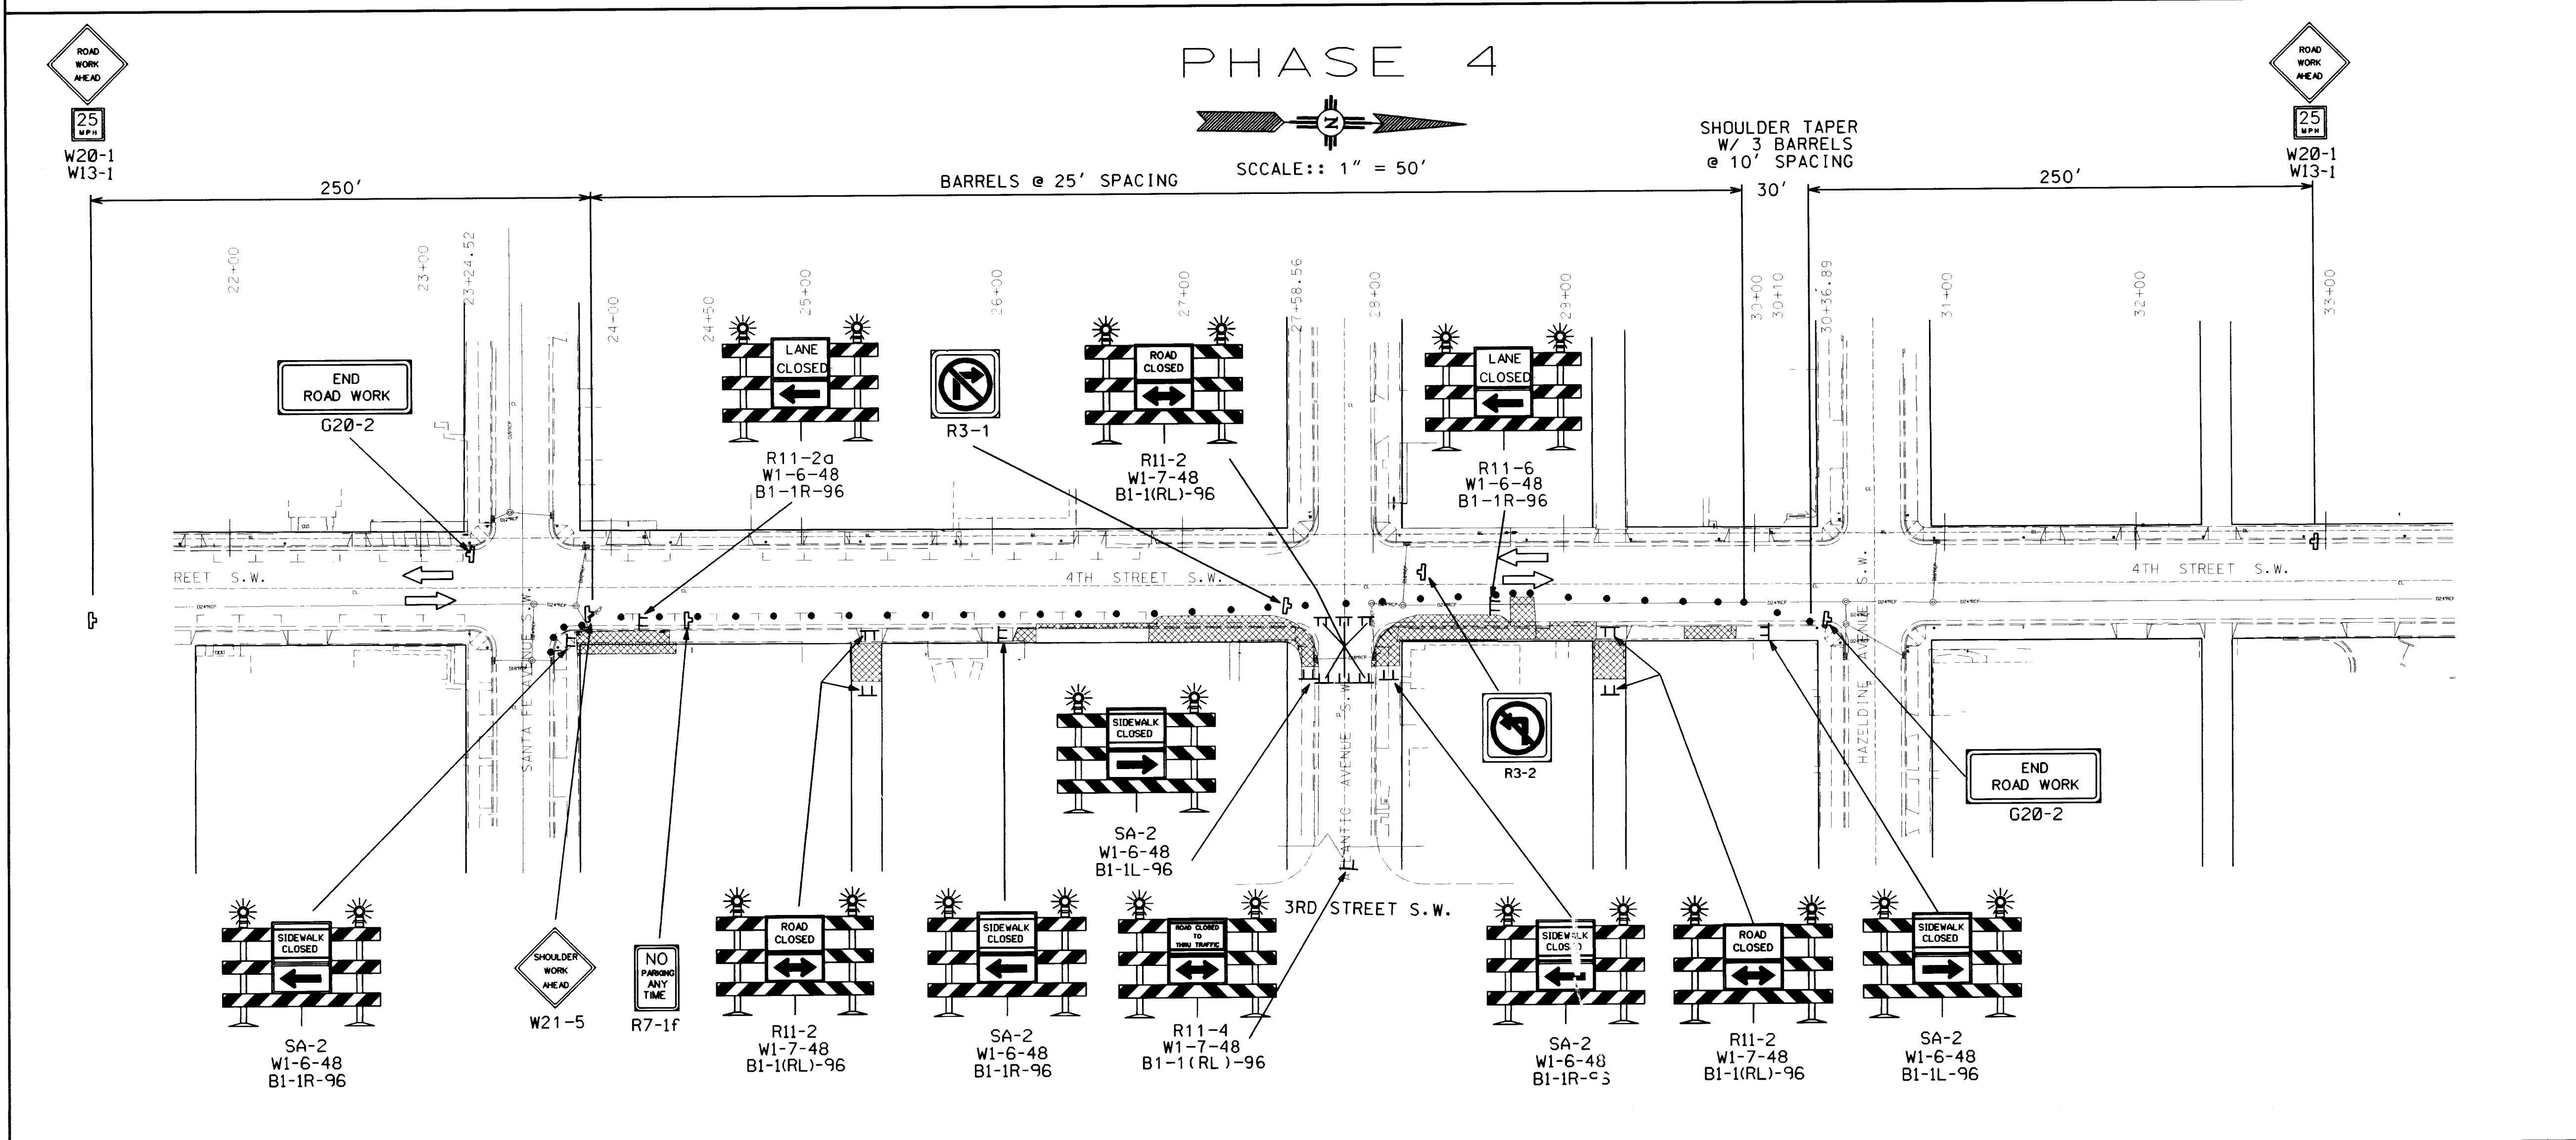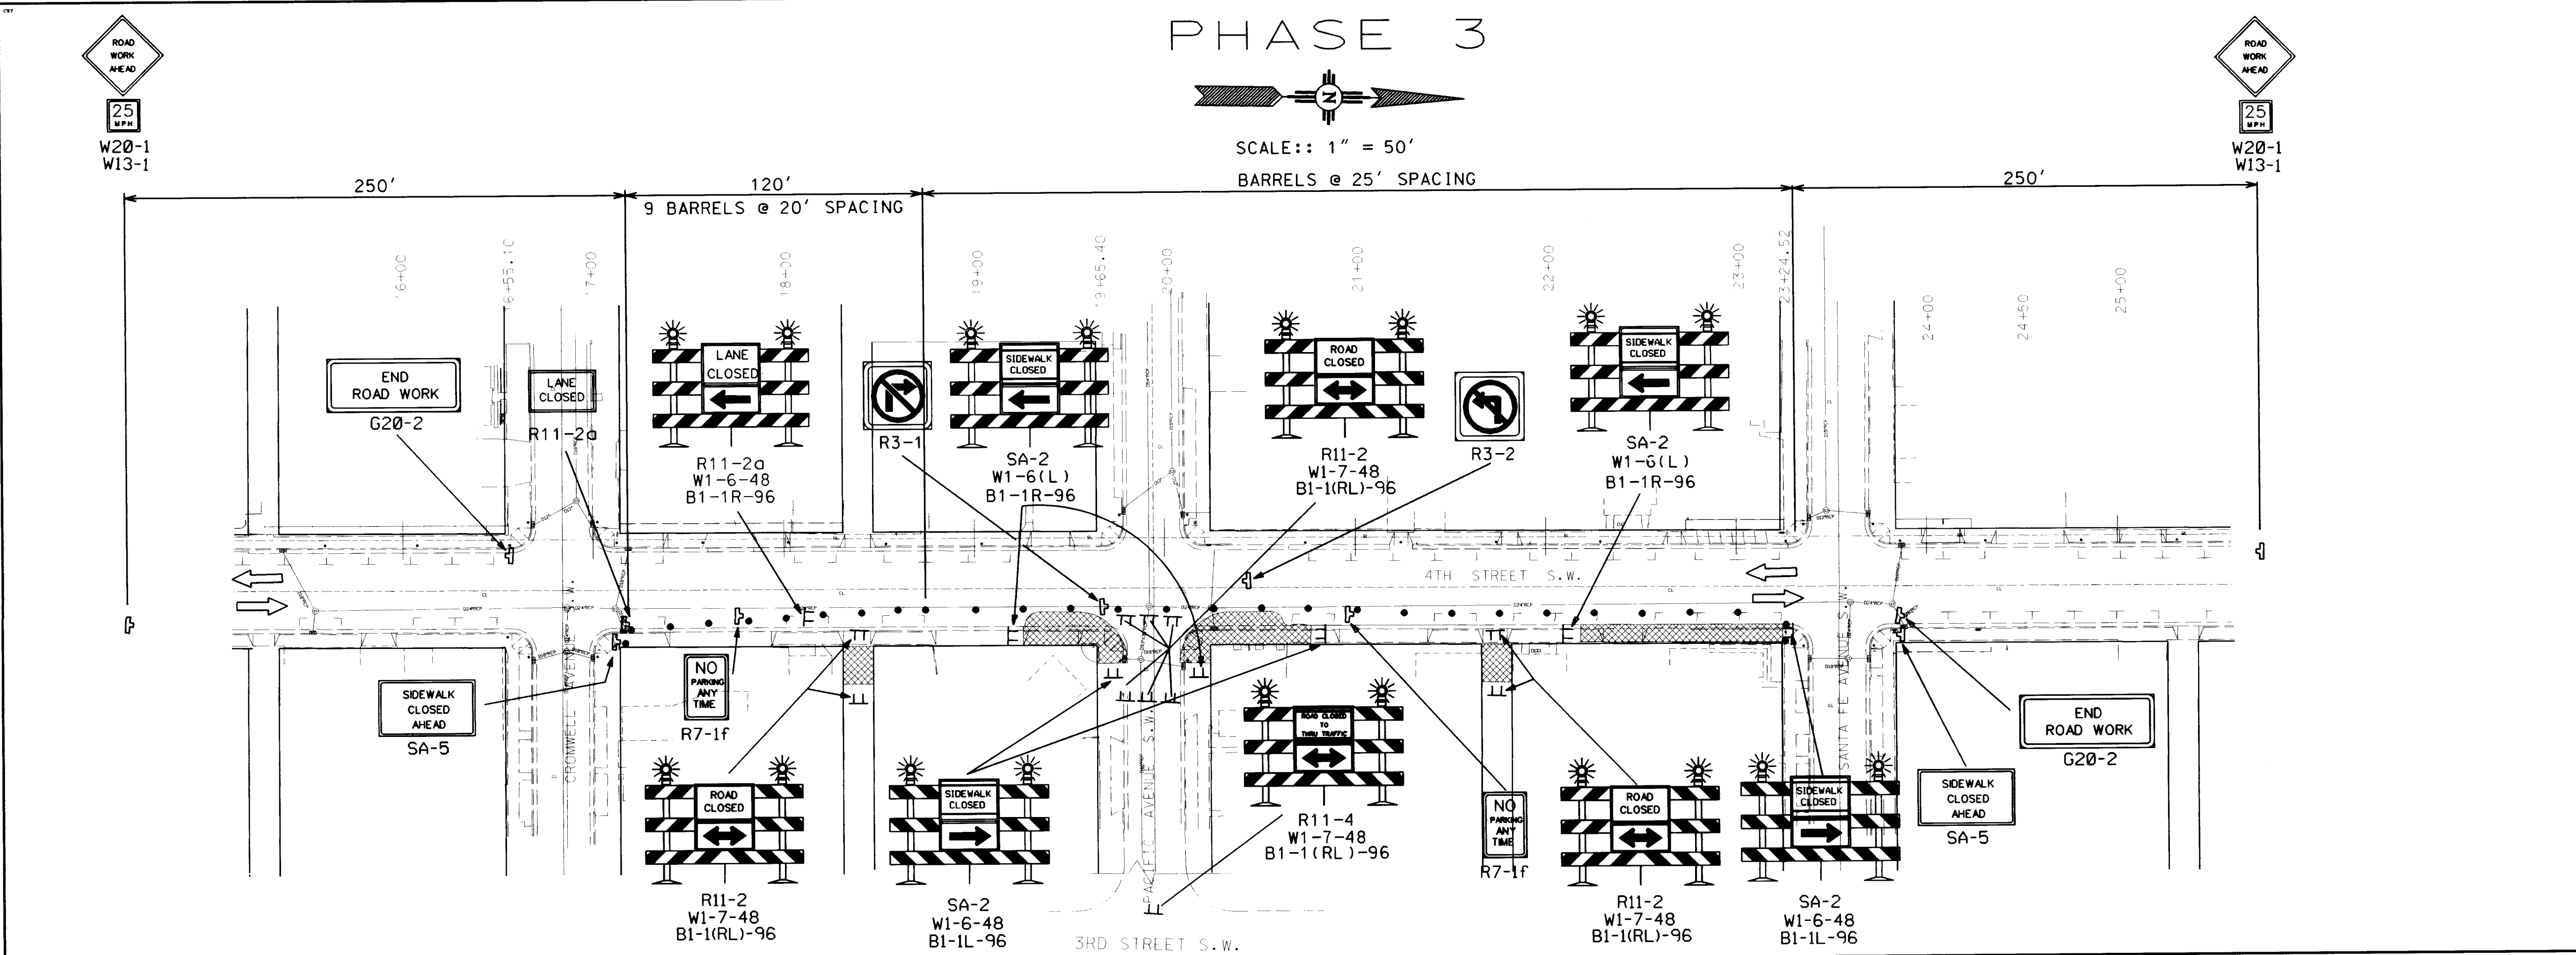

LEGEND

- ⬇ SIGN(S) AS INDICATED
- ➡ INDICATES DIRECTION OF TRAFFIC FLOW
- CHANNELIZATION DEVIC. TYPE "H"
- ⊥ TYPE III BARRICADE LEFT, RIGHT OR CHEVRON AS APPROPRIATE
- ▨ WORK ZONE
- ☑ FLAGMAN

AS BUILT INFORMATION		BENCH MARKS		SURVEY INFORMATION		ENGINEER'S SEAL	
CONTRACTOR	DATE	NO.	DATE	NO.	DATE	NO.	DATE
ALBUQUERQUE UNDERGROUND INC.	4/97						
INSPECTOR	DATE						
ACCEPTANCE BY	DATE						
PREPARED BY	DATE						
DRAWINGS	DATE						
CHECKED BY	DATE						
MICRO-FILM INFORMATION	DATE						
RECORDED BY	DATE						

RECORD SET

May 1, 1997

ISSUED FOR CONSTRUCTION
 NO. 61896 DATE 4/97
 REMARKS
 REVISIONS
 DESIGN

BOHANNAN HUSTON INC.
ENGINEERS • PLANNERS • PHOTOGRAMMETRISTS • SURVEYORS • LANDSCAPE ARCHITECTS
 ALBUQUERQUE LAS CRUCES SANTA FE

CITY OF ALBUQUERQUE
 PUBLIC WORKS DEPARTMENT
 ENGINEERING GROUP

TITLE: SOUTH 4th STREET STREETScape
TRAFFIC CONTROL

APPROVALS	ENGINEER	DATE	APPROVALS	ENGINEER	DATE
DRC CHAIRMAN			WATER		
TRANSPORTATION			WASTE WATER		
HYDROLOGY			TRAF. OPER.		


DRAWING NO. 4917.90

SCANNED BY LASON

MAP NO.

SHEET OF

TC-6 10

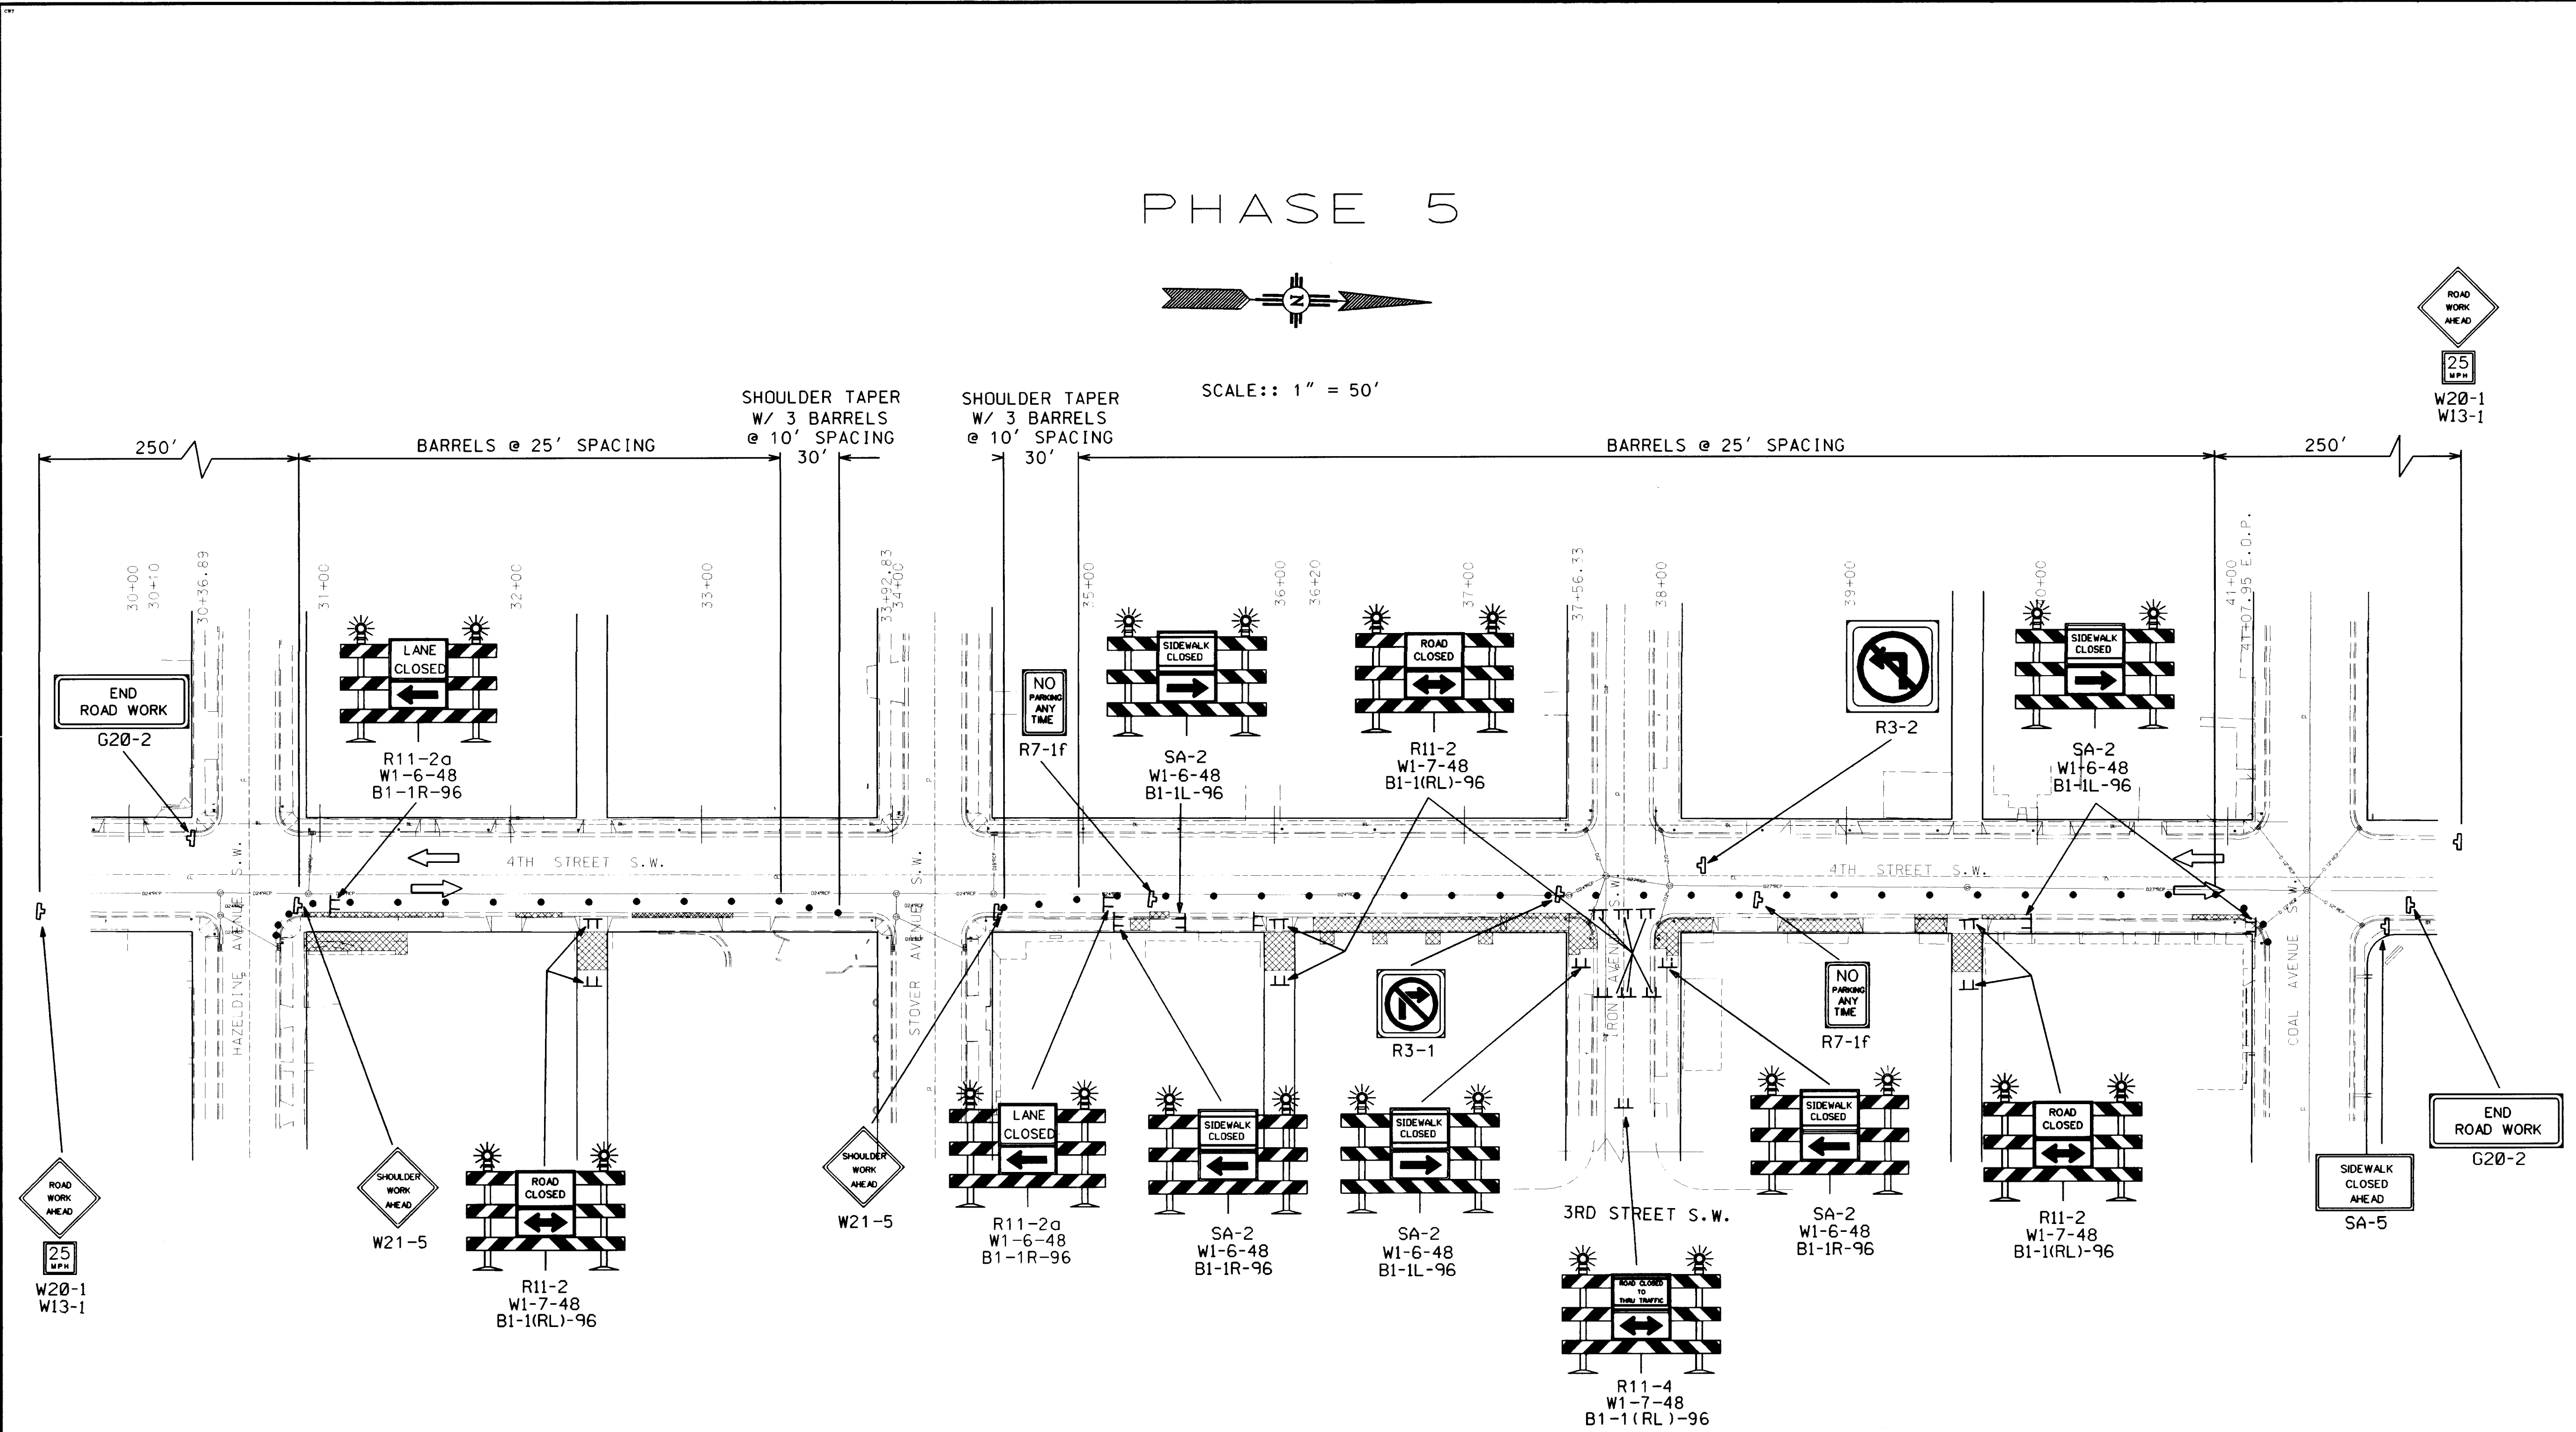

LEGEND

☐ SIGN(S) AS INDICATED

➔ INDICATES DIRECTION OF TRAFFIC FLOW

• CHANNELIZATION DEVIC. TYPE 'H'

☐ TYPE III BARRICADE LEFT, RIGHT OR CHEVRON AS APPROPRIATE

▨ WORK ZONE

☑ FLAGMAN

AS BUILT INFORMATION

CONTRACTOR	DATE	NO.	BY	DATE
BOHANNAN-HUSTON INC.	11/16/96			
WORKED BY				
INSPECTED BY				
ACCEPTANCE BY				
VERIFICATION BY				
DESIGNED BY				
DRAWN BY				
CHECKED BY				

ENGINEER'S SEAL

FIELD NOTES

NO. BY DATE

ISSUED FOR CONSTRUCTION

REMARKS

REVISIONS

DESIGN

DESIGNED BY

DRAWN BY

CHECKED BY

BOHANNAN-HUSTON INC.

ENGINEERS • PLANNERS • PHOTOGRAMMETRISTS • SURVEYORS • LANDSCAPE ARCHITECTS

ALBUQUERQUE LAS CRUCES SANTA FE

CITY OF ALBUQUERQUE

PUBLIC WORKS DEPARTMENT

ENGINEERING GROUP

TITLE: SOUTH 4th STREET STREETScape

TRAFFIC CONTROL

APPROVALS	ENGINEER	DATE	APPROVALS	ENGINEER	DATE
DRC CHAIRMAN			WATER		
TRANSPORTATION			WASTE WATER		
HYDROLOGY			TRAF. OPEN		


DRAWING NO. 4917.90

MAP NO.

SHEET TC-7 OF 10


PHASE 6

SCALE: 1" = 50'

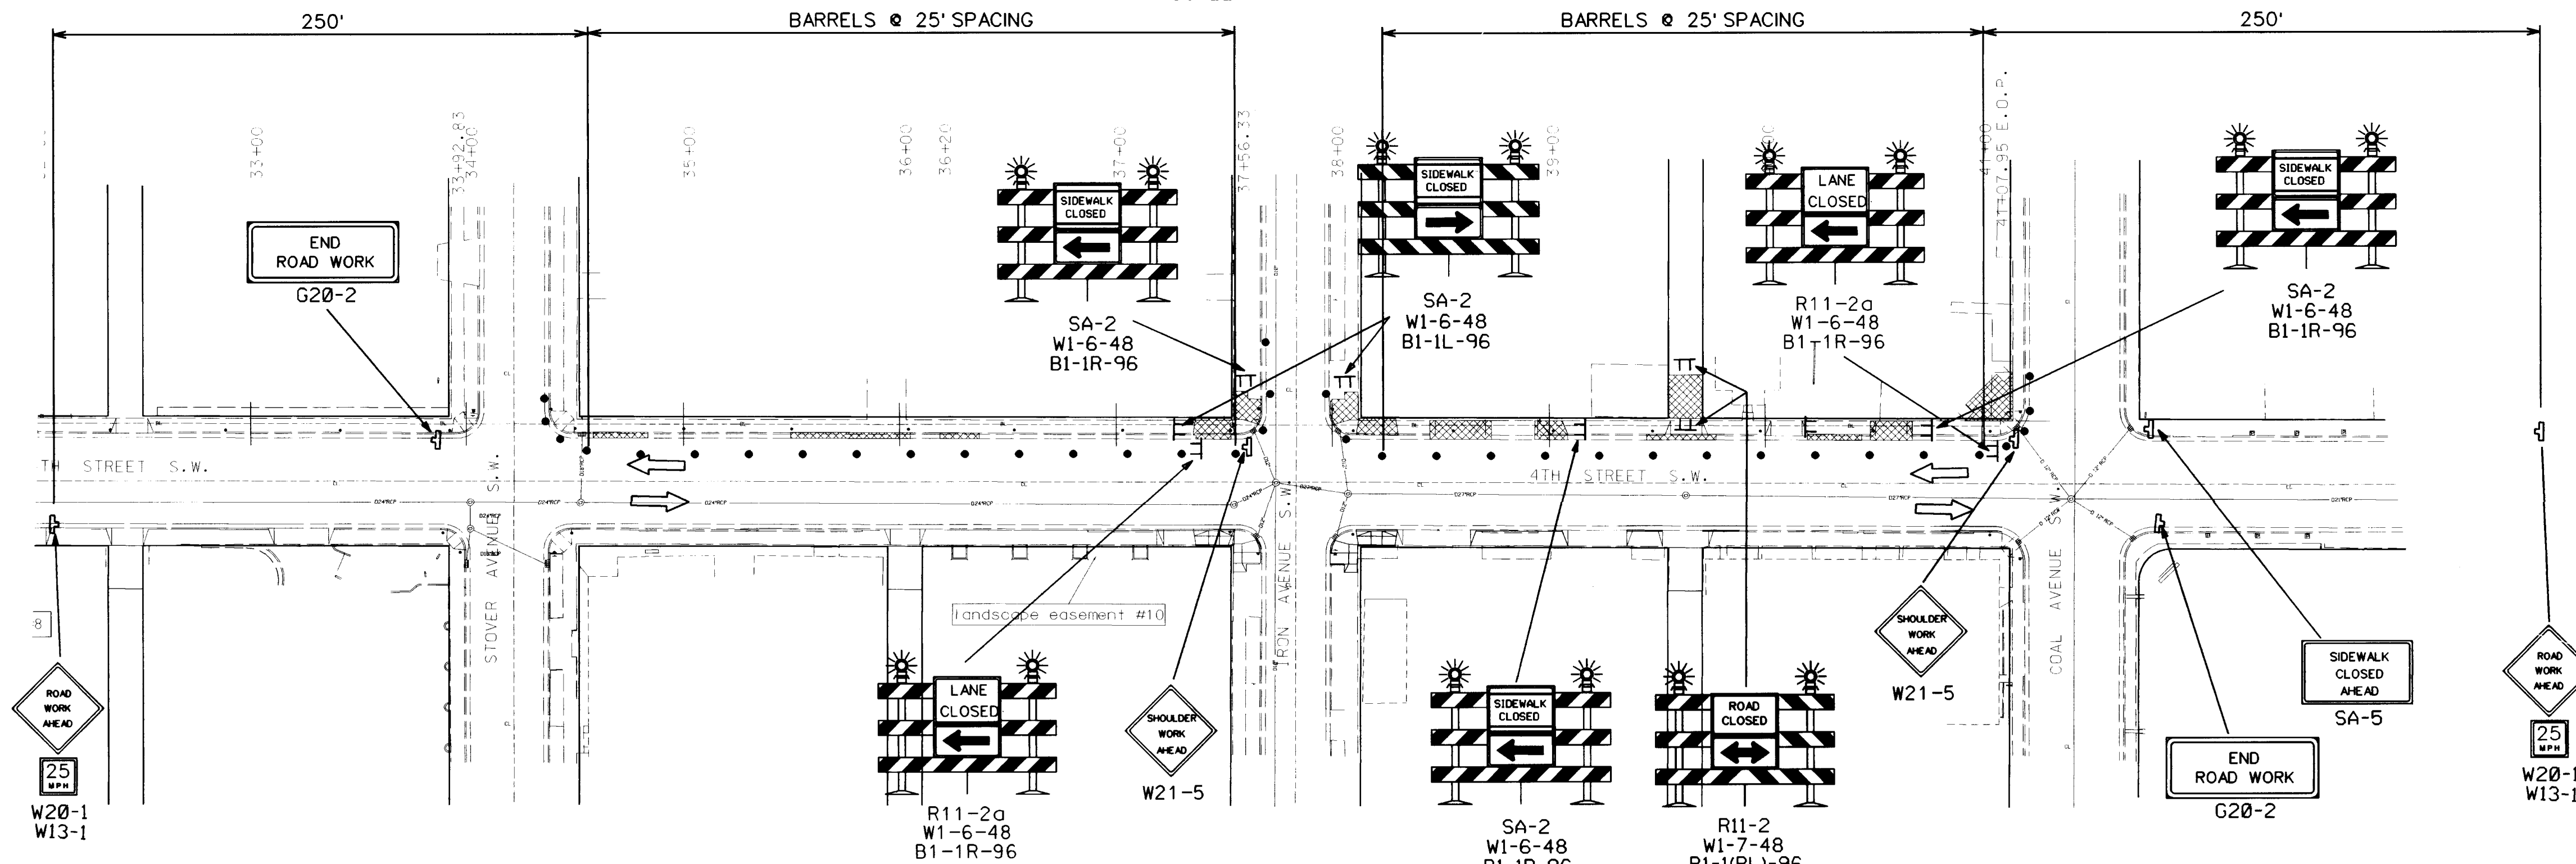

PHASE 7

SCALE: 1" = 50'

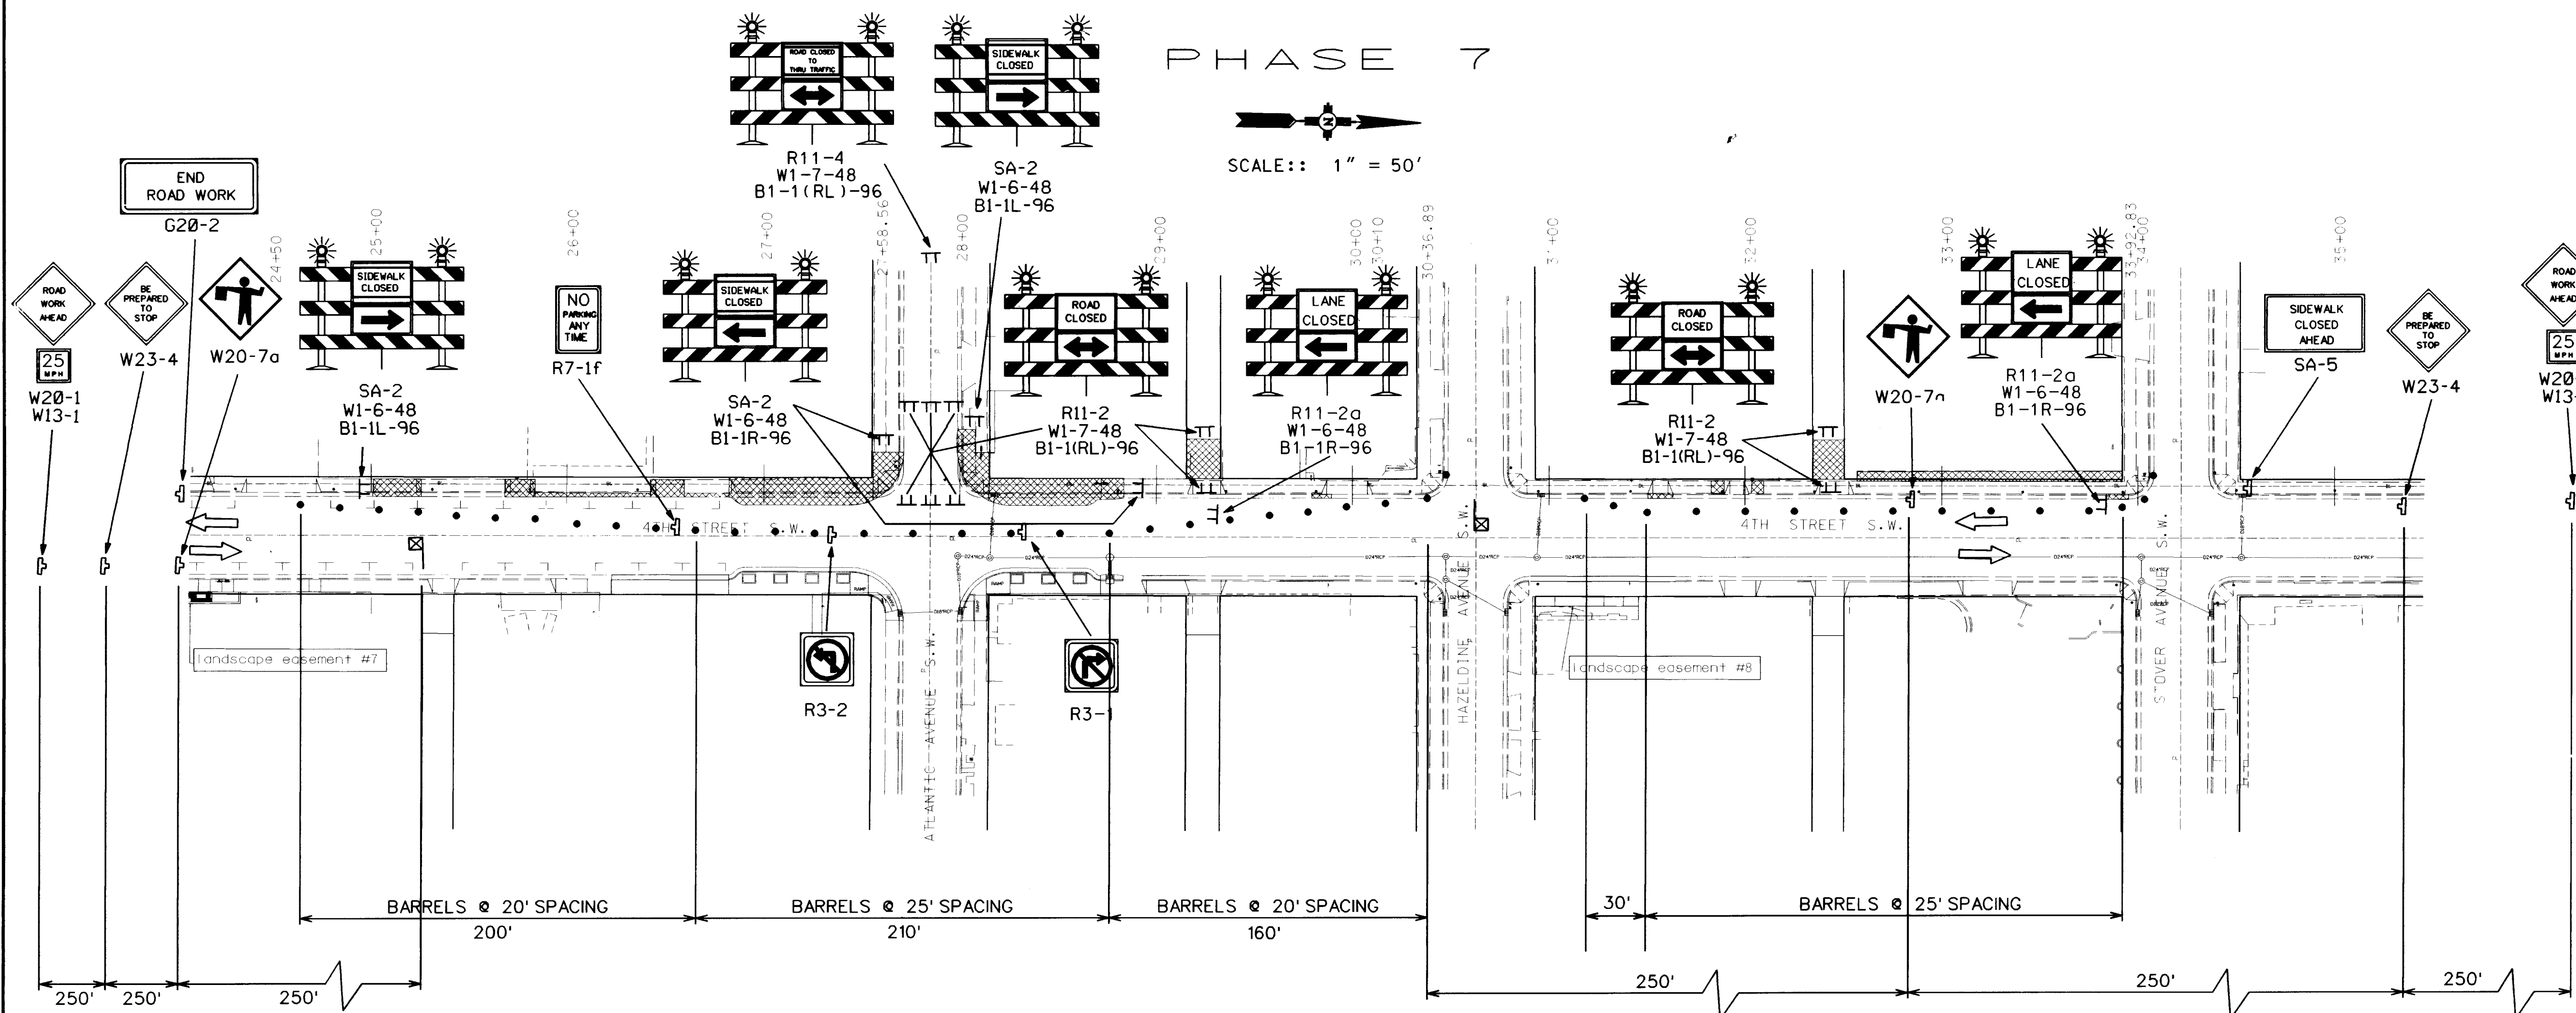


LEGEND

- SIGN(S) AS INDICATED
- INDICATES DIRECTION OF TRAFFIC FLOW
- CHANNELIZATION DEVIC. TYPE "H"
- TYPE III BARRICADE LEFT, RIGHT OR CHEVERON AS APPROPRIATE
- WORK ZONE
- FLAGMAN

AS-BUILT INFORMATION		BENCH MARKS	
CONTRACTOR	DATE	NO.	DATE
INSPECTOR	DATE	NO.	DATE
FIELD VERIFICATION BY	DATE	NO.	DATE
CORRECTED BY	DATE	NO.	DATE
MICRO-FILM INFORMATION		NO.	DATE
RECORDED BY		NO.	DATE

SURVEY INFORMATION		FIELD NOTES	
NO.	DATE	NO.	DATE

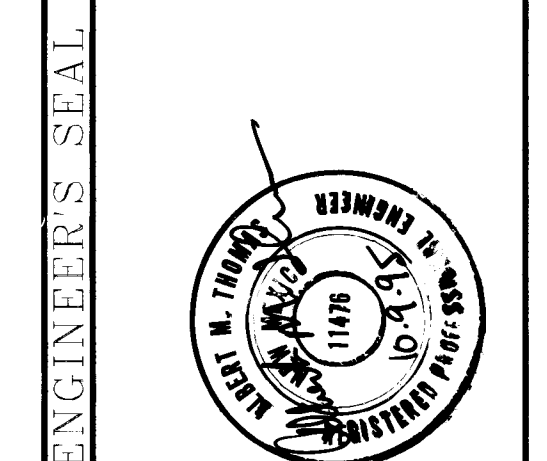

ENGINEER'S SEAL		ISSUED FOR CONSTRUCTION	
NO.	DATE	NO.	DATE
DESIGNED BY		REMARKS	
DRAWN BY		REVISIONS	
CHECKED BY		DESIGN	

RECORD SET
May 1, 1997

BOHANNAN HUSTON INC.
ENGINEERS • PLANNERS • PHOTOGRAMMETRISTS • SURVEYORS • LANDSCAPE ARCHITECTS
ALBUQUERQUE LAS CRUCES



CITY OF ALBUQUERQUE
PUBLIC WORKS DEPARTMENT
ENGINEERING GROUP

TITLE: SOUTH 4th STREET STREETSCAPE
TRAFFIC CONTROL

APPROVALS	ENGINEER	DATE	APPROVALS	ENGINEER	DATE
DRC CHAIRMAN			WATER		
TRANSPORTATION			WASTE WATER		
HYDROLOGY			TRAF. OPER.		

DRAWING NO.	4917.90	MAP NO.		SHEET	10
				OF	TC-8

SCANNED BY
BY JASON

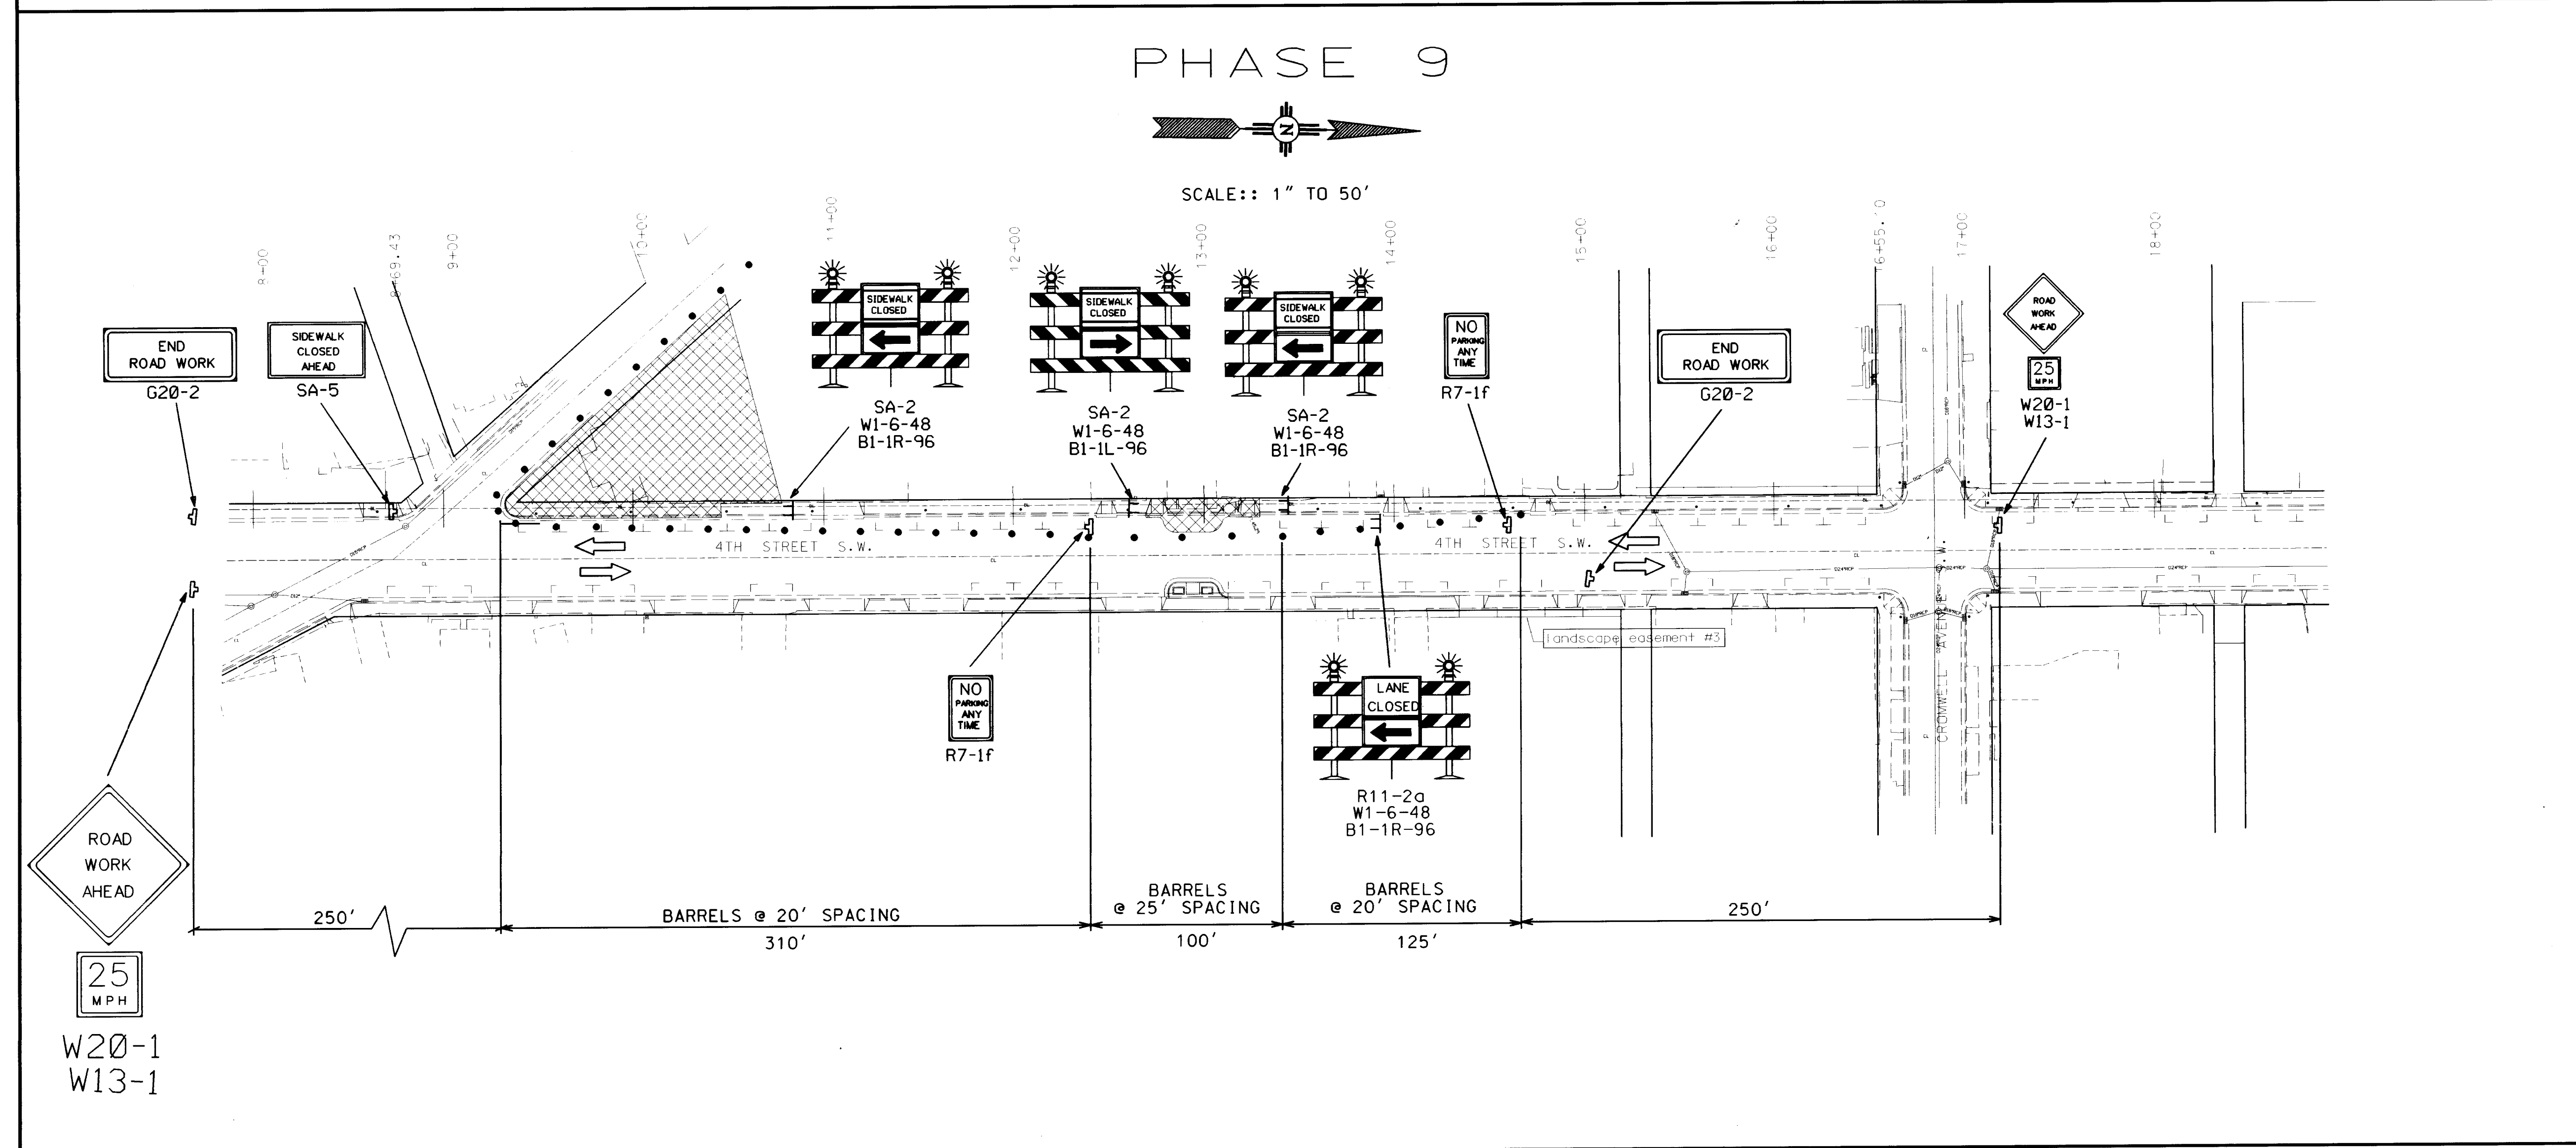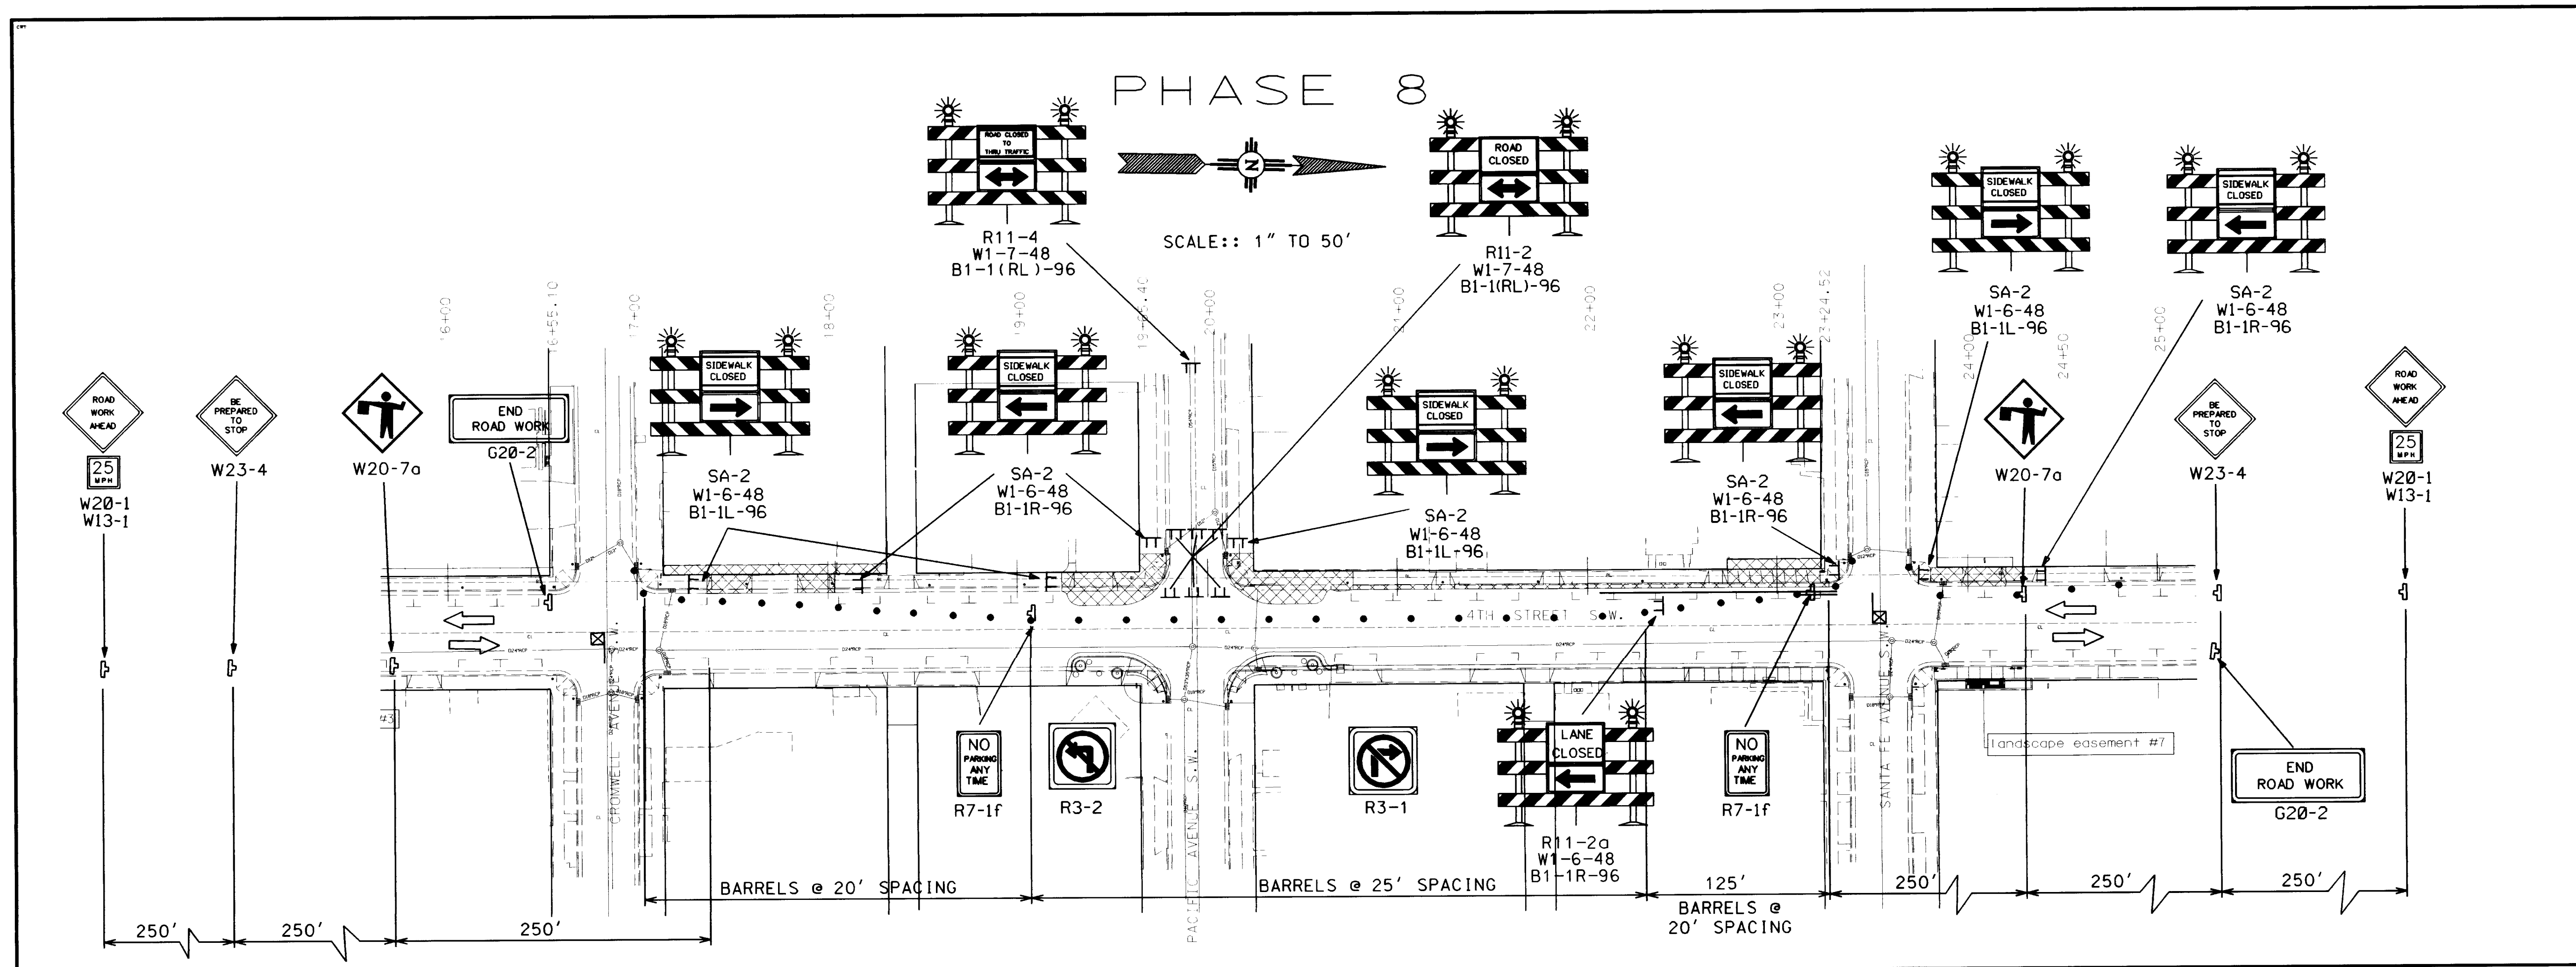

LEGEND

- SIGN(S) AS INDICATED
- INDICATES DIRECTION OF TRAFFIC FLOW
- CHANNELIZATION DEVIC. TYPE "H"
- TYPE III BARRICADE LEFT, RIGHT OR CHEVRON AS APPROPRIATE
- WORK ZONE
- FLAGMAN

RECORD SET

May 1, 1997

[Signature]

BOHANNAN HUSTON INC.

ENGINEERS • PLANNERS • PHOTOGRAMMETRISTS • SURVEYORS • LANDSCAPE ARCHITECTS
ALBUQUERQUE LAS CRUCES SANTA FE

CITY OF ALBUQUERQUE

PUBLIC WORKS DEPARTMENT
ENGINEERING GROUP

TITLE: SOUTH 4th STREET STREETScape

TRAFFIC CONTROL

APPROVALS	ENGINEER	DATE	APPROVALS	ENGINEER	DATE
DRC CHAIRMAN			WATER		
TRANSPORTATION			WASTE WATER		
HYDROLOGY			TRAF. OPER.		

DRAWING NO.	4917.90	MAP NO.		SHEET	OF
				TC-9	10


AS-BUILT INFORMATION

CONTRACTOR	DATE	CONTRACTOR	DATE
C.O.A.	4/97	C.O.A.	4/97
FIELD ASSISTANCE BY	LENNY CAMERO	FIELD ASSISTANCE BY	LENNY CAMERO
DRAWINGS	C.O.A.	DRAWINGS	C.O.A.
CORRECTIONS BY	A.O.I.	CORRECTIONS BY	A.O.I.
MICRO-FILM INFORMATION		MICRO-FILM INFORMATION	
RECORDED BY		RECORDED BY	
NO.		NO.	

PHASE 10



SCALE: 1" = 50'

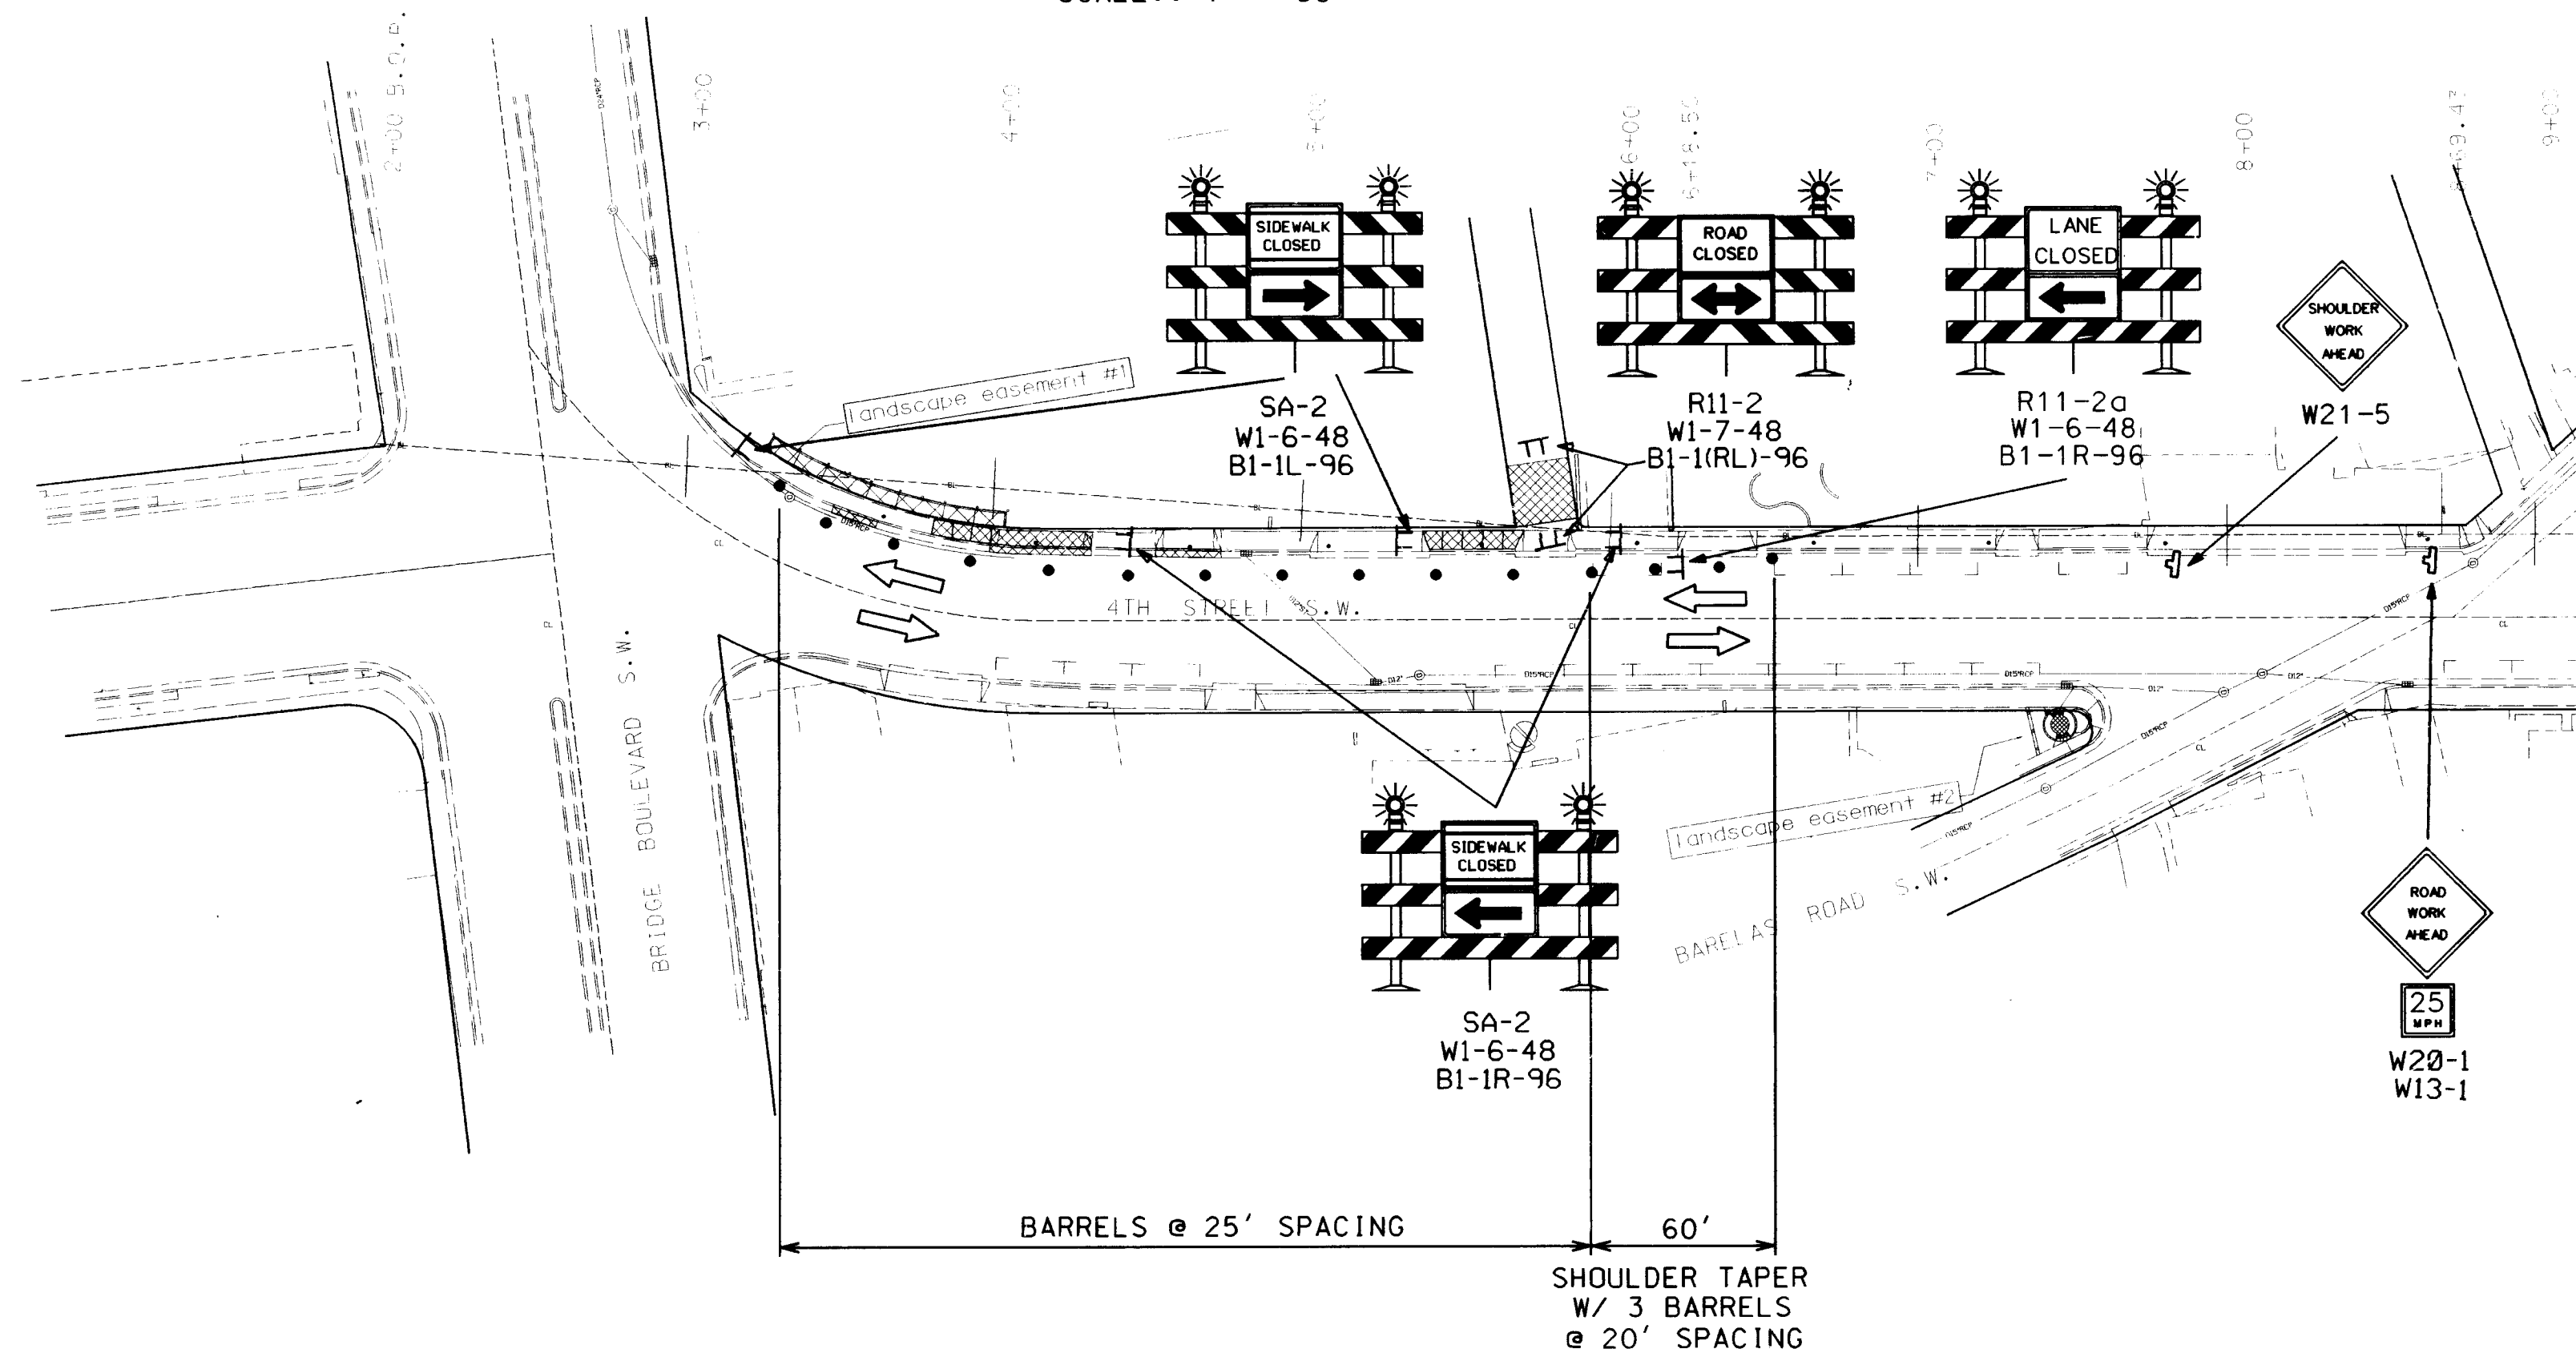

LEGEND

- SIGN(S) AS INDICATED
- INDICATES DIRECTION OF TRAFFIC FLOW
- CHANNELIZATION DEVIC. TYPE "H"
- TYPE III BARRICADE LEFT, RIGHT OR CHEVRON AS APPROPRIATE
- WORK ZONE
- FLAGMAN

RECORD SET
May 1, 1997

BOHANNAN-HUSTON, INC.
ENGINEERS - PLANNERS - PHOTOGRAMMETRISTS - SURVEYORS - LANDSCAPE ARCHITECTS
ALBUQUERQUE, NEW MEXICO

CITY OF ALBUQUERQUE
PUBLIC WORKS DEPARTMENT
ENGINEERING GROUP

TITLE: SOUTH 4TH STREET STREETSCAPE
TRAFFIC CONTROL

APPROVALS	ENGINEER	DATE	APPROVALS	ENGINEER	DATE
DRG. CHAIRMAN			WATER		
TRANSPORTATION			WASTE WATER		
HYDROLOGY			TRAFFIC		

DRAWING NO.	4917.90	MAP NO.		SHEET OF	TC-10 10
-------------	---------	---------	--	----------	----------

SCANNED BY
BY LASON