


TAYLOR RIDGE SUBDIVISION

ALBUQUERQUE, NEW MEXICO

JULY, 1994

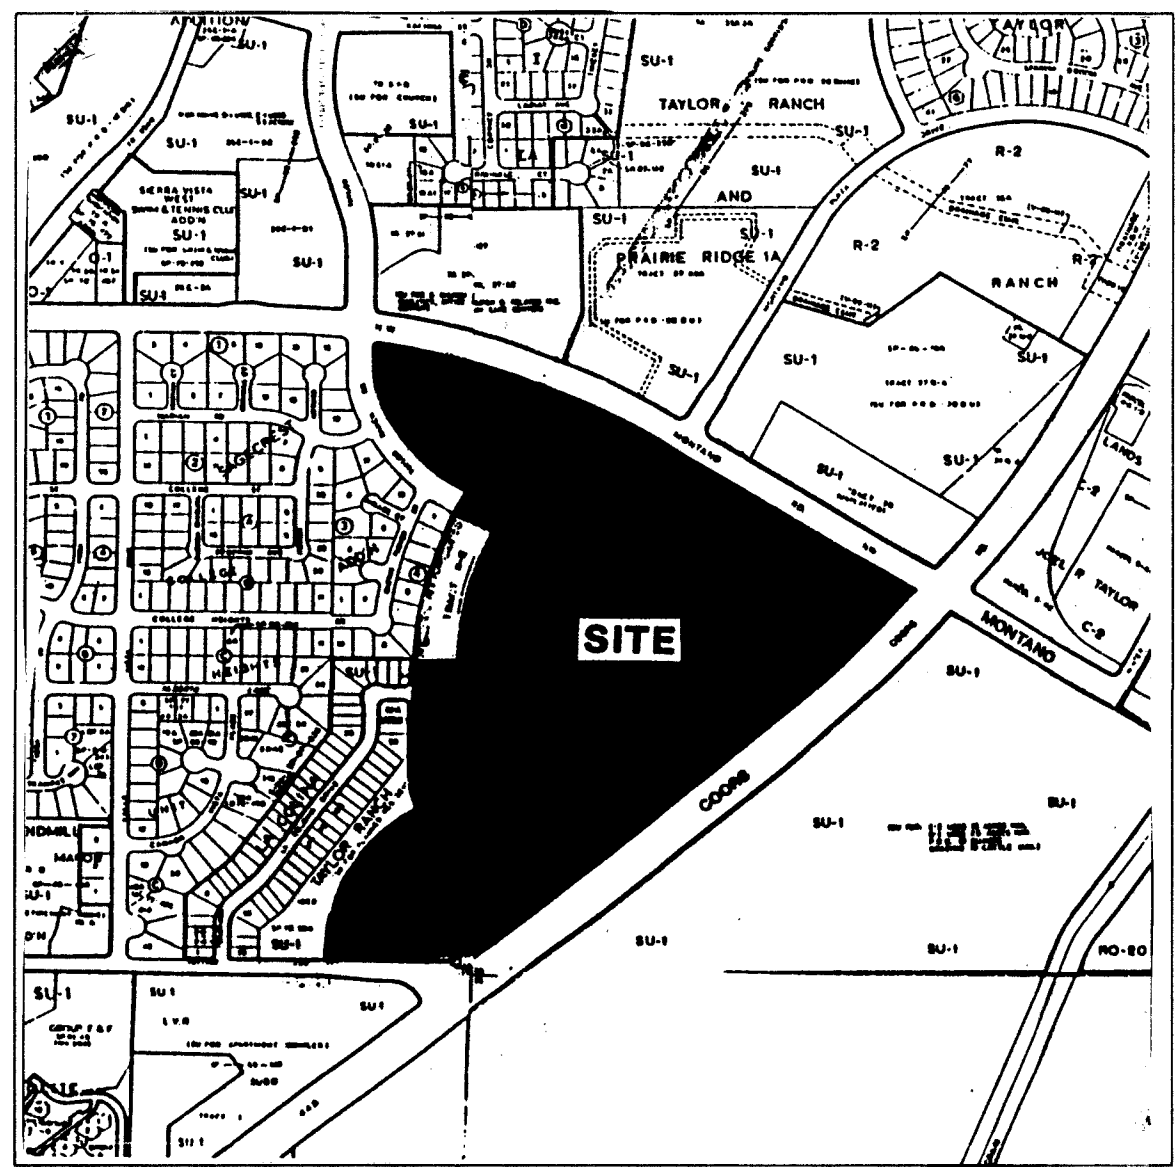

E-12 VICINITY MAP 1"=750'

GENERAL NOTES

- All work detailed on these plans to be performed under contract shall, except as otherwise stated or provided for hereon, be constructed in accordance with the City of Albuquerque Standard Specifications for Public Works Construction 1986, as amended through Update #4.
- Prior to construction, the Contractor shall excavate & verify the horizontal and vertical locations of all obstructions. Should a conflict exist, the Contractor shall notify the Engineer so that the conflict can be resolved with minimum delay.
- Two (2) working days prior to any excavation, Contractor must contact Line Locating Service @ 260-1990 for location of existing utilities.
- Contractor shall support all existing, underground utility lines which become exposed during construction. Payment for supporting work shall be incidental to water-line and/or sewerline costs.
- All water line stationing refers to survey centerline stationing.
- Contractor shall conduct his operations in a manner which will minimize interference with local traffic. Contractor shall comply with all applicable laws, ordinances, rules, regulations, and orders of any public body having jurisdiction for the safety of persons or property, and to protect them from damage, injury, or loss. Contractor shall erect and maintain, as required by the conditions and progress of the work, all necessary safeguards for safety continuously and not limited to normal working hours, throughout the duration of the project. Contractor shall adhere to Section 19 of the General Conditions of the City of Albuquerque Standard Specifications for Public Works Construction, 1986, as amended through Update #4.
- The Contractor agrees that he shall assume the sole and complete responsibility for the job site conditions during the course of construction of this project, including safety of all persons and property; that this requirement shall apply continuously and not be limited to normal working hours; and that the Contractor shall defend, indemnify, and hold harmless the Owner & Engineer from any and all liability real or alleged, in connection with the performance of work on this project, excepting liability arising from the sole negligence of the Owner or Engineer.
- Proposed utility line materials shall be as follows:
Waterline: PVC (AWWA C900) 6"-12" or DI Class 50 6"-16"
Sanitary Sewer: PVC SDR 35
Storm Drain: Reinforced Concrete Pipe Class III
- There are existing walls located adjacent to this project. Any walls damaged or removed by the Contractor during the construction activities shall be reinstated or replaced by the Contractor to an equal or better condition at no additional cost to the Owner.
- TRAFFIC CONTROL: Three (3) working days prior to beginning construction the Contractor shall submit to the Construction Co-ordination Division a detailed construction schedule. Two (2) working days prior to construction the Contractor shall obtain a barricading permit from the Construction Co-ordination Division. Contractor shall notify Barricade Engineer (768-2551) prior to occupying an intersection. See section 19 of the specifications. All Street striping altered or destroyed shall be replaced by Contractor to location and in kind as existing.
- The Contractor shall promptly clean up any material excavated within the public right-of-way so that the excavated material is not susceptible to being washed down a public street.
- Contractor shall assist the Engineer/Inspector in the recording of data on all utility lines and accessories as required by the City of Albuquerque for the preparation of record drawings. Contractor shall not cover utility lines and accessories until all data has been recorded.
- Existing curb and gutter not to be removed under the contract which is damaged or displaced by the Contractor shall be removed and replaced by the Contractor at his expense.
- All work on this project shall be performed in accordance with applicable federal, state, and local laws, rules, and regulations concerning construction safety and health.
- All fittings on waterlines shall have pipe to fitting restrained joints. In addition, pipe to pipe restrained joints measured each way from fittings are required as follows, unless noted otherwise on plans:

LINE SIZE	BENDS 90°	45°	22½°	ROCKS	VALVES, DEAD ENDS & TEE BRANCHES (FH)
6"	20'	9'	4'	6x8: 22'	46' (FH LEGS TO BE FULLY RESTRAINED FROM TEE THROUGH FLANGE)
8"	26'	11'	5'	10x8: 21'	60'
10"	32'	13'	6'	10x6: 49'	72'
- The Contractor is responsible for protecting and maintaining all existing monumentation controls. In the event of inadvertent destruction or alteration, the Contractor must immediately notify the City Chief Surveyor.
- PNM will provide at no cost to the City or the Contractor the required personnel for inspection or observation deemed necessary by PNM while the Contractor is exposing PNM's cables. However, the Contractor shall be charged the total cost associated with repairs to any damaged cables or for any cost associated with supporting or relocating the poles and cables during construction.
- WARNING—EXISTING UTILITY LINE LOCATIONS are shown in an approximate manner only, and such lines may exist where none are shown. The location of any such existing lines is based upon information provided by the utility company, the Owner, or by others, and the information may be incomplete or may be obsolete by the time construction commences.

The Engineer has undertaken no field verification of the location, depth, size, or type of existing underground utility lines, makes no representation pertaining thereto, and assumes no responsibility or liability therefor. The Contractor shall inform itself of the location of any utility line in or near the area of the work in advance of and during excavation work. The Contractor is fully responsible for any and all damage caused by its failure to locate, identify, and preserve any and all existing utilities. The Contractor shall comply with State statutes, municipal and local ordinances, rules and regulations pertaining to the location of these lines and facilities, in planning and conducting excavation, whether by calling or notifying the utilities, complying with "Blue Stakes" procedures, or otherwise.
- Contractor is responsible for contacting Water Systems (857-8200) for operation of water valves.


INDEX TO DRAWINGS

Sheet	Title
1.	VICINITY MAP & GENERAL NOTES
2.-3.	SUBDIVISION PLAT
4.-7.	GRADING & DRAINAGE PLAN
8.	GRADING & DRAINAGE DETAILS
9.	DETENTION BASIN
10.	NORTH STORM DRAIN
11.	SOUTH STORM DRAIN & SAS
12.	MASTER PAVING & UTILITY PLAN
13.-15.	MONTANO PLAZA DRIVE PAVING
16.	TAYLOR RANCH DRIVE PAVING
17.	OXNARD DRIVE PAVING
18.-20.	MONTANO PLAZA DRIVE UTILITY
21.	TAYLOR RANCH DRIVE UTILITY
22.	OXNARD DRIVE UTILITY
23.	MEDIAN & PAVING DETAILS

SURVEYOR'S CERTIFICATION

"I, Timothy Aldrich, a duly qualified Registered Professional Land Surveyor under the laws of the State of New Mexico, do hereby certify that the 'as-built' information shown on these drawings was obtained from field construction and 'as-built' surveys performed by me or under my supervision, that the 'as-built' information shown on these drawings was added by me or under my supervision, and that this 'as-built' information is true and correct to the best of my knowledge and belief." Aldrich Land Surveying is not responsible for any of the design concept, calculations, engineering or intent of the record drawings.

Timothy Aldrich, P.S. No. 7719 4-20-95 Date

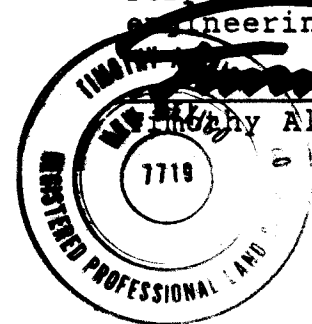


24-19118, 1912, 19178

APPROVED FOR CONSTRUCTION
DATE 11-9-95



PREPARED FOR:
ARGUS DEVELOPMENT CO.
Uptown Blvd. NE, Suite 200W
Albuquerque, NM 87110

REV	SHEETS	CITY ENGINEER	DATE	USER DEPARTMENT	DATE	USER DEPARTMENT	DATE
SCANNED BY BY LASON		PROJECT NO. 4918.90		SHEET 1		OF 23	

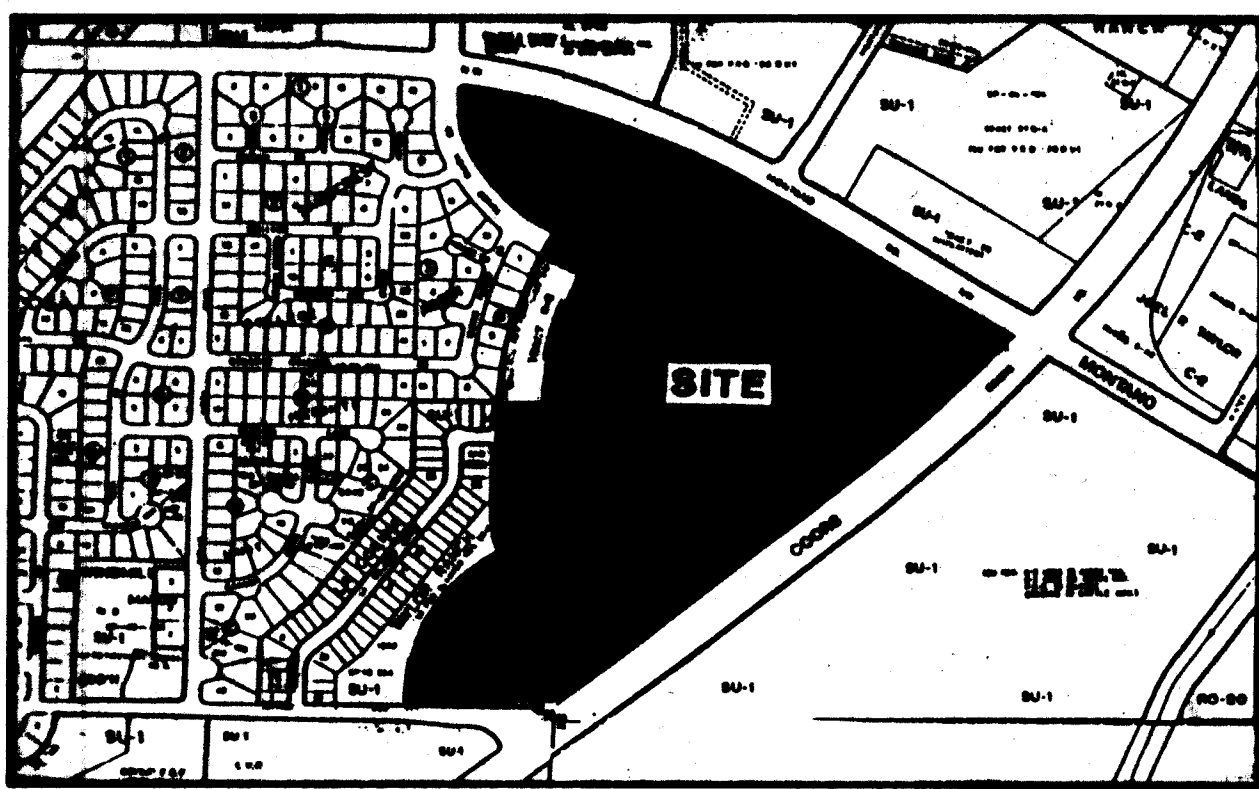

E-12 LOCATION MAP SCALE: 1"=750'

SUBDIVISION DATA / NOTES

- ALL PROPERTY CORNERS ARE SET WITH 5/8" REBAR AND CAP STAMPED "LS 3243", UNLESS OTHERWISE NOTED.
- ROTATE BEARINGS COUNTER-CLOCKWISE 00°00'22" TO ADJUST TO NEW MEXICO STATE PLANE COORDINATE SYSTEM, GRID BEARINGS.
- DISTANCES ARE GROUND DISTANCES.
- FIELD BEARINGS AND DISTANCES MATCH RECORD EXCEPT WHERE FIGURES ARE SHOWN IN PARENTHESIS (RECORD).
- PLAT SHOWS ALL EASEMENTS OF RECORD.
- GROSS ACREAGE: 62.5411 ACRES, MORE OR LESS.
- NUMBER OF EXISTING TRACTS: 1 TRACT.
- NUMBER OF TRACTS CREATED: 9 TRACTS TOTAL INCLUDING 1 FOR DRAINAGE R.O.W. & 3 FOR CITY PARK.
- MILEAGE OF STREETS CREATED: 0.76 MI.
- BASIS OF BEARINGS: EAST LINE (S 51°58'50" W) OF PLAT OF TRACTS R-1 & R-2 TAYLOR RANCH FILED: AUGUST 8, 1984, IN VOL. C24, FOLIO 155.
- DELETED

- ALL STREET CENTERLINE POINTS SHOWN THUS Δ WILL BE MARKED BY A 4" ALUMINUM DISK STAMPED "CENTERLINE MONUMENTATION, PS #7719".
- SEE SHEET 4 FOR BULK LAND VARIANCE AND TEMPORARY DRAINAGE EASEMENT NOTES AND SURVEYOR'S CERTIFICATION.

FREE CONSENT / DEDICATION

THE SUBDIVISION SHOWN HEREON IS WITH THE FREE CONSENT AND IN ACCORDANCE WITH THE DESIRES OF THE UNDERSIGNED OWNER(S) AND/OR PROPRIETOR(S) THEREOF AND SAID OWNER(S) AND/OR PROPRIETOR(S) DO HEREBY DEDICATE ALL STREETS AND PUBLIC RIGHTS-OF-WAY SHOWN HEREON TO THE CITY OF ALBUQUERQUE IN FEE SIMPLE, WITH WARRANTY COVENANTS AND DO HEREBY GRANT: ALL ACCESS, UTILITY AND DRAINAGE EASEMENTS SHOWN HEREON INCLUDING THE RIGHT TO CONSTRUCT, OPERATE, INSPECT, AND MAINTAIN FACILITIES THEREIN; AND ALL PUBLIC UTILITY EASEMENTS SHOWN HEREON FOR THE COMMON AND JOINT USE OF GAS, ELECTRICAL POWER AND COMMUNICATION SERVICES FOR BURIED DISTRIBUTION LINES, CONDUITS, AND PIPES FOR UNDERGROUND UTILITIES WHERE SHOWN OR INDICATED, AND INCLUDING THE RIGHT OF INGRESS AND EGRESS FOR CONSTRUCTION AND MAINTENANCE, AND THE RIGHT TO TRIM INTERFERING TREES AND SHRUBS. SAID OWNER(S) AND/OR PROPRIETOR(S) DO HEREBY CONSENT TO ALL OF THE FOREGOING AND DO HEREBY CERTIFY THAT THIS SUBDIVISION IS THEIR FREE ACT AND DEED.

CITIBANK (ARIZONA)

Daniel R. Porth 2.16.94
DANIEL R. PORTH
CORPORATE VICE PRESIDENT

ACKNOWLEDGEMENT

STATE OF NEW MEXICO } SS
COUNTY OF BERNALILLO }

THIS INSTRUMENT WAS ACKNOWLEDGED BEFORE ME ON 2/16/94, BY DANIEL R. PORTH, AS CORPORATE VICE PRESIDENT OF CITIBANK (ARIZONA), AN ARIZONA CORPORATION, ON BEHALF OF SAID CORPORATION.

MY COMMISSION EXPIRES: 4/22/95

Ruth T. Lozano
RUTH T. LOZANO
NOTARY PUBLIC - NEW MEXICO
Notary Bond Filed with Secretary of State
My Commission Expires: 4/22/95

746PT1.DWG 2/10/94

LEGAL DESCRIPTION

THAT CERTAIN PARCEL OF LAND SITUATE WITHIN SECTIONS 25 & 26, TOWNSHIP 11 NORTH, RANGE 2 EAST, NEW MEXICO PRINCIPAL MERIDIAN, ALBUQUERQUE, NEW MEXICO, AND LABELED TRACT R-1 ON THE PLAT OF "TRACTS R-1 AND R-2, TAYLOR RANCH", AS THE SAME IS SHOWN AND DESIGNATED ON THE PLAT FILED IN THE OFFICE OF THE COUNTY CLERK OF BERNALILLO COUNTY, NEW MEXICO, ON AUGUST 8, 1984, IN VOLUME C24, FOLIO 155 ALONG WITH A VACATED PORTION OF DELLYNE AVENUE RIGHT-OF-WAY AND BEING MORE PARTICULARLY DESCRIBED AS FOLLOWS:

BEGINNING AT A POINT ON THE WESTERLY RIGHT-OF-WAY LINE OF COORS ROAD NW, FROM WHENCE THE ACS SURVEY MONUMENT "NM 448-N5B" (NEW MEXICO STATE PLANE GRID COORDINATES FOR THE CENTRAL ZONE: X=365147.72, Y=1504660.04) BEARS S 35°47'26" W, 4,718.10 FEET AND PROCEEDING FROM SAID BEGINNING POINT N 89°45'19" W, 4.84 FEET;
THENCE PROCEEDING ALONG THE WEST RIGHT-OF-WAY LINE OF COORS ROAD NW S 51°58'50" W, 118.33 FEET TO A POINT OF CURVATURE;
THENCE 40.17 FEET ALONG THE ARC OF A CURVE TO THE RIGHT HAVING A RADIUS OF 25.00 FEET THROUGH A CENTRAL ANGLE OF 92°04'11" TO THE BEGINNING OF A REVERSE CURVE CONCAVE TO THE SOUTHWEST HAVING A RADIUS OF 172.00 FEET THENCE NORTHWESTERLY 135.25 FEET ALONG SAID CURVE THROUGH A CENTRAL ANGLE OF 45°03'10", TO A POINT ON THE NORTH RIGHT-OF-WAY LINE OF DELLYNE AVENUE NW, N 89°45'19" W, 228.05 FEET;
THENCE LEAVING SAID RIGHT-OF-WAY LINE & PROCEEDING N 00°01'22" E, 65.39 FEET TO A POINT OF CURVATURE;
THENCE 628.32 FEET ALONG THE ARC OF A CURVE TO THE RIGHT HAVING A RADIUS OF 600'00" FEET THROUGH A CENTRAL ANGLE OF 60°00'00",
THENCE N 60°01'22" E, 50.00 FEET TO A POINT ON A CURVE CONCAVE TO THE EAST HAVING A RADIUS OF 225.00 FEET AND TO WHICH POINT A RADIAL LINE BEARS S 60°00'00" W;
THENCE NORTHERLY 117.81 FEET ALONG SAID CURVE THROUGH A CENTRAL ANGLE OF 30°00'00";
THENCE N 00°00'00" E, 375.00 FEET TO A POINT OF CURVATURE;
THENCE 113.36 FEET ALONG THE ARC OF A CURVE TO THE RIGHT HAVING A RADIUS OF 1,490.00 FEET THROUGH A CENTRAL ANGLE OF 04°21'33";
THENCE S 89°46'41" E, 150.44 FEET TO A POINT ON A CURVE CONCAVE TO THE EAST HAVING A RADIUS OF 1,340.00 FEET AND TO WHICH POINT A RADIAL LINE BEARS N 85°10'36" W;
THENCE NORTHERLY 545.81 FEET ALONG SAID CURVE THROUGH A CENTRAL ANGLE OF 23°20'17";
THENCE ALONG A NON-RADIAL LINE N 59°58'45" W, 150.11 FEET TO A POINT ON A CURVE TO THE RIGHT HAVING A RADIUS OF 1,490.00 FEET AND TO WHICH POINT A RADIAL LINE BEARS N 61°38'01" W;
THENCE NORTHEASTERLY 43.02 FEET ALONG SAID CURVE THROUGH A CENTRAL ANGLE OF 01°39'16";
THENCE N 30°01'15" E, 78.00 FEET TO A POINT OF CUSP WITH A CURVE CONCAVE TO THE NORTH HAVING A RADIUS OF 25.00 FEET AND TO WHICH POINT A RADIAL LINE BEARS S 59°58'45" E;
THENCE WESTERLY 39.27 FEET ALONG SAID CURVE THROUGH A CENTRAL ANGLE OF 90°00'00" TO A POINT ON THE EASTERLY RIGHT-OF-WAY LINE OF TAYLOR RANCH DRIVE NW;
THENCE PROCEEDING ALONG SAID EASTERLY RIGHT-OF-WAY LINE N 59°58'45" W, 100.00 FEET TO A POINT OF CURVATURE;
THENCE 285.92 FEET ALONG THE ARC OF A CURVE TO THE RIGHT HAVING A RADIUS OF 746.95 FEET THROUGH A CENTRAL ANGLE OF 21°55'54" TO THE BEGINNING OF A COMPOUND CURVE CONCAVE TO THE EAST HAVING A RADIUS OF 338.31 FEET; THENCE NORTHERLY 224.78 FEET ALONG SAID CURVE THROUGH A CENTRAL ANGLE OF 38°04'06";
THENCE N 00°01'15" E, 106.19 FEET TO A POINT OF CURVATURE;
THENCE LEAVING SAID EASTERLY RIGHT-OF-WAY LINE OF TAYLOR RANCH DRIVE NW AND PROCEEDING 42.75 FEET ALONG THE ARC OF A CURVE TO THE RIGHT HAVING A RADIUS OF 25.00 FEET THROUGH A CENTRAL ANGLE OF 97°59'04" TO A POINT ON THE SOUTHERLY RIGHT-OF-WAY LINE OF MONTANO ROAD NW SAID POINT ALSO BEING THE BEGINNING OF A COMPOUND CURVE CONCAVE TO THE SOUTH HAVING A RADIUS OF 2,828.53 FEET;
THENCE PROCEEDING SOUTHEASTERLY ALONG SAID SOUTHERLY RIGHT-OF-WAY LINE OF MONTANO ROAD NW 1,170.76 FEET THROUGH A CENTRAL ANGLE OF 23°42'56";
THENCE S 58°16'45" E, 1,133.06 FEET TO A POINT ON THE WESTERLY RIGHT-OF-WAY LINE OF COORS ROAD NW SAID POINT ALSO BEING ON A CURVE CONCAVE TO THE NORTHWEST HAVING A RADIUS OF 5,654.58 FEET AND TO WHICH POINT A RADIAL LINE BEARS S 48°17'12";
THENCE LEAVING THE SOUTH RIGHT-OF-WAY LINE OF MONTANO ROAD AND PROCEEDING SOUTHWESTERLY ALONG SAID WEST RIGHT-OF-WAY OF COORS ROAD NW 1,013.28 FEET ALONG THE ARC OF A CURVE TO THE RIGHT THROUGH A CENTRAL ANGLE OF 10°16'02"; THENCE CONTINUING ALONG THE WEST RIGHT-OF-WAY LINE OF COORS ROAD NW S 51°58'50" W, 1,292.43 FEET TO THE POINT OF BEGINNING AND CONTAINING 2,724,295 SQ FT OF LAND (62.5411 ACRES) MORE OR LESS.

PLAT OF
TAYLOR RIDGE
SUBDIVISIONBEING A REPLAT OF TRACT R-1, TAYLOR RANCH
AS FILED 8-8-84, VOL C24, FOLIO 155ALBUQUERQUE, NEW MEXICO
FEBRUARY, 1994

APPROVALS S-93-20 DRB NO: 92-295

Robt. Philp 4-19-94
PUBLIC SERVICE COMPANY OF NEW MEXICO DATE

Donna Bera 2-18-94
GAS COMPANY OF NEW MEXICO DATE

Donna Bera 2-23-94
U.S. WEST COMMUNICATIONS DATE

Donna Bera 2-18-94
JONES INTERCABLE DATE

Donna Bera 02-22-94
CITY SURVEYOR, ENGR. DIV., P.W.D. DATE

Donna Bera 3-01-94
TRAFFIC ENGINEERING, TRANS. DEV. DIV., P.W.D. DATE

Donna Bera 3-1-94
PARKS & RECREATION DEPARTMENT DATE

Donna Bera 3-1-94
UTILITY DEVELOPMENT DIV., P.W.D. DATE

Donna Bera 3-3-94
REAL PROPERTY DIVISION, D.F.M. DATE

A.M.A.F.C.A. DATE

CITY ENGINEER, PUBLIC WORKS DEPT. DATE

APPROVAL AND CONDITIONAL ACCEPTANCE AS SPECIFIED BY THE ALBUQUERQUE SUBDIVISION ORDINANCE, ARTICLE XI OF THE REVISED ORDINANCES OF ALBUQUERQUE, N.M.

CITY PLANNER, ALBUQUERQUE PLANNING DIVISION DATE


DISCLOSURE STATEMENT

THE PURPOSE OF THIS PLAT IS TO SUBDIVIDE TRACT R-1, TO DEDICATE AND VACATE PUBLIC ROADWAYS AS SHOWN, DRAINAGE RIGHTS-OF-WAY (TRACT F), AND PARK LAND (TRACT P-1) TO THE CITY OF ALBUQUERQUE, AND TO CREATE 2 PARCELS (TRACTS P-2 & P-3) FOR ACQUISITION BY THE CITY OF ALBUQUERQUE FOR A CITY PARK AND TO GRANT THOSE EASEMENTS SHOWN.

SHEET 1 OF 4

PLAT OF
TAYLOR RIDGE
SUBDIVISIONBEING A PLAT OF TRACT R-1, TAYLOR RANCH
AS FILED 8-8-84, VOL C24, FOLIO 155ALBUQUERQUE, NEW MEXICO
FEBRUARY, 1994

TRACT	AREA (ACRES)
A	9.5174
B	12.1301
C	9.9669
D	16.2663
E	4.2457
F	1.7501
P-1	1.0000
P-2	1.0000
P-3	0.8071

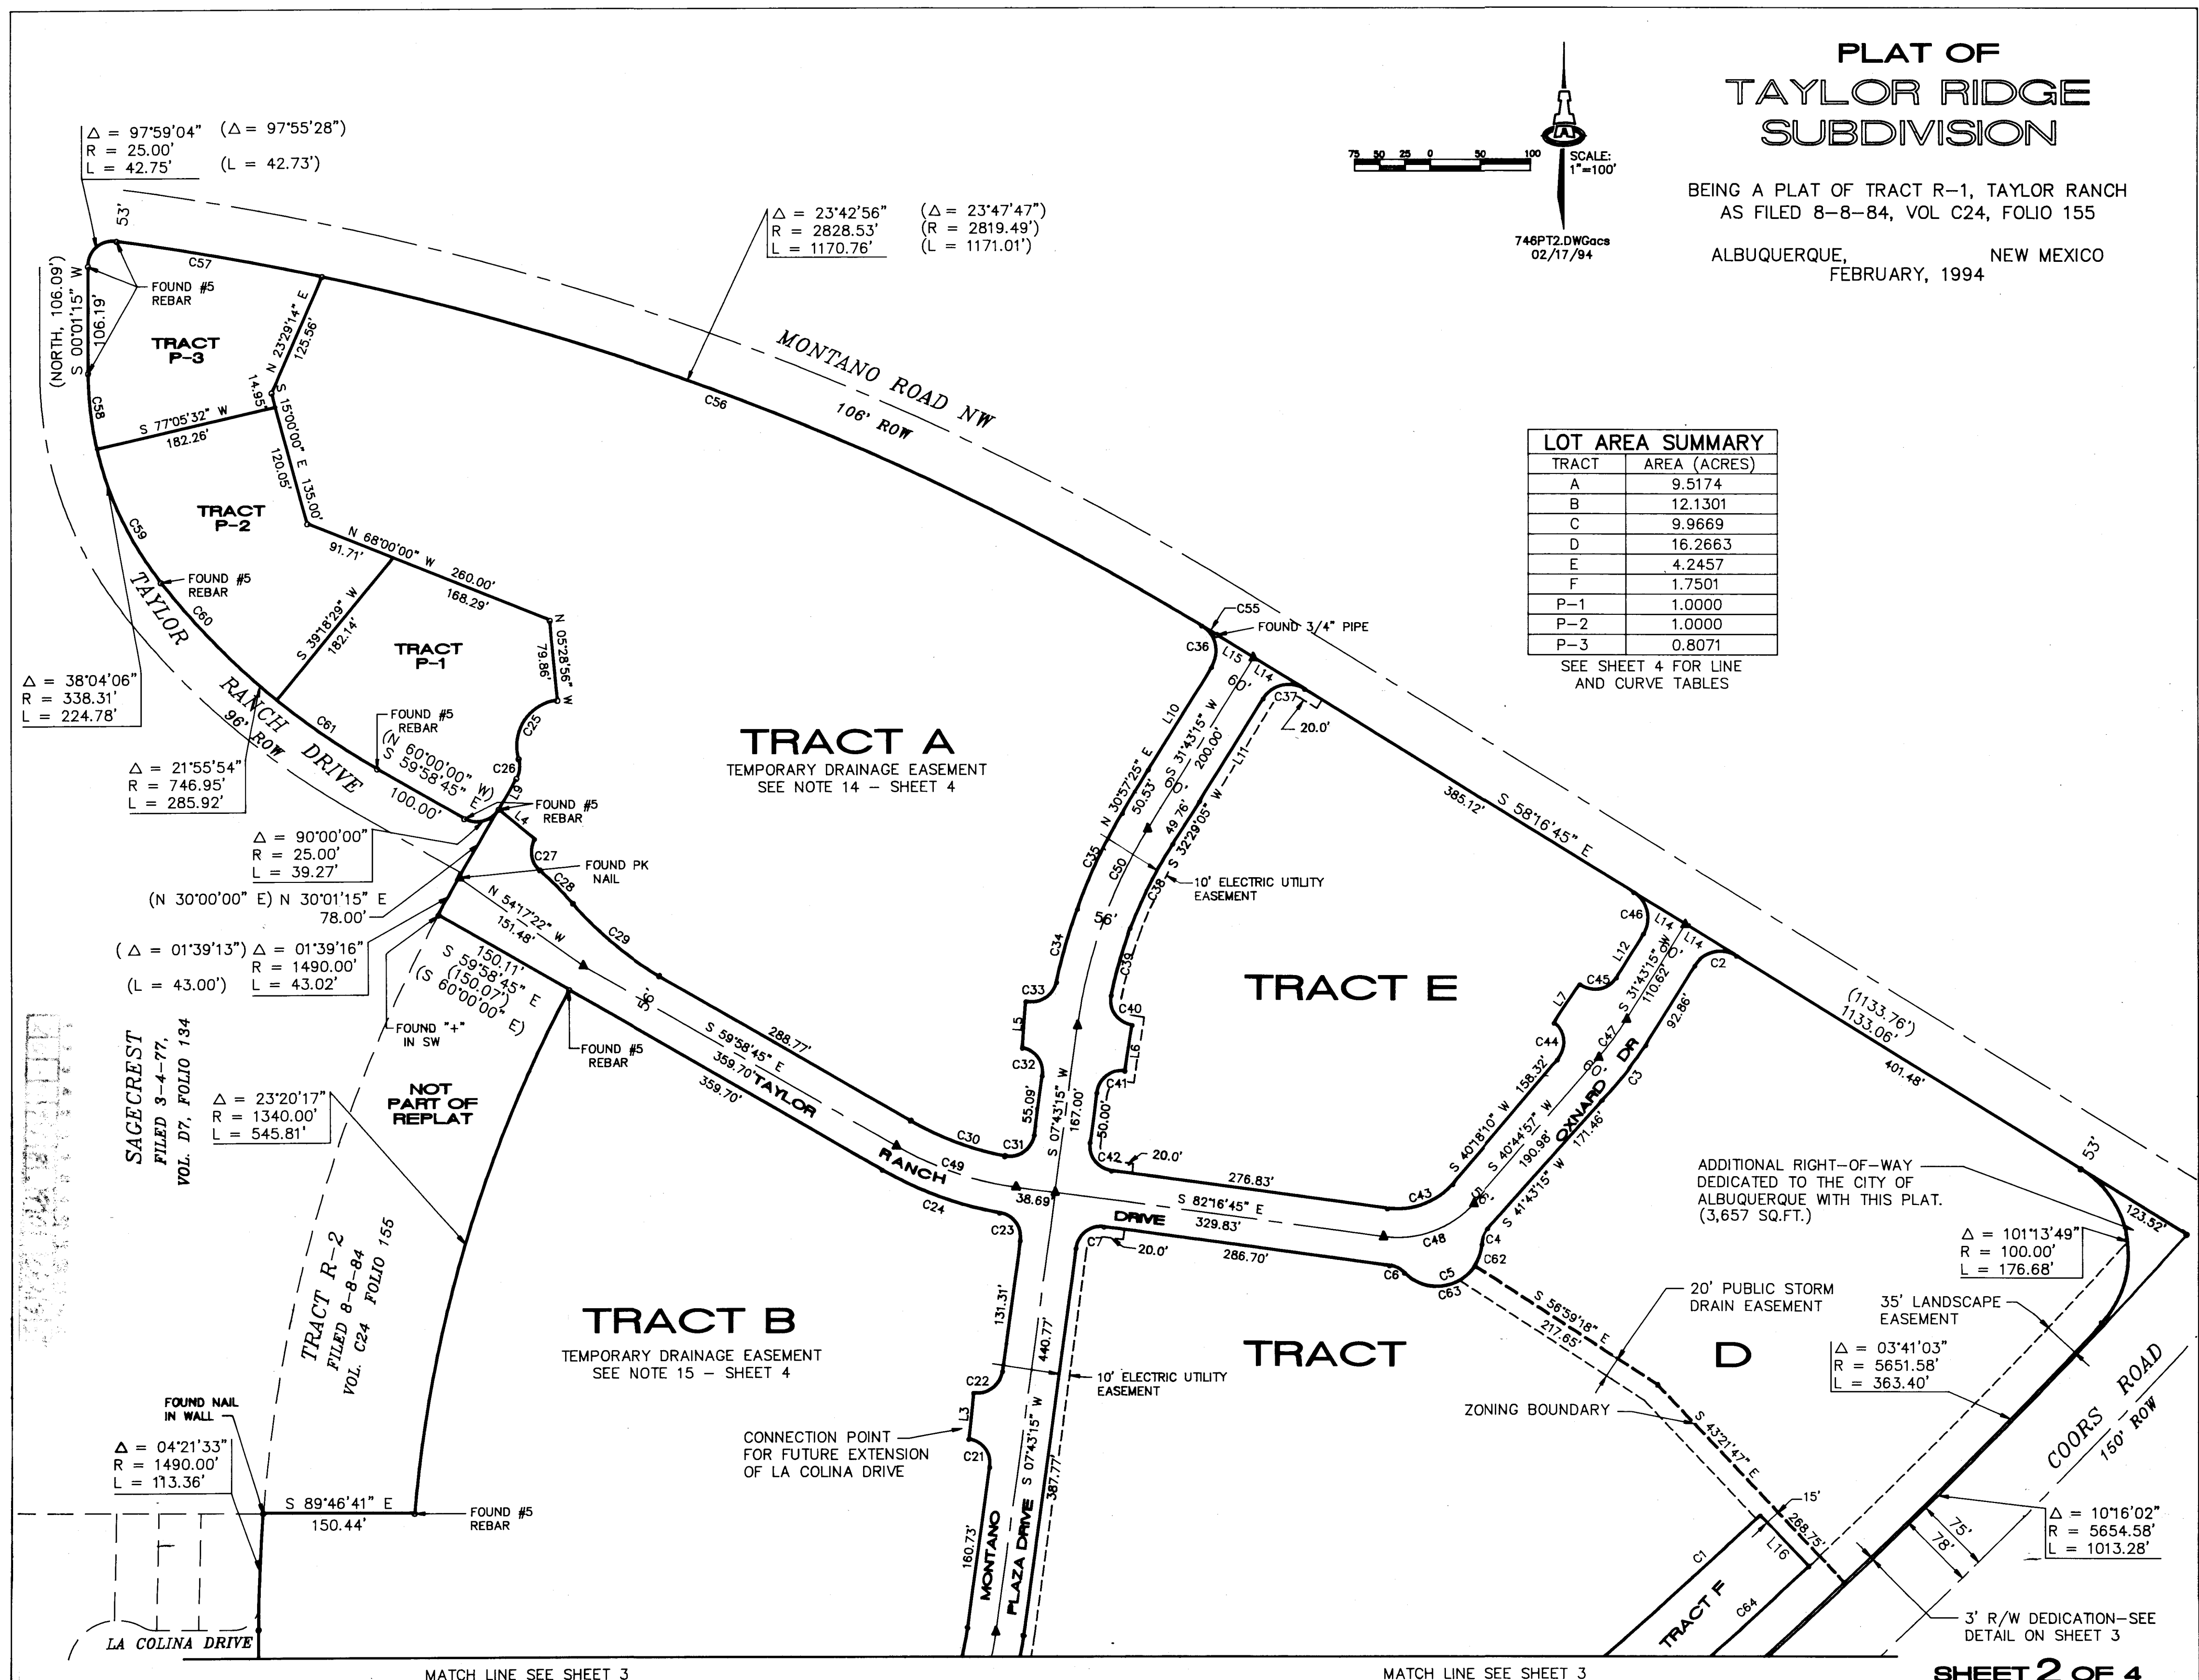SEE SHEET 4 FOR LINE
AND CURVE TABLES



SHEET 2 OF 4

ALBUQUERQUE, NEW MEXICO
FEBRUARY 1994

746PT3.DWGacs
02/17/94



SHEET 4 OF 4

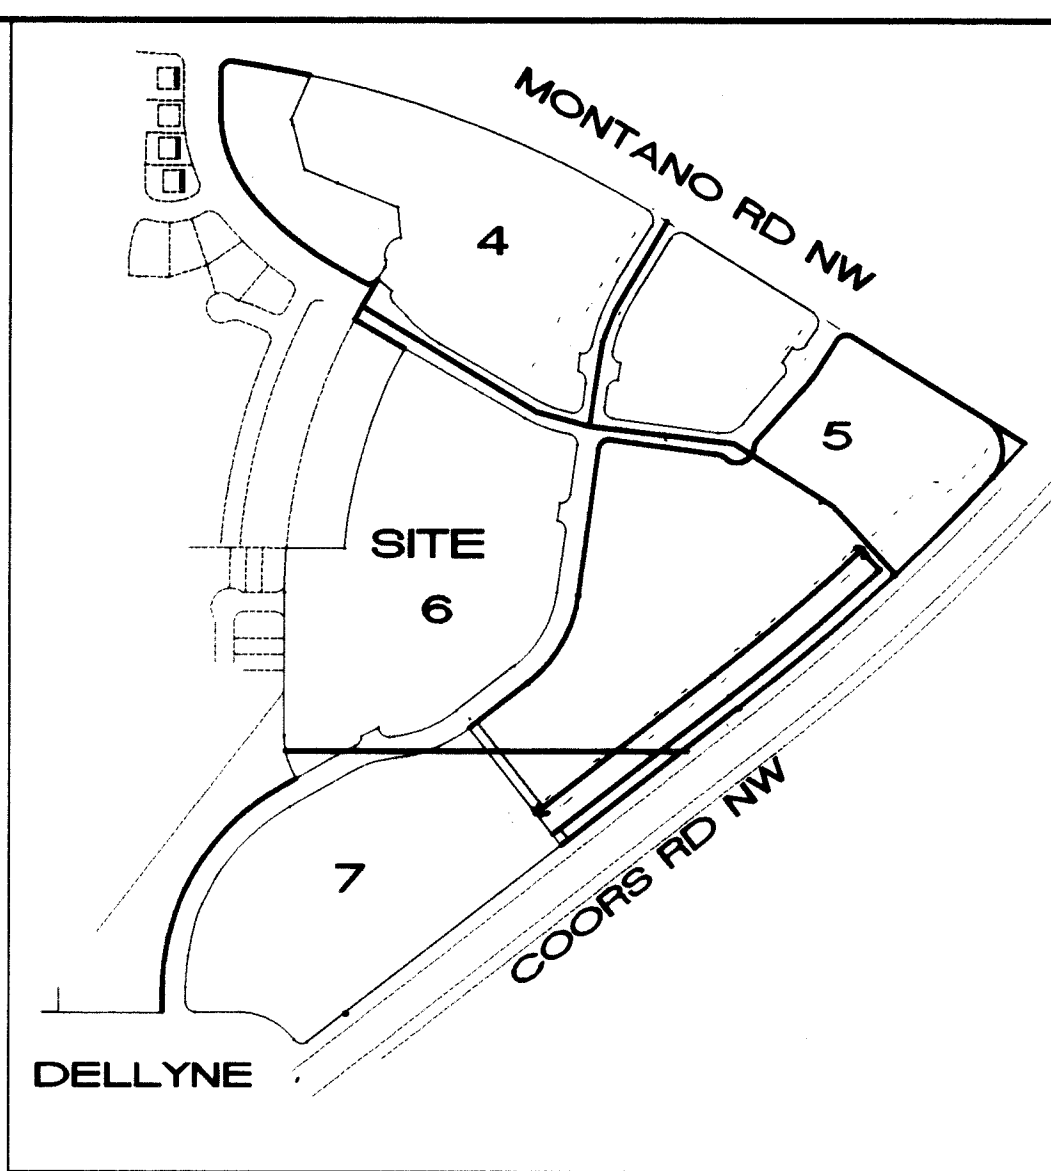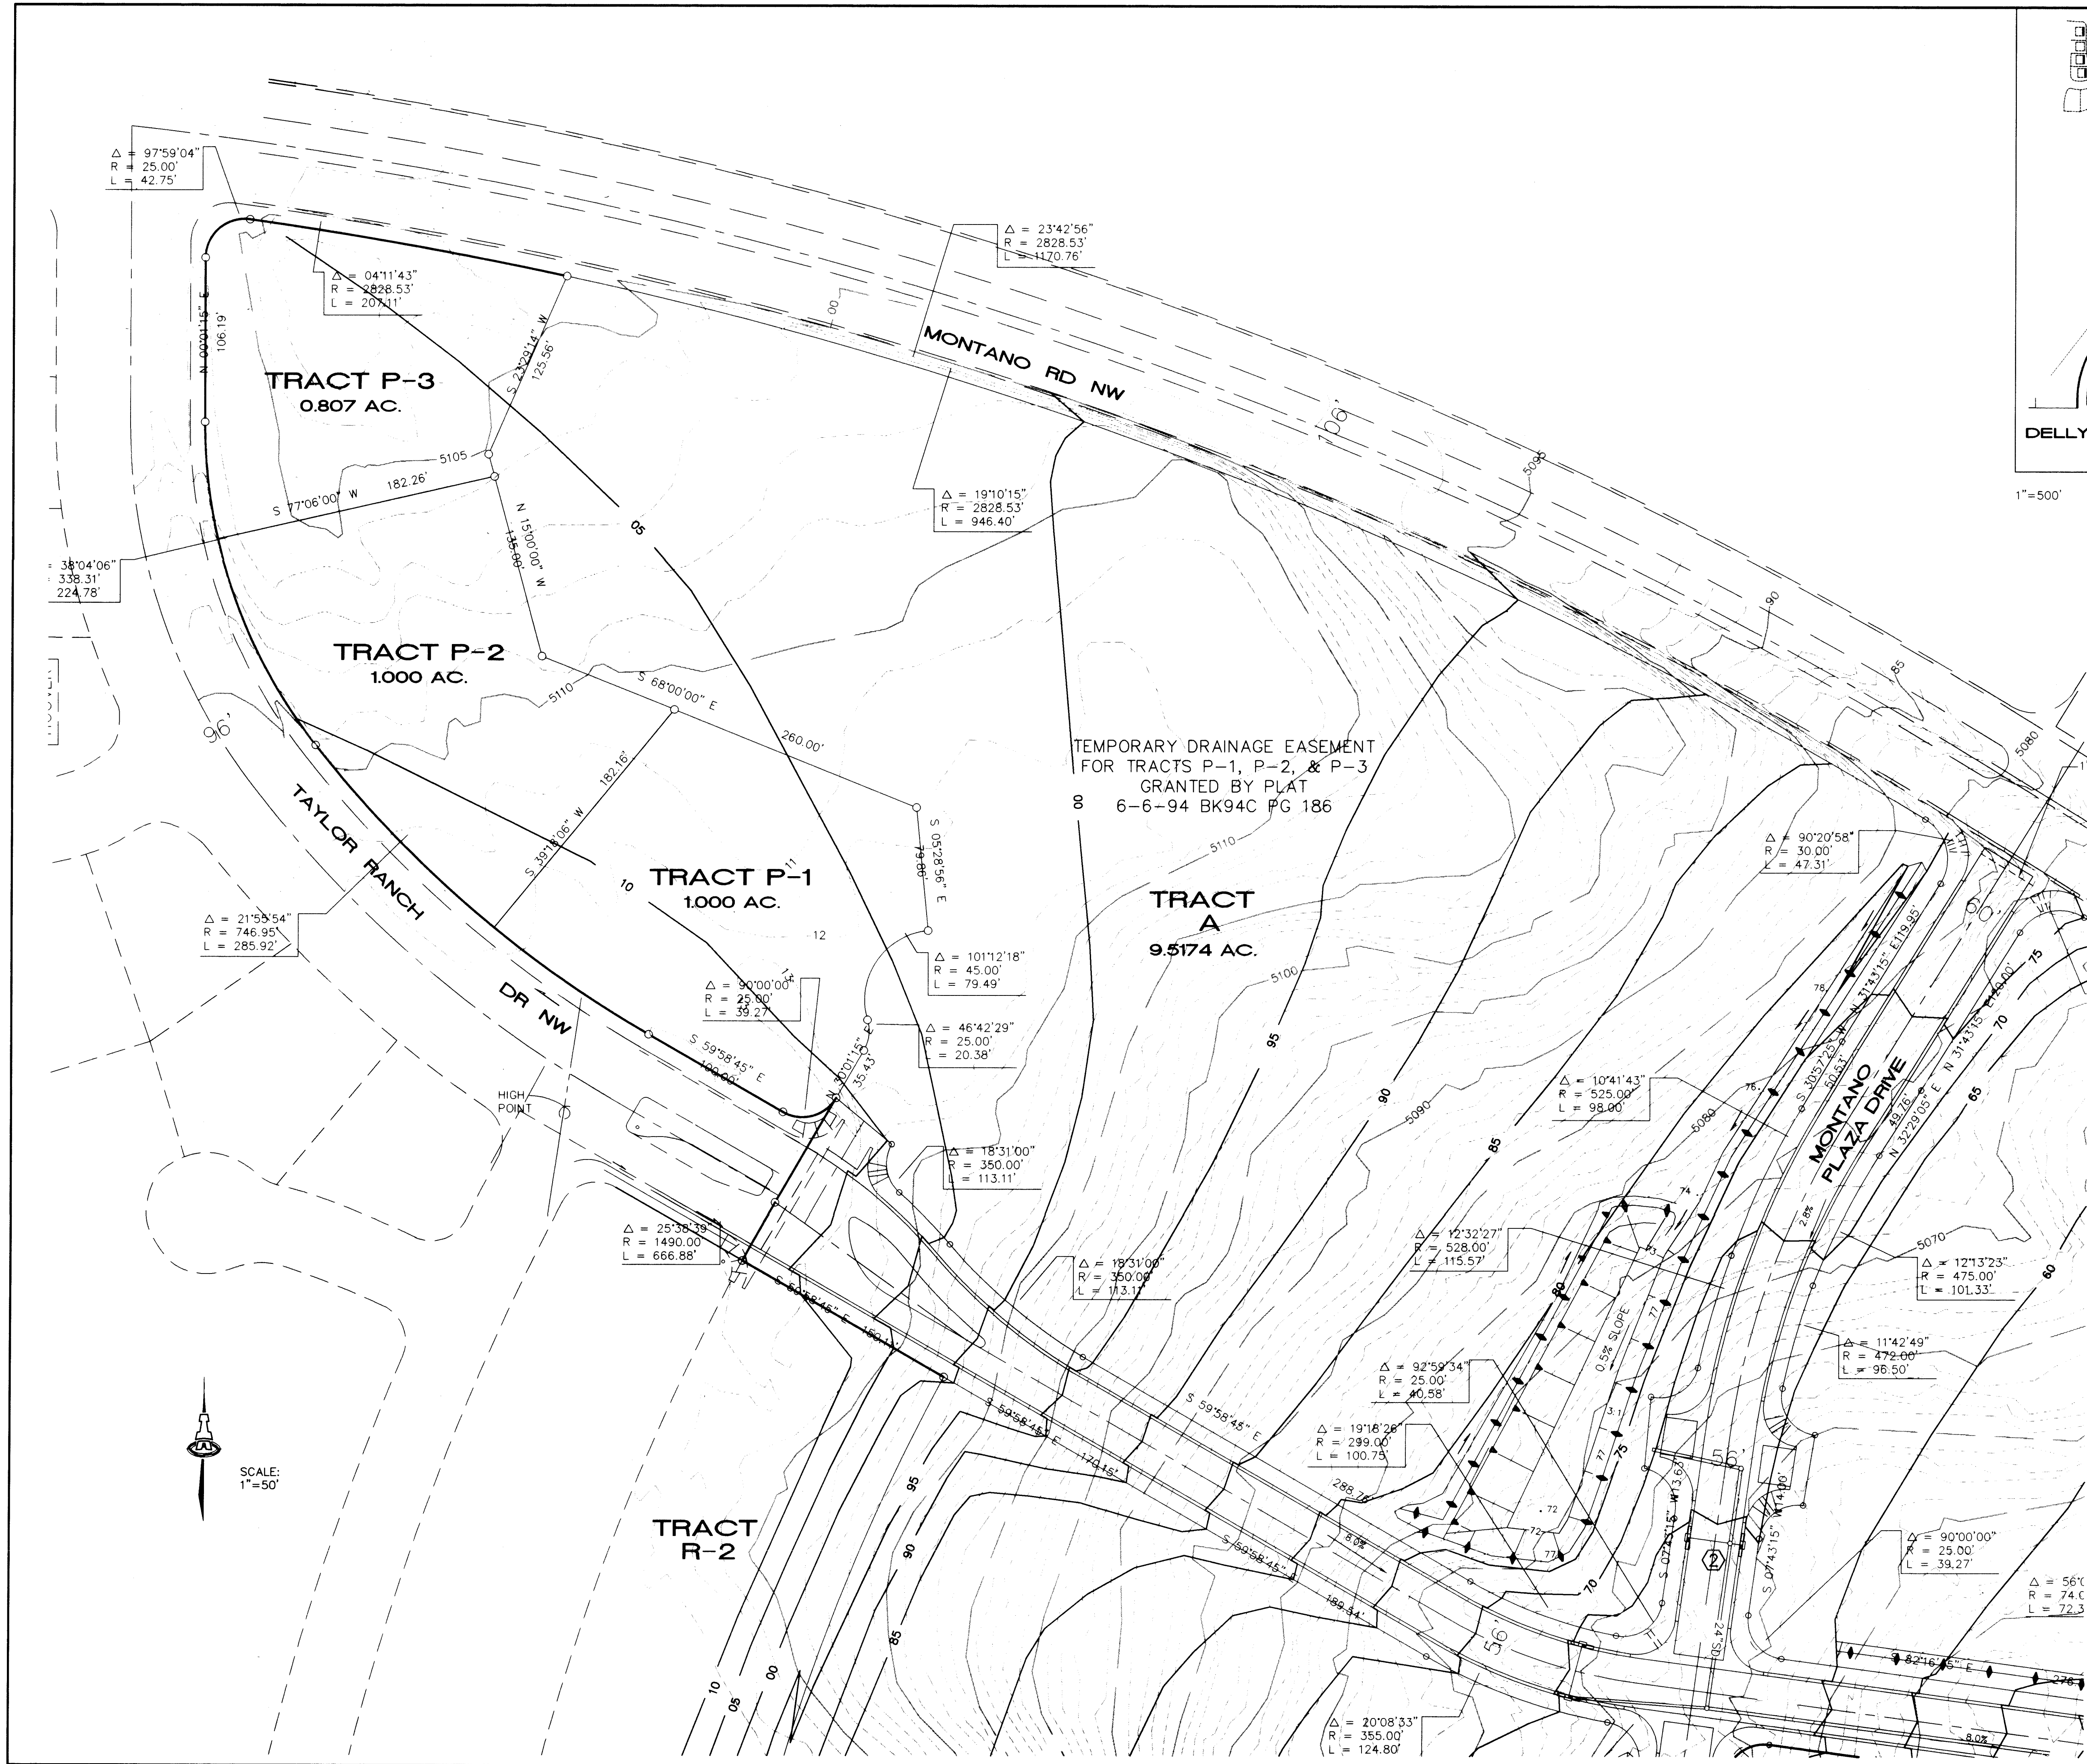

VICINITY MAP & SHEET INDEX

LEGEND

- EXISTING CONTOUR
- PROPOSED CONTOUR
- TRACT LINE
- R/W LINE
- EXISTING CURB LINE
- C INTERIOR ROAD
- FLOWLINE ELEV
- PROPOSED STREET GRADE
- 2.5' EARTH BERM
- FLOW ARROW


24-14718-19-20-21-99-100

746GRD.DWG 6/17/94

CITY OF ALBUQUERQUE PUBLIC WORKS DEPARTMENT ENGINEERING GROUP					
TITLE: TRACT R-1, TAYLOR RANCH GRADING & DRAINAGE PLAN					
APPROVALS	ENGINEER	DATE	APPROVALS	ENGINEER	DATE
DRC CHAIRMAN	8.8.94	8-17-94	WATER	W.A. GOR	8-17-94
TRANSPORTATION	8.8.94	8-17-94	WASTE WATER	W.A. GOR	8-17-94
HYDROLOGY	8.8.94	8-17-94			
PROJECT NO.	4918.90	MAP NO.	E-12	SHEET	4 OF 23

ENGINEER'S SEAL		SURVEY INFORMATION		BENCH MARKS		AS-BUILT INFORMATION	
 7-13-94 8-16-94		FIELD NOTES		ACS BENCHMARK "NM 448-N7A" LOCATED IN THE SOUTH END OF THE MEDIAN IN COORS RD NW NORTH OF MONTANO RD NW		CONTRACTOR	
		BY		DATE		WORK	
NO.		DATE		ELEVATION = 5006.41		BY	
REVISIONS		DATE		FIELD		DATE	
DESIGN		DATE		DRAWINGS		DATE	
DESIGNED BY		DATE		CORRECTED BY		DATE	
DRAWN BY		DATE		MICRO-FILM		INFORMATION	
CHECKED BY		DATE		RECORDED BY		DATE	
NO.		DATE		NO.		DATE	

SHEET		OF	
4		23	

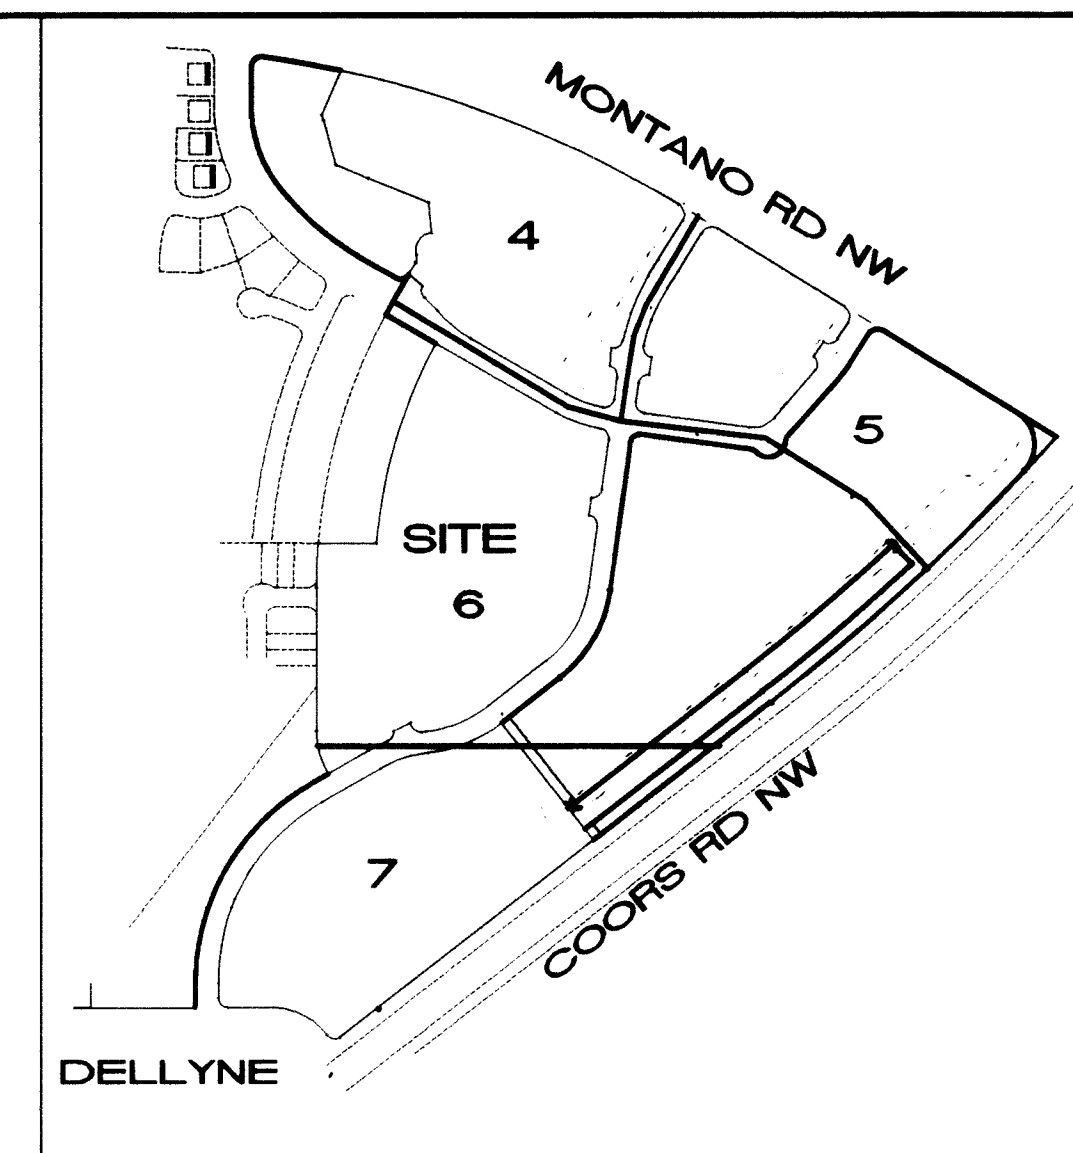

LEGEND

-
- Diagram illustrating a street cross-section with the following components:
- EXISTING CONTOUR
 - PROPOSED CONTOUR
 - TRACT LINE
 - R/W LINE
 - EXISTING CURB LINE
 - C INTERIOR ROAD
 - FLOWLINE ELEV . 73
 - PROPOSED STREET GRA 2.8%
 - 2.5' EARTH BERM
 - FLOW ARROW

1	2	3	4	5	6	7	8	9	10	11	12	13	14	15
2	6	-	4	9	1	8	.	9	0		0	5	9	5

746GRD.DWG 6/17/94


CITY OF ALBUQUERQUE
PUBLIC WORKS DEPARTMENT
ENGINEERING GROUP

TITLE:	TRACT R-1, TAYLOR RANCH GRADING & DRAINAGE PLAN
--------	--

APPROVALS	ENGINEER	DATE	APPROVALS	ENGINEER	DATE
DRC CHAIRMAN	<i>Ag. Bailey</i>	<i>9-12-94</i>	WATER	<i>NA</i>	<i>8-28-94</i>
TRANSPORTATION	<i>W. RHP</i>	<i>8-09-94</i>	WASTE WATER		
HYDROLOGY	<i>APC</i>	<i>8-16-94</i>	<i>E-2</i>		
PROJECT NO. 4918.90		MAP NO. E-12	SHEET 5 OF 23		

SURVEY INFORMATION			BENCH MARKS		AS-BUILT INFORMATION	
NO.	FIELD NOTES		CONTRACTOR	WORK STARTED BY	DATE	DATE
	W.	BY				
1	W. PETTIT	2/93	ACS BENCHMARK "NM 448-N7A" LOCATED IN THE SOUTH END OF THE MEDIAN IN COORS RD NW NORTH OF MONTANO RD NW ELEVATION = 5006.41	CGM, INC.	ALS, INC.	4/18
				FIELD LOCATION BY	DATE	DATE
				DRAWINGS CORRECTED BY	DATE	DATE
				MICRO-FILM INFORMATION		
				REGISTERED BY	DATE	DATE
				NO		



ENGINEER'S SEAL

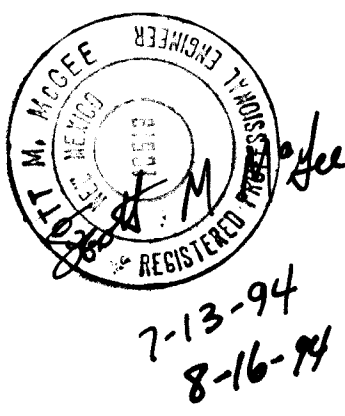

NO.	DATE	REMARKS	BY		
<i>REVIEWS</i>					
DESIGN					
	DESIGNED BY	DATE			
	DRAWN BY	DATE			
	CHECKED BY	DATE			

SCALE:
1"=50'

SCANNED BY
BY LASON

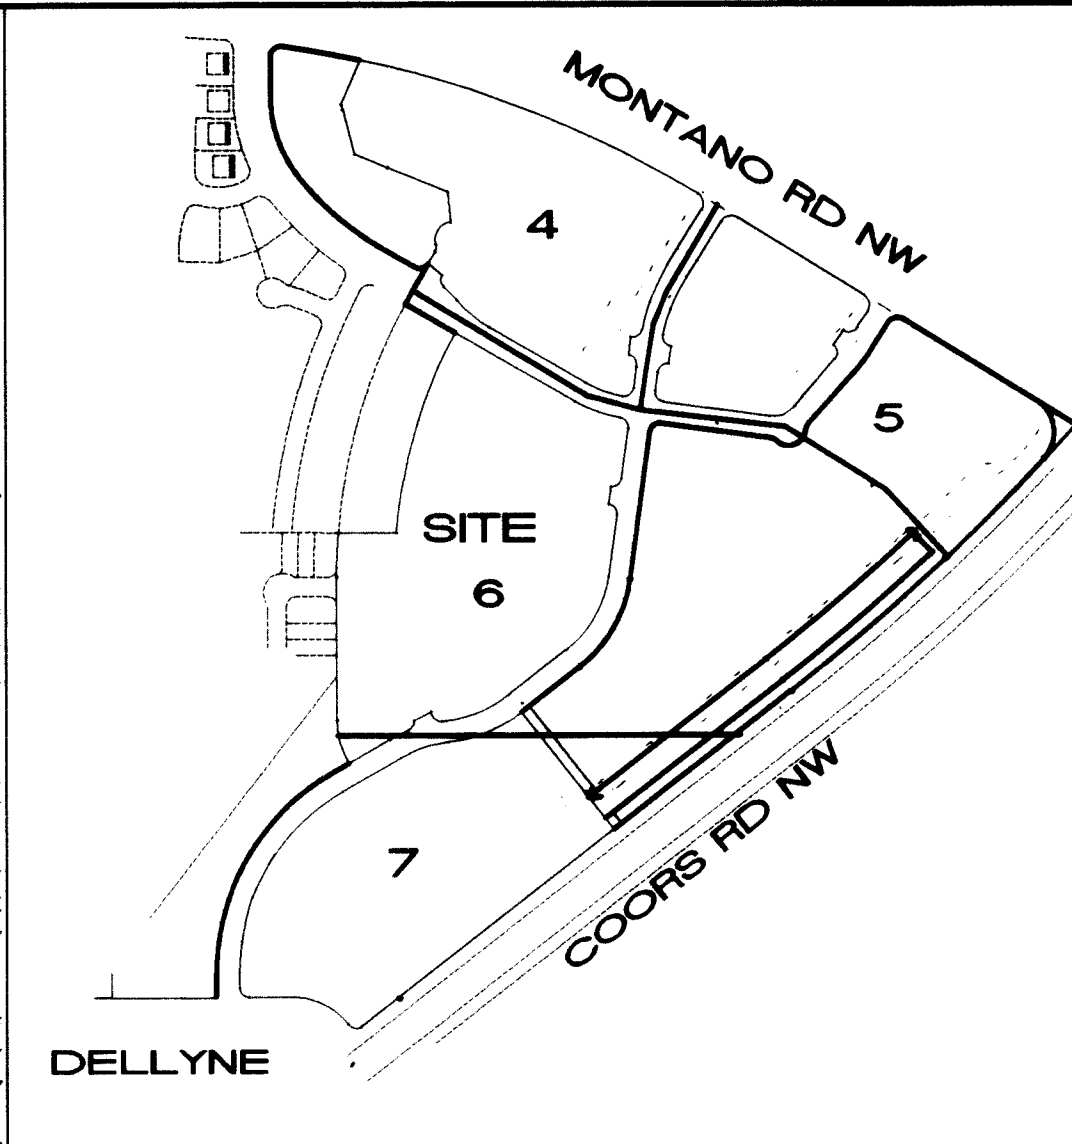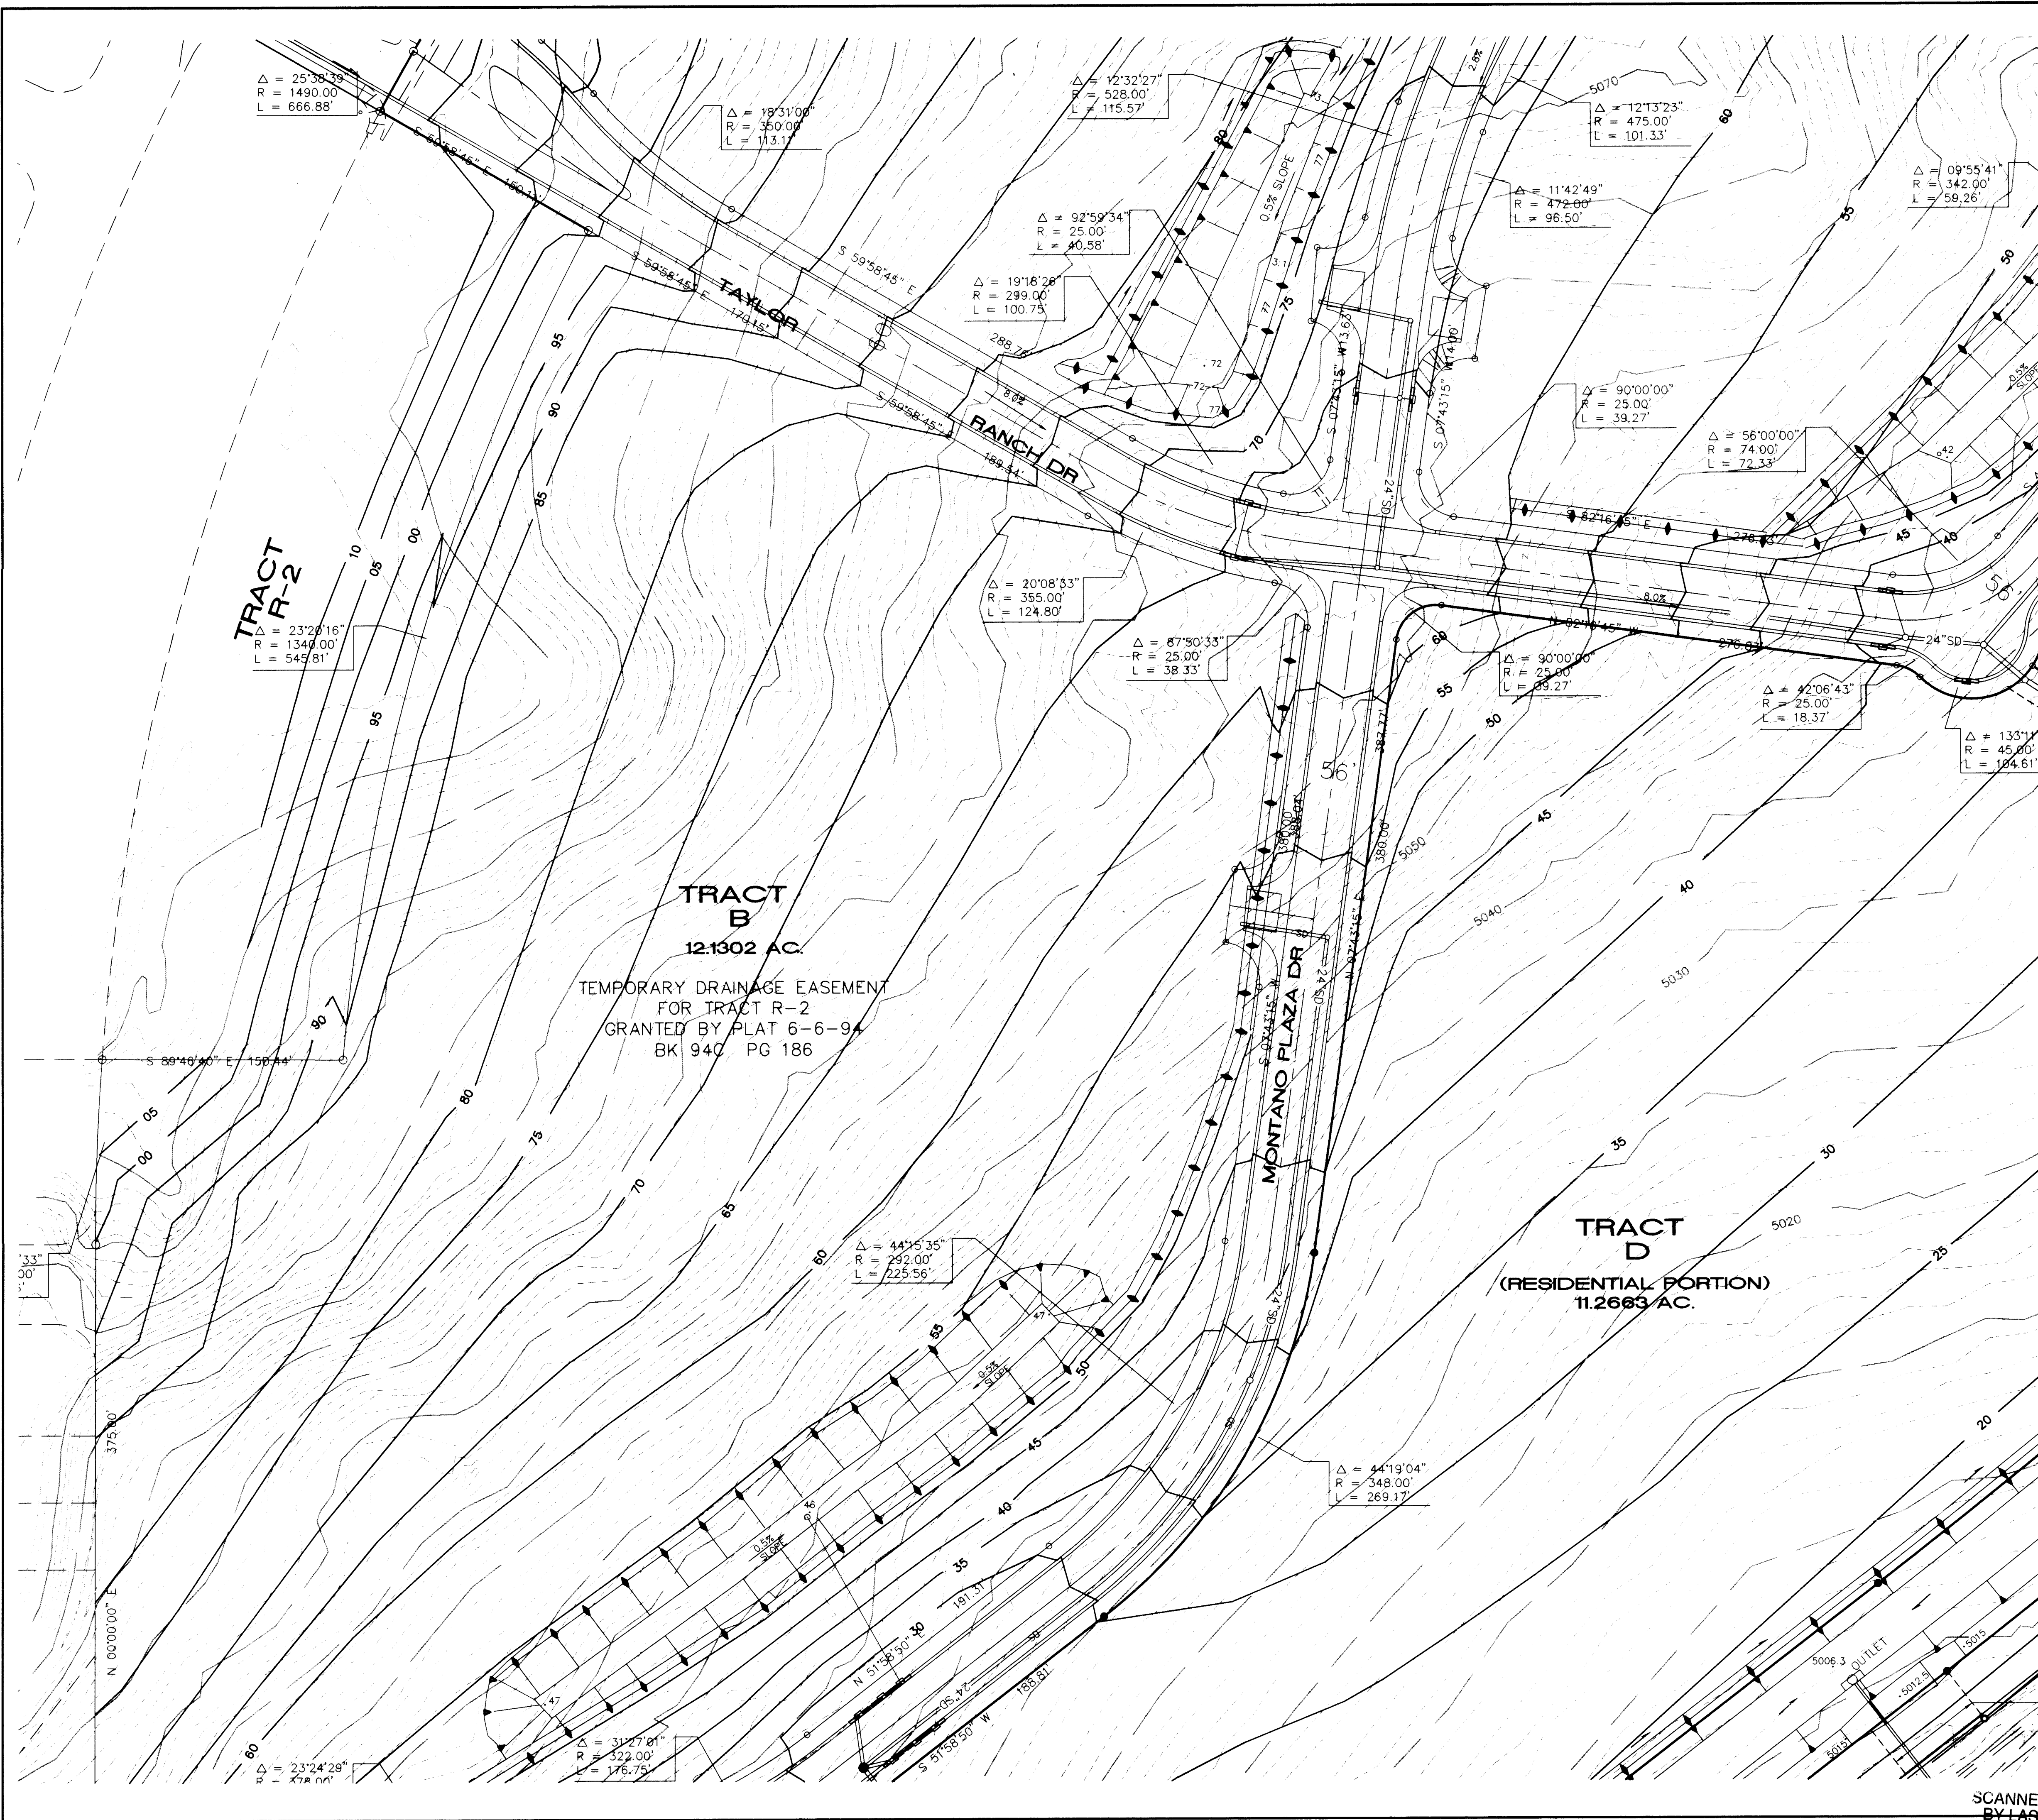

1"=500'

VICINITY MAP & SHEET INDEX

LEGEND

- EXISTING CONTOUR
- PROPOSED CONTOUR
- TRACT LINE
- R/W LINE
- EXISTING CURB LINE
- C INTERIOR ROAD
- FLOWLINE ELEV
- PROPOSED STREET GRADE
- 2.5' EARTH BERM
- FLOW ARROW

1 2 3 4 5 6 7 8 9 10 11 12 13 14 15
26-91 18-90 16-95

AS-BUILT INFORMATION		BENCH MARKS		SURVEY INFORMATION		ENGINEER'S SEAL		APPROVALS	
CONTRACTOR		ACS BENCHMARK "NM 448-N7A" LOCATED IN THE SOUTH END OF THE MEDIAN IN COORS RD NW NORTH OF MONTANO RD NW		FIELD NOTES				FOR RANCH	
WORK STAGED BY		END OF THE MEDIAN IN COORS RD NW NORTH OF MONTANO RD NW		BY				DATE	
FIELD ACCEPTANCE BY		ELEVATION = 5006.41		1 W. PETTIT		REMARKS		DATE	
DRAWINGS CORRECTED BY						REVISIONS		DATE	
MICRO-FILM INFORMATION						DESIGN		DATE	
RECORDED BY						DESIGNED BY		DATE	
NO						DRAWN BY		DATE	
						CHECKED BY		DATE	
								</	

CITY OF ALBUQUERQUE
PUBLIC WORKS DEPARTMENT
ENGINEERING GROUP

TITLE: TRACT R-1, TAYLOR RANCH
GRADING & DRAINAGE PLAN

APPROVALS	ENGINEER	DATE	APPROVALS	ENGINEER	DATE
DRC CHAIRMAN	ALS, INC.	9-12-94	WATER	ALS, INC.	9-12-94
TRANSPORTATION	ALS, INC.	8-01-94	WASTE WATER	ALS, INC.	8-01-94
HYDROLOGY	ALS, INC.	8-16-94			

PROJECT NO. 4918.90

MAY NO. E-12

SHEET 6 OF 23

SCANNED BY
BY LASON

SEEDING NOTES

1. SEEDING SHALL BE PERFORMED ON ALL AREAS STRIPPED OF VEGETATION INCLUDING ROADWAY EMBANKMENT SLOPES, CUT BACKSLOPES, & DETENTION POND SIDE SLOPES. POND BOTTOM AREAS AND 45-FOOT ROADWAY WIDTHS DO NOT REQUIRE REVEGETATION.

2. SEED MIX AND RATES SHALL BE AS FOLLOWS:

SEED MIX		
SPECIES	ORIGIN	LBS. PURE LIVE SEED PER ACRE
ANNUAL RYE	ANY	2
GALLETA GRASS	NEW MEXICO REGION	3
BLUE GRAMA	HACHITA OR LOVINGTON	1
INDIAN RICEGRASS	PALOMA	4
SIDEOTS GRAMA	VAUGHN OR NINER	3
SAND DROPSOED	NEW MEXICO REGION	1
ALKALI SACATON	NEW MEXICO REGION	1
FOURWING SALTBUUSH	NEW MEXICO REGION	1 (DEWINGED)
APACHE PLUME	NEW MEXICO REGION	1
TOTAL		17.0 LBS/ACRE


3. THE SEED BED SHALL BE PREPARED TO A MIN. 4" DEPTH, TILLING ACROSS THE SLOPE WHEN PRACTICAL. NO MORE AREA SHALL BE PREPARED THAN CAN BE SEEDDED BEFORE THE SURFACE EITHER CRUSTS OR ERODES. IF EROSION OR CRUSTING OCCURS, THE ENTIRE AFFECTED AREA SHALL BE REWORKED.

4. SEEDING SHALL BE PERFORMED UNIFORMLY OVER THE AREA TO BE SEEDDED. DRILL SEEDING SHALL BE PERFORMED ACROSS THE SLOPE TO 1/2" DEPTH WITH MAXIMUM FURROW SPACING OF 8". GRASS SEEDING EQUIPMENT SHALL BE IN GOOD WORKING ORDER WITH DOUBLE DISCS OPENERS, DEPTH BANDS, DROP TUBES, PACKER WHEELS, RATE CONTROL ATTACHMENTS AND SHALL BE SUITABLE FOR FLUFFY NATIVE SEEDS. ALL EMBANKMENT AND CUT SLOPES AT 3:1 SHALL BE BROADCAST SEEDDED USING A MECHANICAL SEEDER--HYDRO SEEDING WILL NOT BE ALLOWED.

5. NO MORE AREA SHALL BE SEEDDED THAN CAN BE MULCHED AND CRIMPED BY THE END OF THE WORK DAY, DURING WHICH SEEDING OCCURRED. NO SEEDING MAY OCCUR WHEN THE WIND SPEED IS GREATER THAN 10 MPH.


6. ALL SEEDDED AREAS SHALL BE MULCHED WITH EITHER SMALL GRAIN STRAW (RYE, BARLEY, WHEAT, OATS) OR HAY AT A MINIMUM OF 1.5 TONS/ACRE. MULCH SHALL CONSIST OF STEMS AND LEAVES PREDOMINANTLY 8" OR LONGER AND SHALL BE SPREAD UNIFORMLY OVER THE AREA. MULCH SHALL BE TORN APART AND FLUFFED BEFORE SPREADING. MULCHING SHALL NOT OCCUR WHEN WIND VELOCITY EXCEEDS 15 MPH.

7. MULCH SHALL BE CRIMPED OR ANCHORED WITH A CRIMPER DISK WITH A SPACING OF NO MORE THAN 8" BETWEEN DISKS. THE DISKS SHALL BE SUFFICIENT DIAMETER TO PREVENT THE FRAME OF THE EQUIPMENT FROM DRAGGING THE MULCH. MULCH ANCHORING SHALL BE TO A MINIMUM DEPTH OF 2 INCHES AND SHALL NOT BE COVERED WITH EXCESSIVE AMOUNTS OF SOILD. ANCHORING OPERATIONS SHALL BE ACROSS THE SLOPE WHERE PRACTICAL WITH NO MORE THAN TWO PASSES OF THE ANCHORING EQUIPMENT. CRIMP ALIGNMENT SHALL BE GENERALLY IN A N-S DIRECTION OR 90° TO THE DIRECTION OF PREVAILING WINDS. IF SHAPE, CONTOUR, OR OTHER PHYSICAL LIMITATION PREVENTS USE OF THE CRIMP ALIGNMENT SPECIFIED ABOVE, CRIMPING SHALL BE EITHER CROSS-MATCHED OR DONE IN INTERLOCKING SERPENTINE OR "S" CURVES SO THAT CRIMP LINES ARE NOT ALIGNED WITH PREVAILING WINDS. WHEN SLOPES PREVENT THE USE OF CRIMPING MACHINES, HAND CRIMPING SHALL BE EMPLOYED. SOIL RETENTION BLANKETS MAY BE UTILIZED IN PLACE OF CRIMPING FOR HAND CRIMPING AREAS.

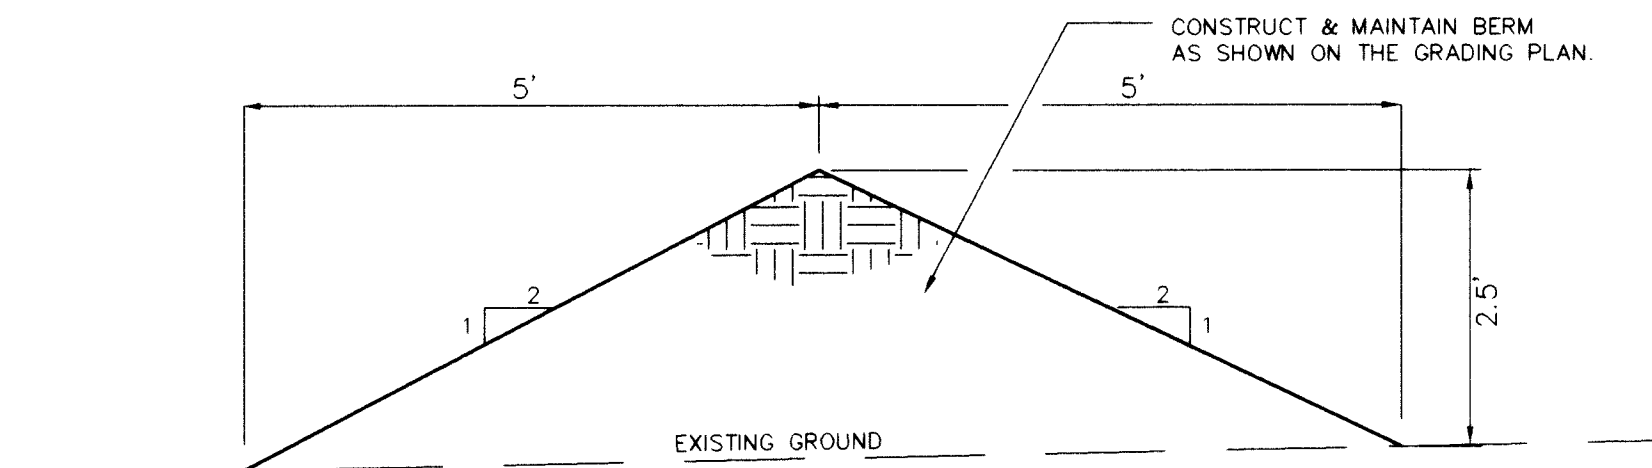


EROSION CONTROL BERM

SCALE: 1"=2'

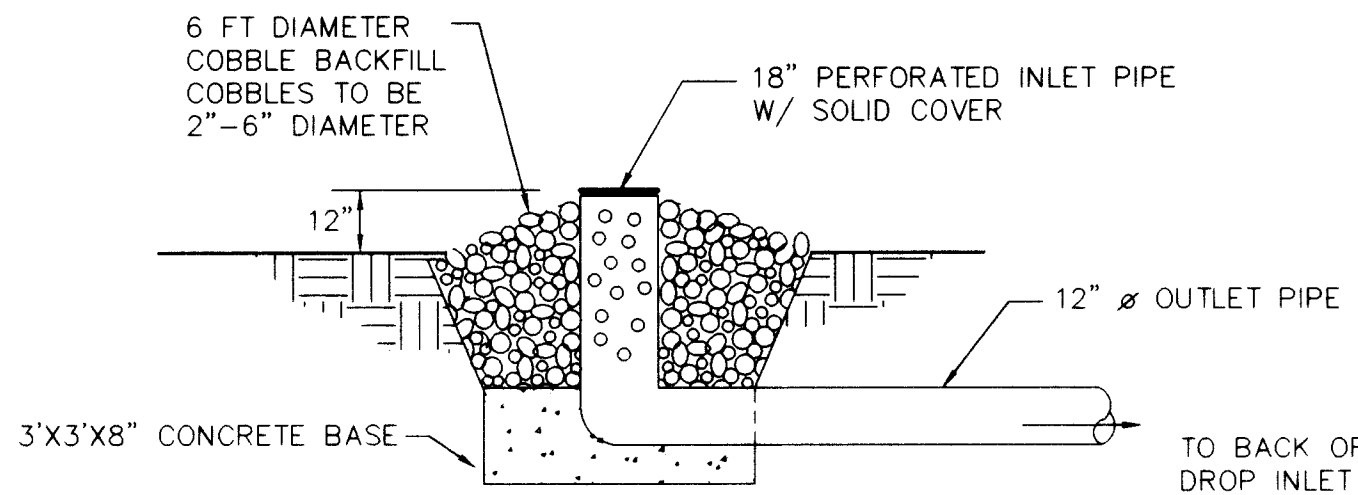

TEMPORARY POND OUTLET

NTS

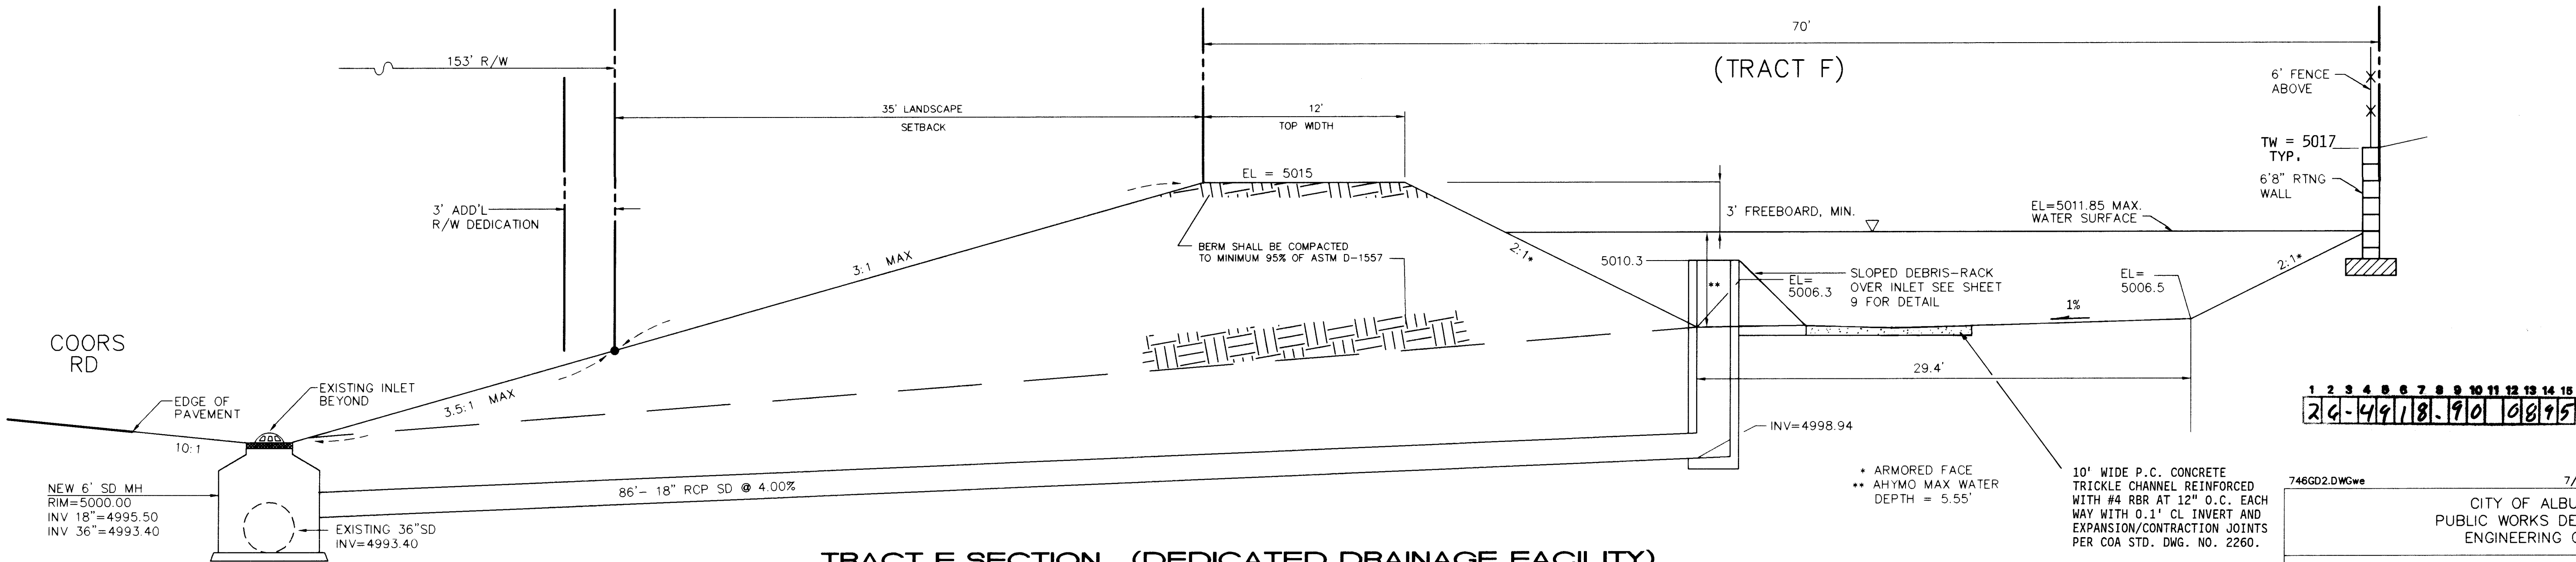

TRACT F SECTION (DEDICATED DRAINAGE FACILITY)

1"=5'

GRADING NOTES

- ALL TRASH, DEBRIS, & SURFACE VEGETATION SHALL BE CLEARED AND LEGALLY DISPOSED OFFSITE.
- ALL SUBGRADE AND FILL SHALL BE COMPACTED TO A MINIMUM OF 90% ASTM D-1557.
- EXCAVATION IS UNCLASSIFIED AND INCLUDES EXCAVATION TO SUBGRADE ELEVATIONS INDICATED, REGARDLESS OF CHARACTER OF MATERIALS ENCOUNTERED.
- CONFORM TO ELEVATIONS AND DIMENSIONS SHOWN ON PLANS WITHIN A TOLERANCE OF 0.3 ± FEET.
- SCARIFY AND COMPACT SUBGRADE FOR FILLS. PLACE FILL MATERIALS IN LAYERS NOT MORE THAN 8" IN LOOSE DEPTH. MOISTEN AS NECESSARY TO PROVIDE OPTIMUM MOISTURE (±2%) CONTENT.
- TOPSOIL ENCOUNTERED WHICH IS UNACCEPTABLE FILL MATERIAL SHALL BE STRIPPED AND SPREAD OVER 3:1 SLOPED AREAS WITHIN 35-FOOT LANDSCAPE EASEMENT SHOWN ALONG COORS RD NW.
- UNIFORMLY GRADE AREAS WITHIN LIMITS OF GRADING AS SHOWN ON PLAN. SMOOTH FINISHED SURFACE WITHIN SPECIFIED TOLERANCE, COMPACT WITH UNIFORM SLOPES BETWEEN POINTS WHERE ELEVATIONS ARE INDICATED.
- MAXIMUM SLOPES SHALL BE 3:1; MINIMUM SLOPES SHALL BE 1% (0.5% SLOPE IN DETENTION POND BOTTOMS).
- TWO (2) WORKING DAYS PRIOR TO ANY EXCAVATION, CONTRACTOR MUST CONTACT NEW MEXICO ONE CALL SYSTEM, 260-1990, FOR LOCATION OF EXISTING UTILITIES.
- IF ANY UTILITY LINES, PIPELINES, OR UNDERGROUND UTILITY LINES ARE SHOWN ON THESE DRAWINGS, THEY ARE SHOWN IN AN APPROXIMATE MANNER ONLY, AND SUCH LINES MAY EXIST WHERE NONE ARE SHOWN. IF ANY SUCH EXISTING LINES ARE SHOWN, THE LOCATION IS BASED UPON INFORMATION PROVIDED BY THE OWNER OF SAID UTILITY, AND THE INFORMATION MAY BE INCOMPLETE, OR MAY BE OBSOLETE BY THE TIME CONSTRUCTION COMMENCES. THE ENGINEER HAS CONDUCTED ONLY PRELIMINARY INVESTIGATION OF THE LOCATION, DEPTH, SIZE, OR TYPE OF EXISTING UTILITY LINES, PIPELINES, OR UNDERGROUND UTILITY LINES. THIS INVESTIGATION IS NOT CONCLUSIVE, AND MAY NOT BE COMPLETE, THEREFORE, MAKES NO REPRESENTATION PERTAINING THERETO, AND ASSUMES NO RESPONSIBILITY OR LIABILITY THEREFOR. THE CONTRACTOR SHALL INFORM ITSELF OF THE LOCATION OF ANY UTILITY LINE, PIPELINE, OR UNDERGROUND UTILITY LINE IN OR NEAR THE AREA OF THE WORK IN ADVANCE OF AND DURING EXCAVATION WORK. THE CONTRACTOR IS FULLY RESPONSIBLE FOR ANY AND ALL DAMAGE CAUSED BY ITS FAILURE TO LOCATE, IDENTIFY AND PRESERVE ANY AND ALL EXISTING UTILITIES, PIPELINES, AND UNDERGROUND UTILITY LINES. IN PLANNING AND CONDUCTING EXCAVATION, THE CONTRACTOR SHALL COMPLY WITH STATE STATUTES, MUNICIPAL AND LOCAL ORDINANCES, RULES AND REGULATIONS, IF ANY, PERTAINING TO THE LOCATION OF THESE LINES AND FACILITIES.
- THE CONTRACTOR SHALL ENSURE THAT NO SOIL ERODES FROM THE SITE INTO PUBLIC RIGHT-OF-WAY OR ONTO PRIVATE PROPERTY. THIS CAN BE ACHIEVED BY CONSTRUCTING EROSION CONTROL BERMS AT THE PROPERTY LINES (AS SHOWN BELOW) AND WETTING THE SOIL TO KEEP IT FROM BLOWING.
- THE CONTRACTOR SHALL PROMPTLY CLEAN UP ANY MATERIAL EXCAVATED WITHIN THE PUBLIC RIGHT-OF-WAY SO THAT THE EXCAVATED MATERIAL IS NOT ERODED AND WASHED DOWN THE STREET.
- OWNER WILL PROVIDE SOIL TESTING AND INSPECTION SERVICES DURING EARTHWORK OPERATIONS. ALLOW TESTING SERVICE TO INSPECT AND APPROVE COMPACTED SUBGRADES AND FILL LAYERS BEFORE FURTHER CONSTRUCTION WORK IS DONE. SHALL COMPACTION TESTS INDICATE INADEQUATE DENSITY, CONTRACTOR SHALL PROVIDE ADDITIONAL COMPACTION AND TESTING AT NO ADDITIONAL EXPENSE.
- OWNER HAS ESTABLISHED SUBDIVSION BOUNDARY CORNERS. CONTRACTOR SHALL LOCATE AND PRESERVE ALL BOUNDARY CORNERS AND REPLACE ANY LOST OR DISTURBED CORNERS.

EROSION CONTROL

- CONTRACTOR SHALL BUILD A SEDIMENTATION/DETENTION POND FOR EACH TRACT AS A PART OF THE ROUGH GRADING PROCESS.
- EACH TRACT WILL REQUIRE ITS OWN EROSION CONTROL PLAN IN CONJUNCTION WITH PROPOSED GRADING PLAN ASSOCIATED WITH FURTHER DEVELOPMENT.
- THE CONTRACTOR SHALL SECURE "TOPSOIL DISTURBANCE PERMIT" FROM CITY ENVIRONMENTAL HEALTH DEPARTMENT PRIOR TO BEGINNING CONSTRUCTION. AN EXCAVATION PERMIT IS REQUIRED FOR ALL WORK WITHIN PUBLIC RIGHT-OF-WAY.

AS-BUILT INFORMATION			
CONTRACTOR	CUM INC.	DATE	4/98
WORK STATED BY	ALB INC.	DATE	4/98
ACCEPTANCE BY	ALB INC.	DATE	4/98
FIELD DRAWINGS BY	ALB INC.	DATE	4/98
CORRECTED BY	ALB INC.	DATE	4/98
RECORDED BY	MICRO-FILM	DATE	

BENCH MARKS			
ACS BENCHMARK	"NW 44B-N7A" LOCATED IN THE SOUTH END OF THE MEDIAN IN COORS RD NW NORTH OF MONTANO RD NW	ELEVATION	= 5006.41

SURVEY INFORMATION			
FIELD NOTES	DATE	BY	
NO. 1	2/93	W. PETTIT	

ENGINEER'S SEAL

W. MACFEE
REGISTERED PROFESSIONAL ENGINEER
NO. 10519
7-13-94
8-16-94

REVISIONS			
NO.	DATE	REMARKS	BY
1			
2			
746GD2.DWGwe 7/8/94

CITY OF ALBUQUERQUE
PUBLIC WORKS DEPARTMENT
ENGINEERING GROUP

TITLE: TRACT R-1, TAYLOR RANCH
GRADING NOTES & DETAILS

APPROVALS	ENGINEER	DATE	APPROVALS	ENGINEER	DATE
DRG CHAIRMAN	8-8-94	8-9-94	WATER	N/A	8-9-94
TRANSPORTATION	8-9-94	8-9-94	WASTE WATER	N/A	8-9-94
HYDROLOGY	8-9-94	8-9-94			

PROJECT NO. 4918.90 MAP NO. E-12 SHEET 8 OF 23

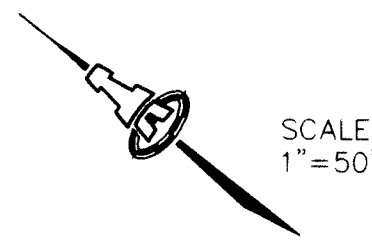

SCALE
1"=50'


KEYED CONSTRUCTION NOTES 

1. SEE SHEET 9 FOR TRACT F DETENTION POND DESIGN.
2. BUILD 65 LF STUB OF 24" SD (BEARING: S 68°30'00" W) AS OUTFALL FOR INTERIM DETENTION POND ON TRACT C.

GENERAL NOTES


1. STATIONING SHOWN IS ALONG TRACT
BOUNDARY.

SCALE:
1" = 50' H
1" = 10' V.

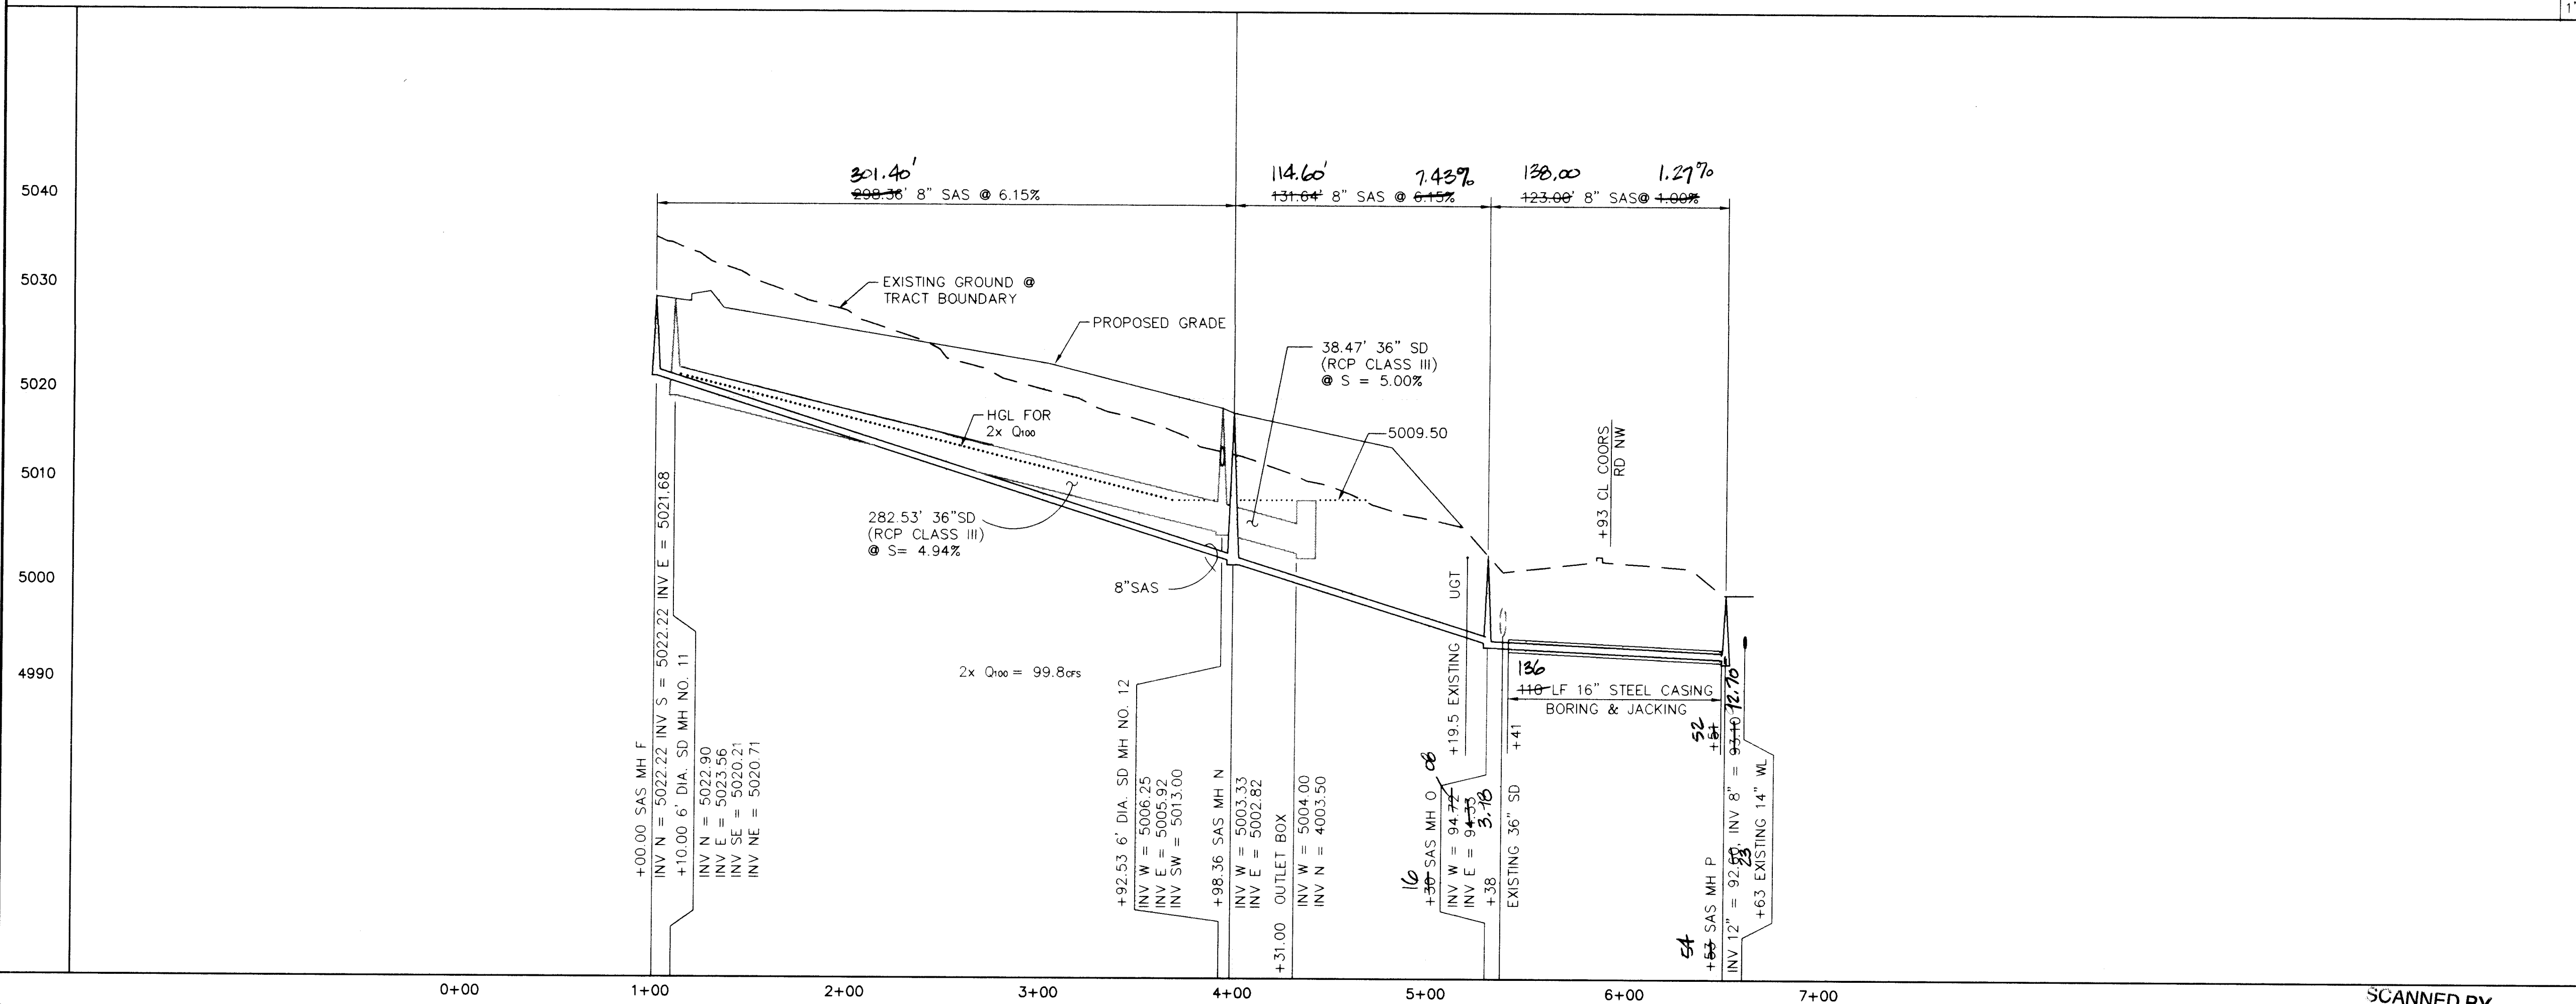

SCANNED BY
BY LASON

1	2	3	4	5	6	7	8	9	10	11	12	13	14	15
2	6	-	4	9	1	8	.	9	0			1	1	95

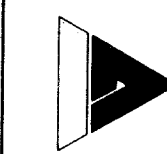

ISAACSON & ARFMAN, P.A.
Consulting Engineering Associates
128 Monroe Street N.E.
Albuquerque New Mexico

CITY OF ALBUQUERQUE
PUBLIC WORKS DEPARTMENT
ENGINEERING GROUP

TITLE: *TAYLOR RIDGE SUBDIVISION*
SOUTH STORM DRAIN & SANITARY SEWER
PLAN & PROFILE

APPROVALS	ENGINEER	DATE	APPROVALS	ENGINEER	DATE
DRC CHAIRMAN	<i>A. S. Smith</i>	9-12-94	WATER	<i>E. S. Smith</i>	9-12-94
TRANSPORTATION	<i>N. K. H. 801-94</i>		WASTE WATER	<i>E. S. Smith</i>	9-12-94
HYDROLOGY	<i>LPC</i>	8-17-94			

PROJECT NO.	4918.90
-------------	---------


MAP NO.	E-12
---------	------

SHEET 11 OF 23



7-14-94

NO.	DATE	REMARKS	BY
<i>REVISIONS</i>			
<i>DESIGN</i>			
DESIGNED BY		DATE	
DRAWN BY		DATE	
CHECKED BY		DATE	

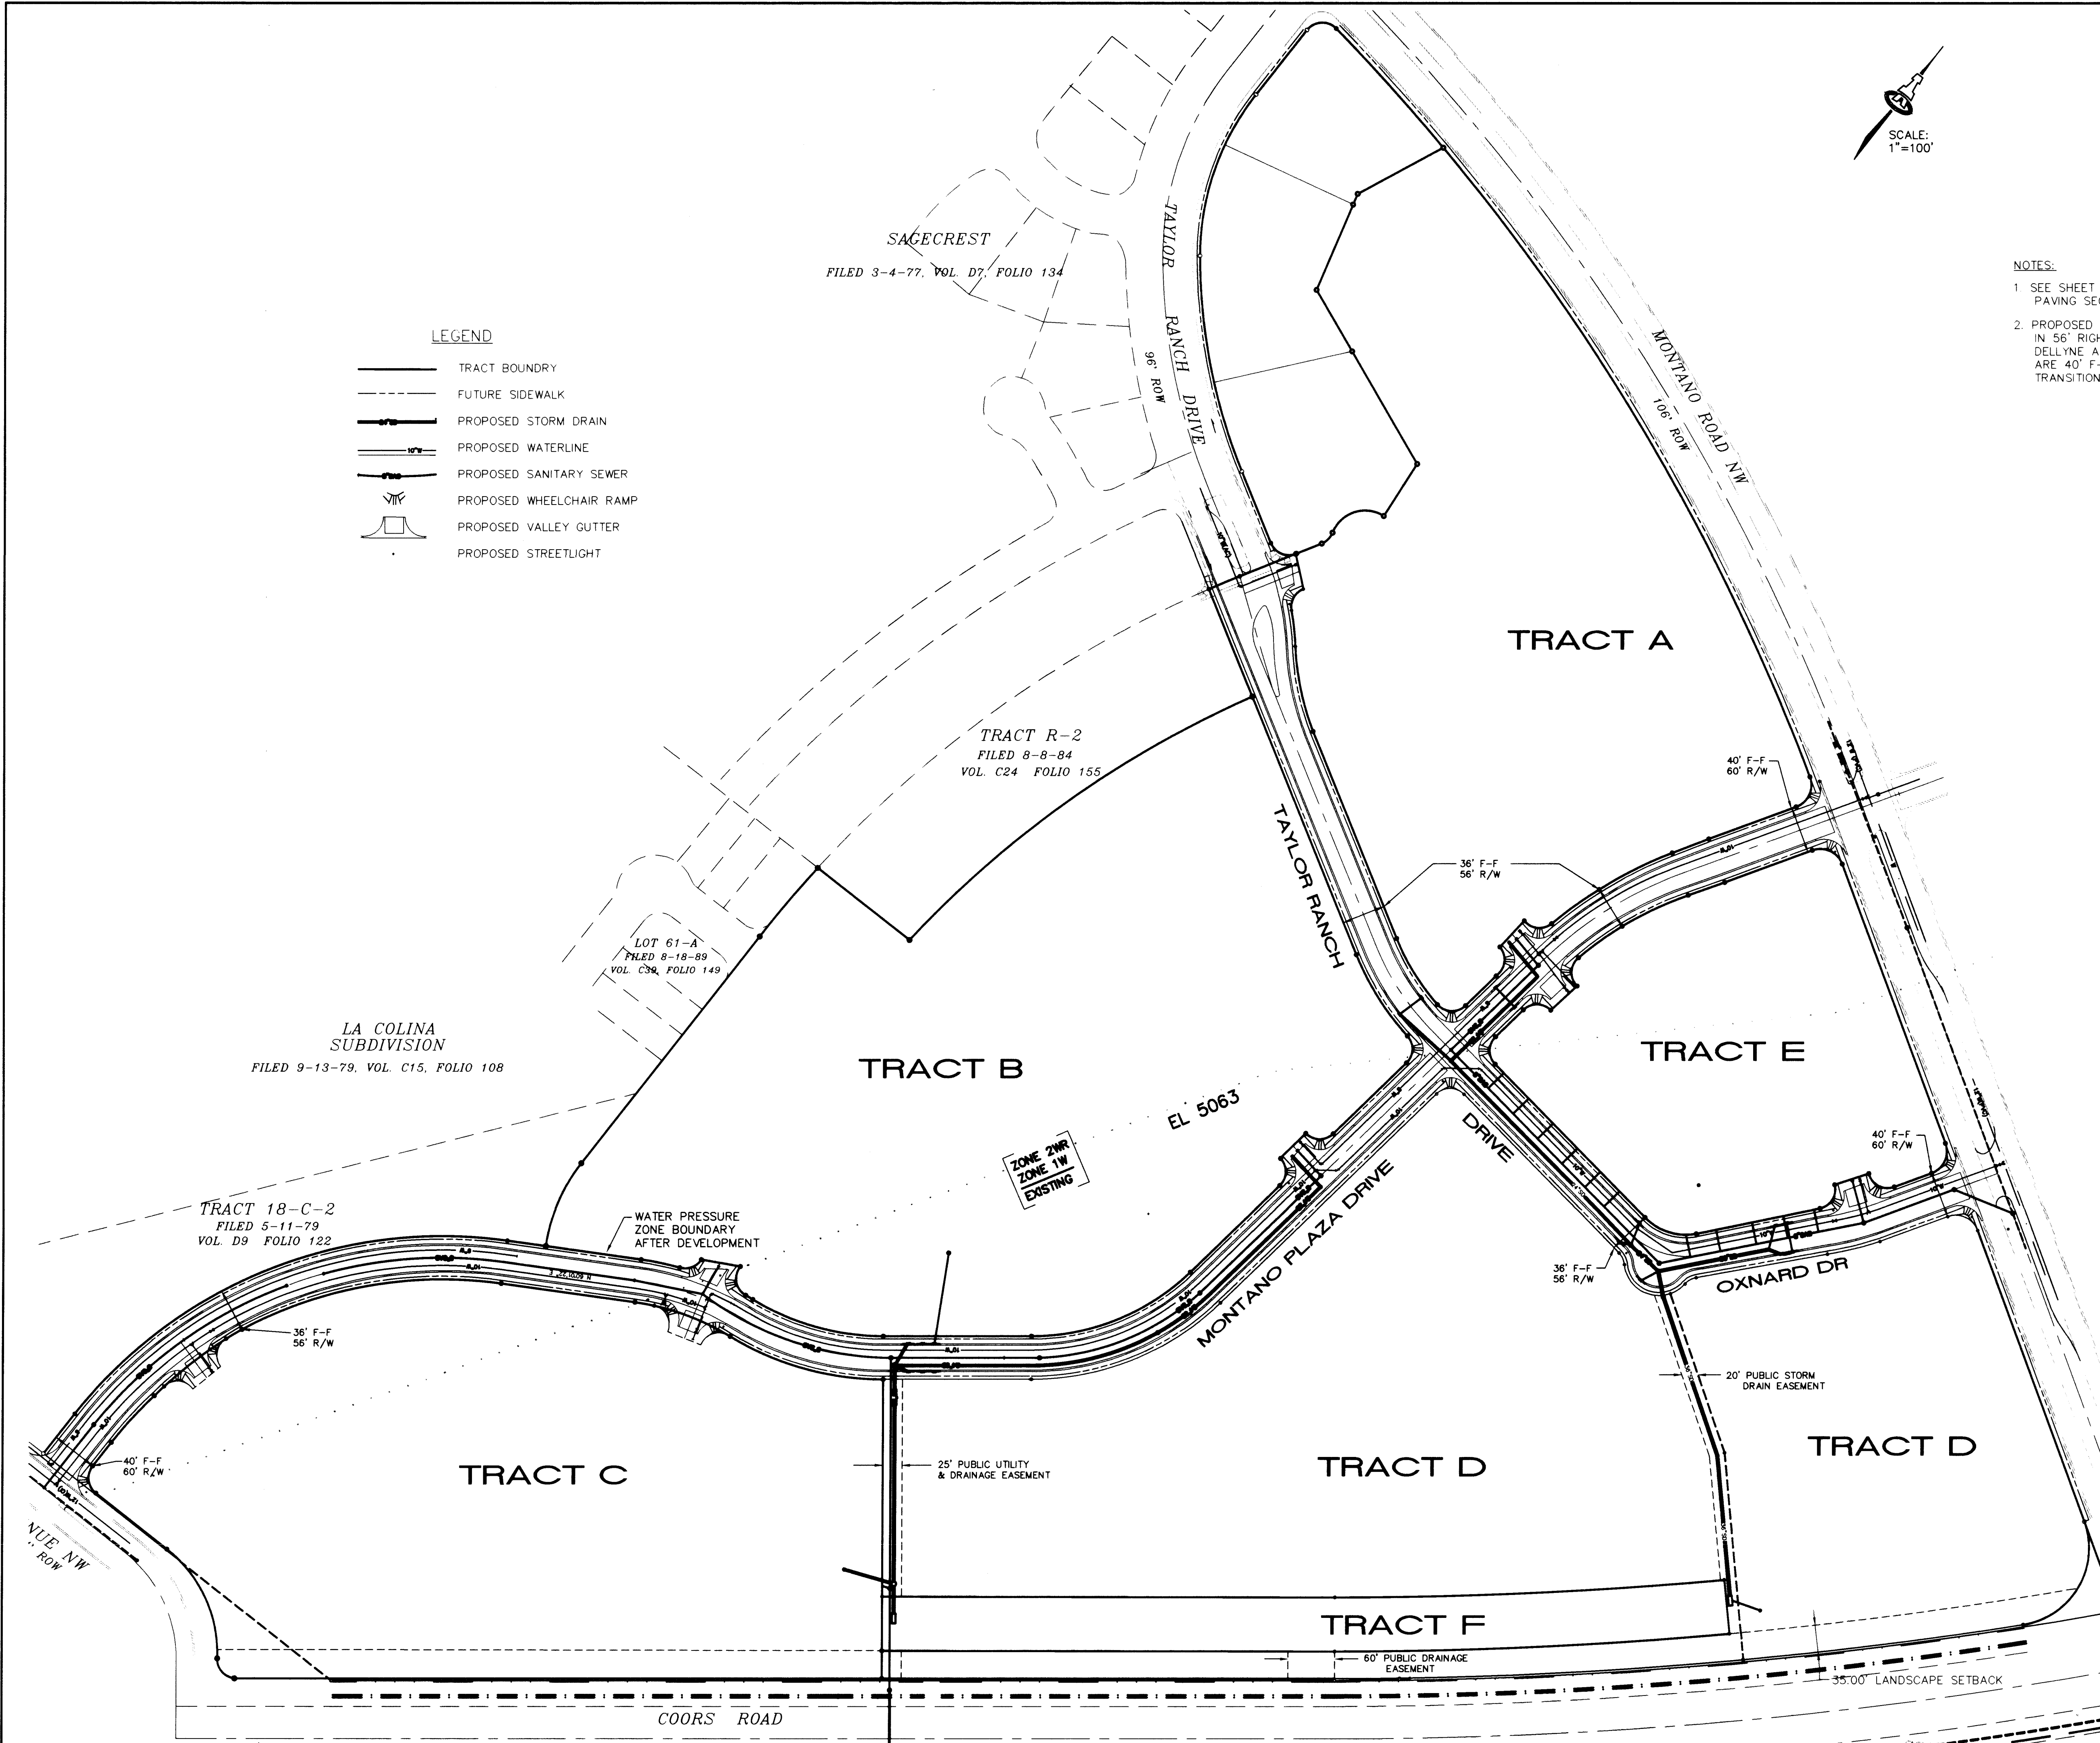

- NOTES:
- SEE SHEET 23 FOR TYPICAL STREET SECTION, PAVING SECTIONS & MEDIAN MODIFICATIONS.
 - PROPOSED ROADS ARE 36' FACE TO FACE (F-F) IN 56' RIGHT OF WAY (R/W). WITHIN 150' OF DELLYNE AVE AND MONTANO ROAD, ROADS ARE 40' F-F WITHIN 60' R/W WITH 150' LONG TRANSITIONS.

LEGEND

- TRACT BOUNDARY
- FUTURE SIDEWALK
- PROPOSED STORM DRAIN
- PROPOSED WATERLINE
- PROPOSED SANITARY SEWER
- PROPOSED WHEELCHAIR RAMP
- PROPOSED VALLEY GUTTER
- PROPOSED STREETLIGHT

AS-BUILT INFORMATION		BENCH MARKS		SURVEY INFORMATION		ENGINEER'S SEAL	
CONTRACTOR	DATE	ACS BENCHMARK "NM 448-N7A", AN ALUMINUM TABLET SET IN THE CONCRETE MEDIAN NOSE OF COORS ROAD NW, 62 FEET NORTH OF THE CENTERLINE OF MONTANO RD NW	DATE	FIELD	NOTES		REMARKS
WORK	DATE		DATE	BY	NOTES		
STATIONED BY	DATE		DATE	W.P.	NOTES		
ACCEPTANCE BY	DATE		DATE		NOTES		
MICRO-FILM INFORMATION		ELEVATION = 5006.41				DESIGNED BY	
						DRAWN BY	
						CHECKED BY	
						DATE	
						DATE	
						DATE	

ISAACSON & ARFMAN, P.A.
Consulting Engineering Associates
128 Monroe Street N.E.
Albuquerque New Mexico
746PMSTR.DWGwe 7/13/94

CITY OF ALBUQUERQUE
PUBLIC WORKS DEPARTMENT
ENGINEERING GROUP

TITLE: TAYLOR RIDGE SUBDIVISION
MASTER PAVING AND UTILITY PLAN


APPROVALS	ENGINEER	DATE	APPROVALS	ENGINEER	DATE
DRC CHAIRMAN	8-17-94	9-12-94	WATER		
TRANSPORTATION	8-17-94	8-17-94	WASTE WATER		
HYDROLOGY	JPC	8-17-94			


PROJECT NO. 4918.90

MAP NO. E-12


SHEET 12 OF 23

SCANNED BY
BY LASON

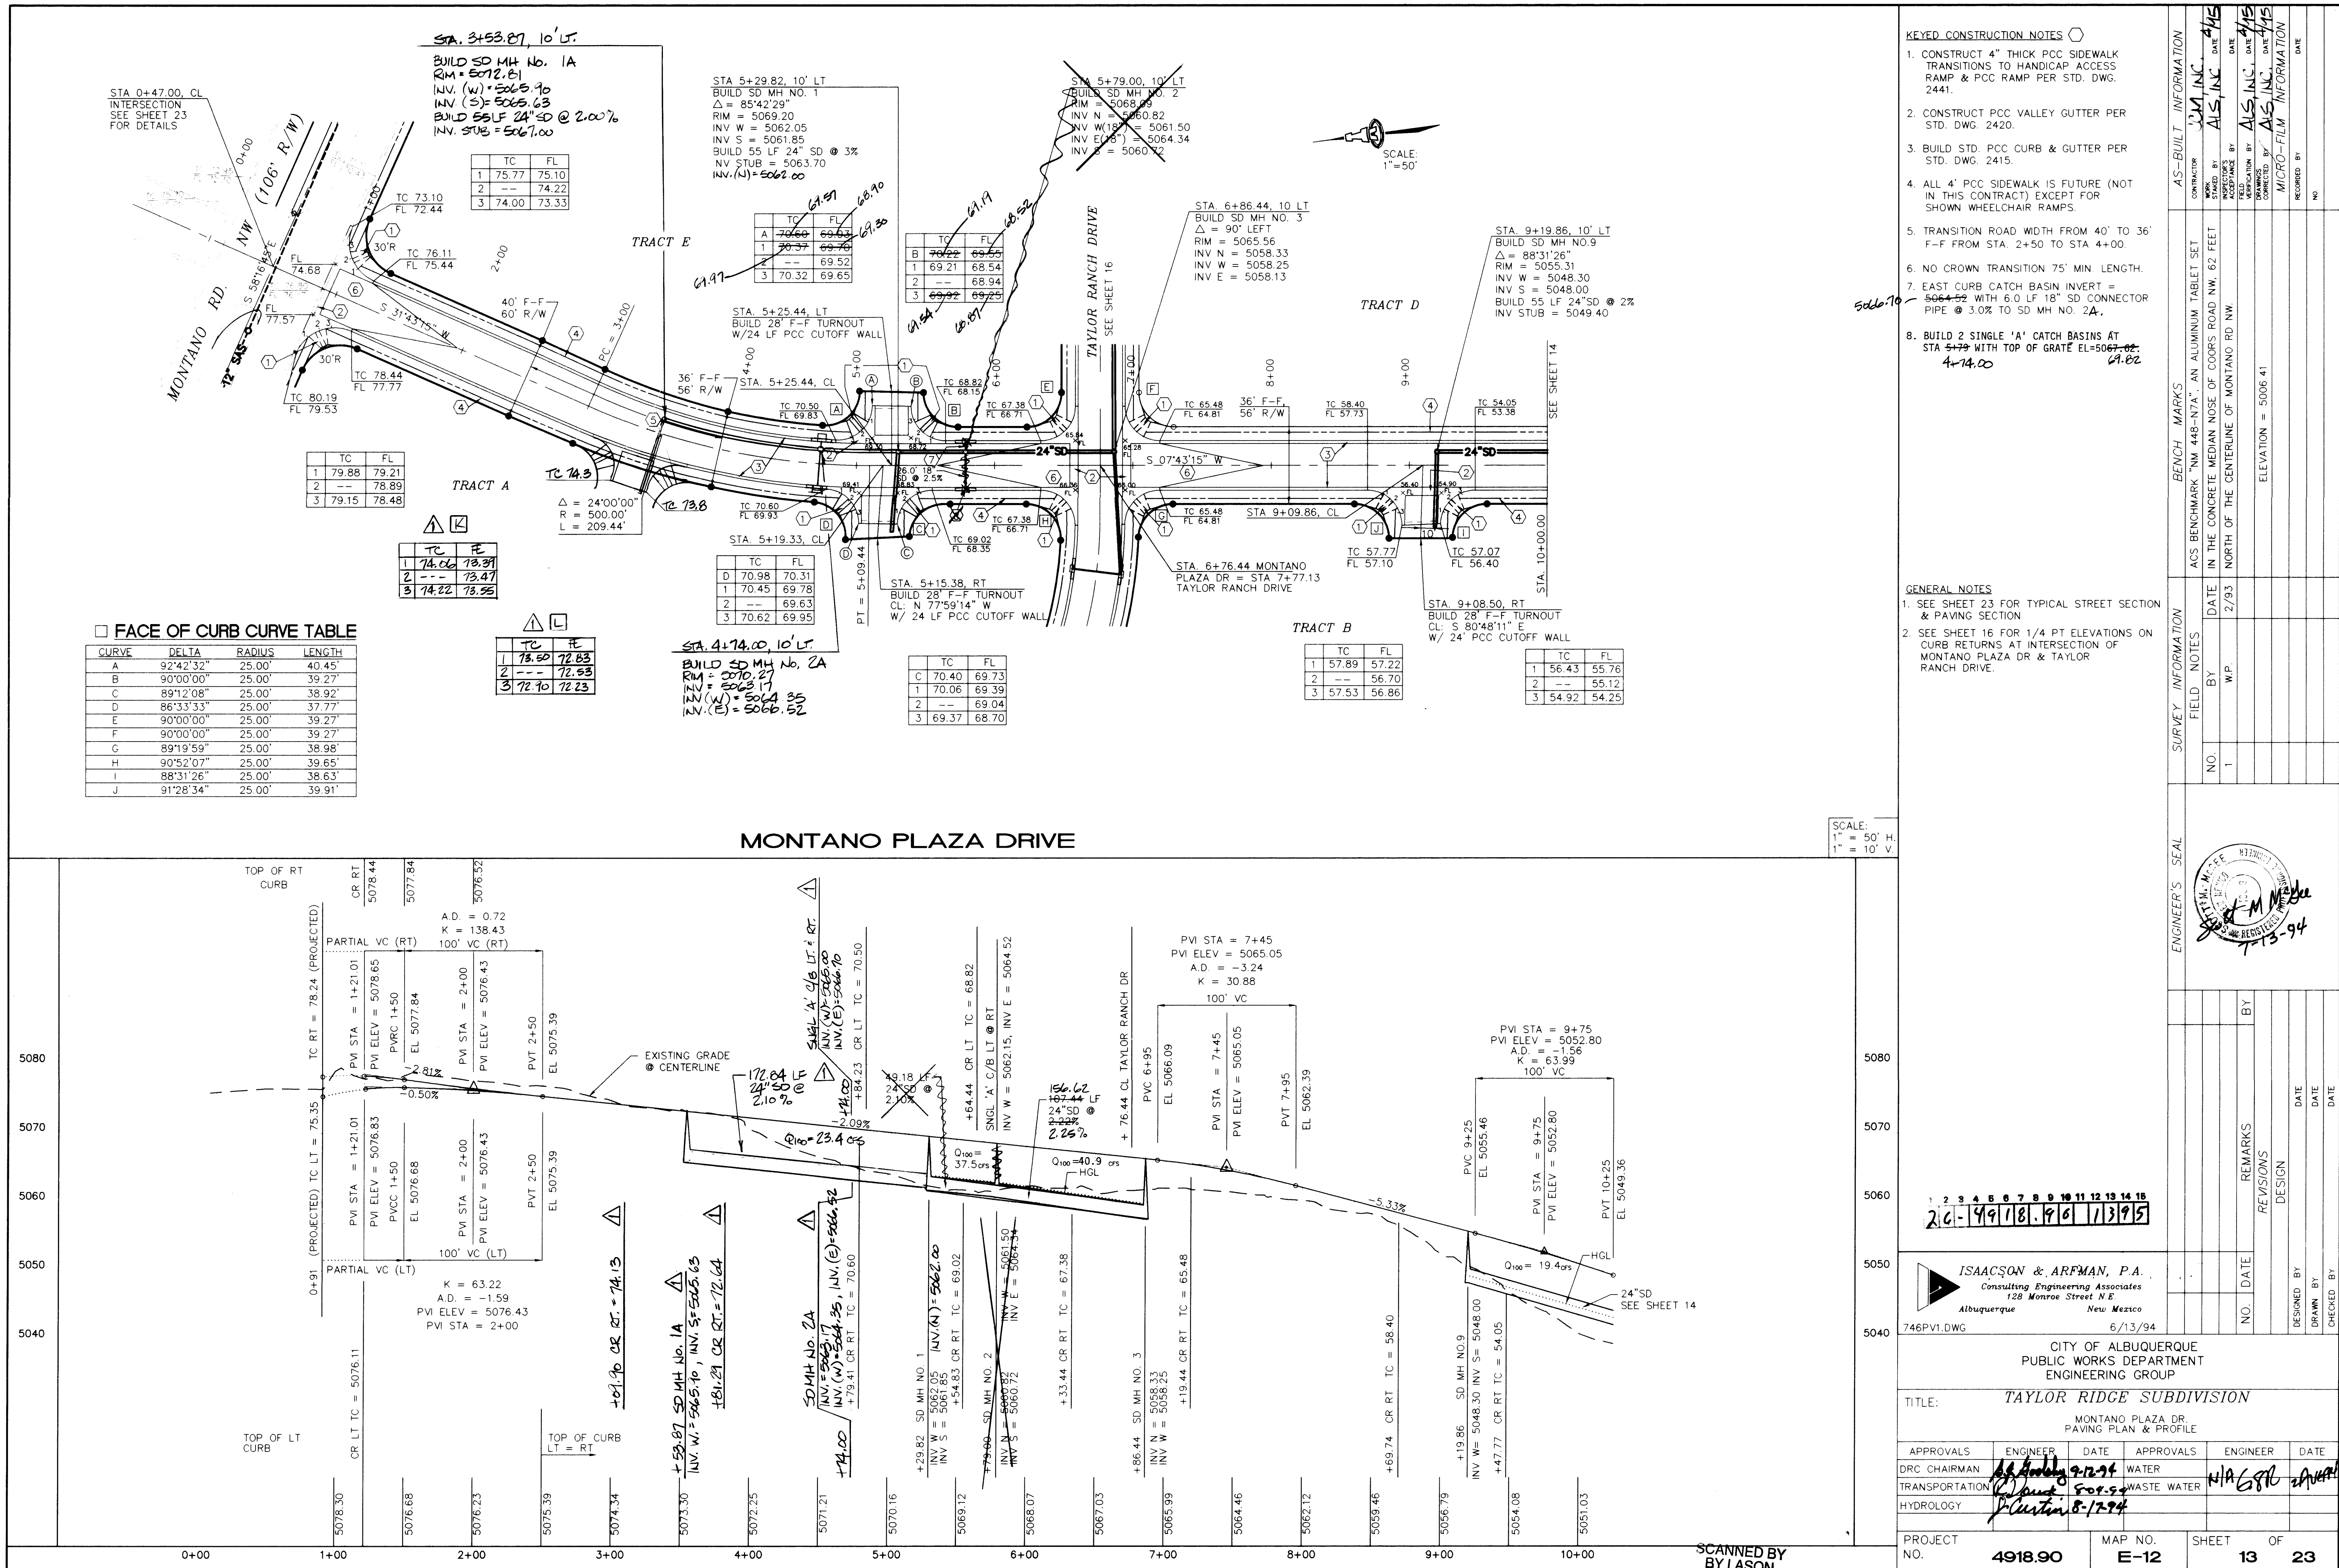

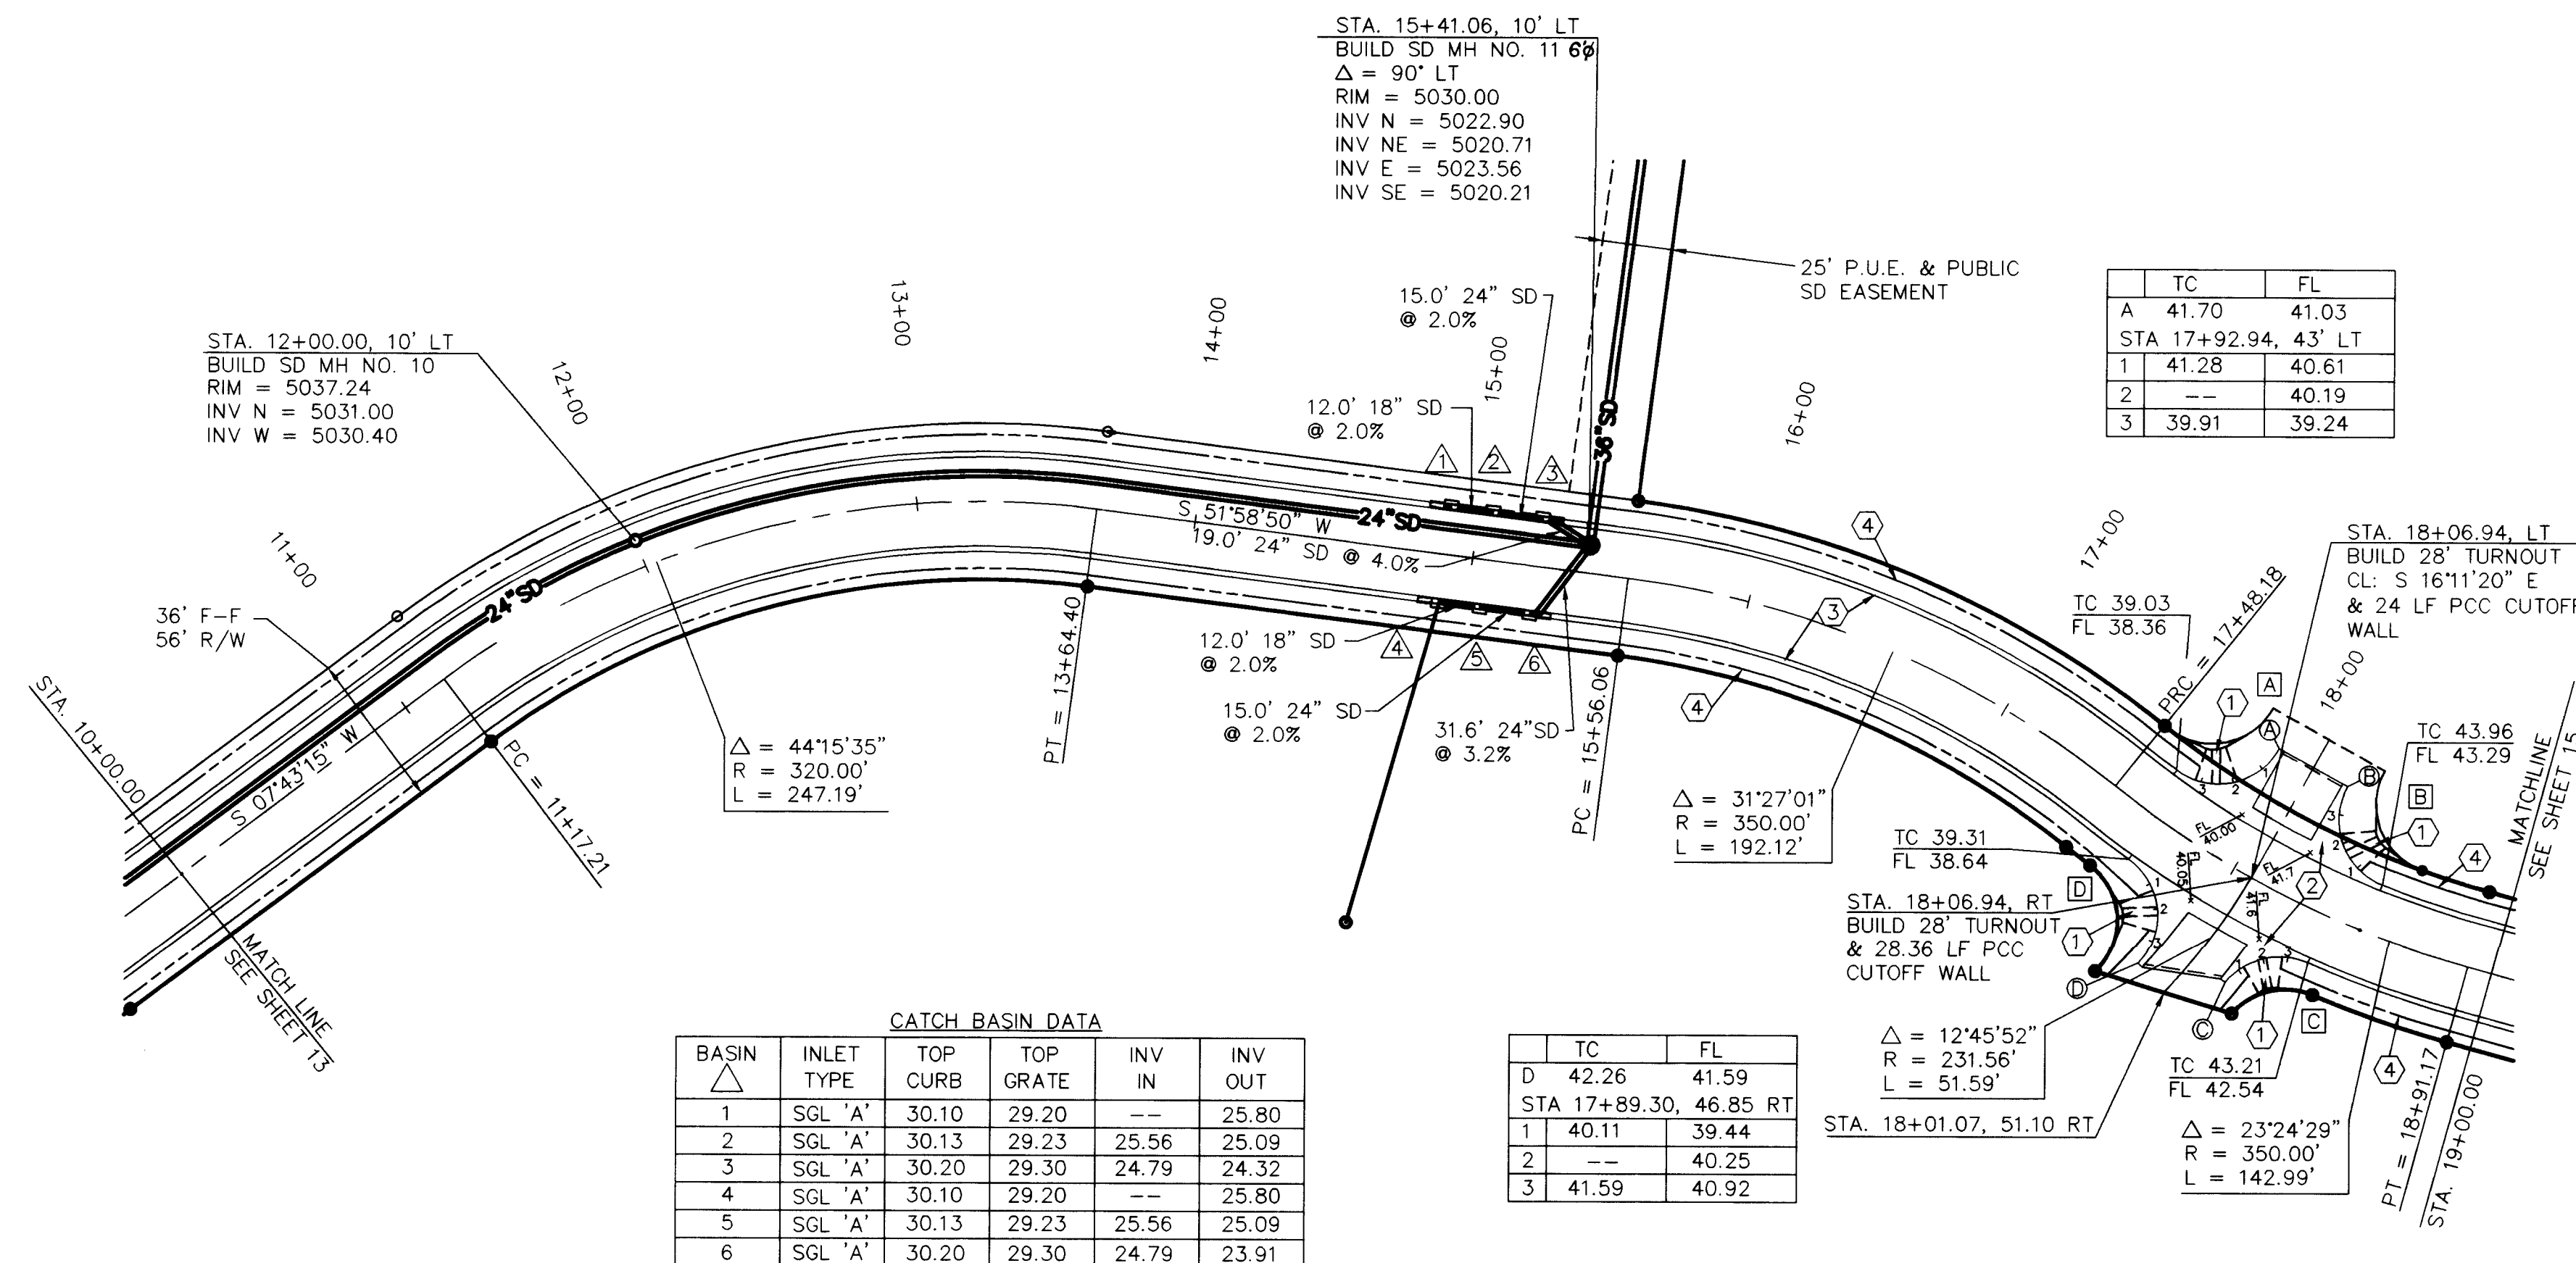

MONTANO PLAZA DRIVE

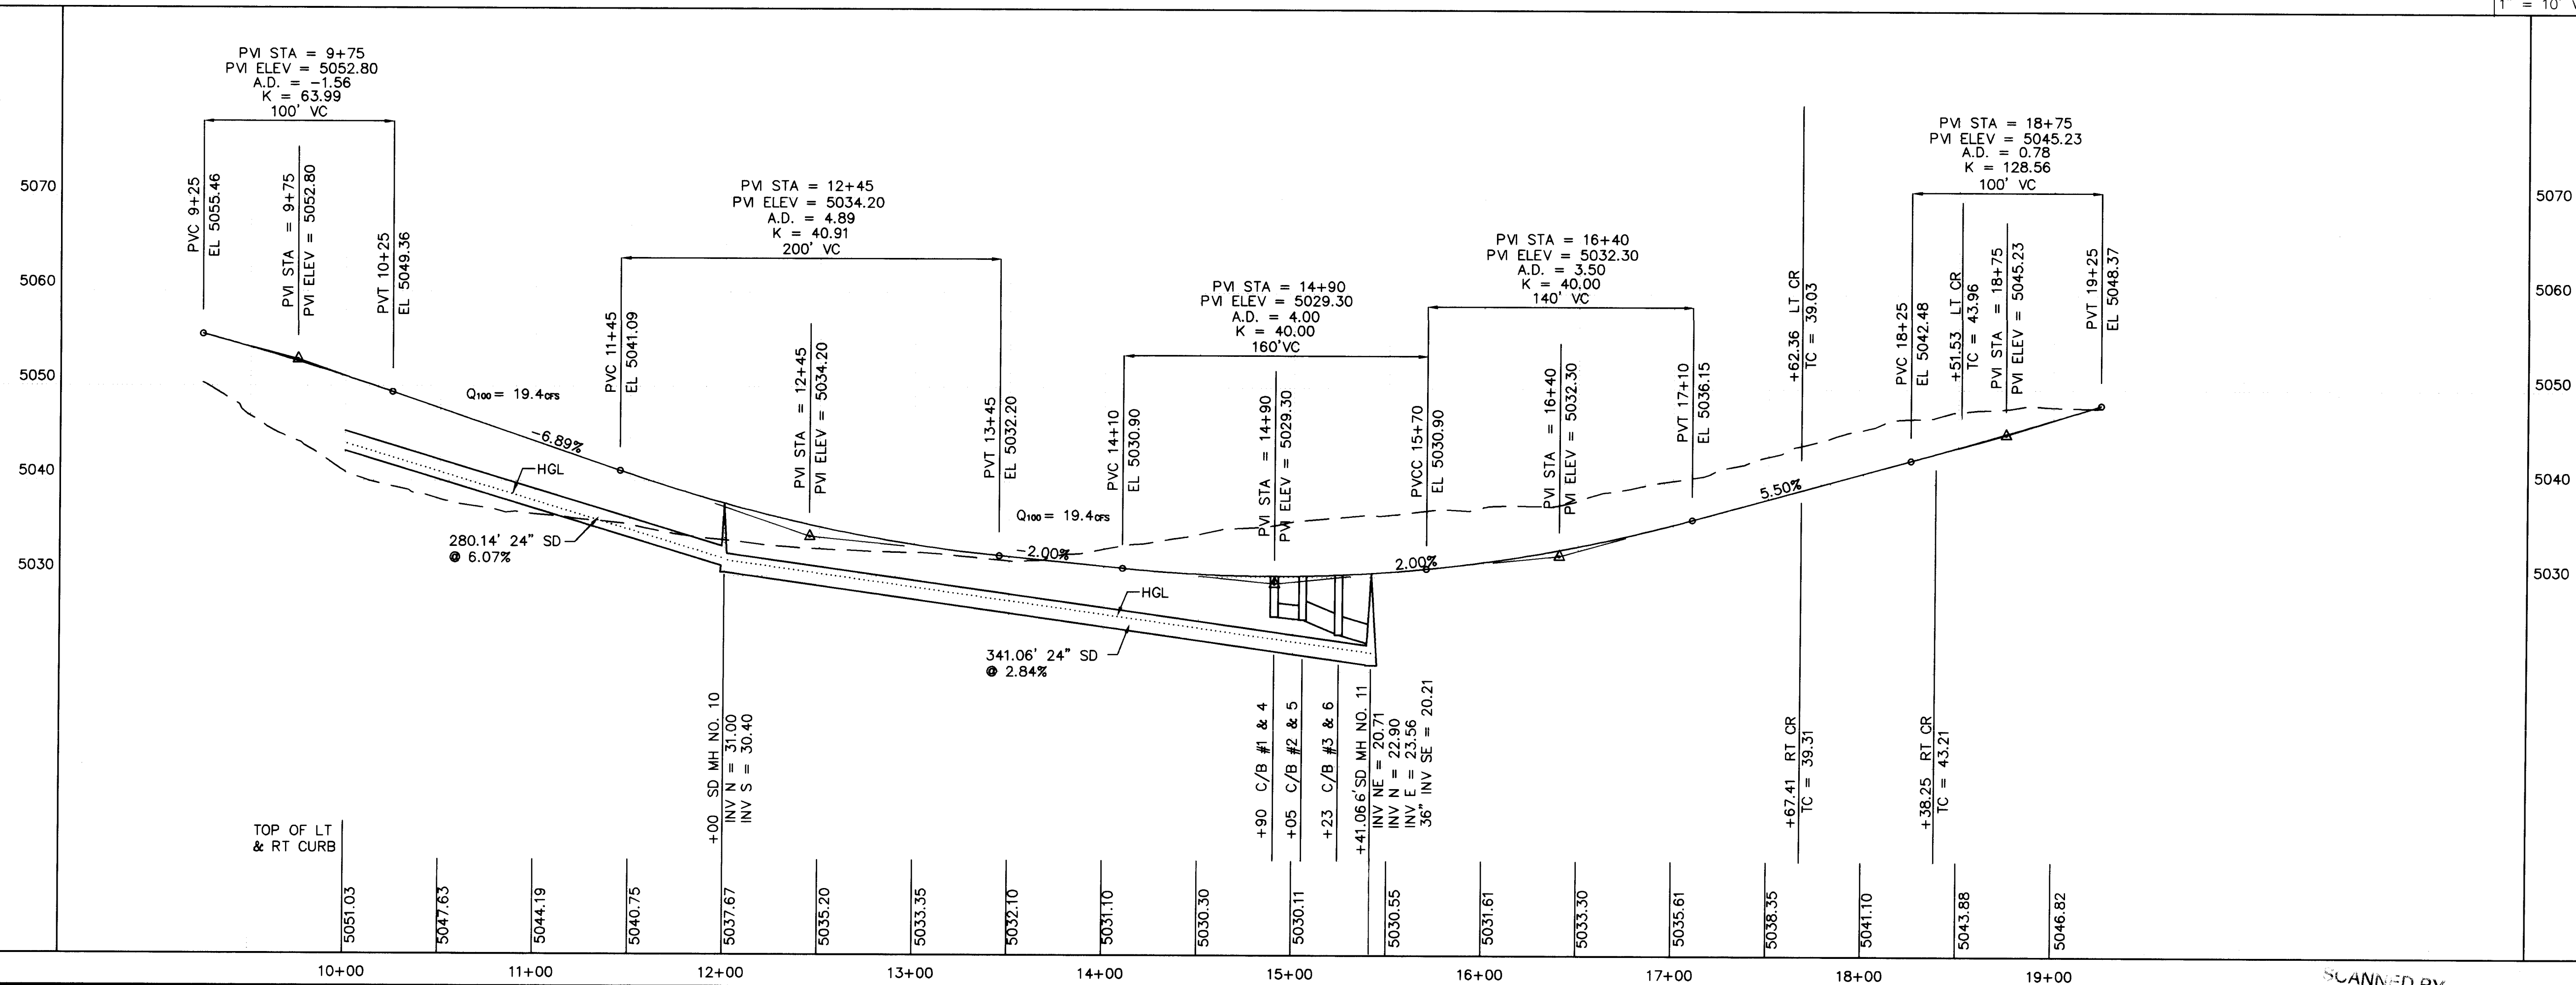

- KEYED CONSTRUCTION NOTES
1. CONSTRUCT 4" THICK PCC SIDEWALK TRANSITIONS TO HANDICAP ACCESS RAMP & PCC RAMP PER STD. DWG. 2441.
 2. CONSTRUCT PCC VALLEY GUTTER PER STD. DWG. 2420.
 3. BUILD STD. PCC CURB & GUTTER PER STD. DWG. 2415.
 4. ALL PCC SIDEWALK IS FUTURE (NOT IN THIS CONTRACT) EXCEPT FOR SHOWN WHEELCHAIR RAMPS.
 5. SEE SHEET 11 FOR STORM DRAIN, EAST OF MONTANO PLAZA DRIVE.

- GENERAL NOTES
1. FROM STA 11+17.21 TO STA 13+64.40 INSTALL STORM DRAIN ON CURVE WITH THE FOLLOWING DATA:
 $\Delta = 44'15'35''$
 $R = 330.00'$
 $L = 254.92'$

FACE OF CURB CURVE TABLE


CURVE	DELTA	RADIUS	LENGTH
A	97°17'54"	25.00'	42.45'
B	97°17'54"	25.00'	42.45'
C	75°05'29"	25.00'	32.76'
D	97°03'17"	25.00'	42.35'

SCALE:
1" = 50' H.
1" = 10' V.

AS-BUILT INFORMATION	
CONTRACTOR	COV, INC.
STANDARD	ALS, INC.
INSPECTOR'S	ALS, INC.
FIELD	ALS, INC.
VERIFICATION	ALS, INC.
CORRECTED	ALS, INC.
RECORDED	MICRO-FILM
DATE	DATE

BENCH MARKS	
ACS BENCHMARK "NM 448-N7A", AN ALUMINUM TABLET SET IN THE CONCRETE MEDIAN NOSE OF COORS ROAD NW, 62 FEET NORTH OF THE CENTERLINE OF MONTANO RD NW.	ELEVATION = 5006.41

SURVEY INFORMATION	
FIELD NOTES	DATE
BY	W.P.
NO.	1

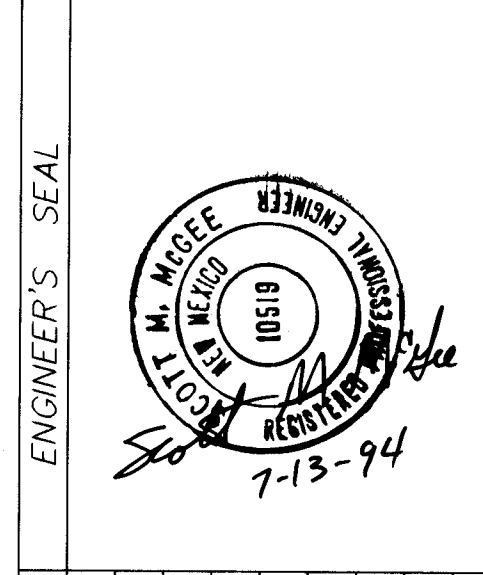

REVISIONS	
NO.	DATE
DESIGNED BY	DATE
DRAWN BY	DATE
CHECKED BY	DATE


ISAACSON & ARFMAN, P.A.
Consulting Engineering Associates
128 Monroe Street N.E.
Albuquerque New Mexico
746PV2.DWGwe 7/12/94

CITY OF ALBUQUERQUE
PUBLIC WORKS DEPARTMENT
ENGINEERING GROUP

TITLE: TAYLOR RIDGE SUBDIVISION
MONTANO PLAZA DR.
PAVING PLAN & PROFILE

APPROVALS	ENGINEER	DATE	APPROVALS	ENGINEER	DATE
DRC CHAIRMAN	By: [Signature]	7-12-94	WATER	NA	6-8-94
TRANSPORTATION	By: [Signature]	8-1-94	WASTE WATER		
HYDROLOGY	By: [Signature]	8-17-94			


PROJECT NO.	4918.90	MAP NO.	E -12	SHEET	14	OF	23
-------------	---------	---------	-------	-------	----	----	----

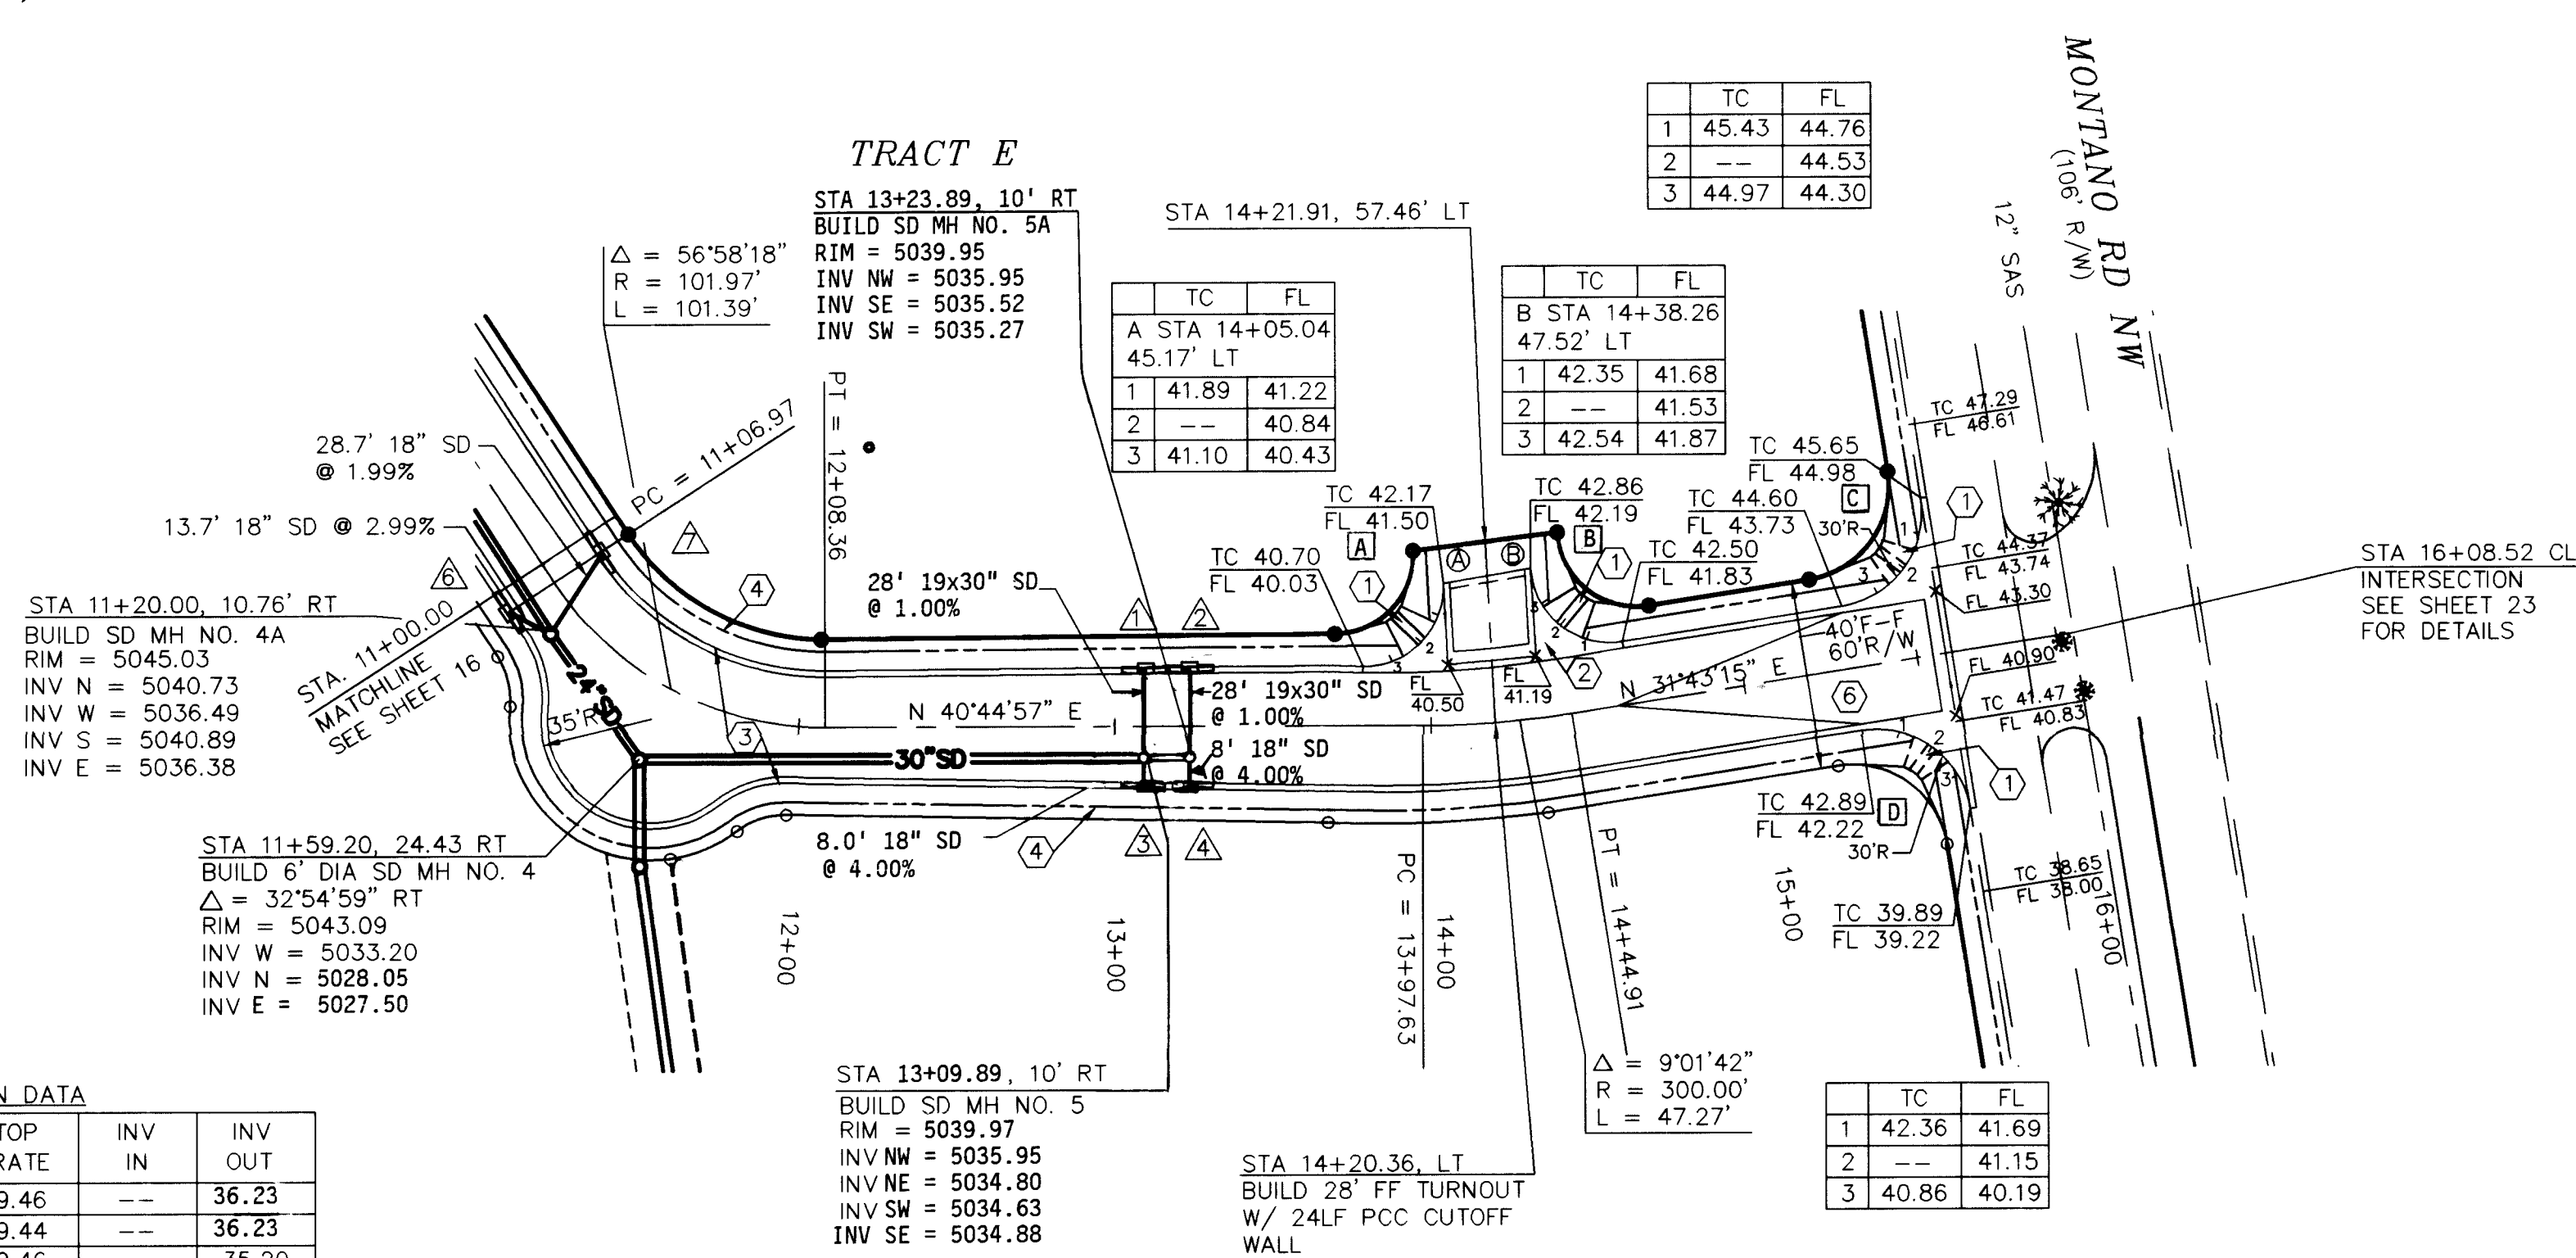

CATCH BASIN DATA						
BASIN △	INLET TYPE	TOP CURB	TOP GRATE	INV IN	INV OUT	
1	DBL 'A'	40.36	39.46	--	36.23	
2*	SNGL 'A'	40.34	39.44	--	36.23	
3	DBL 'A'	40.36	39.46	--	35.20	
4*	SNGL 'A'	40.34	39.44	--	35.84	
	NOT		USED			
6	SNGL 'A'	46.15	45.25	--	41.30	
7	SNGL 'A'	46.15	45.25	--	41.30	

* INLETS #2 & #4 ARE SUMP-TYPE WITH DOUBLE THROATS

OXNARD DRIVE

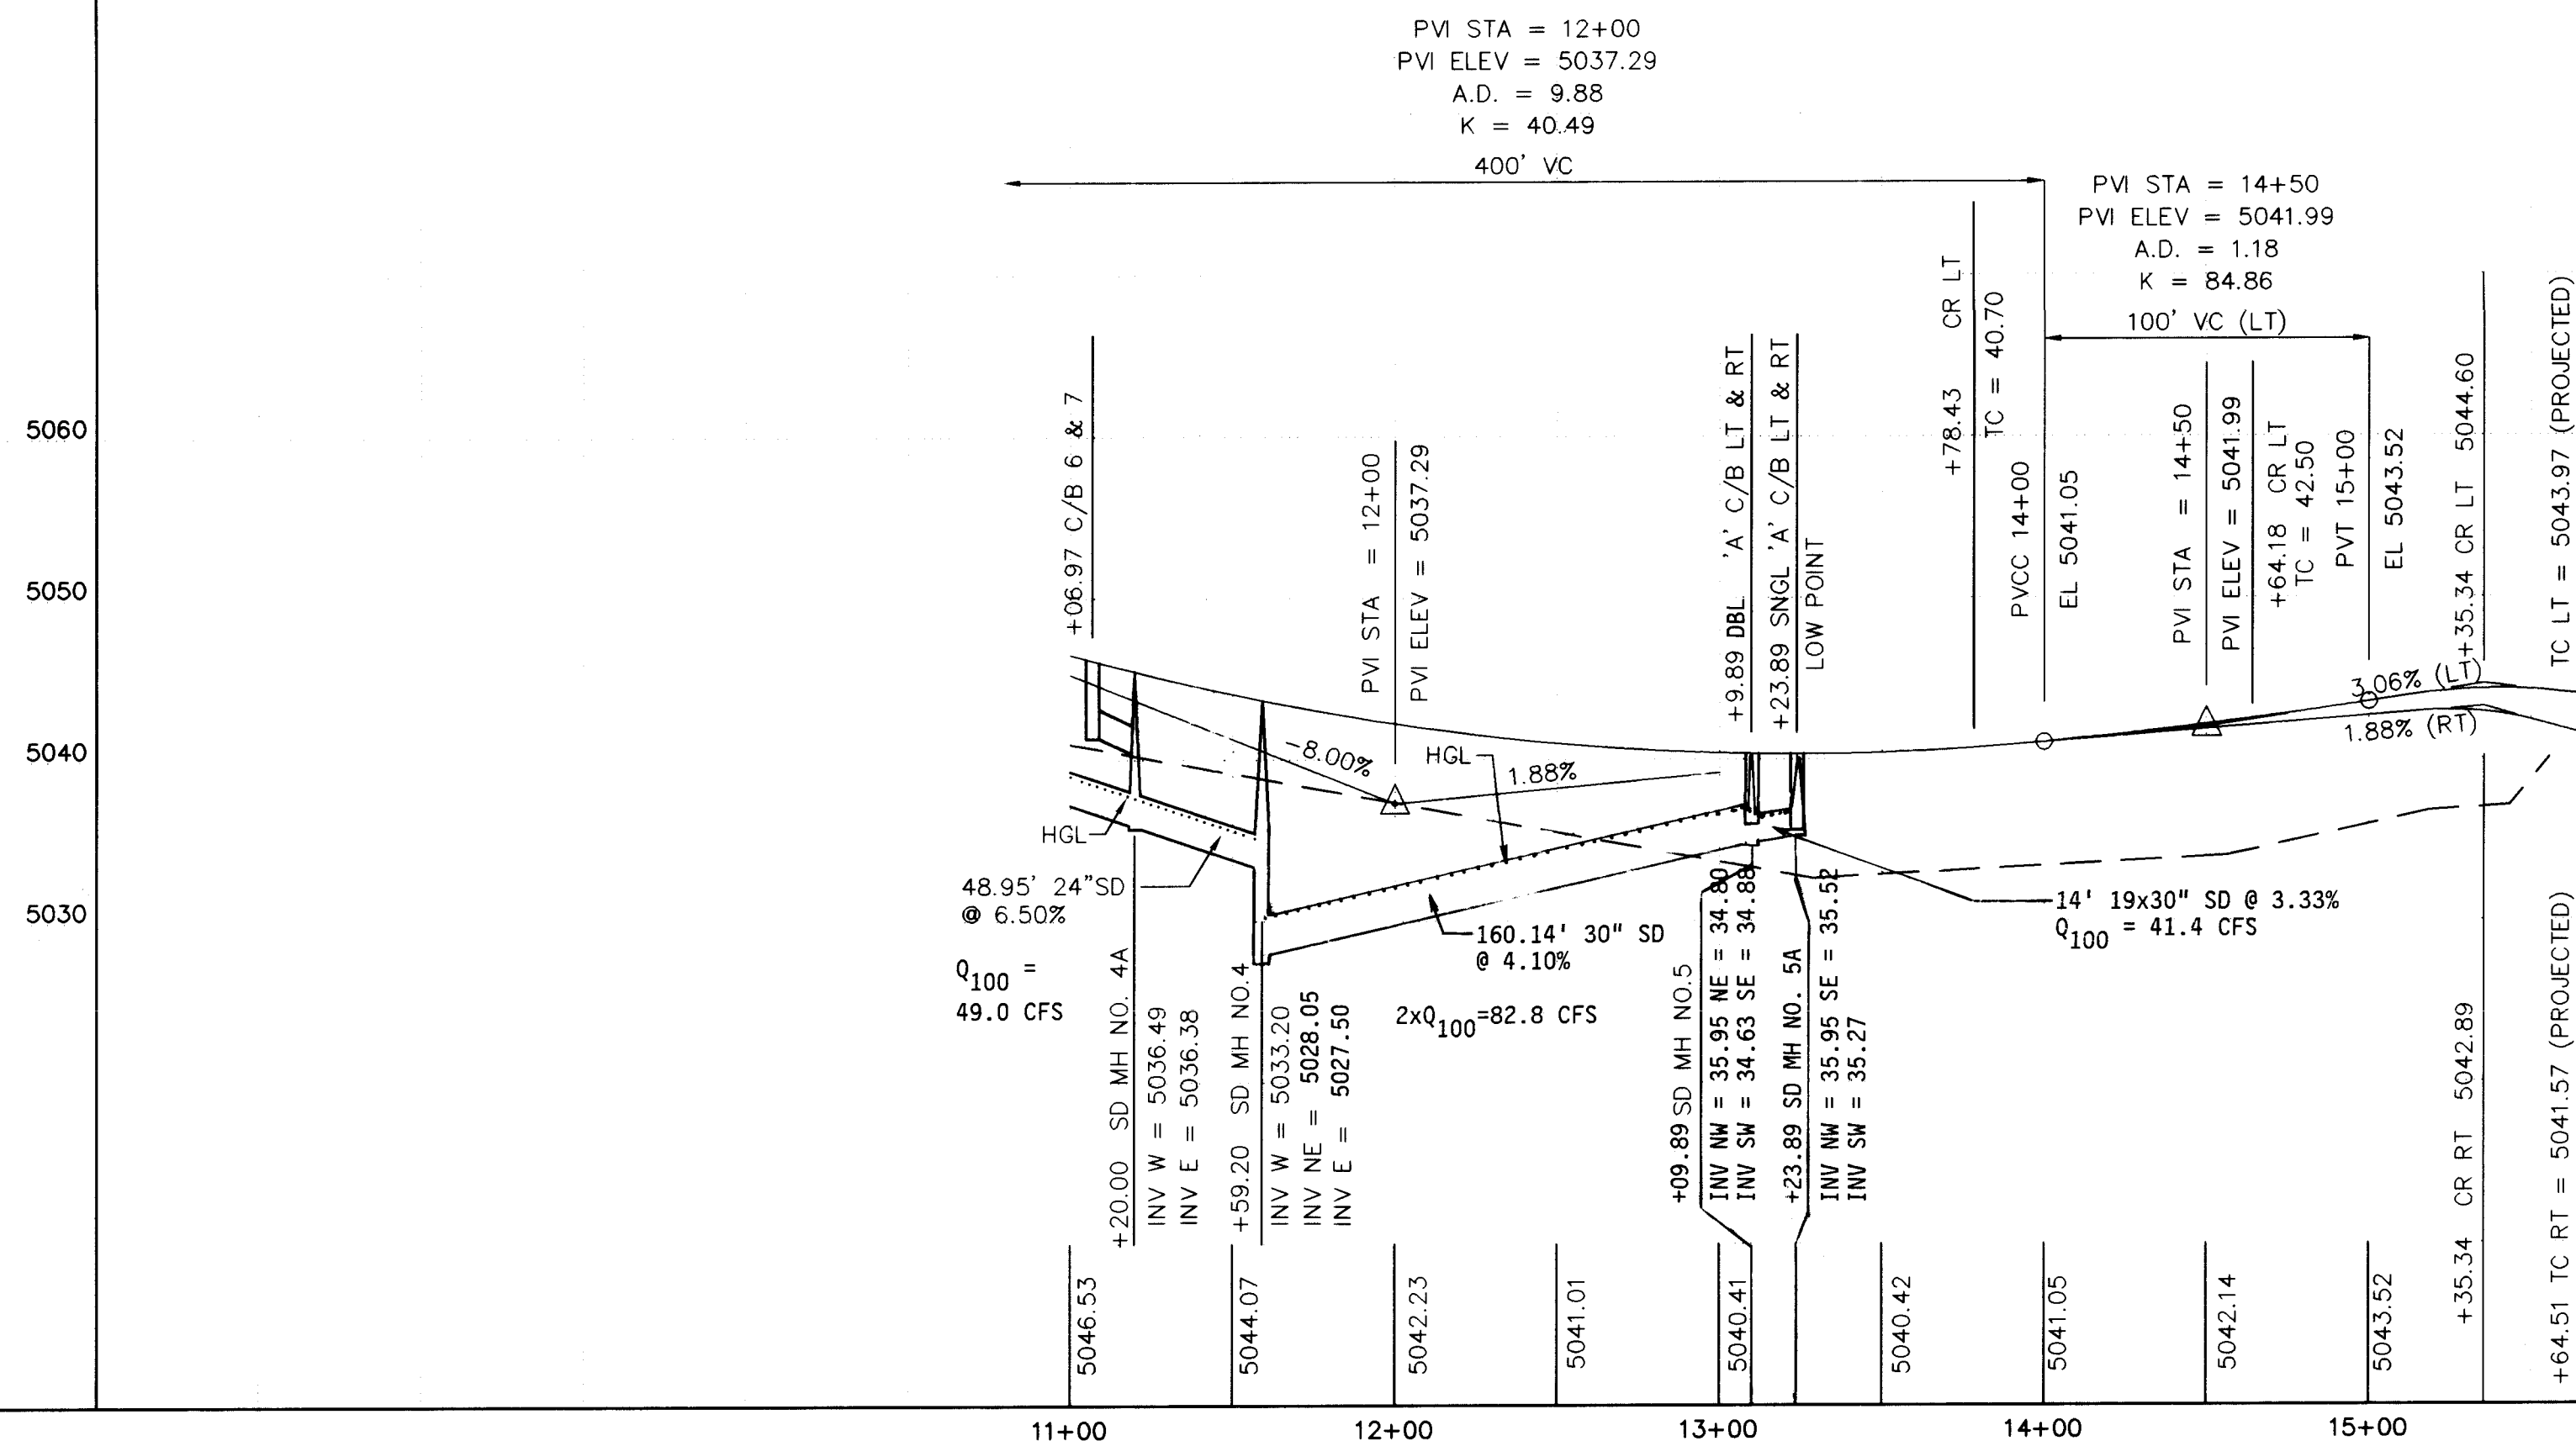

SCALE:
1" = 50' H.
1" = 10' V.

1. CONSTRUCT 4" THICK PCC SIDEWALK TRANSITIONS TO HANDICAP ACCESS RAMP & PCC RAMP PER STD. DWG. 2441.
2. CONSTRUCT PCC VALLEY GUTTER PER STD. DWG. 2420.
3. BUILD STD. PCC CURB & GUTTER PER STD. DWG. 2415.
4. ALL PCC SIDEWALK IS FUTURE (NOT IN THIS CONTRACT) EXCEPT FOR SHOWN WHEELCHAIR RAMPS.
5. SEE SHEET 10 FOR STORM DRAIN LINE. EAST OF OXNARD DRIVE
6. NO CROWN TRANSITION 75' MIN. LENGTH.

1. TRANSITION PAVEMENT CROSS-SLOPE TO 1.5% THROUGH KNUCKLE FROM STA 11+06.97 TO 11+31.97 AND BACK TO 2.0% FROM STA 11+83.36 TO 12+08.36
2. TRANSITION STREET WIDTH FROM 36 FT AT STA. 12+55.52 TO 40 FT AT STA 14+05.52. BUILD 40 FT WIDE STREET FROM 14+05.52 TO 15+55.52.

SCALE:
1" = 50' H.
1" = 10' V.

AS-BUILT INFORMATION		DATE	
CONTRACTOR	ALC, INC.	DATE	4/1/81
WORK	ALC, INC.	DATE	4/1/81
INSPECTOR'S	ALC, INC.	DATE	4/1/81
FIELD	ALC, INC.	DATE	4/1/81
VERIFICATION BY	ALC, INC.	DATE	4/1/81
DRAWINGS	ALC, INC.	DATE	4/1/81
CORRECTED BY	ALC, INC.	DATE	4/1/81
MICRO-FILM INFORMATION		DATE	
RECORDED BY		DATE	
NO.			

BENCH MARKS
ACS BENCHMARK "NM 449-N7A" - AN ALUMINUM TABLET SET IN THE CONCRETE MEDIAN NOSE OF COORS ROAD NW, 62 FEET NORTH OF THE CENTERLINE OF MONTANO RD NW.
ELEVATION = 5006.41

[illegible]

ENGINEER'S SEAL

SCOTT M. MCGEE
MEXICO
101501
PROFESSIONAL ENGINEER

7-13-94

[illegible]



ISAACSON & ARFMAN, P.A.
Consulting Engineering Associates
 128 Monroe Street N.E.
 Albuquerque New Mexico

CITY OF ALBUQUERQUE

TITLE: *TAYLOR RIDGE SUBDIVISION*
OXNARD DRIVE
PAVING PLAN & PROFILE

APPROVALS	ENGINEER	DATE	APPROVALS	ENGINEER	DATE
DRC CHAIRMAN	<i>[Signature]</i>	9-12-94	WATER	<i>[Signature]</i>	
TRANSPORTATION	<i>[Signature]</i>	8-04-94	WASTE WATER	<i>[Signature]</i>	2-10-94
HYDROLOGY	<i>[Signature]</i>	8-17-94			

PROJECT NO.	4918.90	MAP NO.	E-12	SHEET OF	17 23
-------------	---------	---------	------	----------	-------

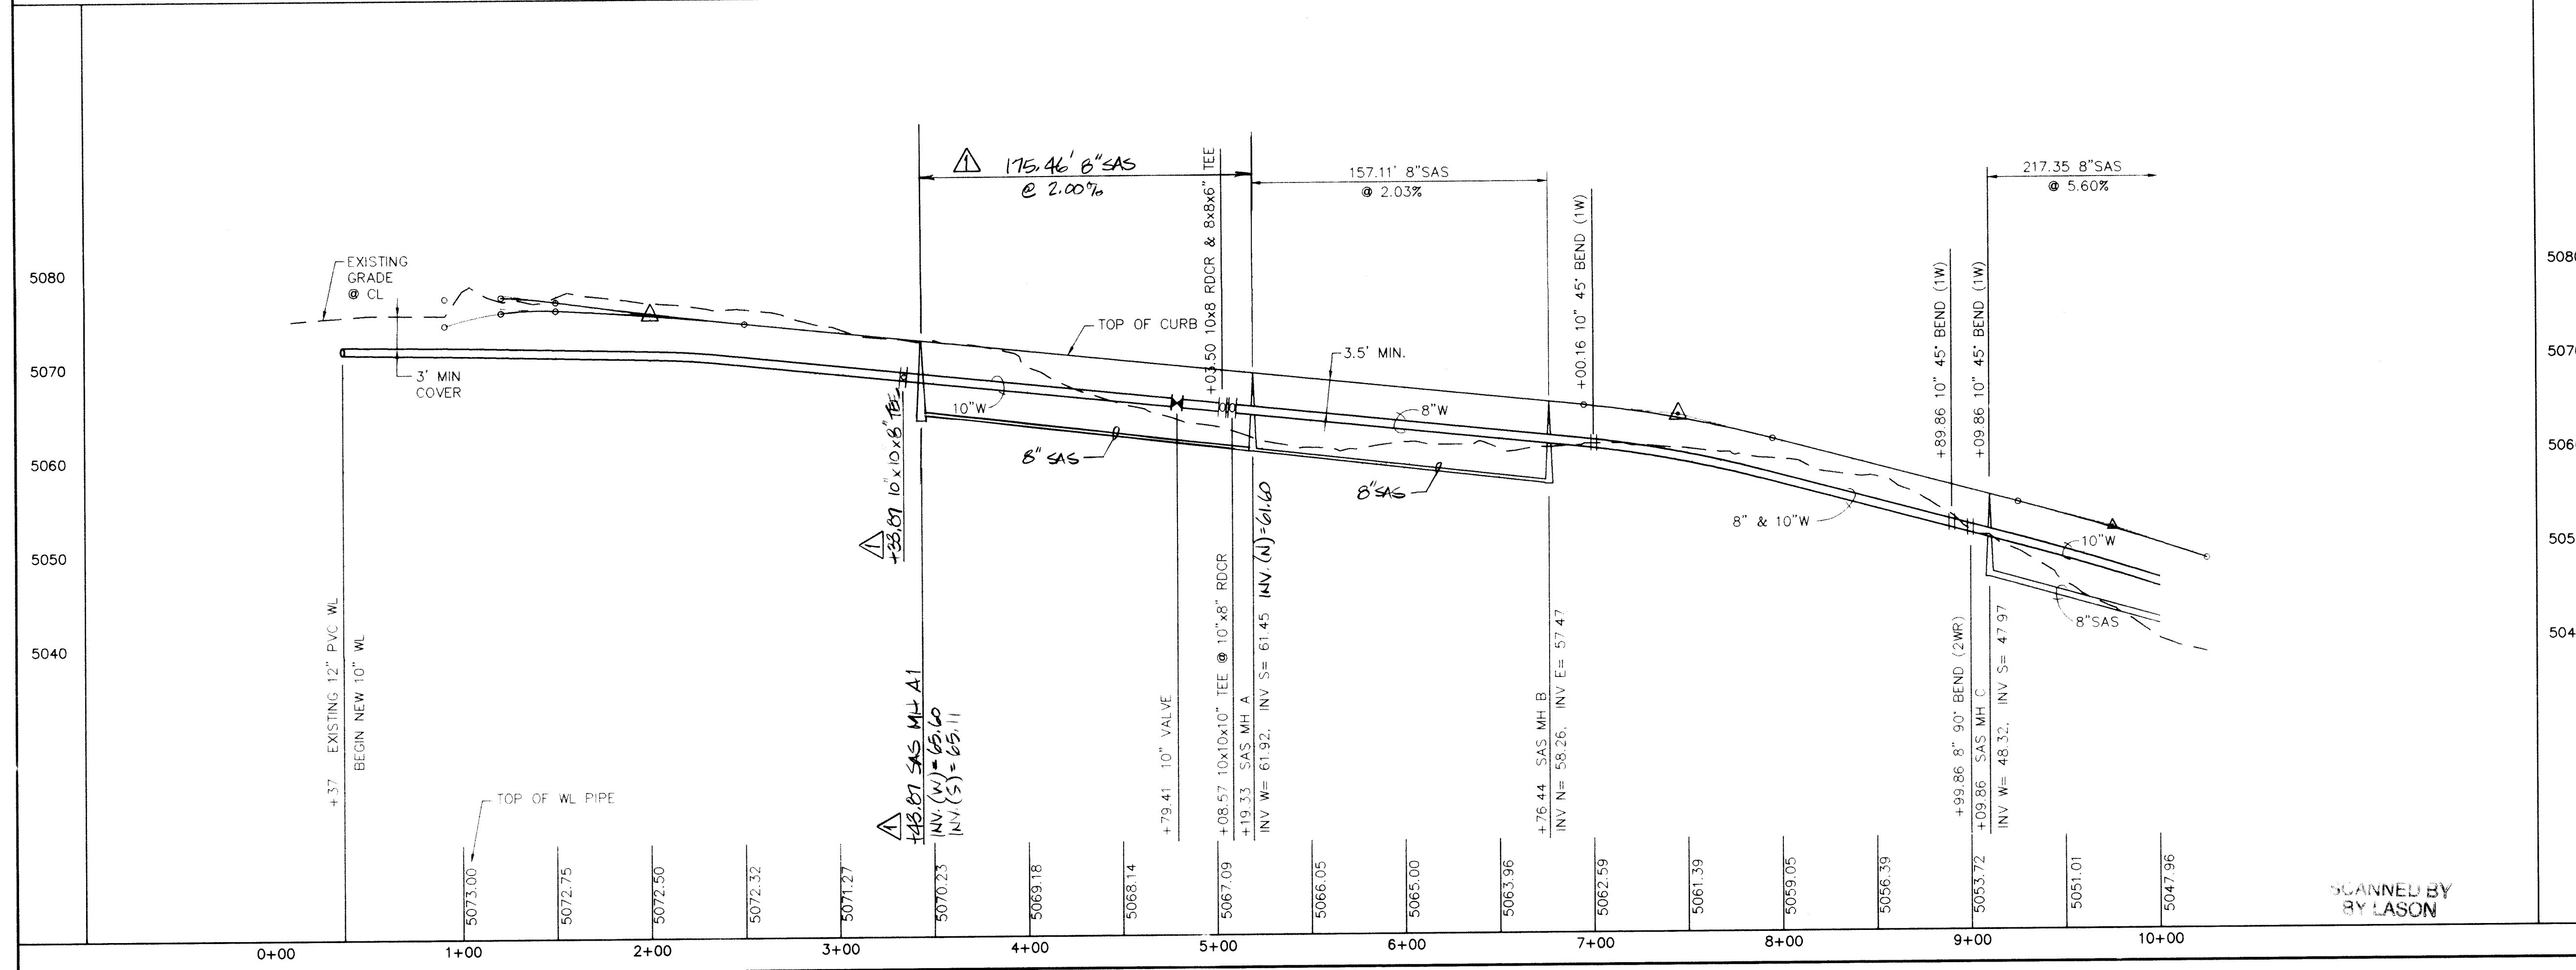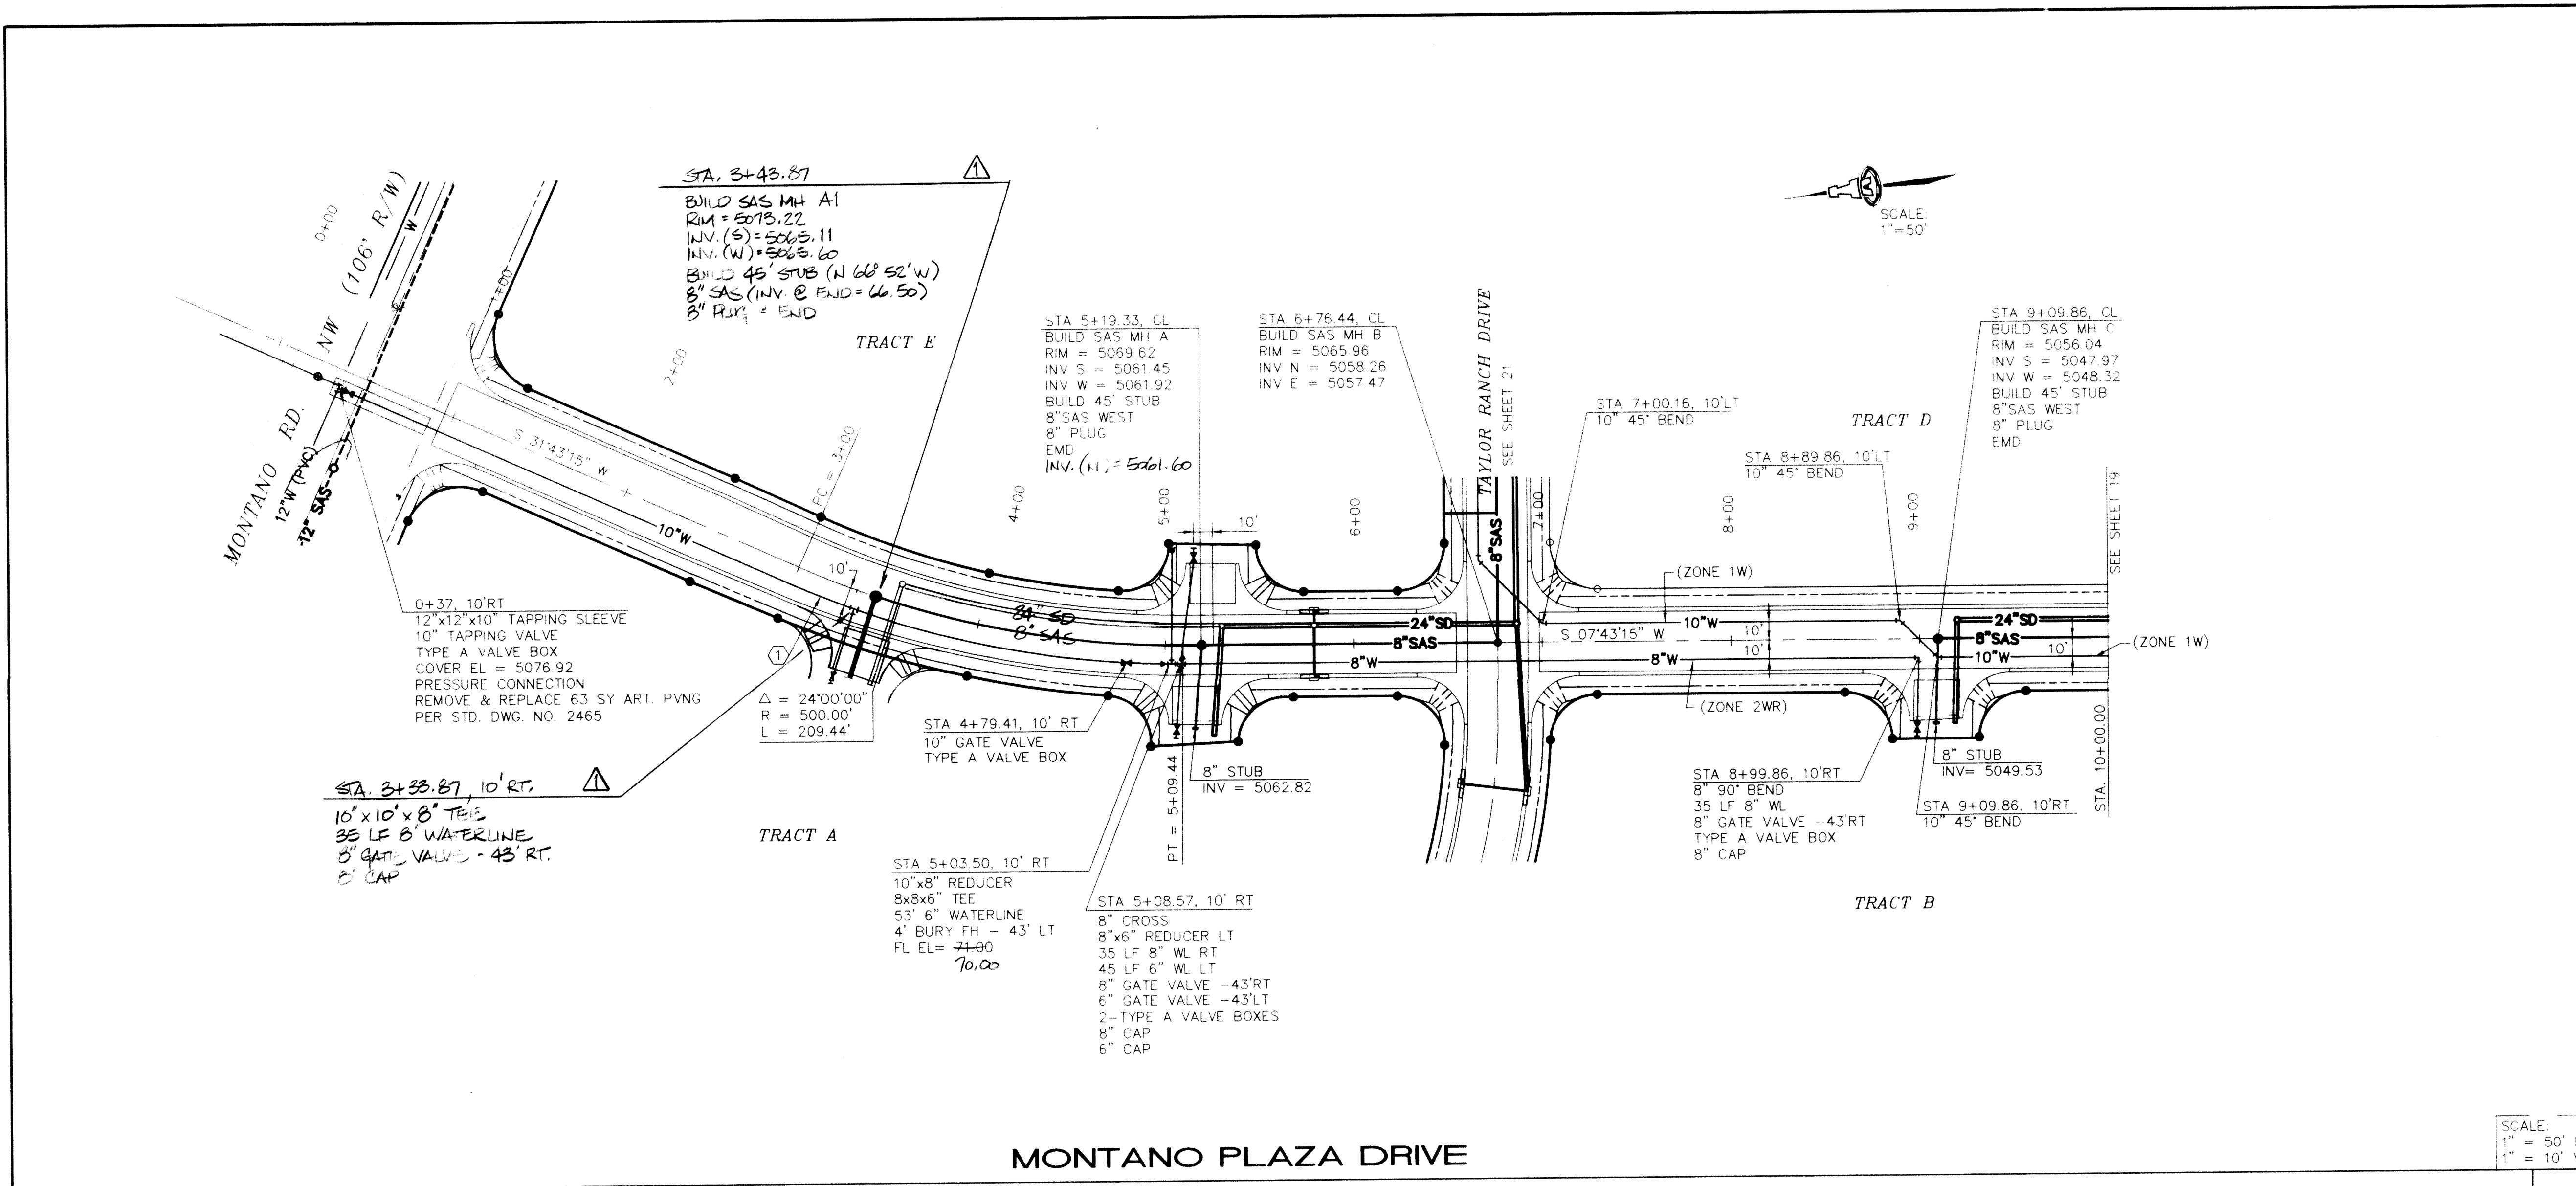

KEYED CONSTRUCTION NOTES

1. INSTALL WATERLINE ON A CURVE FROM STA. 3+00 TO 5+09.44 AS FOLLOWS:
 $\Delta = 24^{\circ}00'00''$
 $R = 510.00'$
 $L = 213.63'$

GENERAL NOTES

ENGINEER'S SEAL


ISAACSON & ARFMAN, P.A.
Consulting Engineering Associates
128 Monroe Street N.E.
Albuquerque New Mexico
6/15/94

AS-BUILT INFORMATION			BENCH MARKS			SURVEY INFORMATION			ENGINEER'S SEAL		
NO.	BY	DATE	NO.	BY	DATE	NO.	BY	DATE	NO.	BY	DATE
1	W.P.	2/93	1	W.P.	2/93	1	W.P.	2/93	1	W.P.	2/93

REVISIONS


NO.	DATE	REMARKS
1	6/15/94	DESIGN

PROJECT NO. 4918.90 **MAP NO.** E-12 **SHEET** 18 **OF** 23

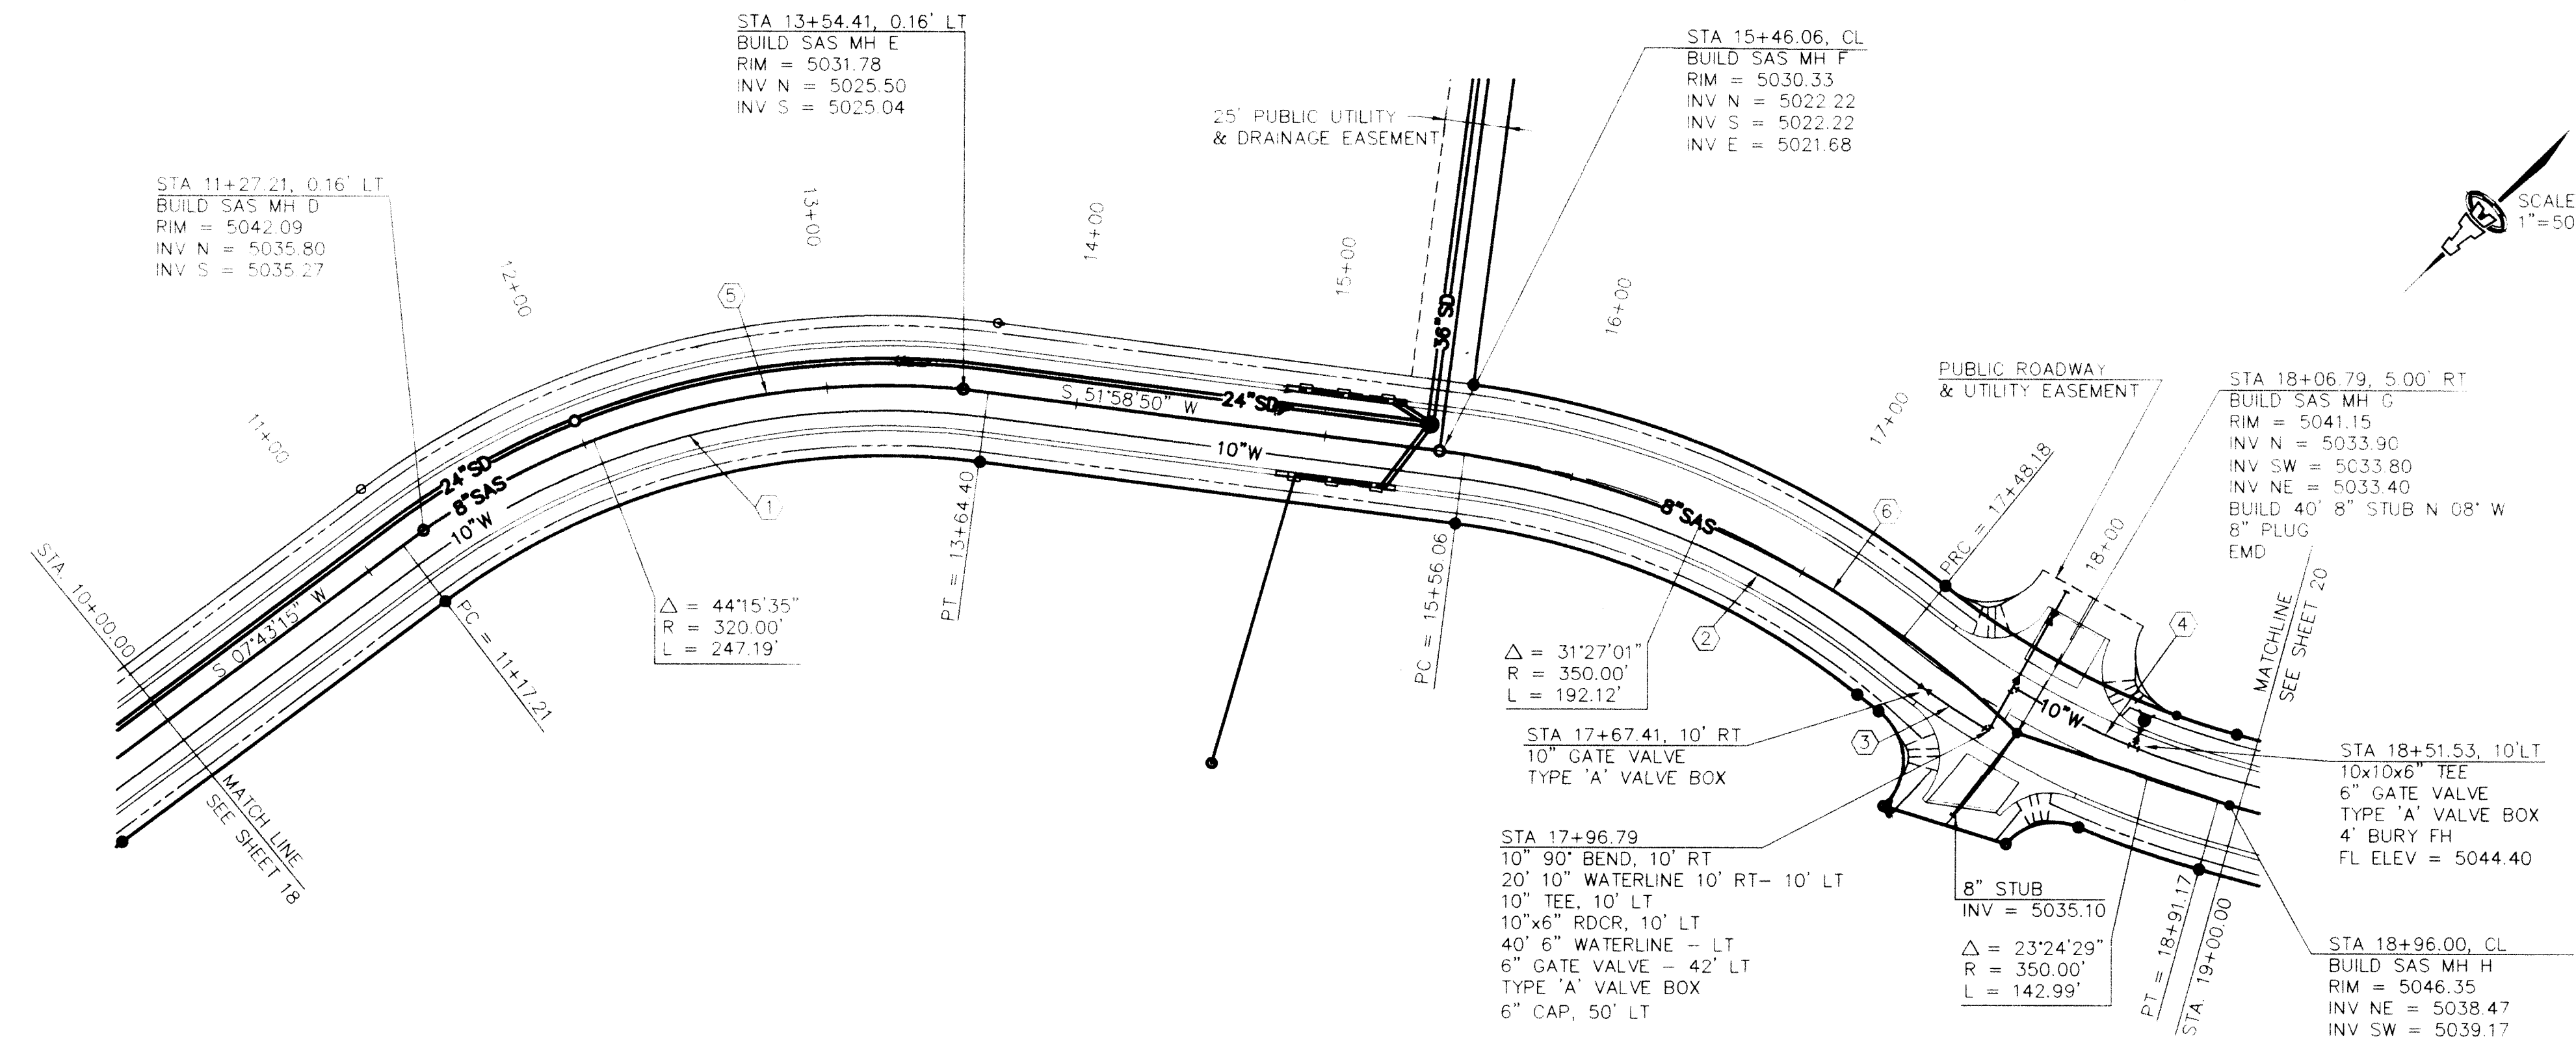

MONTANO PLAZA DRIVE

SCALE:
1" = 50' H.
1" = 10' V.

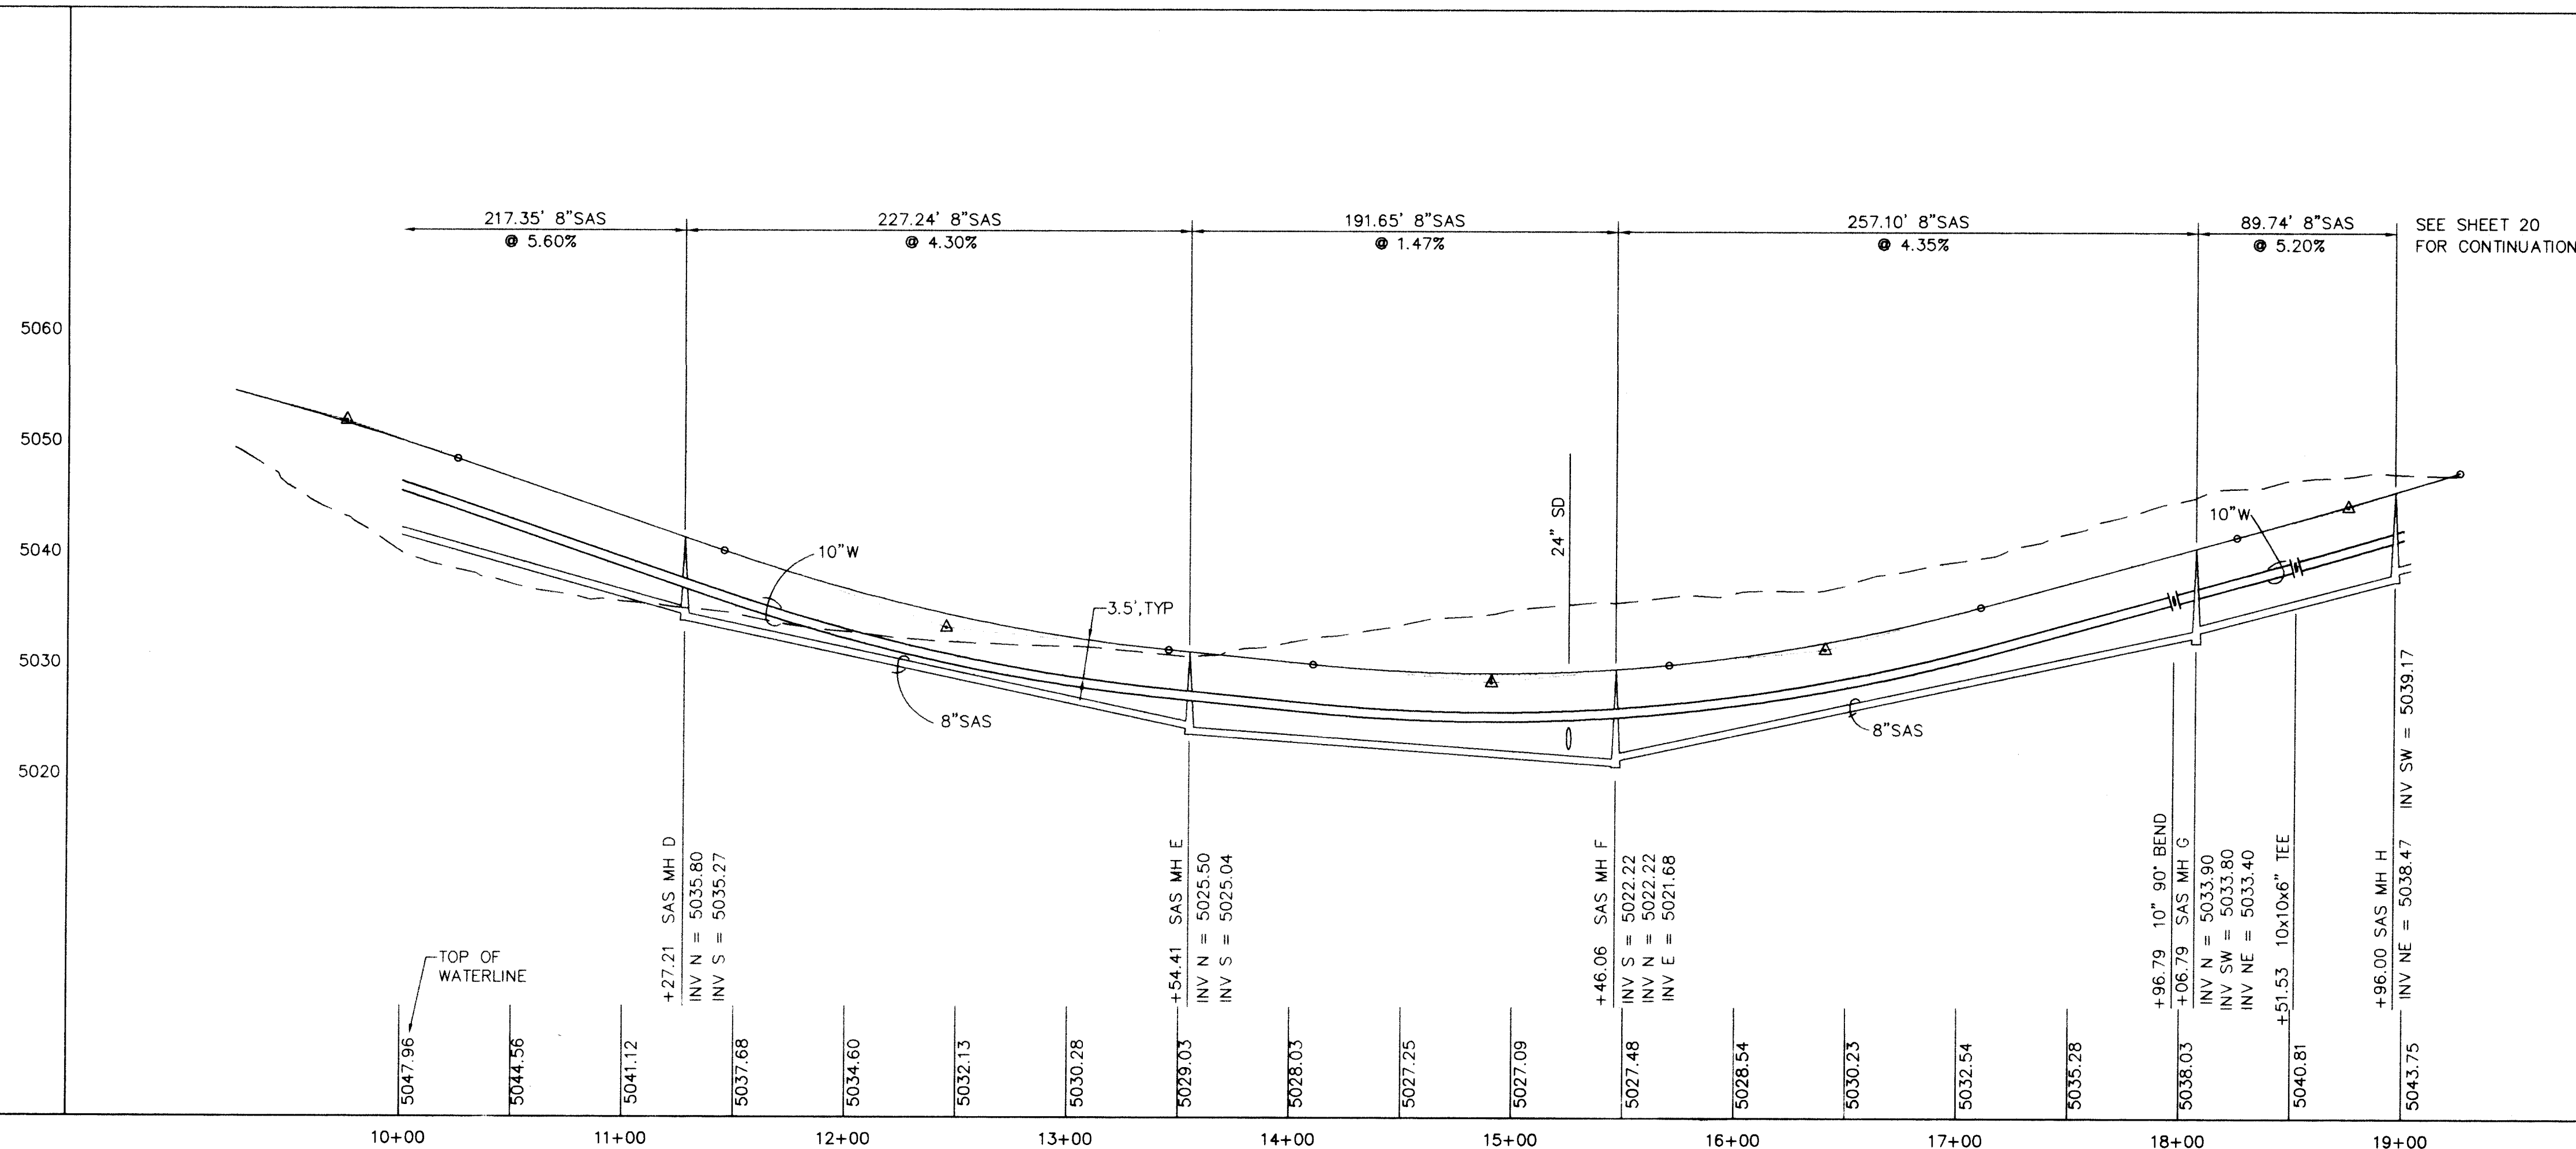


KEYED CONSTRUCTION NOTES

- INSTALL WATERLINE ON A CURVE FROM STA 11+17.21 TO STA 13+64.40 AS FOLLOWS:
 $\Delta = 44'15'35"$
 $R = 310.00'$
 $L = 239.47'$
- INSTALL WATERLINE ON A CURVE FROM STA 15+56.06 TO STA 17+48.18 AS FOLLOWS:
 $\Delta = 31'27'01"$
 $R = 340.00'$
 $L = 186.63'$
- INSTALL WATERLINE ON A CURVE FROM STA 17+48.18 TO STA 17+96.79 AS FOLLOWS:
 $\Delta = 07'57'28"$
 $R = 360.00'$
 $L = 50.00'$
- INSTALL WATERLINE ON A CURVE FROM STA 17+96.79 TO STA 18+91.17 AS FOLLOWS:
 $\Delta = 15'27'01"$
 $R = 340.00'$
 $L = 91.68'$
- INSTALL SANITARY SEWER ON A CURVE FROM STA 11+17.21 TO STA 13+54.41 AS FOLLOWS:
 $\Delta = 40'21'38"$
 $R = 322.58'$
 $L = 227.24'$
- INSTALL SANITARY SEWER ON A CURVE FROM STA 15+56.06 TO STA 18+06.79 AS FOLLOWS:
 $\Delta = 35'01'18"$
 $R = 410.77'$
 $L = 251.08'$

GENERAL NOTES

- SEE SHEET 11 FOR CONTINUATION OF SAS EAST OF MONTANO PLAZA DR.

AS-BUILT INFORMATION			BENCH MARKS			SURVEY INFORMATION			ENGINEER'S SEAL		
CONTRACTOR	DATE	BY	ACS BENCHMARK "NM 448-N7A"	DATE	BY	NO.	BY	DATE	NO.	DATE	REMARKS
AS-BUILT	7/13/94	AS-BUILT	IN THE CONCRETE MEDIAN NOSE OF COOP'S ROAD NW	2/93	W.P.	1	W.P.	7/13/94	1	7/13/94	DESIGN
RECORDED BY	DATE	NO.	ELEVATION = 5006.41								DESIGNED BY
											DRAWN BY
											CHECKED BY

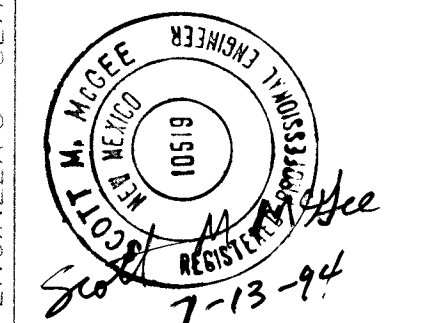

1 2 3 4 5 6 7 8 9 10 11 12 13 14 15
20-1991/18-1901/1995



ISAACSON & ARFMAN, P.A.
Consulting Engineering Associates
128 Monroe Street N.E.
Albuquerque, New Mexico
746UTL2.DWGwe 7/12/94

CITY OF ALBUQUERQUE
PUBLIC WORKS DEPARTMENT
ENGINEERING GROUP
TITLE: TAYLOR RIDGE SUBDIVISION
MONTANO PLAZA DR
UTILITY PLAN & PROFILE

APPROVALS	ENGINEER	DATE	APPROVALS	ENGINEER	DATE
DRC CHAIRMAN	B.G. Arfman	7-12-94	WATER		
TRANSPORTATION	NA RHP	8-04-94	WASTE WATER		
HYDROLOGY	NA JPC	8-17-94			

PROJECT NO. 4918.90 MAP NO. E-12 SHEET 19 OF 23

DRAWN BY LASON

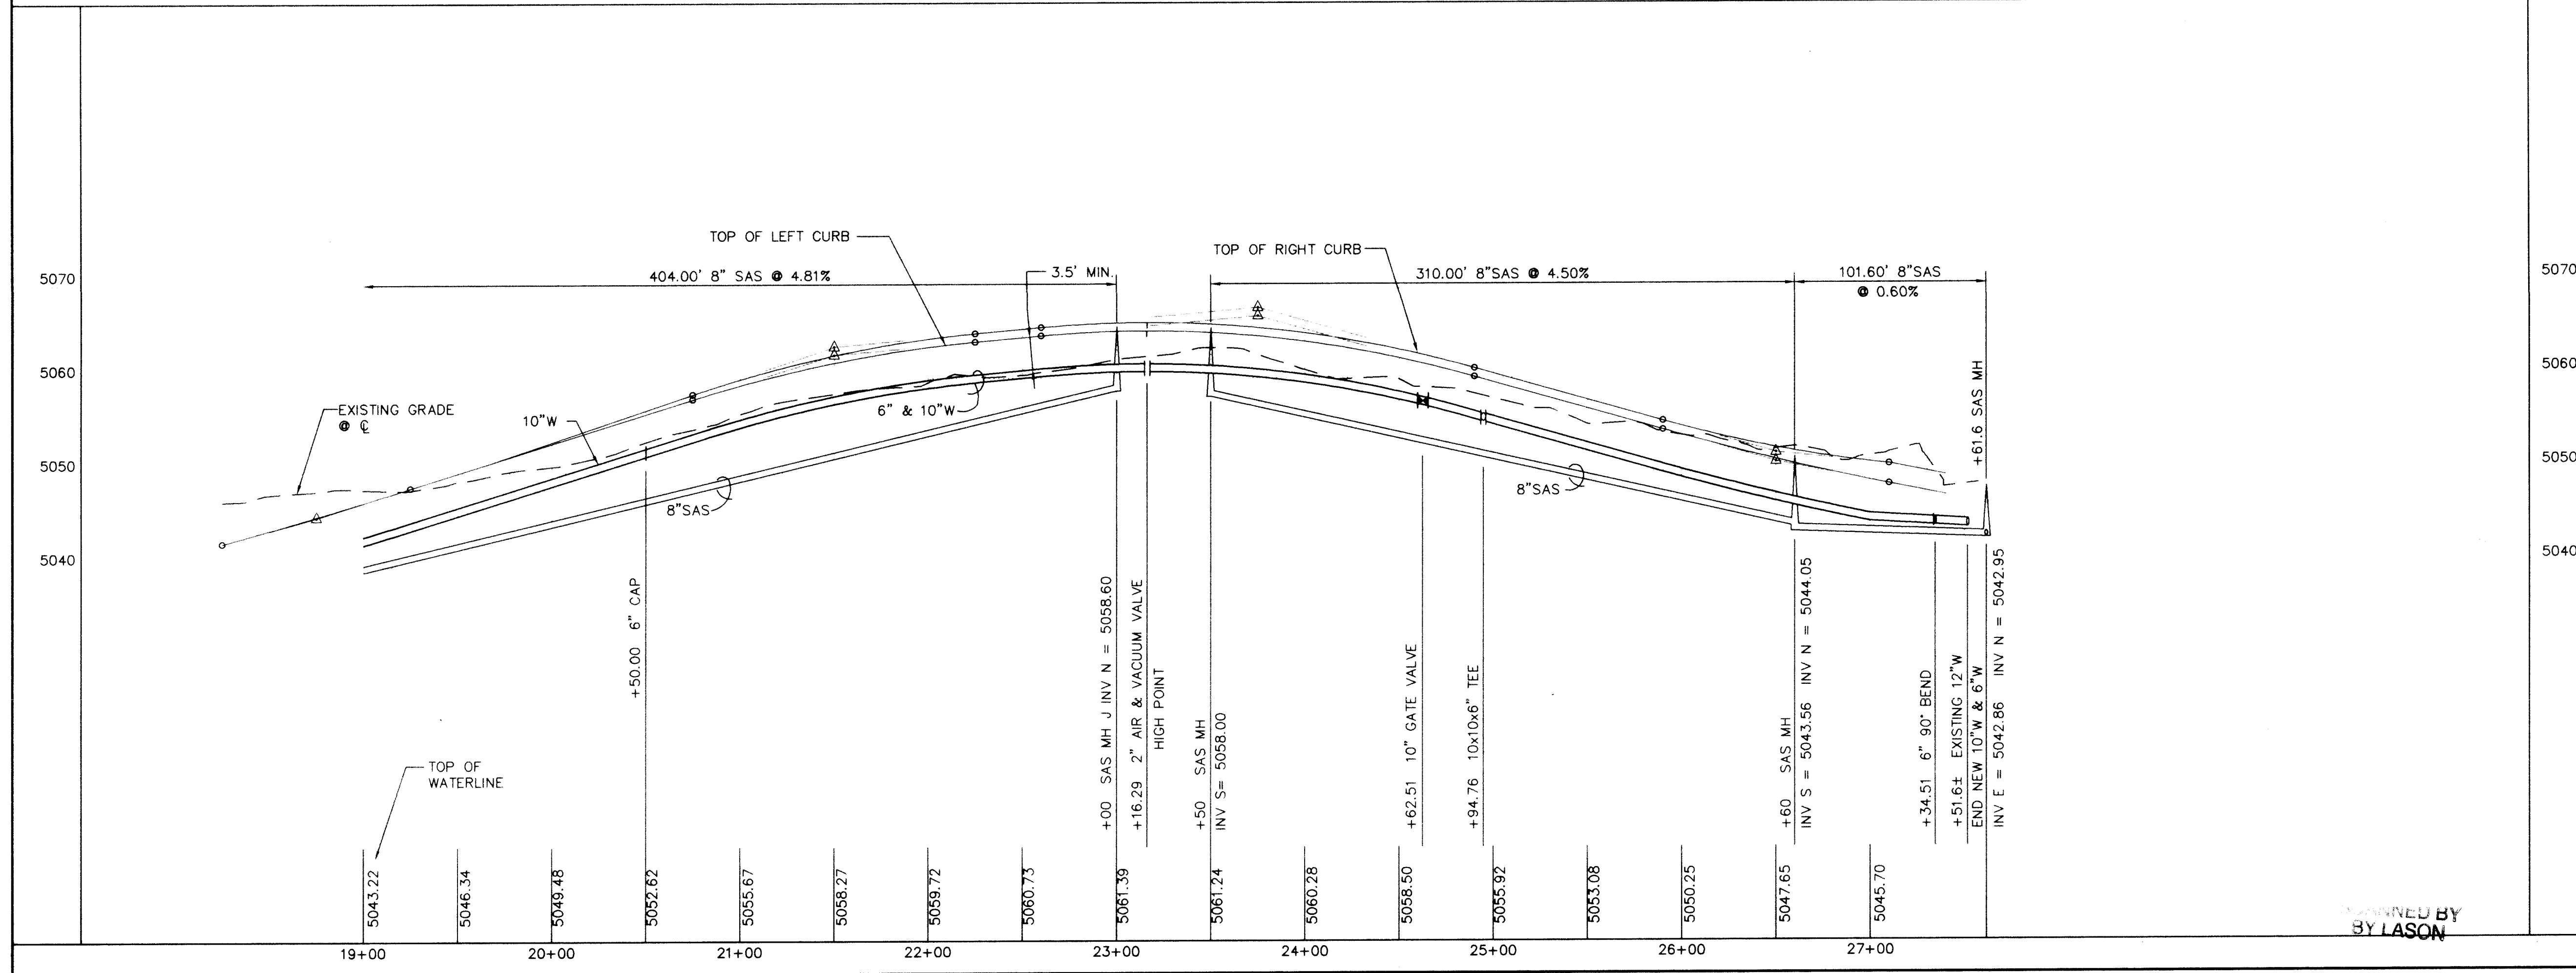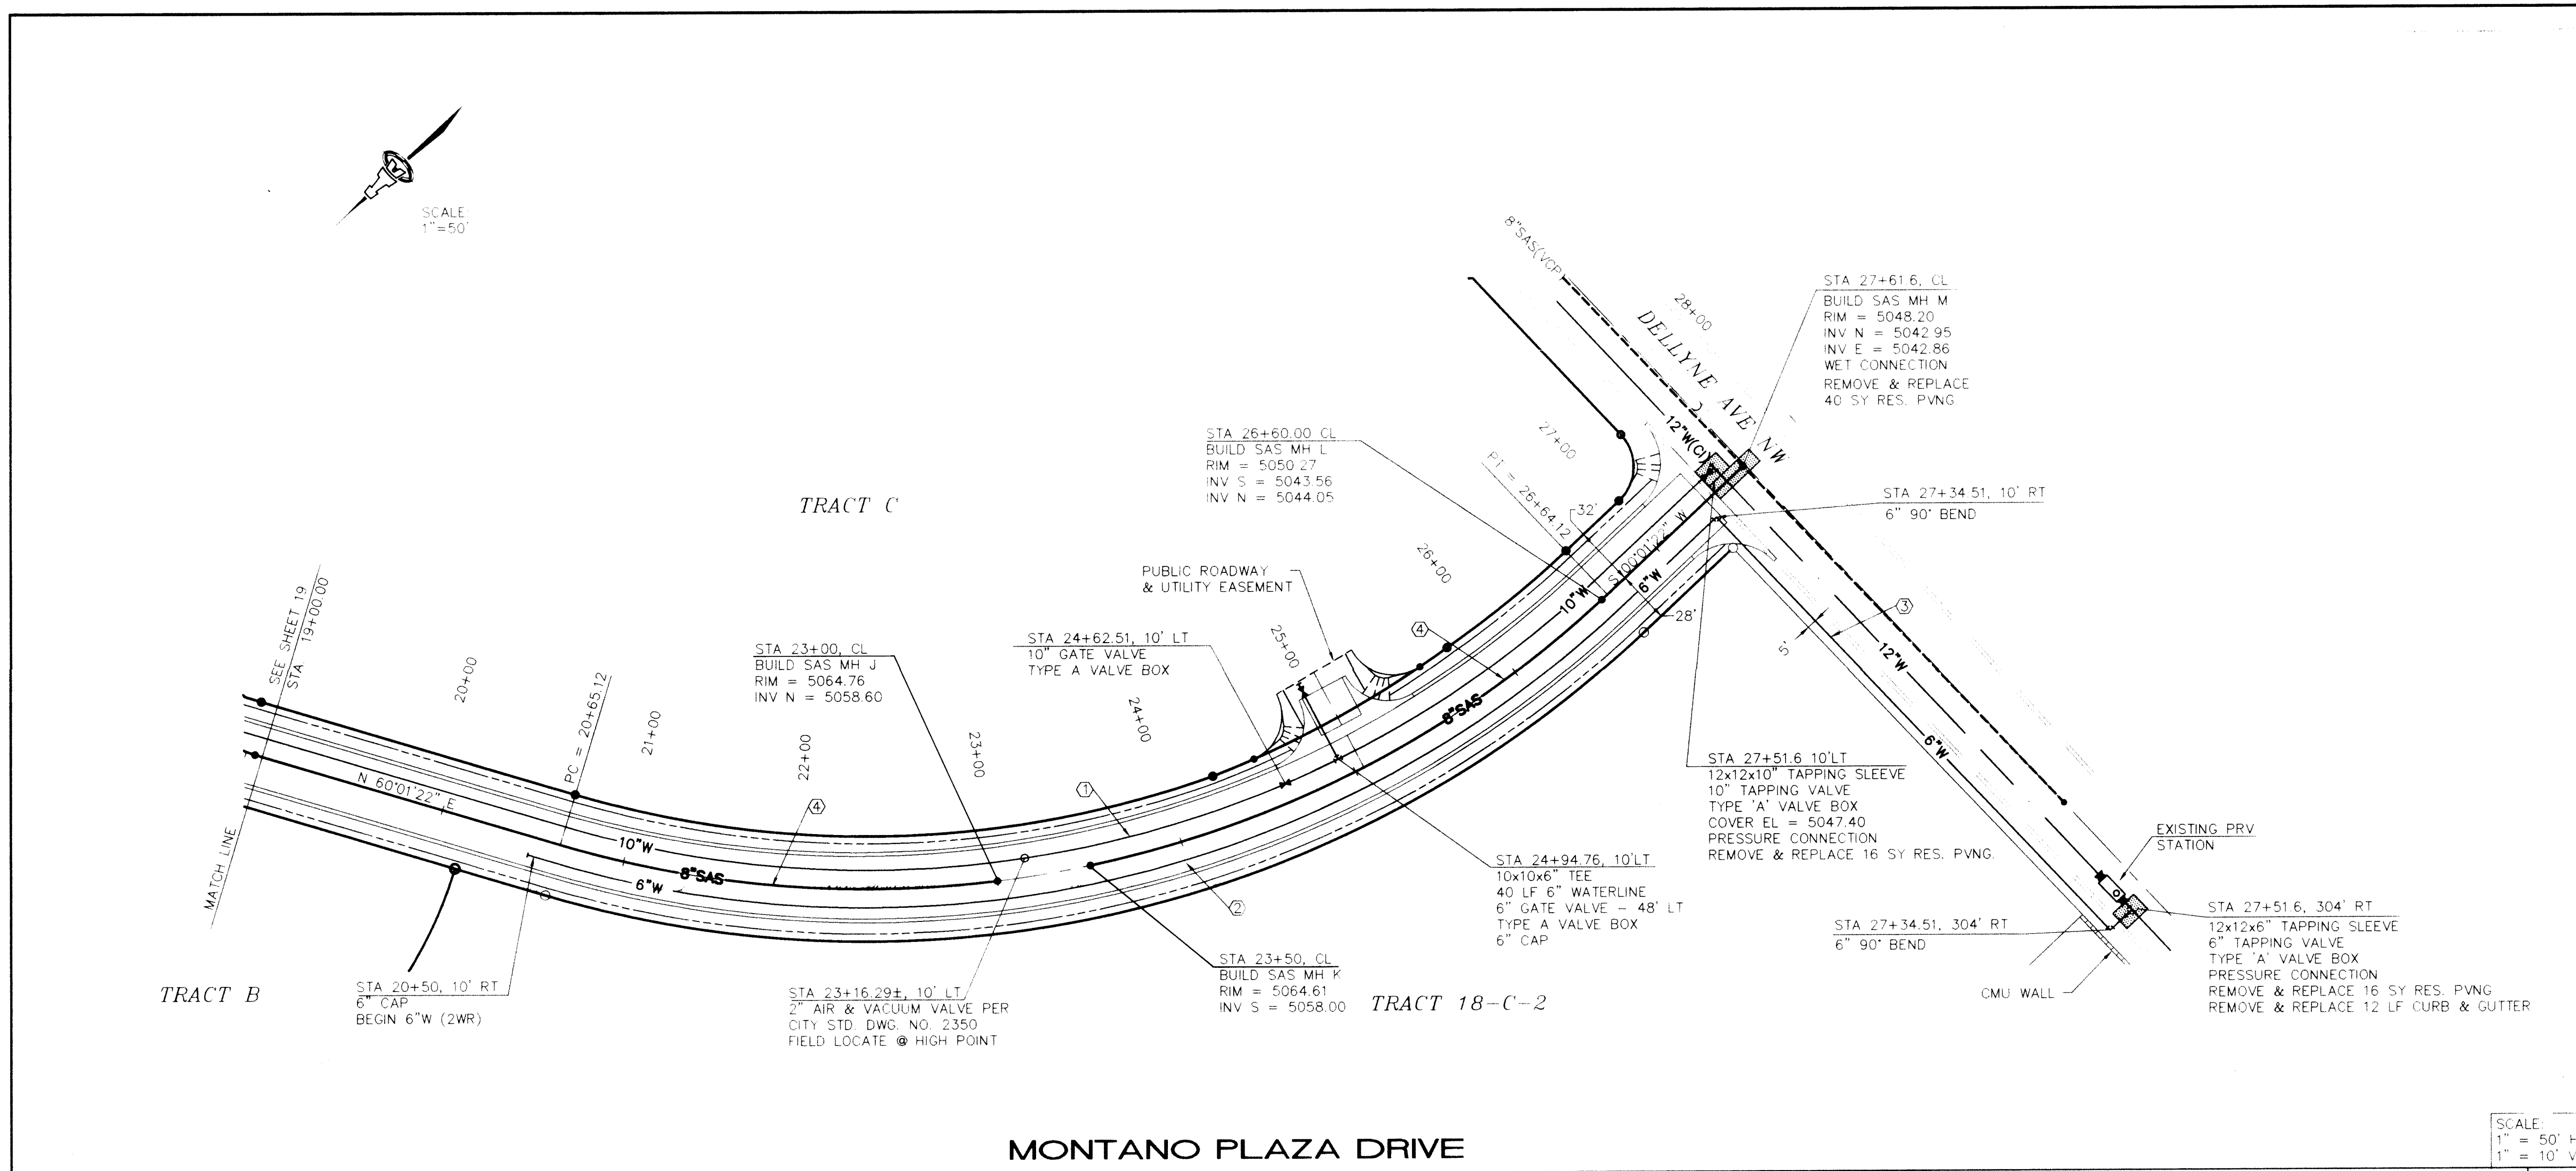

KEYED CONSTRUCTION NOTES

- INSTALL 10" WATERLINE ON A CURVE FROM STA 20+65.12 TO 26+64.12 AS FOLLOWS:
 $\Delta = 60^\circ 00' 00''$
 $R = 562.00'$
 $L = 588.53'$
- INSTALL 6" WATERLINE ON A CURVE FROM STA 20+65.12 TO 26+64.12 AS FOLLOWS:
 $\Delta = 60^\circ 00' 00''$
 $R = 582.00'$
 $L = 609.47'$
- INSTALL 6" WATERLINE A MINIMUM OF 4 FT BELOW ADJACENT TOP OF CURB GRADE OF DELLYNE AVE NW.
- INSTALL 8" SEWERLINE ON A CURVE WITH RADIUS = 572.00' FROM STA 20+65.12 TO STA 23+00 & FROM STA 23+50 TO STA 26+60.

GENERAL NOTES

- WATER & SANITARY SEWER SERVICE LOCATIONS ALONG MONTANO PLAZA DRIVE SHALL BE COORDINATED WITH THE SUBDIVISION OF TRACT 18-C-2.

CONTRACTOR INFORMATION

CONTRACTOR	DATE
U.M. INC.	4/13
DESIGNED BY	DATE
A.S. INC.	4/13
CHECKED BY	DATE
A.S. INC.	4/13
RECORDED BY	DATE
MICRO-FILM INFORMATION	

BENCH MARKS

ACS BENCHMARK	DATE
"NM 448-N7A", AN ALUMINUM TABLE SET IN THE CONCRETE MEDIAN NOSE OF COORS ROAD NW, 62 FEET NORTH OF THE CENTERLINE OF MONTANO RD NW	2/93

ENGINEER'S SEAL

ISAACSON & ARFMAN, P.A.

Consulting Engineering Associates
 128 Monroe Street N.E.
 Albuquerque, New Mexico

CITY OF ALBUQUERQUE


PUBLIC WORKS DEPARTMENT
 ENGINEERING GROUP

TITLE: TAYLOR RIDGE SUBDIVISION


MONTANO PLAZA DR.
 UTILITY PLAN & PROFILE

APPROVALS	ENGINEER	DATE	APPROVALS	ENGINEER	DATE
DRC CHAIRMAN	<i>[Signature]</i>	7-12-94	WATER	<i>[Signature]</i>	
TRANSPORTATION	<i>[Signature]</i>	8-21-94	WASTE WATER	<i>[Signature]</i>	
HYDROLOGY	<i>[Signature]</i>	8-17-94			


PROJECT NO.	MAP NO.	SHEET	OF
4918.90	E-12	20	23

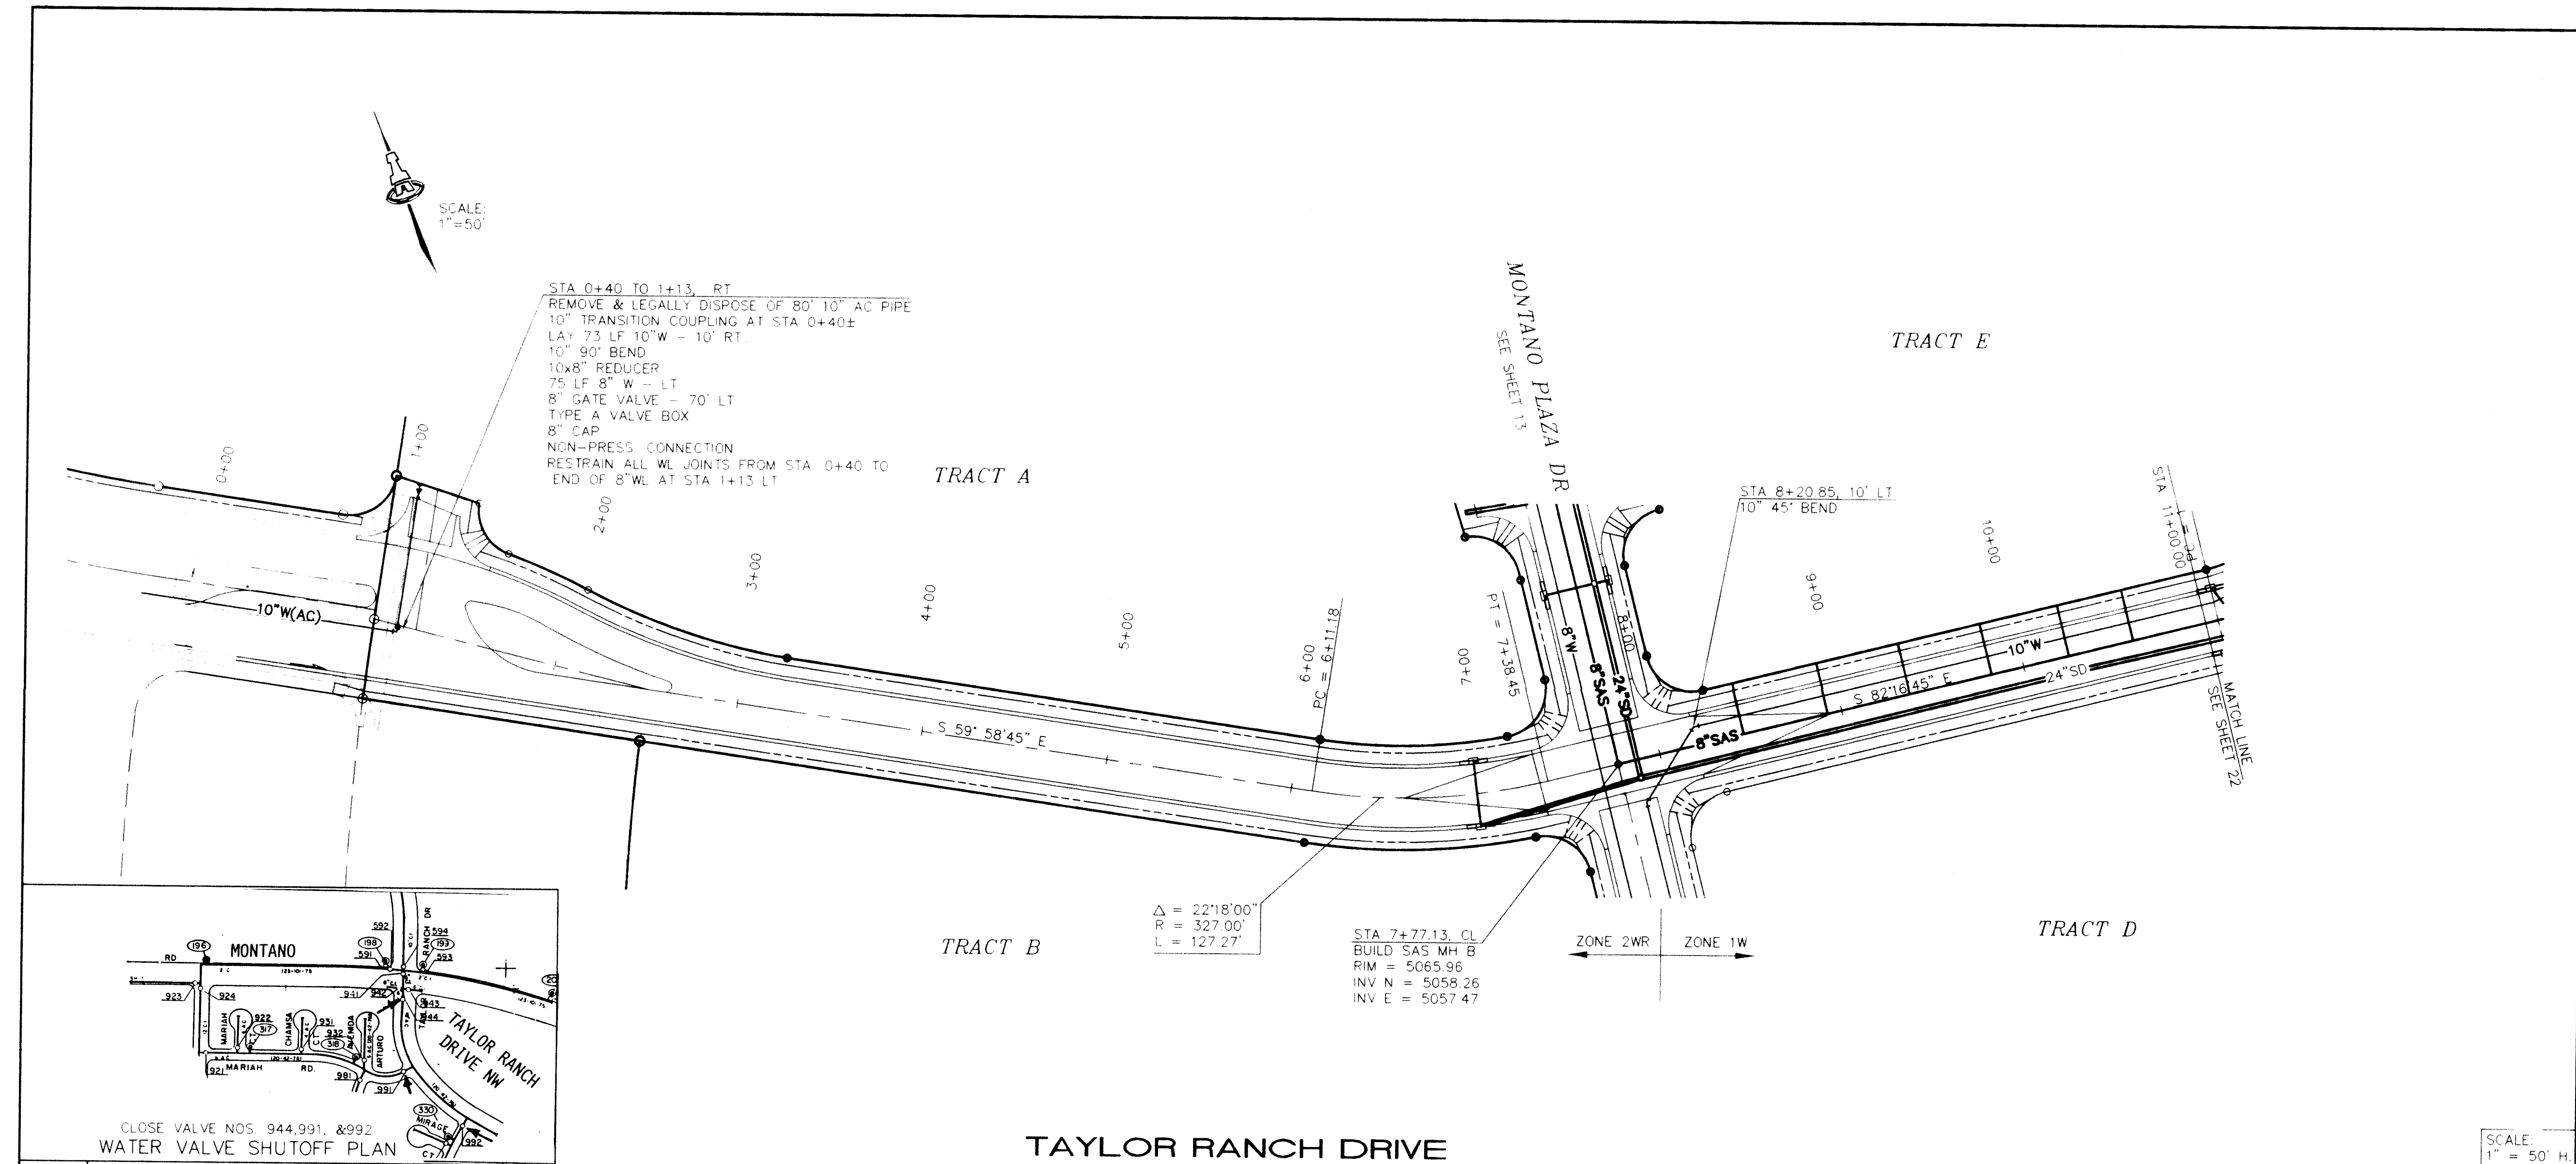


STA. 0+30. REMOVAL LIMITS.
REMOVE EXISTING PAVING, CURB & GUTTER,
AND VALLEY GUTTER TO THIS LINE.
REMOVE EXISTING SW - RT AS SHOWN &
REPLACE WITH TRANSITION TO 4' WIDTH
OVER 16'.

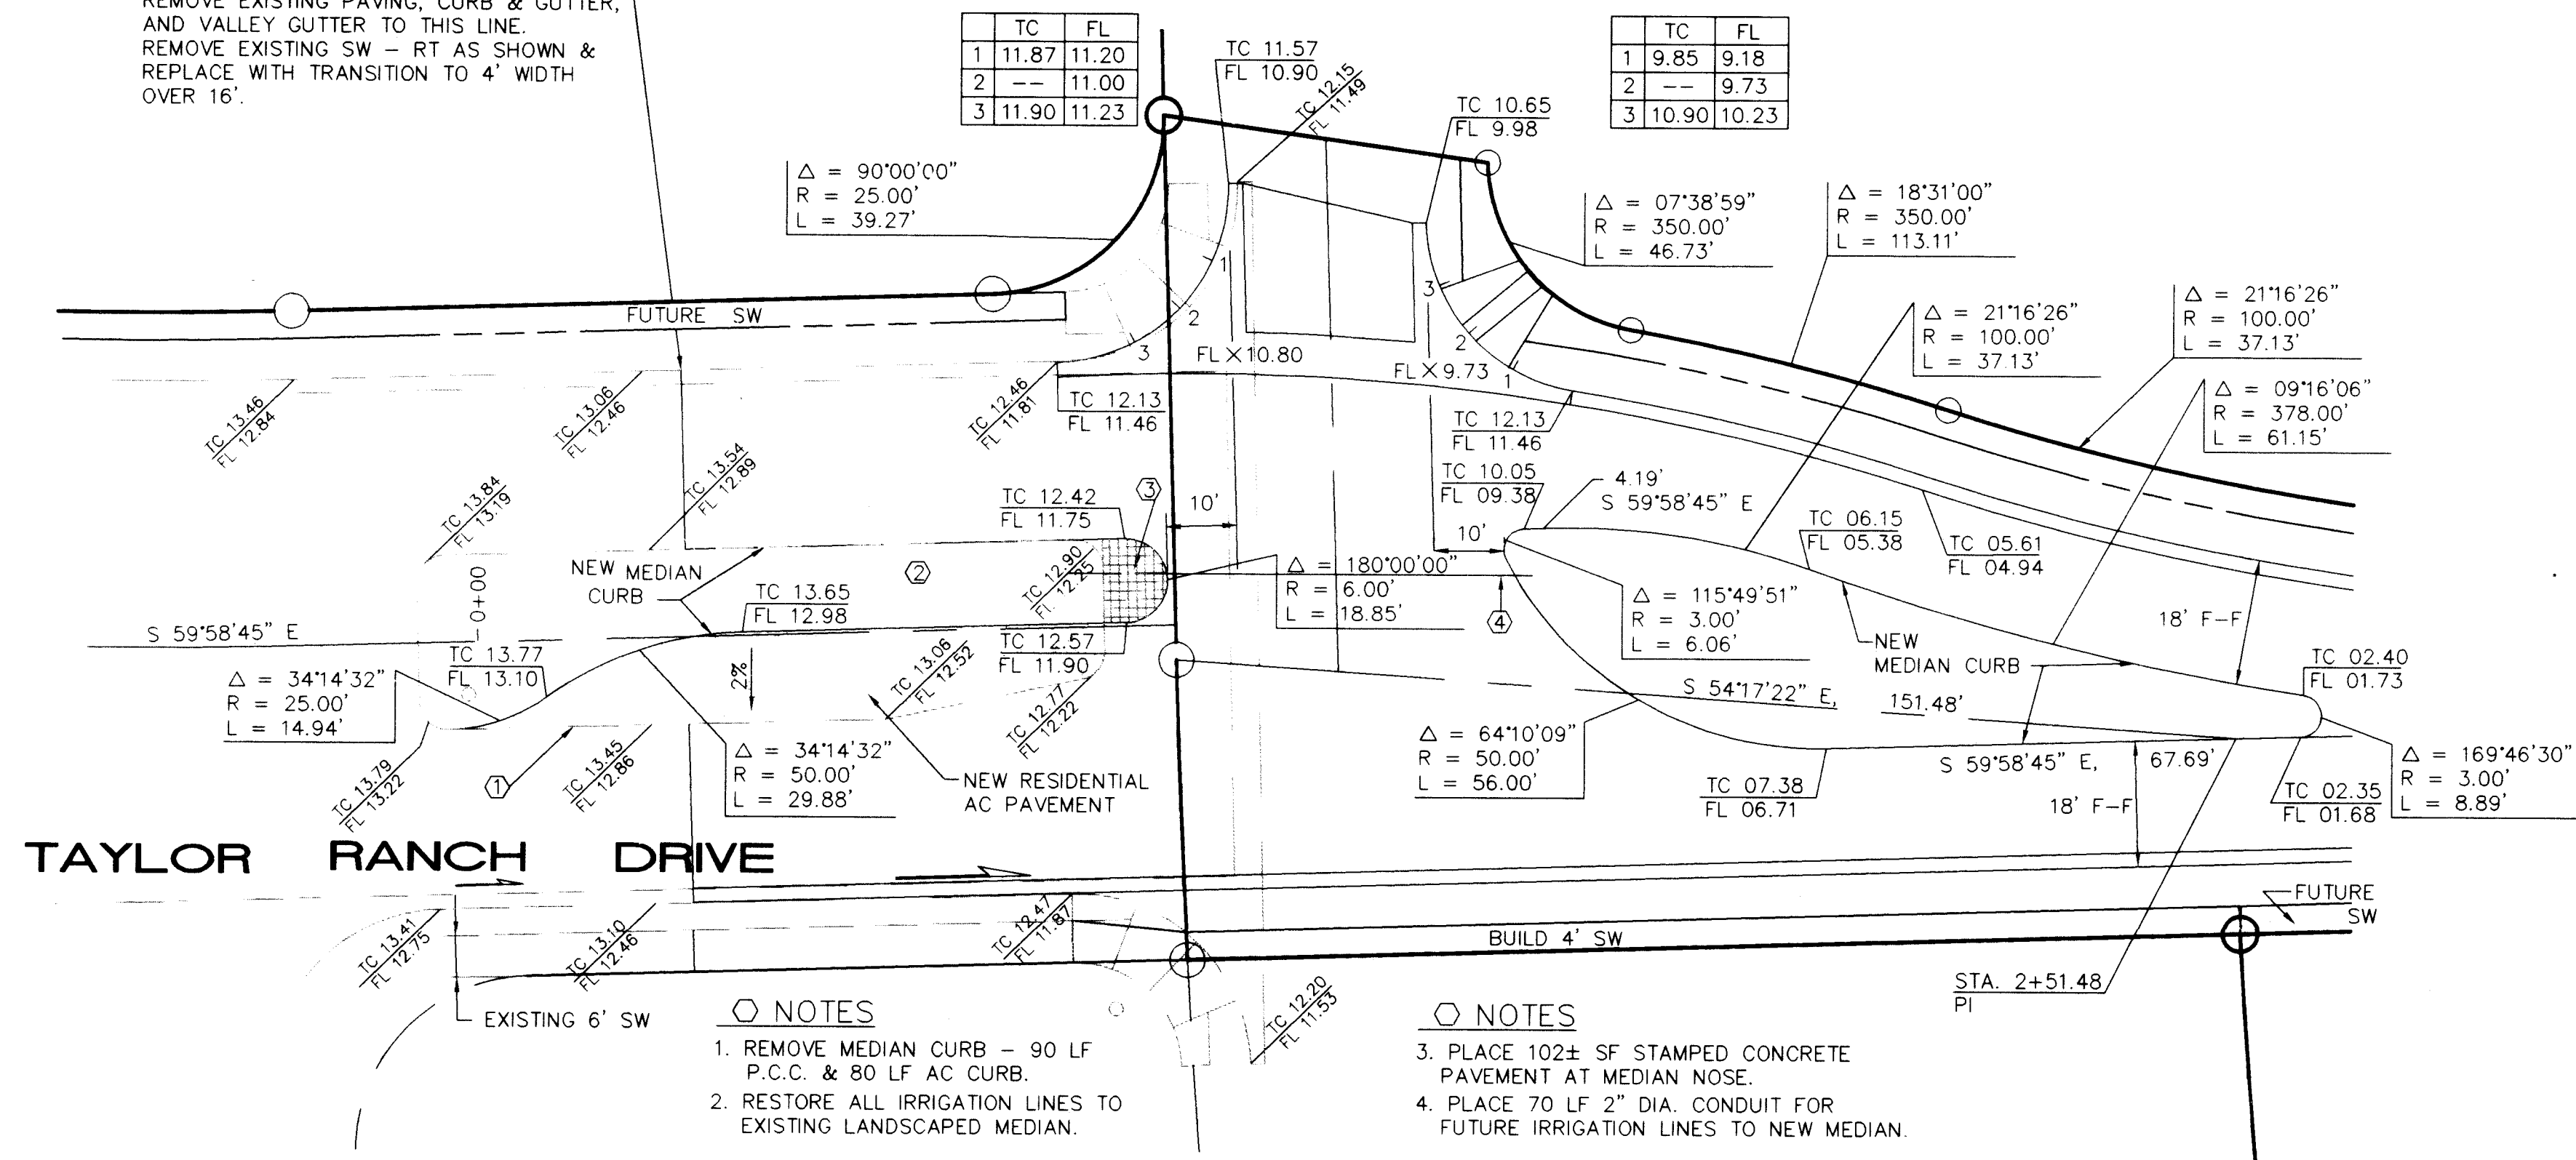



TAYLOR RANCH DRIVE MEDIAN MODIFICATIONS
1" = 20'

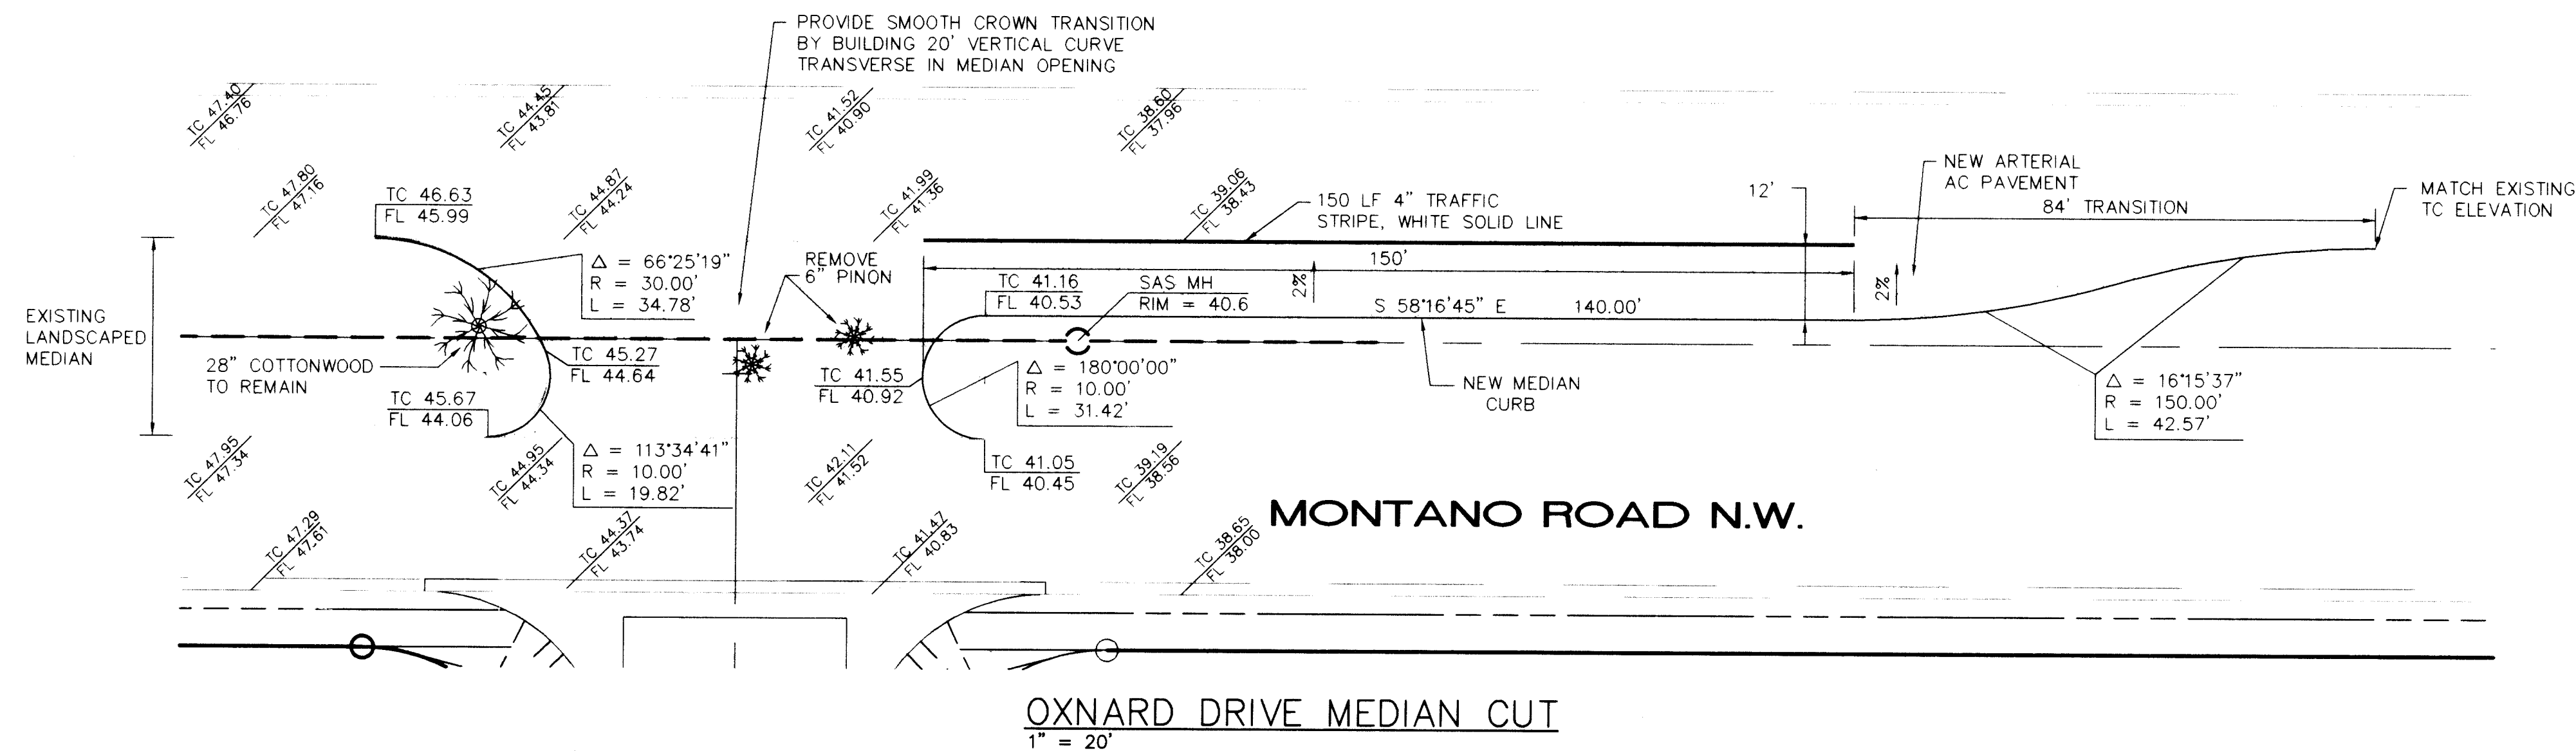


OXNARD DRIVE MEDIAN CUT
1" = 20'

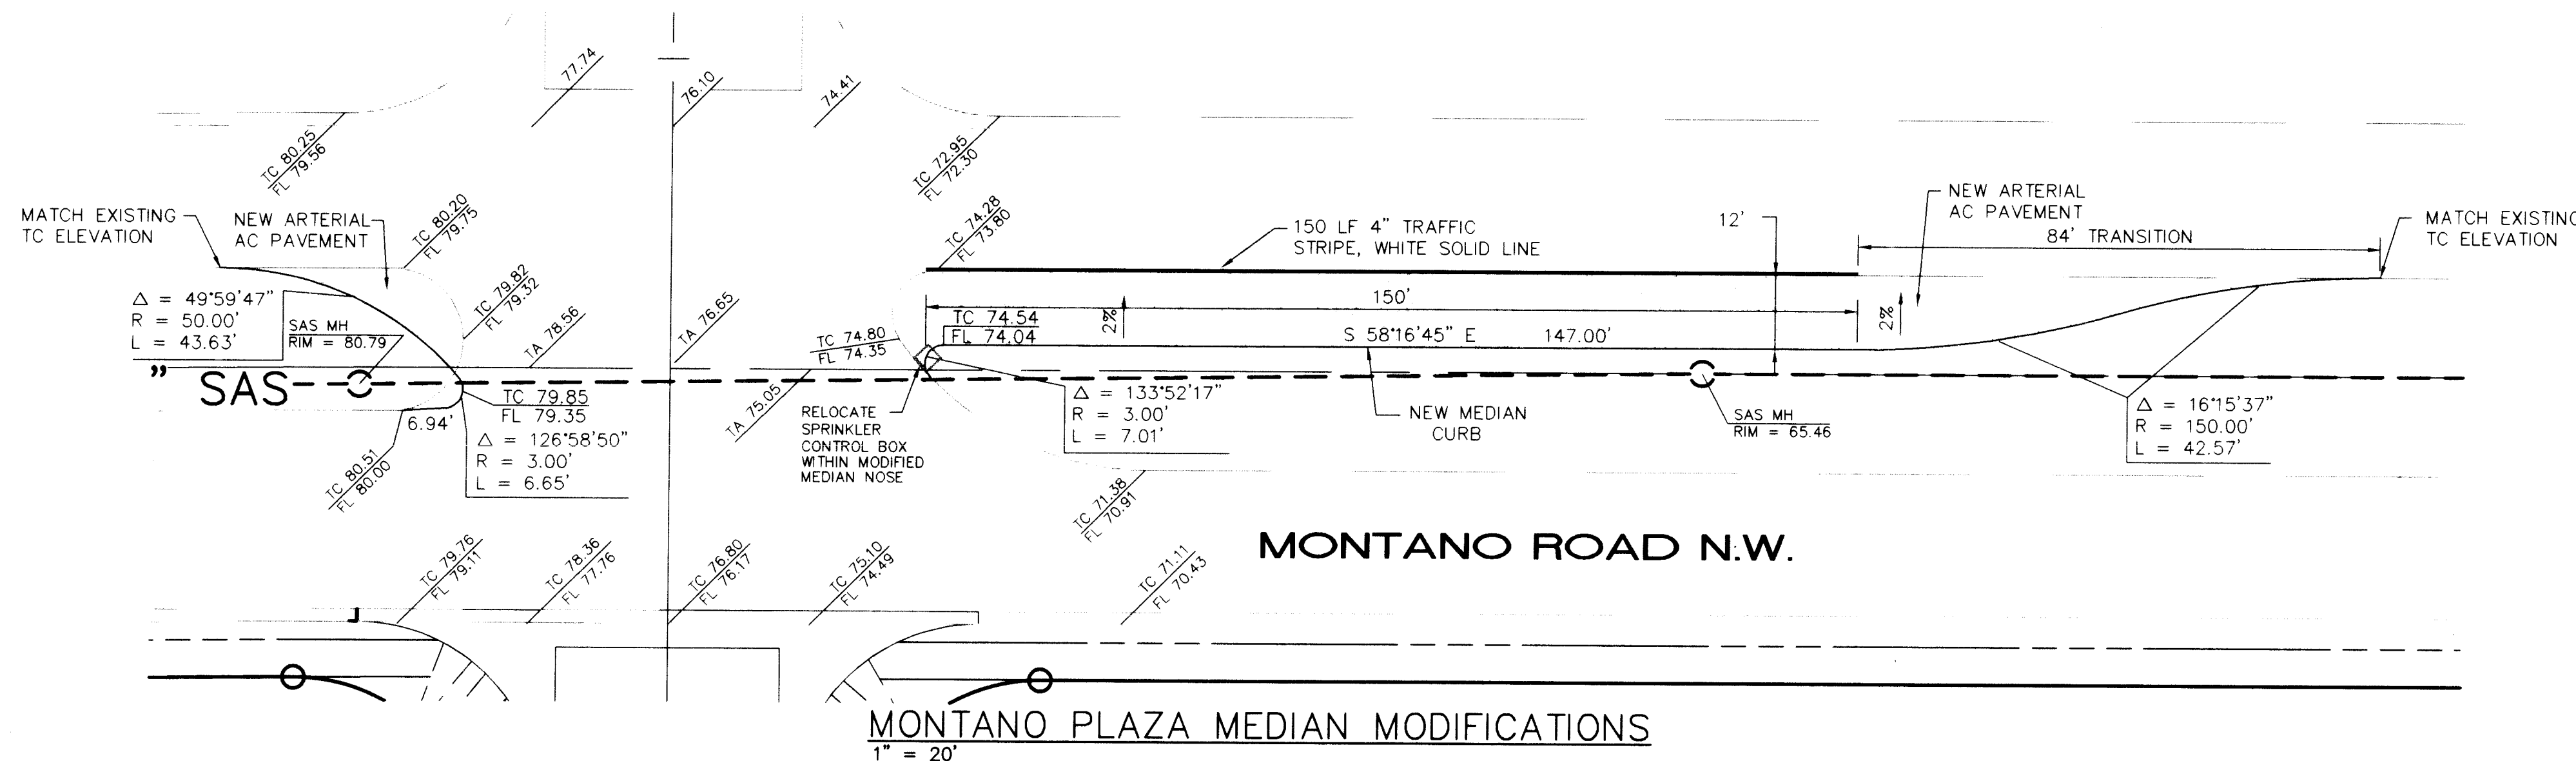

MONTANO PLAZA MEDIAN MODIFICATIONS
1" = 20'

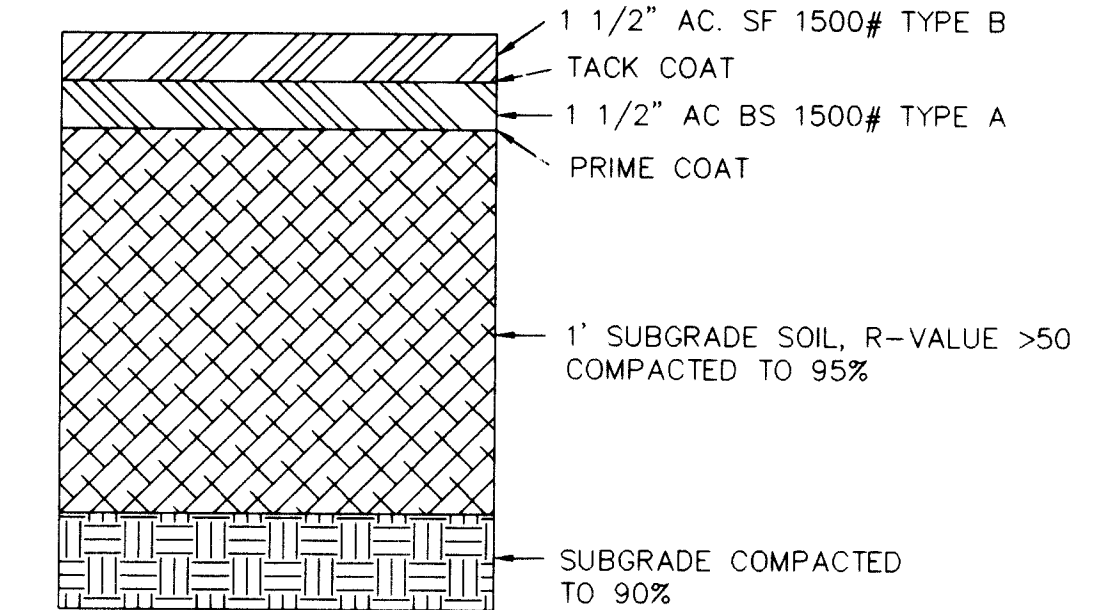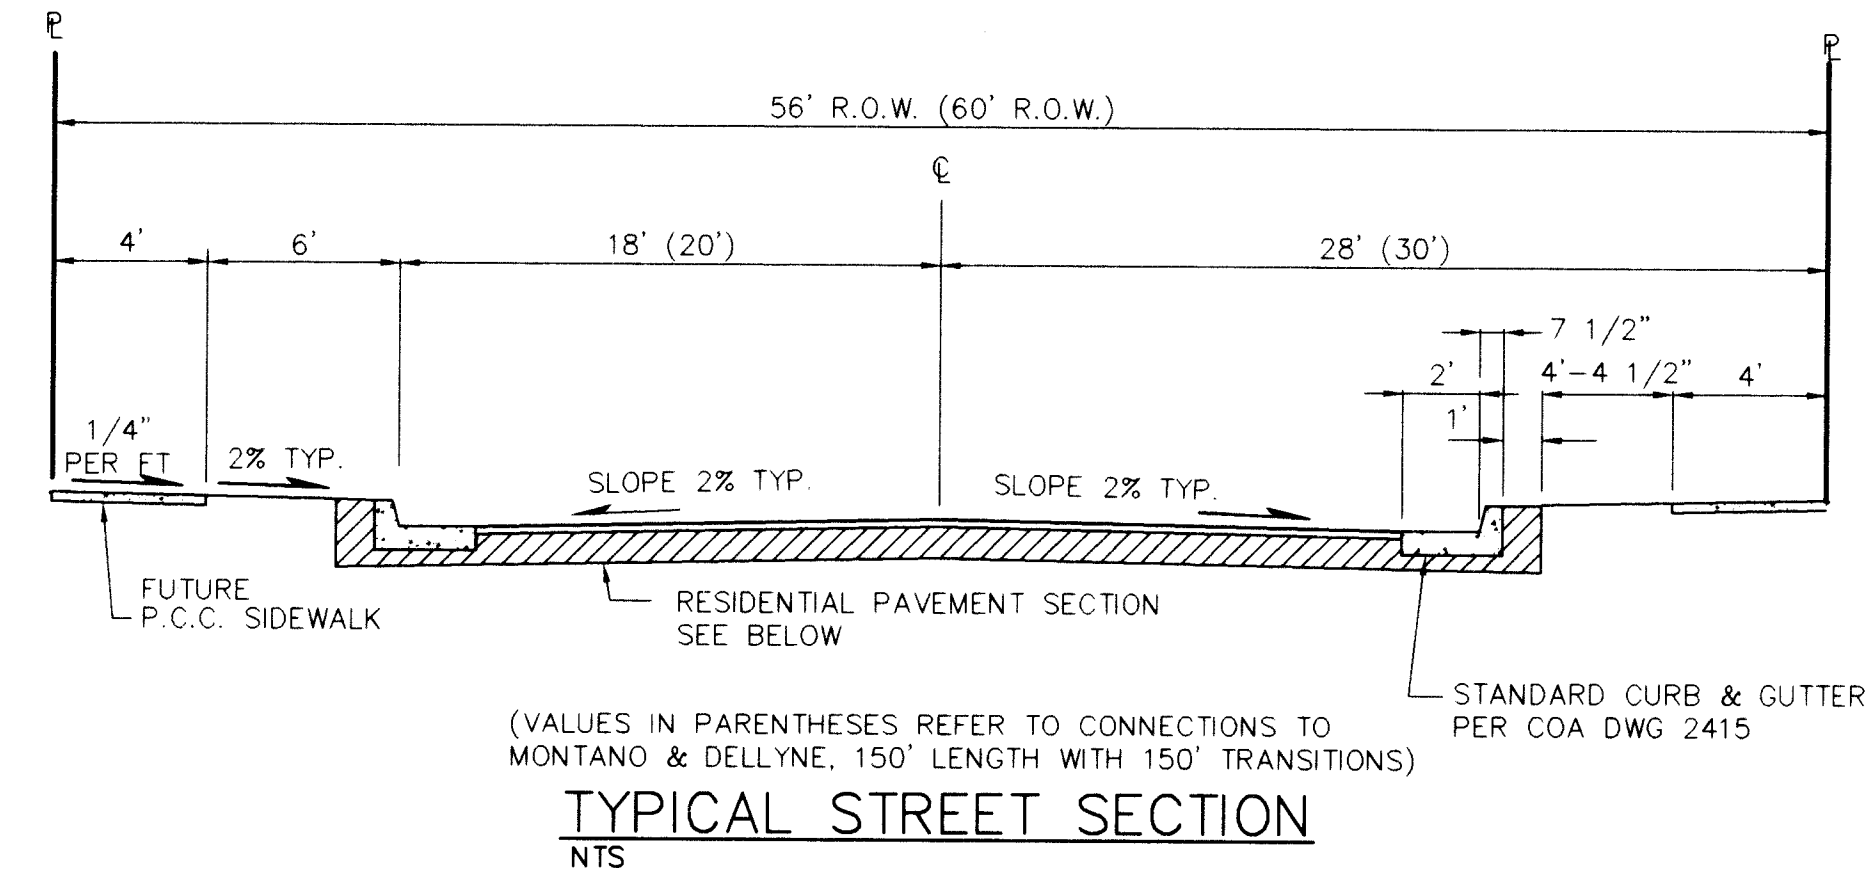

PAVING SECTION
NTS

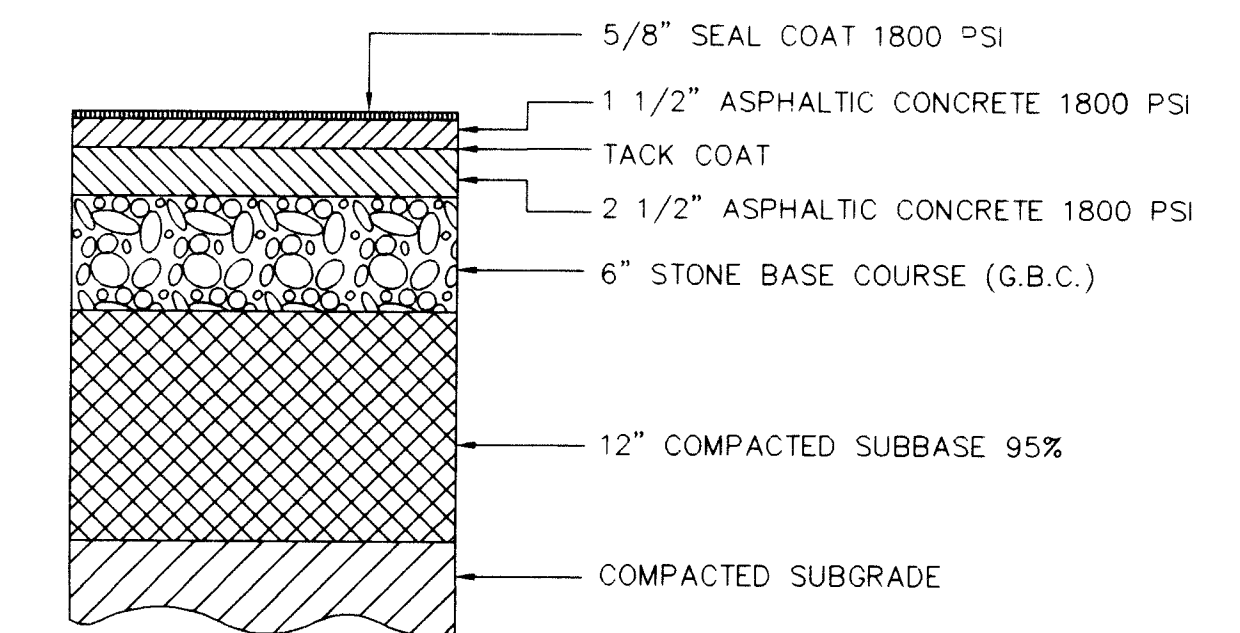

ARTERIAL PAVEMENT SECTION
NTS

24-49118.90 12395

ISAACSON & ARFMAN, P.A.
Consulting Engineering Associates
128 Monroe Street N.E.
Albuquerque New Mexico
746PVDL.DWGwe 7/12/94

CITY OF ALBUQUERQUE
PUBLIC WORKS DEPARTMENT
ENGINEERING GROUP


TITLE: TAYLOR RIDGE SUBDIVISION
MEDIAN AND PAVING DETAILS

APPROVALS	ENGINEER	DATE	APPROVALS	ENGINEER	DATE
DRC CHAIRMAN	NA	9-12-94	WATER	NA	9-12-94
TRANSPORTATION	NA	9-12-94	WASTE WATER	NA	9-12-94
HYDROLOGY	NA	9-12-94			

PROJECT NO. 4918.90 MAP NO. E-12 SHEET 23 OF 23


SCANNED BY LASON

AS-BUILT INFORMATION		BENCH MARKS		SURVEY INFORMATION		ENGINEER'S SEAL	
CONTRACTOR	CCM, INC.	DATE	4/12	DATE	2/93	NO.	1
WORK	AS, INC.	DATE	4/12	BY	W.P.	REMARKS	DESIGN
FIELD	AS, INC.	DATE	4/12	DATE		NO.	
ACCEPTANCE	AS, INC.	DATE	4/12	DATE		NO.	
REVISIONS	AS, INC.	DATE	4/12	DATE		NO.	
CORRECTED BY	AS, INC.	DATE	4/12	DATE		NO.	
RECORDED BY	AS, INC.	DATE	4/12	DATE		NO.	
ELEVATION = 5006.41							

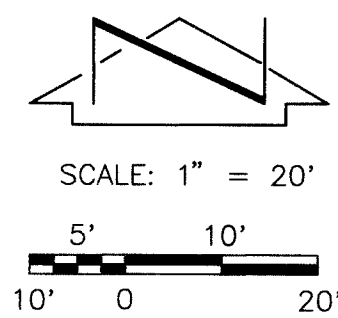

LEGEND

- EXISTING SANITARY SEWER M.H.
- EXISTING SANITARY SEWER
- PROPOSED SANITARY SEWER M.H.
- PROPOSED SANITARY SEWER
- EXISTING WATER LINE
- PROPOSED WATER LINE
- EXISTING WATER VALVE
- PROPOSED WATER VALVE

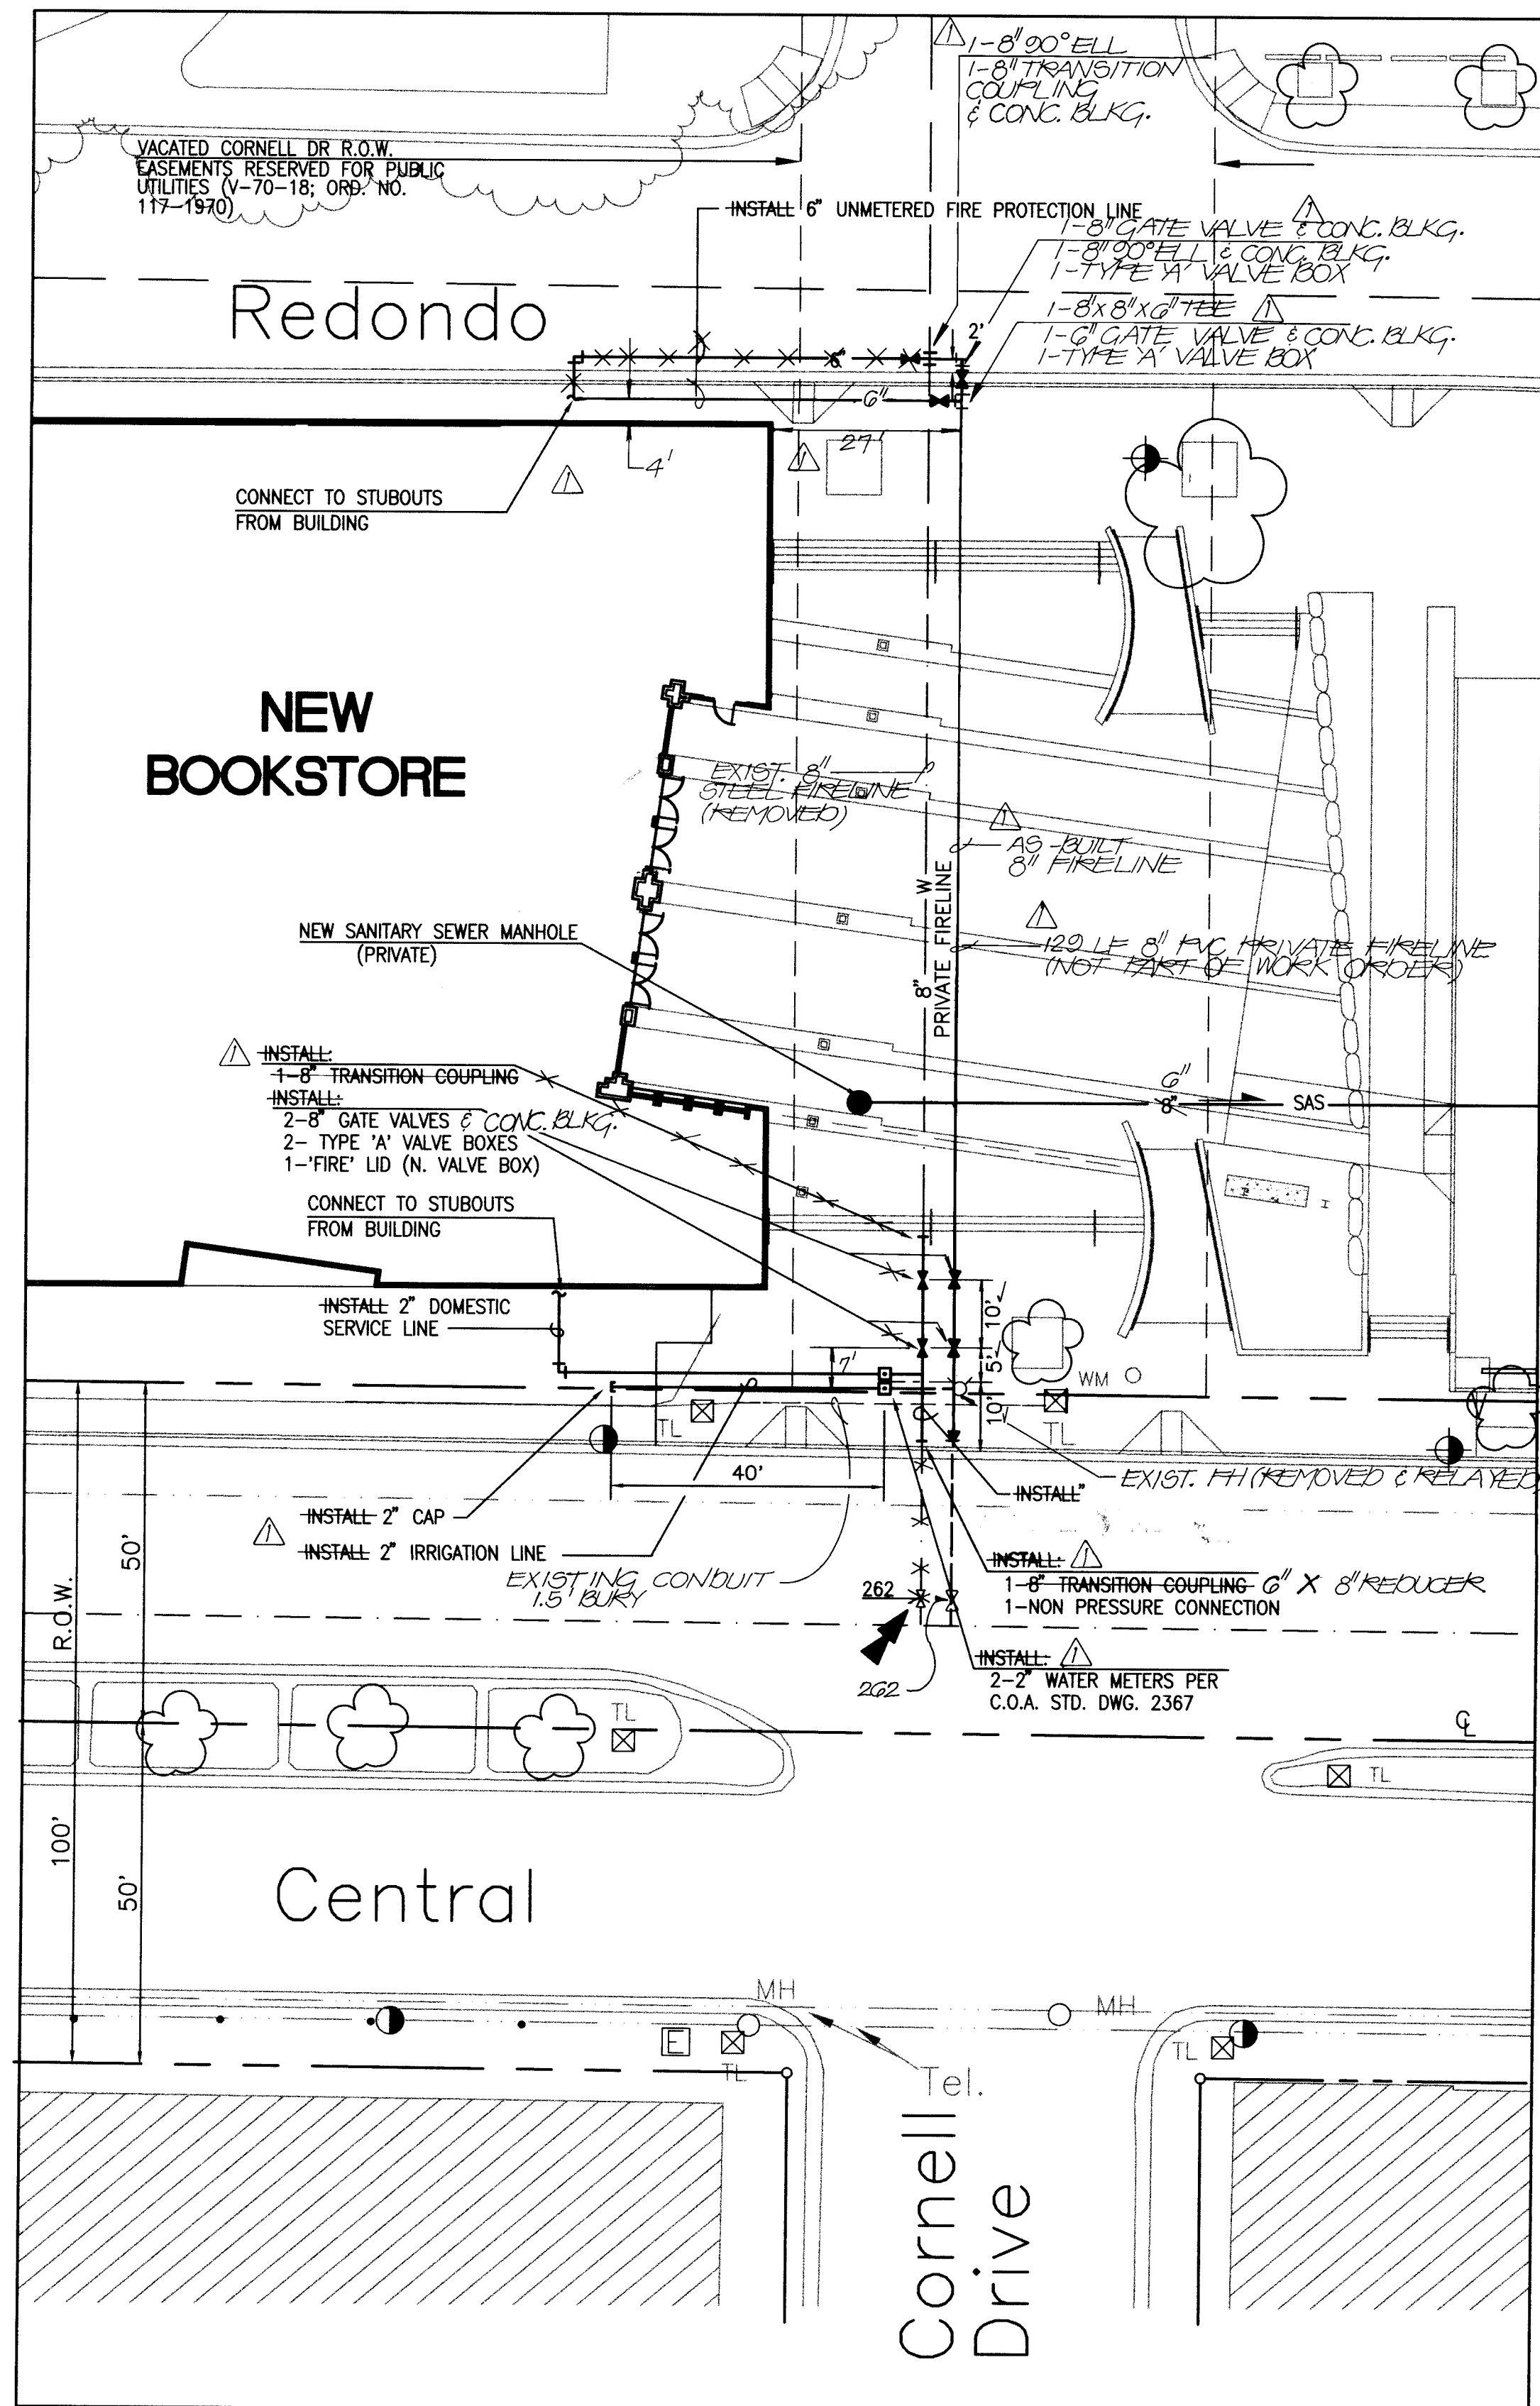

WATER VALVE SHUTOFF PLAN NOTES:



- AS A MINIMUM, THE FOLLOWING VALVES SHALL BE CLOSED TO FACILITATE THE NON-PRESSURE CONNECTION:
- THE CONTRACTOR SHALL NOTIFY WATER SYSTEMS THREE (3) WORKING DAYS IN ADVANCE OF ANY WORK THAT MAY AFFECT EXISTING WATERLINE. ALL SHUTOFFS SHALL BE PERFORMED BY THE WATER SYSTEM DIVISION PERSONNEL (857-8200)
- THE CONTRACTOR SHALL PROVIDE ALL RESTRAINTS AND THRUST BLOCKS NECESSARY TO EFFECT THE NECESSARY SHUTOFFS AND CONNECTIONS.
- EXISTING WATER VALVE AND WATERLINE INFORMATION OBTAINED FROM CITY OF ALBUQUERQUE AUTOMATED WATER DISTRIBUTION SYSTEM SECTIONAL MAPS, PLATE K-16.

NOTE:

SIDEWALK REMOVALS AND REPLACEMENT BY SEPARATE PERMIT.


RECORD DRAWING

I, Jeffrey G. Mortensen, Registered Professional Engineer in the State of New Mexico, do hereby certify that this "as-built" information was obtained by me or under my supervision and represents the "as-built" conditions of this project, and is true and correct to the best of my knowledge and belief. All vertical and horizontal dimensions should be field verified prior to use on future projects.

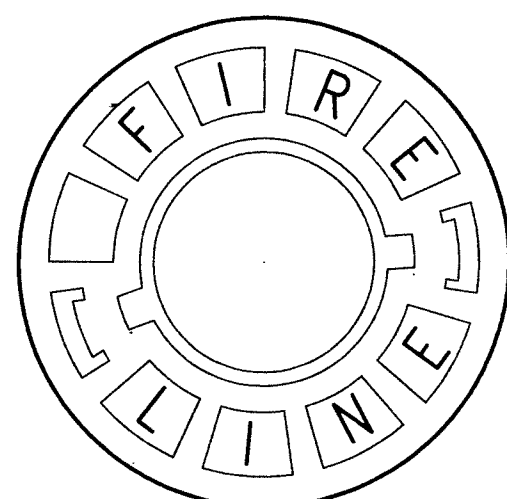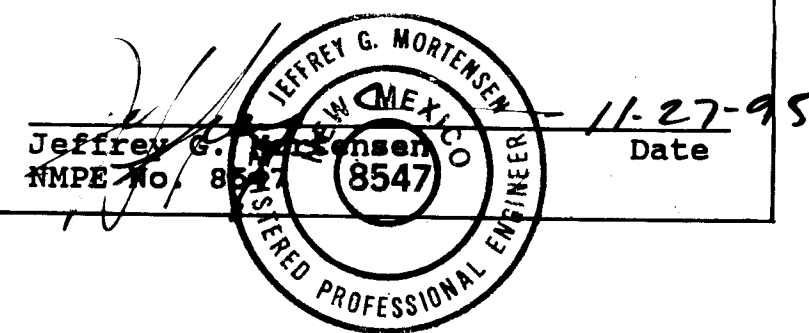

FIRELINE VALVE BOX LID
NO SCALE

RECORD DRAWING

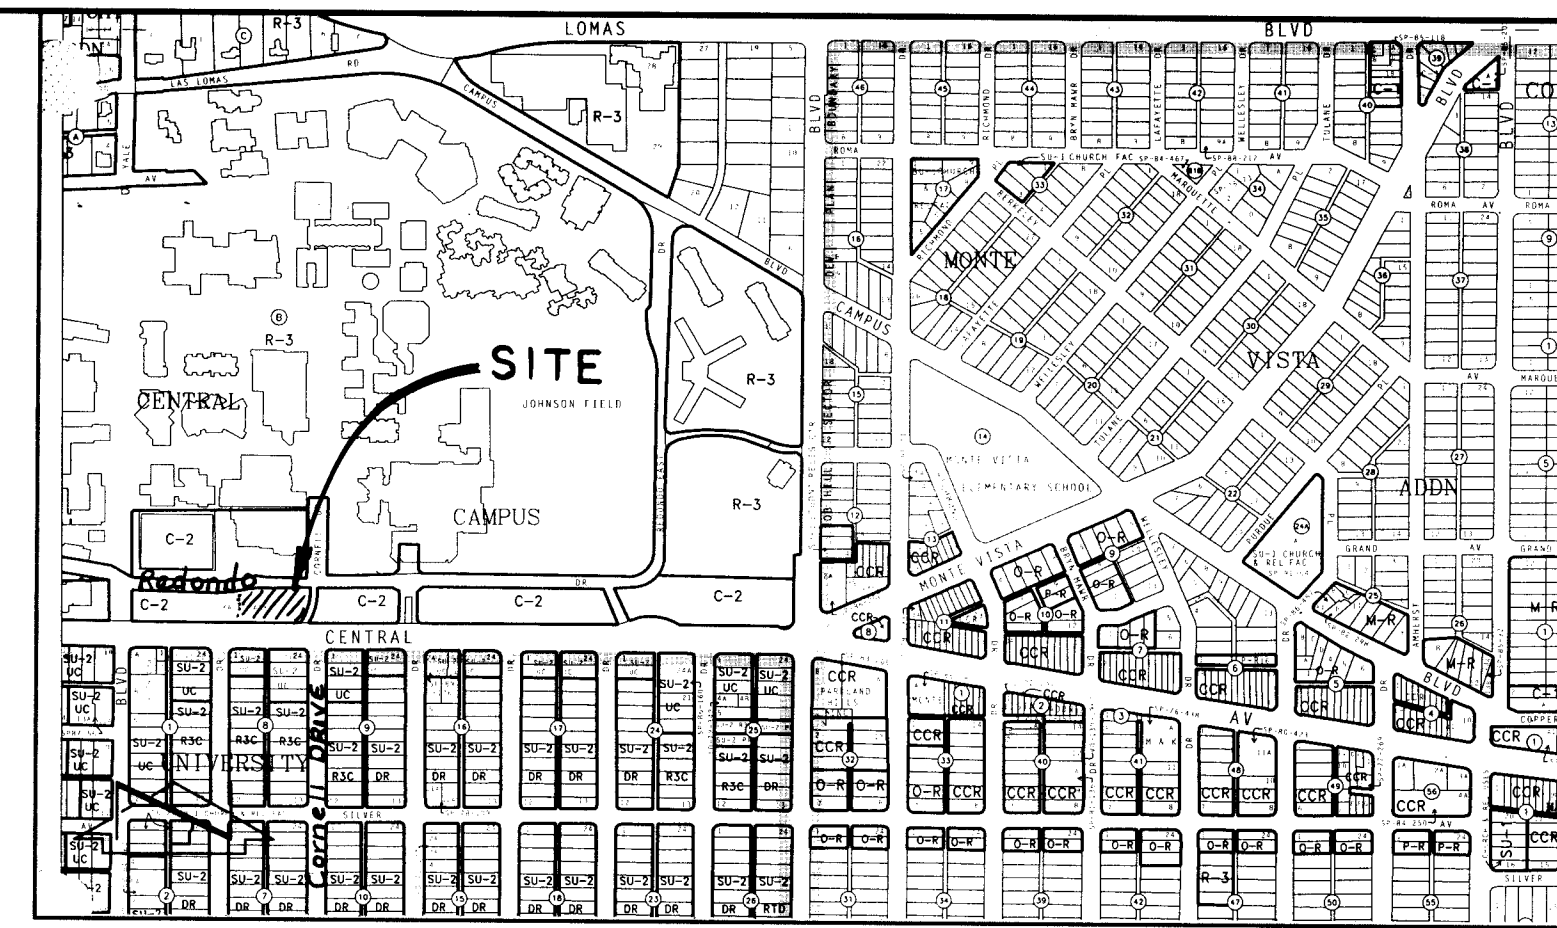


VICINITY MAP

SCALE: 1" = 750'

GENERAL NOTES:

- ALL WORK DETAILED ON THESE PLANS TO BE PERFORMED UNDER CONTRACT SHALL, EXCEPT AS OTHERWISE STATED OR PROVIDED FOR HEREON, BE CONSTRUCTED IN ACCORDANCE WITH THE CITY OF ALBUQUERQUE STANDARD SPECIFICATIONS - PUBLIC WORKS CONSTRUCTION - 1986. (UPDATE NO.5)
- TWO (2) WORKING DAYS PRIOR TO ANY EXCAVATION, CONTRACTOR MUST CONTACT NEW MEXICO ONE CALL SYSTEM, 260-1990, FOR LOCATION OF EXISTING UTILITIES.
- IF ANY UTILITY LINES, PIPELINES, OR UNDERGROUND UTILITY LINES ARE SHOWN ON THESE DRAWINGS, THEY ARE SHOWN IN AN APPROXIMATE MANNER ONLY, AND SUCH LINES MAY EXIST WHERE NONE ARE SHOWN. IF ANY SUCH EXISTING LINES ARE SHOWN, THE LOCATION IS BASED UPON INFORMATION PROVIDED BY THE OWNER OF SAID UTILITY, AND THE INFORMATION MAY BE INCOMPLETE, OR MAY BE OBSOLETE BY THE TIME CONSTRUCTION COMMENCES. THE ENGINEER HAS CONDUCTED ONLY PRELIMINARY INVESTIGATION OF THE LOCATION, DEPTH, SIZE, OR TYPE OF EXISTING UTILITY LINES, PIPELINES, OR UNDERGROUND UTILITY LINES. THIS INVESTIGATION IS NOT CONCLUSIVE, AND MAY NOT BE COMPLETE, THEREFORE, MAKES NO REPRESENTATION PERTAINING THERETO, AND ASSUMES NO RESPONSIBILITY OR LIABILITY THEREFOR. THE CONTRACTOR SHALL INFORM ITSELF OF THE LOCATION OF ANY UTILITY LINE, PIPELINE, OR UNDERGROUND UTILITY LINE IN OR NEAR THE AREA OF THE WORK IN ADVANCE OF AND DURING EXCAVATION WORK. THE CONTRACTOR IS FULLY RESPONSIBLE FOR ANY AND ALL DAMAGE CAUSED BY ITS FAILURE TO LOCATE, IDENTIFY AND PRESERVE ANY AND ALL EXISTING UTILITIES, PIPELINES, AND UNDERGROUND UTILITY LINES. IN PLANNING AND CONDUCTING EXCAVATION, THE CONTRACTOR SHALL COMPLY WITH STATE STATUTES, MUNICIPAL AND LOCAL ORDINANCES, RULES AND REGULATIONS, IF ANY, PERTAINING TO THE LOCATION OF THESE LINES AND FACILITIES.
- SHOULD A CONFLICT EXIST BETWEEN THESE PLANS AND ACTUAL FIELD CONDITIONS, THE CONTRACTOR SHALL PROMPTLY NOTIFY THE ENGINEER IN WRITING SO THAT THE CONFLICT CAN BE RESOLVED WITH A MINIMUM AMOUNT OF DELAY FOR ALL PARTIES.
- THE CONTRACTOR SHALL MAINTAIN ACCESS TO ADJACENT PROPERTIES DURING CONSTRUCTION.
- ALL WORK ON THIS PROJECT SHALL BE PERFORMED IN ACCORDANCE WITH APPLICABLE FEDERAL, STATE AND LOCAL LAWS, RULES AND REGULATIONS CONCERNING SAFETY AND HEALTH.
- ALL UTILITIES AND UTILITY SERVICE LINES SHALL BE INSTALLED PRIOR TO PAVING.
- BACKFILL COMPACTION SHALL BE ACCORDING TO SPECIFIED STREET USE.
- TACK COAT REQUIREMENTS SHALL BE DETERMINED DURING CONSTRUCTION BY THE PROJECT ENGINEER.
- SIDEWALKS AND WHEELCHAIR RAMPS WITHIN THE CURB RETURNS SHALL BE CONSTRUCTED WHEREVER A NEW CURB RETURN IS CONSTRUCTED.
- IF CURB IS DEEPER FOR A DRIVEPAD OR A HANDICAP RAMP, THE DRIVEPAD OR RAMP SHALL BE CONSTRUCTED PRIOR TO ACCEPTANCE OF THE CURB AND GUTTER.
- ALL STORM DRAINAGE FACILITIES SHALL BE COMPLETED PRIOR TO FINAL ACCEPTANCE.
- CONTRACTOR SHALL NOTIFY THE CITY SURVEYOR NOT LESS THAN SEVEN (7) DAYS PRIOR TO STARTING WORK IN ORDER THAT THE CITY SURVEYOR MAY TAKE NECESSARY MEASURES TO INSURE THE PRESERVATION OF SURVEY MONUMENTS. CONTRACTOR SHALL NOT DISTURB PERMANENT SURVEY MONUMENTS WITHOUT THE CONSENT OF THE CITY SURVEYOR AND SHALL NOTIFY THE CITY SURVEYOR AND BEAR THE EXPENSE OF REPLACING ANY THAT MAY BE DISTURBED WITHOUT PERMISSION. REPLACEMENT SHALL BE DONE ONLY BY THE CITY SURVEYOR. WHEN A CHANGE IS MADE IN THE FINISHED ELEVATION OF THE PAVEMENT OF ANY ROADWAY IN WHICH A PERMANENT SURVEY MONUMENT IS LOCATED, CONTRACTOR SHALL, AT HIS OWN EXPENSE, ADJUST THE MONUMENT COVER TO THE NEW GRADE UNLESS OTHERWISE SPECIFIED. REFER TO SECTION 4.4 OF THE SPECIFICATIONS.
- THREE (3) WORKING DAYS PRIOR TO BEGINNING CONSTRUCTION THE CONTRACTOR SHALL SUBMIT TO THE CONSTRUCTION CO-ORDINATION DIVISION A DETAILED CONSTRUCTION SCHEDULE. TWO (2) WORKING DAYS PRIOR TO CONSTRUCTION THE CONTRACTOR SHALL OBTAIN A BARRICADING PERMIT FROM THE CONSTRUCTION CO-ORDINATION DIVISION. CONTRACTOR SHALL NOTIFY BARRICADE ENGINEER (768-2551) PRIOR TO OCCUPYING AN INTERSECTION. CONTRACTOR MUST REFER TO SECTION 19 OF THE STANDARD SPECIFICATION FOR TRAFFIC CONTROL.
- ALL STREET STRIPING ALTERED OR DESTROYED SHALL BE REPLACED. IN KIND BY CONTRACTOR TO LOCATION AND IN KIND AS EXISTING OR AS INDICATED BY THIS PLAN SET.
- CAUTION: THESE DRAWINGS DO NOT INCLUDE NECESSARY COMPONENTS FOR CONSTRUCTION SAFETY WHICH SHALL REMAIN THE RESPONSIBILITY OF THE CONTRACTOR.
- ANY WORK OCCURRING WITHIN AN ARTERIAL ROADWAY REQUIRES TWENTY-FOUR HOUR CONSTRUCTION.
- ALL UTILITIES ENCOUNTERED WITHIN THE WORK AREA SHALL BE ADJUSTED TO GRADE. ALL COSTS INCURRED IN MAKING THE ADJUSTMENTS SHALL BE CONSIDERED INCIDENTAL TO CONSTRUCTION, THEREFORE, NO SEPARATE PAYMENT WILL BE MADE.

2025.09.02 01/19/95

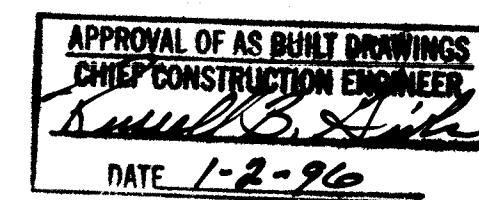

JEFF MORTENSEN & ASSOCIATES, INC.
6010-B MIDWAY PARK BLVD. N.E.
ALBUQUERQUE, NEW MEXICO 87109
ENGINEERS SURVEYORS (505) 345-4250


SCANNED BY 930085
BY LASON

CITY OF ALBUQUERQUE PUBLIC WORKS DEPARTMENT ENGINEERING GROUP			
TITLE: UNUM BOOKSTORE PRIVATE FIRELINE AND WATER SERVICE			
APPROVALS	ENGINEER	DATE	APPROVALS
DRC CHAIRMAN	BO. G. G. 8-18-95		ENGINEER
TRANSPORTATION	7-25-95		WATER
HYDROLOGY	7-25-95		WASTE WATER
PROJECT NO. 5253.90		MAP NO. K-16	
SHEET 1		OF 1	

• L E G E N D •


MATERIALS

CONCRETE
RIP-RAP

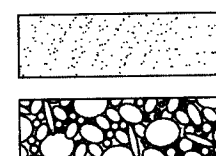


LINES

SUBDIVISION BOUNDARY
PROPERTY LINE (PLAN)
PROPERTY LINE (SECTION)
CENTERLINE
EASEMENT LINE
MATCH LINE
SECTION CUT LINE

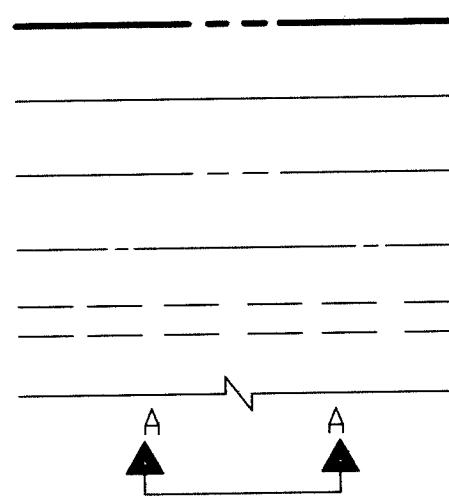


EARTHWORK

CONTOUR LINE
SPOT ELEVATION
PROJECT / PHASE BOUNDARY
FLOWLINE
DIRECTION OF FLOW

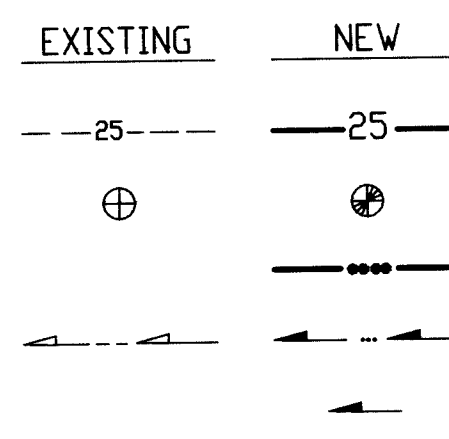


MISCELLANEOUS UTILITIES

GAS LINE
UNDERGROUND TELEPHONE
UNDERGROUND ELECTRICAL
STORM DRAIN
STORM DRAIN MANHOLE
STORM DRAIN INLET

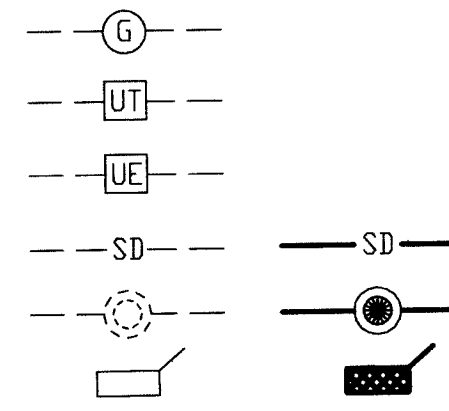


SANITARY SEWER

SANITARY SEWER LINE
SANITARY SEWER MANHOLE
SAS SERVICE CONNECTIONS
SAS CAP OR PLUG
ENCASEMENT

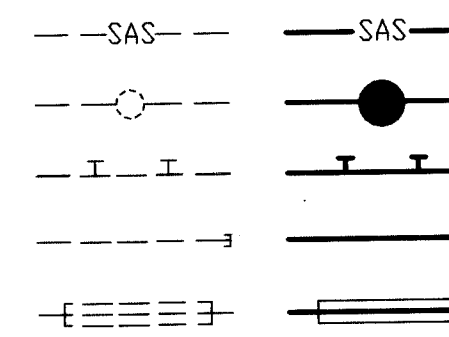


WATER

WATER LINE
WATER SERVICE CONNECTIONS
GATE VALVE
FIRE HYDRANT
BUTTERFLY VALVE
REDUCER
WATER PRESSURE ZONE BOUNDARY

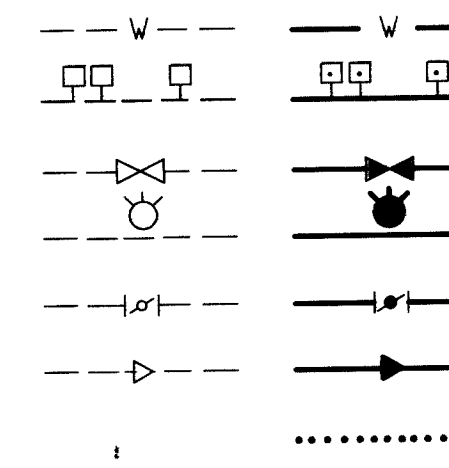


WATER FITTINGS

CAPS AND PLUGS
ELBOW
CROSS
TEE

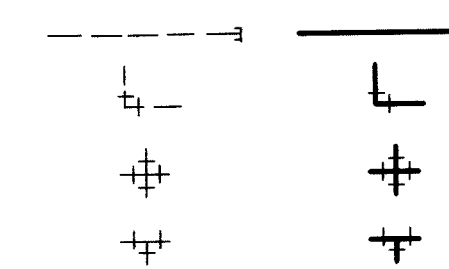

MISCELLANEOUS

CHAINLINK FENCE
FIELD FENCE
COMMON YARD WALL
RETAINING WALL
POWER OR TELEPHONE POLE

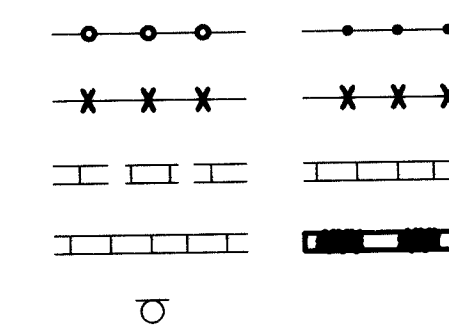

CONSTRUCTION PLANS
for
LOT 1, BLOCK A
KIRTLAND ADDITION
WATER AND SANITARY
SEWER EXTENSIONS
ALBUQUERQUE, NEW MEXICO
AUGUST, 1995



INDEX OF DRAWINGS

SHEET	DESCRIPTION
1	COVER SHEET, VICINITY MAP, GENERAL NOTES, LEGEND AND INDEX OF DRAWINGS
2	TOPOGRAPHIC SURVEY (FOR INFORMATION ONLY)
3	PUBLIC ALLEY SANITARY SEWER LINE EXTENSION
4	WALKER DRIVE S.E. WATERLINE EXTENSION
5	SIGNING AND CONSTRUCTION TRAFFIC CONTROL STANDARDS
6	TYPICAL TRAFFIC CONTROL AND SIGNING EXAMPLES

RECORD DRAWING


RECORD DRAWING

I, Jeffrey G. Mortensen, Registered Professional Engineer in the State of New Mexico, do hereby certify that this "as-built" information was obtained by me or under my supervision and represents the "as-built" conditions of this project, and is true and correct to the best of my knowledge and belief. All vertical and horizontal dimensions should be field verified prior to use on future projects.

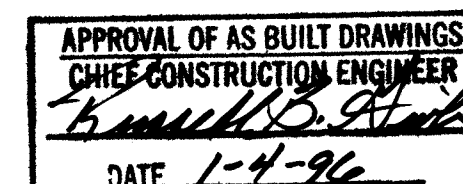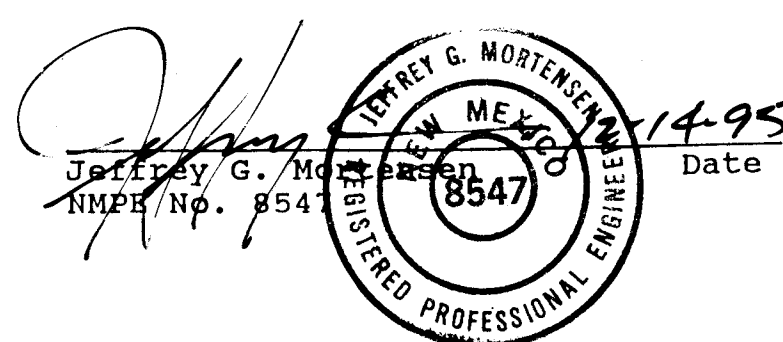

1 2 3 4 5 6 7 8 9 10 11 12 13 14 15
26-5283.90 01/19/95

SCANNED BY
BY LASON 940866

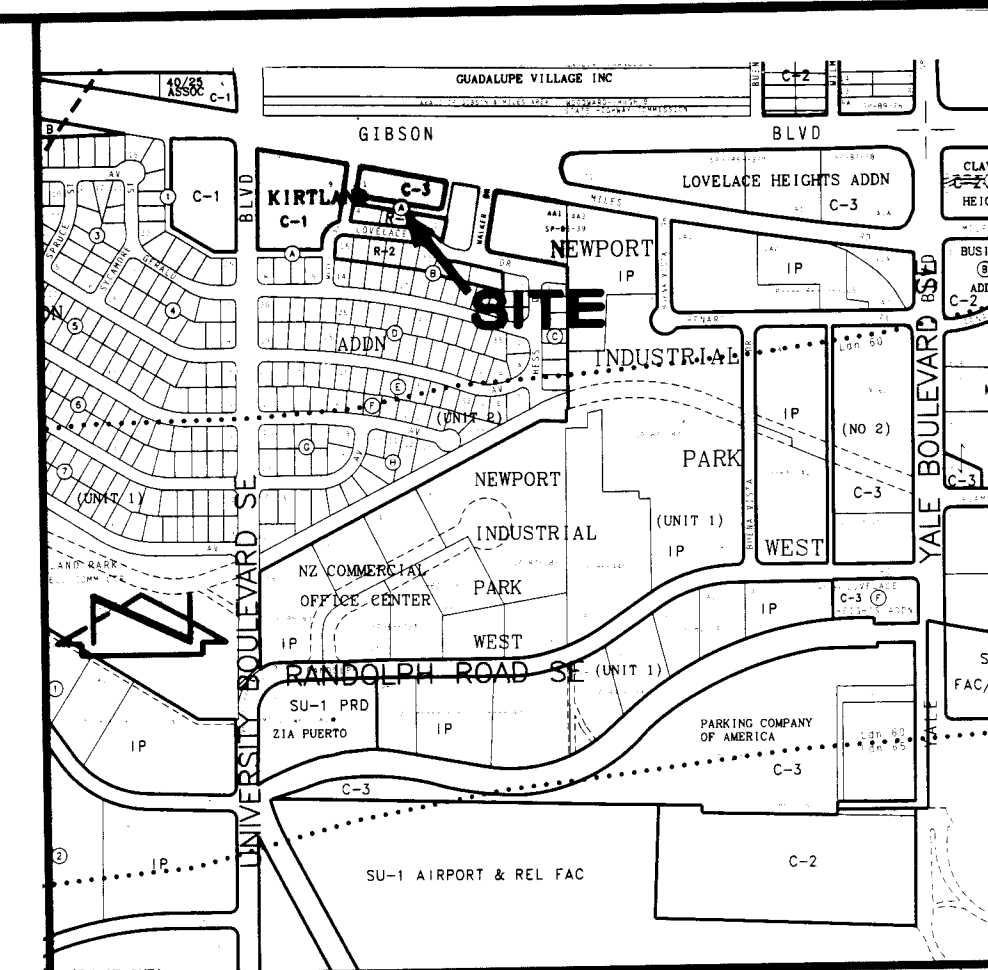

VICINITY MAP
SCALE: 1" = 750'

M-15

GENERAL NOTES

- ALL WORK DETAILED ON THESE PLANS TO BE PERFORMED UNDER CONTRACT SHALL, EXCEPT AS OTHERWISE STATED OR PROVIDED FOR HEREON, BE CONSTRUCTED IN ACCORDANCE WITH THE CITY OF ALBUQUERQUE STANDARD SPECIFICATIONS-PUBLIC WORKS CONSTRUCTION-1986 (UPDATE NO. 6).
- TWO (2) WORKING DAYS PRIOR TO ANY EXCAVATION, CONTRACTOR MUST CONTACT NEW MEXICO ONE CALL SYSTEM, 260-1990, FOR LOCATION OF EXISTING UTILITIES.
- IF ANY UTILITY LINES, PIPELINES, OR UNDERGROUND UTILITY LINES ARE SHOWN ON THESE DRAWINGS, THEY ARE SHOWN IN AN APPROXIMATE MANNER ONLY, AND SUCH LINES MAY EXIST WHERE NONE ARE SHOWN. IF ANY SUCH EXISTING LINES ARE SHOWN, THE LOCATION IS BASED UPON INFORMATION PROVIDED BY THE OWNER OF SAID UTILITY, AND THE INFORMATION MAY BE INCOMPLETE, OR MAY BE OBSOLETE BY THE TIME CONSTRUCTION COMMENCES. THE ENGINEER HAS CONDUCTED ONLY PRELIMINARY INVESTIGATION OF THE LOCATION, DEPTH, SIZE, OR TYPE OF EXISTING UTILITY LINES, PIPELINES, OR UNDERGROUND UTILITY LINES. THIS INVESTIGATION IS NOT CONCLUSIVE, AND MAY NOT BE COMPLETE, THEREFORE, MAKES NO REPRESENTATION PERTAINING THERETO, AND ASSUMES NO RESPONSIBILITY OR LIABILITY THEREFOR. THE CONTRACTOR SHALL INFORM ITSELF OF THE LOCATION OF ANY UTILITY LINE, PIPELINE, OR UNDERGROUND UTILITY LINE IN OR NEAR THE AREA OF THE WORK IN ADVANCE OF AND DURING EXCAVATION WORK. THE CONTRACTOR IS FULLY RESPONSIBLE FOR ANY AND ALL DAMAGE CAUSED BY ITS FAILURE TO LOCATE, IDENTIFY AND PRESERVE ANY AND ALL EXISTING UTILITIES, PIPELINES, AND UNDERGROUND UTILITY LINES. IN PLANNING AND CONDUCTING EXCAVATION, THE CONTRACTOR SHALL COMPLY WITH STATE STATUTES, MUNICIPAL AND LOCAL ORDINANCES, RULES AND REGULATIONS, IF ANY, PERTAINING TO THE LOCATION OF THESE LINES AND FACILITIES.
- SHOULD A CONFLICT EXIST BETWEEN THESE PLANS AND ACTUAL FIELD CONDITIONS, THE CONTRACTOR SHALL PROMPTLY NOTIFY THE ENGINEER IN WRITING SO THAT THE CONFLICT CAN BE RESOLVED WITH A MINIMUM AMOUNT OF DELAY FOR ALL PARTIES.
- THE CONTRACTOR SHALL MAINTAIN ACCESS TO ADJACENT PROPERTIES DURING CONSTRUCTION.
- ALL WORK ON THIS PROJECT SHALL BE PERFORMED IN ACCORDANCE WITH APPLICABLE FEDERAL, STATE AND LOCAL LAWS, RULES AND REGULATIONS CONCERNING SAFETY AND HEALTH.
- ALL UTILITIES AND UTILITY SERVICE LINES SHALL BE INSTALLED PRIOR TO PAVING.
- BACKFILL COMPACTION SHALL BE ACCORDING TO SPECIFIED STREET USE.
- TACK COAT REQUIREMENTS SHALL BE DETERMINED DURING CONSTRUCTION BY THE PROJECT ENGINEER.
- SIDEWALKS AND WHEELCHAIR RAMPS WITHIN THE CURB RETURNS SHALL BE CONSTRUCTED WHEREVER A NEW CURB RETURN IS CONSTRUCTED.
- IF CURB IS DEPRESSED FOR A DRIVEPAD OR A HANDICAP RAMP, THE DRIVEPAD OR RAMP SHALL BE CONSTRUCTED PRIOR TO ACCEPTANCE OF THE CURB AND GUTTER.
- ALL STORM DRAINAGE FACILITIES SHALL BE COMPLETED PRIOR TO FINAL ACCEPTANCE.
- CONTRACTOR SHALL COORDINATE WITH NEW MEXICO UTILITIES, INC. FOR THE EXECUTION OF A VALVE SHUT OFF PLAN, NOT LESS THAN THREE (3) WORKING DAYS IN ADVANCE OF ANY WORK THAT MAY AFFECT THE EXISTING PUBLIC WATER UTILITIES. ONLY NMU, INC. PERSONNEL SHALL OPERATE EXISTING VALVES.
- CONTRACTOR SHALL NOTIFY THE CITY SURVEYOR NOT LESS THAN SEVEN (7) DAYS PRIOR TO STARTING WORK IN ORDER THAT THE CITY SURVEYOR MAY TAKE NECESSARY MEASURES TO INSURE THE PRESERVATION OF SURVEY MONUMENTS. CONTRACTOR SHALL NOT DISTURB PERMANENT SURVEY MONUMENTS WITHOUT THE CONSENT OF THE CITY SURVEYOR AND SHALL NOTIFY THE CITY SURVEYOR AND BEAR THE EXPENSE OF REPLACING ANY THAT MAY BE DISTURBED WITHOUT PERMISSION. REPLACEMENT SHALL BE DONE ONLY BY THE CITY SURVEYOR. WHEN A CHANGE IS MADE IN THE FINISHED ELEVATION OF THE PAVEMENT OF ANY ROADWAY IN WHICH A PERMANENT SURVEY MONUMENT IS LOCATED, CONTRACTOR SHALL, AT HIS OWN EXPENSE, ADJUST THE MONUMENT COVER TO THE NEW GRADE UNLESS OTHERWISE SPECIFIED.
- THREE (3) WORKING DAYS PRIOR TO BEGINNING CONSTRUCTION THE CONTRACTOR SHALL SUBMIT TO THE CONSTRUCTION DIVISION A DETAILED CONSTRUCTION SCHEDULE. TWO (2) WORKING DAYS PRIOR TO CONSTRUCTION THE CONTRACTOR SHALL OBTAIN A BARRICADEING PERMIT FROM THE CONSTRUCTION CO-ORDINATION DIVISION. CONTRACTOR SHALL NOTIFY BARRICADE ENGINEER (768-2551) PRIOR TO OCCUPYING AN INTERSECTION. CONTRACTOR MUST REFER TO SECTION 19 OF THE STANDARD SPECIFICATIONS FOR TRAFFIC CONTROL.
- ALL STREET STRIPING ALTERED OR DESTROYED SHALL BE REPLACED IN KIND BY CONTRACTOR TO LOCATION AND IN KIND AS EXISTING OR AS INDICATED BY THIS PLAN SET.
- CAUTION: THESE DRAWINGS DO NOT INCLUDE NECESSARY COMPONENTS FOR CONSTRUCTION SAFETY WHICH SHALL REMAIN THE RESPONSIBILITY OF THE CONTRACTOR.
- ANY WORK OCCURING WITHIN AN ARTERIAL ROADWAY REQUIRES TWENTY-FOUR HOUR CONSTRUCTION.




△	1-8		11/95						
REV.	SHEETS	CITY ENGINEER	DATE	USER	DEPARTMENT	DATE	USER	DEPARTMENT	DATE
APPROVAL OF REVISIONS									

	Jma JEFF MORTENSEN & ASSOCIATES, INC. 6000-B MIDWAY PARK BLVD. SE. ALBUQUERQUE, N.M. 87109 ENGINEERS & SURVEYORS (505) 945-4295	APPROVED FOR CONSTRUCTION <i>Remond</i> C.E.
PROJECT NO. 5283.90		SHEET 1 OF 6

- LEGEND**
- TC TOP OF CURB
 - FL FLOW LINE
 - NG NATURAL GROUND
 - SPOT ELEVATION
 - GUY WIRE/ANCHOR
 - POWER POLE
 - LIGHT POLE
 - MANHOLE
 - CONTROL POINT

PROJECT BENCHMARK = T.B.M.
CITY OF ALBUQUERQUE BENCHMARK "G-9A".
STATION IS STAMPED "ACS-G-9A, 1984". A
3 1/4" ALUMINUM TABLET SET FLUSH IN THE
CONCRETE GUTTER. TO REACH THE STATION
FROM 1-25, TRAVEL EAST ON GIBSON BLVD. 0.7
MILES. AS SHOWN BELOW.
ELEVATION = 5143.07' (M.S.L.D.)


LEGAL DESCRIPTION
LOT 9, BLOCK A, KIRTLAND ADDITION
LOT 1, BLOCK A, KIRTLAND ADDITION
UNPLATTED PARCELS
TRACT 4-A-1, NEWPORT INDUSTRIAL PARK-WEST, UNIT 2
MILES RD. S.E., WALKER DRIVE S.E., AND PUBLIC ALLEYS (VACATED BY V-95-9)

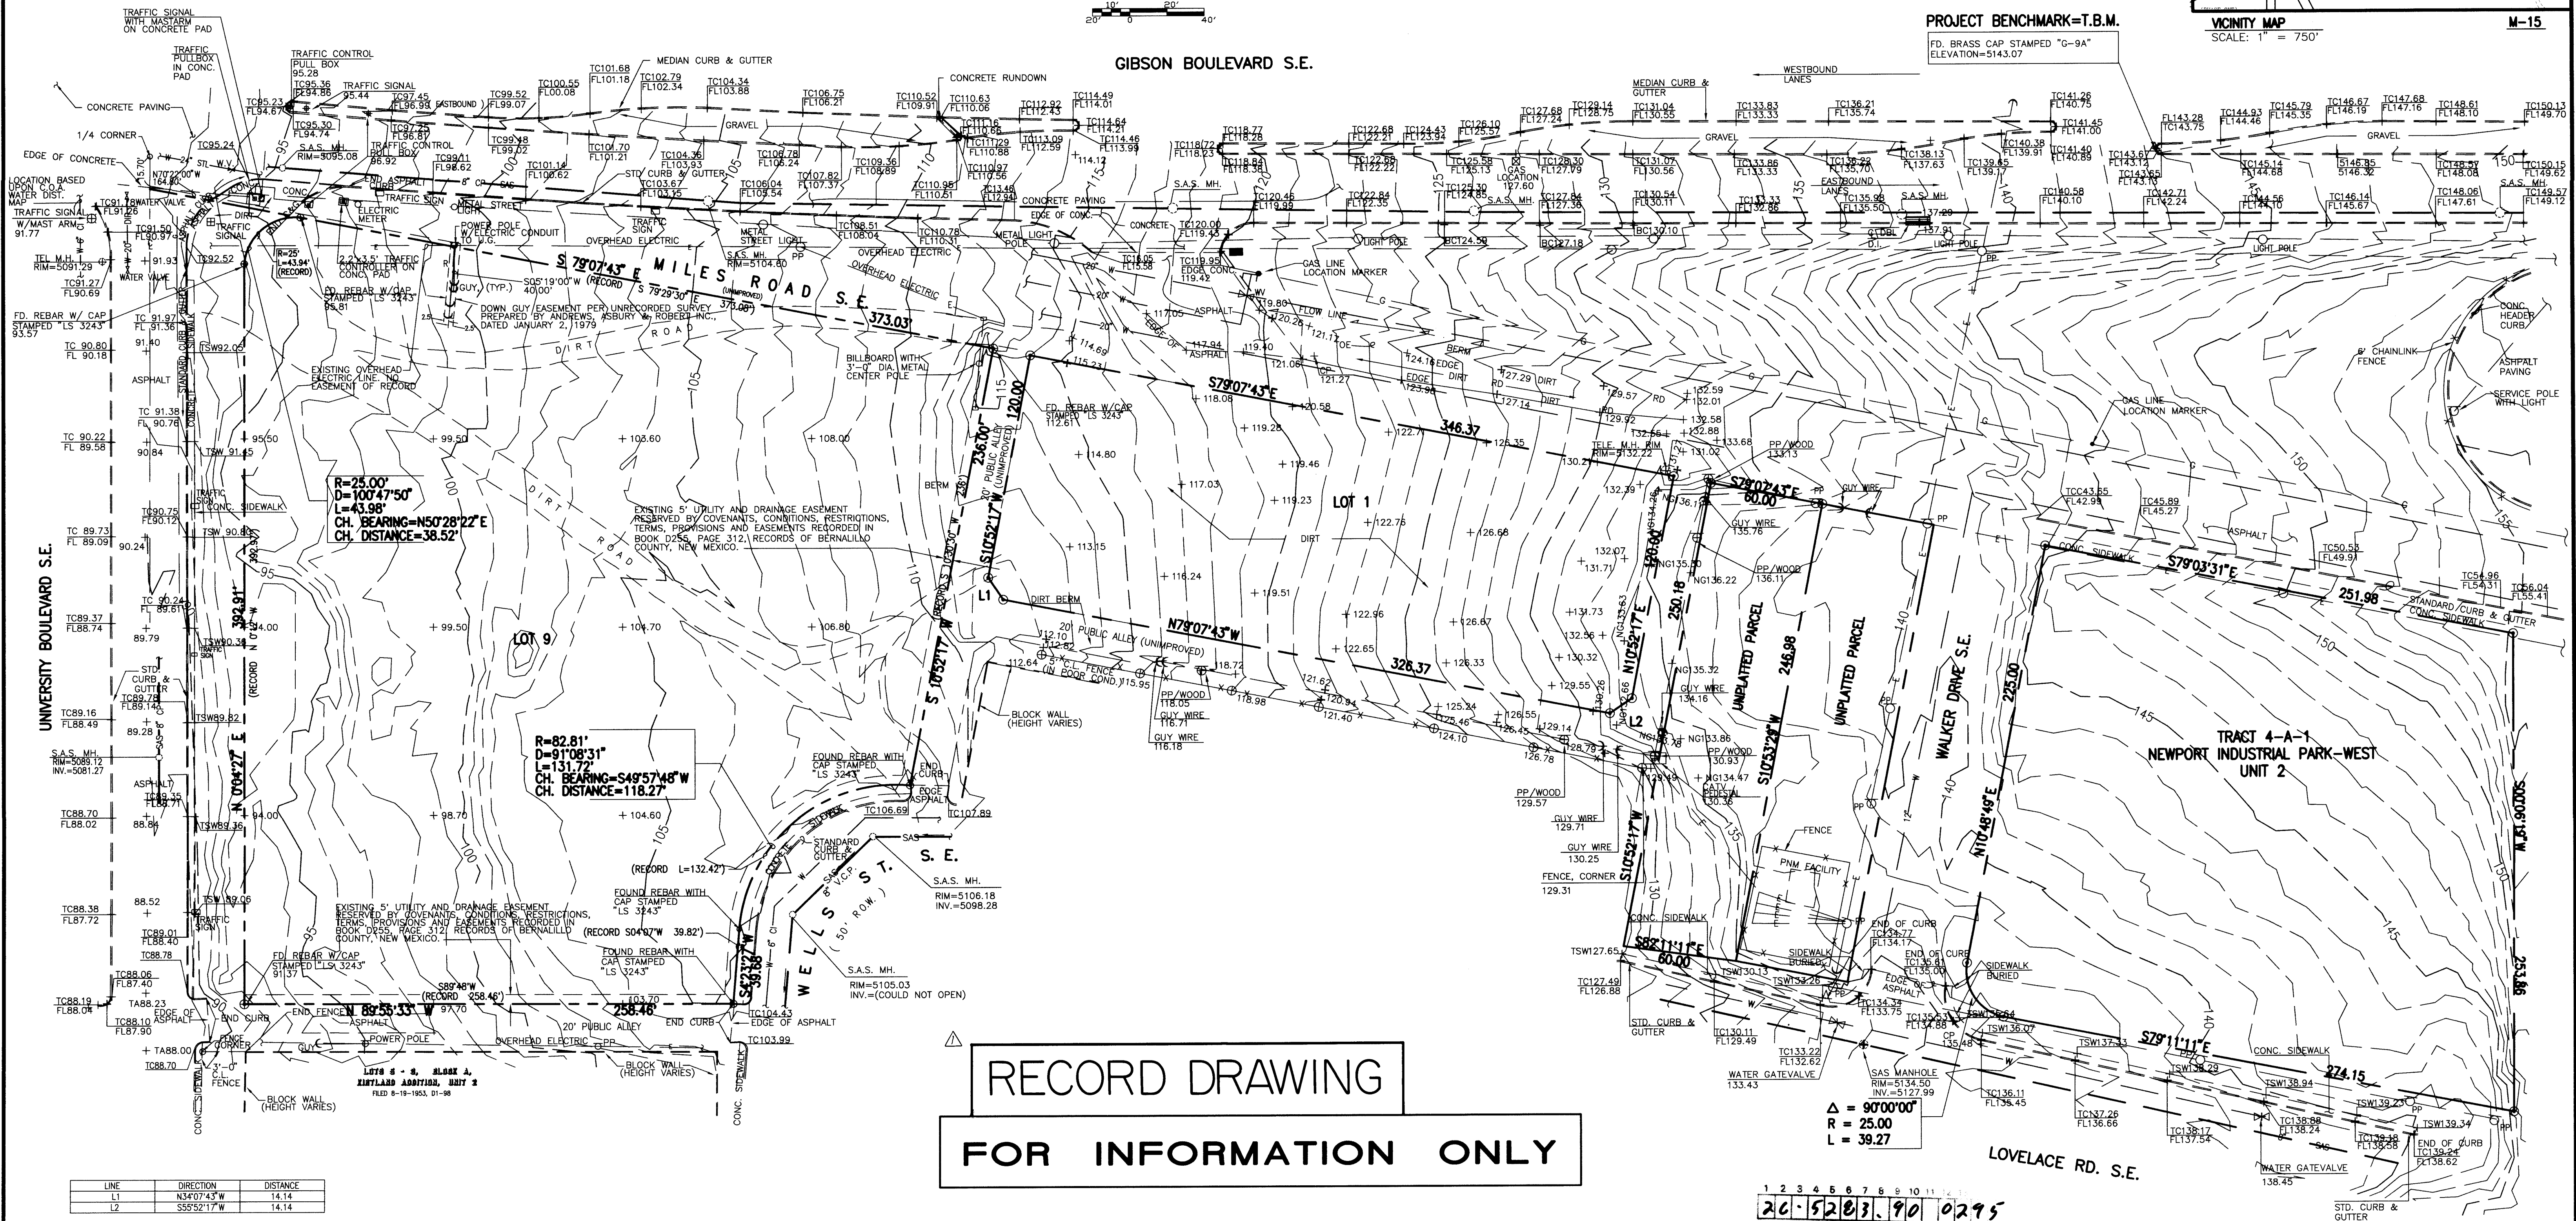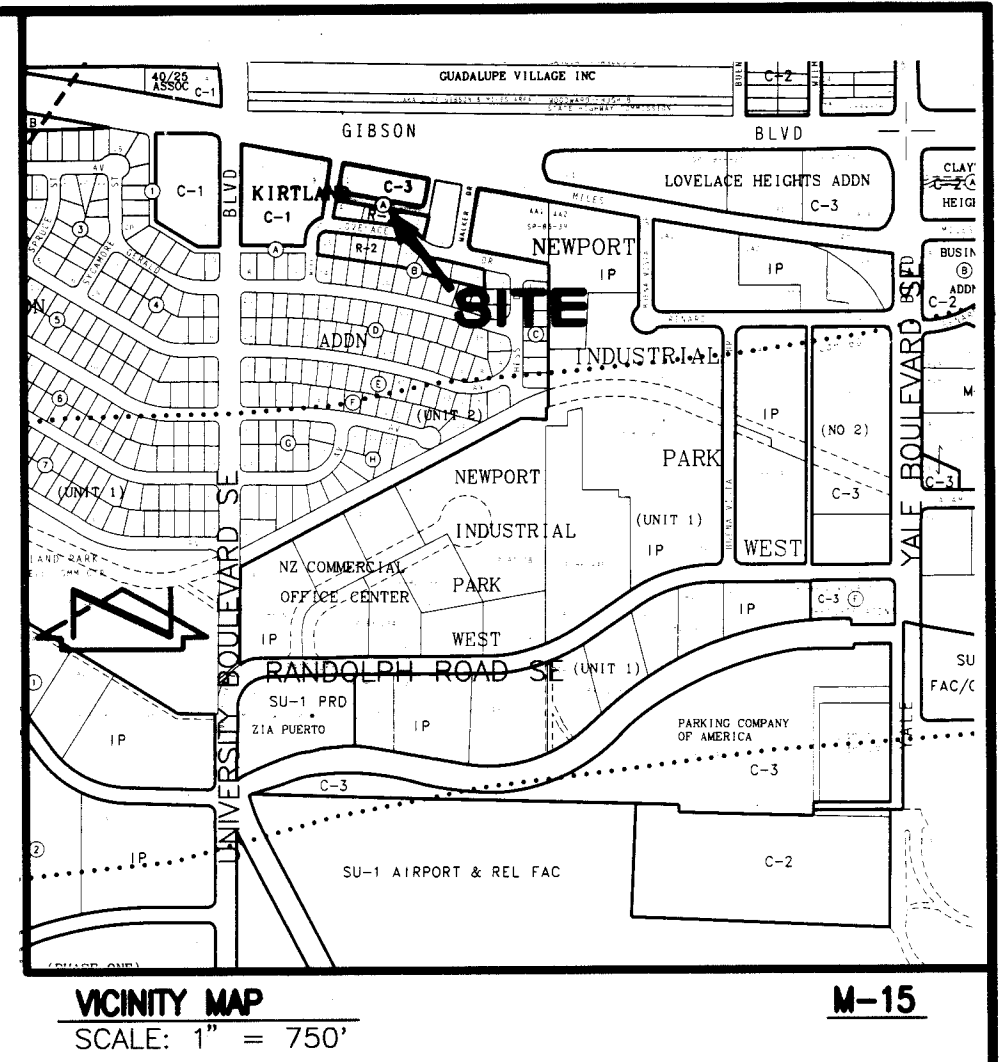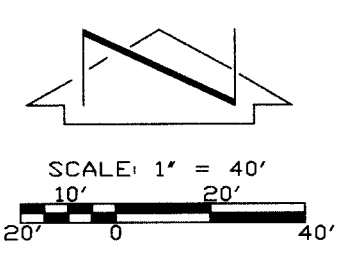

LINE	DIRECTION	DISTANCE
L1	N34°07'43" W	14.14
L2	S55°52'17" W	14.14

$\Delta = 90'00'00''$
 $R = 25.00$
 $L = 39.27$



20 52 03.90 0295

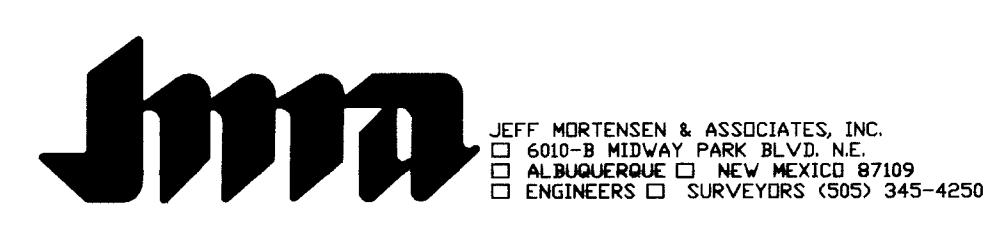

TOPOGRAPHIC SURVEY
MILES ROAD EXTENSION PROPERTIES

SCANNED BY
BY LASON

SURVEYED BY			DATE			BY			REVISIONS			JOB NO.		
R.C.W.			11/05/2003			M.D.B.			RECORD DRAWING			940866		
C.J.H./T.N.T.												08-1995		
C.G.C.												2 OF 6		

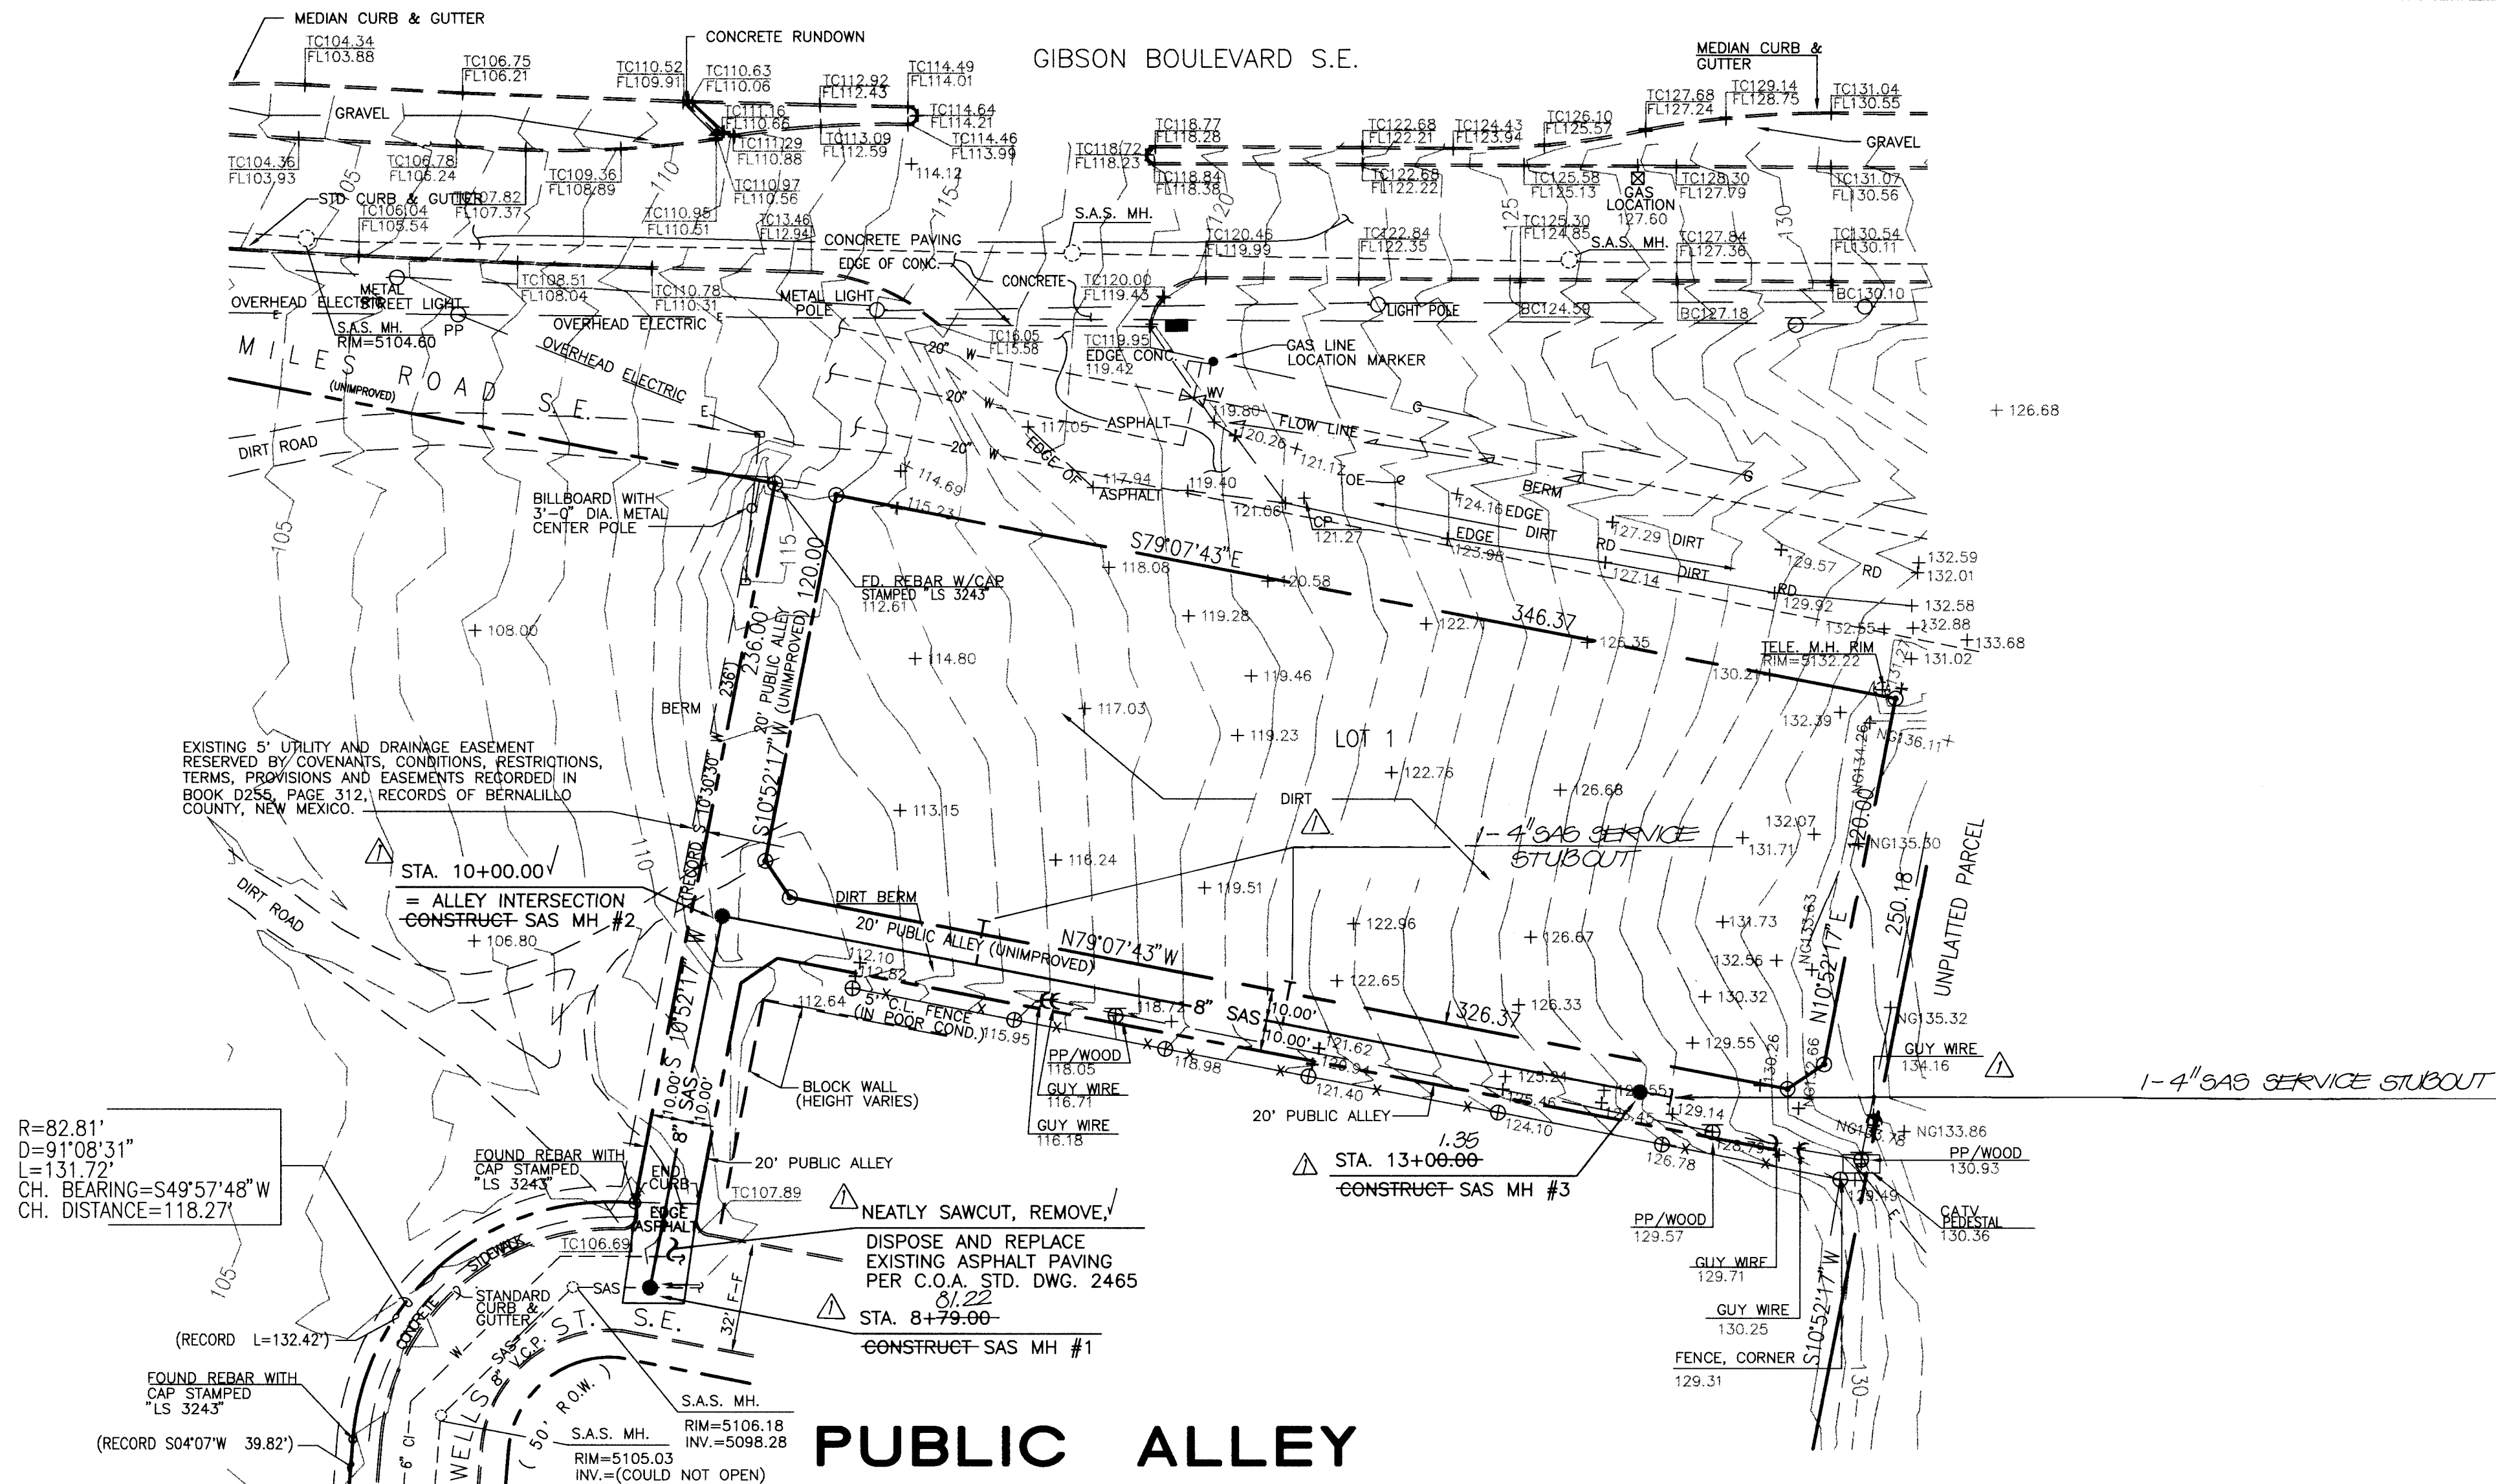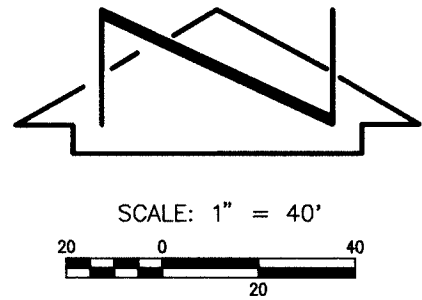


R=82.81'
D=91°08'31"
L=131.72'
CH. BEARING=S49°57'48"W
CH. DISTANCE=118.27'

FOUND REBAR WITH
CAP STAMPED
"LS 3243"
(RECORD S04°07'W 39.82')

PUBLIC ALLEY

SCALE:
1" = 40' HORIZONTAL
1" = 5' VERTICAL

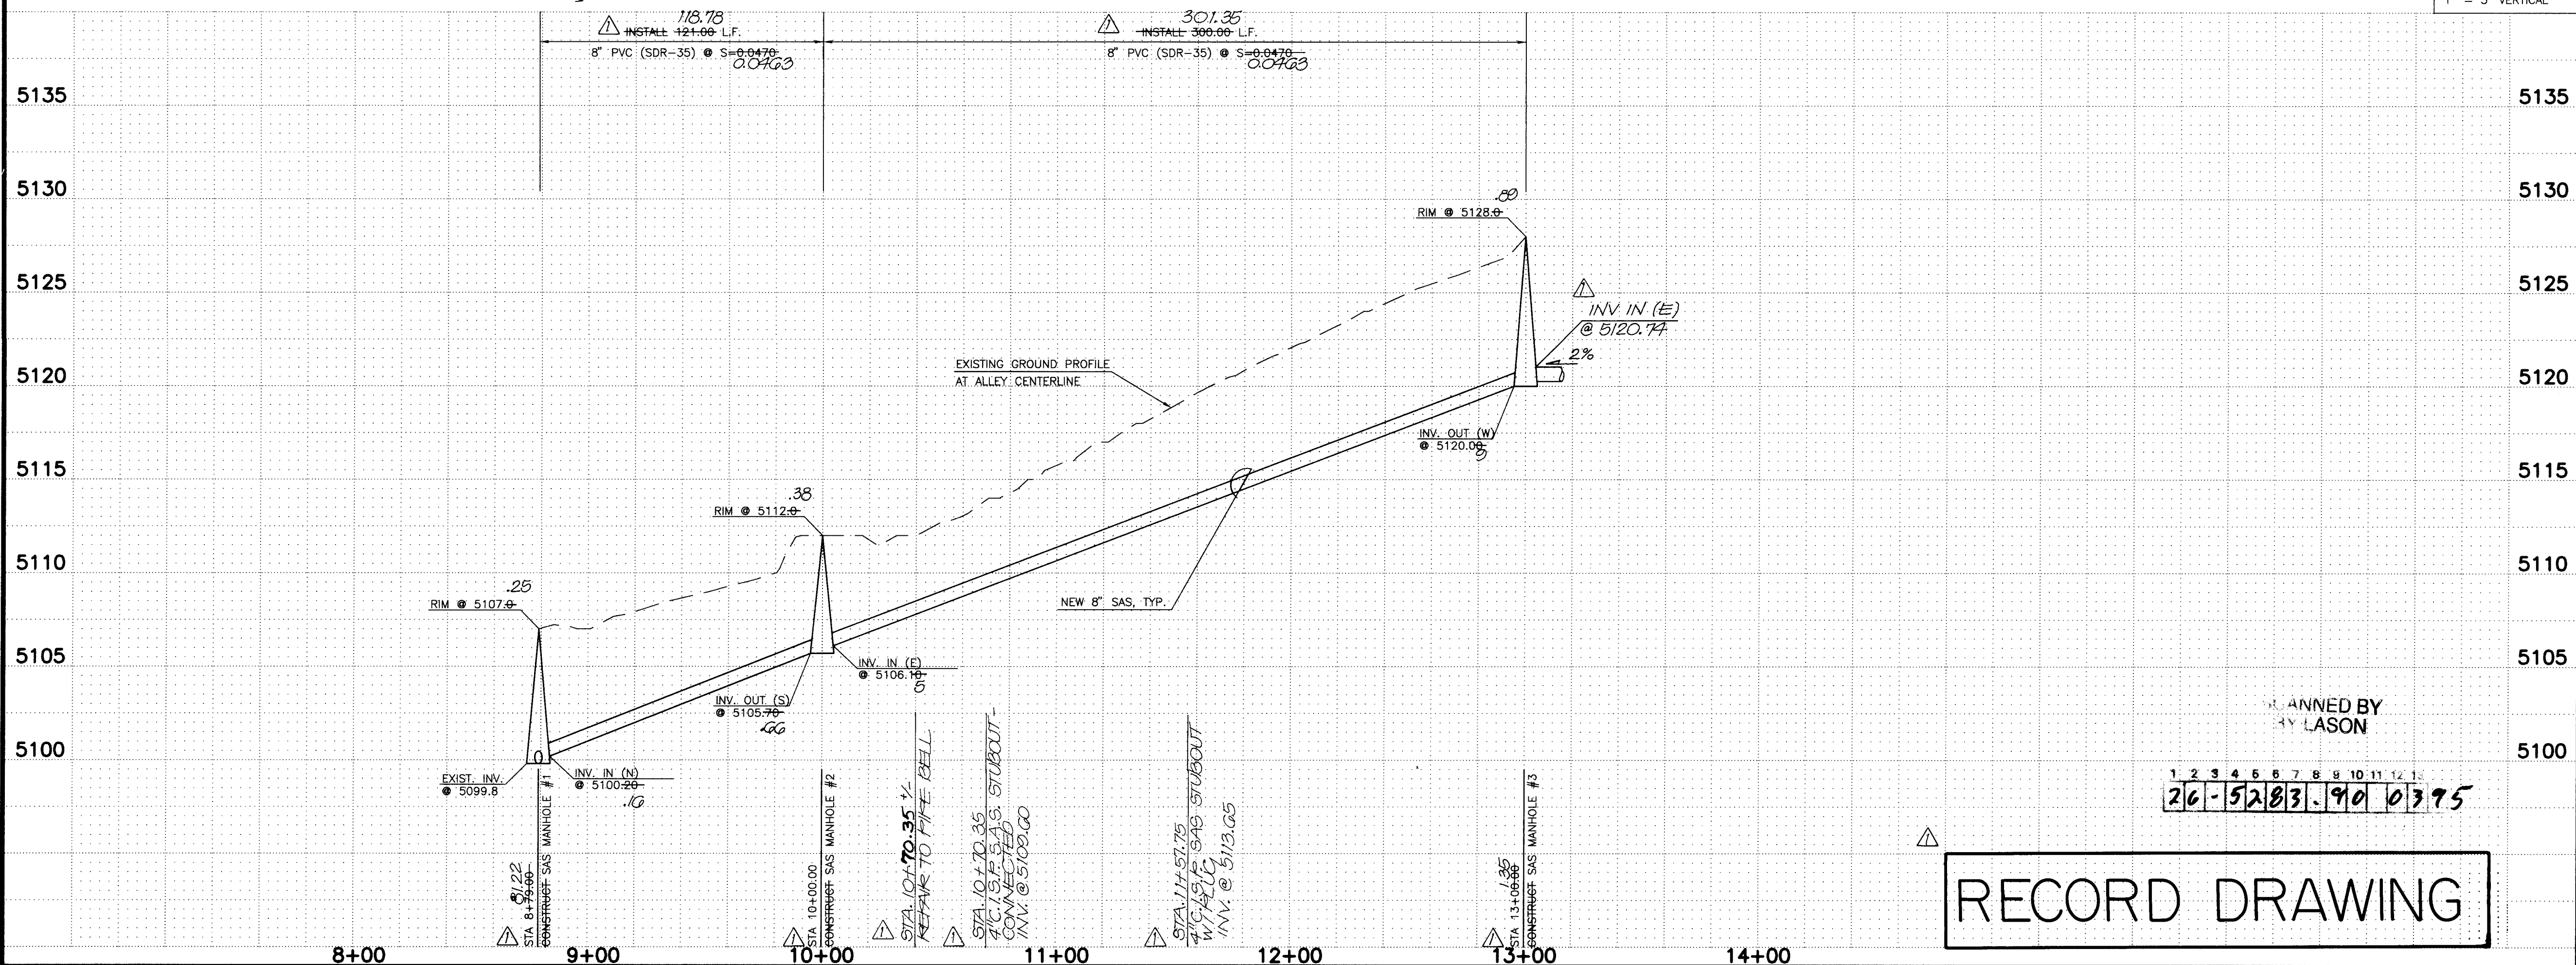

DESIGNED BY
BY LASON
26-5283.90 0395

RECORD DRAWING

- SANITARY SEWER CONSTRUCTION NOTES:**
1. ALL STATIONING IS BASED ON ALLEY CENTERLINE UNLESS INDICATED OTHERWISE.
 2. ALL SEWER PIPE SHALL BE PVC (SDR 35).
 3. SLOPES SHOWN ON THE PROFILES ARE BASED ON TRUE DISTANCES.
 4. ALL MANHOLES SHALL BE FOUR-FOOT DIAMETER TYPE 'E' AS PER CITY OF ALBUQUERQUE STANDARD DRAWING 2102 UNLESS OTHERWISE NOTED. MANHOLE STEPS ARE REQUIRED IN ACCORDANCE WITH CITY OF ALBUQUERQUE STANDARD SPECIFICATIONS.
 5. SEWER SERVICE LATERALS SHALL BE PROVIDED WITH ELECTRONIC MARKER DISCS AS PER CITY OF ALBUQUERQUE STANDARD DRAWING 2125. EMD SHALL BE PROVIDED IN ACCORDANCE WITH THE STANDARD SPECIFICATION.
 6. THE CONTRACTOR SHALL BE RESPONSIBLE FOR SELECTING APPROPRIATE MEANS AND METHODS TO EXCAVATE AND TRENCH AND INSTALL PIPE SO AS TO NOT EXCEED RIGHT-OF-WAY OR EASEMENT LIMITS, AND SO AS NOT TO INTERFERE WITH OTHER UTILITIES. THIS SHALL BE CONSIDERED INCIDENTAL TO TRENCHING, THEREFORE, NO SEPARATE PAYMENT WILL BE MADE.
 7. THE CONTRACTOR SHALL BE RESPONSIBLE FOR PROTECTING, SUPPORTING AND REPLACING, IF DAMAGED, ALL OTHER UTILITIES ENCOUNTERED DURING CONSTRUCTION. THIS SHALL BE CONSIDERED INCIDENTAL TO TRENCHING, THEREFORE, NO SEPARATE PAYMENT WILL BE MADE.
 8. WHERE WATER AND SANITARY SEWER LINES CROSS, THE SANITARY SEWER LINE SHALL BE INSTALLED AS PRESSURE PIPE BETWEEN MANHOLES IF 18 INCHES OF VERTICAL SEPARATION DOES NOT EXIST.




RECORD DRAWING

I, Jeffrey G. Mortensen, Registered Professional Engineer in the State of New Mexico, do hereby certify that this "as-built" information was obtained by me or under my supervision and represents the "as-built" conditions of this project, and is true and correct to the best of my knowledge and belief. All vertical and horizontal dimensions should be field verified prior to use on future projects.

Jeffrey G. Mortensen
Professional Engineer
No. 8547
Date 08-28-95


CITY OF ALBUQUERQUE PUBLIC WORKS DEPARTMENT ENGINEERING GROUP					
TITLE: LOT 1, BLOCK A - KIRTLAND ADDITION PUBLIC ALLEY SANITARY SEWER LINE EXTENSION STA. 8+79.00 TO STA. 13+00.00					
APPROVALS	ENGINEER	DATE	APPROVALS	ENGINEER	DATE
DRC CHAIRMAN	R.W. Kane	9-26-95	WATER	R.W. Kane	8-30-95
TRANSPORTATION	R.W. Kane	9-27-95	WASTE WATER	R.W. Kane	8-30-95
HYDROLOGY	W.A. Am	9/9/95			
PROJECT NO. 5283.90		MAP NO. M-15		SHEET 3 OF 6	

CONTRACTOR		BENCH MARKS		SURVEY INFORMATION		ENGINEER'S SEAL	
CONTRACTOR	AS BUILT INFORMATION	CONTRACTOR	MECH.	NO.	DATE	NO.	DATE
STATED BY	J.M.A.	DATE	10/95	BY	DATE	BY	DATE
ACCEPTED BY	M.D.G.	DATE	11/95	REVISIONS		REVISIONS	
FIELD CHECKED BY	M.D.G.	DATE	11/95	DESIGN		DESIGN	
DRAWINGS	J.M.A.	DATE	11/95	NO.	DATE	NO.	DATE
CORRECTED BY	J.M.A.	DATE	11/95	DESIGNED BY	J.G.M.	DATE	08-95
RECORDED BY		DATE		DRAWN BY	T.N.T.	DATE	08-95
NO.		DATE		CHECKED BY	J.G.M.	DATE	08-95

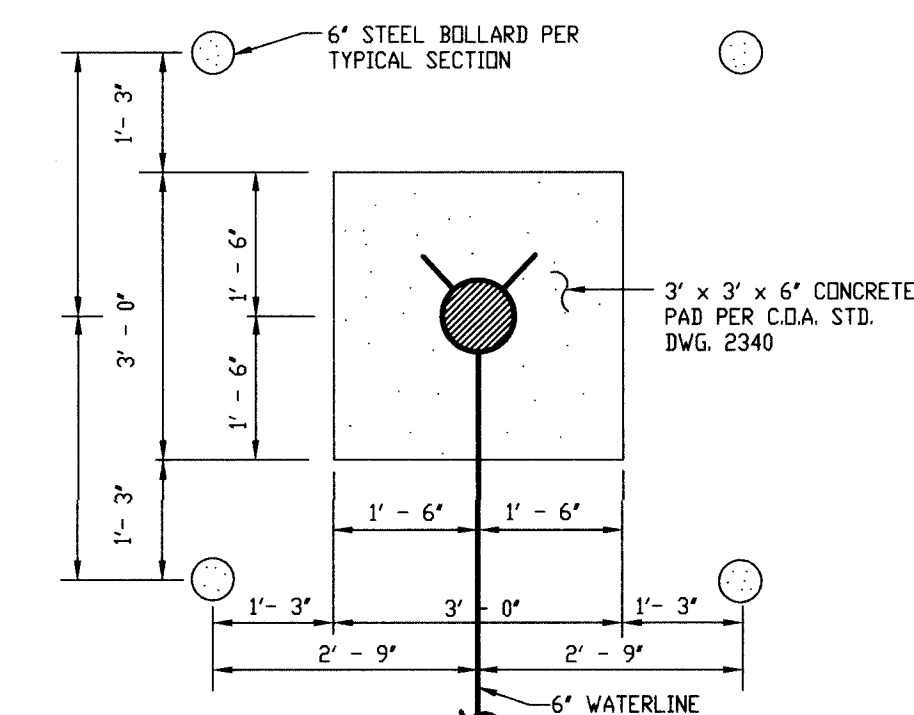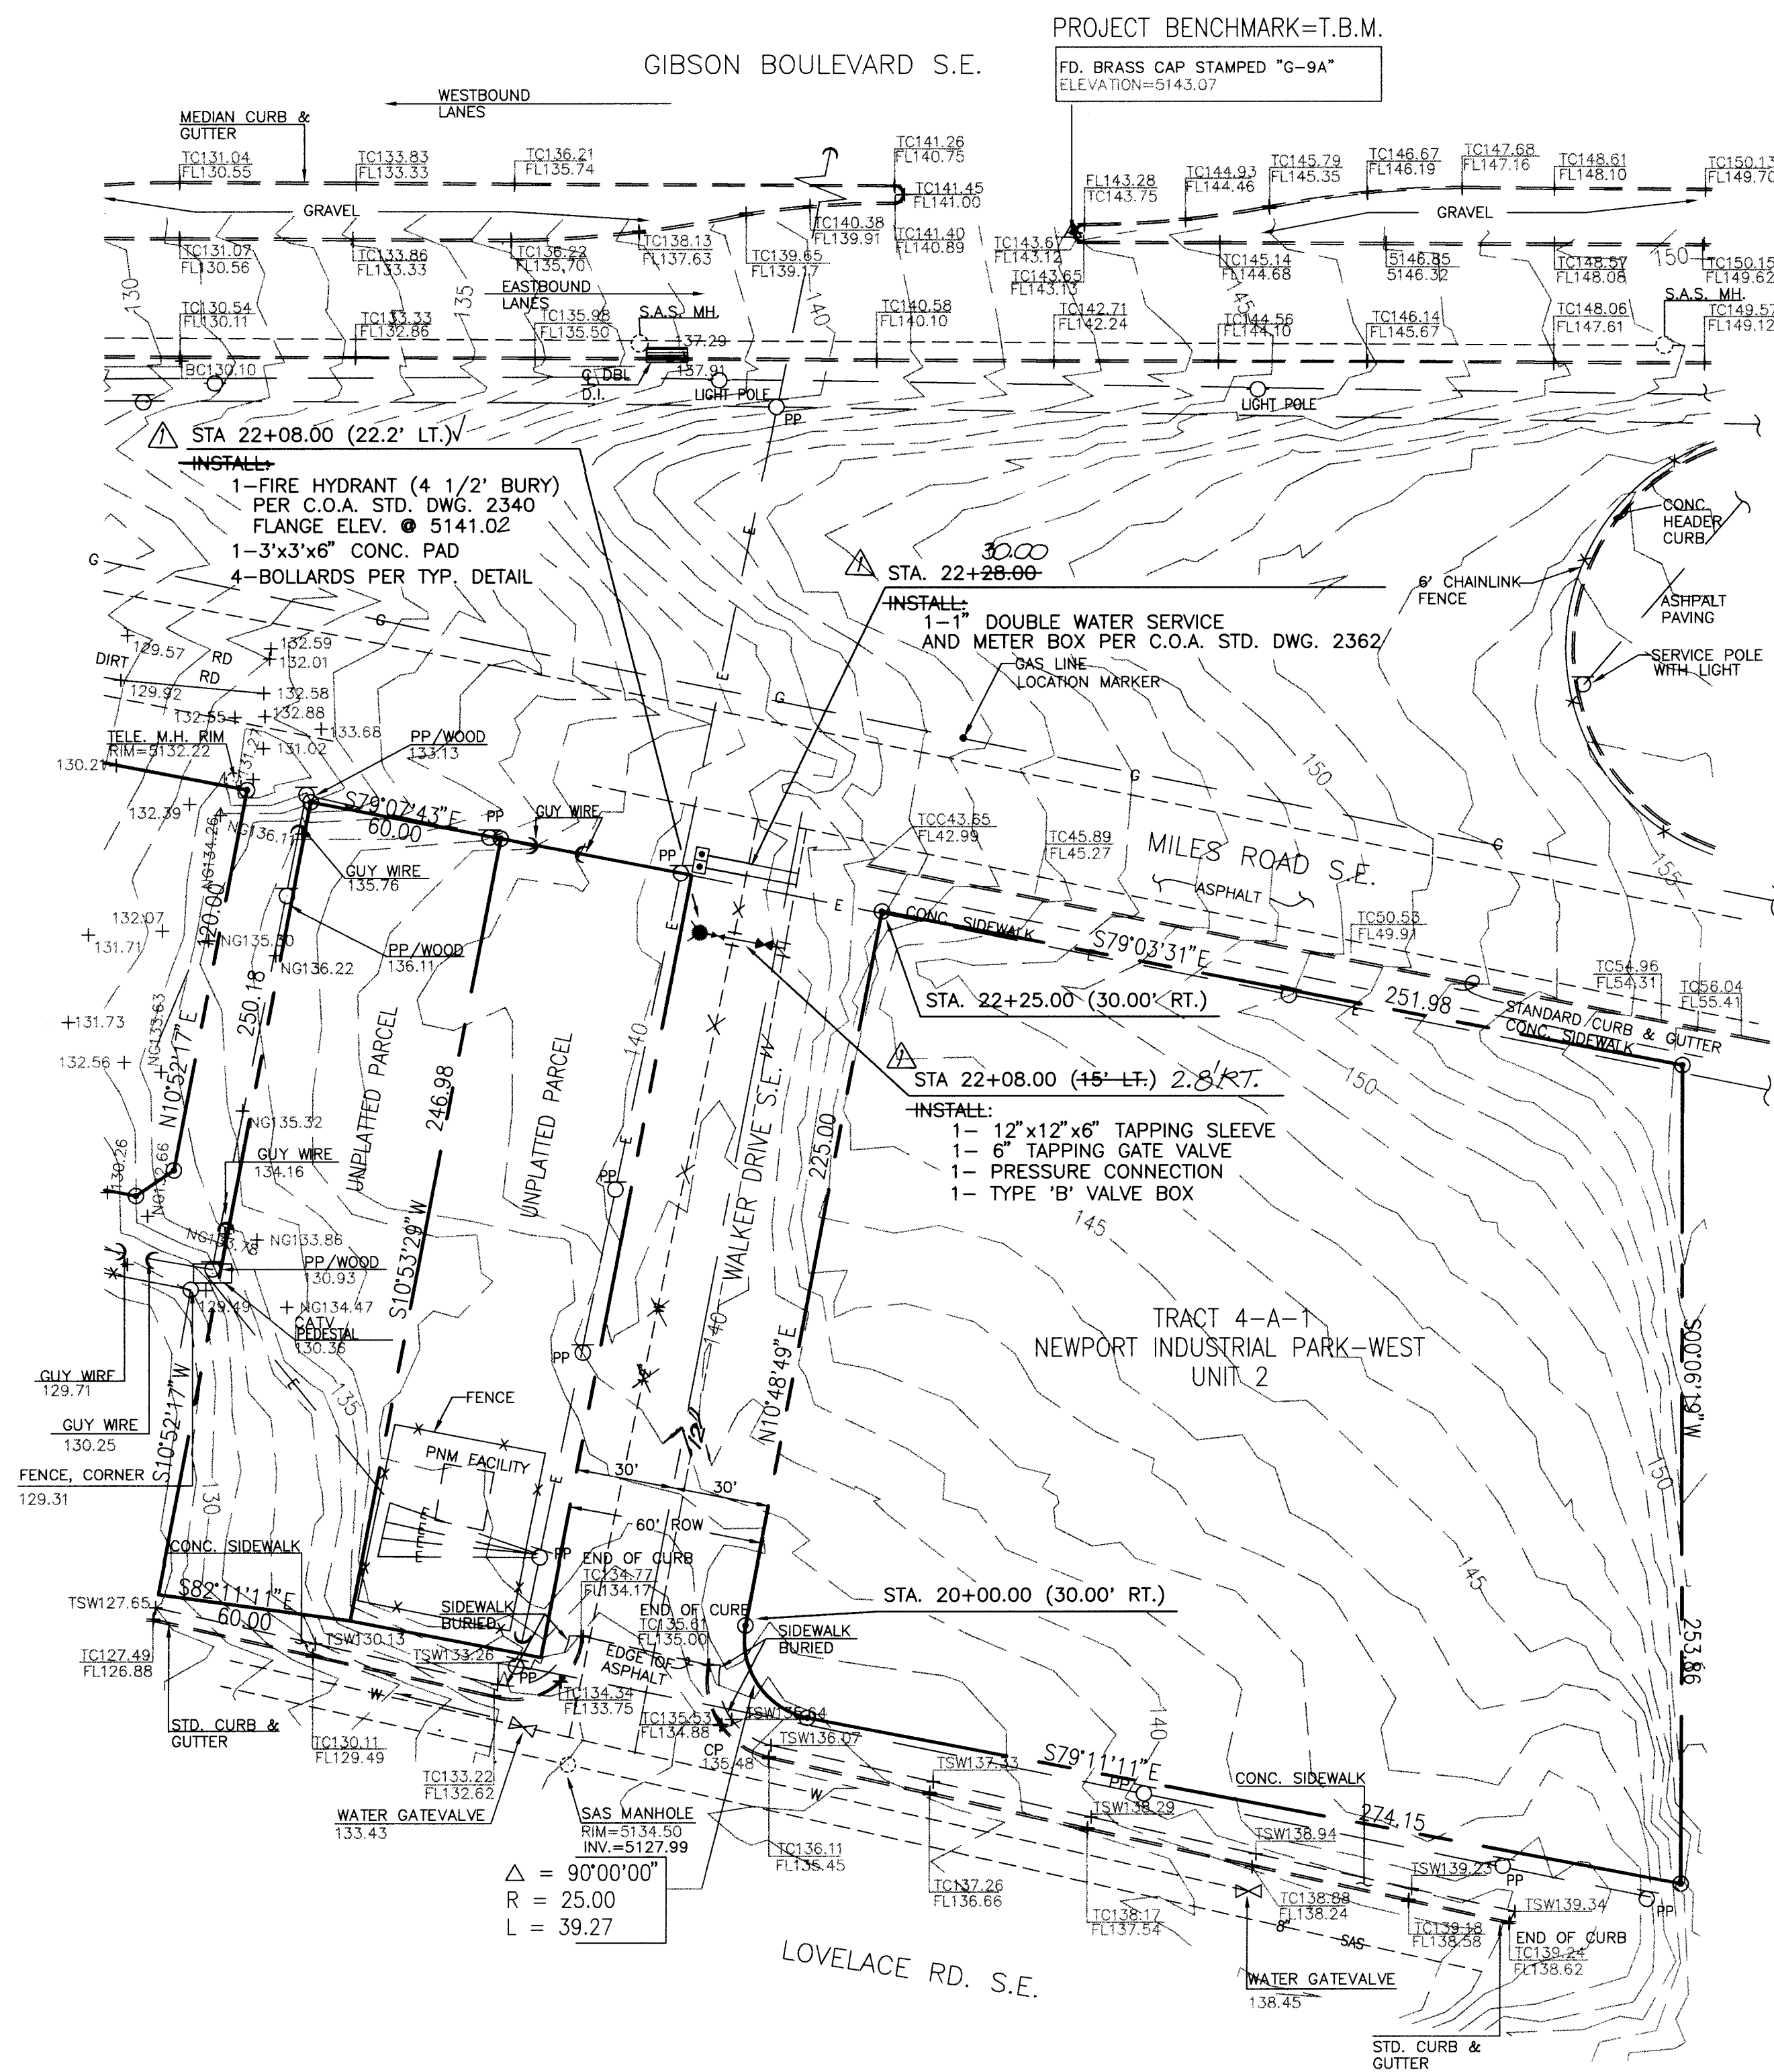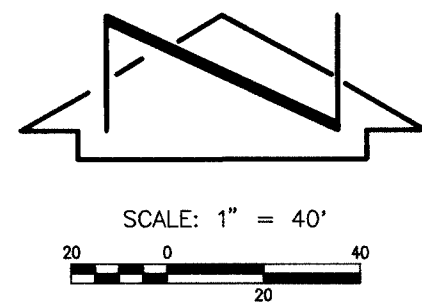

FIRE HYDRANT BOLLARD DETAIL

SCALE: 1' = 2' - 0"

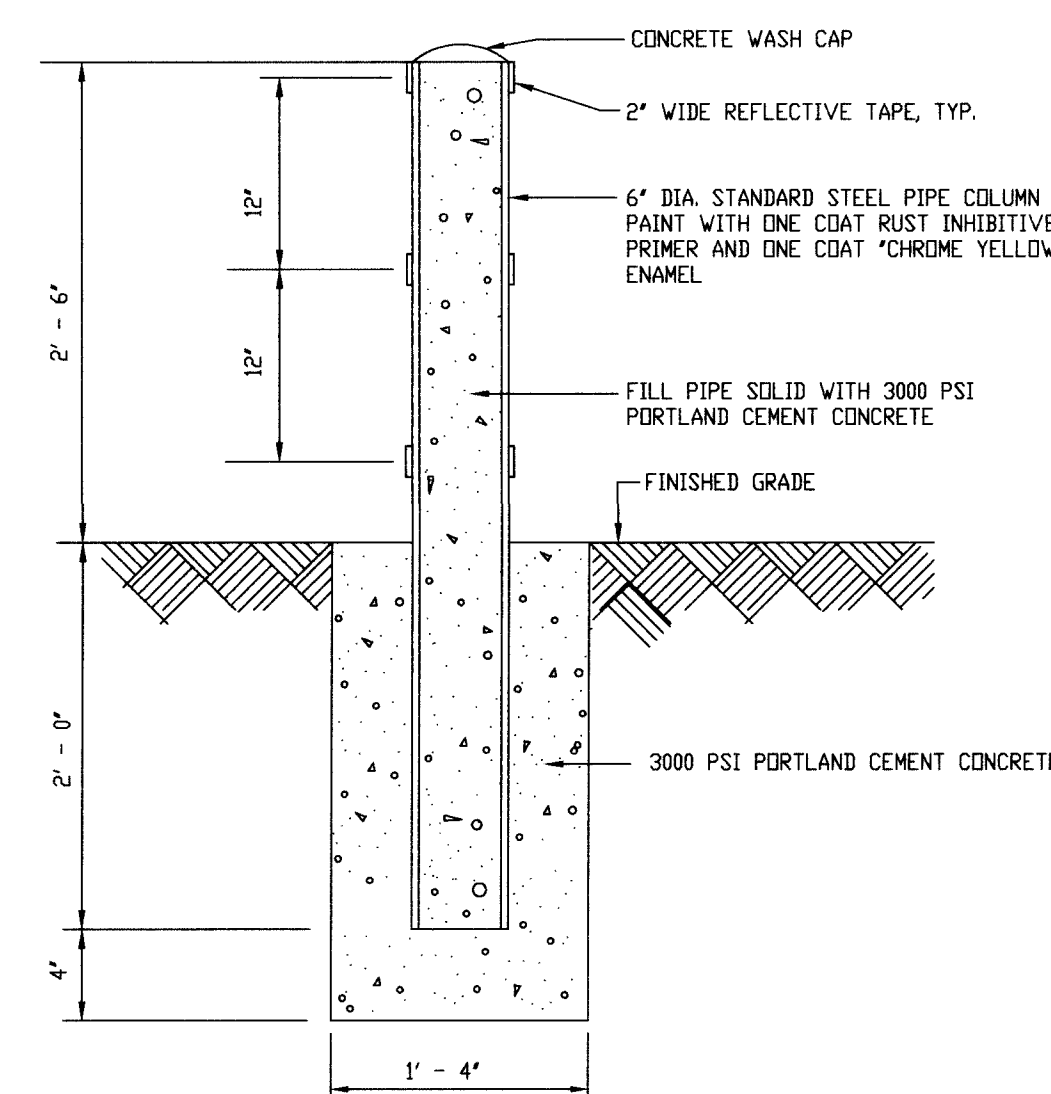

TYPICAL BOLLARD SECTION

SCALE: 1' = 1' - 0"

SCANNED BY
BY LASON

1	2	3	4	5	6	7	8	9	10	11	12	13	14	15
2	6	-	5	2	8	3	.	9	0		0	4	9	0


RECORD DRAWING

940866

WATERLINE CONSTRUCTION NOTES:

1. ALL STATIONING IS BASED ON STREET CENTERLINE UNLESS INDICATED OTHERWISE.
2. FOR ALL LINES 12" AND SMALLER, WATER MAIN SHALL BE PVC C-900 PIPE OR AS APPROVED BY THE CITY OF ALBUQUERQUE.
3. FOR ALL LINES 14" AND LARGER, WATER MAIN SHALL BE DUCTILE IRON OR AS APPROVED BY THE CITY OF ALBUQUERQUE.
4. WATERLINE SHALL HAVE A MINIMUM COVER OF 4'-0" (FINISHED GRADE TO TOP OF PIPE). IF TRENCHING, IF REQUIRED, SHALL BE CONSIDERED INCIDENTAL TO CONSTRUCTION, THEREFORE, NO SEPARATE PAYMENT WILL BE MADE.
5. ELECTRONIC MARKER DISCS (EMD) SHALL BE INSTALLED IN ACCORDANCE WITH THE STANDARD SPECIFICATION.
6. IN ACCORDANCE WITH SECTION 801 OF THE "STANDARD SPECIFICATIONS", METALIZED DETECTABLE WARNING TAPE SHALL BE INSTALLED 18" ABOVE ALL PVC PIPE INSTALLED ON THIS PROJECT.
7. VALVE STEM AND FIRE HYDRANT EXTENSIONS SHALL BE PROVIDED IN ACCORDANCE WITH THE STANDARD SPECIFICATIONS. THE COST OF EACH EXTENSION SHALL BE CONSIDERED INCIDENTAL TO CONSTRUCTION THEREFORE NO SEPARATE PAYMENT WILL BE MADE.
8. JOINT RESTRAINT SHALL BE CONSIDERED INCIDENTAL TO WATERLINE CONSTRUCTION THEREFORE NO SEPARATE PAYMENT WILL BE MADE.
9. JOINT RESTRAINT SHALL BE PROVIDED ON ALL JOINTS OF FIRE HYDRANT LEGS FROM TEE TO FIRE HYDRANT INCLUDING THE TEE AND FIRE HYDRANT.
10. FOR THE PURPOSES OF THIS PROJECT, ALL RESTRAINED JOINTS AND JOINT RESTRAINT SHALL BE MECHANICALLY RESTRAINED.

I, Jeffrey G. Mortensen, Registered Professional Engineer in the State of New Mexico, do hereby certify that this "as-built" information was obtained by me or under my supervision and represents the "as-built" conditions of this project, and is true and correct to the best of my knowledge and belief. All vertical and horizontal dimensions should be field verified prior to use on future projects.

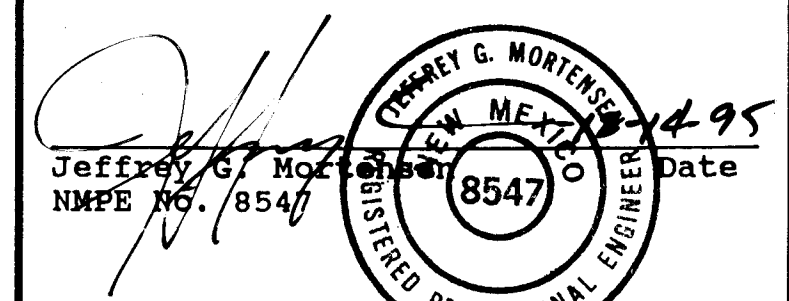

CITY OF ALBUQUERQUE
PUBLIC WORKS DEPARTMENT
ENGINEERING GROUP

TITLE:	LOT 1, BLOCK A - KIRTLAND ADDITION WALKER DRIVE SE WATERLINE EXTENSION STA. 20+00.00 TO STA. 22+28.00
--------	---

APPROVALS	ENGINEER	DATE	APPROVALS	ENGINEER	DATE
DRC CHAIRMAN	<i>B. G. Gendley</i>	9-26-95	WATER	<i>R.W. Kane</i>	8-30-95
TRANSPORTATION	<i>W. W. W.</i>	9-07-95	WASTE WATER	<i>R.W. Kane</i>	8-30-95
HYDROLOGY	<i>W. W. W.</i>	9-07-95			

PROJECT NO.	5283.90
-------------	---------

MAP No. M-15	
-----------------	--

SHEET 4 OF 6

AS BUILT INFORMATION
: SUNDBANCE MECH.

BENCH MARKS
CS CONTROL MONUMENT "G-9A",

SURVEY INFORMATION	
FIELD NOTES	

ENGINEER'S SEAL

	M36		
--	-----	--	--

F. E. O'NEILL

1	56/11	△
---	-------	---

AND ADD
NE EXT
22+28

NOVALS
WATER

15	
----	--

CONSTRUCTION TRAFFIC CONTROL GENERAL NOTES

1. CONTRACTOR MUST OBTAIN FROM CONSTRUCTION COORDINATION AN EXCAVATION/BARRICADING PERMIT BEFORE ENGAGING IN ANY CONSTRUCTION, MAINTENANCE OR REPAIR WORK IN ANY OF THE CITY OF ALBUQUERQUE'S RIGHTS-OF-WAY. EMERGENCY WORK THAT WOULD PRESERVE LIFE OR PROPERTY IS EXCLUDED WITH THE UNDERSTANDING, THAT A PERMIT SHALL BE OBTAINED WITHIN 24 TO 48 HOURS.

2. CONTRACTOR SHALL AT THE TIME OF PERMIT REQUEST, SUBMIT FOR APPROVAL BY CONSTRUCTION COORDINATION, A TRAFFIC CONTROL PLAN DETAILING ALL EXISTING TOPOGRAPHY SUCH AS LANE WIDTHS, DRIVEWAYS, AND BUSINESS/RESIDENTIAL ACCESSES. THE TRAFFIC CONTROL PLAN SHALL INCLUDE ALL PHASES OF WORK AND SCHEDULES INVOLVED IN THE CONSTRUCTION PROJECT. ANY SEPARATE PHASES OF A CONSTRUCTION PROJECT SHALL BE GIVEN AN INDIVIDUAL PERMIT EACH. BLANKET PERMITS WILL NOT BE ISSUED.

3. THESE TYPICAL TRAFFIC CONTROL PLANS DO NOT REFLECT THE EXISTING TOPOGRAPHY SUCH AS DRIVEWAYS, LANE WIDTHS, AND BUSINESS/RESIDENTIAL ACCESSES. EVERY LOCATION THAT REQUIRES CONSTRUCTION TRAFFIC CONTROL SHALL HAVE A DETAILED TRAFFIC CONTROL PLAN SHOWING ALL EXISTING TOPOGRAPHY.

4. CONSTRUCTION SHALL NOT BEGIN UNLESS A TRAFFIC CONTROL PLAN HAS BEEN APPROVED AND VERIFIED BY CONSTRUCTION COORDINATION.

5. CONSTRUCTION COORDINATION SHALL BE NOTIFIED 48 HOURS PRIOR TO ANY TRAFFIC CONTROL CHANGES NEEDED BY CONTRACTOR, THAT WERE NOT PREVIOUSLY APPROVED. THESE TRAFFIC CONTROL CHANGES SHALL BE REQUESTED IN WRITING ACCOMPANIED WITH A TRAFFIC CONTROL PLAN REFLECTING SUCH CHANGES.

6. ALL CONSTRUCTION TRAFFIC CONTROL DEVICES SHALL COMPLY TO THE MANUAL ON UNIFORM TRAFFIC CONTROL DEVICES (MUTCD), LATEST EDITION. IT IS THE RESPONSIBILITY OF THE CONTRACTOR TO INSTALL, SERVICE AND MAINTAIN ALL TRAFFIC CONTROL DEVICES. TRAFFIC CONTROL DEVICES SHALL NOT BE REMOVED OR ALTERED IN ANY WAY WITHOUT THE APPROVAL OF CONSTRUCTION COORDINATION, PER SECTION 6A-4 OF THE MUTCD, LATEST EDITION.

7. THE CONSTRUCTION TRAFFIC CONTROL INITIAL SET-UP SHALL BE BY AN AMERICAN TRAFFIC SAFETY SERVICES ASSOCIATION (ATSSA) CERTIFIED WORKSITE TRAFFIC SUPERVISOR. THE MAINTENANCE AND SERVICING SHALL ALSO BE DONE BY AN ATSSA CERTIFIED WORKSITE TRAFFIC SUPERVISOR OR EQUIVALENT.

8. CONTRACTOR IS RESPONSIBLE TO MAINTAIN AND SERVICE ALL TRAFFIC CONTROL DEVICES 24 HOURS A DAY, 7 DAYS A WEEK THROUGHOUT LENGTH OF PROJECT. CONTRACTOR IS RESPONSIBLE THAT ALL TRAFFIC CONTROL DEVICES COMPLY WITH THE MUTCD, LATEST EDITION.

9. ALL ADVANCE WARNING SIGNS SHALL BE DOUBLE INDICATED WHENEVER THERE ARE MULTI-LANE TRAFFIC IN ANY ONE GIVEN DIRECTION AND THERE IS SUFFICIENT MEDIAN SPACE.

10. ALL BARRICADES IN ALL TAPERS AND TANGENTS SHALL BE PLACED APART, A DISTANCE MEASURED IN FEET, EQUAL TO THAT OF THE POSTED SPEED LIMIT. NO EXCEPTIONS UNLESS APPROVED BY CONSTRUCTION COORDINATION PER MUTCD SECTION 6A-4.

11. CONTRACTOR SHALL NOT BEGIN WORK BEFORE 8:30 A.M. OR END WORK AFTER 4:00 P.M. WITHOUT THE APPROVAL OF CONSTRUCTION COORDINATION.

12. CONTRACTOR IS RESPONSIBLE TO PROVIDE CONSTRUCTION COORDINATION, A WEEKLY LOG OF DAILY INSPECTIONS OF BARRICADE AND MAINTENANCE SCHEDULES ON PROJECTS THAT ARE OVER ONE WEEK DURATION.

13. EQUIPMENT OR MATERIALS SHALL NOT BE STORED WITHIN 15 FEET OF A TRAVELLED TRAFFIC LANE DURING NON-WORKING HOURS WITHOUT THE APPROVAL OF CONSTRUCTION COORDINATION.

14. CONTRACTOR SHALL PROVIDE AND MAINTAIN A SAFE AND ADEQUATE MEANS OF CHANNELIZING PEDESTRIAN TRAFFIC AROUND AND THROUGH THE CONSTRUCTION AREA.

15. CONTRACTOR IS RESPONSIBLE FOR OBLITERATION OF ANY CONFLICTING STRIPING AND RESPONSIBLE FOR ALL TEMPORARY STRIPING.

16. CONTRACTOR SHALL MAINTAIN ACCESS TO ALL FACILITIES, BUSINESSES AND/OR RESIDENTS AT ALL TIMES.

17. CONTRACTOR SHALL PROVIDE ACCESS SIGNS FOR BUSINESSES LOCATED WITHIN THE CONSTRUCTION AREA UNDER THE SUPERVISION OF CONSTRUCTION COORDINATION. EACH ACCESS SIGN SHALL HAVE 5 INCH, WHITE OPAQUE LETTERING ON BLUE REFLECTORIZED BACKGROUND. ACCESS SIGNS SHALL BE CONSIDERED INCIDENTAL TO THE BID AND NOT PART OF THE CONTRACT UNLESS OTHERWISE STATED. NO MORE THAN 3 BUSINESSES SHALL BE LISTED ON A ACCESS SIGN. SHOPPING CENTERS AND MALLS SHALL BE LISTED AS SUCH.

18. ALL ADVANCE WARNING SIGNS SHALL MEET THE MINIMUM REFLECTIVE INTENSITY REQUIREMENTS SET FORTH BY THE CITY OF ALBUQUERQUE. CONSTRUCTION COORDINATION SHALL DETERMINE ALL REQUIREMENTS AND APPROVE OR DISAPPROVE ANY ADVANCE WARNING SIGN PER SECTION 6A-4 OF THE MUTCD, LATEST EDITION.

19. 24 HOURS PRIOR TO OCCUPANCY OR CLOSING OF A RIGHT-OF-WAY, CONTRACTOR SHALL NOTIFY: POLICE, FIRE DEPARTMENT, SCHOOLS, HOSPITALS, TRANSIT AUTHORITY, BUSINESSES AND/OR RESIDENTS THAT WILL BE AFFECTED BY THE CONSTRUCTION.

20. ANY FIELD ADJUSTMENTS SHALL BE APPROVED BY CONSTRUCTION COORDINATION.

21. EXCAVATIONS SHALL BE PLATED, TEMPORARILY PATCHED OR RESURFACED PRIOR TO OPENING OF TRAFFIC. A MINIMUM OF 11 FEET SHALL BE PROVIDED FOR TRAFFIC IN ANY GIVEN DIRECTION. CONTRACTOR IS RESPONSIBLE FOR ANY WORK INVOLVED IN SATISFYING THESE REQUIREMENTS.


22. CONTRACTOR SHALL AT ALL TIMES COMPLY WITH THE FOLLOWING:
1. STANDARDS AND REQUIREMENTS SET FORTH IN THE MANUAL ON UNIFORM TRAFFIC CONTROL DEVICES, LATEST EDITION.
2. THE CITY OF ALBUQUERQUE TRAFFIC CODE, LATEST EDITION.
3. SECTION 19 OF THE CITY OF ALBUQUERQUE'S STANDARD SPECIFICATIONS FOR PUBLIC WORK CONSTRUCTION, AS WELL AS OTHER SECTIONS.

23. FAILURE TO COMPLY WITH ANY OF THE ABOVE MENTIONED, WILL BE ADEQUATE CAUSE TO CEASE ALL WORK ON ANY CONSTRUCTION PROJECT. WORK WILL NOT RESUME UNTIL ALL REQUIREMENTS ARE ADDRESSED AND APPROVED BY CONSTRUCTION COORDINATION.


24. ALL TRAFFIC CONTROL DEVICES SHALL BE KEPT IN NEW-CLEAN CONDITION. WASHING OF EQUIPMENT IS INCIDENTAL TO ITS PLACEMENT AND MAINTENANCE.

25. TRAFFIC CONTROL STANDARDS APPLY ONLY WHERE THE CONSTRUCTION TRAFFIC CONTROL PLANS ARE NOT SPECIFIC.

PROJECT CONSTRUCTION TRAFFIC CONTROL GENERAL NOTES

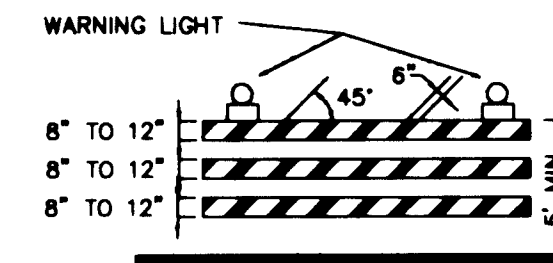


TYPE III BARRICADE

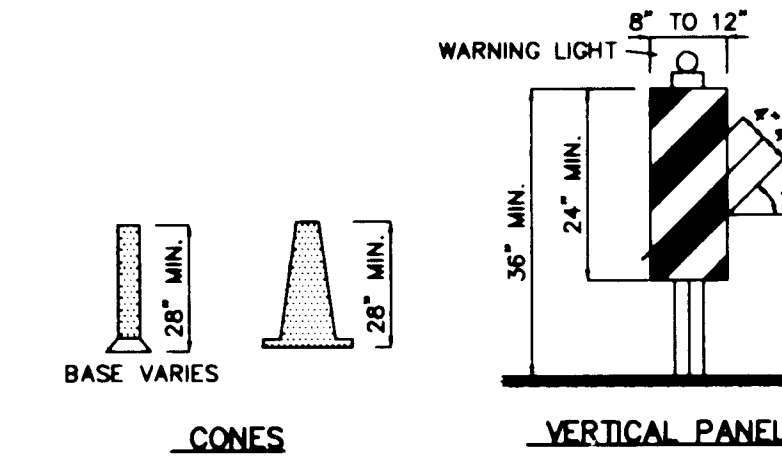


CONES


VERTICAL PANEL

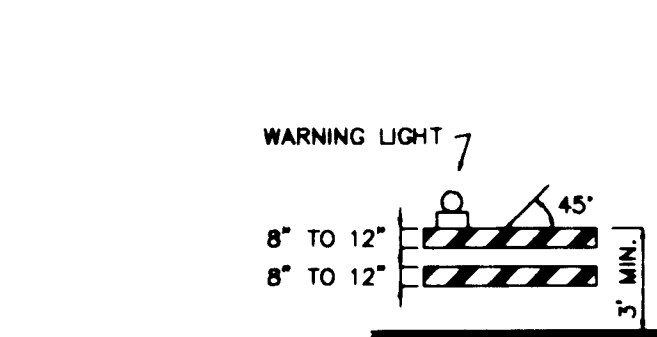


TYPE II BARRICADE COLLAPSIBLE

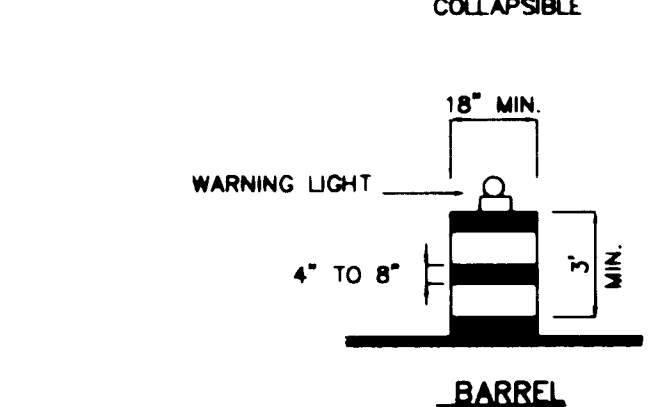


BARREL

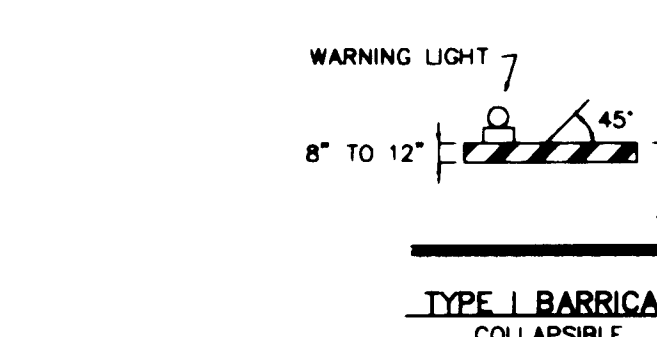

TYPE I BARRICADE COLLAPSIBLE

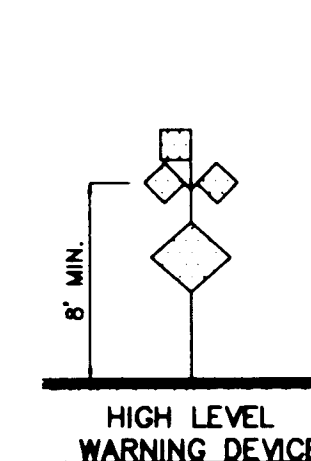

HIGH LEVEL WARNING DEVICE

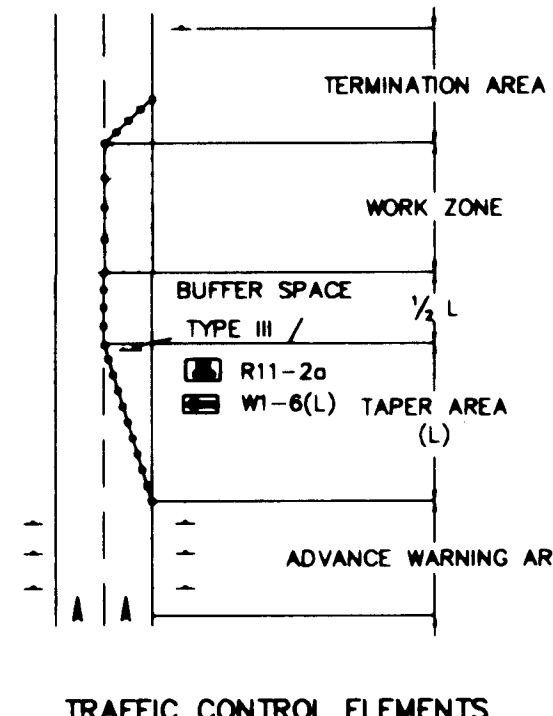

TRAFFIC CONTROL ELEMENTS

LEGEND

WORK AREA
BARRICADE - TYPE I, TYPE II, OR BARREL
BARRICADE - TYPE III
VERTICAL PANEL
WARNING SIGN
DISTANCE BETWEEN SIGNS - A DISTANCE MEASURED IN FEET EQUAL TO A VALUE OF TEN TIMES THE SPEED LIMIT OF THE STREET
FLAGMAN POSITION
SPACING BETWEEN BARRICADES- A DISTANCE MEASURED IN FEET EQUAL TO THE SPEED LIMIT OF THE STREET
TAPER LENGTH - SEE CHART BELOW
THE TANGENT LENGTH IS EQUAL TO THE TAPER LENGTH FOR A GIVEN STREET.

TAPER REQUIREMENTS

SPEED LIMIT (MPH)	TAPER LENGTH (FEET)			MINIMUM NUMBER OF DEVICES FOR TAPER	MAXIMUM DEVICE SPACING IN FEET	
	10' LANE	11' LANE	12' LANE		ALONG TAPER	AFTER TAPER
20	70	75	80	5	20	20
25	105	115	125	6	25	25
30	150	165	180	7	30	30
35	205	225	245	8	35	35
40	270	295	320	9	40	40
45	450	495	540	13	45	45
50	500	550	600	13	50	50
55	550	605	660	13	55	55

RECOMMENDED SIGN SPACING FOR ADVANCE WARNING SIGN SERIES

SPEED MILES PER HOUR	MINIMUM DISTANCE IN FEET	
	BETWEEN SIGNS	FROM LAST SIGN TO TAPER
0-20	10 X SPEED LIMIT	10 X SPEED LIMIT
25-30	10 X SPEED LIMIT	10 X SPEED LIMIT
30-35	10 X SPEED LIMIT	10 X SPEED LIMIT
40-45	10 X SPEED LIMIT	10 X SPEED LIMIT
50-60	10 X SPEED LIMIT	10 X SPEED LIMIT


TAPER CRITERIA

TYPE OF TAPER	TAPER LENGTH
UPSTREAM TAPER:	
MERGING TAPER	L MINIMUM
SHIFTING TAPER	1/2 L MINIMUM
SHOULDER TAPER	1/2 L MINIMUM
TWO-WAY TRAFFIC TAPER	100 FEET MAXIMUM
DOWNSIDE TAPERS	100 FEET PER LANE

TAPER LENGTH COMPUTATION

SPEED LIMIT
40 MPH OR LESS $L = \frac{WS^2}{60}$
45 MPH OR GREATER $L = W \times S$
L = TAPER LENGTH
W = WIDTH OF OFFSET IN FEET
S = POSTED SPEED OR OFF-PEAK 85-PERCENTILE SPEED IN MPH

SIGN FACE DETAILS

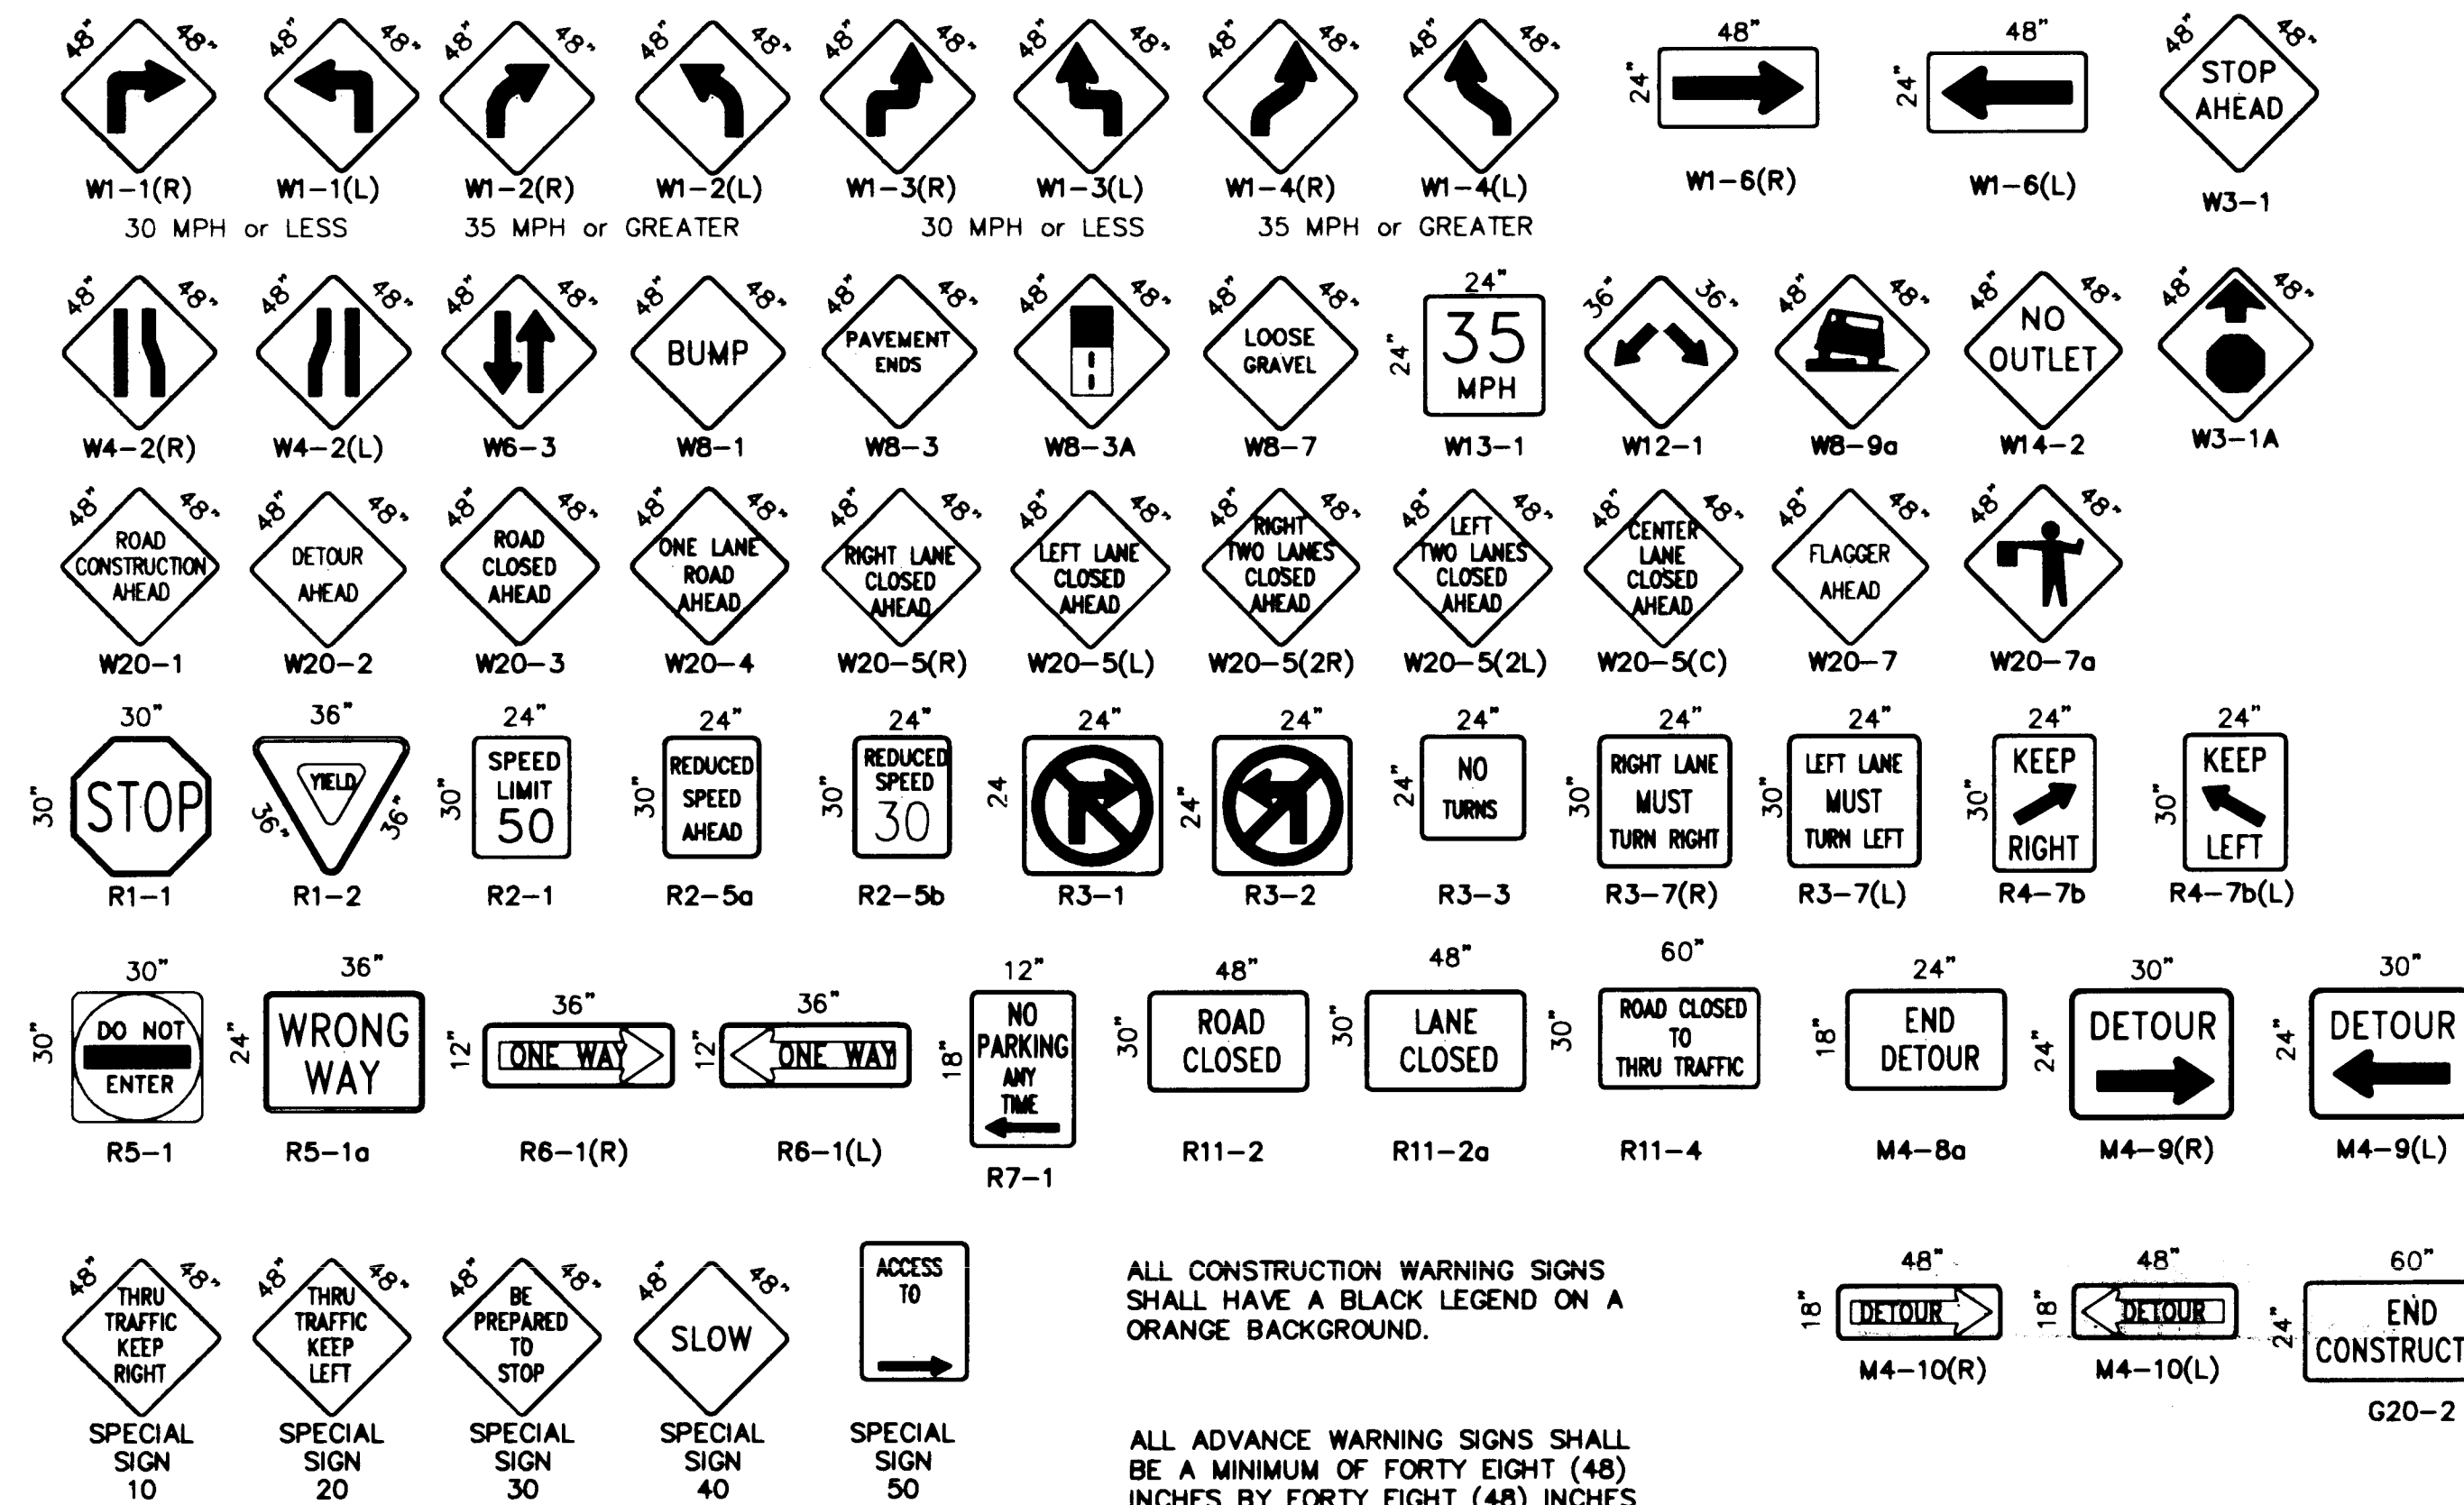

ALL CONSTRUCTION WARNING SIGNS SHALL HAVE A BLACK LEGEND ON A ORANGE BACKGROUND.

ALL ADVANCE WARNING SIGNS SHALL BE A MINIMUM OF FORTY EIGHT (48) INCHES BY FORTY EIGHT (48) INCHES IN SIZE AND SHALL HAVE ONE WARNING LIGHT.

RECORD DRAWING

940866

CITY OF ALBUQUERQUE
PUBLIC WORKS DEPARTMENT
ENGINEERING GROUP

TITLE: LYT 1, BLOCK A
KIEFLAND ADDITION

SIGNING AND CONSTRUCTION TRAFFIC CONTROL STANDARDS

APPROVALS	ENGINEER	DATE	APPROVALS	ENGINEER	DATE
DRC CHAIRMAN	B. J. Boudry	9-26-95	WATER	N/A RWK	8-30-95
TRANSPORTATION	N/A RWK	9-26-95	WASTE WATER	N/A RWK	8-30-95
HYDROLOGY	N/A RWK	9-26-95			

PROJECT NO. 5283.90

MAP NO. M-15

SHEET 5 OF 6

