

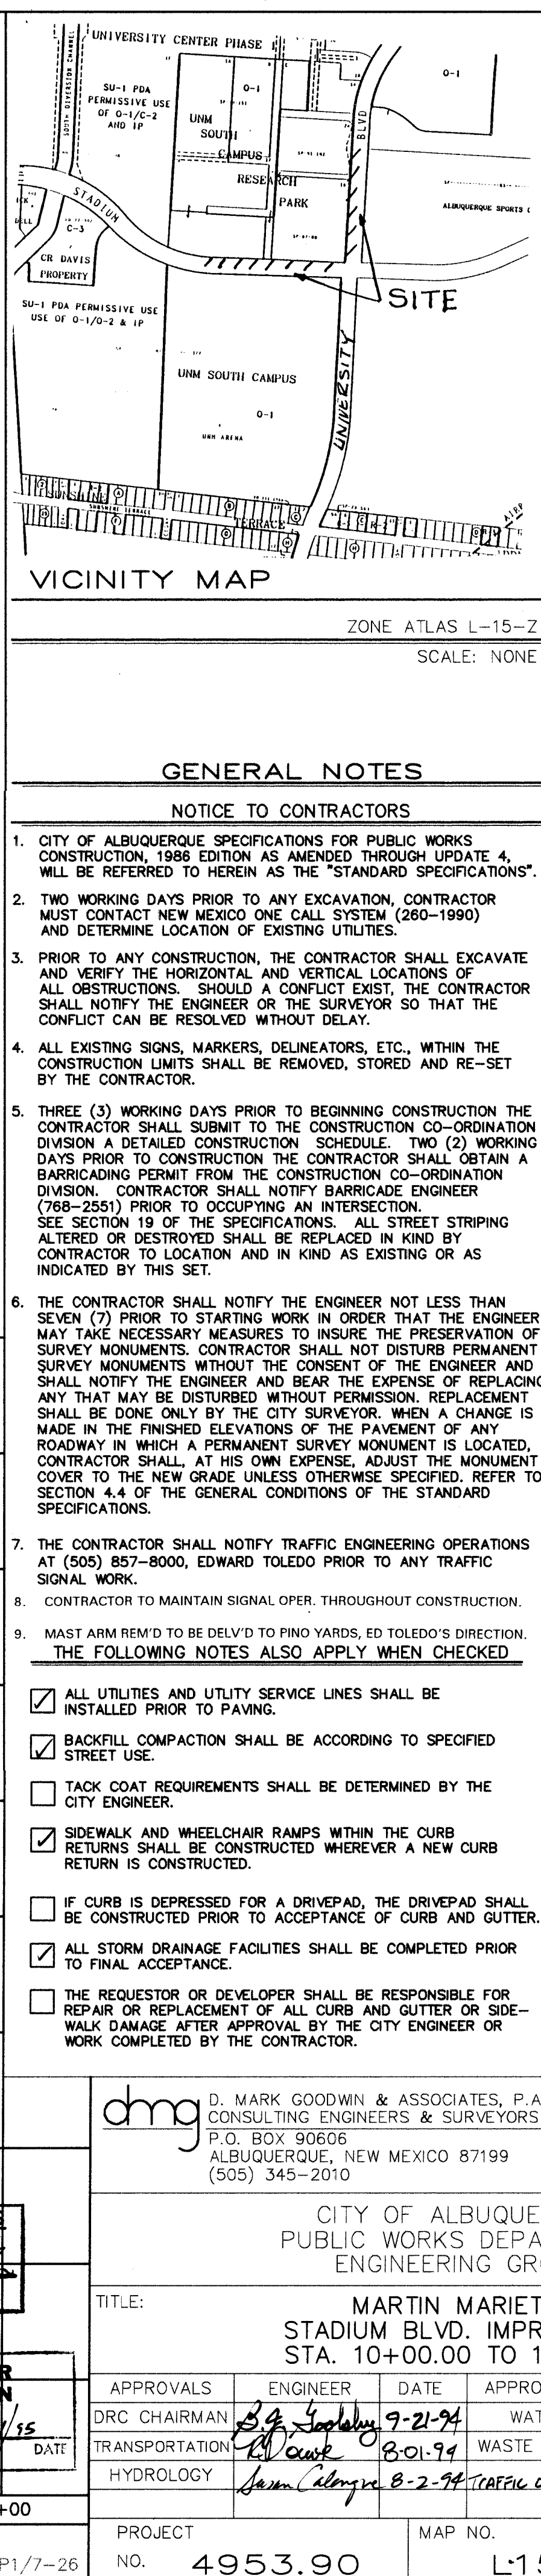


[illegible]

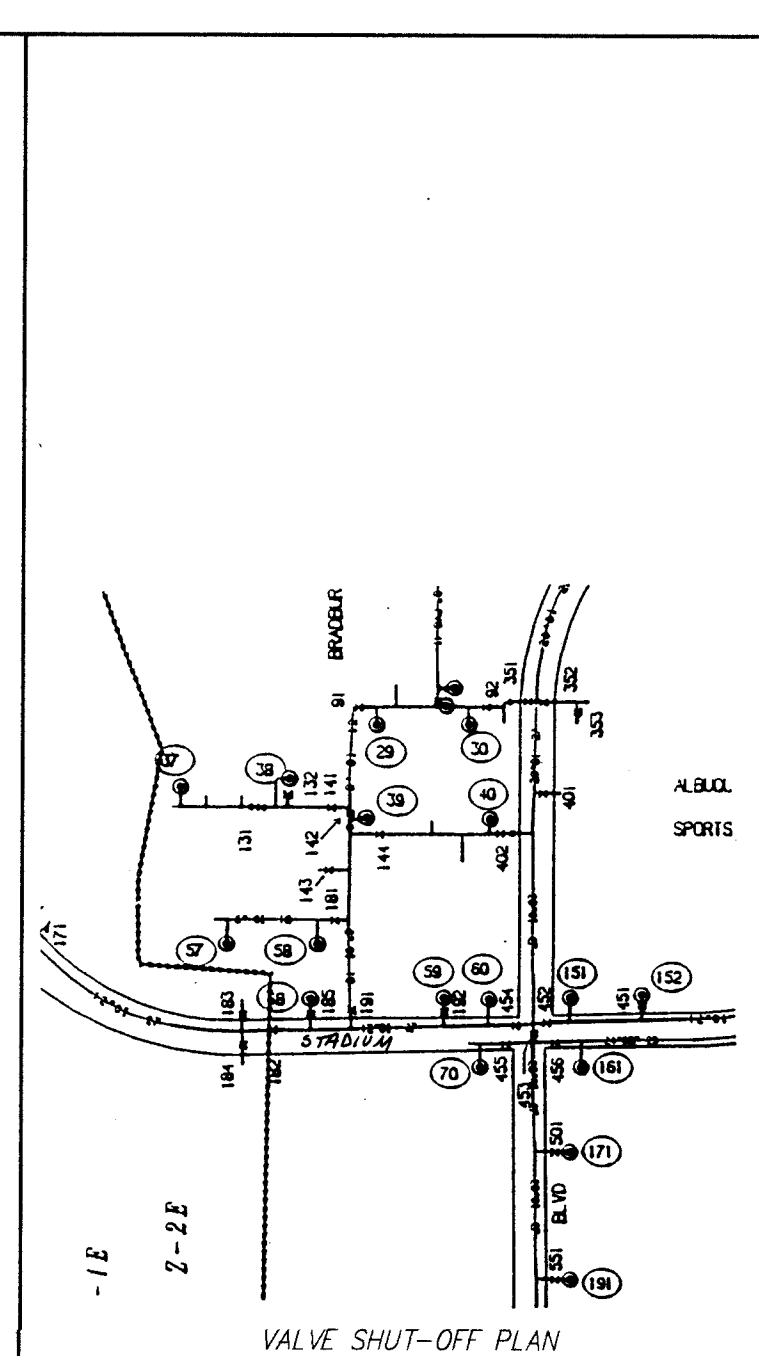

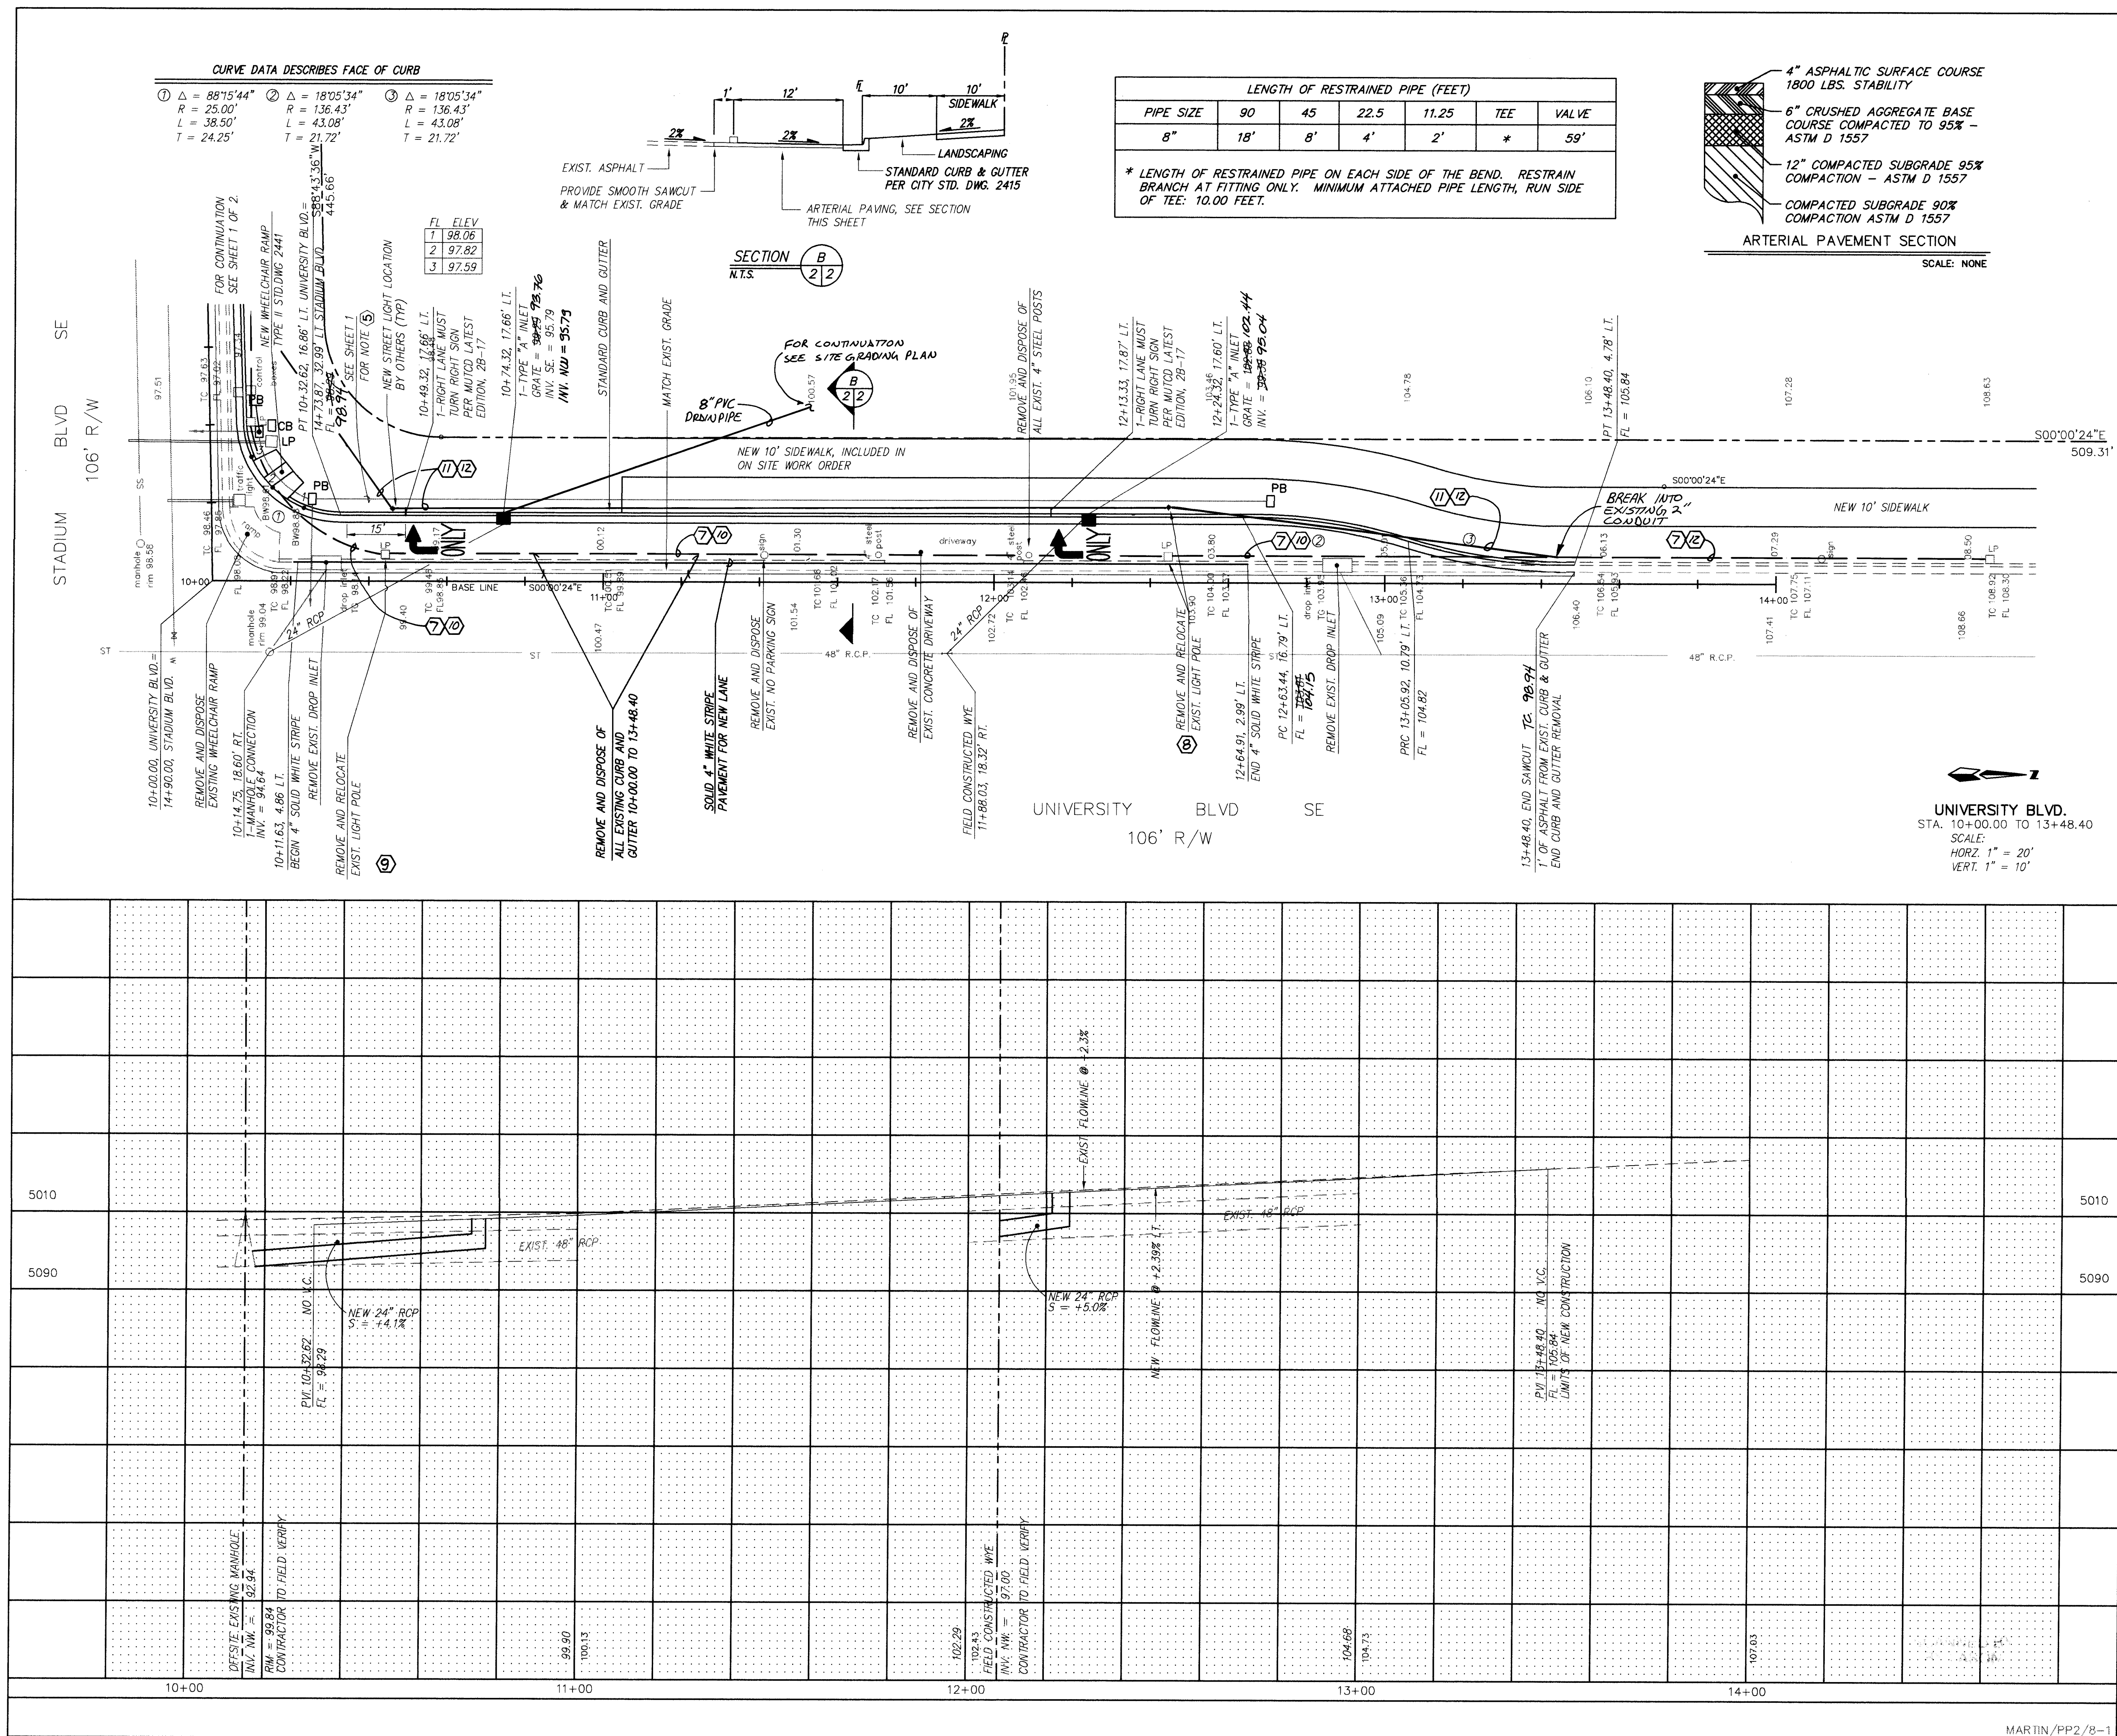

1. FOR WATERLINE CONNECTION SHOWN VALVES NO. 454, 191, AND 182. NEED TO BE CLOSED.
2. CONTRACTOR WILL CONTACT WATER SYSTEMS AT 857-8200 3 DAYS PRIOR TO NECESSARY SHUT-OFF.
3. VALVES SHALL BE OPERATED BY CITY WATER EMPLOYEES ONLY

[illegible]