

CONSTRUCTION PLANS

FOR

ROME DEPOT 2



ALBUQUERQUE II

~~JUNE 1993~~
September 1994

FW

INDEX TO DRAWINGS

1. TITLE SHEET
2. PLAT
3. DECELERATION LANE-CENTRAL
4. PAVING IMPROVEMENTS-EUBANK 1+00 TO 11+55.64
5. PAVING IMPROVEMENTS-EUBANK 11+55.64 TO 18+75.30
6. UTILITY IMPROVEMENTS "A" / STORM DRAIN IMPROVEMENTS
7. UTILITY IMPROVEMENTS "B"
8. STORM DROP INLET CONNECTION
9. STRIPING IMPROVEMENTS-EUBANK BVD

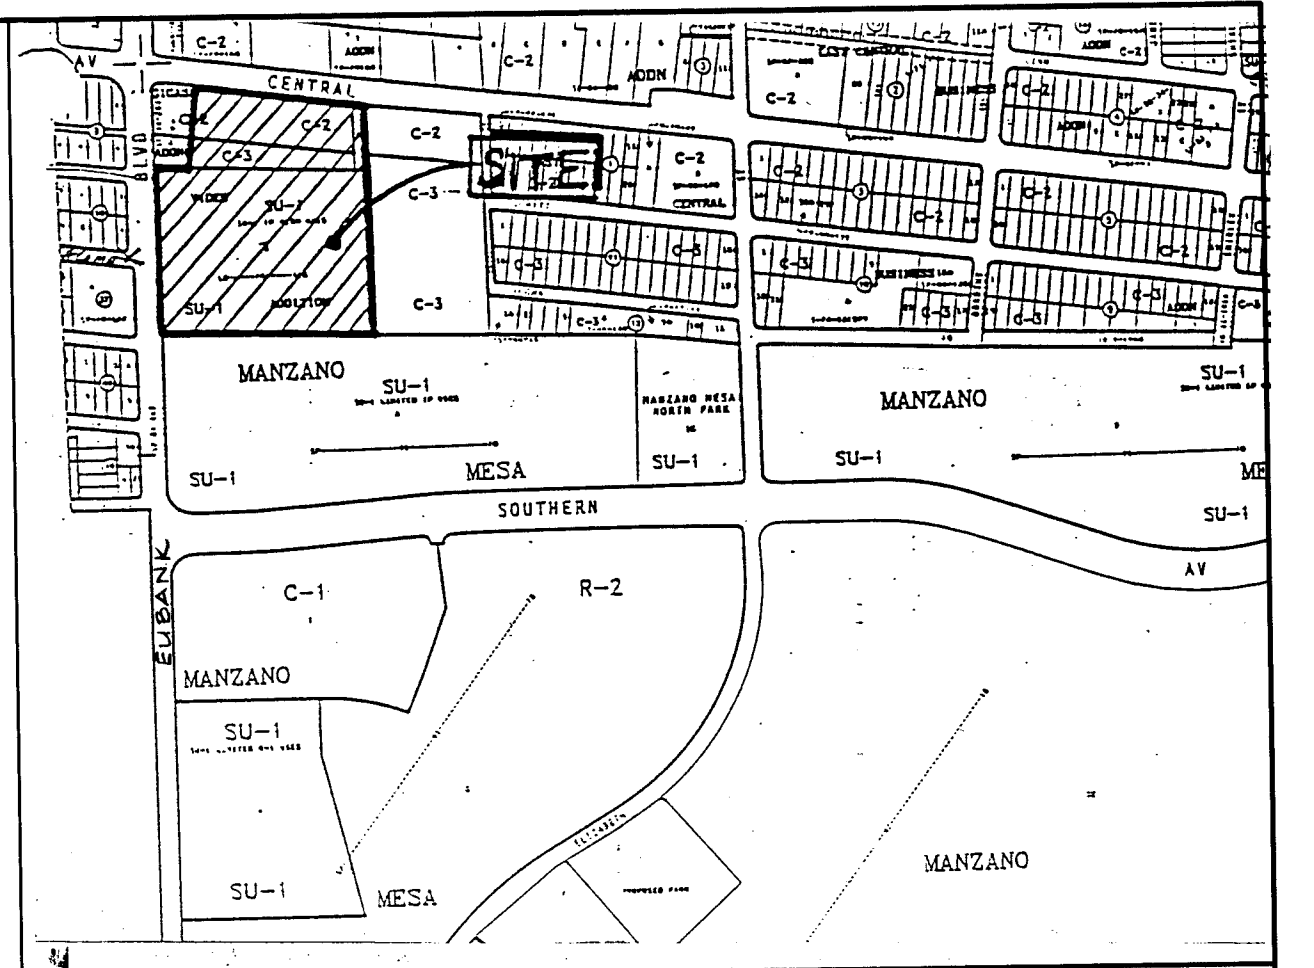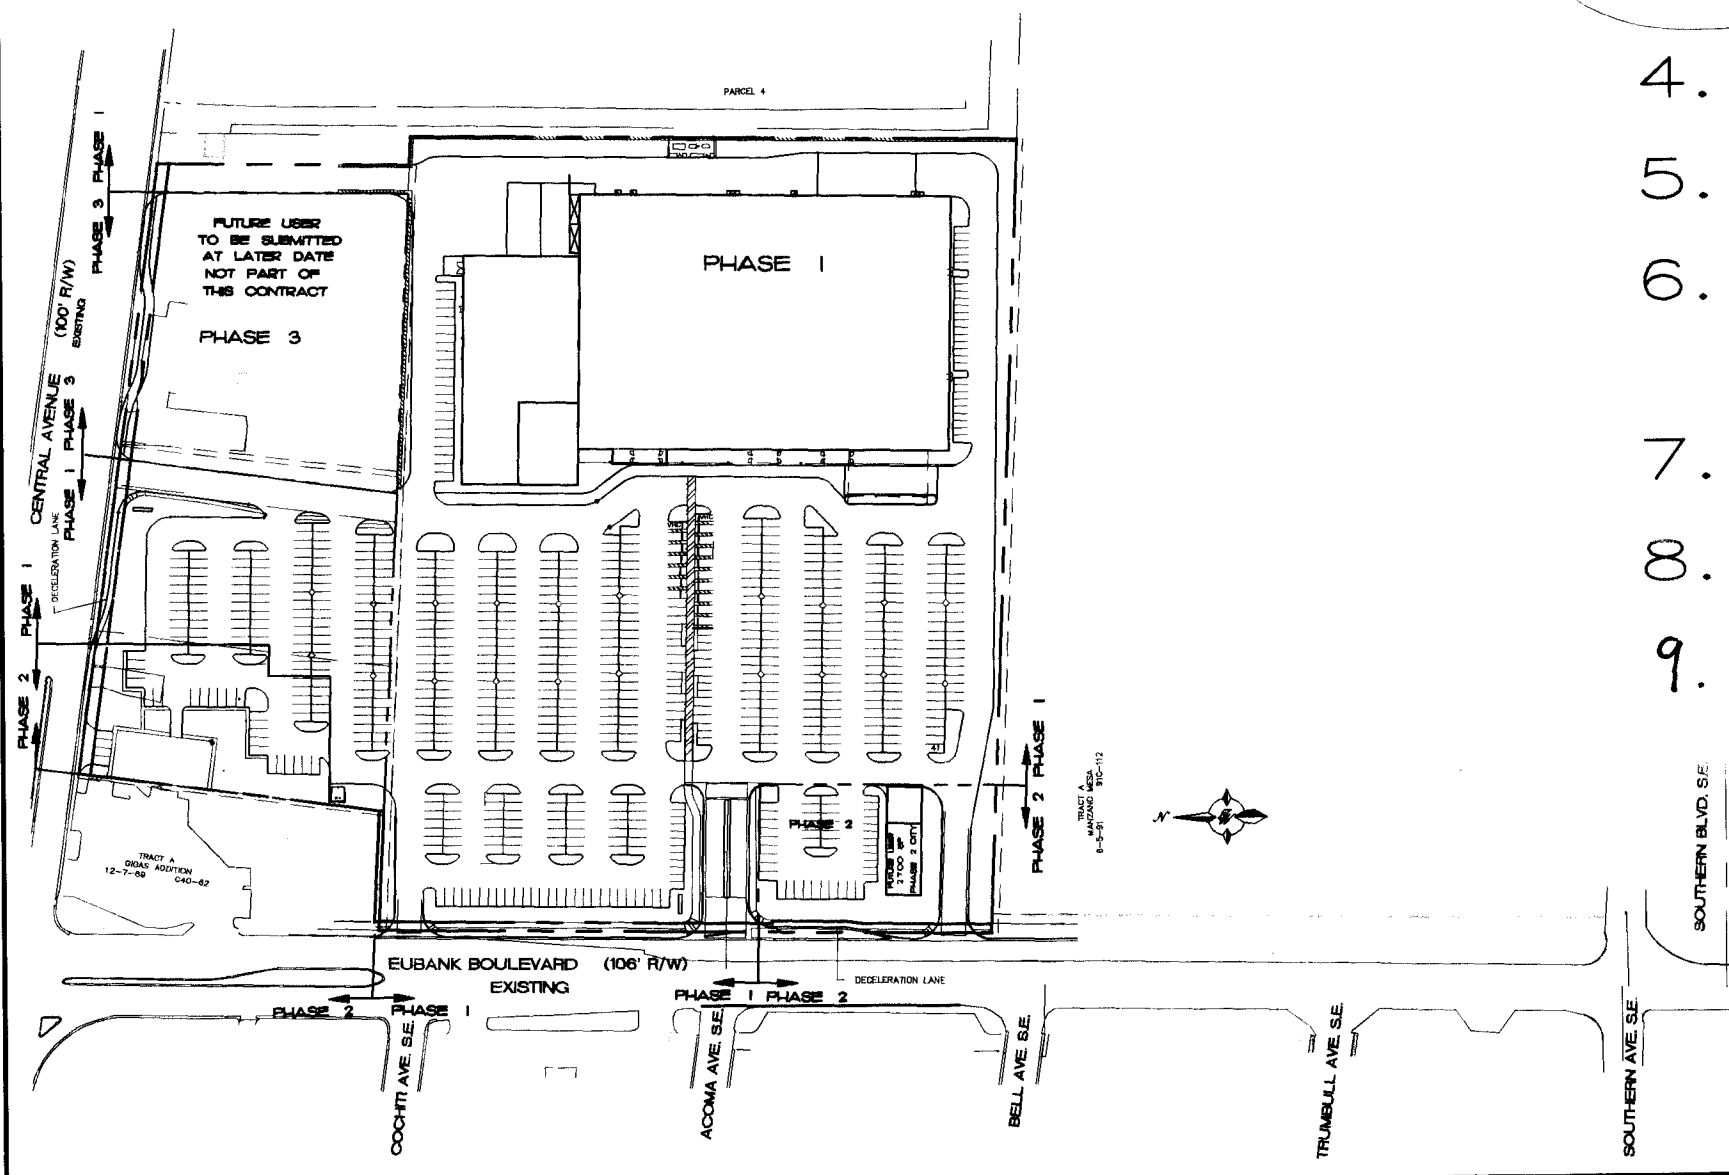

VICINITY MAP ZONE ATLAS L-21-Z
SCALE NONE


NOTICE TO CONTRACTORS

1. ALL WORK DETAILED ON THESE PLANS TO BE PERFORMED UNDER CONTRACT SHALL, EXCEPT AS OTHERWISE STATED OR PROVIDED FOR HEREON, BE CONSTRUCTED IN ACCORDANCE WITH THE CITY OF ALBUQUERQUE STANDARD SPECIFICATIONS FOR PUBLIC WORKS CONSTRUCTION, 1986 EDITION (UPDATE #4)
2. TWO WORKING DAYS PRIOR TO ANY EXCAVATION, THE CONTRACTOR MUST CONTACT NEW MEXICO ONE CALLS SYSTEM (260-1990) FOR LOCATION OF EXISTING UTILITIES.
3. PRIOR TO CONSTRUCTION, THE CONTRACTOR SHALL EXCAVATE AND VERIFY THE HORIZONTAL AND VERTICAL LOCATIONS OF ALL OBSTRUCTIONS. SHOULD A CONFLICT EXIST, THE CONTRACTOR SHALL NOTIFY THE ENGINEER OR SURVEYOR IMMEDIATELY SO THAT THE CONFLICT CAN BE RESOLVED WITH A MINIMUM AMOUNT OF DELAY.
4. THREE(3) WORKING DAYS PRIOR TO BEGINNING OF CONSTRUCTION, THE CONTRACTOR SHALL SUBMIT TO CONSTRUCTION COORDINATIONS DIVISION A DETAILED CONSTRUCTION SCHEDULE. TWO(2) WORKING DAYS PRIOR TO CONSTRUCTION, THE CONTRACTOR SHALL OBTAIN A BARRICADING PERMIT FROM THE CONST. COORDINATION DIVISION. CONTRACTOR SHALL NOTIFY BARRICADE ENGINEER (768-2551) PRIOR TO OCCUPYING AN INTERSECTION. REFER TO STANDARD SPECIFICATIONS.
5. ALL STREET STRIPING ALTERED OR DESTROYED SHALL BE REPLACED IN KIND BY CONTRACTOR TO LOCATION AND IN KIND AS EXISTING OR AS INDICATED BY THIS PLAN SET.
6. CONTRACTOR SHALL NOTIFY THE ENGINEER NOT LESS THAN SEVEN(7) DAYS PRIOR TO STARTING WORK IN ORDER THAT THE ENGINEER MAY TAKE NECESSARY MEASURES TO INSURE THE PRESERVATION OF SURVEY MONUMENTS. CONTRACTOR SHALL NOT DISTURB PERMANENT SURVEY MONUMENTS WITHOUT THE CONSENT OF THE ENGINEER AND SHALL NOTIFY THE ENGINEER AND BEAR THE EXPENSE OF REPLACING ANY THAT MAY BE DISTURBED WITHOUT PERMISSION. REPLACEMENT SHALL BE DONE ONLY BY THE CITY SURVEYOR. WHEN A CHANGE IS MADE IN THE FINISHED ELEVATIONS OF THE PAVEMENT OF ANY ROADWAY IN WHICH A PERMANENT SURVEY MONUMENT IS LOCATED, CONTRACTOR SHALL, AT HIS OWN EXPENSE, ADJUST THE MONUMENT COVER TO THE NEW GRADE UNLESS OTHERWISE SPECIFIED. REFER TO SECTION 4.4 OF THE GENERAL CONDITIONS OF THE STANDARD SPECIFICATIONS.

THE FOLLOWING NOTES ALSO APPLY WHEN CHECKED

- ☒ ALL UTILITIES AND UTILITY SERVICE LINES SHALL BE INSTALLED PRIOR TO PAVING.
- ☒ BACKFILL COMPACTION SHALL BE ACCORDING TO SPECIFIED STREET USE.
- ☒ TACK COAT REQUIREMENTS SHALL BE DETERMINED BY THE CITY ENGINEER.
- ☒ SIDEWALKS AND WHEELCHAIR RAMPS WITHIN THE CURB RETURNS SHALL BE CONSTRUCTED WHEREVER A NEW CURB RETURN IS CONSTRUCTED.
- ☒ IF CURB IS DEPRESSED FOR A DRIVEPAD, THE DRIVEPAD SHALL BE CONSTRUCTED PRIOR TO ACCEPTANCE OF CURB AND GUTTER.
- ☒ ALL STORM DRAINAGE FACILITIES SHALL BE COMPLETED PRIOR TO FINAL ACCEPTANCE.

1 2 3 4 5 6 7 8 9 10 11 12 13 14 15
26-49611-910101915

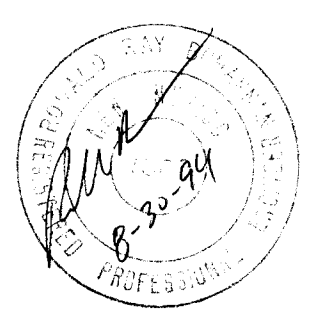

APPROVAL OF AS BUILT DRAWINGS
CHIEF CONSTRUCTION ENGINEER
Ricardo Ruybal
DATE 8-16-95

APPROVED FOR
CONSTRUCTION
Ricardo Ruybal
CITY ENGINEER 9-26-94 DATE


TIERRA WEST DEVELOPMENT
MANAGEMENT SERVICES
4600 MONTGOMERY BLVD. N.E., SUITE 3
ALBUQUERQUE, NEW MEXICO 87109
(505)883-7592

Deceleration lane & Manhole change Permit 12/30/94

REV	SHEETS	CITY ENGINEER	DATE	USER DEPT.	DATE	USER DEPT.	DATE
A	3		3/28/95				
B	3, 6, 8						
C	9		12/21/94				

PROJECT NO. 4961.90

SCANNED BY
CLASON

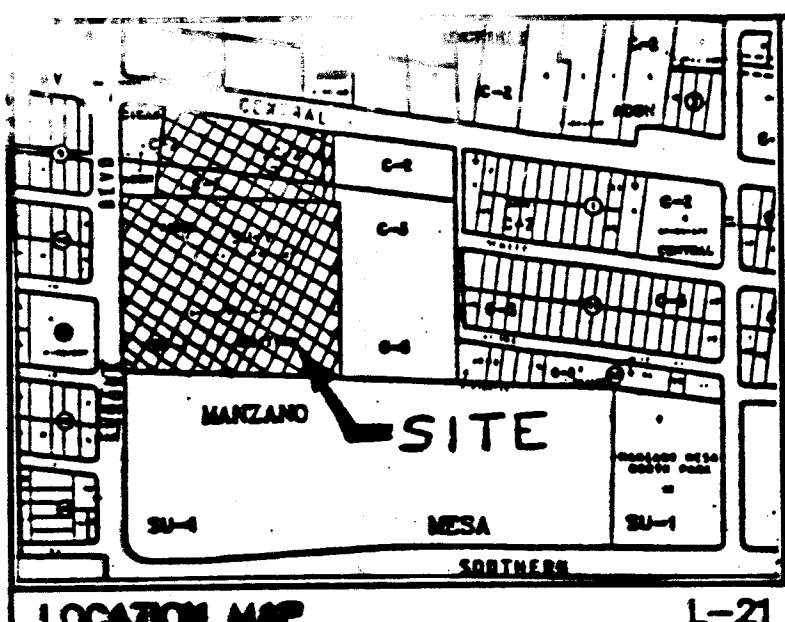

SCALE: 1"=750'

PURPOSE OF PLAT

1. Grant easements for public streets and right-of-way as shown hereon.
2. Grant an easement for private common access as shown hereon.
3. To plat three previously unplatted parcels and incorporate them into "VIDEO ADDITION".
4. To create three tracts as shown hereon.

SUBDIVISION DATA

1. DRB Case No.: 94-188
2. Zone Atlas Index No.: L-21
3. Total Number of Tracts created: 3
4. Gross Subdivision Acreage: 16.3802 Acres
5. Utility Council Log No.: 94052410140239

NOTES

1. Bearings are grid based on the New Mexico State Plane Coordinate System (Central Zone).
2. Distances are ground distances.
3. Bearings and distances in parenthesis are record.
4. Basis of boundary are the following plats of record entitled:

"PLAT OF TRACT A, GIGAS ADDITION" (12-7-89, C40-62),
"AMENDED PLAT OF VIDEO ADDITION" (10-14-70, B5-63),
"REPLAT FOR TRACTS A THROUGH J, MANZANO MESA" (6-5-91, 91C-112),
"CONTRACT FOR THE PURCHASE OF PUBLIC LANDS" (Doc. #7984172),
"ASSIGNMENT OF STATE LAND PURCHASE CONTRACT" (11-7-79, Bk. Misc. 730, Pg. 847-850),
"WARRANTY DEED" (5-1-89, Bk. D359A, Pg. 391),
"PATENT FOR STATE LAND" (10-27-52, Bk. D221, Pg. 199),

all being records of Bernalillo County, New Mexico, and an
unfiled survey entitled "CERTIFICATE OF SURVEY, 4 PARCELS OF LAND
IN THE NW 1/4, NW 1/4 OF SECTION 28, T.10N., R.4E., N.M.P.M.",
dated February, 1985 prepared by Wayjohn Surveying Company,
Albuquerque, New Mexico.

5. Field Survey performed November 8, 1993 (FB#108).

DESCRIPTION

A tract of land situate within the NW 1/4, NW 1/4 of Section 28,
Township 10 North, Range 4 East, New Mexico Principal Meridian
within the City of Albuquerque, Bernalillo County, New Mexico being
all of TRACTS A and B, VIDEO ADDITION as the same is shown and
designated on said amended plat filed for record in the office of
the County Clerk of Bernalillo County, New Mexico on October 14,
1970 in Volume 85, Folio 63 together with all of PARCELS 1, 2 and
3 as the same is shown and designated on an unfiled certificate of
survey entitled 4 PARCELS OF LAND IN THE NW 1/4, NW 1/4 OF SECTION
28, T.10 N., R.4 E., N.M.P.M. prepared by Wayjohn Surveying
Company, Albuquerque, New Mexico and being more particularly
described as follows:

BEGINNING at the southeast corner of the herein described tract,
said point being common with the southwest corner of PARCEL 4 of
said unfiled certificate of survey, and further being on the
northerly boundary line of TRACT A, MANZANO MESA as the same is
shown and designated on said plat filed for record in the office of
the County Clerk of Bernalillo County, New Mexico on June 5, 1991
in Volume 91C, Folio 112 from whence the Albuquerque Control Survey
Monument "3-L21" bears S 82°13'08" E, 1256.16 feet;

THENCE N 87°42'48" W, 827.02 feet to the southwest corner, said
point being on the easterly right-of-way line of Eubank Boulevard
N.E.;

THENCE along said right-of-way line N 00°55'16" E, 635.98 feet to
a point, said point being common with the southeast corner of TRACT
A, GIGAS ADDITION on the same is shown and designated on said plat
filed for record in the office of the County Clerk of Bernalillo
County, New Mexico on December 7, 1989 in Volume C40, Folio 62;

THENCE leaving said right-of-way line S 87°16'56" E, 123.95 feet to
a point, said point being common with the southeast corner of said
TRACT A, GIGAS ADDITION;

THENCE N 07°42'18" E, 319.14 feet to the northeast corner, said
point being common with the northeast corner of said TRACT A, GIGAS
ADDITION, and further being on the southerly right-of-way line of
Central Avenue N.E.;

THENCE along said right-of-way line S 82°12'04" E, 640.20 feet to
the northeast corner, said point being common with the northwest
corner of said PARCEL 4;

THENCE leaving said right-of-way line along the westerly line of
said PARCEL 4 S 00°55'26" W, 281.36 feet to a point;

THENCE continuing S 87°16'56" E, 30.06 feet to a point;

THENCE continuing S 00°57'36" W, 829.74 feet to the point of
beginning and containing 16.3802 acres more or less.

FREE CONSENT AND GRANT

The subdivision hereon described is with the free consent and in
accordance with the desires of the undersigned owner(s) and/or
proprietor(s) thereof and said owner(s) and/or proprietor(s) do
hereby grant to the City of Albuquerque an easement for public
access, drainage, and utilities as indicated herein, including the
right to construct, operate, inspect, and maintain facilities therein.
Further, said owner(s) and/or proprietor(s) do hereby grant
easements as shown and indicated.

In the event the City should every cease use of the easement for
public purpose, the easement granted herein may be vacated
per the subdivision ordinance. Said owner(s) and/or
proprietor(s) do hereby warrant that they are the owners in fee
simple of the land upon which the easements are granted and do
hereby consent to all of the foregoing and do hereby certify that
this subdivision is their free act and deed.


Owner TRACT B1
HOME DEPOT U.S.A., INC.

Daniel R. Hatch 6-20-94
DANIEL R. HATCH, CORPORATE COUNSEL - WESTERN DIVISION
COUNSEL

STATE OF CALIFORNIA)
COUNTY OF ORANGE)

On this 20th day of June, 1994, this instrument was
acknowledged before me by Daniel R. Hatch as Corporate Counsel - Western Division.

Jeannette McClain
Notary Public

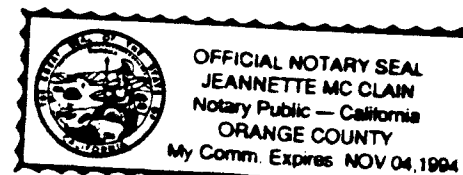

Owner TRACTS C AND D
STATE OF NEW MEXICO

Ray Powell 6-21-94
Ray Powell, Commissioner of Public Lands

STATE OF NEW MEXICO)
COUNTY OF SAGUARO)

On this 21st day of June, 1994, this instrument was
acknowledged before me by Ray Powell as Commissioner of Public
Lands for the State of New Mexico.

Deborah Padilla
Notary Public

Commission Expires
May 10, 1997

94100048

PLAT
FOR

TRACTS B1, C & D
VIDEO ADDITION

WITHIN THE

NW 1/4, NW 1/4 OF SECTION 28
TOWNSHIP 10 NORTH, RANGE 4 EAST, NMPM
CITY OF ALBUQUERQUE
BERNALILLO COUNTY, NEW MEXICO
JUNE 1994

APPROVED AND ACCEPTED BY:

Subdivision Case No. SP-94-149

Jack Clark 6-9-94
Planning Director, City of Albuquerque, N.M. Date

Frank J. Caprin 6-28-94
City Engineer, Div. City of Albuquerque, N.M. Date

Frank J. Caprin 6-28-94
Albuquerque Metropolitan Arroyo Flood Control Authority Date

Michael J. Smith 7-13-94
Traffic Div., City of Albuquerque, N.M. Date

Robert W. Kane 6-28-94
Water Utilities Dept., City of Albuquerque, N.M. Date

Carman Chavez 6-24-94
Parks and Recreation Dept., City of Albuquerque, N.M. Date

David Chel 062994
City Surveyor, City of Albuquerque, N.M. Date

NA
Property Management, City of Albuquerque, N.M. Date

Bonnie M. Sullivan 8-9-94
County Treasurer, Bernalillo County, N.M. Date

SURVEYOR'S CERTIFICATION

"I, Timothy Aldrich, a duly qualified Registered Professional
Land Surveyor under the laws of the State of New Mexico, do
hereby certify that this plat and description were prepared
by me or under my supervision, shows all easements as shown
on the plat of record or made known to me by the owners
and/or proprietors of the subdivision shown hereon, utility
companies and other parties expressing an interest and meets
the minimum requirements for monumentation and surveys of the
Albuquerque Subdivision Ordinance, and further meets the
Minimum Standards for Land Surveying in the State of New
Mexico (Effective November 1, 1989 and revisions effective
December 25, 1991 and February 2, 1994), and is true and correct
to the best of my knowledge and belief."

Timothy Aldrich 6-17-94
Timothy Aldrich, P.S. No. 7719 Date

**ALDRICH LAND
SURVEYING**

P.O. BOX 30701, ALBU., N.M. 87190
505-884-1990 SHEET 1 OF 2

File name: C:\BIN\3154RP2

94100048

PLAT
FOR

TRACTS B1, C & D
VIDEO ADDITION

WITHIN THE

NW 1/4, NW 1/4 OF SECTION 28
TOWNSHIP 10 NORTH, RANGE 4 EAST, NMPM
CITY OF ALBUQUERQUE
BERNALILLO COUNTY, NEW MEXICO
JUNE 1994

State of New Mexico) SS
County of Bernalillo)
This instrument was filed for record on
AUG - 9 1994
of records of said County File # 94-149
City Clerk

ADDITIONAL NOTES


6. Prior to development, City of Albuquerque Water and Sanitary Sewer
Service to TRACT B1 must be verified and coordinated
with the Public Works Department, City of Albuquerque, via a request
for a water and sanitary sewer availability statement.


RECIPROCAL EASEMENT AGREEMENT

The owner of Tract B1 and the owner of Tract D each grant
to the other reciprocal easements for cross access and
vehicular parking on and over Tract B1 for the benefit of
Tract D and on and over Tract D for the benefit of Tract B1.
The owner of Tract B1 and the owner of Tract D grant to the
owner of Tract C vehicular access across Tracts B1 and D
respectively for purposes of ingress and egress. The owner
of Tract B1 and the owner of Tracts C and D each grant to
the other reciprocal easements for storm drainage flows on
and over Tract B1 for the benefit of Tracts C and D and on
and over Tracts C and D for the benefit of Tract B1. The
owner of Tract B1 will, at its expense, construct and maintain
the facilities necessary on Tracts B1 and D to provide the
required access and vehicular parking, and to accept, retain,
convey and/or discharge as appropriate, the required storm
drainage flows on Tracts B1 and D. The owner of Tract C
will be responsible for the required facilities necessary to
accept, retain, convey and/or discharge required storm
drainage flows on Tract C.


**ALDRICH LAND
SURVEYING**



P.O. BOX 30701, ALBU., N.M.
505-884-1990

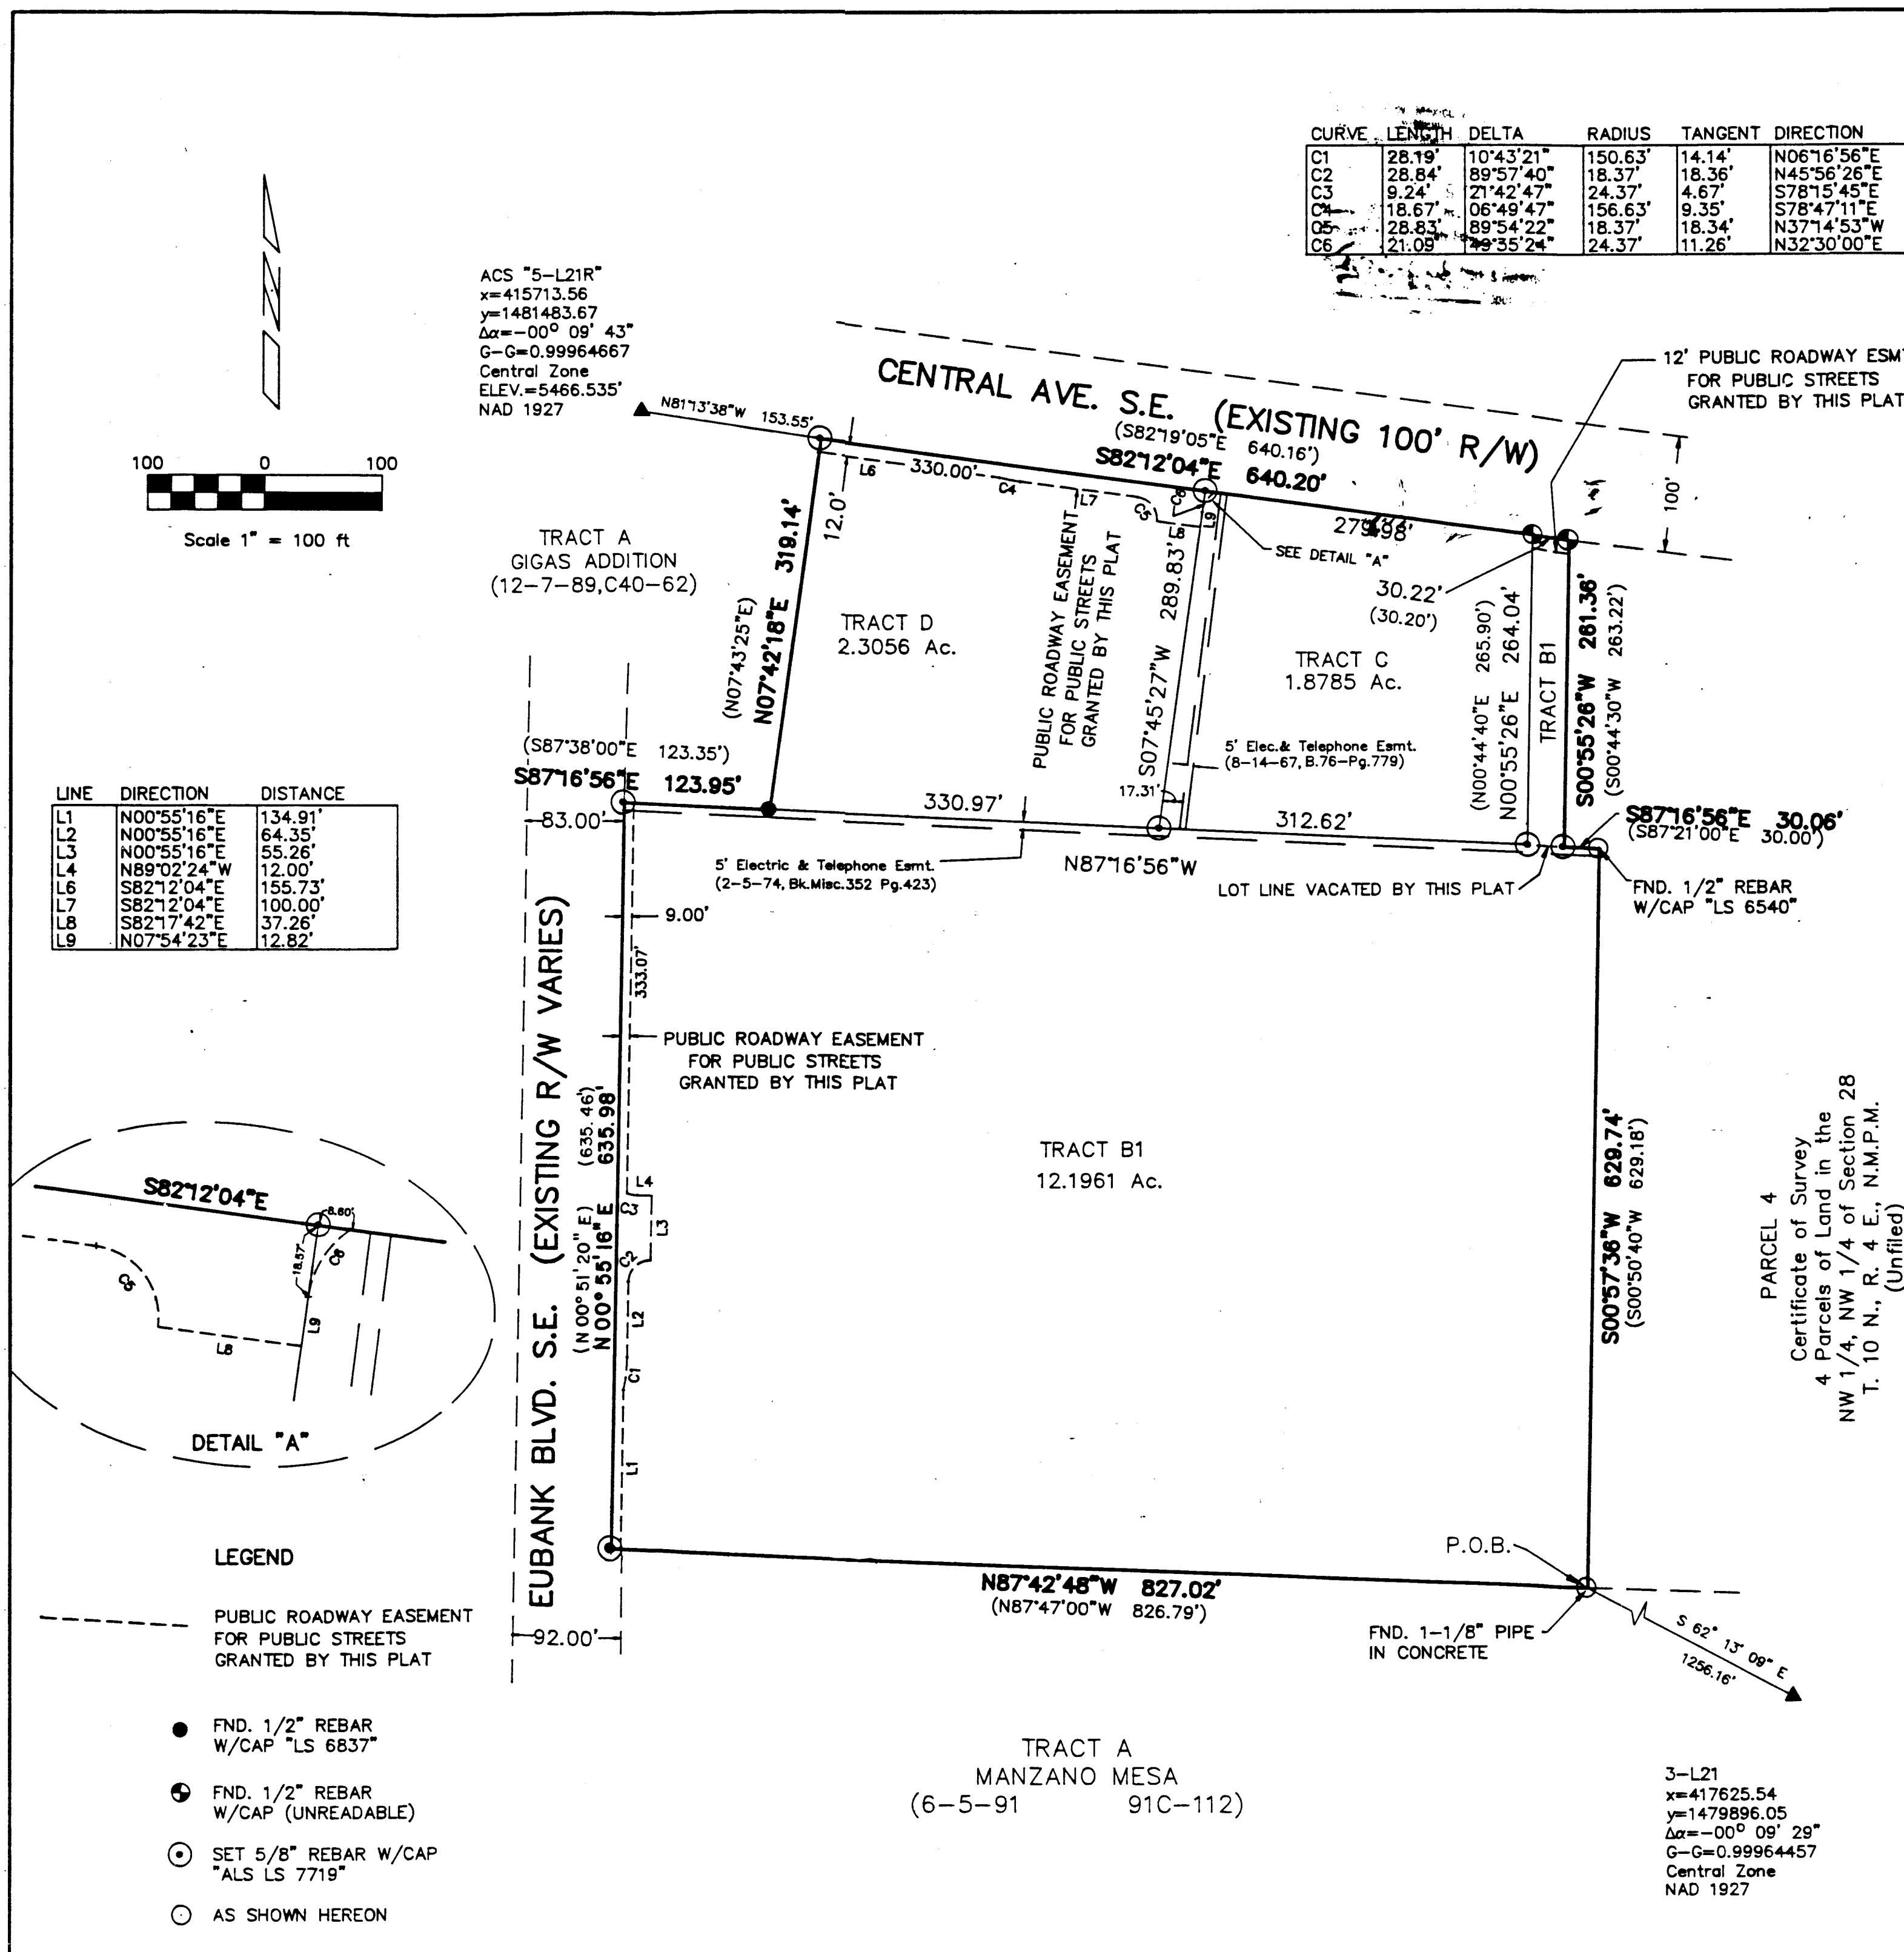

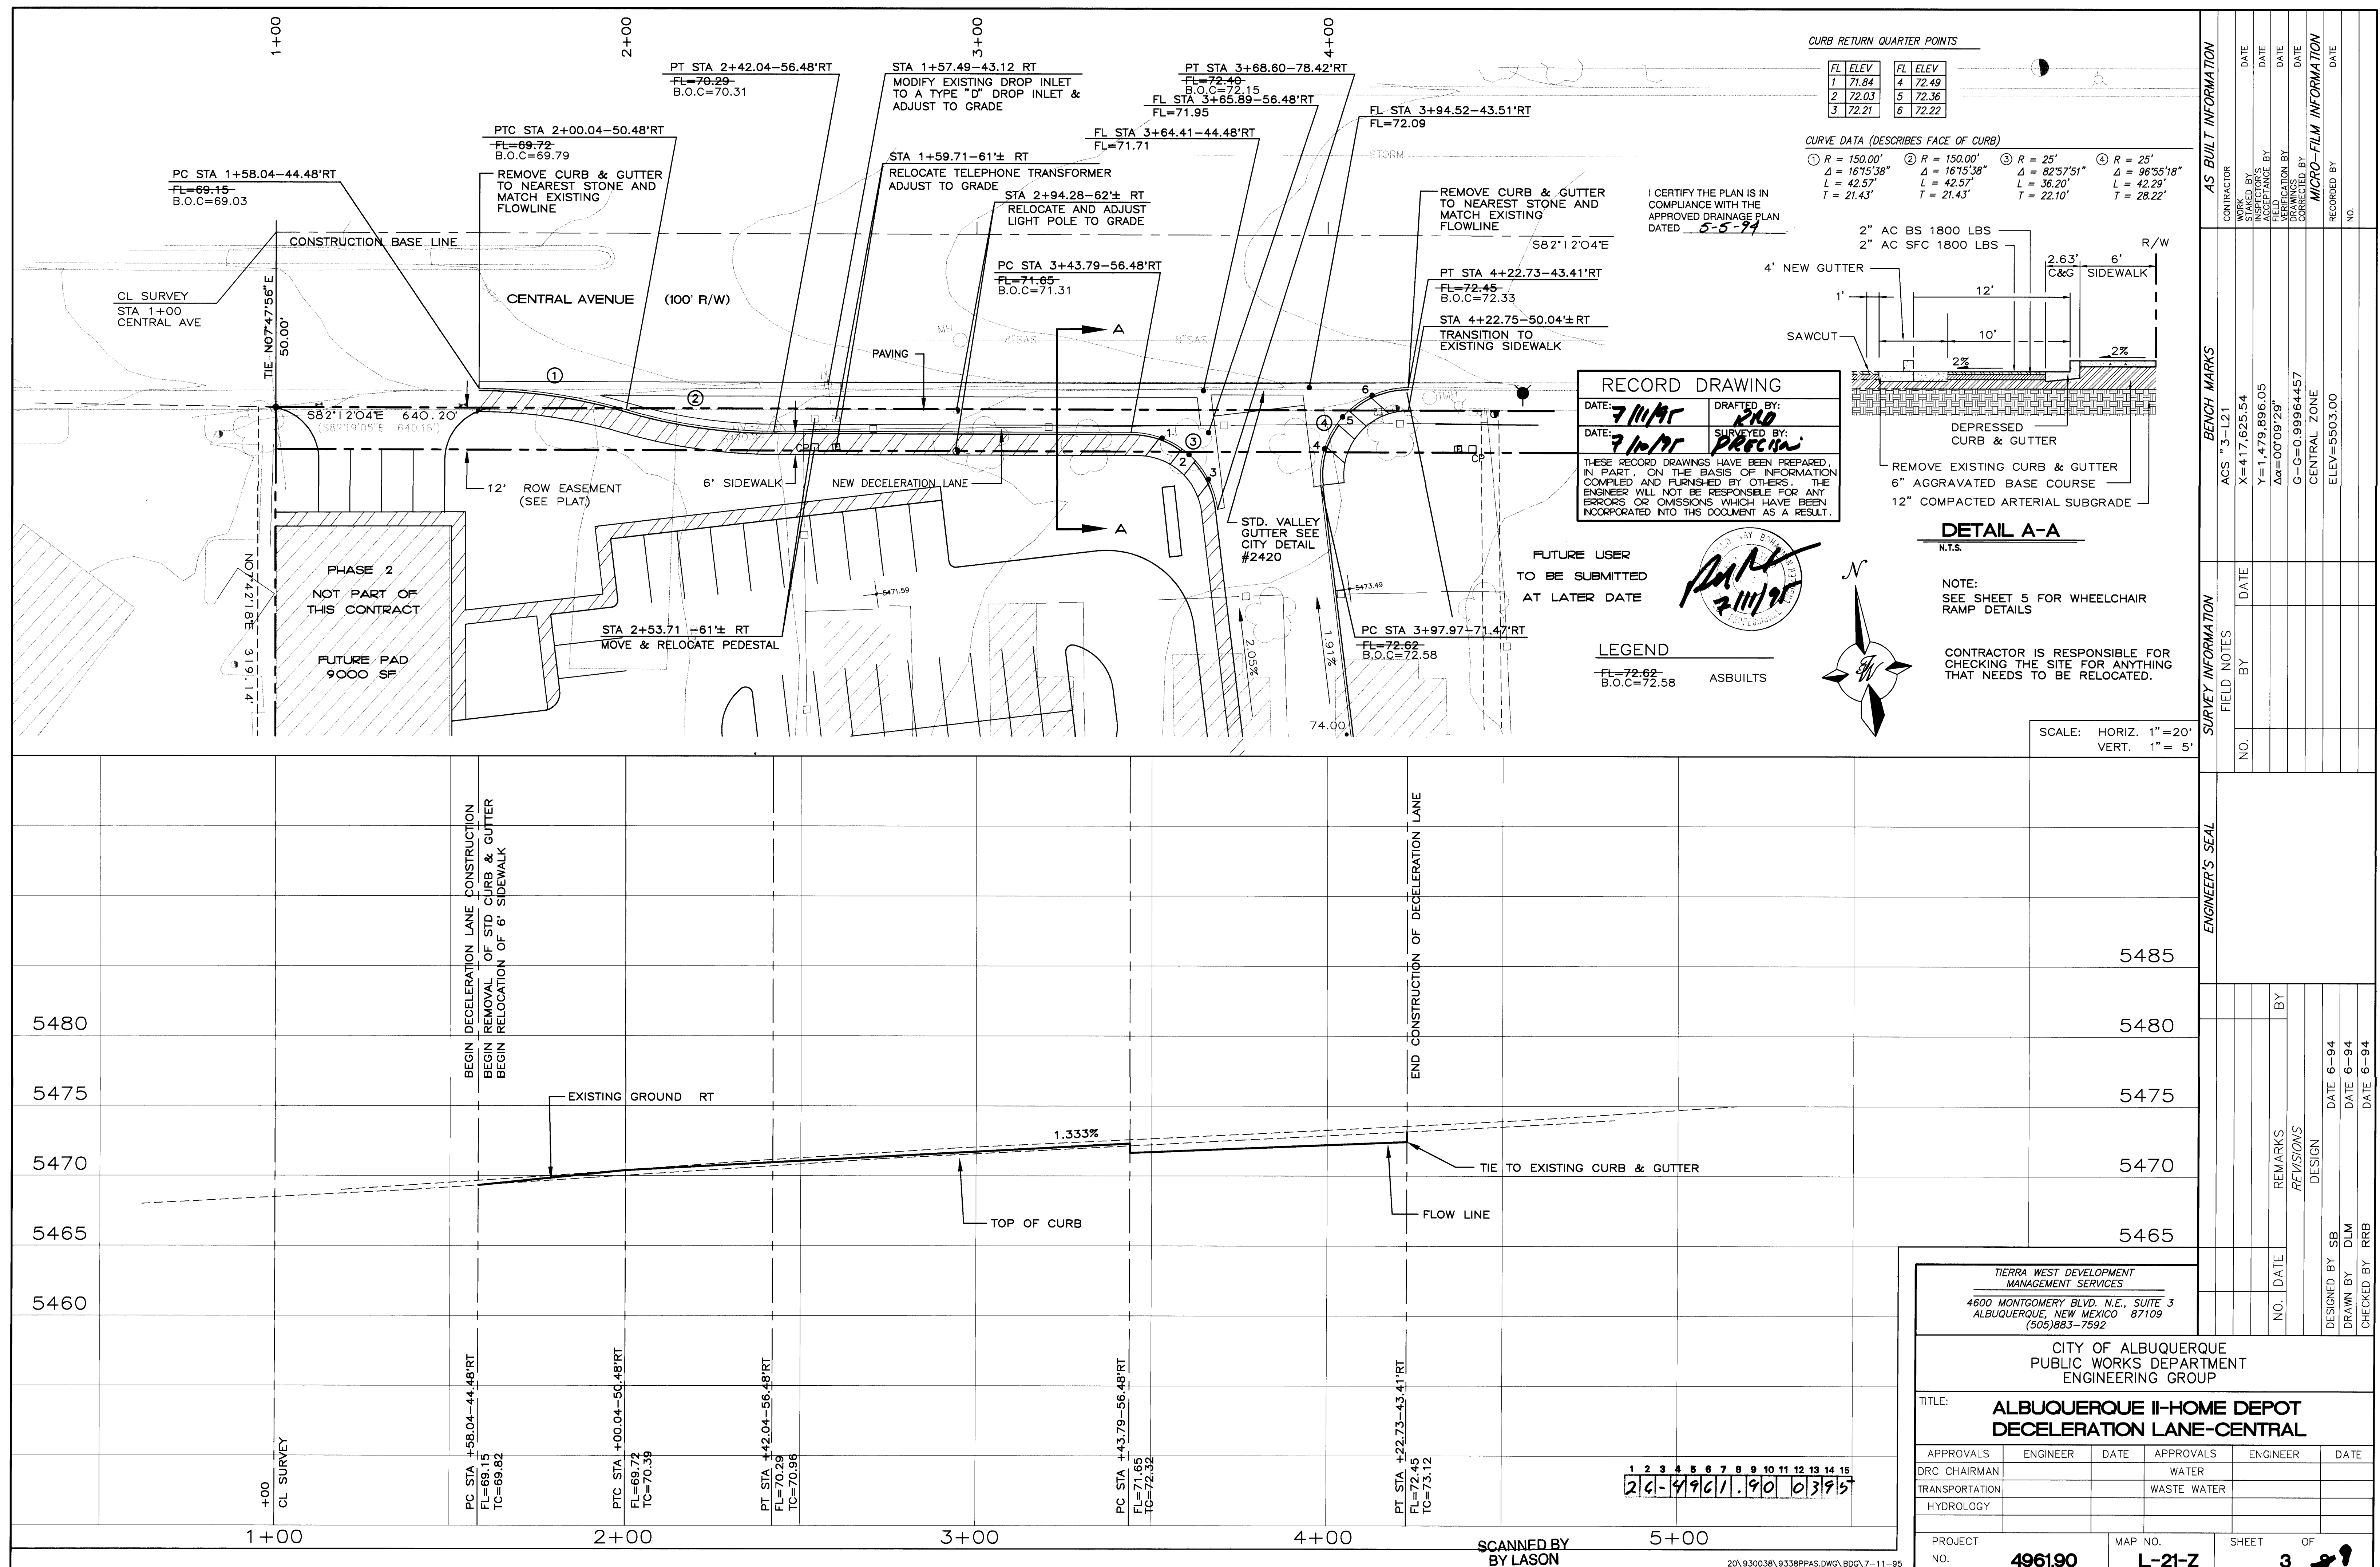

new



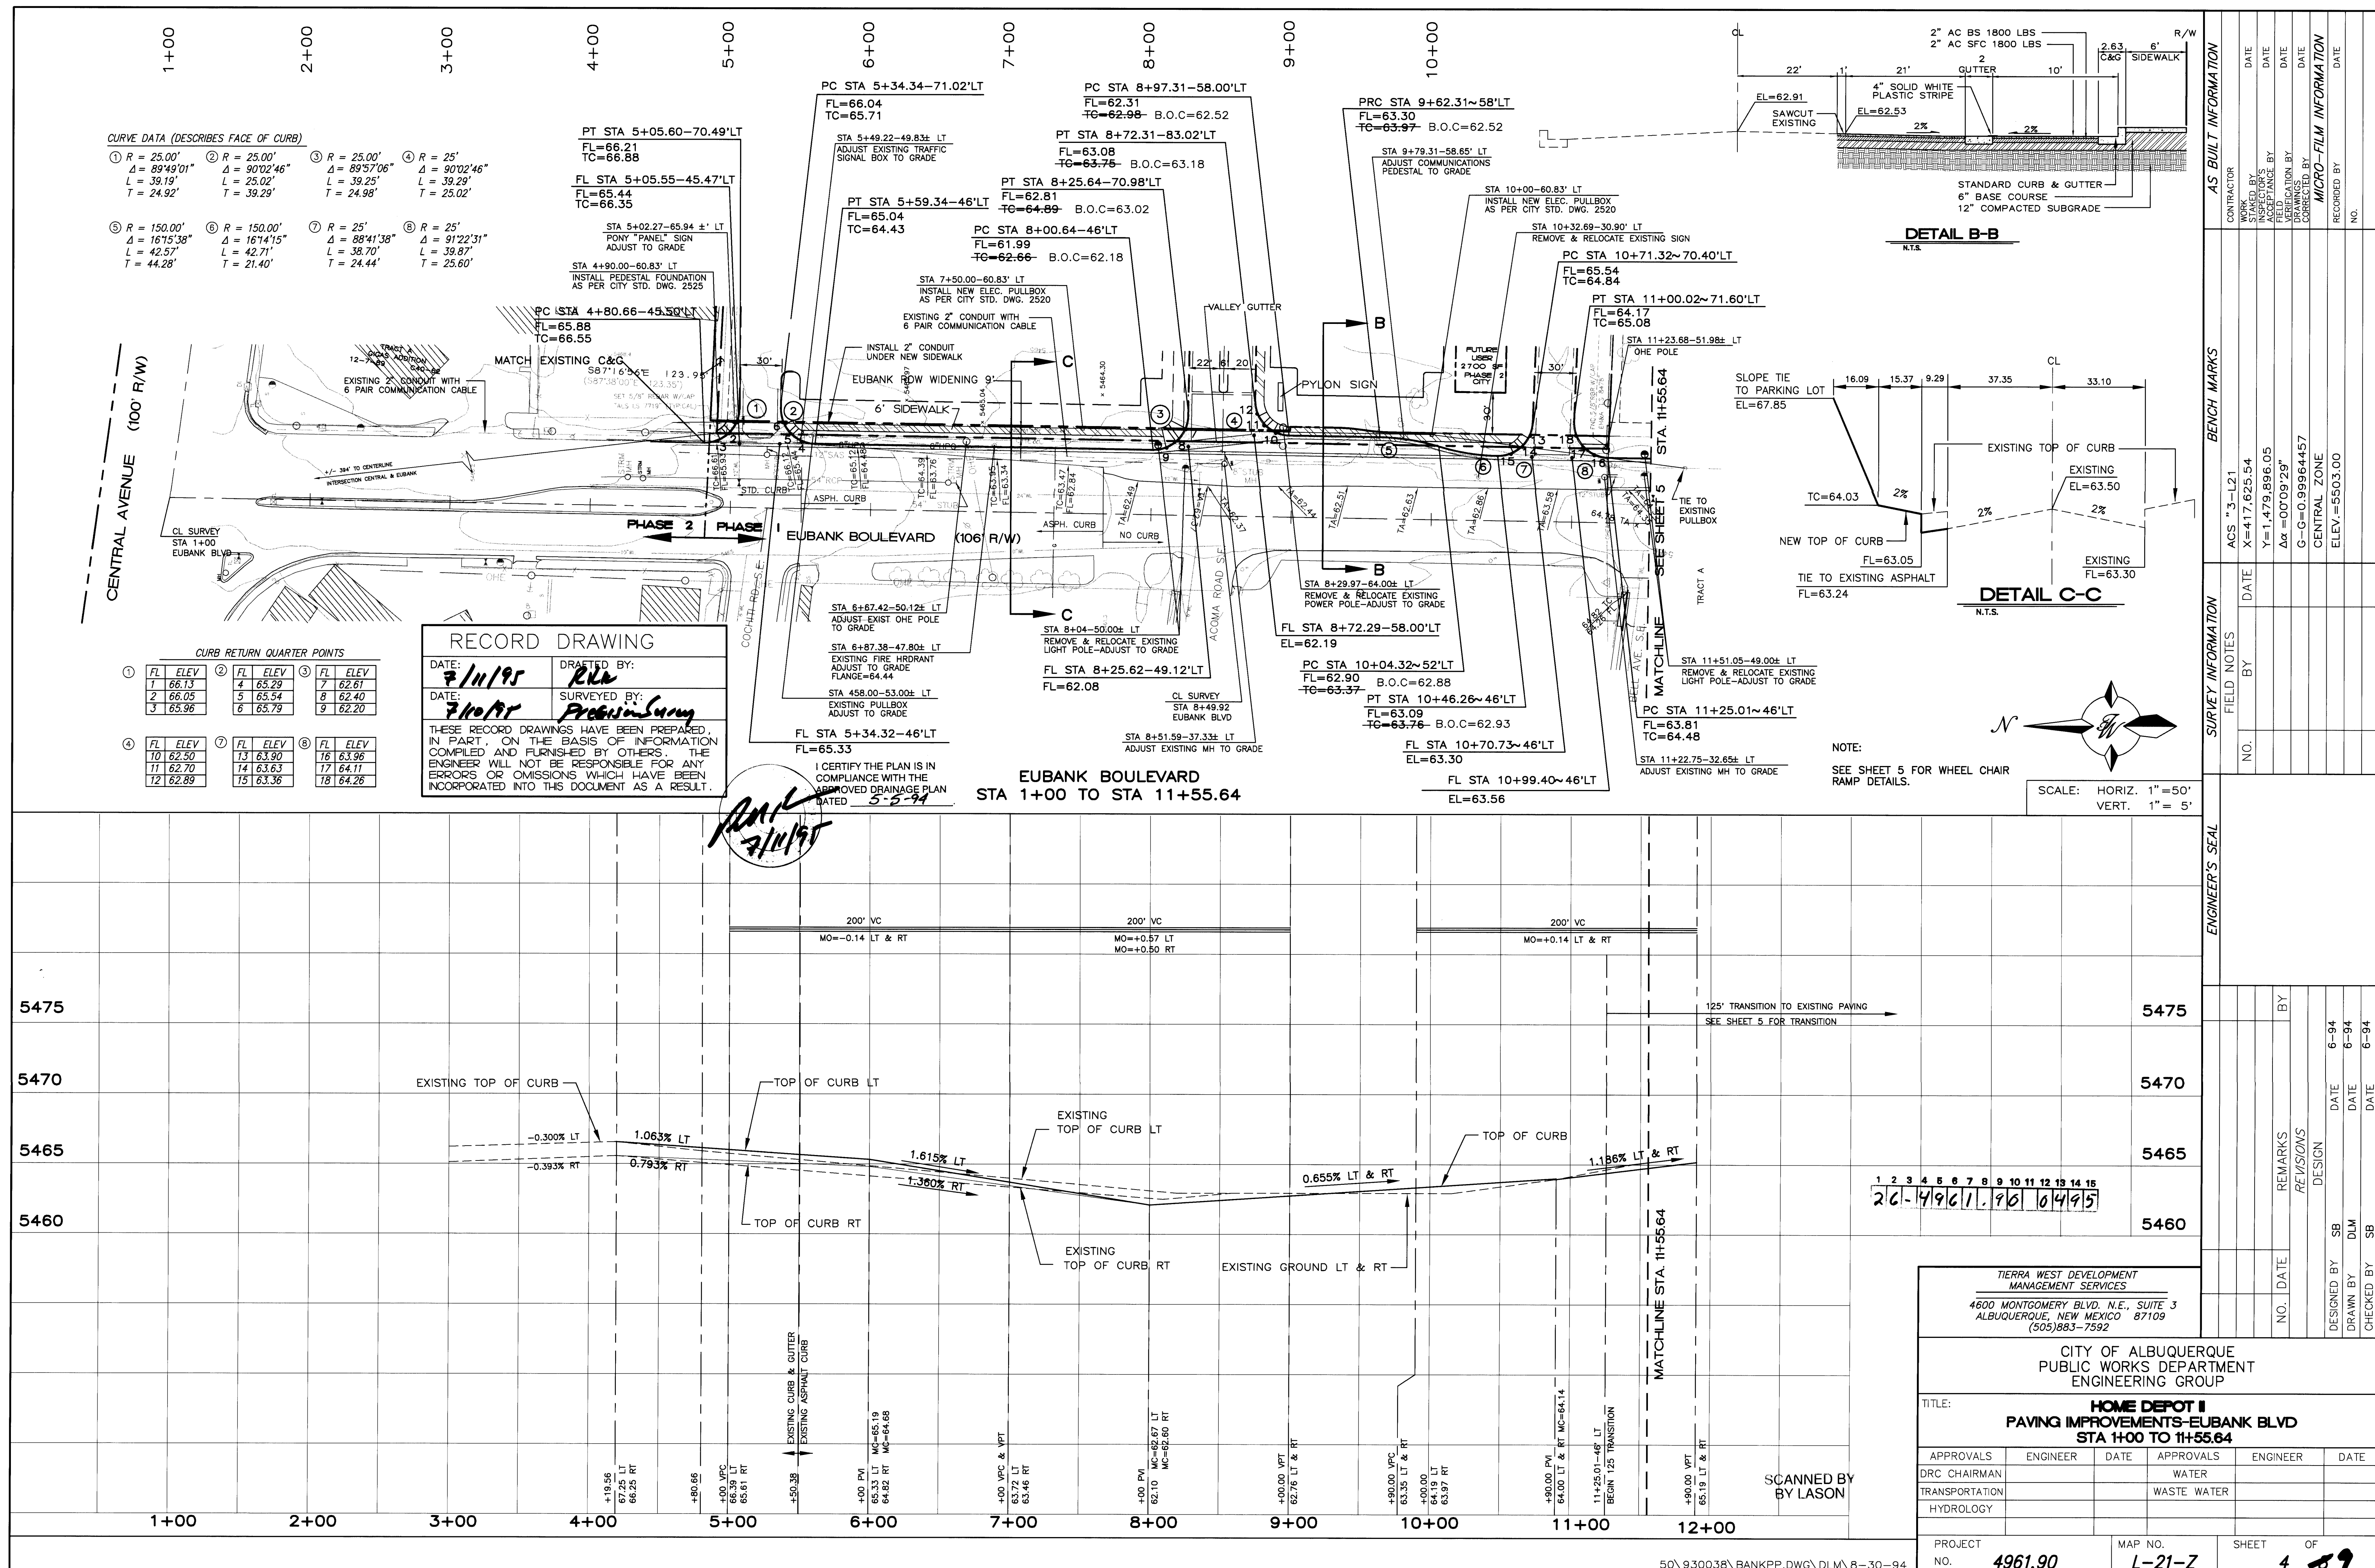


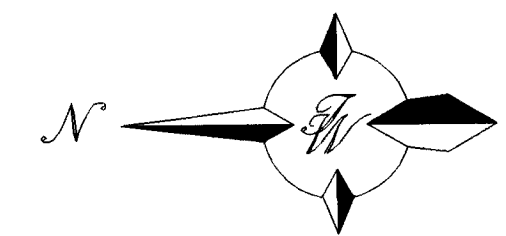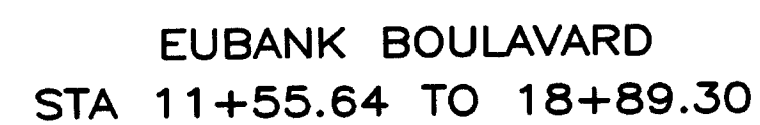

SCALE: HORIZ. 1"=50'
VERT. 1"= 5'




100 BANK BLVD #89.30		SHEET 5 OF 9	
FIRE WATER	VALS ER WATER	ENGINEER N/A RWE N/A RWE	DATE 9-8-94 9-8-94
ENGINEER'S SEAL 		SURVEY INFORMATION NO. BY DATE FIELD NOTES NO. BY DATE REMARKS REMOVS DESIGN DESIGNED BY SB DATE 6-94 DRAWN BY DLM DATE 6-94 CHECKED BY SB DATE 6-94	
BENCH MARKS ACS "3-L21 X=417.825.54 Y=1,479.896.05 Δα=00°09'29" G-G=0.99984457 CENTRAL ZONE ELEV=5503.00		AS BUILT INFORMATION CONTRACTOR WORK STARTED BY DATE FIELD ACCEPTANCE BY DATE FIELD REVISIONS DATE DRAWINGS CORRECTED BY DATE MICRO-FILM INFORMATION RECORDED BY DATE NO.	

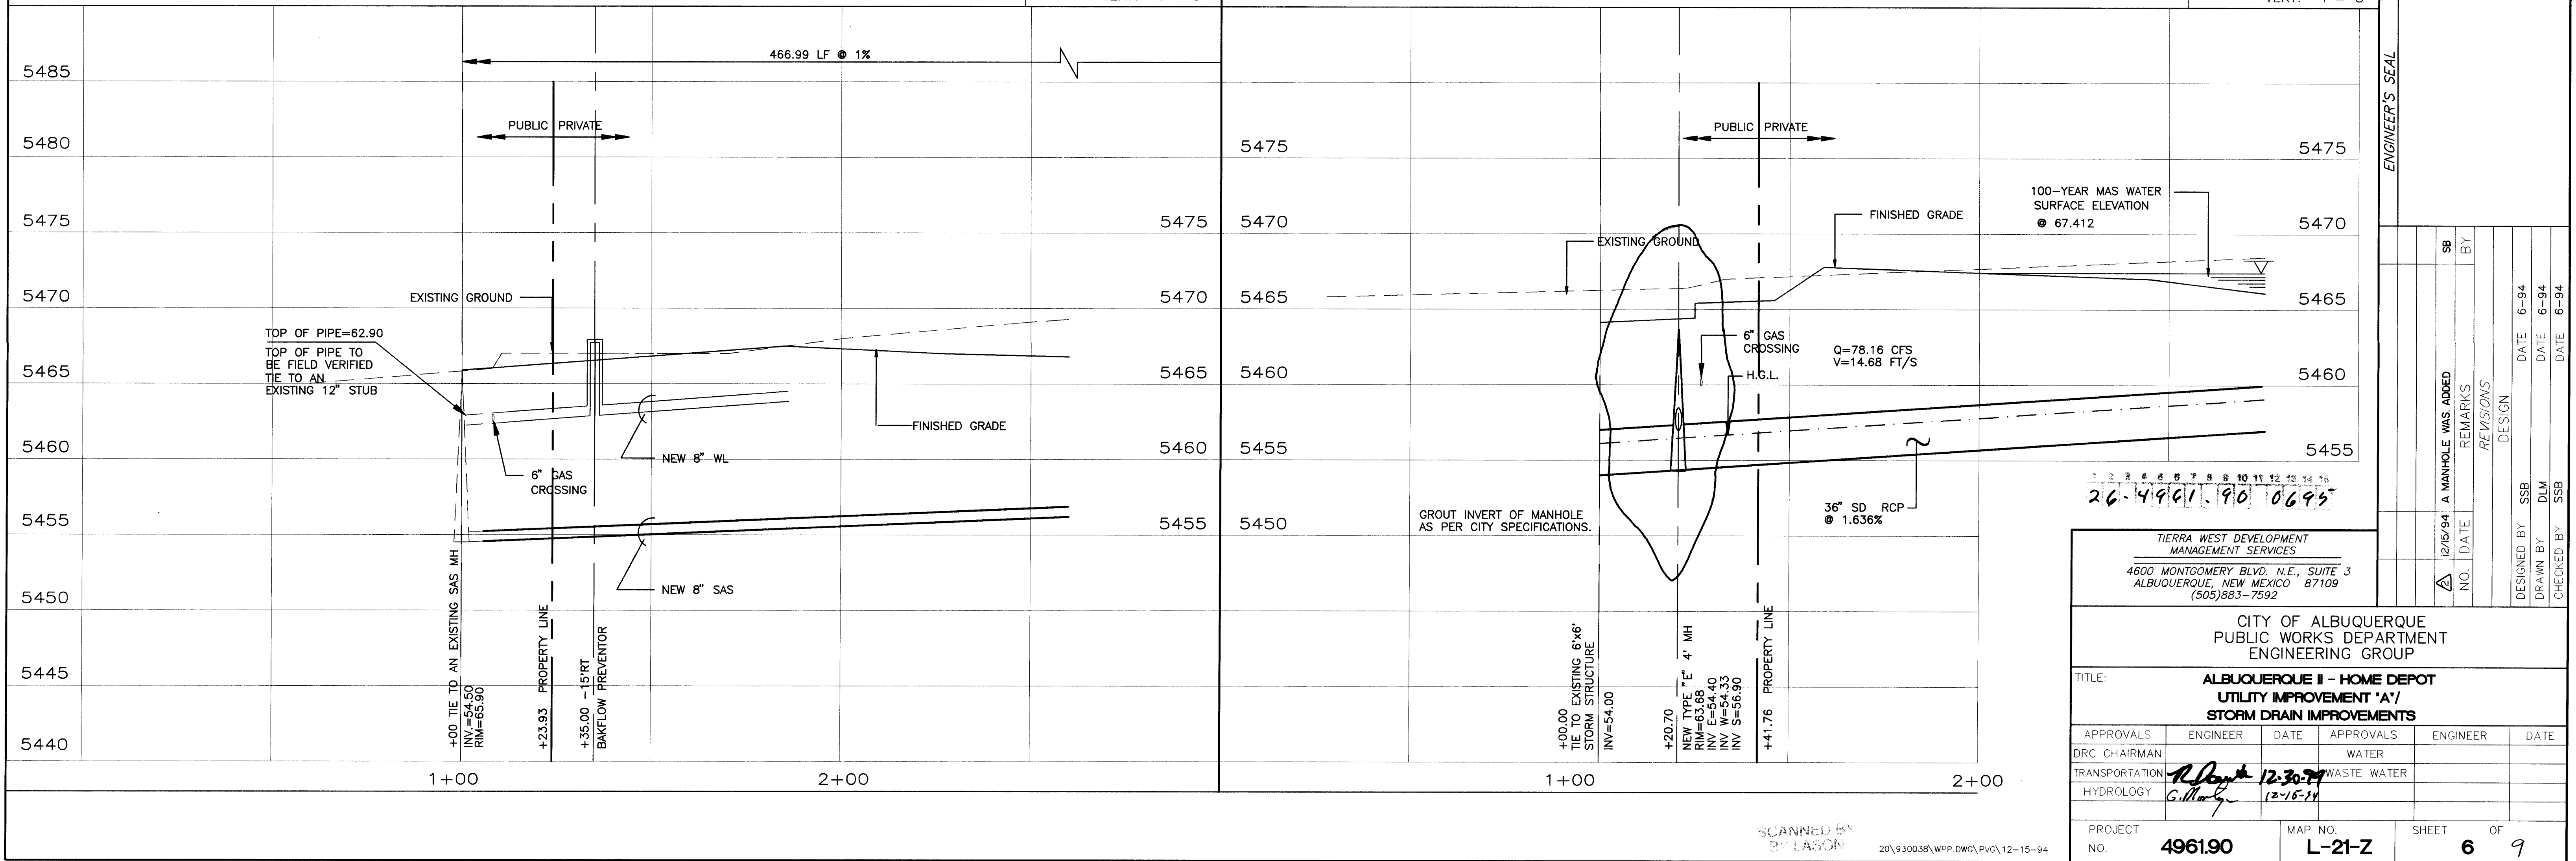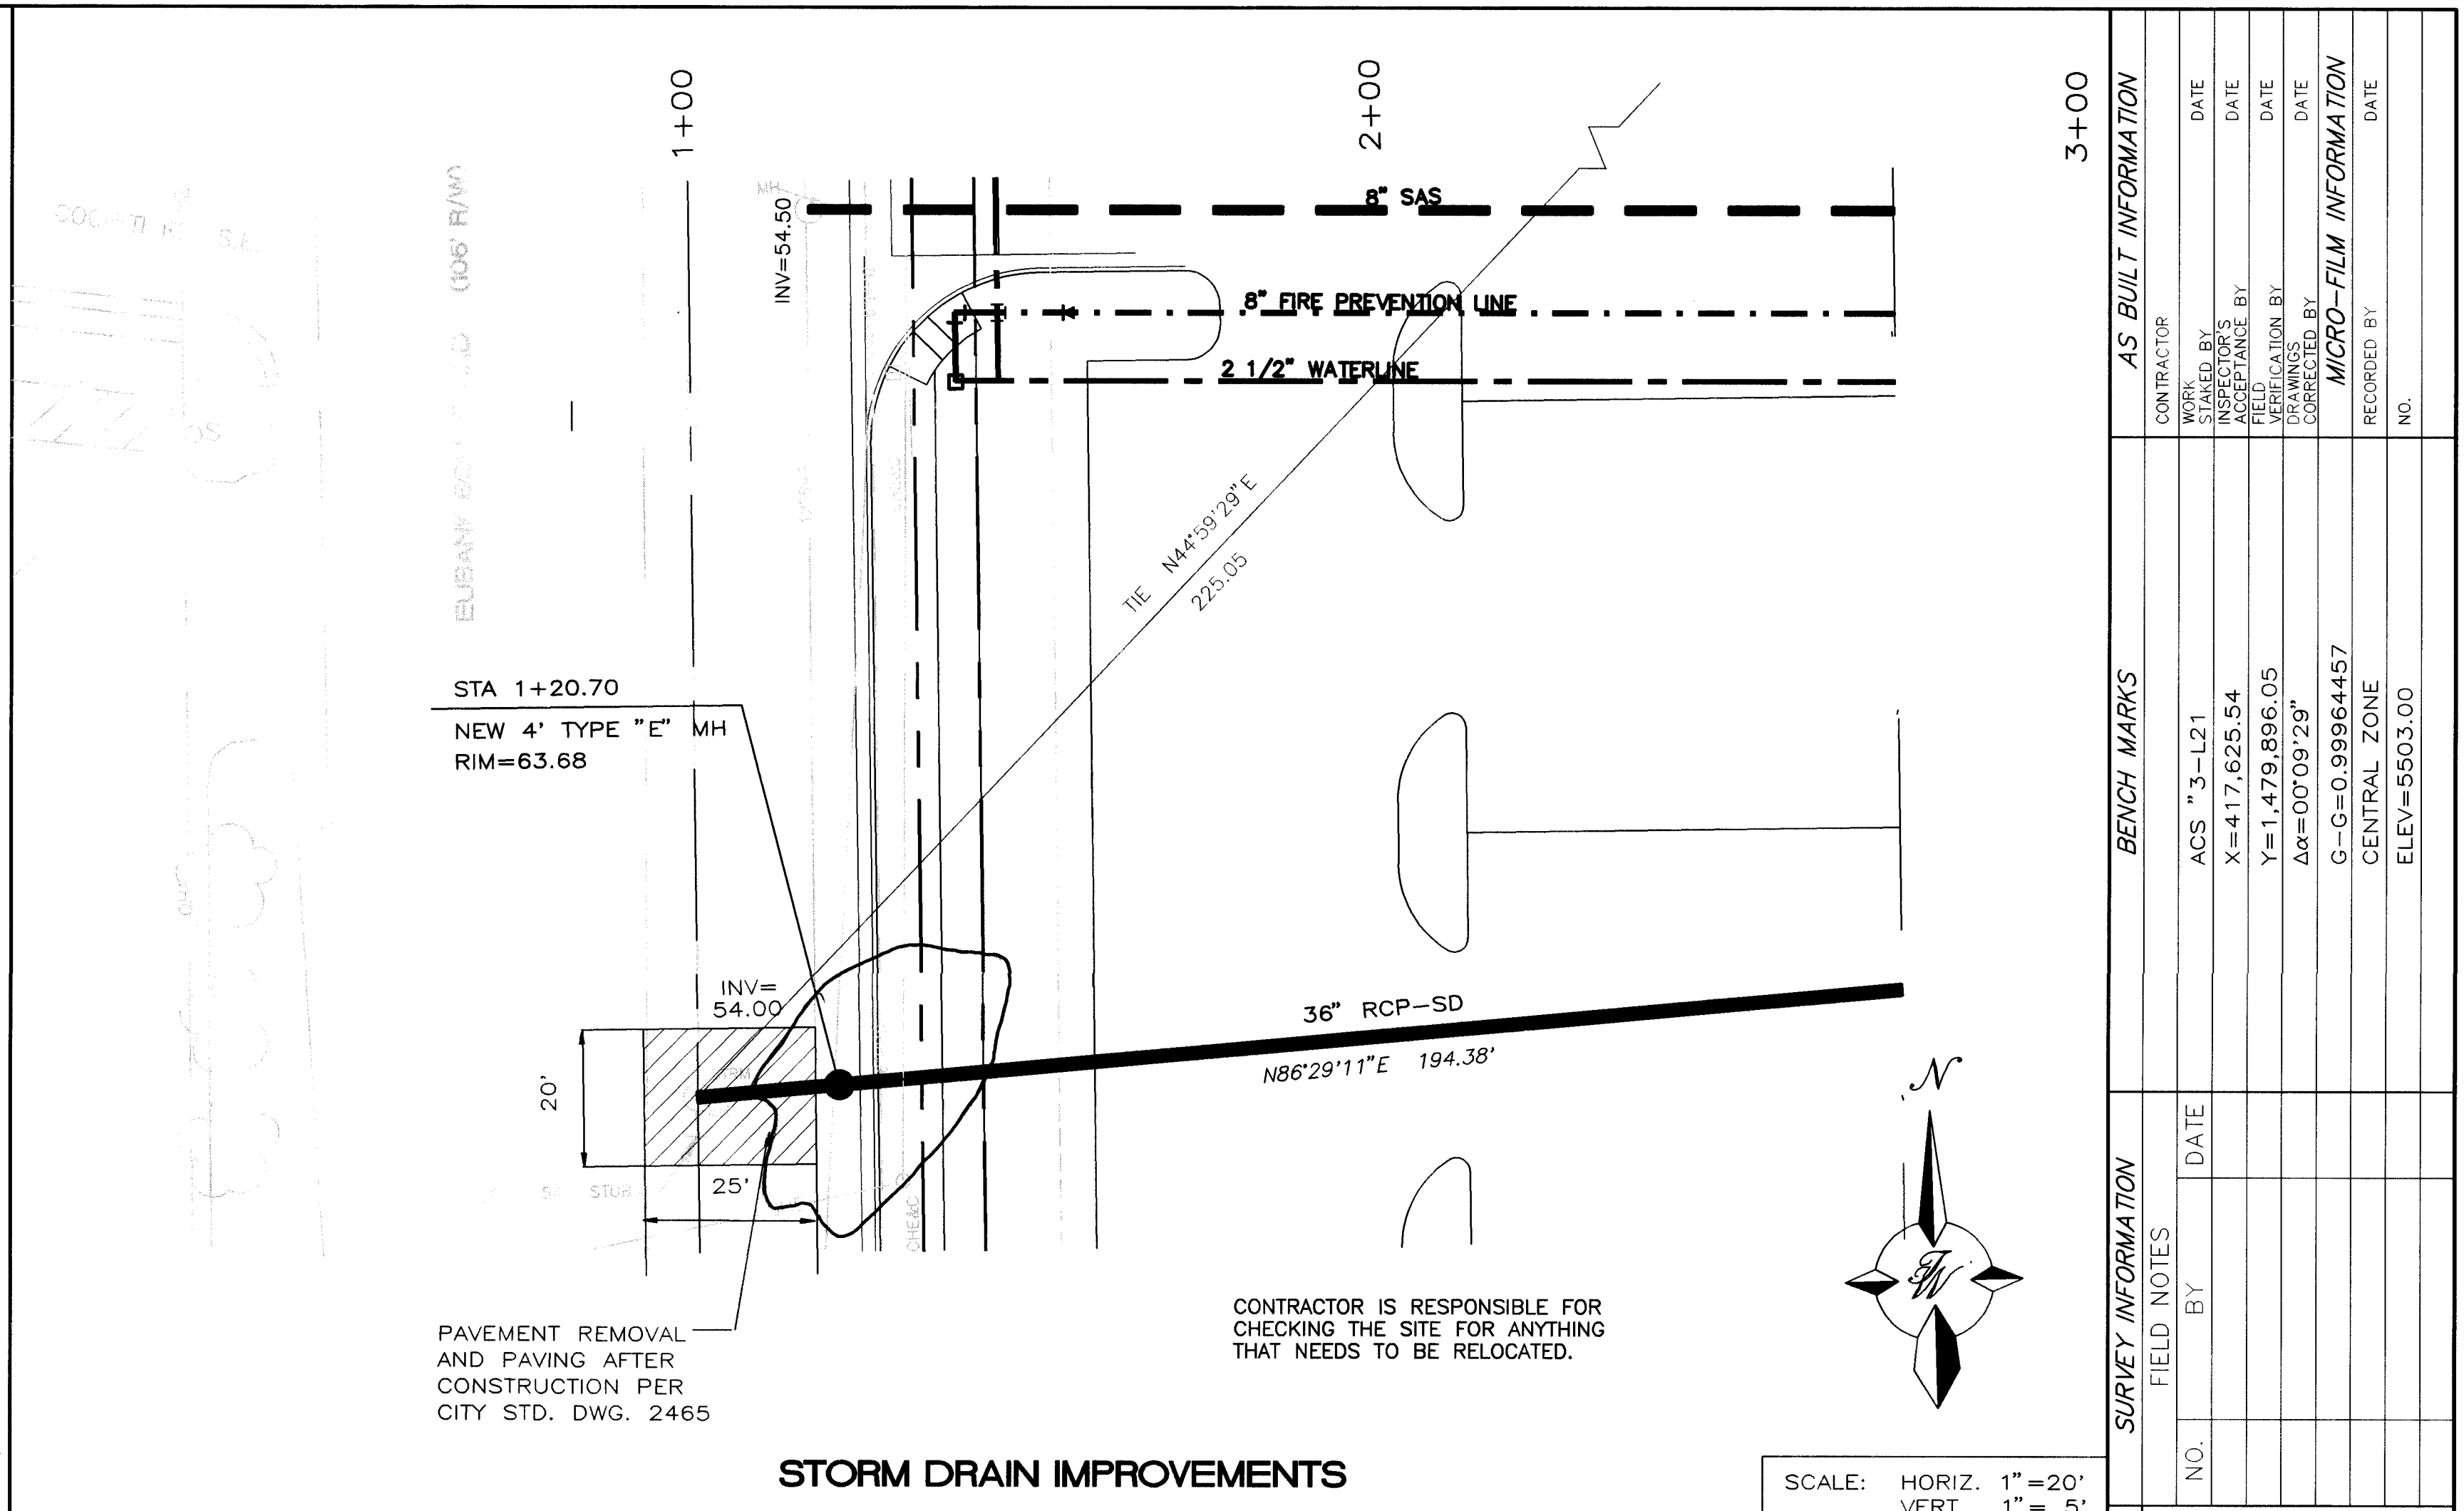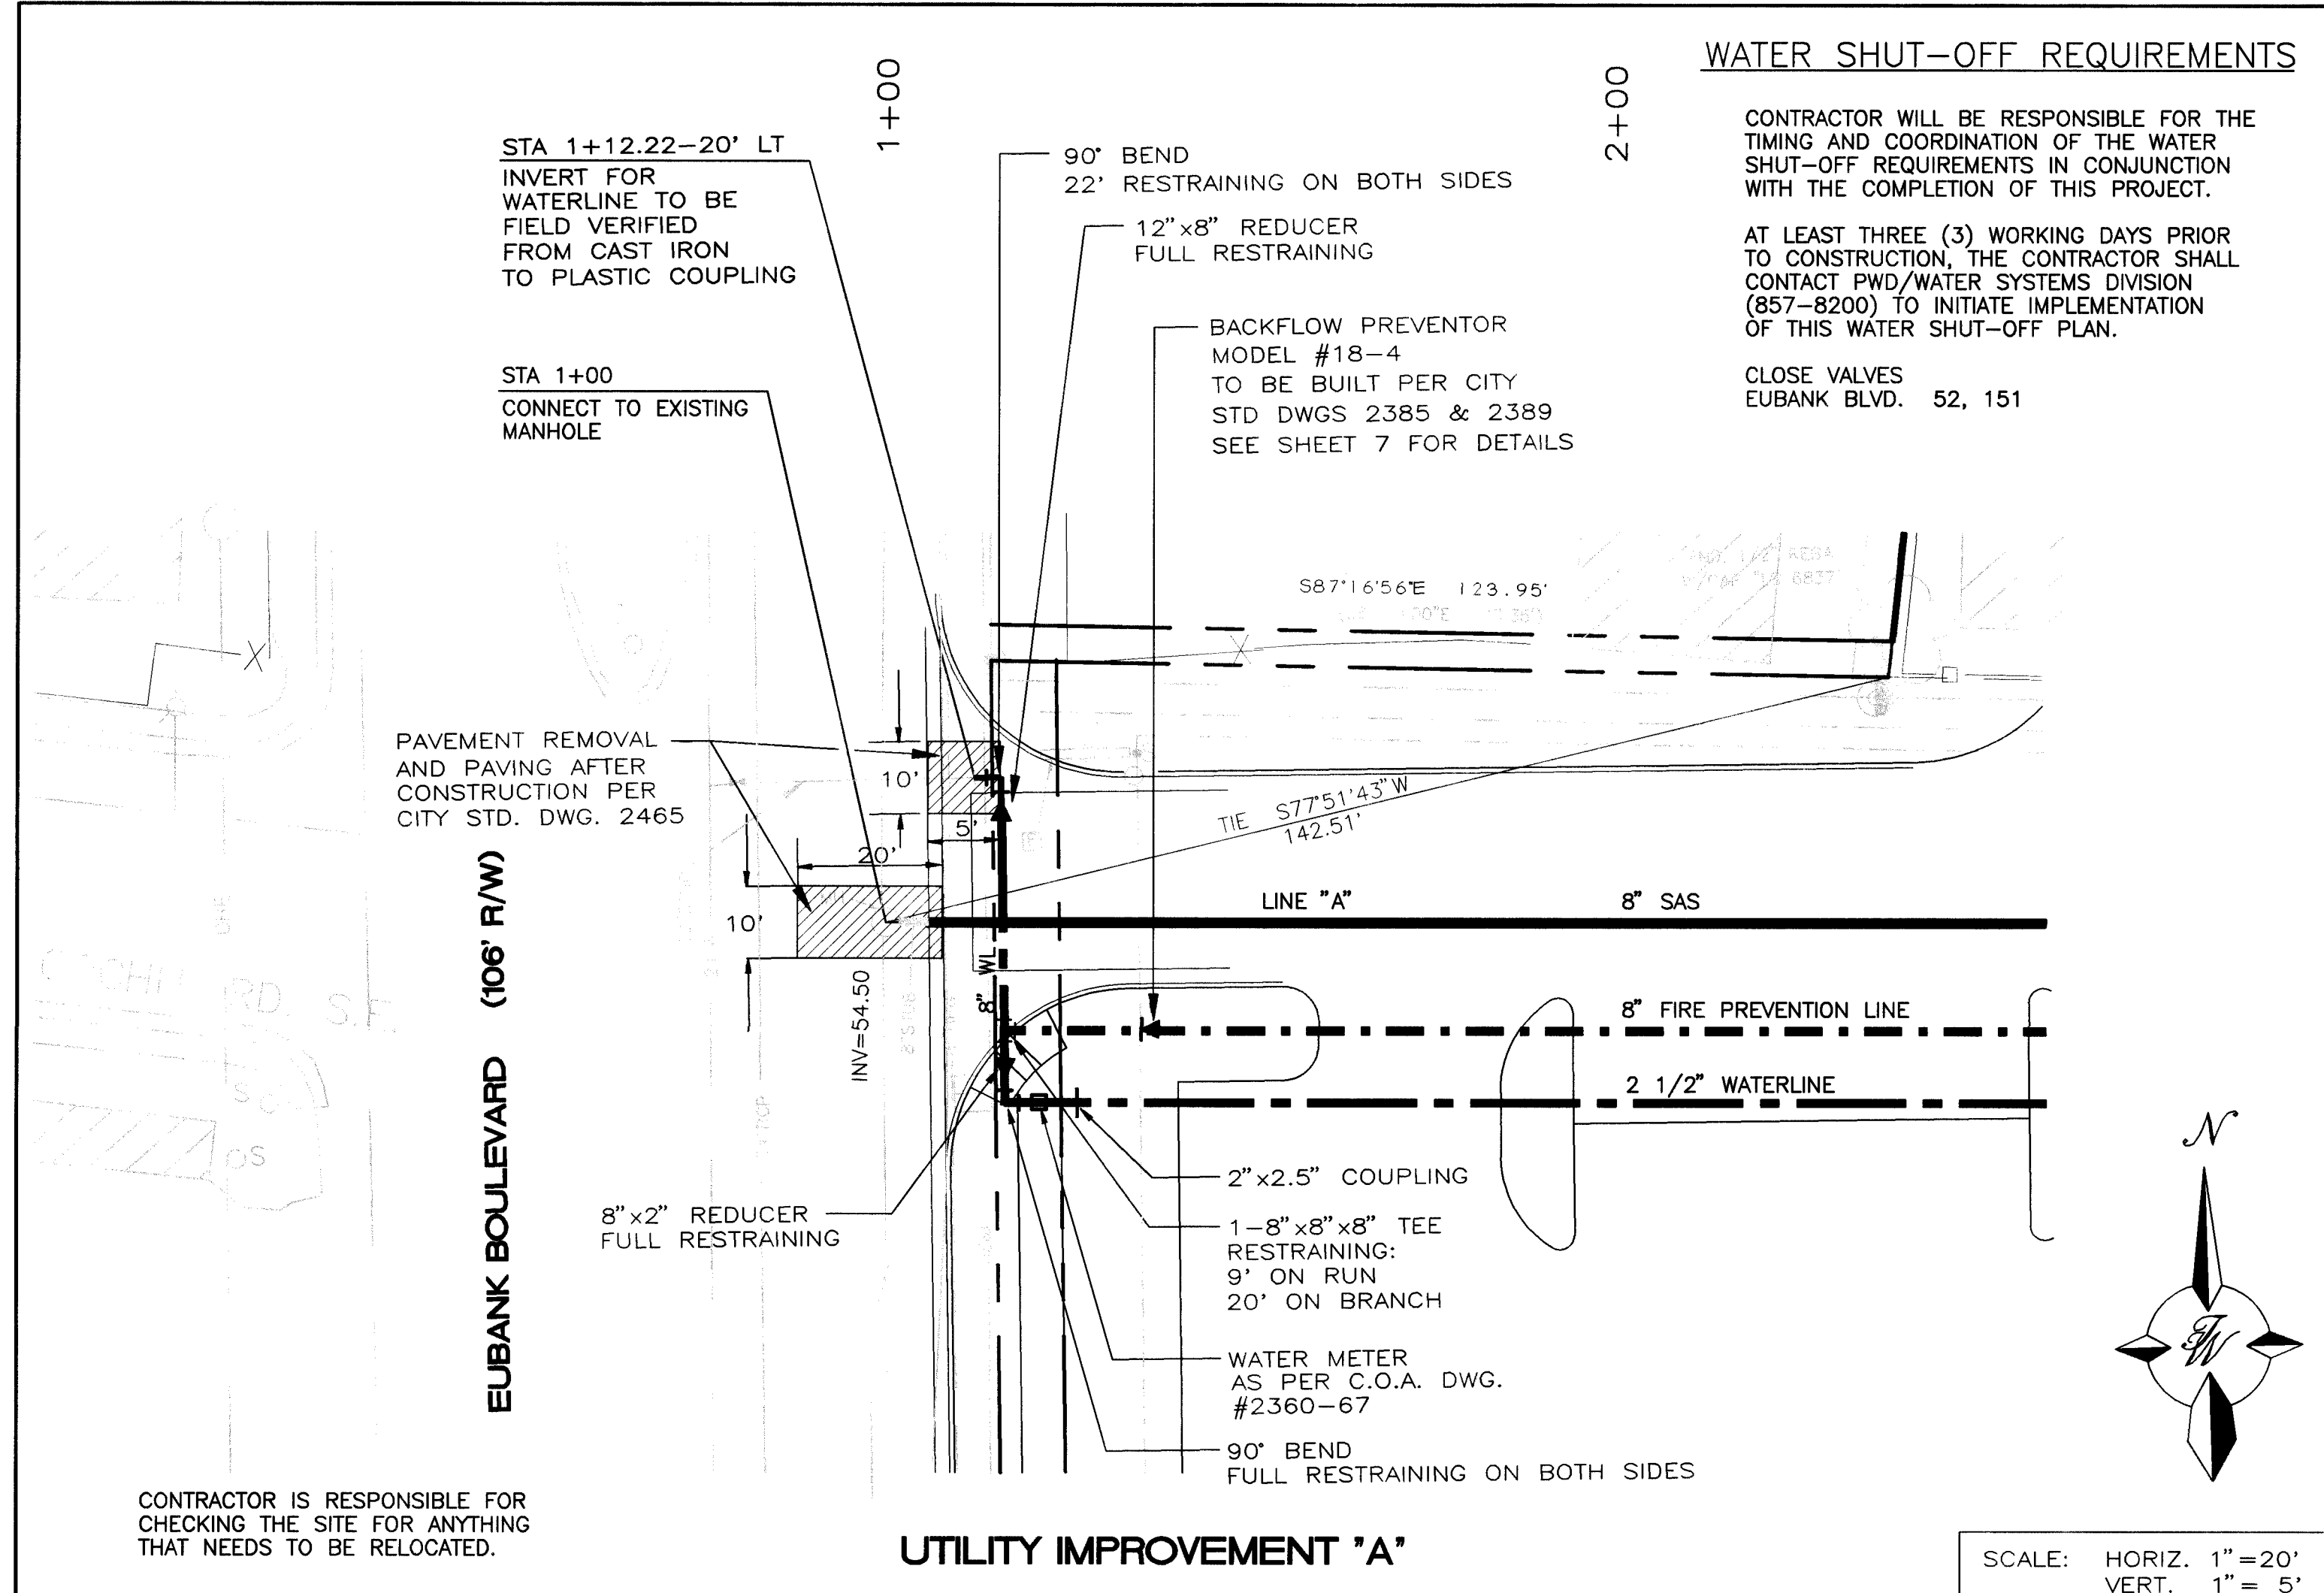

NOTE:
SEE SHEET 6 FOR VALVE
SHUT-OFF PLAN.





CONTRACTOR IS RESPONSIBLE FOR
CHECKING THE SITE FOR ANYTHING
THAT NEEDS TO BE RELOCATED.

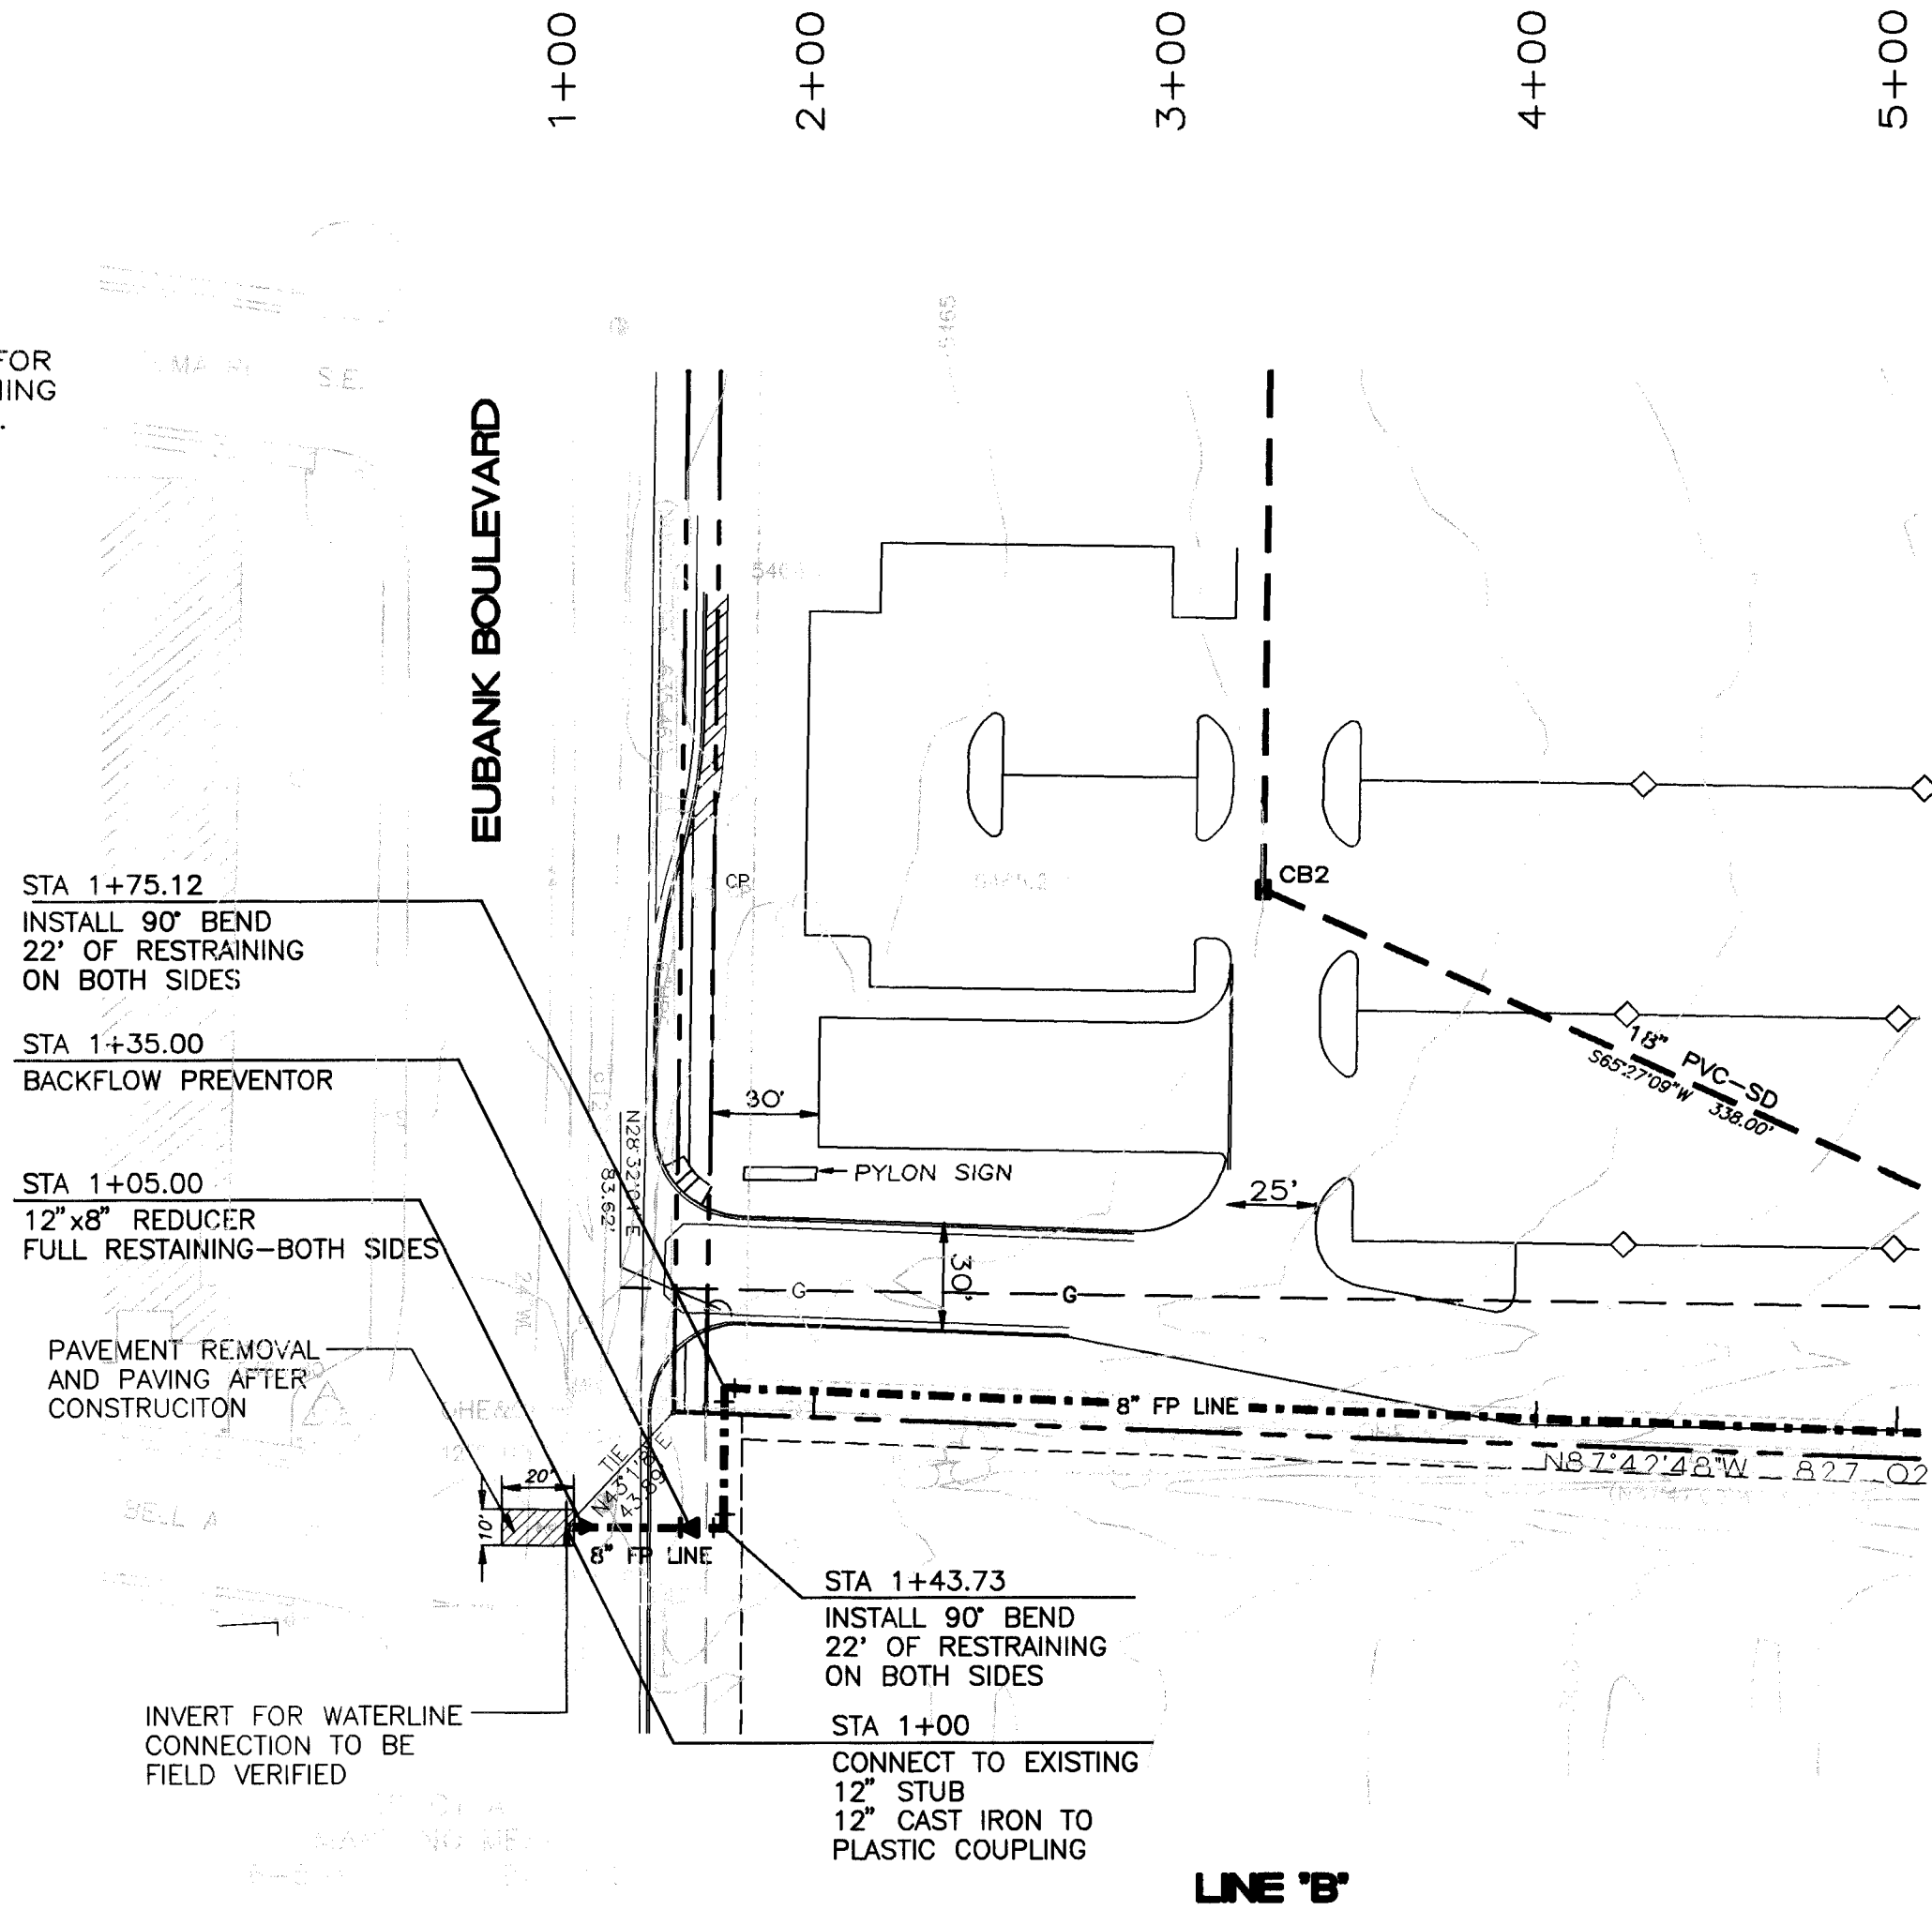



- GENERAL NOTES:
- HORIZONTAL RPBA INSTALLATION REQD.
 - ABOVE GRADE RPBA INSTALLATION REQD.
 - WATER LINE PRESSURE AND TEMP MUST NOT EXCEED RATED CAPACITY OF RPBA.
 - PROTECT FROM FREEZING WITH POSITIVE HEAT SOURCE AND INSULATION.
 - MIN. RPBA SIZE MUST BE THE BLDG SERVICE LINE SIZE.
 - DO NOT INSTALL IN FLOOD PRONE AREAS.
 - INSTALL WATER HAMMER ARRESTORS & THERMO EXPANSION PROTECTION, AS NECESSARY.
 - METALIC RISER PIPING REQD.
 - JOINTS TO BE ADEQUATELY RESTRAINED.
 - DEVIATIONS FROM THESE SPECIFICATIONS MUST HAVE PRIOR WRITTEN APPROVAL FROM THE ADMINISTRATIVE AUTHORITY.

- CONSTRUCTION NOTES:
- CURB STOP AND BOX.
 - METER.
 - SERVICE LINE, NO OUTLETS ALLOWED.
 - ADEQUATE SLEEVE & INSULATION (MIN. 1" THICK).
 - MIN. 4" CONCRETE SLAB.
 - UNIONS OR FLANGED FITTINGS, INSTALLED A MIN. OF 4" ABOVE GRADE.
 - 30" MAX., 12" MIN. (FROM LOWEST PT. OF ASSEMBLY TO TOP OF CONC. SLAB).
 - PROVIDE METALIC OR REIN. CONC. SUPPORTS ON UNITS > 2'.
 - APPROVED RPBA, AS SHOWN.
 - PROTECTIVE ENCLOSURE, SEE DWG 2389 FOR DESIGN CRITERIA.
 - DRAIN, SIZE DRAIN TO HANDLE FULL DISCHARGE OF RELIEF VALVE. DRAIN TO DAYLIGHT.
 - BUILDING SERVICE LINE.



CITY OF ALBUQUERQUE
WATER
REDUCED PRESSURE PRINCIPLE
BACKFLOW PREVENTION ASSEMBLY (RPBA)
DWG. 2385

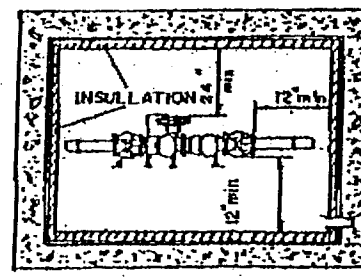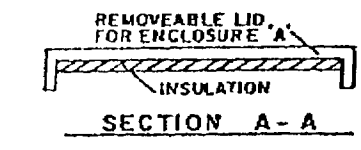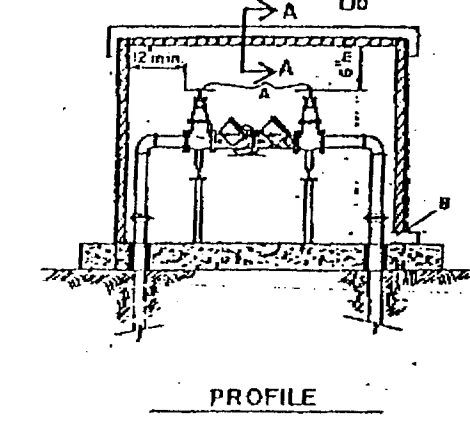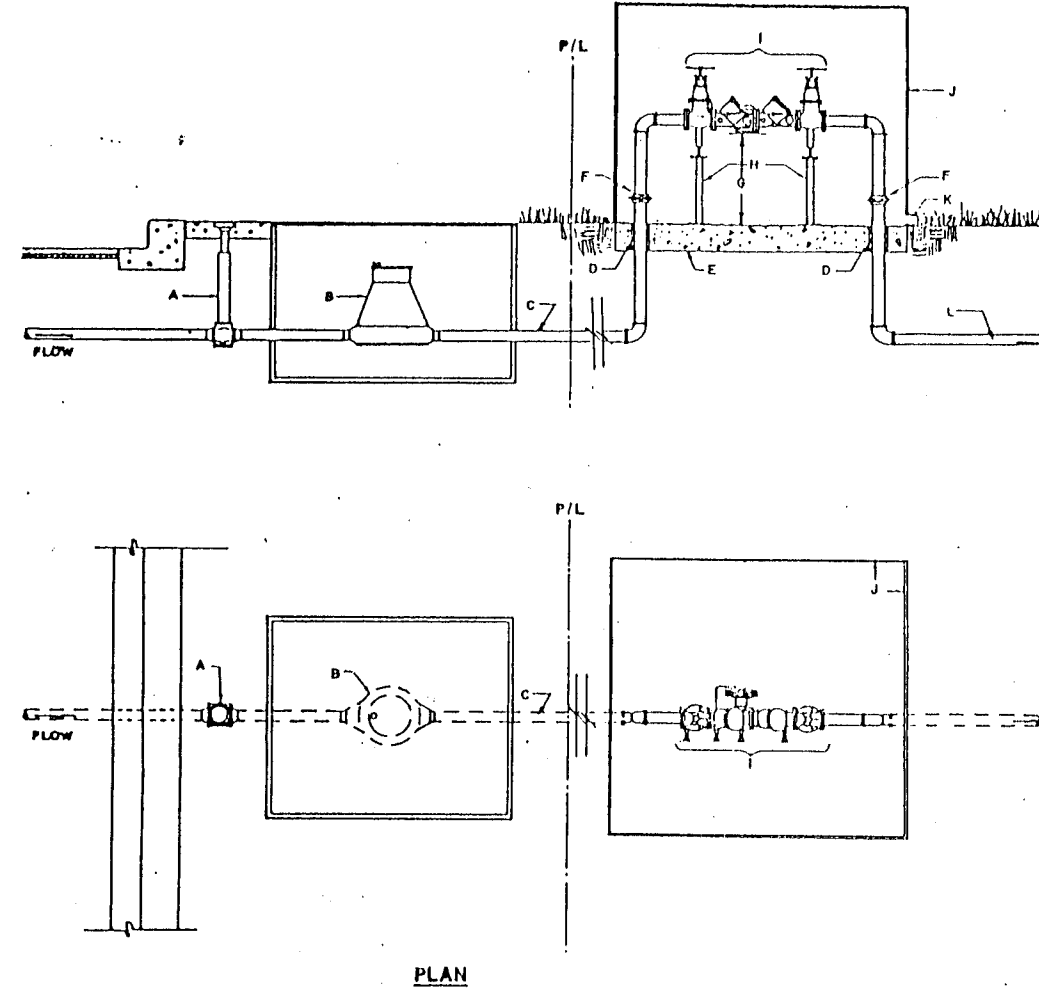

TYPE A ENCLOSURE WITH
PERMANENT SIDE WALLS

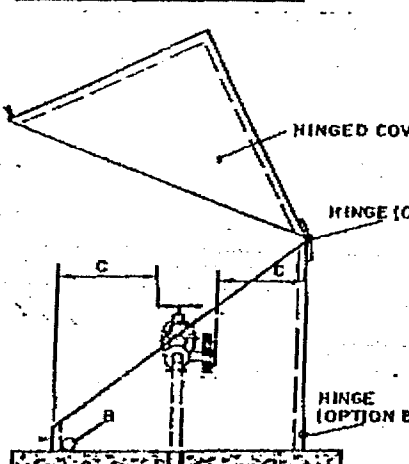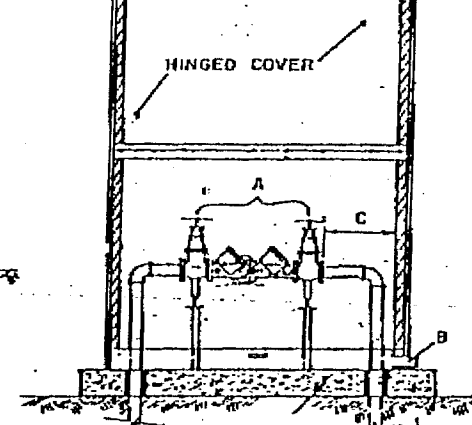

TYPE B ENCLOSURE WITH
HINGED COVER

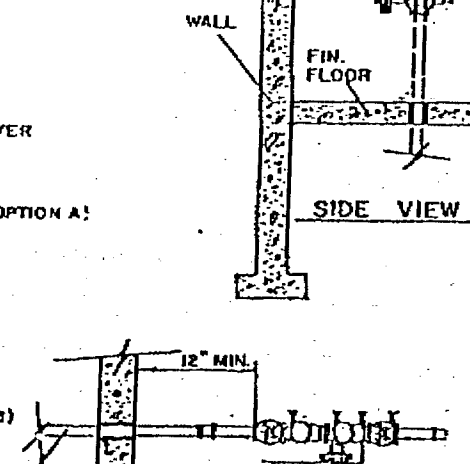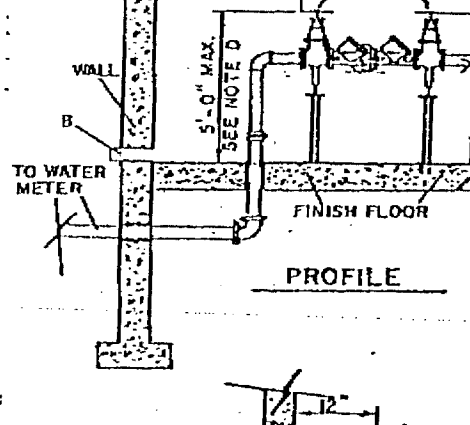


TYPE C ENCLOSURE AND
TYPICAL INSTALLATION
INDOOR STRUCTURE

- GENERAL NOTES:
- ENCLOSURE DESIGN, CONSTRUCTION AND MAINT. IS THE RESPONSIBILITY OF THE CONSUMER. THE DESIGN OF ENCLOSURES MUST MEET THESE MIN. SPECS. CONSUMER MAY SELECT THE USE OF TYPE A, B OR C ENCLOSURE.
 - INSULATION ON WALLS & COVER FOR TYPE A & B ENCLOSURE IS OPTIONAL. IF INSULATION IS USED, IT MUST BE AT LEAST 3 LB. WT. & 2" THICK.
 - ENCLOSURES MUST BE INSTALLED AND MAINTAINED SO THAT UNITS ARE SAFELY & READILY ACCESSIBLE FOR TESTING, MAINT. & REPAIRS.
 - FOR TYPE B ENCLOSURE, THE HINGE MAY BE LOCATED AT OPTION A OR B, AS SHOWN.
 - ALTERNATE DESIGNS MAY BE USED WITH PRIOR WRITTEN APPROVAL FROM THE ADMINISTRATIVE AUTHORITY.

- CONSTRUCTION NOTES:
- APPROVED RPBA, DCVA, DCDA OR PVB.
 - DRAIN.
 - ADEQUATE CLEARANCES REQUIRED FOR TESTING, MAINT. & REPAIR.
 - 5' MAX. FROM HANDWHEEL TO FINISH FLOOR. AS SHOWN, UNITS INSTALLED HIGHER THAN 5', CONSUMER MUST PROVIDE ACCESS PLATFORM/LADDER.


CITY OF ALBUQUERQUE
WATER
ENCLOSURES
DWG. 2389

Model 18-4
Reduced Pressure Principle
Detector Check
Backflow Preventer

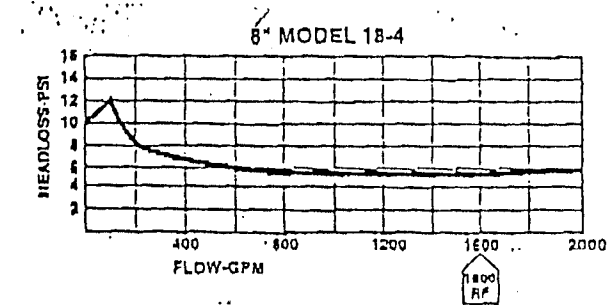


CLA-VAL MODEL 18-4
BACKFLOW PREVENTER
TO BE BUILT TO CITY STANDARD 2385


VALVE SIZE - 8"
-A = 50.81 B = 13.00 C = 14.75 D = 11.38 E = 18.50

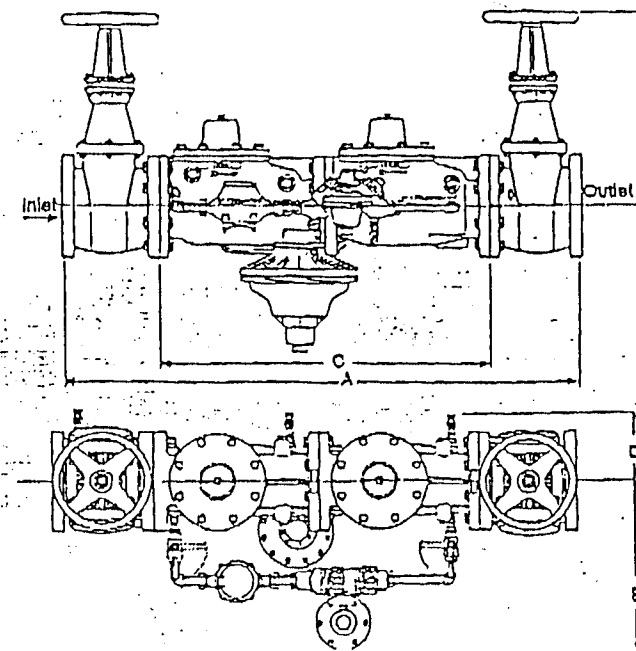

It is recommended that this unit be installed in a horizontal position and that provisions for adequate drainage be made. Right hand mount of relief valve is standard. Left hand mount is optional.

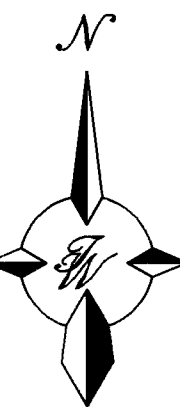

SCALE: HORIZ. 1"=50'
VERT. 1"=5'

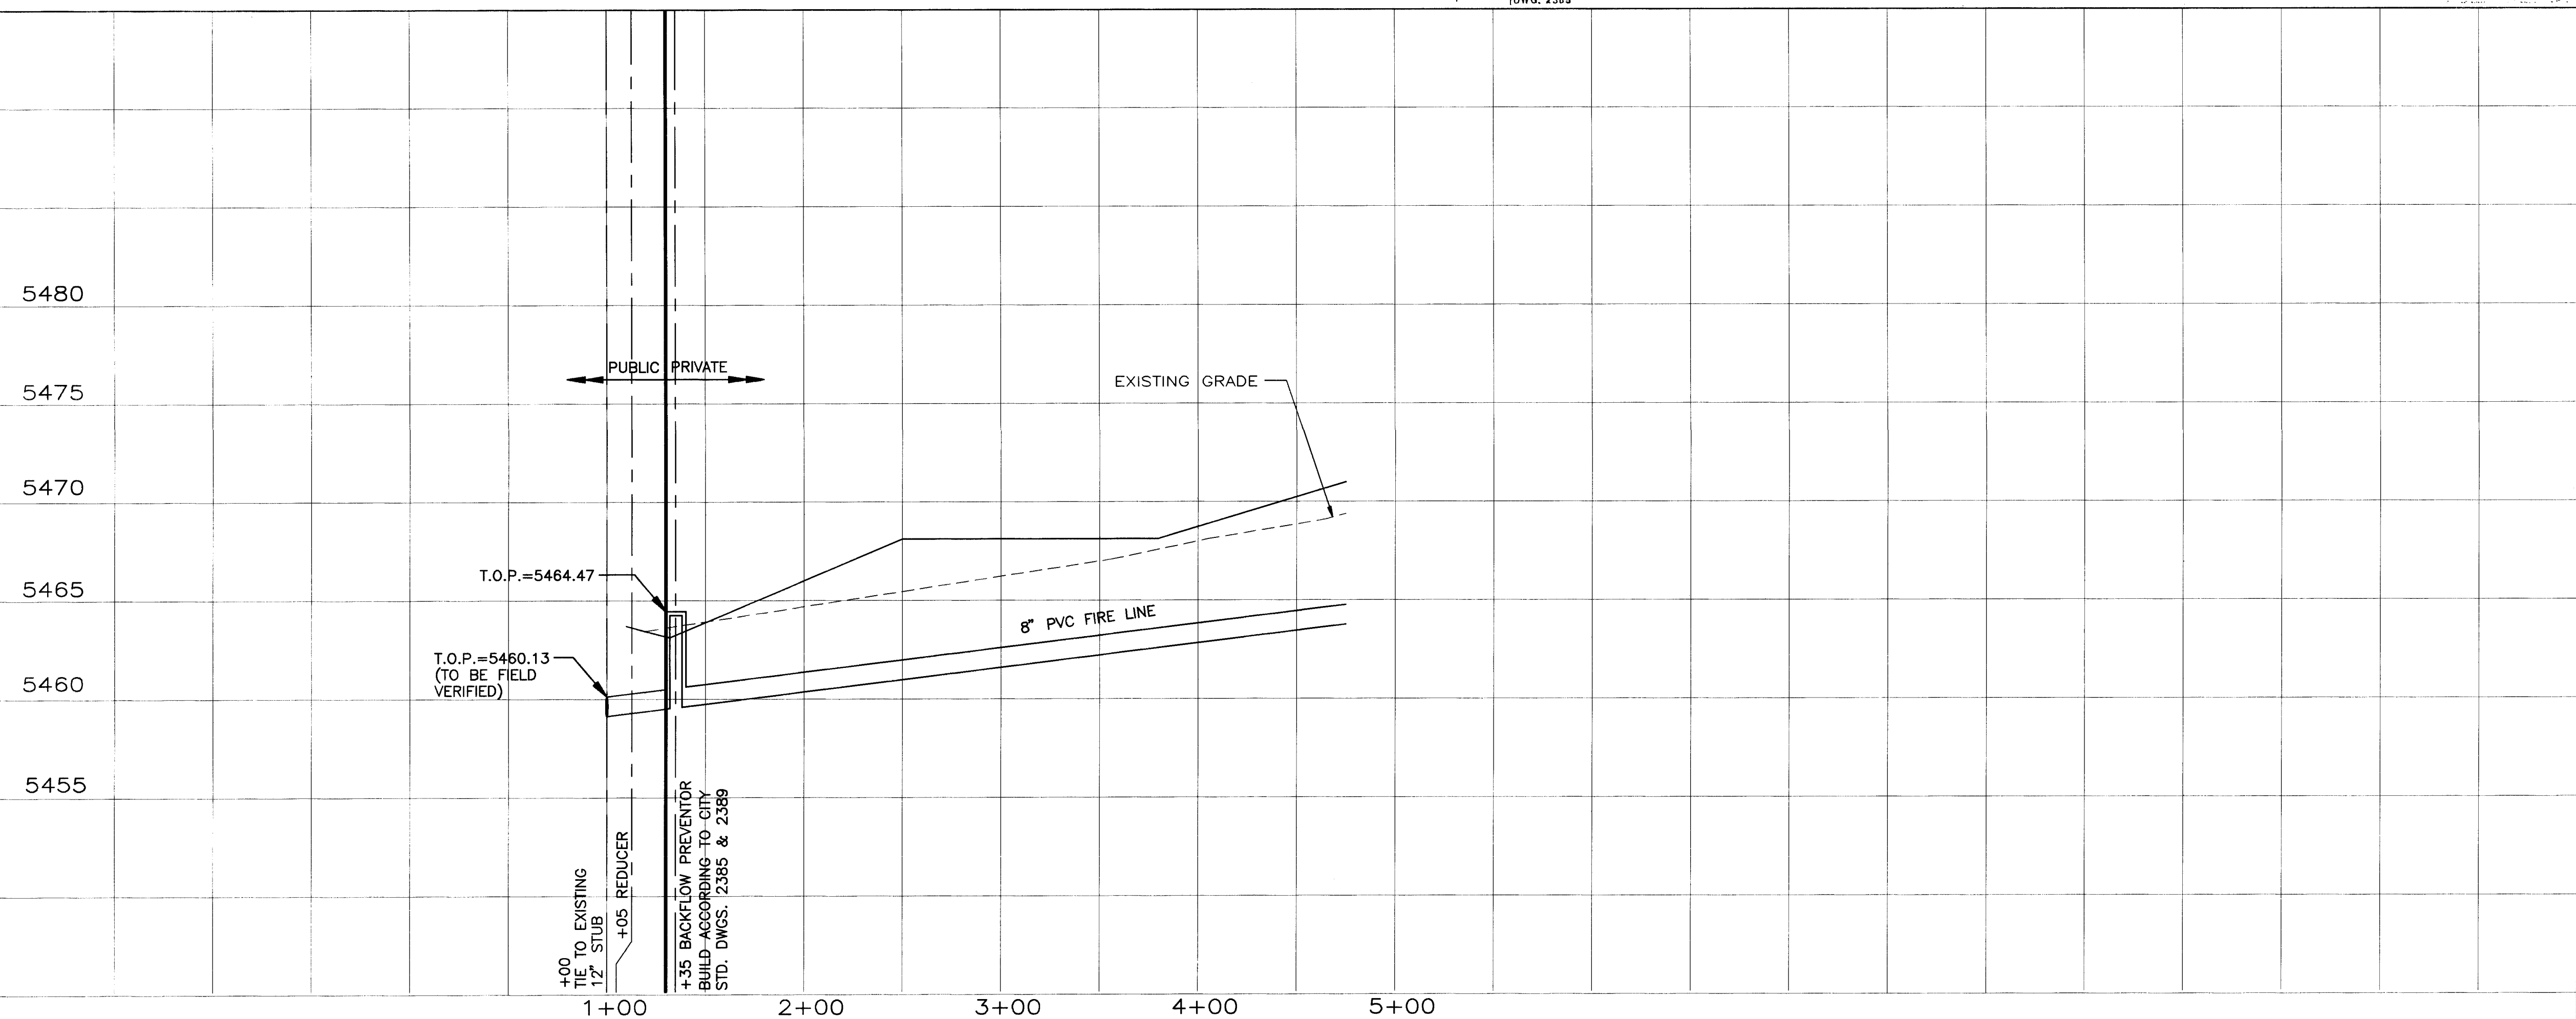


1 2 3 4 5 6 7 8 9 10 11 12 13 14 15
201-419611.90 0795

TIERRA WEST DEVELOPMENT
MANAGEMENT SERVICES
4600 MONTGOMERY BLVD. N.E., SUITE 3
ALBUQUERQUE, NEW MEXICO 87109
(505)883-7592

CITY OF ALBUQUERQUE
PUBLIC WORKS DEPARTMENT
ENGINEERING GROUP


APPROVALS					
ENGINEER			DATE		
DRC CHAIRMAN			WATER		
TRANSPORTATION			WASTE WATER		
HYDROLOGY					

PROJECT NO. 496190
MAP NO. L-21-Z
SHEET 7 OF 8

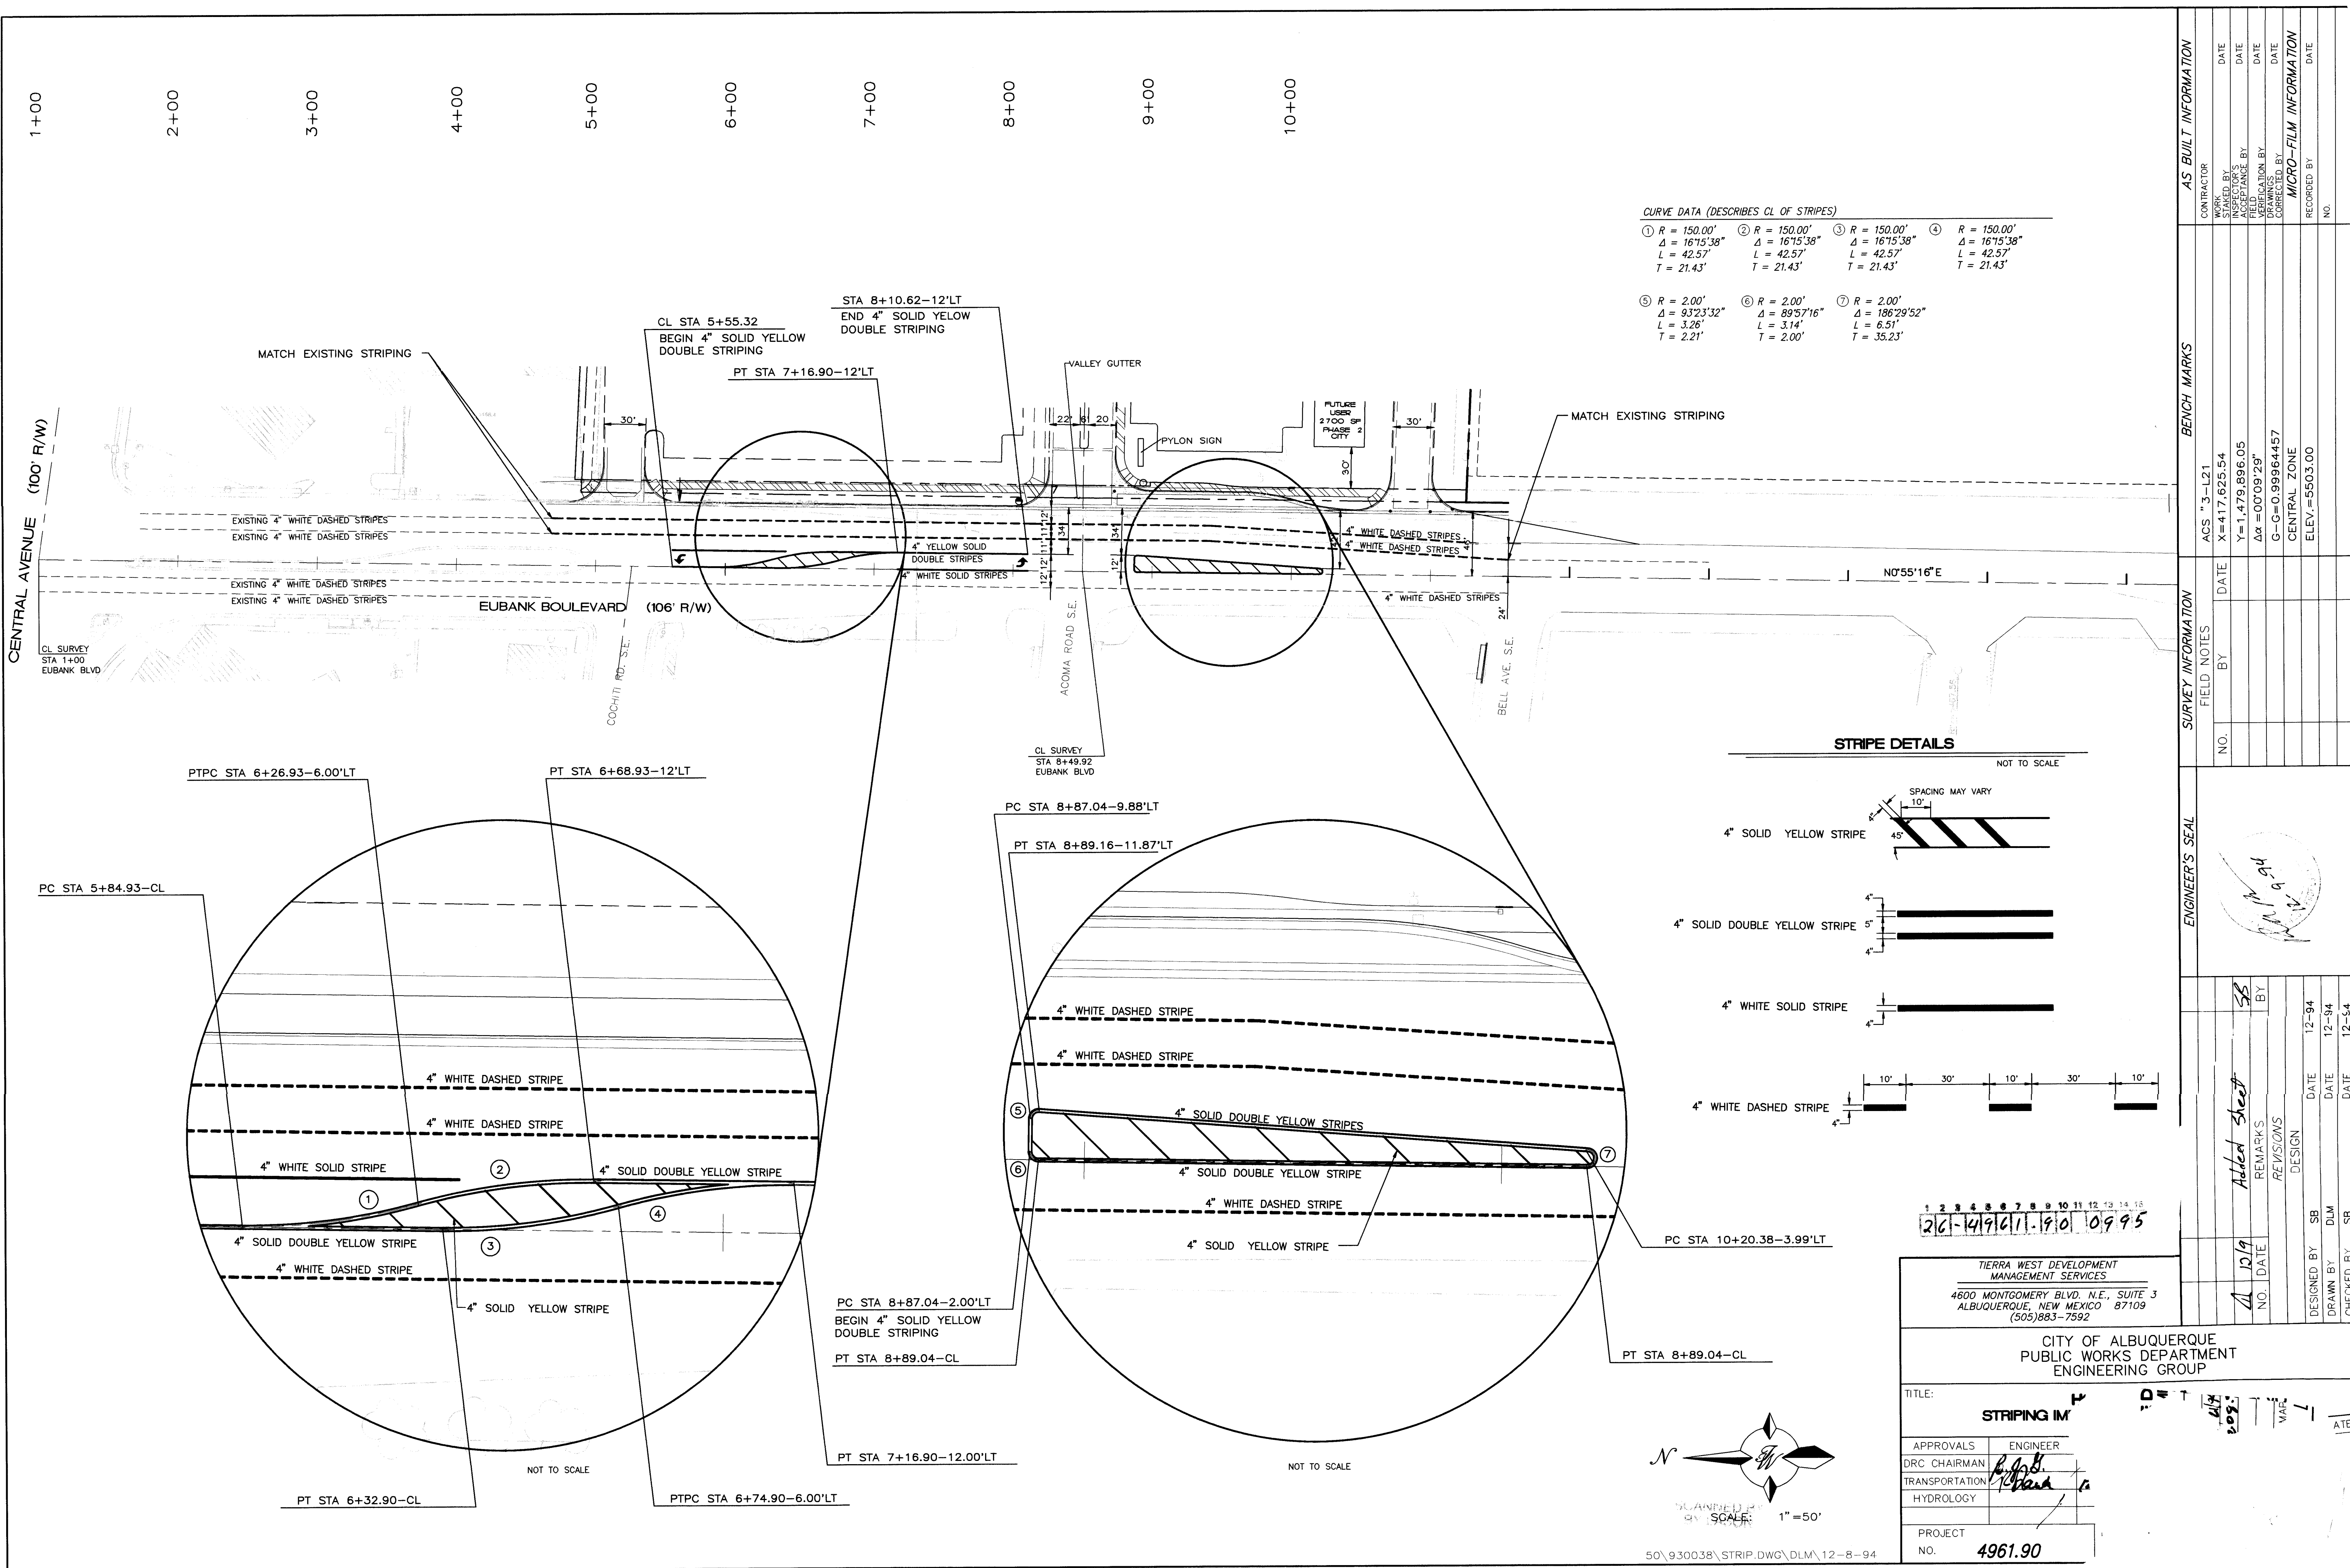

CURVE DATA (DESCRIBES CL OF STRIPES)

① R = 150.00' Δ = 161°5'38" L = 42.57' T = 21.43'	② R = 150.00' Δ = 161°5'38" L = 42.57' T = 21.43'	③ R = 150.00' Δ = 161°5'38" L = 42.57' T = 21.43'	④ R = 150.00' Δ = 161°5'38" L = 42.57' T = 21.43'
⑤ R = 2.00' Δ = 93°23'32" L = 3.26' T = 2.21'	⑥ R = 2.00' Δ = 89°57'16" L = 3.14' T = 2.00'	⑦ R = 2.00' Δ = 186°29'52" L = 6.51' T = 35.23'	

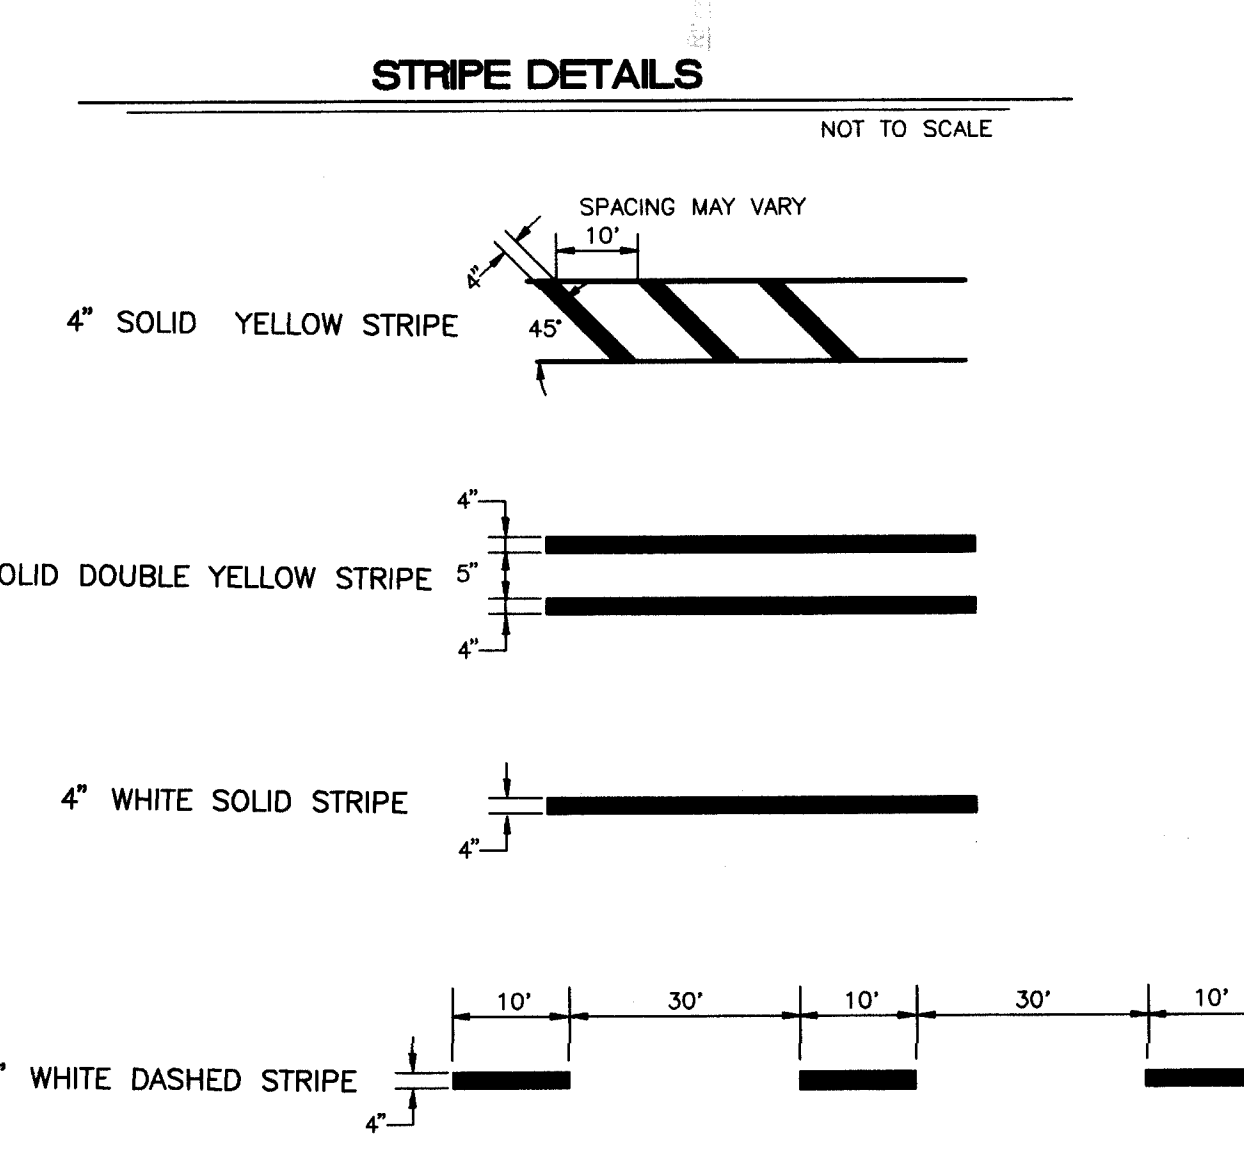

1 2 3 4 5 6 7 8 9 10 11 12 13 14 15
2016-14191611.910 10995

TERRA WEST DEVELOPMENT
MANAGEMENT SERVICES
4600 MONTGOMERY BLVD. N.E., SUITE 3
ALBUQUERQUE, NEW MEXICO 87109
(505)883-7592

CITY OF ALBUQUERQUE
PUBLIC WORKS DEPARTMENT
ENGINEERING GROUP

TITLE: STRIPING IM

APPROVALS	ENGINEER
DRC CHAIRMAN	
TRANSPORTATION	
HYDROLOGY	

PROJECT NO. 4961.90

DESIGNED BY	SB	DATE	12-94
DRAWN BY	DLM	DATE	12-94
CHECKED BY	SB	DATE	12-94

REVISIONS

NO.	DATE	REMARKS
1	12/19	Added Sheet

DESIGN

DATE	12-94
DATE	12-94
DATE	12-94

AS BUILT INFORMATION			
CONTRACTOR	DATE	INSPECTOR'S	DATE
STAKED BY	DATE	FIELD	DATE
FIELD	DATE	VERIFICATION BY	DATE
CORRECTED BY	DATE	MICRO-FILM INFORMATION	
RECORDED BY	DATE		
NO.			

SURVEY INFORMATION			
NO.	DATE	BY	DATE

BENCH MARKS			
ACS "3-L21	X=417.625.54	Y=1.479.896.05	Δα=00°09'29"
			G-G=0.99964457
			CENTRAL ZONE
			ELEV.=5503.00

ENGINEER'S SEAL			