

SUNRISE TERRACE SUBDIVISION, UNIT V
ALBUQUERQUE, NEW MEXICO

IMPROVEMENTS FOR
GRADING, PAVING, AND UTILITIES


INDEX OF DRAWINGS

Table with 2 columns: SHEET NO. and DESCRIPTION. Includes entries for Title Sheet, Subdivision Plat, Master Grading Plan, Composite Paving Plan, Composite Utility Plan, Paving Plan and Profiles (Paso Fino Place, Andalusian Avenue, Halter Drive, Wrangler/Saddle, Vaquero/Sandpiper), and Utility Plan and Profiles (Paso Fino Place, Andalusian Avenue, Halter Drive, Vaquero/Sandpiper).

GRADING AND DRAINAGE CERTIFICATION
I, Robert B. Ryals, a Registered Professional Engineer in the State of New Mexico, hereby certify, based on as-built information provided by Aldrich Land Surveying, Inc., that grading and drainage improvements, including retaining wall construction have been completed in substantial compliance with the approved plan for Sunrise Terrace Unit V.

SURVEYOR'S CERTIFICATION
I, Timothy Aldrich, a duly qualified Registered Professional Land Surveyor under the Laws of the State of New Mexico, do hereby certify that the "as-built" information shown on these drawings was obtained from field construction and "as-built" surveys performed by me, or under my supervision, that the "as-built" information shown on these drawings was made by me, or under my supervision and that this "as-built" information is true and correct to the best of my knowledge and belief.

APPROVAL OF AS-BUILT DRAWINGS
CHIEF CONSTRUCTION ENGINEER
DATE 6-25-96

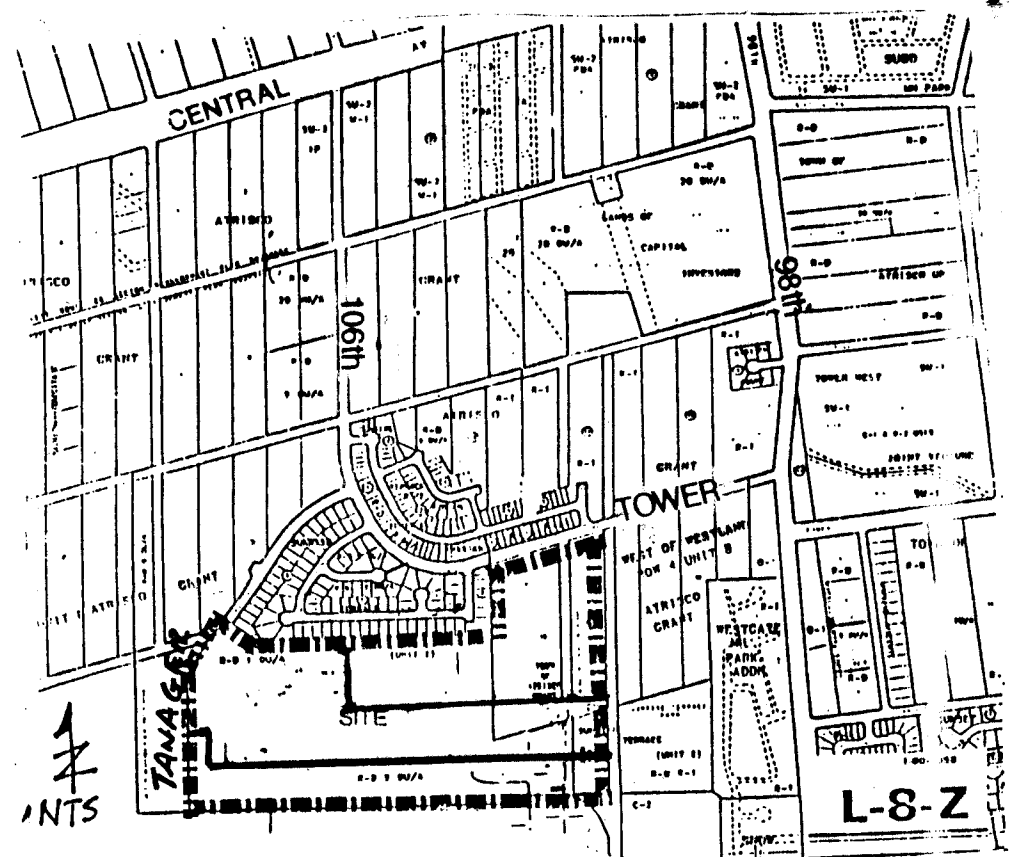


VICINITY MAP

GENERAL NOTES

- 1. All work detailed on these plans to be performed under contract shall, except as otherwise stated or provided for hereon, be constructed in accordance with the City of Albuquerque Standard Specifications for Public Works Construction 1986 Edition as amended with Update No. 4.
- 2. Prior to construction, the Contractor shall excavate & verify the horizontal and vertical locations of all obstructions. Should a conflict exist, the Contractor shall notify the Engineer so that the conflict can be resolved with minimum delay.
- 3. Two (2) working days prior to any excavation, Contractor must contact Line Locating Service @ 260 - 1990 for location of existing utilities.
- 4. Warning - EXISTING UTILITY LINE LOCATIONS are shown in an approximate manner only, and such lines may exist where none are shown. The location of any such existing lines is based upon information provided by the utility company, the owner, or by others, and the information may be incomplete or may be obsolete by the time construction commences.
- 5. TRAFFIC CONTROL: Three (3) working days prior to beginning construction the contractor shall submit to the Construction Co-ordination Division a detailed construction schedule. Two (2) working days prior to construction the contractor shall obtain a barricading permit from the Construction Coordination Division. Contractor shall notify Barricade Engineer (768-2551) prior to occupying an intersection. See section 19 of the specifications. All street striping altered or destroyed shall be replaced by contractor to location and in kind as existing at no additional cost to the owner.
- 6. The contractor shall promptly clean up any material excavated within the public right-of-way so that the excavated material is not susceptible to being washed down the street.
- 7. The contractor is responsible for protecting and maintaining all existing monumentation controls. In the event of inadvertent destruction or alteration the contractor must immediately notify the City Chief Surveyor.
- 8. Any work affecting an arterial roadway requires twenty-four hour notification prior to construction.

DWG-C:\SUN\T-SHT5 DATE08/17/95 TIME:11:19 RYALS Engineering-HB

Table with 6 columns: REV., SHEETS, CITY ENGINEER, DATE, USER, DEPARTMENT. Includes sections for ENGINEER'S SEAL, PROJECT NO. 4970.92, and SHEET 1 OF 19.

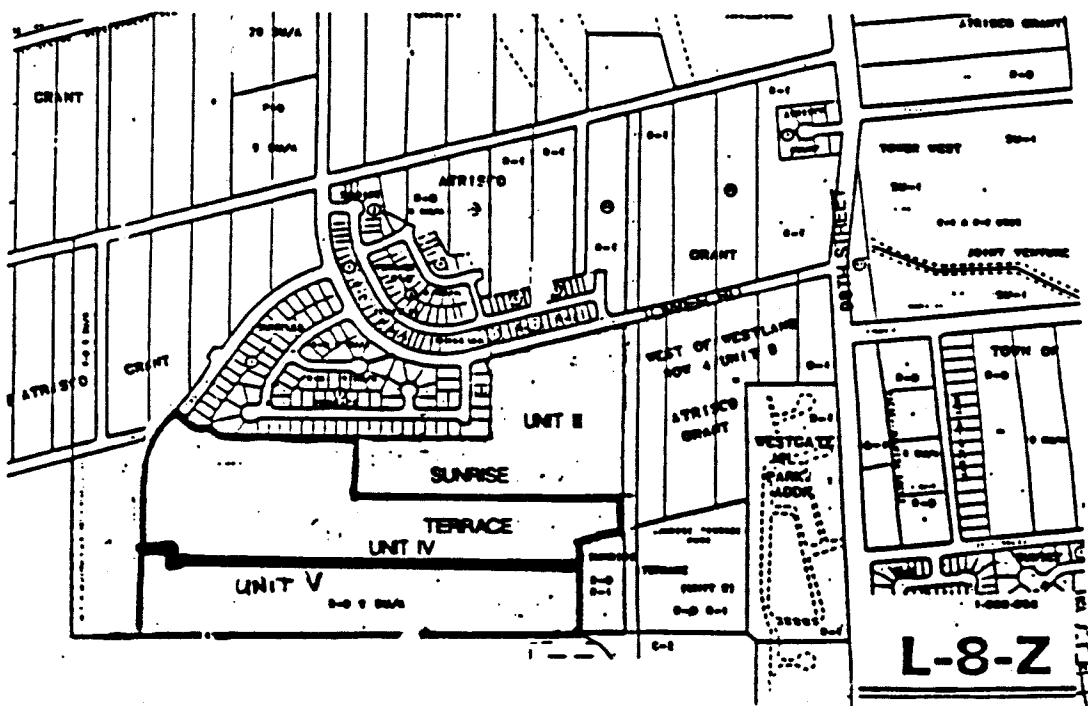

VICINITY MAP

PLAT FOR SUNRISE TERRACE UNIT V SUBDIVISION

CITY OF ALBUQUERQUE
BERNALILLO COUNTY
NEW MEXICO

MAY, 1995

DESCRIPTION

A certain parcel of land situated within projected section 29, T. 10 N., R. 2 E., N.M.P.M., comprising all of Tract 3A, of SUNRISE TERRACE, UNIT IV, as the same is shown and designated on the plat filed in the office of the County Clerk of Bernalillo County, New Mexico, on April 1, 1995, Vol. 1, Folio 1, and being further described by New Mexico State Plane Grid Bearings (Central Zone) and ground distances as follows:

BEGINNING at the Northeast corner of the parcel herein described, being a 1/2" rebar w/survey cap stamped LS 7439, Whence the City of Albuquerque Survey Brass Cap "7-L9" having New Mexico State Plane Coordinates (Central Zone) Y=1,478,346.71 and X=352,978.14 Bears N 52° 55' 00" E, 1542.71 feet, also being the southeast corner of Lot 6-P1, Block (6) Six, of said SUNRISE TERRACE UNIT IV, and a point on the westerly right of way of HALTER DR.;

THENCE S 45° 19' 40" W, 14.70 feet along the said westerly right of way of HALTER DR. to a point of curvature;

THENCE 80.01 feet along the arc of a curve to the left having a radius 143.71 feet, a central angle of 31° 54' 04", and a chord bearing S 29° 22' 38" W, 78.99 feet to a point;

THENCE S 74° 59' 37" W, 11.14 feet to a point on the westerly right of way of 102nd Street S.W.;

THENCE S 00° 19' 40" W, 446.1 feet along said westerly right of way of 102nd Street S.W., to the southeast corner of said TRACT 3A, and the southeast corner of the parcel herein described;

THENCE N 89° 22' 26" W, 1908.38 feet along the southerly boundary of said TRACT 3A to a point;

THENCE S 00° 17' 55" W, 20.00 feet to a point;

THENCE N 89° 22' 26" W, 60.00 feet, to the southwest corner of the parcel herein described, being a found 5/8" rebar w/cap, also being the southwest corner of said TRACT 3A;

THENCE leaving said southerly boundary and continuing N00° 17' 55" E, 519.53 feet along the westerly boundary of the parcel herein described to the northwest corner, also being the northwest corner of said TRACT 3A, a point on the westerly right of way of TANAGER DR.;

THENCE leaving said westerly right of way of TANAGER DR. and continuing along the northerly boundary of the parcel herein described S 89° 42' 05" E, 155.00 feet to a point;

THENCE N 00° 17' 55" E, 18.31 feet to a point, said point being the southwest corner of Lot 30-P1, Block 2, of said SUNRISE TERRACE UNIT IV;

THENCE S 89° 41' 57" E, 1871.11 feet to the point and place of beginning and containing 23.6462 acres more or less.

APPROVED AND ACCEPTED BY

Subdivision Case No. _____

Planning Director, City of Albuquerque, N.M. _____

City Engineering Division, City of Albuquerque, N.M. _____

Albuquerque Metropolitan Arroyo Flood Control Authority _____

Trading Division, City of Albuquerque, N.M. _____

Water Utilities Department, City of Albuquerque, N.M. _____

Parks and Recreation Department, City of Albuquerque, N.M. _____

City Surveyor, City of Albuquerque, N.M. _____

Property Management, City of Albuquerque N.M. _____

County Treasurer, Bernalillo County, N.M. _____

Gas Company of New Mexico _____

U.S. West Telecommunications _____

Public Service Company of New Mexico _____

Jones Interchange, Inc. _____

SURVEYOR'S CERTIFICATION

I, Perfilo B. Lucero, a duly qualified Registered Professional Land Surveyor under the laws of the State of New Mexico, do hereby certify that this plat and description were prepared by me or under my supervision, shows all easements as shown on the plat of record or made known to me by the owners and/or proprietors of the subdivision shown hereon, utility companies and other parties expressing an interest and meets the minimum requirements for monumentation and surveys of the Albuquerque Subdivision Ordinance, and further meets the Minimum Standards for Land Surveying in the State of New Mexico (Effective November 1, 1989) and is true and correct to the best of my knowledge and belief.

PERFILO B. LUCERO _____ 4/24/95
N.M.R.P.L.S. No. 7439 Date

PURPOSE OF THE PLAT

1. Create lots, dedicate public right of way and grant public utility easements as shown hereon.

SUBDIVISION DATA

- Case No.: DRB-93-419, V-94-21 S-94-21
- Zone Atlas Index No.: L-8
- Number of Lots Created: 128
- Net Area: 23.6462 acres
- Date of Survey: June 1, 1994
- .93 miles of street created.
- Talos Log

NOTES

- Bearings are New Mexico State Plane Grid Bearings (Central Zone).
- Distances are ground distances
- Bearings and distances in parenthesis are record.

PUBLIC UTILITY EASEMENTS

PUBLIC UTILITY EASEMENTS shown on this plat are granted for the common and joint use of:

- The Public Service Company of New Mexico for the installation, maintenance, and service of overhead and underground electrical lines, transformers, poles and any other equipment, fixtures, structures and related facilities reasonably necessary to provide electrical services.
- The Gas Company of New Mexico for installation, maintenance, and service of natural gas lines, valves and other equipment and facilities reasonably necessary to provide natural gas.
- U.S. West for installation, maintenance and services of all buried and aerial communication lines and other related equipment and facilities reasonably necessary to provide communication services, including but not limited to above ground pedestal and closures.
- Jones Interchange for the installation, maintenance, and services of such lines, cable and other related facilities reasonably necessary to provide Cable TV Services.

Included the right to build, rebuild, construct, reconstruct, locate, relocate, change, remove, modify, renew, operate and maintain facilities for the purpose described above, together with free access to, from, and over said easements, including sufficient working area spaces for electric transformers, with the right and privilege to trim and remove trees, shrubs or bushes which interfere with the purpose set forth herein. No building, sign, pool (aboveground or subsurface), hot tub, concrete, or wood pool decking, or other structure shall be erected or constructed on said easements, nor shall any well be drilled or operated hereon. Property owners shall be solely responsible for correcting any violations of National Electric or Safety Code caused by construction or pools, decking or any structures adjacent to within or near easements shown on this plat.

OWNERS FREE CONSENT AND DEDICATION

The subdivision shown hereon is with the free consent and in accordance with the desires of the undersigned owner(s) and/or proprietor(s) thereof and said owner(s) and/or proprietor(s) do hereby dedicate all streets and public rights-of-way shown hereon to the City of Albuquerque in fee simple with warranty covenants and do hereby grant all access utility and drainage easements shown hereon including the right to construct, operate, inspect, and maintain facilities therein, and all public utility easements shown hereon for the common and joint use of gas, electrical power and communication services for buried distribution lines, conduits, and pipes for underground services for buried distribution lines, conduits, and pipes for underground utilities where shown or indicated, and including the right of ingress and egress for construction and maintenance, and the right to trim interfering trees and shrubs (see notes). Said owner(s) and/or proprietor(s) do hereby consent to all of the foregoing and do hereby certify that this subdivision is their free act and deed.

American Southwest Homes, LTD Company _____ 4/25/95
By: L.L. Bell, New Mexico Registered Agent Date

STATE OF NEW MEXICO
COUNTY OF BERNALILLO
On this 25 day of April, 1995, the foregoing instrument was acknowledged before me. My commission expires 9-16-97

LORETTA M. PARENTI
NOTARY PUBLIC - STATE OF NEW MEXICO
Notary Public

KEYED NOTES:

- CREATED, DEDICATED OR GRANTED BY PLAT OF SUNRISE TERRACE UNIT IV, RECORDED ON APRIL 1, 1995 IN VOL. 1, FOLIO 1.
- R.O.W. DEDICATED AND EASEMENTS GRANTED BY SUNRISE TERRACE UNIT II, PHASE A, RECORDED ON APRIL 5, 1983, VOL. C21 FOLIO 25.
- CREATED, DEDICATED OR GRANTED BY PLAT OF SUNRISE TERRACE UNIT III, RECORDED ON AUGUST 5, 1994 IN VOL. 94C, FOLIO 260.

GENERAL NOTES:



- ALL SIDE LOTS ARE PERPENDICULAR OR RADIAL TO STREET RIGHT-OF-WAY UNLESS OTHERWISE NOTED.
- 10' UTILITY EASEMENTS ALONG THE FRONTAGE OF ALL LOTS ARE GRANTED BY THIS PLAT UNLESS OTHERWISE NOTED.
- CENTERLINE (IN LIEU OF R.O.W.) MONUMENTATION TO BE INSTALLED AT ALL CENTERLINE P.C.'S, P.T.'S ANGLE POINTS AND STREET INTERSECTIONS PRIOR TO ACCEPTANCE OF SUBDIVISION STREET IMPROVEMENTS AND WILL CONSIST OF A FOUR-INCH (4") ALUMINUM ALLOY CAP STAMPED "CITY OF ALBUQUERQUE", "CENTERLINE MONUMENTATION", "SURVEY MARKER", "DO NOT DISTURB", "LS. #7439".
- SEE SHEET 4 OF 4 FOR LINE AND CURVE TABLES.

LEGEND

EXISTING EASEMENTS

- EXISTING R.O.W.
- C.O.A. CENTERLINE MONUMENTS
- EXISTING C.O.A. C.L. MONUMENTS
- FOUND REBAR W/CAP
- FOUND AMAFCA BRASS CAP
- SET REBAR W/CAP LS 7439

PLAT FOR SUNRISE TERRACE UNIT V

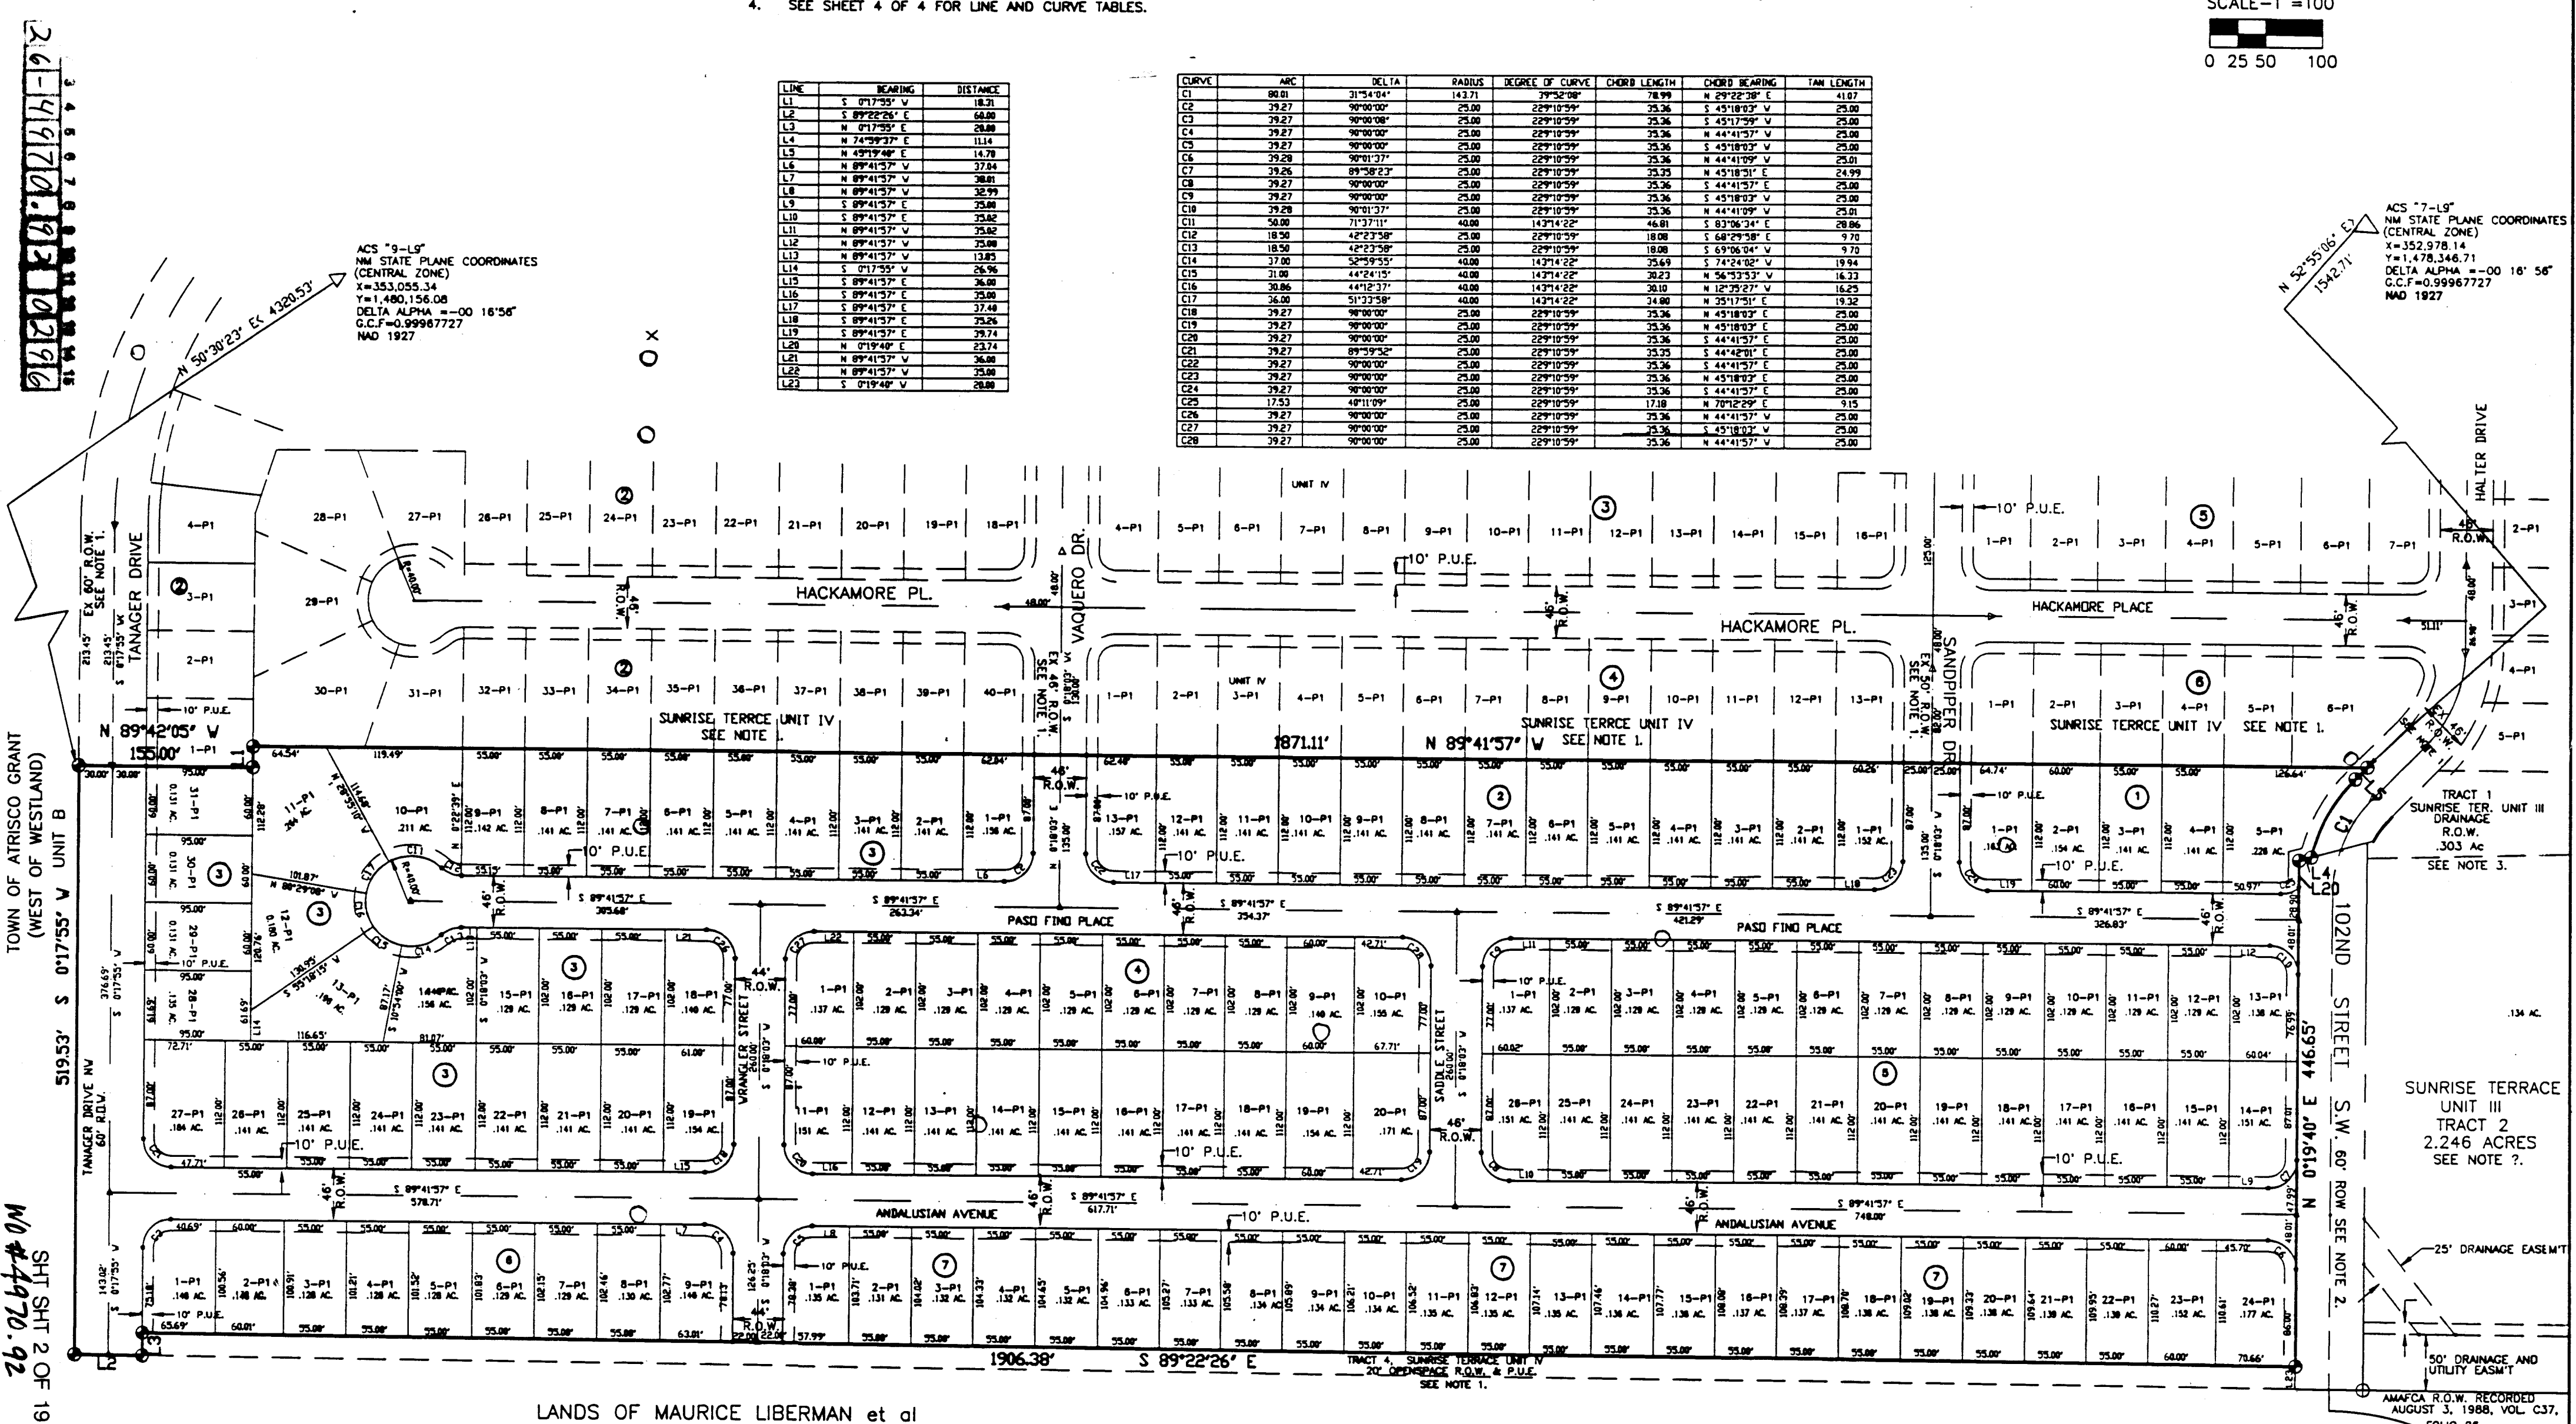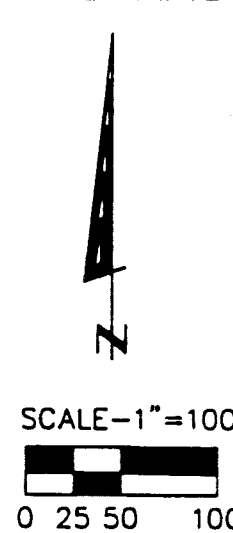

RYALS engineering & construction services
5301 Central Ave. Albuquerque, NM 87108
(505) 256-4701 239-4726 mobile telephone

SHEET NO. 2 OF 2

THE CONTRACTOR MUST OBTAIN A TOPSOIL DISTURBANCE PERMIT FROM THE ENVIRONMENTAL HEALTH DIVISION PRIOR TO CONSTRUCTION.

THE CONTRACTOR IS TO COMPLY WITH EARTHWORK SPECIFICATIONS AS NOTED IN THE SOILS REPORT SUPPLIED BY THE OWNER.

THE CONTRACTOR SHALL CONFORM TO ALL CITY, COUNTY, STATE AND FEDERAL DUST CONTROL MEASURES AND REQUIREMENTS AND WILL BE RESPONSIBLE FOR PREPARING AND OBTAINING ALL NECESSARY APPLICATIONS AND APPROVALS.

THE CONTRACTOR SHALL ENSURE THAT NO SOIL ERODES FROM THE CONSTRUCTION SITE. EROSION CONTROL MEASURES ARE INTENDED TO CONTROL MINOR FLOWS AND PROHIBIT THE RELEASE OF SEDIMENT INTO ADJACENT STREETS AND PROPERTY. TEMPORARY EROSION CONTROL BERM SHALL BE CONSTRUCTED IN ACCORDANCE WITH THE DETAIL ON THIS GRADING PLAN AT LOCATIONS SHOWN.

THE CONTRACTOR IS RESPONSIBLE FOR MAINTAINING TEMPORARY BERMS THROUGHOUT THE CONSTRUCTION PHASE. THE OWNER WILL MAINTAIN BERMS AFTER COMPLETION AND ACCEPTANCE OF CONSTRUCTION.

TEMPORARY EROSION CONTROL BERMS LOCATED ON INDIVIDUAL LOTS SHALL REMAIN IN PLACE UNTIL THE CONSTRUCTION OF EACH RESPECTIVE BUILDING IS COMPLETED ON A LOT BY LOT BASIS.

THE TOLERANCES FOR ROUGH GRADING SHALL CONFORM TO THE FOLLOWING:

PAD SUBGRADE:	± 0.1'
STREET SUBGRADE:	± 0.1'
ALL OTHER AREAS:	± 0.3'

THERE ARE EXISTING WALLS LOCATED ADJACENT TO THIS PROJECT. ANY WALLS DAMAGED OR REMOVED BY THE CONTRACTOR DURING THE CONSTRUCTION ACTIVITIES SHALL BE REINSTALLED OR REPLACED BY THE CONTRACTOR TO AN EQUAL OR BETTER CONDITION AT NO ADDITIONAL COST TO THE OWNER.

-
- Diagram illustrating the cross-section of a temporary erosion control berm. The berm is constructed from compacted material, with the top surface labeled "TEMPORARY EROSION CONTROL BERM" and "COMPACT BERM TO 90% OF OPTIMUM USING PLACEMENT EQUIPMENT WHEELS AS REQUIRED". The berm is shown with a "FINISH ROUGH GRADING" line and a "CURB & GUTTER" line. The height of the berm is indicated as "1'-0\"". The diagram also shows a "3" (likely representing 3 feet) dimension for the width of the berm.

EROSION CONTROL BERMS ARE TO BE INSTALLED ON ALL LOTS ADJACENT TO THE PROPOSED STREETS OF THIS PROJECT, AND FOR THE 1ST 25' BACK FROM THE CURB ON EVERY FIFTH LOT

NOTES:

1. FLOW FROM REAR YARD OF SPLIT PADS MUST BE MAINTAINED TO FRONT YARD, EITHER A RETAINING WALL WITH WEEP HOLES OR A MAXIMUM SLOPE OF 3:1 SHALL BE PROVIDED AT SIDE YARD GRADE BREAK TO ACCOMPLISH THIS.
2. MAXIMUM COMBINED HEIGHT OF GARDEN WALL PLUS RETAINING WALL MUST NOT EXCEED 8 FEET UNLESS A VARIANCE IS APPROVED THROUGH THE C.O.A. ZONING HEARING EXAMINER.



1. FLOW FROM REAR YARD OF SPLIT PADS MUST BE MAINTAINED TO FRONT YARD. EITHER A RETAINING WALL WITH WEEP HOLES OR A MAXIMUM SLOPE OF 3:1 SHALL BE PROVIDED AT SIDE YARD GRADE BREAK TO ACCOMPLISH THIS.
2. MAXIMUM COMBINED HEIGHT OF GARDEN WALL PLUS RETAINING WALL MUST NOT EXCEED 8 FEET UNLESS A VARIANCE IS APPROVED THROUGH THE C.O.A. ZONING HEARING EXAMINER.

TYPICAL LOT DETAIL

NTS



NTS

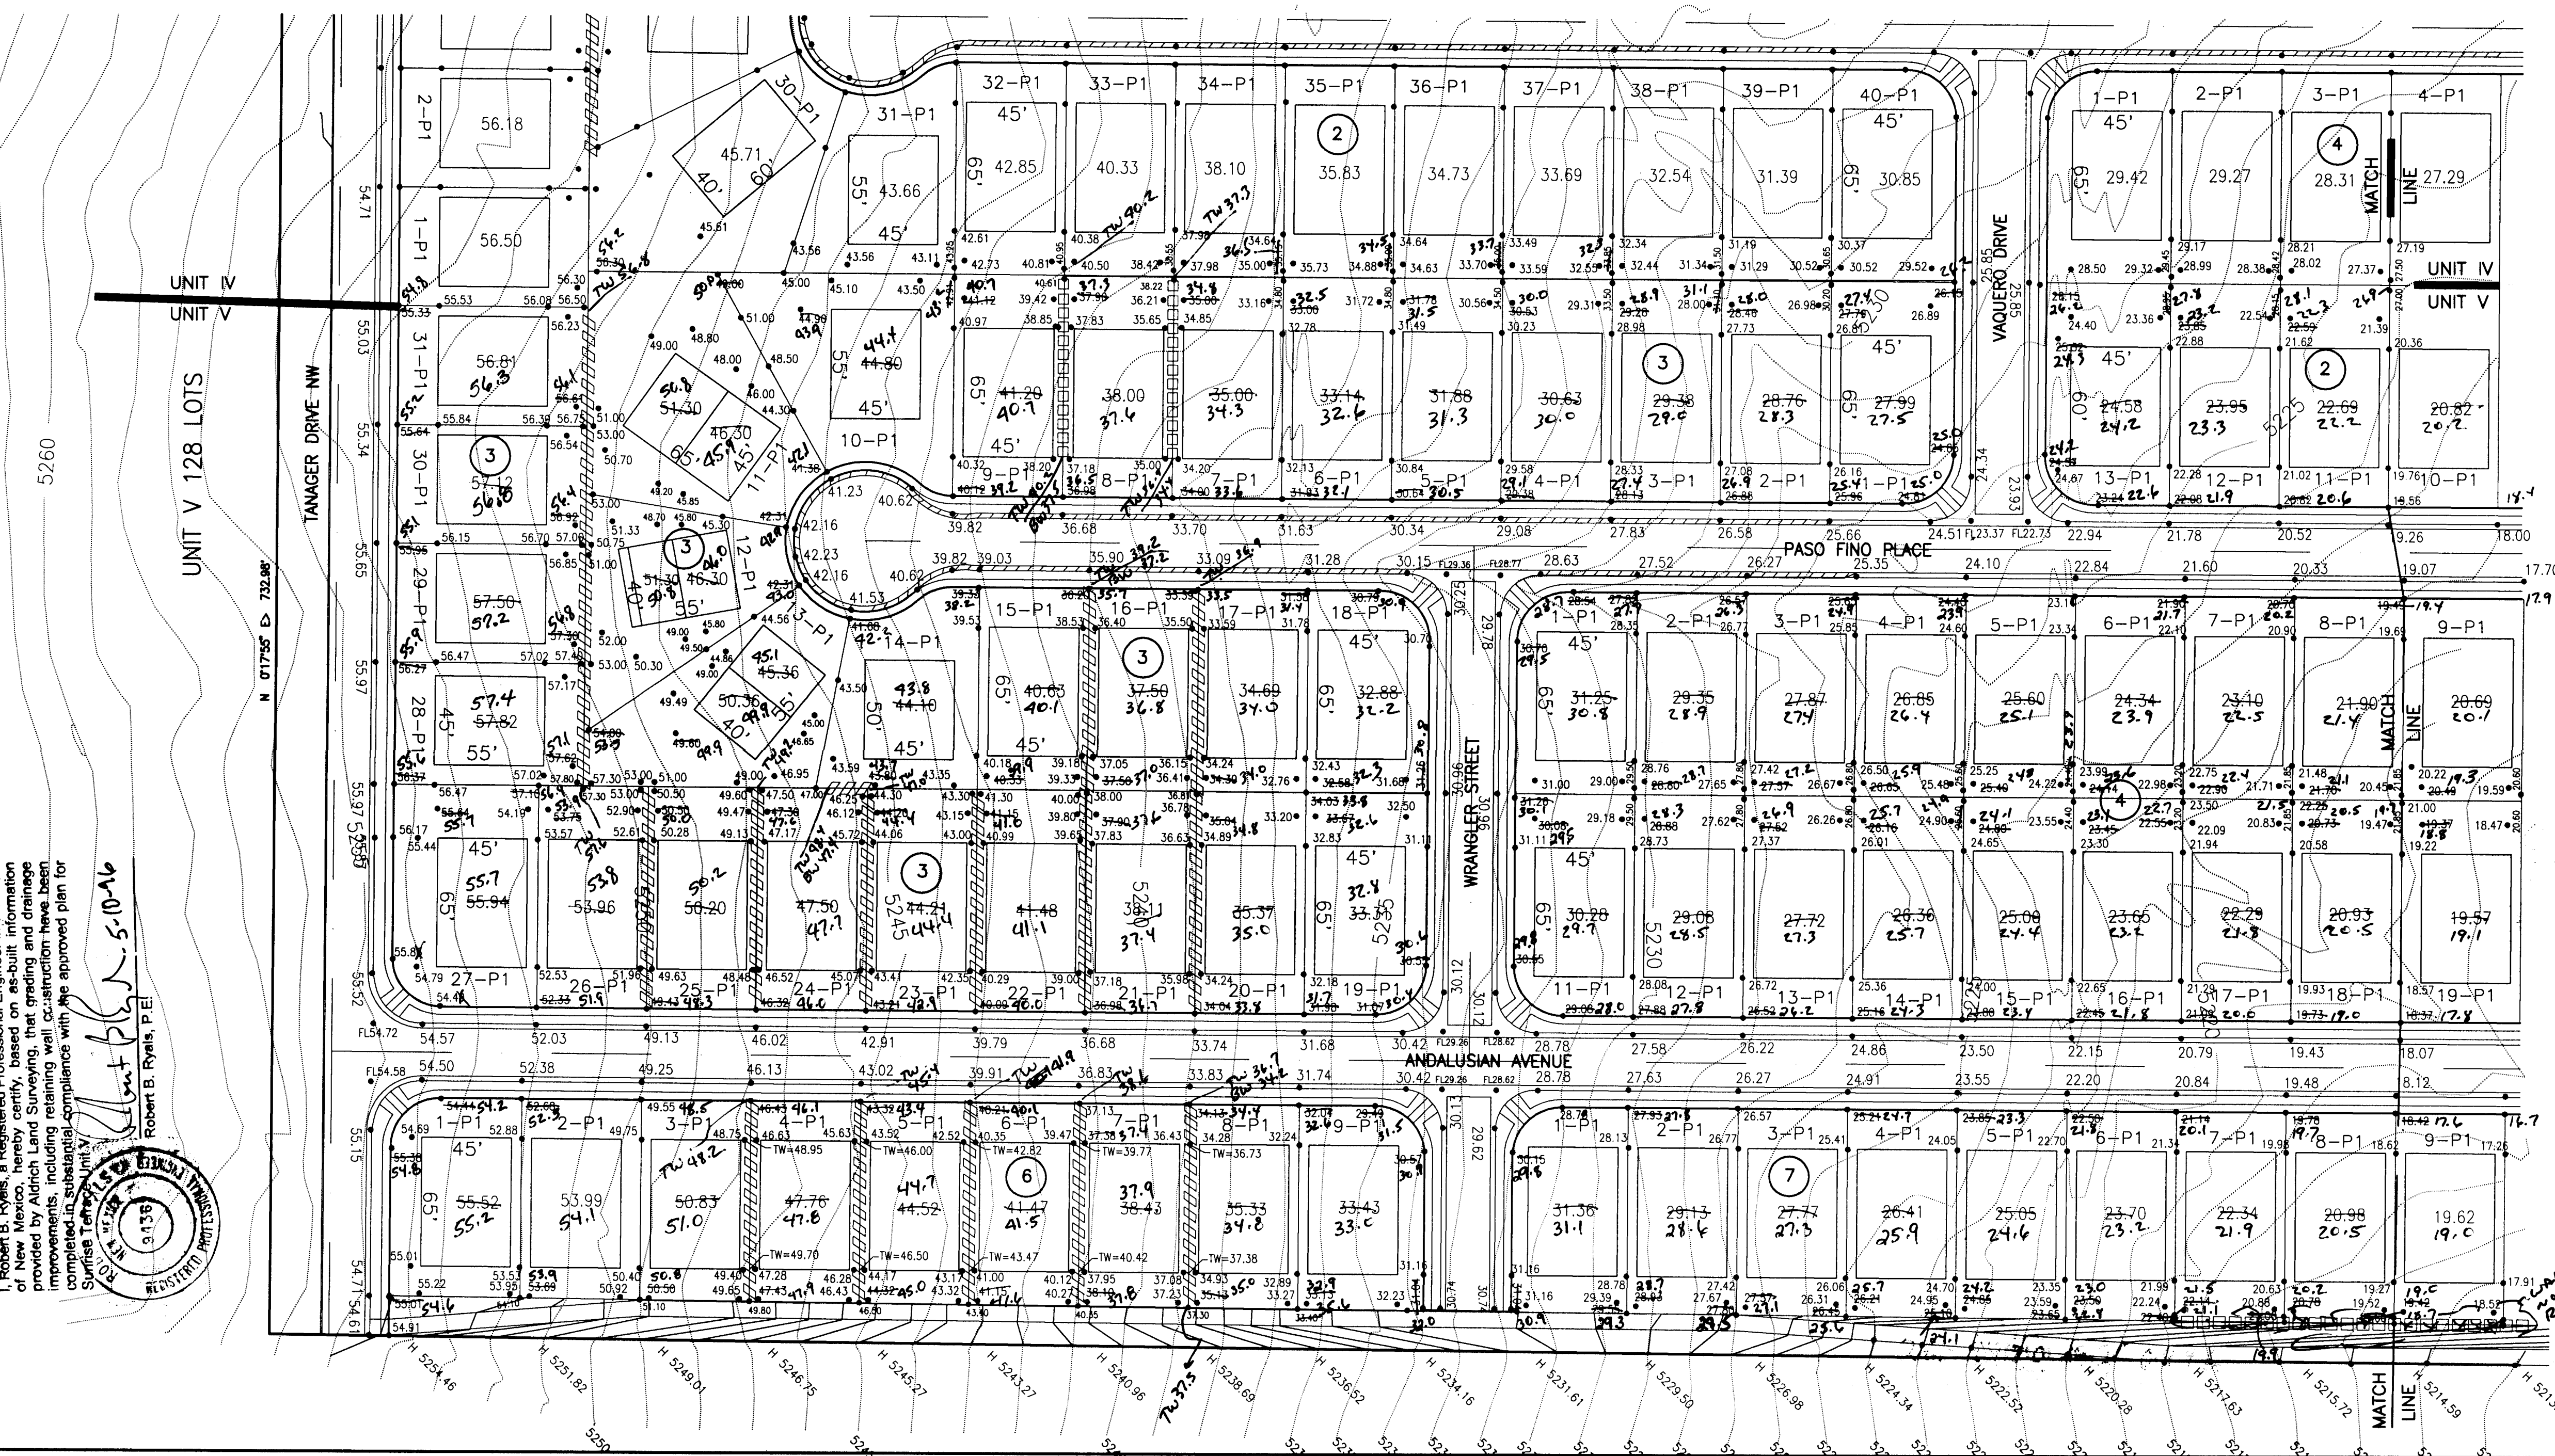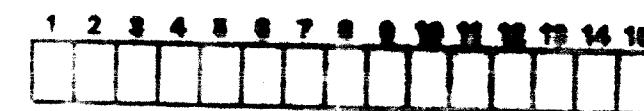

GRADING AND DRAINAGE CERTIFICATION

1. Robert B. Ryals, a Registered Professional Engineer in the State of New Mexico, hereby certifies, based on as-built information provided by Aldrich Land Surveying, that grading and drainage improvements, including retaining wall construction, have been completed in substantial compliance with the approved plan for Sunrise Terraced Community.

Robert B. Ryals R-5-10-16
Robert B. Ryals, P.E.

Robert B. Ryals, P.E.


N

SCALE-1"=50'



0 25 50

LEGEND

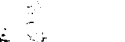- | | |
|---|--|
|  | A RETAINING WALL
RETAINING 18" OR LESS. |
|  | A RETAINING WALL
RETAINING 18" OR MORE. |
|  | EXISTING RETAINING WALL
18" OR MORE |
|  | STORM DRAIN WITH
MANHOLE |
|  | STORM DRAIN INLET |
|  | EXISTING CONTOURS |
|  | PROPOSED GRADE |
|  | EXISTING GROUND |

APPROVED FOR RO
(±1 FT.)

CITY HYDROLOGY

DWG.C:\SUN\SVN\GR3V DATE08/17/95 TIME:11:20 RYALS Engineering-HB

RYALS **engineering &
construction services**


5301 Central, N.E. Albuquerque, NM 87108
(505) 256-4701 239-4726 mobile telephone



CITY OF ALBUQUERQUE
PUBLIC WORKS DEPARTMENT
ENGINEERING GROUP

TITLE: SUNRISE TERRACE UNIT V
 MASTER GRADING PLAN

APPROVALS	ENGINEER	DATE	APPROVALS	ENGINEER	DATE
DRC CHAIR	<i>A.P. Sathya</i>	<i>9-28-95</i>	HYDROLOGY	<i>S.Catanga</i>	<i>9-13-95</i>
WATER WASTE WATER	<i>MA RWF</i>	<i>9-11-95</i>	INSPECTION		
TRANSPORTATION	<i>N.R.W.</i>				
PROJECT NO.	4970.92	MAP L-8	SHEET 3 OF 19		

26-4970.92 0396

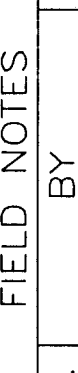ENGINEER'S SEAL		SURVEY INFORMATION		BENCH MARKS		AS BUILT INFORMATION		
		FIELD NOTES		ACS "3-Lg" A 140 PENNY NAIL IN POWER POLE		CONTRACTOR HYDQD SYSTEMS		
		NO.	BY	DATE	#61 LOCATED ON THE WEST SIDE OF 98TH STREET AND 450' SOUTH OF RYNO CT.	WORK STARTED BY	AL S	9/6
					ELEV. = 5184.872	ADJUSTED ACCEPTANCE BY	AL S	9/6
						FIELD VERIFICATION BY	AL S	9/6
						CORRECTED BY	AL S	5/96
DESIGNED BY: RBR		DATE: 6/8/94				MICRO-FILM INFORMATION		
DRAWN BY: PBD, HFB		DATE: 6/8/94				RECORDED BY		
CHECKED BY:		DATE:				NO.		

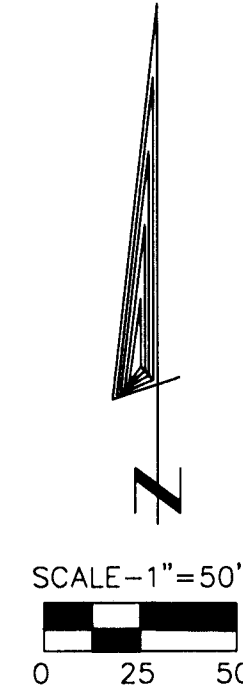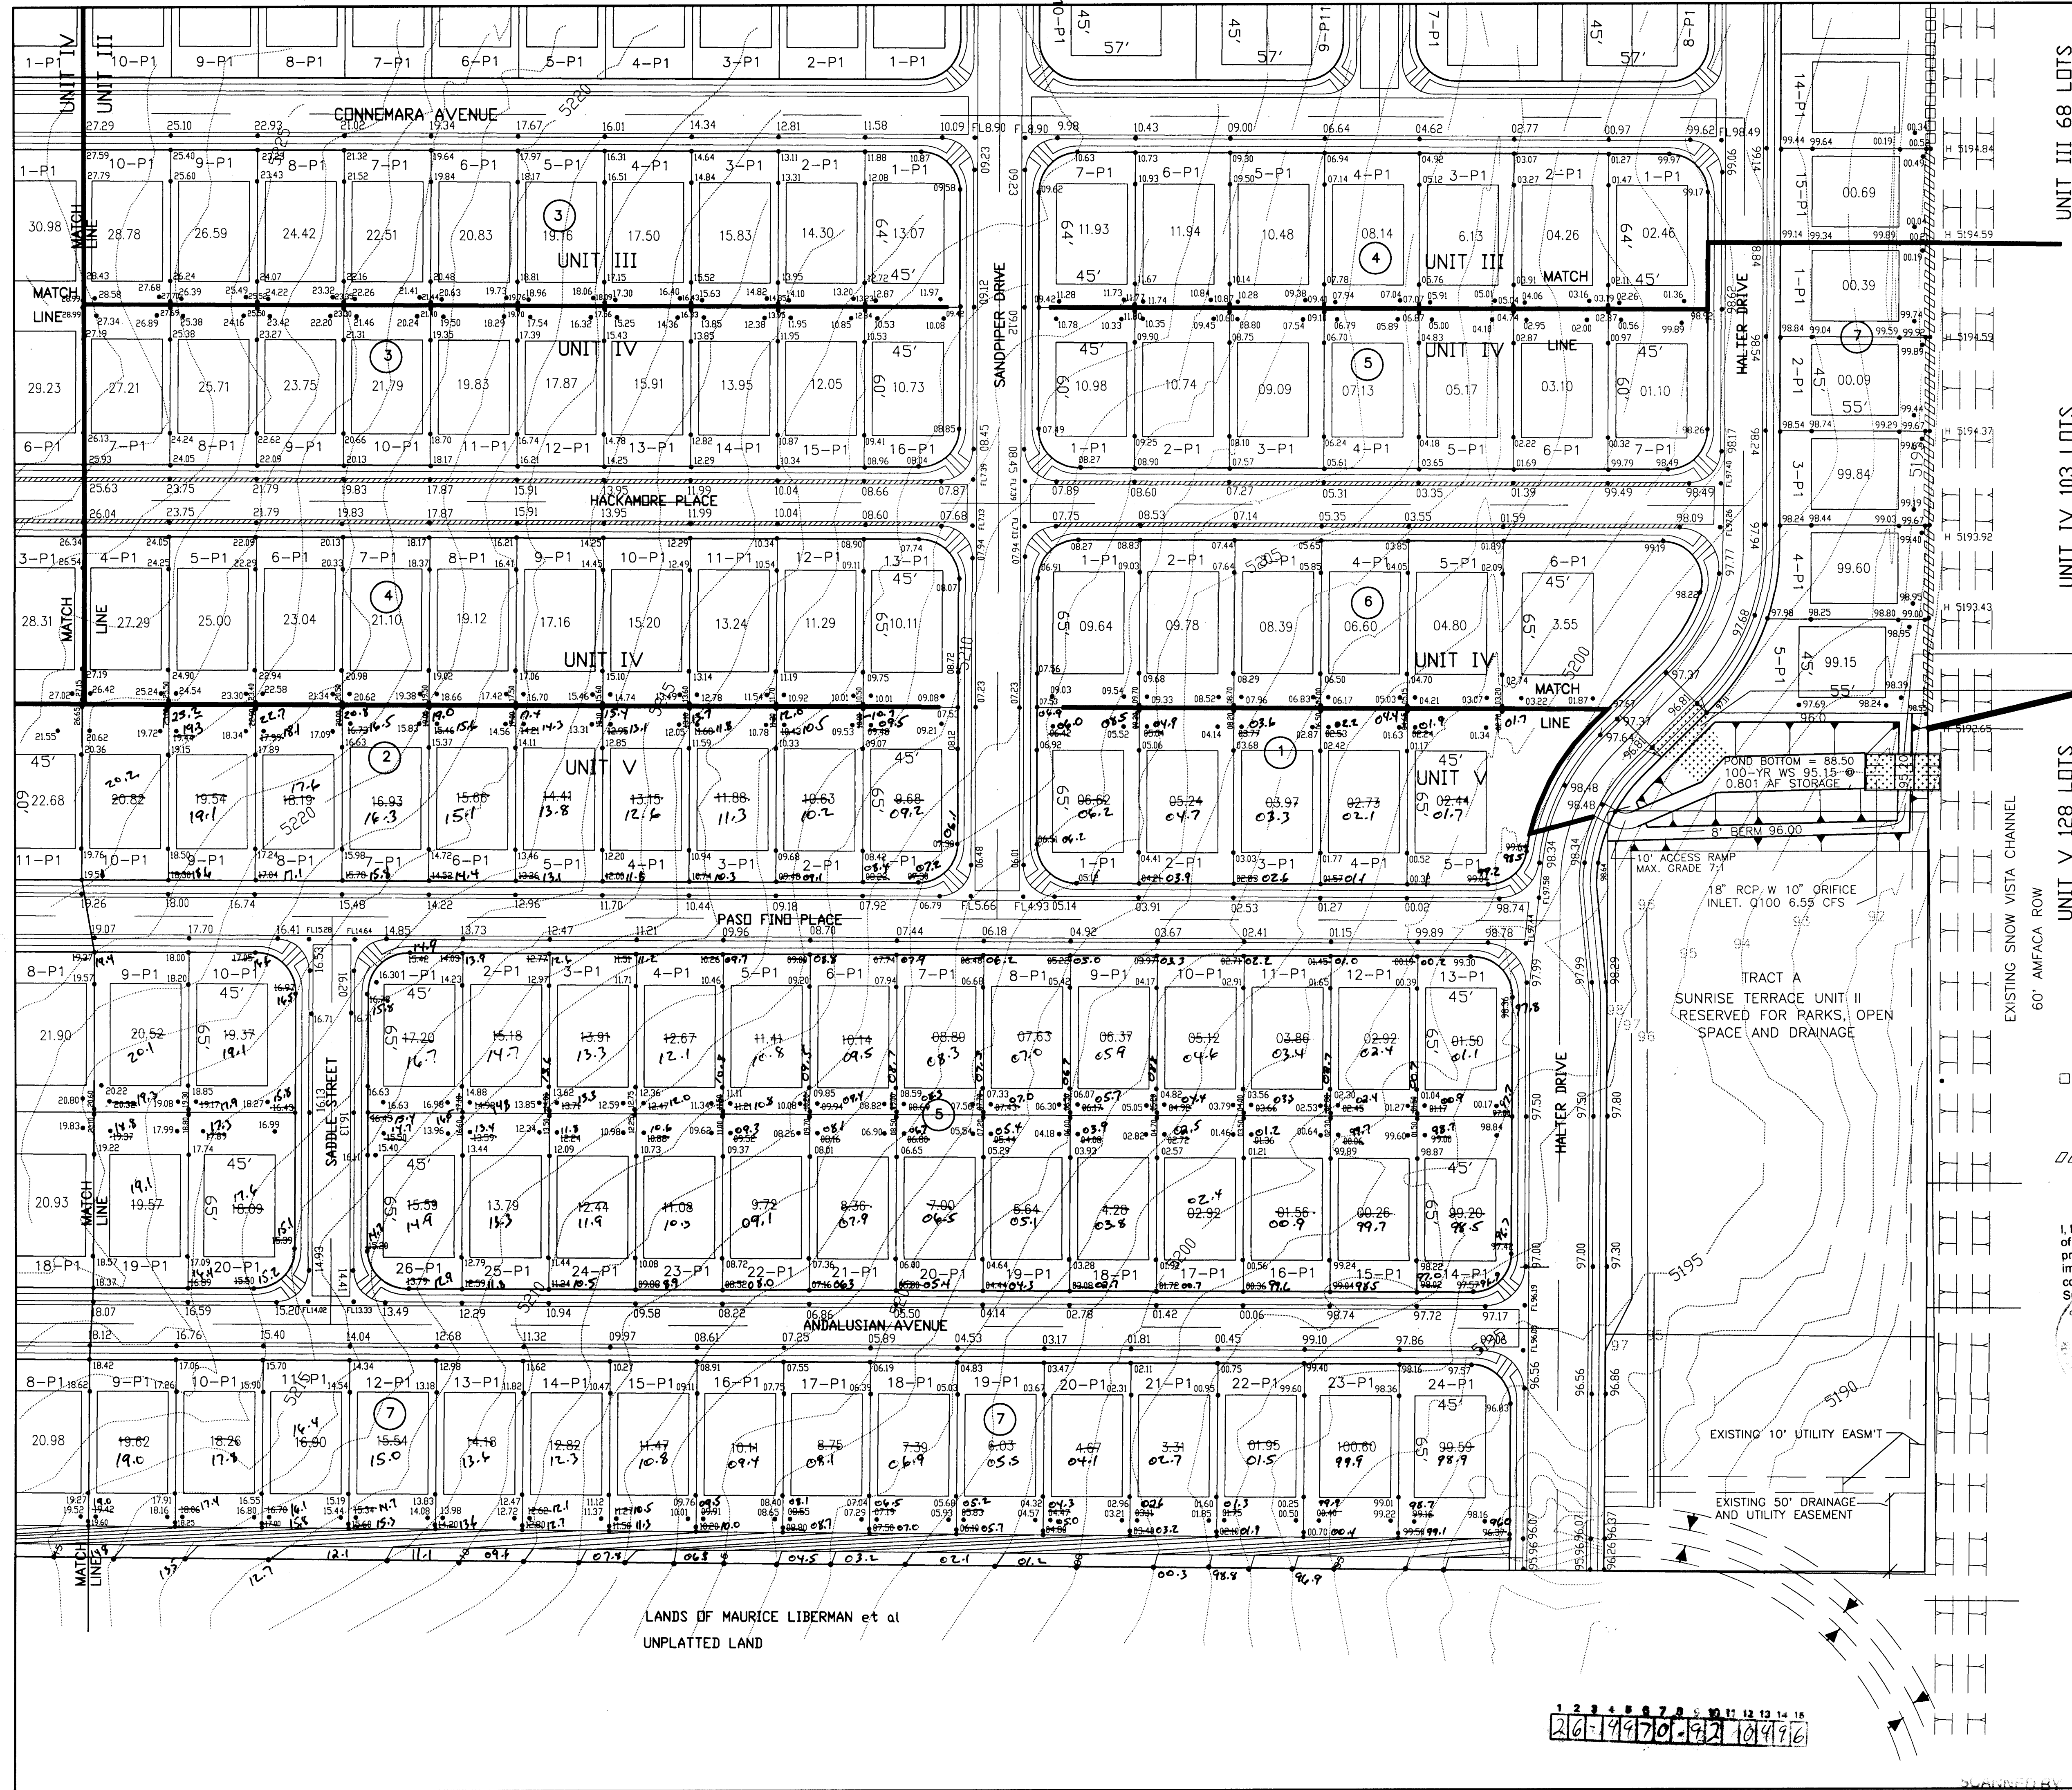

PROPOSED CONCRETE
SPILLWAY 22' WIDE
CAPACITY 47.2 CFS
PROPOSED CONCRETE
SURFACE RUNDOWN
Q100 38.4 CFS

□□□□□ = A RETAINING WALL RETAINING
18" OR LESS.

= A RETAINING WALL RETAINING
18" OR MORE.

GRADING AND DRAINAGE CERTIFICATION

I, Robert B. Ryals, a Registered Professional Engineer in the State of New Mexico, hereby certify, based on as-built information provided by Aldrich Land Surveying, that grading and drainage improvements, including retaining wall construction have been completed in substantial compliance with the approved plan for Sunrise Terrace Unit V.

Robert B. Ryals, P.E.












DWG:C:\SUN\SUN\GR4V DATED:08/17/95 TIME:11:21 RYALS Engineering

	CITY HYDROLOGY	DATE
RYALS	engineering & construction services	
5301 Central, N.E.	Albuquerque, NM 87108	
(505) 256-4701	239-4726 mobile telephone	

CITY OF ALBUQUERQUE
PUBLIC WORKS DEPARTMENT
ENGINEERING GROUP

TITLE: SUNRISE TERRACE UNIT
 MASTER GRADING PLAN

APPROVALS	ENGINEER	DATE	APPROVALS	ENGINEER	DATE
DRC CHAIR	<i>S.P. Gabely</i>	<i>9-28-95</i>	HYDROLOGY	<i>Salinger</i>	<i>9-13-95</i>
WATER	<i>NA RWF</i>	<i>9-11-95</i>	INSPECTION		
WASTE WATER					
TRANSPORTATION	<i>NA EMO</i>	<i>9-28-95</i>			
PROJECT NO.	4970.92	MAP NO.	L-8	SHEET	4 OF 19

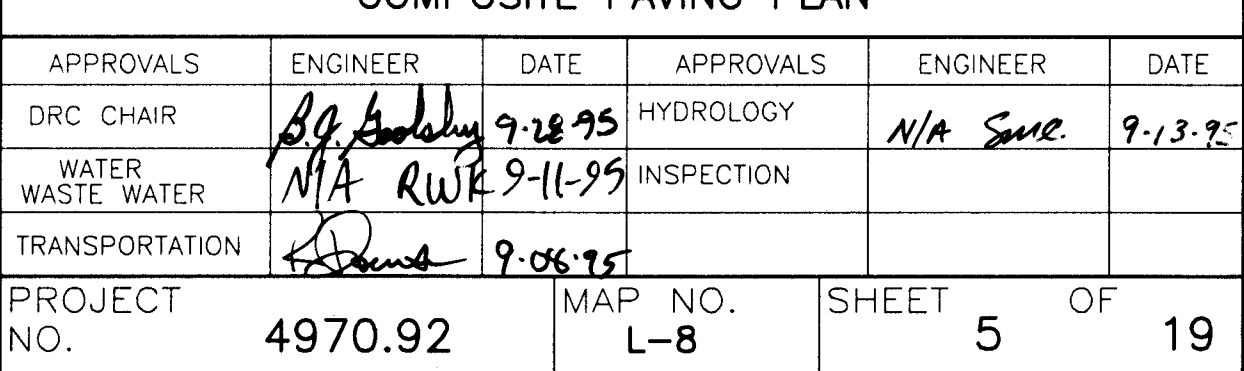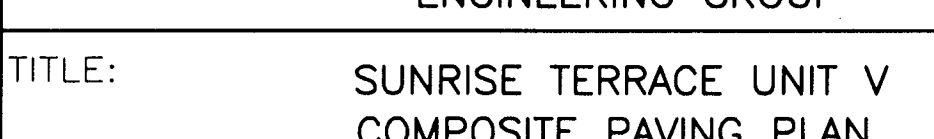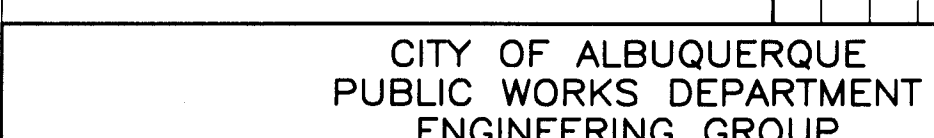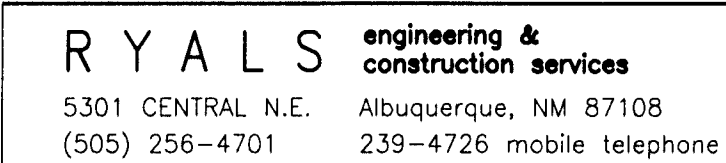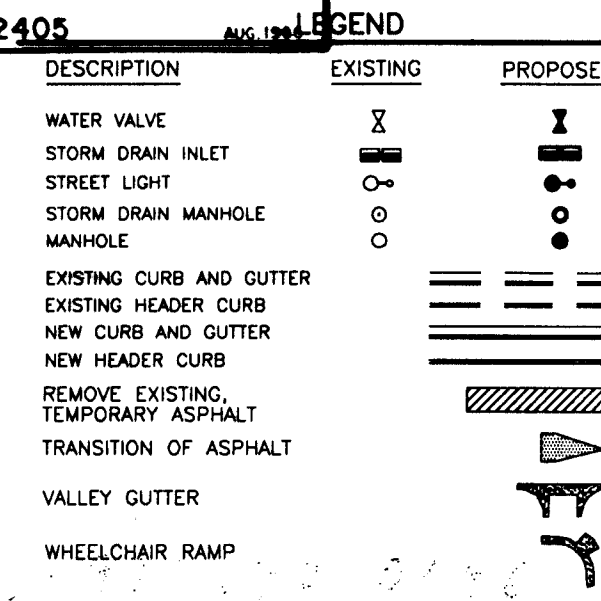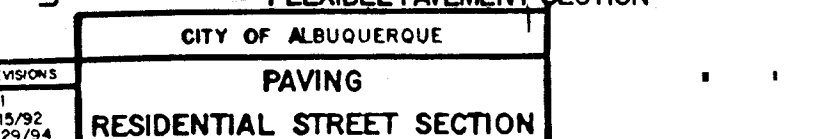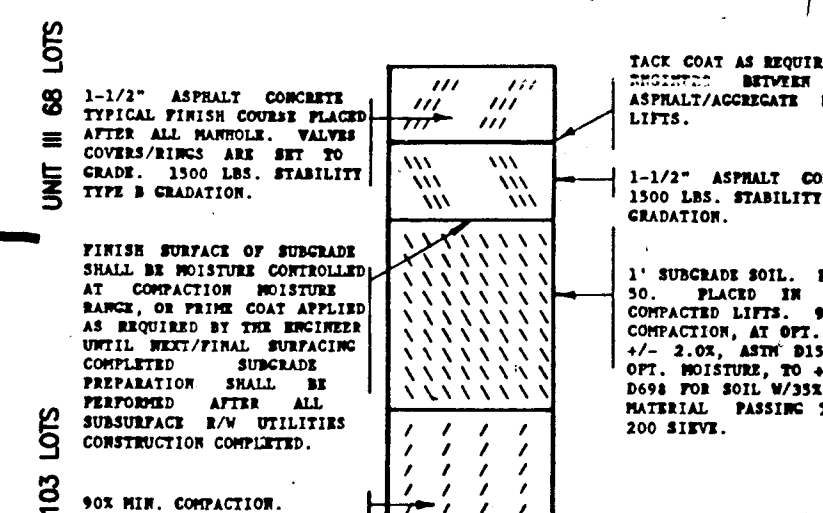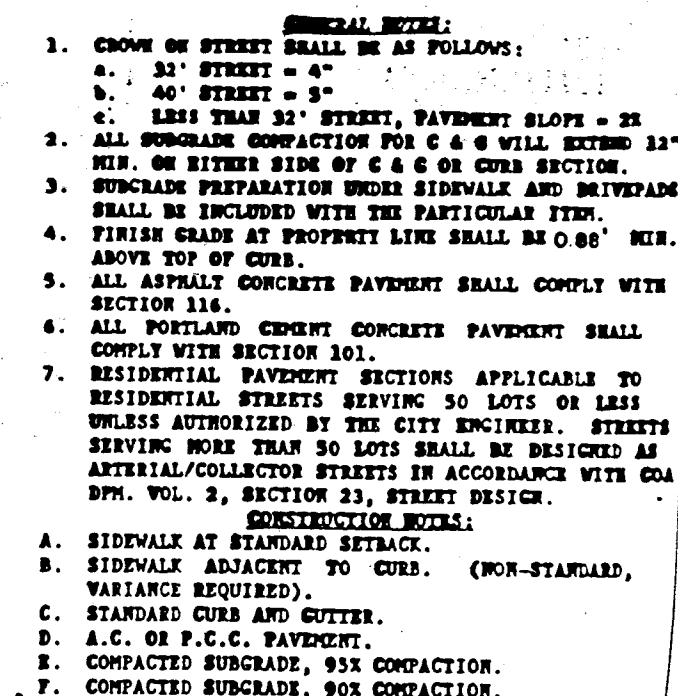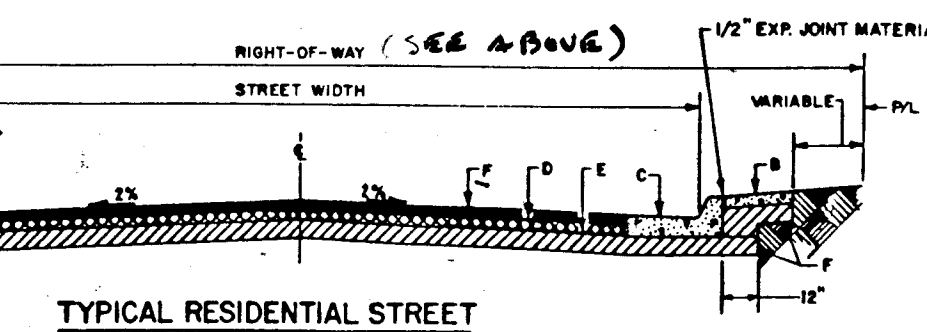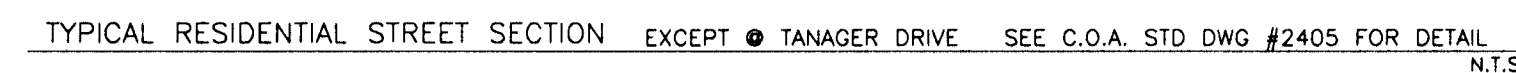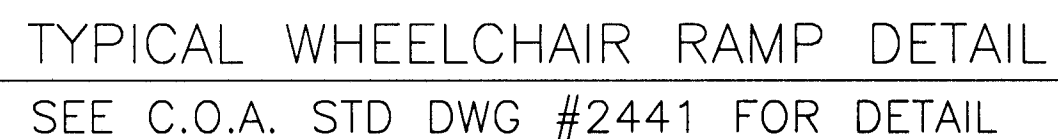


AS BUILT INFORMATION	HYDRO SYSTEMS	DATE	9/6
CONTRACTOR	ALC	DATE	9/6
DESIGNED BY	INSPECTORS	DATE	5/22/96
APPROVED BY	APPROVED BY	DATE	9/6
FIELD	REVISION BY	DATE	5/9/96
RECORDED BY	ALC	DATE	5/9/96
MICRO-FILM INFORMATION			
RECORDED BY		DATE	
NO.			

SURVEY INFORMATION		BENCH MARKS
NO.	FIELD NOTES	CITY OF ALBUQUERQUE SURVEY MONUMENT
	BY DATE	" 7"-LS" . LOCATED 200' SOUTH OF
		TOWER ON WEST ROW OF 98TH STREET.
		ELEV. = 5175.70


ENGINEER'S SEAL

[illegible]

REQUIRE PARTMENT OUP		
UNIT V PLAN		
EVALS GY ON	ENGINEER <i>N/A SMC</i>	DATE <i>9-13-95</i>
SHEET 5		OF 19

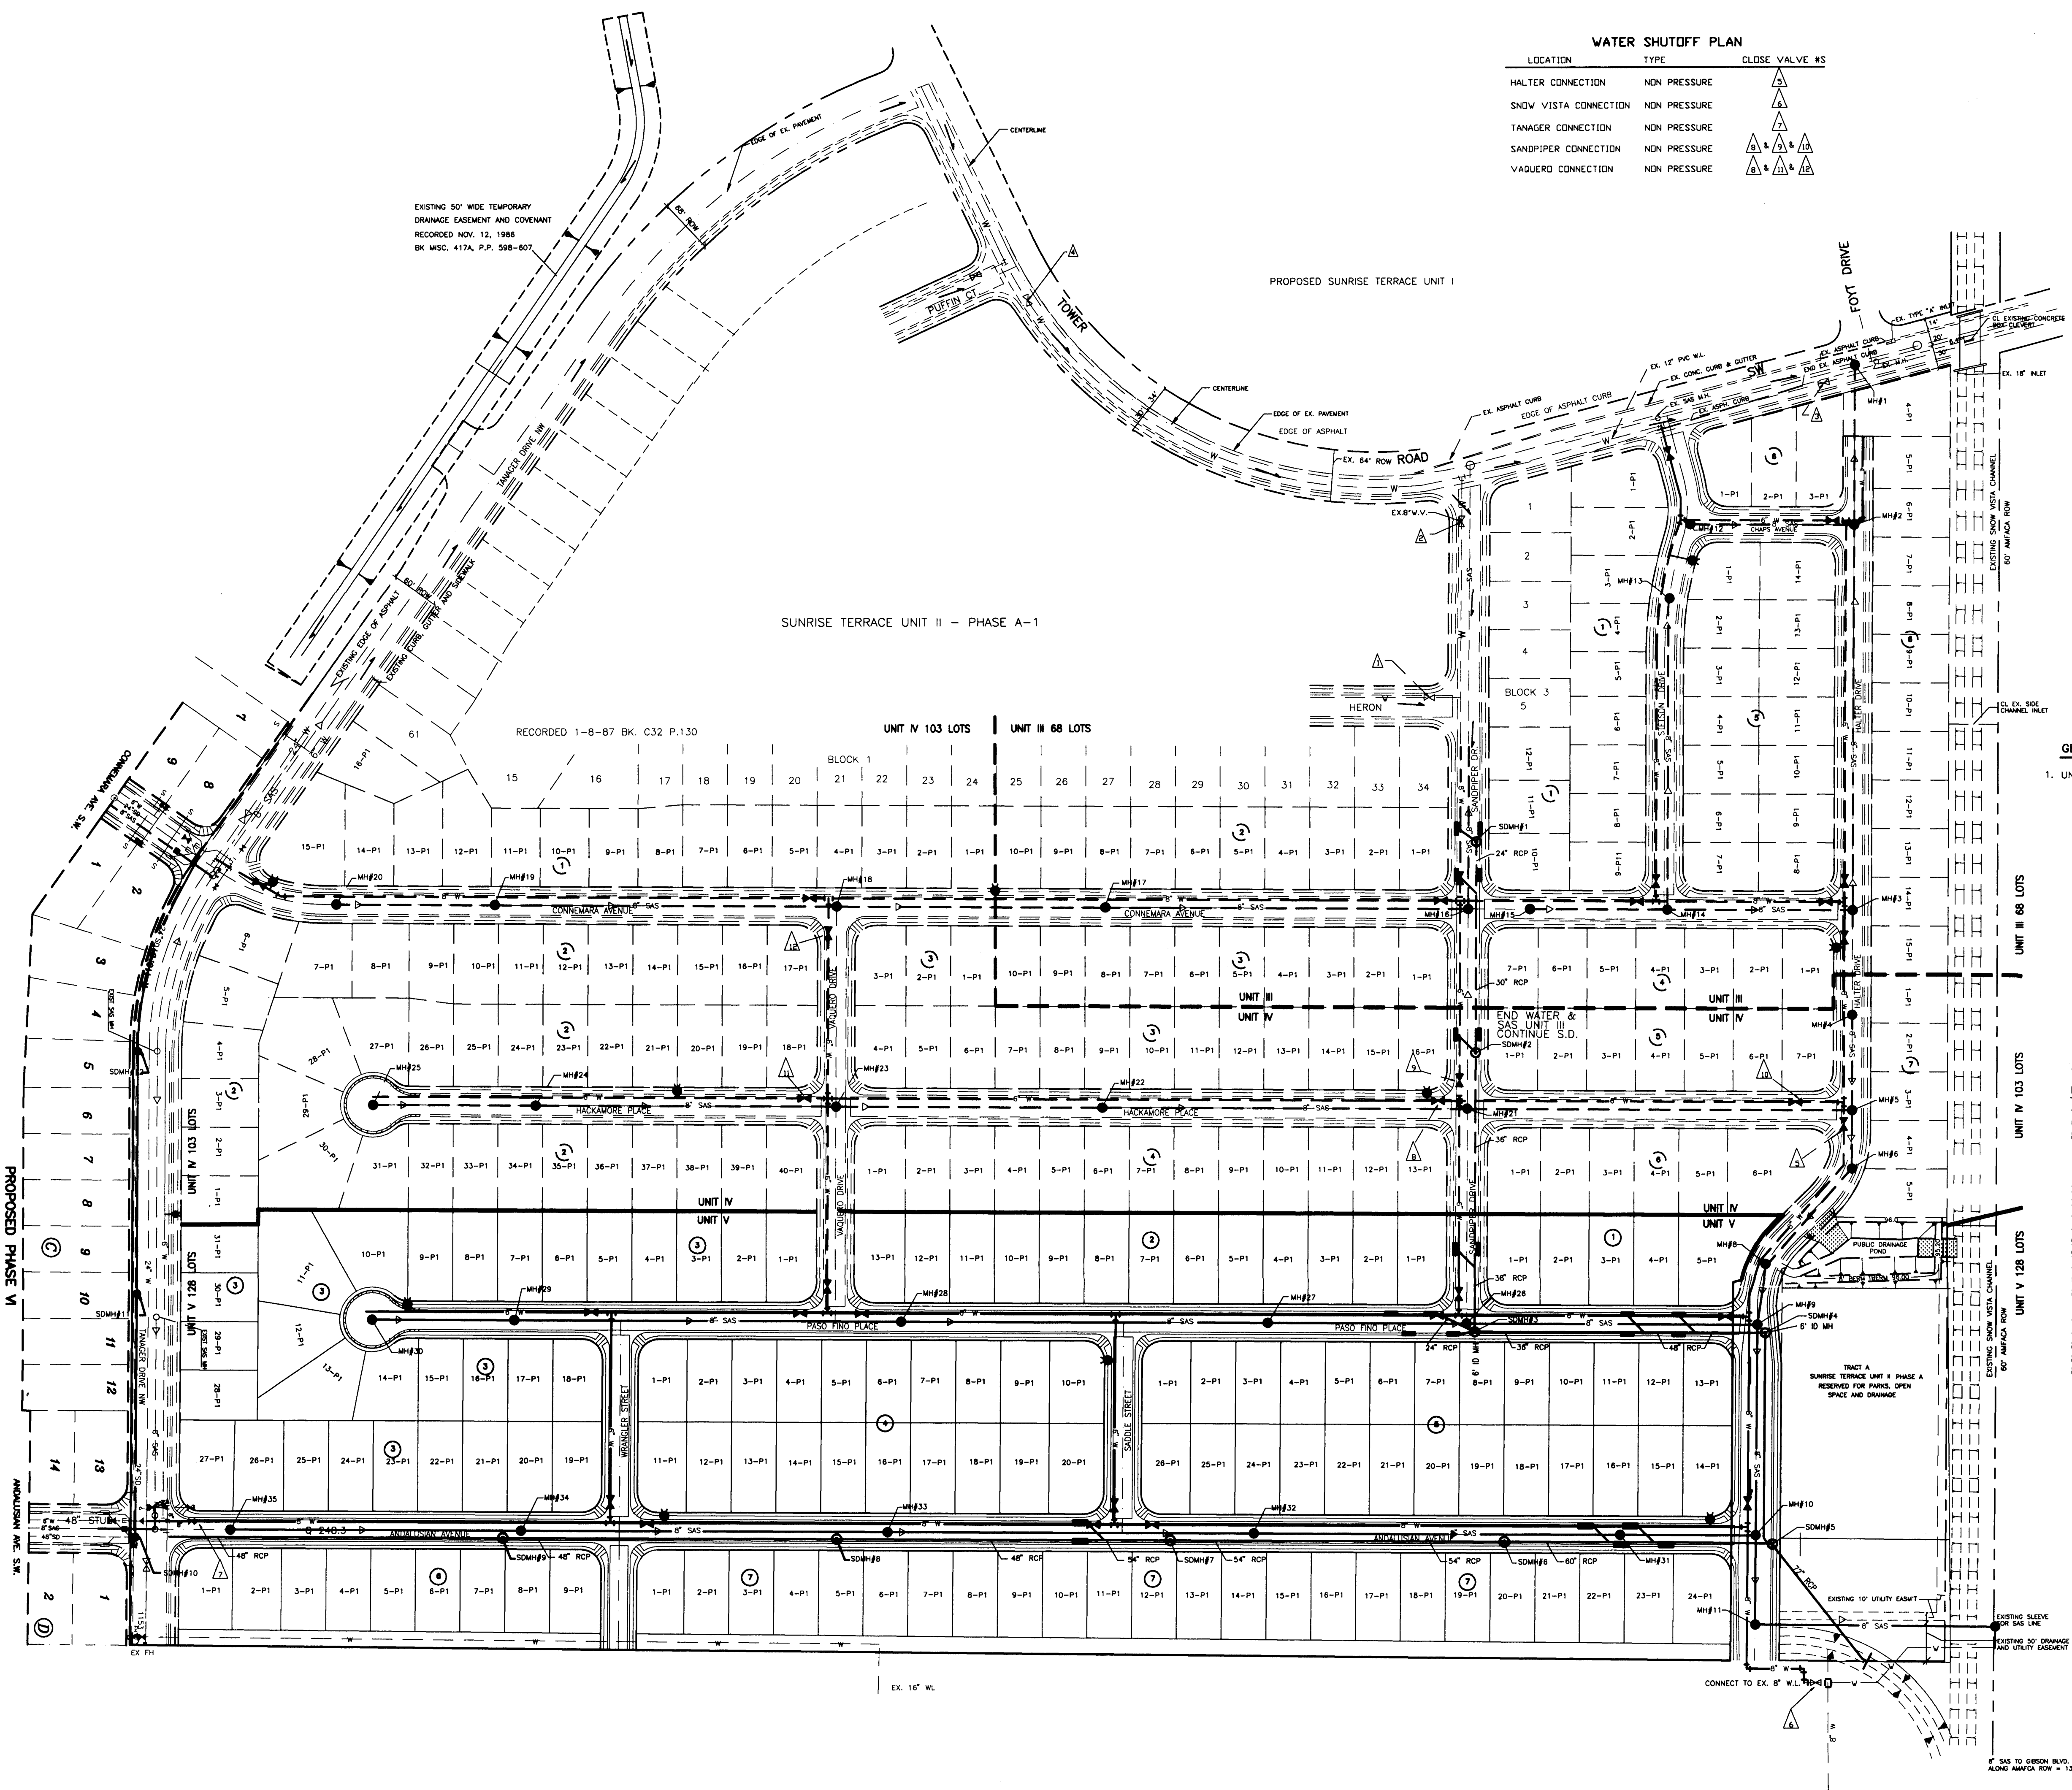

WATER SHUTOFF PLAN		
LOCATION	TYPE	CLOSE VALVE #S
HALTER CONNECTION	NON PRESSURE	△
SNDV VISTA CONNECTION	NON PRESSURE	△
TAMAGER CONNECTION	NON PRESSURE	△
SANDPIPER CONNECTION	NON PRESSURE	△
VADUERO CONNECTION	NON PRESSURE	△

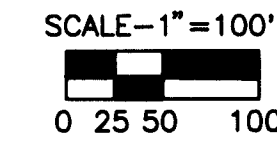

LEGEND		
DESCRIPTION	PROPOSED	EXISTING
WATER VALVE	●	○
FIRE HYDRANT	●	○
STREET LIGHT	●	○
STORM DRAIN MANHOLE	○	○
STORM DRAIN INLET	○	○
MANHOLE	○	○
CURB & GUTTER	—	—
WATER LINE	—	—
SEWER LINE	—	—

GENERAL NOTES
1. UNIT V CONSTRUCTION ON HALTER TO INCLUDE WATER AND PAVING.

RESTRAINED JOINT SCHEDULE

FITTING	RESTRAINED LENGTH (ft)
4" GATE VALVE	39"
6" GATE VALVE	55"
8" GATE VALVE	72"
10" GATE VALVE	86"
11 1/4" BEND (6")	2'
11 1/4" BEND (8")	3'
22 1/2" BEND (6")	5'
22 1/2" BEND (8")	6'
45° BEND (6")	10'
45° BEND (8")	13'
90° BEND (6")	25'
90° BEND (8")	32'
4" CAP	39"
6" CAP	55"
8" CAP	72"
10" CAP	86"
4" X 6" TEE	34" (4" SIDE)
6" X 8" TEE	34" (4" SIDE)
8" X 10" TEE	34" (4" SIDE)
16" (6" SIDE)	
25' (8" SIDE) OR 33' (6" SIDE)	

20-199701-92 10696

RYALS engineering & construction services
5201 Central, N.E. Albuquerque, NM 87108
(505) 256-4701 269-1142 mobile telephone

CITY OF ALBUQUERQUE
PUBLIC WORKS DEPARTMENT
ENGINEERING GROUP

TITLE: SUNRISE TERRACE UNIT V
COMPOSITE UTILITY PLAN


APPROVALS	ENGINEER	DATE	APPROVALS	ENGINEER	DATE
DRC CHAIR	<i>[Signature]</i>	9-28-95	HYDROLOGY	<i>[Signature]</i>	9-13-95
WATER	<i>[Signature]</i>	9-11-95	INSPECTION		
WASTE WATER					
TRANSPORTATION	<i>[Signature]</i>	9-08-95			
PROJECT NO.	4970.92		MAP NO.	L-8	
			SHEET	6	OF 19

AS BUILT INFORMATION		BENCH MARKS		SURVEY INFORMATION		ENGINEER'S SEAL	
CONTRACTOR	HYDRO SYSTEMS	CITY OF ALBUQUERQUE	SURVEY MONUMENT	FIELD NOTES	NO.	BY	DATE
WORKED BY	AL-S	"7-L9"	LOCATED 200' SOUTH OF				
INSPECTOR'S	DATE 96	TOWER ON WEST ROW OF 98TH STREET.					
ACCEPTANCE BY	DATE 5-28-96	ELEV. = 5175.70					
VERIFICATION BY	DATE 5/96						
COMPARISON BY	DATE 5/96						
MICRO-FILM INFORMATION							
RECORDED BY							
NO.							

DESIGNED BY: RBR
DRAWN BY: PBO, HFB
CHECKED BY:

REVISIONS
DESIGN

DATE: 6/8/94
DATE: 6/8/94
DATE:

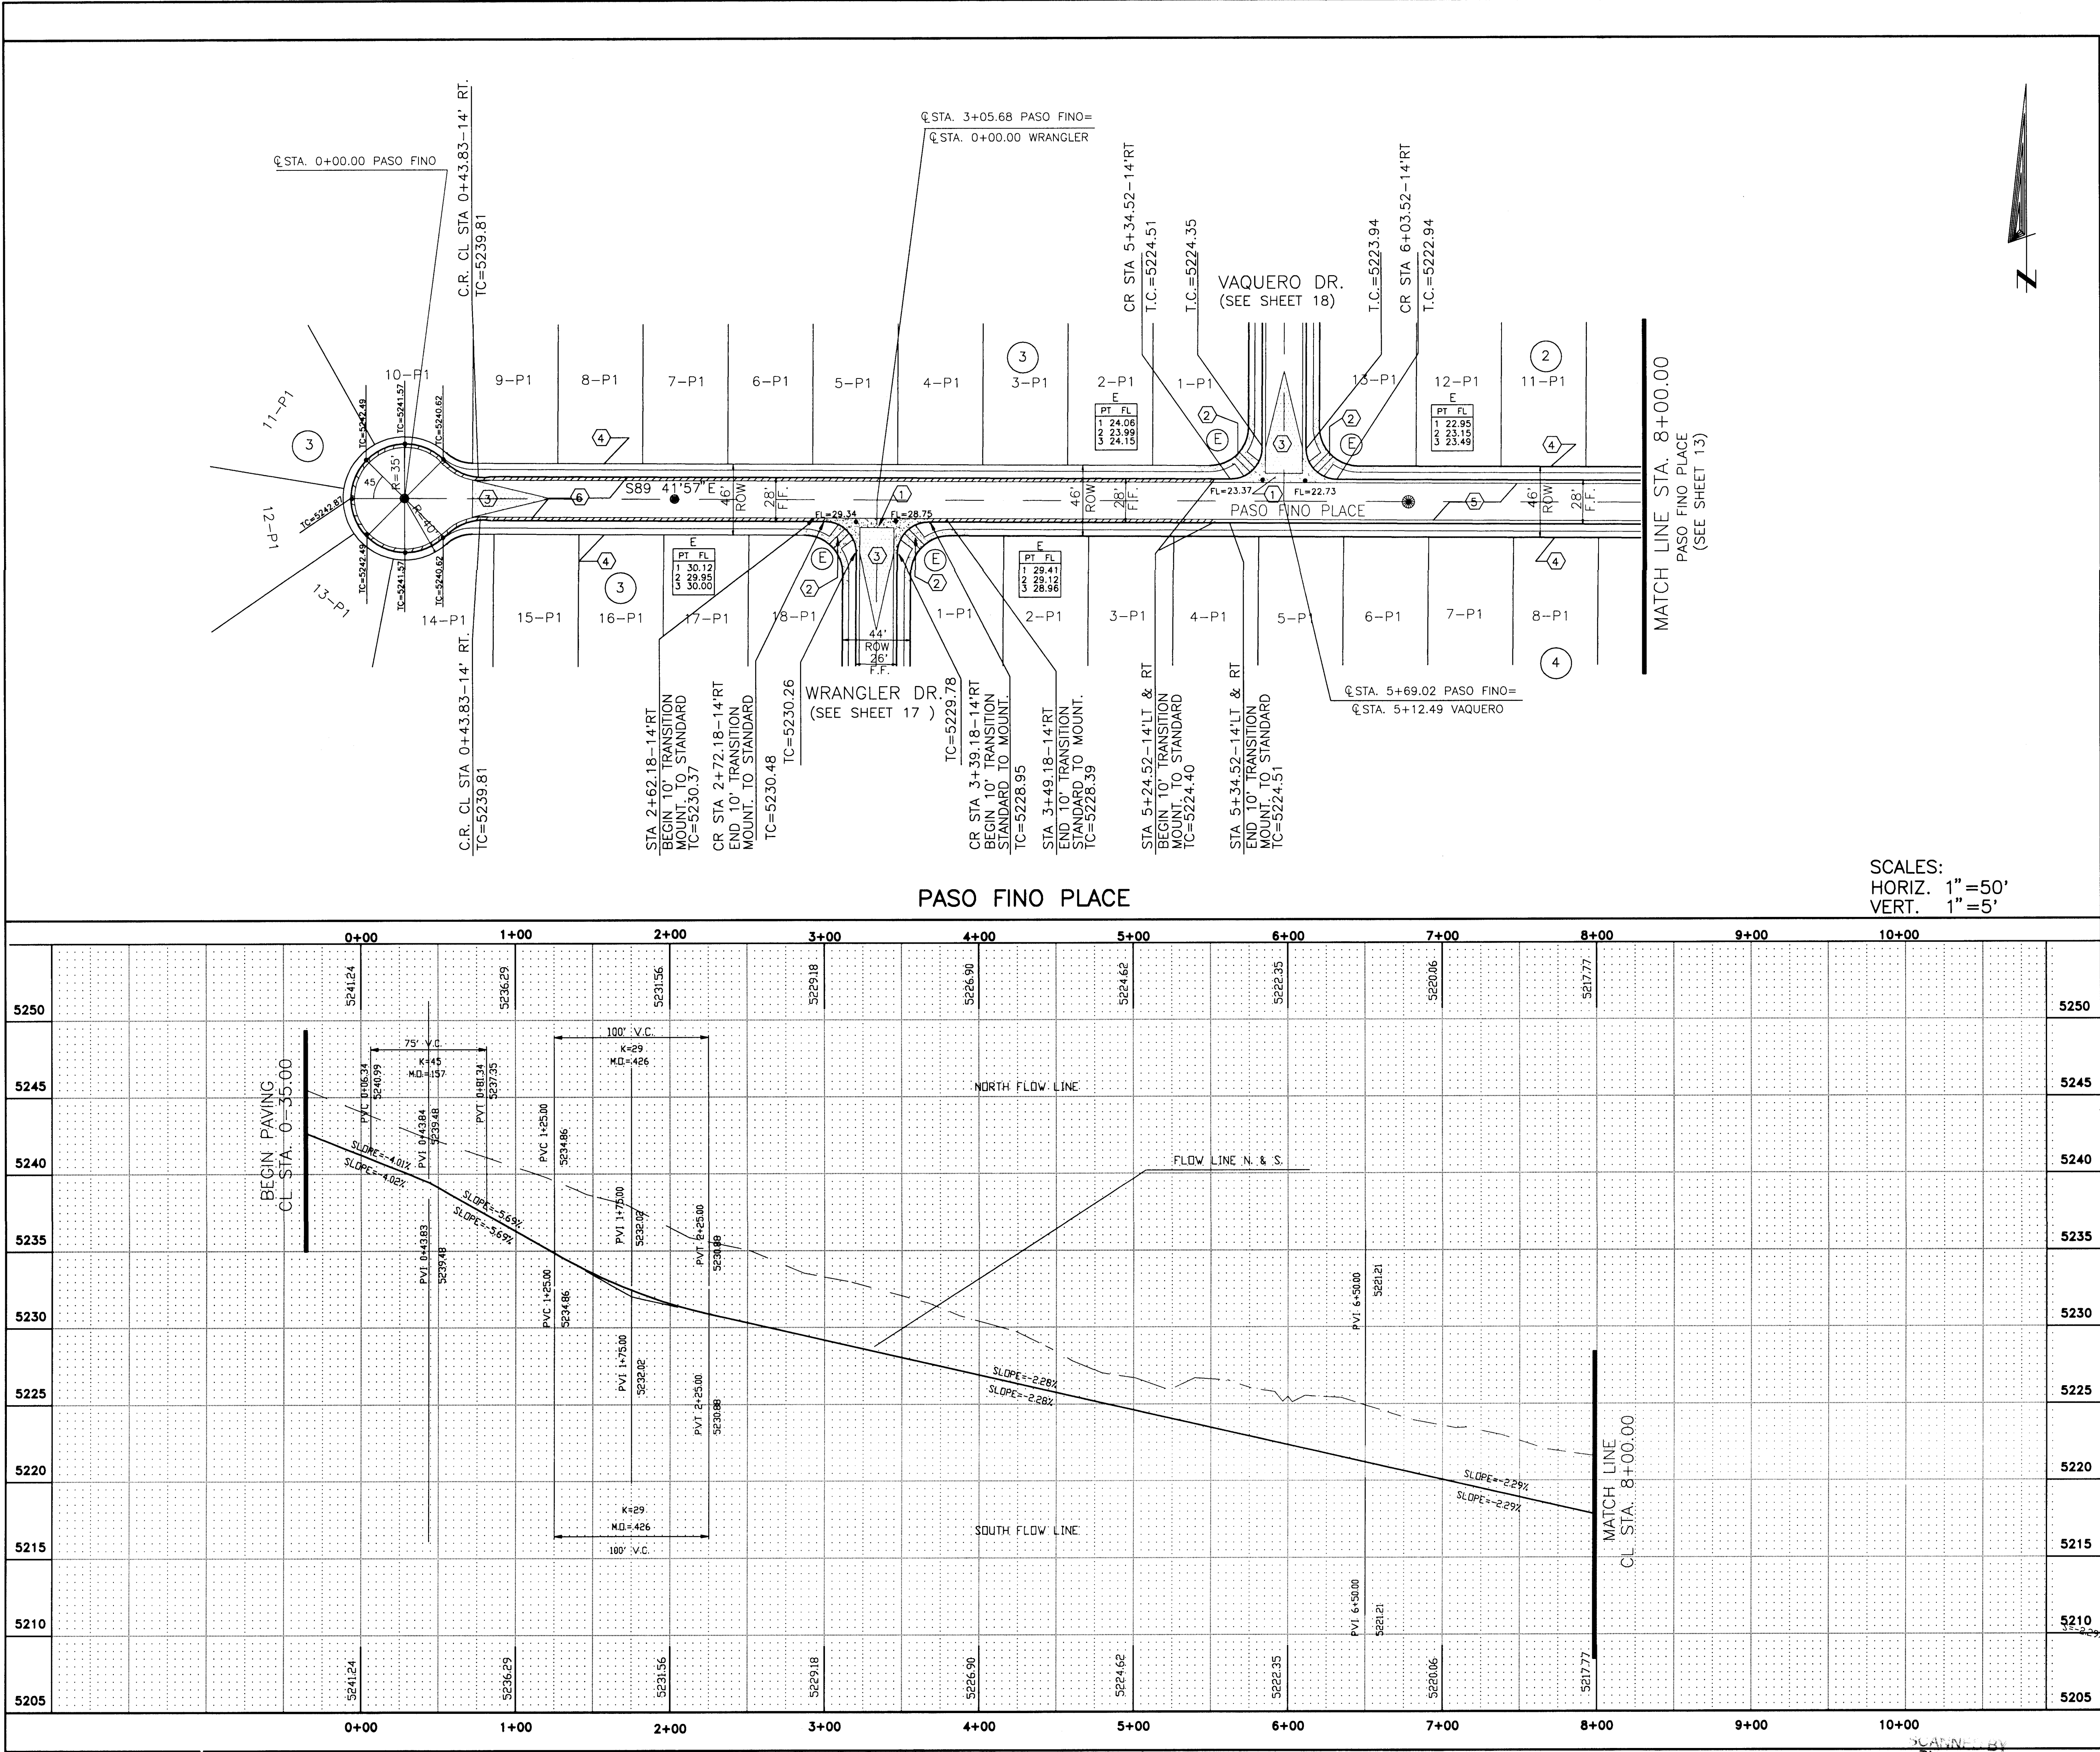

CURB CURVE DATA			
NO.	RADIUS	ARC	DELTA
E	20.50	32.20	90 00'00"

- CONSTRUCTION NOTES**
- CONC. VALLEY GUTTER PER C.O.A. DWG. 2420. (UNLESS OTHERWISE SHOWN.)
 - CONSTRUCT WHEELCHAIR RAMP PER C.O.A. STD DWG #2441. (TYPE II)
 - 50' TRANSITION PER C.O.A. DWG. 2401.
 - 4' WIDE CONC. S.W. BY OTHERS
 - CONSTRUCT STANDARD CURB & GUTTER PER C.O.A. DWG #2415.
 - CONSTRUCT MOUNTABLE CURB & GUTTER PER C.O.A. DWG #2415.

- LEGEND**
- NEW CURB AND GUTTER
 - EXISTING CURB AND GUTTER
 - REMOVE EXISTING TEMPORARY ASPHALT
 - TRANSITION OF ASPHALT
 - VALLEY GUTTER
 - WHEELCHAIR RAMP

26-19970192 107196

DWG: C:\SUN\WPA\SP DATE: 08/17/95 TIME: 11:24 RYALS Engineering-HB

RYALS engineering & construction services
5301 Central, N.E. Albuquerque, NM 87108
(505) 256-4701 239-4726 mobile telephone


CITY OF ALBUQUERQUE
PUBLIC WORKS DEPARTMENT
ENGINEERING GROUP

TITLE:
SUNRISE TERRACE UNIT V
PAVING PLAN AND PROFILE
PASO FINO PLACE
STA. 0+00.00 - 8+00.00

APPROVALS	ENGINEER	DATE	APPROVALS	ENGINEER	DATE
DRC CHAIR	W.A. RWR	9-28-95	HYDROLOGY	N/A SMC	9-13-95
WATER			INSPECTION		
WASTE WATER					
TRANSPORTATION					

PROJECT NO. 4979.92
MAP NO. L-8
SHEET 7 OF 19

AS BUILT INFORMATION		BENCH MARKS		SURVEY INFORMATION		ENGINEER'S SEAL	
CONTRACTOR	HYDRO SYSTEMS	CITY OF ALBUQUERQUE	SURVEY MONUMENT	FIELD NOTES	NO.	DATE	BY
WORK	PAVING	"7-19"	"LOCATED 200' SOUTH OF TOWER ON WEST ROW OF 98TH STREET."	NO.	DATE	DATE	BY
STATED BY	AKS						
APPROVED BY	AKS						
FIELD	9/6						
DATE	5-22-98						
FORWARDED BY	AKS						
DATE	9/6						
CORRECTED BY	AKS						
DATE	5/96						
MICRO-FILM INFORMATION		RECORDS BY		NO.		DATE	

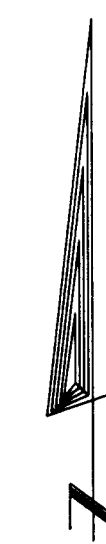

SCALES:
HORIZ. 1"=50'
VERT. 1"=5'

CURB CURVE DATA			
NO.	RADIUS	ARC	DELTA
E	20.50	32.20	90 00'00"
M	25.50	37.42	84 04'06"
N	25.50	40.07	90 01'37"

CONSTRUCTION NOTES

- ① CONC. VALLEY GUTTER PER C.O.A. DWG. 2420. (UNLESS OTHERWISE SHOWN.)
- ② CONSTRUCT WHEELCHAIR RAMP PER C.O.A. STD DWG #2441. (TYPE II).
- ③ 50' TRANSITION PER C.O.A. DWG. 2401.
- ④ 4' WIDE CONC. S.W. BY OTHERS
- ⑤ CONSTRUCT STANDARD CURB & GUTTER PER C.O.A. DWG #2415.
- ⑥ CONSTRUCT WHEELCHAIR RAMP PER C.O.A. STD DWG #2441. (TYPE I).

AS BUILT INFORMATION	
CONTRACTOR	HYDRO SYSTEMS
WORK ORDER NO.	ALSD
DATE	9/6
PERFORMED BY	ALSD
DATE	5-20-84
FIELD	ALSD
VERIFICATION BY	ALSD
DATE	9/6
RECORDED BY	5/9/84
MICRO-FILM INFORMATION	
RECORDED BY	DATE
NO	

SURVEY INFORMATION			BENCH MARKS
NO.	BY	FIELD NOTES	
			CITY OF ALBUQUERQUE SURVEY MONUMENT
		DATE	"7-19" . LOCATED 200' SOUTH OF
			TOWER ON WEST ROW OF 98TH STREET.
			ELEV. = 5175.70

ENGINEER'S SEAL


[illegible]

ERQUE
PARTMENT
ROUP


TITLE:	SUNRISE TERRACE UNIT V PAVING PLAN AND PROFILE PASO FINO PLACE STA. 8+00.00 - 17+01.51
--------	---

APPROVALS	ENGINEER	DATE	APPROVALS	ENGINEER	DATE
DRC CHAIR	<i>SA Soble</i>	9-28-95	HYDROLOGY	<i>N/A Soble</i>	9-28-95
WATER WASTE WATER	<i>N/A RWE</i>	9-11-95	INSPECTION		
TRANSPORTATION	<i>SA Soble</i>	9-28-95			

PROJECT NO.	4970.9	MAP NO.	L-8	SHEET	8	OF	19
-------------	--------	---------	-----	-------	---	----	----

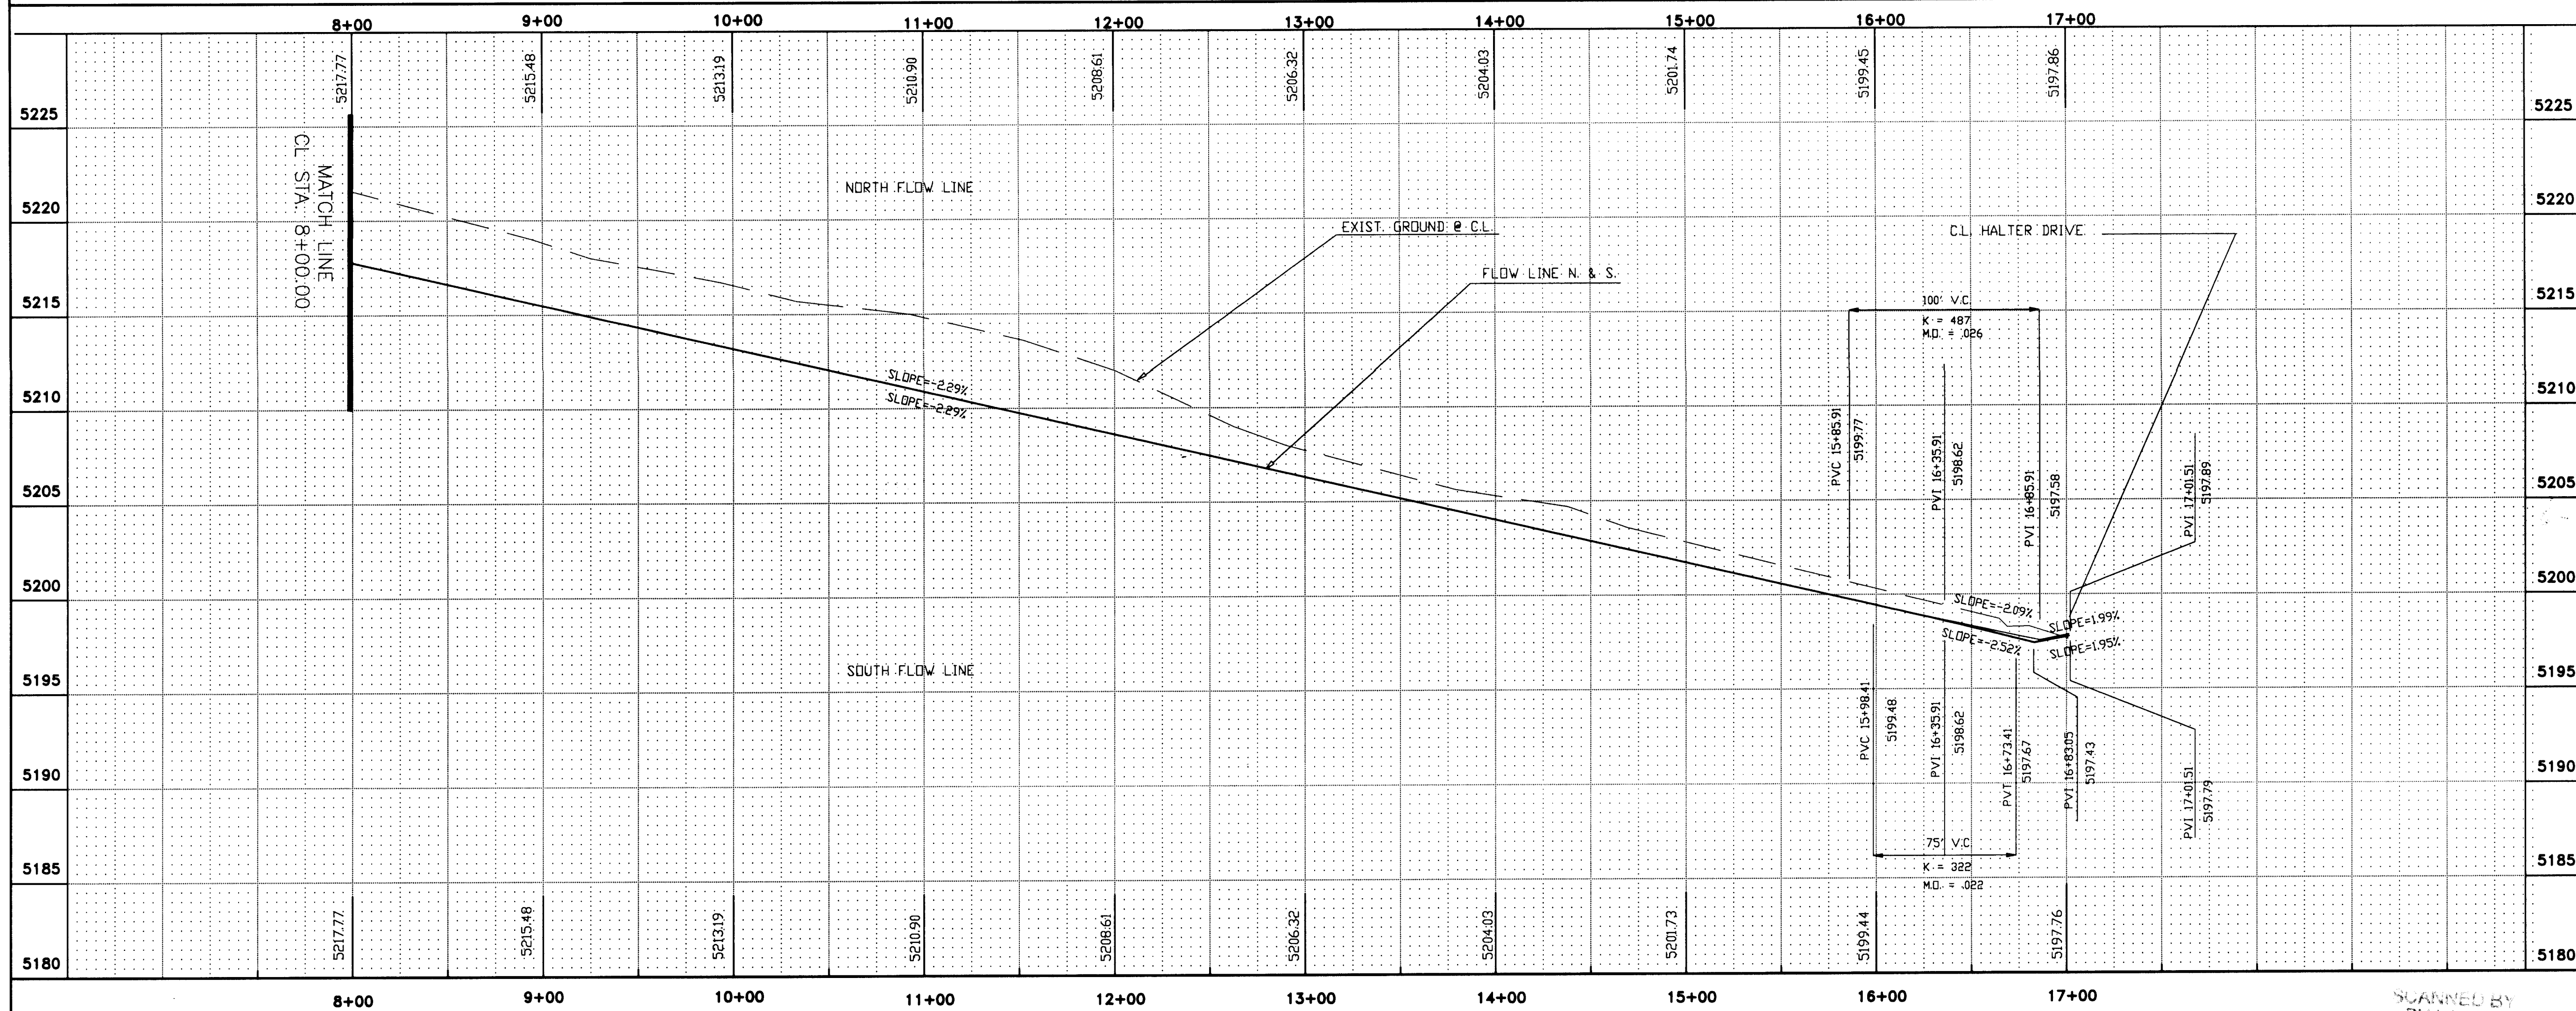


SCANNED BY
BY LASON

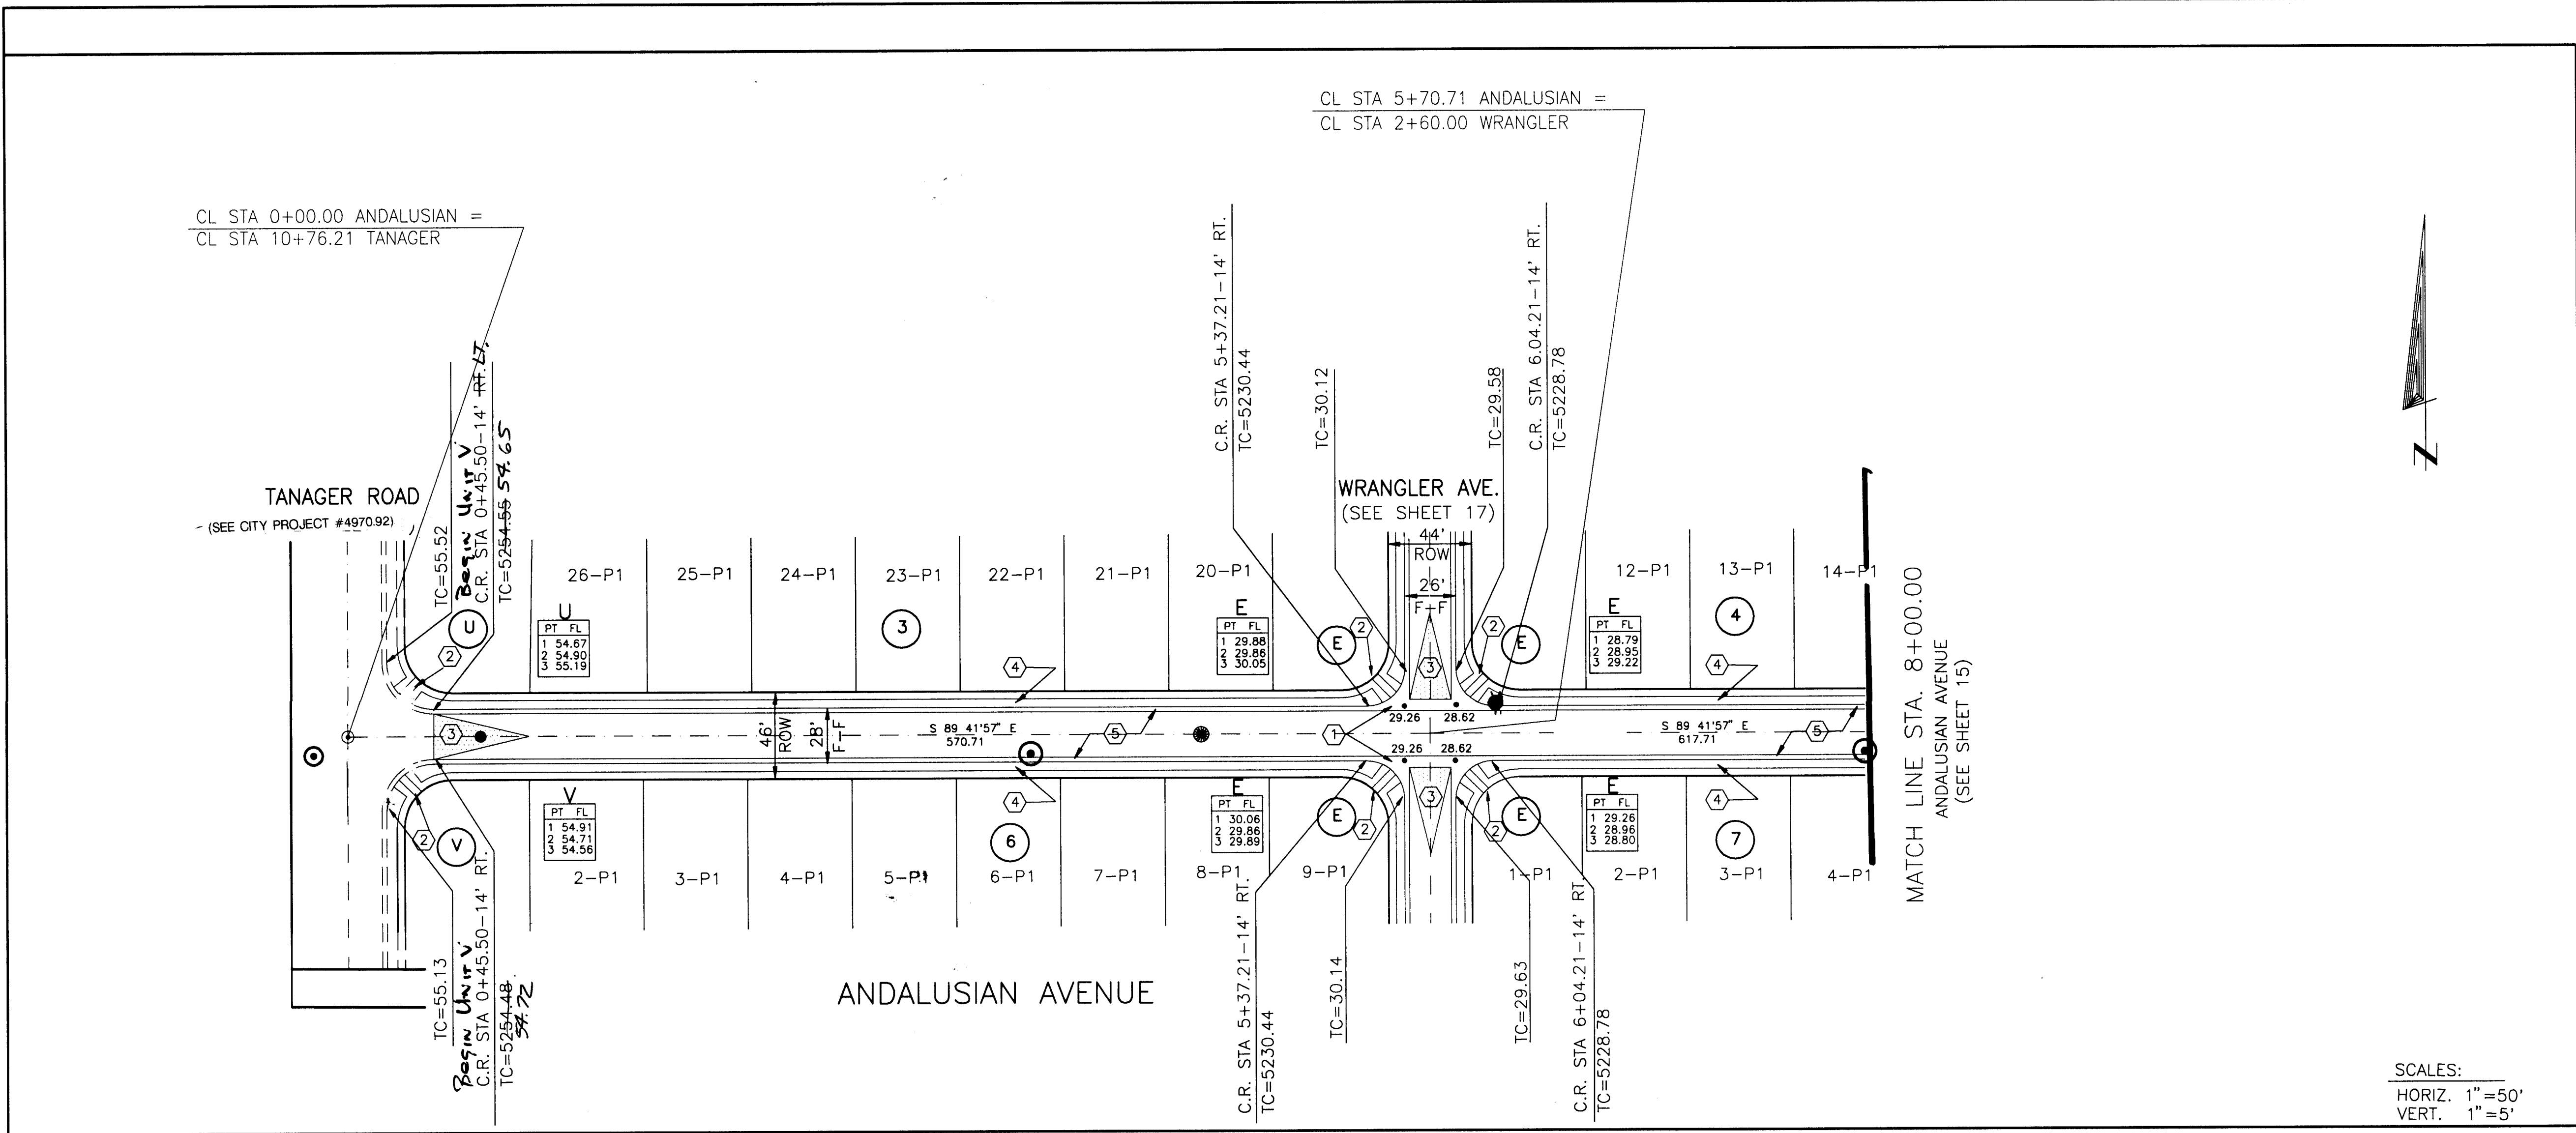

CURB CURVE DATA			
NO.	RADIUS	ARC	DELTA
E	20.50	32.20	90 00'00"
U	25.00	39.27	89 59'52"
V	25.00	39.27	90 00'08"

- CONSTRUCTION NOTES:**
- 1 CONC. VALLEY GUTTER PER C.O.A. DWG. 2420. (UNLESS OTHERWISE SHOWN.)
 - 2 CONSTRUCT WHEELCHAIR RAMP PER C.O.A. STD DWG #2441. (TYPE II)
 - 3 50' TRANSITION PER C.O.A. DWG. 2401.
 - 4 4' WIDE CONC. S.W. BY OTHERS
 - 5 CONSTRUCT STANDARD CURB & GUTTER PER C.O.A. DWG #2415.

SCALES:
HORIZ. 1"=50'
VERT. 1"=5'

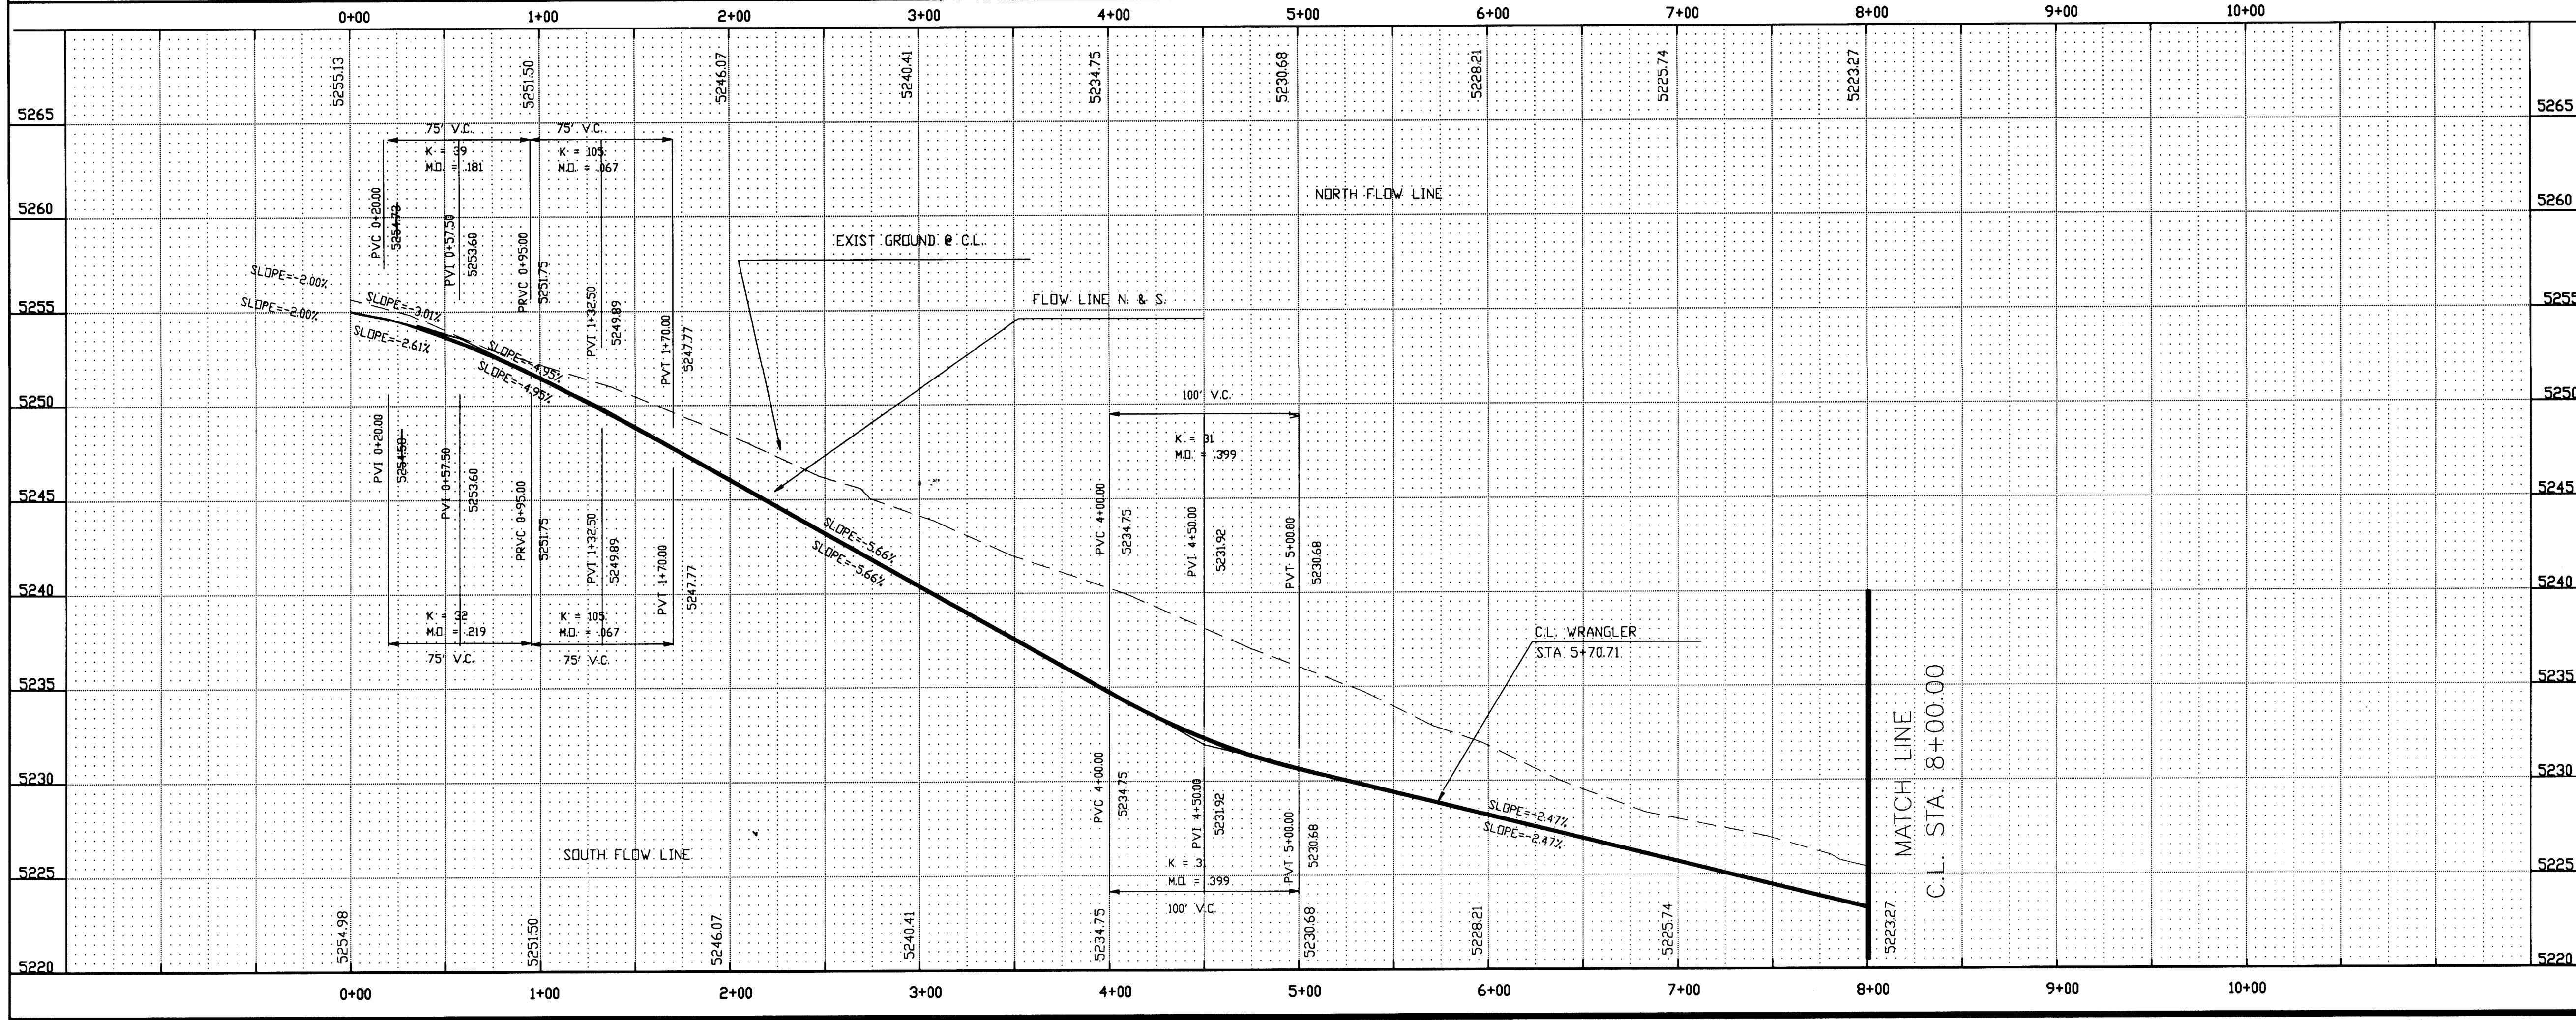

LEGEND	
DESCRIPTION	PROPOSED
NEW CURB AND GUTTER	
EXISTING CURB AND GUTTER	
REMOVE EXISTING TEMPORARY ASPHALT	
TRANSITION OF ASPHALT VALLEY GUTTER	
WHEELCHAIR RAMP	



20-19770-92 19996

DWG: C:\SUNVA\WANDALP DATE: 08/17/95 TIME: 11:26 RYALS Engineering-HB

RYALS engineering & construction services
5301 Central N.E. Albuquerque, NM 87108
(505) 256-4701 239-4726 mobile telephone

CITY OF ALBUQUERQUE PUBLIC WORKS DEPARTMENT ENGINEERING GROUP				
TITLE: SUNRISE TERRACE UNIT V PAVING PLAN AND PROFILE ANDALUSIAN AVENUE (STA. 0+00.00 - STA. 8+00.00)				
APPROVALS	ENGINEER	DATE	APPROVALS	ENGINEER
DRG CHAIR		9-28-95	HYDROLOGY	N/A SMC
WATER	N/A RWP	9-11-95	INSPECTION	
WASTE WATER				
TRANSPORTATION		9-08-95		
PROJECT NO.	4970.92	MAP NO.	L-8	SHEET 9 OF 19

RETURNED BY
ASGN

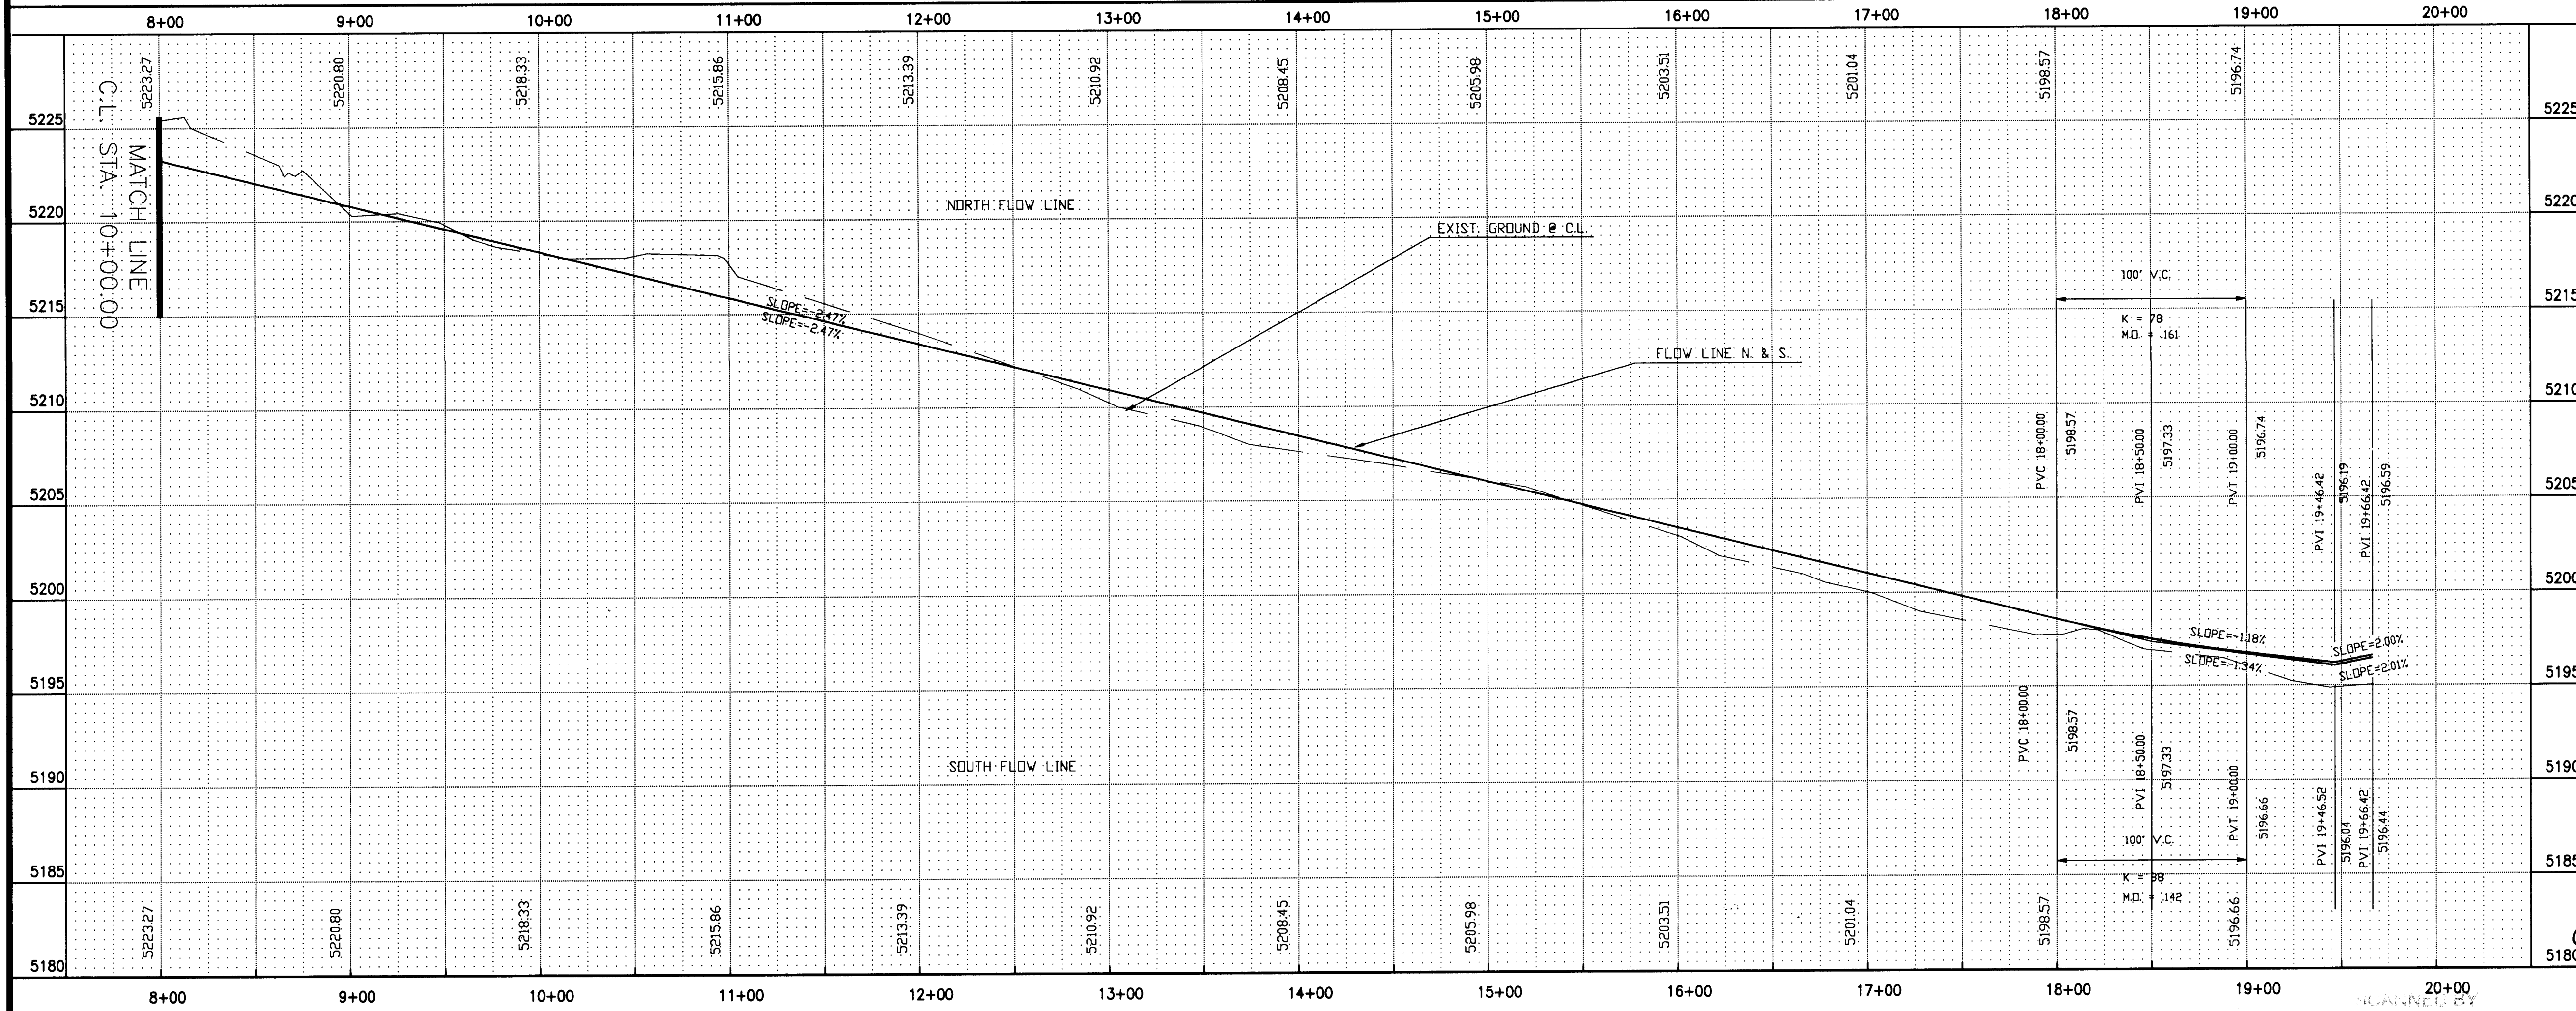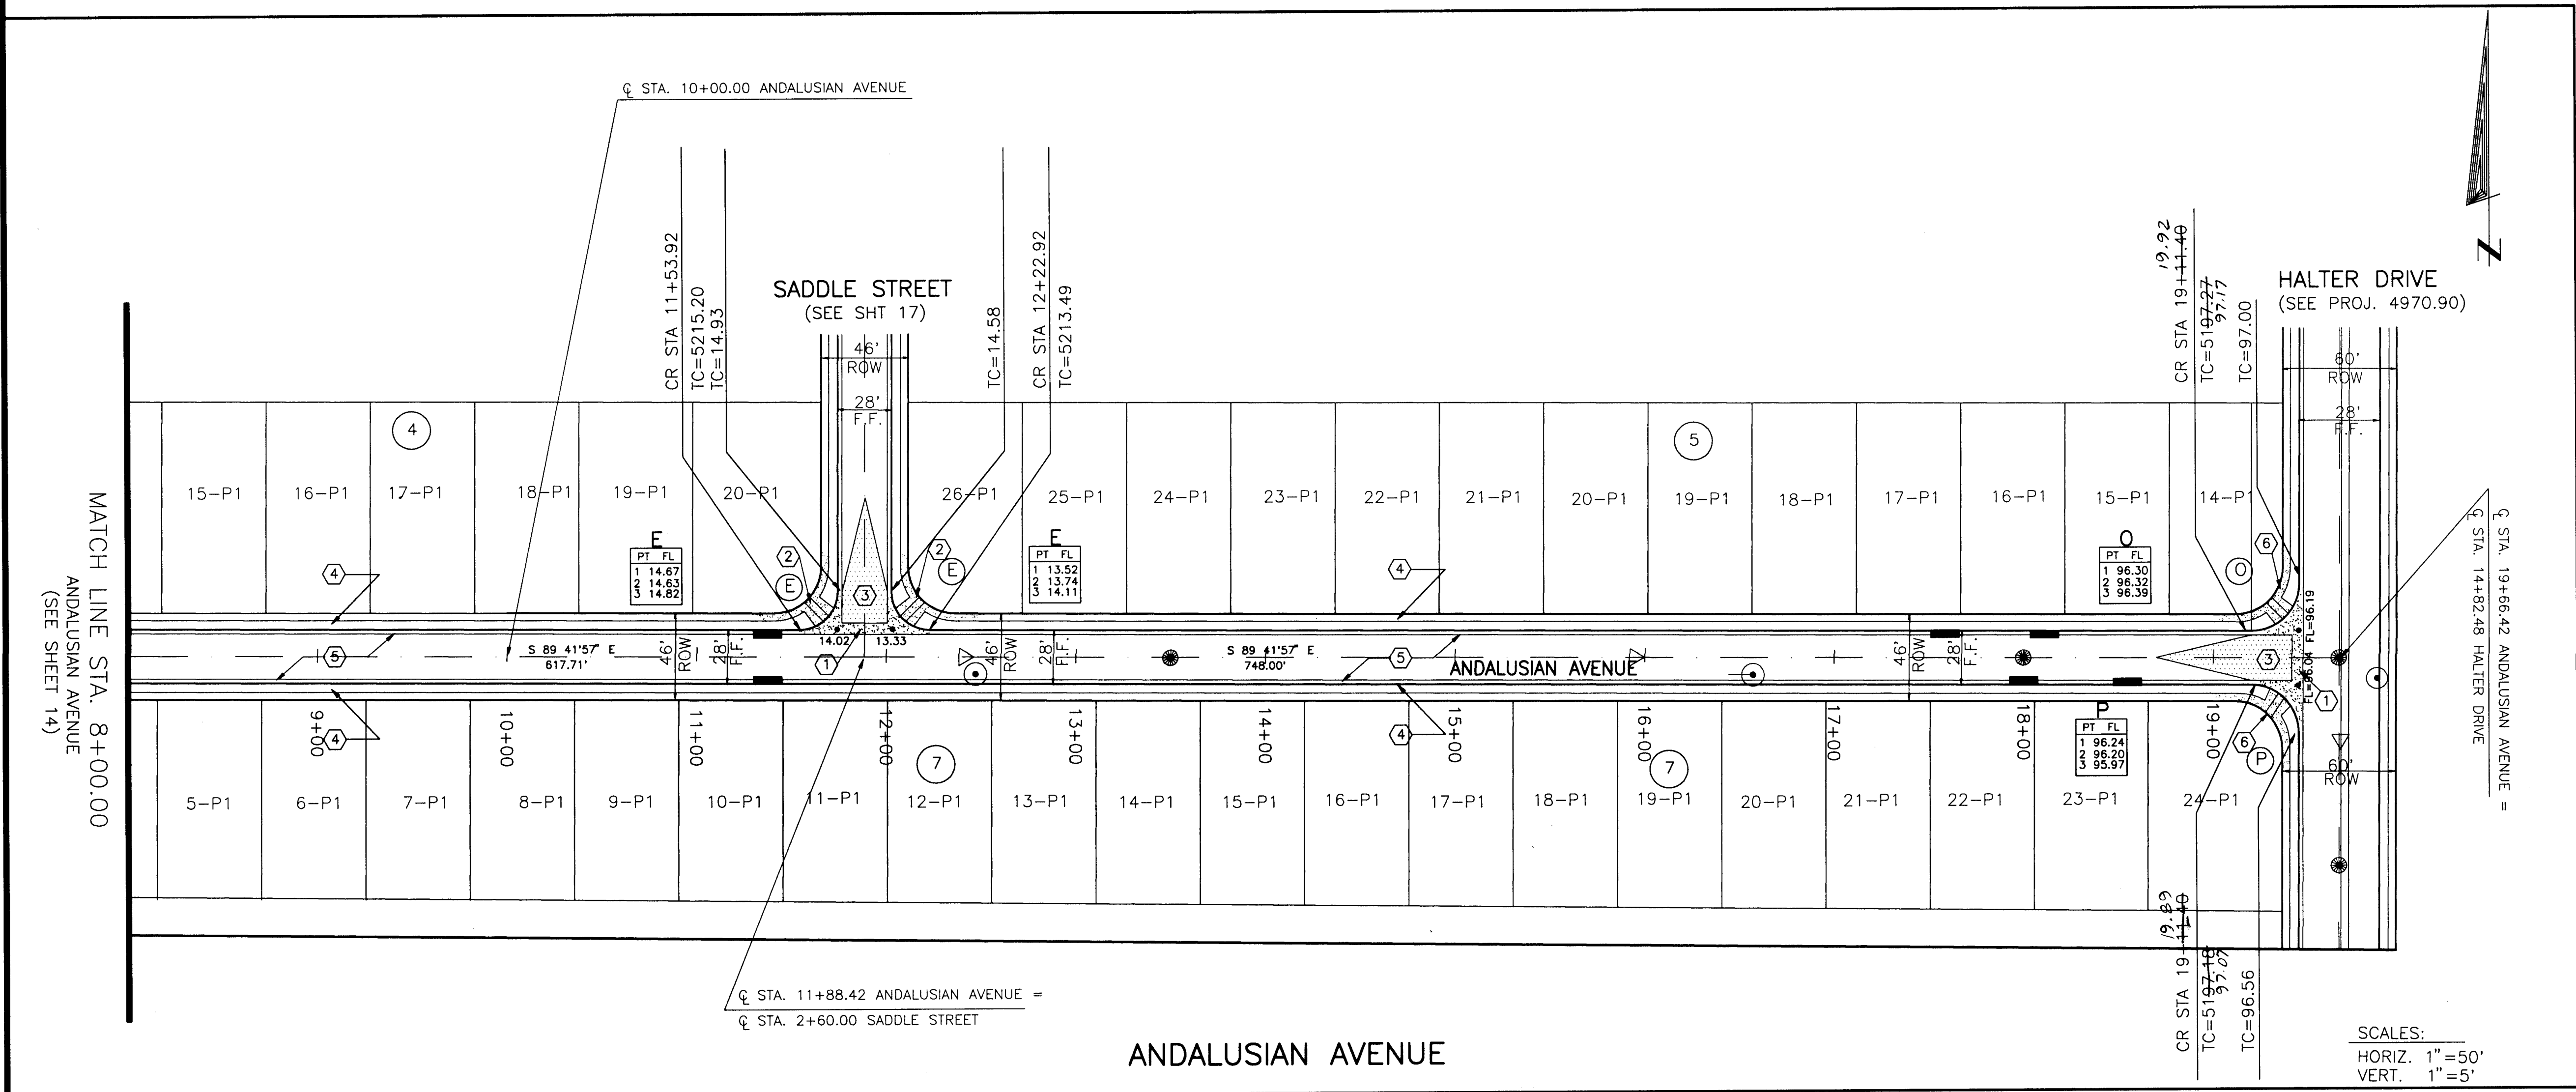

CONSTRUCTION NOTES

- CONC. VALLEY GUTTER PER C.O.A. DWG. 2420. (UNLESS OTHERWISE SHOWN.)
- CONSTRUCT WHEELCHAIR RAMP PER C.O.A. DWGS. 2441 (TYPE II).
- 50' TRANSITION PER C.O.A. DWG. 2401.
- 4' WIDE CONC. S.W. BY OTHERS
- CONSTRUCT STANDARD CURB & GUTTER PER C.O.A. DWG #2415.
- CONSTRUCT WHEELCHAIR RAMP PER C.O.A. DWGS. 2441 (TYPE I)

CURB CURVE DATA

NO.	RADIUS	ARC	DELTA
E	20.50	32.20	90 00'00"
O	25.50	40.04	89 58'23"
P	25.50	40.06	90 00'08"

LEGEND

- NEW CURB AND GUTTER
- EXISTING CURB AND GUTTER
- REMOVE EXISTING TEMPORARY ASPHALT
- TRANSITION OF ASPHALT GUTTER
- SIDEWALK AND WHEEL-CHAIR RAMP PAVING

RYALS engineering & construction services
5301 Central, N.E. Albuquerque, NM 87108
(505) 256-4701 293-4726 mobile telephone


CITY OF ALBUQUERQUE
PUBLIC WORKS DEPARTMENT
ENGINEERING GROUP

TITLE: SUNRISE TERRACE UNIT V PAVING PLAN AND PROFILE ANDALUSIAN AVENUE (STA. 8+00.00 - STA. 19+66.42)					
APPROVALS	ENGINEER	DATE	APPROVALS	ENGINEER	DATE
DRC CHAIR	9-28-95	9-28-95	HYDROLOGY	N/A	9-13-95
WATER	9-08-95	9-08-95	INSPECTION		
WASTE WATER					
TRANSPORTATION	N/A	9-11-95			
PROJECT NO. 4970.92			MAP NO. L-8		
SHEET 10			OF 19		


AS BUILT INFORMATION					
CONTRACTOR	HYDRO SYSTEMS	DATE	9-28-95	BY	AL
INSPECTOR'S	AL	DATE	9-28-95	BY	AL
FIELD	AL	DATE	9-28-95	BY	AL
VERIFICATION	AL	DATE	9-28-95	BY	AL
CORRECTED	AL	DATE	9-28-95	BY	AL
MICRO-FILM INFORMATION					
RECORDED		DATE		BY	
NO.					

BENCH MARKS					
CITY OF ALBUQUERQUE	SURVEY MONUMENT	DATE	7-19-95	BY	AL
TOWER ON WEST ROW OF 98TH STREET					
ELEV. = 5175.70					

SURVEY INFORMATION					
FIELD NOTES	DATE	7-19-95	BY	AL	
NO.					

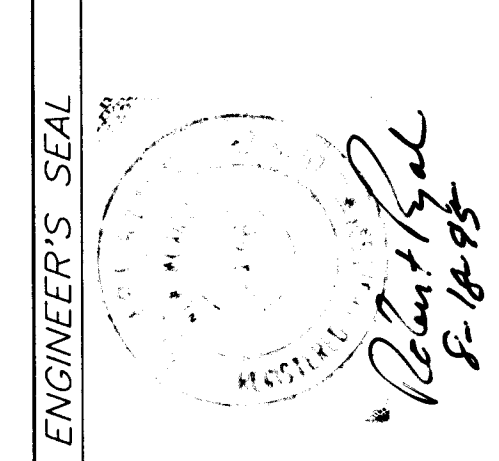

REVISIONS					
NO.	DATE	REMARKS	BY	DATE	DATE
1	8-18-95	DESIGN			
2	8-18-95	DESIGN			
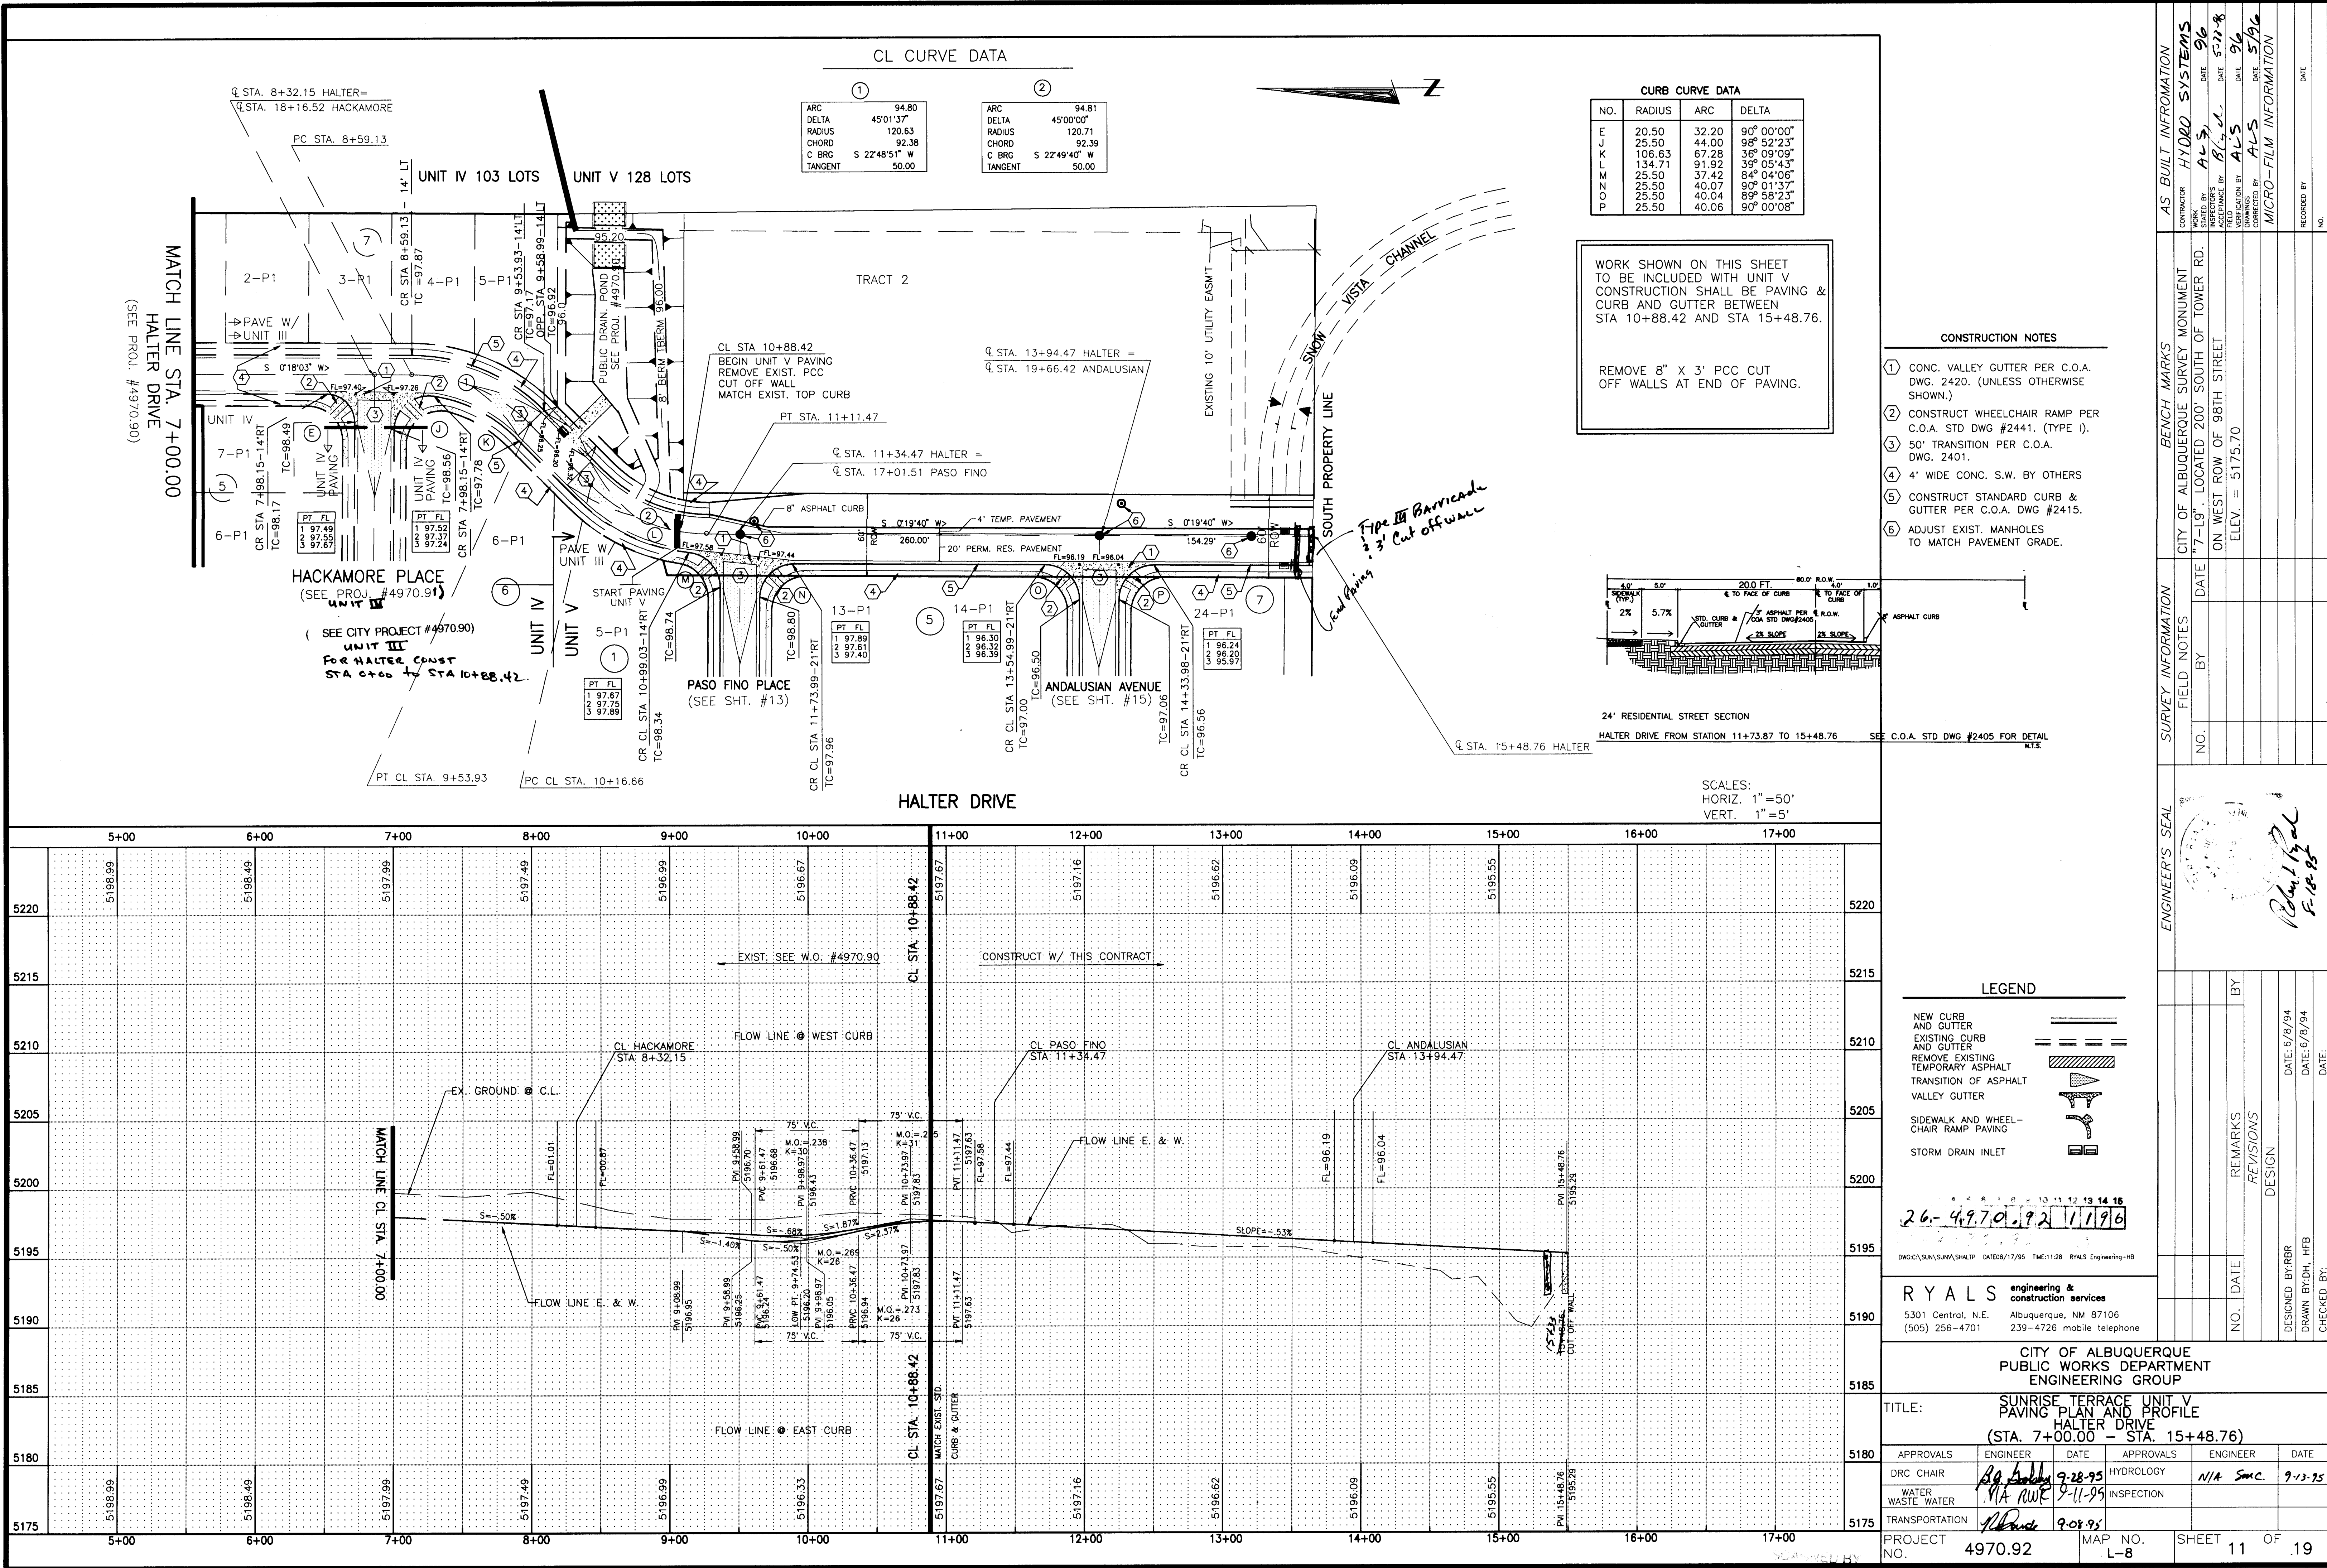

CL CURVE DATA			
①	ARC	94.80	
	DELTA	45°01'37"	
	RADIUS	120.63	
	CHORD	92.38	
	C BRG	S 22°48'51" W	
	TANGENT	50.00	


CL CURVE DATA			
②	ARC	94.81	
	DELTA	45°00'00"	
	RADIUS	120.71	
	CHORD	92.39	
	C BRG	S 22°49'40" W	
	TANGENT	50.00	

CURB CURVE DATA			
NO.	RADIUS	ARC	DELTA
E	20.50	32.20	90° 00' 00"
J	25.50	44.00	98° 52' 23"
K	106.63	67.28	36° 09' 09"
L	134.71	91.32	39° 05' 43"
M	25.50	37.42	84° 04' 06"
N	25.50	40.07	90° 01' 37"
O	25.50	40.04	89° 58' 23"
P	25.50	40.06	90° 00' 08"

WORK SHOWN ON THIS SHEET TO BE INCLUDED WITH UNIT V CONSTRUCTION SHALL BE PAVING & CURB AND GUTTER BETWEEN STA 10+88.42 AND STA 15+48.76.

REMOVE 8" X 3' PCC CUT OFF WALLS AT END OF PAVING.

- CONSTRUCTION NOTES
- ① CONC. VALLEY GUTTER PER C.O.A. DWG. 2420. (UNLESS OTHERWISE SHOWN.)
 - ② CONSTRUCT WHEELCHAIR RAMP PER C.O.A. STD DWG #2441. (TYPE I).
 - ③ 50' TRANSITION PER C.O.A. DWG. 2401.
 - ④ 4' WIDE CONC. S.W. BY OTHERS
 - ⑤ CONSTRUCT STANDARD CURB & GUTTER PER C.O.A. DWG #2415.
 - ⑥ ADJUST EXIST. MANHOLES TO MATCH PAVEMENT GRADE.

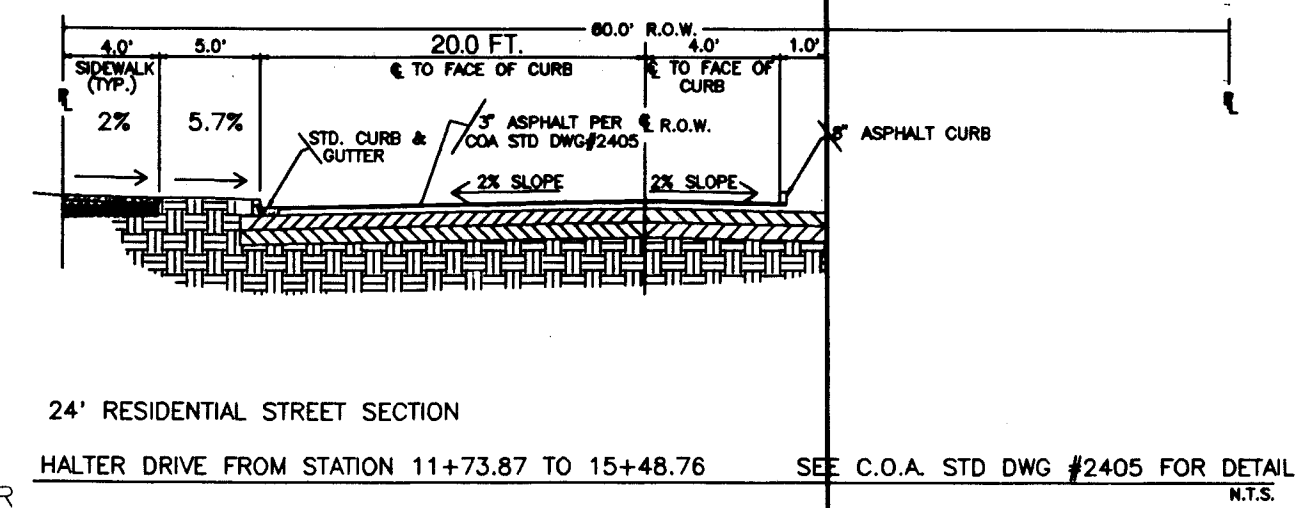

SCALES:
HORIZ. 1"=50'
VERT. 1"=5'


- LEGEND
- NEW CURB AND GUTTER
 - EXISTING CURB AND GUTTER
 - REMOVE EXISTING TEMPORARY ASPHALT
 - TRANSITION OF ASPHALT VALLEY GUTTER
 - SIDEWALK AND WHEEL-CHAIR RAMP PAVING
 - STORM DRAIN INLET

26-4970.92-171796

RYALS engineering & construction services
5301 Central, N.E. Albuquerque, NM 87106
(505) 256-4701 239-4726 mobile telephone

CITY OF ALBUQUERQUE PUBLIC WORKS DEPARTMENT ENGINEERING GROUP			
TITLE: SUNRISE TERRACE UNIT V PAVING PLAN AND PROFILE HALTER DRIVE (STA. 7+00.00 - STA. 15+48.76)			
APPROVALS	ENGINEER	DATE	DATE
DRC CHAIR	9-28-95	HYDROLOGY	N/A SMC. 9-13-95
WATER	9-11-95	INSPECTION	
TRANSPORTATION	9-08-95		
PROJECT NO.	4970.92	MAP NO.	L-8
SHEET 11		OF 19	

AS BUILT INFORMATION	BENCH MARKS	SURVEY INFORMATION	ENGINEER'S SEAL
CONTRACTOR HYDRO SYSTEMS	CITY OF ALBUQUERQUE SURVEY MONUMENT 7-Lg. LOCATED 200' SOUTH OF TOWER RD. ON WEST ROW OF 98TH STREET ELEV. = 5175.70	FIELD NOTES NO. BY DATE	NO. DATE REVISIONS DESIGN
INSPECTOR'S DATE 9-28-95			DESIGNED BY: RBR DRAWN BY: DH, HFB CHECKED BY:
FIELD DATE 9-28-95			
VERIFICATION BY DATE 9-28-95			
CONTRACTOR'S DATE 9-28-95			
RECORDED BY DATE			

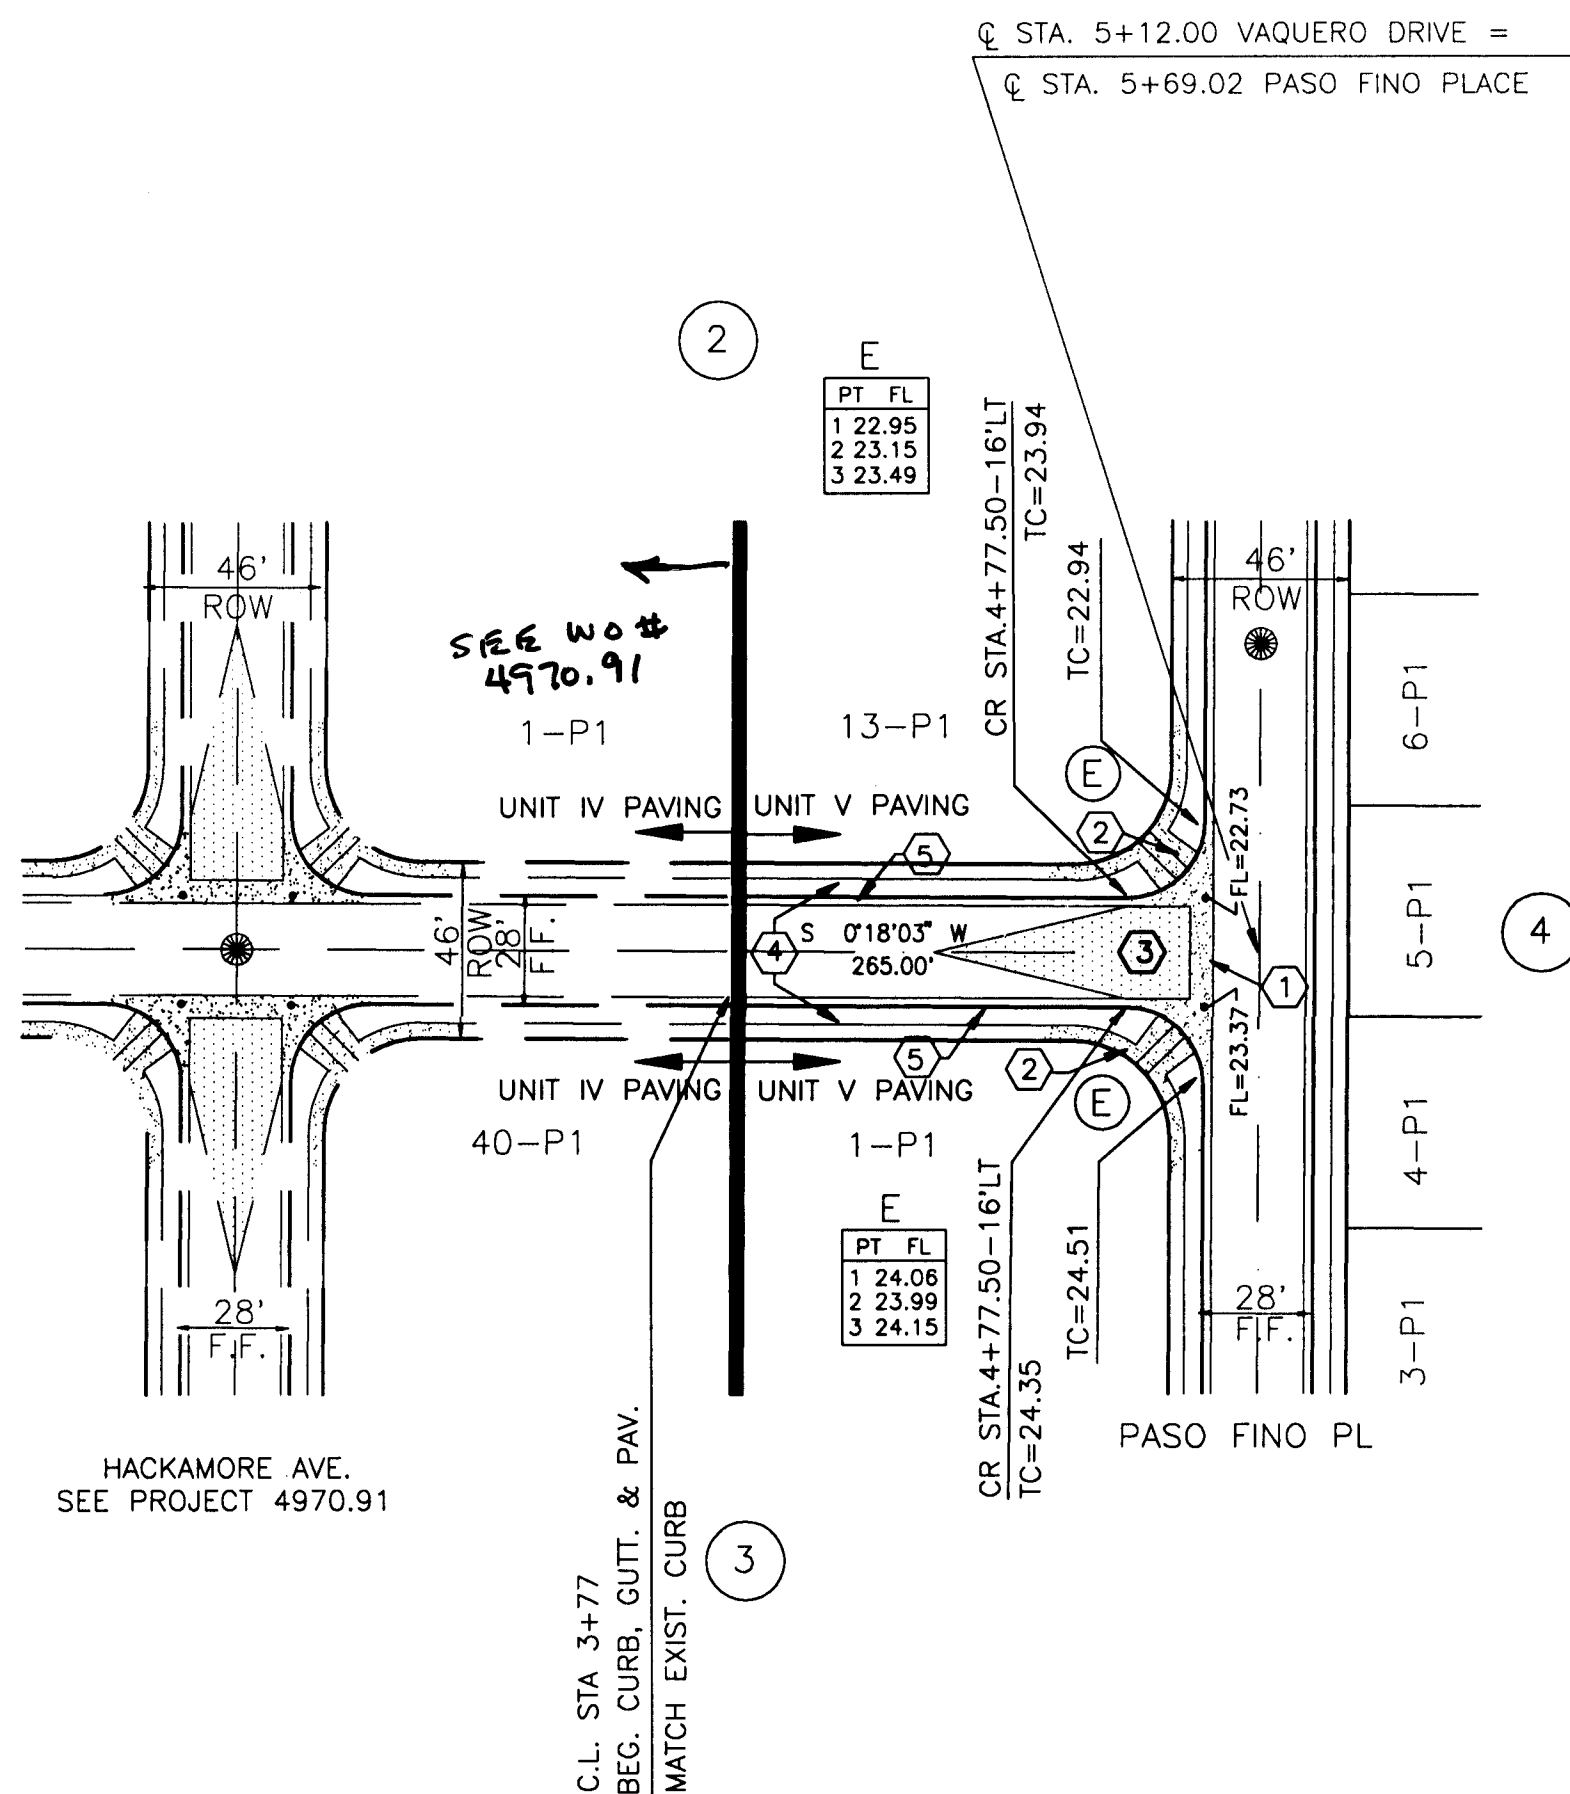


CONSTRUCTION NOTES

- CONC. VALLEY GUTTER PER C.O.A. DWG. 2420. (UNLESS OTHERWISE SHOWN.)
- CONSTRUCT WHEELCHAIR RAMP PER C.O.A. STD DWG #2441 (TYPE II).
- 50' TRANSITION PER C.O.A. DWG. 2401.
- 4' WIDE CONC. S.W. BY OTHERS
- CONSTRUCT STANDARD CURB & GUTTER PER C.O.A. DWG #2415.

CURB CURVE DATA

NO.	RADIUS	ARC	DELTA
E	20.50	32.20	90° 00' 00"

SCALES:
HORIZ. 1"=50'
VERT. 1"=5'

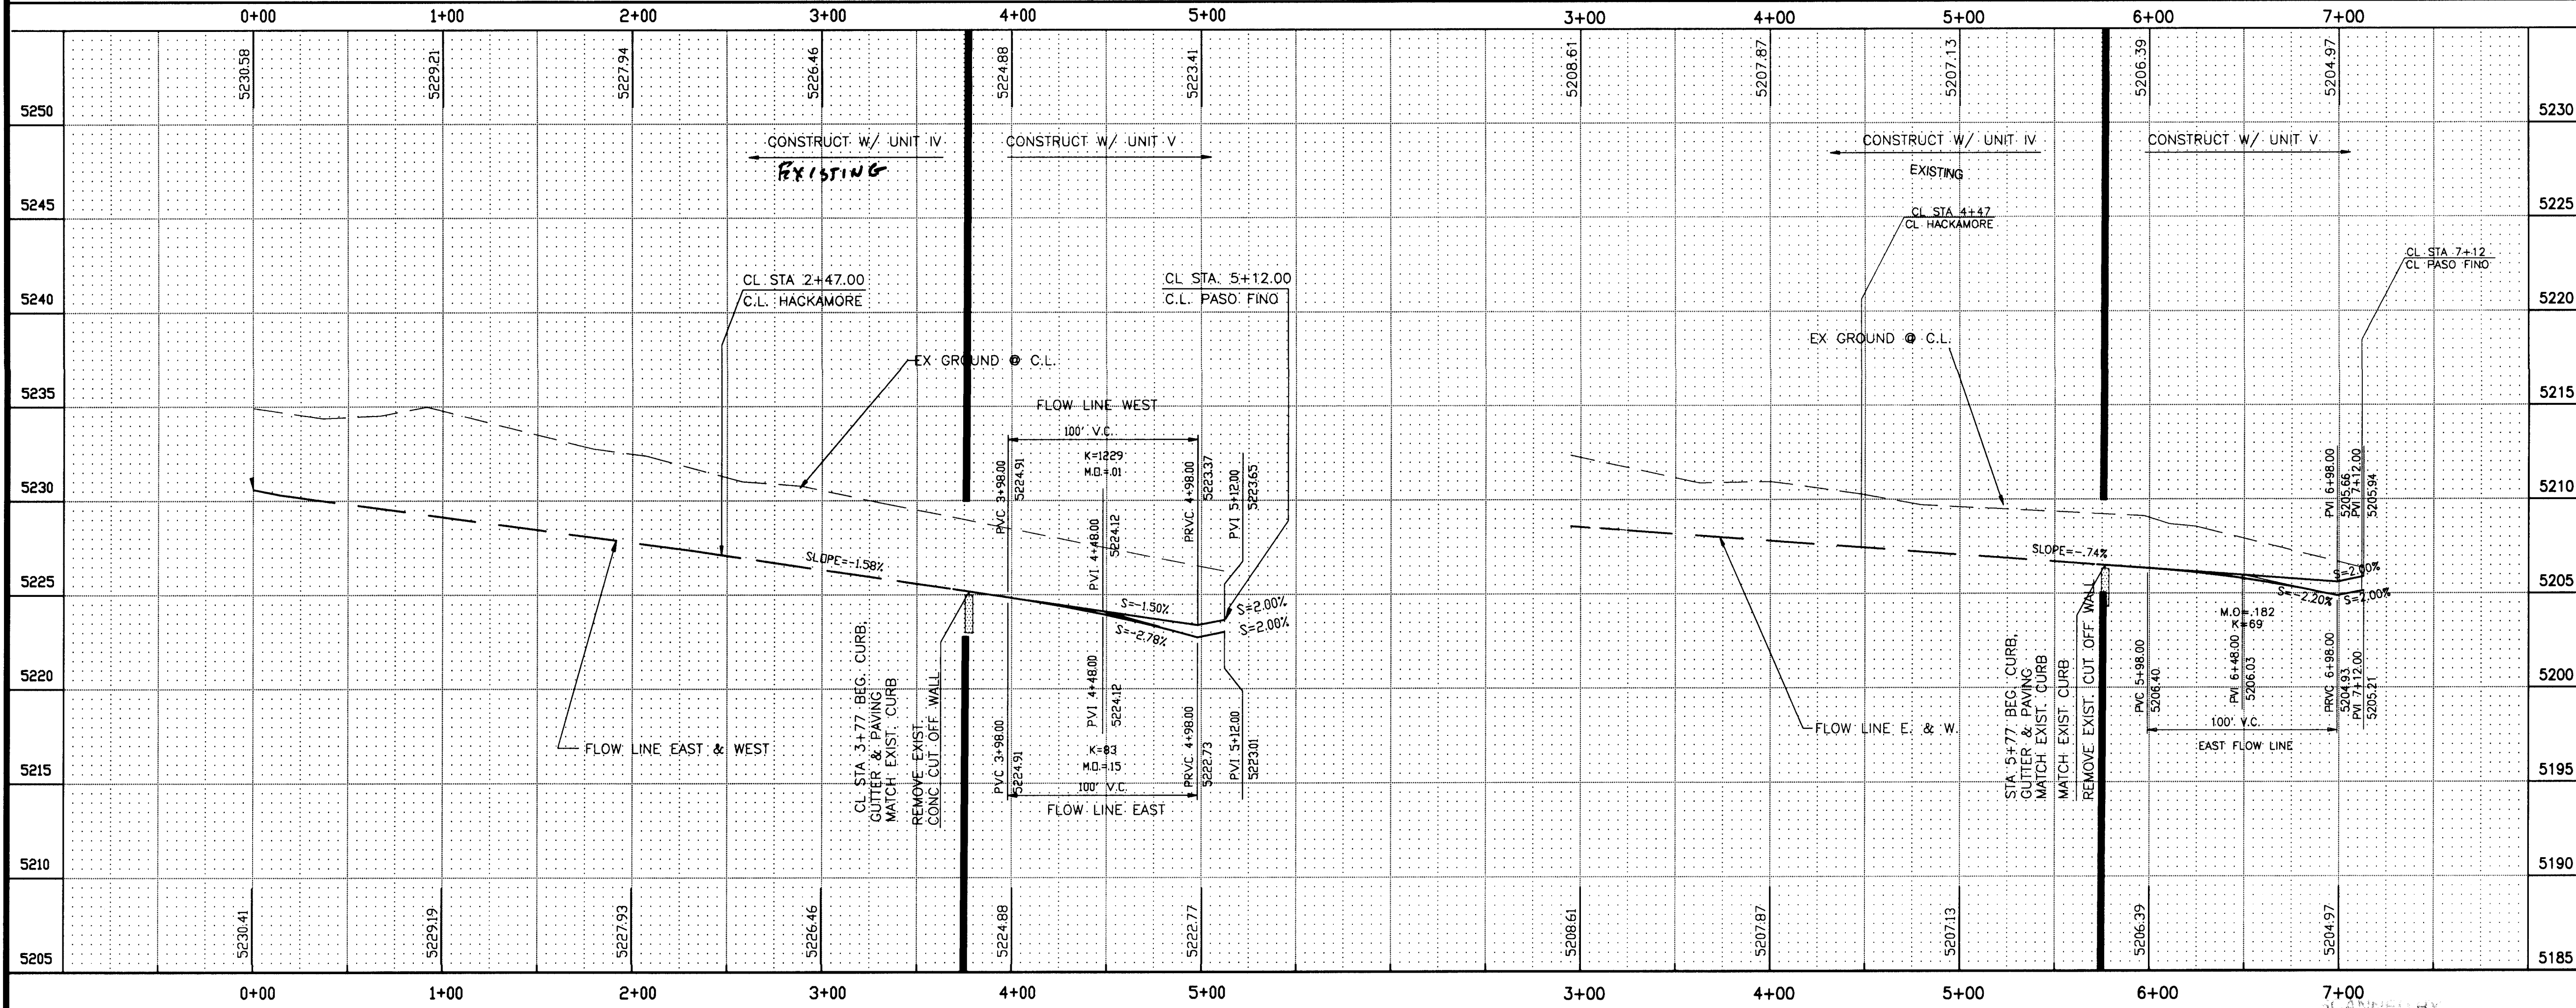

LEGEND

- NEW CURB AND GUTTER
- MOUNTABLE CURB AND GUTTER
- EXISTING CURB AND GUTTER
- REMOVE EXISTING TEMPORARY ASPHALT
- TRANSITION OF ASPHALT VALLEY GUTTER
- SIDEWALK AND WHEEL-CHAIR RAMP PAVING
- STORM DRAIN INLET
- QUARTER POINT ELEVATIONS

EXISTING ITEMS SHOWN DASHED

201-149701-9121 11/3/96

DWG: C:\SUN\VAQUERO.DWG DATE: 08/17/95 TIME: 11:31 RYALS Engineering-HB

RYALS engineering & construction services
5301 Central, N.E. Albuquerque, NM 87108
(505) 256-4701 239-4726 mobile telephone

CITY OF ALBUQUERQUE
PUBLIC WORKS DEPARTMENT
ENGINEERING GROUP

TITLE: SUNRISE TERRACE UNIT V
PAVING PLAN AND PROFILE
VAQUERO DRIVE & SANDPIPER DRIVE

APPROVALS	ENGINEER	DATE	APPROVALS	ENGINEER	DATE
DRC CHAIR	8/28/95	8/28/95	HYDROLOGY	N/A SMC	9-13-95
WATER WASTE WATER	N/A RWK	9-11-95	INSPECTION		
TRANSPORTATION	9-11-95				


PROJECT NO. 4970.92 MAP NO. L-8 SHEET 13 OF 19

AS BUILT INFORMATION	BENCH MARKS	SURVEY INFORMATION	ENGINEER'S SEAL
CONTRACTOR HYDRO SYSTEMS	CITY OF ALBUQUERQUE SURVEY MONUMENT "7-Lg" LOCATED 200' SOUTH OF TOWER ON WEST ROW OF 98TH STREET. ELEV. = 5175.70	FIELD NOTES NO. BY DATE	ENGINEER'S SEAL DATE: 11-94 DATE: 11-94 DATE:

REVISIONS	NO.	DATE	REMARKS
1	08.20		
2	08.31		
3	08.62		

REVISIONS	NO.	DATE	REMARKS
1	08.20		
2	08.31		
3	08.62		

REVISIONS	NO.	DATE	REMARKS
1	08.20		
2	08.31		
3	08.62		

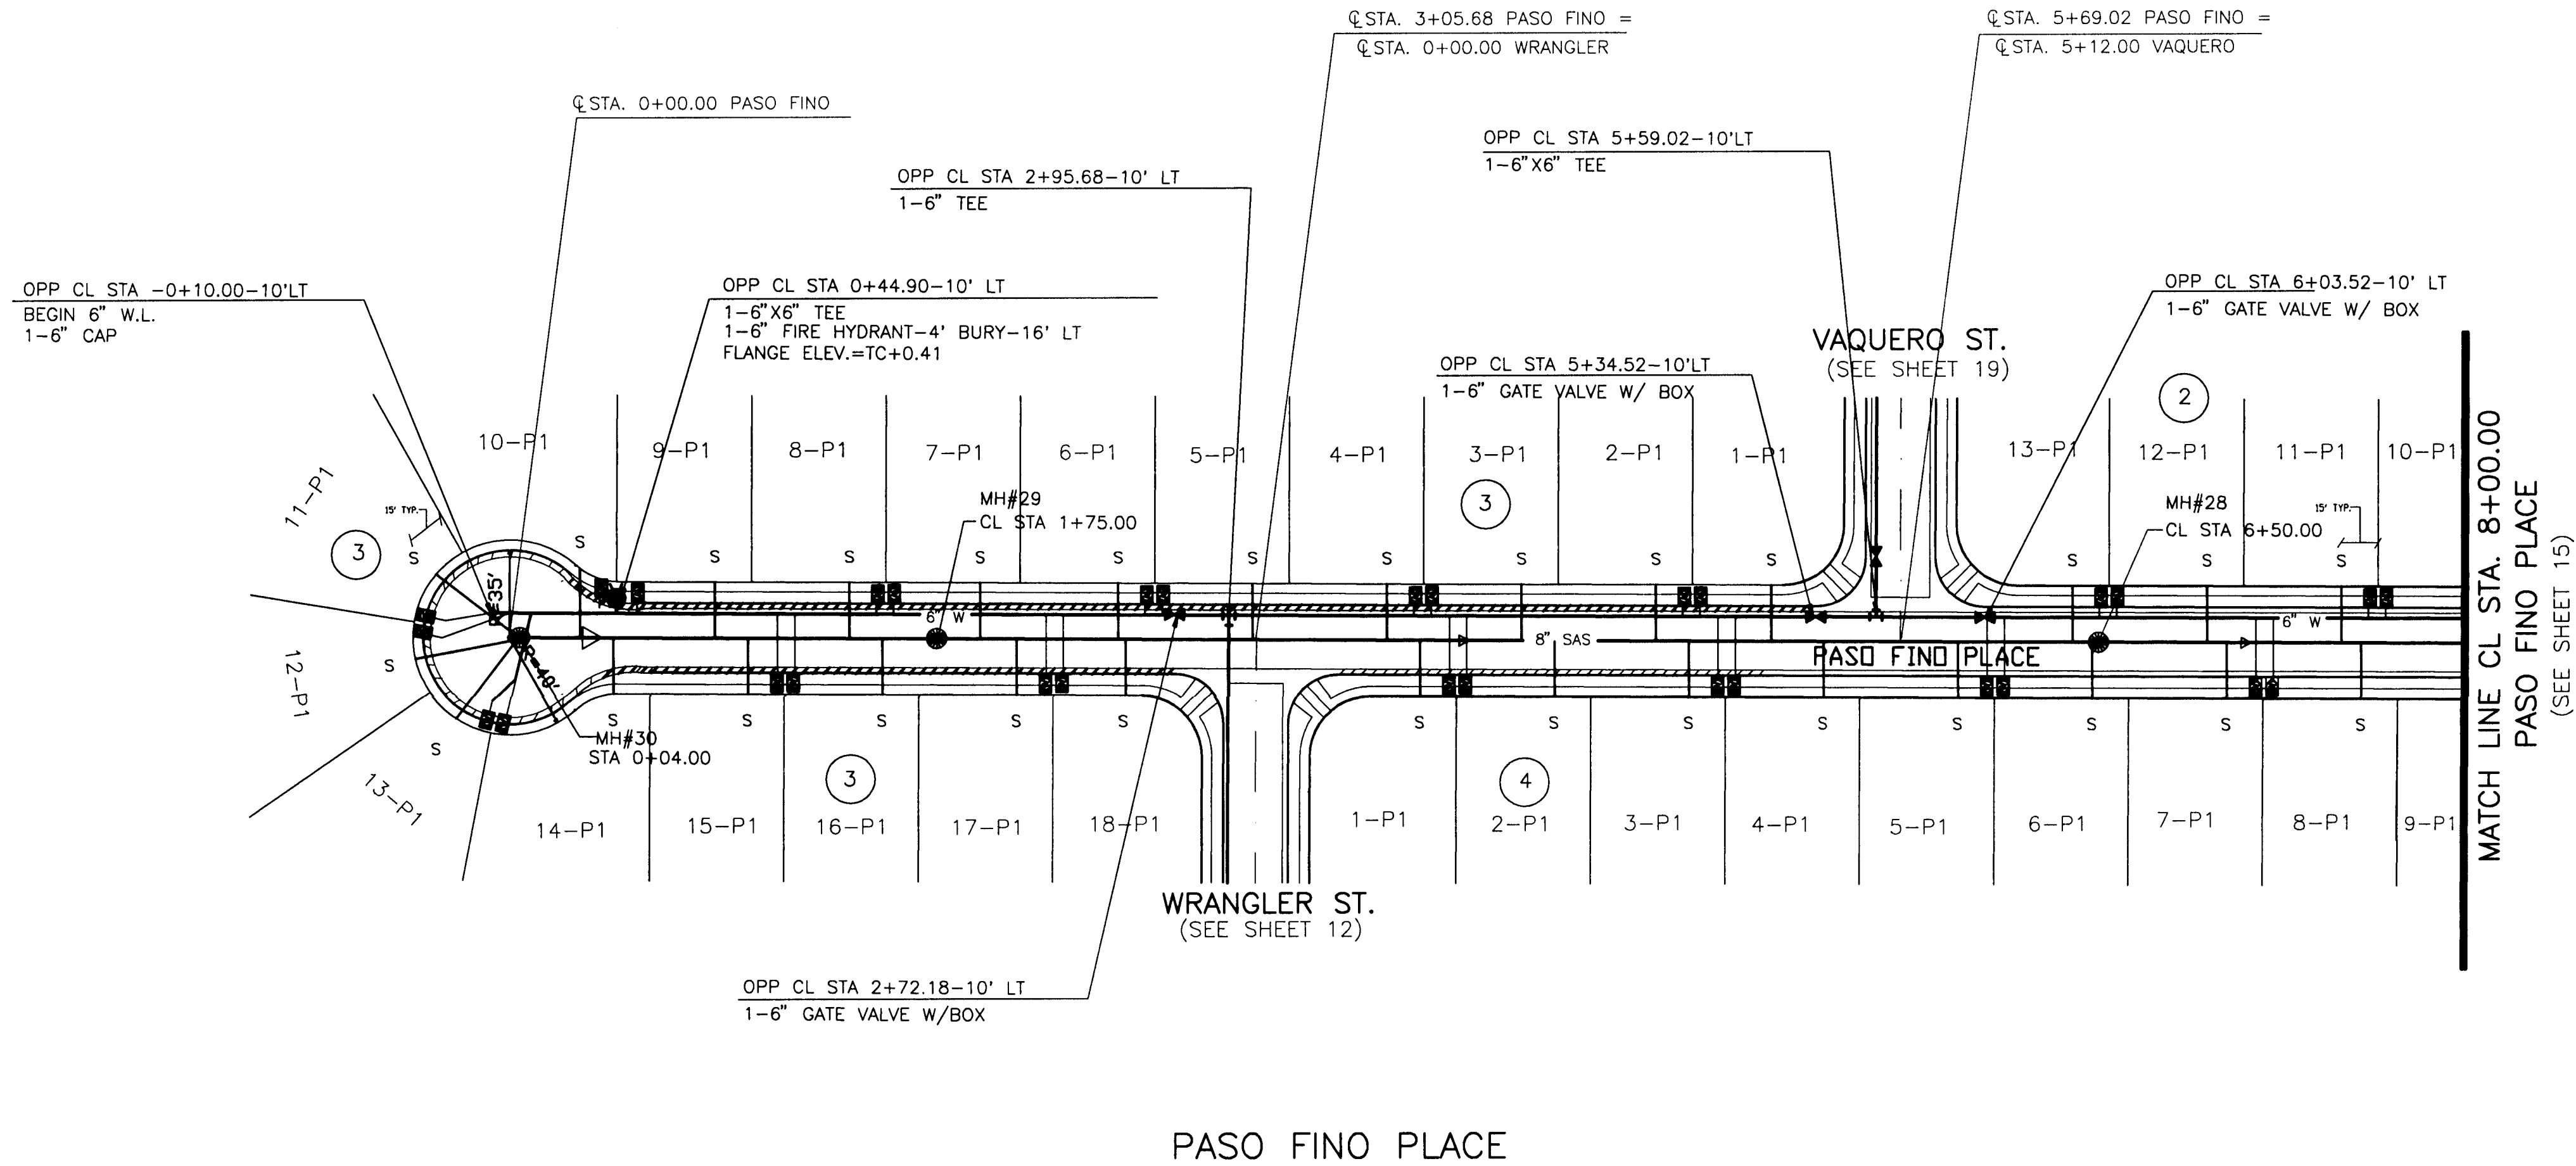

SCALES:
HORIZ. 1"=50'
VERT. 1"=5'

GENERAL NOTES:

- CONTRACTOR SHALL SUPPORT ALL EXISTING UNDERGROUND UTILITY LINES WHICH BECOME EXPOSED DURING CONSTRUCTION. PAYMENT FOR SUPPORTING WORK SHALL BE INCIDENTAL TO WATERLINE AND/OR SEWERLINE COSTS.
- ALL WATER LINE STATIONING REFERS TO STREET CENTERLINE STATIONING.
- ALL FITTINGS ON WATERLINES SHALL HAVE RESTRAINED JOINTS AS NOTED ON SHEET 6.
- CONSTRUCT SAS SERVICES PER STD. DWG. #2125.
- CONSTRUCT FIRE HYDRANTS PER DESIGNATED DEPTHS & LENGTHS PER STD. DWG. #2340.
- CONSTRUCT ALL SINGLE & DOUBLE WATER SERVICES PER STD. DWGS #2361, #2362 & #2363.
- SEE SHIT. 6 FOR WATER SHUT-OFF PLAN.
- UNLESS OTHERWISE INDICATED, ALL SAS MANHOLES SHALL BE 4' DIAMETER, TYPE "E" PER STD. DWG# 2102.

CONSTRUCTION NOTES:

SEWER SERVICE TABLE

BLK #	LOT #	CL STA	INV @ PL
3	1	5+16.28	20.58
3	2	4+68.98	21.66
3	3	4+13.98	22.91
3	4	3+58.98	24.16
3	5	3+03.98	25.38
3	6	2+48.98	26.67
3	7	1+93.98	28.08
3	8	1+38.98	30.43
3	9	0+83.98	33.53
3	10	0+28.88	36.74
3	11	-0+31.50, 5.8 LT	37.53
3	12	-0+39.00, 8.8 RT	38.46
3	13	-0+21.8, 33.5 RT	37.68
3	14	0+42.68	35.86
3	15	0+97.68	32.75
3	16	1+52.68	29.75
3	17	2+07.68	27.66
3	18	2+51.88	26.60
2	13	6+39.42	18.12
2	12	6+94.42	16.86
2	11	7+49.42	15.60
4	1	3+72.68	23.85
4	2	4+27.68	22.60
4	3	4+82.68	21.35
4	4	5+37.68	20.44
4	5	5+92.68	19.18
4	6	6+47.68	17.93
4	7	7+02.68	16.67
4	8	7+57.68	15.41

LEGEND

DESCRIPTION	PROPOSED
WATER VALVE	
FIRE HYDRANT	
SINGLE WATER SERVICE	
DOUBLE WATER SERVICE	
STREET LIGHT	
STORM DRAIN MANHOLE	
CATCH BASIN	
SAS MANHOLE	
SEWER SERVICE	
WATER LINE	
SEWER LINE	

1 2 3 4 5 6 7 8 9 10 11 12 13 14 15 16
201-149710192 114916

DWG: C:\SUN\SUN\WPA50U DATE: 06/17/95 TIME: 11:33 RYALS Engineering-HB

RYALS engineering & construction services
5301 Central, N.E. Albuquerque, NM 87108
(505) 256-4701 239-4726 mobile telephone

CITY OF ALBUQUERQUE
PUBLIC WORKS DEPARTMENT
ENGINEERING GROUP

TITLE: **SUNRISE TERRACE UNIT V**
UTILITY PLAN AND PROFILE
STA. 0+00.00-8+00.00 PASO FINO PLACE

APPROVALS	ENGINEER	DATE	APPROVALS	ENGINEER	DATE
DRC CHAIR	<i>Sg. Booddy</i>	7-28-95	HYDROLOGY	<i>N/A SMC</i>	9-13-95
WATER WASTE WATER	<i>R.W. Kone</i>	9-11-95	INSPECTION		
TRANSPORTATION	<i>N/A R.W. Kone</i>	9-11-95			

PROJECT NO. **4970.92** MAP NO. **L-8** SHEET **14** OF **19**

AS BUILT INFORMATION		BENCH MARKS		SURVEY INFORMATION		ENGINEER'S SEAL	
CONTRACTOR	HYDRO SYSTEMS	CITY OF ALBUQUERQUE	SURVEY MONUMENT	FIELD NOTES	NO.	DATE	BY
WORK	ALB	"7-L9"	LOCATED 200' SOUTH OF TOWER ON WEST ROW OF 98TH STREET.	DATE	DATE	DATE	DATE
STATED BY	ALB	DATE	ELEV. = 5175.70	NO.	NO.	NO.	NO.
ACCEPTED BY	ALB	DATE		NO.	NO.	NO.	NO.
FIELD CHECKED BY	ALB	DATE		NO.	NO.	NO.	NO.
REVISIONS	ALB	DATE		NO.	NO.	NO.	NO.
CORRECTED BY	ALB	DATE		NO.	NO.	NO.	NO.
MICRO-FILM INFORMATION		RECORDED BY		NO.		DATE	


Robert J. Del
9-18-95

REMARKS
DESIGN
REVISIONS

DESIGNED BY: RBR, THG
DRAWN BY: PBD, HFB
CHECKED BY:

DATE: DATE: DATE:

STORM DRAIN DROP INLET SCHEDULE						
STREET	INLET	TYPE	STATION	OFFSET	TOP CURB	INV. OUT
PASO FINO	9	SGL A	12+53.00	14' L	5208.02	5204.35
	10	SGL A	12+76.00	14' R	5207.56	5203.89
	11	DBL C	12+97.00	14' L	5207.06	5203.33
	12	DBL C	13+31.00	14' R	5206.31	5202.64
	13	SGL A	15+51.00	14' L	5201.24	5197.57
	14	SGL A	15+51.00	14' R	5201.24	5197.57
	15	DBL C	16+06.00	14' L	5199.98	5196.31
	16	DBL C	16+06.00	14' R	5199.98	5196.31

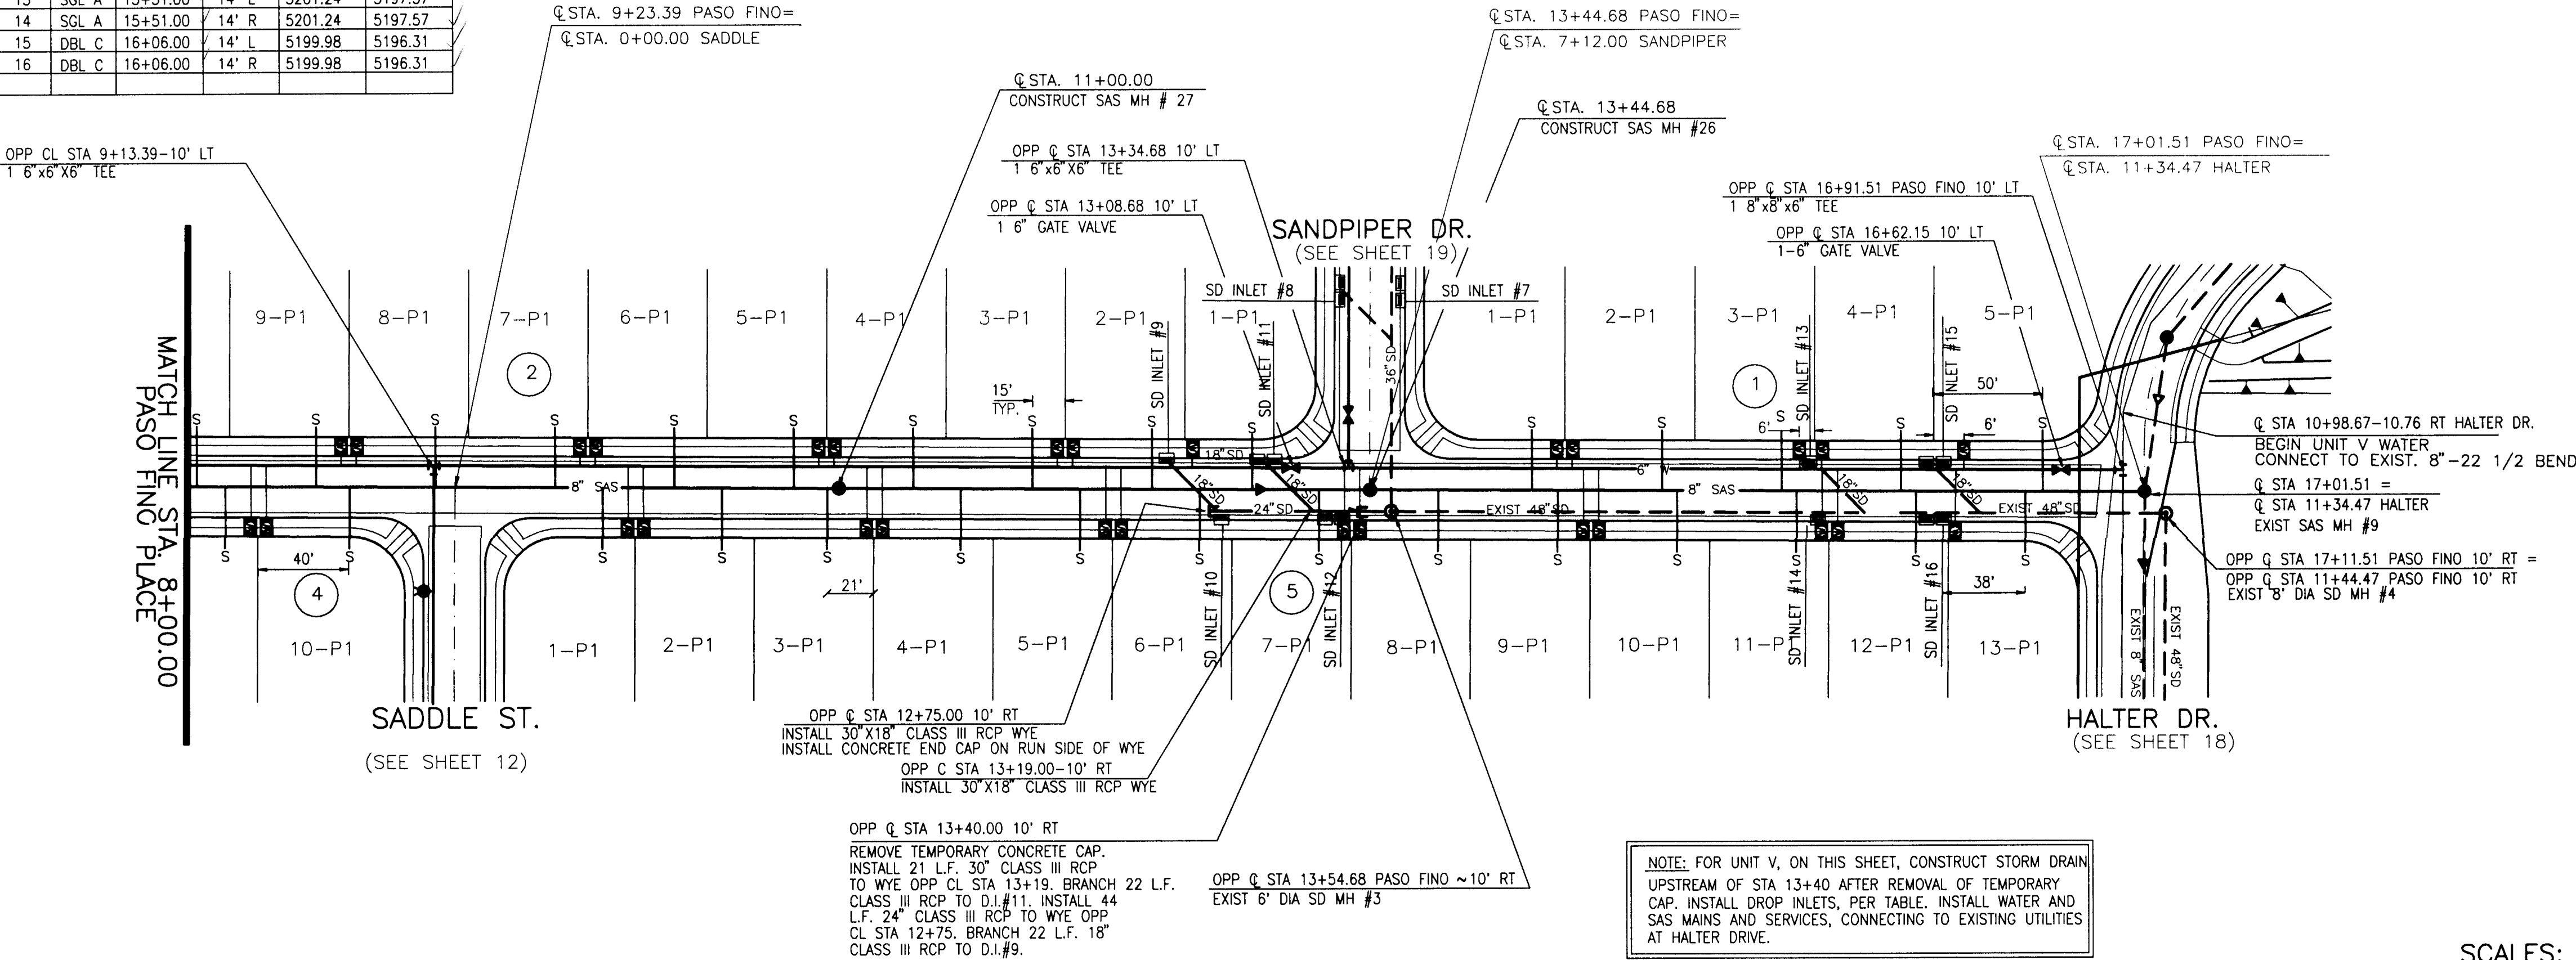

GENERAL NOTES:

- CONTRACTOR SHALL SUPPORT ALL EXISTING UNDERGROUND UTILITY LINES WHICH BECOME EXPOSED DURING CONSTRUCTION. PAYMENT FOR SUPPORTING WORK SHALL BE INCIDENTAL TO WATERLINE AND OR SEWERLINE COSTS.
- ALL WATER LINE STATIONING REFERS TO STREET CENTERLINE STATIONING.
- ALL FITTINGS ON WATERLINES SHALL HAVE RESTRAINED JOINTS AS NOTED ON SHT. 6.
- CONSTRUCT SAS SERVICES PER STD. DWG. #2125.
- CONSTRUCT FIRE HYDRANTS PER DESIGNATED DEPTHS & LENGTHS PER STD. DWG. #2340.
- CONSTRUCT ALL SINGLE & DOUBLE WATER SERVICES PER STD. DWGS. #2361, #2362 & #2363.
- SEE SHT. 6 FOR WATER SHUT-OFF PLAN.
- ALL MANHOLES ARE TYPE "E" UNLESS OTHERWISE NOTED.

CONSTRUCTION NOTES:

SEWER SERVICE TABLE

BLK #	LOT #	Q STA	INV @ PL
2	10	8+04.42	5214.34
2	9	8+59.42	5213.08
2	8	9+14.42	5211.82
2	7	9+69.42	5210.56
2	6	10+24.42	5209.30
2	5	10+79.42	5208.04
2	4	11+34.42	5206.76
2	3	11+89.42	5205.52
2	2	12+44.42	5204.26
2	1	12+90.00	5203.22
4	9	8+17.69	5214.04
4	10	8+75.39	5212.72
5	1	9+91.41	5210.06
5	2	10+46.41	5208.80
5	3	10+95.00	5207.68
5	4	11+56.41	5206.28
5	5	12+11.41	5205.02
5	6	12+66.41	5203.76
5	7	13+21.41	5202.50
5	8	13+76.41	5201.24
5	9	14+31.41	5199.98
5	10	14+86.41	5198.72
5	11	15+41.41	5197.46
5	12	15+96.41	5196.20
5	13	16+49.41	5194.94
1	1	14+19.42	5200.25
1	2	14+79.42	5198.88
1	3	15+34.42	5197.62
1	4	15+89.42	5196.36
1	5	16+54.42	5194.92

LEGEND

DESCRIPTION	PROPOSED
WATER VALVE	
FIRE HYDRANT	
SINGLE WATER SERVICE	
DOUBLE WATER SERVICE	
STREET LIGHT	
STORM DRAIN MANHOLE	
STORM DRAIN INLET	
SAS MANHOLE	
SEWER SERVICE	
WATER LINE	
SEWER LINE	
HYDRAULIC GRADE LINE	

26-17970-92 1596

DWG(SUN)/SUN/EP/030, DATE:08/17/95, TIME:11:34, RYALS Engineering-HB

RYALS engineering & construction services
5301 Central, N.E. Albuquerque, NM 87108
(505) 256-4701 269-1142 mobile telephone

CITY OF ALBUQUERQUE
PUBLIC WORKS DEPARTMENT
ENGINEERING GROUP

TITLE: SUNRISE TERRACE UNIT V
UTILITY PLAN AND PROFILE
PASO FINO PLACE
STA. 8+00.00 - 17+01.51

APPROVALS	ENGINEER	DATE	APPROVALS	ENGINEER	DATE
DRC CHAIR	J.G. Sully	9-28-95	HYDROLOGY	J. Valenzuela	9-13-95
WATER	R.W. Kane	9-11-95	INSPECTION		
WASTE WATER					
TRANSPORTATION	N/A RWD	9-08-95			

PROJECT NO. 4970.92

MAP NO. L-8

SHEET 15 OF 19

UNIT V CONSTRUCTION THIS SHEET INCLUDES
WATER LINE
ALL WL INSTALLATIONS AS SHOWN
STORM DRAIN
BUILD LATERAL LEGS AND D.I.'S AS SHOWN
SANITARY SEWER (SAS)
MAIN SAS AND M.H.'S AS SHOWN
SAS SERVICES TO BLOCK 4, LOTS 18-20;
BLOCK 5, LOTS 14-26; BLOCK 7, LOTS 8-24

1. CONTRACTOR SHALL SUPPORT ALL EXISTING UNDERGROUND UTILITY LINES WHICH BECOME EXPOSED DURING CONSTRUCTION. PAYMENT FOR SUPPORTING WORK SHALL BE INCIDENTAL TO WATERLINE AND/OR SEWERLINE COSTS.
2. ALL RATIONING REFERS TO STREET CENTERLINE.
3. ALL FITTINGS ON WATERLINES SHALL HAVE RESTRAINED JOINTS AS NOTED ON SHT. 6.
4. CONSTRUCT SAS SERVICES PER STD. DWG. #2125.
5. CONSTRUCT FIRE HYDRANT DESIGNATED DEPTHS & LENGTHS PER STD. DWG. #2340.
6. CONSTRUCT ALL SINGLE & DOUBLE WATER SERVICES PER STD. DWG. #2340.
7. UNLESS OTHERWISE INDICATED, ALL SAS MANHOLES SHALL BE 4' DIAMETER, TYPE "E" PER STD. DWG. #2102.
8. SEE SHEET 6 FOR WATER SHUT-OFF PLAN.

SCALES:

HORIZ. 1"=50'

VERT. 1"=5'

DESCRIPTION	PROPOSED
WATER VALVE	
FIRE HYDRANT	
SINGLE WATER SERVICE	
DOUBLE WATER SERVICE	
STREET LIGHT	
STORM DRAIN MANHOLE	
CATCH BASIN	
SAS MANHOLE	
SEWER SERVICE	_____ S
WATER LINE	_____ W _____
SEWER LINE	_____ SAS _____

NOTE: EXISTING ITEMS SHOWN DASHED

20-497092 1796

DWG:C:\SUN\SUN\EANDALU DATE:08/17/95 TIME:11:36 RYALS Engineering-HB

RYALS **engineering &
construction services**

5301 Central N.E. Albuquerque, NM 87108
(505) 256-4701 239-4726 mobile telephone

CITY OF ALBUQUERQUE
PUBLIC WORKS DEPARTMENT
ENGINEERING GROUP

TITLE:	SUNRISE TERRACE UNIT V UTILITY PLAN AND PROFILE ANDALUSIAN AVENUE (STA. 10+00.00 - STA. 19+66.42)
--------	--

APPROVALS	ENGINEER	DATE	APPROVALS	ENGINEER	DATE
DRC CHAIR	B.G. Landry	9-28-95	HYDROLOGY	B.G. Landry	9-28-95
WATER WASTE WATER	R.W. Kane	9-11-95	INSPECTION		
TRANSPORTATION	M. R. Kane	9-28-95			

PROJECT NO.	4970.92	MAP NO.	L-8	SHEET	17	OF	19
-------------	---------	---------	-----	-------	----	----	----

AS FILM INFORMATION	CONTRACTOR	HYDRO SYSTEMS
WORK	STARTED BY	ALS 96
INSPECTOR'S	PERFORMANCE BY	15% AL 582-94
REMARKS	VEHICLE	96
DOWNINGS	CORRECTED BY	ALS 5/96
MICRO-FILM INFORMATION		
RECORDED BY		
NO.		

<i>BENCH MARKS</i>
CITY OF ALBUQUERQUE SURVEY MONUMENT
"7-18" LOCATED 200' SOUTH OF

SURVEY INFORMATION		FIELD NOTES	NO	BY	DATE



ENGINEER'S SEAL

RECEIVED
JUN 17 1954
8-18-54



NO.	DATE	REMARKS	BY	
REVISIONS				
DESIGN				
DESIGNED BY: RBR, THG			DATE: 10-94	
DRAWN BY: PD, THG, HFB			DATE: 10-94	
CHECKED BY:			DATE:	

[illegible]

E

ENGINEER	DATE
<i>Calder</i>	<i>9.1.95</i>

T 17 OF 19


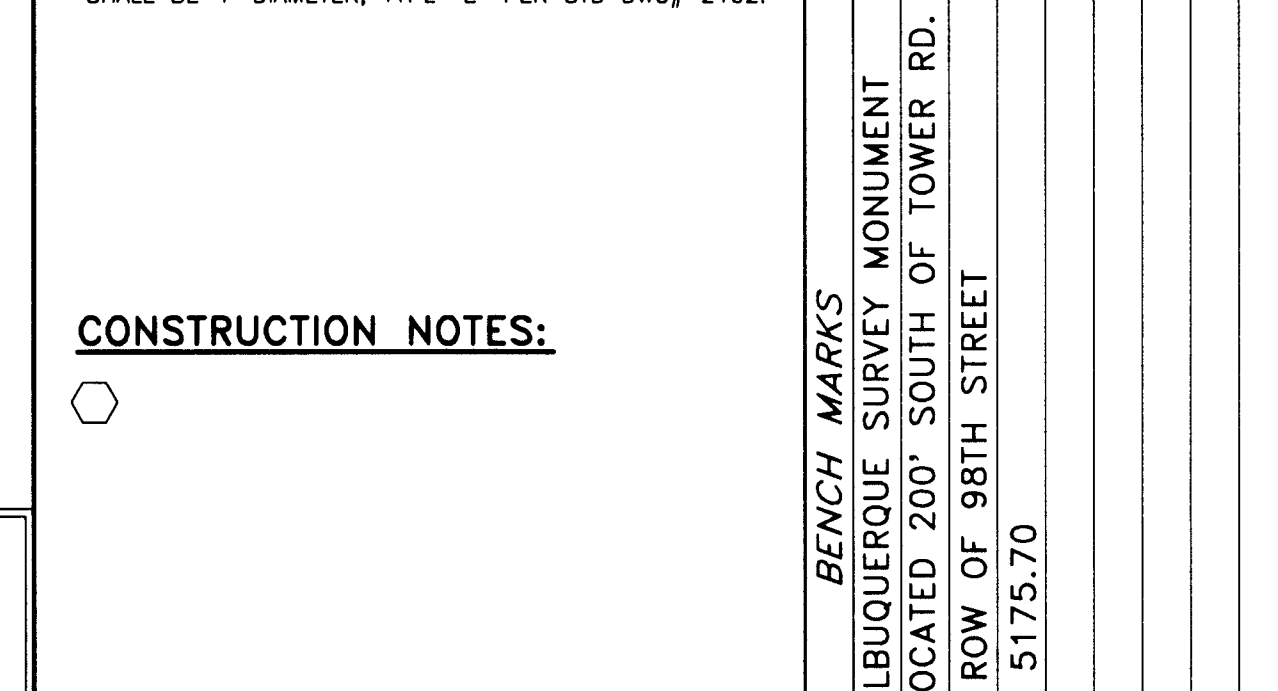
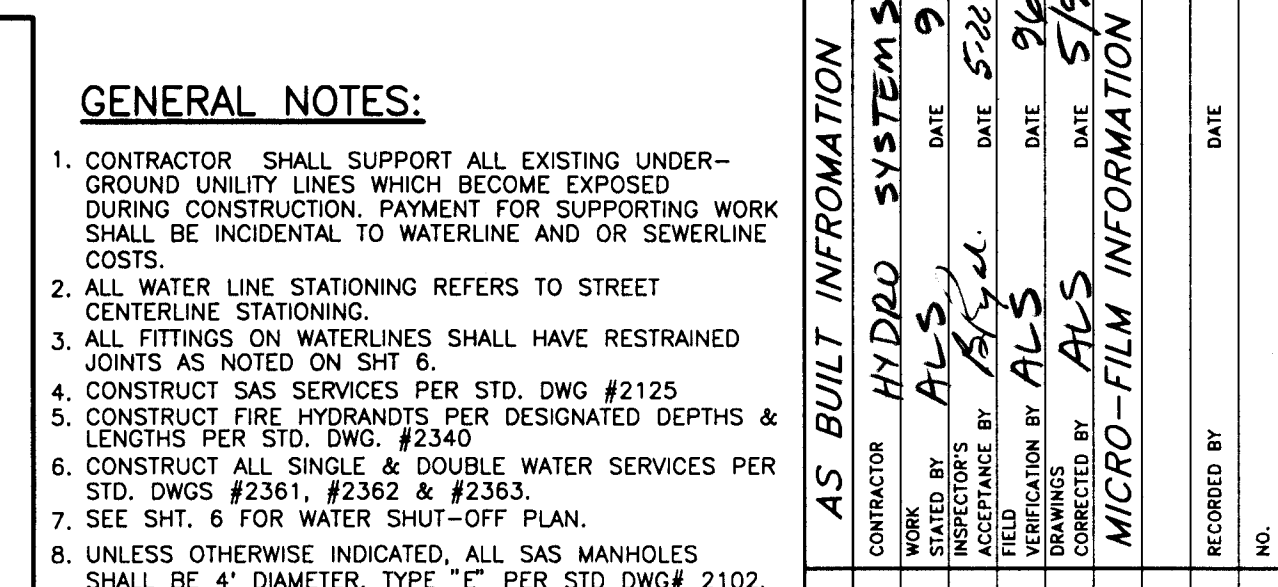


LEGEND		ENGINEER'S SEAL
DESCRIPTION	PROPOSED	
WATER VALVE		
FIRE HYDRANT		
SINGLE WATER SERVICE		

DWG-C:\SUN\SUMA\SHALTU DATE08/17/95 TIME11:37 RYALS Engineering-HB RYALS engineering & construction services 5301 Central, N.E. Albuquerque, NM 87108 (505) 256-4701 239-4726 mobile telephone		DESIGNED BY: THC DRAWN BY: DQH, THC, HFB CHECKED BY:
		NO. DATE

CITY OF ALBUQUERQUE PUBLIC WORKS DEPARTMENT ENGINEERING GROUP					
TITLE:		SUNRISE TERRACE UNIT V UTILITY PLAN AND PROFILE HALTER DRIVE (STA. 7+00.00 - STA. 15+48.76)			
APPROVALS	ENGINEER	DATE	APPROVALS	ENGINEER	DATE
DRC CHAIR	<i>Sp. Gandy</i>	9-28-95	HYDROLOGY	<i>N/A Smc.</i>	9-13-95
WATER WASTE WATER	<i>R.W. Kane</i>	9-11-95	INSPECTION		
TRANSPORTATION	<i>N/A RHO</i>	9-08-95			
PROJECT NO.	4970.92		MAP NO. L-8	SHEET 18	OF 19

STORM DRAIN DROP INLET SCHEDULE						
STREET	INLET	TYPE	STATION	OFFSET	TOP CURB	INV. OUT
SANDPIPER	7	SGL A	6+22.00	16' L	5206.69	5203.22
	8	SGL A	6+22.00	16' R	5206.69	5203.22

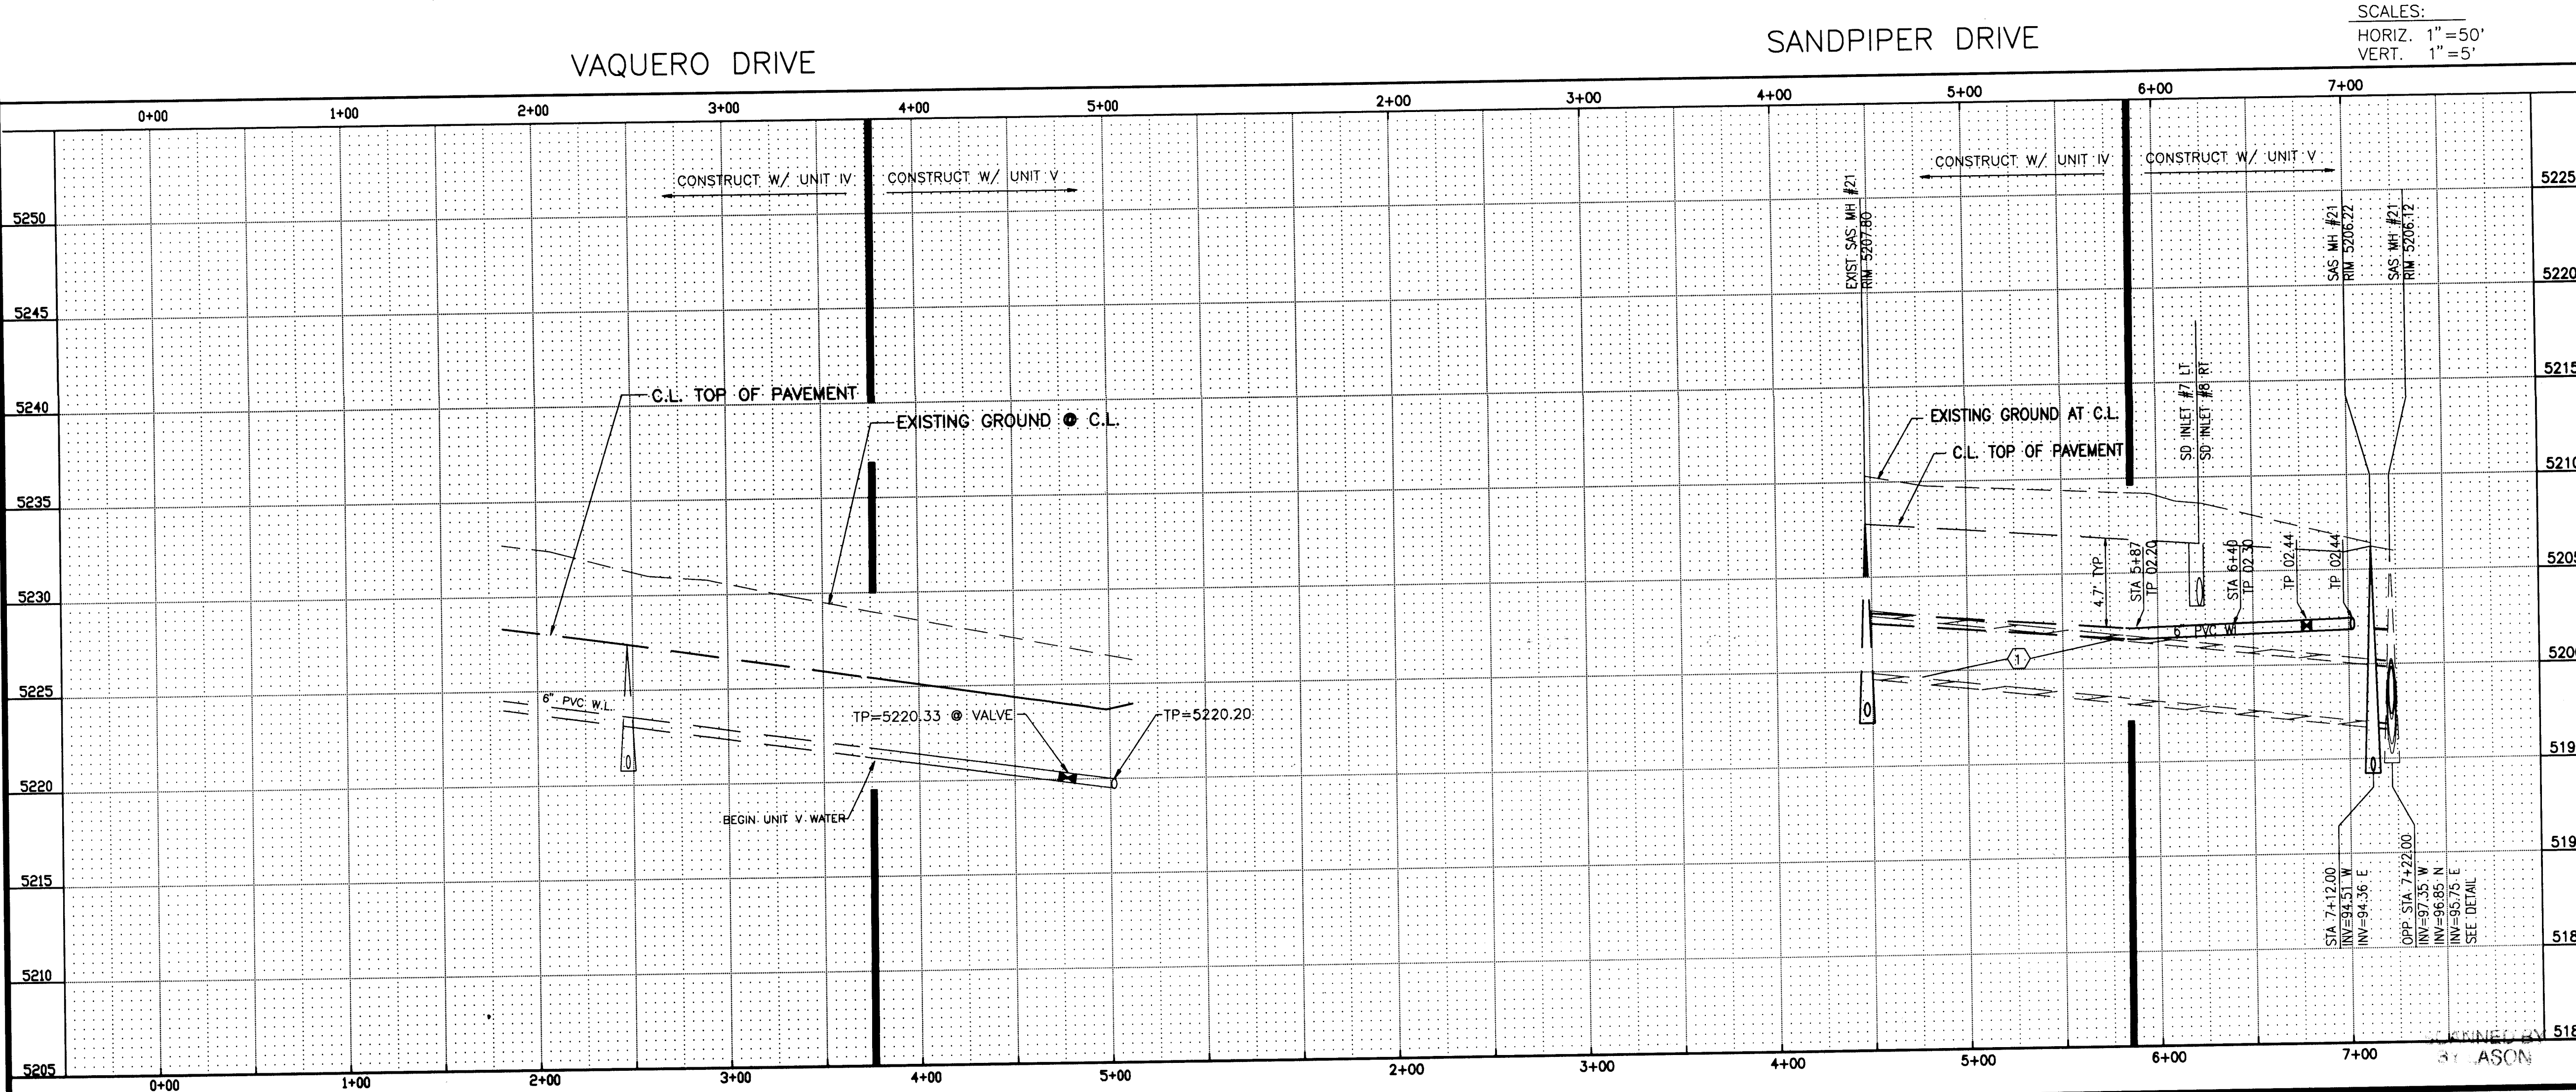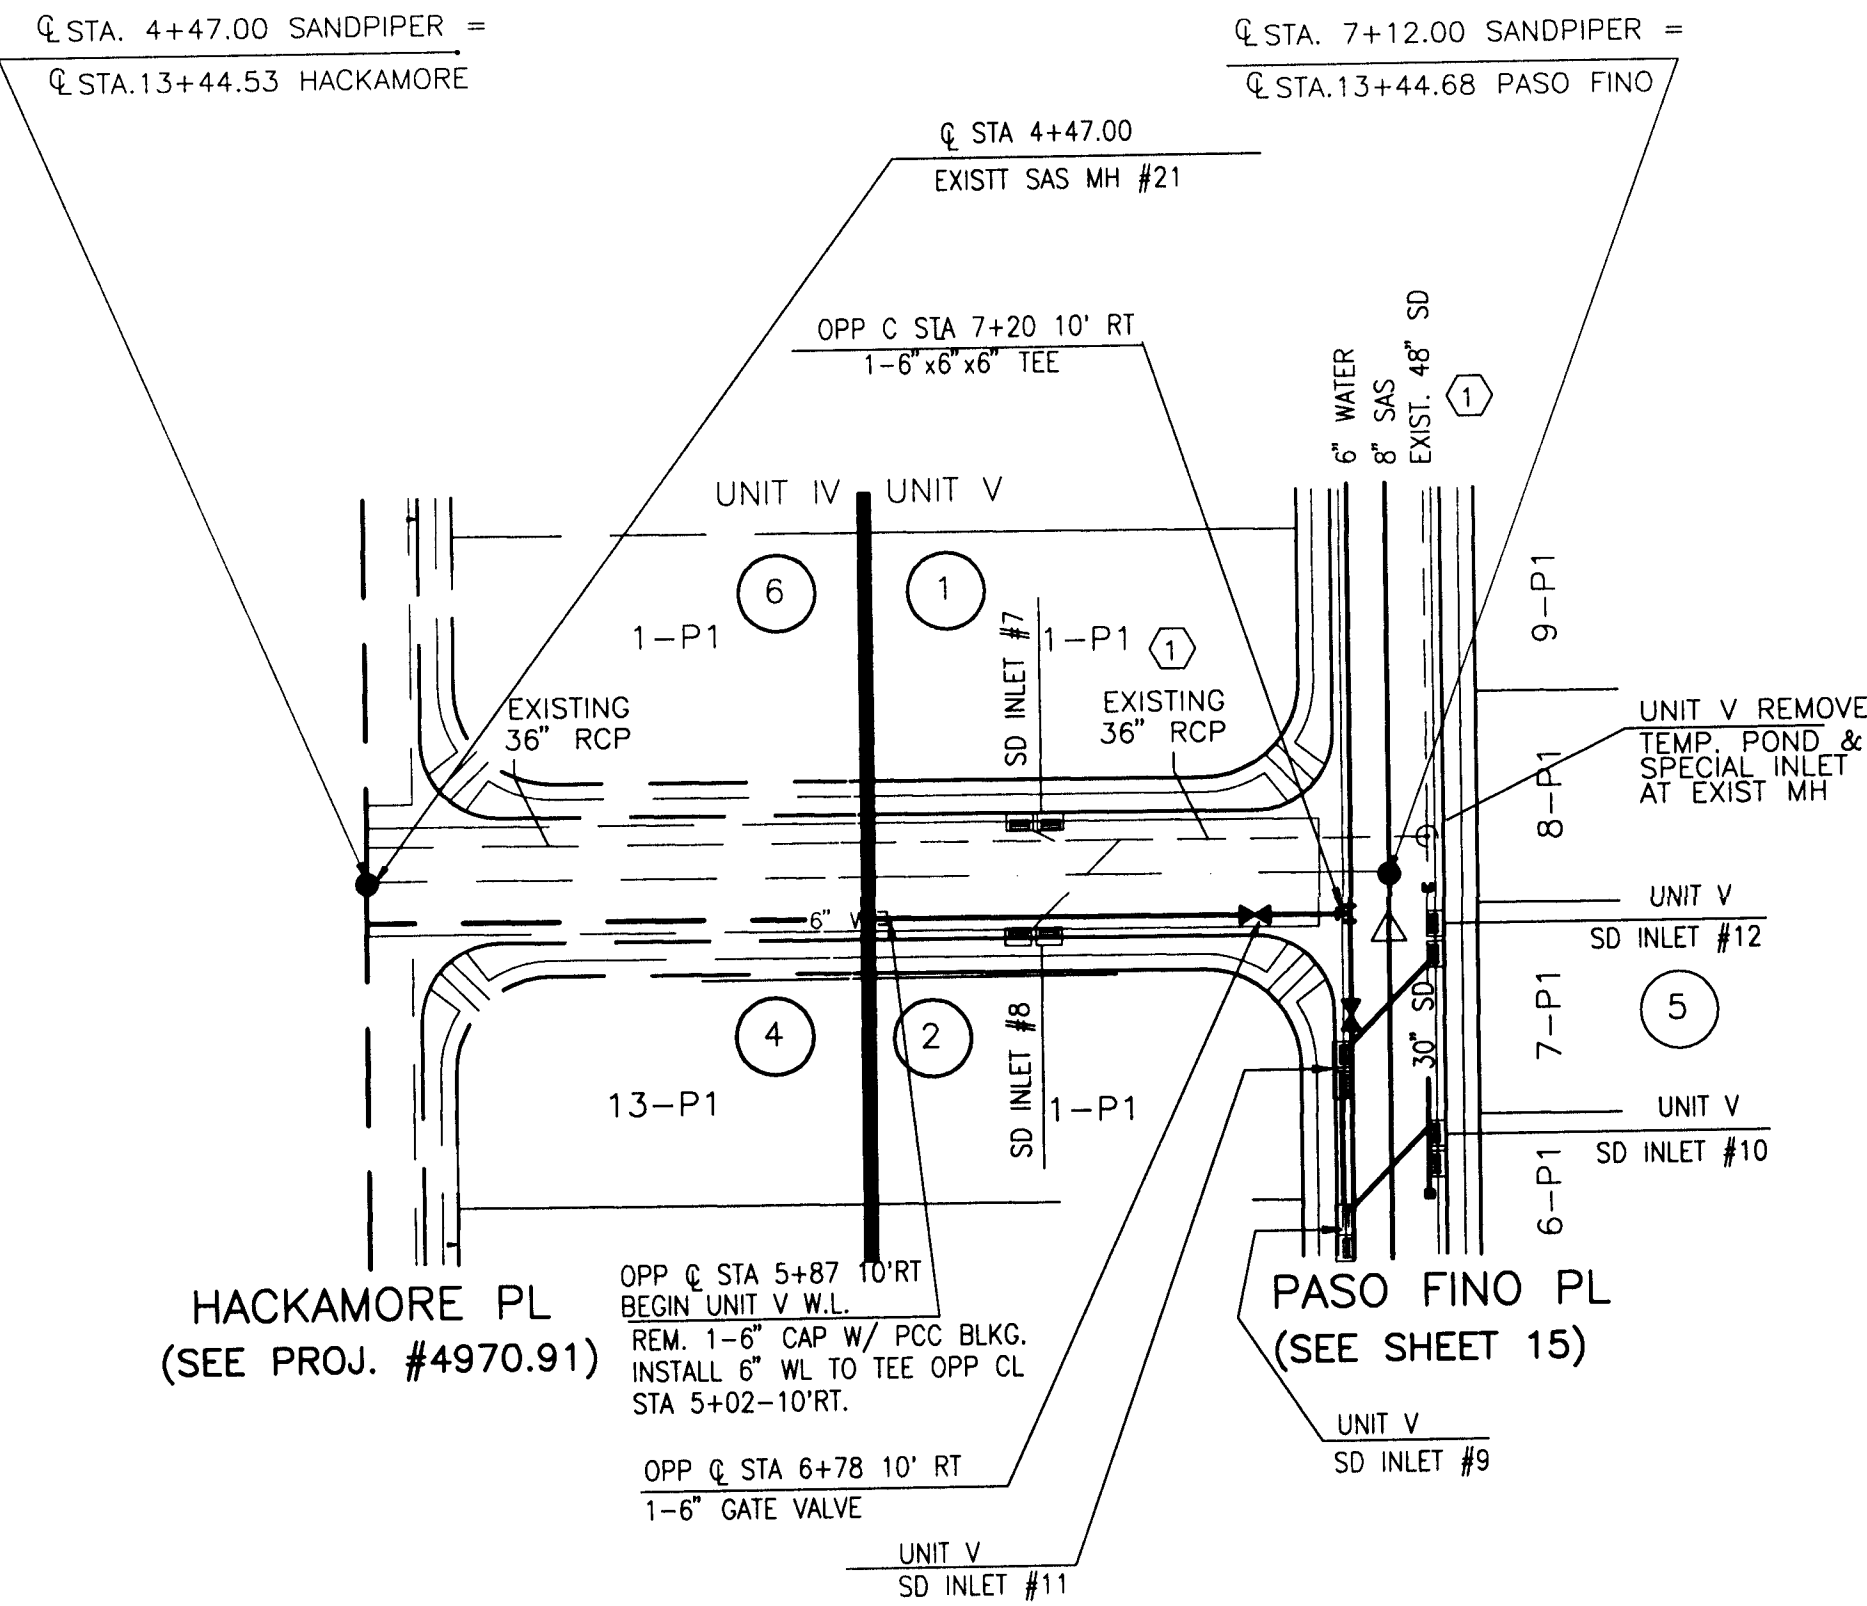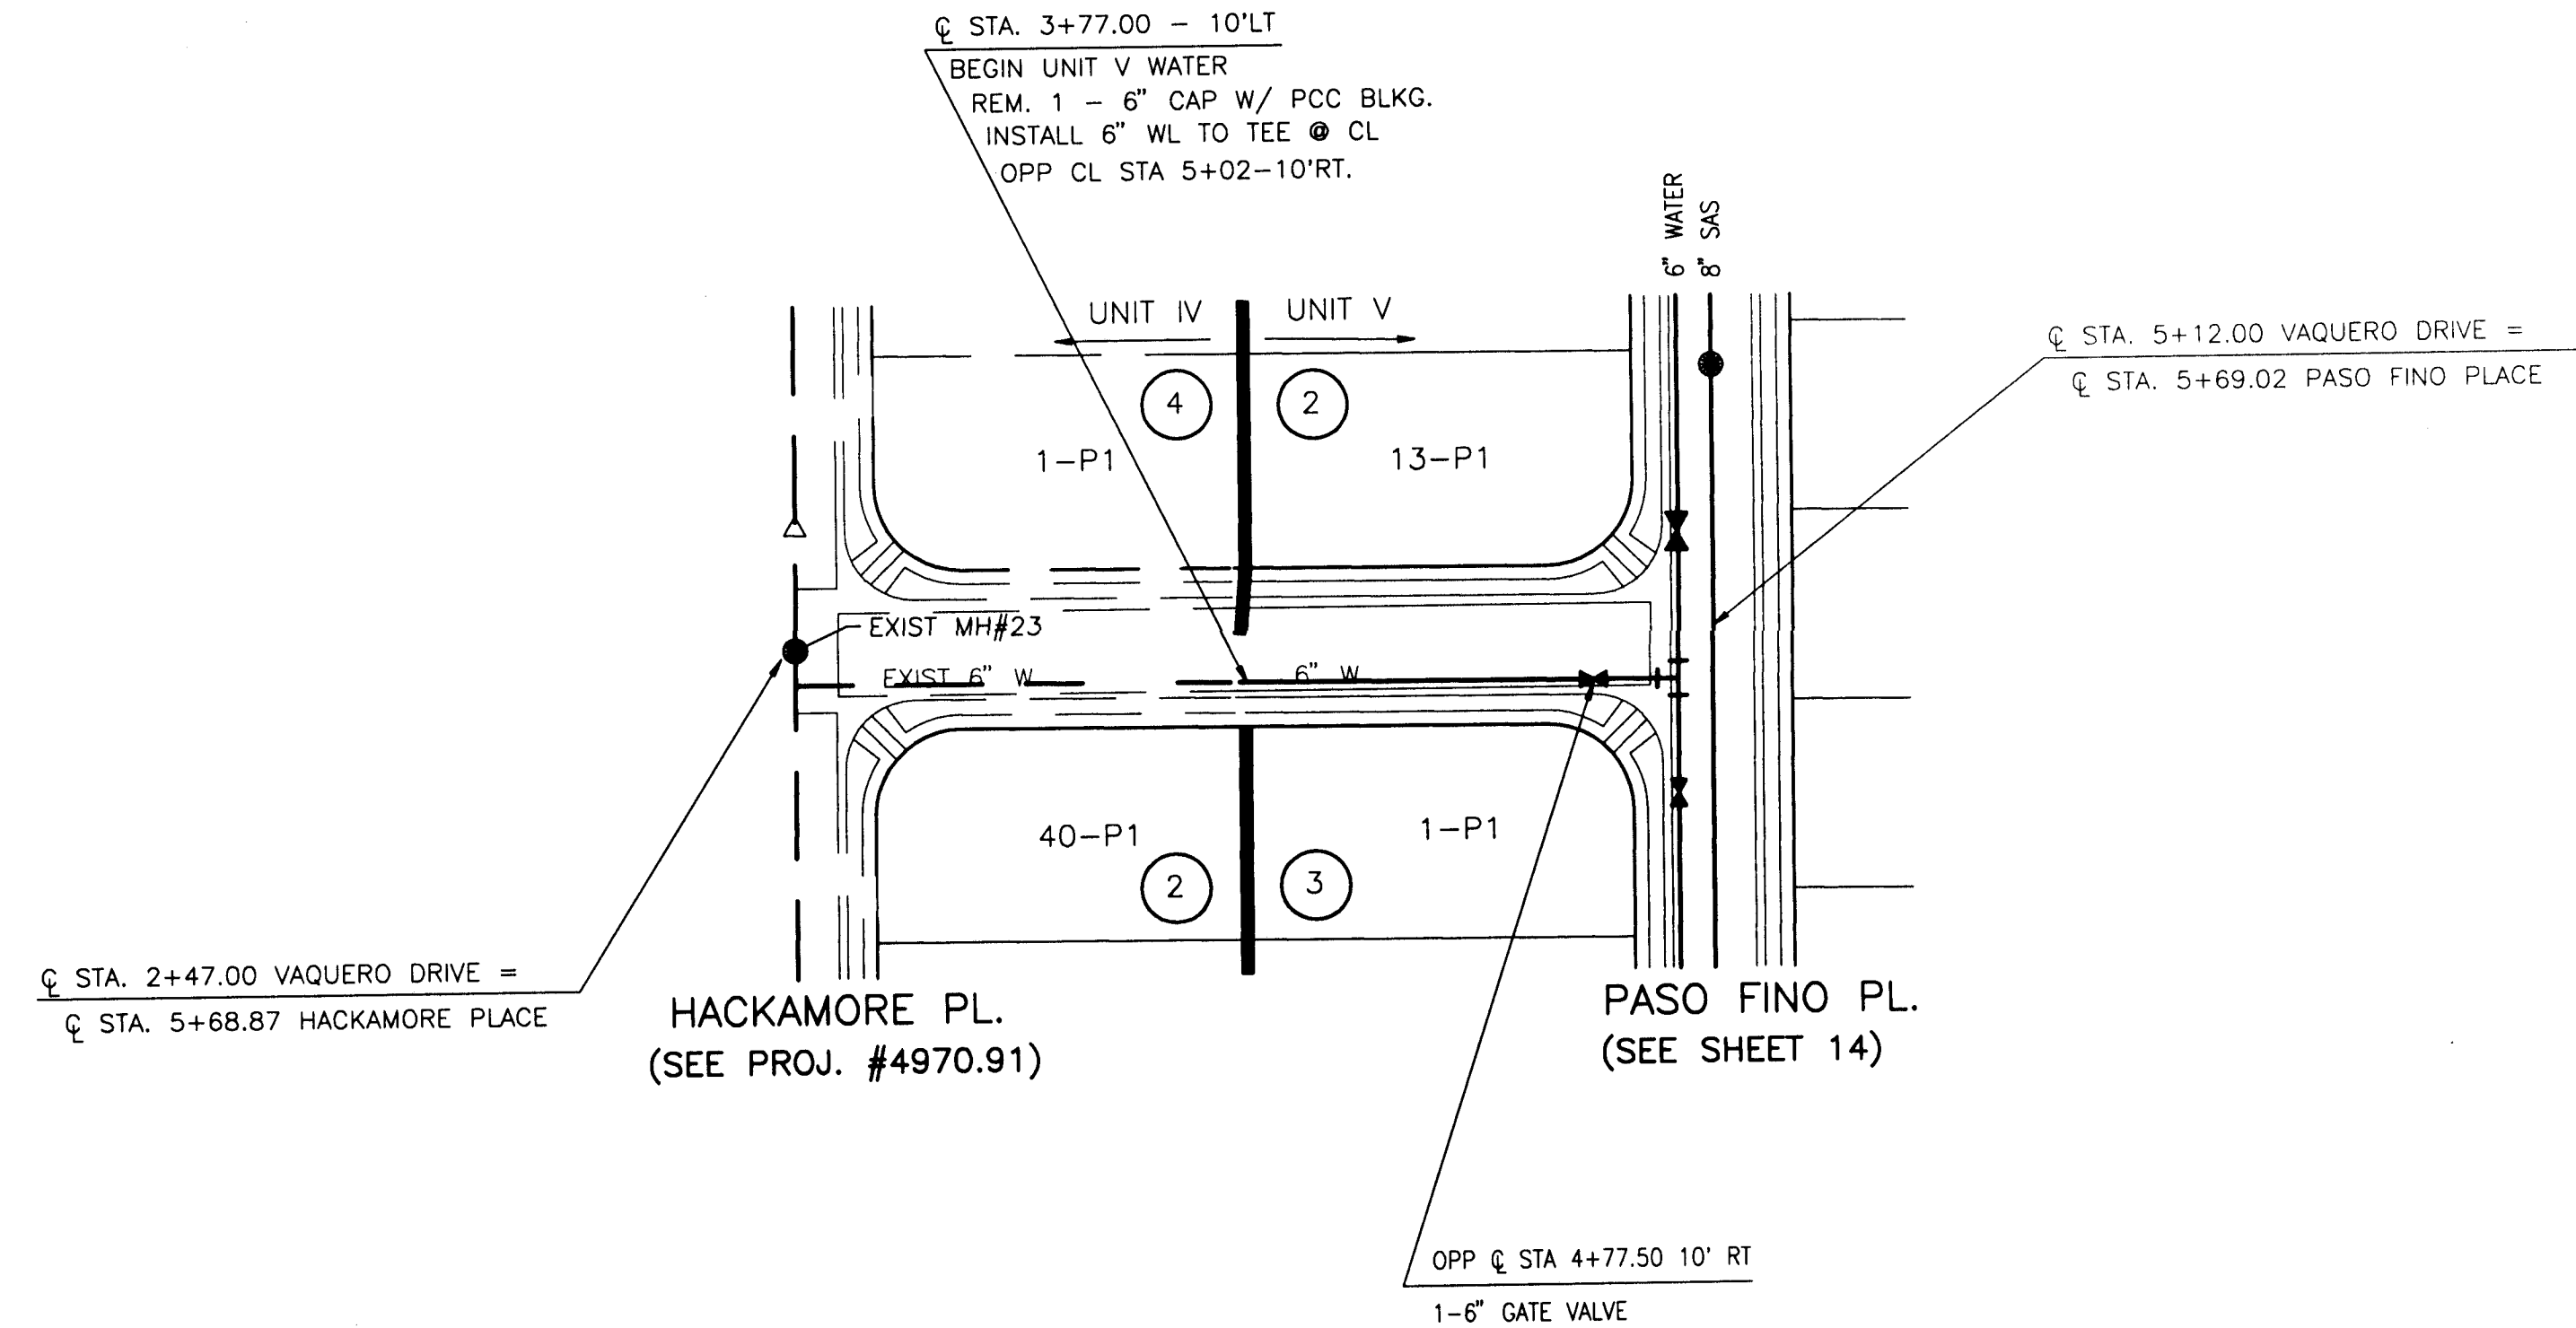

- GENERAL NOTES:**
- CONTRACTOR SHALL SUPPORT ALL EXISTING UNDERGROUND UTILITY LINES WHICH BECOME EXPOSED DURING CONSTRUCTION. PAYMENT FOR SUPPORTING WORK SHALL BE INCIDENTAL TO WATERLINE AND OR SEWERLINE COSTS.
 - ALL WATER LINE STATIONING REFERS TO STREET CENTERLINE STATIONING.
 - ALL FITTINGS ON WATERLINES SHALL HAVE RESTRAINED JOINTS AS NOTED ON SHT. 6.
 - CONSTRUCT SAS SERVICES PER STD. DWG. #2125.
 - CONSTRUCT FIRE HYDRANTS PER DESIGNATED DEPTHS & LENGTHS PER STD. DWG. #2340.
 - CONSTRUCT ALL SINGLE & DOUBLE WATER SERVICES PER STD. DWGS. #2361, #2362 & #2363.
 - SEE SHT. 6 FOR WATER SHUT-OFF PLAN.
 - UNLESS OTHERWISE INDICATED, ALL SAS MANHOLES SHALL BE 4' DIAMETER, TYPE "E" PER STD DWG# 2102.

- CONSTRUCTION NOTES**
- EXISTING STORM DRAIN. SEE SUNRISE TERRACE UNIT III. W.O.#4970.90
- SANDPIPER UTILITY CONSTRUCTION TO BE DONE WITH UNIT V**
- CONSTRUCTION OF REMAINING STORM DRAIN INLETS.
 - WATERLINE AND APPURTENANCES AS SHOWN.

SCALES:
HORIZ. 1"=50'
VERT. 1"=5'

LEGEND	
DESCRIPTION	PROPOSED
WATER VALVE	
FIRE HYDRANT	
SINGLE WATER SERVICE	
DOUBLE WATER SERVICE	
STREET LIGHT	
STORM DRAIN MANHOLE	
CATCH BASIN	
SAS MANHOLE	
SEWER SERVICE	
WATER LINE	
SEWER LINE	

EXISTING ITEMS SHOWN DASHED

RYALS engineering & construction services
5301 Central N.E. Albuquerque, NM 87108
(505) 256-4701 239-4726 mobile telephone

CITY OF ALBUQUERQUE PUBLIC WORKS DEPARTMENT ENGINEERING GROUP					
TITLE: SUNRISE TERRACE UNIT V UTILITY PLAN AND PROFILE VAQUERO DRIVE & SANDPIPER DRIVE					
APPROVALS	ENGINEER	DATE	APPROVALS	ENGINEER	DATE
DRC CHAIR	<i>Ag. Amador</i>	9-28-95	HYDROLOGY	N/A SMC	9-11-95
WATER WASTE WATER	<i>R.W. Kane</i>	9-11-95	INSPECTION		
TRANSPORTATION	<i>NA RHO</i>	9-08-95			
PROJECT NO.	4970.92	MAP NO.	L-8	SHEET	19 OF 19

AS BUILT INFORMATION		BENCH MARKS		SURVEY INFORMATION		ENGINEER'S SEAL	
CONTRACTOR	HYDRO SYSTEMS	CITY OF ALBUQUERQUE	DATE	FIELD NOTES	NO.	SEAL	REVISIONS
WORK BY	ALB	"7-L9", LOCATED 200' SOUTH OF	BY				DESIGN
ACCEPTANCE BY	ALB	TOWER ON WEST ROW OF 98TH STREET					REVISIONS
VERIFICATION BY	ALB	ELEV. = 5175.70					DESIGN
DRAWING BY	ALB						DESIGN
CHECKED BY	ALB						DESIGN
RECORDED BY							DESIGN
NO.							DESIGN