




# MANZANO MESA PARK - PHASE 4

CITY OF ALBUQUERQUE  
DEPARTMENT OF MUNICIPAL DEVELOPMENT  
PARK AND MEDIAN DESIGN DIVISION

October 16, 2003

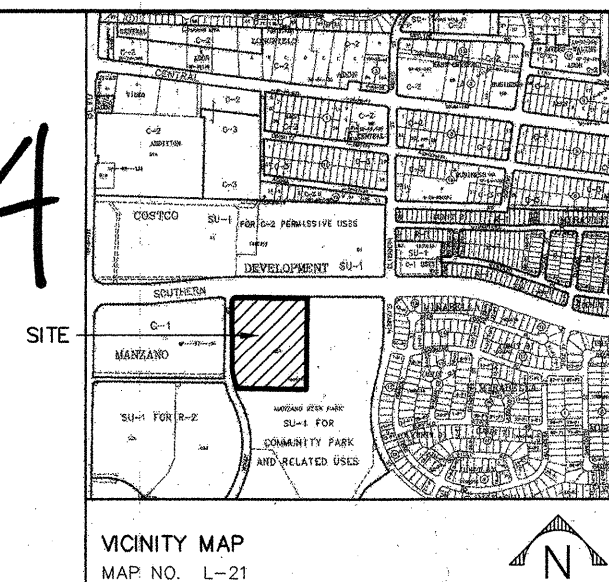

**CONSENSUS PLANNING, INC.**

PLANNING / LANDSCAPE ARCHITECTURE

924 PARK AVENUE SW

ALBUQUERQUE, NM 87102

(505) 764-9801

## Property Information

Legal Description: Tract G2A, Manzano Mesa Addition

Meter Address: Stephen Moody Street NE

Zoning: SU-1

Total Site Area: 15.0 acres <sup>12.22</sup>

Total Landscape Area: <sup>7.21</sup>

Total Turf Area: 303,641 SF (6.97 acres)

Existing Parking

Multi-Generation Center: 245 spaces

Zia Little League: 208 spaces

Proposed Parking

Soccer Fields: 333 spaces

Total 786 spaces

## Consultants

Civil Engineering

Smith Engineering Company

6400 Uptown Blvd. NE, Suite 500E

Albuquerque, New Mexico 87110

(505) 884-0700

Electrical Engineering

CME, Inc.

6400 Uptown Blvd. NE, Suite 500E

Albuquerque, New Mexico 87110

(505) 884-8868

## Index of Drawings

General

- 1 G1 Cover Sheet
- 2 G2 General Notes

Site

- 3 S1 Site Plan (North)
- 4 S2 Site Plan (South)
- 5 S3 Site Details
- 6 S4 Crosswalk Plan/Amenities Schedule
- 7 S5 Playground Plan/Details

Civil

- 8 C1 Hydrology Plan
- 9 C2 Layout Plan
- 10 C3 Layout Plan and Curves Table
- 11 C4 Layout Plan and Curves Table
- 12 C5 Node Data Sheet
- 13 C6 Miscellaneous Details
- 14 C7 Storm Water Pollution Prevention Notes (SWPPP)
- 15 C8 Storm Water Pollution Prevention Plan (SWPPP)
- 16 C9 Storm Water Pollution Prevention Details (SWPPP)
- 17 C10 Electrical Conduit Layout Plan
- 18 C11 Signing and Construction Traffic Control Standards
- 19 C12 Traffic Control Standards

Landscape

- 20 L1 Irrigation Plan (North)
- 21 L2 Irrigation Plan (South)
- 22 L4 Planting Plan (North)
- 23 L5 Planting Plan (South)

## UTILITY COMPANY CONTACTS

### PNM-ELECTRIC

4201 Edith Boulevard NE  
Albuquerque, New Mexico 87107  
(505) 241-0525

### PNM-GAS

4625 Edith Boulevard NE  
Albuquerque, New Mexico 87107  
(505) 241-7745

### QWEST


201 Third Street NW, Suite 700  
Albuquerque, New Mexico 87103  
(505) 245-8706

### COMCAST

4611 Montbel Place NE  
Albuquerque, NM 87107  
(505) 761-6235

### CITY OF ALBUQUERQUE UTILITY DEVELOPMENT

P.O. Box 1293  
Albuquerque, New Mexico 87103  
(505) 768-2719

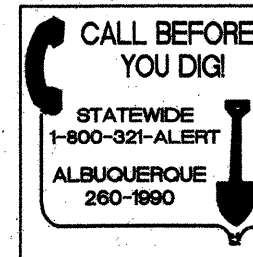

REV.	SHEETS	CITY ENGINEER	DATE	USER DEPARTMENT	DATE	USER DEPARTMENT	DATE
ENGINEERS STAMP & SIGNATURE		APPROVED		ENGINEER		DATE	
		DRC Chairman		12/2/03		APPROVED FOR CONSTRUCTION	
		Transportation		11/21/03			
		Water/Wastewater		11/25/03			
		Hydrology		01/31/04			
CIP							
Constr./Mngmt.							
Constr. Coord.							
PROJECT NUMBER				498092			
SHEET				1 OF 23			
				G1			

- 1 FIVE (5) WORKING DAYS PRIOR TO BEGINNING CONSTRUCTION, THE CONTRACTOR WILL SUBMIT A DETAILED CONSTRUCTION SCHEDULE TO THE CITY CONSTRUCTION COORDINATION DIVISION. TWO (2) DAYS PRIOR TO CONSTRUCTION, THE CONTRACTOR WILL OBTAIN A BARRICADING PERMIT FROM THE CONSTRUCTION COORDINATION DIVISION. CONTRACTOR SHALL NOTIFY BARRICADE ENGINEER (924-3400) PRIOR TO OCCUPYING AN INTERSECTION. REFER TO SECTION 19 OF SPECIFICATIONS.
- 2 THE CONTRACTOR WILL NOTIFY THE FIELD ENGINEER NOT LESS THAN SEVEN (7) DAYS PRIOR TO STARTING WORK, IN ORDER THAT THE CITY SURVEY SECTION MAY TAKE NECESSARY MEASURES TO INSURE THE PRESERVATION OF SURVEY MONUMENTS. THE CONTRACTOR WILL NOTIFY THE ENGINEER IF A MONUMENT IS DISTURBED. REPLACEMENT WILL BE DONE ONLY BY THE CITY OF ALBUQUERQUE SURVEY SECTION AT THE CONTRACTOR'S EXPENSE. WHEN A CHANGE IS MADE IN THE FINISHED ELEV. OF THE PAVEMENT OF ANY ROADWAY IN WHICH A PERMANENT SURVEY MONUMENT IS LOCATED, CONTRACTOR WILL, AT HIS OWN EXPENSE, HAVE THE CITY SURVEY SECTION ADJUST THE MONUMENT COVER TO THE NEW GRADE UNLESS OTHERWISE SPECIFIED. REFER TO SECTION 4 OF SPECIFICATIONS.
- 3 THE SPECIFICATIONS USED FOR THIS PROJECT ARE THE CITY OF ALBUQUERQUE STANDARD SPECIFICATIONS FOR PUBLIC WORKS CONSTRUCTION, 1994 EDITION, UPDATE NO.6.
- 4 ALL NEW MANHOLES SHALL BE TYPE "E" (COA DWG. 2102) UNLESS OTHERWISE NOTED ON THE PLANS.
- 5 THE CONTRACTOR WILL BE RESPONSIBLE FOR DISPOSING OF ALL DEBRIS, INCLUDING, BUT NOT LIMITED TO HAZARDOUS WASTE AT DISPOSAL SITES APPROVED BY GOVERNMENTAL AGENCIES REGULATING THE DISPOSAL OF SUCH MATERIALS.
- 6 ALL WATER VALVE BOXES AND MANHOLES IN THE STREET CONSTRUCTION ARE TO BE ADJUSTED TO FINISH GRADE AND WILL BE MEASURED AND PAID PER EACH.
- 7 SUBGRADE PREPARATION UNDER SIDEWALKS AND DRIVE PADS, AND SUBGRADE AND SUBBASE PREPARATION UNDER CURB AND GUTTER IS CONSIDERED INCIDENTAL TO THE CONSTRUCTION OF SUCH, AND NO DIRECT PAYMENT SHALL BE MADE FOR THOSE ITEMS OF WORK.
- 8 THE CONTRACTOR WILL REPLACE ANY STRIPPING THAT HAS BEEN RUINED OR REMOVED IN THE COURSE OF CONSTRUCTION.
- 9 ALL EXCAVATION WILL BE GOVERNED BY FEDERAL, STATE AND LOCAL LAWS, RULES, AND REGULATIONS CONCERNING CONSTRUCTION SAFETY AND HEALTH.
- 10 ALL SIGNS AND CODING WILL BE IN ACCORDANCE WITH THE "MANUAL OF UNIFORM TRAFFIC CONTROL DEVICES FOR STREETS AND HIGHWAYS" CURRENT EDITION PUBLISHED BY THE U.S. DEPARTMENT OF TRANSPORTATION.
- 11 THE CONTRACTOR IS TO EXERCISE CARE TO AVOID DISTURBING ANY EXISTING UNDERGROUND UTILITIES. IT WILL BE HIS RESPONSIBILITY TO COORDINATE WITH THE UTILITY COMPANIES IN ORDER TO PREVENT ANY SERVICE DISRUPTION. SEE SECTION 18 "UTILITIES", CITY OF ALBUQUERQUE, STANDARD SPECIFICATIONS FOR CONTRACTOR REQUIREMENTS.
- 12 WHEN ABUTTING NEW PAVEMENT TO EXISTING INTERSECTING STREETS, SAW CUT EXISTING PAVEMENT TO A STRAIGHT LINE AND AT RIGHT ANGLES AND REMOVE ANY BROKEN OR CRACKED PAVEMENT. NO DIRECT PAYMENT WILL BE MADE FOR SAW CUTTING.
- 13 ALL GAS VALVES, GAS MANHOLES, ELECTRICAL MANHOLES, TELEPHONE MANHOLES, AND UTILITY POLES WILL BE ADJUSTED TO GRADE BY EACH UTILITY COMPANY. CONTRACTOR WILL COORDINATE THROUGH CITY UTILITY COORDINATOR.
- 14 WHEN REMOVAL OF EXISTING CURB AND GUTTER OR SIDEWALK IS REQUIRED, REMOVE BACK TO NEAREST SUITABLE JOINT UNLESS OTHERWISE DIRECTED BY THE CITY FIELD ENGINEER.
- 15 THE CONTRACTOR WILL NOTIFY THE NEW MEXICO ONE CALL SYSTEM 260-1990 TWO (2) WORKING DAYS PRIOR TO COMMENCING WORK IN NEW AREAS.
- 16 CONTRACTOR WILL MAKE ALL WATER VALVES AND MANHOLES ACCESSIBLE TO THE CITY AT ALL TIMES.
- 17 CONTRACTOR WILL PLACE BITUMINOUS MATERIAL WITH THE USE OF A LAYDOWN MACHINE WHERE PAVEMENT IS 8 FEET IN WIDTH OR WIDER.
- 18 ALL SUBGRADE AND SUBBASE MATERIAL ENCOUNTERED IN PAVEMENT REMOVAL AND REPLACEMENT THAT IS DETERMINED BY THE FIELD ENGINEER TO MEET THE SPECIFICATIONS, CAN BE REUSED. HOWEVER, THE MATERIAL WILL BE PROCESSED AND COMPACTED TO MEET MOISTURE CONTENT AND PERCENT COMPACTION REQUIRED BY THE SPECIFICATIONS.
- 19 CONTRACTOR WILL NOT PAVE OVER ANY SURFACE FEATURE, I.E., GAS VALVE, MANHOLE COVER, ETC. WITHOUT PRIOR APPROVAL FROM THE CITY FIELD ENGINEER.
- 20 CONTRACTOR WILL CONFINE HIS WORK WITHIN THE CONSTRUCTION EASEMENT LIMITS AND/OR RIGHT-OF-WAY, OR PROVIDE COPIES OF AGREEMENTS WITH ADJACENT LANDOWNERS TO THE CITY OF ALBUQUERQUE.
- 21 ALL WATER VALVES AND FIRE HYDRANTS REMOVED TO BE SALVAGED AND RETURNED TO THE C.O.A.
- 22 MINIMUM BOTTOM WIDTH OF TRENCHES FOR RIGID PIPE SHALL BE EQUAL TO THE OUTSIDE DIAMETER PLUS 16 INCHES. BEDDING MATERIAL SHALL BE CLASS II, III, OR IV UNLESS OTHERWISE SPECIFICALLY NOTED ON THE PLANS.
- 23 MINIMUM BOTTOM WIDTH OF TRENCHES FOR NON-RIGID PIPE SHALL BE EQUAL TO THE OUTSIDE DIAMETER PLUS 12 INCHES. BEDDING MATERIAL SHALL BE CLASS I, II, OR III.
- 24 THE CONTRACTOR AGREES TO TAKE NECESSARY SAFETY PRECAUTIONS AS REQUIRED BY FEDERAL, STATE AND LOCAL AUTHORITIES TO PROTECT PEDESTRIAN AND VEHICULAR TRAFFIC IN THE CONSTRUCTION AREA, WHICH INCLUDE BUT ARE NOT LIMITED TO: MAINTAINING ADEQUATE WARNING SIGNS, BARRICADES, LIGHTS, GUARD FENCES, WALKS AND BRIDGES.
- 25 ALL STRUCTURAL CONCRETE WILL BE 4000 PSI UNLESS OTHERWISE NOTED ON PLANS.
- 26 ALL REINFORCING STEEL WILL BE GRADE 60.
- 27 ALL EXPOSED EDGES ON CAST-IN-PLACE CONCRETE STRUCTURES WILL HAVE A 1" CHAMFER UNLESS OTHERWISE NOTED.
- 28 ALL SPLICES IN REINFORCING STEEL TO BE 2-FOOT 6-INCH MINIMUM UNLESS OTHERWISE NOTED.

- 29 PRIOR TO CONSTRUCTION, THE CONTRACTOR WILL EXCAVATE AND VERIFY THE HORIZONTAL AND VERTICAL LOCATIONS OF ALL POTENTIAL CONFLICTING UTILITIES. SHOULD A CONFLICT EXIST BETWEEN THE FIELD INFORMATION AND THE PLANS, THE CONTRACTOR WILL NOTIFY THE FIELD ENGINEER SO THE CONFLICT CAN BE RESOLVED WITH MINIMUM AMOUNT OF DELAY.
- 30 THE REPLACEMENT OF THE EXISTING UTILITIES AND THE INSTALLATION OF NEW UTILITY LINES WILL BE COMPLETED IN ADVANCE OF STARTING THE PAVEMENT WORK. TEMPORARY PAVEMENT WILL BE PLACED IN ALL TRENCHES REQUIRED FOR THE UTILITY REPLACEMENTS IN THOSE AREAS THAT MUST MAINTAIN TRAFFIC UNTIL THE FINAL PAVEMENT WORK STARTS IN EACH AREA. TEMPORARY STRIPING SHALL BE THE CONTRACTOR'S RESPONSIBILITY. MAINTENANCE OF THE TEMPORARY PAVING AND STRIPING WILL BE AT THE CONTRACTOR'S EXPENSE.
- 31 TACK COAT FOR SURFACE COURSE REQUIREMENTS WILL BE DETERMINED BY THE FIELD ENGINEER.
- 32 THE CONTRACTOR WILL CONTACT THE CITY OF ALBUQUERQUE TRAFFIC DIVISION 857-8025, ONE (1) WEEK IN ADVANCE OF ANY CHANGES REQUIRED IN THE TRAFFIC SIGNALIZATION OF THIS PROJECT. ALL WORK ASSOCIATED WITH NEW TRAFFIC SIGNALIZATION SHALL BE THE RESPONSIBILITY OF THE CONTRACTOR.
- 33 ALL NEW STREET PAVING, DRIVEWAYS, SIDEWALKS, AND CURB AND GUTTERS, ABUTTING EXISTING AREAS SHALL MATCH THE ELEVATION OF THOSE AREAS.
- 34 PERMANENT PAVEMENT STRIPING AND MARKINGS WILL BE PLACED BY THE CONTRACTOR. ROAD SHALL NOT BE OPENED TO TRAFFIC UNTIL IT IS STRIPED. ALL STRIPING, PAVEMENT MARKINGS INCLUDING CROSSWALKS, ARROWS AND LINE MARKINGS ARE TO BE CONSTRUCTED OF HOT PLASTIC OR COLD PLASTIC IN ACCORDANCE WITH THE MANUAL OF UNIFORM TRAFFIC CONTROL DEVICES.
- 35 ALL EXCAVATED MATERIAL THAT IS NOT REQUIRED TO BE REUSED MUST BE REMOVED FROM THE PROJECT AREA WITHIN FOUR DAYS OF EXCAVATION. SPOIL PILES WILL BE ALLOWED ONLY AS DIRECTED BY THE CITY FIELD ENGINEER.
- 36 THE CONTRACTOR WILL COORDINATE THE CONSTRUCTION ACTIVITIES WITH ALL OTHER CONTRACTORS AND UTILITY COMPANIES WORKING IN THE SAME AREA. THE CONTRACTOR MAY BE REQUIRED TO RESCHEDULE THEIR ACTIVITIES TO ALLOW UTILITY CREWS TO PERFORM THEIR REQUIRED WORK. NO ADDITIONAL COMPENSATION WILL BE ALLOWED FOR DELAYS OR INCONVENIENCE CAUSED BY UTILITY COMPANY WORK CREWS. A CONTRACT EXTENSION MAY BE ALLOWED AS DELINEATED IN CITY OF ALBUQUERQUE STANDARD SPECIFICATIONS.
- 37 ALL CONSTRUCTION EASEMENTS ON PRIVATE PROPERTY WILL BE OBTAINED BY THE CITY OF ALBUQUERQUE PRIOR TO THE BEGINNING OF CONSTRUCTION.
- 38 EXISTING MEDIAN CURB AND GUTTER AND STANDARD CURB AND GUTTER, NOT DISTURBED BY CONTRACTOR, BUT OUT OF ALIGNMENT, DISPLACED VERTICALLY, BADLY BROKEN AND/OR DETERIORATED, WILL BE REPLACED AS DIRECTED BY THE FIELD ENGINEER AND PAID FOR AT CONTRACT UNIT PRICES.
- 39 ALL TRAFFIC CONTROL DEVICES REQUIRED FOR DRIVEWAY CLOSURES, UTILITY CONSTRUCTION OR FOR OTHER REASONS AND NOT SHOWN ON THE SIGNING PLANS WILL BE FURNISHED BY THE CONTRACTOR AND WILL BE PAID AS SPECIFIED IN THE TECHNICAL SPECIFICATIONS AND BID PROPOSAL. PRIOR TO PLACING THE TRAFFIC CONTROL DEVICES, THE CONTRACTOR WILL NOTIFY THE AFFECTED OWNERS IN ACCORDANCE WITH THE SPECIFICATIONS. CONTRACTOR MUST MAKE PROVISIONS TO PROVIDE ACCESS TO PROPERTIES. REFER TO SECTION 19 OF THE SPECIFICATIONS.
- 40 ALL UTILITY LINES WHICH ARE NOT SPECIFICALLY DESIGNATED TO BE REMOVED AND REPLACED ON THE PLANS, WILL BE MAINTAINED IN SERVICE. SHORING, SHEETING AND OTHER MEANS OF SUPPORT SHALL BE EMPLOYED BY THE CONTRACTOR TO PREVENT DAMAGE OR LOSS OF THESE EXISTING UTILITIES AND THESE SHORING, SHEETING, AND SUPPORTS ARE CONSIDERED INCIDENTAL TO THIS PROJECT. BEAM AND CABLE OR OTHER ADEQUATE SUPPORTS WILL BE USED FOR TEMPORARY SUPPORT OF ALL UTILITY LINES WHICH CROSS THE TRENCH. ANY DAMAGE TO EXISTING UTILITIES WILL PROMPTLY BE REPAIRED AT THE CONTRACTOR'S EXPENSE. THE CONTRACTOR WILL NOTIFY THE ENGINEER IMMEDIATELY OF ANY SIGNIFICANT DEVIATION OF EXPOSED UTILITIES FROM THE LOCATIONS SHOWN ON THE PLANS SO THAT CONFLICTS CAN BE RESOLVED IN A TIMELY MANNER.
- 41 THE CONTRACTOR WILL ASSUME RESPONSIBILITY FOR ANY DAMAGE TO EXISTING COA INFRASTRUCTURE (C & G, PAVING, ETC.) DURING CONSTRUCTION, APART FROM THOSE SECTIONS INDICATED FOR REMOVAL ON THE PLANS, AND WILL REPAIR OR REPLACE SAME AT HIS OWN EXPENSE. HE WILL SUITABLY PROTECT THE CURB AND GUTTER FROM INCIDENTAL SPLASHING DURING THE TACK COAT APPLICATION AND WILL BE RESPONSIBLE FOR CLEANING SAME AT HIS OWN COST SHOULD SPLASHING OCCUR.
- 42 ALL INTERFERING PORTIONS OF ABANDONED UTILITY LINES WHICH ARE EXPOSED AS A RESULT OF CONSTRUCTION WILL BE REMOVED AND DISPOSED OF BY THE CONTRACTOR.
- 43 STATIONS OF STORM DRAIN INLETS ARE TO THE CENTER OF GRATE. ALL STORM DRAIN INLETS WILL BE TYPE "A" UNLESS OTHERWISE NOTED ON THE PLANS.
- 44 SHORING COSTS WILL BE CONSIDERED INCIDENTAL TO THE TRENCH AND BACKFILL COSTS.
- 45 THE CONTRACTOR WILL BE RESPONSIBLE FOR SECURING NPDES PERMITS REQUIRED BY APPLICABLE CITY, STATE, AND FEDERAL REGULATIONS.
- 46 ALL STORM DRAIN AND CONNECTOR PIPE WILL BE CLASS IV REINFORCED CONCRETE PIPE UNLESS OTHERWISE NOTED ON THE PLANS.
- 47 THE TERM REMOVE USED IN THIS PLAN SET INCLUDES THE DISPOSAL OF SAID MATERIAL IN ACCORDANCE WITH CITY OF ALBUQUERQUE SPECIFICATIONS, LATEST EDITION.
- 48 CONTRACTOR WILL SURVEY AND LOG EXISTING ELEVATIONS OF CURB-AND-GUTTER, SIDEWALK, AND PAVEMENT WHICH WILL BE REMOVED FOR CONSTRUCTION OF IMPROVEMENTS. CONTRACTOR WILL REPLACE REMOVED CURB-AND-GUTTER, SIDEWALK, DRIVE PADS, AND PAVEMENT TO ELEVATIONS PRIOR TO REMOVAL UNLESS OTHERWISE INDICATED ON THE PLANS.
- 49 CONTRACTOR WILL CONSTRUCT TEMPORARY ASPHALT PAVEMENT AS DIRECTED BY THE FIELD ENGINEER TO PROVIDE ACCESS TO LOCAL BUSINESS, ETC. TEMPORARY PAVEMENT SHALL BE REMOVED AND DISPOSED OF PRIOR TO PLACEMENT OF FULL WIDTH PAVEMENT SECTION. TEMPORARY PAVING SHALL BE PER COA STD. DWG. 2415 AND PAID FOR PER COA STD. SPECIFICATIONS.

- 50 ALL CLASSES OF SEEDING SHALL BE DRY LAND MIX PLACED AT 1.5 LBS/1000 S.F. WITH FERTILIZER 21-12-12 PLACED AT 5 LBS/1000 S.F.
- 51 ALL ASPHALTIC CONCRETE SHALL BE MINIMUM 1800 LB. STABILITY AND COMPACTED TO 95% MODIFIED MARSHALL DENSITY UNLESS OTHERWISE NOTED ON THE PLANS.
- 52 ANY WORK OCCURRING WITHIN AN ARTERIAL ROADWAY REQUIRES TWENTY-FOUR (24) HOUR CONSTRUCTION.
- 53 ALL EXCAVATION, TRENCHING AND SHORING ACTIVITIES MUST BE CARRIED-OUT IN ACCORDANCE WITH OSHA 29 CFR 1926.650 SUBPART P.
- 54 THE CONTRACTOR SHALL BE RESPONSIBLE FOR TIMING AND COORDINATION OF WATER SHUTOFF AT LEAST SEVEN (7) WORKING DAYS PRIOR TO CONSTRUCTION. CONTRACTOR SHALL CONTACT THE WATER SYSTEMS DIVISION, 857-8200, TO INITIATE IMPLEMENTATION OF THE NON-PRESSURIZED CONNECTION PLAN.
- 55 FOR STORM DRAIN CONSTRUCTION, RCP PIPE JOINTS SHALL NOT BE GROUTED PRIOR TO FINAL INSPECTION. FINAL INSPECTION WILL DETERMINE JOINTS TO BE GROUTED FOR FINAL ACCEPTANCE OF THE CONSTRUCTION.
- 56 CONTRACTOR SHALL MAINTAIN A GRAFFITI-FREE WORK SITE. CONTRACTOR SHALL PROMPTLY REMOVE ANY AND ALL GRAFFITI FROM EQUIPMENT, WHETHER PERMANENT OR TEMPORARY.



EXISTING FEATURES LEGEND:

- o — EXISTING WOOD POST FENCE
- x — EXISTING CHAIN-LINK FENCE
- 2" HPG — EXISTING GAS LINE W/ VALVE
- 6" W — EXISTING WATERLINE W/ VALVE
- ⊗ EXISTING WATERLINE METER
- ⊙ EXISTING FIRE HYDRANT
- 8" SAS — EXISTING SANITARY SEWER LINE W/ MANHOLE
- 36" RCP — EXISTING STORM DRAIN
- OHE — EXISTING OVERHEAD ELECTRIC W/POLE
- UE — EXISTING UNDERGROUND ELECTRIC
- 1' — EXISTING 1' CONTOUR
- 4945 — EXISTING 5' CONTOUR
- ===== EXISTING CURB & GUTTER
- ===== EXISTING CONCRETE
- — EXISTING BUILDING LINE
- — EXISTING EASEMENT LINE
- S — EXISTING SPRINKLER HEAD


NEW FEATURES LEGEND:

- — CONSTRUCTION CENTERLINE
- x — NEW CHAIN-LINK FENCE
- 2" HPG — NEW GAS LINE W/ VALVE
- 6" W — NEW WATERLINE W/ VALVE
- ⊗ NEW WATERLINE METER
- ⊙ NEW FIRE HYDRANT
- 8" SAS — NEW SANITARY SEWER LINE W/ MANHOLE
- NEW STORM DRAIN W/ MH
- NEW UTILITY POLE
- 1' — NEW 1' CONTOUR
- 4945 — NEW 5' CONTOUR
- ===== NEW CURB & GUTTER
- ===== NEW CONCRETE
- — NEW EASEMENT LINE
- 1' — POT HOLE LOCATION W/ NO.
- ===== NEW EDGE OF PAVEMENT

 **CONSENSUS PLANNING, INC.**  
Planning / Landscape Architecture  
924 Park Avenue SW  
Albuquerque, NM 87102  
(505) 764-9801 Fax 842-5495  
e-mail: cp@consensusplanning.com

CITY OF ALBUQUERQUE DEPARTMENT OF MUNICIPAL DEVELOPMENT PARK AND MEDIAN DESIGN DIVISION	
TITLE: MANZANO MESA PARK GENERAL NOTES	
 CITY ENGINEER	 CITY ENGINEER
City Project No. 498092	Sheet 2 of 23

AS BUILT INFORMATION		BENCH MARKS		SURVEY INFORMATION		ENGINEERS SEAL	
CONTRACTOR	DATE	CONTRACTOR	DATE	FIELD NOTES	DATE	NO.	DATE
WORK STARTED BY	DATE	WORK STARTED BY	DATE	BY	DATE	NO.	DATE
ACCEPTANCE BY	DATE	ACCEPTANCE BY	DATE	NO.	DATE	NO.	DATE
FIELD INSPECTION BY	DATE	FIELD INSPECTION BY	DATE	NO.	DATE	NO.	DATE
DRAWINGS CORRECTED BY	DATE	DRAWINGS CORRECTED BY	DATE	NO.	DATE	NO.	DATE
RECORDED BY	DATE	RECORDED BY	DATE	NO.	DATE	NO.	DATE
NO.	DATE	NO.	DATE	NO.	DATE	NO.	DATE

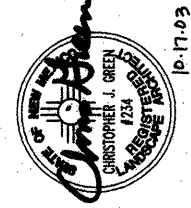

10-17-03

REVISIONS	BY	DATE
DESIGN	CG	10/16
DRAWN BY	MA	10/16
CHECKED BY	CG	10/16

SOUTHERN BOULEVARD SE  
(156' R.O.W.)

GENERAL NOTES

- CONTRACTOR TO REVIEW AND COORDINATE ALL CONTRACT DOCUMENTS.
- CONTRACTOR TO NOTIFY LANDSCAPE ARCHITECT OF ANY DISCREPANCIES IN CONTRACT DOCUMENTS.
- CONTRACTOR TO NOTIFY LANDSCAPE ARCHITECT OF ANY DISCREPANCIES BETWEEN CONTRACT DOCUMENTS AND FIELD CONDITIONS.
- CONTRACTOR TO REFER TO ANNOTATED DIMENSIONS ONLY. CONTRACTOR NOT TO SCALE OFF DRAWINGS.
- LARGER SCALE DRAWINGS TAKE PRECEDENCE OVER SMALLER SCALE, TYP.
- CONTRACTOR SHALL COORDINATE WITH PARK MANAGEMENT REGARDING PROVISIONS FOR MOWER ACCESS.

KEYED NOTES

- EXISTING TRANSFORMER TO REMAIN.
- TERMINATION POINT OF EXISTING SIDEWALK.
- EXISTING CURB AND GUTTER TO REMAIN.
- EXISTING SIDEWALK TO REMAIN.
- EXISTING CURB AND GUTTER TO BE REMOVED BACK TO TANGENT POINT.
- EXISTING ASPHALT CURB TO BE REMOVED.
- EXISTING METAL GATE TO REMAIN.
- BOLLARDS. SEE 8/55.
- CONCRETE SPEED CONTROL BUMP. SEE CIVIL SHEETS.
- CONCRETE SIDEWALK, C.O.A. STANDARD DWG. NO. 2480.
- TURN-DOWN CONCRETE SIDEWALK WITH TOOLED CURB JOINT.
- ACCESSIBLE RAMP. SEE SHEET 9.
- REFUSE ENCLOSURE. SEE 5/55.
- PRECAST CONC. WHEEL STOPS TYPICAL AT ALL ACCESSIBLE PARKING SPACES. INSTALL WITH #6 18" SPIKES. INSTALL 18" CLEAR FROM END OF STALL.
- PROPERTY LINE.
- CENTERLINE OF RIGHT-OF-WAY.
- BICYCLE LOOPS. SEE SITE AMENITIES SCHEDULE SHEET 54.
- BENCH, TYP. SEE SITE AMENITIES SCHEDULE SHEET 54.
- CURB AND GUTTER, SEE SHEET 10.
- CONCRETE SIDEWALK INTEGRALLY COLORED W/ROCK SALT FINISH TO MATCH EXISTING.
- ASPHALT PAVEMENT. SEE CIVIL SHEETS.
- POLE MOUNTED H.C. SIGN. SEE DETAIL 3/55.
- CONCRETE MONSTRIP (6" X 6"), SEE C.O.A. STANDARD DRAWING, 2726.
- DEPRESSED CONCRETE SIDEWALK, FLUSH WITH H.C. PARKING ACCESS POINTS. SEE SHEET 13.
- PAINTED ACCESSIBILITY SYMBOL, SEE 2/55.
- LITTER RECEPTACLE, TYP. SEE SITE AMENITIES SCHEDULE, SHEET 54.
- SOCCER GOALS, SEE SITE AMENITIES SCHEDULE SHEET 54.
- LANDSCAPE BOULDERS, SEE LANDSCAPE PLANS.
- PUBLIC UTILITY EASEMENT.
- WATERLINE EASEMENT.
- SANITARY SEWER EASEMENT.
- PLAYGROUND AREA, SEE ENLARGED PLAN ON SHEET 55.
- 5' x 5' TREE WELL.
- PICNIC TABLES, SEE SITE AMENITIES SCHEDULE, SHEET 54.
- 35 SIDEWALK BASEMENT. #2003216722, Bk. A61, Pg. 6265.



**CONSensus PLANNING, INC.**  
Planning / Landscape Architecture  
924 Park Avenue SW  
Albuquerque, NM 87102  
(505) 764-9801 Fax 842-5495  
e-mail: cp@consensusplanning.com

CITY OF ALBUQUERQUE  
DEPARTMENT OF MUNICIPAL DEVELOPMENT  
PARK AND MEDIAN DESIGN DIVISION

TITLE: MANZANO MESA PARK  
SITE PLAN



City Project No. 498092 Zone Map No. L-21 Sheet 3 of 23  
S1

AS-BUILT INFORMATION	
CONTRACTOR	DATE
WORKED BY	DATE
INSPECTED BY	DATE
FIELD VERIFICATION BY	DATE
CORRECTED BY	DATE
MICRO-FILM INFORMATION	
RECORDED BY	DATE
NO.	


BENCH MARKS	
NO.	DATE
BY	

SURVEY INFORMATION	
NO.	DATE
BY	


ENGINEERS SEAL	
NO.	DATE
BY	




REMARKS	
NO.	DATE
BY	
DESIGNED BY	CG DATE 10/16
DRAWN BY	MA DATE 10/16
CHECKED BY	CG DATE 10/16

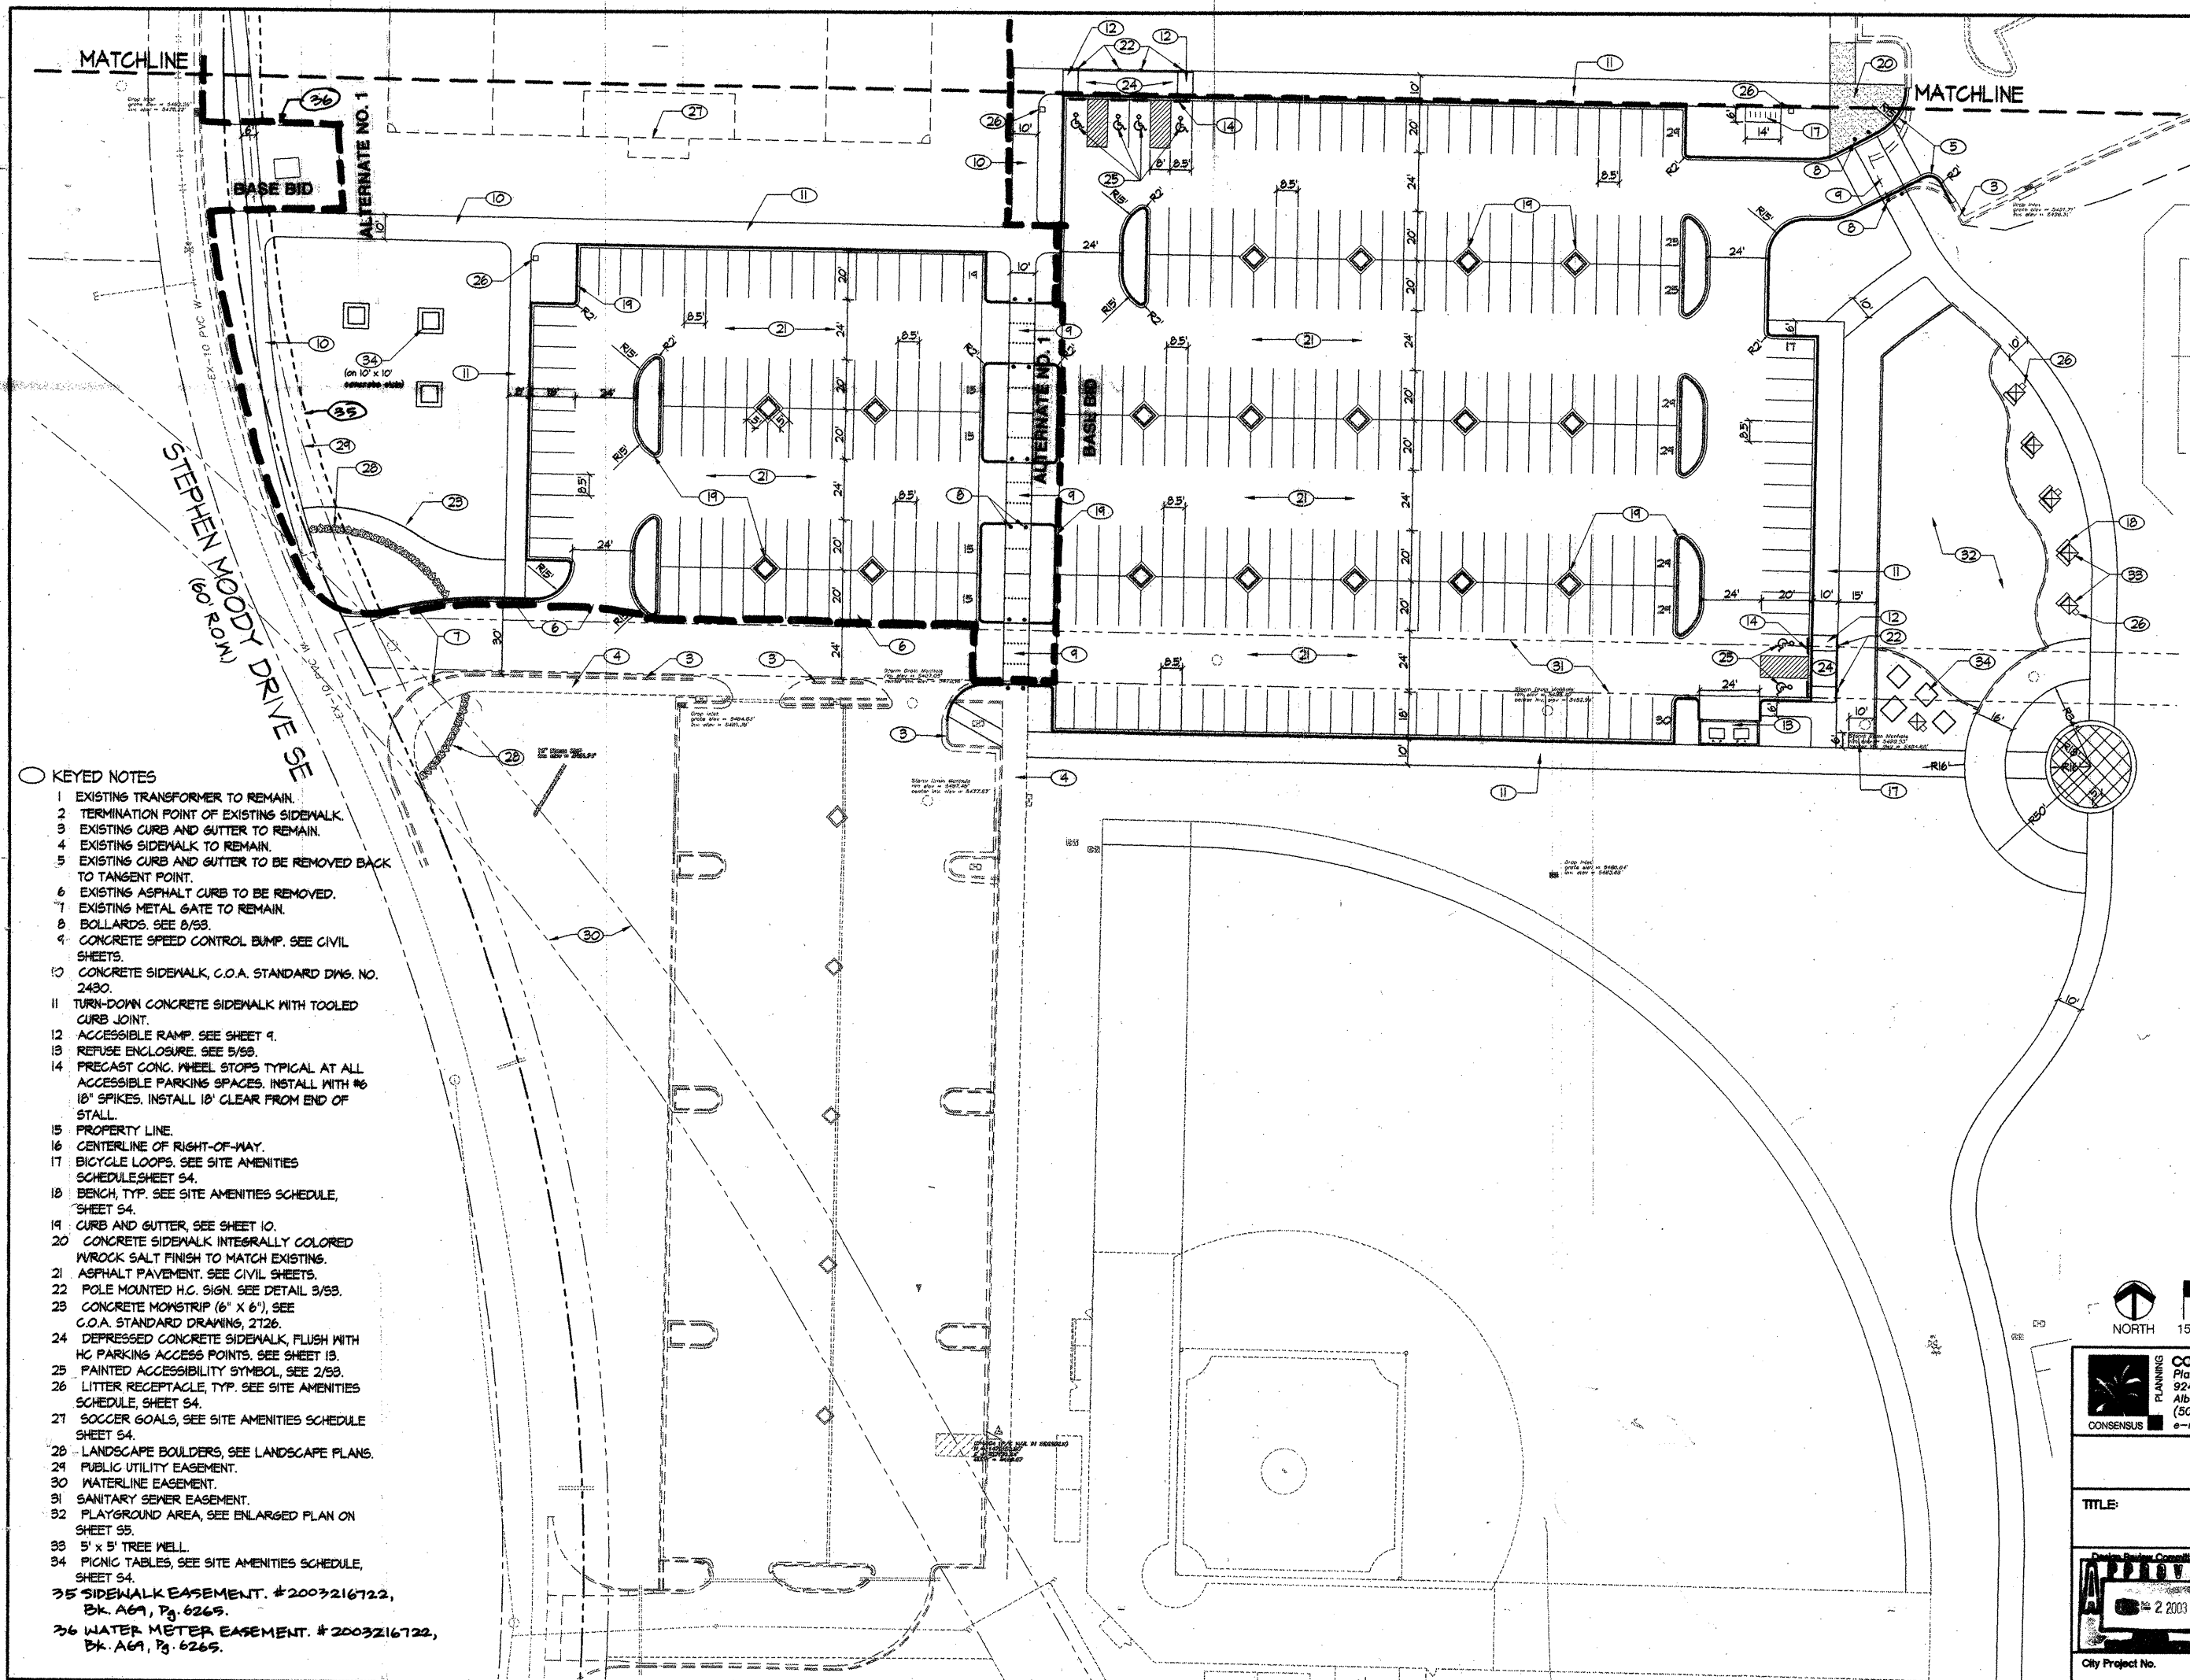[illegible]


NOTE: FOR EXPANSION JOINTS, SEE C.O.A. DETAIL 2451 TYPE 5, WHICH INCLUDES CONT. SEALANT

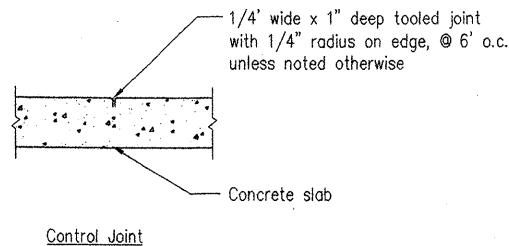


1 CONCRETE JOINTS N.T.S.

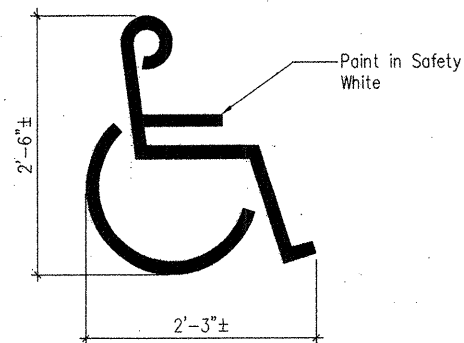


2 PAVEMENT MARKING N.T.S.

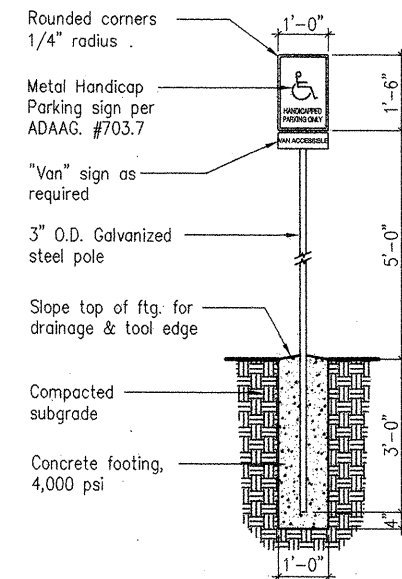


3 H.C. SIGN N.T.S.

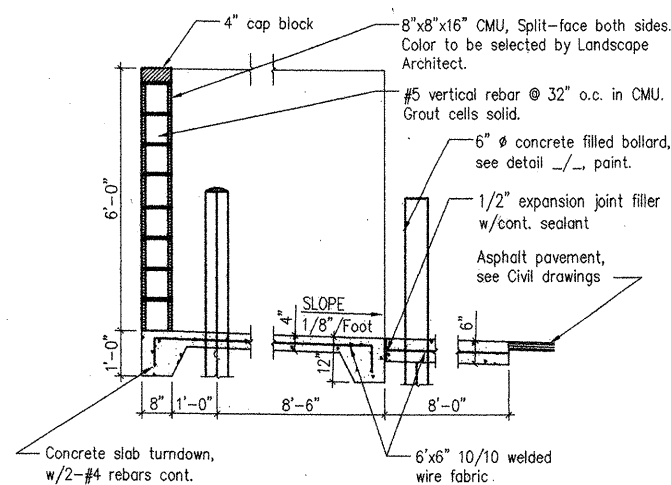


4 ENCLOSURE SECTION N.T.S.

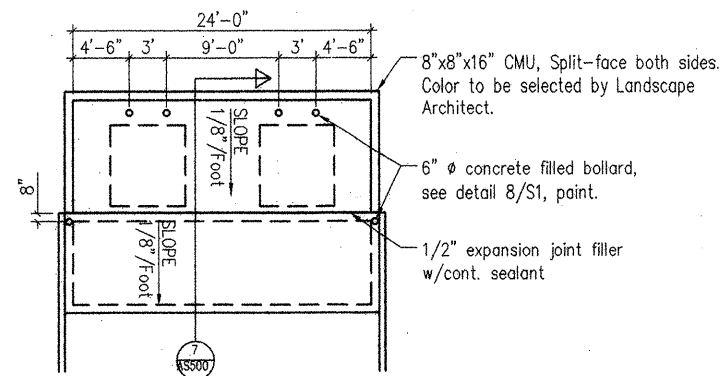


5 ENCLOSURE PLAN N.T.S.

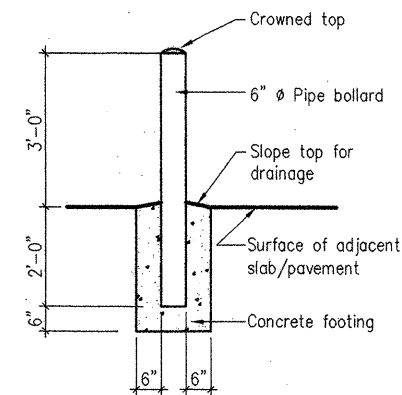

6 REFUSE ENCLOSURE BOLLARD N.T.S.

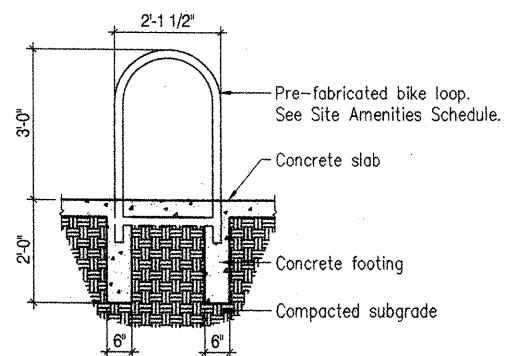

7 BICYCLE LOOP N.T.S.

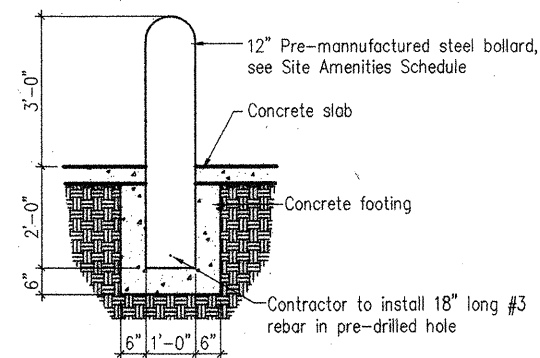

8 WALKWAY BOLLARD DETAIL N.T.S.

**CONSENSUS PLANNING, INC.**  
Planning / Landscape Architecture  
924 Park Avenue SW  
Albuquerque, NM 87102  
(505) 764-9801 Fax 842-5495  
e-mail: cp@consensusplanning.com

CITY OF ALBUQUERQUE  
DEPARTMENT OF MUNICIPAL DEVELOPMENT  
PARK AND MEDIAN DESIGN DIVISION


TITLE: MANZANO MESA PARK  
SITE DETAILS

APPROVE DATE: 2-2003 CITY ENGINEER	APPROVE DATE: 2-2003 CITY ENGINEER	No. / Day / Yr.	

City Project No. 498092 Zone Map No. L-21 Sheet 5 of 23 S3

AS BUILT INFORMATION				BENCH MARKS				SURVEY INFORMATION				ENGINEER'S SEAL			
CONTRACTOR	NO.	DATE	NO.	NO.	DATE	NO.	DATE	NO.	DATE	NO.	DATE	NO.	DATE	NO.	DATE
INSPECTOR'S	NO.	DATE	INSPECTOR'S	NO.	DATE	INSPECTOR'S	NO.	DATE	INSPECTOR'S	NO.	DATE	INSPECTOR'S	NO.	DATE	INSPECTOR'S
FIELD	NO.	DATE	FIELD	NO.	DATE	FIELD	NO.	DATE	FIELD	NO.	DATE	FIELD	NO.	DATE	FIELD
VERIFICATION	NO.	DATE	VERIFICATION	NO.	DATE	VERIFICATION	NO.	DATE	VERIFICATION	NO.	DATE	VERIFICATION	NO.	DATE	VERIFICATION
BY	NO.	DATE	BY	NO.	DATE	BY	NO.	DATE	BY	NO.	DATE	BY	NO.	DATE	BY
CONTRACTOR	NO.	DATE	CONTRACTOR	NO.	DATE	CONTRACTOR	NO.	DATE	CONTRACTOR	NO.	DATE	CONTRACTOR	NO.	DATE	CONTRACTOR
MICRO-FILM INFORMATION				REVISIONS				DESIGN				REVISIONS			
RECORDED BY	NO.	DATE	RECORDED BY	NO.	DATE	RECORDED BY	NO.	DATE	RECORDED BY	NO.	DATE	RECORDED BY	NO.	DATE	RECORDED BY
NO.			NO.			NO.			NO.			NO.			NO.



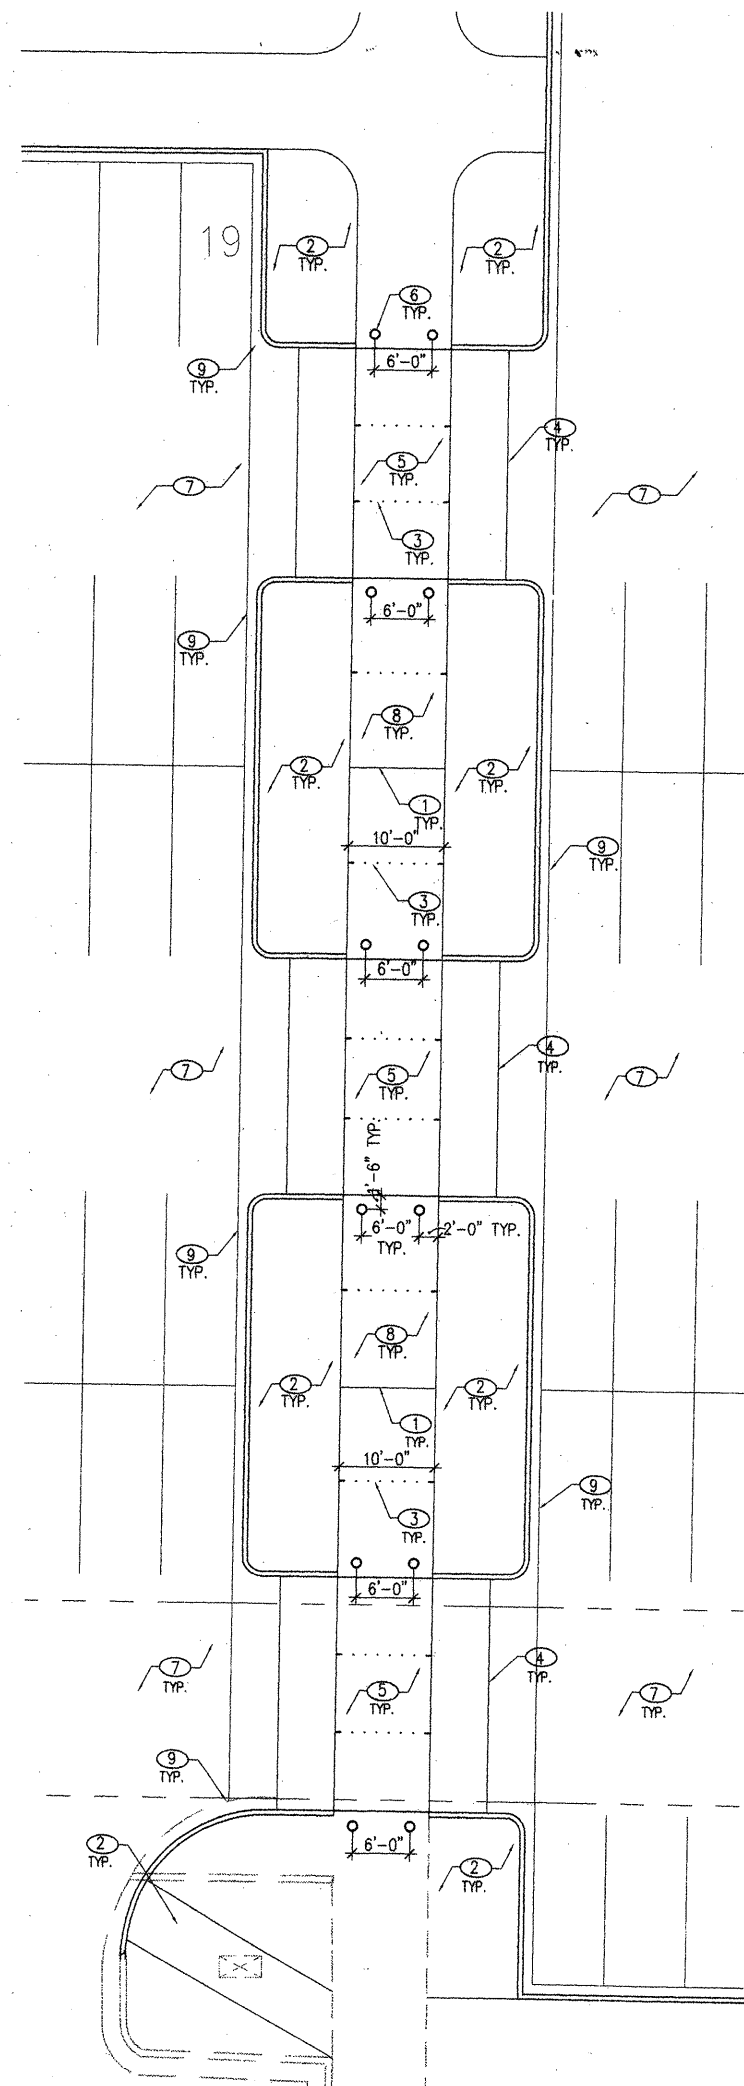

### GENERAL NOTES

- A CONTRACTOR TO REVIEW AND COORDINATE ALL CONTRACT DOCUMENTS.
  - B CONTRACTOR TO NOTIFY LANDSCAPE ARCHITECT OF ANY DISCREPANCIES IN CONTRACT DOCUMENTS
  - C CONTRACTOR TO NOTIFY LANDSCAPE ARCHITECT OF ANY DISCREPANCIES BETWEEN CONTRACT DOCUMENTS AND FIELD CONDITIONS.
  - D CONTRACTOR TO REFER TO ANNOTATED DIMENSIONS ONLY. CONTRACTOR NOT TO SCALE OFF DRAWINGS.
  - E LARGER SCALE DRAWINGS TAKE PRECEDENCE OVER SMALLER SCALE, TYP.
- KEYED NOTES
- 1 CONCRETE EXPANSION JOINT, TYPE 5, C.O.A. STANDARD DWG. 2451.
  - 2 PLANTING AREA. SEE LANDSCAPE SHEETS.
  - 3 CONTROL JOINT, SEE DETAIL 1/S3, TYP.
  - 4 CONCRETE SPEED CONTROL BUMP RAMP. SEE CIVIL DWGS. BROOM FINISH.
  - 5 CONCRETE SPEED CONTROL BUMP TOP SURFACE. SEE CIVIL DWGS. BROOM FINISH W/4" SMOOTH TROWELLED EDGE AROUND EACH PANEL.
  - 6 BOLLARDS. SEE DETAIL 9/S3.
  - 7 ASPHALT PAVING. SEE CIVIL SHEETS.
  - 8 CONCRETE SIDEWALK BROOM FINISH W/4" SMOOTH TROWELLED EDGE AROUND EACH PANEL, TYP. SEE CIVIL SHEETS AND SITE PLAN, TYP.
  - 9 C.O.A. STANDARD CURB AND GUTTER, TYP.


### SITE AMENITIES SCHEDULE

QTY.	MODEL #	DESCRIPTION	MANUFACTURER
10	BL1436	36" Bike Loop Color: Blue	Wabash Valley
16	B-2	12" Bollards Color: Royal Blue	FairWeather
7	RSO-25	Litter Receptacle. Color: Green	McClintock Metal Fabricators
8	CW8560	6' Bench w/back & armrests Color: Green	Wabash Valley
2 pr.	2237-01	Soccer Goals -- Steel w/end frames (portable)	Patterson Williams
2 pr.	8346-31	Premium Grade Soccer Net	Patterson Williams
2 pr.	8367	Soccer Goals Anchors w/neoprene caps	Patterson Williams
3	5506	6' Picnic Table w/surface mount adapter. Color: Cranberry	Wabash Valley
1	5511	8' Handicap Accessible Picnic Table w/Anti-Vandalism bar, and surface mounted adapter. Color: Cranberry	Wabash Valley

 **PLANNING** **CONSENSUS PLANNING, INC.**  
Planning / Landscape Architecture  
924 Park Avenue SW  
Albuquerque, NM 87102  
(505) 764-9801 Fax 842-5495  
e-mail: [co@consensusplanning.com](mailto:co@consensusplanning.com)

CITY OF ALBUQUERQUE  
DEPARTMENT OF MUNICIPAL DEVELOPMENT  
PARK AND MEDIAN DESIGN DIVISION

TITLE: MANZANO MESA PARK  
CROSSWALK PLAN/AMENITIES SCHEDULE

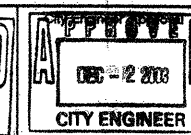

Last Design Update	Mo. / Day / Yr.		Mo. / Day /	


City Project No.	498092	Zone Map No.	21	Sheet	6	of	23
						S4	



POINT	NORTHING	EASTING
P-1	1474570.18	417569.85
P-2	1474552.68	417576.85
P-3	1474526.80	417554.09
P-4	1474526.80	417589.09
P-5	1474493.82	417576.96
P-6	1474483.62	417593.44



- A CONTRACTOR TO REVIEW AND COORDINATE ALL CONTRACT DOCUMENTS.
- B CONTRACTOR TO NOTIFY LANDSCAPE ARCHITECT OF ANY DISCREPANCIES IN CONTRACT DOCUMENTS
- C CONTRACTOR TO NOTIFY LANDSCAPE ARCHITECT OF ANY DISCREPANCIES BETWEEN CONTRACT DOCUMENTS AND FIELD CONDITIONS.
- D CONTRACTOR TO REFER TO ANNOTATED DIMENSIONS ONLY. CONTRACTOR NOT TO SCALE OFF DRAWINGS.
- E LARGER SCALE DRAWINGS TAKE PRECEDENCE OVER SMALLER SCALE, TYP.

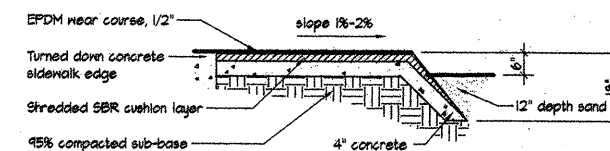- 1 CONCRETE EXPANSION JOINT, TYPE 5, C.O.A. STANDARD DWS. 2451.
- 2 CONTROL JOINT, SEE DETAIL 1/51, TYP.
- 3 PLANTING AREA, SEE LANDSCAPE SHEETS.
- 4 CONCRETE SIDEWALK W/INTEGRAL COLOR (GC CONSTRUCTION PRODUCTS-LIGHT OAK) - BROOM FINISH W/4" SMOOTH TROWELLED EDGE AROUND EACH 5' X 5' PANEL, TYP.
- 5 CONCRETE SIDEWALK W/INTEGRAL COLOR (GC CONSTRUCTION PRODUCTS-CRANBERRYBROOM FINISH.
- 6 CONCRETE SIDEWALK, BROOM FINISH.
- 7 RESILIENT SURFACING, POURED IN-PLACE RUBBER WITH 1/2" EPDM WEAR COURSE. THICKNESS OF SURFACE SHALL BE 3-INCH. COLOR SHALL BE 50% BLUE AND 50% BLACK.
- 8 TURNDOWN SLAB AT SAND PLAY AREA, C.O.A. STANDARD DWS. 212B.
- 9 EDGER WALL AT SAND PLAY AREA, C.O.A. STANDARD DWS. 212A.
- 10 5' x 5' TREE WELL.
- 11 SAND AREA - 12" DEPTH.
- 12 BENCH, SEE SITE AMENITIES SCHEDULE, SHEET S4.
- 13 LITTER RECEPTACLE, SEE SITE AMENITIES SCHEDULE, SHEET S4.
- 14 BICYCLE LOOPS, SEE SITE AMENITIES SCHEDULE, SHEET S4.
- 15 PICNIC TABLE, SEE SITE AMENITIES SCHEDULE, SHEET S4.
- 16 EXISTING SAS MANHOLE.
- 17 EXISTING STORMDRAIN MANHOLE.
- 18 EXISTING 20' SAS EASEMENT.
- 19 6" THICKENED CONCRETE SIDEWALK FOR MAINTENANCE ACCESS.




### Safety Surface Detail

NO SCALE

 PLANNING CONSENSUS	CONSENSUS PLANNING, INC. Planning / Landscape Architecture 924 Park Avenue SW Albuquerque, NM 87102 (505) 764-9801 Fax 842-5495 e-mail: cp@consensusplanning.com		NO. DATE	DESIGNED BY DRAWN BY
	CITY OF ALBUQUERQUE DEPARTMENT OF MUNICIPAL DEVELOPMENT PARK AND MEDIAN DESIGN DIVISION			
TITLE: MANZANO MESA PARK PLAYGROUND PLAN/DETAILS				
City Engineer Approval 	City Engineer Approval 	Last Design Update	No. / Day / Yr.	No. / Day / Yr.
City Project No. 498092	Zone Map No. L-21	Sheet 7	of S5	23



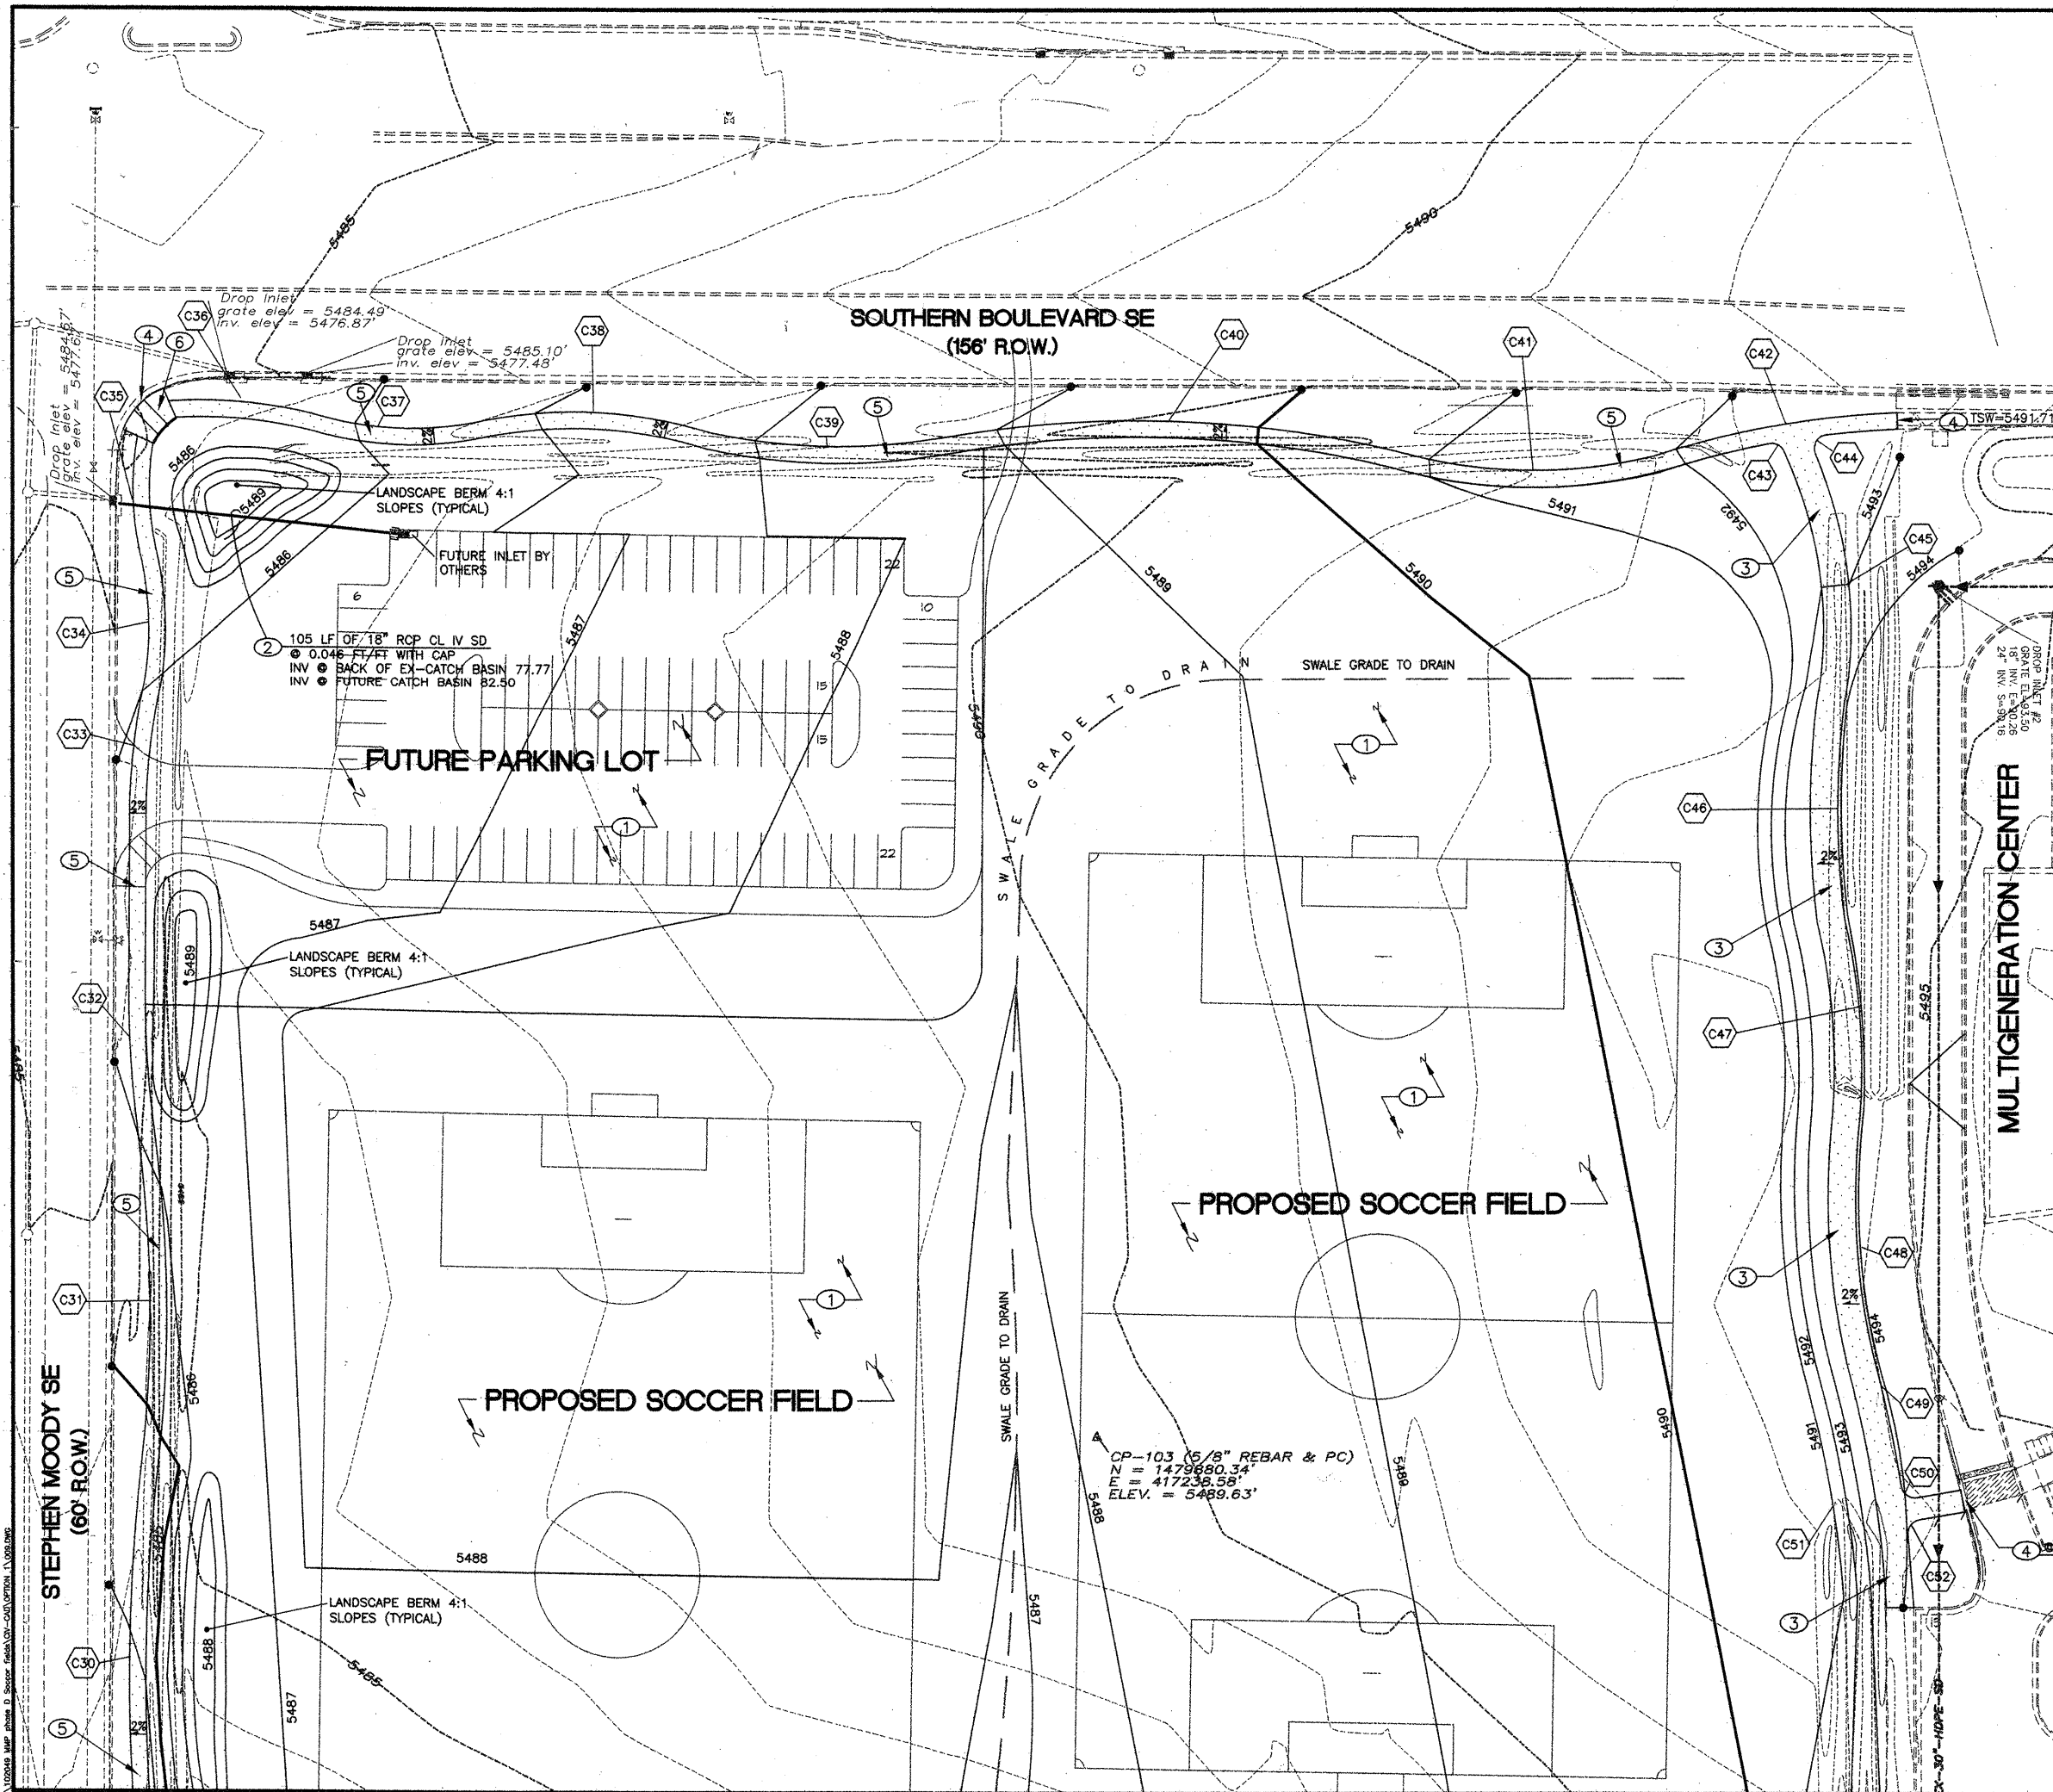


### KEYED NOTES:

1. GRADE SITE TO CONTOURS AND SPOT ELEVATION SHOWN.
2. INSTALL 18" RCP CLASS IV STORM DRAIN PIPE, @ SLOPE AS SHOWN IN THIS SHEET.
3. CONSTRUCT NEW 10' WIDE SIDEWALK PER C.O.A. STD. DWG 2430, SLOPE 2% TOWARDS SOCCER FIELDS.
4. MATCH EXISTING ELEVATIONS.
5. CONSTRUCT NEW 6' WIDE SIDEWALK PER C.O.A. STD. DWG 2430, SLOPE 2% AS SHOWN IN THESE PLANS.
6. CONSTRUCT HANDICAP RAMP PER DETAIL THIS SHEET.


### NOTES:

1. FOR CURVE DATA SEE TABLE SHEET 10 OF 20
2. CURVE DATA FOR OUTSIDE EDGE OF SIDEWALK UNLESS OTHERWISE SHOWN.

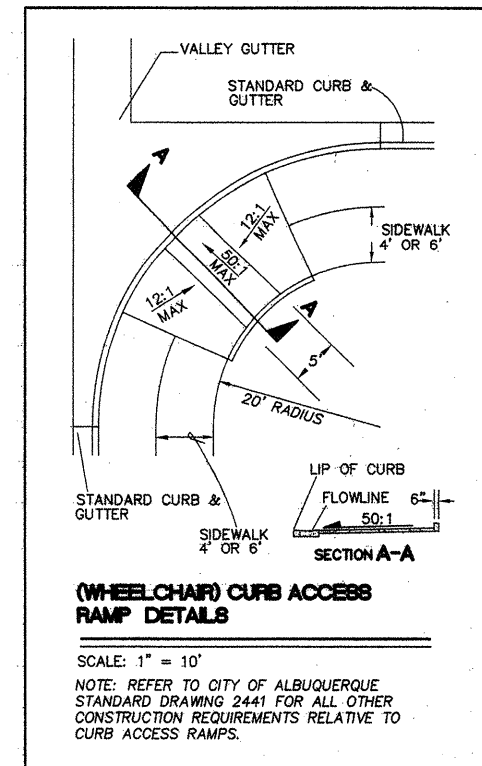

SCALE: 1" = 10'

NOTE: REFER TO CITY OF ALBUQUERQUE STANDARD DRAWING 2441 FOR ALL OTHER CONSTRUCTION REQUIREMENTS RELATIVE TO CURB ACCESS RAMPS.

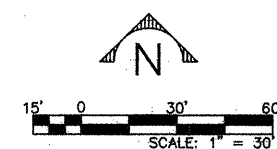

CITY OF ALBUQUERQUE PARKS AND RECREATION DEPARTMENT	
TITLE: MANZANO MESA PHASE D SOCCER FIELDS LAYOUT PLAN	
DESIGNED BY: SEC	DATE: 10/03
DRAWN BY: SEC	DATE: 10/03
CHECKED BY: SEC	DATE: 10/03
NO.	DATE
1	10/03
2	10/03
MATCH LINE SEE SHEET 10

**MATCH LINE SEE SHEET 10**

○ KEYED NOTES:

- 1 EDGE OF NEW PERMANENT PAVEMENT, SEE SHEET 13 FOR SECTIONS.
- 2 CONSTRUCT NEW MEDIAN CURB & GUTTER PER COA STANDARDS DRAWING 2415A.
- 3 REMOVE & DISPOSE 284 LF EXISTING EXTRUDED ASPHALT CURB & GUTTER
- 4 GRADE SITE TO CONTOURS AND SPOT ELEVATION SHOWN.
- 5 REMOVE AND DISPOSE OF EXISTING DRAINAGE CHANNEL.
- 6 CONSTRUCT 488 LF OF ALLEY GUTTER PER COA STANDARD DRAWING 2415A.
- 7 INSTALL 8'X 10' WATER METER PIT (VAULT) PER DETAIL SHEET 13
- 8 RAISE EXISTING MANHOLE RIM TO MATCH TOP OF ASPHALT
- 9 INSTALL RCP CLASS IV STORM DRAIN PIPE, @ SLOPE AS SHOWN IN THIS SHEET.
- 10 CONSTRUCT 60 LF OF STD C & G PER C.O.A. STD. DWG. 2415A. TRANSITION TO MEDIAN C & G AT CATTLE GUARD INLET.
- 11 CONSTRUCT NEW 10' SIDEWALK PER COA STD. DWG 2430, SLOPE 2% TOWARDS PARKING LOT.
- 12 MATCH EXISTING ELEVATIONS
- 13 CONSTRUCT NEW 6' SIDEWALK PER COA STD DWG 2430, SLOPE 2% AS SHOWN IN THIS SHEET.
- 14 CONSTRUCT ISLAND PER DETAIL SHEET 13, TYPICAL OF ALL.
- 15 CONSTRUCT PLANTER AREAS, SEE ARCHITECTURAL PLANS FOR DETAILS, TYPICAL OF ALL.
- 16 INSTALL 3" OF PARKING LOT ASPHALT PAVEMENT PER PAVEMENT SECTION DETAIL SHEET 13
- 17 DUMPSTIE ENCLOSURE: SEE ARCHITECTURAL PLANS FOR DETAILS. PAD ELEVATION AS SHOWN ON SHEET 12.
- 18 CONSTRUCT NEW HANDICAP RAMP, INSTALL PAVEMENT MARKINGS WITH HANDICAP PAVEMENT MARKINGS. FURNISH & INSTALL HANDICAP SIGN AND POST WITH "VAN ACCESSIBLE", AND 6' LONG 4000 PSI PRECAST CONC. PARKING BARRIERS ANCHORED WITH @-#5 X 15" INTO PVMT. ELEVATIONS AT SHOWN DETAIL SHEET 13.
- 19 INSTALL STORM DRAIN INLET SINGLE TYPE 'A' PER COA STD DWG. 2201 AT INVERT & GRATE ELEVATIONS SHOWN.
- 20 INSTALL STORM DRAIN INLET SINGLE TYPE 'D' PER COA STD DWG 2206 AT INVERT & GRATE ELEVATIONS SHOWN.
- 21 CONTRACTOR TO CONSTRUCT ELEVATED SIDEWALK RAMPS & CURB & GUTTER PER DETAIL SHEET 13. TYPICAL FOUR PLACES.
- 22 CONTRACTOR TO REMOVE AND DISPOSE 55 LF OF CONCRETE CURB AND GUTTER
- 23 CONTRACTOR TO RAISE SD MANHOLE TO MATCH EXISTING GRADE, RIM=5193.2
- 24 SAW CUT, REMOVE AND DISPOSE OF EXISTING ASPHALT PAVEMENT.
- 25 INSTALL A TYPE 'C' MANHOLE OVER EXISTING STORM DRAIN PIPE AT LOCATION SHOWN, COA STD DWG 2101.
- 26 SAWCUT, REMOVE & DISPOSE 40 LF CURB & CUTTER AND 45 SY OF CONCRETE HANDICAP RAMP AND SIDEWALK. SEE SHEET 13 FOR DETAILS.
- 27 SAWCUT, REMOVE, DISPOSE AND REPLACE 6 SY ARTERIAL PVMT AND 5 LF STD. CURB & GUTTER, PVMT TO THICKNESS TO MATCH EXISTING + 2"
- 28 CONTRACTOR TO TAP NEW 24" RCP SD TO EXISTING SD MH INV=5478.26.
- 29 INSTALL A TYPE 'C' MANHOLE AT LOCATION SHOWN, COA STD DWG 2101.
- 30 CONTRACTOR TO PROTECT INLET PIPE FROM SEDIMENT DURING AND AFTER CONSTRUCTION WITH SILT FENCE. CONTRACTOR SHALL GRADE EXISTING DRAINAGE DITCH TO FLOW SMOOTHLY TO EXISTING INLET & PIPE, CONTRACTOR TO EXTEND DRAINAGE PIPE 9 LF OF 18" HDPE PIPE @ 1% AS NEEDED TO DRAIN DITCH PROPERLY AND CONSTRUCT A CONCRETE HEAD WALL PER DETAIL THIS SHEET.
- 31 CONTRACTOR TO CONSTRUCT MODIFIED CATTLE GUARD INLET C.O.A. STD. DWG. 2271. MODIFICATIONS PER DETAIL SHEET 13.
- 32 CONTRACTOR TO CONSTRUCT CONCRETE RECTANGULAR DRAINAGE CHANNEL AND CURB CUT, SEE SHEET 13 FOR DETAILS.
- 33 CONTRACTOR TO PROTECT INLET PIPE FROM SEDIMENT DURING AND AFTER CONSTRUCTION WITH SILT FENCE. CONTRACTOR SHALL GRADE EXISTING DRAINAGE DITCH TO FLOW SMOOTHLY TO EXISTING INLET.

BENCH MARKS		AS BUILT INFORMATION	
C.O.A. BENCHMARK "6-121"	CONTRACTOR	WORK STARTED BY	DATE
FROM THE INTERSECTION OF EUBANK AND THE FUTURE INTERSECTION GO DIRECTLY EAST 292 FEET	INSPECTOR'S FIELD VERIFICATION BY	DATE	DATE
ELEVATION 5500.87'	FIELD VERIFICATION BY	DATE	DATE
GROUND COORDINATES: NORTHING=1,481,748.33 EASTING =418,123.51	CORRECTED BY	MICRO-FILM INFORMATION	
GRID COORDINATES: NORTHING=1,481,220.09 EASTING =417,975.01	RECORDED BY	DATE	
GROUND TO GRID 0.999844850	NO.		


[illegible]

ENGINEERS SEAL

PATRICK J. CONLEY  
NEW MEXICO  
10141  
REGISTERED ENGINEER  
10/17/03

NO.	DATE	REMARKS	BY
REVISIONS			
DESIGN			
DESIGNED BY	SEC	DATE	10/03
DRAWN BY	SEC	DATE	10/03
CHECKED BY	SEC	DATE	10/03

E ARTMENT	
ACER FIELDS	
TABLES	
No. / Day / Yr.	No. / Day / Yr.
Drawing No. 10 of 23	

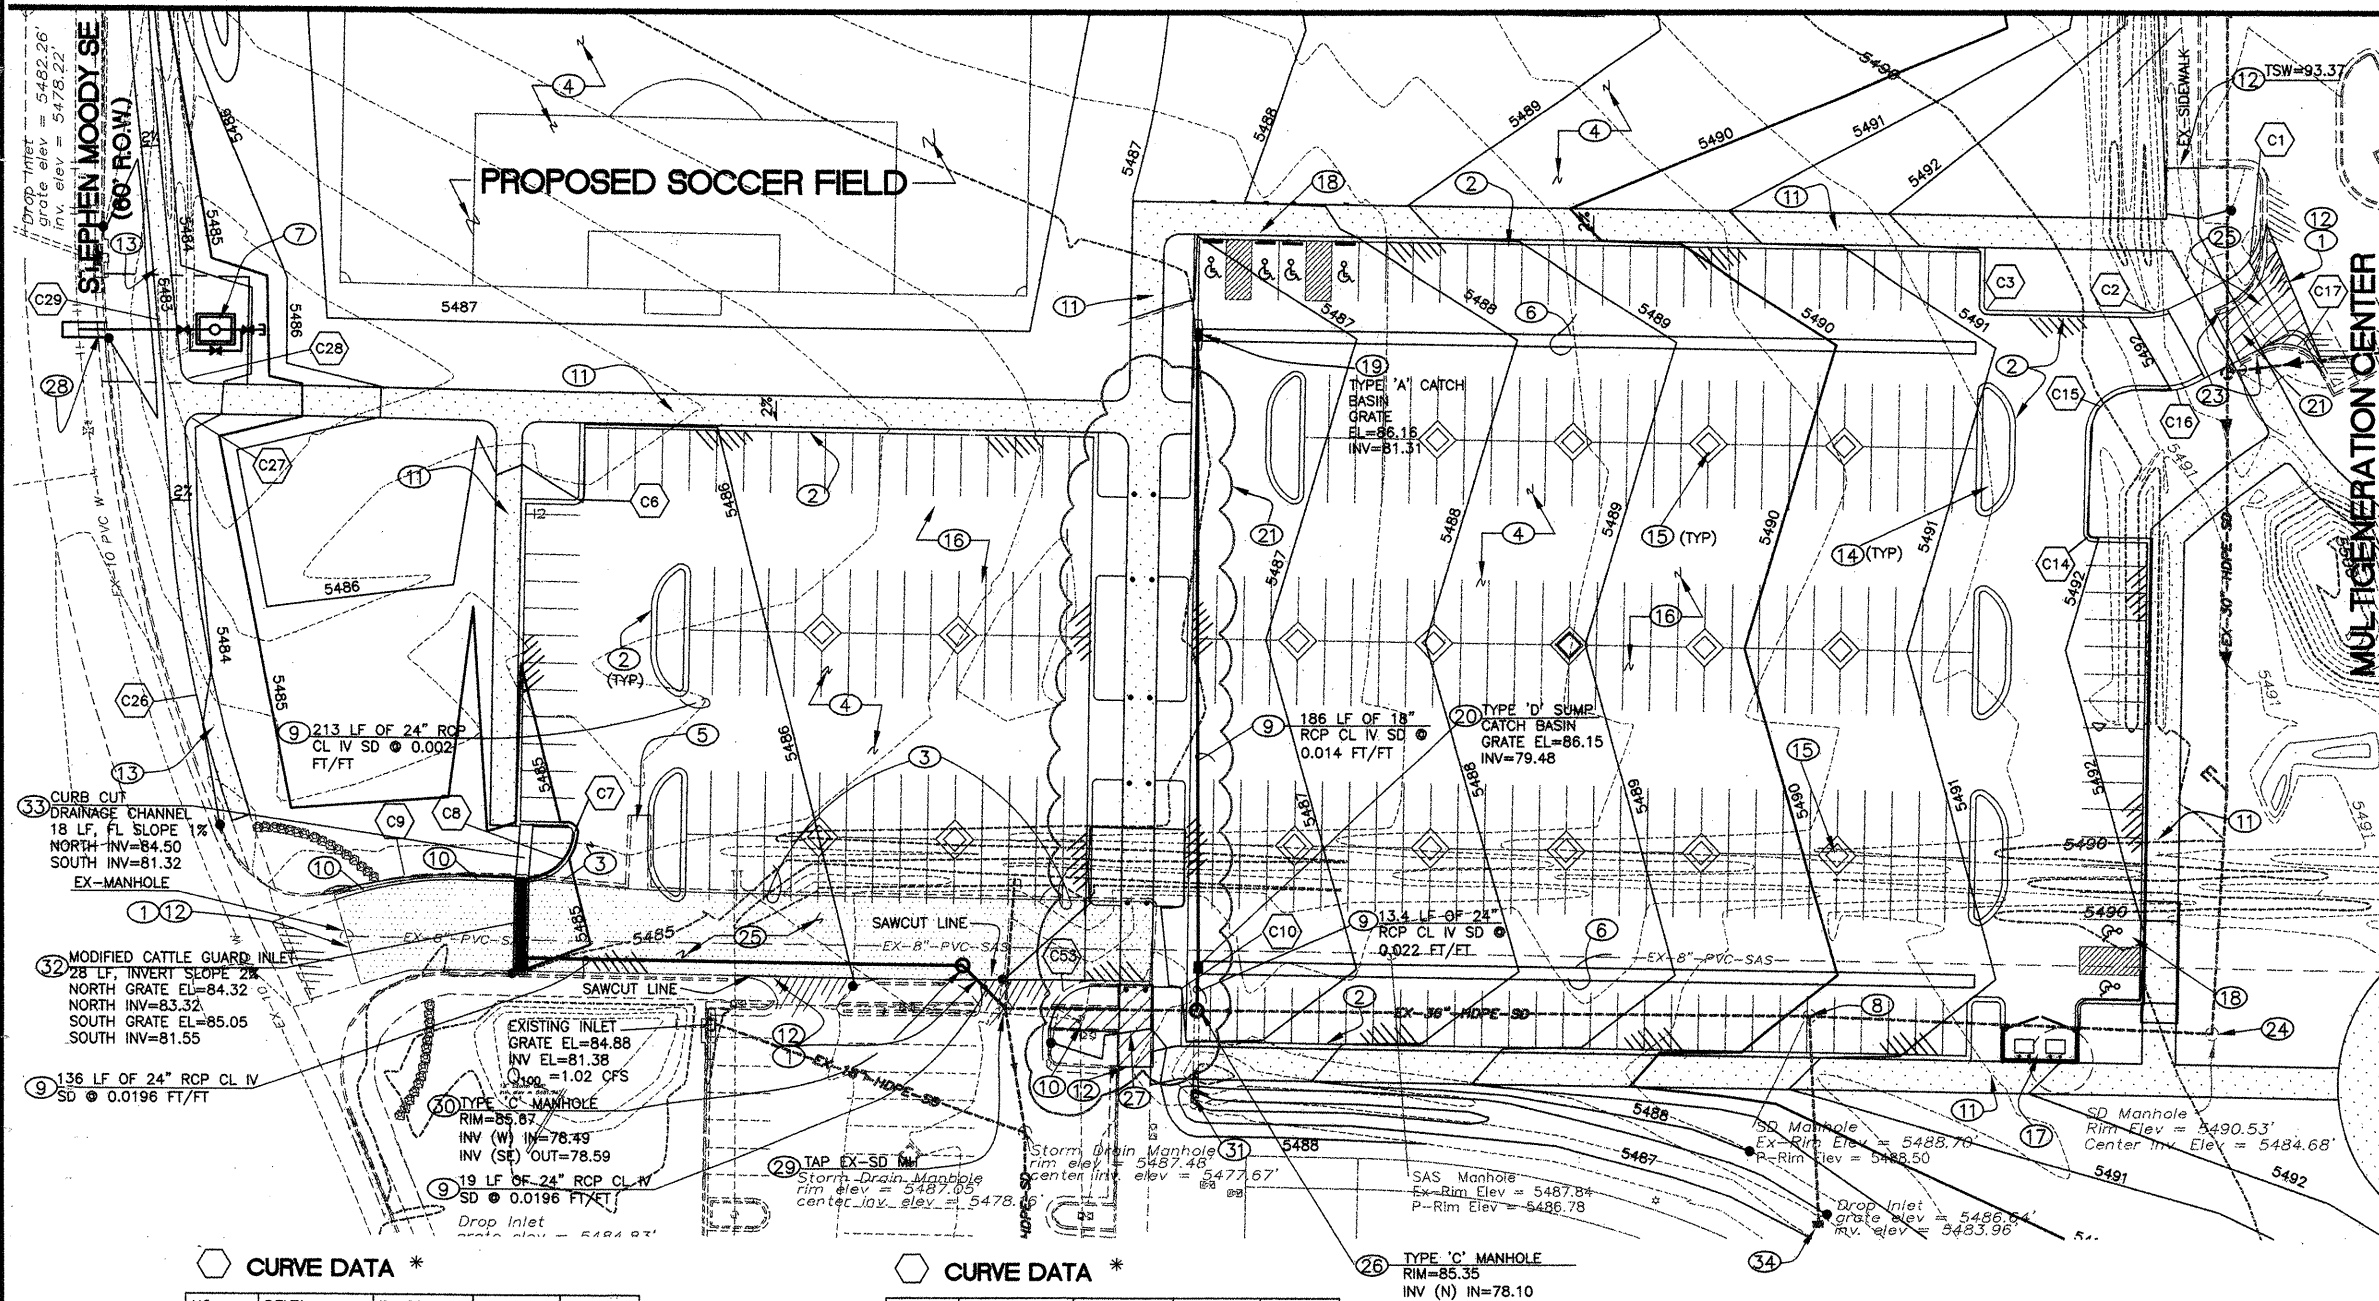

**CURVE DATA \***

NO.	DELTA	TANGENT (FEET)	RADIUS (FEET)	LENGTH (FEET)
C1	63°25'31"	8.96'	14.50'	16.05'
C2	23°12'39"	5.24'	25.50'	10.33'
C3	90°00'00"	1.50'	1.50'	2.26'
C4	90°00'00"	1.50'	1.50'	2.26'
C5	90°00'00"	1.50'	1.50'	2.26'
C6	90°00'00"	1.50'	1.50'	2.26'
C7	93°01'57"	1.58'	1.50'	2.44'
C8	86°59'12"	13.76'	14.50'	22.01'
C9	14°21'29"	20.56'	163.21'	40.90'
C10	90°00'00"	1.50'	1.50'	2.36'
C14	90°00'00"	1.50'	1.50'	2.26'
C15	90°00'00"	14.50'	14.50'	22.78'
C16	23°12'39"	10.37'	50.50'	20.46'
C17	91°56'13"	1.55'	1.50'	2.41'
C26	14°1'25"	47.39'	385.30'	94.31'
C27	94°38'51"	5.42'	5.00'	8.26'

\* ALL CURVE DATA FOR CURB & GUTTER IS AT FLOWLINE



**CURVE DATA \***

NO.	DELTA	TANGENT (FEET)	RADIUS (FEET)	LENGTH (FEET)
28	84°50'15"	4.57'	5.00'	7.40'
29	03°38'57"	70.79'	2222.36'	141.54'
30	12°29'06"	71.25'	651.33'	141.93'
31	16°16'11"	58.89'	411.97'	116.98'
32	10°42'31"	26.21'	279.62'	52.26'
33	09°38'23"	22.25'	263.81'	44.39'
34	21°36'42"	22.07'	115.63'	43.62'
35	23°51'12"	22.47'	106.36'	44.28'
36	17°04'24"	26.44'	176.12'	52.48'
37	26°50'47"	29.82'	124.96'	58.55'
38	29°33'48"	44.71'	169.46'	87.44'
39	22°02'29"	43.56'	223.68'	86.05'
40	23°25'50"	83.67'	403.48'	165.00'
41	28°34'21"	48.42'	190.16'	94.83'
42	15°29'28"	48.30'	333.04'	90.04'
43	75°12'30"	3.85'	5.00'	6.56'
44	106°23'52"	6.68'	5.00'	9.29'
45	33°31'29"	47.63'	158.14'	92.53'
46	13°33'44"	39.26'	330.17'	78.15'
47	17°47'21"	36.72'	234.63'	72.85'
48	21°09'05"	47.10'	252.28'	93.13'
49	05°32'12"	20.53'	424.51'	41.02'
50	91°08'32"	5.10'	5.00'	7.95'
51	86°27'16"	4.70'	5.00'	7.54'
52	03°34'32"	13.25'	424.51'	26.49'
53	90°00'00"	14.50'	14.50'	22.74'

NOTE:  
SEE SHEET 17 FOR ELECTRICAL CONDUIT AND J-BOX  
INSTALLATION.

NOTE:

1. ALL LAP TO BE 18" MIN
2. 2" MIN COVER ALL REBAR
3. 4000 PSI CONCRETE PER C.O.A. STD. SPEC.

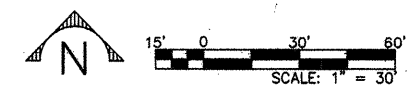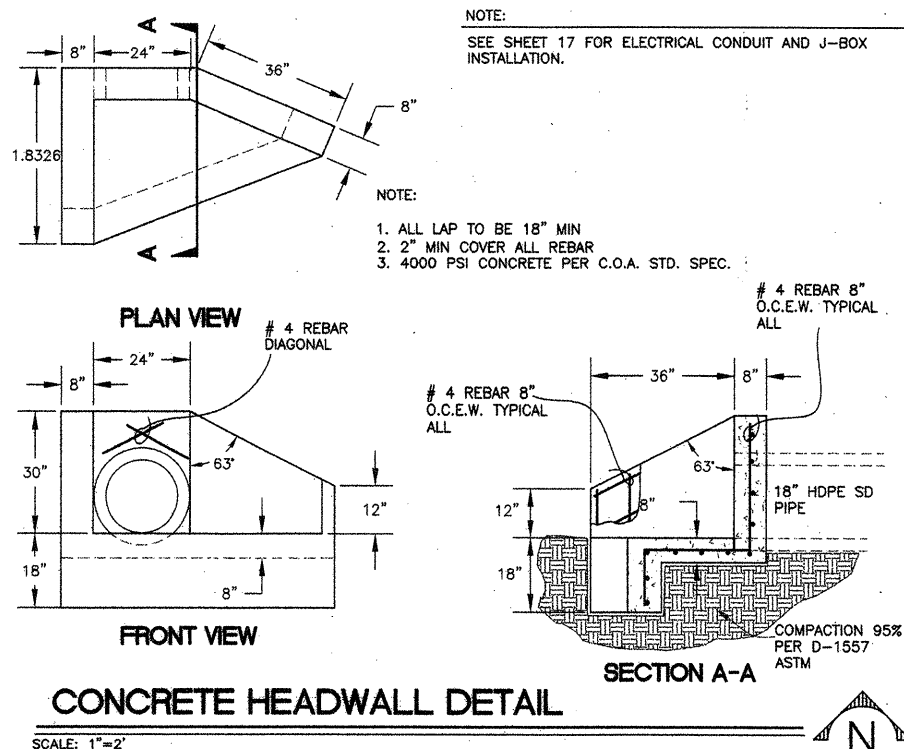

1020

**Smith Engineering Company**  
A Full Service Engineering Company

6420 Upland Boulevard, N.E. Suite 3008 Albuquerque, New Mexico 87111

CITY OF ALBUQUERQUE  
PARKS AND RECREATION DEPARTMENT

TITLE: MANZANO MESA PHASE D SOCCER FIELDS  
LAYOUT PLAN + CURVE TABLES

Design Review Committee  
**APPROVE**

APPROV

DEC - 2 2003  
DESIGN  
REVIEW COMMITTEE

DEC - 2 2003  
CITY ENGINEER


City Project No. 498092

Zone Map No.	8
L-21-Z	

Sheet No.	Drawing No.
-----------	-------------

10 of 23



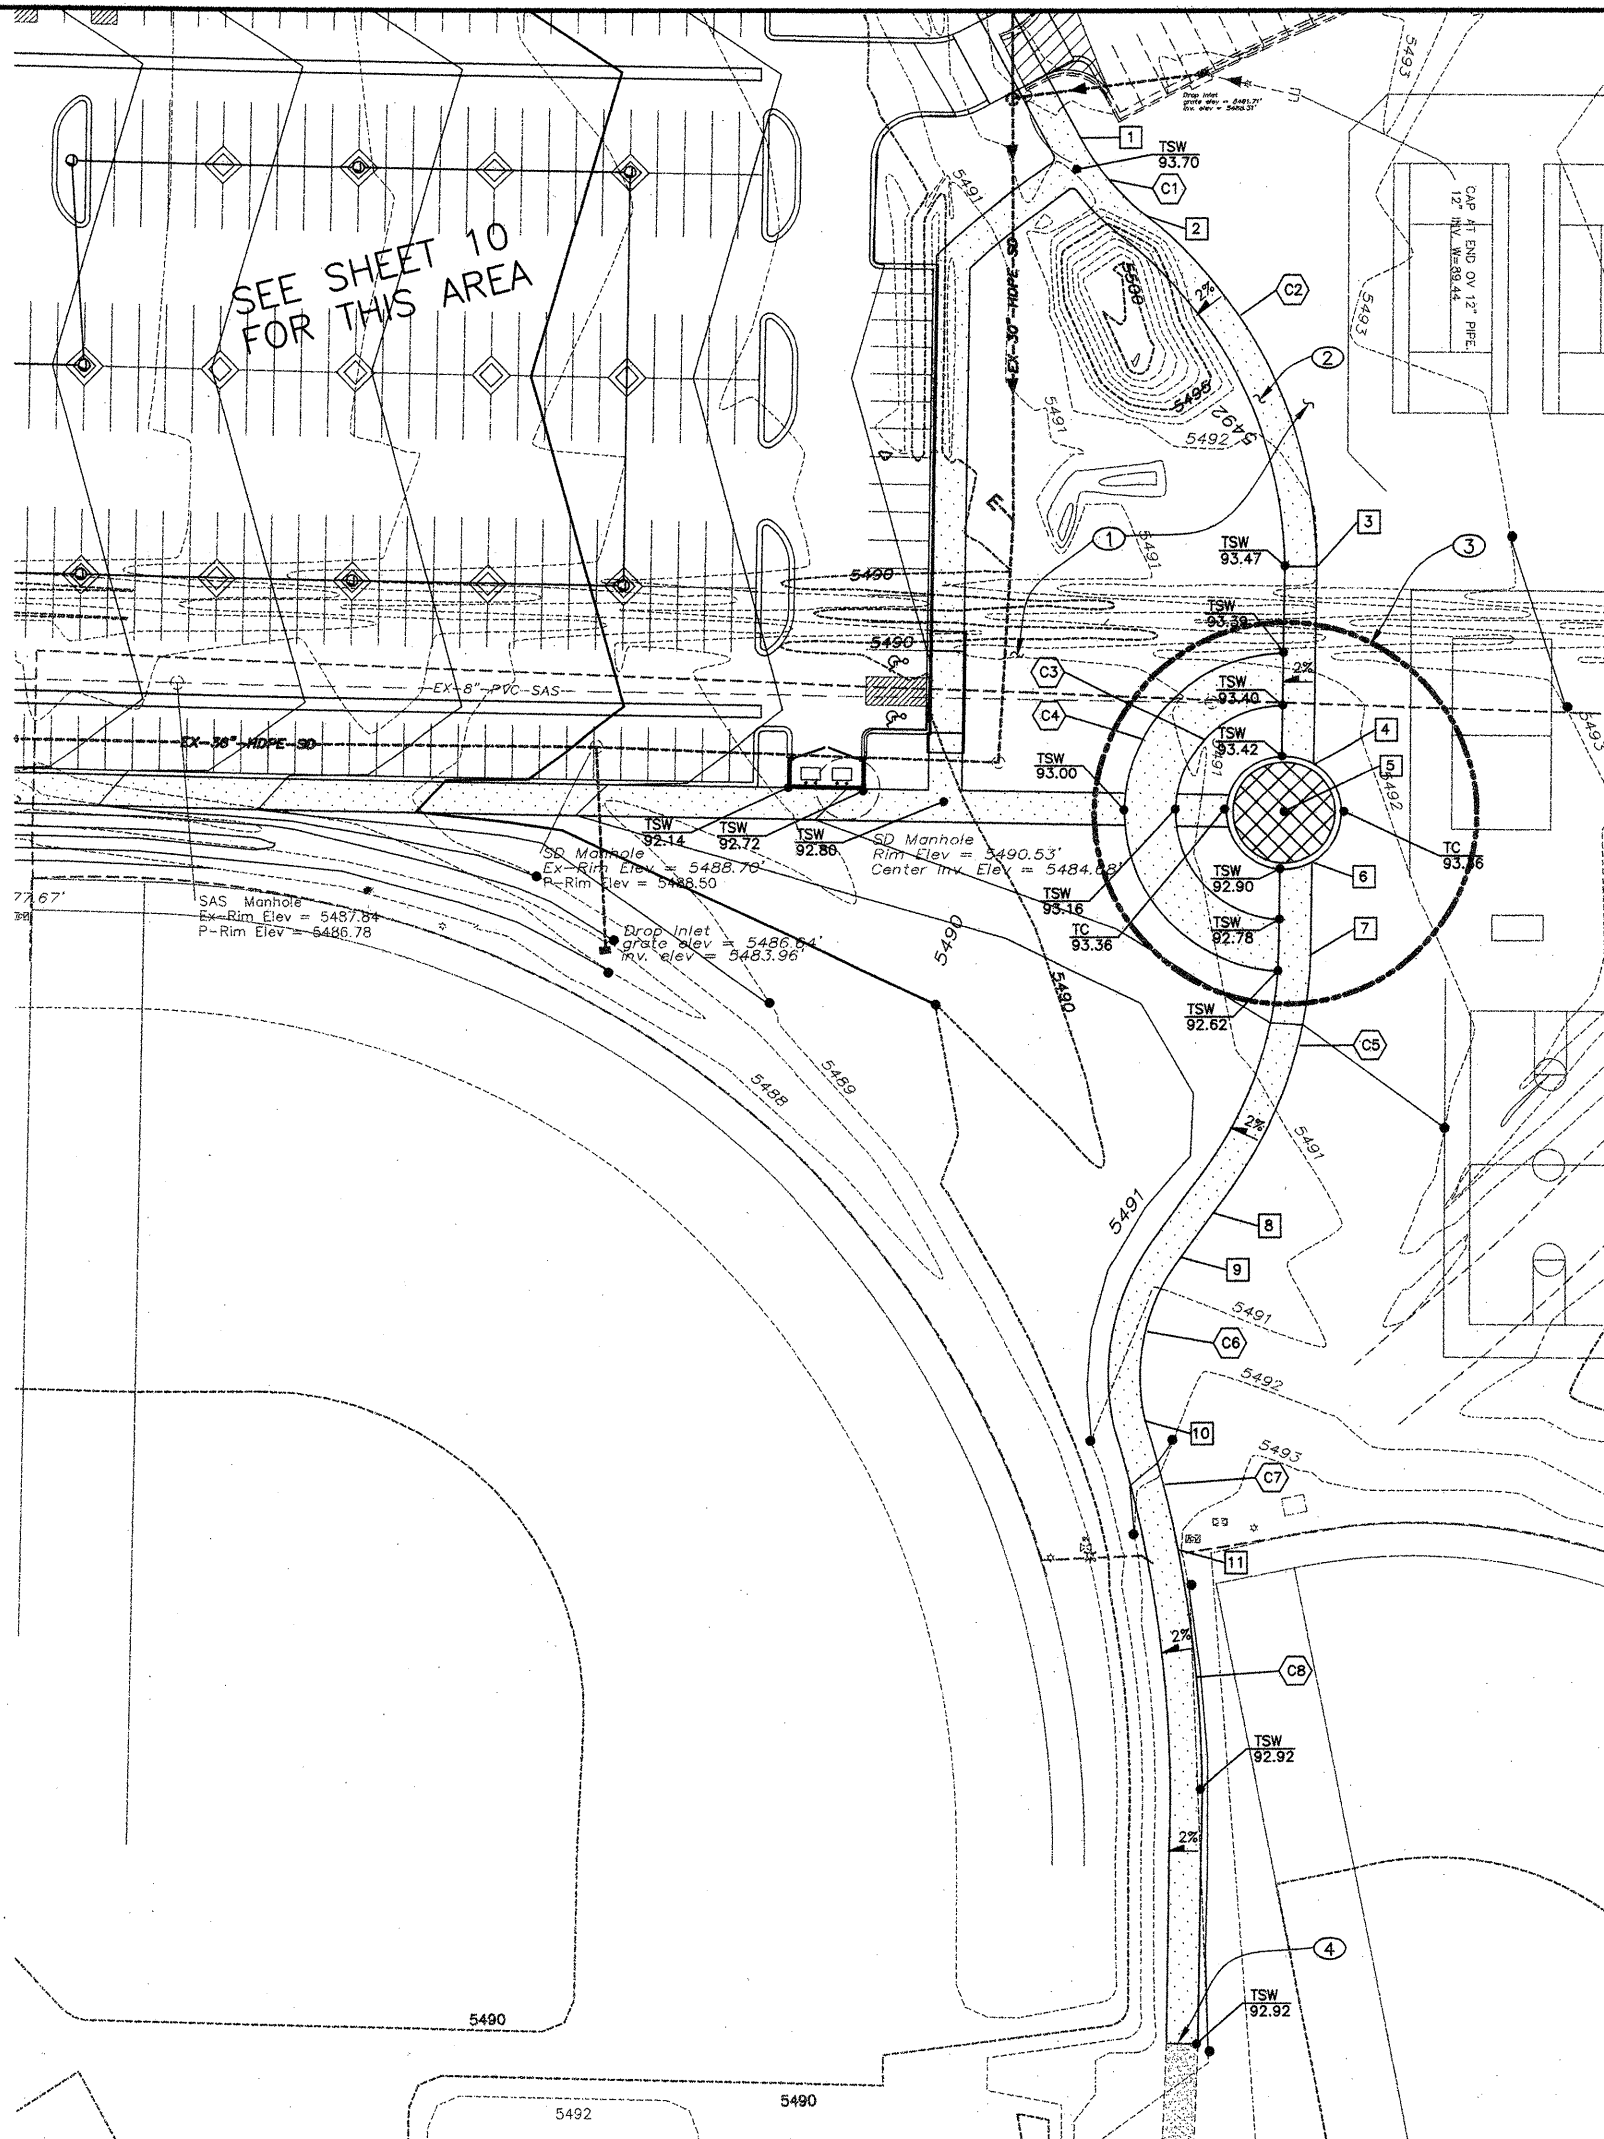

KEYED NOTES:


- GRADE SITE TO CONTOURS AND SPOT ELEVATION SHOWN.
- CONSTRUCT NEW 10' SIDEWALK PER COA STD DWG 2430, SLOPE 2% TOWARDS PARKING LOT.
- CONSTRUCT NEW PLAYGROUND AREA - SEE ARCHITECTURAL PLANS FOR DETAILS.
- MATCH EXISTING

CURVE DATA

NO.	DELTA	TANGENT (FEET)	RADIUS (FEET)	LENGTH (FEET)
C1	24°56'38"	16.31'	73.75'	32.11'
C2	50°44'49"	66.93'	141.13'	125.00'
C3	176°37'52"	1156.20'	34.00'	104.82'
C4	177°30'16"	2295.52'	50.00'	177.50'
C5	37°56'51"	45.28'	131.69'	87.22'
C6	50°17'47"	28.07'	59.80'	52.49'
C7	06°04'50"	21.48'	404.43'	42.92'
C8	13°31'18"	47.41'	402.47'	94.98'


NODE DATA (ALL SPOTS ARE FLOWLINE UNLESS OTHERWISE NOTED)

NODE ID	NORTHING	EASTING	ELEVATION	DESCRIPTION
1	1479626.4	417566.0	5493.55	P.C. TOP OF SIDEWALK
2	1479602.0	417586.4	5493.52	P.C. TOP OF SIDEWALK
3	1479493.3	417639.9	5493.59	TOP OF SIDEWALK
4	1479431.8	417638.8	5493.62	TOP OF SIDEWALK
5	1479400.6	417638.2	5493.10	ARCH PLAN CENTER OF PLAYGROUND
6	1479400.6	417524.5	5493.10	TOP OF SIDEWALK
7	1479371.2	417637.8	5492.90	TOP OF SIDEWALK
8	1479290.8	417607.1	5491.43	TOP OF SIDEWALK
9	1479277.6	417597.1	5491.53	TOP OF SIDEWALK
10	1479228.1	417585.6	5491.63	TOP OF SIDEWALK
11	1479186.5	417596.1	EXIST	END OF SIDEWALK

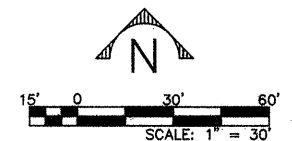


CITY OF ALBUQUERQUE PARKS AND RECREATION DEPARTMENT	
TITLE: MANZANO MESA PHASE D SOCCER FIELDS LAYOUT PLAN + CURVE TABLES	
DESIGNED BY SEC	DATE 10/03
DRAWN BY SEC	DATE 10/03
CHECKED BY SEC	DATE 10/03
APPROVED DEC - 2 2003 CITY ENGINEER	APPROVED DEC - 2 2003 CITY ENGINEER
City Project No. 498092	Zone Map No. L-21-Z
Sheet No.	Drawing No. 11 of 23

AS BUILT INFORMATION	
CONTRACTOR	DATE
WORK STARTED BY	DATE
FIELD ACCEPTANCE BY	DATE
FIELD REVISION BY	DATE
DRAWINGS CORRECTED BY	DATE
MICRO-FILM INFORMATION	
RECORDED BY	DATE
NO.	NO.
BENCH MARKS	
C.O.A. BENCHMARK "6-121"	DATE
FROM THE INTERSECTION OF EUBANK AND THE FUTURE	DATE
INTERSECTION GO DIRECTLY EAST 292 FEET	DATE
ELEVATION 5500.67'	DATE
GROUND COORDINATES: NORTHING=1481,746.33	DATE
EASTING =418,123.51	DATE
GRID COORDINATES: NORTHING=1481,220.09	DATE
EASTING =417,975.01	DATE
GROUND TO GRID 0.999644850	DATE
SURVEY INFORMATION	
FIELD NOTES	DATE
NO.	DATE
BY	DATE
ENGINEERS SEAL	
PATRICK J. CONLEY REGISTERED PROFESSIONAL ENGINEER 10141 10/17/03	
REVISIONS	
NO.	DATE
REMARKS	
DESIGN	

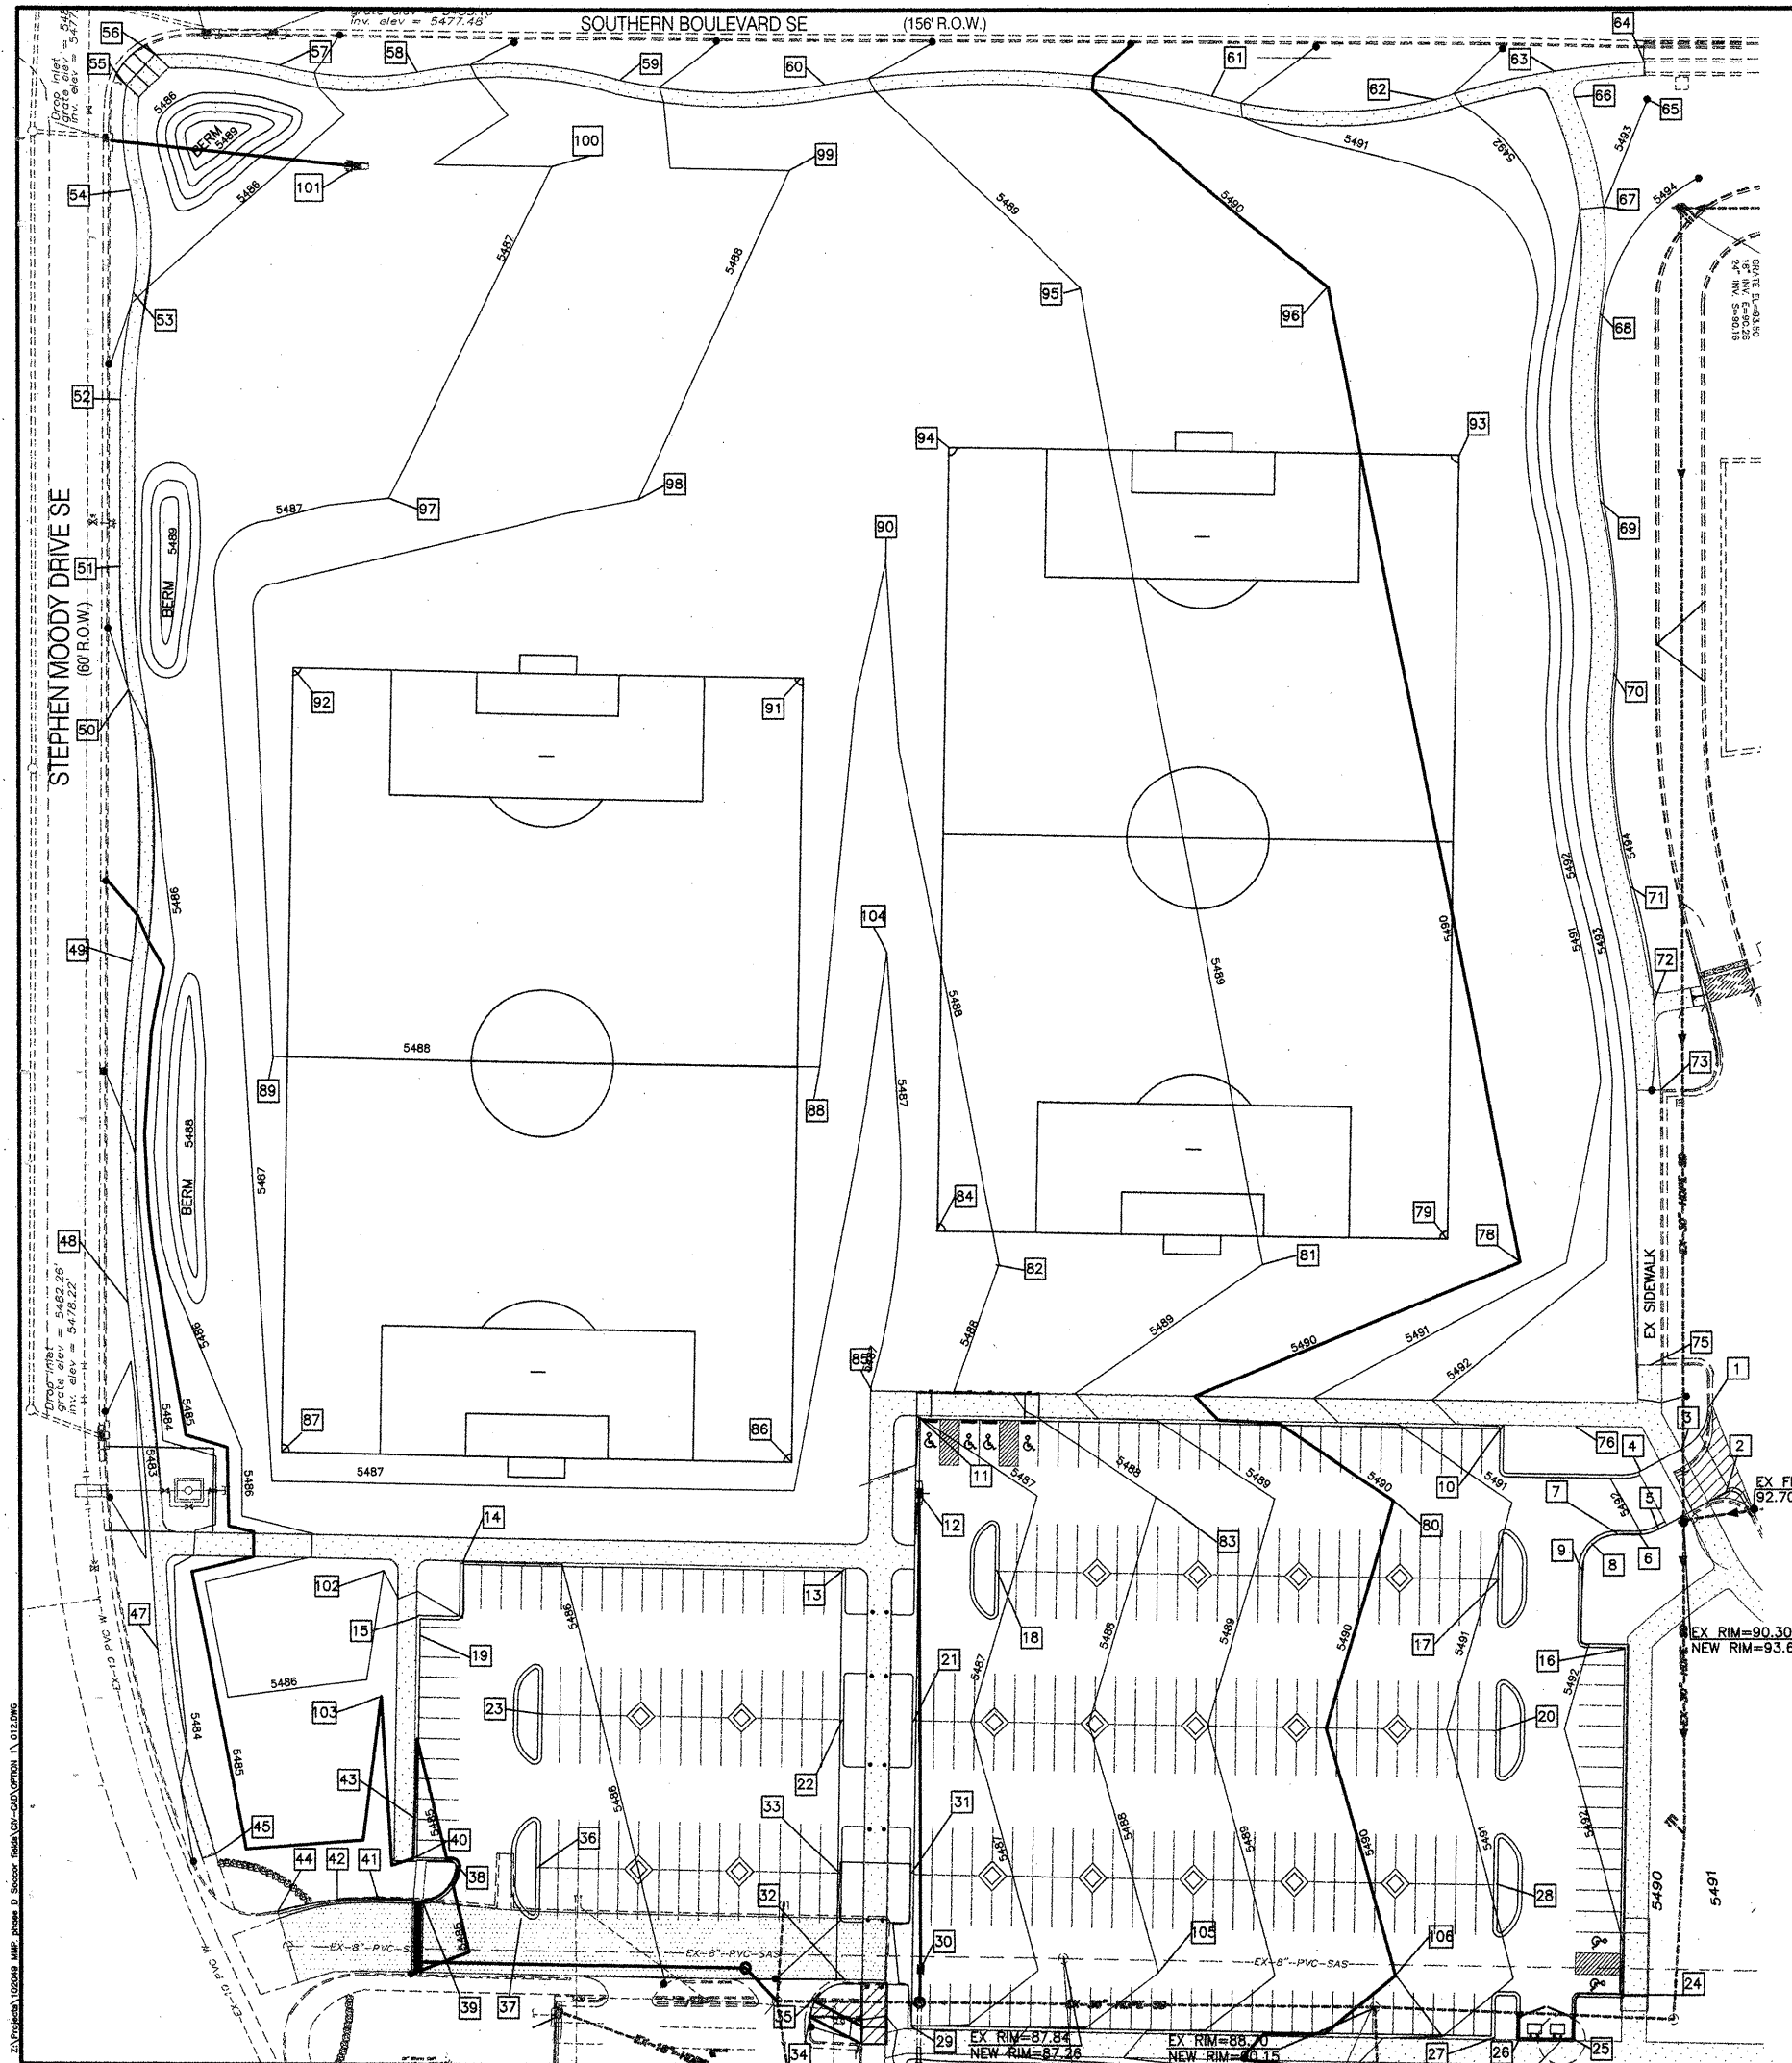

**NODE DATA** (ALL SPOTS ARE FLOWLINE UNLESS OTHERWISE NOTED)

NODE ID	NORTHING	EASTING	ELEVATION	DESCRIPTION
1	1479666.5	147555.8	5492.56	PC FLOWLINE OF CURB RETURN
2	1479668.9	147545.2	5492.76	PCC BASE OF CURB / BR
3	1479660.0	147528.4	5493.00	PT TOP FACE OF CURB RETURN / TR
4	1479660.0	147528.4	5477.12	PC TOP FACE OF CURB RETURN / RAMP
5	1479660.0	147528.4	5492.27	PCC FLOWLINE OF CURB
6	1479633.6	147524.5	5492.00	PT FLOWLINE OF CURB RETURN
7	1479633.7	147516.6	5491.90	PT FLOWLINE OF CURB RETURN
8	1479629.5	147506.0	5491.82	PCC FLOWLINE OF CURB
9	1479619.0	147501.4	5491.74	PC FLOWLINE OF CURB RETURN
10	1479678.6	147468.4	5491.88	FLOWLINE INTERSECTION
11	1479682.7	147221.9	5487.00	FLOWLINE INTERSECTION
12	1479682.7	147221.9	5486.00	TOP OF GRATE @ FL
13	1479619.2	147190.8	5486.70	FLOWLINE INTERSECTION
14	1479621.9	147029.4	5485.75	FLOWLINE INTERSECTION
15	1479598.1	147011.0	5485.40	FLOWLINE INTERSECTION
16	1479586.2	147520.8	5492.34	FLOWLINE INTERSECTION
17	1479614.6	147467.3	5491.02	MID PT OF ISLAND @ FLOWLINE OF CURB
18	1479618.1	147254.8	5486.84	MID PT OF ISLAND @ FLOWLINE OF CURB
19	1479590.1	147011.9	5485.55	TOP CENTER OF GRATE
20	1479550.6	147466.2	5491.42	MID PT OF ISLAND @ FLOWLINE OF CURB
21	1479554.7	147219.8	5486.53	FLOWLINE @ MID PT OF CURB
22	1479555.2	147189.8	5486.89	FLOWLINE @ MID PT OF CURB
23	1479557.3	147062.3	5485.68	MID PT OF ISLAND @ FLOWLINE OF CURB
24	1479441.7	147518.4	5492.00	FLOWLINE INTERSECTION
25	1479424.2	147497.5	5492.12	TOP CONC AT BACK OF DUMPSTER PAD
26	1479424.6	147474.8	5491.64	TOP CONC AT BACK OF DUMPSTER PAD
27	1479424.8	147464.1	5491.42	FLOWLINE INTERSECTION
28	1479486.6	147465.2	5491.05	MID PT OF ISLAND @ FLOWLINE OF CURB
29	1479428.7	147217.7	5487.00	FLOWLINE INTERSECTION
30	1479458.6	147222.5	5486.00	TOP CENTER OF GRATE
31	1479490.7	147218.7	5486.31	FLOWLINE @ MID PT OF CURB
32	1479447.2	147190.8	5486.50	PT FLOWLINE OF CURB RETURN
33	1479491.9	147188.6	5486.54	FLOWLINE @ MID PT OF CURB
34	1479432.5	147197.4	5487.52	PC FLOWLINE OF CURB RETURN
35	1479439.7	147177.7	5487.05	PCC FLOWLINE OF CURB RETURN
36	1479493.3	147061.2	5485.51	FLOWLINE @ MID PT OF CURB
37	NOT USED			
38	1479493.7	147027.2	5484.88	PC FLOWLINE OF CURB RETURN
39	1479479.9	147013.6	5484.43	PTPC FLOWLINE OF CURB RETURN
40	1479496.2	147009.3	5484.50	FLOWLINE INTERSECTION
41	1479480.1	146992.1	5484.65	PCC FLOWLINE OF CURB RETURN
42	1479474.5	146951.8	5484.40	PT FLOWLINE OF CURB RETURN
43	1479521.7	147009.8	5484.50	FLOWLINE OF CURB
44	1479474.6	146951.8	5484.35	PT FLOWLINE OF CURB RETURN
45	1479498.8	146925.4	5484.04	PC TOP OF SIDEWALK
46	NOT USED			
47	1479589.0	146900.9	5483.57	PC TOP OF SIDEWALK
48	1479729.8	146889.3	5483.32	PT TOP OF SIDEWALK
49	1479871.4	146891.2	5484.76	PTPC TOP OF SIDEWALK
50	1479988.0	146889.9	5486.00	PC TOP OF SIDEWALK
51	1480040.1	146886.5	5486.33	PT TOP OF SIDEWALK
52	1480109.6	146886.9	5486.23	PC TOP OF SIDEWALK
53	1480153.6	146892.3	5486.02	PT TOP OF SIDEWALK
54	1480197.0	146891.4	5485.67	PC TOP OF SIDEWALK
55	1480240.9	146889.7	5485.44	PT TOP OF SIDEWALK
56	1480254.3	146901.7	5485.52	PC TOP OF SIDEWALK
57	1480250.0	146953.8	5485.76	PTPC TOP OF SIDEWALK
58	1480247.0	147012.3	5486.78	PT TOP OF SIDEWALK
59	1480243.9	147098.2	5487.82	PTPC TOP OF SIDEWALK
60	1480242.2	147183.7	5488.81	PT TOP OF SIDEWALK
61	1480237.2	147347.6	5490.86	PTPC TOP OF SIDEWALK
62	1480235.6	147441.3	5491.91	PTPC TOP OF SIDEWALK
63	1480247.4	147493.5	5492.47	PCC TOP OF SIDEWALK
64	1480251.2	147529.6	MATCH EX	PT TOP OF SIDEWALK
65	1480235.1	147531.0	5493.00	TOP OF GROUND
66	1480236.2	147500.0	5492.67	PC TOP OF SIDEWALK
67	1480189.9	147510.4	5493.00	PCC TOP OF SIDEWALK
68	1480145.3	147509.4	5493.90	PTPC TOP OF SIDEWALK
69	1480067.8	147510.4	5493.90	PTPC TOP OF SIDEWALK
70	1479995.3	147516.1	5493.90	PTPC TOP OF SIDEWALK
71	1479902.7	147522.9	5493.90	PTPC TOP OF SIDEWALK
72	1479853.6	147532.6	5494.00	PT TOP OF SIDEWALK
73	1479845.1	147533.5	5494.08	PC TOP OF SIDEWALK @ EXISTING
74	NOT USED			
75	NOT USED			
76	1479678.5	147499.2	5492.38	PT TOP SIDEWALK
77	NOT USED			
78	1479747.6	147475.9	5490.00	TOP OF GROUND @ CONTOUR PT
79	1479757.5	147445.3	5489.73	TOP OF GROUND
80	1479647.4	147421.1	5490.00	FLOWLINE ALLEY GUTTER/CONTOUR PT
81	1479746.9	147367.4	5489.00	TOP OF GROUND @ CONTOUR PT
82	1479746.9	147256.3	5488.00	TOP OF GROUND @ CONTOUR PT
83	1479648.9	147321.0	5488.00	FLOWLINE ALLEY GUTTER/CONTOUR PT
84	1479761.1	147230.4	5487.40	TOP OF GROUND/CORNER OF SOCCER FIELD
85	1479693.5	147202.1	5487.00	TOP OF GROUND/CORNER OF SIDEWALK
86	1479663.6	147168.7	5487.05	TOP OF GROUND/CORNER OF SOCCER FIELD
87	1479667.2	146953.7	5487.05	TOP OF GROUND/CORNER OF SOCCER FIELD
88	1479828.6	147180.9	5488.00	TOP OF GROUND @ CONTOUR PT
89	1479832.3	146950.4	5488.00	TOP OF GROUND @ CONTOUR PT
90	1480042.8	147209.1	5488.00	TOP OF GROUND @ CONTOUR PT FL SWALE
91	1479993.5	147174.2	5490.00	TOP OF GROUND/CORNER OF SOCCER FIELD
92	1479997.1	146959.3	5490.00	TOP OF GROUND/CORNER OF SOCCER FIELD
93	1480087.4	147450.8	5490.39	TOP OF GROUND/CORNER OF SOCCER FIELD
94	1480091.0	147235.9	5488.38	TOP OF GROUND/CORNER OF SOCCER FIELD
95	1480156.6	147291.6	5489.00	TOP OF GROUND @ CONTOUR PT
96	1480156.7	147395.9	5490.00	TOP OF GROUND @ CONTOUR PT
97	1480069.0	147105.0	5487.00	TOP OF GROUND @ CONTOUR PT
98	1480069.0	146999.8	5487.00	TOP OF GROUND @ CONTOUR PT
99	1480205.7	147168.6	5488.00	TOP OF GROUND @ CONTOUR PT
100	1480207.6	147068.8	5487.00	TOP OF GROUND @ CONTOUR PT
101	1480207.2	146984.7	5486.40	TOP OF GROUND @ CAP
102	1479617.9	146996.7	5486.00	TOP OF GROUND @ FL OF SWALE
103	1479564.3	146995.4	5485.00	TOP OF GROUND @ FL OF SWALE
104	1479875.9	147209.2	5487.00	FL OF SWALE
105	1479451.2	147322.9	5488.00	FLOWLINE ALLEY GUTTER/CONTOUR PT
106	1479450.0	147422.7	5490.00	FLOWLINE ALLEY GUTTER/CONTOUR PT

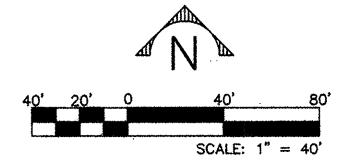

102049  
**Smith Engineering Company**  
 A Full Service Engineering Company  
 6400 Lytle Road, Suite 1000, Albuquerque, New Mexico 87120

**CITY OF ALBUQUERQUE  
 PARKS AND RECREATION DEPARTMENT**

**TITLE: MANZANO MESA PHASE D SOCCER FIELDS  
 NODE DATA SHEET**

**APPROVED** (Stamp: 10/2/2003)  
**DESIGN REVIEW COMMITTEE**

**APPROVED** (Stamp: 10/2/2003)  
**CITY ENGINEER**

City Project No. **498092** Zone Map No. **L-21-Z** Sheet No. **12** of **23**

DESIGNED BY SEC DATE 10/03  
 DRAWN BY SEC DATE 10/03  
 CHECKED BY SEC DATE 10/03

REMARKS  
 REVISIONS  
 DESIGN

AS BUILT INFORMATION  
 CONTRACTOR  
 WORK STARTED BY  
 DATE  
 INSPECTED BY  
 DATE  
 FIELD NOTES BY  
 DATE  
 MICRO-FILM INFORMATION  
 RECORDED BY  
 DATE  
 NO.

BENCH MARKS  
 C.O.A. BENCHMARK "6-121"  
 FROM THE INTERSECTION OF EUBANK AND THE FUTURE  
 INTERSECTION GO DIRECTLY EAST 292 FEET  
 ELEVATION 5500.67'  
 GROUND COORDINATES: NORTHING=1,481,746.33  
 EASTING=418,123.51  
 GRID COORDINATES: NORTHING=1,481,220.09  
 EASTING=417,975.01  
 GROUND TO GRID 0.999644850



# STORM WATER POLLUTION PREVENTION PLAN (SWPPP)

## 1. SITE DESCRIPTION

a. Description and nature of construction activity: Intended use of the property is for construction of a public park. The native vegetation for the site is sparse native grasses and desert type vegetation. The proposed site will be developed as a public park.

The Erosion and Sediment Control Plan (ESCP) is a sheet of this SWPPP. All drainage patterns, areas of soil disturbance, structural controls, and nonstructural controls will be shown on the ESCP. The first major activities that will disturb the soil will consist of the clearing and grubbing the site. After clearing and grubbing are complete, earthwork will begin. After earthwork, the site will be graded to the proposed elevations. The site will consist of both cut and fill areas. The sequence of construction with estimated dates follows:

b. Sequence of Construction Activities

Contractor shall provide final construction schedule after bidding.

1. Construct the silt fences and straw bale barriers as necessary
2. Clear and grub the site.
3. Begin grading the site and excavation for storm drain
4. Start construction of park
5. Pave parking lot
6. Complete grading and install permanent seeding and planting or surface treatment as approved
7. Remove all temporary erosion and sediment control devices (only if site is stabilized). The site is stabilized when all soil disturbing activities are completed and a landscaped cover for unpaved areas, and areas not covered by permanent structures, has been employed.

Important: The contractor shall be responsible for implementing, restoring and/or revising the temporary sediment and erosion control measures (silt fences, straw bale barriers, etc.) as necessary during construction to help prevent soil erosion and storm water pollution. Ongoing inspection and maintenance records MUST be kept throughout the project to the Notice of Termination (NOT).

c. The total area of disturbance for this street and storm drain project is 4.5 acres as shown on the ESCP under "Site Description". Clearing, grading and construction of the site shall proceed in accordance with the general notes on the ESCP and the most current Grading and Drainage Plan, and Landscape Plan.

d. Hydrologic Information (before and after runoff coefficients, etc.) is shown on the ESCP under "Site Description". The storm water from the site will outfall to a storm drain system that outfalls to a lined arroyo.

e. See vicinity map on "Erosion and Sediment Control - Plan" (ESCP) for location and legal description. See the ESCP (attached) for the drainage patterns, soil disturbance areas and the locations of all SWPPP measures. The site will require grading in accordance with the attached ESCP or the most current approved Grading and Drainage Plan (not part of this SWPPP).

f. There are no industrial activities that will occur on this construction site. No concrete or asphalt plants will be located on or adjacent to this site.

g. The receiving waters from this project is the Rio Grande River.

h. A copy of the Permit Requirements as listed in the Federal Register are attached to this document.

## 2. CONTROLS

a. Erosion and Sediment Controls

(1). Short and Long Term Goals

(a). The short and long term goals of the Erosion and Sediment Controls are to retain sediment on the site to the maximum extent possible.

(2). Stabilization Practices

(a) Temporary Seeding: Disturbed areas where construction has temporarily ceased must be stabilized within fourteen (14) days of the last disturbance. Areas that will again be disturbed within twenty-one (21) days do not have to be stabilized. Refer to the ESCP, Grading Plan and seeding specifications.

(b) Permanent Stabilization: Disturbed portions of the site where construction activity has permanently stopped shall be permanently seeded as required. These areas shall be seeded no later than 14 days after the last construction activity in that area. Refer to the ESCP, Grading and Drainage Plan and seeding specifications.

(3) Structural Practices: (all are "temporary" unless noted as "final")

(a). Silt Fence: Silt fences shall be placed and constructed in accordance with the ESCP.

(b). Straw Bale Barriers: Straw bale barriers shall be placed and constructed in accordance with the ESCP.

(c). Inlet and Outlet Protection: Inlet and Outlet protection shall be installed at proposed detention pond inlets and curb opening outlets in accordance with the ESCP and the approved Grading and Drainage Plan.

(d). Rock Outlet Protection: Hand placed rip-rap pads shall be provided at discharge points in accordance with the ESCP and the approved Grading and Drainage Plan. These rip-rap pads will provide velocity dissipation and shall be placed as soon as practicable.

(e). Slope Protection: Drainage ditches to be installed at the top and toe of slopes as shown on the Grading Plan. All slopes to be stabilized with Sod, Straw, Mulch or an approved wire or jute mat or combination of the above. Hydro seed slopes as required.

(f). Drainage Systems: All Drainage systems (storm drains (final), detention ponds, etc.) are to be installed per the approved Grading and Drainage Plan and any subsequently approved document. All drainage systems are to be protected in place.

(g). Sediment and Storm Water Runoff Basin: The total construction site area is 4.5 acres. EPA regulations require that a sediment basin / storm water basin be installed to contain the 2-yr. 24-hour storm water runoff volume if the site disturbs greater than 10 acres. Therefore, a sediment and storm water runoff basin is not required and the other controls as listed in this SWPPP will provide adequate sediment and erosion control.

b. Storm Water Management

(1). Temporary Storm Drain Inlets and inlet protection will be installed as shown on the ESCP and associated details to provide storm water management after construction is completed. Existing Depression areas will be utilized as sediment and storm water management, storm water will outfall to the temporary storm drain inlets.

(2). Velocity dissipation will occur due to silt fence installation at locations of flow concentration.

c. Other Controls

(1). Temporary Construction Entrances: Off-site vehicle tracking of sediment shall be controlled by providing temporary gravel construction entrances. When the action of vehicles traveling over the gravel construction entrances is not sufficient in removing the majority of the mud, the tires must be washed before the vehicles enter a public road. When off-site tracking occurs, the deposits shall be removed from the roads.

(2). Temporary Parking and Storage: A temporary parking and storage area (gravel base) shall be established by the contractor on the site. The temporary parking and storage area shall also be used as the equipment maintenance area, equipment cleaning area, employee break area, and area for locating portable facilities, office trailers, and toilet facilities.

(3). Dust Control: Dust on the site shall be minimized by sprinkling water on dry areas of the site. The use of motor oils and other petroleum based toxic liquids for dust suppression operations are prohibited.

(4). Construction Waste: All construction waste and trash (paper, plastic, wood, scrap metals, rubber, etc.) Shall be collected and stored in containers with lids or covers that can be placed over the container prior to rainfall. This waste shall be disposed of according to state and local solid waste management regulations.

(5). Hazardous Waste: All hazardous waste (paints, acids for cleaning masonry surfaces, cleaning solvents, concrete curing compounds and additives, etc.) shall be disposed of according to local, state and federal regulations. Any hazardous wastes locations will be shown on the ESCP.

(6). Sanitary Waste: Sanitary waste that is generated on the site shall be disposed of in accordance with local and state regulations.

(7). Concrete Truck Waste: Excess concrete and wash water shall be disposed of in a manner that prevents contact between these materials and storm water that is discharged from the site.

(8). Vehicle and Equipment Cleaning: Wash water generated from vehicle and equipment cleaning shall be disposed of in a manner that prevents contact between these materials and storm water that is discharged from the site.

Material Management

(1). Petroleum Products: All on-site vehicles shall be monitored for leaks and receive regular preventive maintenance to reduce the chance of leakage. Petroleum products (oils, gasoline, lubricants, asphaltic substances, etc.) shall be stored in tightly sealed containers which are clearly labeled. Any asphalt substances used on-site will be applied according to the manufacturer's recommendations.

(2). Paints: All containers shall be tightly sealed and stored when not required for use. Excess paint shall not be discharged to the storm sewer or temporary ponding area but will be properly disposed of according to manufacturer's instructions or state and local requirements.

(3). Fertilizers: Fertilizers used shall be applied only in the minimum amounts recommended by the manufacturer. Once applied, fertilizer shall be worked into the soil (to 6 inches) to limit exposure to storm water. Fertilizers shall be stored in a covered area.

(4). Hazardous Products: Products shall be kept in original containers unless they are not reusable. Original labels and material safety date shall be retained (the labels contain important product information). If surplus products must be disposed of, local, state, and federal requirements shall be followed.

Spill Control Practices

(1). Materials shall be tightly sealed in containers that are clearly labeled and shall be neatly and securely stacked.

(2). Materials and equipment necessary for spill cleanups shall be kept in the material storage area on-site.

(3). All spills shall be cleaned up immediately after discovery.

(4). The spill area shall be kept well ventilated and personnel shall wear appropriate protective clothing to prevent injury from contact with a hazardous substance.

(5). Spills of toxic or hazardous materials shall be reported to the appropriate local, state and federal government agencies as soon as possible, regardless of the size.

(6). Contaminated materials shall be disposed of according to local, state and federal requirements.

(7). One person shall be selected to be the spill prevention and cleanup coordinator.

Good House Keeping

The following good housekeeping practices shall be followed on-site during the construction project:

(1). Neat and orderly storage of any chemicals, fertilizers, fuels, etc., that are being stored on the site.

(2). Regular garbage, rubbish, construction waste, and sanitary waste disposal.

(3). Prompt cleanup of any spills that have occurred.

(4). Cleanup of sediment that has been deposited off of the site by vehicle tracking, wind, and storm water.

## 3. MAINTENANCE

All measures stated in this SWPPP and shown on the ESCP for the prevention of storm water pollution and erosion control shall be maintained in complete functional condition until the final stabilization of the site. All erosion and sedimentation control measures shall be cleaned and repaired in accordance with the following ("ESCP" and the "Detail" Sheet for construction details):

(1). The straw bales used for the straw bale barriers shall be fixed or replaced if they show signs of undermining or deterioration.

(2). All seeded areas shall be checked regularly to see that a good stand of grass is maintained. Areas should be reseeded and fertilized as needed to provide a good stand of grass for erosion control.

(3). Silt fences shall be repaired to their original conditions if damaged. Sediment shall be removed from the silt fences when it reaches one-third to one-half the height of the silt fence.

(4). The construction entrances shall be maintained in a condition which will prevent tracking or flow of mud onto public rights-of-way. This may require periodic top dressing as conditions demand.

(5). The temporary parking and storage area shall be kept in good condition (suitable for parking and storage). This may require periodic top dressing as conditions demand.

(6). If the stones in the block and aggregate inlet sediment filters become clogged with sediment, the stones shall be pulled away, cleaned and replaced.

(7). The responsible party will keep a separate log book an "Inspection / Maintenance / Storm" records. The detailed qualifications of the inspector will be kept in the log book and inspections will be performed on a periodic basis. Repairs must begin within 7 days of noted problem - all inspections, repairs, maintenance must be documented.

(8). A "washout area" will be designated by the contractor to show when debris and excess concrete will be disposed of. Upon completion of the project all debris - material will be disposed of by proper disposal measures.

## 4. INSPECTION and RETENTION OF RECORDS

Qualified personnel shall inspect all erosion, sedimentation, and storm water pollution devices stated in this SWPPP and shown on the ESCP at least once every 14 calendar days and within 24 hours of the end of a rainfall event of 0.5 inches or more or equivalent snowfall. Disturbed areas and areas used for material storage that area exposed to precipitation shall be inspected for evidence of, or the potential for, pollutants entering the drainage systems. Erosion and sediment control measures identified in this SWPPP and shown on the ESCP shall be inspected to ensure that they are operating correctly. Discharge locations shall be inspected to ascertain whether the erosion and sedimentation control measures are effective in preventing significant impacts to receiving waters.

Based on the results of the inspection, the SWPPP and the ESCP erosion and sedimentation control measures shall be revised or modified as appropriate, but in no case shall it take more than 7 calendar days following the inspection to revise or modify the SWPPP and the ESCP. An "Inspection / Maintenance / Storm" records must be retained as part of the SWPPP for 3 years.

## 5. NON-STORM WATER DISCHARGE

Anticipated non-storm water discharges on the construction site may include the following:

(1). Water line flushing from the newly installed water lines. Silt fences shall be used to collect sediment from water that is flushed from new water lines.

(2). Discharge from fire fighting activities. Any materials from fire fighting activities that may pollute the storm water shall be disposed of in a proper manner.

(3). Water discharge from dust control. Silt fences shall be used to collect sediment from discharge waters associated with dust control.

## 6. APPROVED STATE OR LOCAL PLANS and SWPPP KEPT AT SITE

To the best knowledge of all parties involved with implementation of this SWPPP, all measures and consideration specified in this plan meet the requirements of the NPDES General Permit for Storm Water Discharges from Construction Activities as listed in the Federal Register / Vol. 63, No. 128 / Monday, July 6 1998 Notices (page 36498) and Part IV. Storm Water Pollution Prevention Plans. (page 36502). This Plan was prepared in accordance with the EPA Storm Water Management Requirements for Construction Activities. A copy of these pages are attached as part of this SWPPP. Both the Regulations and the SWPPP must be kept at the construction site at all times.

EPA General Permit No. NMR10### (page 36498) (The specific permit number is supplied by the EPA after approval of the NOI)

## 7. SIGNATURE REQUIREMENTS

The contractor shall obtain and sign copies of the following forms / plans, reports, certifications as required by NPDES and the General Permit for Storm Water discharges from construction activities, as required by the permit during the period the permit is active on this site. All records are to be kept on site and presented to authorized officials as noted in the permit.

Notice of Intent (N.O.I.), Notice of Termination (N.O.T.),  
Storm Water Pollution Prevention Plan (SWPPP),  
Reports, Certifications

When the site has been stabilized by permanent seeding, mulching, paving, landscaping, sodding, etc., the permit shall be terminated. The Operator (General Contractor) shall submit a Notice of Termination (Form N.O.T.) of the General Permit to discharge storm water associated with construction activities.

## 8. EPA CHECKLIST

See [www.epa.gov/region6/sw](http://www.epa.gov/region6/sw) for the latest EPA checklist.

## 9. STORM WATER POLLUTION PREVENTION PLAN and EROSION AND SEDIMENTATION CONTROL PLAN CERTIFICATION

"I certify, under penalty of law, that this document and all attachments were prepared under my direction or supervision in accordance with a system designed to assure that qualified personnel properly gathered and evaluated the information submitted. Based on my inquiry of the person or persons who manage the system, or those persons directly responsible for gathering the information, the information submitted is, to the best of my knowledge and belief, true, accurate, and complete. I am aware that there are significant penalties for submitting false information including the possibility of fine and imprisonment for knowing violations."

Name (please print): Patrick Conley, PE  
Title: Civil Engineer

Signature: \_\_\_\_\_  
Date: \_\_\_\_\_

## 10. CONTRACTOR / SUBCONTRACTOR CERTIFICATION

"I certify, under penalty of law, that I understand the terms and conditions of the general National Pollutant Discharge Elimination System (NPDES) Permit that authorizes the storm water discharge associated with commercial activity from the construction site identified as part of this certification. Further, by my signature, I understand that I am becoming a co-permittee, along with the owner(s) and other contractors and subcontractors signing such certifications, to the general NPDES permit for the storm water discharges associated with commercial activity from the identified site. As a co-permittee, I understand that I, and my company, are legally required under the Environment Protection Act and the Clean Water Act to ensure compliance with the terms and conditions of the Storm Water Pollution Prevention Plan developed under the NPDES permit and the terms of the NPDES permit."

NOTE: The General Contractor and any Subcontractors involved with the implementation of this Storm Water Pollution Prevention Plan shall sign an individual copy of this certification and state in the space provided the measures in which they are responsible for performing (make copies if needed).

Please check one ( X )  
CONTRACTOR ( ): SUBCONTRACTOR ( )

COMPANY NAME: \_\_\_\_\_  
ADDRESS: \_\_\_\_\_  
TELEPHONE: \_\_\_\_\_

SITE: LOCATION (CITY, STATE, Zip): \_\_\_\_\_  
ADDRESS: \_\_\_\_\_

## CONTRACTOR / SUBCONTRACTOR CERTIFICATION

CONTINUED IN NEXT COLUMN

Name (please print): \_\_\_\_\_  
Title: \_\_\_\_\_

Signature: \_\_\_\_\_  
Date: \_\_\_\_\_

Storm Water Pollution Prevention Plan measures that your company is responsible for performing:

Please check one ( X )  
CONTRACTOR ( ): SUBCONTRACTOR ( )


COMPANY NAME: \_\_\_\_\_  
ADDRESS: \_\_\_\_\_  
TELEPHONE: \_\_\_\_\_

Name (please print): \_\_\_\_\_  
Title: \_\_\_\_\_


Signature: \_\_\_\_\_  
Date: \_\_\_\_\_

Storm Water Pollution Prevention Plan measures that your company is responsible for performing:

AS-BUILT INFORMATION				BENCH MARKS				SURVEY INFORMATION				ENGINEER'S SEAL				REVISIONS			
CONTRACTOR	STARTED BY	DATE	INSPECTED BY	DATE	VERIFIED BY	DATE	RECORDED BY	NO.	BY	DATE	NO.	BY	DATE	NO.	DATE	DESIGNED BY	DRAWN BY	CHECKED BY	

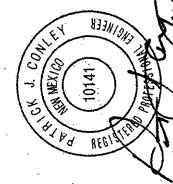

10/17/03



**Smith Engineering Company**  
A Full Service Engineering Company  
2000 Upper Boulevard, S.E. Suite 2000 Albuquerque, New Mexico 87102

103606

**CITY OF ALBUQUERQUE**  
**PUBLIC WORKS DEPARTMENT**  
**ENGINEERING DEVELOPMENT GROUP**

TITLE: **QUINTESSANCE PARK**

**STORMWATER POLLUTION PREVENTION NOTES (SWPPP)**

DESIGN REVIEW COMMITTEE

DEC - 2 2003

CITY ENGINEER

DEC - 2 2003

City Project No.

Zone Map No.

Sheet

D-21

14 of 23



SITE DESCRIPTION

A. General Information

Project Name: \_\_\_\_\_  
Project Address / Location: \_\_\_\_\_  
City/County/State/Zip: Albuquerque / Bernalillo County, NM 87102  
Location map attached: Yes

Owner name and address: \_\_\_\_\_  
City of Albuquerque  
Transportation Department  
100 1 Street SW  
Albuquerque, NM 87102  
(505) 724-3174

Operator name and address: \_\_\_\_\_

B. Hydrologic Information

Hydrologic Data and Calculations per COA DPM  
Project size (acres): \_\_\_\_\_ Area to be graded (acres): \_\_\_\_\_  
Land Treatment Type Prior to Construction(%): A \_\_\_\_\_ B \_\_\_\_\_ C \_\_\_\_\_ D \_\_\_\_\_  
Land Treatment Type After Construction(%): A \_\_\_\_\_ B \_\_\_\_\_ C \_\_\_\_\_ D \_\_\_\_\_  
Precipitation Zone: 1, 2, 3 or 4: \_\_\_\_\_  
2-yr. 24-hour Rainfall Depth: \_\_\_\_\_  
2-yr. 24-hour Peak Discharge(post development) (cfs): \_\_\_\_\_  
2-yr. 24-hr. Runoff Volume (cu ft or ac-ft): \_\_\_\_\_  
2-yr. Sediment Volume: \_\_\_\_\_

On-Site Flood Control Structure(s) (describe): \_\_\_\_\_

Off-Site Flood Control Structure(s) (describe): \_\_\_\_\_

Soils report: \_\_\_\_\_  
If yes, prepared by: \_\_\_\_\_

C. Type of Construction

Residential: \_\_\_\_\_ Single Family: \_\_\_\_\_ Multi-Family: \_\_\_\_\_ Commercial: \_\_\_\_\_  
Roadways: \_\_\_\_\_ Utilities: \_\_\_\_\_ Industrial: \_\_\_\_\_  
Other: \_\_\_\_\_

On-Site Construction Activities

Grading: \_\_\_\_\_ Acres: \_\_\_\_\_ Blasting: \_\_\_\_\_  
Roadways: \_\_\_\_\_ Linear Feet: \_\_\_\_\_ Sewer, Water, Utilities: \_\_\_\_\_


Off-Site Construction Activities (may require separate permit)

Grading: \_\_\_\_\_ Acres: \_\_\_\_\_ Blasting: \_\_\_\_\_  
Roadways: \_\_\_\_\_ Linear Feet: \_\_\_\_\_ Sewer, Water, Utilities: \_\_\_\_\_


D. Sequence of Major Activities

See schedule on Sheet 1 of this SWPPP

E. Location / Vicinity Map COA Zone Atlas Page L-21-Z

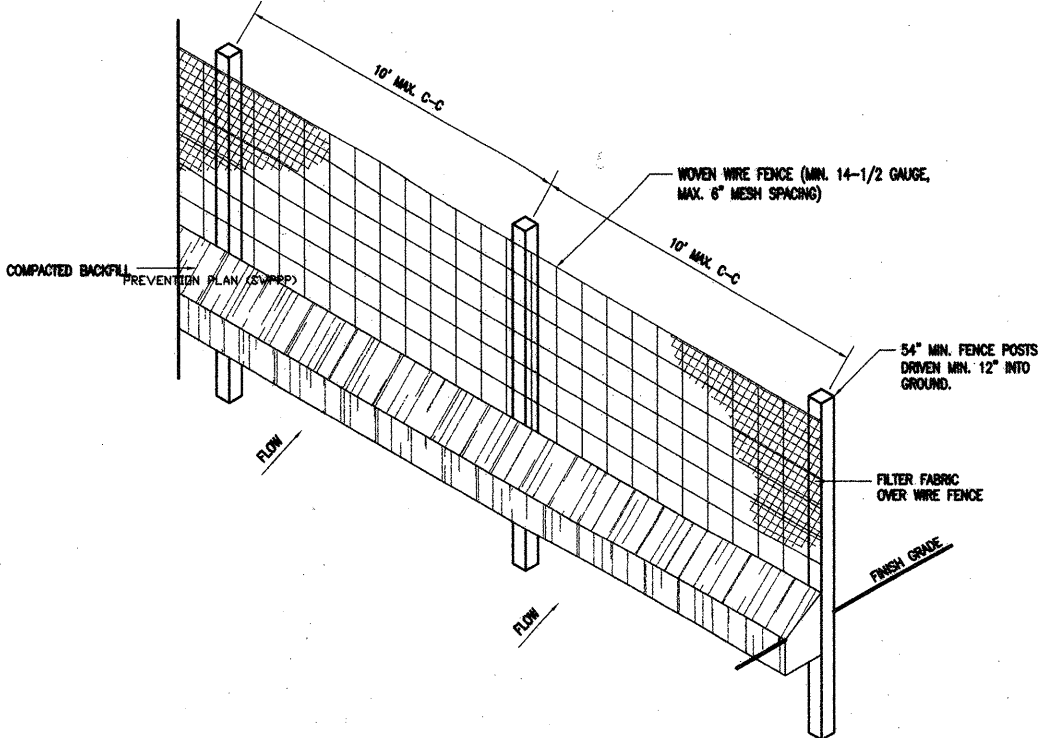

SILT FENCE ELEVATION

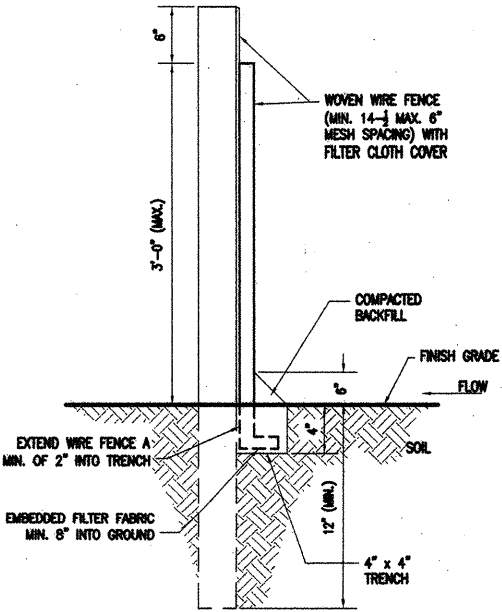

SILT FENCE CROSS-SECTION


SILT FENCE

WOVEN WIRE FENCE TO BE FASTENED SECURELY TO FENCE POSTS WITH WIRE TIES OR STAPLES

FILTER CLOTH TO BE FASTENED SECURELY TO WOVEN WIRE FENCE WITH TIES SPACED EVERY 24" AT TOP AND MID SECTION.

WHEN TWO SECTIONS OF FILTER CLOTH ADJOIN EACH OTHER THEY SHALL BE OVERLAPPED BY SIX INCHES AND FOLDED.

MAINTENANCE SHALL BE PERFORMED AS NOTED IN THE SWPPP. SOIL COLLECTED AT THE SILT FENCE SHALL BE REMOVED WHEN "BULGES" DEVELOP IN THE SILT FENCE.

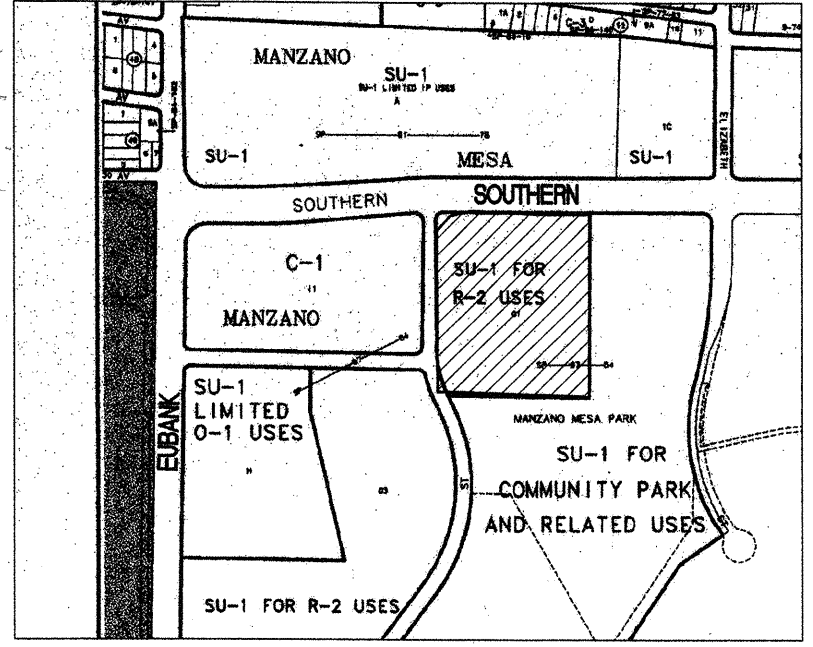

102049  
Smith Engineering Company  
A Full Service Engineering Company  
5400 10th Avenue, N.E. Suite 200 Albuquerque, New Mexico 87110

CITY OF ALBUQUERQUE  
CAPITAL IMPLEMENTATION PROGRAM

TITLE: DETAILS FOR THE ESCP  
STORMWATER POLLUTION PREVENTION DETAILS (SWPPP)


DESIGNED BY: PJC  
DRAWN BY: BG  
CHECKED BY: PJC

REVISIONS  
NO. DATE  
1 DEC - 2 2003  
2 DEC - 2 2003


City Project No. XXXX Zone Map No. L-21-Z Sheet 16 Of 21

SURVEY INFORMATION		BENCH MARKS		AS BUILT INFORMATION	
NO.	DATE	CONTRACTOR	DATE	NO.	DATE
11599	2000	STEVE TOLER	2000	CONTRACTOR	DATE
				INSPECTOR'S	DATE
				FIELD CHANGE BY	DATE
				VERIFICATION BY	DATE
				CORRECTED BY	DATE
				RECORDED BY	DATE
				NO.	DATE

ENGINEER'S SEAL		MICRO-FILM INFORMATION	
PATRICK J. CONLEY REGISTERED PROFESSIONAL ENGINEER 10141 12/1/00		GROUND COORDINATES: NORTHING=1,481,746.33 EASTING=418,123.51	GROUND COORDINATES: NORTHING=1,481,220.09 EASTING=417,975.01
		GROUND TO GRID 0.99964527	

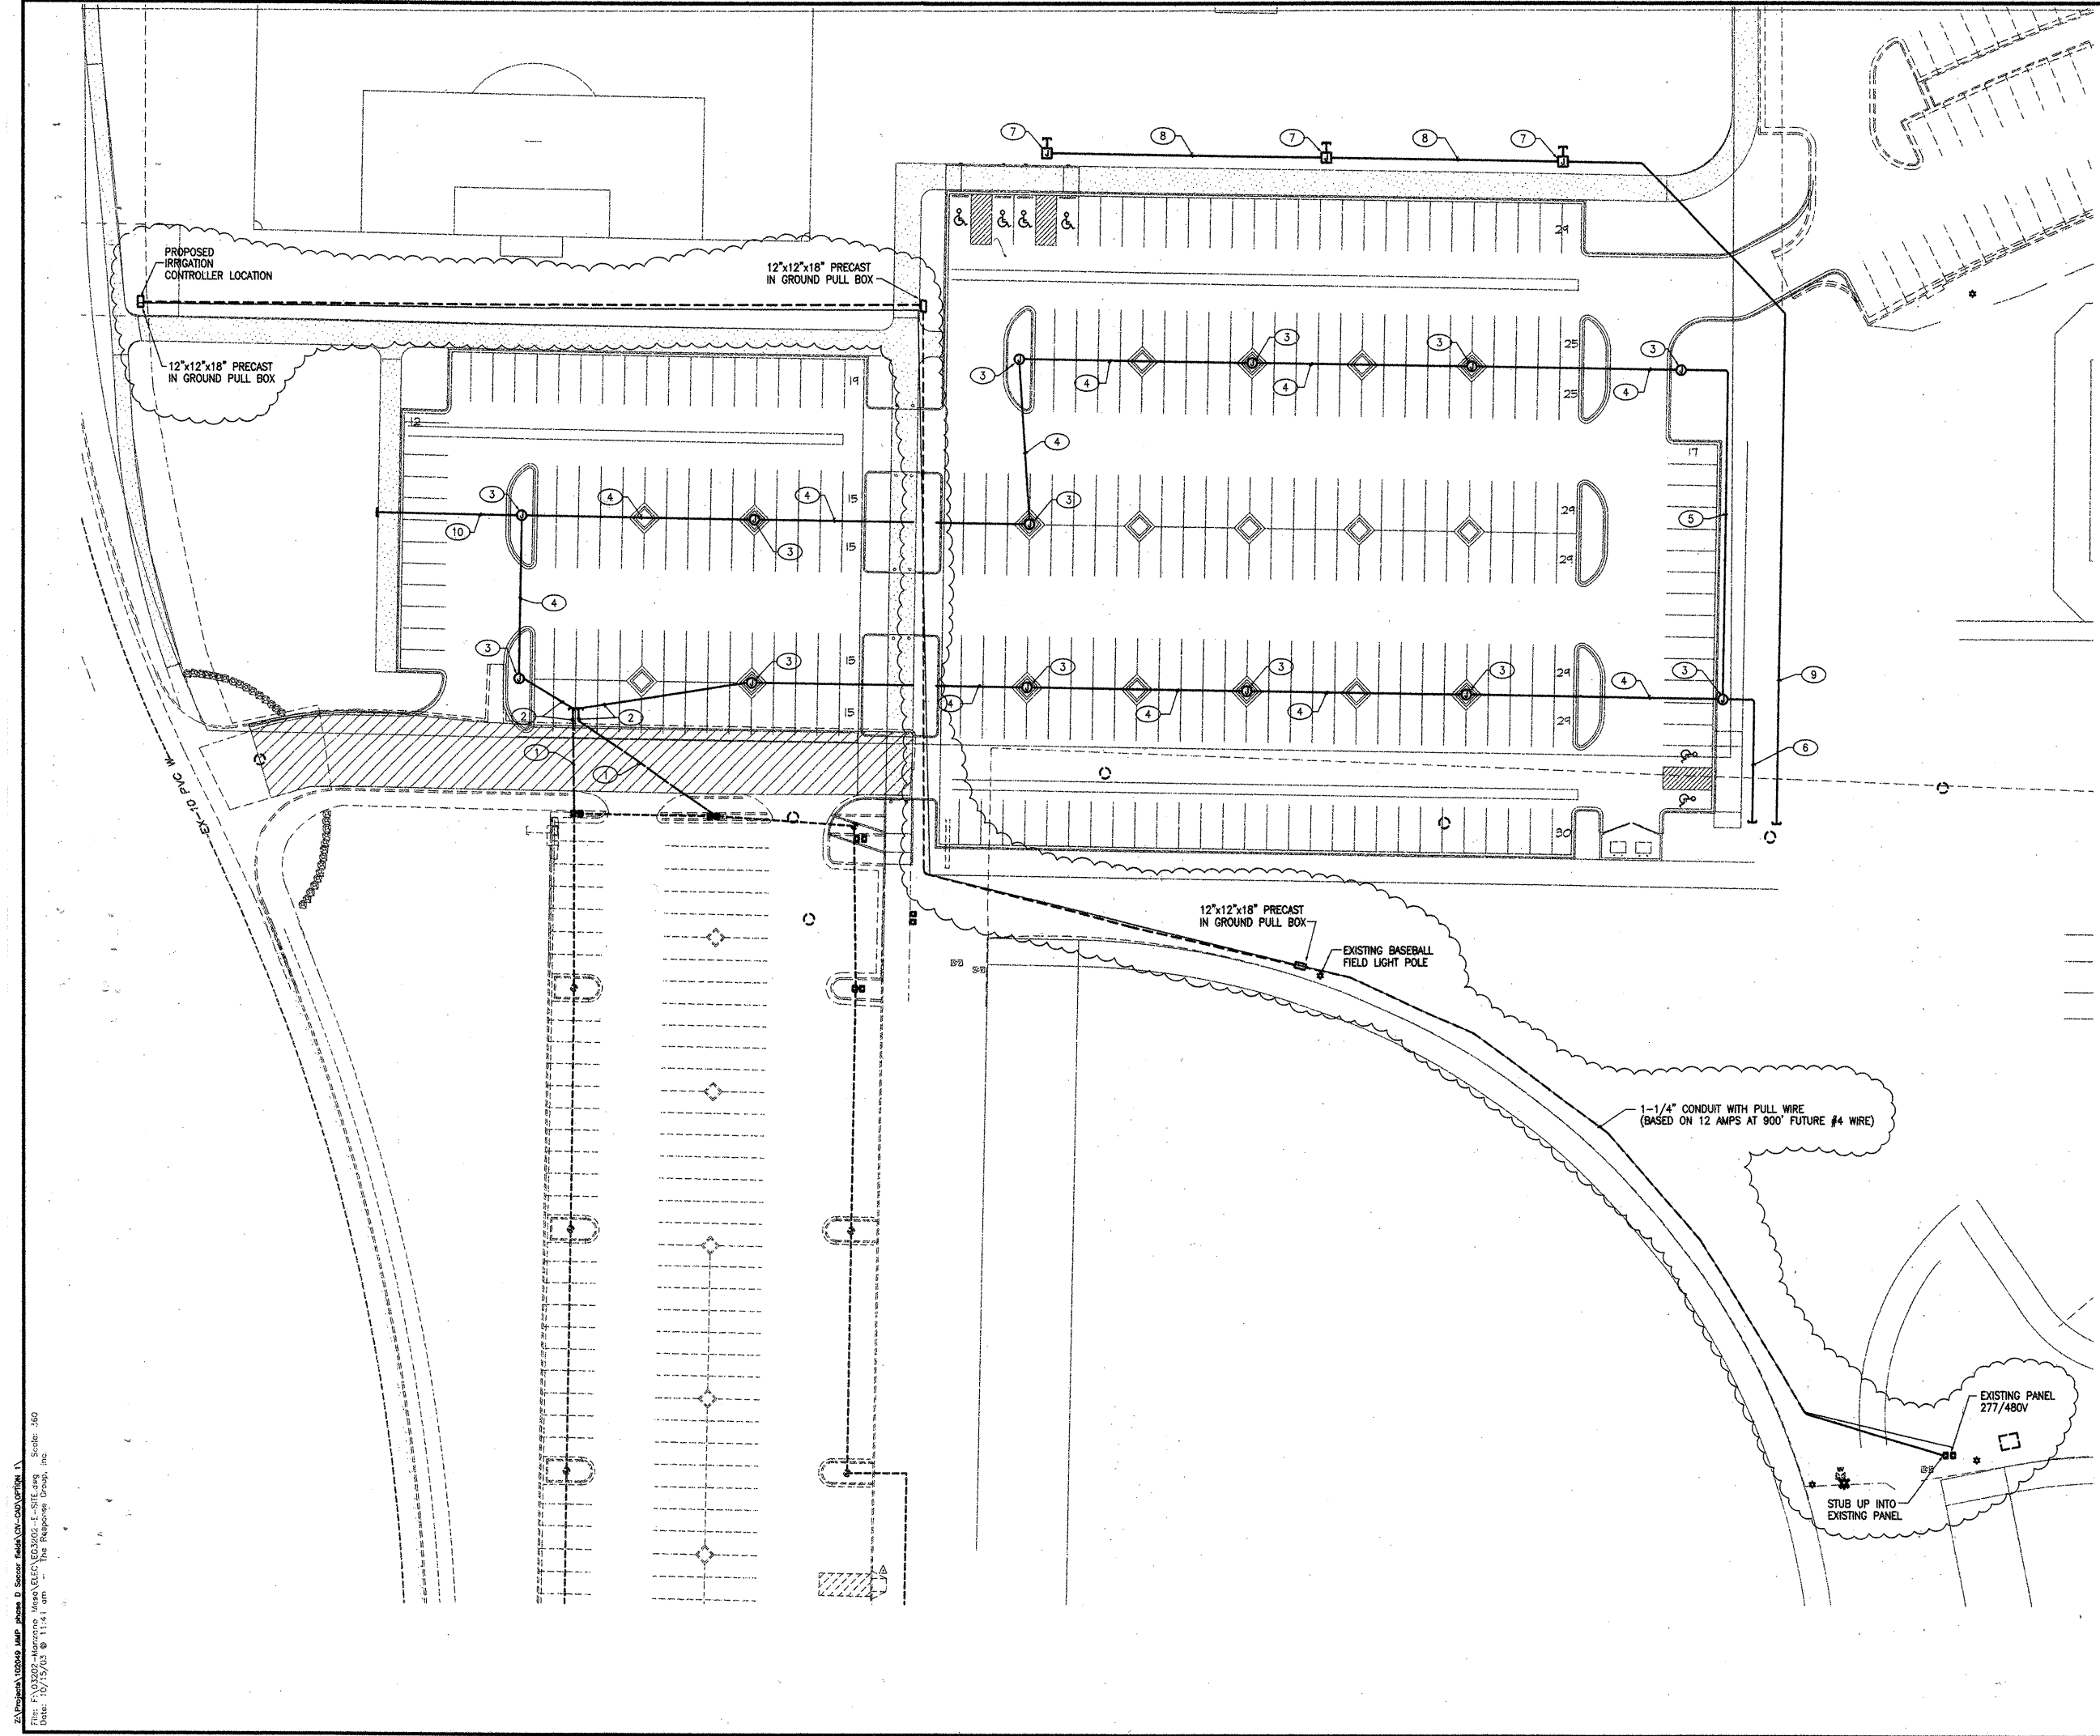

- KEYED NOTES**
- 1 EXISTING 1" CONDUIT STUB OUT NORTH OF EXISTING ROAD. CONTRACTOR SHALL FIELD VERIFY EXACT STUB OUT LOCATION.
  - 2 EXTEND A 1" CONDUIT FROM STUB OUT LOCATION TO NEW IN GROUND PULLBOX.
  - 3 PROVIDE AND INSTALL A NEW 18" X 12" X 24" DEEP, IN GROUND, PRE CAST CONCRETE PULLBOX, TRAFFIC RATED, SCREW DOWN COVER, LABEL "ELECTRICAL". TOP OF PULLBOX AT 6" ABOVE FINISH GRADE.
  - 4 EXTEND A 1" CONDUIT WITH PULL WIRE BETWEEN PULLBOXES. STUB CONDUIT UP INTO PULLBOX.
  - 5 EXTEND A 1 1/4" CONDUIT WITH PULL WIRE BETWEEN PULLBOXES. STUB CONDUIT UP INTO PULLBOX.
  - 6 STUB OUT A 1 1/4" CONDUIT WITH PULLWIRE FROM PULLBOX, TO END OF PARKING LOT AS SHOWN. CAP CONDUIT. PROVIDE A 36" HIGH STEEL BOLLARD AT END OF STUB OUT LOCATION.
  - 7 PROVIDE AND INSTALL A NEW 18" X 18" X 24" DEEP, IN GROUND, PRE CAST CONCRETE PULLBOX, TRAFFIC RATED, SCREW DOWN COVER, LABEL "ELECTRICAL". TOP OF PULLBOX AT 6" ABOVE FINISH GRADE. PULLBOX FOR THE EXTENSION OF POWER TO FUTURE VENDER STANDS. STUB OUT A 2" CONDUIT 36" NORTH OF PULLBOX AS SHOWN.
  - 8 EXTEND A 2" CONDUIT WITH PULLWIRE BETWEEN

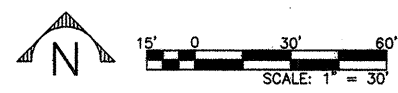

CITY OF ALBUQUERQUE PARKS AND RECREATION DEPARTMENT	
TITLE: MANZANO MESA PHASE D SOCCER FIELDS ELECTRICAL CONDUIT LAYOUT PLAN	
City Project No. 498092	Zone Map No. L-21-Z
Sheet No.	Drawing No. 17 of 23

DESIGNED BY	SEC/RESPONSE GROUP	DATE	10/03
DRAWN BY	SEC/RESPONSE GROUP	DATE	10/03
CHECKED BY	SEC/RESPONSE GROUP	DATE	10/03

NO.	DATE	REMARKS	BY

AS BUILT INFORMATION	
CONTRACTOR	DATE
INSPECTOR'S	DATE
ACCEPTANCE BY	DATE
VERIFICATION BY	DATE
DRAWN BY	DATE
MICRO-FILM INFORMATION	
RECORDED BY	DATE
NO.	DATE





SOUTHERN BOULEVARD SE  
(156' R.O.W.)

STEPHEN MOODY DRIVE SE  
(60' R.O.W.)


**Alternates Description (Irrigation)**  
Base Bid - Includes waterline tap; meter vault; backflow prevention assembly; mainline, mainline components, valves, sprinklers, and bubblers to serve east soccer field; and controller and control wiring.  
Alternate No. 1 - Includes mainline, mainline components, valves, control wiring, sprinklers, and bubblers to serve west soccer field, and turf area south of west field.  
Alternate No. 2 - Includes mainline, valves, control wiring, and bubblers to serve plant material within parking lot islands, site entry and play area.

IRRIGATION EQUIPMENT SCHEDULE

SYMBOL	DESCRIPTION
[M]	3" Meter (By City of Albuquerque, see Irrigation Construction Note #1, Sheet L02)
====	Sleeving: Class 200 PVC (2 sizes larger than pipe to be sleeved)
[Symbol]	Backflow Prevention Assembly: Febco 825Y-3" Reduced Pressure Backflow Assembly W/Arad Flow Meter (3") in Strongbox Model No. SBBC w/Raychem Pipe Heating Cable w/Master Valve (2") (COA Detail 2701)
[Symbol]	Gate Valve Assembly (COA Detail 2706)
[Symbol]	Quick Coupler Assembly: Rain Bird 33DNP (COA Detail 2708)
[Symbol]	Manual Drain Valve: Champion 100-2"
---	Irrigation Mainline: Schedule 40 Bell End PVC (4"), 26" Depth upstream of Master Valve, 18" depth downstream of Master Valve
---	Lateral Pipe: Schedule 40 PVC, 18" Depth, Size per chart
[Symbol]	Automatic Valve Assembly: Rain Bird Series (COA Detail 2703)
[Symbol]	Rotor Sprinkler Assembly: Hunter I-25 Series (COA Detail 2709)
[Symbol]	I-25-ADS-5 (90°), 4.8 gpm @ 50 psi
[Symbol]	I-25-ADS-8 (180°) 8.3 gpm @ 50 psi
[Symbol]	I-25-36S-8 (360°) 8.3 gpm @ 50 psi
[Symbol]	Bubbler Assembly: Rain Bird 1400 Series Pressure Compensating Bubbler
[Symbol]	1401 (.25 gpm) - 1 per shrub
[Symbol]	1402 (.5 gpm) - 3 per tree in turf area
[Symbol]	1408 (2.0 gpm) - 1 per tree (COA Detail 2710)
[Symbol]	Irrigation Controller: Toro MIR5000s M5S-2S (48 station) in interlocking enclosure. Ground per manufacturers recommendations.
[Symbol]	Indicates Controller and Station Number
[Symbol]	Indicates Lateral Discharge in GPM
[Symbol]	Indicates Remote Control Valve Size in Inches

PIPE SIZE CHART

3/4"	0-8 gpm
1"	8-12 gpm
1 1/4"	12-22 gpm
1 1/2"	22-30 gpm
2"	30-50 gpm
2 1/2"	50-70 gpm
3"	70-110 gpm

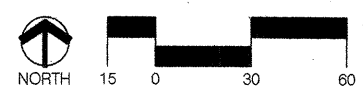

**CONSENSUS PLANNING, INC.**  
Planning / Landscape Architecture  
924 Park Avenue SW  
Albuquerque, NM 87102  
(505) 764-9801 Fax 842-5495  
e-mail: cp@consensusplanning.com

CITY OF ALBUQUERQUE  
DEPARTMENT OF MUNICIPAL DEVELOPMENT  
PARK AND MEDIAN DESIGN DIVISION

TITLE: MANZANO MESA PARK  
IRRIGATION PLAN

DESIGNED BY CG DATE 10/16  
DRAWN BY MA DATE 10/16  
CHECKED BY CG DATE 10/16

APPROVED  
CITY ENGINEER  
DEC - 2 2003

AS-BUILT INFORMATION		BENCH MARKS		SURVEY INFORMATION		ENGINEER'S SEAL	
CONTRACTOR	DATE	NO.	BY	NO.	BY	NO.	BY
INSPECTOR'S	DATE	NO.	BY	NO.	BY	NO.	BY
FIELD	DATE	NO.	BY	NO.	BY	NO.	BY
VERIFICATION	DATE	NO.	BY	NO.	BY	NO.	BY
CORRECTED	DATE	NO.	BY	NO.	BY	NO.	BY
MICRO-FILM INFORMATION		REVISIONS		DESIGN		REVISIONS	
RECORDED BY	DATE	NO.	BY	NO.	BY	NO.	BY
NO.	DATE	NO.	BY	NO.	BY	NO.	BY



SOUTHERN BOULEVARD SE  
(156' R.O.W.)

PLANT. LEGEND

Quantity	Symbol	Scientific Name Common Name	Size	Remarks	Water Use
7		Chilopsis lin. 'Luc. Hamilton' Desert Willow	15 Gallon	Multi-trunk	Medium
18		Fraxinus oxycarpa Raywood Ash	2" B&B	14' ht. x 6' spr.	Medium +
36		Fraxinus velutina 'Modesto' Modesto Ash	2" B&B	14' ht. x 6' spr.	Medium +
24		Pyrus calleryana 'Bradford' Bradford Pear	2" B&B	14' ht. x 5' spr.	Medium +
11		Pinus nigra Austrian Pine	B&B	6' min. ht.	Medium
45		Platanus occidentalis Sycamore	2" B&B	14' ht. x 6' spr.	High
13		Pistachia chinensis Chinese Pistache	2-1/2" B&B	16' ht. x 6' spr.	Medium
19		Gymnocladus dioica Kentucky Coffee Tree	2-1/2" B&B	16' ht. x 6' spr.	Medium
7		Tilia cordata Little-leaf Linden	2" B&B	14' ht. x 5' spr.	Medium
20		Artemisia 'Powis Castle' Powis Castle Sage	1 Gallon	4' o.c.	Low +
74		Caryopteris clandonensis Blue Mist	5 Gallon	4' o.c.	Medium
40		Ericameria laricifolia Turpentine Bush	1 Gallon	3' o.c.	Medium +
98		Juniperus sabina 'Buffalo' Buffalo Juniper	5 Gallon	6' o.c.	Low +
104		Nassella tenuissimum Threadgrass	1 Gallon	3' o.c.	Low +
9		Nolina texana Beargrass	5 Gallon	5' o.c.	Medium
21		Perovskia atriplicifolia Russian Sage	1 Gallon	6' o.c.	Low +
38		Potentilla fruticosa Shrubby Cinquefoil	1 Gallon	4' o.c.	Medium
19		Salvia greggii Cherry Sage	5 Gallon	4' o.c.	Medium
314,225 SF		Turfgrass Seed COA Specification 1011			
50,380 SF		Native Seed Mix COA Specification 1012 (East Side Mix)			
37		Moss Rock Boulders, 3' X 3' (min.)			

### GENERAL LANDSCAPE NOTES

1. Prior to beginning work on the project, the Landscape Contractor shall review the project in the field with the Owner's Representative.
2. If discrepancies occur between the drawings and the site, the Landscape Contractor shall notify the Owner's Representative for clarification prior to proceeding on that portion of work.
3. All planting areas are to have weeds and competitive vegetation removed prior to preparation for planting.
4. All existing plant materials shall be protected during construction. Damaged materials shall be replaced in kind at the Contractor's expense.
5. Plant quantities are provided for Contractor's convenience only, plans shall take precedence.
6. The Owner's Representative shall approve all plant material prior to planting. In addition, the Owner's Representative reserves the right to refuse any plant material deemed unacceptable. The Owner's Representative is to approve any and all substitutions.
7. It is the Landscape Contractor's responsibility to locate all underground utilities prior to commencement of planting operations.
8. Planting installation shall be in accordance with all City of Albuquerque standard specifications (Section 1005 - Planting) and details (Isolated Tree Planting - 2714, Tree Planting on Slope - 2716).

Substitutions to City Specification Section 1041  
Fertilizer: In lieu of the fertilizer specified in the City of Albuquerque  
Specifications Section 1011/Turf Grass Seeding, paragraph 1011.3.2,  
substitute Nature's Bio-Custom Dry Fertilizer (16-6-3). Apply fertilizer  
at a rate of 500 lbs. per acre.

Humate: In lieu of the organic amendment specified in the City of Albuquerque Specifications Section 1011/Turf Grass Seeding, paragraph 1011.3.3, substitute Nature's Bio-Custom Blended Humate. Apply humates at a rate of 2 tons per acre.

Additions to City Specification Section 1011      ↓      ↓      ↓      ↓  
 Water Absorbent Polymer: Stockhausen Stockosorb 400 Series Polymer.  
 Apply polymers at a rate of 440 lbs. per acre.      ↓      ↓      ↓

Biological Activator/Inoculant: Nature's Bio Custom  
Biological Activator/Inoculant. Apply inoculant at a rate of 22 gallons per acre.

The above materials shall be evenly applied over the entire area to be turf seeded. Incorporate by disking or rototilling into the top 6 to 8 inches of soil. Obtain a uniform mixture with no pockets of soil or amendments remaining. Materials are available from Organic Technology International, Albuquerque, New Mexico (505) 291-1100.

Alternates Description (Planting)  
Base Bid - Includes turf, trees, and concrete header surrounding the east soccer field.

Alternate No. 1 - includes turf, trees, concrete header, and picnic tables/concrete pads (3) within west soccer field and turf area south of west field.

Alternate No. 2 - Includes all trees, shrubs, rock mulch, and boulders within parking lot islands, site entry and play area.

ALTERNATE NO. 1

**SPACE**

CP-103 (8/8" REBAR & PC)  
N = 1479880.34'  
E = 417233.58'  
ELEV. = 5489.83'

EAST FIELD

WEST FIELD

ALTERNATE NO. 2
-----------------

MATCHLINE



**PLANNING**  
**CONSENSUS** **PLANNING, INC.**  
*Planning / Landscape Architecture*  
 924 Park Avenue SW  
 Albuquerque, NM 87102  
 (505) 764-9801 Fax 842-5495  
 e-mail: [cp@consensusplanning.com](mailto:cp@consensusplanning.com)

CITY OF ALBUQUERQUE  
DEPARTMENT OF MUNICIPAL DEVELOPMENT  
PARK AND MEDIAN DESIGN DIVISION

**TITLE:** MANZANO MESA PARK  
PLANTING PLAN



### Fast Design Update

City Project No.	498092	Zone Map No.	Sheet 22	Of 23
------------------	--------	--------------	----------	-------

