


CONSTRUCTION PLANS
FOR
STOWE AT SEVEN BAR NORTH
ALBUQUERQUE, NEW MEXICO

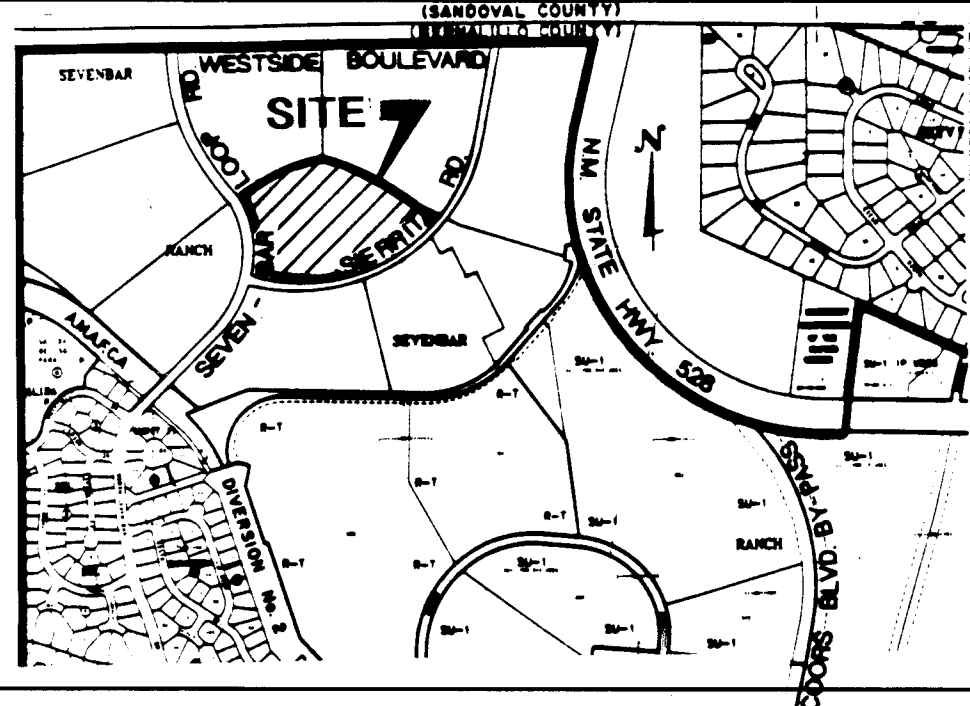

VICINITY MAP
NOT TO SCALE
A-13

NOTICE TO CONTRACTORS

- ALL WORK DETAILED ON THESE PLANS TO BE PERFORMED UNDER CONTRACT SHALL, EXCEPT AS OTHERWISE STATED OR PROVIDED FOR HEREON, BE CONSTRUCTED IN ACCORDANCE WITH THE CITY OF ALBUQUERQUE STANDARD SPECIFICATIONS FOR PUBLIC WORKS NEW MEXICO UTILITIES, INC. SPECIFICATIONS FOR WATER & CONSTRUCTION, 1986 EDITION (THROUGH UPDATE #6), AND WASTEWATER FACILITIES. (MOST RECENT REVISION)
- TWO WORKING DAYS PRIOR TO ANY EXCAVATION, THE CONTRACTOR MUST CONTACT NEW MEXICO ONE CALL SYSTEM (260-1990) FOR LOCATION OF EXISTING UTILITIES.
- THE CONTRACTOR SHALL NOTIFY NEW MEXICO UTILITIES, INC. (898-2661) THREE WORKING DAYS PRIOR TO BEGINNING THE CONSTRUCTION OF THE UTILITIES.
- PRIOR TO CONSTRUCTION, THE CONTRACTOR SHALL EXCAVATE AND VERIFY THE HORIZONTAL AND VERTICAL LOCATIONS OF ALL OBSTRUCTIONS. SHOULD A CONFLICT EXIST, THE CONTRACTOR SHALL NOTIFY THE ENGINEER OR SURVEYOR IMMEDIATELY SO THAT THE CONFLICT CAN BE RESOLVED WITH A MINIMUM AMOUNT OF DELAY.
- THREE (3) WORKING DAYS PRIOR TO BEGINNING CONSTRUCTION, THE CONTRACTOR SHALL SUBMIT TO CONSTRUCTION COORDINATION DIVISION A DETAILED CONSTRUCTION SCHEDULE. TWO (2) WORKING DAYS PRIOR TO CONSTRUCTION, THE CONTRACTOR SHALL OBTAIN A BARRICADING PERMIT FROM THE CONST. COORDINATION DIVISION. CONTRACTOR SHALL NOTIFY BARRICADE ENGINEER (768-2551) PRIOR TO OCCUPYING AN INTERSECTION. REFER TO SECTION 19 OF THE GENERAL CONDITIONS OF THE STANDARD SPECIFICATIONS.
- ALL STREET STRIPING ALTERED OR DESTROYED SHALL BE REPLACED IN KIND BY CONTRACTOR TO LOCATION AND IN KIND AS EXISTING OR AS INDICATED BY THIS PLAN SET.
- CONTRACTOR SHALL NOTIFY THE ENGINEER NOT LESS THAN SEVEN (7) DAYS PRIOR TO STARTING WORK IN ORDER THAT THE ENGINEER MAY TAKE NECESSARY MEASURES TO INSURE THE PRESERVATION OF SURVEY MONUMENTS. CONTRACTOR SHALL NOT DISTURB PERMANENT SURVEY MONUMENTS WITHOUT THE CONSENT OF THE CITY SURVEYOR AND SHALL NOTIFY THE CITY SURVEYOR AND BEAR THE EXPENSE OF REPLACING ANY THAT MAY BE DISTURBED WITHOUT PERMISSION. REPLACEMENT SHALL BE DONE ONLY BY THE CITY SURVEYOR. WHEN A CHANGE IS MADE IN THE FINISHED ELEVATIONS OF THE PAVEMENT OF ROADWAY IN WHICH A PERMANENT SURVEY MONUMENT IS LOCATED, CONTRACTOR SHALL, AT HIS OWN EXPENSE, ADJUST THE MONUMENT COVER TO THE NEW GRADE UNLESS OTHERWISE SPECIFIED. REFER TO SECTION 4.4 OF THE GENERAL CONDITIONS OF THE STANDARD SPECIFICATIONS.
- ANY WORK OCCURRING WITHIN AN ARTERIAL ROADWAY REQUIRES TWENTY FOUR-HOUR CONSTRUCTION.

THE FOLLOWING NOTES ALSO APPLY WHEN CHECKED

- ☒ ALL UTILITIES AND UTILITY SERVICE LINES SHALL BE INSTALLED PRIOR TO PAVING.
- ☒ BACKFILL COMPACTION SHALL BE ACCORDING TO SPECIFIED STREET USE.
- ☐ TACK COAT REQUIREMENTS SHALL BE DETERMINED BY THE CITY ENGINEER.
- ☒ SIDEWALKS AND WHEELCHAIR RAMPS WITHIN THE CURB RETURNS SHALL BE CONSTRUCTED WHEREVER A NEW CURB RETURN IS CONSTRUCTED.
- ☒ IF CURB IS DEPRESSED FOR A DRIVEPAD, THE DRIVEPAD SHALL BE CONSTRUCTED PRIOR TO ACCEPTANCE OF CURB AND GUTTER.
- ☒ ALL STORM DRAINAGE FACILITIES SHALL BE COMPLETED PRIOR TO FINAL ACCEPTANCE.
- ☒ THE REQUESTOR OR DEVELOPER SHALL BE RESPONSIBLE FOR REPAIR OR REPLACEMENT OF ALL CURB AND GUTTER OR SIDEWALK DAMAGED AFTER APPROVAL BY THE CITY ENGINEER OF WORK COMPLETED BY THE CONTRACTOR.

INDEX	
SHEET NUMBER	DESCRIPTION
1	TITLE SHEET
2	PLAT
3	FINAL GRADING PLAN - STOWE
4A & 4B	GRADING DETAILS
5	PAVING PLAN
	PAVING PLAN AND PROFILE
6	BROMLEY COURT
7	KILLINGTON ROAD & BROEAS DRIVE
8	STOWE ROAD
9	KILLINGTON ROAD
10	SUNAPEE ROAD
11	UTILITY PLAN
	UTILITY PLAN AND PROFILE
12	BROMLEY COURT
13	KILLINGTON ROAD & BROEAS DRIVE
14	STOWE ROAD
15	KILLINGTON ROAD
16	SUNAPEE ROAD
17	STORM DRAIN PLAN AND PROFILE
18	MISCELLANEOUS DETAILS

1 2 3 4 5 6 7 8 9 10 11 12 13 14 15
26-4480-9A 1196

SURVEYOR'S CERTIFICATION
"I, Timothy Aldrich, a duly qualified Registered Professional Land Surveyor under the Laws of the State of New Mexico, do hereby certify that the "as-built" information shown on these drawings was obtained from field construction and "as-built" surveys performed by me, or under my supervision, that the "as-built" information shown on these drawings was added by me, or under my supervision and that this "as-built" information is true and correct to the best of my knowledge and belief." Aldrich Land Surveying, Inc., is not responsible for any of the design concepts, calculations, engineering or intent of the record drawings.
Timothy Aldrich N.M.P.S. 7719 Date 09.22.96


SCANNED BY
BY LASON

APPROVAL OF AS BUILT DRAWING
CHIEF CONSTRUCTION ENGINEER
DATE 10-24-96

REV	SHEETS	CITY ENGINEER	DATE	USER DEPARTMENT	DATE	USER DEPARTMENT	DATE
Δ c	17	Bill G. Spalding	5/1/96	HC	4-24-96		
Δ b	3, 4A & 4B	Bill G. Spalding	5/1/96	HC	4-24-96		
Δ a	4A, 11, 17 & 18	Bill G. Spalding	5/1/96	HC	4-24-96		
APPROVAL OF REVISIONS							
BOHANNAN HUSTON INC. ALBUQUERQUE, NEW MEXICO ENGINEERS PLANNERS PHOTOGRAMMETRISTS				APPROVED FOR CONSTRUCTION 3/28/96 C.E.			
PROJECT NUMBER 4982.94				SHEET 1 OF 18			

PLAT OF
LOTS 1 THRU 57 & TRACT B7-A
STOWE AT SEVEN BAR NORTH
A REPLAT OF TRACT B-7, SEVEN BAR NORTH
ALBUQUERQUE, NEW MEXICO
OCTOBER, 1995

TRACT B-8
PLAT OF SEVEN BAR NORTH
TRACTS B-1 THRU B-9
FILED: JUNE 20, 1994
(94C-206)

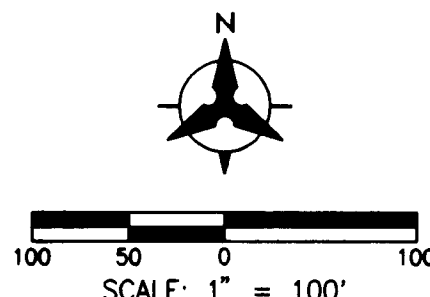

ACS Aluminum Tablet stamped "ACS 3-A12, 1986"
Geographic Position (NAD 1927)
N.M. State Plane Coordinates (Central Zone)
X = 370,567.68 Y = 1,534,779.51
Ground-to-Grid Factor = 0.9996697
LGS = -0714.557
SLD 1929 Elevation = 5214.38

TRACT B7-A 0.4442 ACRES
FOR PEDESTRIAN NON-VEHICULAR
ACCESS TO BE OWNED AND
MAINTAINED BY A NON-PROFIT
HOMEOWNERS CORPORATION.

TRACT B7-A 0.4442 ACRES
FOR PEDESTRIAN NON-VEHICULAR
ACCESS TO BE OWNED AND
MAINTAINED BY A NON-PROFIT
HOMEOWNERS CORPORATION.

TRACT B-9
PLAT OF SEVEN BAR NORTH
TRACTS B-1 THRU B-9
FILED: JUNE 20, 1994
(94C-206)

TRACT B-5
PLAT OF SEVEN BAR NORTH
TRACTS B-1 THRU B-9
FILED: JUNE 20, 1994
(94C-206)

TRACT B-3
PLAT OF SEVEN BAR NORTH
TRACTS B-1 THRU B-9
FILED: JUNE 20, 1994
(94C-206)

TRACT B-2B
CERRO CRESTADO AT
SEVEN BAR NORTH
FILED: JUNE 19, 1995
(95C-216)

NMHC Brass Tablet stamped "NM448-N12, 1989"
Geographic Position (NAD 1927)
N.M. State Plane Coordinates (Central Zone)
X = 381,108.54 Y = 1,528,910.94
Ground-to-Grid Factor = 0.99967595
LGS = -0713.465
SLD 1929 Elevation = 5023.41

ESTRELLA DEL NORTE
AT SEVEN BAR NORTH
FILED: AUGUST 1, 1995
(95C-283)

CORRECTED PLAT OF
LOTS 1 THRU 73
MONTERA AT SEVEN BAR NORTH
FILED: APRIL 27, 1995
(95C-147)

SEE SHEET 3 OF 3 FOR
CURVE DATA, TANGENT DATA
AND LOT ACREAGES

LEGEND	
---	SUBDIVISION BOUNDARY LINE
---	NEW LOT LINE
---	ADJOINING PROPERTY LINE
---	MONUMENT TIE LINE
---	STREET CENTERLINE
---	EXISTING EASEMENT LINE
---	NEW EASEMENT LINE
▲	CENTERLINE MONUMENT TO BE INSTALLED
●	FOUND CAPPED REBAR STAMPED "WEAVER LS 6544"
▲	CITY OF ALBUQUERQUE SURVEY CONTROL MONUMENT
●	SET 5/8" CAPPED REBAR STAMPED "WEAVER LS 6544"
▲	EXISTING CENTERLINE MONUMENT



BOHANNAN-HUSTON INC.

ENGINEERS • PLANNERS • PHOTOGRAMMETRISTS • SURVEYORS • LANDSCAPE ARCHITECTS
ALBUQUERQUE LAS CRUCES SANTA FE

SHEET 2 OF 3

JOB NO. 94250.00

C:\ADDCAD\CIVIL\PHASEB7\SHET2.DWG 10/23/95

SCANNED BY
BY LASON

SP 95102409440154

PLAT OF
LOTS 1 THRU 57 & TRACT B7-A
STOWE AT SEVEN BAR NORTH
A REPLAT OF TRACT B-7, SEVEN BAR NORTH
ALBUQUERQUE, NEW MEXICO
OCTOBER, 1995

DESCRIPTION

A certain tract of land situate within the Town of Alameda Grant, within projected Section 6, Township 11 North, Range 3 East, New Mexico Principal Meridian, Bernalillo County, Albuquerque, New Mexico, said tract being and comprising all of TRACT B-7, PLAT OF SEVEN BAR NORTH, TRACTS B-1 THRU B-9, as the same is shown and designated on said Plat filed in the office of the County Clerk of Bernalillo County, New Mexico on June 20, 1994 in Volume 94C, Folio 206, and being more particularly described by New Mexico State Plane Grid Bearings (Central Zone) and ground distances as follows:

BEGINNING at the northwest corner of TRACT B-7, a point on the easterly right-of-way of Seven Bar Loop Road, whence the ACS Survey Monument "3-A12", a 3 1/4" Aluminum Cap (having New Mexico State Plane Coordinates, Central Zone, X=370,567.68, Y=1,534,779.51) bears N75°34'26"W, a distance of 4,116.25 feet and from said point of beginning leaving said right-of-way line and running thence along the northerly boundary line of said TRACT B-7, 592.40 feet along the arc of a curve to the right having a radius of 1000.00 feet and a chord which bears N63°46'26"E, a distance of 583.78 feet to a point of non-tangency also being the most northerly corner of TRACT B-7, thence; 720.05 feet along the arc of a curve to the right having a radius of 1800.00 feet and a chord which bears S62°29'14"E, a distance of 715.26 feet to a point of non-tangency, thence; S62°52'18"E, a distance of 95.24 feet to the northeast corner of said TRACT B-7, a point on the northerly right-of-way line of Sierrita Road, thence running southwesterly along said northerly right-of-way line and also along the southerly boundary line of said TRACT B-7; 1086.71 feet along the arc of a curve to the right having a radius of 1086.00 feet and a chord which bears S66°58'08"W, a distance of 1041.94 feet to a point of non-tangency, thence; N76°49'58"W, a distance of 34.69 feet to a point of non-tangency, thence; 113.97 feet along the arc of a curve to the right having a radius of 1082.00 feet and a chord which bears N79°31'33"W, a distance of 113.91 feet to a point of tangency, thence; N76°30'30"W, a distance of 32.99 feet to a point of curvature, thence; 37.40 feet along the arc of a curve to the right having a radius of 25.00 feet and a chord which bears N33°39'07"W, a distance of 34.01 feet to a point of reverse curvature on the westerly boundary line of said TRACT B-7 and also being a point on the easterly right-of-way line of Seven Bar Loop Road, thence running along the westerly boundary line of said TRACT B-7 and also along said right-of-way line; 476.68 feet along the arc of a curve to the left having a radius of 684.00 feet and a chord which bears N10°45'37"W, a distance of 467.09 feet to the point and place of beginning.

Tract contains 15.1285 acres, more or less.

FREE CONSENT AND DEDICATION

The foregoing Plat of that certain tract of land situate within the Town of Alameda Grant, within Projected Section 6, Township 11 North, Range 3 East, New Mexico Principal Meridian, Bernalillo County, Albuquerque, New Mexico, being and comprising all of Tract B-7, of PLAT OF SEVEN BAR NORTH TRACTS B-1 THRU B-9, Albuquerque, New Mexico as the same is shown and designated on the plat filed in the office of the County Clerk of Bernalillo County, New Mexico on June 20, 1994 in Volume 94C, Folio 206, now comprising Lots 1 thru 57 and Tract B7-A, STOWE AT SEVEN BAR NORTH is with the free consent and in accordance with the desires of the undersigned owner(s) and/or proprietor(s) thereof and said owner(s) and/or proprietor(s) do hereby dedicate all streets and public right-of-ways shown hereon to the City of Albuquerque in Fee Simple with Warranty Covenants and do hereby grant: All access, Utility and Drainage Easements hereon including the right to construct, operate, inspect, and maintain facilities therein; and all Public Utility easements shown hereon for the common and joint use of Gas, Electrical Power and Communication Services for buried distribution lines, conduits, pipes for underground Utilities where shown or indicated, and including the right of ingress and egress for construction and maintenance, and the right to trim interfering trees and shrubs. Said owner(s) and/or proprietor(s) do hereby consent to all of the foregoing and do hereby certify that this subdivision is with their free act and deed.

Brown/NZD (Development) Joint Venture
By: Brown Associates, Inc., Managing General Partner

By: Ronald D. Brown, President

State of New Mexico)
 SS
County of Bernalillo)

This instrument was acknowledged before me on ____ day of ____, 1995 by Ronald D. Brown, President, Brown & Associates, Inc., Managing General Partner, Brown/NZD (Development) Joint Venture, a New Mexico General Partnership.

My Commission Expires: _____ Notary Public

APPROVALS

PLAT NUMBER _____	
PLANNING DIRECTOR _____	DATE _____
CITY ENGINEER _____	DATE _____
A.M.A.F.C.A. _____	DATE _____
TRAFFIC ENGINEER _____	DATE _____
CITY SURVEYOR _____	DATE _____
PROPERTY MANAGEMENT _____	DATE _____
UTILITY DEVELOPMENT DEPARTMENT _____	DATE _____
PARKS AND GENERAL SERVICES DEPARTMENT _____	DATE _____
PNM ELECTRIC SERVICES _____	DATE _____
U.S. WEST COMMUNICATIONS _____	DATE _____
PNM GAS SERVICES _____	DATE _____
NEW MEXICO UTILITIES, INC. _____	DATE _____
THIS IS TO CERTIFY THAT TAXES ARE CURRENT AND PAID ON UP: _____	
PROPERTY OWNER OF RECORD: _____	
BERNALILLO COUNTY TREASURER'S OFFICE _____	DATE _____

DISCLOSURE STATEMENT

The purpose of this plat is to subdivide Tract B-7, of PLAT OF SEVEN BAR NORTH, TRACTS B-1 THRU B-9, Albuquerque, New Mexico, filed June 20, 1994 in Volume 94C, Folio 206, into 57 Lots and 1 Tract, to dedicate Street Right-of-Way to the City of Albuquerque and to grant easements.

SURVEYOR'S CERTIFICATION

I, A. Dwin Weaver, a registered Professional New Mexico Surveyor, certify that this plat was prepared by me or under my supervision, shows all easements of record, and conforms to the Minimum Requirements of the Board of Registration for Professional Engineers and Professional Surveyors in February 1994 and meets the minimum requirements for monumentation and surveys contained in the Albuquerque Subdivision Ordinance, and is true and accurate to the best of my knowledge and belief.

Bohannon-Huston Inc. A. Dwin Weaver
Courtney D. New Mexico Professional Surveyor 6544
7500 Jefferson Street, N.E.
Albuquerque, New Mexico 87109 Date: _____

JOB NO. 94250.00



BOHANNAN-HUSTON INC.

ENGINEERS • PLANNERS • PHOTOGRAMMETRISTS • SURVEYORS • LANDSCAPE ARCHITECTS

LOCATION MAP
ZONE ATLAS INDEX MAP No. A-13-Z
NOT TO SCALE

SUBDIVISION DATA

- DRB No. 94-458
- Zone Atlas Index No. A-13-Z
- Gross Subdivision Acreage: 15.1285 Acres.
- Total Number of Lots and Tracts Created: 57 Lots, 1 Tract.
- Total Mileage of full width Streets created: 0.4792 miles.
- Date of Survey: 1995
- Plat is located within the Town of Alameda Grant, and within Projected Section 6, T11N, R3E, NMPM.

NOTES

- Bearings are New Mexico State Plane Grid Bearings (Central Zone).
- Distance are ground distances.
- All easements of record are shown.
- Centerline (in lieu of R/W monumentation) to be installed at all centerline PC's, PT's, angle points and street intersections prior to acceptance of subdivision street improvements and will consist of a standard four-inch (4") aluminum alloy cap stamped "City of Albuquerque", "Centerline Monumentation", "Survey Marker", "Do Not Disturb", "PLS# 6544".
- These properties are within the New Mexico Utilities, Inc. (NMU, Inc.) franchise area. Water and Sanitary Sewer Systems capabilities are based on NMU, Inc. facilities, not the City of Albuquerque.
- No individual Lots shall be allowed direct access to Seven-Bar Loop Road.
- All Lots are to be "P.U." and shall conform to Intermittent Parking Criteria, Item #1.
- With the filing of this plat, and only for the lands covered by this plat, "Notice of Subdivision Plat Conditions" including those recorded on April 23, 1985, August 14, 1989 and June 20, 1994 (all for bulk land transfer) are removed.

PUBLIC UTILITY EASEMENTS

PUBLIC UTILITY EASEMENTS shown on this plat are ten (10) feet wide and are for the common joint use of:


- The PNM Electric Services for the installation, maintenance, and service of overhead and underground electrical lines, transformers, and other equipment, fixtures, structures and related facilities reasonably necessary to provide electrical service.
- The PNM Gas Services for installation, maintenance, and service of natural gas lines, valves and other equipment and facilities reasonably necessary to provide natural gas.
- U.S. West for the installation, maintenance and service of all buried and aerial communication lines and other related equipment and facilities reasonably necessary to provide communication services, including but not limited to above ground pedestals and closures.
- Jones Interco for the installation, maintenance, and service of such lines, cable, and other related equipment and facilities reasonably necessary to provide Cable TV service.
- New Mexico Utilities, Inc. for the installation, maintenance and service of underground water and sanitary sewer lines necessary to provide service.


Included is the right to build, rebuild, construct, reconstruct, locate, relocate, change, remove, modify, renew, operate, and maintain facilities for the purposes described above, together with free access to, from, and over said easements, including sufficient working area space for electric transformers, with the right and privilege to trim and remove trees, shrubs or bushes which interfere with the purposes set forth herein. No building, sign, pool (above ground or subsurface), hot tub, concrete or wood pool decking, or other structure shall be erected or constructed on said easements, nor shall any well be drilled or operated thereon. Property owners shall be solely responsible for correcting any violations of National Electric Safety Code caused by operation of pools, decking, or any structures adjacent to or near easements shown on this plat.

SCANNED BY
BY LASON


CURVE DATA

CURVE	RADIUS	LENGTH	TANGENT	CHORD	CHORD BEARING	DELTA	CURVE	RADIUS	LENGTH	TANGENT	CHORD	CHORD BEARING	DELTA
C1	1000.00'	592.40'	305.18'	583.78'	N63°46'26"E	33°56'31"	C92	1790.00'	88.10'	44.06'	88.10'	S56°34'58"E	02°49'12"
C2	1800.00'	720.05'	364.90'	715.26'	S62°29'14"E	22°55'11"	C93	98.00'	25.12'	12.63'	25.05'	N48°40'32"W	14°41'02"
C3	1086.00'	1086.71'	593.75'	1041.94'	S66°58'08"W	57°20'00"	C94	1688.00'	58.20'	29.10'	58.19'	N57°00'18"W	01°58'31"
C4	1082.00'	113.97'	57.04'	113.91'	N79°31'33"W	06°02'06"	C95	1790.00'	84.04'	42.03'	84.03'	S53°49'40"E	02°41'24"
C5	25.00'	37.40'	23.20'	34.01'	N10°45'37"W	39°55'47"	C96	40.00'	24.85'	12.84'	24.45'	N59°32'48"W	35°35'56"
C6	684.00'	476.68'	248.48'	467.09'	N10°11'45"W	16°42'20"	C97	98.00'	15.83'	7.93'	15.81'	N36°42'24"W	09°15'13"
C7	812.00'	236.75'	119.22'	235.91'	N19°10'09"E	75°26'09"	C98	1790.00'	46.50'	23.25'	46.50'	S51°44'18"E	01°29'19"
C8	75.00'	98.75'	58.00'	91.77'	N65°58'08"E	18°09'49"	C99	1086.00'	23.59'	11.80'	23.59'	S41°55'43"W	01°14'41"
C9	865.00'	274.22'	138.27'	273.07'	S88°00'27"E	33°53'02"	C100	40.00'	34.63'	18.48'	33.56'	N16°56'45"W	49°36'10"
C10	180.00'	106.45'	54.83'	104.90'	S63°32'29"E	15°02'53"	C101	1086.00'	144.84'	72.53'	144.73'	S46°22'18"W	07°38'30"
C11	1665.00'	437.29'	219.91'	436.04'	S01°12'45"E	109°36'34"	C102	25.00'	1.36'	0.68'	1.36'	N73°21'59"E	03°06'34"
C12	75.00'	143.48'	106.34'	122.58'	S74°47'13"W	42°23'21"	C103	40.00'	46.82'	26.51'	44.19'	N41°23'18"E	67°03'56"
C13	958.00'	708.76'	371.48'	692.71'	N42°55'51"W	82°10'31"	C104	1086.00'	83.85'	41.95'	83.83'	S52°24'16"W	04°25'26"
C14	75.00'	107.57'	65.40'	98.58'	N51°17'13"W	63°12'18"	C105	981.00'	17.53'	8.77'	17.53'	N54°06'15"E	01°01'27"
C15	240.00'	264.75'	147.66'	251.53'	S61°21'38"E	88°57'00"	C106	25.00'	18.39'	9.64'	17.98'	N50°44'00"E	42°09'24"
C16	25.00'	38.81'	24.55'	35.03'	N28°58'06"E	90°58'28"	C107	1086.00'	78.26'	39.15'	78.25'	S56°40'51"W	04°07'45"
C17	25.00'	39.70'	25.43'	35.65'	N17°32'02"W	02°01'48"	C108	981.00'	70.70'	35.36'	70.68'	N60°57'26"W	04°25'26"
C18	789.00'	27.95'	13.98'	27.95'	N11°23'19"W	14°19'12"	C109	1086.00'	83.85'	41.95'	83.83'	S65°33'52"W	04°47'26"
C19	98.00'	24.49'	12.31'	24.43'	N16°53'17"W	25°19'09"	C110	981.00'	75.74'	37.89'	75.72'	N60°57'26"W	04°25'26"
C20	25.00'	11.05'	5.62'	10.96'	N19°10'09"E	97°26'02"	C111	1086.00'	90.80'	45.43'	90.78'	S65°33'52"W	04°47'26"
C21	40.00'	68.02'	45.56'	60.12'	N55°13'35"E	14°19'12"	C112	981.00'	92.00'	41.04'	91.50'	S70°22'27"W	04°49'43"
C22	25.00'	11.05'	5.62'	10.96'	N49°43'37"E	18°09'49"	C113	1086.00'	86.91'	43.48'	86.88'	S75°04'51"W	04°35'06"
C23	98.00'	24.49'	12.31'	24.43'	S88°00'27"E	33°53'02"	C114	981.00'	78.51'	39.27'	78.48'	N75°04'51"E	04°35'06"
C24	888.00'	281.51'	141.95'	280.33'	S63°32'29"E	15°02'53"	C115	1086.00'	81.52'	40.78'	81.50'	S79°31'26"W	04°18'03"
C25	203.00'	120.05'	61.84'	118.31'	N63°32'29"W	52°05'53"	C116	981.00'	73.64'	36.84'	73.62'	N79°31'26"E	04°18'03"
C26	1688.00'	443.33'	222.51'	442.06'	S63°32'29"E	15°02'53"	C117	1086.00'	80.39'	40.21'	80.37'	S83°47'41"W	04°14'28"
C27	1642.00'	431.25'	216.87'	430.01'	N63°32'29"W	52°05'53"	C118	981.00'	73.64'	36.84'	73.62'	N83°47'41"E	04°14'28"
C28	157.00'	95.95'	47.83'	91.50'	N88°00'27"W	33°53'02"	C119	1086.00'	80.39'	40.21'	80.37'	S88°12'50"W	04°35'50"
C29	842.00'	266.93'	134.59'	265.81'	S65°58'08"W	18°09'49"	C120	981.00'	72.61'	36.32'	72.60'	N88°12'50"E	04°35'50"
C30	52.00'	68.46'	40.22'	63.62'	S19°10'09"W	75°26'09"	C121	1086.00'	87.14'	43.59'	87.11'	S88°12'50"W	04°35'50"
C31	835.00'	243.46'	122.60'	242.60'	S10°11'45"E	16°42'20"	C122	981.00'	78.71'	39.38'	78.69'	N88°12'50"E	04°35'50"
C32	789.00'	77.10'	38.58'	77.07'	N04°38'34"W	05°35'56"	C123	1086.00'	81.00'	40.52'	80.98'	N87°21'03"W	04°16'24"
C33	25.00'	39.72'	25.46'	35.67'	S52°57'38"W	91°02'13"	C124	981.00'	73.17'	36.60'	73.15'	S87°21'03"E	04°16'24"
C34	25.00'	38.78'	24.52'	35.01'	S37°20'13"W	88°52'57"	C125	1086.00'	16.10'	8.05'	16.10'	N84°47'19"W	00°50'59"
C35	98.00'	40.94'	20.77'	40.65'	S44°02'55"E	23°56'14"	C126	1082.00'	21.75'	10.87'	21.75'	N81°58'03"W	01°09'06"
C36	25.00'	19.75'	10.42'	19.24'	S54°42'47"E	45°15'58"	C127	40.00'	5.78'	2.90'	5.78'	N83°59'26"E	08°16'47"
C37	40.00'	106.30'	162.04'	77.67'	S01°12'45"E	152°16'02"	C128	981.00'	20.47'	10.23'	20.47'	S84°36'58"E	01°11'44"
C38	25.00'	19.75'	10.42'	19.24'	S52°17'17"W	45°15'58"	C129	1082.00'	92.22'	46.14'	92.19'	N78°57'00"W	04°53'09"
C39	98.00'	40.94'	20.77'	40.65'	S41°37'25"W	23°56'14"	C130	684.00'	25.59'	12.80'	25.59'	N08°07'57"E	02°08'37"
C40	981.00'	725.78'	380.40'	709.34'	S74°47'13"W	42°23'21"	C131	40.00'	27.50'	14.32'	26.96'	S72°10'31"E	39°23'20"
C41	98.00'	25.16'	12.65'	25.09'	N76°39'50"W	14°42'34"	C132	684.00'	118.01'	59.15'	117.87'	N02°07'05"E	09°53'08"
C42	25.00'	13.46'	6.90'	13.29'	N84°43'45"W	30°50'25"	C133	78.00'	13.51'	6.76'	13.51'	S02°20'02"E	00°58'53"
C43	40.00'	79.89'	62.11'	67.26'	N42°55'51"W	114°26'13"	C134	40.00'	46.61'	26.36'	44.02'	S19°05'48"E	66°46'06"
C44	25.00'	13.46'	6.90'	13.29'	N01°12'45"E	109°36'34"	C135	684.00'	51.09'	25.56'	51.08'	N04°57'52"W	04°16'47"
C45	98.00'	25.16'	12.65'	25.09'	N09°11'53"W	14°42'34"	C136	789.00'	63.59'	31.81'	63.57'	S05°08'00"E	04°37'03"
C46	52.00'	74.58'	45.34'	68.35'	S42°55'51"E	82°10'31"	C137	935.00'	81.20'	40.62'	81.17'	S75°49'29"W	04°58'33"
C47	935.00'	369.53'	187.21'	367.13'	N84°39'33"E	22°38'42"	C138	218.00'	154.94'	80.91'	151.70'	S45°46'28"E	40°43'23"
C48	935.00'	225.25'	113.17'	224.71'	N60°29'38"E	13°48'12"	C139	935.00'	77.01'	38.53'	76.99'	S80°40'20"W	04°43'09"
C49	25.00'	99.48'	73.73'	84.99'	N01°12'45"W	109°36'34"	C140	40.00'	28.20'	14.71'	27.62'	N79°16'36"E	40°23'27"
C50	25.00'	43.09'	29.14'	37.95'	N23°57'43"E	98°45'00"	C141	218.00'	18.18'	9.10'	18.18'	S68°31'32"E	04°46'42"
C51	218.00'	173.12'	91.42'	168.61'	N48°09'50"W	45°00'16"	C142	935.00'	82.50'	41.27'	82.47'	S85°33'34"W	05°03'19"
C52	25.00'	21.82'	11.66'	21.13'	S84°05'00"W	50°30'56"	C143	822.00'	72.53'	36.29'	72.50'	N85°33'34"E	05°03'19"
C53	40.00'	186.29'	58.10'	186.29'	N12°30'17"E	266°50'49"	C144	935.00'	77.01'	38.53'	76.99'	S89°33'12"E	04°43'09"
C54	25.00'	17.02'	8.85'	16.69'	S53°34'25"E	39°00'12"	C145	822.00'	67.70'	33.87'	67.68'	N89°33'12"E	04°43'09"
C55	262.00'	226.62'	120.95'	219.62'	S48°17'45"E	49°33'31"	C146	935.00'	51.82'	25.92'	51.81'	N85°36'22"W	03°10'31"
C56	25.00'	38.87'	24.61'	35.07'	S68°03'38"E	89°05'17"	C147	835.00'	54.54'	27.28'	54.53'	N03°42'52"W	03°44'33"
C57	25.00'	1.03'	0.52'	1.03'	S05°24'50"E	02°22'13"	C148	822.00'	35.98'	17.99'	35.98'	S85°56'24"E	02°30'28"
C58	684.00'	51.12'	25.57'	51.10'	N19°01'35"W	04°16'54"	C149	835.00'	78.09'	39.07'	78.06'	N08°15'53"W	05°21'29"
C59	990.00'	21.61'	10.81'	21.61'	N49°39'43"E	01°15'03"	C150	949.00'	95.75'	47.91'	95.71'	S08°15'53"E	02°49'46"
C60	40.00'	41.35'	22.74'	39.54'	S00°04'11"W	59°14'06"	C151	822.00'	42.82'	21.42'	42.82'	N86°10'42"W	02°59'05"
C61	25.00'	10.01'	5.07'	9.95'	S18°04'24"E	22°56'56"	C152	835.00'	73.21'	36.63'	73.19'	N13°27'20"W	05°01'25"
C62	684.00'	49.87'	24.95'	49.86'	N23°15'22"W	04°10'38"	C153	949.00'	83.21'	41.63'	83.18'	S13°27'20"E	05°01'25"
C63	990.00'	111.95'	56.04'	111.89'	N53°31'37"E	06°28'46"	C154	842.00'	74.45'	37.25'	74.42'	N59°25'12"E	05°03'58"
C64	98.00'	23.48'	11.79'	23.42'	S49°25'45"W	13°43'29"	C155	949.00'	108.65'	54.38'	108.59'	S19°14'50"E	06°33'35"
C65	40.00'	26.67'	13.85'	26.18'	N58°46'40"E	04°01'19"	C156	842.00'	74.45'	37.25'	74.42'	N64°15'12"E	04°36'03"
C66	990.00'	69.49'	34.76'	69.41'	S58°50'16"W	03°54'06"	C157	842.00'	67.61'	33.82'	67.59'	S63°39'08"W	05°48'10"
C67	888.00'	60.47'	30.25'	60.46'	S56°35'22"W	00°35'43"	C158	740.00'	74.95'	37.51'	74.91'	N69°01'08"E	04°55'49"
C68	990.00'	73.57'	36.80'	73.55'	N62°55'03"E	04°15'28"	C159	842.00'	72.46'	36.25'	72.43'	S69°01'08"E	04°55'49"
C69	888.00'	69.44'	34.74'	69.42'	S63°01'44"W	04°28'50"	C160	740.00'	63.68'	31.86'	63.66'	N73°16'03"E	03°33'59"
C70	888.00'	70.89'	35.46'	70.87'	N68°50'02"E	04°06'09"	C161	842.00'	52.41'	26.21'	52.40'	N84°11'21"E	18°16'38"
C71	888.00'	67.04'	33.54'	67.02'	S68°43'21"W	04°19'32"	C162	157.00'	50.08'	25.26'	50.08'	N71°39'31"W	00°02'24"
C72	888.00'	88.10'	44.08'	88.07'	N73°26'05"E	05°05'56"	C163	1540.00'	1.20'	0.60'	1.20'	S73°55'16"W	04°52'25"
C73	990.00'	80.02'	40.03'	80.00'	S76°33'53"W	03°01'41"	C164	740.00'	62.95'	31.49'	62.93'	S78°52'08"E	15°36'24"
C74	203.00'	10.73'	5.37'	10.73'	S72°58'05"W	04°09'56"	C165	157.00'	42.77'	21.52'	42.63'	S70°01'41"E	02°04'29"
C75	888.00'	64.56'	32.29'	64.54'	N78°17'59"E	04°37'52"	C166	1642.00'	59.45'	29.73'	59.45'	N70°18'49"W	02°38'43"
C76	990.00'	80.02'	40.03'	80.00'	S73°33'46"E	00°37'28"	C167	1540.00'	71.10'	35.56'	71.10'	N67°32'57"E	02°53'00"
C77	1790.00'	19.51'	9.75'	19.51'	S87°10'24"W	18°11'21"	C168	1642.00'	82.63'	41.32'	82.62'	S64°41'34"E	02°49'46"
C78	203.00'	64.44'	32.50'	64.17'	S71°53'57"E	02°42'12"	C169	1540.00'	77.50'	38.76'	77.50'	N64°41'34"W	02°49'46"
C79	1790.00'	84.46'	42.24'	84.45'	N70°48								

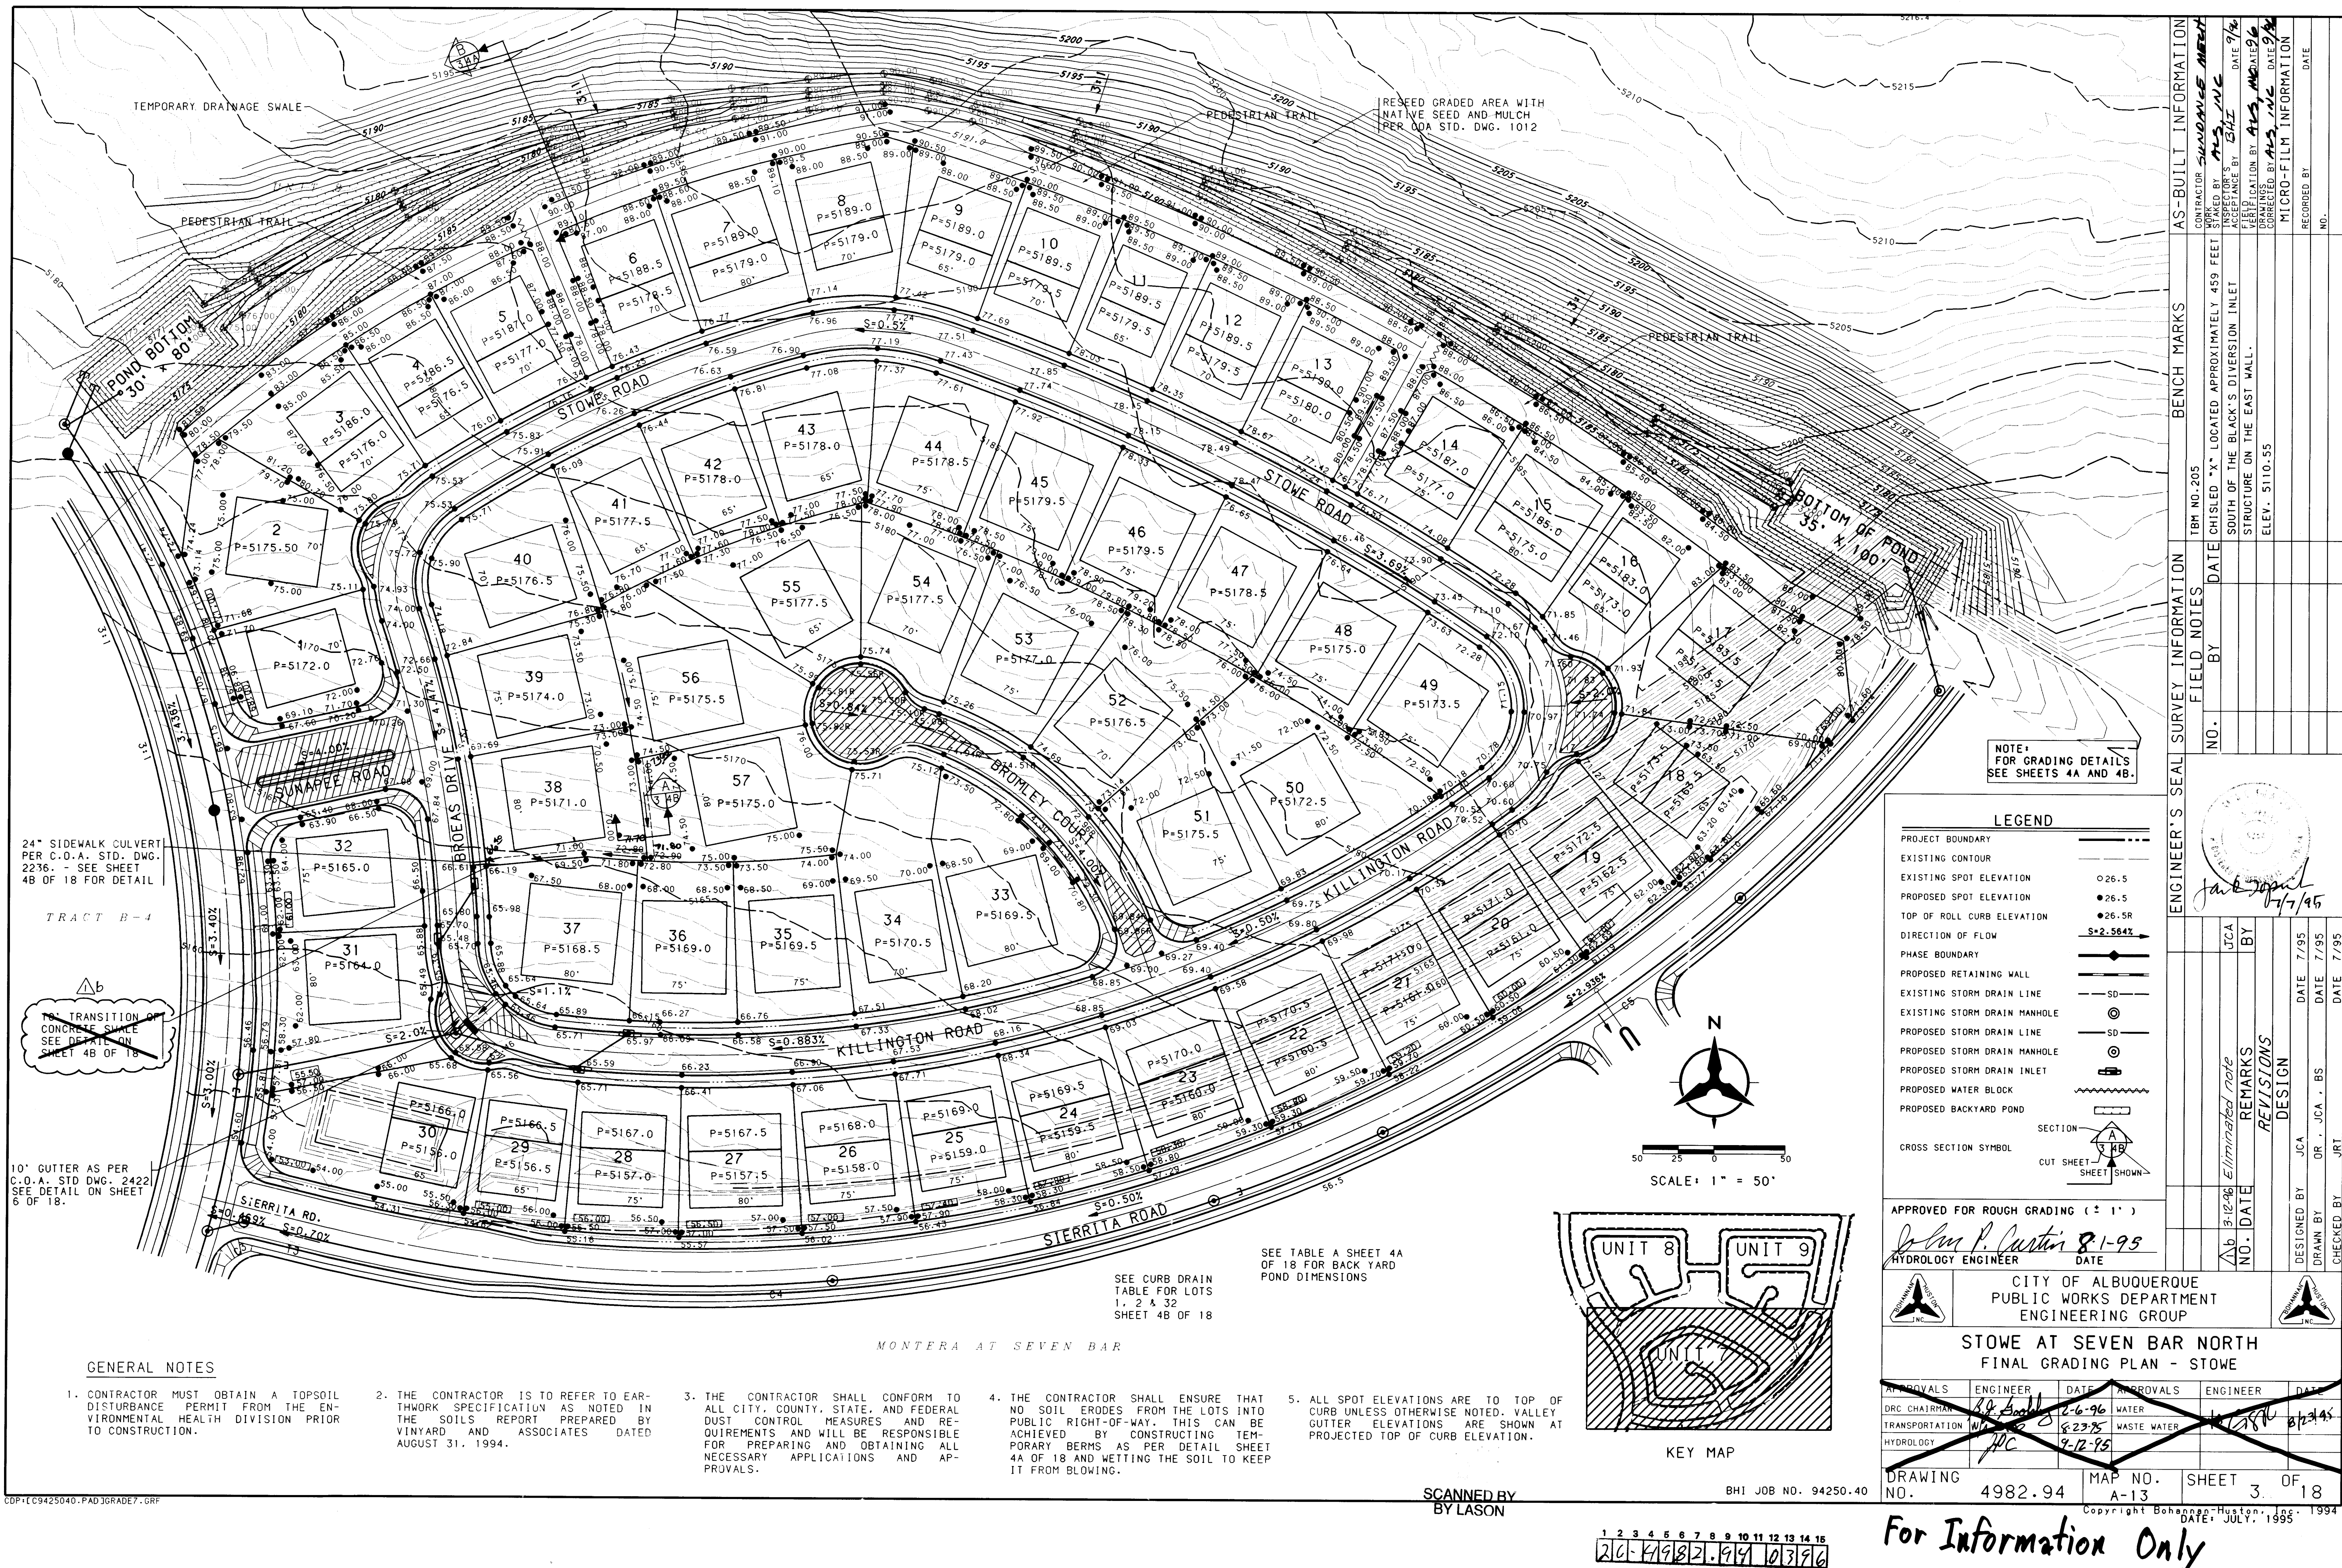


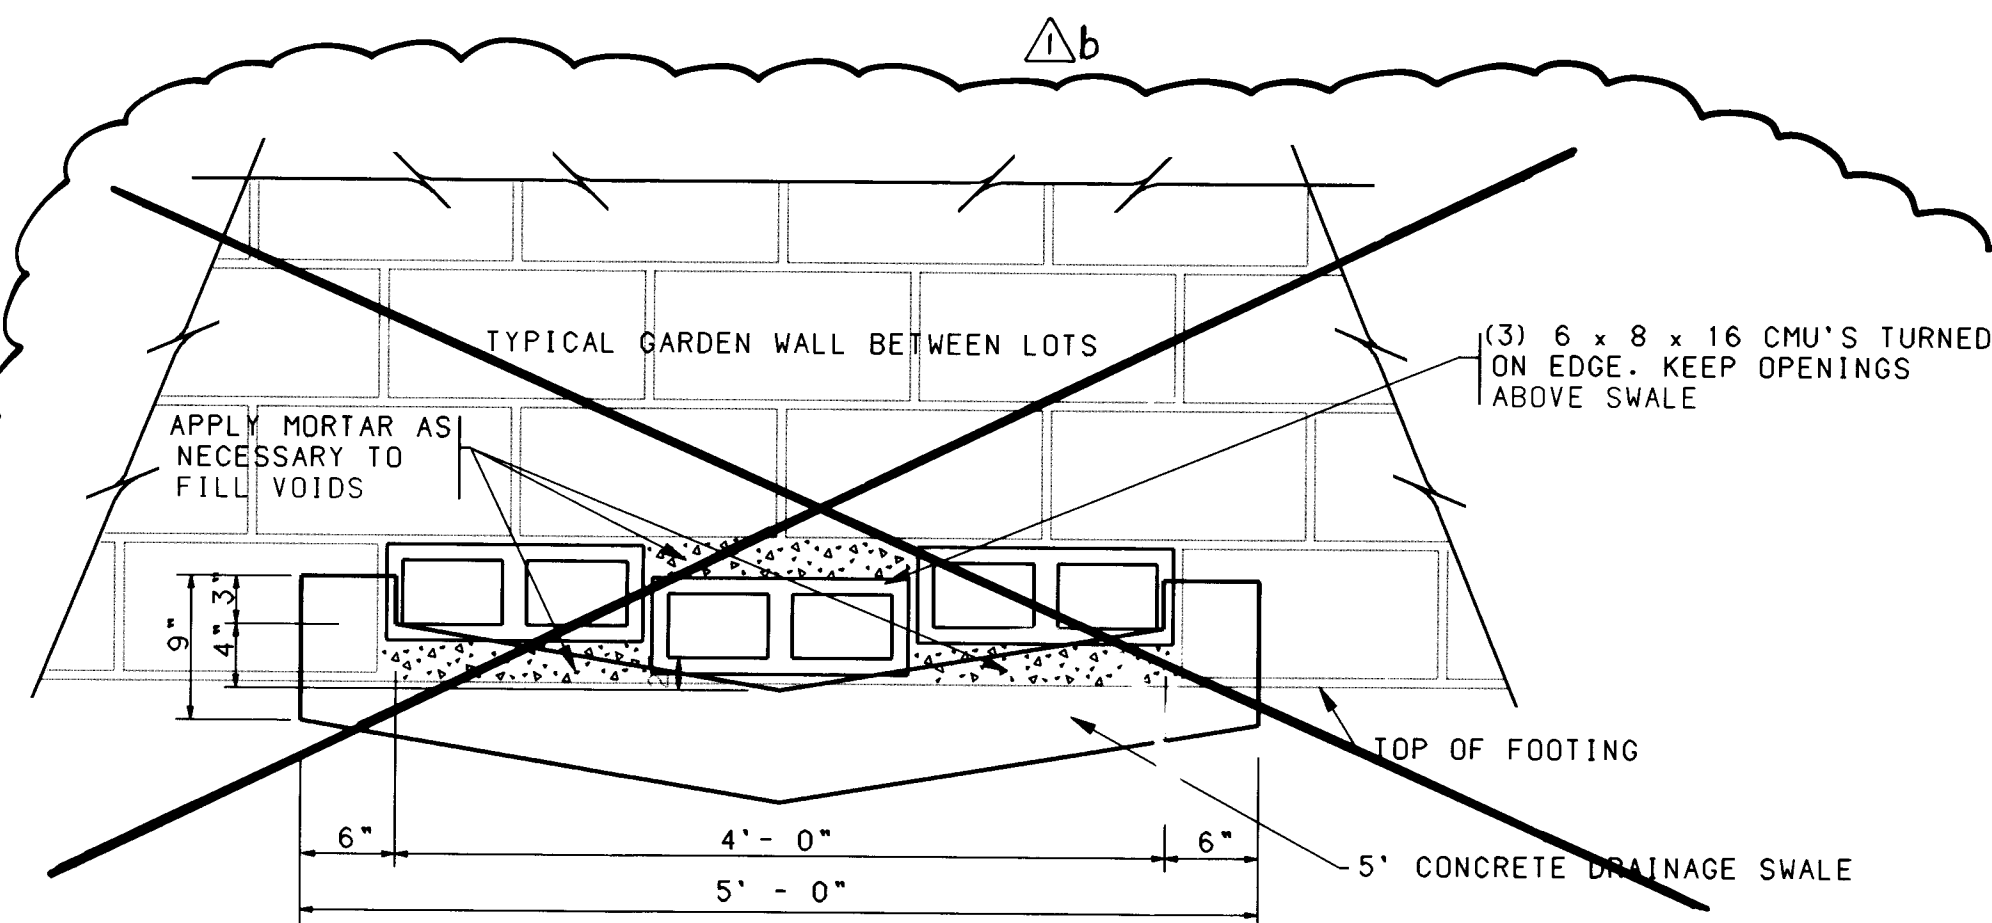

Private
PUBLIC DRAINAGE EASEMENT
PER C.O.A. STANDARD DRAWING 2260 TYPE B
NO SCALE

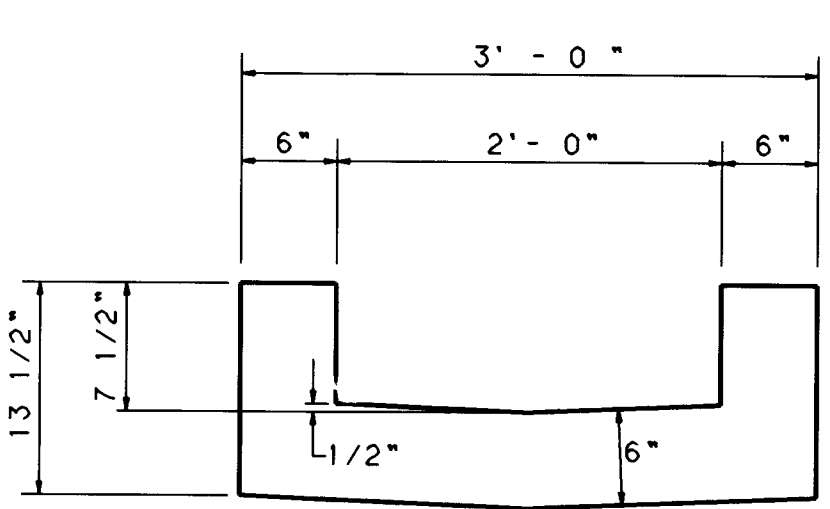

B SECTION
3' CONCRETE CHANNEL
PER C.O.A. STD. DWG. #2260 - B
NO SCALE

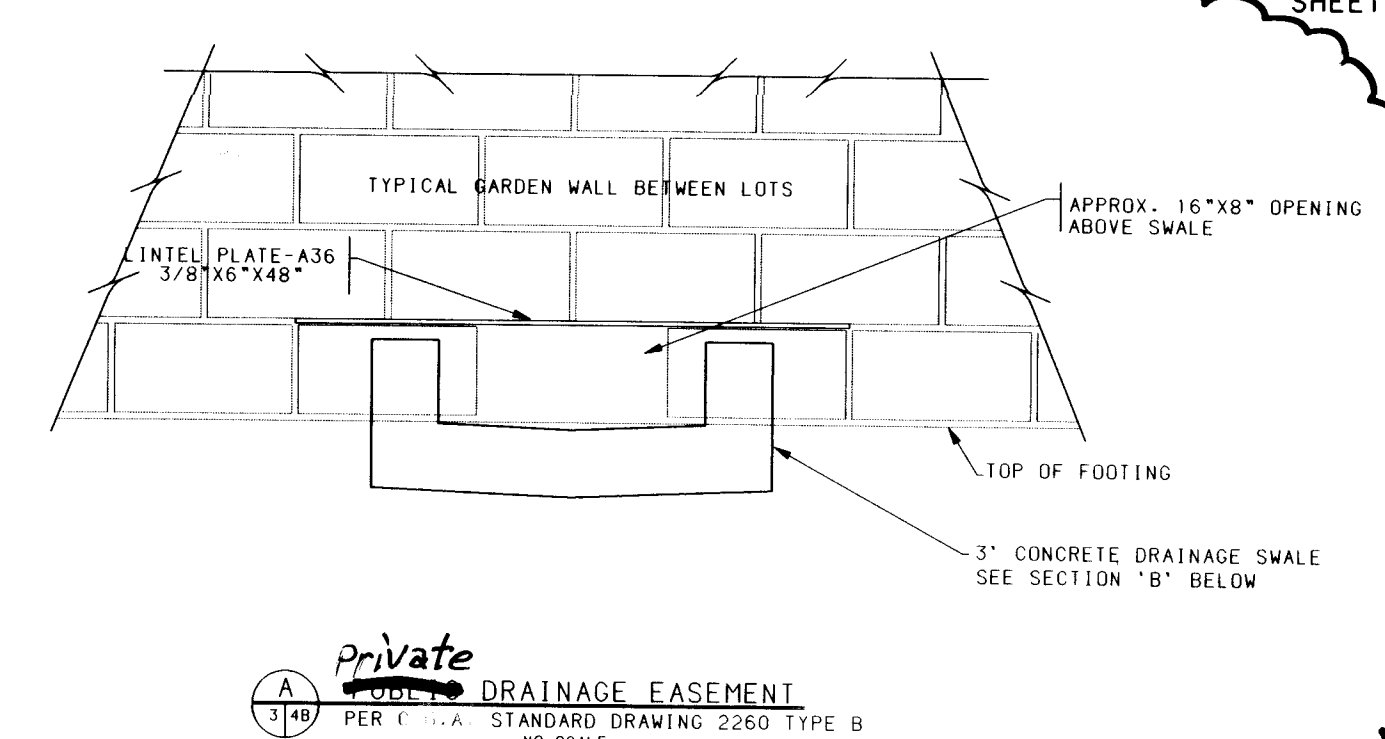

Private
PUBLIC DRAINAGE EASEMENT
PER C.O.A. STANDARD DRAWING 2260 TYPE B
NO SCALE

EXISTING STD. CURB
GUTTER AND 4" PVC
STUB OUT

STA. AND OFFSET AT
EXISTING STUB OUT
(SEE TABLE THIS
SHEET)


CURB DRAIN SHALL CONFORM
TO C.O.A. STD. DWG. # 2235

TYPICAL CURB DRAIN SECTION
NO SCALE


CURB DRAIN TABLE C

LOT	TOP OF GRATE EL.	GRATE TYPE	STATION & OFFSET AT GRADE	FLOWLINE ELEV.	CURB DRAIN INVERT EL.	STATION & OFFSET AT EXISTING STUB OUT
1	68.38	NDS-75	21+43.72, 42.53' RT.	66.80	66.84	21+43.72, 19.00' RT.
2	71.38	NDS-75	21+99.75, 39.52' RT.	69.44	69.48	22+00.70, 19.00' RT.
32	61.38	NDS-75	19+91.92, 43.35' RT.	59.72	59.76	19+91.99, 19.00' RT.


* = STATIONING WITH RESPECT TO CENTERLINE SEVEN BAR LOOP ROAD

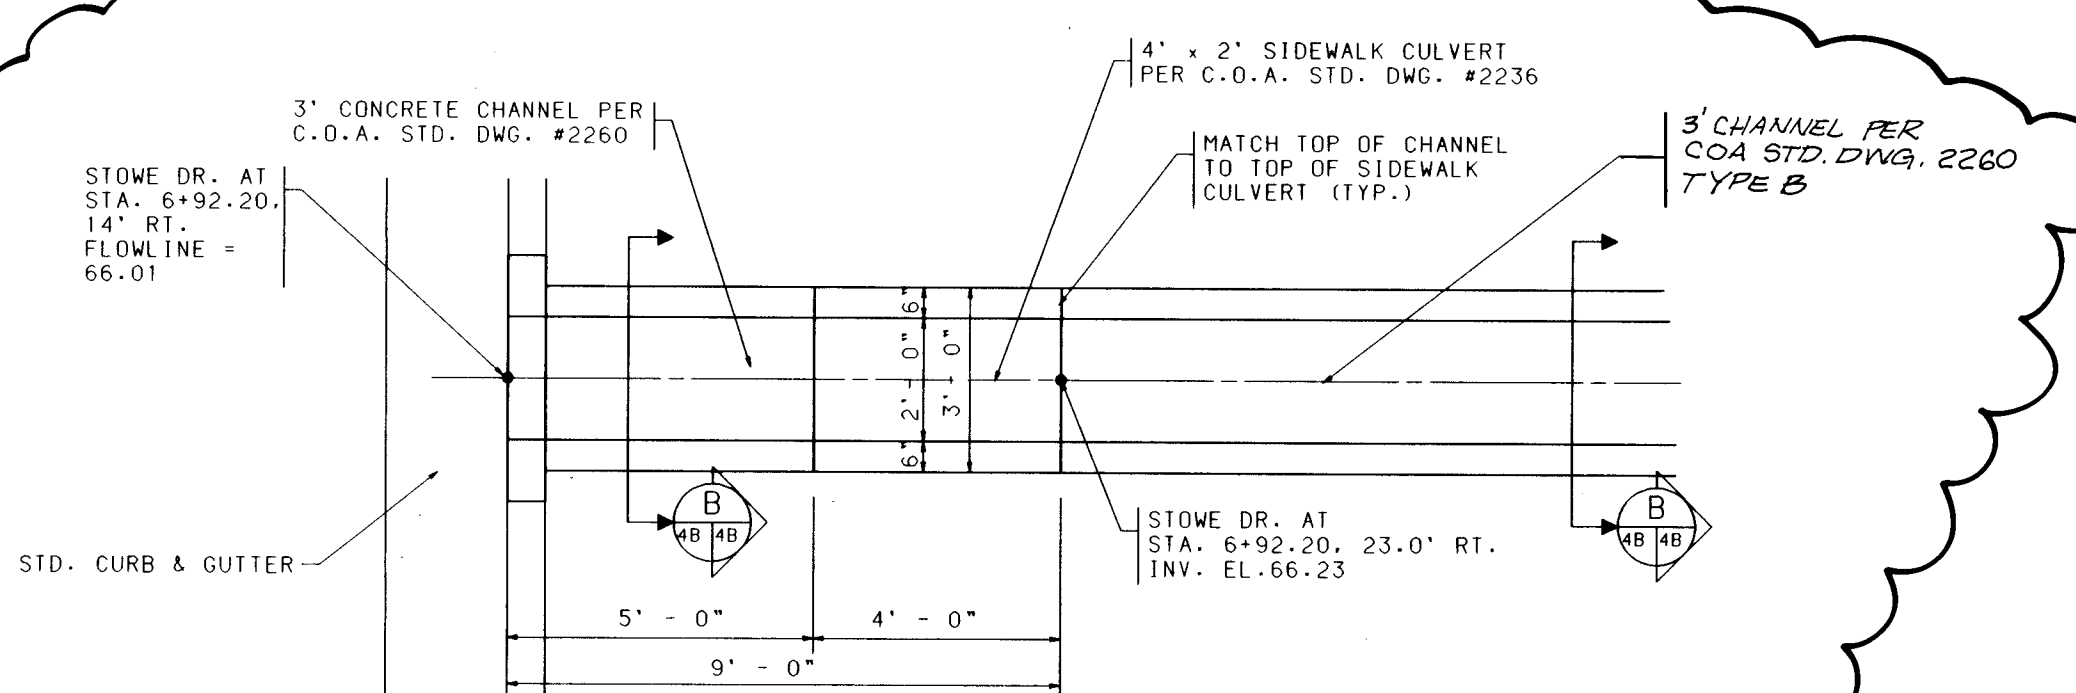

PLAN
CONCRETE CHANNEL & SIDEWALK CULVERT
NO SCALE

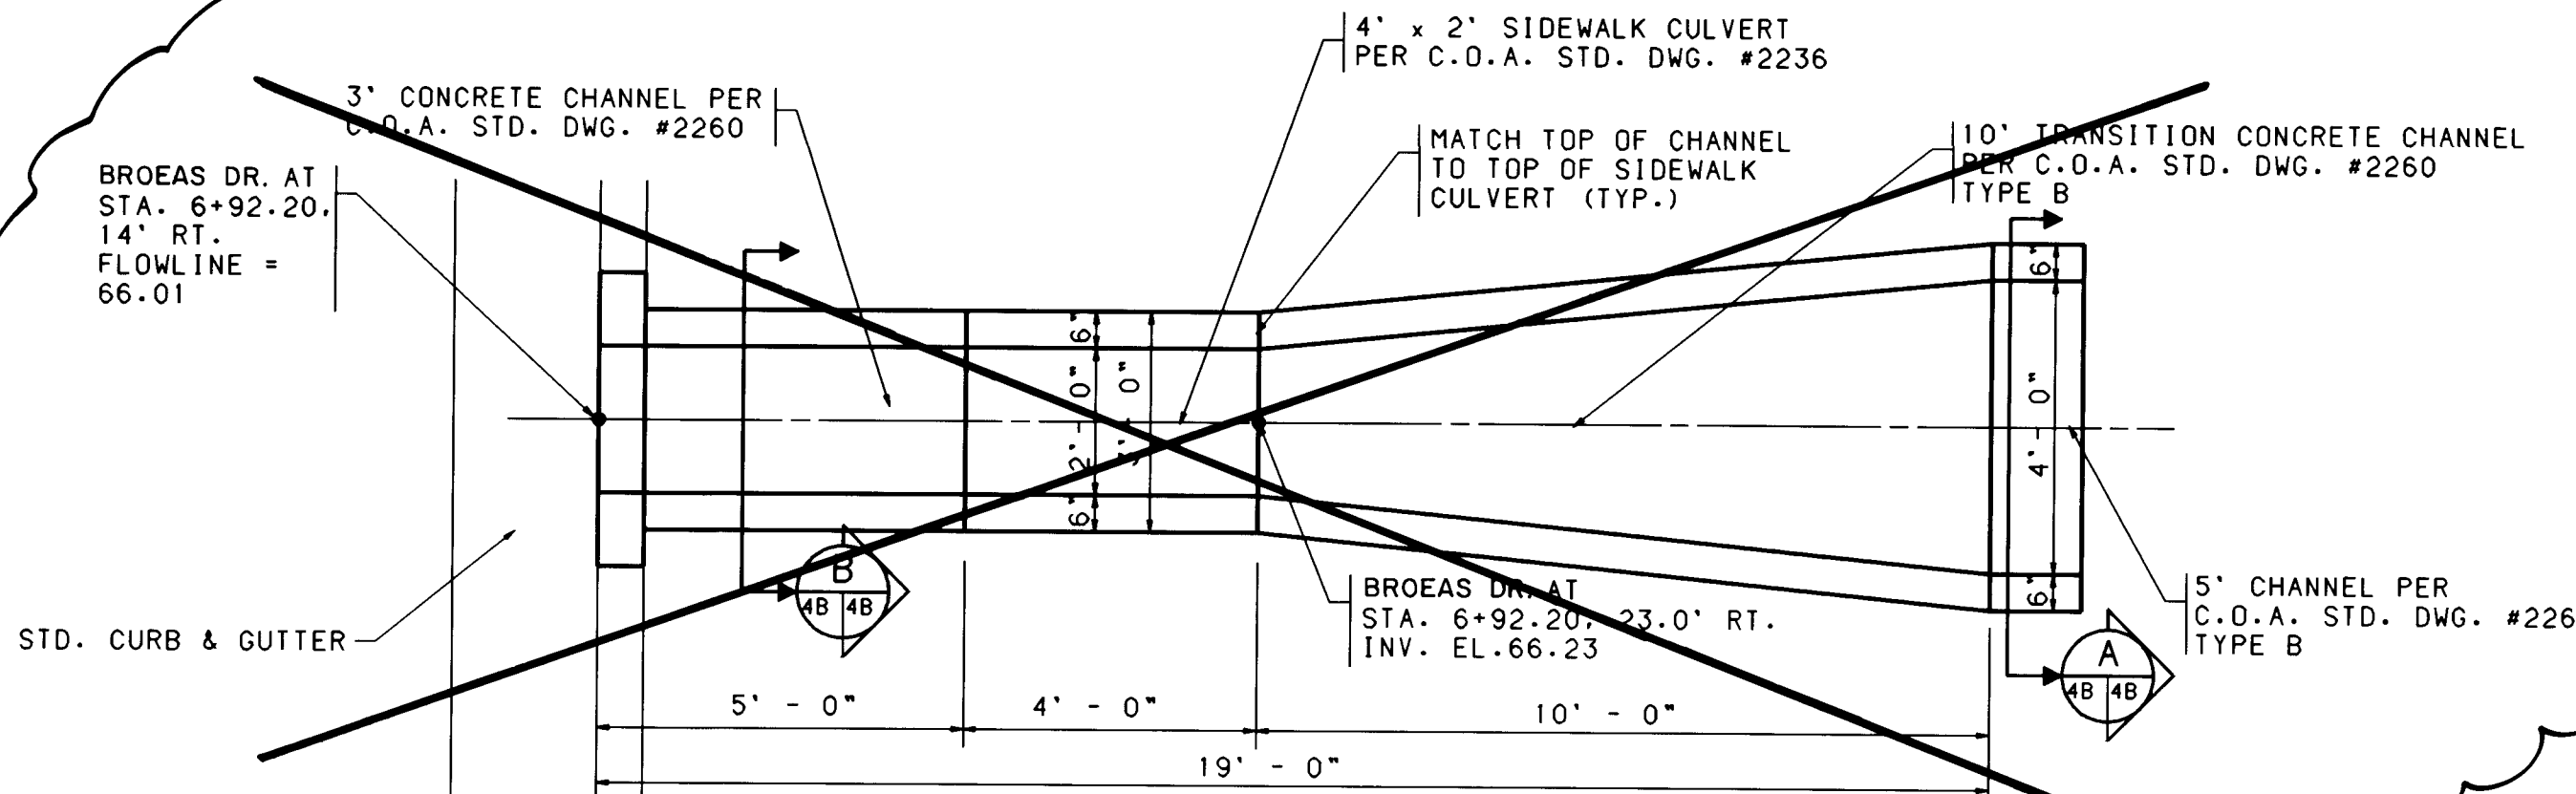

PLAN
CONCRETE CHANNEL & SIDEWALK CULVERT
NO SCALE

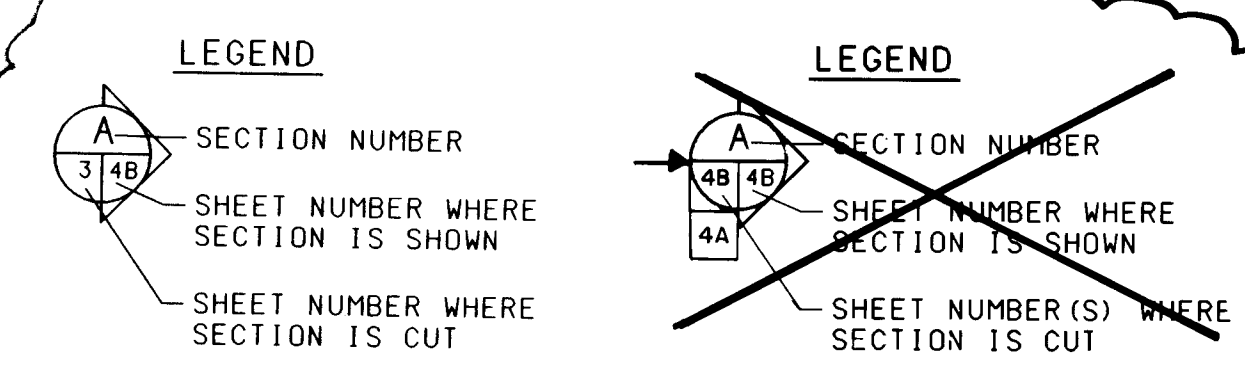

GENERAL NOTES

- CONTRACTOR MUST OBTAIN A TOPSOIL DISTURBANCE PERMIT FROM THE ENVIRONMENTAL HEALTH DIVISION PRIOR TO CONSTRUCTION.
- THE CONTRACTOR IS TO REFER TO EARTHWORK SPECIFICATION AS NOTED IN THE SOILS REPORT PREPARED BY VINYARD AND ASSOCIATES DATED AUGUST 31, 1994.
- THE CONTRACTOR SHALL CONFORM TO ALL CITY, COUNTY, STATE, AND FEDERAL DUST CONTROL MEASURES AND REQUIREMENTS AND WILL BE RESPONSIBLE FOR PREPARING AND OBTAINING ALL NECESSARY APPLICATIONS AND APPROVALS.
- THE CONTRACTOR SHALL ENSURE THAT NO SOIL ERODES FROM THE LOTS INTO PUBLIC RIGHT-OF-WAY. THIS CAN BE ACHIEVED BY CONSTRUCTING TEMPORARY BERMS AS PER DETAIL THIS SHEET AND WETTING THE SOIL TO KEEP IT FROM BLOWING.
- ALL SPOT ELEVATIONS ARE TO TOP OF CURB UNLESS OTHERWISE NOTED. VALLEY GUTTER ELEVATIONS ARE SHOWN AT PROJECTED TOP OF CURB ELEVATION.

AS-BUILT INFORMATION

CONTRACTOR: **SUNSHINE MECH**
INSPECTOR: **ALB, INC**
DATE: **9/16**
APPROVED BY: **ALB, INC**
DATE: **9/16**
DRAWING: **ALB, INC**
DATE: **9/16**
RECORDED BY: **ALB, INC**
DATE: **9/16**
NO.

ENGINEER'S SEAL

APPROVED FOR ROUGH GRADING (+/- 1')

HYDROLOGY ENGINEER **DATE**

CITY OF ALBUQUERQUE
PUBLIC WORKS DEPARTMENT
ENGINEERING GROUP



STOWE AT SEVEN BAR NORTH
GRADING DETAILS

APPROVALS	ENGINEER	DATE	APPROVALS	ENGINEER	DATE
	B.G. Gentry	2-6-96		B.G. Gentry	2-6-96
	B.G. Gentry	2-6-96		B.G. Gentry	2-6-96
	B.G. Gentry	2-6-96		B.G. Gentry	2-6-96

DRAWING NO. **4982.94** **MAP NO.** **A-13** **SHEET** **4B** **OF** **18**


DATE: **JUNE, 1995**

For Information Only

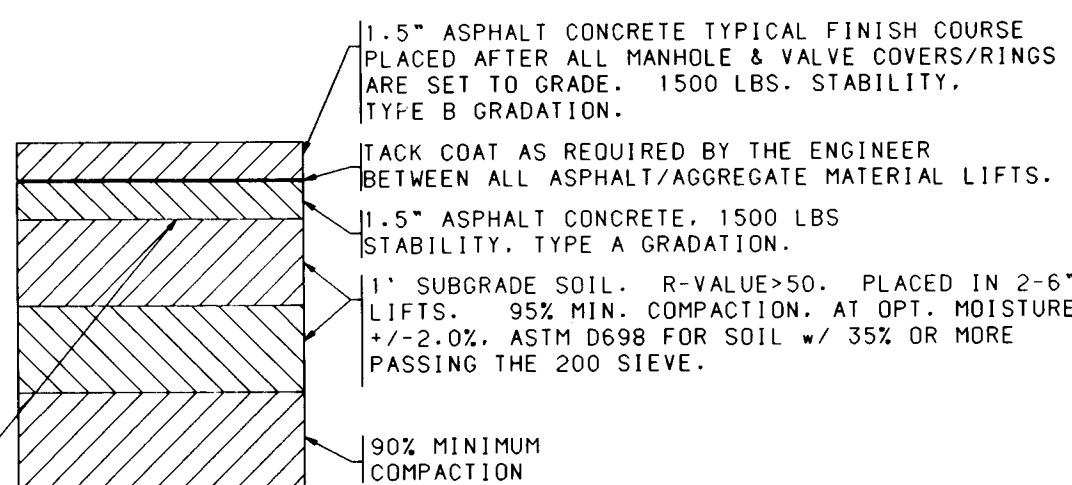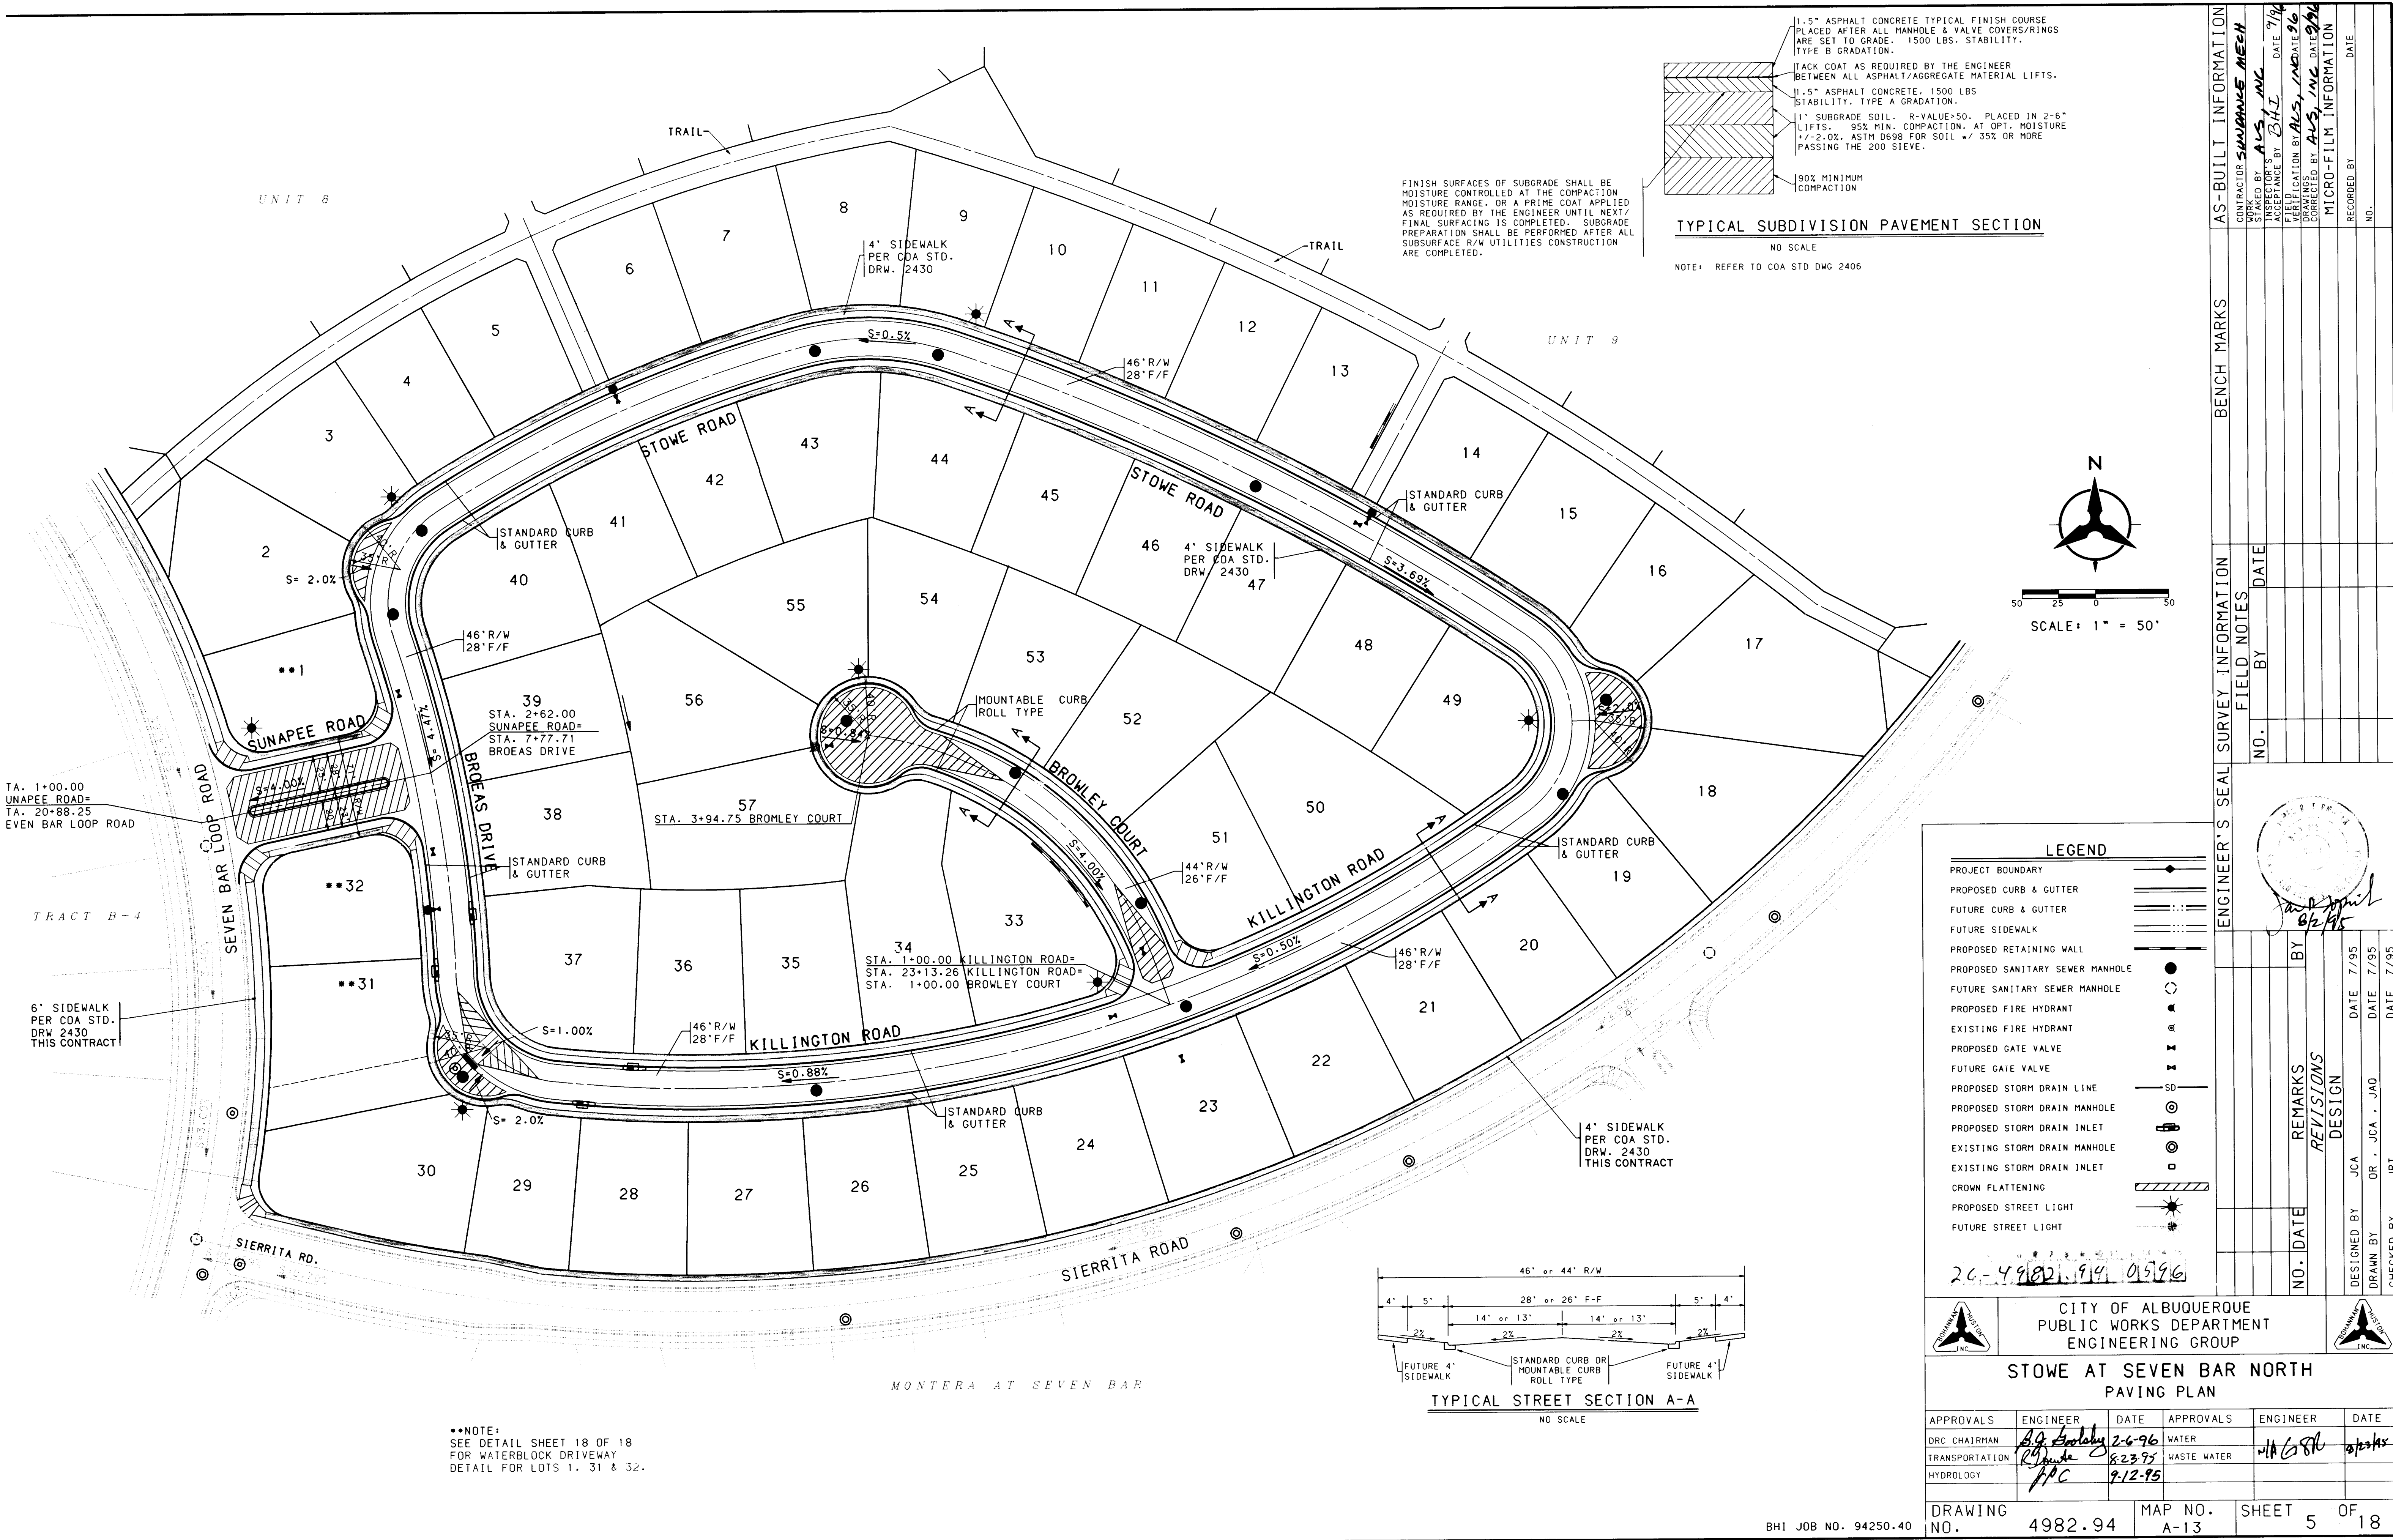


FINISH SURFACES OF SUBGRADE SHALL BE MOISTURE CONTROLLED AT THE COMPACTION MOISTURE RANGE, OR A PRIME COAT APPLIED AS REQUIRED BY THE ENGINEER UNTIL NEXT FINAL SURFACING IS COMPLETED. SUBGRADE PREPARATION SHALL BE PERFORMED AFTER ALL SUBSURFACE R/W UTILITIES CONSTRUCTION ARE COMPLETED.

TYPICAL SUBDIVISION PAVEMENT SECTION
NO SCALE
NOTE: REFER TO COA STD DWG 2406

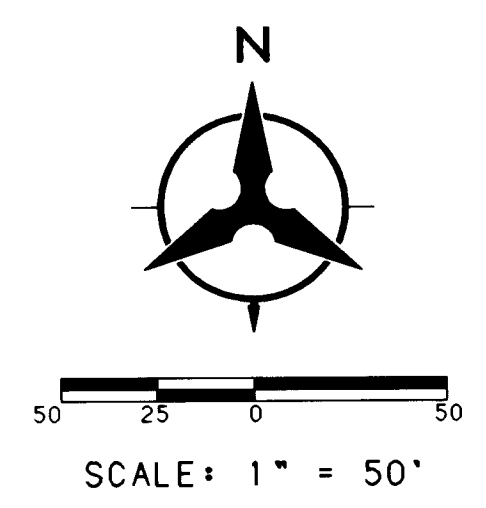

- LEGEND
- PROJECT BOUNDARY
 - PROPOSED CURB & GUTTER
 - FUTURE CURB & GUTTER
 - FUTURE SIDEWALK
 - PROPOSED RETAINING WALL
 - PROPOSED SANITARY SEWER MANHOLE
 - FUTURE SANITARY SEWER MANHOLE
 - PROPOSED FIRE HYDRANT
 - EXISTING FIRE HYDRANT
 - PROPOSED GATE VALVE
 - FUTURE GATE VALVE
 - PROPOSED STORM DRAIN LINE
 - PROPOSED STORM DRAIN MANHOLE
 - PROPOSED STORM DRAIN INLET
 - EXISTING STORM DRAIN MANHOLE
 - EXISTING STORM DRAIN INLET
 - CROWN FLATTENING
 - PROPOSED STREET LIGHT
 - FUTURE STREET LIGHT

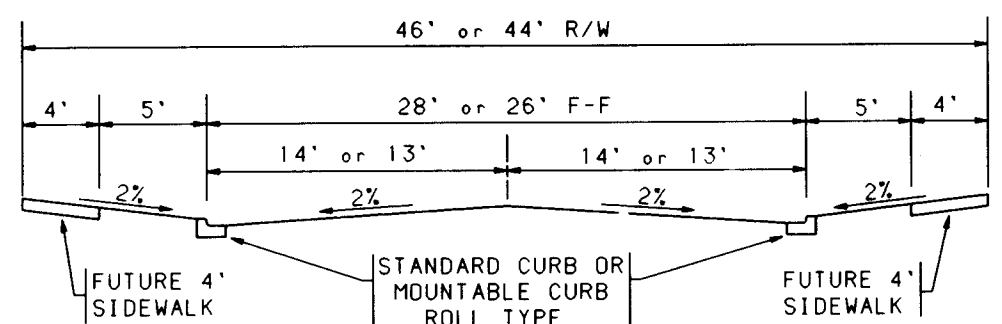

TYPICAL STREET SECTION A-A
NO SCALE

NOTE:
SEE DETAIL SHEET 18 OF 18
FOR WATERBLOCK DRIVEWAY
DETAIL FOR LOTS 1, 31 & 32.

ENGINEER'S SEAL

REVISIONS

NO. DATE

DESIGNED BY

DRAWN BY

CHECKED BY

REMARKS

DESIGN

JCA

OR JCA

JRT

DATE 7/95

DATE 7/95

DATE 7/95

APPROVALS

ENGINEER

DATE

APPROVALS

ENGINEER

DATE

DRC CHAIRMAN

TRANSPORTATION

HYDROLOGY

DATE 2-6-96

DATE 8-23-95

DATE 7-12-95

DRAWING NO.

MAP NO.

SHEET

OF

4982-94

A-13

5

18

BHI JOB NO.

94250-40

CITY OF ALBUQUERQUE

PUBLIC WORKS DEPARTMENT

ENGINEERING GROUP


STOWE AT SEVEN BAR NORTH

PAVING PLAN

CENTERLINE CURVE DATA				
NUMBER	PI STA.	DELTA	TANGENT	ARC RADIUS
C1	4+30.66	63°12'18"	147.66'	264.75'

CENTERLINE TANGENT DATA		
NUMBER	BEARING	DISTANCE
T1	N19° 41' 04" W	30.00'

STA. 1+00.00 BROMLEY CT. =
STA. 1+00.00 KILLINGTON RD. =
STA. 22+13.26 KILLINGTON RD.

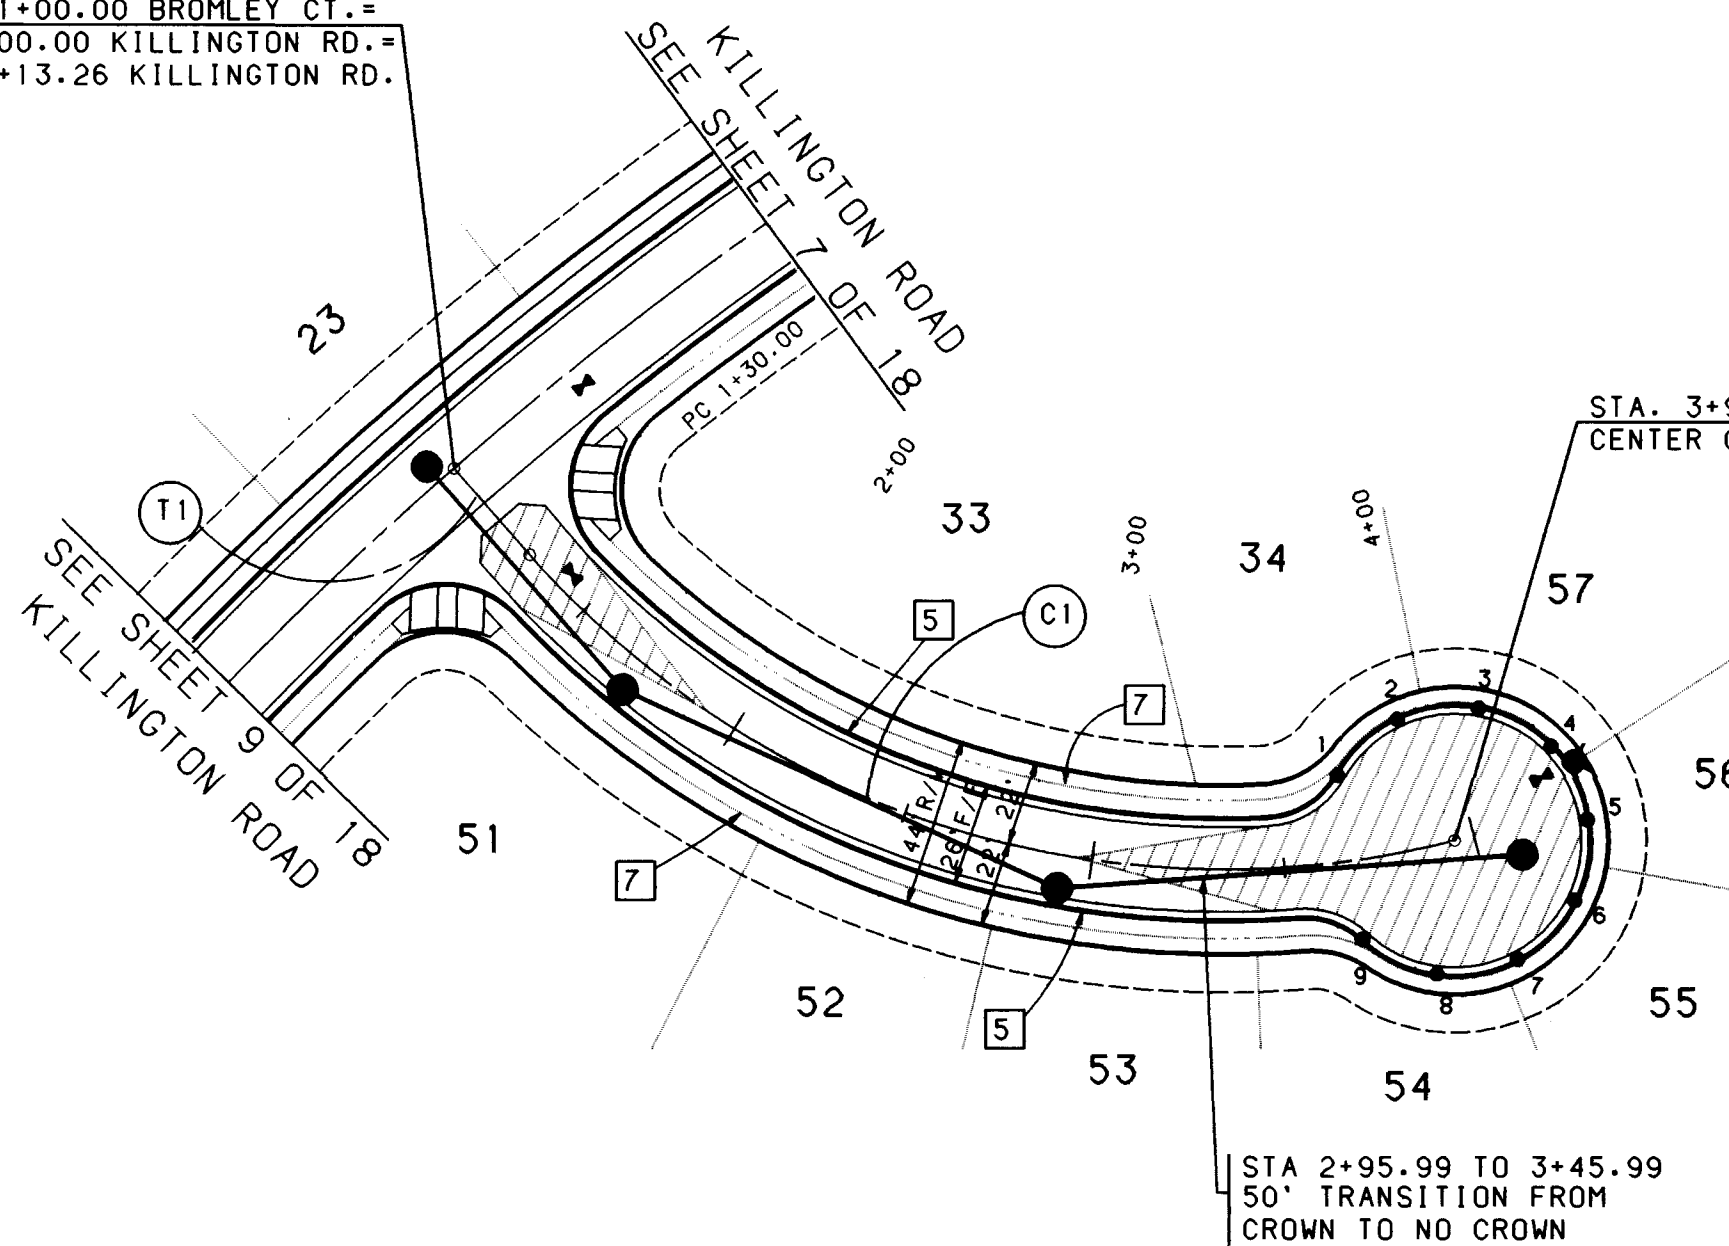


NOTE:
ALL TC ELEVATIONS ARE
TOP OF STD. CURB.
* = TOP OF MOUNTABLE
CURB ROLL TYPE.

BROMLEY COURT

CUL-DE-SAC CURB DATA			
PT	TC	STATION & OFFSET	DELTA
1	75.28	3+66.65, 22.59' LT.	35°28'48"
2	75.45	3+86.93, 34.24' LT.	35°28'48"
3	75.64	4+09.23, 31.87' LT.	35°28'48"
4	75.77	4+25.04, 17.55' LT.	35°28'48"
5	75.81	4+29.60, 3.29' RT.	35°28'48"
6	75.74	4+21.22, 22.90' RT.	35°28'48"
7	75.59	4+03.01, 34.01' RT.	35°28'48"
8	75.42	3+83.30, 32.80' RT.	35°28'48"
9	75.29	3+67.53, 20.57' RT.	35°28'48"
R=35.00', L=173.39' (BETWEEN POINTS)			

SEE SHEET 7 OF 18
FOR INTERSECTION
AND DETAILS.

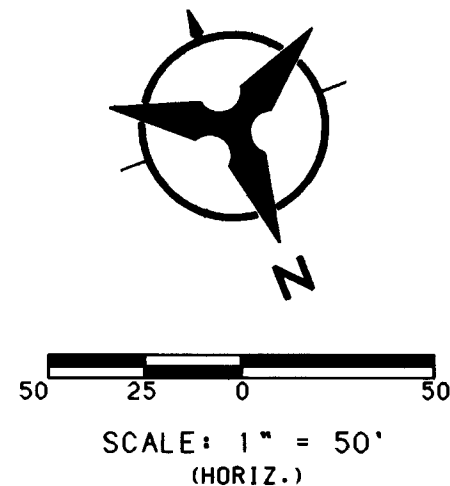


STA 6+26.47 TO 5+88.47
38' TRANSITION FROM CROWN TO NO CROWN

STA 5+83.46, CENTERLINE
BUILD 10' VALLEY GUTTER
AS PER 2422

STA 5+82.92, CENTERLINE =
RADIUS POINT CUL-DE-SAC

NOTE:
SEE SHEET 17 OF 18 FOR STORM DRAIN

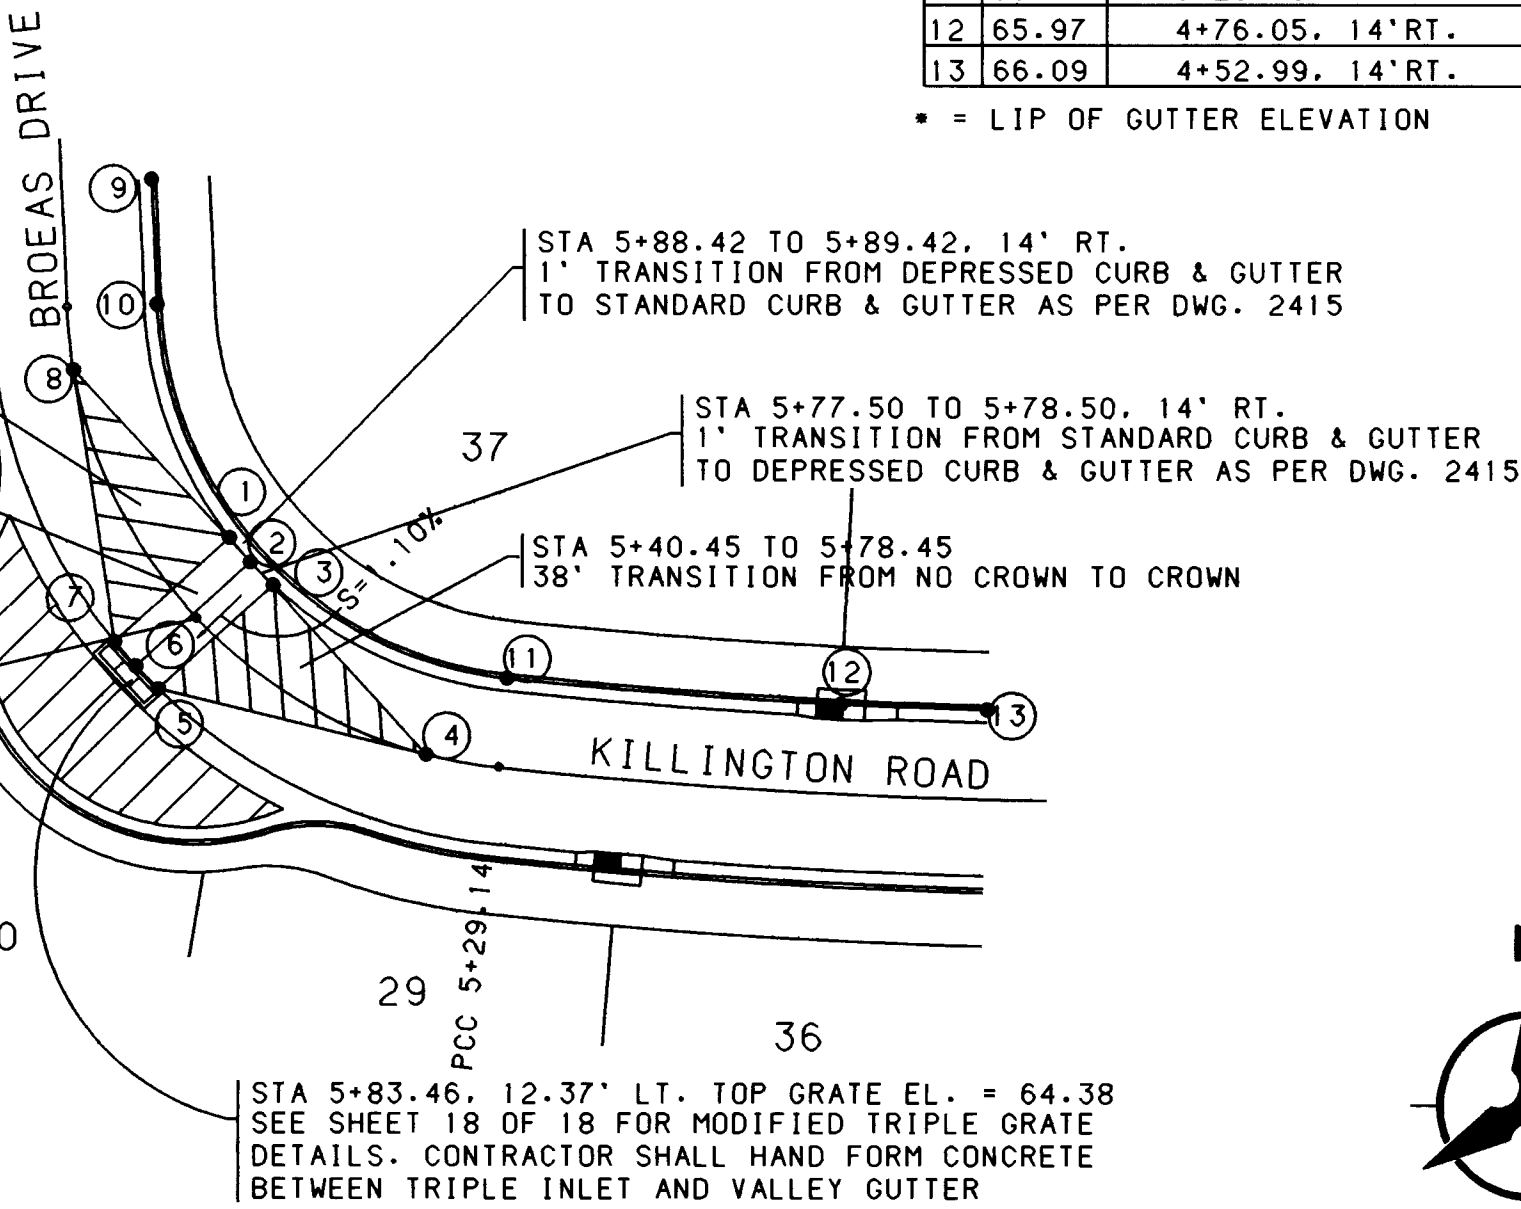


VALLEY GUTTER DETAIL

VALLEY GUTTER CURB DATA		
PT	TC	STATION & OFFSET
1	64.92	5+89.42, 12' RT.
2	64.75	5+83.40, 12' RT.
3	64.92	5+77.50, 12' RT.
4	65.35	5+40.45, CENTERLINE
5	64.55	5+79.15, 12' LT.
6	64.49	5+83.46, 12' LT.
7	64.55	5+87.77, 12' LT.
8	65.19	6+26.47, CENTERLINE
9	65.80	6+55.58, 14' RT.
10	65.70	6+36.71, 14' RT.
11	65.71	5+29.49, 14' RT.
12	65.97	4+76.05, 14' RT.
13	66.09	4+52.99, 14' RT.

* = LIP OF GUTTER ELEVATION

- NOTES**
1. THE CONTRACTOR SHALL FIELD VERIFY ALL EXISTING UTILITY LOCATIONS AND NOTIFY THE ENGINEER IMMEDIATELY OF ANY DISCREPANCIES.
 2. ALL CURB RETURN RADI SHALL BE 25' TO FACE OF CURB UNLESS OTHERWISE SPECIFIED.
 3. ALL CURVE DATA AND DIMENSIONS REFER TO FACE OF CURB UNLESS OTHERWISE SPECIFIED.
 4. GRADE ELEVATIONS, WHERE NOTED, ARE FOR TOP OF CURB UNLESS OTHERWISE SPECIFIED.
 5. CONTRACTOR IS TO INSTALL A 4"x4"x5' POST AND EMD AT THE END OF EACH SANITARY SEWER SERVICE.
 6. CONTRACTOR IS RESPONSIBLE FOR REPAIR AND/OR REPLACEMENT OF ALL UTILITY CONDUITS AND EXISTING LINES.
 7. ANY ADDITIONAL GRADING REQUIRED TO MATCH PROPOSED STREET GRADES SHALL BE INCIDENTAL TO PAVING ITEMS.
 8. CONTRACTOR SHALL PROVIDE THE INSPECTORS, (CITY AND PRIVATE) WITH THE PROPOSED HYDROSTATIC TESTING PLAN. THE PLAN MUST BE APPROVED BEFORE TESTING OPERATIONS BEGIN.
 9. CONTRACTOR SHALL PARK EQUIPMENT AND VEHICLES AS NOT TO INTERFERE WITH NORMAL ACTIVITIES OF RESIDENTS OR OTHER CONTRACTORS ON SITE.
 10. ANY DAMAGE TO THE EXISTING FACILITIES (CURB AND GUTTER, PAVEMENT, CONDUITS, LANDSCAPING, UTILITY LINES, ETC.) DURING CONSTRUCTION SHALL BE REPLACED AT THE CONTRACTORS EXPENSE.
 11. REMOVAL OF THE EXISTING CURB AND GUTTER SHALL BE AS PER COA STD. DWG. 2415 (SAMCUT ONLY).
 12. WHEEL CHAIR RAMPS SHALL BE CONSTRUCTED PRIOR TO ACCEPTANCE OF CURB AND GUTTER.

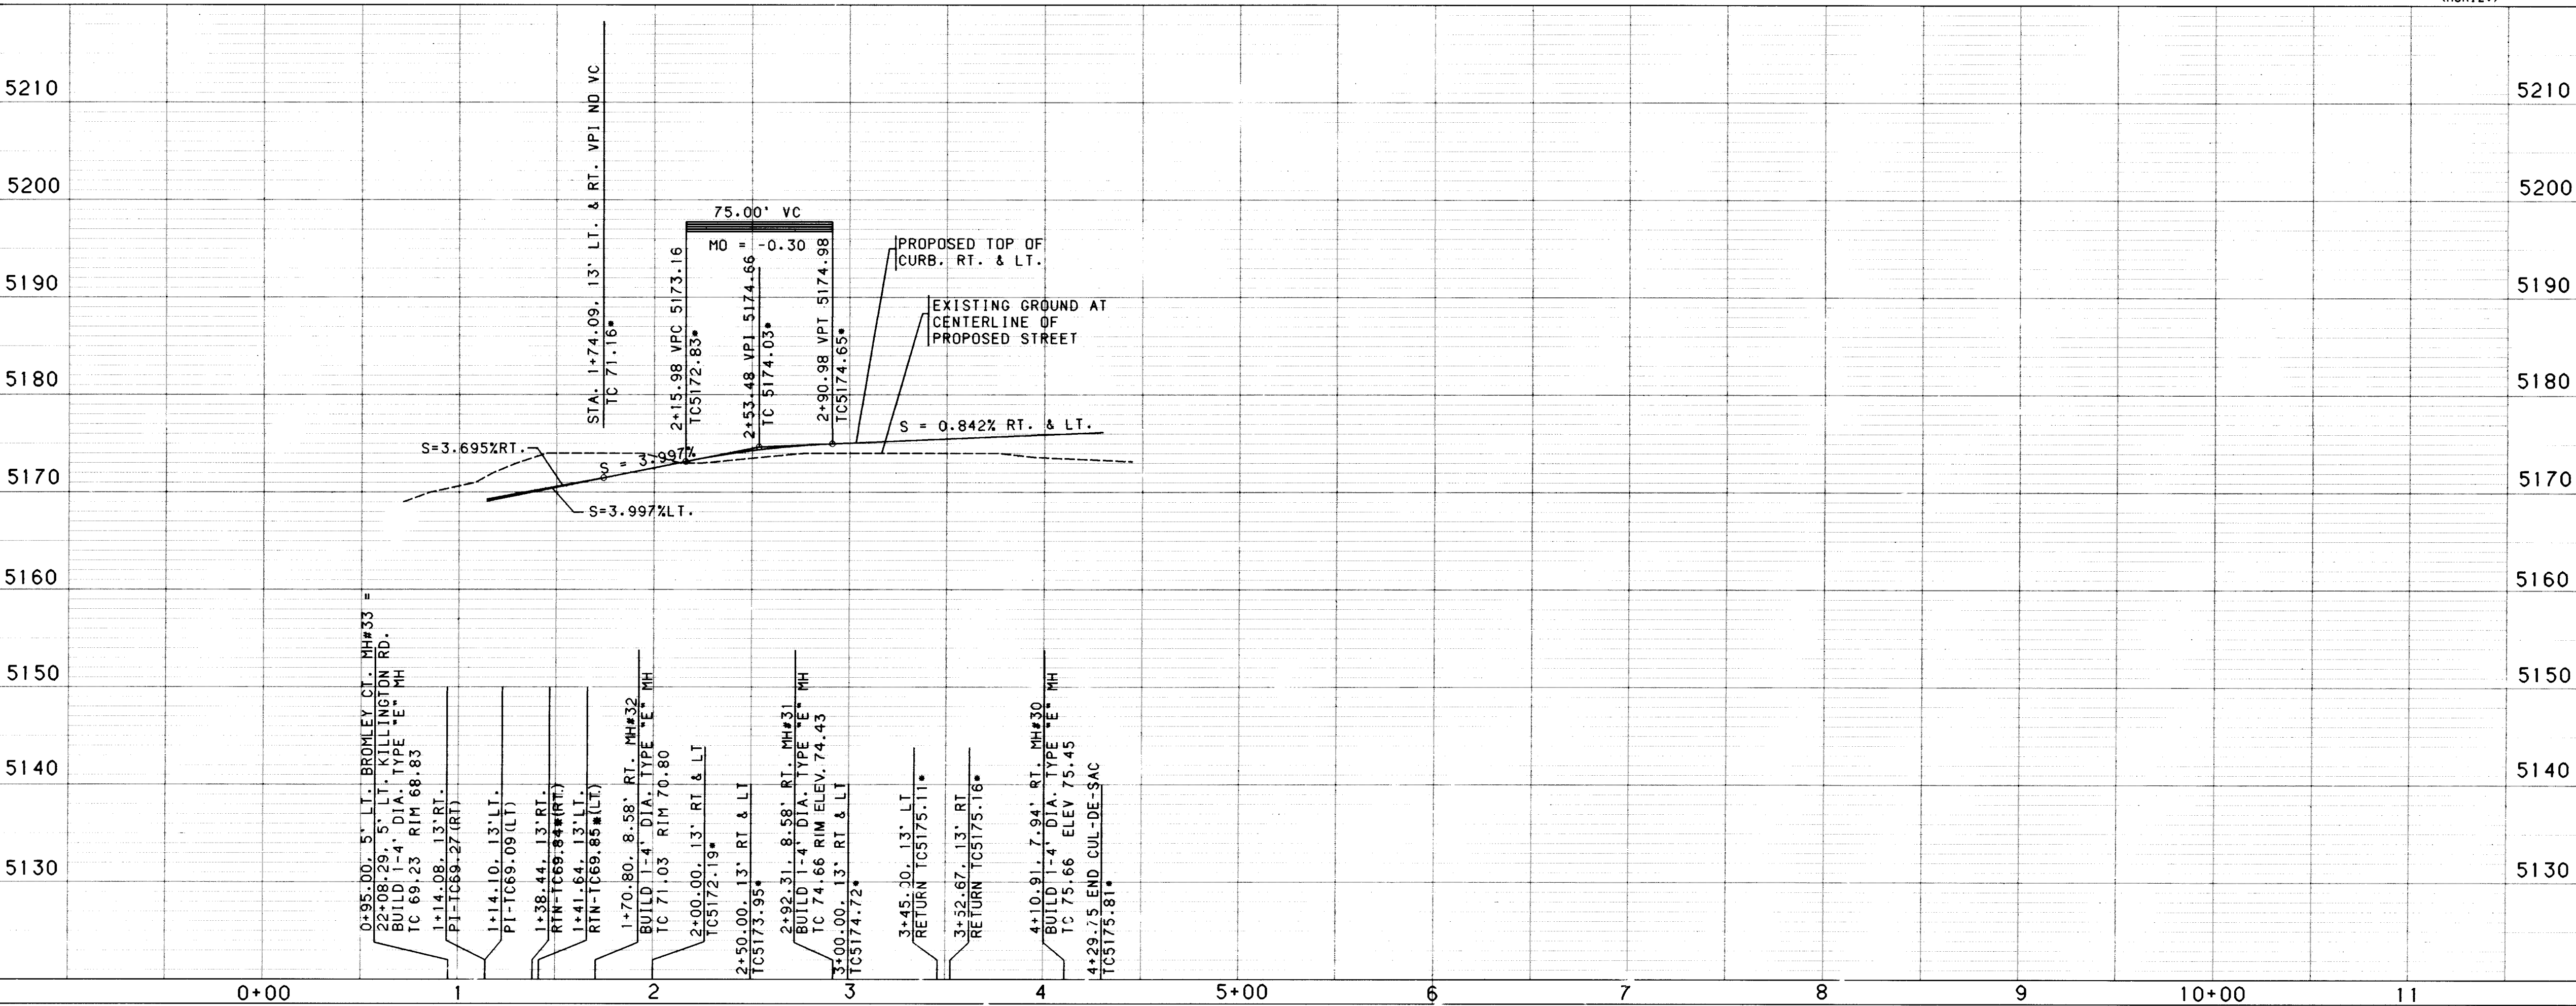

KEYED GENERAL NOTES

1. INSTALL CONCRETE VALLEY GUTTER AS PER STD. DWG. 2420
 2. INSTALL WHEEL CHAIR RAMP AS PER STD. DWG. 2441, CASE 11
 3. INSTALL WHEEL CHAIR RAMP AS PER STD. DWG. 2441, CASE I
 4. STD. CURB & GUTTER AS PER STD. DWG. 2415
 5. MOUNTABLE CURB ROLL TYPE AS PER STD. DWG. 2415
 6. MEDIAN CURB & GUTTER AS PER STD. DWG. 2415
 7. FUTURE 4' SIDEWALK
 8. BUILD 4' SIDEWALK
 9. BUILD 6' SIDEWALK
 10. INSTALL CONCRETE VALLEY GUTTER AS PER STD. DWG. 2421
- * NOT APPLICABLE THIS SHEET

CITY OF ALBUQUERQUE PUBLIC WORKS DEPARTMENT ENGINEERING					
STOWE AT SEVEN BAR NORTH PAVING PLAN & PROFILE BROMLEY COURT					
APPROVALS	ENGINEER	DATE	APPROVALS	ENGINEER	DATE
DRG CHAIRMAN	<i>[Signature]</i>	2-6-96	WATER		
TRANSPORTATION	<i>[Signature]</i>	2-23-95	WASTE WATER	<i>[Signature]</i>	2-23-95
HYDROLOGY	<i>[Signature]</i>	2-23-95			
DRAWING NO. 4982.94					
MAP NO. A-13					
SHEET 6 OF 18					

CENTERLINE CURVE DATA	
P.I.	3+18.23
Delta	25° 39' 57.2"
D	5° 58' 51"
T	218.23'
L	429.14'
R	958.00'

CENTERLINE CURVE DATA	
P.I.	5+94.54
Delta	82° 10' 31.3"
D	76° 23' 40"
T	65.40'
L	107.57'
R	75.00'

KNUCKLE CURB DATA			
PT	TC	STATION & OFFSET	DELTA
1	65.39	5+57.38, 20.13' LT.	26° 05' 29"
2	65.53	5+66.95, 29.51' LT.	26° 05' 29"
3	65.58	5+77.50, 34.38' LT.	26° 05' 29"
4	65.58	5+88.35, 34.38' LT.	26° 05' 29"
5	65.54	5+98.90, 29.51' LT.	26° 05' 29"
6	65.39	6+08.47, 20.13' LT.	26° 05' 29"
R=35.00', L=79.69' (BETWEEN POINTS)			

CENTERLINE CURVE DATA	
P.I.	7+55.93
Delta	16° 42' 19.8"
D	7° 3' 22"
T	119.22'
L	236.75'
R	812.00'



CENTERLINE CURVE DATA	
P.I.	9+31.46
Delta	75° 25' 50.6"
D	76° 23' 40"
T	58.00'
L	98.74'
R	75.00'

SEE SHEET 10 OF 18
FOR INTERSECTION AND
MEDIAN DETAILS.

KNUCKLE CURB DATA			
PT	TC	STATION & OFFSET	DELTA
1	75.11	8+98.71, 18.53' LT.	23° 03' 22"
2	75.38	9+07.95, 25.79' LT.	23° 03' 22"
3	75.60	9+17.81, 29.53' LT.	23° 03' 22"
4	75.71	9+27.86, 29.53' LT.	23° 03' 22"
5	75.69	9+37.71, 25.79' LT.	23° 03' 22"
6	75.59	9+46.96, 18.53' LT.	23° 03' 22"
R=35.00', L=70.42' (BETWEEN POINTS)			

KNUCKLE CURB DATA			
PT	TC	STATION & OFFSET	DELTA
1	75.11	8+98.71, 18.53' LT.	23° 03' 22"
2	75.38	9+07.95, 25.79' LT.	23° 03' 22"
3	75.60	9+17.81, 29.53' LT.	23° 03' 22"
4	75.71	9+27.86, 29.53' LT.	23° 03' 22"
5	75.69	9+37.71, 25.79' LT.	23° 03' 22"
6	75.59	9+46.96, 18.53' LT.	23° 03' 22"
R=35.00', L=70.42' (BETWEEN POINTS)			

- NOTES**
1. THE CONTRACTOR SHALL FIELD VERIFY ALL EXISTING UTILITY LOCATIONS AND NOTIFY THE ENGINEER IMMEDIATELY OF ANY DISCREPANCIES.
 2. ALL CURB RETURN RADI SHALL BE 25' TO FACE OF CURB UNLESS OTHERWISE SPECIFIED.
 3. ALL CURVE DATA AND DIMENSIONS REFER TO FACE OF CURB UNLESS OTHERWISE SPECIFIED.
 4. GRADE ELEVATIONS, WHERE NOTED, ARE FOR TOP OF CURB UNLESS OTHERWISE SPECIFIED.
 5. CONTRACTOR IS TO INSTALL A 4"x4"x5' POST AND EMD AT THE END OF EACH SANITARY SEWER SERVICE.
 6. CONTRACTOR IS RESPONSIBLE FOR REPAIR AND/OR REPLACEMENT OF ALL UTILITY CONDUITS AND EXISTING LINES.
 7. ANY ADDITIONAL GRADING REQUIRED TO MATCH PROPOSED STREET GRADES SHALL BE INCIDENTAL TO PAVING ITEMS.
 8. CONTRACTOR SHALL PROVIDE THE INSPECTORS, (CITY AND PRIVATE) WITH THE PROPOSED HYDROSTATIC TESTING PLAN. THE PLAN MUST BE APPROVED BEFORE TESTING OPERATIONS BEGIN.
 9. CONTRACTOR SHALL PARK EQUIPMENT AND VEHICLES AS NOT TO INTERFERE WITH NORMAL ACTIVITIES OF RESIDENTS OR OTHER CONTRACTORS ON SITE.
 10. ANY DAMAGE TO THE EXISTING FACILITIES (CURB AND GUTTER, PAVEMENT, CONDUITS, LANDSCAPING, UTILITY LINES, ETC.) DURING CONSTRUCTION SHALL BE REPLACED AT THE CONTRACTORS EXPENSE.
 11. REMOVAL OF THE EXISTING CURB AND GUTTER SHALL BE AS PER COA STD. DWG. 2415 (SAMCUT ONLY).
 12. WHEEL CHAIR RAMPS SHALL BE CONSTRUCTED PRIOR TO ACCEPTANCE OF CURB AND GUTTER.

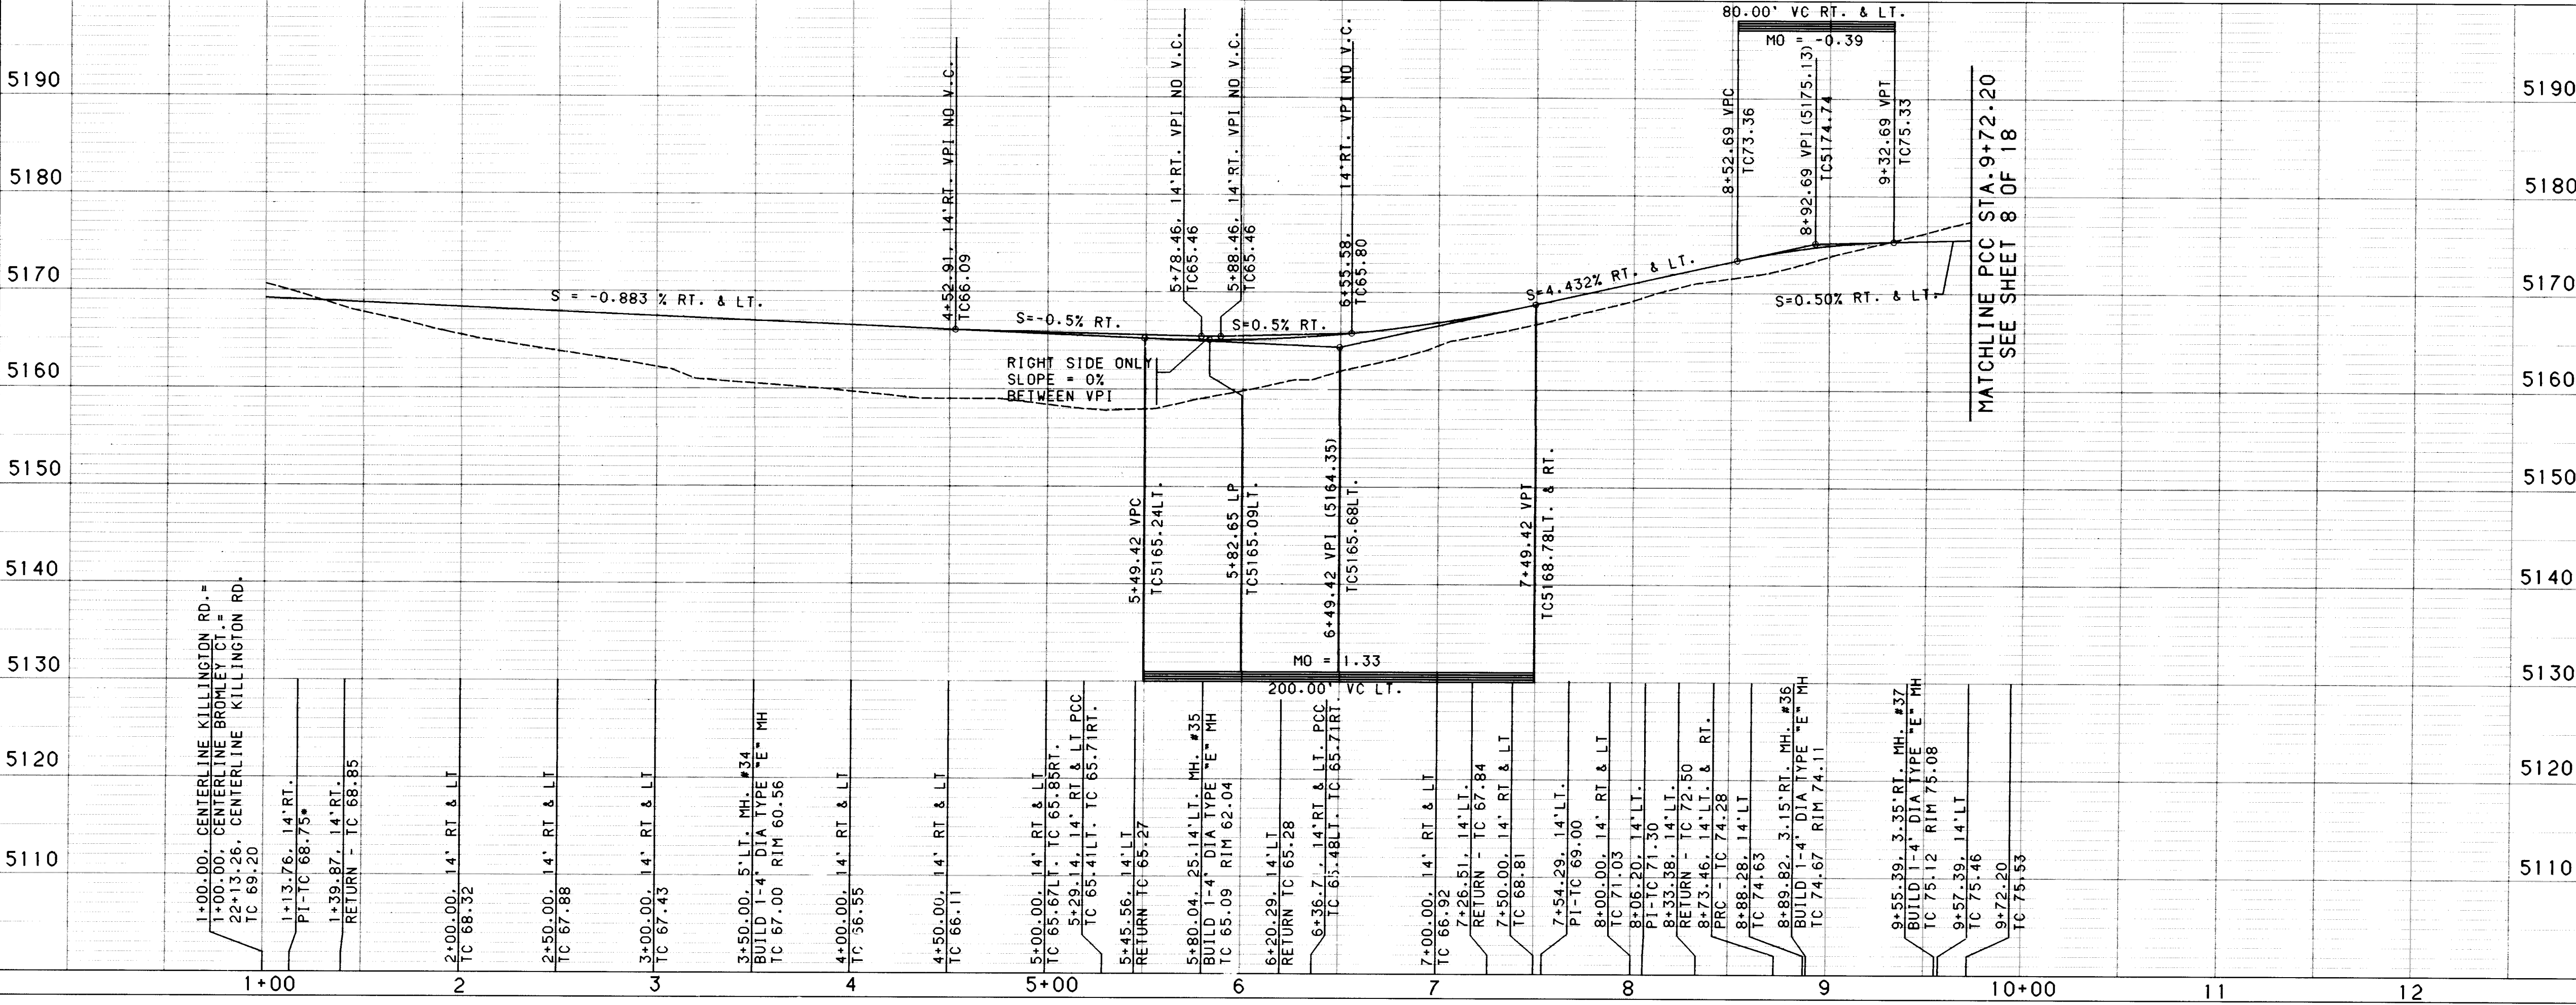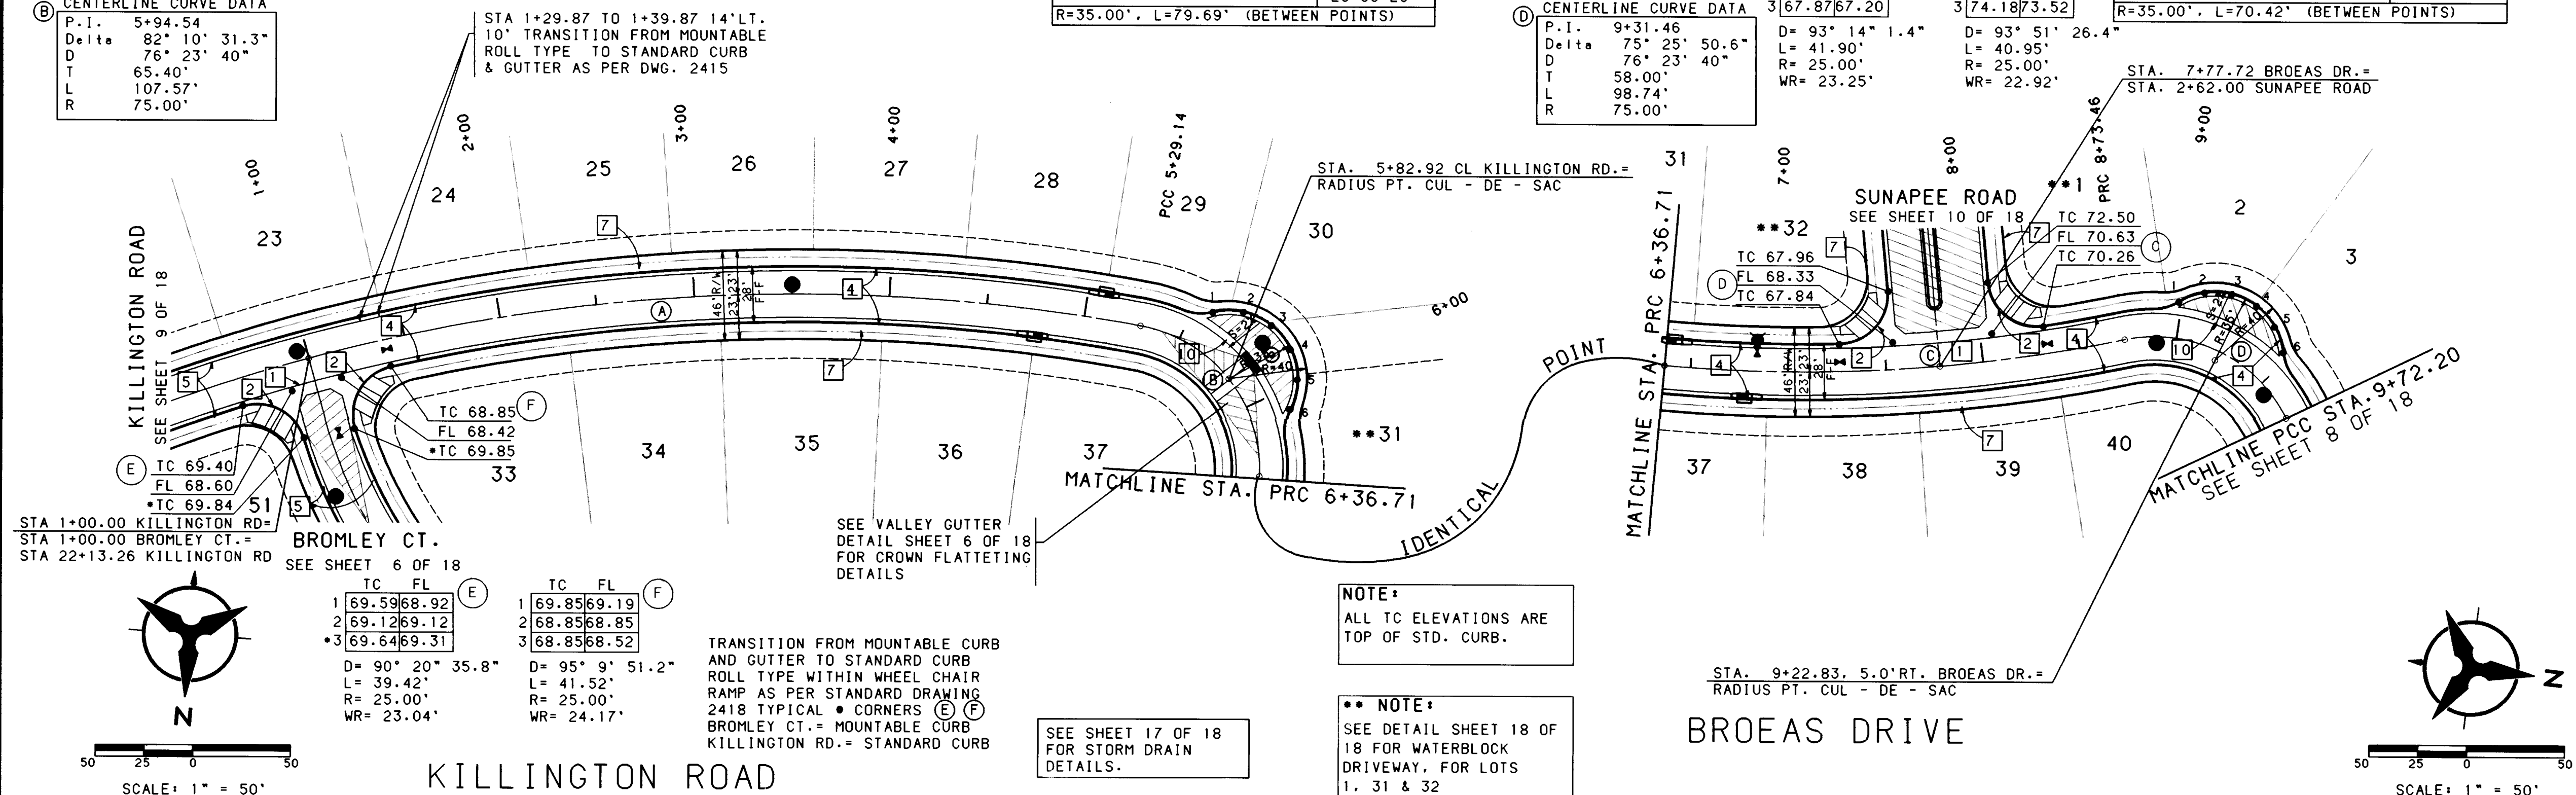

KEYED GENERAL NOTES

1. INSTALL CONCRETE VALLEY GUTTER AS PER STD. DWG. 2420
 2. INSTALL WHEEL CHAIR RAMP AS PER STD. DWG. 2441, CASE II
 3. INSTALL WHEEL CHAIR RAMP AS PER STD. DWG. 2441, CASE I
 4. STD. CURB & GUTTER AS PER STD. DWG. 2415
 5. MOUNTABLE CURB ROLL TYPE AS PER STD. DWG. 2415
 6. MEDIAN CURB & GUTTER AS PER STD. DWG. 2415
 7. FUTURE 4' SIDEWALK
 8. BUILD 4' SIDEWALK
 9. BUILD 6' SIDEWALK
 10. INSTALL CONCRETE VALLEY GUTTER AS PER STD. DWG. 2421
- NOT APPLICABLE THIS SHEET

CITY OF ALBUQUERQUE
PUBLIC WORKS DEPARTMENT
ENGINEERING

STOWE AT SEVEN BAR NORTH
PAVING PLAN & PROFILE
KILLINGTON ROAD/BROEAS DRIVE

APPROVALS	ENGINEER	DATE	APPROVALS	ENGINEER	DATE
DRG CHAIRMAN	8/2/95	2-6-96	WATER		
TRANSPORTATION	8/2/95	WASTE WATER			
HYDROLOGY	8/2/95				

DRAWING NO. 4982.94 MAP NO. A-13 SHEET 7 OF 18

⑤ CENTERLINE CURVE DATA


P.I.	11+10.47
Delta	18° 37' 49.5"
D	6° 37' 26"
T	138.27'
L	274.22'
R	865.00'

⑥ CENTERLINE CURVE DATA

P.I.	13+01.25
Delta	33° 53' 2.0"
D	31° 49' 52"
T	54.83'
L	106.45'
R	180.00'

⑦ CENTERLINE CURVE DATA



P.I.	15+72.79
Delta	15° 2' 53.9"
D	3° 26' 28"
T	219.92'
L	437.30'
R	1665.00'

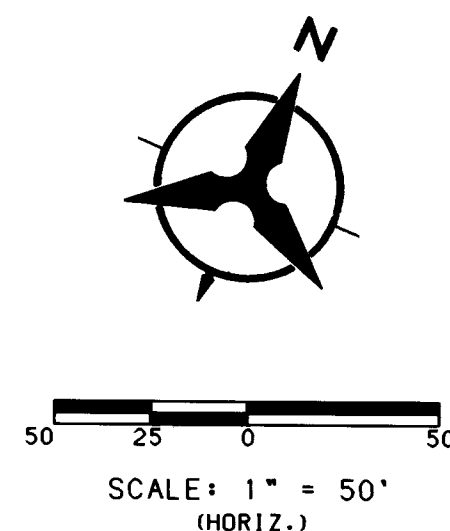

STOWE ROAD

NOTE:
ALL TC ELEVATIONS ARE TOP OF STD. CURB.
• = TOP OF MOUNTABLE CURB ROLL TYPE.

STOWE ROAD

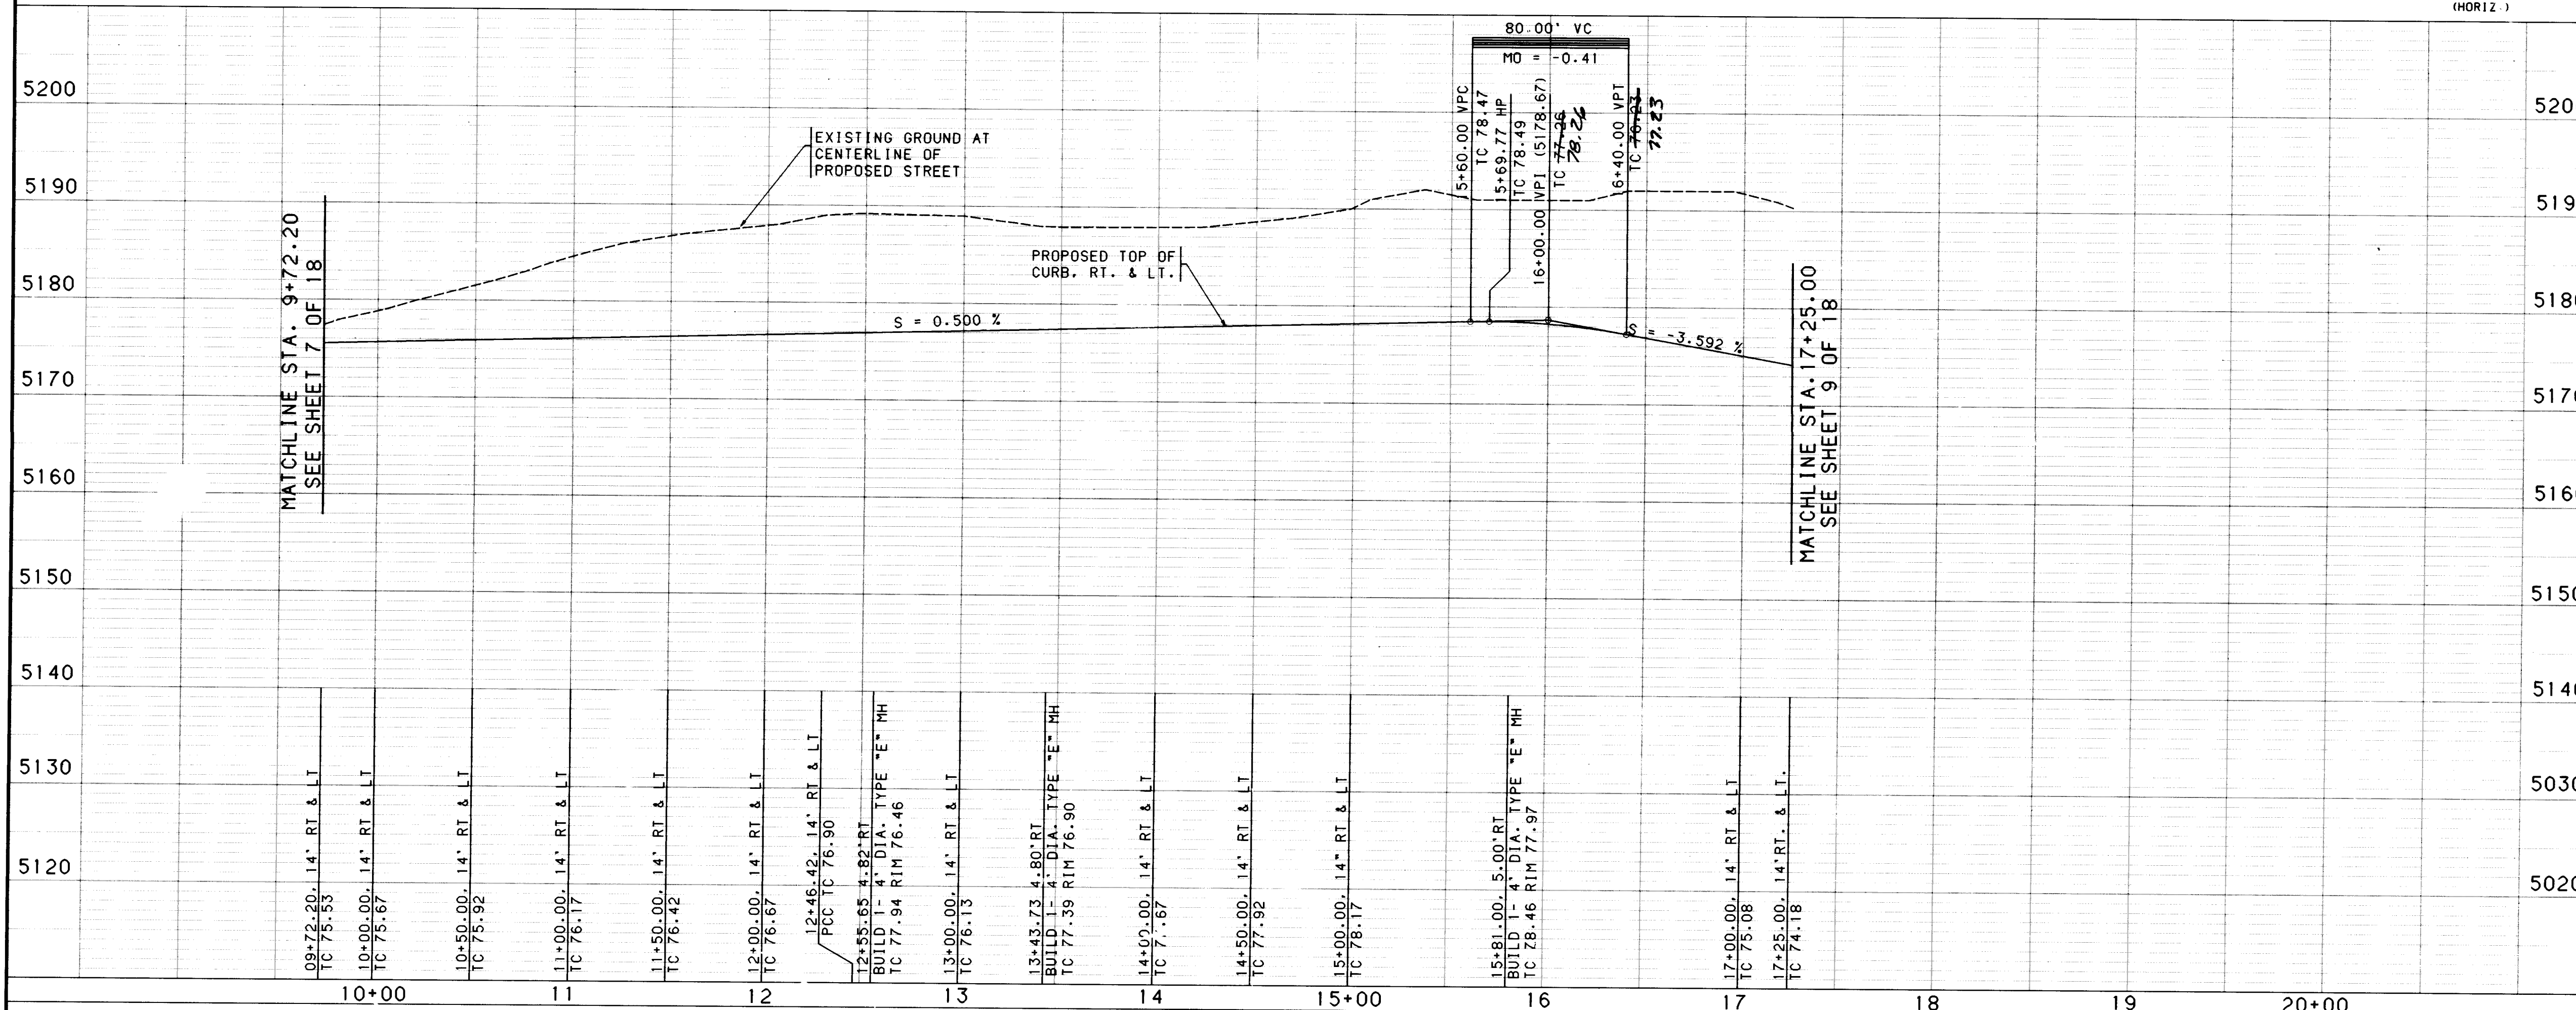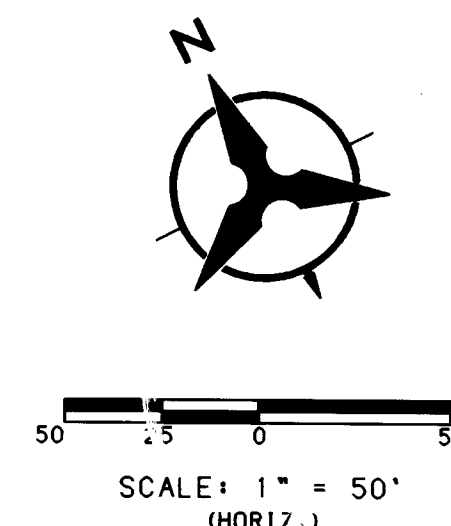

- NOTES**
1. THE CONTRACTOR SHALL FIELD VERIFY ALL EXISTING UTILITY LOCATIONS AND NOTIFY THE ENGINEER IMMEDIATELY OF ANY DISCREPANCIES.
 2. ALL CURB RETURN RADII SHALL BE 25' TO FACE OF CURB UNLESS OTHERWISE SPECIFIED.
 3. ALL CURVE DATA AND DIMENSIONS REFER TO FACE OF CURB UNLESS OTHERWISE SPECIFIED.
 4. GRADE ELEVATIONS, WHERE NOTED, ARE FOR TOP OF CURB UNLESS OTHERWISE SPECIFIED.
 5. CONTRACTOR IS TO INSTALL A 4"x4"x5' POST AND EMD AT THE END OF EACH SANITARY SEWER SERVICE.
 6. CONTRACTOR IS RESPONSIBLE FOR REPAIR AND/OR REPLACEMENT OF ALL UTILITY CONDUITS AND EXISTING LINES.
 7. ANY ADDITIONAL GRADING REQUIRED TO MATCH PROPOSED STREET GRADES SHALL BE INCIDENTAL TO PAVING ITEMS.
 8. CONTRACTOR SHALL PROVIDE THE INSPECTOR (CITY AND PRIVATE) WITH THE PROPOSED HYDROSTATIC TESTING PLAN. THE PLAN MUST BE APPROVED BEFORE TESTING OPERATIONS BEGIN.
 9. CONTRACTOR SHALL PARK EQUIPMENT AND VEHICLES AS NOT TO INTERFERE WITH NORMAL ACTIVITIES OF RESIDENTS OR OTHER CONTRACTORS ON SITE.
 10. ANY DAMAGE TO THE EXISTING FACILITIES (CURB AND GUTTER, PAVEMENT, CONDUITS, LANDSCAPING, UTILITY LINES, ETC.) DURING CONSTRUCTION SHALL BE REPLACED AT THE CONTRACTORS EXPENSE.
 11. REMOVAL OF THE EXISTING CURB AND GUTTER SHALL BE AS PER COA STD. DWG. 2415 (SAWCUT ONLY).
 12. WHEEL CHAIR RAMPS SHALL BE CONSTRUCTED PRIOR TO ACCEPTANCE OF CURB AND GUTTER.

KEYED GENERAL NOTES

1. INSTALL CONCRETE VALLEY GUTTER AS PER STD. DWG. 2420
 2. INSTALL WHEEL CHAIR RAMP AS PER STD. DWG. 2441, CASE 11
 3. INSTALL WHEEL CHAIR RAMP AS PER STD. DWG. 2441, CASE 1
 4. STD. CURB & GUTTER AS PER STD. DWG. 2415
 5. MOUNTABLE CURB ROLL TYPE AS PER STD. DWG. 2415
 6. MEDIAN CURB & GUTTER AS PER STD. DWG. 2415
 7. FUTURE 4' SIDEWALK
 8. BUILD 4' SIDEWALK
 9. BUILD 6' SIDEWALK
 10. INSTALL CONCRETE VALLEY GUTTER AS PER STD. DWG. 2421
- NOT APPLICABLE THIS SHEET

26-4982.94 0896


CITY OF ALBUQUERQUE PUBLIC WORKS DEPARTMENT ENGINEERING STOWE AT SEVEN BAR NORTH PAVING PLAN & PROFILE STOWE ROAD					
APPROVALS	ENGINEER	DATE	APPROVALS	ENGINEER	DATE
DRC CHAIRMAN	<i>[Signature]</i>	2-6-96	WATER	<i>[Signature]</i>	2-6-96
TRANSPORTATION	<i>[Signature]</i>	2-23-95	WASTE WATER	<i>[Signature]</i>	2-23-95
HYDROLOGY	<i>[Signature]</i>	2-23-95			
NMUT					
DRAWING NO.		4982.94	MAP NO.		A-13
			SHEET		8 OF 18

ENGINEER'S SEAL		SURVEY INFORMATION		FIELD NOTES		BENCH MARKS		AS-BUILT INFORMATION	
NO.	DATE	NO.	DATE	NO.	DATE	NO.	DATE	NO.	DATE
REMARKS		REVISIONS		DESIGN		DESIGNED BY		JCA	
DATE		DATE		DATE		DRAWN BY		JAO	
DATE		DATE		DATE		CHECKED BY		JRT	

CENTERLINE CURVE DATA	
P.I.	18+96.50
Delta	109° 36' 33.9"
D	76° 23' 40"
T	106.34'
L	143.48'
R	75.00'



CENTERLINE CURVE DATA	
P.I.	20+74.45
Delta	16° 43' 24.2"
D	5° 58' 51"
T	140.81'
L	279.62'
R	958.00'

KNUCKLE CURB DATA		
PT	TC	STATION & OFFSET
1	71.60	18+35.38, 25.40' LT
2	71.83	18+42.43, 43.80' LT
3	71.91	18+56.14, 49.05' LT
4	71.74	18+65.20, 49.68' LT
5	71.53	18+78.17, 42.02' LT
6	71.17	18+88.39, 25.40' LT
R=35.00', L=101.54 (BETWEEN POINTS)		

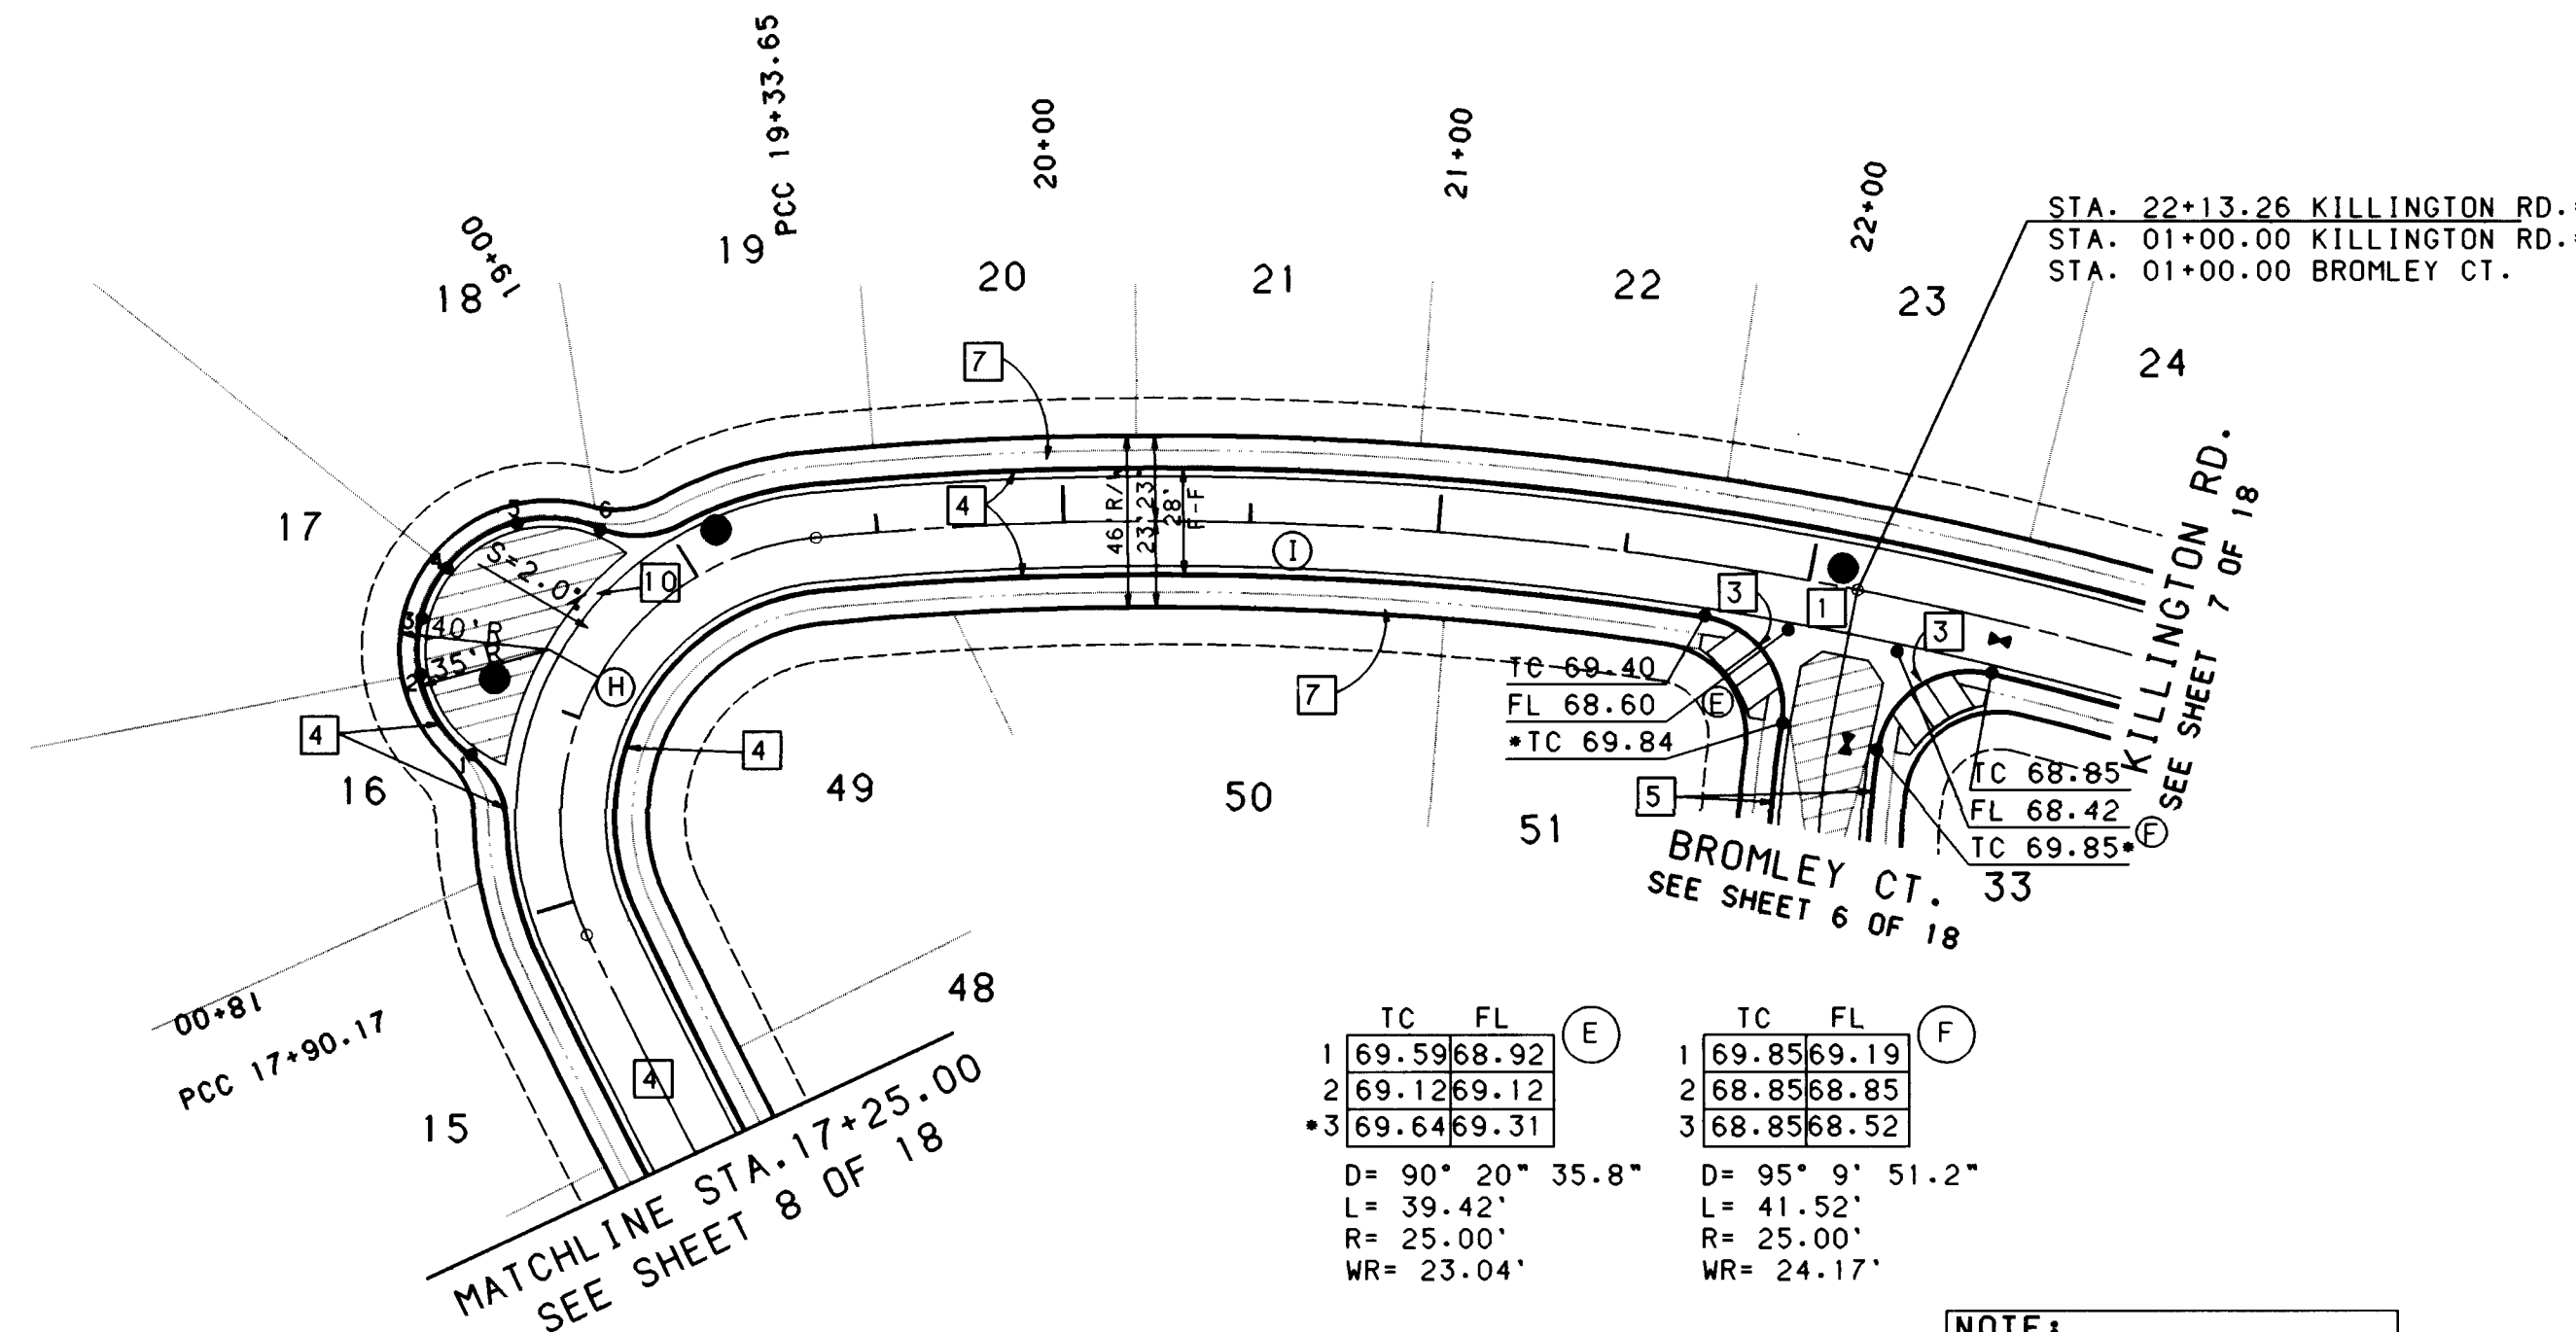

KILLINGTON ROAD

NOTE:
ALL TC ELEVATIONS ARE
TOP OF STANDARD CURB.
• = TOP OF MOUNTABLE
CURB ROLL TYPE.

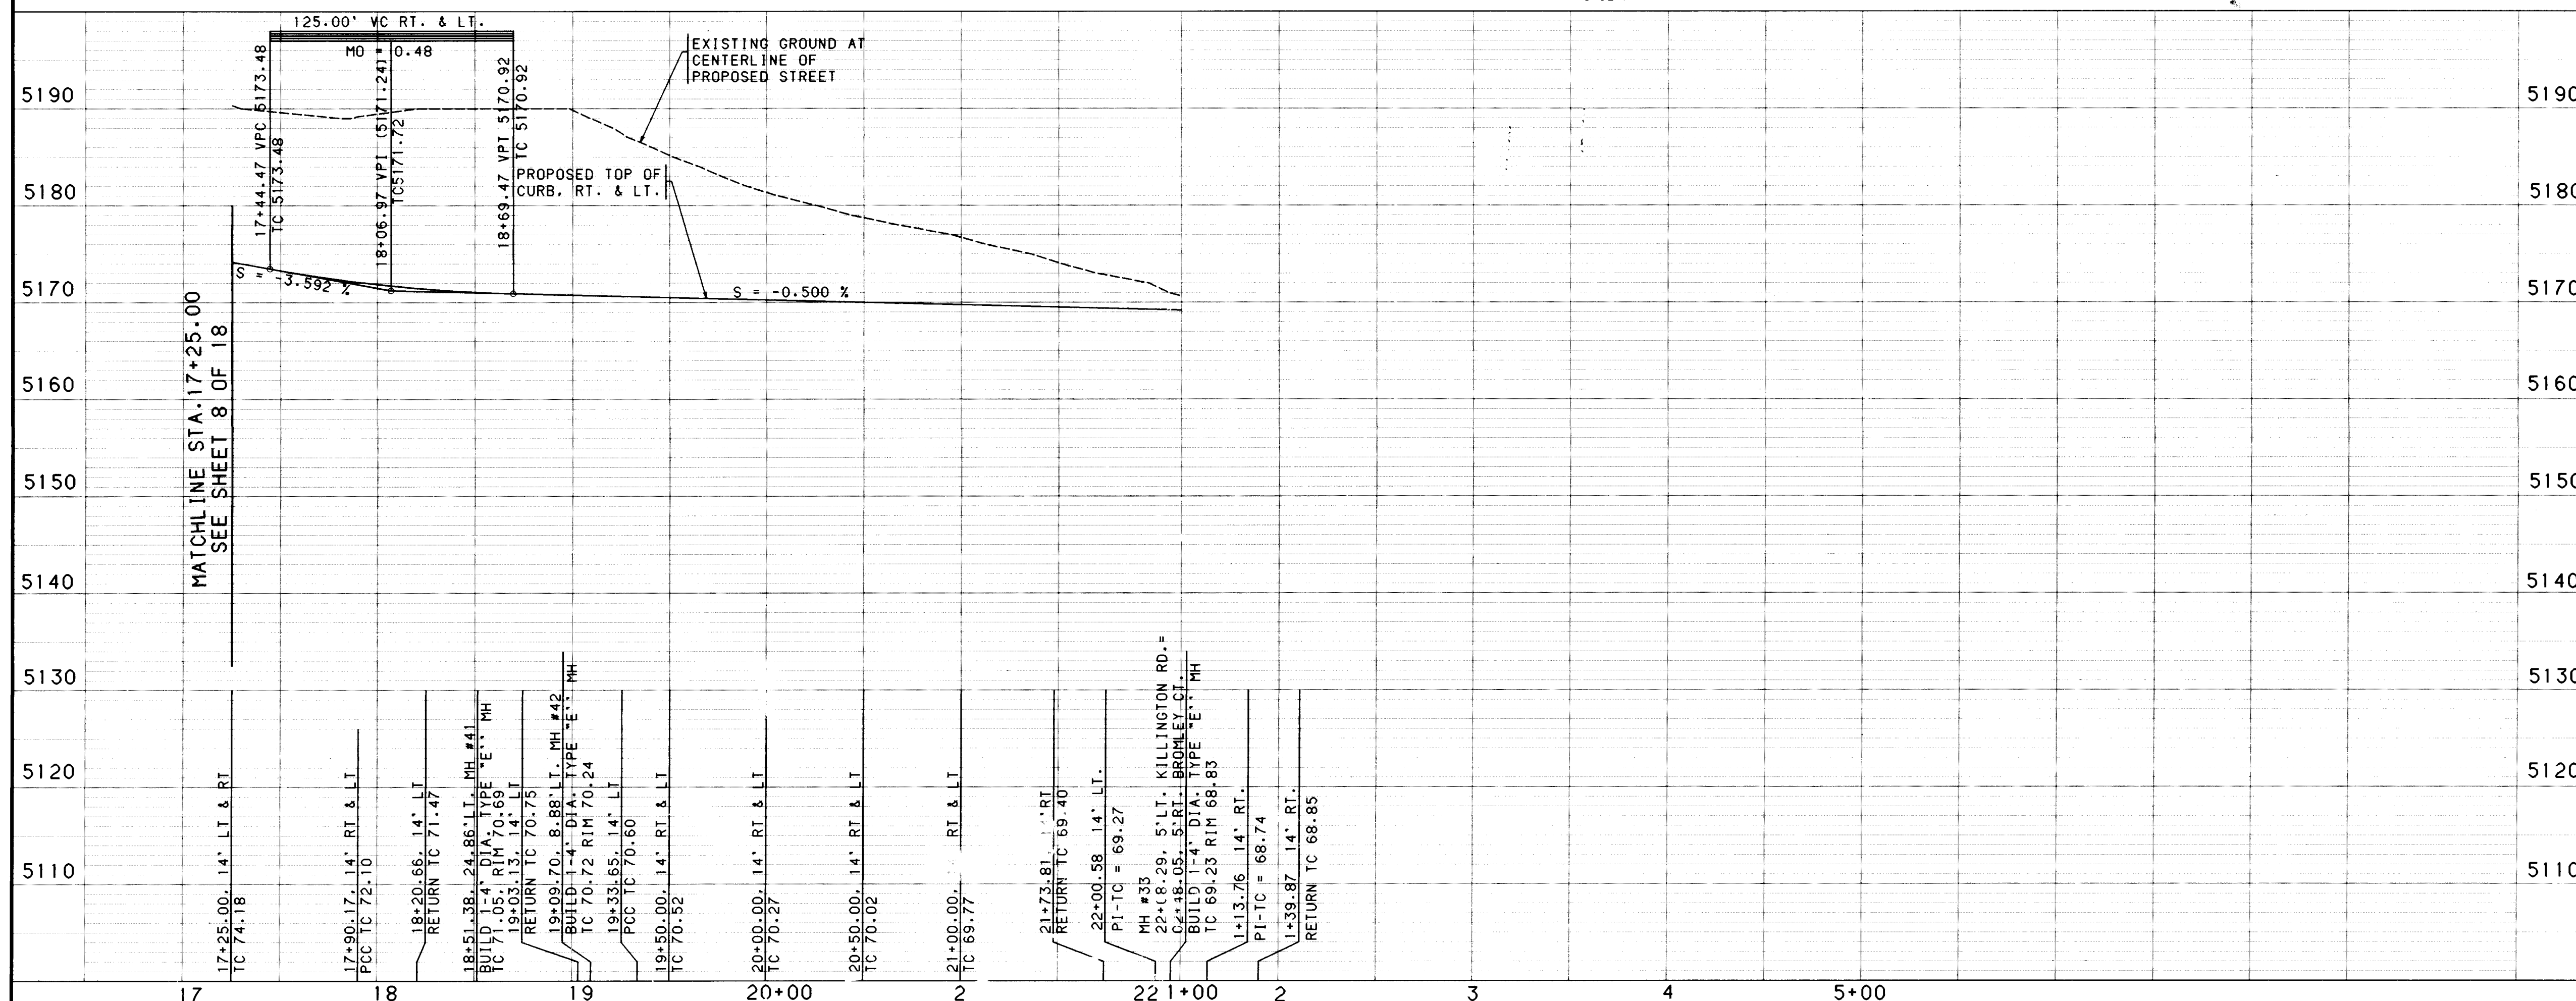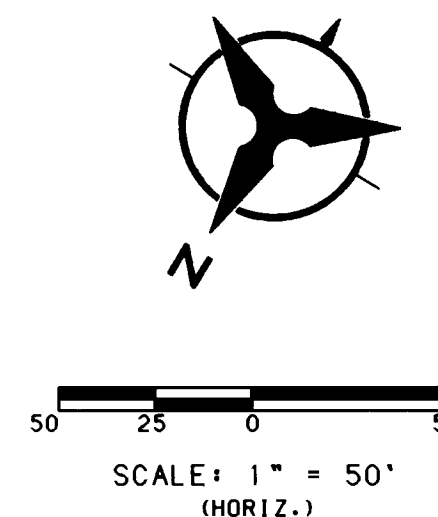


- NOTES**
1. THE CONTRACTOR SHALL FIELD VERIFY ALL EXISTING UTILITY LOCATIONS AND NOTIFY THE ENGINEER IMMEDIATELY OF ANY DISCREPANCIES.
 2. ALL CURB RETURN RADII SHALL BE 25' TO FACE OF CURB UNLESS OTHERWISE SPECIFIED.
 3. ALL CURVE DATA AND DIMENSIONS REFER TO FACE OF CURB UNLESS OTHERWISE SPECIFIED.
 4. GRADE ELEVATIONS, WHERE NOTED, ARE FOR TOP OF CURB UNLESS OTHERWISE SPECIFIED.
 5. CONTRACTOR IS TO INSTALL A 4"x4"x5" POST AND EMD AT THE END OF EACH SANITARY SEWER SERVICE.
 6. CONTRACTOR IS RESPONSIBLE FOR REPAIR AND/OR REPLACEMENT OF ALL UTILITY CONDUITS AND EXISTING LINES.
 7. ANY ADDITIONAL GRADING REQUIRED TO MATCH PROPOSED STREET GRADES SHALL BE INCIDENTAL TO PAVING ITEMS.
 8. CONTRACTOR SHALL PROVIDE THE INSPECTORS, (CITY AND PRIVATE) WITH THE PROPOSED HYDROSTATIC TESTING PLAN. THE PLAN MUST BE APPROVED BEFORE TESTING OPERATIONS BEGIN.
 9. CONTRACTOR SHALL PARK EQUIPMENT AND VEHICLES AS NOT TO INTERFERE WITH NORMAL ACTIVITIES OF RESIDENTS OR OTHER CONTRACTORS ON SITE.
 10. ANY DAMAGE TO THE EXISTING FACILITIES (CURB AND GUTTER, PAVEMENT, CONDUITS, LANDSCAPING, UTILITY LINES, ETC.) DURING CONSTRUCTION SHALL BE REPLACED AT THE CONTRACTORS EXPENSE.
 11. REMOVAL OF THE EXISTING CURB AND GUTTER SHALL BE AS PER COA STD. DWG. 2415 (SAWCUT ONLY).
 12. WHEEL CHAIR RAMPS SHALL BE CONSTRUCTED PRIOR TO ACCEPTANCE OF CURB AND GUTTER.

KEYED GENERAL NOTES

1. INSTALL CONCRETE VALLEY GUTTER AS PER STD. DWG. 2420
 2. INSTALL WHEEL CHAIR RAMP AS PER STD. DWG. 2441, CASE 11
 3. INSTALL WHEEL CHAIR RAMP AS PER STD. DWG. 2441, CASE 1
 4. STD. CURB & GUTTER AS PER STD. DWG. 2415
 5. MOUNTABLE CURB ROLL TYPE AS PER STD. DWG. 2415
 6. MEDIAN CURB & GUTTER AS PER STD. DWG. 2415
 7. FUTURE 4' SIDEWALK
 8. BUILD 4' SIDEWALK
 9. BUILD 6' SIDEWALK
 10. INSTALL CONCRETE VALLEY GUTTER AS PER STD. DWG. 2421
- NOT APPLICABLE THIS SHEET

CITY OF ALBUQUERQUE PUBLIC WORKS DEPARTMENT ENGINEERING STOWE AT SEVEN BAR NORTH PAVING PLAN & PROFILE KILLINGTON ROAD					
APPROVALS	ENGINEER	DATE	APPROVALS	ENGINEER	DATE
DRC CHAIRMAN	<i>[Signature]</i>	2-6-96	WATER	<i>[Signature]</i>	2-6-96
TRANSPORTATION	<i>[Signature]</i>	8-23-95	WASTE WATER	<i>[Signature]</i>	8-23-95
HYDROLOGY	<i>[Signature]</i>	9-12-95			
NHUI					
DRAWING NO. 4982.94		MAP NO. A-13		SHEET 9 OF 18	

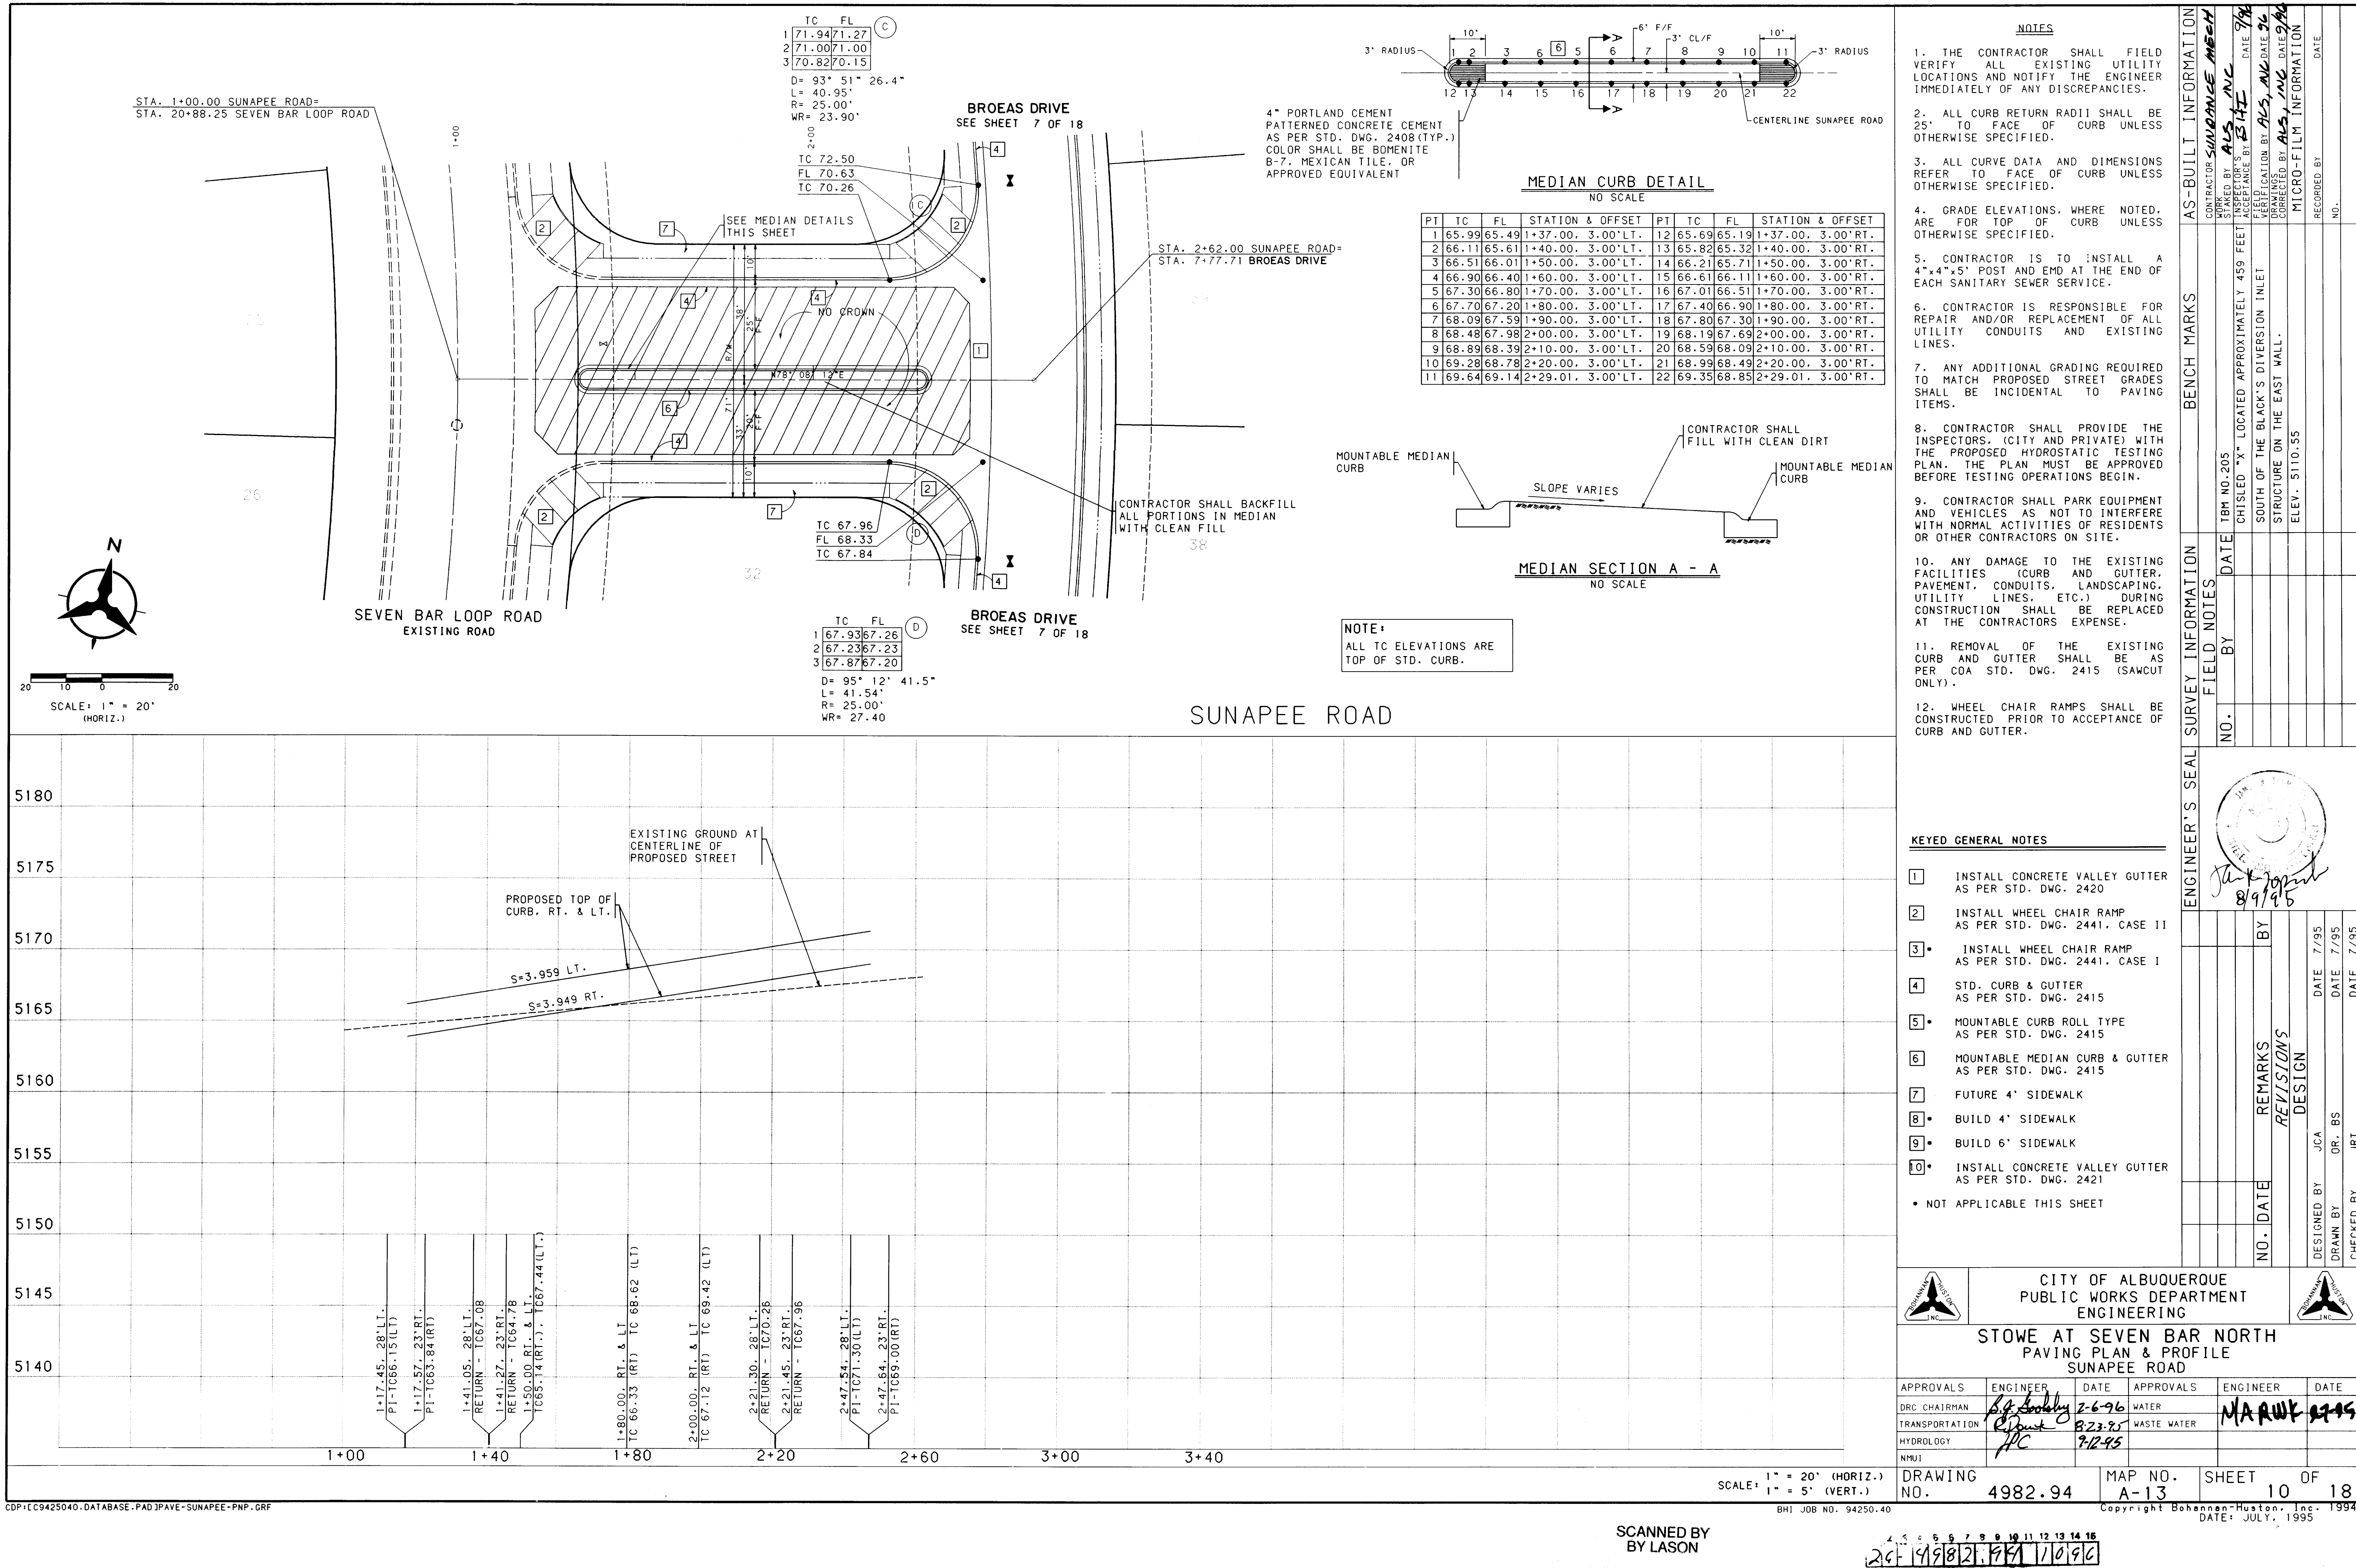

WATER & SANITARY SEWER SERVICES						
LOT NUMBER	STATION & OFFSET	WL TYPE	SAS STATION & OFFSET	SAS LENGTH	TOP OF PIPE AT PLUG	
10	14+35.76, 5'L.T.	DOUBLE	13+99.37, 5'RT	38.00'	71.7'	
12			14+65.17, 5'RT	38.00'		72.16
13	15+67.80, 5'L.T.	DOUBLE	15+31.00, 5'RT	38.00'		72.60
14			15+99.79, 5'RT	38.00'		72.35
15	SEE SHEET 15 OF 18	-----	16+98.50, 5'RT	38.00'		69.62
				-----		----



STA. 16+59.61, 5' RT
INSTALL 1-8" x 6" TEE w/
APPROX. 11LF 6" PVC
1-6" GATE VALVE ON BRANCH
1- 8" GATE VALVE ON RUN
w/ 2 TYPE "A" BOXES & LIDS
1 FIRE HYDRANT 4' BURY
PER STD. DWG. 2340
FLANGE ELEV. = 5172.39

WATERLINE TANGENT DATA		
NUMBER	BEARING	DISTANCE
T4	S88°00'26"E	87.77'


WATERLINE CURVE DATA					
NUMBER	PI STA.	DELTA	TANGENT	ARC	RADIUS
C8	11+08.76	20°08'12"	154.47'	305.76'	870.00'
C9	15+85.46	16°32'19.5"	242.72'	482.06'	1670.00'

WATER & SANITARY SEWER SERVICES					
LOT NUMBER	STATION & WL OF OFFSET	WL TYPE	SAS STATION & OFFSET	SAS LENGTH	TOP OF PIPE AT PLUG
41	11+18.14, 5' LT.	DOUBLE	10+80.92, 5' RT	28.00'	68.98
42			11+55.36, 5' RT	28.00'	69.49
43			12+35.29, 5' RT	28.00'	70.03
44	13+03.84	DOUBLE	13+70.44, 5' RT	28.00'	71.12
45			14+52.26, 5' RT	28.00'	71.67
46			15+34.38, 5' RT	28.00'	72.23
47	16+61.40, 5' LT.	DOUBLE	16+16.71, 5' RT	28.00'	71.49
48			17+01.51, 5' RT	28.00'	69.13

SAS CURVE DATA					
NUMBER	PI STA.	DELTA	TANGENT	ARC	RADIUS
C4	11+05.66	19°49'23.1"	150.27'	297.54'	860.00'
C5	14+62.10'	8°09'26.5"	118.37'	236.34'	1660.00'
C6	16+99.51	8°10' 0.5"	118.51'	236.61'	1660.00'

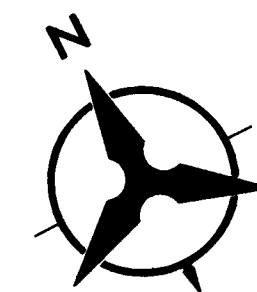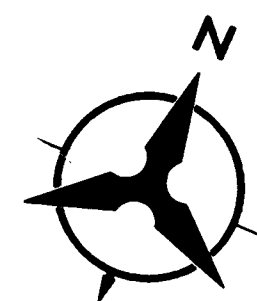

STOWE ROAD

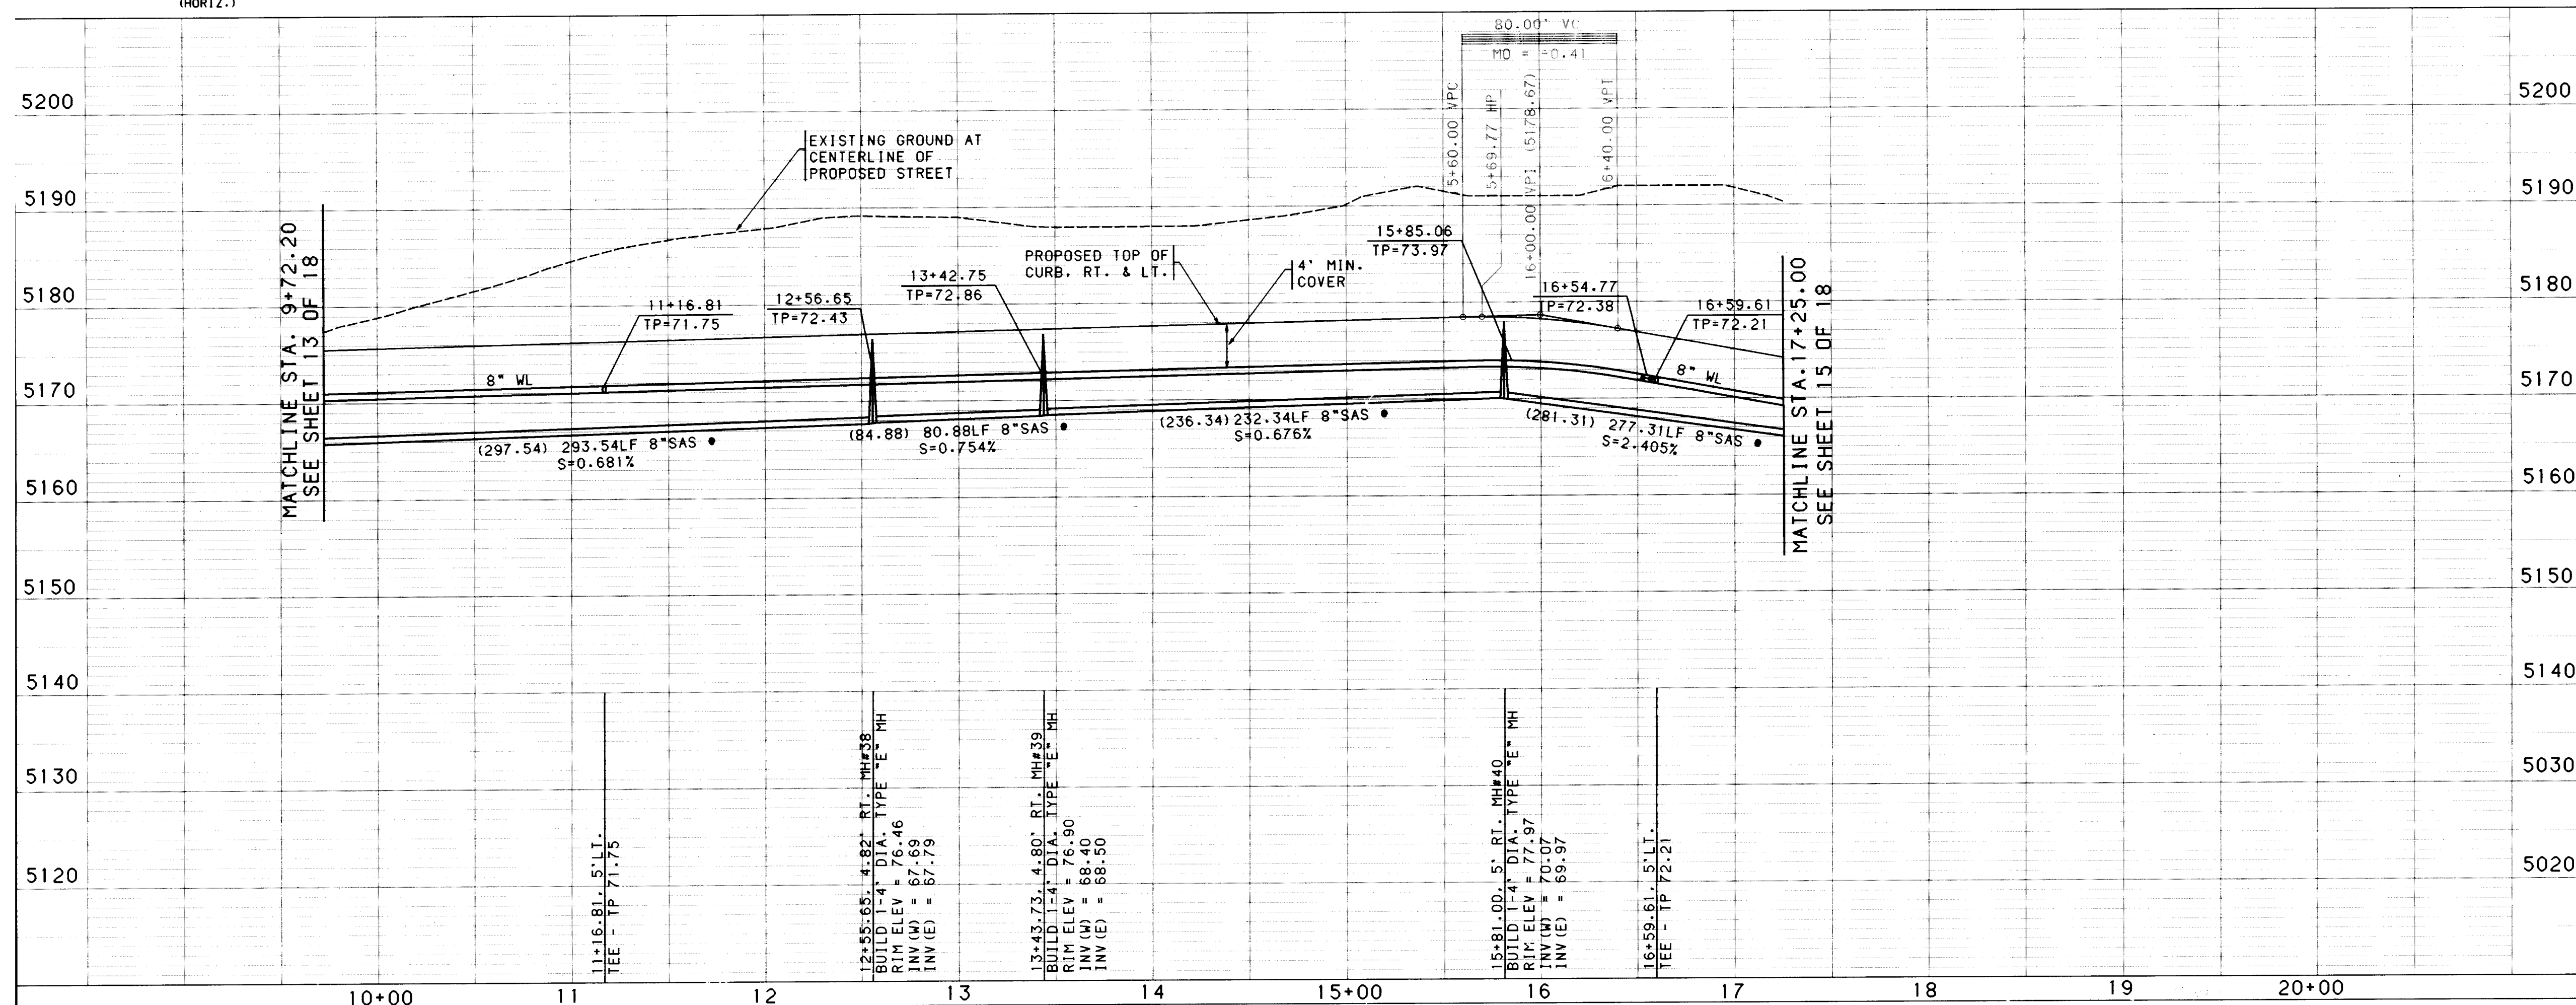

SCANNED BY
BY LASON

SCALE: 1" = 50' (HORIZ.)
1" = 10' (VERT.)

DRAWING NO.	4982.94
-------------	---------


MAP NO. A-13	SHEET 14 OF 18
-----------------	----------------

Copyright Bohannon-Huston, Inc. 19
DATE: JULY, 1995

CDP:[C9425040.DATABASE.PAD]UTIL-STOWE-PNP.GRF

BHI JOB NO. 94250.40

Copyright Bohannon-Huston, Inc. 19
DATE: JULY, 1995

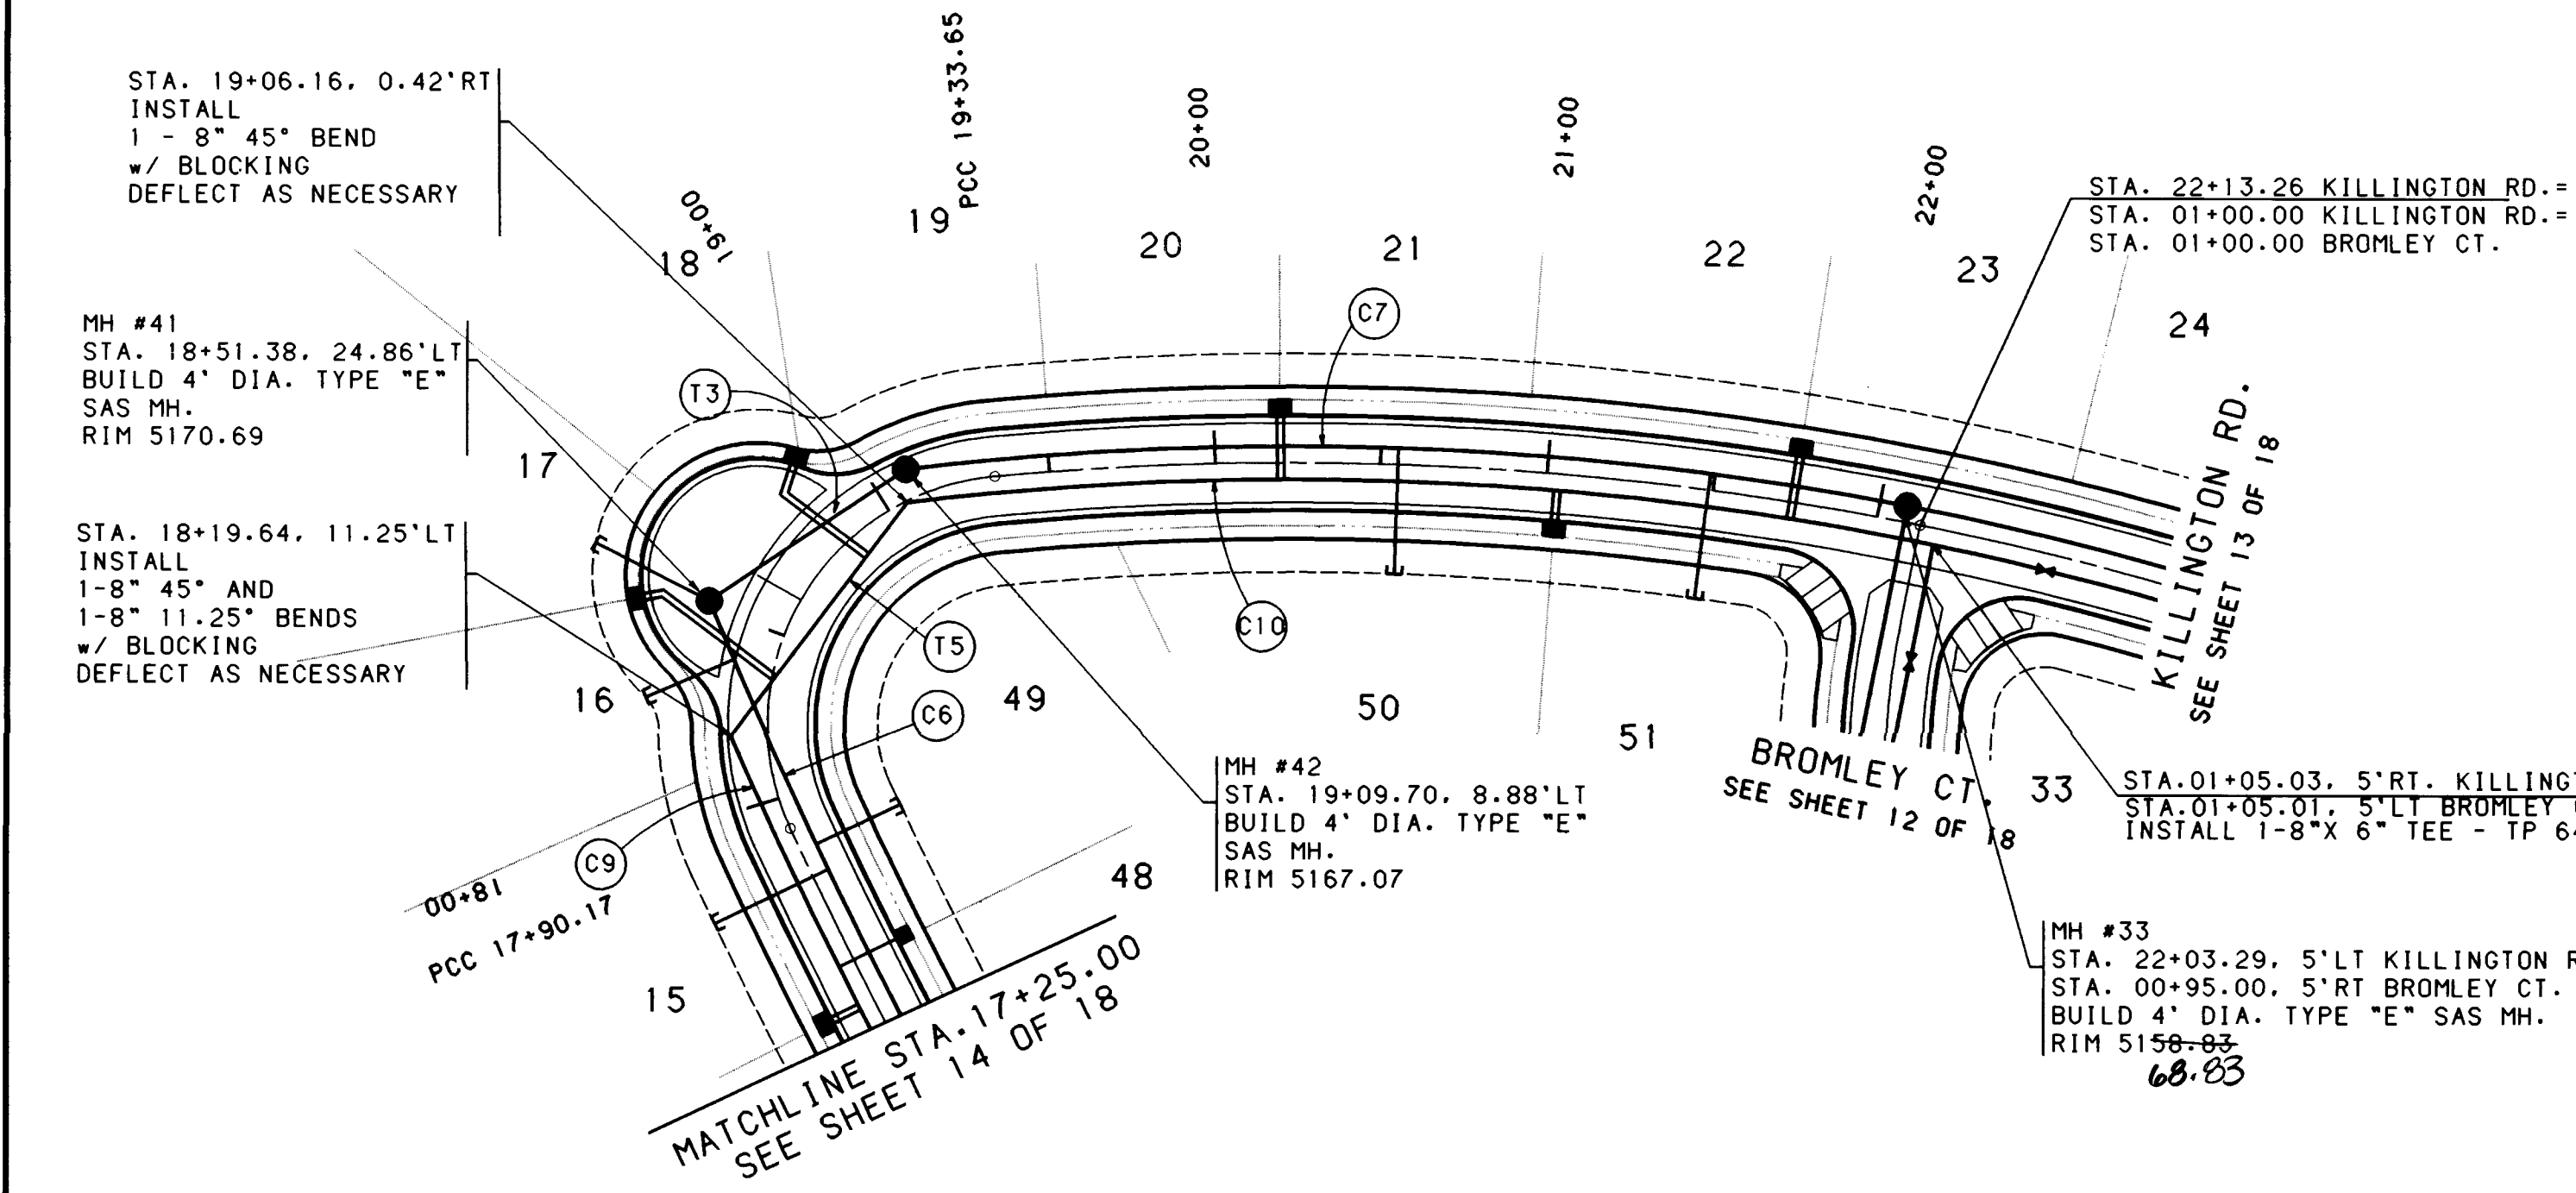

SAS TANGENT DATA		
NUMBER	BEARING	DISTANCE
T3	S25°00'24"E	71.20'


WATERLINE TANGENT DATA		
NUMBER	BEARING	DISTANCE
T5	S05°54'50"W	88.25'

WATER & SANITARY SEWER SERVICES					
LOT NUMBER	STATION & OFFSET	WL TYPE	SAS STATION & OFFSET	SAS LENGTH	TOP OF PIPE AT PLUG
14	17+32.76, 5.00'LT.	DOUBLE	SEE SHEET 14 OF 18	----	65.94
15	17+32.76, 5.00'LT.	DOUBLE	17+74.17, 5.00'RT	38.00'	65.67
16	18+36.93, 0.73'RT.	DOUBLE	18+39.62, 2.47'LT	29.00'	65.40
17	18+36.93, 0.73'RT.	DOUBLE	18+51.38, 24.86'RT	38.60'	66.02
18	18+86.01, 7.05'RT.	DOUBLE	SEE NOTE BELOW **	----	----
19	18+86.01, 7.05'RT.	DOUBLE	SEE NOTE BELOW **	----	----
20	20+19.78, 5'RT.	DOUBLE	SEE NOTE BELOW **	----	----
21	20+19.78, 5'RT.	DOUBLE	SEE NOTE BELOW **	----	----
22	21+74.14, 5'RT.	DOUBLE	SEE NOTE BELOW **	----	----
23	21+74.14, 5'RT.	DOUBLE	SEE NOTE BELOW **	----	----
49	17+46.23, 5'RT.	DOUBLE	17+82.70, 5.00'LT	28.00'	66.60
50	21+03.40, 5'RT.	DOUBLE	20+55.17, 5.00'LT	38.00'	64.23
51	21+03.40, 5'RT.	DOUBLE	21+48.63, 5.00'LT	38.00'	63.98


** SAS LATERALS EXIST PER C.O.A. PROJECT NO'S 4982.90 & 4982.91 (TRACTS B1 & B2)

SAS CURVE DATA					
NUMBER	PI STA.	DELTA	TANGENT	ARC	RADIUS
C6	17+21.99	9°42'34.2"	140.99'	281.31'	1660.00'
C7	20+59.58	17°41'36.5"	149.88'	297.38'	963.00'

WATERLINE CURVE DATA					
NUMBER	PI STA.	DELTA	TANGENT	ARC	RADIUS
C9	15+85.46	16°32'19.5"	242.72'	482.06'	1670.00'
C10	20+53.42	19°25'48.5"	163.16'	323.18'	953.00'

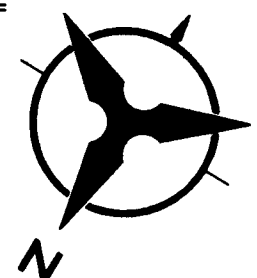

SCALE: 1" = 50' (HORIZ.)

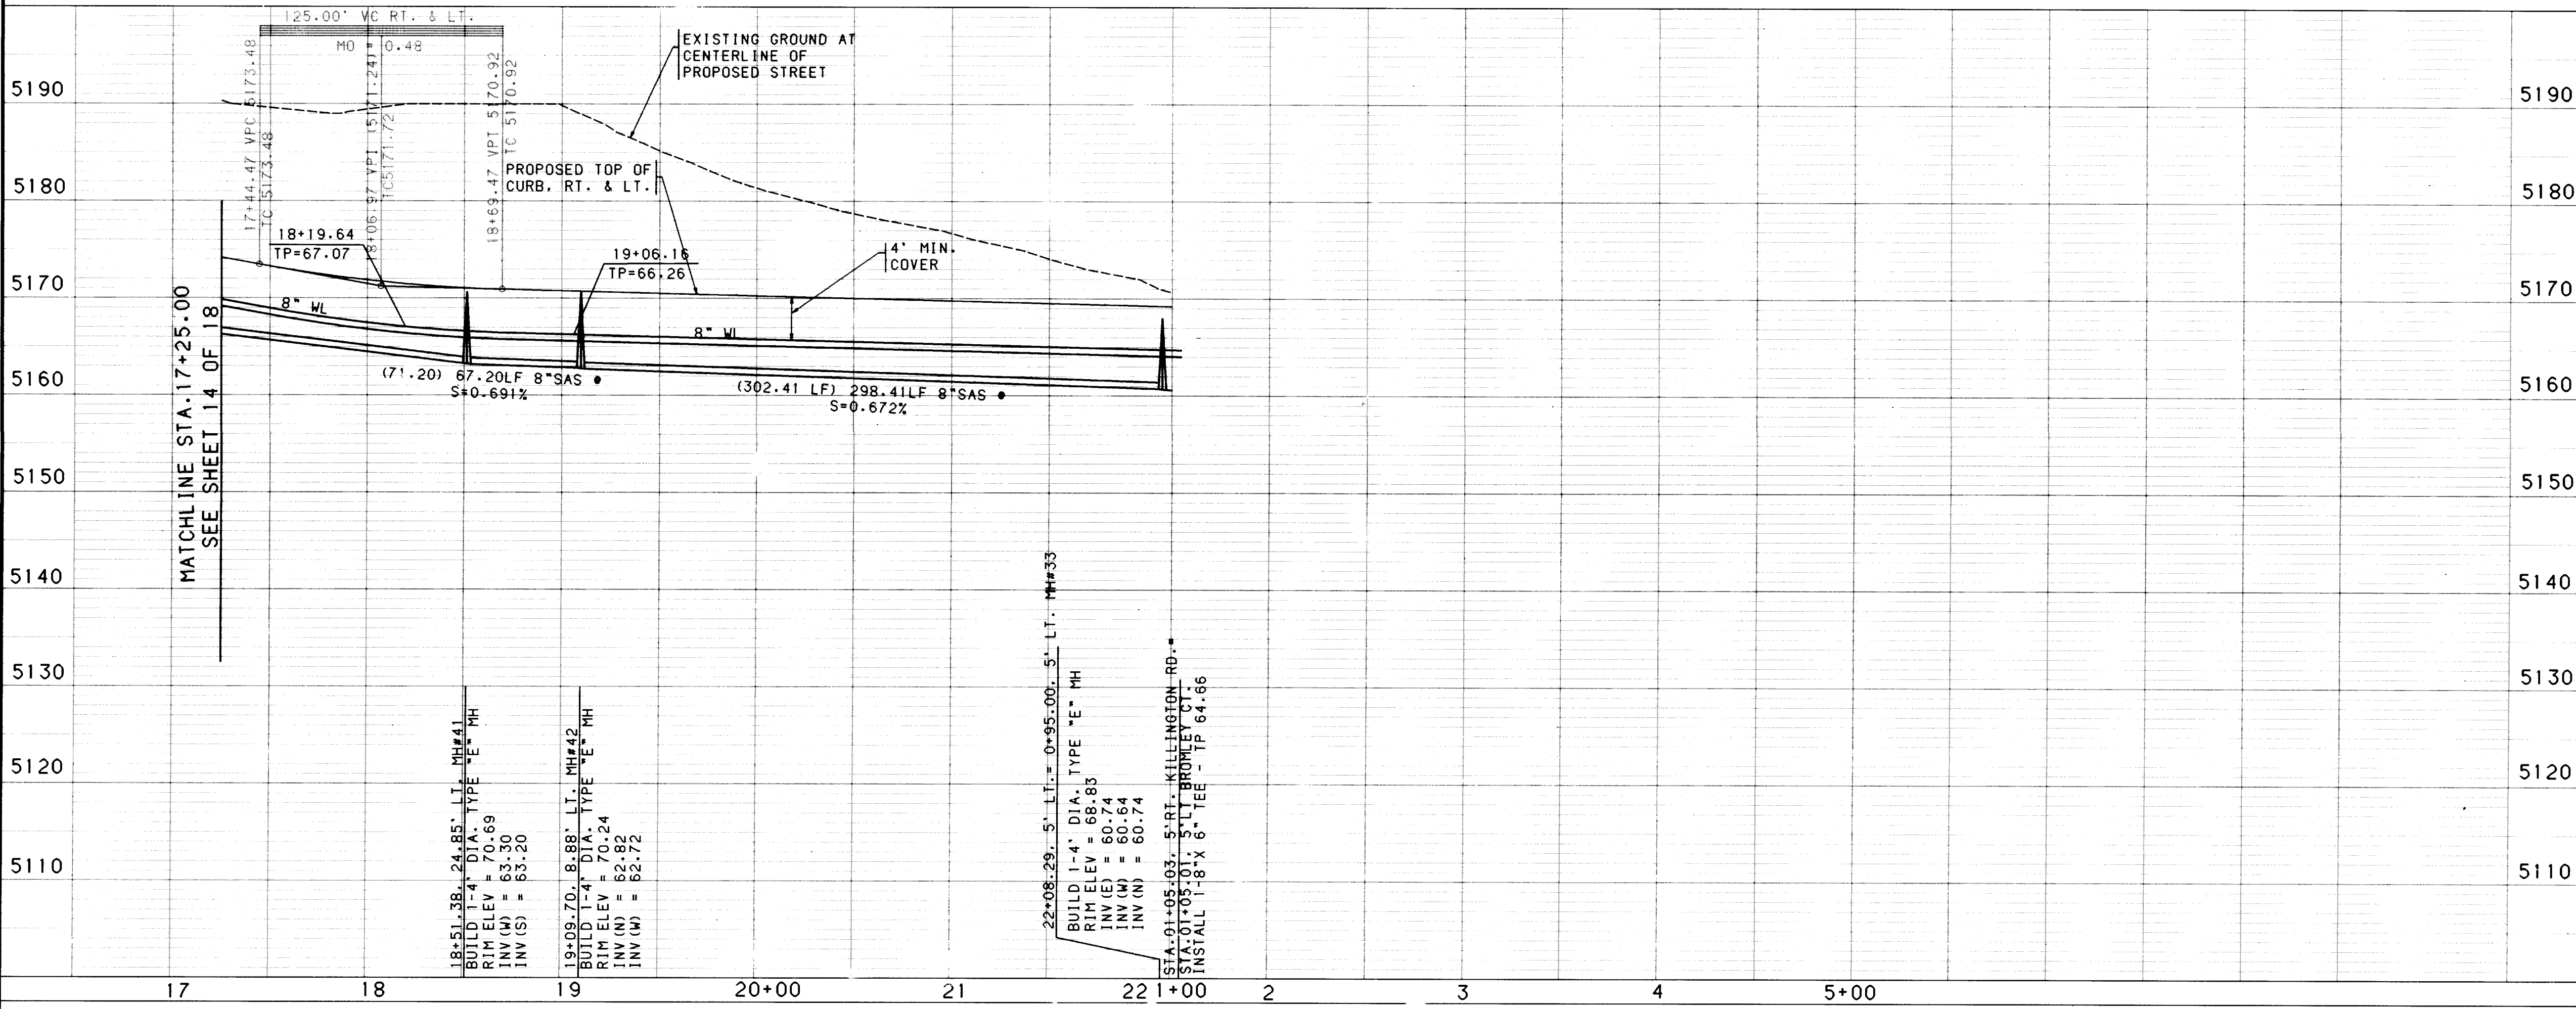

- NOTES**
1. THE CONTRACTOR SHALL FIELD VERIFY ALL EXISTING UTILITY LOCATIONS AND NOTIFY THE ENGINEER IMMEDIATELY OF ANY DISCREPANCIES.
 2. ALL CURB RETURN RADII SHALL BE 25' TO FACE OF CURB UNLESS OTHERWISE SPECIFIED.
 3. ALL CURVE DATA AND DIMENSIONS REFER TO FACE OF CURB UNLESS OTHERWISE SPECIFIED.
 4. GRADE ELEVATIONS, WHERE NOTED, ARE FOR TOP OF CURB UNLESS OTHERWISE SPECIFIED.
 5. CONTRACTOR IS TO INSTALL A 4"x4"x5' POST AND END AT THE END OF EACH SANITARY SEWER SERVICE.
 6. CONTRACTOR IS RESPONSIBLE FOR REPAIR AND/OR REPLACEMENT OF ALL UTILITY CONDUITS AND EXISTING LINES.
 7. ANY ADDITIONAL GRADING REQUIRED TO MATCH PROPOSED STREET GRADES SHALL BE INCIDENTAL TO PAVING ITEMS.
 8. CONTRACTOR SHALL PROVIDE THE INSPECTORS, (CITY AND PRIVATE) WITH THE PROPOSED HYDROSTATIC TESTING PLAN. THE PLAN MUST BE APPROVED BEFORE TESTING OPERATIONS BEGIN.
 9. CONTRACTOR SHALL PARK EQUIPMENT AND VEHICLES AS NOT TO INTERFERE WITH NORMAL ACTIVITIES OF RESIDENTS OR OTHER CONTRACTORS ON SITE.
 10. ANY DAMAGE TO THE EXISTING FACILITIES (CURB AND GUTTER, PAVEMENT, CONDUITS, LANDSCAPING, UTILITY LINES, ETC.) DURING CONSTRUCTION SHALL BE REPLACED AT THE CONTRACTORS EXPENSE.
 11. REMOVAL OF THE EXISTING CURB AND GUTTER SHALL BE AS PER COA STD. DWG. 2415 (SAWCUT ONLY).
 12. WHEEL CHAIR RAMPS SHALL BE CONSTRUCTED PRIOR TO ACCEPTANCE OF CURB AND GUTTER.

AS-BUILT INFORMATION		BENCH MARKS		FIELD NOTES	
CONTRACTOR	DATE	BM NO.	DATE	NO.	BY
BY: <i>ALS, INC.</i>	DATE: <i>7/94</i>	CHI SECT "X" LOCATED APPROXIMATELY 450 FEET SOUTH OF THE BLACK'S DIVERSION INLET STRUCTURE ON THE EAST WALL. ELEV. 5110.55			
ENGINEER'S SEAL	NO.	REMARKS	BY	NO.	DATE
		DESIGN	JCA		6/95
		OR . JAO . BS			6/95
		CHECKED BY	JRT		6/95





**CITY OF ALBUQUERQUE
PUBLIC WORKS DEPARTMENT
ENGINEERING**


**STOWE AT SEVEN BAR NORTH
UTILITY PLAN & PROFILE
KILLINGTON ROAD**

APPROVALS	ENGINEER	DATE	APPROVALS	ENGINEER	DATE
DRG CHAIRMAN	<i>R. R. Amador</i>	2-6-96	WATER		
TRANSPORTATION	<i>N. H. Galt</i>	8-23-95	WASTE WATER	<i>N. H. Galt</i>	8/23/95
HYDROLOGY	<i>W. J. Galt</i>	8-12-95			
NMUI	<i>W. J. Galt</i>	8-12-95			

DRAWING NO. 4982.94 MAP NO. A-13 SHEET 15 OF 18

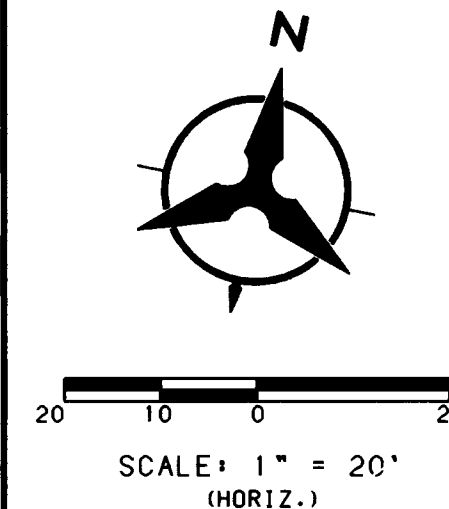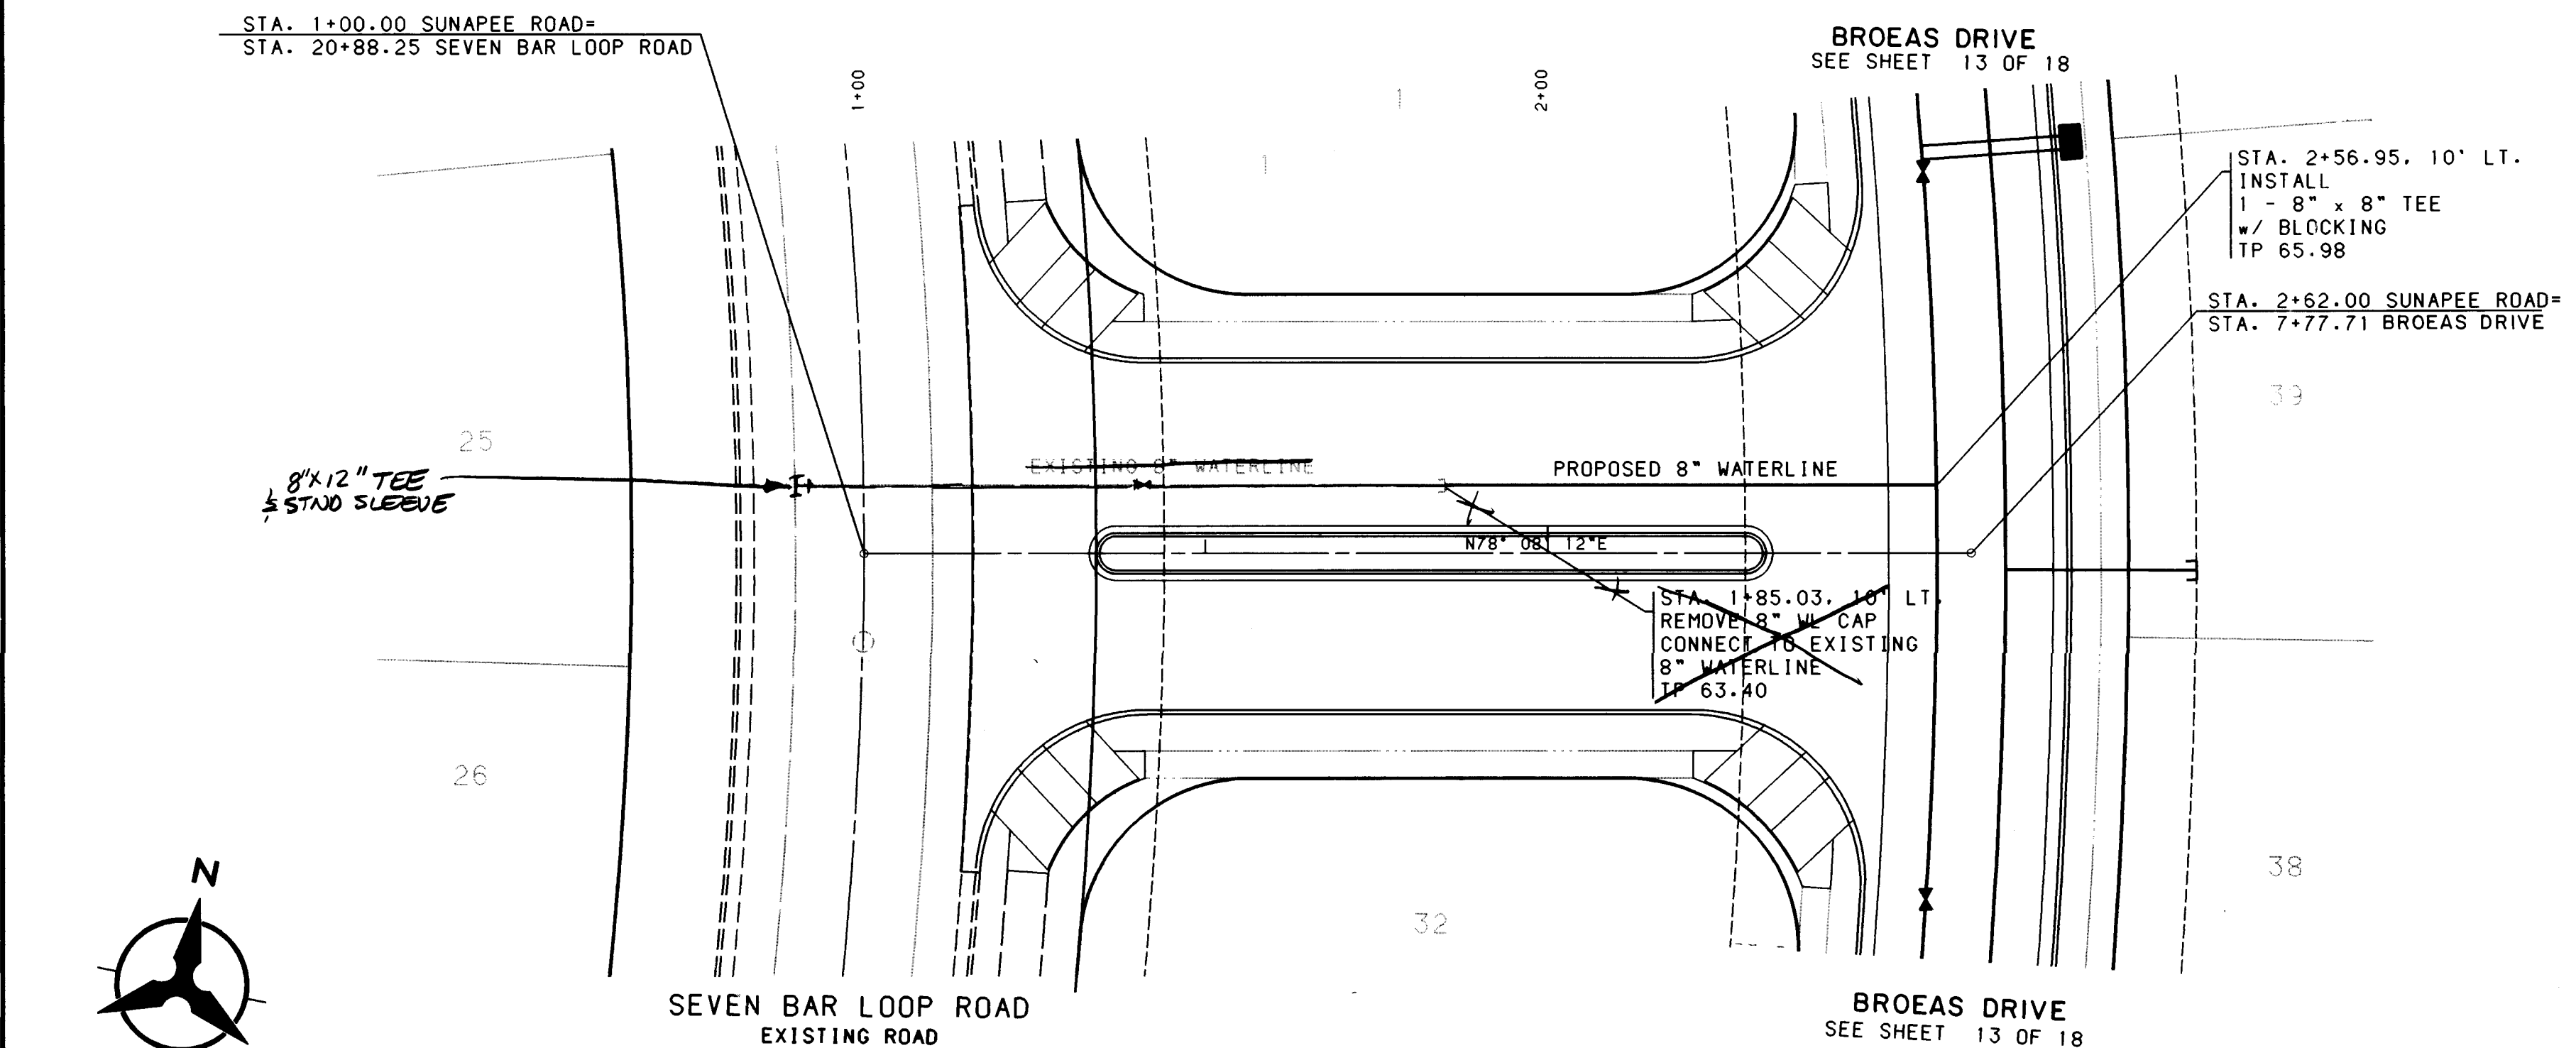

SUNAPEE ROAD

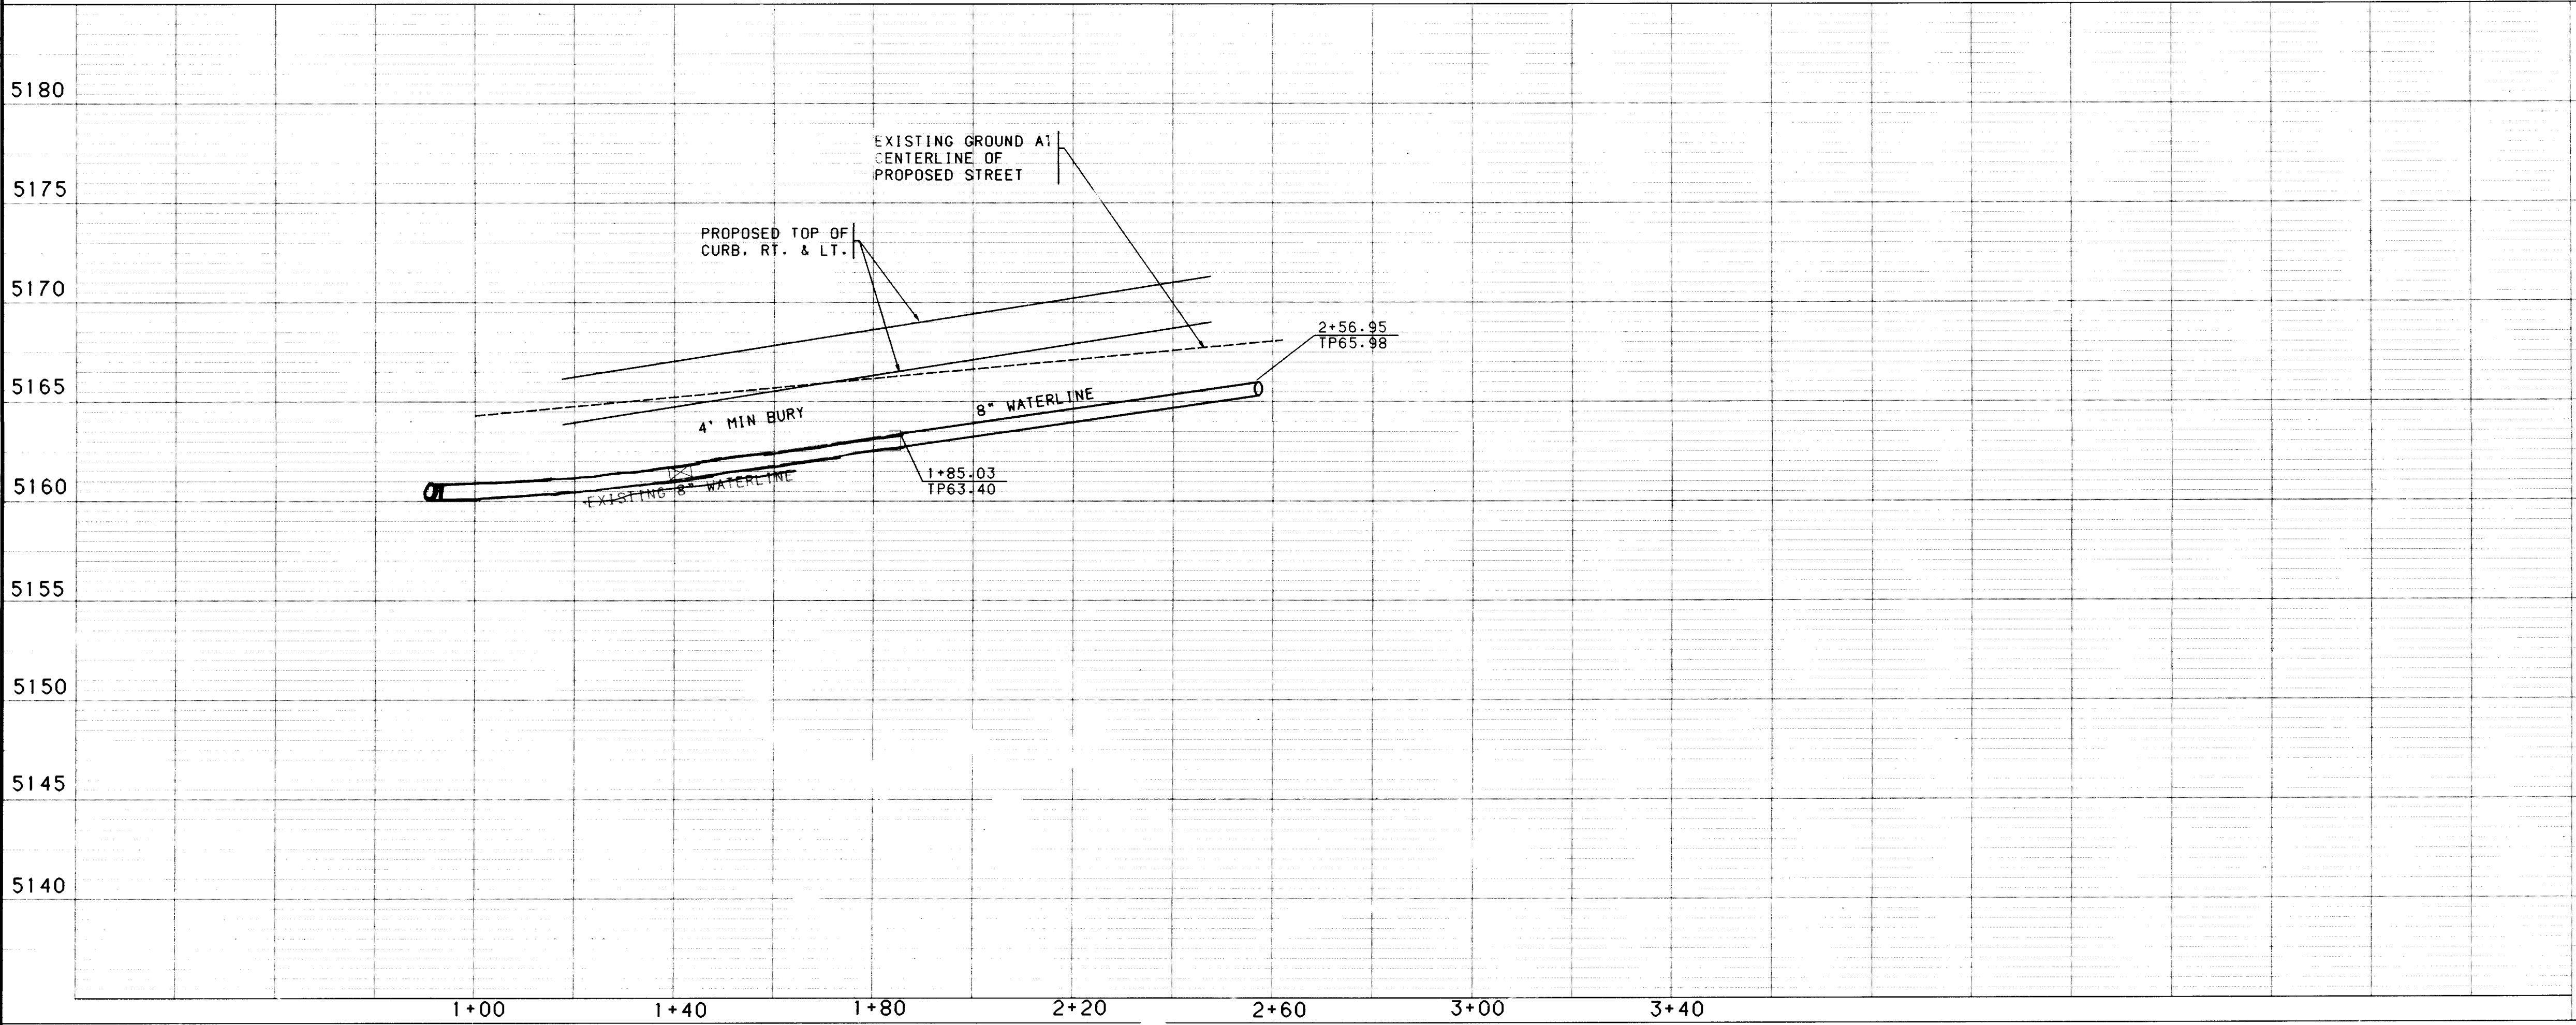

NOTES

1. THE CONTRACTOR SHALL FIELD VERIFY ALL EXISTING UTILITY LOCATIONS AND NOTIFY THE ENGINEER IMMEDIATELY OF ANY DISCREPANCIES.
2. ALL CURB RETURN RADII SHALL BE 25' TO FACE OF CURB UNLESS OTHERWISE SPECIFIED.
3. ALL CURVE DATA AND DIMENSIONS ARE FOR TOP OF CURB UNLESS OTHERWISE SPECIFIED.
4. GRADE ELEVATIONS, WHERE NOTED, ARE FOR TOP OF CURB UNLESS OTHERWISE SPECIFIED.
5. CONTRACTOR IS TO INSTALL A 4"x4"x5' POST AND END AT THE END OF EACH SANITARY SEWER SERVICE.
6. CONTRACTOR IS RESPONSIBLE FOR REPAIR AND/OR REPLACEMENT OF ALL UTILITY CONDUITS AND EXISTING LINES.
7. ANY ADDITIONAL GRADING REQUIRED TO MATCH PROPOSED STREET GRADES SHALL BE INCIDENTAL TO PAVING ITEMS.
8. CONTRACTOR SHALL PROVIDE THE INSPECTORS, (CITY AND PRIVATE) WITH THE PROPOSED HYDROSTATIC TESTING PLAN. THE PLAN MUST BE APPROVED BEFORE TESTING OPERATIONS BEGIN.
9. CONTRACTOR SHALL PARK EQUIPMENT AND VEHICLES AS NOT TO INTERFERE WITH NORMAL ACTIVITIES OF RESIDENTS OR OTHER CONTRACTORS ON SITE.
10. ANY DAMAGE TO THE EXISTING FACILITIES (CURB AND GUTTER, PAVEMENT, CONDUITS, LANDSCAPING, UTILITY LINES, ETC.) DURING CONSTRUCTION SHALL BE REPLACED AT THE CONTRACTORS EXPENSE.
11. REMOVAL OF THE EXISTING CURB AND GUTTER SHALL BE AS PER COA STD. DWG. 2415 (SAMCUT ONLY).
12. WHEEL CHAIR RAMPS SHALL BE CONSTRUCTED PRIOR TO ACCEPTANCE OF CURB AND GUTTER.

AS-BUILT INFORMATION

CONTRACTOR: *SUNAPEE NECH.*
STAKED BY: *ALB, INC.*
DATE: *7/95*

BENCH MARKS

BM NO. 205
CHISLED "X" LOCATED APPROXIMATELY 459 FEET SOUTH OF THE BLACK'S DIVERSION INLET STRUCTURE ON THE EAST WALL.
ELEV. 5110.55

ENGINEER'S SEAL

NO. DATE BY
REMARKS
DESIGN

DESIGNED BY: JCA
DRAWN BY: DR. BS
CHECKED BY: JRT



DATE: 7/95
DATE: 7/95
DATE: 7/95

**CITY OF ALBUQUERQUE
PUBLIC WORKS DEPARTMENT
ENGINEERING**

**STOWE AT SEVEN BAR NORTH
UTILITY PLAN & PROFILE
SUNAPEE ROAD**



APPROVALS	ENGINEER	DATE	APPROVALS	ENGINEER	DATE
DRC CHAIRMAN	<i>[Signature]</i>	2-6-96	WATER		
TRANSPORTATION	<i>[Signature]</i>	8-23-95	WASTE WATER	<i>[Signature]</i>	8/23/95
HYDROLOGY	<i>[Signature]</i>	8-12-95			
NHUI	<i>[Signature]</i>	8-15-95			

DRAWING NO. 4982.94 MAP NO. A-13 SHEET 16 OF 18

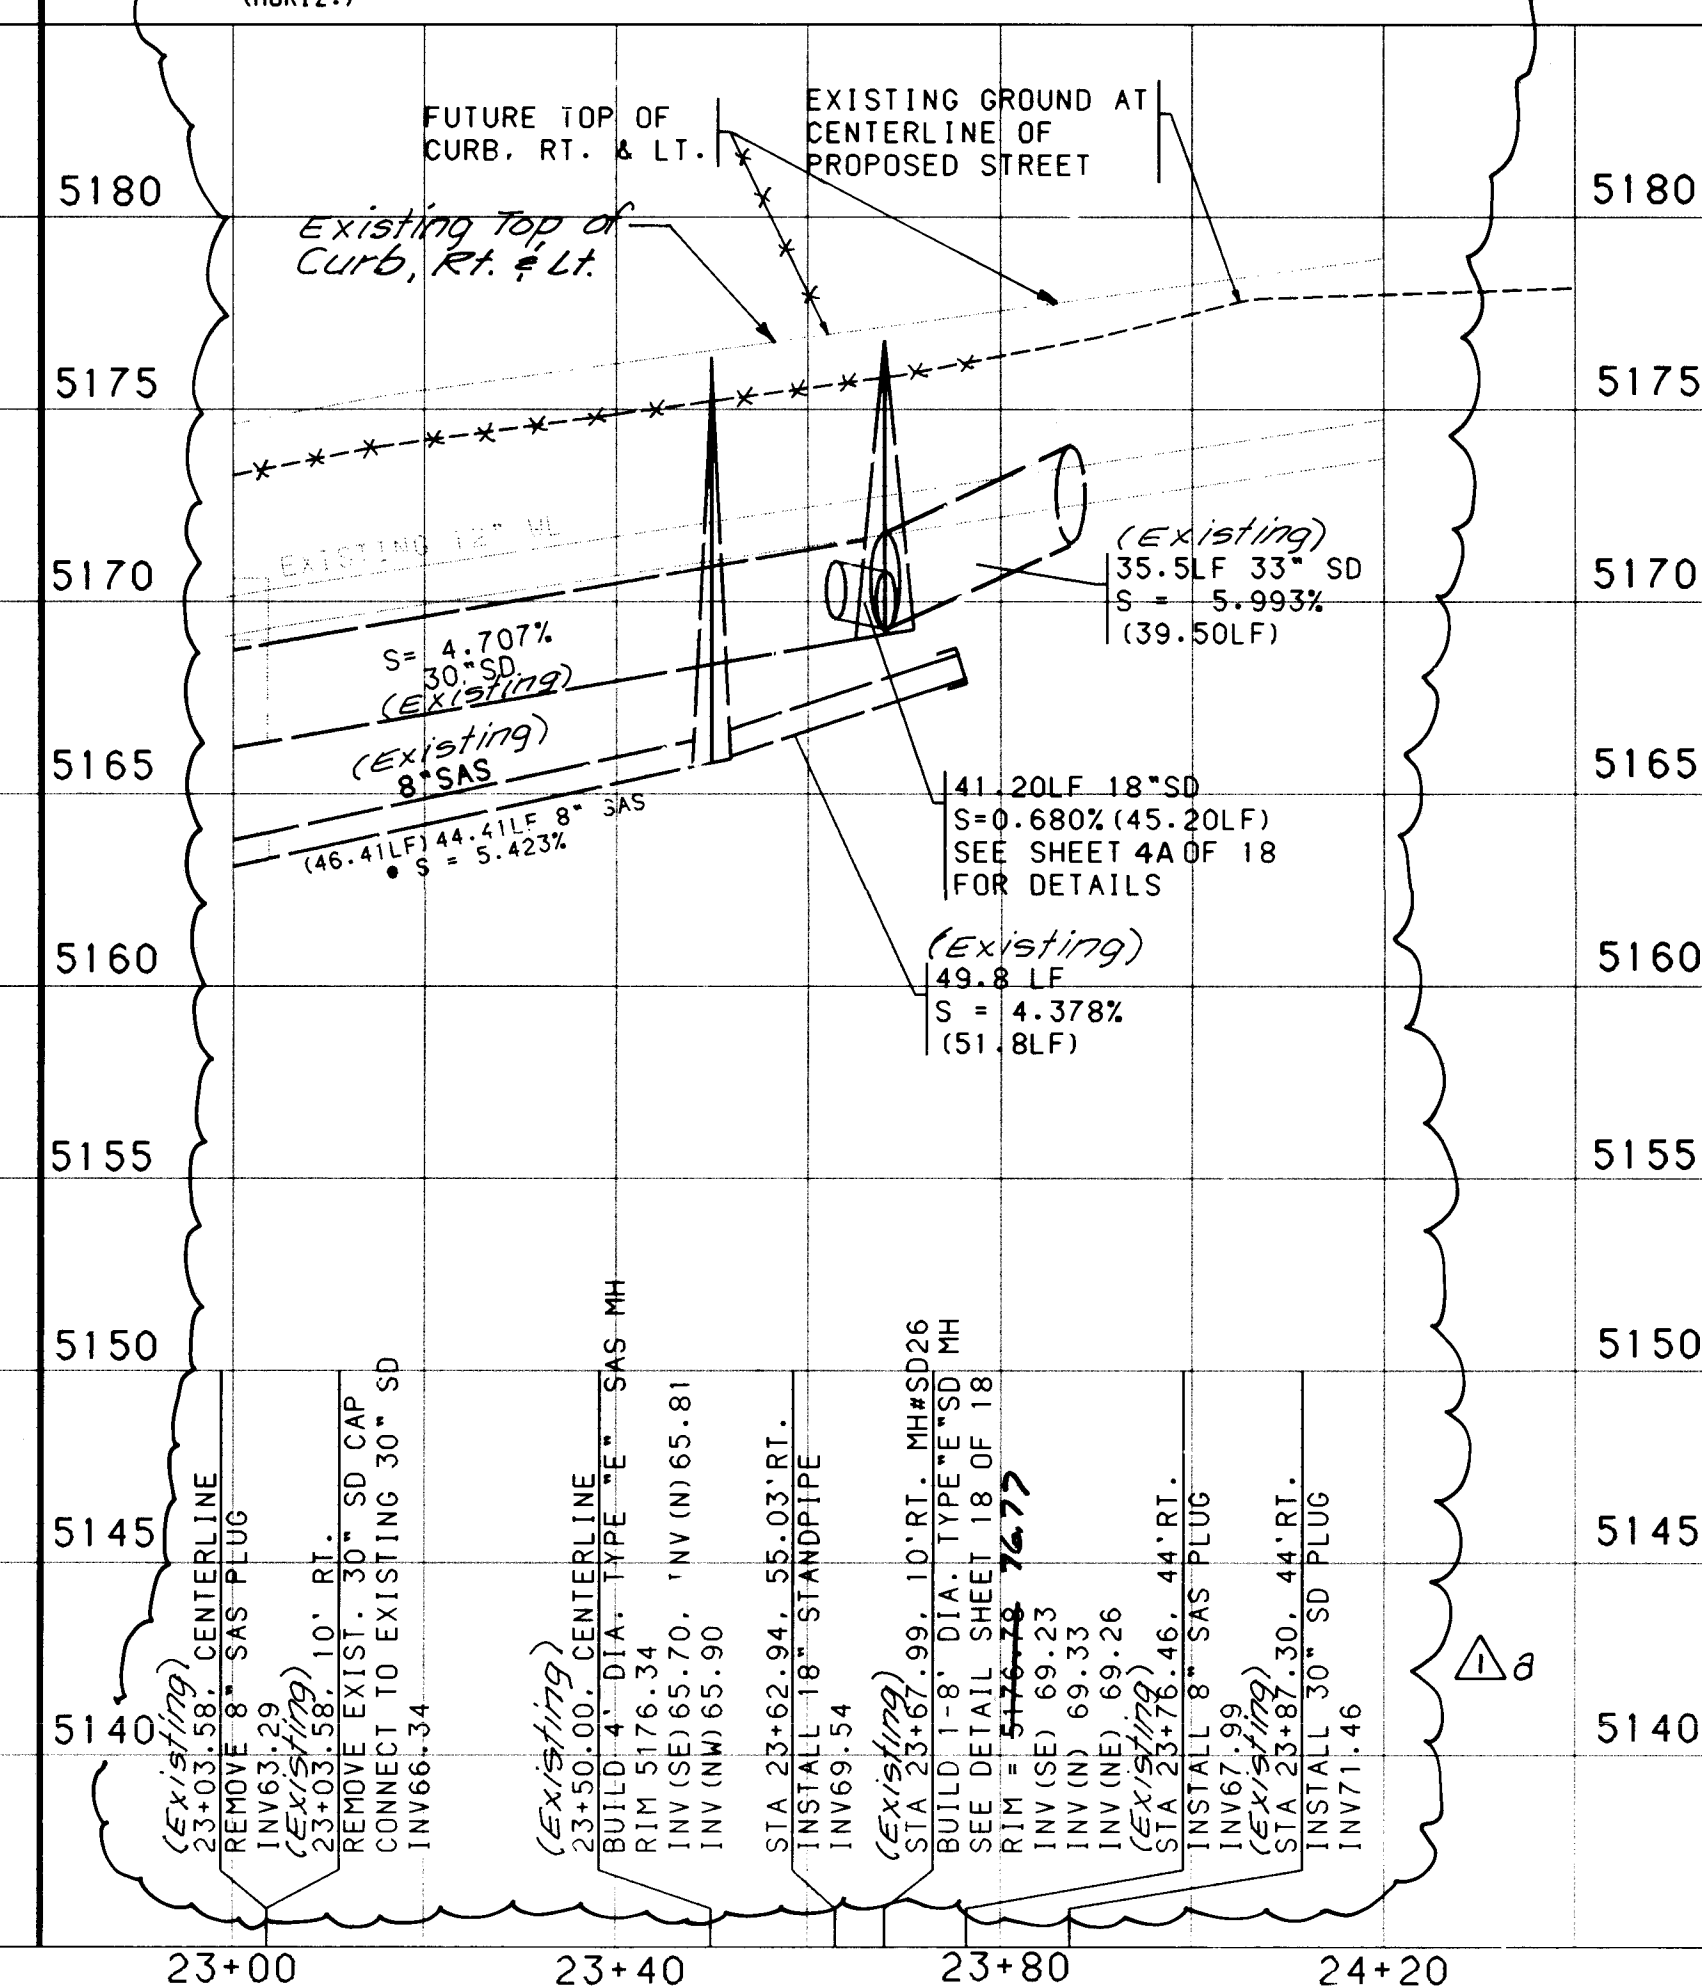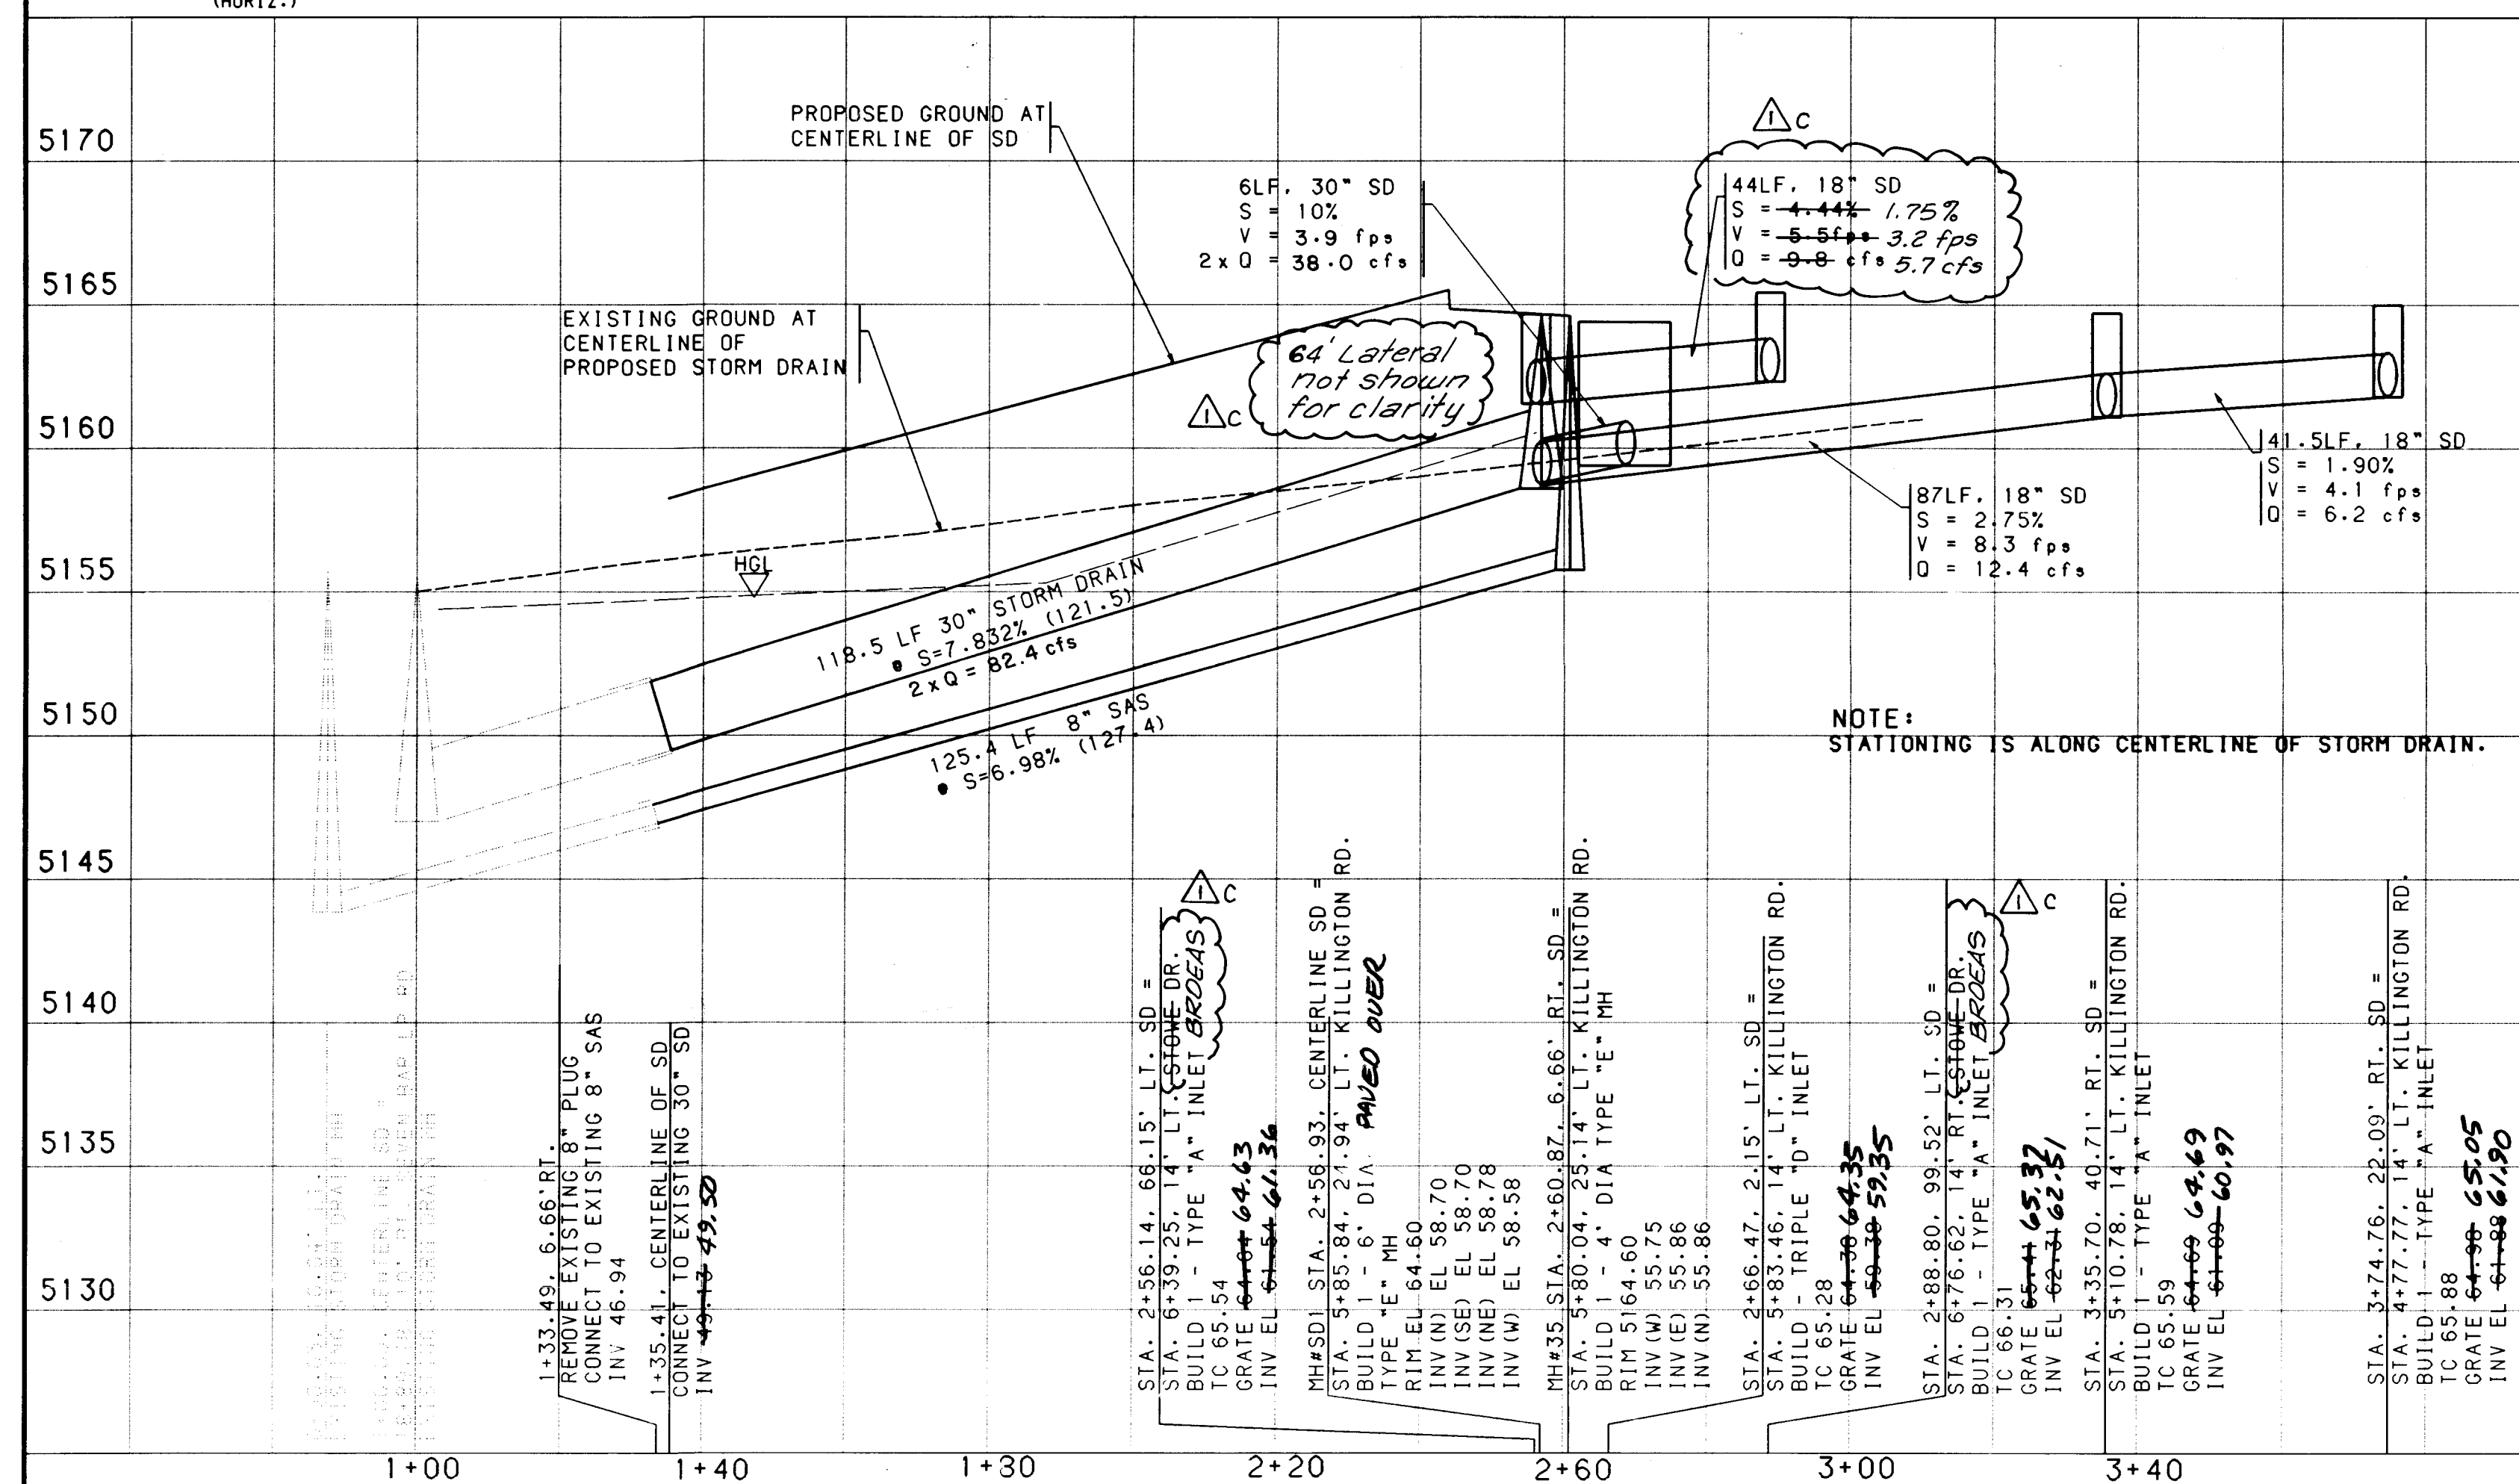


- | | 6 | 7 | 8 | 9 | 10 | 11 | 12 | 13 | 14 | 15 |
|-----|-------|---|-------|---|----|----|----|----|----|----|
| 25. | 99.82 | - | 99.91 | I | 79 | C | | | | |

		CITY OF ALBUQUERQUE PUBLIC WORKS DEPARTMENT ENGINEERING					
STOWE AT SEVEN BAR NORTH STORM DRAIN PLAN & PROFILE							
APPROVALS	ENGINEER	DATE	APPROVALS	ENGINEER	DATE		
DRC CHAIRMAN	<i>PS</i>	2-6-96	WATER				
TRANSPORTATION	<i>PS</i>	5-23-95	WASTE WATER	<i>NIA</i>	3/23/95		
HYDROLOGY	<i>PS</i>	9-12-95					
N.M.U.I.	<i>PS</i>	8-15-95					
DRAWING NO.	4982-94	MAP NO.	A-13	SHEET	17	OF	18
Copyright Bohannan-Huston, Inc. 1994 DATE: JUNE 1, 1995							

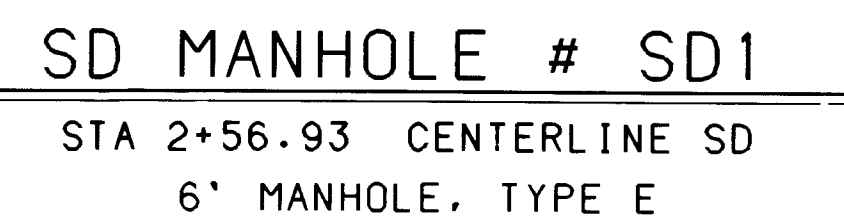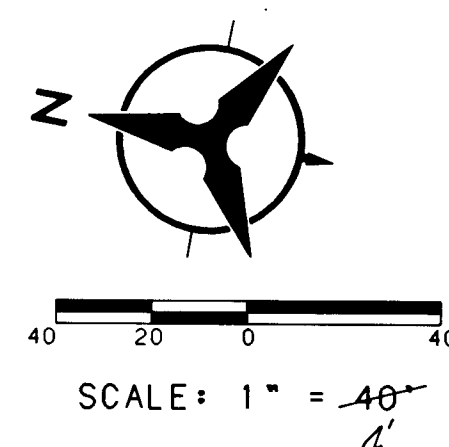

NO SCALE

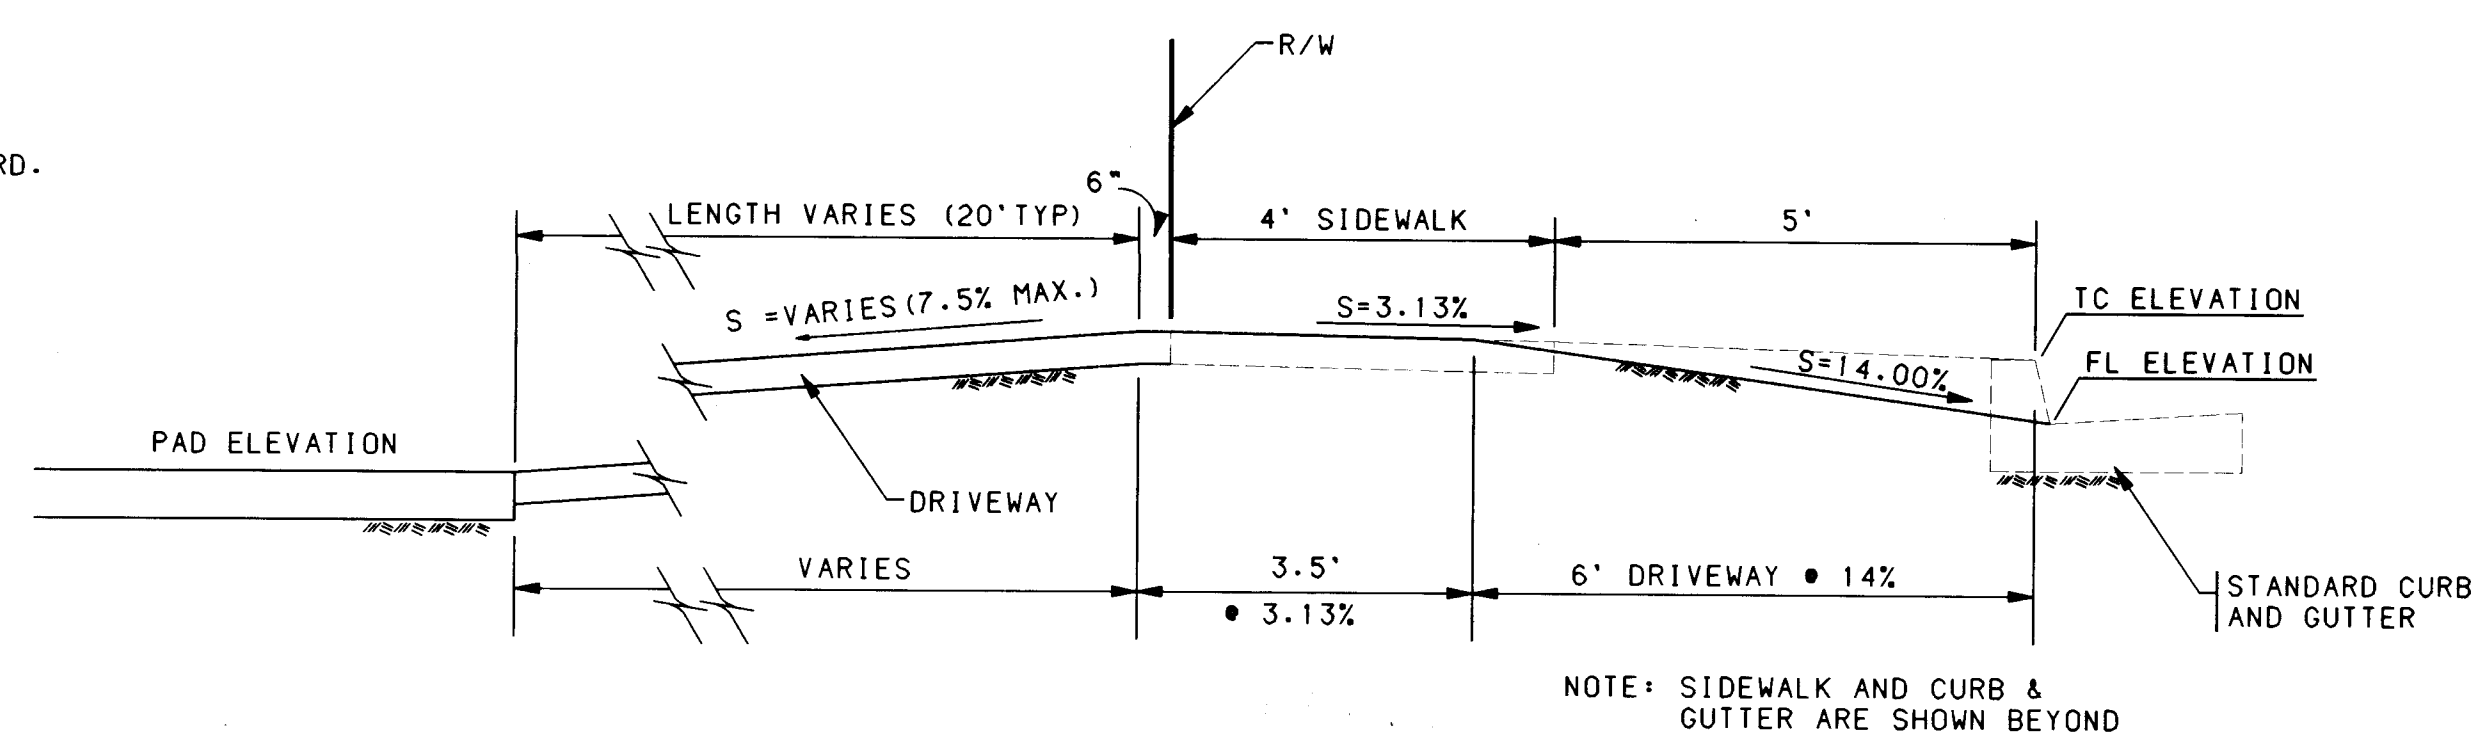

TYPICAL WATER BLOCK DRIVEWAY

FOR LOTS 1, 31, & 32

SCALE = 1' = 2'-0"

- A. FRAME & GRATE
- B. CENTER SUPPORT ASSEMBLY.
- C. CUT ONE HORIZONTAL AND ONE VERTICAL BAR MAX. AT PIPE OPENING.
- D. NO.4 BARS AT 6" O.C. EACH WAY.
- E. USE STANDARD STEPS. SEE DWG.2229.
- F. CONC. FILL. SEE NOTE C. DWG. 2201
- G. INVERT PER DESIGN
- H. INSTALL STEPS ON DOWNSTREAM FACE.

AS REVISED FOR
TRIPLE GRATE TYPE "D" INLET

REVISIONS	DRAINAGE STORM INLET TYPE "D" PLAN AND SECTION A-A
-----------	--

ENGINEER'S SEAL		SURVEY INFORMATION		BENCH MARKS		AS-BUILT INFORMATION	
 James A. Smith 7/7/95		FIELD NOTES					
		NO.	BY DATE				
				TBM NO. 205		CONTRACTOR <i>SUNDANCE MECH</i>	
				CHISEL "X" LOCATED APPROXIMATELY 459 FEET		WORKED BY <i>ALS, INC</i>	
				SOUTH OF THE BLACK'S DIVERSION INLET		INSPECTOR'S ACCEPTANCE BY <i>BS+I</i> DATE <i>7/19/96</i>	
				STRUCTURE ON THE EAST WALL.		FIELD GATION BY <i>ALS, INC</i> DATE <i>9/6/96</i>	
				ELEV. 5110.55		DRAWINGS CORRECTED BY <i>ALS, INC</i> DATE <i>9/19/96</i>	
						MICRO-FILM INFORMATION	
						RECORDED BY _____ DATE _____	
						NO. _____	

7/7/95

DESIGNED BY	JCA	DATE	7-95
DRAWN BY	OR	DATE	7-95
CHECKED BY		DATE	7-95
DESIGN			
REVISONS			
NO.	DATE	REMARKS	BY
Δ 1	2-20-95	Eliminated Detail	JCA

		CITY OF ALBUQUERQUE PUBLIC WORKS DEPARTMENT ENGINEERING GROUP					
STOWE AT SEVEN BAR NORTH MISC. DETAILS							
APPROVALS	ENGINEER	DATE	APPROVALS	ENGINEER	DATE		
DRC CHAIRMAN	<i>B.G. Bradley</i>	<i>2-6-96</i>	WATER				
TRANSPORTATION	<i>W.A. RHO</i>	<i>8-23-95</i>	WASTE WATER	<i>W.A. RHO</i>	<i>8/23/95</i>		
HYDROLOGY	<i>JAC</i>	<i>9-12-95</i>					
DRAWING NO.		MAP NO.		SHEET		OF	
4982.94		A-13		18		18	

