


GRACE CHURCH


TRACT CDS-1A, BLK. 20, UNIT A
NORTH ALBUQUERQUE ACRES
ALBUQUERQUE, NEW MEXICO
OCTOBER 1994

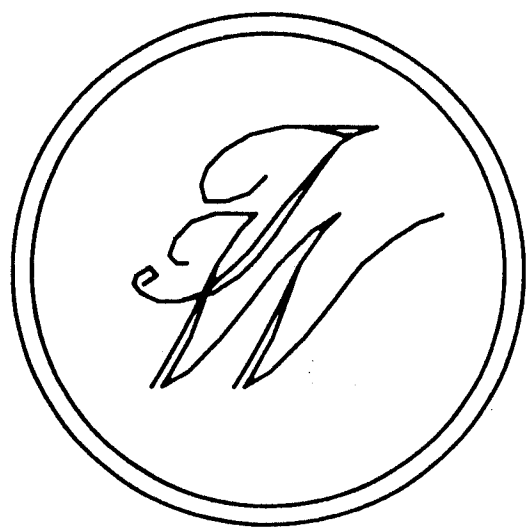

INDEX TO DRAWINGS


- 01 TITLE SHEET, VICINITY MAP, NOTES
- 02 SANITARY SEWER PLAN AND PROFILE
STA. 1+00 - STA. 11+54.11
- 03 SANITARY SEWER PLAN AND PROFILE
STA. 11+54.11 - STA. 17+74.95
PARTIAL SITE PLAN (FIRE HYDRANT)
- 04 MASTER UTILITY PLAN, PHASE I

1 2 3 4 5 6 7 8 9 10 11 12 13 14 15
24 5007.900173

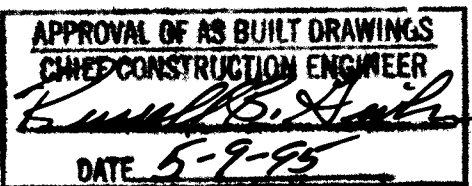

PROJECT NO. 5009.90

SCANNED BY
BY LASON

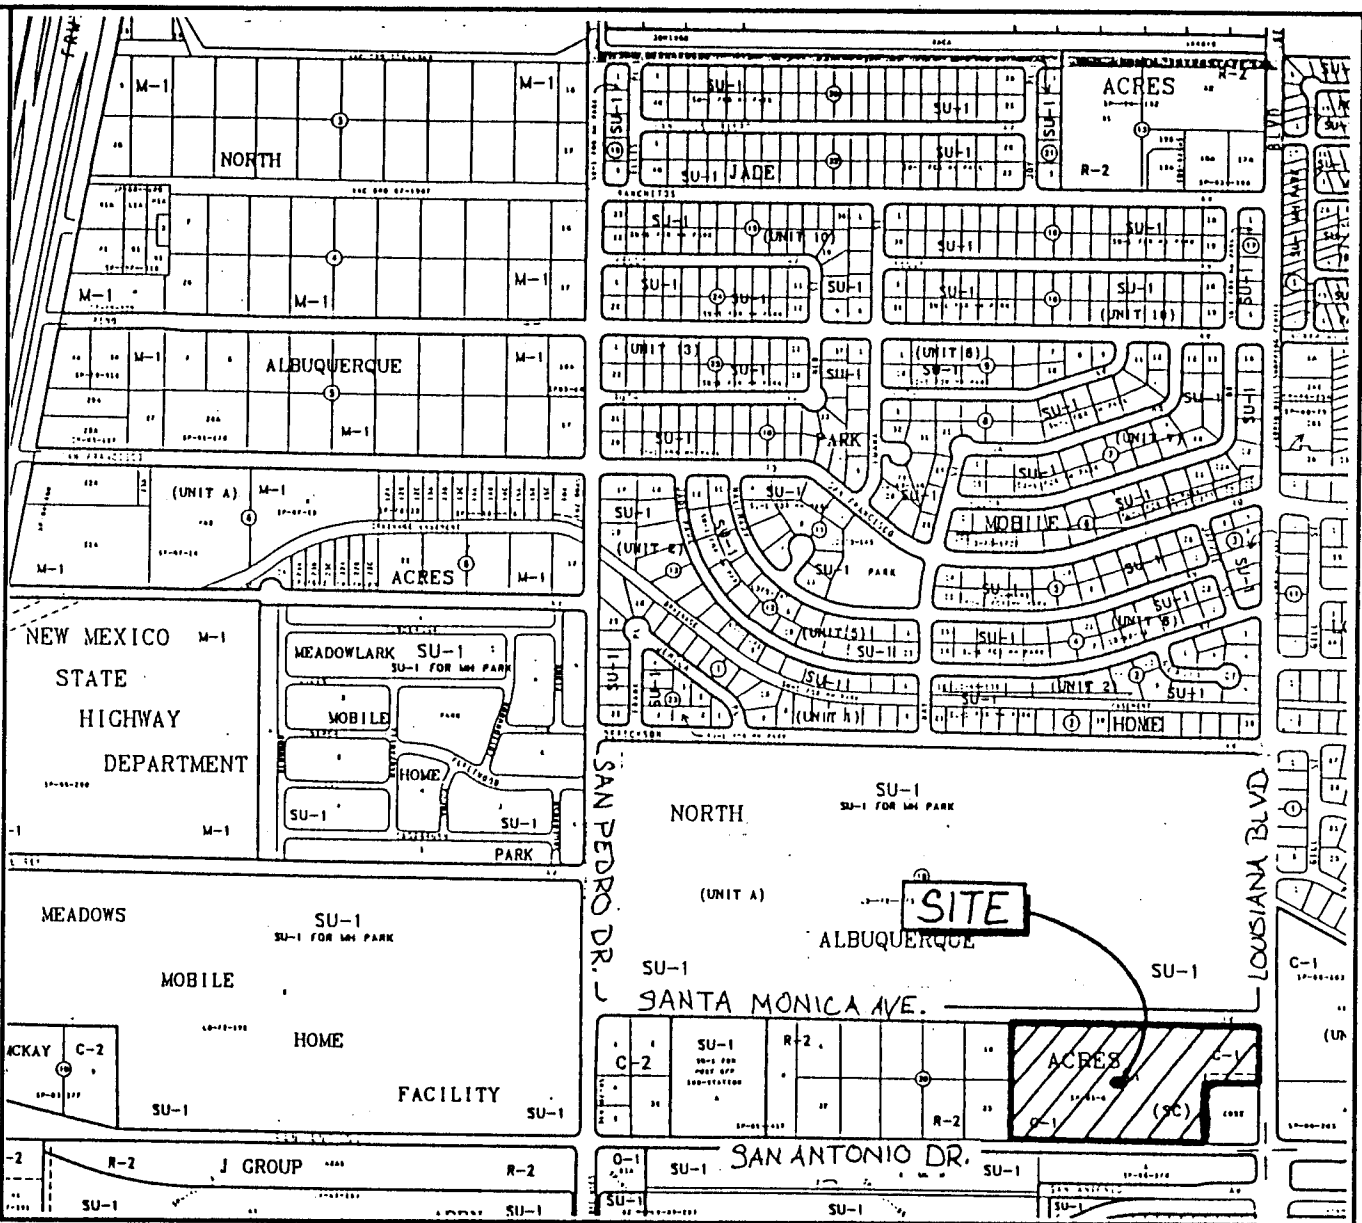

VICINITY MAP ZONE ATLAS D-18
SCALE NONE





NOTICE TO CONTRACTORS:

- ALL WORK DETAILED ON THESE PLANS TO BE PERFORMED UNDER CONTRACT SHALL, EXCEPT AS OTHERWISE STATED OR PROVIDED FOR HEREON, BE CONSTRUCTED IN ACCORDANCE WITH THE CITY OF ALBUQUERQUE STANDARD SPECIFICATIONS FOR PUBLIC WORKS CONSTRUCTION, 1986 EDITION (UPDATE#5).
- TWO WORKING DAYS PRIOR TO ANY EXCAVATION, THE CONTRACTOR MUST CONTACT NEW MEXICO ONE CALLS SYSTEM (260-1990) FOR LOCATION OF EXISTING UTILITIES.
- PRIOR TO CONSTRUCTION, THE CONTRACTOR SHALL EXCAVATE AND VERIFY THE HORIZONTAL AND VERTICAL LOCATIONS OF ALL OBSTRUCTIONS. SHOULD A CONFLICT EXIST, THE CONTRACTOR SHALL NOTIFY THE ENGINEER OR SURVEYOR IMMEDIATELY SO THAT THE CONFLICT CAN BE RESOLVED WITH A MINIMUM AMOUNT OF DELAY.
- THREE(3) WORKING DAYS PRIOR TO BEGINNING OF CONSTRUCTION, THE CONTRACTOR SHALL SUBMIT TO CONSTRUCTION COORDINATIONS DIVISION A DETAILED CONSTRUCTION SCHEDULE. TWO(2) WORKING DAYS PRIOR TO CONSTRUCTION, THE CONTRACTOR SHALL OBTAIN A BARRICADING PERMIT FROM THE CONSTRUCTION COORDINATION DIVISION. CONTRACTOR SHALL NOTIFY BARRICADE ENGINEER (768-2551) PRIOR TO OCCUPYING AN INTERSECTION. REFER TO STANDARD SPECIFICATIONS.
- ALL STREET STRIPING ALTERED OR DESTROYED SHALL BE REPLACED IN KIND BY CONTRACTOR TO LOCATION AND IN KIND AS EXISTING OR AS INDICATED BY THIS PLAN SET.
- CONTRACTOR SHALL NOTIFY THE ENGINEER NOT LESS THAN SEVEN(7) DAYS PRIOR TO STARTING WORK IN ORDER THAT THE ENGINEER MAY TAKE NECESSARY MEASURES TO INSURE THE PRESERVATION OF SURVEY MONUMENTS. CONTRACTOR SHALL NOT DISTURB PERMANENT SURVEY MONUMENTS WITHOUT THE CONSENT OF THE ENGINEER AND SHALL NOTIFY THE ENGINEER AND BEAR THE EXPENSE OF REPLACING ANY THAT MAY BE DISTURBED WITHOUT PERMISSION. REPLACEMENT SHALL BE DONE ONLY BY THE CITY SURVEYOR. WHEN A CHANGE IS MADE IN THE FINISHED ELEVATIONS OF THE PAVEMENT OF ANY ROADWAY IN WHICH A PERMANENT SURVEY MONUMENT IS LOCATED, CONTRACTOR SHALL, AT HIS OWN EXPENSE, ADJUST THE MONUMENT COVER TO THE NEW GRADE UNLESS OTHERWISE SPECIFIED. REFER TO SECTION 4.4 OF THE GENERAL CONDITIONS OF THE STANDARD SPECIFICATIONS.


THE FOLLOWING NOTES ALSO APPLY WHEN CHECKED


- ☒ ALL UTILITIES AND UTILITY SERVICE LINES SHALL BE INSTALLED PRIOR TO PAVING.
- ☒ BACKFILL COMPACTION SHALL BE ACCORDING TO SPECIFIED STREET USE.
- ☐ TACK COAT REQUIREMENTS SHALL BE DETERMINED BY THE CITY ENGINEER.
- ☒ SIDEWALK AND DRIVEPAD CURBS WITHIN THE CURB RETURNS SHALL BE CONSTRUCTED WHENEVER A NEW CURB RETURN IS CONSTRUCTED.
- ☒ IF CURB IS DEPRESSED FOR A DRIVEPAD, THE DRIVEPAD SHALL BE CONSTRUCTED PRIOR TO ACCEPTANCE OF CURB AND GUTTER.
- ☒ ALL STORM DRAINAGE FACILITIES SHALL BE COMPLETED PRIOR TO FINAL ACCEPTANCE.

ENGINEER'S SEAL 	GRACE CHURCH ALBUQUERQUE, NEW MEXICO	DRAWN BY NB
	TITLE SHEET	DATE 10/05/94
	TIERRA WEST DEVELOPMENT MANAGEMENT SERVICES 4600 MONTGOMERY BLVD. N.E., SUITE 3 ALBUQUERQUE, NEW MEXICO 87109 (505)883-7592	9233T.DWG
		SHEET # 01 OF 4
		JOB # 920033

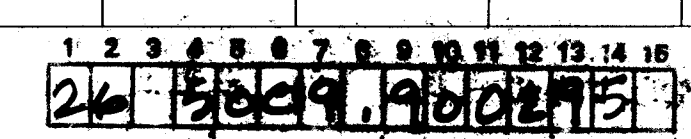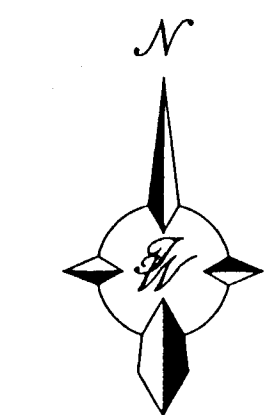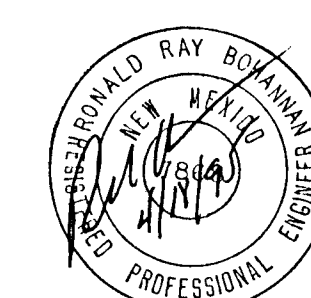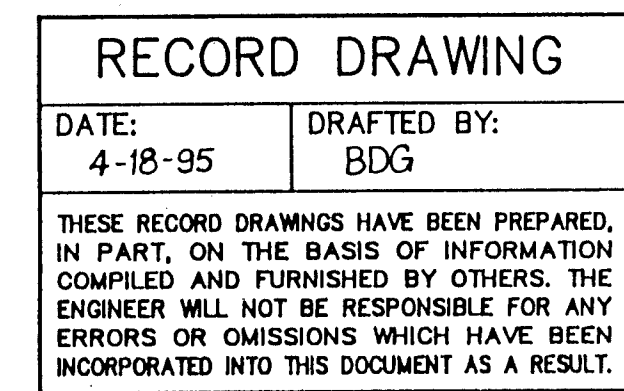


TIERRA WEST DEVELOPMENT MANAGEMENT SERVICES						NO.		DATE		DESIGNED BY		DRAWN BY		CHECKED BY	
4600 MONTGOMERY BLVD. N.E., SUITE 3 ALBUQUERQUE, NEW MEXICO 87109 (505)883-7592															
CITY OF ALBUQUERQUE PUBLIC WORKS DEPARTMENT ENGINEERING GROUP															
TITLE: GRACE CHURCH															
LOUISIANA BLVD. & SANTA MONICA AVE. N.E. ALBUQUERQUE, NM SANITARY SEWER PLAN AND PROFILE, STA. 1+00 - STA. 11+54.11															
APPROVALS		ENGINEER		DATE		APPROVALS		ENGINEER		DATE					
DRC CHAIRMAN		<i>Edith J. Smith</i>		11-8-94		WATER		<i>R.W. Kane</i>		10-18-94					
TRANSPORTATION		<i>R. Smith</i>		10-19-94		WASTE WATER		<i>R.W. Kane</i>		10-18-94					
HYDROLOGY		<i>7/2</i>		10-20-94											
PROJECT NO. 5009.90				MAP NO. D-18				SHEET 02							

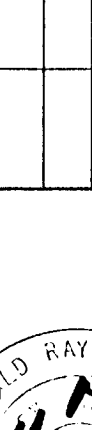ENGINEER'S SEAL										SURVEY INFORMATION										BENCH MARKS										AS BUILT INFORMATION									
										FIELD NOTES										ACS MONUMENT *10-D18* THE STATION IS LOCATED 7.4 MILES NORTHEAST OF THE INTERSECTION OF JADE PARK AVE. N.E. AND LOUISIANA BLVD. N.E. TO REACH THE STATION FROM THE INTERCHANGE AT I-40 AND LOUISIANA BLVD., GO NORTH ON LOUISIANA, 4.7 MILES TO THE INTERCHANGE. THE STATION MARK IS A STANDARD ACS BRASS TABLET STAMPED *10-D18 1978* SET IN TOP OF A CONCRETE POST FLUSH WITH GROUND. ELEVATION 5319.15																			
										NO.		BY		DATE																									
NO.		DATE		REMARKS						BY		DESIGN																											
NO.		DATE		REVISIONS						BY																													
NO.		DATE		DESIGN						BY																													
NO.		DATE		DESIGN						BY																													
DESIGNED BY RRB										DATE 7/14/94																													
DRAWN BY NB										DATE 7/14/94																													
CHECKED BY RRB										DATE 7/15/94																													
N.E. ALBUQUERQUE, NM STA. 11+00 - STA. 11+54.11																																							
SURVEYOR										ENGINEER										DATE																			
R.W. Kane										R.W. Kane										10-18-94																			
WATER										R.W. Kane										10-18-94																			
18										SHEET										02																			

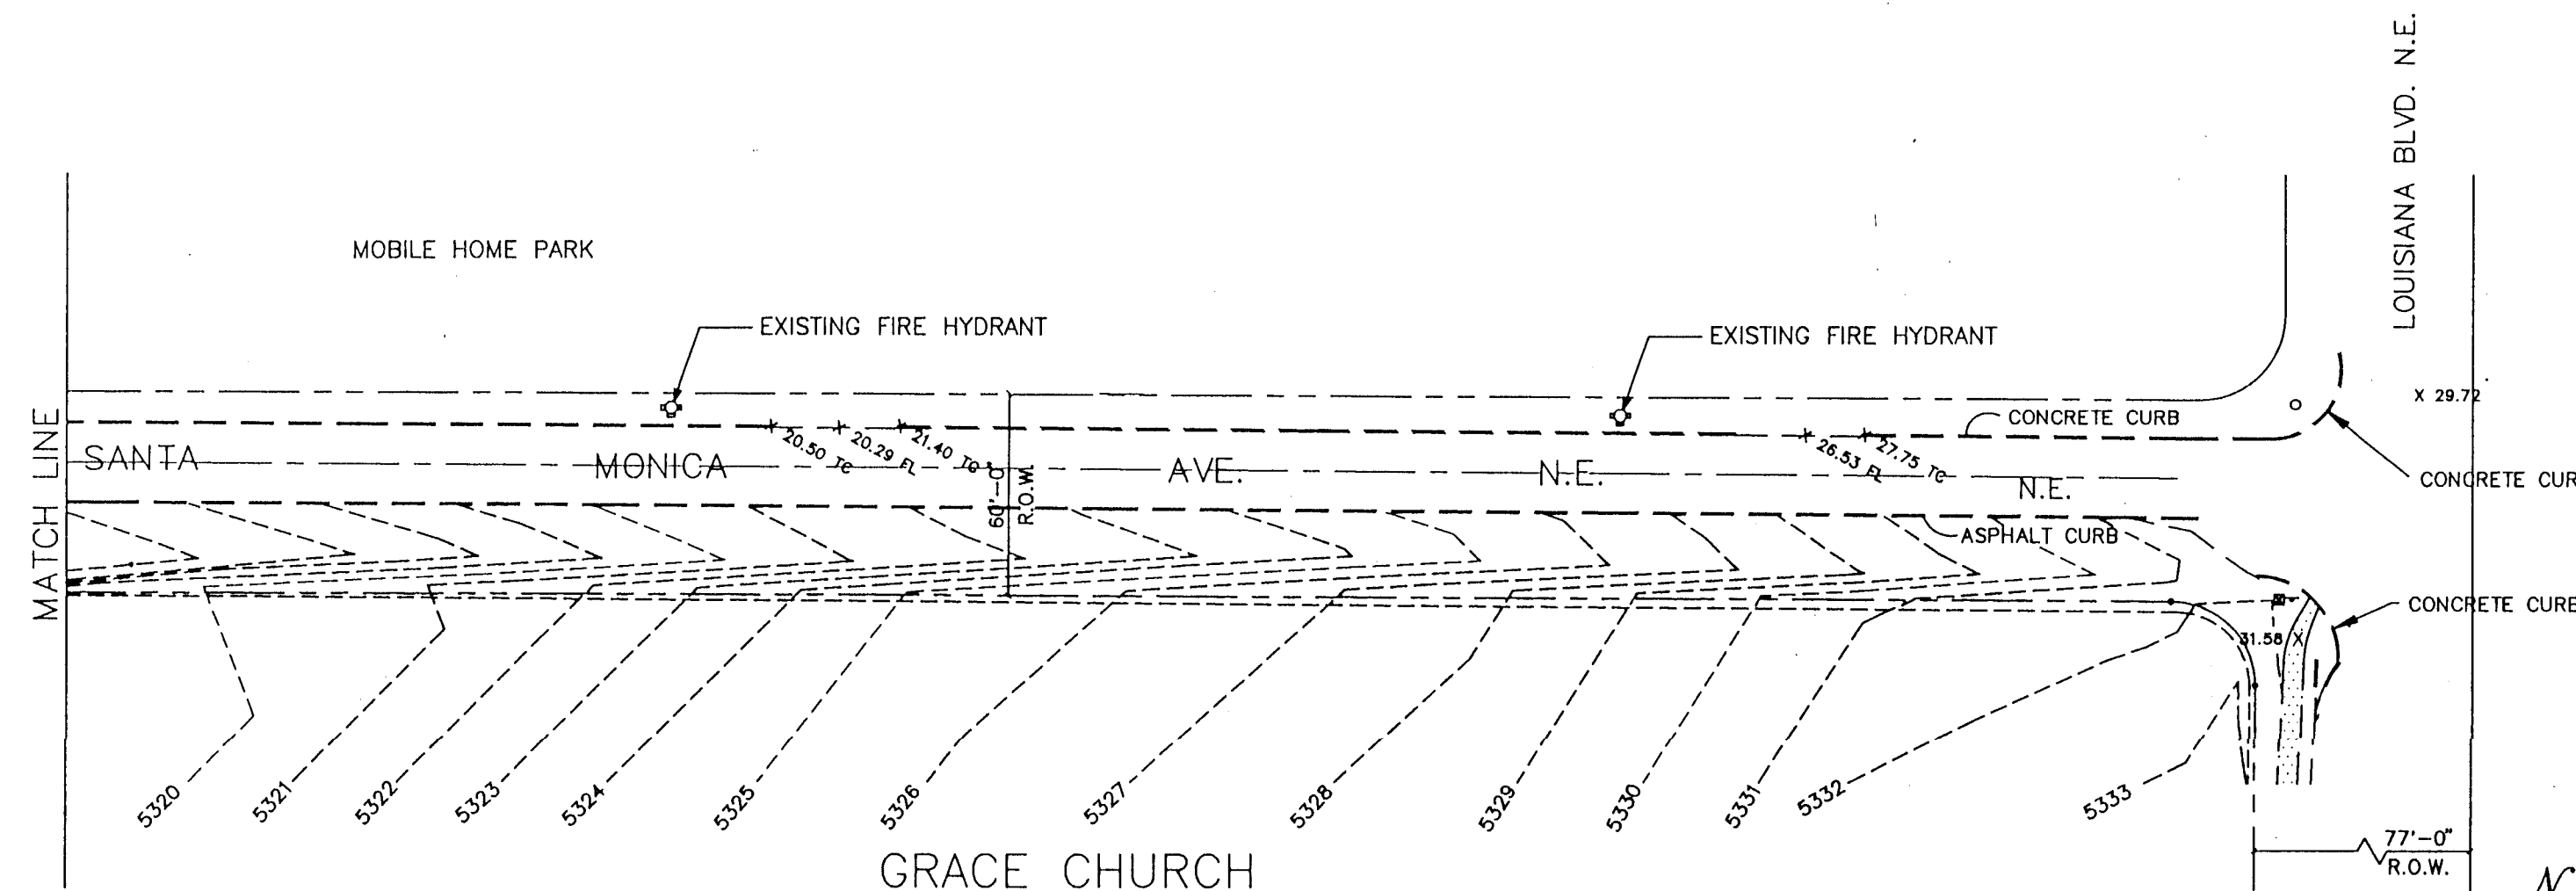


PLAN EXTENSION OF SHEET 02 TO SHOW TIE TO PROPERTY

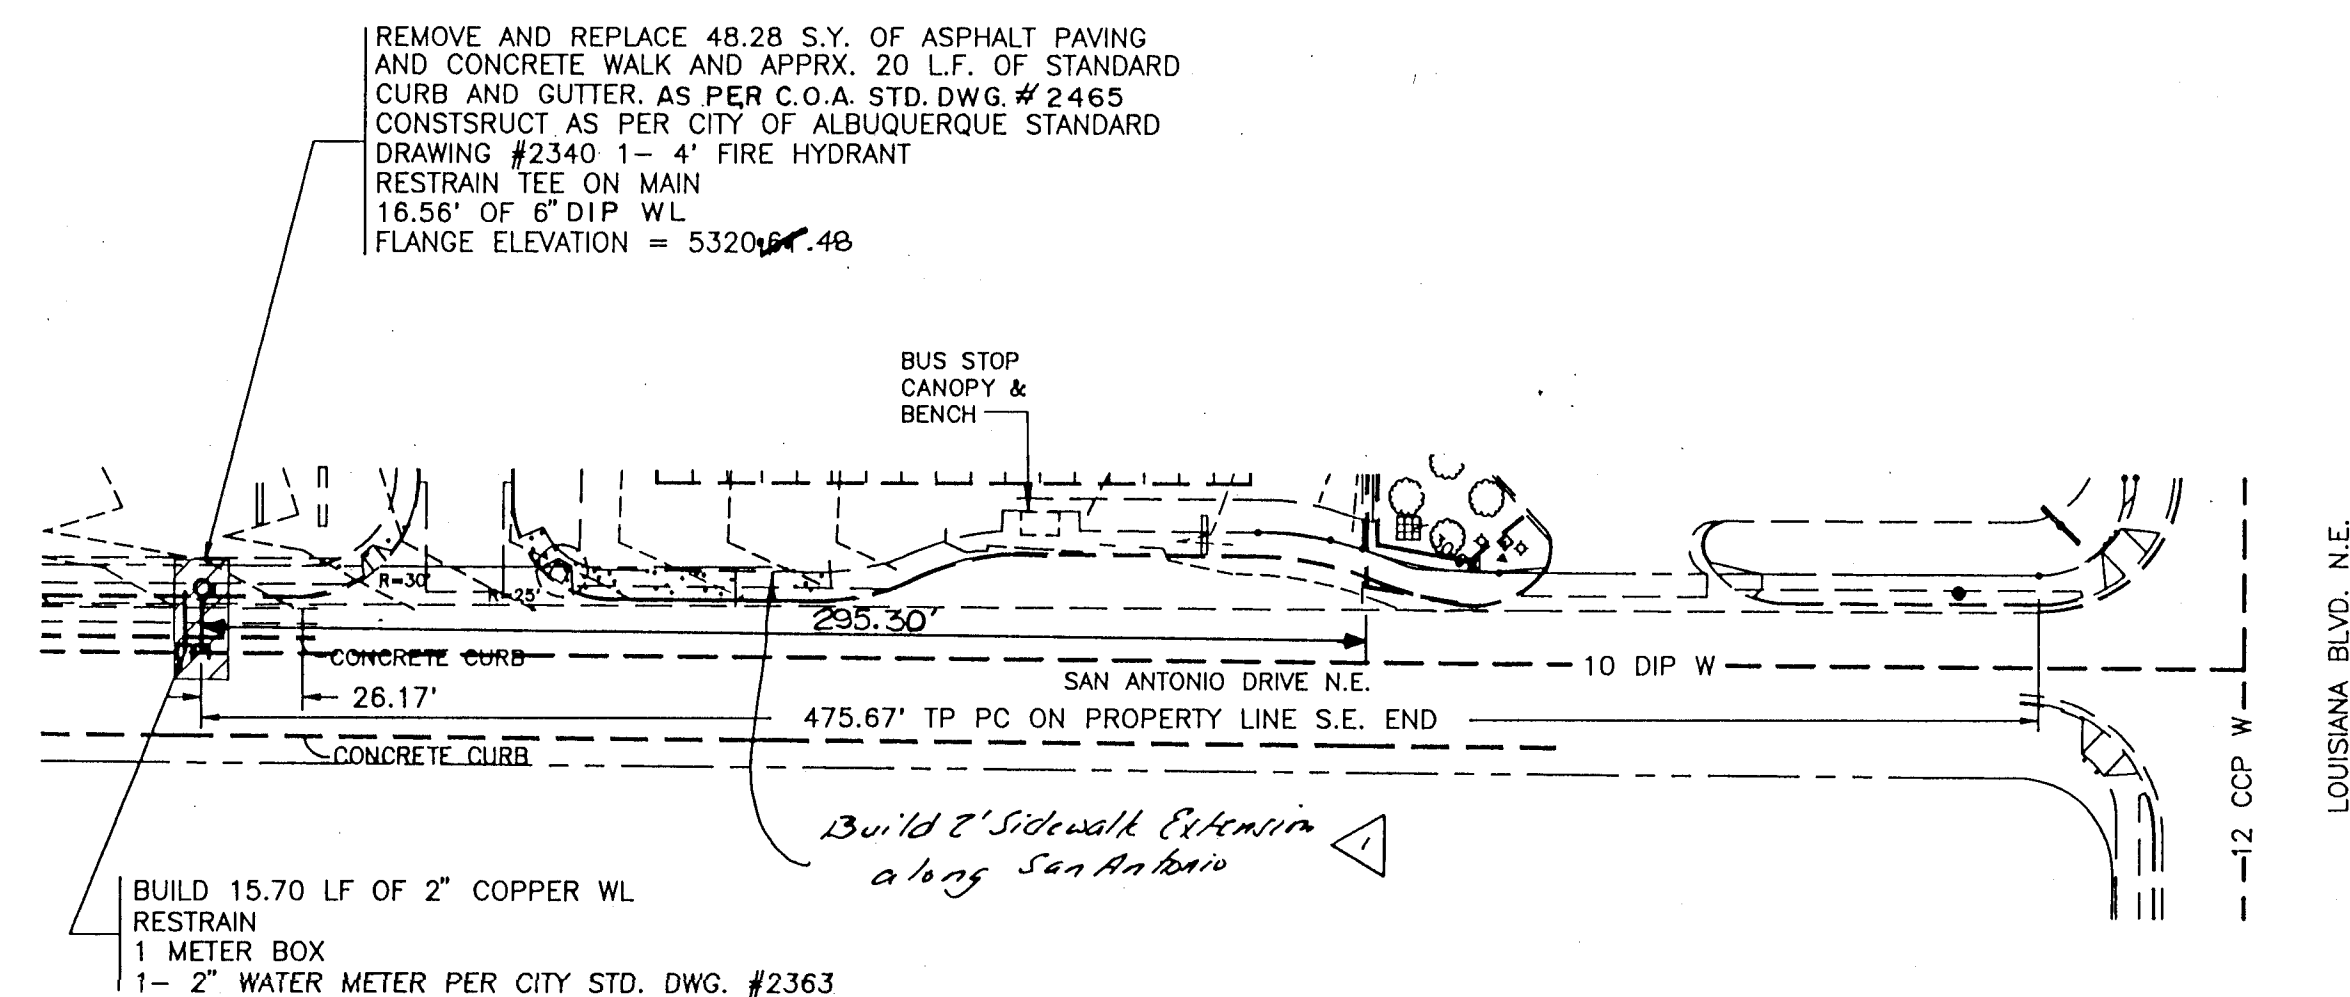



PARTIAL SITE PLAN
SHOWING FIRE HYDRANT

RECORD DRAWING	
DATE: 4-18-95	DRAFTED BY: BDG
THESE RECORD DRAWINGS HAVE BEEN PREPARED, IN PART, ON THE BASIS OF INFORMATION COMPILED AND FURNISHED BY OTHERS. THE ENGINEER WILL NOT BE RESPONSIBLE FOR ANY ERRORS OR OMISSIONS WHICH HAVE BEEN INCORPORATED INTO THIS DOCUMENT AS A RESULT.	

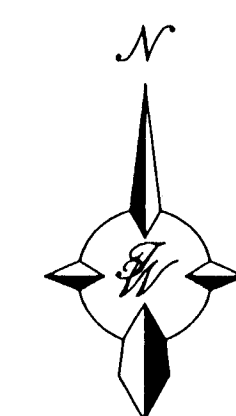

NOTE: CONTRACTOR WILL VERIFY VER. & HOR. LOCATION OF EXISTING WATER LINES;


SCALE: 1" = 50.00'
VER: 1" = 5.00'

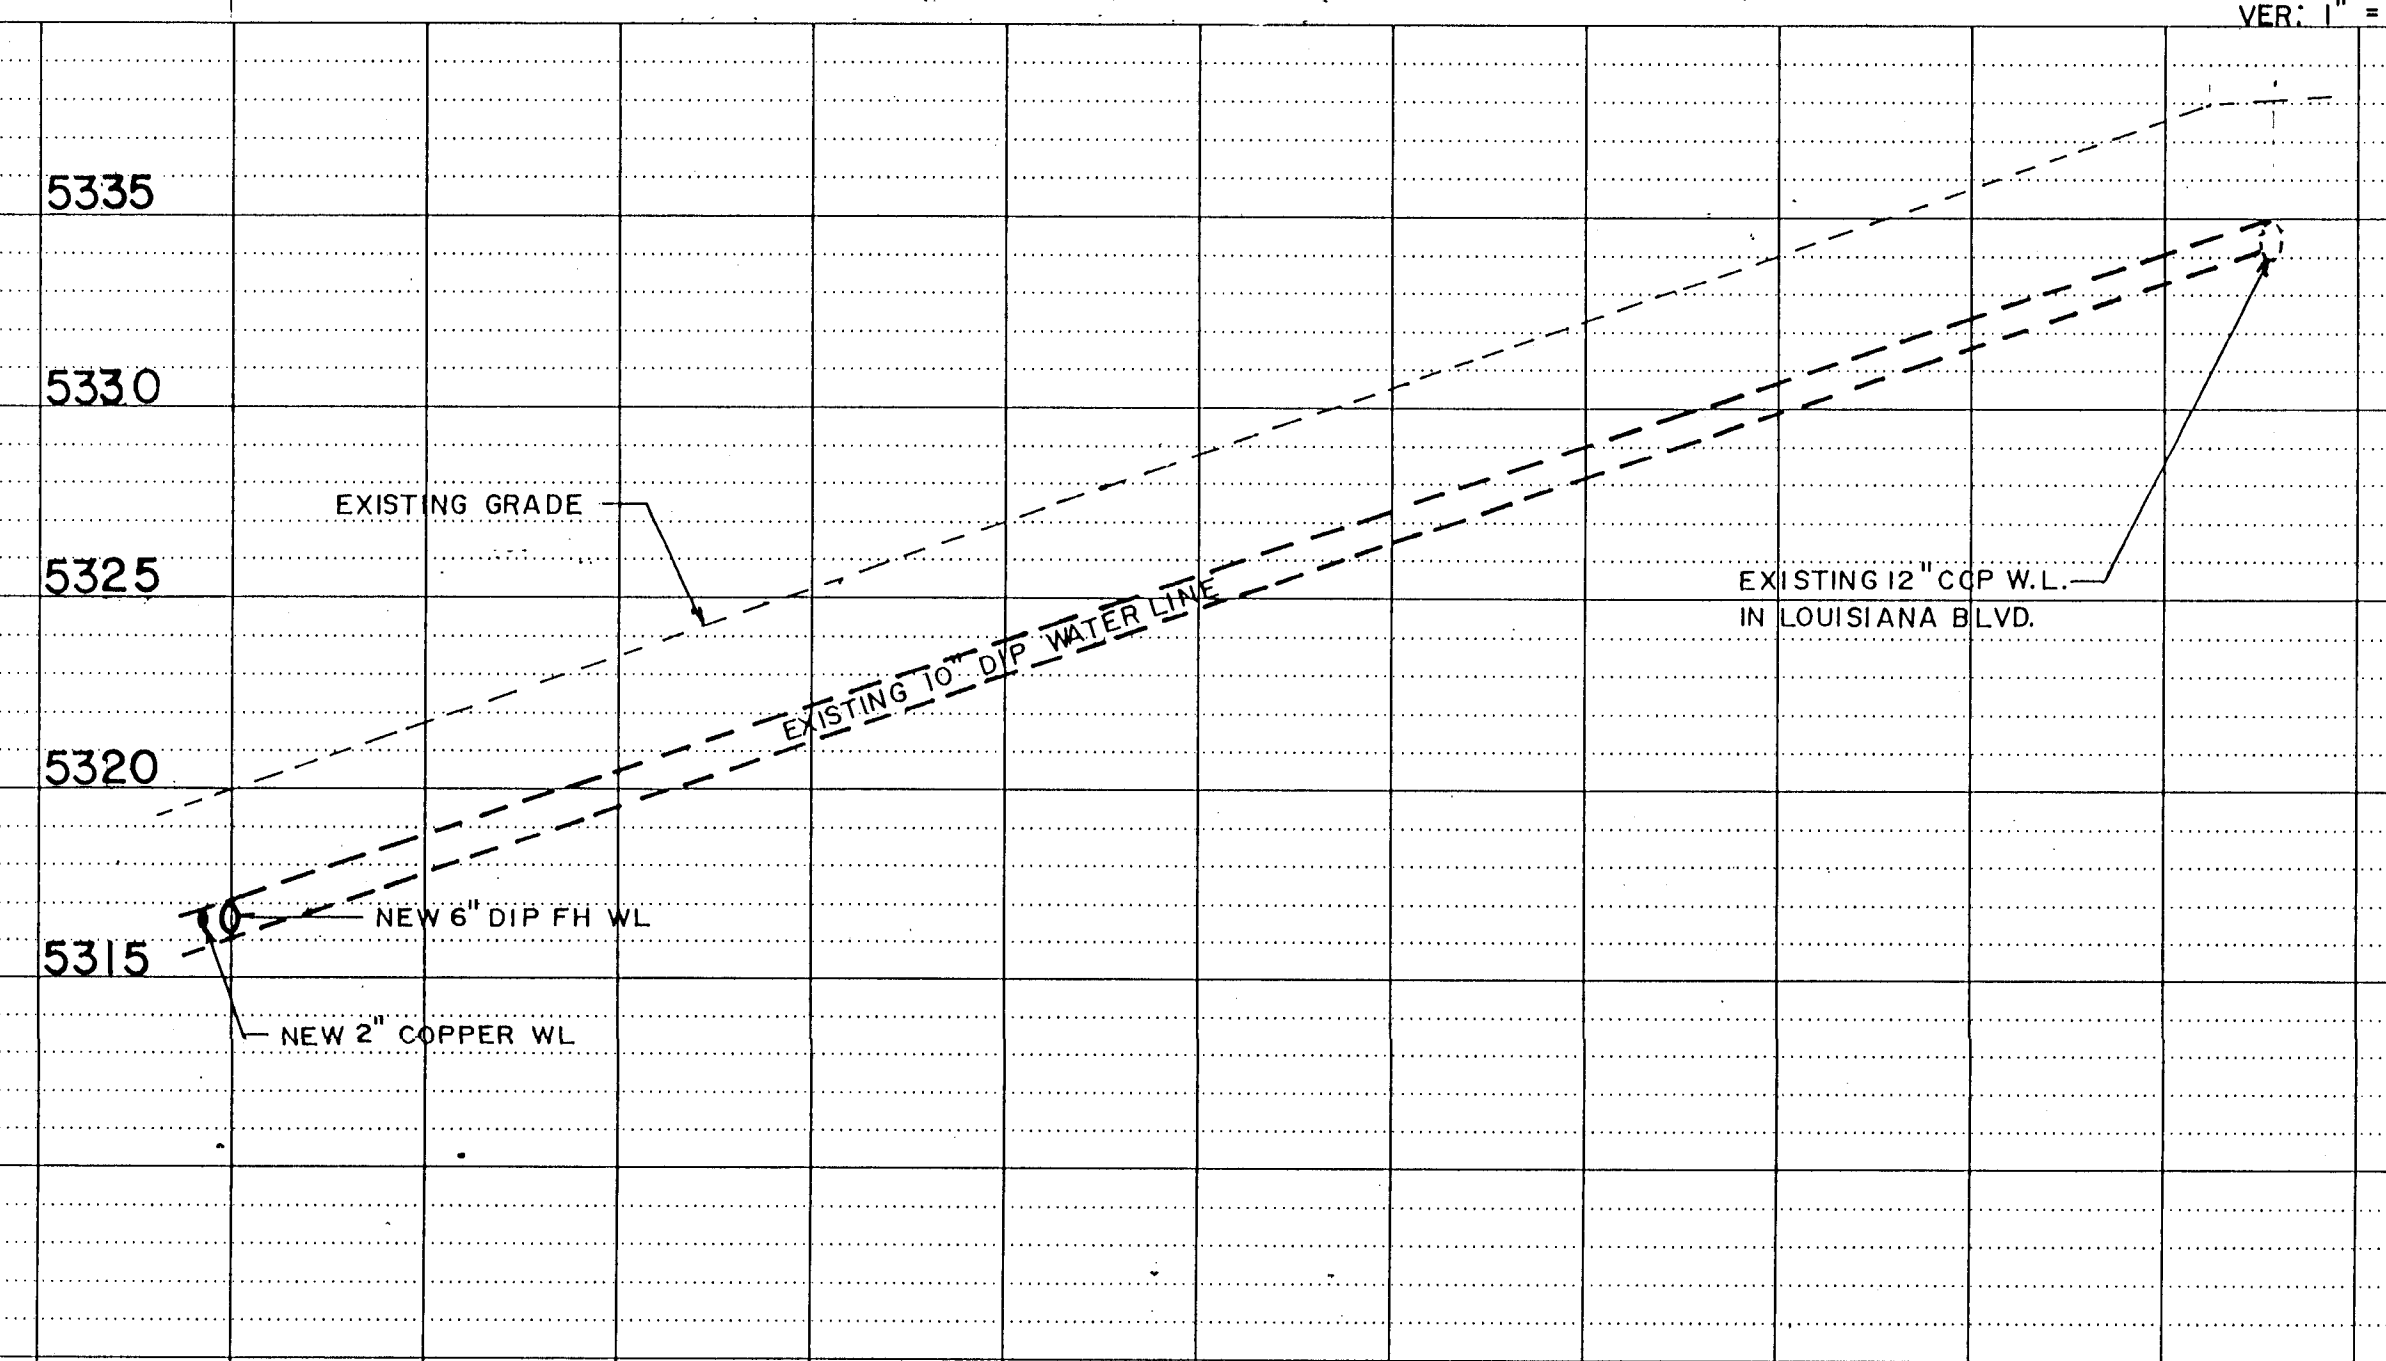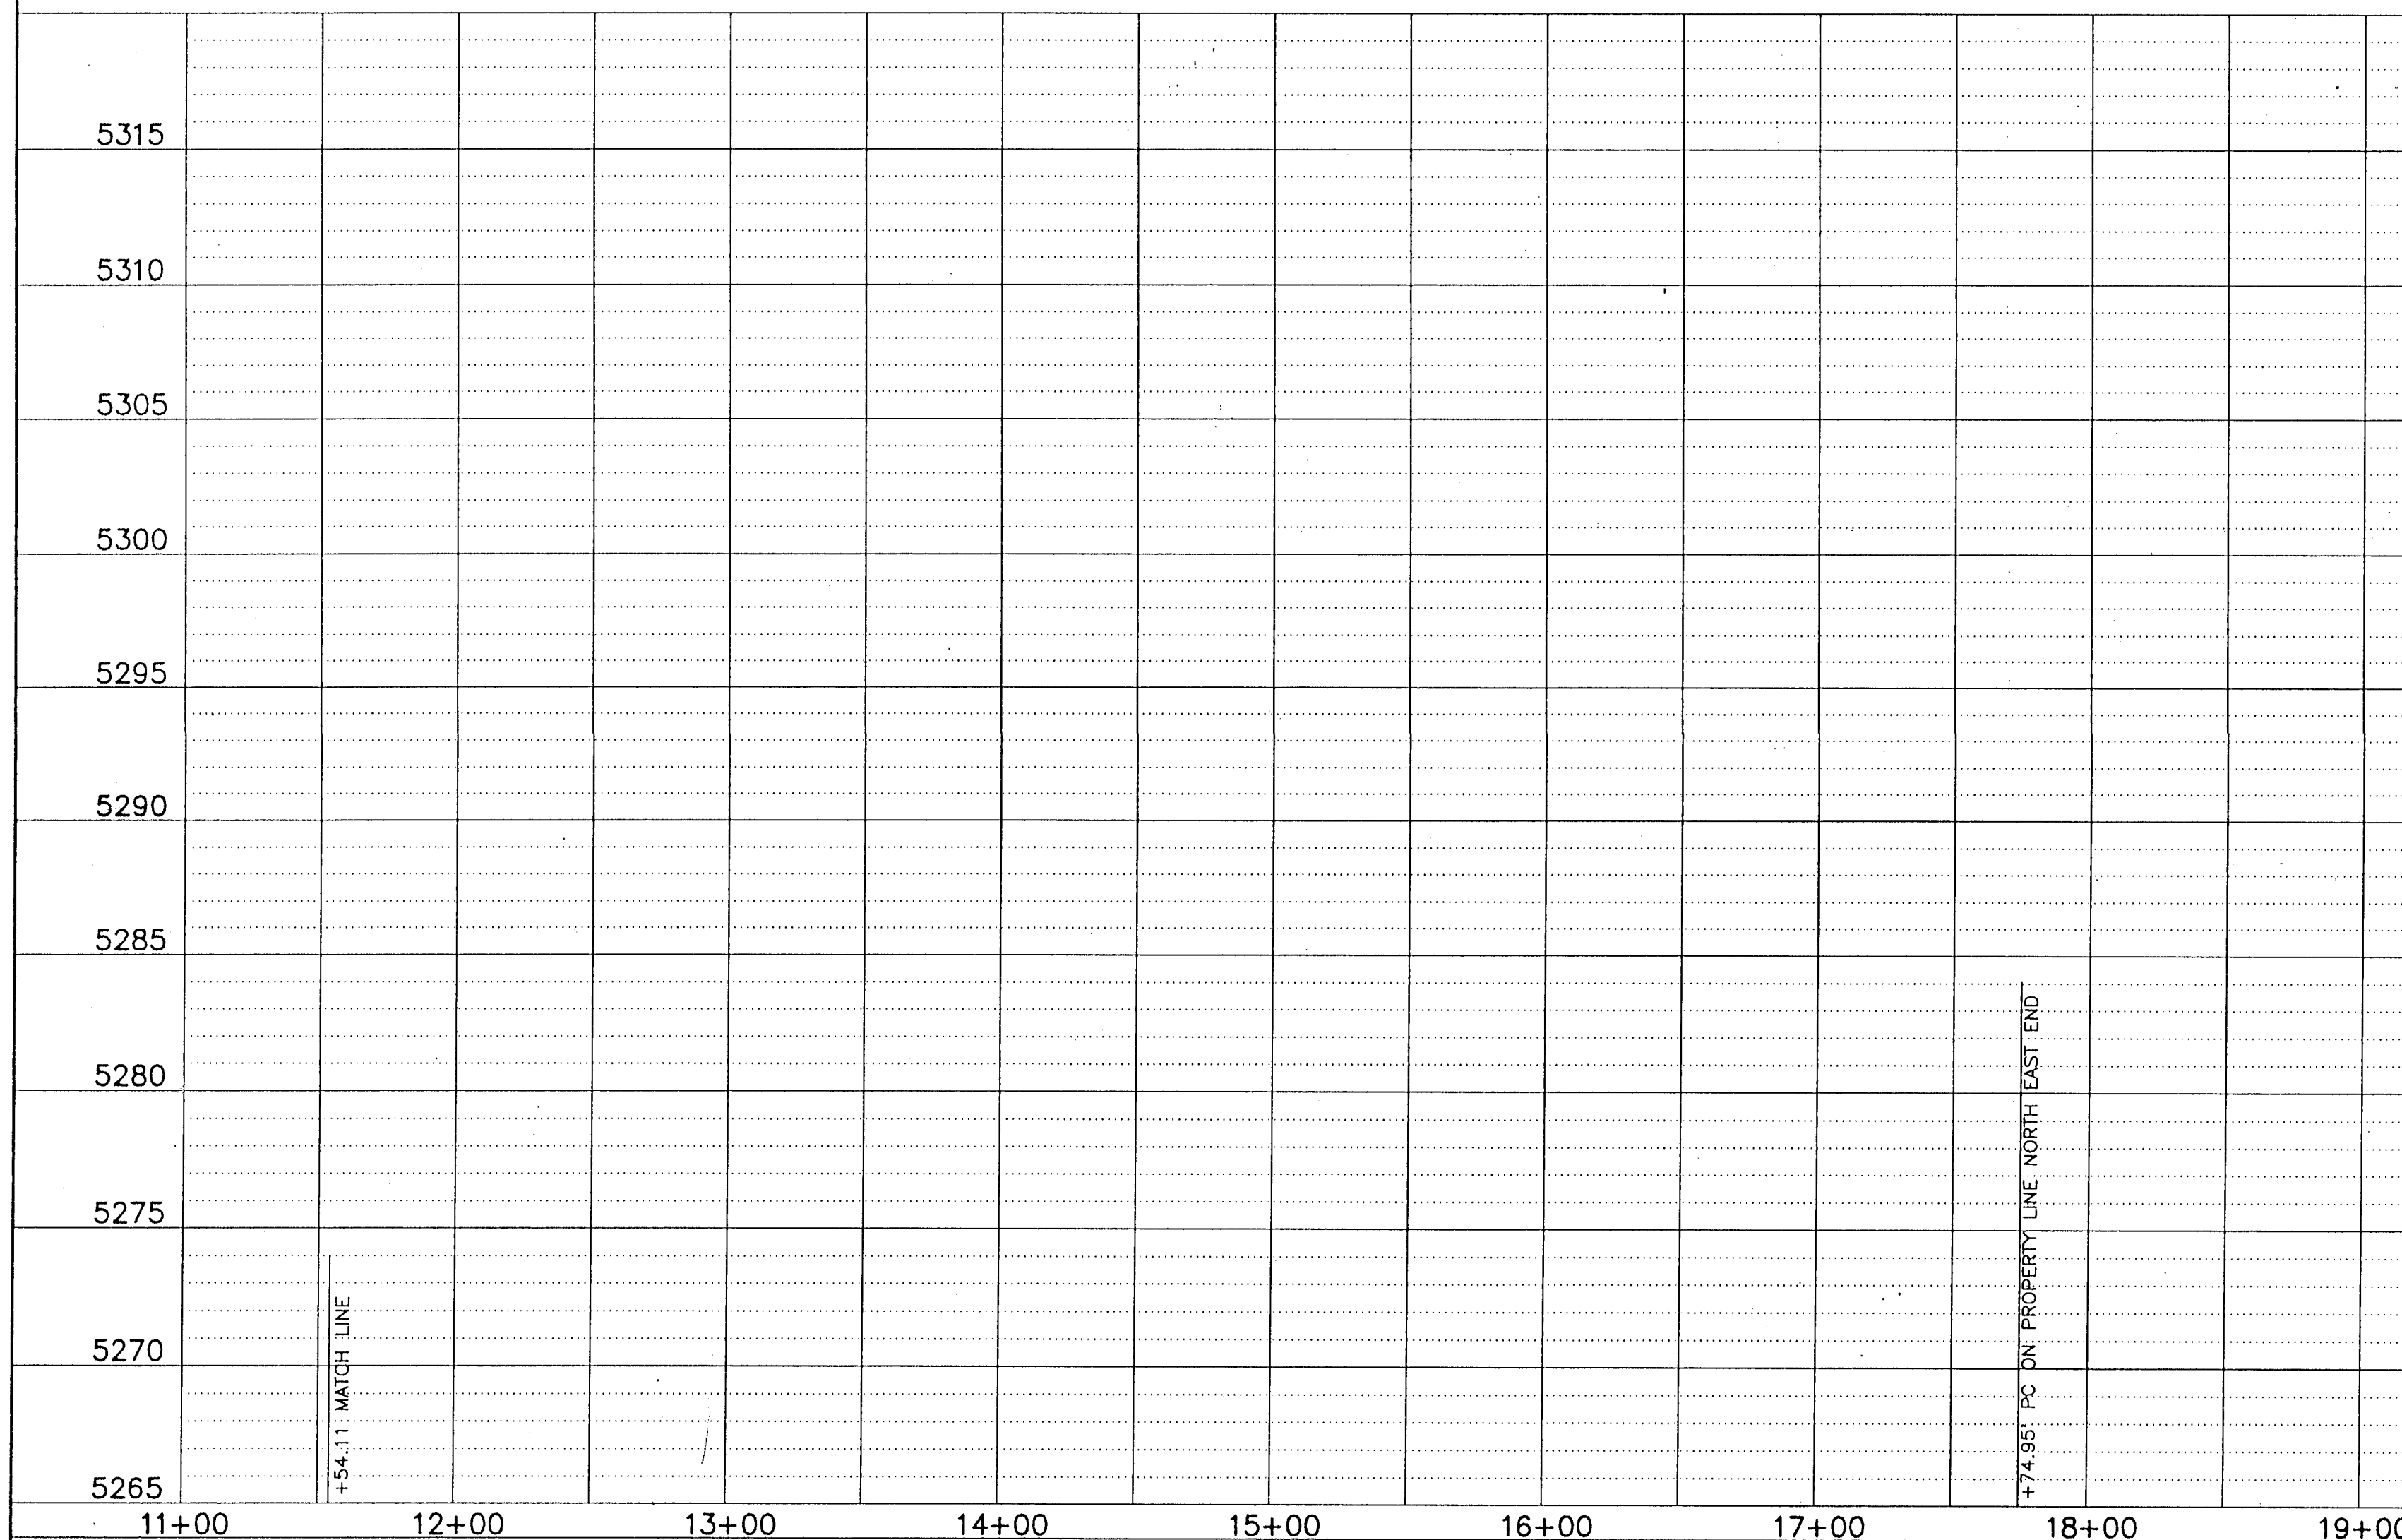

1 2 3 4 5 6 7 8 9 10 11 12 13 14 15
24 5009.90 9999


TIERRA WEST DEVELOPMENT
MANAGEMENT SERVICES
4600 MONTGOMERY BLVD. N.E., SUITE 3
ALBUQUERQUE, NEW MEXICO 87109
(505)883-7592

CITY OF ALBUQUERQUE PUBLIC WORKS DEPARTMENT ENGINEERING GROUP					
TITLE: GRACE CHURCH PARTIAL SITE PLAN (FIRE HYDRANT)					
LOUISIANA BLVD. & SANTA MONICA AVE. N.E. ALBUQUERQUE, NM					
SAS PLAN AND PROFILE STA 11+54.11 - STA 17+74.95					
APPROVALS	ENGINEER	DATE	APPROVALS	ENGINEER	DATE
DRC CHAIRMAN	R.W. Kane	11-8-94	WATER	R.W. Kane	10-18-94
TRANSPORTATION	R.W. Kane	10-14-94	WASTE WATER	R.W. Kane	10-18-94
HYDROLOGY	R.W. Kane	10-20-94			
PROJECT NO. 5009.90		MAP NO. D-18		SHEET 03	

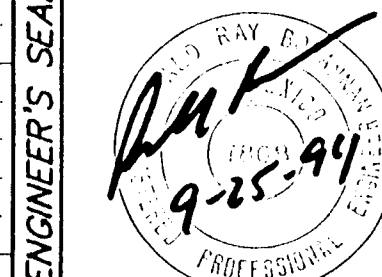


ENGINEER'S SEAL	
DATE	BY
7/14/94	R.R.B.
DESIGNED BY	DATE
RB	7/14/94
CHECKED BY	DATE
RB	7/15/94

9280337
BY LASON

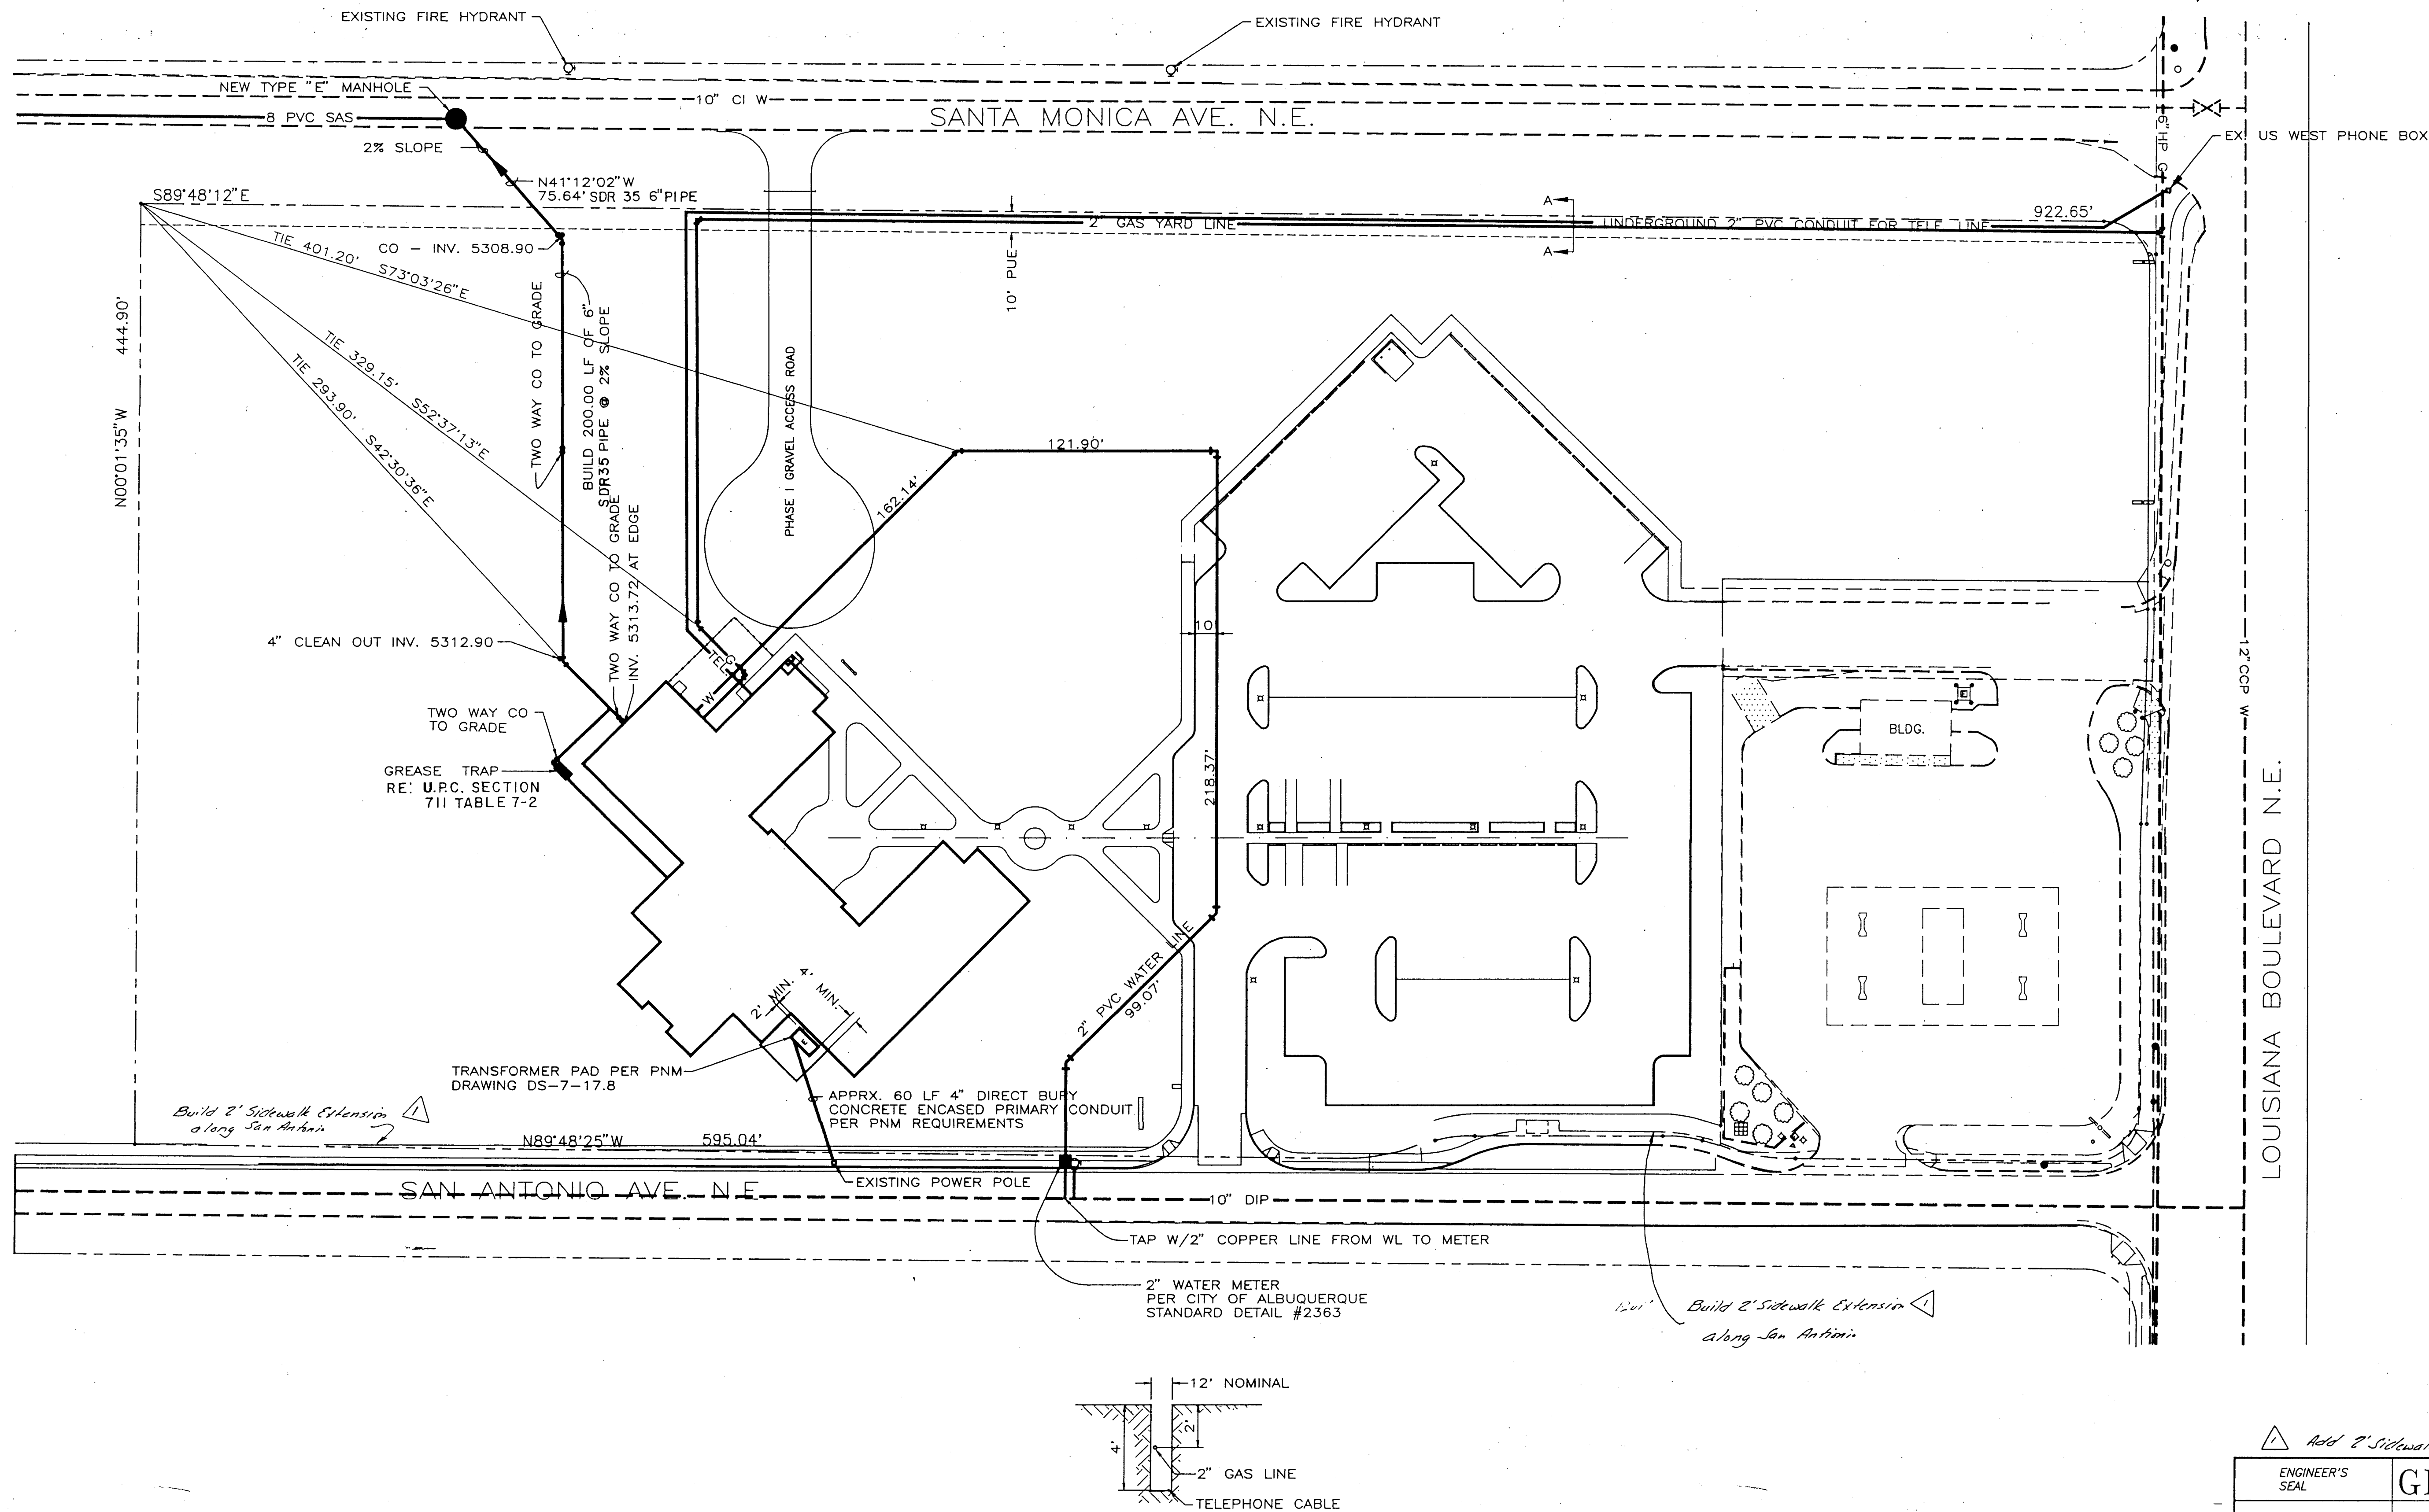

UTILITY TRENCH DETAIL SECTION AA
NO SCALE

NOTE: ALL WORK WITHIN PRIVATE PROPERTY WILL BE IN ACCORDANCE WITH THE UNIFORM PLUMBING CODE.

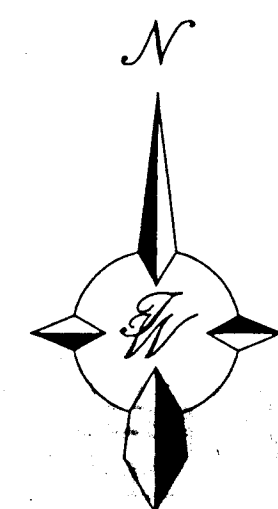

SCALE: 1" = 40.00'

Build 2' Sidewalk Extension RRB 3-15-94

 ENGINEER'S SEAL RONALD R. BOHANNAN P.E. #7868	GRACE CHURCH		DRAWN BY NB
	ALBUQUERQUE, NEW MEXICO		DATE 09/07/94
	MASTER UTILITY PLAN PHASE-1		9233MU.DWG
	TIERRA WEST DEVELOPMENT MANAGEMENT SERVICES 4600 MONTGOMERY BLVD. N.E., SUITE 3 ALBUQUERQUE, NEW MEXICO 87109 (505)863-7592		SHEET # 04 JOB # 920033

20 100 200 300 180000 1