


CONSTRUCTION PLANS
FOR
POINTE WEST SUBDIVISION - UNIT II
ALBUQUERQUE, NEW MEXICO

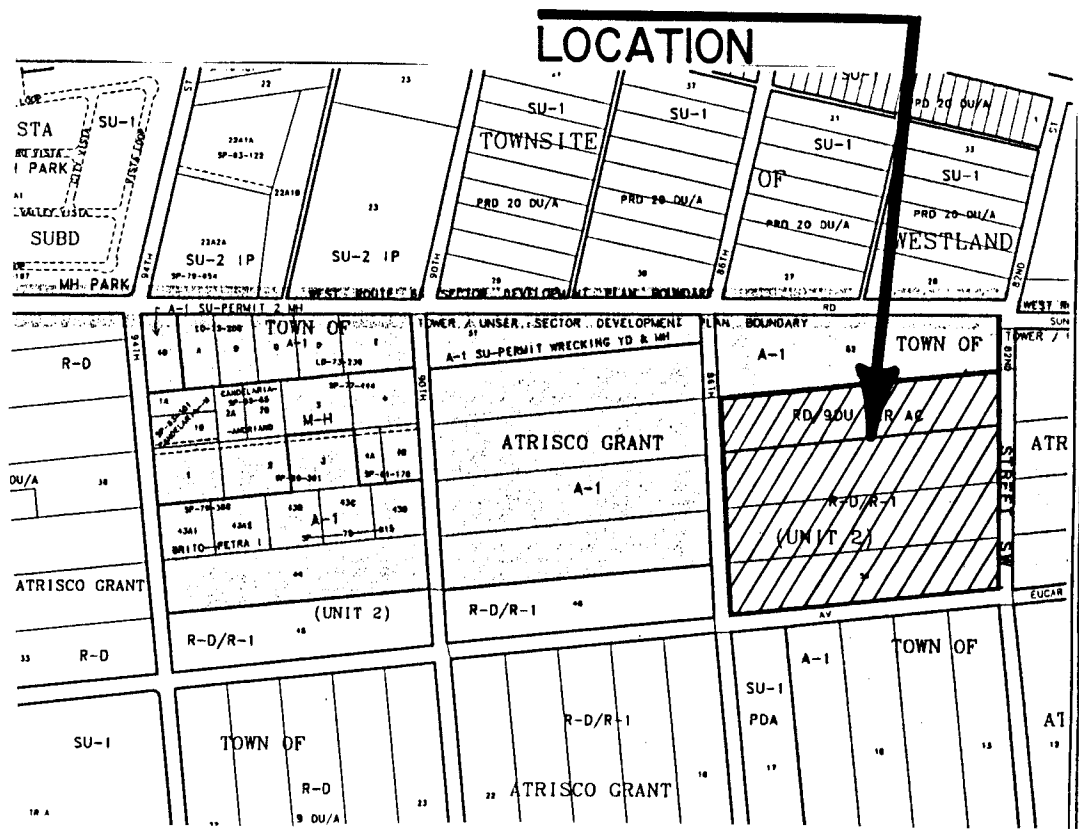

VICINITY MAP
SCALE: NONE

GENERAL NOTES

NOTICE TO CONTRACTORS

- CITY OF ALBUQUERQUE SPECIFICATIONS FOR PUBLIC WORKS CONSTRUCTION, 1986 EDITION AS AMENDED THROUGH UPDATE 6, WILL BE REFERRED TO HEREIN AS THE "STANDARD SPECIFICATIONS".
- TWO WORKING DAYS PRIOR TO ANY EXCAVATION, CONTRACTOR MUST CONTACT NEW MEXICO ONE CALL SYSTEM (260-1990) AND DETERMINE LOCATION OF EXISTING UTILITIES.
- PRIOR TO ANY CONSTRUCTION, THE CONTRACTOR SHALL EXCAVATE AND VERIFY THE HORIZONTAL AND VERTICAL LOCATIONS OF ALL OBSTRUCTIONS. SHOULD A CONFLICT EXIST, THE CONTRACTOR SHALL NOTIFY THE ENGINEER OR THE SURVEYOR SO THAT THE CONFLICT CAN BE RESOLVED WITHOUT DELAY.
- ALL EXISTING SIGNS, MARKERS, DELINEATORS, ETC., WITHIN THE CONSTRUCTION LIMITS SHALL BE REMOVED, STORED AND RE-SET BY THE CONTRACTOR.
- THE CONTRACTOR SHALL NOTIFY THE ENGINEER NOT LESS THAN SEVEN (7) PRIOR TO STARTING WORK IN ORDER THAT THE ENGINEER MAY TAKE NECESSARY MEASURES TO INSURE THE PRESERVATION OF SURVEY MONUMENTS. CONTRACTOR SHALL NOT DISTURB PERMANENT SURVEY MONUMENTS WITHOUT THE CONSENT OF THE ENGINEER AND SHALL NOTIFY THE ENGINEER AND BEAR THE EXPENSE OF REPLACING ANY THAT MAY BE DISTURBED WITHOUT PERMISSION. REPLACEMENT SHALL BE DONE ONLY BY THE CITY SURVEYOR. WHEN A CHANGE IS MADE IN THE FINISHED ELEVATIONS OF THE PAVEMENT OF ANY ROADWAY IN WHICH A PERMANENT SURVEY MONUMENT IS LOCATED, CONTRACTOR SHALL, AT HIS OWN EXPENSE, ADJUST THE MONUMENT COVER TO THE NEW GRADE UNLESS OTHERWISE SPECIFIED. REFER TO SECTION 4.4 OF THE GENERAL CONDITIONS OF THE STANDARD SPECIFICATIONS.
- THREE (3) WORKING DAYS PRIOR TO BEGINNING CONSTRUCTION THE CONTRACTOR SHALL SUBMIT TO THE CONSTRUCTION CO-ORDINATION DIVISION A DETAILED CONSTRUCTION SCHEDULE. TWO (2) WORKING DAYS PRIOR TO CONSTRUCTION THE CONTRACTOR SHALL OBTAIN A BARRICADING PERMIT FROM THE CONSTRUCTION CO-ORDINATION DIVISION. CONTRACTOR SHALL NOTIFY BARRICADE ENGINEER (768-2551) PRIOR TO OCCUPYING AN INTERSECTION.
- ANY WORK OCCURRING WITHIN AN ARTERIAL ROADWAY REQUIRES 24 HOURS CONSTRUCTION.

THE FOLLOWING NOTES ALSO APPLY WHEN CHECKED

- ☒ ALL UTILITIES AND UTILITY SERVICE LINES SHALL BE INSTALLED PRIOR TO PAVING.
- ☒ BACKFILL COMPACTION SHALL BE ACCORDING TO SPECIFIED STREET USE.
- ☐ TACK COAT REQUIREMENTS SHALL BE DETERMINED BY THE CITY ENGINEER.
- ☒ SIDEWALK AND WHEELCHAIR RAMPS WITHIN THE CURB RETURNS SHALL BE CONSTRUCTED WHEREVER A NEW CURB RETURN IS CONSTRUCTED.
- ☐ IF CURB IS DEPRESSED FOR A DRIVEPAD, THE DRIVEPAD SHALL BE CONSTRUCTED PRIOR TO ACCEPTANCE OF CURB AND GUTTER.
- ☒ ALL STORM DRAINAGE FACILITIES SHALL BE COMPLETED PRIOR TO FINAL ACCEPTANCE.
- ☒ THE REQUESTOR OR DEVELOPER SHALL BE RESPONSIBLE FOR REPAIR OR REPLACEMENT OF ALL CURB AND GUTTER OR SIDEWALK DAMAGE AFTER APPROVAL BY THE CITY ENGINEER OR WORK COMPLETED BY THE CONTRACTOR.

CAUTION:
NOTE THAT ALL EXISTING UTILITIES MAY NOT BE SHOWN. ALL EXISTING SERVICE CONNECTIONS ARE NOT SHOWN. ANY EXISTING UTILITIES THAT ARE SHOWN ARE APPROXIMATE LOCATION ONLY. IT SHALL BE THE SOLE RESPONSIBILITY OF THE CONTRACTOR TO CONTACT ALL THE UTILITY OWNERS AND TO CONDUCT ALL NECESSARY FIELD INVESTIGATIONS PRIOR TO ANY EXCAVATIONS TO DETERMINE THE ACTUAL LOCATION OF UTILITIES AND OTHER IMPROVEMENTS.

LEGEND

	CURB AND GUTTER		WATER METER
	CONCRETE		CABLE T.V.
	ELECTRIC TRANSFORMER		POWER POLE
	ELECTRIC PANEL		ANCHOR
	SANITARY SEWER MANHOLE		LIGHT POLE
	TELEPHONE MANHOLE		TRAFFIC LIGHT
	ELECTRIC MANHOLE		CROSSWALK SIGNAL
	STORM SEWER MANHOLE		SPRINKLER CONTROL
	WATER VALVE		TRAFFIC CONTROL
	FIRE HYDRANT		LIGHTING BOX
	TELEPHONE BOX		SIGN
	SPOT ELEVATION		GRATE

INDEX TO DRAWINGS

SHEET NO.	SHEET
1	TITLE SHEET
2-4	PLAT
5	GRADING PLANS
6	MASTER PAVING PLAN
7-9	PAVING PLAN & PROFILES
10	MASTER UTILITY & STORM DRAIN PLAN
11-13	UTILITY PLAN & PROFILES

RECORD DRAWING - UNIT II

I hereby certify that the information contained on this drawing has been revised in accordance with information furnished by the contractor, Franklin's Earthmoving, Inc. and by the surveyor, A.L.S., Inc., and reflects the construction as actually accomplished. This plan as constructed is in substantial compliance with the Approved Plan.

Mark Goodwin NMPE 8948

APPROVAL OF AS BUILT DRAWINGS
CHIEF CONSTRUCTION ENGINEER
DATE 2-28-97



SCANNED BY
BY JASON

dmg D. MARK GOODWIN & ASSOCIATES, P.A.
CONSULTING ENGINEERS & SURVEYORS
P. O. BOX 90606
ALBUQUERQUE, NEW MEXICO 87199
(505) 345-2010

REV.	SHEETS	CITY ENGINEER	DATE	USER DEPARTMENT	DATE	USER DEPARTMENT	DATE
ENGINEERS STAMP & SIGNATURE	APPROVALS	ENGINEER	DATE	*****	*****	*****	*****
	DRC CHAIRMAN	Billy J. Goodwin	7-1-96	APPROVED FOR CONSTRUCTION			
	TRANSPORTATION						
	WATER/WASTEWATER						
	HYDROLOGY						
	PARKS						
	CONSTR. MGMT.						
	CITY PROJECT NO.						
	5048.91						
	SHEET OF						
	1						

26-15048.91 10/97

CURVE DATA				
NO.	RADIUS	DELTA	LENGTH	CHORD
1	25.00	87-12-41	38.05	N 40-25-30 E 34.48
2	25.00	94-21-04	41.17	N 48-47-37 W 36.67
3	25.00	92-47-19	40.49	N 49-34-30 W 36.21
4	25.00	85-38-56	37.37	N 41-12-23 E 33.99
5	25.00	39-43-07	17.33	N 21-28-38 W 16.99
6	40.00	08-28-54	5.92	N 37-05-45 W 5.92
7	40.00	58-06-44	40.57	N 03-47-56 W 38.85
8	40.00	42-53-37	29.95	N 48-42-15 E 29.25
9	40.00	55-35-42	38.81	N 84-03-05 W 37.31
10	25.00	22-45-50	9.93	N 67-38-10 W 9.87
11	75.00	42-49-31	56.06	N 62-37-05 E 54.78
12	75.00	42-49-25	56.06	N 19-47-38 E 54.78
13	50.00	85-38-56	74.74	N 41-12-23 E 67.98
14	25.00	94-21-04	41.17	N 48-47-37 W 36.67
15	25.00	85-38-56	41.17	N 41-12-23 E 33.99
16	25.00	94-21-04	41.17	N 48-47-37 W 36.67
17	25.00	85-38-56	37.37	N 41-12-23 E 33.99
18	50.00	94-21-04	82.34	N 48-47-37 W 73.34
19	75.00	47-10-32	61.75	N 25-12-21 W 60.02
20	75.00	47-10-32	61.75	N 72-22-53 W 60.02
21	25.00	16-54-19	7.38	N 75-34-41 E 7.35
22	40.00	55-31-15	38.76	N 72-04-34 E 37.28
23	40.00	41-49-18	29.20	N 59-15-09 W 28.55
24	40.00	44-58-22	31.37	N 15-52-19 W 30.58
25	40.00	31-29-58	21.99	N 22-20-51 E 21.71
26	25.00	36-52-54	17.33	N 18-14-28 W 16.99
27	25.00	94-21-04	41.17	N 48-47-37 W 36.67
28	25.00	86-05-47	37.57	N 40-58-57 E 34.13
29	25.00	93-54-13	40.97	N 49-01-03 W 36.54
30	25.00	85-38-56	37.37	N 41-12-23 E 33.99
31	25.00	42-37-00	18.60	N 22-55-35 W 18.17
32	48.00	64-16-58	50.49	N 17-17-57 W 47.88
33	45.00	35-13-33	27.87	N 32-27-18 E 27.23
34	45.00	35-17-58	27.72	N 67-43-04 E 27.29
35	45.00	35-17-58	27.72	N 78-58-59 W 27.29
36	45.00	34-12-25	26.87	N 42-13-47 W 26.47
37	48.00	55-29-20	43.58	N 02-37-06 E 41.90
38	25.00	47-49-21	20.87	N 22-17-36 E 20.27
39	25.00	41-43-32	18.21	N 22-28-51 W 17.81
40	45.00	63-12-09	49.64	N 17-50-22 W 47.16
41	45.00	36-18-23	28.52	N 31-54-54 E 28.04
42	45.00	36-17-58	27.72	N 67-43-04 E 27.29
43	45.00	35-17-58	27.72	N 78-58-59 W 27.29
44	45.00	34-12-25	26.87	N 42-13-47 W 26.47
45	45.00	55-30-18	43.59	N 02-37-34 E 41.91
46	25.00	47-49-21	20.87	N 22-17-36 E 20.27
47	25.00	41-52-25	18.27	N 22-33-18 W 17.87
48	48.00	63-12-09	49.64	N 17-50-22 W 47.16
49	45.00	36-18-23	28.52	N 31-54-54 E 28.04
50	45.00	35-17-58	27.72	N 67-43-04 E 27.29
51	45.00	35-17-58	27.72	N 78-58-59 W 27.29
52	45.00	34-12-25	26.87	N 42-13-47 W 26.47
53	45.00	55-25-58	43.54	N 02-35-24 E 41.86
54	25.00	47-49-21	20.87	N 22-17-36 E 20.27
55	25.00	41-10-31	17.97	N 22-12-21 W 17.58
56	45.00	63-12-09	49.64	N 17-50-22 W 47.16
57	45.00	37-02-44	29.10	N 32-17-04 E 28.59
58	48.00	32-51-50	25.81	N 67-14-21 E 25.46
59	45.00	33-04-14	25.97	N 79-47-37 W 25.61
60	45.00	34-38-42	27.21	N 47-56-09 W 26.80
61	45.00	53-54-02	42.33	N 01-39-47 W 40.79
62	25.00	47-49-21	20.87	N 22-17-36 E 20.27
63	25.00	92-47-29	40.49	N 49-34-35 W 36.21
64	25.00	86-05-37	37.57	N 40-58-52 E 34.13
65	25.00	22-48-35	9.95	N 55-43-14 E 9.89
66	25.00	16-57-04	7.40	N 67-29-37 W 7.37
67	25.00	5-12-21	2.27	N 48-50-16 W 2.27
68	45.00	15-50-30	12.44	N 37-17-01 E 12.40
69	25.00	6-05-49	2.66	N 48-23-32 W 2.66
70	45.00	15-49-33	12.43	N 38-17-30 E 12.39
71	25.00	5-56-56	2.60	N 48-27-58 W 2.59
72	45.00	15-53-53	12.49	N 38-15-20 E 12.45
73	25.00	6-38-50	2.90	N 48-07-01 W 2.90
74	45.00	20-55-02	16.43	N 35-44-45 E 16.34

LOT AREAS

LOT	ACRES	LOT	ACRES	LOT	ACRES	LOT	ACRES
1	0.1194	1	0.1247	31	0.1206	61	0.1792
2	0.1148	2	0.1173	32	0.1163	62	0.1906
3	0.1148	3	0.1178	33	0.1848	63	0.1183
4	0.1148	4	0.1182	34	0.1662	64	0.1175
5	0.1246	5	0.1179	35	0.1790	65	0.1213
6	0.2169	6	0.1153	36	0.1905	66	0.1213
7	0.1416	7	0.1767	37	0.1184	67	0.1213
8	0.1322	8	0.1662	38	0.1175	68	0.1213
9	0.1323	9	0.1790	39	0.1213	69	0.1213
10	0.1324	10	0.1905	40	0.1213	70	0.1213
11	0.1325	11	0.1184	41	0.1213	71	0.1213
12	0.1326	12	0.1178	42	0.1213	72	0.1213
13	0.1328	13	0.1213	43	0.1213	73	0.1302
14	0.1327	14	0.1213	44	0.1213	74	0.1200
15	0.1328	15	0.1213	45	0.1213	75	0.1179
16	0.1328	16	0.1213	46	0.1213	76	0.1179
17	0.1329	17	0.1196	47	0.1302	77	0.1179
18	0.1330	18	0.1179	48	0.1313	78	0.1179
19	0.1331	19	0.1179	49	0.1213	79	0.1196
20	0.1331	20	0.1179	50	0.1213	80	0.1213
21	0.1331	21	0.1151	51	0.1213	81	0.1213
22	0.1435	22	0.1313	52	0.1213	82	0.1213
23	0.2335	23	0.1213	53	0.1213	83	0.1206
24	0.1584	24	0.1213	54	0.1213	84	0.1167
25	0.1307	25	0.1213	55	0.1213	85	0.1733
26	0.1306	26	0.1213	56	0.1213	86	0.1649
27	0.1306	27	0.1213	57	0.1206	87	0.1648
28	0.1457	28	0.1213	58	0.1162	88	0.1899
		29	0.1213	59	0.1849	89	0.1196
		30	0.1213	60	0.1664	90	0.1158

PLAT OF
 POINTE WEST SUBDIVISION
 WITHIN THE
 TOWN OF ATRISCO GRANT
 PROJECTED SECTIONS 27 AND 28
 TOWNSHIP 10 NORTH, RANGE 2 EAST, NMPM
 CITY OF ALBUQUERQUE
 BERNALILLO COUNTY, NEW MEXICO
 JUNE 1994


PUBLIC UTILITY EASEMENTS:

PUBLIC UTILITY EASEMENTS shown on this plat are granted for the common and joint use of:


- The Public Service Company of New Mexico for the installation, maintenance, and service of overhead and underground electrical lines, transformers, poles and any other equipment, fixtures, structures and related facilities reasonably necessary to provide electrical services.
- The Gas Company of New Mexico for installation, maintenance, and service of natural gas lines, valves and other equipment and facilities reasonably necessary to provide natural gas.
- U.S. West for installation, maintenance and service of all buried and aerial communication lines and other related equipment and facilities reasonably necessary to provide communication services, including but not limited to above ground pedestals and closures.
- Jones Interchange for the installation, maintenance, and service of such lines, cable, and other related equipment and facilities reasonably necessary to provide Cable TV service.


Included, is the right to build, rebuild, construct, reconstruct, locate, relocate, change, remove, modify, renew, operate, and maintain facilities for the purposes described above, together with free access to, from, and over said easements, including sufficient working area space for electric transformers, with the right and privilege to trim and remove trees, shrubs or bushes which interfere with the purposes set forth herein. No building, sign, pool (aboveground or subsurface), hot tub, concrete or wood pool, decking, or other structure shall be erected or constructed on said easements, nor shall any well be drilled or operated thereon. Property owners shall be solely responsible for correcting any violations of National Electrical Safety Code caused by construction of pools, decking, or any structures adjacent to within or near easements shown on this plat.

By approving this document, the utility companies do not waive or release any easement rights which may have been granted by prior plat, replat or document.

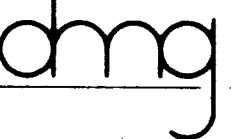PLAT OF			
POINTE WEST SUBDIVISION			
CURVE DATA AND LOT AREAS			
 D. MARK GOODWIN & ASSOCIATES, P.A. CONSULTING ENGINEERS & SURVEYORS P.O. BOX 90606 ALBUQUERQUE, NEW MEXICO 87199 (505) 345-2010			
Designed: ALS	Drawn: BJC	Checked: ALS	Sheet 3 of 3
Scale: 1"=100'	Date: 6/94	Job: 93109	

SCANNED BY
 BY LASON

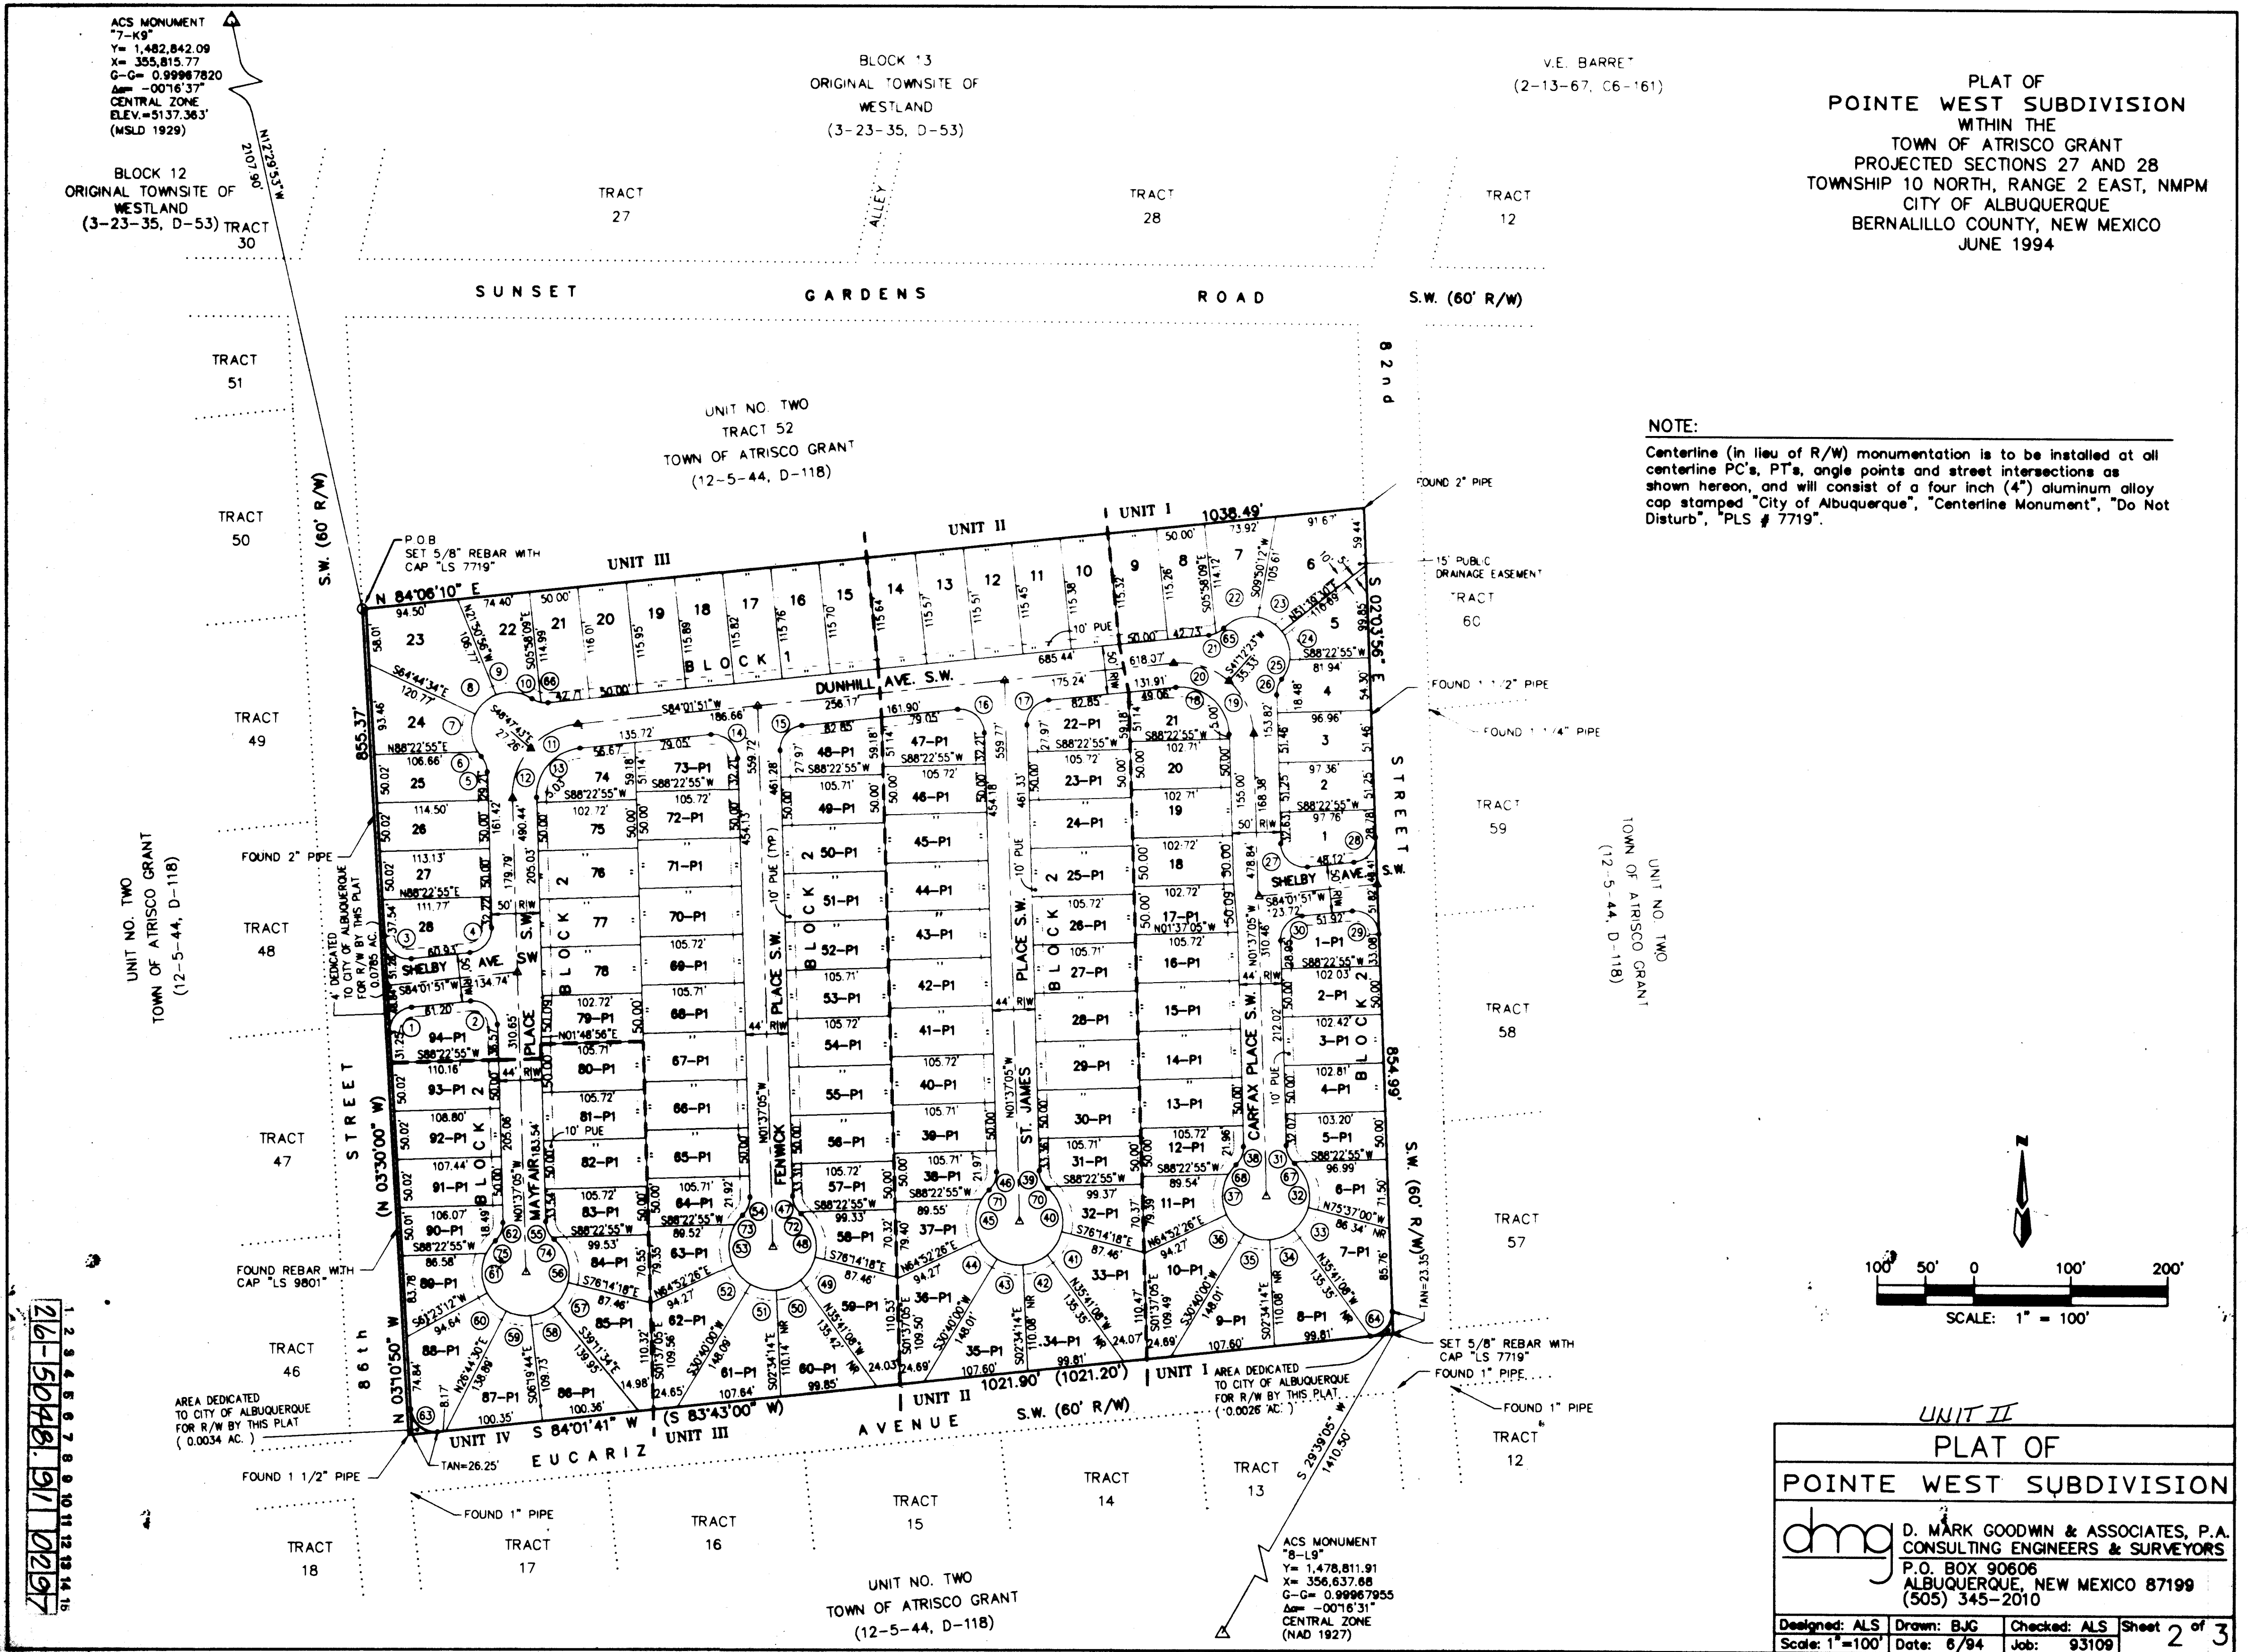

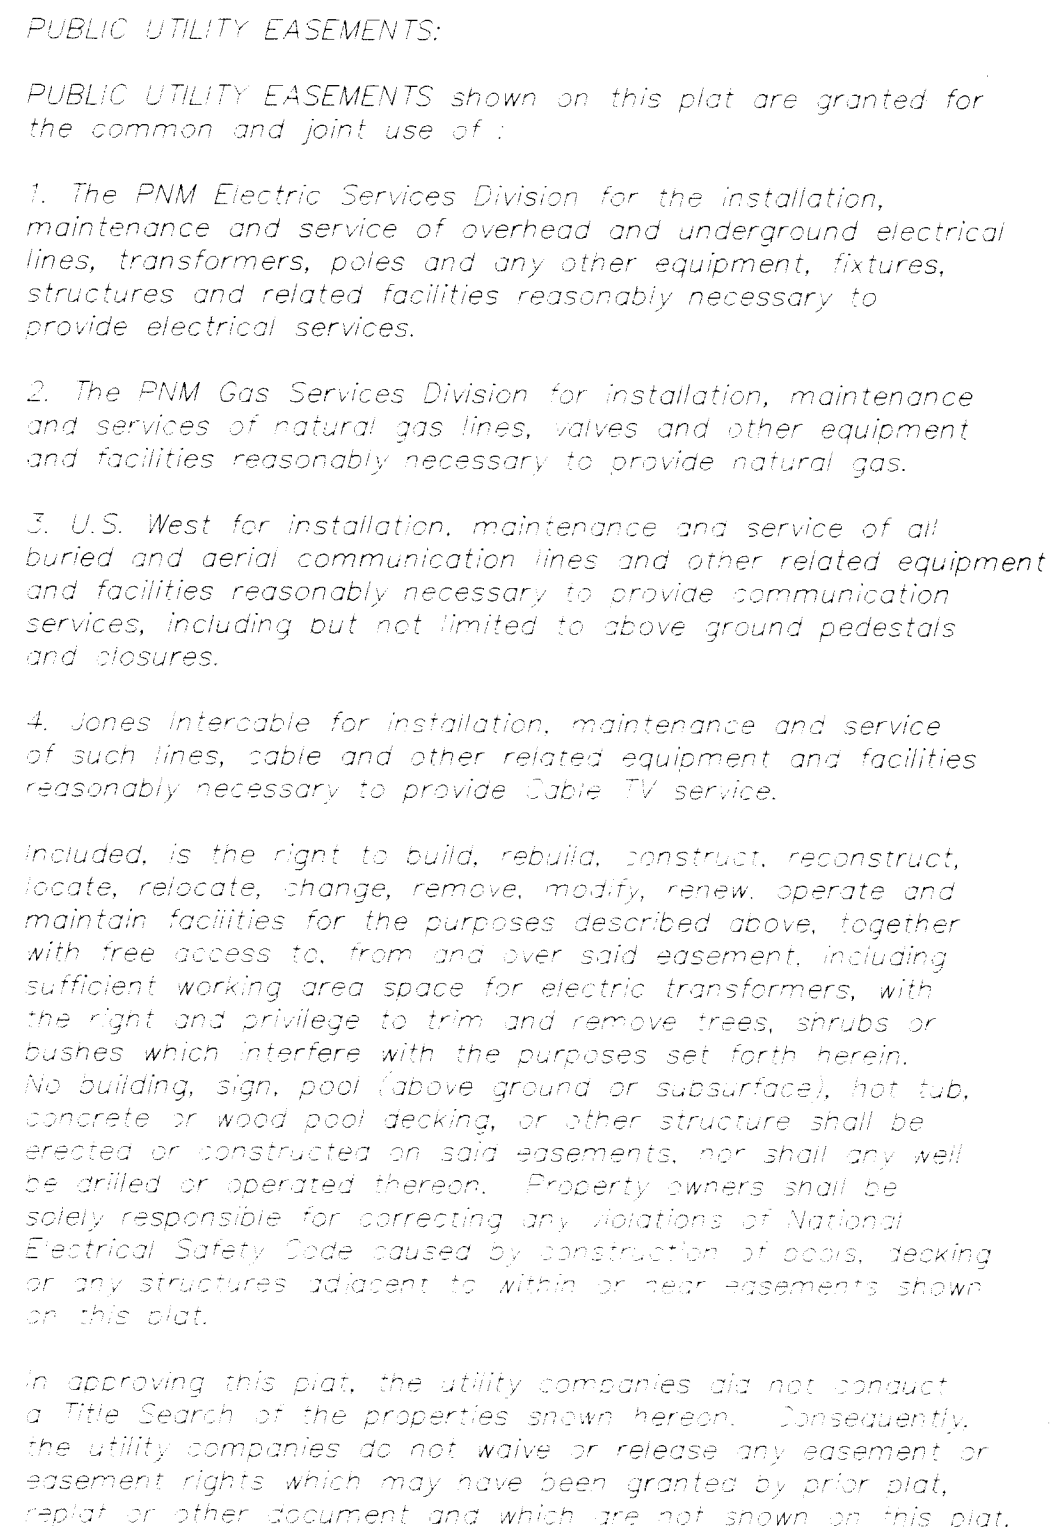

SCANNED BY
BY LASON

POINTE WEST SUBDIVISION

UNIT II


D. MARK GOODWIN & ASSOCIATES, P.A.
CONSULTING ENGINEERS & SURVEYORS
 P.O. BOX 90606
 ALBUQUERQUE, NEW MEXICO 87199
 (505) 345-2010

Designed:	Drawn: B/JG	Checked: ALS	Sheet
Scale: 1"=100'	Date: 5/96	Job: 96068	2 of 2

3109POIN\3109MAP2



A tract of land situate within the Town of Atrisco Grant within projected Sections 27 and 28, Township 10 North, Range 2 East, New Mexico Principal Meridian, City of Albuquerque, Bernalillo County, New Mexico, being all of TRACT A, UNIT I, POINTE WEST SUBDIVISION, as the same is shown and designated on said plat filed for record in the office of the County Clerk of Bernalillo County, New Mexico, on March 4, 1996, in Volume 96C, Folio 97, and being more particularly described as follows:

BEGINNING at the northwest corner of the herein described tract, said point being on the south boundary of TRACT 52, TOWN OF ATRISCO GRANT, UNIT NO. 2, as the same is shown and designated on said plat filed for record in the office of the County Clerk of Bernalillo County, New Mexico, on December 5, 1944, in Volume D, Folio 118, and further being on the easterly right-of-way line of 86th Street SW from whence the Albuquerque Control Survey Monument "7-K9" bears N 12°36'23" W, 2108.36 feet;

THENCE leaving said easterly right-of-way line along the southerly line of said TRACT 52, N 84°06'10" E, 768.90 feet to the northeast corner, said point being on the southerly line of said TRACT 52, and further being common with the northwest corner of said UNIT 1, POINTE WEST SUBDIVISION;

THENCE S 05°58'09" E, 115.32 feet to a point;

THENCE S 10°51'30" E, 50.18 feet to a point;

THENCE S 01°37'05" E, 690.02 feet to the southeast corner, said point being common with the southwest corner of said UNIT 1, POINTE WEST SUBDIVISION, and further being along the northerly right-of-way line of Eucariz Avenue SW;

THENCE along said northerly right-of-way line S 84°01'41" W, 736.19 feet to a point;

THENCE leaving said northerly right-of-way line and continuing 40.49 feet along a curve to the right whose radius is 25.00 feet through a central angle of 92°47'29" and whose long chord bears N 49°34'35" W, 36.21 feet to a point of tangency, said point being along the easterly right-of-way line of 86th Street SW;

THENCE along said easterly right-of-way line N 03°10'50" W, 829.12 feet to the point of beginning and containing 15.1330 acres more or less.

PURPOSE OF PLAT

1. TO SUBDIVIDE THE EXISTING TRACT¹ A' INTO 31 RESIDENTIAL LOTS (4.999 AC) AND 1 TRACT (15.1330 ACRES)
2. DEDICATE PUBLIC STREET RIGHT-OF-WAY AS SHOWN HEREON.
3. GRANT PUBLIC UTILITY EASEMENTS AS SHOWN HEREON.

SURVEYOR'S CERTIFICATION

"I, Timothy Aldrich, a duly qualified Registered Professional Land Surveyor under the laws of the State of New Mexico, do hereby certify that this plat and description were prepared by me or under my supervision, shows all easements as shown on the plat of record or made known to me by the owners and/or proprietors of the subdivision shown hereon, utility companies and other parties expressing an interest and meets the minimum requirements for monumentation and surveys of the Albuquerque Subdivision Ordinance, and further meets the Minimum Standards and Surveying Regulations of the State of New Mexico (Effective November 1, 1989 and revision effective December 25, 1991), and is true and correct to the best of my knowledge and belief."

PLAT OF
 POINTE WEST SUBDIVISION
UNIT II
 WITHIN THE
 TOWN OF ATRISCO GRANT
 PROJECTED SECTIONS 27 AND 28
 OWNSHIP 10 NORTH, RANGE 2 EAST, NM
 CITY OF ALBUQUERQUE
 BERNALILLO COUNTY, NEW MEXICO
 MAY 1996

APPROVED AND ACCEPTED BY:

APPROVAL AND CONDITIONAL ACCEPTANCE as specified by the Albuquerque Subdivision Ordinance, Article XI of Chapter 7 of the Revised Ordinances of Albuquerque, New Mexico.

Planning Director, City of Albuquerque, N.M. Date _____

City Engineer, City of Albuquerque, N.M. Date

Albuquerque Metropolitan Arroyo Flood Control Authority Date

Transportation Development, City of Albuquerque, N.M. Date

Utility Development Division, City of Albuquerque, N.M. Date

Parks and General Services, City of Albuquerque, N.M. Date

City Surveyor, City of Albuquerque, N.M. Date

Property Management, City of Albuquerque, N.M. Date

PNM GAS _____ Date _____

U.S. West Telecommunications Date _____

PNM ELECTRIC Date _____


Jones Intercable, Inc. Date

POINTE WEST SUBDIVISION
UNIT II

 D. MARK GOODWIN & ASSOCIATES, P.A.
CONSULTING ENGINEERS & SURVEYORS
P.O. BOX 90606
ALBUQUERQUE, NEW MEXICO 87199
(505) 345-2010

Sheet 1 of 2

26-5084.91 0397 SH. 3 of 12

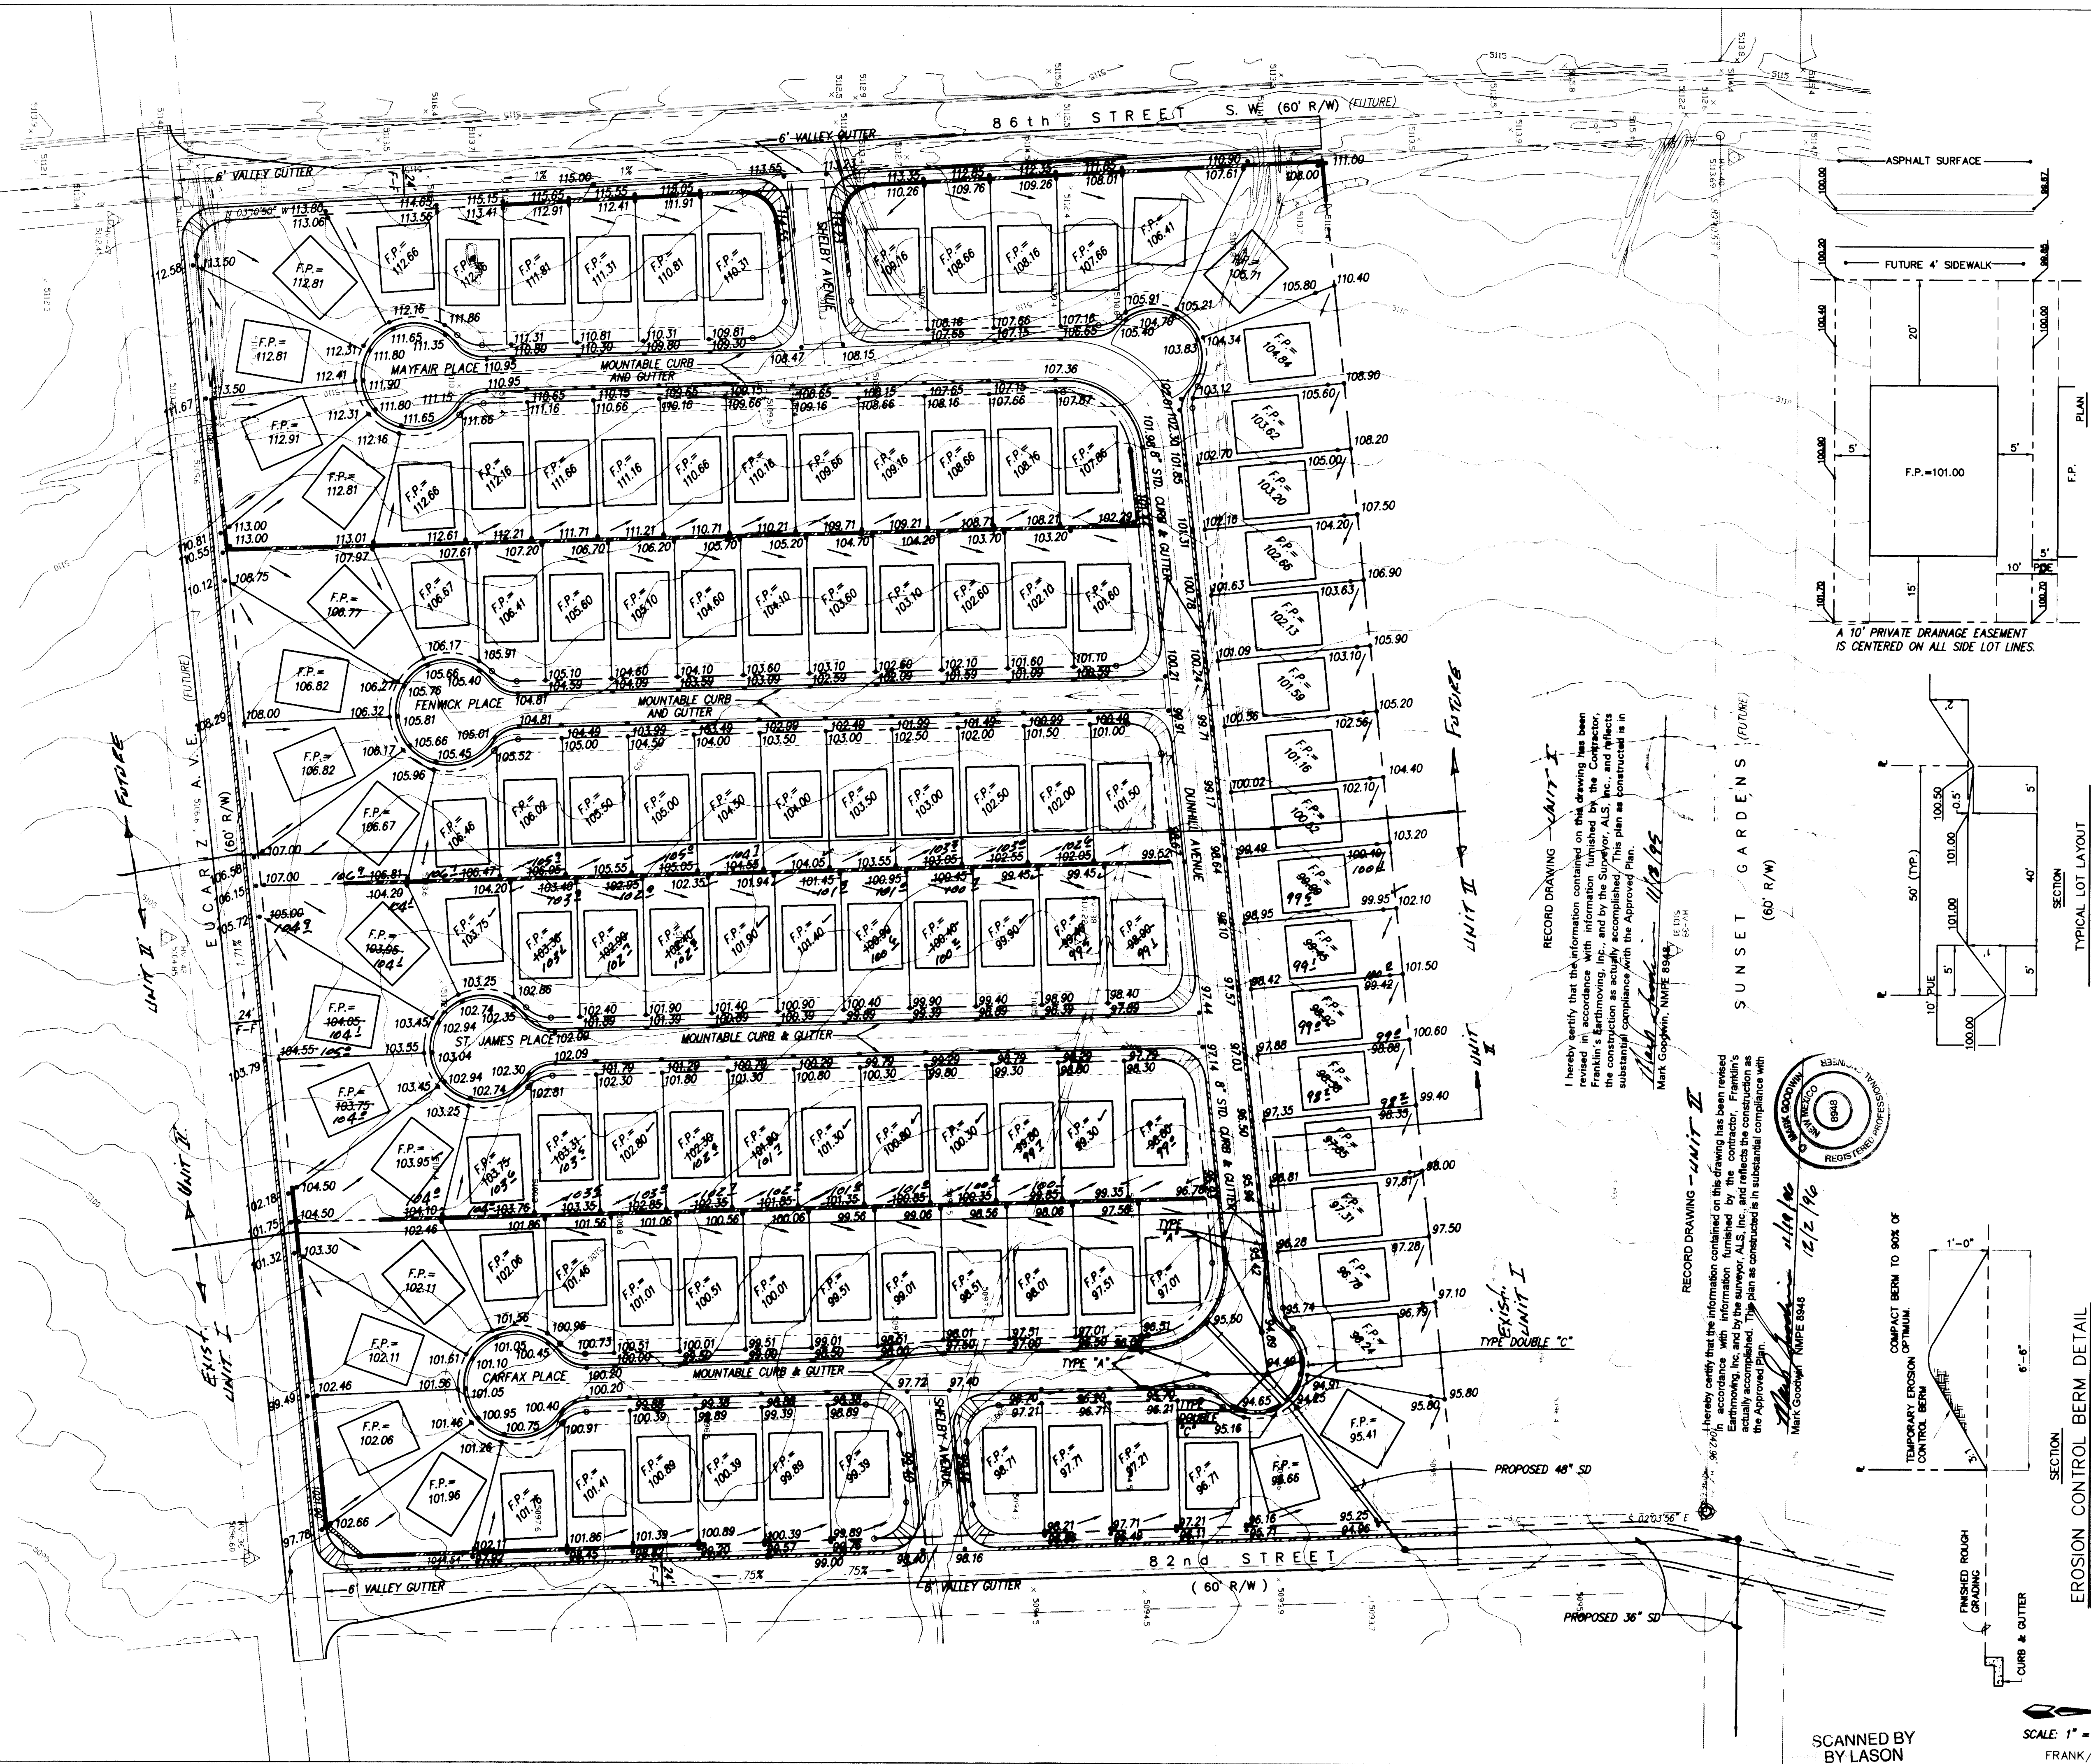

AS BUILT INFORMATION

CONTRACTOR: **Franklin's**

WORK BY: **ALS**

DATE: **7/96**

INSPECTED BY: **ALS**

DATE: **7/96**

ACCEPTANCE BY: **ALS**

DATE: **7/96**

REVISIONS BY: **ALS**

DATE: **7/96**

CHECKED BY: **ALS**

DATE: **7/96**

RECORDED BY: **ALS**

DATE: **7/96**

VICINITY MAP

L-9-Z

LEGAL DESCRIPTION

TRACTS 53-56, TOWN OF ATRISCO GRANT UNIT 2

GENERAL NOTES

- CONTRACTOR MUST OBTAIN A TOPSOIL DISTURBANCE PERMIT FROM THE ENVIRONMENTAL HEALTH DIVISION PRIOR TO CONSTRUCTION.
- CITY OF ALBUQUERQUE STANDARD SPECIFICATIONS FOR PUBLIC WORKS CONSTRUCTION, LATEST EDITION SHALL GOVERN ALL WORK.
- THE CONTRACTOR SHALL CONFORM TO ALL CITY, COUNTY, STATE AND FEDERAL DUST CONTROL MEASURES AND REQUIREMENTS AND WILL BE RESPONSIBLE FOR PREPARING AND OBTAINING ALL NECESSARY APPLICATIONS AND APPROVALS.
- THE CONTRACTOR SHALL ENSURE THAT NO SOIL ERODES FROM THE LOTS INTO PUBLIC RIGHT-OF-WAY. THIS CAN BE ACHIEVED BY CONSTRUCTING TEMPORARY BERMS AS PER DETAIL. THIS SHEET AND METTING THE SOIL TO KEEP IT FROM BLOWING.
- THE EARTHWORK CONTRACTOR SHALL STOCKPILE ENOUGH MATERIALS ADJACENT TO RETAINING WALL LOCATIONS TO BE UTILIZED FOR WALL BACKFILL.
- ALL CONCRETE CURBING TO BE 4000 PSI @ 28 DAYS.

LEGEND

STANDARD CURB & GUTTER

NEW RETAINING WALL

F.P. = FINISHED PAD ELEVATION

PROPOSED SPOT ELEVATION

FLOW LINE

EROSION CONTROL NOTES

- CONTRACTOR IS RESPONSIBLE FOR OBTAINING A TOPSOIL DISTURBANCE PERMIT PRIOR TO WORK BEGINNING.
- CONTRACTOR IS RESPONSIBLE FOR KEEPING ALL SEDIMENT OUT OF EXISTING RIGHT-OF-WAY.
- CONTRACTOR IS RESPONSIBLE FOR CLEANING UP ANY SEDIMENT THAT GETS INTO EXISTING RIGHT-OF-WAY.
- EROSION CONTROL BERMS ARE REQUIRED AROUND ENTIRE SITE.
- ALL EROSION CONTROL BERMS MUST BE IN PLACE AND ENGINEER CERTIFIED PRIOR TO BUILDING PERMIT RELEASE.

dmg

D. MARK GOODWIN & ASSOCIATES, P.A.

CONSULTING ENGINEERS & SURVEYORS

P.O. BOX 90606

ALBUQUERQUE, NEW MEXICO 87199

(505) 345-2010

CITY OF ALBUQUERQUE

PUBLIC WORKS DEPARTMENT

ENGINEERING GROUP

TITLE: **POINTE WEST SUBDIVISION MASTER GRADING PLAN**

APPROVALS	ENGINEER	DATE	APPROVALS	ENGINEER	DATE
DRC CHAIRMAN	<i>B. J. Bailey</i>	11-21-94	WATER		
TRANSPORTATION	<i>B. J. Bailey</i>	11-22-94	WASTE WATER	<i>688</i>	<i>11/24/94</i>
HYDROLOGY	<i>B. J. Bailey</i>	11-7-94			


PROJECT NO.	MAP NO.	SHEET	OF
5048.9	L9	4	12


SCANNED BY LASON

SCALE: 1" = 60'

FRANK/GD60



26-5048.91 10497

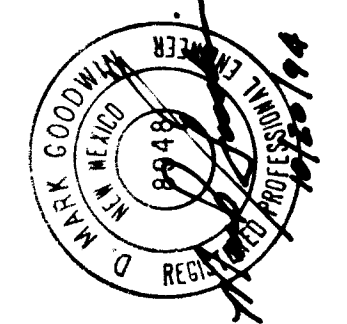

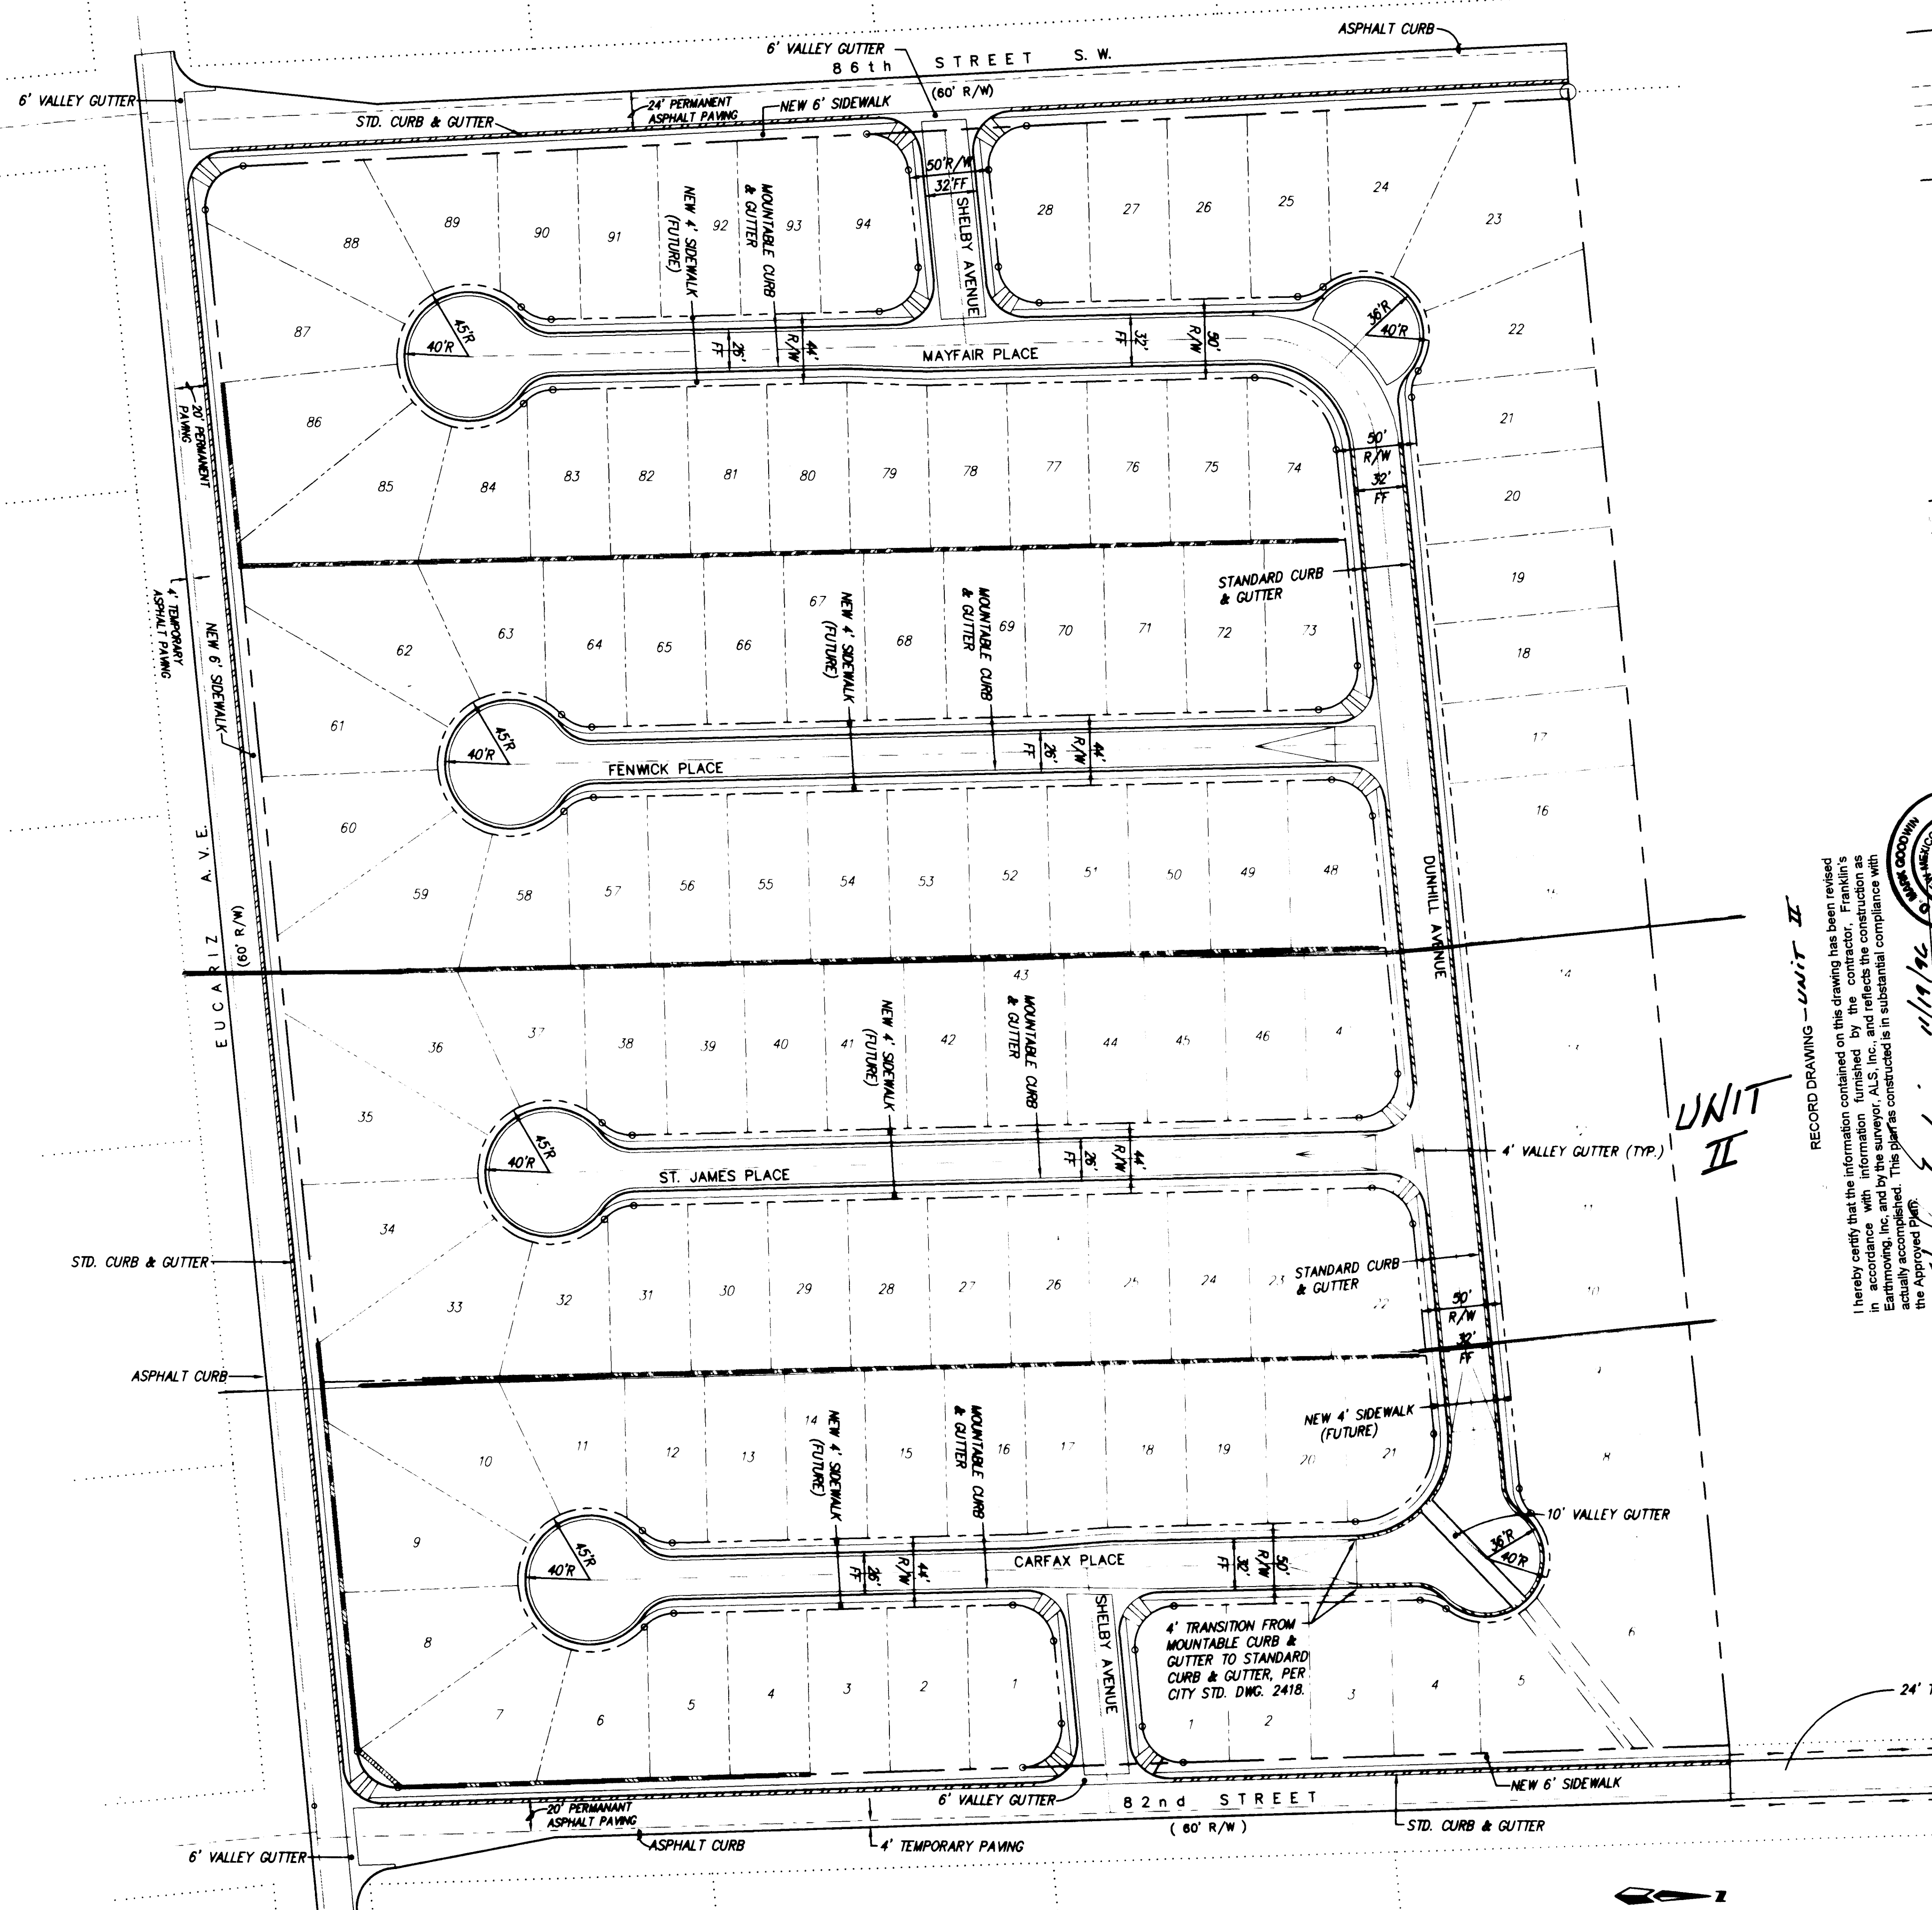

UNIT II

RECORD DRAWING - UNIT II
I hereby certify that the information contained on this drawing has been revised in accordance with information furnished by the Contractor, Franklin's Earthmoving, Inc., and reflects the construction as actually accomplished. This plan as constructed is in substantial compliance with the Approved Plan.
Mark Goodwin, NMPE 8948

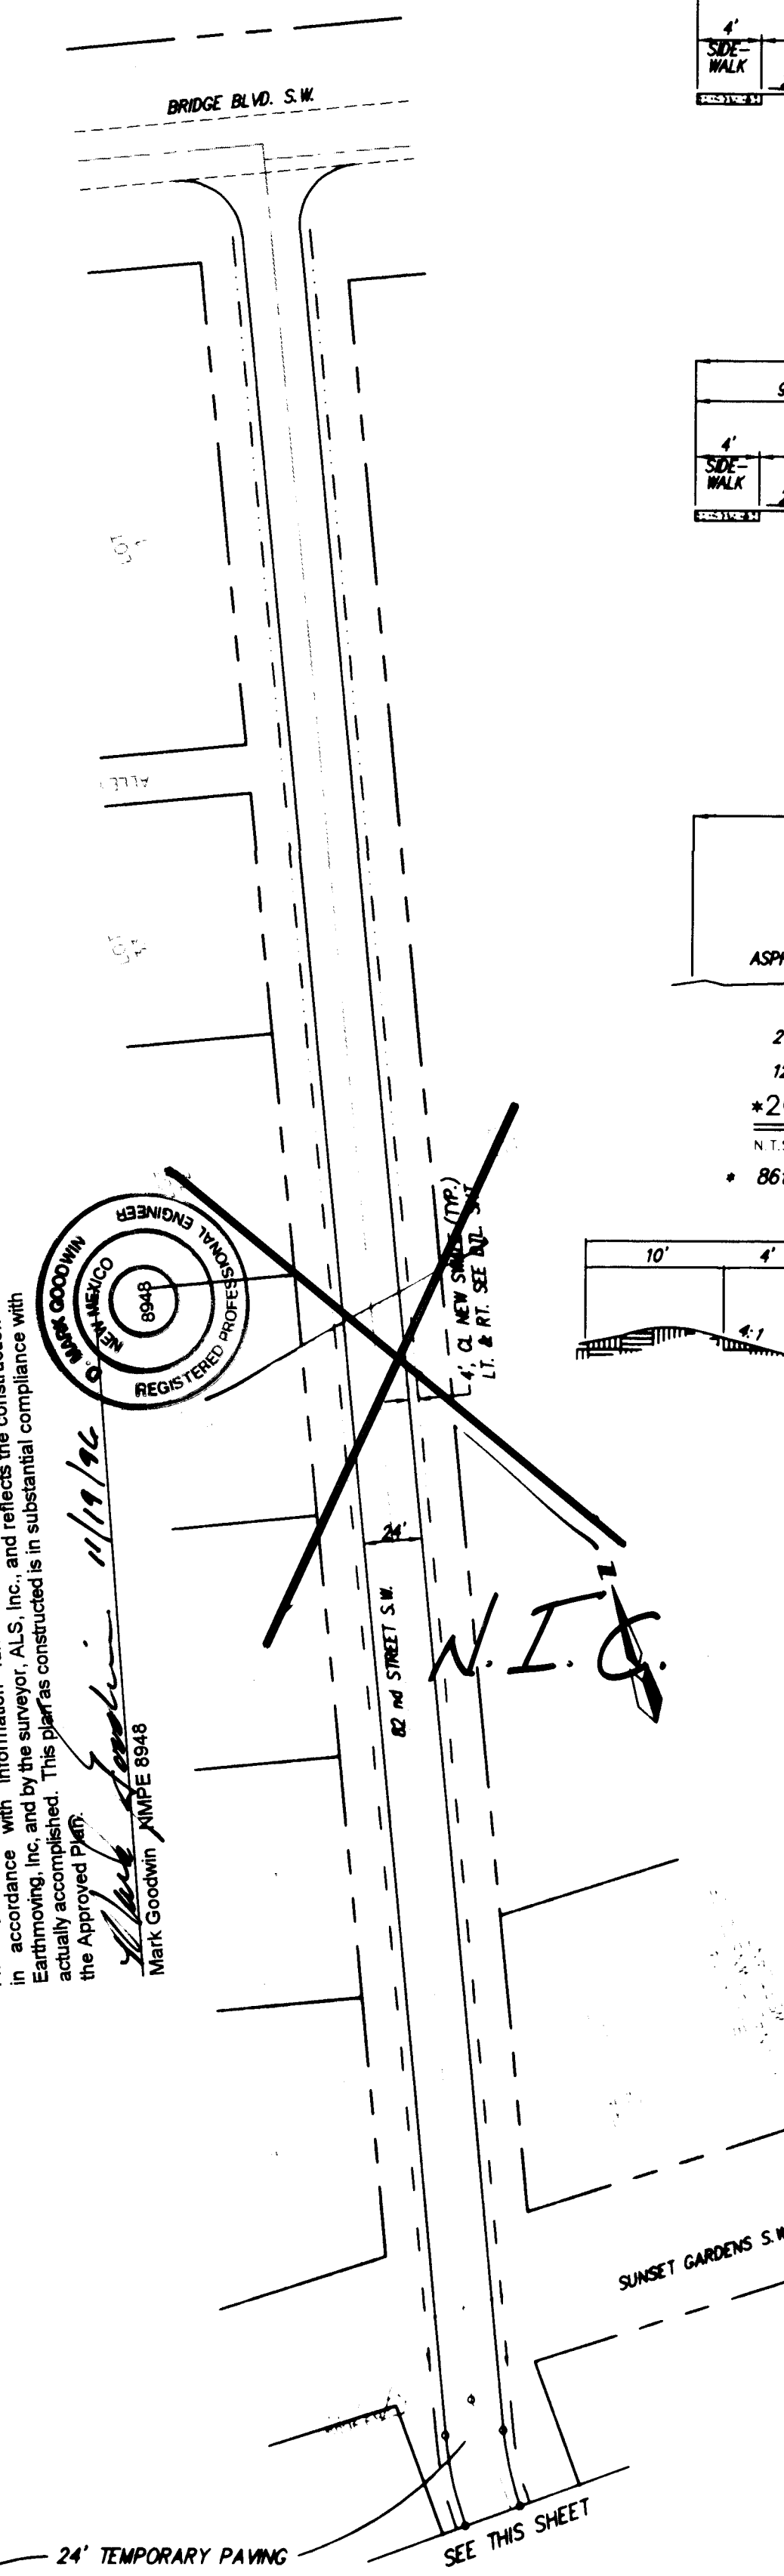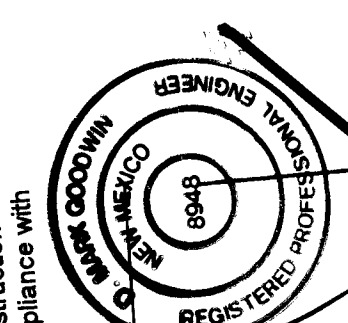

GENERAL NOTES

1. ALL VALLEY GUTTERS ARE TO HAVE 3/4" INVERT. PER CITY STD. DWG. 2422.
2. ALL 4' INTERIOR SIDEWALKS ARE DEFERRED.
3. ALL HANDICAP RAMPS TO BE CASE 2. PER CITY STD. DWG. 2441.
4. TRANSITION SECTION FROM FULL CROWN TO NO CROWN TO BE A MINIMUM OF 50'.


LEGEND

	STANDARD CURB & GUTTER
	NEW RETAINING WALL
	HANDICAP RAMP

dmg D. MARK GOODWIN & ASSOCIATES, P.A.
CONSULTING ENGINEERS & SURVEYORS
P.O. BOX 90606
ALBUQUERQUE, NEW MEXICO 87199
(505) 345-2010

CITY OF ALBUQUERQUE PUBLIC WORKS DEPARTMENT ENGINEERING GROUP					
UNIT II POINTE WEST SUBDIVISION MASTER PAVING PLAN					
APPROVALS		ENGINEER	DATE	APPROVALS	ENGINEER
DRC CHAIRMAN			11-21-94	WATER	
TRANSPORTATION			11-07-94	WASTE WATER	
HYDROLOGY		WA POC	11-7-94		
PROJECT NO.		5048.91	MAP NO.	L9	SHEET 5 OF 12

I hereby certify that the information contained on this drawing has been revised in accordance with information furnished by the Contractor, Franklin's Earthmoving, Inc., and reflects the construction as actually accomplished. This plan as constructed is in substantial compliance with the Approved Plan.
Mark Goodwin, NMPE 8948

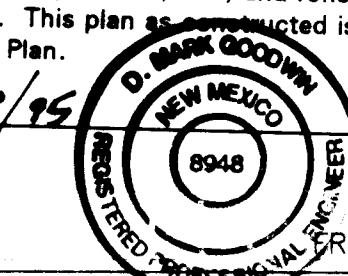



SCANNED BY LASON

26-5048.91 0597



- RECORD DRAWING - UNIT II


Mark Goodwin NMPE 8948 11/19/96

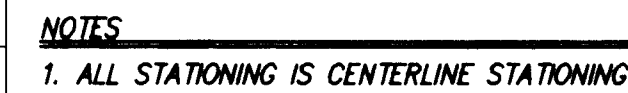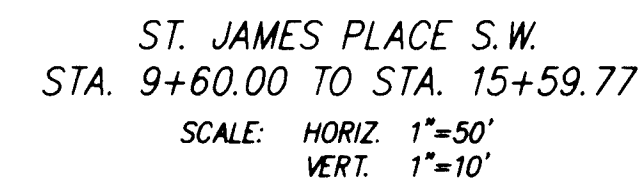

dmg D. MARK GOODWIN & ASSOCIATES, P.A.
CONSULTING ENGINEERS & SURVEYORS
P.O. BOX 90606
ALBUQUERQUE, NEW MEXICO 87199
(505) 345-2010


APPROVALS	ENGINEER	DATE	APPROVALS	ENGINEER	DATE
DRC CHAIRMAN	B.G. Ashby	11-21-94	WATER		
TRANSPORTATION	R. Davis	11-02-99	WASTE WATER		
HYDROLOGY	N/A DPC	11-7-94			

PROJECT NO.	5048.91	MAP NO. L9	SHEET 7	OF 12
----------------	---------	---------------	------------	----------

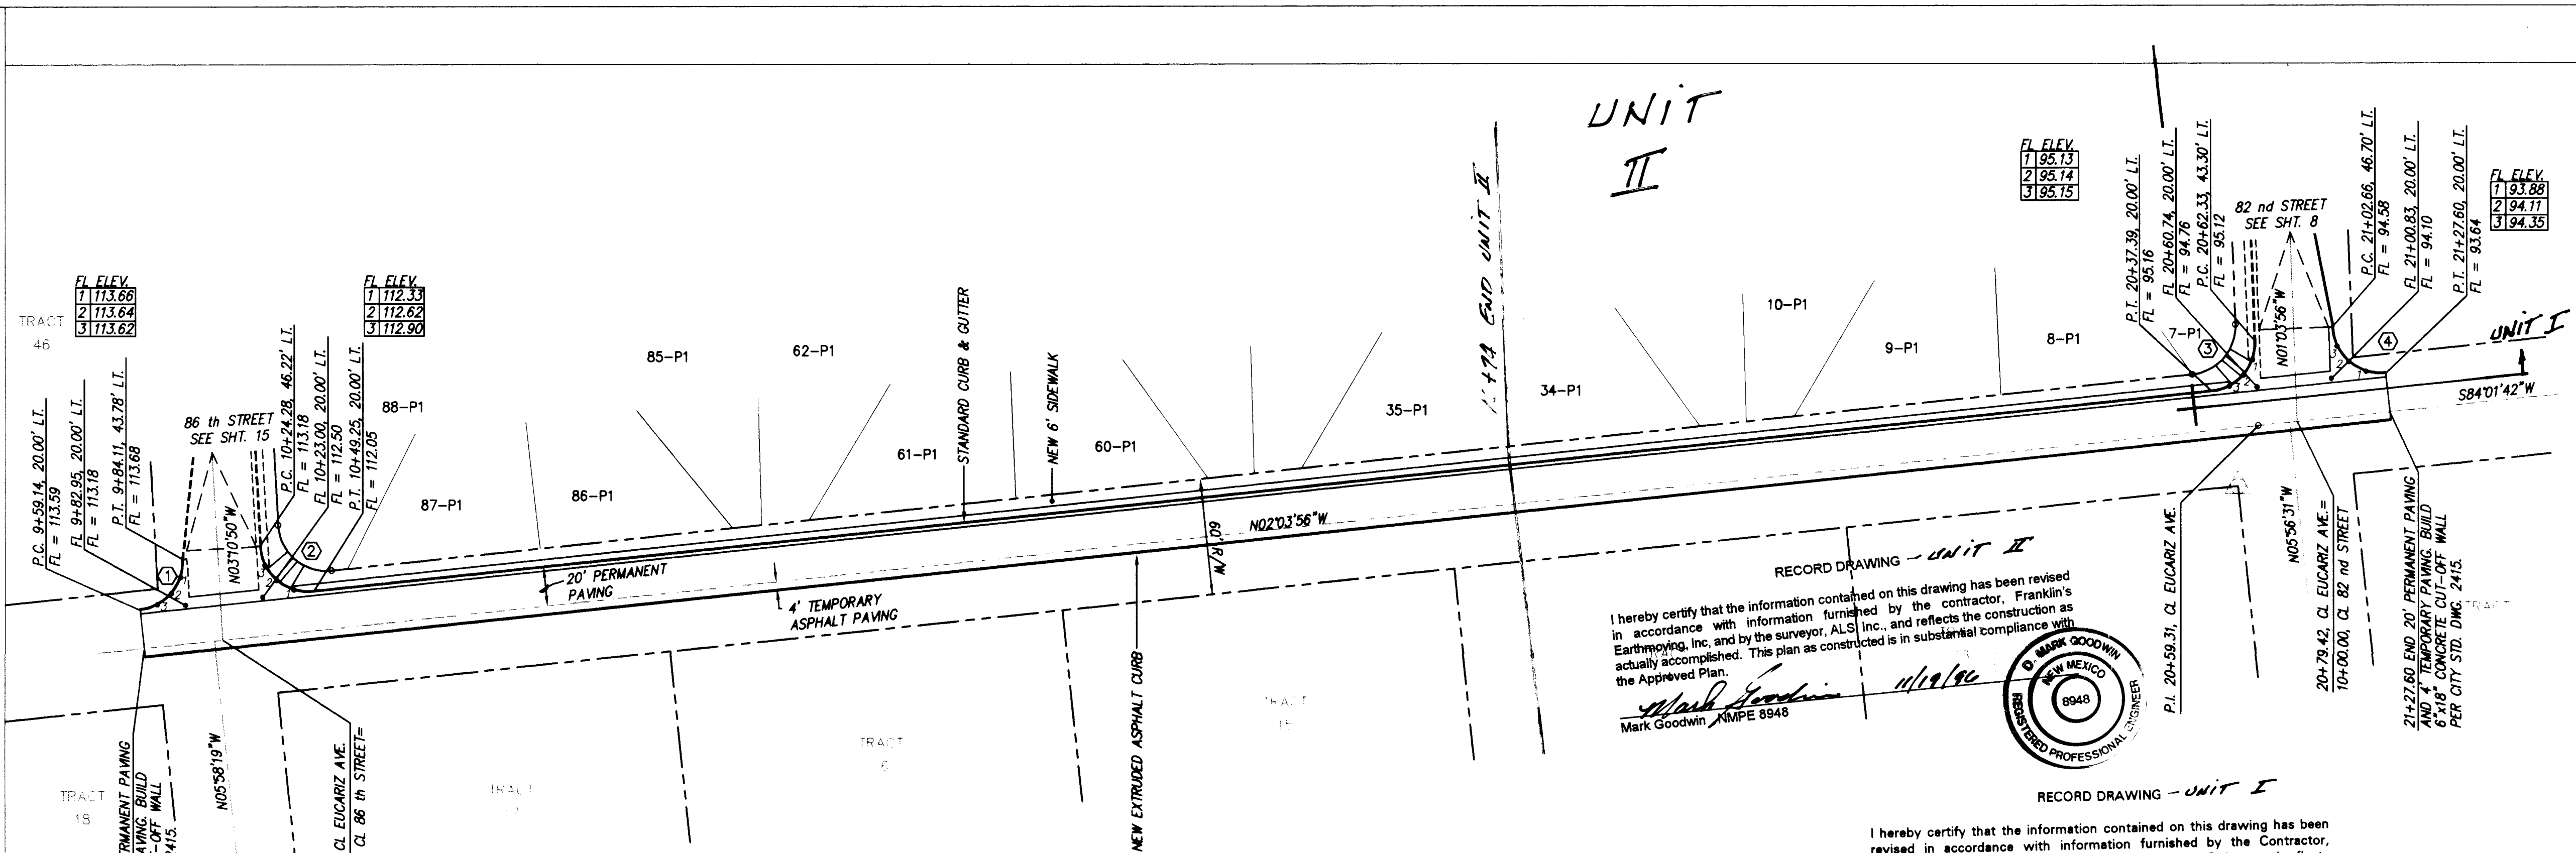

CURVE DATA - DESCRIBES FACE OF CURB

① $\Delta = 87^{\circ}12'31''$ $R = 25.00'$ $L = 38.05'$ $T = 23.81'$	② $\Delta = 92^{\circ}47'29''$ $R = 25.00'$ $L = 40.49'$ $T = 26.25'$	③ $\Delta = 86^{\circ}05'37''$ $R = 25.00'$ $L = 37.57'$ $T = 23.35'$
④ $\Delta = 93^{\circ}54'22''$ $R = 25.00'$ $L = 40.97'$ $T = 26.77'$		

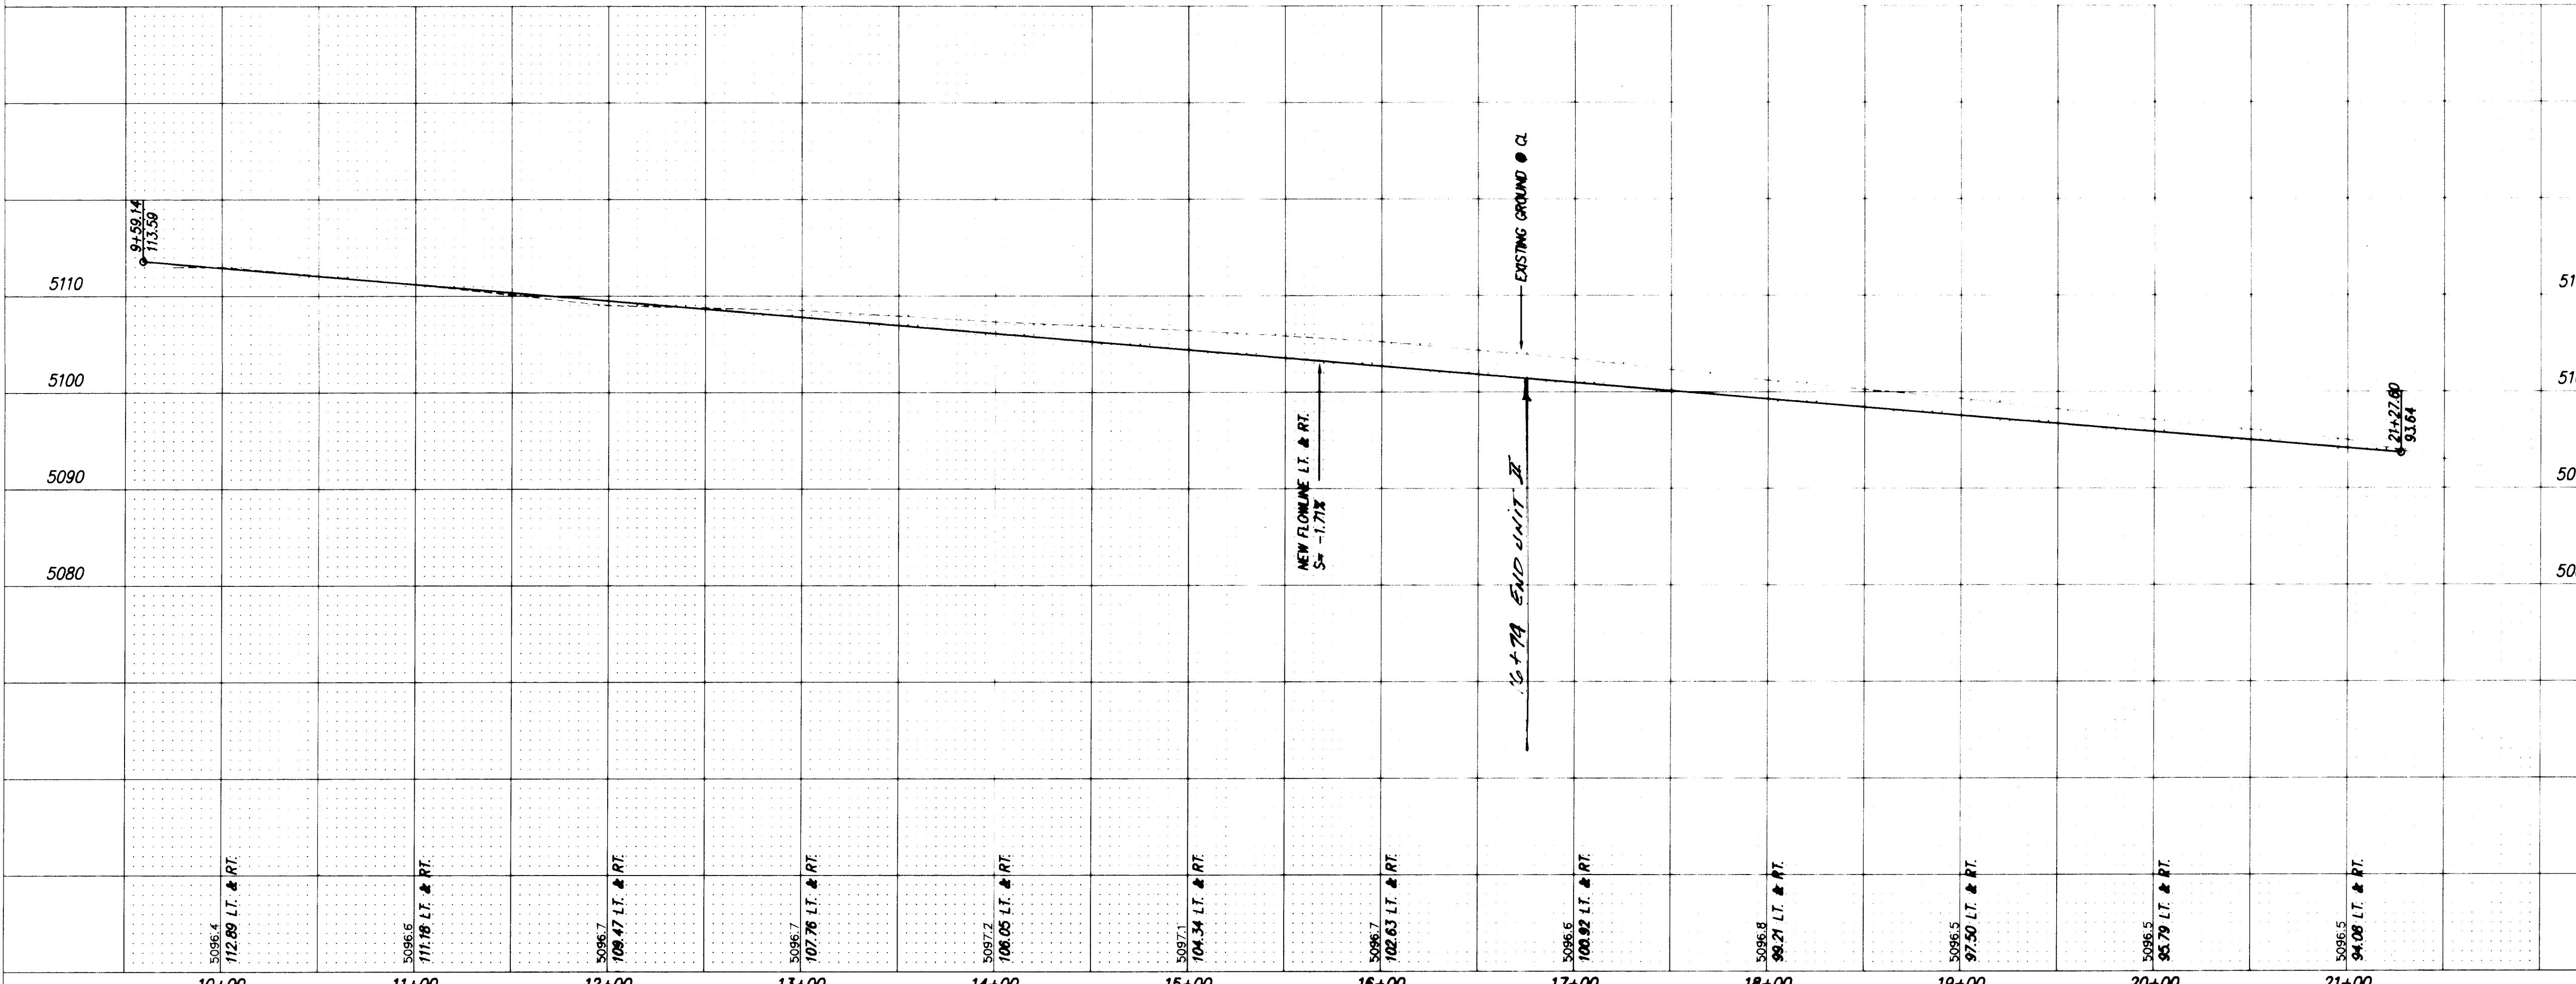

NOTES

- ALL STATIONING IS CENTERLINE STATIONING
- NORTHWEST CURB RETURN AT INTERSECTION OF EUCARIZ AVE. AND 86th STREET TO BE STANDARD CURB & GUTTER.

AS BUILT INFORMATION

TRACTOR	DATE	7/95
INSPECTOR'S	DATE	7/95
FIELD	DATE	7/95
VERIFICATION BY	DATE	7/95
CORRECTED BY	DATE	7/95
RECORDED BY	DATE	7/95

BENCH MARKS

THE STATION IS AN ACS 3 1/4" ALUM. CAP RIVETED TO A PIPE 0.20' ABOVE GROUND AND IS STAMPED "7-K9, 1989" TO REACH THE STATION FROM THE INTERSECTION OF I-40 AND UNSEB BLVD., TRAVEL SOUTH ON UNSEB BLVD. 1.3 MILES TO CENTRAL AVE., THEN WEST ON CENTRAL AVE. 0.58 MILES TO STATION ON THE CENTER MEDIAN OF CENTRAL AVE. THE STATION IS 530' EAST OF CENTERLINE OF 90TH ST.

SURVEY INFORMATION

NO.	BY	DATE

ENGINEER'S SEAL

REVISIONS

NO.	DATE	REMARKS	DESIGNED BY	DRAWN BY	CHECKED BY

APPROVALS

ENGINEER	DATE	APPROVALS	ENGINEER	DATE


PROJECT NO. 5048.91 **MAP NO.** L9, L10 **SHEET** 8 **OF** 12

PROJECT TITLE: CITY OF ALBUQUERQUE
PUBLIC WORKS DEPARTMENT
ENGINEERING GROUP
POINT WEST SUBDIVISION
OFFSITE PAVING IMPROVEMENTS
EUCARIZ AVENUE S.W.

SCANNED BY LASON **FRANK\EUC-PP1**

26-5048.91

SANITARY SEWER SERVICES					
BLK2 LOT	STA.	INV. ELEV. PL	LENGTH PL	INV. ELEV. M.H.	
21	11+16	5094.17	25.00	N/A	
20	11+66	5093.71	25.00	N/A	
19	12+16	5093.24	25.00	N/A	
18	12+66	5092.78	25.00	N/A	
17	13+16	5092.34	25.00	N/A	
16	13+66	5092.14	25.00	N/A	
15	14+16	5091.94	25.00	N/A	
14	14+66	5091.74	25.00	N/A	
13	15+16	5091.54	25.00	N/A	
12	15+66	5091.24	25.00	N/A	
11	16+16	5091.04	25.00	N/A	
10	16+66	5090.84	25.00	N/A	
9	17+16	5090.64	25.00	N/A	

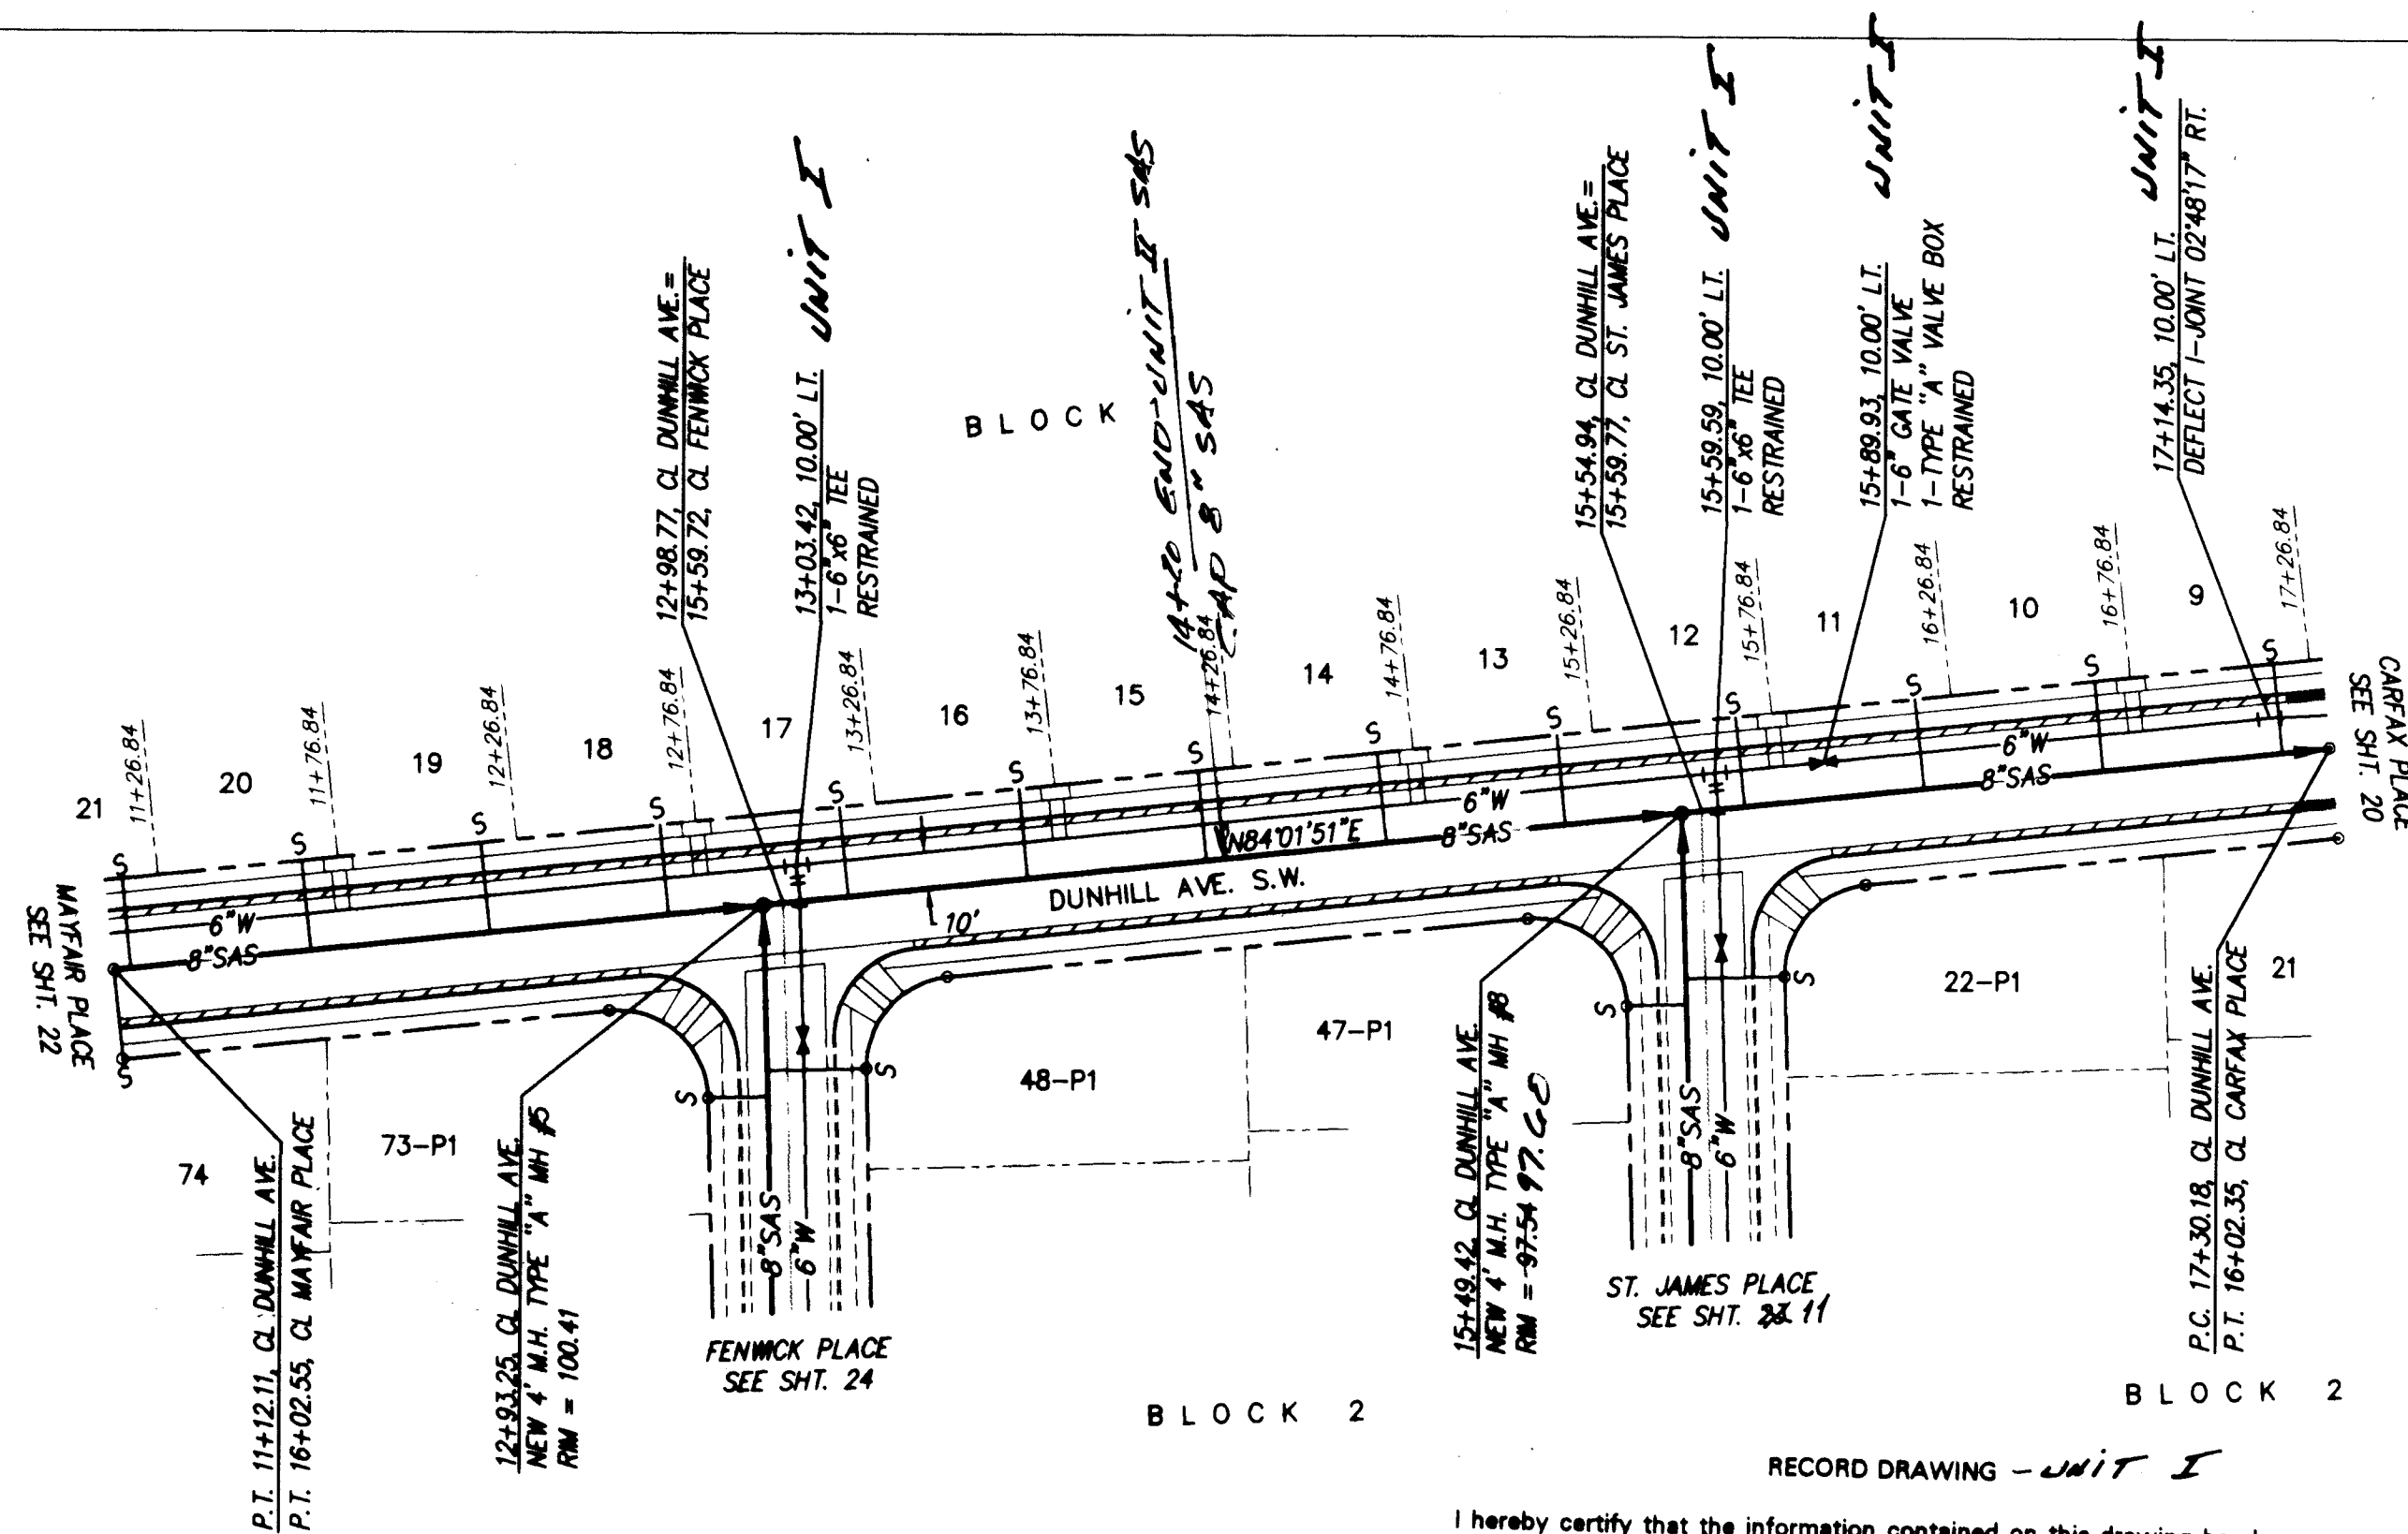

I hereby certify that the information contained on this drawing has been revised in accordance with information furnished by the Contractor, Franklin's Earthmoving, Inc., and by the Surveyor, ALS, Inc., and reflects the construction as actually accomplished. This plan as constructed is in substantial compliance with the Approved Plan.

Mark Goodwin, NMPE 8948


RECORD DRAWING - UNIT II

I hereby certify that the information contained on this drawing has been revised in accordance with information furnished by the Contractor, Franklin's Earthmoving, Inc. and by the Surveyor, ALS, Inc., and reflects the construction as actually accomplished. This plan as constructed is in substantial compliance with the Approved Plan.

Mark Goodwin, NMPE 8948




DUNHILL AVENUE
STA. P.T. 11+21.11 TO STA. P.C. 17+30.18
SCALE: HORIZ. 1"=50'
VERT. 1"=10'

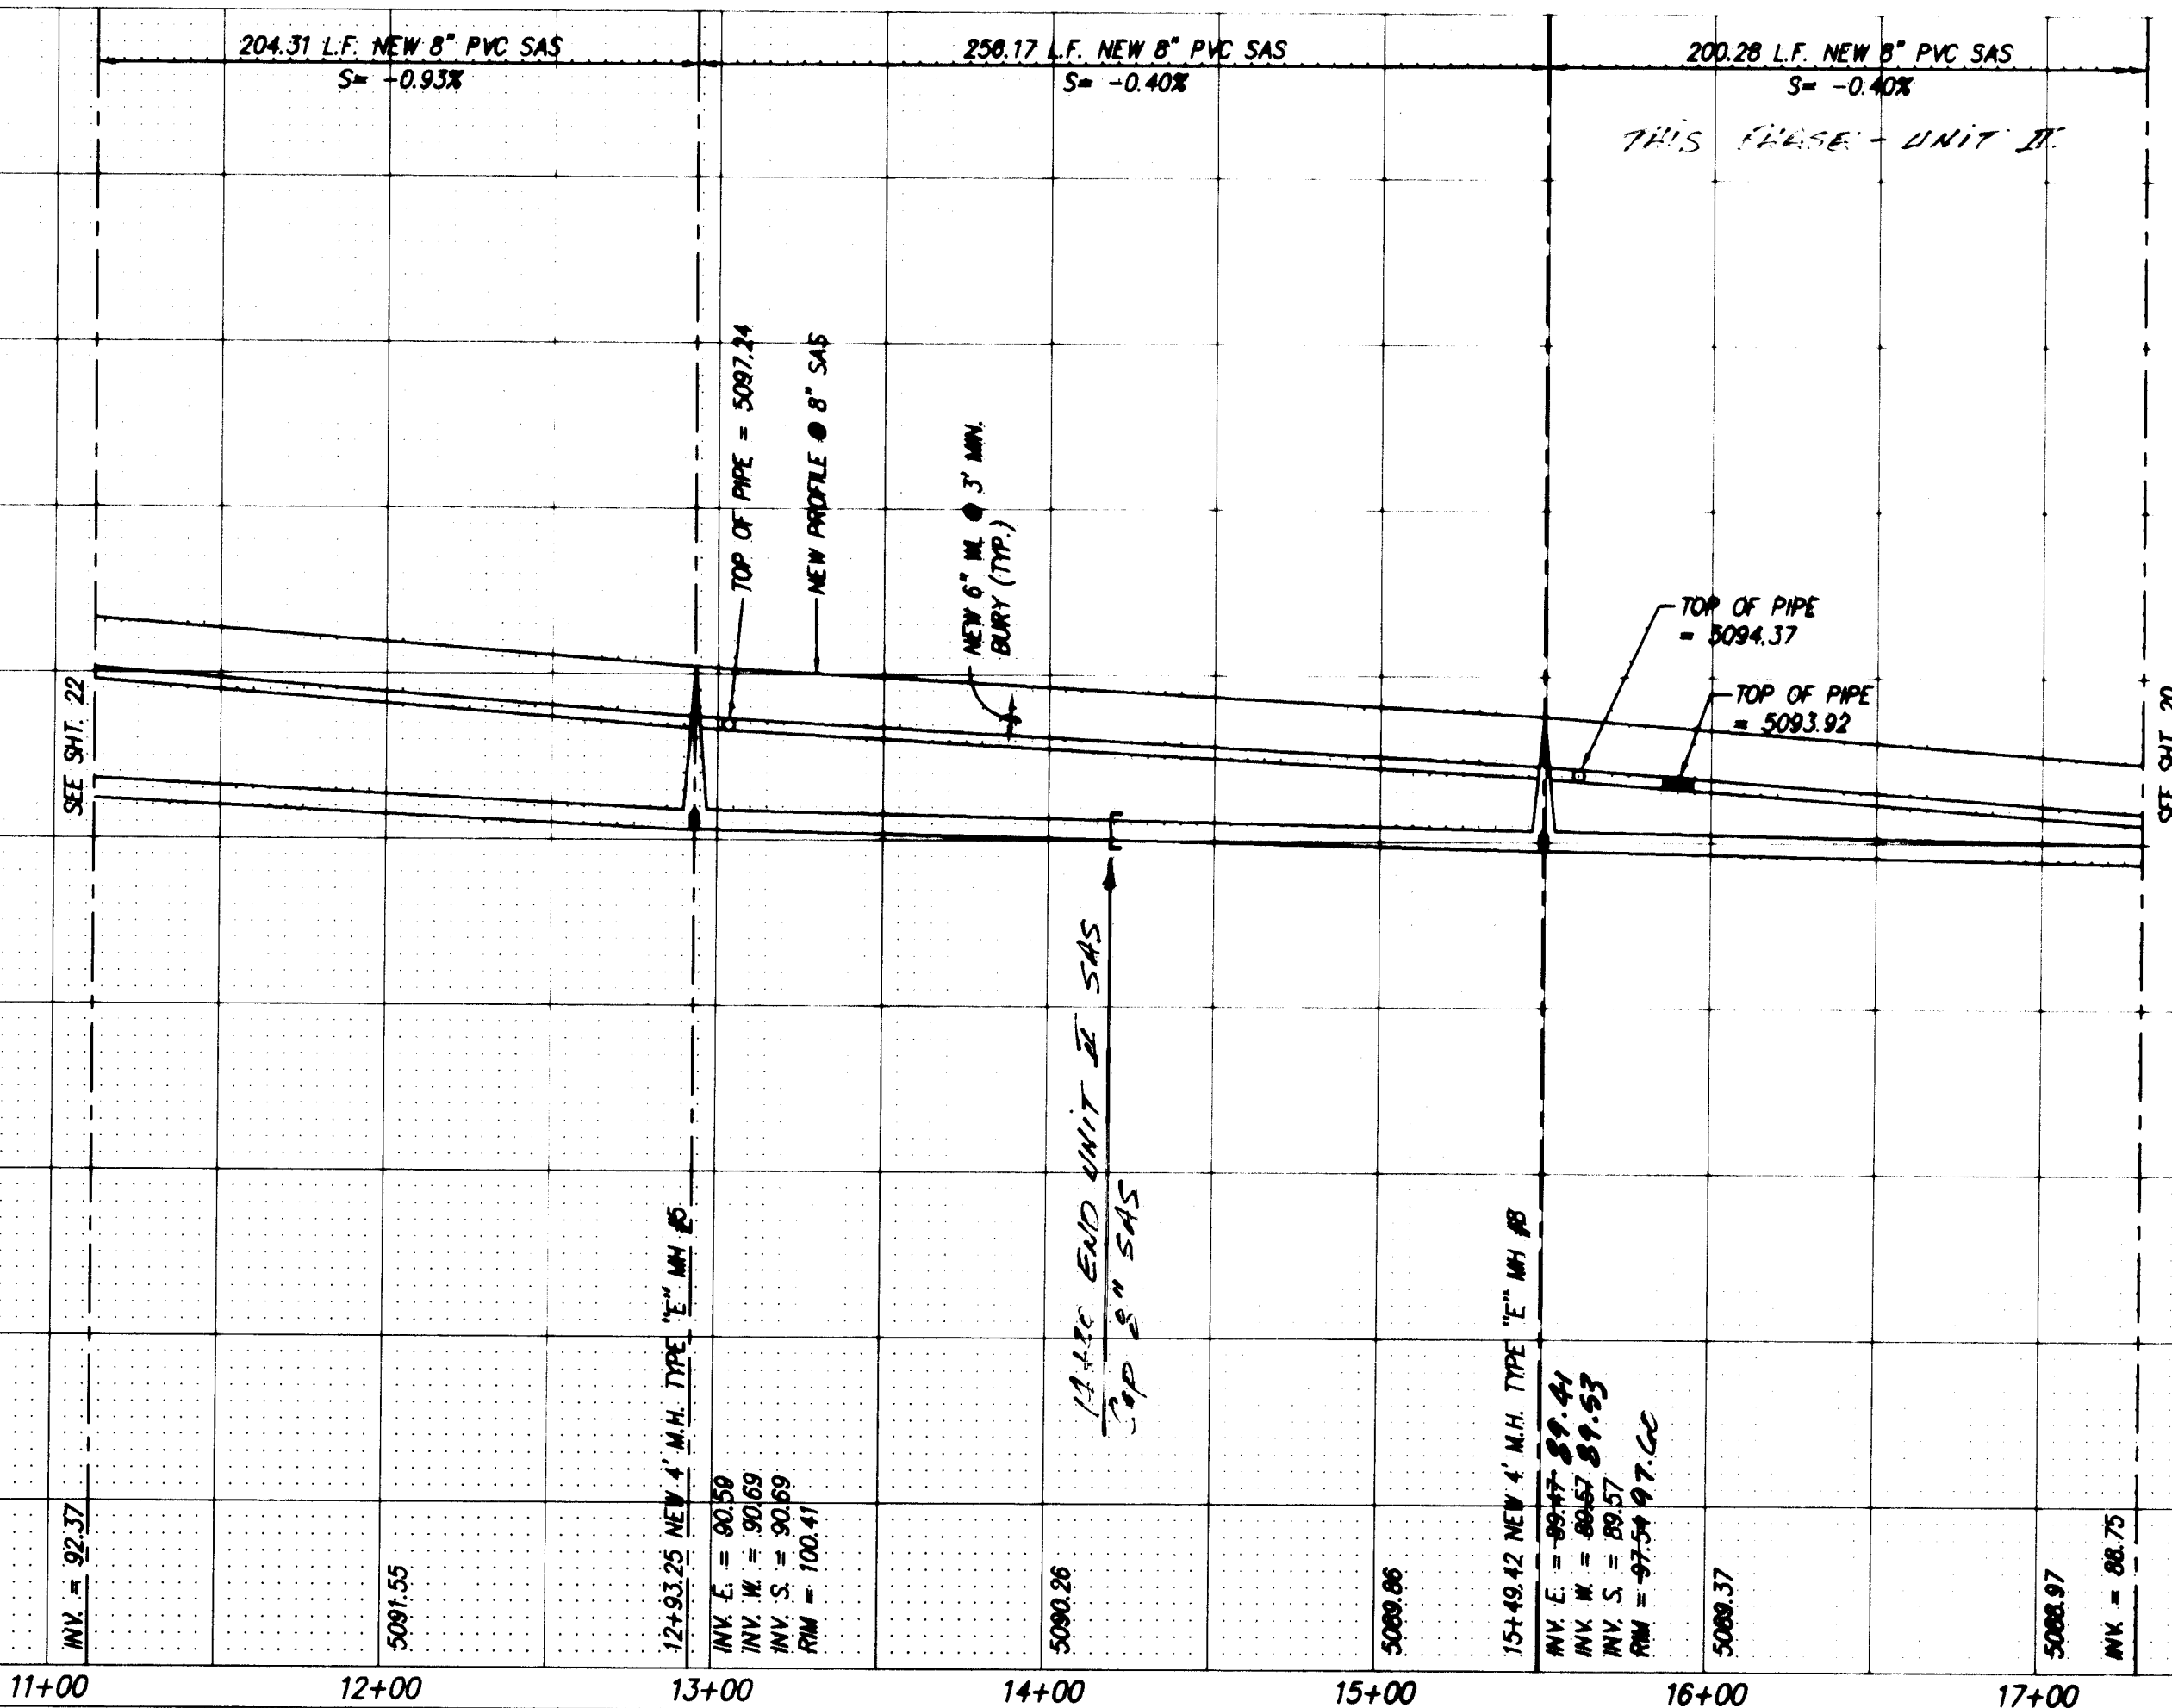

NOTES
1. ALL STATIONING IS CENTERLINE STATIONING

AS BUILT INFORMATION			BENCH MARKS		
CONTRACTOR	DATE	DATE	THE STATION IS AN ACS 3 1/4" ALUM. CAP RIVETED TO A PIPE	DATE	DATE
INSPECTED BY	DATE	DATE	0.20' ABOVE GROUND AND IS STAMPED "7-K9 1989" TO REACH	DATE	DATE
ACCEPTANCE BY	DATE	DATE	THE STATION FROM THE INTERSECTION OF I-40 AND UNTER BLVD.	DATE	DATE
VERIFICATION BY	DATE	DATE	TRAVEL SOUTH ON UNTER BLVD. 1.3 MILES TO CENTRAL AVE. THEN	DATE	DATE
DRAWN BY	DATE	DATE	WEST ON CENTRAL AVE. 0.88 MILES TO STATION ON THE CENTER	DATE	DATE
CHECKED BY	DATE	DATE	MEAN OF CENTRAL AVE. THE STATION IS 530' EAST OF CENTERLINE	DATE	DATE
RECORDED BY	DATE	DATE	OF 90TH ST.	DATE	DATE
NO.			X=553,815.77, Y=1,432,842.08, Z=5137.363		

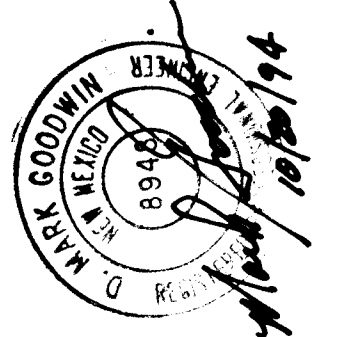

dmg D. MARK GOODWIN & ASSOCIATES, P.A.
CONSULTING ENGINEERS & SURVEYORS
P.O. BOX 90606
ALBUQUERQUE, NEW MEXICO 87199
(505) 345-2010

CITY OF ALBUQUERQUE
PUBLIC WORKS DEPARTMENT
ENGINEERING GROUP
TITLE: POINTE WEST SUBDIVISION
UTILITY IMPROVEMENTS
DUNHILL AVENUE S.W.

APPROVALS	ENGINEER	DATE	APPROVALS	ENGINEER	DATE
DRC CHAIRMAN	11-21-94	11-21-94	WATER		
TRANSPORTATION	11-21-94	11-21-94	WASTE WATER		
HYDROLOGY	11-21-94	11-21-94			


PROJECT NO.	5048.91	MAP NO.	L9	SHEET OF	10 12
-------------	---------	---------	----	----------	-------

26-5048.91 11/21/94

SCANNED BY
BY LASON

FRANK\DUN-UT1


SANITARY SEWER SERVICES				
BLK2 LOT	STA.	INV. ELEV. PL	LENGTH PL	INV. ELEV. M.H.
22-P1	15+13.20	5091.87	17.50	N/A
23-P1	14+75	5092.20	17.50	N/A
24-P1	14+25	5092.64	17.50	N/A
25-P1	13+75	5093.08	17.50	N/A
26-P1	13+25	5093.52	17.50	N/A
27-P1	12+75	5094.06	17.50	N/A
28-P1	12+25	5094.51	17.50	N/A
29-P1	11+75	5094.96	17.50	N/A
30-P1	11+25	5095.41	17.50	N/A
31-P1	10+75	5095.86	17.50	N/A
32-P1	10+25	5096.32	32.76	N/A
33-P1	9+78	5095.97	41.02	5094.97
34-P1	9+54	5095.92	43.22	5094.97
35-P1	9+45	5095.86	45.93	5094.97
36-P1	9+72	5095.78	48.83	5094.97
37-P1	10+13	5096.61	47.32	N/A
38-P1	10+63	5095.74	26.50	N/A
39-P1	11+13	5095.29	26.50	N/A
40-P1	11+63	5095.84	26.50	N/A
41-P1	12+13	5094.39	26.50	N/A
42-P1	12+63	5093.94	26.50	N/A
43-P1	13+13	5093.41	26.50	N/A
44-P1	13+63	5092.97	26.50	N/A
45-P1	14+13	5092.53	26.50	N/A
46-P1	14+63	5092.09	26.50	N/A
47-P1	15+06.05	5091.71	26.50	N/A

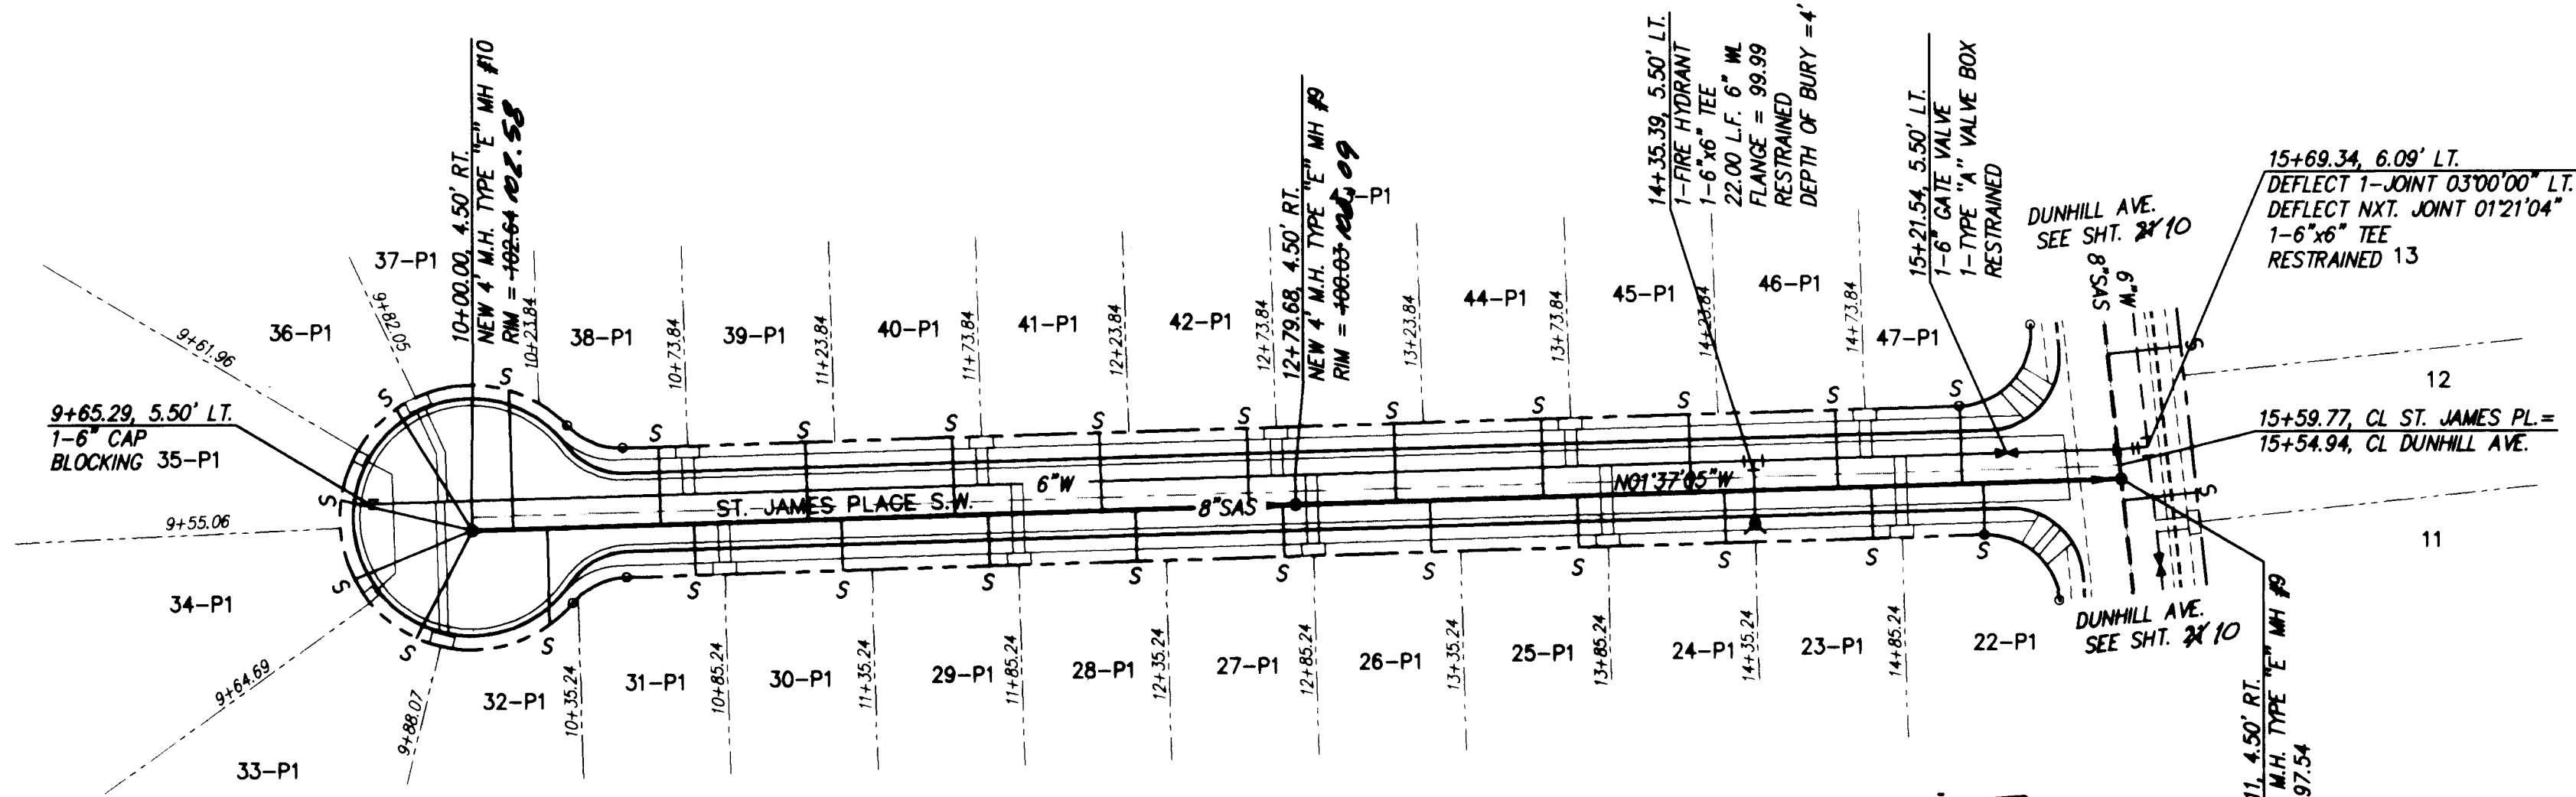


BLOCK 2 RECORD DRAWING - UNIT II

I hereby certify that the information contained on this drawing has been revised in accordance with information furnished by the contractor, Franklin's Earthmoving, Inc. and by the surveyor, A.L.S. Inc., and reflects the construction as actually accomplished. This plan as constructed is in substantial compliance with the Approved Plan.

Mark Goodwin 11/18/94
Mark Goodwin, NMPE 8948

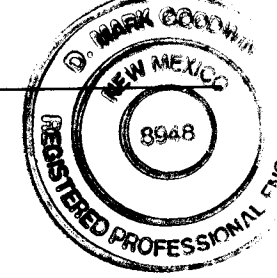

ST. JAMES PLACE S.W.
STA. 10+00.00 TO STA. 15+61.90
SCALE: HORIZ. 1"=50'
VERT. 1"=10'

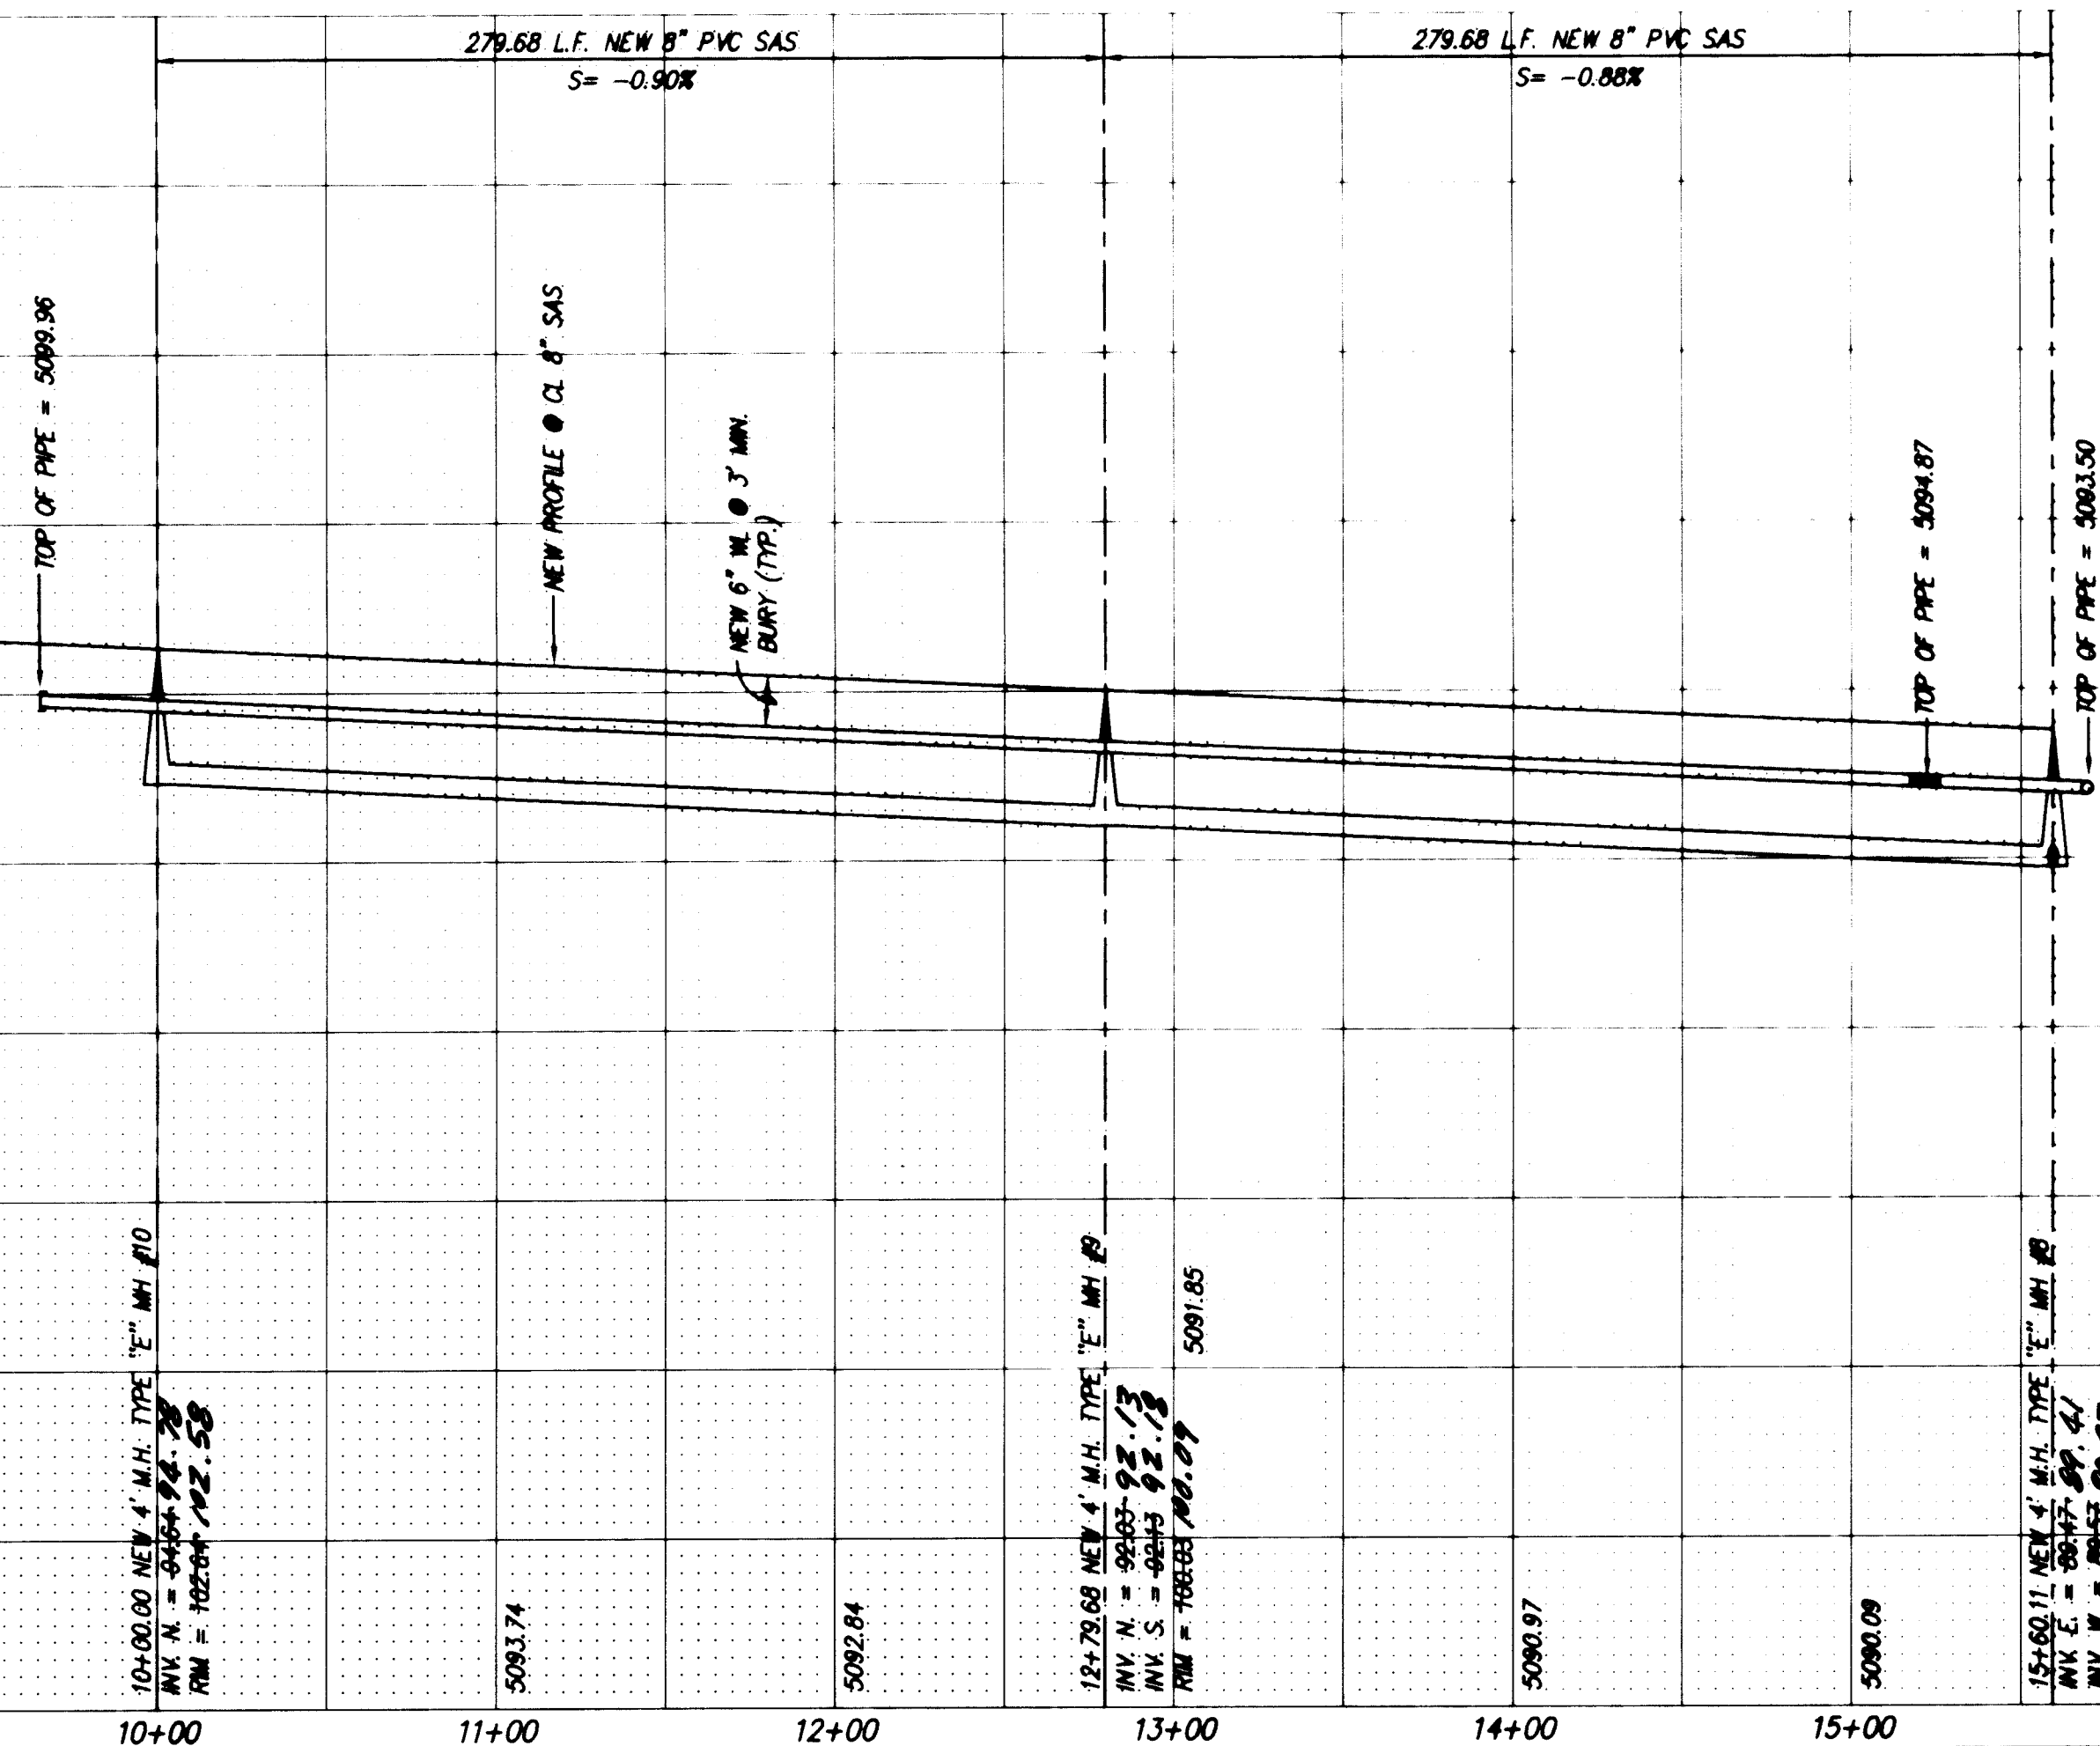

NOTES
1. ALL STATIONING IS CENTERLINE STATIONING

AS BUILT INFORMATION			BENCH MARKS			SURVEY INFORMATION			ENGINEER'S SEAL		
CONTRACTOR	DATE	NO.	THE STATION IS AN ACS 3 1/4" ALUM. CAP RIVETED TO A PIPE 0.20' ABOVE GROUND AND IS STAMPED "7-KB 1989" TO REACH THE STATION FROM THE INTERSECTION OF I-40 AND UNSET BLVD., TRAVEL SOUTH ON UNSET BLVD. 1.3 MILES TO CENTRAL AVE., THEN WEST ON CENTRAL AVE. 0.58 MILES TO STATION ON THE CENTER MEDIAN OF CENTRAL AVE. THE STATION IS 530 EAST OF CENTERLINE OF 90TH ST.	DATE	NO.	NO.	DATE	NO.	NO.	DATE	NO.
INSPECTOR'S	DATE	NO.		DATE	NO.	DATE	NO.	DATE	NO.	DATE	NO.
FIELD BY	DATE	NO.		DATE	NO.	DATE	NO.	DATE	NO.	DATE	NO.
VERIFICATION BY	DATE	NO.		DATE	NO.	DATE	NO.	DATE	NO.	DATE	NO.
CHECKED BY	DATE	NO.		DATE	NO.	DATE	NO.	DATE	NO.	DATE	NO.
MICRO-FILM INFORMATION			MICRO-FILM INFORMATION			MICRO-FILM INFORMATION			MICRO-FILM INFORMATION		
RECORDED BY	DATE	NO.		RECORDED BY	DATE	NO.		RECORDED BY	DATE	NO.	

dmg D. MARK GOODWIN & ASSOCIATES, P.A.
CONSULTING ENGINEERS & SURVEYORS
P.O. BOX 90606
ALBUQUERQUE, NEW MEXICO 87199
(505) 345-2010

CITY OF ALBUQUERQUE
PUBLIC WORKS DEPARTMENT
ENGINEERING GROUP


TITLE: **POINT WEST SUBDIVISION
UTILITY IMPROVEMENTS
ST. JAMES PLACE S.W.**

APPROVALS	ENGINEER	DATE	APPROVALS	ENGINEER	DATE
DRC CHAIRMAN	<i>[Signature]</i>	11-21-94	WATER	<i>[Signature]</i>	11-21-94
TRANSPORTATION	<i>[Signature]</i>	11-10-94	WASTE WATER	<i>[Signature]</i>	11-10-94
HYDROLOGY	<i>[Signature]</i>	11-7-94			

PROJECT NO. **5048.91** MAP NO. **L9** SHEET **11** OF **12**

SCANNED BY
BY LASON

1 2 3 4 5 6 7 8 9 10 11 12 13 14 15
26-5048.91 11/19/97

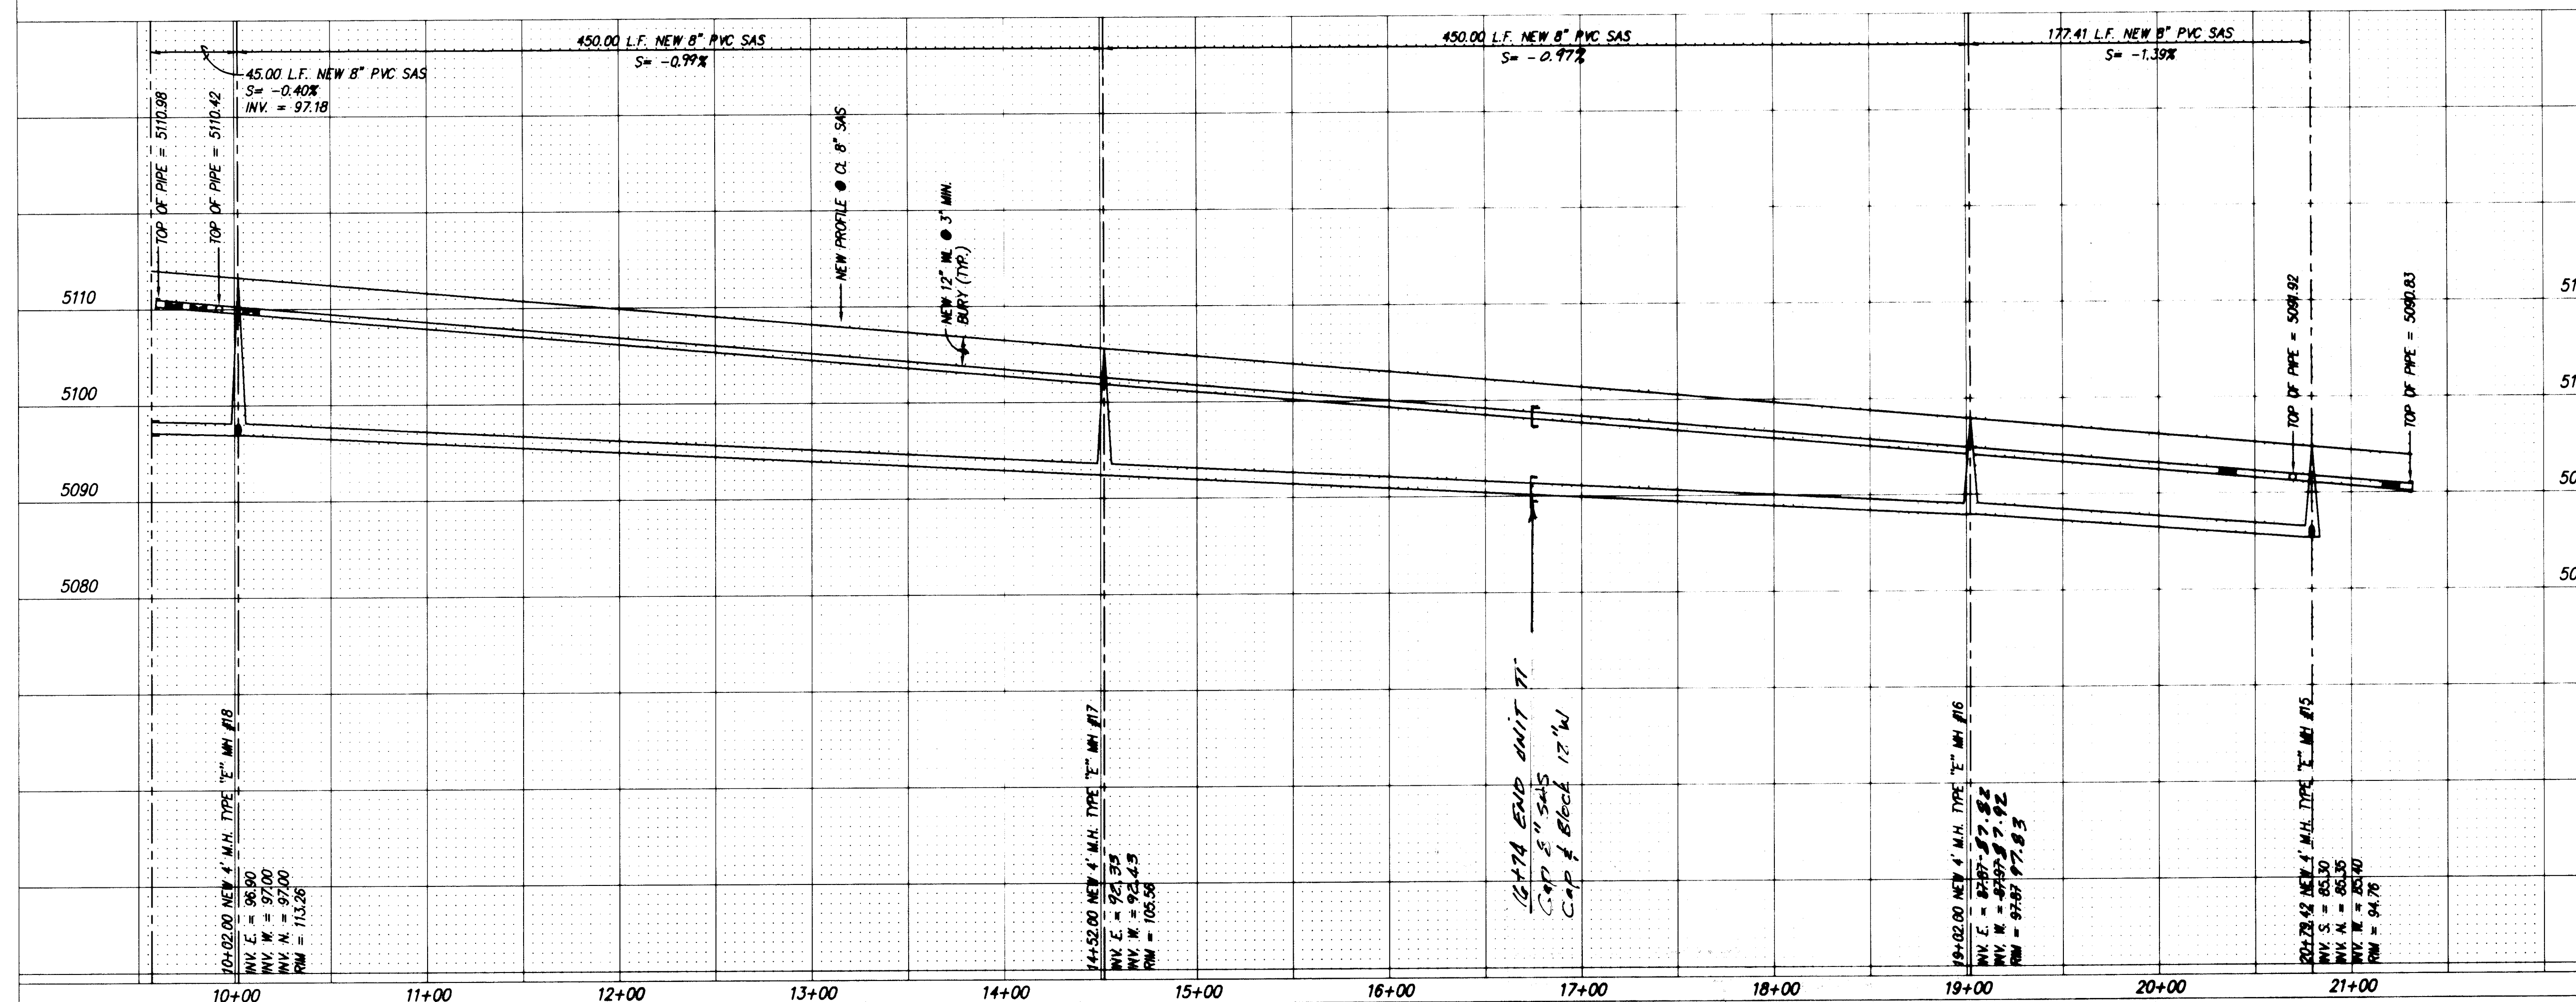

1	2	3	4	5	6	7	8	9	10	11	12	13	14	15
2	6	-	5	0	4	8	.	9	1			1	2	9

[illegible]