


CONSTRUCTION PLANS
FOR
CASITA DE LA MESA SUBDIVISION
ALBUQUERQUE, NEW MEXICO

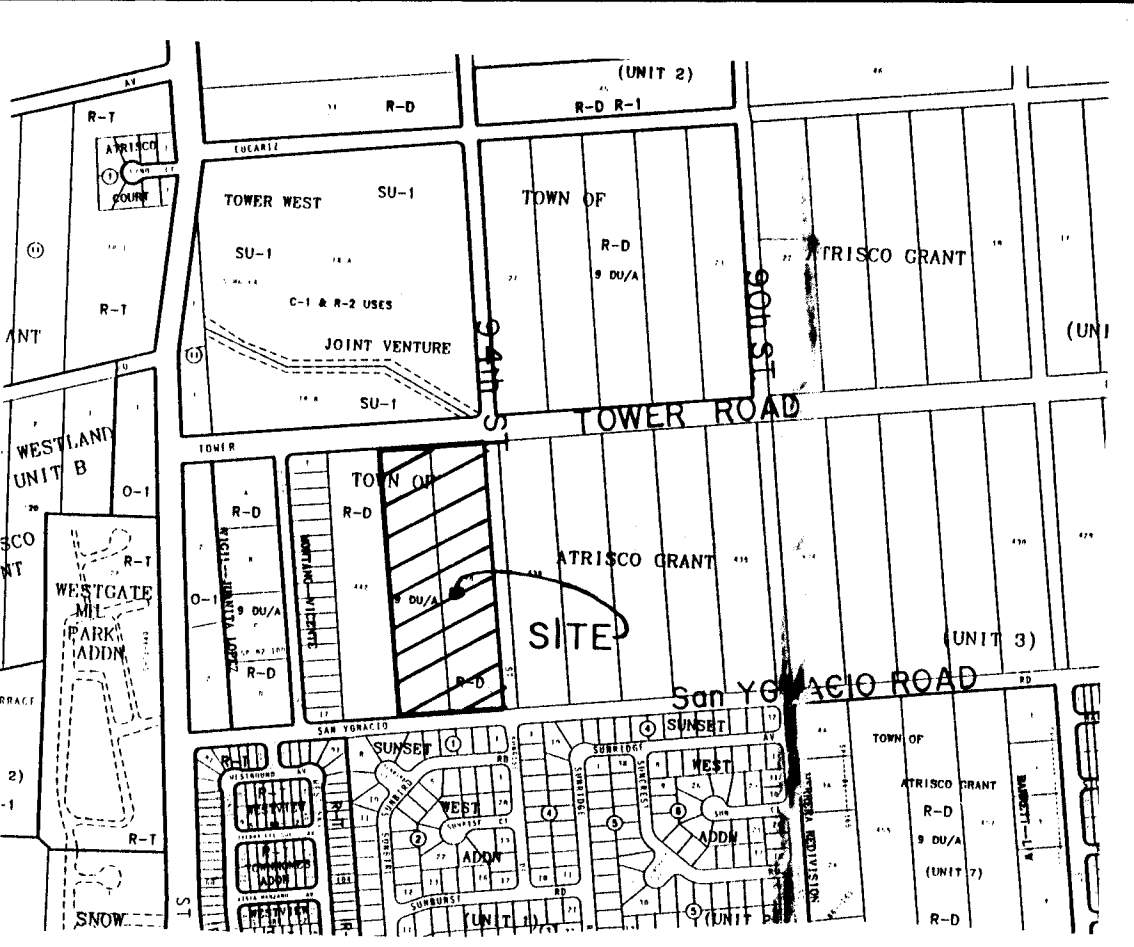

VICINITY MAP
SCALE: NONE

GENERAL NOTES

NOTICE TO CONTRACTORS

- CITY OF ALBUQUERQUE SPECIFICATIONS FOR PUBLIC WORKS CONSTRUCTION, 1986 EDITION AS AMENDED THROUGH UPDATE 5, WILL BE REFERRED TO HEREIN AS THE "STANDARD SPECIFICATIONS".
- TWO WORKING DAYS PRIOR TO ANY EXCAVATION, CONTRACTOR MUST CONTACT NEW MEXICO ONE CALL SYSTEM (260-1990) AND DETERMINE LOCATION OF EXISTING UTILITIES.
- PRIOR TO ANY CONSTRUCTION, THE CONTRACTOR SHALL EXCAVATE AND VERIFY THE HORIZONTAL AND VERTICAL LOCATIONS OF ALL OBSTRUCTIONS. SHOULD A CONFLICT EXIST, THE CONTRACTOR SHALL NOTIFY THE ENGINEER OR THE SURVEYOR SO THAT THE CONFLICT CAN BE RESOLVED WITHOUT DELAY.
- ALL EXISTING SIGNS, MARKERS, DELINEATORS, ETC., WITHIN THE CONSTRUCTION LIMITS SHALL BE REMOVED, STORED AND RE-SET BY THE CONTRACTOR.
- THREE (3) WORKING DAYS PRIOR TO BEGINNING CONSTRUCTION THE CONTRACTOR SHALL SUBMIT TO THE CONSTRUCTION CO-ORDINATION DIVISION A DETAILED CONSTRUCTION SCHEDULE. TWO (2) WORKING DAYS PRIOR TO CONSTRUCTION THE CONTRACTOR SHALL OBTAIN A BARRICADING PERMIT FROM THE CONSTRUCTION CO-ORDINATION DIVISION. CONTRACTOR SHALL NOTIFY BARRICADE ENGINEER (768-2551) PRIOR TO OCCUPYING AN INTERSECTION. SEE SECTION 19 OF THE SPECIFICATIONS. ALL STREET STRIPING ALTERED OR DESTROYED SHALL BE REPLACED IN KIND BY CONTRACTOR TO LOCATION AND IN KIND AS EXISTING OR AS INDICATED BY THIS SET.
- THE CONTRACTOR SHALL NOTIFY THE ENGINEER NOT LESS THAN SEVEN (7) PRIOR TO STARTING WORK IN ORDER THAT THE ENGINEER MAY TAKE NECESSARY MEASURES TO INSURE THE PRESERVATION OF SURVEY MONUMENTS. CONTRACTOR SHALL NOT DISTURB PERMANENT SURVEY MONUMENTS WITHOUT THE CONSENT OF THE ENGINEER AND SHALL NOTIFY THE ENGINEER AND BEAR THE EXPENSE OF REPLACING ANY THAT MAY BE DISTURBED WITHOUT PERMISSION. REPLACEMENT SHALL BE DONE ONLY BY THE CITY SURVEYOR. WHEN A CHANGE IS MADE IN THE FINISHED ELEVATIONS OF THE PAVEMENT OF ANY ROADWAY IN WHICH A PERMANENT SURVEY MONUMENT IS LOCATED, CONTRACTOR SHALL, AT HIS OWN EXPENSE, ADJUST THE MONUMENT COVER TO THE NEW GRADE UNLESS OTHERWISE SPECIFIED. REFER TO SECTION 4.4 OF THE GENERAL CONDITIONS OF THE STANDARD SPECIFICATIONS.

THE FOLLOWING NOTES ALSO APPLY WHEN CHECKED

- ☒ ALL UTILITIES AND UTILITY SERVICE LINES SHALL BE INSTALLED PRIOR TO PAVING.
- ☒ BACKFILL COMPACTION SHALL BE ACCORDING TO SPECIFIED STREET USE.
- ☐ TACK COAT REQUIREMENTS SHALL BE DETERMINED BY THE CITY ENGINEER.
- ☒ SIDEWALK AND WHEELCHAIR RAMPS WITHIN THE CURB RETURNS SHALL BE CONSTRUCTED WHEREVER A NEW CURB RETURN IS CONSTRUCTED.
- ☐ IF CURB IS DEPRESSED FOR A DRIVEPAD, THE DRIVEPAD SHALL BE CONSTRUCTED PRIOR TO ACCEPTANCE OF CURB AND GUTTER.
- ☒ ALL STORM DRAINAGE FACILITIES SHALL BE COMPLETED PRIOR TO FINAL ACCEPTANCE.
- ☒ THE REQUESTOR OR DEVELOPER SHALL BE RESPONSIBLE FOR REPAIR OR REPLACEMENT OF ALL CURB AND GUTTER OR SIDEWALK DAMAGE AFTER APPROVAL BY THE CITY ENGINEER OR WORK COMPLETED BY THE CONTRACTOR.

LEGEND			
—	CURB AND GUTTER	□	WATER METER
■	CONCRETE	○	CABLE T.V.
□	ELECTRIC TRANSFORMER	○	POWER POLE
□	ELECTRIC PANEL	—	ANCHOR
○	SANITARY SEWER MANHOLE	□	LIGHT POLE
①	TELEPHONE MANHOLE	□	TRAFFIC LIGHT
②	ELECTRIC MANHOLE	□	CROSSWALK SIGNAL
○	STORM SEWER MANHOLE	□	SPRINKLER CONTROL
○	WATER VALVE	□	TRAFFIC CONTROL
○	FIRE HYDRANT	□	LIGHTING BOX
□	TELEPHONE BOX	+	SIGN
—TC— —FL—	SPOT ELEVATION	■	GRATE

INDEX TO DRAWINGS	
SHEET NO.	TITLE
1	TITLE SHEET
2-3	PLAT
4	MASTER GRADING & DRAINAGE PLAN
5	UNIT I GRADING PLAN
6	MASTER PAVING PLAN
7-10	PAVING IMPROVEMENTS
11	MASTER UTILITY PLAN
12-16	UTILITY IMPROVEMENTS

1 2 3 4 5 6 7 8 9 10 11 12 13 14 15
26-5654-910 0793

CAUTION:
NOTE THAT ALL EXISTING UTILITIES MAY NOT BE SHOWN. ALL EXISTING SERVICE CONNECTIONS ARE NOT SHOWN. ANY EXISTING UTILITIES THAT ARE SHOWN ARE APPROXIMATE LOCATION ONLY. IT SHALL BE THE SOLE RESPONSIBILITY OF THE CONTRACTOR TO CONTACT ALL THE UTILITY OWNERS AND TO CONDUCT ALL NECESSARY FIELD INVESTIGATIONS PRIOR TO ANY EXCAVATIONS TO DETERMINE THE ACTUAL LOCATION OF UTILITIES AND OTHER IMPROVEMENTS.

APPROVAL OF AS BUILT DRAWINGS
CHIEF CONSTRUCTION ENGINEER
R. M. S. S. S.
DATE 11-13-95

RECORD DRAWING -- UNIT I --
I hereby certify that the information contained on this drawing has been revised in accordance with information furnished by the Contractor, Franklin's Earthmoving, Inc., and by the Surveyor, ALS, Inc., and reflects the construction as actually accomplished. This plan as constructed is in substantial compliance with the Approved Plan.
Mark Goodwin, NMPE 8948

dmg D. MARK GOODWIN & ASSOCIATES, P.A.
CONSULTING ENGINEERS & SURVEYORS
P. O. BOX 90606
ALBUQUERQUE, NEW MEXICO 87199
(505) 345-2010

REV.	SHEETS	CITY ENGINEER	DATE	USER DEPT.	DATE	USER DEPT.	DATE

APPROVAL OF REVISIONS

SCANNED BY BY LASON	PROJECT NO. 5054.90	APPROVED FOR CONSTRUCTION
		SHEET 1 OF 16

SCANNED BY
BY LASON

PUBLIC UTILITY EASEMENTS:


PUBLIC UTILITY EASEMENTS shown on this plat are granted for the common and joint use of:

1. The Public Service Company of New Mexico for the installation, maintenance, and service of overhead and underground electrical lines, transformers, poles and any other equipment, fixtures, structures and related facilities reasonably necessary to provide electrical services.
2. The Gas Company of New Mexico for installation, maintenance, and service of natural gas lines, valves and other equipment and facilities reasonably necessary to provide natural gas.
3. U.S. West for installation, maintenance and service of all buried and aerial communication lines and other related equipment and facilities reasonably necessary to provide communication services, including but not limited to above ground pedestals and closures.
4. Jones Interchange for the installation, maintenance, and service of such lines, cable, and other related equipment and facilities reasonably necessary to provide Cable TV service.

Included, is the right to build, rebuild, construct, reconstruct, locate, relocate, change, remove, modify, renew, operate, and maintain facilities for the purposes described above, together with free access to, from, and over said easements, including sufficient working area space for electric transformers, with the right and privilege to trim and remove trees, shrubs or bushes which interfere with the purposes set forth herein. No building, sign, pool (aboveground or subsurface), hot tub, concrete or wood pool decking, or other structure shall be erected or constructed on said easements, nor shall any well be drilled or operated thereon. Property owners shall be solely responsible for correcting any violations of National Electrical Safety Code caused by construction of pools, decking, or any structures adjacent to within or near easements shown on this plat.

By approving this document, the utility companies do not waive or release any easement rights which may have been granted by prior plat, replat or document.

PLAT OF
CASITA de la MESA
SUBDIVISION
WITHIN THE
TOWN OF ATRISCO GRANT
PROJECTED SECTION 28
TOWNSHIP 10 NORTH, RANGE 2 EAST, NMPM
CITY OF ALBUQUERQUE
BERNALILLO COUNTY, NEW MEXICO
JUNE 1994

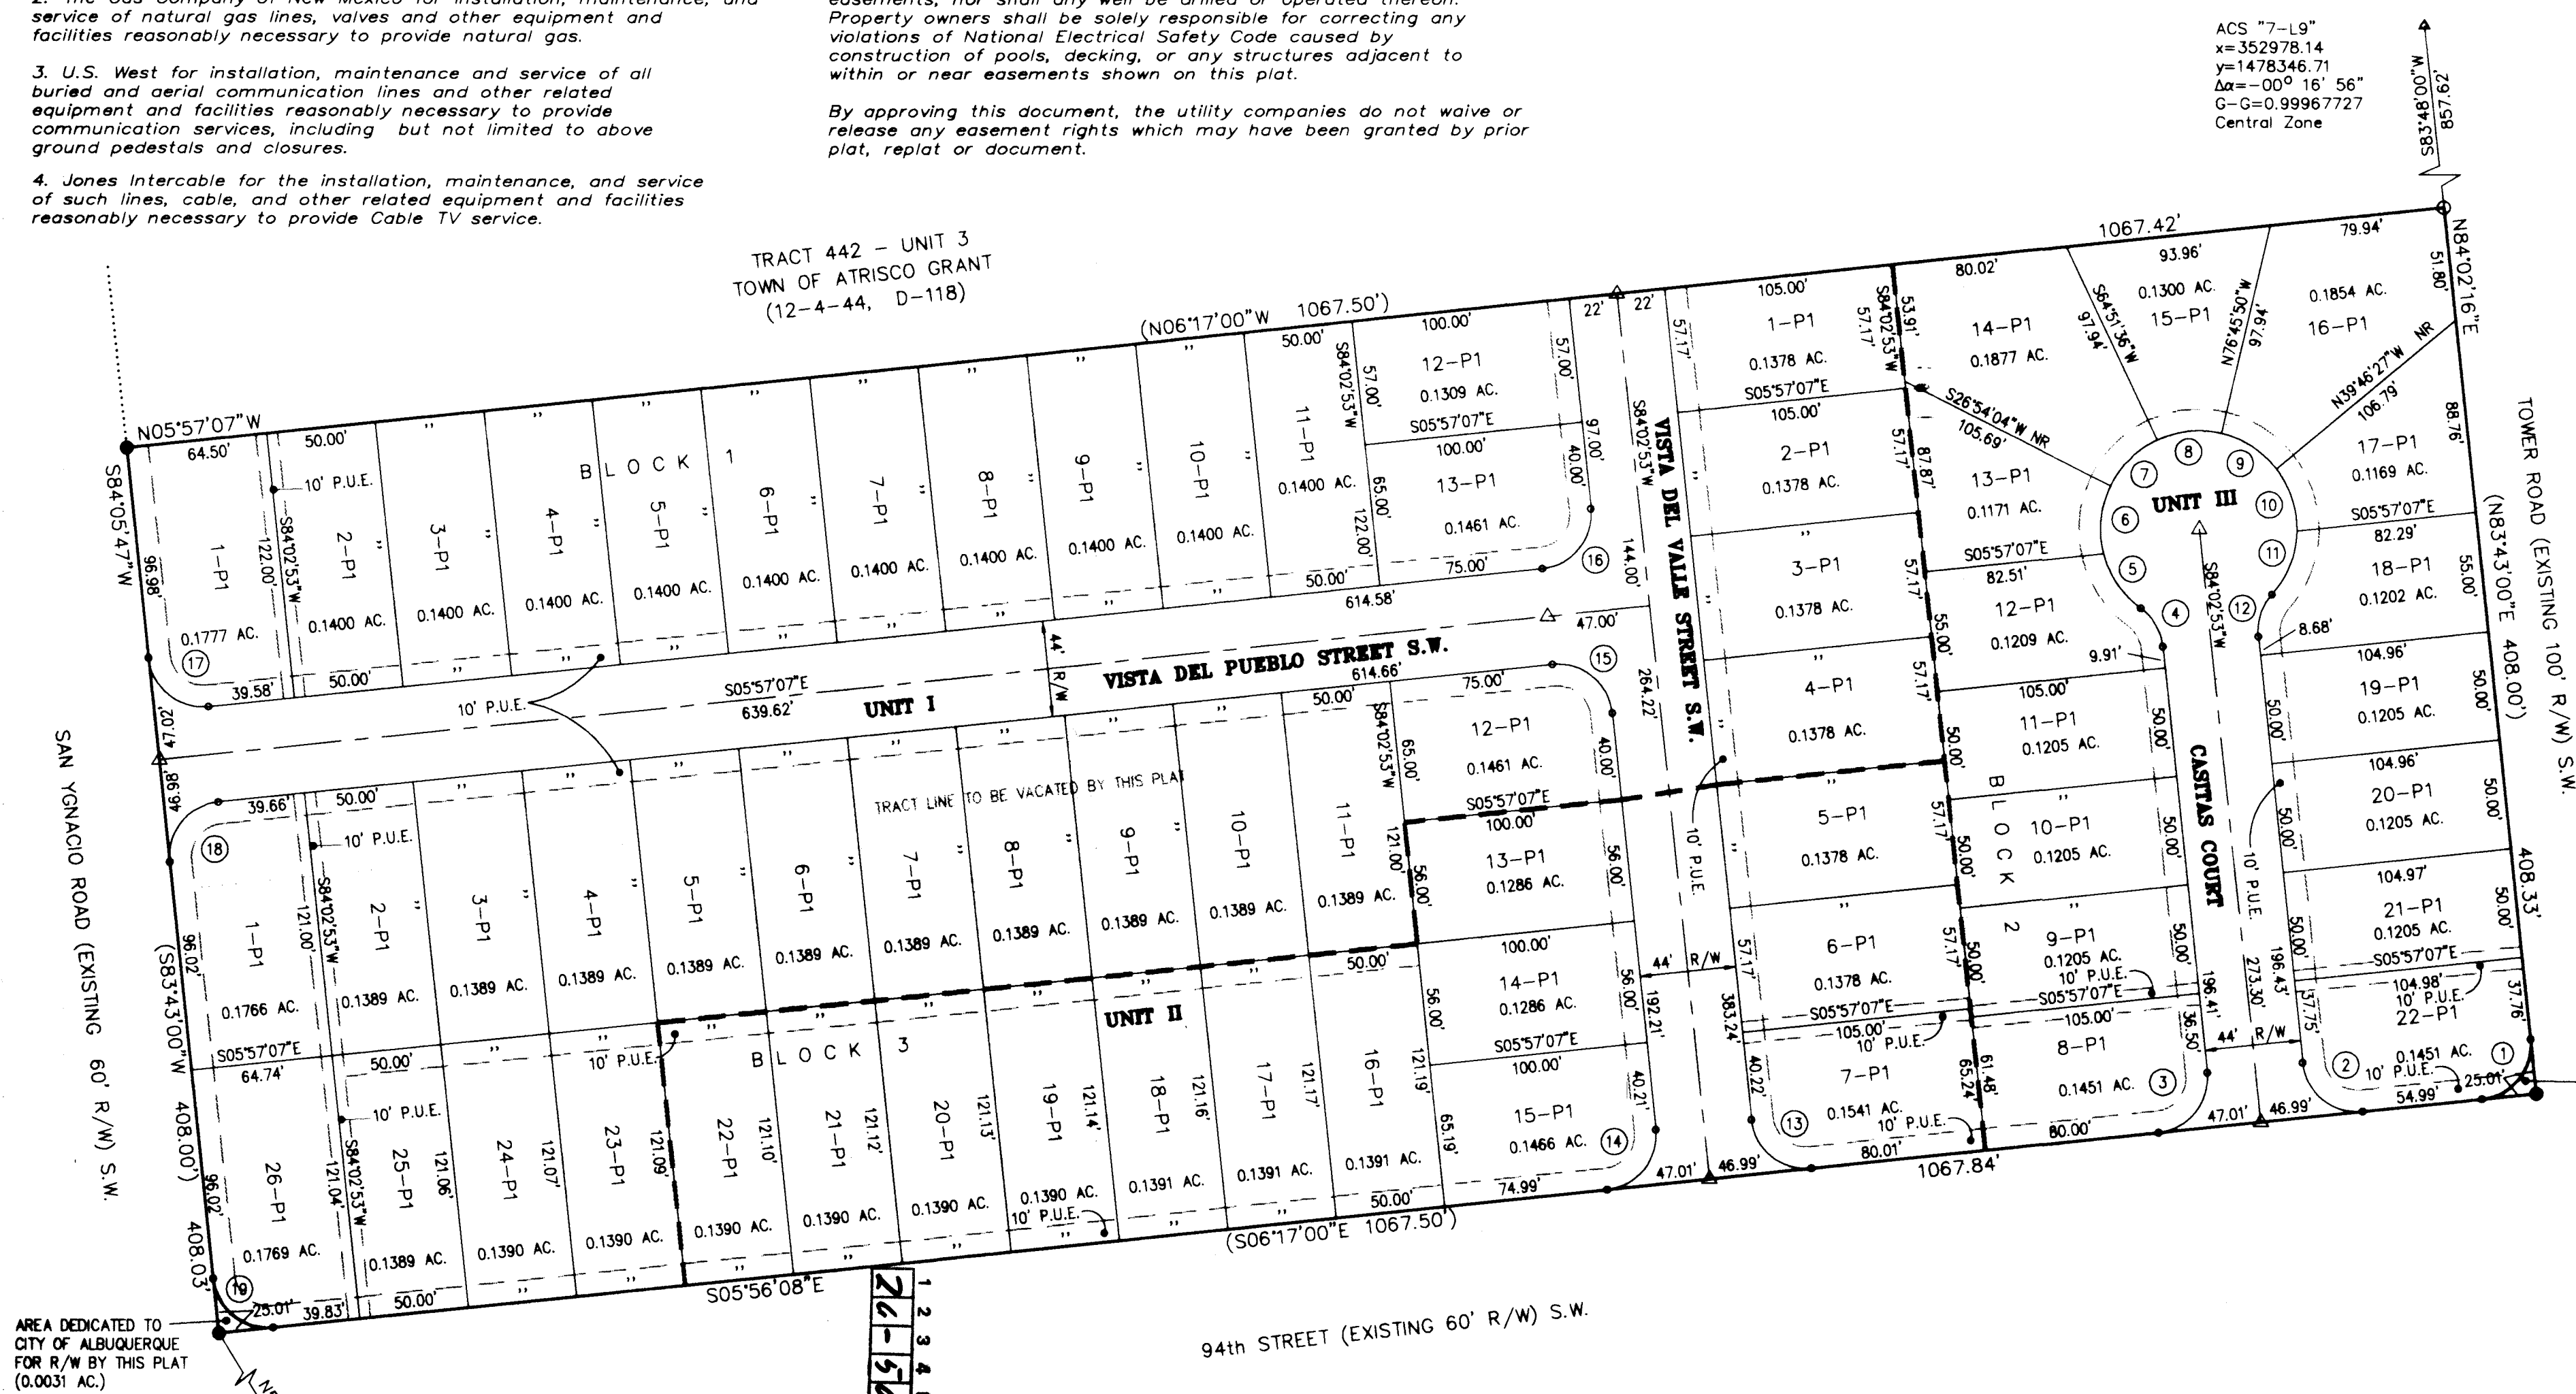

AREA DEDICATED TO
CITY OF ALBUQUERQUE
FOR R/W BY THIS PLAT
(0.0031 AC.)

ACS "8-19"
x=356637.68
y=1478811.91
Δα=-00° 16' 31"
G-G=0.99967955
Central Zone

CURVE DATA

NO.	RADIUS	DELTA	LENGTH	CHORD BEARING & LENGTH	NO.	RADIUS	DELTA	LENGTH	CHORD BEARING & LENGTH
1	25.00	90-01-36	39.28	N 50-56-56 W 35.36	11	45.00	40-43-25	31.98	N 68-29-28 W 31.32
2	25.00	89-59-01	39.26	N 39-03-23 E 35.35	12	25.00	47-40-21	20.87	N 72-02-26 W 20.27
3	25.00	90-00-59	39.28	N 50-56-37 W 35.36	13	25.00	89-59-01	39.26	N 39-03-23 E 35.35
4	25.00	47-49-21	20.87	N 60-08-12 E 20.27	14	25.00	90-00-59	39.28	N 50-56-37 W 35.36
5	45.00	39-09-22	30.75	N 55-48-13 E 30.16	15	25.00	90-00-00	39.27	N 39-02-53 E 35.36
6	45.00	40-32-09	31.84	N 84-21-02 W 31.18	16	25.00	90-00-00	39.27	N 50-57-07 W 35.36
7	45.00	38-56-33	30.59	N 44-36-41 W 30.00	17	25.00	90-02-54	39.29	N 39-04-20 E 35.37
8	45.00	38-22-35	30.14	N 05-57-07 W 29.58	18	25.00	89-57-06	39.25	N 50-55-40 W 35.34
9	45.00	38-56-33	30.59	N 32-42-27 E 30.00	19	25.00	90-01-55	39.28	N 39-04-49 E 35.37
10	45.00	38-58-07	30.61	N 71-39-46 E 30.02					

CURVE DATA

NOTE:

Centerline (in lieu of R/W) monumentation is to be installed at all centerline PC's, PT's, angle points and street intersections as shown hereon, and will consist of a four inch (4") aluminum alloy cap stamped:

City of Albuquerque
Centerline Monument
Do Not Disturb
PLS # 7719

LEGEND



- SET 5/8" RBR.W/CAP "ALS LS 7719"
- FND. 1-1/4" PIPE

PLAT OF
CASITA de la MEAS SUBDIVISION



dmg D. MARK GOODWIN & ASSOCIATES, P.A.
CONSULTING ENGINEERS & SURVEYORS
P.O. BOX 90606
ALBUQUERQUE, NEW MEXICO 87199
(505) 345-2010

Designed: ALS Drawn: BJG Checked: ALS Sheet 2 of 2
Scale: 1"=60' Date: 6/94 Job: 94075

YGNACIO 4075MAP

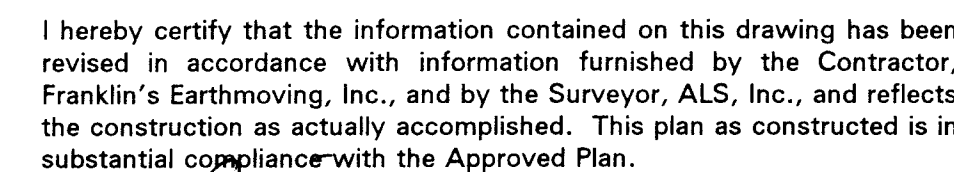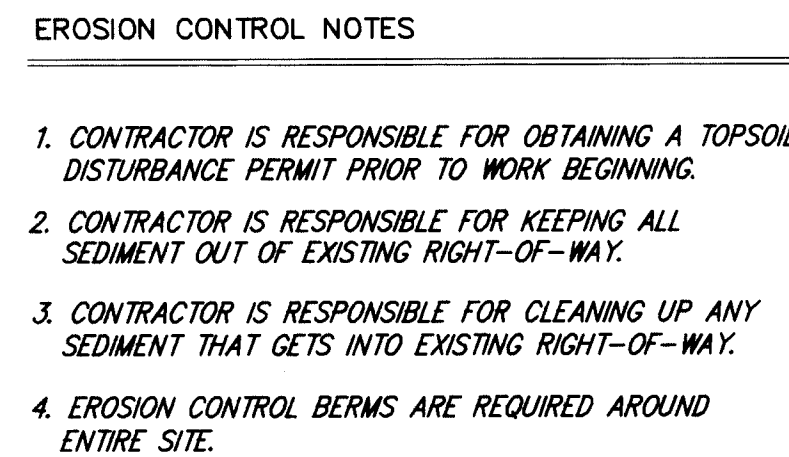


7. *ask Goodwin* 9/6/95
Mark Goodwin, NMPE 8948

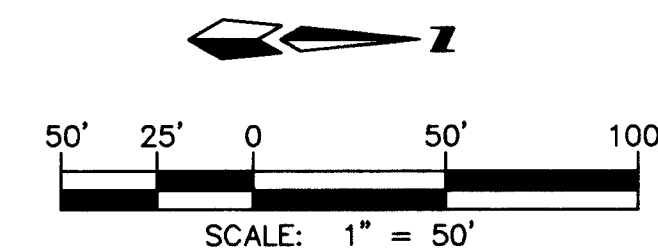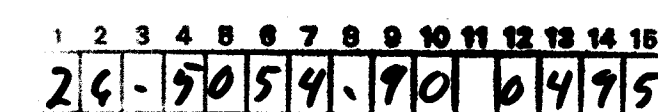

SCANNED BY
BY LASON

SCANNED BY BYLASON SYS/GD50/9-94

						AS BUILT INFORMATION	
				CONTRACTOR <i>Franklin's</i>		DATE <i>6/95</i>	
				WORK STARTED BY <i>ALS</i>		DATE <i>9/95</i>	
				ACCEPTANCE BY <i>ALS</i>		DATE <i>9/95</i>	
				FIELD REVISION BY <i>ALS</i>		DATE <i>9/95</i>	
				DRAWINGS CORRECTED BY <i>ALS</i>		DATE <i>9/95</i>	
				MICRO-FILM INFORMATION			
				RECORDED BY		DATE	
				NO.			

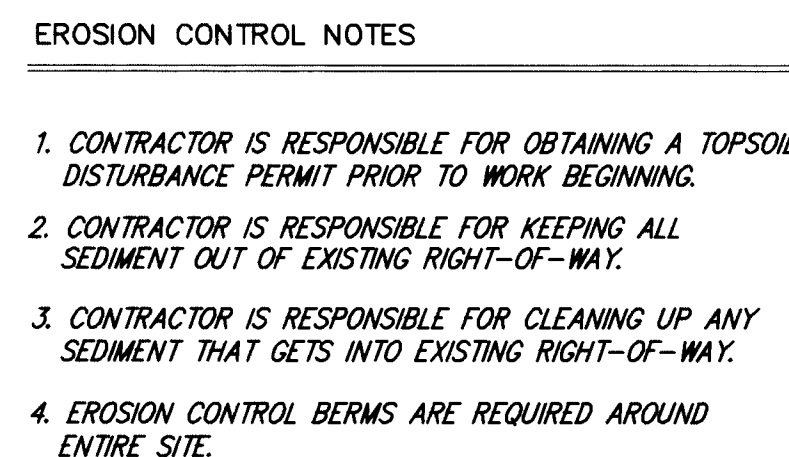


GENERAL NOTES

1. CONTRACTOR MUST OBTAIN A TOPSOIL DISTURBANCE PERMIT FROM THE ENVIRONMENTAL HEALTH DIVISION PRIOR TO CONSTRUCTION.
2. CITY OF ALBUQUERQUE STANDARD SPECIFICATIONS FOR PUBLIC WORKS CONSTRUCTION, LATEST EDITION SHALL GOVERN ALL WORK.
3. THE CONTRACTOR SHALL CONFORM TO ALL CITY, COUNTY, STATE AND FEDERAL DUST CONTROL MEASURES AND REQUIREMENTS AND WILL BE RESPONSIBLE FOR PREPARING AND OBTAINING ALL NECESSARY APPLICATIONS AND APPROVALS.
4. THE CONTRACTOR SHALL ENSURE THAT NO SOIL ERODES FROM THE LOTS INTO PUBLIC RIGHT-OF-WAY. THIS CAN BE ACHIEVED BY CONSTRUCTING TEMPORARY BERMS AS PER DETAIL THIS SHEET AND NETTING THE SOIL TO KEEP IT FROM BLOWING.
5. THE EARTHWORK CONTRACTOR SHALL STOCKPILE ENOUGH MATERIALS ADJACENT TO RETAINING WALL LOCATIONS TO BE UTILIZED FOR WALL BACKFILL.
6. ALL CONCRETE CURBING TO BE 4000 PSI @ 28 DAYS.
7. ALL INTERIOR STREETS HAVE MOUNTABLE CURB AND GUTTER.

LEGAL DESCRIPTION

TRACTS 440 AND 441, TOWN OF ATRISCO GRANT, UNIT 3
PROJ. SEC. 28, T 10 N, R 2 E, N.M.P.M., ALBUQUERQUE,
BERNALILLO COUNTY NEW MEXICO, JUNE 1994

LEGEND

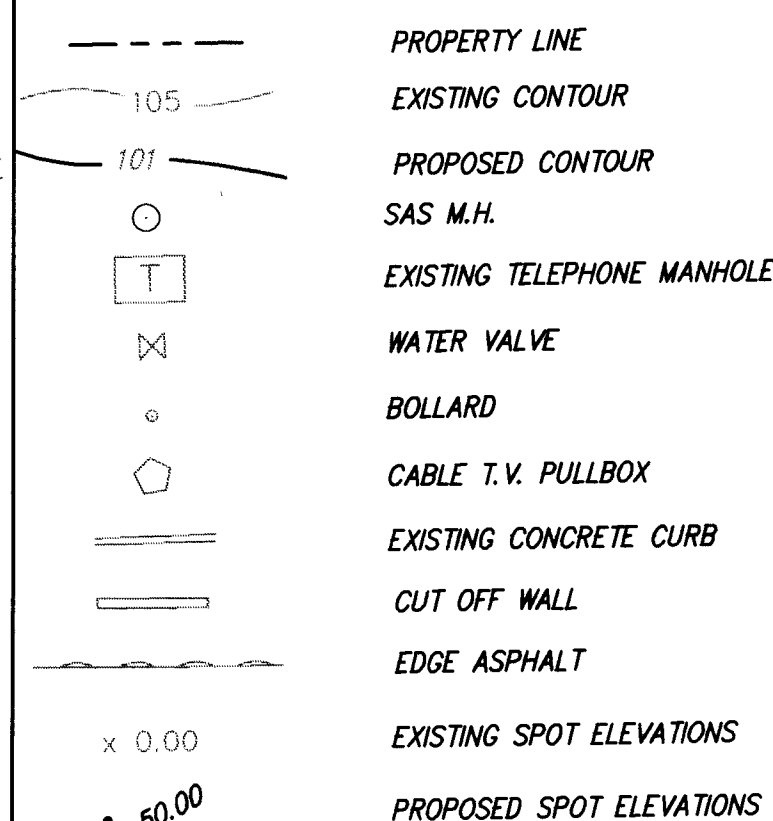

PHASE-I PONDING REQUIRED = 1.56 AC.-FT.
PHASE -II PONDING PROVIDED = 1.58 AC.-FT.

RECORD DRAWING - UNIT I

I hereby certify that the information contained on this drawing has been revised in accordance with information furnished by the Contractor, Franklin's Earthmoving, Inc., and by the Surveyor, ALS, Inc., and reflects the construction as actually accomplished. This plan as constructed is in substantial compliance with the Approved Plan.

Mark Goodwin
Mark Goodwin, NMPE 8948

NOTE: All Elev. not
changed are ± 0.1
of Design Value.

SCANNED BY
BY LASON

dmg D. MARK GOODWIN & ASSOCIATES, P.A.
CONSULTING ENGINEERS & SURVEYORS
P.O. BOX 90606
ALBUQUERQUE, NEW MEXICO 87199
(505) 345-2010

CITY OF ALBUQUERQUE
PUBLIC WORKS DEPARTMENT
ENGINEERING GROUP

TITLE: CASITA DE LA MESA SUBDIVISION
UNIT - I GRADING & DRAINAGE PLAN

APPROVALS	ENGINEER	DATE	APPROVALS	ENGINEER	DATE
DRC CHAIRMAN	<i>B. J. Goring</i>	5-4-95	WATER	NIA AWR	3-17-95
TRANSPORTATION	NIA AWR	3-17-95	WASTE WATER	NIA AWR	3-17-95
HYDROLOGY	J. J. Goring	4-12-95			

PROJECT NO. 5054.90	MAP NO. L9	SHEET 5	OF 16
------------------------	---------------	------------	----------

SYS/PH-1/9-94


SCANNED BY
BY LASON

SCANNED BY
BY LASON


RECORD DRAWING - UNIT I

I hereby certify that the information contained on this drawing has been revised in accordance with information furnished by the Contractor, Franklin's Earthmoving, Inc., and by the Surveyor, ALS, Inc., and reflects the construction as actually accomplished. This plan as constructed is in substantial compliance with the Approved Plan.


Mark Goodwin, NMPE 8948

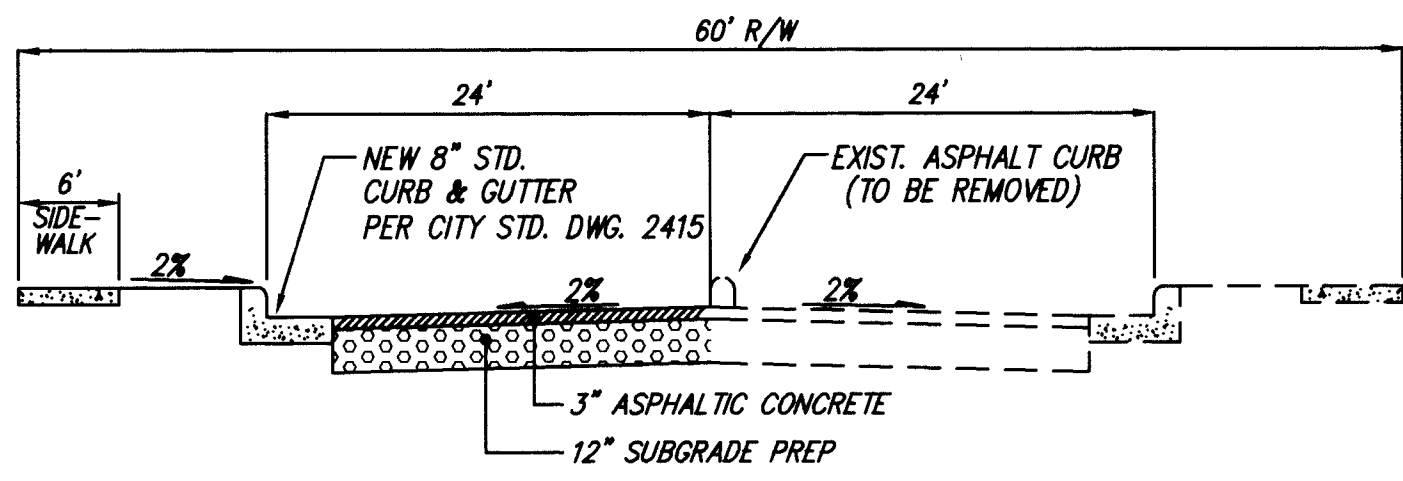

TYPICAL SAN YGNACIO STREET SECTION
N.T.S.

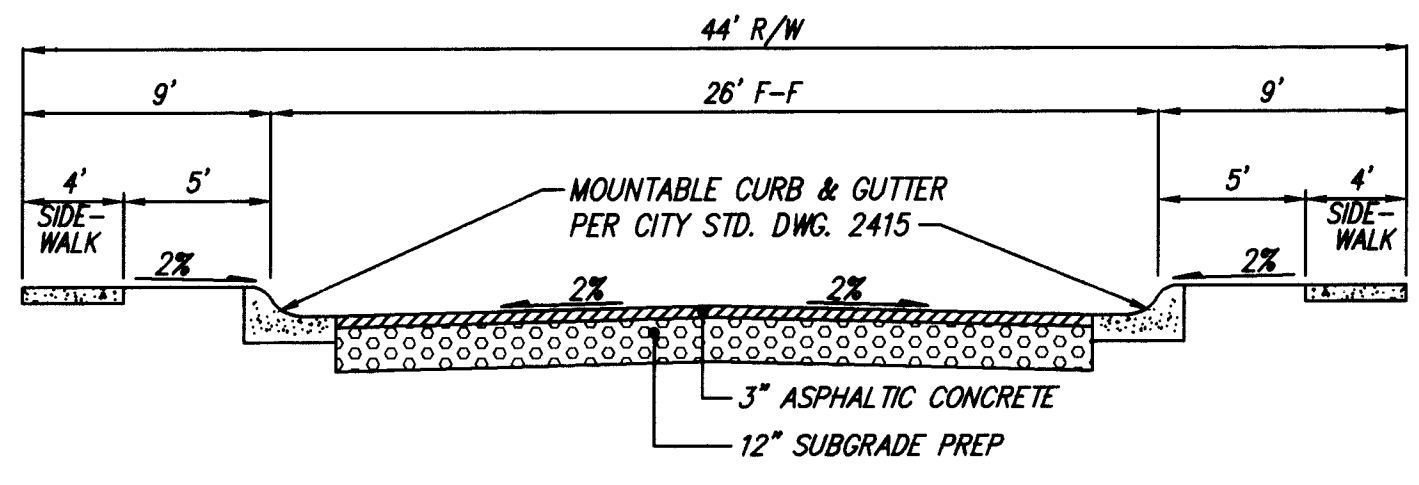

TYPICAL 26' STREET SECTION
N.T.S.

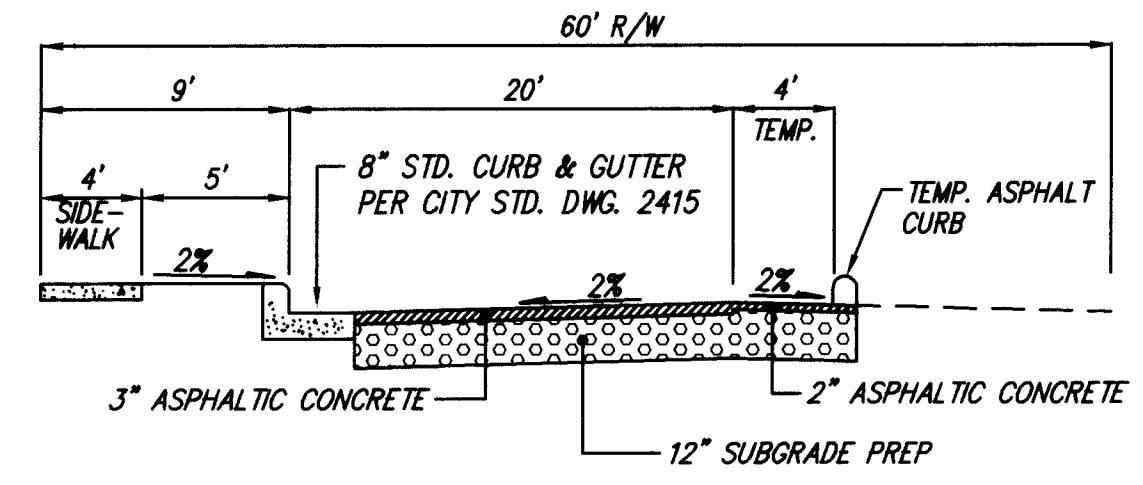


TYPICAL 94TH. STREET SECTION
N.T.S.

GENERAL NOTES

- ALL VALLEY GUTTERS ARE TO HAVE 3/4" INVERT. PER CITY STD. DWG. 2422.
- ALL 4' INTERIOR SIDEWALKS ARE DEFERRED.
- ALL HANDICAP RAMPS TO BE CASE 2. PER CITY STD. DWG. 2441.
- TRANSITION SECTION FROM FULL CROWN TO NO CROWN TO BE A MINIMUM OF 50'.
- ALL 3" AC SHALL BE 1800 LB. PLACED IN 1-2" LIFT & 1-1" LIFT. PER CITY STD. 2405

LEGEND:

- NEW MOUNTABLE CURB & GUTTER
- NEW STANDARD CURB & GUTTER
- HANDICAP RAMP

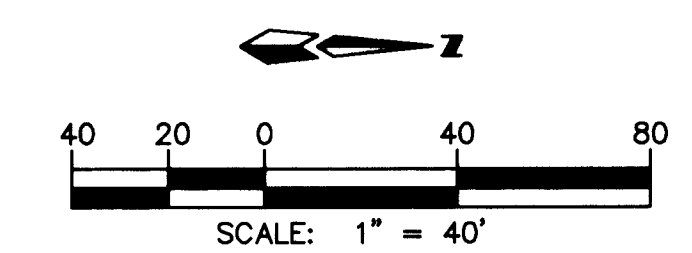

D. MARK GOODWIN & ASSOCIATES, P.A.
CONSULTING ENGINEERS & SURVEYORS
P.O. BOX 90606
ALBUQUERQUE, NEW MEXICO 87199
(505) 345-2010

CITY OF ALBUQUERQUE
PUBLIC WORKS DEPARTMENT
ENGINEERING GROUP


TITLE: CASITA DE LA MESA SUBDIVISION MASTER PAVING PLAN					
APPROVALS	ENGINEER	DATE	APPROVALS	ENGINEER	DATE
DRC CHAIRMAN	<i>[Signature]</i>	5-4-95	WATER	N/A	RWE 9-17-95
TRANSPORTATION	<i>[Signature]</i>	3-17-95	WASTE WATER	N/A	RWE 9-17-95
HYDROLOGY	<i>[Signature]</i>	1-12-95			
PROJECT NO.	5054.90	MAP NO.	L9	SHEET OF	6 16

AS BUILT INFORMATION					
CONTRACTOR	Franklin's	DATE	6/95	RECORDED BY	
INSPECTOR'S NAME	ALS	DATE	9/95	NO.	
FIELD ENGINEER	ALS	DATE	9/95		
VERIFICATION BY	ALS	DATE	9/95		
CORRECTION BY	ALS	DATE	9/95		
MICRO-FILM INFORMATION					
RECORDED BY		DATE			
NO.					


BENCH MARKS		
STATION MARK IS A STANDARD INCH BRASS TABLET STAMPED		
7-40-228" SET 0.5' BELOW THE PAVEMENT. LOCATED ON THE		
98th STREET OVERPASS AT U.S. INTERSTATE HIGHWAY 40 (I-40).		
X = 351650.01	Y = 1,486,656.52	Z = 5299.42

SURVEY INFORMATION		
FIELD NOTES	DATE	BY
NO.		

ENGINEER'S SEAL		
REMARKS	BY	DATE
DESIGN		9/94
DC		9/94
DMG		9/94

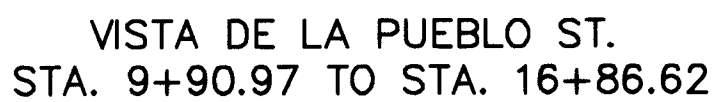

RECORD DRAWING - *ALM*

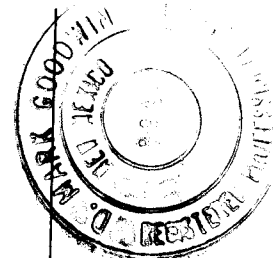

Mark Goodwin
Mark Goodwin, NMPE 8948

D. MARK GOODWIN & ASSOCIATES, P.A.
CONSULTING ENGINEERS & SURVEYORS
P.O. BOX 90606
ALBUQUERQUE, NEW MEXICO 87199
(505) 345-2010


CITY OF ALBUQUERQUE
PUBLIC WORKS DEPARTMENT
ENGINEERING GROUP

TITLE: CASITA DE LA MESA SUBDIVISION
PAVING IMPROVEMENTS
VISTA DE LA PUEBLO STREET

PROJECT NO. 5054.90	MAP NO. L9	SHEET 7	OF 16
------------------------	---------------	------------	----------

ENGINEER'S SEAL		SURVEY INFORMATION		BENCH MARKS		AS BUILT INFORMATION	
NO.	DATE	REMARKS	FIELD NOTES		STATION MARK IS A STANDARD MUSIC BRASS TABLET STAMPED "7-40-22B" SET 0.5' BELOW THE PAVEMENT. LOCATED ON THE 98th STREET OVERPASS AT U.S. INTERSTATE HIGHWAY 40 (I-40). X = 351650.01 Y = 1,486,656.52 Z = 5299.42	CONTRACTOR WORK PERFORMED BY <i>Franklin's</i> DATE <i>6/6/95</i>	INSPECTOR'S ACCEPTANCE BY <i>MGA</i> DATE <i>9/19/95</i>
			BY	DATE			
DESIGN						DRAWINGS CORRECTED BY <i>MGA</i> DATE <i>9/19/95</i>	
DESIGNED BY <i>RM</i>	DATE <i>9/94</i>					MICRO-FILM INFORMATION	
DRAWN BY <i>DC</i>	DATE <i>9/94</i>					RECORDED BY	DATE
CHECKED BY <i>DMG</i>	DATE <i>9/94</i>					NO.	


① $\Delta = 90^{\circ}00'00''$ $R = 25.00'$ $L = 39.27'$ $T = 25.00'$	② $\Delta = 90^{\circ}00'00''$ $R = 25.00'$ $L = 39.27'$ $T = 25.00'$	③ $\Delta = 89^{\circ}59'01''$ $R = 25.00'$ $L = 39.26'$ $T = 24.99'$	④ $\Delta = 90^{\circ}00'59''$ $R = 25.00'$ $L = 39.28'$ $T = 25.00'$
--	--	--	--

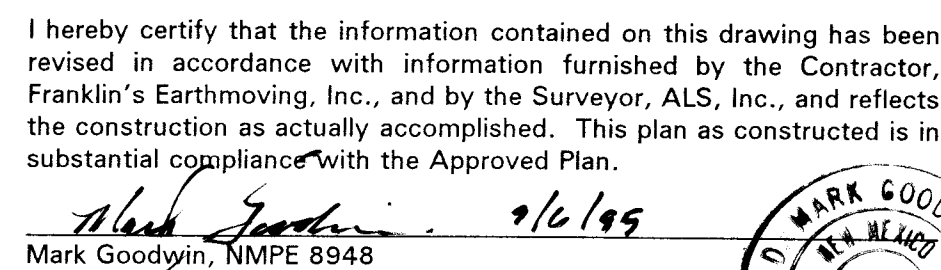

VISTA DE VALLE ST.
STA. 10+00.00 TO STA. 14+38.22

SCALE:
HORIZ. 1" = 50'
VERT. 1" = 10'

$$\begin{array}{llll} \textcircled{1} \Delta = 54^{\circ}13'27'' & \textcircled{2} \Delta = 54^{\circ}13'27'' & \textcircled{3} \Delta = 89^{\circ}59'01'' & \textcircled{4} \Delta = 90^{\circ}00'59'' \\ R = 25.00' & R = 25.00' & R = 25.00' & R = 25.00' \\ L = 23.66' & L = 23.66' & L = 39.26' & L = 39.28' \\ T = 12.80' & T = 12.80' & T = 25.99' & T = 25.00' \end{array}$$

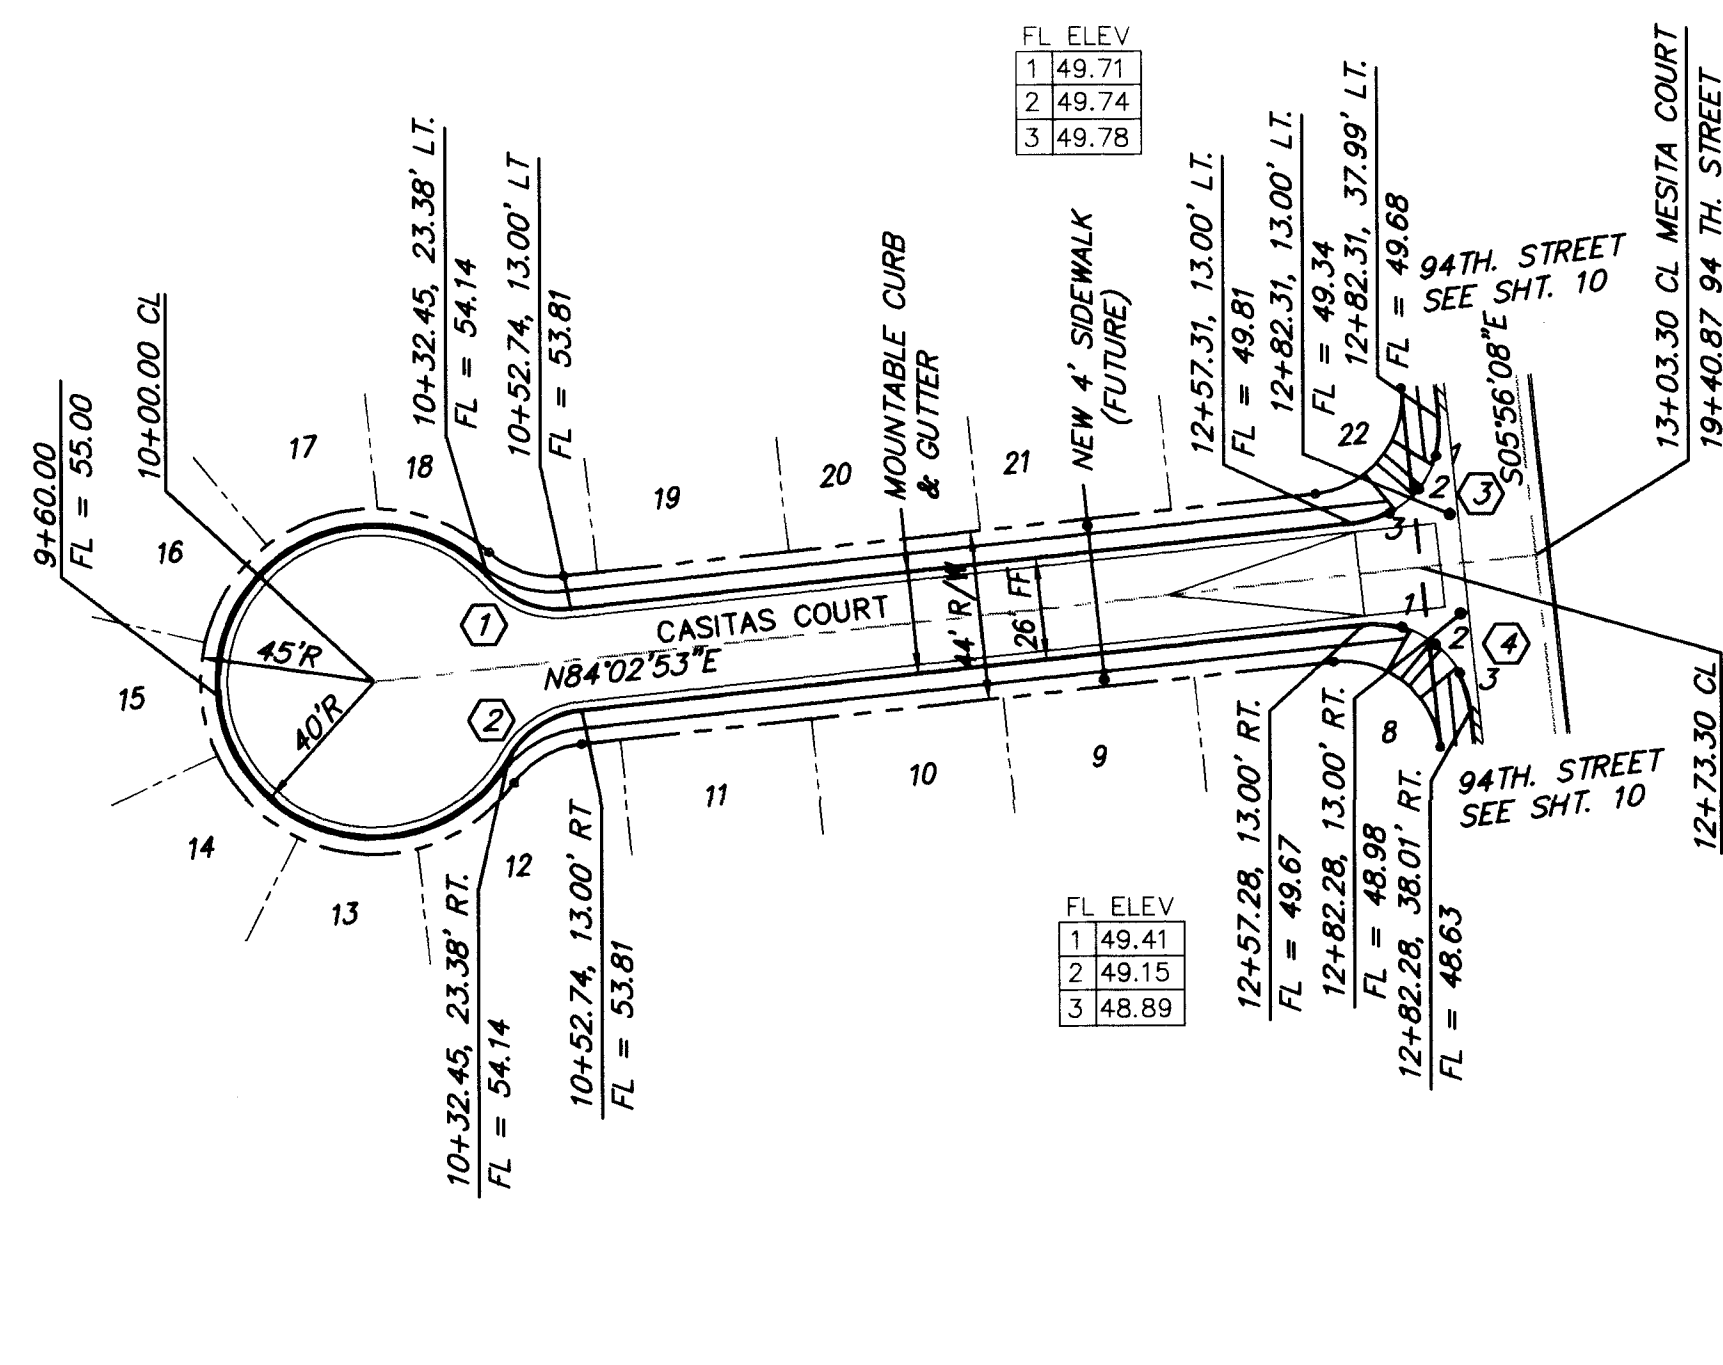

CASITAS COURT
STA. 10+00.00 TO STA. 13+03.30

SCALE:
HORIZ. 1" = 50'
VERT. 1" = 10'

NOTES:

1. ALL STATIONING IS CENTERLINE STATIONING.

DATE		ENGINEER'S SEAL		SURVEY INFORMATION		BENCH MARKS		AS BUILT INFORMATION	
				FIELD NOTES		STATION MARK IS A STANDARD INMISC BRASS TABLET STAMPED		CONTRACTOR	
				NO.		DATE		WORK ORDER BY	
				BY				DATE	
								INSPECTOR'S	
								ACCEPTANCE BY	
								DATE	
NO. DATE		REMARKS				X = 331650.01 Y = 1,496,656.52 Z = 5299.42		FIELD VERIFICATION BY	
		REVISIONS						DATE	
		DESIGN						DRAWINGS	
								CORRECTED BY	
								DATE	
DESIGNED BY		RM		DATE		9/94		MICRO-FILM INFORMATION	
DRAWN BY		DC		DATE		9/94		RECORDED BY	
								DATE	
								NO.	

dmg D. MARK GOODWIN & ASSOCIATES, P.A.
CONSULTING ENGINEERS & SURVEYORS
P.O. BOX 90606
ALBUQUERQUE, NEW MEXICO 87199
(505) 345-2010

CITY OF ALBUQUERQUE
PUBLIC WORKS DEPARTMENT
ENGINEERING GROUP


TITLE: CASITA DE LA MESA SUBDIVISION
PAVING IMPROVEMENTS
VISTA DE VALLE ST. & CASITAS COURT

APPROVALS	ENGINEER	DATE	APPROVALS	ENGINEER	DATE
DRC CHAIRMAN	<i>P. J. Gentry</i>	5-4-95	WATER	N/A RWK	3-17
TRANSPORTATION	<i>R. J. Dantz</i>	3-17-95	WASTE WATER	N/A RWK	3-17
HYDROLOGY	<i>J. J. Gentry</i>	4-12-95			


PROJECT NO. 5054.90	MAP NO. L9	SHEET 8	OF 16
------------------------	---------------	------------	----------

SCANNED BY
BY LASON

$$\begin{array}{ll} \textcircled{5} \Delta = 89^{\circ}59'01'' & \textcircled{6} \Delta = 86^{\circ}02'34'' \\ R = 25.00' & R = 25.00' \\ L = 39.26' & L = 37.54' \\ T = 25.99' & T = 23.33' \end{array}$$

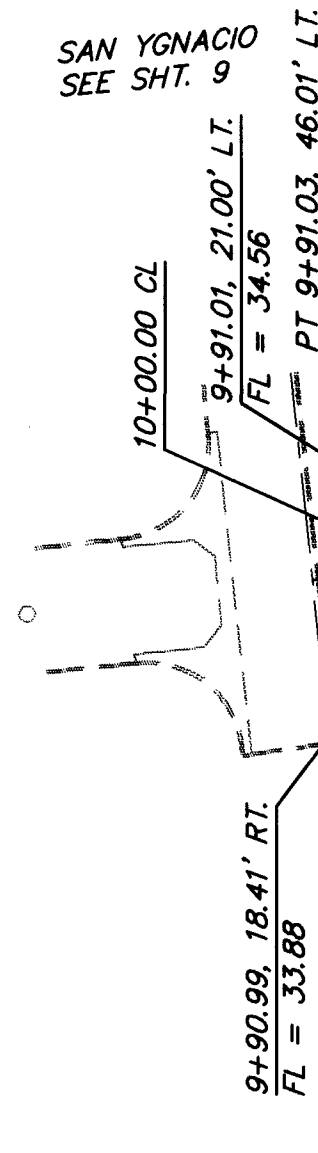


1. ALL STATIONING IS CENTERLINE STATIONING.
2. NORTHEAST CURB RETURN AT INTERSECTION OF SAN YGNACIO & 94 TH. ST. SHALL BE STANDARD CURB & GUTTER.

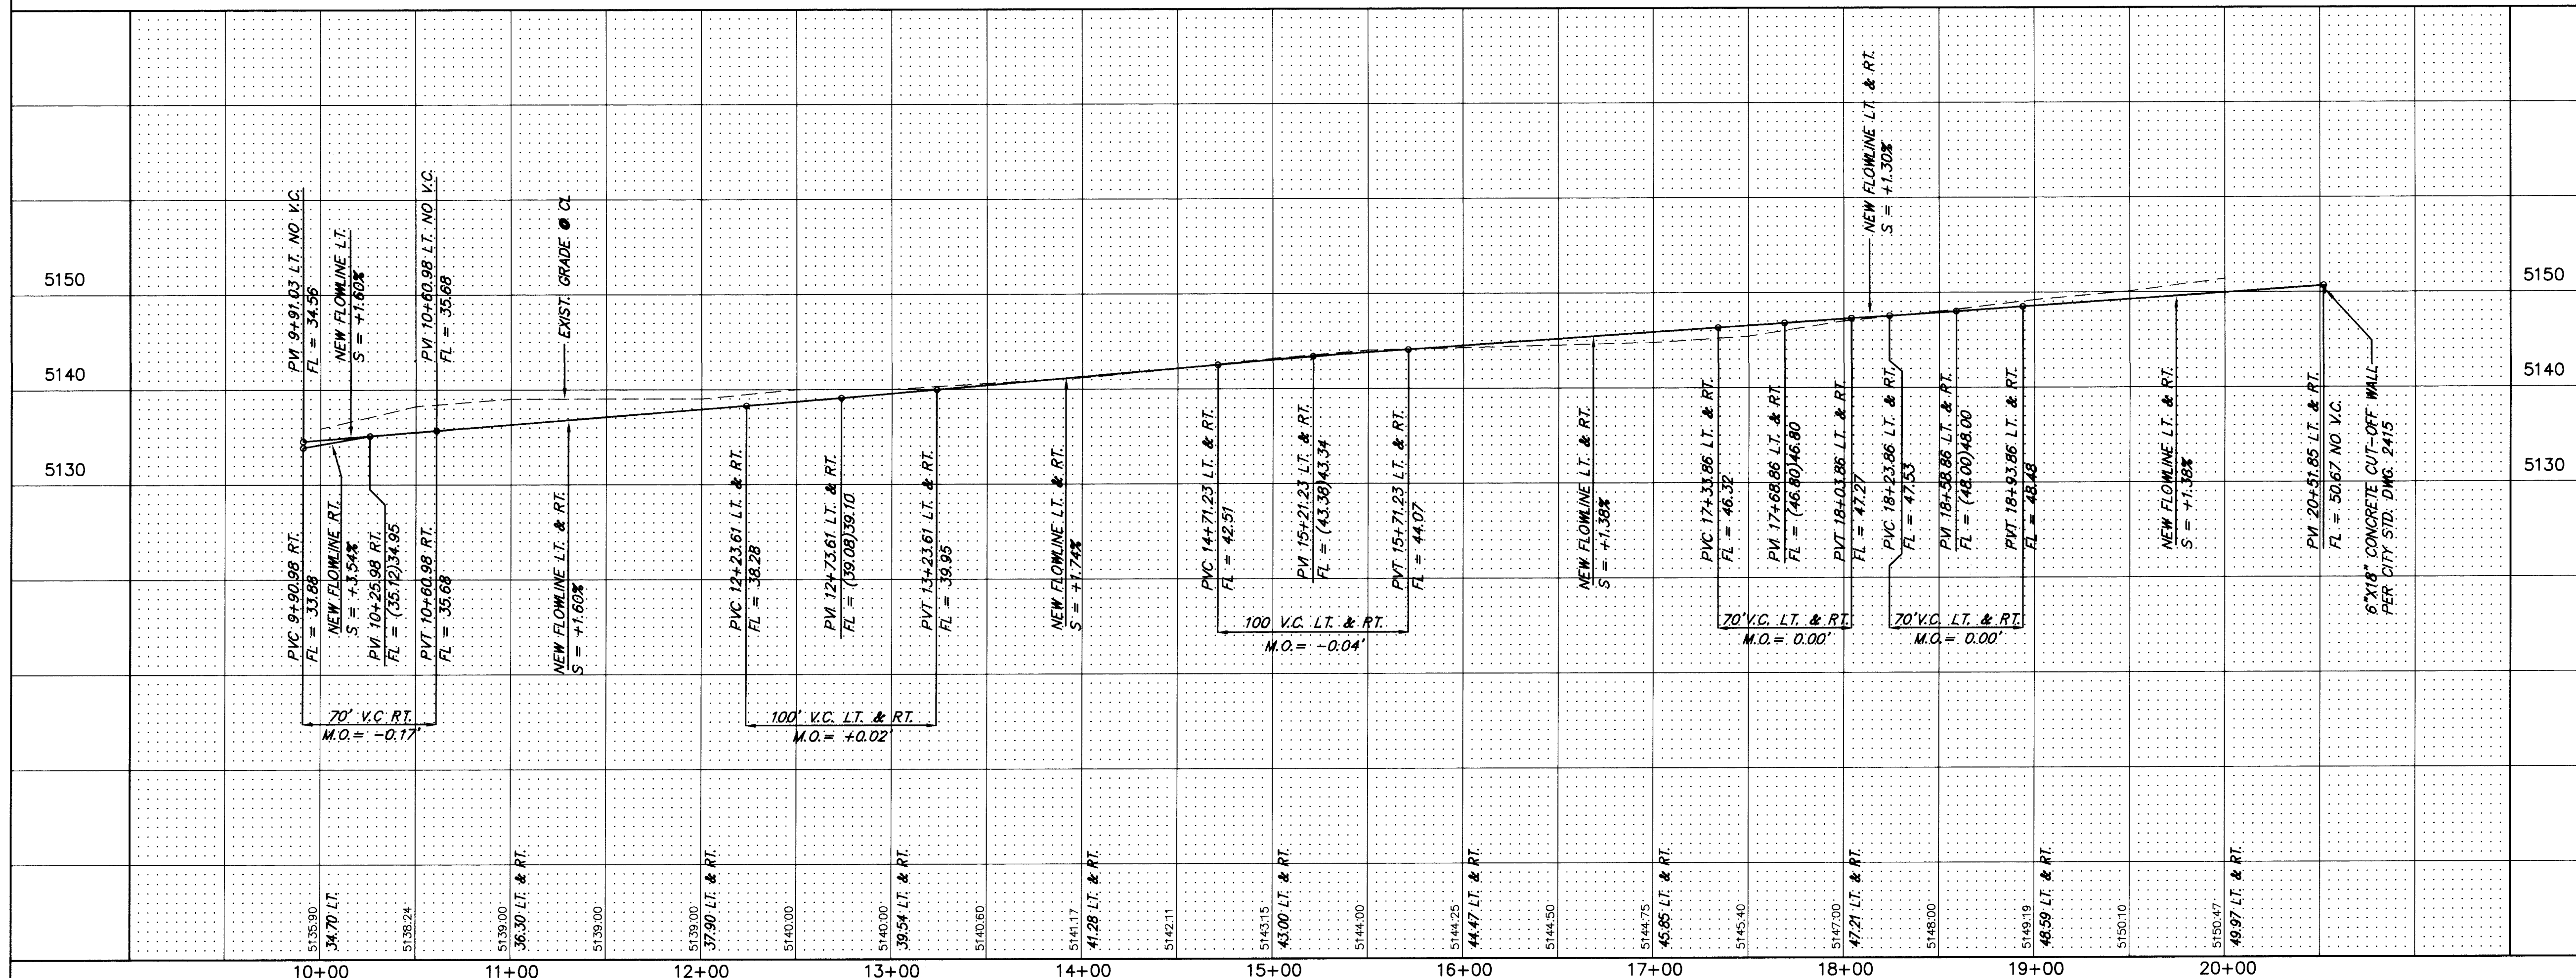[illegible]

SCANNED BY
BY LASON

LENGTH OF RESTRAINED PIPE (FEET)						
PIPE SIZE	90	45	22.5	11.25	TEE	VALVE
6"	18'	7'	4'	2'	*	55'
8"	22'	8'	4'	2'	*	59'
12"	26'	11'	5'	3'	*	83'

LENGTH OF RESTRAINED PIPE ON EACH SIDE OF THE BEND. RESTRAIN BRANCH AT FITTING ONLY. MINIMUM ATTACHED PIPE LENGTH, RUN SIDE OF TEE: 10.00 FEET.

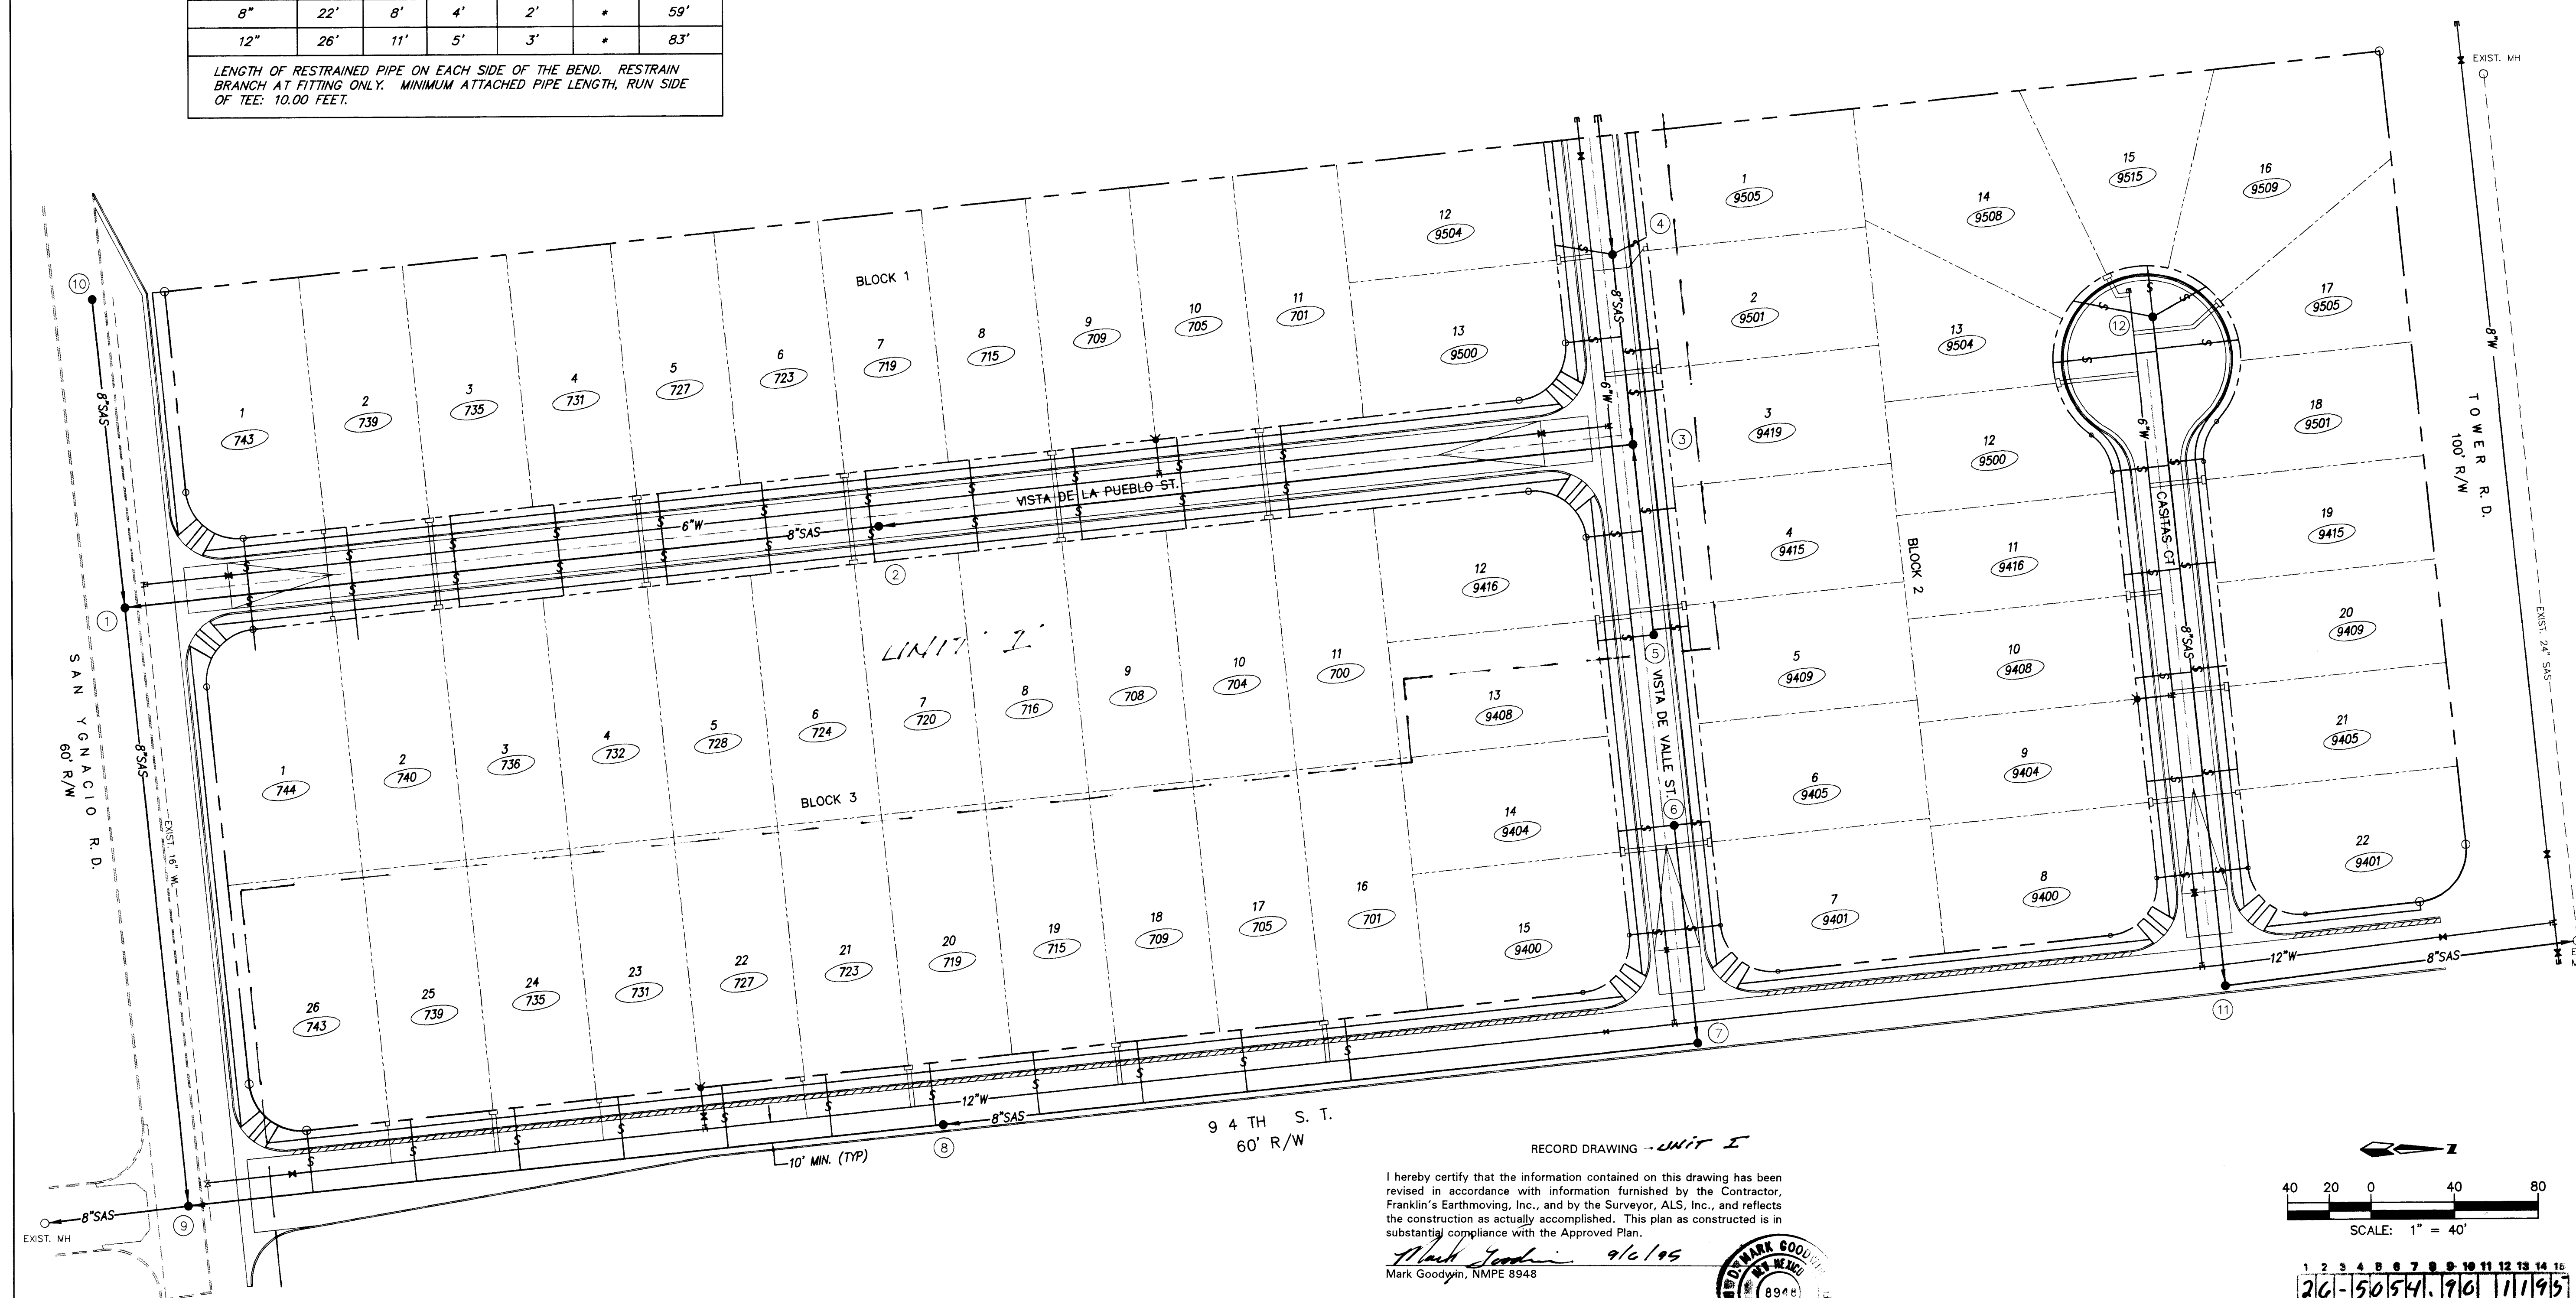


I hereby certify that the information contained on this drawing has been revised in accordance with information furnished by the Contractor, Franklin's Earthmoving, Inc., and by the Surveyor, ALS, Inc., and reflects the construction as actually accomplished. This plan as constructed is in substantial compliance with the Approved Plan.

Mark Goodwin 9/6/95
Mark Goodwin, NMPE 8948



- LEGEND:
- NEW MOUNTABLE CURB & GUTTER
 - NEW STANDARD CURB & GUTTER
 - NEW FIRE HYDRANT
 - DOUBLE WATER SERVICE
 - SINGLE WATER SERVICE
 - SANITARY SEWER SERVICE
 - NEW 4" MH #4
 - LOT 19
 - GATE VALVE
 - TEE
 - BEND


- VALVE SHUT-OFF PLAN
- FOR WATERLINE CONNECTION ON SAN YGNACIO VALVE #B41 & PRESSURE REDUCE VALVE #B31 ON ZONE-2WR & ZONE 2W BOUNDARY NEED TO BE SHUT OFF.
 - CONTRACTOR WILL CONTACT WATER SYSTEMS AT 857-8200 3 DAYS PRIOR TO NECESSARY SHUT-OFF.
 - VALVES SHALL ONLY BE OPERATED BY CITY WATER EMPLOYEES.

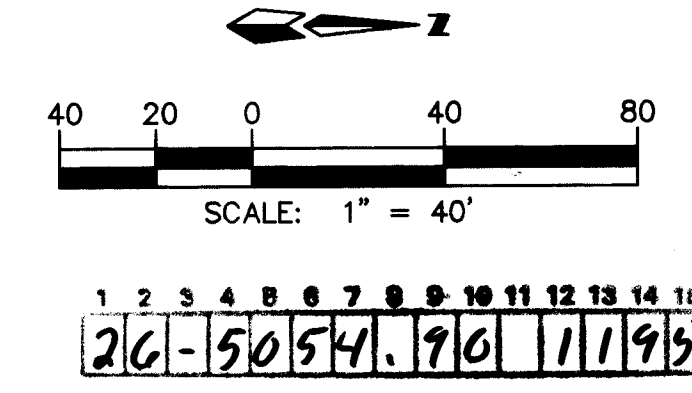

dmg D. MARK GOODWIN & ASSOCIATES, P.A.
CONSULTING ENGINEERS & SURVEYORS
P.O. BOX 90606
ALBUQUERQUE, NEW MEXICO 87199
(505) 345-2010

CITY OF ALBUQUERQUE PUBLIC WORKS DEPARTMENT ENGINEERING GROUP			
TITLE: CASITA DE LA MESA SUBDIVISION MASTER UTILITY PLAN			
APPROVALS	ENGINEER	DATE	APPROVALS
DRC CHAIRMAN	<i>R.W. Kane</i>	5-4-95	WATER
TRANSPORTATION	<i>R.W. Kane</i>	3-17-95	WASTE WATER
HYDROLOGY	<i>R.W. Kane</i>	4-12-95	
PROJECT NO.	5054.90	MAP NO.	L9
SHEET		OF	
11		16	

AS BUILT INFORMATION			
CONTRACTOR	WORKED BY	DATE	INSPECTOR'S
Franklin's	ALS	9/6/95	ALS
WORKED BY	DATE	INSPECTOR'S	DATE
ALS	9/6/95	ALS	9/6/95
ACCEPTANCE BY	DATE	VERIFICATION BY	DATE
ALS	9/6/95	ALS	9/6/95
DRAWINGS	CORRECTED BY	DATE	MICRO-FILM INFORMATION
ALS	ALS	9/6/95	
RECORDED BY	NO.	DATE	

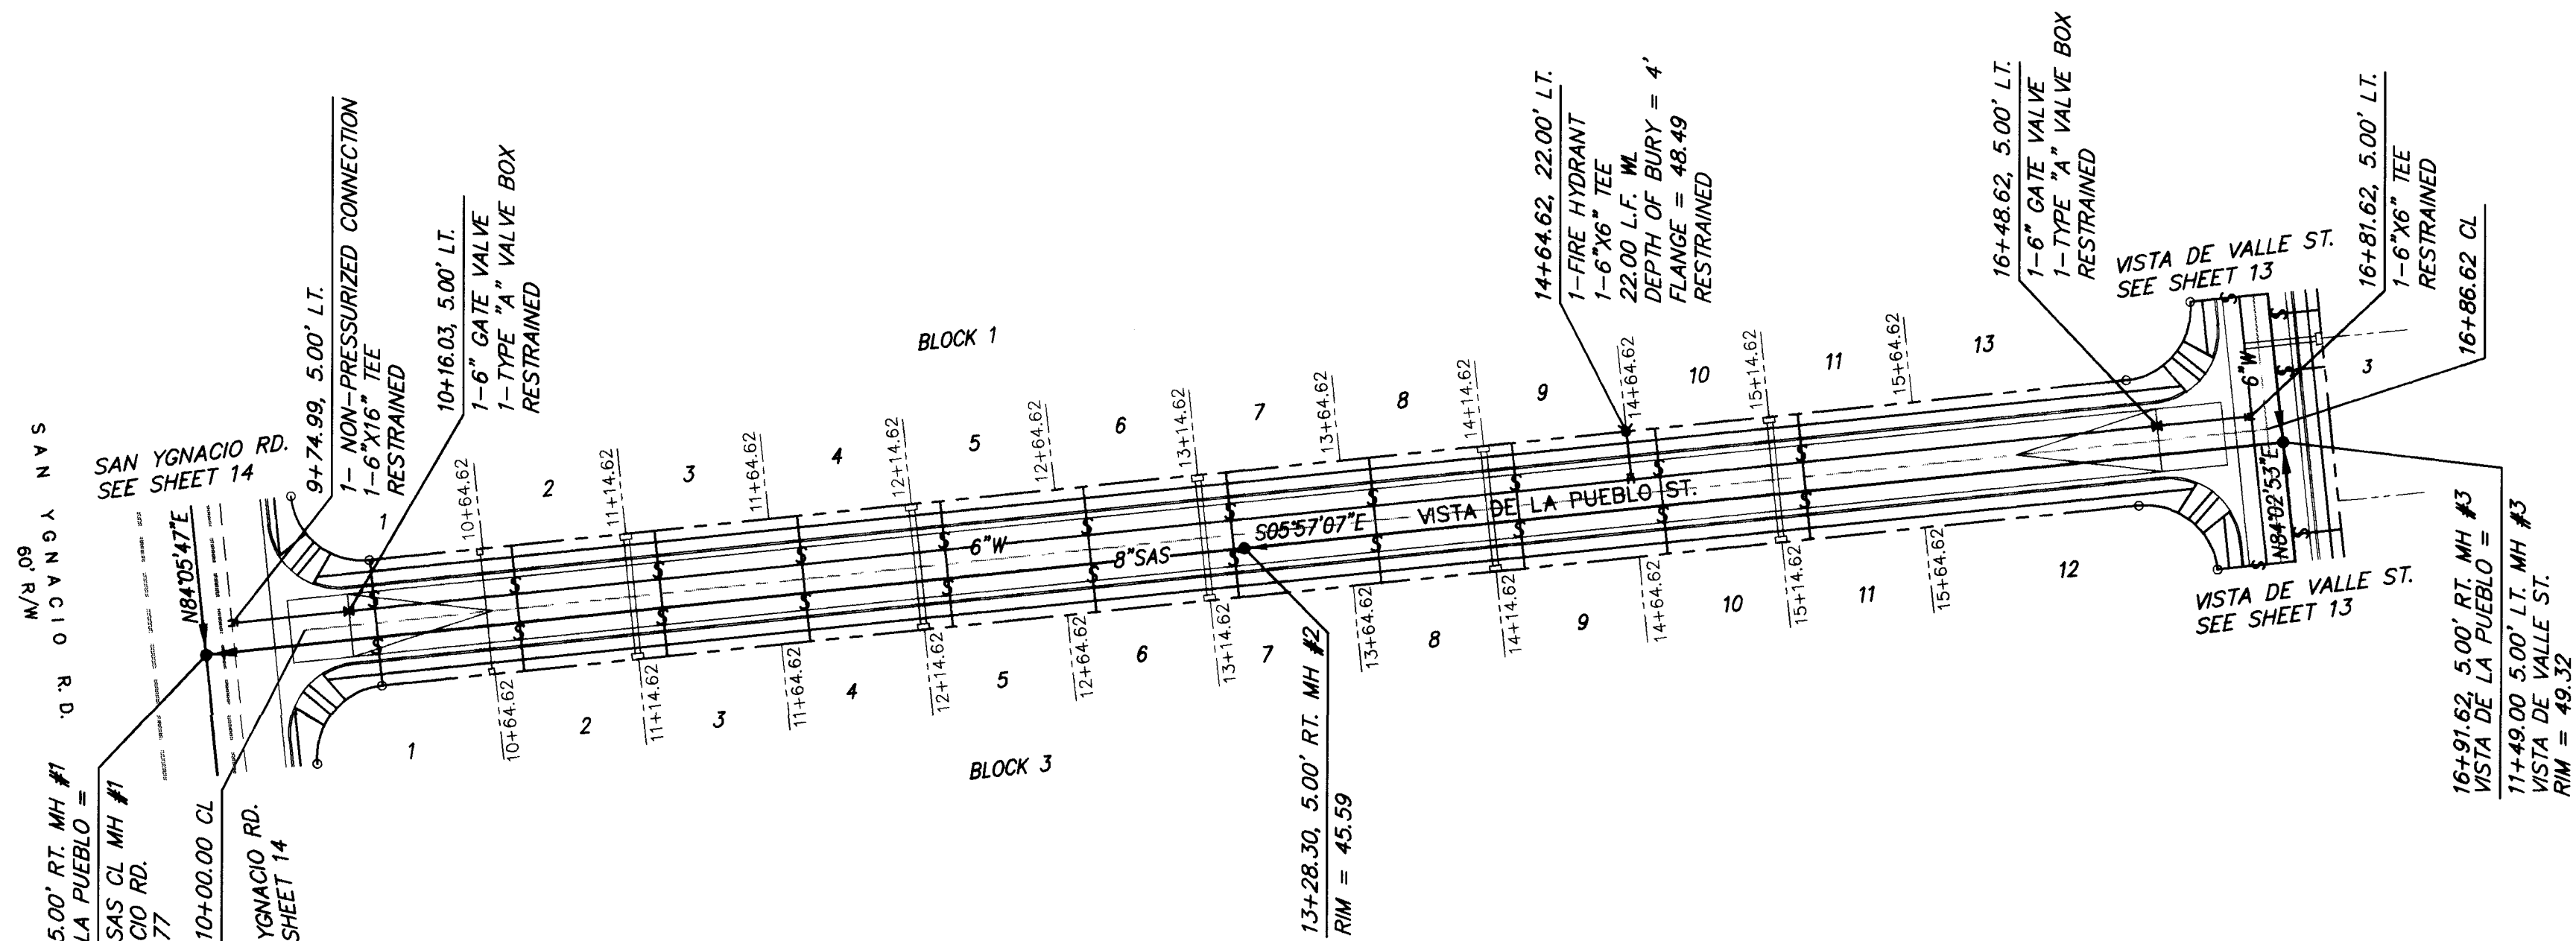


RECORD DRAWING UNIT I

I hereby certify that the information contained on this drawing has been revised in accordance with information furnished by the Contractor, Franklin's Earthmoving, Inc., and by the Surveyor, ALS, Inc., and reflects the construction as actually accomplished. This plan as constructed is in substantial compliance with the Approved Plan.

Mark Goodwin, NMPE 8948

VISTA DE LA PUEBLO ST.
STA. 9+64.99 TO STA. 16+91.62

SCALE:
HORIZ. 1" = 50'
VERT. 1" = 10'

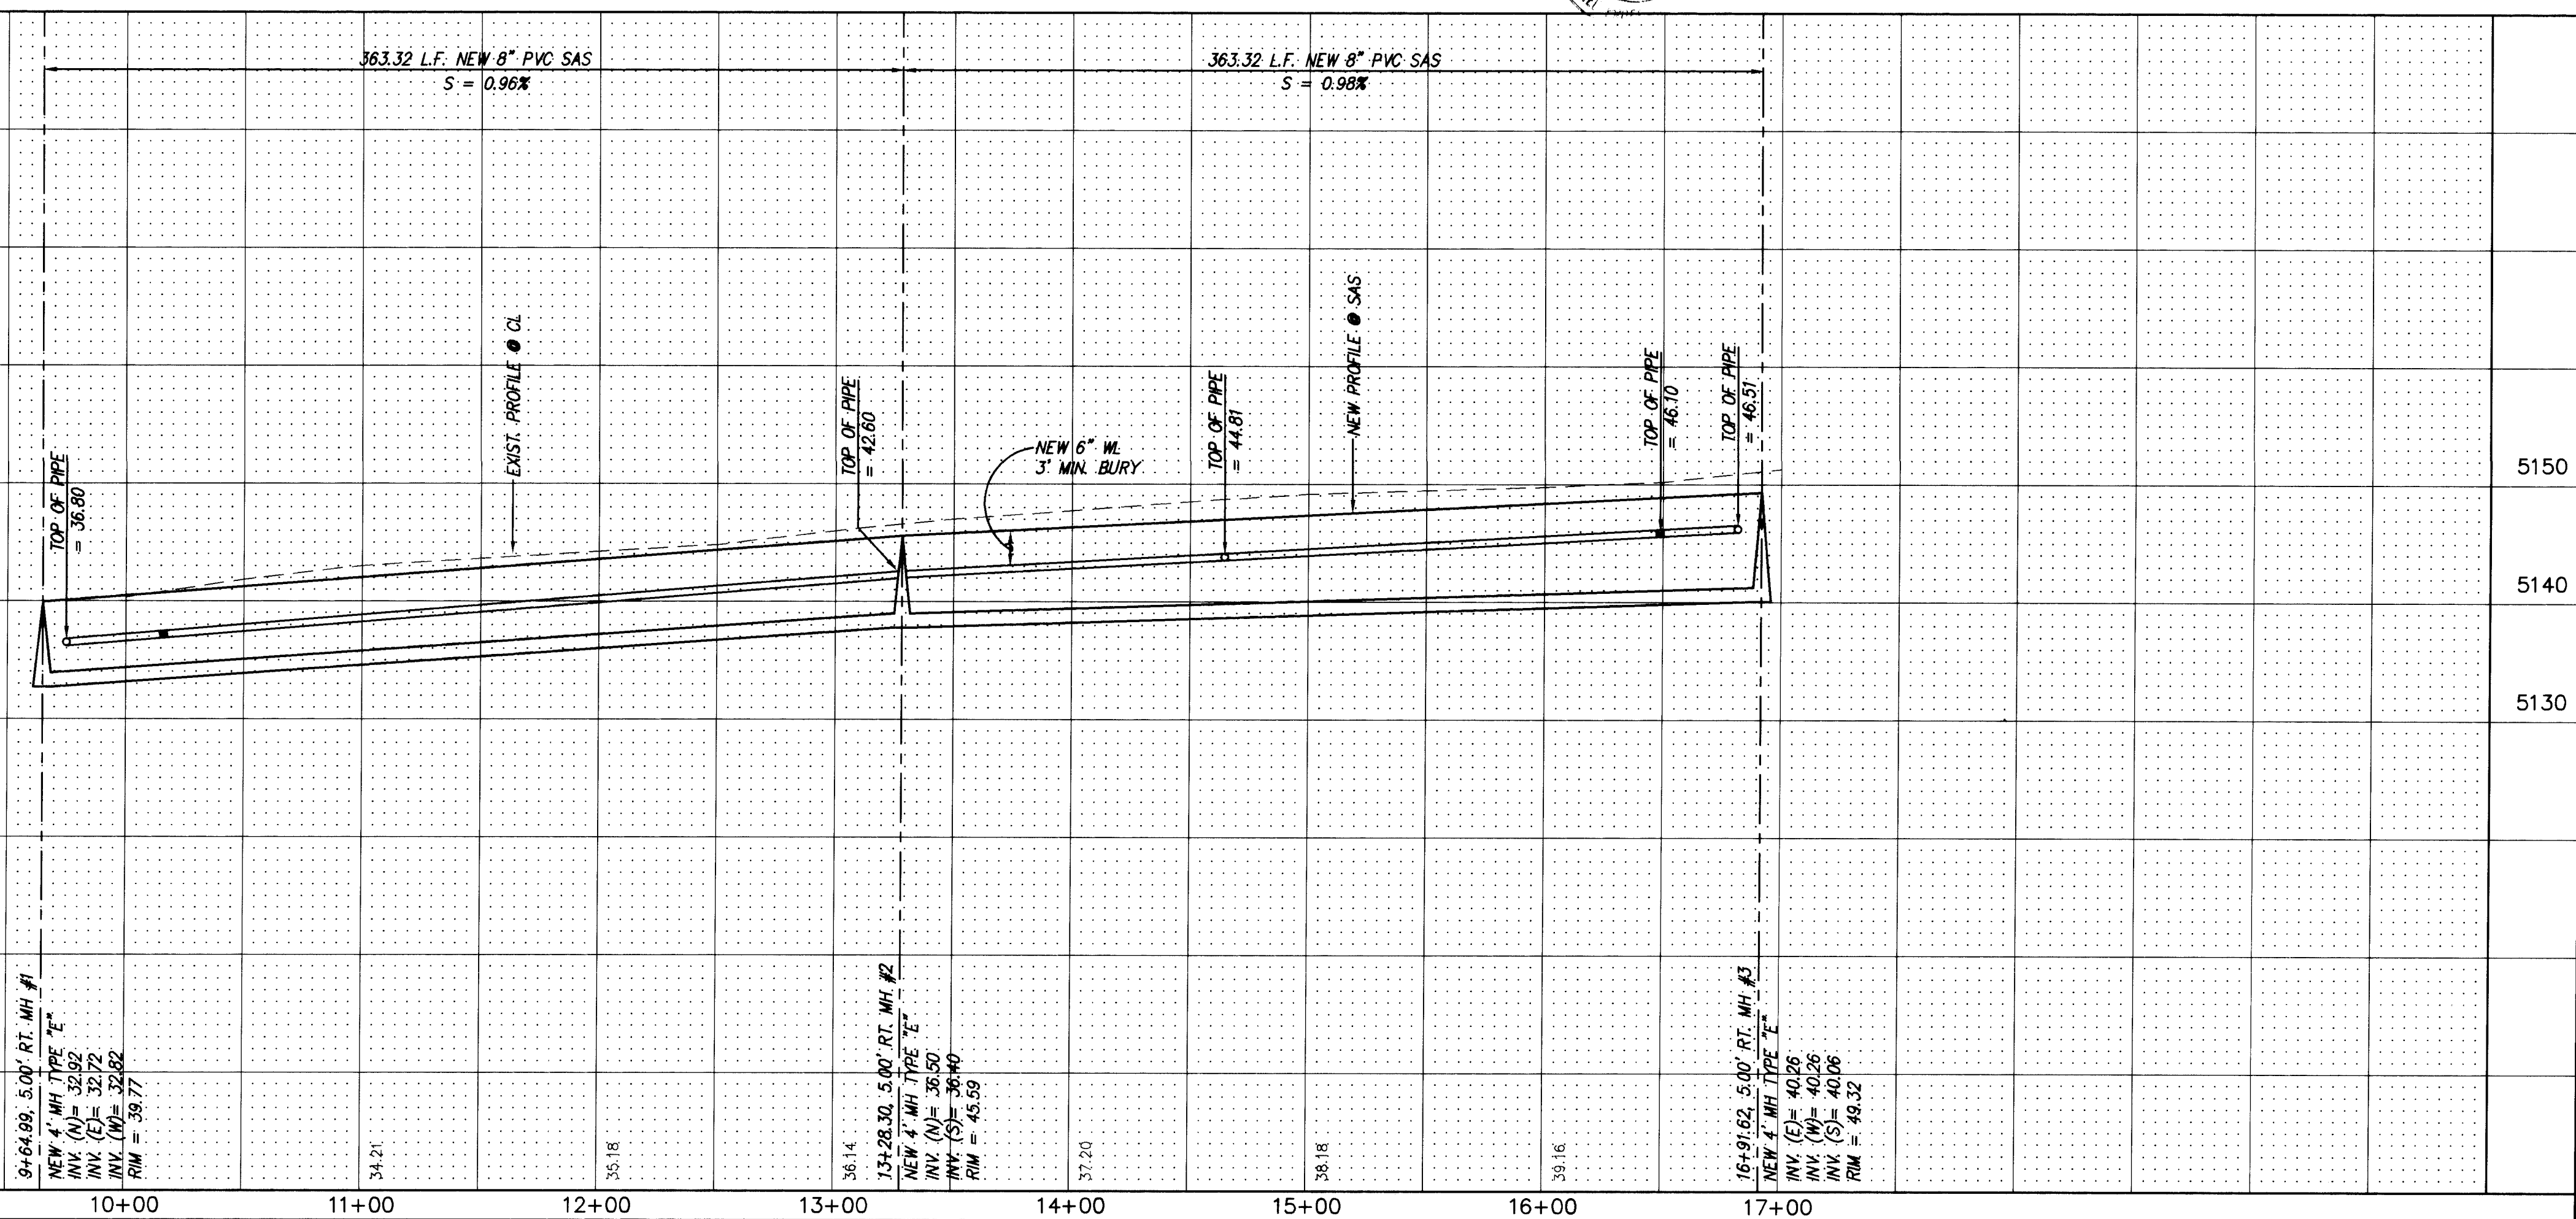


20-5054-190 11295

D.M. GOODWIN & ASSOCIATES, P.A.
CONSULTING ENGINEERS & SURVEYORS
P.O. BOX 90606
ALBUQUERQUE, NEW MEXICO 87199
(505) 345-2010

CITY OF ALBUQUERQUE PUBLIC WORKS DEPARTMENT ENGINEERING GROUP					
TITLE: CASITA DE LA MESA SUBDIVISION UTILITY IMPROVEMENTS VISTA DE LA PUEBLO STREET					
APPROVALS	ENGINEER	DATE	APPROVALS	ENGINEER	DATE
DRC CHAIRMAN	3-17-95	5-4-95	WATER	R.W. Kane	3-17-95
TRANSPORTATION	3-17-95	3-17-95	WASTE WATER	R.W. Kane	3-17-95
HYDROLOGY	3-17-95	3-17-95			
PROJECT NO.	5054.90	MAP NO.	L9	SHEET OF	12 16

SCANNED BY
LASA

SANITARY SEWER SERVICES				
LOT BLK 1	STA.	INV. ELEV. ● PL	LENGTH ● PL	INV. ELEV. ● M.H.
12	10+47	45.07	28	44.51
13	10+97	44.28	28	N/A
BLK 2				
1	10+47	44.87	18	44.51
2	11+04	43.78	18	N/A
3	11+25	42.88	18	
4	11+82	42.16	18	↓
5	12.39	42.50	18	
6	13+33	40.71	18	40.35
7	13+83	41.42	18	N/A
BLK 3				
12	11+91	42.41	28	N/A
13	12+41	41.70	28	41.14
14	13+33	40.91	28	40.35
15	13+83	41.62	28	N/A

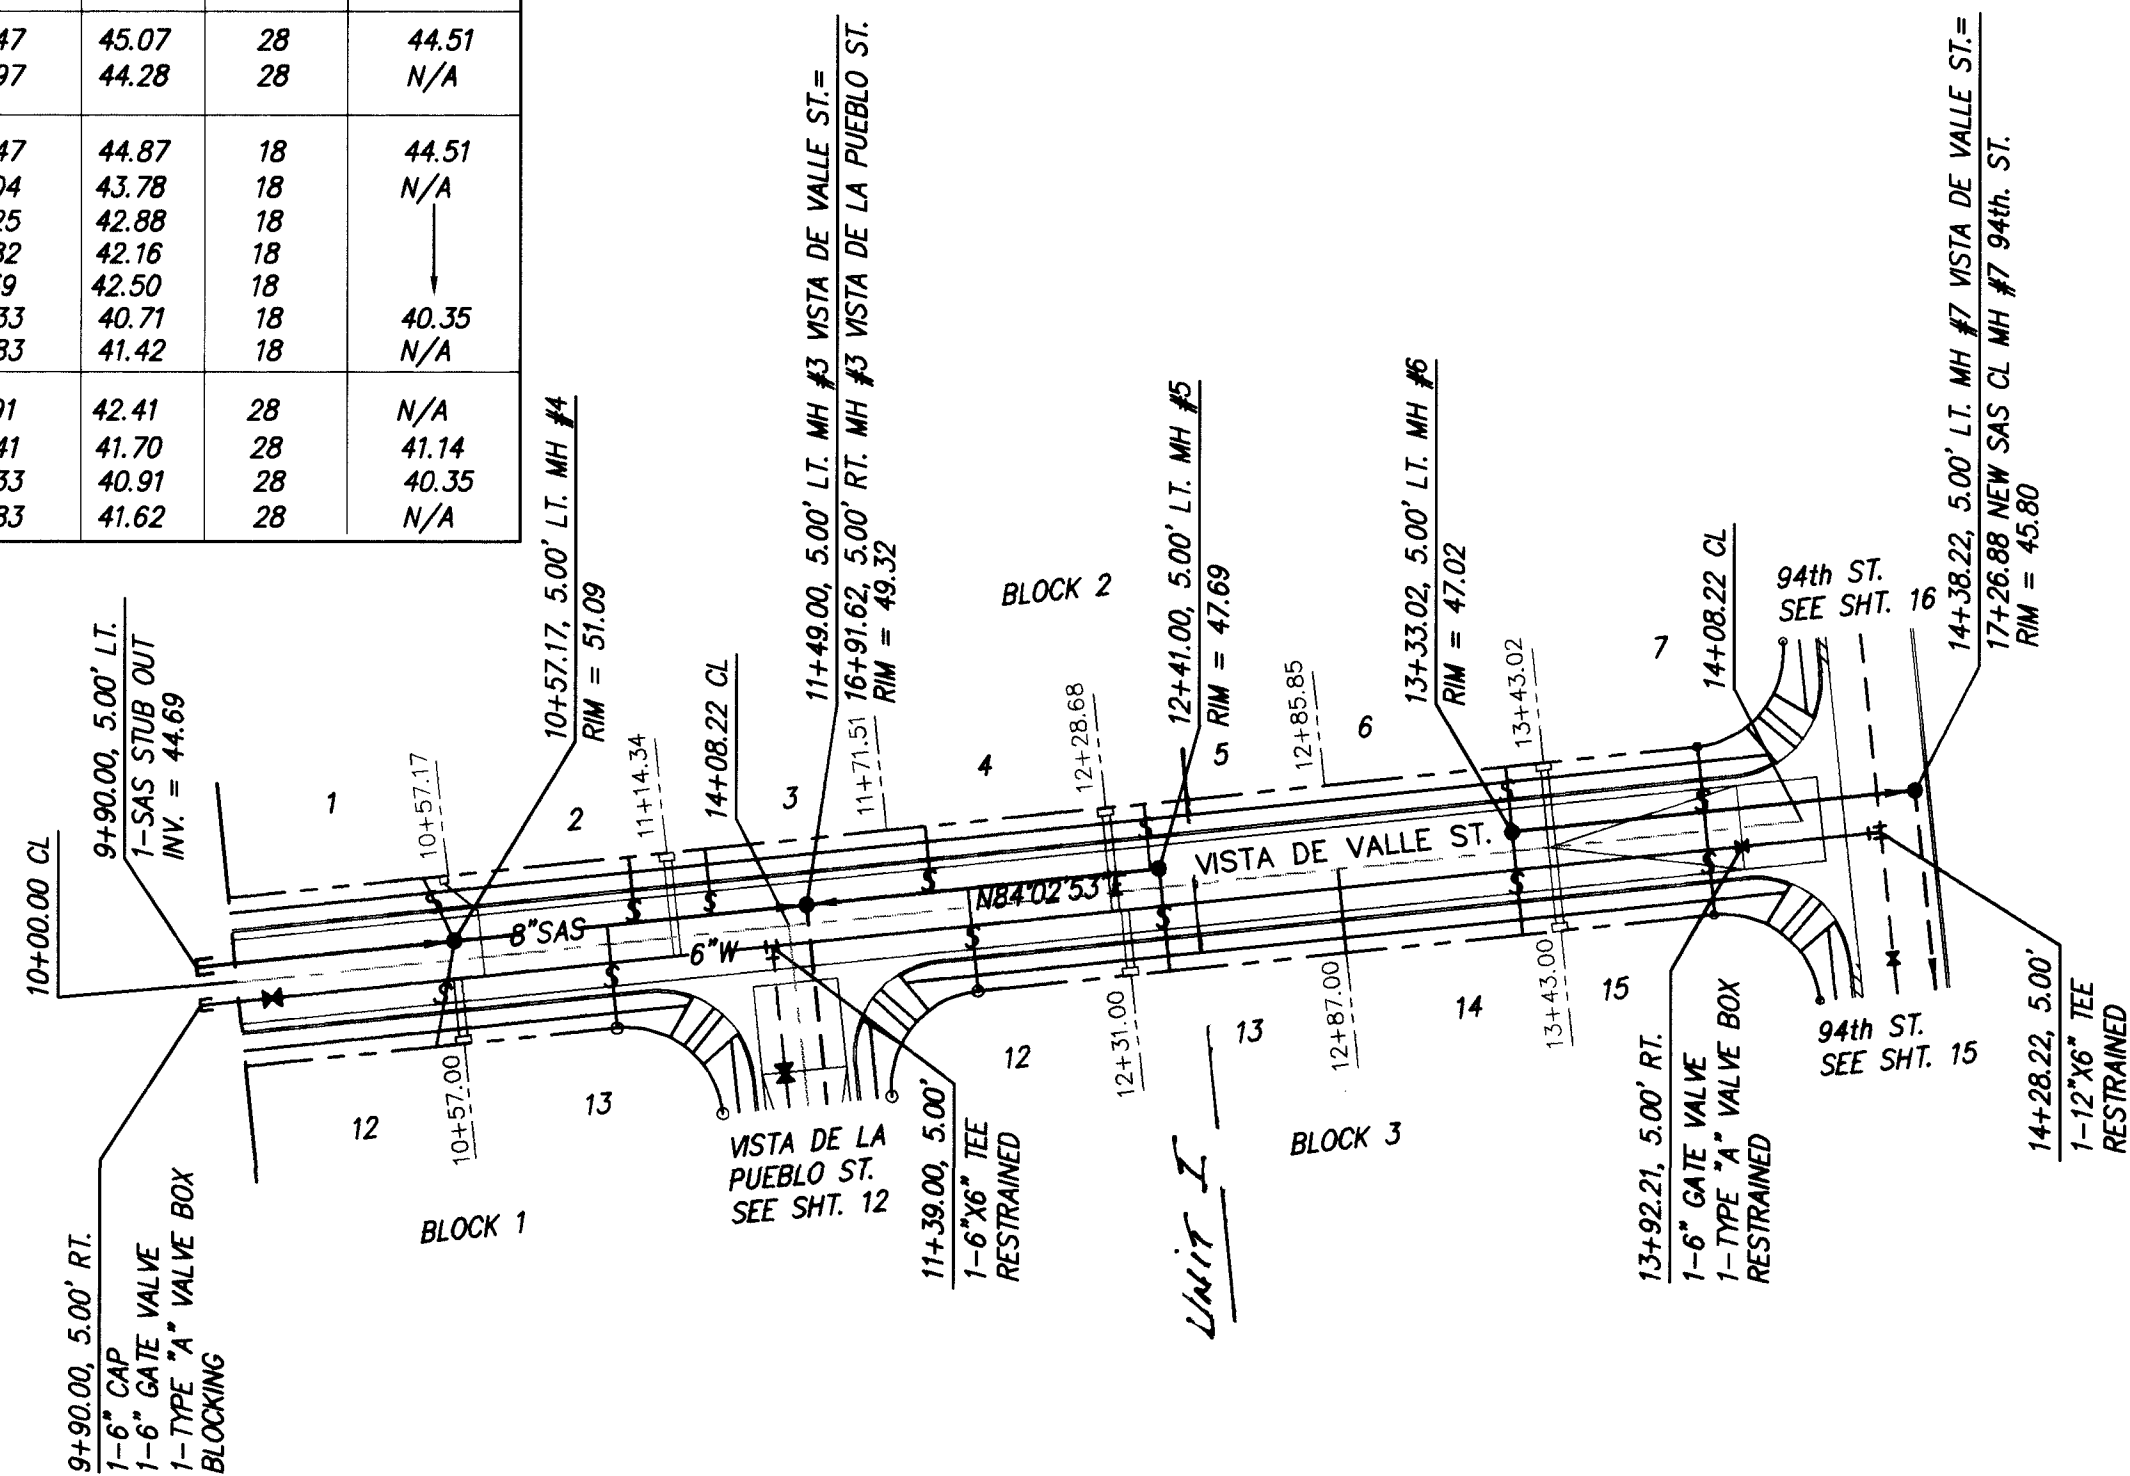

RECORD DRAWING - *UNIT I*



I hereby certify that the information contained on this drawing has been revised in accordance with information furnished by the Contractor, Franklin's Earthmoving, Inc., and by the Surveyor, ALS, Inc., and reflects the construction as actually accomplished. This plan as constructed is in substantial compliance with the Approved Plan.

Mark Goodwin
Mark Goodwin, NMPE 8948



VISTA DE VALLE ST.
STA. 9+90.00 TO STA. 14+38.22


SCALE:
HORIZ. 1" = 50'
VERT. 1" = 10'

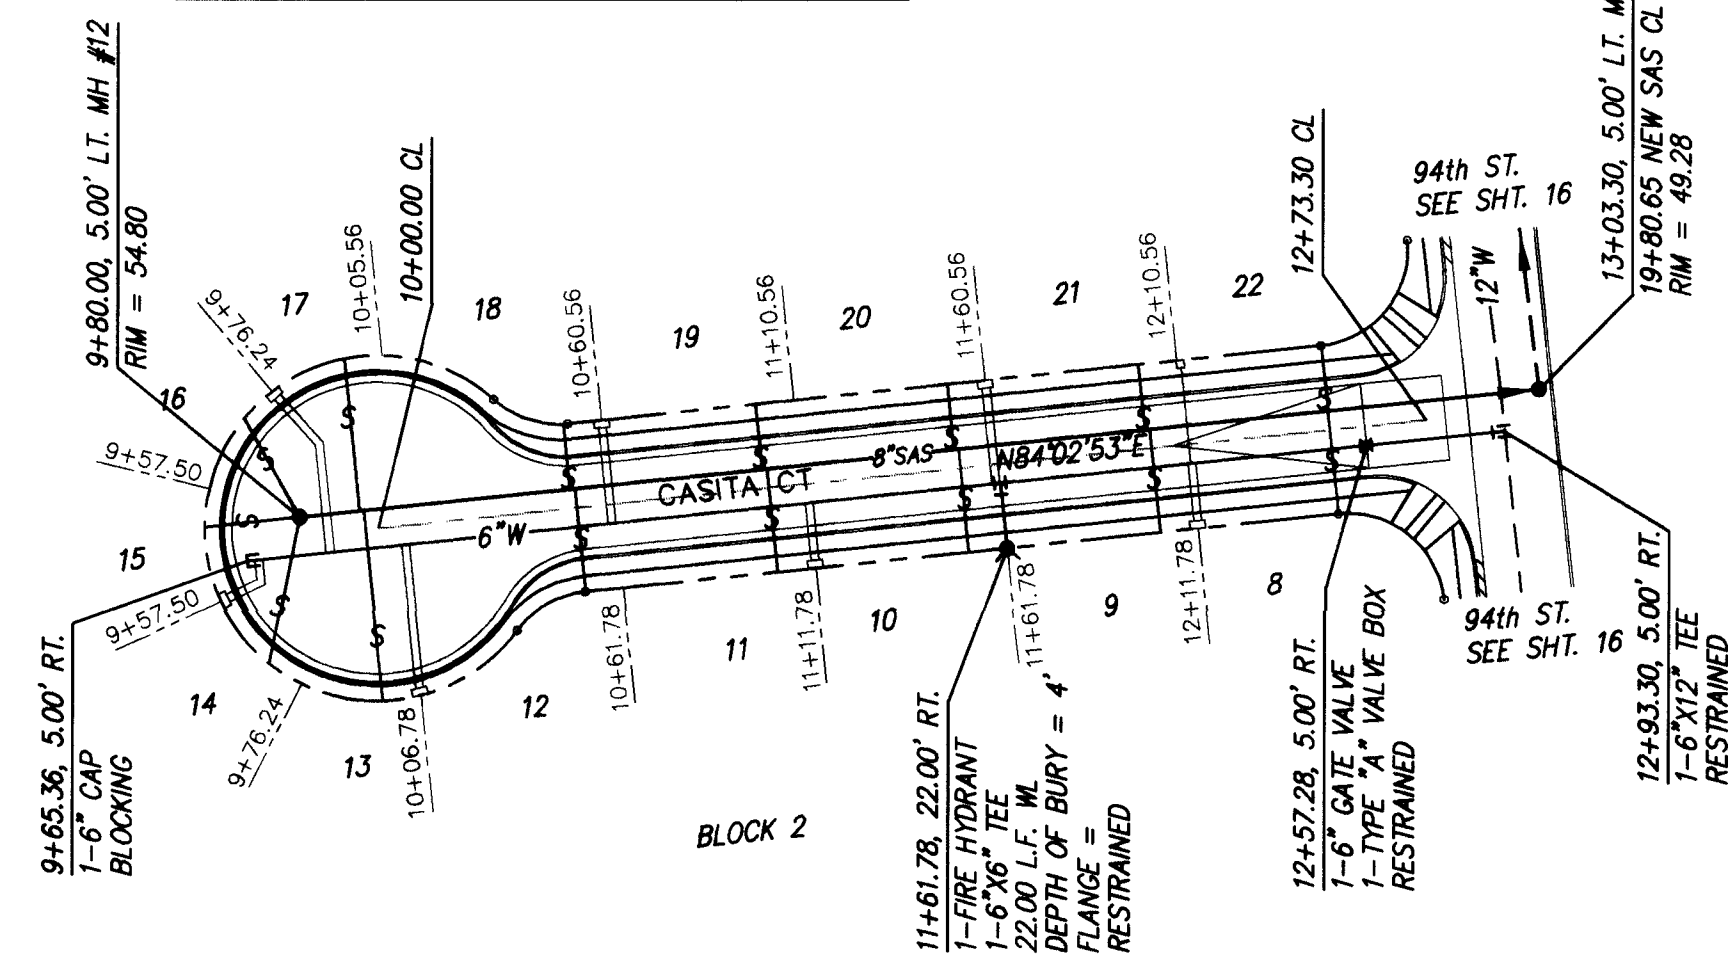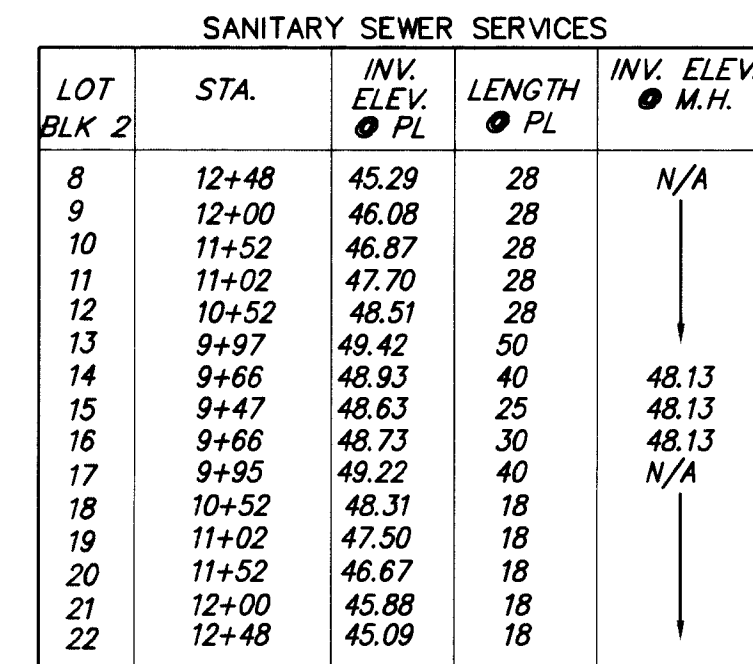

CASITA COURT
STA. 9+65.36 TO STA. 13+03.30

SCALE:
HORIZ. 1" = 50'
VERT. 1" = 10'

NOT CONSTRUCTED IN UNIT I

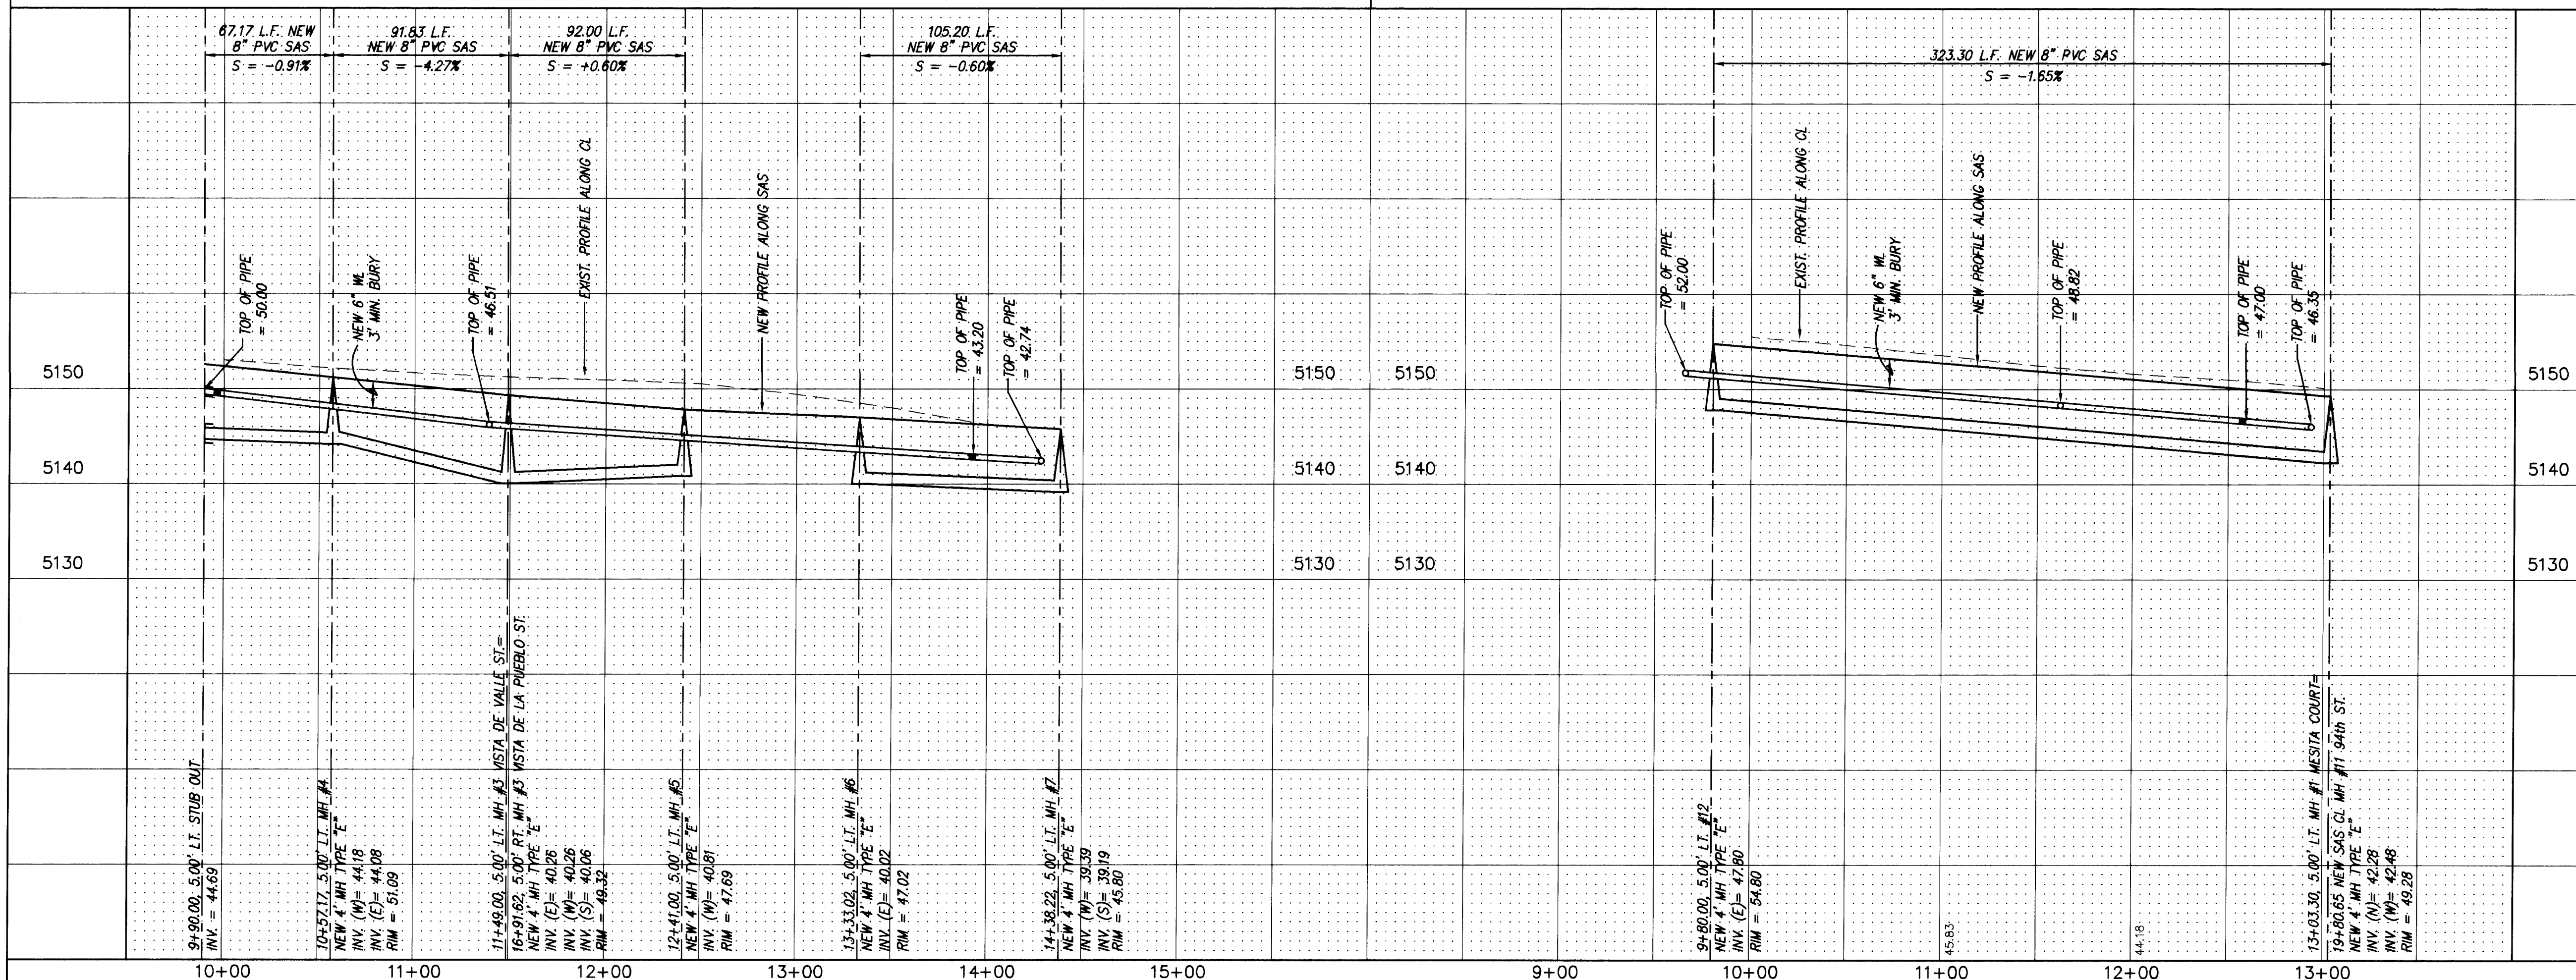

SCANNED BY
BY LASON

SYS\UP-2

NOTES:

1. ALL STATIONING IS CENTERLINE STATIONING.

[illegible]

dmg D. MARK GOODWIN & ASSOCIATES, P.A.
CONSULTING ENGINEERS & SURVEYORS
P.O. BOX 90606
ALBUQUERQUE, NEW MEXICO 87199
(505) 345-2010

CITY OF ALBUQUERQUE
PUBLIC WORKS DEPARTMENT
ENGINEERING GROUP




TITLE: CASITA DE LA MESA SUBDIVISION
UTILITY IMPROVEMENTS
VISTA DE VALLE ST. AND CASITA COURT

APPROVALS	ENGINEER	DATE	APPROVALS	ENGINEER	DATE
DRC CHAIRMAN	<i>34. G. G. G. G.</i>	<i>5-4-95</i>	WATER	<i>R. W. Kame</i>	<i>3-17-95</i>
TRANSPORTATION	<i>N/A. RHO</i>	<i>3-17-95</i>	WASTE WATER	<i>R. W. Kame</i>	<i>3-17-95</i>
HYDROLOGY	<i>3/2/2</i>	<i>3-12-95</i>			


PROJECT	
NO.	5054.90

MAP NO.	19
---------	----

SHEET 13 OF 16

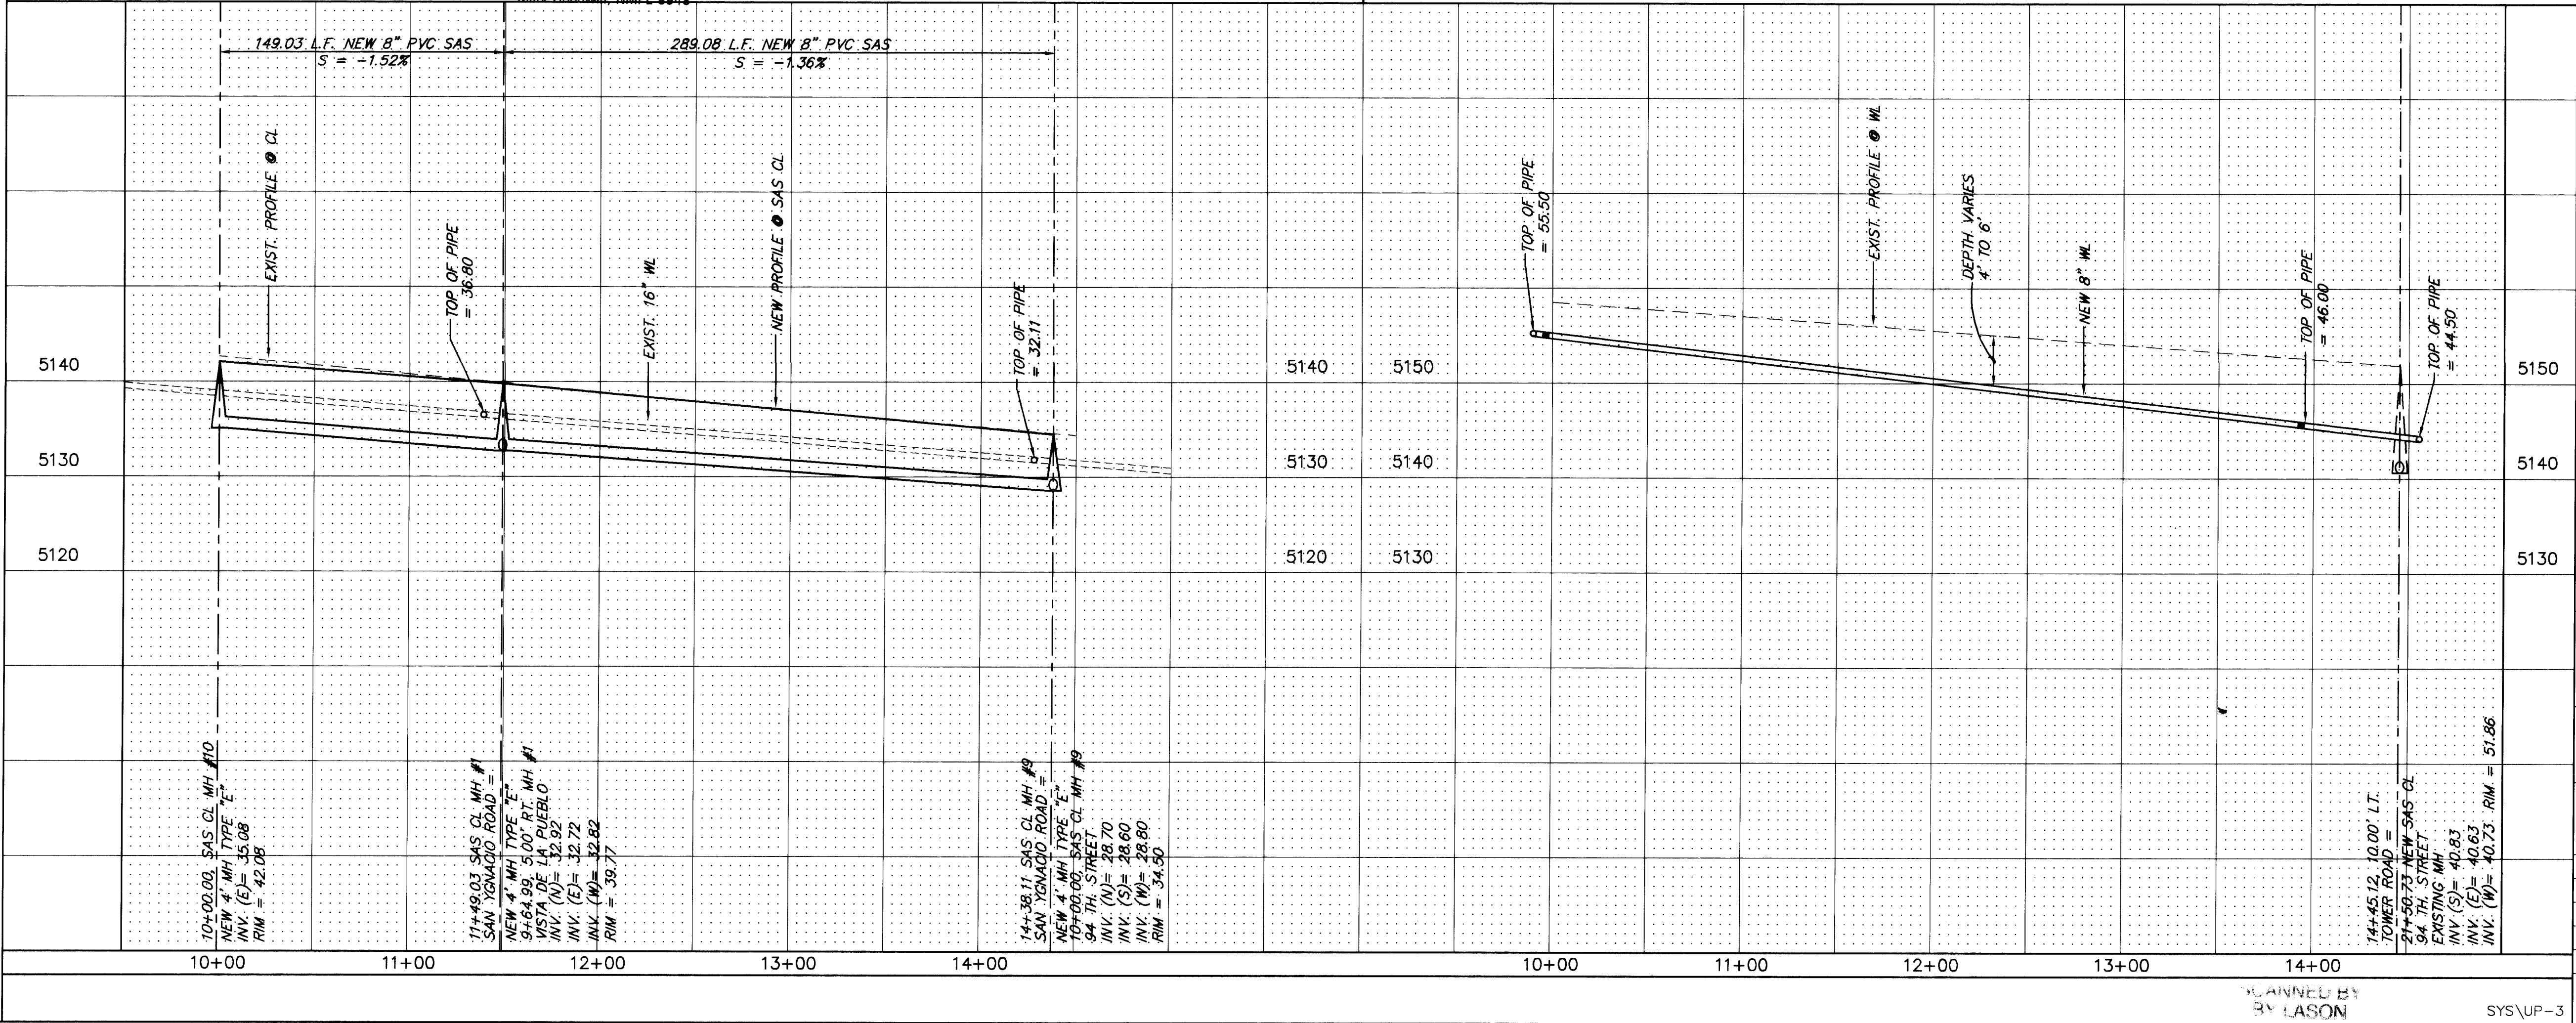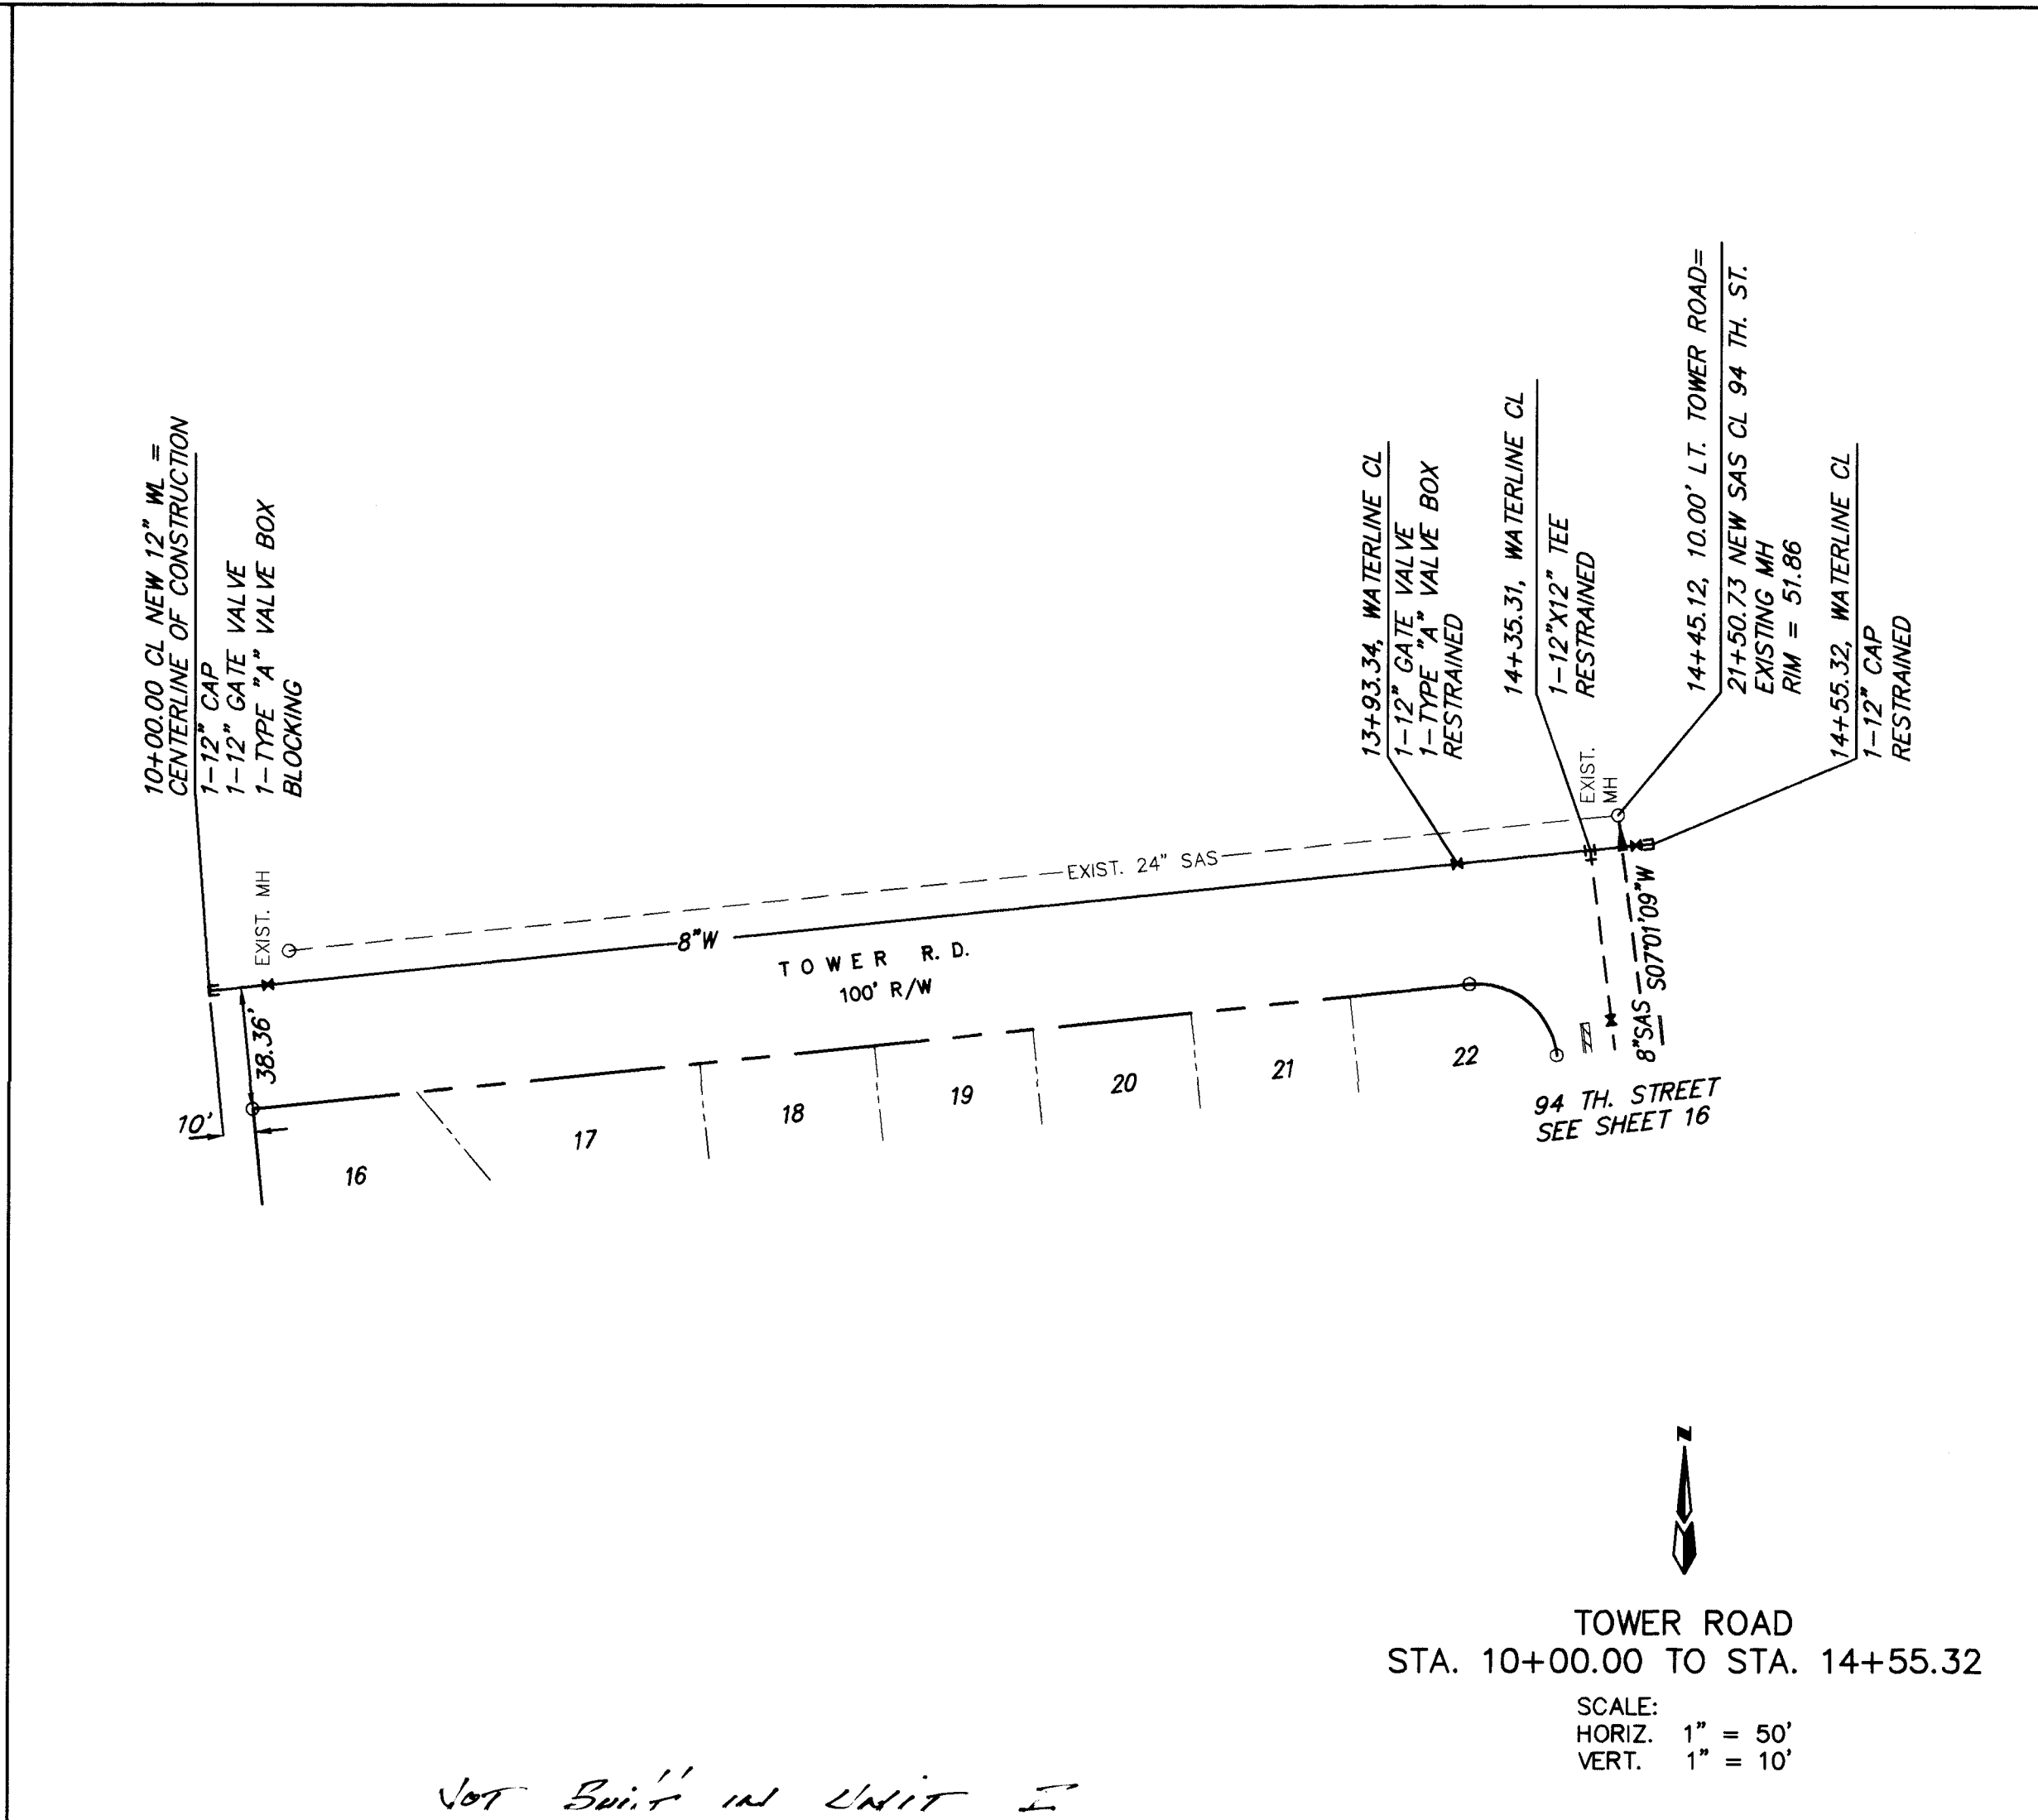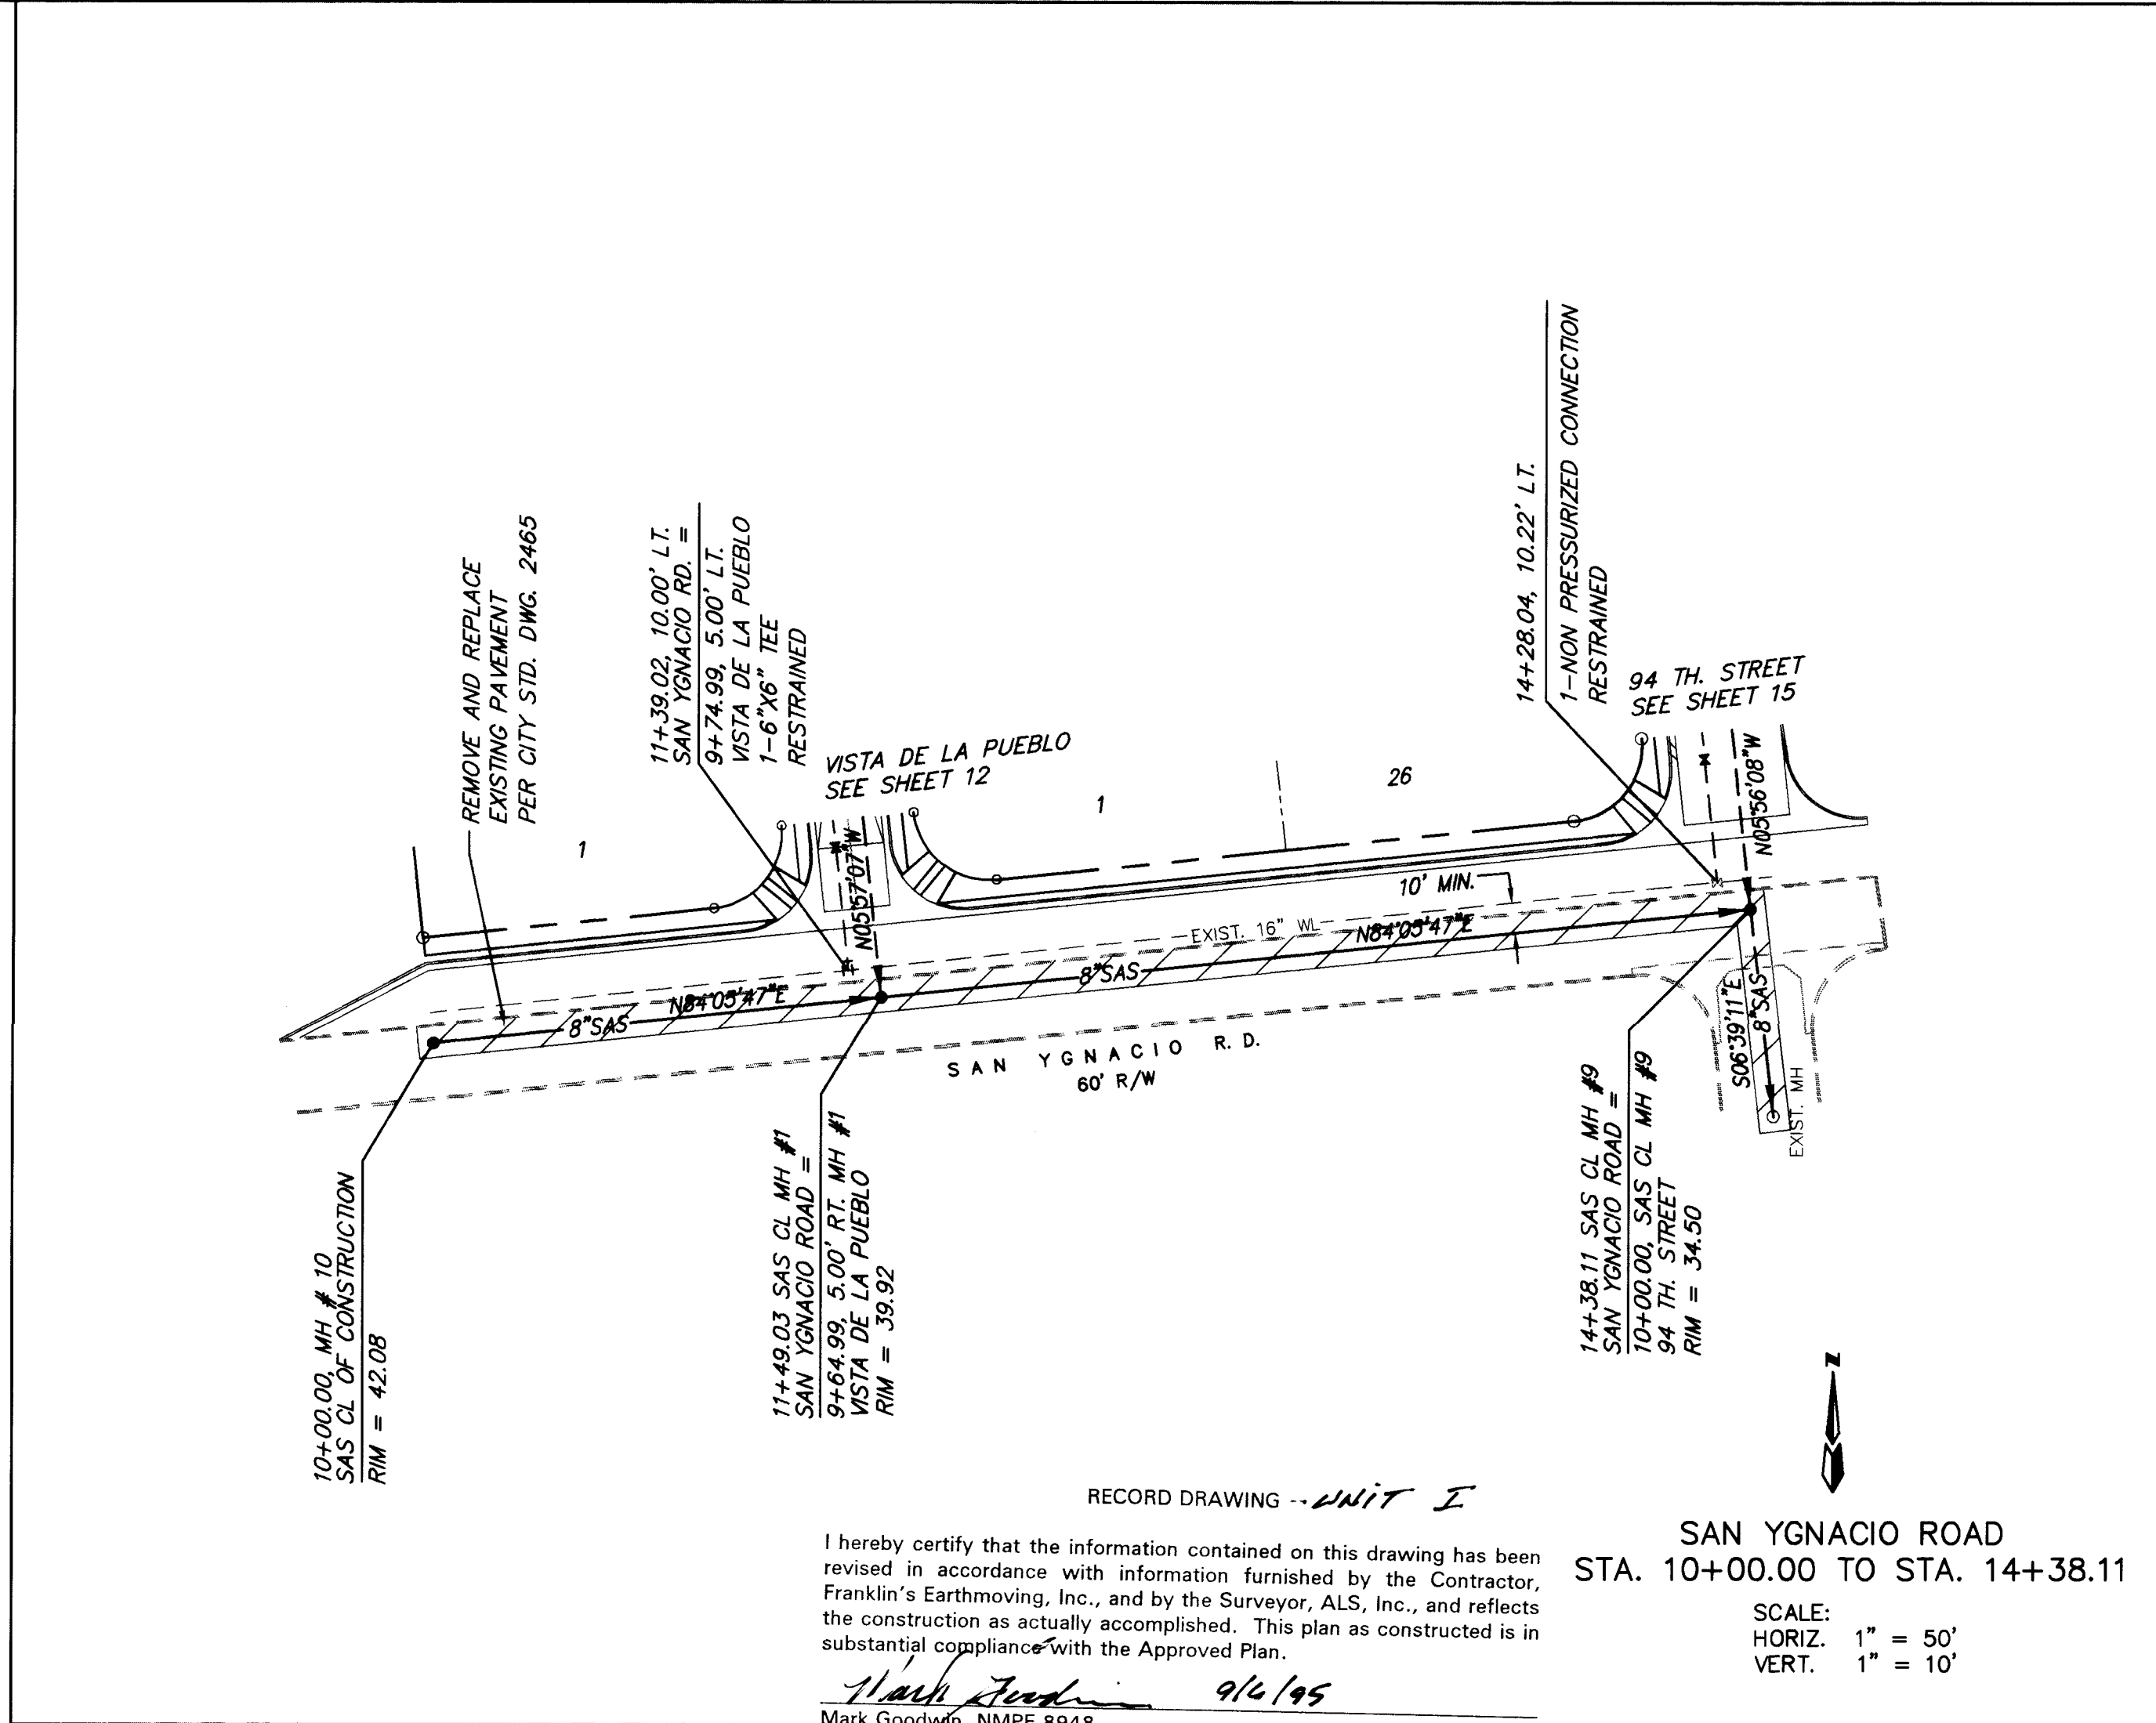

PROJECT NO. 5054.90		MAP NO. L9		SHEET 14 OF 16	
TITLE: CASITA DE LA MESA SUBDIVISION UTILITY IMPROVEMENTS SAN YGNACIO ROAD. & TOWER ROAD		ENGINEER: R.W. Kane		DATE: 3-17-95	
APPROVALS: ENGINEER: R.W. Kane		DATE: 3-17-95		WATER: R.W. Kane	
TRANSPORTATION: R.W. Kane		DATE: 3-17-95		WASTE WATER: R.W. Kane	
HYDROLOGY: R.W. Kane		DATE: 3-17-95		DATE: 3-17-95	
DESIGNED BY: RM		DATE: 9/94		DATE: 9/94	
DRAWN BY: DC		DATE: 9/94		DATE: 9/94	
CHECKED BY: DMG		DATE: 9/94		DATE: 9/94	
CITY OF ALBUQUERQUE PUBLIC WORKS DEPARTMENT ENGINEERING GROUP		ENGINEER'S SEAL: Mark Goodwin 3/16/95		AS BUILT INFORMATION	
STATION MARK IS A STANDARD MNSHC BRASS TABLET STAMPED		CONTRACTOR: Franklin's		DATE: 3/16/95	
7-40-228", SET 0.5' BELOW THE PAVEMENT. LOCATED ON THE		WORK: 7-40-228"		DATE: 3/16/95	
98th STREET OVERPASS AT U.S. INTERSTATE HIGHWAY 40 (I-40).		ACCEPTANCE BY: ALS		DATE: 3/16/95	
X = 351650.01 Y = 1,486,656.52 Z = 5298.42		DRAWINGS: ALS		DATE: 3/16/95	
		CORRECTED BY: ALS		DATE: 3/16/95	
		MICRO-FILM INFORMATION		DATE: 3/16/95	
		RECORDED BY: ALS		DATE: 3/16/95	
		NO.		DATE	

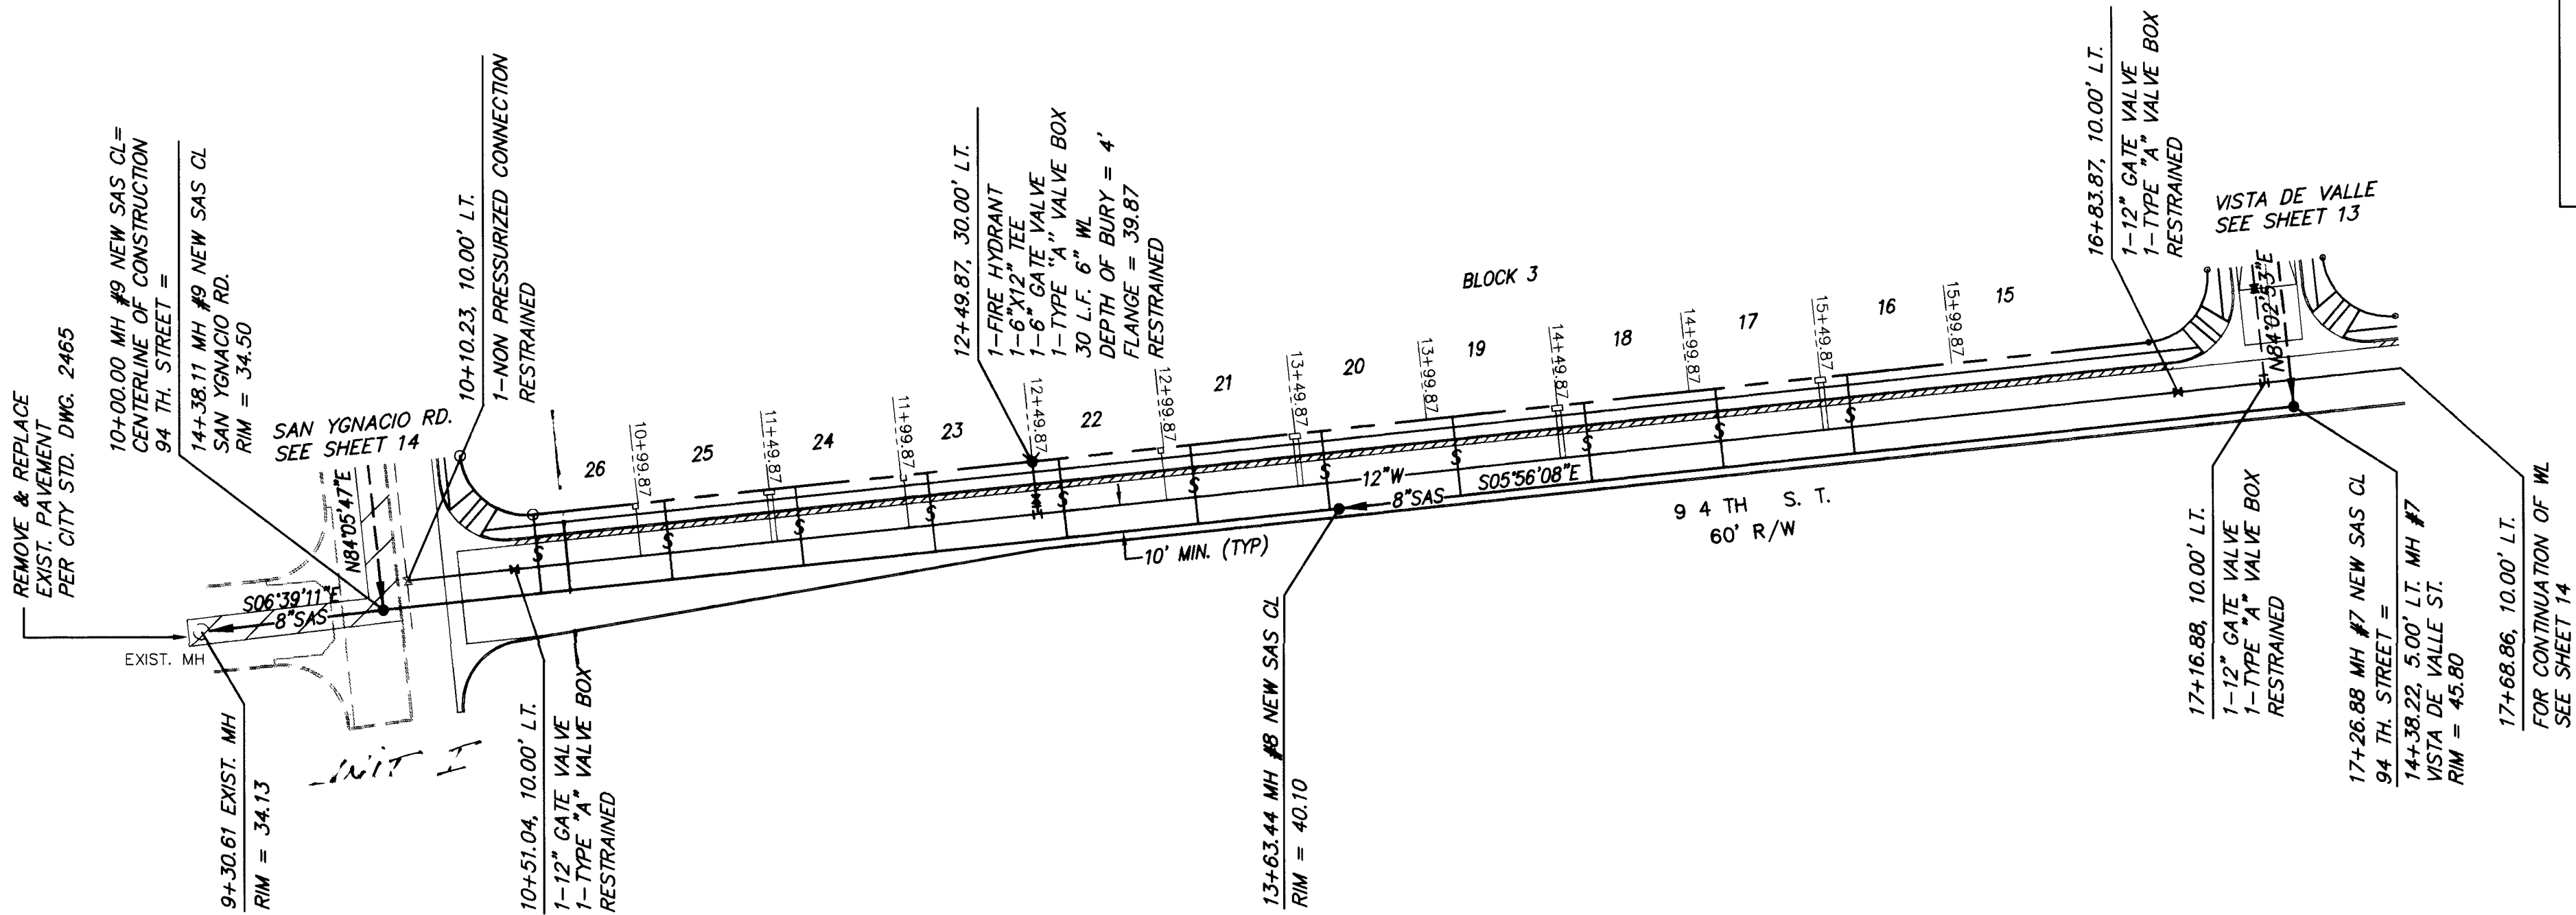

SANITARY SEWER SERVICES				
LOT BLK 3	STA.	INV. ELEV. ● PL	LENGTH ● PL	INV. ELEV. ● M.H.
16	15+60	38.38	30	N/A
17	15+10	37.53		
18	14+60	36.68		
19	14+10	35.83		
20	13+60	35.10		
21	13+10	34.50		
22	12+60	33.89		
23	12+10	33.28		
24	11+60	32.68		
25	11+10	32.07		
26	10+60	31.47		

RECORD DRAWING - UNIT 1


I hereby certify that the information contained on this drawing has been revised in accordance with information furnished by the Contractor, Franklin's Earthmoving, Inc., and by the Surveyor, ALS, Inc., and reflects the construction as actually accomplished. This plan as constructed is in substantial compliance with the Approved Plan.

Mark Goodwin 9/6/95
Mark Goodwin, NMPE 8948



94th. STREET
STA. 9+30.61 TO STA. 17+68.86



SCALE:
HORIZ. 1" = 50'
VERT. 1" = 10'

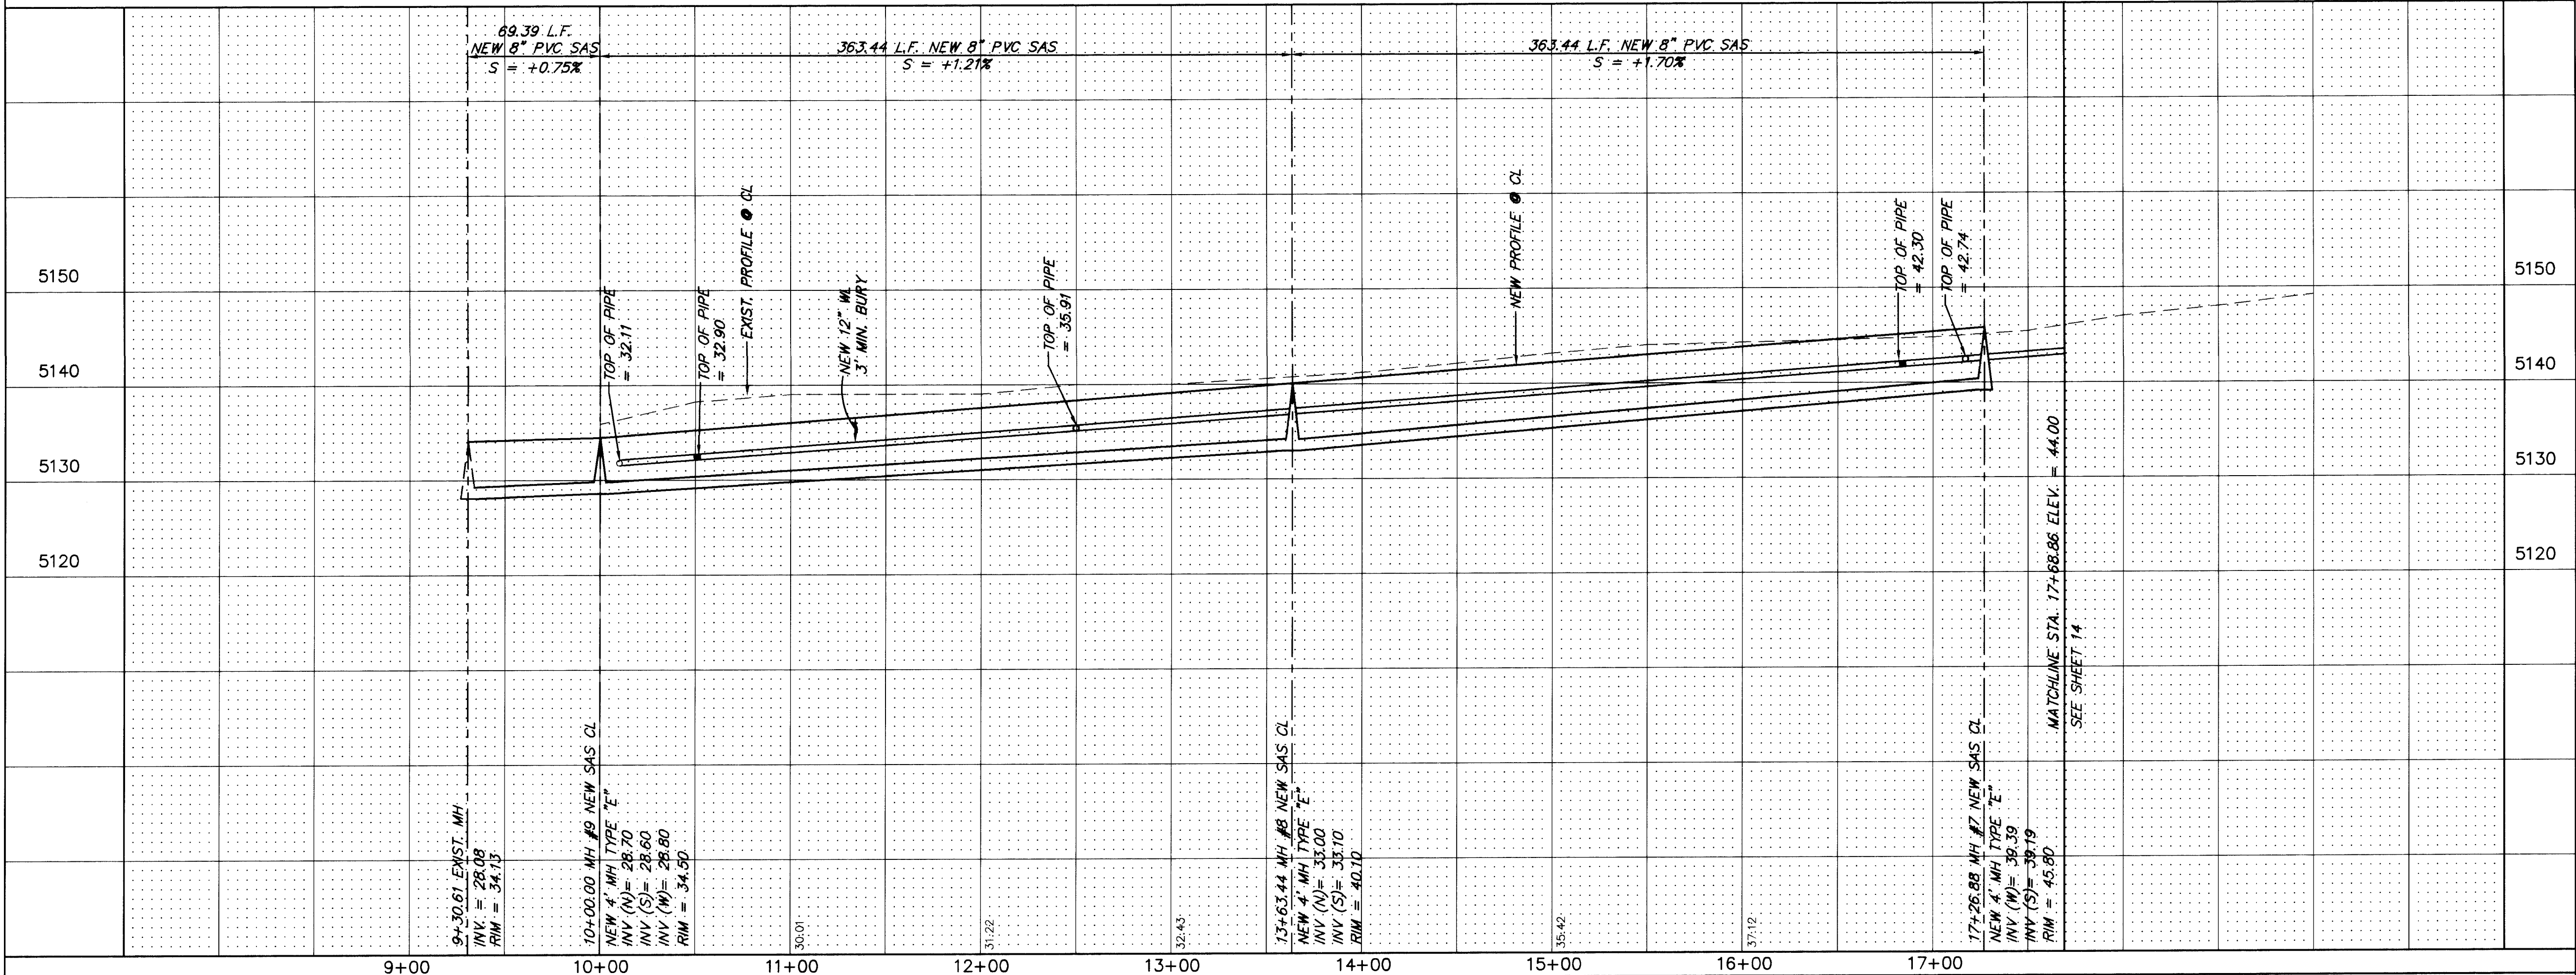


20150519.196 175195

dmg D. MARK GOODWIN & ASSOCIATES, P.A.
CONSULTING ENGINEERS & SURVEYORS
P.O. BOX 90606
ALBUQUERQUE, NEW MEXICO 87199
(505) 345-2010

CITY OF ALBUQUERQUE PUBLIC WORKS DEPARTMENT ENGINEERING GROUP					
TITLE: CASITA DE LA MESA SUBDIVISION UTILITY IMPROVEMENTS 94 TH. STREET					
APPROVALS	ENGINEER	DATE	APPROVALS	ENGINEER	DATE
DRC CHAIRMAN	<i>Dr. Tubby</i>	5-4-95	WATER	<i>R.W. Kane</i>	3-17-95
TRANSPORTATION	<i>MA. QHO</i>	3-17-95	WASTE WATER	<i>R.W. Kane</i>	3-17-95
HYDROLOGY	<i>Julia</i>	7-12-95			
PROJECT NO.	5054.90	MAP NO.	L9	SHEET OF	15 16

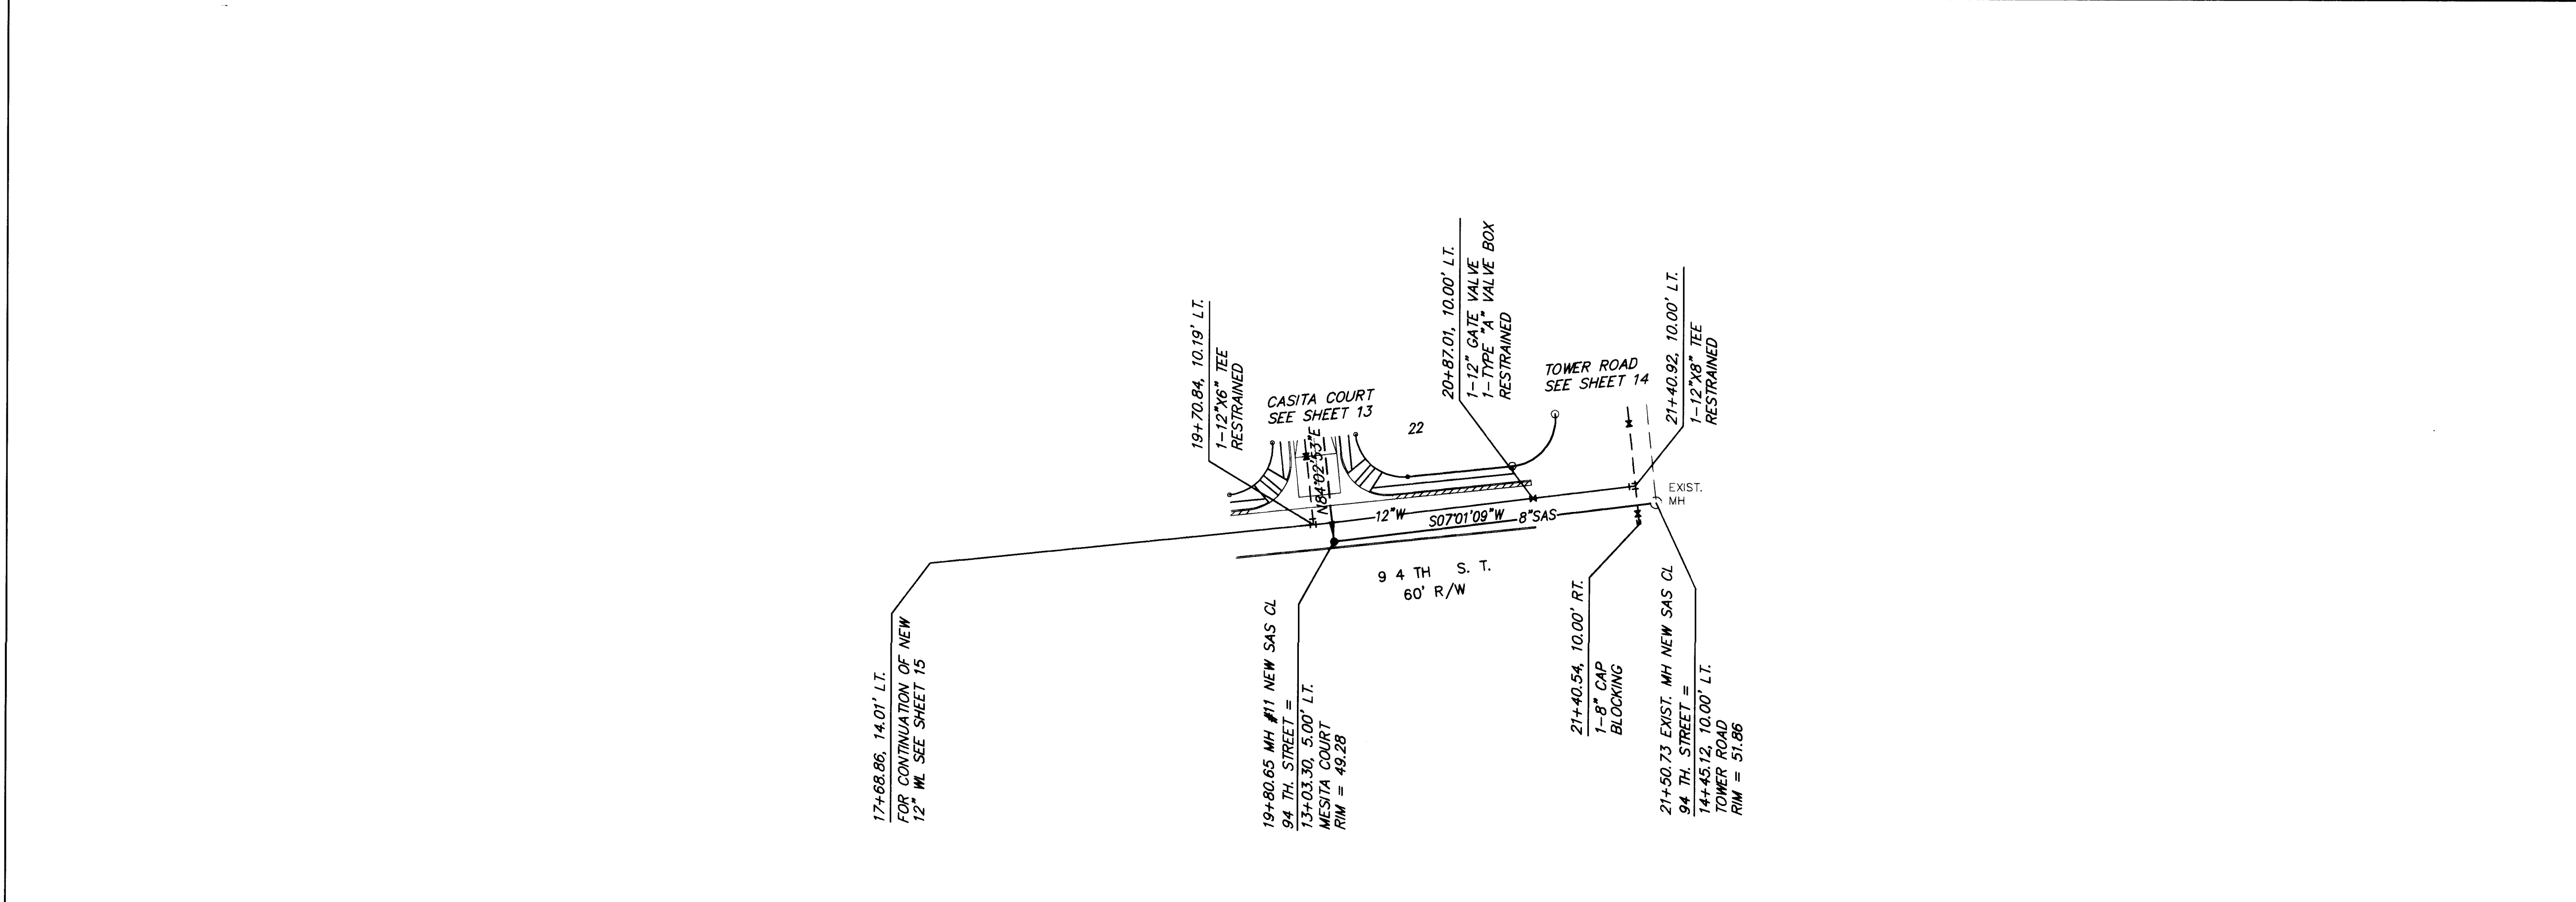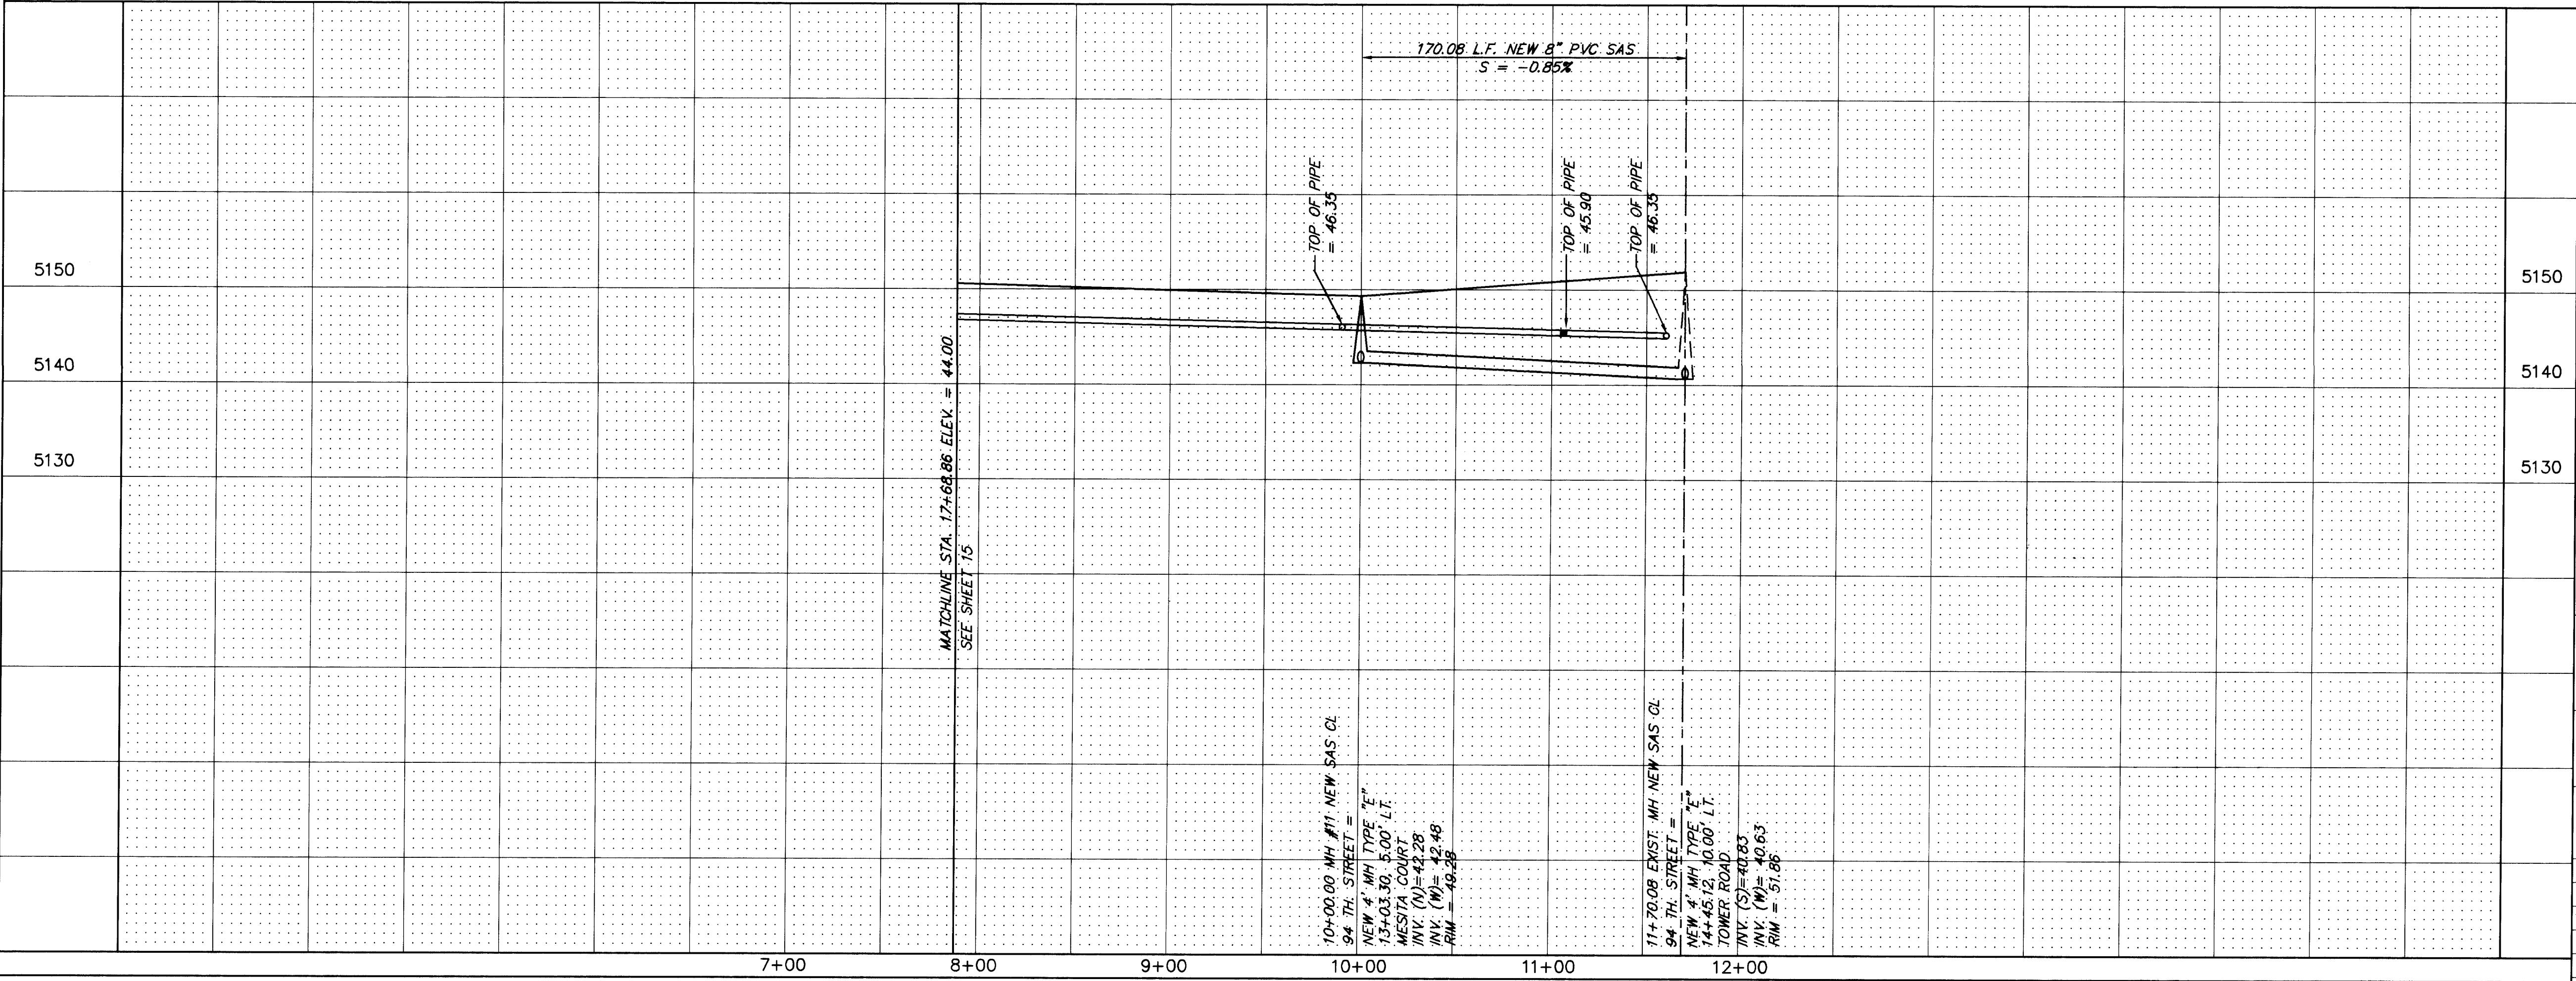

CITY OF ALBUQUERQUE PUBLIC WORKS DEPARTMENT ENGINEERING GROUP					
TITLE: CASITA DE LA MESA SUBDIVISION UTILITY IMPROVEMENTS 94 TH. STREET					
APPROVALS	ENGINEER	DATE	APPROVALS	ENGINEER	DATE
DRC CHAIRMAN	<i>R. W. Kane</i>	5-4-95	WATER	<i>R. W. Kane</i>	3-17-95
TRANSPORTATION	<i>R. W. Kane</i>	3-17-95	WASTE WATER	<i>R. W. Kane</i>	3-17-95
HYDROLOGY	<i>R. W. Kane</i>	4-12-95			
PROJECT NO.	5054.90	MAP NO.	L9	SHEET	16
				OF	16

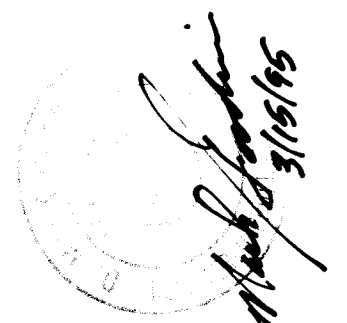ENGINEER'S SEAL			REMARKS		
			REVISIONS		
			DESIGN		
			DESIGNED BY RM DATE 9/94		
			DRAWN BY DC DATE 9/94		
			CHECKED BY DMG DATE 9/94		

SURVEY INFORMATION		BENCH MARKS		AS BUILT INFORMATION	
FIELD NOTES		STATION MARK IS A STANDARD NMHC BRASS TABLE STAMPED		CONTRACTOR	
NO. BY DATE		1-40-228" SET 0.5' BELOW THE PAVEMENT LOCATED ON THE		WORK	
		38th. STREET OVERPASS AT U.S. INTERSTATE HIGHWAY 40 (I-40).		STAMPED BY	
		X = 351650.01 Y = 1,486,656.52 Z = 5298.42		ACCEPTANCE BY	
				FIELD	
				DRAWINGS	
				CORRECTED BY	
				MICRO-FILM INFORMATION	
				RECORDED BY	
				DATE	
				NO.	