
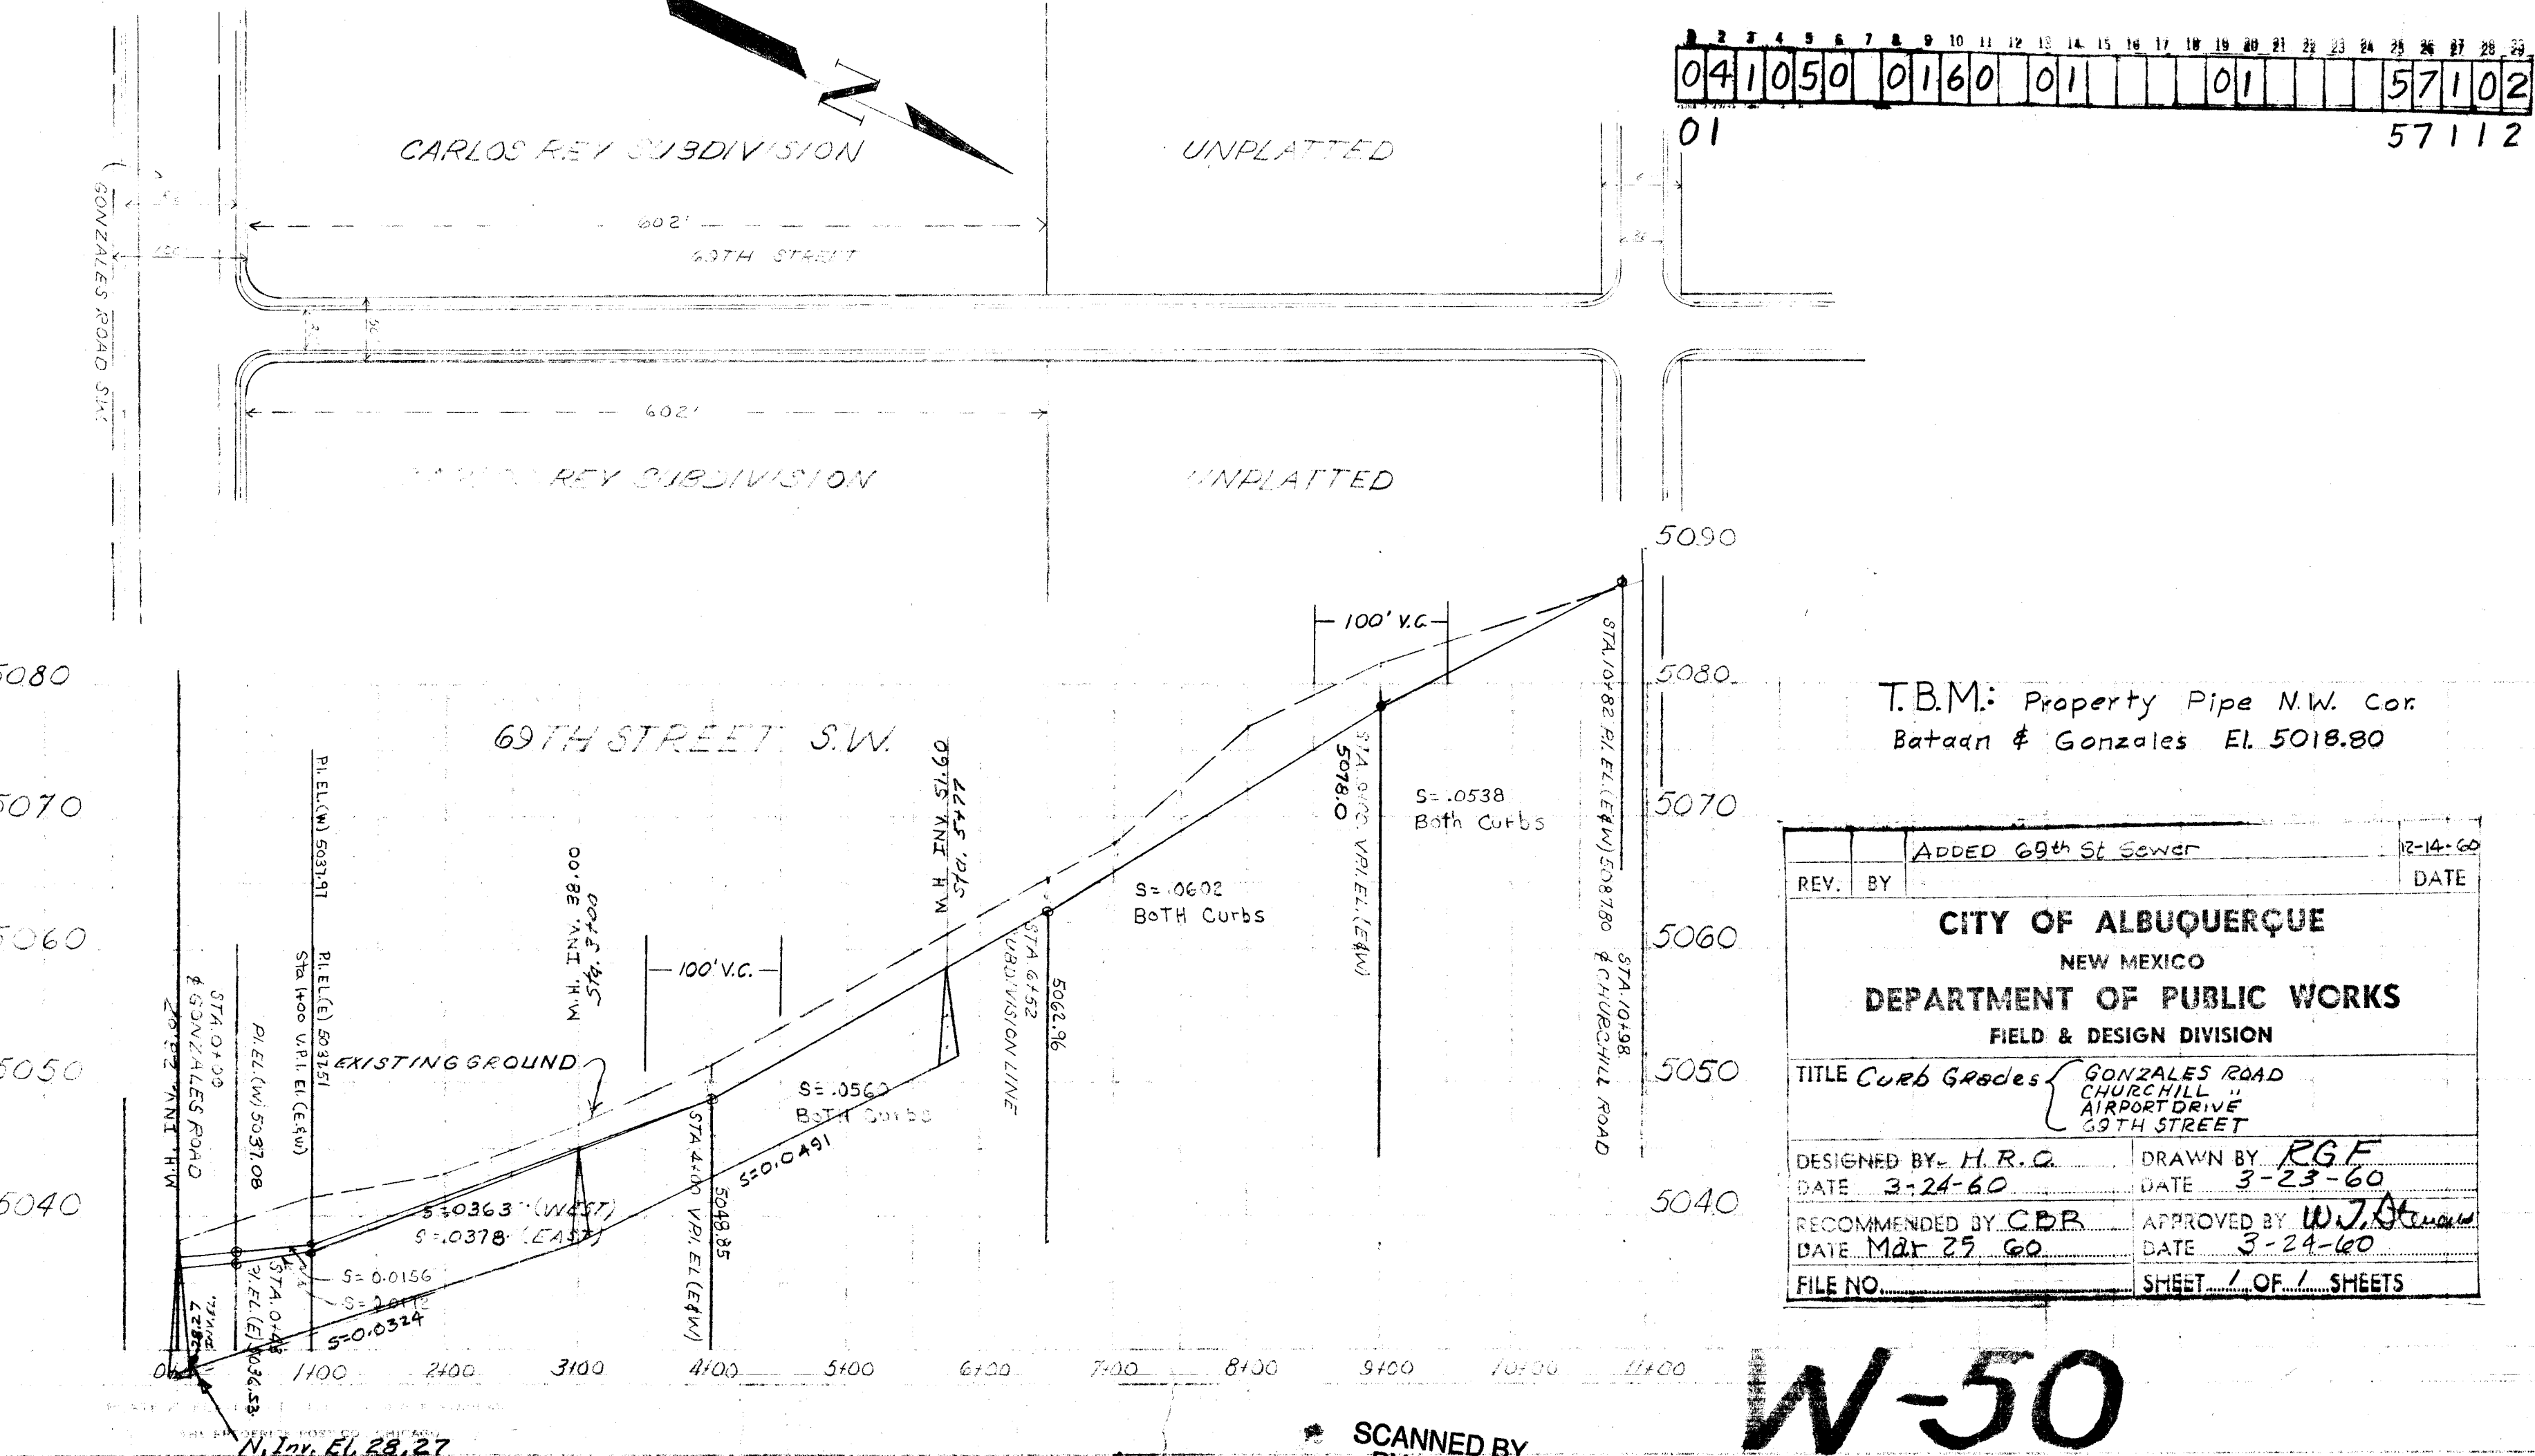


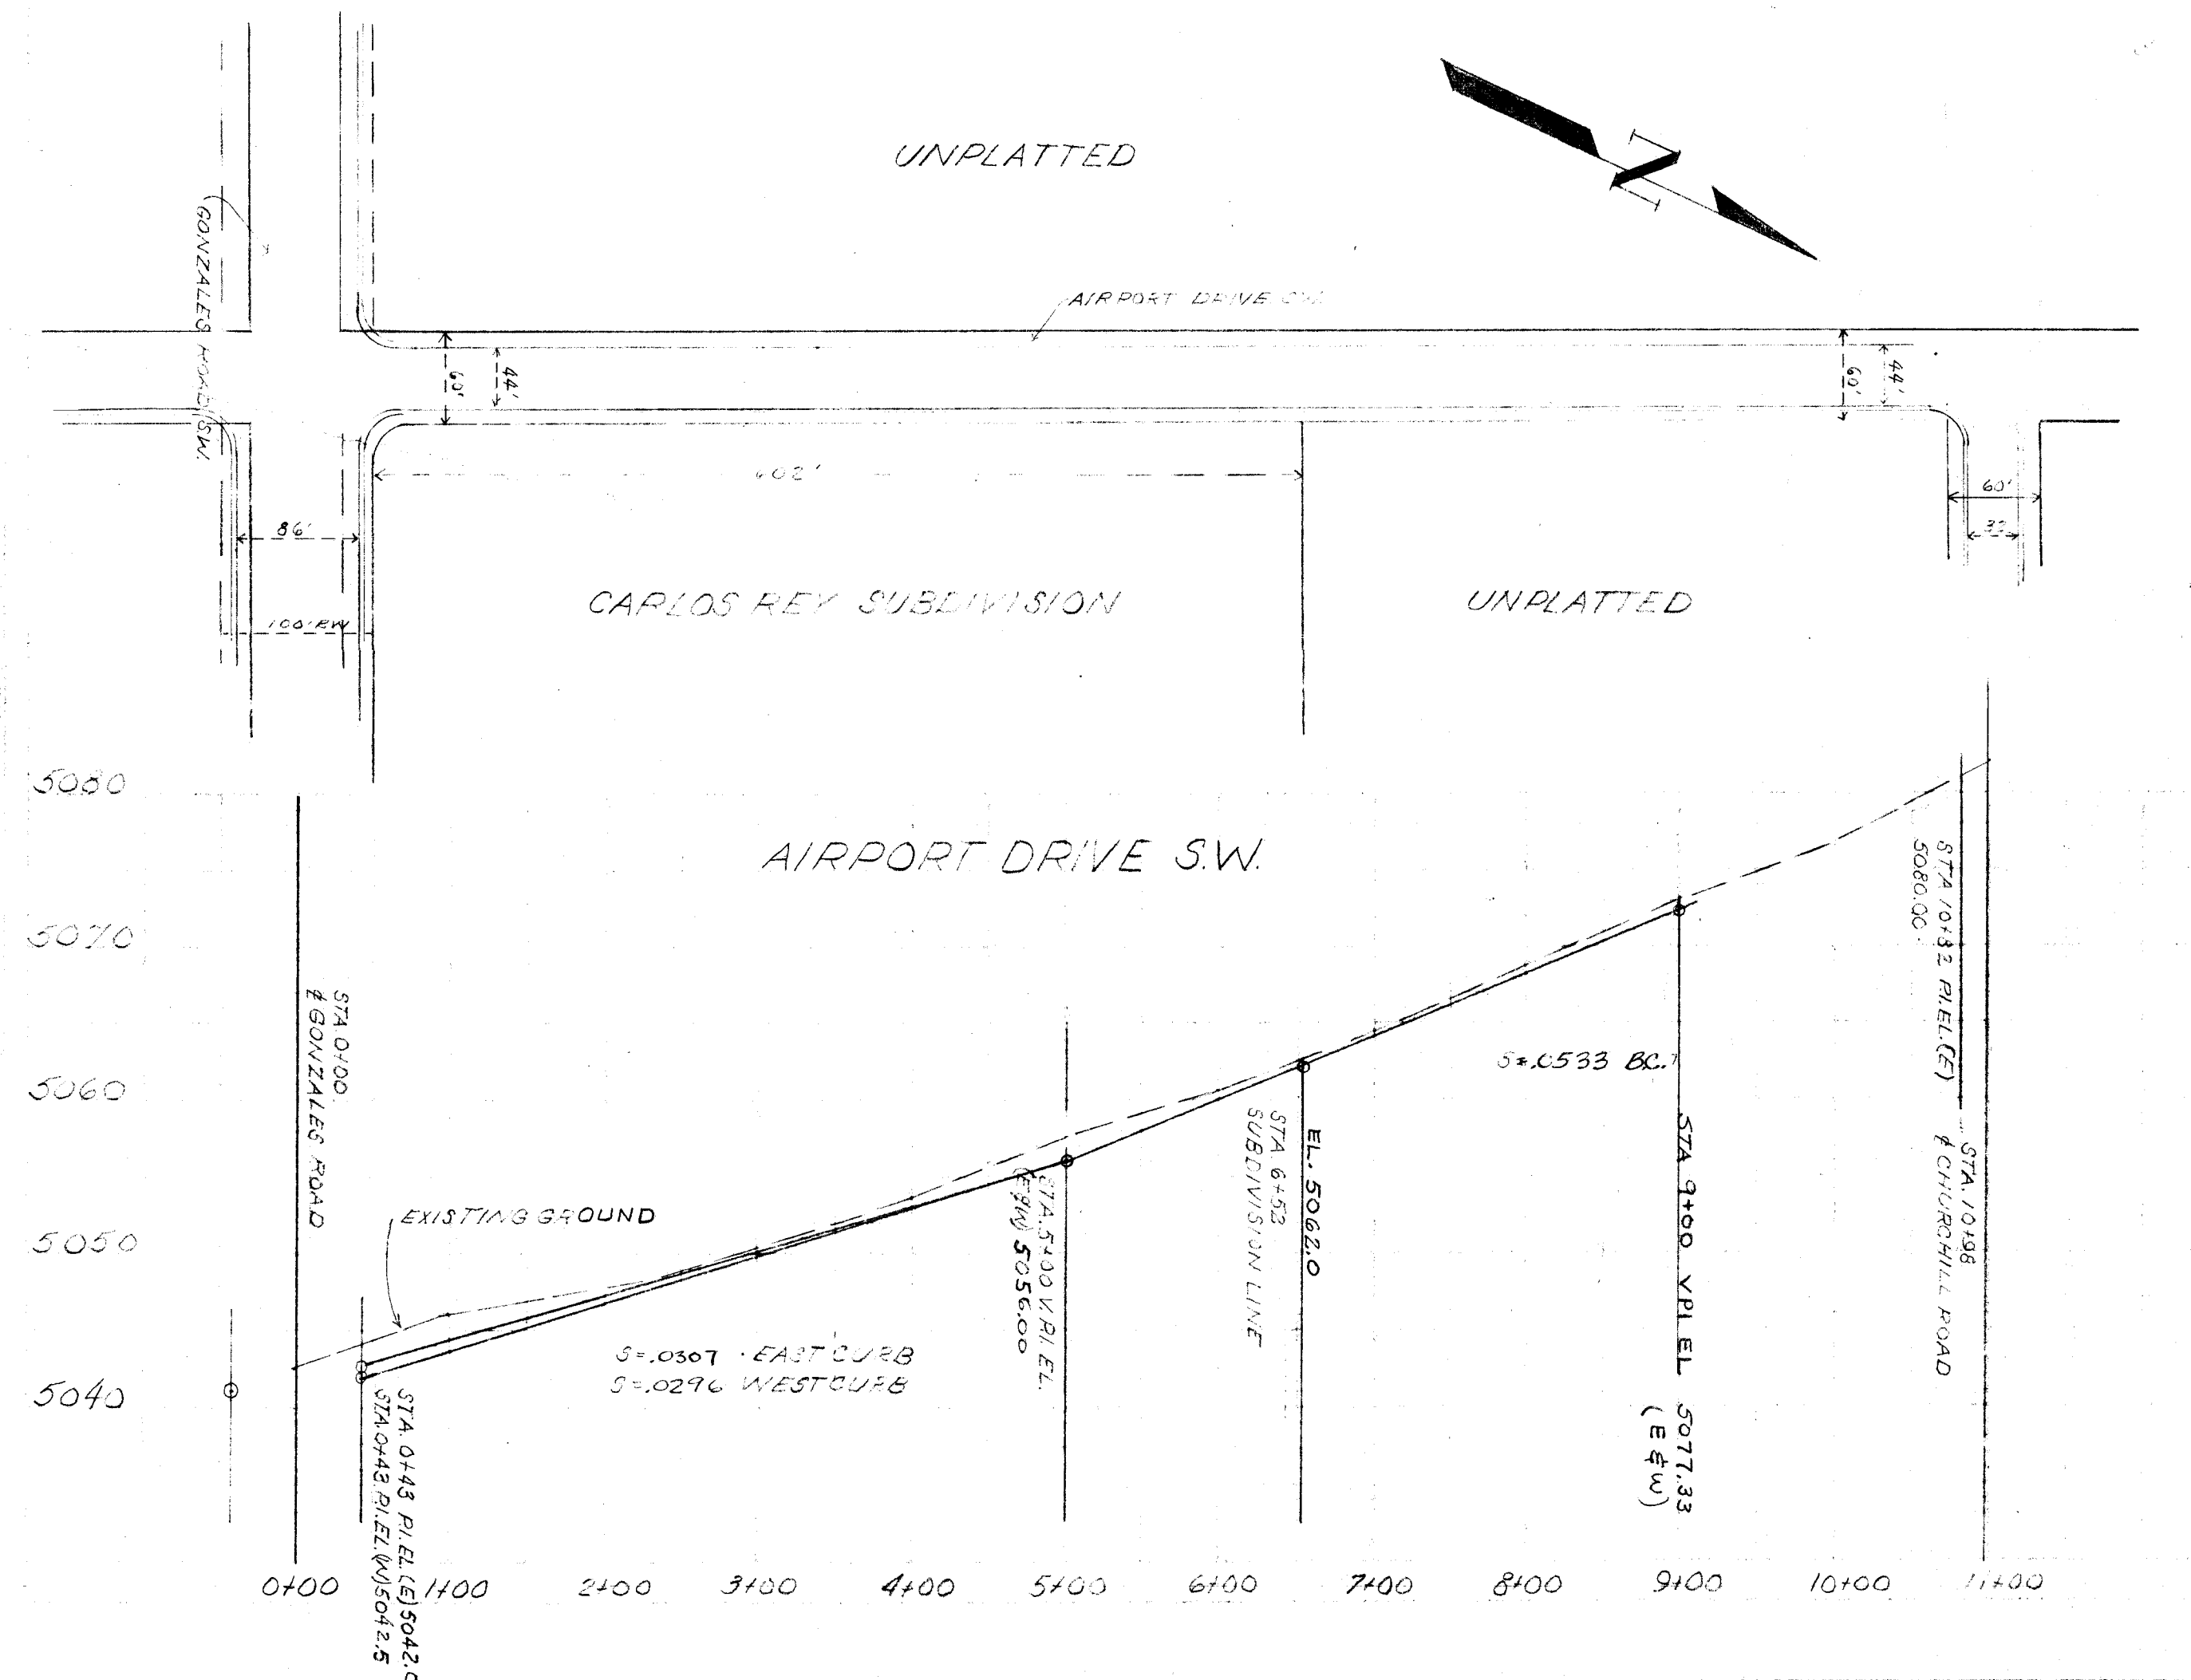

Note: Check with City Engineer before staking Churchill Rd.

T.B.M.: Property Pipe N.W. Cor.
Bataan & Gonzales El. 5018.80

REV.	BY	ADDED 69th St. Sewer	12-14-60
			DATE
CITY OF ALBUQUERQUE NEW MEXICO DEPARTMENT OF PUBLIC WORKS FIELD & DESIGN DIVISION			
TITLE		CURB Grades GONZALES ROAD CHURCHILL AIRPORT DRIVE 39TH STREET	
DESIGNED BY	H. R. G.	DRAWN BY	RGF
DATE	3-24-60	DATE	3-23-60
RECOMMENDED BY	C.B.R.	APPROVED BY	W. J. B. <i>W. J. B. [Signature]</i>
DATE	Mar 23 60	DATE	3-24-60
FILE NO.		SHEET	1 OF 1 SHEETS

SCANNED BY
BY LASON

W-50