



DATE	BY	REMARKS
		PROF. [illegible]
		ADVERSE [illegible]
		ALCOHOL [illegible]
		TRADE COMMISSION [illegible]
		RECEIVED [illegible]

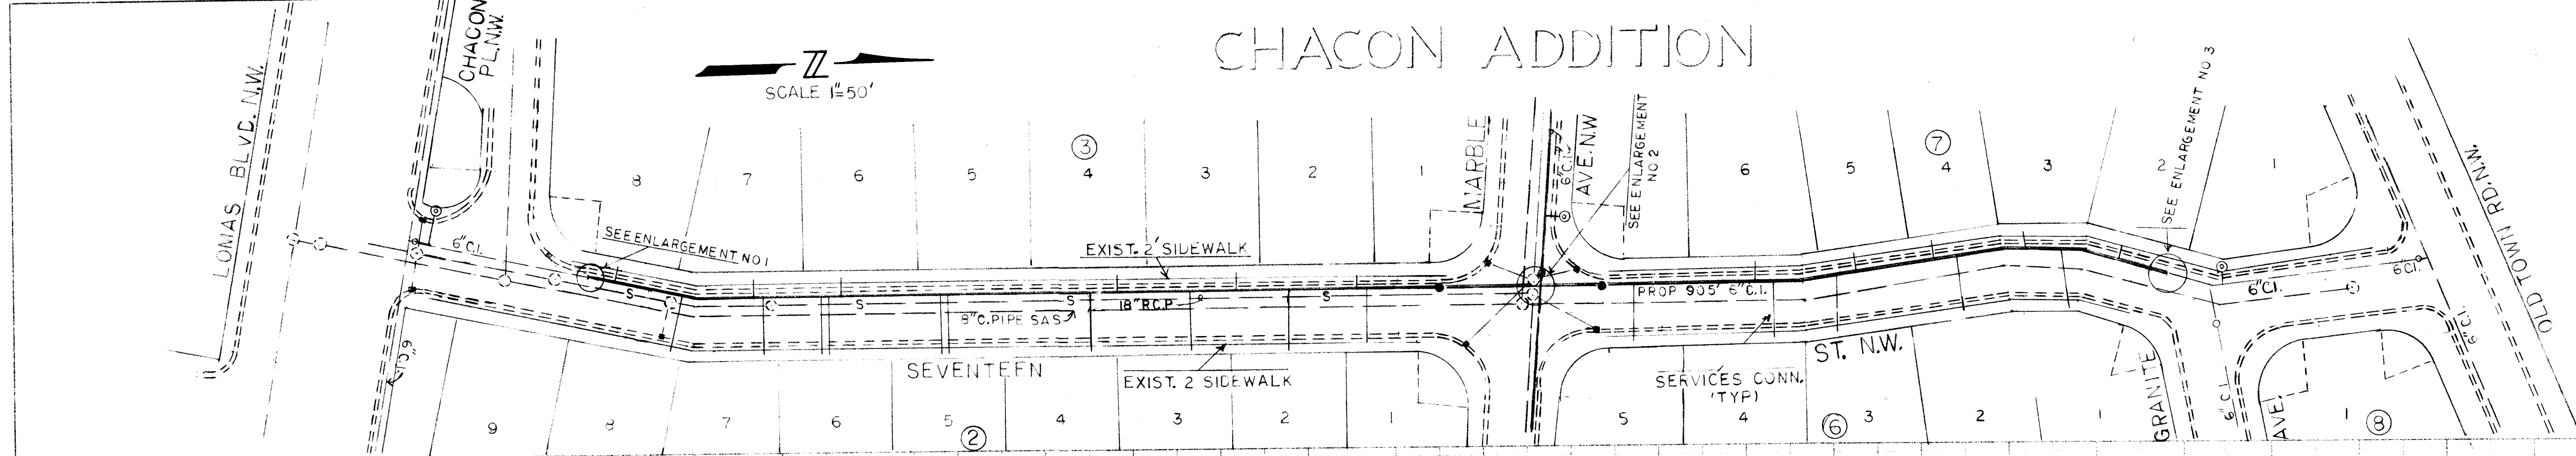

BLOCKING
1-6" WET CONNECTION
1-6" SLEEVE

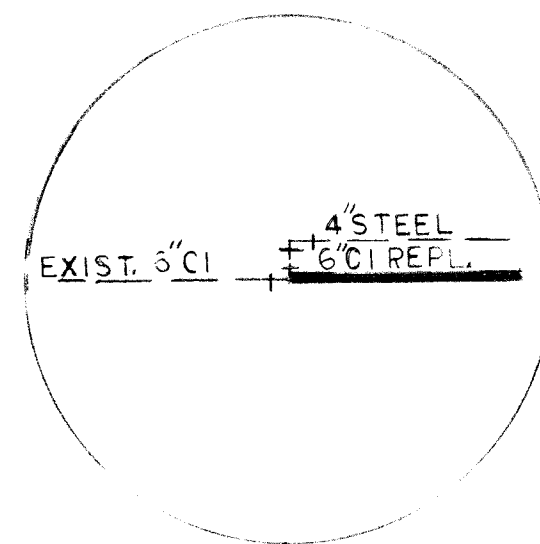

NO. 1


1" A.C. SURFACE COURSE
1500 LBS. STAB.
3" A.C. BASE COURSE
1500 LBS. STAB.

12" SUBBASE MATERIAL
95% COMPACTION

SUBGRADE MATERIAL
90% COMPACTION


TYPICAL RESIDENTIAL PAVING
SECTION

3-6" GATE VALVES AND BOXES
1-6" X 6" CROSS
BLOCKING

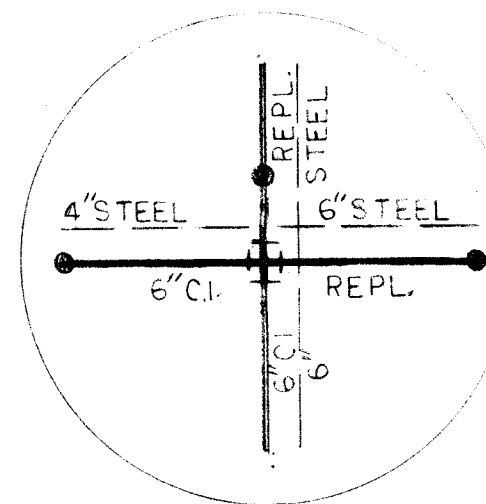

NO. 2

1-6" WET CONNECTION
1-6" SLEEVE
BLOCKING

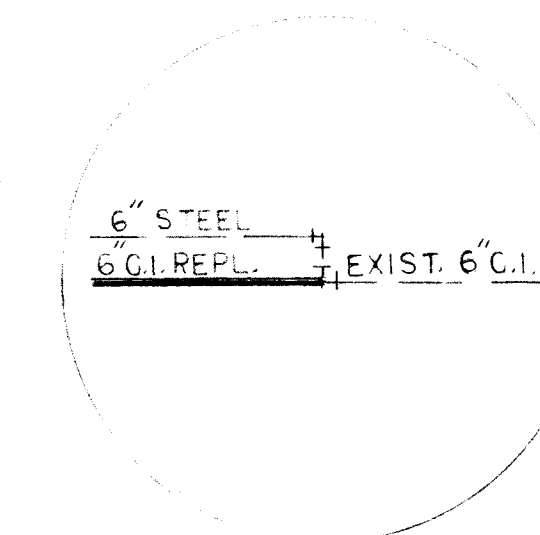

NO. 3

NOTE:

- ① 6" C I WATER LINE TO BE 3.67' MIN COVER FROM TOP OF CURB
- ② 6" ST WATER LINE BEING REPLACED TO BE ABANDONED IN PLACE

REFERENCES				SURVEY INFORMATION				BENCH MARKS				AS-BUILT INFORMATION			
				FIELD NOTES											
MAP NO. J-13				NO. BY DATE								CONTRACTOR			
EST. NO.				W.O. NO.								WORK ACCEPTED BY DATE			
W-50-77				95								CORRECTED BY DATE			
REMARKS				BY											
DESIGNED BY FRED GOMEZ DATE 6-16-77 DRAWN BY H. GARCIA DATE 6-16-77 CHECKED BY <u>B.C.</u> DATE <u>6/16/77</u>															
REVISONS DESIGN															
RECORDED BY DATE NO.															
MICRO-FILM INFORMATION															

23	050	0177
----	-----	------

CITY OF ALBUQUERQUE
PUBLIC WORKS DEPARTMENT
ENGINEERING DIVISION

TITLE: WATER REPLACEMENT ON 17th ST. N.W. FROM
LOMAS BLVD. N.W TO GRANITE AVE. N.W.

APPROVALS	ENGINEER	DATE	APPROVALS	ENGINEER	DATE
City Engineer	<i>[Signature]</i>	7-5-77	Liquid Waste		
A.C.E.-Design	<i>[Signature]</i>	24 Jan 77	Traffic		
A.C.E.-Hydrology			Water	<i>[Signature]</i>	6/2/77

APPROVAL OF AS BUILT DRAWINGS
ASST. CITY ENGINEER - FIELD
W. J. Kearney
DATE 11-29-82

APPROVED FOR
CONSTRUCTION
J. M. [Signature] 7-12-7
CITY ENGINEER DATE


DRAWING NO. W-50-77

SHEET 1 OF 2


PLAN
PROJECT NO. 755-234
SHEET NO. 2 OF 2
DATE 7/12/77

PROFILE
PROJECT NO. 755-234
SHEET NO. 2 OF 2
DATE 7/12/77

SCALE 1"=50'

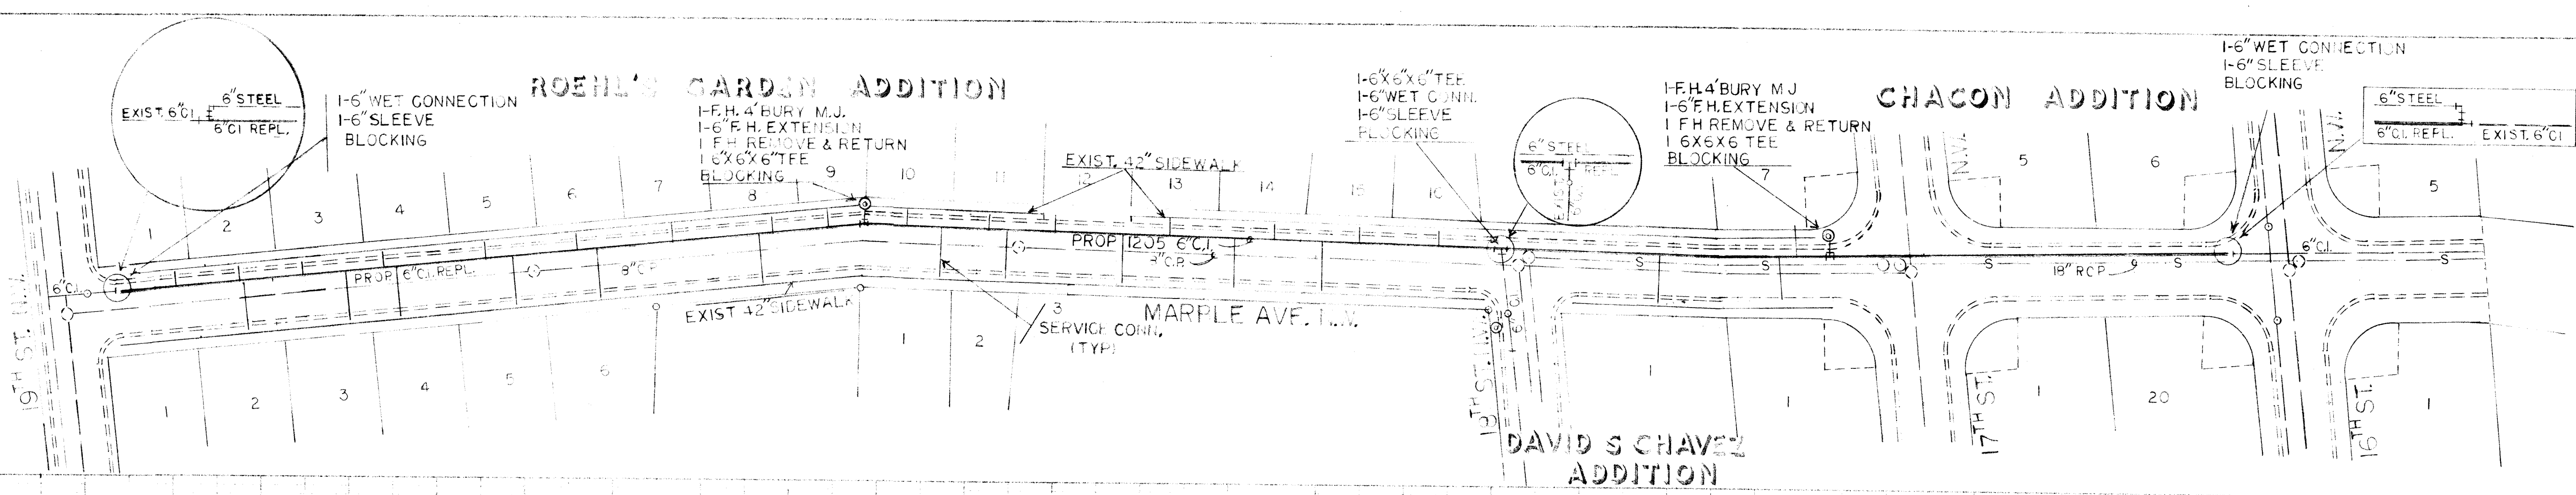

SCALE 1\"/>

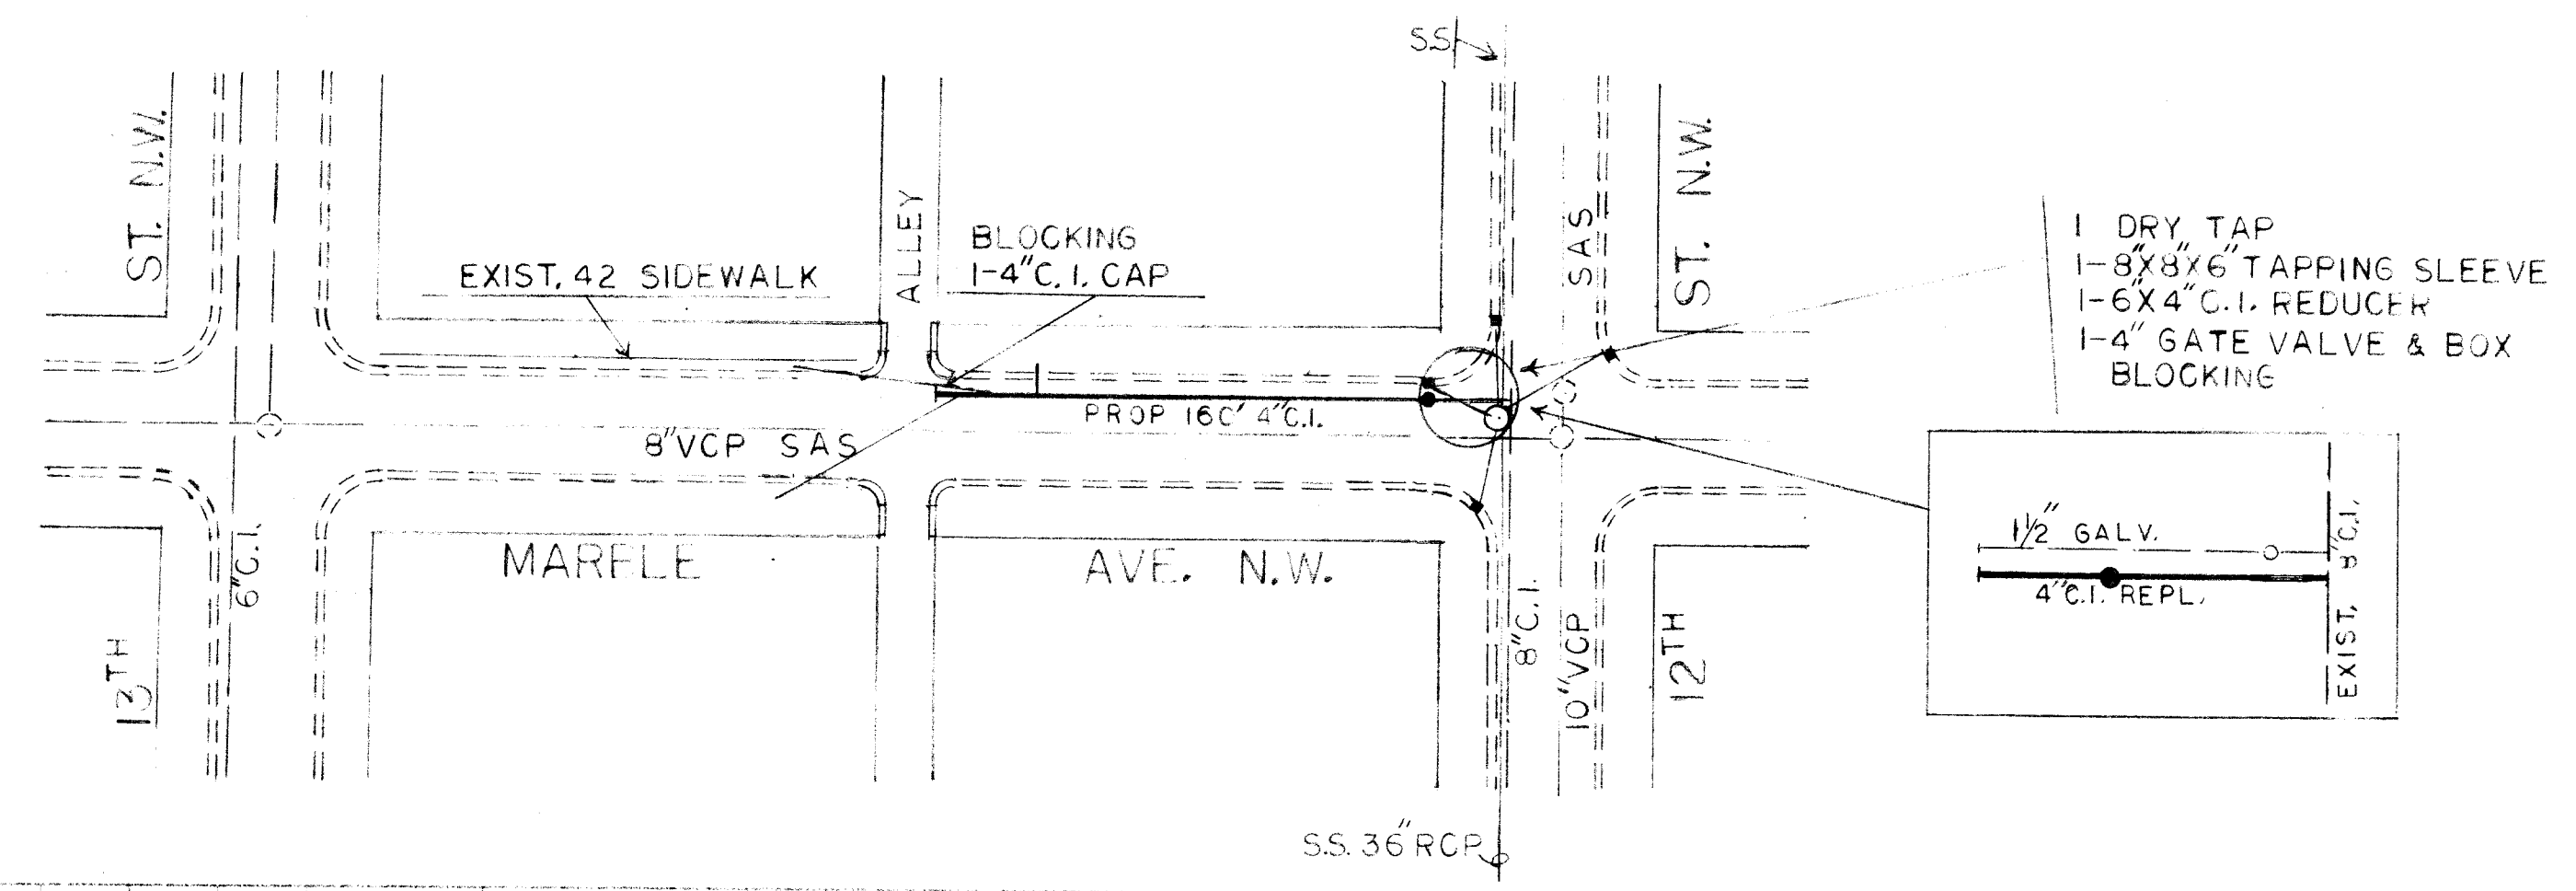

1\"/>

NOTE:
① 6\"/>

48 HOURS PRIOR TO ANY EXCAVATION, CONTRACTOR MUST CONTACT LINE AND CABLE LOCATING SERVICE, 755-234, FOR LOCATION OF EXISTING UTILITIES.

23 050 102177

CITY OF ALBUQUERQUE PUBLIC WORKS DEPARTMENT ENGINEERING DIVISION					
TITLE: WATER REPLACEMENT ON MARBLE AVE. N.W. FROM 19 TH ST. TO 16 TH ST. AND FROM 12 TH ST. WEST TO ALLEY					
APPROVALS	ENGINEER	DATE	APPROVALS	ENGINEER	DATE
City Engineer	<i>[Signature]</i>	7-12-77	Liquid Waste		
A.C.E.-Design	<i>[Signature]</i>	7-12-77	Traffic		
A.C.E.-Hydrology			Water	<i>[Signature]</i>	7/12/77
DRAWING NO. W-50-77			SHEET 2 OF 2		

APPROVED FOR CONSTRUCTION
CITY ENGINEER
DATE 7/12/77

AS-BUILT INFORMATION			BENCH MARKS			SURVEY INFORMATION			REFERENCES			REVISIONS		
CONTRACTOR	DATE	DATE	NO.	BY	DATE	MAP NO. J-13	EST. NO.	W.O. NO.	BY	REMARKS	DESIGN	NO.	DATE	REMARKS
								95						
MICRO-FILM INFORMATION														
RECORDED BY	DATE	NO.												