

LANDSCAPE IMPROVEMENTS FOR

THE UNIVERSITY OF NEW MEXICO SCHOOL OF ARCHITECTURE SCANNED BY PLANNING

2414 CENTRAL AVE. S.E. ALBUQUERQUE, NEW MEXICO

BIDDING PLAN

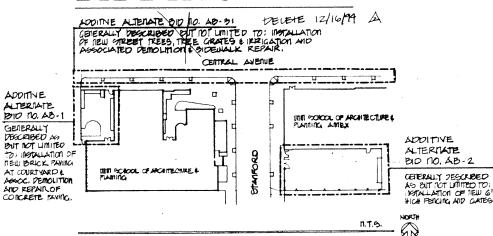

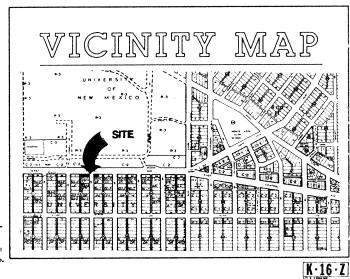

INDEX OF DRAWINGS

COVER SHEET

- L-1 DEMOLITION & CONSTRUCTION PLAN & NOTES
- L-2 IRRIGATION PLAN, LEGEND & NOTES
- L-3 PLANTING PLAN, PLANT LIST & NOTES
- L-4 IRRIGATION DETAILS
- _-5 CONSTRUCTION & PLANTING DETAILS

For Information Only

A 12/16/94 DRC REVISIONS





University of New Mexico
UNM PROJECT NO. 7-10867

	PUBL	C WORKS	BUOUEROÙE DEPARTME NG GROUP					
TITLE LANDSC	APE IMPR	OVE MEN	TS FOR					
	rsity of of Arch			nin	G			
APPROVALS	ENGINEER	DATE	APPROVA	AL 5	EN	GINEE	R	DATE
DRC CHAIRMAN	& a folder	12/22/94	WATER		11	12.	41	La
TRANSPORTATIO	4 Represent	12-04-99	WASTE WAT	ER	60	VOO	17 C	144
HYDROLOGY	Maghery	12/9/94						
	0							
PROJECT 50	991.90	MAF NO.	K-16	St	EET	1	0	6

W

(26)

For Information Only

GENERAL NOTES

- CONTRACTOR SHALL VERIFY LOCATION OF ALL EXISTING UTILITIES PRIOR TO DEMOLITION AND CONSTRUCTION. ANY DAMAGE TO UTILITIES SHALL BE REPAIRED AT CONTRACTOR'S EXPENSE AND AT NO ADDITIONAL EXPENSE TO THE OWNER.

EQUIPMENT NOTES

UMM STANDARD BIKE RACK MODEL 8MP-4113 SECURITY BIKE RACK AS MANUFACTURED BY ARIZOMA CORRECTIONAL INDUSTRIES, 1916 W. VAN BUREN, PHOEMIX, AZ 85005, ATTENTION: MANCY ALLAIRE, (802) 255-1464. COLOR: BLACK POWDERCOAT FINISH. **(A)**

ADDITIVE ALTERNATE NO. AB-1

- INSTALL (1) OWNER PROVIDED SINGLE PEDESTAL SQUARE TABLE IN CONCRETE FOOTING PER MANUFACTURER'S RECOMMENDATION.
- INSTALL (1) OWNER PROVIDED SINGLE PEDESTAL SQUARE TABLE IN CONCRETE FOOTING PER MANUFACTURER'S RECOMMENDATION.

ADDITIVE ALTERNATE NO. AB-2

- 4' WIDE x 6' HIGH SWINGING GATE STYLE MATERIAL AND COLOR TO MATCH FENCING. INSTALL IN CONCRETE FOOTINGS PER MANUFACTURER'S RECOMMENDATIONS. PROVIDE COMPLETE WITH PANCE BAR AT INTERIOR SIDE AND CYLINDER LOCK AND PULL AT OUTSIDE. KEY CYLINDER TO MATCH EXISTING CYLINDER AT ANNEX.
- 6' HIGH POWDER COATED METAL FENCING AS MANUFACTURED BY OMEGA FENCE SYSTEMS NC. AND DISTRIBUTED BY NATIONAL WHOLESALE (1-800-387-5685) INSTALL OM EXISTING CONCRETE CURB AND IN NEW CONCRETE FOOTINGS PER MANUFACTURER'S RECOMMENDATION. COLOR: BLACK.
- PROVIDE A PAIR OF 6" H x 6" WIDE SWINGING GATES FOR VEHICLE ACCESS. STYLE, MATERIAL AND COLOR TO MATCHING FENCING. INSTALL IN CONCRETE FOOTINGS PER MANUFACTURER'S RECOMMENDATIONS. PROVIDE COMPLETE WITH METAL TABS FOR PADLOCK AND ROD. DRILL HOLE FOR ROD INTO EXISTING CONCRETE.

- MODEL B-TG729-1 36" x 36" SQUARE TREE GRATE AS MANUFACTURED BY BARRYCRAFT AND AS DISTRIBUTED BY H & H BUILDING PRODUCTS (505) 344-1747. INSTALL WITH FRAME IN CONCRETE SIDEWALK PER MANUFACTURER'S RECOMMENDATIONS.
- BORE THROUGH EXISTING STUCCOED PLANTER WALL AS REQUIRED TO INSTALL NEW IRRIGATION LINES AND SLEEVES, SEE IRRIGATION DRAWINGS. PROTECT PLANTER AND STUCCO FINISH FROM DAMAGE DURING CONSTRUCTION. REPAIR ANY DAMAGE TO WALL AND COLOCO FINISH AT NO COST TO THE OWNER. SEAL BORED OPENING WITH WATERPROOF SEALANT.
- REMOVE AND RE-INSTALL EXISTING WOOD DECKING AS REQUIRED TO INSTALL NEW WISKEY BARRELL PLANTERS AND NEW DRIP IRRIGATION SYSTEM. REMFORCE EXISTING DECK STRUCTURE AS REQUIRED TO SUPPORT NEW WHISKEY BARRELL PLANTERS.
- REMOVE EXISTING ALANTHUS TREE.
- EXISTING OVERHEAD STREET LIGHT AND OVERHEAD POWER LINES TO REMAIN.
- INSTALL WATERPROOFING MEMBRANE AT BUILDING WALL. WRAP AROUND SIDES OF PLANTER AS SHOWN IN PLAN. SEE DETAIL F.L.S.
- SAWCUT AND REMOVE EXISTING CONCRETE CURB AS SHOWN. PREPARE AREA TO RECEIVE NEW CONCRETE SLAB. TOP OF SLAB SHALL BE FLUSH W/ ADJACENT SURROUNDING TOP OF SLAB.
- INSTALL NEW CONCRETE CURBING AS SHOWN. TOP OF NEW CURB SHALL BE FLUSH WITH ADJACENT TOP OF CURB. SEE DETAIL M.L.S.
- EXISTING CONCRETE WALKS TO REMAIN PROTECT FROM DAMAGE DURING DEMOLITION, CONSTRUCTION AND PLANTING. ANY DAMAGE SHALL BE REPAIRED AT CONTRACTOR'S EXPENSE.

ADDITIVE ALTERNATE NO. AB-1

- SAWCUT AND REMOVE EXISTING CONCRETE. INSTALL NEW 4" CONCRETE SLAB AND BRICK PAVERS PER DETAIL DA.S. SLOPE AS REQUIRED TO MATCH ADJACENT GRADES. SLOPE SHALL NOT EXCEED 1 IN 20. TOP OF NEW BRICKS SHALL BE FLUSH WITH TOP OF ADJACENT BRICK OR CONCRETE TO REMAIN. PROVIDE EXPANSION JOINT WHERE NEW CONCRETE MEETS EXISTING ADJACENT SURFACES.
- REMOVE EXISTING DOOR THRESHOLD AND RE-INSTALL AFTER BRICK HAS BEEN INSTALLED.
- LAY BRICK IN RUNNING BOND (AS SHOWN IN INSERT) IN ALL SHADED AREAS.
- LAY SAILOR COURSE OF BRICKS ALONG TOP OF PLANTER CURBING. MITER ALL CORNERS. SEE DETAIL JALS.
- LAY SAILOR COURSE OF BRICKS ALONG EDGE OF PLANTER BED AS SHOWN, SEE DETAIL
- REMOVE AND RELOCATE EXISTING PICNIC TABLES TO SOUTH OF ANNEX BUILDING IN NEW FENCED AREA. INSTALL NEW PICNIC TABLES IN CONCRETE FOOTINGS. NEW PICNIC TABLES TO BE SUPPLIED BY OWNER.

SAWCUT AND REMOVE CONCRETE. PREPARE AREA TO RECEIVE NEW TREE GRATE. INSTALL TREE GRATE PER MANUFACTURER'S DIRECTION.

A 12/16/94 DEC REVISIONS

4) (REVISIONS PEL D.R.C. REVIEW COMMENTS 11/39/94)

COMPANY, ARCHITECTS

CONSTRUCTION ŏ DEMOLI

LANDSCAPE IN UNIM SCHOOL 2414 CENTRAI ALBUOUEROUE

SHEET NO.

1 of 5

CRN KARIAN

REMOVE EXISTING CONCRETE SIDEWALK STONES, WIDTH AS SHOWN. PREPARE TO INSTALL NEW IRRIGATION LINES AND SLEEVES, SEE IRRIGATION DRAWINGS. REPAIR AREA WITH NEW CONCRETE, INSTALL FLUSH WITH SURROUNDING SURFACES TO REMAIN. INSTALL WITH BROOM FINISH AND TROWELLED EDGE TO MATCH EXISTING ADJACENT CONCRETE SIDEWALK. CONTRACTOR SHALL VERIFY ALL UTILITIES PRIOR TO DELLANDLA OF CONCRETE AND TREACHING END BRIGGATION. REMOVAL OF CONCRETE AND TRENCHING FOR IRRIGATION PNUEMATIC BORE UNDER EXISTING CONCRETE SIDEWALKS AND DRIVES TO INSTALL IRRIGATION SLEEVES AND LINES IN THIS AREA, SEE IRRIGATION DRIVINGS, CONTRCTOR SHALL VERIEVAL UTILITIES PRIOR TO CONSTRUCTION, LIHERE PULLEMATIC BORING IS NOT POSSIBLE, CONTRACT IL SHALL REMOVE CONCRETE STONES AS RESID TO MATCH EVER AND LIKE STADIO SEED AS LIKE CONCRETE STONES AS RESID TO MATCH EVER ADDITIONAL REMOVE.

ADDITIVE ALTERNATE HOLAB-3-

NEW MEXICO

1"=20"-0"

30.0

V.1.F.

30-0

U.M. SCHOOL OF

ARCHITECTURE + PLANNING ANHEX

PARKING LOT

(E)

REMOVE EXISTING SCULPTURES AND SITE AMENITIES, STOCKPILE AND RE-INSTALL PER OWNER'S DIRECTION IN NEW FENCED AREA SOUTH OF ANNEX.

EXISTING METAL FENCE AND GATE TO REMAIN. PROTECT FROM DAMAGE DURING

PROTECT EXISTING TREES OR SHRUB TO REMAIN DURING DEMOLITION, CONSTRUCTION AND PLANTING.

REMOVE ALL EXISTING PLANTINGS EXCEPT ITEMS NOTED OTHERWISE. PREPARE AREA TO RECEIVE NEW PLANTINGS AS SHOWN IN PLANTING PLAN.

PROTECT EXISTING SIGN TO REMAIN DURING DEMOLITION, CONSTRUCTION AND PLANTING. EXISTING PARKING METER TO REMAIN. PROTECT FROM DAMAGE DURING DEMOLITION, CONSTRUCTION AND PLANTING. ANY DAMAGE SHALL BE REPAIRED AT CONTRACTOR'S EXPENSE.

EXISTING TRAFFIC SIGNAL EQUIPMENT TO REMAIN. PROTECT FROM DAMAGE DURING DEMOLITION, CONSTRUCTION AND PLANTING. ANY DAMAGE SHALL BE REPAIRED AT CONTRACTOR'S EXPENSE.

EXISTING PUBLIC PAY TELEPHONES TO REMAIN. PROTECT FROM DAMAGE DURING DEMOLITION, CONSTRUCTION AND PLANTING. ANY DAMAGE SHALL BE REPAIRED AT CONTRACTOR'S EXPENSE.

REMOVE EXISTING BIKE RACKS AND RE-INSTALL IN CONCRETE FOOTINGS SOUTH OF ANNEX BUILDING IN NEW FENCED AREA.

TRANSPLANT EXISTING JAPANESE BLACK PINE TO MAIN CAMPUS AS DIRECTED BY UNIM DEPARTMENT OF FACILITY PLANNING.

SAWCUT AND REMOVE EXISTING CONCRETE WALK, WIDTH AS SHOWN. PREPARE TO INSTALL NEW IRRIGATION LINES AND SLEEVES, SEE IRRIGATION DRAWINGS. REPAIR WALK WITH NEW CONCRETE, INSTALL FLUSH WITH EXISTING SURROUNDING SURFACES TO REMAIN. CONTRACTOR SHALL VERIFY ALL UTILITIES PRIOR TO SAW CUTTING, REMOVAL OF CONCRETE AND TRENCHING FOR IRRIGATION.

SAWCUT AND REMOVE EXISTING ASPHALT PAVING IN ALLEY, WIDTH AS SHOWN. PREPARE TO INSTALL NEW IRRIGATION LINES AND SLEEVES, SEE IRRIGATION DRAWINGS. REPAIR AREA WITH NEW ASPHALT TO MATCH EXISTING, INSTALL FLUSH WITH EXISTING SURROUNDING SURFACES TO REMAIN. CONTRACTOR SHALL VERIFY ALL THILLIFF THE PRIOR TO SAWCUTTING, REMOVAL OF ASPHALT AND TRENCHING FOR IRRIGATION.

ADD 4" DEPTH OF SHREDDED BARK IN SIGNAL PIT.

SAND AND REFINISH EXISTING WOOD BENCHES WITH 2 COATS OF CLEAR SEALER.

PARKING LOT


TEXESTING CONTROLLER BOX

KEYED NOTES

48'-0"


PELETED

12-16-94

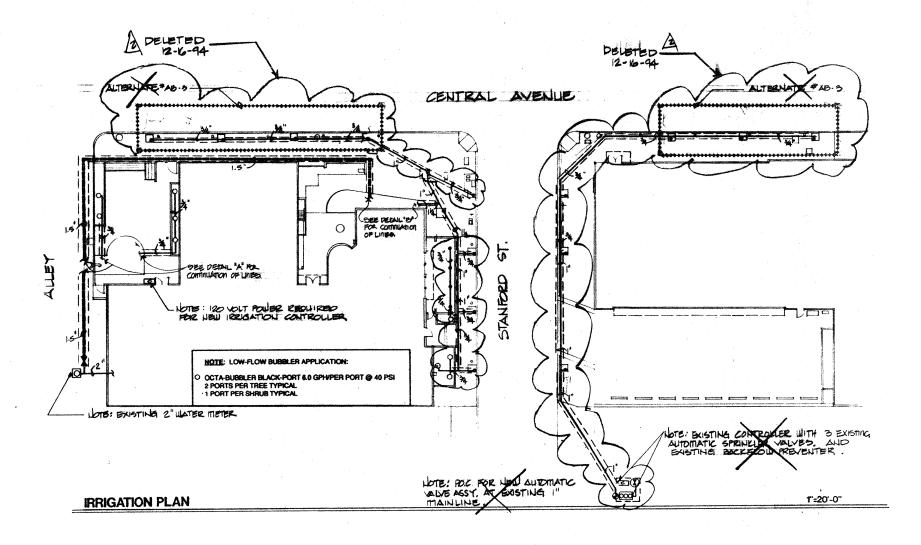


NOTE: LOW-FLOW BUBBLER APPLICATION:

OCTA-BUBBLER BLACK-PORT & 0 GPH/PER PORT @ 40 PSI
2 PORTS PER TREE TYPICAL
1 PORT PER SHRUB TYPICAL

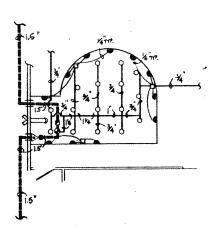

DETAIL "A"

1/8"=1-0"

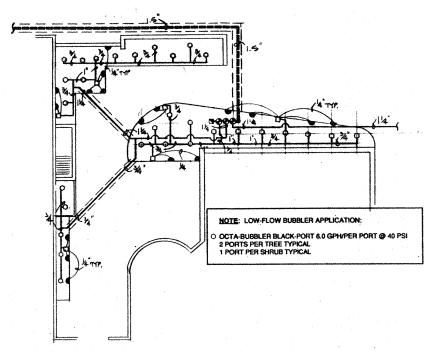

DETAIL "B"

1/8"=1-0"

		_
÷ ;	PEPCO OB-2 BLUE PORT BUBBLER ASSEMBLY	-(
Ф	PEPCO OB-2 GREEN PORT BUBBLER ASSEMBLY	7
4	PEPCO MICRO-POP-UP SPRAY DEVICE #PMP-50 ASSEMBLY	$\langle \rangle$
7	NOTE: CONNECT MICRO-SPRAY TO GREEN PORT BUBBLER ONLY	t
0	PEPCQ - CCTA BUBBLER BLACK-PORT (8 OUTLET PORTS) ASSEMBLY SEE DETAIL OCTA-BUBBLER BLACK-PORT 8.0 GPH/PER PORT (8) 40 PSI	L
•	RAINBIRD 100-PEB 1" AUTOMATIC VALVE ASSEMBLY	\ _
(2)	BAINBIRD RCM-6 SERIES CONTROLLER ASSEMBLY	$\mathcal{X}_{\mathcal{I}}$
•	RAINBIRD 150-PEB 1.5" MASTER VALVE ASSEMBLY	X
3	RAMBIRD 33 DNP W/33K AND SHO HOSE ADAPTER SEE DETAIL	$\langle \cdot \rangle$
	1.5" SCH. 40 PVC MAINLINE BURY 28" SCH 40 PVC LATERALS BURY 18"	\ fī
	CL 200 PVC SLEEVE PIPE 2 SIZES LARGER THAN PIPE BEING SLEEVED CL 200 PVC SLEEVE 1-14" WIRE SLEEVE TYPICAL.	(

IRRIGATION NOTES

- 1. ALL VALVE BOXES FOR AUTOMATIC VALVES SHALL BE INSTALLED AT A MINIMUM OF 12" FROM EDG
- ALL VALVE BOXES SHALL BE SUPPORTED BY CINDER BLOCKS, (MINIMUM 2 PER VALVE BOX). INSTALL
 BLOCKS IN A MANNER WHICH WILL PREVENT CONTACT WITH PIPING, WIRES, VALVES, ETC.
- MARK ALL 24-VOLT WIRE ENDS WITH 3M STD-09 WIRE MARKER TAPE AT THE VALVE BOX AN CONTROLLER LOCATIONS.
- 4. ALL 24-VOLT WIRE SHALL BE MARKED WITH A 4" WIDE YELLOW MARKET TAPE AND MARKED "WARNING
- 24-VOLT WIRE SHALL BE IN COMMON TRENCH WITH MAINLINE AND SHALL HAVE SEPARATE SLEEV WHERE CROSSING ALL HARD CONSTRUCTION. ALL SLEEVE PIPING FOR 24-VOLT WIRE SHALL BE 1-1.
- WHERE PROPOSED PIPING CROSSES EXISTING ASPHALT AND/OR CONCRETE, THE CONTRACT SHALL SAW-CUT, REMOVE AND PROPERLY DISPOSE OF WASTE, EXCAVATE, INSTALL SLEEVE PIPI MAINS AND LATERALS, BACKFILL AND COMPACT TO 95%. CONTRACTOR SHALL REPLACE ASPHA
- THE CONTRACTOR SHALL ADJUST ALL VALVES, LOW-FLOW BUBBLERS, AND MICRO-SPRINKLERS FOR
 OPTIMUM COVERAGE, AND SHALL PROVIDE AND INSTALL NOZZLES OTHER THAN THOSE SPECIFIED AS
 INSTRUCTED BY THE LANDSCAPE ARCHITECT AT NO ADDITIONAL COST TO THE OWNER.
- 8. CONTRACTOR SHALL INSTALL ALL LOW-FLOW BUBBLERS ON HIGH SIDE OF TREE WELLS.
- CONTRACTOR SHALL TAPE CLOSED ALL SLEEVE PIPE OPENINGS USING DUCT TAPE TO PREVENT DEBRIS FROM ENTERING SLEEVES.
- THE CONTRACTOR SHALL EXTEND 120-VOLT A.G. FROM EXISTING POWER TO PROPOSED CONTROLLER AND BACKFLOW PREVENTER LOCATIONS. ALL ELECTRICAL WORK SHALL BE PER LOCAL CODES AND M.E.C. STANDARDS.
- ALL EXISTING DISTRIBUTION LINE LOCATIONS ARE SCHEMATIC. IT SHALL BE THE CONTRACTOR'S RESPONSIBILITY TO POT HOLE AND FIELD CHECK TO DETERMINE ACTUAL LOCATIONS AS AN INCIDENTAL REQUISITE TO THE CONSTRUCTION CONTRACT.
- THE PROPOSED CONTROLLER LOCATION INDICATED ON THE PLANS IS APPROXIMATE. ACTUAL LOCATION OF THE CONTROLLER SHALL BE DETERMINED BY OWNER'S REPRESENTATIVE IN THE FIELD.
- LOCATIONS OF ALL SLEEVE PIPING SHALL BE VERIFIED BY THE CONTRACTOR. EXCAVATION, POT-HOLING, ASSOCIATED WORK, MATERIALS, LABOR, ETC. SHALL BE THE RESPONSIBILITY OF THE CONTRACTOR. NO ADDITIONAL PAYMENT WILL BE MADE TO THE CONTRACTOR FOR LOCATING SLEEVES.
- 14. THIS SYSTEM WAS DESIGNED FOR 55 PSI STATIC WATER PRESSURE AND 25 GPM. SHOULD THE PRESSURE AND GALLONAGE BE LESS THAN THIS, NOTIFY THE LANDSCAPE ARCHITECT BEFORE PROCEEDING WITH THE INSTALLATION SO THAT ADJUSTMENTS CAN BE MADE IN THE PIPE SIZE. IF THE PRESSURE IS NUCH GREATER, NOTIFY THE LANDSCAPE ARCHITECT, AS A PRESSURE REDUCER MAY BE REQUIRED.

For Information Only

12/16/94 brc REVISIONS CHECKED BY ECK. DATE (0/14/99)



MORROW & COMPANY, LTD. LANDSCAPE ARCHITECTS 210 La Vata N.E. 87108

> IRRIGATION PLAN, LEGEND & NOTES

CHOOL OF ARCHITECTURE & PLAN

SHEET NO.

L-2 2 of 5

PLANTING NOTES

- IN CASE OF A DISCREPANCY IN PLANT QUANTITIES SHOWN ON THE PLANT LIST AND THOSE SHOWN ON THE PLANTING PLANS, THE QUANTITIES SHOWN THE PLANS SHALL GOVERN.

- IF THERE IS A DISCREPANCY IN FIELD OR NURSERY THEES BETWEEN THE CONTAINER SIZE CALLED OUT UNDER "REMARKS" AND THE CALIPER AND HEIGHT CALLED OUT UNDER "SIZE". THE SPECIFIED TREE MUST MEET THE CALIPER AND HEIGHT REQUIREMENTS SPECIFIED UNDER "SIZE." EVEN IF A LARGER CONTAINER SIZE IS REQUIRED TO MEET THESE SPECIFICATIONS, AT NO ADDITIONAL COST TO THE OWNER.
- CONTRACTOR SHALL DISTRIBUTE PLANTS EVENLY THROUGHOUT SHRUB BEDS.
- CONTRACTOR SHALL AMEND SOIL TO A DEPTH OF 6"-8" IN A MINIMUM 10" DIAMETER AROUND EXISTING TREES WITH BACKFILL MIXTURE.

For Information Only


			SIZE				
SYMBOL	BOTANICAL NAME	COMMON NAME	QUANTITY	INSTALLED	MATURE	REMARKS	
TREES		•					
CRA PHA	Crataegus phaenopyrum	Washington Hawthorn	6	8'-10' ht, 1-3/4" cal.	20" ht. and spd.	25 gallon	
KOE PAN	Koelreuteria paniculata	Goldenrain Tree	7	10'-12' ht, 2" cal.	25" ht, 20" spd.	24" box (Add. Alt. AZ)	
SHRUBS					•		
ART FIL	Artemisia filifolia	Sand Sage	10	12" ht., 12" spd.	4" ht. and spd.	1 gallon	
CORSTO	Cornus stolonifera	Red Osier Dogwood	2	12" ht., 8" spd.	5 ht. and spd.	1 gallon	
FOR NEO	Forestiera neomexicana	New Mexico Olive	9	24" ht., 24" spd.	13" Nt., 10" spd.	5 gallon (Prune up to tree form)	
ROB NEO	Robinia neomexicana	New Mexico Locust	3	24° ht. and spd.	13" ht., 10" spd.	5 gallon (Prune up to tree form)	
GROUND (COVER						
COTAPT	Cotoneaster apiculatus	Cranberry Cotoneaster	51	8" ht and spd.	24" ht., 4' spd.	1 gallon	
EUO FOR	 Euonymus fortunei 	Creeping Euonymus	50	2" ht.	12" ht, 36" spd.	4" pot	
POT TAB	Potentilla tabernaemontanii	Spring Cinquetoil	30	1" M.	4" ht., 12" spd.	4" pot	
BAN CHA	Santolina chamaecyparissus	Grey Santolina	25	8" ht and spd.	24" ht. and spd.	4" pot	
LOWERS	- PERENNIALS						
DEL BEL	Delphinium belladonna	Delphinium	.16	3" M.	18" ht.	4 pack	
RAT COL	Ratibida columnifera 'Mexican Hat'	Conellower	10	3" ht.	24° N.	4 pack	
BULBS AN	D TURE						
HEM	Hemerocallis	Daylily	15	Min. 8" ht.	18" M.	Tubers	
FI RET	iris reticulata	iris	12	449	18" M.	Bulbs, Purple color flower	
RAN	Narcissus 'King Alfred'	Daffodil	36		18" M.	Bulba	
LOWERS	- ANNUALS						
ANT MAJ	Antirrhinum majus	Snapdragon	12	3" ht.	12" ht.	6 pack	
LOB MAR	Lobularia maritima 'Carpet of Snow	Alyssum	24	1" ht.	4" ht.	6 pack	
VIO WIT	Viola wittrockiana	Pansey	24	3" ht.	6" ht.	6 pack	

12/16/94

REVISIONS


CPN-6001.90

MORROW & COMPANY, LTD. LANDSCAPE ARCHITECTS

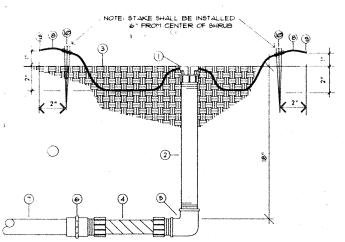

- LOW FLOW OCTA-BUBBLER, W/ (4) PORTS TYPICAL SEE
- LEGEND INSTALL 2" FROM ROOT BALL, TYPICAL 1/2" SCH. 80 PVC THREADED NIPPLE,
- LENGTH AS REQUIRED
- FINISH GRADE EXCALIBER 506-MM, 1/2" X 6" PVC FLEX NIPPLE
- 1/2" SCH. 40 PYC TREADED ELBOW 3/4" X 1/2" SCH. 40 PYC FEMALE ADAPTER
- PVC LATERAL PIPING PEPCO P220Y SERIES, 7/32" VINTL TUBING, LENGTH AS REQUIRED
- OCTA-BUBBLER 2133-100 INSECT PLUG, TYPICAL
 RAINBIRD 19-025 TUBING STAKE, ONE PER PLANT INSTALL 6" FROM CENTER OF SHRUB, TYPICAL

OW FLOW BUBBLER ASSEMBLY (4 PORTS)

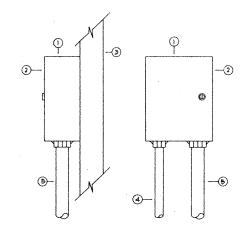


- 1 AUTOMATIC CONTROLLER (SEE LEGEND)
 2 EYE LEVEL
 3 WALL
 4 120 YOLT WIRE CONDUIT
 5 24 YOLT WIRE CONDUIT


CONTROLLER SHALL BE MOUNTED SECURELY TO WALL USING APPROPRIATE FASTENERS FOR WALL TYPE. ALL EXPOSED CONDUIT SHALL BE EMT, OR EQUAL AND APPROVED BY LOCAL CODES. ALL CONDUIT CONNECTIONS SHALL BE MADE USING WATERTIGHT CONNECTORS.




SCANNED BY PLANNING

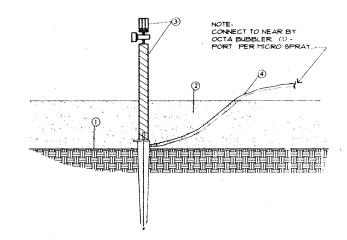

- FINISH GRADE
 MULCH BED
 PEPCO MICRO-POP SPRAY ASSEMBLY (SEE LEGEND) RAIN BIRD MODEL *DT-025 1/4" DISTRIBUTION TUBING (MAX. LENGTH PER SPECIFICATION)
- DRIP MICRO SPRAY SPRINKLER

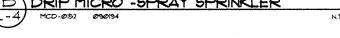

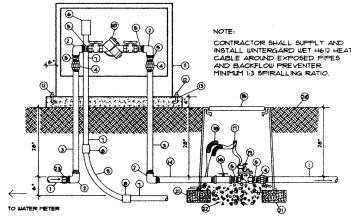

2 GALVANIZED ELBOW 3 GALVANIZED NIPPLE - 42" LENGTH

- 4) GALVANIZED UNION
- WINCTION BOX FOR HEAT TAPE RIGID STEEL CONDUIT
- WATERTIGHT CONNECTOR RIGID STEEL SWEEP ELL REDUCED PRESSURE BACKFLOW
- PREVENTER OR APPROVED EQUAL

 (1) INSULATED ENCLOSURE (SEE LEGEND) (2) ANCHOR BOLTS
- SPEARS TRUE UNION SCH. 80 PVC BALL VALVE PVC BALL VALVE

 1) WATERPROOF WIRE SPLICE

 1) 36" WIRE LOOPS

 1) AUTOMATIC VALVE (SEE LEGEND)

 2) FINISH GRADE


3000 PSI CONCRETE PAD

GALVANIZED NIPPLE - 36" LENGTH

BROOKS 1730 PB-16" VALVE BOX W/ 8" EXTENSIONS AS REQUIRED


(2) PEA GRAVEL - 3 CUBIC FEET SCH 40 PVC MALE ADAPTER

RP. BACKFLOW PREVENTER & MASTER VALVE ASSEMBLY

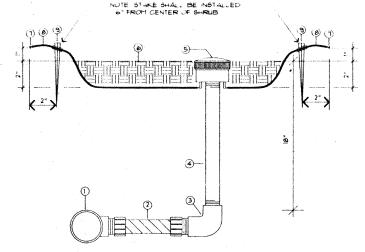

- (1) PVC LATERAL PIPE FITTING (2) EXCALIBUR 506-MM 1/2" x 6" PVC FLEX NIPPLE
- (3) 1/2" SCH. 40 PVC THREADED ELBOW
- (4) 1/2" SCH. 80 PVC NIPPLE, LENGTH AS REQUIRED 5 PEPCO LOW-FLOW OCTA-BUBBLER, SEE LEGEND
- 6 FINISH GRADE, TOP OF GRAVEL MULCH OR DECORATIVE BARK LAYER, SEE PLANTING PLAN 1) OCTA-BUBBLER 2133-100 INSECT PLUG, TYPICAL
- 8 PEPCO P220V SERIES, 1/32" VINYL TUBING, LENGTH AS REQUIRED
- (9) RAINBIRD 15-025 TUBING STAKE, ONE PER PLANT, INSTALL 6" FROM CENTER OF SHRUB TYPICAL



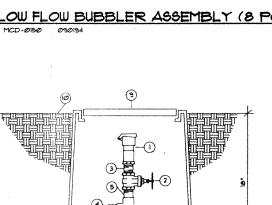


(1) QUICK COUPLER VALVE (SEE LEGEND) SPEARS SCH. 80 PVC BALL VALVE SCH. 80 PVC NIPPLE - 2" LENGTH SPEARS 591-010 SWING JOINT SCH. 80 PYC EXTRUDED TOE NIPPLE - 6" LENGTH SCH 80 PVC PIPE - 18" LENGTH CMU BLOCK - 2 PER VALVE BOX

PEA GRAVEL - 4 CUBIC FEET BROOKS PRODUCTS INC., 1924-PB-18 BODY (ABS) WITH ONE 8" EXTENSION FINISH GRADE

SCH. 40 PVC PIPE (LENGTH AS REQUIRED) MAINLINE FITTING

QUICK COUPLER ASSEMBLY

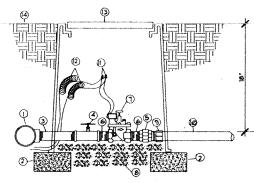

CMU BLOCK
SCH. 80 PVC NIPPLE - 18" LENGTH
SPEARS TRUE UNION SCH. 80 PVC BALL VALVE (5) SPEARS SCH. 80 PVC UNION

SCH. 80 PVC NIPPLE - 3" LENGTH
 AUTOMATIC VALVE (SEE LEGEND)
 PEA GRAVEL - 3 CUBIC FEET
 SCH. 40 PVC MALE ADAPTER

(a) LATERAL PIPE (SEE LEGEND)
(ii) WATERPROOF WIRE CONNECTOR
(iii) 36" WIRE EXPANSION LOOPS
(iii) BROOKS PRODUCTS, INC. 1324 PB-18 BODY (ABS)

AUTOMATIC VALVE ASSEMBLY

For Information Only

COMPANY, LTD. ARCHITECTS

SHEET NO.

SHRUB PLANTING DETAIL


BRICK PAYING ON GIAND, INGTAIL POR

2" DEPTH BARK MICH SALOR COURSE AT EDGE curving bond, are plans for direction EXISTING CONCRETE


BRICK PAVING EDGE DETAIL

WATER PROOFING DETAIL


12" FIBEL EXP. LIBIL BRICK BAING ON GAID BED INGTALL TOP OF BRICK, PLUST W/TOP OF ADJACENT BRICK EXTERIOR CAULK EXISTING THRESHOLD MY FIREL EXP. H. ON COMED BOOD ON EXIST SIDE MAD TO ALLOW FOR BRICK ABOVE EXIST. CONCRETE

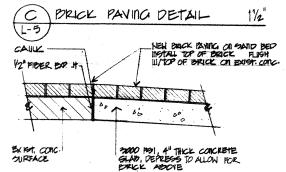


EXTERIOR CAULK-

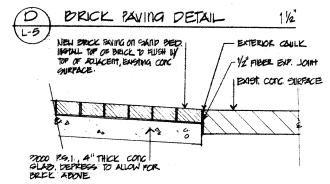


BRICK PAVING DETAIL

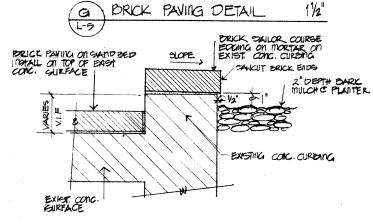


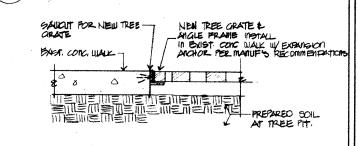





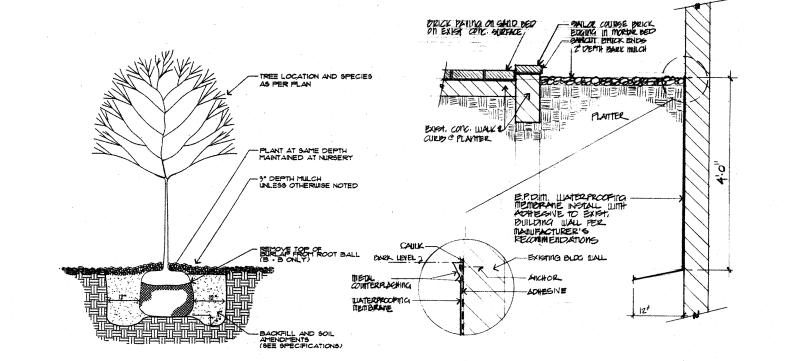


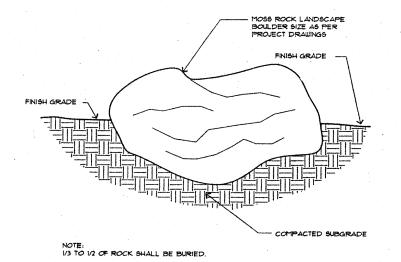

TREE PLANTING DETAIL

LANDSCAPE BOULDER

MCD-0097 081693

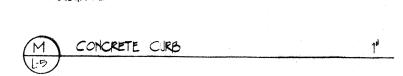

TOP OF HEW CURB TO MATCH EXISTING ADMCENT CONC. GLAD

FINISH GRADE (MATERIAL VARIES)

For Information Only

COMPANY, LTD. ARCHITECTS MORROW & LANDSCAPE 210 La Veta N.E. Abuquerque, N.M. 505 286-2266

> PLANTING 8 CONSTRUCTION

SHEET NO