

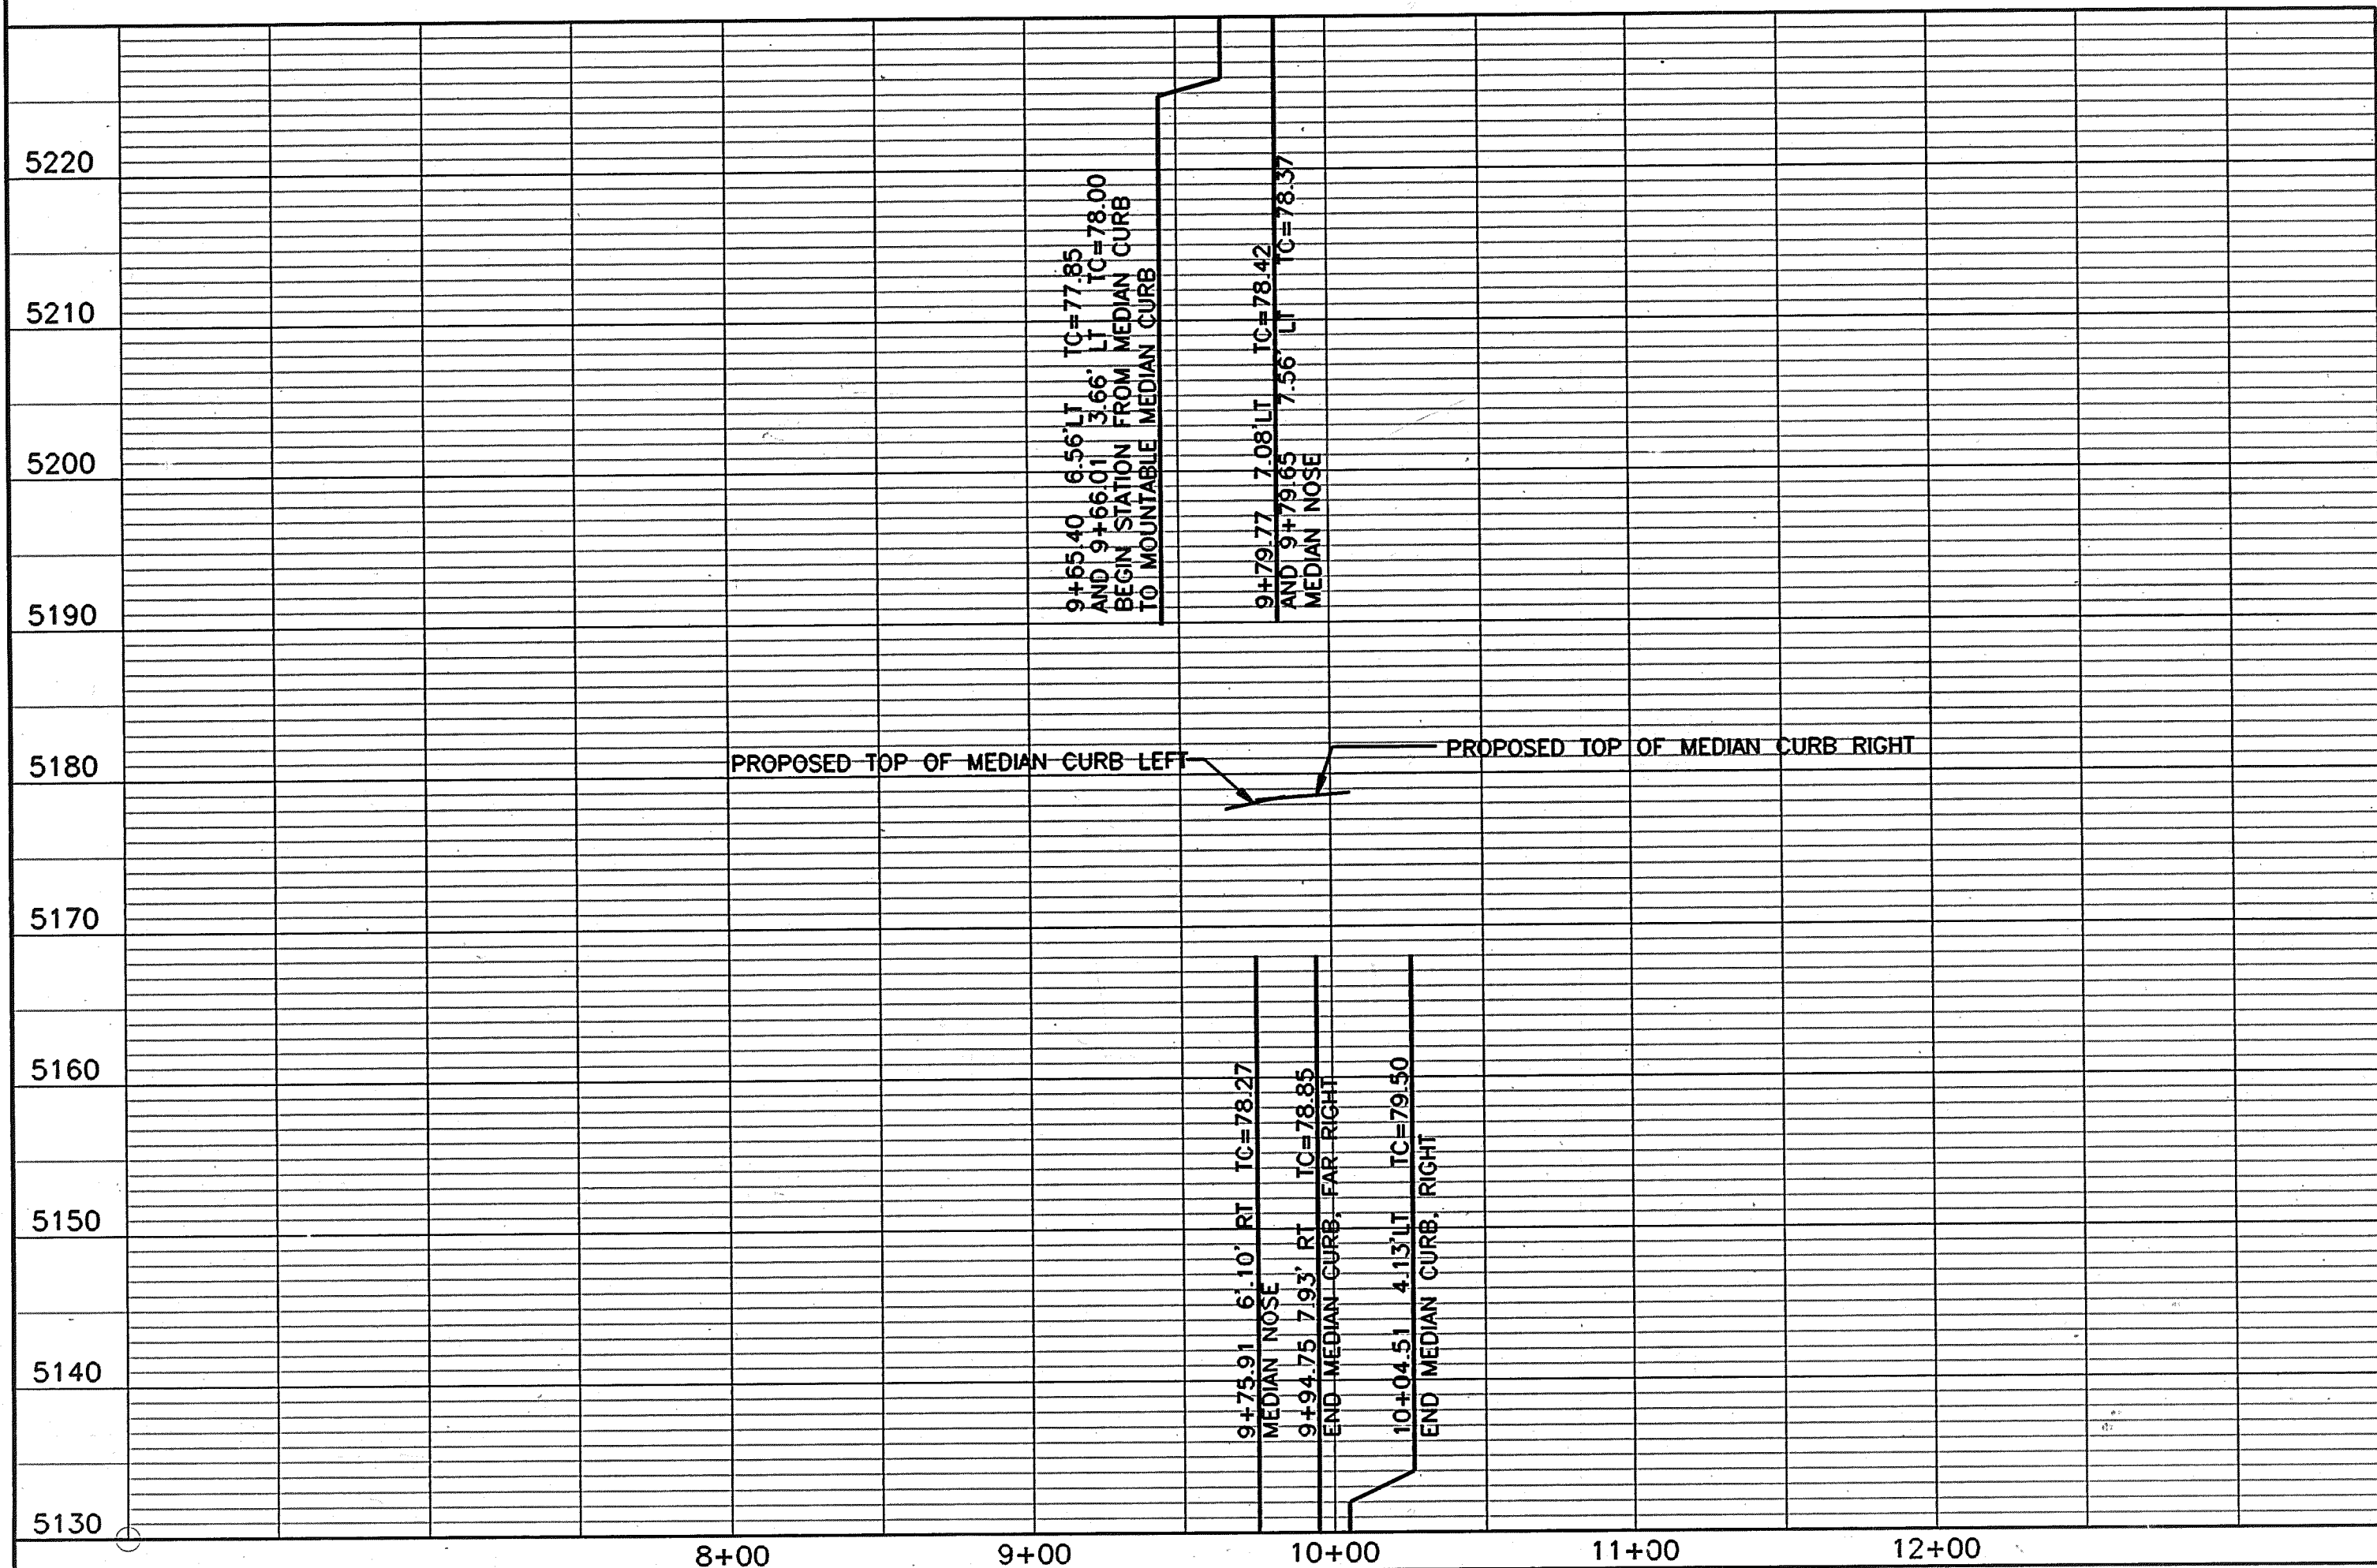
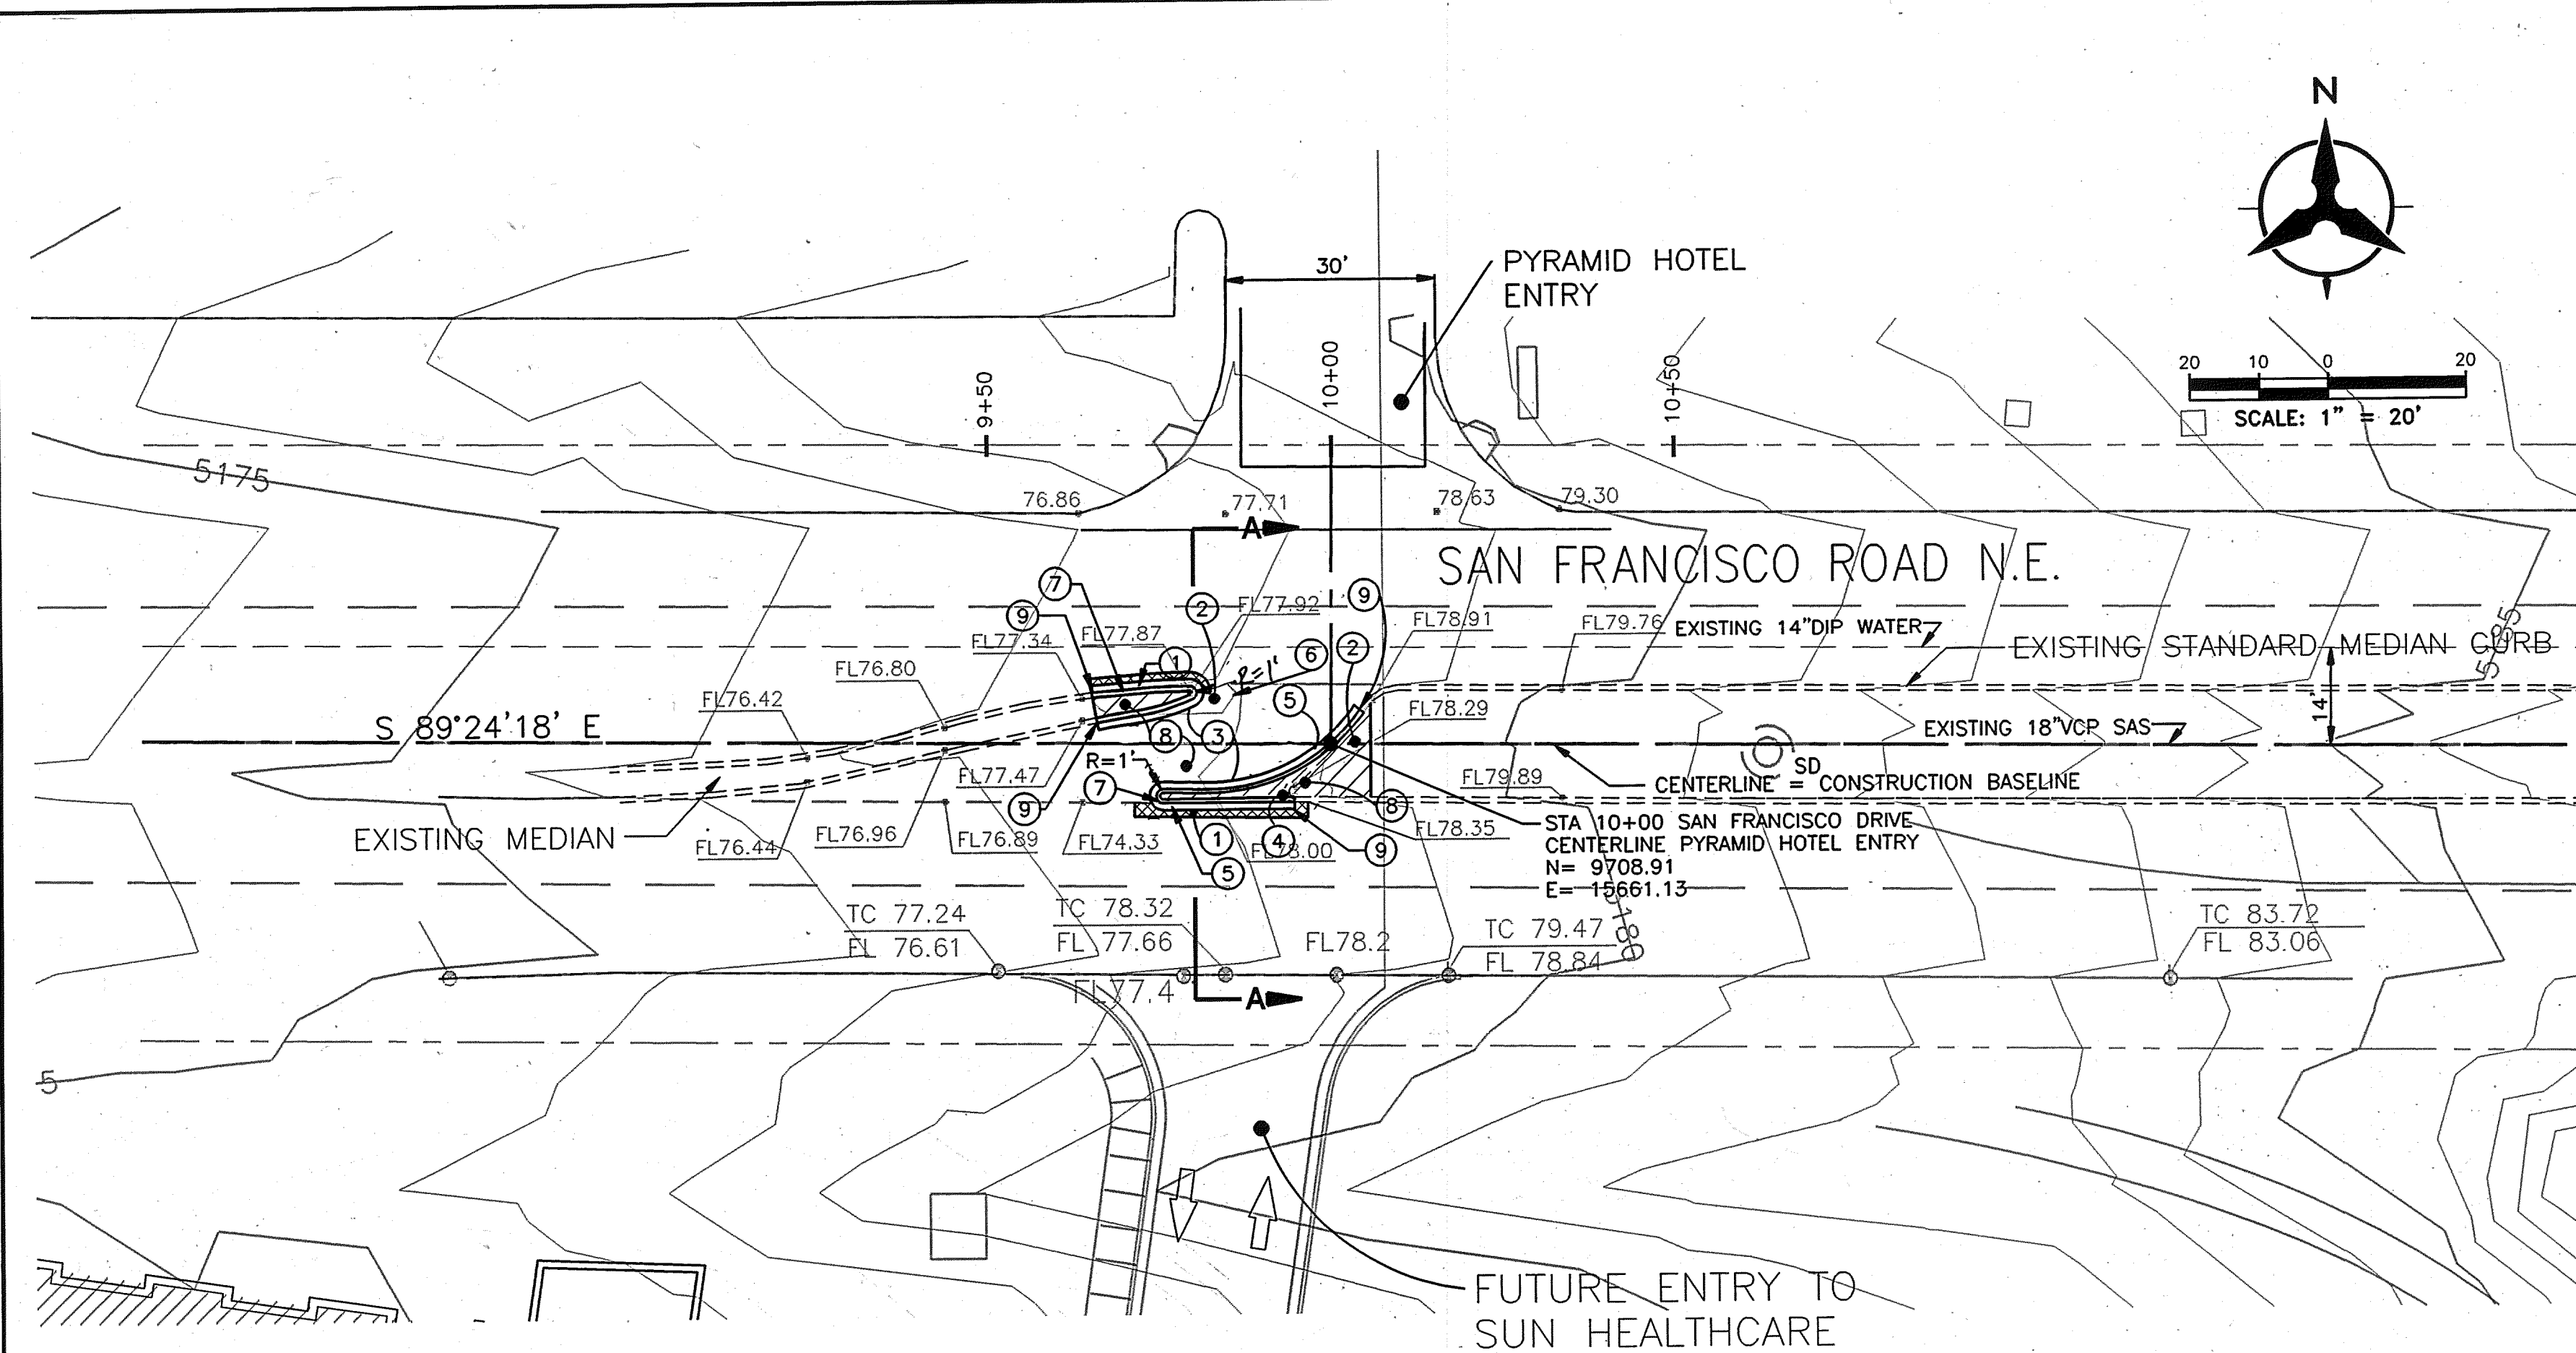



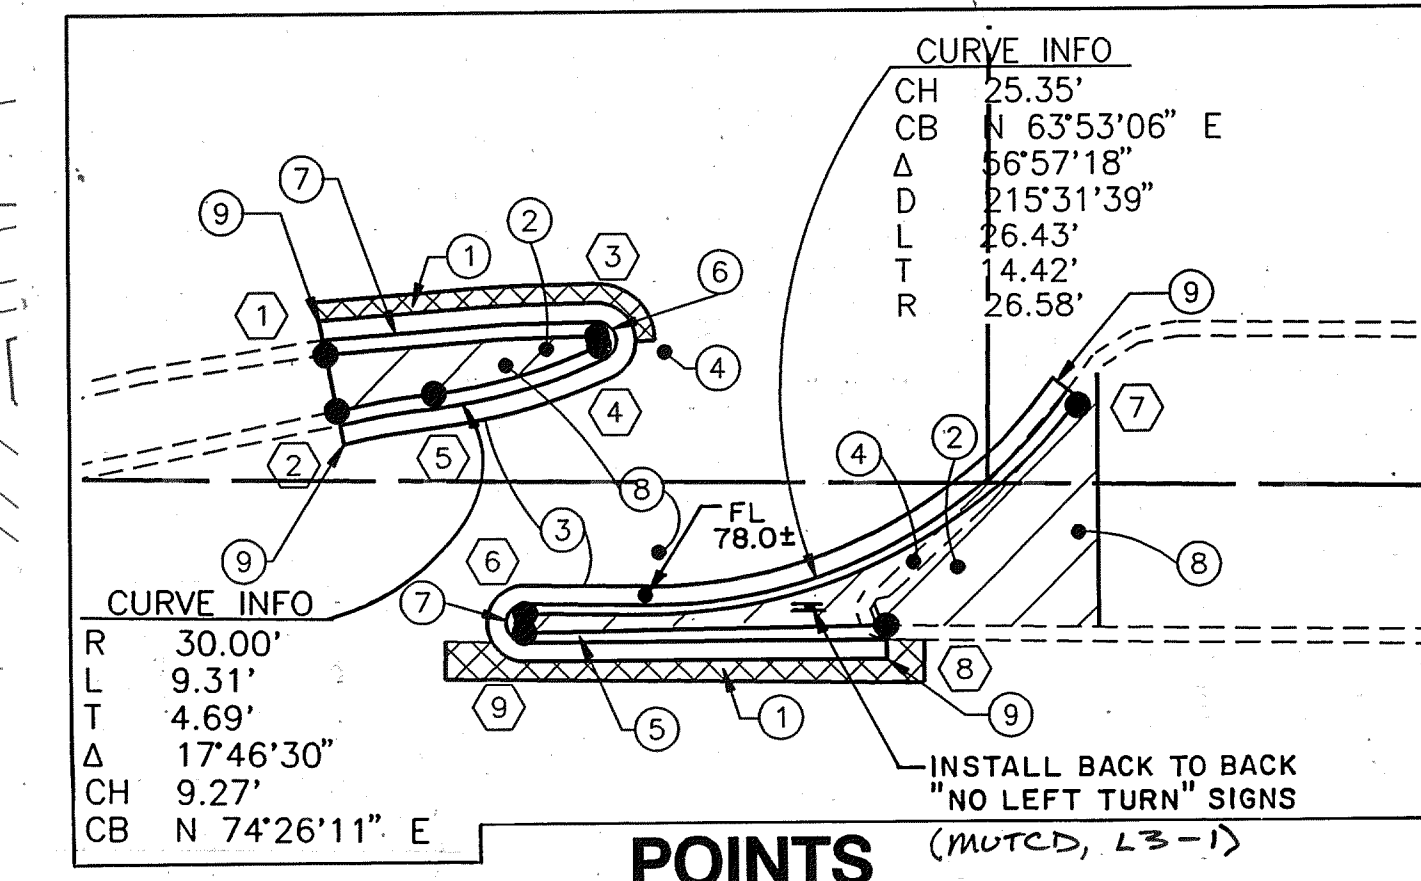


- NOTES**
- NEATLY SAWCUT, REMOVE AND DISPOSE OF EXISTING ASPHALT. (HATCHED AREA)
 - CAREFULLY REMOVE EXISTING BRICK PAVERS FROM THE MEDIAN AND STREET WHERE NECESSARY AND REUSE.
 - SAWCUT 8" CONCRETE PAVEMENT UNDER BRICK STREET PAVERS WHERE NEW MEDIAN CURB AND GUTTER ABUTS WITH THE EXISTING STREET SECTION. ALLOW AN ADDITIONAL 1/2" FOR MASTIC JOINT MATERIAL. (SEE COA STD DWG 2412)
 - NEATLY SAWCUT AND REMOVE AND DISPOSE OF EXISTING MEDIAN CURB AND GUTTER.
 - INSTALL MOUNTABLE MEDIAN CURB AS PER COA STD DETAIL, DWG 2415.
 - NEATLY SAWCUT AND REMOVE AND DISPOSE OF EXISTING MEDIAN CURB AND GUTTER AND REPLACE WITH MOUNTABLE MEDIAN CURB AS PER COA STD DETAIL, DWG 2415.
 - PAINT ALL NEW CURB CONSTRUCTION W/YELLOW REFLECTORIZED PAINT
 - INSTALL BRICK PAVERS IN STREET AND MEDIAN AREAS AS NEEDED TO COMPLETE PAVING IN THE STREET AND MEDIAN AS PER COA STD DWG. 2412
 - TRANSITION FROM STANDARD MEDIAN CURB TO MOUNTABLE MEDIAN CURB IN 8'. START TRANSITION AT BEGINNING OF NEW CONSTRUCTION.

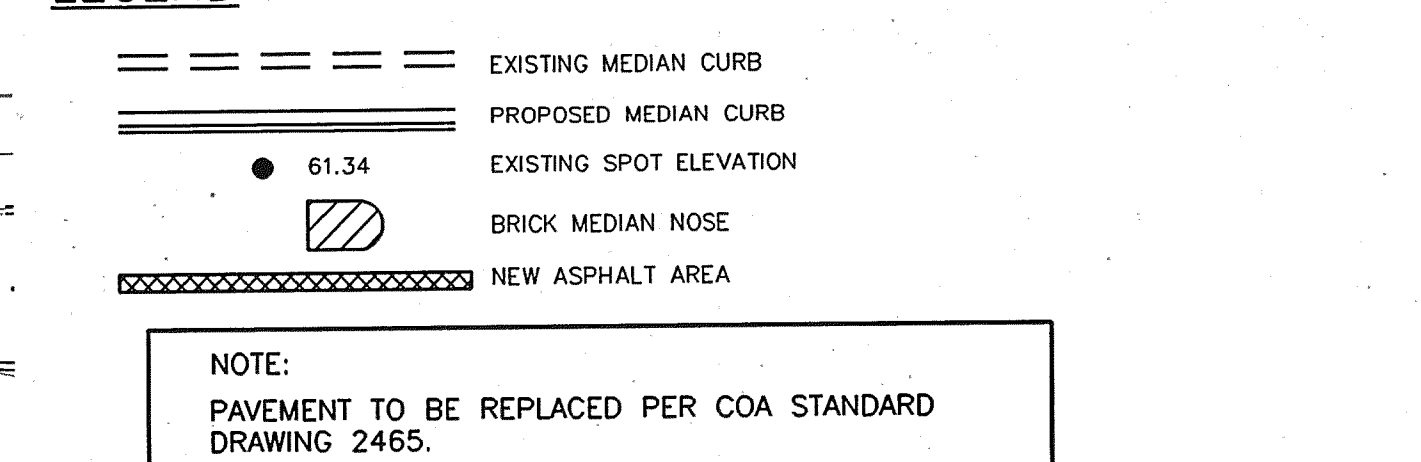

POINT TABLE

STA.	OFFSET	DESC.	TC
9+00	1	9+65.40 6.56'LT	77.85
9+65	2	9+66.04 3.66'LT	78.00
9+70	3	9+70.65 7.56'LT MED NOSE	78.37
9+70	4	9+70.77 7.08'LT MED NOSE	78.42
9+75	5	9+71.09 4.56'LT	78.15
10+04	6	9+75.91 6.10'RT MED NOSE	78.27
9+75	7	10+04.51 4.13'LT	79.50
9+75	8	9+94.75 7.93'RT	78.85
9+75	9	9+75.91 7.93'RT MED NOSE	78.17

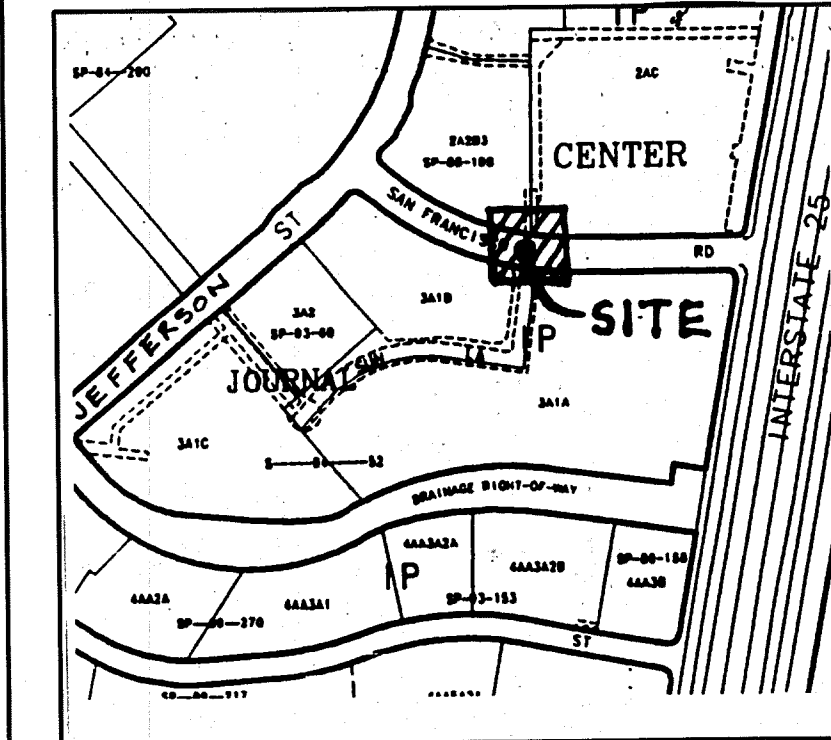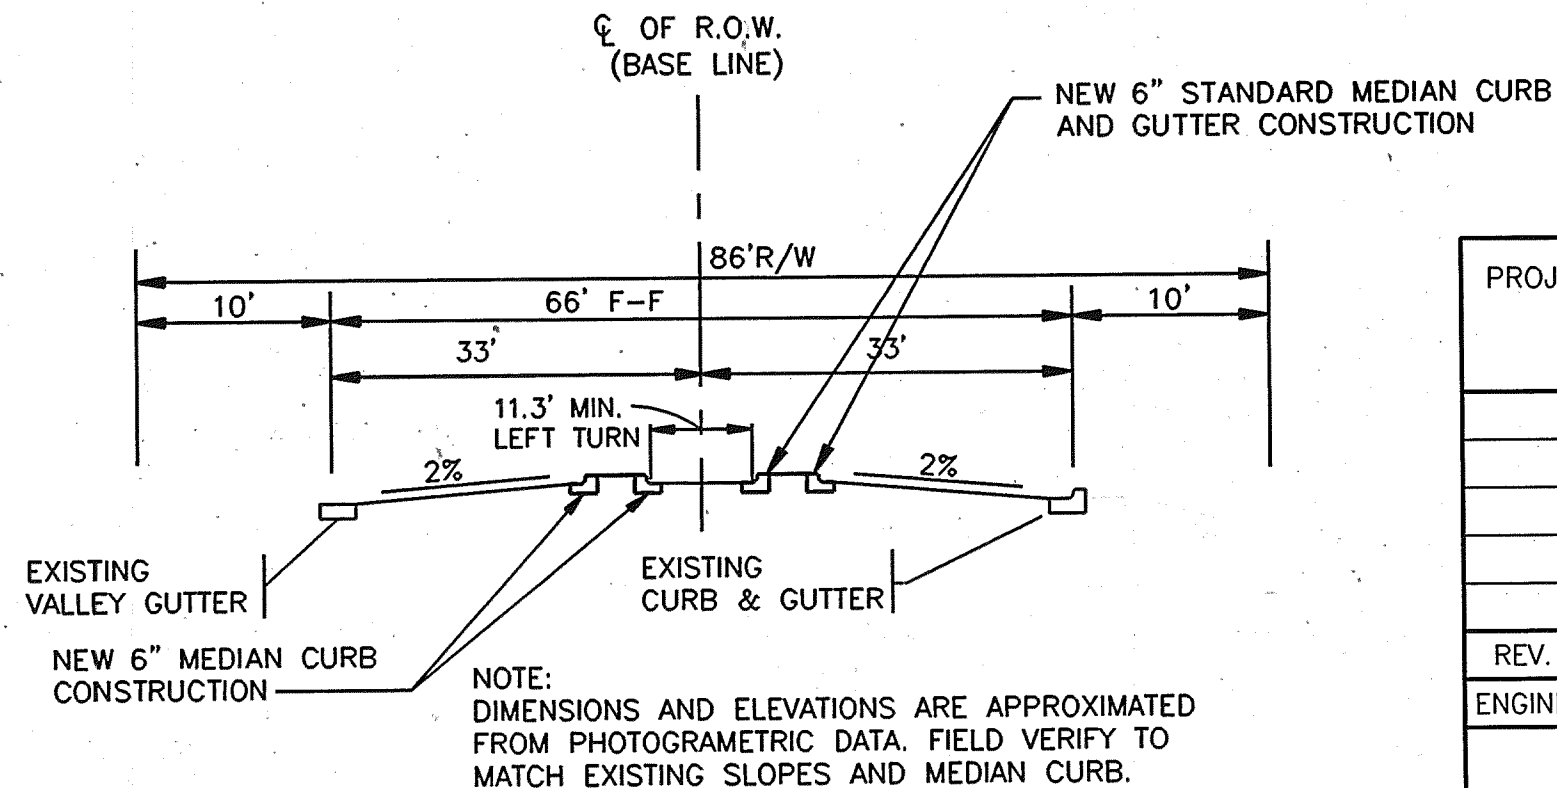

- GENERAL NOTES**
- ALL WORK DETAILED ON THESE PLANS TO BE PERFORMED UNDER CONTRACT SHALL, EXCEPT AS OTHERWISE STATED OR PROVIDED FOR HEREON, BE CONSTRUCTED IN ACCORDANCE WITH THE CITY OF ALBUQUERQUE STANDARD SPECIFICATIONS FOR PUBLIC WORKS CONSTRUCTION, 1986 EDITION AND SHALL INCLUDE UPDATE No. 6.
 - TWO WORKING DAYS PRIOR TO ANY EXCAVATION, THE CONTRACTOR MUST CONTACT NEW MEXICO ONE CALL SYSTEM (260-1990) FOR LOCATION OF EXISTING UTILITIES.
 - FIVE (3) WORKING DAYS PRIOR TO BEGINNING CONSTRUCTION, THE CONTRACTOR SHALL SUBMIT TO CONSTRUCTION COORDINATION DIVISION A DETAILED CONSTRUCTION SCHEDULE. TWO (2) WORKING DAYS PRIOR TO CONSTRUCTION, THE CONTRACTOR SHALL OBTAIN A BARRICADING PERMIT FROM THE CONSTRUCTION COORDINATION DIVISION. CONTRACTOR SHALL NOTIFY BARRICADE ENGINEER (768-2551) PRIOR TO OCCUPYING THE INTERSECTION. REFER TO SECTION 19 OF THE GENERAL CONDITIONS OF THE STANDARD SPECIFICATIONS.
 - ALL STREET STRIPING ALTERED OR DESTROYED SHALL BE REPLACED W/PLASTIC REFLECTORIZED PAVEMENT MARKING BY CONTRACTOR TO LOCATION AS EXISTING OR AS INDICATED BY THIS PLAN SET.
 - GRADE ELEVATIONS, WHERE NOTED, ARE FOR FLOW LINE UNLESS OTHERWISE SPECIFIED.
 - ANY ADDITIONAL GRADING REQUIRED TO MATCH PROPOSED STREET GRADES SHALL BE INCIDENTAL TO PAVING ITEMS.
 - CONTRACTOR SHALL PARK EQUIPMENT AND VEHICLES SO AS NOT TO INTERFERE WITH THE NORMAL ACTIVITIES OF RESIDENTS OR OTHER CONTRACTORS ON SITE.
 - ANY DAMAGE TO THE EXISTING FACILITIES (CURB & GUTTER, PAVEMENT, CONDUITS, LANDSCAPING, UTILITY LINES ETC.) DURING CONSTRUCTION SHALL BE REPLACED AT THE CONTRACTORS EXPENSE.
 - ASPHALT PAVING SHALL BE INSTALLED IN KIND, AS PER COA STANDARD SPECIFICATIONS FOR PUBLIC WORKS. CONTRACTOR SHALL VERIFY EXISTING ASPHALT THICKNESS WITH ENGINEER BEFORE PROCEEDING TO PAVE. SEE DETAIL THIS SHEET.
 - ALL CURVE DATA AND DIMENSIONS REFER TO FACE OF CURB UNLESS OTHERWISE SPECIFIED.
 - ANY WORK WITHIN AN ARTERIAL ROADWAY REQUIRES TWENTY-FOUR HOUR CONSTRUCTION.

APPROVAL OF AS BUILT DRAWINGS
CHIEF CONSTRUCTION ENGINEER
Date 4-16-99

PROJECT TITLE: **SUN HEALTHCARE/SAN FRANCISCO BLVD MEDIAN MODIFICATION**

REV.	SHEETS	CITY ENGINEER	DATE	USER DEPARTMENT	DATE	USER DEPARTMENT	DATE
ENGINEERS STAMP & SIGNATURE		APPROVALS		ENGINEER		DATE	
		DRG Chairman		Billy G. Sandoval		7-22-97	
		Transportation		N/A		7-22-97	
		Water/Wastewater		N/A		7-22-97	
		Hydrology		N/A		7-22-97	
		CIP					
		Const. Mngmt.					
		Const. Coord.		J. L. Luch		8-31-98	
		CITY PROJECT NO.		512891			

AS-BUILT INFORMATION

CONTRACTOR: Gerald M. Luch
DATE: 3-6-99
ENGINEER: Billy G. Sandoval
DATE: 7-22-97
CITY ENGINEER: J. L. Luch
DATE: 8-31-98

ENGINEER'S SEAL

NO. DATE REMARKS REVISIONS DESIGN

DESIGNED BY: PR DATE: 3/97
DRAWN BY: PDF DATE: 3/97
CHECKED BY: JT DATE: 3/97

BOHANNAN-HUSTON, INC.
ENGINEERS • PLANNERS • PHOTOGRAMMETRISTS • SURVEYORS • LANDSCAPE ARCHITECTS
ALBUQUERQUE LAS CRUCES SANTA FE

COPYRIGHT BOHANNAN-HUSTON, INC. DATE: