



LOCATION MAP G-11-Z

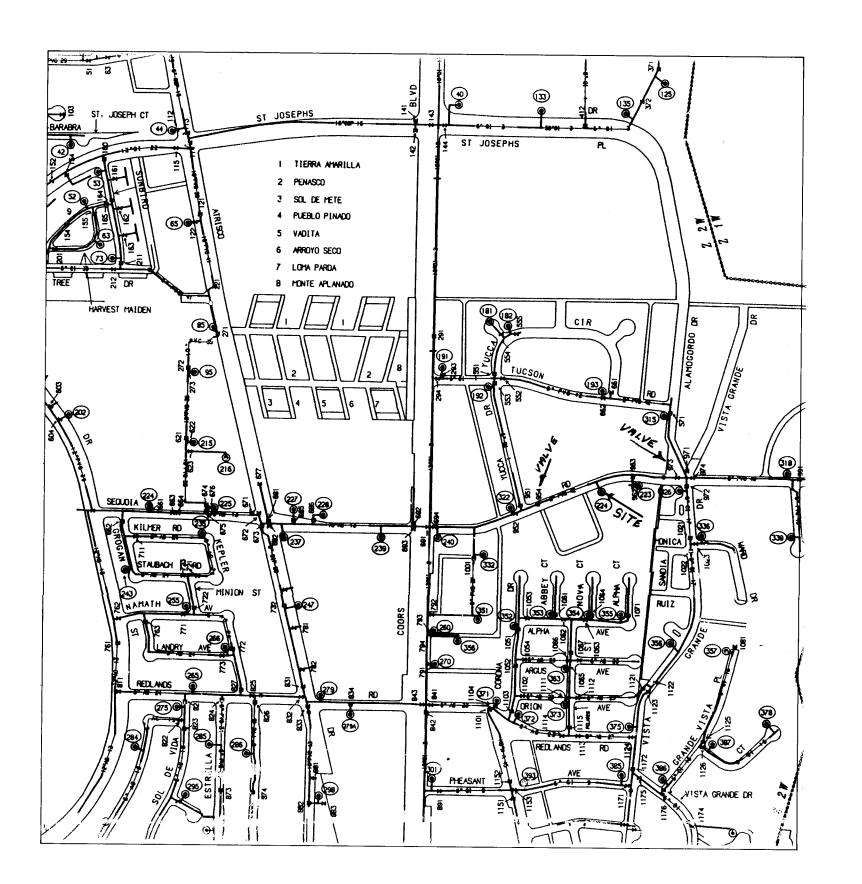

WATER MAP G-11

<u>LEGEND</u>

PROPOSED WATER LINE

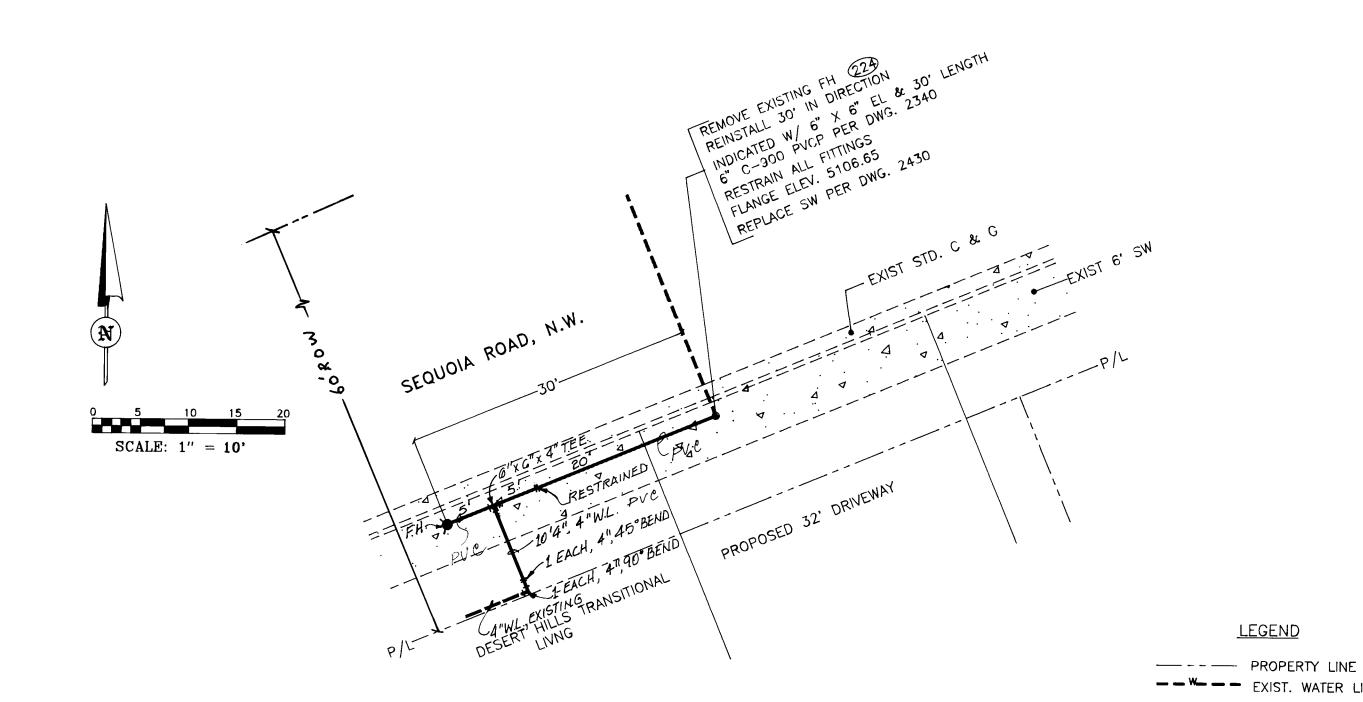

SITE CONFIGURATION

1 2 3 4 5 8 7 8 9 10 11 12 13 14 15 26 5143.900195



SCANNED BY BY LASON

NOTICE TO CONTRACTORS  1. ALL WORK DETAILED ON THESE PLANS TO BE PERFORMED UNDER CONTRACT SHALL, EXCEPT AS OTHERWISE STATED OR PROVIDED FOR HEREON, BE CONSTRUCTED IN ACCORDANCE WITH THE CITY OF ALBUQUERQUE STANDARD SPECIFICATIONS FOR PUBLIC WORKS CONSTRUCTION, 1986 EDITION (UPDATE #4).  2. TWO (2) WORKING DAYS PRIOR TO ANY EXCAVATION, THE CONTRACTOR MUST CONTACT NEW MEXICO ONE CALLS SYSTEM (260–1990) FOR LOCATION OF EXISTING UTILITIES.  3. PRIOR TO CONSTRUCTION, THE CONTRACTOR SHALL EXCAVATE AND VERIFY THE HORIZONTAL AND VERTICAL LOCATIONS OF ALL OBSTRUCTIONS. SHOULD A CONFLICT EXIST, THE CONTRACTOR SHALL NOTIFY THE ENGINEER OR SURVEYOR IMMEDIATELY SO THAT THE CONFLICT CAN BE RESOLVED WITH A MINIMUM AMOUNT OF DELAY.  4. THREE (3) WORKING DAYS PRIOR TO BEGINNING CONSTRUCTION COORDINATIONS DIVISION A DETAILED CONSTRUCTION. THE CONTRACTOR SHALL SUBMIT TO CONSTRUCTION COORDINATIONS DIVISION A DETAILED CONSTRUCTION COORDINATIONS DIVISION A DETAILED CONSTRUCTION SCHEDULE. TWO (2) WORKING DAYS PRIOR TO CONSTRUCTION DIVISION. CONTRACTOR SHALL NOTIFY BARRICADE ENGINEER (768–2551) PRIOR TO OCCUPYING AN INTERSECTION. REFER TO SECTION 19 OF THE GENERAL CONDITIONS OF THE STANDARD SPECIFICATIONS.  5. ALL STREET STRIPING ALTERED OR DESTROYED SHALL BE REPLACED IN KIND BY CONTRACTOR TO LOCATION AND IN KIND AS EXISTING OR AS INDICATED BY THIS PLAN SET.  6. CONTRACTOR SHALL NOTIFY THE ENGINEER NOT LESS THAN SEVEN (7) DAYS PRIOR TO STARTING WORK IN ORDER THAT THE ENGINEER MAY TAKE NECESSARY MEASURES TO INSURE THE PRESERVATION OF SURVEY MONUMENTS. CONTRACTOR SHALL NOT DISTURB PERMANENT SURVEY MONUMENTS WITHOUT THE CONSENT OF THE ENGINEER AND SHALL NOTIFY THE ENGINEER NOT LESS THAN SEVEN (7) DAYS PRIOR TO STARTING WORK IN ORDER THAT THE ENGINEER MAY TAKE NECESSARY MEASURES TO INSURE THE PRESERVATION OF SURVEY MONUMENTS. CONTRACTOR SHALL NOT DISTURB PERMANENT SURVEY MONUMENTS WITHOUT THE CONSENT OF THE ENGINEER TO SHALL NOTIFY THE ENGINEER TO THE ENGINEER TO SHALL NOTIFY THE ENGINEER TO THE ENGINEER TO THE ENGINEER TO SHALL NOTIFY TH	BENCH MARKS AS BUILT INFORMATION	OR 71.C		NCE BY O. J.	BY O. J. DATE	Z. DATE	-FILM INFOF	RECORDED BY DATE	NO.	
PERSONNEL ARE TO OPERATE VALVES.	ENGINEER'S SEAL SURVEY INFORMATION	FIELD N	NO. BY DATE						A D 1, 3/95	
THE FOLLOWING NOTES ALSO APPLY WHEN CHECKED  UTILITIES AND UTILITY SERVICE LINES SHALL BE INSTALLED PRIOR TO PAVING.  BACKFILL COMPACTION SHALL BE ACCORDING TO SPECIFIED STREET USE.  TACK COAT REQUIREMENTS SHALL BE DETERMINED BY THE CITY ENGINEER.  SIDEWALKS AND WHEELCHAIR RAMPS WITHIN THE CURB RETURNS SHALL BE CONSTRUCTED WHEREVER A NEW CURB RETURN IS CONSTRUCTED.  IF CURB IS DEPRESSED FOR A DRIVEPAD, THE DRIVEPAD SHALL BE CONSTRUCTED PRIOR TO ACCEPTANCE OF CURB AND GUTTER.  ALL STORM DRAINAGE FACILITIES SHALL BE COMPLETED PRIOR TO FINAL ACCEPTANCE.	•					KEVIS/ONS	DESIGN	DI CO. COONCE & ASSOC., INC. DALE	ED BY AAC	UAIE
PUBLIC WORKS DEPA ENGINEERING GROUTLE:  FIRE HYDRANT RELOCATION SEQUOIA ROAD, N.W.  APPROVALS ENGINEER DATE APPROVA  R.C. Chairman S.G. Shahara 2-8-95 WATER ansportation WASTE Wordrology  PRAWING 5143.90  MAP NO. G-11	ATE	MEN	ENC (W)	GINE , <b>k</b>	S. C.	he he	2	DAT -  -	99	