

CONSTRUCTION PLANS

FOR

LA CUEVA TIERRA

ROADWAY & UTILITY DESIGN

ALBUQUERQUE, NEW MEXICO

CITY OF ALBUQUERQUE

MAY 1995

INDEX TO DRAWINGS

SHEET NO.	TITLE	SHEET NO.	TITLE
1.	TITLE SHEET & INDEX TO DRAWINGS	7.	PAVING IMPROVEMENTS - VENTURA STREET
2.	PLAT	8.	MASTER UTILITY PLAN
3.	GRADING PLAN	9.	UTILITY IMPROVEMENTS - HELMICK PLACE & ROBS PLACE
4.	MASTER PAVING IMPROVEMENTS	10.	UTILITY IMPROVEMENTS - ROBS PLACE
5.	PAVING IMPROVEMENTS - HELMICK PLACE & ROBS PLACE	11.	UTILITY IMPROVEMENTS - VENTURA STREET
6.	PAVING IMPROVEMENTS - ROBS PLACE	12.	STORM DRAIN IMPROVEMENTS - VENTURA

RECORD DRAWING

DATE: 2/19/96 DRAFTED BY: Tierra West Dev

THESE RECORD DRAWINGS HAVE BEEN PREPARED, IN PART, ON THE BASIS OF INFORMATION COMPILED AND FURNISHED BY OTHERS. THE ENGINEER WILL NOT BE RESPONSIBLE FOR ANY ERRORS OR OMISSIONS WHICH HAVE BEEN INCORPORATED INTO THIS DOCUMENT AS A RESULT.

1 2 3 4 5 6 7 8 9 10 11 12 13 14 15
24-5149.90 0196




BENCH MARKS

ASC MONUMENT "1-C21A"
CENTRAL STATION DATA
NM STATE PLANE COORDINATES
(CENTRAL ZONE) NAD 1927
X=415,503.35
Y=1,518,787.29
EL= 5364.65
GROUND TO GRID FACTOR=0.99963867
DELTA ALPHA=-00'09'46"

APPROVAL OF AS BUILT DRAWINGS
CHIEF CONSTRUCTION ENGINEER
DATE 5-14-96

TIERRA WEST DEVELOPMENT
MANAGEMENT SERVICES
4421 McLEOD ROAD N.E. SUITE D
ALBUQUERQUE, NEW MEXICO 87109
(505)883-7592

APPROVED FOR CONSTRUCTION 7/8/95 CITY ENGINEER				DATE			
REV	SHEETS	CITY ENGINEER	DATE	USER DEPT.	DATE	USER DEPT.	DATE

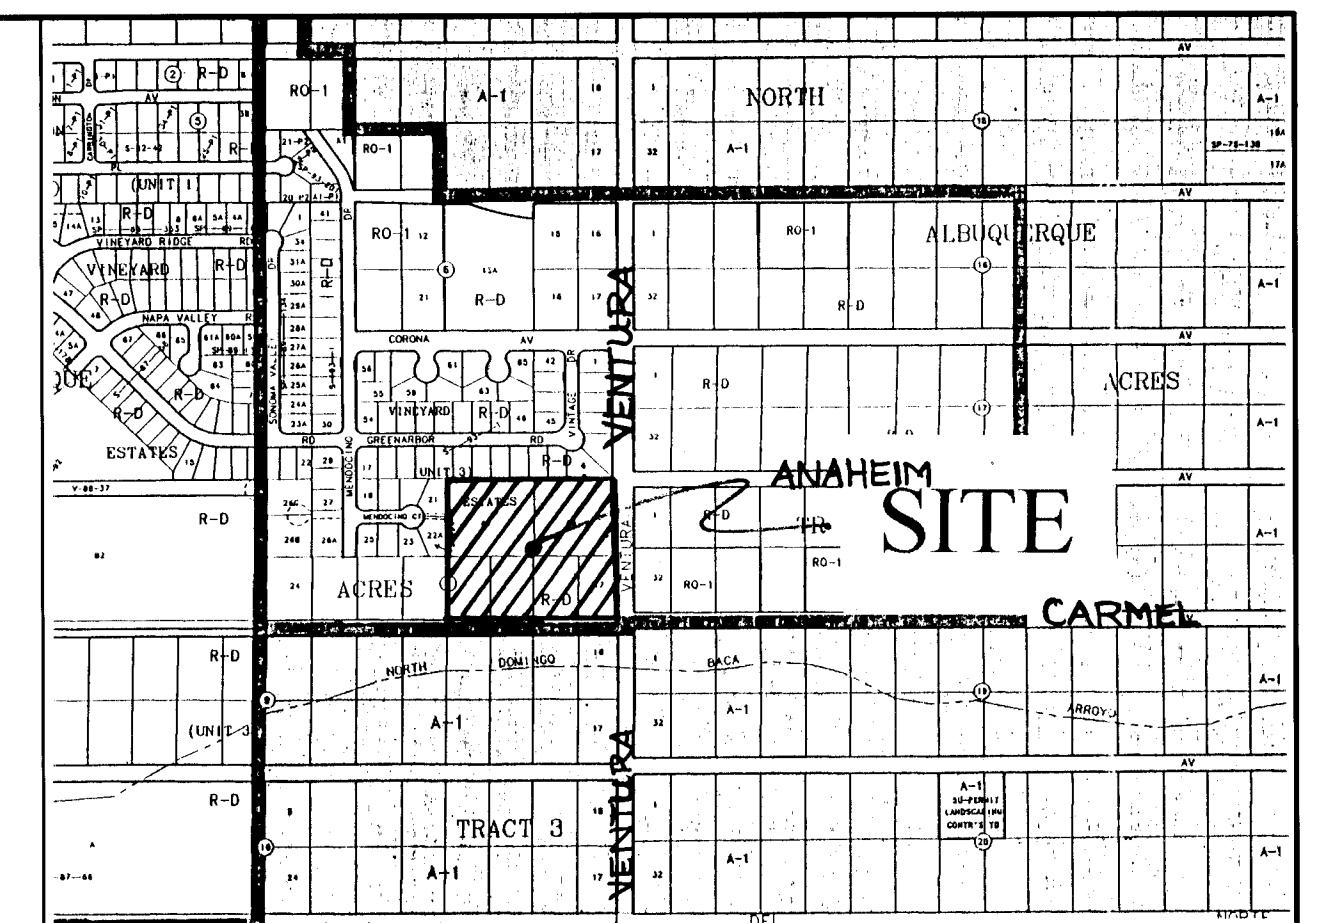

VICINITY MAP ZONE ATLAS C-20-Z


SCALE NONE

NOTICE TO CONTRACTORS:

- ALL WORK DETAILED ON THESE PLANS TO BE PERFORMED UNDER CONTRACT SHALL EXCEPT AS OTHERWISE STATED OR PROVIDED FOR HEREON, BE CONSTRUCTED IN ACCORDANCE WITH THE CITY OF ALBUQUERQUE STANDARD SPECIFICATIONS FOR PUBLIC WORKS CONSTRUCTION, 1986 EDITION (UPDATE #5).
- TWO WORKING DAYS PRIOR TO ANY EXCAVATION, THE CONTRACTOR MUST CONTACT NEW MEXICO ONE CALLS SYSTEM (260-1990) FOR LOCATION OF EXISTING UTILITIES.
- PRIOR TO CONSTRUCTION, THE CONTRACTOR SHALL EXCAVATE AND VERIFY THE HORIZONTAL AND VERTICAL LOCATIONS OF ALL OBSTRUCTIONS. SHOULD A CONFLICT EXIST, THE CONTRACTOR SHALL NOTIFY THE ENGINEER OR SURVEYOR IMMEDIATELY SO THAT THE CONFLICT CAN BE RESOLVED WITH A MINIMUM AMOUNT OF DELAY.
- THREE(3) WORKING DAYS PRIOR TO BEGINNING OF CONSTRUCTION, THE CONTRACTOR SHALL SUBMIT TO CONSTRUCTION COORDINATIONS DIVISION A DETAILED CONSTRUCTION SCHEDULE. TWO(2) WORKING DAYS PRIOR TO CONSTRUCTION, THE CONTRACTOR SHALL OBTAIN A BARRICADING PERMIT FROM THE CONSTRUCTION COORDINATION DIVISION. CONTRACTOR SHALL NOTIFY BARRICADE ENGINEER (768-2551) PRIOR TO OCCUPYING AN INTERSECTION. REFER TO STANDARD SPECIFICATIONS.
- ALL STREET STRIPING ALTERED OR DESTROYED SHALL BE REPLACED IN KIND BY CONTRACTOR TO LOCATION AND IN KIND AS EXISTING OR AS INDICATED BY THIS PLAN SET.
- CONTRACTOR SHALL NOTIFY THE ENGINEER NOT LESS THAN SEVEN(7) DAYS PRIOR TO STARTING WORK IN ORDER THAT THE ENGINEER MAY TAKE NECESSARY MEASURES TO INSURE THE PRESERVATION OF SURVEY MONUMENTS. CONTRACTOR SHALL NOT DISTURB PERMANENT SURVEY MONUMENTS WITHOUT THE CONSENT OF THE ENGINEER AND SHALL NOTIFY THE ENGINEER AND BEAR THE EXPENSE OF REPLACING ANY THAT MAY BE DISTURBED WITHOUT PERMISSION. REPLACEMENT SHALL BE DONE ONLY BY THE CITY SURVEYOR. WHEN A CHANGE IS MADE IN THE FINISHED ELEVATIONS OF THE PAVEMENT OF ANY ROADWAY IN WHICH A PERMANENT SURVEY MONUMENT IS LOCATED, CONTRACTOR SHALL, AT HIS OWN EXPENSE, ADJUST THE MONUMENT COVER TO THE NEW GRADE UNLESS OTHERWISE SPECIFIED. REFER TO SECTION 4.4 OF THE GENERAL CONDITIONS OF THE STANDARD SPECIFICATIONS.
- TWO (2) WORKING DAYS IN ADVANCE CONTRACTOR SHALL COORDINATE ANY WATER SHUT OFF WITH CITY OF ALBUQUERQUE WATER DEPT. CONTRACTOR IS NOT TO OPERATE ANY OF THE CITY VALVES.


THE FOLLOWING NOTES ALSO APPLY WHEN CHECKED

- ☒ ALL UTILITIES AND UTILITY SERVICE LINES SHALL BE INSTALLED PRIOR TO PAVING.
- ☒ BACKFILL COMPACTION SHALL BE ACCORDING TO SPECIFIED STREET USE.
- ☐ TACK COAT REQUIREMENTS SHALL BE DETERMINED BY THE CITY ENGINEER.
- ☒ SIDEWALK AND WHEELCHAIR RAMPS WITHIN THE CURB RETURNS SHALL BE CONSTRUCTED WHEREVER A NEW CURB RETURN IS CONSTRUCTED.
- ☐ IF CURB IS DEPRESSED FOR A DRIVEPAD, THE DRIVEPAD SHALL BE CONSTRUCTED PRIOR TO ACCEPTANCE OF CURB AND GUTTER.
- ☒ ALL STORM DRAINAGE FACILITIES SHALL BE COMPLETED PRIOR TO ACCEPTANCE.





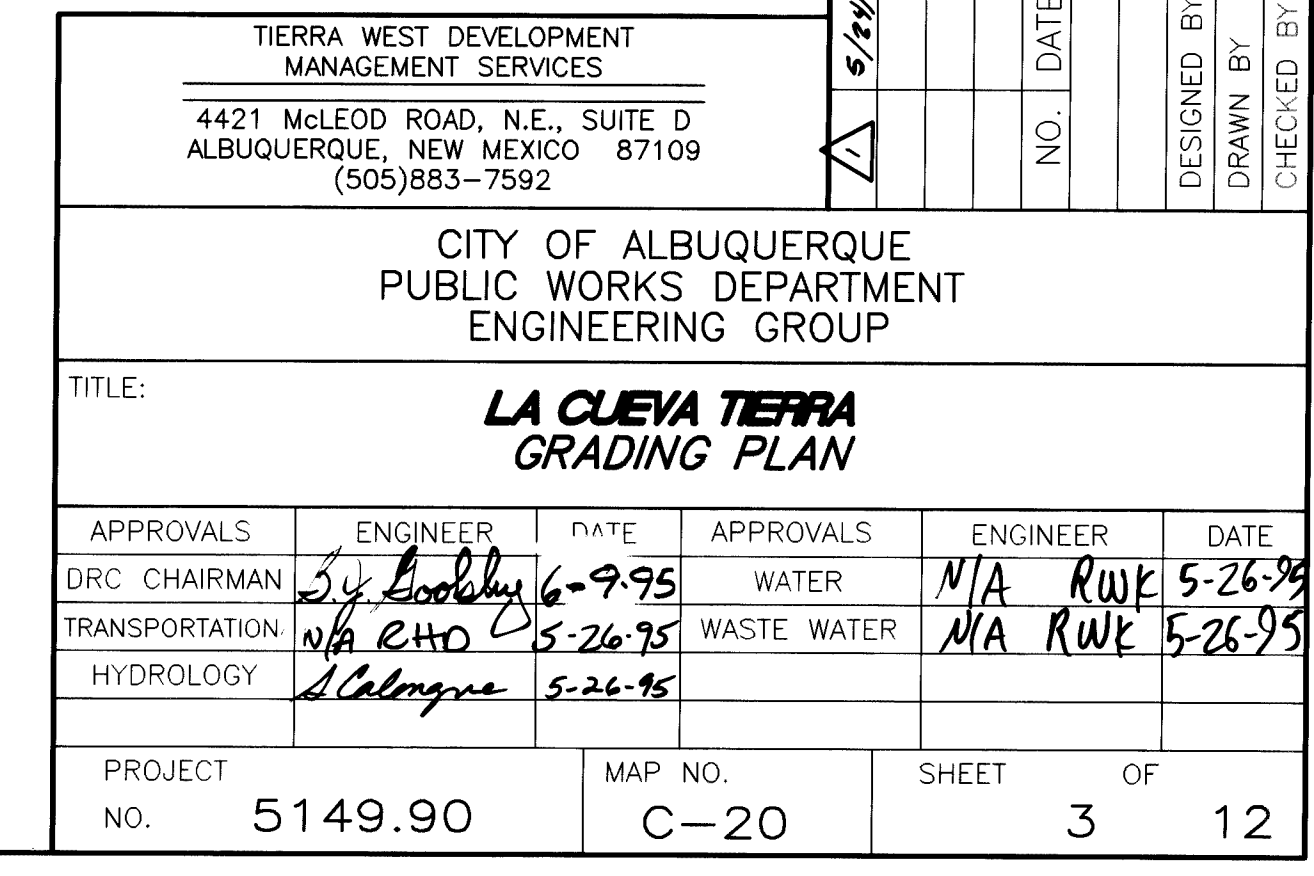


QUERQUE PARTMENT GROUP									
ERRA PLAN									
APPROVALS		ENGINEER			DATE				
WATER		NA RWK			5-26-98				
		NA RWK			5-26-98				
		SHEET			OF			12	

5/26/98 Add'd Temp Bench 1770-1800		2800		ENGINEER'S SEAL		SURVEY INFORMATION		BENCH MARKS		AS BUILT INFORMATION		
						FIELD NOTES		ASC MONUMENT "1-C21A"		CONTRACTOR <i>Franklin's Earthmoving</i>		
						NO.	DATE	CENTRAL STATION DATA	WORK	STARTED BY	DATE	DATE
								NM STATE PLANE COORDINATES	(CENTRAL ZONE) NAD 1927	ACCEPTANCE BY	DATE	DATE
NO.		DATE		REMARKS				X=415,503.35		FIELD DRAWINGS		
				DESIGN				Y=1,518,787.29		CORRECTED BY		
DESIGNED BY		DATE		3-95				EL= 5634.65		MICRO-FILM INFORMATION		
DRAWN BY		DATE		1-95						RECORDED BY		
CHECKED BY		DATE		5-95						NO.		
								GROUND TO GRID FACTOR=0.99963867				
								DELTA ALPHA=-00°09'46"				

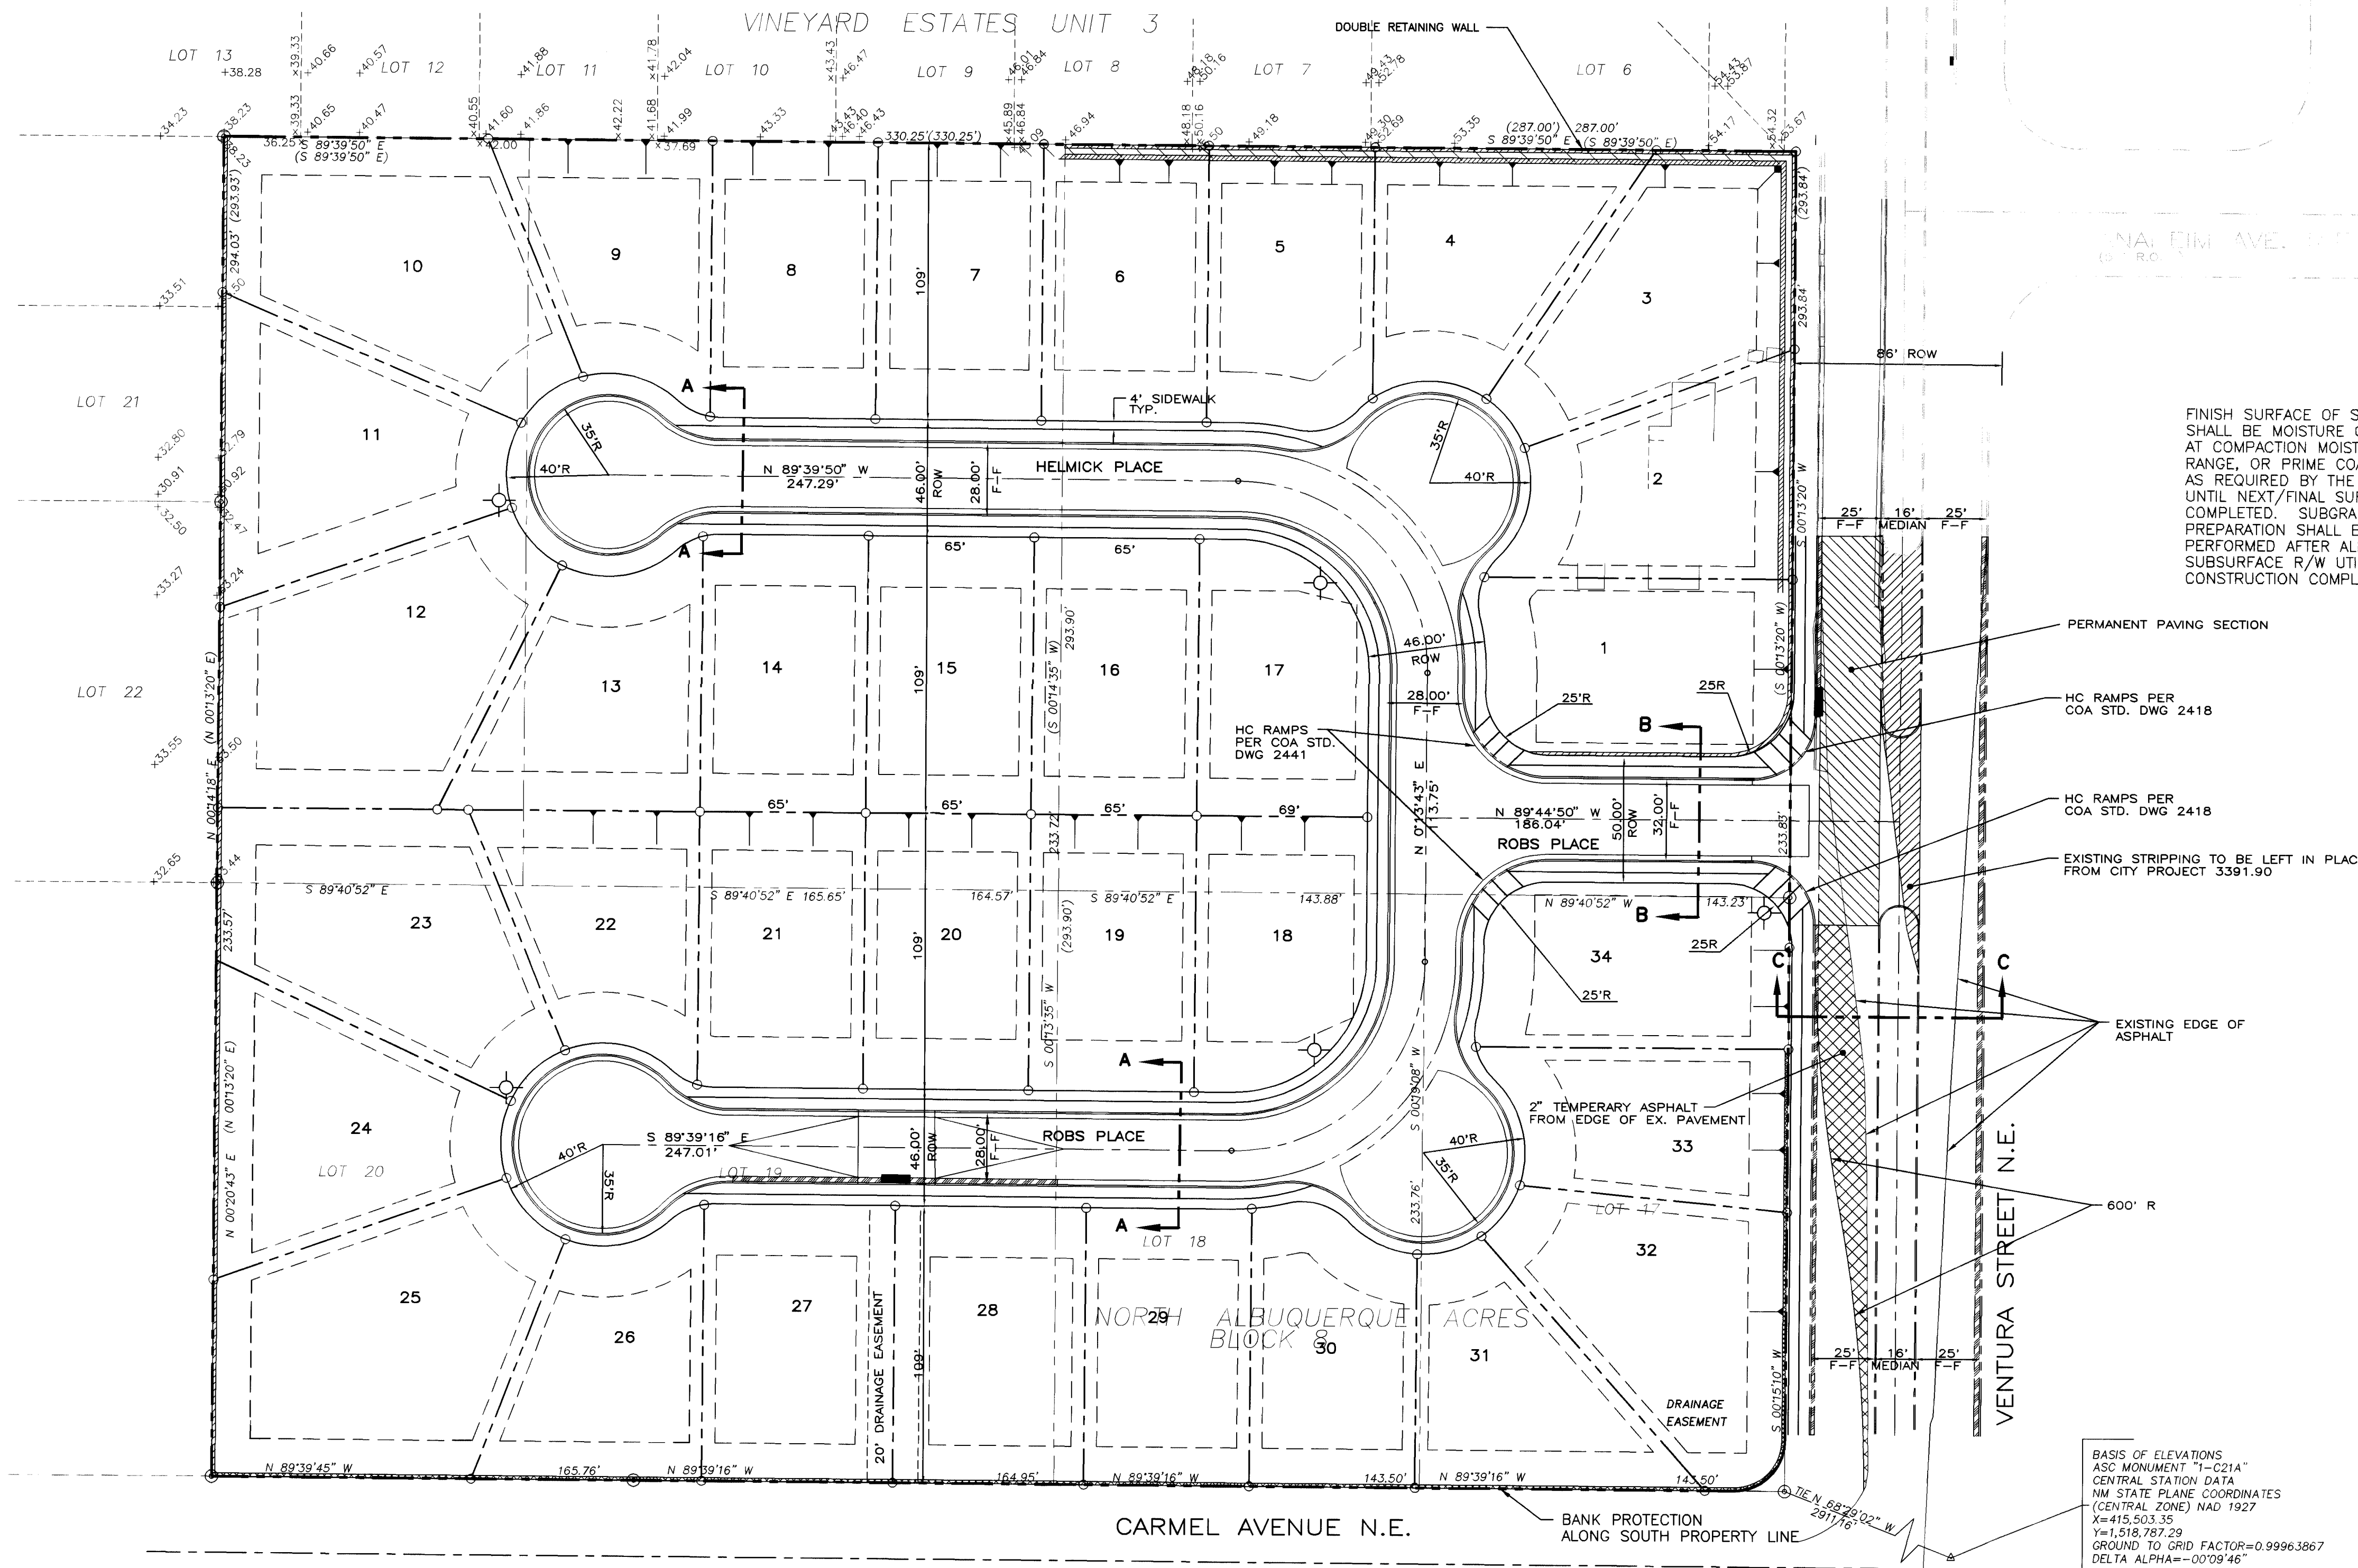


LEGEND	
CENTER LINE	---
PROPERTY LINE	---
SET BACK LINE	---
BOUNDARY LINE	---
EASEMENT LINE	---
FUTURE CURB & GUTTER	---
NEW MOUNTABLE CURB & GUTTER	---
STD. CURB & CUTTER	---
EXISTING STD. CURB & CUTTER	---
RETAINING WALL	---
FLOOD WALL	---
PROPOSED STREET LIGHTS	---

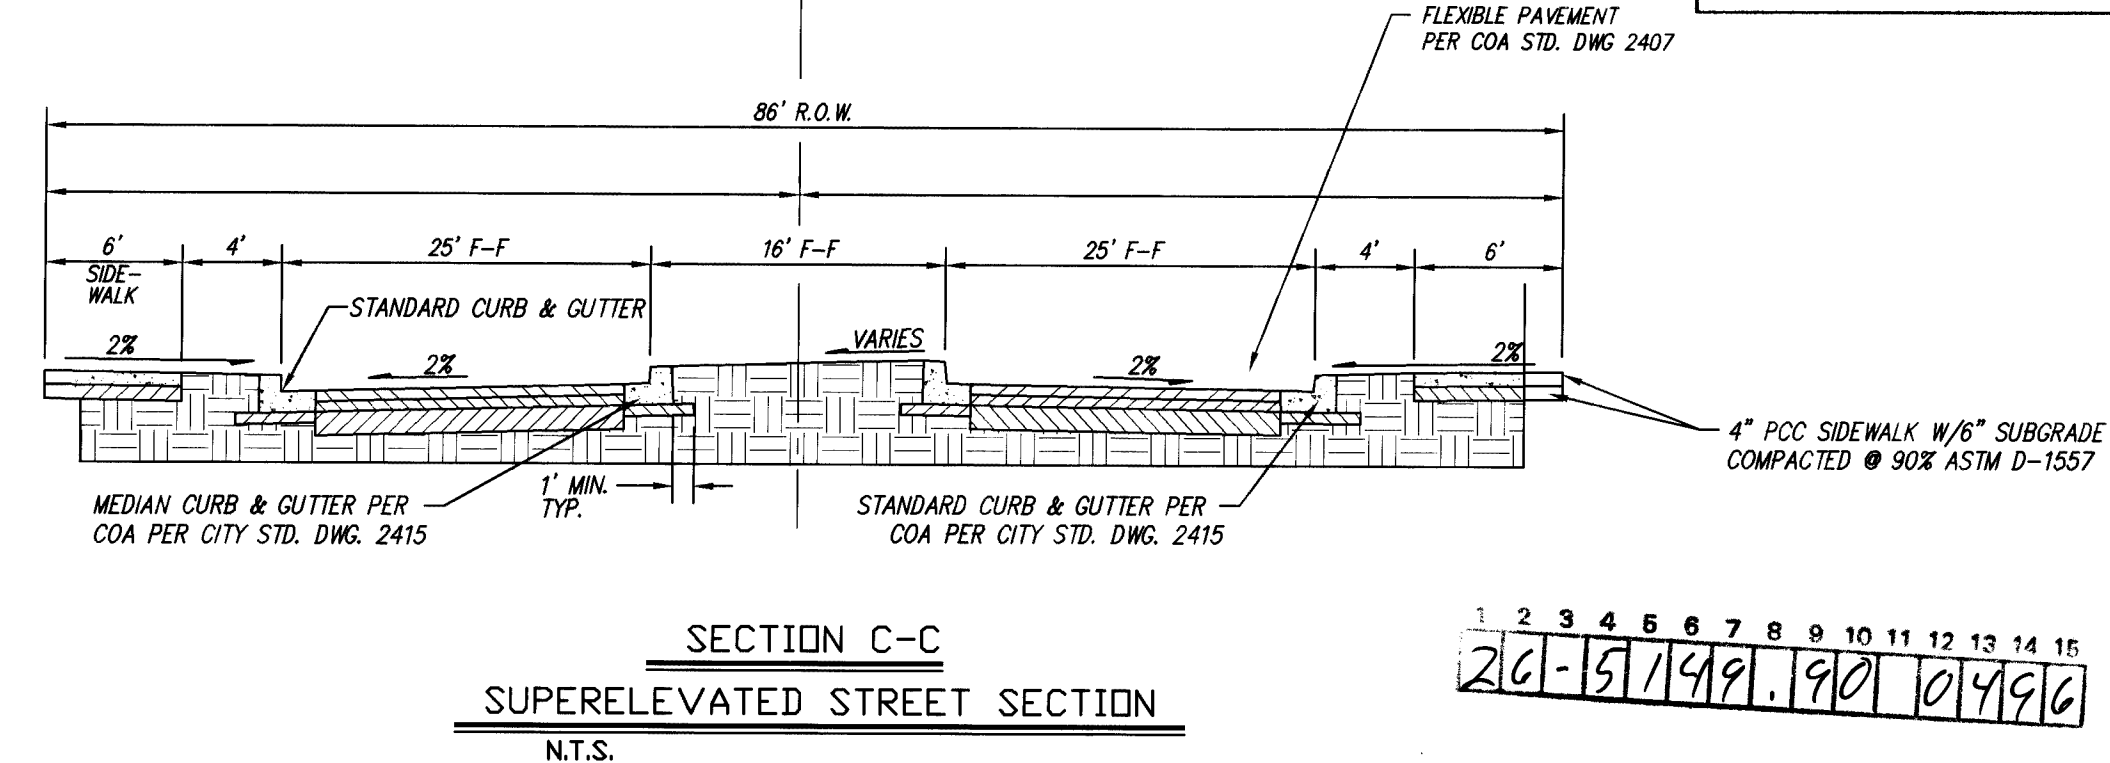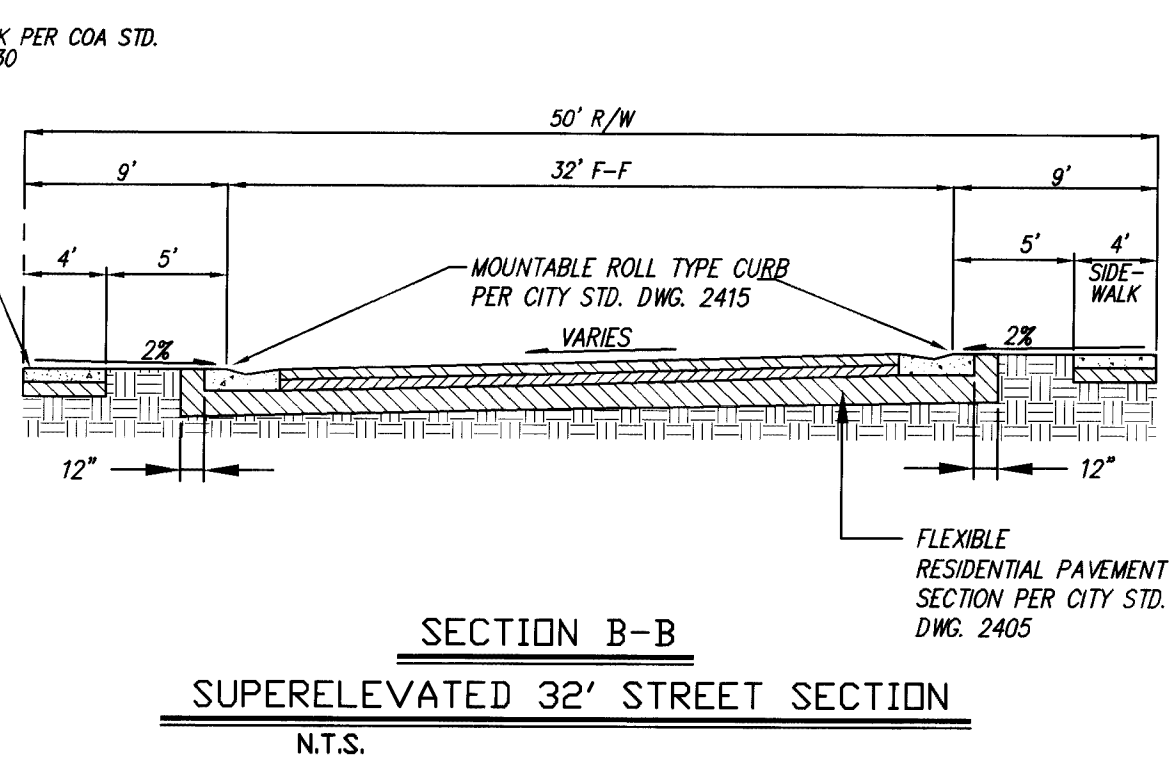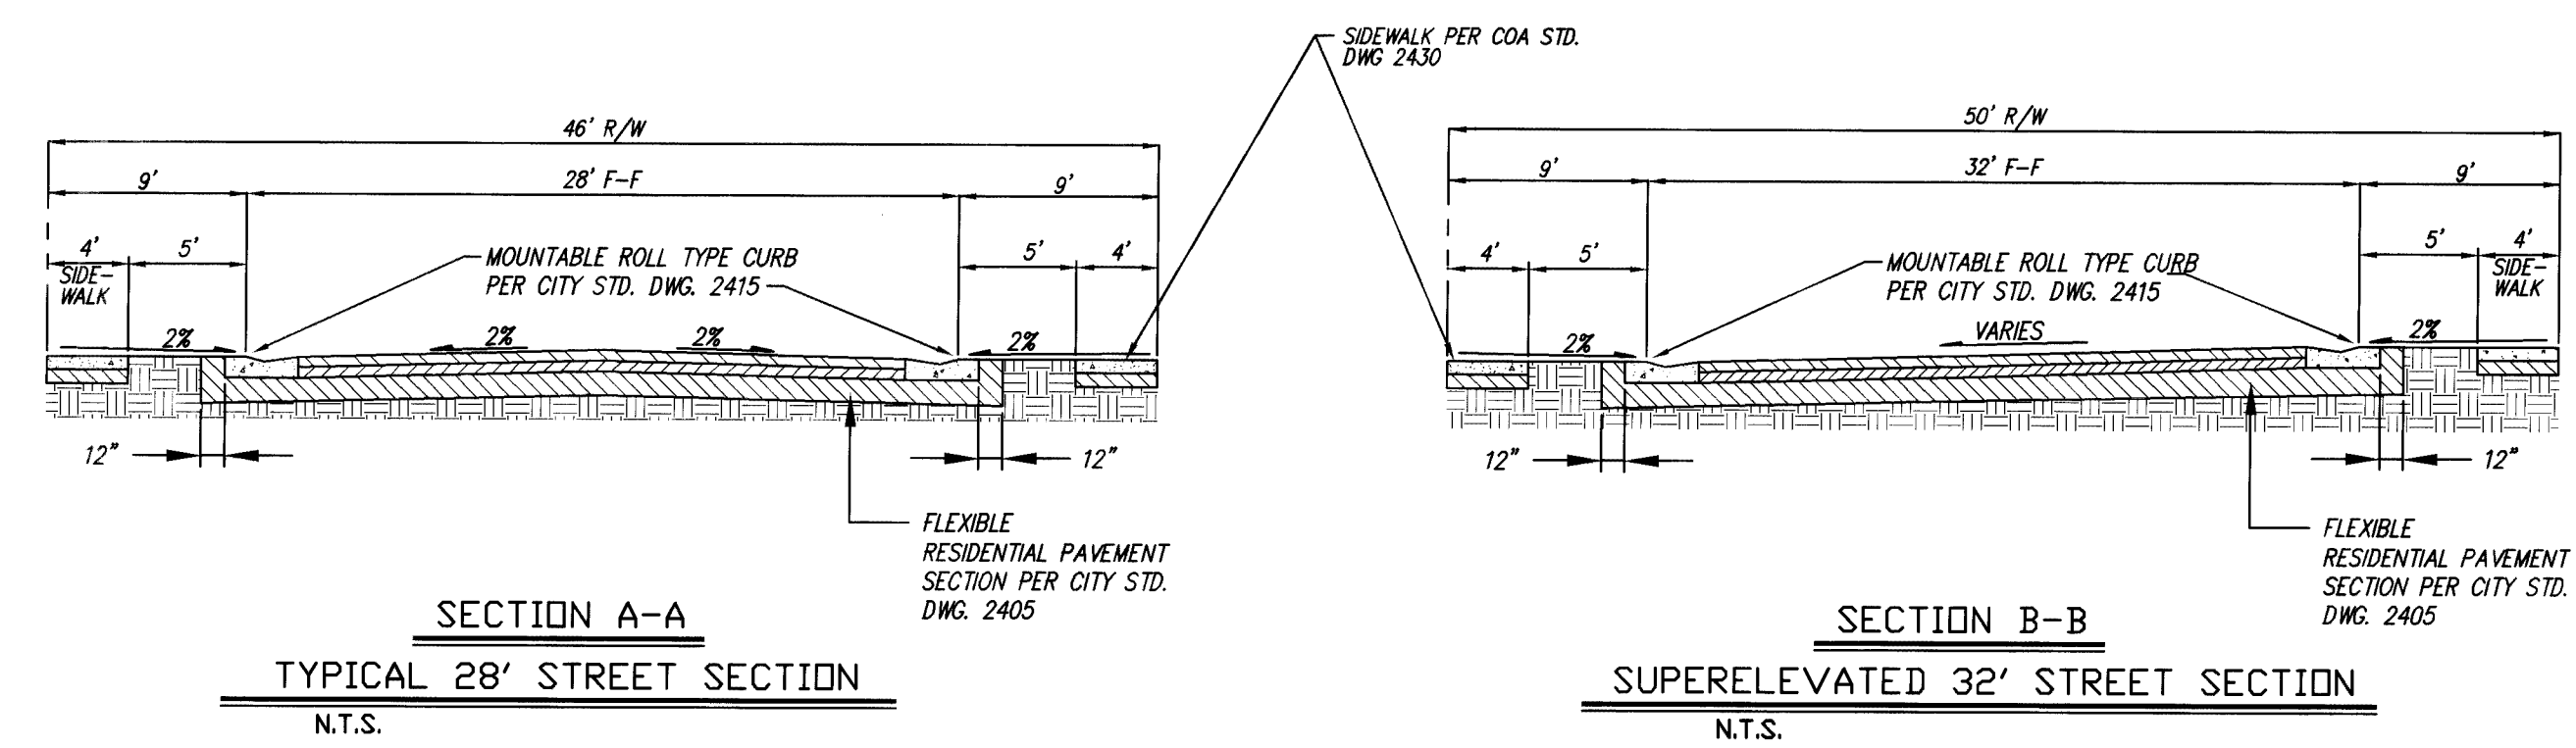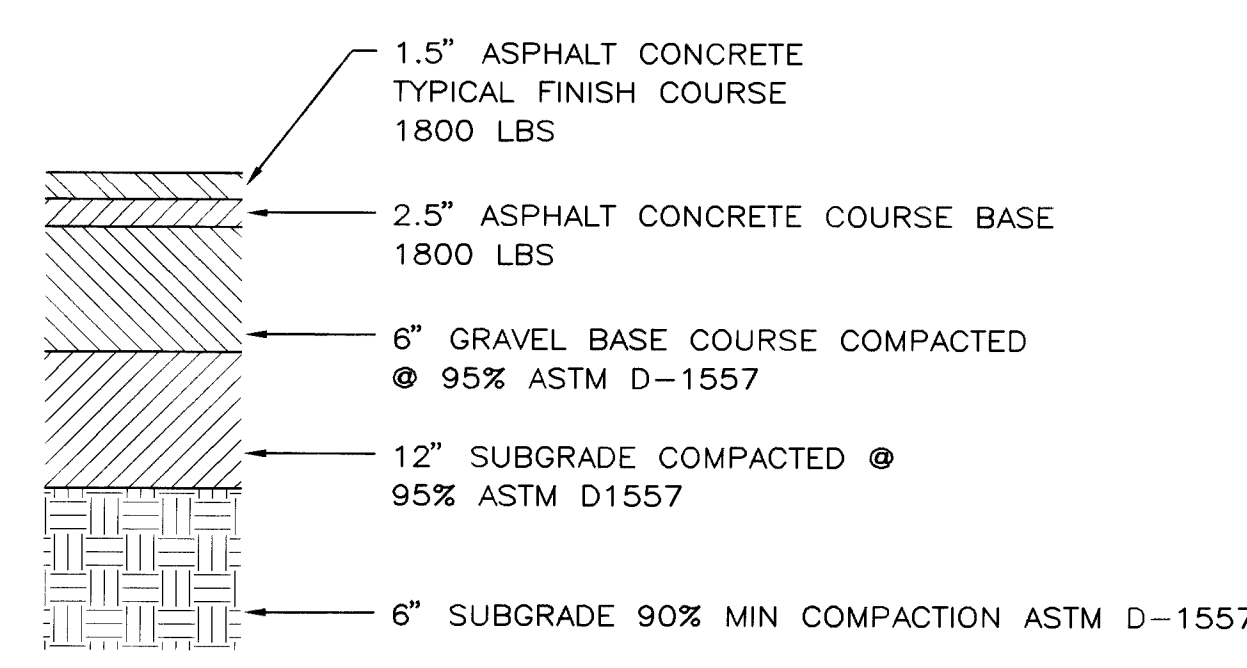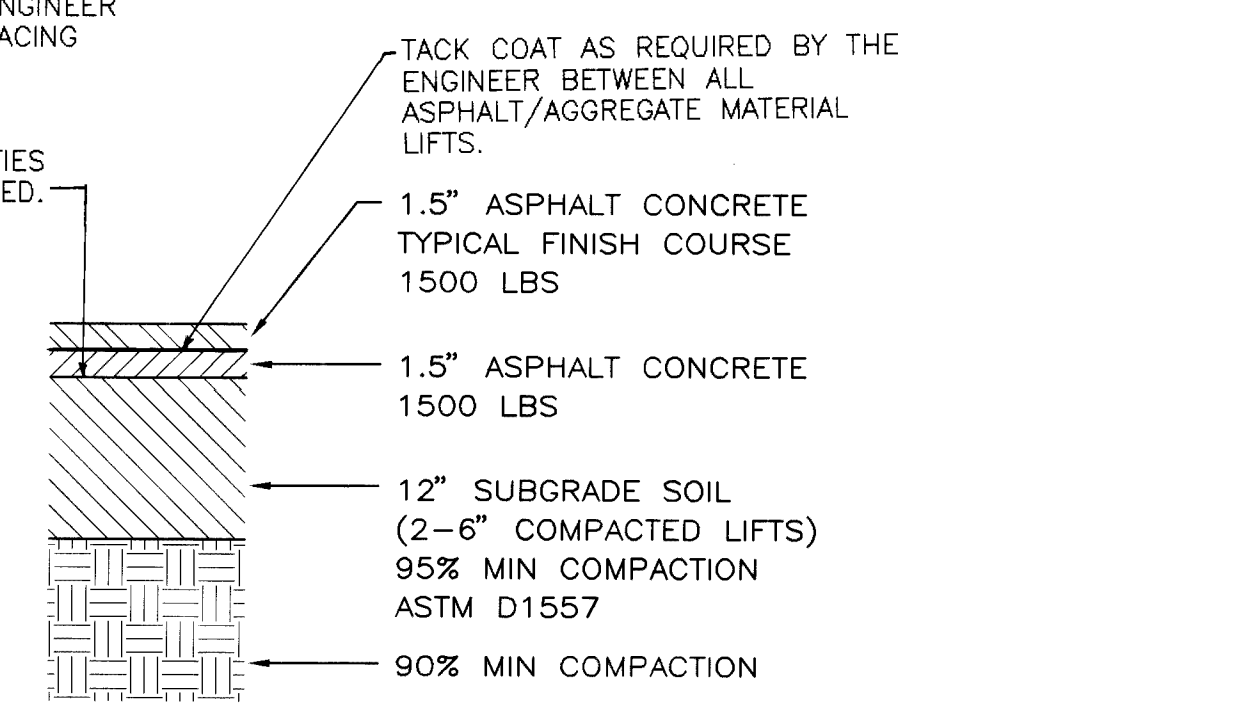

RECORD DRAWING

DATE: 2/19/96 DRAFTED BY: Terra West Dev.

THESE RECORD DRAWINGS HAVE BEEN PREPARED, IN PART, ON THE BASIS OF INFORMATION COMPILED AND FURNISHED BY OTHERS. THE ENGINEER WILL NOT BE RESPONSIBLE FOR ANY ERRORS OR OMISSIONS WHICH HAVE BEEN INCORPORATED INTO THIS DOCUMENT AS A RESULT.

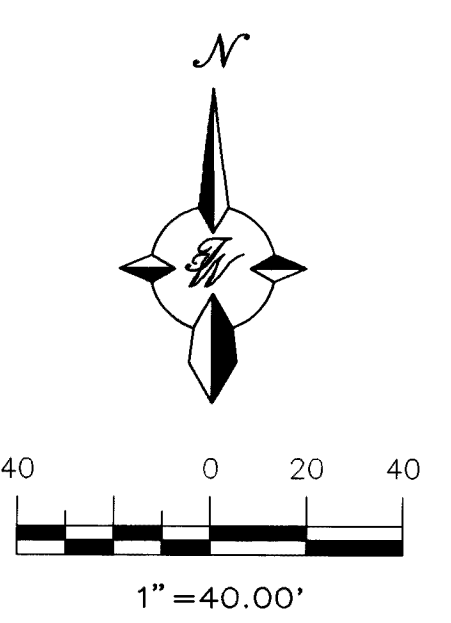

TERRA WEST DEVELOPMENT
MANAGEMENT SERVICES
4421 MCLEOD ROAD, N.E., SUITE D
ALBUQUERQUE, NEW MEXICO 87109
(505)883-7592

CITY OF ALBUQUERQUE
PUBLIC WORKS DEPARTMENT
ENGINEERING GROUP

TITLE:
LA CUEVA TERRA
MASTER PAVING IMPROVEMENTS
HELMICK PLACE & ROBS PLACE

APPROVALS	ENGINEER	DATE	APPROVALS	ENGINEER	DATE
DRC CHAIRMAN	<i>[Signature]</i>	6-9-95	WATER	N/A	5-26-95
TRANSPORTATION	<i>[Signature]</i>	5-26-95	WASTE WATER	N/A	5-26-95
HYDROLOGY	N/A	5-26-95			

PROJECT NO. 5149.90 MAP NO. C-20 SHEET 4 OF 12

AS BUILT INFORMATION		BENCH MARKS		SURVEY INFORMATION		ENGINEER'S SEAL	
CONTRACTOR	Terra West Development	ASC MONUMENT	"1-C21A"	FIELD NOTES	DATE		
WORKED BY	Terra West Development	CENTRAL STATION DATA		NO.	BY		
INSPECTED BY	Terra West Development	NM STATE PLANE COORDINATES					
ACCEPTANCE BY	Terra West Development	(CENTRAL ZONE) NAD 1927					
VERIFICATION BY	Terra West Development	X= 415,503.35				DESIGNED BY	SHAH
DRAWINGS		Y= 1,518,787.29				DRAWN BY	BYRON
CHECKED BY		EL= 5634.65				CHECKED BY	SHAH
MICRO-FILM INFORMATION		GROUND TO GRID FACTOR= 0.99963867					
		DELTA ALPHA= -00'09"46"					

CL ROAD CURVE DATA

CURVE #	RADIUS	DELTA	LENGTH	TANGENT
CL1	75.00	89-53-36	117.67	74.86
CL2	75.00	90-06-53	117.96	75.15

CURVE DATA (DESCRIBES FACE OF CURB)

CURVE #	RADIUS	DELTA	LENGTH	TANGENT	CURVE #	RADIUS	DELTA	LENGTH	TANGENT
C1	35.00	268-19-28	163.91	-----	C6	61.00	89-53-19	95.70	60.88
C2	34.00	45-55-15	27.25	49.54	C7	89.00	11-00-31	17.10	-----
C3	89.00	10-53-33	16.92	-----	C8	34.00	59-29-11	35.30	332.57
C4	34.00	59-19-05	35.20	180.58	C9	35.00	187-04-44	114.28	-----
C5	35.00	184-43-18	112.84	-----	C10	61.00	90-06-51	95.94	61.12

CL ROAD LINE DATA


LINE #	BEARING	DISTANCE
L1	N 89-54-08 W	247.29
L2	N 00-00-35 W	57.03
L3	S 89-53-34 E	247.01
L4	N 00-00-35 W	56.72

RECORD DRAWING


DATE: 2/19/96
DRAFTED BY: Tierra West Dev.
THESE RECORD DRAWINGS HAVE BEEN PREPARED, IN PART, ON THE BASIS OF INFORMATION COMPILED AND FURNISHED BY OTHERS. THE ENGINEER WILL NOT BE RESPONSIBLE FOR ANY ERRORS OR OMISSIONS WHICH HAVE BEEN INCORPORATED INTO THIS DOCUMENT AS A RESULT.

CURB RETURN QUARTER POINTS



C6	FL	ELEV
1	38.50	
2	38.35	
3	38.19	

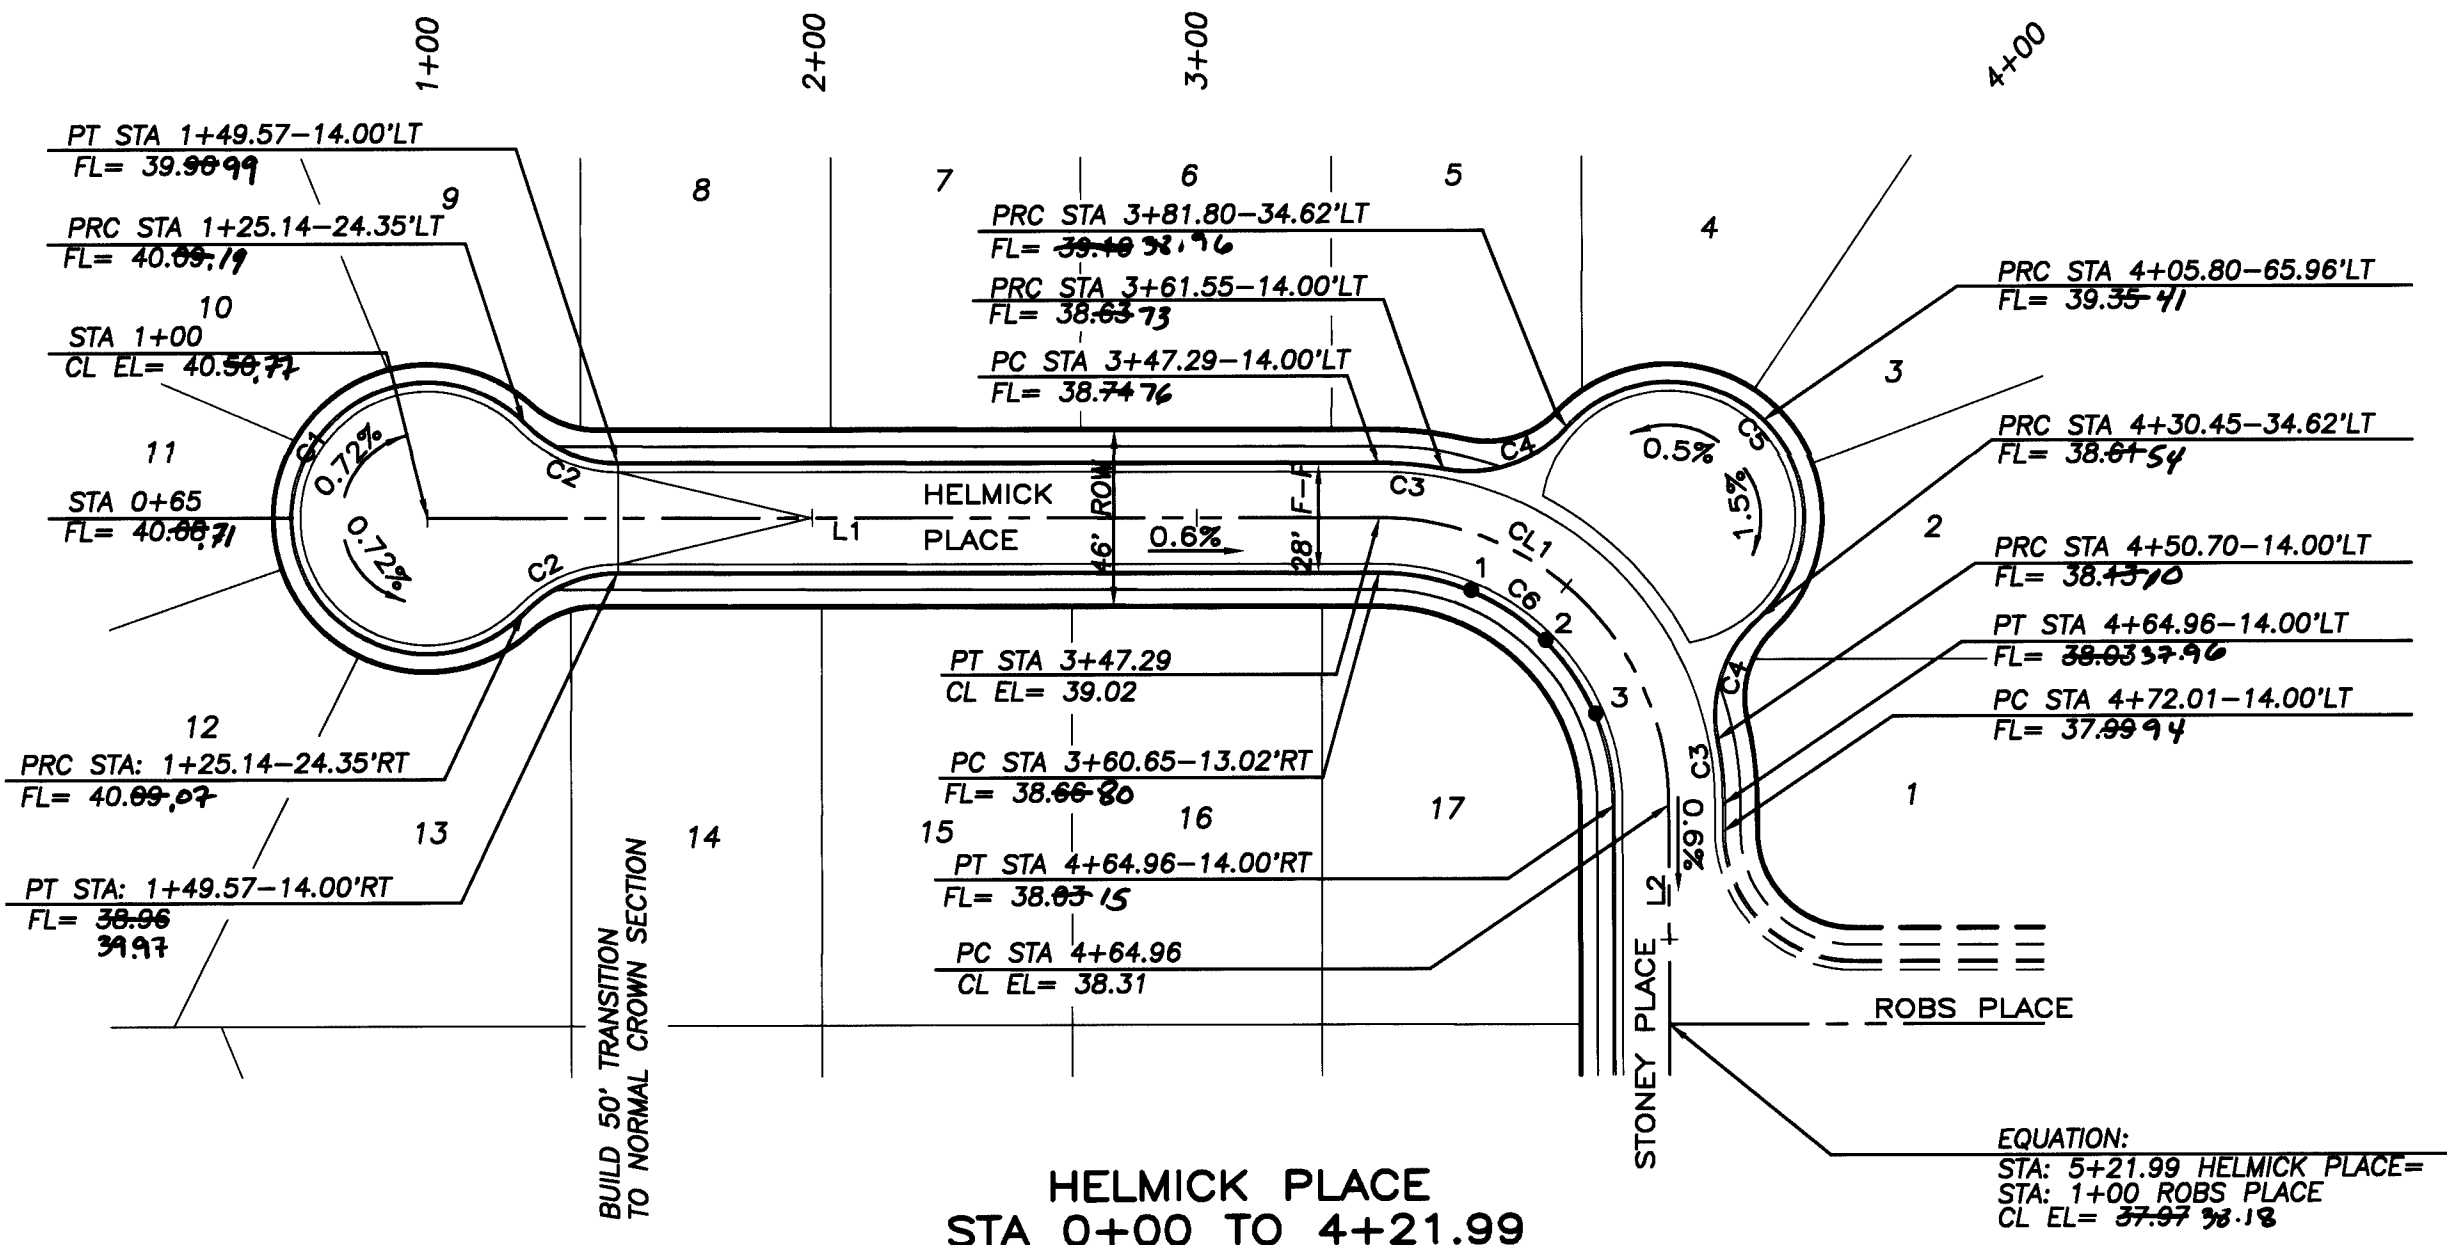

SCALE: HORIZ. 1"=50'
VERT. 1"= 5'

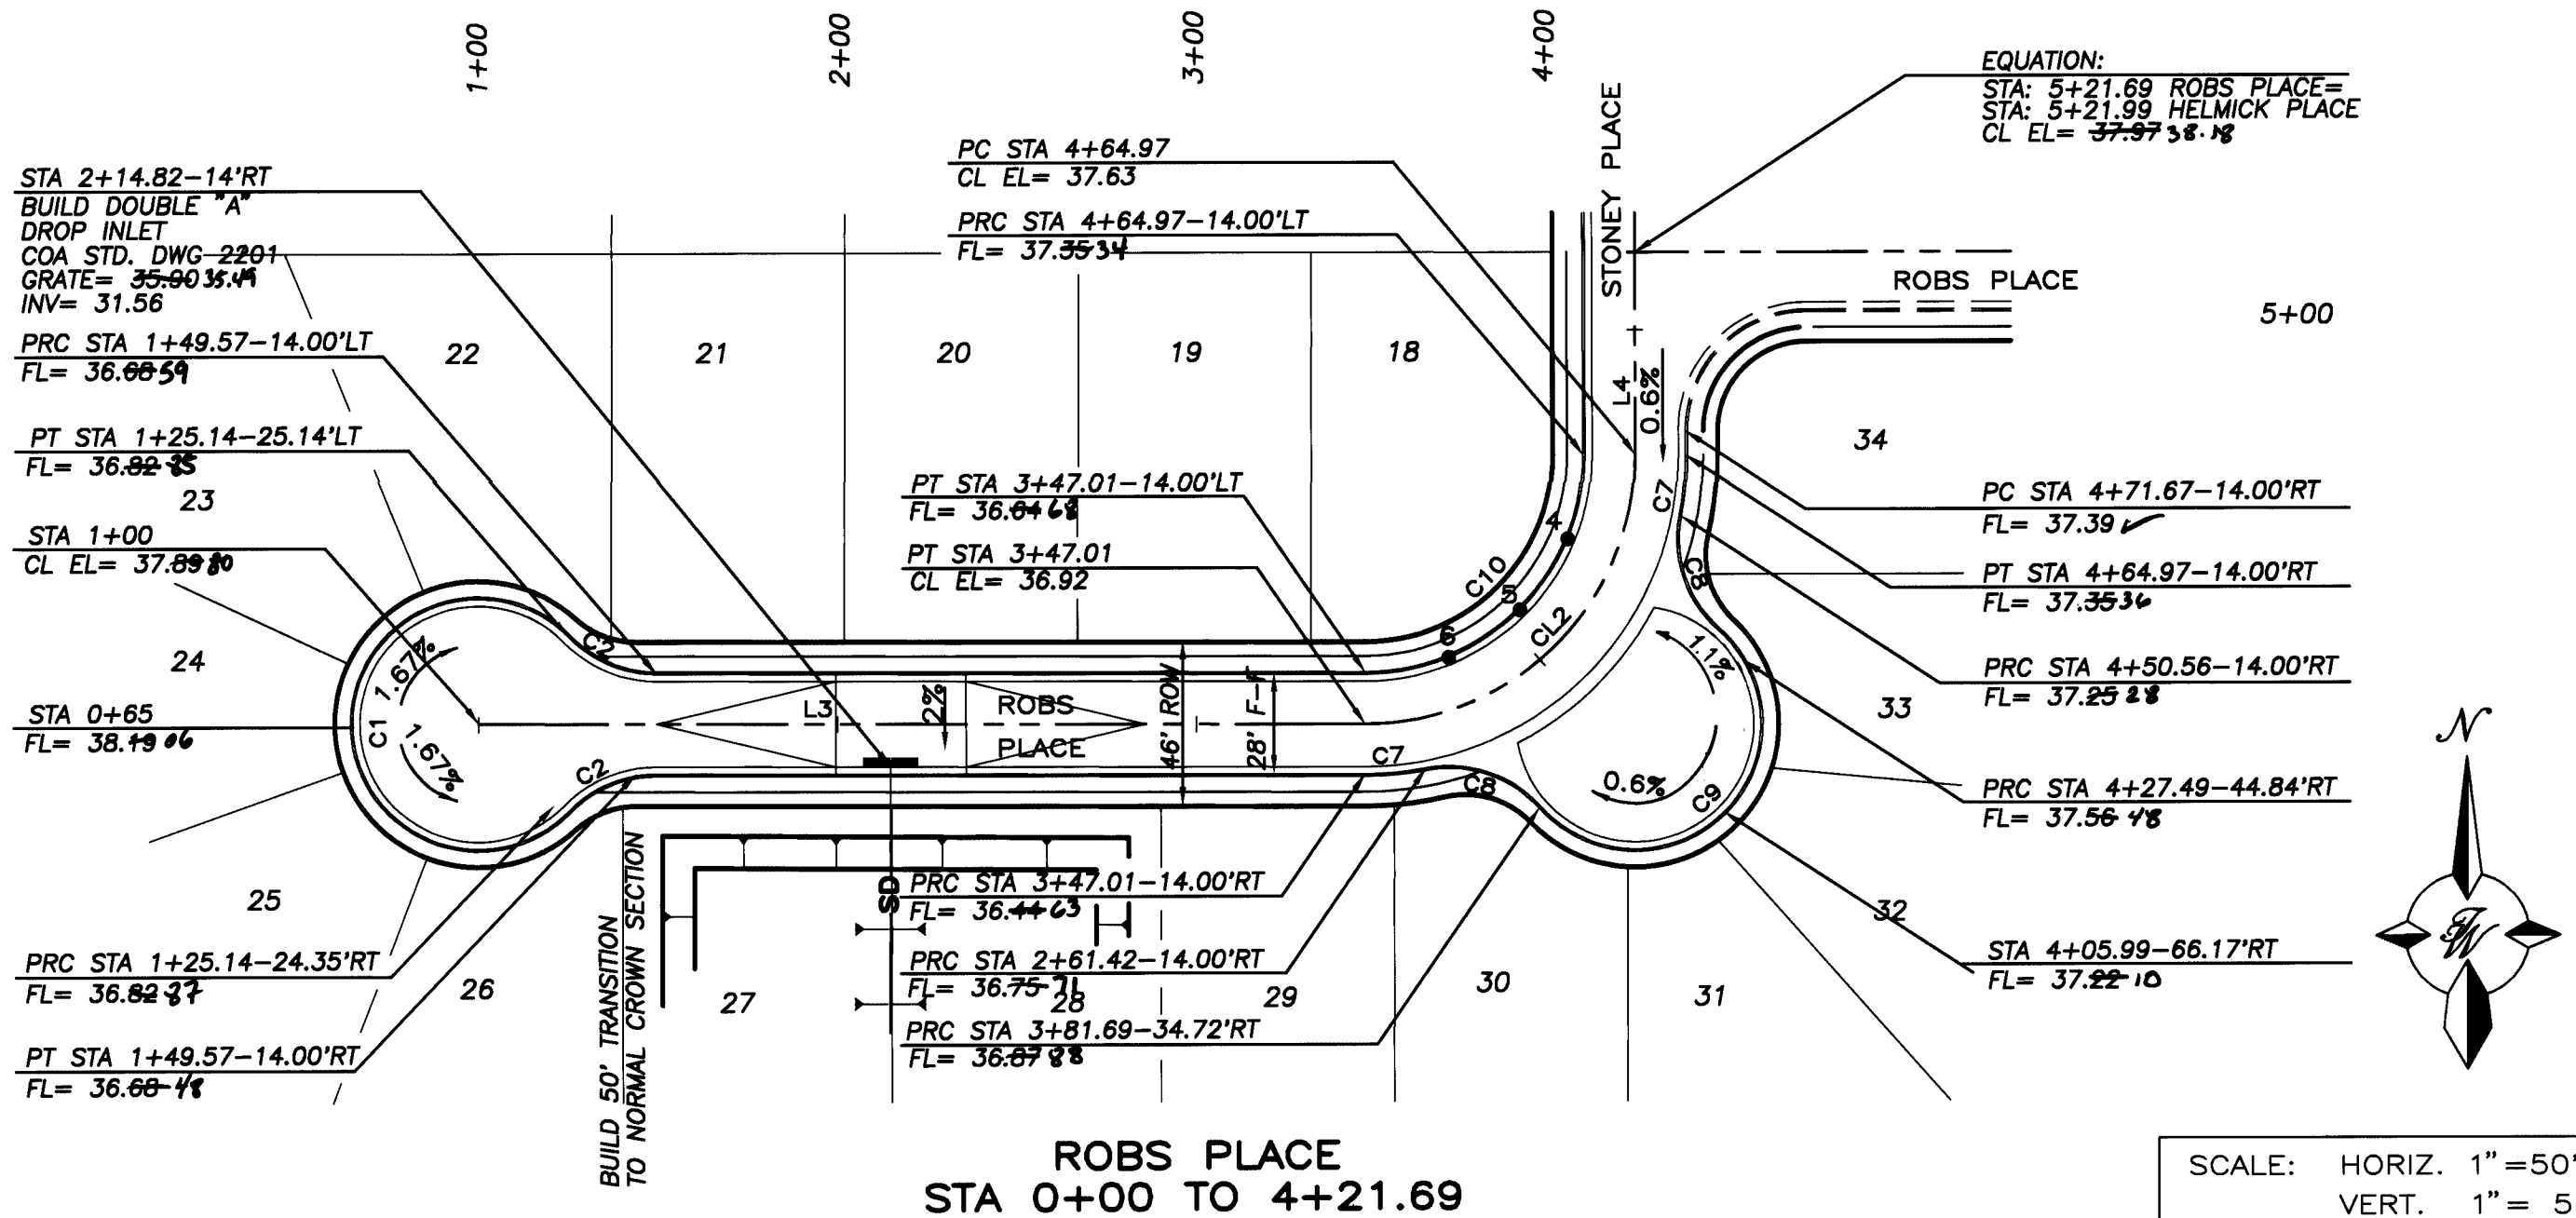

SCALE: HORIZ. 1"=50'
VERT. 1"= 5'

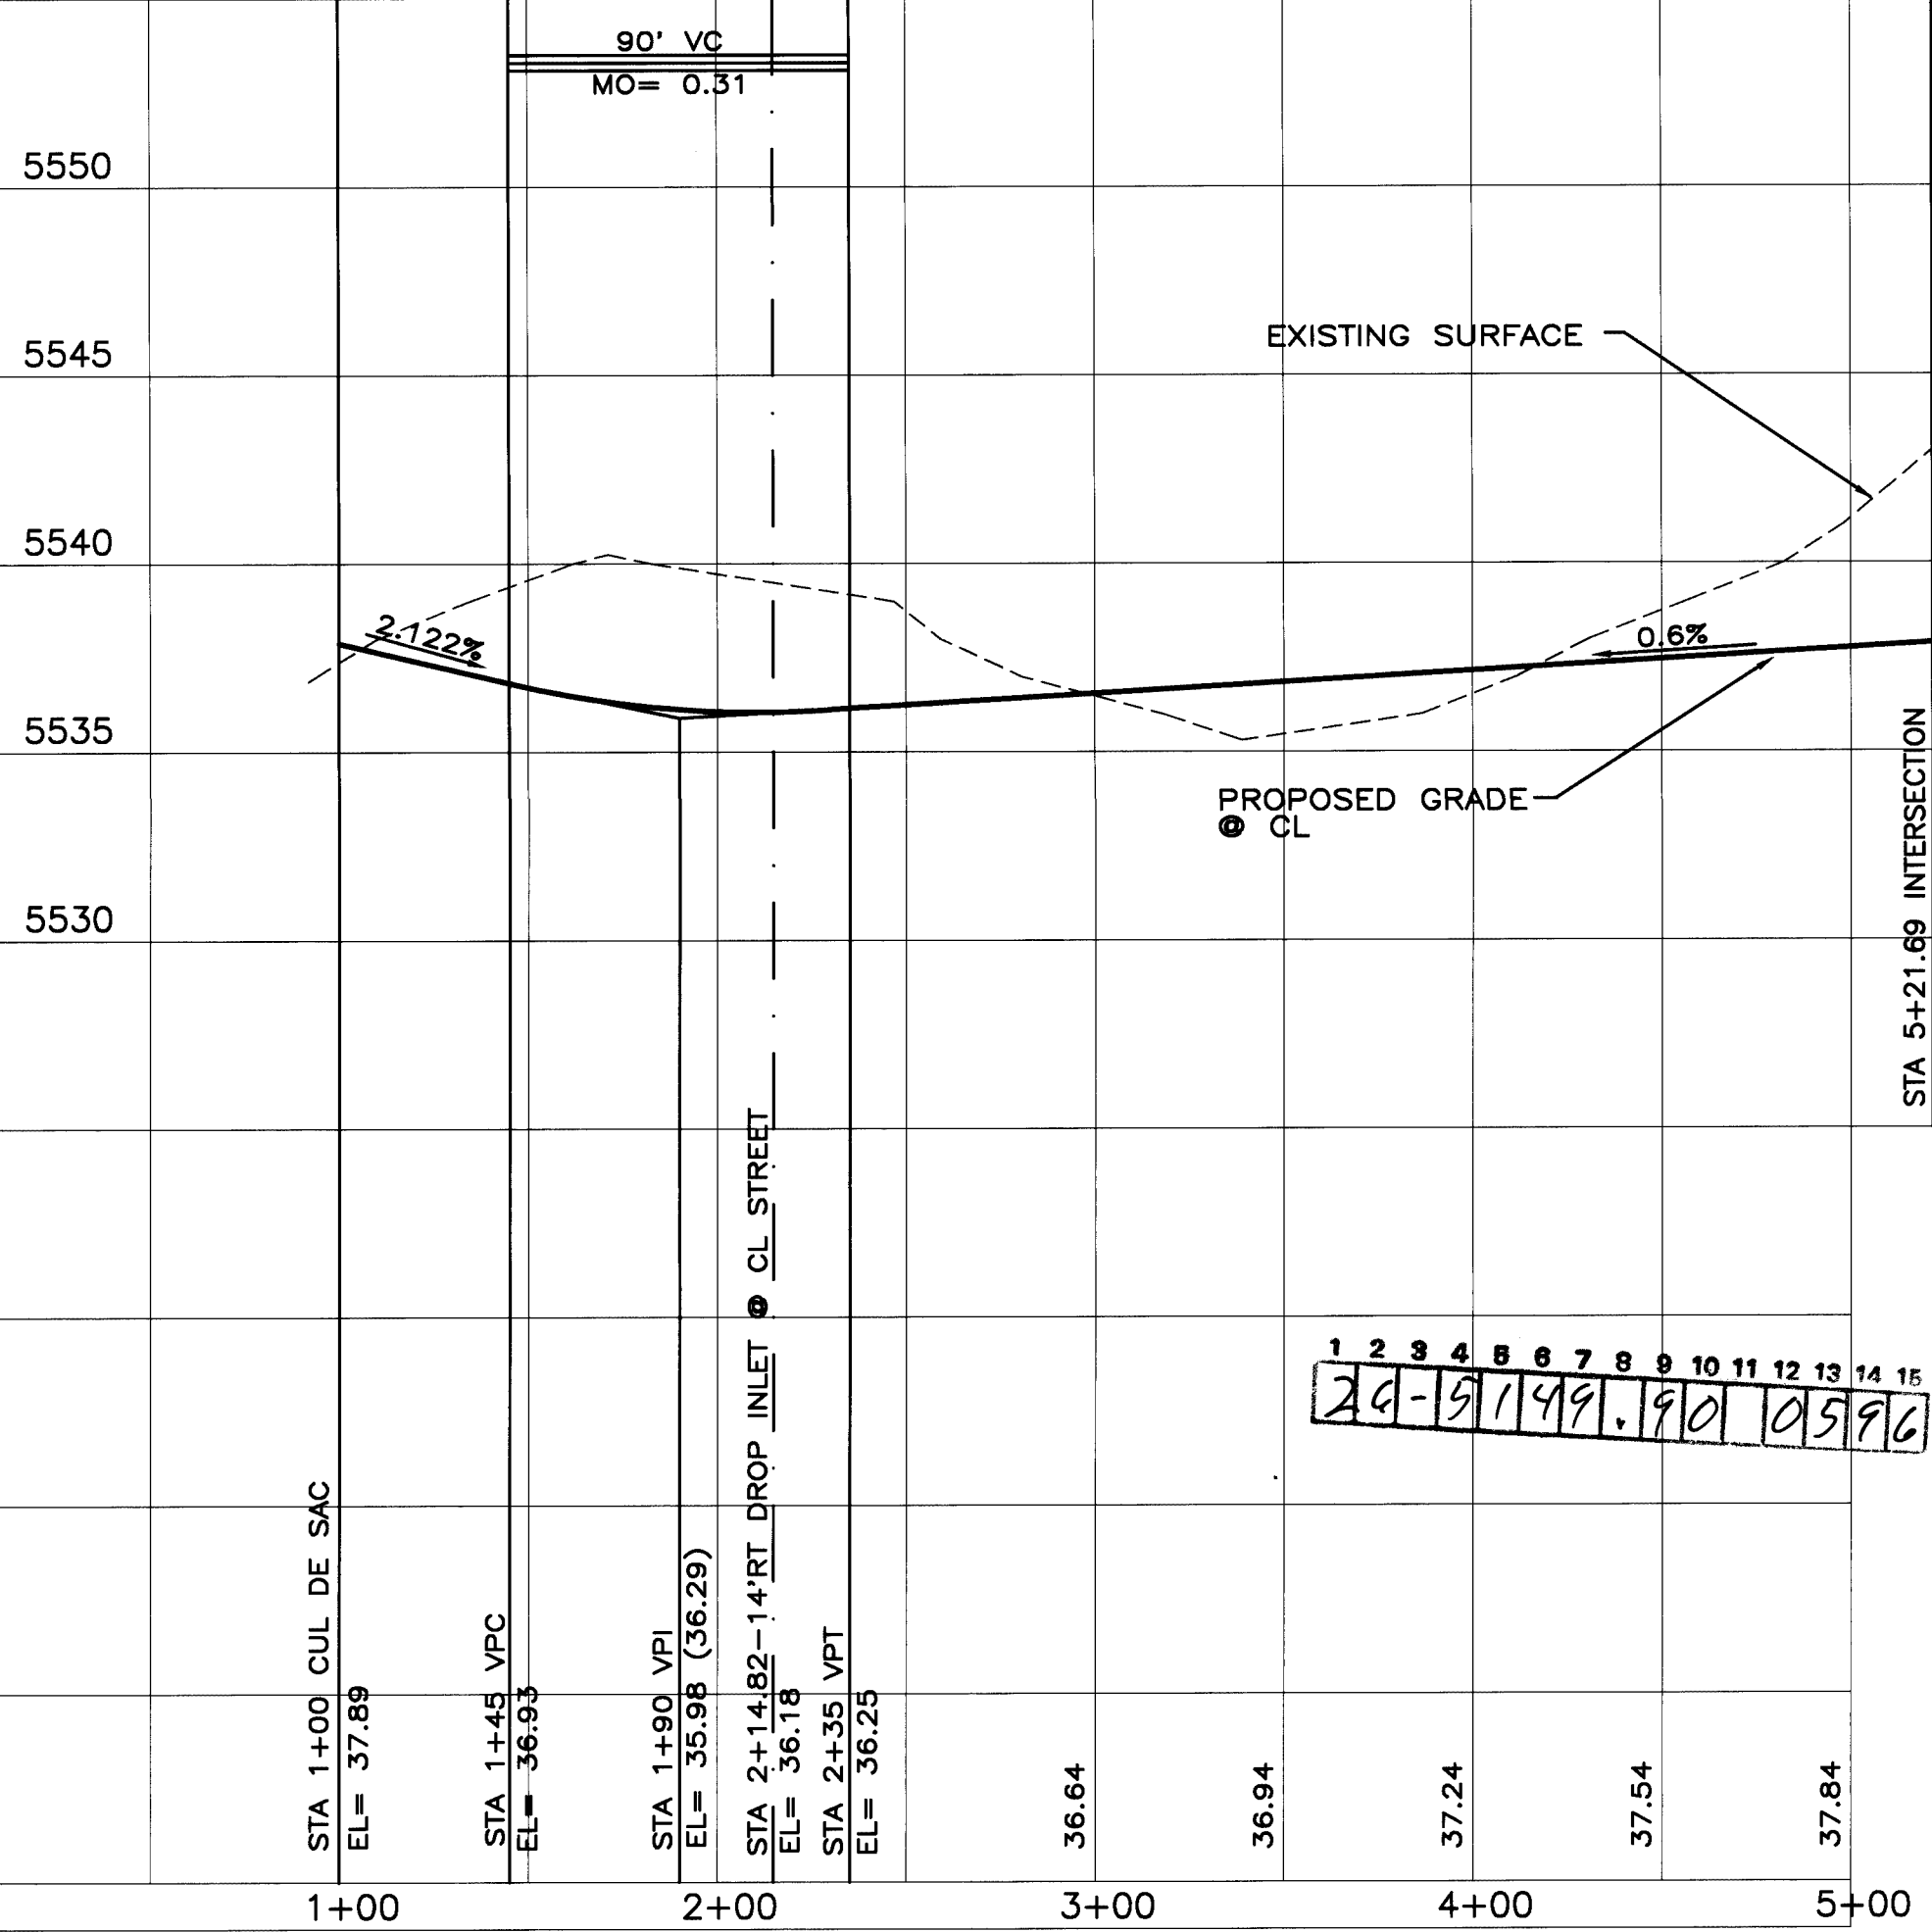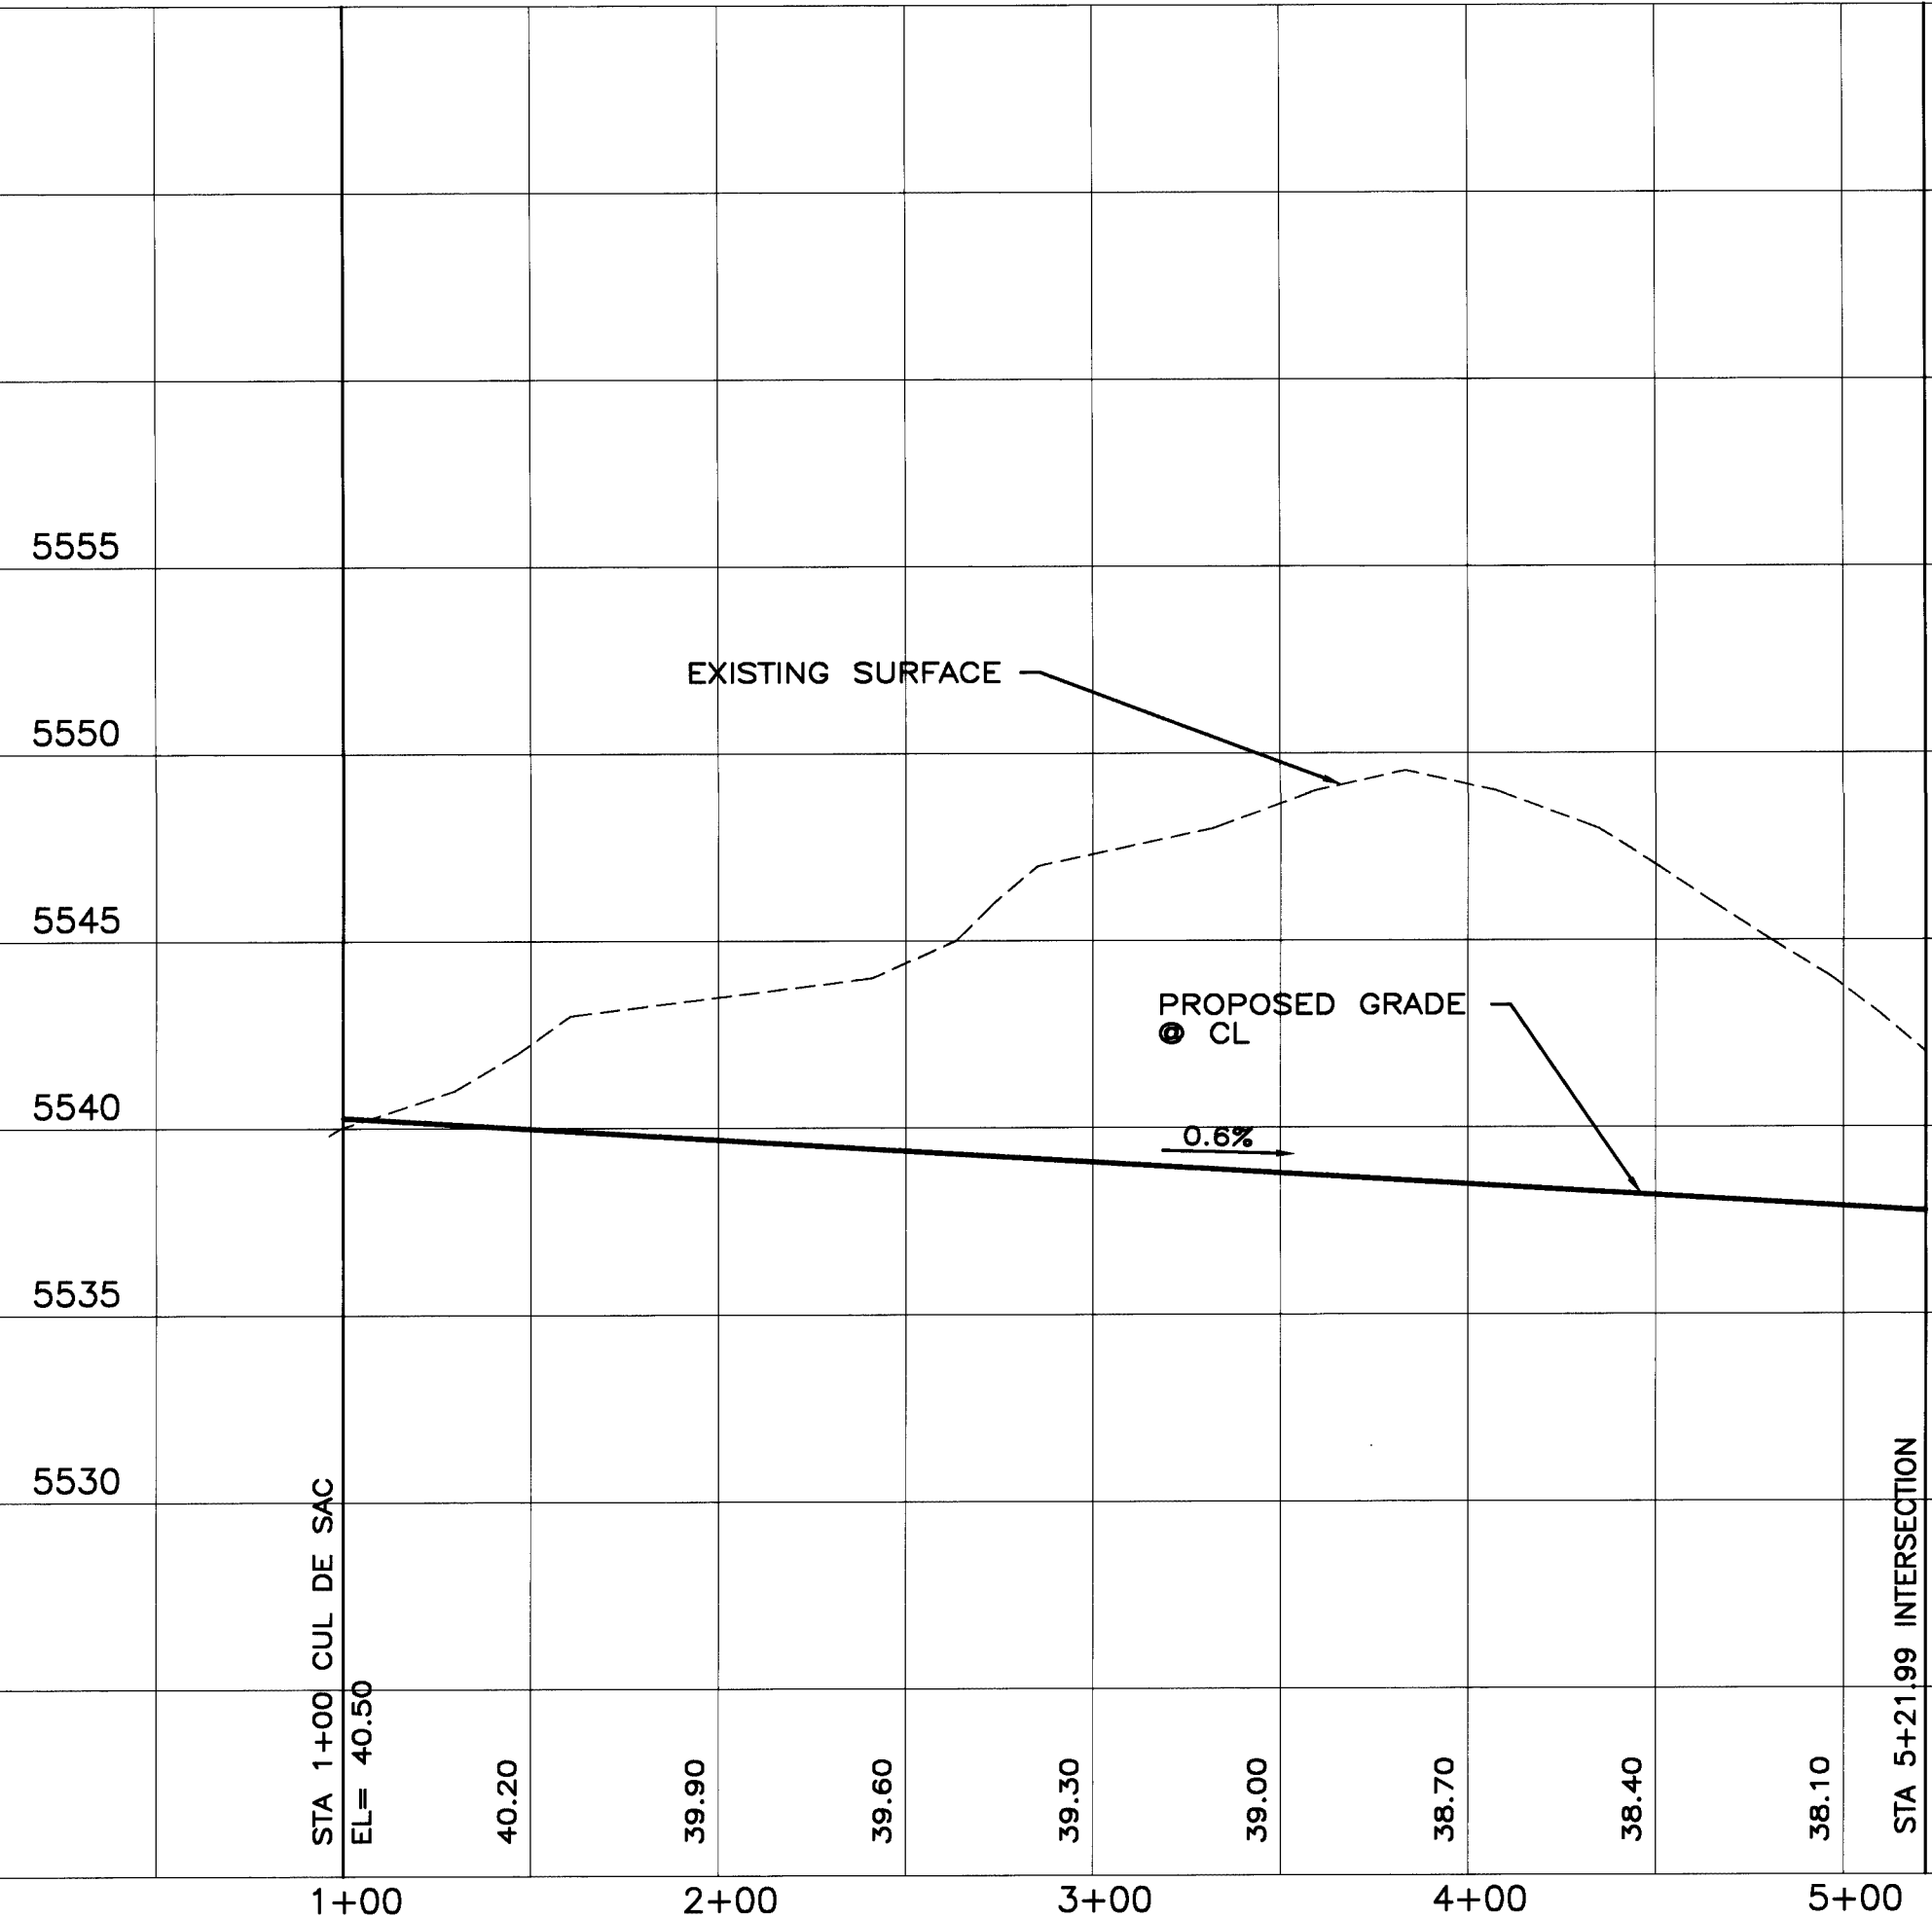


TIERRA WEST DEVELOPMENT
MANAGEMENT SERVICES
4421 McLEOD ROAD, N.E., SUITE D
ALBUQUERQUE, NEW MEXICO 87109
(505)883-7592

CITY OF ALBUQUERQUE
PUBLIC WORKS DEPARTMENT
ENGINEERING GROUP

APPROVALS	ENGINEER	DATE	APPROVALS	ENGINEER	DATE
DRC CHAIRMAN	SP. [Signature]	6-9-95	WATER	N/A	RWK 5-26-95
TRANSPORTATION	RE [Signature]	5-26-95	WASTE WATER	N/A	RWK 5-26-95
HYDROLOGY	N/A SMC	5-26-95			

PROJECT NO. 5149.90
MAP NO. C-20
SHEET 5 OF 12

SCANNED BY
BY LASON

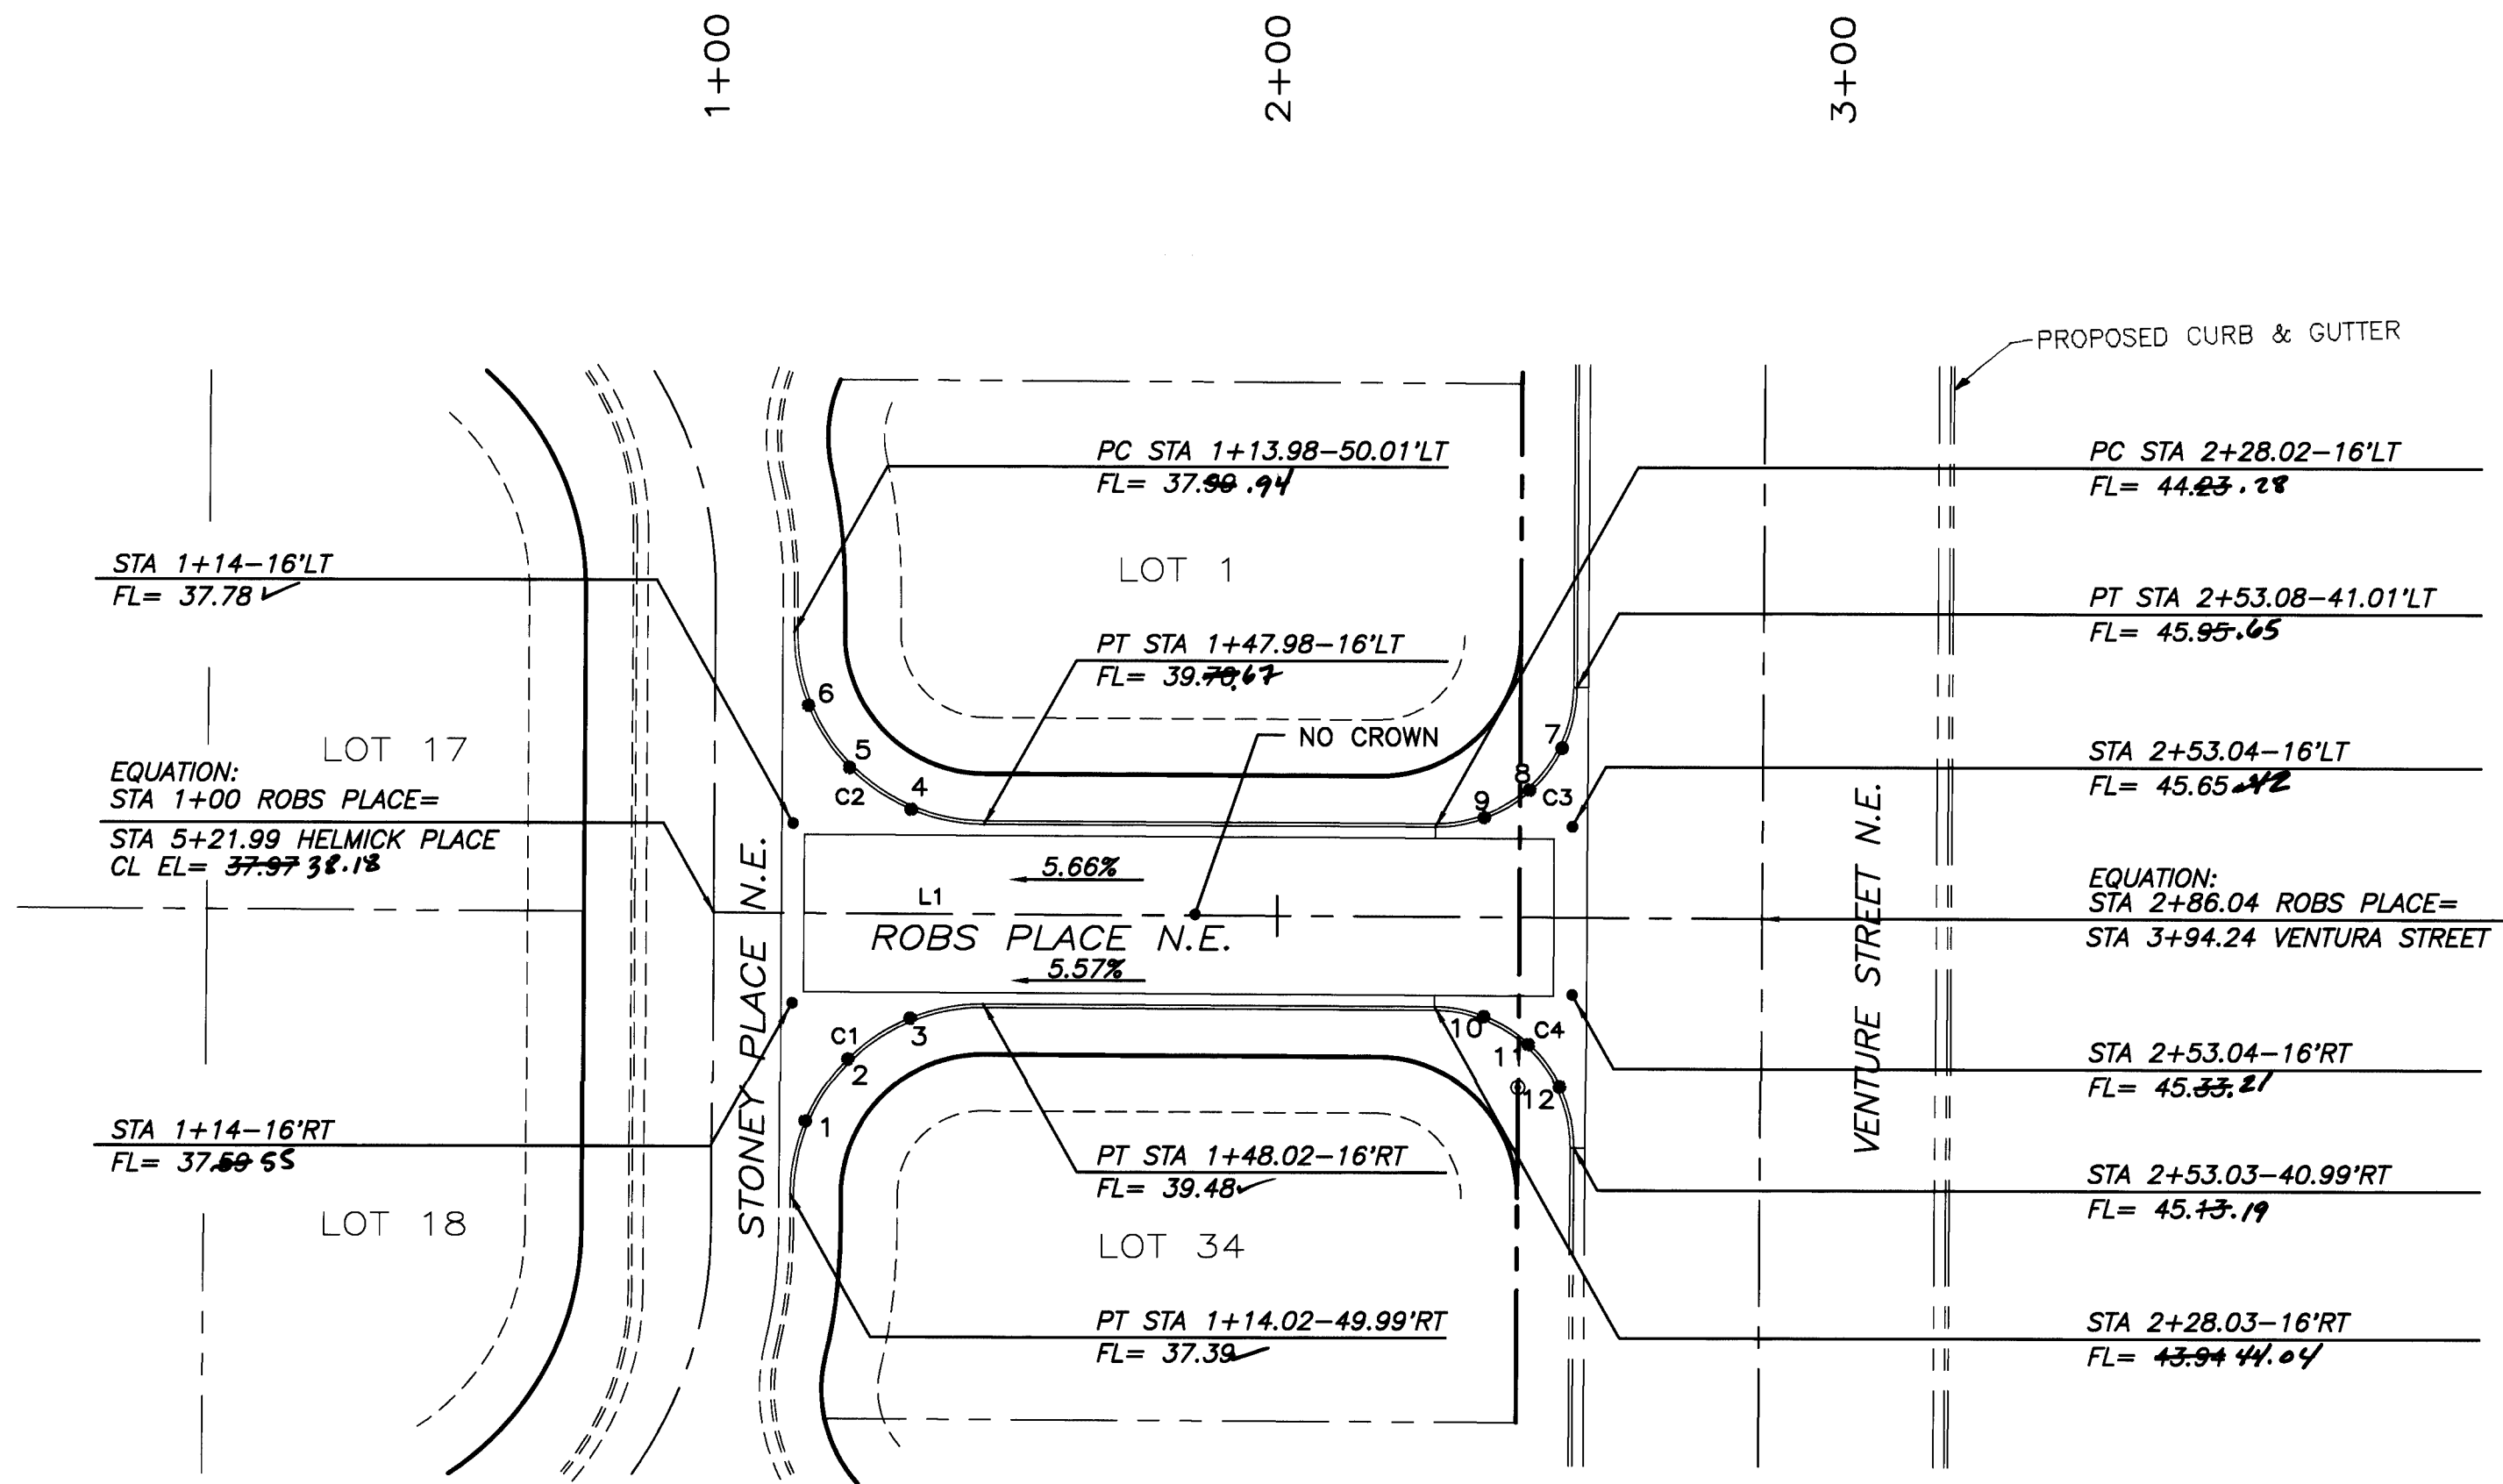

CURVE DATA (DESCRIBES FACE OF CURB)

CURVE #	RADIUS	DELTA	LENGTH	TANGENT
C1	34.00	89-58-16	53.39	33.98
C2	34.00	90-01-18	53.42	34.01
C3	25.00	90-01-23	39.28	41.56
C4	25.00	89-58-38	39.26	39.48

CL ROAD LINE DATA


LINE #	BEARING	DISTANCE
L1	N 00-01-50 E	186.04

CURB RETURN QUARTER POINTS

C1	FL	ELEV	C2	FL	ELEV	C3	FL	ELEV	C4	FL	ELEV
1	37.49		4	38.74		7	45.80		10	44.64	
2	38.02		5	38.32		8	45.75		11	45.43	
3	38.54		6	37.89		9	44.94		12	45.23	

ROBS PLACE
STA 1+00 TO 2+86.04

SCALE: HORIZ. 1"=30'
VERT. 1"= 5'

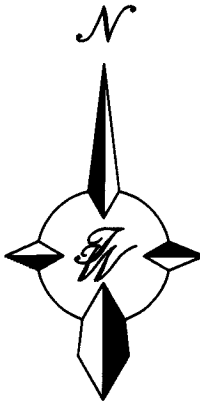

EXISTING SURFACE

22-9199-190 0696

RECORD DRAWING

DATE: 2/19/96
DRAFTED BY: Tierra West Dev
THESE RECORD DRAWINGS HAVE BEEN PREPARED, IN PART, ON THE BASIS OF INFORMATION COMPILED AND FURNISHED BY OTHERS. THE ENGINEER WILL NOT BE RESPONSIBLE FOR ANY ERRORS OR OMISSIONS WHICH HAVE BEEN INCORPORATED INTO THIS DOCUMENT AS A RESULT.


TIERRA WEST DEVELOPMENT
MANAGEMENT SERVICES
4421 MCLEOD ROAD, N.E., SUITE D
ALBUQUERQUE, NEW MEXICO 87109
(505)883-7592

CITY OF ALBUQUERQUE
PUBLIC WORKS DEPARTMENT
ENGINEERING GROUP

TITLES:					
LA CUEVA TIERRA PAVING IMPROVEMENTS ROBS PLACE					
APPROVALS	ENGINEER	DATE	APPROVALS	ENGINEER	DATE
DRC CHAIRMAN	88 Goodley	6-9-95	WATER	N/A RWF	5-26-95
TRANSPORTATION	88 Danks	5-26-95	WASTE WATER	N/A RWF	5-26-95
HYDROLOGY	N/A SMC	5-26-95			

PROJECT NO.	MAP NO.	SHEET OF
5149.90	C-20	6 12

SCANNED BY
BY LASON

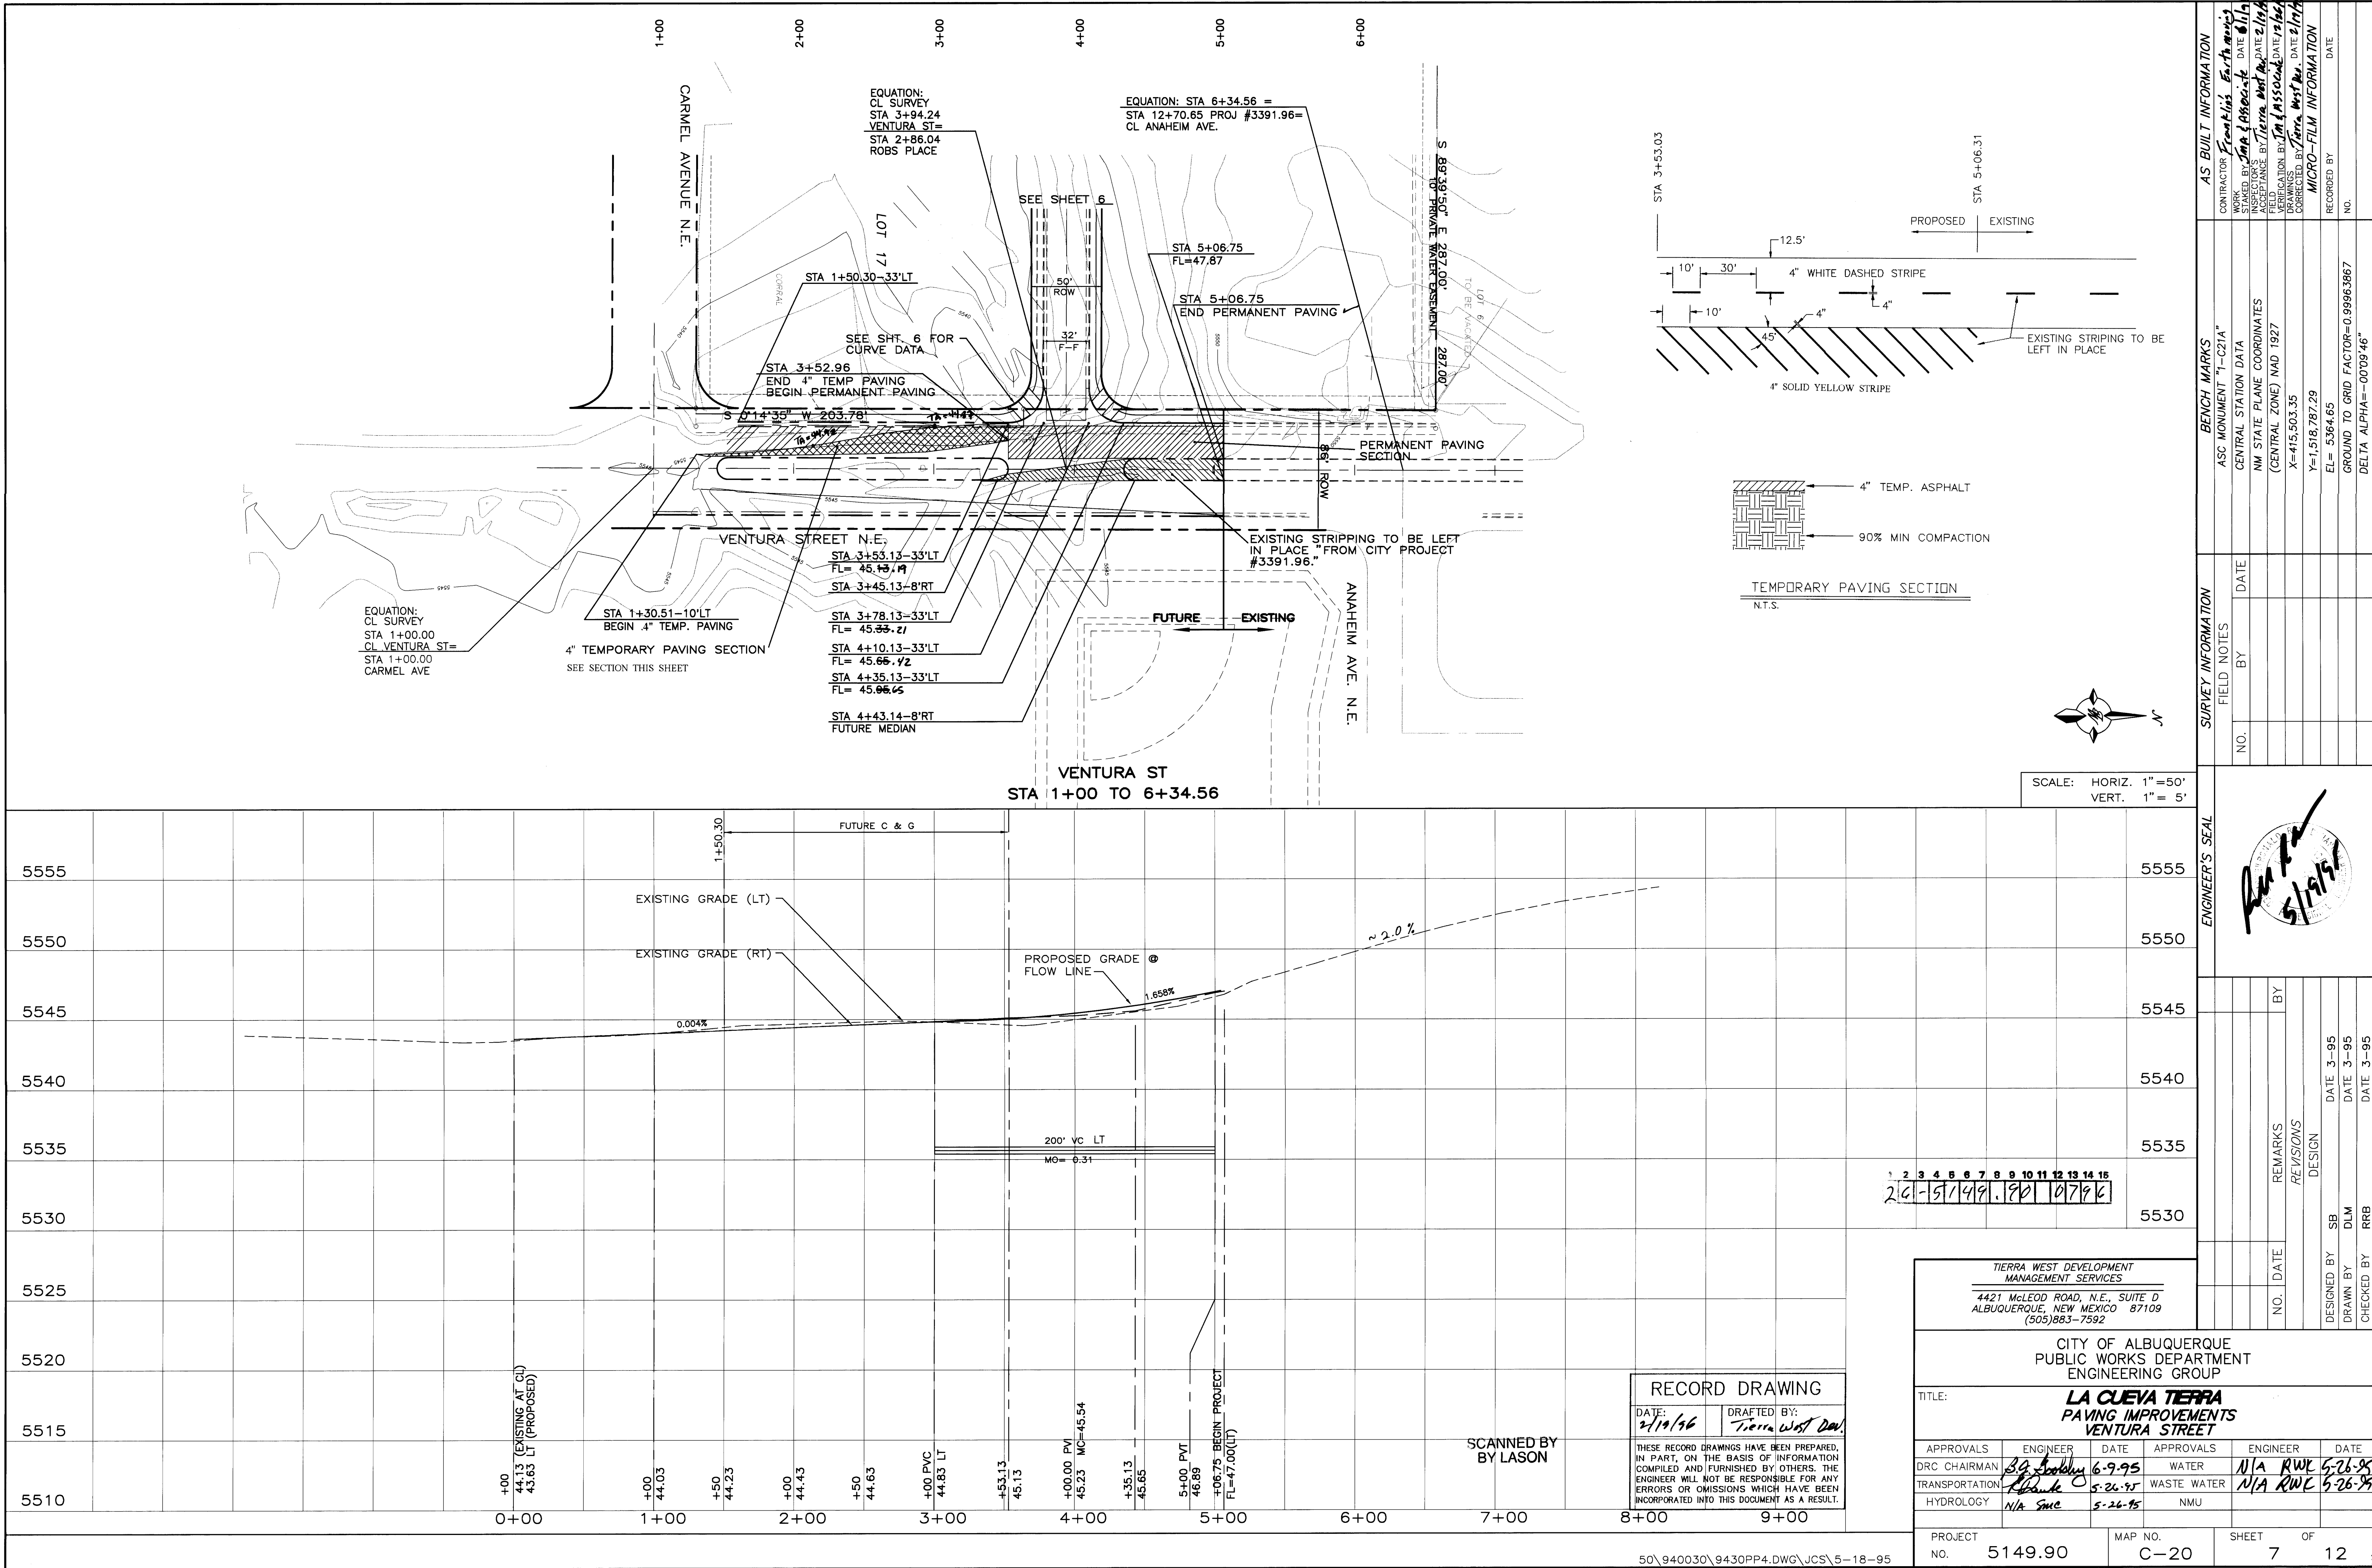




RECORD DRAWING
DATE: 2/19/96
DRAFTED BY: Tierra West Dev.

TIERRA WEST DEVELOPMENT
MANAGEMENT SERVICES
4421 McLEOD ROAD, N.E., SUITE D
ALBUQUERQUE, NEW MEXICO 87109
(505)883-7592

CITY OF ALBUQUERQUE PUBLIC WORKS DEPARTMENT ENGINEERING GROUP				
TITLE: LA CUEVA TIERRA PAVING IMPROVEMENTS VENTURA STREET				
APPROVALS	ENGINEER	DATE	APPROVALS	ENGINEER
DRC CHAIRMAN	3/9/95	6-9-95	WATER	N/A RWE 5-26-95
TRANSPORTATION	3/9/95	5-26-95	WASTE WATER	N/A RWE 5-26-95
HYDROLOGY	N/A SMC	5-26-95	NMU	
PROJECT NO.	5149.90	MAP NO.	C-20	SHEET 7 OF 12

SURVEY INFORMATION		BENCH MARKS		AS BUILT INFORMATION	
NO.	BY	ASC MONUMENT	GENERAL STATION DATA	CONTRACTOR	WORK
		NM STATE PLANE COORDINATES	(CENTRAL ZONE) NAD 1927	WORKED BY	DATE
		X=415,503.35	Y=1,518,787.29	INSPECTED BY	DATE
		EL= 5364.65		ACCEPTANCE BY	DATE
		GROUND TO GRID FACTOR=0.99963867		FIELD CORRECTION BY	DATE
		DELTA ALPHA=-00'09"46"		DRAWINGS	DATE
				CORRECTED BY	DATE
				MICRO-FILM INFORMATION	DATE
				RECORDED BY	DATE
				NO.	

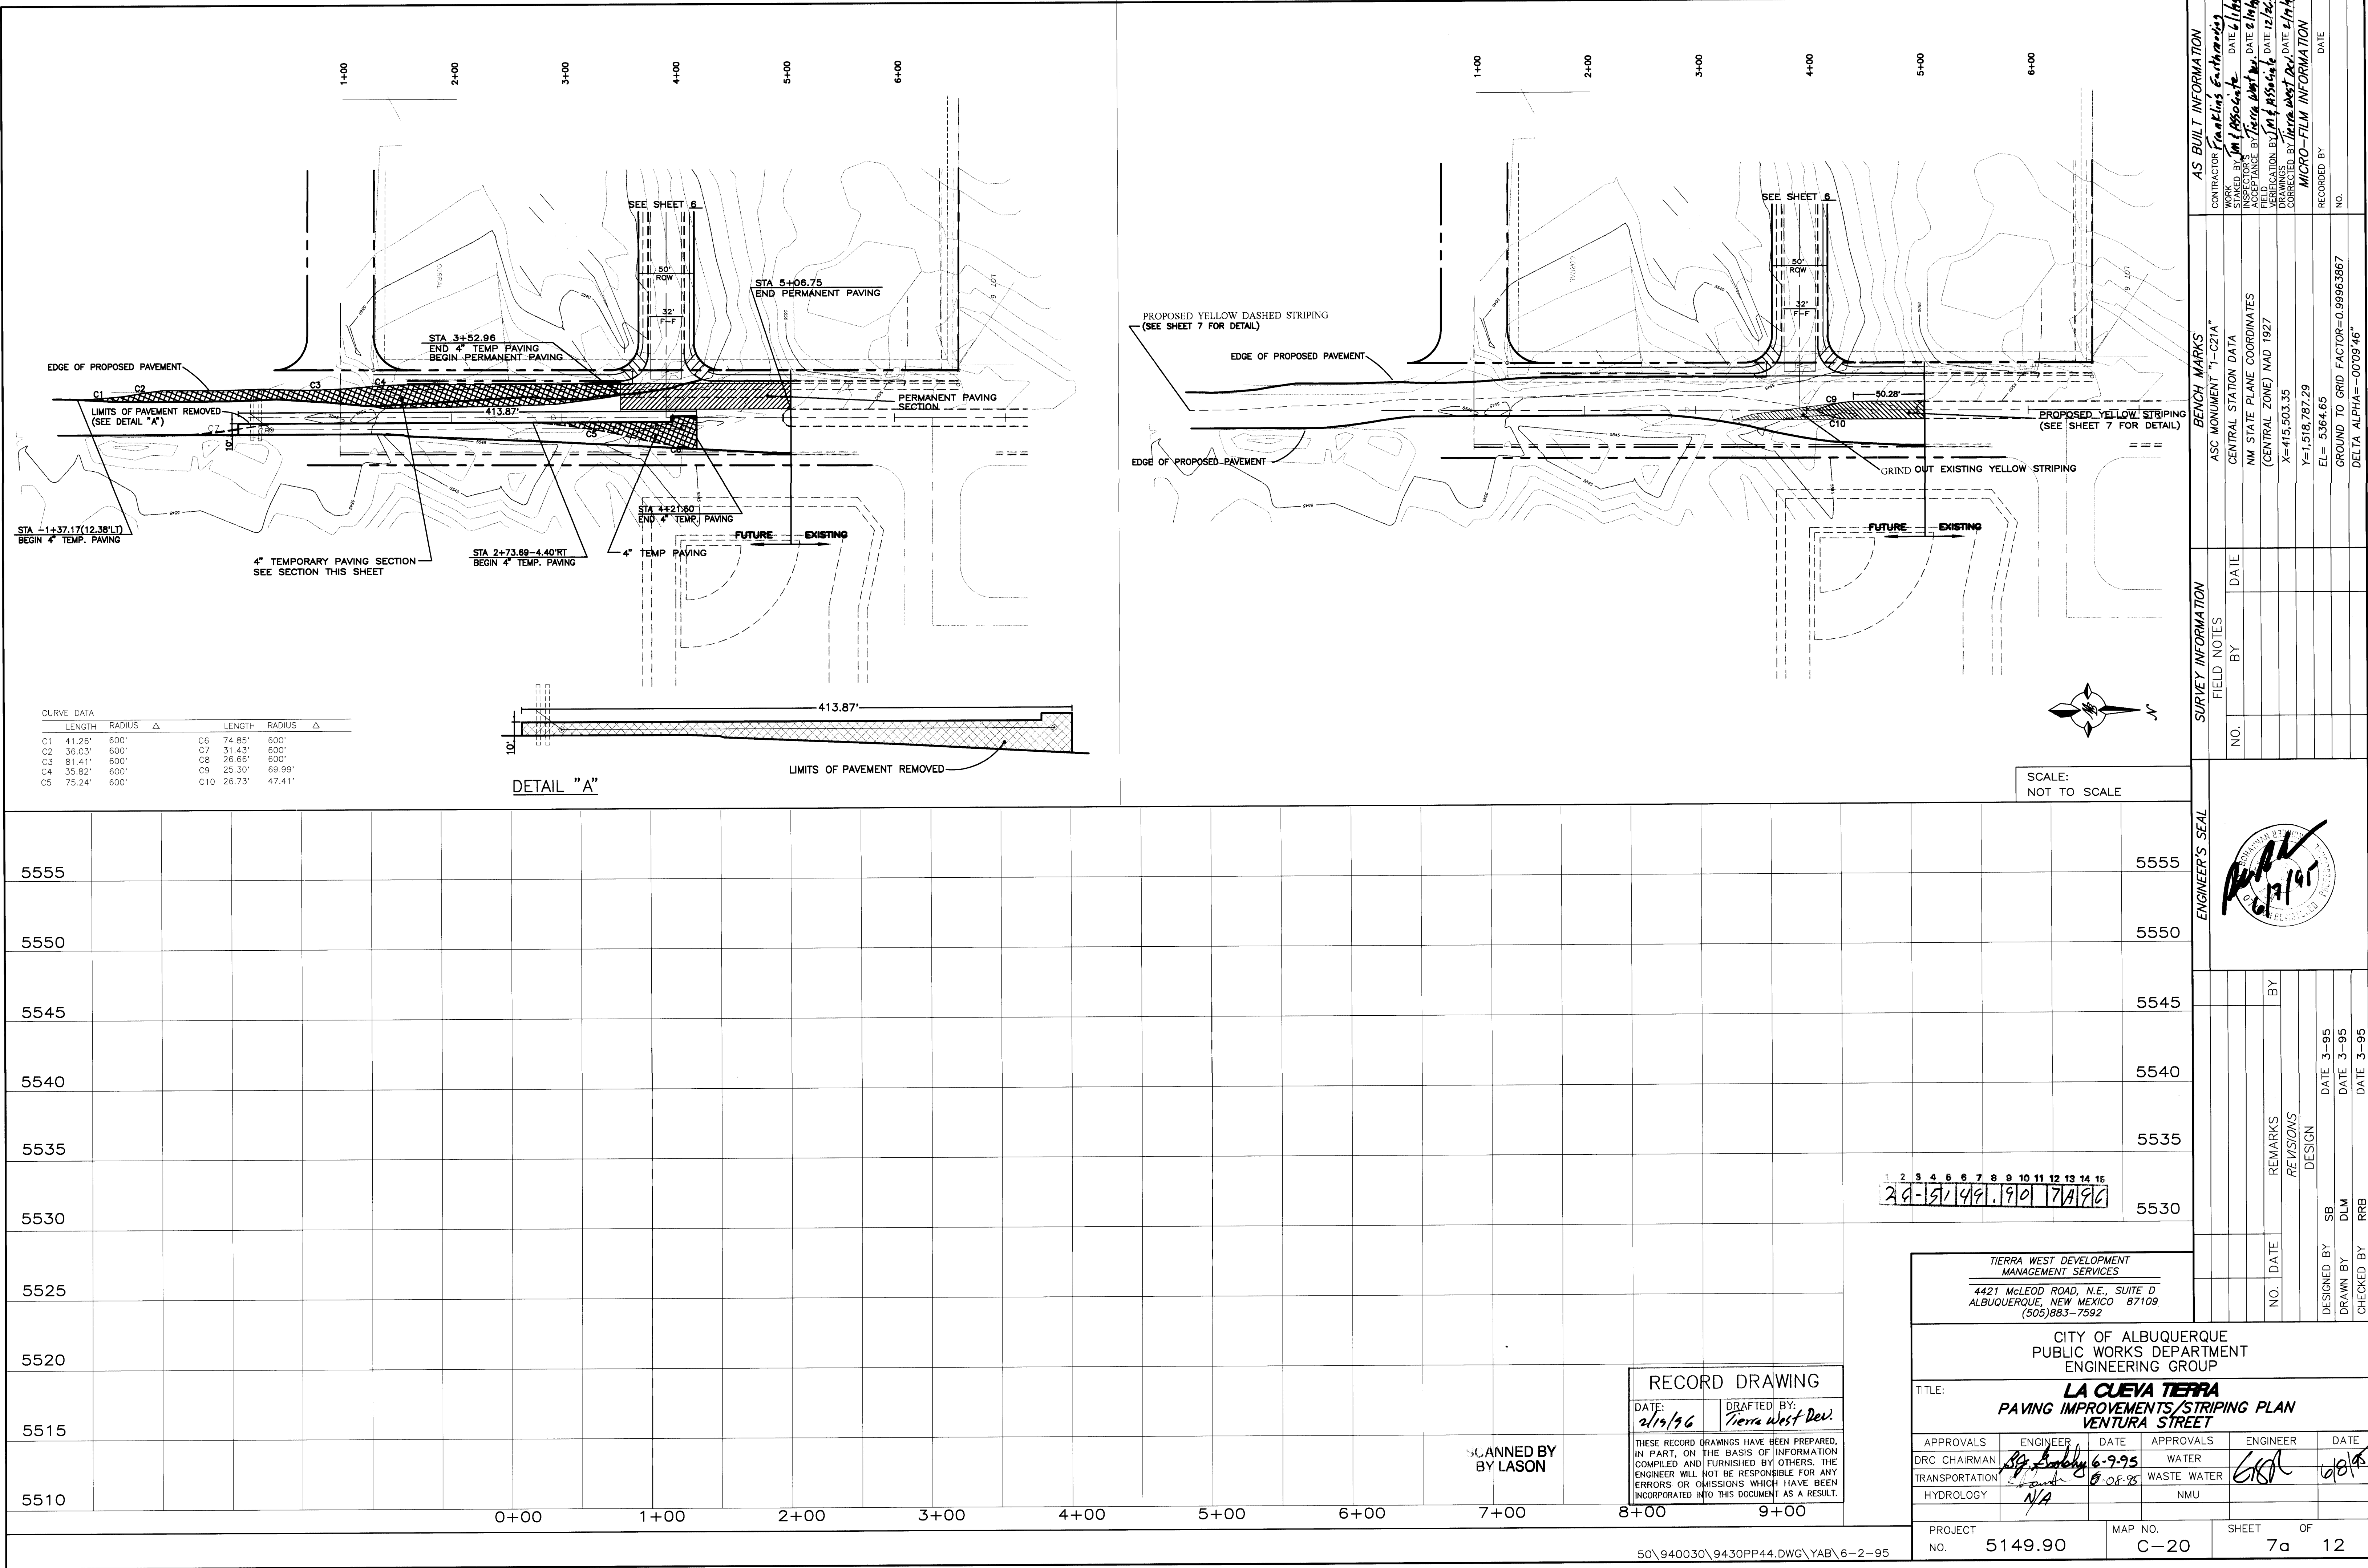

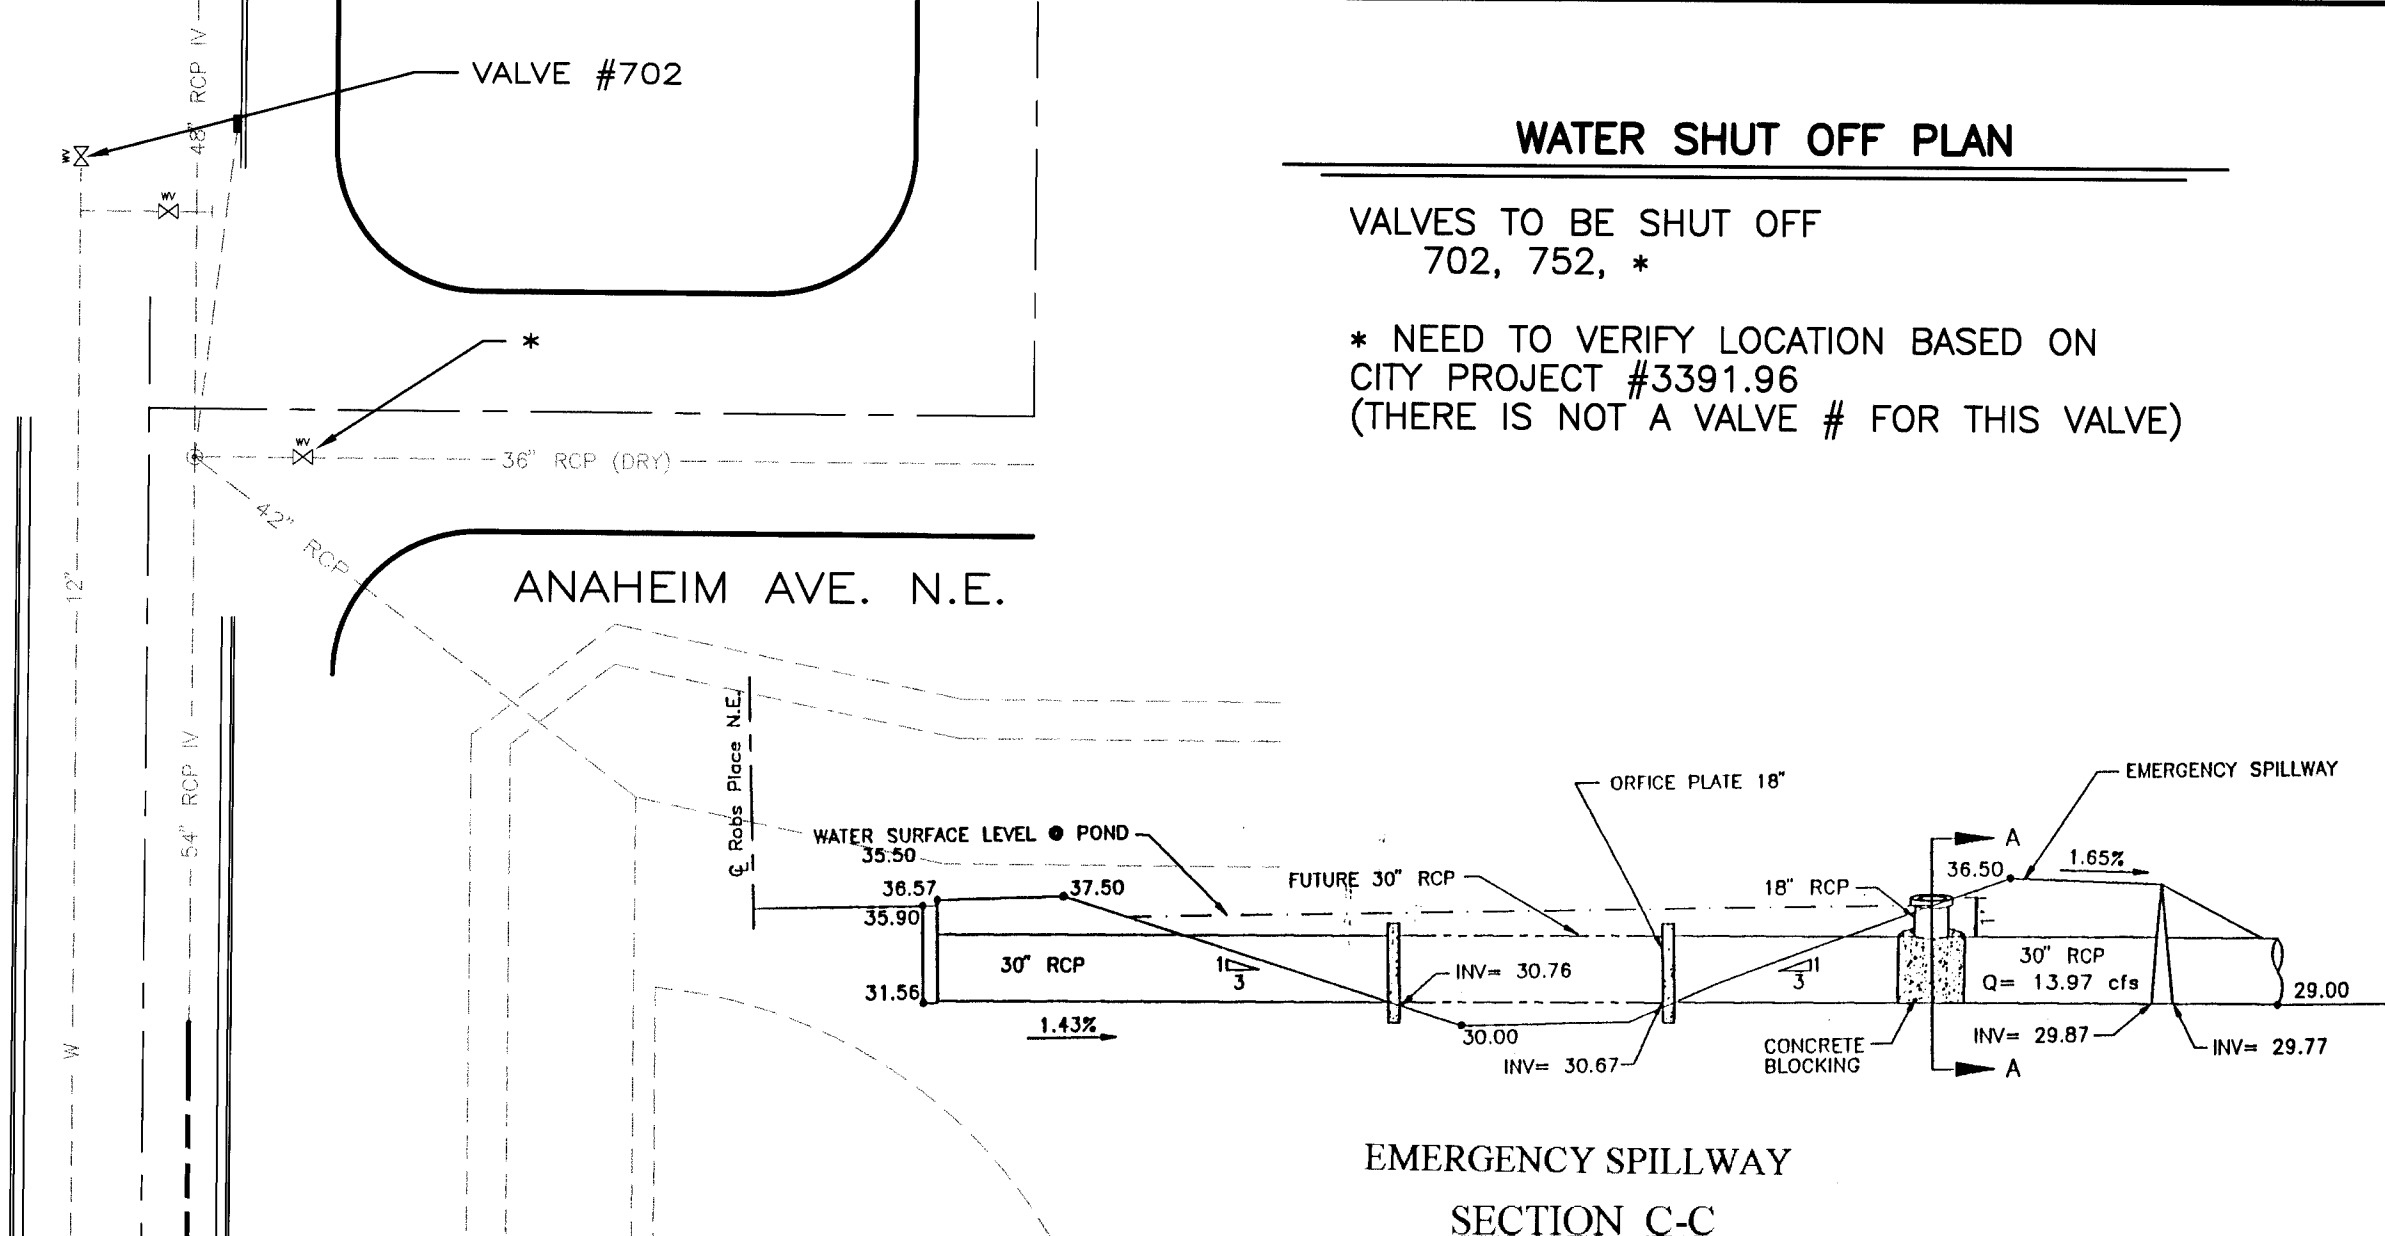
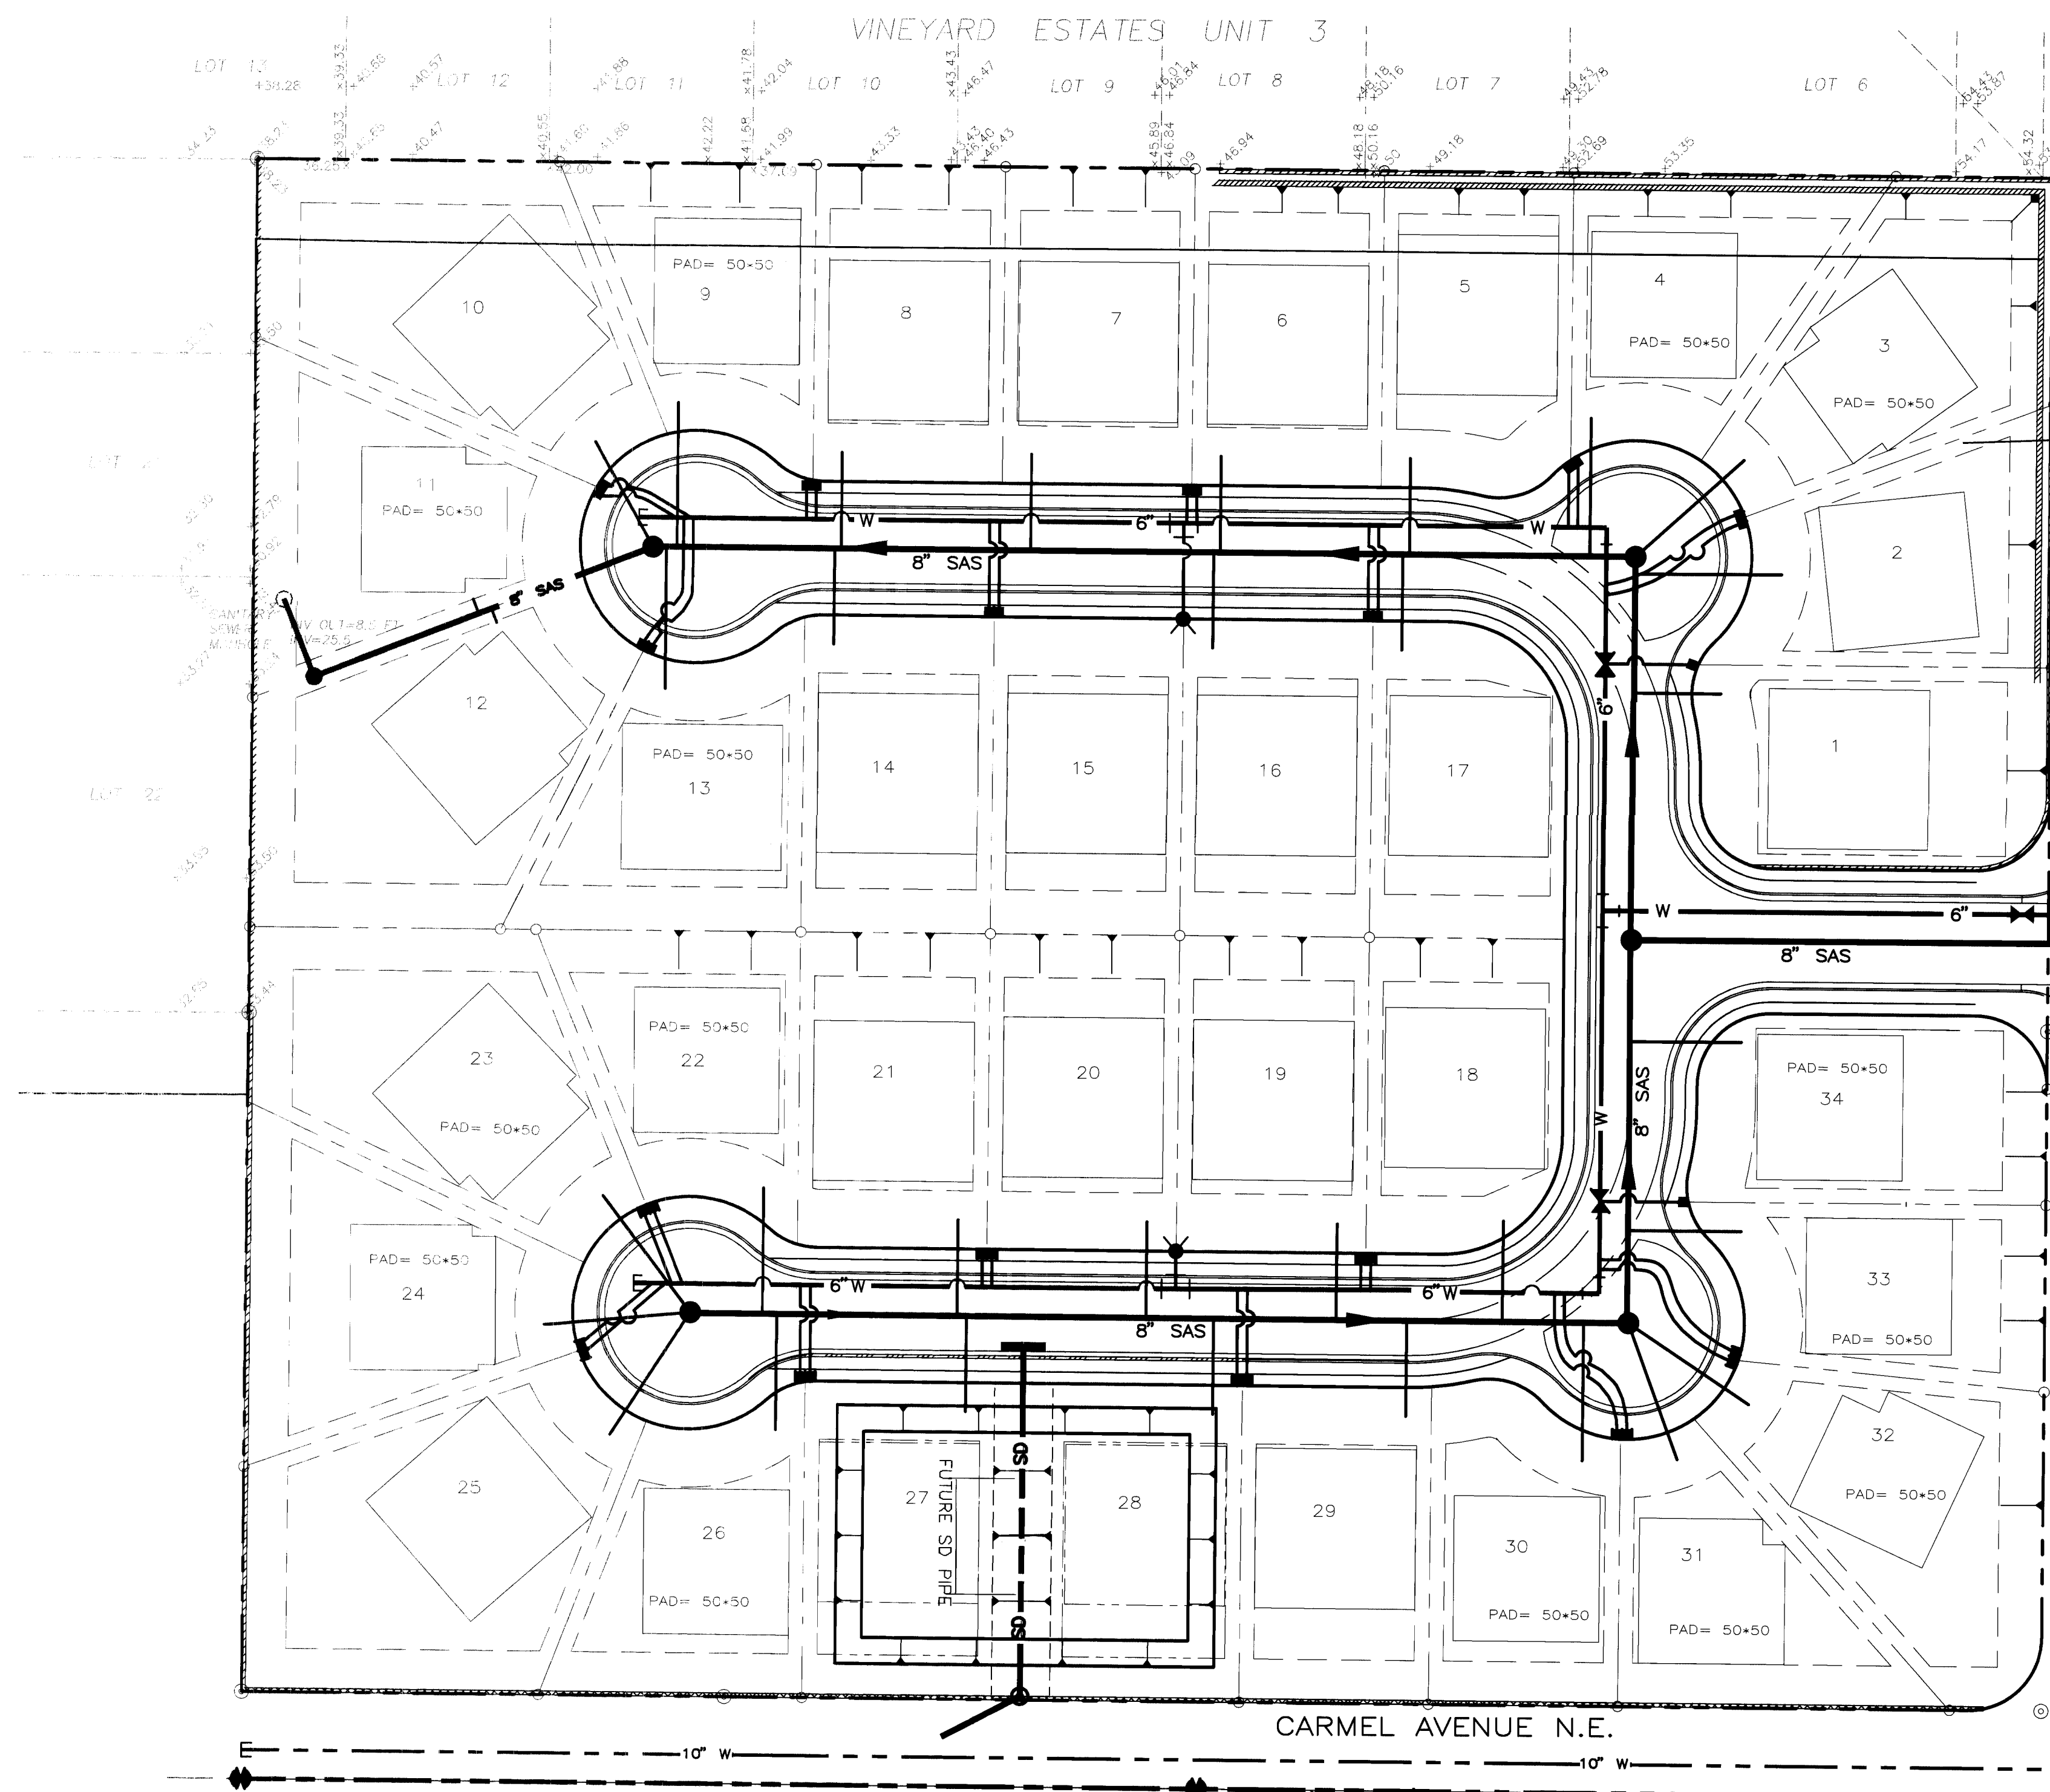


WATER SHUT OFF PLAN

VALVES TO BE SHUT OFF
702, 752, *


* NEED TO VERIFY LOCATION BASED ON
CITY PROJECT #3391.96
(THERE IS NOT A VALVE # FOR THIS VALVE)

- LEGEND**
- CENTER LINE
 - PROPERTY LINE
 - SET BACK LINE
 - BOUNDARY LINE
 - PROPOSED CONTOUR
 - DOUBLE WATER SERVICE
 - SINGLE WATER SERVICE
 - SAS SERVICE
 - MANHOLE
 - 8" SAS
 - 6" WATER LINE
 - STORM DRAIN LINE
 - EXISTING STORM SEWER MH
 - EXISTING STORM SEWER
 - EXISTING 12" WATER LINE
 - EXISTING GATE VALVE
 - EXISTING CROSSES
 - FIRE HYDRANT
 - REDUCER
 - GATE VALVE
 - 90° ELBOW
 - BENDS
 - TEE
 - FUTURE PADS
 - FUTURE CATCH BASIN
 - FUTURE STORM DRAIN MANHOLE
 - FUTURE SAS MANHOLE
 - FUTURE WATER LINE
 - FUTURE STORM DRAIN
 - FUTURE SAS
 - DIRECTION OF FLOW
 - RETAINING WALL
 - FLOOD WALL
 - STD. CURB & CUTTER

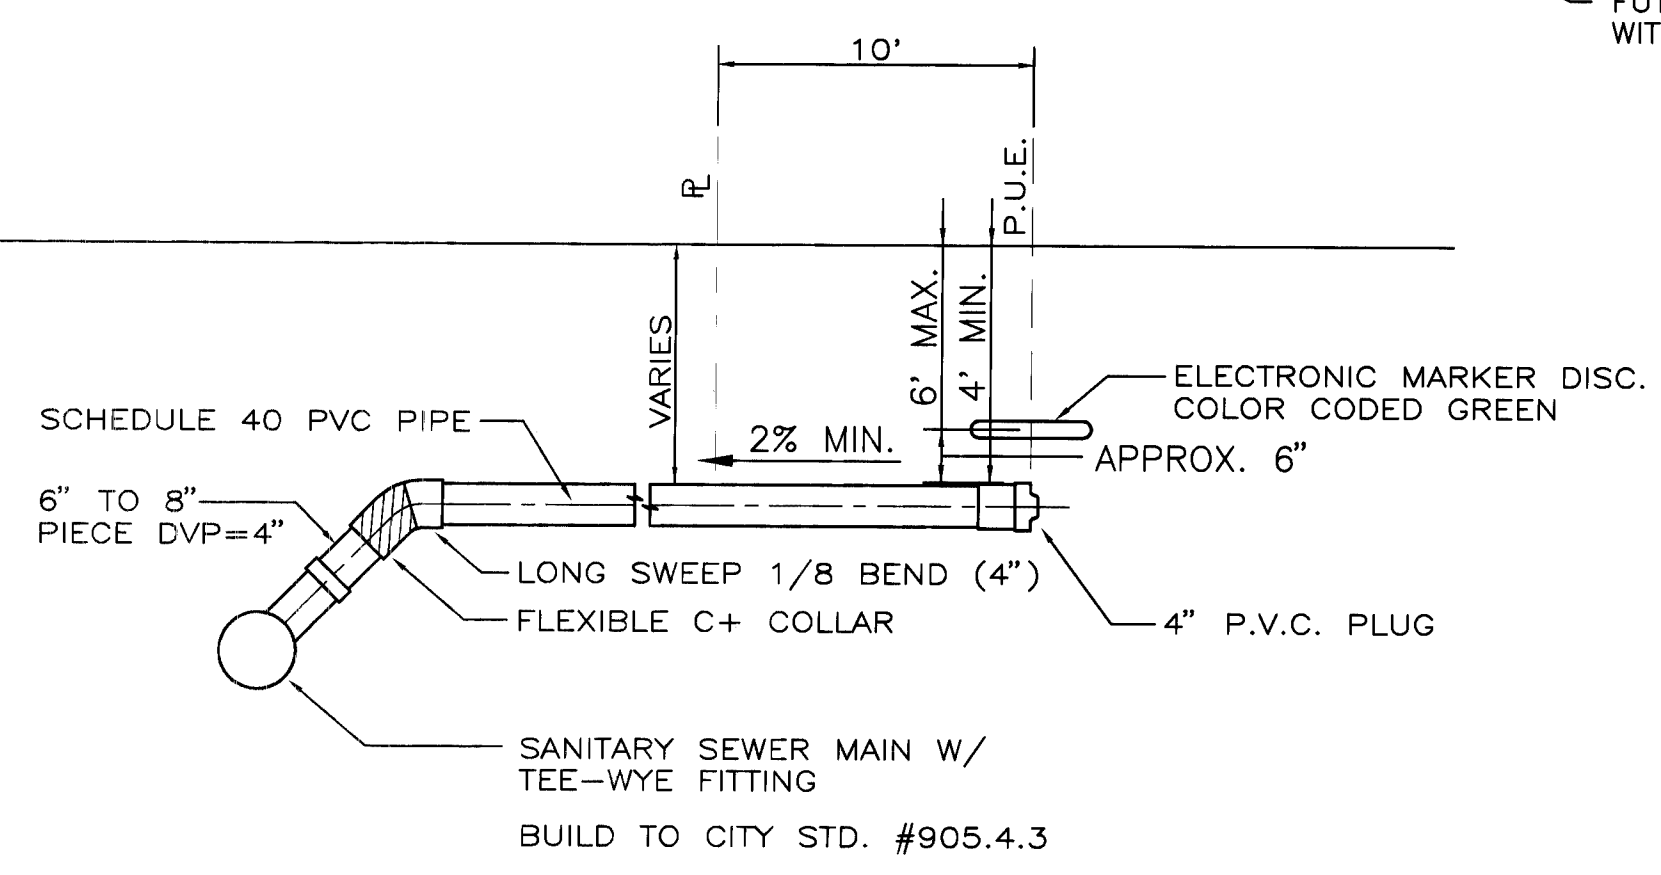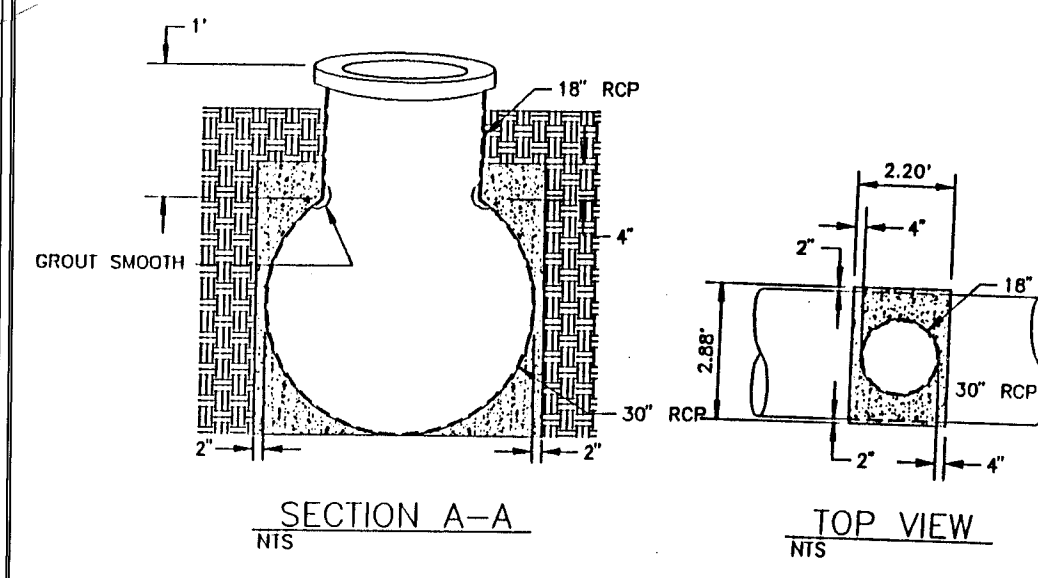

**TYP. SANITARY SYSTEM
SERVICE CONNECTION**
NO SCALE

- NOTE:**
- ALL THE WATERLINE SERVICES TO INDIVIDUAL LOTS ARE COPPER PIPES.
 - WATER LINE TYPE (PVC C-900)
 - SAS TYPE (PVC SDR35)
 - BUILD F.H. WITH ACCORDANCE TO CITY STD. DWG 2340
 - BUILD SAS MH WITH ACCORDANCE TO CITY STD. DWG 2102 FOR TYPE "E" AND TYPE "C"
 - BUILD WATER METER SERVICES WITH ACCORDANCE TO CITY STD. DWG 2361 AND 2362

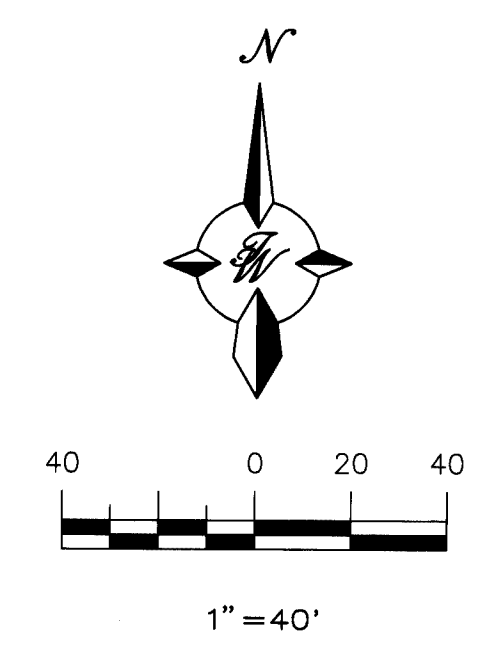





RECORD DRAWING

DATE: 2/19/96 DRAFTED BY: Tierra West Dev.

THESE RECORD DRAWINGS HAVE BEEN PREPARED, IN PART, ON THE BASIS OF INFORMATION COMPILED AND FURNISHED BY OTHERS. THE ENGINEER WILL NOT BE RESPONSIBLE FOR ANY ERRORS OR OMISSIONS WHICH HAVE BEEN INCORPORATED INTO THIS DOCUMENT AS A RESULT.

1 2 3 4 5 6 7 8 9 10 11 12 13 14 15 20-5-149.90 0896					
TIERRA WEST DEVELOPMENT MANAGEMENT SERVICES 4421 McLEOD ROAD N.E., SUITE D ALBUQUERQUE, NEW MEXICO 87109 (505)883-7592					
CITY OF ALBUQUERQUE PUBLIC WORKS DEPARTMENT ENGINEERING GROUP					
TITLE: LA CUEVA TIERRA MASTER UTILITY PLAN					
APPROVALS	ENGINEER	DATE	APPROVALS	ENGINEER	DATE
DRC CHAIRMAN	<i>[Signature]</i>	6-9-95	WATER	<i>[Signature]</i>	5-26-95
TRANSPORTATION	<i>[Signature]</i>	5-26-95	WASTE WATER	<i>[Signature]</i>	5-26-95
HYDROLOGY	<i>[Signature]</i>	5-26-95			
PROJECT NO.	5149.90	MAP NO.	C-20	SHEET	OF 12

AS BUILT INFORMATION CONTRACTOR: <i>[Signature]</i> WORK: <i>[Signature]</i> INSPECTED BY: <i>[Signature]</i> ACCEPTANCE BY: <i>[Signature]</i> DATE: <i>[Signature]</i> DRAWINGS: <i>[Signature]</i> CORRECTED BY: <i>[Signature]</i> MICRO-FILM INFORMATION RECORDED BY: <i>[Signature]</i> DATE: <i>[Signature]</i>	
BENCH MARKS ASC MONUMENT "1-C21A" CENTRAL STATION DATA NW STATE PLANE COORDINATES (CENTRAL ZONE) NAD 1927 X=415,503.35 Y=1,518,787.29 EL= 5364.65 GROUND TO GRID FACTOR=0.99963667 DELTA ALPHA=-000946"	
SURVEY INFORMATION FIELD NOTES BY: <i>[Signature]</i> DATE: <i>[Signature]</i> NO. <i>[Signature]</i>	
ENGINEER'S SEAL <i>[Signature]</i> 5/19/95	
DESIGNED BY: SB DRAWN BY: DLM CHECKED BY: RRB DATE 4-95 DATE 4-95 DATE 4-95	

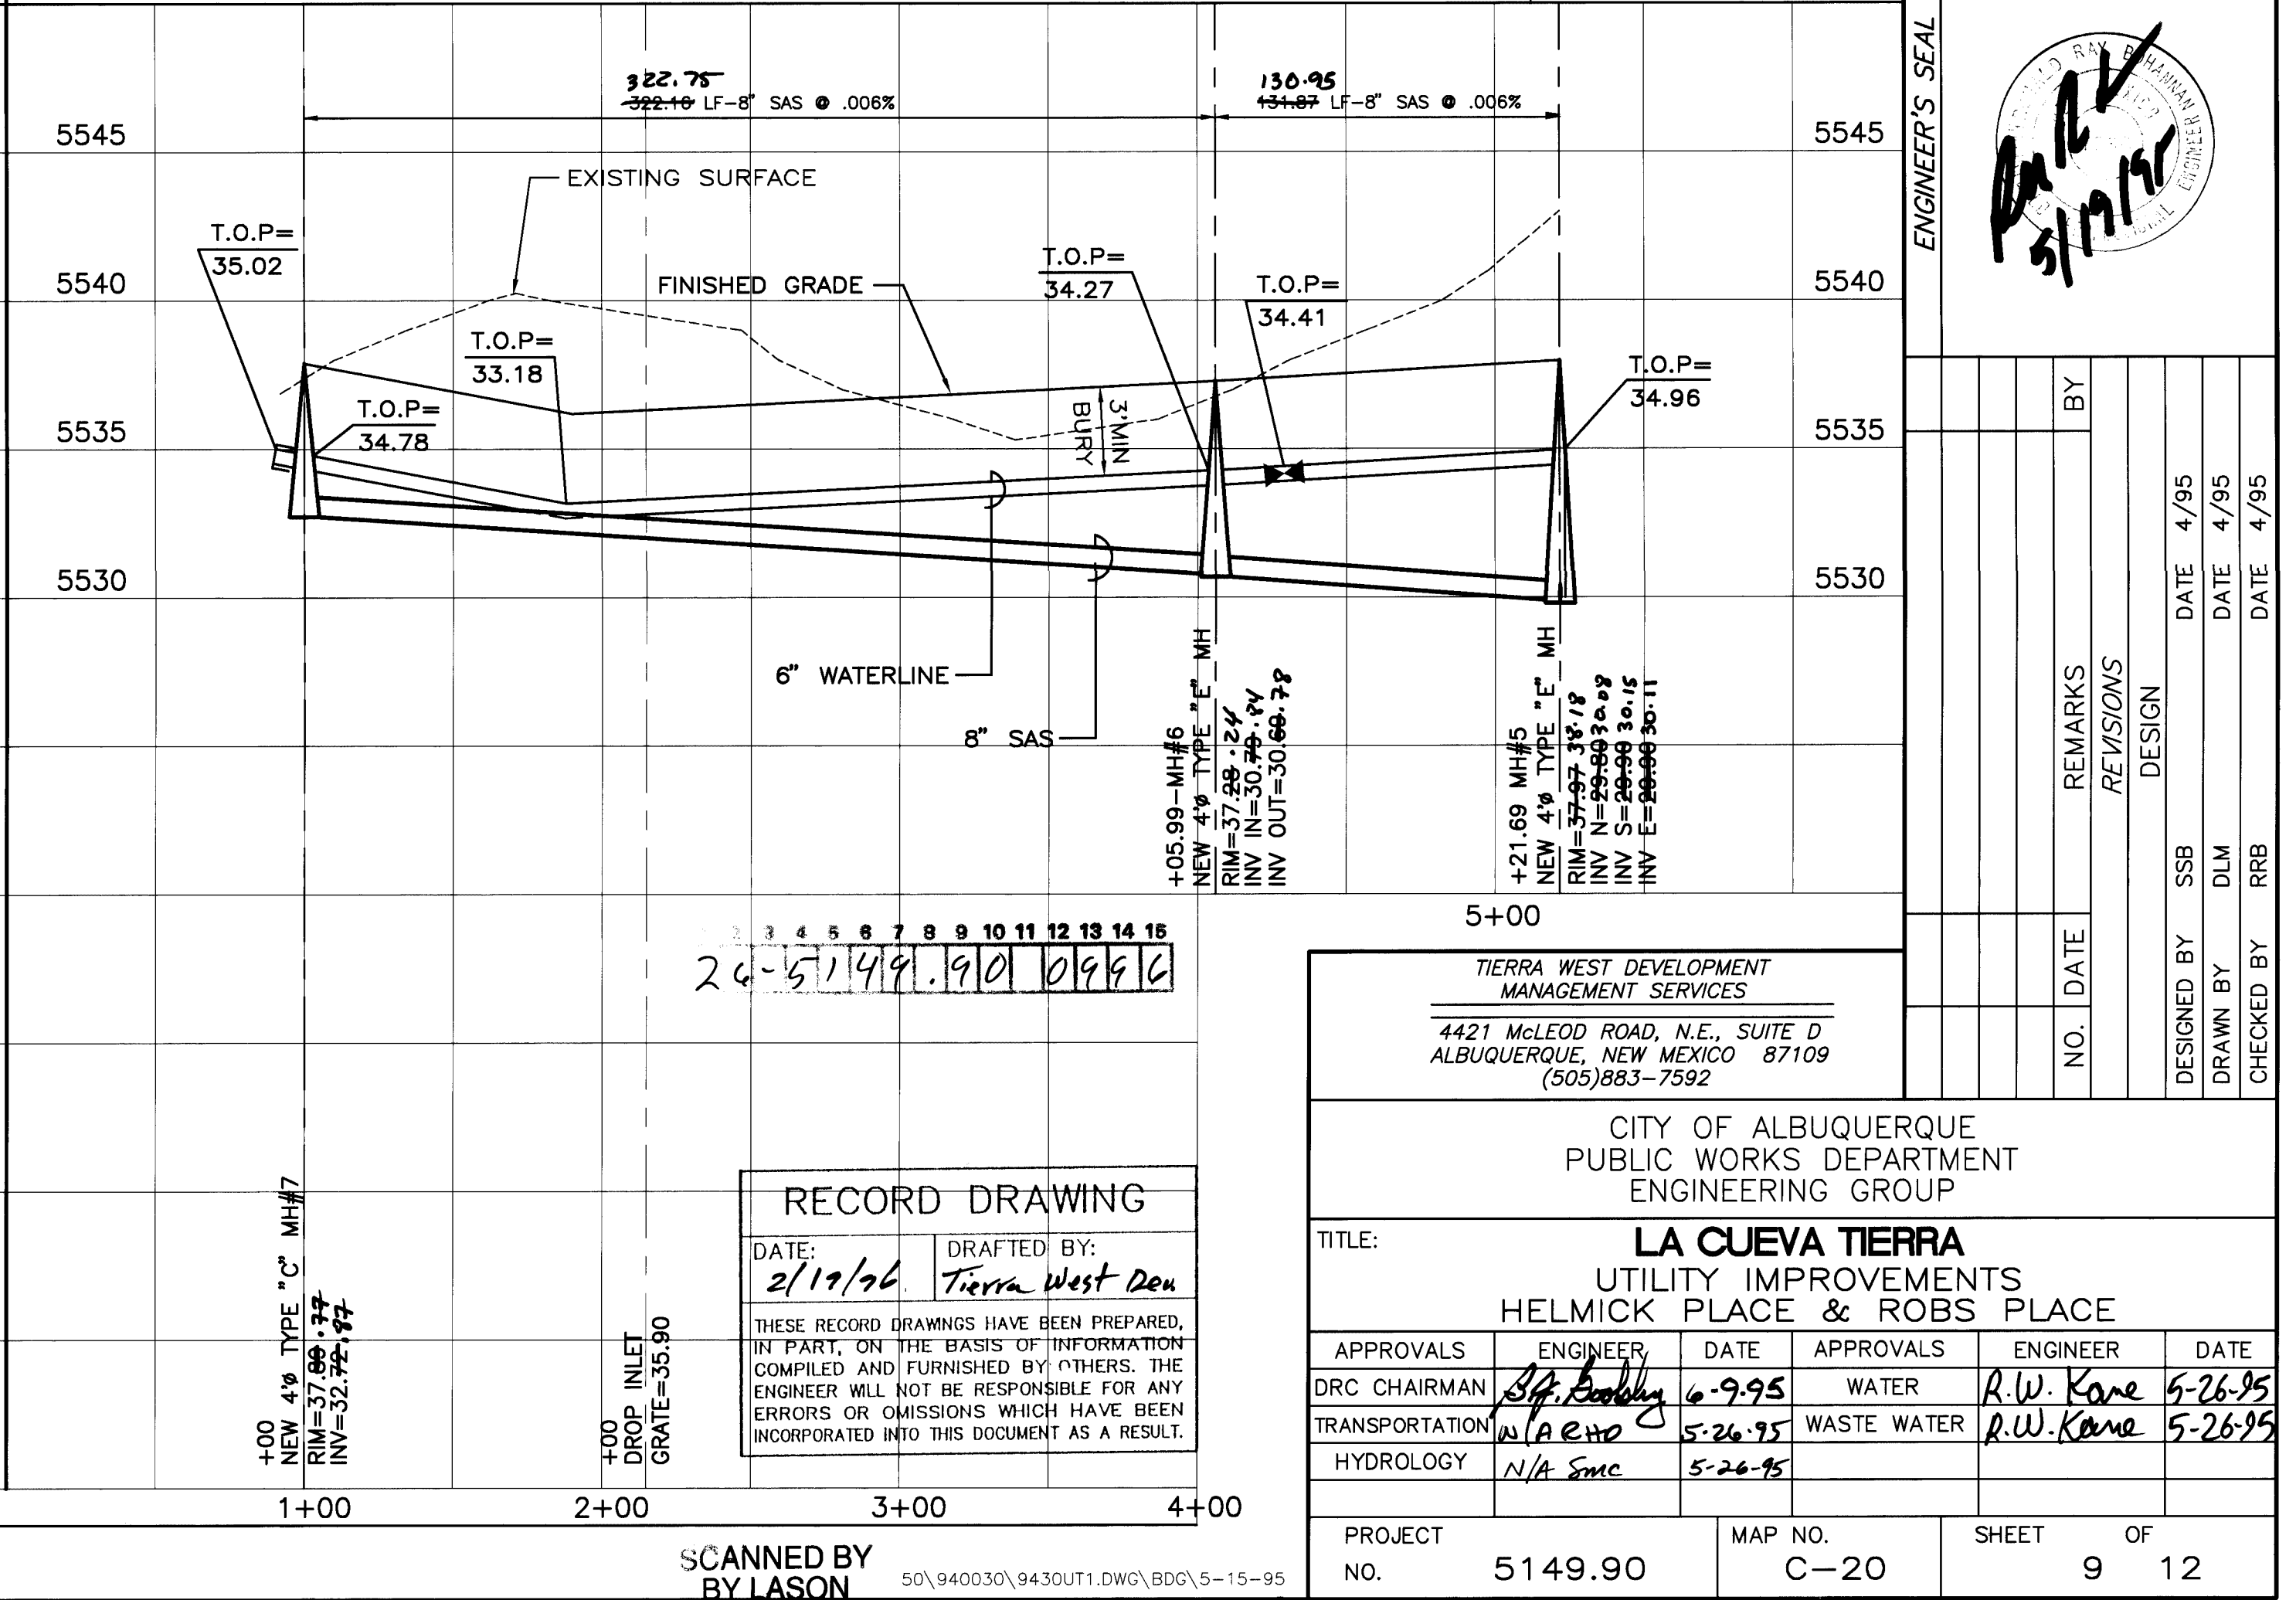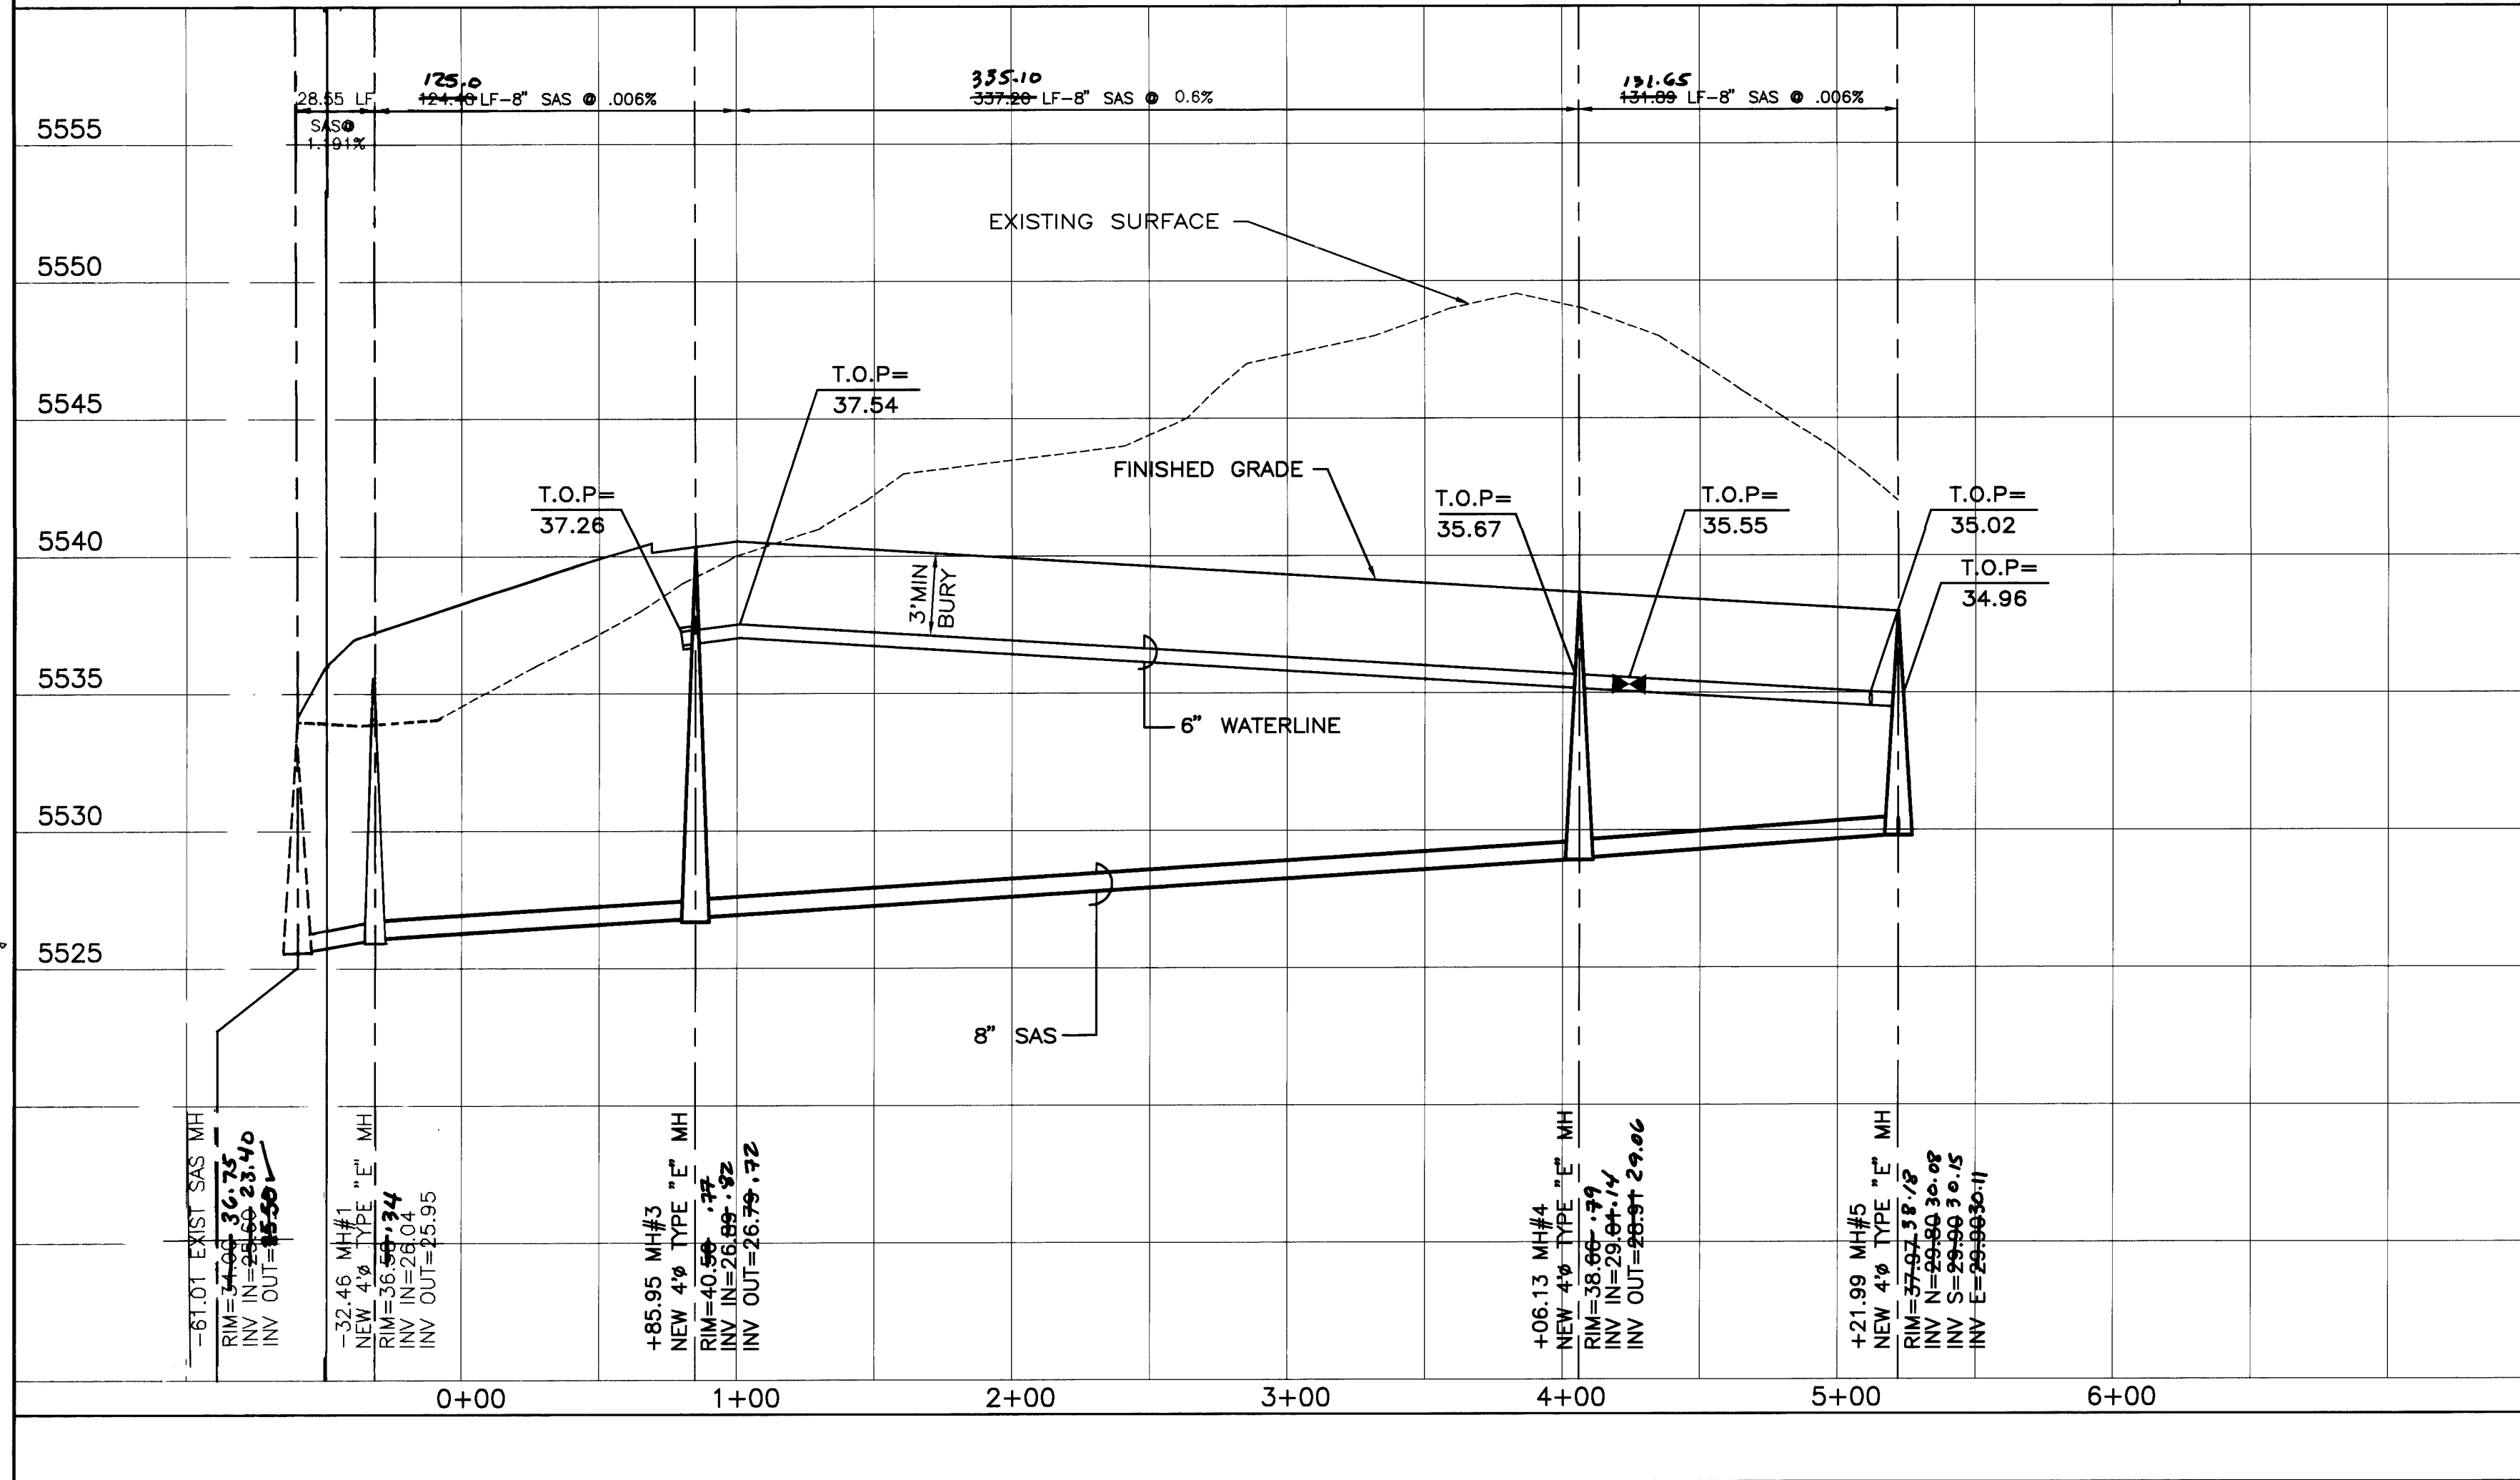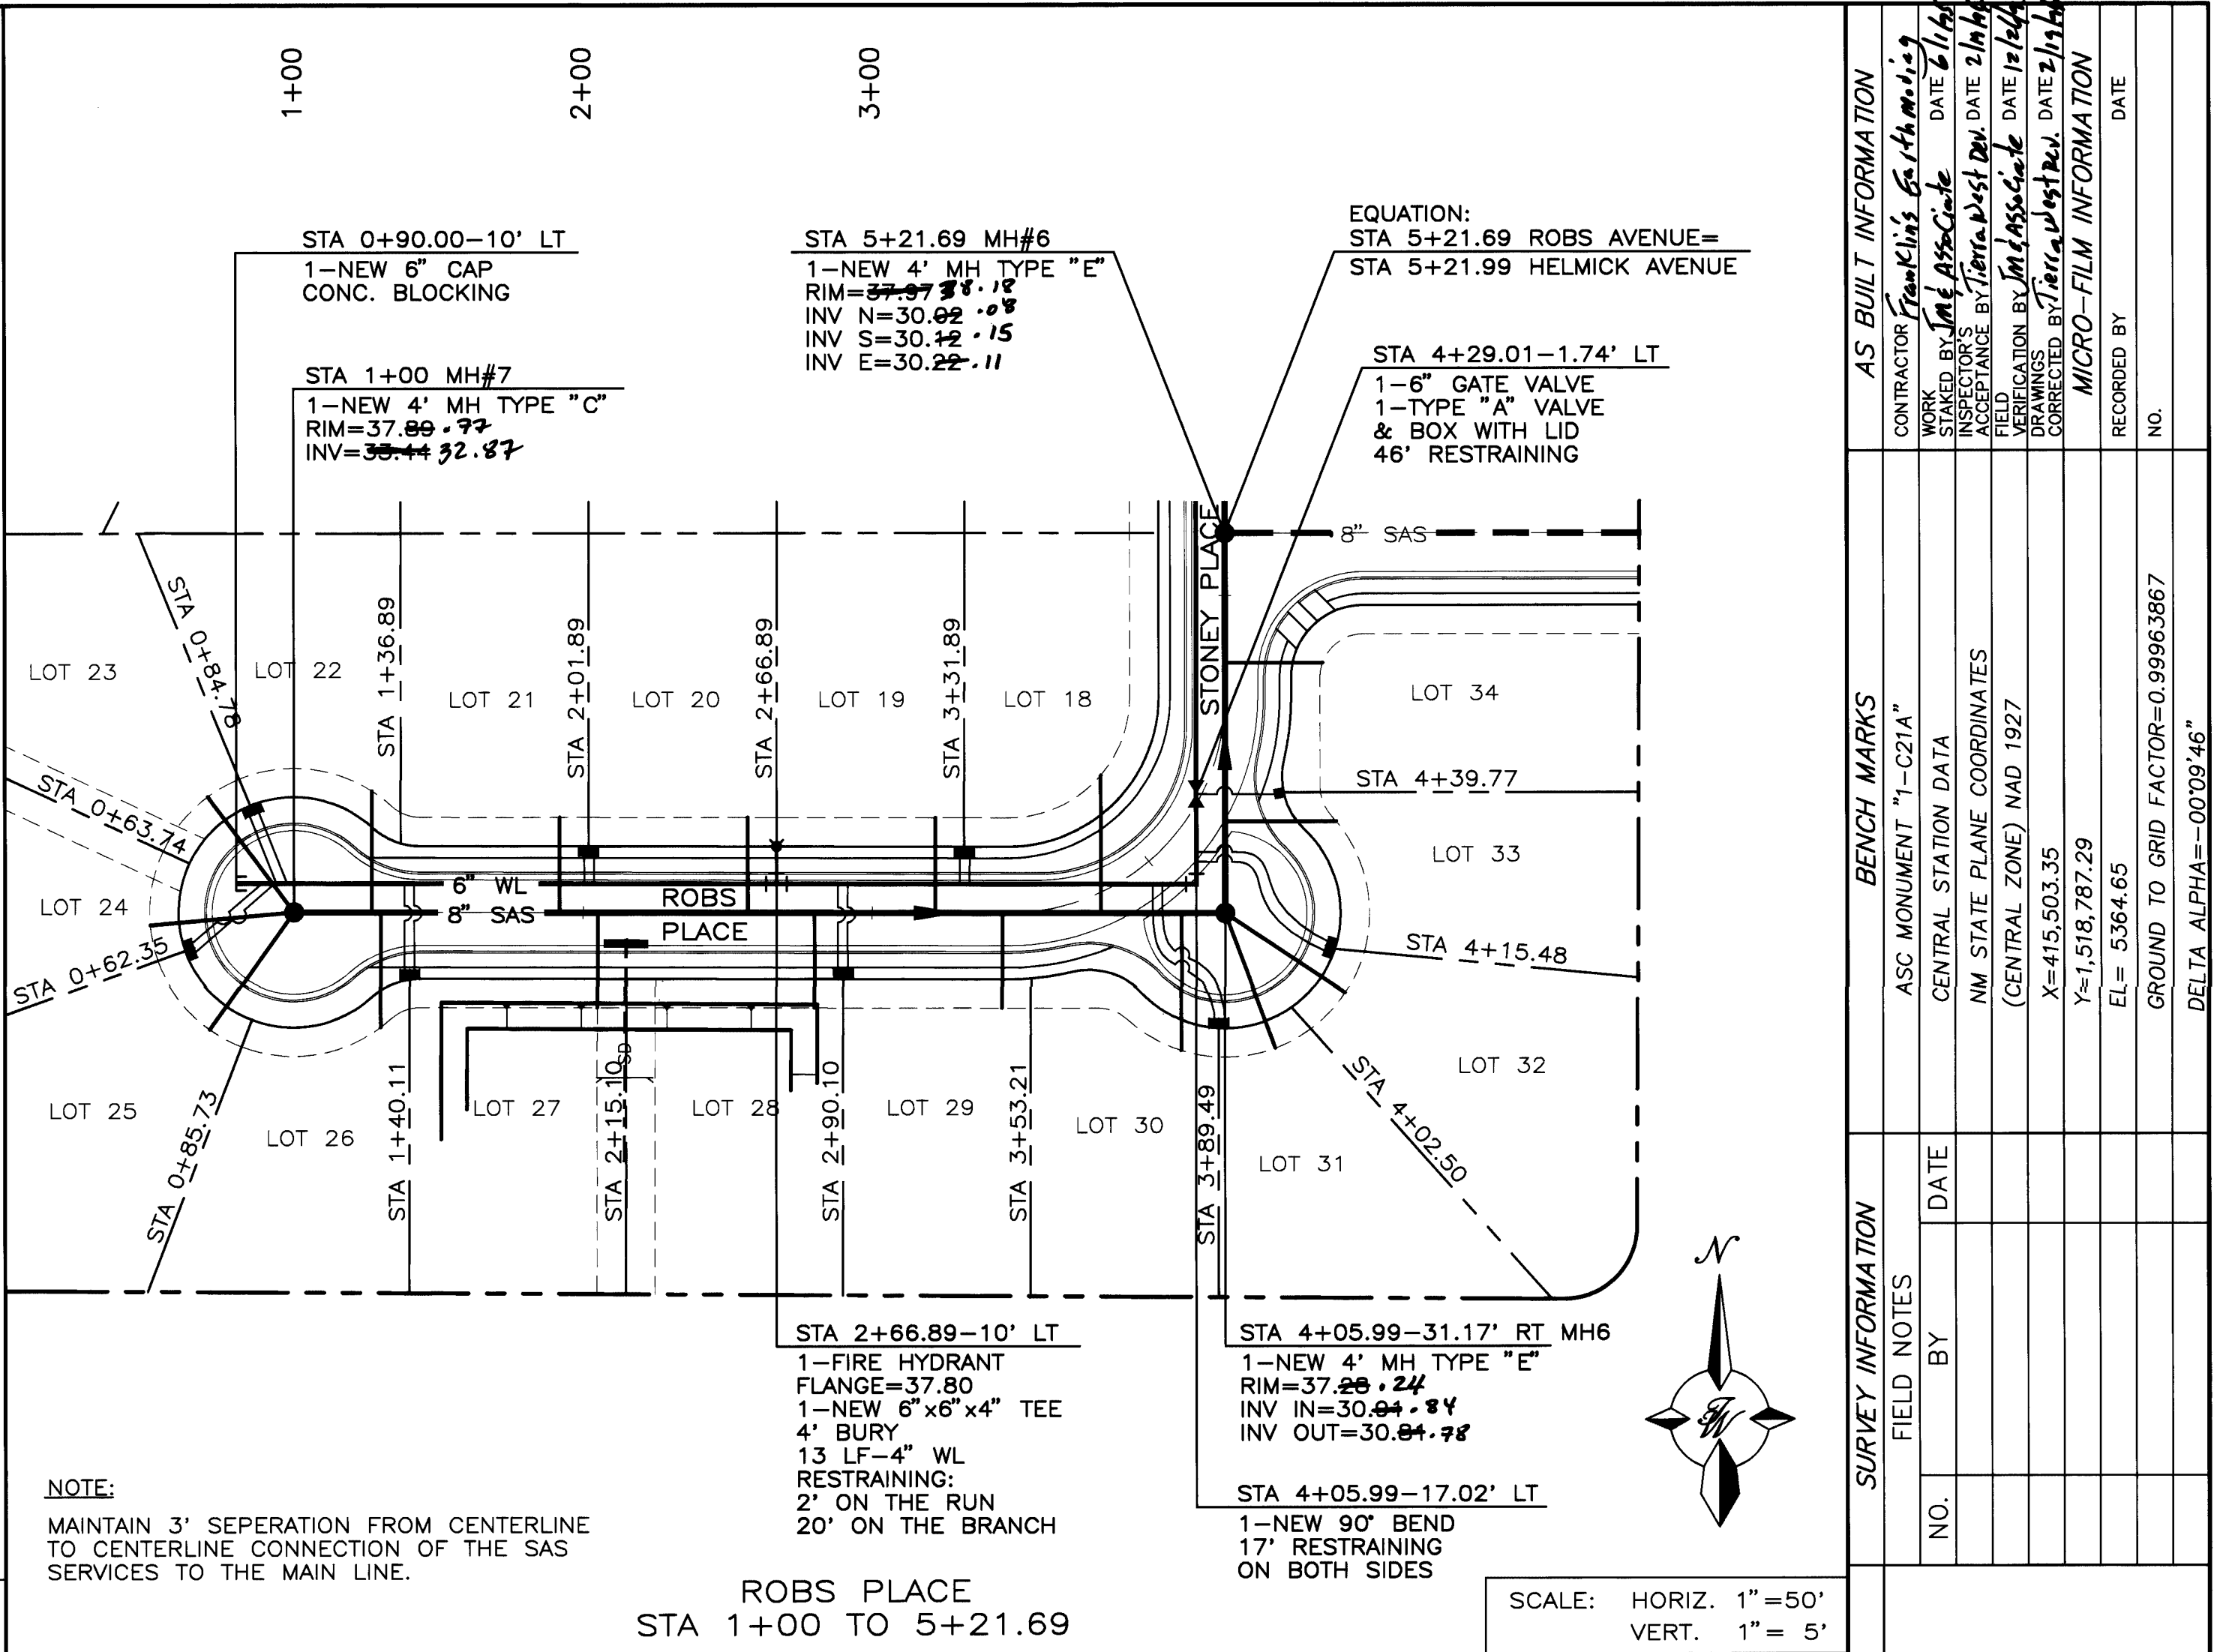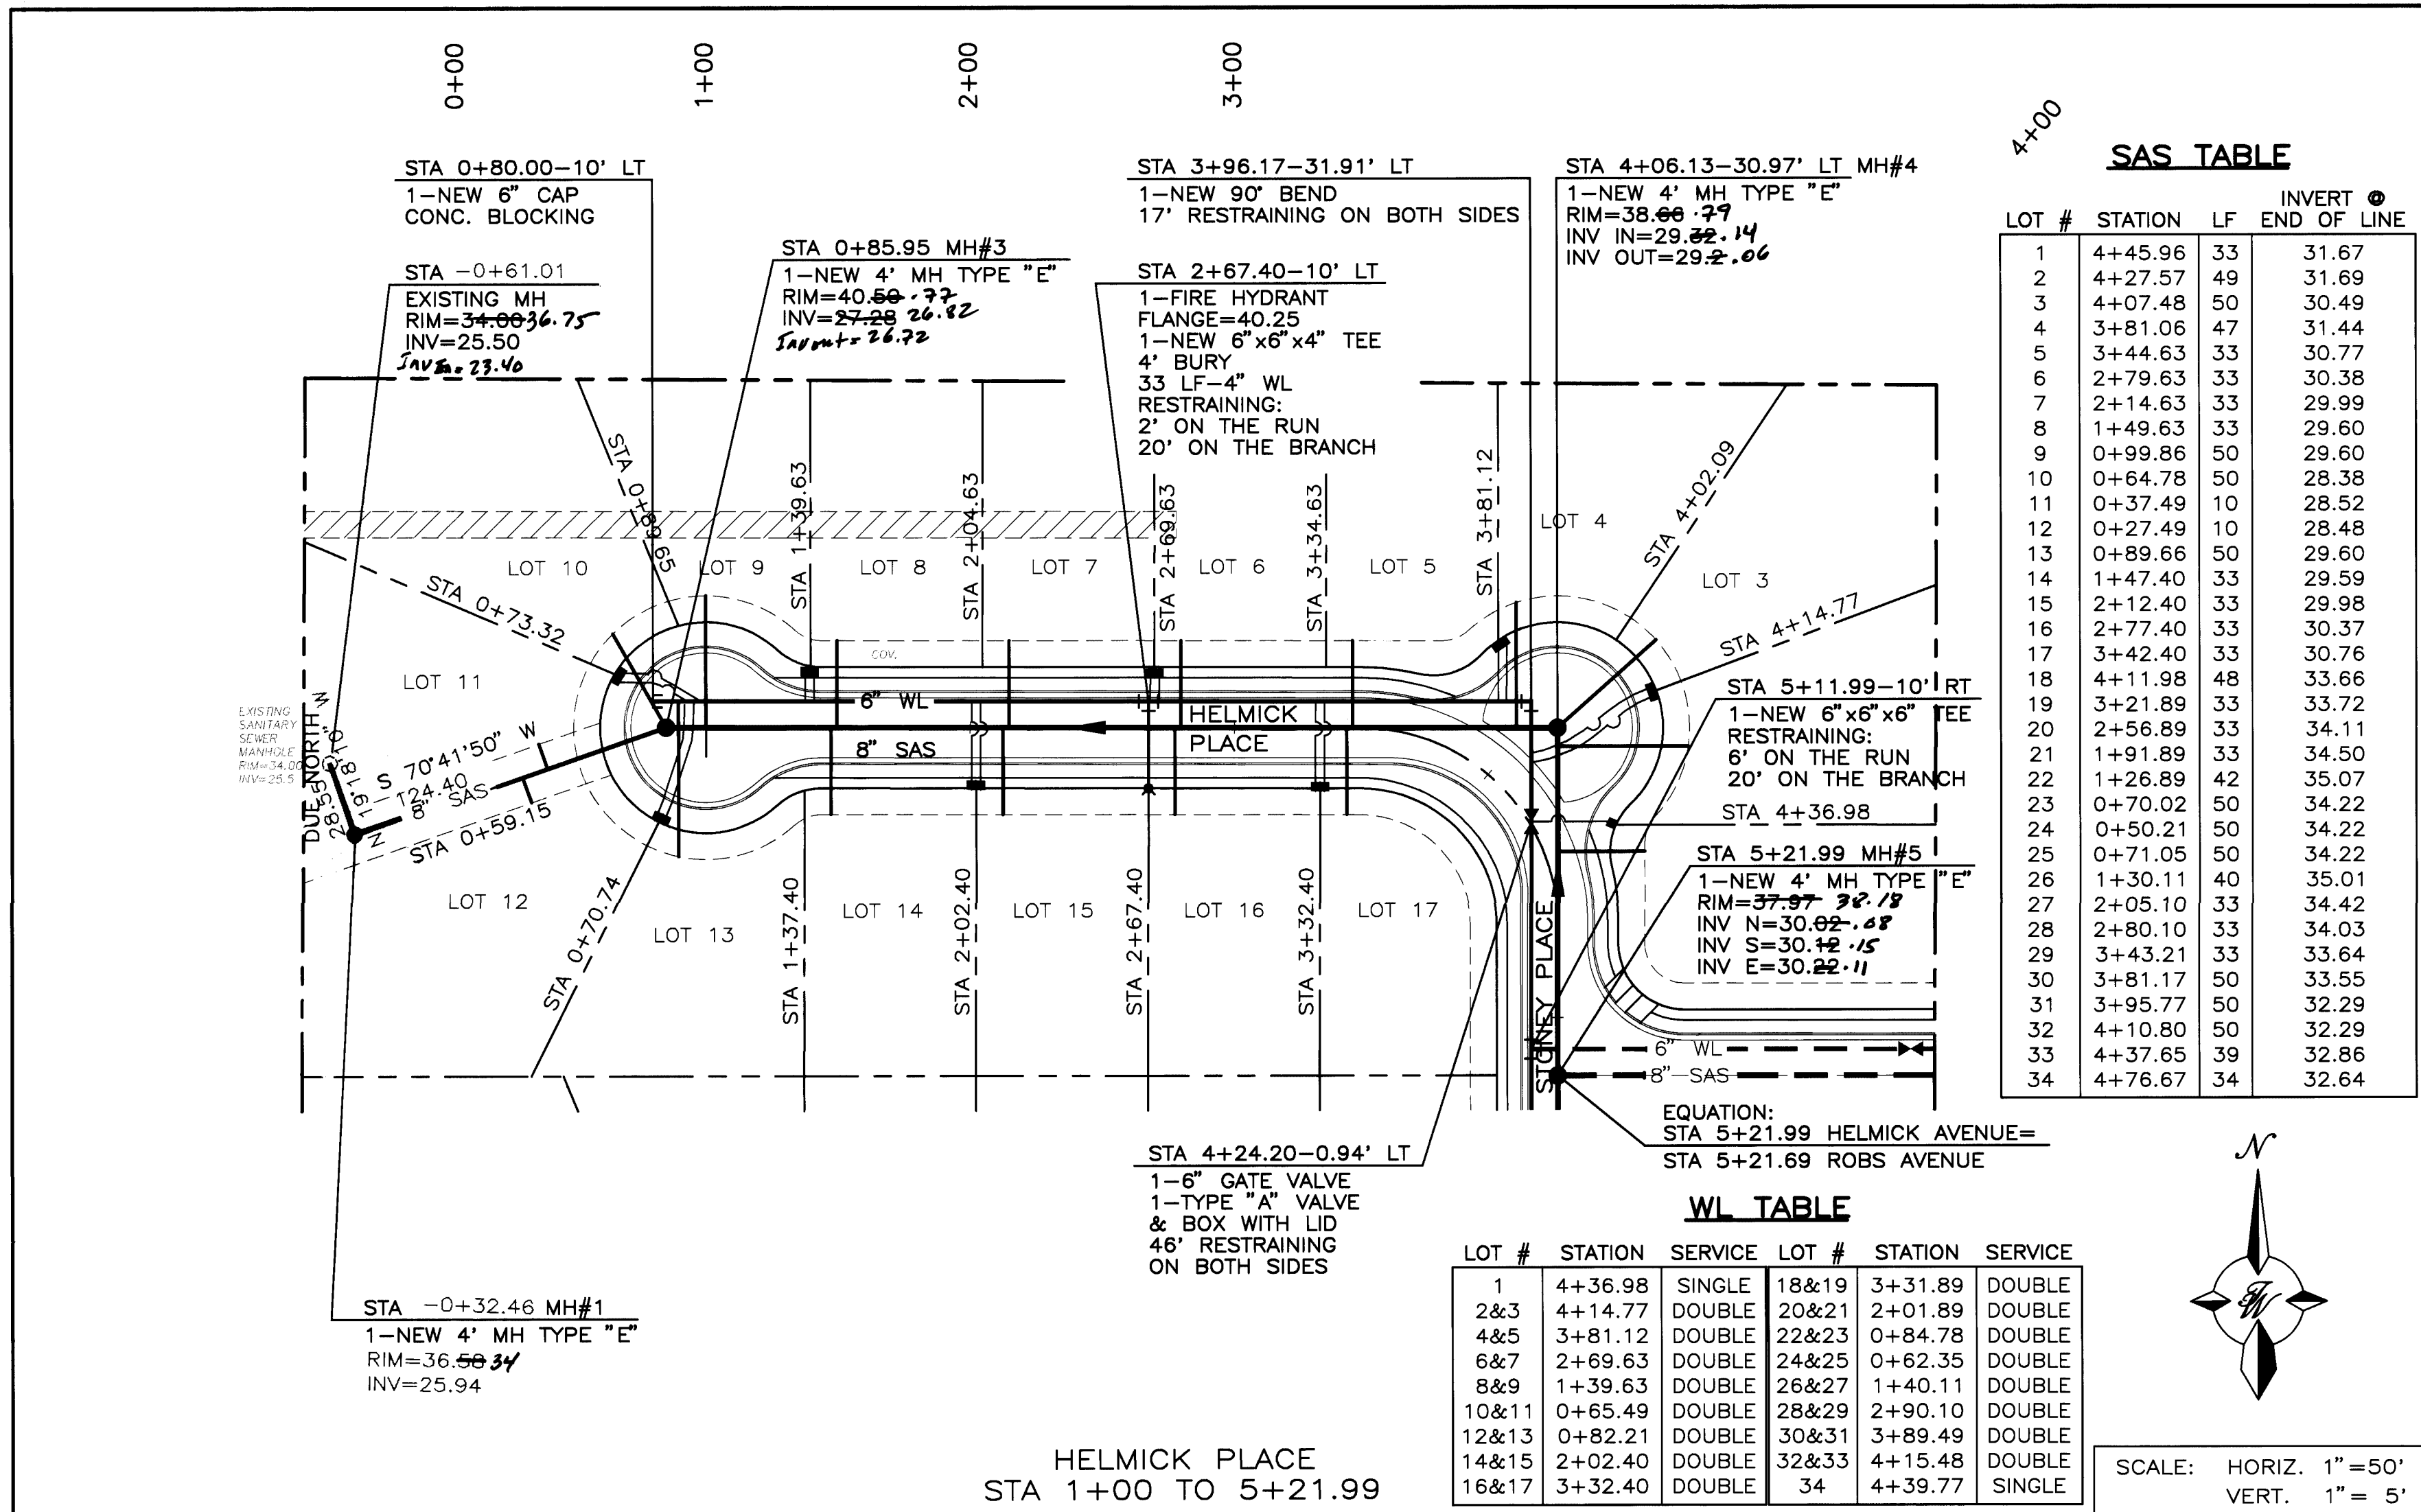

RECORD DRAWING

DATE: 2/19/96 DRAFTED BY: Terra West Dev

THESE RECORD DRAWINGS HAVE BEEN PREPARED, IN PART, ON THE BASIS OF INFORMATION COMPILED AND FURNISHED BY OTHERS. THE ENGINEER WILL NOT BE RESPONSIBLE FOR ANY ERRORS OR OMISSIONS WHICH HAVE BEEN INCORPORATED INTO THIS DOCUMENT AS A RESULT.


CITY OF ALBUQUERQUE
PUBLIC WORKS DEPARTMENT
ENGINEERING GROUP

LA CUEVA TIERRA
UTILITY IMPROVEMENTS
HELMICK PLACE & ROBS PLACE


APPROVALS: ENGINEER DATE: 4/95
DRC CHAIRMAN: 4/95
TRANSPORTATION: 5-26-95
HYDROLOGY: 5-26-95

DESIGNED BY: SSB DATE: 4/95
DRAWN BY: DLM DATE: 4/95
CHECKED BY: RRB DATE: 4/95

PROJECT NO. 5149.90 MAP NO. C-20 SHEET 9 OF 12

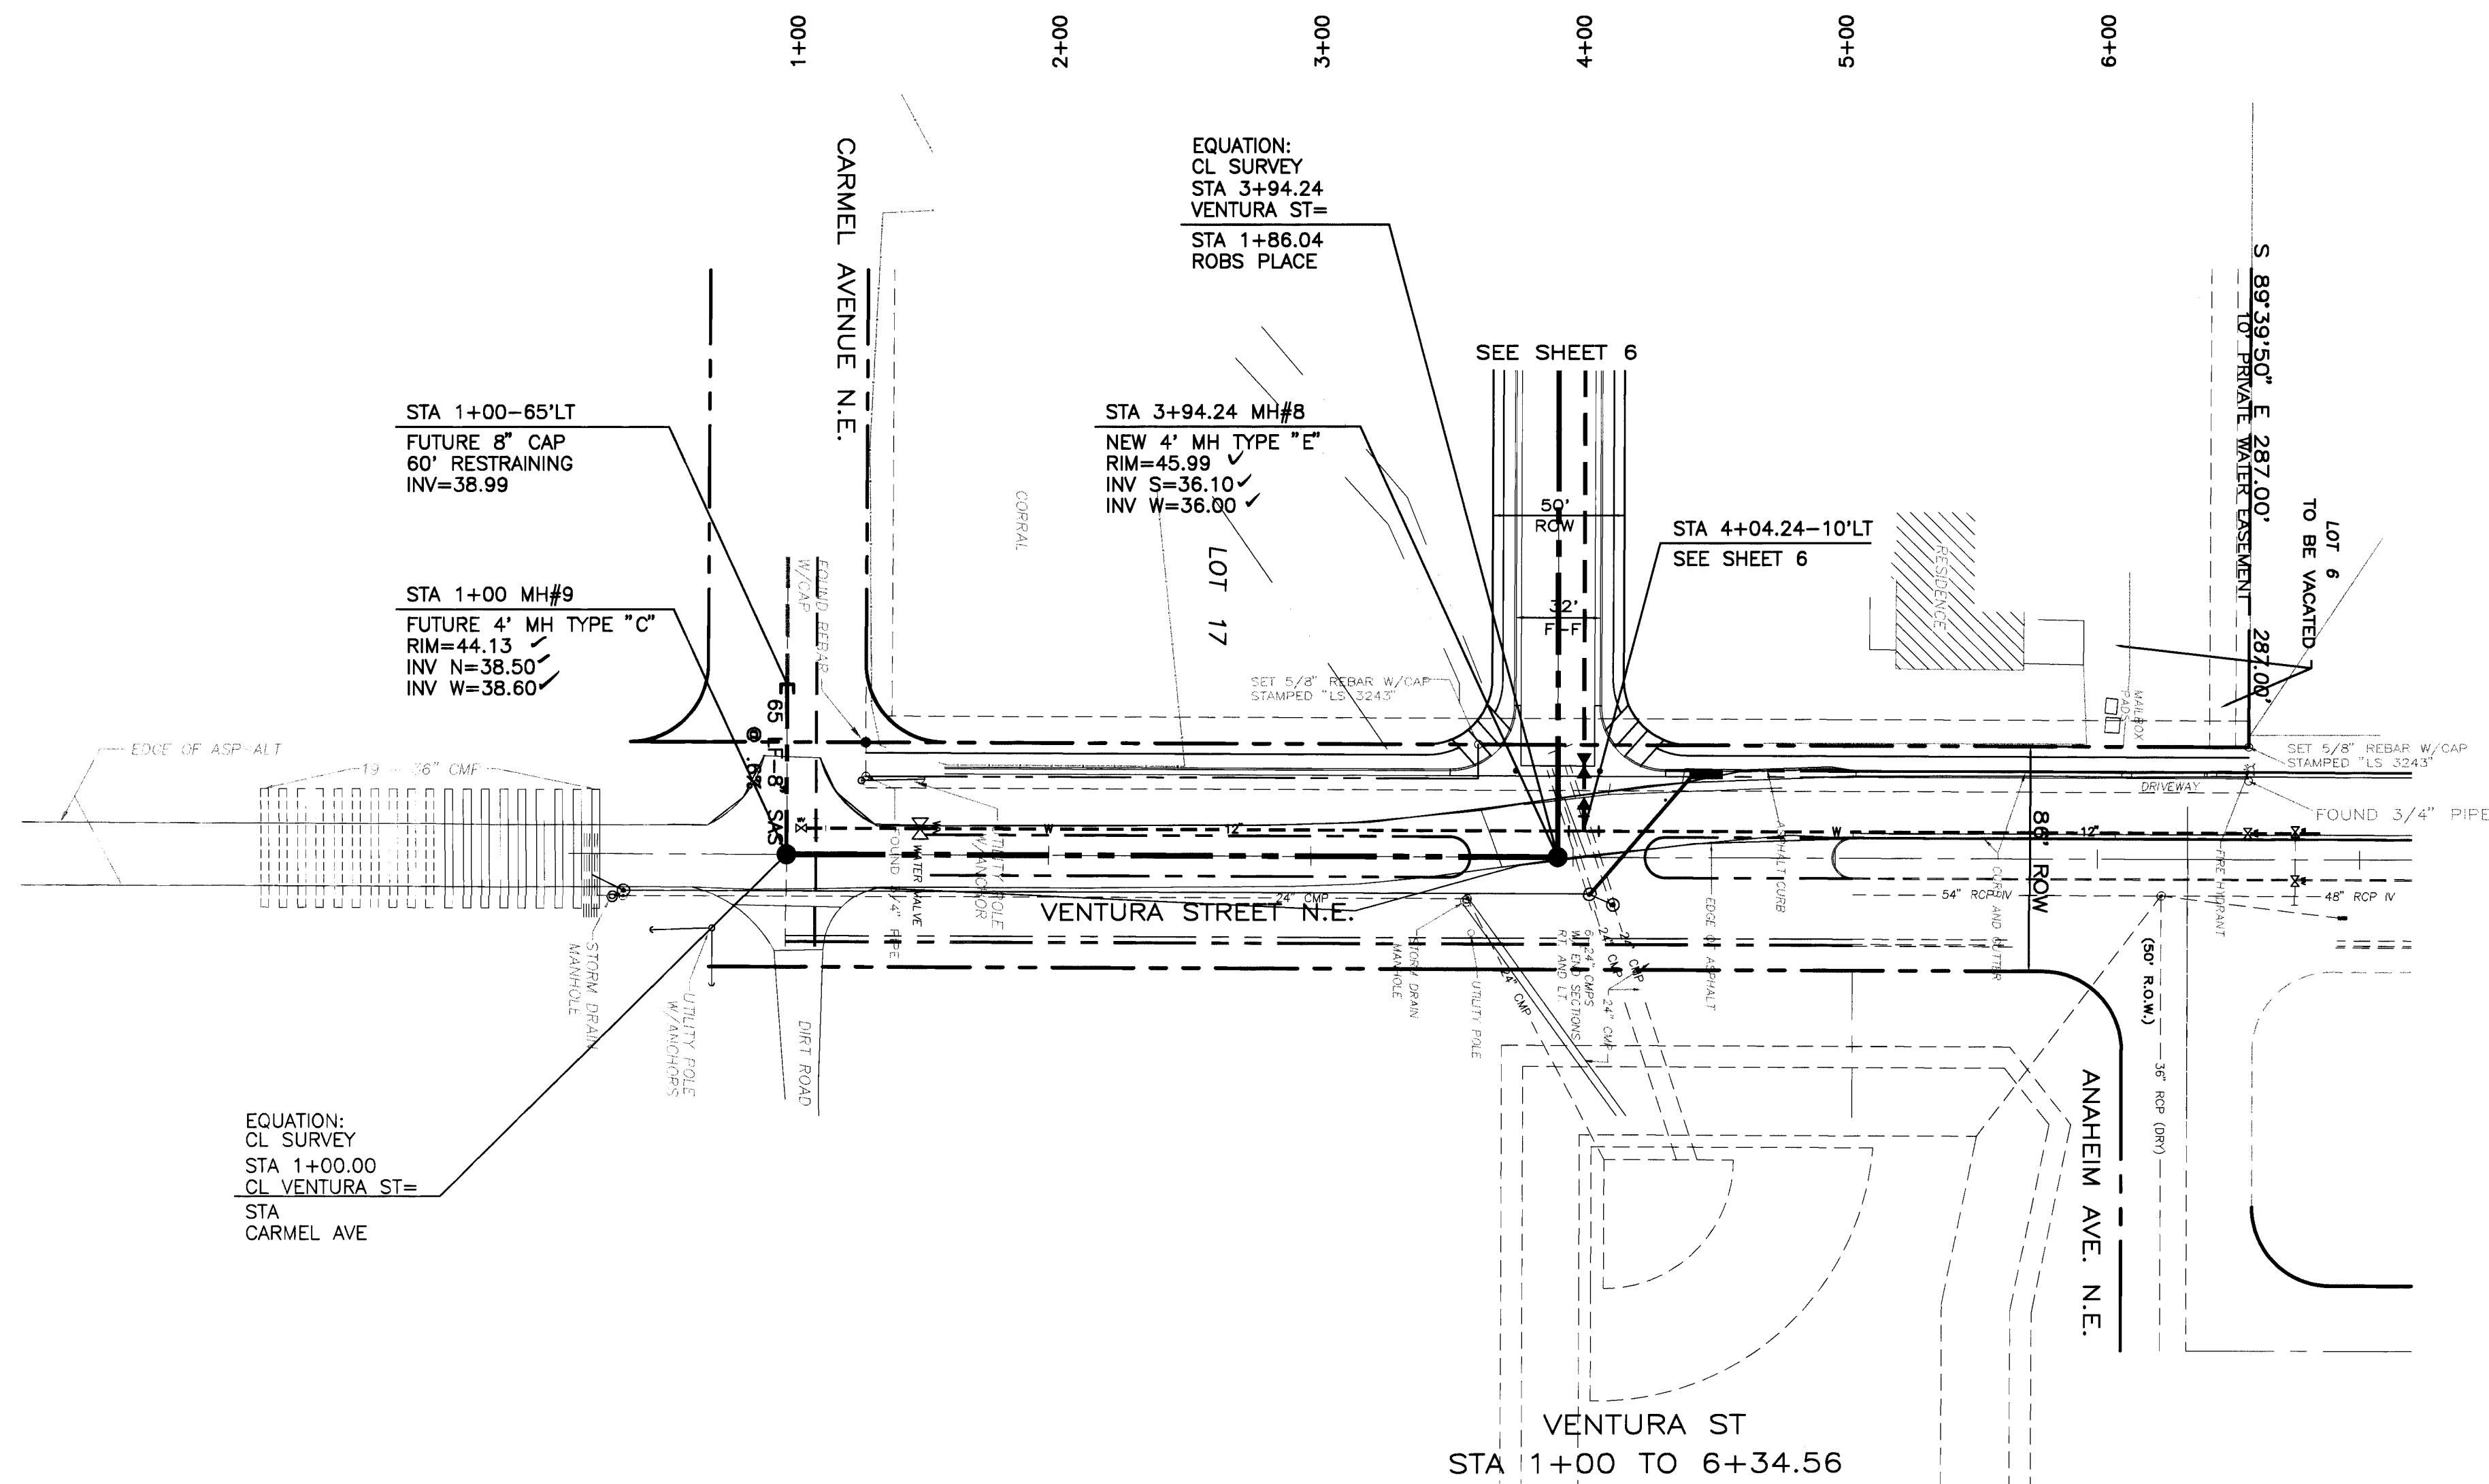

SCALE: HORIZ. 1"=50'
VERT. 1"= 5'

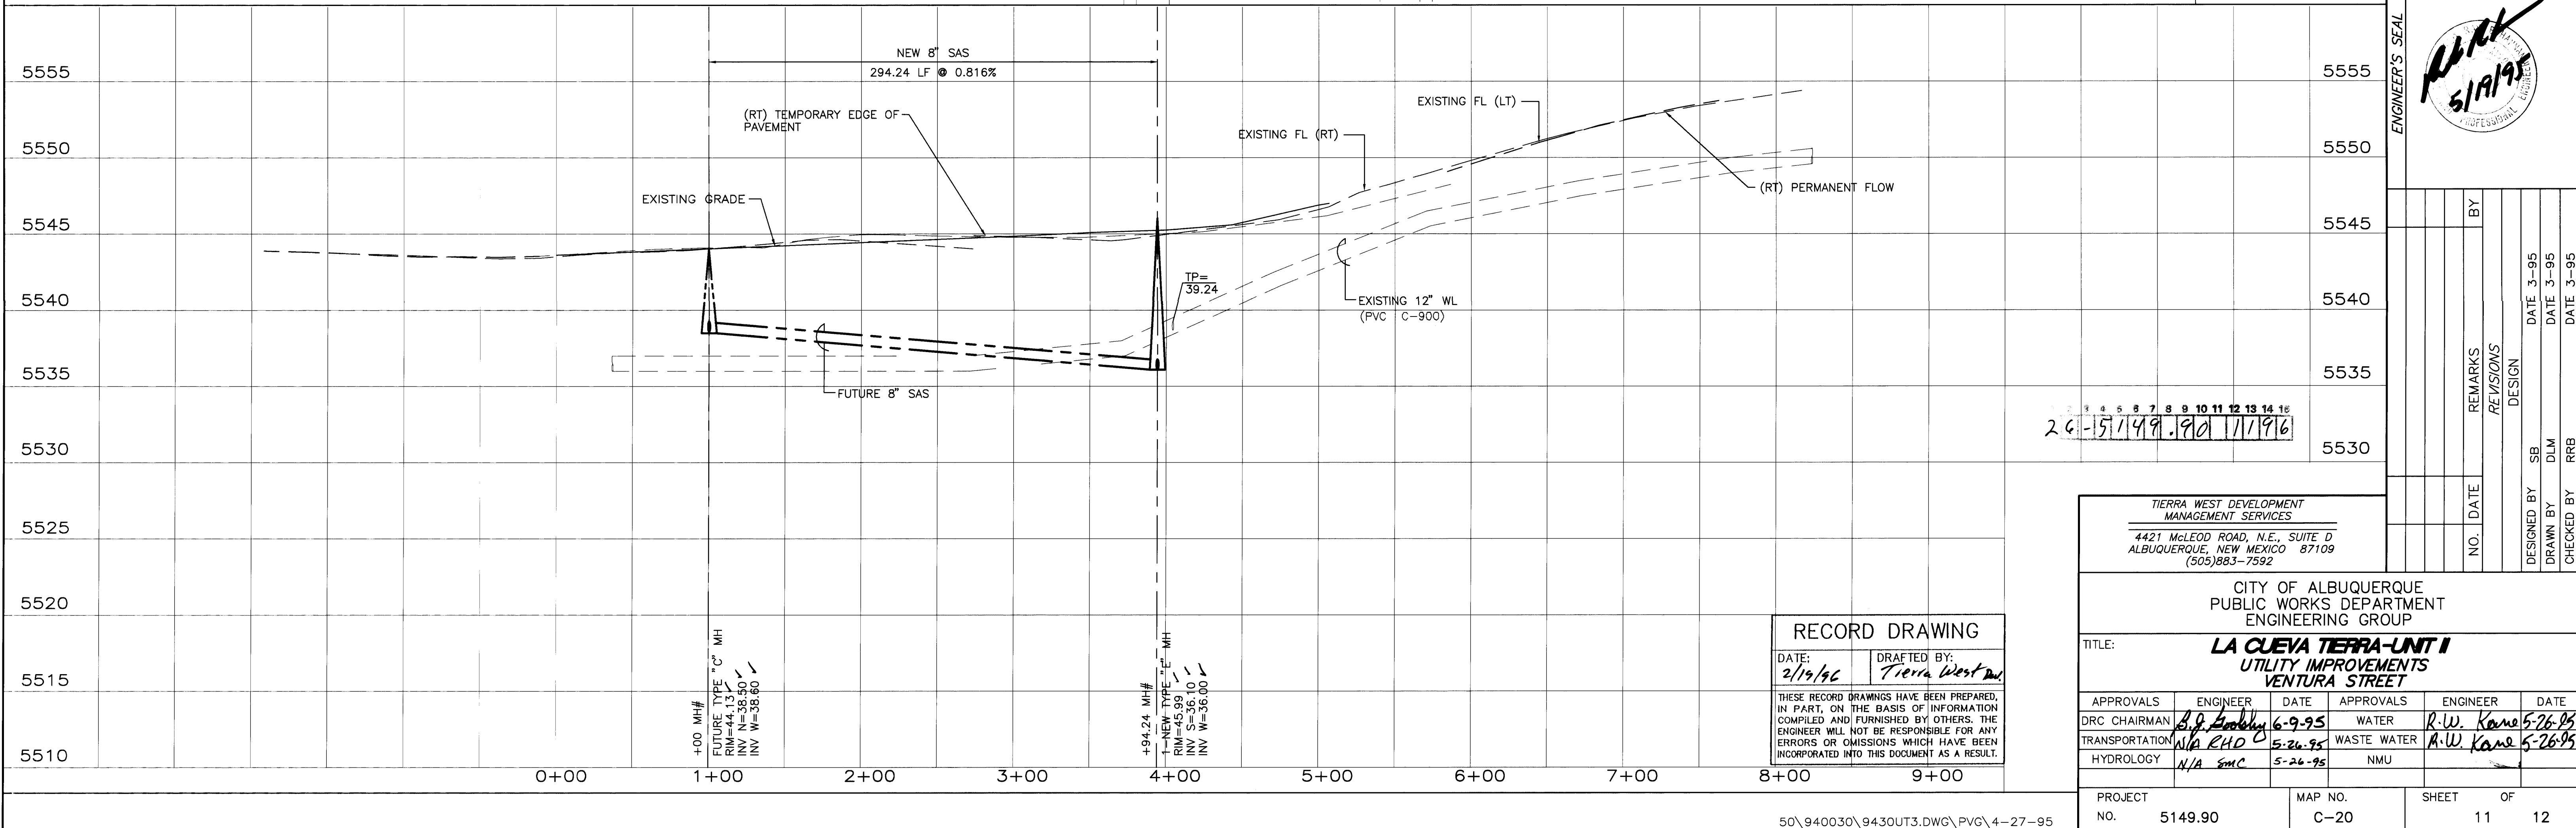



RECORD DRAWING
DATE: 2/19/96
DRAFTED BY: Tierra West Dev.
THESE RECORD DRAWINGS HAVE BEEN PREPARED, IN PART, ON THE BASIS OF INFORMATION COMPILED AND FURNISHED BY OTHERS. THE ENGINEER WILL NOT BE RESPONSIBLE FOR ANY ERRORS OR OMISSIONS WHICH HAVE BEEN INCORPORATED INTO THIS DOCUMENT AS A RESULT.

TIERRA WEST DEVELOPMENT
MANAGEMENT SERVICES
4421 MCLEOD ROAD, N.E., SUITE D
ALBUQUERQUE, NEW MEXICO 87109
(505)883-7592

CITY OF ALBUQUERQUE PUBLIC WORKS DEPARTMENT ENGINEERING GROUP			
TITLE: LA CUEVA TIERRA-UNT II UTILITY IMPROVEMENTS VENTURA STREET			
APPROVALS	ENGINEER	DATE	APPROVALS
DRC CHAIRMAN	B.G. Amador	6-9-95	WATER
TRANSPORTATION	N/A RHD	5-26-95	WASTE WATER
HYDROLOGY	N/A SMC	5-26-95	NMU
DESIGNED BY	SR	DATE 3-95	
DRAWN BY	DLM	DATE 3-95	
CHECKED BY	RRB	DATE 3-95	
PROJECT NO. 5149.90		MAP NO. C-20	SHEET 11 OF 12



SURVEY INFORMATION		BENCH MARKS		AS BUILT INFORMATION	
FIELD NOTES		ASC MONUMENT "1-C2A"		CONTRACTOR Frank's Engineering	
NO. BY DATE		CENTRAL STATION DATA		WORK STATED BY Frank's Engineering	
		NM STATE PLANE COORDINATES		ACCEPTANCE BY Tierra West Dev.	
		(CENTRAL ZONE) NAD 1927		FIELD CHECKED BY Tierra West Dev.	
		X=415,503.35		DRAWINGS CORRECTED BY Tierra West Dev.	
		Y=1,518,787.29		MICRO-FILM INFORMATION	
		EL= 5364.65		RECORDED BY	
		GROUND TO GRID FACTOR=0.99963867		NO.	
		DELTA ALPHA=-00'09"46"			



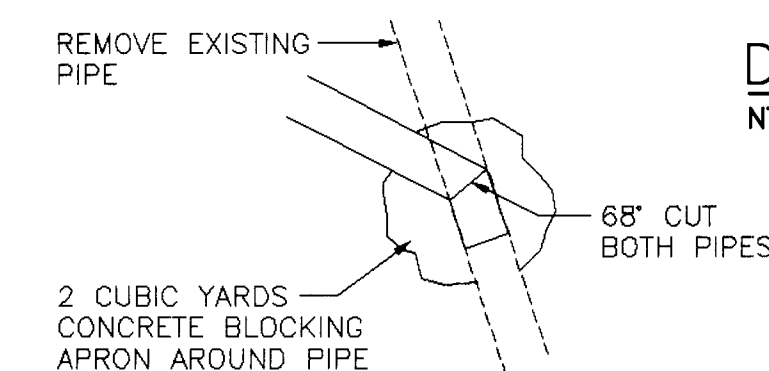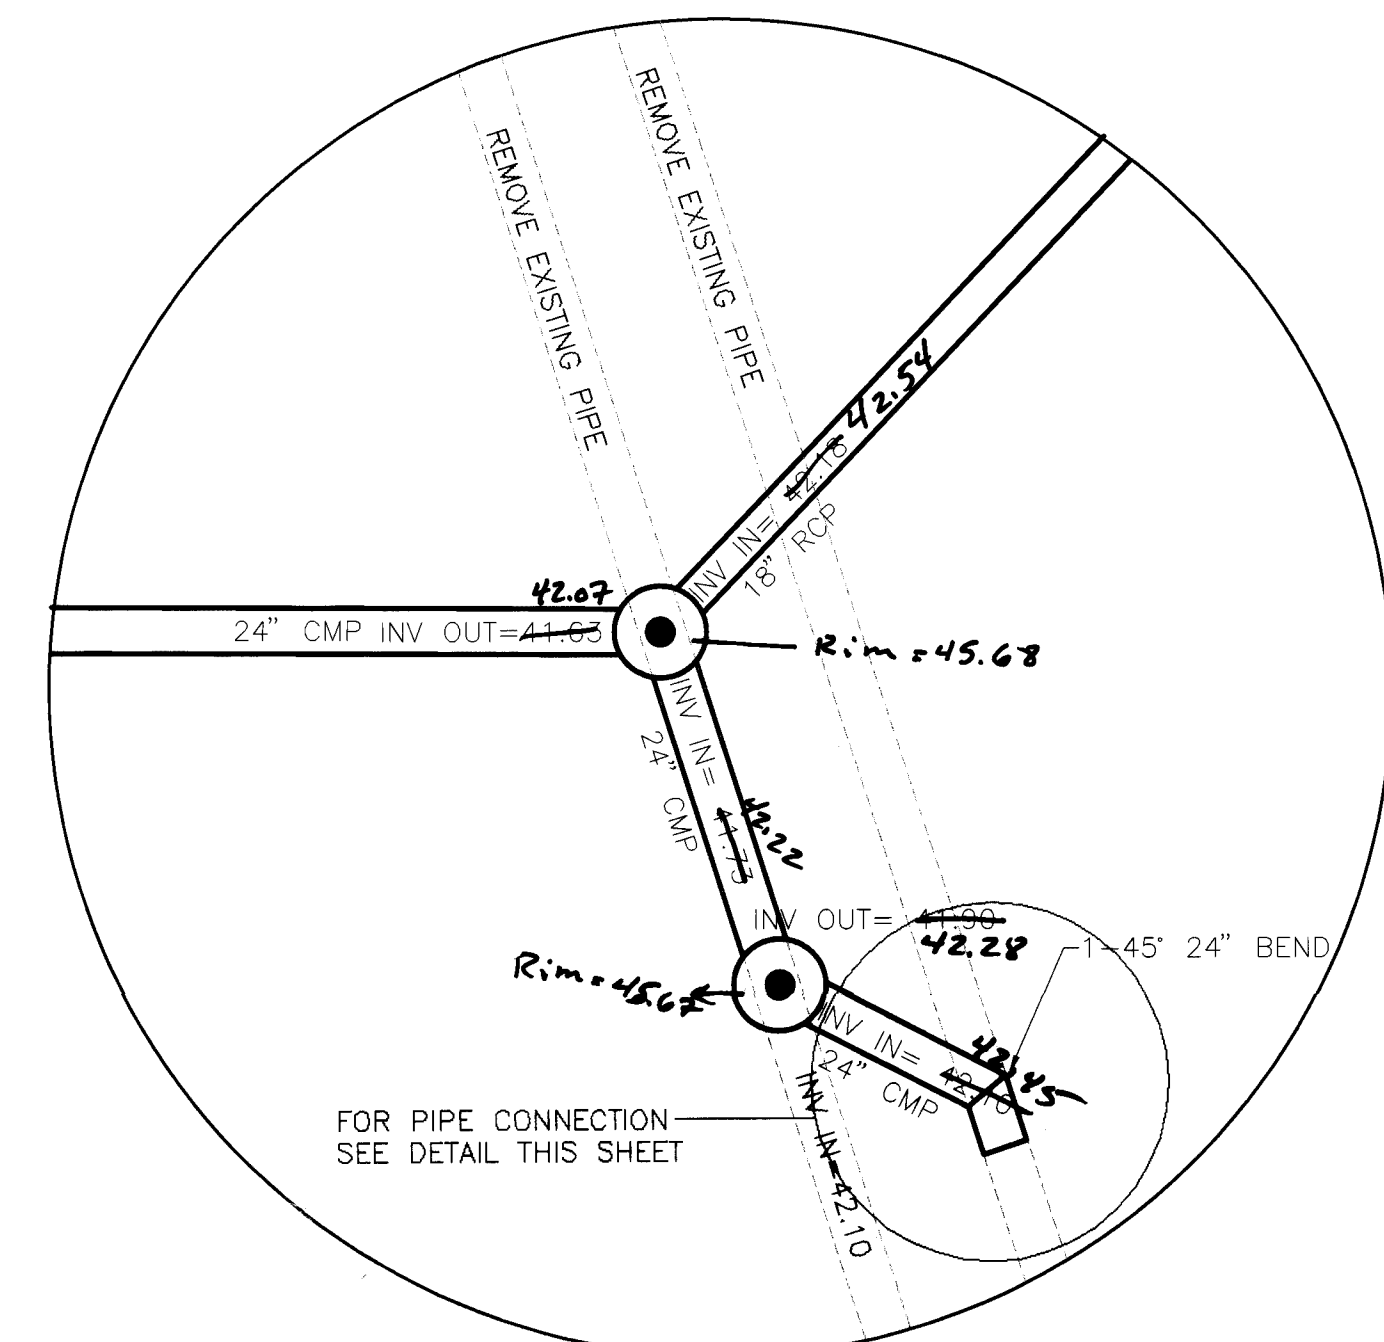

STORM DRAIN CONNECTION
NTS

SCALE: HORIZ. 1"=50'
VERT. 1"= 5'

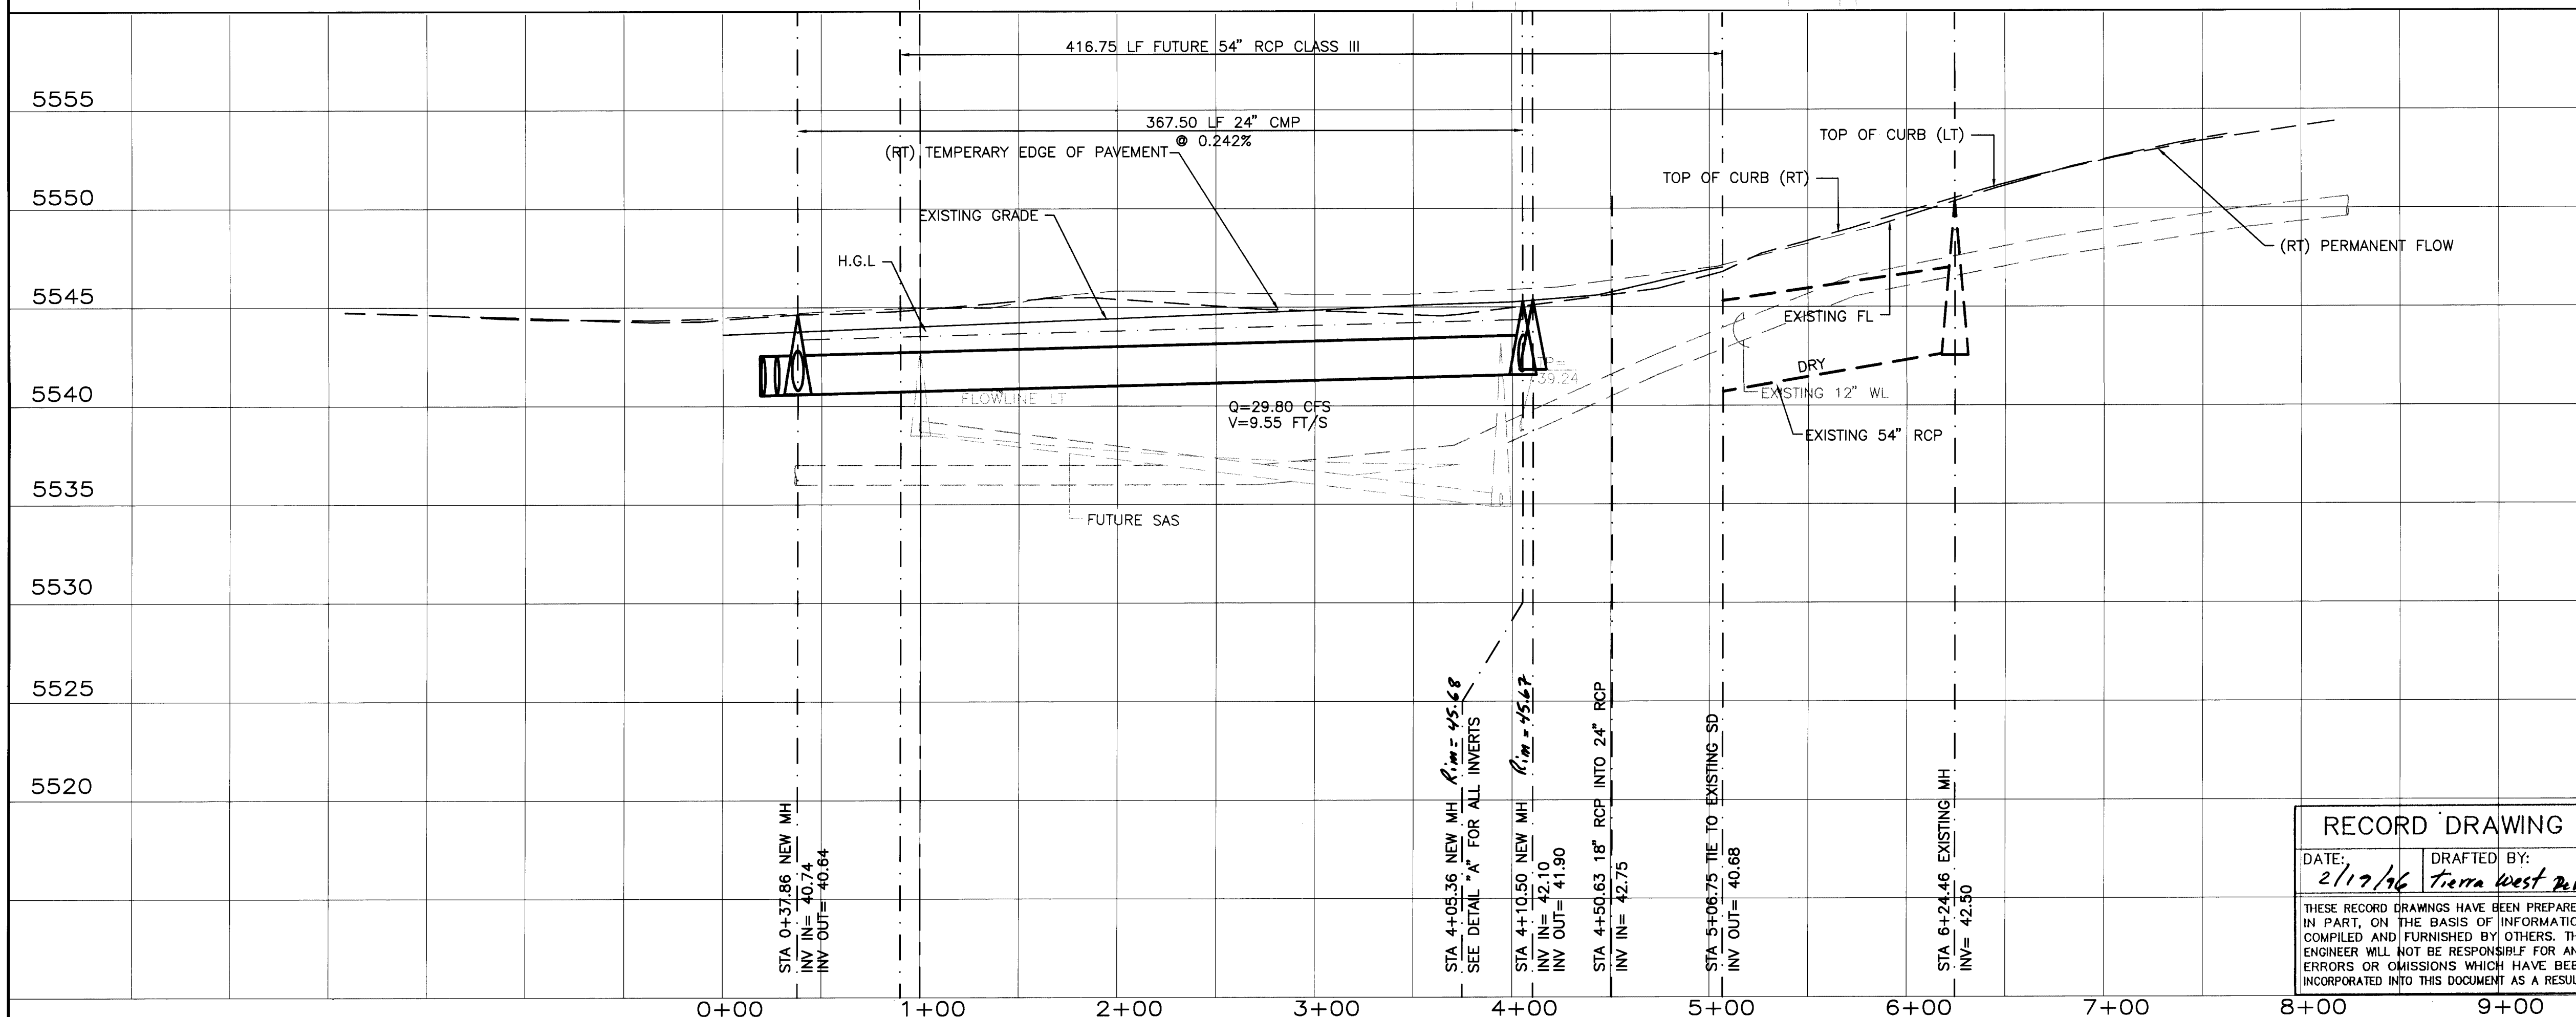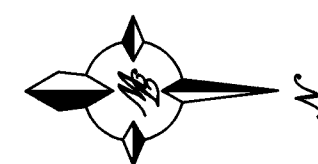

DATE:	2/17/96	DRAFTED BY:	Tierra West Rev.
THESE RECORD DRAWINGS HAVE BEEN PREPARED, IN PART, ON THE BASIS OF INFORMATION COMPILED AND FURNISHED BY OTHERS. THE ENGINEER WILL NOT BE RESPONSIBLE FOR ANY ERRORS OR OMISSIONS WHICH HAVE BEEN INCORPORATED INTO THIS DOCUMENT AS A RESULT.			


TIERRA WEST DEVELOPMENT
MANAGEMENT SERVICES
4421 McLEOD ROAD, NE SUITE D
ALBUQUERQUE, NEW MEXICO 87109
(505)883-7592

CITY OF ALBUQUERQUE PUBLIC WORKS DEPARTMENT ENGINEERING GROUP	
TITLE:	<i>LA CUEVA TERRA STORM DRAIN IMPROVEMENTS VENTURA STREET</i>

APPROVALS	ENGINEER	DATE	APPROVALS	ENGINEER	DATE
DRC CHAIRMAN	B.G. Gooding	6-9-95	WATER	N/A	RWD 5-26-95
TRANSPORTATION	N/A RHD	5-26-95	WASTE WATER	N/A	RWD 5-26-95
HYDROLOGY	J.C. Brown	5-26-95	NMU		

PROJECT NO.	5149.90	MAP NO. C-20	SHEET 12	OF 12
----------------	---------	-----------------	-------------	----------

ENGINEER'S SEAL

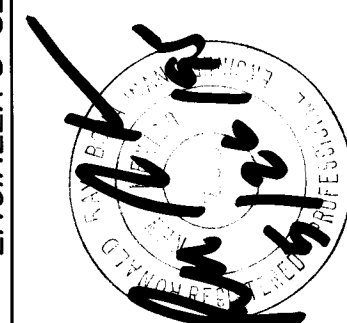[illegible]

AS BUILT INFORMATION	
CONTRACTOR	Franklin's Earthmoving
WORK ORDER NO.	DATE 6/1/85
INSPECTOR'S NAME	DATE 6/1/85
ACCEPTANCE BY	DATE 6/1/85
FIELD LOCATION	DATE 6/1/85
PROJECT NAME	DATE 6/1/85
CORRECTED BY	DATE 6/1/85
MICRO-FILM INFORMATION	
RECORDED BY	DATE
NO.	

SCANNED BY 30\940030\9430PPSD.DWG\YAB\5-26-95
BY LASON