

GENERAL NOTES

THE FOLLOWING NOTES ALSO APPLY WHEN CHECKED

- ☐ ALL UTILITIES AND UTILITY SERVICE LINES SHALL BE INSTALLED PRIOR TO PAVING.
- ☐ BACKFILL COMPACTION SHALL BE ACCORDING TO SPECIFIED STREET USE.
- ☐ TACK COAT REQUIREMENTS SHALL BE DETERMINED BY THE CITY ENGINEER.
- ☐ SIDEWALK AND WHEELCHAIR RAMPS WITHIN THE CURB RETURNS SHALL BE CONSTRUCTED WHEREVER A NEW CURB RETURN IS CONSTRUCTED.
- ☐ IF CURB IS DEPRESSED FOR A DRIVEPAD, THE DRIVEPAD SHALL BE CONSTRUCTED PRIOR TO ACCEPTANCE OF CURB AND GUTTER.
- ☐ ALL STORM DRAINAGE FACILITIES SHALL BE COMPLETED PRIOR TO FINAL ACCEPTANCE.
- ☐ THE REQUESTOR OR DEVELOPER SHALL BE RESPONSIBLE FOR REPAIR OR REPLACEMENT OF ALL CURB AND GUTTER OR SIDEWALK DAMAGE AFTER APPROVAL BY THE CITY ENGINEER OR WORK COMPLETED BY THE CONTRACTOR.

NOTICE TO CONTRACTORS

- CITY OF ALBUQUERQUE SPECIFICATIONS FOR PUBLIC WORKS CONSTRUCTION, 1986 EDITION AS AMENDED THROUGH UPDATE 5, WILL BE REFERRED TO HEREIN AS THE "STANDARD SPECIFICATIONS".
- TWO WORKING DAYS PRIOR TO ANY EXCAVATION, CONTRACTOR MUST CONTACT NEW MEXICO ONE CALL SYSTEM (260-1990) AND DETERMINE LOCATION OF EXISTING UTILITIES.
- PRIOR TO ANY CONSTRUCTION, THE CONTRACTOR SHALL EXCAVATE AND VERIFY THE HORIZONTAL AND VERTICAL LOCATIONS OF ALL OBSTRUCTIONS. SHOULD A CONFLICT EXIST, THE CONTRACTOR SHALL NOTIFY THE ENGINEER OR THE SURVEYOR SO THAT THE CONFLICT CAN BE RESOLVED WITHOUT DELAY.
- ALL EXISTING SIGNS, MARKERS, DELINEATORS, ETC., WITHIN THE CONSTRUCTION LIMITS SHALL BE REMOVED, STORED AND RE-SET BY THE CONTRACTOR.
- THE CONTRACTOR SHALL NOTIFY THE ENGINEER NOT LESS THAN SEVEN (7) PRIOR TO STARTING WORK IN ORDER THAT THE ENGINEER MAY TAKE NECESSARY MEASURES TO INSURE THE PRESERVATION OF SURVEY MONUMENTS WITHOUT THE CONSENT OF THE ENGINEER AND SHALL NOTIFY THE ENGINEER AND BEAR THE EXPENSE OF REPLACING ANY THAT MAY BE DISTURBED WITHOUT PERMISSION. REPLACEMENT SHALL BE DONE ONLY BY THE CITY SURVEYOR. WHEN A CHANGE IS MADE IN THE FINISHED ELEVATIONS OF THE PAVEMENT OF ANY ROADWAY IN WHICH A PERMANENT SURVEY MONUMENT IS LOCATED, CONTRACTOR SHALL, AT HIS OWN EXPENSE, ADJUST THE MONUMENT COVER TO THE NEW GRADE UNLESS OTHERWISE SPECIFIED. REFER TO SECTION 4.4 OF THE GENERAL CONDITIONS OF THE STANDARD SPECIFICATIONS.


KEYED NOTES

- EXISTING 18" RCP LATERAL TO BE PLUGGED, REMAIN IN PLACE, AND ABANDONED IN PLACE.
- EXISTING DOUBLE "C" INLET TO BE REMOVED, CONVERTED TO TYPE "D" INV. 4966.98
- NEW 6" VALLEY GUTTER WITH 3/4" INVERT.
- EXISTING 18" RCP SD LATERAL TO BE CONNECTED TO NEW DOUBLE "C" INLET.
- NEW 18" CLASS III RCP LATERAL TO NEW OLD DOUBLE "C" DOUBLE "C" INLET. SEE PROFILE. 37 L.F.
- NEW DOUBLE "C" INLET.
GRATE = 4966.00
INVERT = 4964.50
CONNECT TO EXISTING 18" LATERAL.
- NEW DOUBLE "C" INLET.
GRATE = 4970.40
INVERT = 4967.42
CONNECT TO NEW 18" LATERAL.

SCALE:
HORIZ. 1" = 20'
VERT. 1" = 10'

ROASTER'S - EUBANK & CONSTITUTION
OFF-SITE STORM DRAIN IMPROVEMENTS
STA. 10+00.00 TO STA. 11+68.00


1 2 3 4 5 6 7 8 9 10 11 12 13 14 15
20-5-95 20-5-95 20-5-95 20-5-95 20-5-95 20-5-95 20-5-95 20-5-95 20-5-95 20-5-95 20-5-95 20-5-95 20-5-95 20-5-95 20-5-95

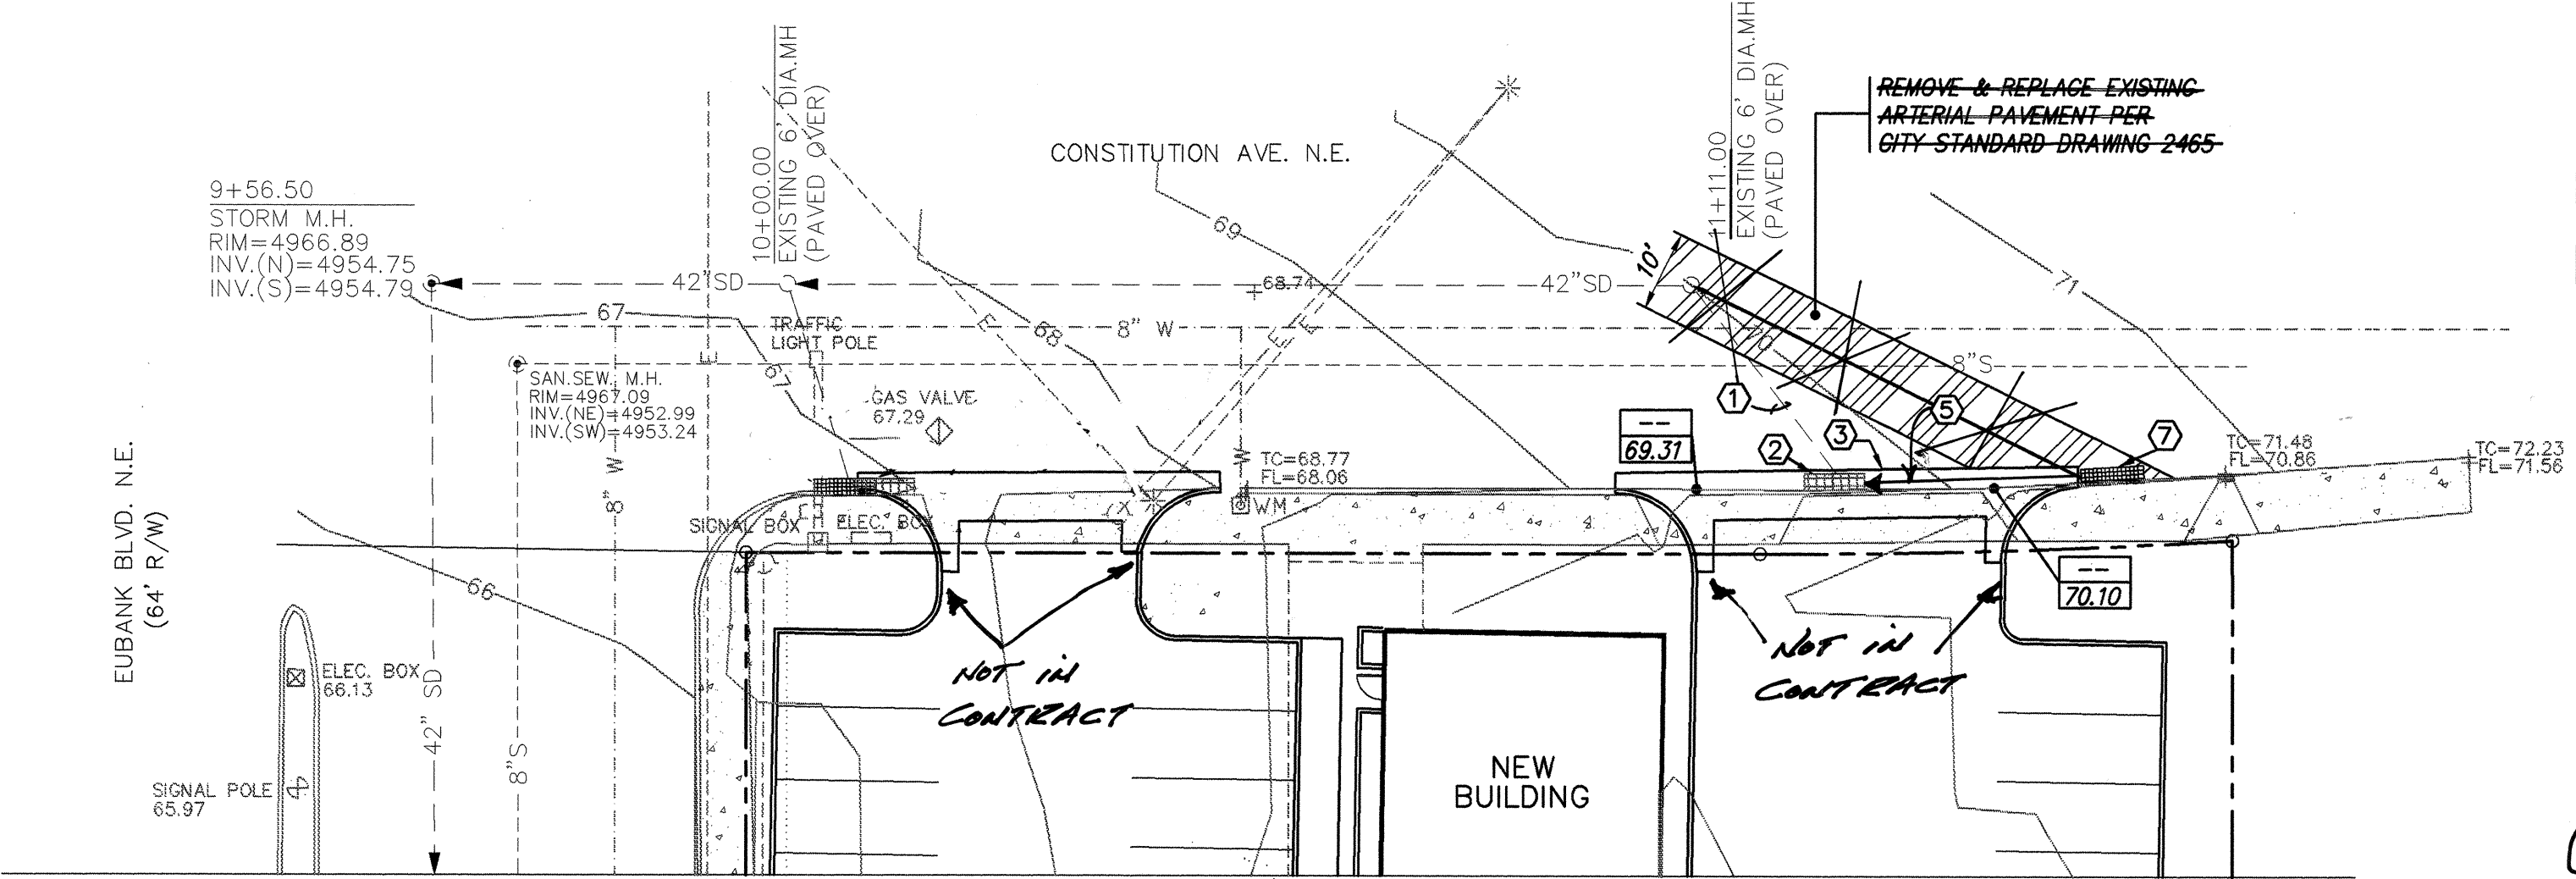

APPROVAL OF AS BUILT DRAWINGS
CHIEF CONSTRUCTION ENGINEER
[Signature]
DATE 10-5-95

CAUTION:

NOTE THAT ALL EXISTING UTILITIES MAY NOT BE SHOWN. ALL EXISTING SERVICE CONNECTIONS ARE NOT SHOWN. ANY EXISTING UTILITIES THAT ARE SHOWN ARE APPROXIMATE LOCATION ONLY. IT SHALL BE THE SOLE RESPONSIBILITY OF THE CONTRACTOR TO CONTACT ALL THE UTILITY OWNERS AND TO CONDUCT ALL NECESSARY FIELD INVESTIGATIONS PRIOR TO ANY EXCAVATIONS TO DETERMINE THE ACTUAL LOCATION OF UTILITIES AND OTHER IMPROVEMENTS.

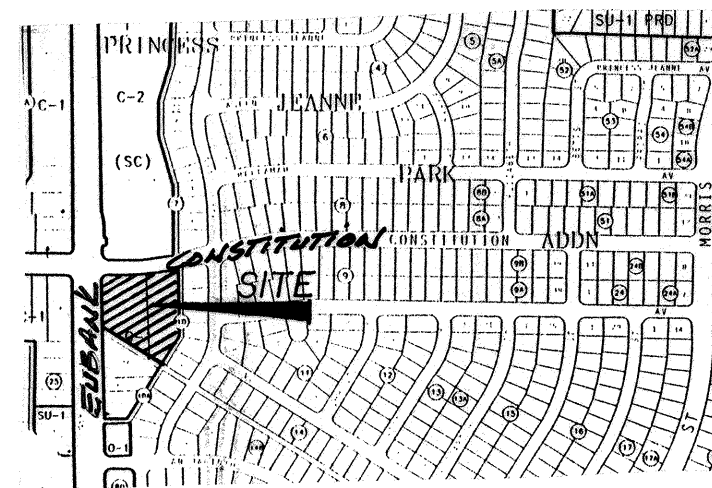

- LEGEND
- PROPERTY LINE
 - EXISTING CONTOUR
 - EXISTING CURB & SPOT ELEVATION
 - EXISTING SAS MH
 - EXISTING UTILITIES
 - EDGE OF EXISTING BUILDING
 - EXISTING WATER METER
 - EXISTING GAS METER
 - PROPOSED SPOT ELEVATION

dmg
D. MARK GOODWIN & ASSOCIATES, P.A.
CONSULTING ENGINEERS & SURVEYORS
P.O. BOX 90606
ALBUQUERQUE, NEW MEXICO 87199
(505) 345-2010

CITY OF ALBUQUERQUE
PUBLIC WORKS DEPARTMENT
ENGINEERING GROUP

TITLE: ROASTER'S - EUBANK & CONSTITUTION
OFF-SITE STORM DRAIN IMPROVEMENTS

APPROVALS	ENGINEER	DATE	APPROVALS	ENGINEER	DATE
DRC CHAIRMAN	<i>[Signature]</i>	3-2-95	WATER	N/A	RWK 3-2-95
TRANSPORTATION	<i>[Signature]</i>	3-02-95	WASTE WATER	N/A	RWK 3-2-95
HYDROLOGY	<i>[Signature]</i>	3-2-95			

PROJECT NO. 5165.90
MAP NO. J-21
SHEET 1 OF 1

ROAST/PP20/1-11