



TO BE INSTALLED @ THE OUTFLOW
OF ALL CATCH BASINS (SEE TABLE FOR
ORFICE PLATE SIZES)





RECORD DRAWING

DATE:
10-5-95

DRAFTED BY:
SHAHRAM BIAZAR

THESE RECORD DRAWINGS HAVE BEEN PREPARED, IN PART, ON THE BASIS OF INFORMATION COMPILED AND FURNISHED BY OTHERS. THE ENGINEER WILL NOT BE RESPONSIBLE FOR ANY ERRORS OR OMISSIONS WHICH HAVE BEEN INCORPORATED INTO THIS DOCUMENT AS A RESULT.

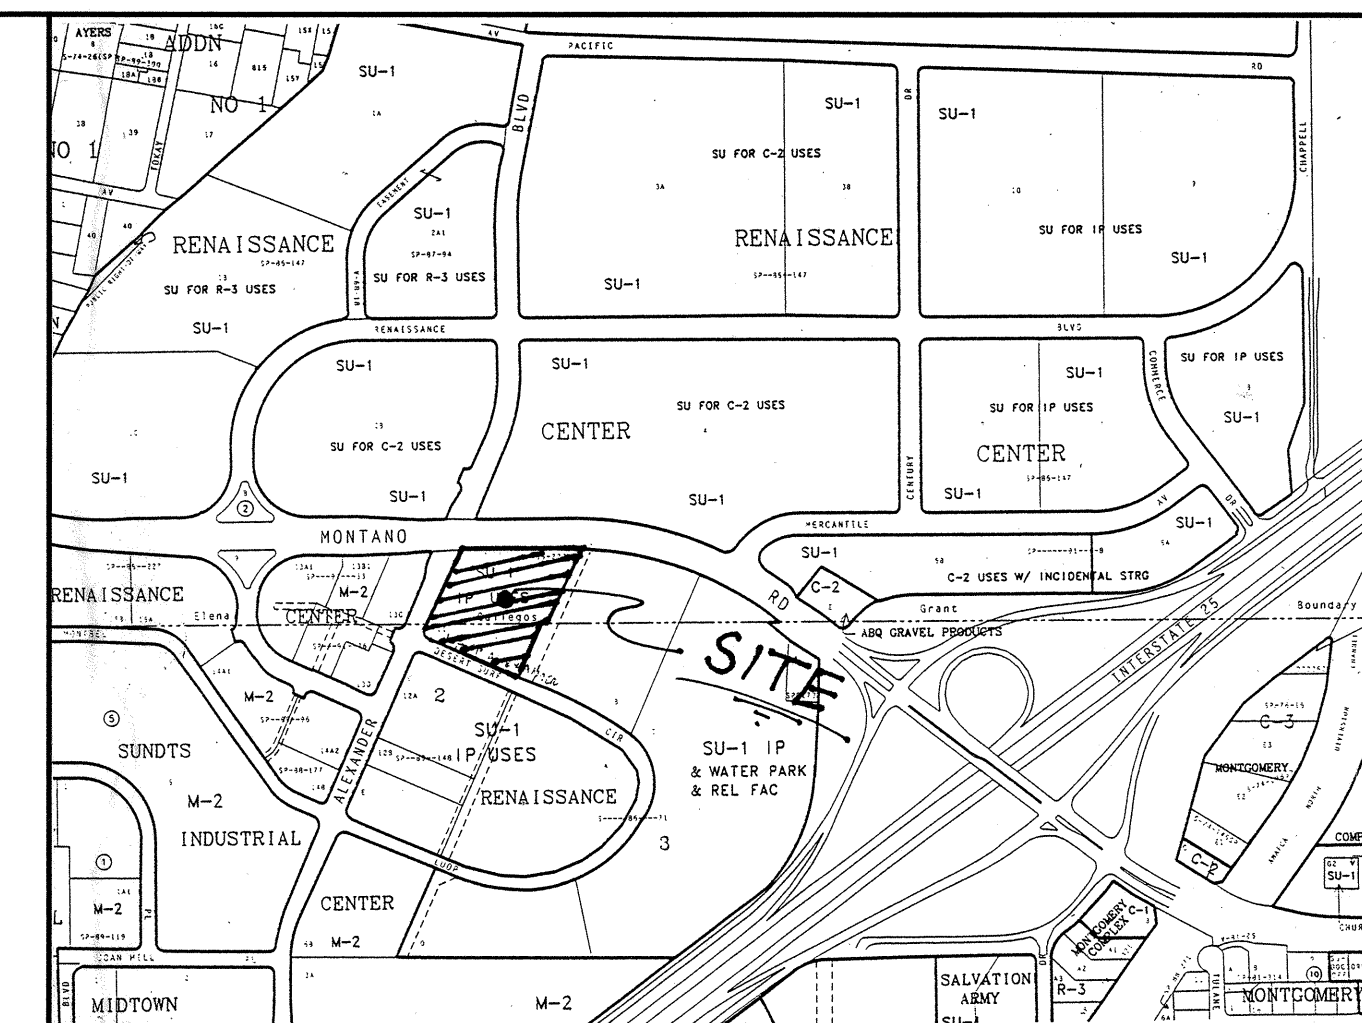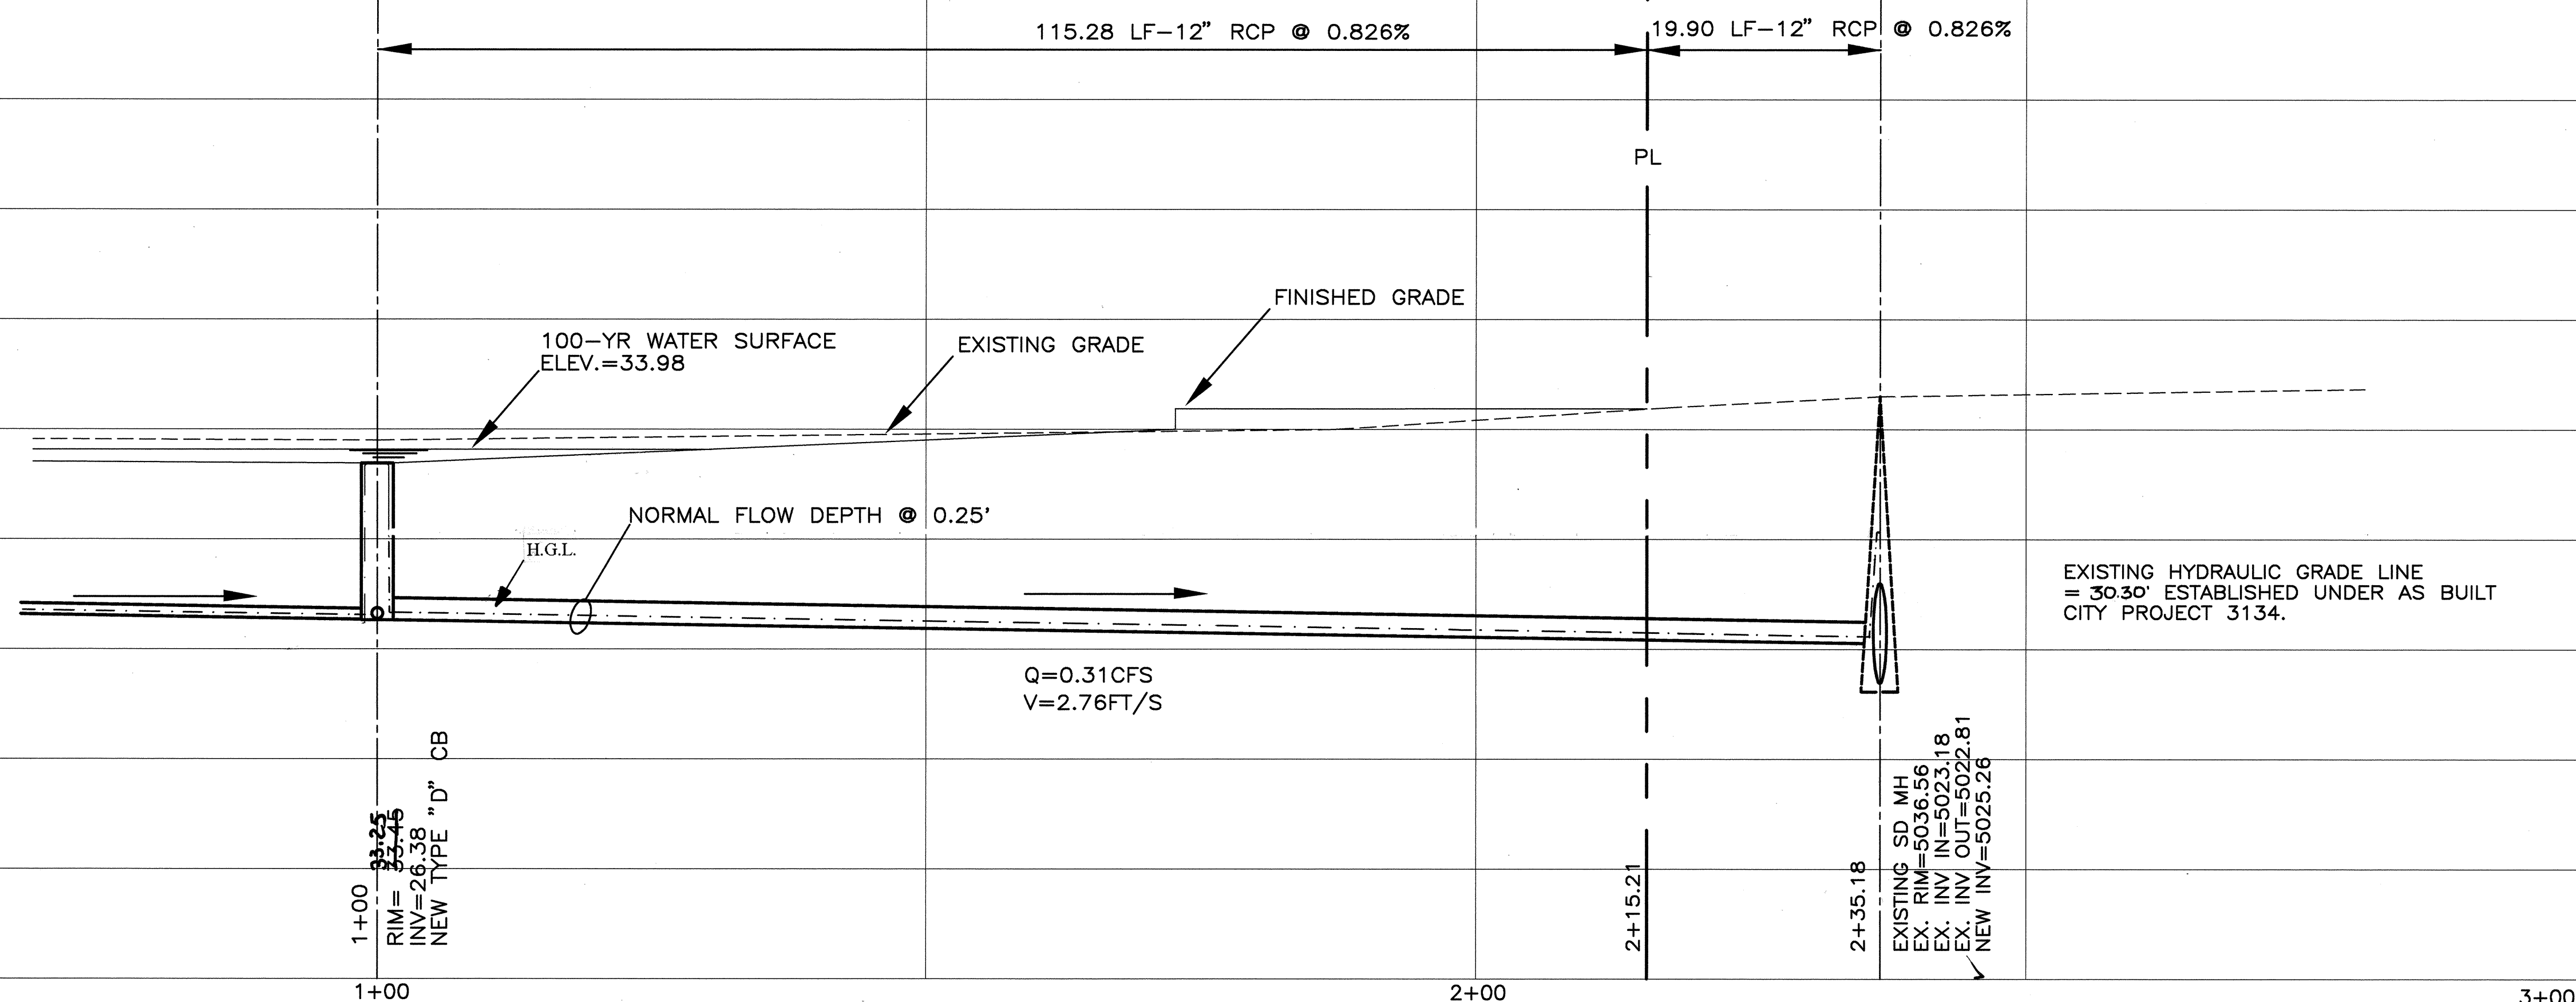

VICINITY MAP

LEGAL DESCRIPTION: TRACT 11 OF RENAISSANCE CENTER

GENERAL NOTES

NOTICE TO CONTRACTORS

- ✓ 1. ALL WORK DETAILED ON THESE PLANS TO BE PERFORMED UNDER CONTRACT SHALL, EXCEPT AS OTHERWISE STATED OR PROVIDED FOR HEREON, BE CONSTRUCTED IN ACCORDANCE WITH THE CITY OF ALBUQUERQUE, NEW MEXICO, SPECIFICATIONS FOR PUBLIC WORKS CONSTRUCTION, 1988 EDITION (UPDATE #1) 12
- ✓ 2. TWO WORKING DAYS PRIOR TO ANY EXCAVATION, THE CONTRACTOR MUST CONTACT NEW MEXICO ONE CALLS SYSTEM (280-1990) FOR LOCATION OF EXISTING UTILITIES.
3. PRIOR TO CONSTRUCTION, THE CONTRACTOR SHALL EXAMINE AND VERIFY THE HORIZONTAL AND VERTICAL LOCATIONS OF ALL EXISTING UTILITIES. PRIOR TO ANY EXCAVATION, THE CONTRACTOR SHALL NOTIFY THE ENGINEER OR SURVEYOR IMMEDIATELY SO THAT THE CONFLICT CAN BE RESOLVED WITH A MINIMUM AMOUNT OF DELAY.
4. THREE(3) WORKING DAYS PRIOR TO BEGINNING OF CONSTRUCTION, THE CONTRACTOR SHALL SUBMIT TO THE CONSTRUCTION COORDINATIONS DIVISION A DETAILED CONSTRUCTION SCHEDULE. TWO(2) WORKING DAYS PRIOR TO CONSTRUCTION, THE CONTRACTOR SHALL OBTAIN A BARRICADING PERMIT FROM THE CONST. COORDINATION DIVISION. CONTRACTOR SHALL NOTIFY THE ENGINEER 72 HOURS PRIOR TO ANY EXCAVATION INVOLVING AN INTERSECTION. REFER TO STANDARD SPECIFICATIONS.
5. ALL STREET STRIPING ALTERED OR DESTROYED SHALL BE REPLACED IN KIND BY CONTRACTOR TO LOCATION AND IN KIND AS EXISTING OR AS INDICATED BY THIS PLAN SET.
- ✓ 6. CONTRACTOR SHALL NOTIFY THE ENGINEER NOT LESS THAN SEVEN (7) DAYS PRIOR TO ANY EXCAVATION. THE CONTRACTOR MAY TAKE NECESSARY MEASURES TO INSURE THE PRESERVATION OF SURVEY MONUMENTS. CONTRACTOR SHALL BE RESPONSIBLE FOR ANY DAMAGE TO SURVEY MONUMENTS. WITH THE CONSENT OF THE ENGINEER AND SHALL NOTIFY THE ENGINEER AND BEAR THE EXPENSE OF REPLACING ANY THAT MAY BE DAMAGED WITHOUT THE CONSENT OF THE ENGINEER. WHEN DONE ONLY BY THE CITY SURVEYOR. WHEN A CHANGE IS MADE IN THE FINISHED ELEVATIONS OF THE PAVEMENT OF ANY HIGHWAY IN THE CITY OF ALBUQUERQUE, NEW MEXICO, IS LOCATED, CONTRACTOR SHALL, AT HIS OWN EXPENSE, ADJUST THE MONUMENT COVER TO THE NEW GRADE UNLESS OTHERWISE SPECIFIED. REFER TO SECTION 4.0 OF THE GENERAL CONDITIONS OF THE STANDARD SPECIFICATIONS.

THE FOLLOWING NOTES ALSO APPLY WHEN CHECKED

- ☒ ALL UTILITIES AND UTILITY SERVICE LINES SHALL BE INSTALLED PRIOR TO PAVING.
- ☒ BACKFILL COMPACTION SHALL BE ACCORDING TO SPECIFIED STREET USE.
- ☐ TACK COAT REQUIREMENTS SHALL BE DETERMINED BY THE CITY ENGINEER.
- ☐ SIDEWALKS AND WHEELCHAIR RAMPS WITHIN THE CURB RETURNS SHALL BE CONSTRUCTED WHEREVER A NEW CURB RETURN IS CONSTRUCTED.
- ☐ IF CURB IS DERESSED FOR A DRIVEPAD, THE DRIVEPAD SHALL BE CONSTRUCTED PRIOR TO ACCEPTANCE OF CURB AND GUTTER.
- ☐ ALL STORM DRAINAGE FACILITIES SHALL BE COMPLETED PRIOR TO FINAL ACCEPTANCE.
7. ALL UTILITY BACKFILL SHALL BE 90% ASTM D1557 ALL ROADWAYS AND SIDEWALKS, IN LANDSCAPE AREAS DENSITY MAY BE 90% OR GREATER.
8. UTILITIES ARE DESIGNING THE DISTRIBUTION LAYOUT. SEE INDIVIDUAL UTILITY FOR LAYOUT, SIZE, AND ROUTING TO ALL BUILDINGS.

1	2	3	4	5	6	7	8	9	10	11	12	13	14	15
2	6	-	5	1	9	7	.	9	0		0	1	9	5

TIERRA WEST DEVELOPMENT
MANAGEMENT SERVICES

4600 MONTGOMERY BLVD. N.E., SUITE 3
ALBUQUERQUE, NEW MEXICO 87109
(505)883-7592

CITY OF ALBUQUERQUE
PUBLIC WORKS DEPARTMENT
ENGINEERING GROUP

TITLE:

ALBUQUERQUE GART SPORTS

Storm Sewer Connection

APPROVALS	ENGINEER	DATE	APPROVALS	ENGINEER	DATE
DRC CHAIRMAN	<i>J. J. Gorking</i>	4-20-95	WATER	N/A	
TRANSPORTATION	<i>N. R. HD</i>	4-13-95	WASTE WATER		
HYDROLOGY	<i>B. Montoya</i>	4/12/95			

PROJECT	5197.90
NO	5179.90

МАР	НП.
-----	-----

SHEET	OF
1	

APPROVED FOR
CONSTRUCTION
Robert R. Rife
CITY ENGINEER

9/14/93
DATE

APPROVED FOR
CONSTRUCTION
CITY ENGINEER

9/14/93
DATE