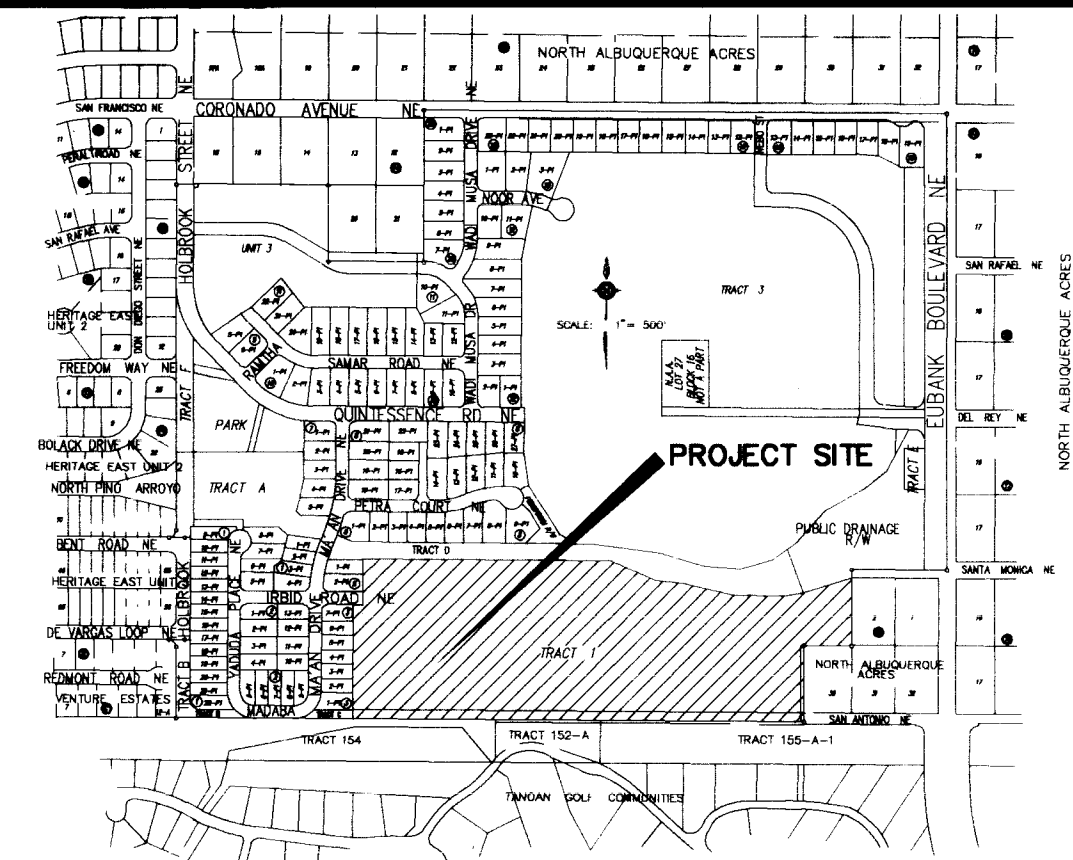


INDEX TO DRAWINGS

SHEET NO.	DESCRIPTION
1	COVER SHEET, VICINITY MAP AND INDEX TO DRAWINGS
2-4	PLATS OF GEOMETRY
5-6	GRADING AND EROSION CONTROL PLANS
7	TYPICAL LOT GRADING DETAILS AND SECTIONS
	<u>PAVING PLAN & PROFILES</u>
8	COMPOSITE PAVING PLAN
9-10	IRBID ROAD NE
11-13	ES SALT ROAD NE
14	JARASH PLACE NE
	<u>UTILITY PLAN & PROFILES</u>
15	COMPOSITE UTILITY PLAN
16-17	IRBID ROAD NE
18-20	ES SALT DRIVE NE
21	JARASH PLACE NE
22	TYPICAL GRADING DETAILS AND SECTIONS

THE ENGINEER HAS UNDERTAKEN LIMITED FIELD VERIFICATION OF THE LOCATION, DEPTH, SIZE, OR TYPE OF EXISTING UNDERGROUND UTILITY LINES, MAKES NO REPRESENTATION PERTAINING THERETO AND ASSUMES NO RESPONSIBILITY OR LIABILITY THEREFORE. THE CONTRACTOR SHALL INFORM ITSELF OF THE LOCATION OF ANY UTILITIES IN OR NEAR THE AREA OF THE WORK IN ADVANCE OF AND DURING EXCAVATION WORK. THE CONTRACTOR IS FULLY RESPONSIBLE FOR ANY AND ALL DAMAGE CAUSED BY ITS FAILURE TO LOCATE, IDENTIFY, AND PRESERVE ANY AND ALL EXISTING UTILITIES. THE CONTRACTOR SHALL COMPLY WITH STATE STATUTES, MUNICIPAL AND LOCAL ORDINANCES, RULES AND REGULATIONS, AND ANY MINIMUM EXCAVATION DEPTH REQUIREMENTS FACILITIES IN PLANNING AND CONDUCTING EXCAVATION, WHETHER BY CALLING OR NOTIFYING THE UTILITIES, COMPLYING WITH (BLUE STAKES) PROCEDURES, OR OTHERWISE.

APPROVAL OF AS BUILT DRAWINGS
CHIEF CONSTRUCTION ENGINEER
Kussell B. Smith
DATE 3-11-97

SCALE: 1" = 500 ± **VICINITY MAP** D-21-Z

GENERAL NOTES:

1. ALL WORK DETAILED ON THESE PLANS TO BE PERFORMED UNDER CONTRACT SHALL, EXCEPT AS OTHERWISE STATED OR PROVIDED FROM HEREON, BE CONSTRUCTED IN ACCORDANCE WITH THE CITY OF ALBUQUERQUE STANDARD SPECIFICATIONS FOR PUBLIC WORKS CONSTRUCTION, 1986 EDITION AS AMENDED WITH UPDATE NO. 6
2. TWO (2) WORKING DAYS PRIOR TO ANY EXCAVATION, CONTRACTOR MUST CONTACT LINE LOCATING SERVICE, (260-1990) FOR LOCATION OF EXISTING UTILITIES.
3. PRIOR TO CONSTRUCTION, THE CONTRACTOR SHALL EXCAVATE AND VERIFY THE HORIZONTAL AND VERTICAL LOCATIONS OF ALL OBSTRUCTIONS AND EXISTING PAVEMENT. SHOULD A CONFLICT EXIST, THE CONTRACTOR SHALL NOTIFY THE ENGINEER OR SURVEYOR SO THAT THE CONFLICT CAN BE RESOLVED WITH MINIMUM AMOUNT OF DELAY.
4. THE CONTRACTOR SHALL FURNISH EMD'S ON ALL WATER AND SEWER SERVICE STUBS, CAPS AND PLUGS.
5. CONTRACTOR SHALL NOTIFY THE PROJECT ENGINEER NOT LESS THAN SEVEN (7) DAYS PRIOR TO STARTING WORK IN ORDER THAT THE ENGINEER MAY TAKE NECESSARY MEASURES TO ENSURE THE PRESERVATION OF SURVEY MONUMENTS. CONTRACTOR SHALL NOT DISTURB PERMANENT SURVEY MONUMENTS WITHOUT THE CONSENT OF THE ENGINEER AND BEAR THE EXPENSE OF REPLACING ANY THAT MAY BE DISTURBED WITHOUT PERMISSION. REPLACEMENT SHALL BE DONE ONLY BY THE CITY SURVEY SECTION. WHEN A CHANGE IS MADE IN ANY ROADWAY IN WHICH A PERMANENT SURVEY MONUMENT IS LOCATED, CONTRACTOR SHALL, AT HIS OWN EXPENSE, ADJUST THE MONUMENT COVER TO THE NEW GRADE UNLESS OTHERWISE SPECIFIED. REFER TO SECTION 4.4 OF GENERAL CONDITIONS OF THE CITY OF ALBUQUERQUE STANDARD SPECIFICATIONS FOR PUBLIC WORKS CONSTRUCTION.
6. RESTRAINED JOINTS ARE REQUIRED AT ALL WATER LINE BENDS, TEES, CAPS AND GATE VALVES.
7. THE PUBLIC WATER LINE MUST BE A MINIMUM OF 18" ABOVE THE SEWER LINE AT ALL CROSSINGS.
8. THE CONTRACTOR SHALL CONTACT WATER SYSTEMS DIVISION (857-8200) FIVE (5) WORKING DAYS PRIOR TO NEEDING SHUT-OFF OR TURN-ON OF VALVES. ONLY CITY WATER SYSTEMS PERSONNEL ARE AUTHORIZED TO OPERATE VALVES.
9. THREE (3) WORKING DAYS PRIOR TO BEGINNING CONSTRUCTION, THE CONTRACTOR SHALL SUBMIT TO THE CONSTRUCTION COORDINATION DIVISION A DETAILED CONSTRUCTION SCHEDULE. TWO (2) WORKING DAYS PRIOR TO STARTING CONSTRUCTION, THE CONTRACTOR SHALL OBTAIN A BARRICADE PERMIT FROM THE CONSTRUCTION COORDINATION DIVISION. CONTRACTOR SHALL NOTIFY BARRICADE ENGINEER (768-2551) PRIOR TO OCCUPYING AN INTERSECTION. SEE SECTION 19 OF THE SPECIFICATIONS.
10. ALL STREET STRIPING ALTERED OR DESTROYED SHALL BE REPLACED IN KIND BY CONTRACTOR TO LOCATION AND IN KIND AS EXISTING OR AS INDICATED BY THIS PLAN SET. ALL NEW STRIPING SHALL BE PLASTIC AS PER CITY STANDARDS.
11. ANY WORK AFFECTING AN ARTERIAL ROADWAY REQUIRES TWENTY-FOUR HOUR CONSTRUCTION.
12. ALL HANDICAP RAMPS WILL MEET ADA STANDARDS

1	2	3	4	5	6	7	8	9	10	11	12	13	14	15	
2	6	-	5	2	0	6	.	9	3			0	1	9	7

1							
REV.	SHEETS	CITY ENGINEER	DATE	USER	DEPARTMENT	DATE	USER DEPARTMENT DATE

ENGINEER'S SEAL		DATE: DEC., 1995		community sciences corporation		APPROVED FOR CONSTRUCTION	
		SCALE: AS SHOWN					
		DESIGNED: JMN					
		DRAWN: AM					
		JOB NO.: 32308-PRE					
		LAND PLANNING P.O. Box 1328		ENGINEERING Corrales, N.M. 87048		SURVEYING DATE: 3/28/96	
PROJECT NO.		5206.93		SHEET 1 OF 22			

00000 89 00000


00000 89 00000

00000 89 00000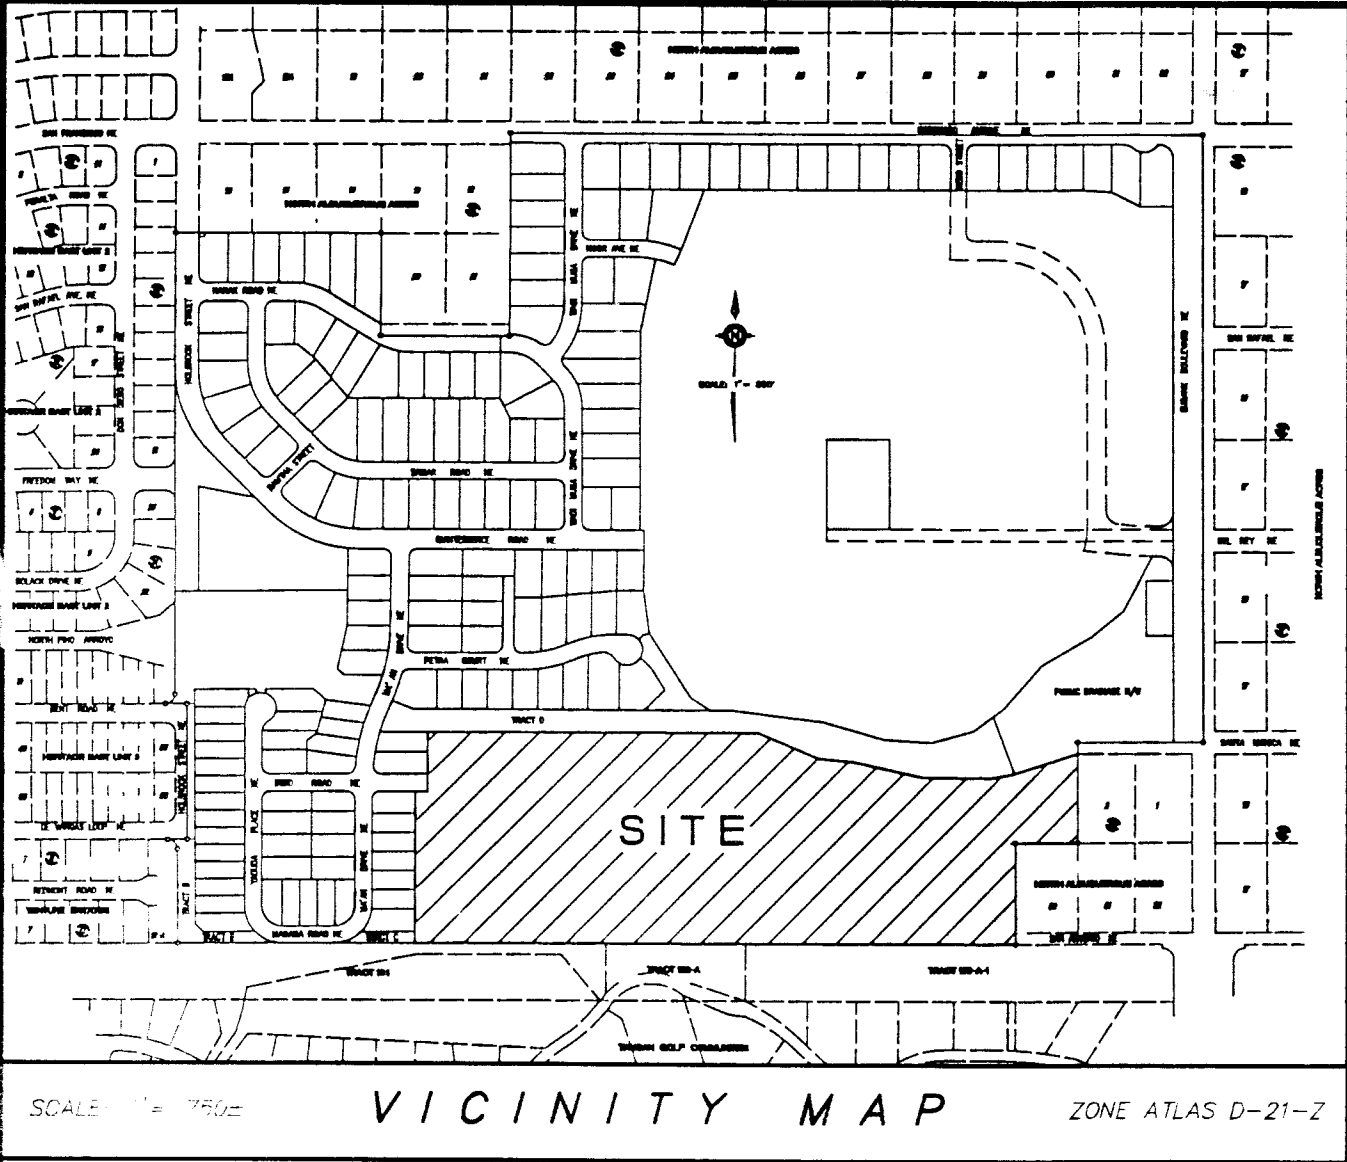

FREE CONSENT AND DEDICATION:

THE SUBDIVISION SHOWN HEREON IS WITH THE FREE CONSENT AND IN ACCORDANCE WITH THE DESIRES OF THE UNDERSIGNED OWNER(S) AND/OR PROPRIETOR(S) THEREOF AND SAID OWNER(S) AND/OR PROPRIETOR(S) DO HEREBY DEDICATE ALL STREETS DRAINAGE RIGHT-OF-WAYS AND PUBLIC RIGHTS-OF-WAY SHOWN HEREON TO THE CITY OF ALBUQUERQUE IN FEE SIMPLE WITH WARRANTY COVENANTS AND DO HEREBY GRANT: ALL ACCESS, UTILITY AND DRAINAGE EASEMENTS SHOWN HEREON INCLUDING THE RIGHT TO CONSTRUCT, OPERATE, INSPECT, AND MAINTAIN FACILITIES THEREIN; AND ALL PUBLIC UTILITY EASEMENTS SHOWN HEREON FOR THE COMMON AND JOINT USE OF GAS, ELECTRICAL POWER AND COMMUNICATION SERVICES FOR BURIED DISTRIBUTION LINES, CONDUITS, AND PIPES FOR UNDERGROUND UTILITIES WHERE SHOWN OR INDICATED, AND INCLUDING THE RIGHT OF INGRESS AND EGRESS FOR CONSTRUCTION AND MAINTENANCE, AND THE RIGHT TO TRIM INTERFERING TREES AND SHRUBS (SEE NOTE 8). SAID OWNER(S) AND/OR PROPRIETOR(S) DO HEREBY CONSENT TO ALL OF THE FOREGOING AND DO HEREBY CERTIFY THAT THIS SUBDIVISION IS THEIR FREE ACT AND DEED.

PARADISE WEST, INC.

A NEW MEXICO CORPORATION


BY: *Samar Dababneh*
SAMAR DABABNEH, PRESIDENT

STATE OF NEW MEXICO) SS
COUNTY OF BERNALILLO)

THIS INSTRUMENT WAS ACKNOWLEDGED BEFORE ME ON January 22, 1996
BY SAMAR DABABNEH, PRESIDENT, ON BEHALF OF SAID CORPORATION.

BY: *Robert C. Miller*
NOTARY PUBLIC

MY COMMISSION EXPIRES: 10/3/98

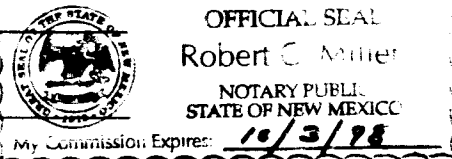

FEMA NOTE:

LOTS EFFECTED BY F.E.M.A. FLOOD PLAIN AS SHOWN ON FIRM COMMUNITY PANEL #5002-0011, EFFECTIVE 10-14-89 AS BEING IN ZONE AO (1' DEPTH) ON THE "NORTH ARROYO DEL PINO" ARE:

BLOCK LOTS
4 6-15
5 5-38

THESE LOTS ARE TO BE REMOVED FROM THAT FLOOD PLAIN THRU THE CONSTRUCTION OF DRAINAGE INFRASTRUCTURE AS REQUIRED BY AND TO BE MAINTAINED BY THE CITY OF ALBUQUERQUE IN CONJUNCTION WITH THIS SUBDIVISION. AFTER THE INFRASTRUCTURE CONSTRUCTION IS COMPLETE AND DOCUMENTED AS BEING ACCEPTABLE TO F.E.M.A., THEY WILL ISSUE A LETTER OF MAP REVISION (LOMR) WHICH OFFICIALLY REMOVES THE LOTS FROM THE FLOOD PLAIN.

LEGAL DESCRIPTION

THAT CERTAIN PARCEL OF LAND SITUATE WITHIN THE ELENA GALLEGOS GRANT ("PROJECTED" SECTION 21, TOWNSHIP 11 NORTH, RANGE 4 EAST, NEW MEXICO PRINCIPAL MERIDIAN), CITY OF ALBUQUERQUE, BERNALILLO COUNTY, NEW MEXICO AND BEING COMPRISED OF TRACT 1 OF QUINTESSENCE UNIT 1, AS THE SAME IS SHOWN AND DESIGNATED ON THE PLAT OF RECORD FILED IN THE OFFICE OF THE COUNTY CLERK OF BERNALILLO COUNTY, NEW MEXICO ON _____ VOLUME _____, FOLIO _____ AND BEING MORE PARTICULARLY DESCRIBED AS FOLLOWS:

BEGINNING FOR A TIE AT THE ALBUQUERQUE CITY SURVEY (ACS) MONUMENT "5-D21" (HAVING NEW MEXICO STATE PLANE COORDINATES, CENTRAL ZONE OF X=415,552.51 AND Y=1,516,380.98); THENCE AS A TIE S06°55'48"E, 4793.61 FEET TO A POINT BEING THE NORTHEAST CORNER OF LOT 1-P1, BLOCK 5 OF SAID QUINTESSENCE UNIT 1, A POINT ON THE SOUTHERLY BOUNDARY LINE OF TRACT D, QUINTESSENCE UNIT 1, AND THE TRUE POINT OF BEGINNING OF THE PARCEL HEREIN DESCRIBED; THENCE ALONG SAID SOUTHERLY BOUNDARY OF TRACT D, S89°36'32"E, 856.71 FEET TO AN ANGLE POINT; THENCE S86°39'17"E, 171.91 FEET TO AN ANGLE POINT; THENCE S84°00'40"E, 90.42 FEET TO AN ANGLE POINT; THENCE S76°50'50"E, 184.52 FEET TO AN ANGLE POINT; THENCE S88°58'05"E, 180.01 FEET TO AN ANGLE POINT; THENCE N80°04'17"E, 63.09 FEET TO THE SOUTHEAST CORNER OF TRACT D, AND THE SOUTHWEST CORNER OF AN EXISTING PUBLIC DRAINAGE RIGHT-OF-WAY, QUINTESSENCE UNIT 1; THENCE ALONG THE SOUTHERLY BOUNDARY LINE OF SAID EXISTING PUBLIC DRAINAGE RIGHT-OF-WAY, N72°42'02"E, 175.20 FEET TO THE NORTHWEST CORNER OF LOT 2, BLOCK 20 OF NORTH ALBUQUERQUE ACRES AS THE SAME IS SHOWN AND DESIGNATED ON THE PLAT OF RECORD FILED IN THE OFFICE OF THE COUNTY CLERK IN BERNALILLO COUNTY, NEW MEXICO ON JUNE 8, 1991 IN VOLUME D, FOLIO 133, SAID POINT ALSO BEING THE NORTHEAST CORNER OF THE PARCEL HEREIN DESCRIBED; THENCE DEPARTING SAID SOUTHERLY BOUNDARY LINE AND ALONG THE WESTERLY BOUNDARY OF SAID LOT 2, BLOCK 20, S00°09'44"W, 233.97 FEET TO THE SOUTHWEST CORNER OF LOT 2, BLOCK 20, AND THE NORTHEAST CORNER OF LOT 30, BLOCK 20 OF SAID NORTH ALBUQUERQUE ACRES; THENCE ALONG THE NORTHERLY BOUNDARY OF LOT 30, BLOCK 20, N89°33'40"W, 164.93 FEET TO THE NORTHWEST CORNER OF LOT 30, BLOCK 20; THENCE ALONG THE WESTERLY BOUNDARY LINE OF LOT 30, BLOCK 20, S00°05'53"W, 264.60 FEET TO A POINT ON THE SOUTHERLY RIGHT-OF-WAY LINE OF SAN ANTONIO NE (30' R/W), AND THE SOUTHEAST CORNER OF THE PARCEL HEREIN DESCRIBED; THENCE N89°36'32"E, 1562.78 FEET TO A POINT BEING THE SOUTHEAST CORNER OF TRACT C, QUINTESSENCE UNIT 1, AND THE SOUTHWEST CORNER OF THE PARCEL HEREIN DESCRIBED; THENCE N00°23'28"E, 396.52 FEET TO A POINT ON THE SOUTHERLY RIGHT-OF-WAY LINE OF IRBID ROAD NE (46' R/W), THE NORTHEAST CORNER OF LOT 7-P1, BLOCK 3 OF QUINTESSENCE UNIT 1; THENCE ALONG SAID SOUTHERLY RIGHT-OF-WAY LINE, S89°36'32"E, 31.46 FEET TO AN ANGLE POINT; THENCE DEPARTING THE SOUTHERLY RIGHT-OF-WAY LINE, N00°23'28"E, 156.00 FEET TO A POINT ON THE SOUTHERLY BOUNDARY LINE OF SAID TRACT D, THE NORTHEAST CORNER OF LOT 1-P1, BLOCK 5, AND THE TRUE POINT OF BEGINNING OF THE PARCEL HEREIN DESCRIBED.

THE ABOVE DESCRIBED PARCEL CONTAINS 18.1600 ACRES (834.609 S.F.) MORE OR LESS.

TREASURER'S CERTIFICATION

THIS IS TO CERTIFY THAT TAXES ARE CURRENT AND PAID ON UPC #s:

QUINTESSENCE UNIT 1:

TRACT 1, UPC # _____

PROPERTY OWNER OF RECORD: PARADISE WEST, INC.

BERNALILLO COUNTY TREASURER'S OFFICE:

BY: _____ DATE: _____

SURVEYOR'S CERTIFICATION:

I, C. A. SPIROCK, HEREBY AFFIRM THAT I AM A DULY QUALIFIED REGISTERED PROFESSIONAL SURVEYOR UNDER THE LAWS OF THE STATE OF NEW MEXICO AND DO CERTIFY THAT THIS PLAT WAS PREPARED BY ME OR UNDER MY DIRECT SUPERVISION; SHOWS ACCURATE DIMENSIONS, AND LAND AREAS; SHOWS ALL EASEMENTS AND RESTRICTIONS AS SHOWN ON THE PLAT OF RECORD OR MADE KNOWN TO ME BY THE OWNERS AND/OR PROPRIETORS OF THE SUBDIVISION SHOWN HEREON, TITLE COMPANIES, UTILITY COMPANIES OR OTHER PARTIES EXPRESSING AN INTEREST. I FURTHER CERTIFY THAT THIS PLAT MEETS THE MINIMUM REQUIREMENTS FOR MONUMENTATION AND SURVEYS OF THE ALBUQUERQUE SUBDIVISION ORDINANCE, MEETS THE MINIMUM STANDARDS FOR LAND SURVEYS SET FORTH BY THE STATE OF NEW MEXICO AND IS TRUE AND CORRECT TO THE BEST OF MY KNOWLEDGE AND BELIEF.

C. A. SPIROCK, N.M.P.S. #4972

1/5/96
DATE

VACATION AND REPLAT
FOR
QUINTESSENCE UNIT 2

COMPRISED OF
TRACT 1
QUINTESSENCE UNIT 1
SITUATE WITHIN
THE ELENA GALLEGOS GRANT
"PROJECTED" SECTION 21, T11N, R4E, N.M.P.M.
CITY OF ALBUQUERQUE, BERNALILLO COUNTY, NEW MEXICO
NOVEMBER, 1995

SUBDIVISION DATA:

CASE NO. _____ DRB-94-552, V-94-132
GROSS SUBDIVISION ACREAGE _____ 19.1600 AC
ZONE ATLAS INDEX NO. _____ D-21-2
NO. OF EXISTING TRACTS _____ 1
NO. OF EXISTING LOTS _____ 0
NO. OF LOTS CREATED _____ 113
NO. OF TRACTS CREATED _____ 1
MILES OF FULL-WIDTH STREETS CREATED _____ 0.74 MILES
DATE OF SURVEY _____ AUGUST, 1994
S.P. TALOS LOG NO. _____ 96-0104-1103-0250

APPROVALS:

SUBDIVISION CASE NUMBER: _____

CITY PLANNER/ALBUQUERQUE, BERNALILLO CO. PLANNING DIVISION _____ DATE _____

PARKS AND GENERAL SERVICE DEPARTMENT _____ DATE _____

TRAFFIC ENGINEER, TRANSPORTATION DEPARTMENT _____ DATE _____

CITY ENGINEER, ENGINEERING DIVISION _____ DATE _____

ALBUQUERQUE METROPOLITAN ARROYO FLOOD CONTROL AUTHORITY _____ DATE _____

UTILITY DEVELOPMENT _____ DATE _____


CITY SURVEYOR, ENGINEERING DIVISION *Neil Chul* 012696 DATE _____

PROPERTY MANAGEMENT _____ DATE _____

PNM GAS SERVICES _____ DATE _____

U S WEST COMMUNICATIONS, INC. _____ DATE _____

PNM ELECTRIC SERVICES _____ DATE _____

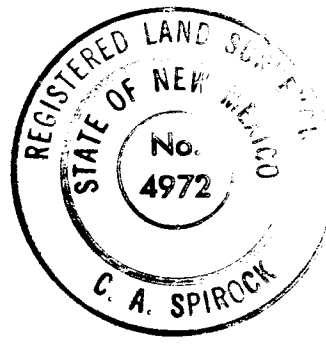


SHEET 1 OF 5

DATE: NOVEMBER, 1995
SCALE: N/A
DESIGNED: S.P.S.
DRAWN: D.E.R.
JOB NO.: 323-08-025

community sciences corporation

LAND PLANNING P.O. Box 1328
ENGINEERING Corrales, N.M. 87048
SURVEYING

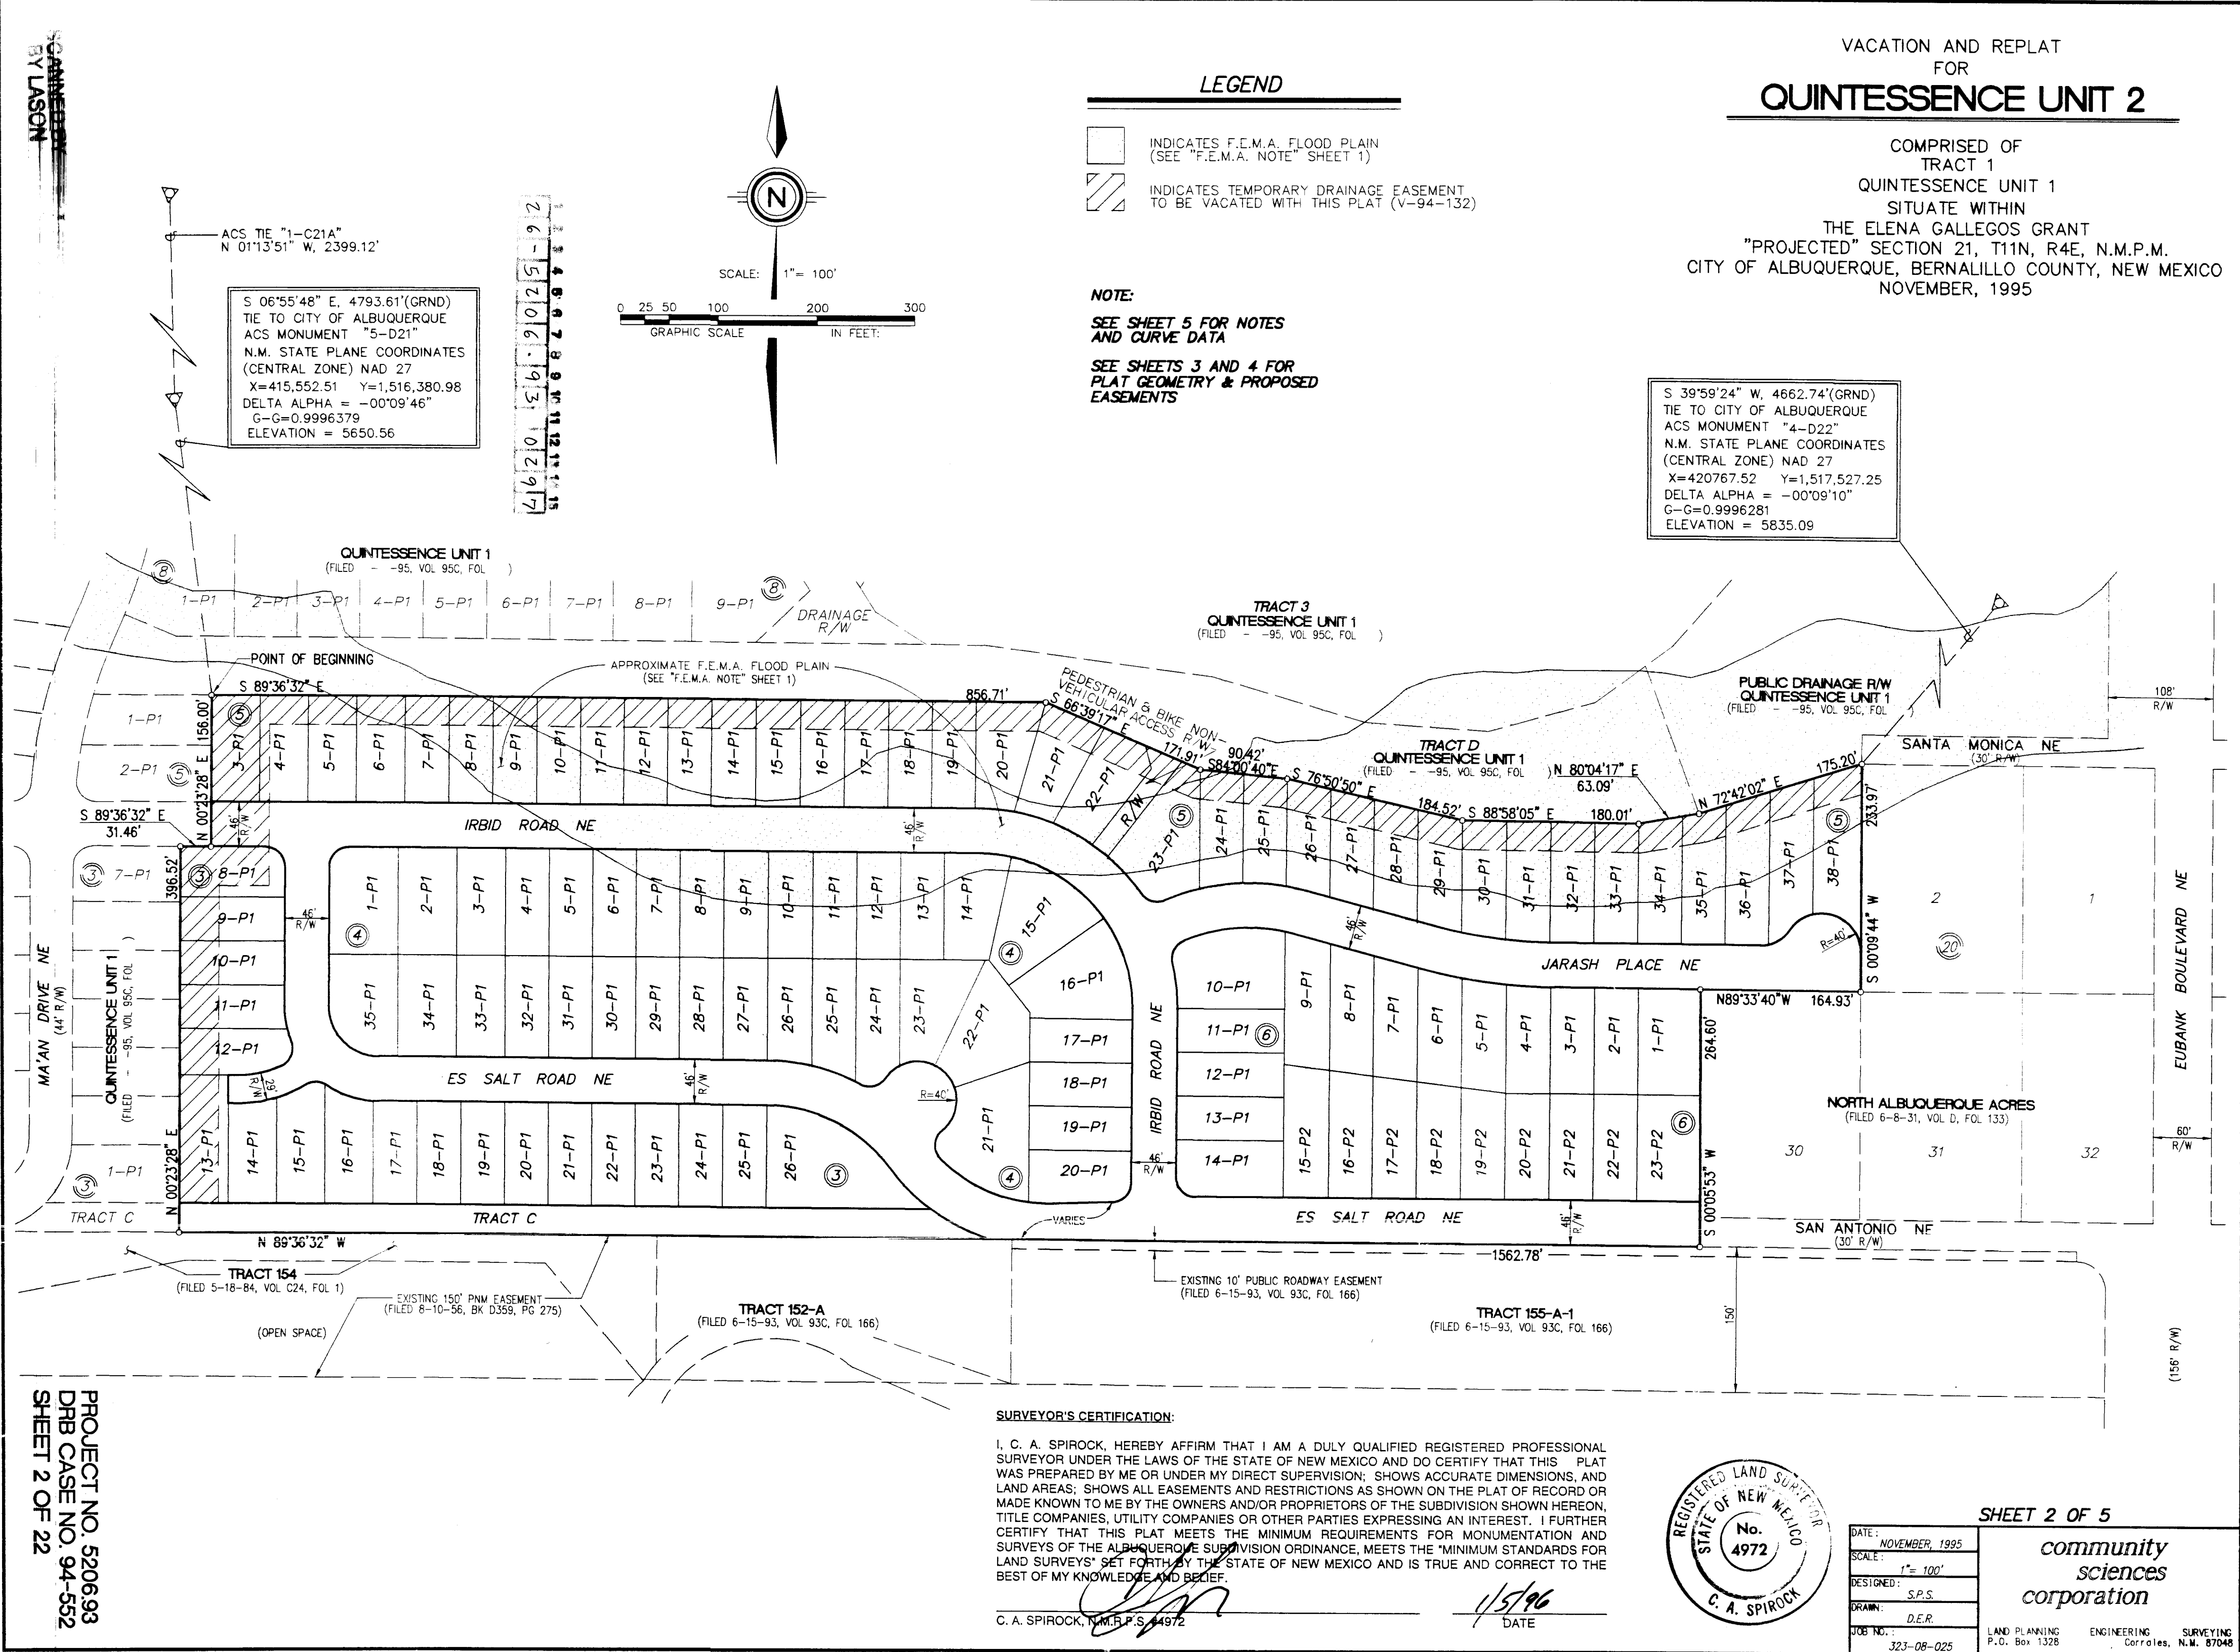

VACATION AND REPLAT
FOR
QUINTESSENCE UNIT 2

COMPRISED OF
TRACT 1
QUINTESSENCE UNIT 1
SITUATE WITHIN
THE ELENA GALLEGOS GRANT
"PROJECTED" SECTION 21, T11N, R4E, N.M.P.M.
CITY OF ALBUQUERQUE, BERNALILLO COUNTY, NEW MEXICO
NOVEMBER, 1995

NOTE:
SEE SHEET 5 FOR NOTES
AND CURVE DATA
SEE SHEETS 3 AND 4 FOR
PLAT GEOMETRY & PROPOSED
EASEMENTS


S 39°59'24" W, 4662.74' (GRND)
TIE TO CITY OF ALBUQUERQUE
ACS MONUMENT "4-D22"
N.M. STATE PLANE COORDINATES
(CENTRAL ZONE) NAD 27
X=420767.52 Y=1,517,527.25
DELTA ALPHA = -00°09'10"
G=0.9996281
ELEVATION = 5635.09

SURVEYOR'S CERTIFICATION:

I, C. A. SPIROCK, HEREBY AFFIRM THAT I AM A DULY QUALIFIED REGISTERED PROFESSIONAL SURVEYOR UNDER THE LAWS OF THE STATE OF NEW MEXICO AND DO CERTIFY THAT THIS PLAT WAS PREPARED BY ME OR UNDER MY DIRECT SUPERVISION; SHOWS ACCURATE DIMENSIONS, AND LAND AREAS; SHOWS ALL EASEMENTS AND RESTRICTIONS AS SHOWN ON THE PLAT OF RECORD OR MADE KNOWN TO ME BY THE OWNERS AND/OR PROPRIETORS OF THE SUBDIVISION SHOWN HEREON, TITLE COMPANIES, UTILITY COMPANIES OR OTHER PARTIES EXPRESSING AN INTEREST. I FURTHER CERTIFY THAT THIS PLAT MEETS THE MINIMUM REQUIREMENTS FOR MONUMENTATION AND SURVEYS OF THE ALBUQUERQUE SUBDIVISION ORDINANCE, MEETS THE MINIMUM STANDARDS FOR LAND SURVEYS SET FORTH BY THE STATE OF NEW MEXICO AND IS TRUE AND CORRECT TO THE BEST OF MY KNOWLEDGE AND BELIEF.

C. A. SPIROCK, N.M.P.S. #4972

1/5/96
DATE

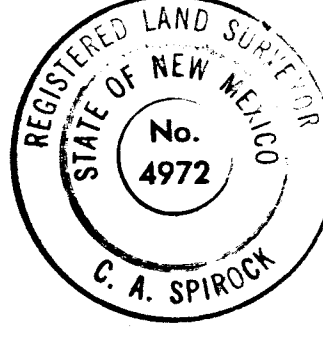



SHEET 2 OF 5

DATE: NOVEMBER, 1995
SCALE: 1" = 100'
DESIGNED: S.P.S.
DRAWN: D.E.R.
JOB NO.: 323-08-025

community sciences corporation


LAND PLANNING P.O. Box 1328
ENGINEERING Corrales, N.M. 87048
SURVEYING

PROJECT NO. 520693
DRB CASE NO. 94-552
SHEET 2 OF 22

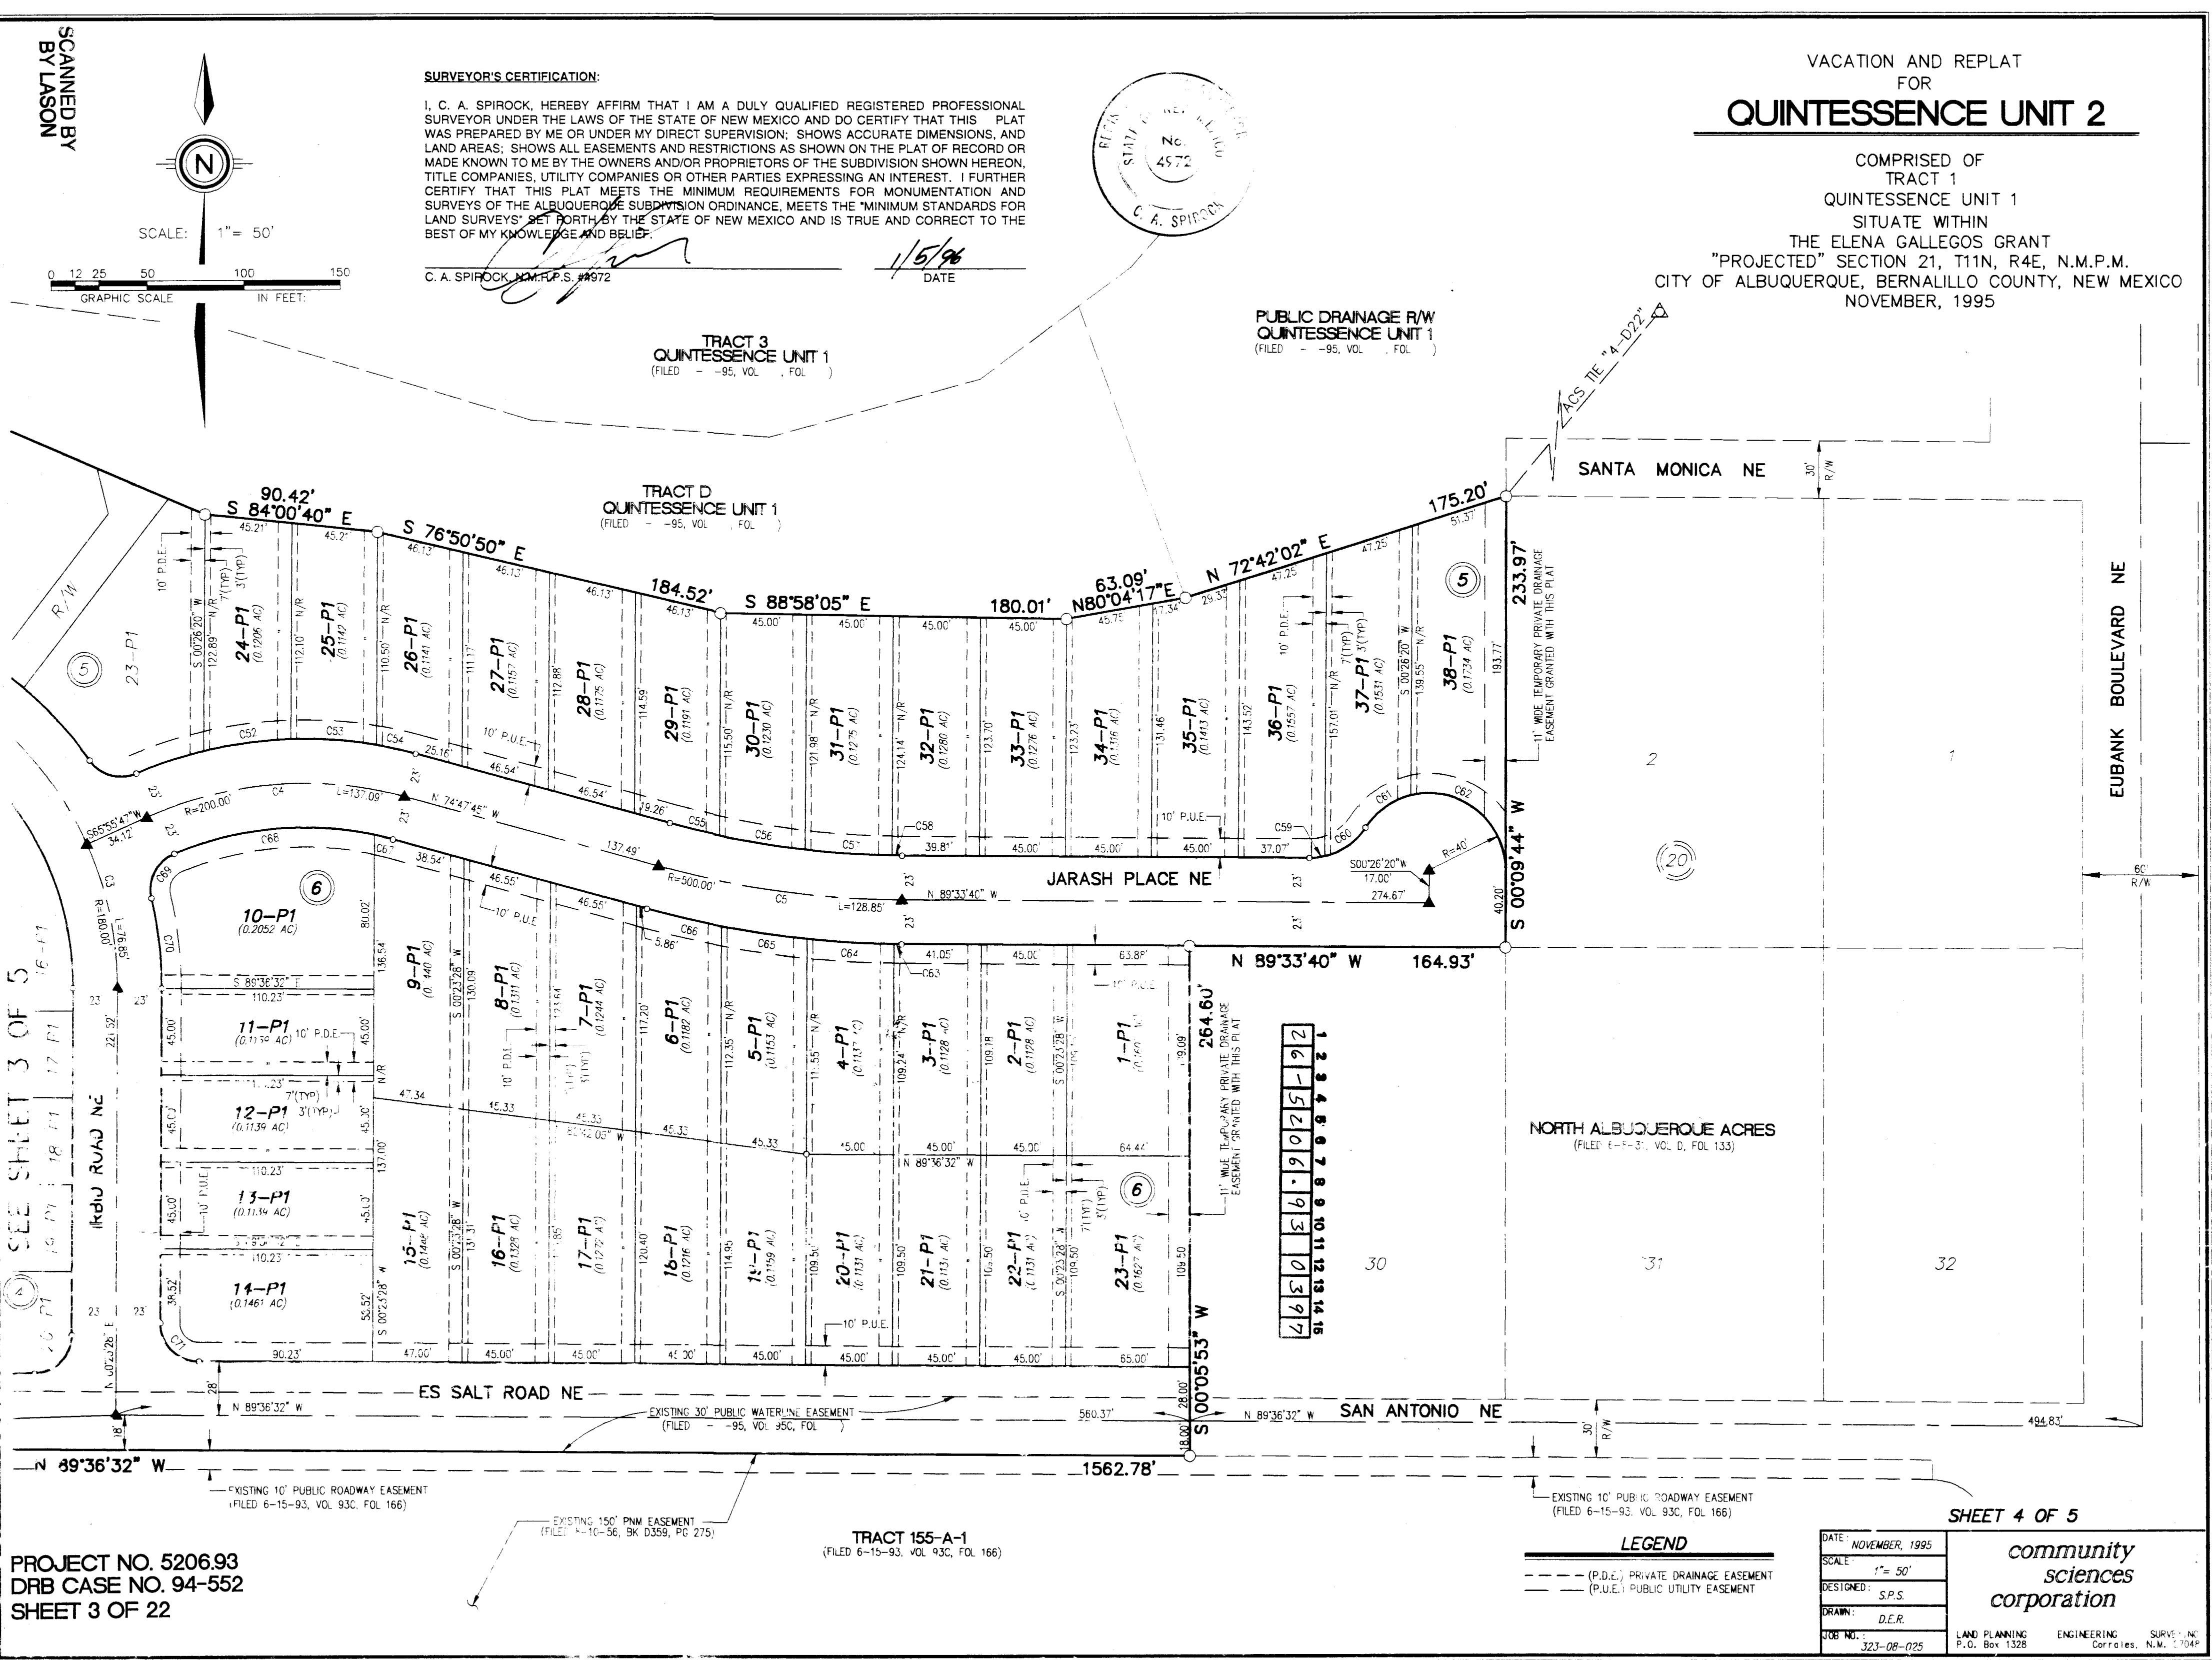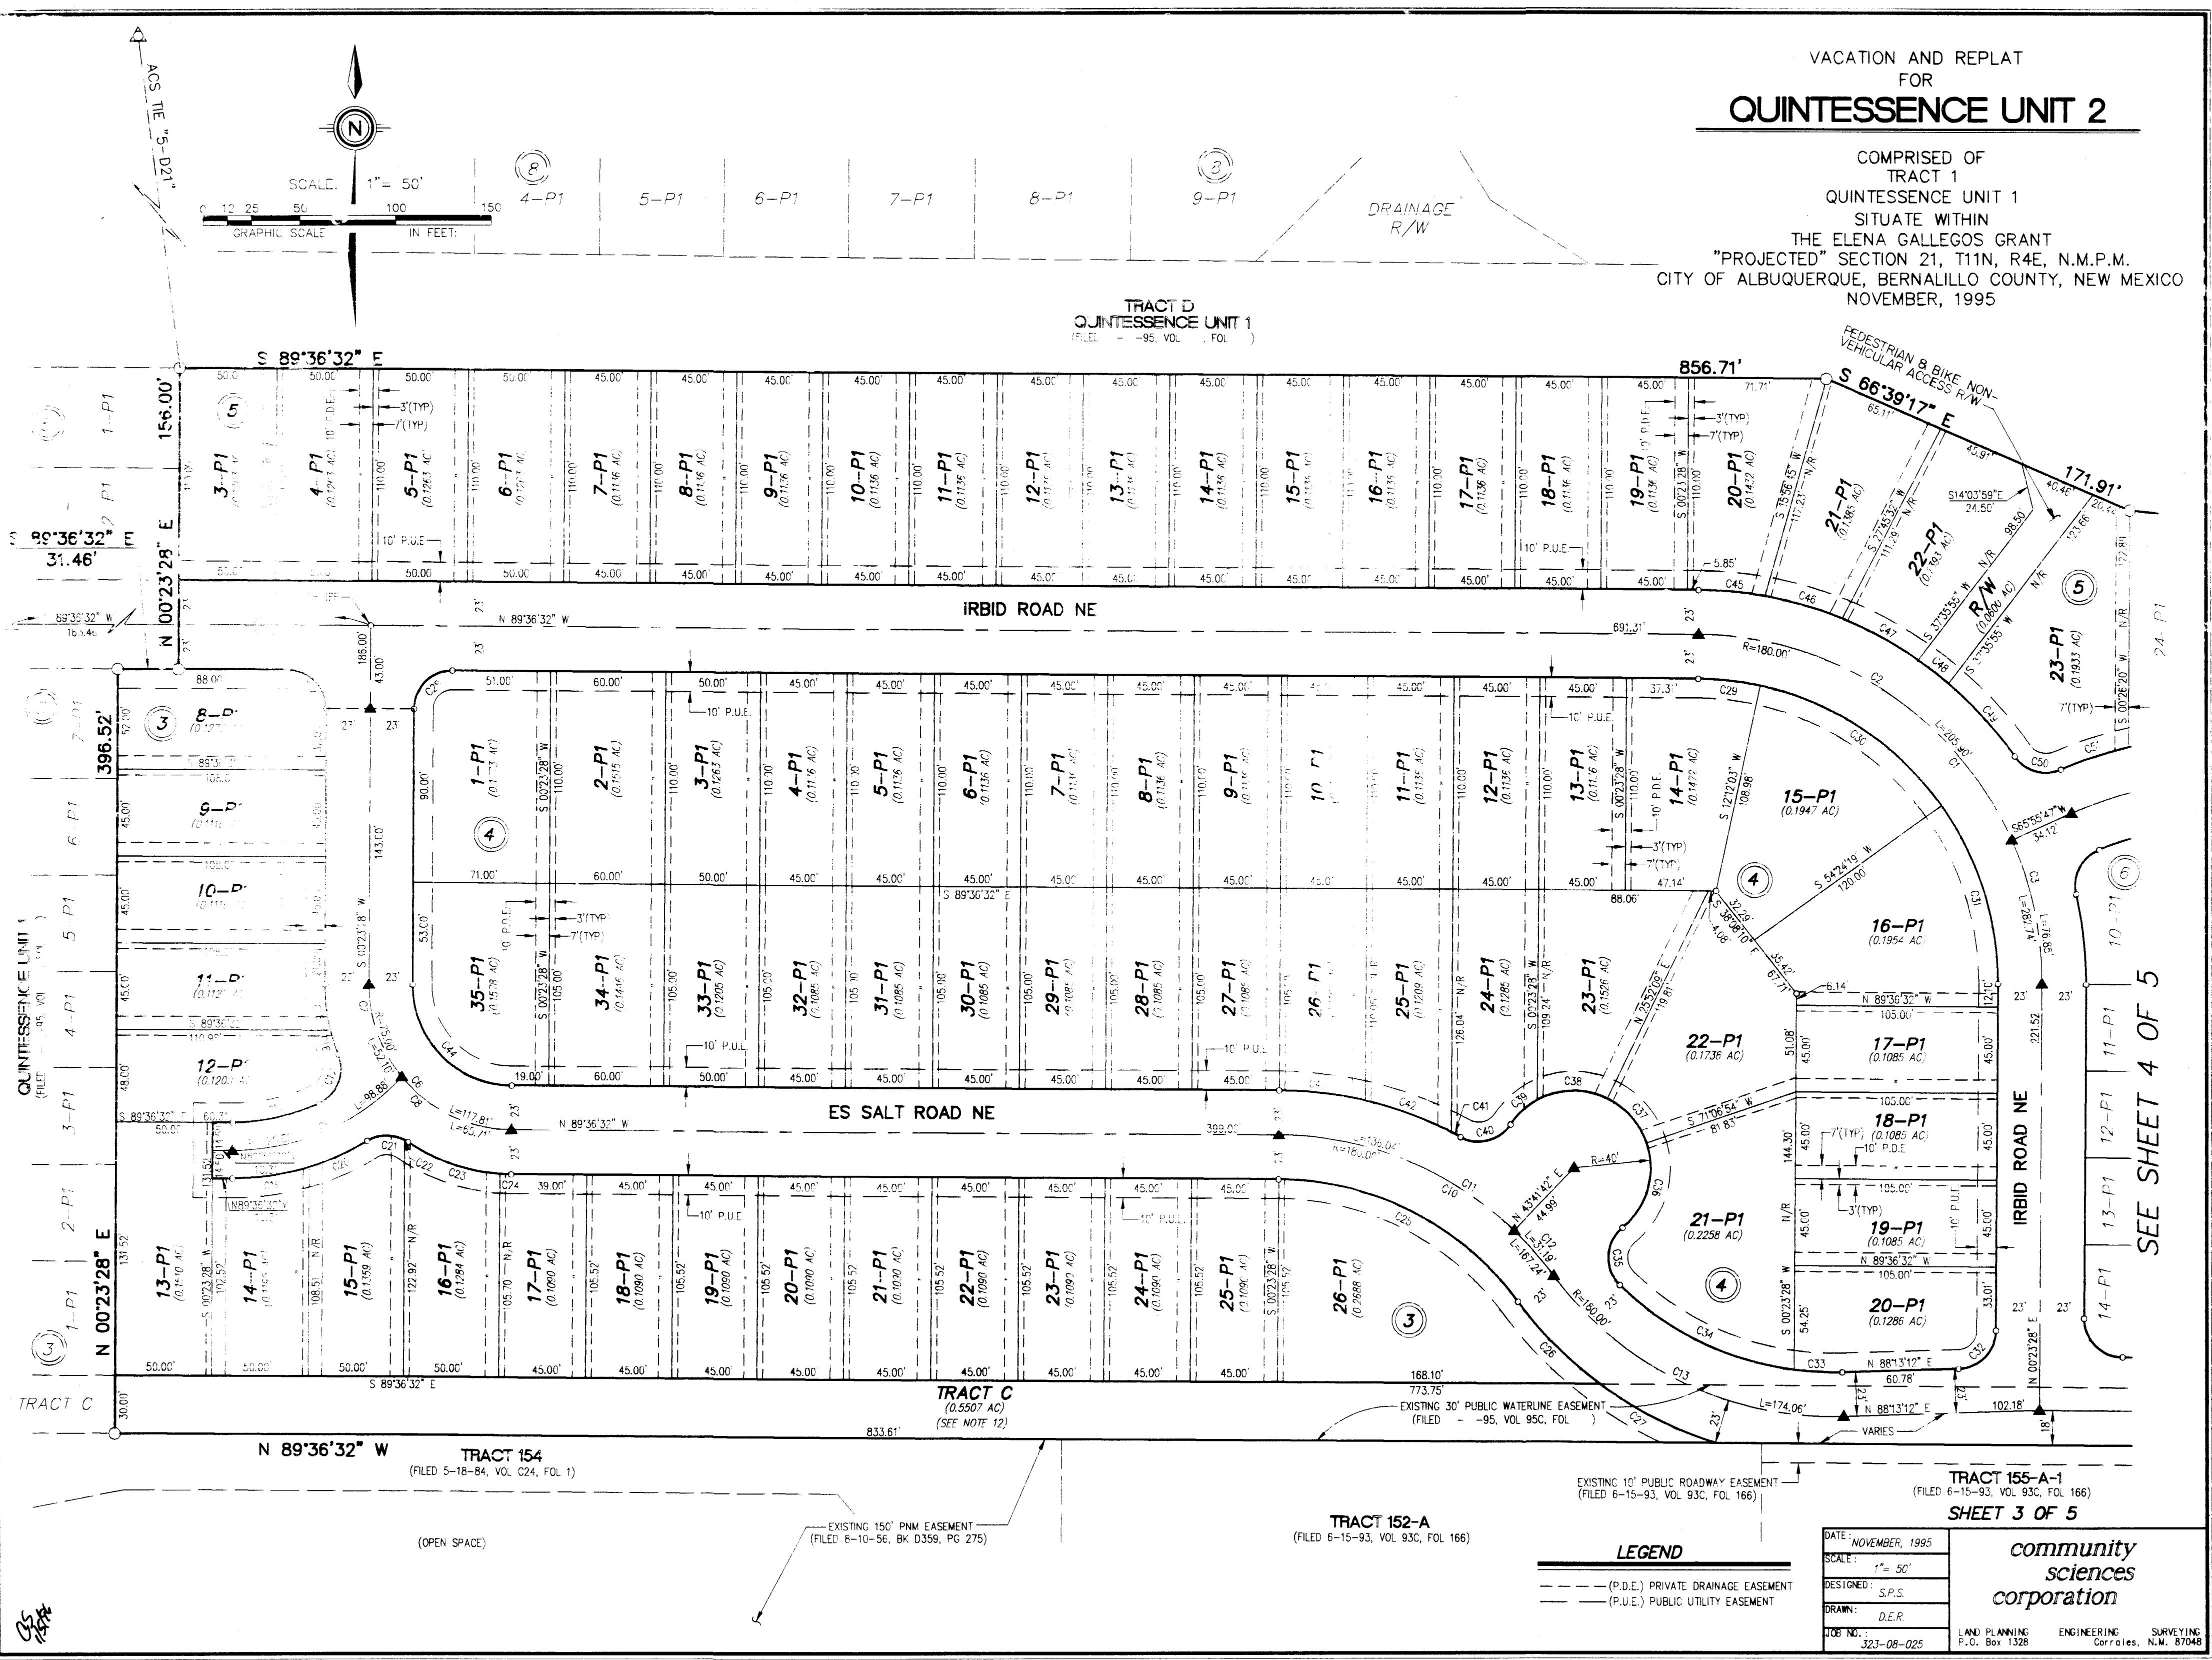

VACATION AND REPLAT
FOR
QUINTESSENCE UNIT 2
COMPRISED OF
TRACT 1
QUINTESSENCE UNIT 1
SITUATE WITHIN
THE ELENA GALLEGOS GRANT
"PROJECTED" SECTION 21, T11N, R4E, N.M.P.M.
CITY OF ALBUQUERQUE, BERNALILLO COUNTY, NEW MEXICO
NOVEMBER, 1995

**TYPICAL 45' LOT DETAIL
WITH USE AND PRIVATE DRAINAGE EASEMENTS**

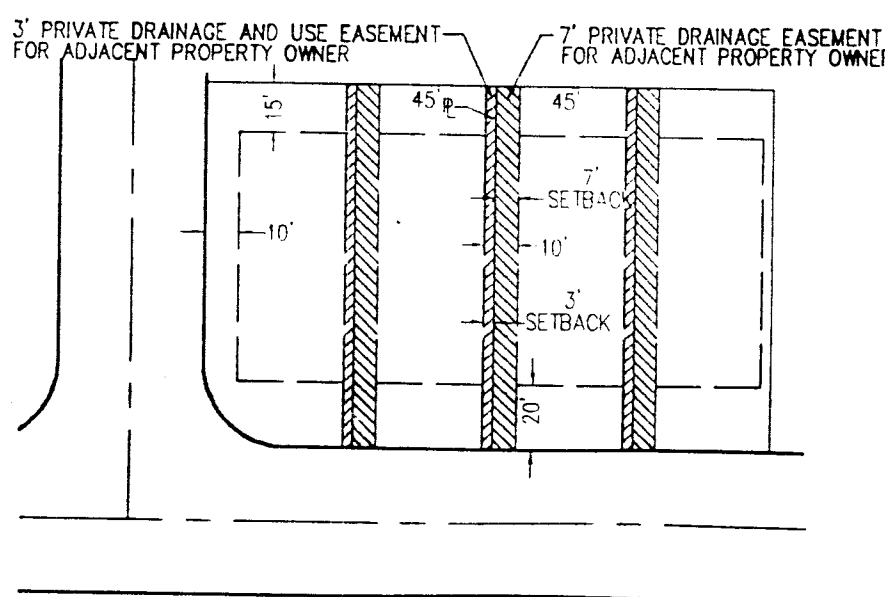

NOTES:


- THE PURPOSE OF THIS PLAT IS TO SUBDIVIDE TRACT 1, QUINTESSENCE UNIT 1, CONTAINING 19.1600 ACRES INTO 113 SINGLE FAMILY LOTS AND ADJOINING STREETS.
 - ALL BEARINGS SHOWN HEREON ARE GRID BEARINGS BASED ON THE NEW MEXICO STATE PLANE COORDINATE SYSTEM, CENTRAL ZONE, NAD 27, MEAN DELTA ALPHA -00°47'41". ALL DISTANCES ARE GROUND DISTANCES.
 - BEARINGS AND DISTANCES SHOWN ARE BOTH RECORD AND MEASURED.
 - ALL DIMENSIONS PUBLISHED ALONG CURVED LINES ARE ARC DISTANCES. LOT LINES MARKED N/R ARE NON-RADIAL.
 - BENCHMARK FOR THIS PLAT IS THE CITY OF ALBUQUERQUE ACS MONUMENT "5-D21", ELEVATION = 5650.56 LOCATED APPROXIMATELY 84.7' EAST OF THE CENTERLINE OF HOLBROOK STREET, N.E. AND 0.45 MILES NORTH OF PASEO DEL NORTE.
 - UNLESS OTHERWISE NOTED, ALL CORNERS ARE EVIDENCED BY A #5 REBAR WITH ALUMINUM CAP STAMPED "P.S. #4972".
 - CENTERLINE (IN LIEU OF R/W) MONUMENTATION TO BE INSTALLED AT ALL CENTERLINE P.C.'S, P.T.'S, ANGLE POINTS AND STREET INTERSECTIONS PRIOR TO ACCEPTANCE OF SUBDIVISION STREET IMPROVEMENTS AND WILL CONSIST OF A FOUR INCH (ALUMINUM ALLOY) CAP STAMPED "CITY OF ALBUQUERQUE CENTERLINE MONUMENTATION SURVEY MARKER DO NOT DISTURB P.L.S. 4972". ▲ DENOTES CENTERLINE MONUMENT.
 - PUBLIC UTILITY EASEMENTS (P.U.E.) SHOWN ON THIS PLAT ARE GRANTED FOR THE COMMON AND JOINT USE OF:
 - PNM ELECTRICAL SERVICES FOR THE INSTALLATION, MAINTENANCE, AND SERVICE OF UNDERGROUND ELECTRICAL LINES, TRANSFORMERS, POLES AND ANY OTHER EQUIPMENT, FIXTURES, STRUCTURES AND RELATED FACILITIES REASONABLY NECESSARY TO PROVIDE ELECTRICAL SERVICE.
 - PNM GAS SERVICES FOR INSTALLATION, MAINTENANCE, AND SERVICE OF NATURAL GAS LINES, VALVES AND OTHER EQUIPMENT AND FACILITIES REASONABLY NECESSARY TO PROVIDE NATURAL GAS.
 - U S WEST FOR THE INSTALLATION, MAINTENANCE AND SERVICE OF ALL BURIED COMMUNICATION LINES AND OTHER RELATED EQUIPMENT AND FACILITIES REASONABLY NECESSARY TO PROVIDE COMMUNICATION SERVICES, INCLUDING BUT NOT LIMITED TO ABOVE GROUND PEDESTALS AND CLOSURES.
 - JONES INTERCABLE FOR THE INSTALLATION, MAINTENANCE, AND SERVICE OF SUCH UNDERGROUND LINES, CABLE, AND OTHER RELATED EQUIPMENT AND FACILITIES REASONABLY NECESSARY TO PROVIDE CABLE TV SERVICE.
- INCLUDED IS THE RIGHT TO BUILD, REBUILD, CONSTRUCT, RECONSTRUCT, LOCATE, RELOCATE, CHANGE, REMOVE, MODIFY, RENEW, OPERATE, AND MAINTAIN FACILITIES FOR THE PURPOSES DESCRIBED ABOVE, TOGETHER WITH FREE ACCESS TO, FROM, AND OVER SAID EASEMENTS, INCLUDING SUFFICIENT WORKING AREA SPACE FOR ELECTRIC TRANSFORMERS, WITH THE RIGHT AND PRIVILEGE TO TRIM AND REMOVE TREES, SHRUBS OR BUSHES WHICH INTERFERE WITH THE PURPOSES SET FORTH HEREIN. NO BUILDING, SIGN, POOL (ABOVE GROUND OR SUBSURFACE), HOT TUB, CONCRETE OR WOOD POOL DECKING, OR OTHER STRUCTURE SHALL BE ERRECTED OR CONSTRUCTED ON SAID EASEMENTS, NOR SHALL ANY WELL BE DRILLED OR OPERATED THEREON. PROPERTY OWNERS SHALL BE SOLELY RESPONSIBLE FOR CORRECTING ANY VIOLATIONS OF NATIONAL ELECTRICAL SAFETY CODE CAUSED BY CONSTRUCTION OR POOLS, DECKING, OR ANY STRUCTURES ADJACENT TO OR NEAR EASEMENTS SHOWN ON THIS PLAT.
- CITY OF ALBUQUERQUE WATER AND SEWER SERVICE TO THESE LOTS MUST BE VERIFIED AND COORDINATED WITH THE PUBLIC WORKS DEPARTMENT, CITY OF ALBUQUERQUE
 - STREET RIGHT-OF-WAY AND PAVEMENT WIDTHS HAVE BEEN REDUCED PER THE STANDARD REQUIREMENTS FOR INTERMITTENT PARKING DESIGN. THE P-1 SUFFIX TO LOT NUMBERS DESIGNATES SPECIAL ON-SITE PARKING CRITERIA WHICH JUSTIFIED THE CITY ALLOWING REDUCED STREET WIDTHS IN THIS SUBDIVISION. SPECIFICALLY, THE PARKING CRITERIA CATEGORY OF "INTERMITTENT" IS MET BY EACH LOT PROVIDING 4 PARKING SPACES (INCLUDING GARAGE) FOR 3-4 BEDROOMS. ALL DWELLINGS WILL HAVE 2-4 BEDROOMS AND 2-CAR ATTACHED GARAGES WITH 2-CAR DRIVEWAYS.
 - MINIMUM DWELLING SETBACKS FOR ALL LOTS ARE DEFINED IN THE ZONING CODE FOR R-D ZONING AND PURSUANT TO THE APPROVED SECTOR DEVELOPMENT PLAN, THEREFORE ALL LOTS ARE SUBJECT TO THE CONTROLS OF R-T ZONING PER SECTION 7-14-18. PARAGRAPH B, OF THE ZONING CODE. THERE ARE NO SOLAR SETBACKS REQUIRED ON THIS PLAN (MINIMUM BUILDING INSULATION IN LIEU OF SOLAR ACCESSIBILITY BY SIDEYARD SETBACK).
 - TRACT C IS HEREBY DEDICATED TO THE CITY OF ALBUQUERQUE FOR THE PURPOSES OF OPEN SPACE, TRAILS, DRAINAGE, UNDERGROUND UTILITIES, PUBLIC WATERLINE LOCATION AND EXISTING FRANCHISE UTILITIES.

SURVEYOR'S CERTIFICATION:

I, C. A. SPIROCK, HEREBY AFFIRM THAT I AM A DULY QUALIFIED REGISTERED PROFESSIONAL SURVEYOR UNDER THE LAWS OF THE STATE OF NEW MEXICO AND DO CERTIFY THAT THIS PLAT WAS PREPARED BY ME OR UNDER MY DIRECT SUPERVISION; SHOWS ACCURATE DIMENSIONS, AND LAND AREAS; SHOWS ALL EASEMENTS AND RESTRICTIONS AS SHOWN ON THE PLAT OF RECORD OR MADE KNOWN TO ME BY THE OWNERS AND/OR PROPRIETORS OF THE SUBDIVISION SHOWN HEREON. I, FURTHER CERTIFY THAT THIS PLAT MEETS THE MINIMUM REQUIREMENTS FOR MONUMENTATION AND SURVEYS OF THE ALBUQUERQUE SUBDIVISION ORDINANCE, MEETS THE MINIMUM STANDARDS FOR AND SURVEYS SET FORTH BY THE STATE OF NEW MEXICO AND IS TRUE AND CORRECT TO THE BEST OF MY KNOWLEDGE AND BELIEF.

J. A. SPIROCK, P.S. #4972

DATE

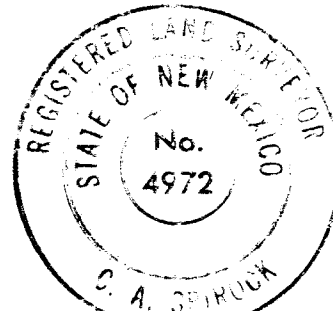

SHEET 5 OF 5

DATE: NOVEMBER, 1995
SCALE: N/A
DESIGNED: S.P.S.
DRAWN: D.E.R.
JOB NO.: 323-06-025

community
sciences
corporation

LAND PLANNING: P.O. Box 1328
ENGINEERING: Corrales, N.M. 87048
SURVEYING

CURVE DATA						
Curve ID	Radius	Arc	Delta	Tangent	Chord	Chord Brg
C1	180.00	282.74	090-00-00	180.00	254.56	S44-36-32E
C2	180.00	205.90	065-32-19	115.87	194.85	S56-50-22E
C3	180.00	76.85	024-27-41	39.02	76.27	S11-50-22E
C4	200.00	137.09	039-16-28	71.36	134.43	N85-34-01E
C5	500.00	128.85	014-45-55	64.78	128.50	N82-10-43W
C6	75.00	117.81	090-00-00	75.00	106.07	N44-36-32W
C7	75.00	52.10	039-48-12	27.15	51.06	N19-30-38W
C8	75.00	65.71	050-11-48	35.13	63.63	N64-30-38W
C9	120.00	98.88	047-12-50	52.44	96.11	S66-47-03W
C10	180.00	167.24	053-14-00	90.20	161.29	S62-59-32E
C11	180.00	136.04	043-18-14	71.46	132.83	S67-57-25E
C12	180.00	31.19	009-55-46	15.64	31.16	S41-20-25E
C13	180.00	174.06	055-24-16	94.51	167.36	N64-04-40W
C14	20.00	31.42	090-00-00	20.00	28.28	S44-36-32E
C15	98.00	24.25	014-10-33	12.19	24.18	N06-41-48W
C16	98.00	13.17	007-42-00	6.60	13.16	N17-38-05W
C17	20.00	30.31	086-50-23	18.93	27.49	S21-56-06W
C18	105.50	46.10	025-02-10	23.42	45.73	S77-52-23W
C19	134.50	40.29	017-09-41	20.29	40.14	S81-48-38W
C20	134.50	33.44	014-14-39	16.81	33.35	S66-06-28W
C21	20.00	20.50	058-43-13	11.25	19.61	N88-20-45E
C22	20.00	2.17	006-12-49	1.09	2.17	S59-11-14E
C23	98.00	51.34	030-01-06	26.28	50.76	N71-05-22W
C24	98.00	6.00	003-30-36	3.00	6.00	N87-51-14W
C25	157.00	145.87	053-14-00	78.68	140.68	S62-59-32E
C26	203.00	60.67	017-07-22	30.56	60.44	N44-56-13W
C27	203.00	67.27	018-59-08	33.94	66.96	N62-59-28W
C28	203.00	48.61	010-00-00	20.00	28.28	N45-23-28E
C29	157.00	32.36	011-48-35	16.24	32.30	S83-42-14E
C30	157.00	115.65	042-12-16	60.59	113.05	S56-41-43E
C31	157.00	98.61	035-59-09	50.99	96.99	S17-36-05E
C32	20.00	30.66	087-49-44	19.26	27.74	S44-18-20W
C33	157.00	25.07	009-09-00	12.56	25.05	N87-12-18W
C34	157.00	102.44	037-22-58	53.12	100.63	N63-56-19W
C35	20.00	33.51	095-59-10	22.21	29.72	N02-44-45E
C36	40.00	34.59	069-37-26	27.81	45.67	S15-55-37W
C37	40.00	31.59	045-14-45	16.67	30.77	S41-30-29E
C38	40.00	37.94	054-20-51	20.53	36.54	N88-41-43E
C39	40.00	19.13	027-24-05	9.75	18.95	N47-49-15E
C40	20.00	29.39	084-11-23	18.07	26.81	S76-12-54W
C41	203.00	5.67	001-36-03	2.84	5.67	S62-29-27E
C42	203.00	47.87	013-30-37	24.05	47.76	S70-02-47E
C43	203.00	45.38	012-48-27	22.78	45.28	S83-12-19E
C44	203.00	81.68	090-00-00	52.00	73.54	N44-36-32W
C45	203.00	34.59	009-45-50	17.34	34.55	S84-43-37E
C46	203.00	41.85	011-48-47	21.00	41.78	S73-56-19E
C47	203.00	45.38	012-48-25	22.78	45.28	S61-37-42E
C48	203.00	20.01	005-38-50	10.01	20.00	S52-24-05E
C49	203.00	51.03	014-24-07	25.65	50.89	S42-22-37E
C50	20.00	27.15	077-47-09	16.13	25.11	N74-04-08W
C51	223.00	36.70	009-25-49	18.39	36.66	N71-45-12E
C52	223.00	45.53	011-41-58	22.85	45.46	N82-19-05E
C53	223.00	45.16	011-36-13	22.66	45.09	S86-01-49E
C54	223.00	21.54	005-25-58	10.58	21.14	S77-30-44E
C55	477.00	45.07	003-15-13	13.55	27.08	N76-25-22W
C56	477.00	45.55	005-28-17	22.79	45.53	N80-47-06W
C57	477.00	45.09	005-14-59	22.56	45.08	N86-13-45W
C58	477.00	5.19	007-37-26	2.60	5.19	N89-14-57W
C59	35.00	8.00	013-06-12	4.02	7.99	S83-53-14W
C60	35.00	26.73	043-45-29	14.05	26.09	S55-27-23W
C61	40.00	29.73	042-74-53	15.59	29.05	N54-52-06E
C62	40.00	72.61	104-00-12	51.20	63.04	S51-50-22E
C63	523.00	3.95	000-25-56	1.97	3.95	N89-20-42W
C64	523.00	45.07	004-56-16	21.74	45.06	N86-39-36W
C65	523.00	45.45	004-58-43	21.77	45.43	N81-42-06W
C66	523.00	40.31	004-24-59	20.17	40.30	N77-00-15W
C67	177.00	10.01	003-14-23	5.01	10.01	S76-24-57E
C68	177.00	106.05	034-19-38	54.67	104.47	N84-48-03E
C69	20.00	28.12	080-34-17	16.95	25.86	N27-21-05E
C70	203.00	47.21	013-19-31	23.71	47.11	S06-16-18E
C71	20.00	31.42	090-00-00	20.00	28.28	N44-36-32W



PROJECT NO. 550693
DRB CASE NO. 94-552
SHEET 4 OF 22

0000 760 0000






0000 760 0000

0000 760 0000

0000 760 0000

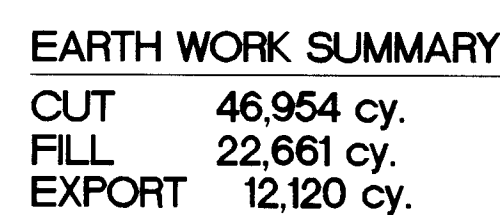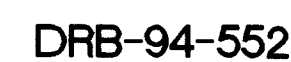


VALUE TABULATED REPRESENTS INPLACE CONDITIONS
WITH C/F= 1.35 AND THE NET EXPORTED IS
TO BE USED IN UNIT 1.

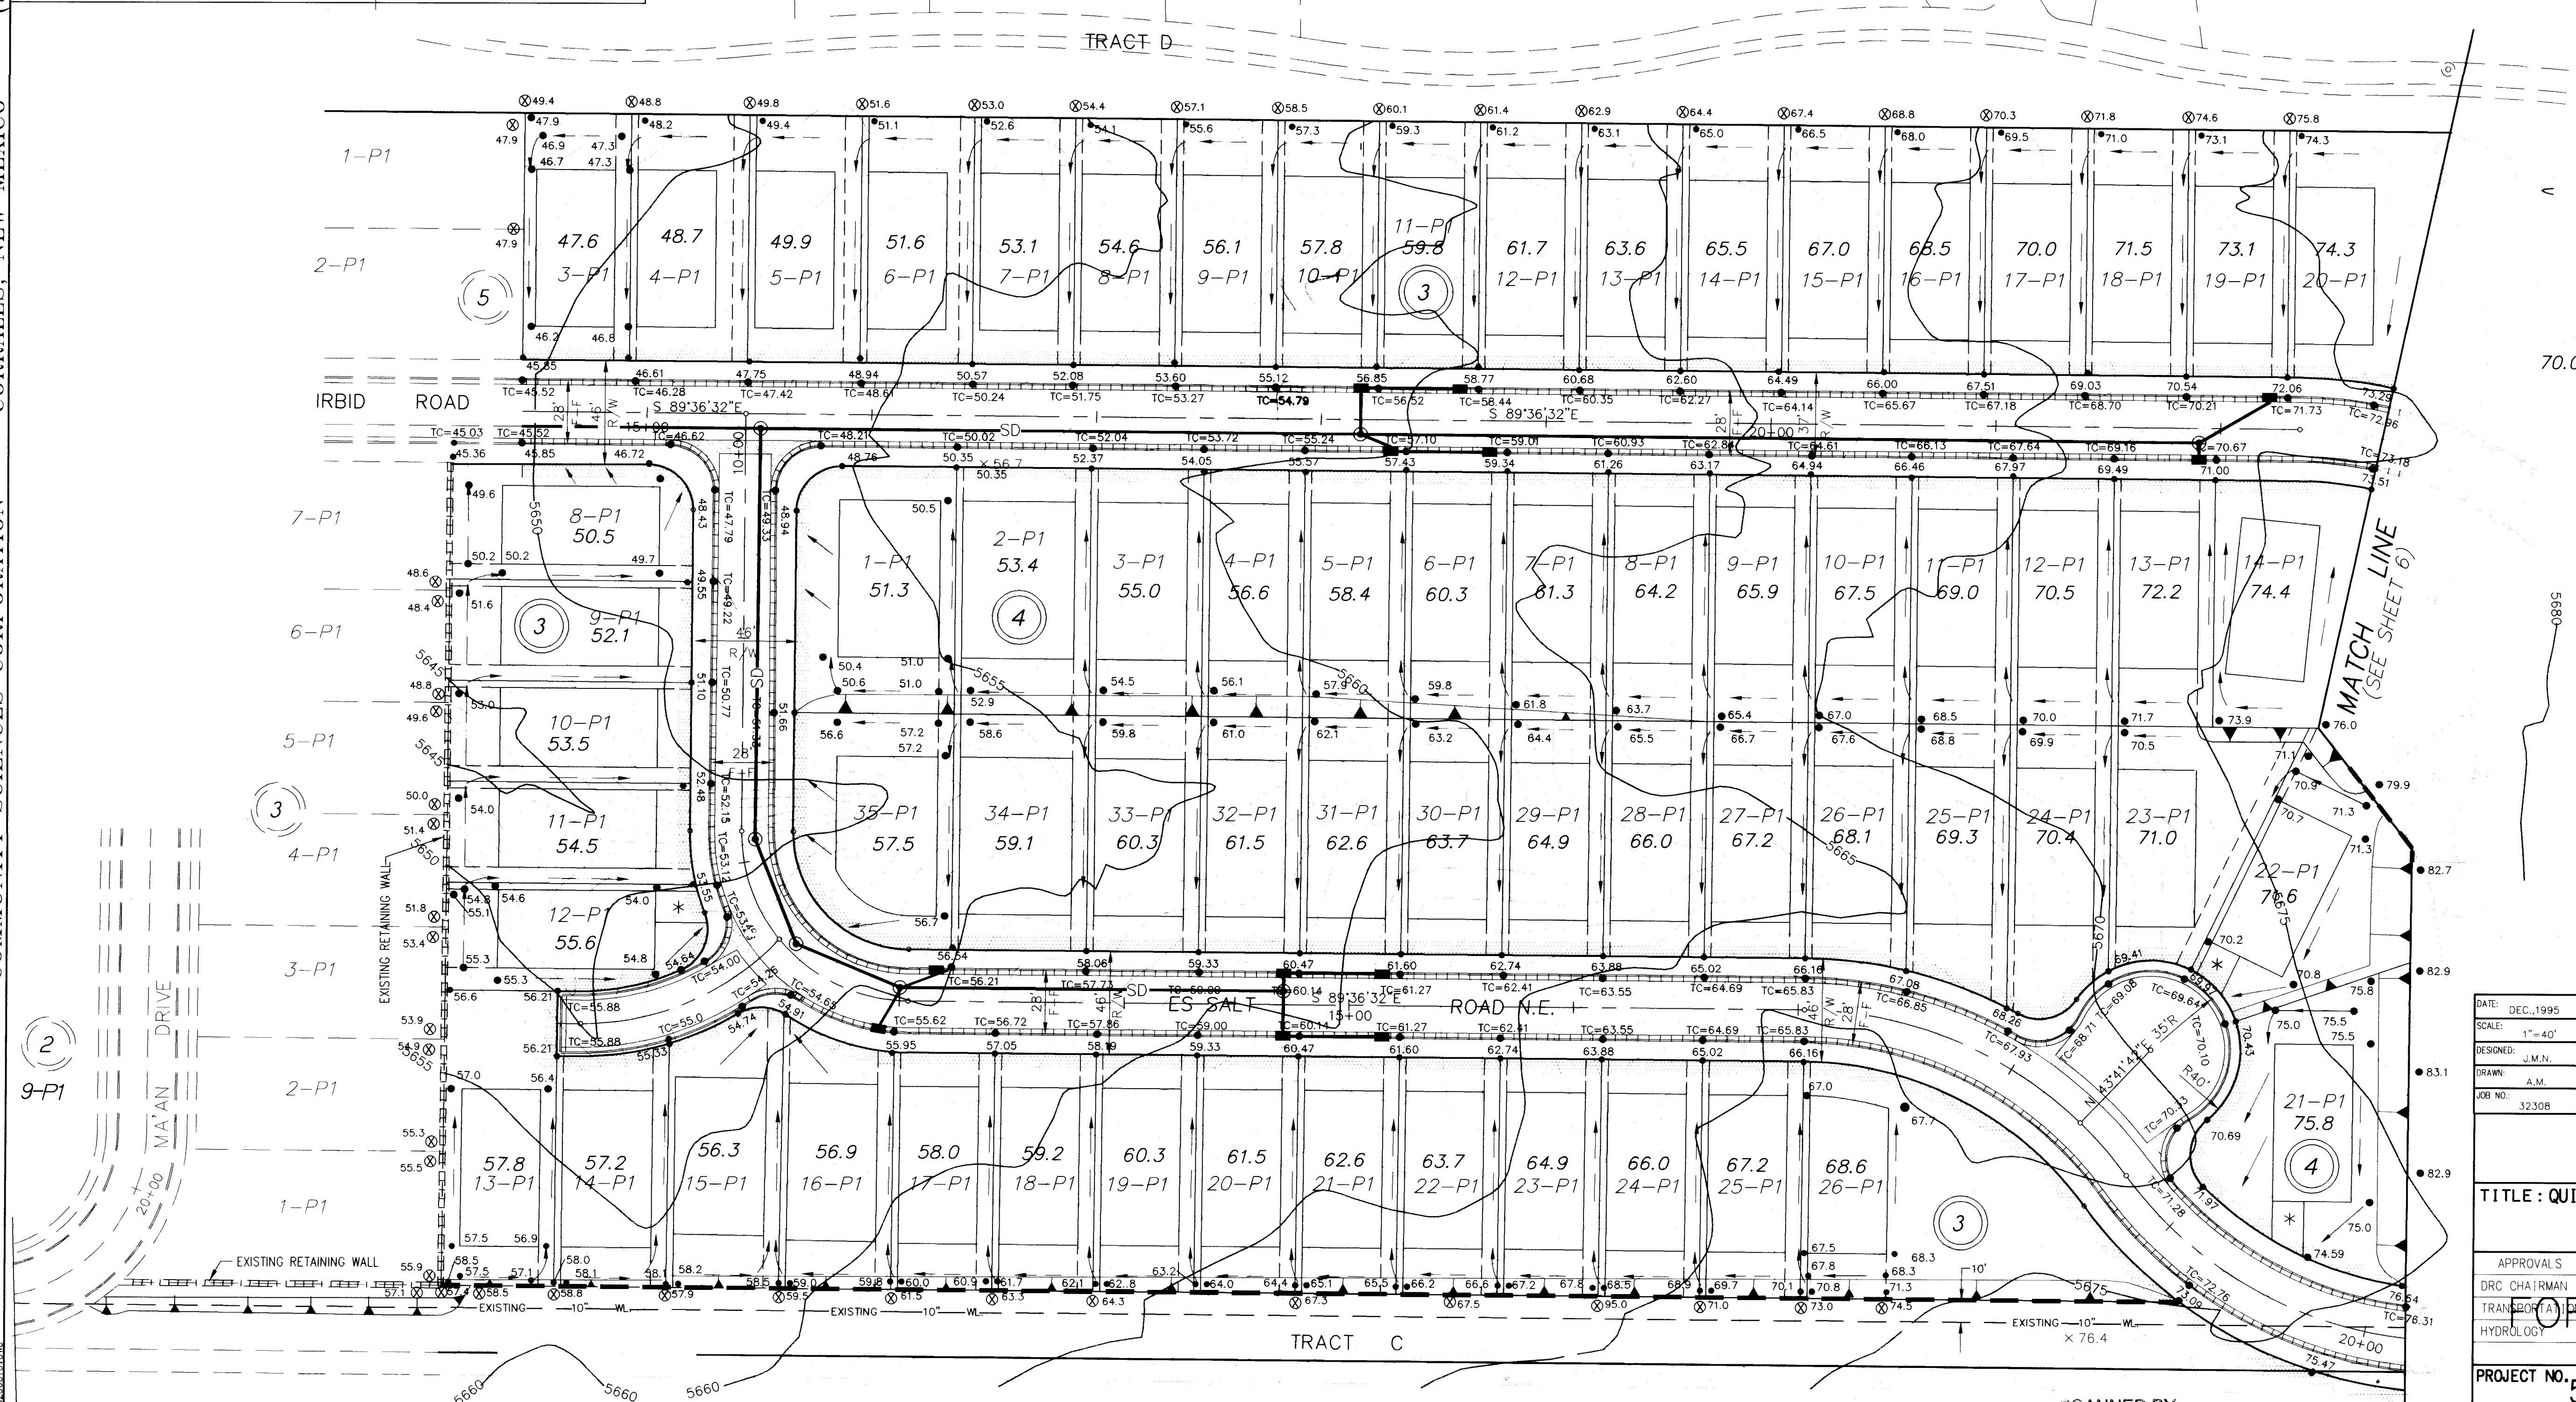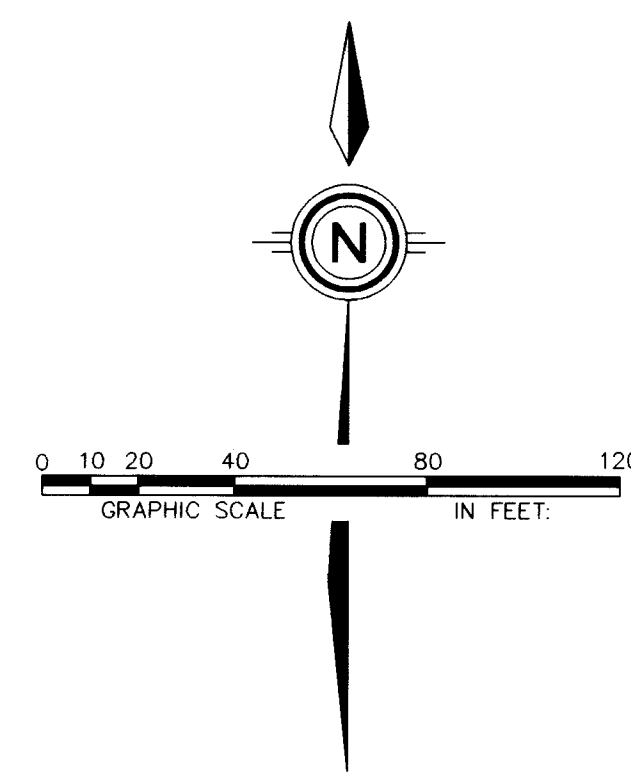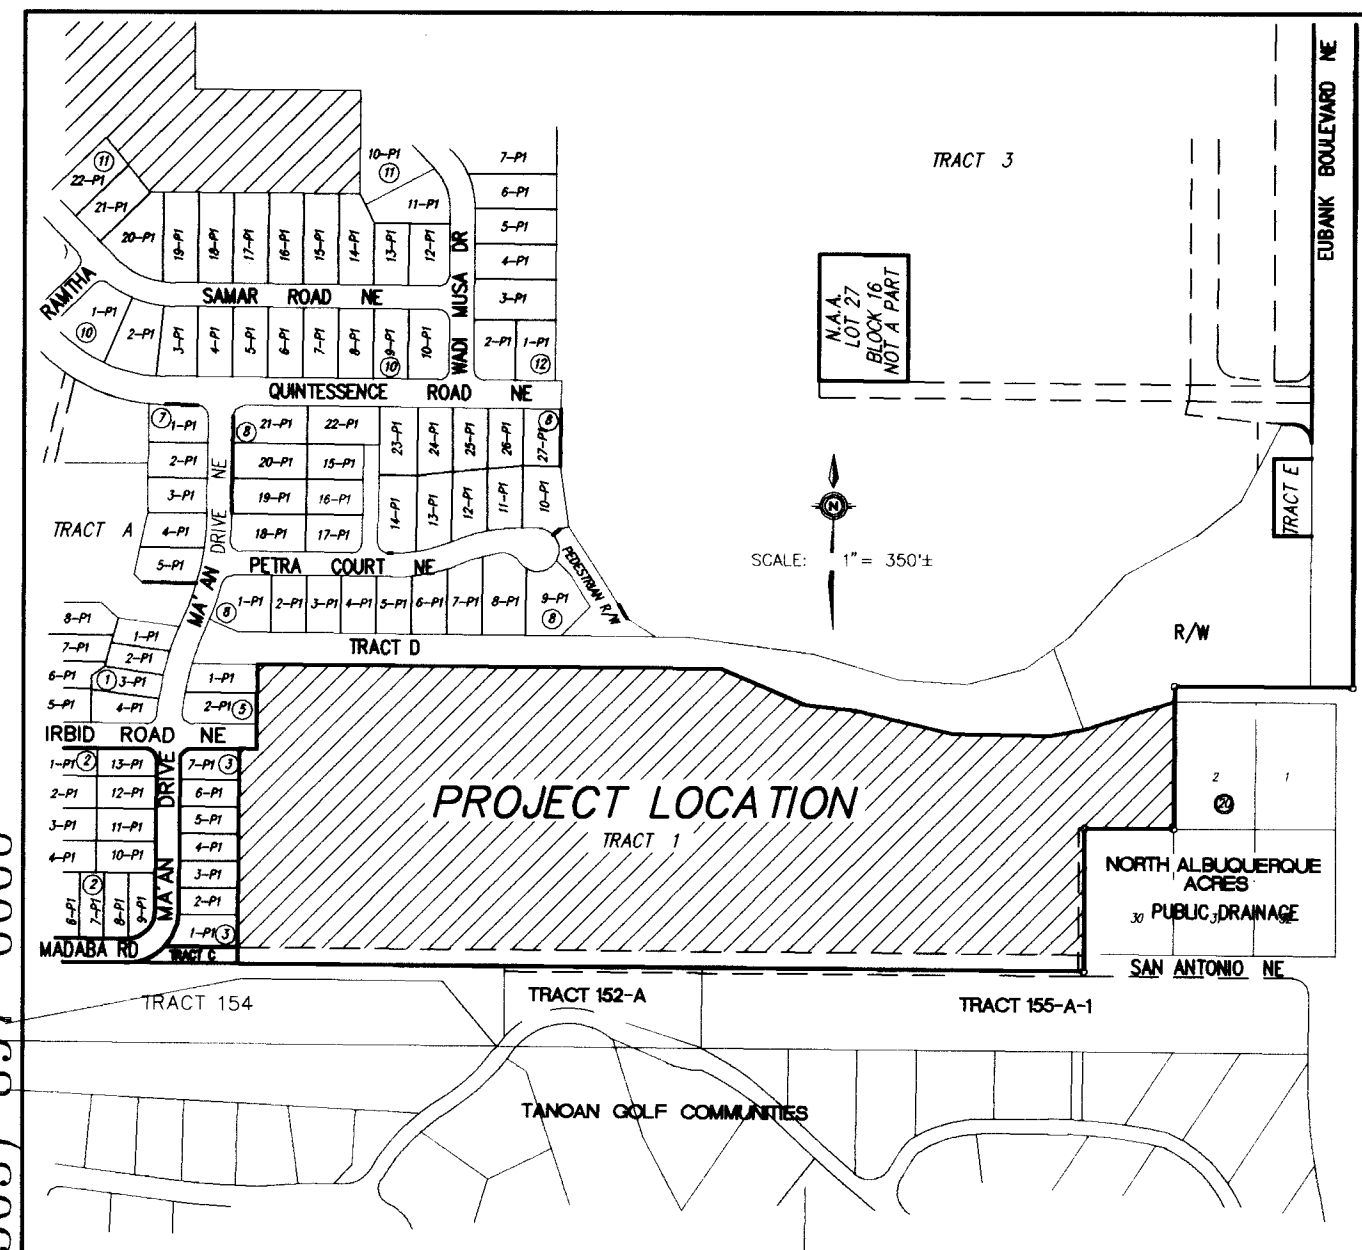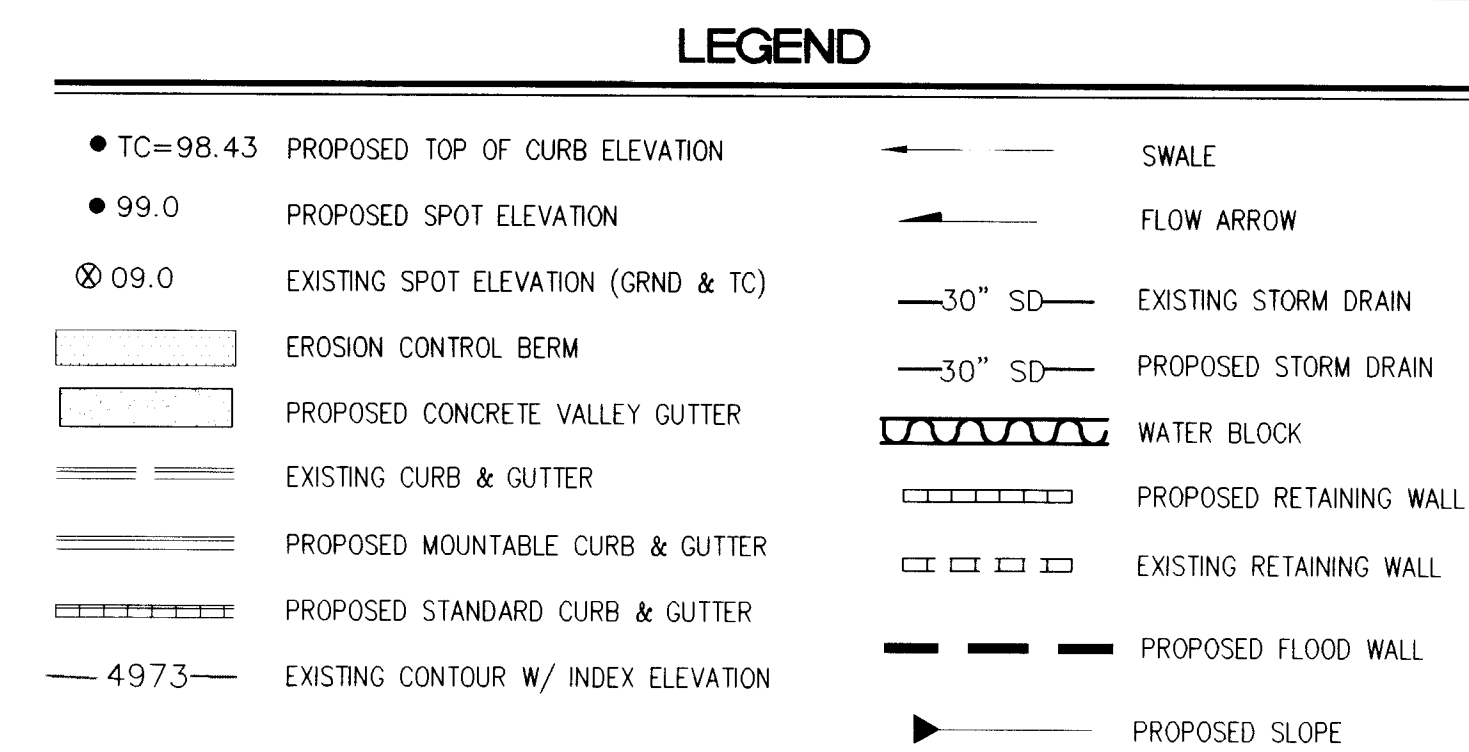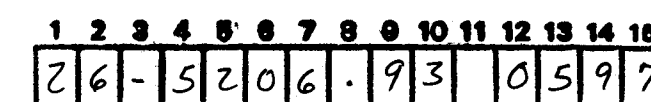

SCANNED BY
BY LASON

ENGINEER'S SEAL		SURVEY INFORMATION		BENCH MARKS		AS BUILT INFORMATION	
		FIELD NOTES		CONTRACTOR		DATE	
		NO.	DATE	STAKE BY		DATE	
		1	COMMUNITY SCIENCES	INSPECTOR'S		DATE	
			12/95	FIELD ACE BY		DATE	
				VERIFICATION BY		DATE	
REMARKS		OF CORONADO AVENUE AND HOLBROOK STREET, AND 85 FEET EAST		MICRO-FILM INFORMATION		RECORDED BY	
DESIGN		ELEV. = 5850.36		NO.		DATE	
DESIGNED BY J.M.N.		DATE 12/95					
DRAWN BY A.M.		DATE 12/95					
CHECKED BY		DATE					
APPROVALS		ENGINEER		DATE			
DATE							
1 SHEET		5 OF		22			

SCANNED BY
BY LASON

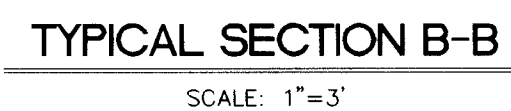

- EROSION CONTROL NOTES :**
1. CONTRACTOR SHALL OBTAIN A TOP SOIL DISTURBANCE PERMIT PRIOR TO GRADING.
 2. PROTECTION OF ADJACENT RIGHT-OF-WAY AND PRIVATE PROPERTY FROM SEDIMENT, WILL BE ACCOMPLISHED BY THE EROSION CONTROL BERM SHOWN HERE ON.
 3. DISTURBED AREAS WILL BE RESEDED PER C.O.A. DPM SECTION 1012, AS INDICATED.



THIS DETAIL APPLIES TO ALL LOTS
AND FINISHED GRADE AROUND PERIMETER

OF HOUSE SHALL BE A MINIMUM OF
6" BELOW TOP OF CONCRETE SLAB.
(SEE SECTIONS THIS SHEET)

1	2	3	4	5	6	7	8	9	10	11	12	13	14	15
2	6	-	5	2	0	6	.	9	2		0	8	9	2

DATE: 11/95	<i>community sciences corporation</i>
SCALE: AS NOTED	
JOB NO. 32308	LAND PLANNING F.O. Box 1328 ENGINEERING Corrales, N.M. 87048 SURVEYING

community
sciences
corporation

LAND PLANNING ENGINEERING SURVEYING
P.O. Box 1328 Corrales, N.M. 87048

CITY OF ALBUQUERQUE
PUBLIC WORKS DEPARTMENT
ENGINEERING GROUP

TITLE: QUINTESSENCE SUBDIVISION - UNIT 2
TYPICAL LOT GRADING DETAILS AND SECTIONS

APPROVALS	ENGINEER	DATE	APPROVALS	ENGINEER	DATE
DRC CHAIRMAN			WATER		
TRANSPORTATION			WASTE WATER		
HYDROLOGY					

FOR INFORMATION ONLY

PROJECT NO.	5206.93	MAP NO.	D-21	SHEET	7	OF	22
-------------	---------	---------	------	-------	---	----	----

APPROVED FOR ROUGH GRADING
(± 1 FT.)

CITY HYDROLOGY

DATE _____

CT NO. 5206.93

MAP NO.	
------------	--

SHEET


7 OF 22

SCANNED BY
BY LASON

COMMUNITY SCIENCES CORPORATION

CONVALES, NEW MEXICO

00001 001 0000

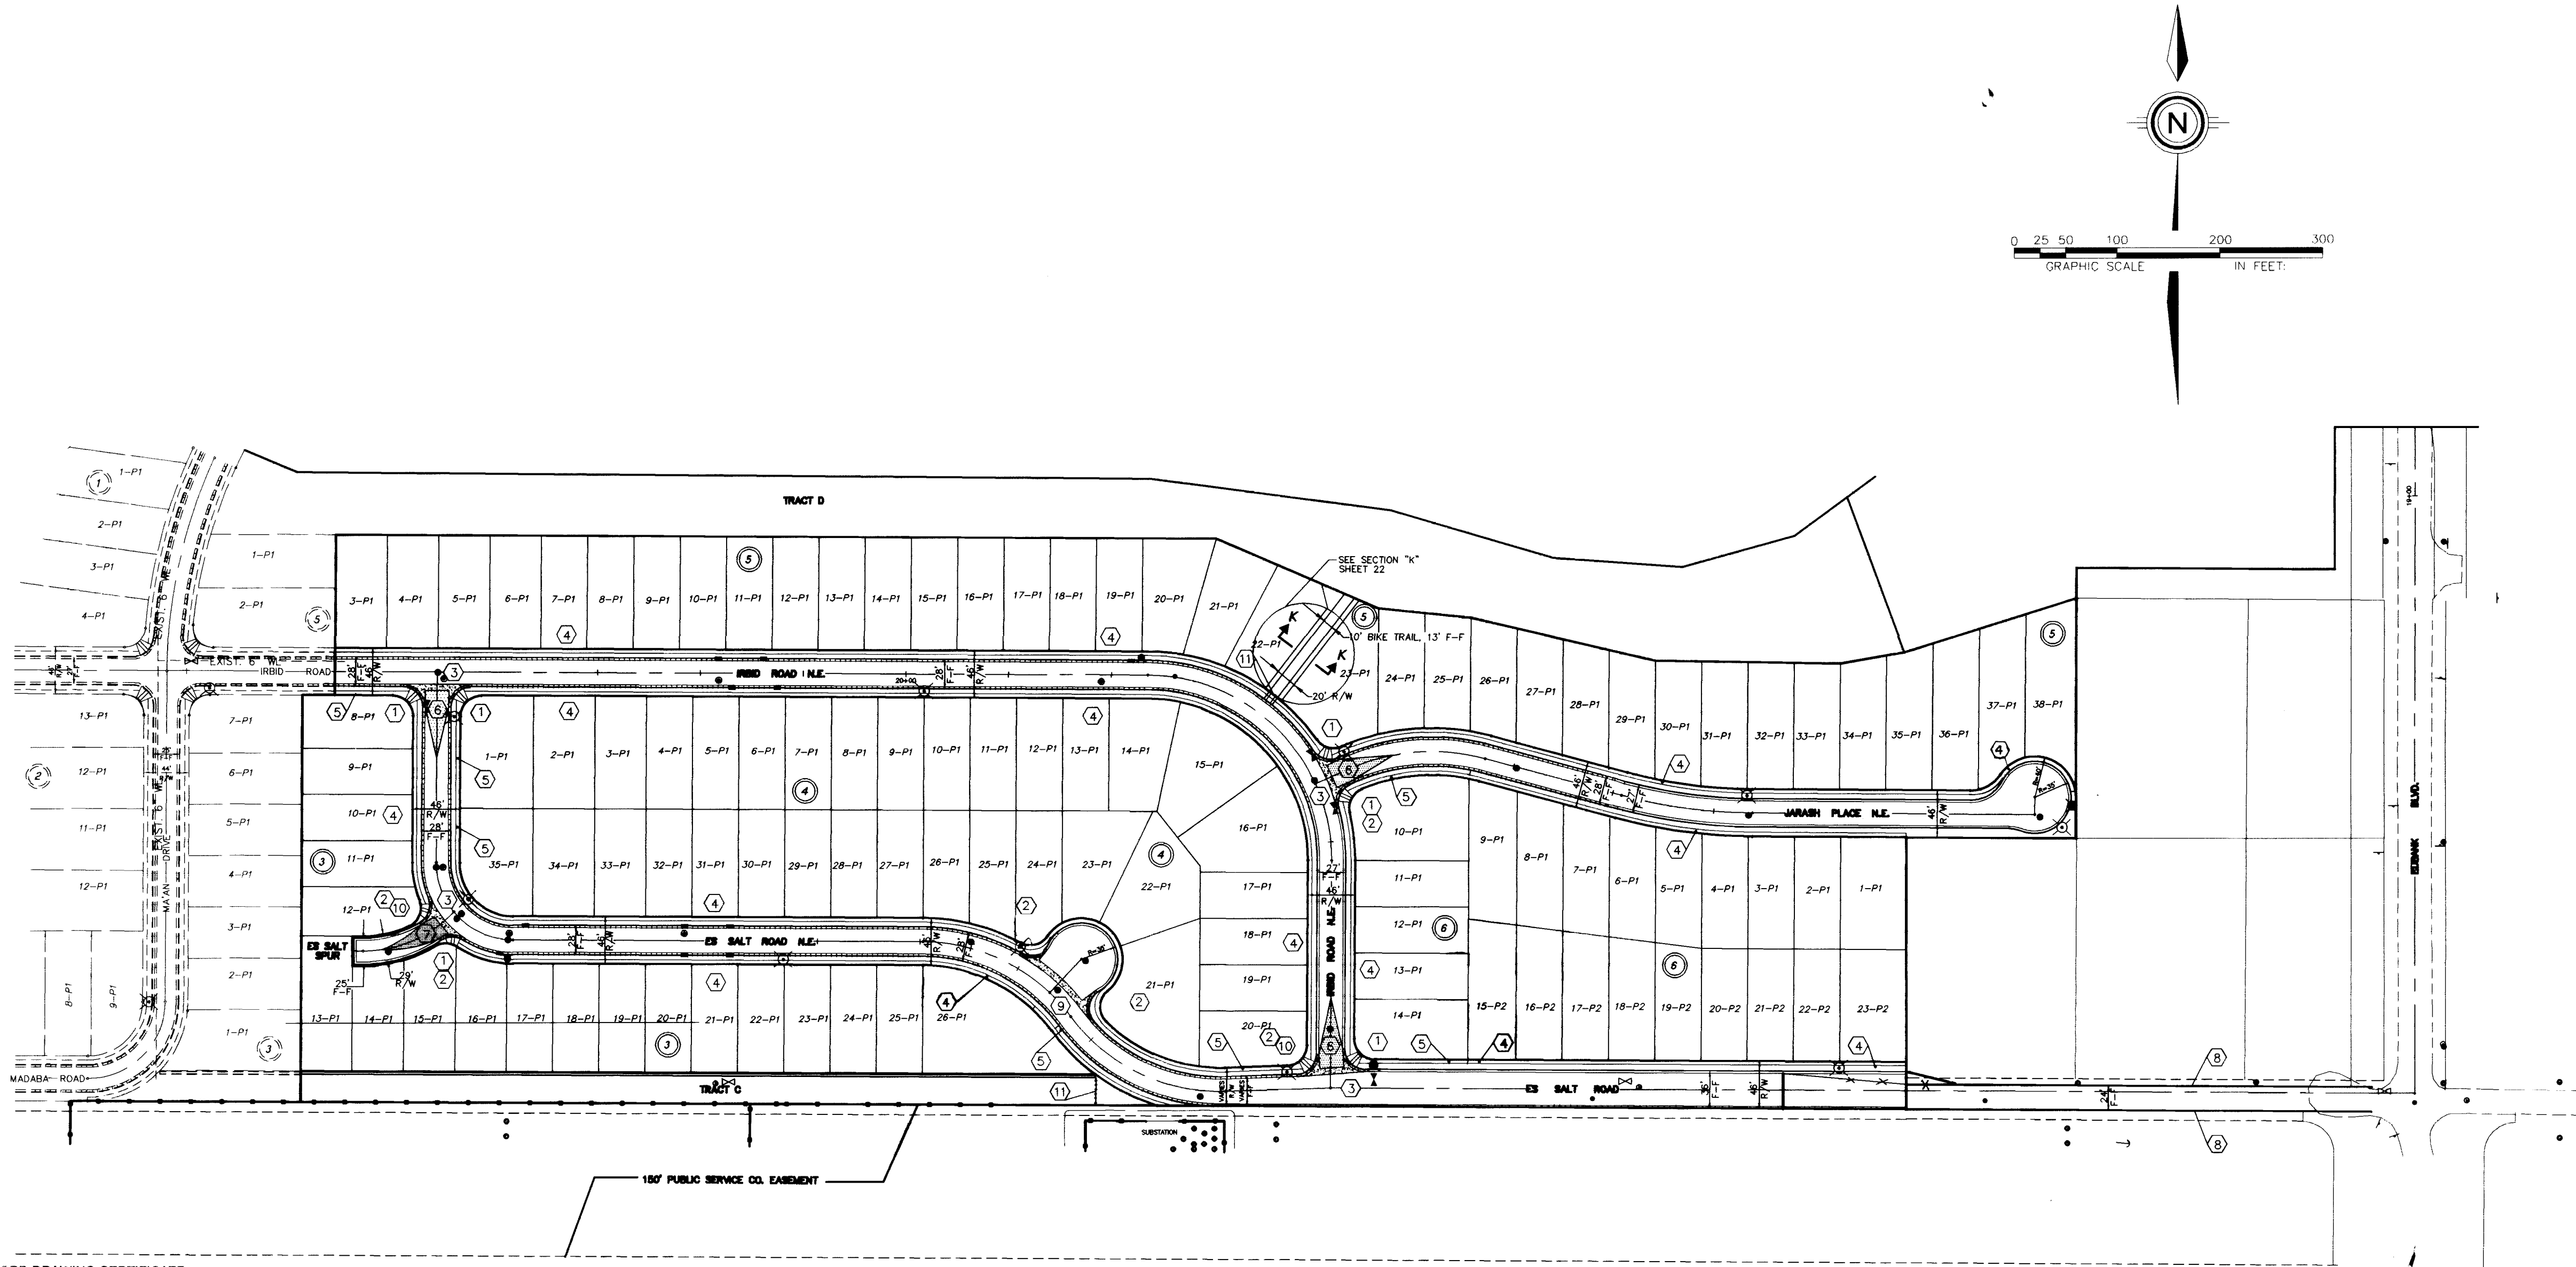


ENGINEER'S RECORD DRAWING CERTIFICATE

I, the undersigned engineer, a duly qualified Registered Professional Engineer under the laws of the State of New Mexico, do hereby certify that the Record Drawing information shown on these drawings was obtained from field construction and post-construction information obtained by me or under my direct supervision, that the Record Drawing information shown on these drawings was prepared by me or under my direct supervision, and that the Record Drawing information is true and correct to the best of my knowledge and belief. Responsibility for the design, construction, design engineering and calculations, or in part of the Record Drawing is assumed with others.

Elery A. Blathrow, Jr. 02-21-97
Elery A. Blathrow, Jr., P.E. New Mexico Civil Registration No. 12070

TANOAN GOLF COMMUNITIES

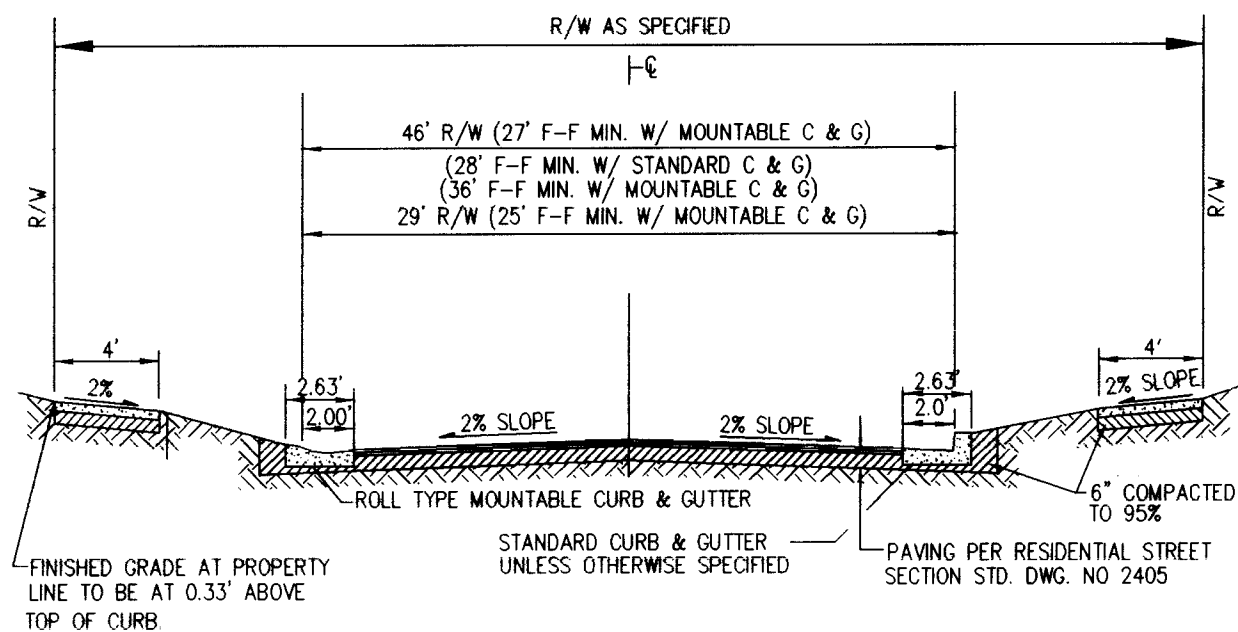


TYPICAL STREET CROSS SECTION

NOT TO SCALE


1-1/2" ASPHALT CONCRETE
TYPICAL FINISH COURSE PLACED
AFTER ALL MANHOLES, VALVES,
COVERS/RINGS ARE SET TO GRADE.
1500 LBS. STABILITY TYPE B
GRADATION.

FINISH SURFACE OF SUBGRADE
SHALL BE MOISTURE CONTROLLED
AT COMPACTION MOISTURE RANGE,
OR PRIME COAT APPLIED AS
REQUIRED BY THE ENGINEER UNTIL
NEXT/FINAL SURFACING COMPLETED.
SUBGRADE PREPARATION SHALL BE
PERFORMED AFTER ALL SUB-
SURFACE R/W UTILITIES CONSTRUCTION COMPLETED.

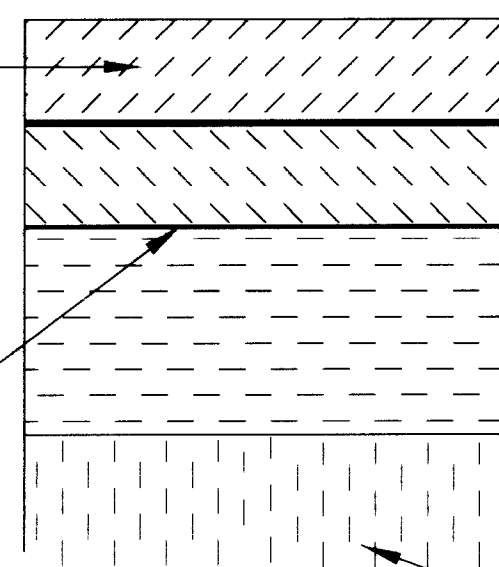

RESIDENTIAL PAVING SECTION COMPONENTS

PER C.O.A. STD. DWG. NO. 2405

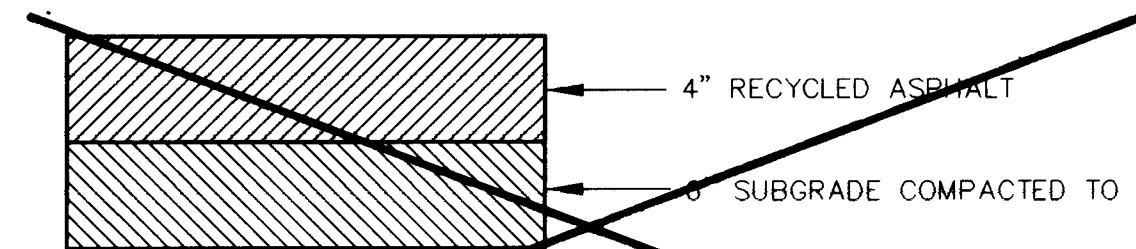

TEMPORARY ASPHALT PAVING

NTS

DATE: NOV, 1995

SCALE:

1" = 100'

JOB NO. 5206-93-041

LAND PLANNING

ENGINEERING

SURVEYING

CONVALES, N.M. 87048

community
sciences
corporation

CITY OF ALBUQUERQUE
PUBLIC WORKS DEPARTMENT
ENGINEERING GROUP

TITLE: QUINTESSENCE SUBDIVISION- UNIT 2
COMPOSITE PAVING PLAN

APPROVALS	ENGINEER	DATE	APPROVALS	ENGINEER	DATE
DRC CHAIRMAN	<i>B. G. Boudreau</i>	3-21-96	WATER	<i>MA RWF 2-1-96</i>	
TRANSPORTATION	<i>MA RWF 2-1-96</i>	3-1-96	WASTE WATER	<i>MA RWF 2-1-96</i>	
HYDROLOGY	<i>N/A Sme</i>	3-6-96			

PROJECT NO. 5206.93

MAP NO. D-21

SHEET 8 OF 22

SCANNED BY
BY LASON


LEGEND

- PROPOSED CURB FLOWLINE ELEVATION
- EXISTING SPOT ELEVATION
- PROPOSED VALLEY GUTTER/ SIDEWALK
- EXISTING CURB & GUTTER
- PROPOSED MOUNTABLE CURB & GUTTER
- PROPOSED STANDARD CURB & GUTTER
- CROWN TRANSITION
- PROPOSED STORM SEWER CATCH BASIN
- EXISTING STORM SEWER CATCH BASIN
- PROPOSED GATE VALVE
- PROPOSED SANITARY SEWER MANHOLE
- PROPOSED STORM DRAIN MANHOLE
- EXISTING STORM DRAIN MANHOLE
- EXISTING SANITARY SEWER MANHOLE
- PROPOSED FIRE HYDRANT
- EXISTING FIRE HYDRANT
- STREET LIGHTS
- EXISTING GATE VALVE

KEY NOTES:

- WHEELCHAIR RAMP PER COA STD. DWG. 2441 CASE I, UNLESS OTHERWISE NOTED.
- MOUNTABLE TO STANDARD CURB TRANSITION PER COA STD. DWG. 2418
- CONC. VALLEY GUTTER PER COA STD. DWG. 2420
- FUTURE 4' SIDEWALK, BY OTHERS
- PROPOSED 4' SIDEWALK, THIS CONTRACT
- 50' CROWN TRANSITION PER C.O.A. STD. DWG. 2401
- 25' CROWN TRANSITION PER C.O.A. STD. DWG. 2401
- 8" TEMPORARY ASPHALT CURB PER C.O.A. STD. DWG. 2405
- CONC. VALLEY GUTTER PER COA STD. DWG. 2421
- WHEELCHAIR RAMP PER COA STD. DWG. 2441 CASE II
- STATIONARY POSTS PER COA STD. DWG. 2250

AS-BUILT INFORMATION		BENCH MARKS		SURVEY INFORMATION		ENGINEER'S SEAL		REVISIONS		REMARKS	
CONTRACTOR	DATE	STATION	DATE	NO.	DATE	NO.	DATE	NO.	DATE	NO.	DATE
community sciences corp	12/95	5-021 1985'	12/95	1	12/95						
INSPECTOR	DATE	THE STATION IS A STANDARD ACS ALUMINUM CAP STAMPED	DATE	COMMUNITY SCIENCES	DATE	ELERY A. BLATHROW, JR.	DATE				
ACCEPTANCE BY	DATE	0.1 FOOT ABOVE GROUND	DATE								
VERIFICATION BY	DATE	IT IS LOCATED 793 FEET NORTH OF THE CENTERLINE INTERSECTION	DATE								
DRAWINGS	DATE	OF CORONADO AVENUE AND HOLBROOK STREET, AND 85 FEET EAST	DATE								
CONTRACT NO.	DATE	OF THE CENTERLINE OF HOLBROOK STREET.	DATE								
PROJECT NO.	DATE	ELEVATION = 5650.56	DATE								
RECORDED BY	DATE		DATE								
NO.	DATE		DATE								

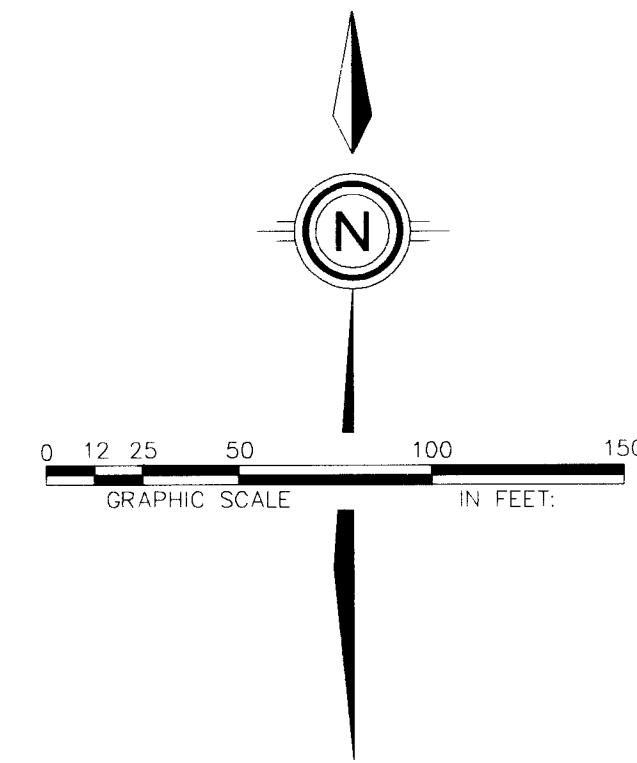

IRBID ROAD., N.E.
STANDARD CURB & GUTTER W/ RESIDENTIAL PAVING
(SEE SHEET 8 FOR STREET CROSS SECTION)



KEY NOTES:

- | | | | | | | | | | | | | | | |
|---|---|---|---|---|---|---|---|---|----|----|----|----|----|----|
| 1 | 2 | 3 | 4 | 5 | 6 | 7 | 8 | 9 | 10 | 11 | 12 | 13 | 14 | 15 |
| 7 | 6 | - | 5 | 7 | 6 | . | 7 | 3 | | | 0 | 9 | 9 | 7 |

SCALE: *community sciences corporation*

HORIZ: 1" = 50'

VERT: 1" = 10'

LAND PLANNING P.O. Box 1328 ENGINEERING Corrigan, N.M. 870 SURV

TITLE: QUINTESSENCE - UNIT 2
PAVING PLAN &
IRBID ROAD N.E.


APPROVALS	ENGINEER	DATE	
DRC CHAIRMAN	<i>J. G. S. S. S.</i>	3-21-96	WAT
TRANSPORTATION	<i>J. G. S. S. S.</i>	3-1-96	WAS
HYDROLOGY	N/A SMC	3-6-96	
<i>THANKS</i>	<i>THANKS</i>	3-11-96	

PROJECT NO.	5206.93	MAP NO.	D-
-------------	---------	---------	----

[illegible]

ENGINEER'S RECORD DRAWING CERTIFICATE
I, the undersigned engineer, a duly qualified Registered Professional Engineer under the laws of the State of New Mexico, do hereby certify that this Record Drawing information was prepared by me or under my direct supervision and that I am a duly Licensed Professional Engineer in the State of New Mexico. I am not aware of any falsification of information or any other act which would constitute a violation of the laws of the State of New Mexico. I am not aware of any falsification of information or any other act which would constitute a violation of the laws of the State of New Mexico. I am not aware of any falsification of information or any other act which would constitute a violation of the laws of the State of New Mexico.

Elery A. Blathrow, Jr. 02-20-97
Elery A. Blathrow, Jr., P.E. New Mexico Civil Registration No. 12070

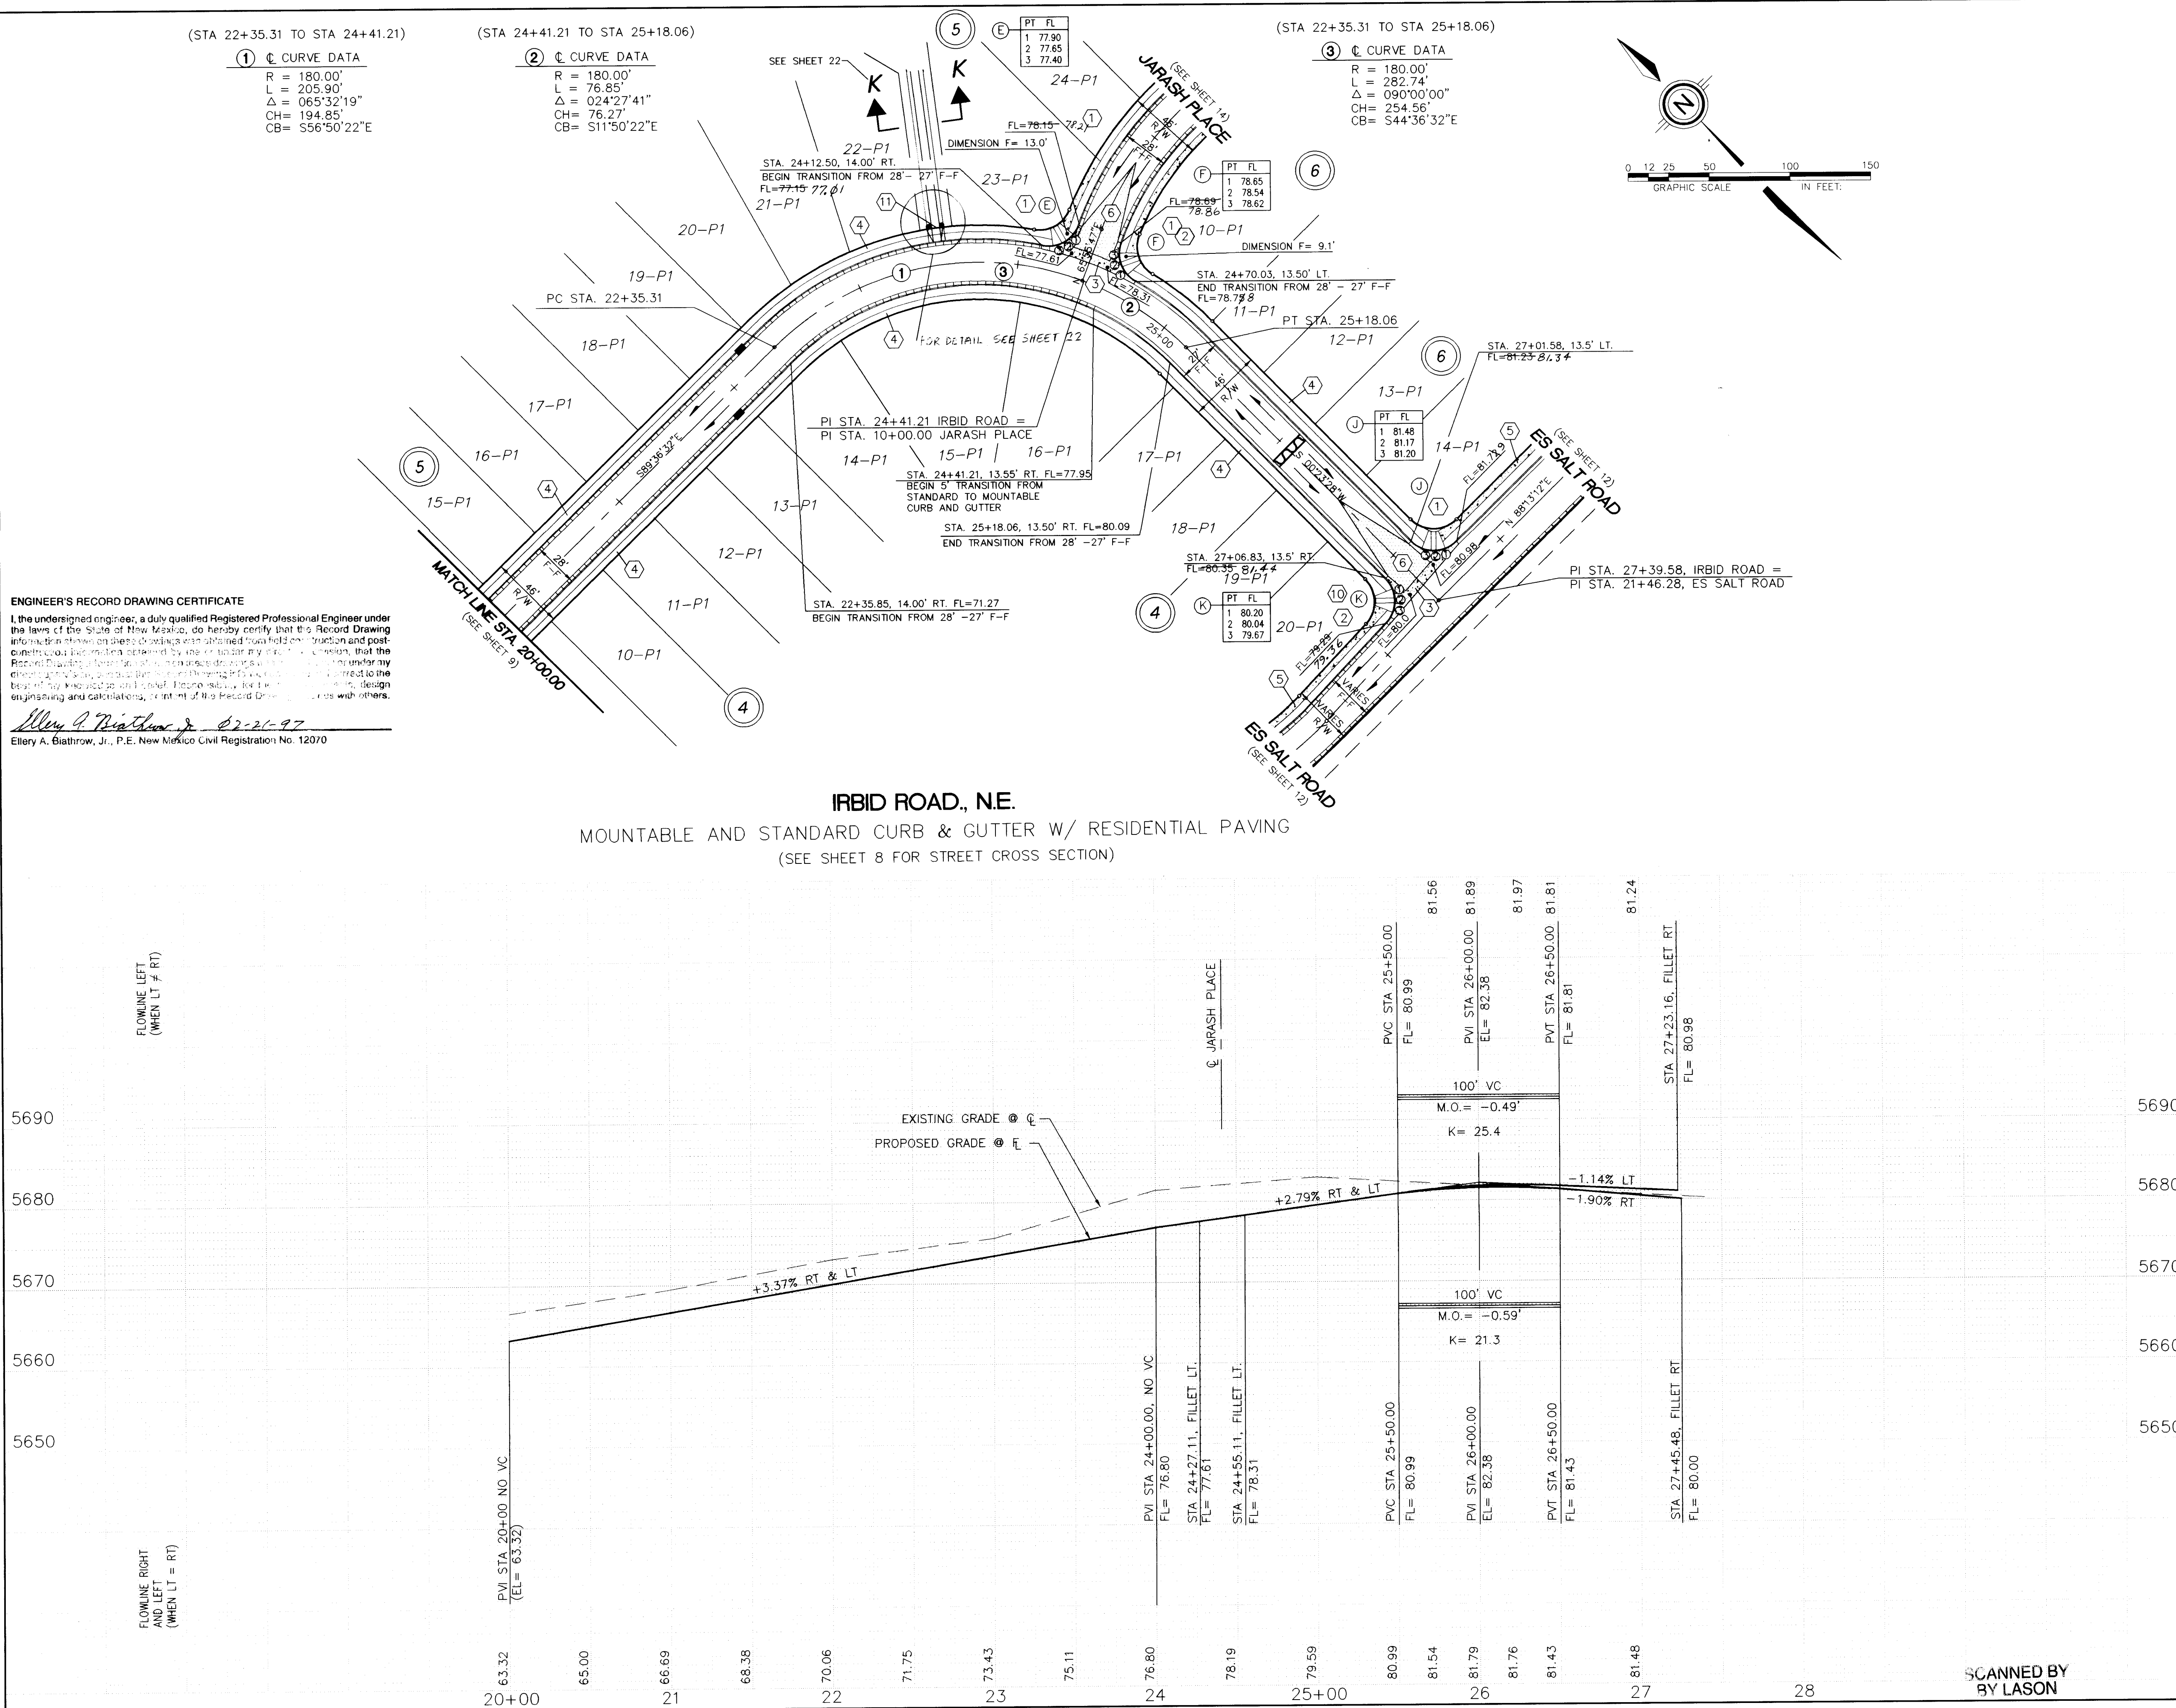

- LEGEND**
- PROPOSED CURB FLOWLINE ELEVATION
 - EXISTING SPOT ELEVATION
 - PROPOSED VALLEY GUTTER/ SIDEWALK
 - EXISTING CURB & GUTTER
 - PROPOSED MOUNTABLE CURB & GUTTER
 - PROPOSED STANDARD CURB & GUTTER
 - CROWN TRANSITION
 - PROPOSED STORM SEWER CATCH BASIN
 - EXISTING STORM SEWER CATCH BASIN
 - PROPOSED GATE VALVE
 - PROPOSED SANITARY SEWER MANHOLE
 - PROPOSED STORM DRAIN MANHOLE
 - EXISTING STORM DRAIN MANHOLE
 - EXISTING SANITARY SEWER MANHOLE
 - PROPOSED FIRE HYDRANT
 - EXISTING FIRE HYDRANT
 - STREET LIGHTS
 - PROPOSED GATE VALVE
 - WATER BLOCK

- KEY NOTES**
- WHEELCHAIR RAMP PER COA STD. DWG. 2441 CASE I, UNLESS OTHERWISE NOTED.
 - MOUNTABLE TO STANDARD CURB TRANSITION PER COA STD. DWG. 2418
 - CONC. VALLEY GUTTER PER COA STD. DWG. 2420
 - FUTURE 4' SIDEWALK, BY OTHERS
 - PROPOSED 4' SIDEWALK, THIS CONTRACT
 - 50' CROWN TRANSITION PER C.O.A. STD. DWG. 2401
 - 25' CROWN TRANSITION PER C.O.A. STD. DWG. 2401
 - 8" TEMPORARY ASPHALT CURB PER C.O.A. STD. DWG. 2405
 - CONC. VALLEY GUTTER PER COA STD. DWG. 2421
 - WHEELCHAIR RAMP PER COA STD. DWG. 2441 CASE II
 - STATIONARY POSTS PER COA STD. DWG. 2250

CURB CURVE TABLE AT FACE OF CURB			
CURVE ID	RADIUS	ARC	DELTA
E	20.00	28.47	81°33'29"
F	20.00	27.81	79°40'11"
J	20.00	31.42	90°00'00"
K	20.00	30.66	87°49'44"

1	2	3	4	5	6	7	8	9	10	11	12	13	14	15	16
2	3	4	5	6	7	8	9	10	11	12	13	14	15	16	17

SCALE:
HORIZ: 1" = 50'
VERT: 1" = 10'


community sciences corporation
LAND PLANNING P.O. Box 1328
ENGINEERING Corrales, N.M. 87048
SURVEYING

**CITY OF ALBUQUERQUE
PUBLIC WORKS DEPARTMENT
ENGINEERING GROUP**


TITLE: QUINTESSENCE - UNIT 2
PAVING PLAN & PROFILE
IRBID ROAD N.E.

APPROVALS	ENGINEER	DATE	APPROVALS	ENGINEER	DATE
DRG CHAIRMAN	<i>B.G. Koolhaas</i>	3-21-96	WATER	<i>N/A RWK</i>	3-21-96
TRANSPORTATION	<i>R. J. ...</i>	3-1-96	WASTE WATER	<i>N/A RWK</i>	3-1-96
HYDROLOGY	<i>N/A SMC</i>	3-2-96			

PROJECT NO. 5206.93 MAP NO. D-21 SHEET 10 OF 22

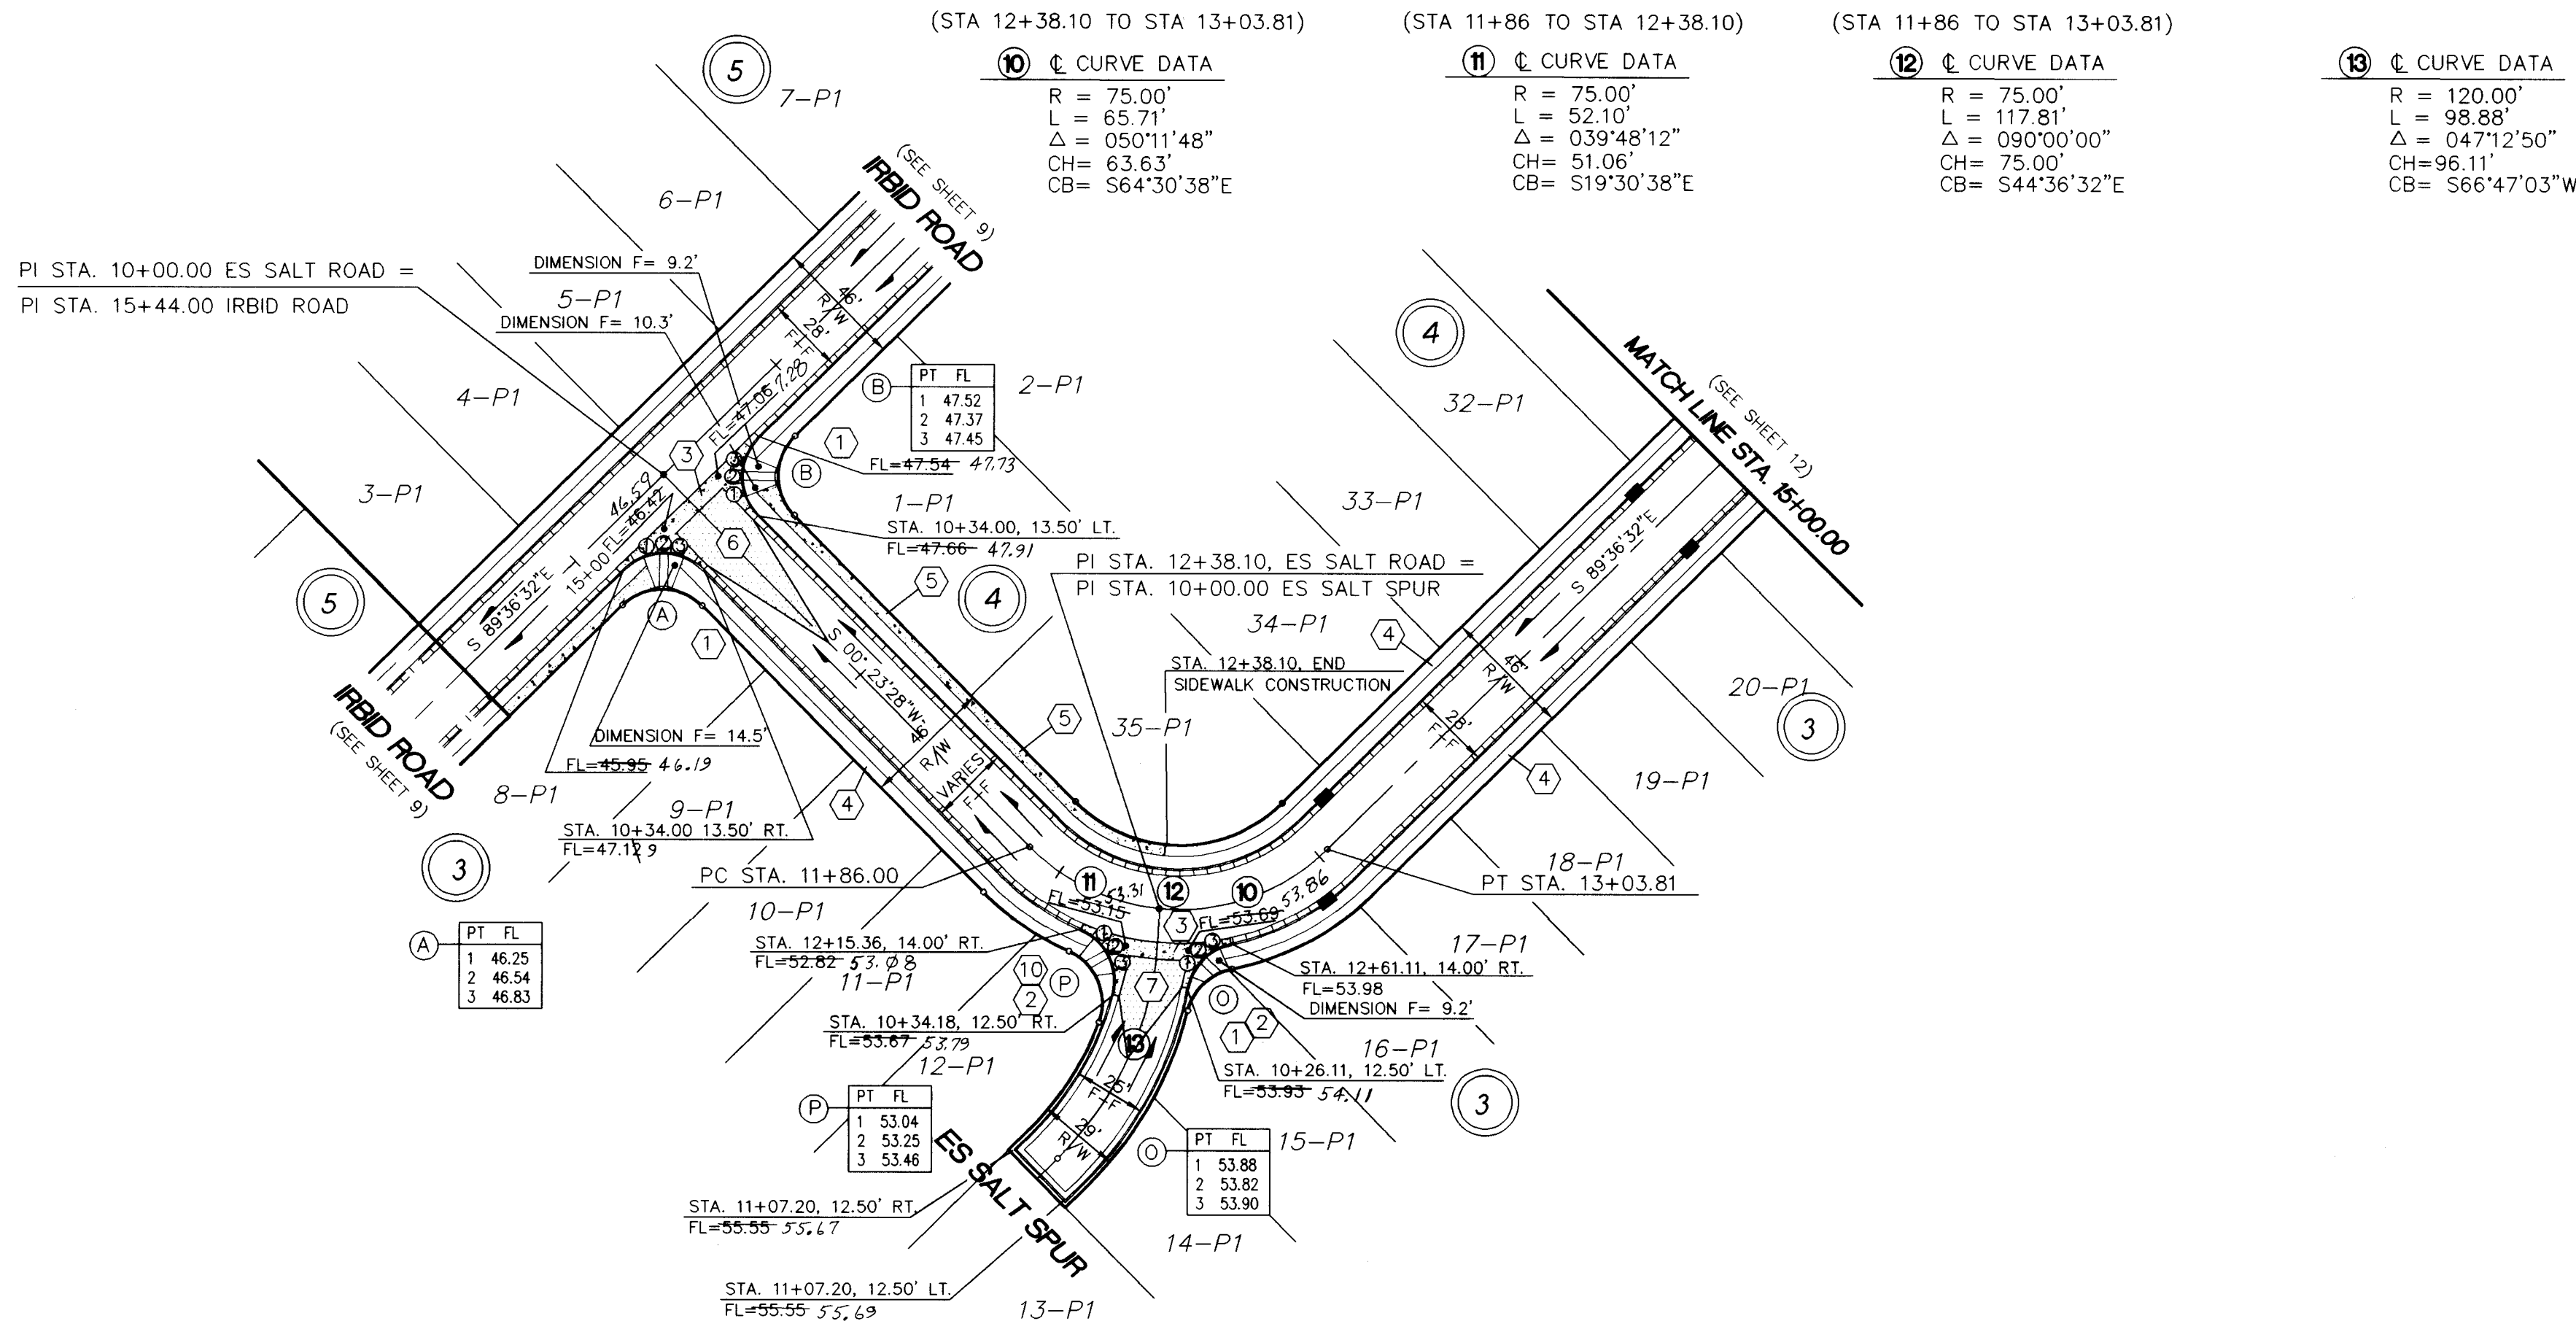

ES SALT ROAD, N.E.
MOUNTABLE AND STANDARD CURB AND GUTTER W/ RESIDENTIAL PAVING
(SEE SHEET 8 FOR STREET CROSS SECTION)

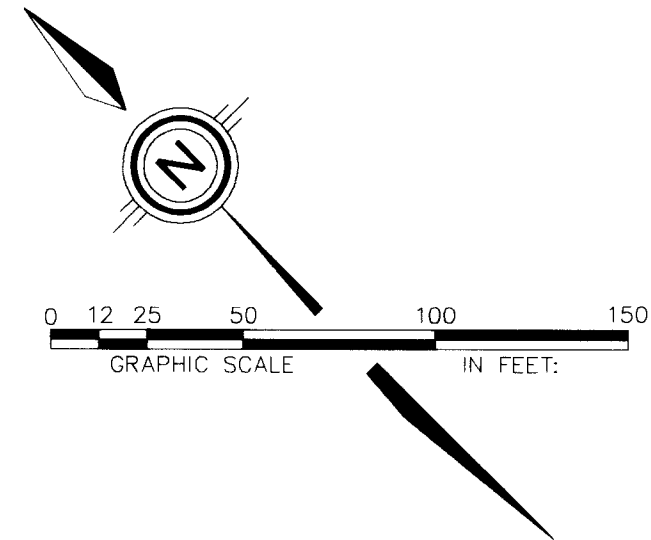

LEGEND	
•	PROPOSED CURB FLOWLINE ELEVATION
⊙	EXISTING SPOT ELEVATION
▨	PROPOSED VALLEY GUTTER/ SIDEWALK
▬	EXISTING CURB & GUTTER
▬	PROPOSED MOUNTABLE CURB & GUTTER
▬	PROPOSED STANDARD CURB & GUTTER
▬	CROWN TRANSITION
■	PROPOSED STORM SEWER CATCH BASIN
□	EXISTING STORM SEWER CATCH BASIN
⊥	PROPOSED GATE VALVE
●	PROPOSED SANITARY SEWER MANHOLE
⊙	PROPOSED STORM DRAIN MANHOLE
⊙	EXISTING STORM DRAIN MANHOLE
⊙	EXISTING SANITARY SEWER MANHOLE
⊙	PROPOSED FIRE HYDRANT
⊙	EXISTING FIRE HYDRANT
⊙	STREET LIGHTS
⊥	PROPOSED GATE VALVE

KEY NOTES

- WHEELCHAIR RAMP PER COA STD. DWG. 2441 CASE I, UNLESS OTHERWISE NOTED.
- MOUNTABLE TO STANDARD CURB TRANSITION PER COA STD. DWG. 2418
- CONC. VALLEY GUTTER PER COA STD. DWG. 2420
- FUTURE 4' SIDEWALK, BY OTHERS
- PROPOSED 4' SIDEWALK, THIS CONTRACT
- 50' CROWN TRANSITION PER C.O.A. STD. DWG. 2401
- 25' CROWN TRANSITION PER C.O.A. STD. DWG. 2401
- 8" TEMPORARY ASPHALT CURB PER C.O.A. STD. DWG. 2405
- CONC. VALLEY GUTTER PER COA STD. DWG. 2421
- WHEELCHAIR RAMP PER COA STD. DWG. 2441 CASE II
- STATIONARY POSTS PER COA STD. DWG. 2250

CURB CURVE TABLE AT FACE OF CURB			
CURVE ID	RADIUS	ARC	DELTA
A	20.00	31.42	90°00'00"
B	20.00	31.42	90°00'00"
O	20.00	22.31	63°56'17"
P	20.00	28.46	81°31'50"


1	2	3	4	5	6	7	8	9	10	11	12	13	14	15
2	6	5	2	4	6	7	9	7	1	1	1	1	1	1

SCALE:	community sciences corporation	
HORIZ: 1" = 50'	LAND PLANNING P.O. Box 1328	SURVEYING Corrales, N.M. 87048
VERT: 1" = 10'		


CITY OF ALBUQUERQUE PUBLIC WORKS DEPARTMENT ENGINEERING GROUP				
TITLE: QUINTESSENCE - UNIT 2 PAVING PLAN & PROFILE ES SALT ROAD N.E.				
APPROVALS	ENGINEER	DATE	APPROVALS	ENGINEER
DRC CHAIRMAN	<i>[Signature]</i>	3-21-96	WATER	<i>N/A RWK</i>
TRANSPORTATION	<i>[Signature]</i>	3-1-96	WASTE WATER	<i>N/A RWK</i>
HYDROLOGY	<i>N/A Sme</i>	3-6-96		
DESIGNED BY	<i>[Signature]</i>	3-14-96	DATE	12/95
DRAWN BY			DATE	12/95
CHECKED BY			DATE	
PROJECT NO.	5206.93	MAP NO.	D-21	SHEET 11 OF 22

ENGINEER'S RECORD DRAWING CERTIFICATE
I, the undersigned engineer, a duly qualified Registered Professional Engineer under the laws of the State of New Mexico, do hereby certify that the Record Drawing information shown on these drawings was obtained from field construction and post-construction information obtained by me or under my direct supervision, that the Record Drawing information shown on these drawings was added by me or under my direct supervision, and that all Record Drawing information is true and correct to the best of my knowledge and belief. Responsibility for the design concepts, design engineering and calculations, or intent of the Record Drawings resides with others.

Elery A. Blathrow, Jr. 02-21-97
Elery A. Blathrow, Jr., P.E. New Mexico Civil Registration No. 12070

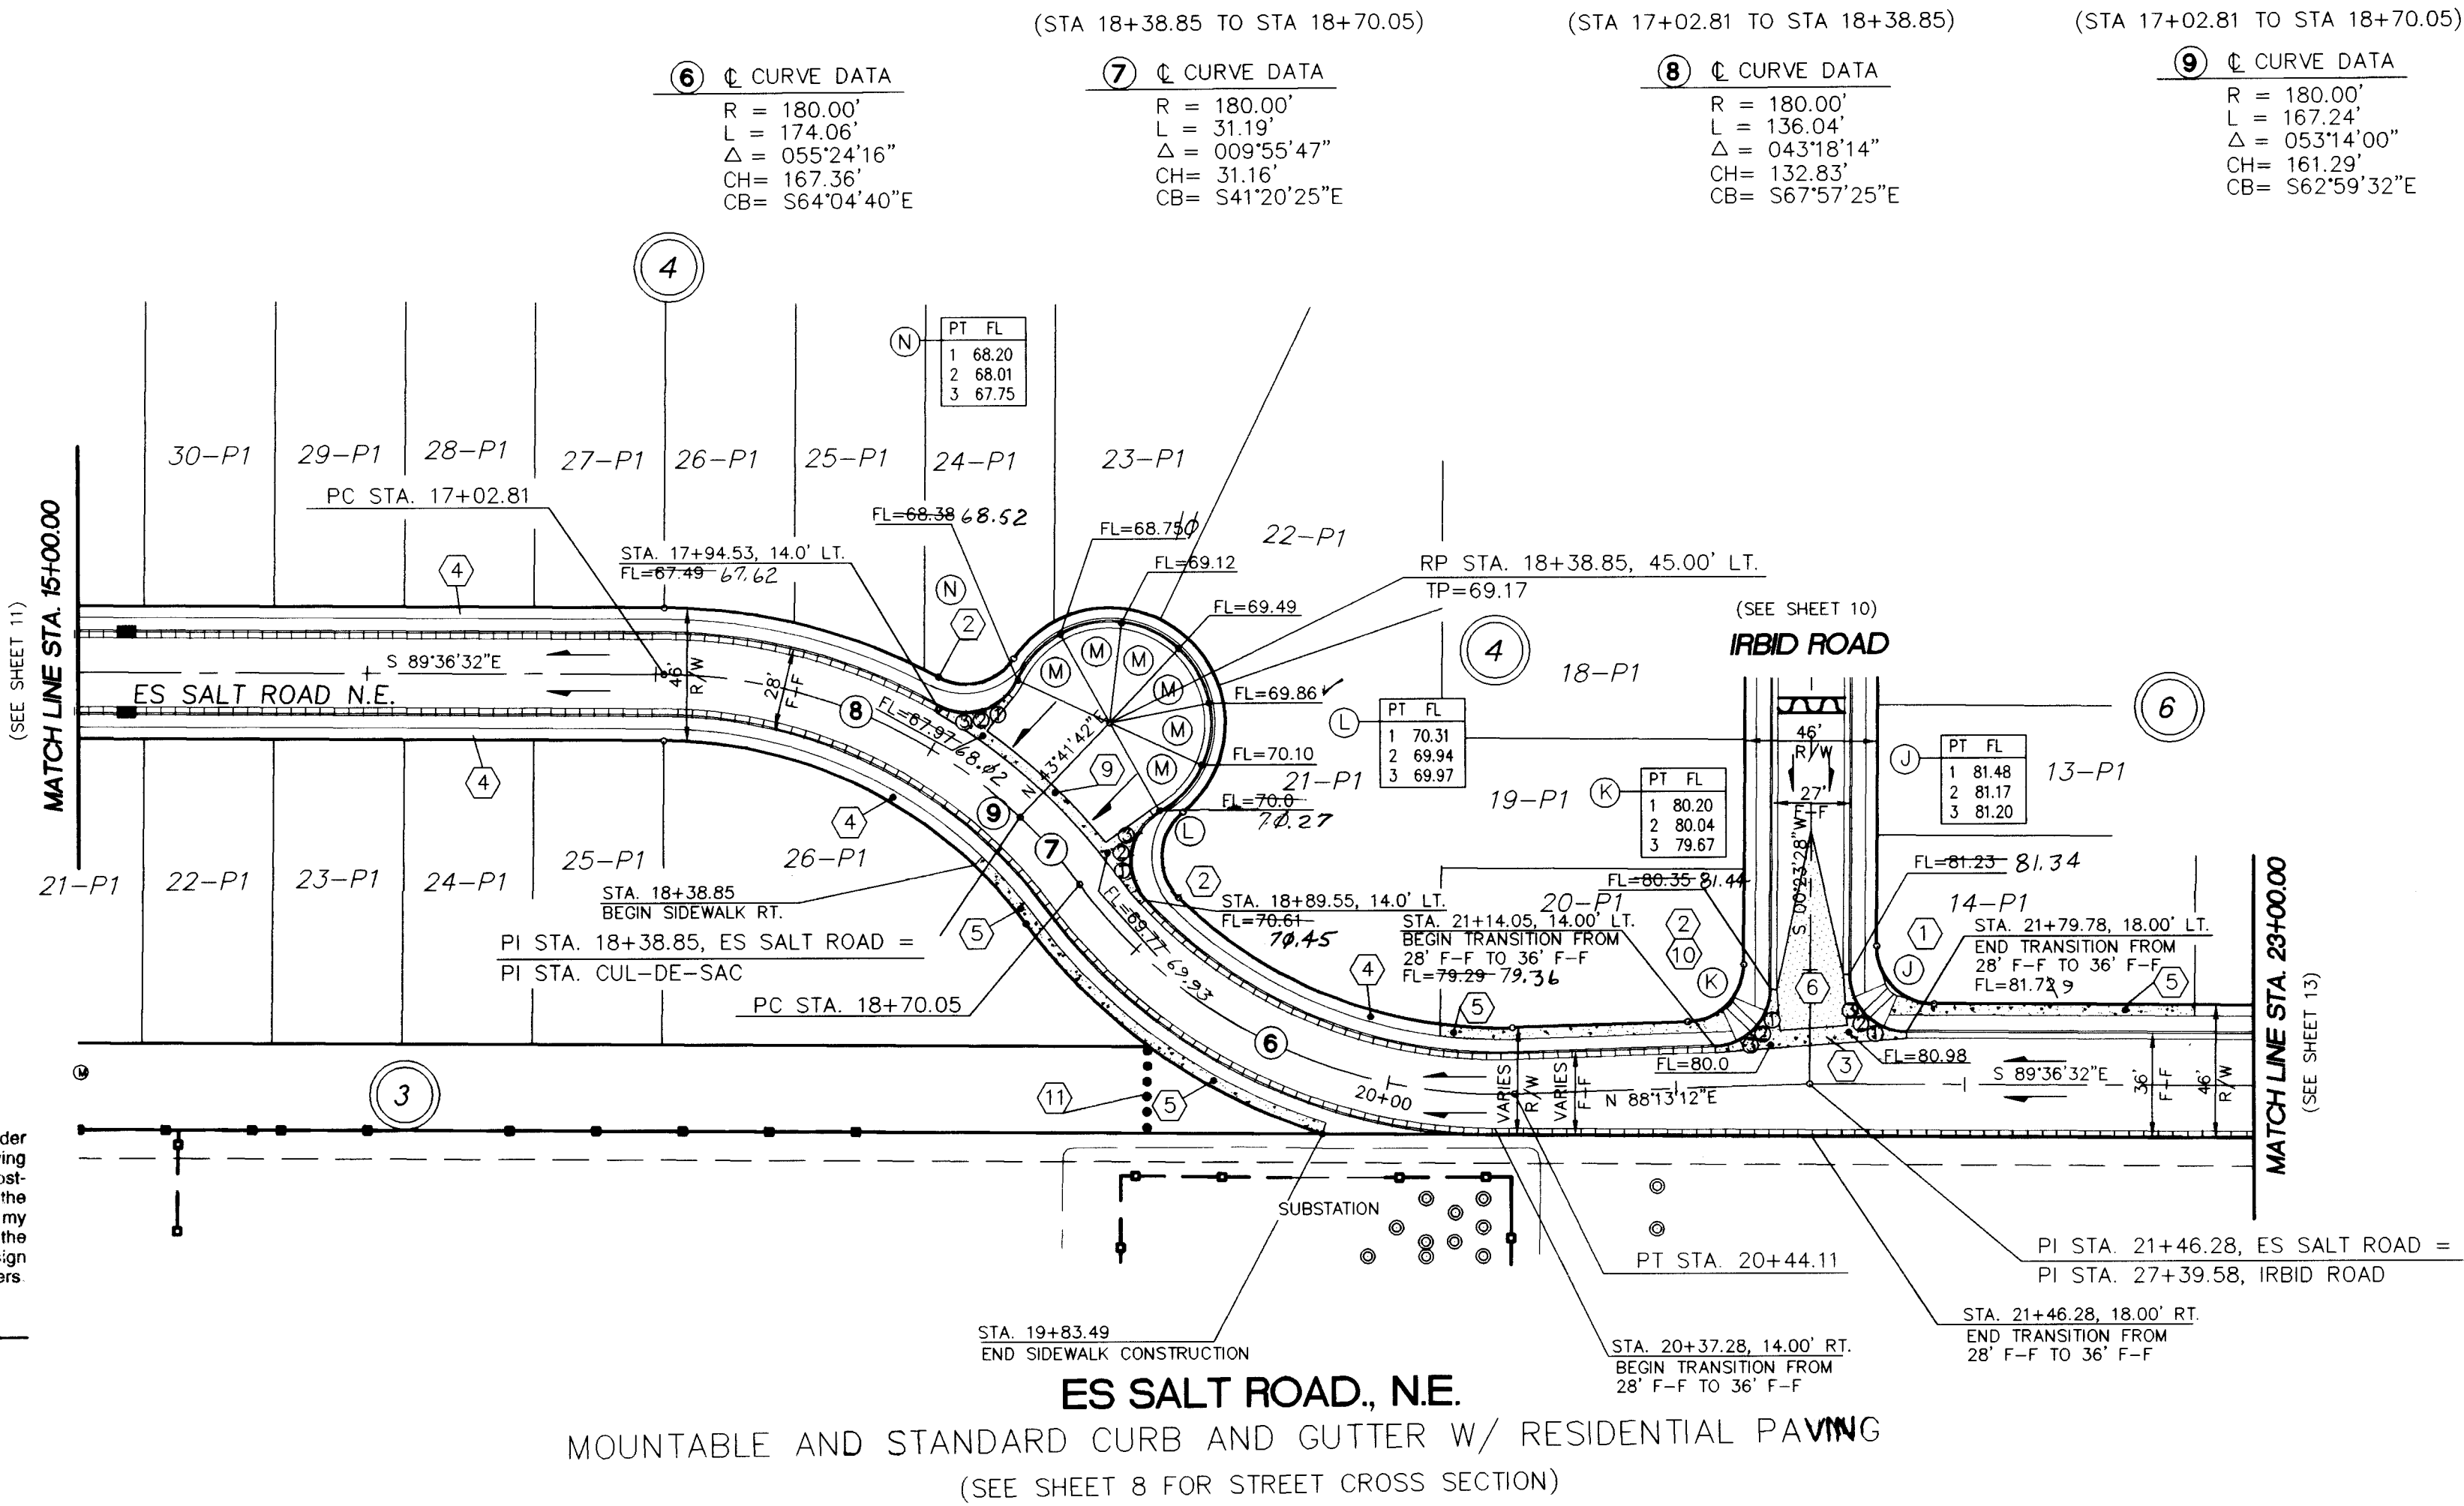

ES SALT ROAD, N.E.
MOUNTABLE AND STANDARD CURB AND GUTTER W/ RESIDENTIAL PAVING
(SEE SHEET 8 FOR STREET CROSS SECTION)

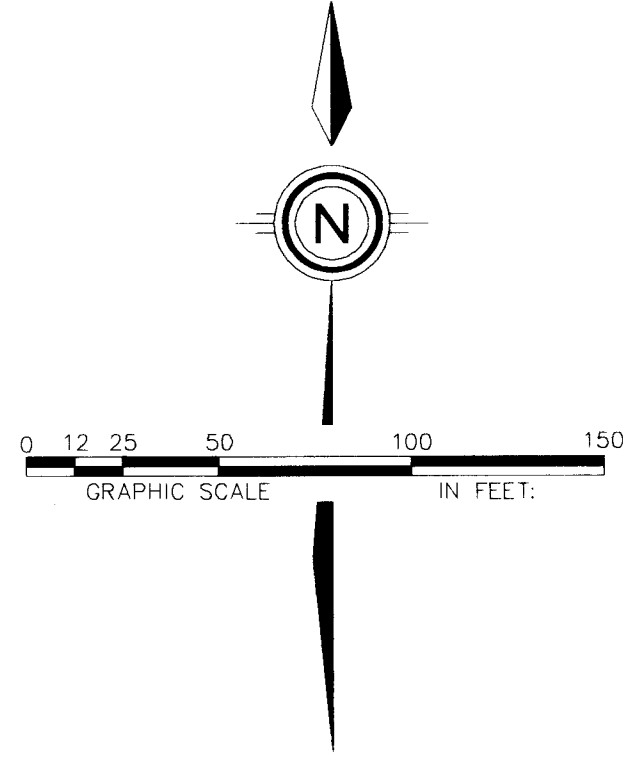

- LEGEND**
- PROPOSED CURB FLOWLINE ELEVATION
 - EXISTING SPOT ELEVATION
 - PROPOSED VALLEY GUTTER/ SIDEWALK
 - EXISTING CURB & GUTTER
 - PROPOSED MOUNTABLE CURB & GUTTER
 - PROPOSED STANDARD CURB & GUTTER
 - CROWN TRANSITION
 - PROPOSED STORM SEWER CATCH BASIN
 - EXISTING STORM SEWER CATCH BASIN
 - PROPOSED GATE VALVE
 - PROPOSED SANITARY SEWER MANHOLE
 - PROPOSED STORM DRAIN MANHOLE
 - EXISTING STORM DRAIN MANHOLE
 - EXISTING SANITARY SEWER MANHOLE
 - PROPOSED FIRE HYDRANT
 - EXISTING FIRE HYDRANT
 - STREET LIGHTS
 - PROPOSED GATE VALVE
 - WATER BLOCK

KEY NOTES

- WHEELCHAIR RAMP PER COA STD. DWG. 2441 CASE I, UNLESS OTHERWISE NOTED.
- MOUNTABLE TO STANDARD CURB TRANSITION PER COA STD. DWG. 2418
- CONC. VALLEY GUTTER PER COA STD. DWG. 2420
- FUTURE 4' SIDEWALK, BY OTHERS
- PROPOSED 4' SIDEWALK, THIS CONTRACT
- 50' CROWN TRANSITION PER C.O.A. STD. DWG. 2401
- 25' CROWN TRANSITION PER C.O.A. STD. DWG. 2401
- 8" TEMPORARY ASPHALT CURB PER C.O.A. STD. DWG. 2405
- CONC. VALLEY GUTTER PER COA STD. DWG. 2421
- WHEELCHAIR RAMP PER COA STD. DWG. 2441 CASE II
- STATIONARY POSTS PER COA STD. DWG. 2250



CURB CURVE TABLE AT FACE OF CURB			
CURVE ID	RADIUS	ARC	DELTA
J	20.00	31.42	90°00'00"
K	20.00	30.66	87°49'44"
L	20.00	36.05	103°16'13"
M	35.00	21.94	35°54'49"
N	20.00	32.95	94°22'58"

1	2	3	4	5	6	7	8	9	10	11	12	13	14	15
2	6	5	7	6	1	9	3	1	2	9	7			

SCALE:
HORIZ: 1" = 50'
VERT: 1" = 10'


community sciences corporation
LAND PLANNING P.O. Box 1328
ENGINEERING Corrales, N.M. 87048
SURVEYING

CITY OF ALBUQUERQUE PUBLIC WORKS DEPARTMENT ENGINEERING GROUP					
TITLE: QUINTESSENCE - UNIT 2 PAVING PLAN & PROFILE ES SALT ROAD, N.E.					
APPROVALS	ENGINEER	DATE	APPROVALS	ENGINEER	DATE
DRC CHAIRMAN	<i>B.G. Sootley</i>	3-21-96	WATER	N/A RWE	2-1-96
TRANSPORTATION	<i>W. S. Sme</i>	3-1-96	WASTE WATER	N/A RWE	2-1-96
HYDROLOGY	N/A Sme	3-6-96			
PROJECT NO.	5206.93	MAP NO.	D-21	SHEET	12 OF 22

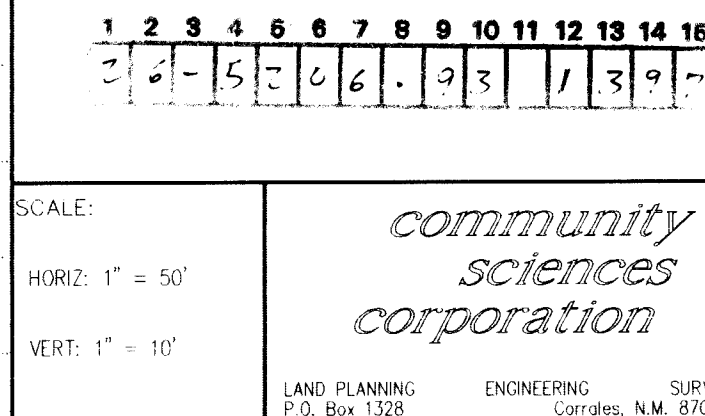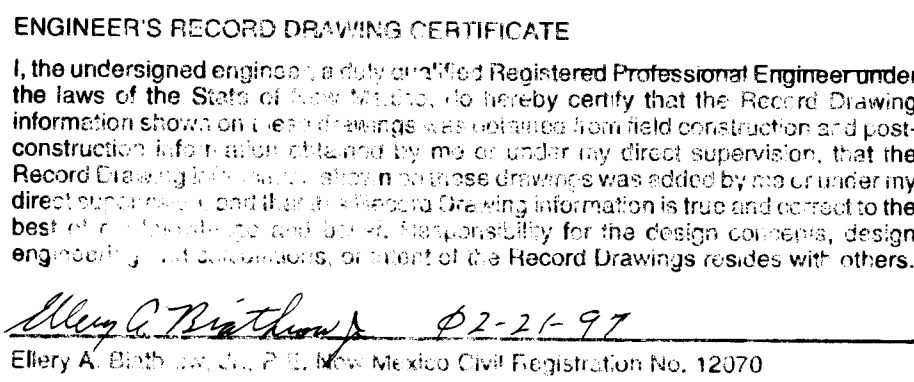


TITLE: QUINTESSENCE - UNIT 2
PAVING PLAN & PROFILE
ES SALT ROAD N.E.

APPROVALS	ENGINEER	DATE	APPROVALS	ENGINEER	DATE
DPC CHAIRMAN	<i>Sgt. Gaudin</i>	3-21-96	WATER	NIA RINK	2-6-96
TRANSPORTATION	<i>3-21-96</i>	3-1-96	WASTE WATER	NIA RINK	2-1-96
HYDROLOGY	NIA SUC	3-6-96			
<i>DNK</i>	H.A. D.S.	3-14-96			
PROJECT NO.	5206.93	MAP NO.	D-21	SHEET	13 OF 22

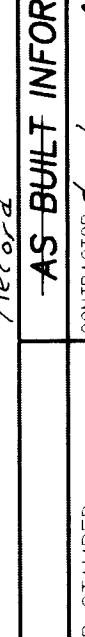	ENGINEER'S SEAL		SURVEY INFORMATION		BENCH MARKS		AS-BUILT INFORMATION	
	FIELD NOTES		NO. 1	BY COMMUNITY SCIENCES	DATE 2/95	THE STATION IS A STANDARD ACS ALUMINUM CAP STAMPED "5-021 1985" AND IS RIVETED TO AN ALUMINUM PIPE PROJECTING 0.1' FOOT ABOVE GROUND. IT IS LOCATED 793 FEET NORTH OF THE CENTERLINE INTERSECTION OF CORONADO AVENUE AND HOLBROOK STREET, AND 85 FEET EAST OF THE CENTERLINE OF HOLBROOK STREET. ELEV = 5650.56	CONTRACTOR: <i>Stansbury Mechanical</i> WORK COMPANY: <i>Community Sciences Corp.</i> INSPECTOR: <i>James P. McGee</i> ACCEPTANCE BY: <i>Elly Kay Romero</i> DATE: <i>2/95</i> CERTIFICATION BY: <i>Elly Kay Romero</i> DATE: <i>2/95</i> DRAWN BY: <i>Elly Kay Romero</i> DATE: <i>2/95</i>	MICRO-FILM INFORMATION RECORDED BY: _____ DATE: _____ NO. _____

[illegible]

32308
C14.DWG
XREF: ***.DWG

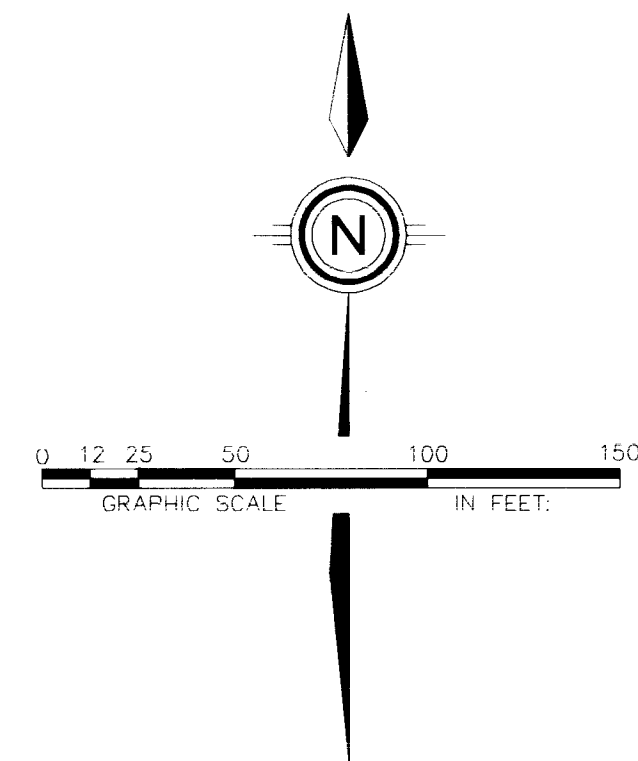

MOUNTABLE & STANDARD CURB & GUTTER W/ RESIDENTIAL PAVING
(SEE SHEET 8 FOR STREET CROSS SECTION)

 
ENGINEER'S RECORD DRAWING CERTIFICATE

I, the undersigned engineer, a duly qualified Registered Professional Engineer under the laws of the State of New Mexico, do hereby certify that the Record Drawing information shown on the said drawings was obtained from field construction and post construction data and was prepared by me or by my duly credentialed engineer, that the said drawings were prepared in accordance with the laws of the State of New Mexico under my direct supervision and control and that the said Drawing Information is true and correct to the best of my knowledge and belief, and I accept full responsibility for the design, design engineering, and construction, or intent of the Record Drawings resides with me, design engineer.

Elly A. Brattin, Jr. 02-21-97

Elly A. Brattin, Jr., P.E., New Mexico Civil Registration No. 12070

LEGEND

•	PROPOSED CURB FLOWLINE ELEVATION
⊗	EXISTING SPOT ELEVATION
	PROPOSED VALLEY GUTTER/ SIDEWALK
==	EXISTING CURB & GUTTER
==	PROPOSED MOUNTABLE CURB & GUTTER
	PROPOSED STANDARD CURB & GUTTER
	CROWN TRANSITION
	PROPOSED STORM SEWER CATCH BASIN
	EXISTING STORM SEWER CATCH BASIN
	PROPOSED GATE VALVE
	PROPOSED SANITARY SEWER MANHOLE
	PROPOSED STORM DRAIN MANHOLE
⊕	EXISTING STORM DRAIN MANHOLE
○	EXISTING SANITARY SEWER MANHOLE
	PROPOSED FIRE HYDRANT
	EXISTING FIRE HYDRANT
	STREET LIGHTS
	PROPOSED GATE VALVE

KEY NOTES:

- ① WHEELCHAIR RAMP PER
COA STD. DWG. 2441
CASE I, UNLESS OTHERWISE NOTED.
- ② MOUNTABLE TO STANDARD CURB
TRANSITION PER COA STD. DWG. 2148
- ③ CONC. VALLEY GUTTER PER
COA STD. DWG. 2420
- ④ FUTURE 4' SIDEWALK, BY OTHERS
- ⑤ PROPOSED 4' SIDEWALK, THIS CONTRACT
- ⑥ 50' CROWN TRANSITION PER
C.O.A. STD. DWG. 2401
- ⑦ 25' TRANSITION PER
C.O.A. STD. DWG. 2401
- ⑧ 8" TEMPORARY ASPHALT CURB PER
C.O.A. STD. DWG. 2405
- ⑨ CONC. VALLEY GUTTER PER
COA STD. DWG. 2421
- ⑩ WHEELCHAIR RAMP PER
COA STD. DWG. 2441
CASE II
- ⑪ STATIONARY POSTS PER
COA STD. DWG. 2250

CURB CURVE TABLE AT FACE OF CURB			
CURVE ID	RADIUS	ARC	DELTA
E	20.00	28.47	81°33'29"
F	20.00	27.81	79°40'11"
G	35.00	38.64	63°15'23"
H	35.00	26.87	43°59'07"
I	35.00	12.62	20°39'22"

SCALE:

community
sciences
corporation

LAND PLANNING ENGINEERING SURVEYING
P.O. Box 1108 Charleston, N.M. 87010

CITY OF ALBUQUERQUE
PUBLIC WORKS DEPARTMENT
ENGINEERING GROUP



TITLE: QUINTESSENCE - UNIT 2
PAVING PLAN & PROFILE
JARASH PLACE N.E.

APPROVALS	ENGINEER	DATE	APPROVALS	ENGINEER	DATE
DRC CHAIRMAN	<i>[Signature]</i>	3-21-96	WATER	NIA RWK	2-1-96
TRANSPORTATION	<i>[Signature]</i>	3-1-96	WASTE WATER	NIA RWK	2-1-96
HYDROLOGY	NIA Sane	3-6-96			
<i>[Signature]</i>	D. SCLNA	3-14-96			

PROJECT NO.	5206.93	MAP NO.	D-21	SHEET	14	OF	22
-------------	---------	---------	------	-------	----	----	----

SURVEY INFORMATION			BENCH MARKS		AS-BUILT INFORMATION	
NO.	FIELD NOTES	DATE				
1	COMMUNITY SENCES	2/95	THE STATION IS A STANDARD ACS ALUMINUM CAP STAMPED "5-021 1985" AND IS RIVETED TO AN ALUMINUM PIPE PROJECTING 0.01 FOOT ABOVE GROUND. IT IS LOCATED 793 FEET NORTH OF THE CENTERLINE INTERSECTION OF CORONADO AVENUE AND HOLBROOK STREET, AND 35 FEET EAST OF THE CENTERLINE OF HOLBROOK STREET. ELEV = 5650.55			
			CONTRACTOR: <i>Elroy Bathman Inc.</i> MARK: <i>Community Corp.</i> RECORDING DATE: _____ RECORDING TIME: _____ APPROVED BY: <i>Elroy Bathman Inc.</i> APPROVED DATE: _____ RECORDED BY: _____ NO. _____			

NO.		DATE	REMARKS	BY
REVISIONS				
DESIGN				
DESIGNED BY		JMN	DATE	12/95
DRAWN BY		AM	DATE	12/95
CHECKED BY			DATE	

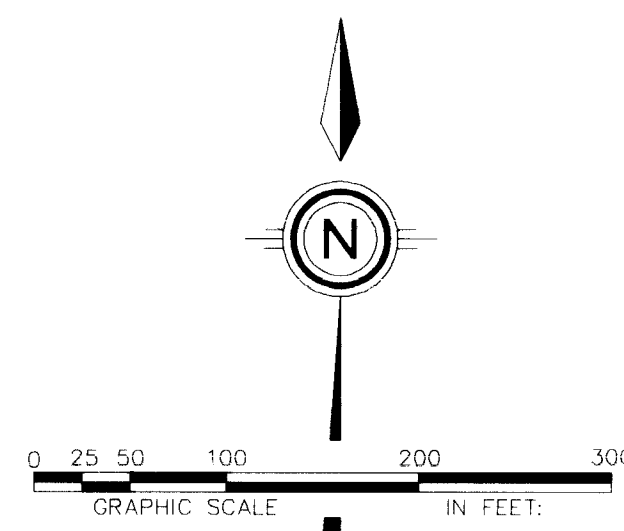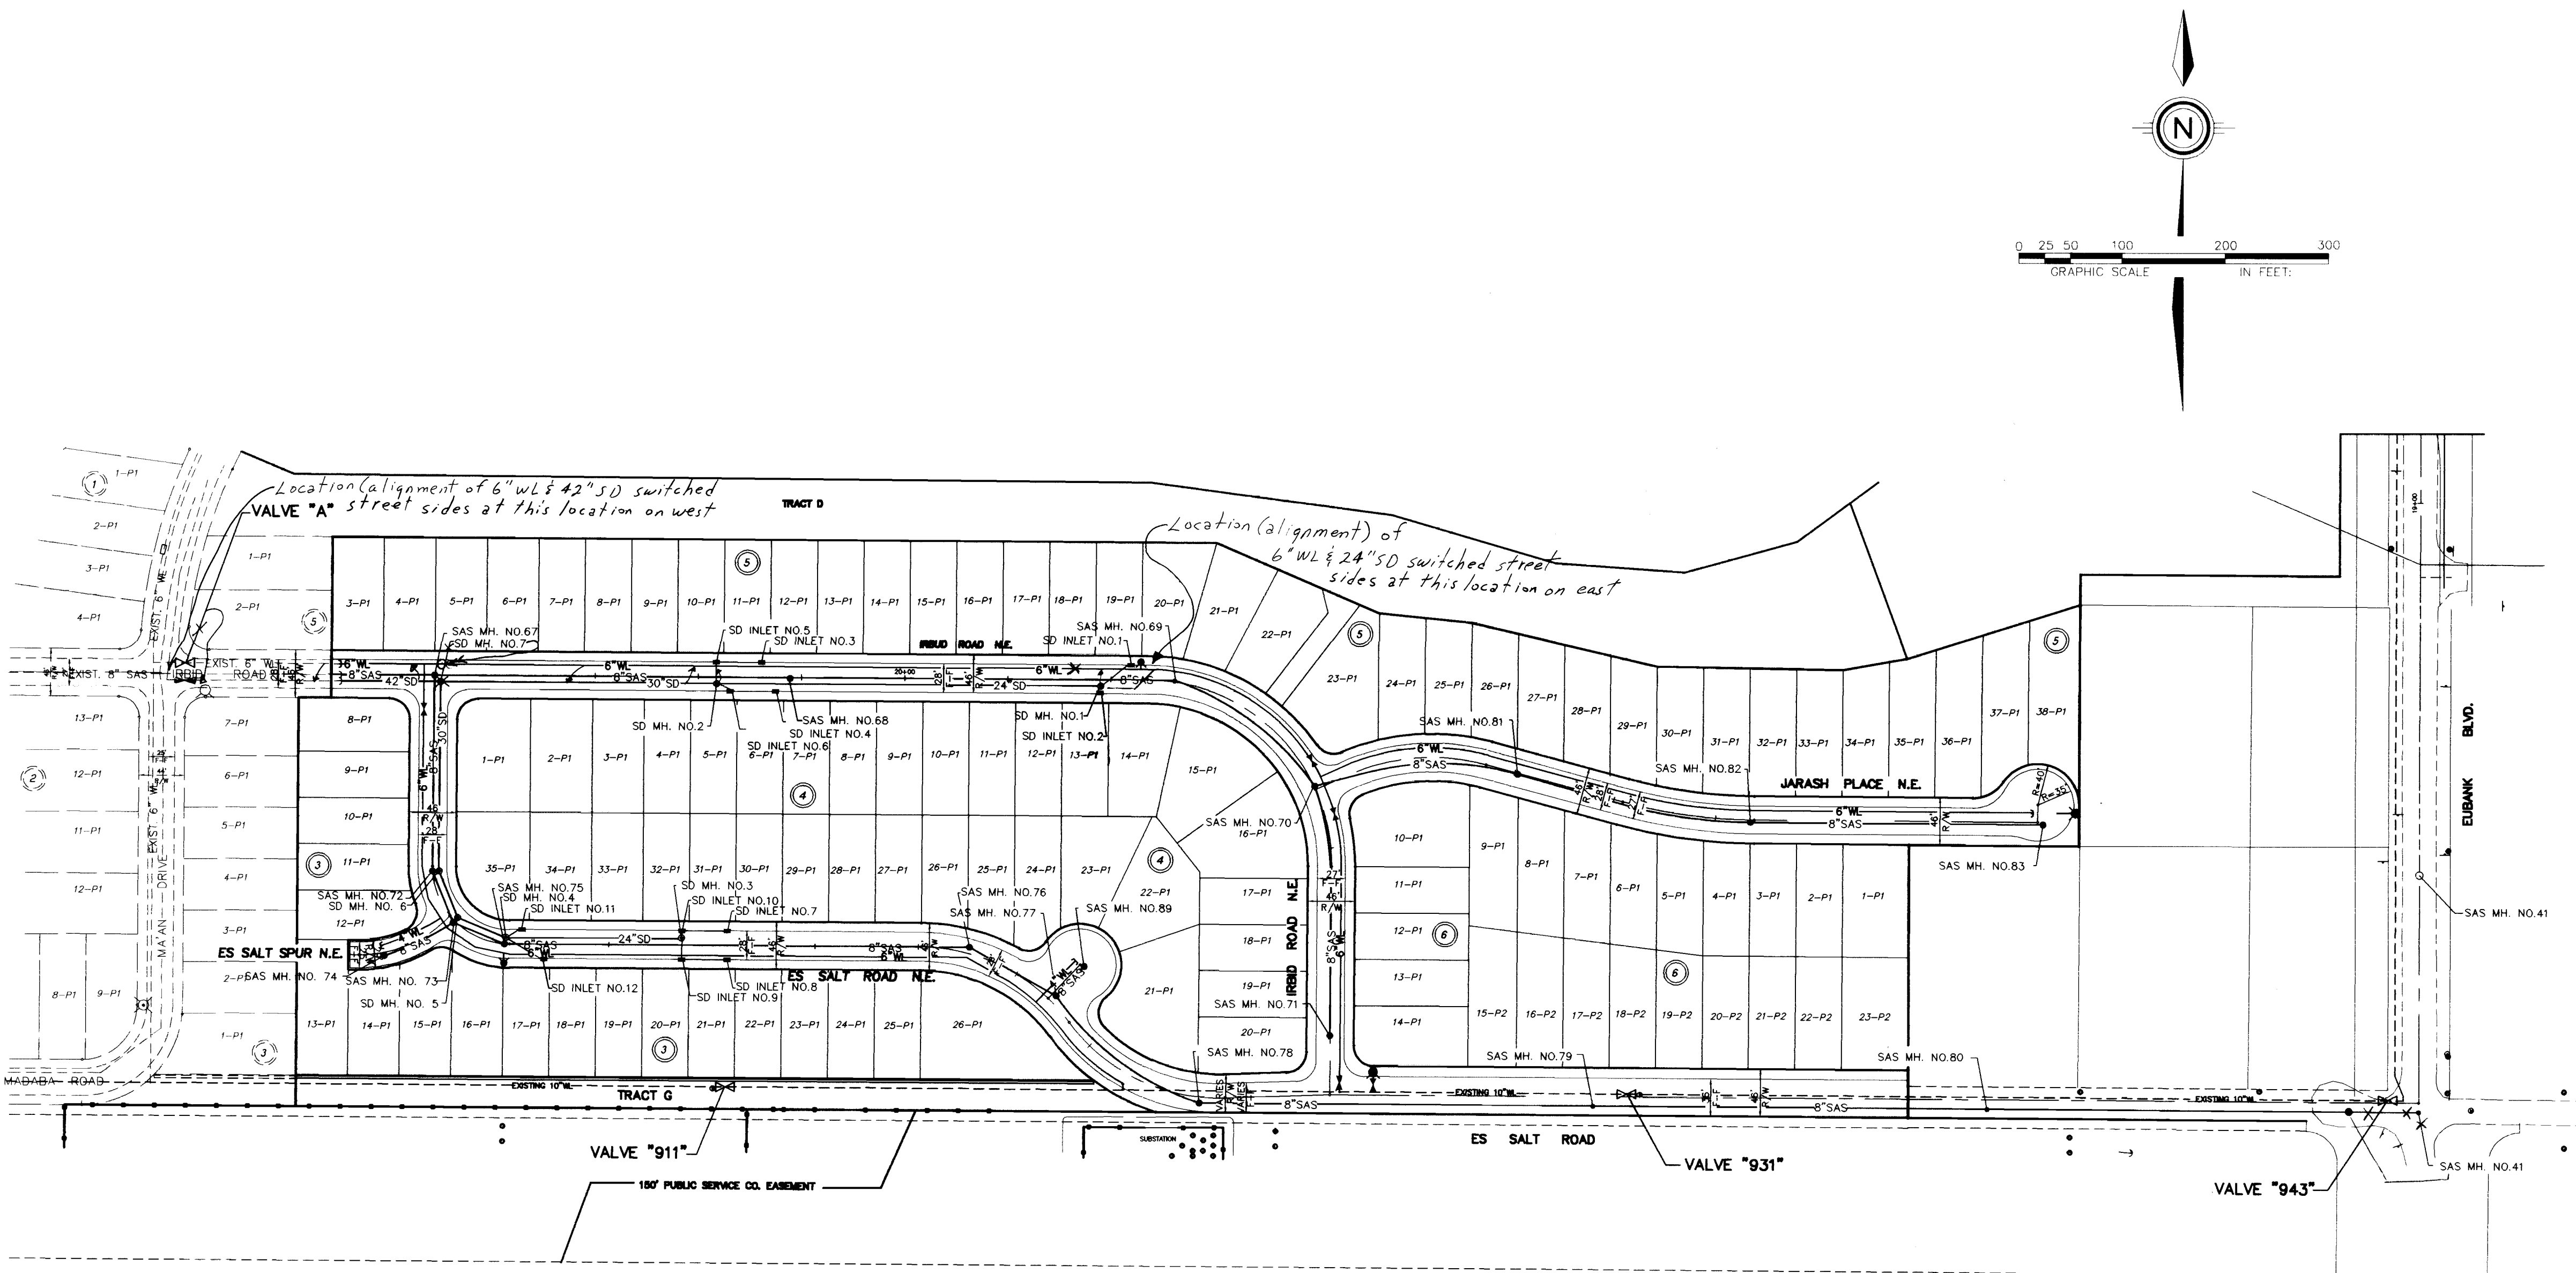


UTILITY LEGEND		
DESCRIPTION	PROPOSED	EXISTING
SANITARY SEWER LINE	8" SAS	8" SAS
ENCASEMENT		
SANITARY SEWER MANHOLE		
SAS SERVICE CONNECTION	S	S
STORM DRAIN LINE	SD-30"	SD-30"
STORM DRAIN MANHOLE		
STORM DRAIN INLETS		
WATER LINE	W-6"	W-6"
GATE VALVE		
BUTTERFLY VALVE		
FIRE HYDRANTS		
REDUCERS		
3/4" WATER SERVICE/ METER		
TEES		
CROSSES		
BENDS		
CAPS & PLUGS		
GAS LINES	N/A	N/A
OVERHEAD ELECTRICAL LINE	N/A	N/A
UNDERGROUND ELECTRICAL	N/A	N/A
OVERHEAD TELEPHONE	N/A	N/A
UNDERGROUND TELEPHONE	N/A	N/A
CABLE TELEVISION	N/A	N/A
POWER OR TELEPHONE POLE	N/A	N/A

TANOAN GOLF COMMUNITIES

WATER SHUT-OFF PLAN

1. VALVES NO. "A", "911", "931" AND 943 SHALL BE SHUT-OFF SO NON-PRESSURE CONNECTIONS CAN BE MADE.
2. CONTRACTOR SHALL CONTACT WATER SYSTEMS DIVISION (857-8200) FIVE (5) DAYS PRIOR TO VALVE SHUT-OFF. ONLY WATER SYSTEMS PERSONNEL ARE AUTHORIZED TO OPERATE VALVES.

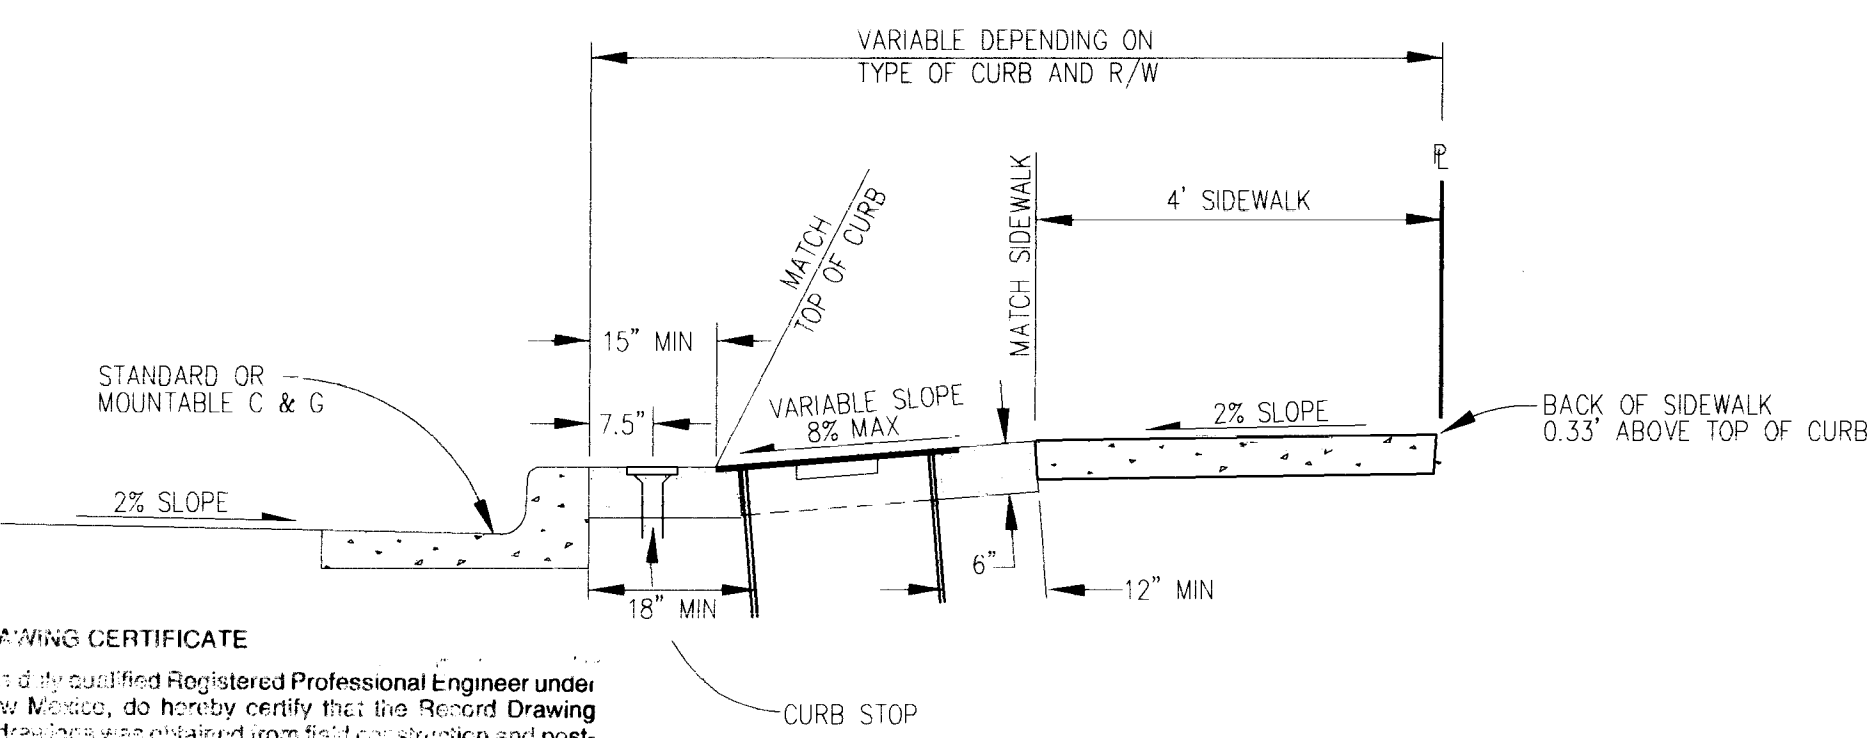

WATER METER BOX INSTALLATION

NOT TO SCALE
NOTE: INSTALL WATER METER PER C.O.A. STD. DWG. 2362

ENGINEER'S RECORD DRAWING CERTIFICATE
I, the undersigned, a duly qualified Registered Professional Engineer under the laws of the State of New Mexico, do hereby certify that the Record Drawing information shown on this drawing was obtained from field observation and post-construction field verification and is true and correct to the best of my knowledge and belief. I am not responsible for the design, engineering and calculations, or intent of the Record Drawings made with others.
Elery A. Bathrow, Jr. 02-21-97
Elery A. Bathrow, Jr., P.E., New Mexico Civil Registration No. 12070

1	2	3	4	5	6	7	8	9	10	11	12	13	14	15	16
2	6	5	2	0	6	.	0	3	1	5	9	7			



DATE: DEC, 1995	community sciences corporation	
SCALE: 1" = 100'		
JOB NO.: 323-08-055		
LAND PLANNING	ENGINEERING	SURVEYING
P.O. Box 1328	Corrales, N.M. 87048	

CITY OF ALBUQUERQUE PUBLIC WORKS DEPARTMENT ENGINEERING GROUP		
TITLE: QUINTESSENCE SUB'D - UNIT 2 COMPOSITE UTILITY PLAN		
APPROVALS	ENGINEER	DATE
DRG. CHAIRMAN	<i>R.W. Kane</i>	3-21-96
TRANSPORTATION	<i>N.R. KS</i>	3-1-96
HYDROLOGY	<i>McLennan</i>	3-6-96
<i>Parsons</i>	<i>W. G. Miller</i>	3-14-96
PROJECT NO. 5206.93	MAP NO. D-21	SHEET 15 OF 22



AS-BUILT INFORMATION		
CONTRACTOR: <i>Quintessence Mechanical</i>	STATE: <i>N.M.</i>	DATE: <i>3-21-96</i>
WORK: <i>Water Shut-off</i>	ACCEPTANCE: <i>By City</i>	DATE: <i>3-21-96</i>
FIELD: <i>By City</i>	DATE: <i>3-21-96</i>	DATE: <i>3-21-96</i>
DESIGNED BY: <i>R.W. Kane</i>	DATE: <i>3-21-96</i>	DATE: <i>3-21-96</i>
DRAWN BY: <i>R.W. Kane</i>	DATE: <i>3-21-96</i>	DATE: <i>3-21-96</i>
CHECKED BY: <i>R.W. Kane</i>	DATE: <i>3-21-96</i>	DATE: <i>3-21-96</i>
MICRO-FILM INFORMATION		
RECORDED BY: <i>R.W. Kane</i>	DATE: <i>3-21-96</i>	NO. <i>15</i>

ENGINEER'S RECORD DRAWING CERTIFICATE
I, the undersigned engineer, a duly qualified Registered Professional Engineer under the laws of the State of New Mexico, do hereby certify that the Record Drawing information shown on these drawings was obtained from field notes, which and just construction information obtained from me or under my direct supervision, and that the Record Drawing is a true and correct representation of the design and construction of the project shown on these drawings, and that the Record Drawing is a true and correct representation of the design and construction of the project shown on these drawings, and that the Record Drawing is a true and correct representation of the design and construction of the project shown on these drawings.

Elery A. Blathrow, Jr. 01-21-97
Elery A. Blathrow, Jr., P.E. New Mexico Civil Registration No. 12070

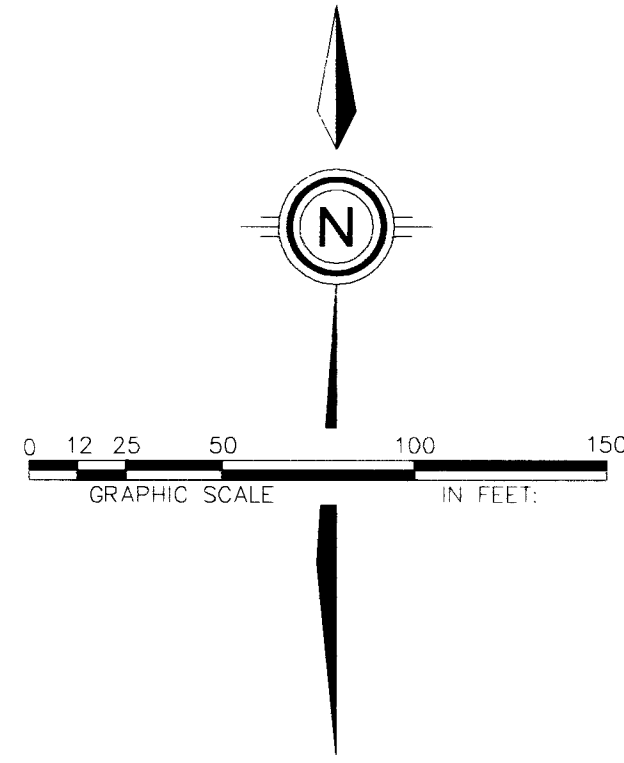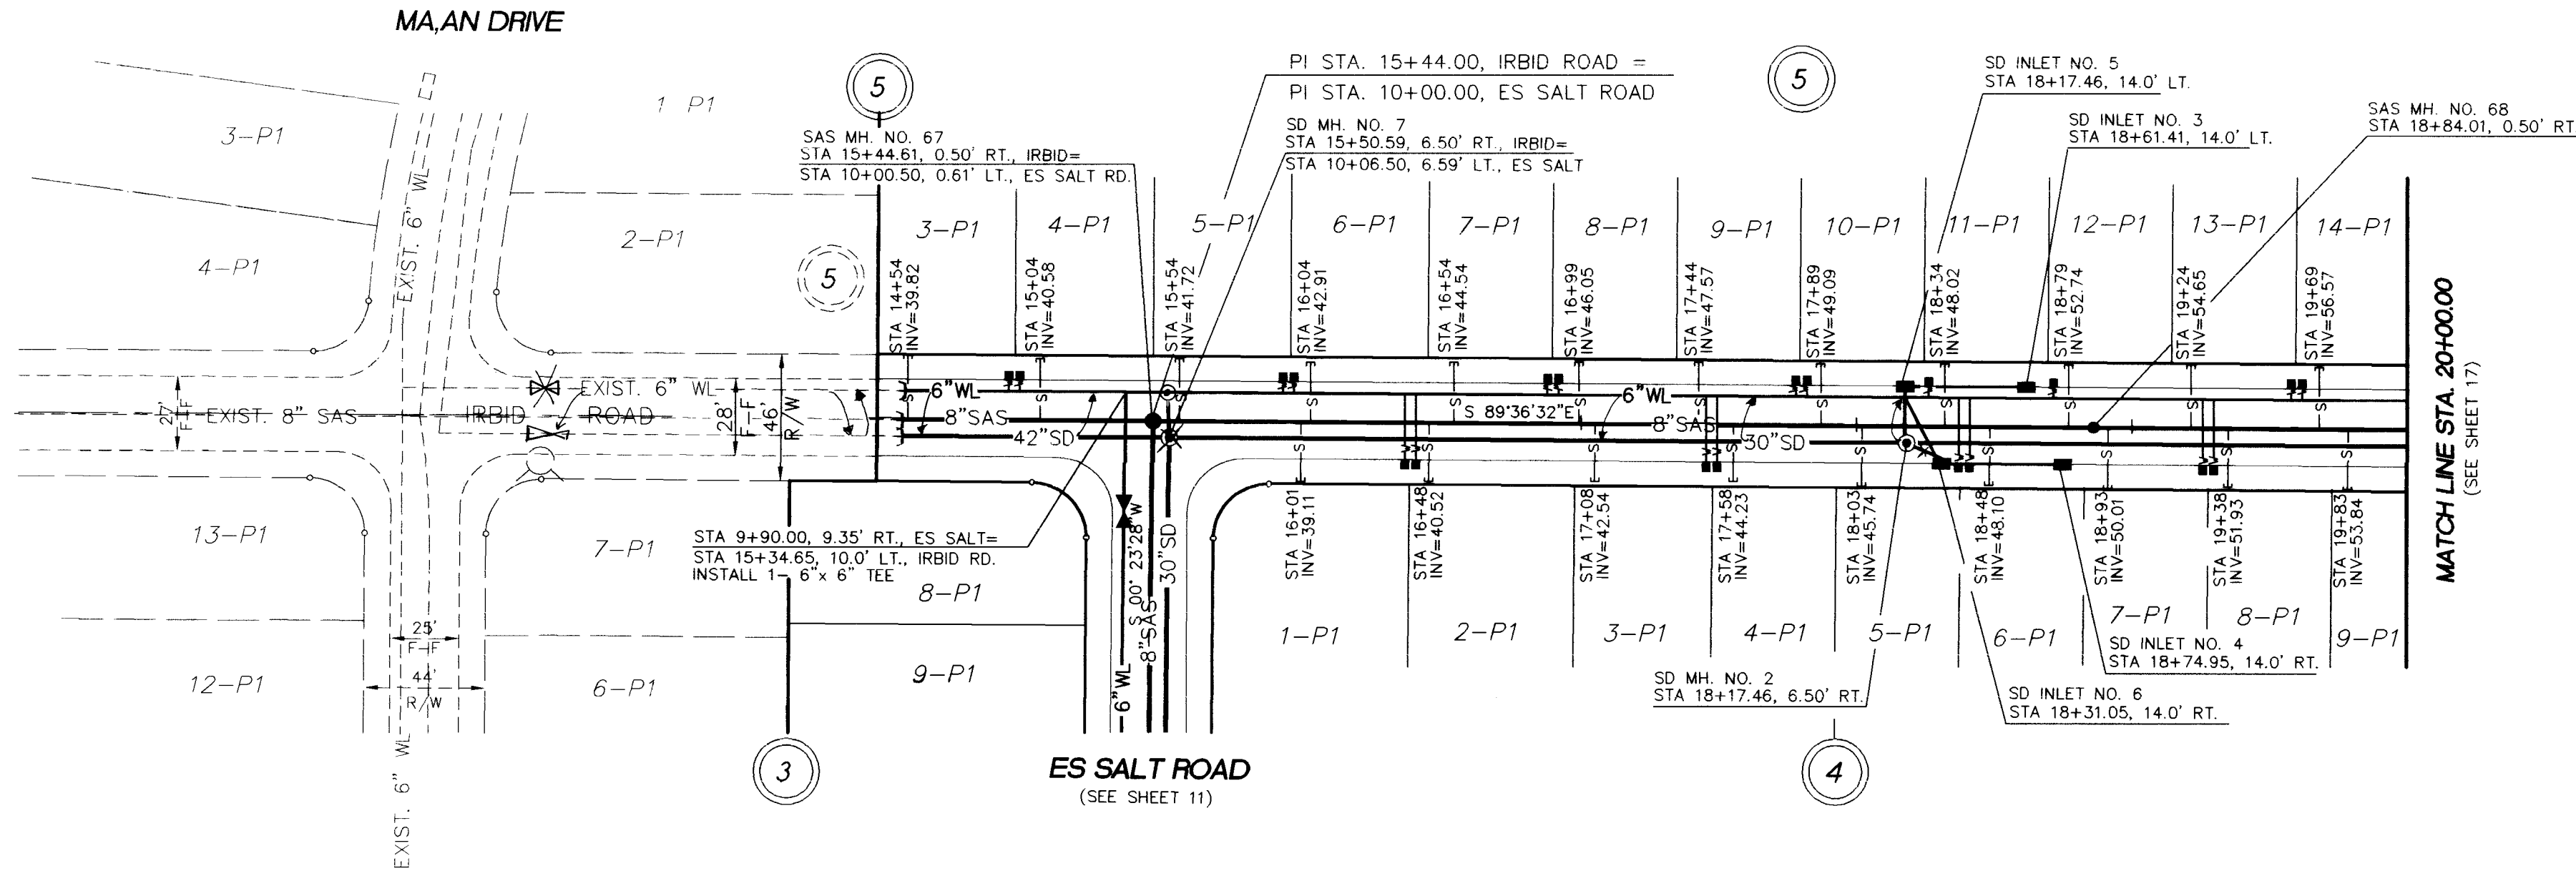

IRBID ROAD, N.E.

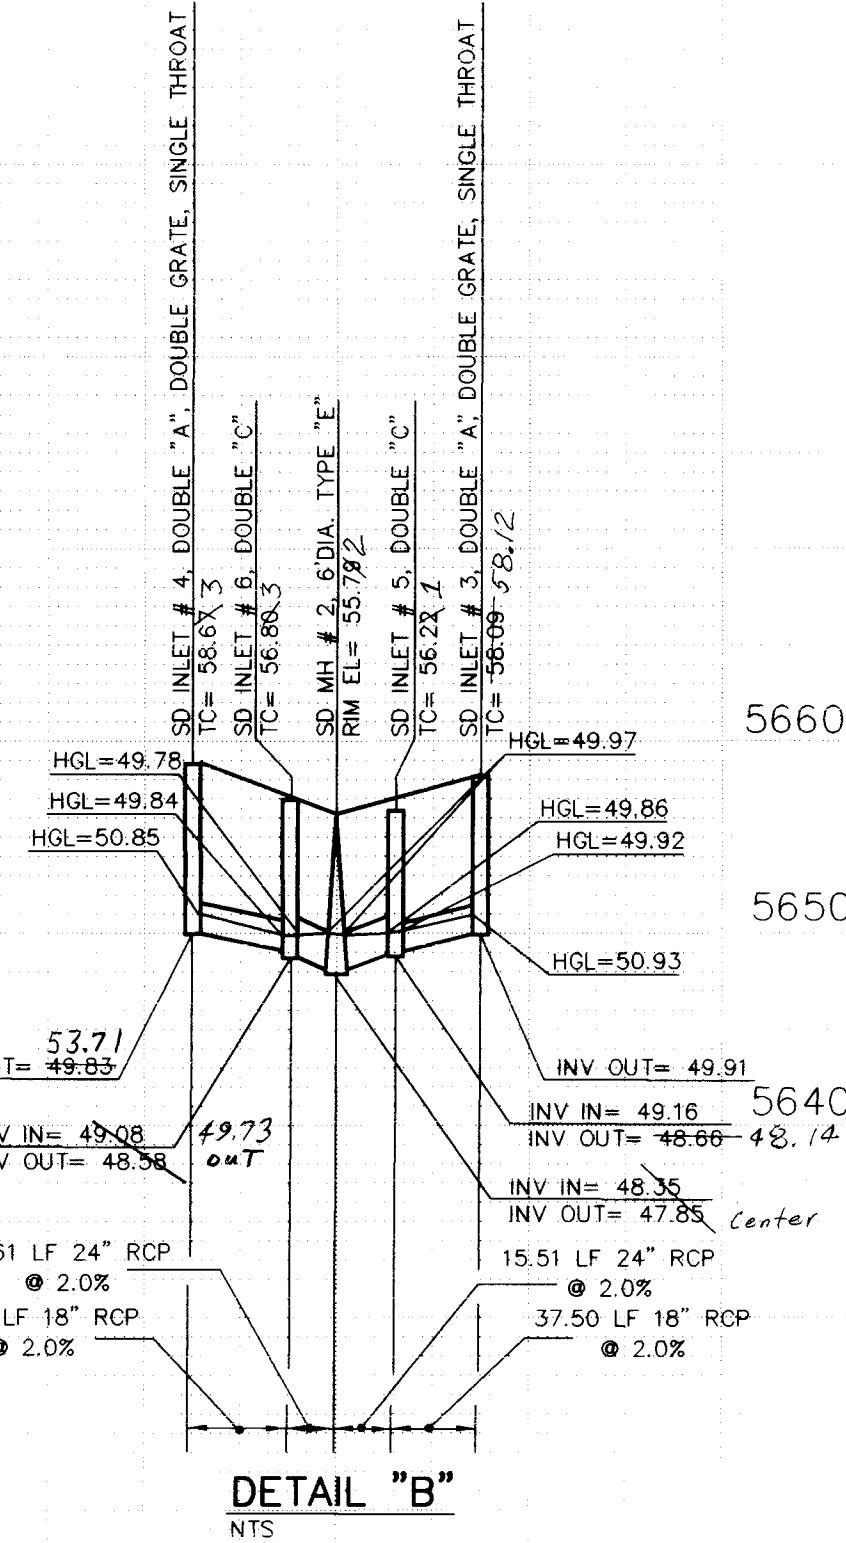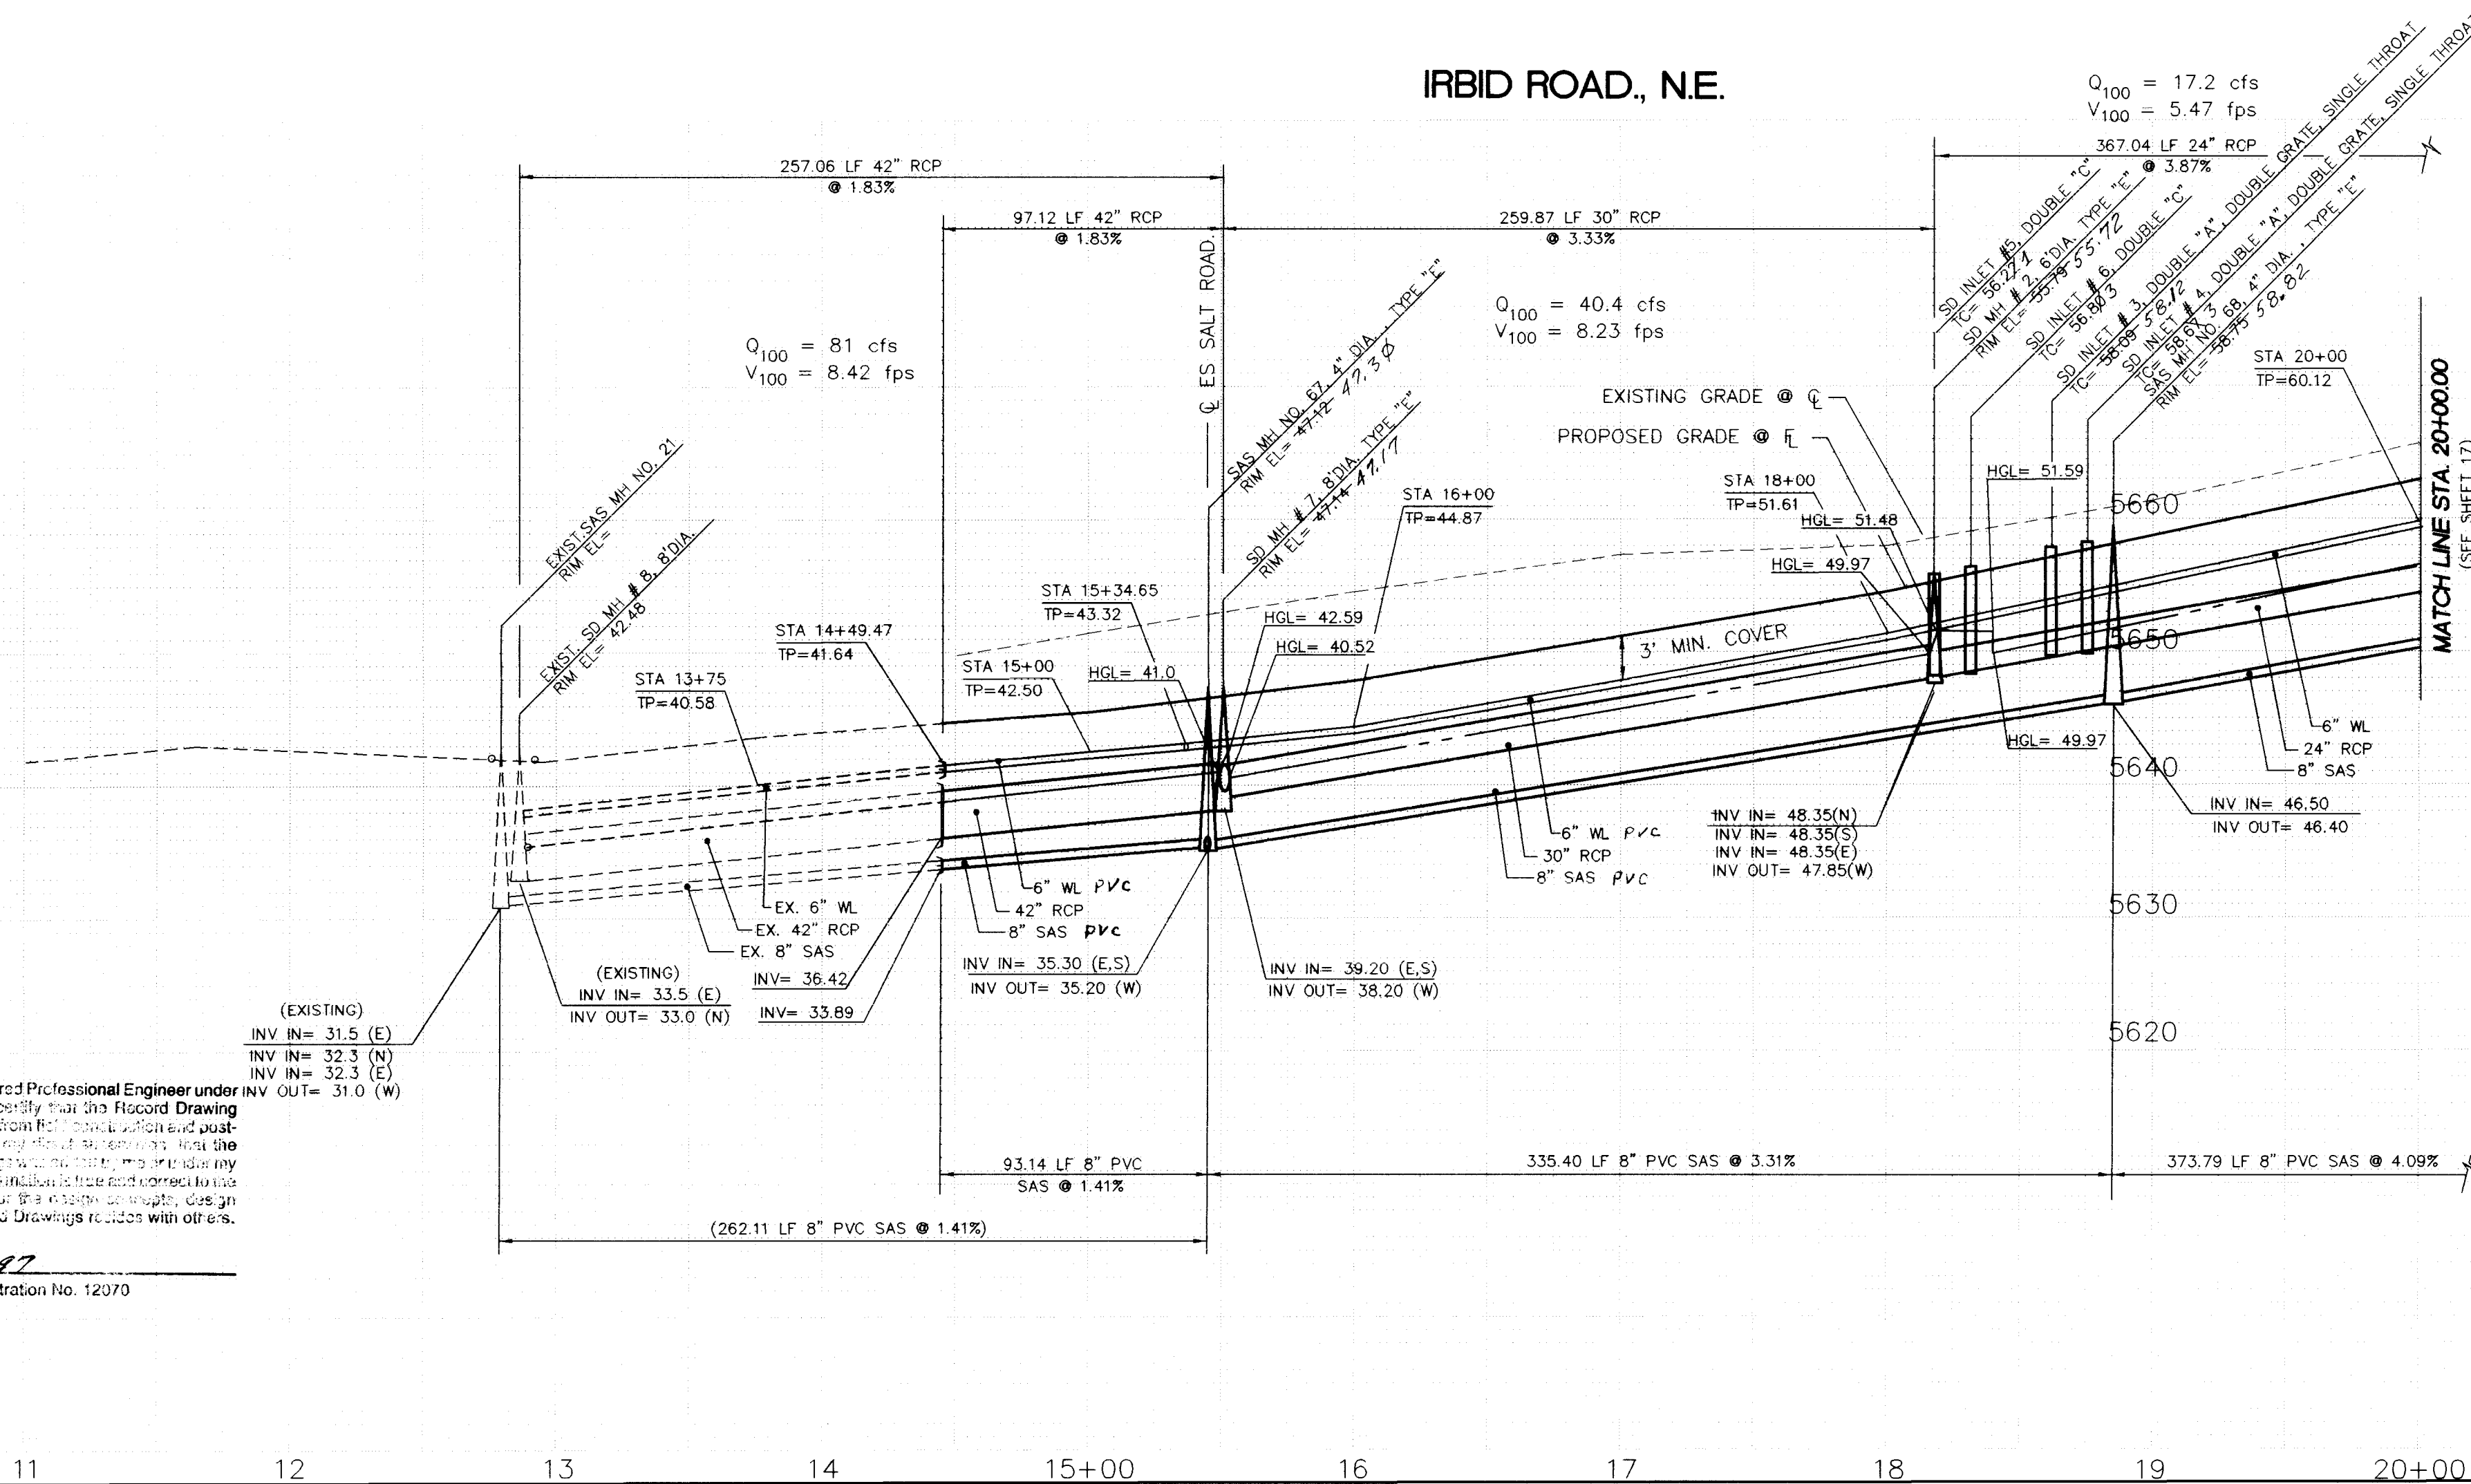

UTILITY LEGEND		
DESCRIPTION	PROPOSED	EXISTING
SANITARY SEWER LINE	8" SAS	8" SAS
ENCASEMENT		
SANITARY SEWER MANHOLE		
SAS SERVICE CONNECTION	S	S
STORM DRAIN LINE	SD-30"	SD-30"
STORM DRAIN MANHOLE		
STORM DRAIN INLETS		
WATER LINE	W-6"	W-6"
GATE VALVE		
BUTTERFLY VALVE		
FIRE HYDRANTS		
REDUCERS		
3/4" WATER SERVICE/ METER TEES		
CROSSES		
BENDS		
CAPS & PLUGS		
GAS LINES	N/A	N/A
OVERHEAD ELECTRICAL LINE	N/A	N/A
UNDERGROUND ELECTRICAL	N/A	N/A
OVERHEAD TELEPHONE	N/A	N/A
UNDERGROUND TELEPHONE	N/A	N/A
CABLE TELEVISION	N/A	N/A
POWER OR TELEPHONE POLE	N/A	N/A

RESTRAINING LENGTHS	
FITTING	LR (FT)
10"x6" TEE	6' RUN, 1' BRANCH
6"x6" TEE	10' RUN, 2' BRANCH
6"x4" TEE	4' RUN, 7' BRANCH
6" GV	46'
6" 22 1/2" BEND	3'
6" 11 1/4" BEND	2'

LR = LENGTH TO BE RESTRAINED
EACH SIDE OF THE FITTING. FOR
TEES, ALL THREE LEGS SHALL BE
RESTRAINED FOR A DISTANCE OF
"LR". FOR REDUCERS, "LR" IS
GIVEN FOR THE LARGER DIAMETER
SIZE OF THE FITTING AND NO
RESTRAINING IS REQUIRED ON THE
SMALL SIDE OF THE FITTING. GATE
VALVES SHALL BE MECHANICALLY
RESTRAINED AND INSTALLED WITH
CONCRETE BLOCKING PER COA STD
DWG 2333 IN ADDITION TO THE
MECHANICALLY RESTRAINED
LENGTHS. ALL CAPS SHALL BE
INSTALLED WITH CONCRETE
BLOCKING PER COA STD DWG 2320.
RESTRAIN ALL JOINTS ON FIRE
HYDRANTS.

1. RESTRAINED JOINTS, SUCH AS MEGA-LUG,
EQUIVALENT BRANDS ACCEPTABLE TO THE
ENGINEER, SHALL BE USED ON ALL TEES, BENDS,
CROSSES AND CAPS IN LIEU OF CONCRETE THRU-
BLOCKING. RESTRAINED JOINTS SHALL BE CONSIDERED
INCIDENTAL TO THIS CONTRACT AND NO ADDITIONAL
COMPENSATION, MEASUREMENT, OR PAYMENT WILL
BE MADE THEREFORE.

2. ALL FIRE HYDRANTS AND FITTINGS, ETC. SHALL
BE BUILT IN ACCORDANCE WITH C.O.A. STD. DWG'S.
2301 THRU 2380 INCLUSIVE.

ENGINEER'S SEAL	
NO.	DATE
1	12/95

REVISIONS	
NO.	DATE
1	12/95

DESIGN	
NO.	DATE
1	12/95


CITY OF ALBUQUERQUE PUBLIC WORKS DEPARTMENT ENGINEERING GROUP					
TITLE: QUINTESSENCE - UNIT 2 UTILITY PLAN & PROFILE IRBID ROAD N.E.					
APPROVALS	ENGINEER	DATE	APPROVALS	ENGINEER	DATE
DRC CHAIRMAN	<i>R.W. Kane</i>	3-21-96	WATER	<i>R.W. Kane</i>	3-21-96
TRANSPORTATION	<i>R.W. Kane</i>	3-1-96	WASTE WATER	<i>R.W. Kane</i>	3-1-96
HYDROLOGY	<i>R.W. Kane</i>	3-6-96			
PROJECT NO.	5206.93	MAP NO.	D-21	SHEET	16 OF 22

ENGINEER'S RECORD DRAWING CERTIFICATE
I, the undersigned engineer, a duly qualified Registered Professional Engineer under the laws of the State of New Mexico, do hereby certify that the Record Drawing information shown on these drawings was obtained from field construction and post-construction information obtained by me or under my direct supervision, that the Record Drawing information shown on these drawings was added by me or under my direct supervision, and that this Record Drawing information is true and correct to the best of my knowledge and belief. Responsibility for the design concepts, design engineering and calculations, or intent of this Record Drawings resides with others.


Elery A. Blathrow, Jr.
Elery A. Blathrow, Jr., P.E. New Mexico Civil Registration No. 12070

①	②
① CURVE DATA R = 180.00' L = 205.90' Δ = 065°32'19" CH = 194.85' CB = S56°50'22"E	② CURVE DATA R = 180.00' L = 76.85' Δ = 024°27'41" CH = 76.27' CB = S11°50'22"E

③
③ CURVE DATA R = 180.00' L = 2827.4' Δ = 090°00'00" CH = 254.56' CB = S44°36'32"E

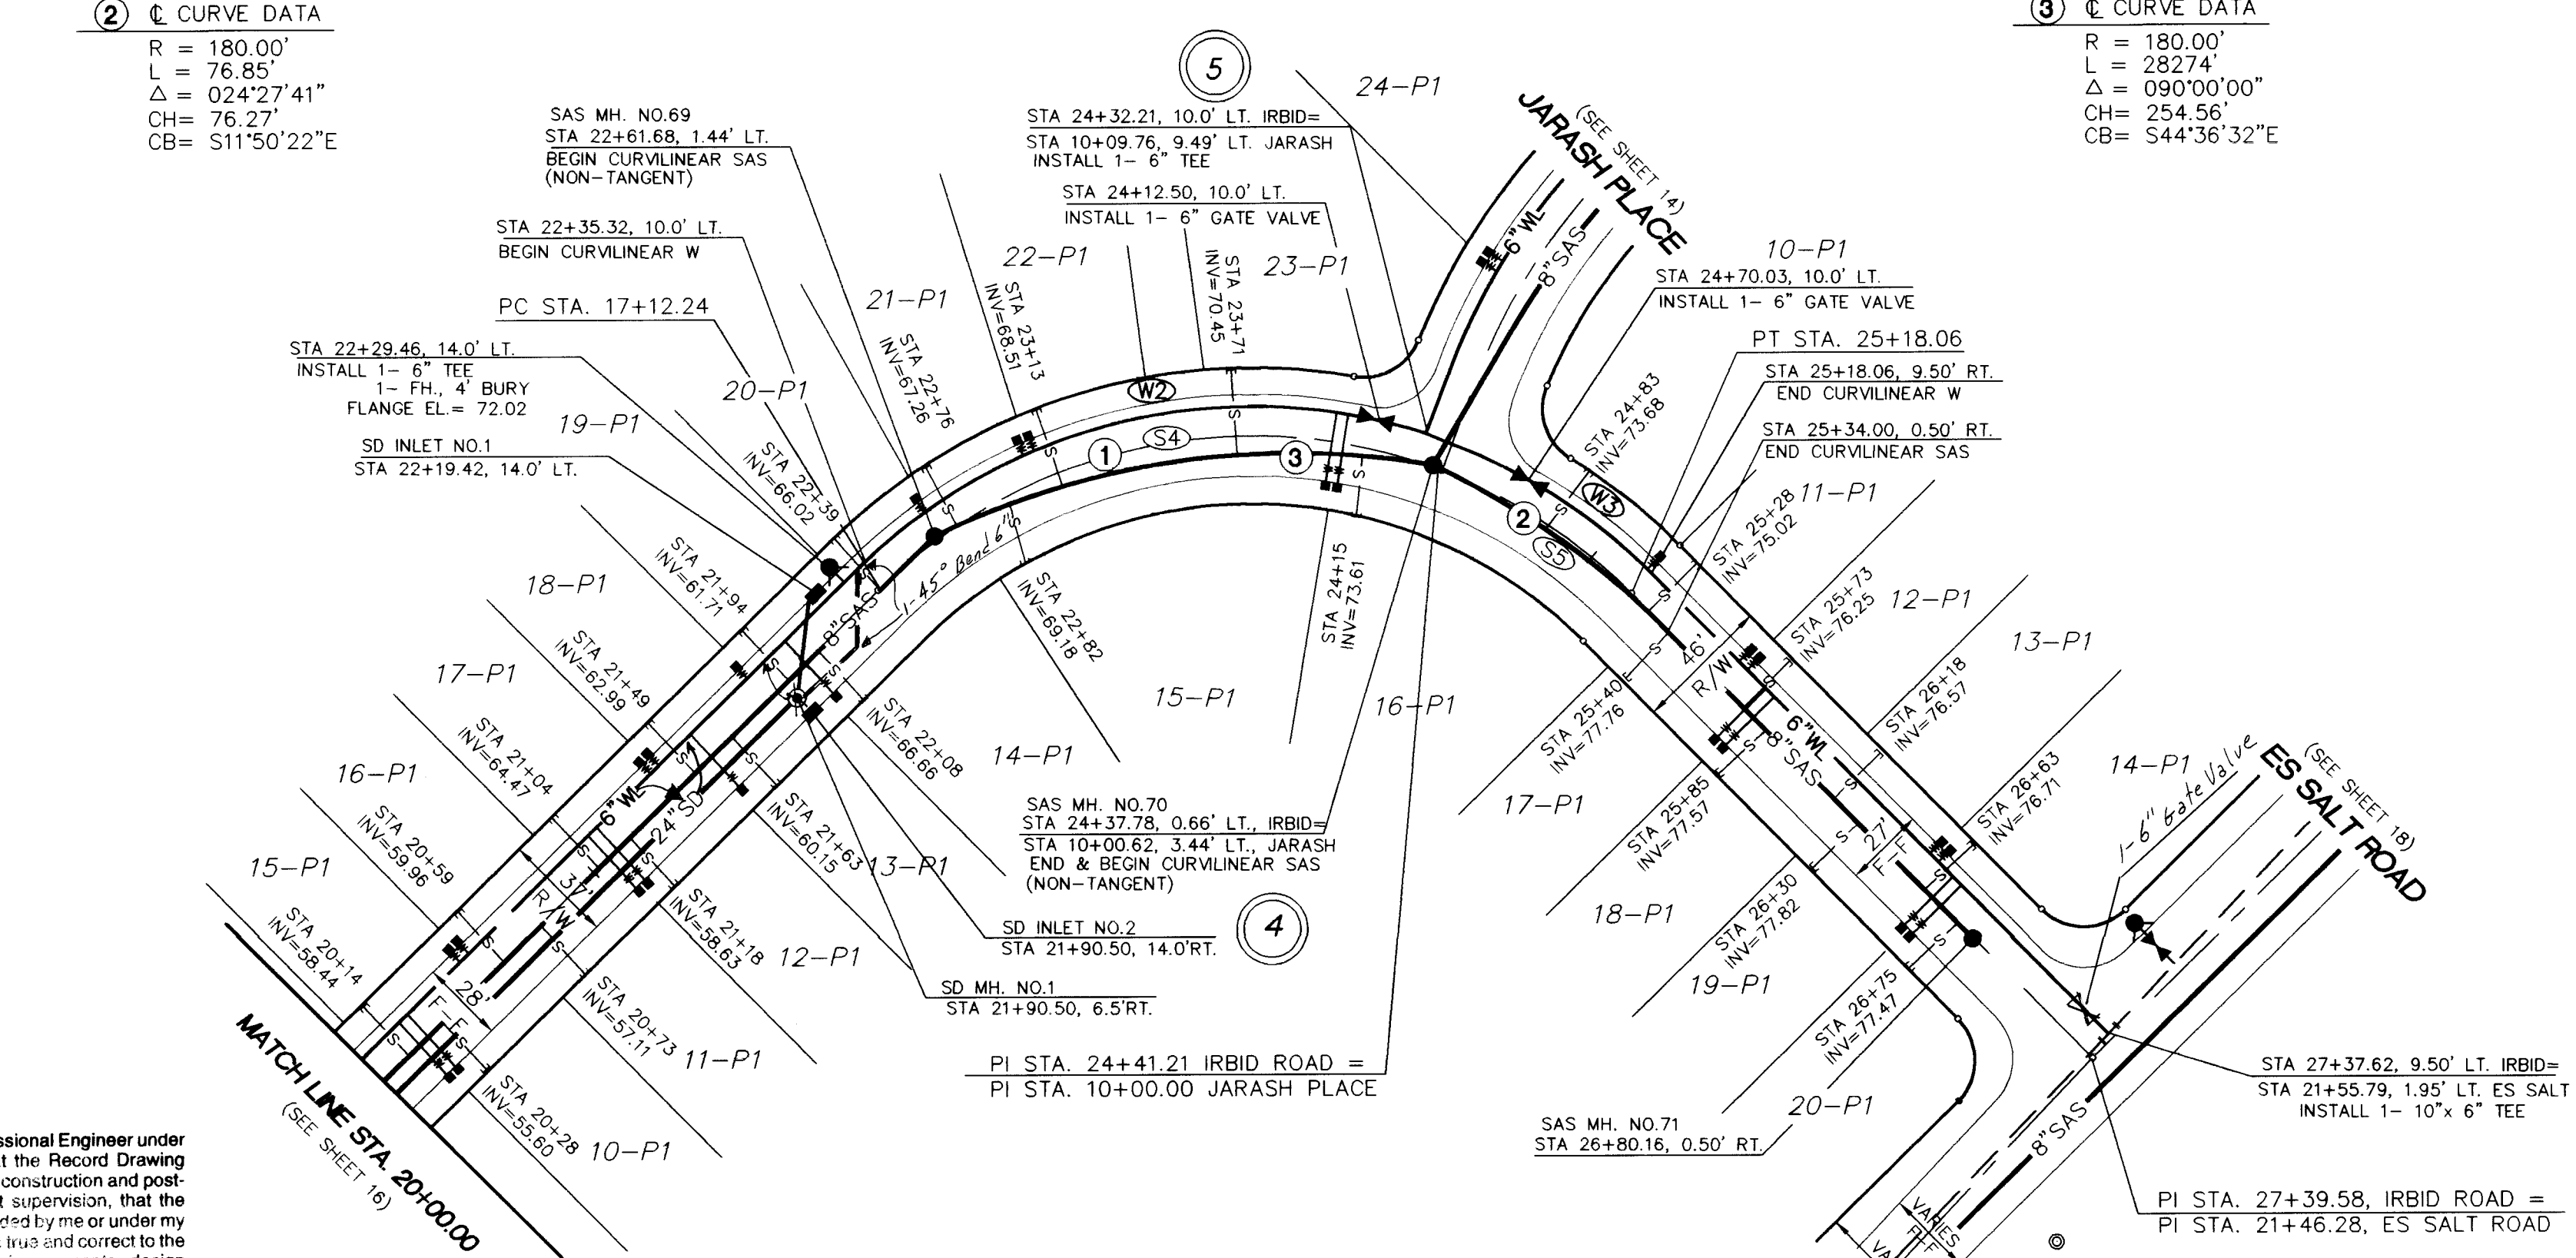

CURVE ID	R	L	DELTA	CH	CHD	20' JOINT
S4	275.00'	172.98'	36°02'25"	S52°57'17"E	170.14'	4'-10"
S5	275.00'	95.79'	19°57'28"	S09°35'16"E	95.31'	4'-10"
W2	190.00'	207.83'	62°40'22"	S58°16'21"E	197.62'	6'-2"
W3	189.50'	76.63'	23°10'11"	S11°11'37"E	76.11'	6'-3"

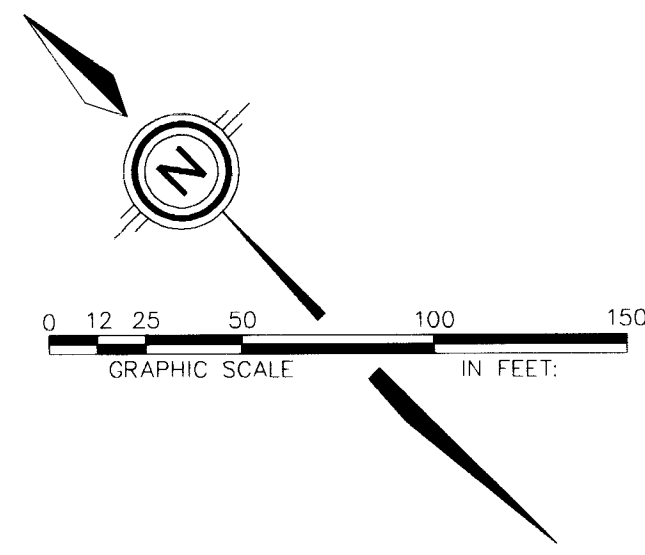

UTILITY LEGEND		
DESCRIPTION	PROPOSED	EXISTING
SANITARY SEWER LINE	8" SAS	8" SAS
ENCASEMENT		
SANITARY SEWER MANHOLE		
SAS SERVICE CONNECTION	S	S
STORM DRAIN LINE	SD-30"	SD-30"
STORM DRAIN MANHOLE		
STORM DRAIN INLETS		
WATER LINE	W-6"	W-6"
GATE VALVE		
BUTTERFLY VALVE		
FIRE HYDRANTS		
REDUCERS		
3/4" WATER SERVICE/ METER TEES		
CROSSES		
BENDS		
CAPS & PLUGS		
GAS LINES	N/A	N/A
OVERHEAD ELECTRICAL LINE	N/A	N/A
UNDERGROUND ELECTRICAL	N/A	N/A
OVERHEAD TELEPHONE	N/A	N/A
UNDERGROUND TELEPHONE	N/A	N/A
CABLE TELEVISION	N/A	N/A
POWER OR TELEPHONE POLE	N/A	N/A

RESTRAINING LENGTHS	
FITTING	LR (FT)
10"x6" TEE	6' RUN, 1' BRANCH
6"x6" TEE	10' RUN, 2' BRANCH
6"x4" TEE	4' RUN, 7' BRANCH
6"GV	4'
6" 22 1/2" BEND	3'
6" 11 1/4" BEND	2'



LR = LENGTH TO BE RESTRAINED EACH SIDE OF THE FITTING FOR TEES. ALL THREE LEGS SHALL BE RESTRAINED FOR A DISTANCE OF "LR". FOR REDUCERS, "LR" IS GIVEN FOR THE LARGER DIAMETER SIZE OF THE FITTING AND NO RESTRAINING IS REQUIRED ON THE SMALL SIDE OF THE FITTING. GATE VALVES SHALL BE MECHANICALLY RESTRAINED AND INSTALLED WITH CONCRETE BLOCKING PER COA STD DWG 2333 IN ADDITION TO THE MECHANICALLY RESTRAINED LENGTHS. ALL CAPS SHALL BE INSTALLED WITH CONCRETE BLOCKING PER COA STD DWG 2320. RESTRAIN ALL JOINTS ON FIRE HYDRANTS.

1. RESTRAINED JOINTS, SUCH AS MEGA-LUG, EQUIVALENT BRANDS ACCEPTABLE TO THE ENGINEER, SHALL BE USED ON ALL TEES, BENDS, CROSSES AND CAPS IN LIEU OF CONCRETE THRUST BLOCKING. RESTRAINED JOINTS SHALL BE CONSIDERED INCIDENTAL TO THIS CONTRACT AND NO ADDITIONAL COMPENSATION, MEASUREMENT, OR PAYMENT WILL BE MADE THEREFORE.
2. ALL FIRE HYDRANTS AND FITTINGS, ETC. SHALL BE BUILT IN ACCORDANCE WITH C.O.A. STD. DWG'S. 2301 THRU 2380 INCLUSIVE.

SCALE:
HORIZ: 1" = 50'
VERT: 1" = 10'



community sciences corporation
LAND PLANNING P.O. Box 1328 CORRALES, N.M. 87048

CITY OF ALBUQUERQUE PUBLIC WORKS DEPARTMENT ENGINEERING GROUP			
TITLE: QUINTESSENCE SUBDIVISION - UNIT 2 UTILITY PLAN & PROFILE IRBID ROAD N.E.			
APPROVALS	ENGINEER	DATE	APPROVALS
DRC CHAIRMAN	<i>[Signature]</i>	3-21-96	WATER
TRANSPORTATION	<i>[Signature]</i>	3-1-96	WASTE WATER
HYDROLOGY	<i>[Signature]</i>	3-6-96	A.M.A.F.C.A.
PROJECT NO.	5206.93	MAP NO.	D-21
SHEET		17 OF 22	

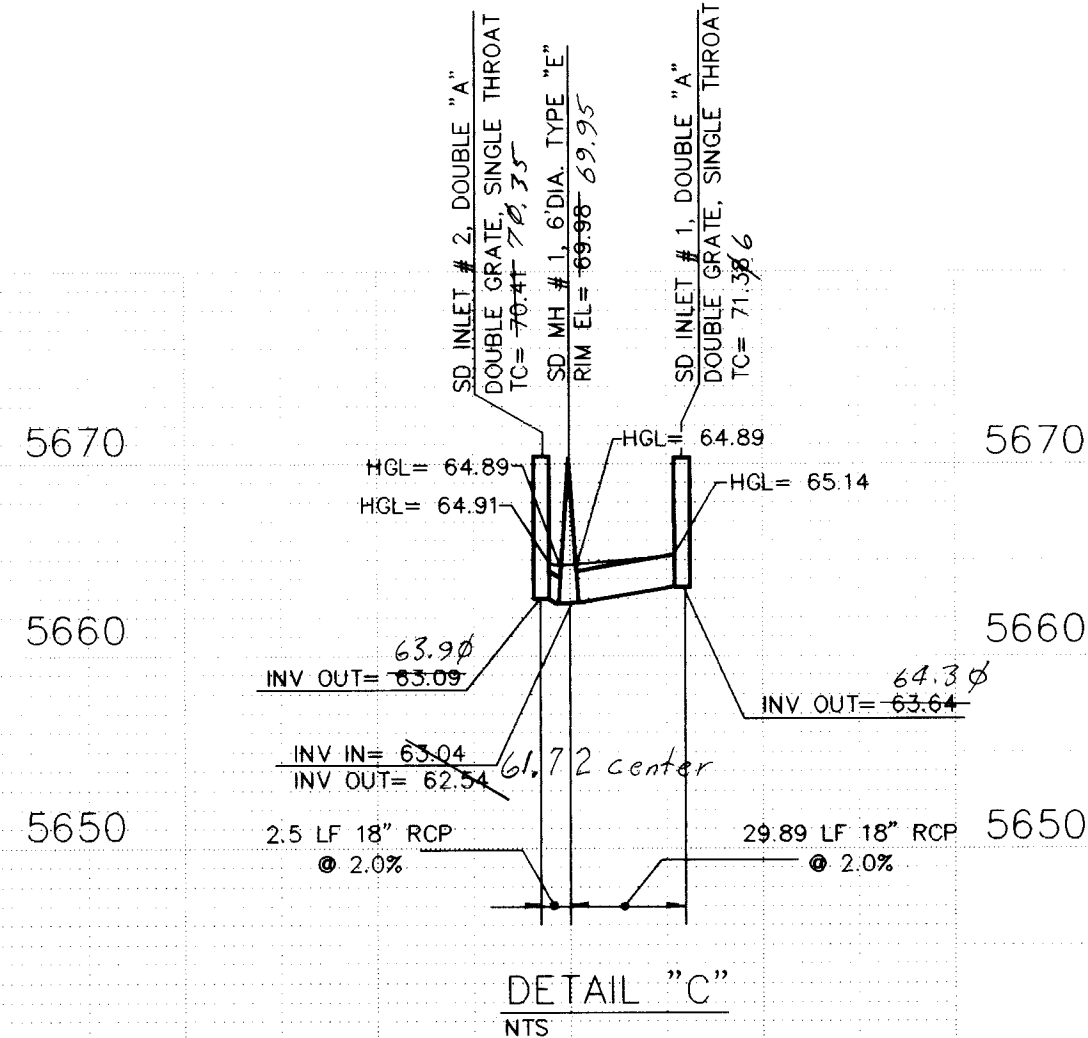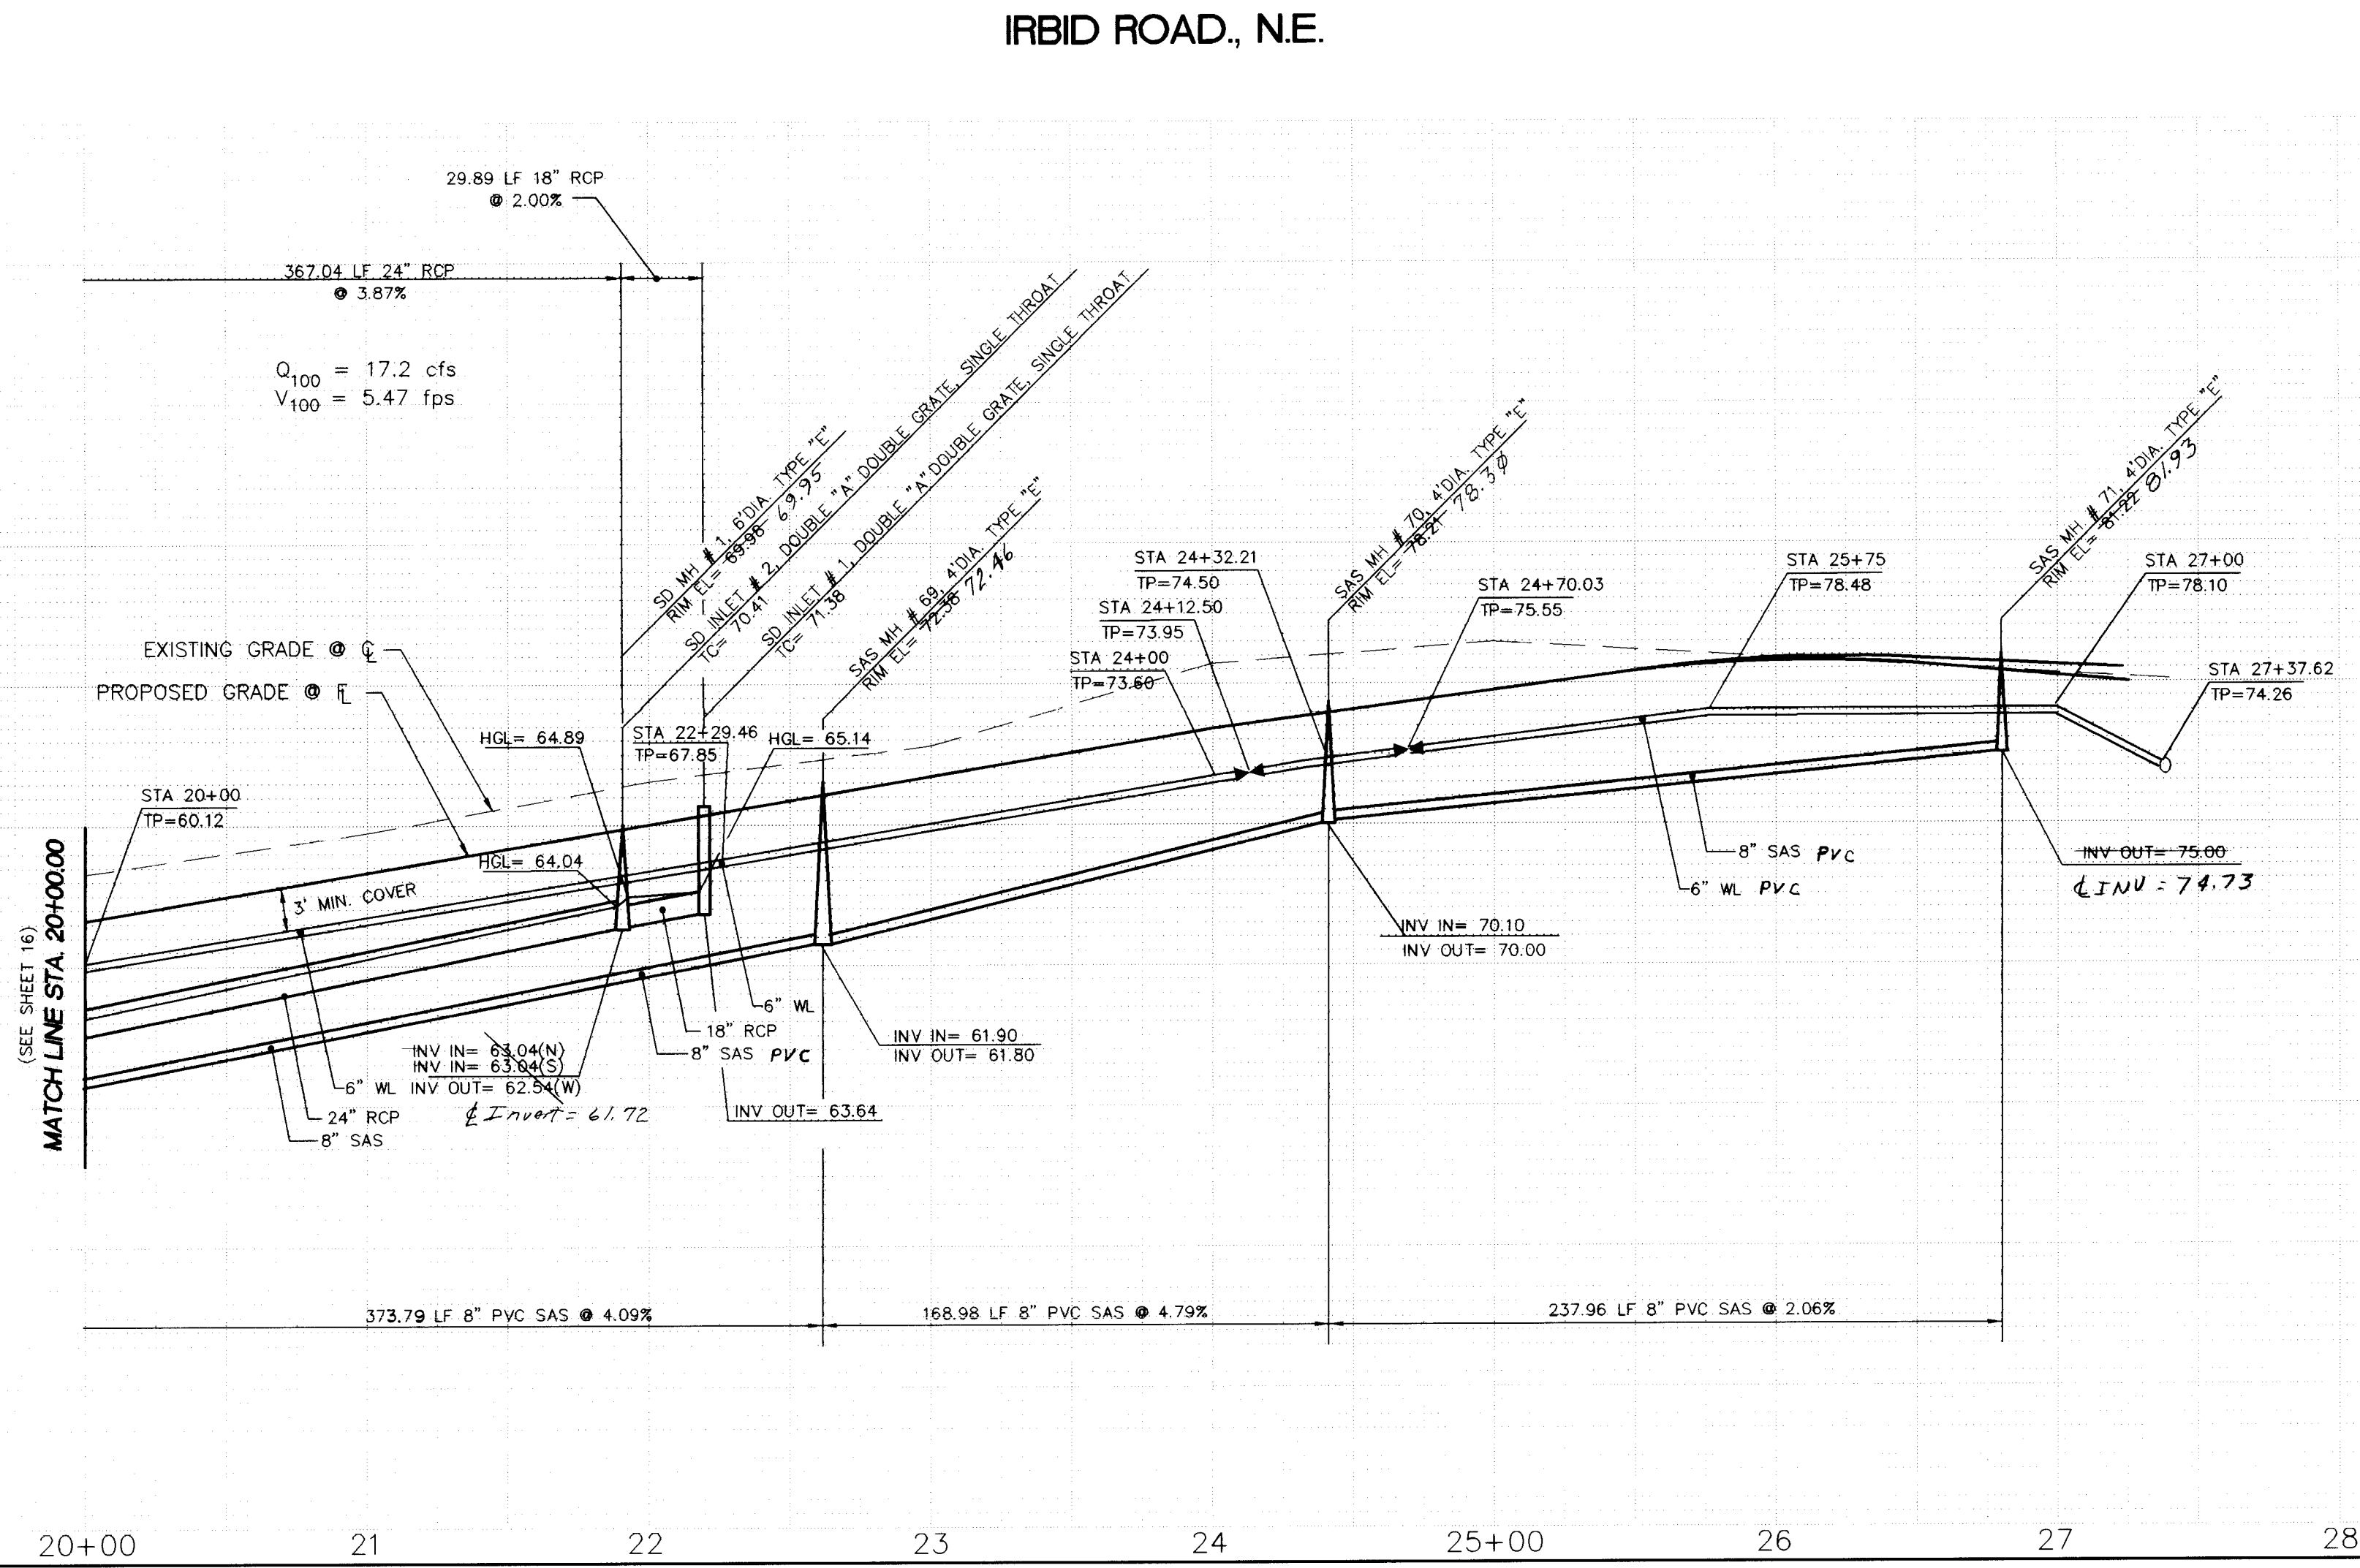

SCANNED BY
BY LASON

⑥	⑦	⑧	⑨
CL CURVE DATA	CL CURVE DATA	CL CURVE DATA	CL CURVE DATA
R = 180.00'	R = 180.00'	R = 180.00'	R = 180.00'
L = 174.06"	L = 31.19'	L = 136.04'	L = 167.24'
Δ = 055°24'16"	Δ = 009°55'47"	Δ = 043°18'14"	Δ = 053°14'00"
CH = 167.36"	CH = 31.16'	CH = 132.83'	CH = 161.29'
CB = S64°04'40"E	CB = S41°20'25"E	CB = S67°57'25"E	CB = S62°59'32"E

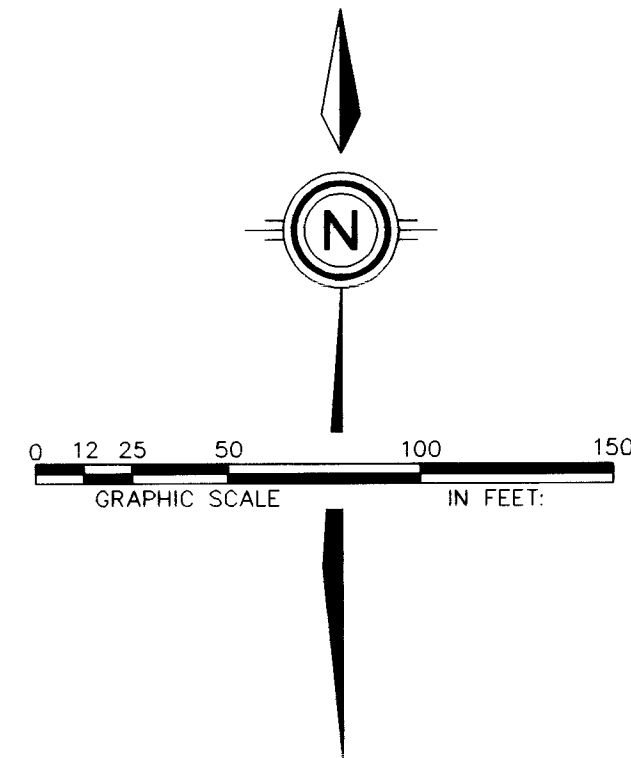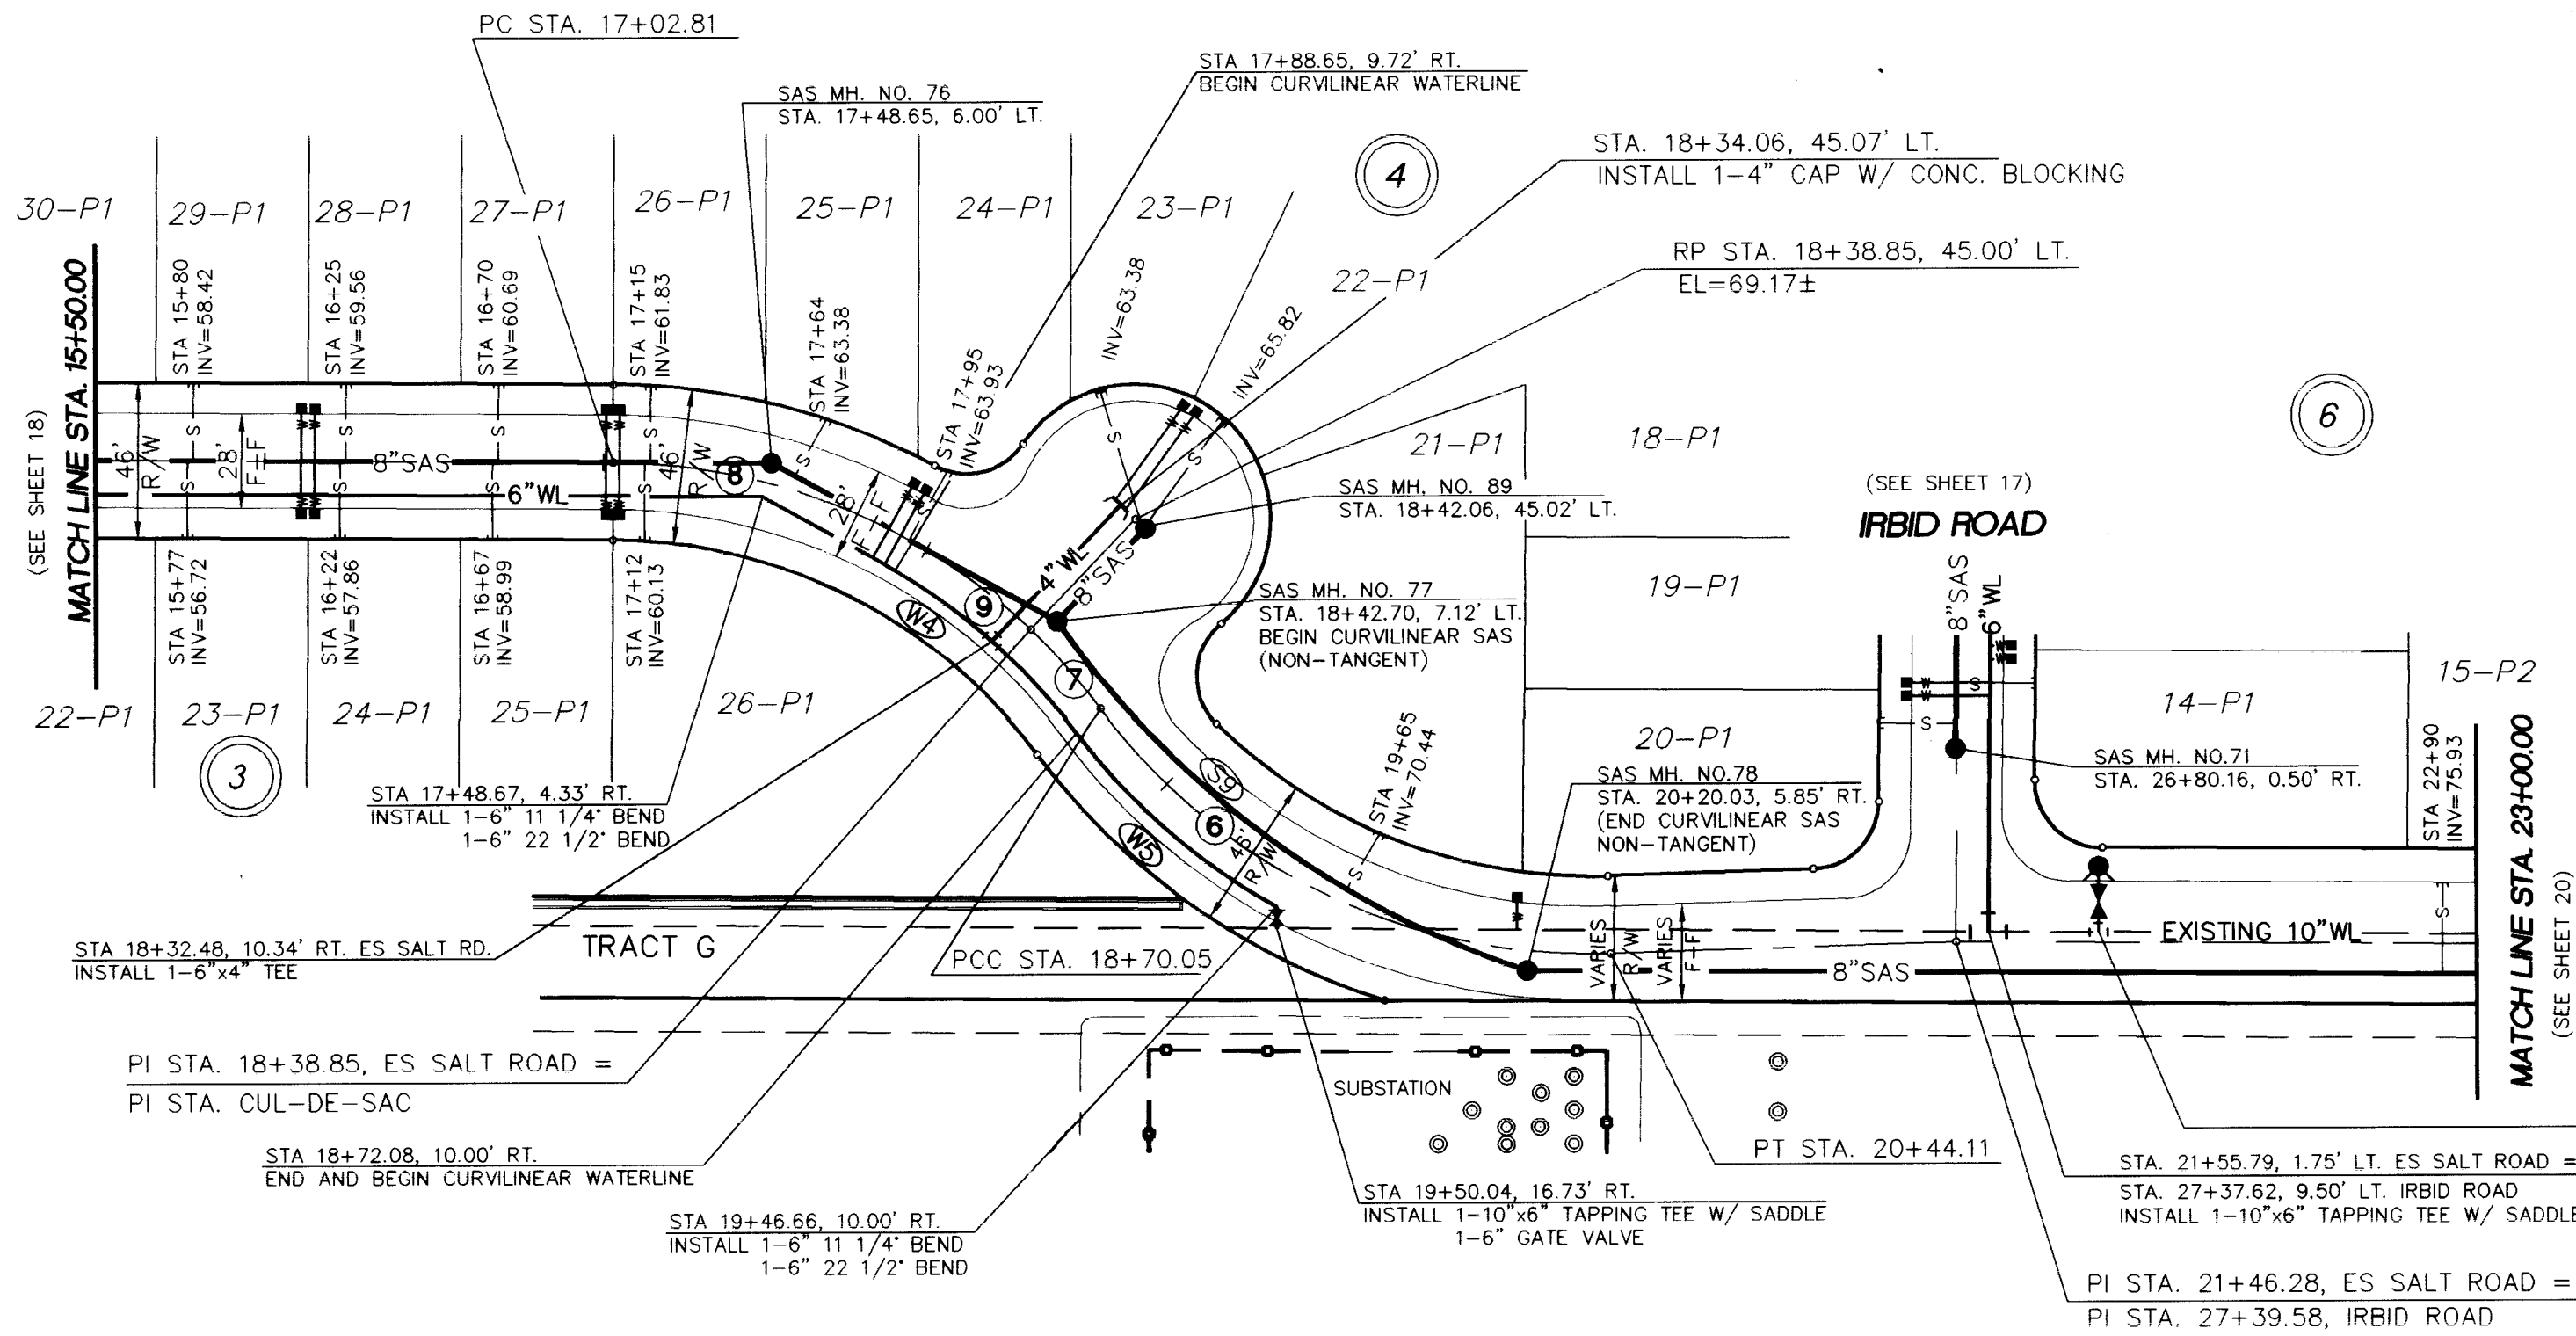

UTILITY LEGEND		
DESCRIPTION	PROPOSED	EXISTING
SANITARY SEWER LINE	8" SAS	8" SAS
ENCASEMENT		
SANITARY SEWER MANHOLE		
SAS SERVICE CONNECTION		
STORM DRAIN LINE	SD-30"	SD-30"
STORM DRAIN MANHOLE		
STORM DRAIN INLETS		
WATER LINE	W-6"	W-6"
GATE VALVE		
BUTTERFLY VALVE		
FIRE HYDRANTS		
REDUCERS		
3/4" WATER SERVICE/METER		
TEES		
CROSSES		
BENDS		
CAPS & PLUGS	N/A	2" H.P.
GAS LINES	N/A	
OVERHEAD ELECTRICAL LINE	N/A	
UNDERGROUND ELECTRICAL	N/A	
OVERHEAD TELEPHONE	N/A	
UNDERGROUND TELEPHONE	N/A	
CABLE TELEVISION	N/A	
POWER OR TELEPHONE POLE	N/A	

1	2	3	4	5	6	7	8	9	10	11	12	13	14	15
2	6	-	5	2	0	6	.	9	3	.	1	9	9	7

RESTRAINING LENGTHS

FITTING	LR (FT)
10"x6" TEE	6' RUN, 1' BRANCH
6"x6" TEE	10' RUN, 2' BRANCH
6"x4" TEE	4' RUN, 7' BRANCH
6" GV	46'
6" 22 1/2" BEND	3'
6" 11 1/4" BEND	2'

LR = LENGTH TO BE RESTRAINED EACH SIDE OF THE FITTING. FOR TEES, ALL THREE LEGS SHALL BE RESTRAINED FOR A DISTANCE OF "LR" FOR REDUCERS, "LR" IS GIVEN FOR THE LARGER DIAMETER SIZE OF THE FITTING AND NO RESTRAINING IS REQUIRED ON THE SMALL SIDE OF THE FITTING. GATE VALVES SHALL BE MECHANICALLY RESTRAINED AND INSTALLED WITH CONCRETE BLOCKING PER COA STD DWG 2333 IN ADDITION TO THE MECHANICALLY RESTRAINED LENGTHS. ALL CAPS SHALL BE INSTALLED WITH CONCRETE BLOCKING PER COA STD DWG 2320. RESTRAIN ALL JOINTS ON FIRE HYDRANTS.

- RESTRAINED JOINTS, SUCH AS MEGA-LUG, EQUIVALENT BRANDS ACCEPTABLE TO THE ENGINEER, SHALL BE USED ON ALL TEES, BENDS, CROSSES AND CAPS IN LIEU OF CONCRETE THRUST BLOCKING. RESTRAINED JOINTS SHALL BE CONSIDERED INCIDENTAL TO THIS CONTRACT AND NO ADDITIONAL COMPENSATION, MEASUREMENT, OR PAYMENT WILL BE MADE THEREFORE.
- ALL FIRE HYDRANTS AND FITTINGS, ETC. SHALL BE BUILT IN ACCORDANCE WITH C.O.A. STD. DWG'S 2301 THRU 2380 INCLUSIVE.

SCALE:
HORIZ: 1" = 50'
VERT: 1" = 10'

community sciences corporation

CITY OF ALBUQUERQUE
PUBLIC WORKS DEPARTMENT
ENGINEERING GROUP


TITLE: QUINTESSENCE SUBDIVISION - UNIT 2 UTILITY PLAN & PROFILE ES SALT ROAD N.E.					
APPROVALS	ENGINEER	DATE	APPROVALS	ENGINEER	DATE
DRC CHAIRMAN	B.G. Anthony	5-21-96	WATER	R.W. Kane	2-1-96
TRANSPORTATION	N/A	3-1-96	WASTE WATER	R.W. Kane	2-1-96
HYDROLOGY	N/A	3-6-96	A.M.A.F.C.A.		
PROJECT NO.	5206.93	MAP NO.	D-21	SHEET	19 OF 22



5650
ENGINEER'S RECORD DRAWING CERTIFICATE
I, the undersigned engineer, a duly qualified Registered Professional Engineer under the laws of the State of New Mexico, do hereby certify that the Record Drawing information shown on these drawings was obtained from field construction and post-construction information obtained by me or under my direct supervision, that the Record Drawing information shown on these drawings was added by me or under my direct supervision, and that the Record Drawing information is true and correct to the best of my knowledge and belief. Responsibility for the design concepts, design engineering and calculations, or intent of the Record Drawings resides with others.
Elery A. Blathrow, Jr., P.E. 02-21-97
Elery A. Blathrow, Jr., P.E. New Mexico Civil Registration No. 12070

ES SALT CUL-DE-SAC
SHOWN HEREON THIS SHEET

STA. 21+79.78, 18.00' LT. ES SALT ROAD
INSTALL 1-10"x6" TAPPING TEE
1-6" GATE VALVE
1-FH, 4' BURY
FLANGE EL= 82.35


CURVE ID	R	L	DELTA	CH	CHD	/20' JOINT
S9	275.00'	176.26'	36°43'21"	N53°09'58"W	173.25'	4'-10"
W4	190.00'	78.72'	23°44'20"	S48°49'18"E	78.72'	6'-2"
W5	190.00'	78.95'	23°48'32"	N48°51'24"W	78.39'	6'-2"

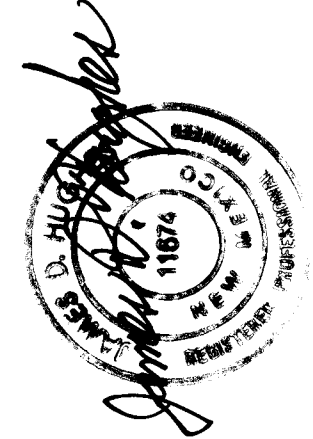

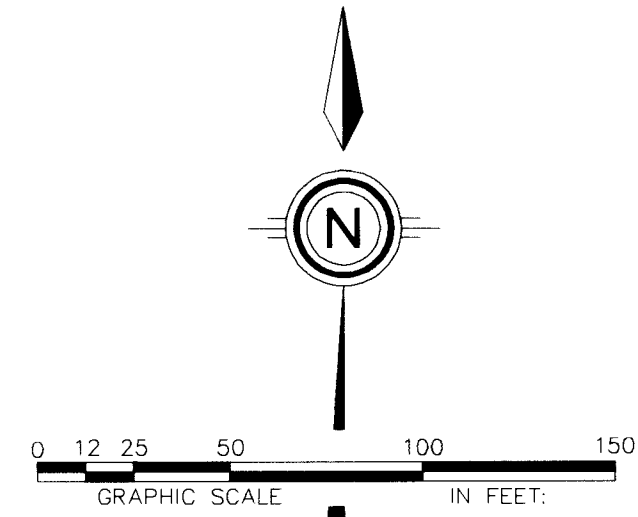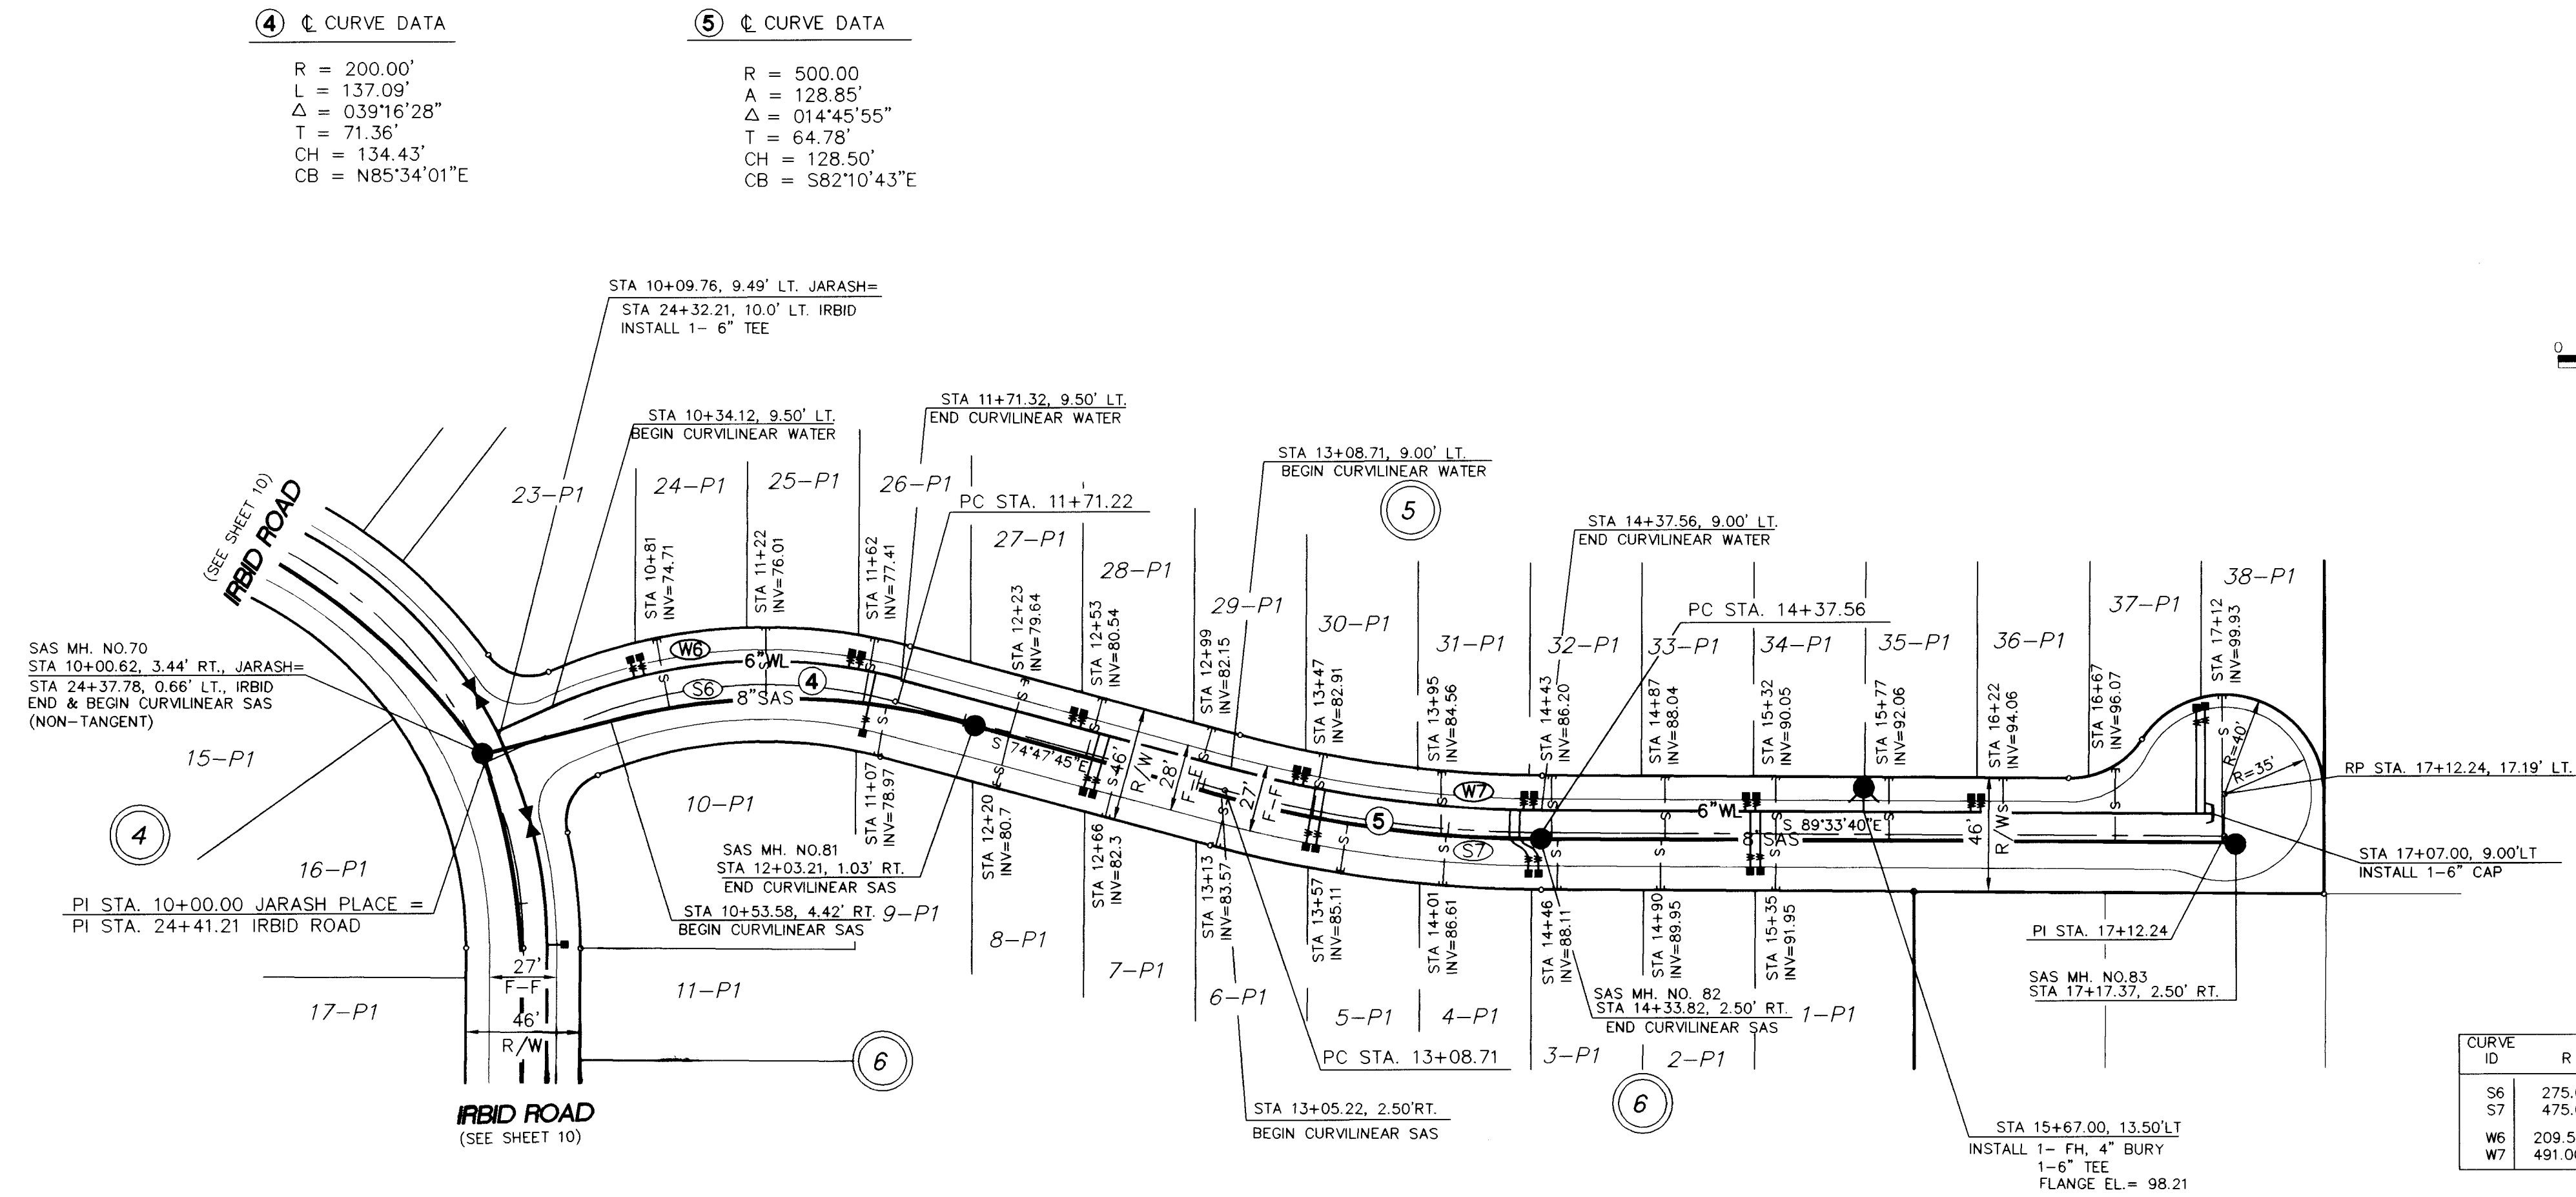

CURVE ID	R	L	DELTA	CH	CHD	DELTA /20' JOINT
S6	275.00'	146.85'	30°35'45"	S89°15'59"E	145.11'	4°10'
S7	475.00'	129.27'	15°35'34"	N81°45'53"W	128.87'	2°25'
W6	209.50'	143.61'	39°16'28"	N85°34'01"E	140.81'	5°28'
W7	491.00'	126.53'	14°45'55"	N82°10'43"W	126.18'	2°20'

JARASH PLACE, N.E.

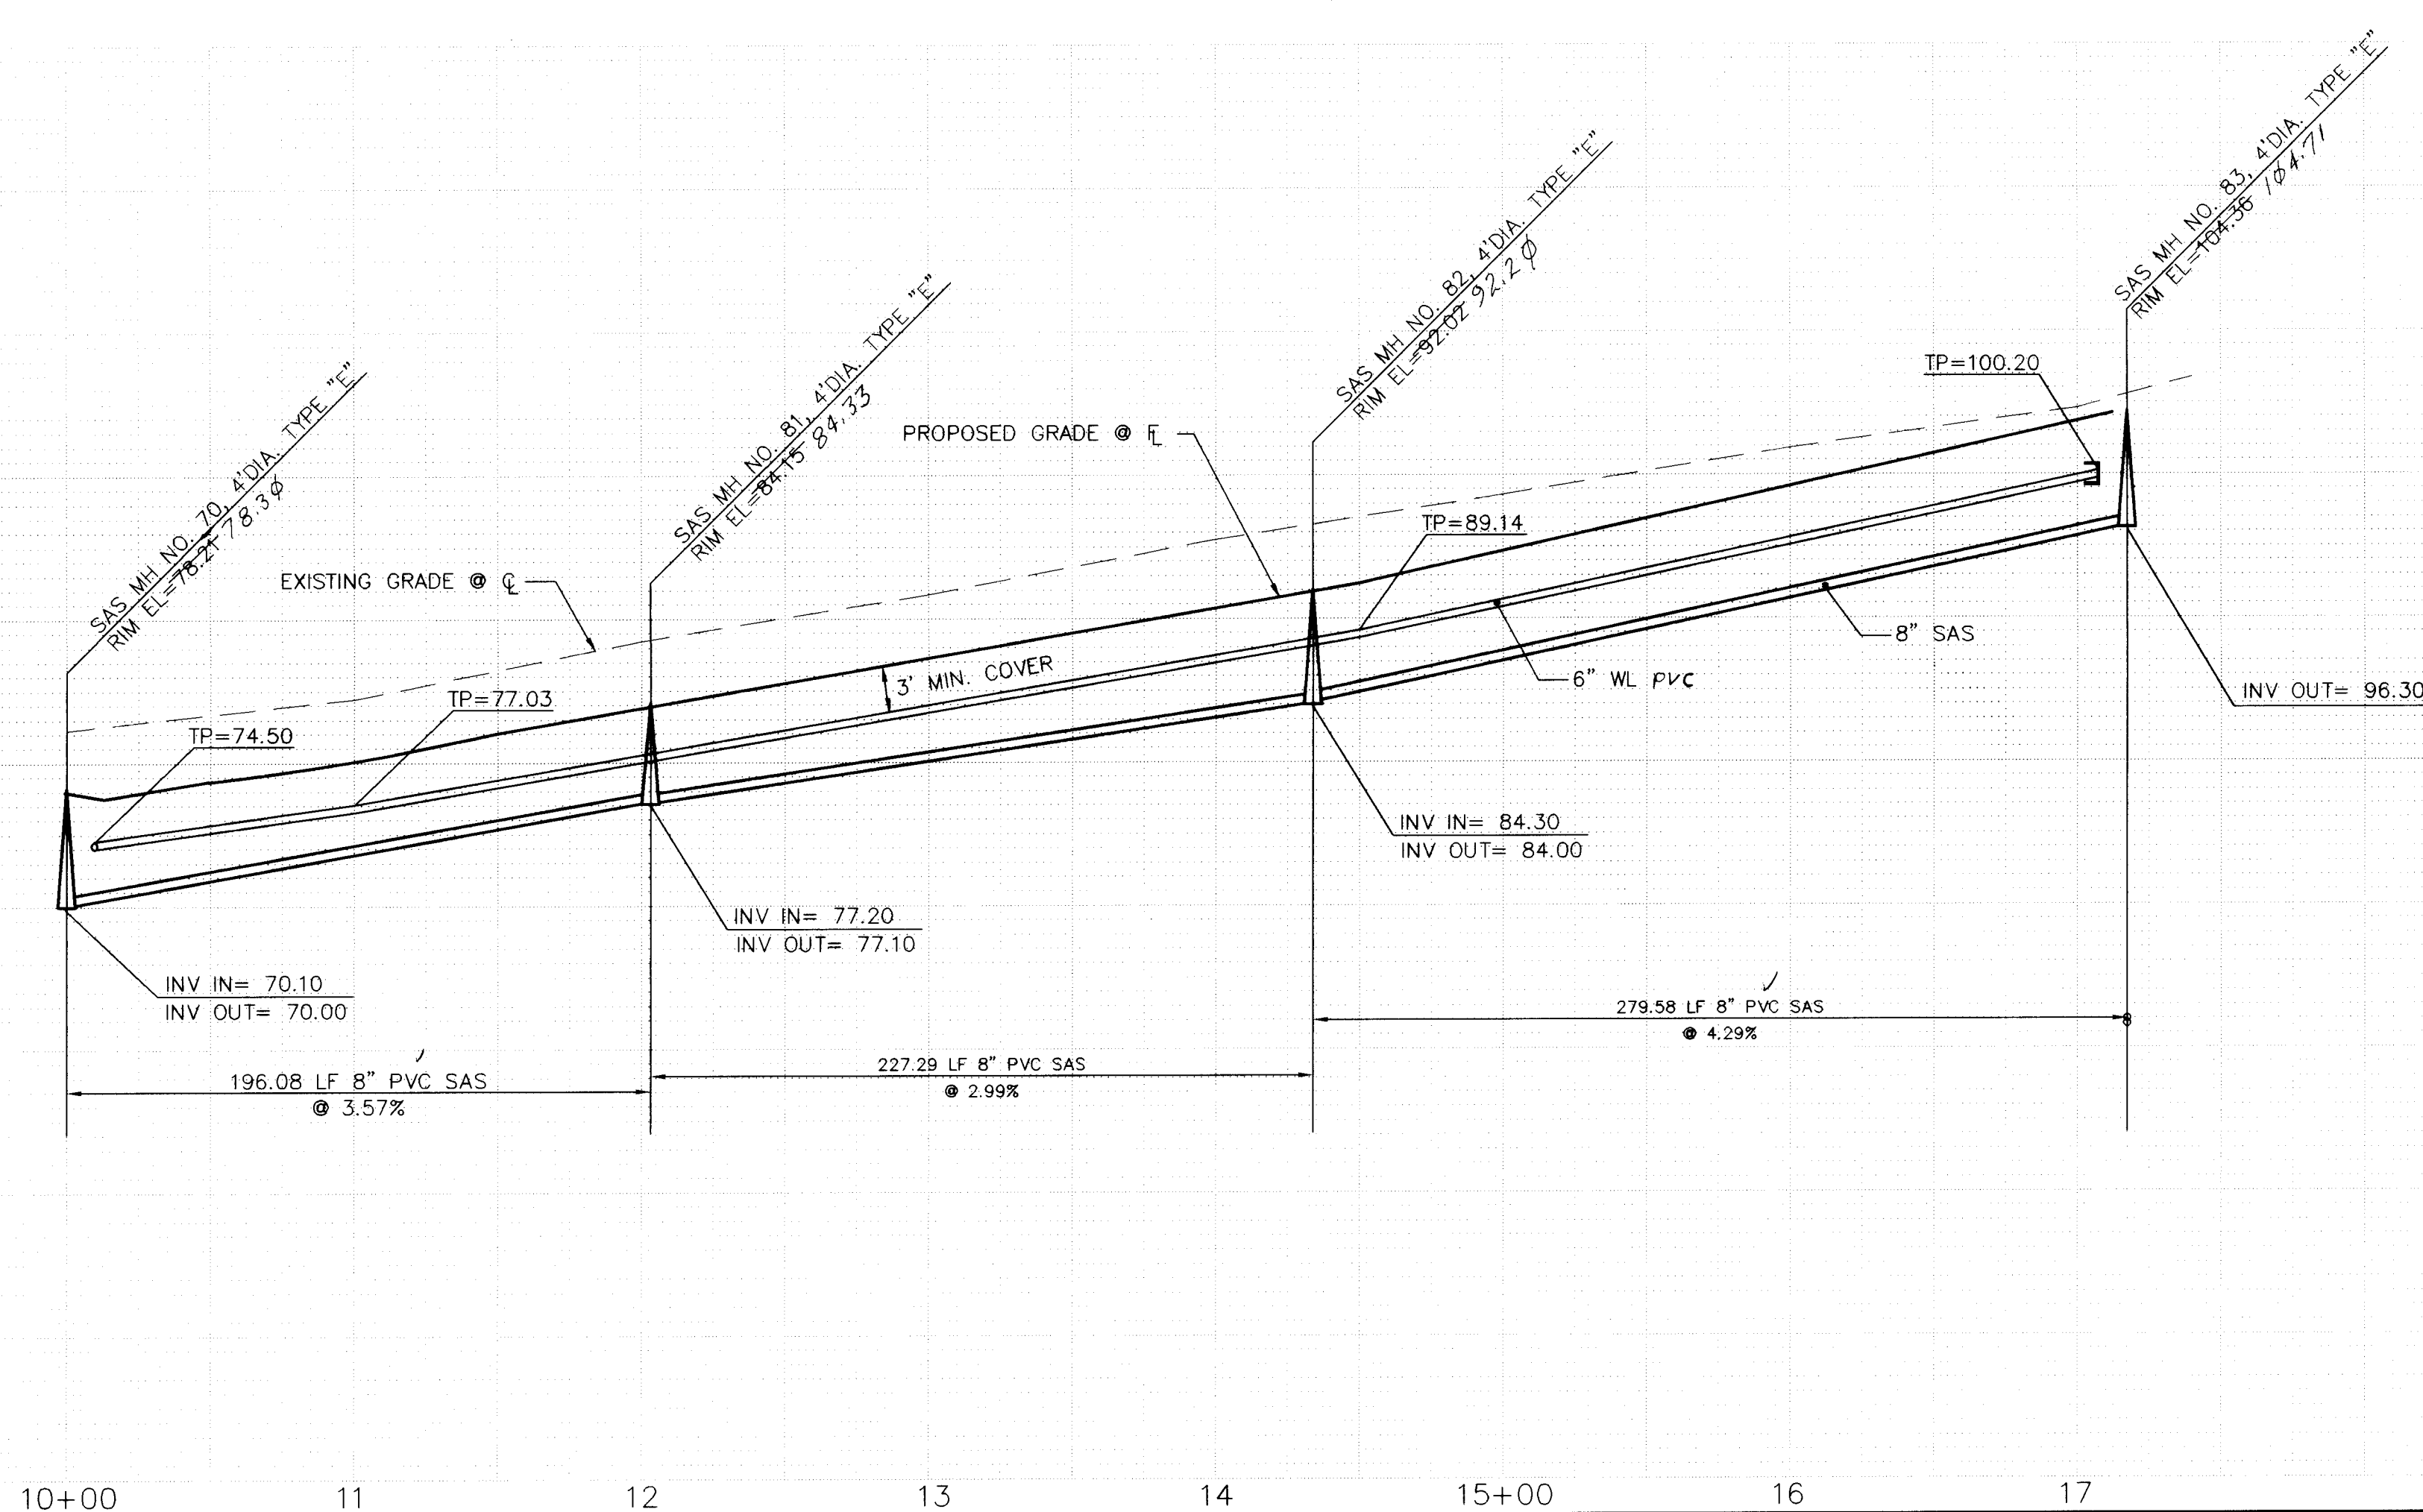

UTILITY LEGEND

DESCRIPTION	PROPOSED	EXISTING
SANITARY SEWER LINE	8" SAS	8" SAS
ENCASEMENT		
SANITARY SEWER MANHOLE		
SAS SERVICE CONNECTION	S	S
STORM DRAIN LINE	SD-30"	SD-30"
STORM DRAIN MANHOLE		
STORM DRAIN INLETS		
WATER LINE	W-6"	W-6"
GATE VALVE		
BUTTERFLY VALVE		
FIRE HYDRANTS		
REDUCERS		
WATER SERVICE/ METER		
TEES		
CROSSES		
BENDS		
CAPS & PLUGS		
GAS LINES	N/A	
OVERHEAD ELECTRICAL LINE	N/A	
UNDERGROUND ELECTRICAL	N/A	
OVERHEAD TELEPHONE	N/A	
UNDERGROUND TELEPHONE	N/A	
CABLE TELEVISION	N/A	
POWER OR TELEPHONE POLE	N/A	

RESTRAINING LENGTHS

FITTING	LR (FT)
10"x6"TEE	6' RUN, 1' BRANCH
6"x6"TEE	10' RUN, 2' BRANCH
6"x4"TEE	4' RUN, 7' BRANCH
6"CV	46'
6" 22 1/2" BEND	3'
6" 11 1/4" BEND	2'

LR = LENGTH TO BE RESTRAINED EACH SIDE OF THE FITTING. FOR TEES, ALL THREE LEGS SHALL BE RESTRAINED FOR A DISTANCE OF "LR". FOR REDUCERS, "LR" IS GIVEN FOR THE LARGER DIAMETER SIZE OF THE FITTING AND NO RESTRAINING IS REQUIRED ON THE SMALL SIDE OF THE FITTING. GATE VALVES SHALL BE MECHANICALLY RESTRAINED AND INSTALLED WITH CONCRETE BLOCKING PER COA STD DWG 2333 IN ADDITION TO THE MECHANICALLY RESTRAINED LENGTHS. ALL CAPS SHALL BE INSTALLED WITH CONCRETE BLOCKING PER COA STD DWG 2320. RESTRAIN ALL JOINTS ON FIRE HYDRANTS.

- RESTRAINED JOINTS, SUCH AS MEGA-LUG, EQUIVALENT BRANDS ACCEPTABLE TO THE ENGINEER, SHALL BE USED ON ALL TEES, BENDS, CROSSES AND CAPS IN LIEU OF CONCRETE THRUST BLOCKING. RESTRAINED JOINTS SHALL BE CONSIDERED INCIDENTAL TO THIS CONTRACT AND NO ADDITIONAL COMPENSATION, MEASUREMENT, OR PAYMENT WILL BE MADE THEREFORE.
- ALL FIRE HYDRANTS AND FITTINGS, ETC. SHALL BE BUILT IN ACCORDANCE WITH C.O.A. STD. DWG'S 2301 THRU 2380 INCLUSIVE.

SCALE:

HORIZ: 1" = 50'

VERT: 1" = 10'

community sciences corporation

LAND PLANNING P.O. Box 1326

ENGINEERING Corrales, N.M. 87648

SURVEYING

CITY OF ALBUQUERQUE PUBLIC WORKS DEPARTMENT ENGINEERING GROUP

TITLE: QUINTESSENCE SUBDIVISION - UNIT 2
UTILITY PLAN & PROFILE
JARASH PLACE N.E.




APPROVALS	ENGINEER	DATE	APPROVALS	ENGINEER	DATE
DRC CHAIRMAN	B.G. Bookley	3-21-96	WATER	R.W. Kane	2-1-96
TRANSPORTATION	N/A	3-1-96	WASTE WATER	R.W. Kane	2-1-96
HYDROLOGY	N/A	3-6-96	A.M.A.F.C.A.		
PROJECT NO.	5206.93	MAP NO.	D-21	SHEET	21 OF 22

SCANNED BY LASON

ENGINEER'S RECORD DRAWING CERTIFICATE

I, the undersigned engineer, a duly qualified Registered Professional Engineer under the laws of the State of New Mexico, do hereby certify that the Record Drawing information shown on these drawings was obtained from field construction and post-construction information obtained by me or under my direct supervision, that the Record Drawing information shown on these drawings was added by me or under my direct supervision, and that the Record Drawing information is true and correct to the best of my knowledge and belief. Responsibility for the design concepts, design engineering and calculations, or use of the Record Drawings resides with others.

Blery A. Blathrow, Jr. 02-21-97
Blery A. Blathrow, Jr., P.E. New Mexico Civil Registration No. 12070

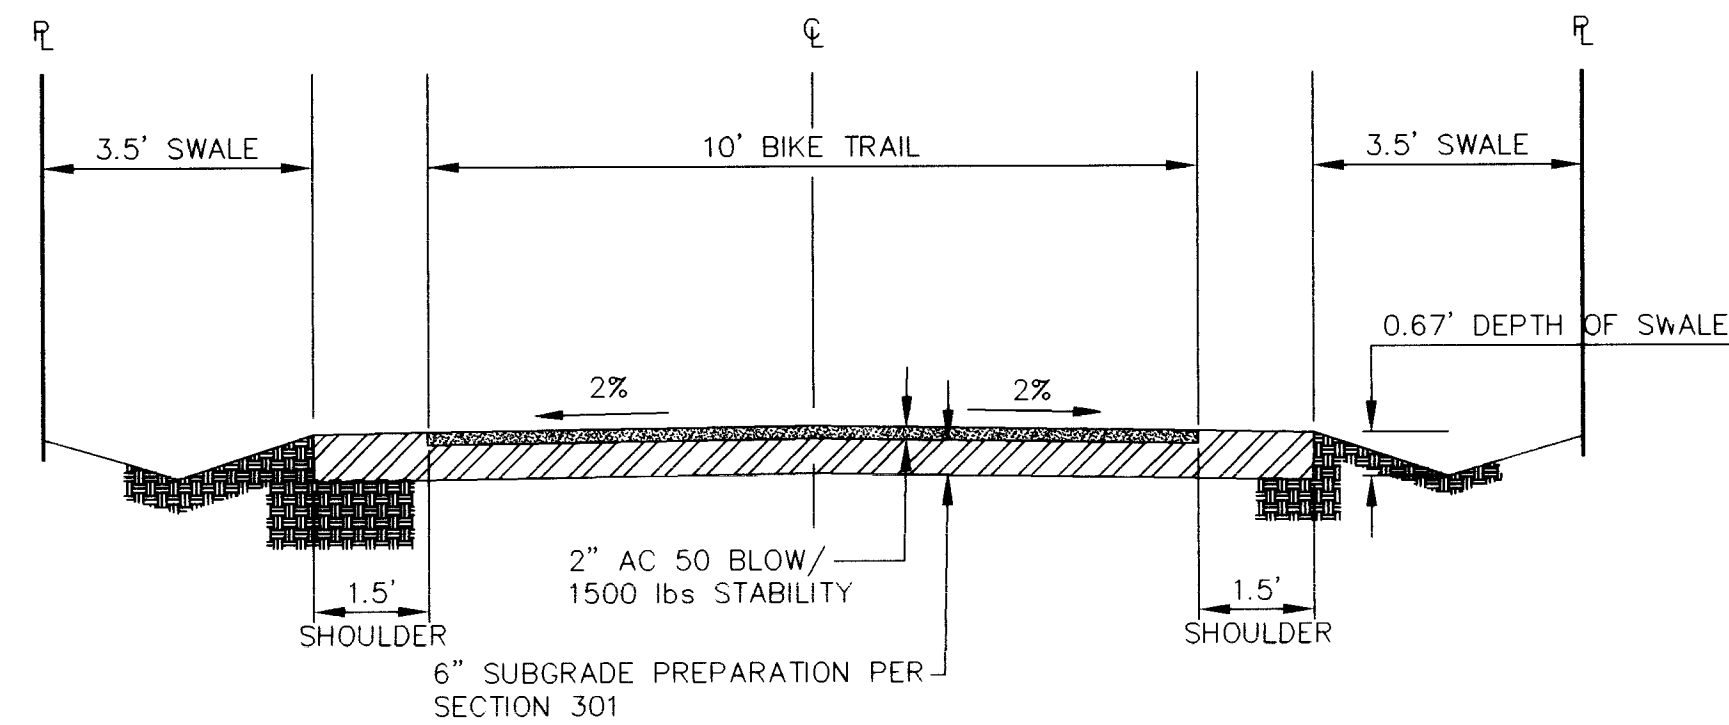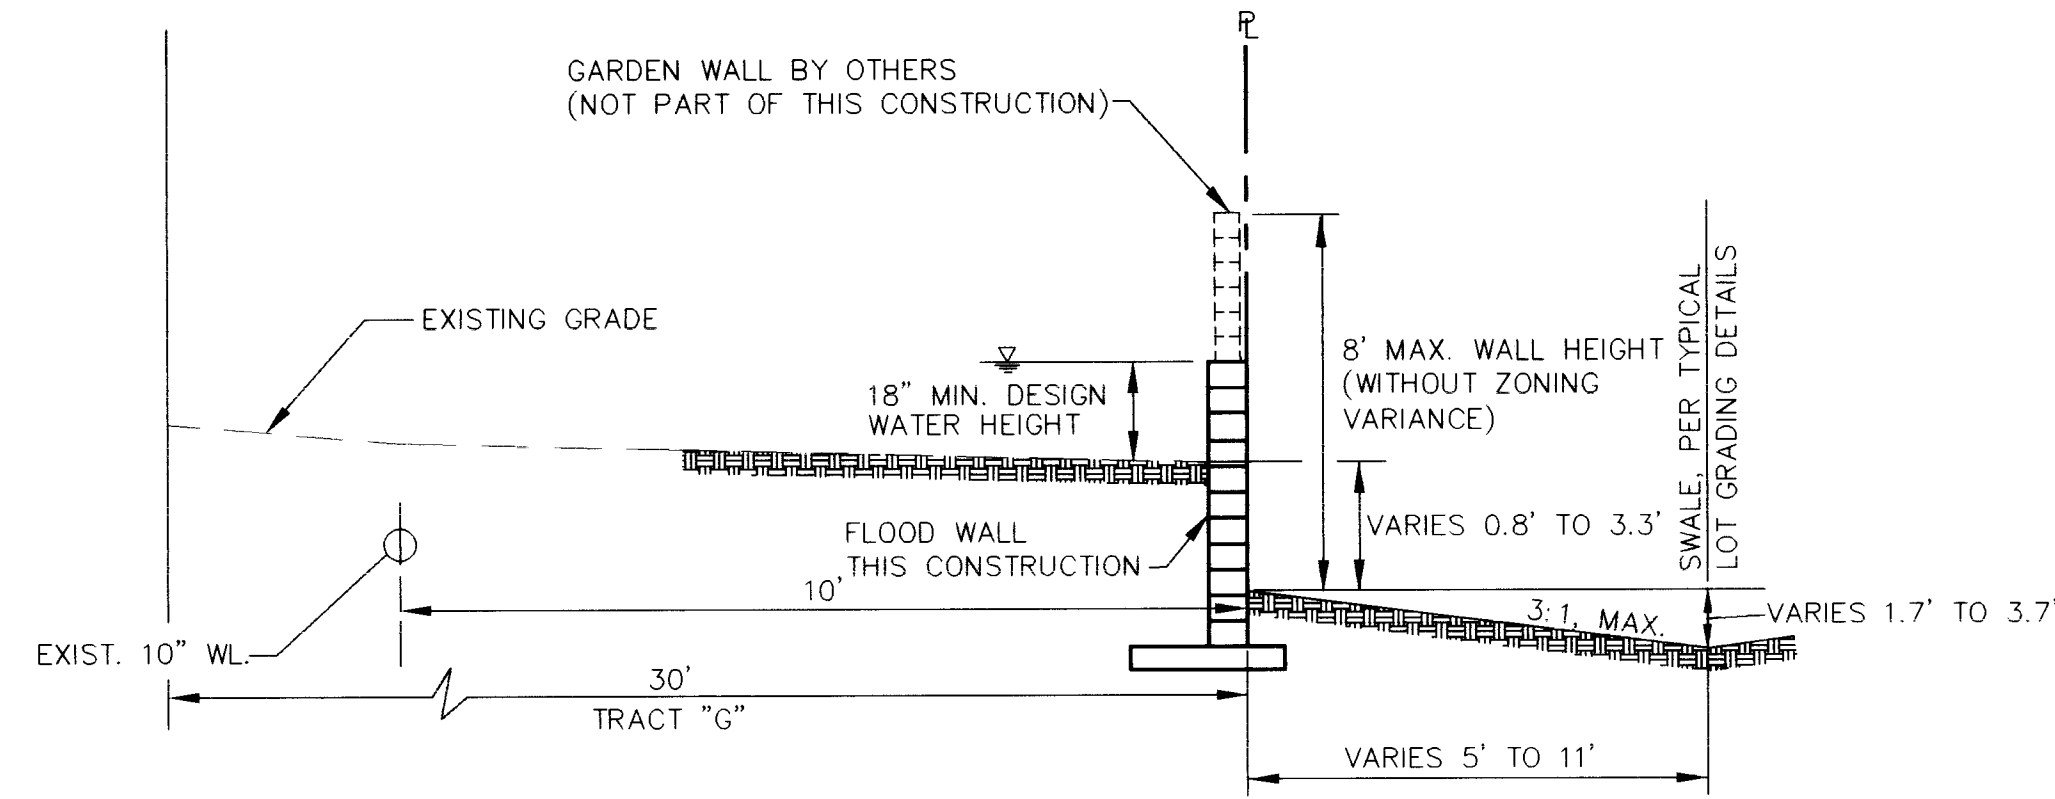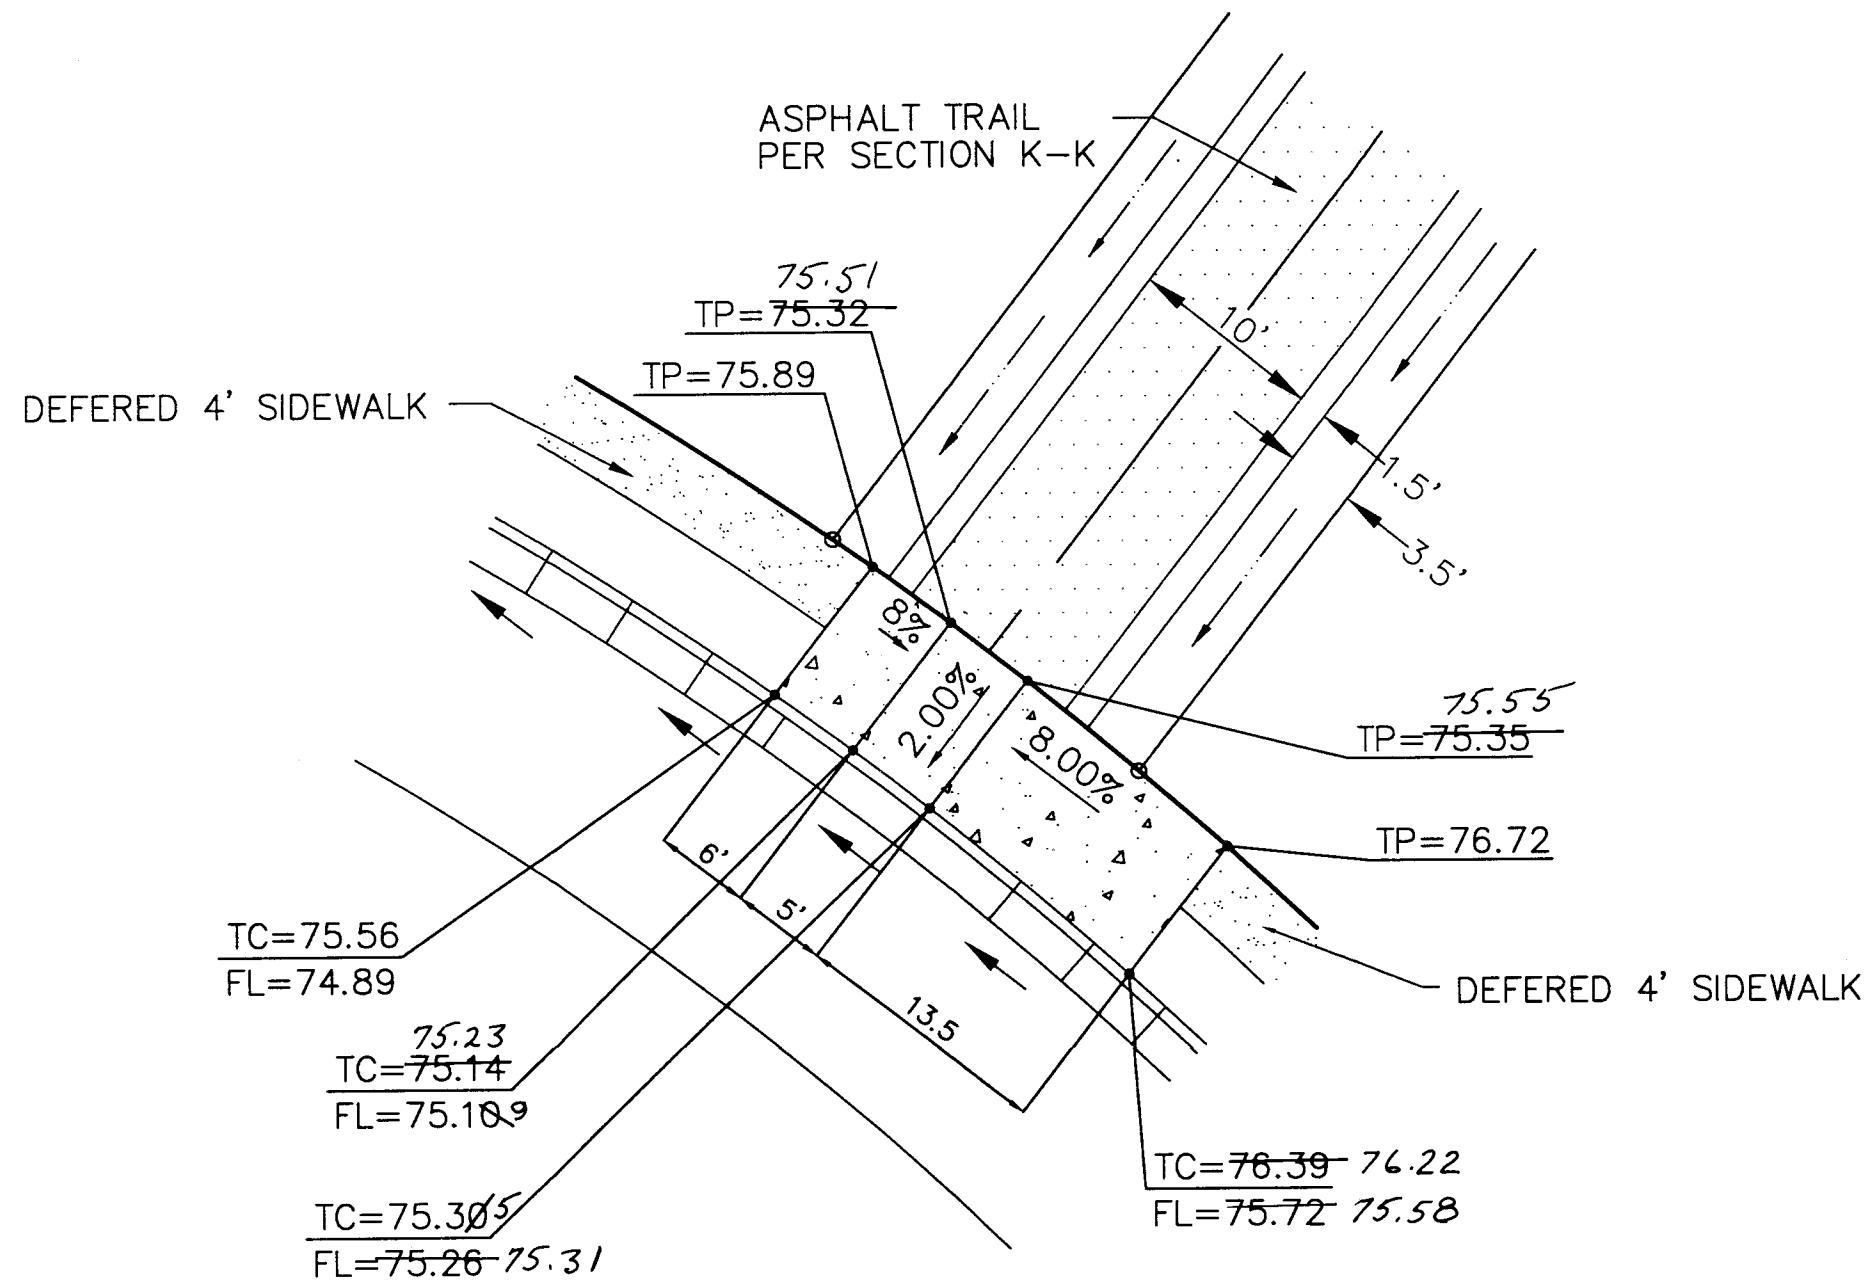

1	2	3	4	5	6	7	8	9	10	11	12	13	14	15
2	6	-	5	2	0	6	.	9	3	2	2	9	7	

DATE: 11/95	community sciences corporation
SCALE: AS NOTED	
JOB NO: 32308	LAND PLANNING P.O. Box 1328 ENGINEERING Corrales, N.M. 87046 SURVEYING

CITY OF ALBUQUERQUE PUBLIC WORKS DEPARTMENT ENGINEERING GROUP					
TITLE: QUINTESSENCE- UNIT 2 TYPICAL GRADING DETAILS AND SECTIONS					
APPROVALS	ENGINEER	DATE	APPROVALS	ENGINEER	DATE
DRC CHAIRMAN	<i>B.G. Baskin</i>	3-21-96	WATER	NIA RWK	2-1-96
TRANSPORTATION	<i>John R. Smith</i>	3-1-96	WASTE WATER	NIA RWK	2-1-96
HYDROLOGY	<i>Al Calogian</i>	3-6-96		<i>P. Soma</i>	3-14-96
PROJECT NO.	5206.93	MAP NO.	D-21	SHEET	22 OF 22

RECORD INFORMATION	
CONTRACTOR	Community Sciences Corp.
DATE	DATE
ACCEPTANCE BY	DATE
VERIFICATION BY	DATE
DRAWINGS	DATE
CORRECTIONS	DATE
MICRO-FILM INFORMATION	
RECORDED BY	DATE
NO.	NO.

SURVEY INFORMATION	
FIELD NOTES	
NO.	DATE
1	2/95
COMMUNITY SCIENCES	
IT IS LOCATED 793 FEET NORTH OF THE CENTERLINE INTERSECTION OF CORONADO AVENUE AND HOLBROOK STREET, AND 85 FEET EAST OF THE CENTERLINE OF HOLBROOK STREET.	
ELEV = 5650.56	

ENGINEER'S SEAL

John R. Smith

1-30-96

SCANNED BY
BY LASON

DATE