

QUINTESSENCE SUBDIVISION - UNIT 4

CITY OF ALBUQUERQUE, BERNALILLO COUNTY, NEW MEXICO

IMPROVEMENTS FOR

GRADING, PAVING AND UTILITIES

INDEX TO DRAWINGS

SHEET NO.	DESCRIPTION
1	COVER SHEET, VICINITY MAP AND INDEX TO DRAWINGS
2-4	PLATS OF GEOMETRY
5-7	GRADING AND EROSION CONTROL PLANS
8	GRADING DETAILS & SECTIONS
PAVING PLAN & PROFILES	
9	COMPOSITE PAVING PLAN
10	AMMAN AVENUE & NOOR AVENUE N.E.
11	SHAUBAK DRIVE N.E. & BASELINE "A"
12	RUSEIFA DRIVE & QUINTESSENCE ROAD N.E.
13	JORDAN AVENUE N.E.
14	ANTON CIRCLE & SAWSAN ROAD N.E.
15	ANTON CIRCLE & SAMEH ROAD N.E.
16	NEBO STREET & QUINTESSENCE ROAD N.E.
UTILITY PLAN & PROFILES	
17	COMPOSITE UTILITY PLAN
18	AMMAN AVENUE & NOOR AVENUE N.E.
19	SHAUBAK DRIVE N.E.
20	RUSEIFA DRIVE & QUINTESSENCE ROAD N.E.
21	JORDAN AVENUE N.E. & BASELINE "A"
22	ANTON CIRCLE & SAWSAN ROAD N.E.
23	ANTON CIRCLE & SAMEH ROAD N.E.
24	NEBO STREET & QUINTESSENCE ROAD N.E.

RECORD DRAWING NOTES

1. The basis of vertical elevations is as stated under the "Bench Marks" notation.
2. Where a measured constructed value is different from the design value, the design value is "lined through" and the measured value written in.
3. Where the measured value is identical to the design value, the design value has a "✓" beside it.
4. Where the design value has not been measured, no distinctive mark has been made, leaving the design value as is.


ENGINEER'S RECORD DRAWING CERTIFICATE

I, the undersigned engineer, a duly qualified and registered Professional Engineer under the laws of the State of New Mexico, on this day certify that this Record Drawing represents the work of my firm and that I am not aware of any falsification or misrepresentation of the data or information upon which this Record Drawing is based, and that I am not aware of any falsification or misrepresentation of the data or information upon which this Record Drawing is based, and that I am not aware of any falsification or misrepresentation of the data or information upon which this Record Drawing is based.

Elery A. Blathrow, Jr. 06-18-98
Elery A. Blathrow, Jr., P.E. New Mexico Civil Registration No. 12070

WARNING - EXISTING UTILITY LINE LOCATIONS ARE SHOWN IN AN APPROXIMATE MANNER ONLY, AND SUCH LINES MAY EXIST WHERE NONE ARE SHOWN. THE LOCATION OF ANY SUCH EXISTING LINES IS BASED UPON INFORMATION PROVIDED BY THE UTILITY COMPANY, THE OWNER, OR BY OTHERS, AND THE INFORMATION MAY BE INCOMPLETE OR MAY BE OBSOLETE BY THE TIME CONSTRUCTION COMMENCES.


THE ENGINEER HAS UNDERTAKEN LIMITED FIELD VERIFICATION OF THE LOCATION, DEPTH, SIZE, OR TYPE OF EXISTING UNDERGROUND UTILITY LINES, MAKES NO REPRESENTATION PERTAINING THERETO AND ASSUMES NO RESPONSIBILITY OR LIABILITY THEREFOR. THE CONTRACTOR SHALL INFORM ITSELF OF THE LOCATION OF ANY UTILITY LINE IN OR NEAR THE AREA OF THE WORK IN ADVANCE OF AND DURING EXCAVATION WORK. THE CONTRACTOR IS FULLY RESPONSIBLE FOR ANY AND ALL DAMAGE CAUSED BY ITS FAILURE TO LOCATE, IDENTIFY, AND PRESERVE ANY AND ALL EXISTING UTILITIES. THE CONTRACTOR SHALL COMPLY WITH STATE STATUTES, MUNICIPAL AND LOCAL ORDINANCES, RULES AND REGULATIONS PERTAINING TO THE LOCATION OF THESE LINES AND FACILITIES IN PLANNING AND CONDUCTING EXCAVATION, WHETHER BY CALLING OR NOTIFYING THE UTILITIES, COMPLYING WITH (BLUE STAKES) PROCEDURES, OR OTHERWISE.

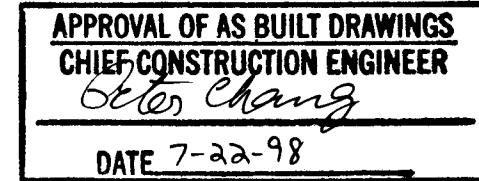

TURNKEY: 5206.94
CITY INSPECTOR: LEMMY ROMERO
(OVERSEE)

1 2 3 4 5 6 7 8 9 10 11 12 13 14 15
26 5206.94 9498021

DRB 94-552

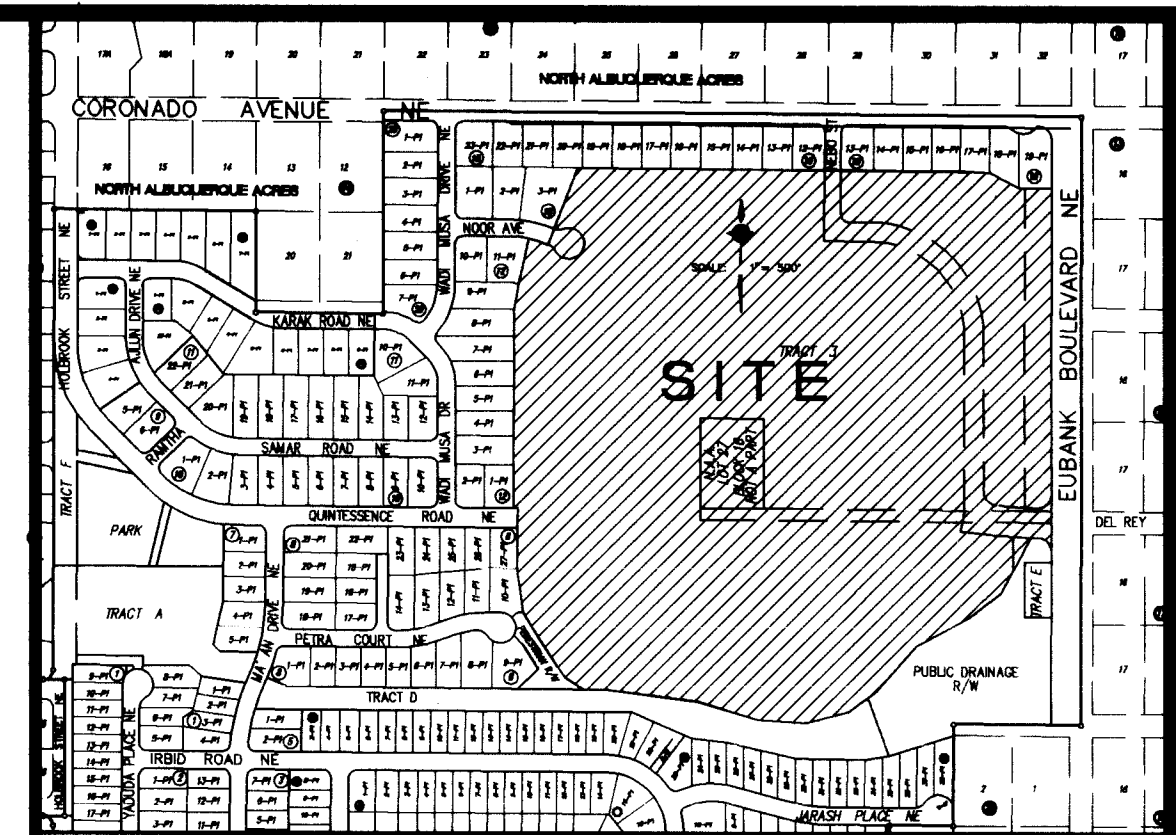


SCALE: 1" = 500' ± VICINITY MAP D 21 Z

GENERAL NOTES:

1. ALL WORK DETAILED ON THESE PLANS TO BE PERFORMED UNDER CONTRACT SHALL, EXCEPT AS OTHERWISE STATED OR PROVIDED FROM HEREON, BE CONSTRUCTED IN ACCORDANCE WITH THE CITY OF ALBUQUERQUE STANDARD SPECIFICATIONS FOR PUBLIC WORKS CONSTRUCTION, 1986 EDITION AS AMENDED WITH UPDATE NO. 6.
2. TWO (2) WORKING DAYS PRIOR TO ANY EXCAVATION, CONTRACTOR MUST CONTACT LINE LOCATING SERVICE, (260-1990) FOR LOCATION OF EXISTING UTILITIES.
3. PRIOR TO CONSTRUCTION, THE CONTRACTOR SHALL EXCAVATE AND VERIFY THE HORIZONTAL AND VERTICAL LOCATIONS OF ALL OBSTRUCTIONS AND EXISTING PAVEMENT. SHOULD A CONFLICT EXIST, THE CONTRACTOR SHALL NOTIFY THE ENGINEER OR SURVEYOR SO THAT THE CONFLICT CAN BE RESOLVED WITH MINIMUM AMOUNT OF DELAY.
4. THE CONTRACTOR SHALL FURNISH EMD'S ON ALL WATER AND SEWER SERVICE STUBS, CAPS AND PLUGS.
5. CONTRACTOR SHALL NOTIFY THE PROJECT ENGINEER NOT LESS THAN SEVEN (7) DAYS PRIOR TO STARTING WORK IN ORDER THAT THE ENGINEER MAY TAKE NECESSARY MEASURES TO ENSURE THE PRESERVATION OF SURVEY MONUMENTS. CONTRACTOR SHALL NOT DISTURB PERMANENT SURVEY MONUMENTS WITHOUT THE CONSENT OF THE ENGINEER AND SHALL BEAR THE EXPENSE OF REPLACING ANY THAT MAY BE DISTURBED WITHOUT PERMISSION. REPLACEMENT SHALL BE DONE ONLY BY THE CITY SURVEY SECTION. WHEN A CHANGE IS MADE IN ANY ROADWAY IN WHICH A PERMANENT SURVEY MONUMENT IS LOCATED, CONTRACTOR SHALL, AT HIS OWN EXPENSE, ADJUST THE MONUMENT COVER TO THE NEW GRADE UNLESS OTHERWISE SPECIFIED. REFER TO SECTION 4.4 OF GENERAL CONDITIONS OF THE CITY OF ALBUQUERQUE STANDARD SPECIFICATIONS FOR PUBLIC WORKS CONSTRUCTION.
6. RESTRAINED JOINTS ARE REQUIRED AT ALL WATER LINE BENDS, TEES, CAPS AND GATE VALVES.
7. THE PUBLIC WATER LINE MUST BE A MINIMUM OF 18" ABOVE THE SEWER LINE AT ALL CROSSINGS.
8. THE CONTRACTOR SHALL CONTACT WATER SYSTEMS DIVISION (857-8200) FIVE (5) WORKING DAYS PRIOR TO NEEDING SHUT-OFF OR TURN-ON OF VALVES. ONLY CITY WATER SYSTEMS PERSONNEL ARE AUTHORIZED TO OPERATE VALVE.
9. THREE (3) WORKING DAYS PRIOR TO BEGINNING CONSTRUCTION, THE CONTRACTOR SHALL SUBMIT TO THE CONSTRUCTION COORDINATION DIVISION A DETAILED CONSTRUCTION SCHEDULE. TWO (2) WORKING DAYS PRIOR TO CONSTRUCTION, THE CONTRACTOR SHALL OBTAIN A BARRICADING PERMIT FROM THE CONSTRUCTION COORDINATION DIVISION. CONTRACTOR SHALL NOTIFY BARRICADE ENGINEER (768-2551) PRIOR TO OCCUPYING AN INTERSECTION. SEE SECTION 19 OF THE SPECIFICATIONS.
10. ALL STREET STRIPING ALTERED OR DESTROYED SHALL BE REPLACED IN KIND BY CONTRACTOR TO LOCATION AND IN KIND AS EXISTING OR AS INDICATED BY THIS PLAN SET. ALL NEW STRIPING SHALL BE PLASTIC AS PER CITY STANDARDS.
11. ANY WORK AFFECTING AN ARTERIAL ROADWAY REQUIRES TWENTY-FOUR HOUR CONSTRUCTION.
12. ALL HANDICAP RAMPS WILL MEET ADA STANDARDS.

DATE: JUNE, 1996	<i>community sciences corporation</i>		
SCALE: AS SHOWN			
DESIGNED: JMN			
DRAWN: LJD			
JOB NO.: 32310	LAND PLANNING P.O. Box 1328 Corrales, N.M. 87048	ENGINEERING P.O. Box 1328 Corrales, N.M. 87048	SURVEYING (505) 897-0000

																																																																																																																																																																																																																																																																																																																																																																																																																																																																																																																																																																																																																																																																																																																																																																																																																																																																																																																																																																																																																																																																																																																																																																																																																																																																																																																																																																																																																					</
--	--	----

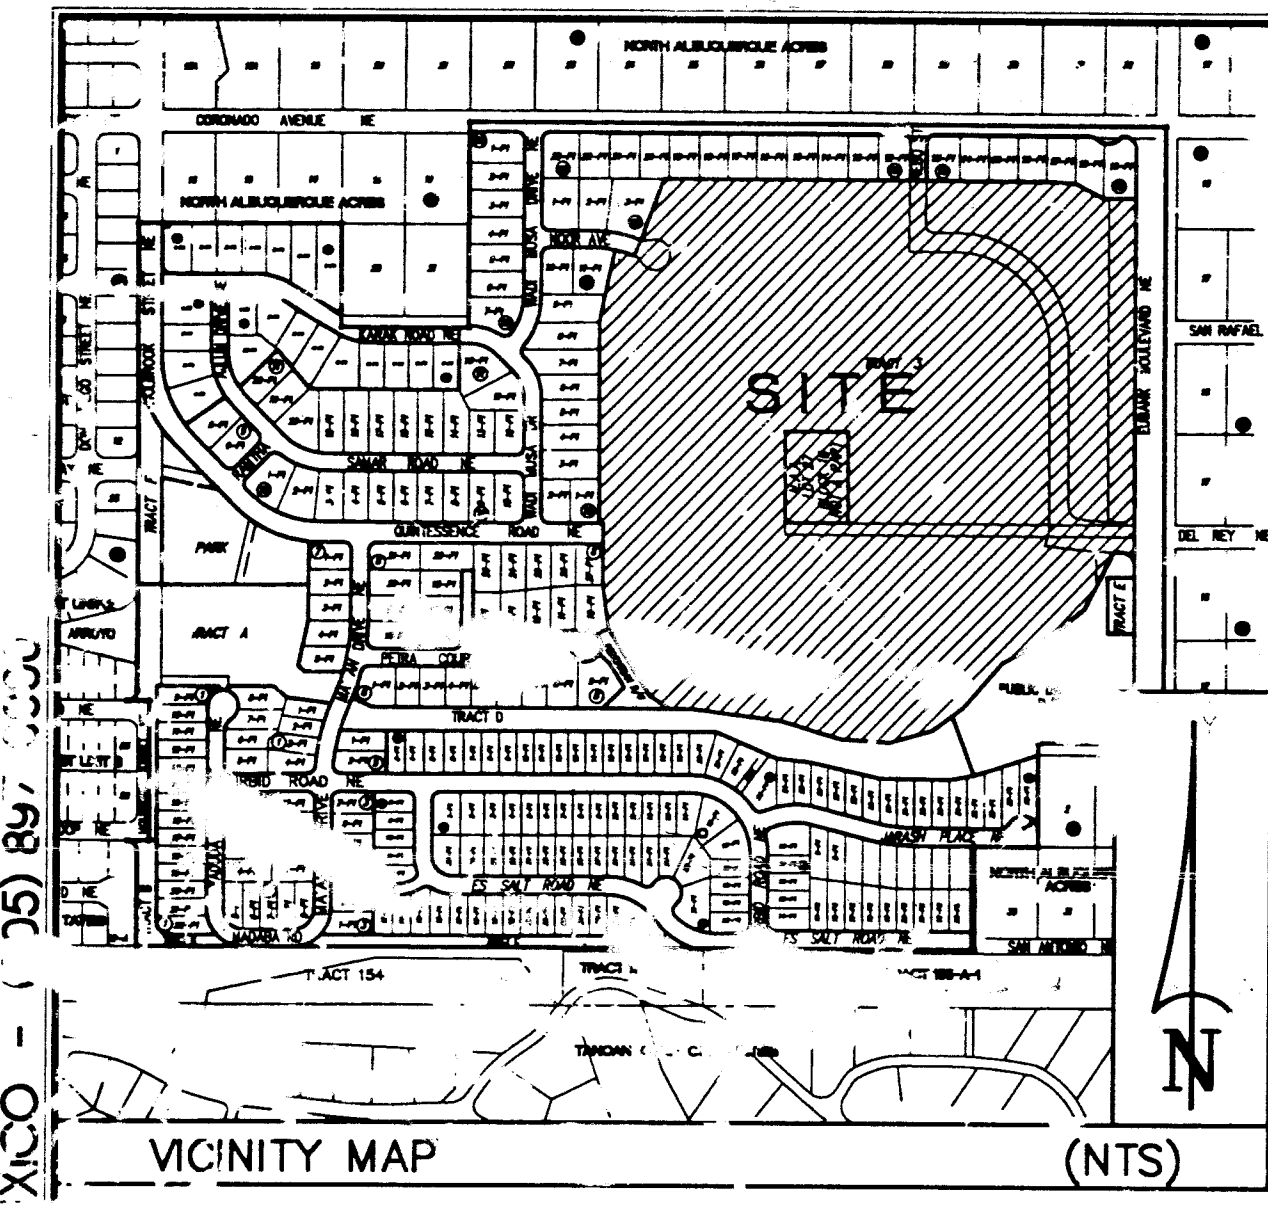

LEGAL DESCRIPTION

THAT CERTAIN PARCEL OF LAND SITUATE WITHIN THE ELENA GALLEGOS GRANT ("PROJECTED" SECTION 21, TOWNSHIP 11 NORTH, RANGE 4 EAST, NEW MEXICO (PRINCIPAL MERIDIAN), CITY OF ALBUQUERQUE, NEW MEXICO AND BEING COMPRISED OF TRACT 3, QUINTESSANCE UNIT 1, AS THE SAME IS SHOWN AND DESIGNATED ON THE PLAT OF RECORD FILED IN THE OFFICE OF THE COUNTY CLERK OF BERNALILLO COUNTY, NEW MEXICO ON JANUARY 18, 1996 IN VOLUME 960, FOLIO 30 TOGETHER WITH LOT 27, BLOCK 16, UNIT 2, TRACT 3, OF NORTH ALBUQUERQUE ACRES AS THE SAME IS SHOWN AND DESIGNATED ON THE PLAT OF RECORD FILED IN THE OFFICE OF THE COUNTY CLERK OF BERNALILLO COUNTY, NEW MEXICO ON JUNE 8, 1993 IN VOLUME D, FOLIO 133 AND BEING MORE PARTICULARLY DESCRIBED AS FOLLOWS:

BEGINNING FOR A TIE AT THE ALBUQUERQUE CITY SURVEY (ACS; MONUMENT "4-022" (HAVING NEW MEXICO STATE PLANE COORDINATES, CENTRAL ZONE OF X=420767.52 AND Y=1517527.25); THENCE S51°57'14"W, 3482.83 FEET TO A POINT ON THE WEST RIGHT-OF-WAY LINE OF EUBANK BOULEVARD NE (108' R/W), SAID POINT BEING THE SOUTHEAST CORNER OF LOT 19-P1, BLOCK 18 OF QUINTESSANCE UNIT 1 AND THE TRUE POINT OF BEGINNING OF THE PARK HEREIN DESCRIBED; THENCE ALONG THE WEST RIGHT-OF-WAY LINE OF EUBANK BOULEVARD NE, S00°06'00"E, 44 FEET TO A POINT ON CURVE; THENCE DEPARTING THE WEST RIGHT-OF-WAY LINE, NORTHWESTERLY, 54.72 FEET ALONG THE ARC OF A CURVE BEARING TO THE LEFT (SAID ARC HAVING A RADIUS OF 300 FEET), A CENTRAL ANGLE OF 89°34'24", A CHORD THAT BEARS N44°41'54"W, 49.31 FEET TO A POINT OF REVERSE CURVATURE (P.C.); THENCE S77°44'12"W, 19.31 FEET ALONG THE ARC OF A CURVE BEARING TO THE RIGHT (SAID ARC HAVING A RADIUS OF 1039.00 FEET, A CENTRAL ANGLE OF 103°05'18" AND A CHORD THAT BEARS N10°05'18"E, 107.58 FEET TO AN ANGLE POINT; THENCE S31°42'46"W, 153.10 FEET TO AN ANGLE POINT; THENCE S11°42'46"W, 153.10 FEET TO AN ANGLE POINT; THENCE N85°59'59"W, 125.51 FEET TO AN ANGLE POINT; THENCE N85°59'59"W, 125.51 FEET TO AN ANGLE POINT; THENCE N73°32'20"W, 165.20 FEET TO AN ANGLE POINT; THENCE N82°22'25"W, 202.28 FEET TO AN ANGLE POINT; THENCE N89°26'32"W, 59.35 FEET TO THE SOUTHEAST CORNER OF AN EXISTING PEDESTRIAN RIGHT-OF-WAY; THENCE N67°24'33"W, 61.34 FEET TO AN ANGLE POINT; THENCE N32°22'25"W, 202.28 FEET TO AN ANGLE POINT BEING THE SOUTHEAST CORNER OF LOT 10-P1, BLOCK 8 OF SAID QUINTESSANCE UNIT 1; THENCE N07°36'52"W, 112.83 FEET TO AN ANGLE POINT BEING THE NORTHEAST CORNER OF LOT 10-P1, BLOCK 8; THENCE N00°33'28"E, 157.00 FEET TO A POINT ON THE NORTH RIGHT-OF-WAY LINE OF QUINTESSANCE ROAD NE (52' R/W); THENCE ALONG SAID NORTH RIGHT-OF-WAY LINE, N89°26'32"W, 10.77 FEET TO AN ANGLE POINT; THENCE DEPARTING THE NORTH RIGHT-OF-WAY LINE OF QUINTESSANCE ROAD NE, N00°06'00"E, 518.06 FEET TO AN ANGLE POINT BEING THE NORTHEAST CORNER OF LOT 9-P1, BLOCK 12 OF QUINTESSANCE UNIT 1; THENCE N11°30'34"E, 66.99 FEET TO AN ANGLE POINT BEING THE NORTHEAST CORNER OF LOT 9-P1, BLOCK 12; THENCE N12°18'40"E, 121.55 FEET TO A POINT ON CURVE ON THE SOUTH RIGHT-OF-WAY LINE OF NOOR AVENUE NE (44' R/W); THENCE ALONG SAID SOUTH RIGHT-OF-WAY LINE, S0°00'00"E, 51.04 FEET ALONG THE ARC OF A CURVE BEARING TO THE RIGHT (SAID ARC HAVING A RADIUS OF 248.00 FEET, A CENTRAL ANGLE OF 11°47'27", AND A CHORD THAT BEARS S71°47'37"E, 50.50 FEET TO AN ANGLE POINT; THENCE DEPARTING THE SOUTH RIGHT-OF-WAY LINE OF NOOR AVENUE NE, N24°06'07"E, 44.00 FEET TO AN ANGLE POINT ON THE NORTH RIGHT-OF-WAY LINE OF NOOR AVENUE NE; THENCE N09°54'42"E, 170.36 FEET TO AN ANGLE POINT BEING THE NORTHEAST CORNER OF LOT 3-P1, BLOCK 19 OF QUINTESSANCE UNIT 1; THENCE S89°33'35"E, 99.84 FEET TO AN ANGLE POINT BEING THE COMMON REAR PROPERTY CORNER OF LOTS 16-P1 AND 17-P1, BLOCK 18 OF QUINTESSANCE UNIT 1; THENCE S86°21'54"E, 75.12 FEET TO AN ANGLE POINT BEING THE COMMON REAR PROPERTY CORNER OF LOTS 17-P1 AND 18-P1, BLOCK 18 OF QUINTESSANCE UNIT 1; THENCE S62°24'34"E, 34.29 FEET TO AN ANGLE POINT BEING THE COMMON REAR PROPERTY CORNER OF LOTS 18-P1 AND 19-P1, BLOCK 18 OF QUINTESSANCE UNIT 1; THENCE S89°54'42"E, 85.78 FEET TO A POINT ON THE WEST RIGHT-OF-WAY LINE OF EUBANK BOULEVARD NE, SAID POINT ALSO BEING THE SOUTHEAST CORNER OF LOT 19-P1, BLOCK 18 OF QUINTESSANCE UNIT 1 AND THE TRUE POINT OF BEGINNING OF THE PARCEL HEREIN DESCRIBED.

THE ABOVE DESCRIBED PARCEL CONTAINS 40.8323 ACRES (1,778,666 S.F.) MORE OR LESS.

VACATION AND REPLAT
FOR
QUINTESSANCE UNIT 4

COMPRISED OF
TRACT 3, QUINTESSANCE UNIT 1
TOGETHER WITH LOT 27, BLOCK 16, UNIT 2, TRACT 3
OF NORTH ALBUQUERQUE ACRES

SITUATE WITHIN
THE ELENA GALLEGOS GRANT
"PROJECTED" SECTION 21, T11N, R4E, N.M.P.M.
CITY OF ALBUQUERQUE, BERNALILLO COUNTY, NEW MEXICO
JUNE, 1996

SUBDIVISION DATA:

CASE NO.	DRB 94-552, V-96-42, SV-96-22
GRASS SUBDIVISION ACREAGE	40.8326 AC
20' ATLAS INDEX NO.	D-21-Z
NO. OF EXISTING TRACTS/LOTS	2
NO. OF LOTS CREATED	121
NO. OF TRACTS CREATED	1
MILES OF FULL-WIDTH STREETS CREATED	1.26 MILES
DATE OF SURVEY	JUNE, 1996
S.P. TALOS LOG NO.	96-0701-1450-0584

APPROVALS:

SUBDIVISION CASE NUMBER:	
CITY PLANNER/ALBUQUERQUE, BERNALILLO CO. PLANNING DIVISION	DATE
PARKS AND GENERAL SERVICE DEPARTMENT	DATE
TRAFFIC ENGINEER, TRANSPORTATION DEPARTMENT	DATE
CITY ENGINEER, ENGINEERING DIVISION	DATE
ALBUQUERQUE METROPOLITAN ARROYO FLOOD CONTROL AUTHORITY	DATE
UTILITY DEVELOPMENT	DATE
CITY SURVEYOR, ENGINEERING DIVISION	DATE
PROPERTY MANAGEMENT	DATE
PNM GAS SERVICES	DATE
U S WEST COMMUNICATIONS, INC.	DATE
PNM ELECTRIC SERVICES	DATE

TREASURER'S CERTIFICATION

THIS IS TO CERTIFY THAT TAXES ARE CURRENT AND PAID ON UPC #s:

QUINTESSANCE UNIT 1: TRACT 3, UPC#
NORTH ALBUQUERQUE ACRES: LOT 27, BLOCK 16, UNIT 2, TRACT 3,
UPC# 1021-063-1-3-119-293-11

PROPERTY OWNER OF RECORD: PARADISE WEST, INC.-TRACT 3
DENNIS HOUSTON-LOT 27, BLK 16, UNIT 2, TRACT 3

BERNALILLO COUNTY TREASURER'S OFFICE:

BY: _____ DATE: _____

ROBERT C. MILLER, N.M.R.P.S. #3794 _____ DATE _____

SURVEYOR'S CERTIFICATION:


I, ROBERT C. MILLER, HEREBY AFFIRM THAT I AM A DULY QUALIFIED REGISTERED PROFESSIONAL SURVEYOR UNDER THE LAWS OF THE STATE OF NEW MEXICO AND DO CERTIFY THAT THIS PLAT WAS PREPARED BY ME OR UNDER MY DIRECT SUPERVISION; SHOWS ACCURATE DIMENSIONS, AND LAND AREAS; SHOWS ALL EASEMENTS AND RESTRICTIONS AS SHOWN ON THE PLAT OF RECORD OR MADE KNOWN TO ME BY THE OWNERS AND/OR PROPRIETORS OF THE SUBDIVISION SHOWN HEREON, TITLE COMPANIES, UTILITY COMPANIES OR OTHER PARTIES EXPRESSING AN INTEREST. I FURTHER CERTIFY THAT THIS PLAT MEETS THE MINIMUM REQUIREMENTS FOR MONUMENTATION AND SURVEYS OF THE ALBUQUERQUE SUBDIVISION ORDINANCE, MEETS THE MINIMUM STANDARDS FOR LAND SURVEYS SET FORTH BY THE STATE OF NEW MEXICO AND IS TRUE AND CORRECT TO THE BEST OF MY KNOWLEDGE AND BELIEF.



SHEET 1 OF 6



DATE: JUNE, 1996
SCALE: N/A
DESIGNED: J.M.N.
DRAWN: D.E.R.
JOB NO.: 323-10-025

community sciences corporation

LAND PLANNING
P.O. Box 1338
ENGINEERING
Corrales, N.M. 87048

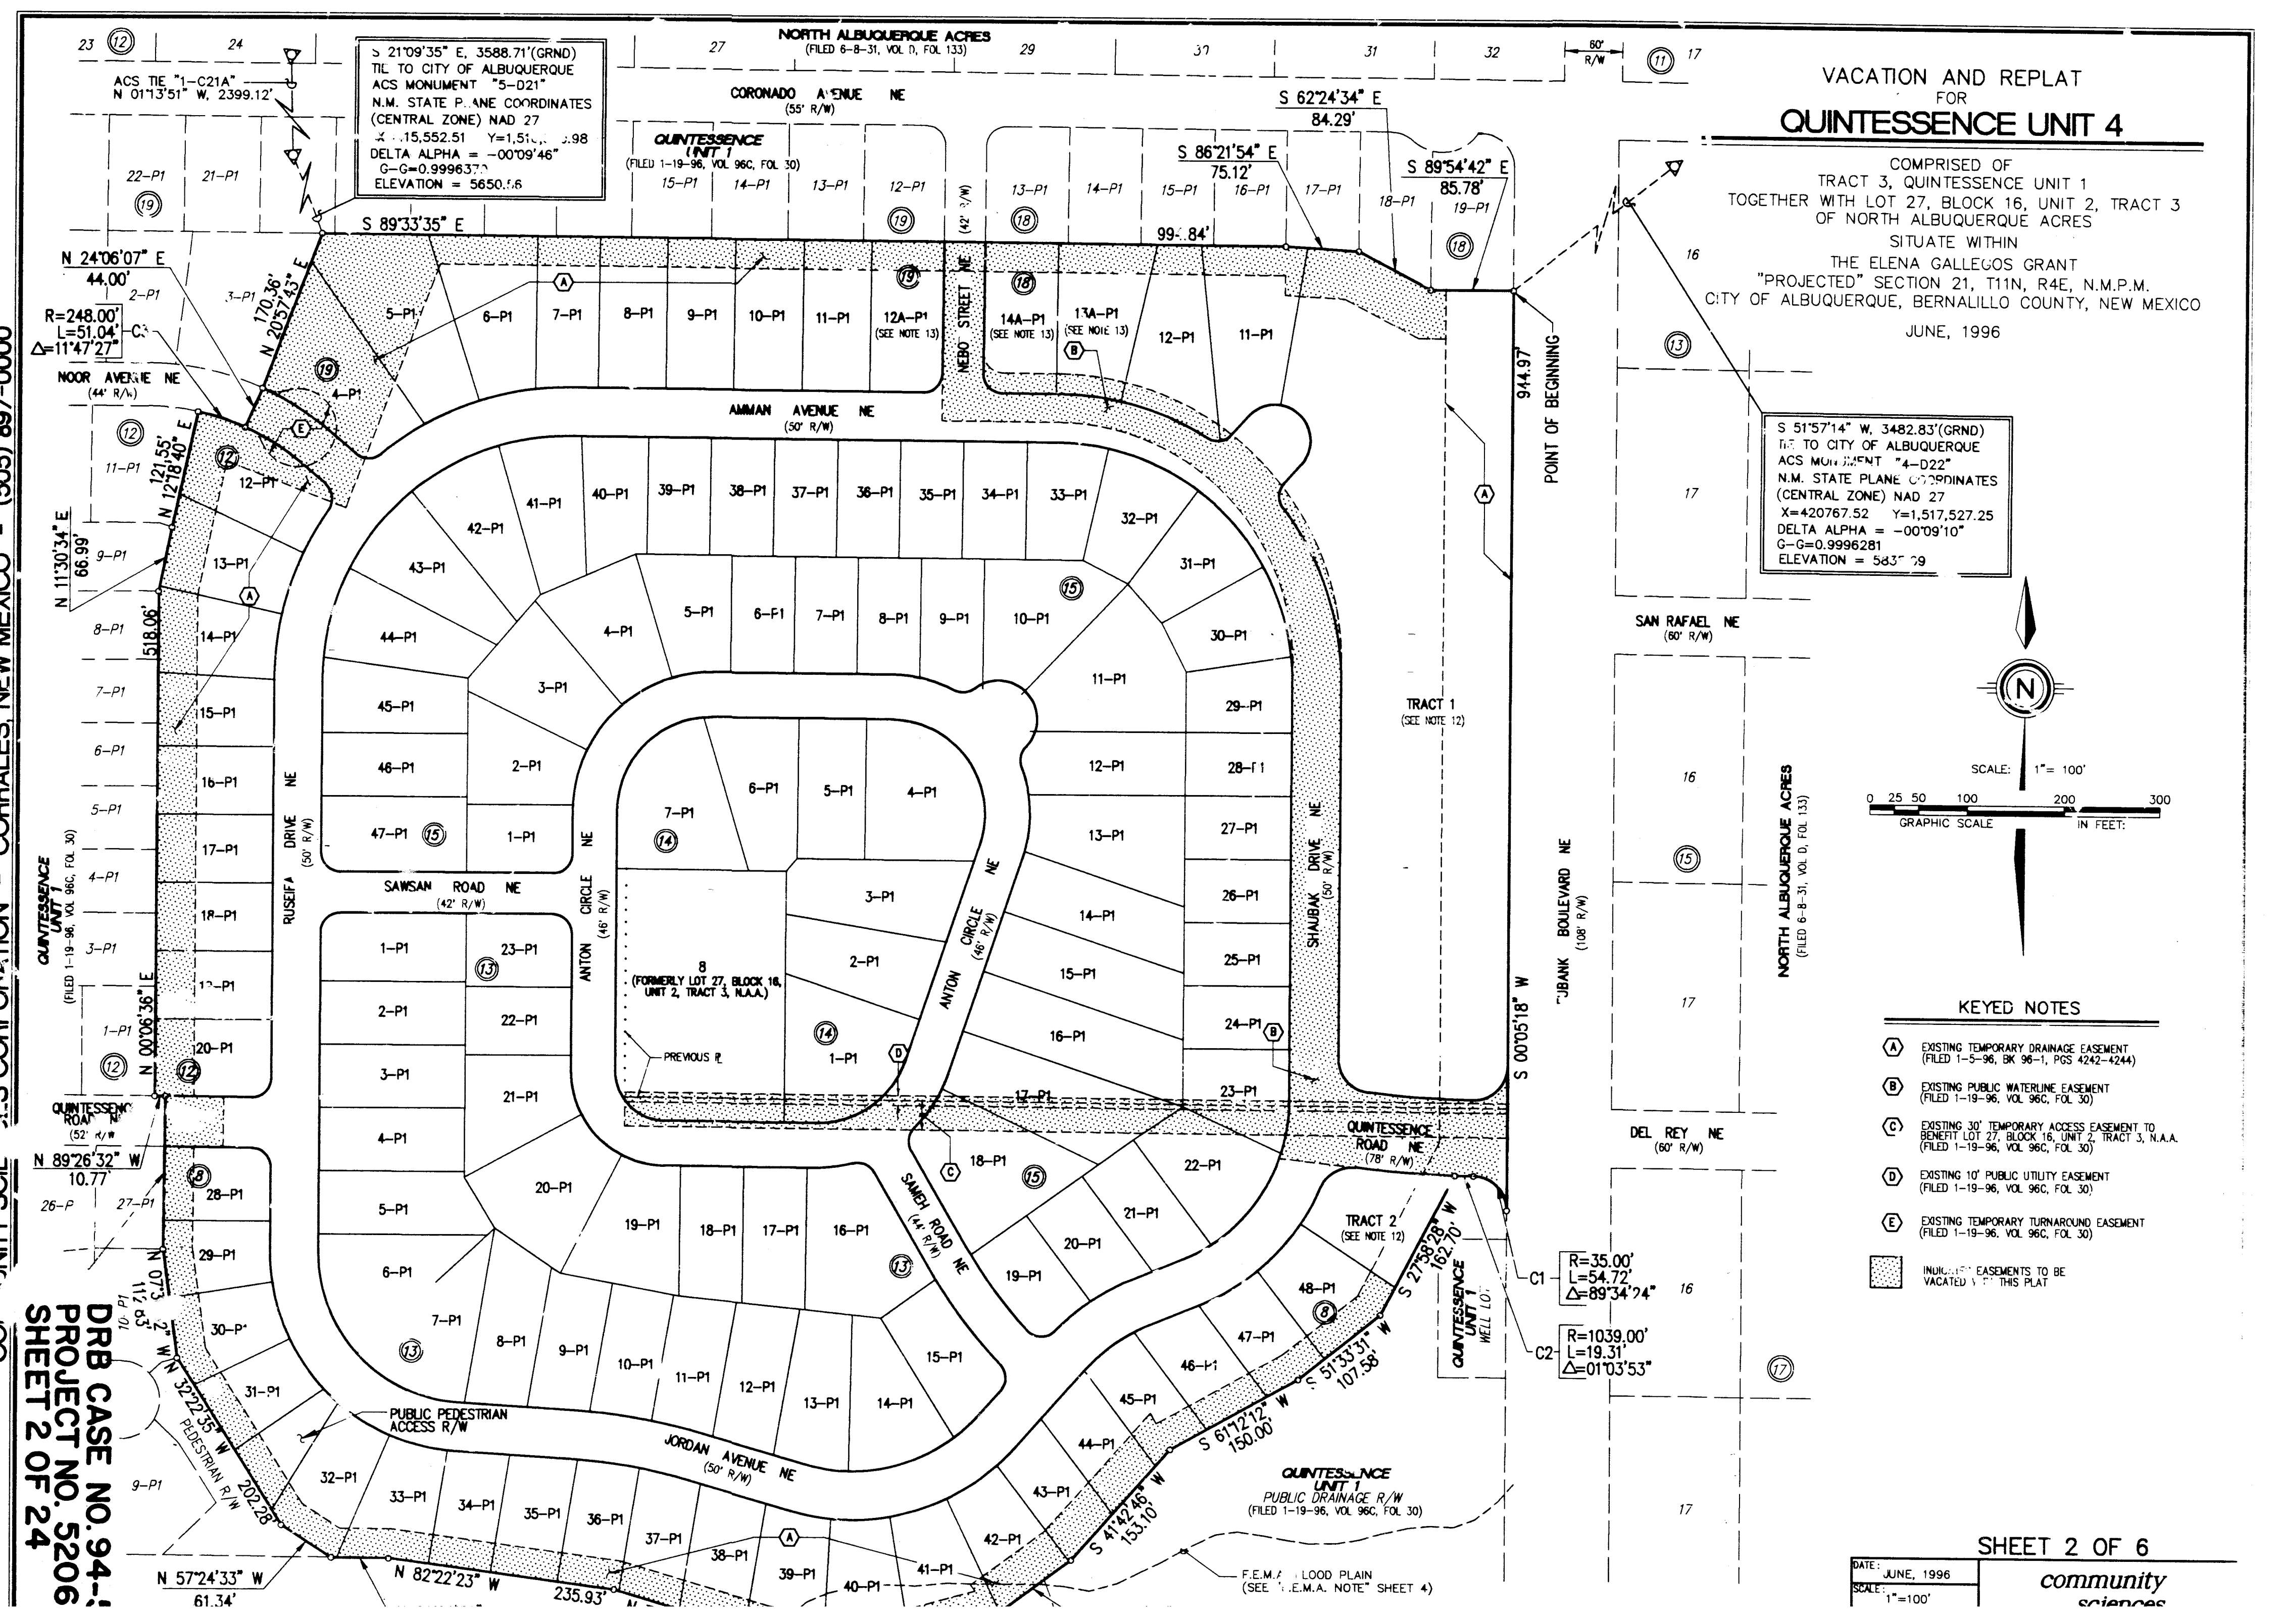


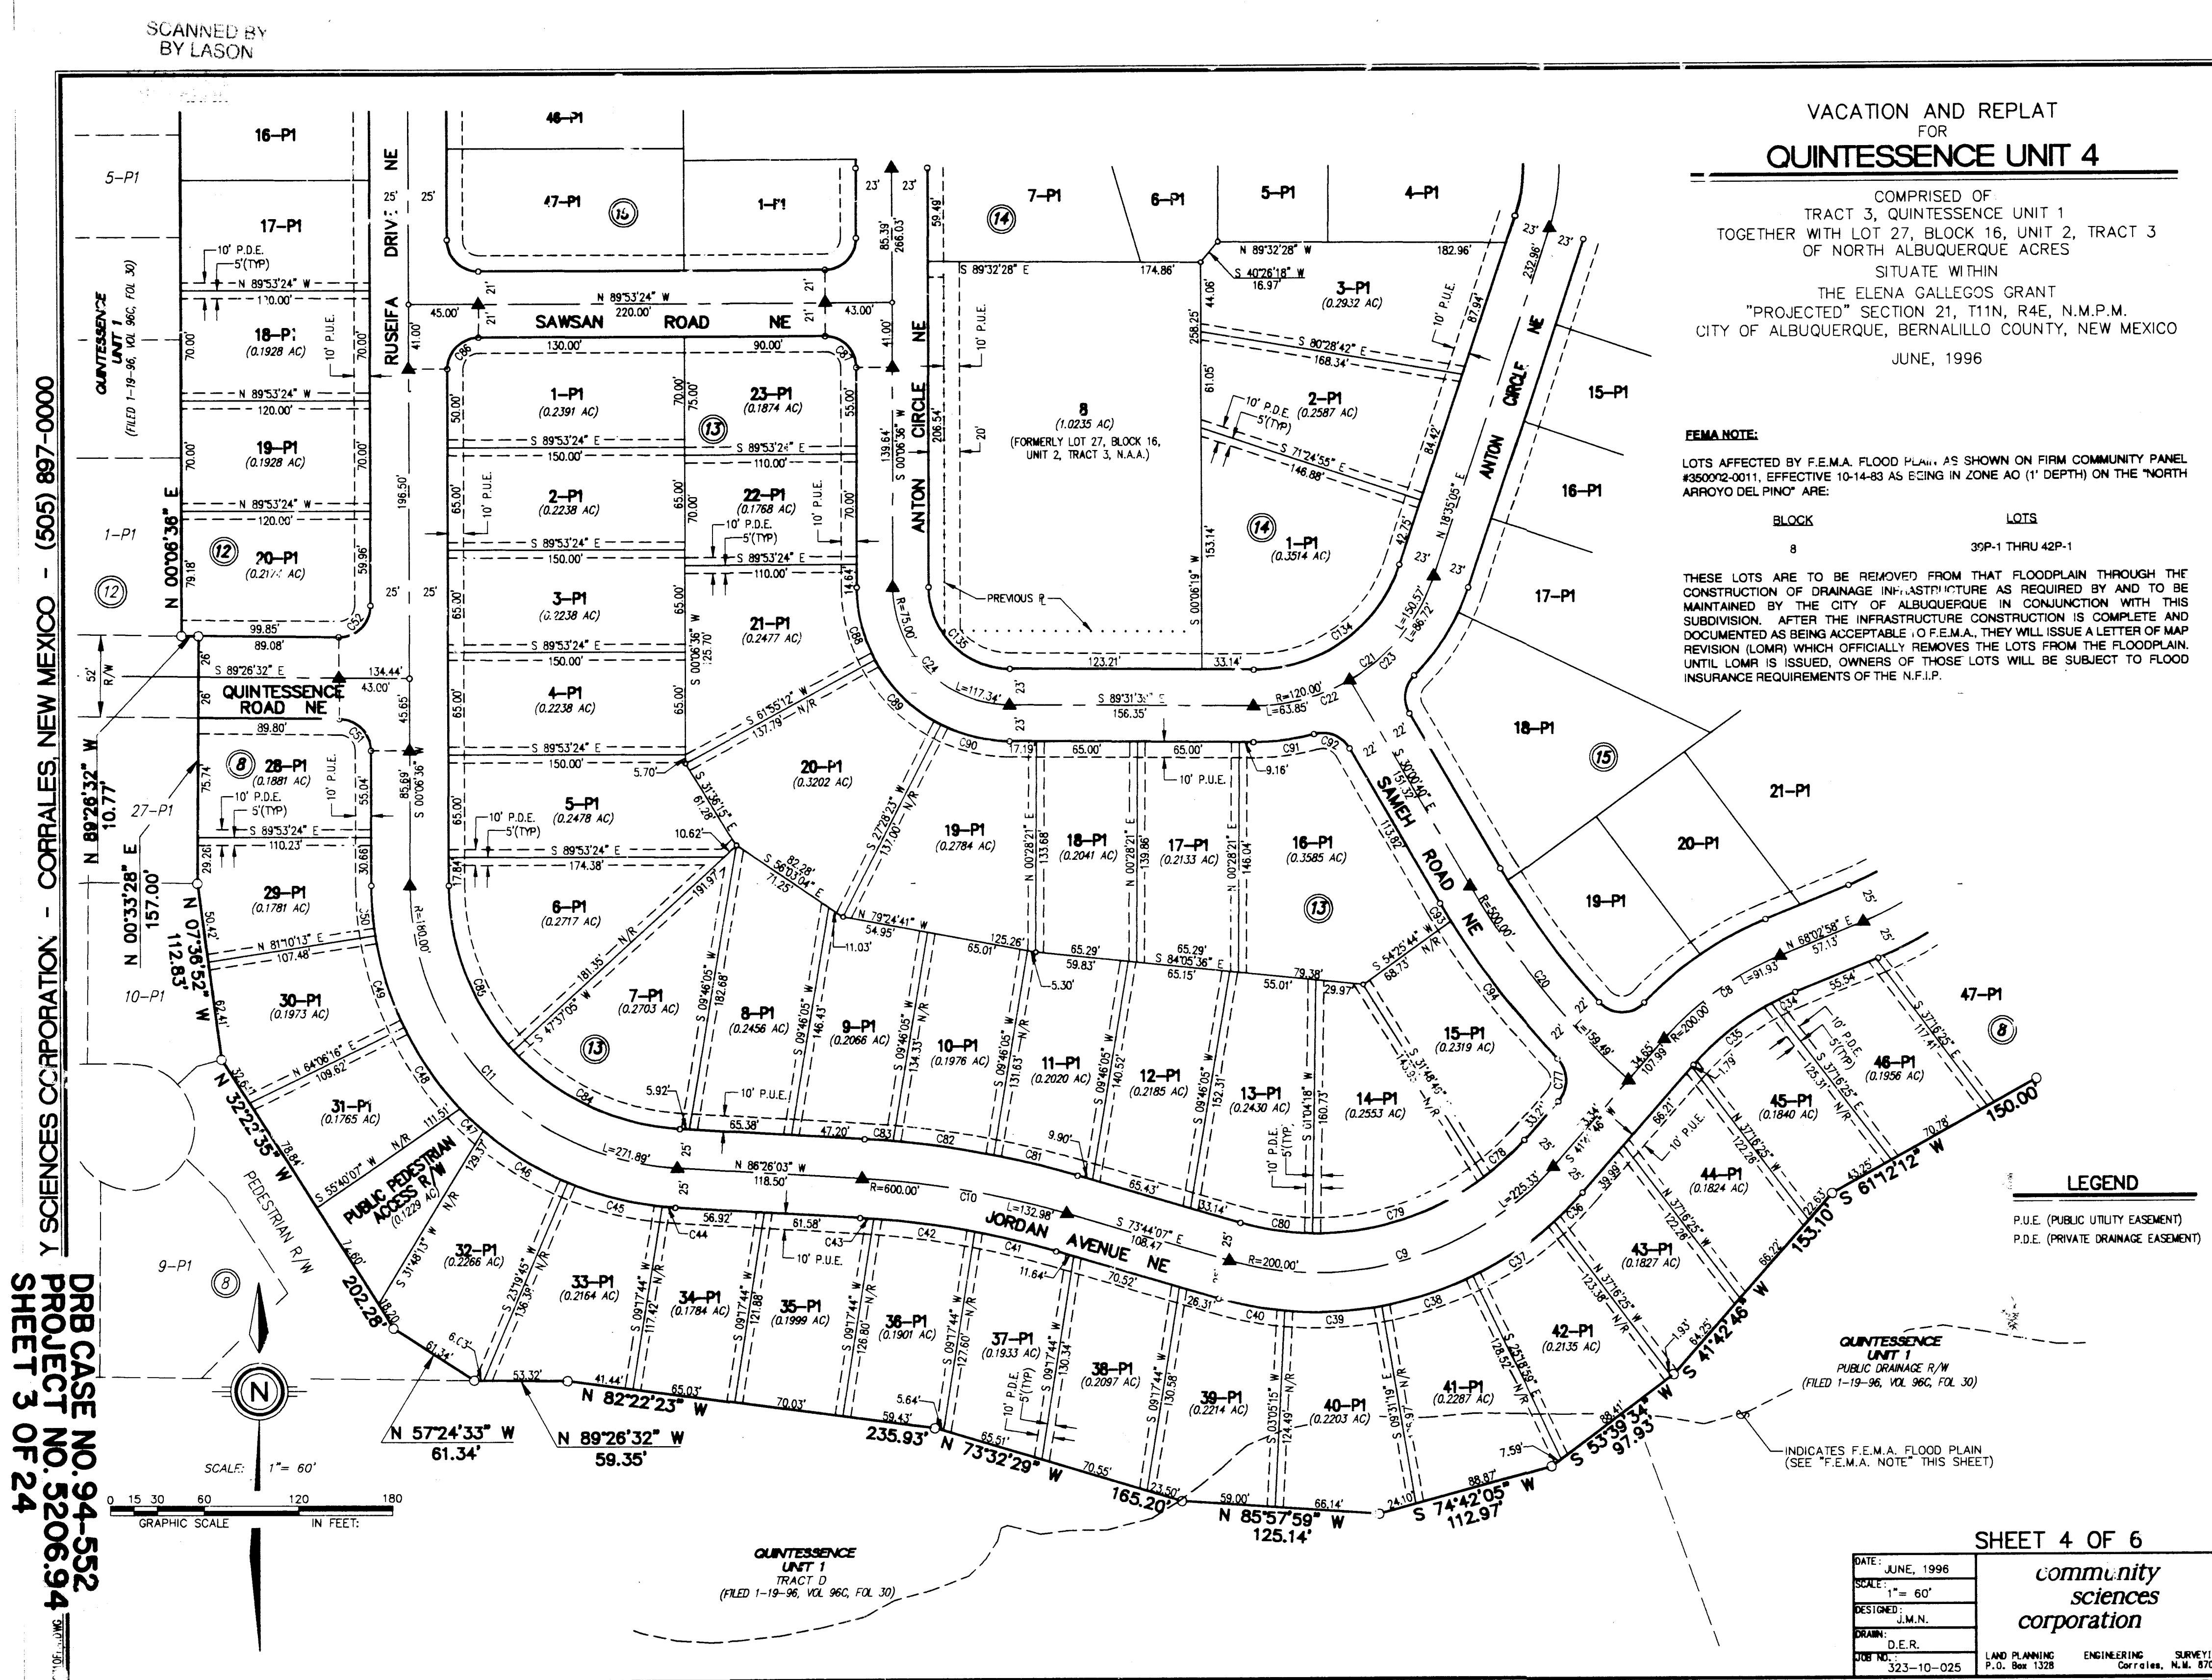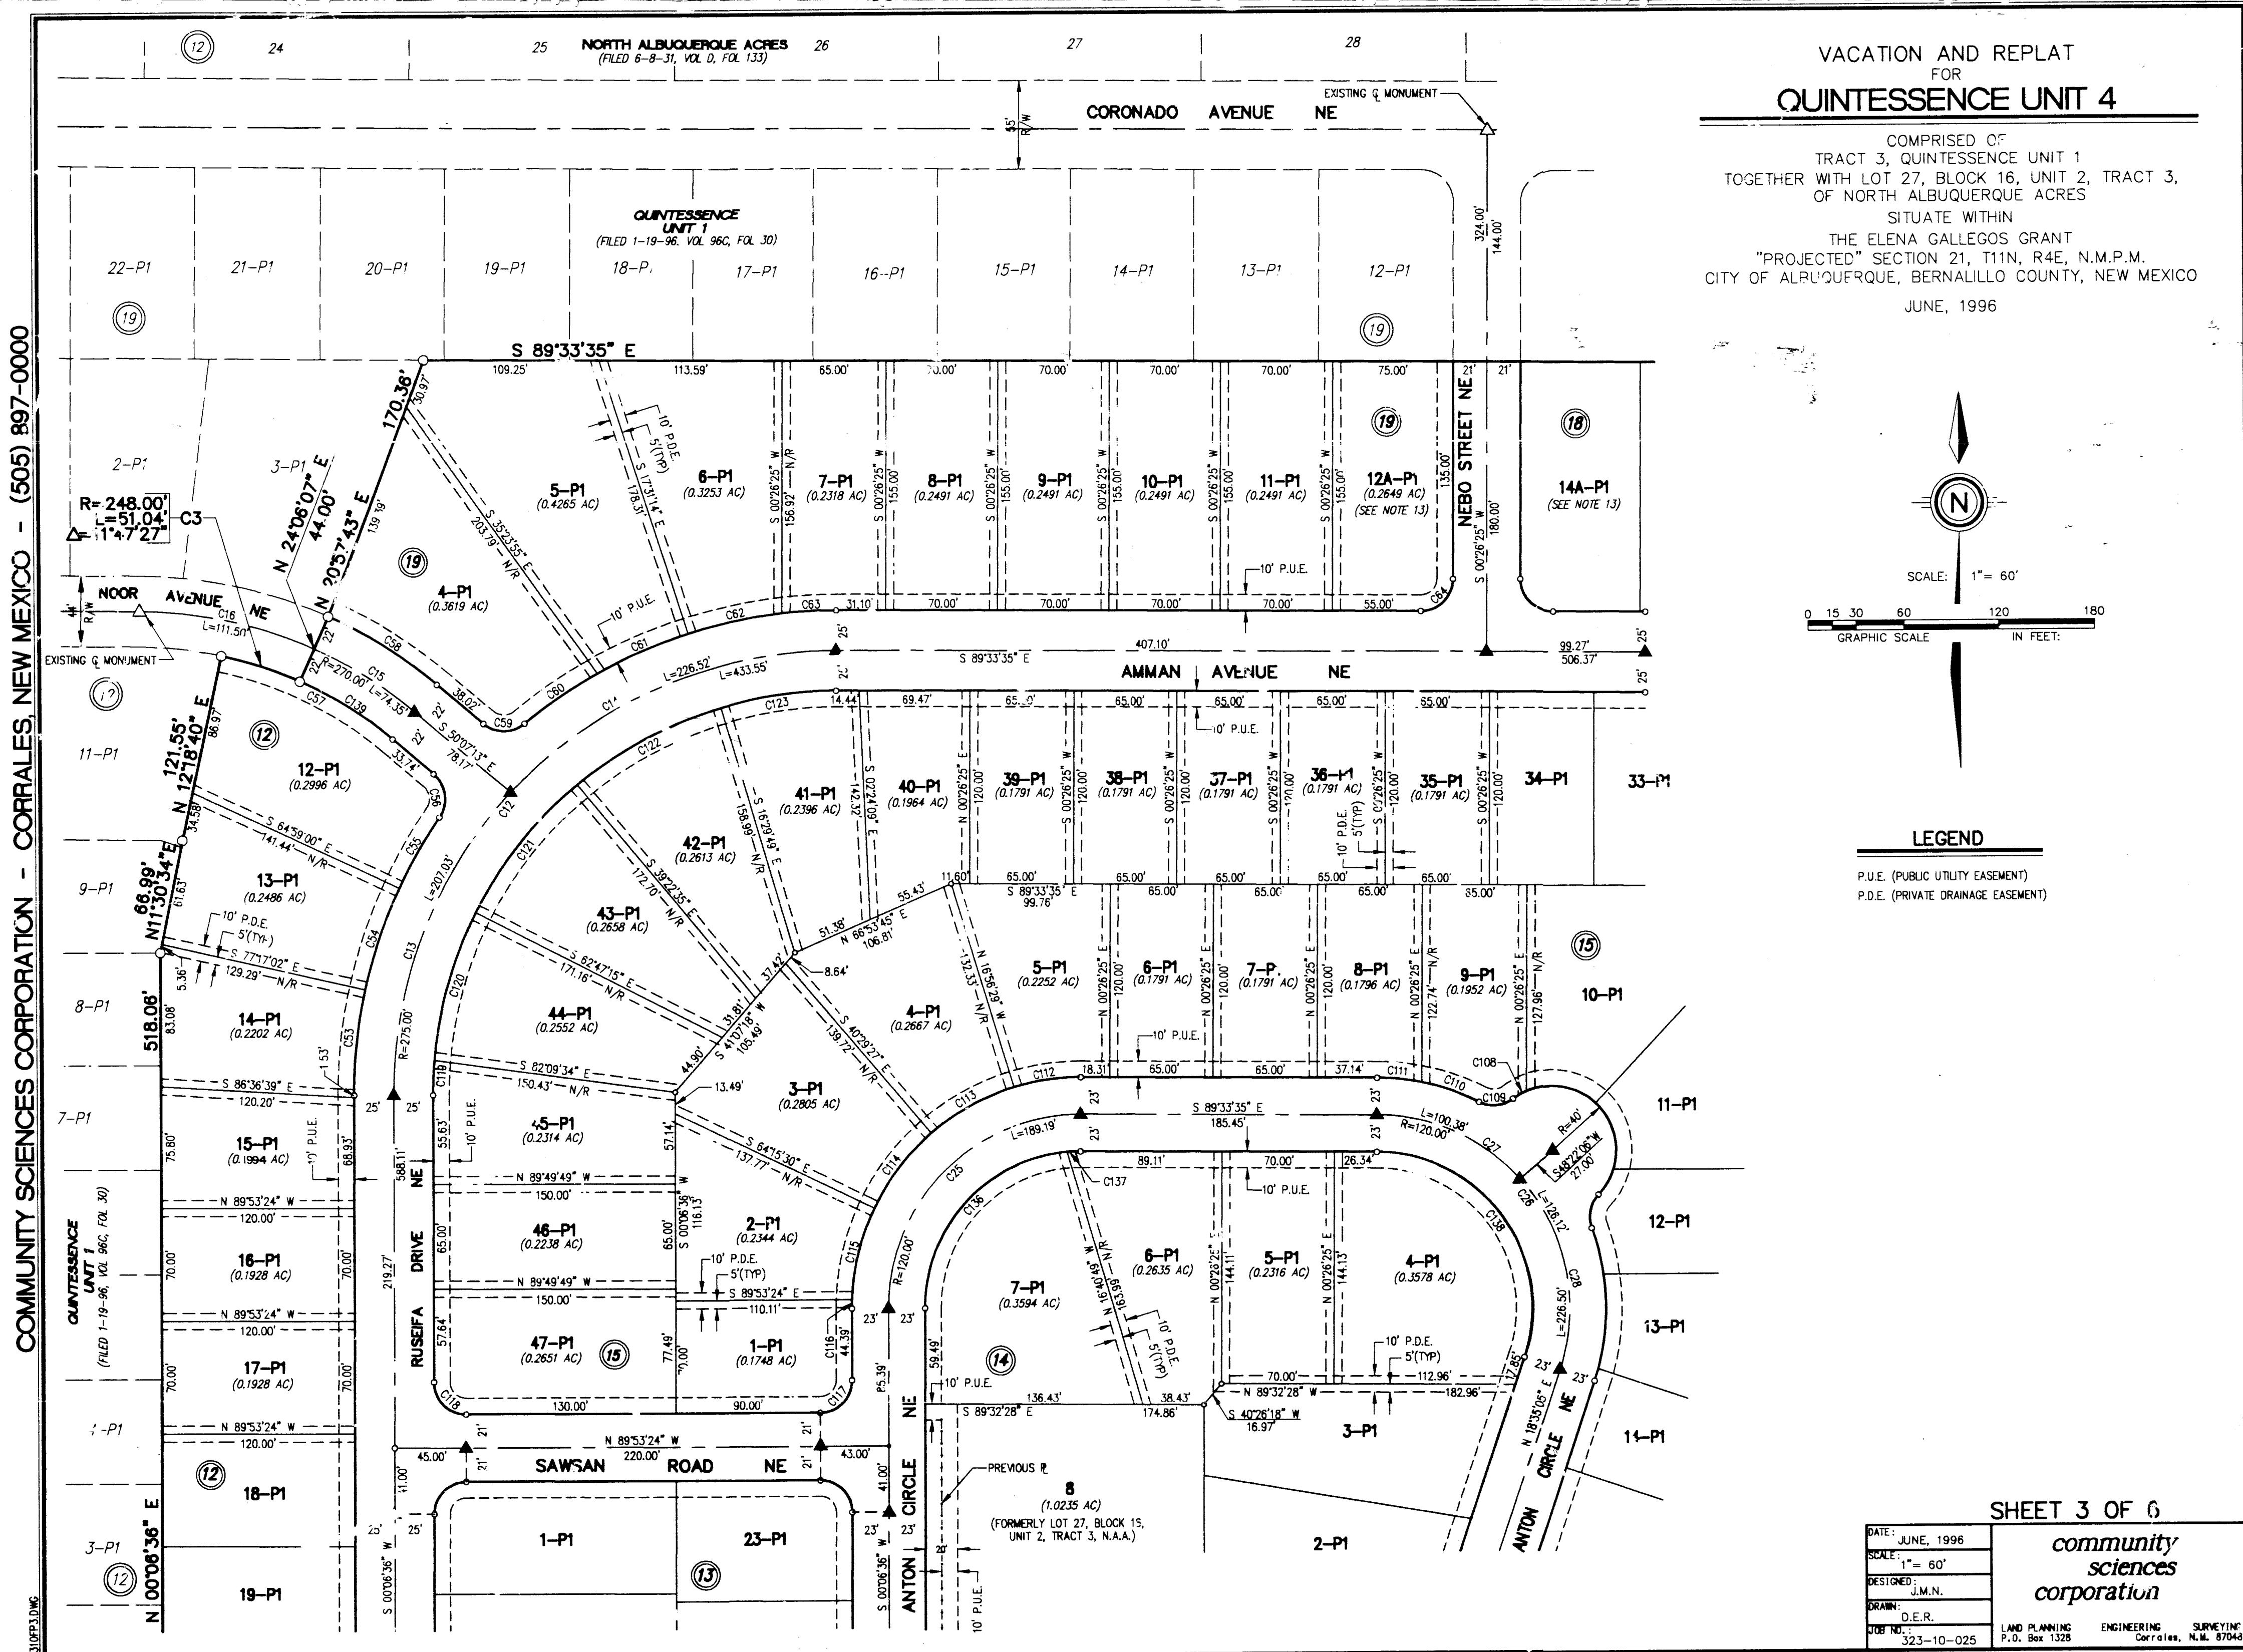

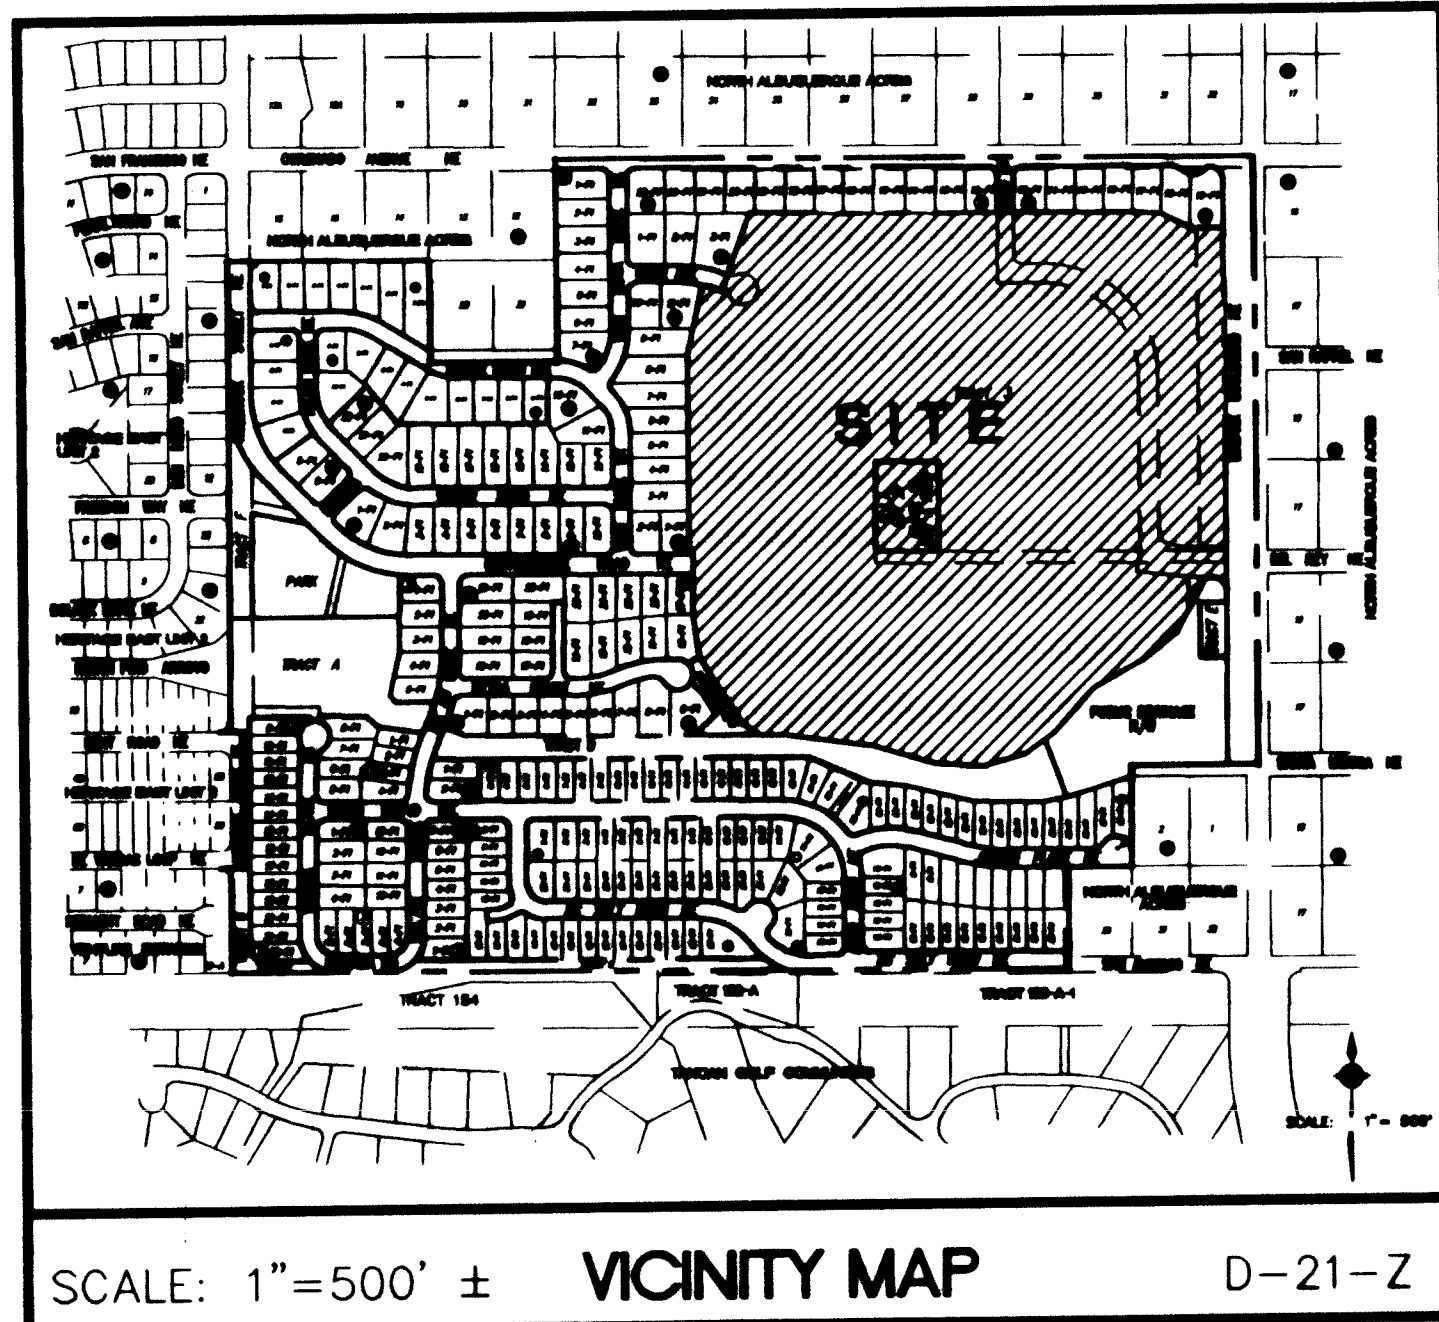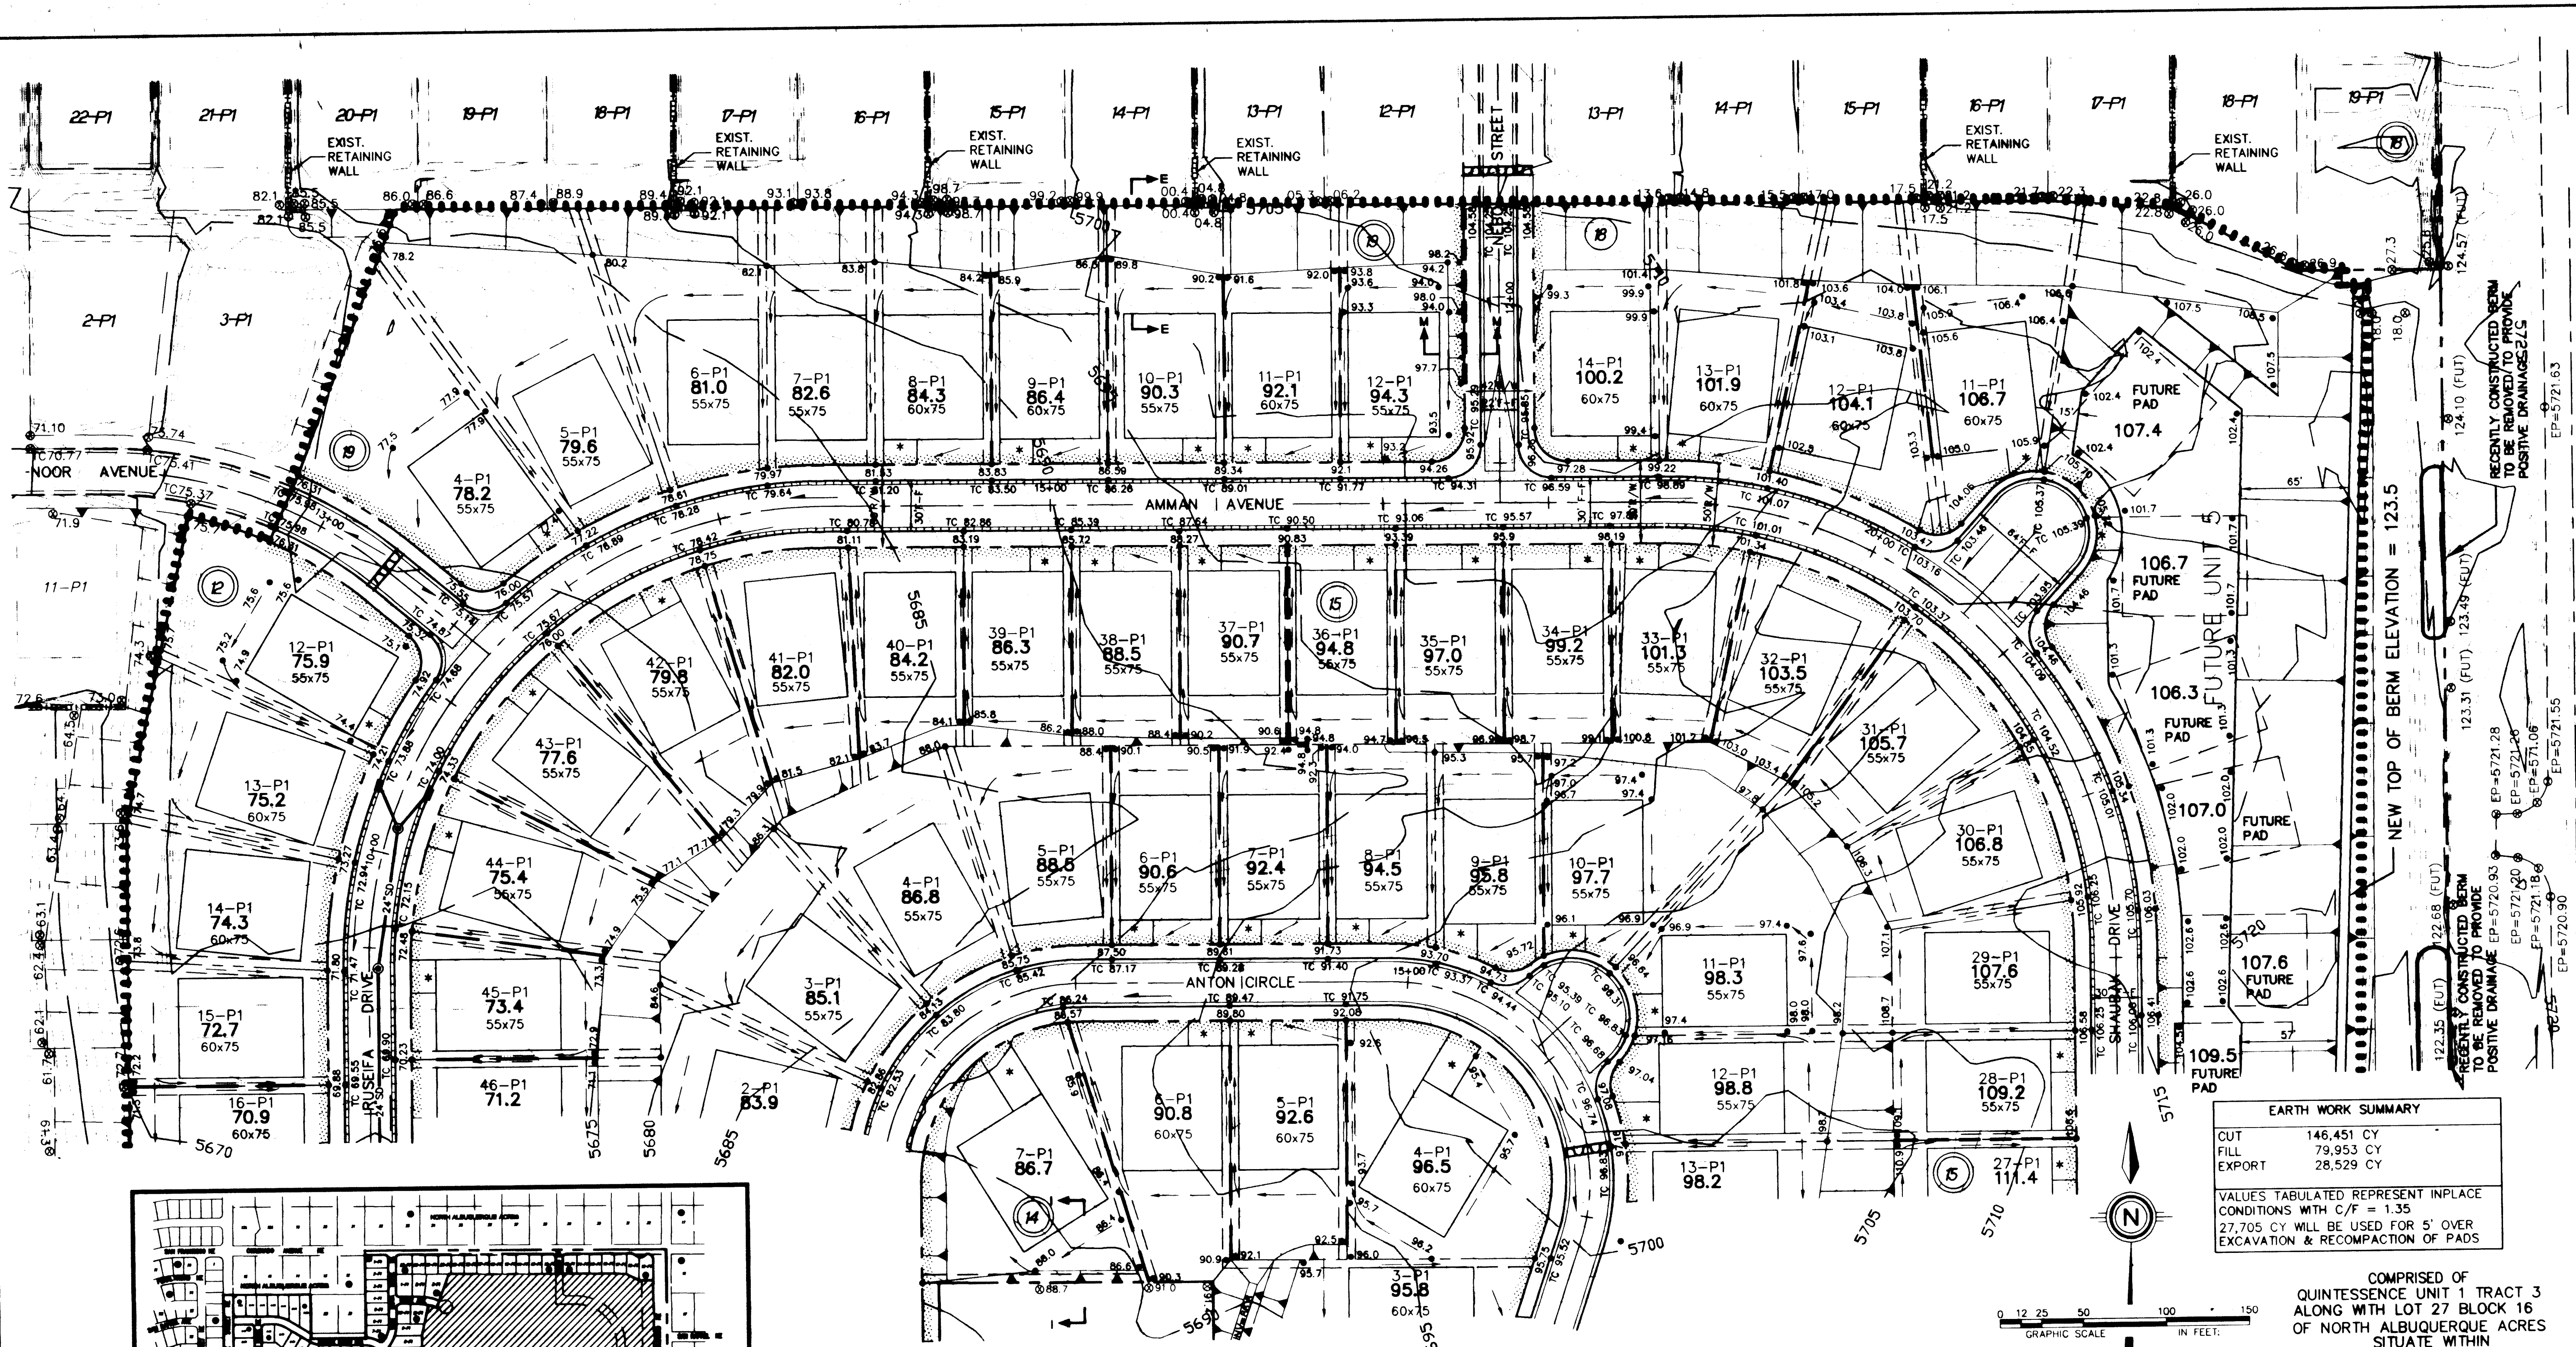

- LEGEND**
- TC=98.43 PROPOSED TOP OF CURB ELEVATION
 - 99.0 PROPOSED SPOT ELEVATION
 - 09.0 EXISTING SPOT ELEVATION (GRND & TC)
 - EROSION CONTROL BERM
 - PROPOSED CONCRETE VALLEY GUTTER
 - EXISTING CURB & GUTTER
 - PROPOSED MOUNTABLE CURB & GUTTER
 - PROPOSED STANDARD CURB & GUTTER
 - 4873 EXISTING CONTOUR W/ INDEX ELEVATION
 - SWALE
 - FLOW ARROW
 - PROPOSED SLOPE
 - 30" SD EXISTING STORM DRAIN
 - 30" SD PROPOSED STORM DRAIN
 - WATER BLOCK
 - PROPOSED RETAINING WALL
 - PROPOSED GARDEN WALL BY OTHERS
 - EXISTING RETAINING WALL
 - LIMITS OF GRADING

NOTE:
FUTURE UNIT 5 IS INCUMBERED BY A BLANKET DRAINAGE EASEMENT AND MAY NOT BE DEVELOPED UNTIL THE PERMANENT DRAINAGE FACILITIES ARE CONSTRUCTED IN EUBANK AND THE TEMPORARY DIVERSION CHANNEL IS REMOVED. THE AREA IS TO BE ROUGH GRADED WITH THIS CONSTRUCTION AS SHOWN HEREON SO THAT THE FUTURE DEVELOPMENT WILL HAVE AN EARTHWORK BALANCE.

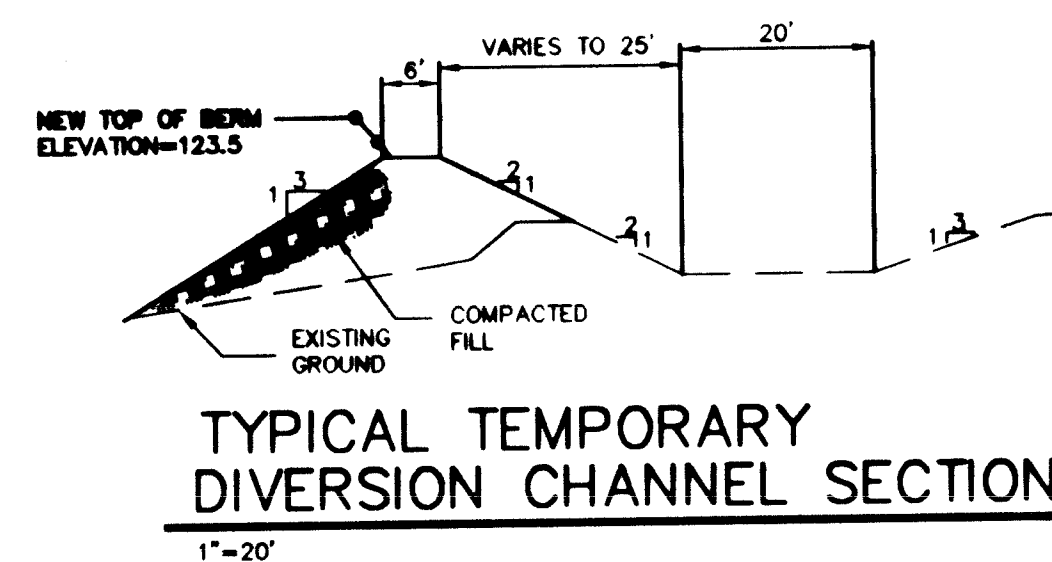

EARTH WORK SUMMARY

CUT	146,451 CY
FILL	79,953 CY
EXPORT	28,529 CY


VALUES TABULATED REPRESENT INPLACE CONDITIONS WITH C/F = 1.35
27,705 CY WILL BE USED FOR 5' OVER EXCAVATION & RECOMPACTION OF PADS

COMPRISED OF
QUINTESSENCE UNIT 1 TRACT 3
ALONG WITH LOT 27 BLOCK 16
OF NORTH ALBUQUERQUE ACRES
SITUATE WITHIN
CITY OF ALBUQUERQUE
BERNALILLO COUNTY, NEW MEXICO
DRB NO. 94-552

DATE: MAY, 1996 SCALE: 1"=50'	community sciences corporation
JOB NO. 323-10-043 LAND PLANNING P.O. Box 1328	ENGINEERING CORP. INC. N.M. 87004
CITY OF ALBUQUERQUE PUBLIC WORKS DEPARTMENT ENGINEERING GROUP	
TITLE: QUINTESSENCE SUBDIVISION - UNIT 4 GRADING AND EROSION CONTROL PLAN	
APPROVED FOR ROUGH GRADING (± 1 FT.) <i>[Signature]</i> CITY ENGINEER	DATE: 7-3-96
PROJECT NO. 5206.94	MAP NO. D-21
SHEET 5	OF 24

AS BUILT INFORMATION		BENCH MARKS	
CONTRACTOR: <i>[Signature]</i>	DATE: <i>[Blank]</i>	THE STATION IS A STANDARD ACS ALUMINUM CAP STAMPED	DATE: <i>[Blank]</i>
STATE BY: <i>[Blank]</i>	DATE: <i>[Blank]</i>	"S-D21 1985" AND IS RIVETED TO AN ALUMINUM PIPE	DATE: <i>[Blank]</i>
APPROVED BY: <i>[Blank]</i>	DATE: <i>[Blank]</i>	PROJECTING 0.1 FOOT ABOVE GROUND.	DATE: <i>[Blank]</i>
FIELD LOCATION BY: <i>[Blank]</i>	DATE: <i>[Blank]</i>	IT IS LOCATED 79.3 FEET NORTH OF THE CENTERLINE	DATE: <i>[Blank]</i>
CORRECTED BY: <i>[Blank]</i>	DATE: <i>[Blank]</i>	INTERSECTION OF CORONADO AVENUE AND HOLBROOK STREET,	DATE: <i>[Blank]</i>
RECORDED BY: <i>[Blank]</i>	DATE: <i>[Blank]</i>	AND 85 FEET EAST OF THE CENTERLINE OF HOLBROOK STREET	DATE: <i>[Blank]</i>
ELEV. = 5650.56		ELEV. = 5650.56	

SURVEY INFORMATION		FIELD NOTES	
NO. 1	DATE 3/96	COMMUNITY SCIENCES	DATE 3/96
ENGINEER'S SEAL		REVISIONS	
DATE: 6-26-96		DATE: 5/96	
DESIGNED BY: JMR		DATE: 5/96	
DRAWN BY: JMR		DATE: 5/96	
CHECKED BY: JMR		DATE: 5/96	

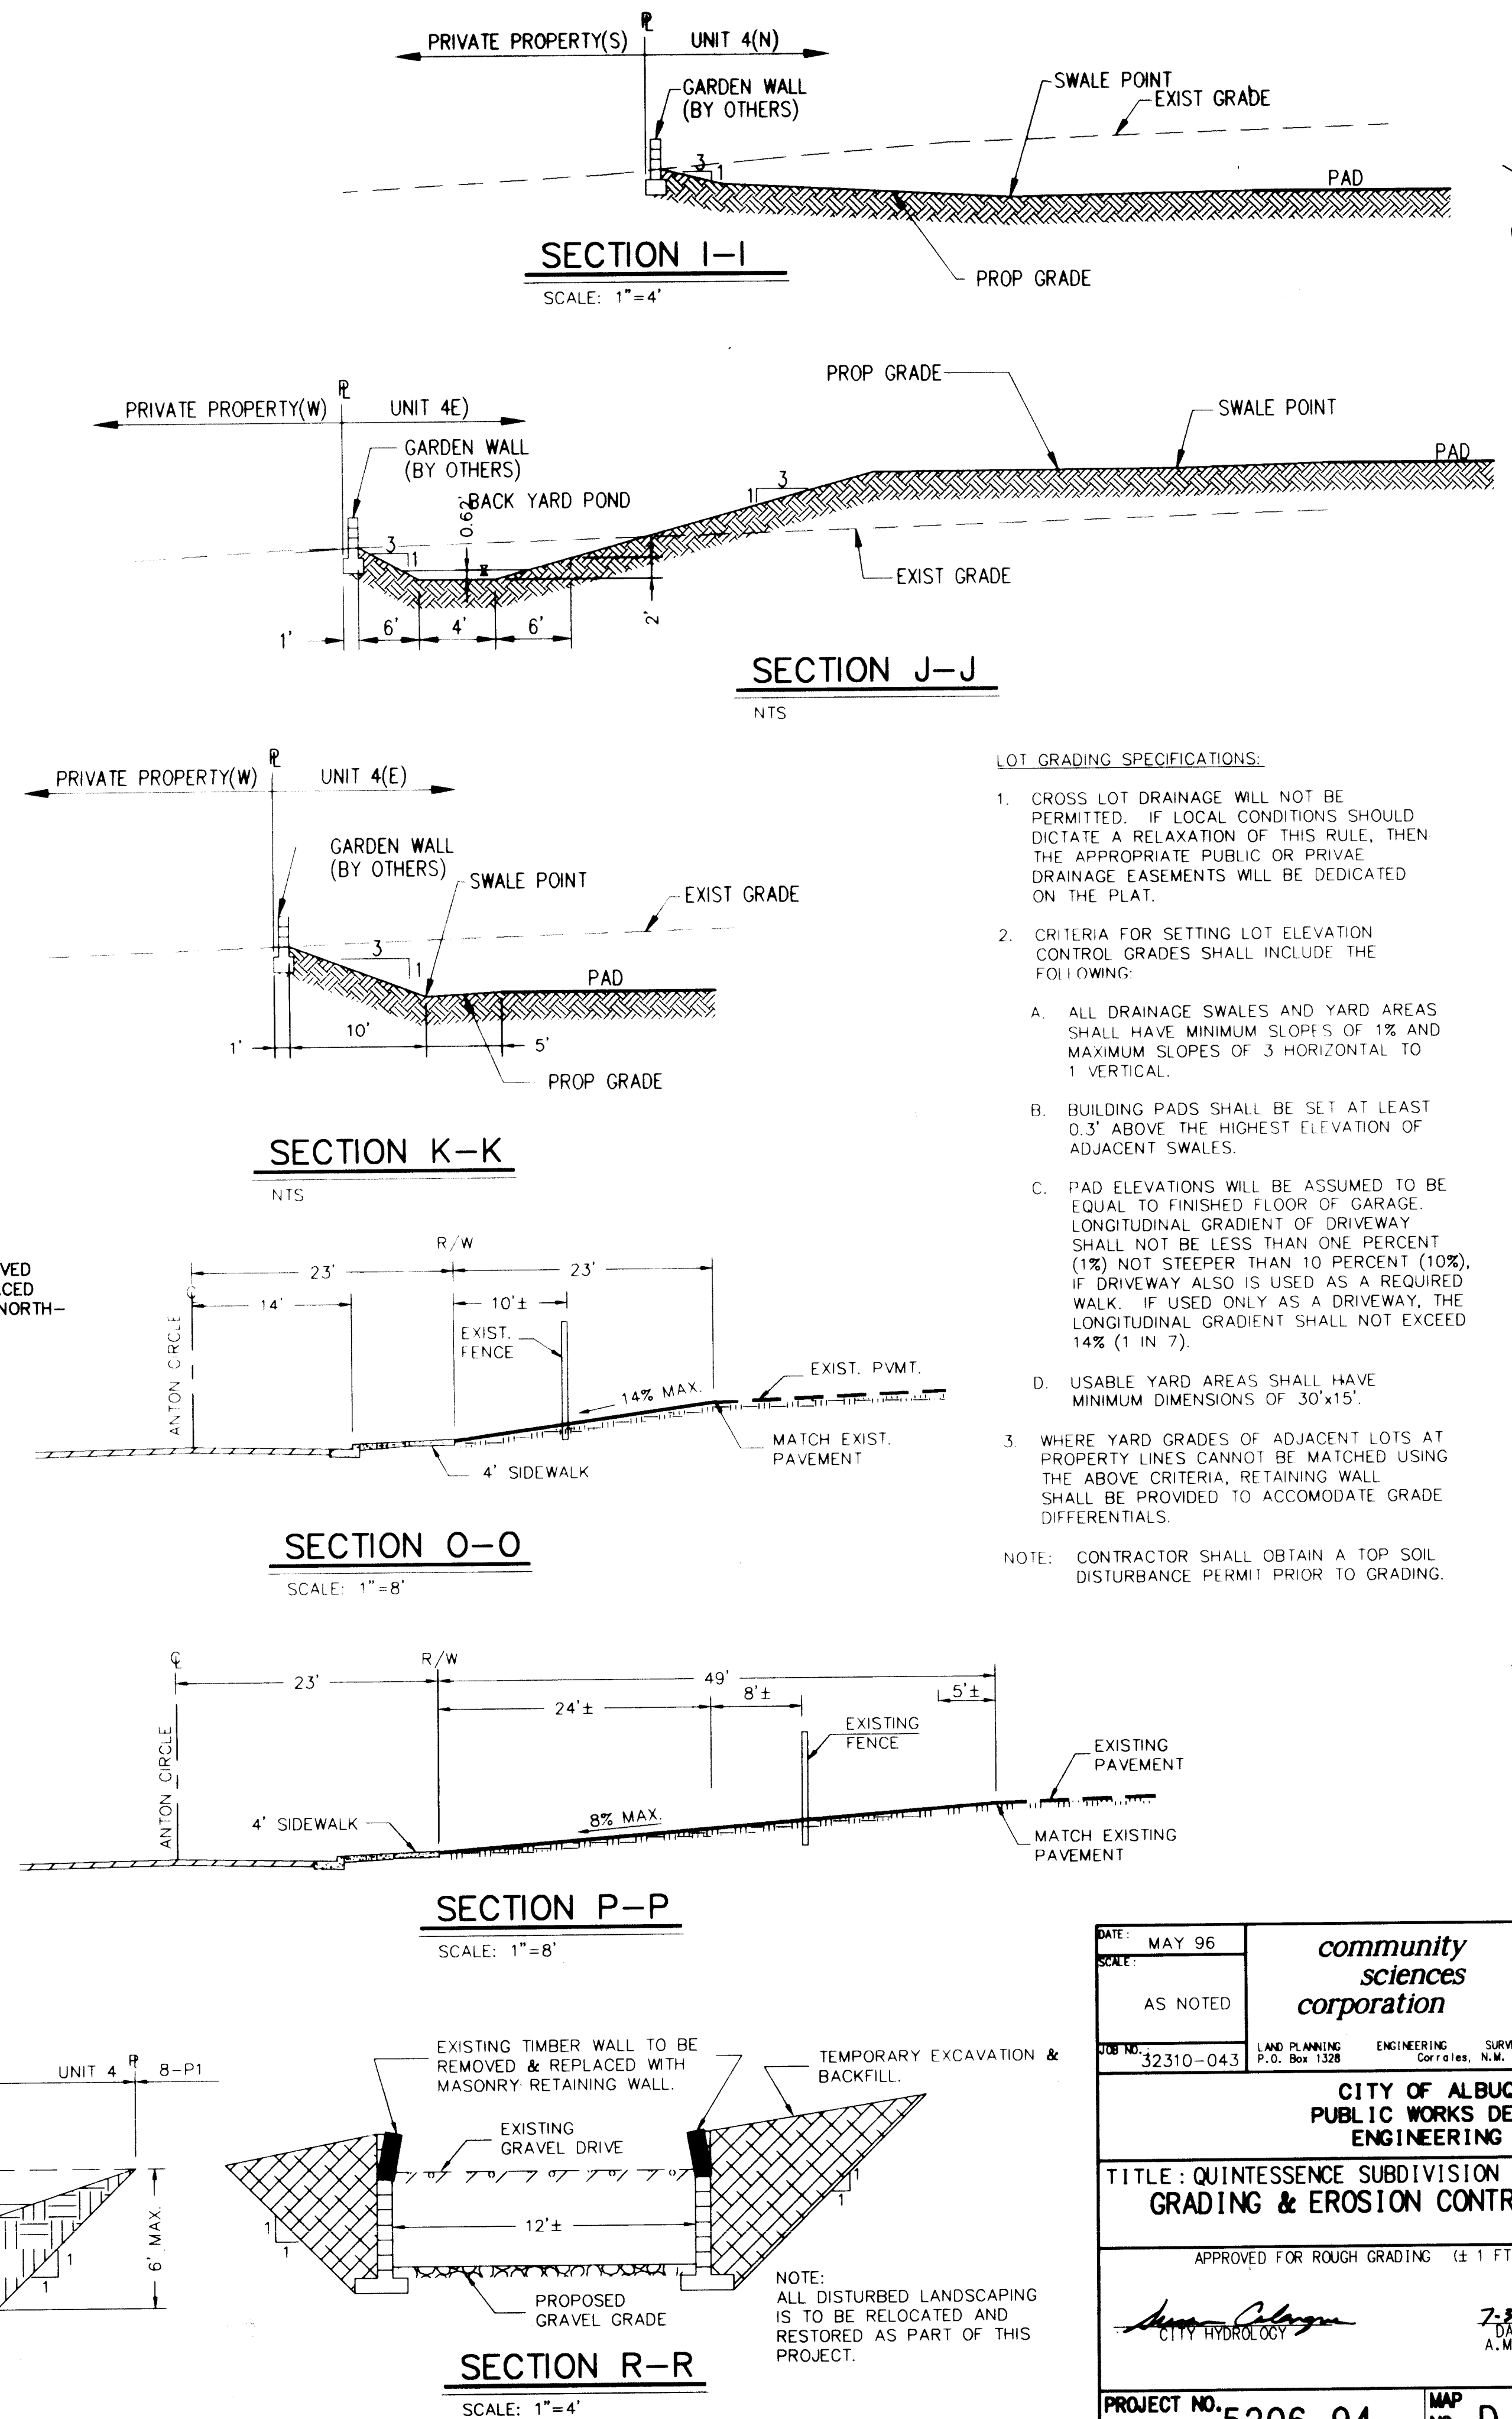


SHEET 7 OF 24 DATE 5-24-96 LAST DESIGN DATE MO./DAY/YR. MO./DAY/YR.		POL PLAN & DETAILS - UNIT 4 QUERQUE PARTMENT GROUP		NO. DATE REMARKS REVISIONS DESIGN DESIGNED BY JMN DATE 5/96 DRAWN BY GWR DATE 5/96 CHECKED BY JDH DATE 5/96		ENGINEER'S SEAL 		SURVEY INFORMATION FIELD NOTES NO. BY DATE 1 COMMUNITY SCIENCES 4/96		BENCH MARKS THE STATION IS A STANDARD ACS ALUMINUM CAP STAMPED "5-021 1985" AND IS RIVETTED TO AN ALUMINUM PIPE PROJECTING 0.1 FOOT ABOVE GROUND. IT IS LOCATED 793 FEET NORTH OF THE CENTERLINE INTERSECTION OF CORDADO AVENUE AND HOLBROOK STREET, AND 85 FEET EAST OF THE CENTERLINE OF HOLBROOK STREET. ELEV = 5650.56		AS-BUILT INFORMATION RECORD CONTRACTOR <i>Canter Excavating & Trucking</i> WORK BY INSPECTOR'S ACCEPTANCE BY 7/12 VERIFICATION BY DATE DRAWINGS CORRECTED BY DATE MICRO-FILM INFORMATION RECORDED BY DATE NO.	
---	--	--	--	--	--	---	--	---	--	---	--	--	--




FLOWLINE LEFT
(WHEN LT ≠ RT)

FLOWLINE RIGHT
AND LEFT
(WHEN LT = RT)

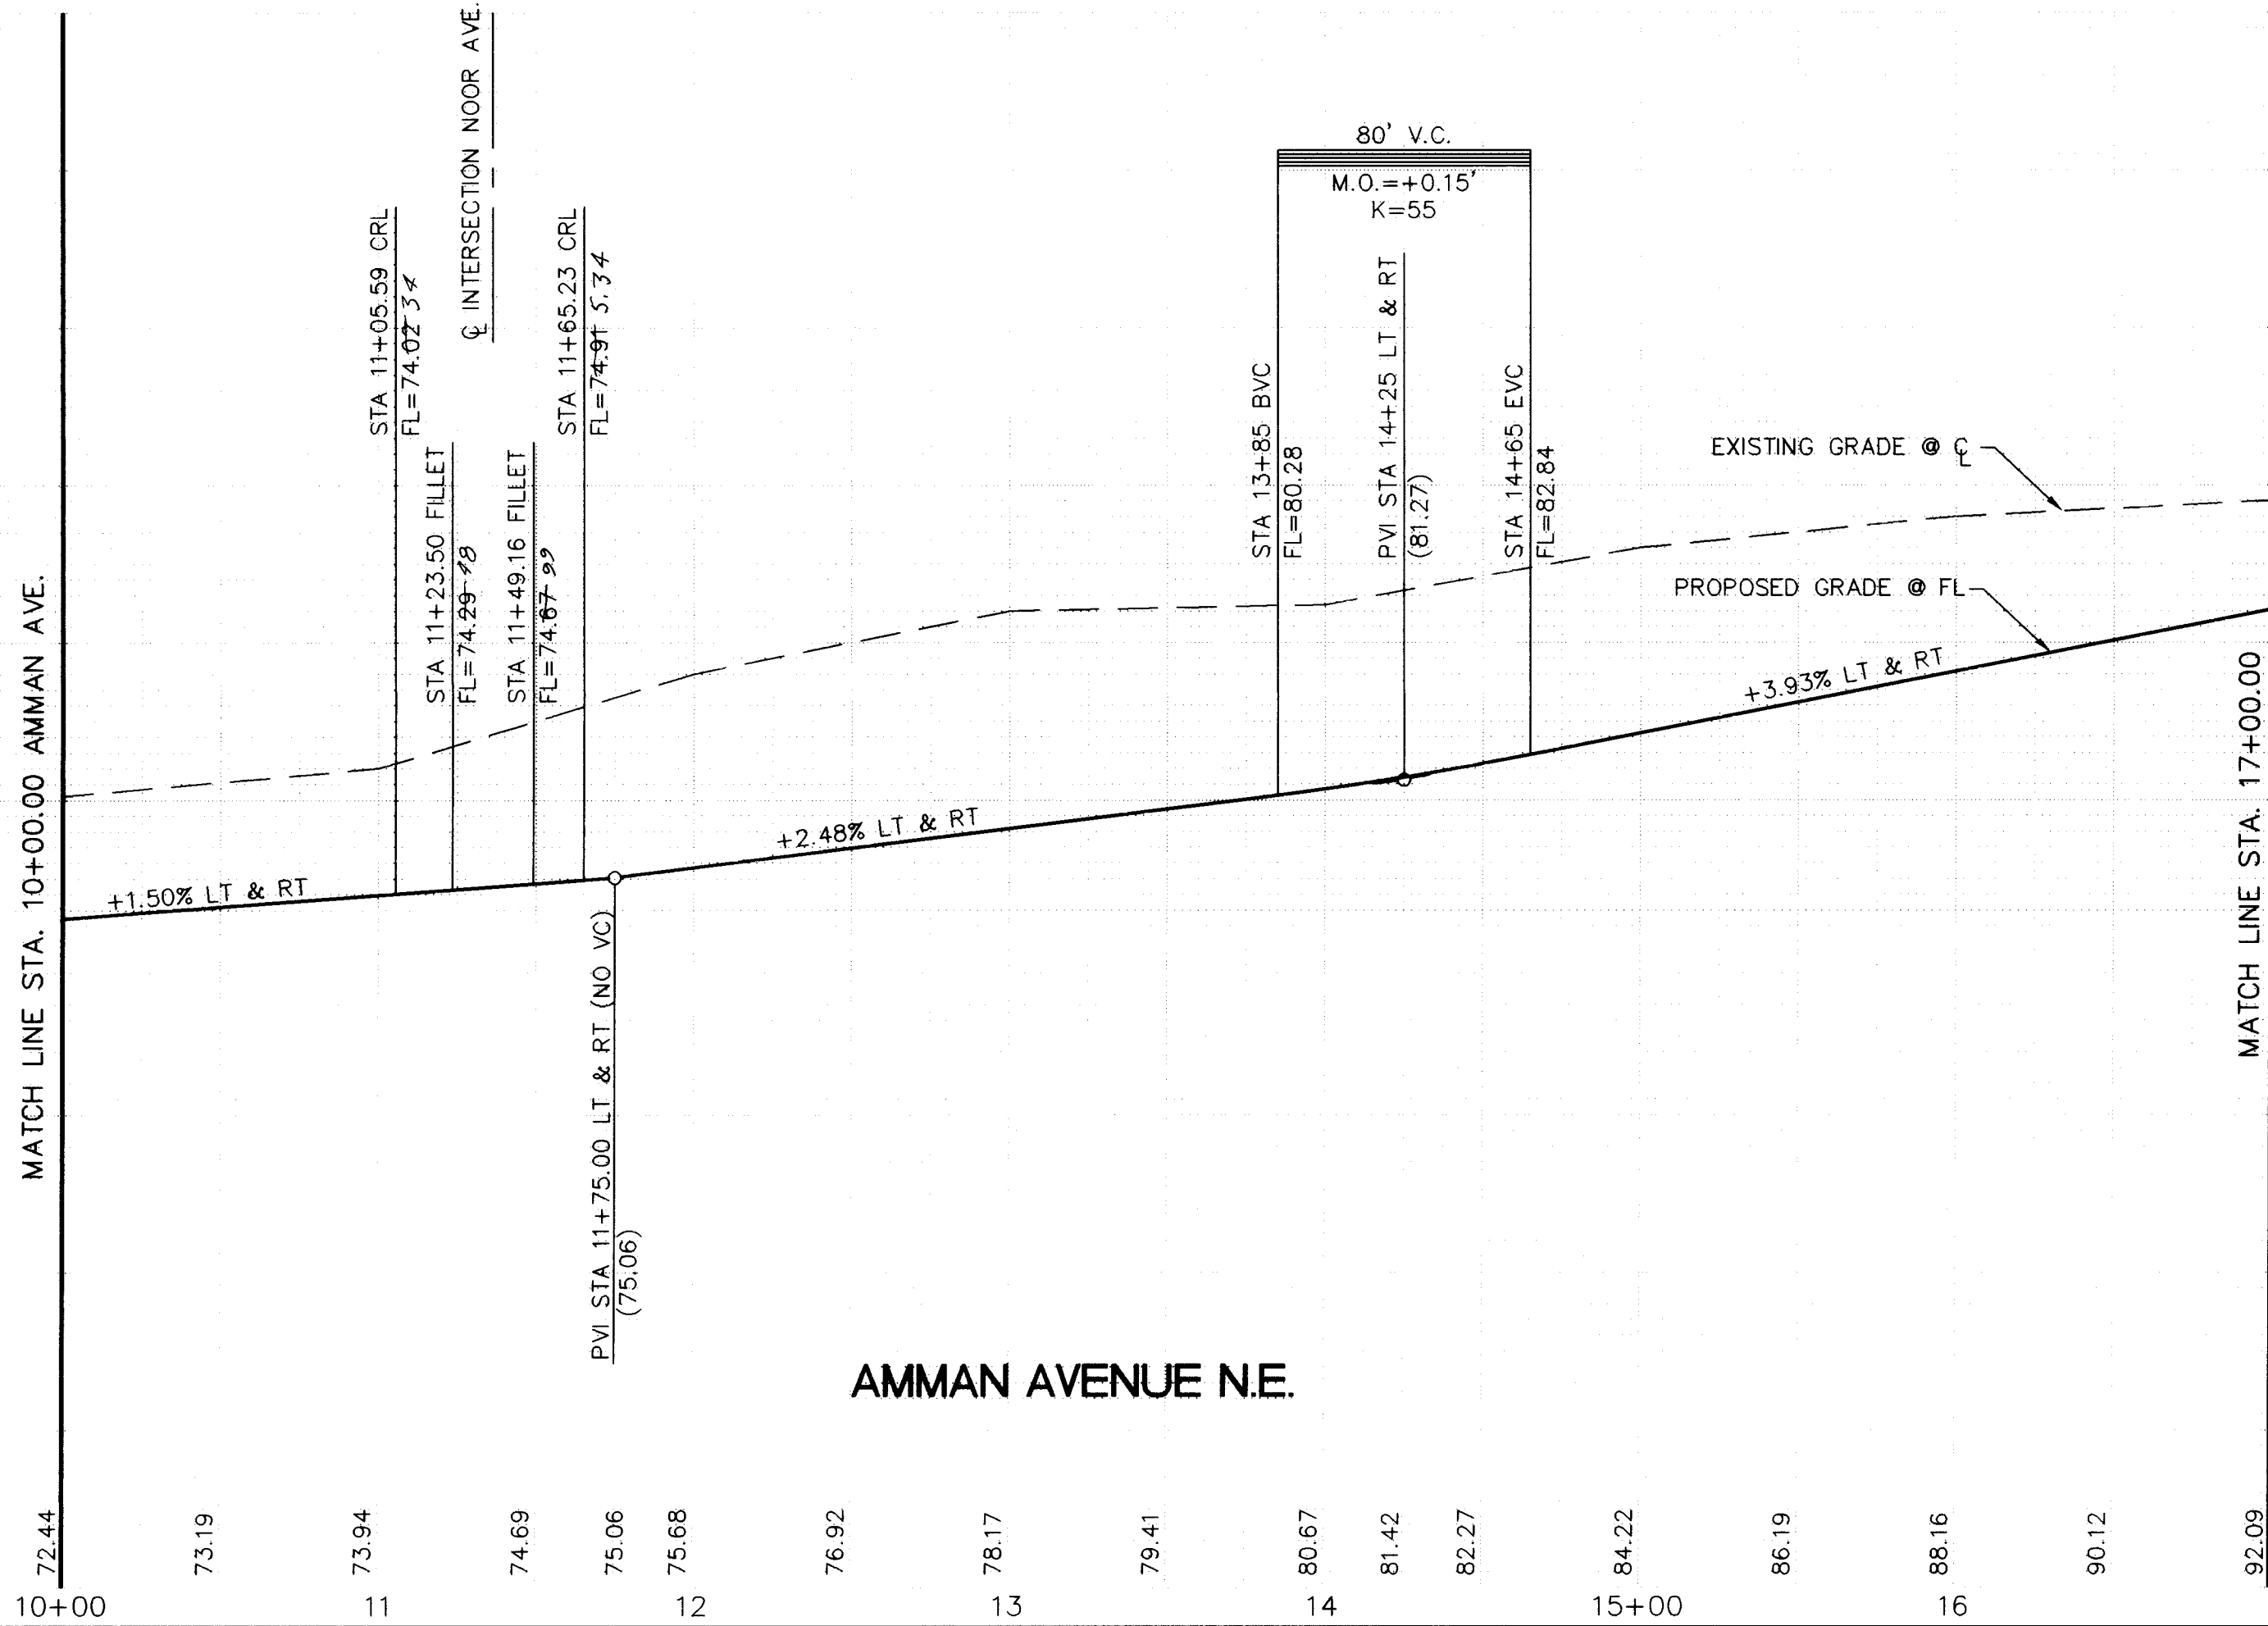

AMMAN AVENUE N.E.


NOOR AVENUE N.E.

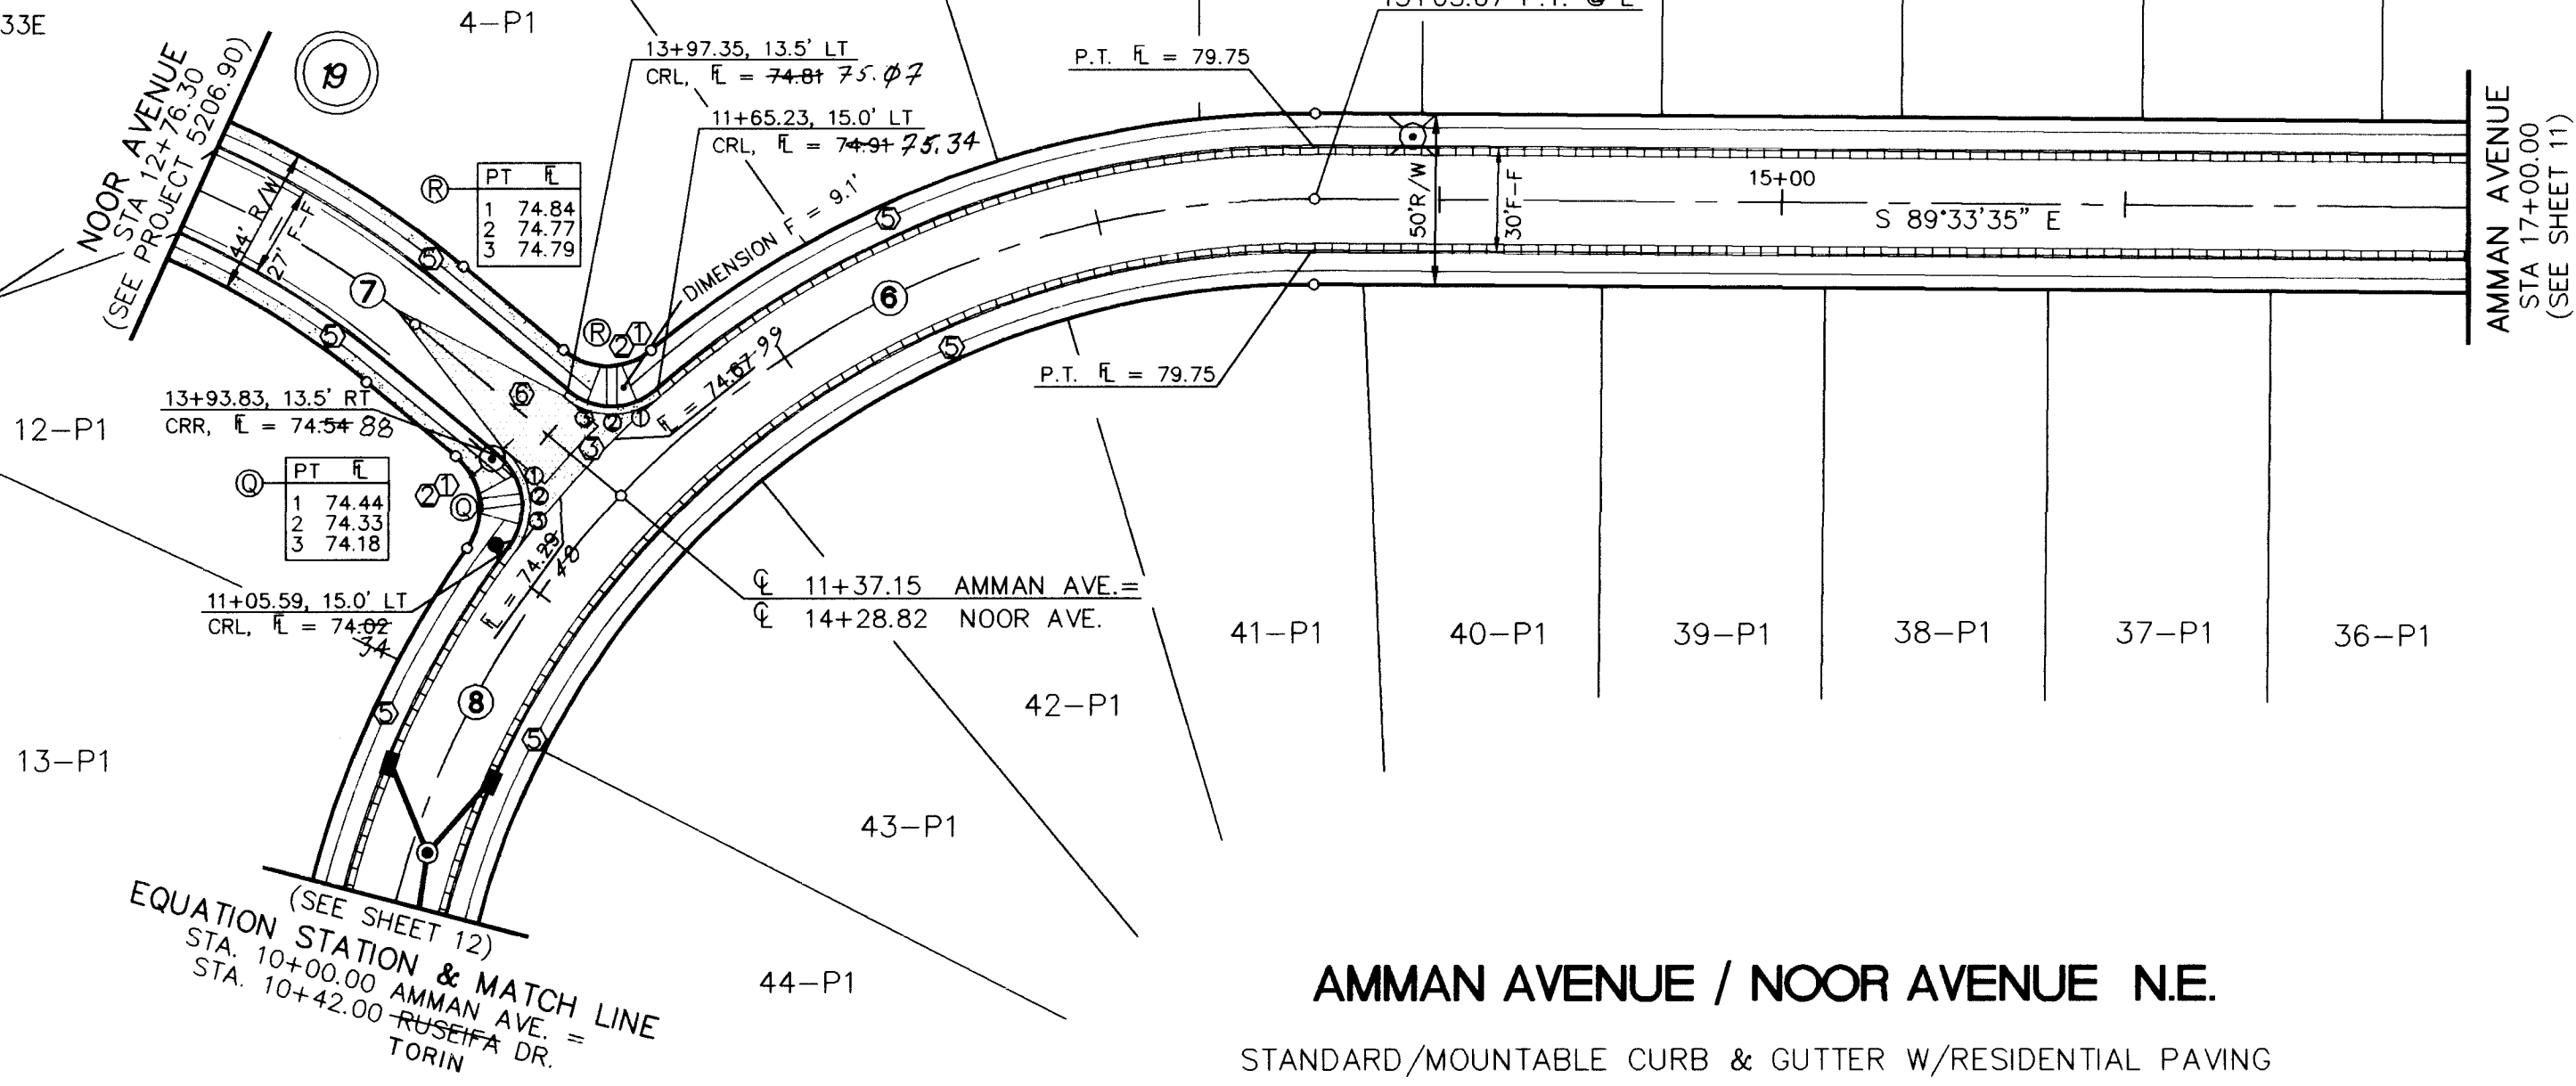

AMMAN AVENUE / NOOR AVENUE N.E.

STANDARD/MOUNTABLE CURB & GUTTER W/RESIDENTIAL PAVING

CURB CURVE DATA (FACE OF CURB)						
CURVE ID	RADIUS	ARC	DELTA	TANGENT	CHORD BRG	CHORD
Q	20.00	30.30	86-47-24	18.91	S06-43-13E	27.48
R	20.00	28.20	80-47-07	17.02	S89-29-13W	25.92

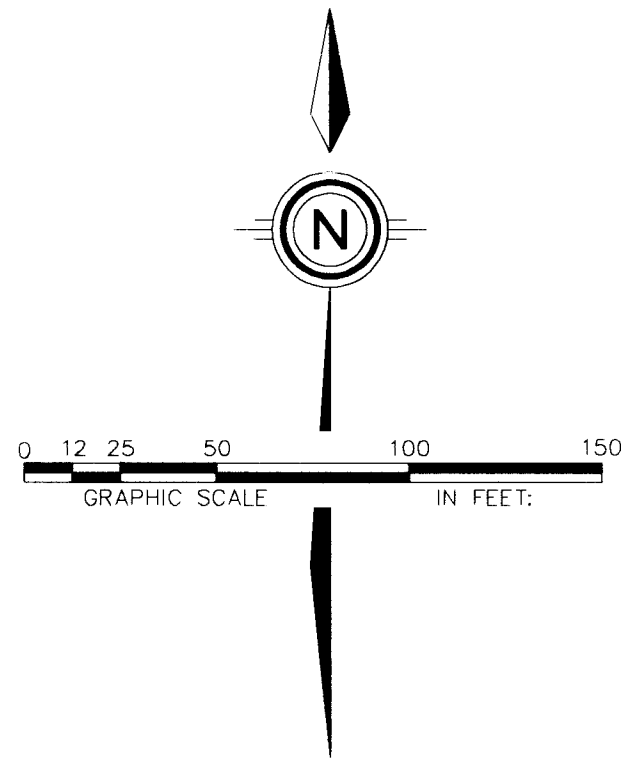

- LEGEND**
- FL=74.11 PROPOSED CURB FLOWLINE ELEVATION
 - ⊙ 73.6 EXISTING SPOT ELEVATION (GRND & TC)
 - ▬ PROPOSED VALLEY GUTTER/ SIDEWALK
 - ▬ EXISTING CURB & GUTTER
 - ▬ PROPOSED MOUNTABLE CURB & GUTTER
 - ▬ PROPOSED STANDARD CURB & GUTTER
 - ➔ FLOW ARROW
 - ➔ CROWN TRANSITION
 - ⦿ PROPOSED FIRE HYDRANT
 - ⦿ STREET LIGHTS
 - ⦿ CURB FLOWLINE ELEV SHOWN IN BOX CORRESPONDS TO QUARTERPOINTS INDICATED IN A CLOCKWISE DIRECTION AS PER COA STD DWG 2418, NOTE 5

KEY NOTES

- WHEELCHAIR RAMP PER COA STD DWG 2441 CASE II (DIMENSION "F" MODIFIED AS SHOWN ON PLAN VIEW)
- MOUNTABLE TO STANDARD CURB TRANSITION PER COA STD DWG 2418
- CONCRETE VALLEY GUTTER PER COA STD DWG 2420
- PROPOSED 4' SIDEWALK, THIS CONTRACT
- PROPOSED 4' SIDEWALK, BY OTHERS
- 50' CROWN TRANSITION PER COA STD DWG 2401
- 25' CROWN TRANSITION PER COA STD DWG 2401
- CONCRETE VALLEY GUTTER PER COA STD DWG 2421
- MEDIAN CURB & GUTTER PER COA STD DWG 2415

DATE: 4/16/96
SCALE:
HORIZ: 1"= 50'
VERT: 1"= 10'

community
sciences
corporation

CITY OF ALBUQUERQUE
PUBLIC WORKS DEPARTMENT
ENGINEERING DEVELOPMENT GROUP

TITLE: QUINTESSENCE SUBDIVISION - UNIT 4
PAVING PLAN & PROFILE
AMMAN AVE. & NOOR AVE. N.E.

DESIGN REVIEW COMMITTEE: CITY ENGINEER APPROVAL

PROJECT NO. 5206.94 MAP NO. D-21

SHEET 10 OF 24

ENGINEER'S SEAL


REVISIONS

DESIGNED BY: JMN DATE: 6/96
DRAWN BY: LUD/D/W DATE: 6/96
CHECKED BY: JDH DATE: 6/96

AS-BUILT INFORMATION


BENCH MARKS

SURVEY INFORMATION

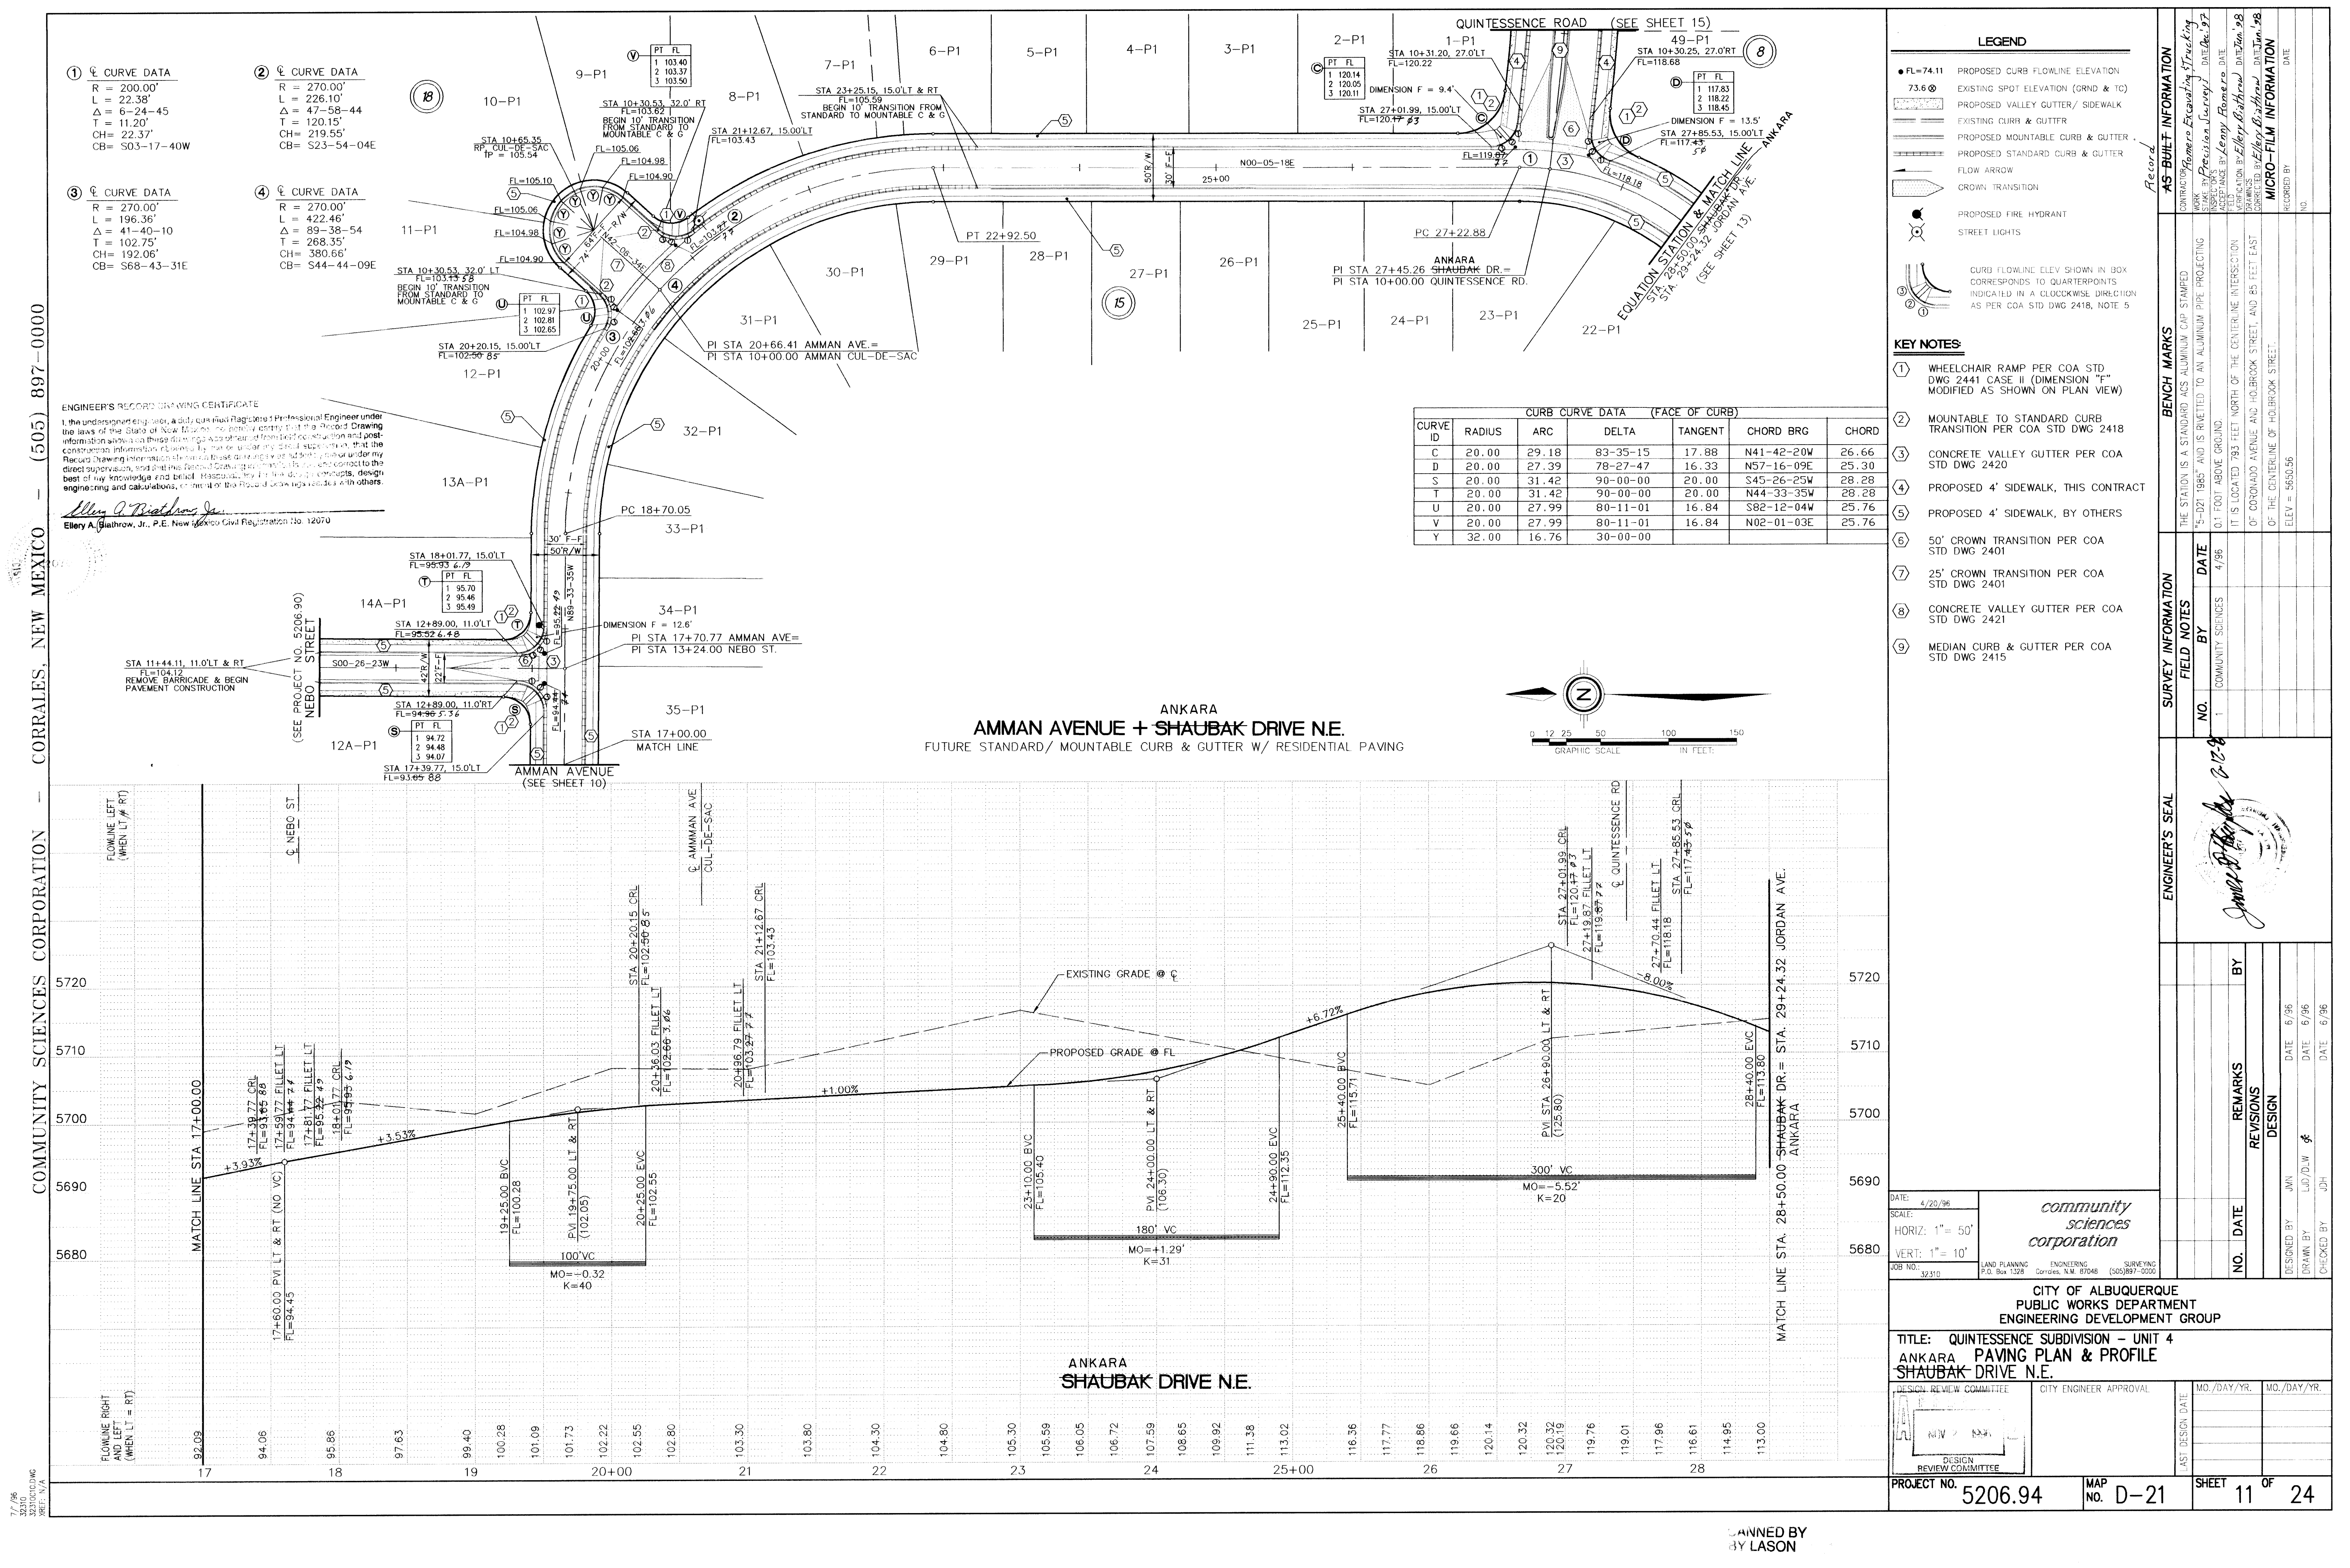


PLANNED BY
BY LASON

FLOWLINE RIGHT
AND LEFT
(WHEN LT = RT)

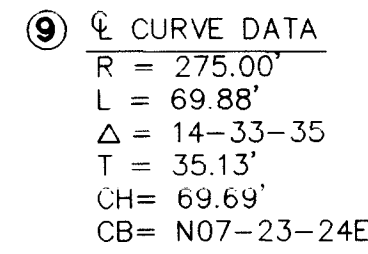

TORIN
~~RUSEIFA DRIVE / QUINTESSENCE ROAD~~
MOUNTABLE AND STANDARD CURB & GUTTER W/ RESIDENTIAL PAVING
(SEE SHEET 8 FOR STREET SECTION)

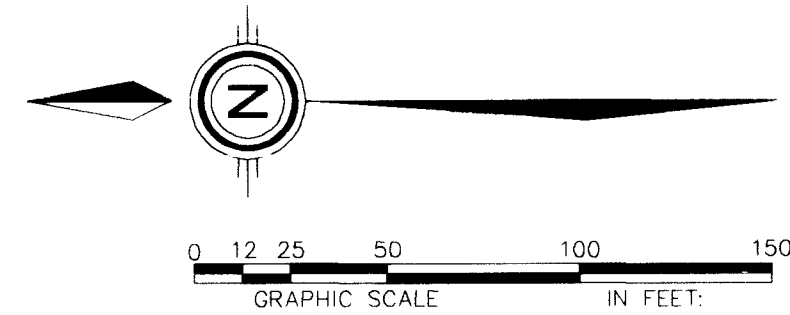

CURB CURVE DATA (FACE OF CURB)						
CURVE ID	RADIUS	ARC	DELTA	TANGENT	CHORD BRG	CHORD
J	20.00	31.26	89-33-08	19.84	N44-39-58W	28.17
K	20.00	31.57	90-26-52	20.16	N45-20-02E	28.39
L	20.00	31.42	90 00 00	20.00	N45-06-36E	28.28
M	20.00	31.42	90-00-00	20.00	N44-53-24W	28.28

- | LEGEND | |
|------------|--|
| ● FL=74.11 | PROPOSED CURB FLOWLINE ELEVATION |
| 73.6 | EXISTING SLOPE ELEVATION (GRND & TC) |
| | PROPOSED VALLEY GUTTER/ SIDEWALK |
| | EXISTING CURB & GUTTER |
| | PROPOSED MOUNTABLE CURB & GUTTER |
| | PROPOSED STANDARD CURB & GUTTER |
| | FLOW ARROW |
| | CROWN TRANSITION |
| | PROPOSED FIRE HYDRANT |
| | STREET LIGHTS |
| | CURB FLOWLINE ELEV SHOWN IN BOX
CORRESPONDS TO QUARTERPOINTS
INDICATED IN A CLOCKWISE DIRECTION
AS PER COA STD DWG 2418, NOTE 5 |

- (1) WHEELCHAIR RAMP PER COA STD DWG 2441 CASE II (DIMENSION "f" MODIFIED AS SHOWN ON PLAN VIEW)
- (2) MOUNTABLE TO STANDARD CURB TRANSITION PER COA STD DWG 2418
- (3) CONCRETE VALLEY GUTTER PER COA STD DWG 2420
- (4) PROPOSED 4' SIDEWALK, THIS CONTRACT
- (5) PROPOSED 4' SIDEWALK, BY OTHERS
- (6) 50' CROWN TRANSITION PER COA STD DWG 2401
- (7) 25' CROWN TRANSITION PER COA STD DWG 2401
- (8) CONCRETE VALLEY GUTTER PER COA STD DWG 2421
- (9) MEDIAN CURB & GUTTER PER COA STD DWG 2415

[illegible]

CITY OF ALBUQUERQUE
PUBLIC WORKS DEPARTMENT
ENGINEERING DEVELOPMENT GROUP

TITLE: QUINTESSENCE SUBDIVISION - UNIT 4
TORIN PAVING PLAN & PROFILE
RUSEIFA DR & QUINTESSENCE RD N.E.

	CITY ENGINEER APPROVAL	LAST DESIGN DATE	MO./DAY/YR.	MO./DAY/YR.

PROJECT NO.	5206.94	MAP NO.	D-21	SHEET	12	OF	24
-------------	---------	---------	------	-------	----	----	----

Record
AS-BUILT INFORMATION

RKS

SURVEY INFORMATION

ENGINEER'S SEAL

NO.	DATE	REMARKS	BY
REVISIONS			

DESIGNED BY	JMN	DATE	6/96
DRAWN BY	LID	DATE	6/96


0./DAY,

24


ENGINEER'S RECORD DRAWING CERTIFICATE
I, the undersigned engineer, a duly qualified Registered Professional Engineer under the laws of the State of New Mexico, do hereby certify that the Record Drawing information shown on these drawings was obtained from my construction and post-construction information obtained by me or under my direct supervision, that the Record Drawing information shown on these drawings was obtained from my construction and post-construction information obtained by me or under my direct supervision, and that this Record Drawing represents the best of my knowledge and belief. Responsibility for the design, construction, design engineering and calculations, or intent of the Record Drawing rests with others.

Elery A. Blathrow, Jr.
Elery A. Blathrow, Jr., P.E. New Mexico Civil Registration No. 12070

CURB CURVE DATA (FACE OF CURB)					
CURVE ID	RADIUS	ARC	DELTA	TANGENT	CHORD BRG
E	20.00	33.03	94-36-56	21.68	S88-41-37E
F	20.00	30.10	86-13-40	18.72	N01-24-04W

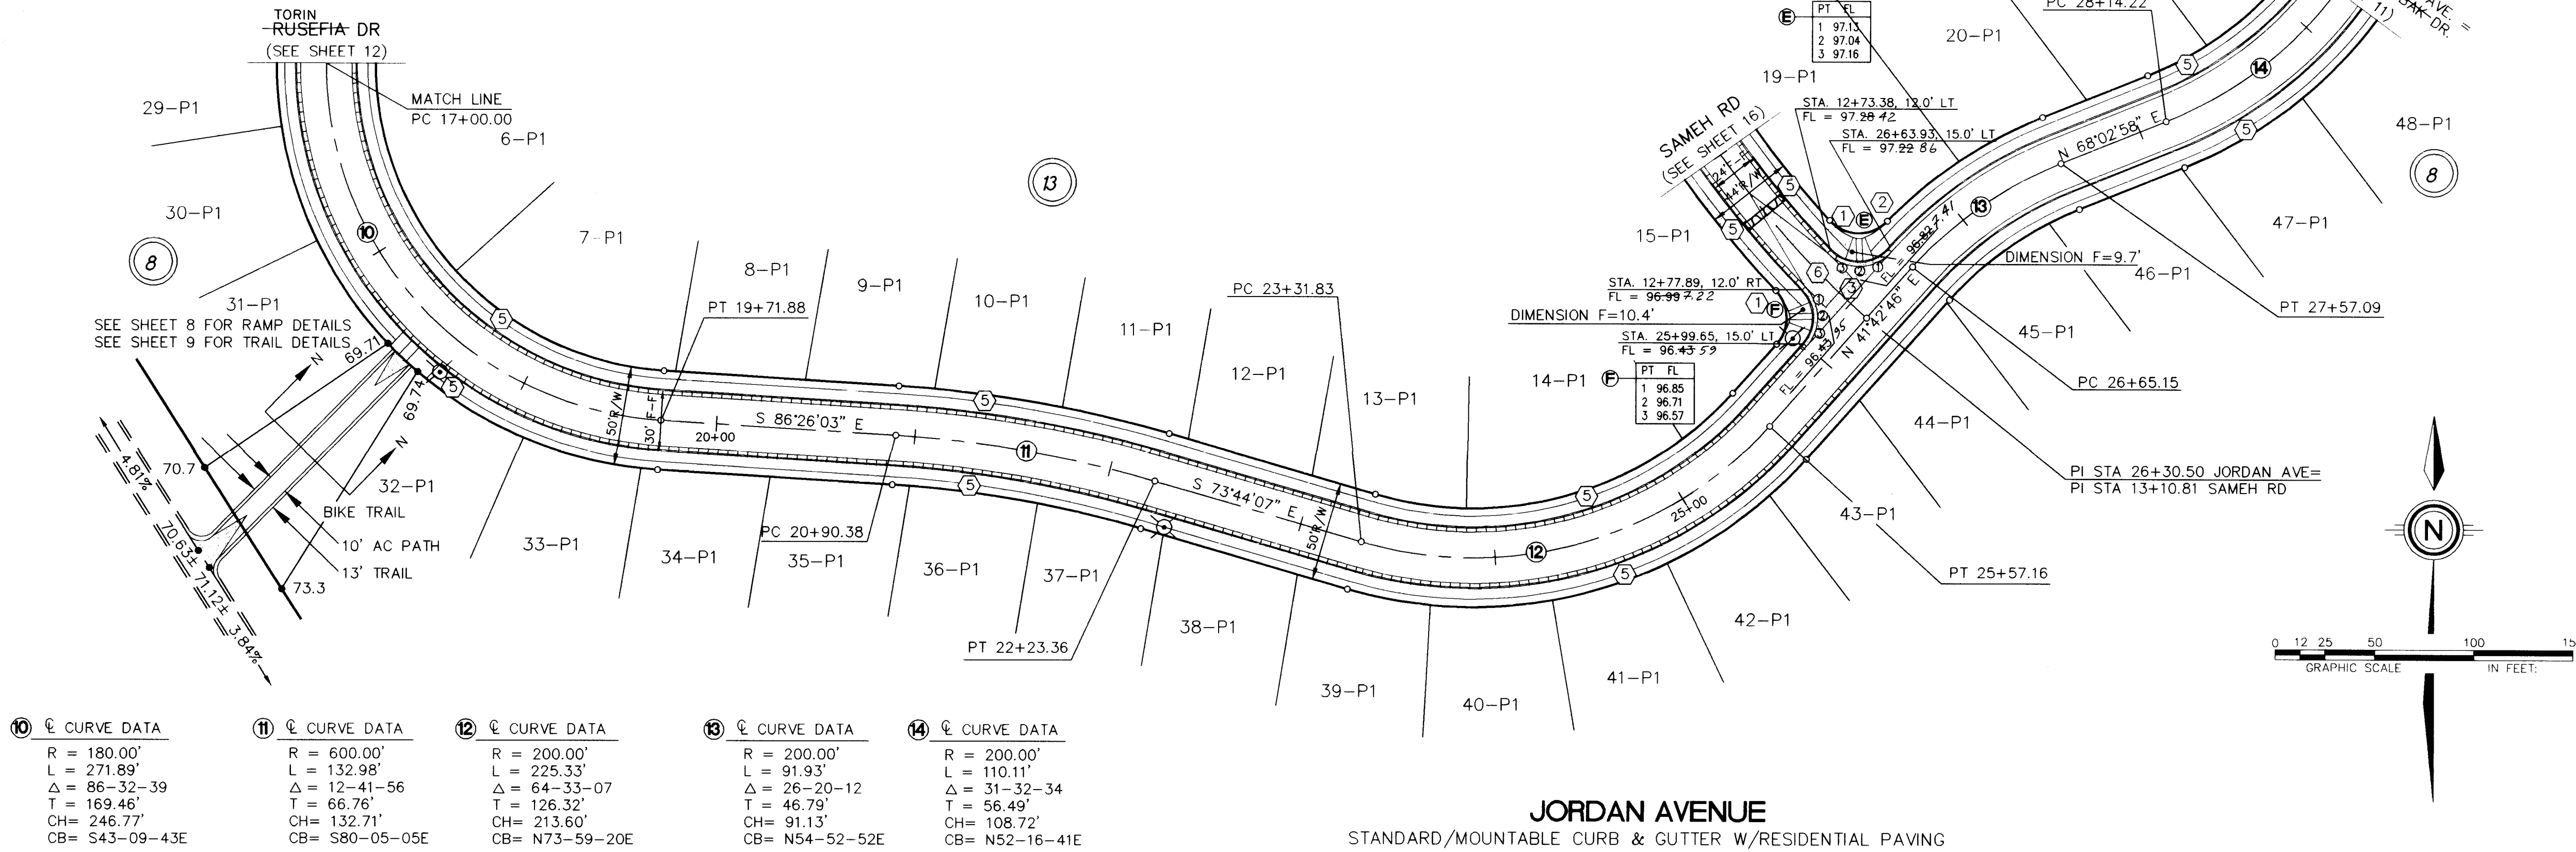

10	11	12	13	14
$R = 180.00'$ $L = 271.89'$ $\Delta = 86-32-39$ $T = 169.46'$ $CH = 246.77'$ $CB = S43-09-43E$	$R = 600.00'$ $L = 132.98'$ $\Delta = 12-41-56$ $T = 66.76'$ $CH = 132.71'$ $CB = S80-05-05E$	$R = 200.00'$ $L = 225.33'$ $\Delta = 64-33-07$ $T = 126.32'$ $CH = 213.60'$ $CB = N73-59-05E$	$R = 200.00'$ $L = 91.93'$ $\Delta = 26-20-12$ $T = 46.79'$ $CH = 91.13'$ $CB = N54-52-52E$	$R = 200.00'$ $L = 110.11'$ $\Delta = 31-32-34$ $T = 56.49'$ $CH = 108.72'$ $CB = N52-16-41E$

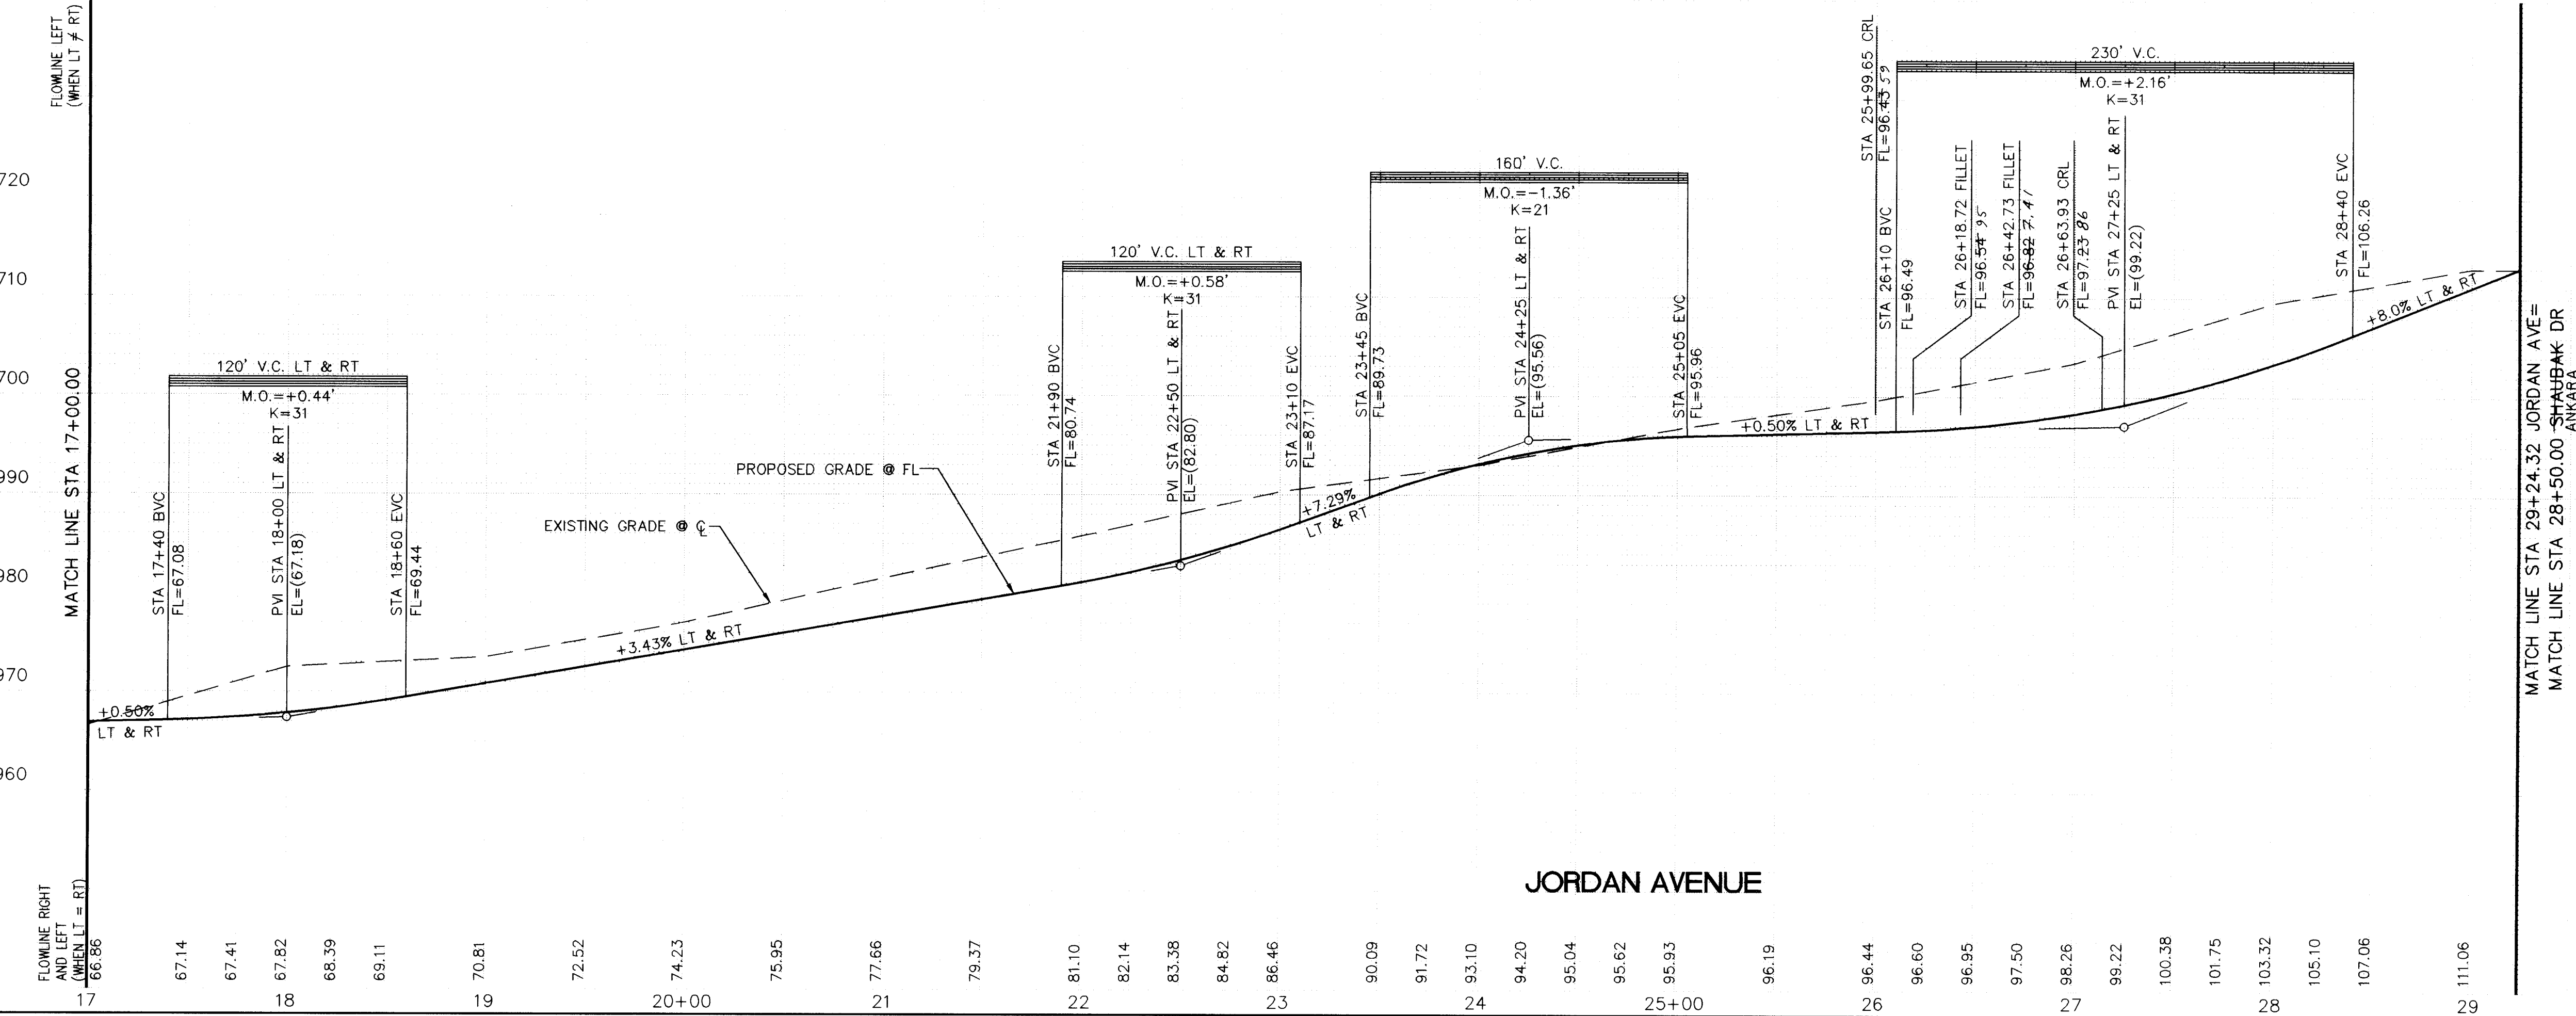

LEGEND

- FL=74.11 PROPOSED CURB FLOWLINE ELEVATION
- 73.6 EXISTING SPOT ELEVATION (GRND & TC)
- PROPOSED VALLEY GUTTER / SIDEWALK
- EXISTING CURB & GUTTER
- PROPOSED MOUNTABLE CURB & GUTTER
- PROPOSED STANDARD CURB & GUTTER
- FLOW ARROW
- CROWN TRANSITION
- FIRE HYDRANT ASSEMBLY
- STREET LIGHT
- WATER BLOCK
- CURB FLOWLINE ELEV SHOWN IN BOX CORRESPONDS TO QUARTERPOINTS INDICATED IN A CLOCKWISE DIRECTION AS PER COA STD DWG 2418, NOTE 5

- KEY NOTES**
- WHEELCHAIR RAMP PER COA STD DWG 2441 CASE II (DIMENSION "F" MODIFIED AS SHOWN ON PLAN VIEW)
 - MOUNTABLE TO STANDARD CURB TRANSITION PER COA STD DWG 2418
 - CONCRETE VALLEY GUTTER PER COA STD DWG 2420
 - PROPOSED 4' SIDEWALK, THIS CONTRACT
 - PROPOSED 4' SIDEWALK, BY OTHERS
 - 50' CROWN TRANSITION PER COA STD DWG 2401
 - 25' CROWN TRANSITION PER COA STD DWG 2401
 - CONCRETE VALLEY GUTTER PER COA STD DWG 2421
 - MEDIAN CURB & GUTTER PER COA STD DWG 2415

ENGINEER'S SEAL

Elery A. Blathrow, Jr. 9-12-96

REVISIONS

NO.	DATE	REMARKS	BY
1	4/96	DESIGN	JWH
2	6/96	DESIGN	JWH
3	6/96	DESIGN	JWH
4	6/96	DESIGN	JWH

CITY OF ALBUQUERQUE PUBLIC WORKS DEPARTMENT ENGINEERING DEVELOPMENT GROUP

TITLE: QUINTESSENCE SUBDIVISION - UNIT 4 PAVING PLAN & PROFILE JORDAN AVENUE N.E.

DESIGN REVIEW COMMITTEE


CITY ENGINEER APPROVAL

PROJECT NO. 5206.94


MAP NO. D-21

SHEET 13 OF 24

23	CURVE DATA	24	CURVE DATA
R = 120.00'		R = 120.00'	
L = 126.12'		L = 226.50'	
$\Delta = 60-12-59$		$\Delta = 108-08-40$	
T = 69.58'		T = 165.60'	
CH = 120.39'		CH = 194.34'	
CB = S11-31-25E		CB = S35-29-15E	

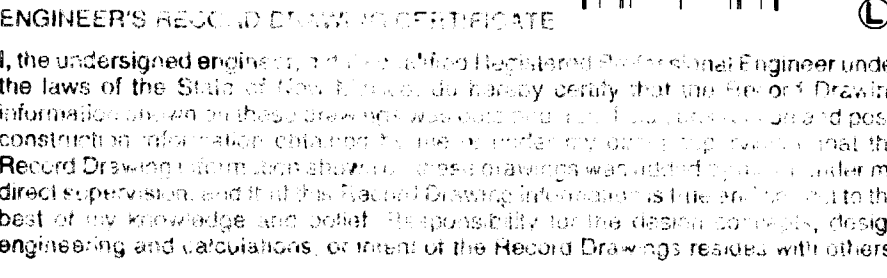

Elery A. Biathrow Jr.
Elery A. Biathrow, Jr., P.E. New Mexico Civil Registration No. 12070

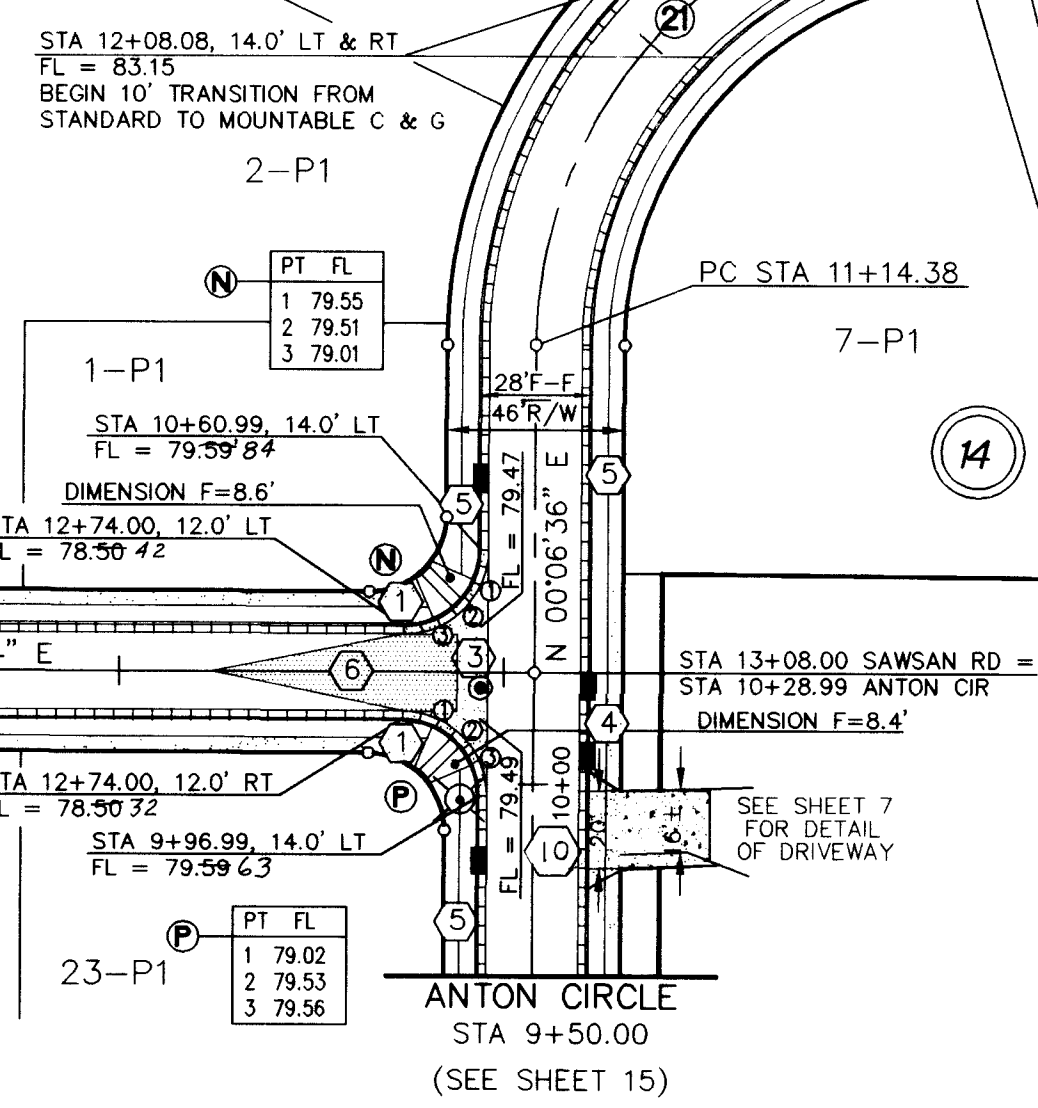

SAWSAN ROAD N.E.


STANDARD CURB & GUTTER W/ RESIDENTIAL PAVING

ANTON CIRCLE N.E.

STANDARD CURB & GUTTER W/ RESIDENTIAL PAVING



CURB CURVE DATA (FACE OF CURB)						
CURVE ID	RADIUS	ARC	DELTA	TANGENT	CHORD BRG	CHORD
L	20.00	31.42	90-00-00	20.00	N45-06-36E	28.28
M	20.00	31.42	90-00-00	20.00	S44-53-24E	28.28
N	20.00	31.42	90-00-00	20.00	N45-06-36E	28.28
P	20.00	31.42	90-00-00	20.00	S44-53-24E	28.28
W	20.00	25.26	72-21-54	14.63	N81-17-46E	23.61
X	20.00	25.26	72-21-54	14.63	S15-26-25W	23.61
Z	35.00	18.99	31-05-06	9.73	VARIABLE	18.76

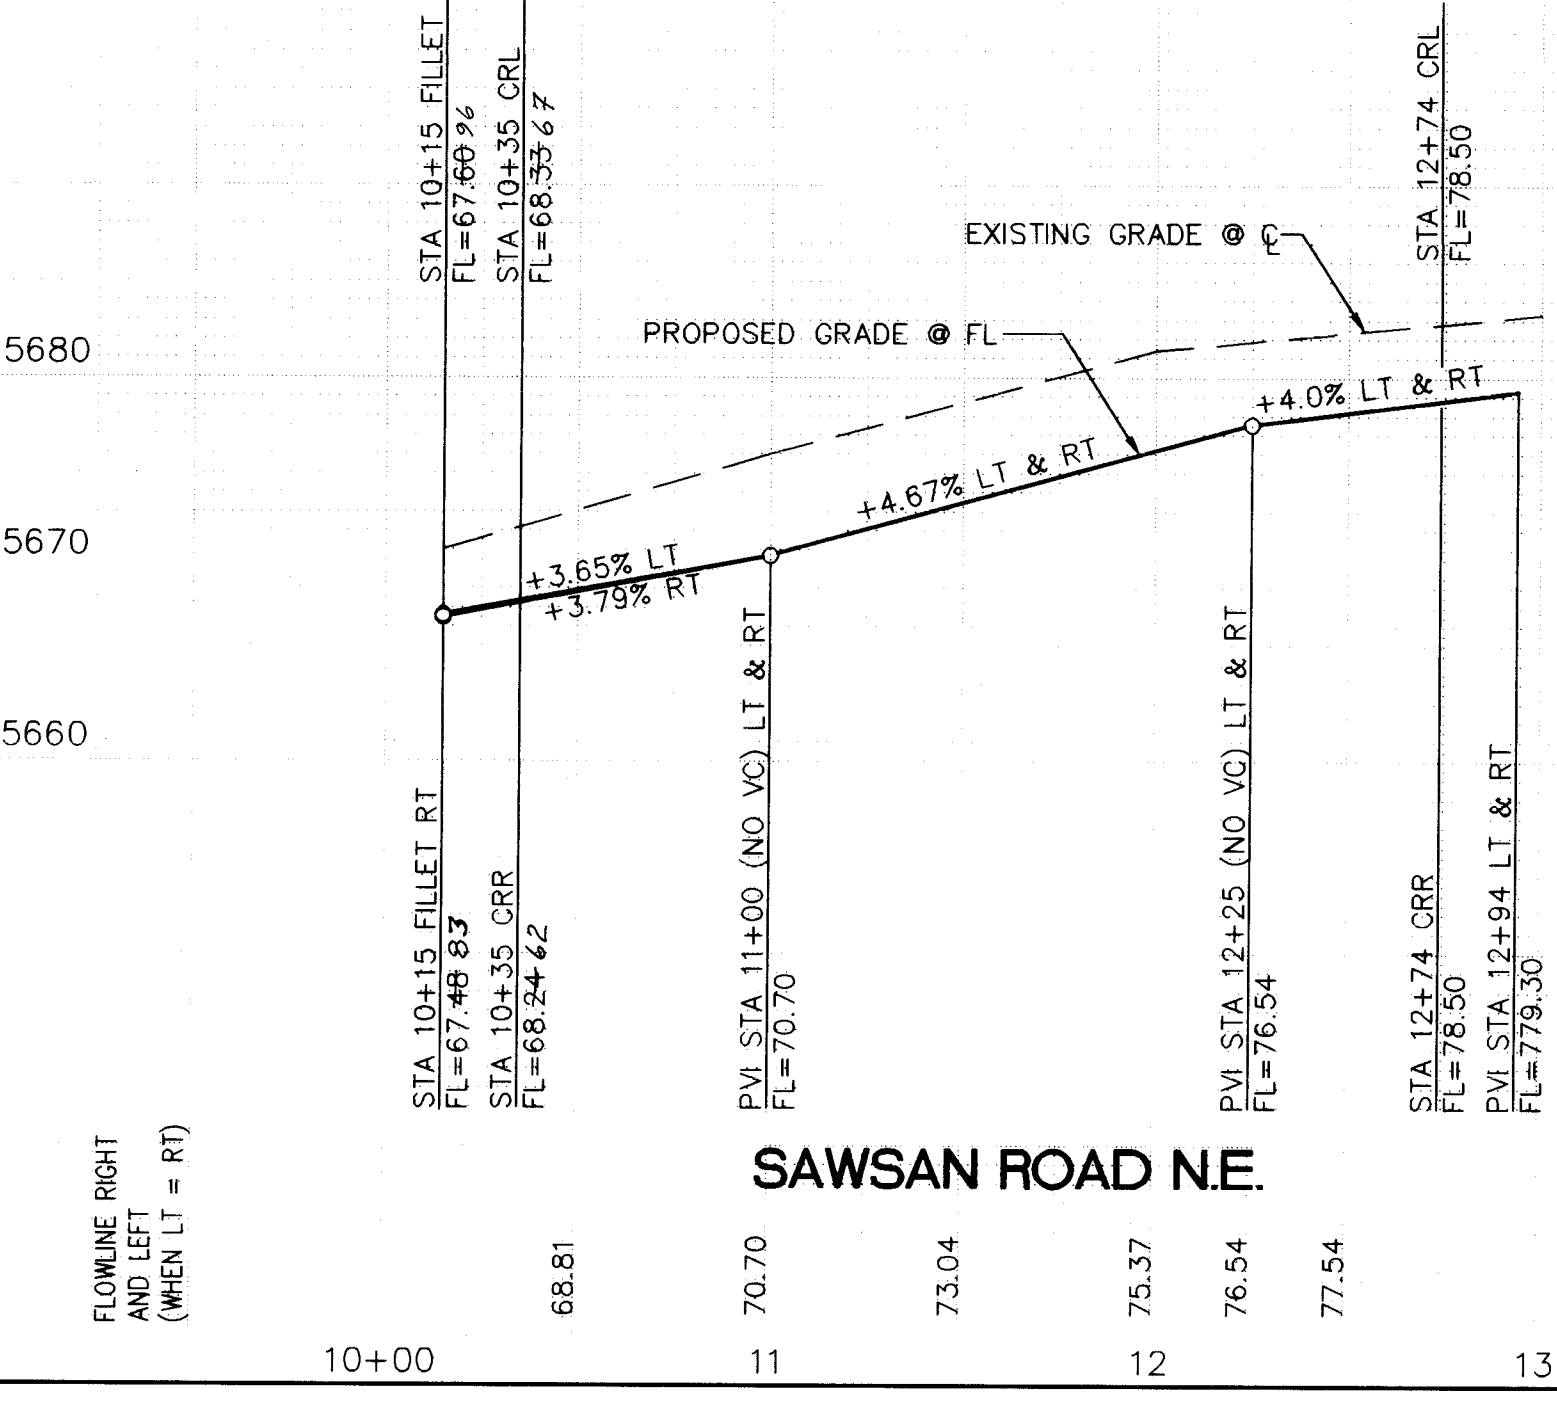

SAWSAN ROAD N.E.

ANTON CIRCLE N.E.

- CURB FLOWLINE ELEV SHOWN IN BOX
CORRESPONDS TO QUARTERPOINTS
INDICATED IN A CLOCCWISE DIRECTION
AS PER COA STD DWG 2418, NOTE 5

KEY NOTES:

- ① WHEELCHAIR RAMP PER COA STD DWG 2441 CASE II (DIMENSION "F" MODIFIED AS SHOWN ON PLAN VIEW)
- ② MOUNTABLE TO STANDARD CURB TRANSITION PER COA STD DWG 2418
- ③ CONCRETE VALLEY GUTTER PER COA STD DWG 2420
- ④ PROPOSED 4' SIDEWALK, THIS CONTRACT
- ⑤ PROPOSED 4' SIDEWALK, BY OTHERS
- ⑥ 50' CROWN TRANSITION PER COA STD DWG 2401
- ⑦ 25' CROWN TRANSITION PER COA STD DWG 2401
- ⑧ CONCRETE VALLEY GUTTER PER COA STD DWG 2421
- ⑨ MEDIAN CURB & GUTTER PER COA STD DWG 2415
- ⑩ CONCRETE DRIVE PAD PER COA STD DWG 2425

SURVEY INFORMATION			BENCH MARKS		AS-BUILT INFORMATION	
NO.	BY	DATE			WORK SUSPECTED BY	DATE
1	COMMUNITY SCIENCES	4/96	THE STATION IS A STANDARD ACS ALUMINUM CAP STAMPED "5-021 1985" AND IS RIGID TO AN ALUMINUM PIPE PROJECTING 0.1 FOOT ABOVE GROUND.		CONTRACTOR <i>Pomero Excavating Inc.</i>	
			IT IS LOCATED 793 FEET NORTH OF THE CENTERLINE INTERSECTION OF CORONADO AVENUE AND HOLBROOK STREET, AND 85 FEET EAST OF THE CENTERLINE OF HOLBROOK STREET.		ACCEPTANCE BY <i>Leopold Pomero</i>	
					FIELD LOCATION BY <i>Ellyen Blathorn</i>	DATE <i>Jan. '97</i>
					DRAWINGS CORRECTED BY <i>Ellyen Blathorn</i>	DATE <i>Jun. '97</i>
			ELEV = 5650.56		MICRO-FILM INFORMATION	
					RECORDED BY	DATE
					NO	

ENGINEER'S SEAL

REVISIONS				BY
NO.	DATE	REMARKS		
DESIGN				
DESIGNED BY	JWN	DATE	6/96	
DRAWN BY	LJD/J.W	DATE	6/96	
CHECKED BY	JDI	DATE	6/96	

DATE: 4/19/96
SCALE:
HORIZ: 1" = 5'
VERT: 1" = 10'
JOB NO.: 32310041

community
sciences
corporation

CITY OF ALBUQUERQUE
PUBLIC WORKS DEPARTMENT
ENGINEERING DEVELOPMENT GROUP

TITLE: QUINTESSENCE SUBDIVISION - UNIT
PAVING PLAN & PROFILE
ANTON CIRCLE & SAWSAN RD N.E.

DESIGN REVIEW COMMITTEE

APPROVE

NOV 28 1996

DESIGN
REVIEW COMMITTEE

CITY ENGINEER APPROVAL







MO./DAY/YR. MO./DAY/YR.

PROJECT NO. 5206 94

MAP
NO. D-21

SHEET	14	OF	24
-------	----	----	----



CURB CURVE DATA				(FACE OF CURB)		
CURVE ID	RADIUS	ARC	DELTA	TANGENT	CHORD BRG	CHORD
2E	20.00	31.42	90-00-00	20.00	N45-26-29E	28.27
2F	20.00	31.42	90-00-00	20.00	S44-33-35E	28.28
A	30.00	47.12	90-00-00	30.00	S44-05-18W	42.43
B	30.00	47.12	90-00-00	30.00	S44-54-42E	42.43
C	20.00	29.18	83-35-15	17.88	N41-42-20W	26.66
D	20.00	27.39	78-27-47	16.33	N57-16-09E	25.30
E1	30.00	47.31	90-21-43	30.19	S44-54-27W	42.56
F1	30.00	46.93	89-38-17	29.81	S45-05-33E	42.29
S	20.00	31.42	90-00-00	20.00	S45-26-25W	28.28
T	20.00	31.42	90-00-00	20.00	N44-33-35E	28.28
U	20.00	27.39	80-11-01	16.88	S52-12-04W	25.76
V	20.00	27.99	80-11-01	16.84	N00-01-03E	25.75
A1	2.01	5.99	171-04-47		N06-30-03E	4.00
B1	993.00	102.18	005-53-45	51.13	N86-26-50W	102.13
C1	2.00	5.98	171-26-17		S00-09-03W	3.99
D1	1003.00	103.21	005-53-45	51.65	N86-26-50W	103.16

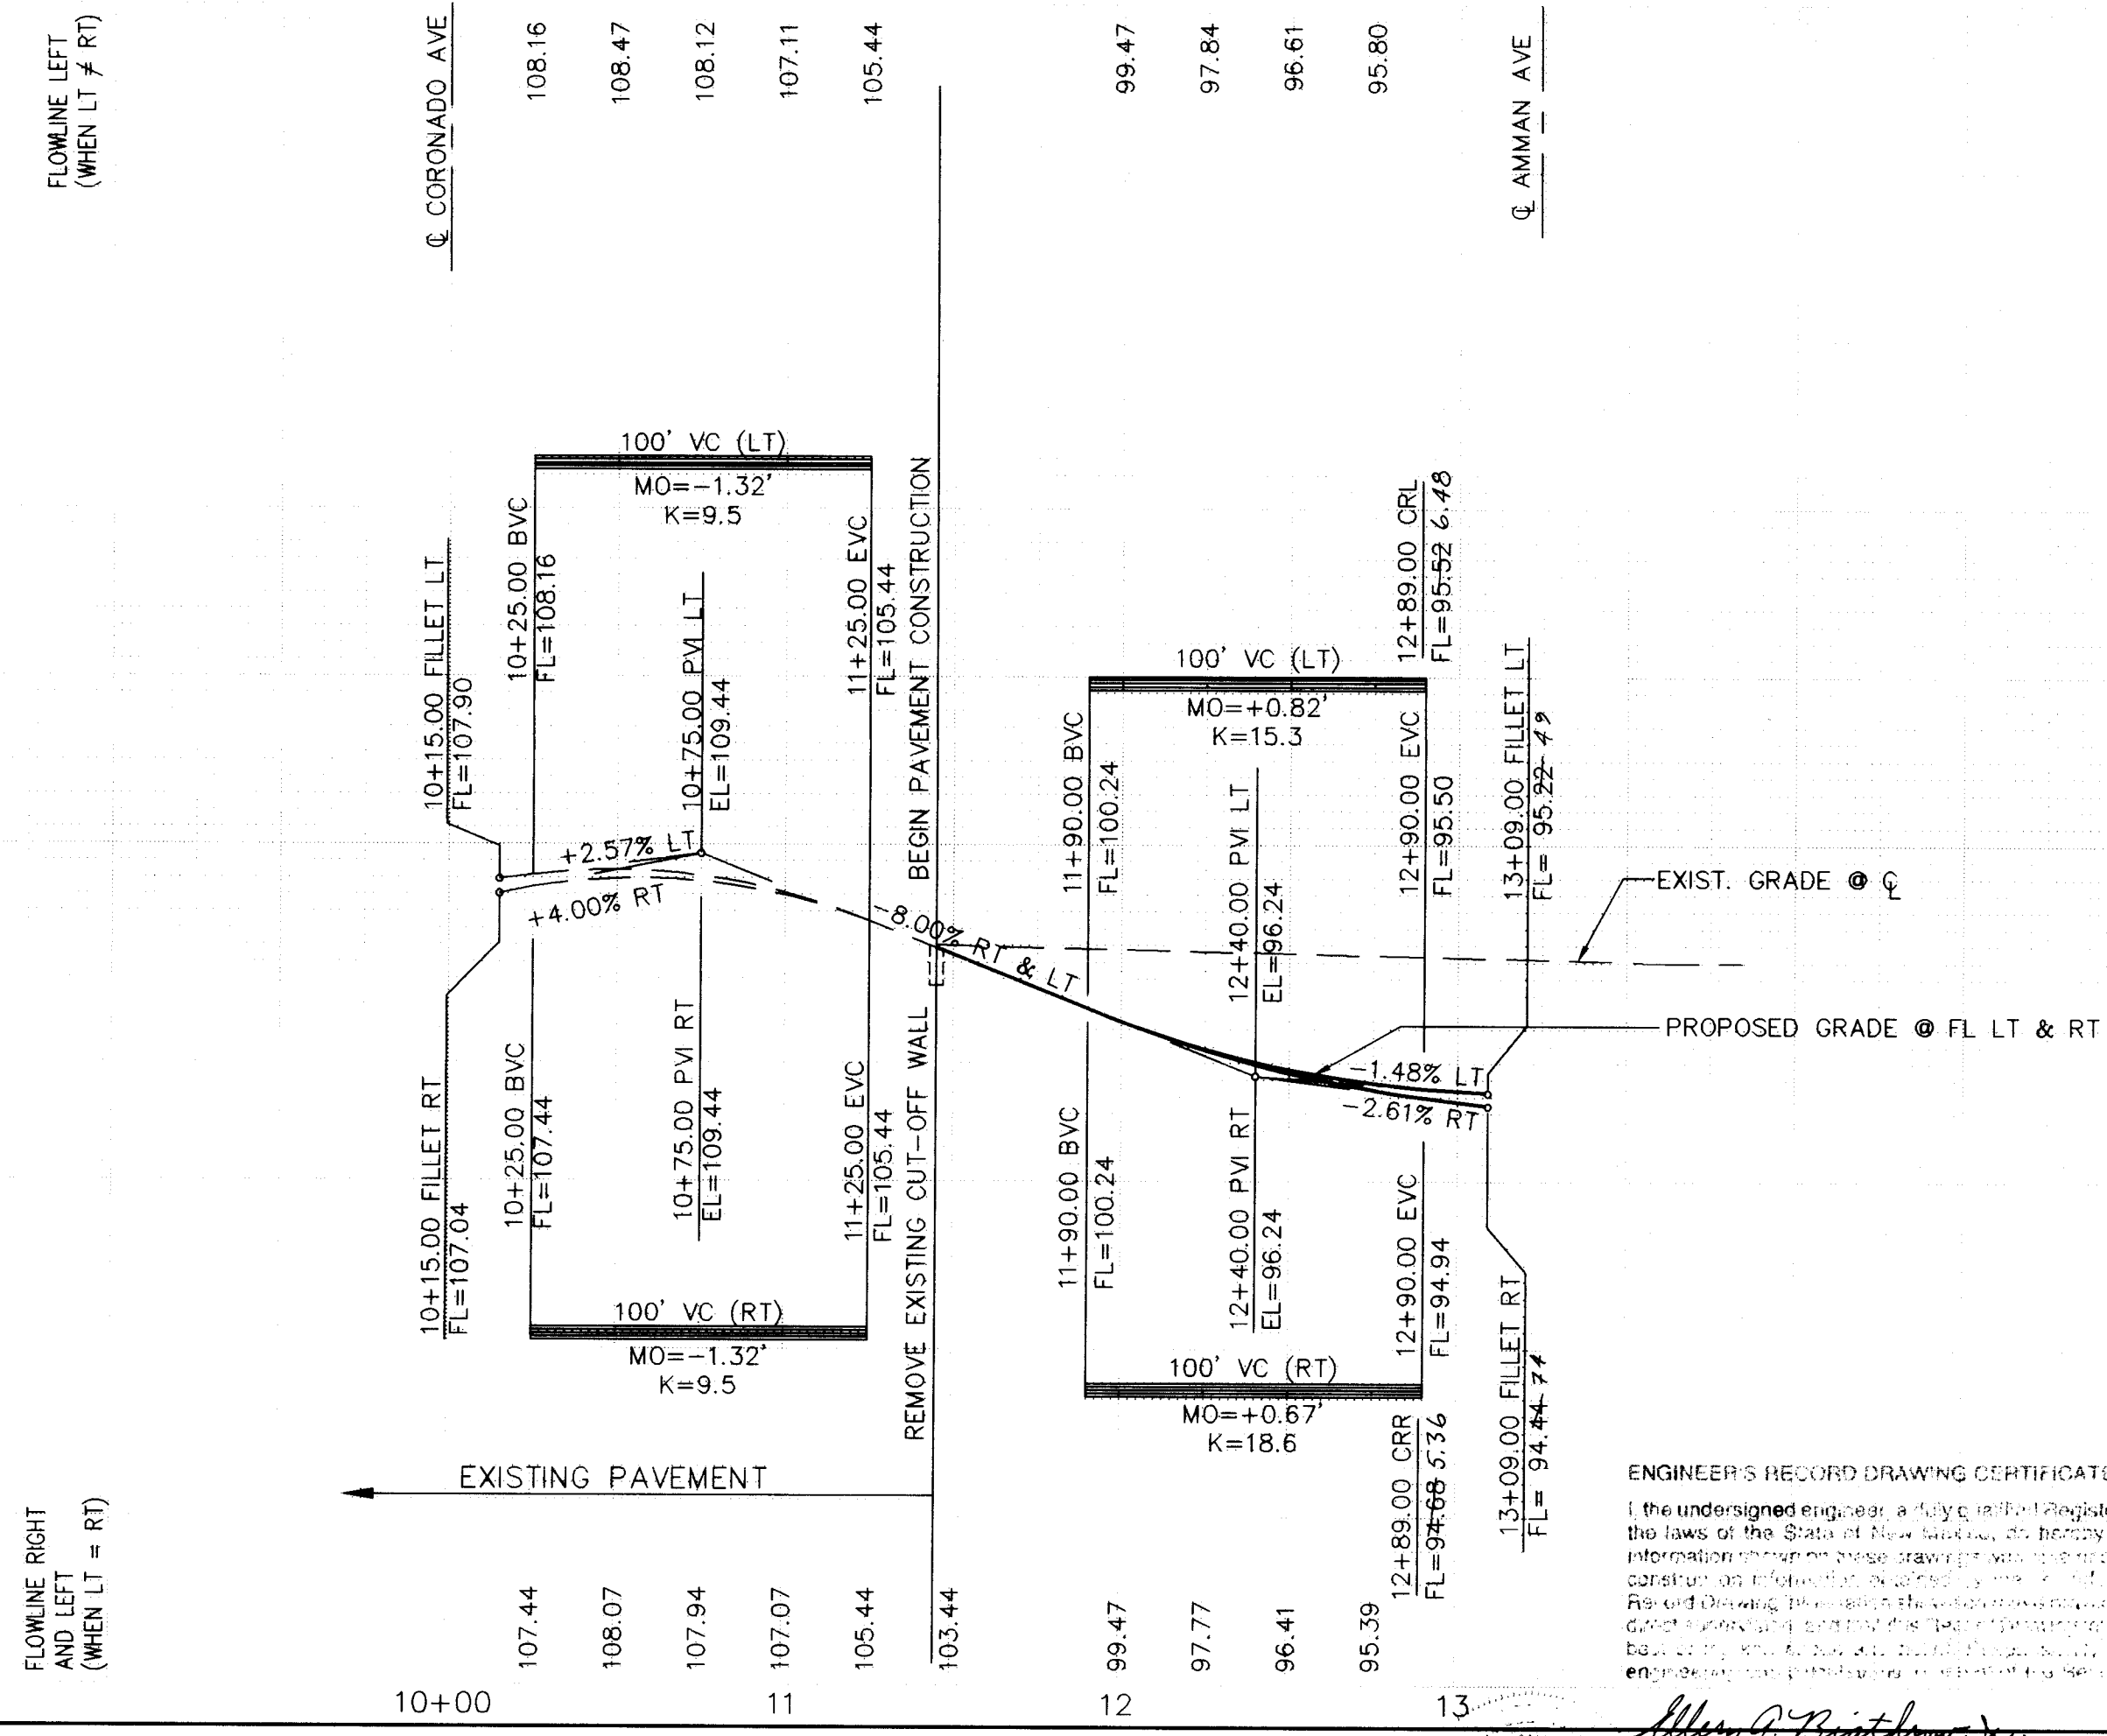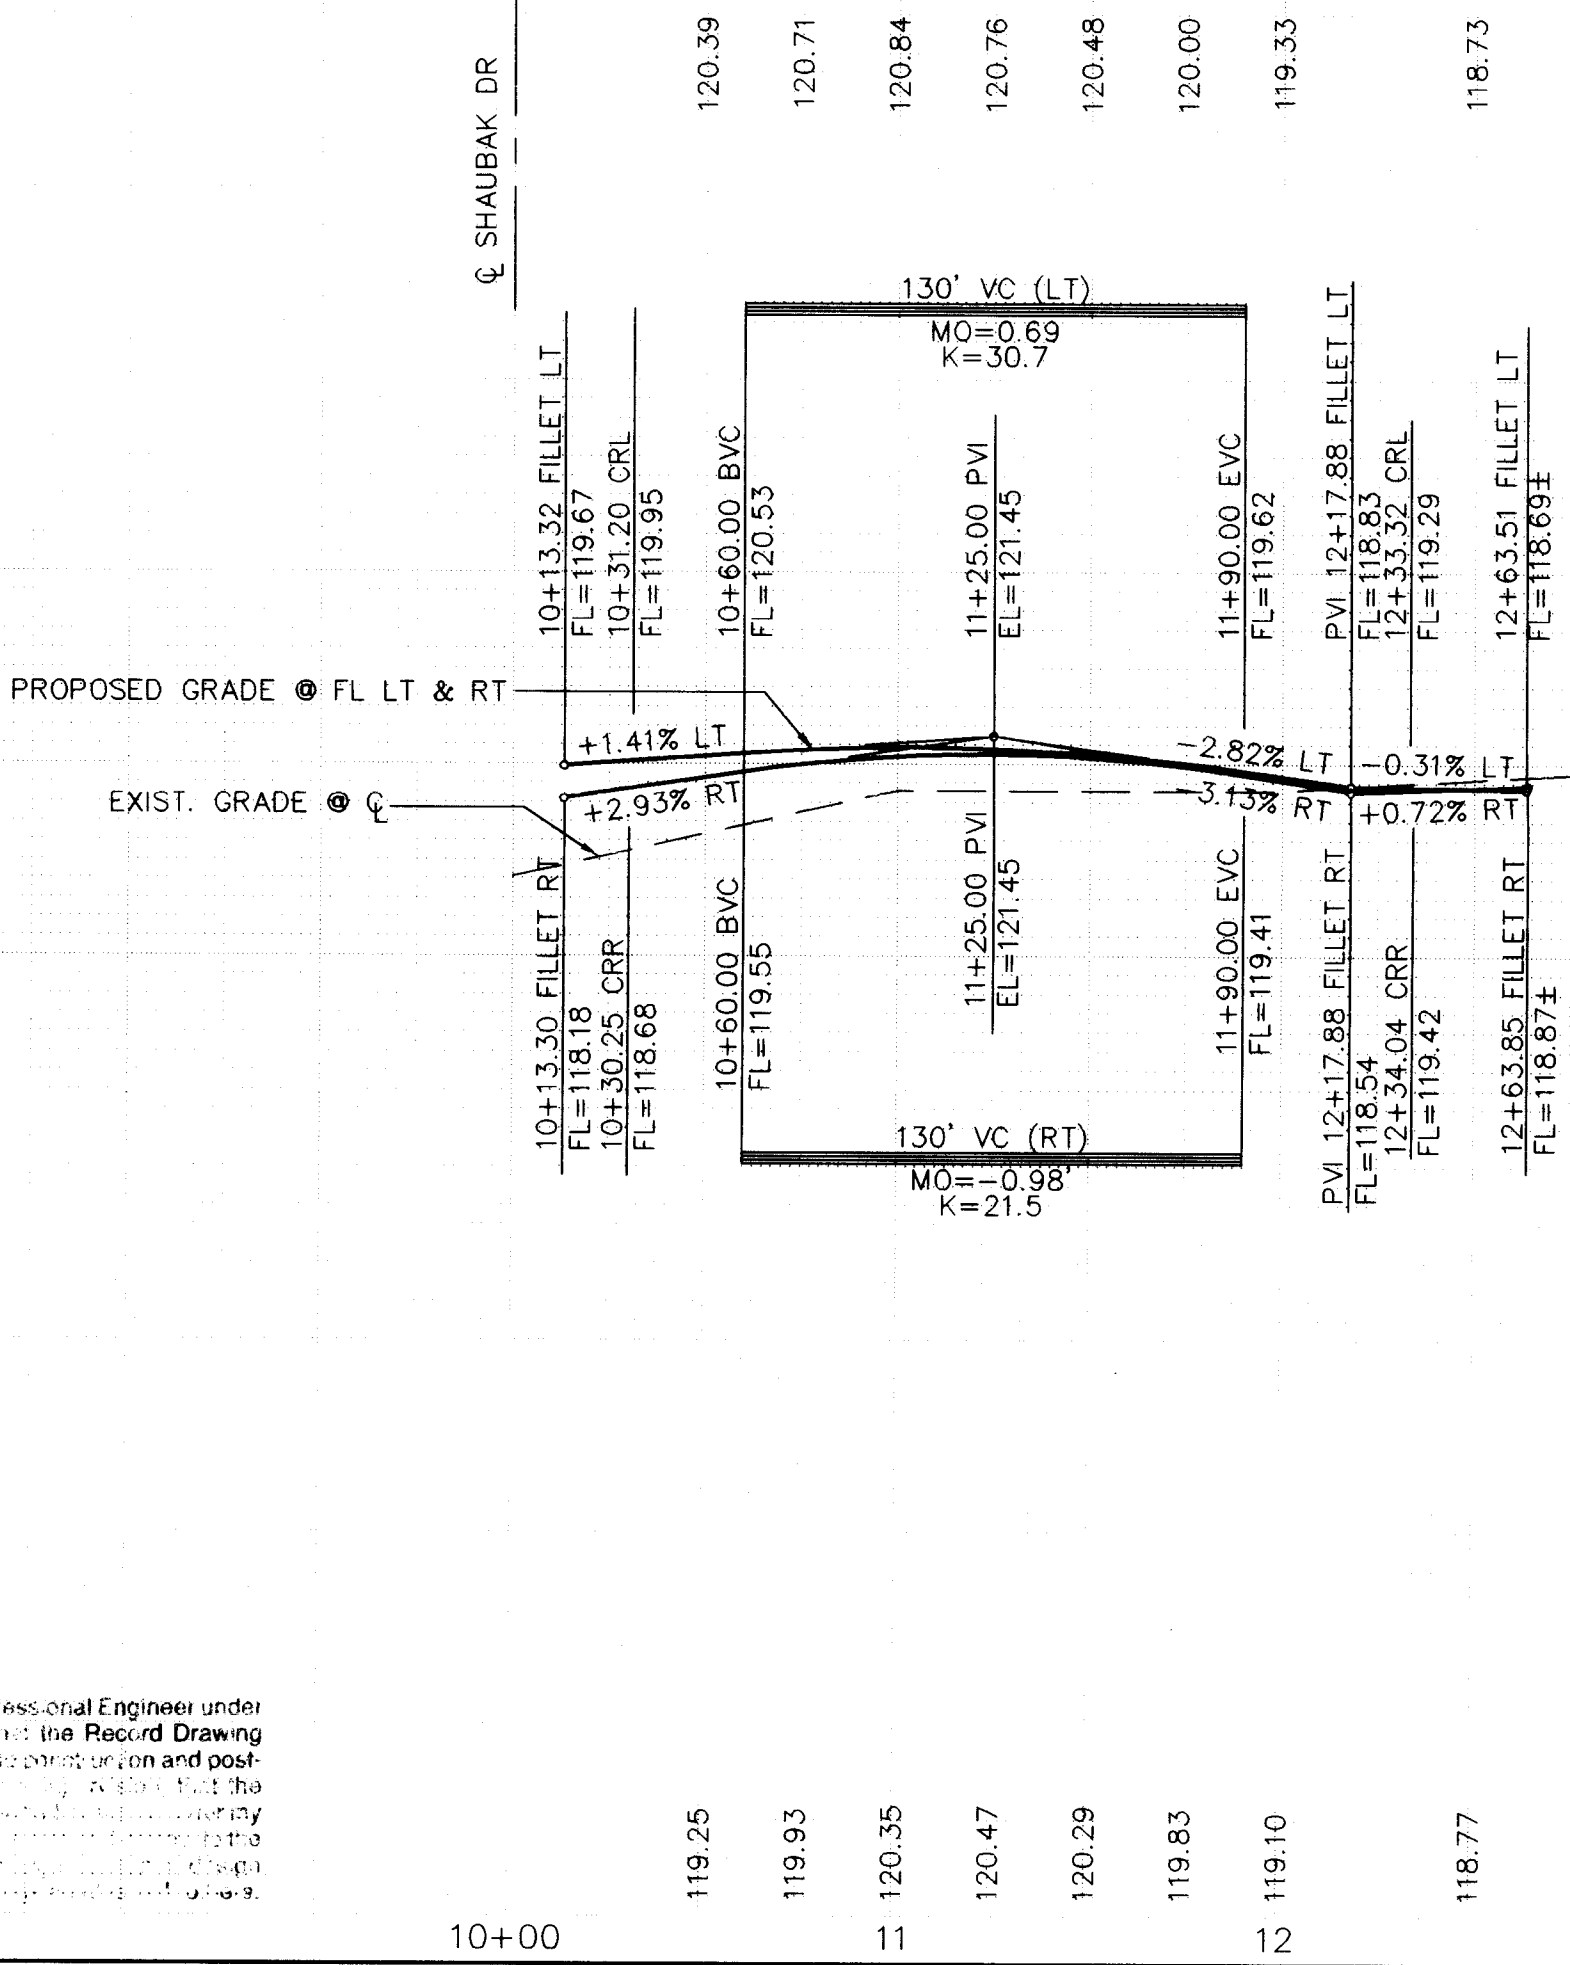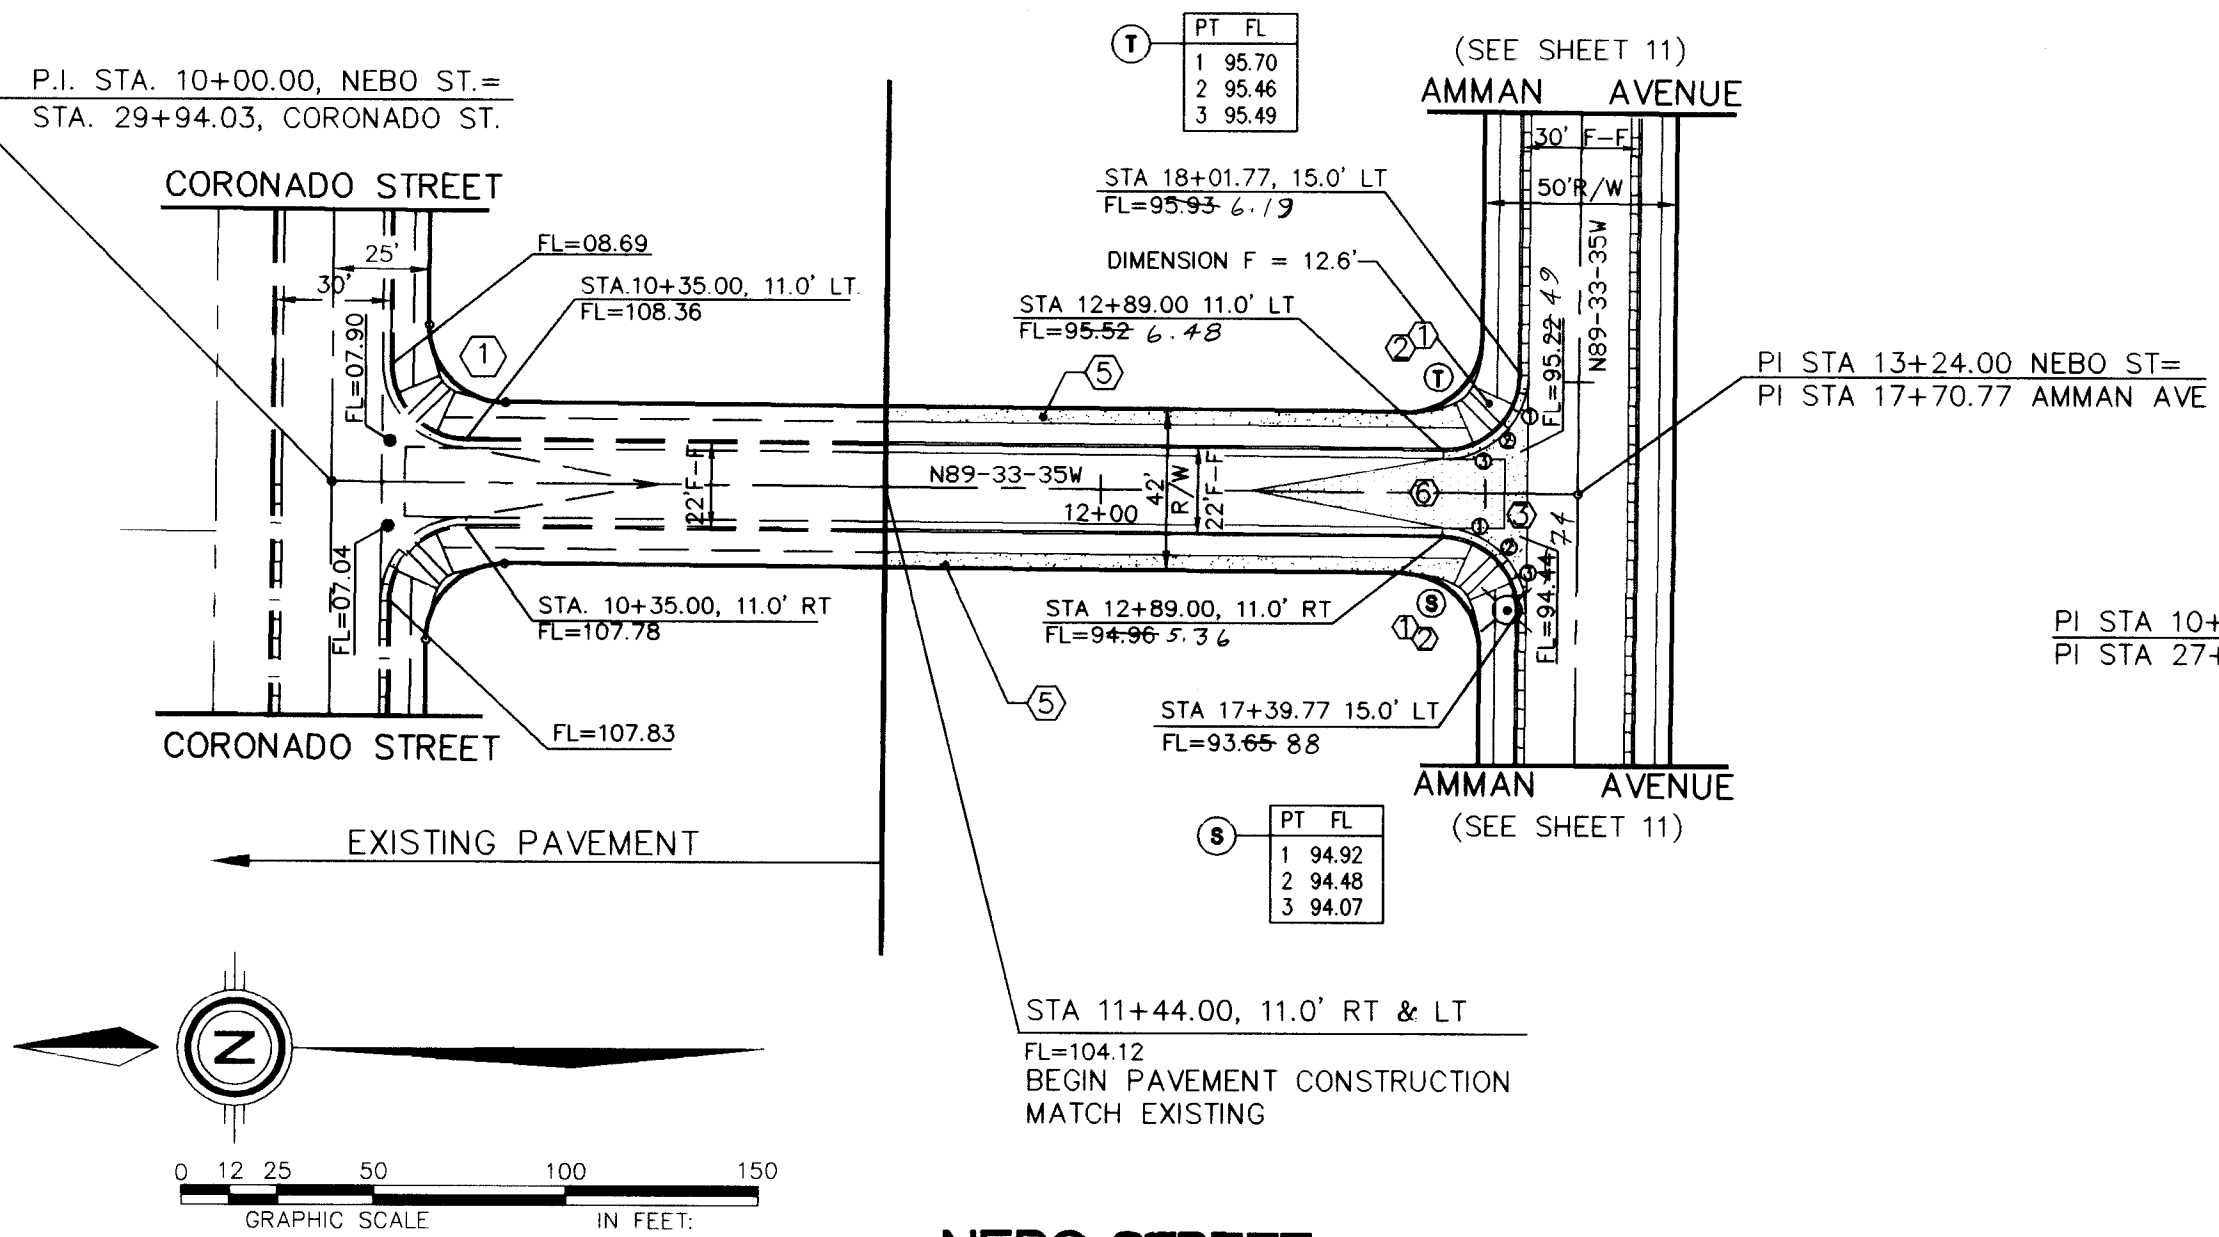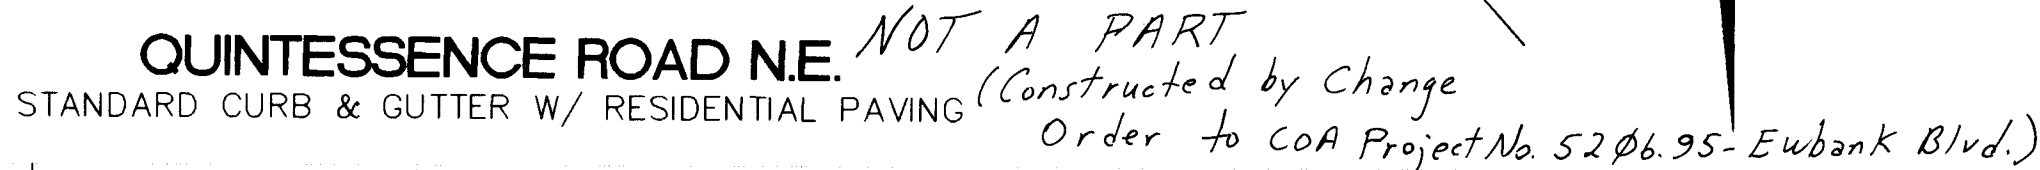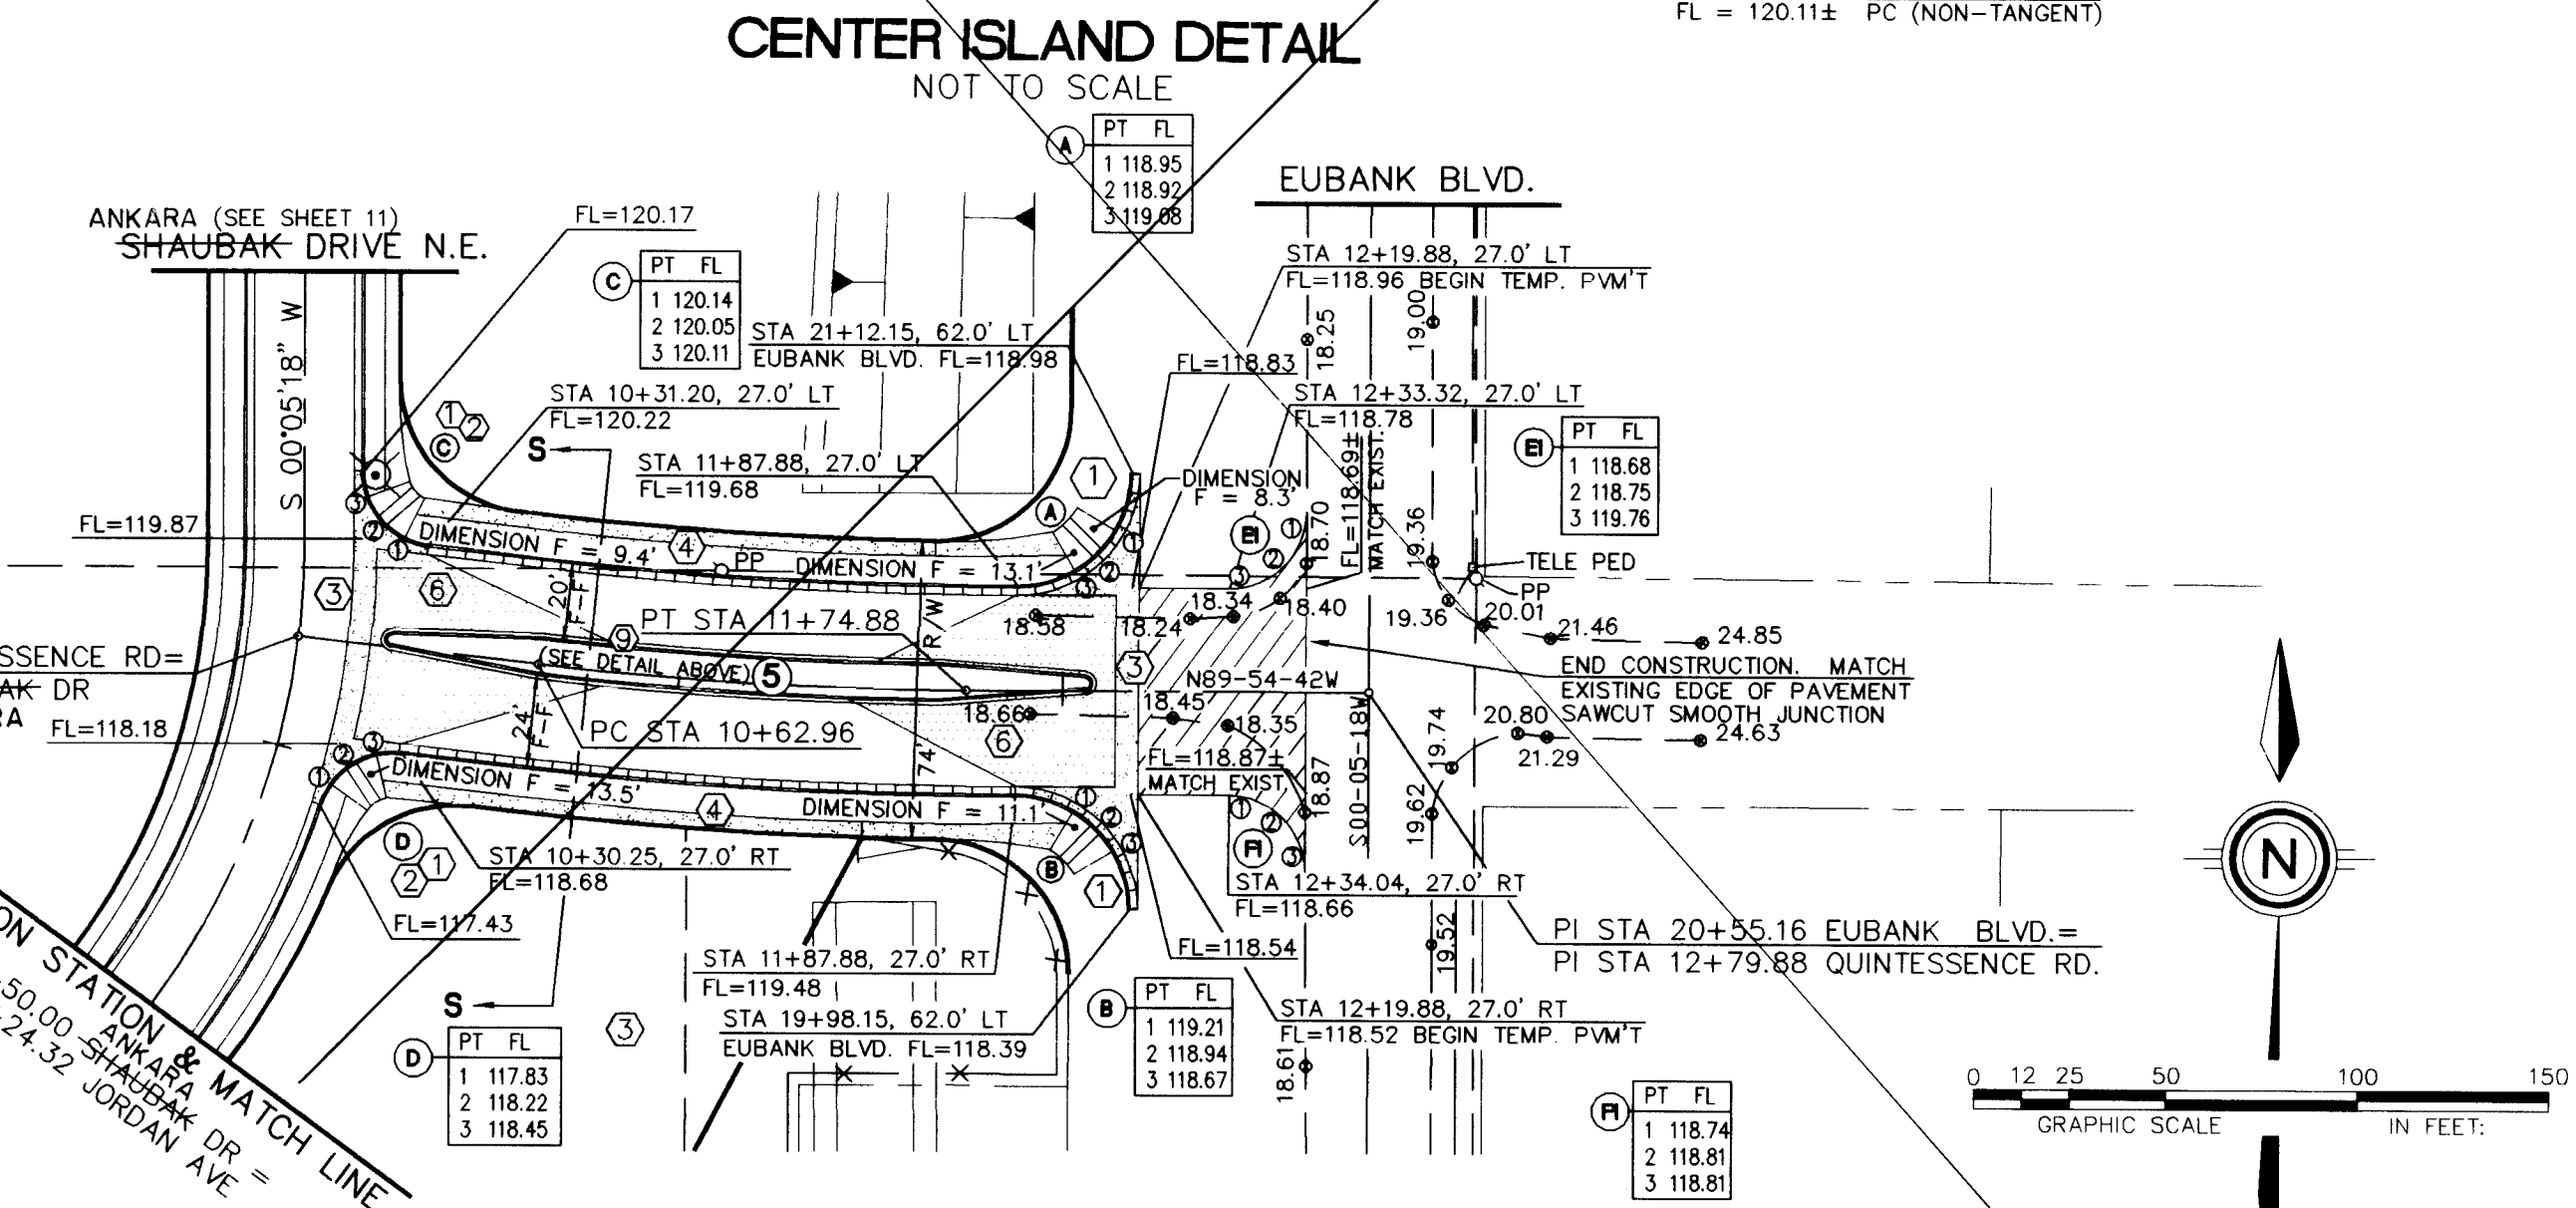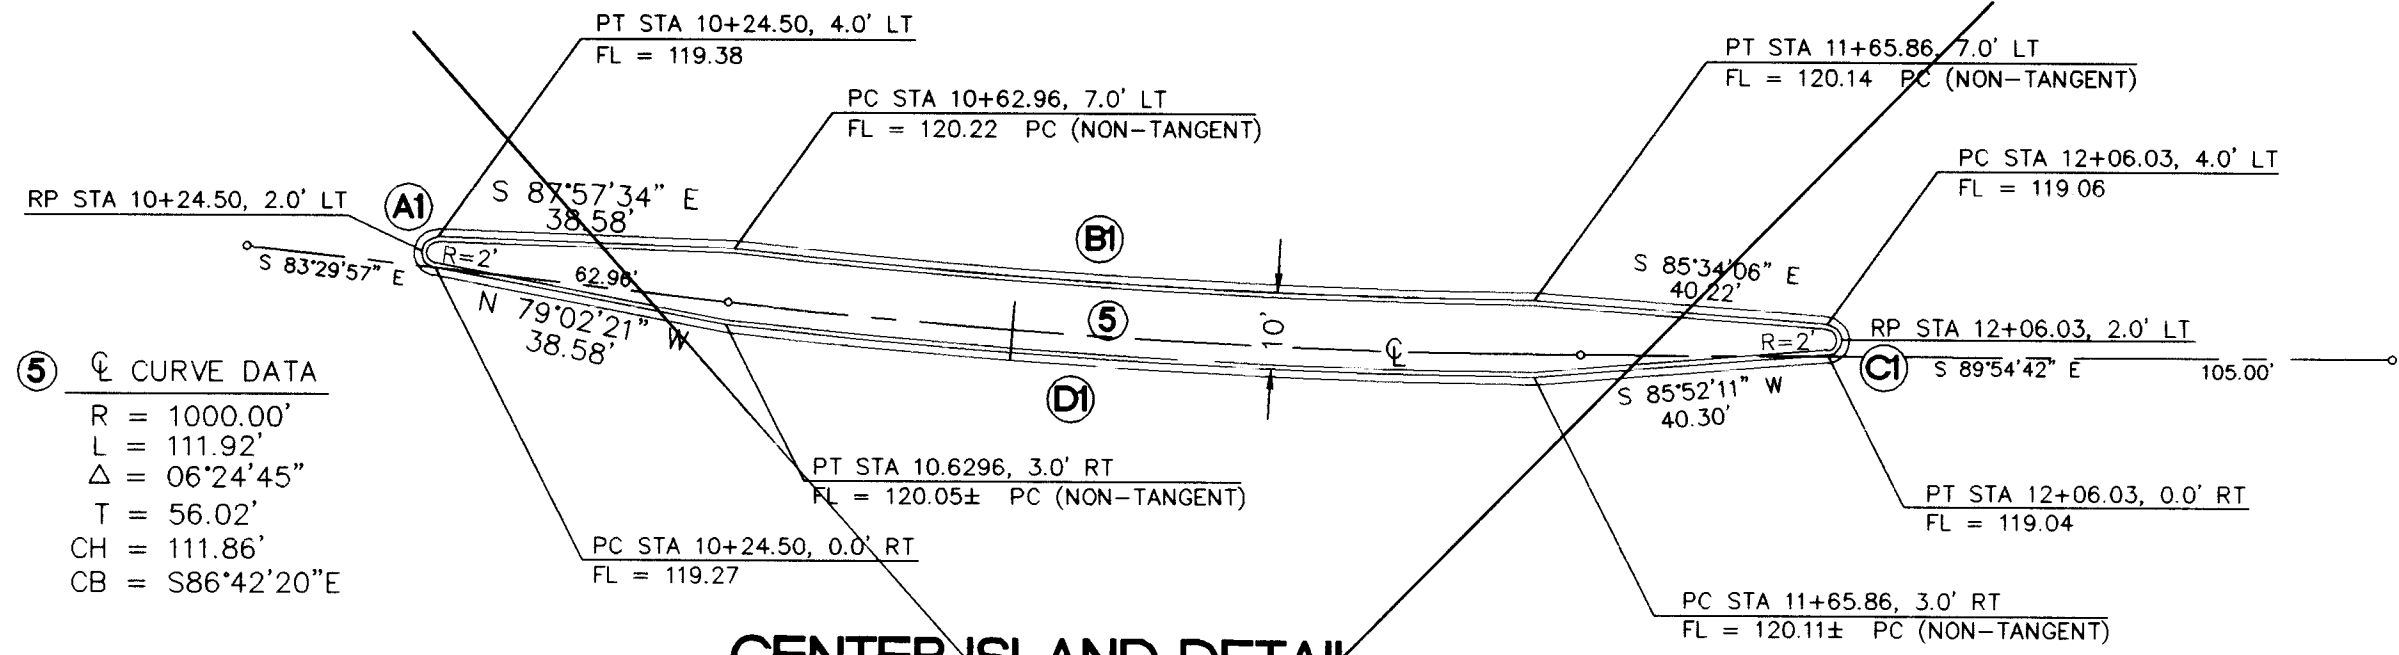

I, the undersigned engineer, a duly qualified Registered

[illegible]

 Elery A. Biatkowski Jr.
Elery A. Biatkowski, Jr. P.O. Box 11000, Oak Ridge, TN 37831

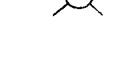- | LEGEND | |
|---|--|
| ● FL=74.11 | PROPOSED CURB FLOWLINE ELEVATION |
| 73.6 ⓧ | EXISTING SPOT ELEVATION (GRND & TC) |
|  | PROPOSED VALLEY GUTTER/ SIDEWALK |
|  | EXISTING CURB & GUTTER |
|  | PROPOSED MOUNTABLE CURB & GUTTER |
|  | PROPOSED STANDARD CURB & GUTTER |
|  | FLOW ARROW |
|  | CROWN TRANSITION |
|  | EXISTING EDGE OF PAVEMENT |
|  | PROPOSED MOUNTABLE CURB & GUTTER |
|  | PROPOSED STANDARD CURB & GUTTER |
|  | CURB FLOWLINE ELEV SHOWN IN BOX
CORRESPONDS TO QUARTERPOINTS
INDICATED IN A CLOCKWISE DIRECTION
AS PER COA STD DWG 2418, NOTE 5 |
|  | TEMPORARY PAVEMENT |

- KEYED NOTES:**
- (1) WHEELCHAIR RAMP PER COA STD.
DWG 2441 CASE II (DIMENSION "F"
MODIFIED AS SHOWN ON PLAN VIEW)
 - (2) MOUNTABLE TO STANDARD CURB
TRANSITION PER COA STD DWG 2418
 - (3) CONCRETE VALLEY GUTTER PER COA
STD DWG 2420
 - (4) PROPOSED 4' SIDEWALK, THIS CONTRACT
 - (5) PROPOSED 4' SIDEWALK, BY OTHERS
 - (6) 50" CROWN TRANSITION PER COA
STD DWG 2401
 - (7) 25" CROWN TRANSITION PER COA
STD DWG 2401
 - (8) CONCRETE VALLEY GUTTER PER COA
STD DWG 2421
 - (9) MEDIAN CURB & GUTTER PER COA
STD DWG 2415

SURVEY INFORMATION			BENCH MARKS		AS BUILT INFORMATION	
NO.	FIELD NOTES	DATE			WORK BY	DATE
1	COMMUNITY SCIENCES	6/98	THE STATION IS A STANDARD ACS ALUMINUM CAP STAMPED "5-DIT 1985" AND IS RIVETED TO AN ALUMINUM PIPE PROJECTING 0.1 FOOT ABOVE GROUND.		INSPECTOR'S ACCEPTANCE BY	DATE
			IT IS LOCATED 793 FEET NORTH OF THE CENTERLINE INTERSECTION OF COPONADO AVENUE AND HOLBROOK STREET, AND 85 FEET EAST OF THE CENTERLINE OF HOLBROOK STREET.		VERIFICATION BY	DATE
					DRAWINGS CORRECTED BY	DATE
			ELEV = 5650.56		RECORDED BY	DATE
					NO	

ENGINEER'S SEAL

Jan 12 1962

[illegible]

DATE:	4/22/96
SCALE:	
HORIZ:	1" = 50'
VERT:	1" = 10'
JOB NO.:	32310041

*community
sciences
corporation*

LAND PLANNING P.O. Box 1328	ENGINEERING Corrales, N.M. 87048	SURVEYING (505)897-0000
--------------------------------	-------------------------------------	----------------------------

CITY OF ALBUQUERQUE
PUBLIC WORKS DEPARTMENT
ENGINEERING DEVELOPMENT GROUP

TITLE: QUINTESSENCE SUBDIVISION - UNIT 4
PAVING PLAN & PROFILE
NEBO ST. & QUINTESSENCE RD. N.E.

DESIGN REVIEW COMMITTEE
APPROVE
NOV 2 1996
DESIGN
REVIEW COMMITTEE


CITY ENGINEER APPROVAL

LAST DESIGN DATE	MO./DAY/YR.	MO./DAY/YR.

PROJECT NO. 5206.94

MAP NO.	D-21
---------	------


SHEET	16	OF	24
-------	----	----	----

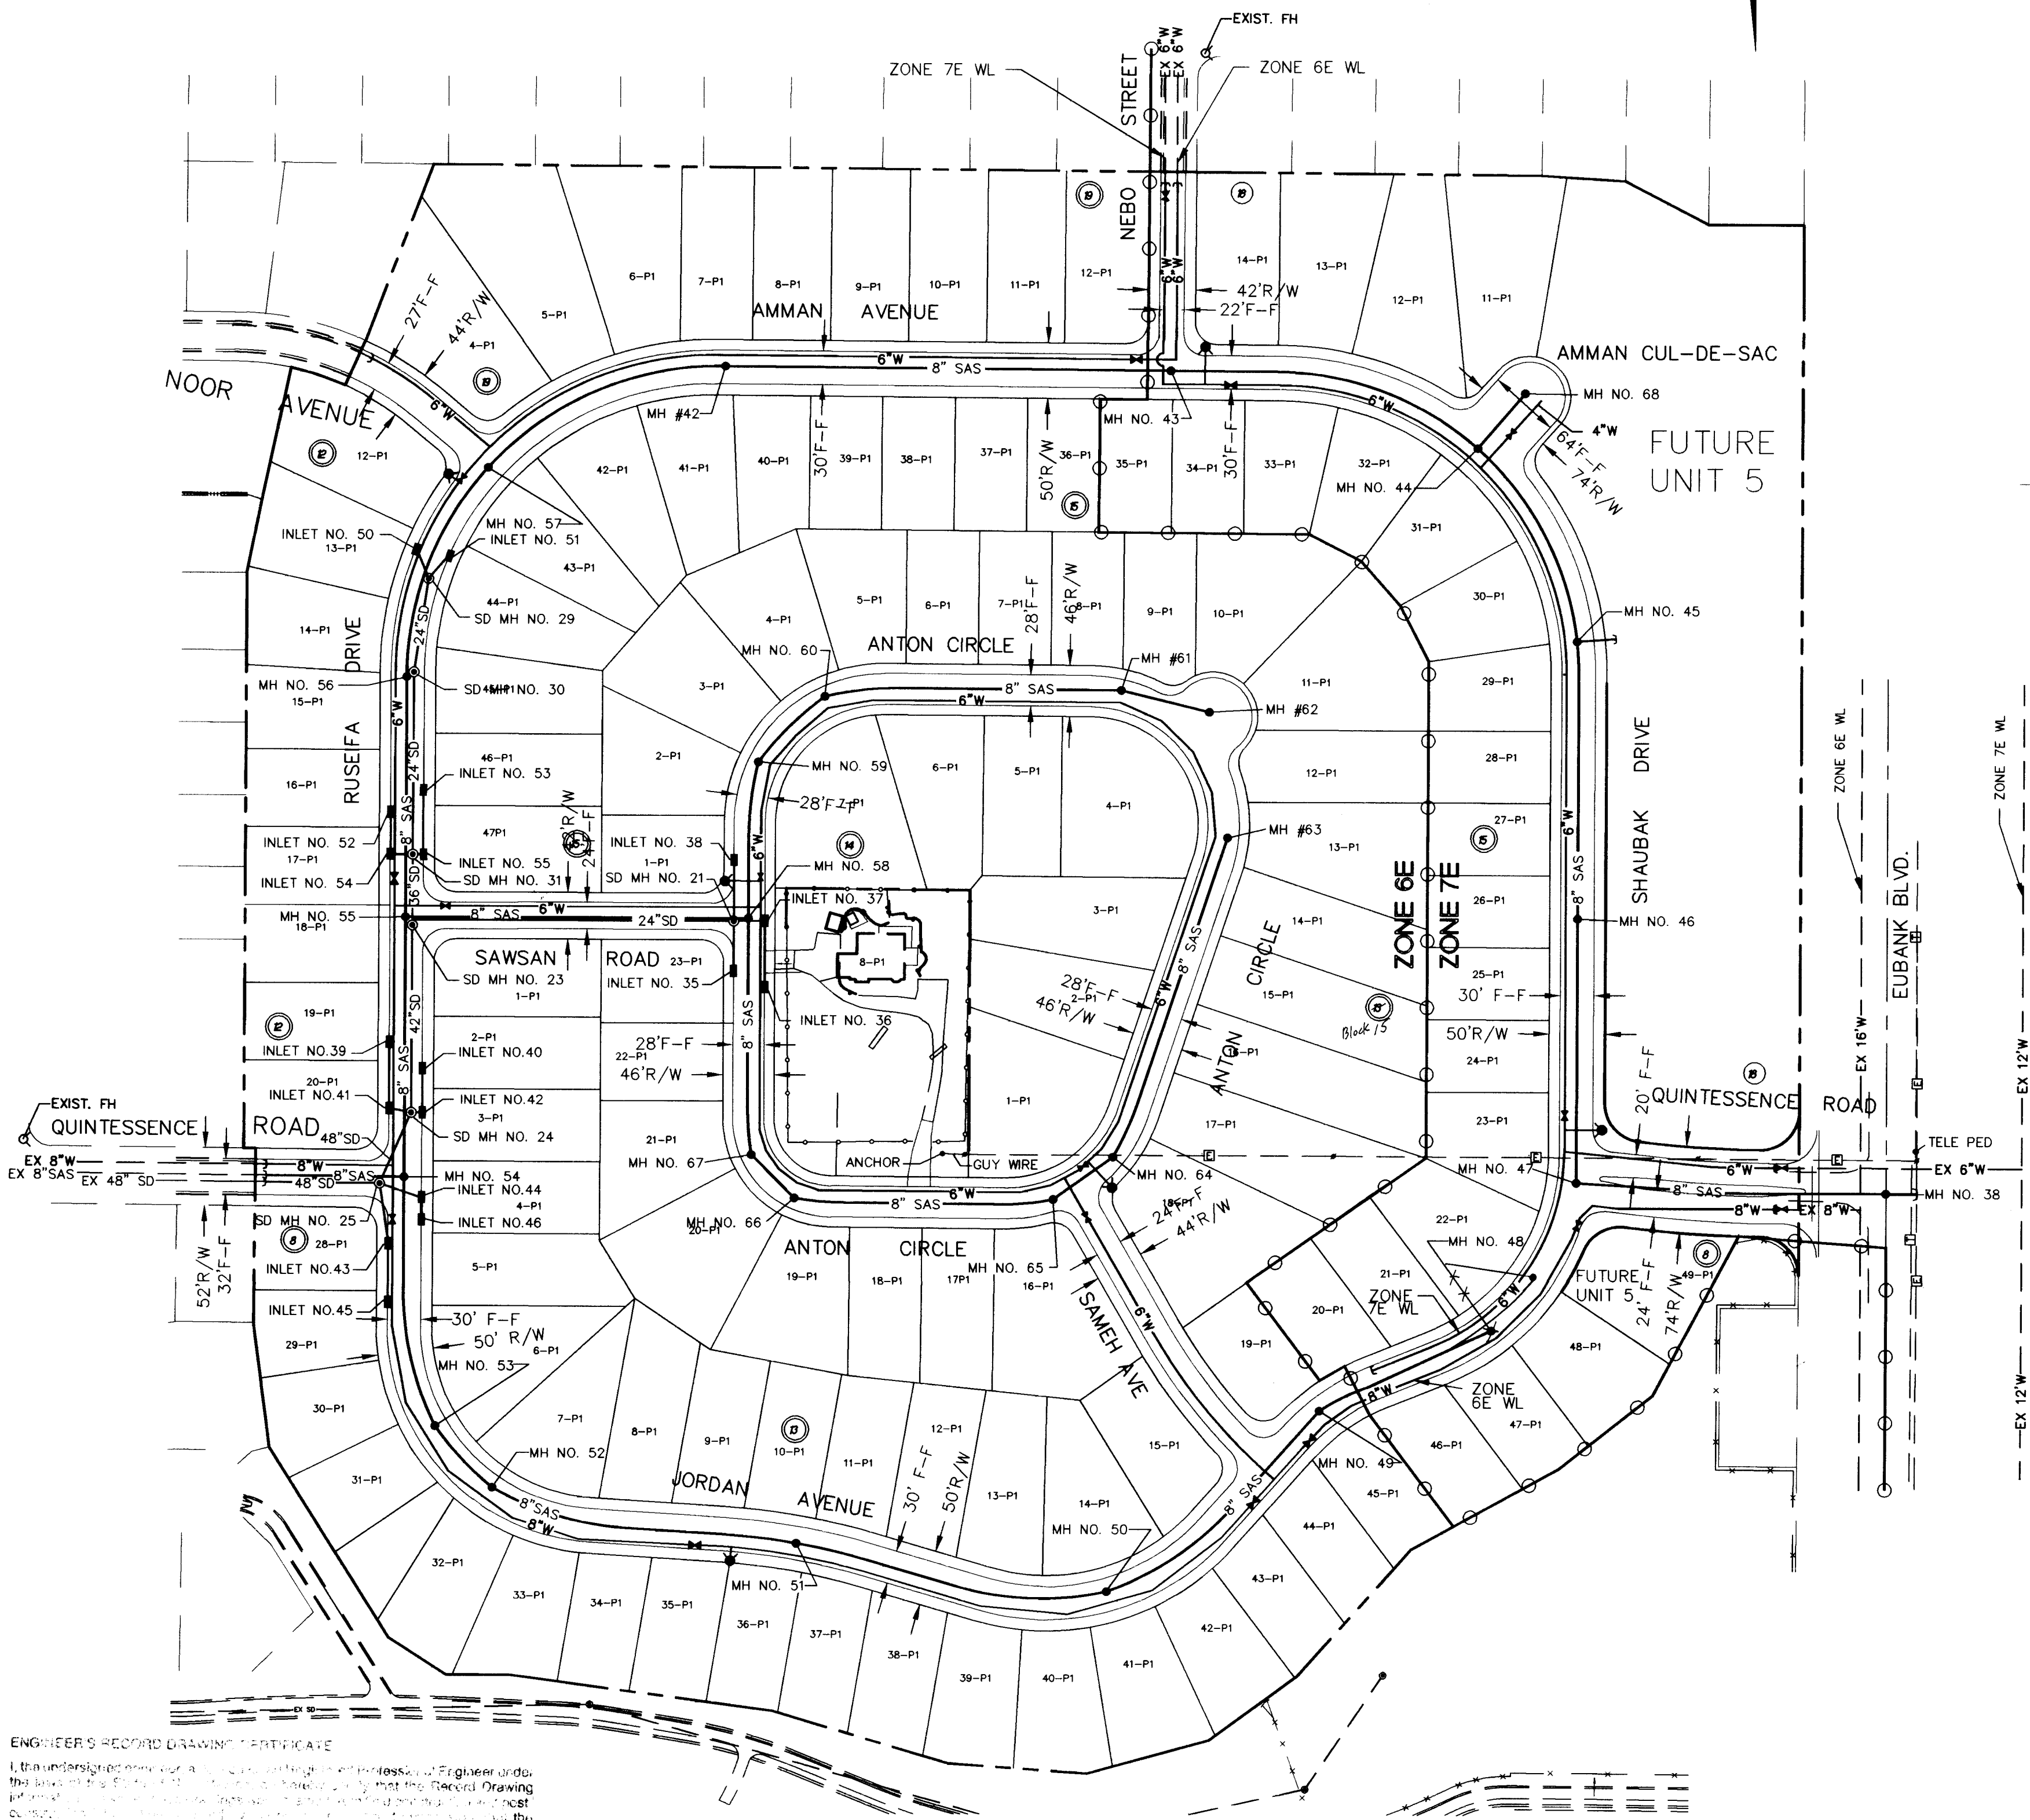


ENGINEER'S RECORD DRAWING CERTIFICATE

I, the undersigned, hereby certify that I am a duly licensed Professional Engineer under the laws of the State of New Mexico, and that I have prepared the above drawing and specifications in accordance with the laws of the State of New Mexico, and that I am not providing any other services to the client that would conflict with my duties as a Professional Engineer. I am not providing any other services to the client that would conflict with my duties as a Professional Engineer.

Elmer R. Brathwaite, Jr.
Elmer R. Brathwaite, Jr.

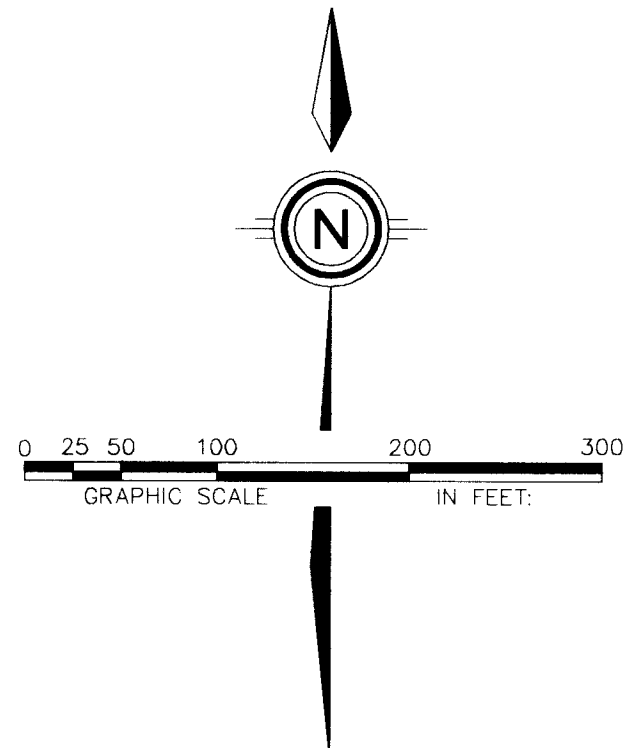

WATER METER BOX INSTALLATION

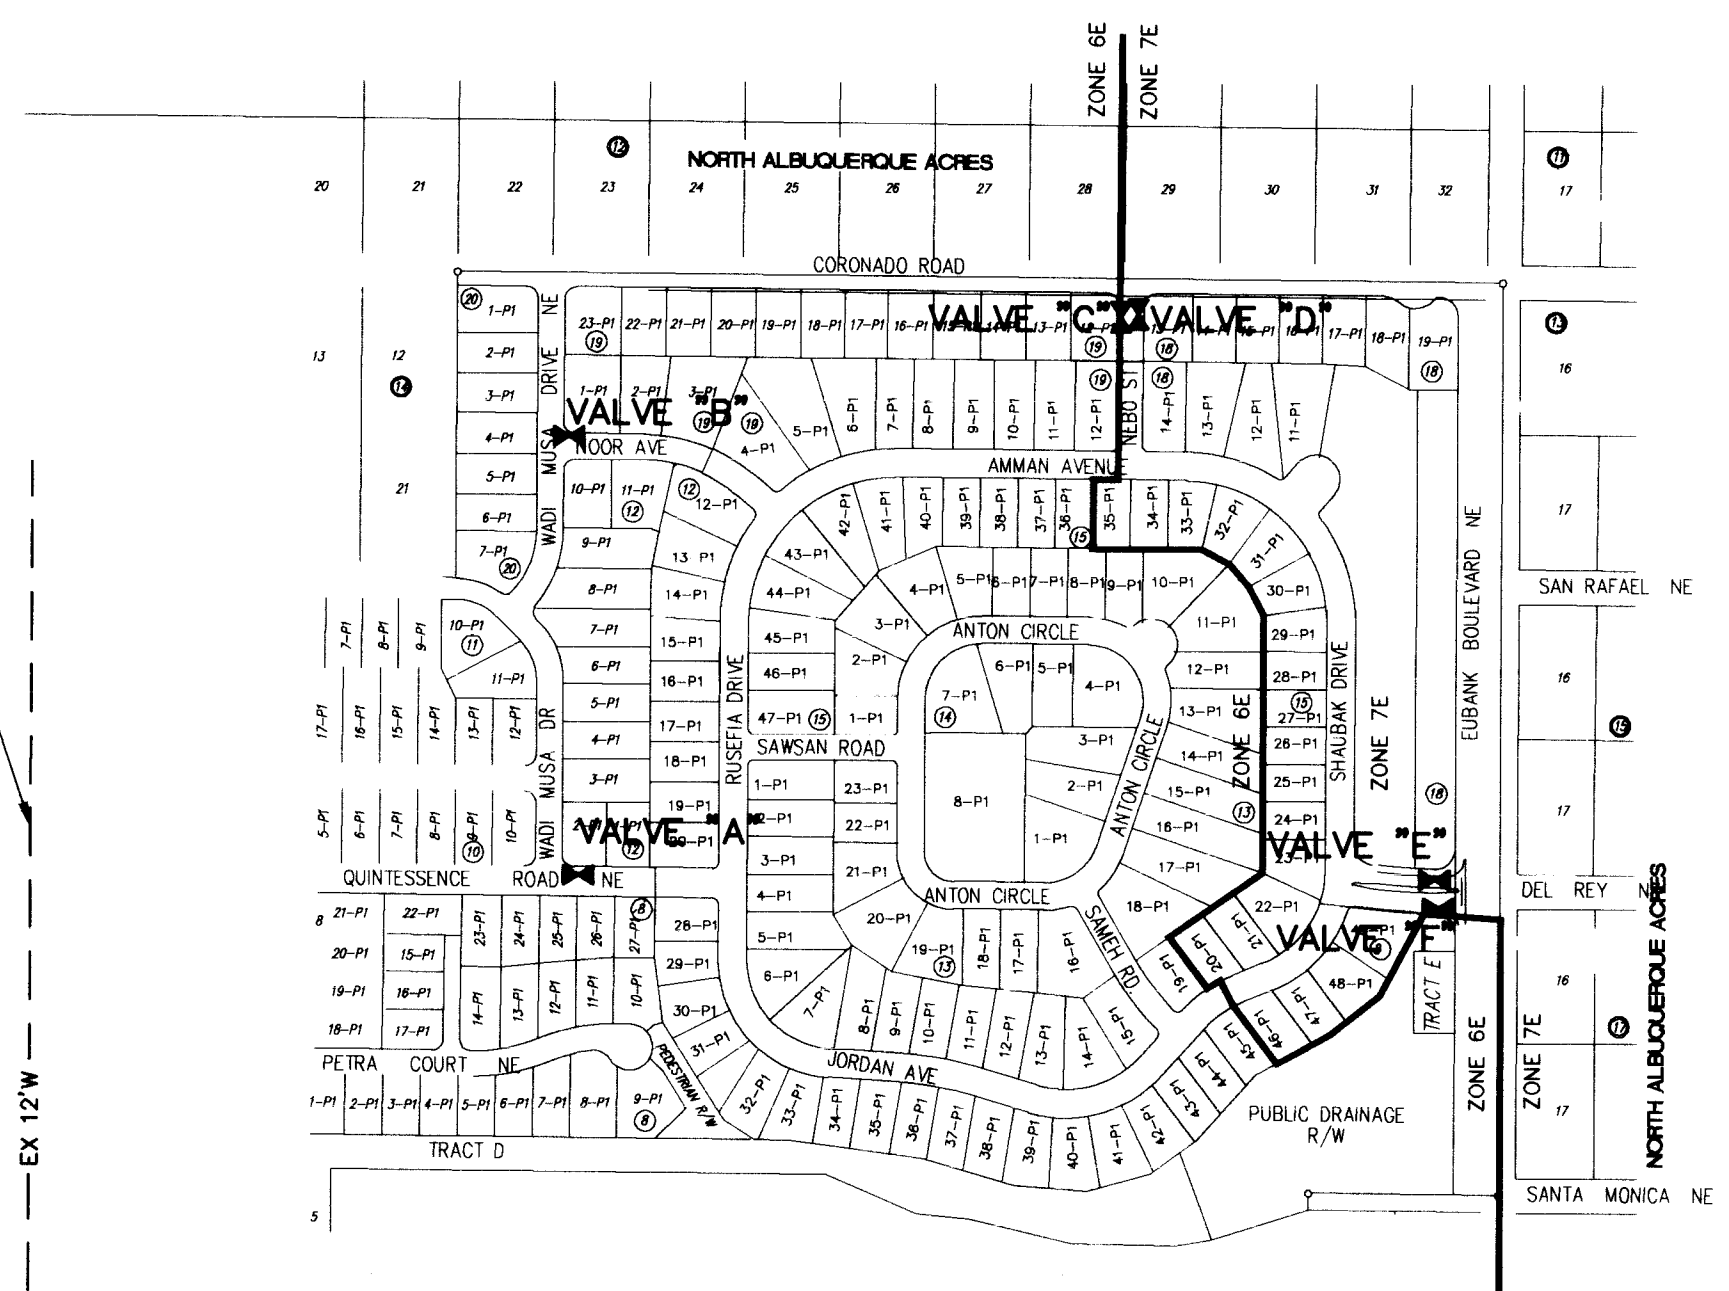NOT TO SCALE
NOTE: INSTALL WATER METER PER C.O.A. STD. DWG. 2362

WATER SHUT-OFF PLAN

- NOTES:
- VALVES "A", "B", "D", & "E" SHALL BE SHUT-OFF SO NON-PRESSURE CONNECTIONS CAN BE MADE IN ZONE 6E; VALVES "C" & "E" FOR ZONE 7E.
 - CONTRACTOR SHALL CONTACT WATER SYSTEMS DIVISION (857-8200) FIVE(5) WORKING DAYS PRIOR TO VALVE SHUT-OFF. ONLY WATER SYSTEMS PERSONNEL ARE AUTHORIZED TO OPERATE VALVES

UTILITY LEGEND		
DESCRIPTION	PROPOSED	EXISTING
SANITARY SEWER LINE	8" SAS	8" SAS
ENCASEMENT		
SANITARY SEWER MANHOLE		
SAS SERVICE CONNECTION	S	S
STORM DRAIN LINE	SD	SD
STORM DRAIN MANHOLE		
STORM DRAIN INLETS		
WATER LINE	W	W
GATE VALVE		
BUTTERFLY VALVE		
FIRE HYDRANTS		
REDUCERS		
3/4" WATER SERVICE/METER		
TEES		
CROSSES		
BENDS		
CAPS & PLUGS		
PRESSURE ZONE LINE		
GAS LINES	N/A	4" HP
OVERHEAD ELECTRICAL LINE	N/A	
UNDERGROUND ELECTRICAL	N/A	
OVERHEAD TELEPHONE	N/A	
UNDERGROUND TELEPHONE	N/A	
CABLE TELEVISION	N/A	
POWER OR TELEPHONE POLE	N/A	

RESTRAINING LENGTHS

FITTING	LR (FT)
6"x6" TEE	RUN 10', BRANCH 2'
8"x8" TEE	RUN 13' BRANCH 3'
6"x4" REDUCER	43'
8"x6" REDUCER	25'
6" 11 1/4" BEND	2'
6" 22 1/2" BEND	3'
6" 90° BEND	17'
8" 11 1/4" BEND	2'
8" 22 1/2" BEND	4'
8" 90° BEND	22'
4" CAP	32'
6" CAP	46'
6" GATE VALVE	46'
8" GATE VALVE	60'

- NOTES:
- RESTRAINED JOINTS, SUCH AS MEGA-LUG EQUIVALENT BRANDS ACCEPTABLE TO THE ENGINEER, SHALL BE USED ON ALL TEES, BENDS, CROSSES & CAPS IN LIEU OF CONCRETE THRUST BLOCKING. RESTRAINED JOINTS SHALL BE MECHANICALLY RESTRAINED TO THIS CONTRACT AND NO ADDITIONAL COMPENSATION, MEASUREMENT, OR PAYMENT WILL BE MADE THEREFOR.
 - LR SHALL BE THE LENGTH OF WATER MAIN THAT REQUIRED JOINTS ON EACH SIDE OF THE FITTINGS.
 - ALL FIRE HYDRANTS & FITTINGS ETC. SHALL BE BUILT IN ACCORDANCE WITH/ COA STD DWG'S 2301 THRU 2380 INCLUSIVE.
 - ALL CURVILINEAR WATER AND SEWER LINES WITH A RADIUS OF LESS THAN 300' SHALL BE PVC PER COA STANDARDS AND SPECIFICATIONS.

DATE:	6/96	<i>community sciences corporation</i>		
SCALE:	1"=100'			
JOB NO.:	32310050			
LAND PLANNING		ENGINEERING	SURVEYING	
P.O.Box 1328		Corrales, N.M. 87048	(505)897-0000	

community sciences corporation

CITY OF ALBUQUERQUE
PUBLIC WORKS DEPARTMENT
ENGINEERING DEVELOPMENT GROUP
TITLE: QUINTESSENCE SUBDIVISION- UNIT 4
COMPOSITE UTILITY PLAN

DESIGN REVIEW COMMITTEE	CITY ENGINEER APPROVAL	MO./DAY/YR.	MO./DAY/YR.
APPROVED			
DESIGN REVIEW COMMITTEE			

PROJECT NO. 5206.94
MAP NO. D-21


SHEET 17 OF 24

BENCH MARKS		AS-BUILT INFORMATION	
THE STATION IS A STANDARD ACS ALUMINUM CAP STAMPED "5-D21 1985" AND IS RIVETED TO AN ALUMINUM PIPE PROJECTING 0.1 FOOT ABOVE GROUND. IT IS LOCATED 793 FEET NORTH OF THE CENTELINE INTERSECTION OF CORONADO AVENUE AND HOLBROOK STREET, AND 85 FEET EAST OF THE CENTERLINE OF HOLBROOK STREET. ELEV. = 9650.56		CONTRACTOR: Power Excavating & Grading, Inc. DATE: 6/96 WORK: Precision Survey, Inc. DATE: 6/96 ACCEPTANCE: By Elmer Brathwaite, Jr. DATE: 6/96 DRAWING: By Elmer Brathwaite, Jr. DATE: 6/96 MICRO-FILM INFORMATION RECORDED BY: J.D.H. NO.	

SURVEY INFORMATION		FIELD NOTES	
NO. 1		DATE 4/96 BY COMMUNITY SCIENCES	

ENGINEER'S SEAL
Elmer R. Brathwaite, Jr.
Professional Engineer
No. 19124
State of New Mexico

REVISIONS		REMARKS	
NO.	DATE	BY	DATE
1	6/96	J.M.N.	6/96
2	6/96	G.W./D.W.	6/96
3	7/96	J.D.H.	7/96

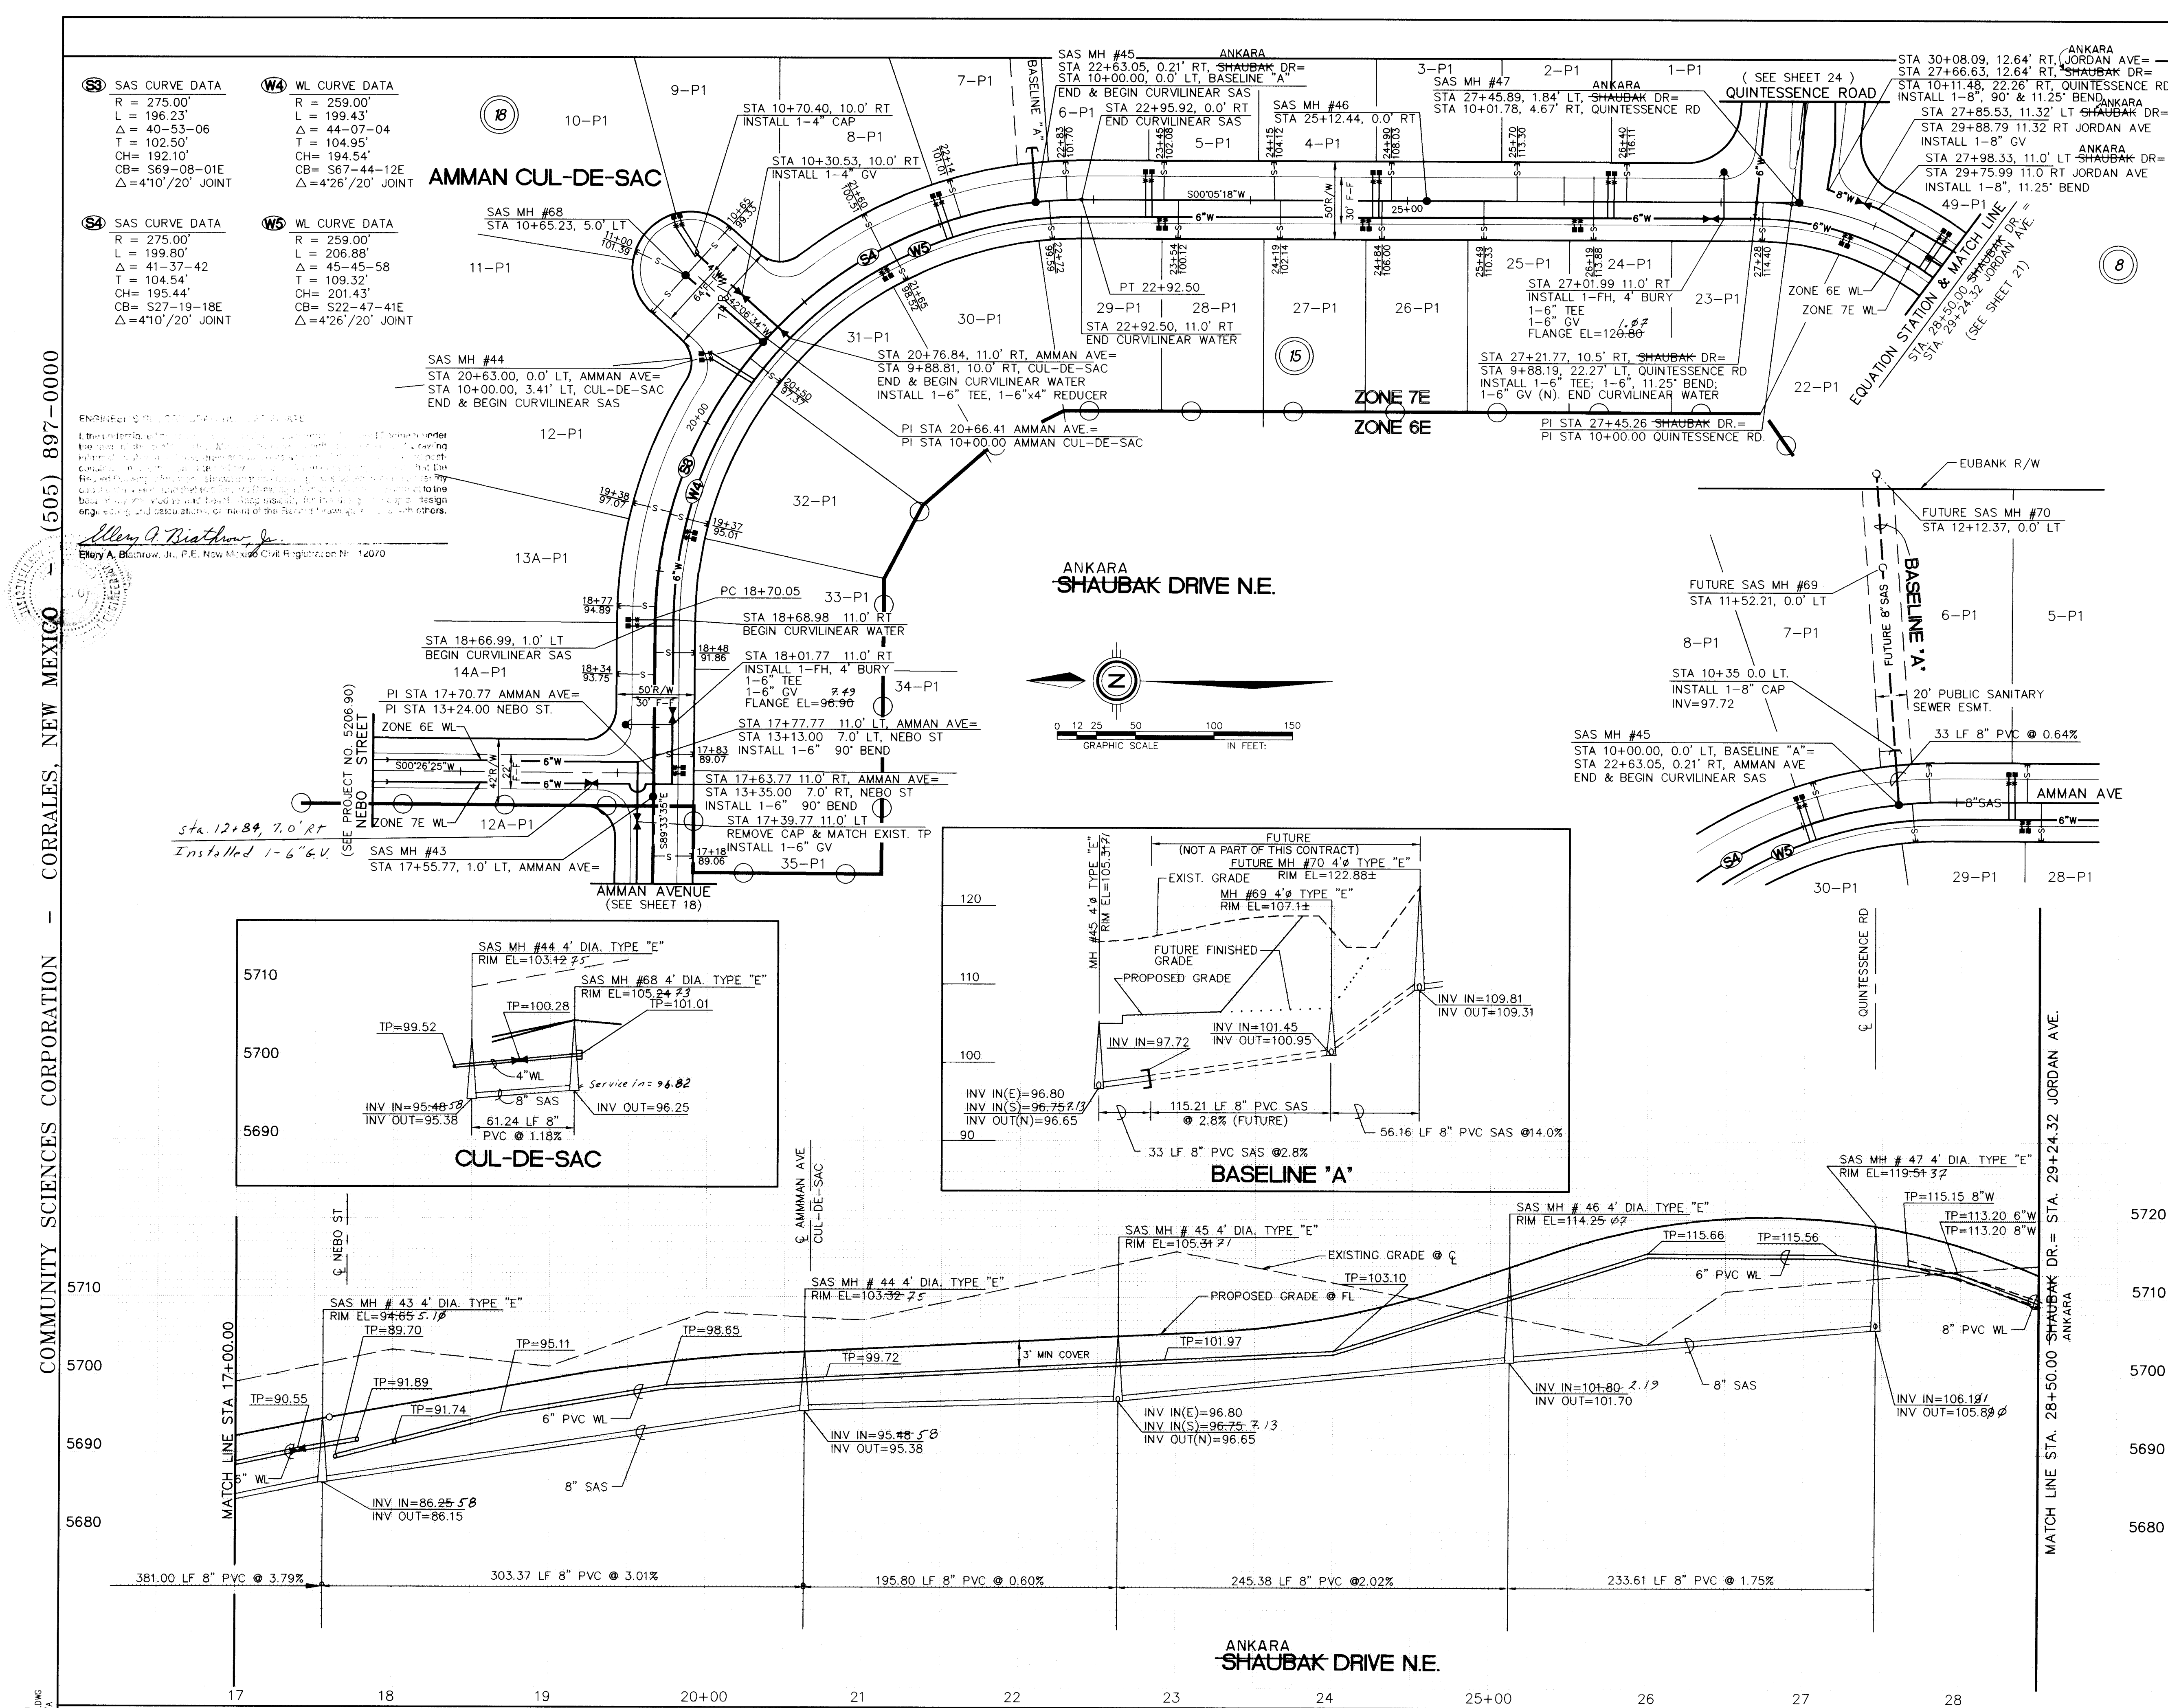

UTILITY LEGEND

DESCRIPTION	PROPOSED	EXISTING
SANITARY SEWER LINE	8" SAS	8" SAS
ENCASEMENT		
SANITARY SEWER MANHOLE		
SAS SERVICE CONNECTION		
STORM DRAIN LINE	SD-30"	SD-30"
STORM DRAIN MANHOLE		
STORM DRAIN INLETS		
WATER LINE	W-6"	W-6"
GATE VALVE		
BUTTERFLY VALVE		
FIRE HYDRANTS		
REDUCERS		
3/4" WATER SERVICE/METER		
TEES		
CROSSES		
BENDS		
CAPS & PLUGS		
GAS LINES	N/A	N/A
OVERHEAD ELECTRICAL LINE	N/A	N/A
UNDERGROUND ELECTRICAL	N/A	N/A
OVERHEAD TELEPHONE	N/A	N/A
UNDERGROUND TELEPHONE	N/A	N/A
CABLE TELEVISION	N/A	N/A
POWER OR TELEPHONE POLE	N/A	N/A
SANITARY SEWER SERVICE (TYP)	(STA) 10+75 (INV) 76.82	

RESTRAINING LENGTHS

FITTING	LR (FT)
6" TEE	RUN 10', BRANCH 2'
8" TEE	RUN 13' BRANCH 3'
6"x4" REDUCER	45'
8"x6" REDUCER	25'
6" 11 1/4" BEND	2'
6" 22 1/2" BEND	3'
6" 90° BEND	17'
8" 11 1/4" BEND	2'
8" 22 1/2" BEND	4'
8" 90° BEND	22'
4" CAP	32'
6" CAP	46'
6" GATE VALVE	46'
8" GATE VALVE	60'

NOTES:

- RESTRAINED JOINTS, SUCH AS MEGA-LUG EQUIVALENT BRANDS ACCEPTABLE TO THE ENGINEER, SHALL BE USED ON ALL TEES, BENDS, CROSSES & CAPS IN LIEU OF CONCRETE THRUST BLOCKING. RESTRAINED JOINTS SHALL BE MECHANICALLY RESTRAINED AND INSTALLED WITH CONCRETE BLOCKING PER COA STD DWG 2333 IN ADDITION TO THE MECHANICALLY RESTRAINED LENGTHS. ALL CAPS SHALL BE INSTALLED WITH CONCRETE BLOCKING PER COA STD DWG 2320. RESTRAIN ALL JOINTS ON FIRE HYDRANTS.
- LR SHALL BE THE LENGTH OF WATER MAIN THAT REQUIRED JOINTS ON EACH SIDE OF THE FITTINGS.
- ALL FIRE HYDRANTS & FITTINGS ETC. SHALL BE BUILT IN ACCORDANCE WITH COA STD DWG 2301 THRU 2380 INCLUSIVE.
- ALL CURVILINEAR WATER AND SEWER LINES WITH A RADIUS OF LESS THAN 300' SHALL BE PVC PER COA STANDARDS AND SPECIFICATIONS.

community sciences corporation

CITY OF ALBUQUERQUE
PUBLIC WORKS DEPARTMENT
ENGINEERING DEVELOPMENT GROUP

TITLE: QUINTESSENCE SUBDIVISION - UNIT 4
ANKARA UTILITY PLAN & PROFILE
SHAUBAK DRIVE N.E. & BASELINE "A"

DESIGN REVIEW COMMITTEE
CITY ENGINEER APPROVAL
DESIGN REVIEW COMMITTEE

APPROVED
4/20/96

PROJECT NO. 5206.94
MAP NO. D-21
SHEET 19 OF 24


SURVEY INFORMATION

FIELD NOTES	DATE
1 COMMUNITY SCIENCES	4/96

ENGINEER'S SEAL







REVISIONS

NO.	DATE	BY
1	4/96	JAN
2	6/96	LUD/LW/DJK
3	6/96	JDH

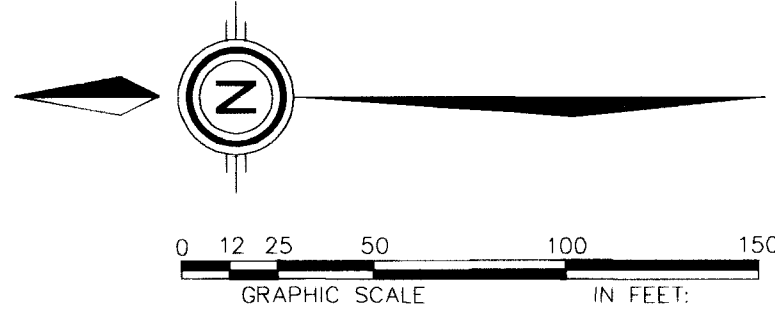

ENCLOSURE: RELEVANT DATA FOR THIS SHEET
The information herein is based on data furnished by the owner and is not to be used for any purpose other than that for which it was prepared. The engineer assumes no responsibility for the accuracy or completeness of the information furnished by the owner. The engineer's only obligation is to prepare the drawings in accordance with the information furnished by the owner. The engineer does not warrant the accuracy or completeness of the information furnished by the owner. The engineer's only obligation is to prepare the drawings in accordance with the information furnished by the owner.

Elly A. Brathorn, Jr.
Elly A. Brathorn, Jr., P.E., Professional Engineer
No. 10,000, State of New Mexico

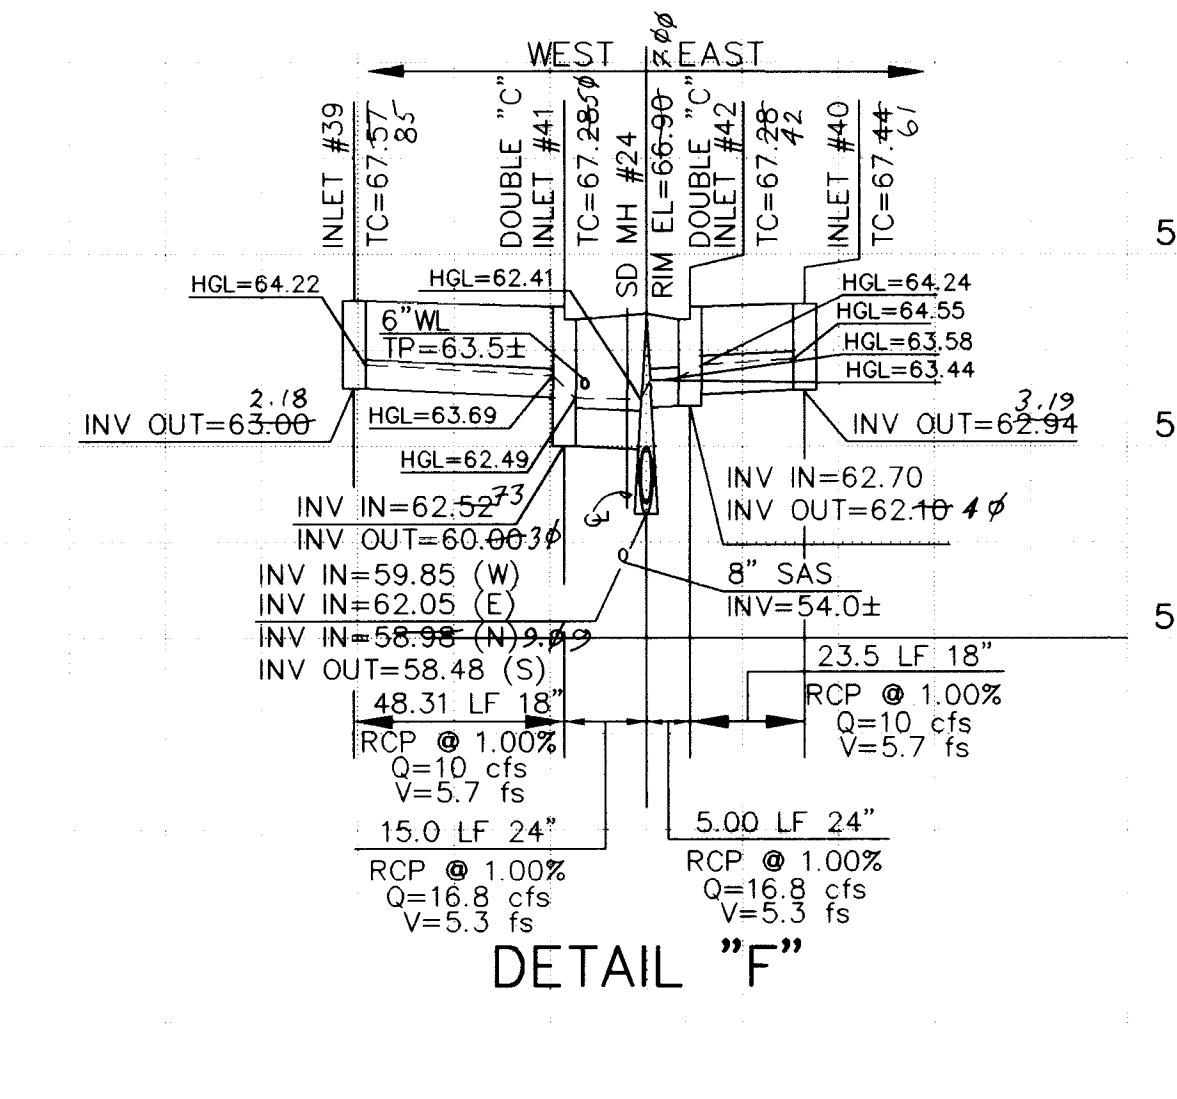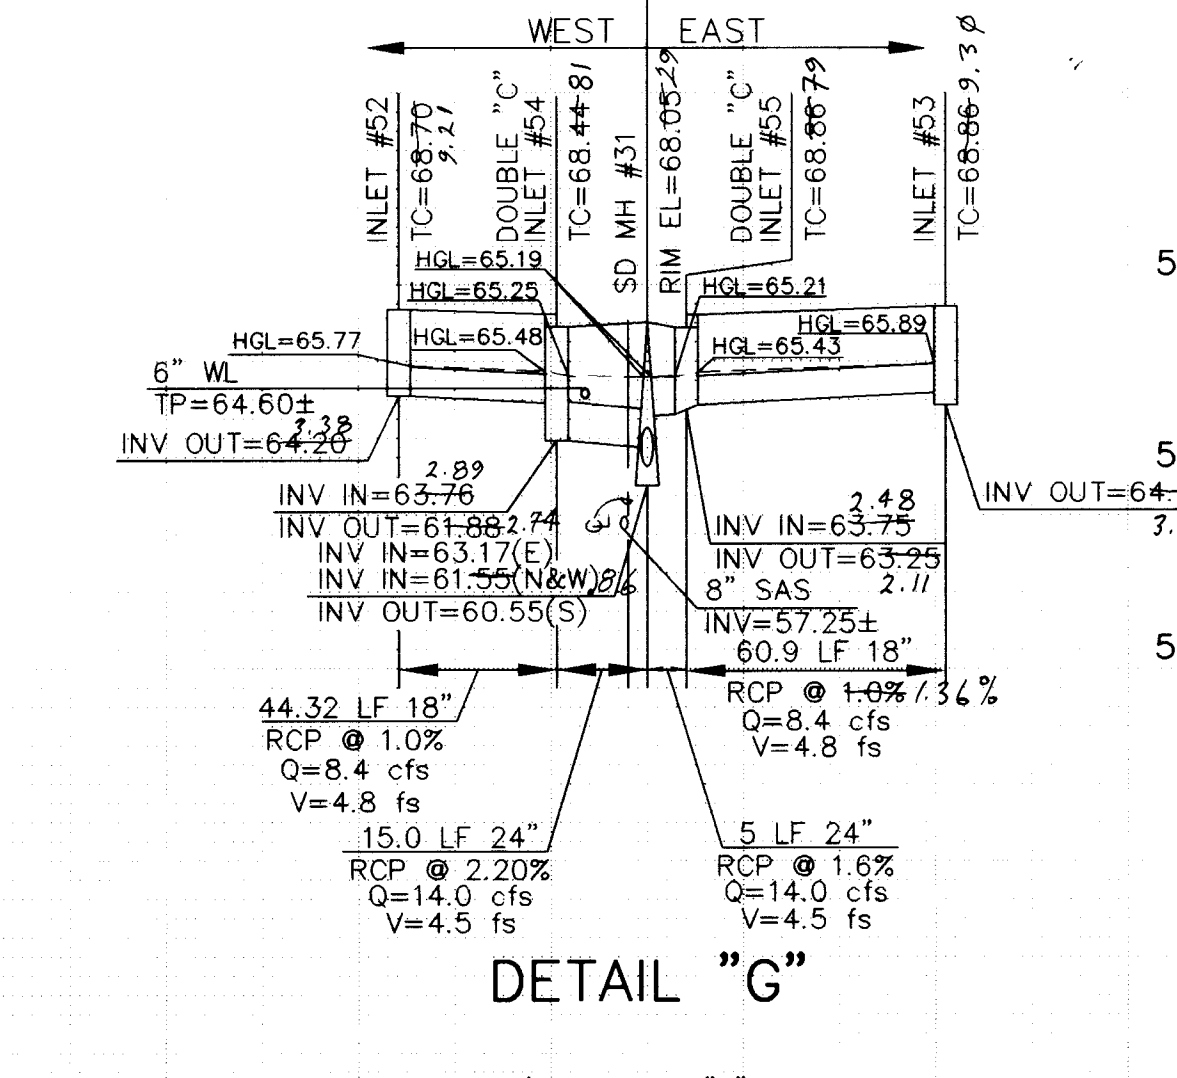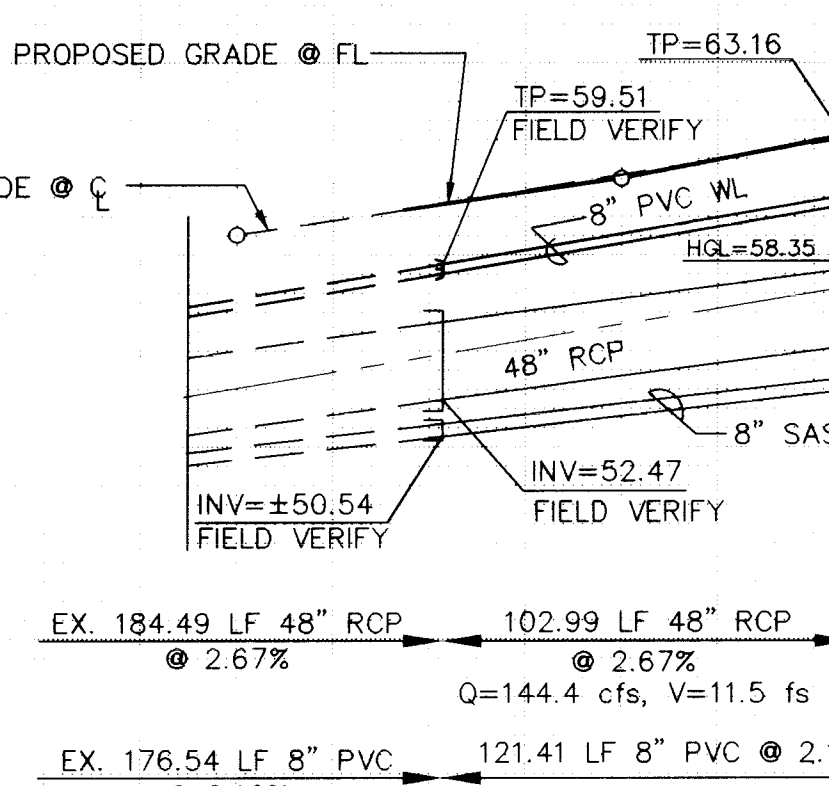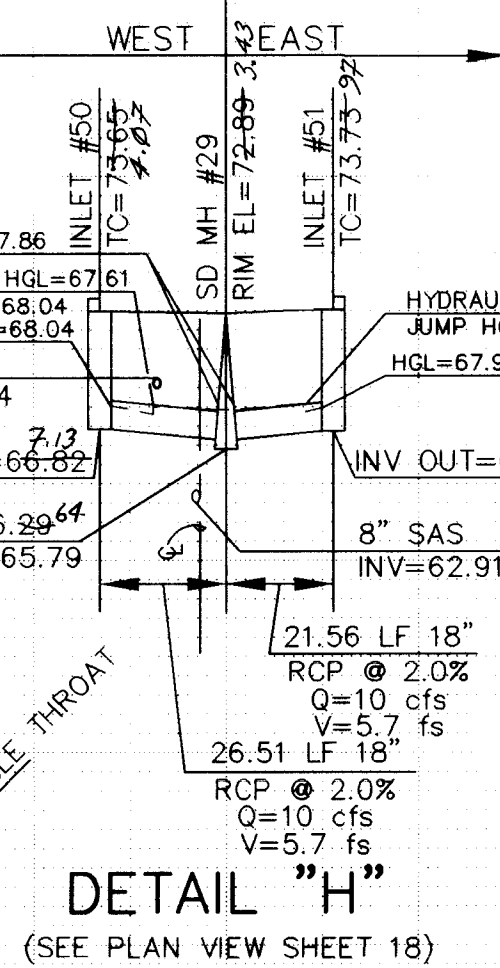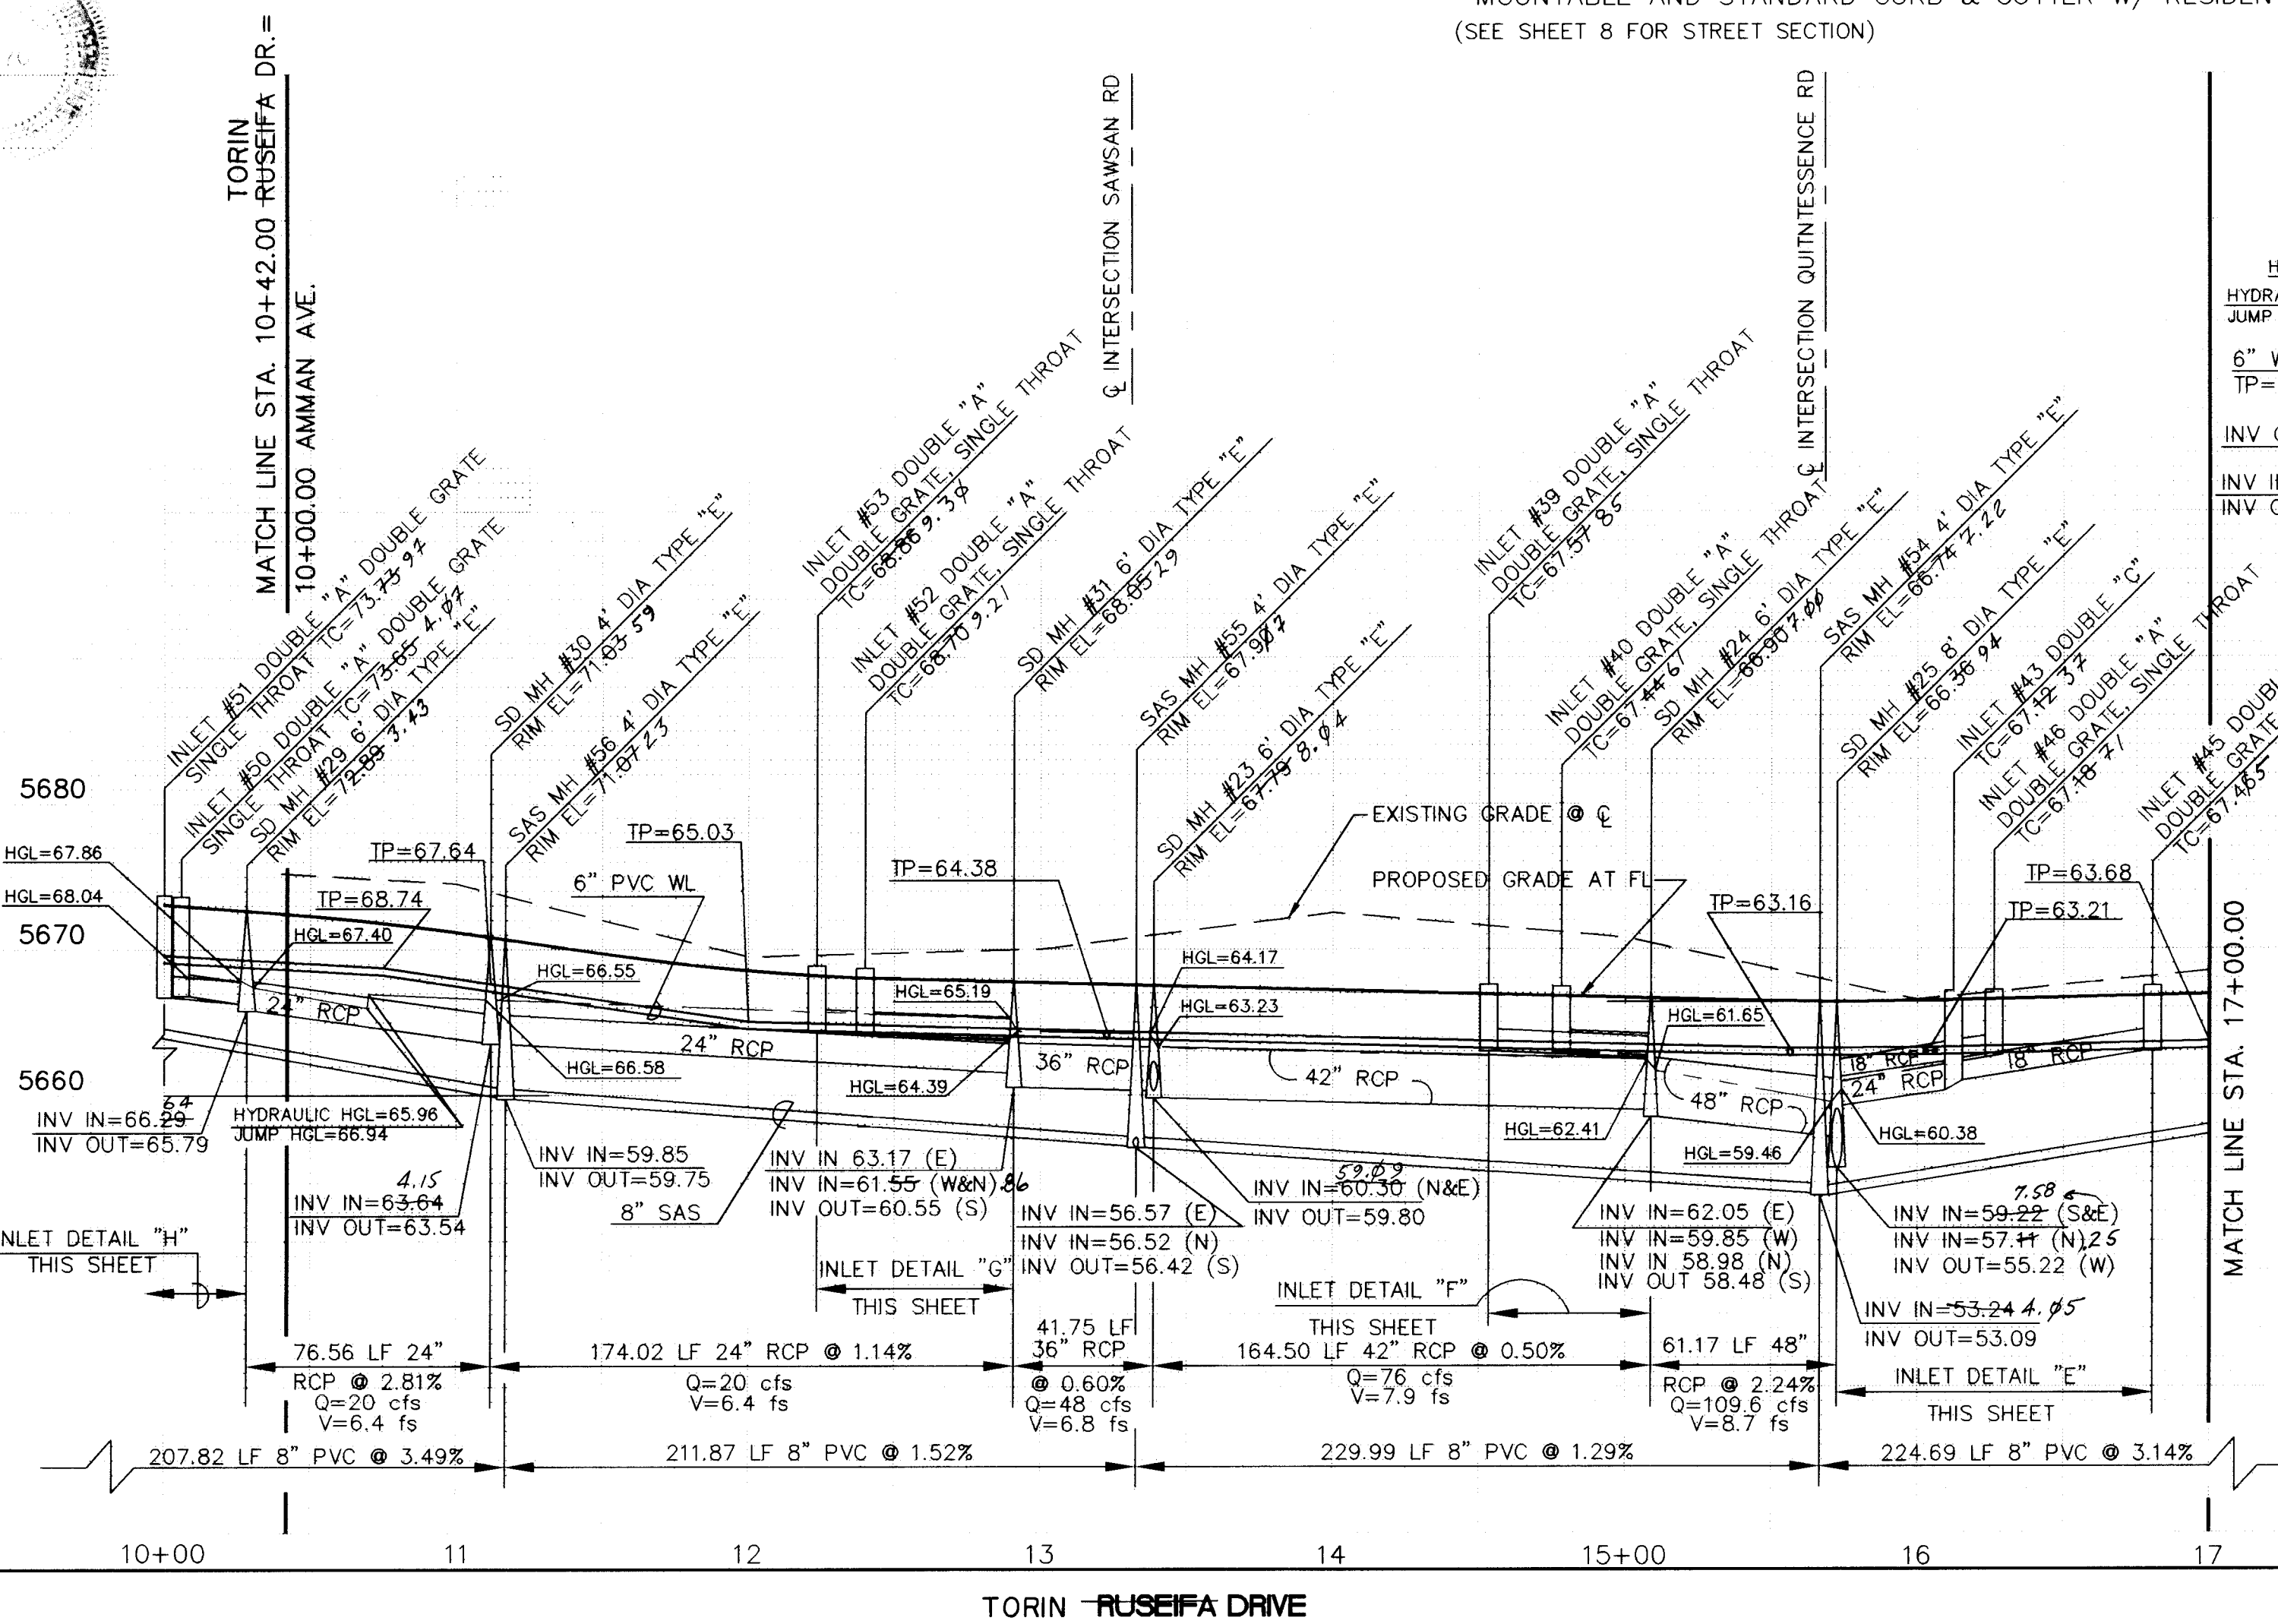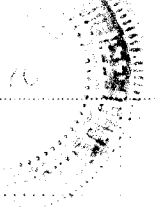

UTILITY LEGEND		
DESCRIPTION	PROPOSED	EXISTING
SANITARY SEWER LINE	8" SAS	8" SAS
ENCASEMENT		
SANITARY SEWER MANHOLE		
SAS SERVICE CONNECTION		
STORM DRAIN LINE	SD-30"	SD-30"
STORM DRAIN MANHOLE		
STORM DRAIN INLETS		
WATER LINE	W-6"	W-6"
GATE VALVE		
BUTTERFLY VALVE		
FIRE HYDRANTS		
REDUCERS		
3/4" WATER SERVICE/METER		
TEES		
CROSSES		
BENDS		
CAPS & PLUGS		
GAS LINES	N/A	6" B.P.
OVERHEAD ELECTRICAL LINE	N/A	
UNDERGROUND ELECTRICAL	N/A	
OVERHEAD TELEPHONE	N/A	
UNDERGROUND TELEPHONE	N/A	
CABLE TELEVISION	N/A	
POWER OR TELEPHONE POLE	N/A	
SANITARY SEWER SERVICE (TYP)	(STA) 10+75 (INV) 76.82	

RESTRAINING LENGTHS	
FITTING	LR (FT)
6"x6" TEE	RUN 10', BRANCH 2'
8" TEE	RUN 13' BRANCH 3'
6"x4" REDUCER	43'
8"x6" REDUCER	25'
6" 11 1/4" BEND	2'
6" 22 1/2" BEND	3'
6" 90° BEND	17'
8" 11 1/4" BEND	2'
8" 22 1/2" BEND	4'
8" 90° BEND	22'
4" CAP	32'
6" CAP	46'
6" GATE VALVE	46'
8" GATE VALVE	60'

LR = LENGTH TO BE RESTRAINER EACH SIDE OF THE FITTING. FOR TEES, ALL THREE LEGS SHALL BE RESTRAINER FOR A DISTANCE OF "LR". FOR REDUCERS, "LR" IS GIVEN FOR THE LARGER DIAMETER SIDE OF THE FITTING AND NO RESTRAINER IS REQUIRED ON THE SMALL SIDE OF THE FITTING. GATE VALVES SHALL BE MECHANICALLY RESTRAINER AND INSTALLED WITH CONCRETE BLOCKING PER COA STD DWG 2333 IN ADDITION TO THE MECHANICALLY RESTRAINER. RESTRAIN ALL JOINTS ON FIRE HYDRANTS.

NOTES:
1. RESTRAINER JOINTS, SUCH AS MEGA-LUG EQUIVALENT BRANDS ACCEPTABLE TO THE ENGINEER, SHALL BE USED ON ALL TEES, BENDS, CROSSES & CAPS IN LIEU OF CONCRETE THRUST BLOCKING. RESTRAINER JOINTS SHALL BE CONSIDERED INCIDENTAL TO THIS CONTRACT AND NO ADDITIONAL COMPENSATION, MEASUREMENT, OR PAYMENT WILL BE MADE THEREFOR.
2. LR SHALL BE THE LENGTH OF WATER MAIN THAT REQUIRED JOINTS ON EACH SIDE OF THE FITTINGS.
3. ALL FIRE HYDRANTS & FITTINGS ETC. SHALL BE BUILT IN ACCORDANCE WITH COA STD DWG'S 2301 THRU 2380 INCLUSIVE.
4. ALL CURVILINEAR WATER AND SEWER LINES WITH A RADIUS OF LESS THAN 300' SHALL BE PVC PER COA STANDARDS AND SPECIFICATIONS.

REMARKS	
DESIGN	REVISIONS
NO.	DATE
1	7/9/96

DESIGNED BY	JAN	DATE	6/96
DRAWN BY	LD/DLW/JK/GJR	DATE	6/96
CHECKED BY	JCH	DATE	7/96

PROJECT NO. 5206.94
MAP NO. D-21
SHEET 20 OF 24

TITLE: QUINTESSENCE SUBDIVISION - UNIT 4
TORIN RUSEIFA DRIVE & QUINTESSENCE RD N.E.

APPROVED: [Signature]
DESIGN REVIEW COMMITTEE

CITY ENGINEER APPROVAL: [Signature]
CITY OF ALBUQUERQUE
PUBLIC WORKS DEPARTMENT
ENGINEERING DEVELOPMENT GROUP


SURVEY INFORMATION	
FIELD NOTES	DATE
NO.	BY
1	COMMUNITY SCIENCES

ENGINEER'S SEAL	
DATE	7/9/96
BY	JCH


BENCH MARKS	
CONTRACTOR: Romero Excavating & Trucking <td>DATE: Dec. 97</td>	DATE: Dec. 97
STATE: New Mexico <td>DATE: Dec. 97</td>	DATE: Dec. 97
FIELD: ACCEPTANCE BY Elly A. Brathorn, Jr. <td>DATE: Dec. 97</td>	DATE: Dec. 97
FIELD: CORRECTION BY Elly A. Brathorn, Jr. <td>DATE: Dec. 97</td>	DATE: Dec. 97
FIELD: MICRO-FILM INFORMATION <td>DATE: Dec. 97</td>	DATE: Dec. 97

SAS CURVE DATA	SAS CURVE DATA	SAS CURVE DATA	CL CURVE DATA	SAS CURVE DATA	SAS CURVE DATA
R = 275.00' L = 128.65' Δ = 26-48-17 T = 65.53' CH = 127.48' CB = S13-18-43E Δ/JOINT = 4'10"/JOINT	R = 277.04' L = 75.76' Δ = 15-40-04 T = 38.12' CH = 75.52' CB = S43-09-46E Δ/JOINT = 4'08"/JOINT	R = 275.00' L = 126.49' Δ = 26-21-13 T = 64.38' CH = 125.38' CB = S73-15-27E Δ/JOINT = 4'10"/JOINT	R = 275.00' L = 143.21' Δ = 29-50-12 T = 73.27' CH = 141.59' CB = S87-23-48E Δ/JOINT = 4'10"/JOINT	R = 275.00' L = 136.16' Δ = 28-22-11 T = 69.51' CH = 134.78' CB = N56-04-37E Δ/JOINT = 4'10"/JOINT	R = 275.00' L = 40.52' Δ = 08-26-33 T = 20.30' CH = 40.48' CB = N61-28-54E Δ/JOINT = 4'10"/JOINT

WL CURVE DATA
R = 589.00' L = 130.54' Δ = 12-41-56 T = 65.54' CH = 130.28' CB = S80-05-05E Δ/JOINT = 1'57"/JOINT

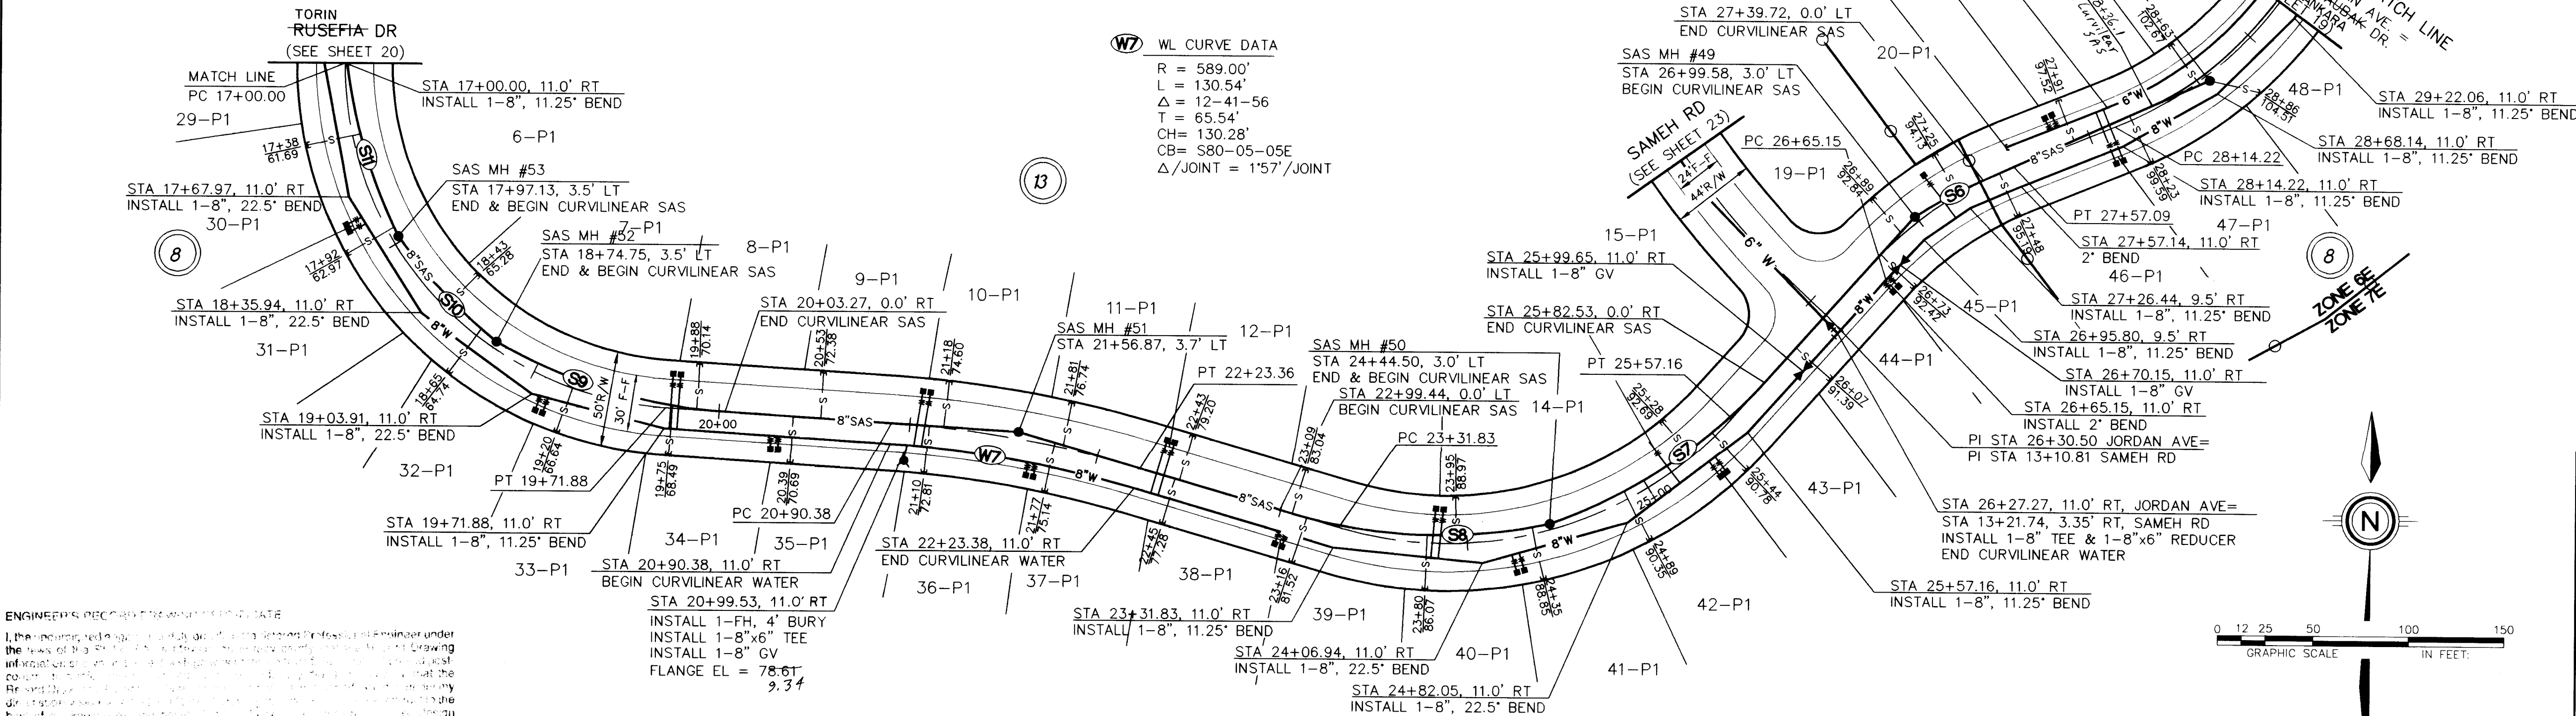

JORDAN AVENUE

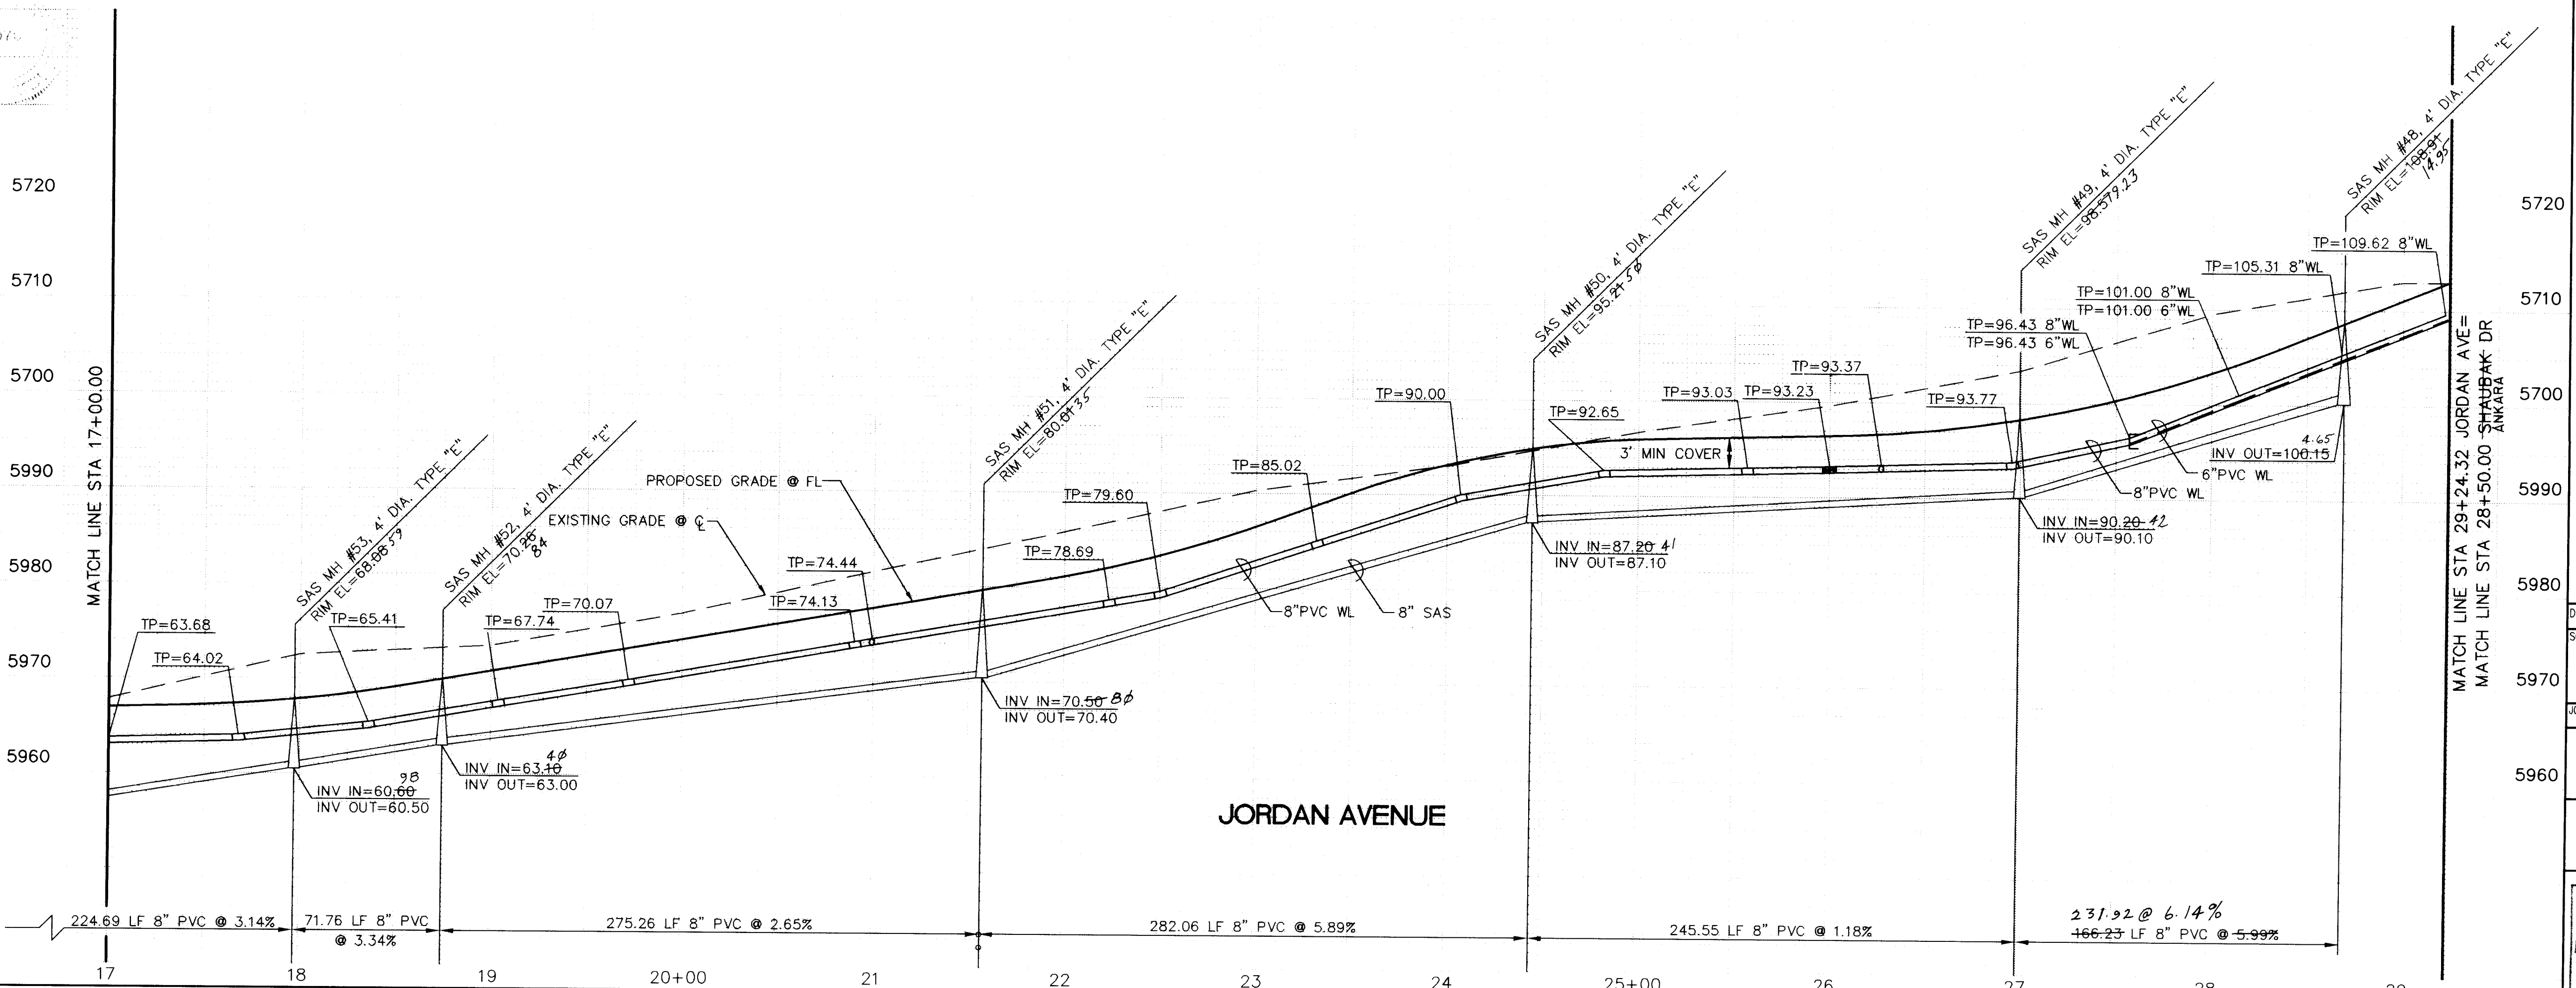

UTILITY LEGEND

DESCRIPTION	PROPOSED	EXISTING
SANITARY SEWER LINE	8" SAS	8" SAS
ENCASEMENT		
SANITARY SEWER MANHOLE		
SAS SERVICE CONNECTION		
STORM DRAIN LINE	SD-30"	SD-30"
STORM DRAIN MANHOLE		
STORM DRAIN INLETS		
WATER LINE	W-6"	W-6"
GATE VALVE		
BUTTERFLY VALVE		
FIRE HYDRANTS		
REDUCERS		
3/4" WATER SERVICE/METER		
TEES		
CROSSES		
BENDS		
CAPS & PLUGS		
GAS LINES	N/A	N/A
OVERHEAD ELECTRICAL LINE	N/A	N/A
UNDERGROUND ELECTRICAL	N/A	N/A
OVERHEAD TELEPHONE	N/A	N/A
UNDERGROUND TELEPHONE	N/A	N/A
CABLE TELEVISION	N/A	N/A
POWER OR TELEPHONE POLE	N/A	N/A
SANITARY SEWER SERVICE (TYP)	(STA) 104.75 (INV) 76.82	

RESTRAINING LENGTHS

FITTING	LR (FT)
6"x 6" TEE	RUN 10', BRANCH 2'
8"x 8" TEE	RUN 13' BRANCH 3'
6"x 4" REDUCER	43'
8"x 6" REDUCER	25'
6" 11 1/4" BEND	2'
6" 22 1/2" BEND	3'
6" 90° BEND	17'
8" 11 1/4" BEND	2'
8" 22 1/2" BEND	4'
8" 90° BEND	22'
4" CAP	32'
6" CAP	46'
6" GATE VALVE	46'
8" GATE VALVE	60'

NOTES:

- RESTRAINED JOINTS, SUCH AS MEGA-LUG, EQUIVALENT BRANDS ACCEPTABLE TO THE ENGINEER, SHALL BE USED ON ALL TEES, BENDS, CROSSES & CAPS IN LIEU OF CONCRETE THRUST BLOCKING. RESTRAINED JOINTS SHALL BE CONSIDERED INCIDENTAL TO THIS CONTRACT AND NO ADDITIONAL COMPENSATION, MEASUREMENT, OR PAYMENT WILL BE MADE THEREFOR.
- LR SHALL BE THE LENGTH OF WATER MAIN THAT REQUIRED JOINTS ON EACH SIDE OF THE FITTINGS.
- ALL FIRE HYDRANTS & FITTINGS ETC. SHALL BE BUILT IN ACCORDANCE WITH COA STD DWG'S 2301 THRU 2380 INCLUSIVE.
- ALL CURVILINEAR WATER AND SEWER LINES WITH A RADIUS OF LESS THAN 300' SHALL BE PVC PER COA STANDARDS AND SPECIFICATIONS.

REMARKS

DESIGN

REVISIONS

NO.	DATE	BY
1	4/96	JAN

ENGINEER'S SEAL

JAN 10 1996

DESIGNED BY JAN
DRAWN BY LUD/DW
CHECKED BY JDN

DATE 6/96
DATE 6/96
DATE 6/96

CITY OF ALBUQUERQUE
PUBLIC WORKS DEPARTMENT
ENGINEERING DEVELOPMENT GROUP

TITLE: QUINTESSENCE SUBDIVISION - UNIT 4
UTILITY PLAN & PROFILE
JORDAN AVENUE N.E.

DESIGN REVIEW COMMITTEE
APPROVED
DATE 6/96



DESIGN REVIEW COMMITTEE

PROJECT NO. 5206.94
MAP NO. D-21
SHEET 21 **OF** 24

S12 SAS CURVE DATA
 R = 275.00'
 L = 68.45'
 Δ = 14-15-41
 T = 34.40'
 CH = 68.27'
 CB = N07-03-20E
 Δ / JOINT = 4'10" / JOINT

S14 SAS CURVE DATA
 R = 275.00'
 L = 67.56'
 Δ = 14-04-37
 T = 33.95'
 CH = 67.39'
 CB = N83-24-06E
 Δ / JOINT = 4'10" / JOINT

S13 SAS CURVE DATA
 R = 275.00'
 L = 84.11'
 Δ = 17-31-28
 T = 42.39'
 CH = 83.78'
 CB = N45-16-36E
 Δ / JOINT = 4'10" / JOINT

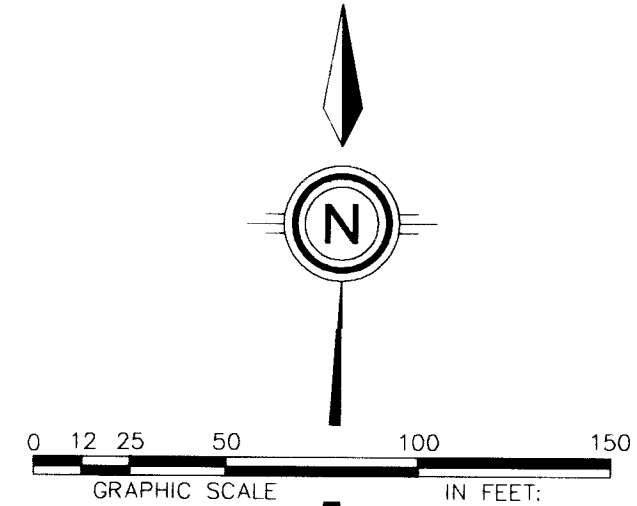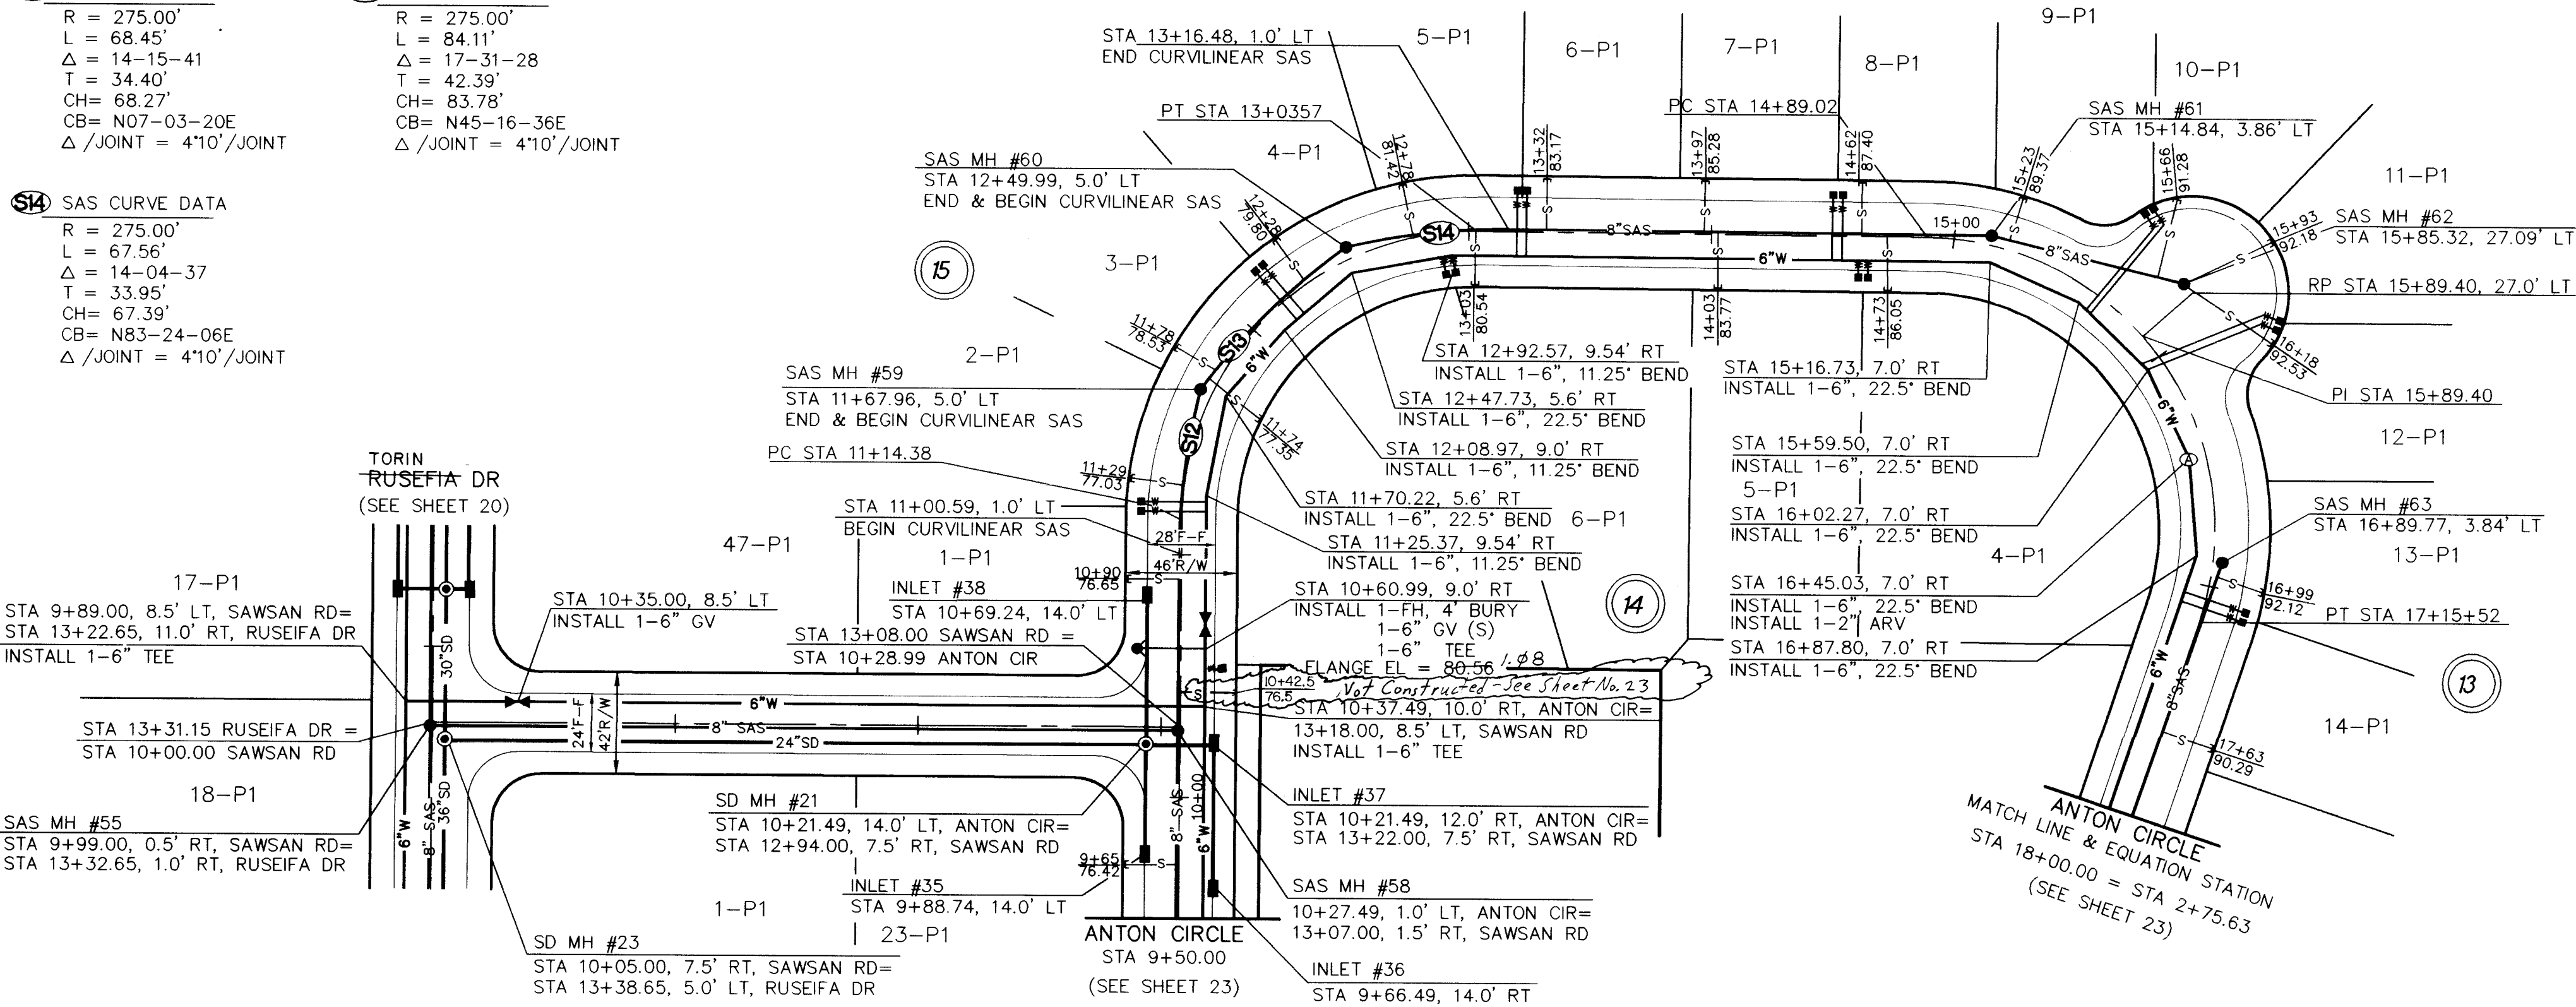


SAWSAN ROAD N.E.

ANTON CIRCLE N.E.

ENGINEER'S RECORD DRAWING CERTIFICATE

I, the undersigned engineer, a duly qualified Registered Professional Engineer under the laws of the State of New Mexico, do hereby certify that the Record Drawing information shown on these drawings was obtained from field inspection and post construction information obtained by me or under my direct supervision, that the Record Drawing information shown on these drawings was obtained by me or under my direct supervision, and that this Record Drawing information is the best to my knowledge and belief. Responsibility for the design concepts, design engineering and calculations, or intent of the Record Drawings resides with others.

Elery A. Gathrow, Jr., P.E.
 Elery A. Gathrow, Jr., P.E. New Mexico Civil Registration No. 12070

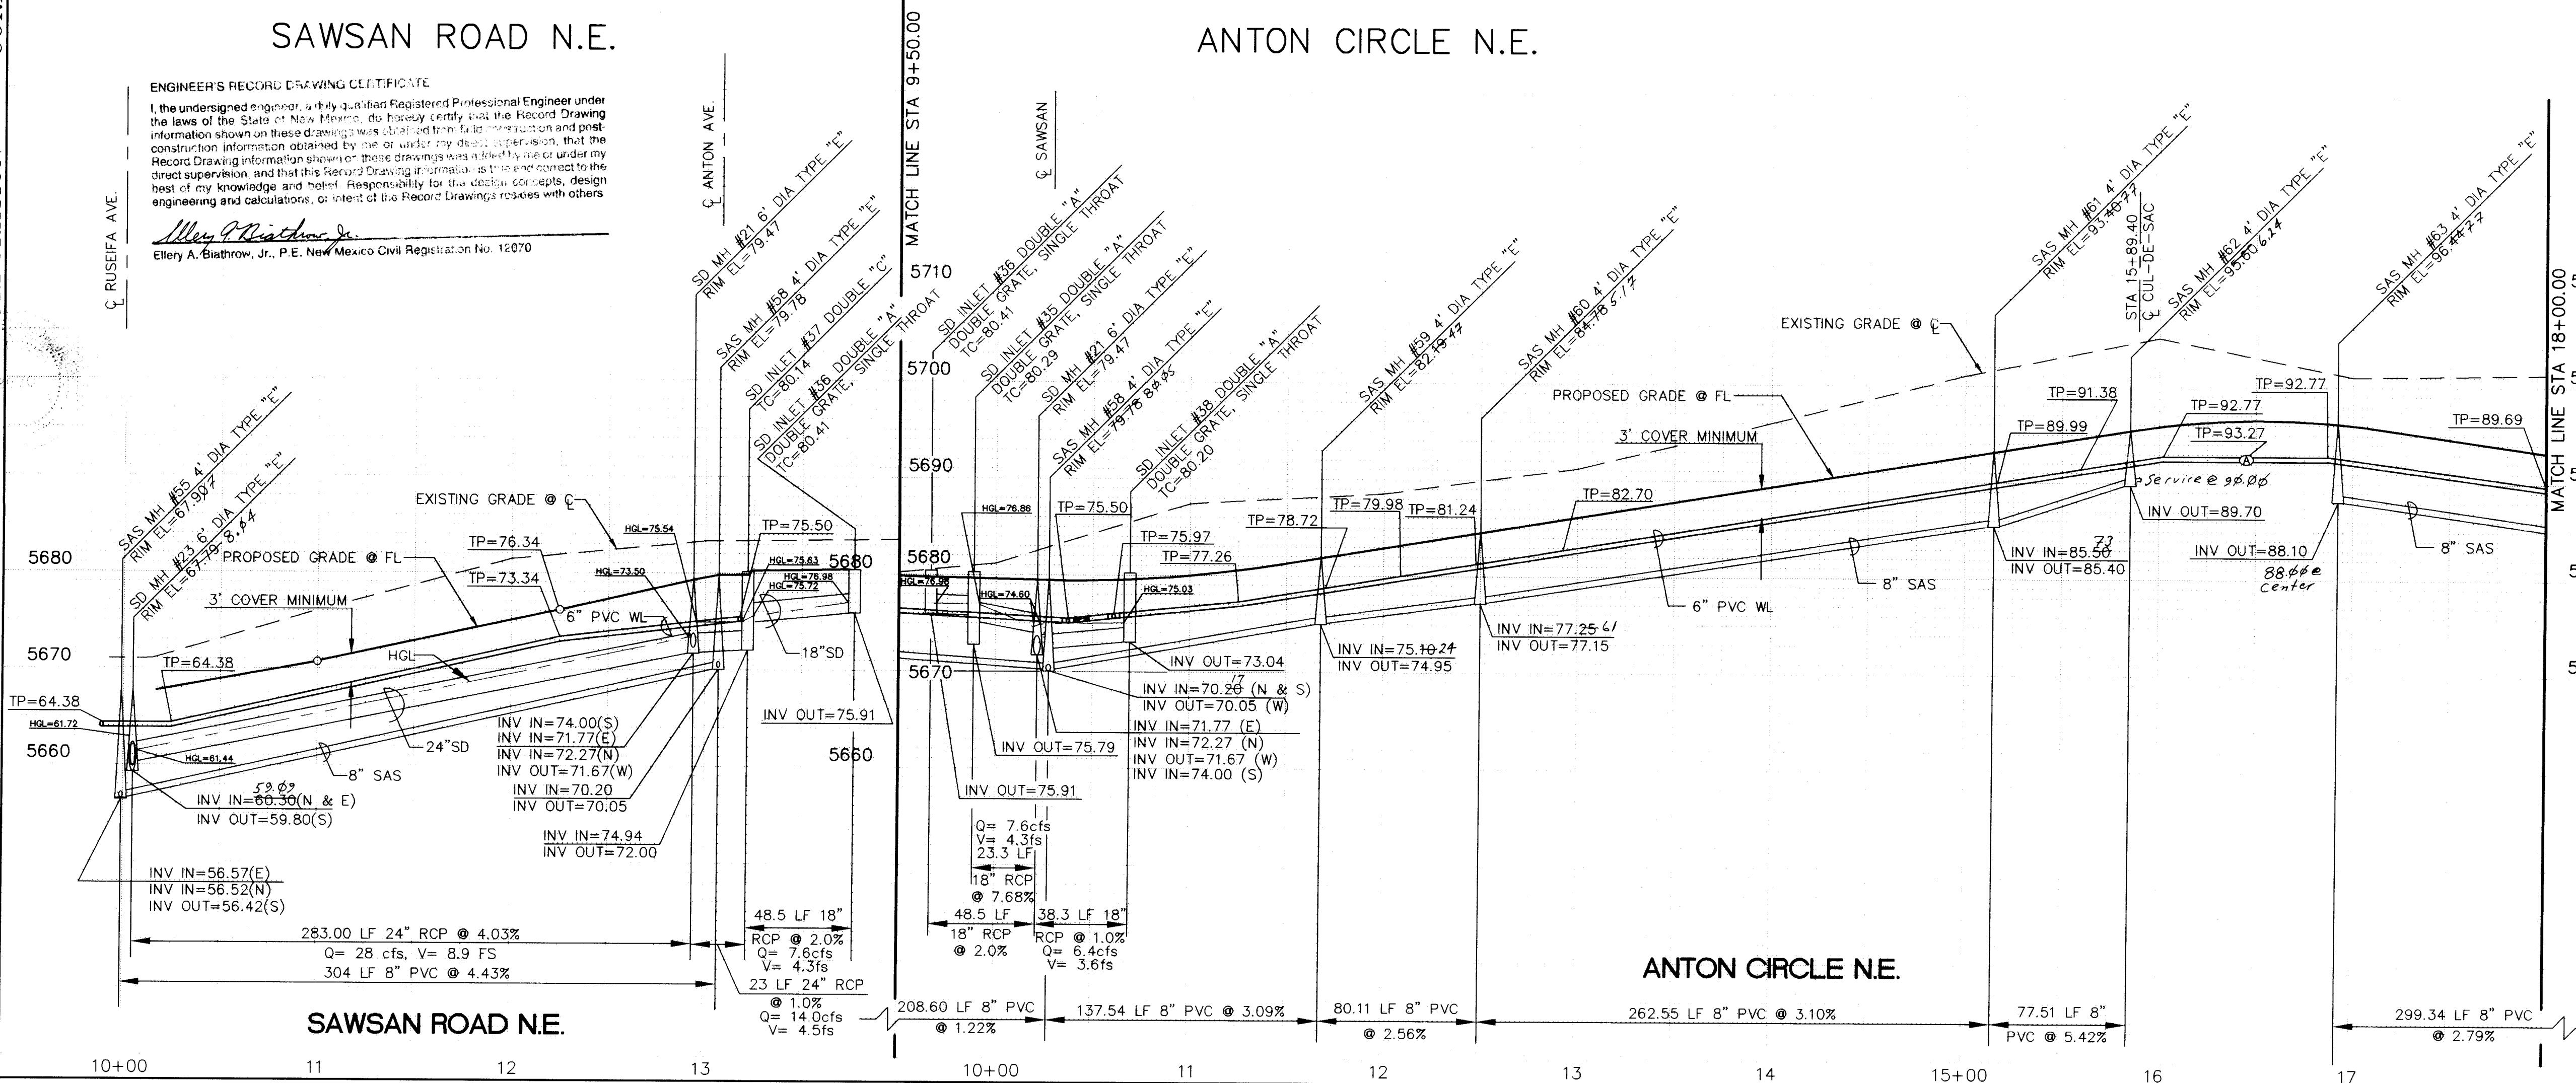

SAWSAN ROAD N.E.

ANTON CIRCLE N.E.

UTILITY LEGEND

DESCRIPTION	PROPOSED	EXISTING
SANITARY SEWER LINE	— 8" SAS —	— 8" SAS —
ENCASEMENT	— 8" SAS —	— 8" SAS —
SANITARY SEWER MANHOLE	— 8" SAS —	— 8" SAS —
SAS SERVICE CONNECTION	— 8" SAS —	— 8" SAS —
STORM DRAIN LINE	— 30" SD —	— 30" SD —
STORM DRAIN MANHOLE	— 30" SD —	— 30" SD —
STORM DRAIN INLETS	— 30" SD —	— 30" SD —
AIR RELEASE VALVE	— 30" SD —	— 30" SD —
WATER LINE	— W-6" —	— W-6" —
GATE VALVE	— 30" SD —	— 30" SD —
BUTTERFLY VALVE	— 30" SD —	— 30" SD —
FIRE HYDRANTS	— 30" SD —	— 30" SD —
REDUCERS	— 30" SD —	— 30" SD —
3/4" WATER SERVICE/METER	— 30" SD —	— 30" SD —
TEES	— 30" SD —	— 30" SD —
CROSSES	— 30" SD —	— 30" SD —
BENDS	— 30" SD —	— 30" SD —
CAPS & PLUGS	— 30" SD —	— 30" SD —
GAS LINES	N/A	N/A
OVERHEAD ELECTRICAL LINE	N/A	N/A
UNDERGROUND ELECTRICAL	N/A	N/A
OVERHEAD TELEPHONE	N/A	N/A
UNDERGROUND TELEPHONE	N/A	N/A
CABLE TELEVISION	N/A	N/A
POWER OR TELEPHONE POLE	N/A	N/A
SANITARY SEWER SERVICE (TYP)	— 8" SAS —	— 8" SAS —

RESTRAINING LENGTHS

FITTING	LR (FT)
6" x 6" TEE	RUN 10', BRANCH 2'
8" x 8" TEE	RUN 13' BRANCH 3'
6" x 4" REDUCER	43'
8" x 6" REDUCER	25'
6" 11 1/4" BEND	2'
6" 22 1/2" BEND	3'
6" 90° BEND	17'
8" 11 1/4" BEND	2'
8" 22 1/2" BEND	4'
8" 90° BEND	22'
4" CAP	32'
6" CAP	46'
6" GATE VALVE	46'
8" GATE VALVE	60'

LR = LENGTH TO BE RESTRAINED EACH SIDE OF THE FITTING. FOR TEES, ALL THREE LEGS SHALL BE RESTRAINED FOR A DISTANCE OF "LR". FOR REDUCERS, "LR" IS GIVEN FOR THE LARGER DIAMETER SIDE OF THE FITTING AND NO RESTRAINED IS REQUIRED ON THE SMALL SIDE OF THE FITTING. GATE VALVES SHALL BE MECHANICALLY RESTRAINED AND INSTALLED WITH CONCRETE BLOCKING PER COA STD DWG 2333 IN ADDITION TO THE MECHANICALLY RESTRAINED LENGTHS. ALL CAPS SHALL BE INSTALLED WITH CONCRETE BLOCKING PER COA STD DWG 2320. RESTRAIN ALL JOINTS ON FIRE HYDRANTS.

- NOTES:
1. RESTRAINED JOINTS, SUCH AS MEGA-LUG EQUIVALENT BRANDS ACCEPTABLE TO THE ENGINEER, SHALL BE USED ON ALL TEES, BENDS, CROSSES & CAPS IN LIEU OF CONCRETE THRUST BLOCKING. RESTRAINED JOINTS SHALL BE CONSIDERED INCIDENTAL TO THIS CONTRACT AND NO ADDITIONAL COMPENSATION, MEASUREMENT OR PAYMENT WILL BE MADE THEREFOR.
 2. LR SHALL BE THE LENGTH OF WATER MAIN THAT REQUIRED JOINTS ON EACH SIDE OF THE FITTINGS.
 3. ALL FIRE HYDRANTS & FITTINGS ETC. SHALL BE BUILT IN ACCORDANCE WITH COA STD DWG'S 2301 THRU 2380 INCLUSIVE.
 4. ALL CURVILINEAR WATER AND SEWER LINES WITH A RADIUS OF LESS THAN 300' SHALL BE PVC PER COA STANDARDS AND SPECIFICATIONS.

DATE: 4/19/96
 SCALE: HORIZ: 1" = 50'
 VERT: 1" = 10'

community sciences corporation

JOB NO.: 5206.94

LAND PLANNING: P.O. Box 1328, Corrales, N.M. 87048

ENGINEERING: (505) 897-0000

SURVEYING: (505) 897-0000

CITY OF ALBUQUERQUE PUBLIC WORKS DEPARTMENT ENGINEERING DEVELOPMENT GROUP

TITLE: QUINTESSENCE SUBDIVISION - UNIT 4

UTILITY PLAN & PROFILE

ANTON CIRCLE & SAWSAN RD N.E.

DESIGN REVIEW COMMITTEE

CITY ENGINEER APPROVAL

NOV 29 1996



DESIGN REVIEW COMMITTEE

PROJECT NO. 5206.94

MAP NO. D-21

SHEET 22 OF 24

S77 SAS CURVE DATA
 R = 275.00'
 L = 44.74'
 Δ = 09-31-03
 T = 22.42'
 CH = 44.69'
 CB = N84-52-01W
 Δ = 4°10' / 20' JOINT

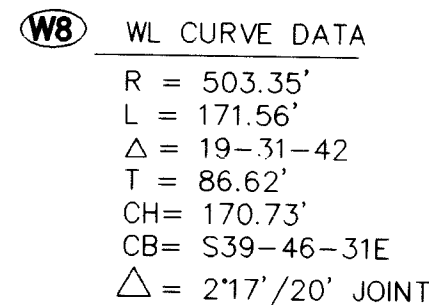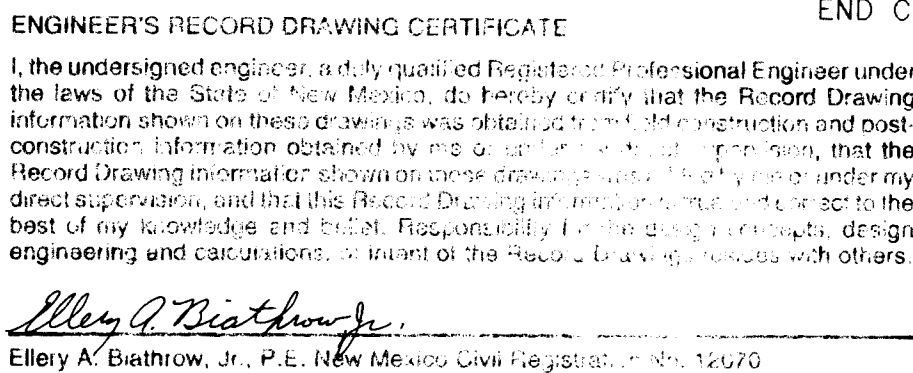

RESTRAINING LENGTHS	
FITTING	LR (FT)
6"x6" TEE	RUN 10', BRANCH 2'
8"x8" TEE	RUN 13' BRANCH 3'
6"x4" REDUCER	43'
8"x6" REDUCER	25'
6" 11 1/4" BEND	2'
6" 22 1/2" BEND	3'
6" 90° BEND	17'
8" 11 1/4" BEND	2'
8" 22 1/2" BEND	4'
8" 90° BEND	22'
4" CAP	32'
6" CAP	46'
6" GATE VALVE	46'
8" GATE VALVE	60'

LR = LENGTH TO BE RESTRAINED.
EACH SIDE OF THE FITTING. FOR
TEES, ALL THREE LEGS SHALL BE
RESTRAINED FOR A DISTANCE OF
"LR". FOR REDUCERS, "LR" IS
GIVEN FOR THE LARGER DIAMETER
SIDE OF THE FITTING.
RESTRAINING IS REQUIRED ON THE
SMALL SIDE OF THE FITTING. GATE
VALVES SHALL BE MECHANICALLY
RESTRAINED AND INSTALLED WITH
CONCRETE BLOCKING PER COA STD
DWC 2333. IN ADDITION, THE
MECHANICALLY RESTRAINED
LENGTHS. ALL CAPS SHALL BE
INSTALLED WITH CONCRETE
BLOCKING PER COA STD DWC 2320.
RESTRAINT ALL JOINTS ON FIRE
HYDRANTS.

NOTES:

1. RESTRAINED JOINTS, SUCH AS MEGA-LUG EQUIVALENT BRANDS ACCEPTABLE TO THE ENGINEER, SHALL BE USED ON ALL TEES, BENDS, CROSSES & CAPS IN LIEU OF CONCRETE THRUST BLOCKING. RESTRAINED JOINTS SHALL BE CONSIDERED INCIDENTAL TO THIS CONTRACT AND NO ADDITIONAL COMPENSATION, MEASUREMENT, OR PAYMENT WILL BE MADE THEREFORE.
2. LR SHALL BE THE LENGTH OF WATER MAIN THAT REQUIRED JOINTS ON EACH SIDE OF THE FITTINGS.
3. ALL FIRE HYDRANTS & FITTINGS ETC. SHALL BE BUILT IN ACCORDANCE WITH/ COA STD DWG'S 2301 THRU 2380 INCLUSIVE.
4. ALL CURB/VULNER WATER AND SEWER LINES WITHIN 15' OF CURB SHALL BE BUILT IN ACCORDANCE WITH COA STD DWG'S 2301 THRU 2380 INCLUSIVE.

DATE: 4/22/96	<i>community sciences corporation</i>
SCALE:	
HORIZ: 1" = 50'	
VERT: 1" = 10'	
JOB NO.: 323100041	LAND PLANNING P.O. Box 1328 ENGINEERING Corrales, N.M. 87048 SURVEYING (505)897-0000

CITY OF ALBUQUERQUE
PUBLIC WORKS DEPARTMENT
ENGINEERING DEVELOPMENT GROUP

TITLE: QUINTESSENCE SUBDIVISION - UNIT 4
UTILITY PLAN & PROFILE
ANTON CIRCLE & SAMEH RD N.E.

DESIGN REVIEW COMMITTEE

A P P R O V E

NOV 24 1980

DESIGN
REVIEW COMMITTEE

CITY ENGINEER APPROVAL

PROJECT NO.	5206.94	MAP NO.	D-21
-------------	---------	---------	------



BENCH MARKS		CONTRACTOR <u>Pomero Excavating & Tracing</u> STATION <u>5-D21 1985</u> AND IS REWETTED TO AN ALUMINUM CAP PROJECTING 0.1' FOOT ABOVE GROUND. IT IS LOCATED 793 FEET NORTH OF THE CENTERLINE INTERSECTION OF CORONADO AVENUE AND HOLBROOK STREET, AND 85 FEET EAST OF THE CENTERLINE OF HOLBROOK STREET. ELEV = 5650.96	
		*S-BUILT INFORMATION DATE <u> </u>	
		MICRO-FILM INFORMATION RECORDED BY <u> </u> DATE <u> </u>	





[illegible]

ENGINEER'S SEAL

NO.		DATE	REMARKS	BY
REVISIONS				
DESIGN				
DESIGNED BY		JMN	DATE	6/96
DRAWN BY		LJB/DLW/DLK/GMR	DATE	6/96
CHECKED BY		JDH	DATE	6/96

E ENT		
GROUP		
LAST DESIGN DATE:	MO./DAY/YR.	MO./DAY/YR.
SHEET	23 OF	24

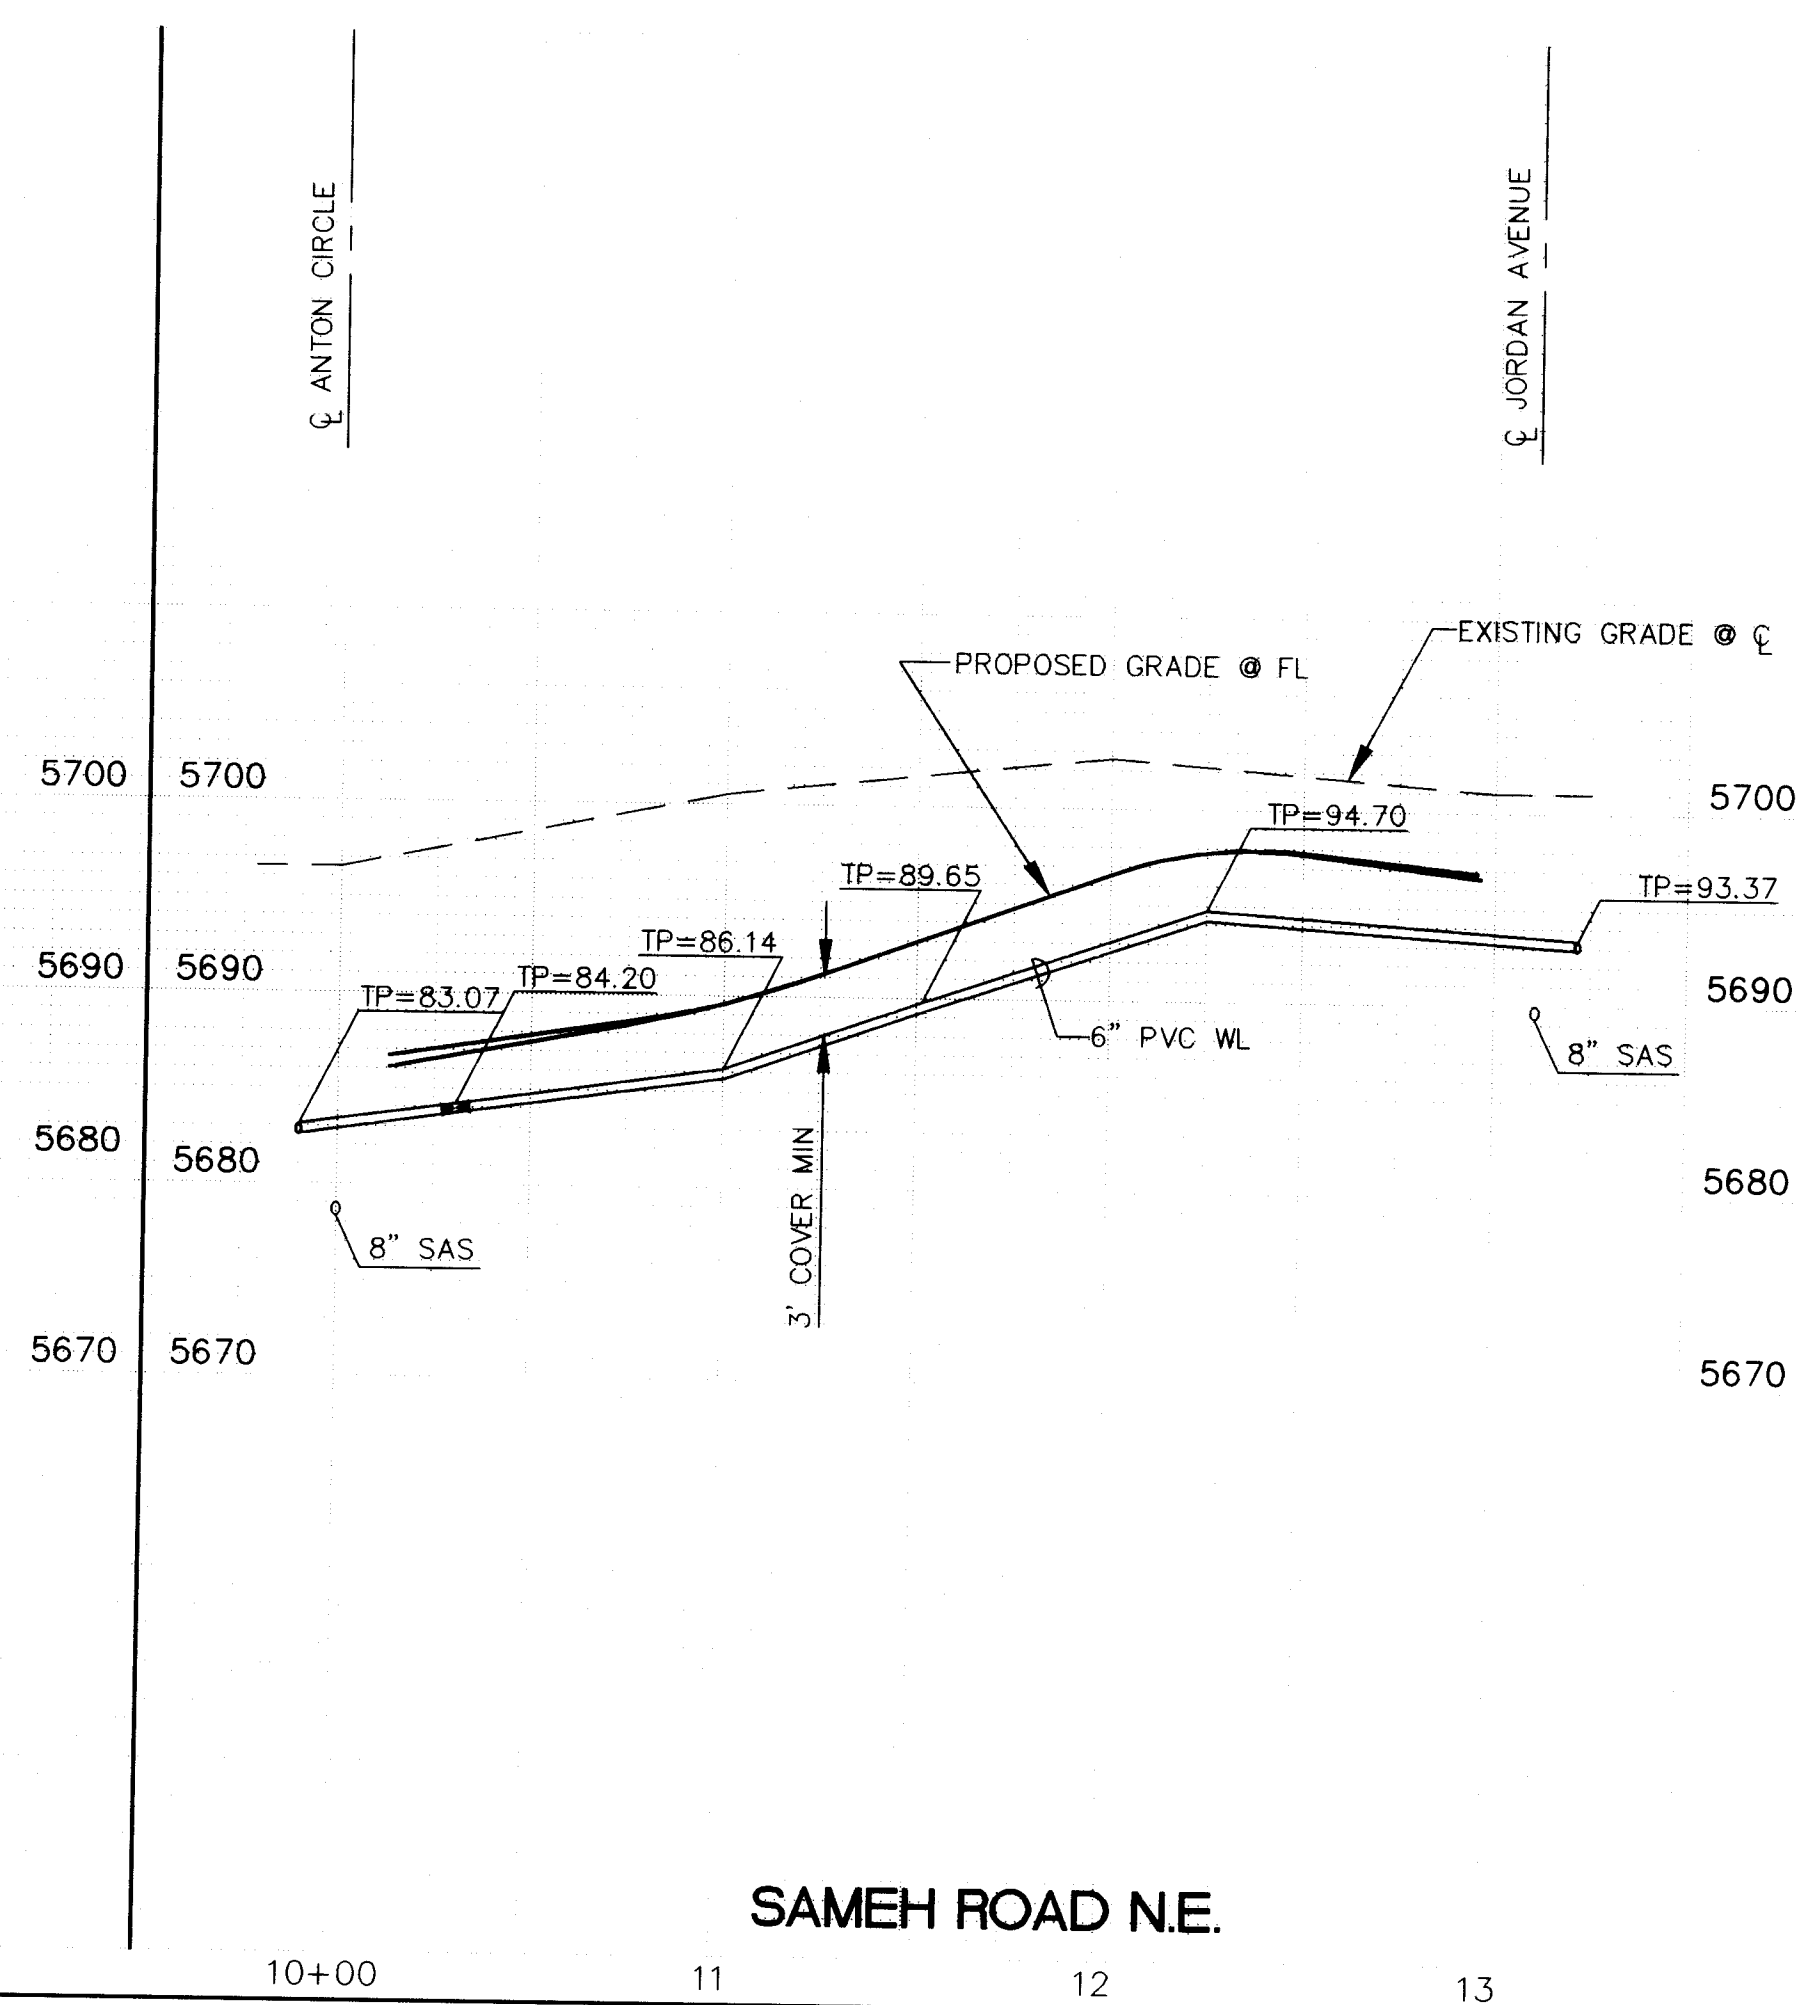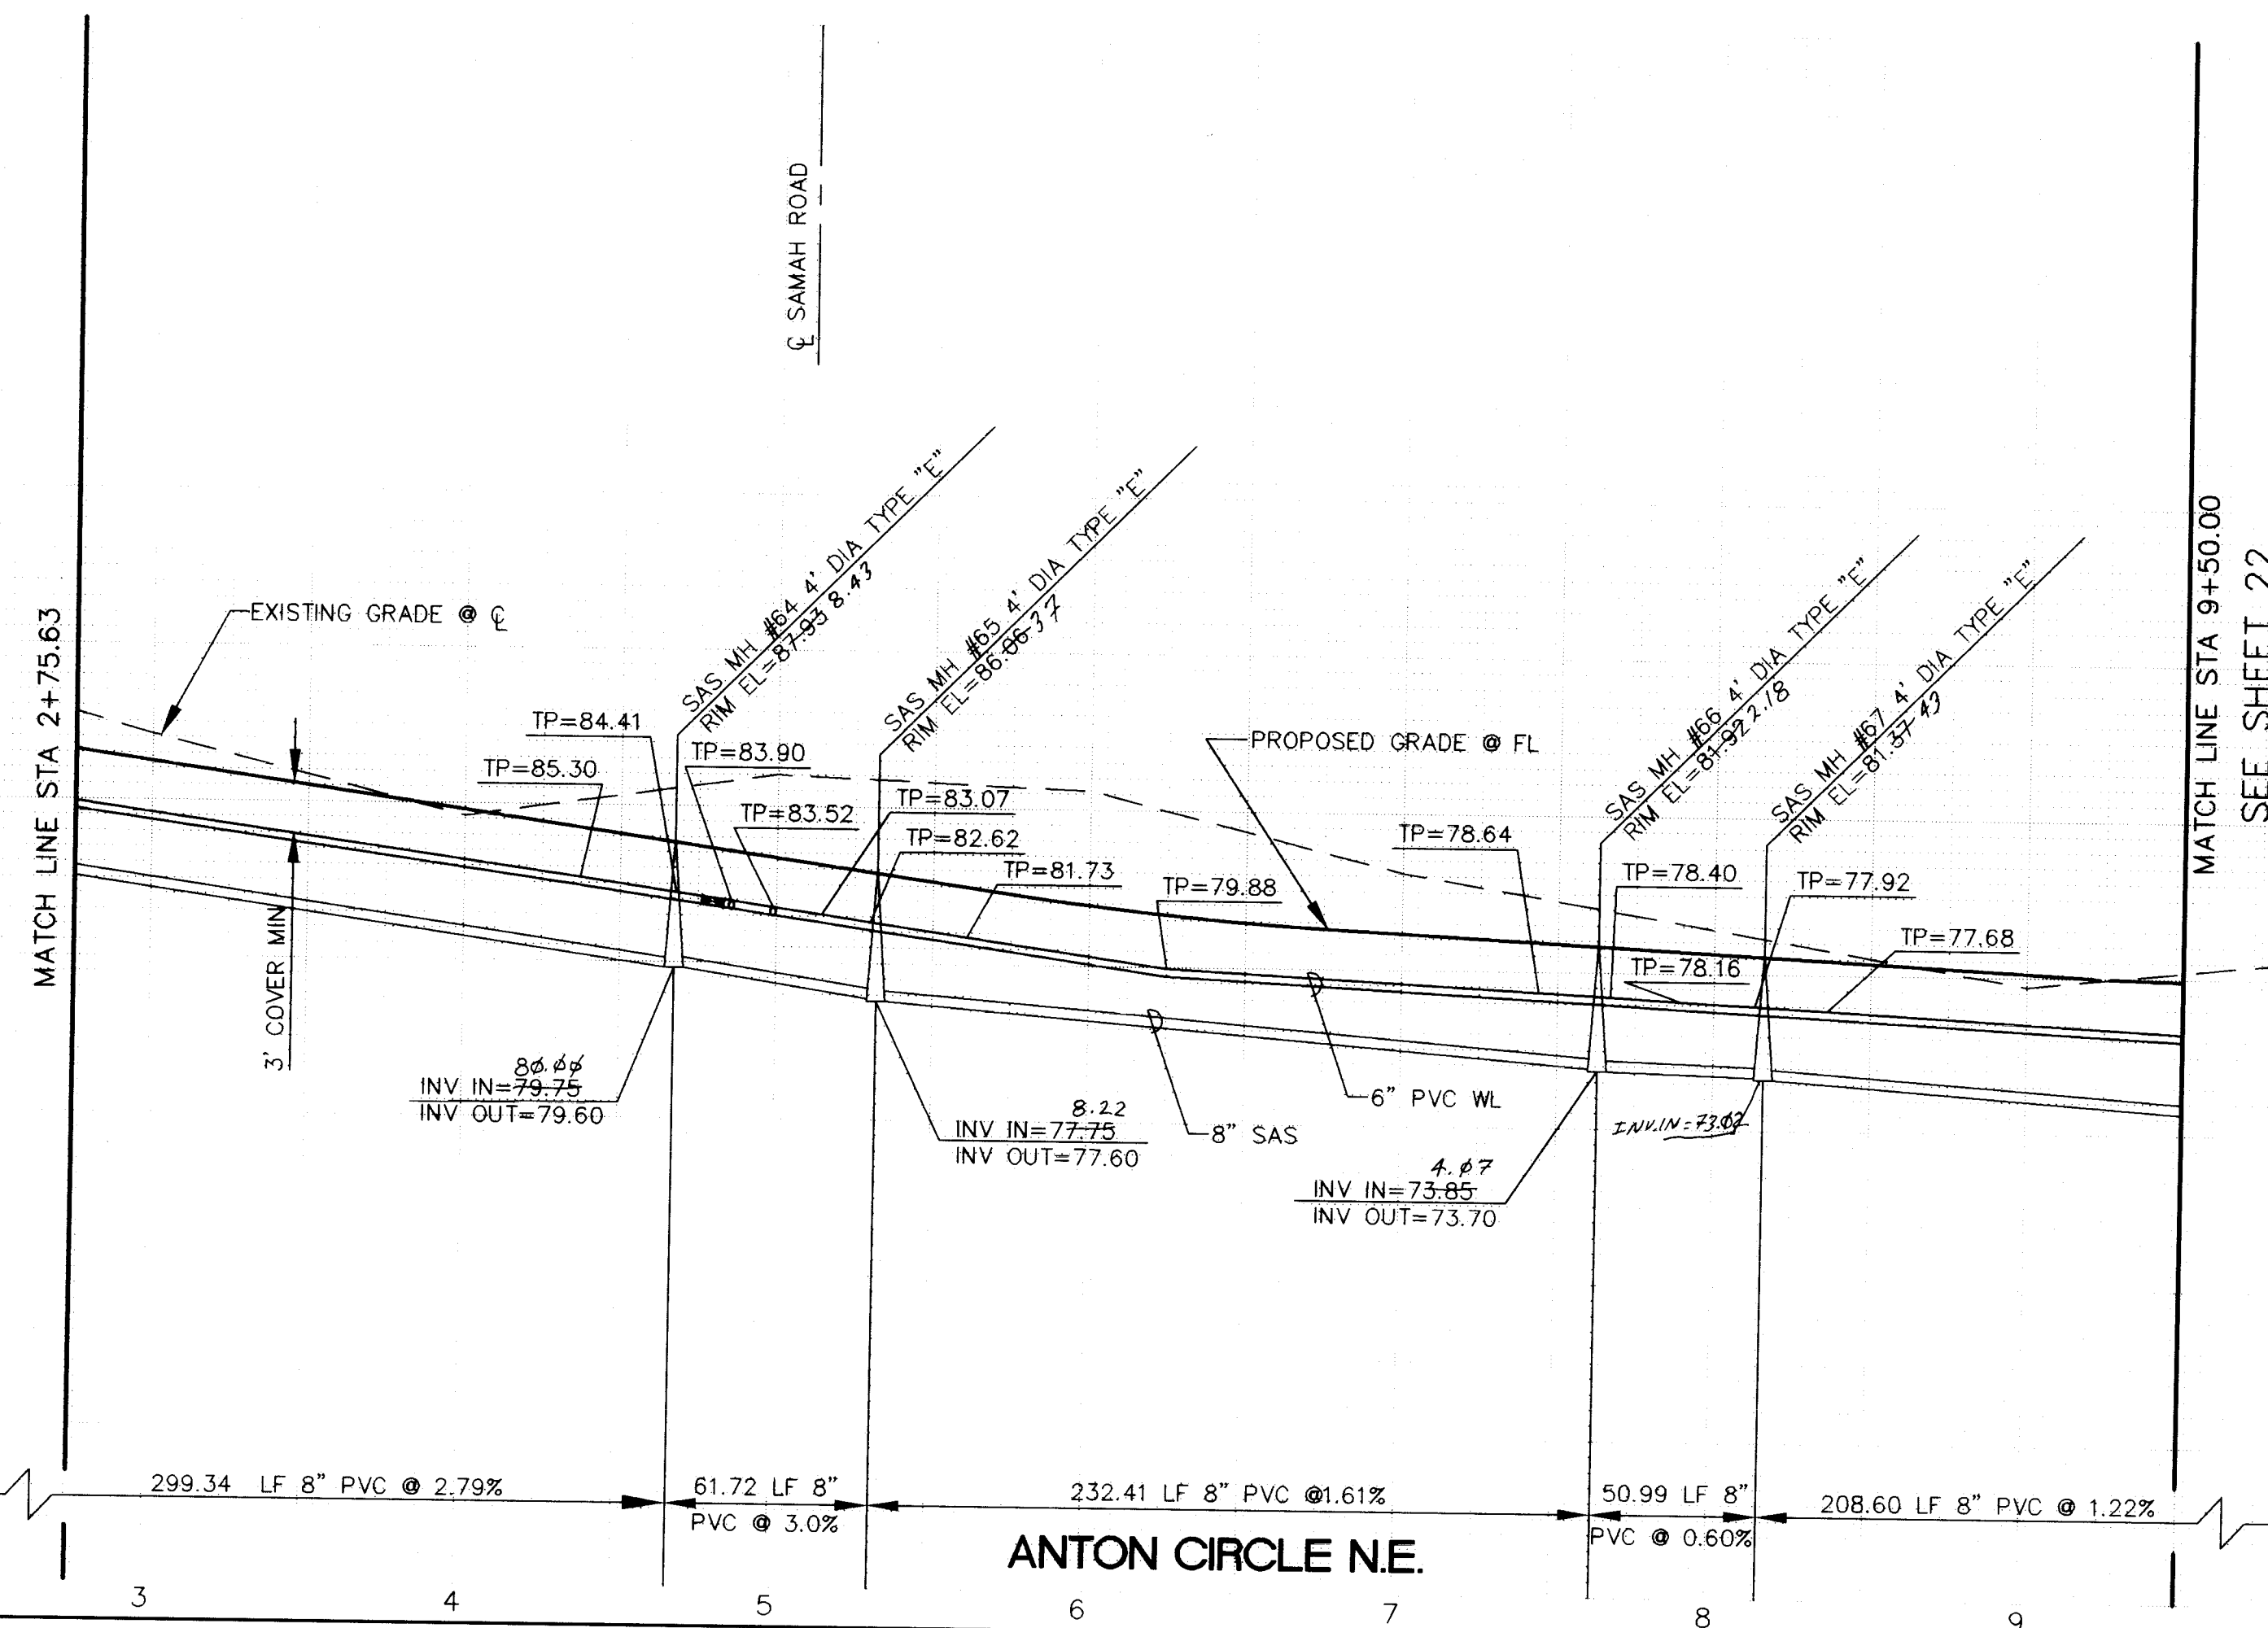

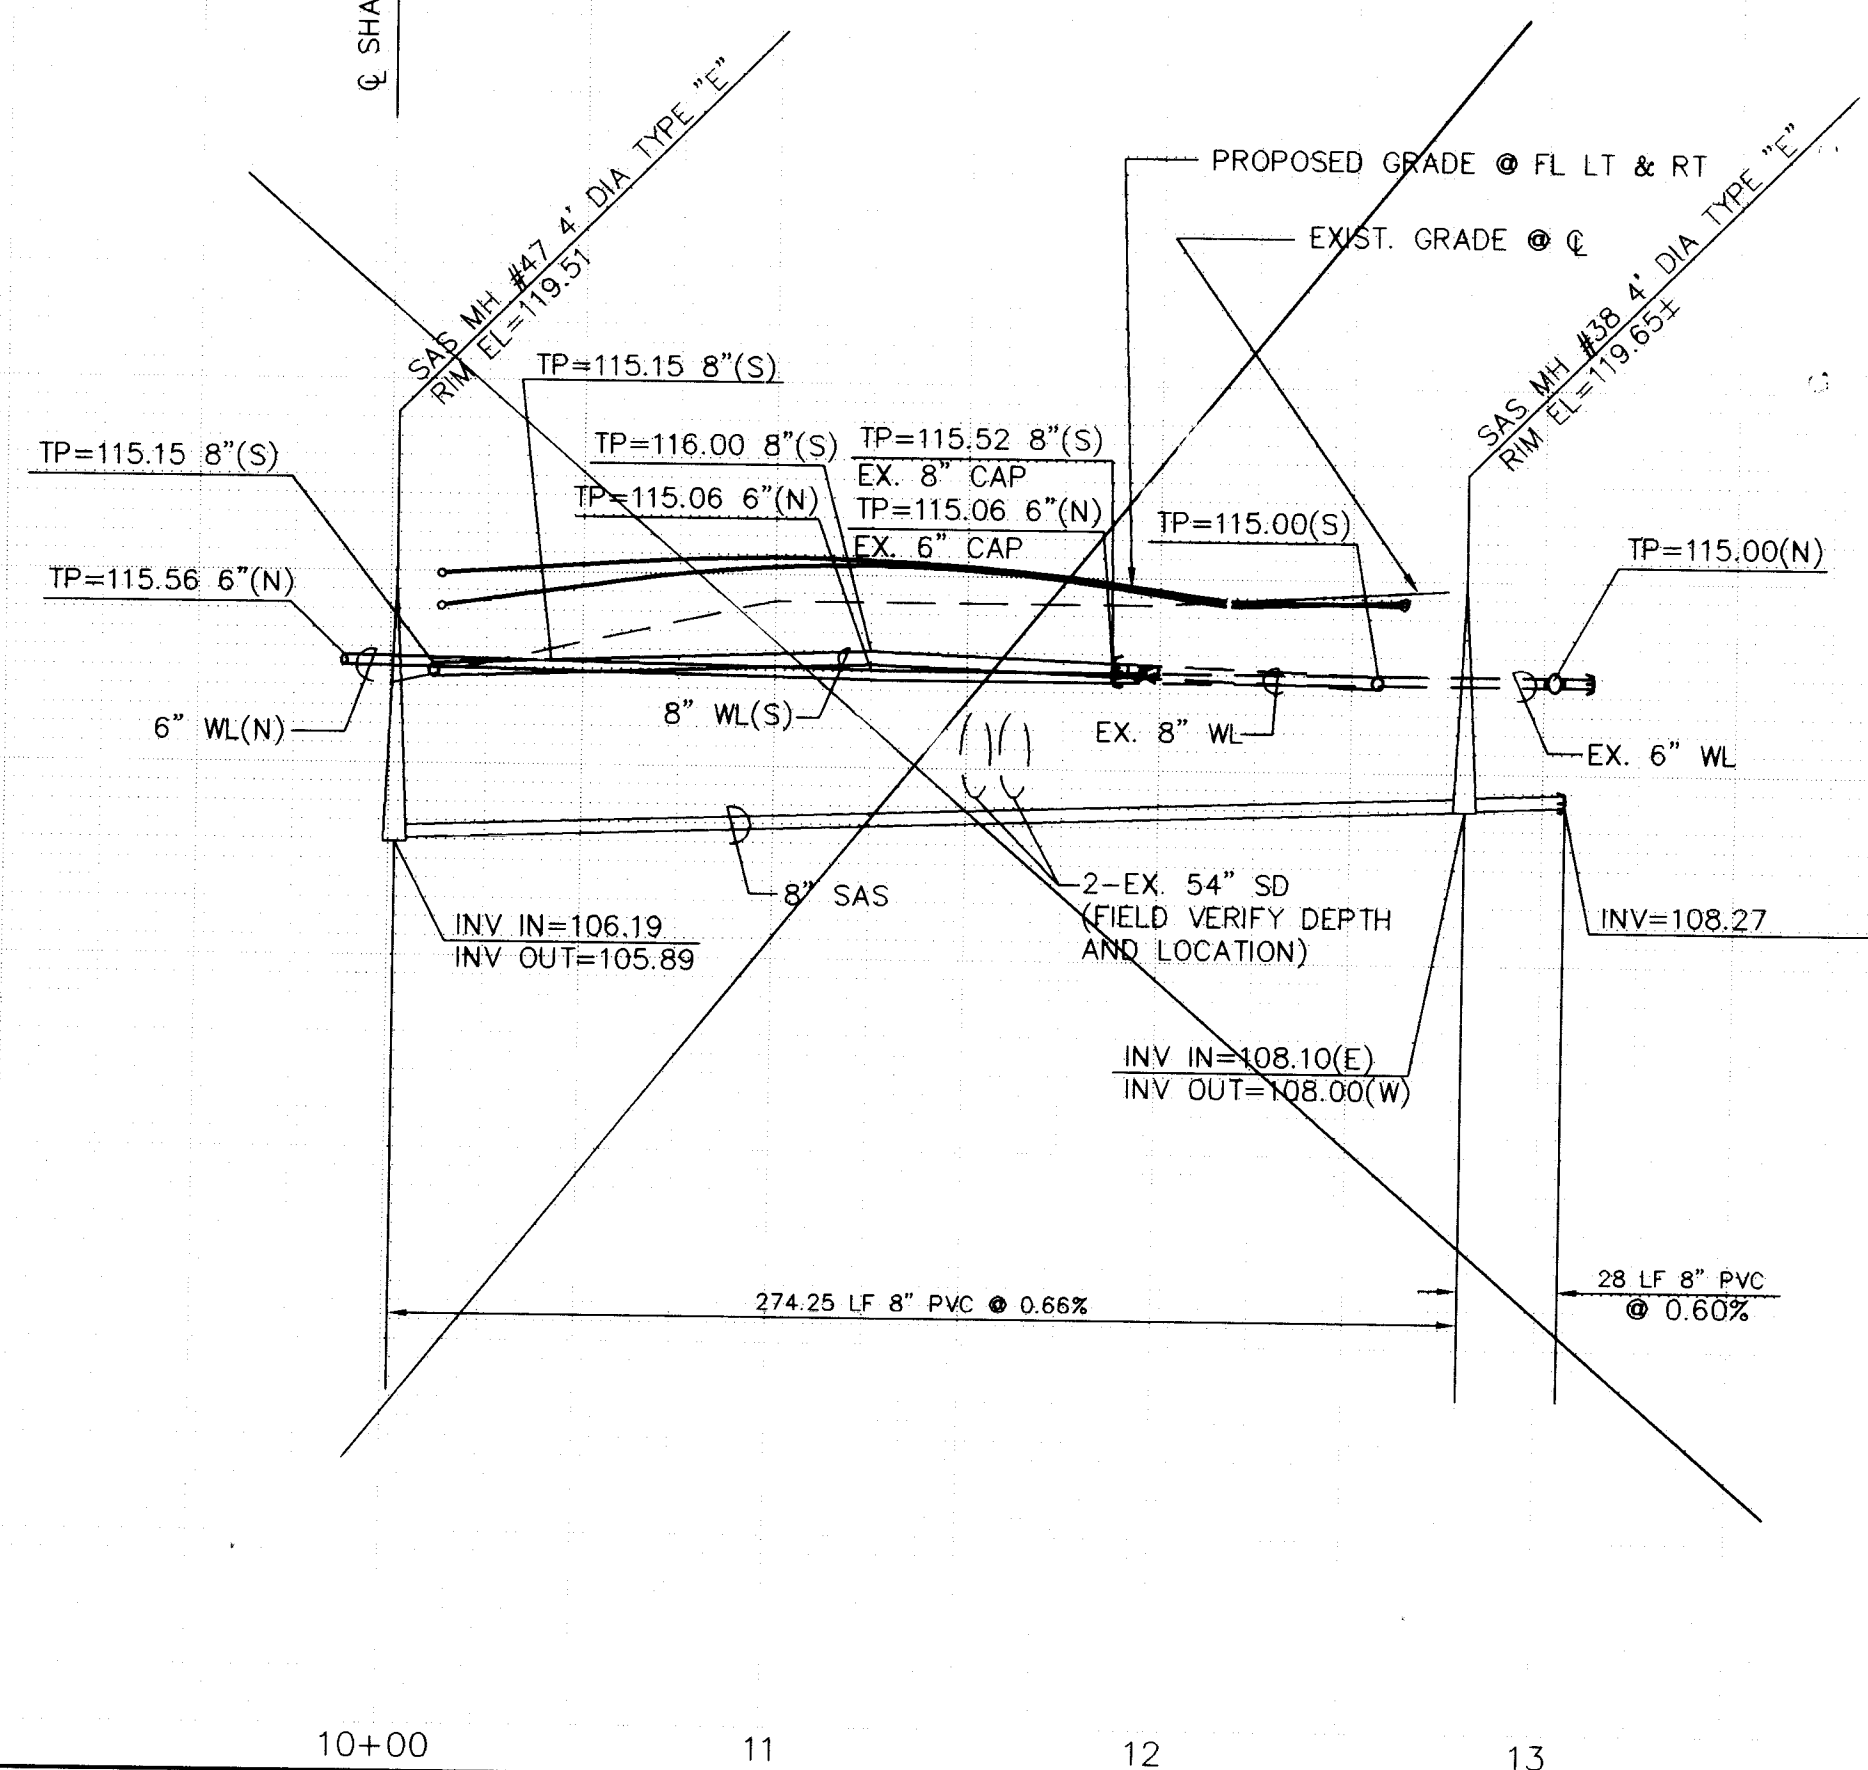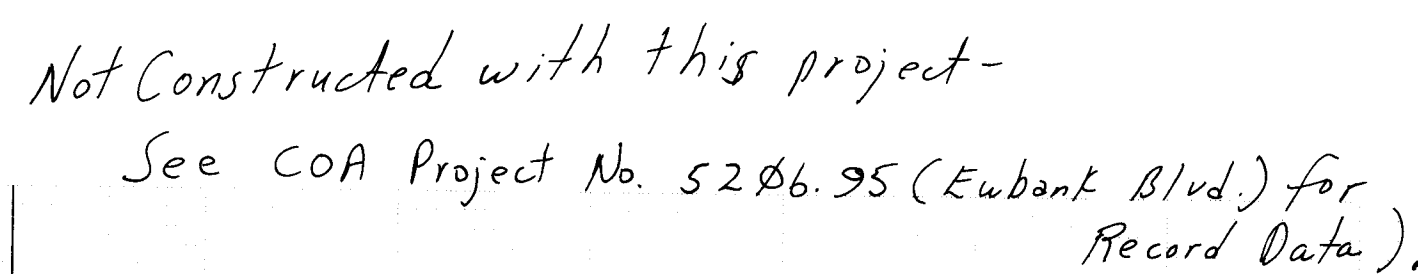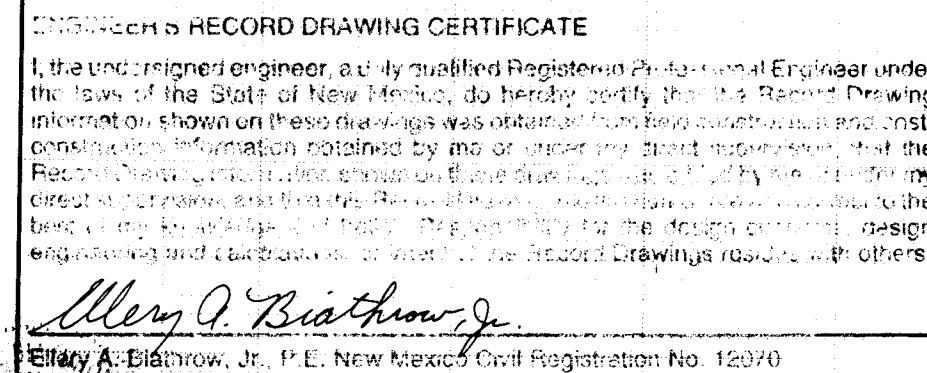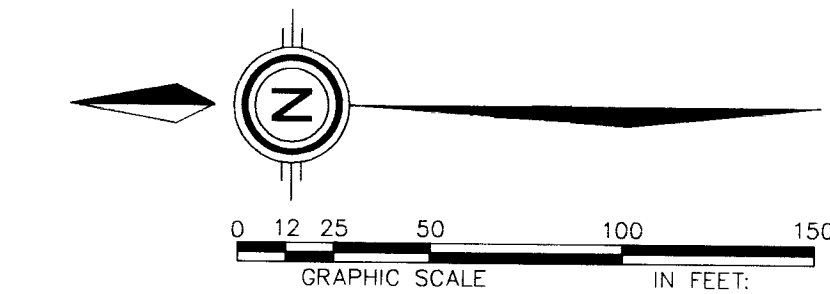

RESTRAINING LENGTHS	
FITTING	LR (FT)
6"x6" TEE	RUN 10', BRANCH 2'
8"x8" TEE	RUN 13' BRANCH 3'
6"x4" REDUCER	43'
8"x6" REDUCER	25'
6" 11 1/4" BEND	2'
6" 22 1/2" BEND	3'
6" 90° BEND	17'
8" 11 1/4" BEND	2'
8" 22 1/2" BEND	4'
8" 90° BEND	22'
4" CAP	32'
6" CAP	46'
6" GATE VALVE	46'
8" GATE VALVE	60'

LR = LENGTH TO BE RESTRAINED
EACH SIDE OF THE FITTING FOR
TEES, ALL THREE LEGS SHALL BE
RESTRAINED FOR A DISTANCE OF "LR"
FOR REDUCERS, "LR" IS
GIVEN FOR THE LARGER DIAMETER
SIDE OF THE FITTING. NO
RESTRAINING IS REQUIRED ON THE
SMALL SIDE OF THE FITTING. GATE
VALVES SHALL BE MECHANICALLY
RESTRAINED AND INSTALLED WITH
CONCRETE BLOCKING PER COA STD
2320.1 IN ALL JOINTS THAT ARE
MECHANICALLY RESTRAINED
LENGTHS. ALL CAPS SHALL BE
INSTALLED WITH CONCRETE
BLOCKING PER COA STD DWG 2320.
RESTRAIN ALL JOINTS ON FIRE
HYDRANTS.

- NOTES:
1. RESTRAINED JOINTS, SUCH AS MEGA-LUG EQUIVALENT BRANDS ACCEPTABLE TO THE ENGINEER, SHALL BE USED ON ALL TEES, BENDS, CROSSES & CAPS IN LIEU OF CONCRETE THRUST BLOCKING. RESTRAINED JOINTS SHALL BE CONSIDERED INCIDENTAL TO THIS CONTRACT AND NO ADDITIONAL COMPENSATION, MEASUREMENT, OR PAYMENT WILL BE MADE THEREFOR.
 2. LR SHALL BE THE LENGTH OF WATER MAIN THAT REQUIRED JOINTS ON EACH SIDE OF THE FITTINGS.
 3. ALL FIRE HYDRANTS & FITTINGS ETC. SHALL BE BUILT IN ACCORDANCE WITH/ OR STD DWG'S 2301 THRU 2380 INCLUSIVE.
 4. ALL FURNISHED WATER AND SEWER LINES WITH THE RADIUS OF CURVE SHALL BE PVC PER PER STD OR CANON STANDARDS & SPECIFICATIONS.

DATE: 4/16/96
SCALE:
HORIZ: 1" = 50'
VERT: 1" = 10'
JOB NO.: 32308

*community
sciences
corporation*

CITY OF ALBUQUERQUE
PUBLIC WORKS DEPARTMENT
ENGINEERING DEVELOPMENT GROUP

TITLE: QUINTESSENCE SUBDIVISION - UNIT 4
UTILITY PLAN & PROFILE
NEBO ST. & QUINTESSENCE RD., N.E.

DESIGN REVIEW COMMITTEE

APPROVED

NOV 26 1996


DESIGN
REVIEW COMMITTEE

CITY ENGINEER APPROVAL

PROJECT SHEET 24 OF 24	LAST DESIGN DATE		MO./DAY/YR.		MO./DAY/YR.						
DESIGNED BY JMN DRAWN BY LJD/DLM/JDFK/GWR CHECKED BY JDH	DATE 6/96		DATE 6/96		DATE 6/96						
ENGINEER'S SEAL 											
SURVEY INFORMATION			FIELD NOTES			BENCH MARKS			AS-BUILT INFORMATION		
NO.			BY			DATE			RECORDING BY		
1			COMMUNITY SCIENCES			4/96			JAMES P. DWYER		
									THE STATION IS A STANDARD ACS ALUMINUM CAP STAMPED "5-021 1985" AND IS RIVETED TO AN ALUMINUM PIPE PROJECTING 0.1 FOOT ABOVE GROUND.		
									IT IS LOCATED 793 FEET NORTH OF THE CENTERLINE INTERSECTION OF CORONADO AVENUE AND HOLBROOK STREET, AND 85 FEET EAST OF THE CENTERLINE OF HOLBROOK STREET.		
									ELEV = 5550.56		
									MICRO-FILM INFORMATION		
									RECORDED BY		
									DATE		
									NO.		

LEGEND


	PROPERTY LINE
	EXISTING CURB AND GUTTER
	EXISTING WATERLINE
	PROPOSED WATERLINE
	PROPOSED CONCRETE
	PROPOSED ASPHALT
	FUTURE CONCRETE
	FUTURE CURB

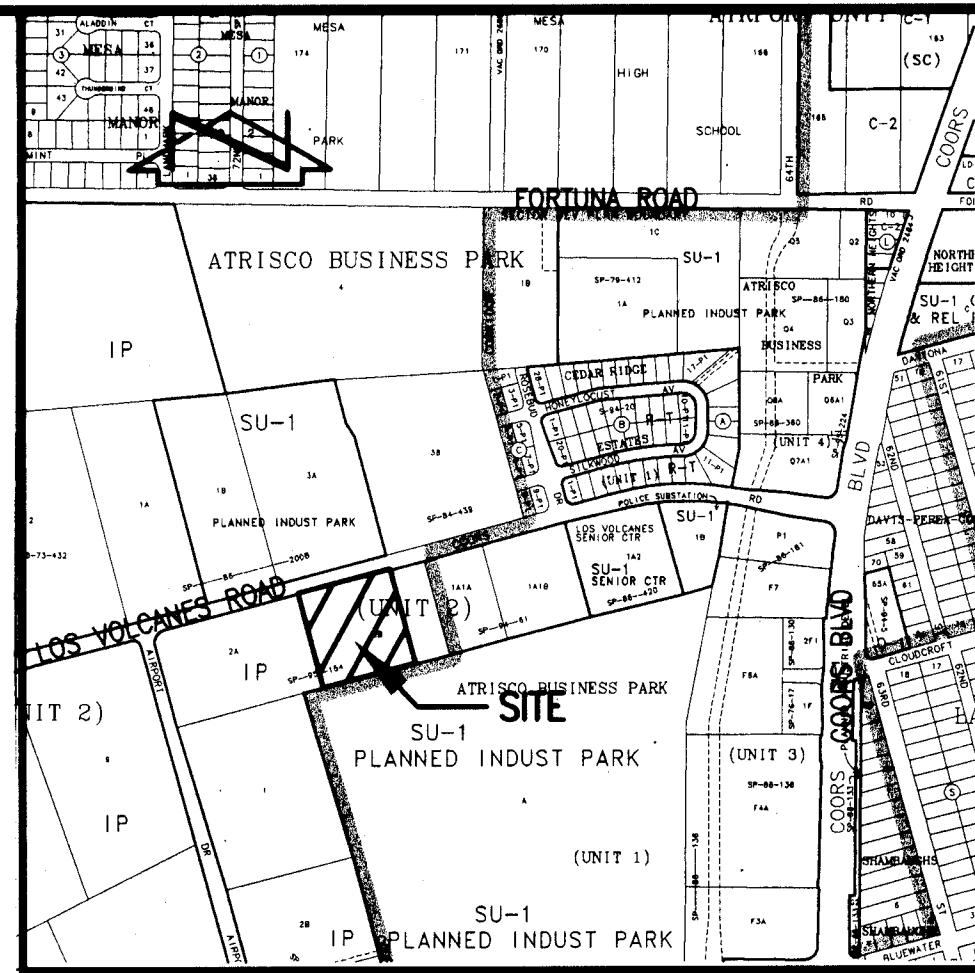


VICINITY MAP

SCALE: 1" = 750'

J-10

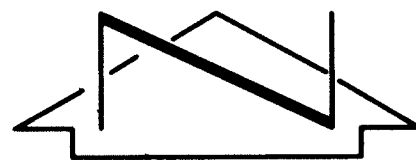

SCALE: 1" = 10'

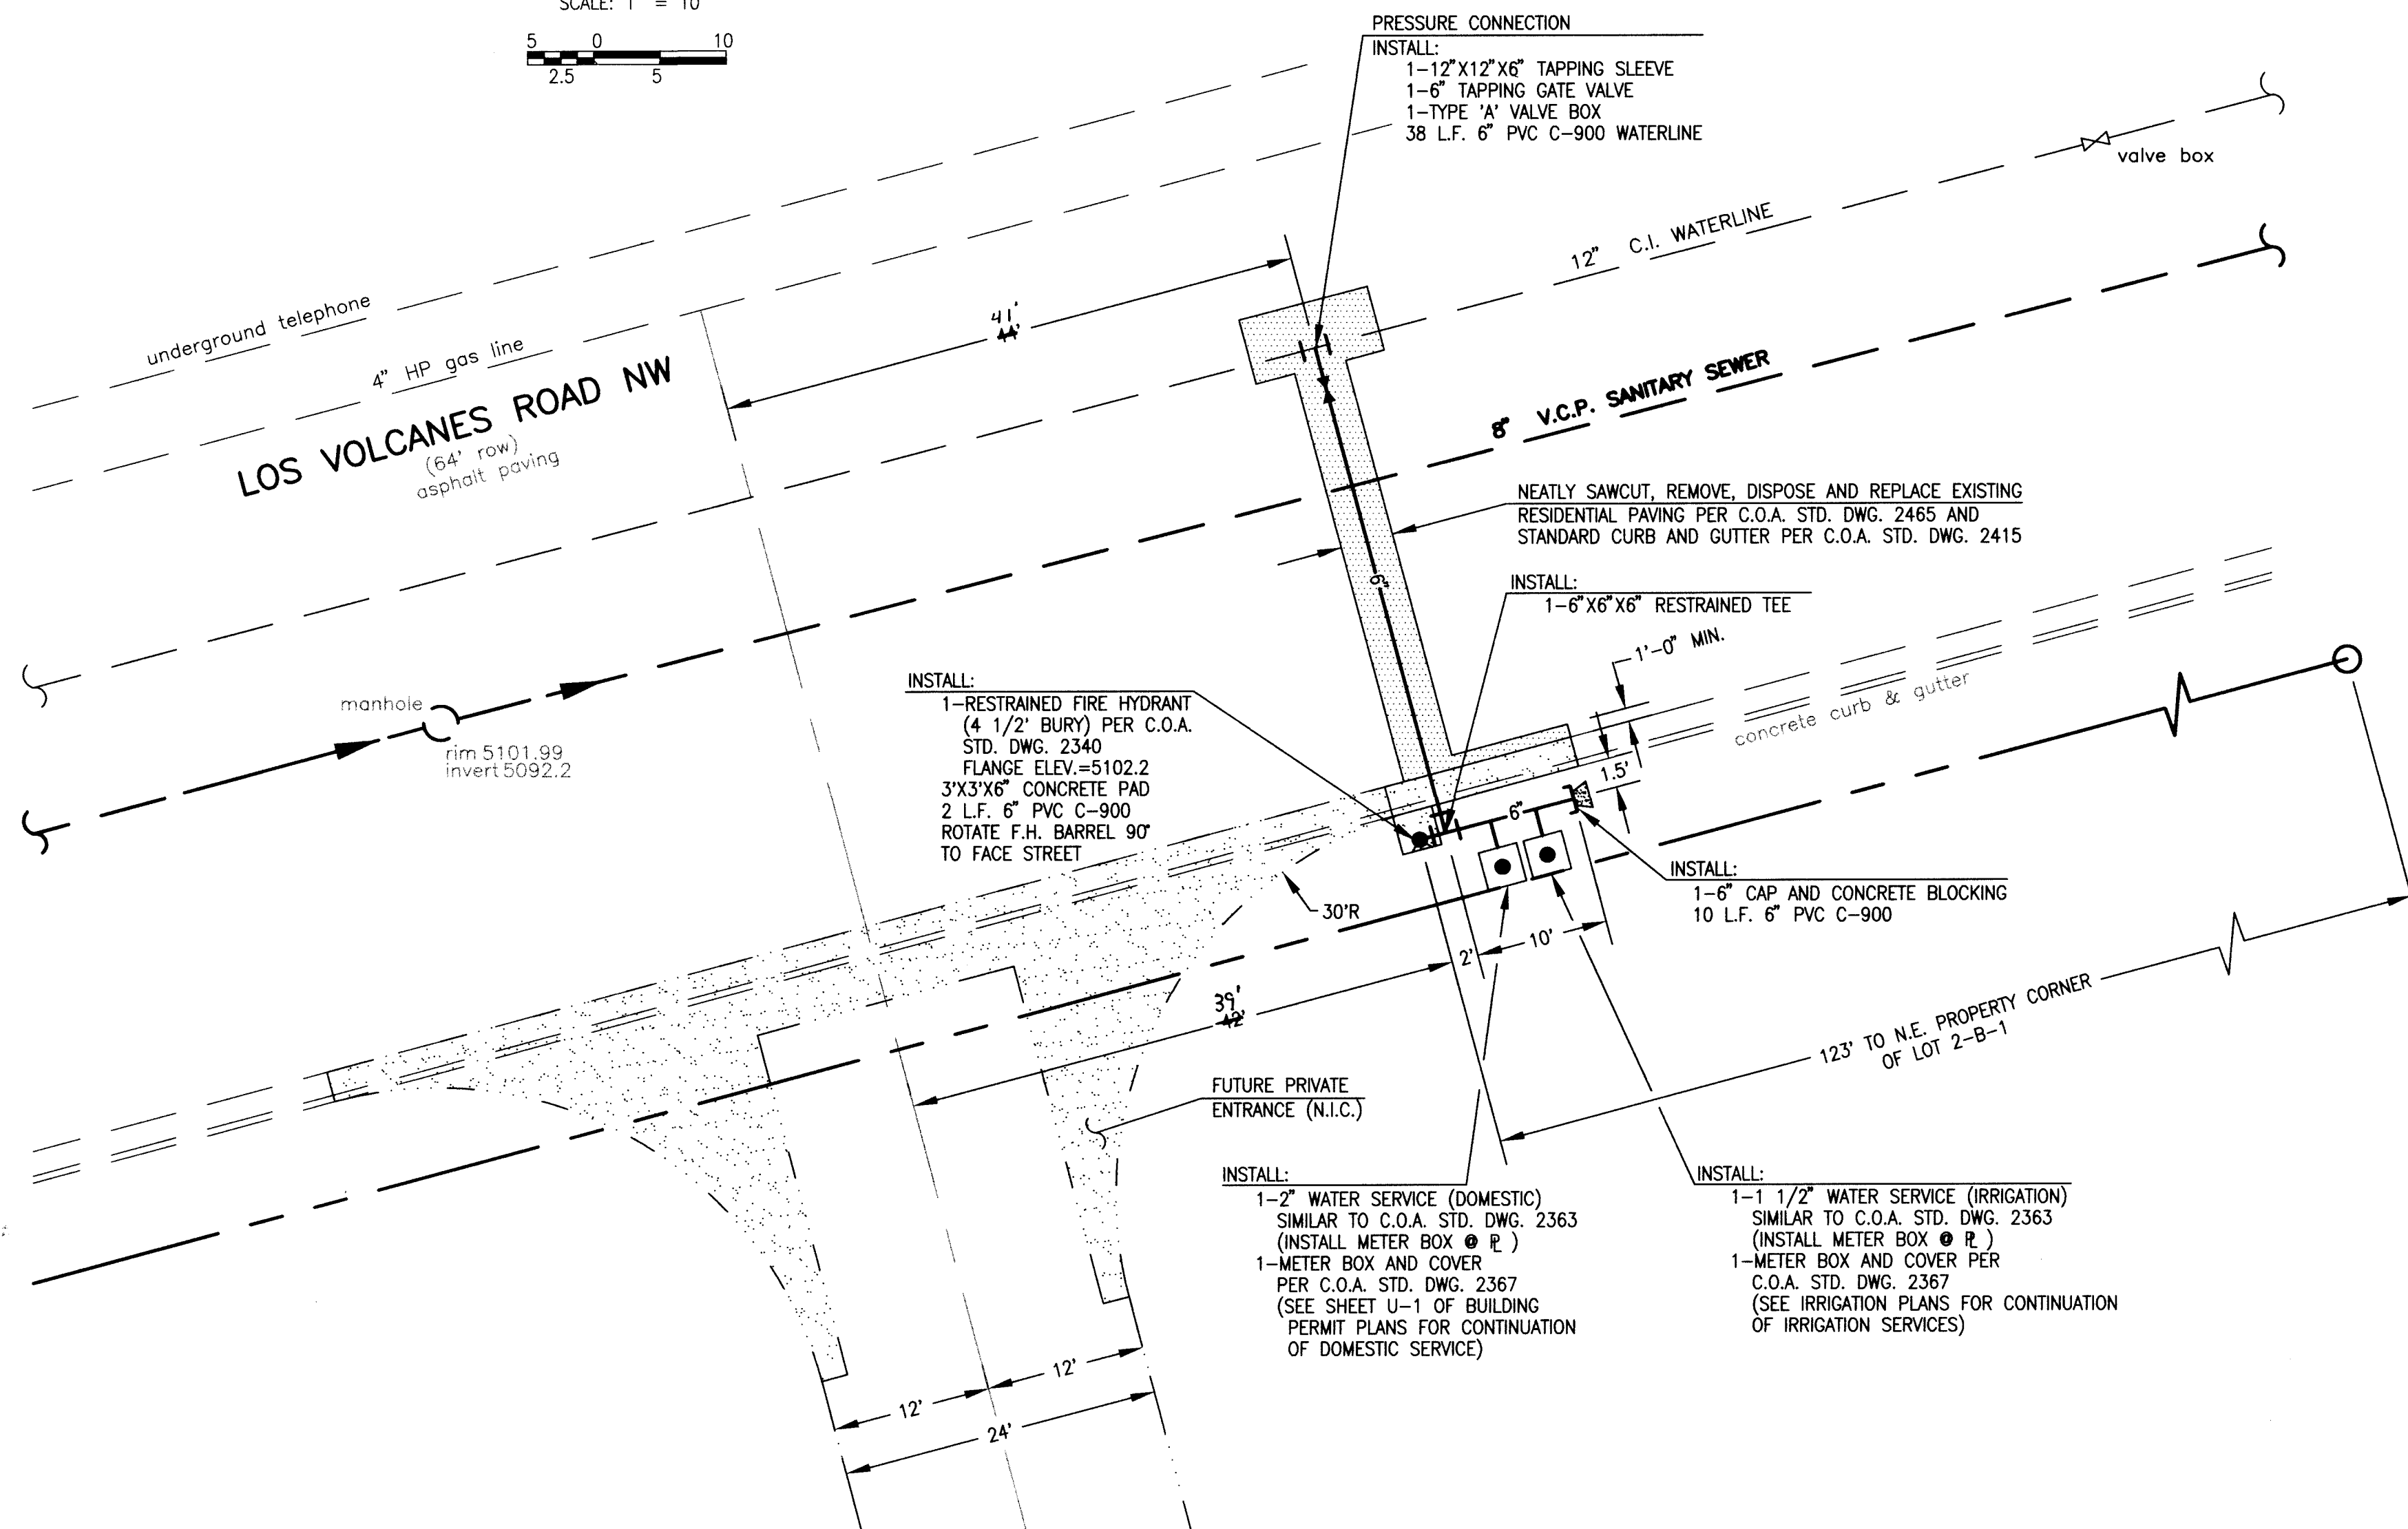5 0 5
2.5

GENERAL NOTES:

- ALL WORK DETAILED ON THESE PLANS TO BE PERFORMED UNDER CONTRACT SHALL, EXCEPT AS OTHERWISE STATED OR PROVIDED FOR HEREON, BE CONSTRUCTED IN ACCORDANCE WITH THE CITY OF ALBUQUERQUE STANDARD SPECIFICATIONS-PUBLIC WORKS CONSTRUCTION-1986 - UPDATE NO. 6.
- TWO (2) WORKING DAYS PRIOR TO ANY EXCAVATION, CONTRACTOR MUST CONTACT NEW MEXICO ONE CALL SYSTEM 260-1990 (ALBUQUERQUE AREA), 1-800-321-ALERT(2537) (STATEWIDE), FOR LOCATION OF EXISTING UTILITIES.
- IF ANY UTILITY LINES, PIPELINES, OR UNDERGROUND UTILITY LINES ARE SHOWN ON THESE DRAWINGS, THEY ARE SHOWN IN AN APPROXIMATE MANNER ONLY, AND SUCH LINES MAY EXIST WHERE NONE ARE SHOWN. IF ANY SUCH EXISTING LINES ARE SHOWN, THE LOCATION IS BASED UPON INFORMATION PROVIDED BY THE OWNER OF SAID UTILITY, AND THE INFORMATION MAY BE INCOMPLETE, OR MAY BE OBSOLETE BY THE TIME CONSTRUCTION COMMENCES. THE ENGINEER HAS CONDUCTED ONLY PRELIMINARY INVESTIGATION OF THE LOCATION, DEPTH, SIZE, OR TYPE OF EXISTING UTILITY LINES, PIPELINES, OR UNDERGROUND UTILITY LINES. THIS INVESTIGATION IS NOT CONCLUSIVE, AND MAY NOT BE COMPLETE, THEREFORE, MAKES NO REPRESENTATION PERTAINING THERETO, AND ASSUMES NO RESPONSIBILITY OR LIABILITY THEREFOR. THE CONTRACTOR SHALL INFORM ITSELF OF THE LOCATION OF ANY UTILITY LINE, PIPELINE, OR UNDERGROUND UTILITY LINE IN OR NEAR THE AREA OF THE WORK IN ADVANCE OF AND DURING EXCAVATION WORK. THE CONTRACTOR IS FULLY RESPONSIBLE FOR ANY AND ALL DAMAGE CAUSED BY ITS FAILURE TO LOCATE, IDENTIFY AND PRESERVE ANY AND ALL EXISTING UTILITIES, PIPELINES, AND UNDERGROUND UTILITY LINES. IN PLANNING AND CONDUCTING EXCAVATION, THE CONTRACTOR SHALL COMPLY WITH STATE STATUTES, MUNICIPAL AND LOCAL ORDINANCES, RULES AND REGULATIONS, IF ANY, PERTAINING TO THE LOCATION OF THESE LINES AND FACILITIES.
- SHOULD A CONFLICT EXIST BETWEEN THESE PLANS AND ACTUAL FIELD CONDITIONS, THE CONTRACTOR SHALL PROMPTLY NOTIFY THE ENGINEER IN WRITING SO THAT THE CONFLICT CAN BE RESOLVED WITH A MINIMUM AMOUNT OF DELAY FOR ALL PARTIES. THE CONTRACTOR SHALL BE RESPONSIBLE FOR ALL INTERPRETATIONS IT MAKES WITHOUT FIRST CONTACTING THE ENGINEER AS REQUIRED ABOVE.
- THE CONTRACTOR SHALL MAINTAIN ACCESS TO ADJACENT PROPERTIES DURING CONSTRUCTION.
- ALL WORK ON THIS PROJECT SHALL BE PERFORMED IN ACCORDANCE WITH APPLICABLE FEDERAL, STATE AND LOCAL LAWS, RULES AND REGULATIONS CONCERNING SAFETY AND HEALTH.
- ALL UTILITIES AND UTILITY SERVICE LINES SHALL BE INSTALLED PRIOR TO PAVING.
- BACKFILL COMPACTION SHALL BE ACCORDING TO SPECIFIED STREET USE.
- TACK COAT REQUIREMENTS SHALL BE DETERMINED DURING CONSTRUCTION BY THE PROJECT ENGINEER.
- SIDEWALKS AND WHEELCHAIR RAMPS WITHIN THE CURB RETURNS SHALL BE CONSTRUCTED WHEREVER A NEW CURB RETURN IS CONSTRUCTED.
- IF CURB IS DEPRESSED FOR A DRIVEPAD OR A HANDICAP RAMP, THE DRIVEPAD OR RAMP SHALL BE CONSTRUCTED PRIOR TO ACCEPTANCE OF THE CURB AND GUTTER.
- ALL STORM DRAINAGE FACILITIES SHALL BE COMPLETED PRIOR TO FINAL ACCEPTANCE.
- CONTRACTOR SHALL COORDINATE WITH THE WATER SYSTEM DIVISION FOR THE EXECUTION OF THE VALVE SHUT OFF PLAN, NOT LESS THAN FIVE (5) WORKING DAYS IN ADVANCE OF ANY WORK THAT MAY AFFECT THE EXISTING PUBLIC WATER UTILITIES. ONLY WATER SYSTEM DIVISION PERSONNEL SHALL OPERATE EXISTING VALVES. REFER TO SECTION 18 OF THE SPECIFICATION. THE WATER SYSTEM DIVISION PHONE NUMBER IS 857-8200.
- CONTRACTOR SHALL NOTIFY THE CITY SURVEYOR NOT LESS THAN SEVEN (7) DAYS PRIOR TO STARTING WORK IN ORDER THAT THE CITY SURVEYOR MAY TAKE NECESSARY MEASURES TO INSURE THE PRESERVATION OF SURVEY MONUMENTS. CONTRACTOR SHALL NOT DISTURB PERMANENT SURVEY MONUMENTS WITHOUT THE CONSENT OF THE CITY SURVEYOR AND SHALL NOTIFY THE CITY SURVEYOR AND BARE THE EXPENSE OF REPLACING ANY THAT MAY BE DISTURBED WITHOUT PERMISSION. REPLACEMENT SHALL BE DONE ONLY BY THE CITY SURVEYOR. WHEN A CHANGE IS MADE IN THE FINISHED ELEVATION OF THE PAVEMENT OF ANY ROADWAY IN WHICH A PERMANENT SURVEY MONUMENT IS LOCATED, CONTRACTOR SHALL, AT HIS OWN EXPENSE, ADJUST THE MONUMENT COVER TO THE NEW GRADE UNLESS OTHERWISE SPECIFIED. REFER TO SECTION 4.4 OF THE SPECIFICATIONS.
- FIVE (5) WORKING DAYS PRIOR TO BEGINNING CONSTRUCTION THE CONTRACTOR SHALL SUBMIT TO THE CONSTRUCTION CO-ORDINATION DIVISION A DETAILED CONSTRUCTION SCHEDULE. TWO (2) WORKING DAYS PRIOR TO CONSTRUCTION THE CONTRACTOR SHALL OBTAIN A BARRICADING PERMIT FROM THE CONSTRUCTION COORDINATION DIVISION. CONTRACTOR SHALL NOTIFY BARRICADE ENGINEER (768-2551) PRIOR TO OCCUPYING AN INTERSECTION. CONTRACTOR MUST REFER TO SECTION 19 OF THE STANDARD SPECIFICATION FOR TRAFFIC CONTROL.
- ALL STREET STRIPING ALTERED OR DESTROYED SHALL BE REPLACED IN KIND BY CONTRACTOR TO LOCATION AND IN KIND AS EXISTING OR AS INDICATED BY THIS PLAN SET.
- CAUTION: THESE DRAWINGS DO NOT INCLUDE NECESSARY COMPONENTS FOR CONSTRUCTION SAFETY WHICH SHALL REMAIN THE RESPONSIBILITY OF THE CONTRACTOR.
- ANY WORK OCCURRING WITHIN AN ARTERIAL ROADWAY REQUIRES TWENTY-FOUR HOUR CONSTRUCTION.

WATERLINE CONSTRUCTION NOTES:

- ALL STATIONING IS BASED ON STREET CENTERLINE UNLESS INDICATED OTHERWISE.
- FOR ALL LINES 12" AND SMALLER, WATER MAIN SHALL BE PVC C-900 PIPE OR AS APPROVED BY THE CITY OF ALBUQUERQUE CITY ENGINEER. DUCTILE IRON IS AN ACCEPTABLE PIPE MATERIAL IN LIEU OF PVC.
- FOR ALL LINES 14" AND LARGER, WATER MAIN SHALL BE DUCTILE IRON OR AS APPROVED BY THE CITY OF ALBUQUERQUE CITY ENGINEER. CONCRETE CYLINDER IS AN ACCEPTABLE PIPE MATERIAL IN LIEU OF DUCTILE IRON.
- WATERLINE SHALL HAVE A MINIMUM COVER OF 4'0" (FINISHED GRADE TO TOP OF PIPE). EXTRA DEPTH TRENCHING, IF REQUIRED, SHALL BE CONSIDERED INCIDENTAL TO CONSTRUCTION, THEREFORE, NO SEPARATE PAYMENT WILL BE MADE.
- ELECTRONIC MARKER DISCS (EMD) SHALL BE INSTALLED IN ACCORDANCE WITH THE STANDARD SPECIFICATION.
- IN ACCORDANCE WITH SECTION 801 OF THE "STANDARD SPECIFICATIONS", METALIZED DETECTABLE WARNING TAPE SHALL BE INSTALLED 18" ABOVE ALL PVC PIPE INSTALLED ON THIS PROJECT.
- VALVE STEM AND FIRE HYDRANT EXTENSIONS SHALL BE PROVIDED IN ACCORDANCE WITH THE STANDARD SPECIFICATIONS. THE COST OF EACH EXTENSION SHALL BE CONSIDERED INCIDENTAL TO CONSTRUCTION THEREFORE NO SEPARATE PAYMENT WILL BE MADE.
- JOINT RESTRAINT SHALL BE CONSIDERED INCIDENTAL TO WATERLINE CONSTRUCTION THEREFORE NO SEPARATE PAYMENT WILL BE MADE.
- JOINT RESTRAINT SHALL BE PROVIDED ON ALL JOINTS OF FIRE HYDRANT LEGS FROM TEE TO FIRE HYDRANT INCLUDING THE TEE AND FIRE HYDRANT.
- FOR THE PURPOSES OF THIS PROJECT, ALL RESTRAINED JOINTS AND JOINT RESTRAINT SHALL BE MECHANICALLY RESTRAINED.

AS BUILT INFORMATION

CONTRACTOR: J.C. Plumbing
WORK: WATERLINE
DATE: 5-97DATE: 12-95
BY: RONALD A. FORSTBAUER
NO: N/A

ENGINEER'S SEAL

BY:

REVISIONS

DESIGN

NO.

DATE

DESIGNED BY: G.M.

DRAWN BY: E.M.S.

CHECKED BY: J.G.M.

DATE: 02-96

DATE: 02-96

JmaJEFF MORTENSEN & ASSOCIATES, INC.
4000-B MIDWAY PARK BLVD. NE.
ALBUQUERQUE, N.M. 87109
ENGINEERS & SURVEYORS (505) 345-4250CITY OF ALBUQUERQUE
PUBLIC WORKS DEPARTMENT
ENGINEERING DEVELOPMENT GROUP

HUD HOUSING PROJECT WATERLINE IMPROVEMENTS

TITLE: LOS VOLCANES ROAD N.W., ALBUQUERQUE, N.M.

APPROVALS	ENGINEER	DATE	*****
DRC Chairman	<i>Jeff Mortensen</i>	3-20-96	APPROVED FOR CONSTRUCTION
Transportation	<i>R.W. Kane</i>	3-20-96	
Water/Wastewater	<i>R.W. Kane</i>	3-20-96	
Hydrology	<i>J.P. Kane</i>	3-20-96	
Parks			
Const. Mgmt.			

City Engineer Date

City Project No. 5399.90 Zone Map No. J-10 Sheet 1 Of 1