

TUSCANY SUBDIVISION- UNIT 1

CITY OF ALBUQUERQUE, BERNALILLO COUNTY, NEW MEXICO

IMPROVEMENTS FOR

GRADING, PAVING AND UTILITIES

EMD, INC. GENERAL NOTES

1. THE CONTRACTOR SHALL CONTACT NMUI AT 899-2661 AT LEAST THREE (3) DAYS PRIOR TO ANY UTILITY CONSTRUCTION (INCLUDING CONNECTIONS TO THE EXISTING SYSTEM) TO COORDINATE THE VARIOUS ITEMS OF WORK WITH NMUI OPERATIONS STAFF. THE CONTRACTOR SHALL CONTACT NMUI 2 WEEKS PRIOR TO WATER SHUT-OFF.
2. ALL UTILITY WORK DETAILED ON THESE PLANS TO BE PERFORMED UNDER CONTRACT SHALL, EXCEPT AS OTHERWISE STATED OR PROVIDED FROM HEREON, BE CONSTRUCTED IN ACCORDANCE WITH THE STATE OF NEW MEXICO STANDARD SPECIFICATIONS FOR PUBLIC WORKS CONSTRUCTION, 1997.
3. ALL UTILITY WORK DETAILED ON THESE PLANS TO BE PERFORMED UNDER CONTRACT SHALL, EXCEPT AS OTHERWISE STATED OR PROVIDED FROM HEREON, BE CONSTRUCTED IN ACCORDANCE WITH NEW MEXICO UTILITIES, INC. (NMUI) STANDARD SPECIFICATIONS. IF NMUI SPECIFICATIONS ARE IN CONFLICT WITH THE NEW MEXICO SPECIFICATIONS, NMUI SPECIFICATIONS SHALL TAKE PRIORITY.
4. TWO (2) WORKING DAYS PRIOR TO ANY EXCAVATION, CONTRACTOR MUST CONTACT LINE LOCATING SERVICE, 260-1990, FOR LOCATION OF EXISTING UTILITIES.
5. PRIOR TO CONSTRUCTION, THE CONTRACTOR SHALL EXCAVATE AND VERIFY THE HORIZONTAL AND VERTICAL LOCATIONS OF ALL OBSTRUCTIONS AND EXISTING PAVEMENT. SHOULD A CONFLICT EXIST, THE CONTRACTOR SHALL NOTIFY THE ENGINEER OR SURVEYOR SO THAT THE CONFLICT CAN BE RESOLVED WITH MINIMUM AMOUNT OF DELAY.
6. THE CONTRACTOR SHALL FURNISH EMD'S ON ALL WATER AND SEWER SERVICE STUBS, CAPS AND PLUGS.
7. CONTRACTOR SHALL NOTIFY THE ENGINEER NOT LESS THAN SEVEN (7) DAYS PRIOR TO STARTING WORK ON UTILITIES IN ORDER THAT THE ENGINEER MAY TAKE NECESSARY MEASURES TO INSURE THE PRESERVATION OF SURVEY MONUMENTS. CONTRACTOR SHALL NOT DISTURB PERMANENT SURVEY MONUMENTS WITHOUT THE CONSENT OF THE ENGINEER AND SHALL NOTIFY THE ENGINEER AND BEAR THE EXPENSE OF REPLACING ANY THAT MAY BE DISTURBED WITHOUT PERMISSION. REPLACEMENT SHALL BE DONE ONLY BY THE CITY SURVEY SECTION. WHEN A CHANGE IS MADE IN THE FINISHED ELEVATION OF THE PAVEMENT OF ANY ROADWAY IN WHICH A PERMANENT SURVEY MONUMENT IS LOCATED, CONTRACTOR SHALL, AT HIS OWN EXPENSE, ADJUST THE MONUMENT COVER TO THE NEW GRADE UNLESS OTHERWISE SPECIFIED. REFER TO SECTION 4.4 OF THE GENERAL CONDITIONS, CITY OF ALBUQUERQUE SPECIFICATIONS.
8. CONTRACTOR SHALL BE RESPONSIBLE FOR OBTAINING A "BARRICADING PERMIT" PRIOR TO COMMENCEMENT OF WATER OR SEWER CONSTRUCTION. REFER TO SECTION 19 OF THE CITY OF ALBUQUERQUE SPECIFICATIONS.


WARNING - EXISTING UTILITY LINE LOCATIONS ARE SHOWN IN AN APPROXIMATE MANNER ONLY, AND SUCH LINES MAY EXIST WHERE NONE ARE SHOWN. THE LOCATION OF ANY SUCH EXISTING LINES IS BASED UPON INFORMATION PROVIDED BY THE UTILITY COMPANY, THE OWNER, OR BY OTHERS, AND THE INFORMATION MAY BE INCOMPLETE OR MAY BE OBSOLETE BY THE TIME CONSTRUCTION COMMENCES.

THE ENGINEER HAS UNDERTAKEN LIMITED FIELD VERIFICATION OF THE LOCATION, DEPTH, SIZE, OR TYPE OF EXISTING UNDERGROUND UTILITY LINES, MAKES NO REPRESENTATION PERTAINING THERE TO AND ASSUMES NO RESPONSIBILITY OR LIABILITY THEREFOR. THE CONTRACTOR SHALL INFORM HIMSELF OF THE LOCATION OF ANY UTILITY LINE IN OR NEAR THE AREA OF THE WORK IN ADVANCE OF AND DURING EXCAVATION WORK. THE CONTRACTOR IS FULLY RESPONSIBLE FOR ANY AND ALL DAMAGE CAUSED BY ITS FAILURE TO LOCATE, IDENTIFY, AND PRESERVE ANY AND ALL EXISTING UTILITIES. THE CONTRACTOR SHALL COMPLY WITH STATE STATUTES, MUNICIPAL AND LOCAL ORDINANCES, RULES AND REGULATIONS PERTAINING TO THE LOCATION OF THESE LINES AND FACILITIES IN PLANNING AND CONDUCTING EXCAVATION, WHETHER BY CALLING OR NOTIFYING THE UTILITIES, COMPLYING WITH "BLUE STAKES" PROCEDURES, OR OTHERWISE.

INDEX TO DRAWINGS

SHEET NO.	DESCRIPTION
1	COVER SHEET, VICINITY MAP AND INDEX TO DRAWINGS
2-4	PLATS OF GEOMETRY
GRADING AND EROSION CONTROL PLANS	
5-6	GRADING AND EROSION CONTROL PLANS
7	OFFSITE GRADING (BANDELIER DRIVE N.W.)
8-10	OFFSITE GRADING & GRADING DETAILS (OFFSITE BORROW AREAS)
PAVING PLAN & PROFILES	
11	COMPOSITE PAVING PLAN
12-14	BANDELIER DRIVE N.W.
15	NAPOLI PLACE N.W.
16	SICILY ROAD N.W.
17	SICILY ROAD, SICILY CUL-DE-SAC AND TUSCANY COURT N.W.
18	MILANO STREET & PALERMO STREET N.W.

SHEET NO.	DESCRIPTION
UTILITY PLAN & PROFILES	
19	COMPOSITE UTILITY PLAN
20-22	BANDELIER DRIVE N.W.
23	NAPOLI PLACE N.W.
24	SICILY ROAD N.W.
25	SICILY ROAD, SICILY CUL-DE-SAC AND TUSCANY COURT N.W.
26	MILANO STREET & PALERMO STREET N.W.
27-29	SANITARY SEWER OUTFALL (TRACT 1-A) (BASELINE "A")
30	OFFSITE DRAINAGE STRUCTURE DETAILS (OUTFALL STRUCTURE NO. 2)
31	OFFSITE DRAINAGE STRUCTURE DETAILS (OUTFALL STRUCTURE NO. 1)
32	OFFSITE DRAINAGE STRUCTURE DETAILS (OUTFALL STRUCTURE NO. 1)
33	SOIL CEMENT SPILLWAY DETAILS
34-36	OUTFALL STRUCTURE DETAILS (REFERENCE ONLY SHEETS)

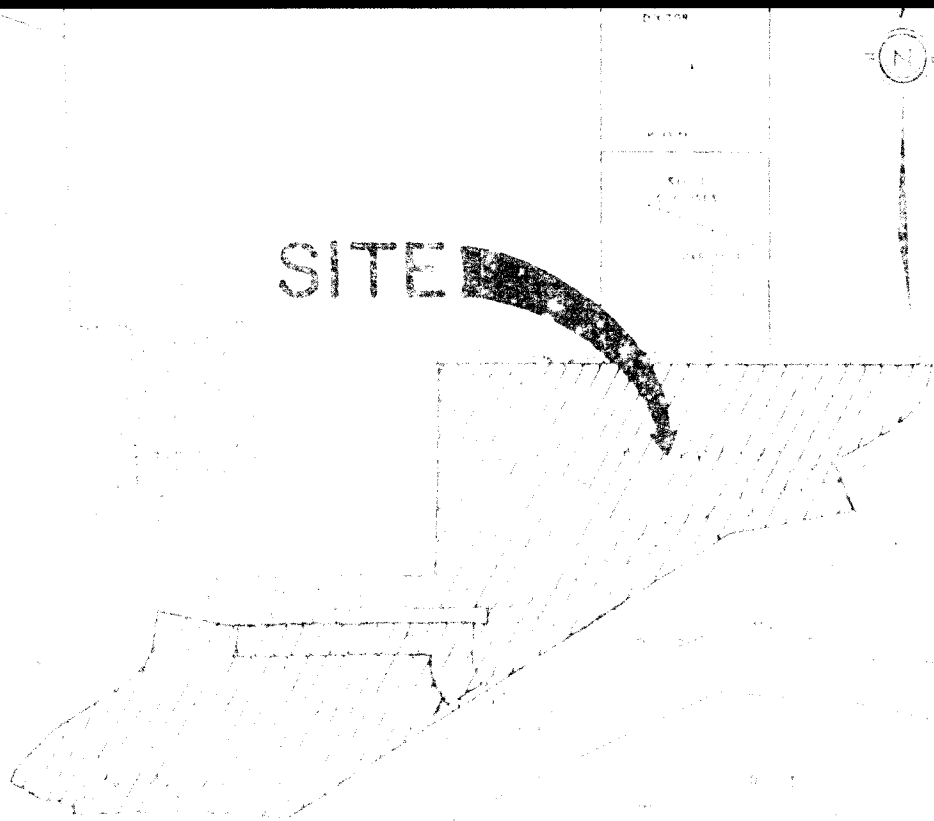

SCALE: 1"= 750 ± VICINITY MAP A-11, A-12-Z


GENERAL NOTES:

1. ALL WORK DETAILED ON THESE PLANS TO BE PERFORMED UNDER CONTRACT SHALL, EXCEPT AS OTHERWISE STATED OR PROVIDED FROM HEREON, BE CONSTRUCTED IN ACCORDANCE WITH THE CITY OF ALBUQUERQUE STANDARD SPECIFICATIONS FOR PUBLIC WORKS CONSTRUCTION, 1986 EDITION AS AMENDED WITH UPDATE NO. 6.
2. TWO (2) WORKING DAYS PRIOR TO ANY EXCAVATION, CONTRACTOR MUST CONTACT LINE LOCATING SERVICE, (260-1990), FOR LOCATION OF EXISTING UTILITIES.
3. PRIOR TO CONSTRUCTION, THE CONTRACTOR SHALL EXCAVATE AND VERIFY THE HORIZONTAL AND VERTICAL LOCATIONS OF ALL OBSTRUCTIONS AND EXISTING PAVEMENT. SHOULD A CONFLICT EXIST, THE CONTRACTOR SHALL NOTIFY THE ENGINEER OR SURVEYOR SO THAT THE CONFLICT CAN BE RESOLVED WITH MINIMUM AMOUNT OF DELAY.
4. CONTRACTOR SHALL NOTIFY THE PROJECT ENGINEER NOT LESS THAN SEVEN (7) DAYS PRIOR TO STARTING WORK IN ORDER THAT THE ENGINEER MAY TAKE NECESSARY MEASURES TO INSURE THE PRESERVATION OF SURVEY MONUMENTS. CONTRACTOR SHALL NOT DISTURB PERMANENT SURVEY MONUMENTS WITHOUT THE CONSENT OF THE ENGINEER AND SHALL BEAR THE EXPENSE OF REPLACING ANY THAT MAY BE DISTURBED WITHOUT PERMISSION. REPLACEMENT SHALL BE DONE ONLY BY THE CITY SURVEY SECTION. WHEN A CHANGE IS MADE IN ANY ROADWAY IN WHICH A PERMANENT SURVEY MONUMENT IS LOCATED, CONTRACTOR SHALL, AT HIS OWN EXPENSE, ADJUST THE MONUMENT COVER TO THE NEW GRADE UNLESS OTHERWISE SPECIFIED. REFER TO SECTION 4.4 OF GENERAL CONDITIONS OF THE CITY OF ALBUQUERQUE STANDARD SPECIFICATION FOR PUBLIC WORKS CONSTRUCTION.
5. THREE (3) WORKING DAYS PRIOR TO BEGINNING PAVING OR DRAINAGE CONSTRUCTION, THE CONTRACTOR SHALL SUBMIT TO THE CONSTRUCTION COORDINATION DIVISION A DETAILED CONSTRUCTION SCHEDULE. TWO (2) WORKING DAYS PRIOR TO CONSTRUCTION, THE CONTRACTOR SHALL OBTAIN A BARRICADING PERMIT FROM THE CONSTRUCTION COORDINATION DIVISION. CONTRACTOR SHALL NOTIFY BARRICADE ENGINEER (768-2551) PRIOR TO OCCUPYING AN INTERSECTION. SEE SECTION 19 OF THE SPECIFICATIONS.
6. ALL STREET STRIPING ALTERED OR DESTROYED SHALL BE REPLACED IN KIND BY CONTRACTOR TO LOCATION AND IN KIND AS EXISTING OR AS INDICATED BY THIS PLAN SET. ALL NEW STRIPING SHALL BE PLASTIC AS PER CITY STANDARDS.
7. ANY WORK AFFECTING AN ARTERIAL ROADWAY REQUIRES TWENTY-FOUR HOUR CONSTRUCTION.
8. ALL HANDICAP RAMPS WILL MEET A.D.A. STANDARDS PER CITY'S REVISED SPECIFICATIONS.

24-5208.91-1910197

1	REV.	SHEETS	CITY ENGINEER	DATE	USER	DEPARTMENT	DATE	USER	DEPARTMENT	DATE
ENGINEER'S SEAL					DATE: AUGUST, 1995 SCALE: AS SHOWN DESIGNED: T.J.B. DRAWN: A.M. JOB NO.: 29107-PRE		community sciences corporation LAND PLANNING P.O. Box 1328 ENGINEERING Corrales, N.M. 87048 SURVEYING		APPROVED FOR CONSTRUCTION CITY ENGINEER 11/24/95 DATE	
PROJECT NO. 5208.91					SHEET 1 OF 36					

APPROVAL OF AS BUILT DRAWINGS
CHIEF CONSTRUCTION ENGINEER
K. Russell B. Smith
DATE 3-24-97

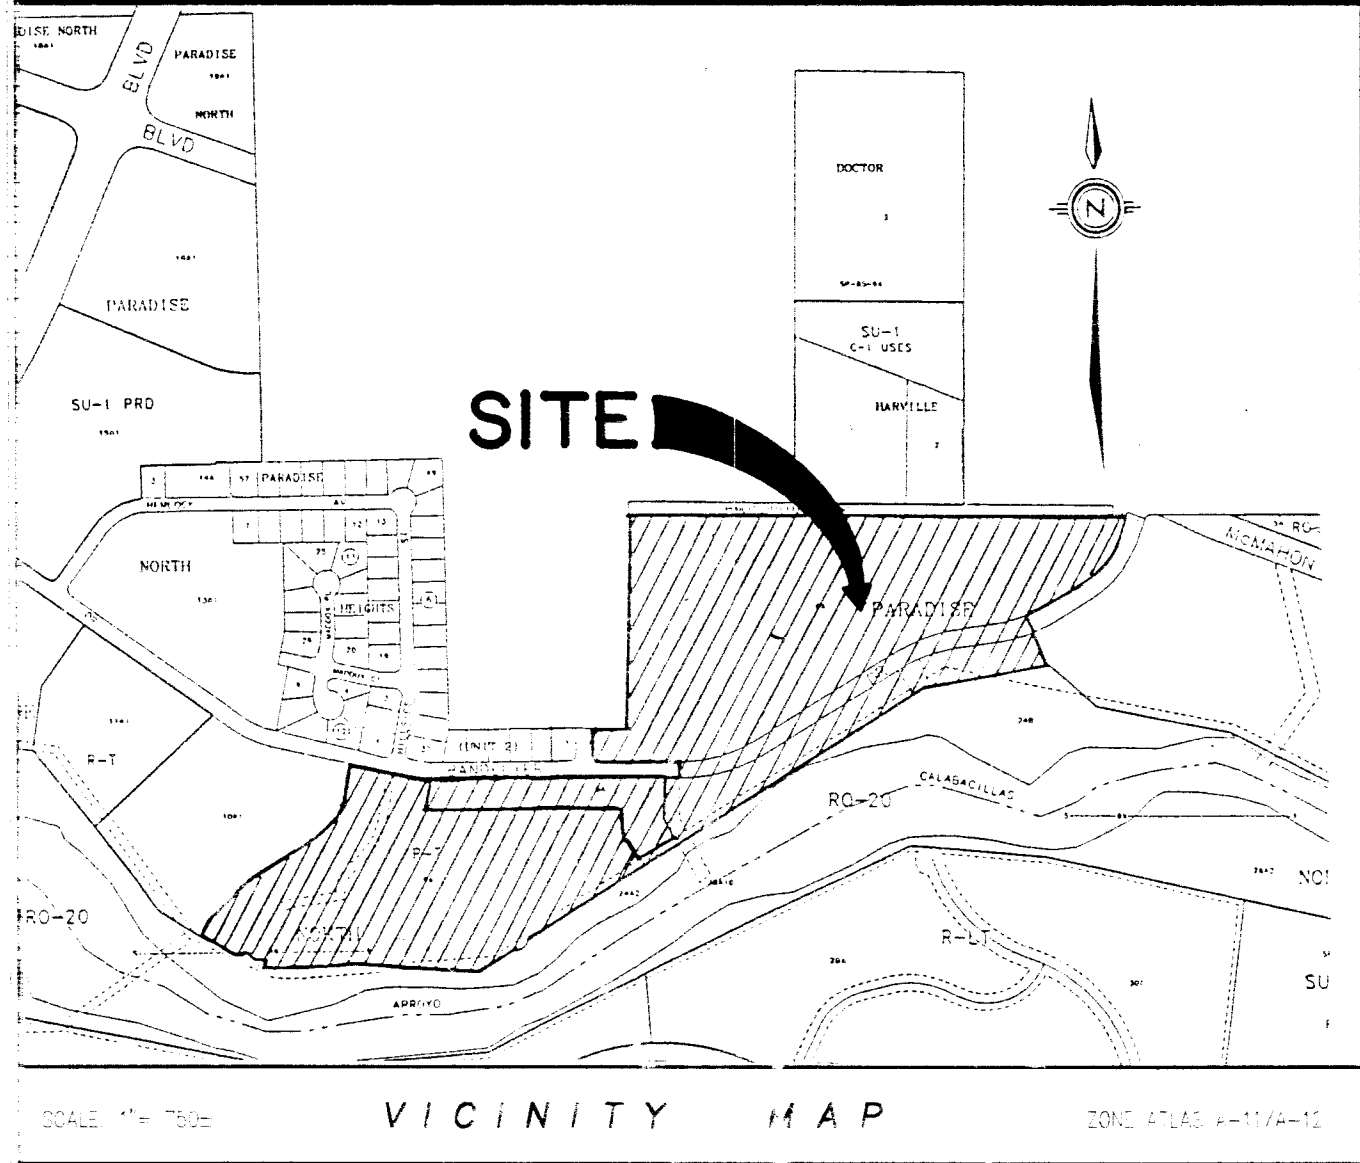

TREASURER'S CERTIFICATION

THIS IS TO CERTIFY THAT TAXES ARE CURRENT AND PAID ON UPC #'S:

PARADISE NORTH:

TRACT 6A, UPC # 1-012-066-080179-30207
TRACT 8A, UPC # 1-012-066-079136-30320
TRACT 9A, UPC # 1-012-066-451069-40175

PROPERTY OWNER OF RECORD: CURB WEST, INC.

BERNALILLO COUNTY TREASURER'S OFFICE:

BY: Quinn Mikal DATE: 6-17-95

NOTES:

- THE PURPOSE OF THIS PLAT IS TO VACATE EXISTING RIGHTS-OF-WAY AND/OR EASEMENTS NO LONGER REQUIRED OR TO BE RELOCATED WITH THIS PLAN AND TO SUBDIVIDE 50.9425 ACRES INTO 87 SINGLE FAMILY LOTS, 5 TRACTS, PARK, AND ADJOINING STREETS.
- ALL BEARINGS SHOWN HEREON ARE GRID BEARINGS BASED ON THE NEW MEXICO STATE PLANE COORDINATE SYSTEM, CENTRAL ZONE, MEAN DELTA ALPHA -00°15'16". ALL DISTANCE ARE GROUND DISTANCE.
- BEARINGS AND DISTANCES SHOWN IN PARENTHESES ARE FROM RECORD PLATS.
- ALL DIMENSIONS PUBLISHED ALONG CURVED LINES ARE ARC DISTANCES. LOT LINES MARKED N/R ARE NON-RADIAL.
- BENCHMARK FOR THIS PLAT IS THE USGS BRASS CAP "BLACK-2" LOCATED 1.3 MILES NORTH ON GOLF COURSE ROAD TO MCMAHON BOULEVARD STATIONED TO THE LEFT.
- UNLESS OTHERWISE NOTED, ALL CORNERS ARE EVIDENCED BY A #5 REBAR WITH ALUMINUM CAP STAMPED "P.S. #12657".
- CENTERLINE (IN LIEU OF R/W) MONUMENTATION TO BE INSTALLED AT ALL CENTERLINE P.C.'S, P.T.S, ANGLE POINTS AND STREET INTERSECTIONS PRIOR TO ACCEPTANCE OF SUBDIVISION STREET IMPROVEMENTS AND WILL CONSIST OF A FOUR INCH ALUMINUM ALLOY CAP STAMPED "CITY OF ALBUQUERQUE CENTERLINE MONUMENTATION SURVEY MARKER DO NOT DISTURB P.L.S. 12657". ▲ DENOTES CENTERLINE MONUMENT
- PUBLIC UTILITY EASEMENTS (P.U.E.) SHOWN ON THIS PLAT ARE GRANTED FOR THE COMMON AND JOINT USE OF:**
 - THE PUBLIC SERVICE COMPANY OF NEW MEXICO FOR THE INSTALLATION, MAINTENANCE AND SERVICE OF UNDERGROUND ELECTRICAL LINES, TRANSFORMERS, POLES AND ANY OTHER EQUIPMENT, FIXTURES, STRUCTURES AND RELATED FACILITIES REASONABLY NECESSARY TO PROVIDE ELECTRICAL SERVICE.
 - THE GAS COMPANY OF NEW MEXICO FOR INSTALLATION, MAINTENANCE, AND SERVICE OF NATURAL GAS LINES, VALVES AND OTHER EQUIPMENT AND FACILITIES REASONABLY NECESSARY TO PROVIDE NATURAL GAS.
 - U.S. WEST FOR THE INSTALLATION, MAINTENANCE AND SERVICE OF ALL BURIED COMMUNICATION LINES AND OTHER RELATED EQUIPMENT AND FACILITIES REASONABLY NECESSARY TO PROVIDE COMMUNICATION SERVICES, INCLUDING BUT NOT LIMITED TO ABOVE GROUND PEDESTALS AND CLOSURES.
 - JONES INTERCABLE FOR THE INSTALLATION, MAINTENANCE, AND SERVICE OF SUCH UNDERGROUND LINES, CABLE, AND OTHER RELATED EQUIPMENT AND FACILITIES, REASONABLY NECESSARY TO PROVIDE CABLE TV SERVICE.

(NOTES CONTINUED ON SHEET 6)

LEGAL DESCRIPTION

THAT CERTAIN PARCEL OF LAND SITUATE WITHIN THE TOWN OF ALAMEDA GRANT ("PROJECTED" SECTIONS 1 AND 2, TOWNSHIP 11 NORTH, RANGE 2 EAST, NEW MEXICO PRINCIPAL MERIDIAN), CITY OF ALBUQUERQUE, BERNALILLO COUNTY, NEW MEXICO AND BEING COMPRISED OF TRACTS 6A, 8A AND 9A, PARADISE NORTH AS THE SAME IS SHOWN AND DESIGNATED ON THE PLAT OF RECORD FILED IN THE OFFICE OF THE COUNTY CLERK OF BERNALILLO COUNTY, NEW MEXICO ON AUGUST 8, 1990 IN VOLUME 90C, FOLIO 182; TOGETHER WITH A PORTION OF BANDELER DRIVE NW AS THE SAME IS SHOWN AND DESIGNATED ON THE PLAT OF RECORD FILED IN THE OFFICE OF THE COUNTY CLERK OF BERNALILLO COUNTY, NEW MEXICO ON AUGUST 17, 1987 IN VOLUME C34, FOLIO 99 AND BEING MORE PARTICULARLY DESCRIBED AS FOLLOWS:

BEGINNING FOR A TIE, AT THE ALBUQUERQUE CITY SURVEY "BLACK-2" (ALUMINUM CAP HAVING NEW MEXICO STATE PLANE COORDINATES, CENTRAL ZONE OF X=372,920.43 AND Y=1,530,241.52); THENCE N85°17'43"W, 3,323.30 FEET TO A POINT ON THE NORTHERLY RIGHT-OF-WAY LINE OF BANDELER DRIVE NW (66' R/W) AND THE TRUE POINT OF BEGINNING OF THE PARCEL HEREIN DESCRIBED; THENCE ALONG SAID NORTHERLY RIGHT-OF-WAY S20°37'02"W, 77.11 FEET TO A POINT OF CURVATURE (PC); THENCE ALONG THE ARC OF A CURVE BEARING TO THE RIGHT, (SAID ARC HAVING A RADIUS OF 346.00 FEET, ARC LENGTH OF 224.16 FEET, CENTRAL ANGLE OF 037°07'08" AND A CHORD THAT BEARS S39°10'37"W, 220.26 FEET) TO A POINT OF TANGENCY (PT); THENCE S57°44'11"W, 149.97 FEET TO A POINT OF CURVATURE (PC); THENCE ALONG THE ARC OF A CURVE BEARING TO THE RIGHT, (SAID ARC HAVING A RADIUS OF 541.00 FEET, ARC LENGTH OF 92.11 FEET, CENTRAL ANGLE OF 09°45'19", AND A CHORD THAT BEARS S62°36'50"W, 92.00 FEET) TO A POINT ON CURVE; THENCE DEPARTING NORTHERLY RIGHT-OF-WAY S22°30'31"E, 196.00 FEET TO AN ANGLE POINT; THENCE S77°44'11"W, 208.48 FEET TO AN ANGLE POINT; THENCE S82°15'28"W, 240.83 FEET TO AN ANGLE POINT; THENCE S57°44'11"W, 175.17 FEET TO A POINT ON CURVE; THENCE ALONG THE ARC OF A CURVE BEARING TO THE RIGHT, (SAID ARC HAVING A RADIUS OF 50.00 FEET, ARC LENGTH OF 64.35 FEET, A CENTRAL ANGLE OF 073°44'23", AND A CHORD THAT BEARS S52°01'07"E, 60.00 FEET) TO A POINT; THENCE S57°44'11"W, 151.63 FEET TO AN ANGLE POINT; THENCE N85°30'29"W, 459.78 FEET TO AN ANGLE POINT; THENCE S87°21'45"W, 201.43 FEET TO AN ANGLE POINT; THENCE N85°30'29"W, 131.21 FEET TO AN ANGLE POINT; THENCE N11°24'25"W, 25.99 FEET TO A POINT ON CURVE; THENCE ALONG THE ARC OF A CURVE BEARING TO THE RIGHT, (SAID ARC HAVING A RADIUS OF 50.00 FEET, ARC LENGTH OF 64.40 FEET, A CENTRAL ANGLE OF 073°44'23", AND A CHORD THAT BEARS N64°30'29"W, 60.04 FEET) TO A POINT; THENCE S82°23'28"W, 31.26 FEET TO AN ANGLE POINT; THENCE N64°30'29"W, 158.54 FEET TO AN ANGLE POINT; THENCE N27°04'31"E, 78.43 FEET TO AN ANGLE POINT; THENCE N46°43'24"E, 175.37 FEET TO AN ANGLE POINT; THENCE N58°00'54"E, 318.07 FEET TO AN ANGLE POINT; THENCE N47°56'52"E, 103.75 FEET TO AN ANGLE POINT; THENCE N23°59'33"E, 71.22 FEET TO AN ANGLE POINT; THENCE N12°32'28"E, 139.77 FEET TO A POINT ON THE SOUTHERLY RIGHT-OF-WAY LINE OF BANDELER DRIVE NW (66' R/W); THENCE ALONG SAID SOUTHERLY RIGHT-OF-WAY S77°24'34"E, 193.94 FEET TO A POINT OF CURVATURE (PC); THENCE ALONG THE ARC OF A CURVE BEARING TO THE LEFT (SAID ARC HAVING A RADIUS OF 721.16 FEET, ARC LENGTH OF 155.23 FEET, A CENTRAL ANGLE OF 012°20'00", AND A CHORD THAT BEARS S83°34'3"E, 154.94 FEET) TO A POINT OF TANGENCY (PT); THENCE S89°44'34"E, 845.69 FEET TO AN ANGLE POINT; THENCE DEPARTING SAID SOUTHERLY RIGHT-OF-WAY N00°15'26"E, 60.00 FEET TO A POINT ON THE NORTHERLY RIGHT-OF-WAY LINE OF BANDELER DRIVE NW; THENCE ALONG SAID NORTHERLY RIGHT-OF-WAY N89°44'34"W, 295.69 FEET TO A POINT OF CURVATURE (PC); THENCE DEPARTING NORTHERLY RIGHT-OF-WAY N00°15'26"E, 60.00 FEET TO A POINT OF CURVATURE (PC); THENCE ALONG THE ARC OF A CURVE BEARING TO THE RIGHT, (SAID ARC HAVING A RADIUS OF 25.00 FEET, ARC LENGTH OF 39.27 FEET, AND A CENTRAL ANGLE OF 090°00'00", AND A CHORD THAT BEARS N44°44'34"W, 35.36 FEET TO AN ANGLE POINT; THENCE N00°15'26"E, 95.58 FEET TO AN ANGLE POINT; THENCE S89°49'11"E, 137.29 FEET TO AN ANGLE POINT; THENCE N00°13'07"E, 786.99 FEET TO AN ANGLE POINT; THENCE S89°49'03"E, 1843.80 FEET TO A POINT ON THE NORTHERLY RIGHT-OF-WAY LINE OF BANDELER DRIVE NW (66' R/W), AND THE TRUE POINT OF BEGINNING OF THE PARCEL HEREIN DESCRIBED.

THE ABOVE DESCRIBED PARCEL CONTAINS 2,219,057 SQUARE FEET OR 50.943 ACRES MORE OR LESS.

FREE CONSENT AND DEDICATION:

THE SUBDIVISION SHOWN HEREON IS WITH THE FREE CONSENT AND IN ACCORDANCE WITH THE DESIRES OF THE UNDERSIGNED OWNER(S) AND/OR PROPRIETOR(S) THEREOF AND SAID OWNER(S) AND/OR PROPRIETOR(S) DO HEREBY DEDICATE ALL STREETS, PARK AND PUBLIC RIGHTS-OF-WAY SHOWN HEREON TO THE CITY OF ALBUQUERQUE IN FEE SIMPLE WITH WARRANTY COVENANTS AND DO HEREBY GRANT: ALL ACCESS, UTILITY AND DRAINAGE EASEMENTS SHOWN HEREON INCLUDING THE RIGHT TO CONSTRUCT, OPERATE, INSPECT, AND MAINTAIN FACILITIES THEREIN; AND ALL PUBLIC UTILITY EASEMENTS SHOWN HEREON FOR THE COMMON AND JOINT USE OF GAS, ELECTRICAL POWER AND COMMUNICATION SERVICES FOR BURIED DISTRIBUTION LINES, CONDUITS, AND PIPES FOR UNDERGROUND UTILITIES WHERE SHOWN OR INDICATED, AND INCLUDING THE RIGHT OF INGRESS AND EGRESS FOR CONSTRUCTION AND MAINTENANCE, AND THE RIGHT TO TRIM INTERFERING TREES AND SHRUBS (SEE NOTE 8). SAID OWNER(S) AND/OR PROPRIETOR(S) DO HEREBY CONSENT TO ALL OF THE FOREGOING AND DO HEREBY CERTIFY THAT THIS SUBDIVISION IS THEIR FREE ACT AND DEED.

CURB WEST, INC.

A NEW MEXICO CORPORATION

BY: Charles A. Haegelin
CHARLES A. HAEGELIN, PRESIDENT

STATE OF NEW MEXICO) SS
COUNTY OF BERNALILLO)

THIS INSTRUMENT WAS ACKNOWLEDGED BEFORE ME ON June 30, 1995
BY CHARLES A. HAEGELIN, PRESIDENT, ON BEHALF OF SAID CORPORATION.

BY: Notary Public

MY COMMISSION EXPIRES: 1-12-99

95083618

VACATION AND REPLAT
FOR

TUSCANY SUBDIVISION UNIT 1

COMPRISED OF
TRACTS 6A, 8A AND 9A, PARADISE NORTH
AND A PORTION OF BANDELER DRIVE NW
SITUATE WITHIN

THE TOWN OF ALAMEDA GRANT
"PROJECTED" SECTIONS 1 AND 2, T11N, R2E, N.M.P.M.
CITY OF ALBUQUERQUE, BERNALILLO COUNTY, NEW MEXICO
JUNE, 1995

SUBDIVISION DATA:

CASE NO. _____ DRB-95-41, SV-95-12
GROSS SUBDIVISION ACREAGE _____
ZONE ATLAS INDEX NO. _____
NO. OF EXISTING TRACTS _____
NO. OF LOTS CREATED _____
NO. OF TRACTS CREATED _____
MILES OF FULL-WIDTH STREETS CREATED _____
DATE OF SURVEY _____
TALOS LOG NO. _____

APPROVALS:

*SUBDIVISION PLAT CONDITIONS: FILED N/A DOC. NO. N/A
VOLUME N/A

FOLIO N/A

SUBDIVISION CASE NUMBER: 5-95-9

CITY PLANNING, ALBUQUERQUE, BERNALILLO CO. PLANNING DIVISION

PARKS AND RECREATION SERVICE DEPARTMENT

TRAFFIC ENGINEER, TRANSPORTATION DEPARTMENT

CITY ENGINEER, ENGINEERING DIVISION

ALBUQUERQUE METROPOLITAN ARROYO FLOOD CONTROL AUTHORITY

UTILITY DEVELOPMENT

CITY SURVEYOR, ENGINEERING DIVISION

PROPERTY MANAGEMENT

GAS COMPANY OF NEW MEXICO

US WEST COMMUNICATIONS, INC.


NEW MEXICO UTILITIES, INC.

PUBLIC SERVICE COMPANY OF NEW MEXICO

SURVEYOR'S CERTIFICATION: Robert W. Kane

I, DAVID J. THOMPSON, HEREBY AFFIRM THAT I AM A DULY QUALIFIED REGISTERED PROFESSIONAL SURVEYOR UNDER THE LAWS OF THE STATE OF NEW MEXICO AND DO CERTIFY THAT THIS PLAT WAS PREPARED BY ME OR UNDER MY DIRECT SUPERVISION; SHOWS ACCURATE DIMENSIONS, AND LAND AREAS; SHOWS ALL EASEMENTS AND RESTRICTIONS AS SHOWN ON THE PLAT OF RECORD OR MADE KNOWN TO ME BY THE OWNERS AND/OR PROPRIETORS OF THE SUBDIVISION SHOWN HEREON, TITLE COMPANIES, UTILITY COMPANIES OR OTHER PARTIES EXPRESSING AN INTEREST. I FURTHER CERTIFY THAT THIS PLAT MEETS THE MINIMUM REQUIREMENTS FOR MONUMENTATION AND SURVEYS OF THE ALBUQUERQUE SUBDIVISION ORDINANCE, MEETS THE "MINIMUM STANDARDS FOR LAND SURVEYS" SET FORTH BY THE STATE OF NEW MEXICO AND IS TRUE AND CORRECT TO THE BEST OF MY KNOWLEDGE AND BELIEF.

DAVID J. THOMPSON, N.M.P.S. #12657

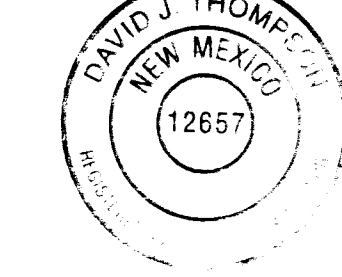

SHEET 1 OF 6

DATE: JUNE, 1995
SCALE: 1" = 200'
DESIGNED: N/A
DRAWN: S.P.S.
JOB NO.: 291-07-025

community sciences corporation

LAND PLANNING ENGINEERING SURVEYING
P.O. Box 1328 Corrales, N.M. 87046

KEYED EASEMENT NOTES


- (A) EXISTING 10' WIDE A.M.F.C.A. EASEMENT (FILED 8-17-87, VOL. C34, FOL. 99) VACATED WITH THIS PLAT (V-95-28) QUIT CLAIM DEED DOC. # 95-082907
- (B) EXISTING 20' TEMPORARY DRAINAGE EASEMENT (FILED 8-17-87, VOL. C34, FOL. 99) VACATED WITH THIS PLAT (V-95-28) QUIT CLAIM DEED DOC. # 95-082907
- (C) EXISTING 30' TEMPORARY WATERLINE AND SANITARY SEWER EASEMENT (FILED 8-8-90, VOL. C90, FOL. 182) VACATED WITH THIS PLAT (V-95-28)
- (D) EXISTING ACCESS, DRAINAGE, SANITARY SEWER, WATERLINE AND PUBLIC UTILITY EASEMENT (FILED 8-17-87, VOL. C34, FOL. 99) VACATED WITH THIS PLAT (V-95-28)
- (E) EXISTING DRAINAGE EASEMENT (FILED 3-04-85, MISC BK 206A, PG. 373-375) VACATED WITH THIS PLAT (V-95-28) QUIT CLAIM DEED DOC. # 95-082907
- (F) EXISTING 60' RIGHT-OF-WAY (FILED 8-17-87, VOL. C34, FOL. 99) VACATED WITH THIS PLAT (V-95-28)
- (G) EXISTING 10' UTILITY EASEMENT (FILED 8-17-87, VOL. C34, FOL. 99) VACATED WITH THIS PLAT (V-95-28)
- (H) EXISTING 50' DRAINAGE EASEMENT (FILED 3-28-85, VOL. C26, FOL. 167) VACATED WITH THIS PLAT (V-95-28) QUIT CLAIM DEED DOC. # 95-082907
- (I) EXISTING 10' ELECTRIC AND TELEPHONE EASEMENT (FILED 9-2-80, BK 0560, PG. 47) VACATED WITH THIS PLAT (V-95-28)
- (J) EXISTING 30' NEW MEXICO UTILITIES INC. RES. SITE ACCESS EASEMENT (FILED 12-10-86, VOL. C32, FOL. 99) VACATED WITH THIS PLAT (V-95-28)
- (K) EXISTING NEW MEXICO UTILITIES INC. RES. SITE ACCESS EASEMENT (FILED 12-10-86, VOL. C32, FOL. 99) VACATED WITH THIS PLAT (V-95-28)

LEGEND

- FND #5 REBAR
LS 4972
● FND #5 REBAR
LS 5443
□ FND #5 REBAR
LS 7270
■ FND #5 REBAR
LS 7474
⊗ FND #5 REBAR
LS 7474

NOTE: SHEET 2 ONLY

TANGENT TABLE		
T-1	N 11°24'25" W	25.99'
T-2	S 82°12'28" W	31.16'
T-3	N 00°15'26" E	60.00'
T-4	N 89°44'34" W	295.69'
T-5	N 00°15'26" E	95.68'

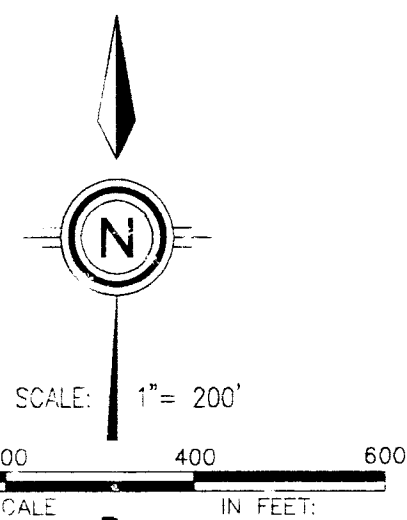

95083618

VACATION AND REPLAT
FOR

TUSCANY SUBDIVISION UNIT 1

COMPRISED OF
TRACTS 6A, 8A AND 9A, PARADISE NORTH
AND A PORTION OF BANDELER DRIVE NW
SITUATE WITHIN

THE TOWN OF ALAMEDA GRANT
"PROJECTED" SECTIONS 1 AND 2, T11N, R2E, N.M.P.M.
CITY OF ALBUQUERQUE, BERNALILLO COUNTY, NEW MEXICO
JUNE, 1995

State of New Mexico) SS
County of Bernalillo)
This instrument was filed for record on

11-13-95
11-13-95
SURVEYOR'S CERTIFICATION:

I, DAVID J. THOMPSON HEREBY AFFIRM THAT I AM A DULY QUALIFIED REGISTERED PROFESSIONAL SURVEYOR UNDER THE LAWS OF THE STATE OF NEW MEXICO AND DO CERTIFY THAT THIS PLAT WAS PREPARED BY ME OR UNDER MY DIRECT SUPERVISION; SHOWS ACCURATE DIMENSIONS, AND LAND AREAS; SHOWS ALL EASEMENTS AND RESTRICTIONS AS SHOWN ON THE PLAT OF RECORD OR MADE KNOWN TO ME BY THE OWNERS AND/OR PROPRIETORS OF THE SUBDIVISION SHOWN HEREON, TITLE COMPANIES, UTILITY COMPANIES OR OTHER PARTIES EXPRESSING AN INTEREST. I FURTHER CERTIFY THAT THIS PLAT MEETS THE MINIMUM REQUIREMENTS FOR MONUMENTATION AND SURVEYS OF THE ALBUQUERQUE SUBDIVISION ORDINANCE, MEETS THE "MINIMUM STANDARDS FOR LAND SURVEYS" SET FORTH BY THE STATE OF NEW MEXICO AND IS TRUE AND CORRECT TO THE BEST OF MY KNOWLEDGE AND BELIEF.

DAVID J. THOMPSON, N.M.P.S. #12657

DATE: 6/30/95

SHEET 2 OF 6

DATE: JUNE, 1995
SCALE: 1" = 200'
DESIGNED: S.P.S.
DRAWN: S.P.S.
JOB NO.: 291-07-025



community sciences corporation

LAND PLANNING ENGINEERING SURVEYING
P.O. Box 1328 Corrales, N.M. 87046

TUSCANY SUBDIVISION UNIT 1

COMPRISED OF
TRACTS 6A, 8A AND 9A, PARADISE NORTH
AND A PORTION OF BANDELIER DRIVE NW
SITUATE WITHIN


THE TOWN OF ALAMEDA GRANT
"PROJECTED" SECTIONS 1 AND 2, T11N, R2E, N.M.P.M.
CITY OF ALBUQUERQUE, BERNALILLO COUNTY, NEW MEXICO
JUNE, 1995

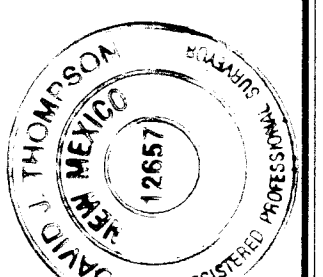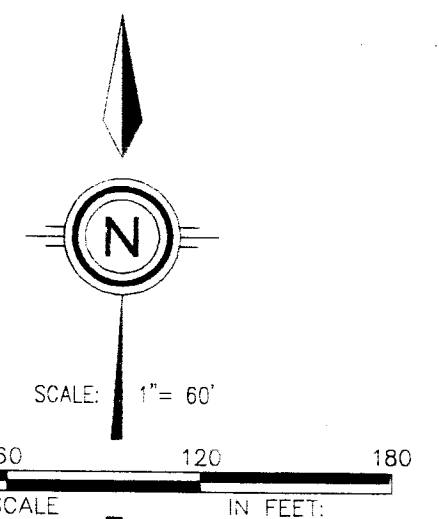

SURVEYOR'S CERTIFICATION:
I, DAVID J. THOMPSON, HEREBY AFFIRM THAT I AM A DULY QUALIFIED REGISTERED PROFESSIONAL SURVEYOR UNDER THE LAWS OF THE STATE OF NEW MEXICO AND DO CERTIFY THAT THIS PLAT WAS PREPARED BY ME OR UNDER MY CLOSE PERSONAL SUPERVISION AND THAT I AM AWARE OF THE CONTENTS AND ACCURACY OF THE INFORMATION CONTAINED HEREIN. I FURTHER CERTIFY THAT THIS PLAT MEETS THE MINIMUM REQUIREMENTS FOR MONUMENTATION AND SURVEYS OF THE ALBUQUERQUE SUBDIVISION ORDINANCE MEETS THE MINIMUM STANDARDS FOR THE STATE OF NEW MEXICO AND IS TRUE AND CORRECT TO THE BEST OF MY KNOWLEDGE AND BELIEF.

DATE: JUNE, 1995
SCALE: 1" = 60'
DRAWN: S.P.S.
CHECKED: D.E.R.
FILE NO.: 291-07-025


community sciences corporation
LAND PLANNING ENGINEERING SURVEYING
P.O. Box 1328 Fort Collins, CO 80504

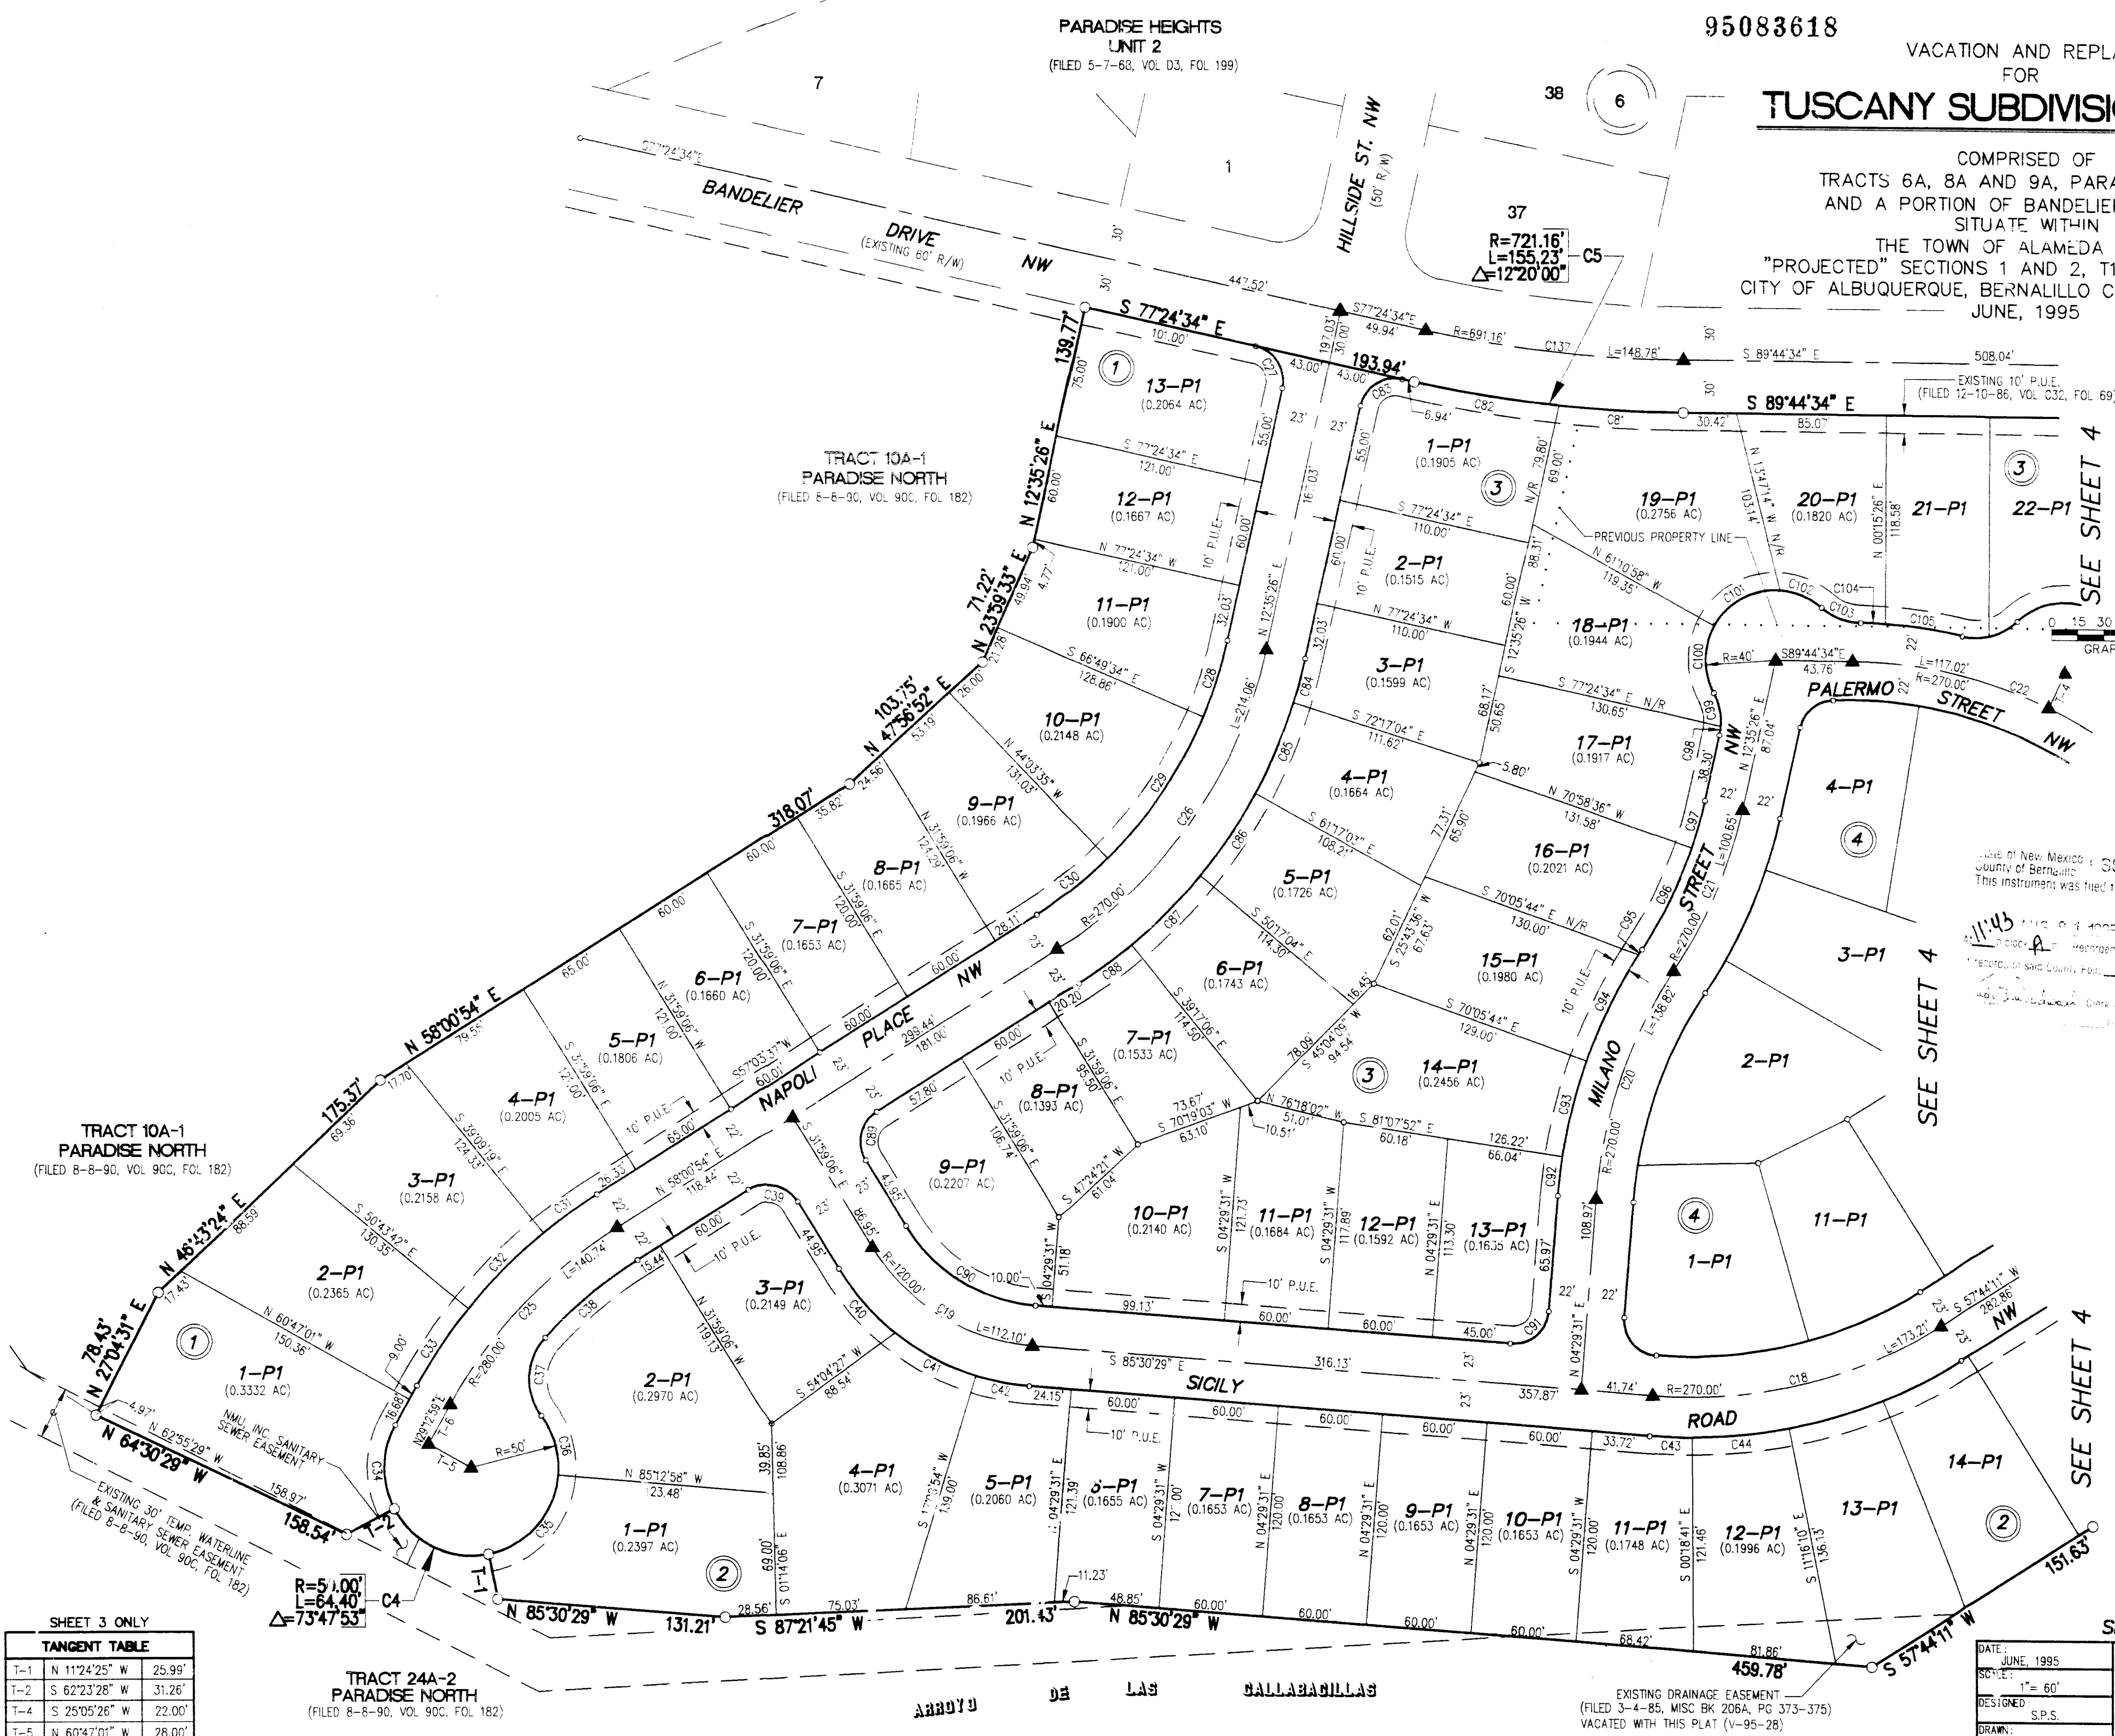

SHEET 3 ONLY



TANGENT TABLE	
T-1	N 11°24'25" W 25.99'
T-2	S 62°23'28" W 31.26'
T-3	S 57°44'11" E 17.00'
T-4	S 25°05'26" W 22.00'
T-5	N 60°47'01" W 28.00'
T-6	N 29°12'59" E 25.68'
T-7	S 04°36'22" W 10.00'
T-8	S 69°08'01" E 10.00'

SCANNED BY
BY LASON

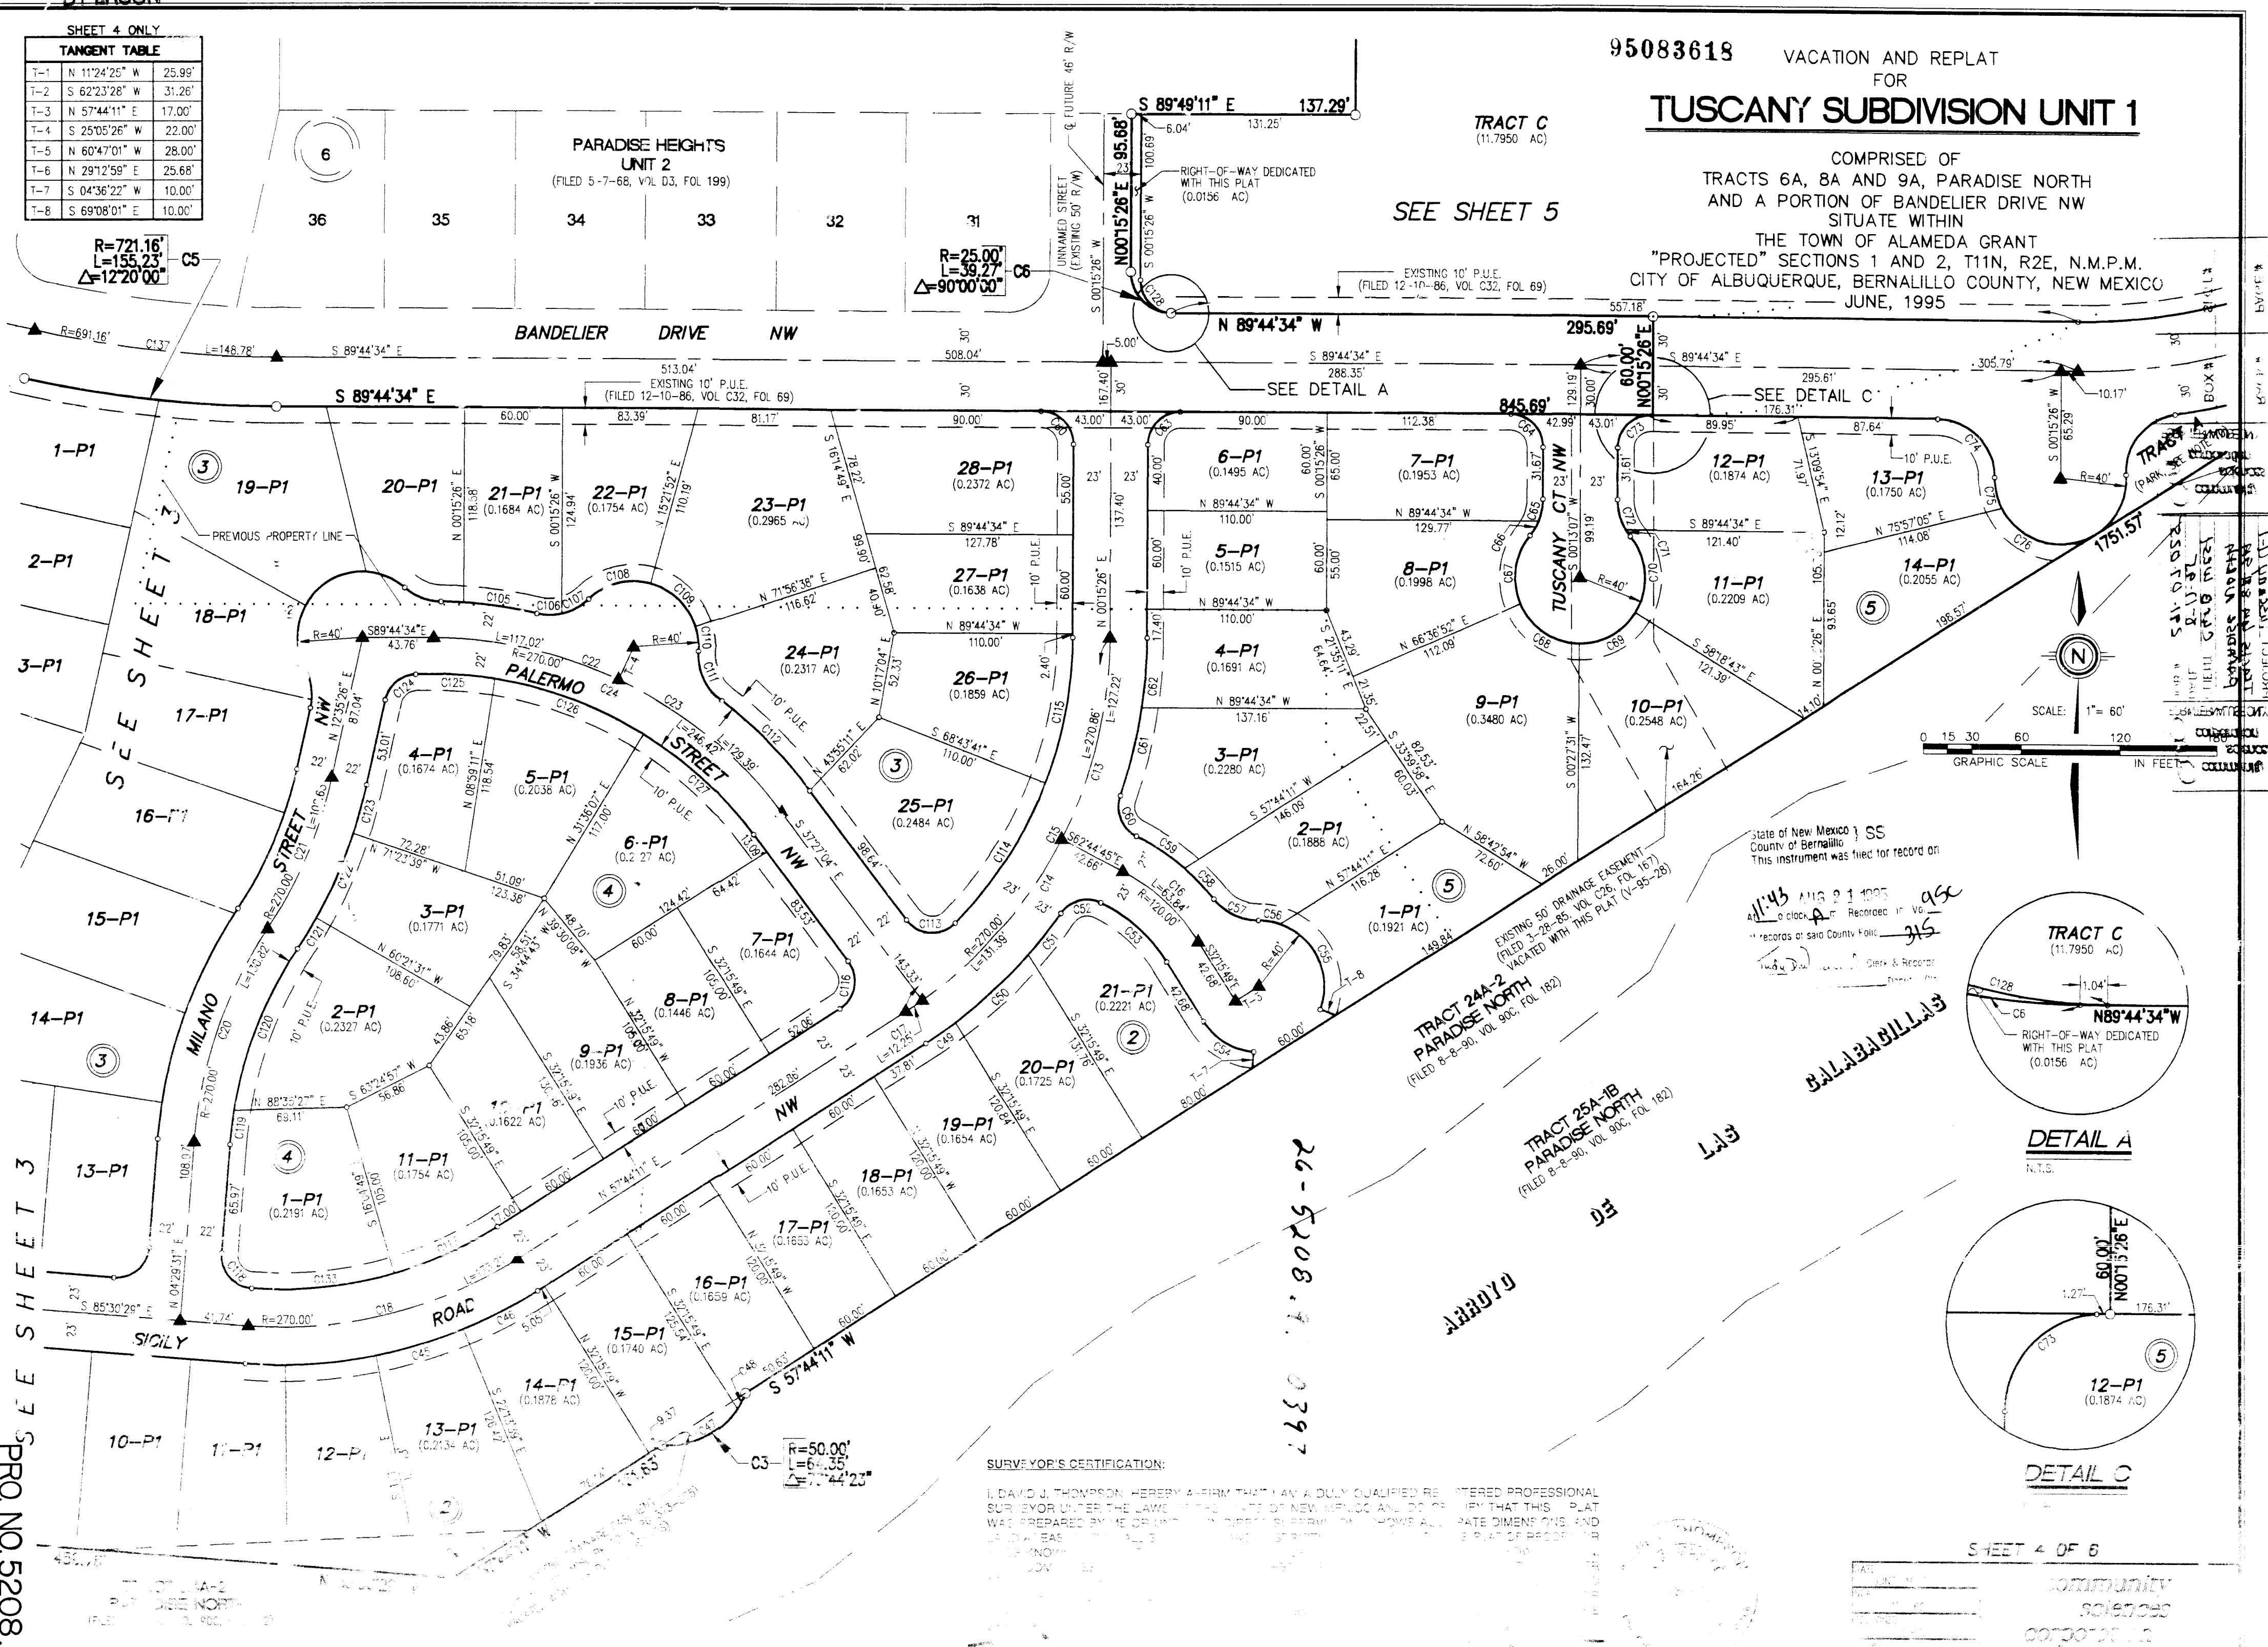

SHEET 4 ONLY

TANGENT TABLE	
T-1	N 11°24'25" W 25.99'
T-2	S 62°23'28" W 31.26'
T-3	S 57°44'11" E 17.00'
T-4	S 25°05'26" W 22.00'
T-5	N 60°47'01" W 28.00'
T-6	N 29°12'59" E 25.68'
T-7	S 04°36'22" W 10.00'
T-8	S 69°08'01" E 10.00'

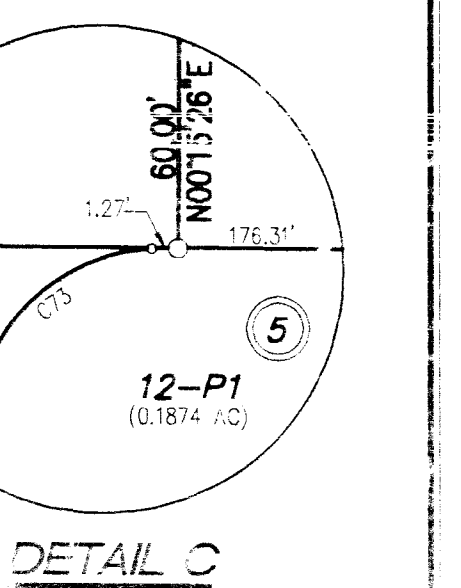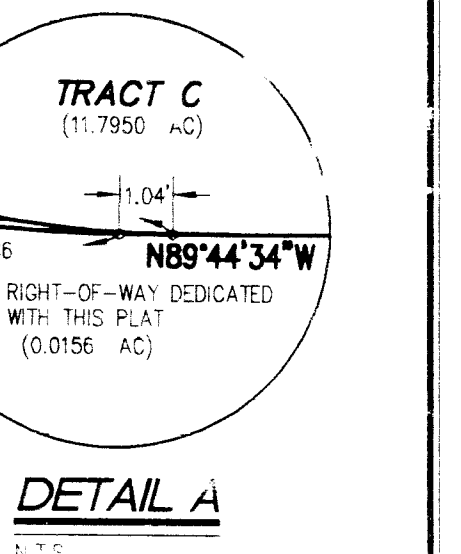

TRACT C
(11.7950 AC)
N 89°44'34" W
(0.0156 AC)
RIGHT-OF-WAY DEDICATED
WITH THIS PLAT


DETAIL A
N.T.S.

DETAIL C
N.T.S.


SHEET 4 OF 6

community sciences corporation

TANGENT TABLE			
T-3	N 00°15'26" E	60.00'	
T-4	N 89°44'34" W	295.69'	
T-5	N 00°15'26" E	95.68'	

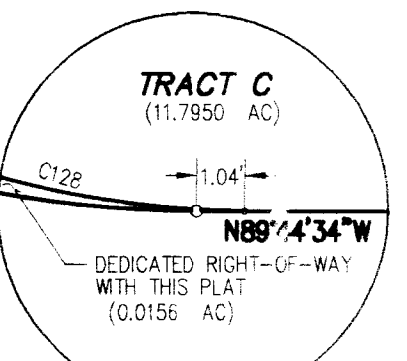

DETAIL A
N.T.S.

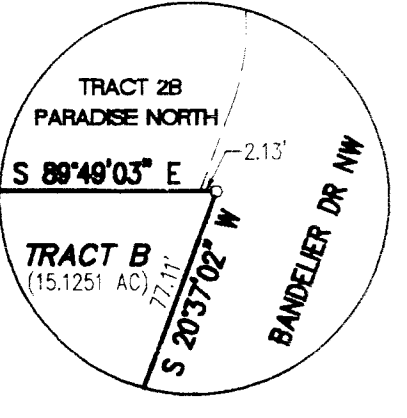

DETAIL B
N.T.S.

UNPLATTED LANDS OF LINCOLN ROAD LTD

TRACT C
(11,795.00 AC)
(SEE NOTE 14)

UNPLATTED LANDS OF LINCOLN ROAD LTD

TRACT C
(11,795.00 AC)
(SEE NOTE 14)

95083618

VACATION AND REPLAT

TUSCANY SUBDIVISION UNIT 1

COMPRISED OF
TRACTS 6A, 8A AND 9A, PARADISE NORTH
AND A PORTION OF BANDELER DRIVE NW
SITUATE WITHIN
THE TOWN OF ALAMEDA GRANT
"PROJECTED" SECTIONS 1 AND 2, T11N, R2E, N.M.P.M.
CITY OF ALBUQUERQUE, BERNALILLO COUNTY, NEW MEXICO
JUNE, 1995

TRACT 1

TRACT 2

N/F
UNPLATTED
LANDS OF
A & P #1

N/F
UNPLATTED
LANDS OF
A & P #2

N/F
UNPLATTED
LANDS OF
BROWN

TRACT 2B
PARADISE NORTH
(FILED 3-28-85, VOL C26, FOL 167)

LANDS OF HARVILLE
(FILED 2-24-85, VOL C26, PG 117)

TRACT 2B
PARADISE NORTH
(FILED 3-28-85, VOL C26, FOL 167)

TRACT 2B
PARADISE NORTH
(FILED 3-28-85, VOL C26, FOL 167)

I, DAVID J. THOMPSON, HEREBY AFFIRM THAT I AM A DULY QUALIFIED REGISTERED PROFESSIONAL SURVEYOR UNDER THE LAWS OF THE STATE OF NEW MEXICO AND DO CERTIFY THAT THIS PLAT WAS PREPARED BY ME OR UNDER MY DIRECT SUPERVISION, SHOWS ACCURATE DIMENSIONS, AND LAND AREAS, SHOWS ALL EASEMENTS AND RESTRICTIONS AS SHOWN ON THE PLAT OF RECORD OR MADE KNOWN TO ME BY THE OWNERS AND/OR PROPRIETORS OF THE SUBDIVISION SHOWN HEREON, TITLE COMPANIES, UTILITY COMPANIES OR OTHER PARTIES EXPRESSING AN INTEREST. I FURTHER CERTIFY THAT THIS PLAT MEETS THE MINIMUM REQUIREMENTS FOR MONUMENTATION AND SURVEYS OF THE ALBUQUERQUE SUBDIVISION ORDINANCE, MEETS THE MINIMUM STANDARDS FOR LAND SURVEYS SET FORTH BY THE STATE OF NEW MEXICO AND IS TRUE AND CORRECT TO THE BEST OF MY KNOWLEDGE AND BELIEF.

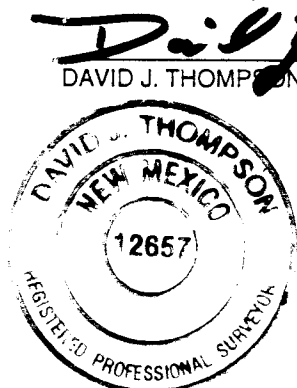


DATE: JUNE 1995
SCALE: 1" = 100'
DESIGNED: S.P.S.
BY: D.E.R.
JOB NO.: 291-07-025
LAND PLANNING: P.O. Box 1328
ENGINEERING: Corrales, N.M. 87048
SURVEYING: Corrales, N.M. 87048


SHEET 5 OF 6
community sciences corporation



CURVE DATA						C91	20.00	31.42	090-00-00	20.00	28.28	S49-29-31W
CURVE IDEN.	RADIUS	ARC	DELTA	TANGENT	CHORD	C92	292.00	22.31	004-22-37	11.16	22.30	S06-40-50W
						C93	292.00	56.24	011-02-08	28.21	56.15	S14-23-12W
C1	346.00	224.16	037-07-08	116.17	220.26	C94	292.00	67.89	013-19-16	34.10	67.74	S26-33-54W
C2	541.00	92.11	039-45-19	46.17	92.00	C95	292.00	3.69	000-43-27	1.85	3.69	S33-35-15W
C3	50.00	64.35	073-44-23	37.50	60.00	C96	248.00	64.61	014-55-35	32.49	64.42	S26-29-11W
C4	50.00	64.40	073-47-53	37.54	60.04	C97	248.00	27.84	005-25-58	13.94	27.83	S15-42-25W
C5	721.16	155.23	012-20-00	77.92	154.94	C98	35.00	4.97	008-18-33	2.49	4.97	S06-31-10W
C6	25.00	39.27	090-00-00	25.00	35.36	C99	35.00	19.79	032-23-36	10.17	19.53	S11-44-55E
C7	380.00	246.18	037-07-08	127.59	241.90	C100	40.00	39.63	056-45-45	21.61	38.03	S00-26-10W
C8	575.00	97.90	009-45-19	49.07	97.78	C101	40.00	45.00	054-27-28	25.22	42.66	S61-02-40W
C9	575.00	72.28	007-12-08	36.19	71.23	C102	40.00	26.22	037-33-49	13.60	25.76	N67-56-35W
C10	575.00	170.18	016-57-27	85.72	169.56	C103	35.00	24.25	039-41-58	12.64	23.77	N69-00-40W
C11	575.00	170.18	016-57-27	85.72	169.56	C104	292.00	13.91	002-43-43	6.95	13.91	N87-29-47W
C12	380.00	215.69	032-31-16	110.84	212.80	C105	35.00	19.07	031-12-53	9.78	18.83	S62-10-40W
C13	270.00	127.22	026-59-49	64.81	126.05	C106	35.00	15.26	024-58-48	7.75	15.14	N89-43-21W
C14	270.00	131.39	027-52-57	67.02	130.10	C107	35.00	19.07	031-12-53	9.78	18.83	S62-10-40W
C15	270.00	270.86	57-28-44	148.06	259.65	C108	40.00	41.04	058-47-30	22.54	39.27	S75-58-06W
C16	120.00	63.84	030-28-56	32.70	63.09	C109	40.00	39.50	056-34-46	21.53 <th>37.91</th> <th>N46-20-45W</th>	37.91	N46-20-45W
C17	270.00	12.25	002-35-58	6.13	12.25	C110	40.00	15.12	021-39-53	7.65	15.03	N47-13-26W
C18	270.00	173.21	036-45-20	89.70	170.25	C111	35.00	34.33	056-11-41	18.69	32.97	N24-29-20W
C19	120.00	112.10	053-31-23	60.52	108.08	C112	292.00	77.13	015-06-07	38.79	76.91	N45-01-07W
C20	270.00	138.80	029-27-28	70.98	137.29	C113	20.00	34.05	097-32-45	22.82	30.08	N08-13-20W
C21	270.00	100.65	021-21-33	59.92	100.07	C114	247.00	102.30	023-43-52	51.80	101.57	S33-08-15W
C22	270.00	117.02	024-50-00	59.45	116.11	C115	247.00	90.59	021-00-53	45.81	90.09	S10-45-33W
C23	270.00	129.39	027-27-30	65.96	128.16	C116	20.00	33.23	095-11-15	21.90	29.54	S10-08-33W
C24	270.00	246.42	052-17-30	132.54	237.95	C117	247.00	69.77	016-11-00	35.12 <th>69.53</th> <th>S65-49-41W</th>	69.53	S65-49-41W
C25	280.00	140.74	028-47-55	71.89	138.26	C118	20.00	31.44	090-03-56	20.02	28.30	N40-32-27W
C26	270.00	214.06	045-25-28	113.01	208.50	C119	248.00	21.00	004-51-06	10.51 <th>20.99</th> <th>N06-55-04E</th>	20.99	N06-55-04E
C27	20.00	31.42	090-00-00	20.00	28.28	C120	248.00	106.51	024-36-22	54.09	105.69	N21-38-40E
C28	247.00	45.62	010-35-00	22.88	45.62	C121	292.00	21.96	004-18-30	10.98	21.95	N41-47-44E
C29	247.00	98.15	022-45-59	49.73	97.50	C122	292.00	-6.24	011-02-08	28.21	56.15	N24-07-25E
C30	247.00	52.05	012-04-29	26.12	51.96	C123	392.00	30.66	006-00-55	15.34 <th>30.64</th> <th>N15-35-54E</th>	30.64	N15-35-54E
C31	302.00	37.79	001-10-14	18.92	37.77	C124	20.00	26.23	075-09-15	15.39	24.39	N50-10-04E
C32	302.00	61.00	011-34-3	30.60	60.90	C125	248.00	48.65	011-14-29	24.51	48.58	S86-38-04E
C33	302.00	53.00	010-03-19	26.57	52.93	C126	248.00	97.89	022-36-58	43.49	97.26	S68-22-21E
C34	50.00	49.39	056-49-31	25.05	47.58	C127	248.00	90.67	025-16-49	45.81	90.16	S47-55-28E
C35	50.00	64.41	073-48-33	35.55	60.05	C128	20.00	31.42	090-00-00	20.00	28.28	N44-44-34W
C36	50.00	35.94	041-11-18	18.79	35.17	C129	350.00	128.63	021-03-52 <th>65.07</th> <th>127.95</th> <th>S79-43-30W</th>	65.07	127.95	S79-43-30W
C37	35.00	48.28	0-0-12-14	28.87	44.54	C130	350.00	69.68	011-27-24	35.11	69.87	S79-43-30W
C38	258.00	89.27	0-0-22-57	48.84	69.06	C131	517.00	153.01	016-57-27	77.07	152.45	S68-12-54W
C39	20.00	31.42	090-00-00	20.00	28.28	C132	247.00	86.40	020-30-24	44.68	87.93	S64-10-23W
C40	143.00	49.00	019-39-19	24.77	48.82	C133	247.00	107.34	0-5-27-27	94.36	186.66	N68-12-54E
C41	143.00	52.94	021-12-41	26.78	52.64	C134	633.00	609.00	007-12-08	36.33	76.50	S71-05-33E
C42	143.00	31.59	012-30-23	15.86	31.52	C135	541.00	68.01	007-12-08	34.05	67.96	S71-05-33W
C43	293.00	24.56	004-48-12	12.29	24.56	C136	691.16	148.78	012-20-00	74.68 <th>148.49</th> <th>S83-34-34E</th>	148.49	S83-34-34E
C44	293.00	56.04	010-54-29	28.10	55.95							
C45	293.00	56.04	010-54-29	28.10	55.95							
C46	293.00	51.32	0-0-12-10	25.73	51.26							
C47	50.00	53.44	061-14-36	29.60	50.94							
C48	50.00	10.91	012-29-47	5.47	10.88							
C49	293.00	22.21	004-20-35	-1.11	22.20							
C50	293.00	61.10	011-56-50	30.66	60.99							
C51	293.00	32.15	006-17-14	16.09	32.14							
C52	70.00	27.97	080-08-11	16.82	25.75							
C53	97.00	54.92	032-26-28	28.22	54.19							
C54	40.00	37.09	053-07-48	20.00	35.78							
C55	40.00	64.10	091-48-44	41.29	57.46							
C56	40.00	13.47	019-17-46	6.80	13.41							
C57	35.00	31.30	051-14-00	16.78	30.26							
C58	143.00	26.13	010-28-05	13.10	26.09							
C59	143.00	35.42	014-11-28	17.80	35.33							
C60	20.00	28.98	083-01-47	17.70	26.51							
C61	293.00	54.95	010-44-43	27.56	4.87							
C62	293.00	42.75	088-21-33	21.47	42.71							
C63	20.00	31.42	090-00-00	20.00	28.28							
C64	293.00	49.89	059-57-41	19.99	28.27							
C65	35.00	13.69	022-24-24	6.93	13.60							
C66	35.00	10.35	016-56-21	5.21	10.31							
C67	40.00	42.95	080-57-05	24.43	41.77							
C68	40.00	48.00	025-29-25	24.96	43.51							
C69	40.00	41.22	059-02-11	22.65	39.42							
C70	40.00	49.44	070-48-55	26.43	46.35							
C71	35.00	4.69	007-40-21	2.35	4.68							
C72	35.00	19.35	031-40-24	9.93	19.10							
C73	20.00	31.43	090-02-19	20.01	28.29							
C74	35.00	55.11	090-13-26	35.14	49.59							
C75	40.00	19.55	027-59-55	9.97	19.35							
C76	40.00	66.15	094-44-47	43.46	58.86							
C77	40.00	42.80	061-18-49	23.71	40.79							
C78	40.00	52.22	085-28-47	32.34	47.51							
C79	410.00	172.93	024-09-59	87.77	171.65							
C80	20.00	31.42	090-00-00	20.00	28.28							
C81	721.16	71.99	005-43-12	36.03	71.97							
C82	721.16	83.24	006-36-48	41.67	83.19							
C83	20.00	31.42	090-00-00	20.00	28.28							
C84	293.00	26.21	005-07-30	13.11	26.20							
C85	293.00	56.25	011-00-01	28.21	54.17							
C86	293.00	56.25	010-59-59	28.21	54.17							
C87	293.00	56.25	010-59-59	28.21	54.17							
C88	293.00	37.33	027-16-00	18.69	37.31							
C89	26.00	31.42	090-00-00	20.00	28.28							
C90	97.00	90.61	024-31-25	44.92	90.56							

U.S. WEST COMMUNICATIONS OUTCLOSING (SEE NOTE 16)

KNOW ALL MEN BY THESE PRESENTS: THAT U.S. WEST COMMUNICATIONS CORPORATION, HEREINAFTER CALLED "COMPANY" FOR AND IN BEHALF OF ITSELF AND OTHER GOOD AND VALUABLE CONSIDERATIONS IN HAND, HEREBY CONFESSED AND ACKNOWLEDGED, DOES HEREBY RELEASE, WARRANT, GUARANTEE, CONFIRM, CONF

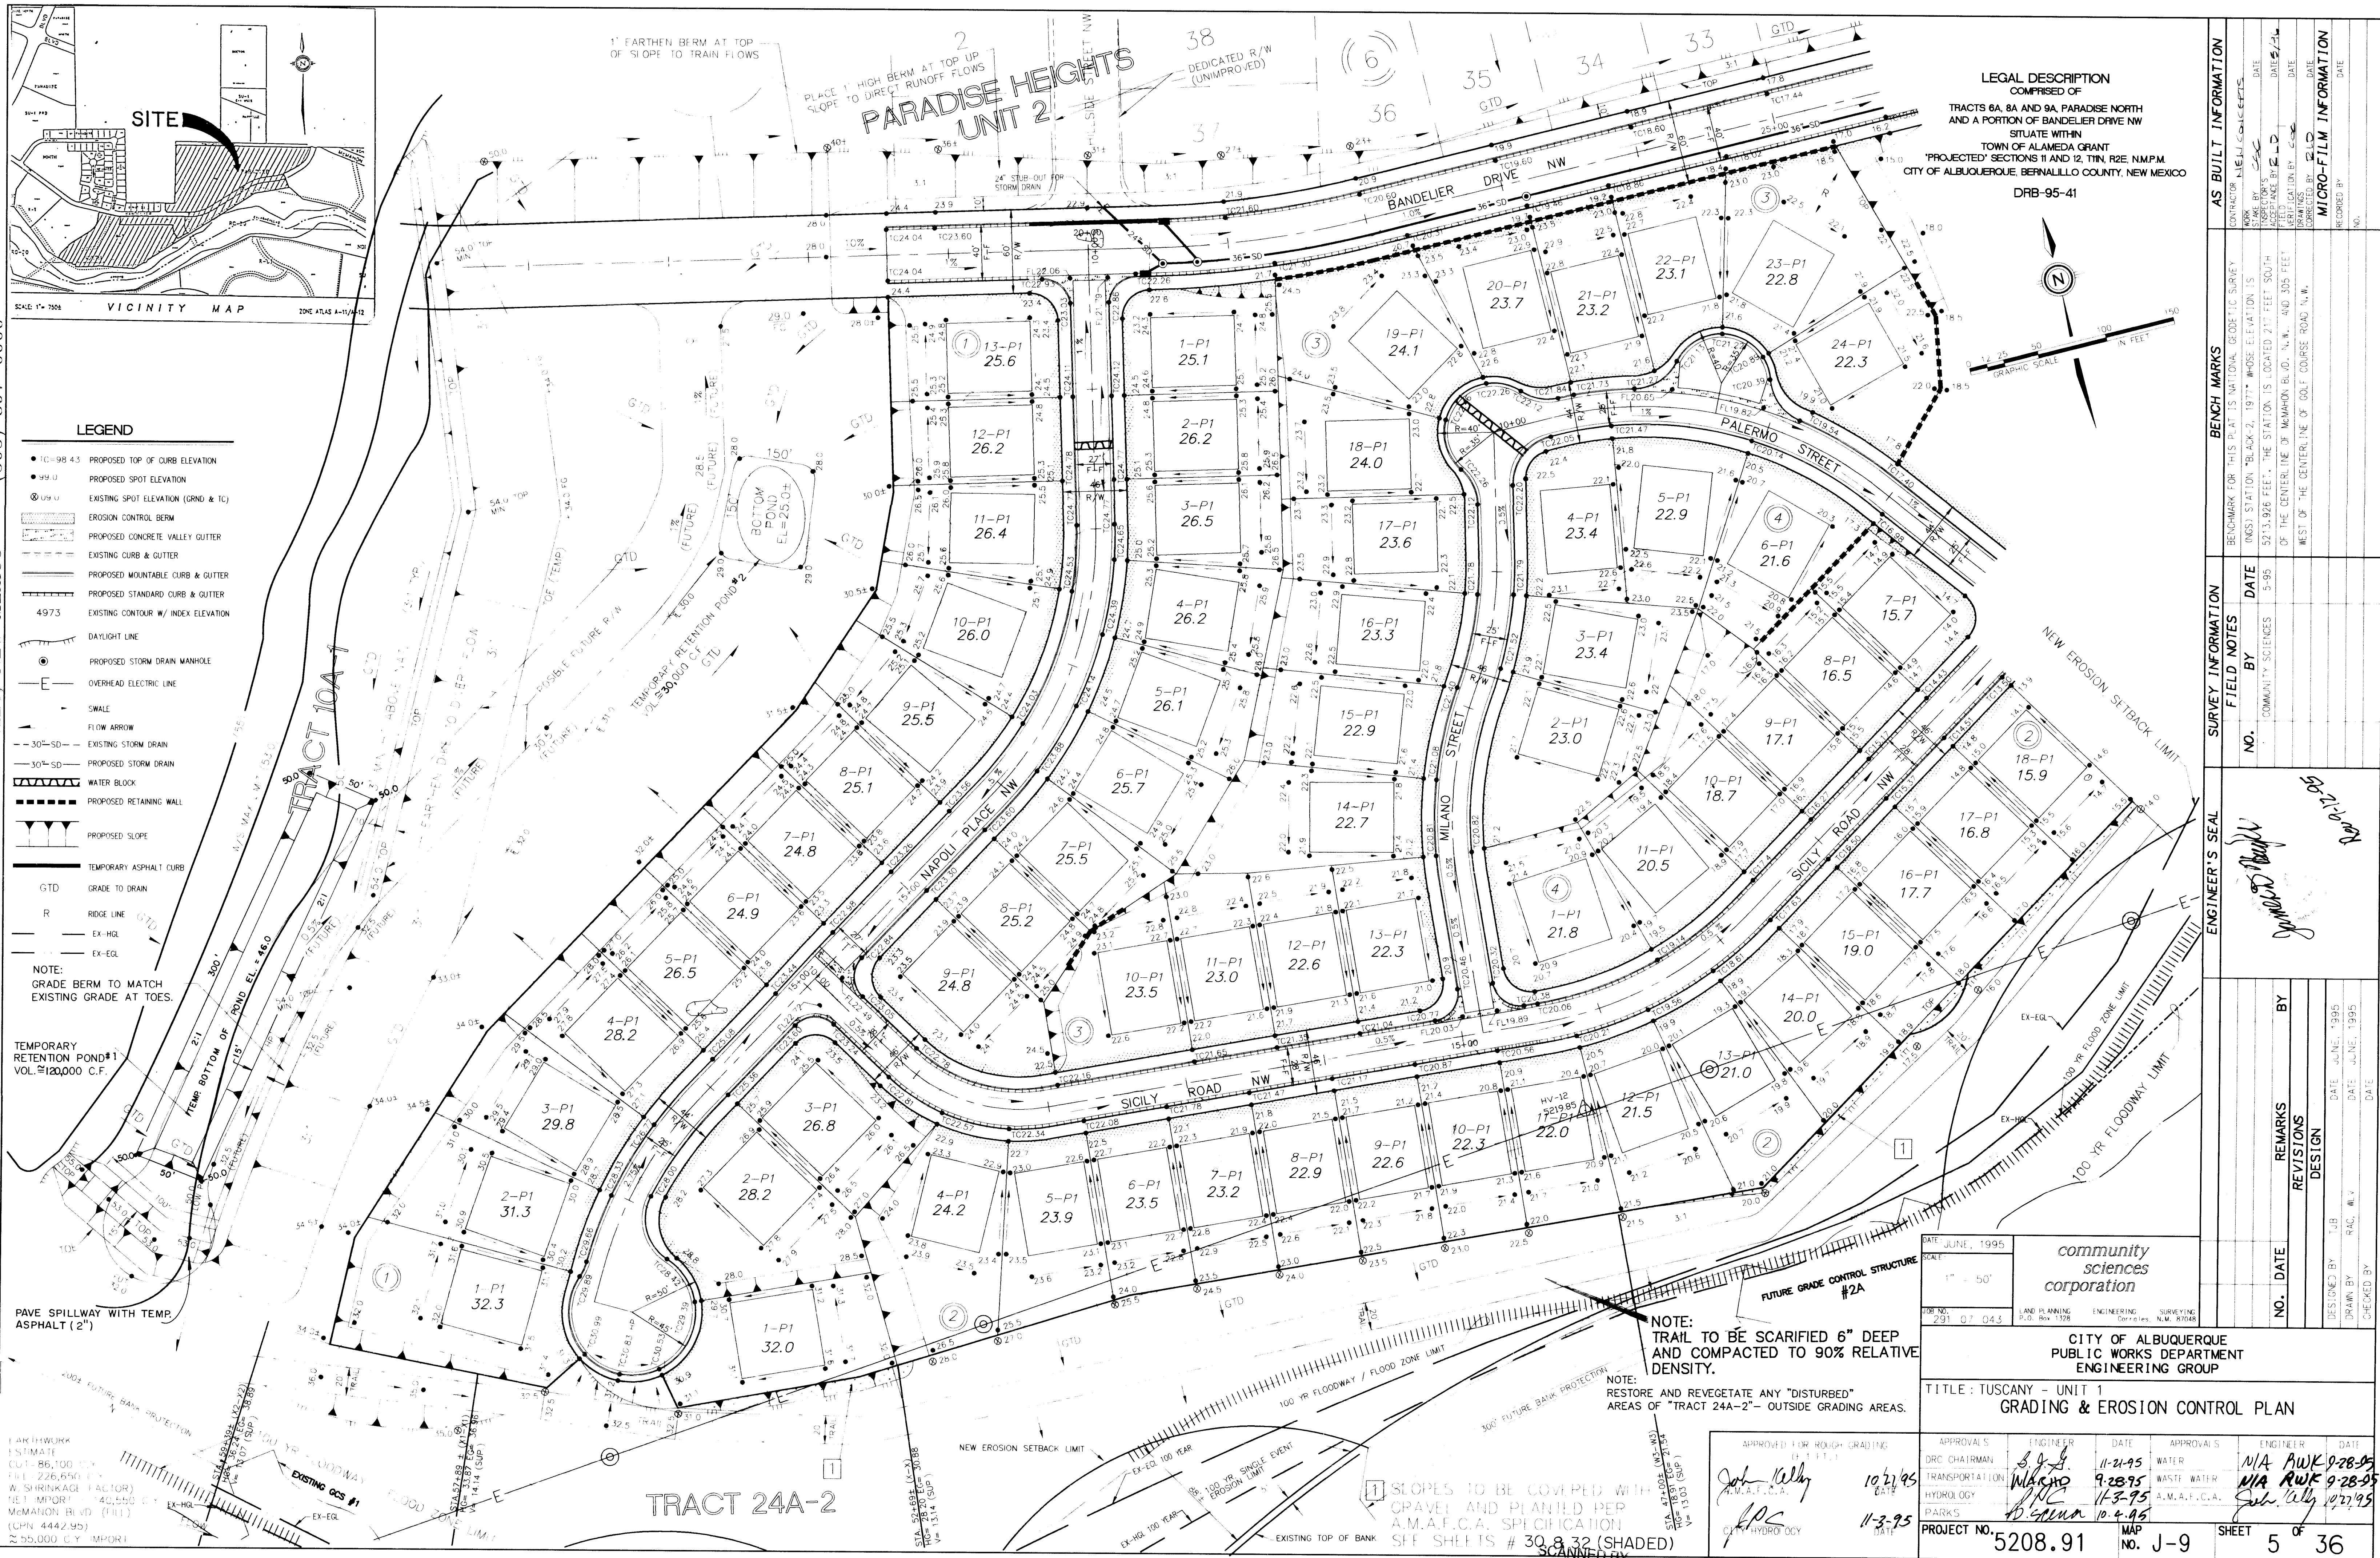

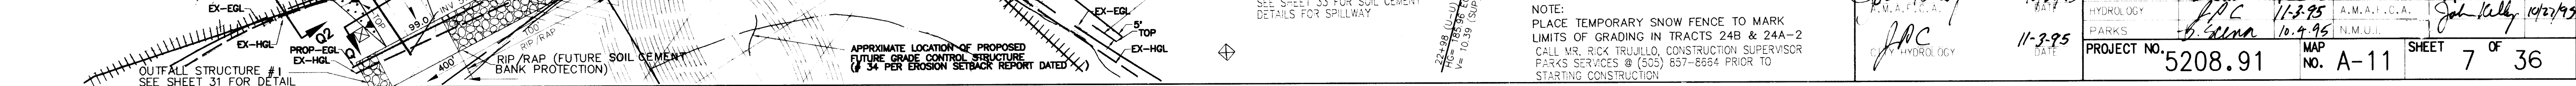


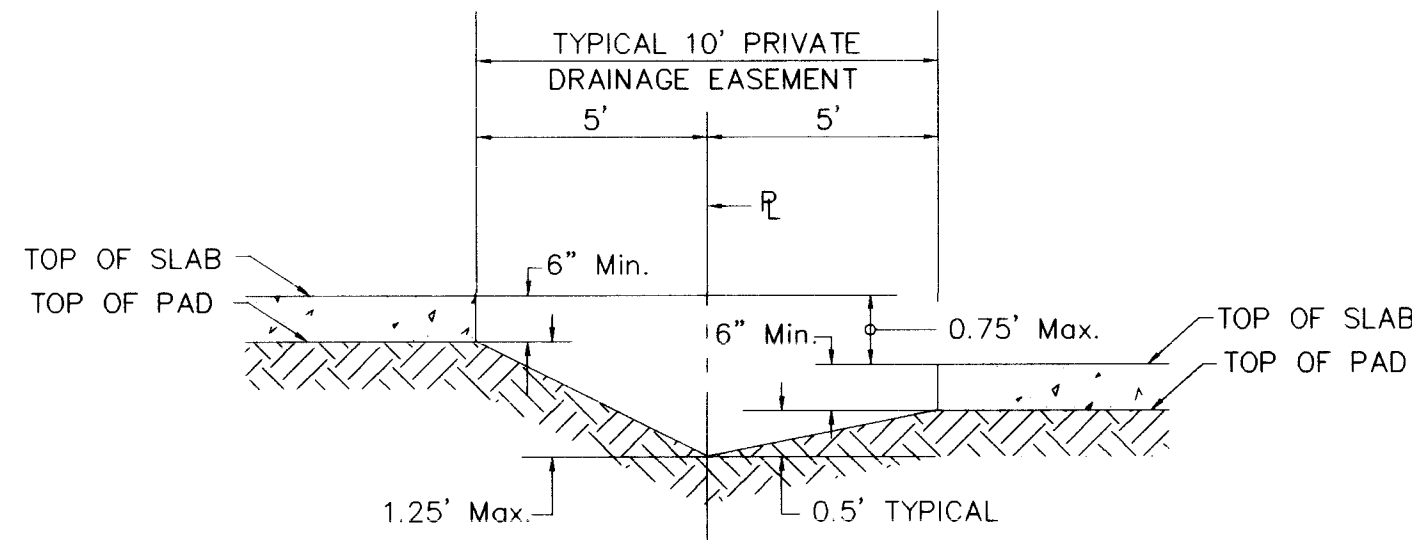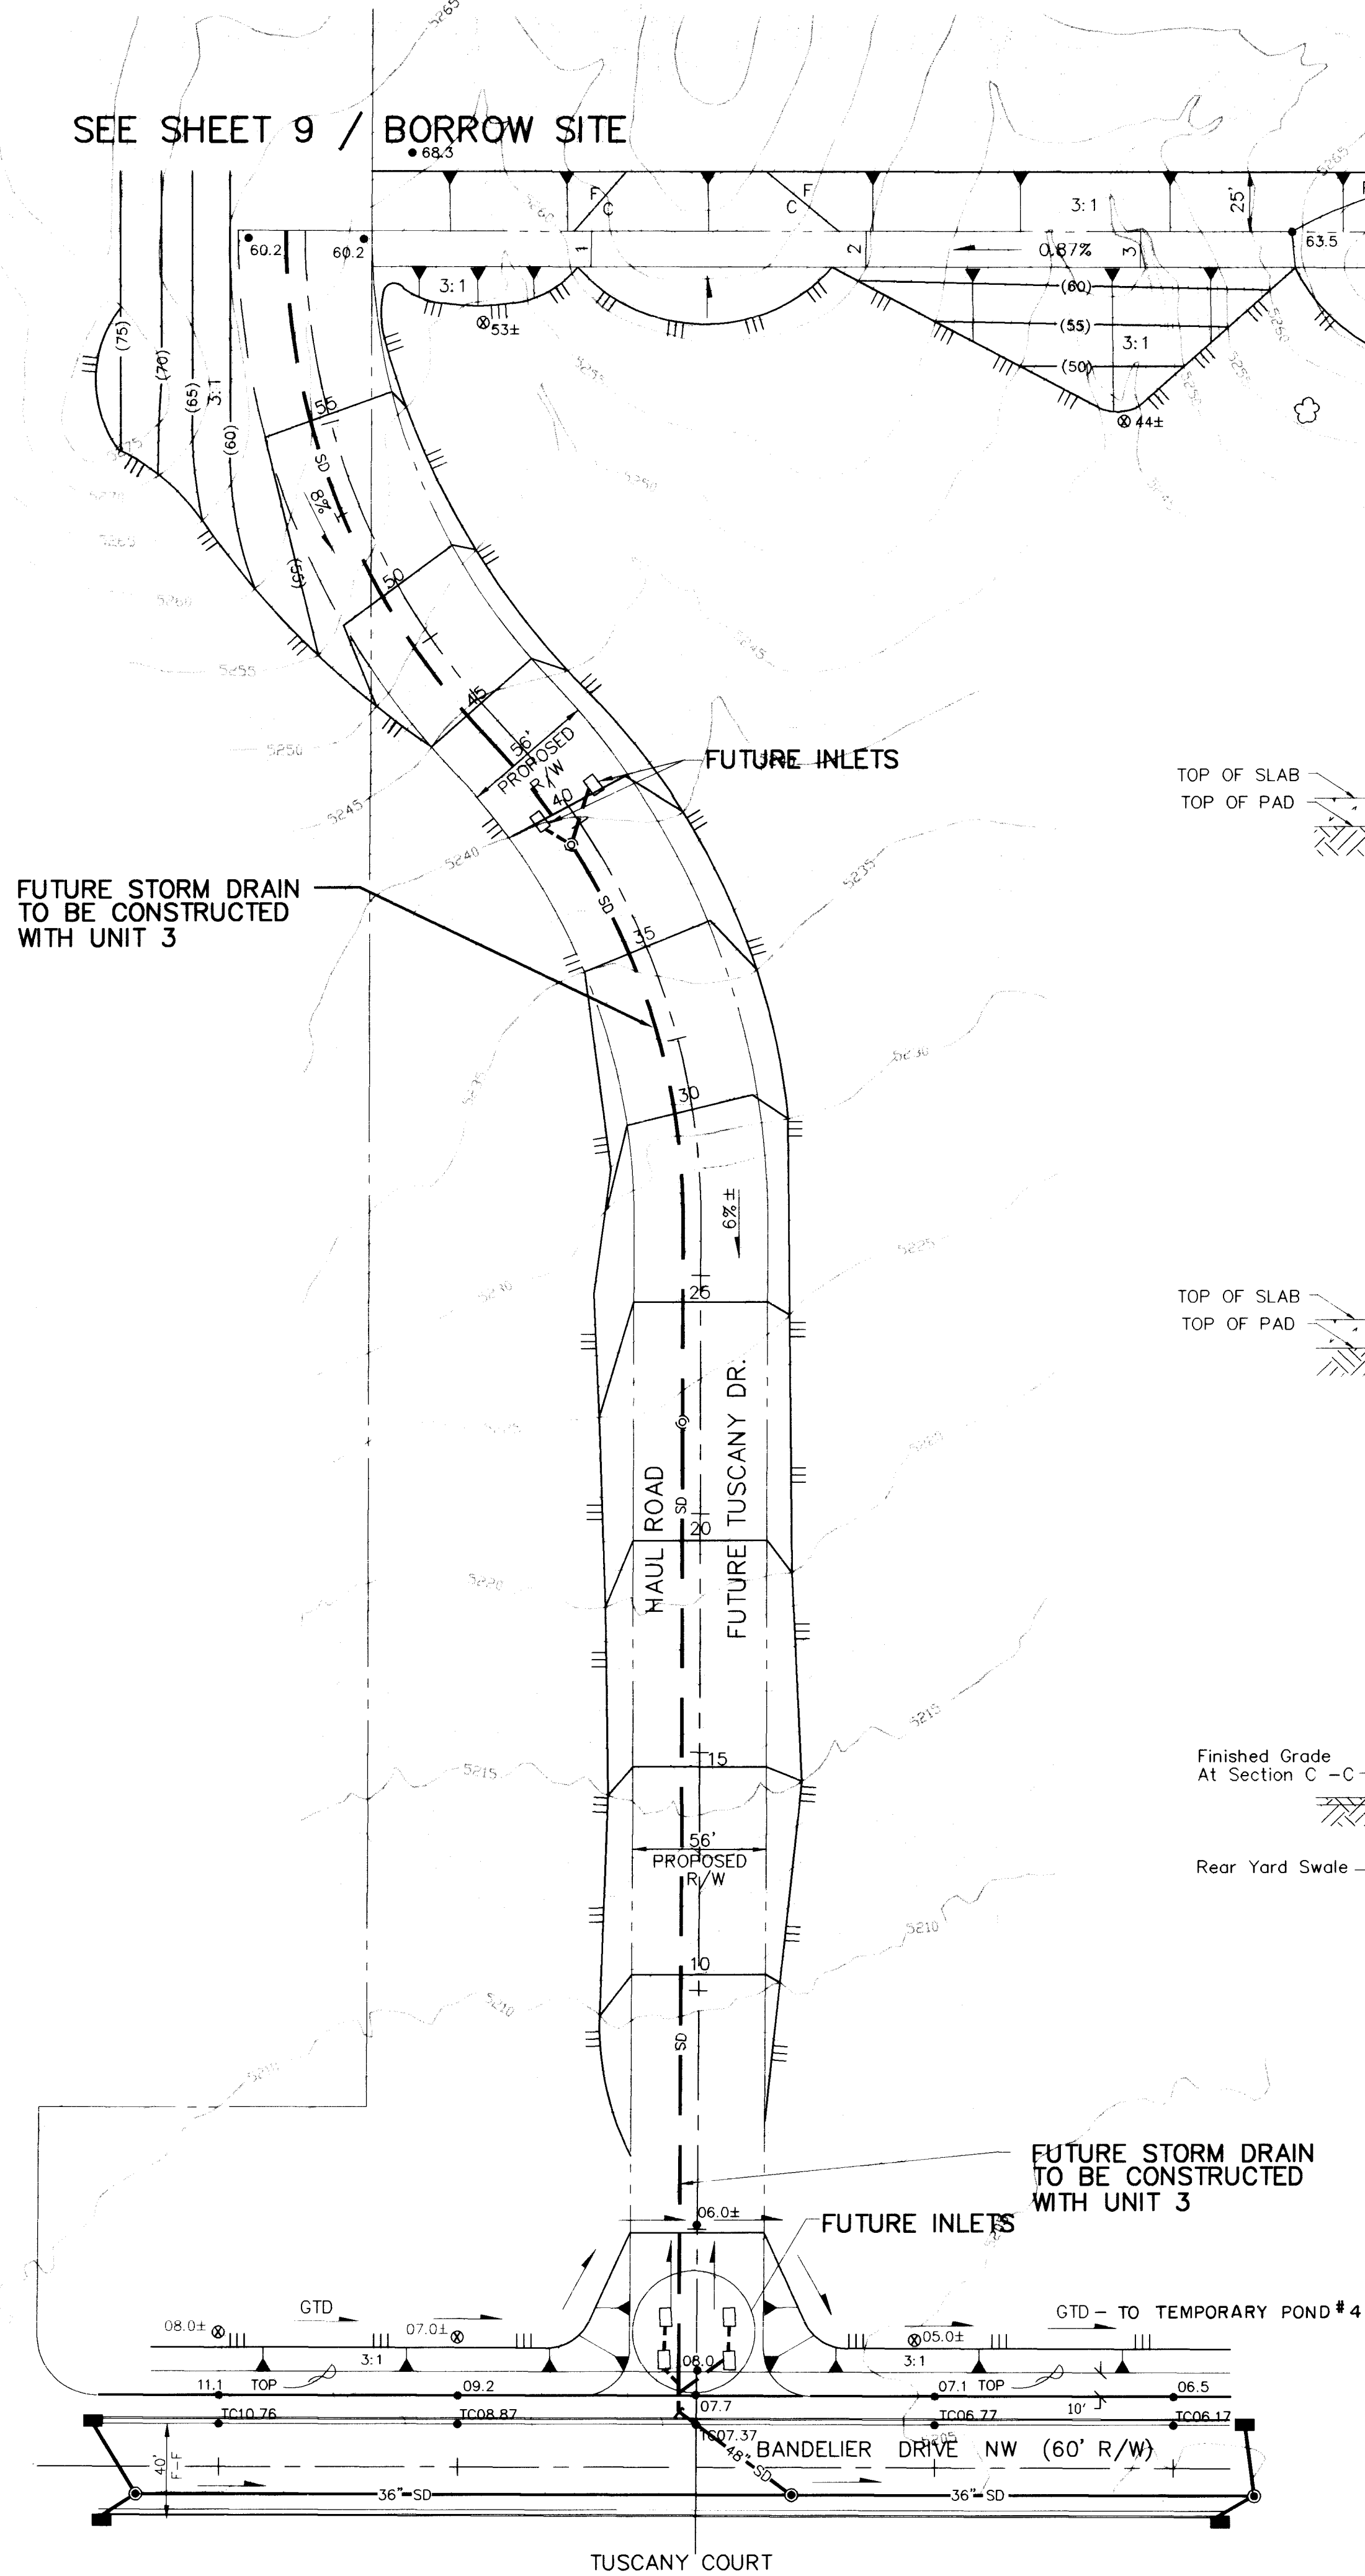

TYPICAL SECTION A - A


N.T.S.

NOTE: FENCES ARE ALLOWED ON THE PROPERTY LINE WITHIN THE PRIVATE DRAINAGE EASEMENT.

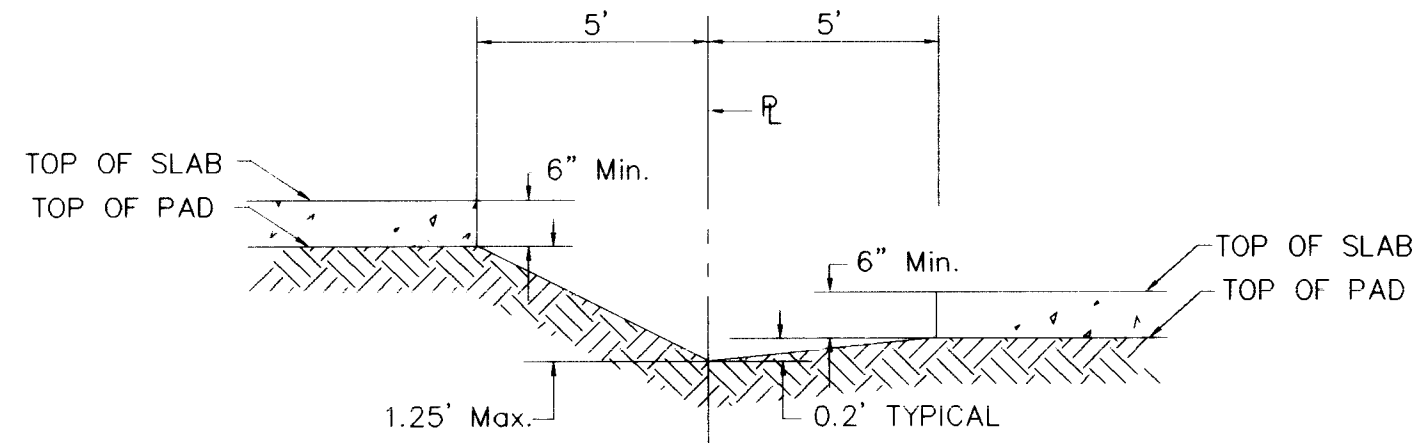

TYPICAL SECTION B - B


N.T.S.

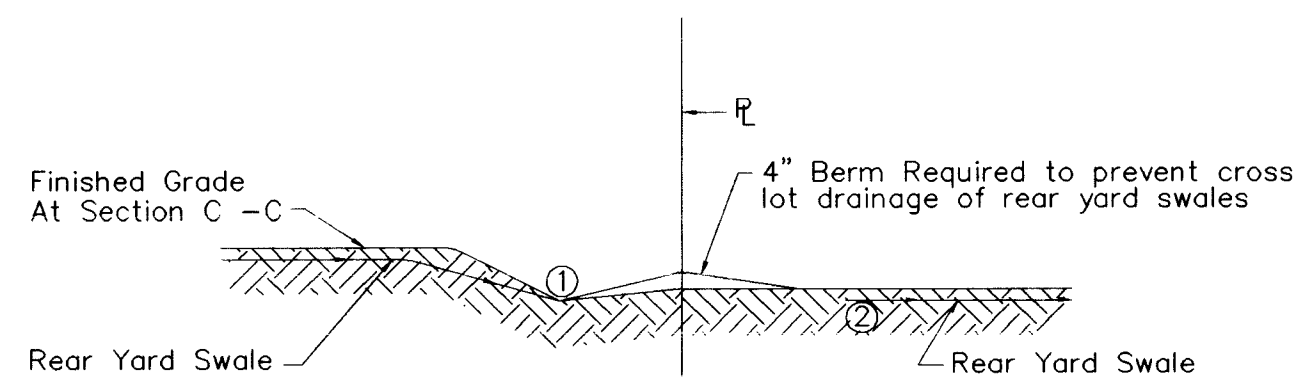

TYPICAL SECTION C - C


N.T.S.

NOTE: Drainage from Point # 1 must be directed to the street, and prevented from continuing across the property line to Point # 2.

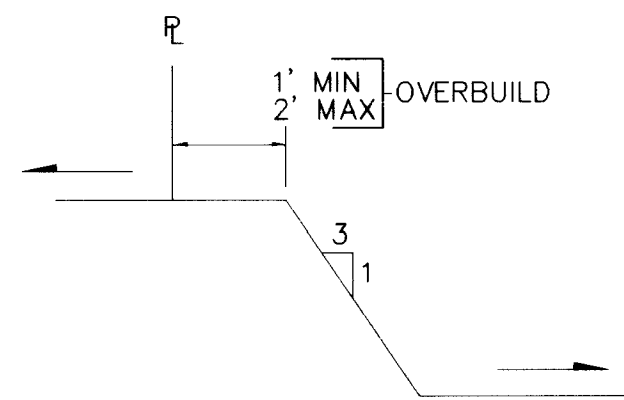

TYPICAL DETAIL REAR YD. SLOPE

N.T.S.

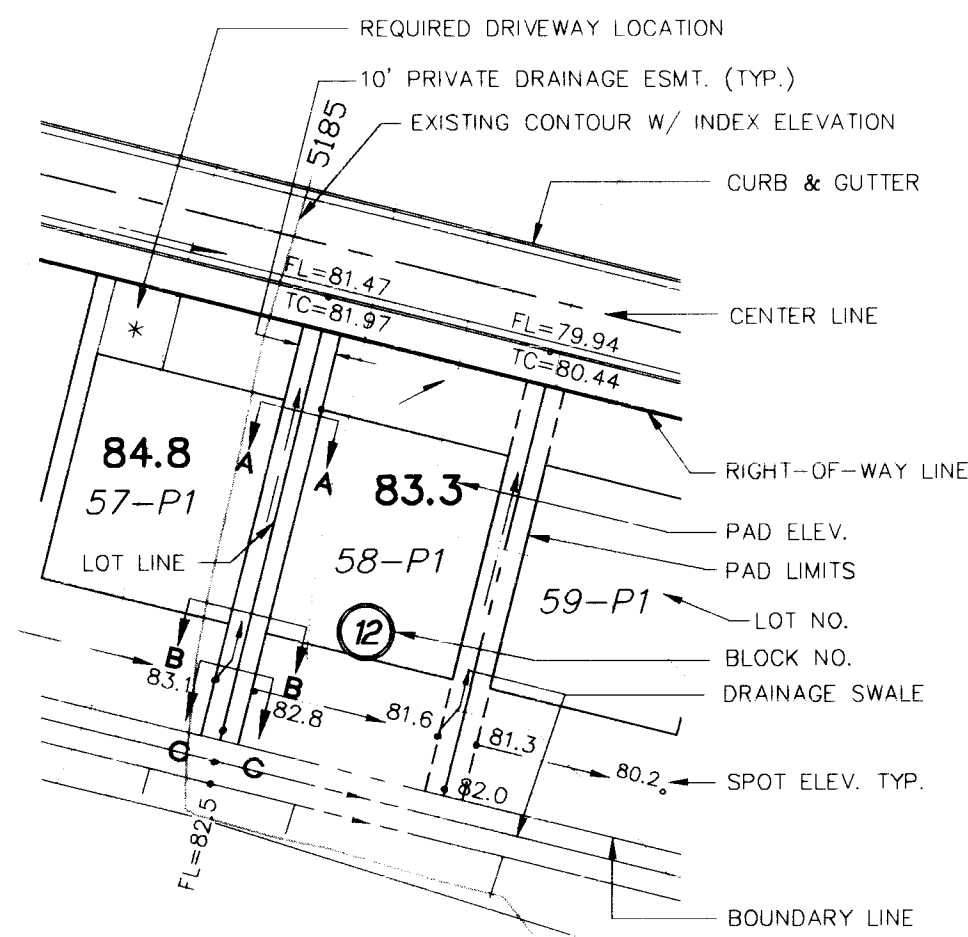


TYPICAL LOT DETAIL

N.T.S.

* FINISHED GRADE AROUND PERIMETER OF HOUSE SHALL BE A MINIMUM OF 6" BELOW TOP OF CONCRETE SLAB. (SEE SECTIONS THIS SHEET)

LEGEND	
• TC=98.43	PROPOSED TOP OF CURB ELEVATION
• 99.0	PROPOSED SPOT ELEVATION
• 09.0	EXISTING SPOT ELEVATION (GRND & TC)
---	EROSION CONTROL BERM
---	PROPOSED CONCRETE VALLEY GUTTER
---	EXISTING CURB & GUTTER
---	PROPOSED MOUNTABLE CURB & GUTTER
---	PROPOSED STANDARD CURB & GUTTER
4973	EXISTING CONTOUR W/ INDEX ELEVATION
---	DAYLIGHT LINE
---	SWALE
---	FLOW ARROW
---	EXISTING STORM DRAIN
---	PROPOSED STORM DRAIN
---	WATER BLOCK
---	PROPOSED RETAINING WALL
---	PROPOSED SLOPE
---	TEMPORARY ASPHALT CURB
---	GTD GRADE TO DRAIN

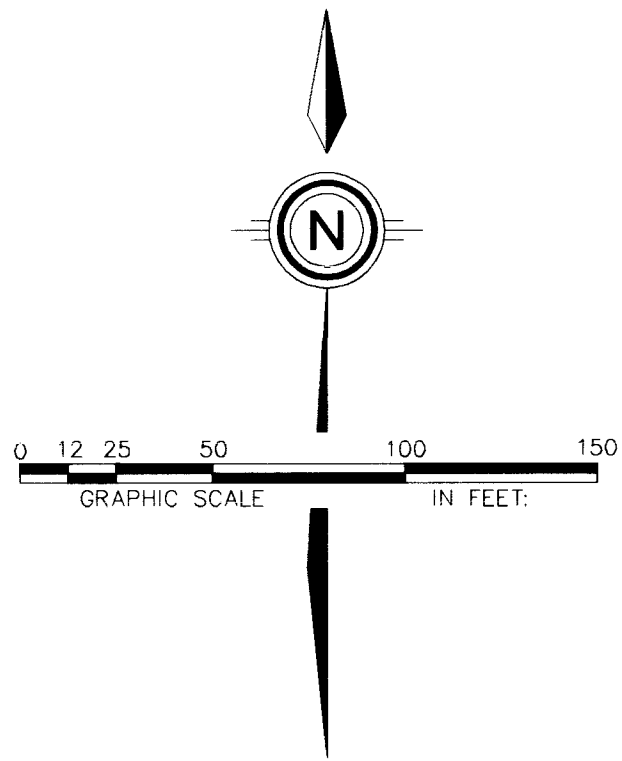

LEGAL DESCRIPTION
COMPRISED OF
TRACTS 6A, 8A AND 9A, PARADISE NORTH
AND A PORTION OF BANDELIER DRIVE NW
SITUATE WITHIN
TOWN OF ALAMEDA GRANT
'PROJECTED' SECTIONS 11 AND 12, T1N, R2E, NMP.M.
CITY OF ALBUQUERQUE, BERNALILLO COUNTY, NEW MEXICO

DRB-95-41

2 3 4 5 6 7 8 9 10 11 12 13 14
26-15208.191 0897

DATE: JUNE, 1995

SCALE:

1" = 50'

community
sciences
corporation

JOB NO.:

291-07-043

LAND PLANNING

P.O. Box 1528

ENGINEERING

Corrales, N.M. 87048

SURVEYING

Corrales, N.M. 87048


CITY OF ALBUQUERQUE
PUBLIC WORKS DEPARTMENT
ENGINEERING GROUP

TITLE: TUSCANY - UNIT 1
OFFSITE GRADING AND GRADING DETAILS


APPROVALS	ENGINEER	DATE	APPROVALS	ENGINEER	DATE
APPROVED FOR ROUGH GRADING (+/- 1 FT.)			APPROVED FOR ROUGH GRADING (+/- 1 FT.)		
DRG CHAIRMAN	B.G.H.	11-21-95	WATER	N/A RWK	9-28-95
TRANSPORTATION	N/A CHO	9-28-95	WASTE WATER	N/A RWK	9-28-95
HYDROLOGY	B.P.C.	11-3-95	A.M.A.F.C.A.	John Kelly	10/21/95
PARKS	B.G.H.	11-4-95			
PROJECT NO.	5208.91	MAP NO. J-9	SHEET	8	OF 36





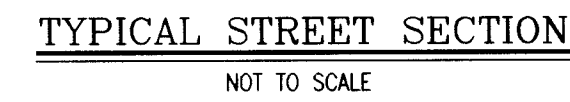


FINISH SURFACE OF SUBGRADE SHALL BE MOISTURE CONTROLLED AT COMPACTION MOISTURE RANGE OR PRIME COAT APPLIED AS REQUIRED BY THE ENGINEER UNTIL NEXT/FINAL SURFACING COMPLETED. SUBGRADE PREPARATION SHALL BE PERFORMED AFTER ALL SUB-SURFACE R/W UTILITIES CONSTRUCTION COMPLETED.

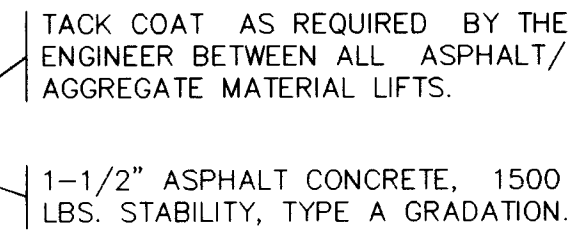

1' SUBGRADE SOIL. R-VALUE >50.
PLACED IN 2- 6" COMPACTED LIFT.
95% MIN. COMPACTION, AT OPT.
MOISTURE +/- 2.0%. ASTM D1557,
OR OPT. MOISTURE, TO +4%, ASTM
D698 FOR SOIL W/35% OR MORE
MATERIAL PASSING THE NO. 200
SIEVE.


PER C.O.A. STD. DWG. NO. 2405

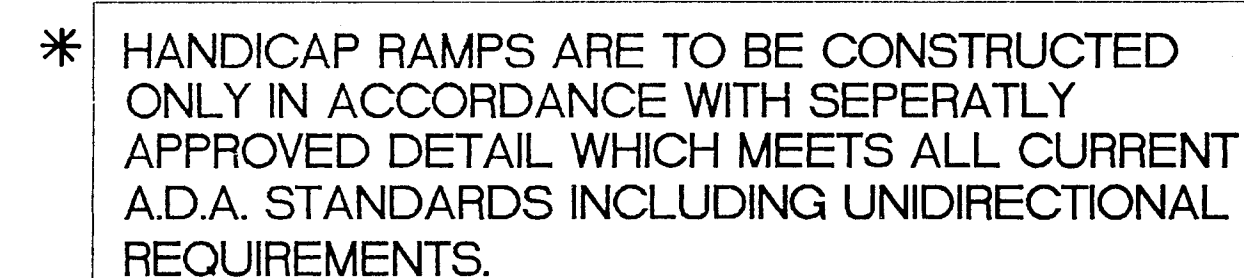

- * ① WHEELCHAIR RAMP PER
COA STD. DWG. 2441
CASE II, UNLESS OTHERWISE NOTED.
- * ② WHEELCHAIR RAMP PER
COA STD. DWG. 2441
CASE I
- ③ MOUNTABLE TO STANDARD CURB
TRANSITION PER COA STD. DWG. 2418
- ④ CONC. VALLEY GUTTER PER
COA STD. DWG. 2420
- ⑤ SPECIAL CONC. VALLEY GUTTER (10' WIDE,
3/4" INVERT) PER COA STD. DWG. 2422
- ⑥ FUTURE 4' SIDEWALK, BY OTHERS
- ⑦ PROPOSED 4' SIDEWALK, THIS CONTRACT
- ⑧ 50' CROWN TRANSITION PER
C.O.A. STD. DWG. 2401
- ⑨ PROPOSED 6' SIDEWALK, THIS CONTRACT
- ⑩ ASPHALT CURB, PER C.O.A. STD. DWG. 2415
- ⑪ KNUCKLE VALLEY GUTTER, PER C.O.A.
STD. DWG. 2421
- ⑫ INSTALL TYPE III BARRICADE
- ⑬ CUT-OFF WALL (FULL STREET WIDTH, 24"
DEEP x 8" THICK) PER C.O.A. STD. DWG. 2415

40-21-2
OFFICE OF THE
SHERIFF
CLERK OF COURT
JAN 10 1961

VERQUE ARTMENT GROUP		
1 NG PLAN		
APPROVALS	ENGINEER	DATE
WATER	N/A RWE	9-28-95
F.C.A.	N/A RWE	9-28-95
12	SHEET	11 OF 36

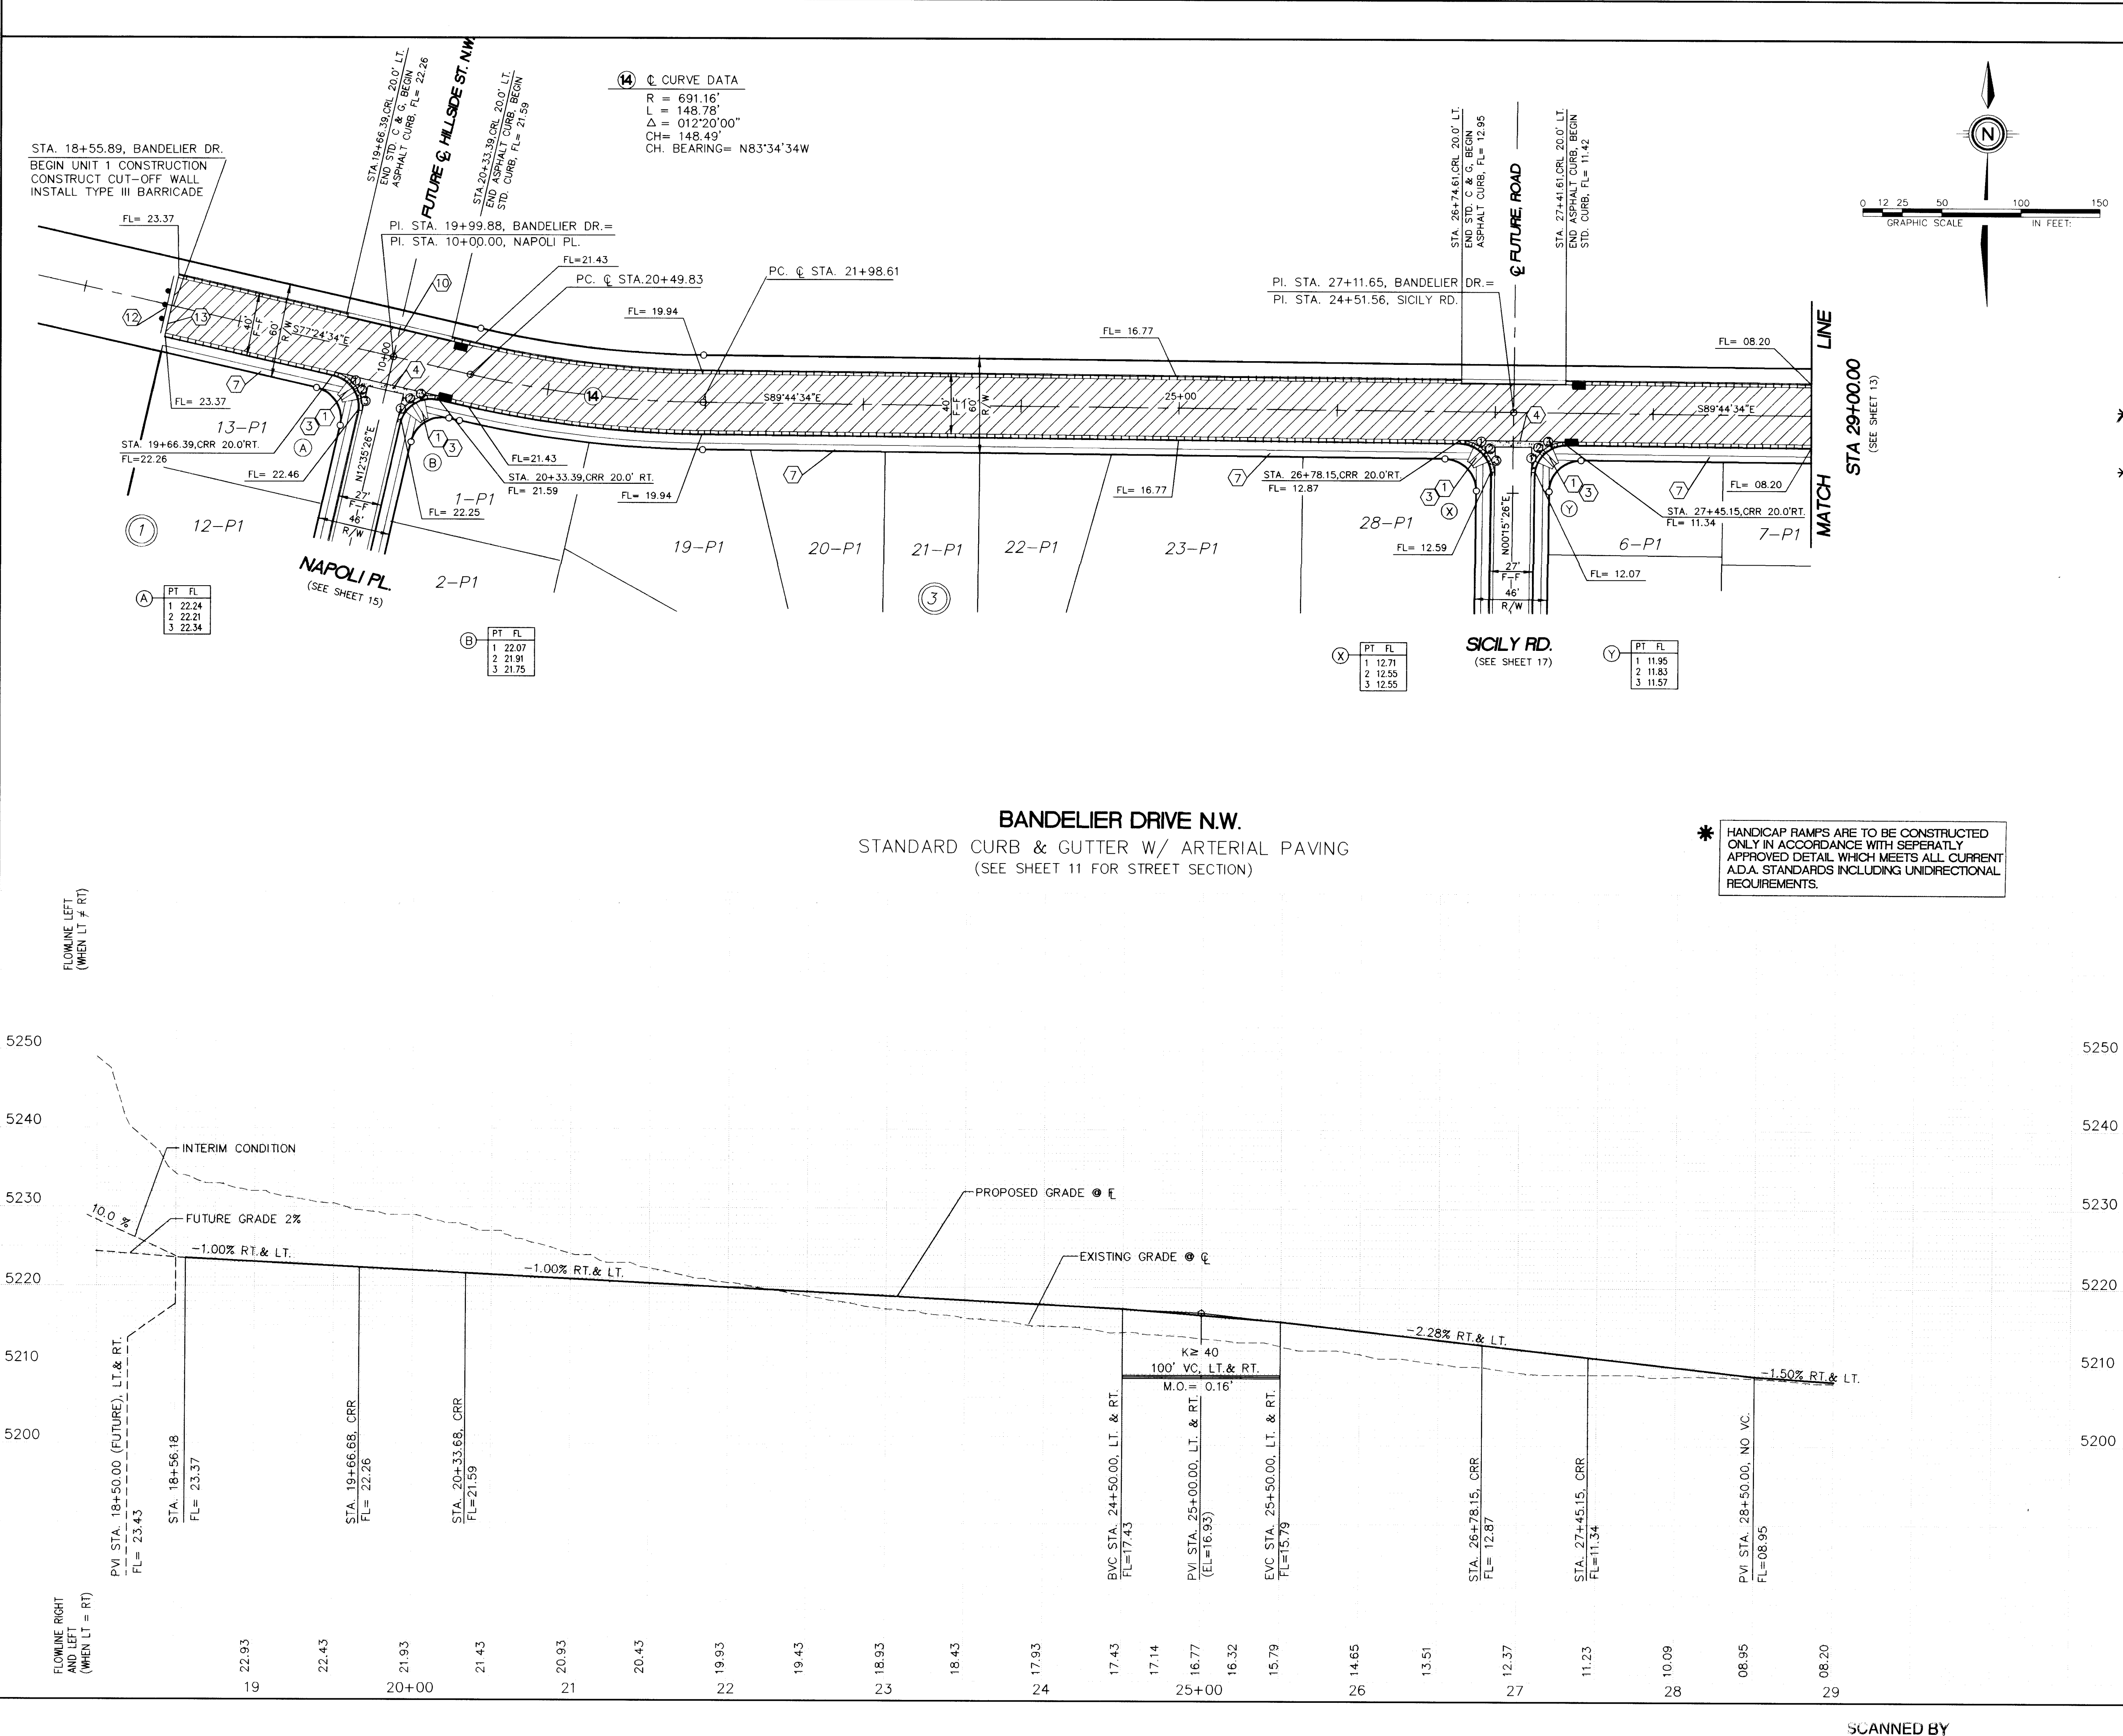

LEGEND

- FL=74.11 PROPOSED CURB FLOWLINE ELEVATION
- 73.6 EXISTING SPOT ELEVATION (GRND & TC)
- PROPOSED VALLEY GUTTER/ SIDEWALK
- EXISTING CURB & GUTTER
- PROPOSED MOUNTABLE CURB & GUTTER
- PROPOSED STANDARD CURB & GUTTER
- CROWN TRANSITION
- PROPOSED STORM SEWER CATCH BASIN
- EXISTING STORM SEWER CATCH BASIN
- PROPOSED ARTERIAL SECTION

KEYNOTES:

- WHEELCHAIR RAMP PER COA STD. DWG. 2441 CASE II, UNLESS OTHERWISE NOTED.
- WHEELCHAIR RAMP PER COA STD. DWG. 2441 CASE I
- MOUNTABLE TO STANDARD CURB TRANSITION PER COA STD. DWG. 2418
- CONC. VALLEY GUTTER PER COA STD. DWG. 2420
- SPECIAL CONC. VALLEY GUTTER (10' WIDE, 3/4" INVERT) PER COA STD. DWG. 2422
- FUTURE 4' SIDEWALK, BY OTHERS
- PROPOSED 4' SIDEWALK, THIS CONTRACT
- 50' CROWN TRANSITION PER C.O.A. STD. DWG. 2401
- PROPOSED 6' SIDEWALK, THIS CONTRACT
- ASPHALT CURB, PER C.O.A. STD. DWG. 2415
- KNUCKLE VALLEY GUTTER, PER C.O.A. STD. DWG. 2421
- INSTALL TYPE III BARRICADE
- CUT-OFF WALL (FULL STREET WIDTH, 24" DEEP x 8" THICK) PER C.O.A. STD. DWG. 2415

CURB CURVE TABLE
AT FACE OF CURB

CURVE ID	RADIUS	ARC	DELTA
A	20.00	31.42	090-00-00
B	20.00	31.42	090-00-00
X	20.00	31.42	090-00-00
Y	20.00	31.42	090-00-00

SCALE:
HORIZ: 1" = 50'
VERT: 1" = 10'

community sciences corporation
LAND PLANNING P.O. Box 1328 CORRALES, N.M. 87046

CITY OF ALBUQUERQUE
PUBLIC WORKS DEPARTMENT
ENGINEERING GROUP

TITLE: TUSCANY SUBDIVISION - UNIT 1
PAVING PLAN & PROFILE
BANDELIER DRIVE N.W.

APPROVALS	ENGINEER	DATE	APPROVALS	ENGINEER	DATE
DRG. CHAIRMAN	B.A. Smith	11-21-95	WATER	N/A RWE	9-28-94
TRANSPORTATION	K. Smith	9-28-95	WASTE WATER	N/A RWE	9-28-94
HYDROLOGY	N/A JAL	11-3-95	A.M.A.F.C.A.		

PROJECT NO. 5208.91 MAP NO. G-11 SHEET 12 OF 36


AS BUILT INFORMATION

CONTRACTOR: NEW CONCRETE INC.
STATE BY: COA
INSPECTOR: JLD
FIELD NO. BY: JLD
DATE: 11-21-95
DATE: 9-28-95
DATE: 11-3-95

ENGINEER'S SEAL

REVISIONS

NO.	DATE	BY	REMARKS
1	AUGUST, 1995	T.J.B.	DESIGN
2	AUGUST, 1995	A.M.	
3	JULY, 1995	J.D.H.	

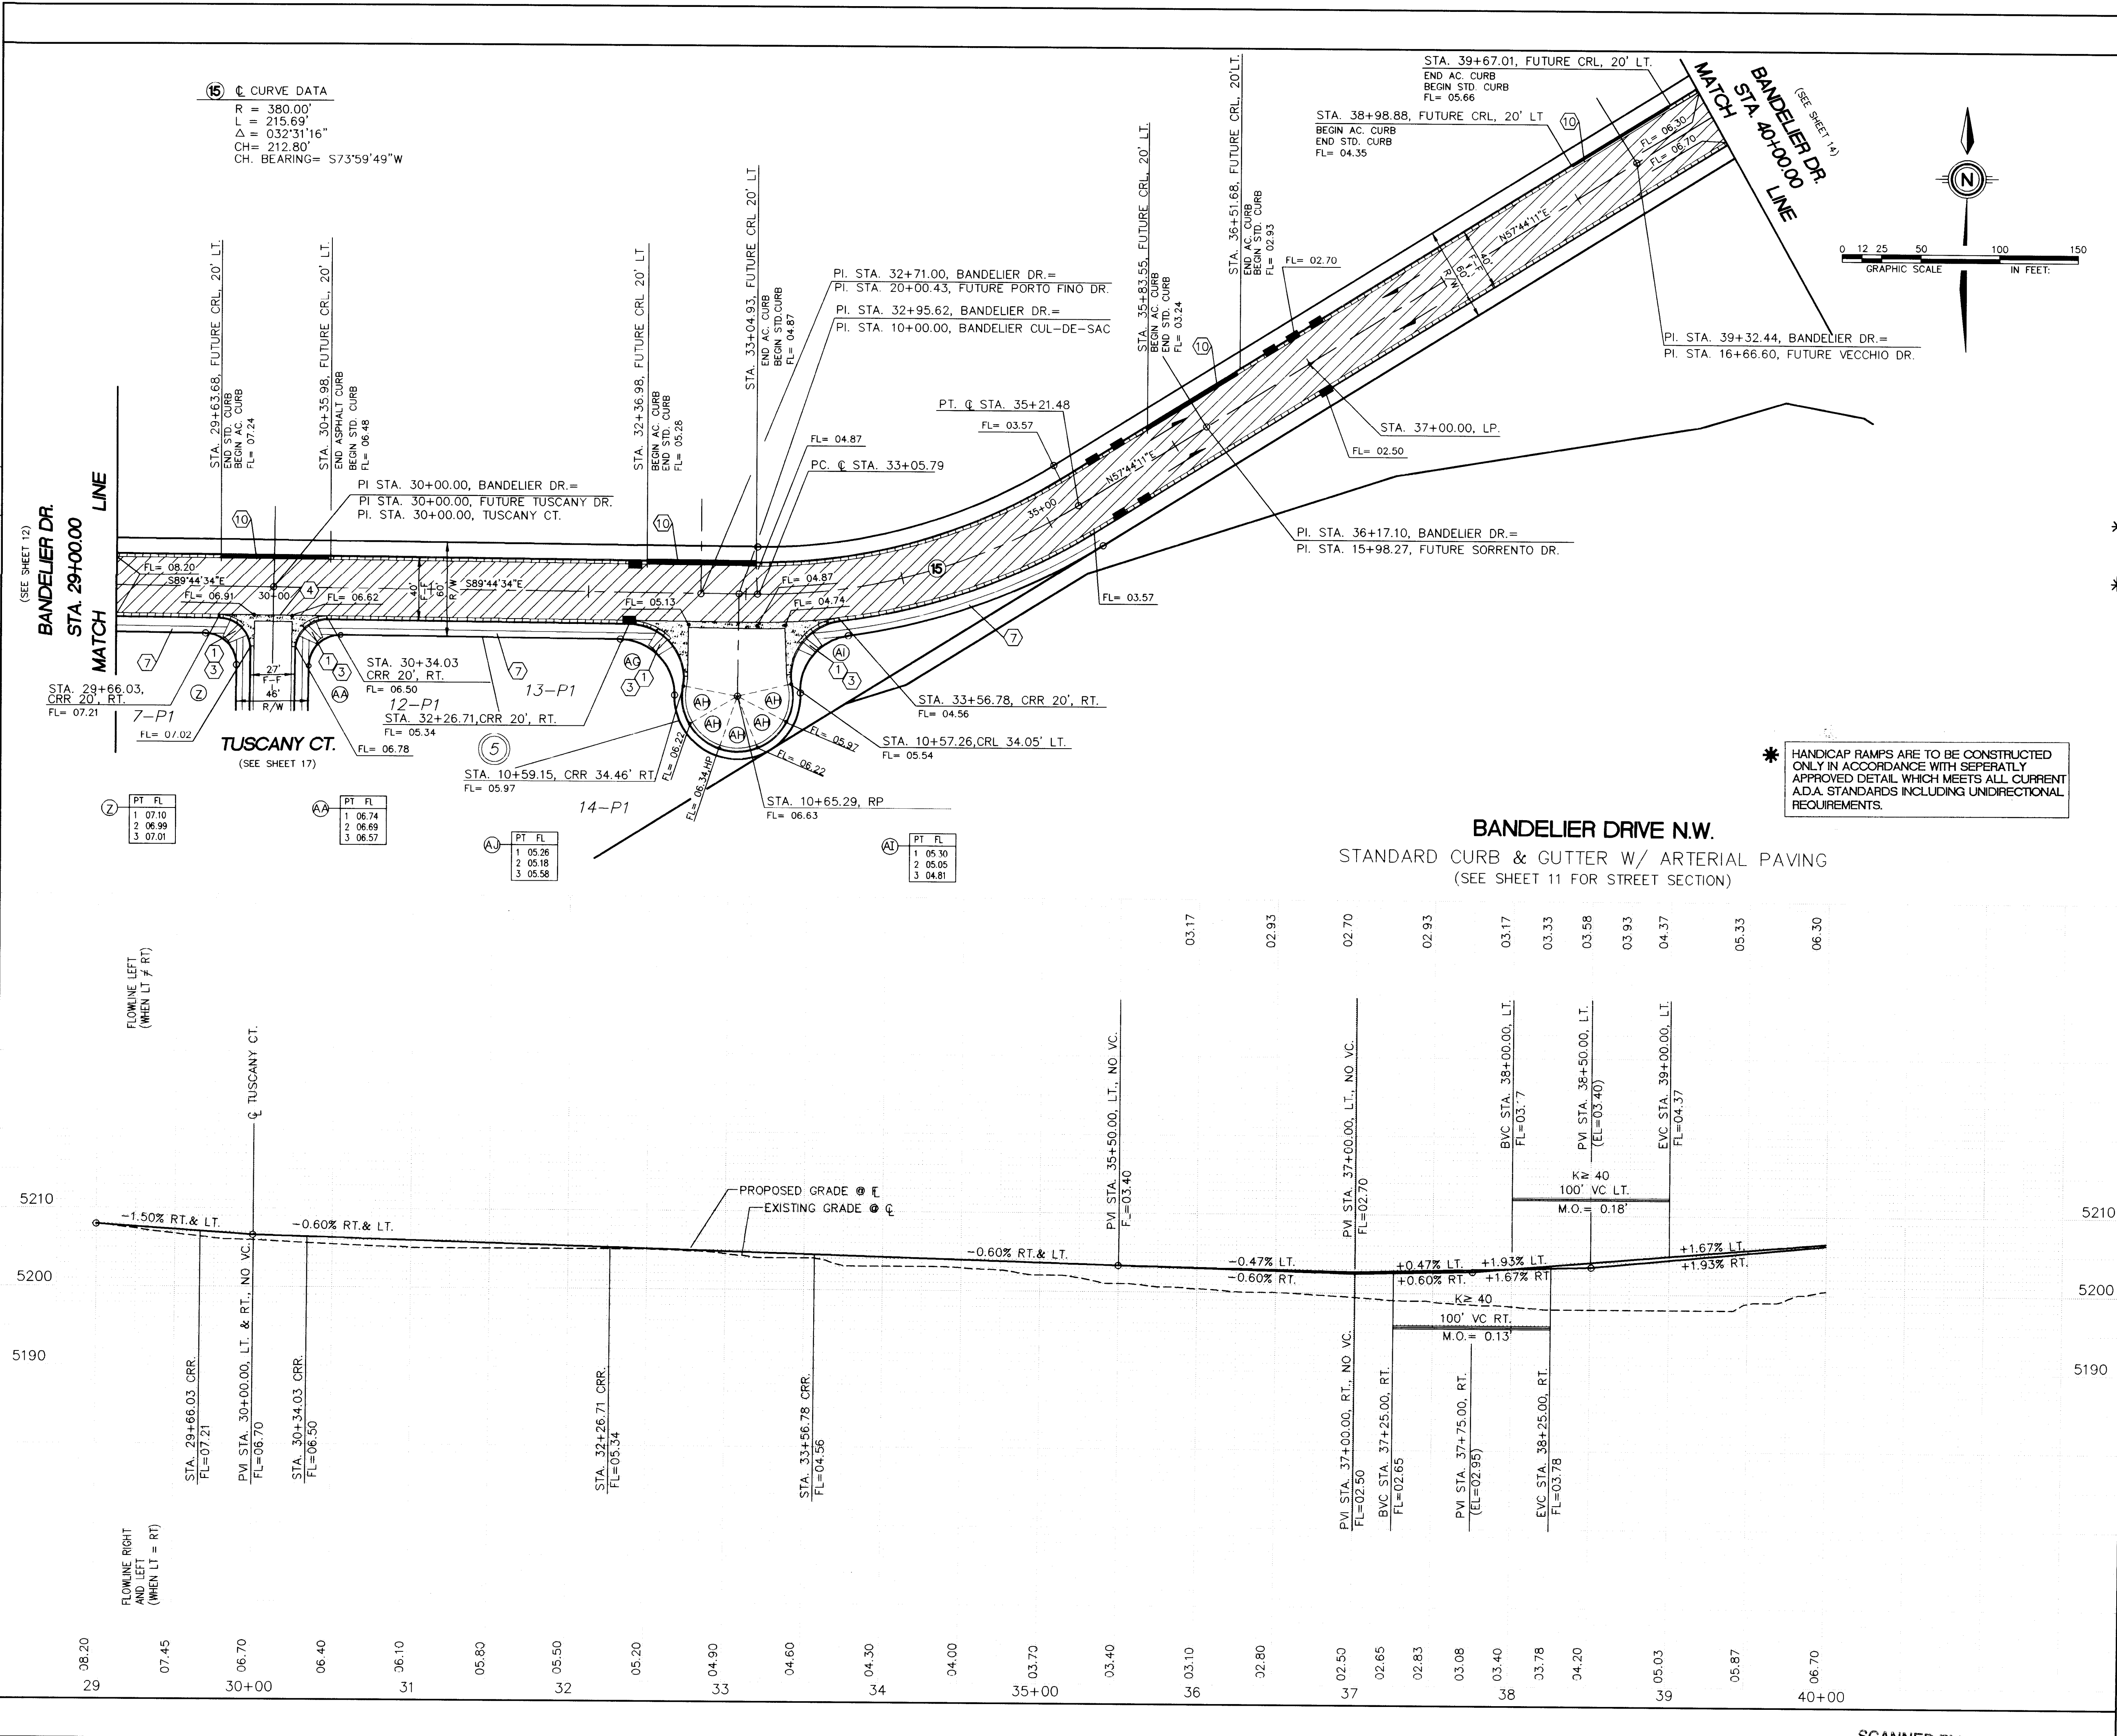

LEGEND

- FL=74.11 PROPOSED CURB FLOWLINE ELEVATION
- 73.6 • EXISTING SPOT ELEVATION (GRND & TC)
- ===== PROPOSED VALLEY GUTTER/ SIDEWALK
- ===== EXISTING CURB & GUTTER
- ===== PROPOSED MOUNTABLE CURB & GUTTER
- ===== PROPOSED STANDARD CURB & GUTTER
- ===== PROPOSED 8" ASPHALT CURB
- ===== CROWN TRANSITION
- ===== PROPOSED STORM SEWER CATCH BASIN
- ===== EXISTING STORM SEWER CATCH BASIN
- ===== PROPOSED ARTERIAL SECTION

KEYNOTES:

- * ① WHEELCHAIR RAMP PER COA STD. DWG. 2441 CASE II, UNLESS OTHERWISE NOTED.
- * ② WHEELCHAIR RAMP PER COA STD. DWG. 2441 CASE I
- ③ MOUNTABLE TO STANDARD CURB TRANSITION PER COA STD. DWG. 2418
- ④ CONC. VALLEY GUTTER PER COA STD. DWG. 2420
- ⑤ SPECIAL CONC. VALLEY GUTTER (10' WIDE, 3/4" INVERT) PER COA STD. DWG. 2422
- ⑥ FUTURE 4' SIDEWALK, BY OTHERS
- ⑦ PROPOSED 4' SIDEWALK, THIS CONTRACT
- ⑧ 50' CROWN TRANSITION PER C.O.A. STD. DWG. 2401
- ⑨ PROPOSED 6' SIDEWALK, THIS CONTRACT
- ⑩ ASPHALT CURB PER C.O.A. STD. DWG. 2415
- ⑪ KNUCKLE VALLEY GUTTER, PER C.O.A. STD. DWG. 2421
- ⑫ INSTALL TYPE III BARRICADE
- ⑬ CUT-OFF WALL (FULL STREET WIDTH, 24" DEEP x 8" THICK) PER C.O.A. STD. DWG. 2415

CURB CURVE TABLE AT FACE OF CURB

CURVE ID	RADIUS	ARC	DELTA
Z	20.00	31.40	089-57-41
AA	20.00	31.43	090-02-19
AG	35.00	61.16	100-06-52
AH	35.00	24.86	040-41-48
AI	35.00	58.45	095-40-51

SCALE: HORIZ: 1" = 50' VERT: 1" = 10'

community sciences corporation


LAND PLANNING P.O. Box 1328 ENGINEERING Corrales, N.M. 87048 SURVEYING

CITY OF ALBUQUERQUE PUBLIC WORKS DEPARTMENT ENGINEERING GROUP

TITLE: TUSCANY SUBDIVISION - UNIT 1 PAVING PLAN & PROFILE BANDELIER DRIVE N.W.

APPROVALS	ENGINEER	DATE	APPROVALS	ENGINEER	DATE
DRC CHAIRMAN	SA, Bobby	11-21-95	WATER	NIA RWK	9-28-95
TRANSPORTATION	R. Hunt	9-28-95	WASTE WATER	NIA RWK	9-28-95
HYDROLOGY	NA PPC	11-3-95	A, M, A, F, C, A.		

PROJECT NO. 5208.91 MAP NO. G-11 SHEET 13 OF 36

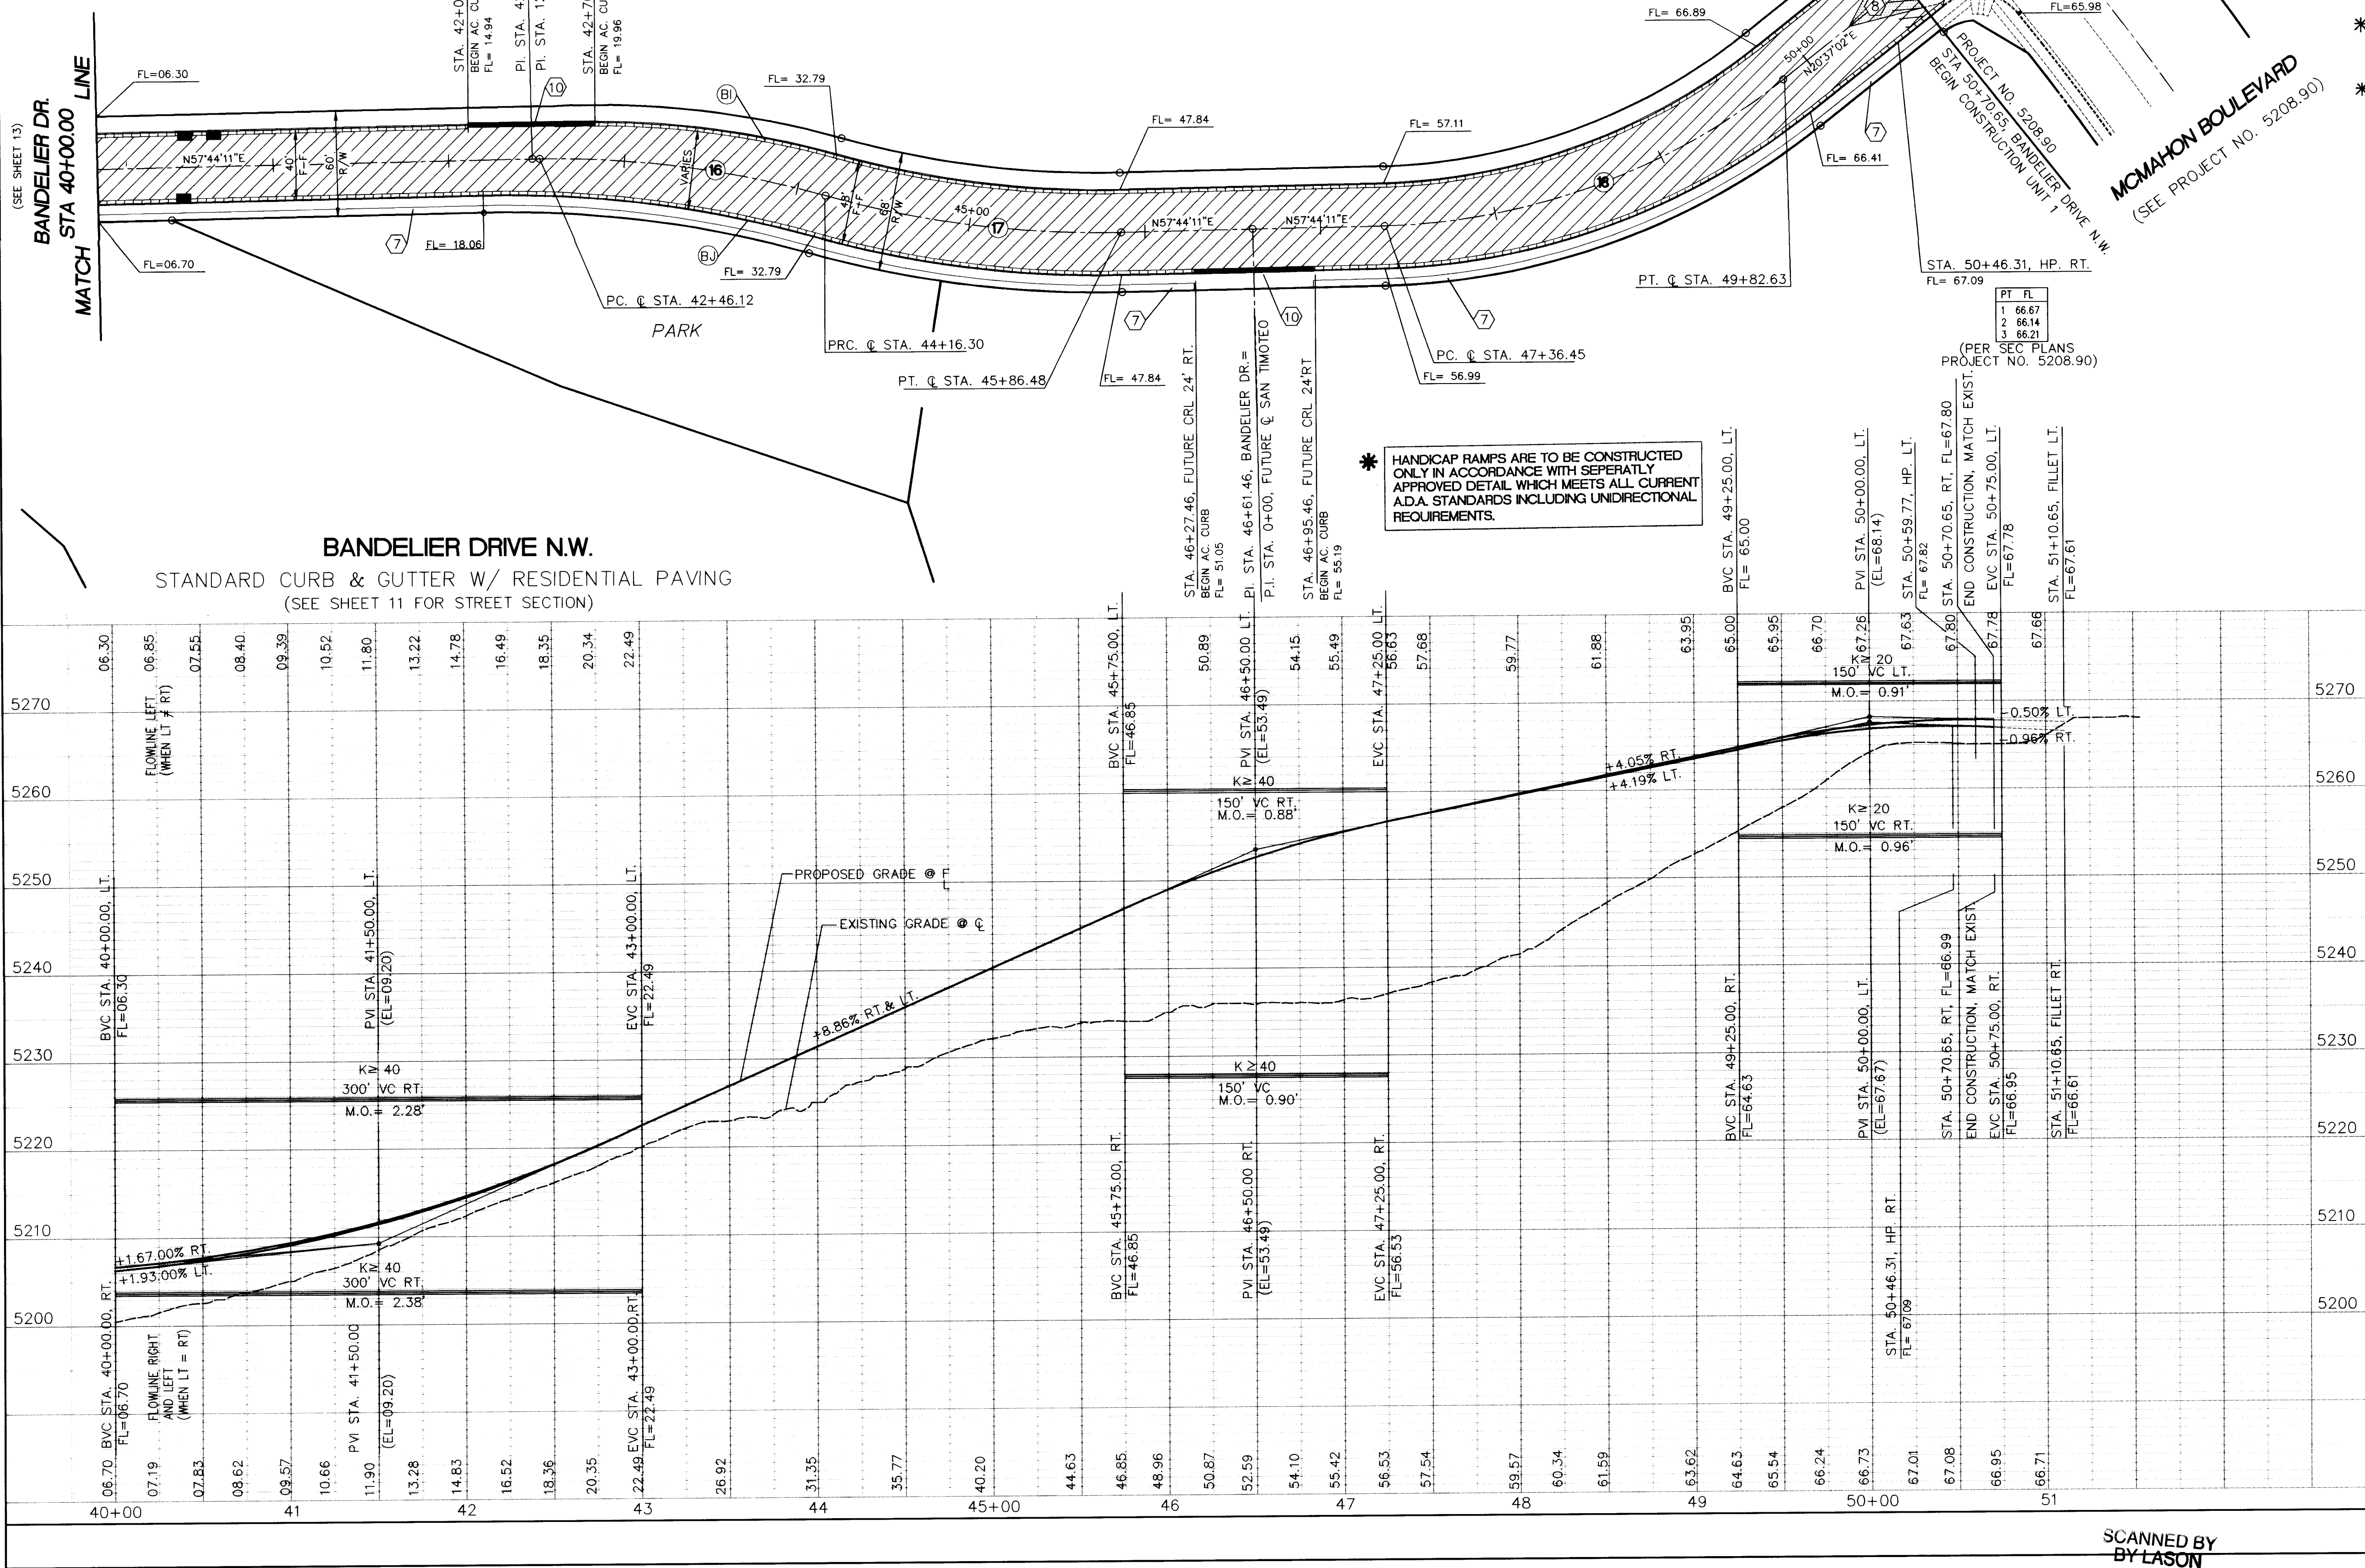

LEGEND

- FL=74.11 PROPOSED CURB FLOWLINE ELEVATION
- 73.6 EXISTING SPOT ELEVATION (GRND & TC)
- PROPOSED VALLEY GUTTER / SIDEWALK
- EXISTING CURB & GUTTER
- PROPOSED MOUNTABLE CURB & GUTTER
- PROPOSED STANDARD CURB & GUTTER
- PROPOSED 8" ASPHALT CURB
- CROWN TRANSITION
- PROPOSED STORM SEWER CATCH BASIN
- EXISTING STORM SEWER CATCH BASIN
- PROPOSED ARTERIAL SECTION

KEYNOTES

- 1 WHEELCHAIR RAMP PER COA STD. DWG. 2441. CASE II, UNLESS OTHERWISE NOTED.
- 2 WHEELCHAIR RAMP PER COA STD. DWG. 2441. CASE I
- 3 MOUNTABLE TO STANDARD CURB TRANSITION PER COA STD. DWG. 2418
- 4 CONC. VALLEY GUTTER PER COA STD. DWG. 2420
- 5 SPECIAL CONC. VALLEY GUTTER (10' WIDE, 3/4" INVERT) PER COA STD. DWG. 2422
- 6 FUTURE 4' SIDEWALK, BY OTHERS
- 7 PROPOSED 4' SIDEWALK, THIS CONTRACT
- 8 50' CROWN TRANSITION PER C.O.A. STD. DWG. 2401
- 9 PROPOSED 6' SIDEWALK, THIS CONTRACT
- 10 ASPHALT CURB, PER C.O.A. STD. DWG. 2415
- 11 KNUCKLE VALLEY GUTTER, PER C.O.A. STD. DWG. 2421
- 12 INSTALL TYPE III BARRICADE
- 13 CUT-OFF WALL (FULL STREET WIDTH, 24" DEEP x 8" THICK) PER C.O.A. STD. DWG. 2415

CURB CURVE TABLE AT FACE OF CURB

CURVE ID	RADIUS	ARC	DELTA
BI	507	152.28	17°12'33"
BJ	643	190.30	16°57'27"

1 2 3 4 5 6 7 8 9 10 11 12 13 14 15
20-5208.91-9111497

SCALE:
HORIZ: 1" = 50'
VERT: 1" = 10'

community sciences corporation
LAND PLANNING ENGINEERING SURVEYING
P.O. Box 1328 Corrales, N.M. 87046

**CITY OF ALBUQUERQUE
PUBLIC WORKS DEPARTMENT
ENGINEERING GROUP**

**TITLE: TUSCANY SUBDIVISION - UNIT 1
PAYING PLAN & PROFILE
BANDELIER DRIVE N.W.**



APPROVALS	ENGINEER	DATE	APPROVALS	ENGINEER	DATE
DRG CHAIRMAN	<i>[Signature]</i>	11-21-95	WATER	N/A RWK	9-28-95
TRANSPORTATION	<i>[Signature]</i>	9-28-95	WASTE WATER	N/A RWK	9-28-95
HYDROLOGY	<i>[Signature]</i>	11-3-95	A.M.A.F.C.A.		

PROJECT NO. 5208.91 MAP NO. G-11 SHEET 14 OF 36

SCANNED BY
BY LASON

FLOWLINE LEFT
(WHEN LT ≠ RT)

FLOWLINE RIGHT
AND LEFT
(WHEN LT = RT)

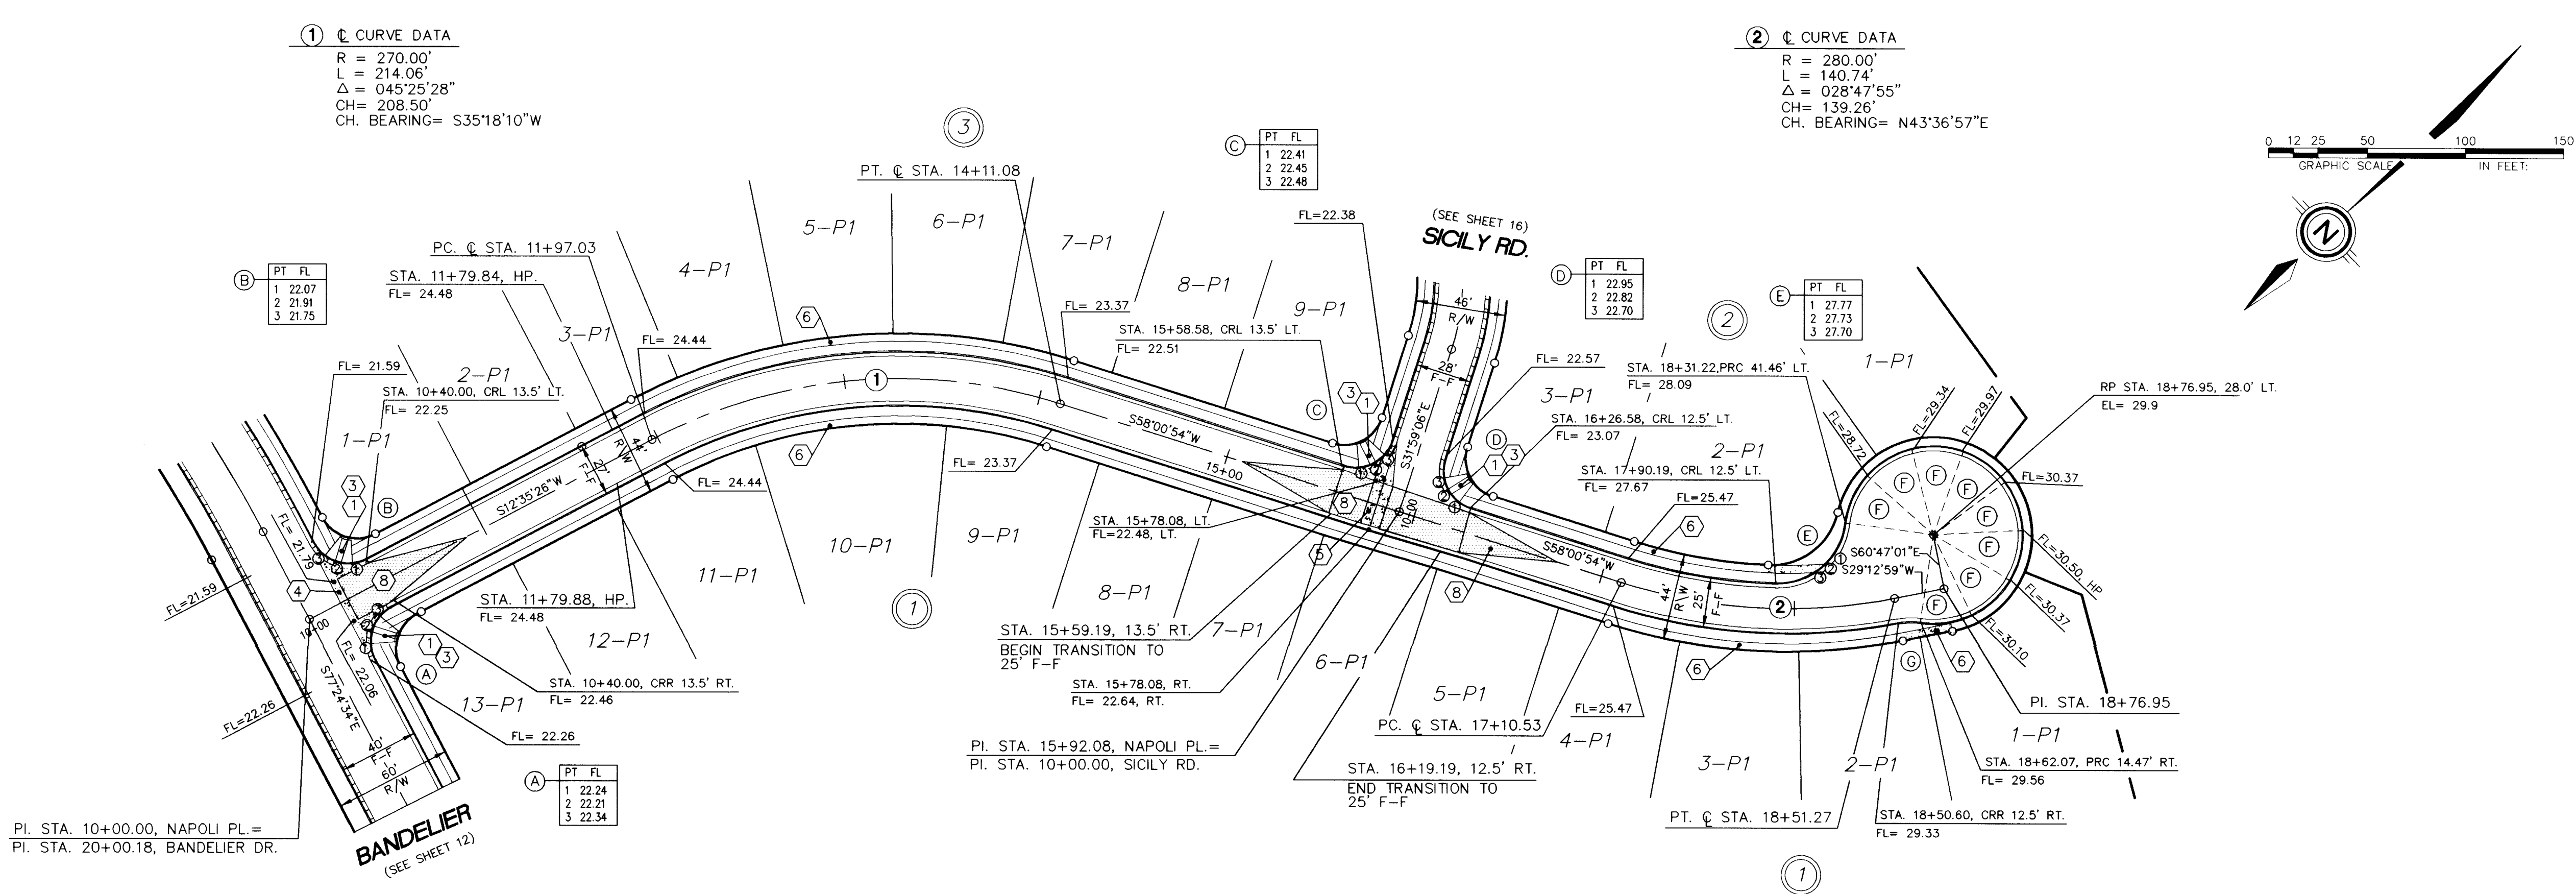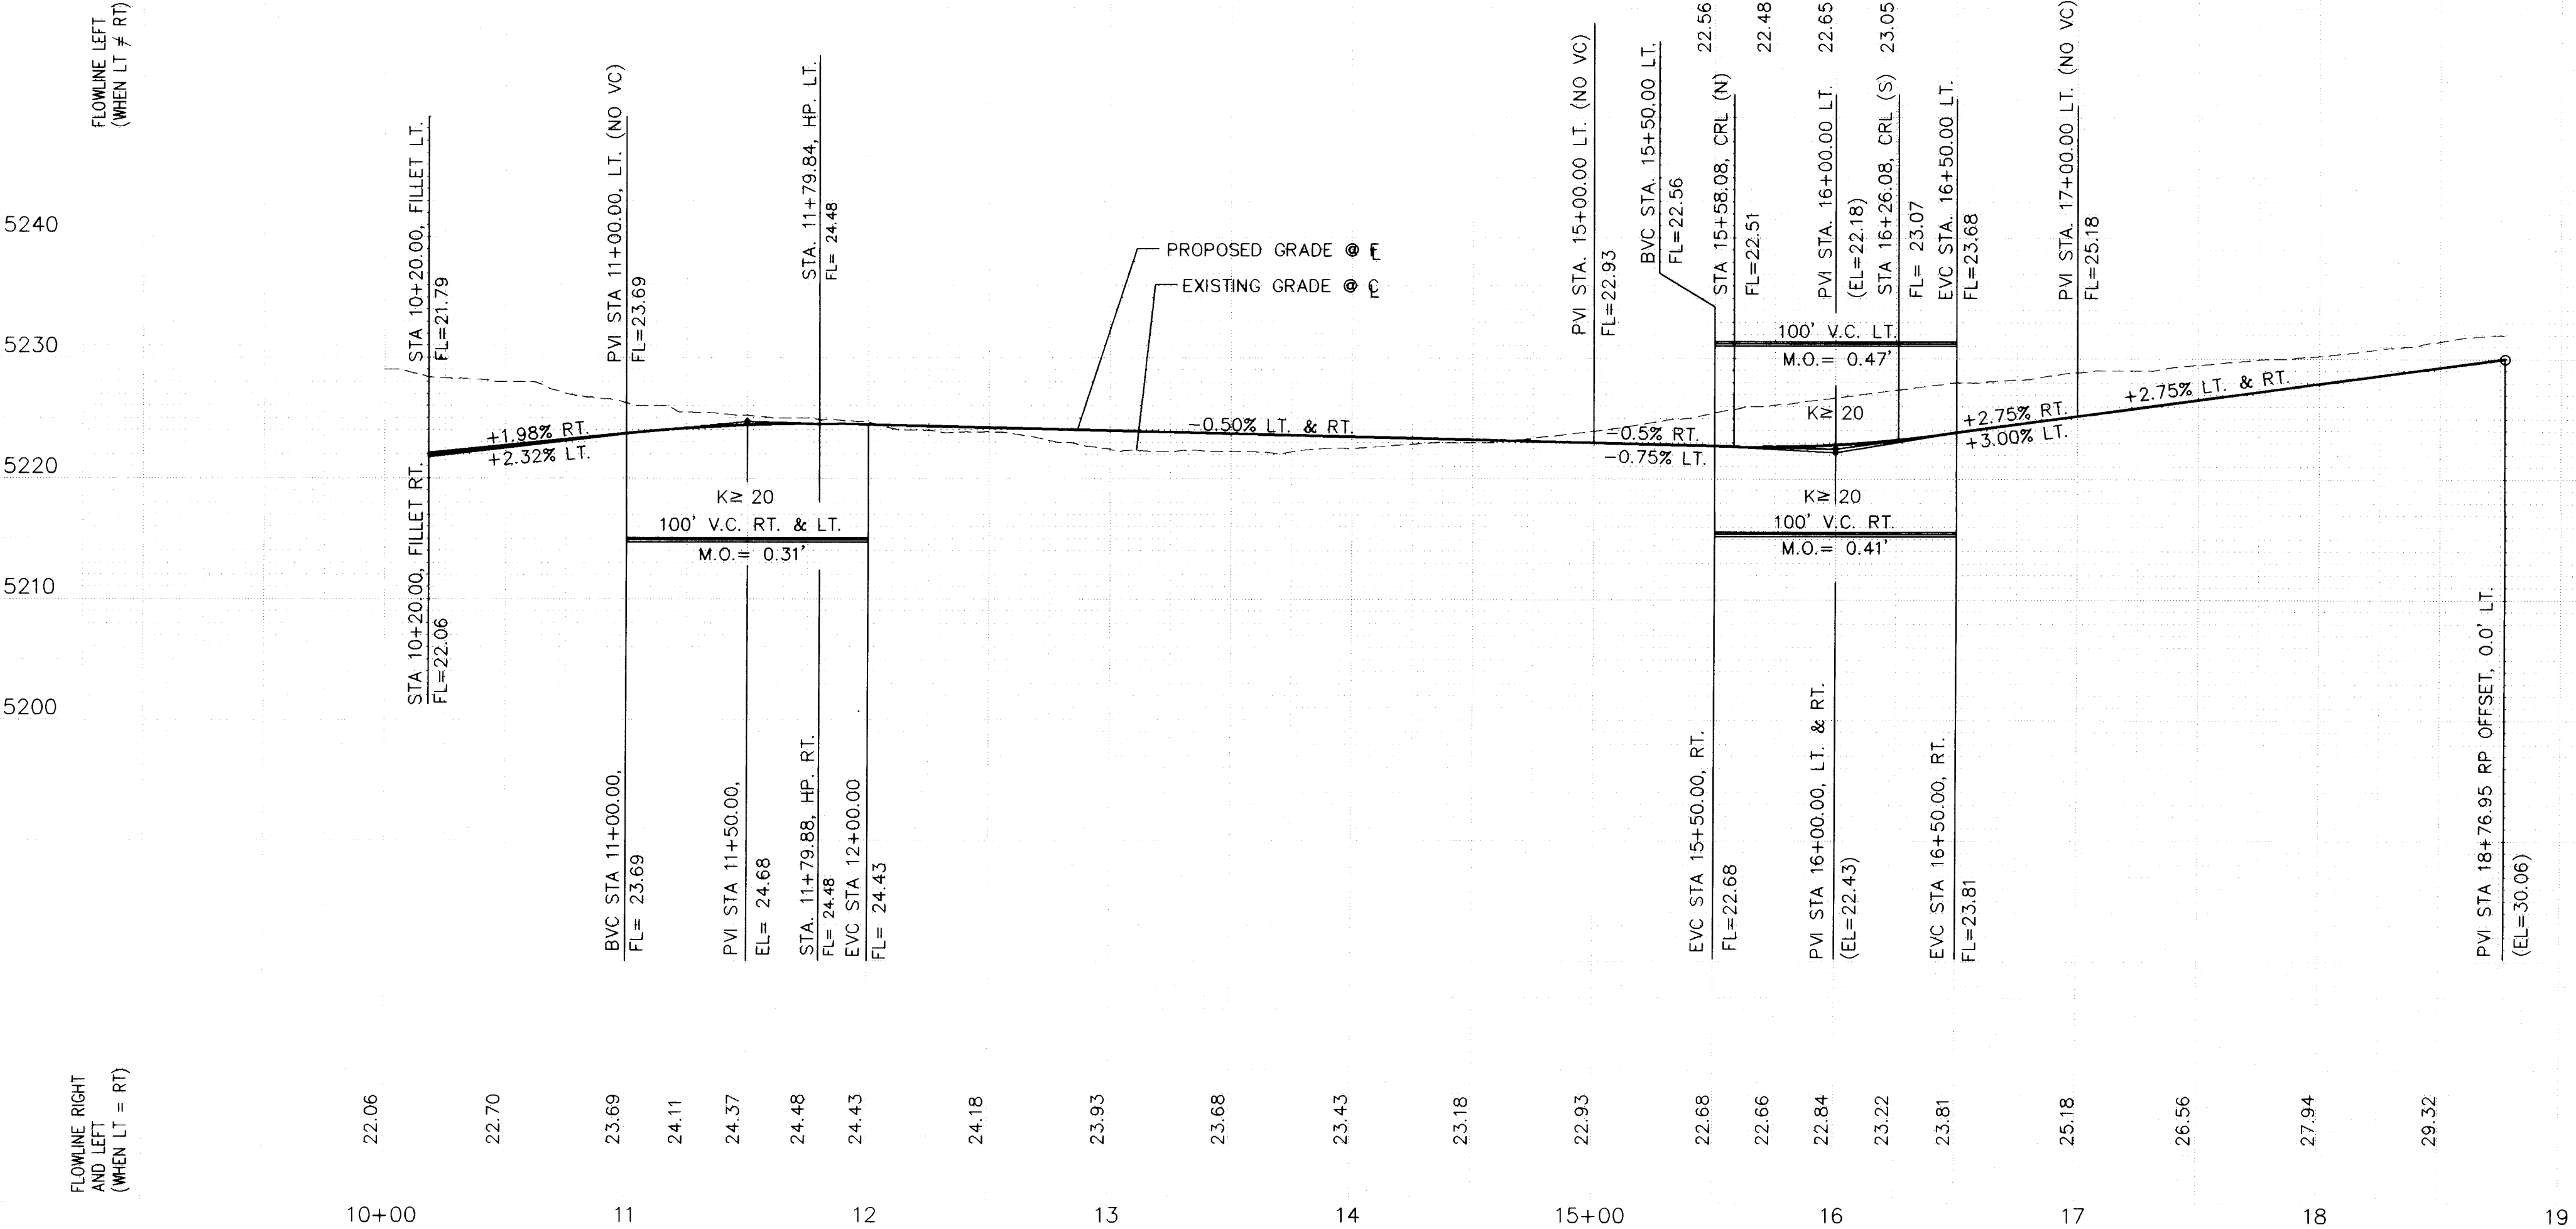

LEGEND

- FL=74.11 PROPOSED CURB FLOWLINE ELEVATION
- 73.6 EXISTING SPOT ELEVATION (GRND & TC)
- PROPOSED VALLEY GUTTER/ SIDEWALK
- EXISTING CURB & GUTTER
- PROPOSED MOUNTABLE CURB & GUTTER
- PROPOSED STANDARD CURB & GUTTER
- CROWN TRANSITION
- PROPOSED STORM SEWER CATCH BASIN
- EXISTING STORM SEWER CATCH BASIN

KEYNOTES

- WHEELCHAIR RAMP PER COA STD. DWG. 2441 CASE II, UNLESS OTHERWISE NOTED.
- WHEELCHAIR RAMP PER COA STD. DWG. 2441 CASE I
- MOUNTABLE TO STANDARD CURB TRANSITION PER COA STD. DWG. 2418
- CONC. VALLEY GUTTER PER COA STD. DWG. 2420
- SPECIAL CONC. VALLEY GUTTER (10' WIDE, 3/4" INVERT) PER COA STD. DWG. 2422
- FUTURE 4' SIDEWALK, BY OTHERS
- PROPOSED 4' SIDEWALK, THIS CONTRACT
- 50' CROWN TRANSITION PER C.O.A. STD. DWG. 2401
- PROPOSED 6' SIDEWALK, THIS CONTRACT
- ASPHALT CURB, PER C.O.A. STD. DWG. 2415
- NUCKLE VALLEY GUTTER, PER C.O.A. STD. DWG. 2421

CURB CURVE TABLE
AT FACE OF CURB

CURVE ID	RADIUS	ARC	DELTA
A	20.00	31.42	090-00-00
B	20.00	31.42	090-00-00
C	20.00	31.42	090-00-00
D	20.00	31.42	090-00-00
E	35.00	51.48	084-16-50
F	45.00	26.61	033-53-12
G	35.00	11.71	019-10-30

SCALE :

HORIZ : 1" = 50'

VERT : 1" = 10'

community sciences corporation

LAND PLANNING P.O. Box 1328 ENGINEERING CORRALES, N.M. 87048 SURVEYING

CITY OF ALBUQUERQUE
PUBLIC WORKS DEPARTMENT
ENGINEERING GROUP

TITLE: TUSCANY SUBDIVISION - UNIT 1
PAVING PLAN & PROFILE
NAPOLI PLACE N.W.

APPROVALS	ENGINEER	DATE	APPROVALS	ENGINEER	DATE
DRC CHAIRMAN	B.G. Smith	11-21-95	WATER	NA RWK 9-28-95	
TRANSPORTATION	NA	9-28-95	WASTE WATER	NA RWK 9-28-95	
HYDROLOGY	NA	11-3-95	A.M.A.F.C.A.		

PROJECT NO. 5208.91

MAP NO. G-11

SHEET 15 OF 36

AS BUILT INFORMATION

CONTRACTOR NEW CORRALES INC.

WORK STATE BY CORRALES

DATE 11/2/95

FIELD LOCATION BY CORRALES

DATE 11/2/95

RECORDED BY CORRALES

DATE 11/2/95

NO.

BENCH MARKS

BENCHMARK: STATION IS A USGS BRASS TABLET STAMPED "BLACK-2, 1977", SET FLUSH WITH THE GROUND.

LOCATED AT THE INTERSECTION OF MONAHAN BLVD. AND GOLF COURSE RD., TO REACH THE STATION FROM THE INTERSECTION OF CORRS BLVD. AND PARADISE BLVD. TURN LEFT, GO WEST ON PARADISE BLVD. 1.1 MILES TO GOLF COURSE RD., TURN RIGHT, GO NORTH ON GOLF COURSE RD. 1.3 MILES TO MONAHAN BLVD., AND THE STATION IS ON THE LEFT.

ELEVATION REVISED BY ACS, 1987 = 5213.93

SURVEY INFORMATION

FIELD NOTES

NO. 1

BY COMMUNITY SCIENCES

DATE

REMARKS

DESIGN

NO.

DATE

DESIGNED BY T.J.B.

DATE AUGUST, 1995

DRAWN BY A.M.A. W.L.V.

DATE AUGUST, 1995

CHECKED BY J.D.H.

DATE JULY, 1995

ENGINEER'S SEAL


community sciences corporation

LAND PLANNING P.O. Box 1328 ENGINEERING CORRALES, N.M. 87048 SURVEYING

SCANNED BY
BY LASON


FLOWLINE LEFT
(WHEN LT ≠ RT)

FLOWLINE RIGHT
AND LEFT
(WHEN LT = RT)

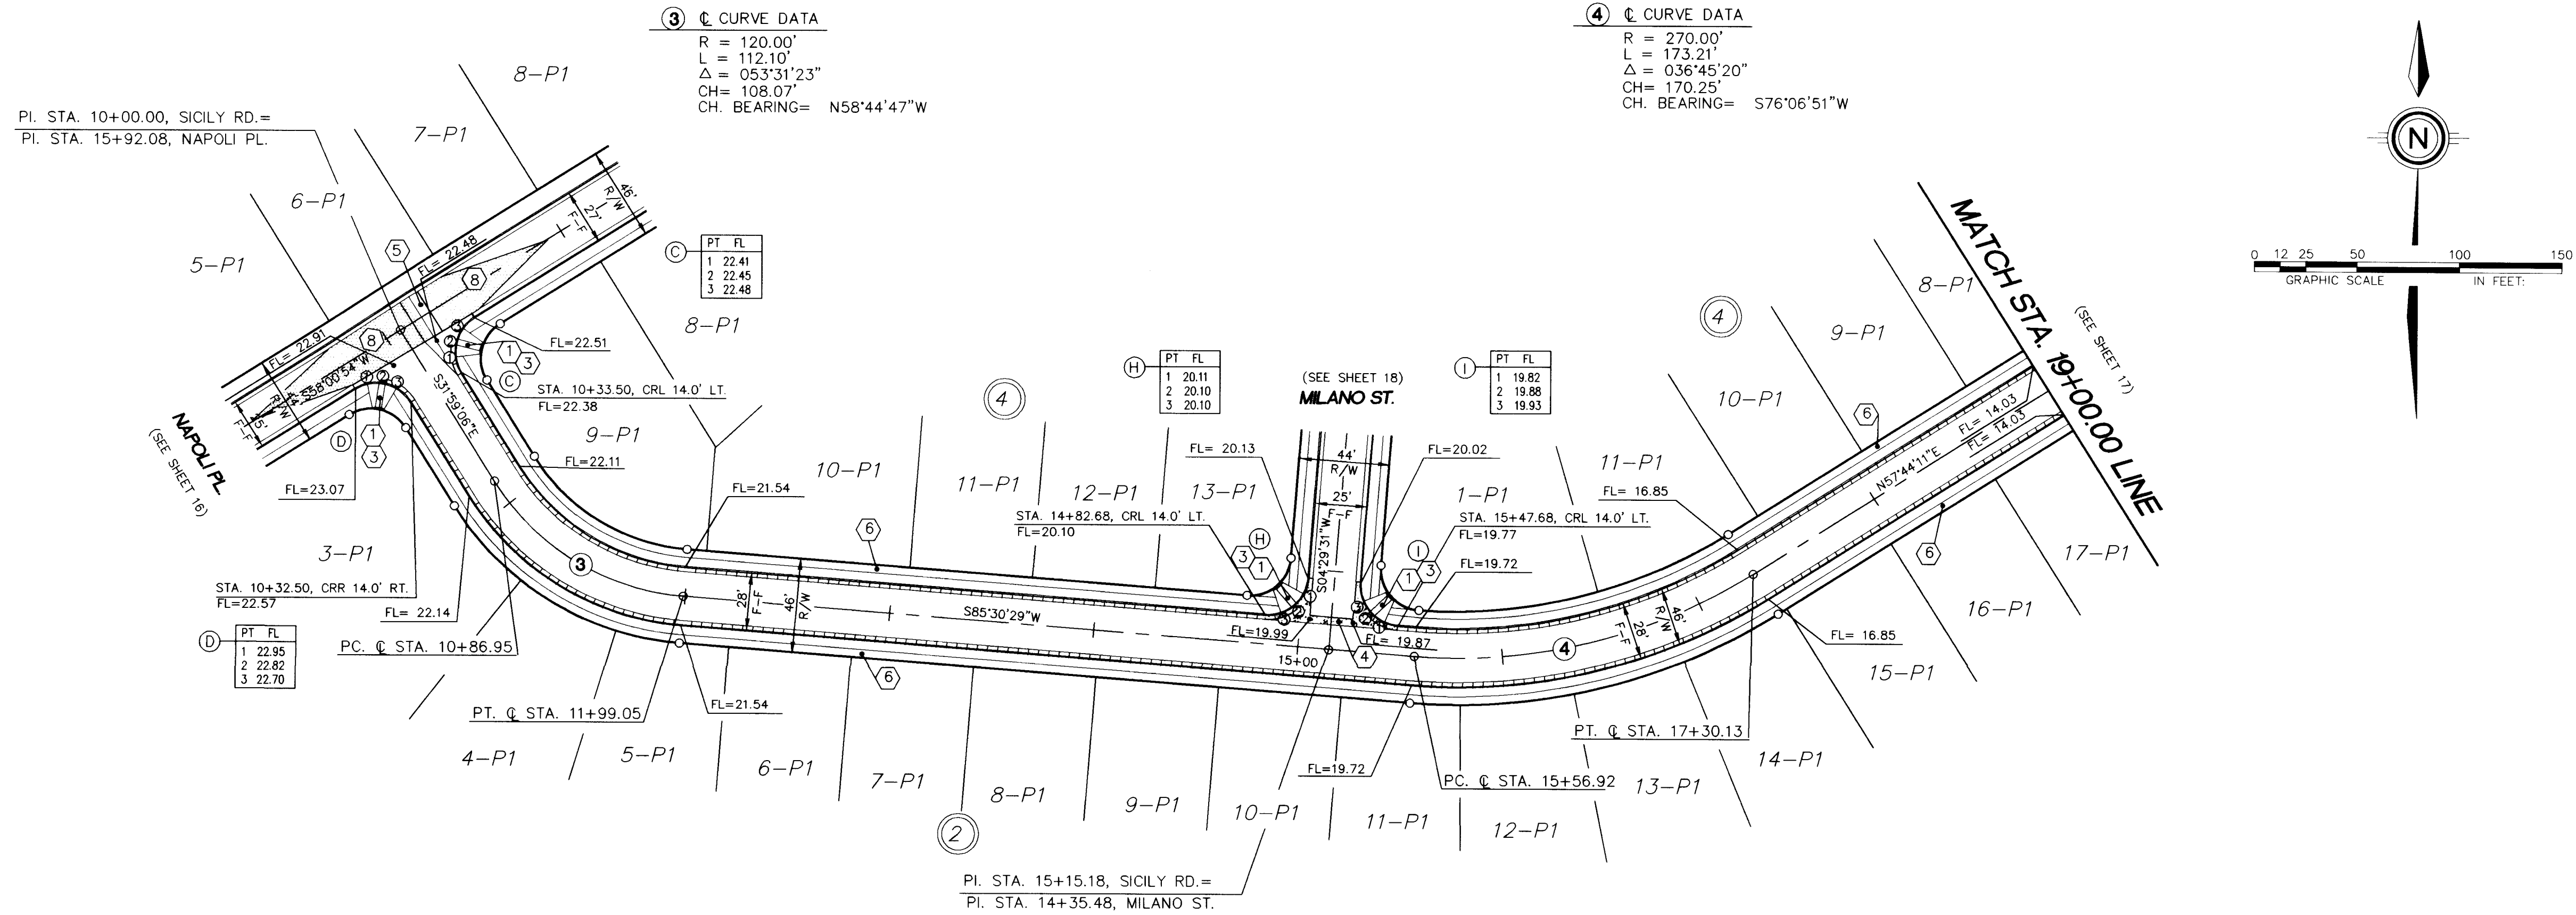

SICILY ROAD N.W.
MOUNTABLE CURB & GUTTER W/ RESIDENTIAL PAVING
(SEE SHEET 11 FOR STREET SECTION)

* HANDICAP RAMPS ARE TO BE CONSTRUCTED ONLY IN ACCORDANCE WITH SEPERATLY APPROVED DETAIL WHICH MEETS ALL CURRENT ADA STANDARDS INCLUDING UNIDIRECTIONAL REQUIREMENTS.

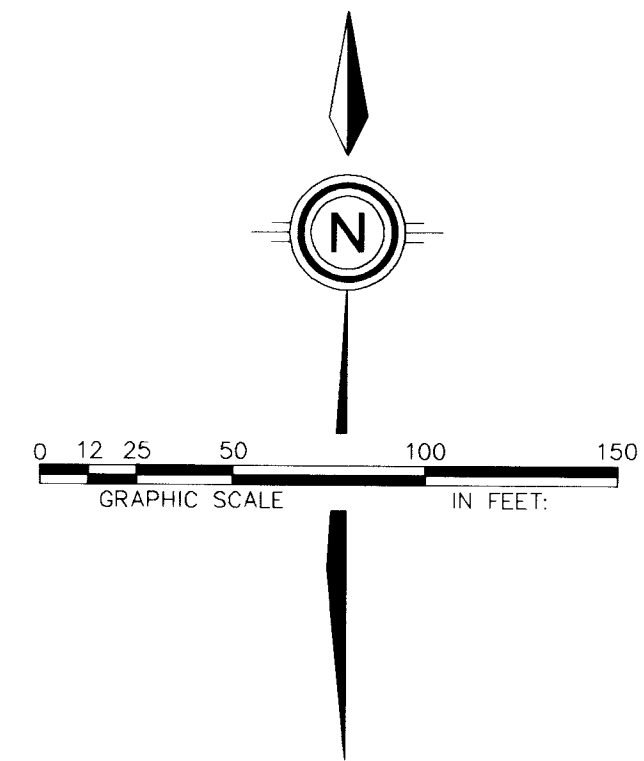

- LEGEND**
- FL=74.11 PROPOSED CURB FLOWLINE ELEVATION
 - 73.6 EXISTING SPOT ELEVATION (GRND & TC)
 - PROPOSED VALLEY GUTTER/ SIDEWALK
 - EXISTING CURB & GUTTER
 - PROPOSED MOUNTABLE CURB & GUTTER
 - PROPOSED STANDARD CURB & GUTTER
 - CROWN TRANSITION
 - PROPOSED STORM SEWER CATCH BASIN
 - EXISTING STORM SEWER CATCH BASIN

- KEYNOTES:**
- ① WHEELCHAIR RAMP PER COA STD. DWG. 2441 CASE II, UNLESS OTHERWISE NOTED.
 - ② WHEELCHAIR RAMP PER COA STD. DWG. 2441 CASE I
 - ③ MOUNTABLE TO STANDARD CURB TRANSITION PER COA STD. DWG. 2418
 - ④ CONC. VALLEY GUTTER PER COA STD. DWG. 2420
 - ⑤ SPECIAL CONC. VALLEY GUTTER (10' WIDE, 3/4" INVERT) PER COA STD. DWG. 2422
 - ⑥ FUTURE 4' SIDEWALK, BY OTHERS
 - ⑦ PROPOSED 4' SIDEWALK, THIS CONTRACT
 - ⑧ 50' CROWN TRANSITION PER C.O.A. STD. DWG. 2401
 - ⑨ PROPOSED 6' SIDEWALK, THIS CONTRACT
 - ⑩ ASPHALT CURB, PER C.O.A. STD. DWG. 2415
 - ⑪ KNUCKLE VALLEY GUTTER, PER C.O.A. STD. DWG. 2421

CURB CURVE TABLE AT FACE OF CURB			
CURVE ID	RADIUS	ARC	DELTA
C	20.00	31.42	090-00-00
D	20.00	31.42	090-00-00
H	20.00	31.42	090-00-00
I	20.00	31.42	090-00-00


SCALE:
HORIZ: 1" = 50'
VERT: 1" = 10'


community sciences corporation
LAND PLANNING P.O. Box 1328
ENGINEERING Corrales, N.M. 87048
SURVEYING

CITY OF ALBUQUERQUE PUBLIC WORKS DEPARTMENT ENGINEERING GROUP			
TITLE: TUSCANY SUBDIVISION - UNIT 1 PAVING PLAN & PROFILE SICILY ROAD N.W.			
APPROVALS	ENGINEER	DATE	APPROVALS
DRC CHAIRMAN	B.G. Soley	11-21-95	WATER
TRANSPORTATION	NA	9-28-95	WASTE WATER
HYDROLOGY	NA	11-3-95	A.M.A.F.C.A.
DESIGNED BY	T.J.B.	DATE	AUGUST, 1995
DRAWN BY	A.M.A.	DATE	AUGUST, 1995
CHECKED BY	J.D.H.	DATE	JULY, 1995
PROJECT NO.	5208.91	MAP NO.	G-11
SHEET	16	OF	36

AS BUILT INFORMATION		BENCH MARKS		SURVEY INFORMATION		FIELD NOTES		ENGINEER'S SEAL	
CONTRACTOR	NEW CONCRETS, INC.	BENCHMARK	STATION IS A USGS BRASS TABLET STAMPED	NO.	BY	DATE	DATE	NO.	BY
WORK	DATE	STATION	DATE	1	COMMUNITY SCIENCES				
FIELD LAYOUT BY	DATE	FIELD LAYOUT BY	DATE						
RECORDED BY	DATE	RECORDED BY	DATE						
NO.		NO.							

REVISIONS		DESIGN	
NO.	DATE	NO.	DATE
1	11-21-95	1	11-21-95
2	11-21-95	2	11-21-95
3	11-21-95	3	11-21-95
4	11-21-95	4	11-21-95
5	11-21-95	5	11-21-95
6	11-21-95	6	11-21-95
7	11-21-95	7	11-21-95
8	11-21-95	8	11-21-95
9	11-21-95	9	11-21-95
10	11-21-95	10	11-21-95
11	11-21-95	11	11-21-95
12	11-21-95	12	11-21-95
13	11-21-95	13	11-21-95
14	11-21-95	14	11-21-95
15	11-21-95	15	11-21-95

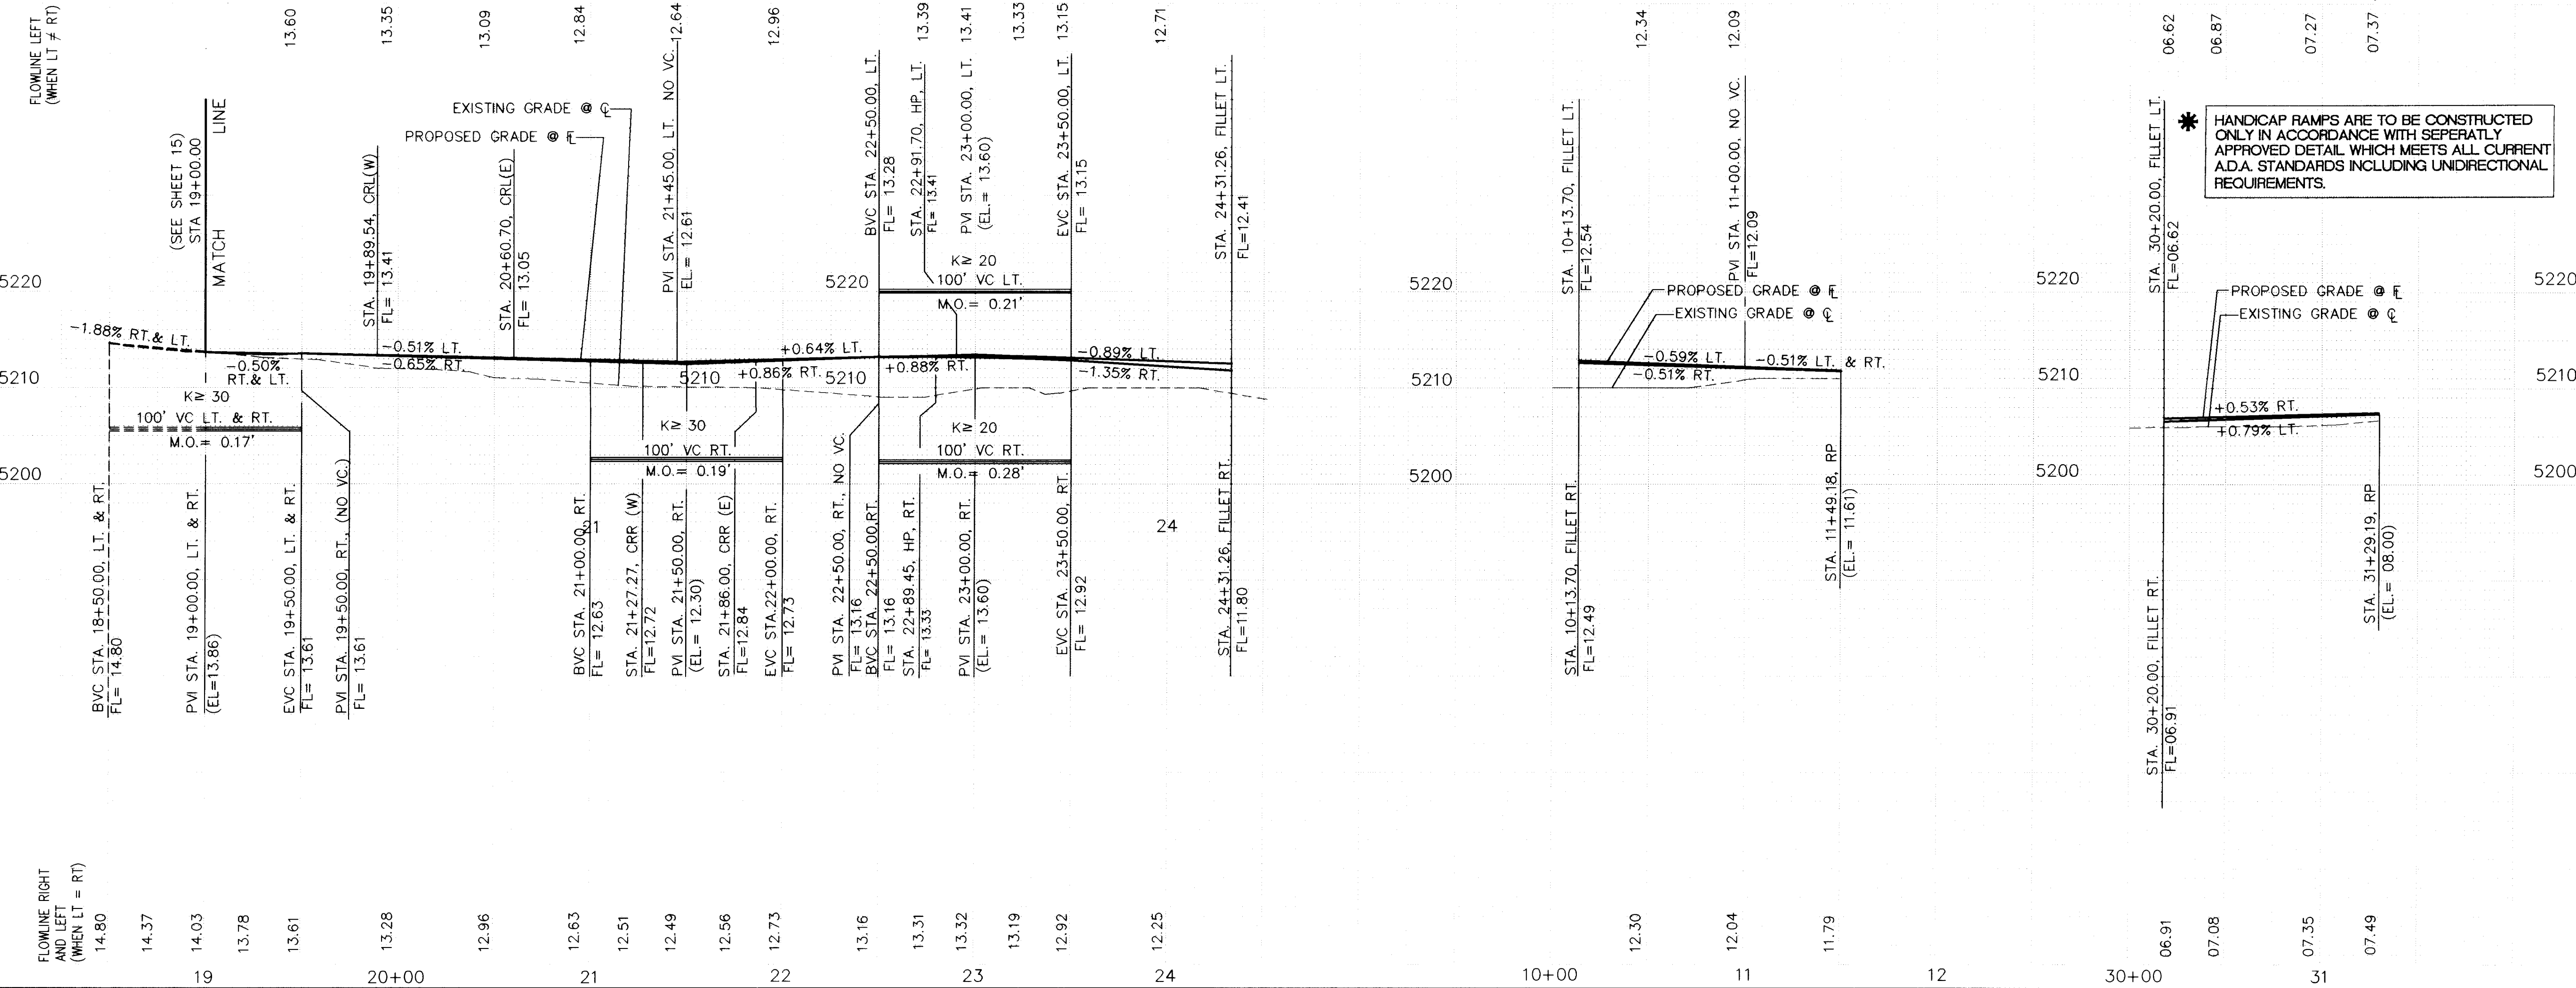[illegible]

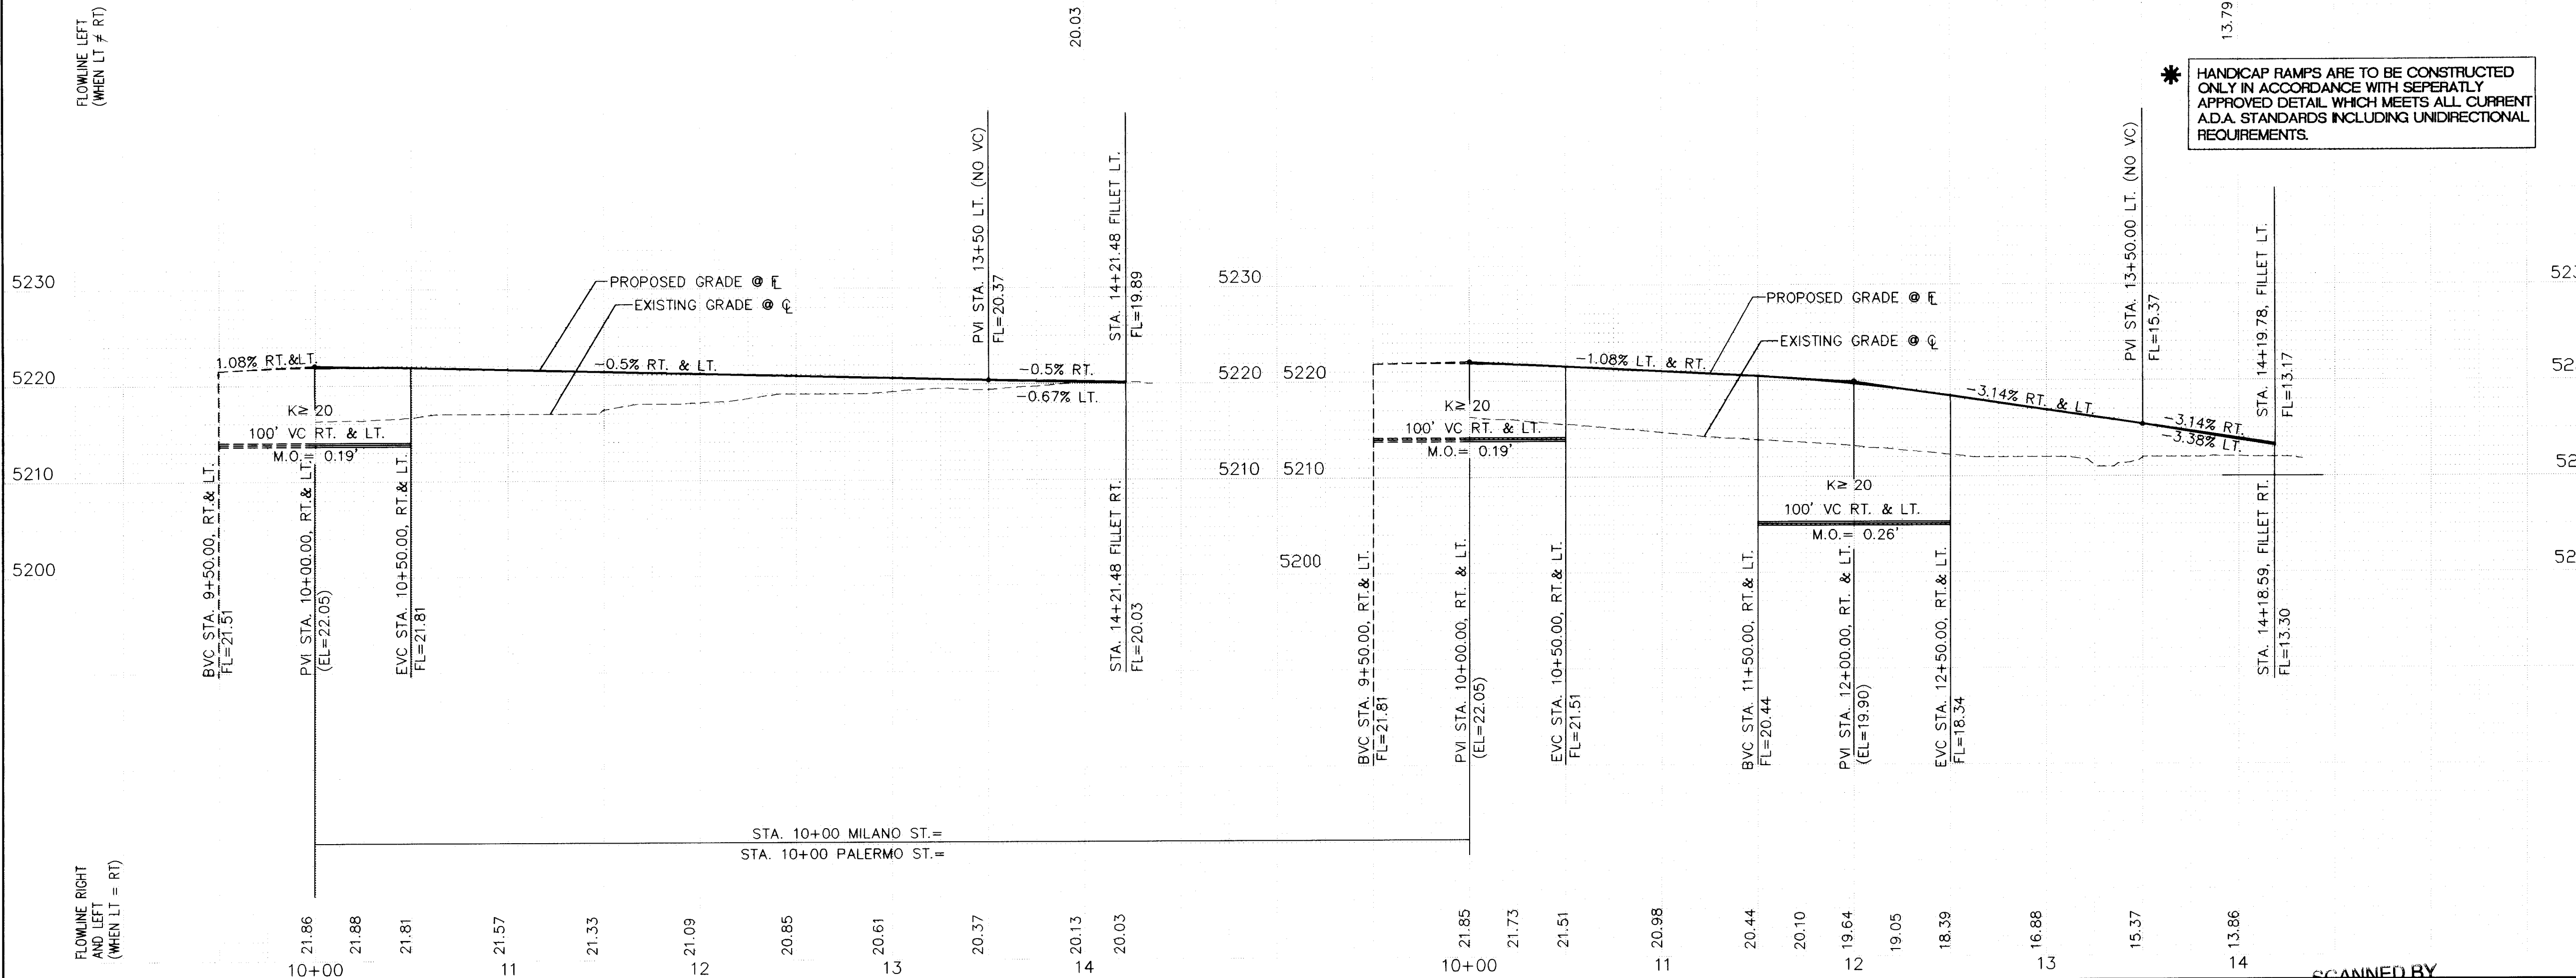

KEYNOTES:

- (1) WHEELCHAIR RAMP PER
COA STD. DWG. 2441
CASE II, UNLESS OTHERWISE NOTED
- (2) WHEELCHAIR RAMP PER
COA STD. DWG. 2441
CASE I
- (3) MOUNTABLE TO STANDARD CURB
TRANSITION PER COA STD. DWG. 2418
- (4) CONC. VALLEY GUTTER PER
COA STD. DWG. 2420
- (5) SPECIAL CONC. VALLEY GUTTER (10"
3/4" INVERT) PER COA STD. DWG. 2420
- (6) FUTURE 4' SIDEWALK, BY OTHERS
- (7) PROPOSED 4' SIDEWALK, THIS CONTRA
- (8) 50' CROWN TRANSITION PER
C.O.A. STD. DWG. 2401
- (9) PROPOSED 6' SIDEWALK, THIS CONTRA
- (10) ASPHALT CURB, PER C.O.A.
STD. DWG. 2415
- (11) KNUCKLE VALLEY GUTTER, PER C.O.A.
STD. DWG. 2421

CURB CURVE TABLE AT FACE OF CURB			
CURVE ID	RADIUS	ARC	DELTA
H	20.00	31.42	090-00-0
I	20.00	31.42	090-00-0
J	35.00	28.87	047-16-0
K	35.00	21.05	034-27-0
L	35.00	47.44	077-40-0
M	35.00	28.08	045-58-0
N	35.00	38.25	062-37-0
O	35.00	22.88	037-27-0
P	35.00	38.25	062-37-0
Q	20.00	33.14	094-56-1
R	20.00	33.23	095-11-1

SCALE :

HORIZ : 1" = 50'

VERT : 1" = 10'

*community
sciences
corporation*

LAND PLANNING ENGINEERING SUR
P.O. Box 1378 Corvallis, N.M.


CITY OF ALBUQUERQUE
PUBLIC WORKS DEPARTMENT
ENGINEERING GROUP

TITLE: TUSCANY SUBDIVISION - UNIT 1
PAVING PLAN & PROFILE
MILANO ST. & PALERMO ST. N.W.

APPROVALS	ENGINEER	DATE	APPROVALS	ENGINEER	DATE
DRC CHAIRMAN	<i>B.G. Aboody</i>	11-21-95	WATER	<i>NIA RWK</i>	9-28-95
TRANSPORTATION	<i>R. Davis</i>	9-28-95	WASTE WATER	<i>NIA RWK</i>	9-28-95
HYDROLOGY	<i>IA JPC</i>	11-3-95	A.M.A.F.C.A.		

PROJECT NO.	5208.91	MAP NO.	G-11	SHEET	18 ^{OF}	36
-------------	---------	---------	------	-------	------------------	----

[illegible]

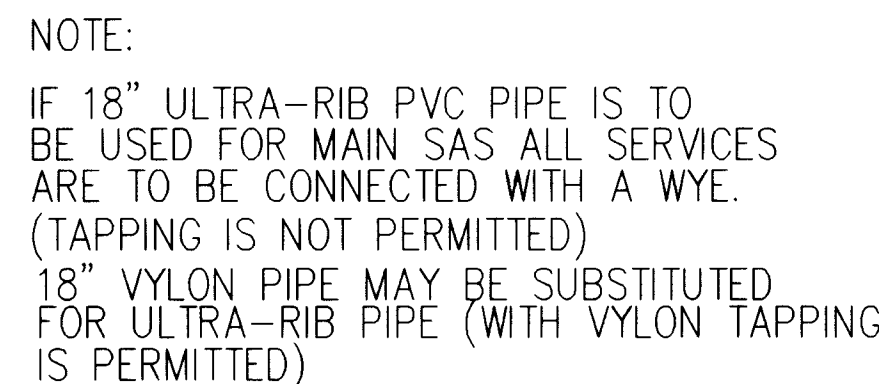

NOTE:
WATERLINE IS SHOWN AS
DASHED TO DISTINGUISH IT
FROM THE SD PIPE IN FRONT
OF IT. WATERLINE IS A NEW
CONSTRUCTION, NOT EXISTING


ENGINEER'S SEAL

616-21-6

616-21-6

ERQUE
ARTMENT
ROUP



APPROVALS	ENGINEER	DATE	APPROVALS	ENGINEER	DATE
DRC CHAIRMAN	<i>B.G. Sordley</i>	11-21-95	WATER	<i>A.W. Kane</i>	9-28-95
TRANSPORTATION	<i>N/A RTH</i>	9-28-95	WASTE WATER	<i>R.W. Kane</i>	9-28-95
HYDROLOGY	<i>JPC</i>	11-3-95	A.M.A.F.C.A.	<i>NA JK</i>	10/27/95
			N.M.U.I.	<i>RES</i>	7/2/96

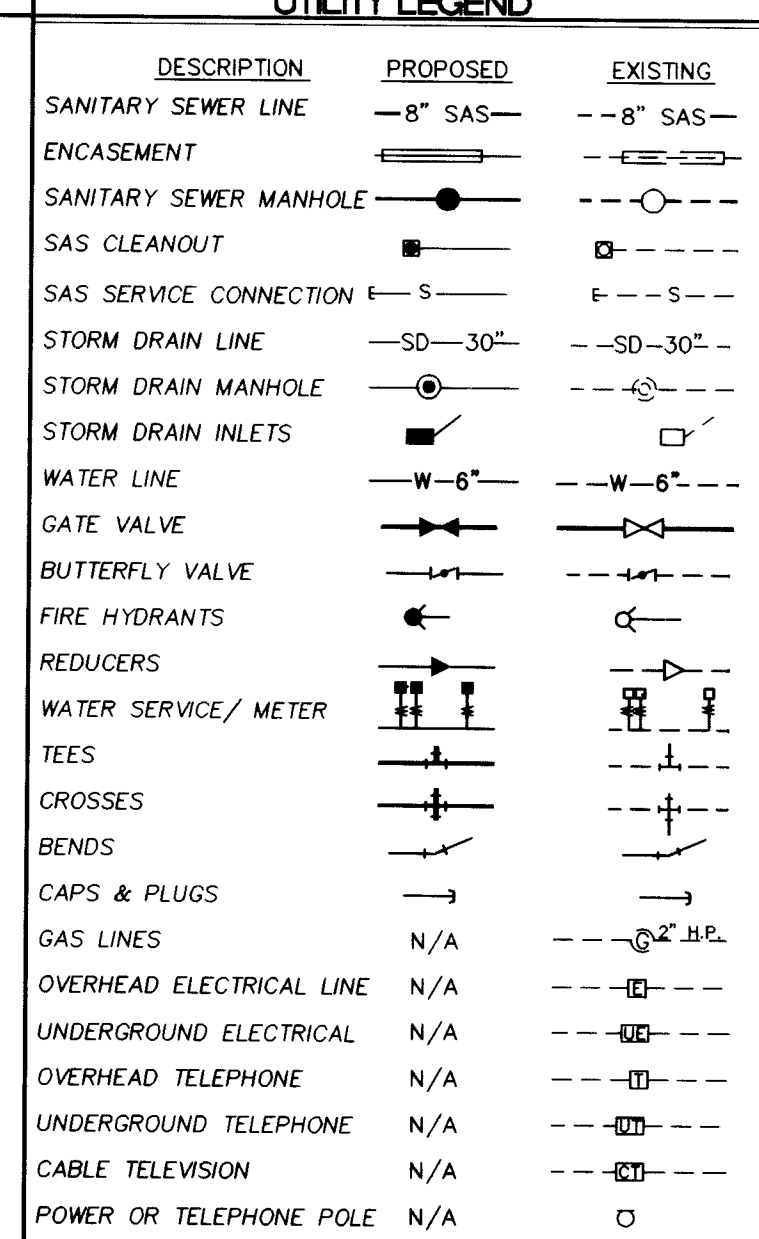

(A)	30 LF, 24" CIPP OR EQUIVALENT
(B)	15 LF, 24" CIPP OR EQUIVALENT
(C)	12 LF, 24" CIPP OR EQUIVALENT
(D)	8' DIA. MH.
(E)	15 LF, 24" CIPP OR EQUIVALENT
(F)	31 LF, 24" CIPP OR EQUIVALENT
(G)	12 LF, 24" CIPP OR EQUIVALENT

NOTE:
WATERLINE IS SHOWN AS DASHED
TO DISTINGUISH IT FROM THE S.D.
PIPE IN FRONT OF IT. WATERLINE
IS NEW CONSTRUCTION, NOT EXIST.

NOTE:
IF 18" ULTRA-RIB PVC PIPE IS TO
BE USED FOR MAIN SAS ALL SERVICES
ARE TO BE CONNECTED WITH A WYE.
(TAPPING IS NOT PERMITTED)
18" VYLON PIPE IS ACCEPTABLE
SUBSTITUTE FOR 18" ULTRA RIB
PIPE SEE SHEET 19.

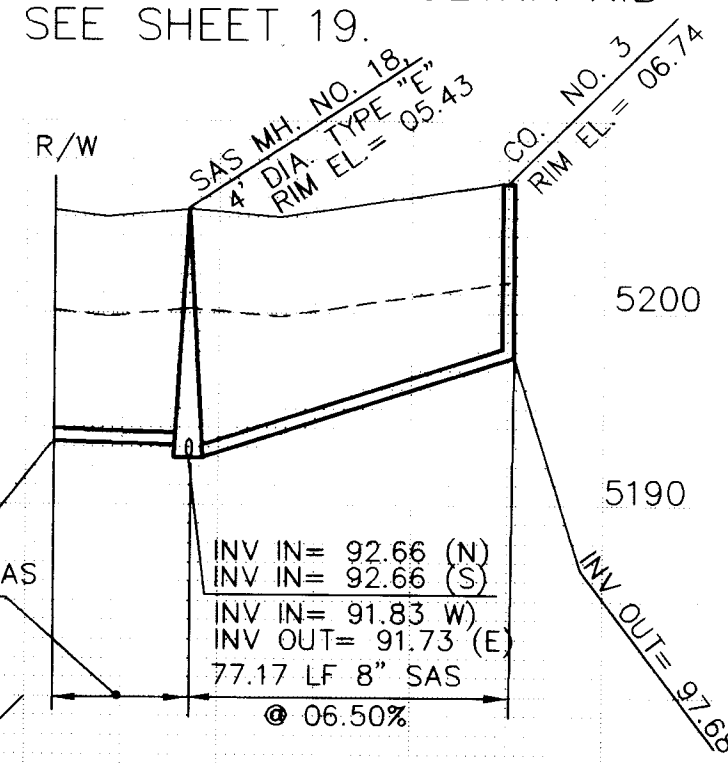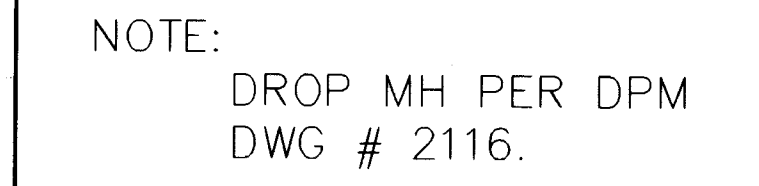

	3	4	8	6	7	8	9	10	11	12	13	14
2	5	2	0	8	.	9	1	2	1	4		


SCALE :	<i>community sciences corporation</i>		
HORIZ : 1" = 50'	LAND PLANNING	ENGINEERING	SURVEYING
VERT : 1" = 10'0	P.O. Box 1328	Corrales, N.M.	87048

CITY OF ALBUQUERQUE
PUBLIC WORKS DEPARTMENT
ENGINEERING GROUP

TITLE: TUSCANY SUBDIVISION - UNIT 1
UTILITY PLAN & P
BANDELIER DRIVE N.W.

APPROVALS	ENGINEER	DATE	APPROX
DRC CHAIRMAN	<i>B. G. Goodby</i>	11-21-95	WATER
TRANSPORTATION	<i>N/A RHO</i>	9-28-95	WASTE W
HYDROLOGY	<i>JPC</i>	11-3-95	A.M.A.F
			N.M.I.

ENGINEER'S SEAL		ENGINEER'S SEAL		ENGINEER'S SEAL	
DESIGNED BY <u>Z.J.R., J.D.D.</u> DATE <u>AUGUST, 1995</u> DRAWN BY <u>A.M.</u> DATE <u>AUGUST, 1995</u> CHECKED BY <u>J.D.H.</u> DATE <u>JULY, 1995</u>		DESIGNED BY <u>Z.J.R., J.D.D.</u> DATE <u>AUGUST, 1995</u> DRAWN BY <u>A.M.</u> DATE <u>AUGUST, 1995</u> CHECKED BY <u>J.D.H.</u> DATE <u>JULY, 1995</u>		DESIGNED BY <u>Z.J.R., J.D.D.</u> DATE <u>AUGUST, 1995</u> DRAWN BY <u>A.M.</u> DATE <u>AUGUST, 1995</u> CHECKED BY <u>J.D.H.</u> DATE <u>JULY, 1995</u>	
NO. DATE REMARKS BY REVISIONS DESIGN		NO. DATE REMARKS BY REVISIONS DESIGN		NO. DATE REMARKS BY REVISIONS DESIGN	
NO. BY DATE 1 COMMUNITY SCIENCES		NO. BY DATE 1 COMMUNITY SCIENCES		NO. BY DATE 1 COMMUNITY SCIENCES	
BENCHMARK: STATION IS A USGS BRASS TABLET STAMPED "BLACK-2, 1977". SET FLUSH WITH THE GROUND. LOCATED AT THE INTERSECTION OF MOHAWH BLVD. AND GOLF COURSE RD., TO REACH THE STATION FROM THE INTERSECTION OF COOPS BLVD. AND PARADISE BLVD. TURN LEFT, GO WEST ON PARADISE BLVD. 1.1 MILES TO GOLF COURSE RD., TURN RIGHT, GO NORTH ON GOLF COURSE RD. 1.3 MILES TO MOHAWH BLVD., AND THE STATION IS ON THE LEFT. ELEVATION REVISED BY ACS, 1987 = 5213.93		BENCHMARK: STATION IS A USGS BRASS TABLET STAMPED "BLACK-2, 1977". SET FLUSH WITH THE GROUND. LOCATED AT THE INTERSECTION OF MOHAWH BLVD. AND GOLF COURSE RD., TO REACH THE STATION FROM THE INTERSECTION OF COOPS BLVD. AND PARADISE BLVD. TURN LEFT, GO WEST ON PARADISE BLVD. 1.1 MILES TO GOLF COURSE RD., TURN RIGHT, GO NORTH ON GOLF COURSE RD. 1.3 MILES TO MOHAWH BLVD., AND THE STATION IS ON THE LEFT. ELEVATION REVISED BY ACS, 1987 = 5213.93		BENCHMARK: STATION IS A USGS BRASS TABLET STAMPED "BLACK-2, 1977". SET FLUSH WITH THE GROUND. LOCATED AT THE INTERSECTION OF MOHAWH BLVD. AND GOLF COURSE RD., TO REACH THE STATION FROM THE INTERSECTION OF COOPS BLVD. AND PARADISE BLVD. TURN LEFT, GO WEST ON PARADISE BLVD. 1.1 MILES TO GOLF COURSE RD., TURN RIGHT, GO NORTH ON GOLF COURSE RD. 1.3 MILES TO MOHAWH BLVD., AND THE STATION IS ON THE LEFT. ELEVATION REVISED BY ACS, 1987 = 5213.93	
AS BUILT INFORMATION CONTRACTOR <u>JEH</u> CONCERNS <u>INC.</u> WORK BY <u>COB</u> / <u>CLC</u> INSPECTORS <u>CLC</u> ACCEPTANCE BY <u>COB</u> DATE <u>5/96</u> VERIFICATION BY <u>COB</u> DATE DRAWINGS <u>CLC</u> DATE CORRECTED BY <u>CLC</u> DATE MICRO-FILM INFORMATION RECORDED BY NO.		AS BUILT INFORMATION CONTRACTOR <u>JEH</u> CONCERNS <u>INC.</u> WORK BY <u>COB</u> / <u>CLC</u> INSPECTORS <u>CLC</u> ACCEPTANCE BY <u>COB</u> DATE <u>5/96</u> VERIFICATION BY <u>COB</u> DATE DRAWINGS <u>CLC</u> DATE CORRECTED BY <u>CLC</u> DATE MICRO-FILM INFORMATION RECORDED BY NO.		AS BUILT INFORMATION CONTRACTOR <u>JEH</u> CONCERNS <u>INC.</u> WORK BY <u>COB</u> / <u>CLC</u> INSPECTORS <u>CLC</u> ACCEPTANCE BY <u>COB</u> DATE <u>5/96</u> VERIFICATION BY <u>COB</u> DATE DRAWINGS <u>CLC</u> DATE CORRECTED BY <u>CLC</u> DATE MICRO-FILM INFORMATION RECORDED BY NO.	

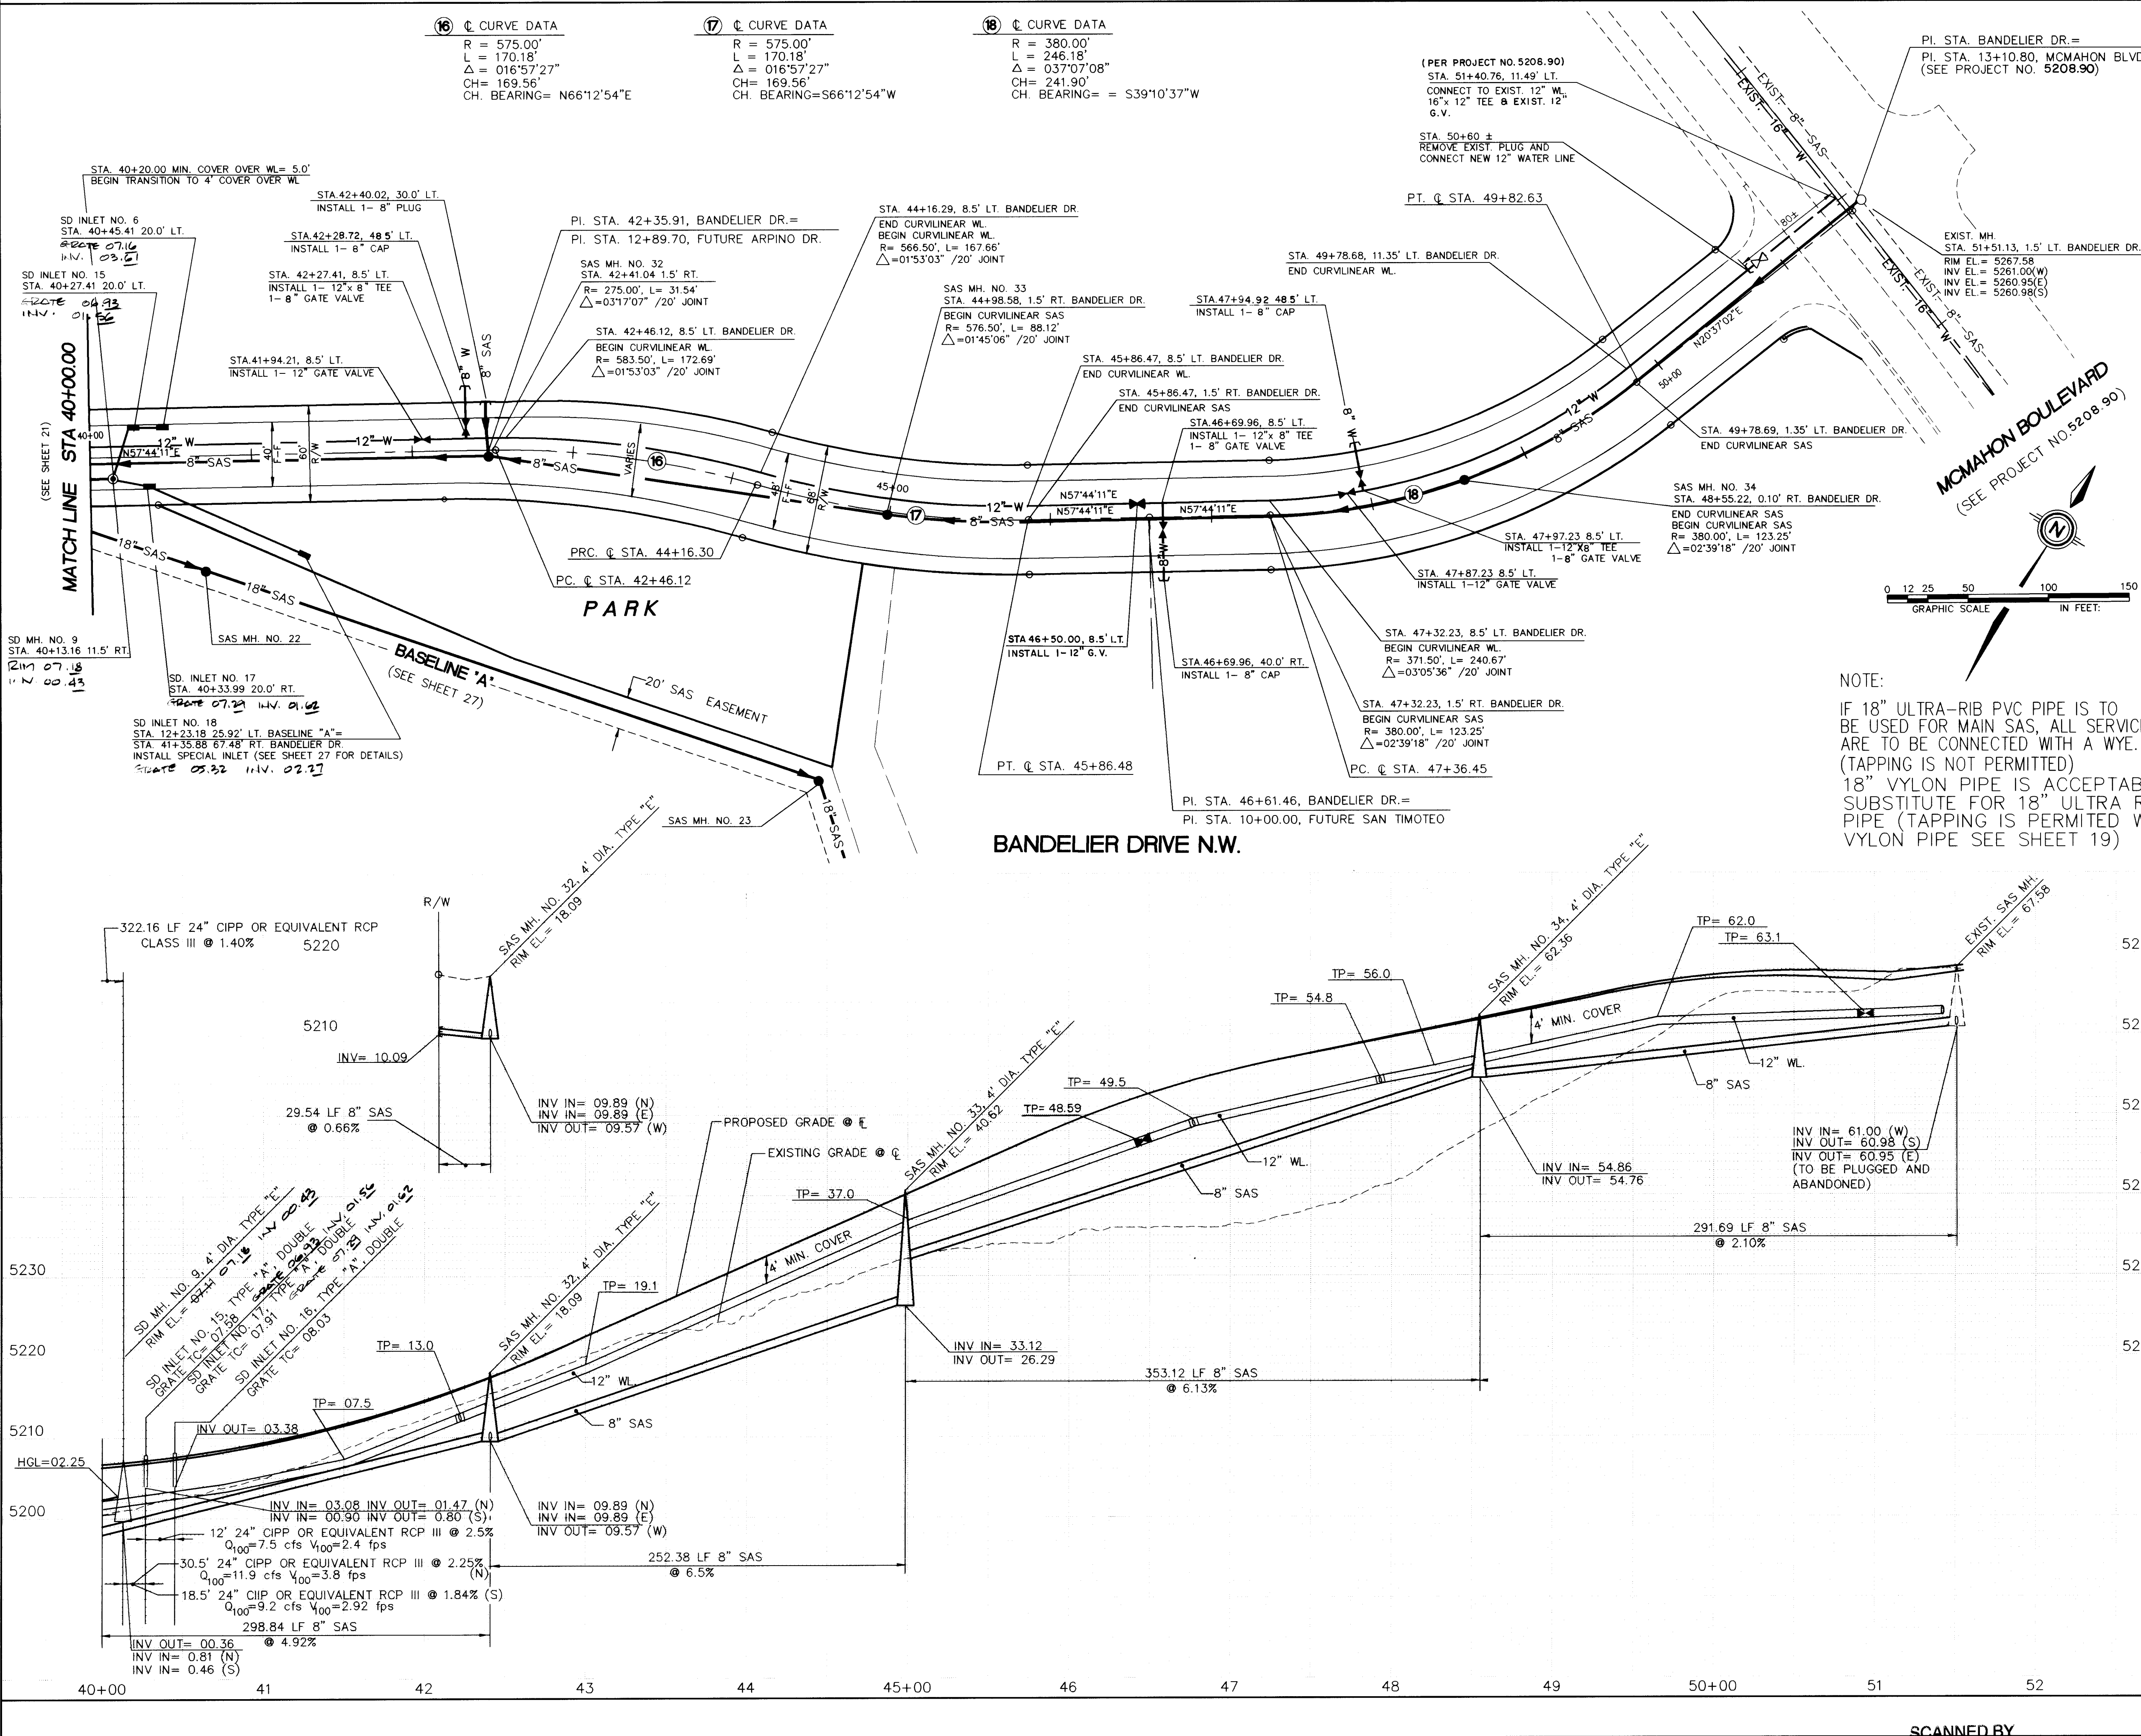

UTILITY LEGEND

DESCRIPTION	PROPOSED	EXISTING
SANITARY SEWER LINE	8" SAS	8" SAS
ENCASEMENT		
SANITARY SEWER MANHOLE		
SAS CLEANOUT		
SAS SERVICE CONNECTION		
STORM DRAIN LINE		
STORM DRAIN MANHOLE		
STORM DRAIN INLETS		
WATER LINE		
GATE VALVE		
BUTTERFLY VALVE		
FIRE HYDRANTS		
REDUCERS		
WATER SERVICE/ METER		
TEES		
CROSSES		
BENDS		
CAPS & PLUGS		
GAS LINES		
OVERHEAD ELECTRICAL LINE		
UNDERGROUND ELECTRICAL		
OVERHEAD TELEPHONE		
UNDERGROUND TELEPHONE		
CABLE TELEVISION		
POWER OR TELEPHONE POLE		

NOTE:

IF 18" ULTRA-RIB PVC PIPE IS TO BE USED FOR MAIN SAS, ALL SERVICES ARE TO BE CONNECTED WITH A WYE. (TAPPING IS NOT PERMITTED)

18" VYLON PIPE IS ACCEPTABLE SUBSTITUTE FOR 18" ULTRA RIB PIPE (TAPPING IS PERMITTED W/ VYLON PIPE SEE SHEET 19)

NOTE:

DROP MH. PER DPM DWG # 2116

ENGINEER'S SEAL

[Signature]

DATE: 01-12-95

REVISIONS	
NO.	DATE
1	01-12-95

COMMUNITY SCIENCES CORPORATION

LAND PLANNING P.O. Box 1326
ENGINEERING
SURVEYING
Corrales, N.M. 87048


CITY OF ALBUQUERQUE
PUBLIC WORKS DEPARTMENT
ENGINEERING GROUP

TITLE: TUSCANY SUBDIVISION - UNIT 1
UTILITY PLAN & PROFILE
BANDELIER DRIVE N.W.

APPROVALS	ENGINEER	DATE	APPROVALS	ENGINEER	DATE
APPROVED	R.W. Kane	11-21-95	APPROVED	R.W. Kane	11-21-95
TRANSPORTATION	R.W. Kane	11-21-95	TRANSPORTATION	R.W. Kane	11-21-95
HYDROLOGY	R.W. Kane	11-21-95	HYDROLOGY	R.W. Kane	11-21-95

PROJECT NO. 5208.91
MAP NO. G-11
SHEET 22 OF 36

[illegible]

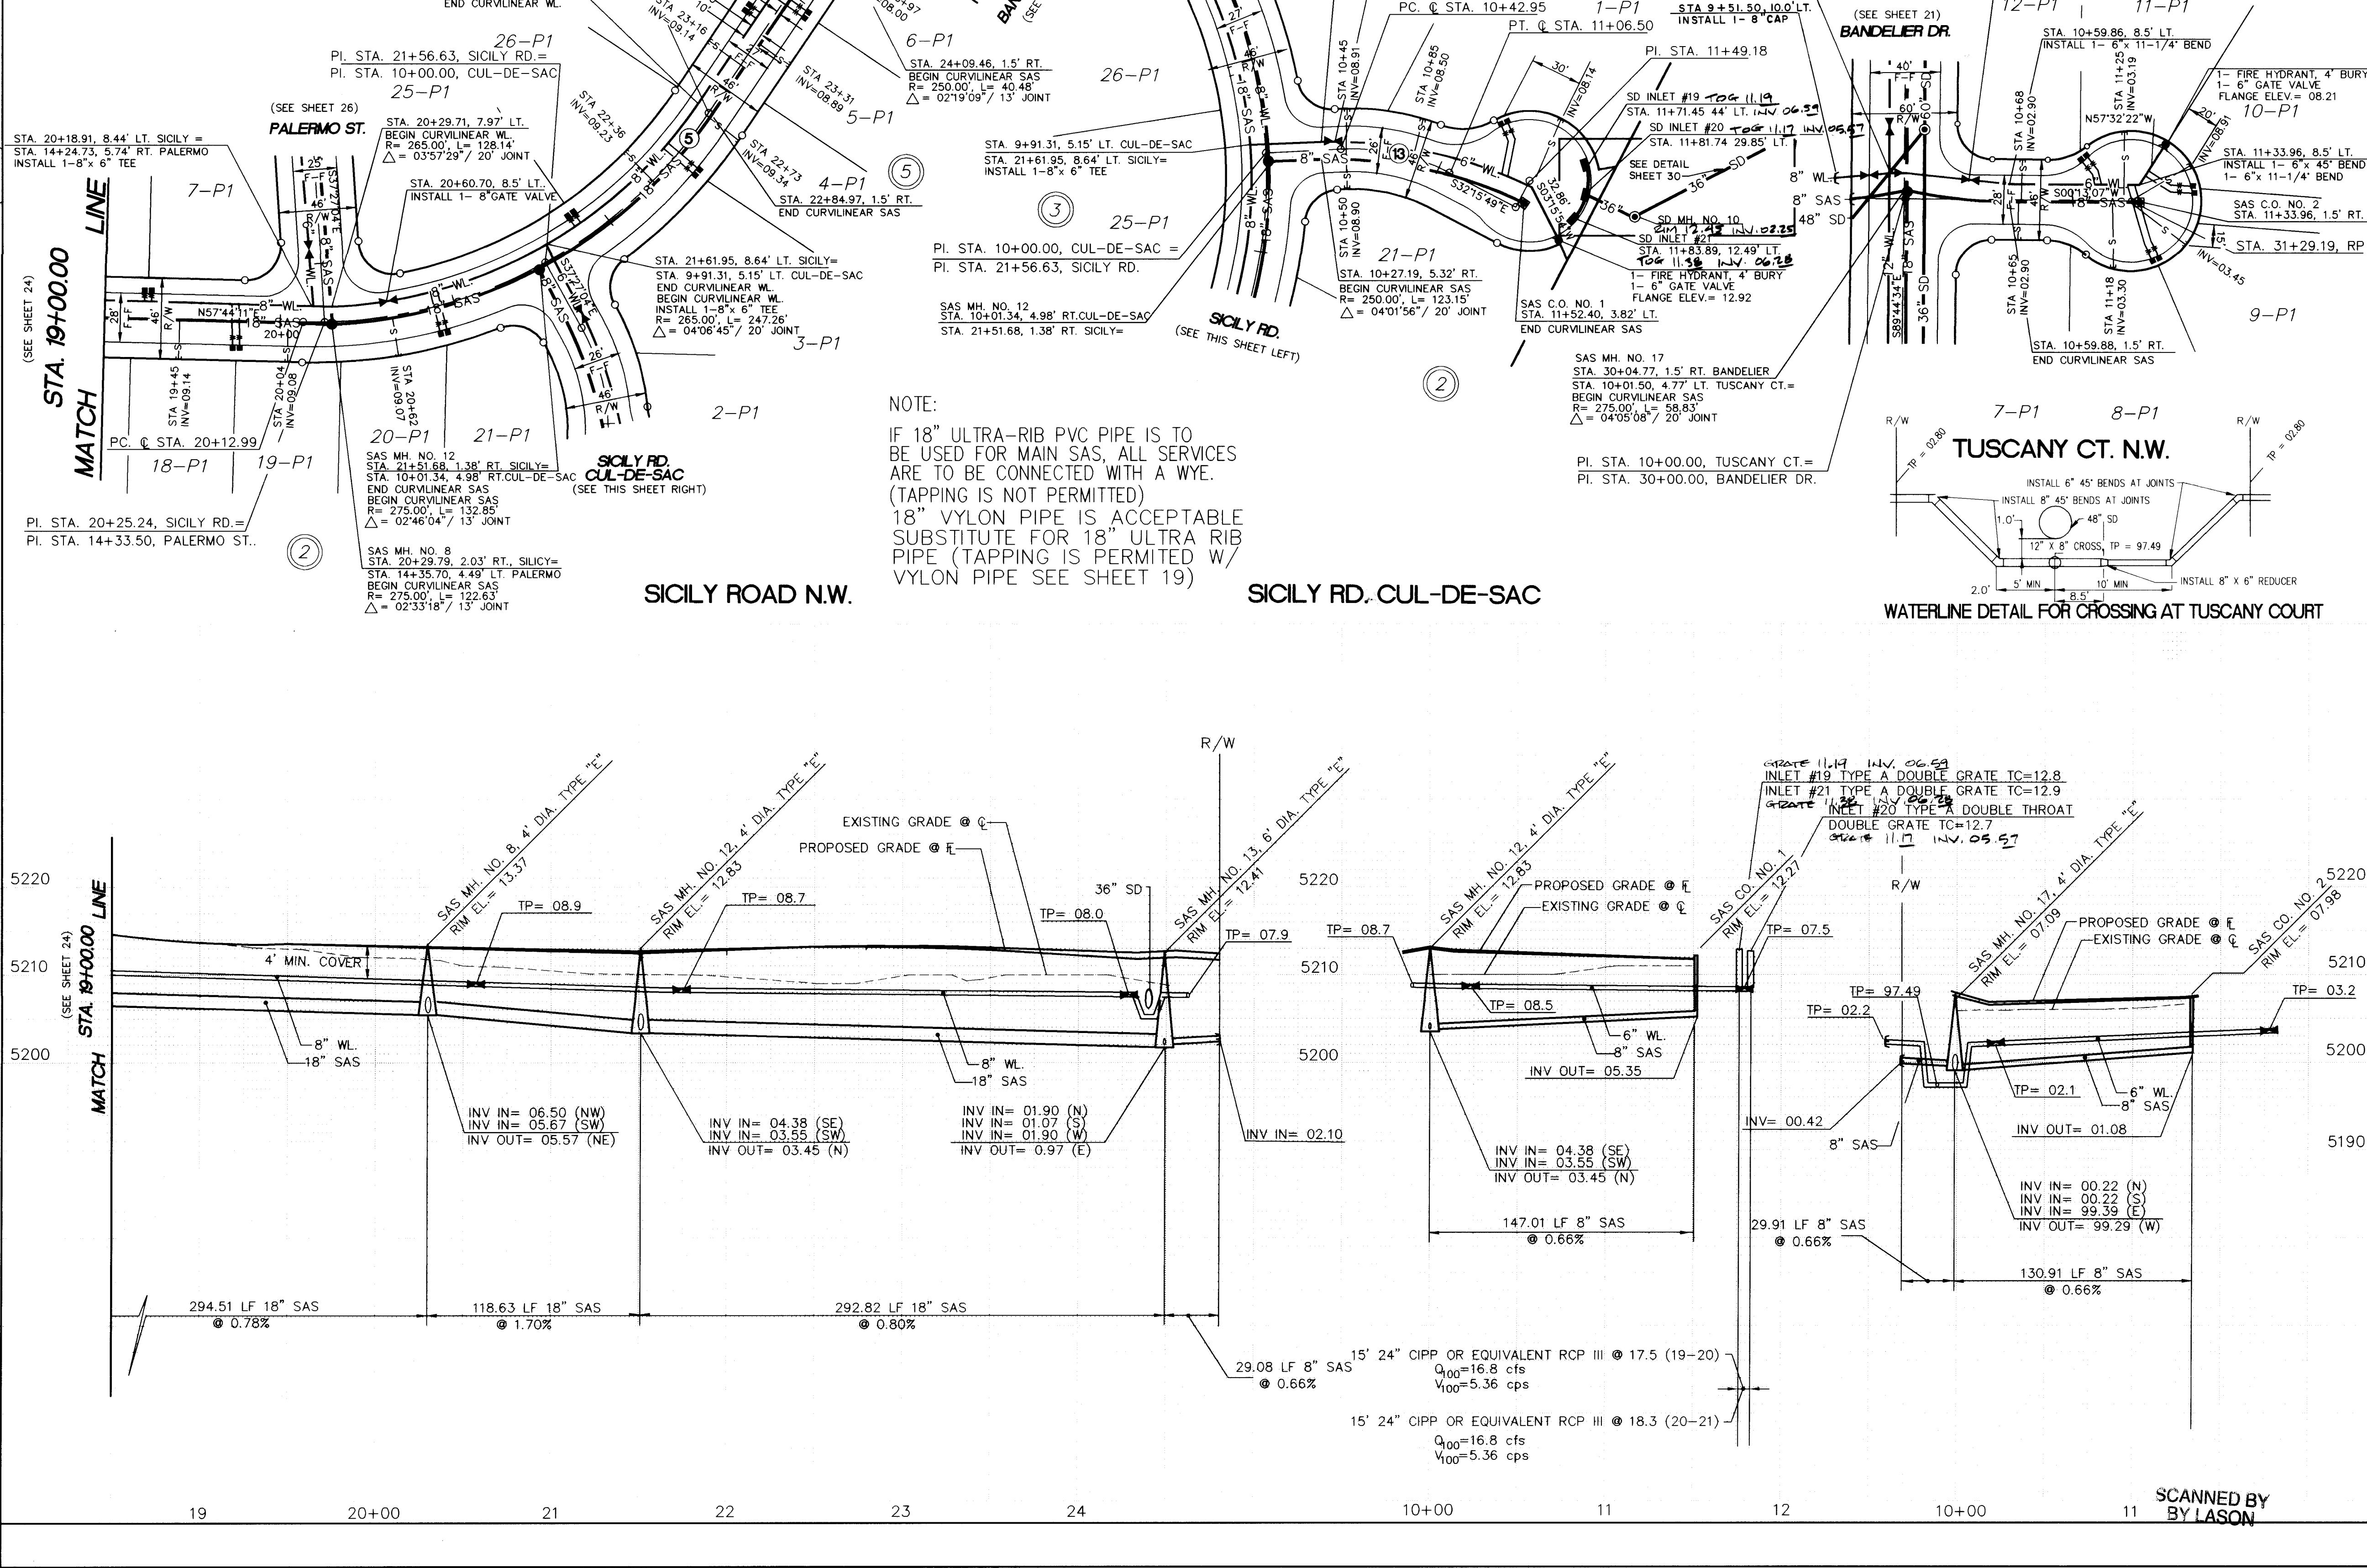

UTILITY LEGEND		
DESCRIPTION	PROPOSED	EXISTING
SANITARY SEWER LINE	8" SAS	8" SAS
ENCASEMENT		
SANITARY SEWER MANHOLE		
SAS CLEANOUT		
SAS SERVICE CONNECTION		
STORM DRAIN LINE	SD-30"	SD-30"
STORM DRAIN MANHOLE		
STORM DRAIN INLETS		
WATER LINE	W-6"	W-6"
GATE VALVE		
BUTTERFLY VALVE		
FIRE HYDRANTS		
REDUCERS		
WATER SERVICE/ METER		
TEES		
CROSSES		
BENDS		
CAPS & PLUGS		
GAS LINES	N/A	N/A
OVERHEAD ELECTRICAL LINE	N/A	N/A
UNDERGROUND ELECTRICAL	N/A	N/A
OVERHEAD TELEPHONE	N/A	N/A
UNDERGROUND TELEPHONE	N/A	N/A
CABLE TELEVISION	N/A	N/A
POWER OR TELEPHONE POLE	N/A	N/A

SURVEY INFORMATION	
NO.	DATE
1	COMMUNITY SCIENCES

ENGINEER'S SEAL	
NO.	DATE
1	COMMUNITY SCIENCES

REVISIONS	
NO.	DATE
1	COMMUNITY SCIENCES

26-5208.91-2597

SCALE:
HORIZ: 1" = 50'
VERT: 1" = 10'


community sciences corporation
LAND PLANNING P.O. Box 1328 ENGINEERING Corrales, N.M. 87048 SURVEYING


CITY OF ALBUQUERQUE
PUBLIC WORKS DEPARTMENT
ENGINEERING GROUP

TITLE: TUSCANY SUBDIVISION - UNIT 1
UTILITY PLAN & PROFILE
SICILY RD., SICILY CUL-DE-SAC, TUSCANY CT.

APPROVALS	ENGINEER	DATE	APPROVALS	ENGINEER	DATE
DRG CHAIRMAN	R.W. Kane	11-21-95	WATER	R.W. Kane	9-28-95
TRANSPORTATION	R.W. Kane	9-28-95	WASTE WATER	R.W. Kane	9-28-95
HYDROLOGY	R.W. Kane	11-3-95	A.M.A.F.C.A.	R.W. Kane	10/21/95

PROJECT NO. 5208.91 MAP NO. G-11 SHEET 25 OF 36

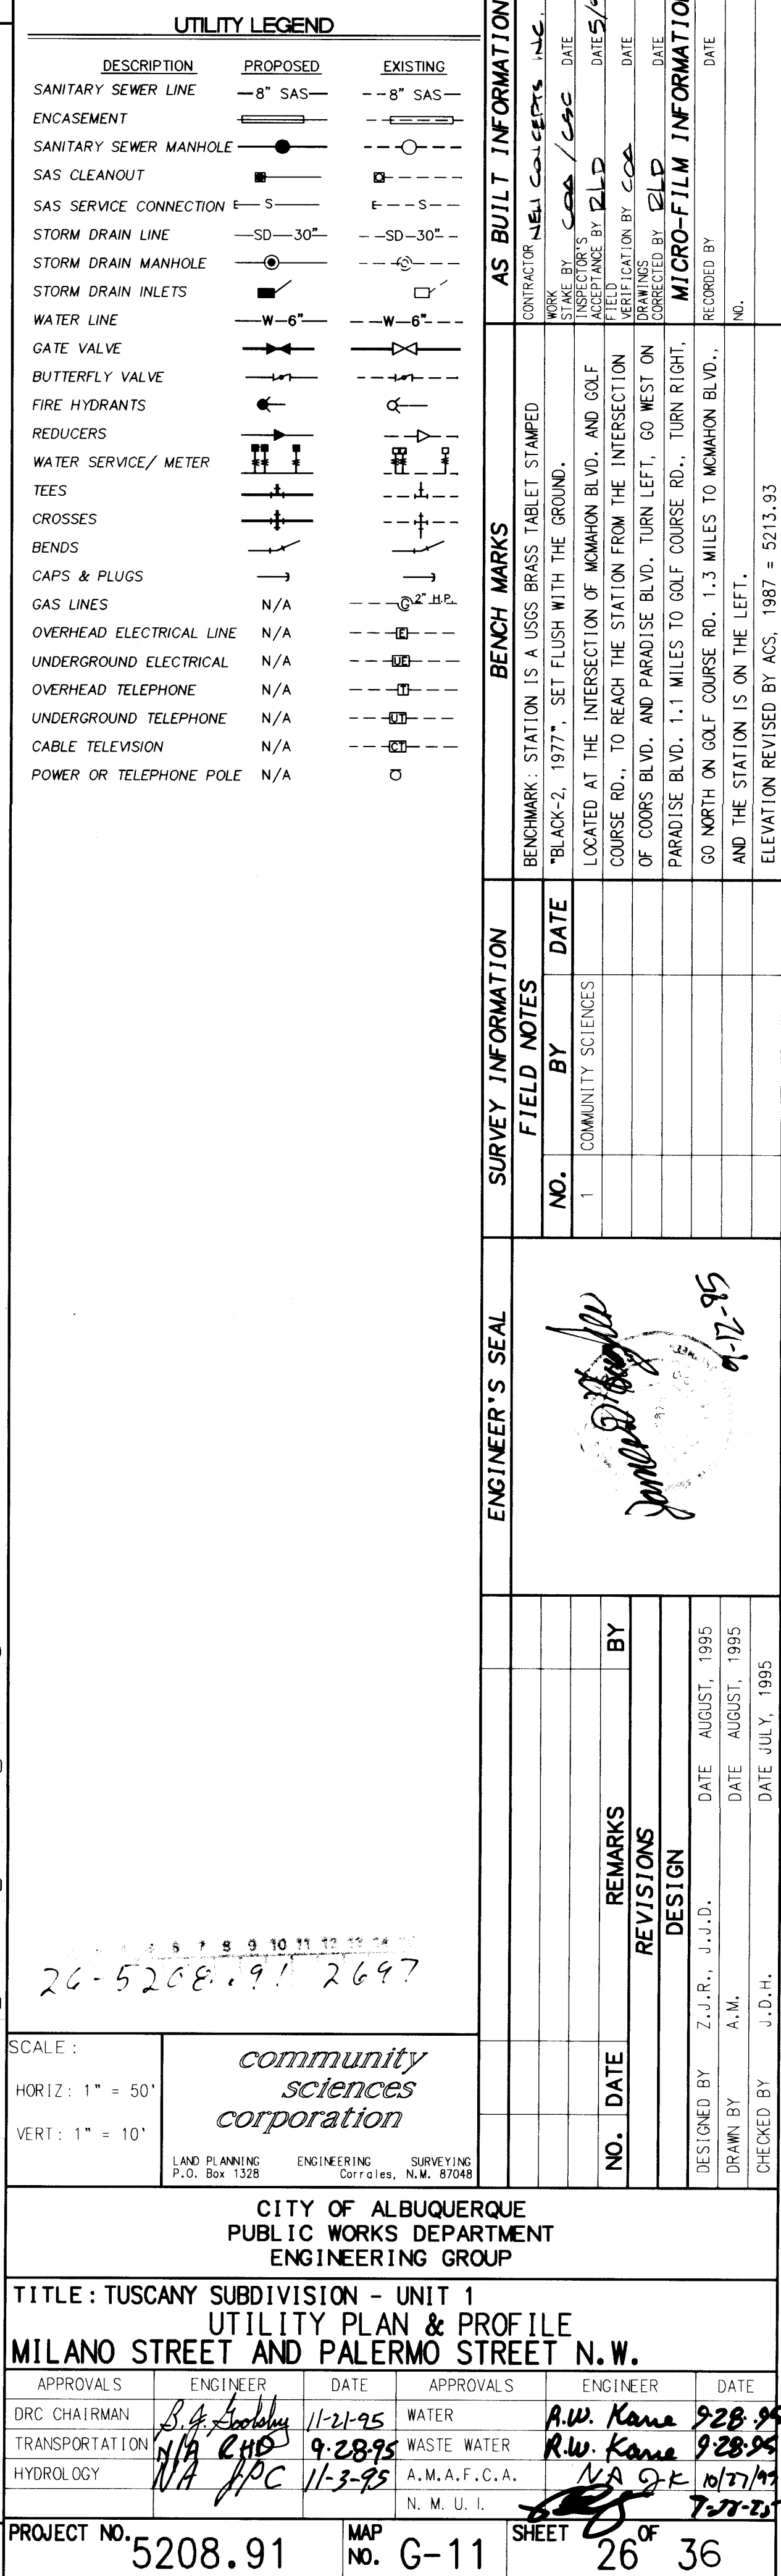

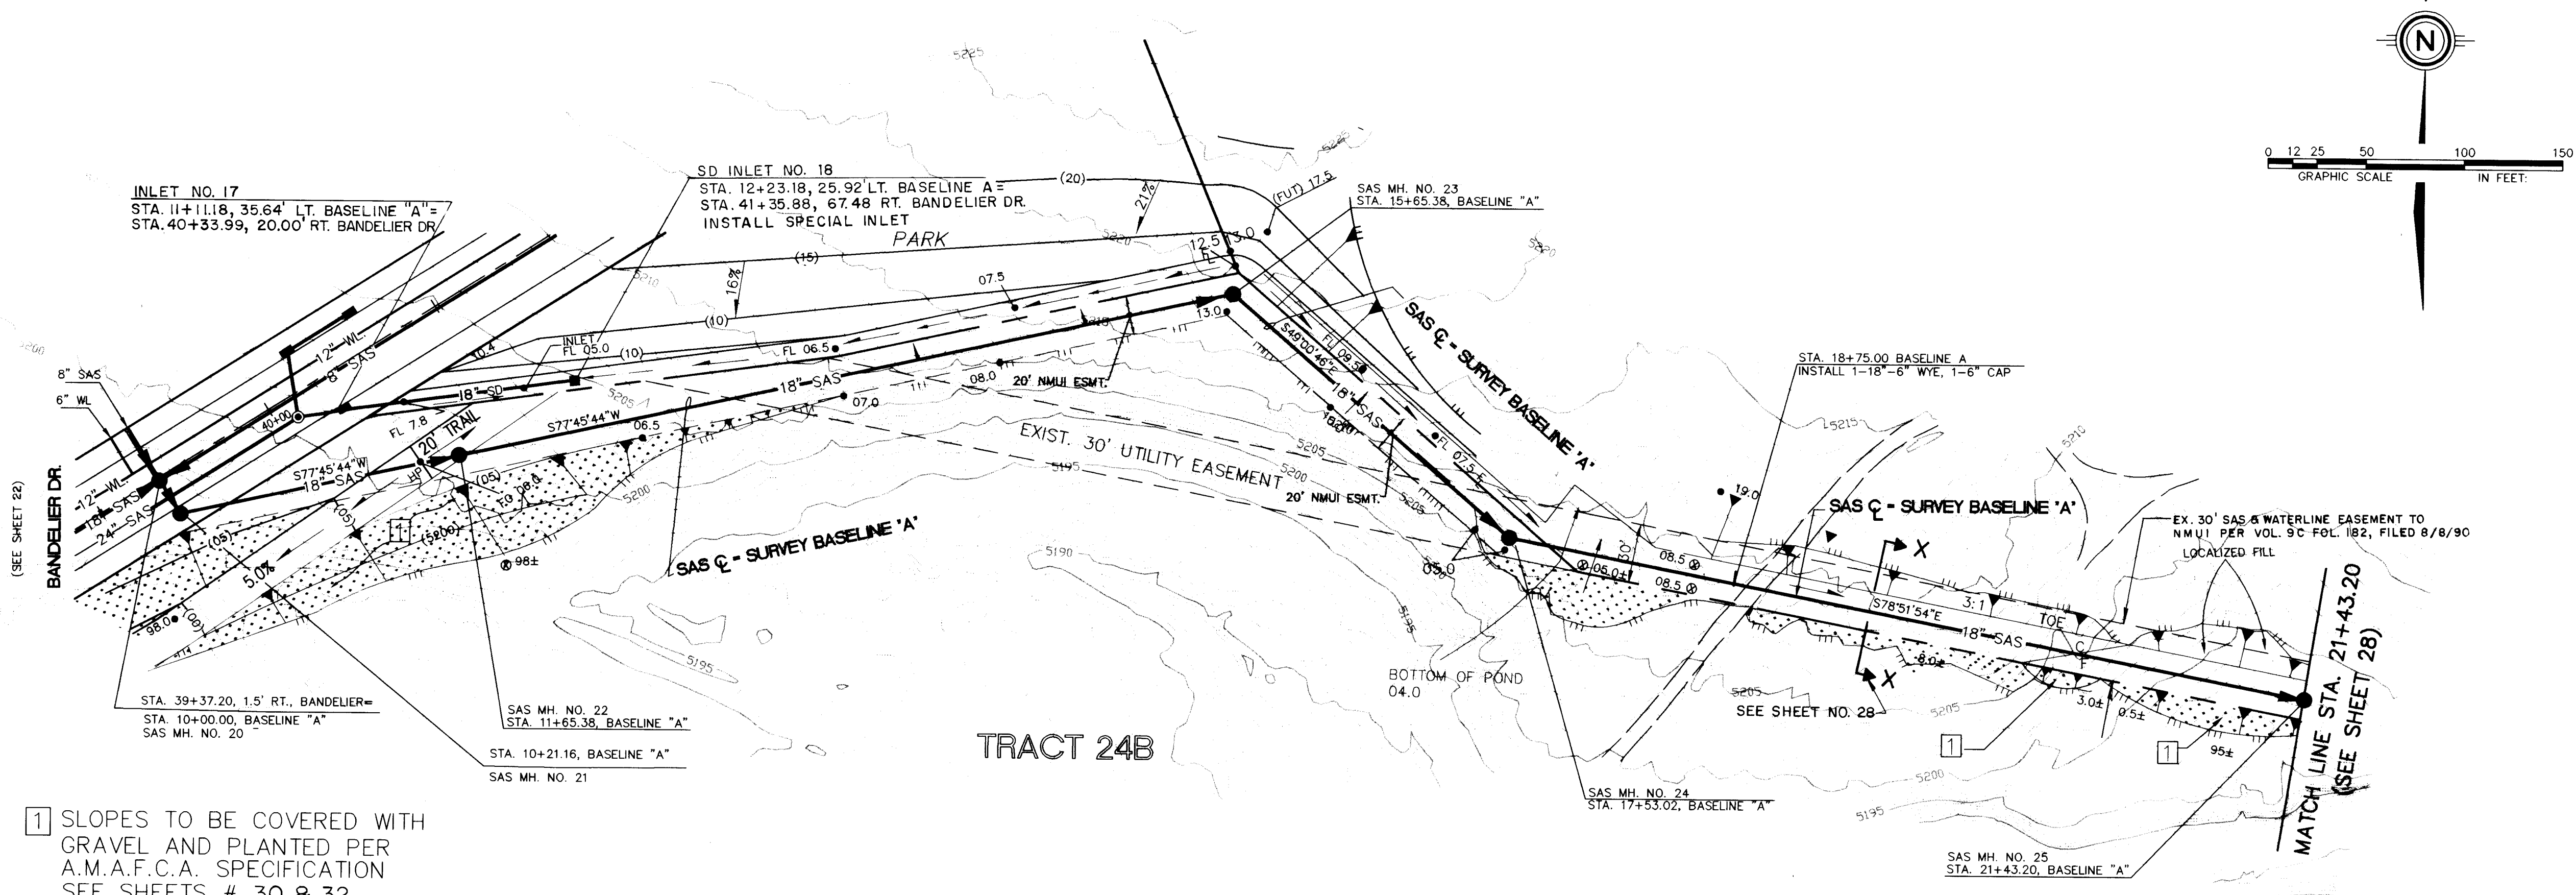


1 SLOPES TO BE COVERED WITH GRAVEL AND PLANTED PER A.M.A.F.C.A. SPECIFICATION SEE SHEETS # 30 & 32 FLAT AREAS ARE STRAW MULCH

UTILITY LEGEND		
DESCRIPTION	PROPOSED	EXISTING
SANITARY SEWER LINE		
ENCASEMENT		
SANITARY SEWER MANHOLE		
SAS SERVICE CONNECTION		
STORM DRAIN LINE		
STORM DRAIN MANHOLE		
STORM DRAIN INLETS		
WATER LINE		
GATE VALVE		
BUTTERFLY VALVE		
FIRE HYDRANTS		
REDUCERS		
WATER SERVICE/ METER		
TEES		
CROSSES		
BENDS		
CAPS & PLUGS		
GAS LINES	N/A	
OVERHEAD ELECTRICAL LINE	N/A	
UNDERGROUND ELECTRICAL	N/A	
OVERHEAD TELEPHONE	N/A	
UNDERGROUND TELEPHONE	N/A	
CABLE TELEVISION	N/A	
POWER OR TELEPHONE POLE	N/A	
GRADE TO DRAIN		GTD
DAYLIGHT LINE		


NOTE:
IF 18" ULTRA-RIB PVC PIPE IS TO BE USED FOR MAIN SAS ALL SERVICES ARE TO BE CONNECTED WITH A WYE. (TAPPING IS NOT PERMITTED)
18" VYLON PIPE (13' SECTIONS) MAY BE SUBSTITUTED FOR ULTRA-RIB PIPE (TAPPING IS PERMITTED)

AS BUILT INFORMATION			
CONTRACTOR	NEEL CONCEPTS, INC.	DATE	5/10/95
WORK	STAGE BY	DATE	5/10/95
FIELD	ACCEPTANCE BY	DATE	5/10/95
BRANNING	CORRECTED BY	DATE	5/10/95
MICRO-FILM INFORMATION			
RECORDED BY	DATE		
NO.			

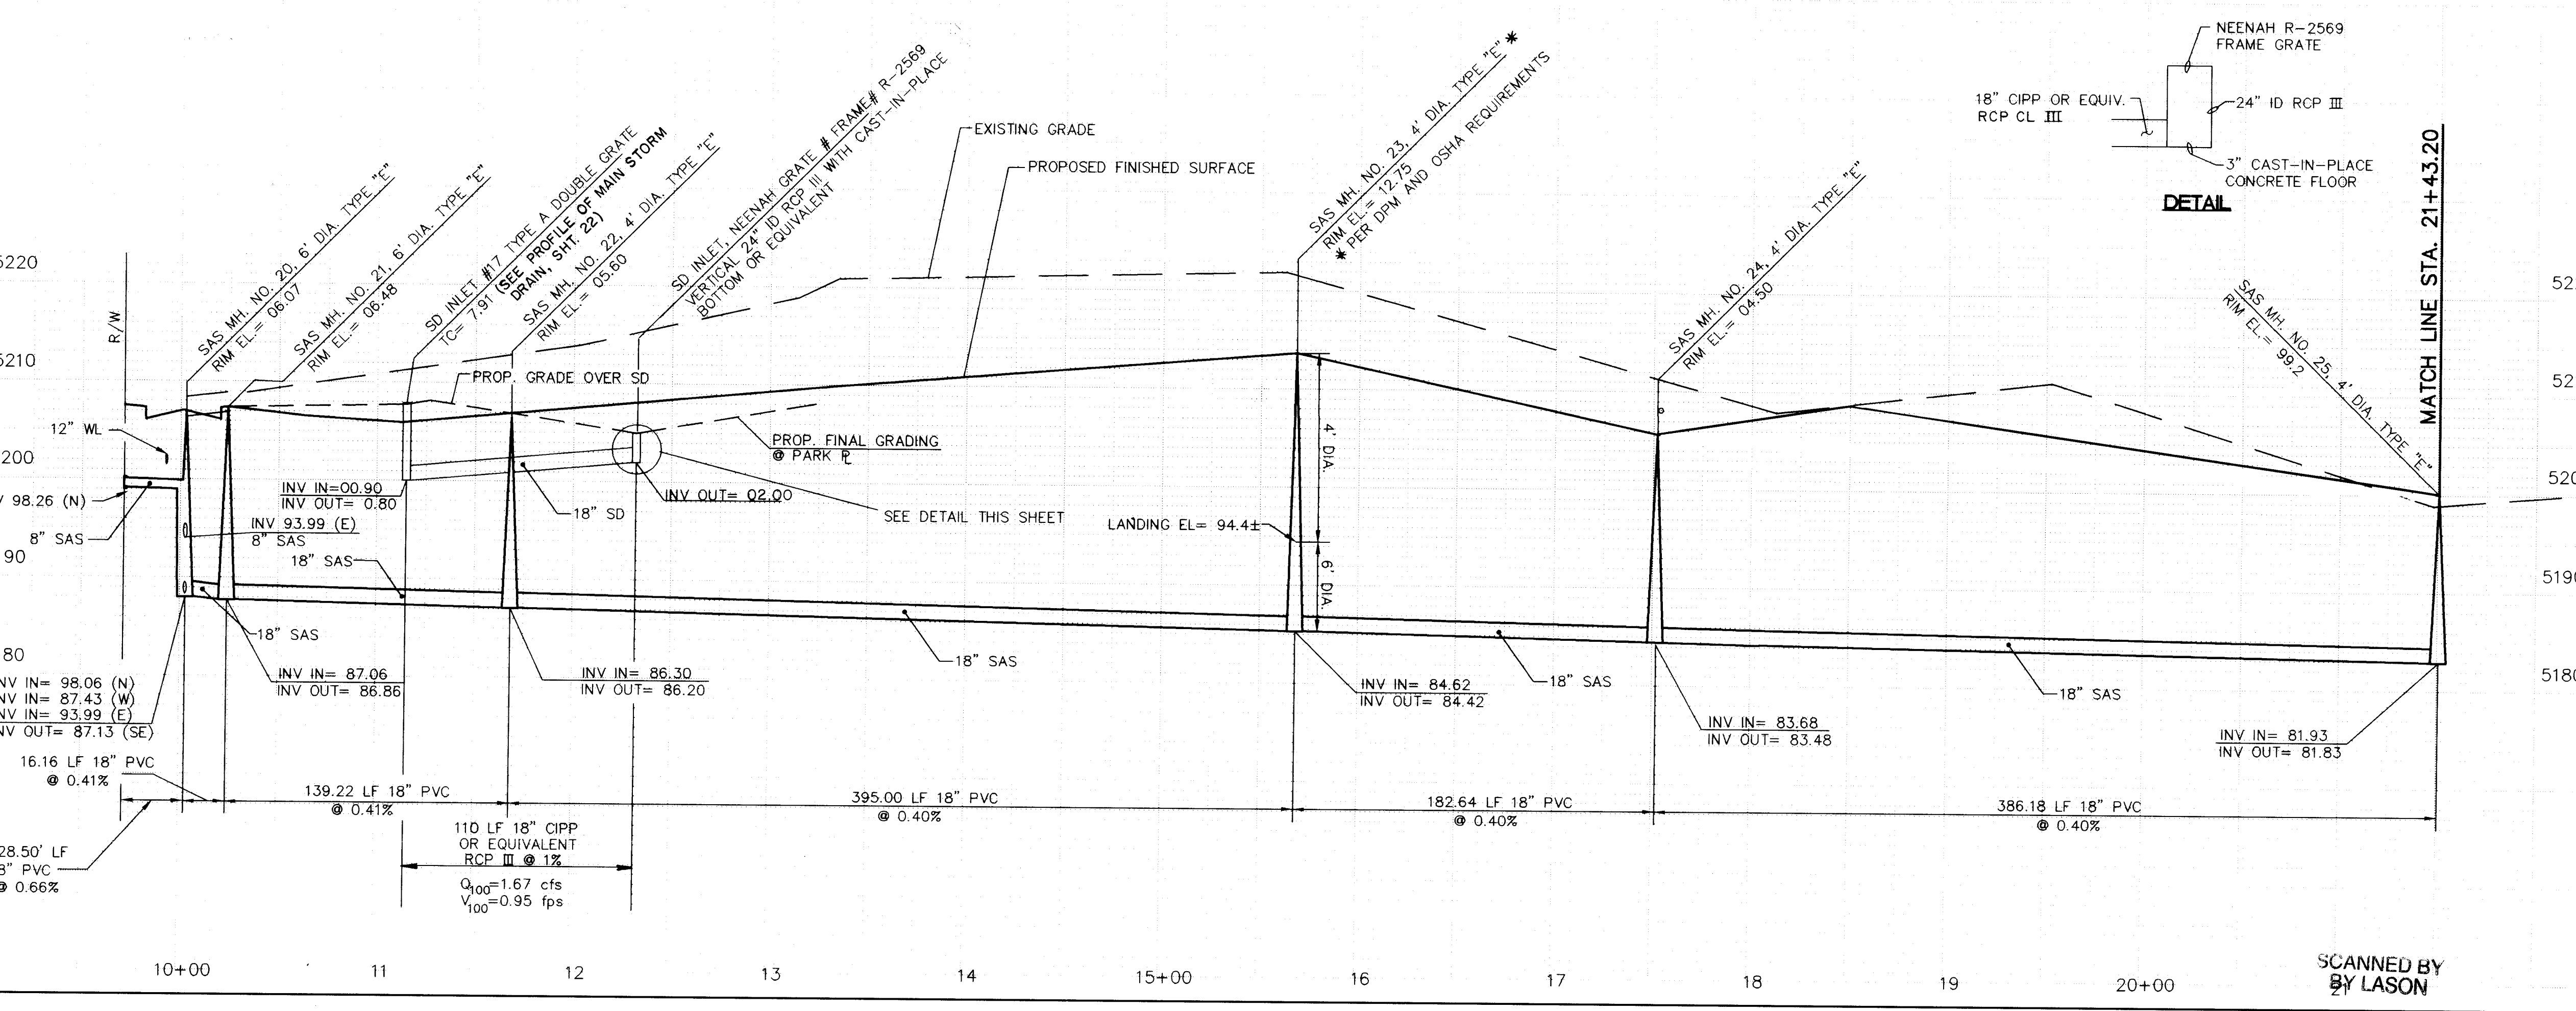

NO.	DATE	REMARKS	BY
1	5/10/95	COMMUNITY SCIENCES	
2	5/10/95	DESIGN	
3	5/10/95	DESIGN	
CITY OF ALBUQUERQUE PUBLIC WORKS DEPARTMENT ENGINEERING GROUP					
TITLE: TUSCANY SUBDIVISION - UNIT 1 UTILITY PLAN & PROFILE SANITARY SEWER OUTFALL					
APPROVALS	ENGINEER	DATE	APPROVALS	ENGINEER	DATE
DRC CHAIRMAN	R.W. Kane	11-21-95	WATER	R.W. Kane	9-28-95
TRANSPORTATION	R.W. Kane	9-28-95	WASTE WATER	R.W. Kane	9-28-95
HYDROLOGY	R.W. Kane	11-21-95	A.M.A.F.C.A.	R.W. Kane	10/27/95
			N.M.U.I.		7-27-95
PROJECT NO.	5208.91	MAP NO.	G-11	SHEET	27 OF 36

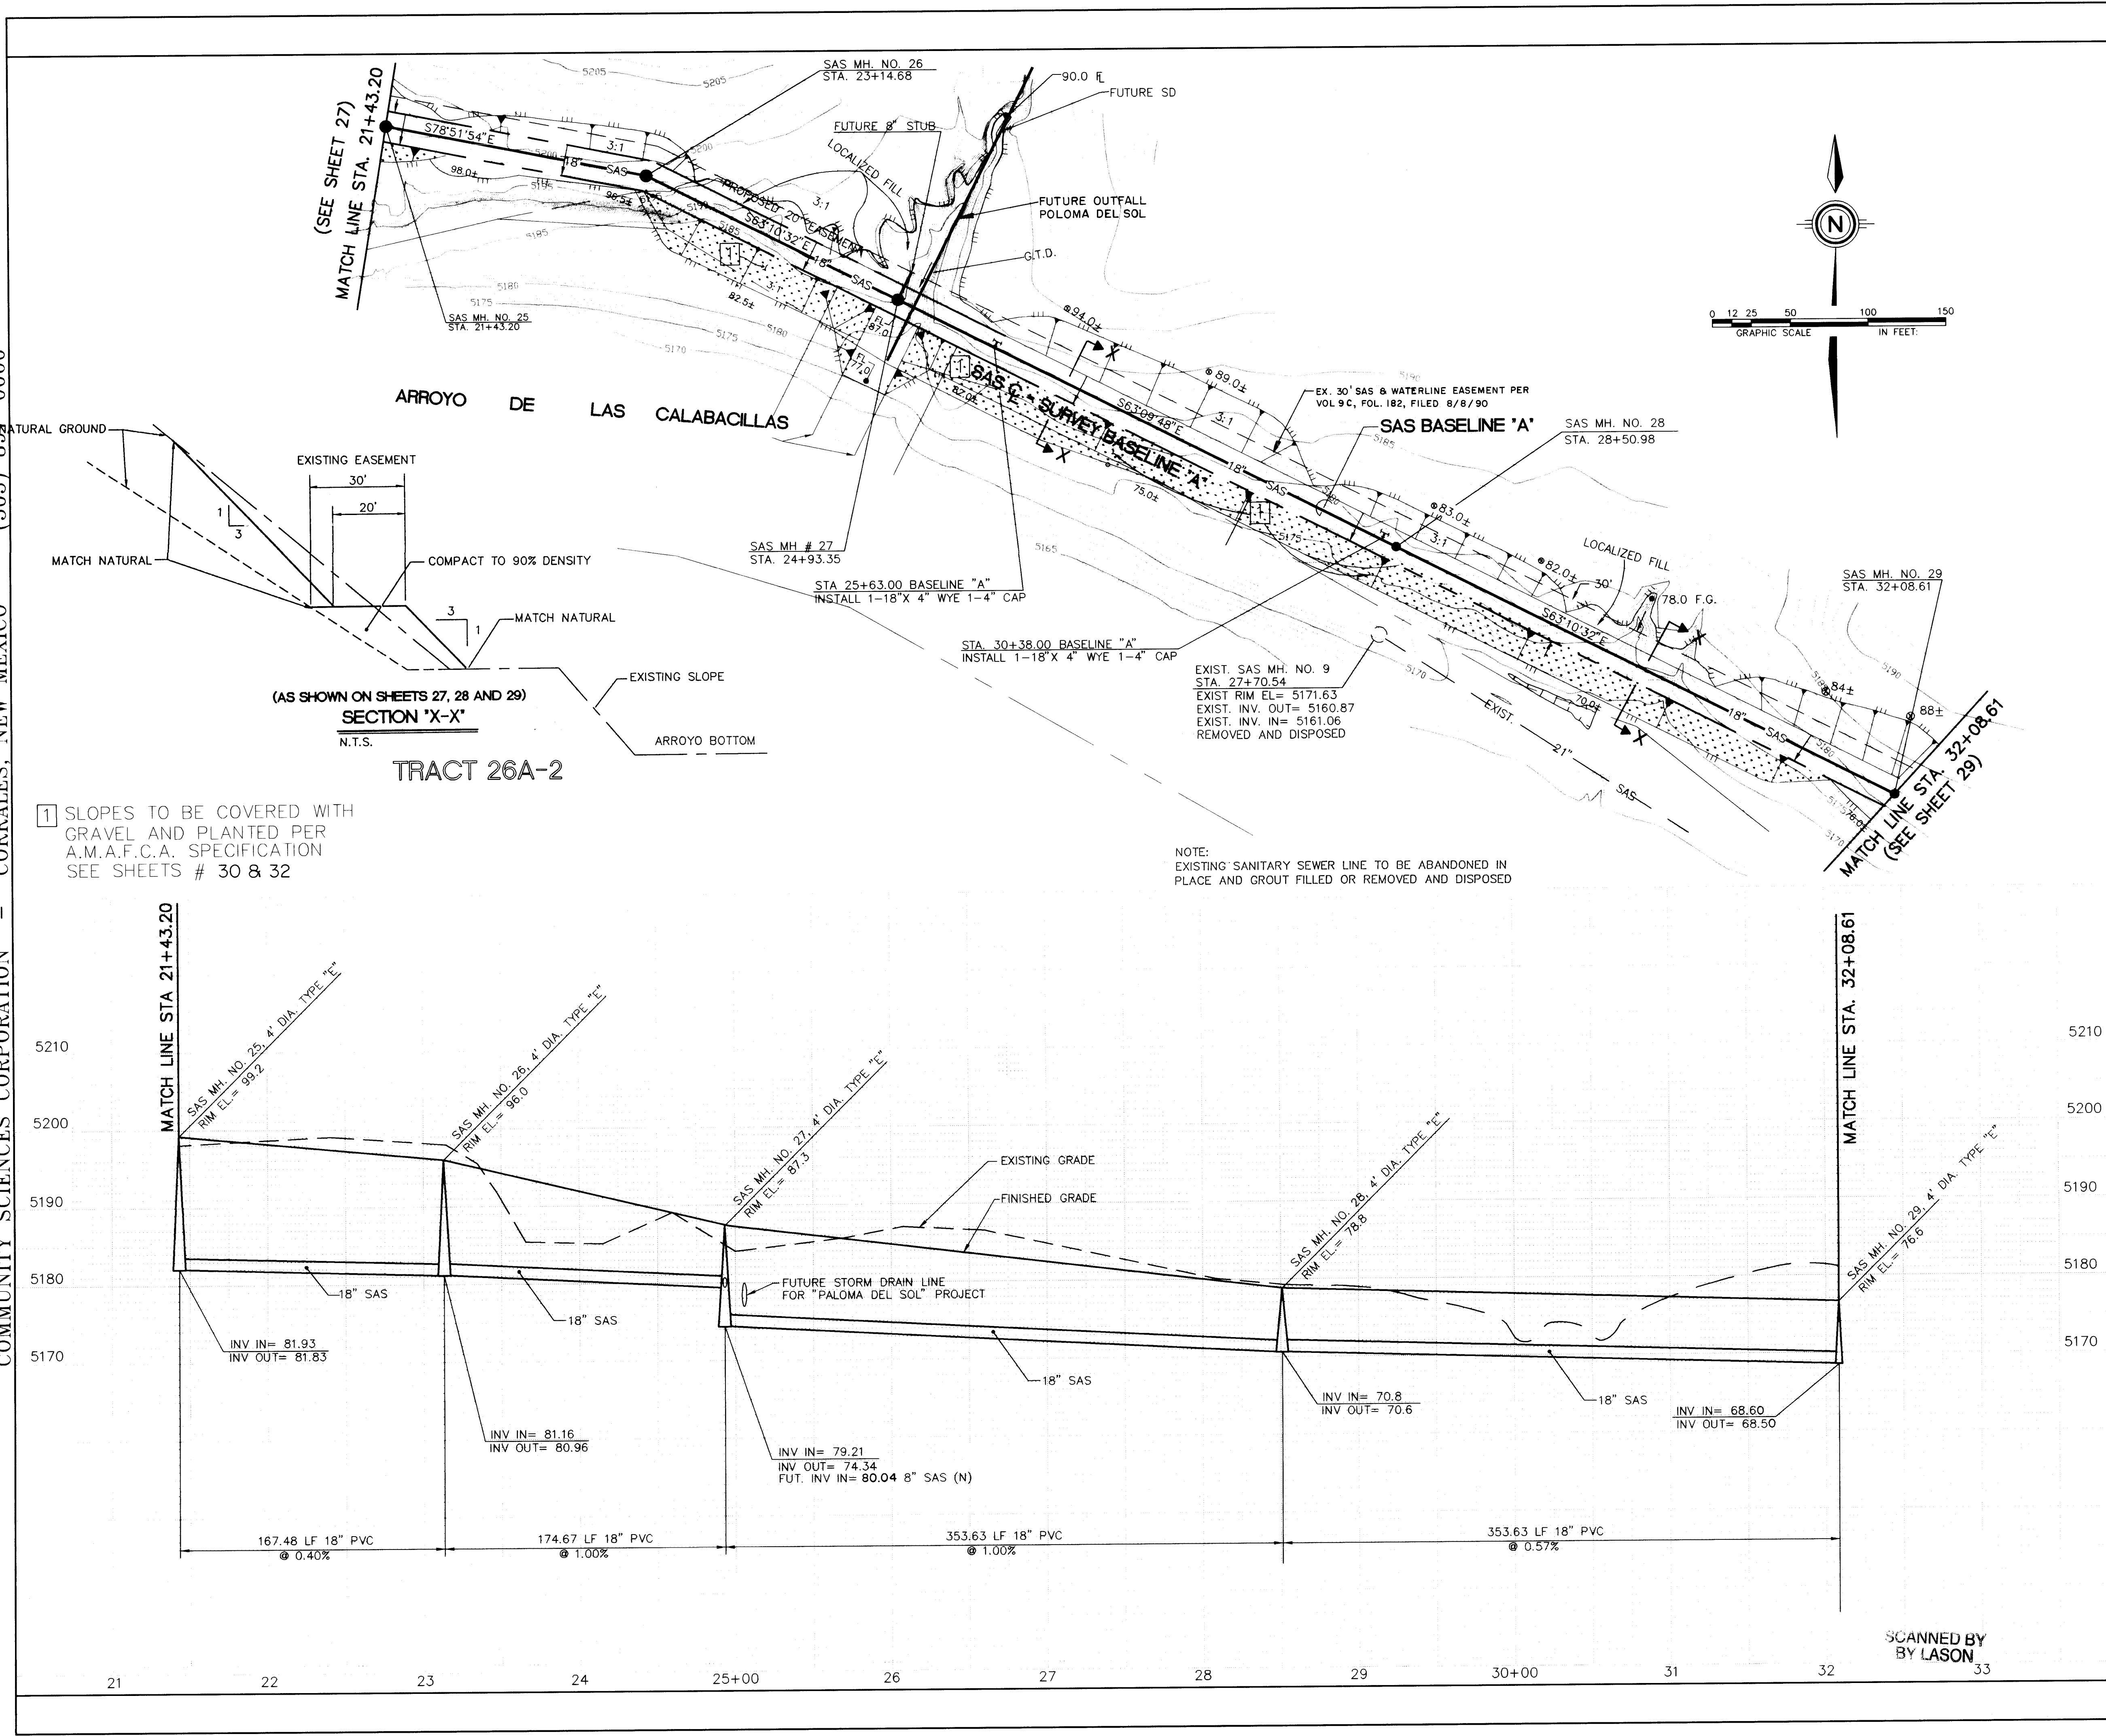

UTILITY LEGEND

DESCRIPTION	PROPOSED	EXISTING
SANITARY SEWER LINE	8" SAS	8" SAS
ENCASEMENT		
SANITARY SEWER MANHOLE		
SAS SERVICE CONNECTION		
STORM DRAIN LINE	SD-30"	SD-30"
STORM DRAIN MANHOLE		
STORM DRAIN INLETS		
WATER LINE	W-6"	W-6"
GATE VALVE		
BUTTERFLY VALVE		
FIRE HYDRANTS		
REDUCERS		
WATER SERVICE/ METER		
TEES		
CROSSES		
BENDS		
CAPS & PLUGS		
GAS LINES	N/A	
OVERHEAD ELECTRICAL LINE	N/A	
UNDERGROUND ELECTRICAL	N/A	
OVERHEAD TELEPHONE	N/A	
UNDERGROUND TELEPHONE	N/A	
CABLE TELEVISION	N/A	
POWER OR TELEPHONE POLE	N/A	
GRADE TO DRAIN		
DAYLIGHT LINE		

AS BUILT INFORMATION

CONTRACTOR	DATE
WELLS CONSULTANTS INC.	1/25/96

AS BUILT INFORMATION

CONTRACTOR	DATE
WELLS CONSULTANTS INC.	1/25/96

ENGINEER'S SEAL

[Signature]

REVISIONS

NO.	DATE	REMARKS
1	7-12-95	DESIGN

COMMUNITY SCIENCES CORPORATION

LAND PLANNING P.O. Box 1328
ENGINEERING Corrales, N.M. 87048
SURVEYING

CITY OF ALBUQUERQUE
PUBLIC WORKS DEPARTMENT
ENGINEERING GROUP

TITLE: TUSCANY SUBDIVISION - UNIT 1
UTILITY PLAN & PROFILE
SANITARY SEWER OUTFALL

APPROVALS	ENGINEER	DATE	APPROVALS	ENGINEER	DATE
DRG CHAIRMAN	<i>[Signature]</i>	11-21-95	WATER	<i>R.W. Kane</i>	9-28-95
TRANSPORTATION	<i>[Signature]</i>	9-28-95	WASTE WATER	<i>R.W. Kane</i>	9-28-95
HYDROLOGY	<i>[Signature]</i>	11-3-95	A.M.A.F.C.A.	<i>[Signature]</i>	10/15/95

PROJECT NO. 5208.91
MAP NO. G-11
SHEET 28 OF 36


NOTE:
IF 18" ULTRA-RIB PVC PIPE IS TO BE USED FOR MAIN SAS ALL SERVICES ARE TO BE CONNECTED WITH A WYE. (TAPPING IS NOT PERMITTED)
18" VYLON PIPE (13' SECTIONS MAY BE SUBSTITUTED FOR ULTRA-RIB PIPE (TAPPING IS PERMITTED)

NOTE:
DROP MANHOLE PER D.P.M. STD. DWG. 2116


SCALE:
HORIZ: 1" = 50'
VERT: 1" = 10'

SCANNED BY
BY LASON

1 SLOPES TO BE COVERED WITH GRAVEL AND PLANTED PER A.M.A.F.C.A. SPECIFICATION SEE SHEETS # 30 & 32

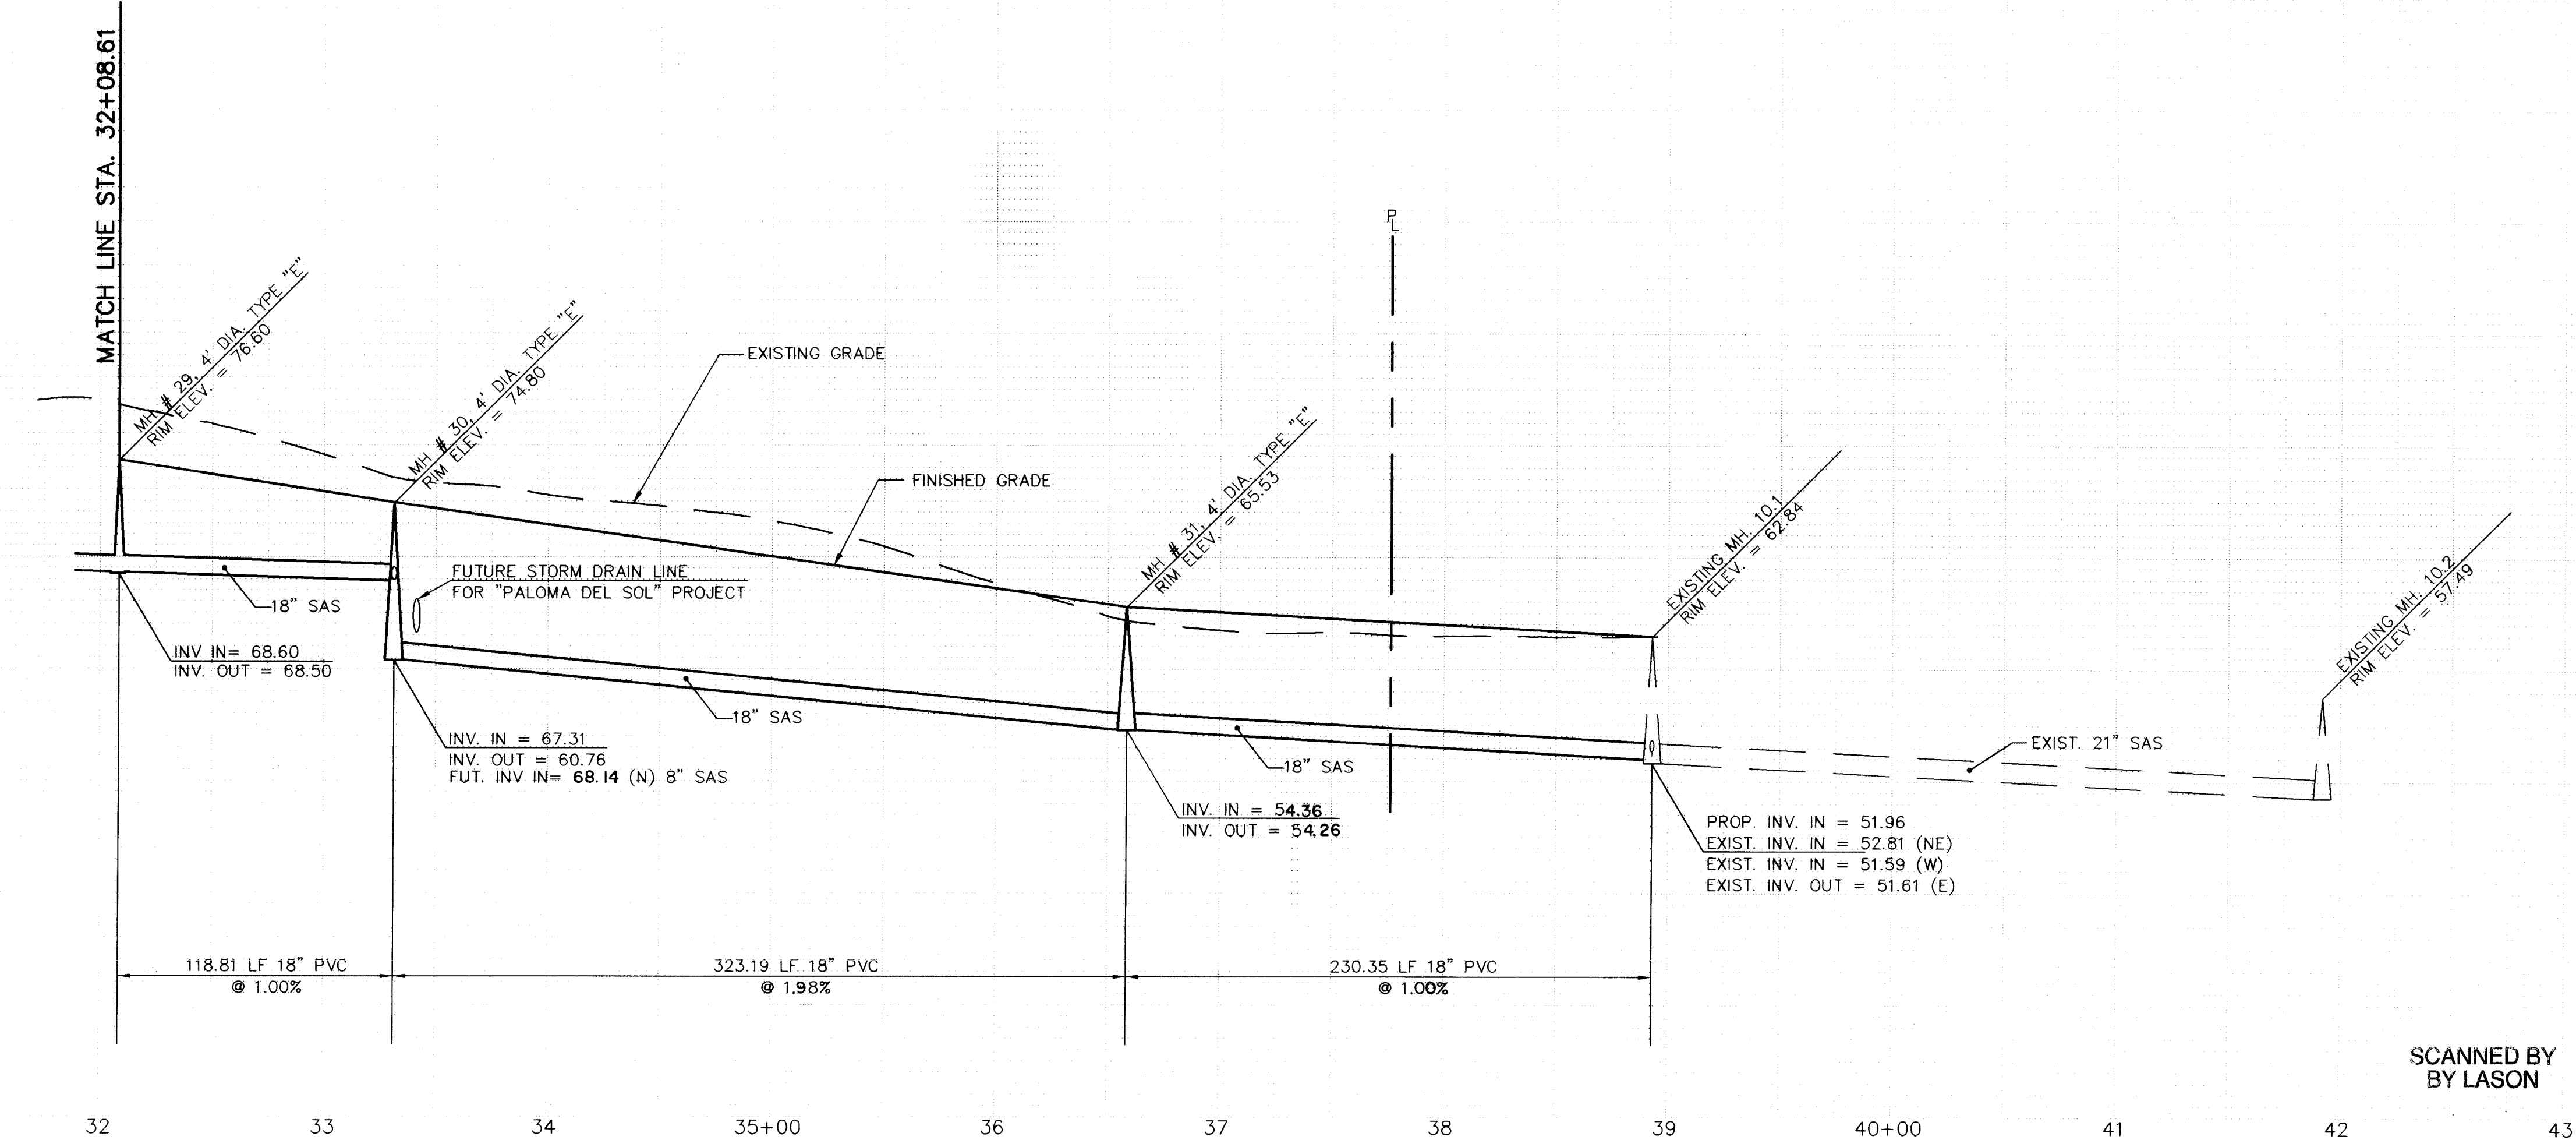

SCANNED BY LASON

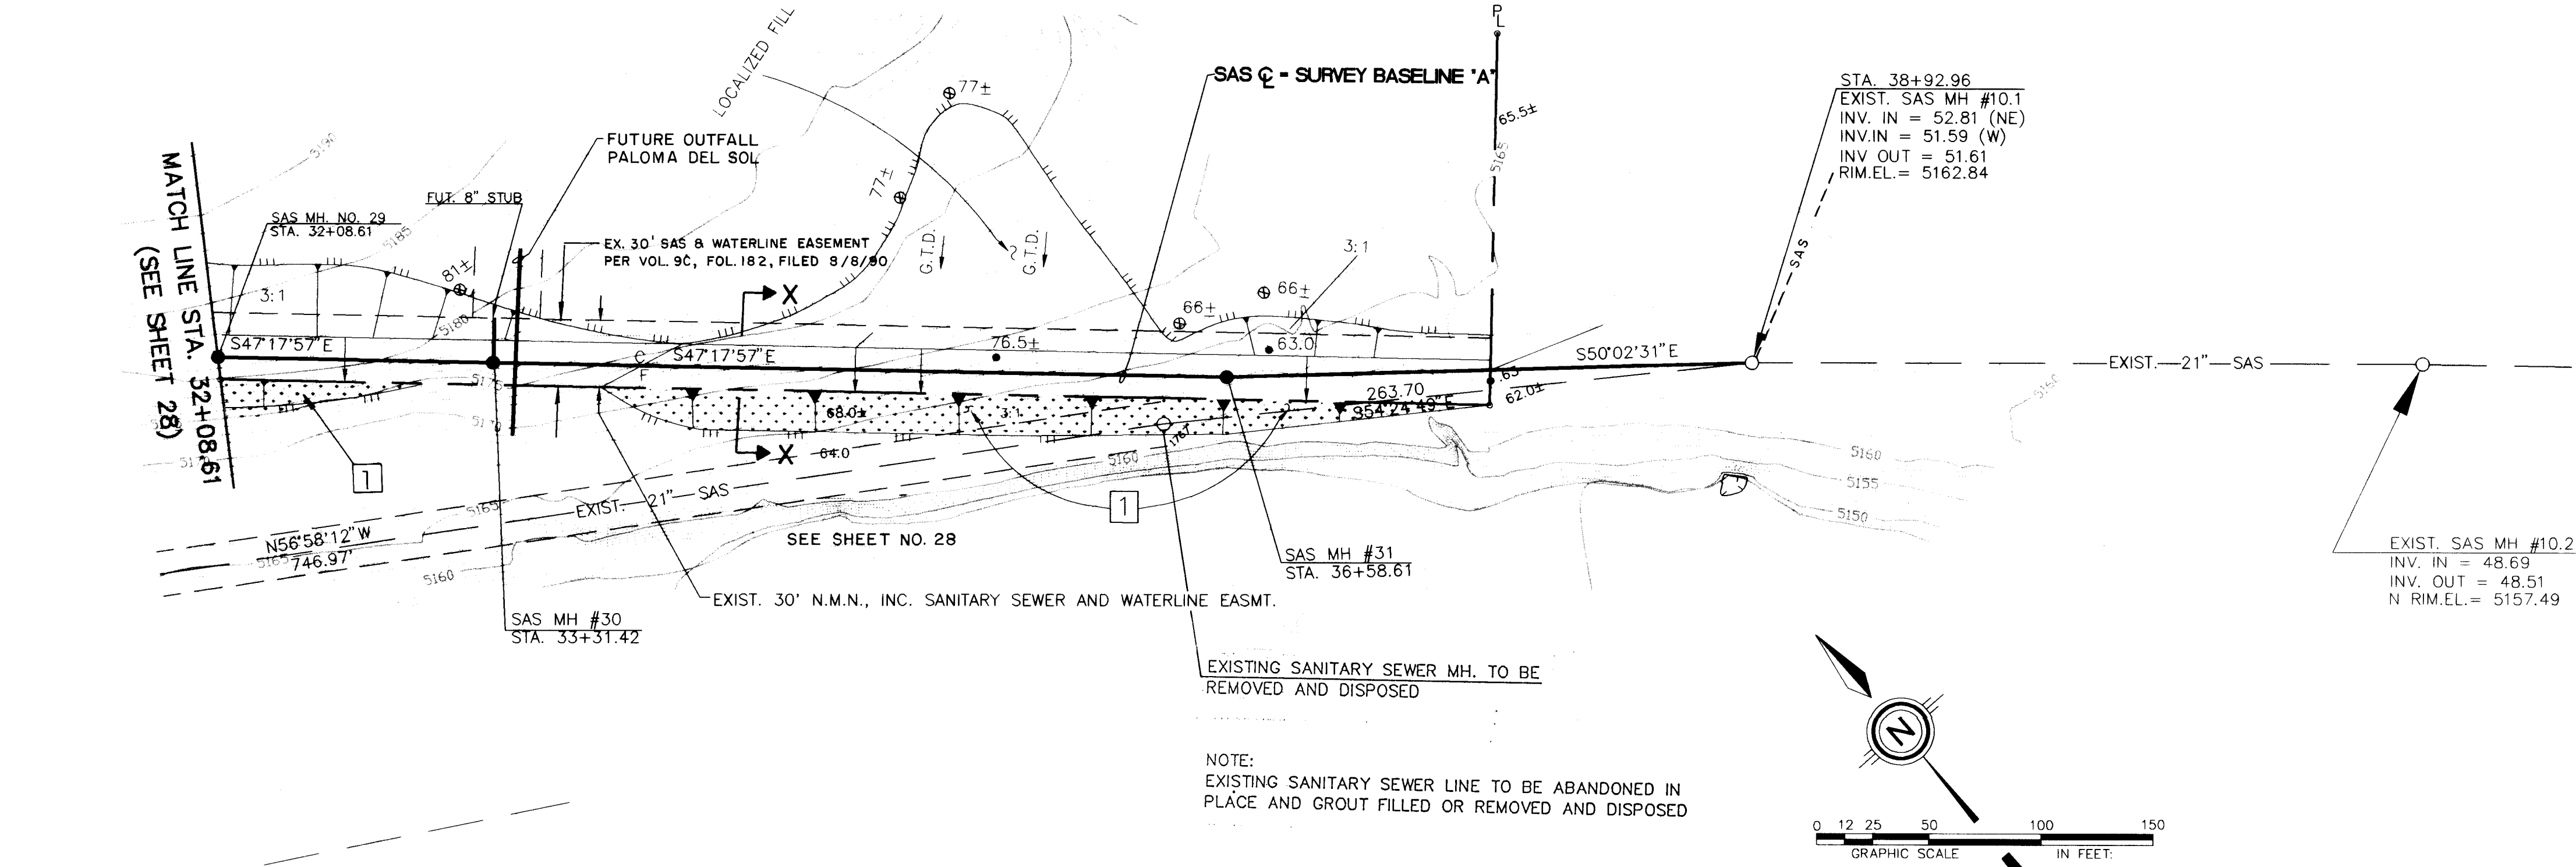

UTILITY LEGEND

DESCRIPTION	PROPOSED	EXISTING
SANITARY SEWER LINE	8" SAS	8" SAS
ENCASEMENT		
SANITARY SEWER MANHOLE		
SAS SERVICE CONNECTION	S	S
STORM DRAIN LINE	SD-30"	SD-30"
STORM DRAIN MANHOLE		
STORM DRAIN INLETS		
WATER LINE	W-6"	W-6"
GATE VALVE		
BUTTERFLY VALVE		
FIRE HYDRANTS		
REDUCERS		
WATER SERVICE/ METER		
TEES		
CROSSES		
BENDS		
CAPS & PLUGS		
GAS LINES	N/A	2" H.P.
OVERHEAD ELECTRICAL LINE	N/A	
UNDERGROUND ELECTRICAL	N/A	
OVERHEAD TELEPHONE	N/A	
UNDERGROUND TELEPHONE	N/A	
CABLE TELEVISION	N/A	
POWER OR TELEPHONE POLE	N/A	
GRADE TO DRAIN		GTD
DAYLIGHT LINE		

NOTE:

IF 18" ULTRA-RIB PVC PIPE IS TO BE USED FOR MAIN SAS ALL SERVICES ARE TO BE CONNECTED WITH A WYE. (TAPPING IS NOT PERMITTED) 18" VYLON PIPE (13' SECTIONS) MAY BE SUBSTITUTED FOR ULTRA-RIB PIPE (TAPPING IS PERMITTED)

ENGINEER'S SEAL

24-1512018.1911219.97

NOTE: DROP MANHOLE PER D.P.M. STD. DWG. 2116

SCALE :

HORIZ : 1" = 50'

VERT : 1" = 10'0"

community sciences corporation

LAND PLANNING P.O. Box 1328

ENGINEERING Corrales, N.M. 87048

SURVEYING

CITY OF ALBUQUERQUE PUBLIC WORKS DEPARTMENT ENGINEERING GROUP

TITLE: TUSCANY SUBDIVISION - UNIT 1 UTILTY PLAN & PROFILE SANITARY SEWER OUTFALL

APPROVALS	ENGINEER	DATE	APPROVALS	ENGINEER	DATE
DRC CHAIRMAN	B.G. Lashley	11-21-95	WATER	A.W. Kane	9-28-95
TRANSPORTATION	N/A RHO	9-28-95	WASTE WATER	A.W. Kane	9-28-95
HYDROLOGY	N/A FPC	11-3-95	A.M.A.F.C.A.	J.P. Kelly	10/26/95
			N.M.U.I.		7-12-95

PROJECT NO. 5208.91

MAP NO. G-11

SHEET 29 OF 36

AS BUILT INFORMATION

CONTRACTOR ALEA Concepts INC.

WORK BY COA/CSC

ACCEPTANCE BY JLD

DATE 5/5/96

DRAWINGS BY JLD

DATE

RECORDED BY

DATE

MICRO-FILM INFORMATION

NO.

DATE

BENCH MARKS

BENCHMARK: STATION IS A USGS BRASS TABLET STAMPED "BLACK-2, 1977". SET FLUSH WITH THE GROUND. LOCATED AT THE INTERSECTION OF MOMAHON BLVD. AND GOLF COURSE RD., TO REACH THE STATION FROM THE INTERSECTION OF COORS BLVD. AND PARADISE BLVD. TURN LEFT, GO WEST ON PARADISE BLVD. 1.1 MILES TO GOLF COURSE RD., TURN RIGHT, GO NORTH ON GOLF COURSE RD. 1.3 MILES TO MOMAHON BLVD., AND THE STATION IS ON THE LEFT.

NO.

ELEVATION REVISED BY ACS, 1987 = 5213.93

SURVEY INFORMATION

FIELD NOTES

NO.

DATE

BY

COMMUNITY SCIENCES

NO.

DATE

BY

REMARKS

DESIGN

DESIGNED BY Z.J.R.


DATE JULY, 1995

DRAWN BY A.M./D.L.W.

DATE JULY, 1995

CHECKED BY J.D.H.

DATE JULY, 1995

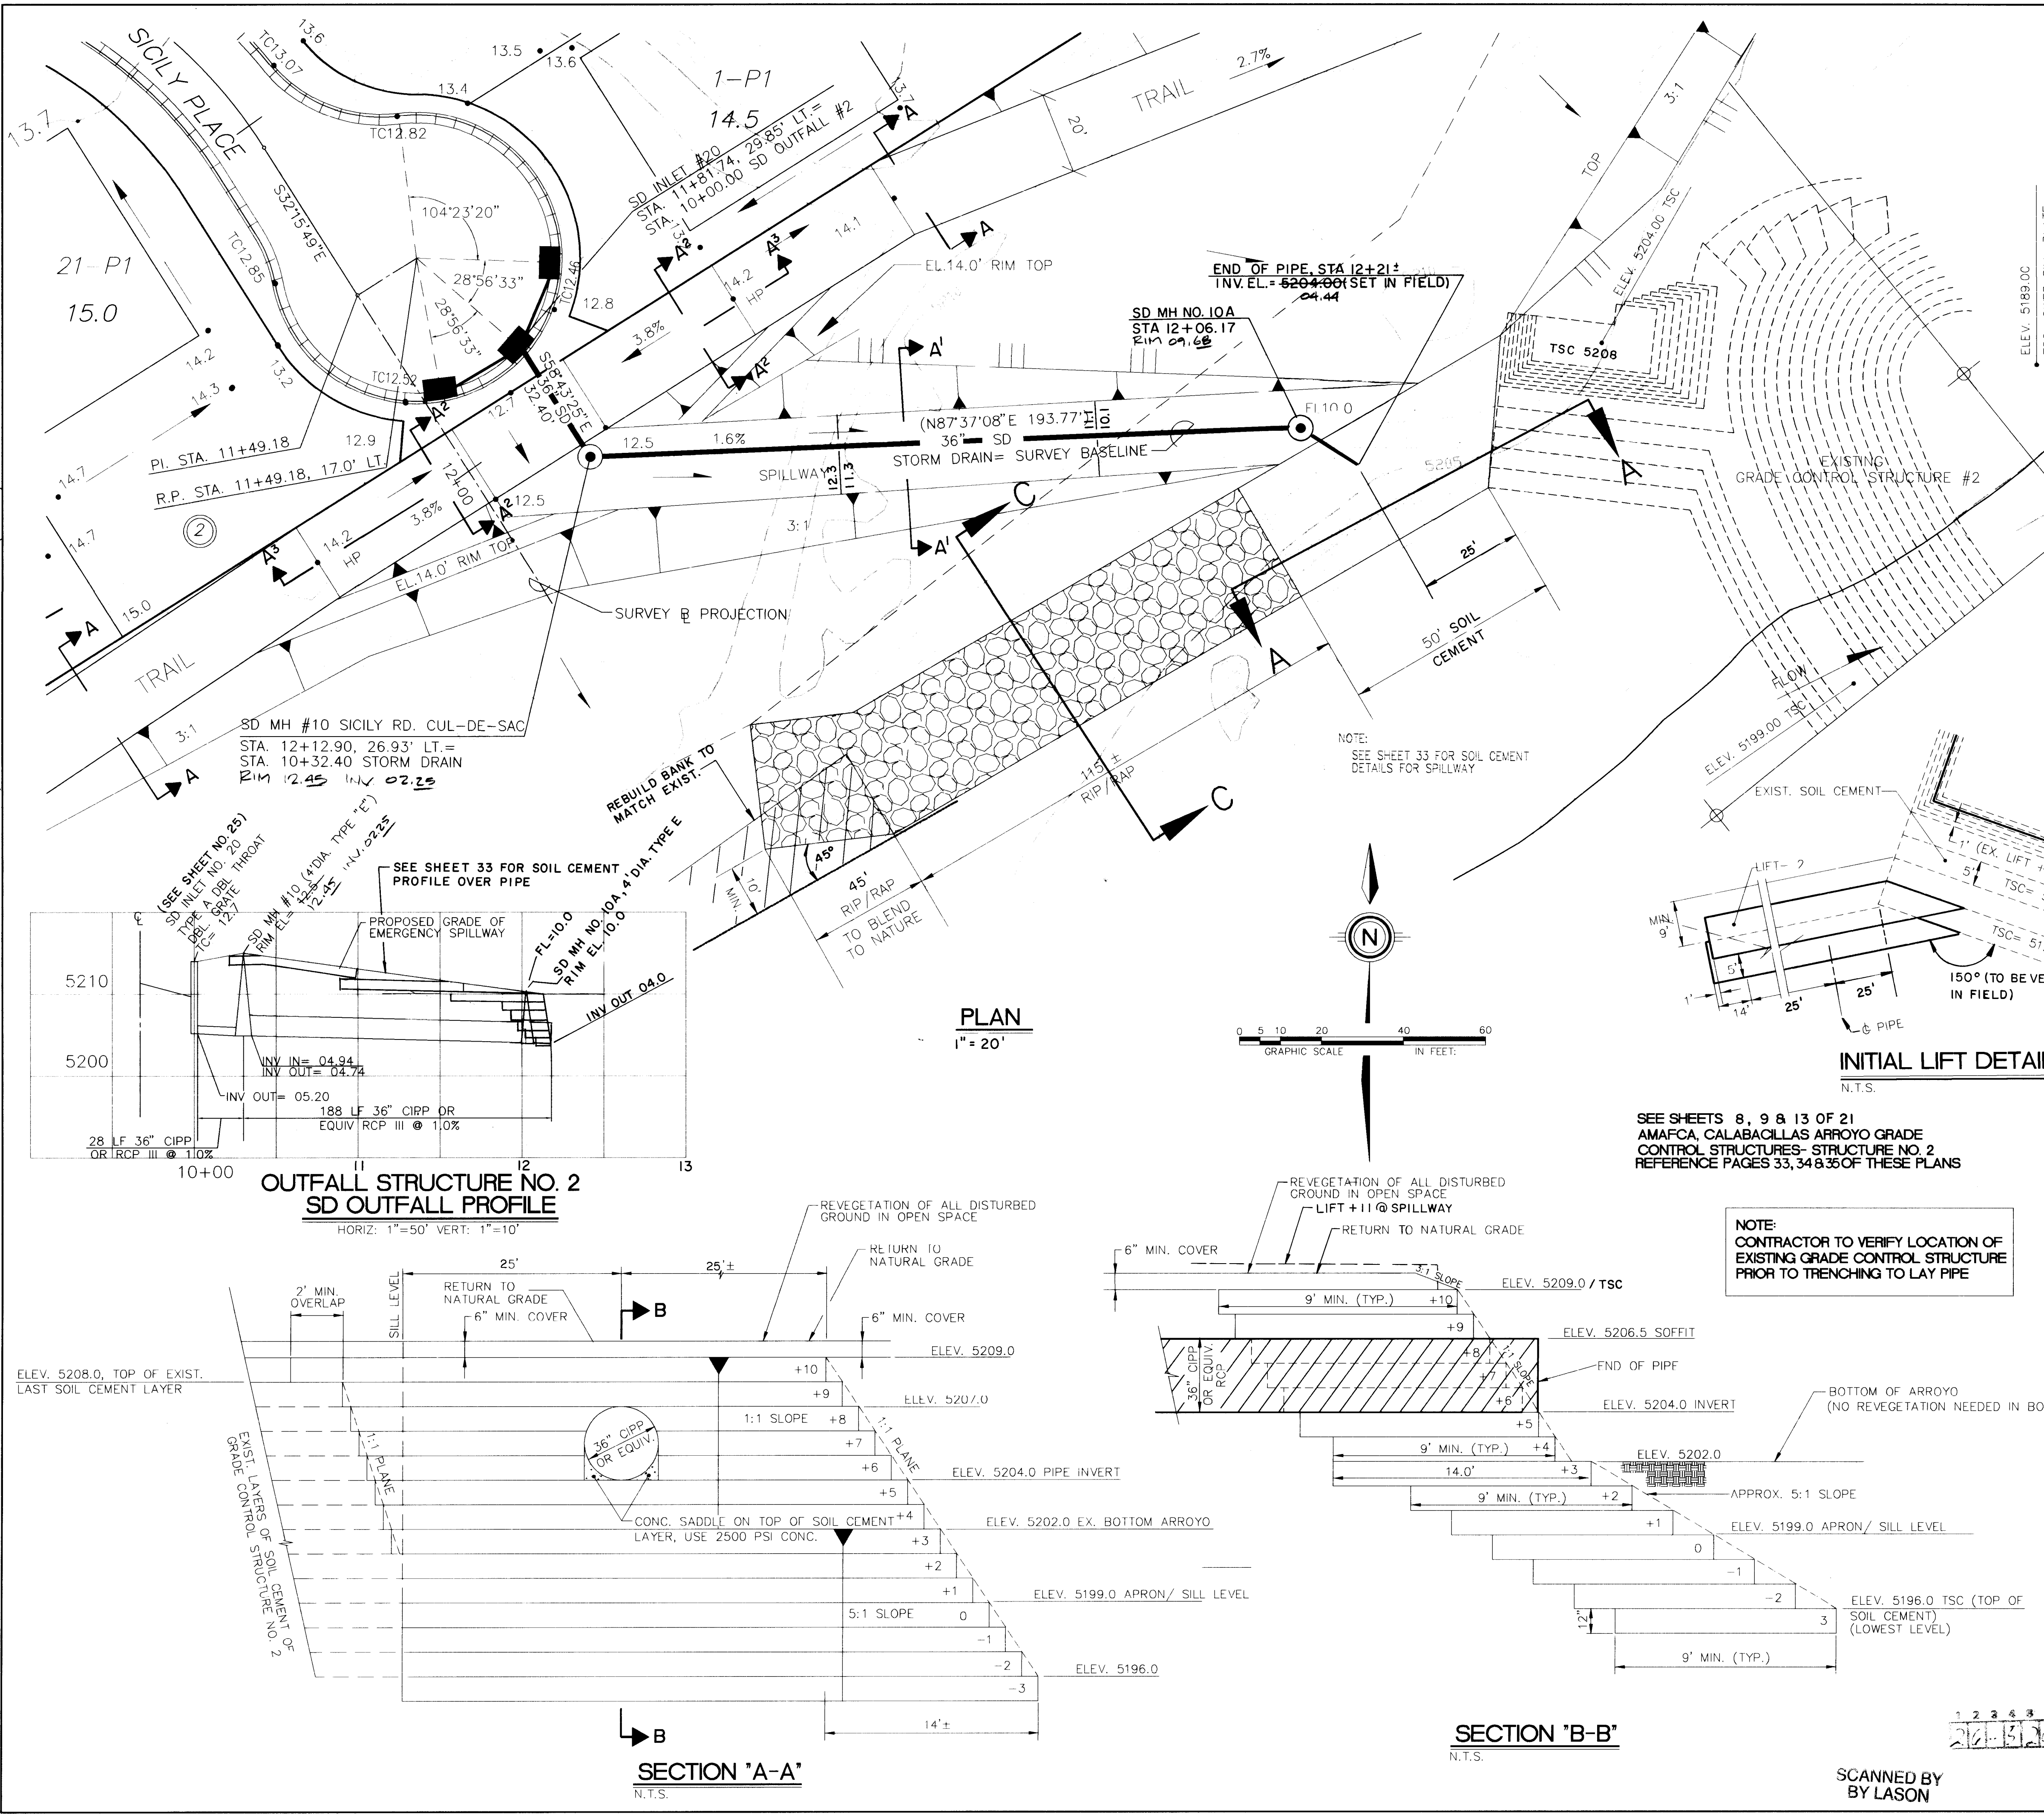

NOTES:


- SOIL CEMENT SHALL BE IN ACCORDANCE WITH SECTION 624 OF THE AMAFCA STANDARD SPECIFICATIONS DEC. 1992.
 - NO GRADATION "B" SOIL.
 - USF 10% CEMENT CONTENT SOIL CEMENT.
 - HIGH PRESSURE WASH OF EXIST. SOIL CEMENT SURFACE BEFORE JOINING WITH NEW, BONDING GROUT REQUIRED BETWEEN EXIST. SOIL CEMENT AND NEW SOIL CEMENT.
 - SOIL CEMENT AGGREGATE SHALL BE NATIVE MATERIAL FROM THE BOTTOM OF THE CALABACILLAS ARROYO, FROM WHICH THE +1-1/2" MATERIAL HAS BEEN SCALPED, 10% CEMENT BY WEIGHT SHALL BE THE MINIMUM CEMENT CONTENT.
 - EXPOSED SOIL CEMENT TO HAVE STEEPED EDGES, THIS WILL REQUIRE OVERBUILDING EACH LIFT, COMPACTING AND TRIMMING EDGE BACK TO COMPLETE SOIL CEMENT, TRIMMED EXCESS MAY BE INCORPORATED, IN NEXT LIFT IF LESS THAN 1-1/2 HOURS OLD.
 - WORK ADJACENT TO THE CALABACILLAS ARROYO GRADE CONTROL RESTRICTED TO PERIOD = SEPT. 15 TO JUNE 15, IF THE STORM DRAIN NEEDS TO BE USED PRIOR TO SEPT. 15 THE TEMP. OUT LCT DITCH WILL BE CONSTRUCTED. WHEN THE PERMANENT OUTFALL IS CONSTRUCTED, THIS WILL BE FILLED IN AND REVEGETATED.
- REVEGETATION:
- ALL DISTURBED AREAS (EXCEPT IN THE AMAFCA EASEMENT) NORTH OF ARROYO BANK AND ALL POND AREAS SHALL BE REVEGETATED WITH NATIVE SEED IN ACCORDANCE WITH THE CITY OF ALBUQUERQUE STANDARDS FOR PUBLIC WORKS CONSTRUCTION SECTION 1012, NATIVE GRASS SEEDING.
 - ALL DISTURBED AREAS IN THE AMAFCA EASEMENT SHALL BE SEED IN ACCORDANCE WITH THE FOLLOWING MIXTURE AND RATE, AND MULCHED IN ACCORDANCE WITH SECTION 1012, CITY OF ALBUQUERQUE STANDARD SPECIFICATIONS FOR PUBLIC WORKS CONSTRUCTION.
 - GRAVEL MULCH SANTA ANA TAN (2" THICK ± 1/2")

AMAFCA EASEMENT SEED MIX (DRILL SEED)
(DRILL SEED)

	RATF	ACRF	PIS
"PALOMA" INDIAN RICE GRASS	4.0		
"VIVA" GALLETA GRASS	2.5		
"EL RENO" SIDEOTS GRAMA	3.0		
"HACHITA" BLUE GRAMA	1.0		
SAND DROPSEED	0.5		
FOURWING SALT BUSH	1.0		
APACHE PLUME	1.0		
RABBITBRUSH	1.0		

WILDFLOWER MIX

EVENING PRIMROSE
CALIFORNIA POPPY
CHOCOLATE FLOWER
BACHELOR BUTTON
OXEYE DAISY
FIREWHEEL
YELLOW CONEFLOWER
MEXICAN HAT
CORFOPIS
SKYROCKET
GAYFEATHER
PRAIRIE ASTER
ROCKY MOUNTAIN PENSTEMAN

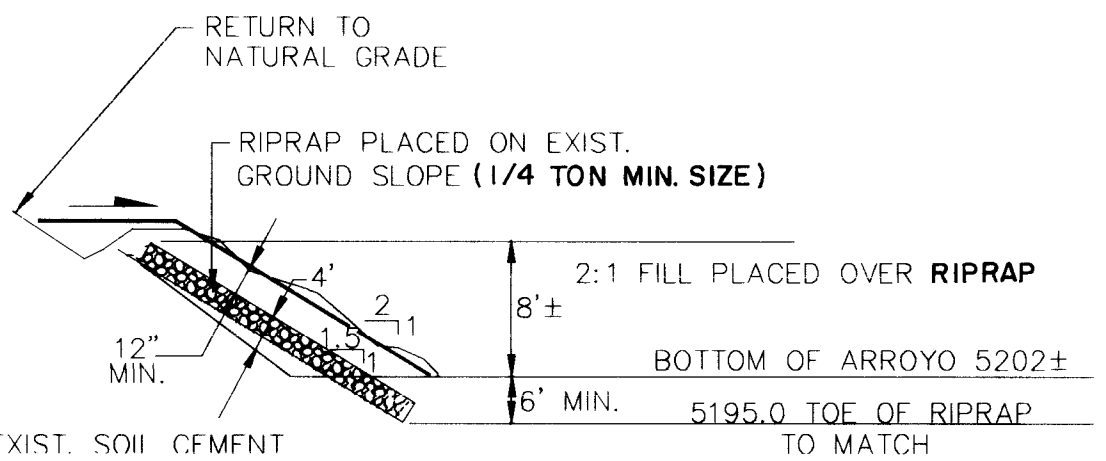

SECTION "C-C"

N.T.S.

DATE: JULY, 1995	<i>community sciences corporation</i>		
SCALE: AS SHOWN			
DESIGNED: T.J.B.			
DRAWN: A.M.			
JOB NO.: 29107-057	LAND PLANNING P.O. Box 1328	ENGINEERING Corrales, N.M. 87048	SURVEYING Corrales, N.M. 87048

CITY OF ALBUQUERQUE
PUBLIC WORKS DEPARTMENT
ENGINEERING GROUP

TITLE: TUSCANY SUBDIVISION - UNIT 1
OFFSITE DRAINAGE STRUCTURE DETAILS
OUTFALL STRUCTURE NO. 2

APPROVALS	ENGINEER	DATE	APPROVALS	ENGINEER	DATE
DRC CHAIRMAN	<i>S.G. Robby</i>	11-21-95	WATER	<i>NIA RWE</i>	9-28-95
TRANSPORTATION	<i>NIA RWE</i>	9-28-95	WASTE WATER	<i>NIA RWE</i>	9-28-95
HYDROLOGY	<i>NIA RWE</i>	11-3-95	A.M.A.F.C.A.	<i>S.G. Robby</i>	10/27/95
PROJECT NO.	5208.91	MAP NO.	G-11	SHEET	30 OF 36





NOTES:

- REVEGETATION:


- AMAFCA EASEMENT SEED MIX (DRILL SEED)
(DRILL SEED)

RATE / ACRE PLS


WILDFLOWER MIX

26-5208.913297


SCANNED BY
BY LASON

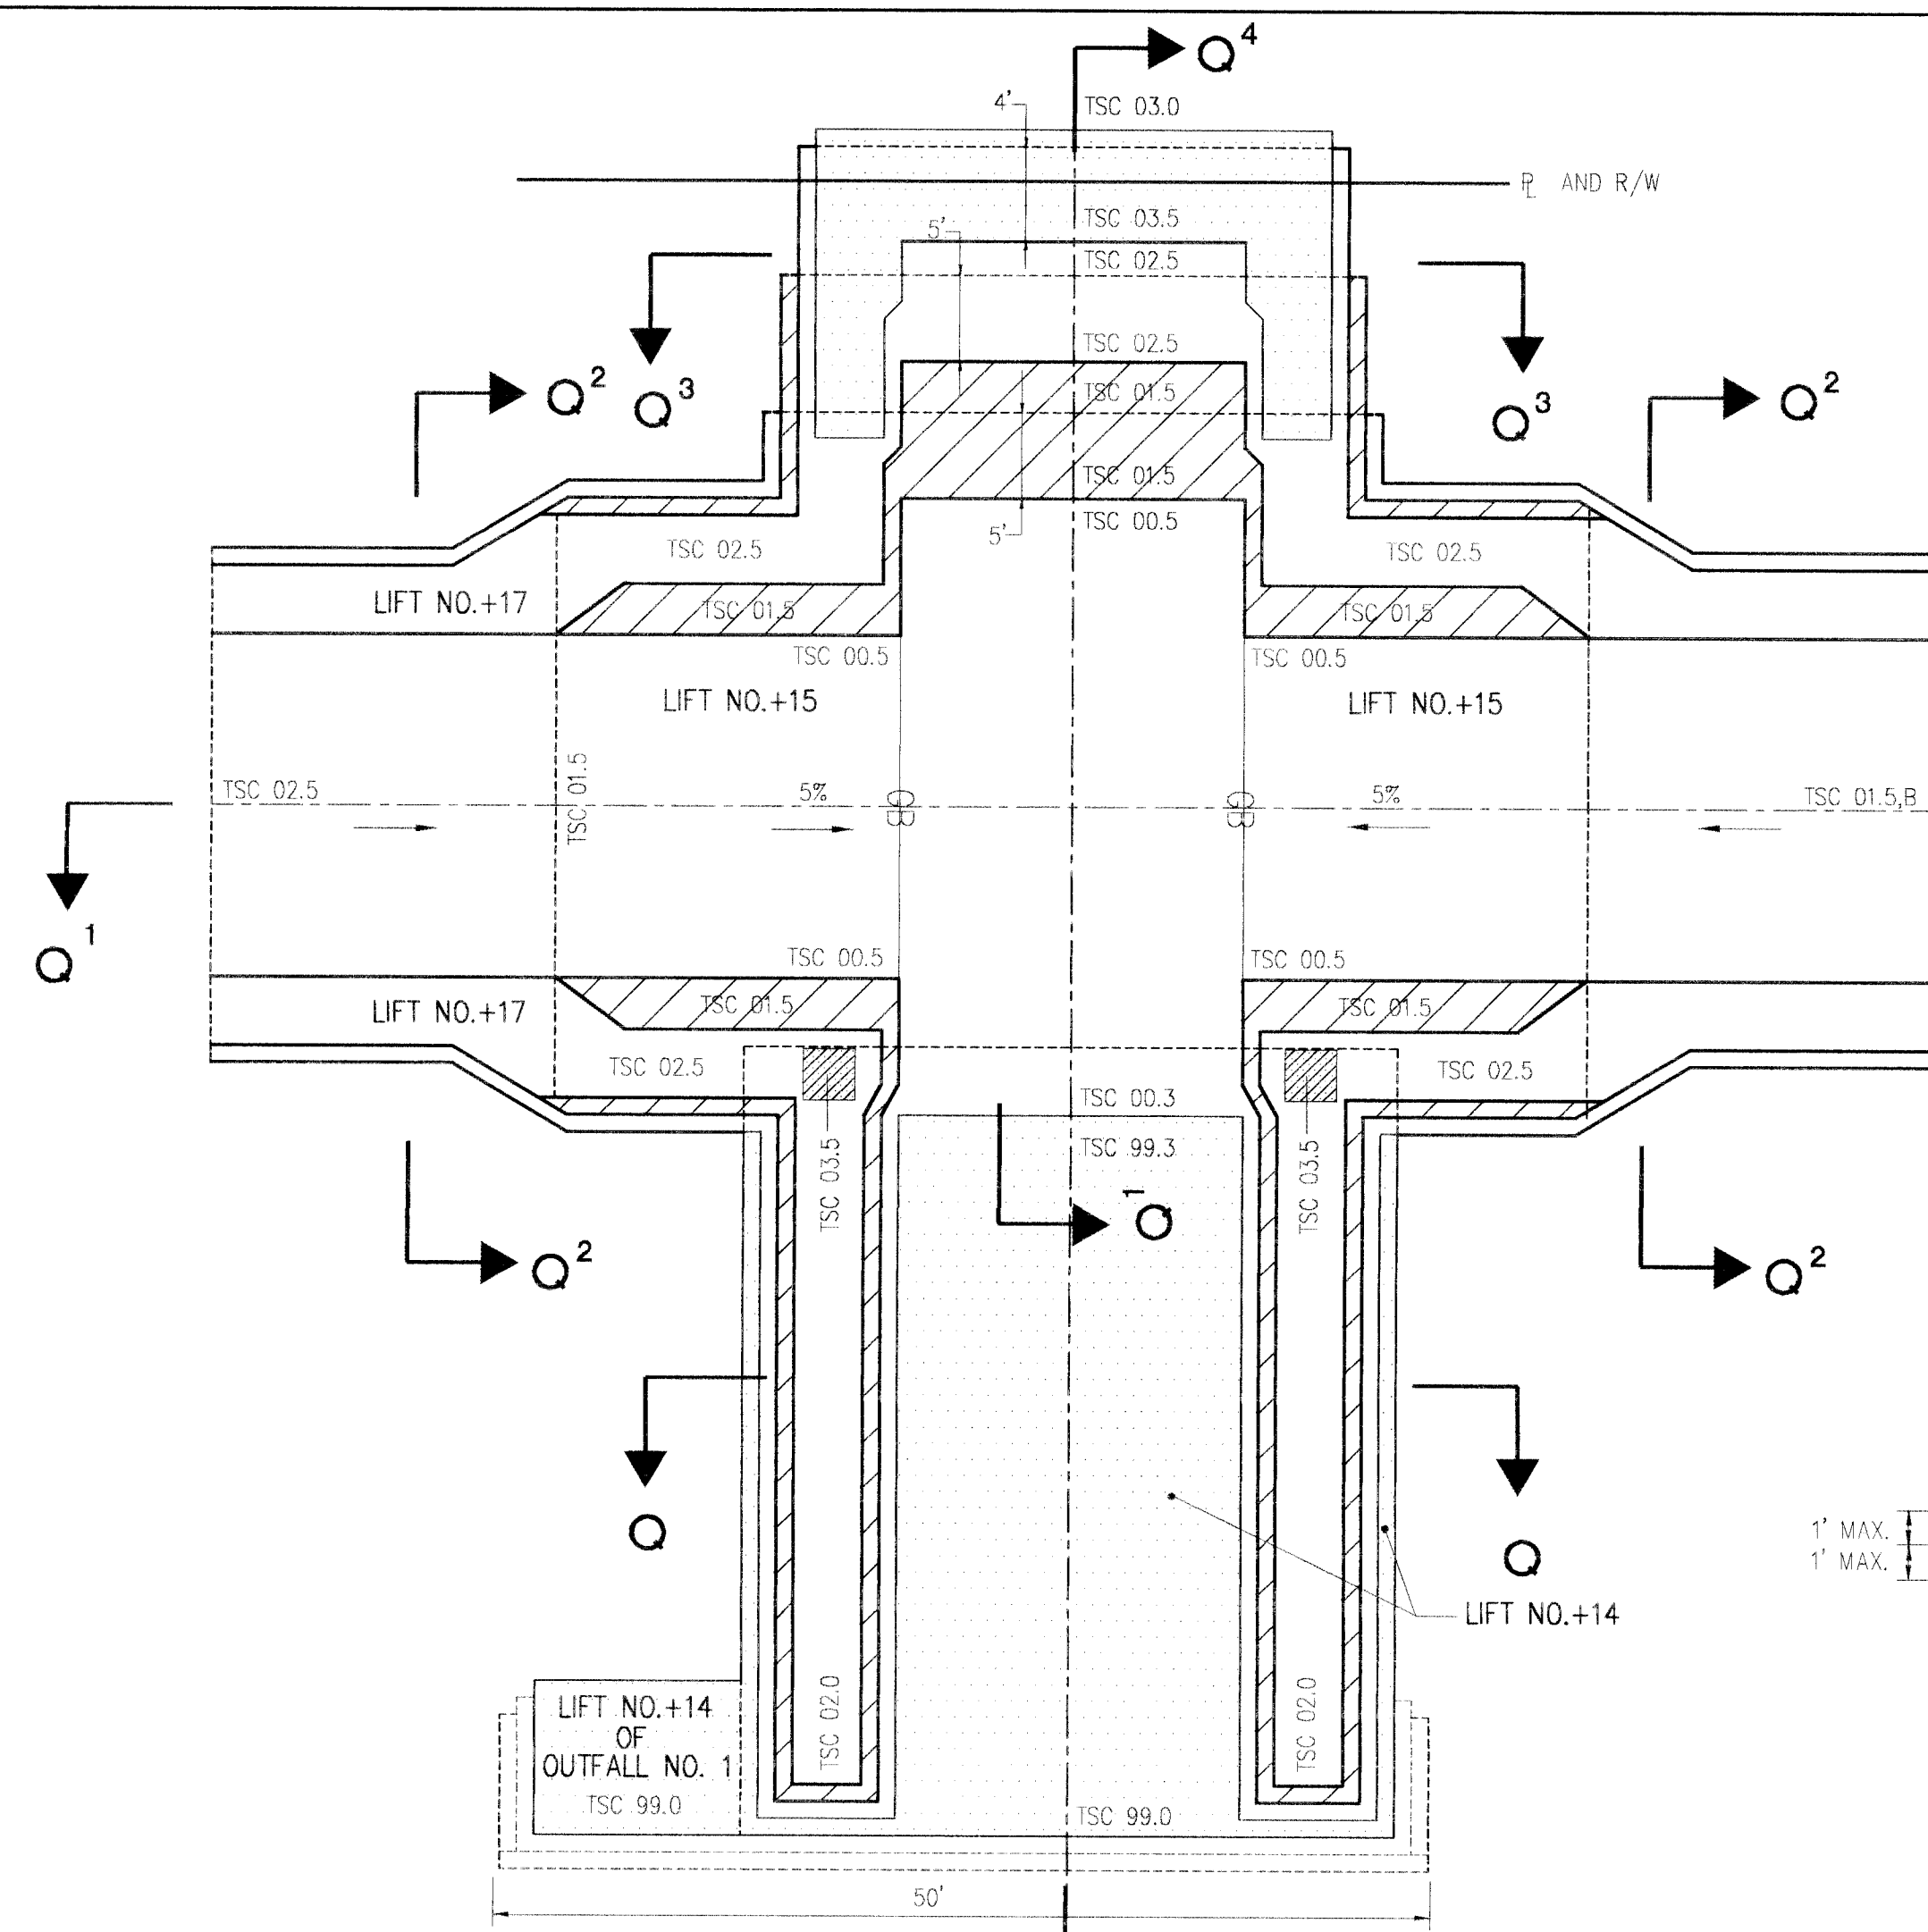

OUTFALL NO. 1 SPILLWAY
SCALE: 1"= 10'

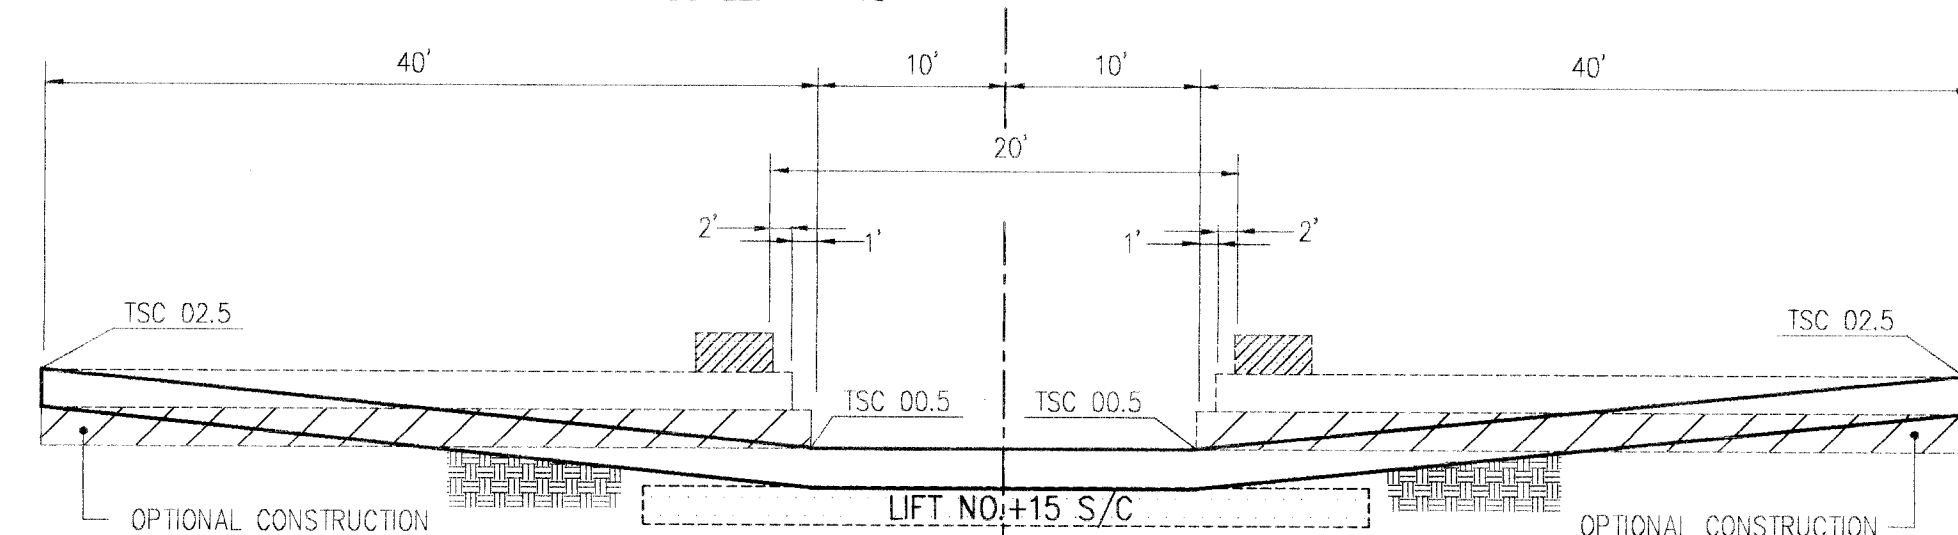


SECTION Q¹- Q¹
SCALE: 1" = 10'

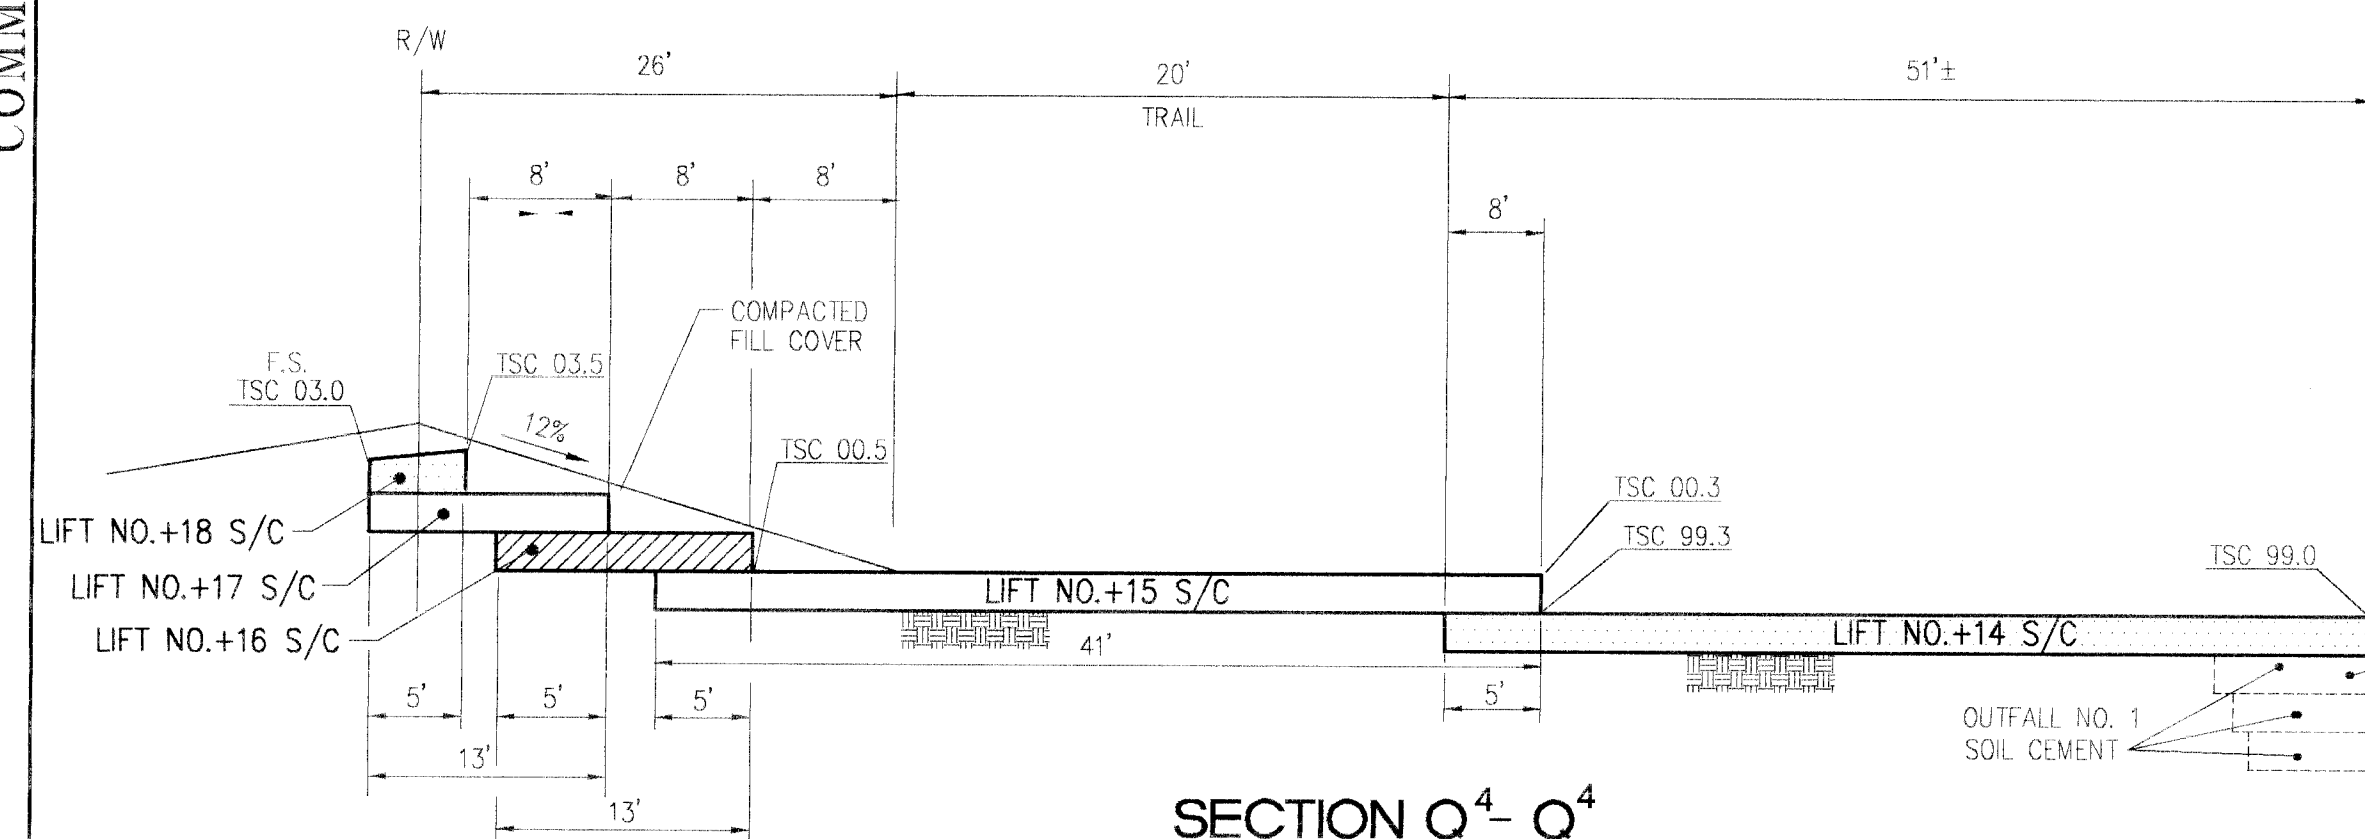


SECTION Q⁴-Q⁴
SCALE: 1" = 10'


OUTFALL NO. 1 SPILLWAY

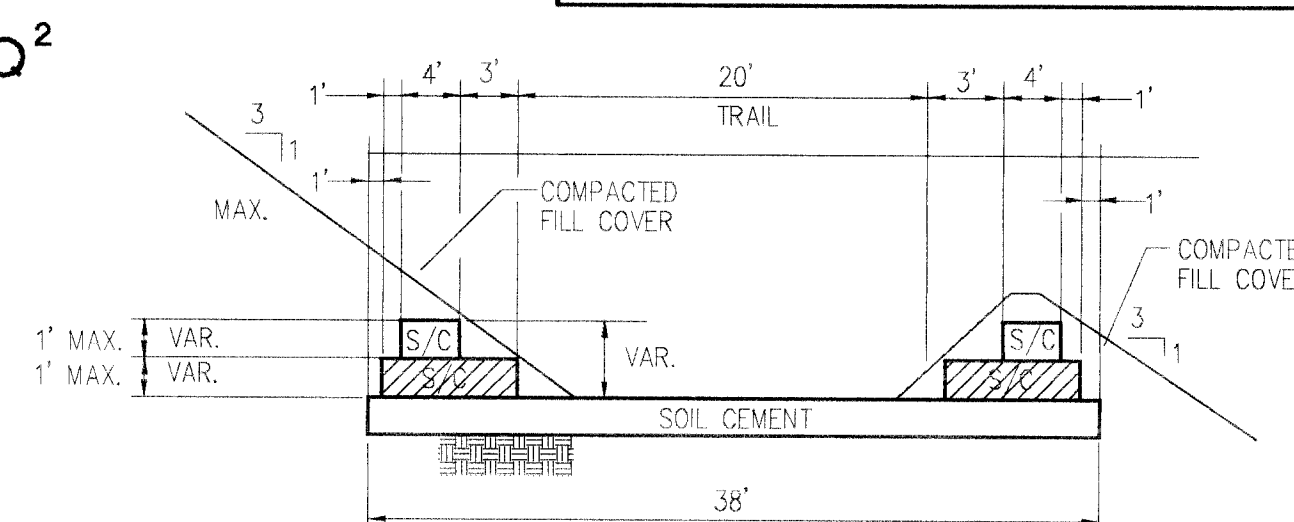


SECTION Q²- Q²
SCALE: 1" = 10'

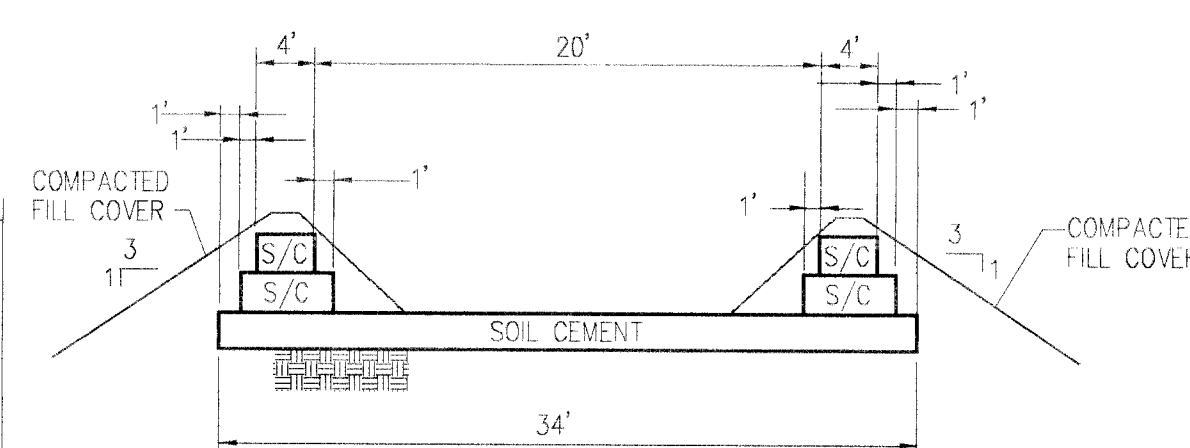


SECTION Q³- Q³
SCALE: 1" = 10'

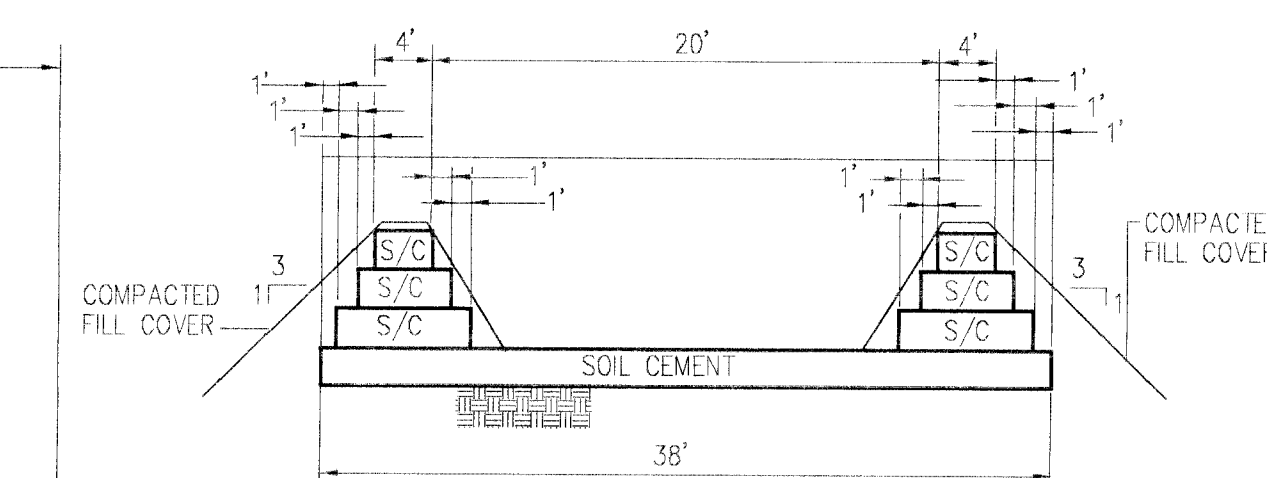


SECTION Q - Q
SCALE: 1" = 10'

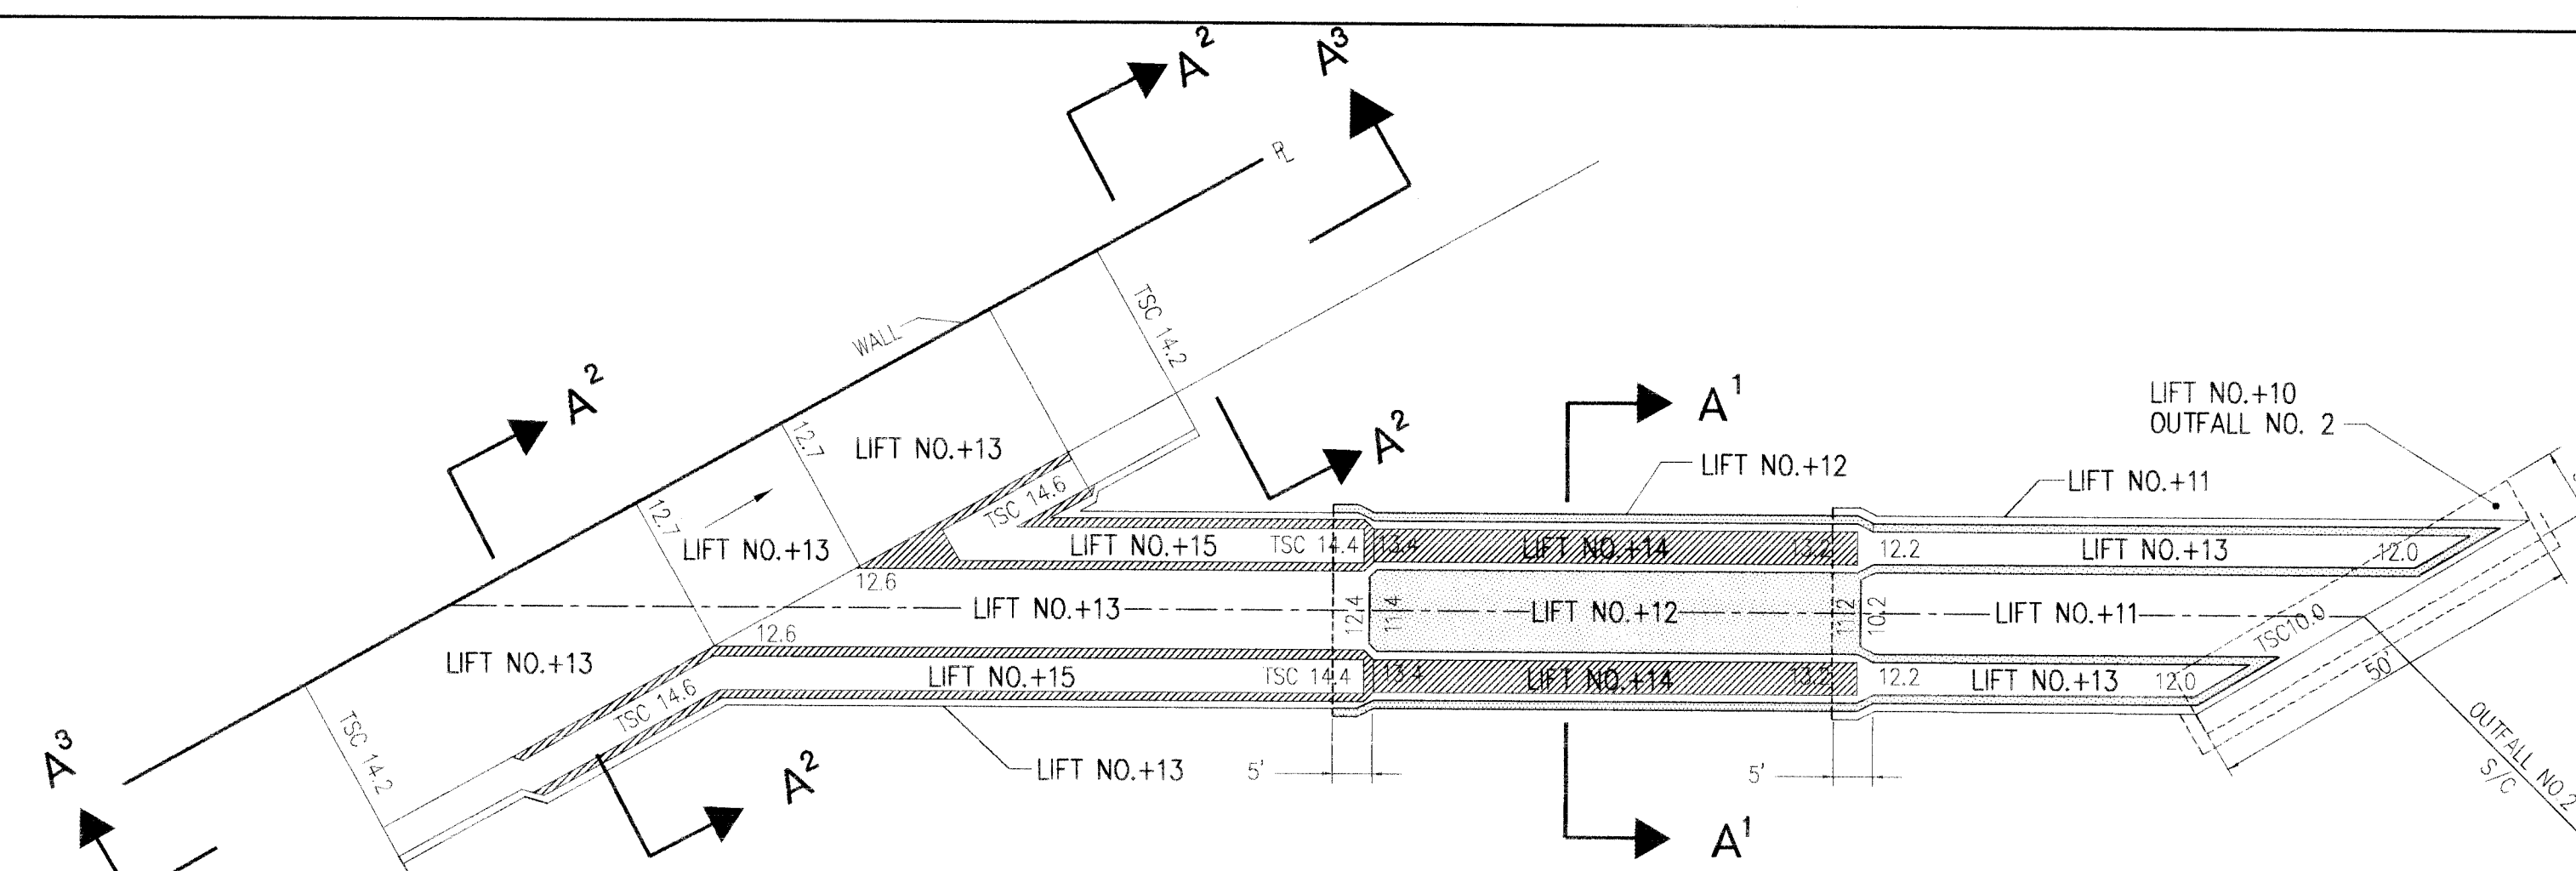


PLAN
OUTFALL NO. 2 SPILLWAY
SCALE: 1" = 20'

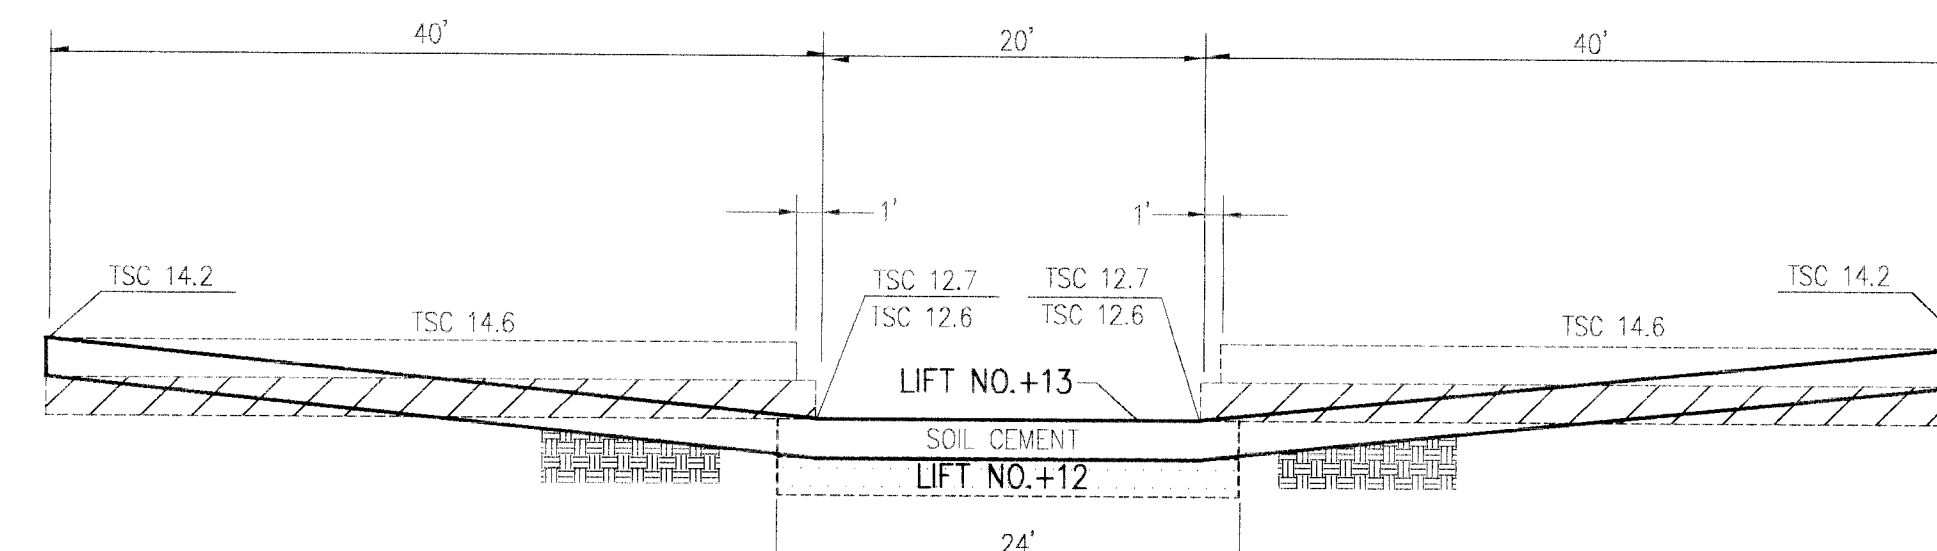

SECTION A³ - A³
SCALE: 1" = 10'

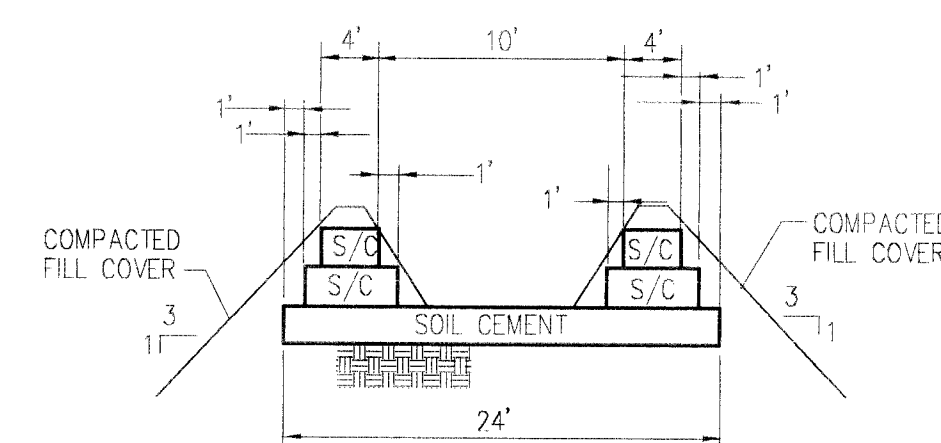


SECTION A¹ - A¹
SCALE: 1" = 10'

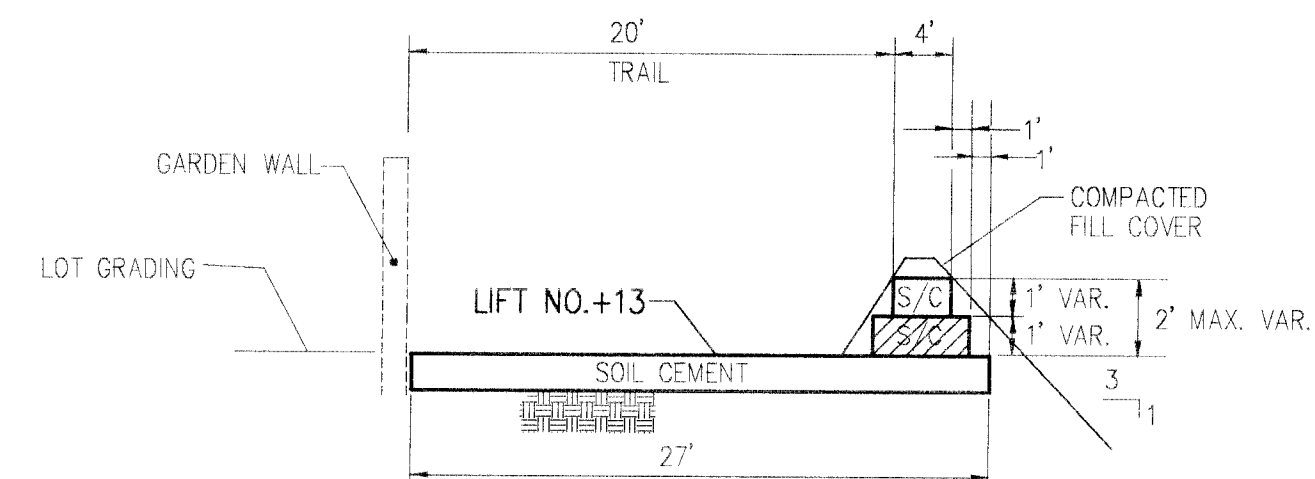

SECTION A² - A²
SCALE: 1" = 10'

OUTFALL NO. 2 SPILLWAY

ERQUE ARTMENT ROUP		1 AY DETAILS 1 AND 2		APPROVALS		ENGINEER		DATE	
WATER		F.C.A.		John Kelly		10/27/94			
11		SHEET		33		OF		36	

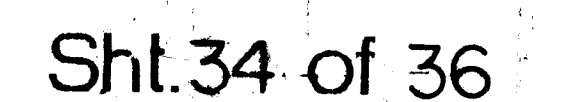

SPECIFIC DIMENSIONS: STRUCTURE 2

LENGTHS		
BASE RADIUS	WIDTH	Z1-Z2
142.7	162.0	92.70
ELEVATIONS		
UPPER CREST	LEFT DIKE	RIGHT DIKE
5199.0	5208.0	5208.0
PROJECT COORDINATES		
PT X	5980.68	56418.93
PT Y	6109.20	56610.00
BM 10	7501.76	53383.40
BEARINGS / DISTANCES		
BM -> X	S 63d 23' 33" E	3396.20
X -> Y	S 55d 56' 04" E	229.44
ESTIMATED QUANTITIES: STRUCTURE 2		
UNCLASSIFIED EXCAVATION	CY	14078
COMPACTED FILL	CY	4377
UNCOMPACTED FILL	CY	9069
SOIL CEMENT	CY	3115
LEAN CONCRETE	CY	0
RESEEDING AREA	AC	0.8
DRAINAGE PIPE	LF	84

REFERENCE ONLY

20-5208-191 3597

I, ELVIDIO V. DINIZ CERTIFY THAT THE DRAWING OF THE "AS BUILT" DIMENSIONS WAS DONE UNDER MY SUPERVISION.



ALBUQUERQUE METROPOLITAN ARROYO FLOOD CONTROL AUTHORITY
CALABACILLAS ARROYO GRADE CONTROL STRUCTURES

**STRUCTURE 2
PLAN AND DETAILED GRADING**


PROJECT NO.:	
DESIGNED BY:	
DRAWN BY:	
CHECKED BY:	
DATE:	JANUARY 1991

SCANNED BY BY LASON

Resource Technology, Inc.
ENGINEERS & ENVIRONMENTAL SCIENTISTS
2700 ORANGE AVE., SUITE 200, ALBUQUERQUE, NEW MEXICO 87113
TELEPHONE - (505) 346-3116

SHEET 13 OF 20 21

SURVEY LAYOUT DIAGRAM

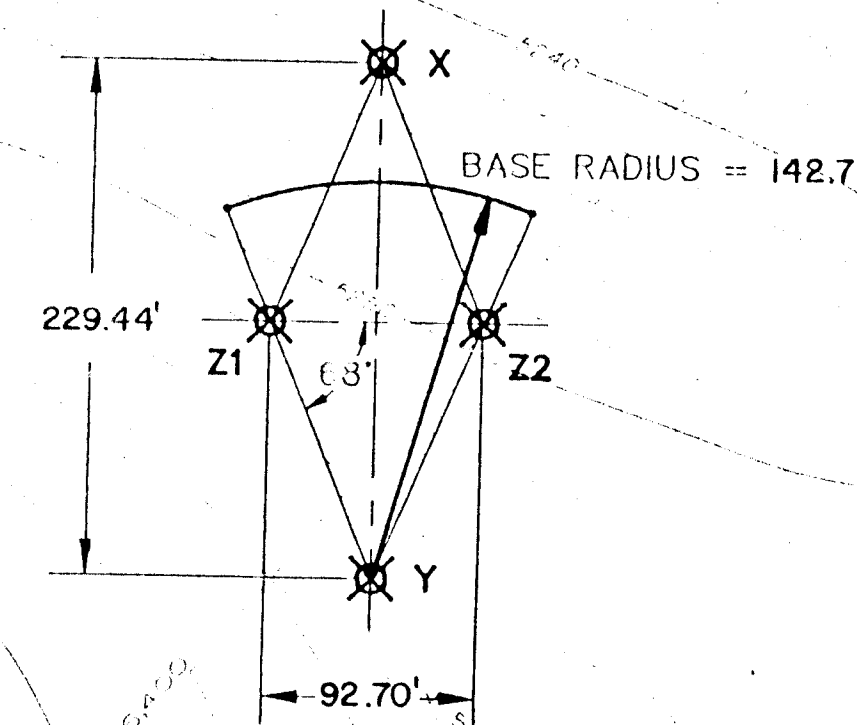


PRUDEN LINE

PROTECT POWER POLE (INCIDENTAL TO CONSTRUCTION)

CONDUCT ALL WORK BETWEEN PRUDENT LINES

SCANNED BY BY LASON

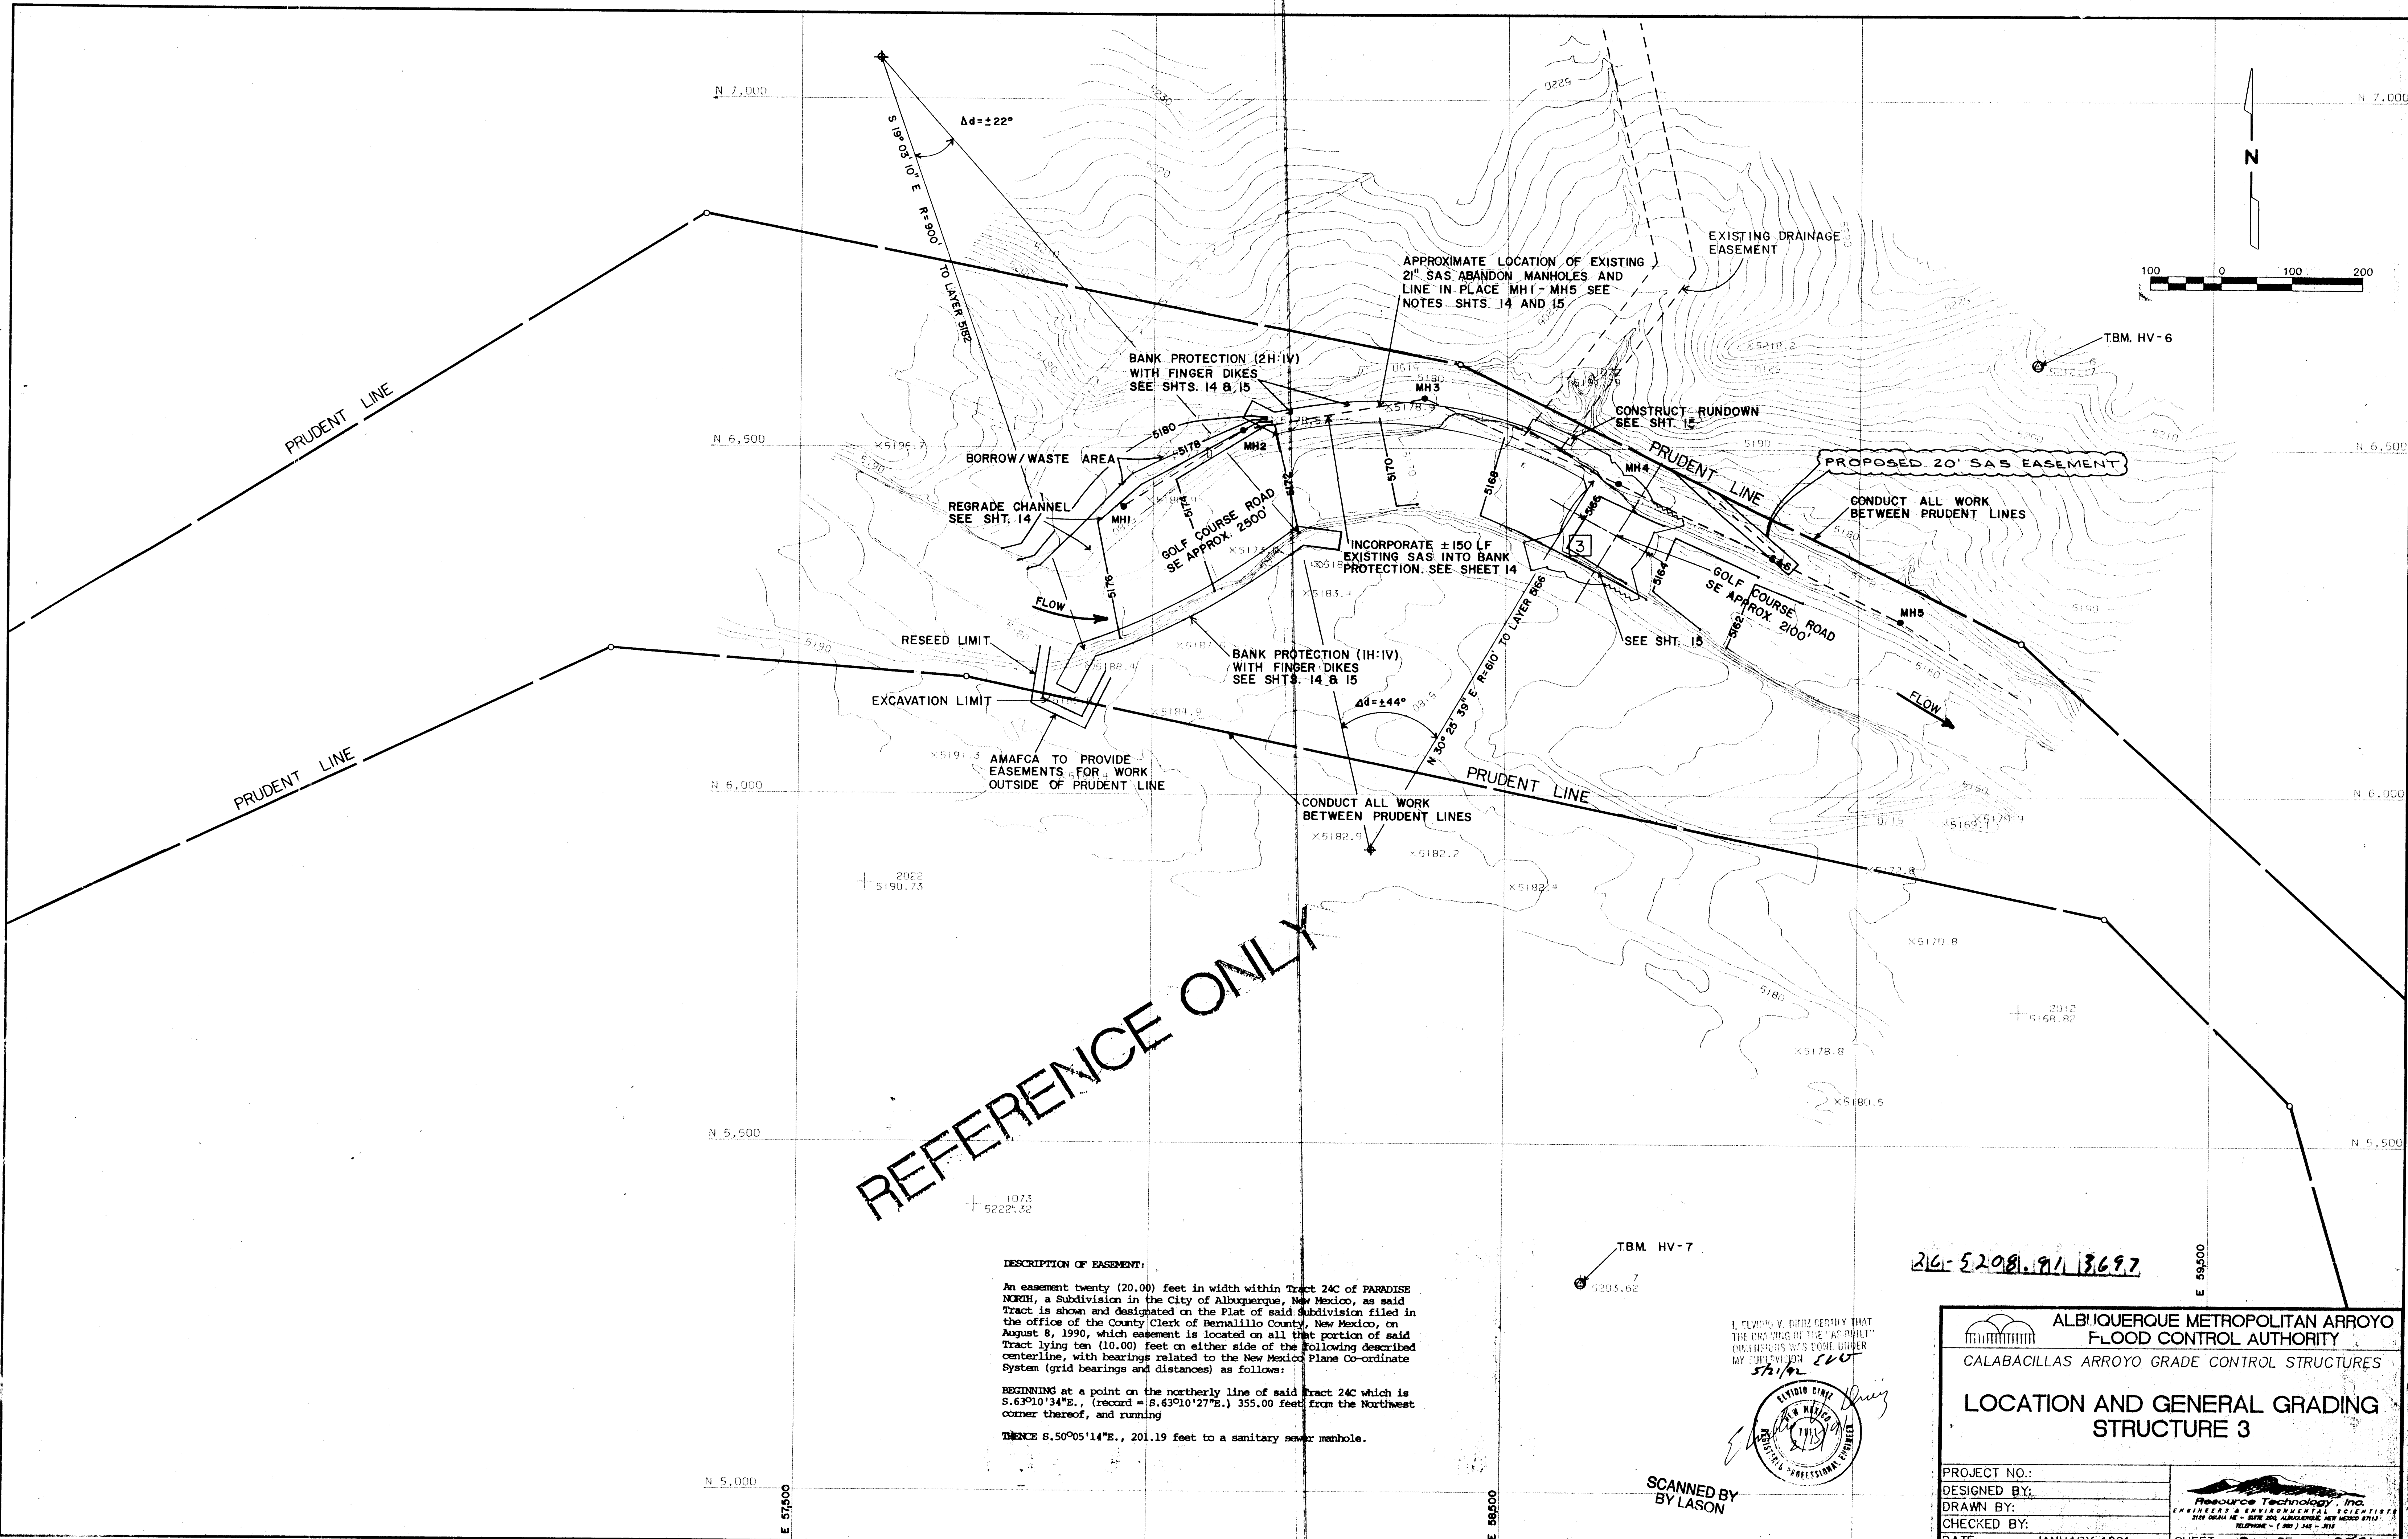

REFERENCE ONLY

DESCRIPTION OF EASEMENT:
An easement twenty (20.00) feet in width within Tract 24C of PARADISE NORTH, a Subdivision in the City of Albuquerque, New Mexico, as said Tract is shown and designated on the Plat of said Subdivision filed in the office of the County Clerk of Bernalillo County, New Mexico, on August 8, 1990, which easement is located on all that portion of said Tract lying ten (10.00) feet on either side of the following described centerline, with bearings related to the New Mexico Plane Co-ordinate System (grid bearings and distances) as follows:
BEGINNING at a point on the northerly line of said Tract 24C which is S.63°10'34"E., (record = S.63°10'27"E.) 355.00 feet from the Northwest corner thereof, and running
THENCE S.50°05'14"E., 201.19 feet to a sanitary sewer manhole.

I, CLAYTON V. GIBBS CERTIFY THAT THE DRAWING OF THE "AS BUILT" EASEMENT WAS DONE UNDER MY SUPERVISION
5/11/92



SCANNED BY LASON

216-5208.91 13697

ALBUQUERQUE METROPOLITAN ARROYO FLOOD CONTROL AUTHORITY	
CALABACILLAS ARROYO GRADE CONTROL STRUCTURES	
LOCATION AND GENERAL GRADING STRUCTURE 3	
PROJECT NO.:	
DESIGNED BY:	
DRAWN BY:	
CHECKED BY:	
DATE:	JANUARY 1991
SHEET 9 OF 2021	