

LA CUEVA OESTE

UNIT 1

Albuquerque, New Mexico

Prepared for:
Development Services, Ltd.
P. O. Box 30107
Albuquerque, NM 87190-0107

August, 1995

Prepared by:
Terry O. Brown, P.E.
P. O. Box 92051
Albuquerque, NM 87199

GENERAL NOTES:

1. ALL WORK DETAILED ON THESE PLANS TO BE PERFORMED UNDER CONTRACT SHALL, EXCEPT AS OTHERWISE STATED OR PROVIDED FOR HEREON, BE CONSTRUCTED IN ACCORDANCE WITH THE CITY OF ALBUQUERQUE STANDARD SPECIFICATIONS FOR PUBLIC WORKS CONSTRUCTION, 1986 EDITION W/UPDATE #6.
2. PRIOR TO CONSTRUCTION, THE CONTRACTOR SHALL EXCAVATE & VERIFY THE HORIZONTAL AND VERTICAL LOCATIONS OF ALL OBSTRUCTIONS. SHOULD A CONFLICT EXIST, THE CONTRACTOR SHALL NOTIFY THE ENGINEER SO THAT THE CONFLICT CAN BE RESOLVED WITH MINIMUM DELAY.
3. TWO (2) WORKING DAYS PRIOR TO ANY EXCAVATION, CONTRACTOR SHALL CONTACT LINE LOCATING SERVICE @ 260-1990 FOR LOCATION OF EXISTING UTILITIES.
4. CONTRACTOR SHALL SUPPORT ALL EXISTING UNDERGROUND UTILITY LINES WHICH BECOME EXPOSED DURING CONSTRUCTION. PAYMENT FOR SUPPORTING WORK SHALL BE INCIDENTAL TO WATERLINE AND / OR SEWERLINE COSTS.
5. ALL STATIONING REFERS TO STREET CENTERLINE STATIONING.
6. CONTRACTOR SHALL CONDUCT OPERATIONS IN A MANNER WHICH WILL MINIMIZE INTERFERENCE WITH LOCAL TRAFFIC. CONTRACTOR SHALL COMPLY WITH ALL APPLICABLE LAWS, ORDINANCES, RULES, REGULATIONS, AND ORDERS OF ANY PUBLIC BODY HAVING JURISDICTION FOR THE SAFETY OF PERSONS OR PROPERTY, AND TO PROTECT THEM FROM DAMAGE, INJURY, OR LOSS. CONTRACTOR SHALL ERECT AND MAINTAIN, AS REQUIRED BY THE CONDITIONS AND PROGRESS OF THE WORK, ALL NECESSARY SAFEGUARDS FOR SAFETY CONTINUOUSLY AND NOT LIMITED TO NORMAL WORKING HOURS, THROUGHOUT THE DURATION OF THE PROJECT. CONTRACTOR SHALL ADHERE TO SECTION 19 (CONSTRUCTION TRAFFIC CONTROL) OF THE GENERAL CONDITIONS OF THE CITY OF ALBUQUERQUE STANDARD SPECIFICATIONS FOR PUBLIC WORKS CONSTRUCTION, 1986 EDITION W/UPDATE #6.
7. PROPOSED WATERLINE MATERIALS SHALL BE EITHER P.V.C. PIPE MEETING AWWA C900 REQUIREMENTS (6" - 12" DIAM.) OR DUCTILE IRON PIPE, THICKNESS CLASS 50 (6" - 16" DIAM.).

8. THE CONTRACTOR AGREES THAT HE SHALL ASSUME THE SOLE AND COMPLETE RESPONSIBILITY FOR THE JOB SITE CONDITIONS DURING THE COURSE OF CONSTRUCTION OF THIS PROJECT, INCLUDING SAFETY OF ALL PERSONS AND PROPERTY; THAT THIS REQUIREMENT SHALL APPLY CONTINUOUSLY AND NOT BE LIMITED TO NORMAL WORKING HOURS; AND THAT THE CONTRACTOR SHALL DEFEND, INDEMNIFY, AND HOLD HARMLESS THE OWNER & ENGINEER FROM ANY AND ALL LIABILITY REAL OR ALLEGED, IN CONNECTION WITH THE PERFORMANCE OF WORK ON THIS PROJECT, EXCEPTING LIABILITY ARISING FROM THE SOLE NEGLIGENCE OF THE OWNER OR ENGINEER.
9. THREE (3) WORKING DAYS PRIOR TO BEGINNING CONSTRUCTION THE CONTRACTOR SHALL SUBMIT TO THE CONSTRUCTION CO-ORDINATION DIVISION A DETAILED CONSTRUCTION SCHEDULE. TWO (2) WORKING DAYS PRIOR TO CONSTRUCTION THE CONTRACTOR SHALL OBTAIN A BARRICADING PERMIT FROM THE CONSTRUCTION CO-ORDINATION DIVISION. CONTRACTOR SHALL NOTIFY BARRICADE ENGINEER (768-2551) PRIOR TO OCCUPYING AN INTERSECTION. SEE SECTION 19 OF THE SPECIFICATIONS. ALL STREET STRIPING ALTERED OR DESTROYED SHALL BE REPLACED IN KIND BY CONTRACTOR TO LOCATION AND IN KIND AS EXISTING OR AS INDICATED BY THIS PLAN SET.
10. CONTRACTOR SHALL PROMPTLY CLEAN UP ANY MATERIAL EXCAVATED WITHIN THE PUBLIC RIGHT-OF-WAY SO THAT THE EXCAVATED MATERIAL IS NOT SUSCEPTIBLE TO BEING WASHED DOWN THE STREET.
11. CONTRACTOR SHALL ASSIST THE ENGINEER / INSPECTOR IN THE RECORDING OF DATA ON ALL UTILITY LINES AND ACCESSORIES AS REQUIRED BY THE CITY OF ALBUQUERQUE FOR THE PREPARATION OF RECORD DRAWINGS. CONTRACTOR SHALL NOT COVER UTILITY LINES AND ACCESSORIES UNTIL ALL DATA HAS BEEN OBTAINED AND RECORDED.
12. EXISTING CURB AND GUTTER NOT CALLED OUT TO BE REMOVED UNDER THE CONTRACT WHICH IS DAMAGED OR DISPLACED BY THE CONTRACTOR SHALL BE REMOVED AND REPLACED BY THE CONTRACTOR AT HIS OWN EXPENSE.
13. ALL WORK ON THIS PROJECT SHALL BE PERFORMED IN ACCORDANCE WITH APPLICABLE FEDERAL, STATE, AND LOCAL LAWS, RULES, AND REGULATIONS CONCERNING CONSTRUCTION SAFETY AND HEALTH.
14. ALL FITTINGS ON WATERLINES SHALL HAVE JOINT RESTRAINT IN ACCORDANCE WITH THE JOINT RESTRAINT LENGTHS TABLE ON SHEET 4 EXCEPT WHERE SPECIFICALLY INDICATED TO HAVE LOCKED MECHANICAL JOINTS OR CONCRETE BLOCKING.

15. THE CONTRACTOR SHALL SUPPORT AND MAINTAIN THE INTEGRITY OF ALL UTILITIES AT NO ADDITIONAL COST TO THE OWNER. ANY UTILITY RELOCATION THAT IS NECESSARY IS TO BE COORDINATED WITH THE UTILITY OWNER AND SHALL BE PAID FOR AS OUTLINED IN THE SPECIAL PROVISIONS OF THE CONTRACT DOCUMENTS.

16. THE CONTRACTOR IS RESPONSIBLE FOR PROTECTING AND MAINTAINING ALL EXISTING MONUMENTATION CONTROLS. IN THE EVENT OF INADVERTENT DESTRUCTION OR ALTERATION, THE CONTRACTOR MUST IMMEDIATELY NOTIFY THE CITY CHIEF SURVEYOR.



17. PNM (PUBLIC SERVICE CO. OF NEW MEXICO) WILL PROVIDE AT NO COST TO THE CITY OR TO THE CONTRACTOR THE REQUIRED PERSONNEL FOR INSPECTION OR OBSERVATION DEEMED NECESSARY BY PNM WHILE THE CONTRACTOR IS EXPOSING PNM'S CABLES. HOWEVER, THEN CONTRACTOR SHALL BE CHARGED THE TOTAL COST ASSOCIATED WITH REPAIRS TO ANY DAMAGES CABLES OR FOR ANY COST ASSOCIATED WITH SUPPORTING OR RELOCATING THE POLES AND CABLES DURING CONSTRUCTION.

18. ** WARNING ** - EXISTING UTILITY LINE LOCATIONS ARE SHOWN IN APPROXIMATE MANNER ONLY, AND SUCH LINES MAY EXIST WHERE NONE ARE SHOWN. THE LOCATION OF ANY SUCH EXISTING LINES IS BASED UPON INFORMATION PROVIDED BY THE UTILITY COMPANY, THE OWNER, OR BY OTHERS, AND THE INFORMATION MAY BE INCOMPLETE OR MAY BE OBSOLETE BY THE TIME CONSTRUCTION COMMENCES.

THE ENGINEER HAS UNDERTAKEN NO FIELD VERIFICATION OF THE LOCATION, DEPTH, SIZE, OR TYPE OF EXISTING UNDERGROUND UTILITY LINES, MAKES NO REPRESENTATION PERTAINING THERETO, AND ASSUMES NO RESPONSIBILITY OR LIABILITY THEREFOR. THE CONTRACTOR SHALL INFORM HIMSELF OF THE LOCATION OF ANY UTILITY LINE IN OR NEAR THE AREA OF THE WORK IN ADVANCE OF AND DURING EXCAVATION WORK. THE CONTRACTOR IS FULLY RESPONSIBLE FOR ANY AND ALL DAMAGE CAUSED BY ITS FAILURE TO LOCATE, IDENTIFY, AND PRESERVE ANY AND ALL EXISTING UTILITIES. THE CONTRACTOR SHALL COMPLY WITH STATE STATUTES, MUNICIPAL AND LOCAL ORDINANCES, RULES AND REGULATIONS PERTAINING TO THE LOCATION OF THESE LINES AND FACILITIES, IN PLANNING AND CONDUCTING EXCAVATION, WHETHER BY CALLING OR NOTIFYING THE UTILITIES, COMPLYING WITH "BLUE STAKES" PROCEDURES, OR OTHERWISE.

19. ANY CONSTRUCTION OCCURRING WITHIN AN ARTERIAL ROADWAY REQUIRES TWENTY-FOUR HOUR CONSTRUCTION.

C of A PWD Maps & Records
1 2 3 4 5 6 7 8 9 10 11 12
26-52321-90 0196

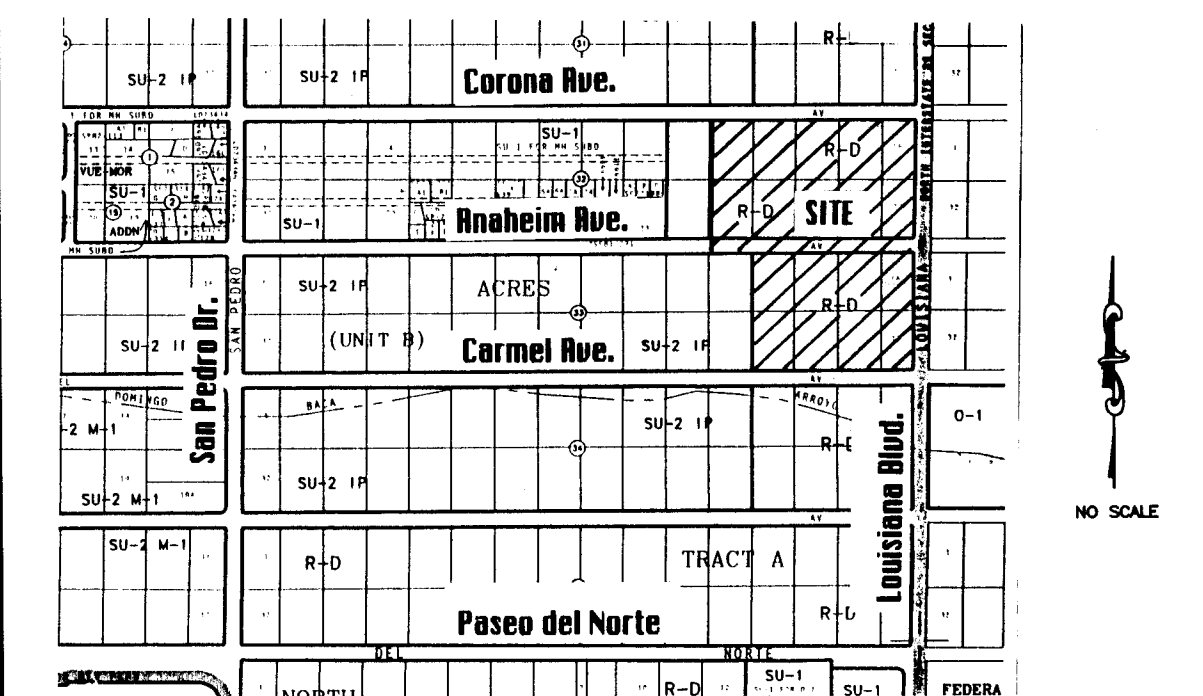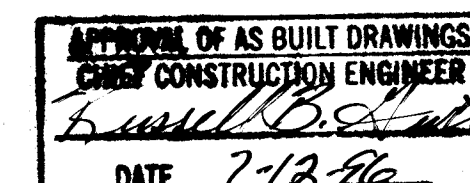

VICINITY MAP

C-18-Z

INDEX TO DRAWINGS

SHEET	DESCRIPTION
1	COVER SHEET
2	PLAT
2a	GRADING PLAN
3	MASTER UTILITY AND PAVING LAYOUT
4	MISCELLANEOUS TABLES
5	PAVING PLAN AND PROFILE LOUISIANA BLVD.-STA:10+00 TO STA:22+50
6	PAVING PLAN AND PROFILE LOUISIANA BLVD.-STA:22+50 TO STA:33+39.01
7	PAVING PLAN AND PROFILE CORONA AVE.-STA:24+50 TO STA:36+43.15
8	PAVING PLAN AND PROFILE - CARMEL AVE.
9	PAVING PLAN AND PROFILE - ANAHEIM AVE. (WEST), ANAHEIM AVE.(EAST) & WARP DR.
10	PAVING PLAN AND PROFILE - MILKY WAY DR.
11	PAVING PLAN AND PROFILE - NEPTUNE DR.
12	PAVING PLAN AND PROFILE TAURUS DR. / MARS ST.
13	PAVING PLAN AND PROFILE - VENUS ST.
14	UTILITY PLAN AND PROFILE LOUISIANA BLVD.-STA:10+00 TO STA:22+50
15	UTILITY PLAN AND PROFILE LOUISIANA BLVD.-STA:22+50 TO STA:33+39.01
16	UTILITY PLAN AND PROFILE CARMEL AVE.-STA:9+75 TO STA:23+00
17	UTILITY PLAN AND PROFILE CARMEL AVE.-STA:23+00 TO STA:36+40.46
18	UTILITY PLAN AND PROFILE CORONA AVE.-STA:10+00 TO STA:23+50
19	UTILITY PLAN AND PROFILE CORONA AVE.-STA:23+50 TO STA:36+43.15
20	UTILITY PLAN AND PROFILE - ANAHEIM AVE. (WEST), ANAHEIM AVE.(EAST) & WARP DR.
21	UTILITY PLAN AND PROFILE TAURUS DR. / MARS ST.
22	UTILITY PLAN AND PROFILE - MILKY WAY DR.
23	UTILITY PLAN AND PROFILE - NEPTUNE DR.
24	UTILITY PLAN AND PROFILE - VENUS ST.
25	STREET DETAILS
26	STREET / DRAINAGE DETAILS
27	WHEELCHAIR RAMP DETAILS / TABLE
28 (1SD)	STORM DRAINAGE PLAN & PROFILE LOUISIANA BLVD. & MARS ST.
29 (2SD)	STORM DRAINAGE PLAN & PROFILE NEPTUNE ST. & VENUS ST.

Terry O. Brown
8/16/95

26-52321-90 0196


CITY OF ALBUQUERQUE
PUBLIC WORKS DEPARTMENT
ENGINEERING GROUP

TITLE: LA CUEVA OESTE, UNIT 1
IMPROVEMENT PLANS

Terry O. Brown, P.E.
P. O. Box 92051
Albuquerque, NM 87199
(505) 883-8807

APPROVED FOR
CONSTRUCTION

PROJECT NO.	5232.90	MAP NO.	C-18-Z	SHEET	1 of 29
-------------	---------	---------	--------	-------	---------

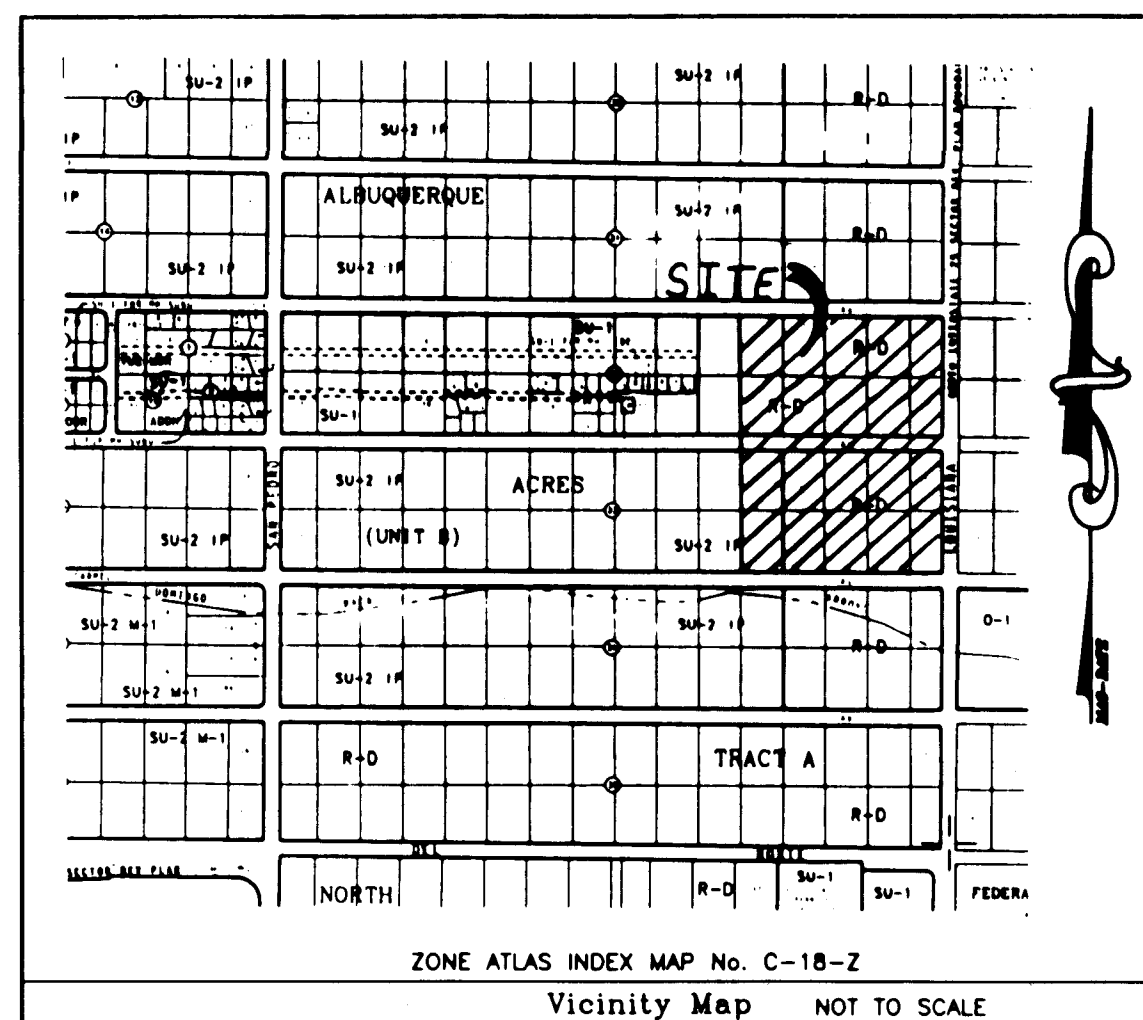


D.R.B.-94-597

SURVEYOR'S CERTIFICATE

I, Jerry Nickels, a Registered Professional Land Surveyor under the Laws of the State of New Mexico, do hereby certify that this Plat was prepared by me, meets the minimum requirements of monumentation and surveys of the Albuquerque Subdivision Ordinance, and that it is true and correct to the best of my knowledge and belief.

Jerry Nickels, N.M. L.S. No. 6256 February 17, 1995

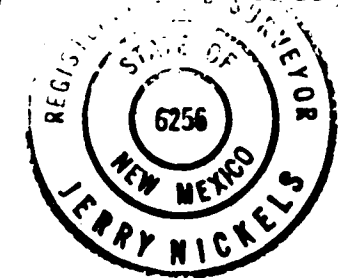



NOTES

- UNLESS OTHERWISE NOTED, ALL BOUNDARY CORNERS SHOWN THIS PLAT WILL BE MARKED BY A NO. 5 IRON REBAR WITH PLASTIC CAP STAMPED "P.L.S. NO. 6256".
- ALL STREET CENTERLINE POINT SHOWN THIS PLAT WILL BE MARKED BY A 4" ALUMINUM DISK STAMPED "CENTERLINE MONUMENT, P.L.S. NO. 6256".
- BOUNDARY WILL BE TIED TO THE NEW MEXICO STATE PLANE COORDINATE SYSTEM AS SHOWN.
- BASIS OF BEARINGS WILL BE NMSP GRID BEARINGS.
- DISTANCES WILL BE GROUND DISTANCES.
- MANHOLES WILL BE OFFSET AT ALL POINTS OF CURVATURE, POINTS OF TANGENCY, STREET INTERSECTIONS AND ALL OTHER ANGLE POINTS TO ALLOW USE OF CENTERLINE MONUMENTATION.

APPROVED FOR MONUMENTATION AND STREET NAMES

Will Clark 021795
CITY SURVEYOR Date

ACS STA. No. 11-D-18
Y=1518764.72
X=402300.89
Z=5235.67
N.M. State Plane
Coordinates (Central Zone)
C.F. = 0.99966051
dX = -0.001118"
Datum = 1927 N.A.D.

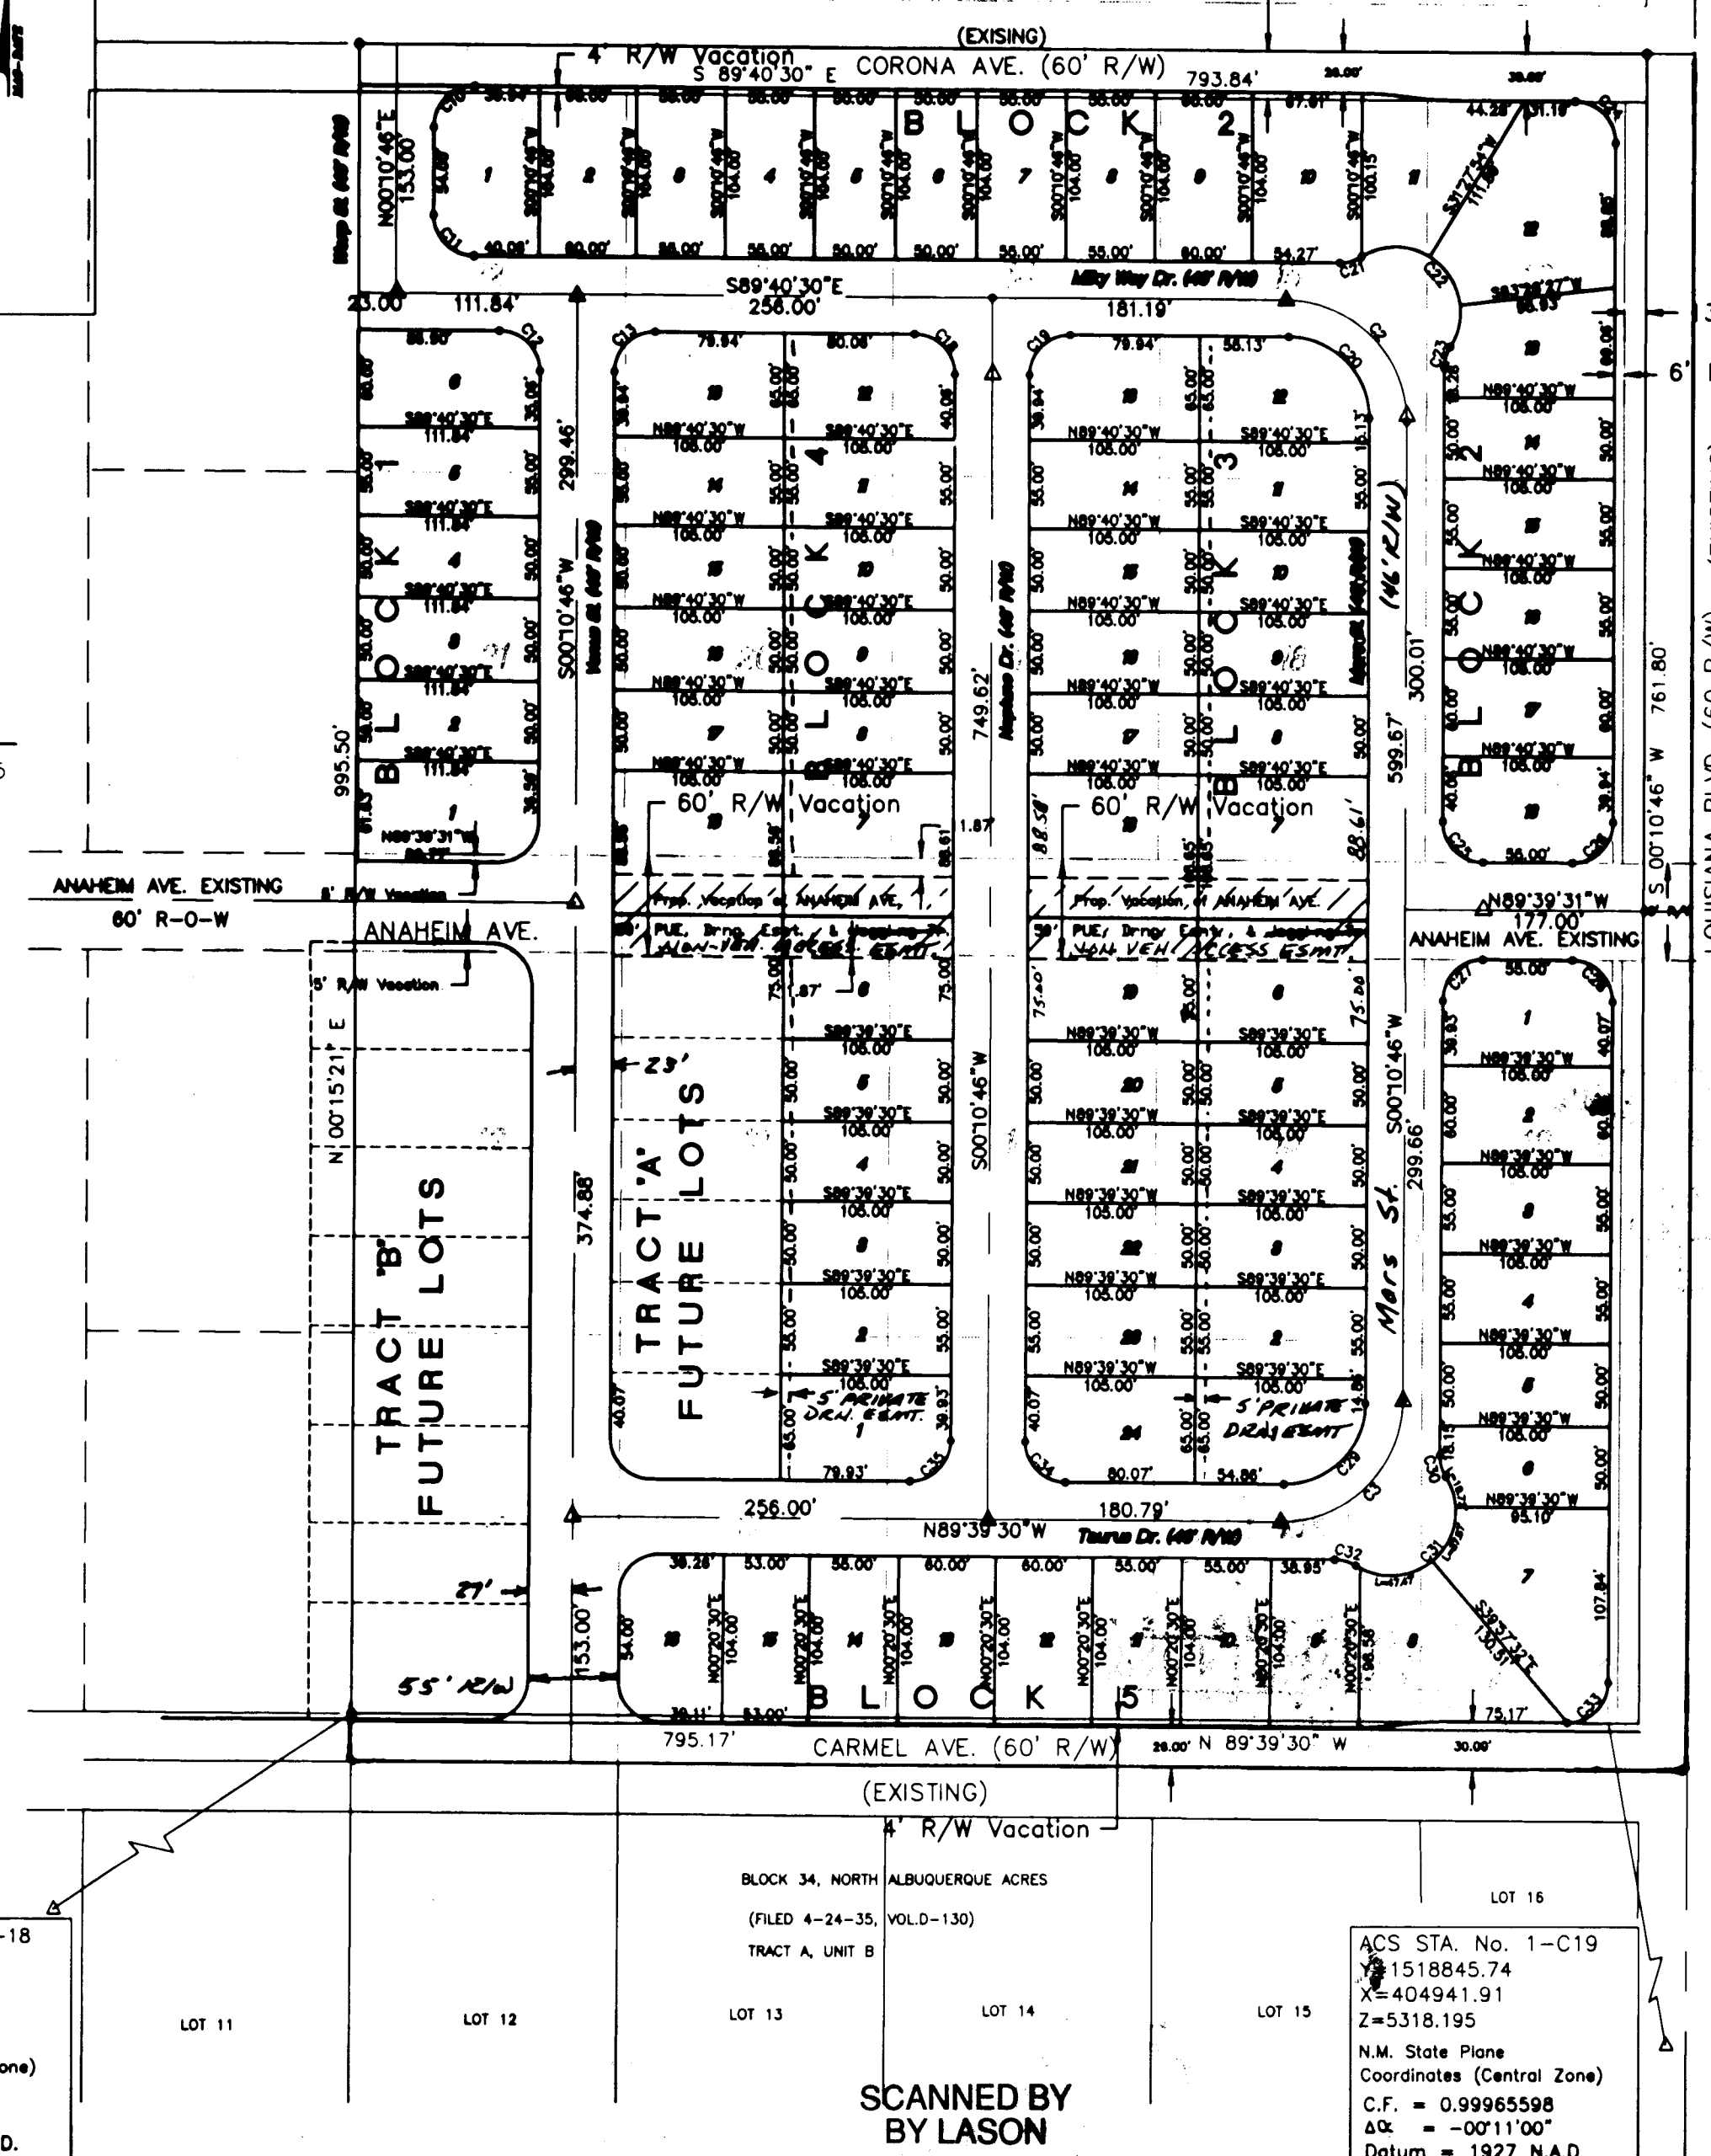
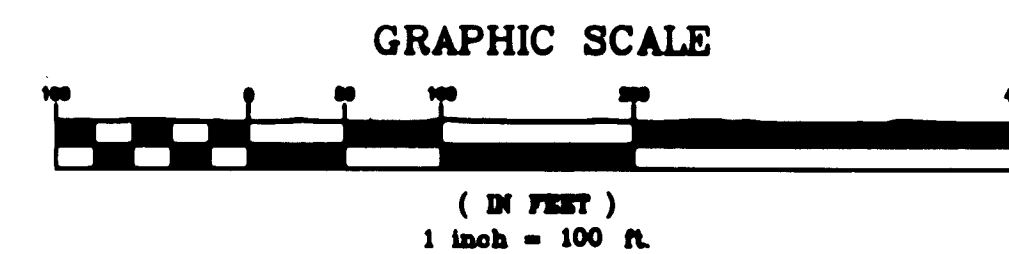


SCANNED BY
BY LASON

ACS STA. No. 1-C19
Y=1518845.74
X=404941.91
Z=5318.195
N.M. State Plane
Coordinates (Central Zone)
C.F. = 0.99965598
dX = -0.0011100"
Datum = 1927 N.A.D.

PRELIMINARY PLAT OF La Cueva Oeste Unit One ALBUQUERQUE, NEW MEXICO JUNE, 1995

STATION	CHORD BEARING	RADIUS	LENGTH	TANGENT	CHORD	DELTA
1+00.00	N 89° 40' 30" E	75.00	11.84	7.21	11.84	7.21
1+11.84	S 89° 40' 30" E	75.00	11.84	7.21	11.84	7.21
1+23.68	N 89° 40' 30" E	75.00	11.84	7.21	11.84	7.21
1+35.52	S 89° 40' 30" E	75.00	11.84	7.21	11.84	7.21
1+47.36	N 89° 40' 30" E	75.00	11.84	7.21	11.84	7.21
1+59.20	S 89° 40' 30" E	75.00	11.84	7.21	11.84	7.21
1+71.04	N 89° 40' 30" E	75.00	11.84	7.21	11.84	7.21
1+82.88	S 89° 40' 30" E	75.00	11.84	7.21	11.84	7.21
1+94.72	N 89° 40' 30" E	75.00	11.84	7.21	11.84	7.21
1+106.56	S 89° 40' 30" E	75.00	11.84	7.21	11.84	7.21
1+118.40	N 89° 40' 30" E	75.00	11.84	7.21	11.84	7.21
1+130.24	S 89° 40' 30" E	75.00	11.84	7.21	11.84	7.21
1+142.08	N 89° 40' 30" E	75.00	11.84	7.21	11.84	7.21
1+153.92	S 89° 40' 30" E	75.00	11.84	7.21	11.84	7.21
1+686.72	N 89° 40' 30" E	75.00	11.84	7.21	11.84	7.21
1+698.56	S 89° 40					

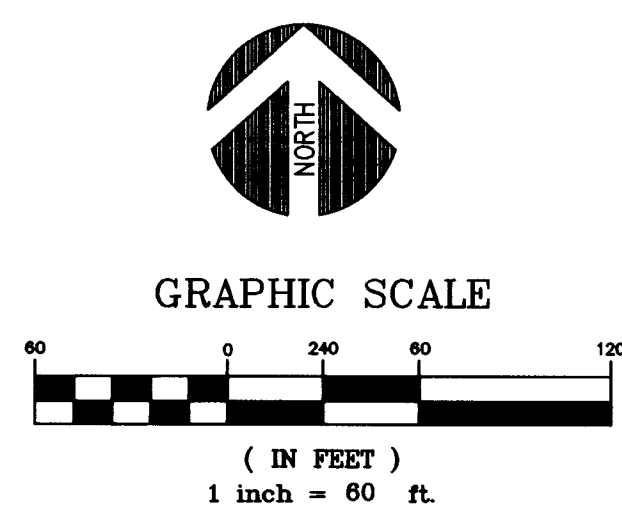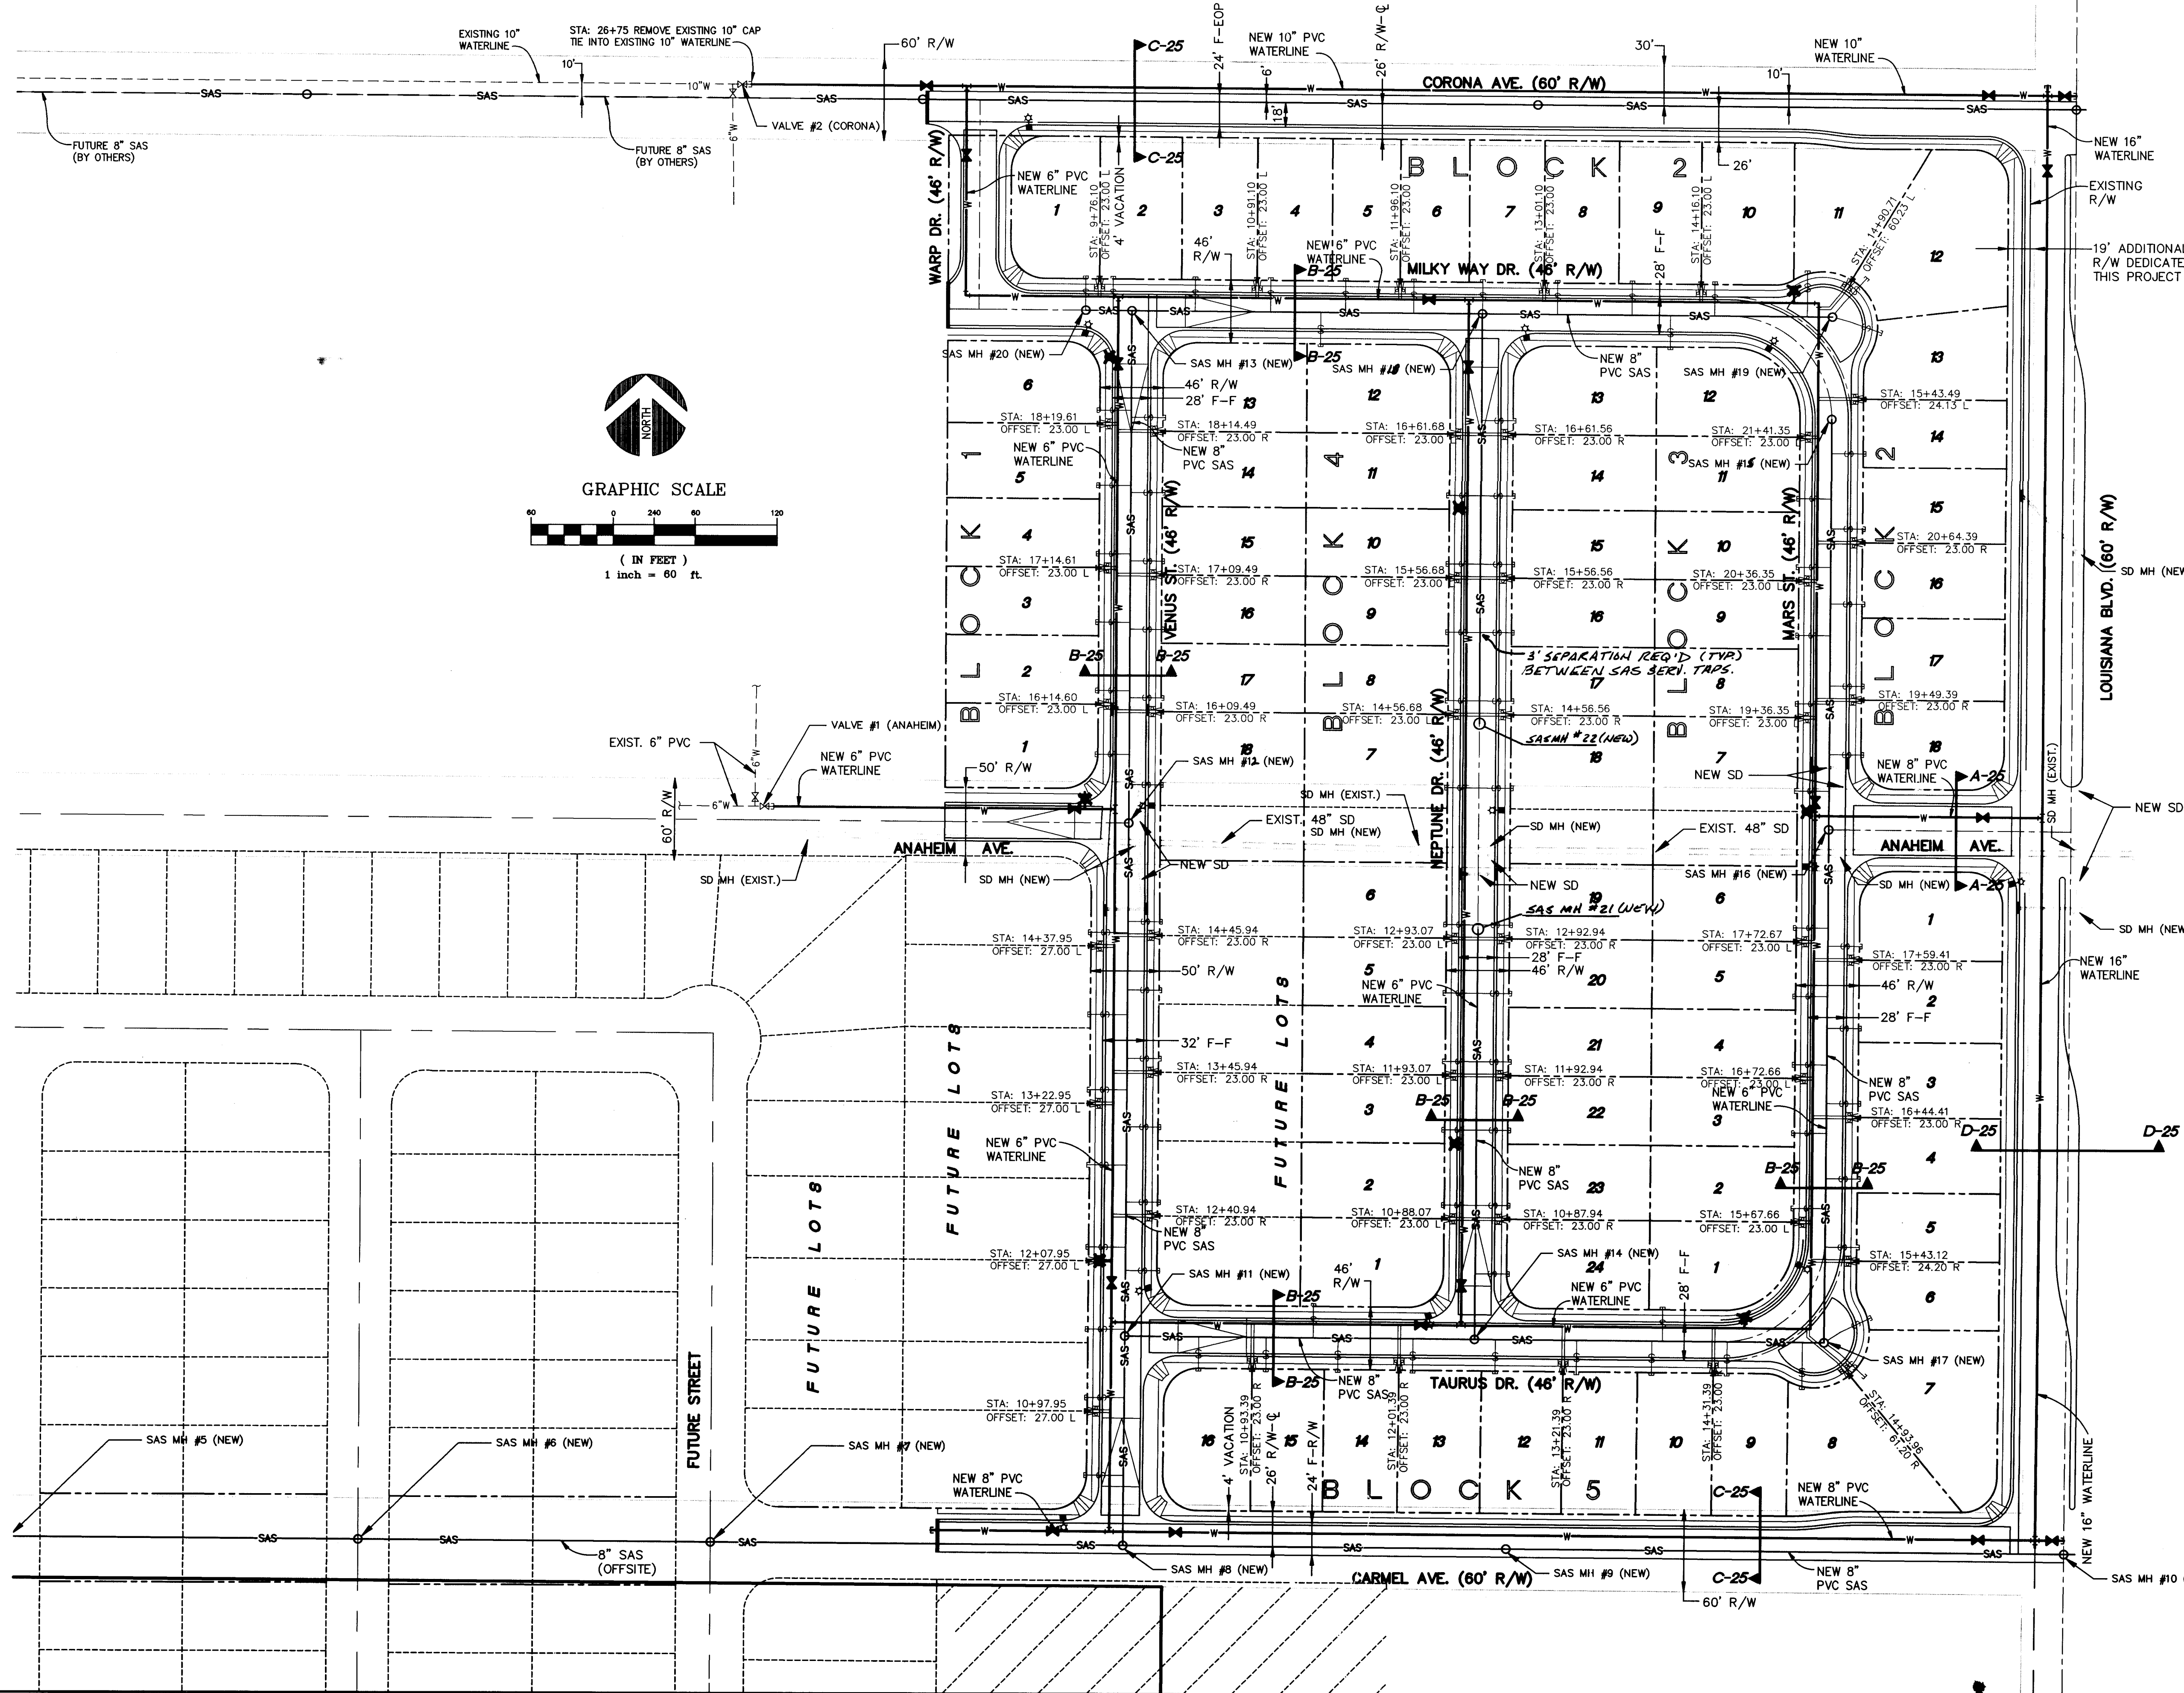


LEGEND	
NEW CURB & GUTTER	---
NEW SAS MAINLINE	—SAS—
NEW SAS SERVICE LINE	—S—
NEW SAS MANHOLE	○
NEW WATER MAINLINE	—W—
NEW WATER SERVICE LINE	—WS—
NEW GATE VALVE	⋈
NEW FIRE HYDRANT	⋈
NEW STREET LIGHT	⋈
NEW VALLEY GUTTER	---

- WATER AND SEWER NOTES
1. CONSTRUCT 4" TYPE "C" MANHOLES PER STD. DWG.# 2101.
 2. CONSTRUCT SAS SERVICE LINES PER STD. DWG.# 2125.
 3. CONSTRUCT ALL CONCRETE BLOCKING PER STD. DWG.# 2320.
 4. CONSTRUCT ALL VALVE BOXES PER C.O.A. VALVE BOX DETAIL DWG.# 2325. USE TAPERED CONC. COLLAR IN UNPAVED AREAS.
 5. CONSTRUCT ALL FIRE HYDRANTS PER DESIGNATED DEPTHS AND LENGTHS PER STD. DWG.# 2340.
 6. CONSTRUCT ALL SINGLE AND DOUBLE WATER SERVICE LINES PER STD. DWG.# 2361, 2362 AND 2363.
 7. SEE SHEET 4 FOR SAS AND WATER SERVICE INFORMATION.
 - *8. RESTRAINT DISTANCES FOR PIPE FITTINGS SHALL BE DEFINED BY TABLE ON SHEET 4.

WATER SHUTOFF PLAN

VALVE #1 (ANAHEIM) AND VALVE #2 (CORONA) SHALL BE CLOSED PRIOR TO TIE INTO EXISTING 6" AND/OR 10" WATERLINES ON ANAHEIM AND CORONA. CONTRACTOR SHALL NOTIFY CITY 48 HOURS IN ADVANCE OF TIME OF SHUTOFF. CONTRACTOR SHALL NOT OPERATE VALVES. ONLY CITY PERSONNEL WILL BE PERMITTED TO OPERATE VALVES.

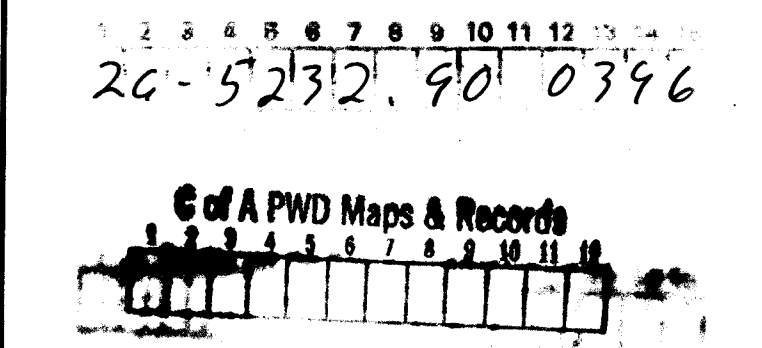

Terry O. Brown, P.E.
P. O. Box 92051
Albuquerque, NM 87199
(505) 883-8807

CITY OF ALBUQUERQUE
PUBLIC WORKS DEPARTMENT
ENGINEERING GROUP

TITLE: LA CUEVA OESTE, UNIT 1
MASTER UTILITY AND PAVING LAYOUT

APPROVALS	ENGINEER	DATE	APPROVALS	ENGINEER	DATE
DRC CHAIRMAN	3/9/95	10-3-95	WATER	3/17/95	3/17/95
TRANSPORTATION	3/17/95		WASTE WATER	3/17/95	
HYDROLOGY	3/17/95				

PROJECT NO.	5232.90	MAP NO.	C-18-Z	SHEET	3	OF	29
-------------	---------	---------	--------	-------	---	----	----

AS BUILT INFORMATION

CONTRACTOR: New Concepts

WORK ORDER: COA

INSPECTOR: L. Ramero

DATE: 3/17/95

ACCEPTANCE BY: L. Ramero

DATE: 3/17/95

DESIGNED BY: L. Ramero

DATE: 3/17/95

DRAWN BY: L. Ramero

DATE: 3/17/95

CHECKED BY: L. Ramero

DATE: 3/17/95

RECORDED BY: L. Ramero

DATE: 3/17/95

NO.

BENCH MARKS

ACS STA. No. 1-C19

Y=1518845.74

X=404941.91

Z=5318.195

SURVEY INFORMATION

FIELD NOTES

DATE

BY

NO.

ENGINEER'S SEAL

8/16/95

BY

REMARKS

DESIGN

NO.

DATE

DESIGNED BY: TOB

DATE: 08/95

DRAWN BY: TOB

DATE: 08/95



CHECKED BY: TOB

DATE: 08/95

SANITARY SEWER SERVICE TABLE - LA CUEVA OESTE, UNIT 1						
Block 1						
Lot No.	Street	SAS Serv. Sta.	Offset to PL	Elev. FL Curb	Elev. SAS Inv. @ PL	
1	Venus St.	15+78.01	23' Lt.	5282.75	5278.75	
2	Venus St.	16+24.60	23' Lt.	5282.71	5278.71	
3	Venus St.	16+74.60	23' Lt.	5282.89	5278.89	
4	Venus St.	17+24.61	23' Lt.	5283.18	5279.18	
5	Venus St.	17+74.61	23' Lt.	5283.47	5279.47	
6	Venus St.	18+29.61	23' Lt.	5283.79	5279.79	
Block 2						
Lot No.	Street	SAS Serv. Sta.	Offset to PL	Elev. FL Curb	Elev. SAS Inv. @ PL	
1	Milky Way Dr.	9+66.10	23' Lt.	5284.47	5280.47	
2	Milky Way Dr.	9+86.10	23' Lt.	5284.14	5280.14	
3	Milky Way Dr.	10+46.10	23' Lt.	5284.18	5280.18	
4	Milky Way Dr.	11+01.10	23' Lt.	5285.77	5281.77	
5	Milky Way Dr.	11+56.10	23' Lt.	5287.67	5283.67	
6	Milky Way Dr.	12+06.10	23' Lt.	5289.39	5285.39	
7	Milky Way Dr.	12+56.10	23' Lt.	5291.11	5287.11	
8	Milky Way Dr.	13+11.10	23' Lt.	5293.01	5289.01	
9	Milky Way Dr.	13+66.10	23' Lt.	5294.74	5290.74	
10	Milky Way Dr.	14+26.10	23' Lt.	5296.25	5292.25	
11	Milky Way Dr.	14+73.81	45.5' Lt.	5297.45	5293.45	
12	Milky Way Dr.	14+94.77	61.0' Lt.	5297.97	5293.97	
13	Milky Way Dr.	15+14.77	50.6' Lt.	5298.46	5294.46	
14	Mars St.	21+29.39	23' Rt.	5300.10	5296.10	
15	Mars St.	20+74.39	23' Rt.	5301.06	5297.06	
16	Mars St.	20+19.39	23' Rt.	5301.04	5297.04	
17	Mars St.	19+59.39	23' Rt.	5300.59	5296.59	
18	Mars St.	19+09.33	23' Rt.	5300.29	5296.29	
Block 3						
Lot No.	Street	SAS Serv. Sta.	Offset to PL	Elev. FL Curb	Elev. SAS Inv. @ PL	
1	Taurus Dr.	13+93.94	23' Lt.	5297.43	5293.43	
2	Mars St.	15+77.66	23' Lt.	5301.95	5297.95	
3	Mars St.	16+32.66	23' Lt.	5301.75	5297.75	
4	Mars St.	16+82.66	23' Lt.	5301.45	5297.45	
5	Mars St.	17+32.67	23' Lt.	5301.15	5297.15	
6	Mars St.	17+82.67	23' Lt.	5300.85	5296.85	
7	Mars St.	18+82.67	23' Lt.	5300.29	5296.29	
8	Mars St.	19+46.35	23' Lt.	5300.50	5296.50	
9	Mars St.	19+96.35	23' Lt.	5300.87	5296.87	
10	Mars St.	20+46.35	23' Lt.	5301.17	5297.17	
11	Mars St.	20+96.35	23' Lt.	5300.79	5296.79	
12	Milky Way Dr.	13+94.06	23' Rt.	5295.45	5291.45	
13	Neptune St.	16+71.56	23' Rt.	5292.03	5288.03	
14	Neptune St.	16+16.56	23' Rt.	5292.42	5288.42	
15	Neptune St.	15+66.56	23' Rt.	5292.76	5288.76	
16	Neptune St.	15+16.56	23' Rt.	5293.07	5289.07	
17	Neptune St.	14+66.56	23' Rt.	5292.91	5288.91	
18	Neptune St.	14+02.94	23' Rt.	5292.49	5288.49	
19	Neptune St.	13+02.94	23' Rt.	5292.32	5288.32	
20	Neptune St.	12+52.94	23' Rt.	5292.86	5288.86	
21	Neptune St.	12+02.94	23' Rt.	5293.42	5289.42	
22	Neptune St.	11+52.94	23' Rt.	5293.98	5289.98	
23	Neptune St.	10+97.94	23' Rt.	5294.38	5290.38	
24	Neptune St.	10+47.86	23' Rt.	5294.09	5290.09	
Block 4						
Lot No.	Street	SAS Serv. Sta.	Offset to PL	Elev. FL Curb	Elev. SAS Inv. @ PL	
1	Taurus Dr.	11+37.94	23' Lt.	5289.81	5285.81	
2	Neptune St.	10+98.07	23' Lt.	5294.38	5290.38	
3	Neptune St.	11+53.07	23' Lt.	5293.97	5289.97	
4	Neptune St.	12+03.07	23' Lt.	5293.42	5289.42	
5	Neptune St.	12+53.07	23' Lt.	5292.86	5288.86	
6	Neptune St.	13+03.07	23' Lt.	5292.32	5288.32	
7	Neptune St.	14+03.07	23' Lt.	5287.04	5283.04	
8	Neptune St.	14+66.68	23' Lt.	5292.91	5288.91	
9	Neptune St.	15+16.68	23' Lt.	5293.06	5289.06	
10	Neptune St.	15+66.68	23' Lt.	5292.76	5288.76	
11	Neptune St.	16+16.68	23' Lt.	5292.42	5288.42	
12	Milky Way	11+38.06	23' Lt.	5287.04	5283.04	
13	Venus St.	18+24.49	23' Rt.	5283.76	5279.76	
14	Venus St.	17+69.49	23' Rt.	5283.44	5279.44	
15	Venus St.	17+19.49	23' Rt.	5283.15	5279.15	
16	Venus St.	16+69.49	23' Rt.	5282.86	5278.86	
17	Venus St.	16+19.49	23' Rt.	5282.71	5278.71	
18	Venus St.	15+55.94	23' Rt.	5282.85	5278.85	
19*	Venus St.	14+55.94	23' Rt.	5283.60	5279.60	
20*	Venus St.	14+05.94	23' Rt.	5284.00	5280.00	
21*	Venus St.	13+55.94	23' Rt.	5284.39	5280.39	
22*	Venus St.	13+05.94	23' Rt.	5284.79	5280.79	
23*	Venus St.	12+50.94	23' Rt.	5285.23	5281.23	
24*	Venus St.	12+00.87	23' Rt.	5285.63	5281.63	
Block 5						
Lot No.	Street	SAS Serv. Sta.	Offset to PL	Elev. FL Curb	Elev. SAS Inv. @ PL	
1	Mars St.	17+69.41	23' Rt.	5300.23	5296.23	
2	Mars St.	17+09.41	23' Rt.	5301.29	5297.29	
3	Mars St.	16+54.41	23' Rt.	5301.62	5297.62	
4	Mars St.	15+99.41	23' Rt.	5301.95	5297.95	
5	Mars St.	15+50.68	23' Rt.	5301.72	5297.72	
6	Mars St.	15+17.51	46.4' Rt.	5301.08	5297.08	
7	Mars St.	14+97.67	61.2' Rt.	5300.52	5296.52	
8	Taurus Dr.	14+74.89	47.6' Rt.	5299.81	5295.81	
9	Taurus Dr.	14+40.31	23' Rt.	5299.21	5295.21	
10	Taurus Dr.	13+86.39	23' Rt.	5297.57	5293.57	
11	Taurus Dr.	13+31.39	23' Rt.	5293.78	5289.78	
12	Taurus Dr.	12+71.39	23' Rt.	5293.02	5289.02	
13	Taurus Dr.	12+11.39	23' Rt.	5292.00	5288.00	
14	Taurus Dr.	11+56.39	23' Rt.	5290.36	5286.36	
15	Taurus Dr.	11+03.39	23' Rt.	5288.78	5284.78	
16	Taurus Dr.	10+54.14	23' Rt.	5287.31	5283.31	
Future Block						
Lot No.	Street	SAS Serv. Sta.	Offset to PL	Elev. FL Curb	Elev. SAS Inv. @ PL	
1*	Venus St.	10+51.15	27' Lt.	5285.51	5281.51	
2*	Venus St.	11+07.95	27' Lt.	5286.30	5282.30	
3*	Venus St.	11+57.95	27' Lt.	5285.97	5281.97	
4*	Venus St.	12+17.95	27' Lt.	5285.49	5281.49	
5*	Venus St.	12+77.95	27' Lt.	5285.02	5281.02	
6*	Venus St.	13+32.95	27' Lt.	5284.58	5280.58	
7*	Venus St.	13+87.95	27' Lt.	5284.14	5280.14	
8*	Venus St.	14+47.95	27' Lt.	5283.66	5279.66	
* - Services to Future Lots						

WATER SERVICE TABLE - LA CUEVA OESTE, UNIT 1					
Block 1					
Lot No.	Street	Type Service	CL Sta.	Offset to PL	
1 & 2	Venus St.	Double	16+14.60	23' Lt.	
3 & 4	Venus St.	Double	17+14.61	23' Lt.	
5 & 6	Venus St.	Double	18+19.61	23' Lt.	
Block 2					
Lot No.	Street		CL Sta.	Offset to PL	
1 & 2	Milky Way Dr.	Double	9+76.10	23' Lt.	
3 & 4	Milky Way Dr.	Double	10+91.10	23' Lt.	
5 & 6	Milky Way Dr.	Double	11+96.10	23' Lt.	
7 & 8	Milky Way Dr.	Double	13+01.10	23' Lt.	
9 & 10	Milky Way Dr.	Double	14+16.10	23' Lt.	
11 & 12	Milky Way Dr.	Double	14+90.71	60.23' Lt.	
13 & 14	Milky Way Dr.	Double	15+43.49	24.13' Rt.	
15 & 16	Mars St.	Double	20+64.39	23' Rt.	
17 & 18	Mars St.	Double	19+49.39	23' Rt.	
Block 3					
Lot No.	Street		CL Sta.	Offset to PL	
1 & 2	Mars St.	Double	15+67.66	23' Lt.	
3 & 4	Mars St.	Double	16+72.66	23' Lt.	
5 & 6	Mars St.	Double	17+72.67	23' Lt.	
7 & 8	Mars St.	Double	19+36.35	23' Lt.	
9 & 10	Mars St.	Double	20+36.35	23' Lt.	
11 & 12	Mars St.	Double	21+41.35	23' Lt.	
13 & 14	Neptune St.	Double	16+61.56	23' Rt.	
15 & 16	Neptune St.	Double	15+56.56	23' Rt.	
17 & 18	Neptune St.	Double	14+56.56	23' Rt.	
19 & 20	Neptune St.	Double	12+92.94	23' Rt.	
21 & 22	Neptune St.	Double	11+92.94	23' Rt.	
23 & 24	Neptune St.	Double	10+87.94	23' Rt.	
Block 4					
Lot No.	Street		CL Sta.	Offset to PL	
1 & 2	Neptune St.	Double	10+88.07	23' Lt.	
3 & 4	Neptune St.	Double	11+93.07	23' Lt.	
5 & 6	Neptune St.	Double	12+93.07	23' Lt.	
7 & 8	Neptune St.	Double	14+56.68	23' Lt.	
9 & 10	Neptune St.	Double	15+56.68	23' Lt.	
11 & 12	Neptune St.	Double	16+61.68	23' Lt.	
13 & 14	Venus St.	Double	18+14.49	23' Rt.	
15 & 16	Venus St.	Double	17+09.49	23' Rt.	
17 & 18	Venus St.	Double	16+09.49	23' Rt.	
19*	Venus St.	Double	14+45.94	23' Rt.	
21*	Venus St.	Double	13+45.94	23' Rt.	
23*	Venus St.	Double	12+40.94	23' Rt.	
Block 5					
Lot No.	Street		CL Sta.	Offset to PL	
1 & 2	Mars St.	Double	17+59.41	23' Rt.	
3 & 4	Mars St.	Double	16+44.41	23' Rt.	
5 & 6	Mars St.	Double	15+43.12	24.20' Rt.	
7 & 8	Mars St.	Double	14+93.96	61.20' Rt.	
9 & 10	Taurus Dr.	Double	14+31.39	23' Rt.	
11 & 12	Taurus Dr.	Double	13+21.39	23' Rt.	
13 & 14	Taurus Dr.	Double	12+01.39	23' Rt.	
15 & 16	Taurus Dr.	Double	10+93.39	23' Rt.	
Future Block					
Lot No.	Street		CL Sta.	Offset to PL	
1*	Venus St.	Double	10+97.95	27' Lt.	
3*	Venus St.	Double	12+07.95	27' Lt.	
5*	Venus St.	Double	13+22.95	27' Lt.	
7*	Venus St.	Double	14+37.95	27' Lt.	
* - Services to Future Lots					
** - SERVICE CONNECTION IS LOCATED ON MARS STREET. STATIONING IS MILKY WAY STATIONING.					

CURVE DATA AT FACE OF CURB (SEE PAVING PLAN AND PROFILE SHEETS FOR CURVE LOCATION)					
CURVE	RADIUS	LENGTH	TANGENT	CHORD	BEARING
C1	26.00'	40.77'	25.93'	36.72'	N44°44'22"W 89°50'17'
C2	25.00'	39.34'	25.07'	35.41'	N45°15'38"E 90°09'43'
C3	25.00'	39.34'	25.07'	35.41'	N45°15'38"E 90°09'43'
C4	25.00'	39.20'	24.93'	35.31'	S44°44'22"E 89°50'17'
C5	25.00'	39.20'	24.93'	35.31'	S44°44'22"E 89°50'16'
C6	25.00'	39.34'	25.07'	35.41'	S45°15'38"W 90°09'44'
C7	25.00'	39.34'	25.07'	35.41'	N45°15'38"E 90°09'44'
C8	25.00'	39.20'	24.93'	35.31'	S44°44'22"E 89°50'16'
C9	187.95'	28.15'	14.10'	28.12'	N86°04'54"E 08°34'52'
C10	171.94'	25.75'	12.90'	25.73'	S86°04'54"W 08°34'52'
C11	25.00'	39.35'	25.08'	35.41'	N45°16'33"E 90°11'34'
C12	61.00'	95.99'	61.17'	86.39'	N45°15'38"E 90°09'44'
C13	34.00'	19.11'	9.82'	18.86'	N73°33'23"W 32°12'16'
C14	31.00'	83.63'	137.39'	60.48'	N45°15'38"E 154°34'14'
C15	34.00'	19.11'	9.82'	18.86'	S15°55'18"E 32°12'22'
C16	25.00'	39.34'	25.07'	35.41'	N45°15'38"E 90°09'43'

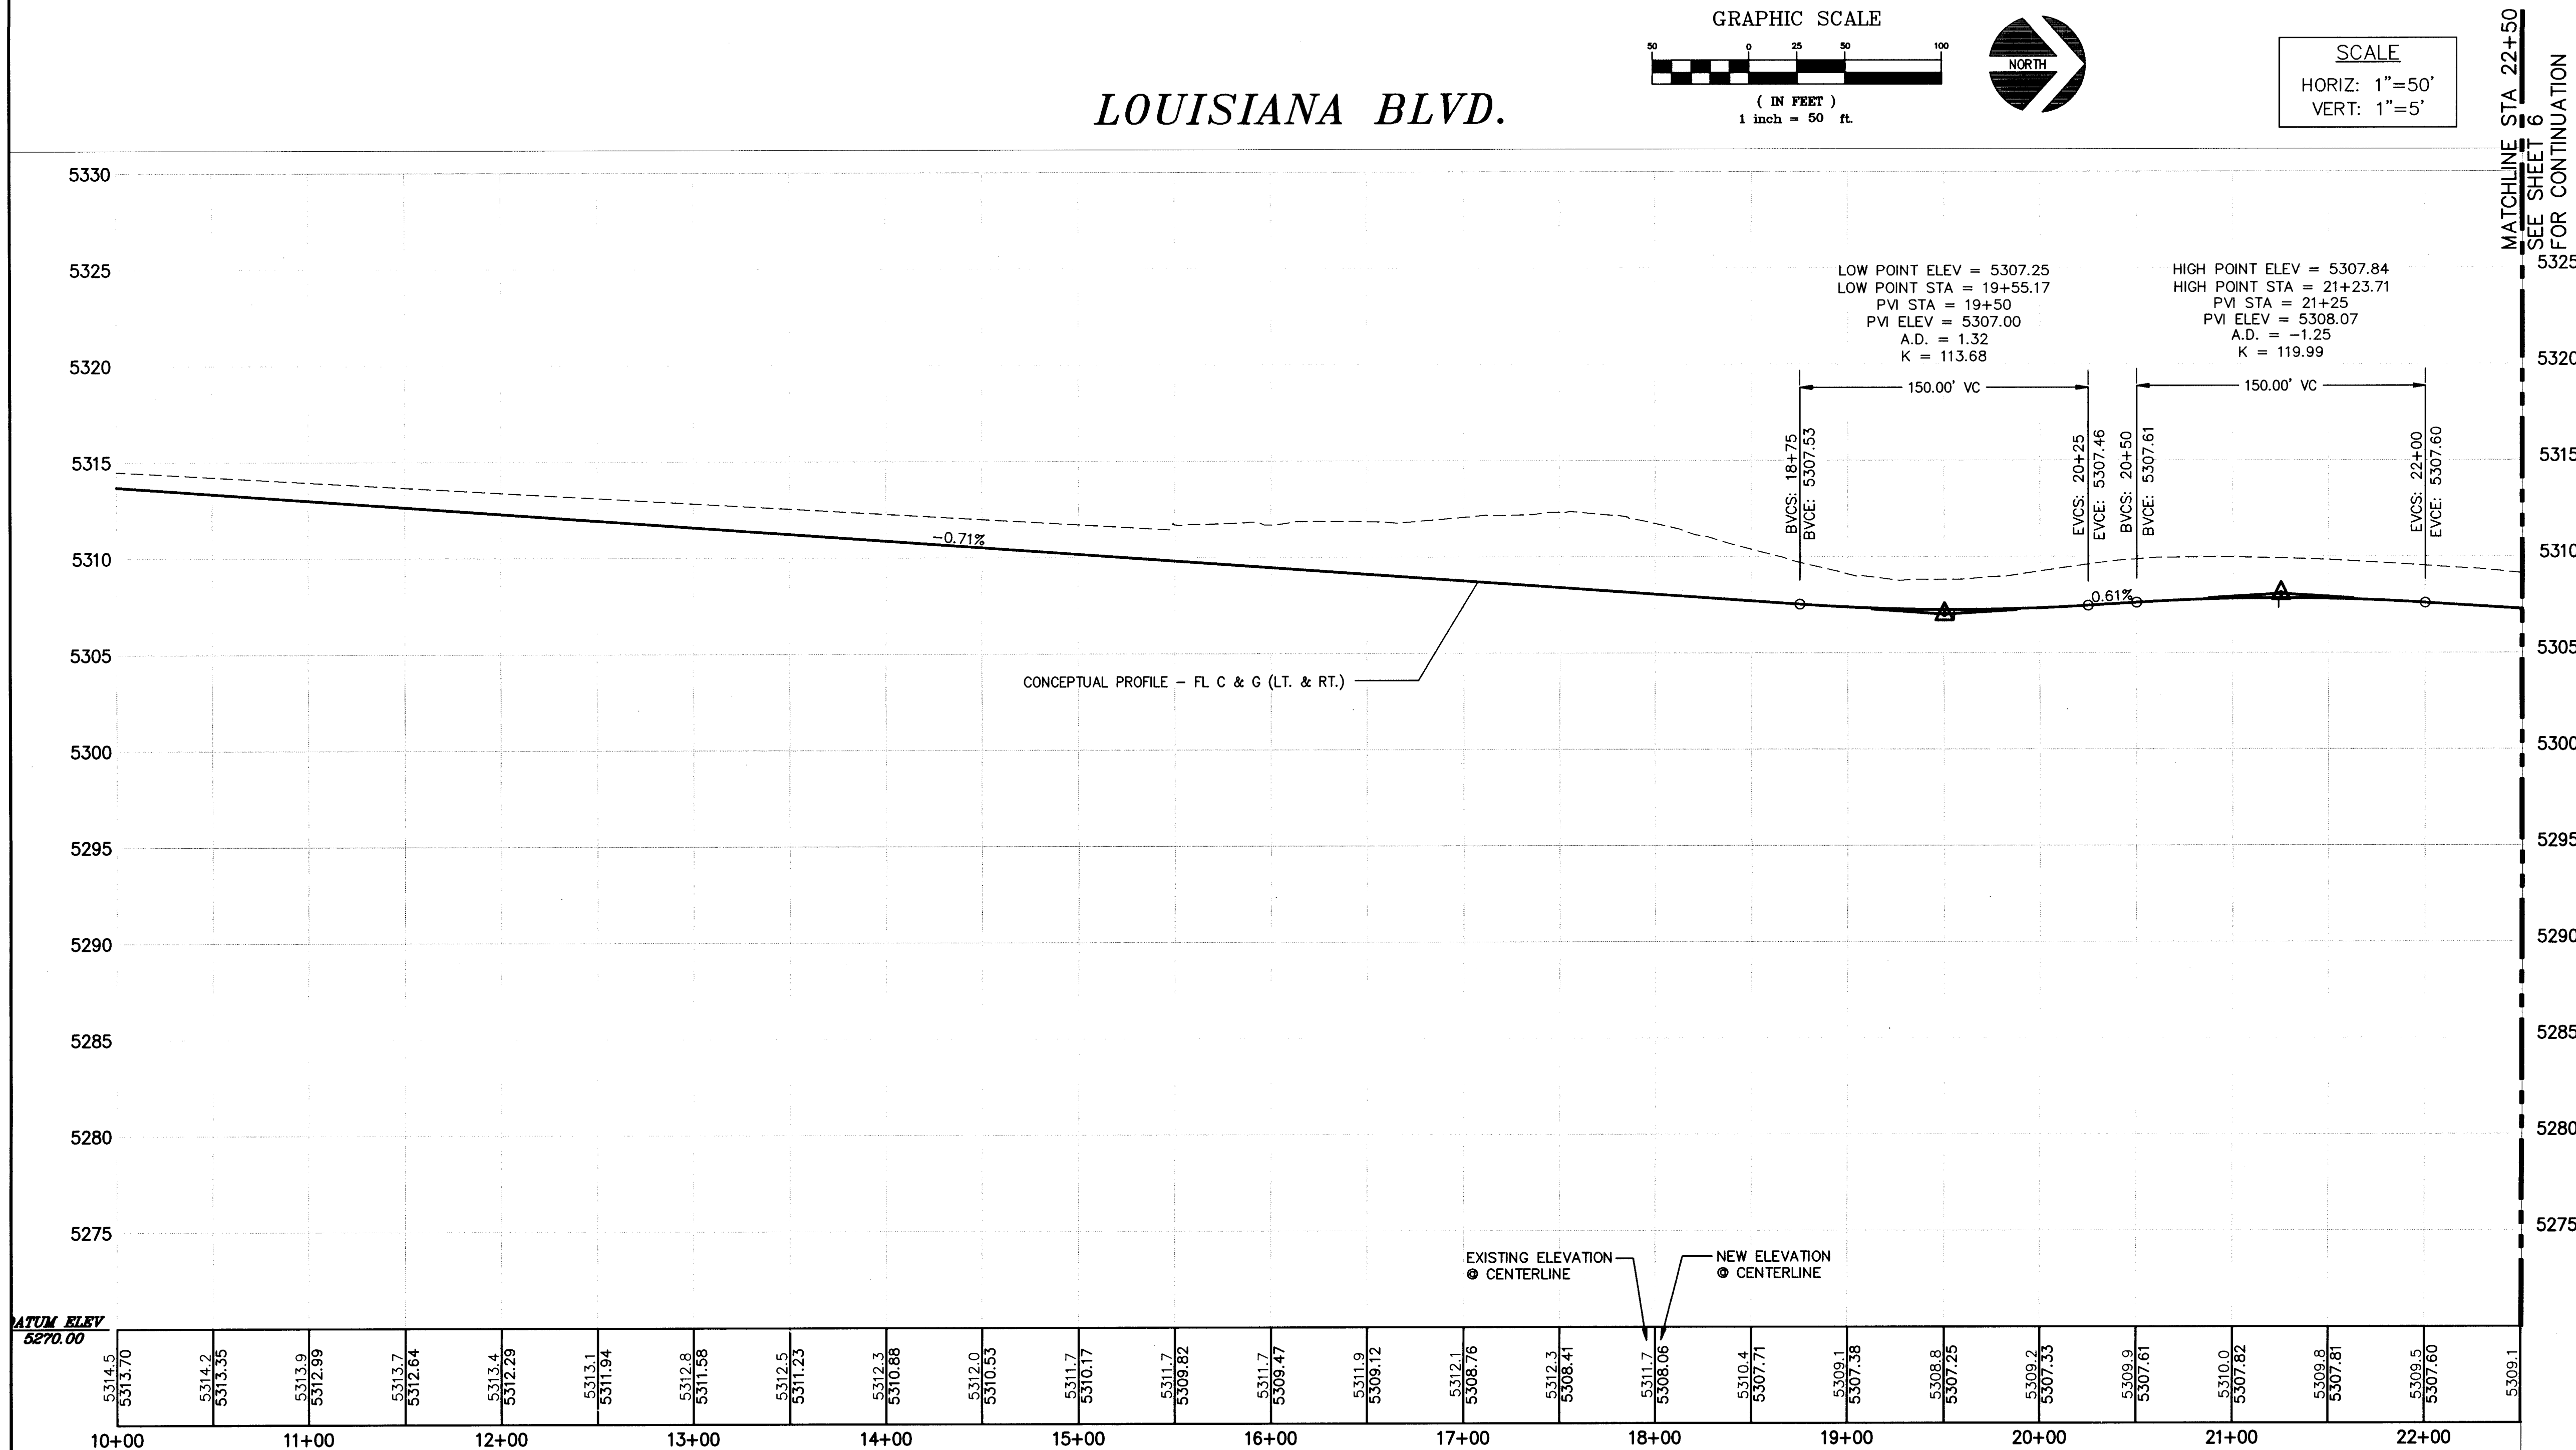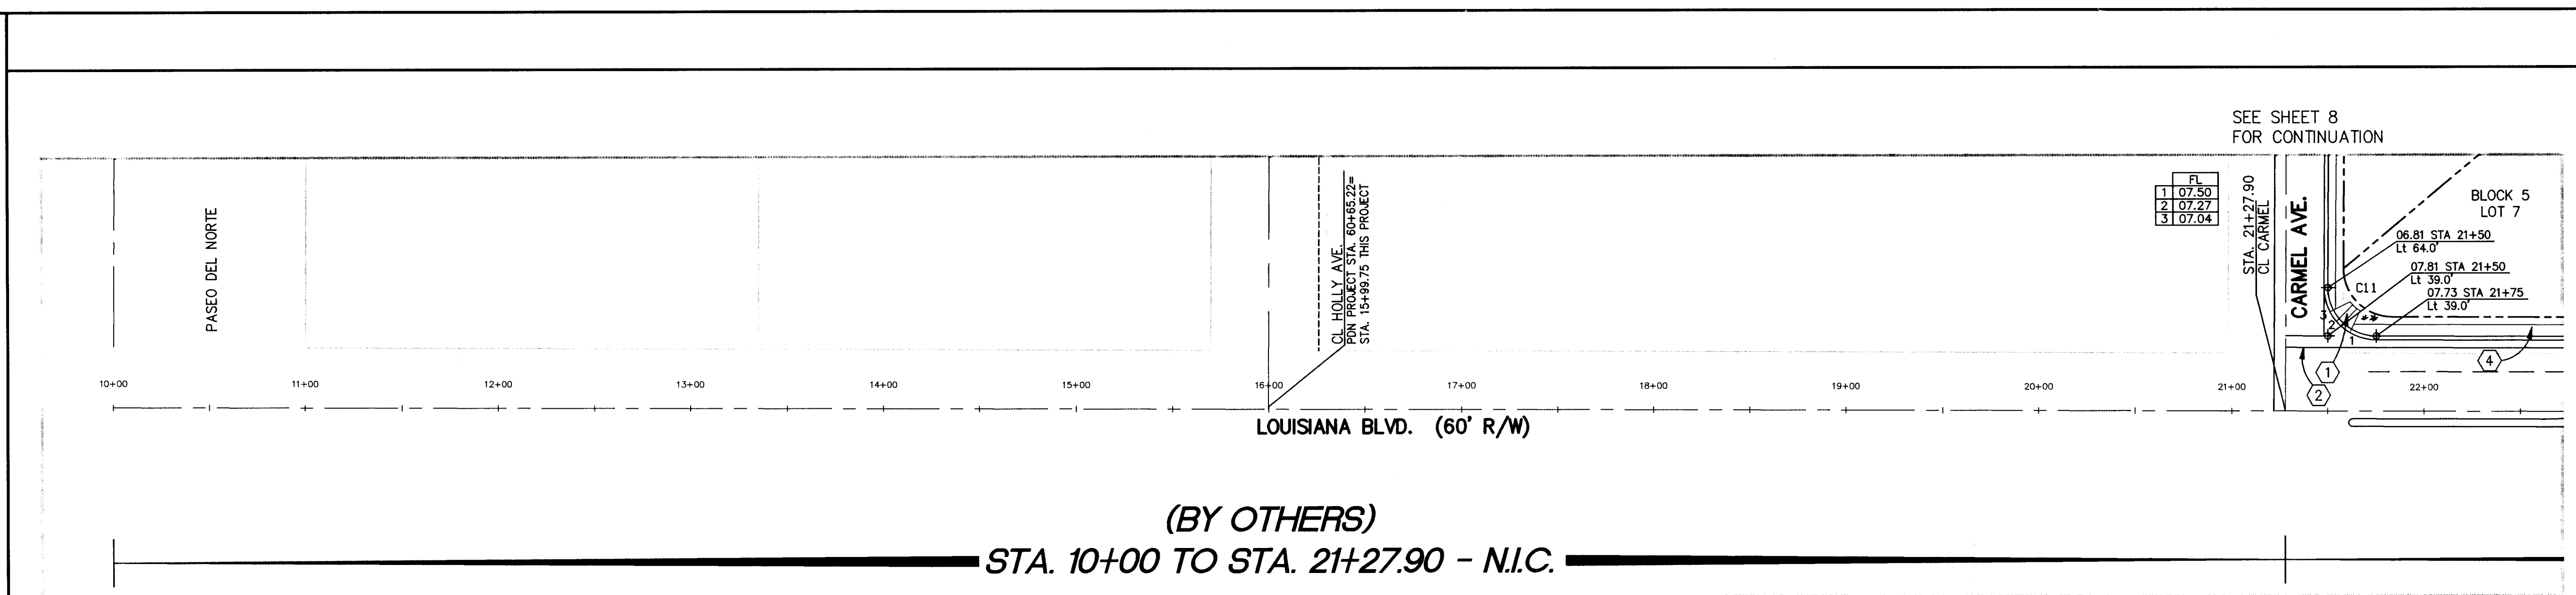

NOTES:

- NEW ELEVATIONS SHOWN ARE FLOWLINE OF CURB AND GUTTER UNLESS OTHERWISE NOTED.
- THE FOLLOWING CITY OF ALBUQUERQUE STANDARD DETAIL DRAWINGS APPLY TO THIS SHEET:
DWG 2401 - TYP. RES. STREET INTERS.
DWG 2405 - RESIDENTIAL STREET SECTION
DWG 2415 - CURB AND GUTTER
DWG 2418 - MOUNTABLE TO STANDARD CURB TRANSITION
DWG 2420 - CONCRETE VALLEY GUTTER
DWG 2430 - SIDEWALK DETAILS
DWG 2440 - WHEEL CHAIR RAMP
DWG 2441 - WHEEL CHAIR RAMP
- SEE PLAT, SHEET 2, FOR RIGHT OF WAY WIDTHS AND STREET CENTERLINE BEARING & DISTANCE INFORMATION.
- SEE SHEET 4 FOR CURVE DATA AT FACE OF CURB TABLE.

CONSTRUCTION KEYED NOTES:

- CONSTRUCT P.C.C. SIDEWALK, 4" THICK, TRANSITIONS TO HANDICAP ACCESS RAMPS AND P.C.C. RAMP PER STD. DWG.# 2441.
** WHEEL CHAIR RAMPS MODIFIED TO EXTEND LATERAL RAMP AREA(S) TO ALIGN WITH PC OR PT OF CURB RETURNS.
- CONSTRUCT P.C.C. VALLEY GUTTER AND GUTTER AND CURB PER STD. DWG.# 2420, 6' WIDE WITH 1" INVERT DEPTH.
- NO CROWN TRANSITION (50' LENGTH).
- 4' WIDE P.C.C. SIDEWALK (NOT IN THIS CONTRACT).

AS BUILT INFORMATION

CONTRACTOR: New Concept
WORKED BY: C.A.A.
INSPECTOR'S: L. Romero
ACCEPTANCE DATE: 12/95
DATE: 1/96
DRAWN BY: L.R.
VERIFICATION DATE: 3/96
DATE: 4/96
MICRO-FILM INFORMATION
RECORDED BY: NO.

BENCH MARKS

ACS STA. No. 1-C19
Y=1518845.74
X=404941.91
Z=5318.195

SURVEY INFORMATION

FIELD NOTES
BY: Terry O. Brown
NO. 8/16/95

ENGINEER'S SEAL

REMARKS
DESIGN
20-3252-190 10596


NO. DATE
DESIGNED BY: TOB
DRAWN BY: TOB
CHECKED BY: TOB

CITY OF ALBUQUERQUE
PUBLIC WORKS DEPARTMENT
ENGINEERING GROUP


TITLE:
LA CUEVA OESTE, UNIT 1
PAVING PLAN AND PROFILE
LOUISIANA BLVD.- STA:10+00 TO STA: 22+50

APPROVALS
ENGINEER DATE
APPROVALS ENGINEER DATE
DRC CHAIRMAN 8/3/95
TRANSPORTATION 8/1/95
HYDROLOGY N/A Sme 9-15-95

PROJECT NO. 5232.90
MAP NO. C-18-Z
SHEET 5 OF 29

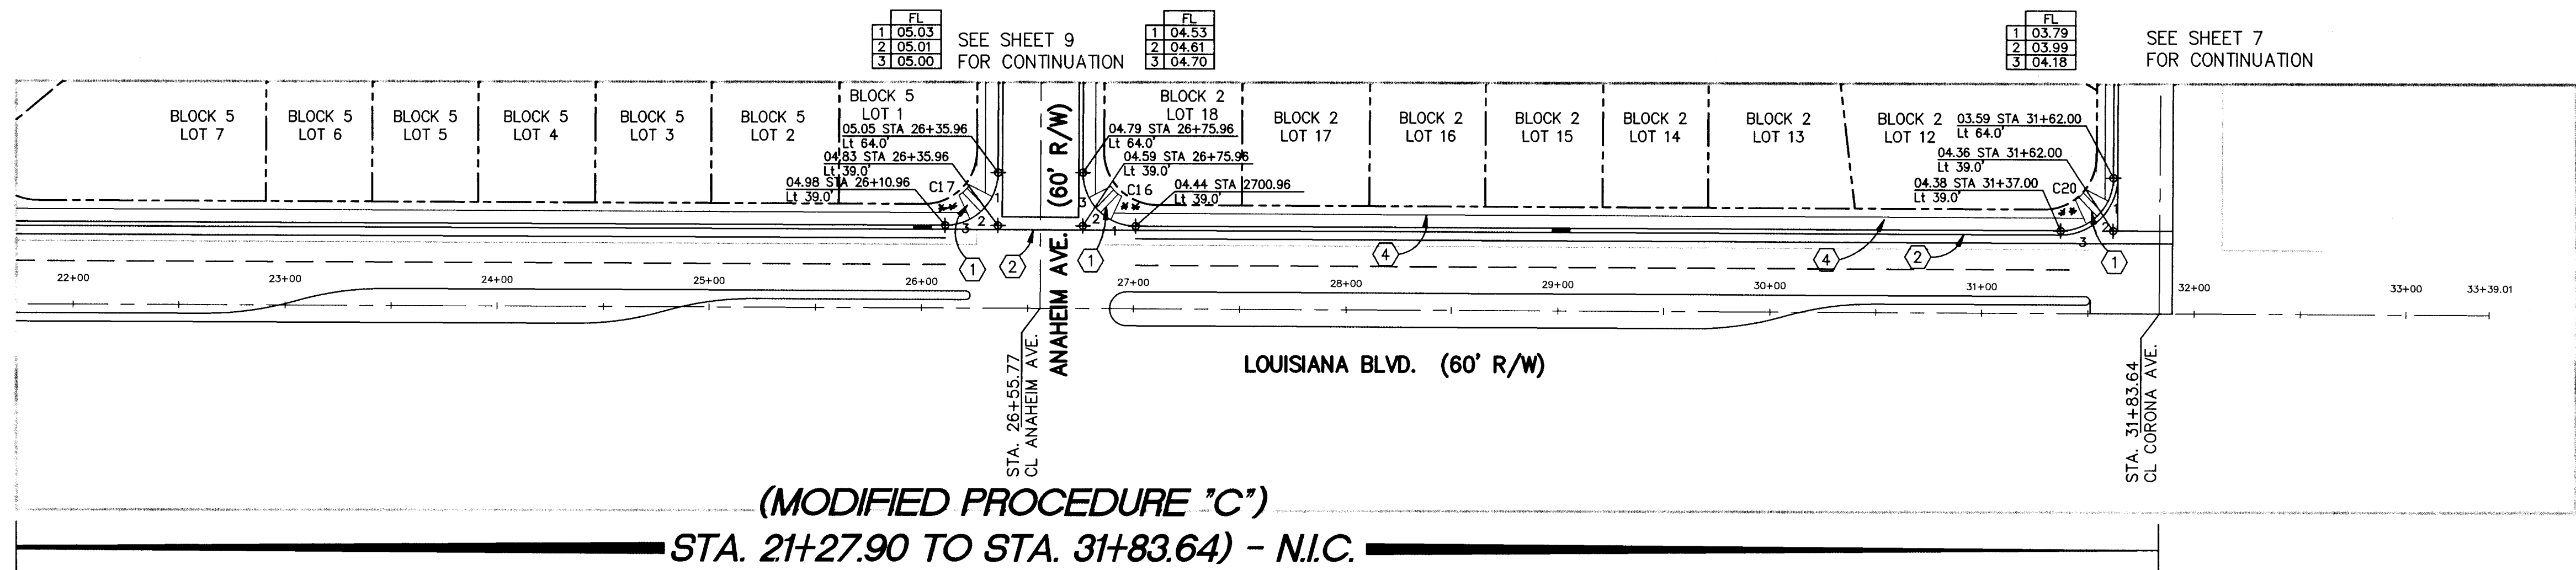

MATCHLINE STA. 22+50
SEE SHEET 5
FOR CONTINUATION

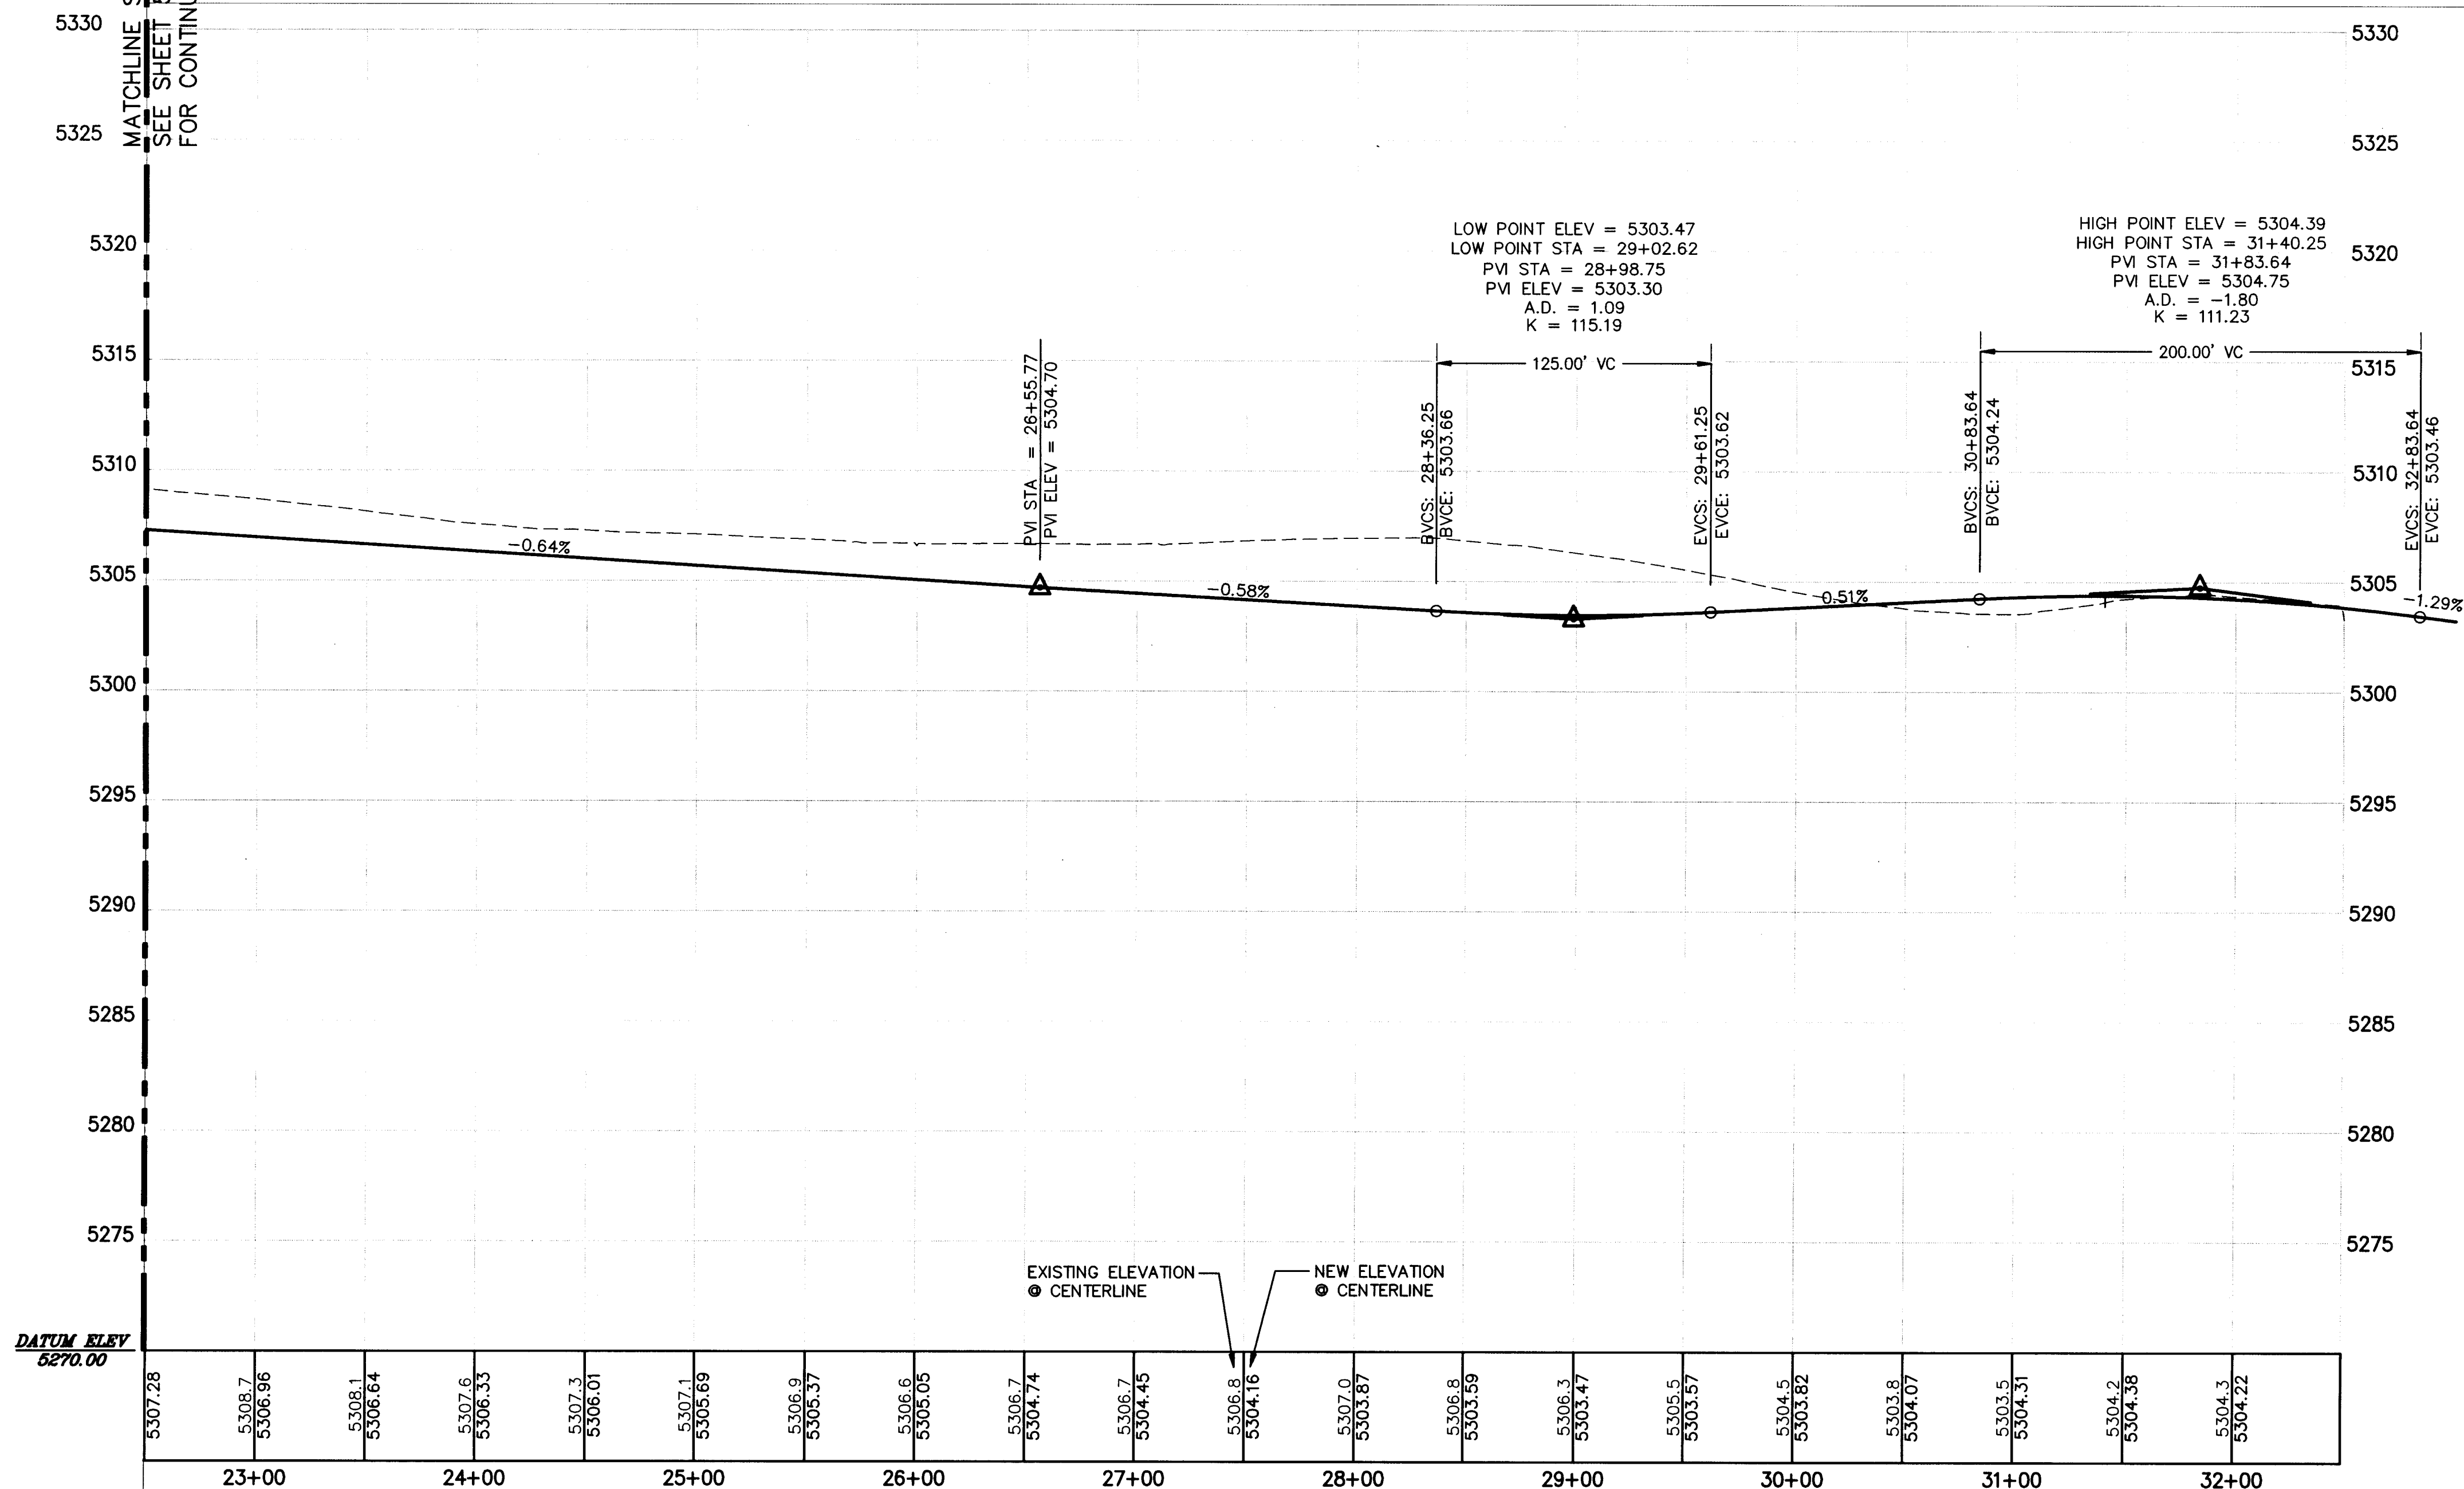

SCANNED BY
BY JASON

LC_PP.DWG / VIEW:R,3

NOTES:

1. NEW ELEVATIONS SHOWN ARE FLOWLINE OF CURB AND GUTTER UNLESS OTHERWISE NOTED.
2. THE FOLLOWING CITY OF ALBUQUERQUE STANDARD DETAIL DRAWINGS APPLY TO THIS SHEET:
DWG 2401 - TYP. RES. STREET INTERS.
DWG 2405 - RESIDENTIAL STREET SECTION
DWG 2415 - CURB AND GUTTER
DWG 2418 - MOUNTABLE TO STANDARD CURB TRANSITION
DWG 2420 - CONCRETE VALLEY GUTTER
DWG 2430 - SIDEWALK DETAILS
DWG 2440 - WHEEL CHAIR RAMP
DWG 2441 - WHEEL CHAIR RAMP
3. SEE PLAT, SHEET 2, FOR RIGHT OF WAY WIDTHS AND STREET CENTERLINE BEARING & DISTANCE INFORMATION.
4. SEE SHEET 4 FOR CURVE DATA AT FACE OF CURB TABLE.

CONSTRUCTION KEYED NOTES:

1. CONSTRUCT P.C.C. SIDEWALK, 4" THICK, TRANSITIONS TO HANDICAP ACCESS RAMPS AND P.C.C. RAMP PER STD. DWG.# 2441.
** WHEEL CHAIR RAMPS MODIFIED TO EXTEND LATERAL RAMP AREA(S) TO ALIGN WITH PC OR PT OF CURB RETURNS (SEE SHT. 27).
2. CONSTRUCT P.C.C. VALLEY GUTTER AND GUTTER AND CURB PER STD. DWG.# 2420, 6" WIDE WITH 1" INVERT DEPTH.
3. NO CROWN TRANSITION (50' LENGTH).
4. 4' WIDE P.C.C. SIDEWALK (NOT IN THIS CONTRACT).

AS BUILT INFORMATION			
CONTRACTOR	NEW CONCEPT	DATE	10/15
WORK	LA CUEVA OESTE	DATE	10/15
INSPECTOR	COA	DATE	10/15
ACCEPTANCE	BY L. Romero	DATE	10/15
VERIFICATION	BY L.R.	DATE	10/15
DRAWINGS	COMPILED BY L.R.	DATE	10/15
MICRO-FILM INFORMATION			
RECORDED BY		DATE	
NO.			

BENCH MARKS

ACS STA. No. 1-C19	
Y=1518845.74	
X=404941.91	
Z=5318.195	

SURVEY INFORMATION

FIELD NOTES

BY

NO.

ENGINEER'S SEAL

BY

REMARKS

DESIGN

NO.

DATE

DESIGNED BY: TOB

DRAWN BY: TOB

CHECKED BY: TOB

DATE: 07/95

DATE: 07/95

DATE: 07/95

26-5232.90 0696




Terry O. Brown, P.E.
P. O. Box 92051
Albuquerque, NM 87199
(505) 883-8807

CITY OF ALBUQUERQUE
PUBLIC WORKS DEPARTMENT
ENGINEERING GROUP

TITLE:			
LA CUEVA OESTE, UNIT 1 PAVING PLAN AND PROFILE LOUISIANA BLVD.- STA: 22+50 TO STA: 33+39.01			
APPROVALS	ENGINEER	DATE	APPROVALS
DRC CHAIRMAN	10-3-95	WATER	DATE
TRANSPORTATION	8-17-95	WASTE WATER	DATE
HYDROLOGY	9-15-95		DATE

PROJECT NO.	MAP NO.	SHEET	OF
5232.90	C-18-Z	6	29

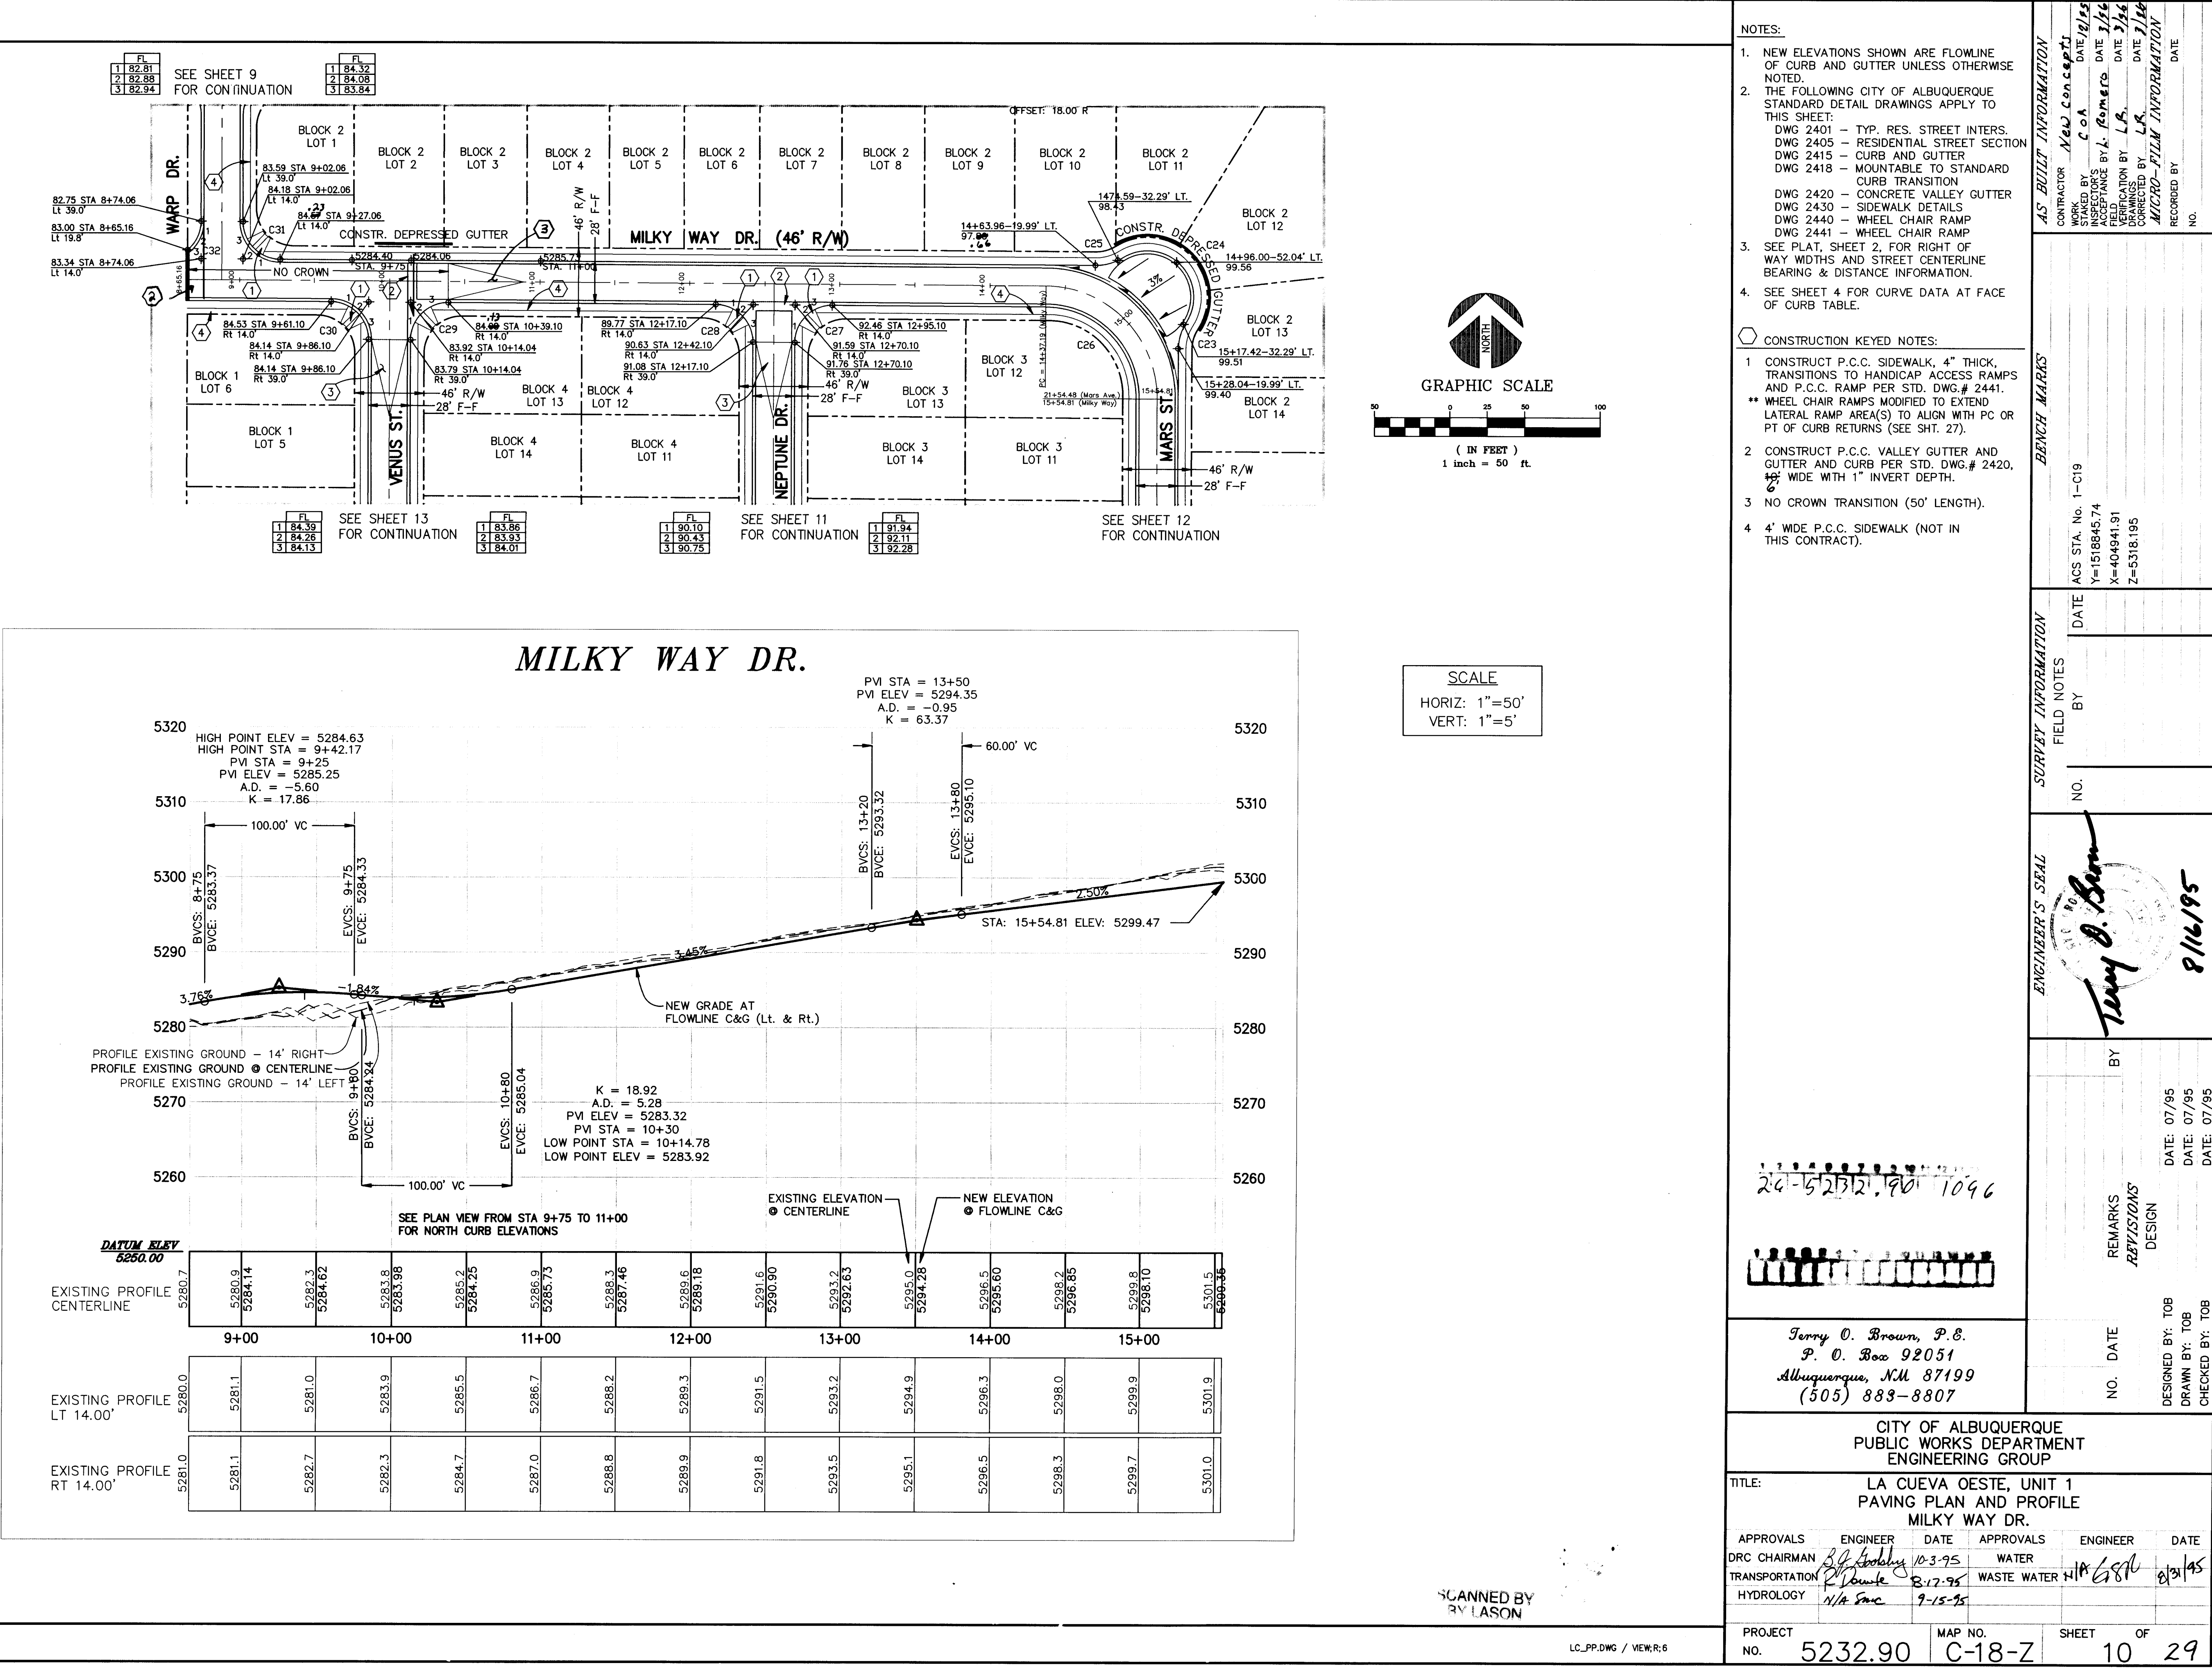

NOTES:

- NEW ELEVATIONS SHOWN ARE FLOWLINE OF CURB AND GUTTER UNLESS OTHERWISE NOTED.
- THE FOLLOWING CITY OF ALBUQUERQUE STANDARD DETAIL DRAWINGS APPLY TO THIS SHEET:
DWG 2401 - TYP. RES. STREET INTERS.
DWG 2405 - RESIDENTIAL STREET SECTION
DWG 2415 - CURB AND GUTTER
DWG 2418 - MOUNTABLE TO STANDARD CURB TRANSITION
DWG 2420 - CONCRETE VALLEY GUTTER
DWG 2430 - SIDEWALK DETAILS
DWG 2440 - WHEEL CHAIR RAMP
DWG 2441 - WHEEL CHAIR RAMP
- SEE PLAT, SHEET 2, FOR RIGHT OF WAY WIDTHS AND STREET CENTERLINE BEARING & DISTANCE INFORMATION.
- SEE SHEET 4 FOR CURVE DATA AT FACE OF CURB TABLE.

CONSTRUCTION KEYED NOTES:

- CONSTRUCT P.C.C. SIDEWALK, 4" THICK, TRANSITIONS TO HANDICAP ACCESS RAMPS AND P.C.C. RAMP PER STD. DWG.# 2441.
- WHEEL CHAIR RAMPS MODIFIED TO EXTEND LATERAL RAMP AREA(S) TO ALIGN WITH PC OR PT OF CURB RETURNS (SEE SHT. 27).
- CONSTRUCT P.C.C. VALLEY GUTTER AND GUTTER AND CURB PER STD. DWG.# 2420, 1/8" WIDE WITH 1" INVERT DEPTH.
- NO CROWN TRANSITION (50' LENGTH).
- 4' WIDE P.C.C. SIDEWALK (NOT IN THIS CONTRACT).

AS BUILT INFORMATION

CONTRACTOR: New Concept
WORK: PAVING
INSPECTOR: C.O.A.
ACCEPTANCE BY: L. Romero
DATE: 1/16/95
REVISIONS: L.A.
DATE: 3/16/95
CORRECTED BY: L.A.
DATE: 3/16/95
RECORDED BY: NO.

BENCH MARKS

ACS STA. No. 1-C19
Y=1518845.74
X=404941.91
Z=5318.195

SURVEY INFORMATION

FIELD NOTES

DATE: 8/16/95

ENGINEER'S SEAL

Terry O. Brown

REVISIONS

DESIGN

DATE: 07/95

DATE: 07/95

DATE: 07/95

DESIGNED BY: TOB
DRAWN BY: TOB
CHECKED BY: TOB

Terry O. Brown, P.E.
P. O. Box 92051
Albuquerque, NM 87199
(505) 889-8807

CITY OF ALBUQUERQUE
PUBLIC WORKS DEPARTMENT
ENGINEERING GROUP

TITLE: LA CUEVA OESTE, UNIT 1
PAVING PLAN AND PROFILE
MILKY WAY DR.

APPROVALS

ENGINEER: DATE: 10-3-95

APPROVALS


ENGINEER: DATE: 8-17-95

DATE: 9-15-95


PROJECT NO. 5232.90

MAP NO. C-18-Z

SHEET 10 OF 29

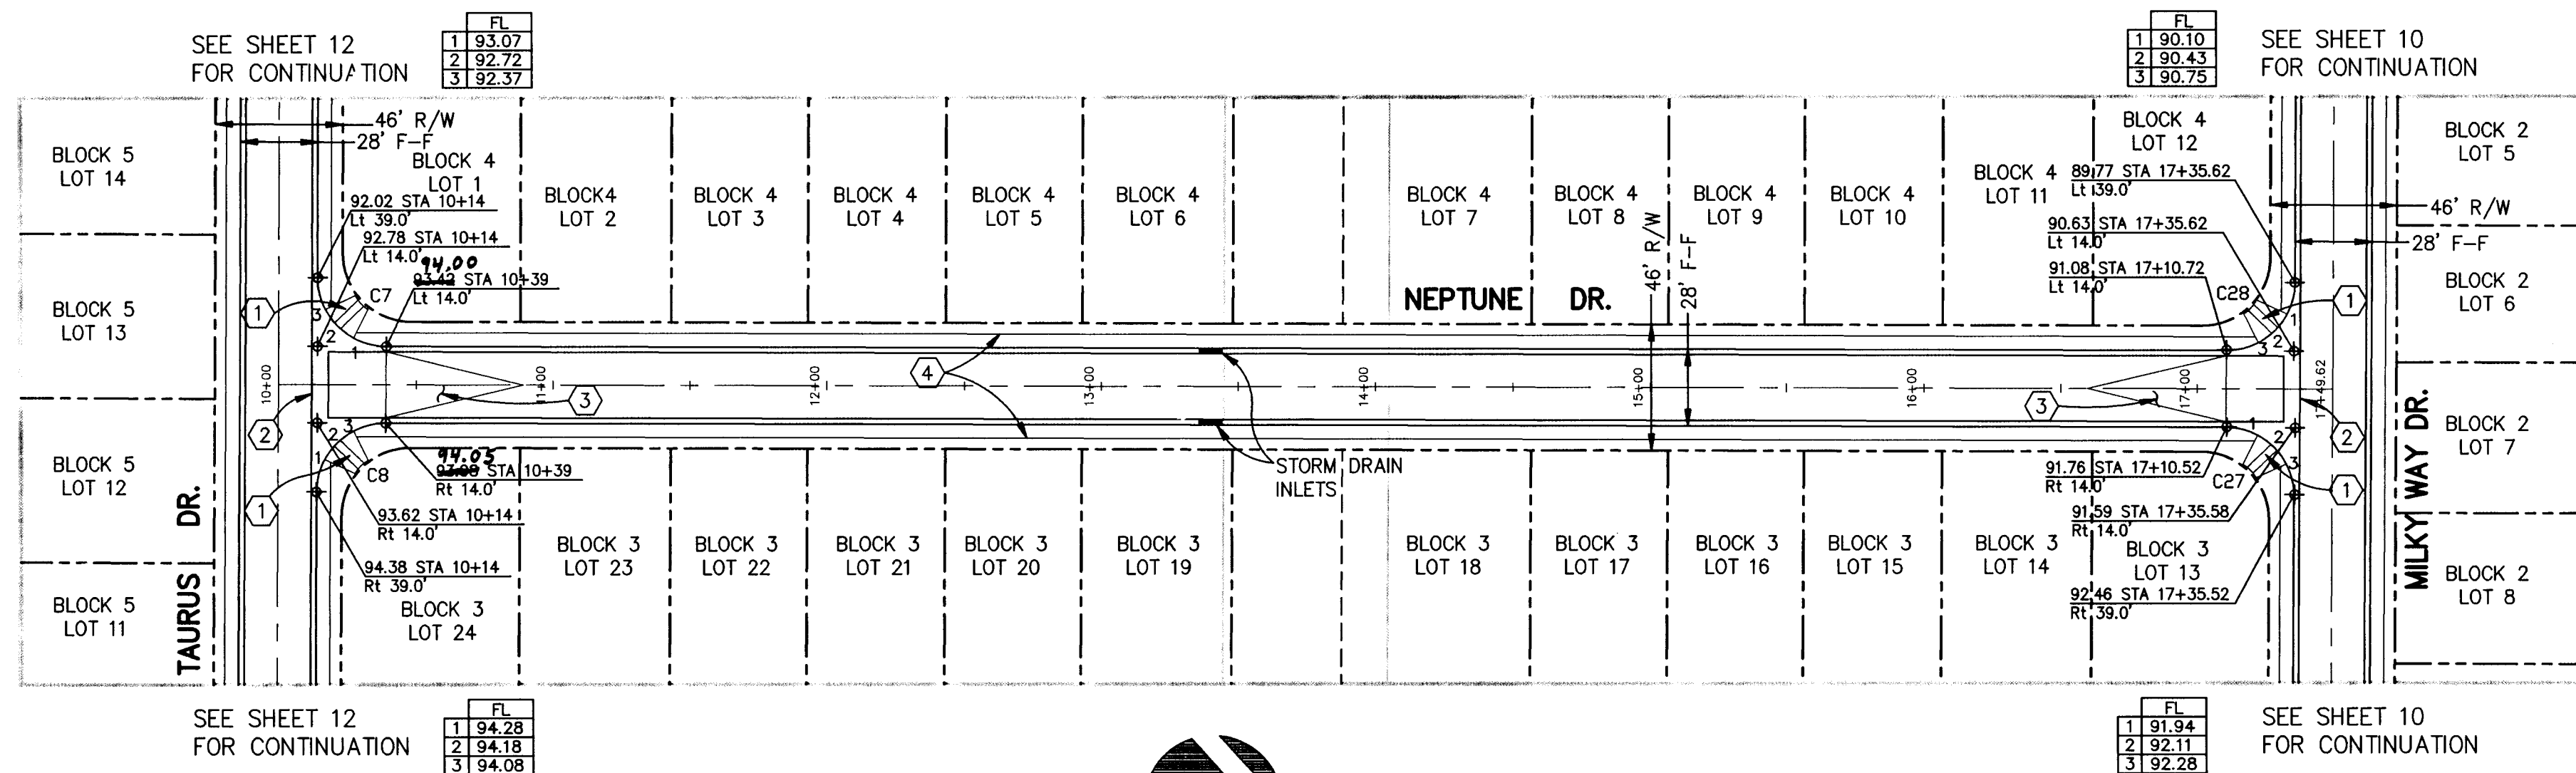

NEPTUNE DR.

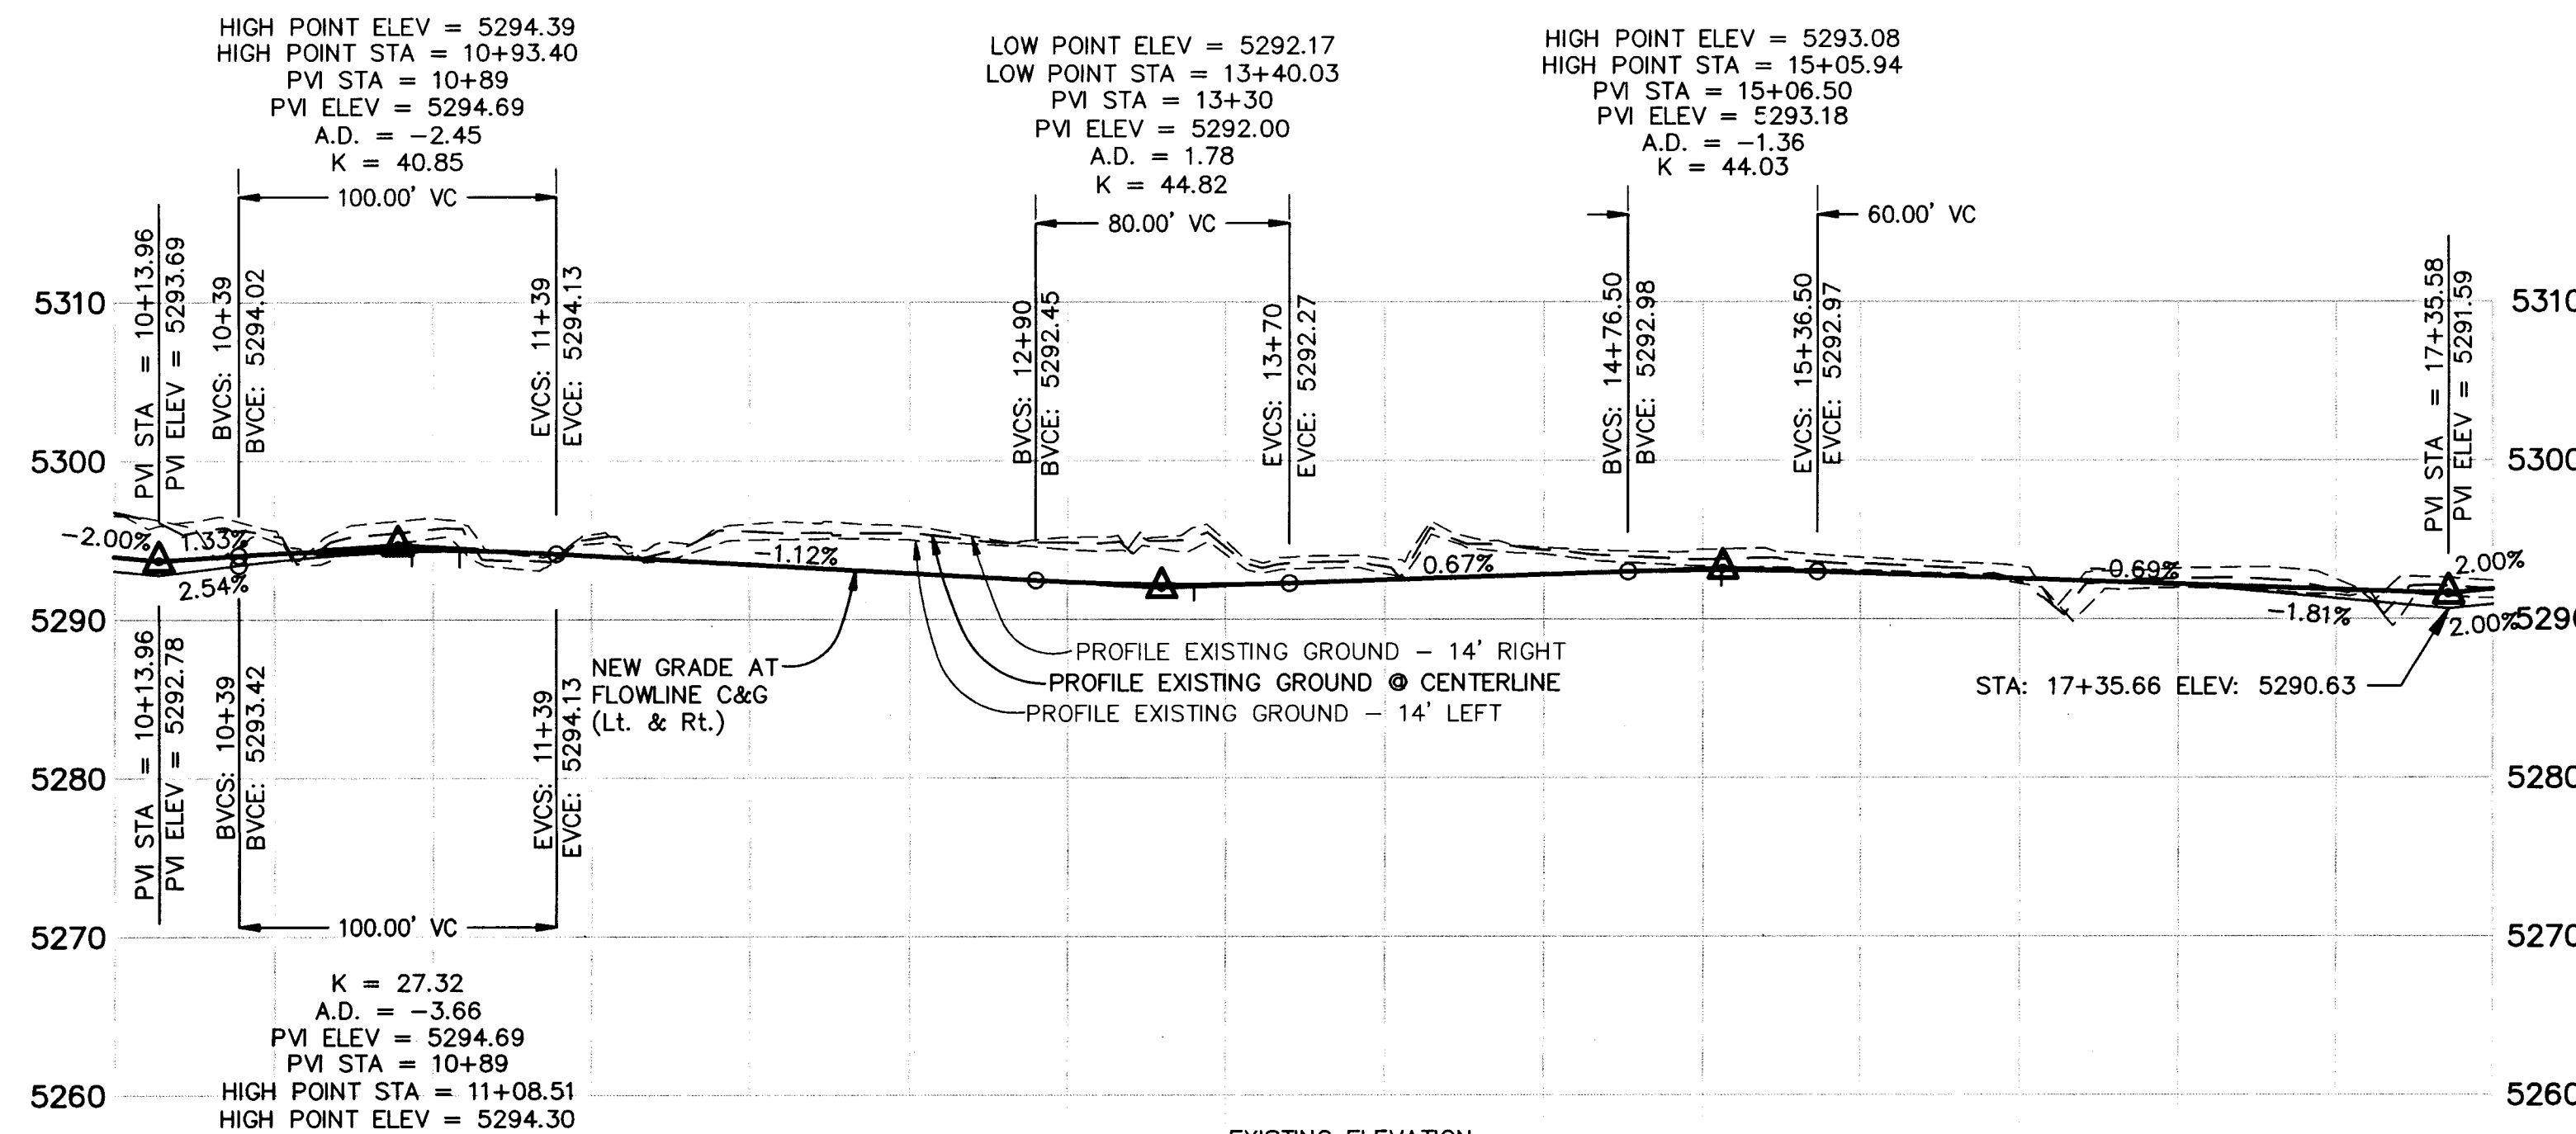

DATUM ELEV 5250.00	5296.8	5295.3	5295.7	5295.1	5295.5	5295.4	5294.8	5294.6	5293.3	5294.4	5293.8	5293.5	5292.3	5292.5	5291.8
EXISTING PROFILE CENTERLINE	10+00	11+00	12+00	13+00	14+00	15+00	16+00	17+00							
EXISTING PROFILE LT 14.00'	5296.6	5294.9 5293.68	5295.1 5294.29	5294.8 5294.01	5295.0 5293.45	5295.0 5292.89	5294.4 5292.35	5294.1 5292.18	5292.9 5292.47	5294.1 5292.80	5293.3 5293.07	5293.1 5292.88	5292.2 5292.53	5291.9 5292.18	5291.5 5291.28
EXISTING PROFILE RT 14.00'	5296.7	5295.6 5294.16	5296.4 5294.38	5295.3 5294.01	5296.0 5293.45	5295.9 5292.89	5295.2 5292.35	5295.0 5292.18	5293.8 5292.47	5294.5 5292.80	5294.4 5293.07	5293.9 5292.88	5293.3 5292.53	5293.2 5292.18	5292.5 5291.84

SCALE
HORIZ: 1"=50'
VERT: 1"=5'

- NOTES:
- NEW ELEVATIONS SHOWN ARE FLOWLINE OF CURB AND GUTTER UNLESS OTHERWISE NOTED.
 - THE FOLLOWING CITY OF ALBUQUERQUE STANDARD DETAIL DRAWINGS APPLY TO THIS SHEET:
DWG 2401 - TYP. RES. STREET INTERS.
DWG 2405 - RESIDENTIAL STREET SECTION
DWG 2415 - CURB AND GUTTER
DWG 2418 - MOUNTABLE TO STANDARD CURB TRANSITION
DWG 2420 - CONCRETE VALLEY GUTTER
DWG 2430 - SIDEWALK DETAILS
DWG 2440 - WHEEL CHAIR RAMP
DWG 2441 - WHEEL CHAIR RAMP
 - SEE PLAT, SHEET 2, FOR RIGHT OF WAY WIDTHS AND STREET CENTERLINE BEARING & DISTANCE INFORMATION.
 - SEE SHEET 4 FOR CURVE DATA AT FACE OF CURB TABLE.

CONSTRUCTION KEYED NOTES:

- CONSTRUCT P.C.C. SIDEWALK, 4" THICK, TRANSITIONS TO HANDICAP ACCESS RAMPS AND P.C.C. RAMP PER STD. DWG.# 2441.
** WHEEL CHAIR RAMPS MODIFIED TO EXTEND LATERAL RAMP AREA(S) TO ALIGN WITH PC OR PT OF CURB RETURNS (SEE SHT. 27).
- CONSTRUCT P.C.C. VALLEY GUTTER AND GUTTER AND CURB PER STD. DWG.# 2420, 6" WIDE WITH 1" INVERT DEPTH.
- NO CROWN TRANSITION (50' LENGTH).
- 4' WIDE P.C.C. SIDEWALK (NOT IN THIS CONTRACT).

24-15-2321.91A 1196

Terry O. Brown, P.E.
P. O. Box 92051
Albuquerque, N.M. 87199
(505) 883-8807

CITY OF ALBUQUERQUE
PUBLIC WORKS DEPARTMENT
ENGINEERING GROUP

TITLE: LA CUEVA OESTE, UNIT 1
PAVING PLAN AND PROFILE
NEPTUNE DR.

APPROVALS	ENGINEER	DATE	APPROVALS	ENGINEER	DATE
DRC CHAIRMAN	10-3-95	WATER	11-6-95	8/3/95	
TRANSPORTATION	8-17-95	WASTE WATER			
HYDROLOGY	N/A Sme	9-15-95			

PROJECT NO. 5232.90 MAP NO. C-18-Z SHEET 11 OF 29

CONTRACTOR: New Concepts
WORK BY: C.O.A.
INSPECTOR'S: L. Romero
ACCEPTANCE BY: L.R.
VERIFICATION BY: L.R.
DRAWING NO.: 1196
DATE: 8/3/95
RECORDED BY: L.R.
DATE: 8/3/95

BENCH MARKS

ACS STA. No. 1-C19
Y=1518845.74
X=404941.91
Z=5318.195

FIELD NOTES

NO.

ENGINEER'S SEAL

BY

REMARKS

DESIGN

DATE

NO.

DESIGNED BY: TOB



DRAWN BY: TOB

CHECKED BY: TOB


DATE: 07/95

DATE: 07/95

DATE: 07/95

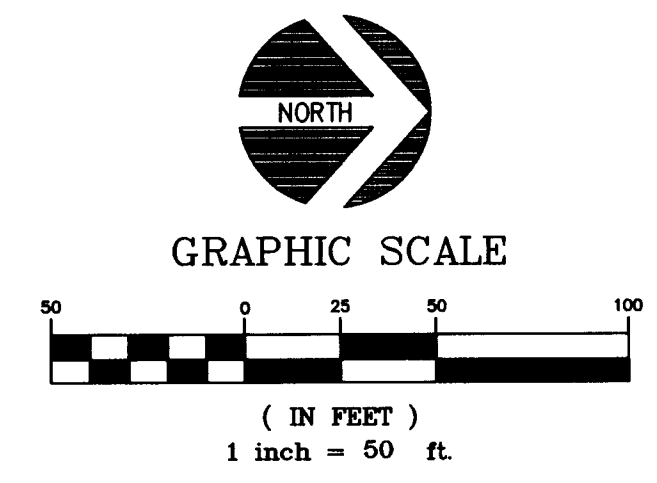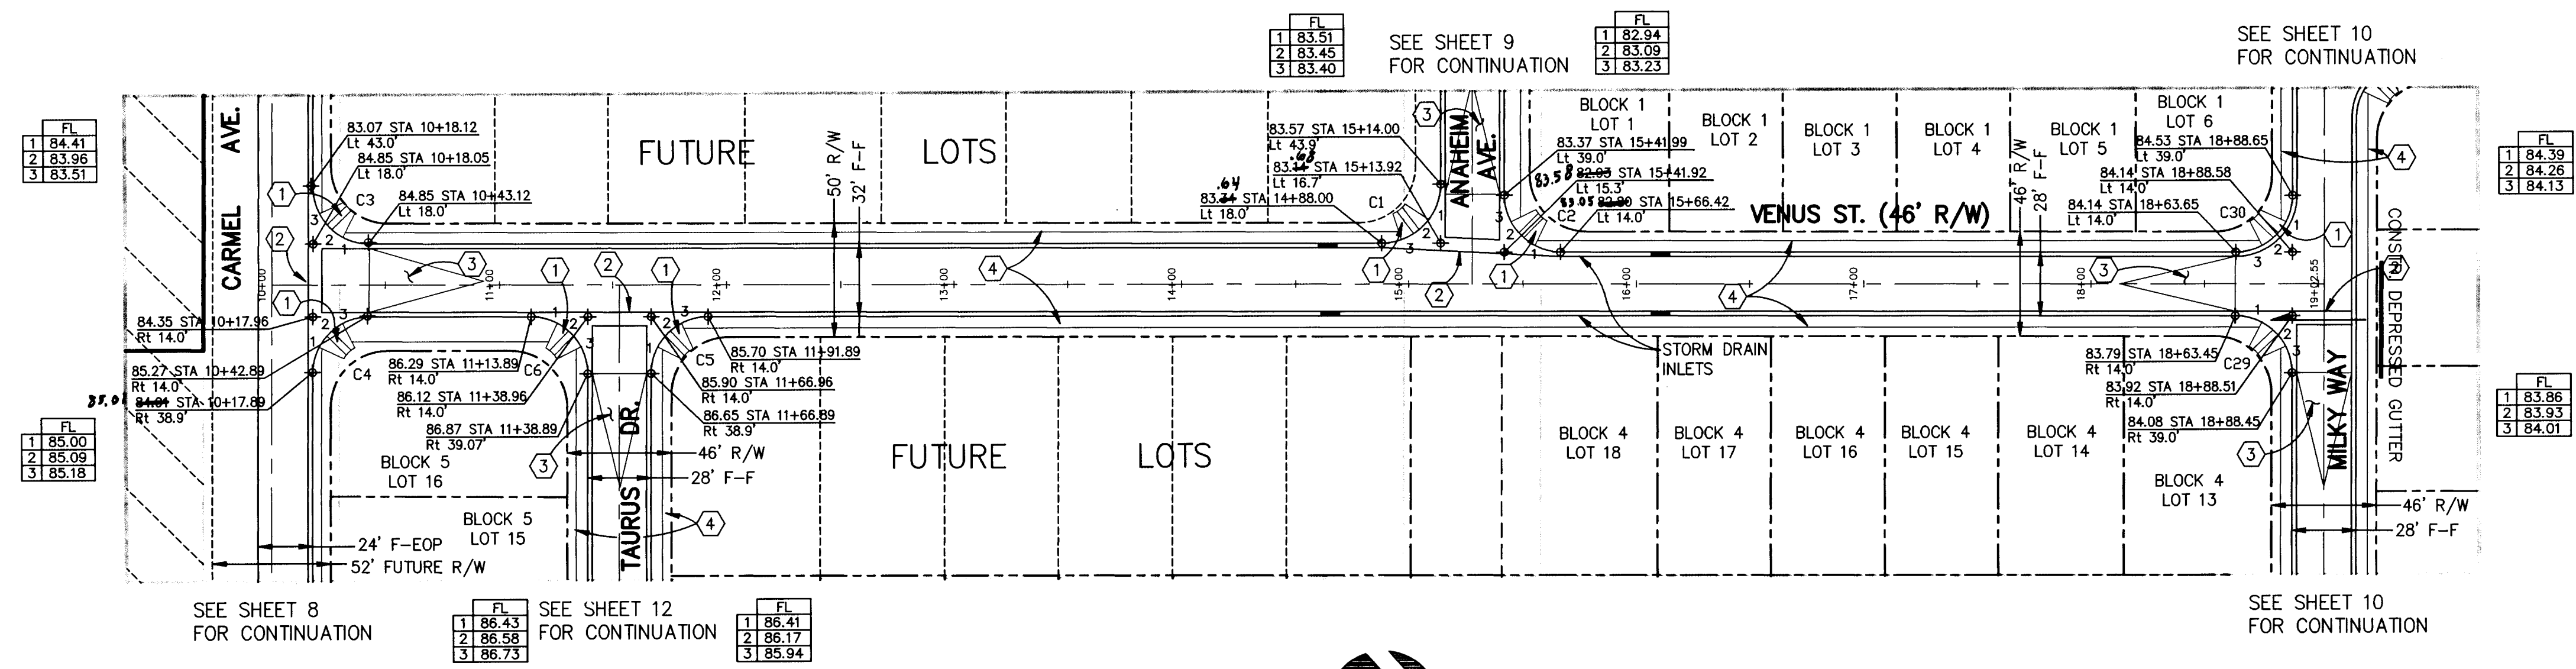

SCALE
HORIZ: 1"=50'
VERT: 1"=10'

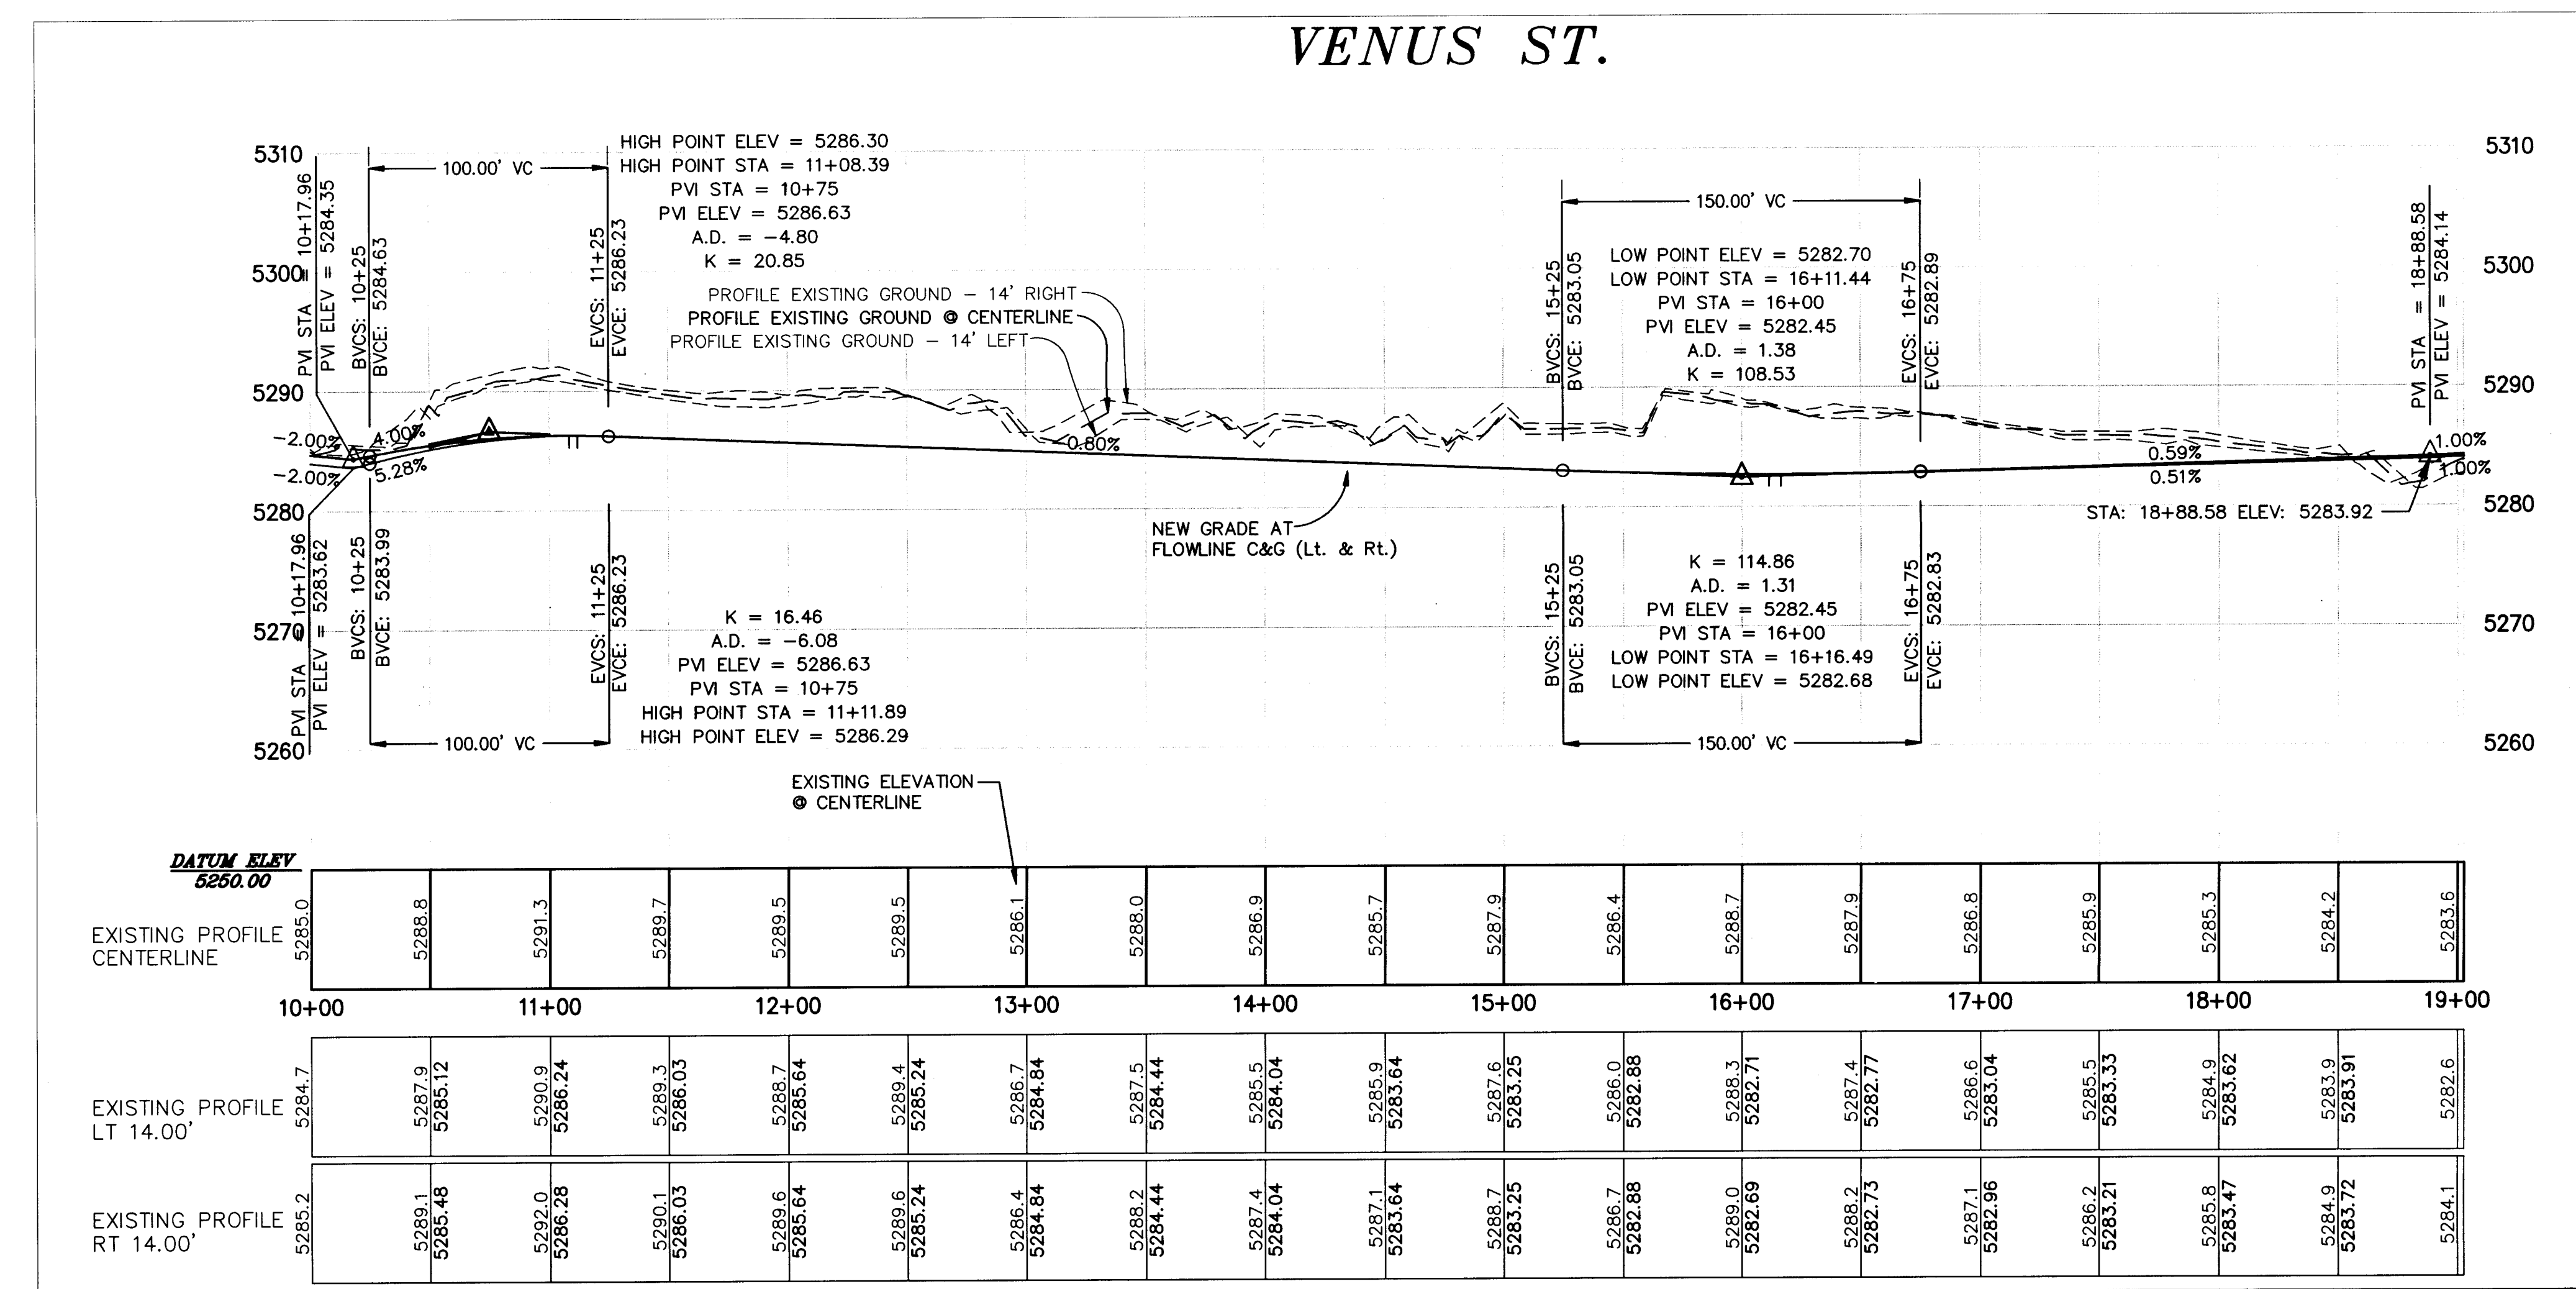

	DATUM ELEV 5260.00																			
EXISTING PROFILE CENTERLINE	5285.0	5288.8	5291.3	5289.7	5289.5	5289.5	5286.1	5288.0	5286.9	5285.7	5287.9	5286.4	5288.7	5287.9	5286.8	5285.9	5285.3	5284.2	5283.6	
	10+00	11+00		12+00		13+00		14+00		15+00		16+00		17+00		18+00		19+00		
EXISTING PROFILE LT 14.00'	5284.7	5287.9 5285.12	5290.9 5286.24	5289.3 5286.03	5288.7 5285.64	5289.4 5285.24	5286.7 5284.84	5287.5 5284.44	5285.5 5284.04	5285.9 5283.64	5287.6 5283.25	5286.0 5282.88	5286.3 5282.71	5287.4 5282.77	5286.6 5283.04	5285.5 5283.33	5284.9 5283.62	5283.9 5283.91	5282.6 5282.6	
EXISTING PROFILE RT 14.00'	5285.2	5289.1 5285.48	5292.0 5286.28	5290.1 5286.03	5289.6 5285.64	5289.6 5285.24	5286.4 5284.84	5288.2 5284.44	5287.4 5284.04	5287.1 5283.64	5288.7 5283.25	5286.7 5282.88	5289.0 5282.69	5288.2 5282.73	5287.1 5282.96	5286.2 5283.21	5285.8 5283.47	5284.9 5283.72	5284.1 5282.6	



- NOTES:
- NEW ELEVATIONS SHOWN ARE FLOWLINE OF CURB AND GUTTER UNLESS OTHERWISE NOTED.
 - THE FOLLOWING CITY OF ALBUQUERQUE STANDARD DETAIL DRAWINGS APPLY TO THIS SHEET:
DWG 2401 - TYP. RES. STREET INTERS.
DWG 2405 - RESIDENTIAL STREET SECTION
DWG 2415 - CURB AND GUTTER
DWG 2418 - MOUNTABLE TO STANDARD CURB TRANSITION
DWG 2420 - CONCRETE VALLEY GUTTER
DWG 2430 - SIDEWALK DETAILS
DWG 2440 - WHEEL CHAIR RAMP
DWG 2441 - WHEEL CHAIR RAMP
 - SEE PLAT, SHEET 2, FOR RIGHT OF WAY WIDTHS AND STREET CENTERLINE BEARING & DISTANCE INFORMATION.
 - SEE SHEET 4 FOR CURVE DATA AT FACE OF CURB TABLE.

- CONSTRUCTION KEYED NOTES:
- CONSTRUCT P.C.C. SIDEWALK, 4" THICK, TRANSITIONS TO HANDICAP ACCESS RAMPS AND P.C.C. RAMP PER STD. DWG.# 2441.
** WHEEL CHAIR RAMPS MODIFIED TO EXTEND LATERAL RAMP AREA(S) TO ALIGN WITH PC OR PT OF CURB RETURNS (SEE SHT. 27).
 - CONSTRUCT P.C.C. VALLEY GUTTER AND GUTTER AND CURB PER STD. DWG.# 2420, 6" WIDE WITH 1" INVERT DEPTH.
 - NO CROWN TRANSITION (50' LENGTH).
 - 4' WIDE P.C.C. SIDEWALK (NOT IN THIS CONTRACT).

20-5232.90 1396

Terry O. Brown, P.E.
P. O. Box 92051
Albuquerque, NM 87199
(505) 883-8807

CITY OF ALBUQUERQUE PUBLIC WORKS DEPARTMENT ENGINEERING GROUP					
TITLE: LA CUEVA OESTE, UNIT 1 PAVING PLAN & PROFILE VENUS ST.					
APPROVALS	ENGINEER	DATE	APPROVALS	ENGINEER	DATE
DRC CHAIRMAN	<i>S. J. Gentry</i>	10-3-95	WATER	<i>N/A</i>	8/5/95
TRANSPORTATION	<i>P. D. Smith</i>	8-12-95	WASTE WATER		
HYDROLOGY	<i>N/A</i>	9-15-95			
PROJECT NO.	5232.90	MAP NO.	C-18-Z	SHEET	13 OF 29

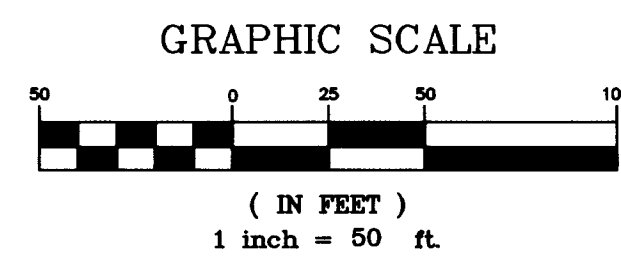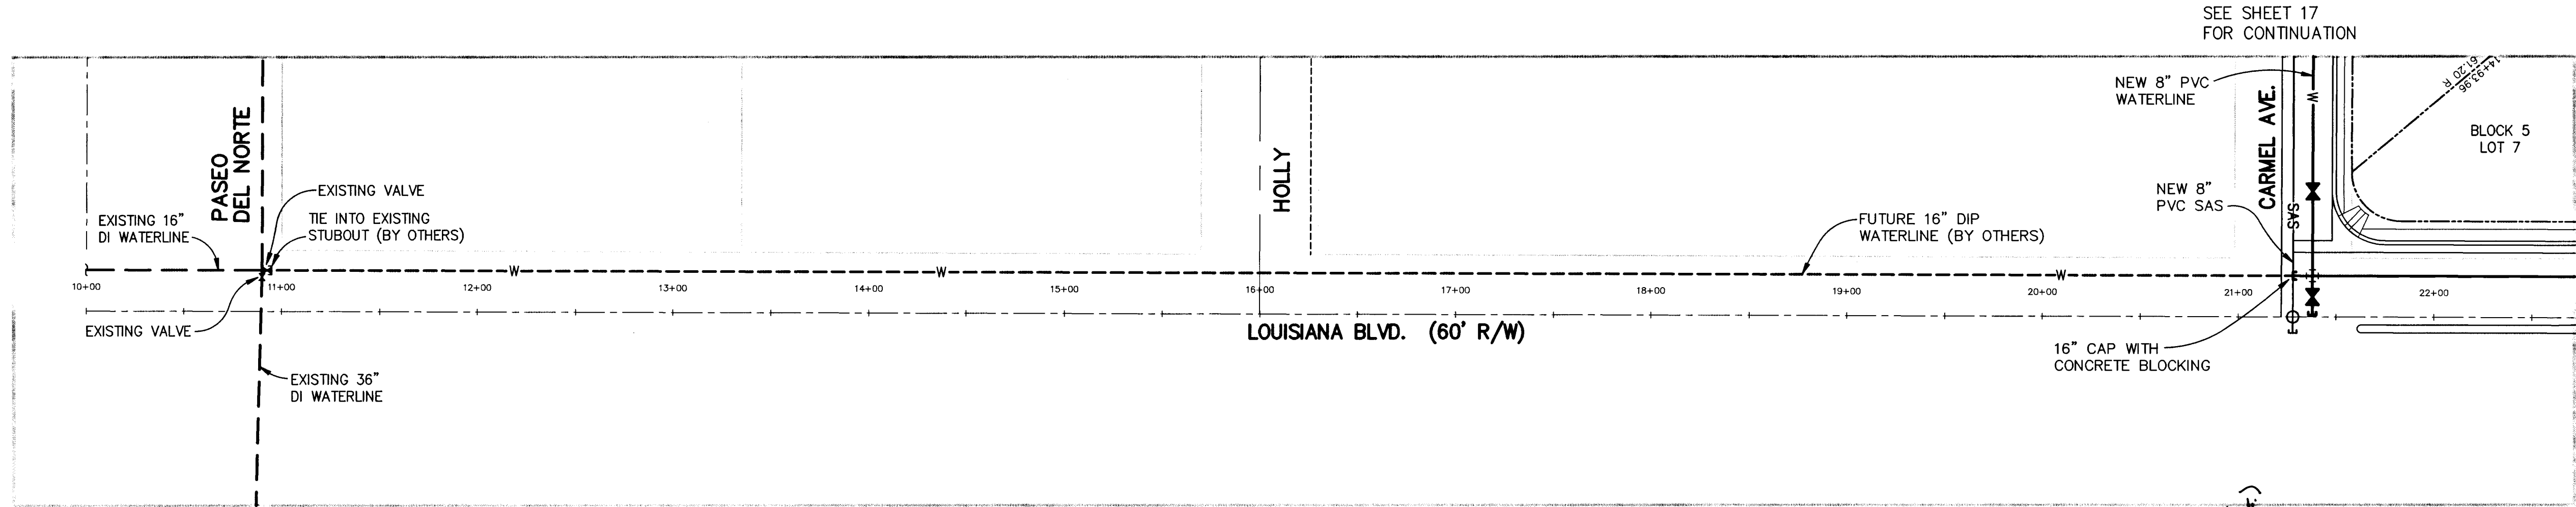


SCALE

HORIZ: 1"=50'

VERT: 1"=5'

LOUISIANA BLVD.

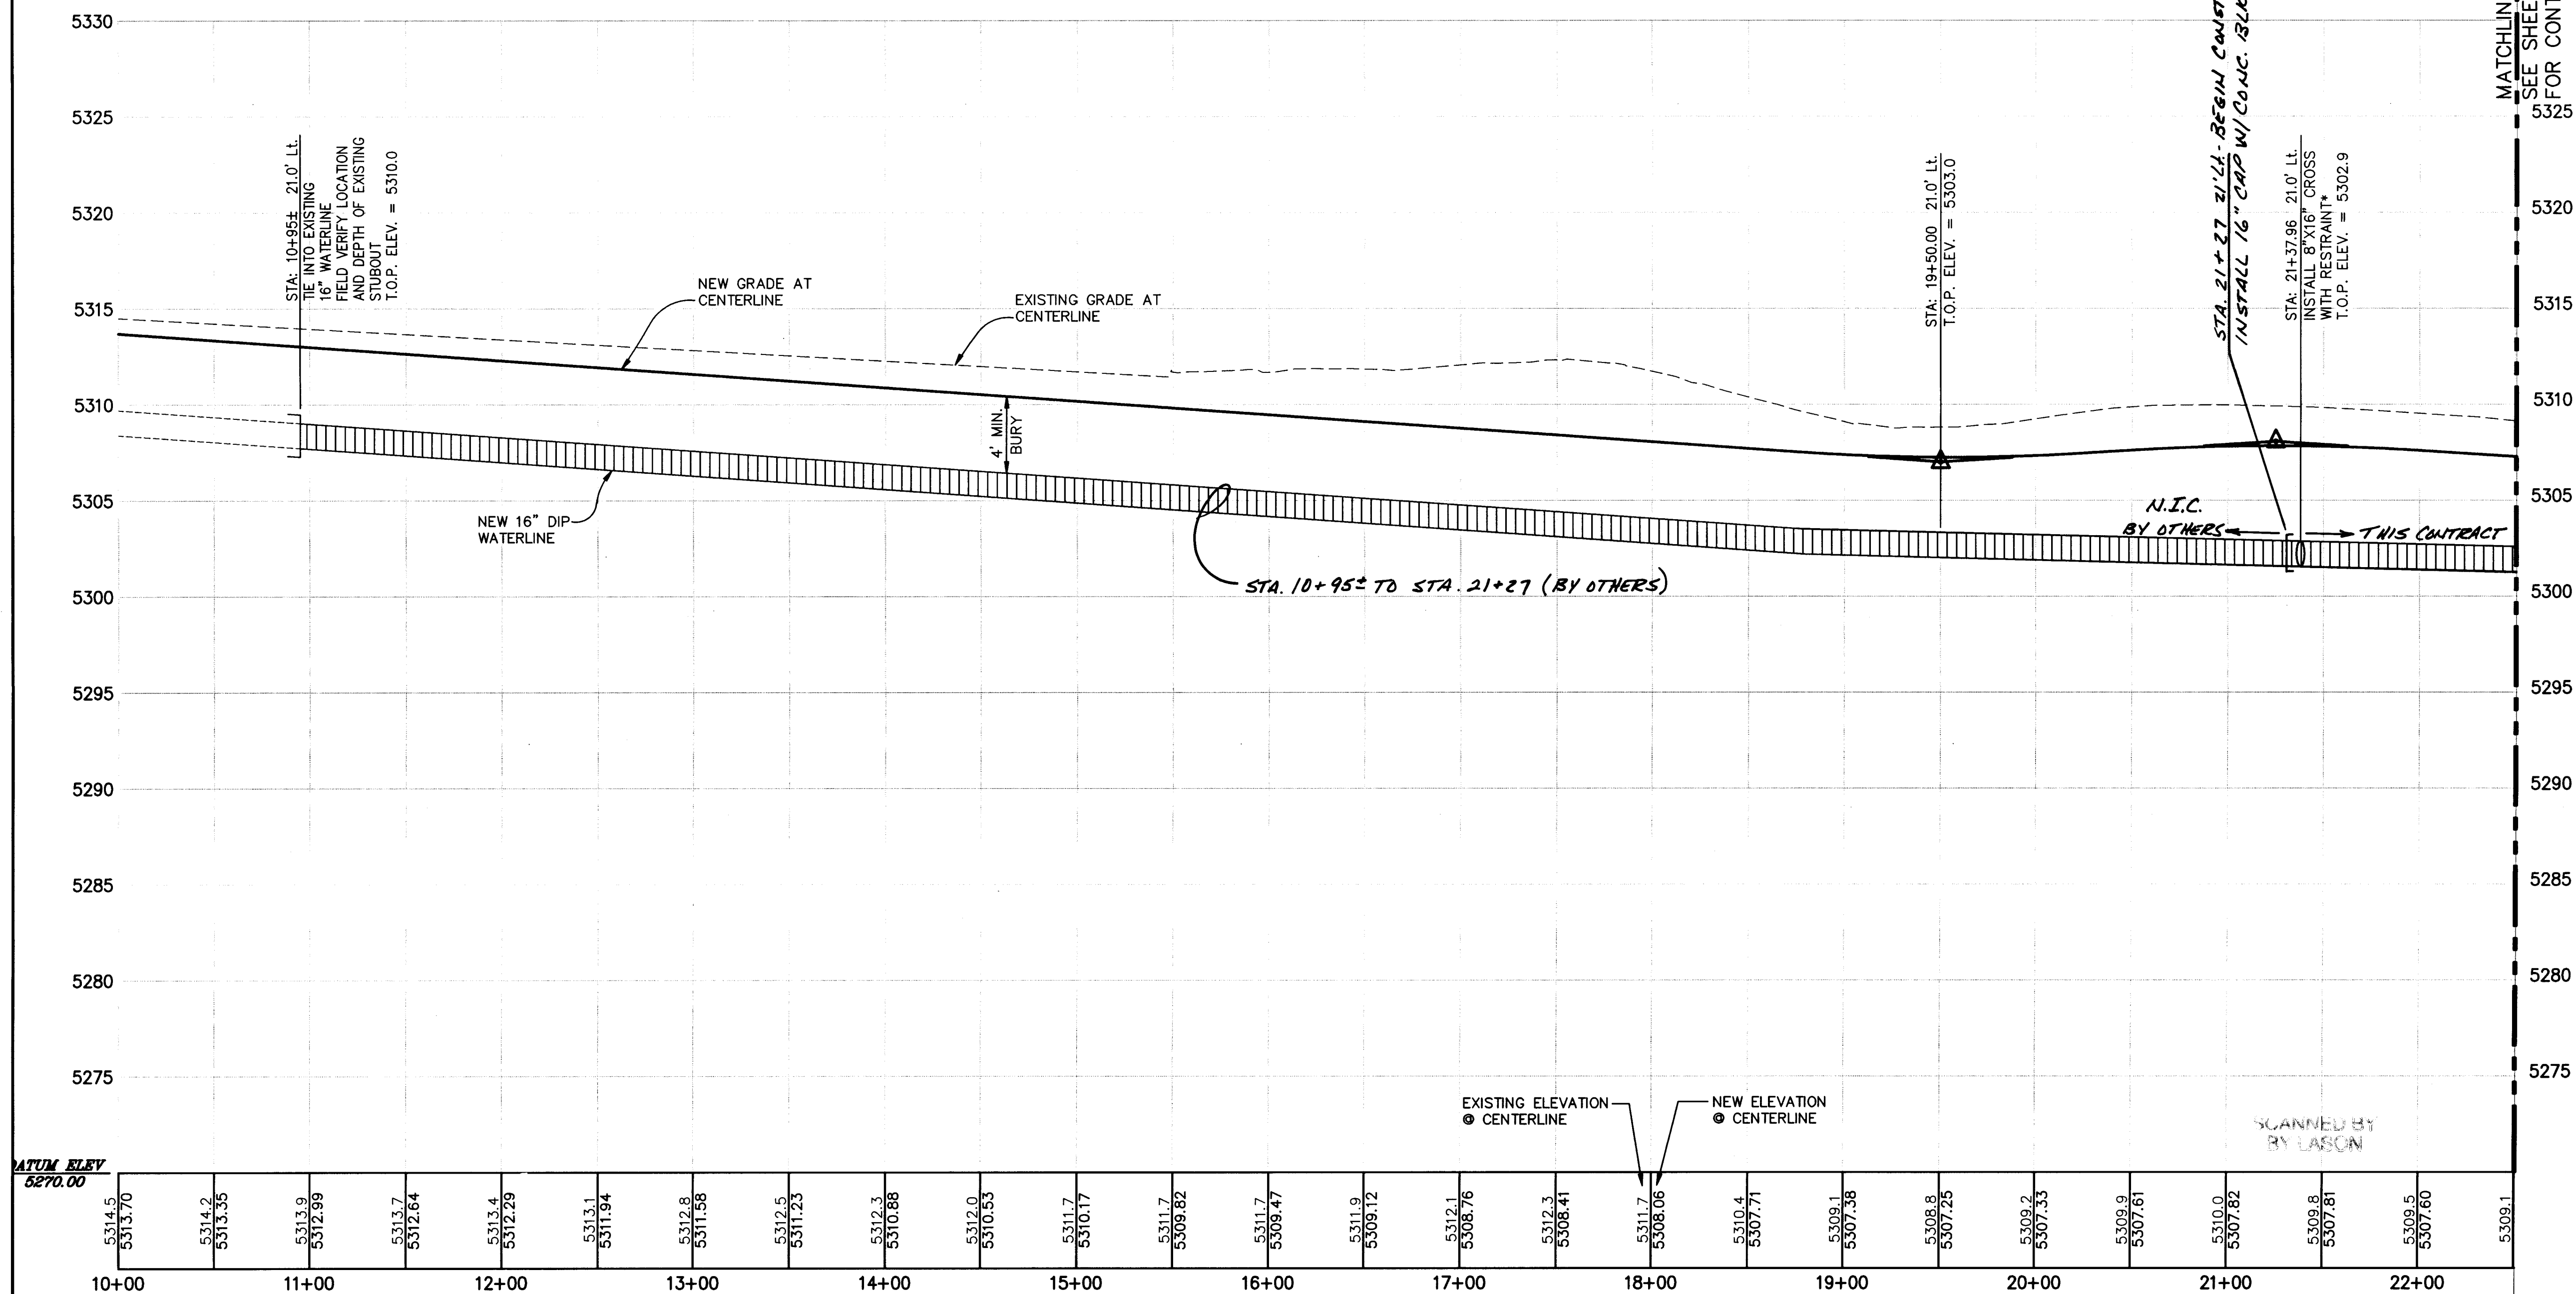

LEGEND		
NEW CURB & GUTTER		
NEW SAS MAINLINE	SAS	
NEW SAS SERVICE LINE	S	
NEW SAS MANHOLE	O	
NEW WATER MAINLINE	W	
NEW WATER SERVICE LINE	W	
NEW GATE VALVE	X	
NEW FIRE HYDRANT	*	
NEW STREET LIGHT	+	
NEW VALLEY GUTTER		

WATER AND SEWER NOTES		
1. CONSTRUCT 4" TYPE "E" MANHOLES PER STD. DWG. # 2102.		
2. CONSTRUCT SAS SERVICE LINES PER STD. DWG. # 2125.		
3. CONSTRUCT ALL CONCRETE BLOCKING PER STD. DWG. # 2320. CONCRETE BLOCKING SHALL BE UTILIZED ONLY WHERE SPECIFICALLY CALLED OUT ON PLAN.		
4. CONSTRUCT ALL VALVE BOXES PER NEW C.O.A. VALVE BOX DETAIL WITH NON-TAPERED CONCRETE COLLAR. No. 2325.		
5. CONSTRUCT ALL FIRE HYDRANTS PER DESIGNATED DEPTHS AND LENGTHS PER STD. DWG. # 2340. USE FULL RESTRAINT ON FIRE HYDRANT LEGS FROM MAIN TO FIRE HYDRANT FLANGE.		
6. CONSTRUCT ALL SINGLE AND DOUBLE WATER SERVICE LINES PER STD. DWG. # 2361, 2362 AND 2363.		
7. SEE SHEET 4 FOR SAS AND WATER SERVICE INFORMATION.		
*8. RESTRAINT DISTANCES FOR PIPE FITTINGS SHALL BE DEFINED BY TABLE ON SHEET 4.		
9. ALL WATERLINES SHALL BE C-900 PVC UNLESS OTHERWISE NOTED.		

AS BUILT INFORMATION	
CONTRACTOR	New Concepts
WORKED BY	COA
INSPECTOR'S	DATE 12/15
ACCEPTANCE BY	DATE 1/16
VERIFICATION BY	DATE 1/16
DRAWINGS	DATE 4/95
RECORDED BY	DATE
NO.	

BENCH MARKS	
ACS STA. No. 1-C19	
Y=1518845.74	
X=404941.91	
Z=5318.195	



SURVEY INFORMATION	
DATE	
BY	
NO.	

ENGINEER'S SEAL	
Terry O. Brown	8/16/95

REMARKS	
DESIGN	

NO. DATE	
DESIGNED BY: TOB	DATE: 08/95
DRAWN BY: TOB	DATE: 08/95
CHECKED BY: TOB	DATE: 08/95

CITY OF ALBUQUERQUE PUBLIC WORKS DEPARTMENT ENGINEERING GROUP			
TITLE: LA CUEVA OESTE, UNIT 1 UTILITY PLAN AND PROFILE LOUISIANA BLVD. - STA:10+00 TO STA:22+50			
APPROVALS	ENGINEER	DATE	APPROVALS
DRC CHAIRMAN	B. G. Goodby	10-3-95	WATER
TRANSPORTATION	W. R. L. L. L.	8-12-95	WASTE WATER
HYDROLOGY	N/A	9-15-95	
PROJECT NO.	5232.90	MAP NO.	C-18-Z
		SHEET	14
		OF	29

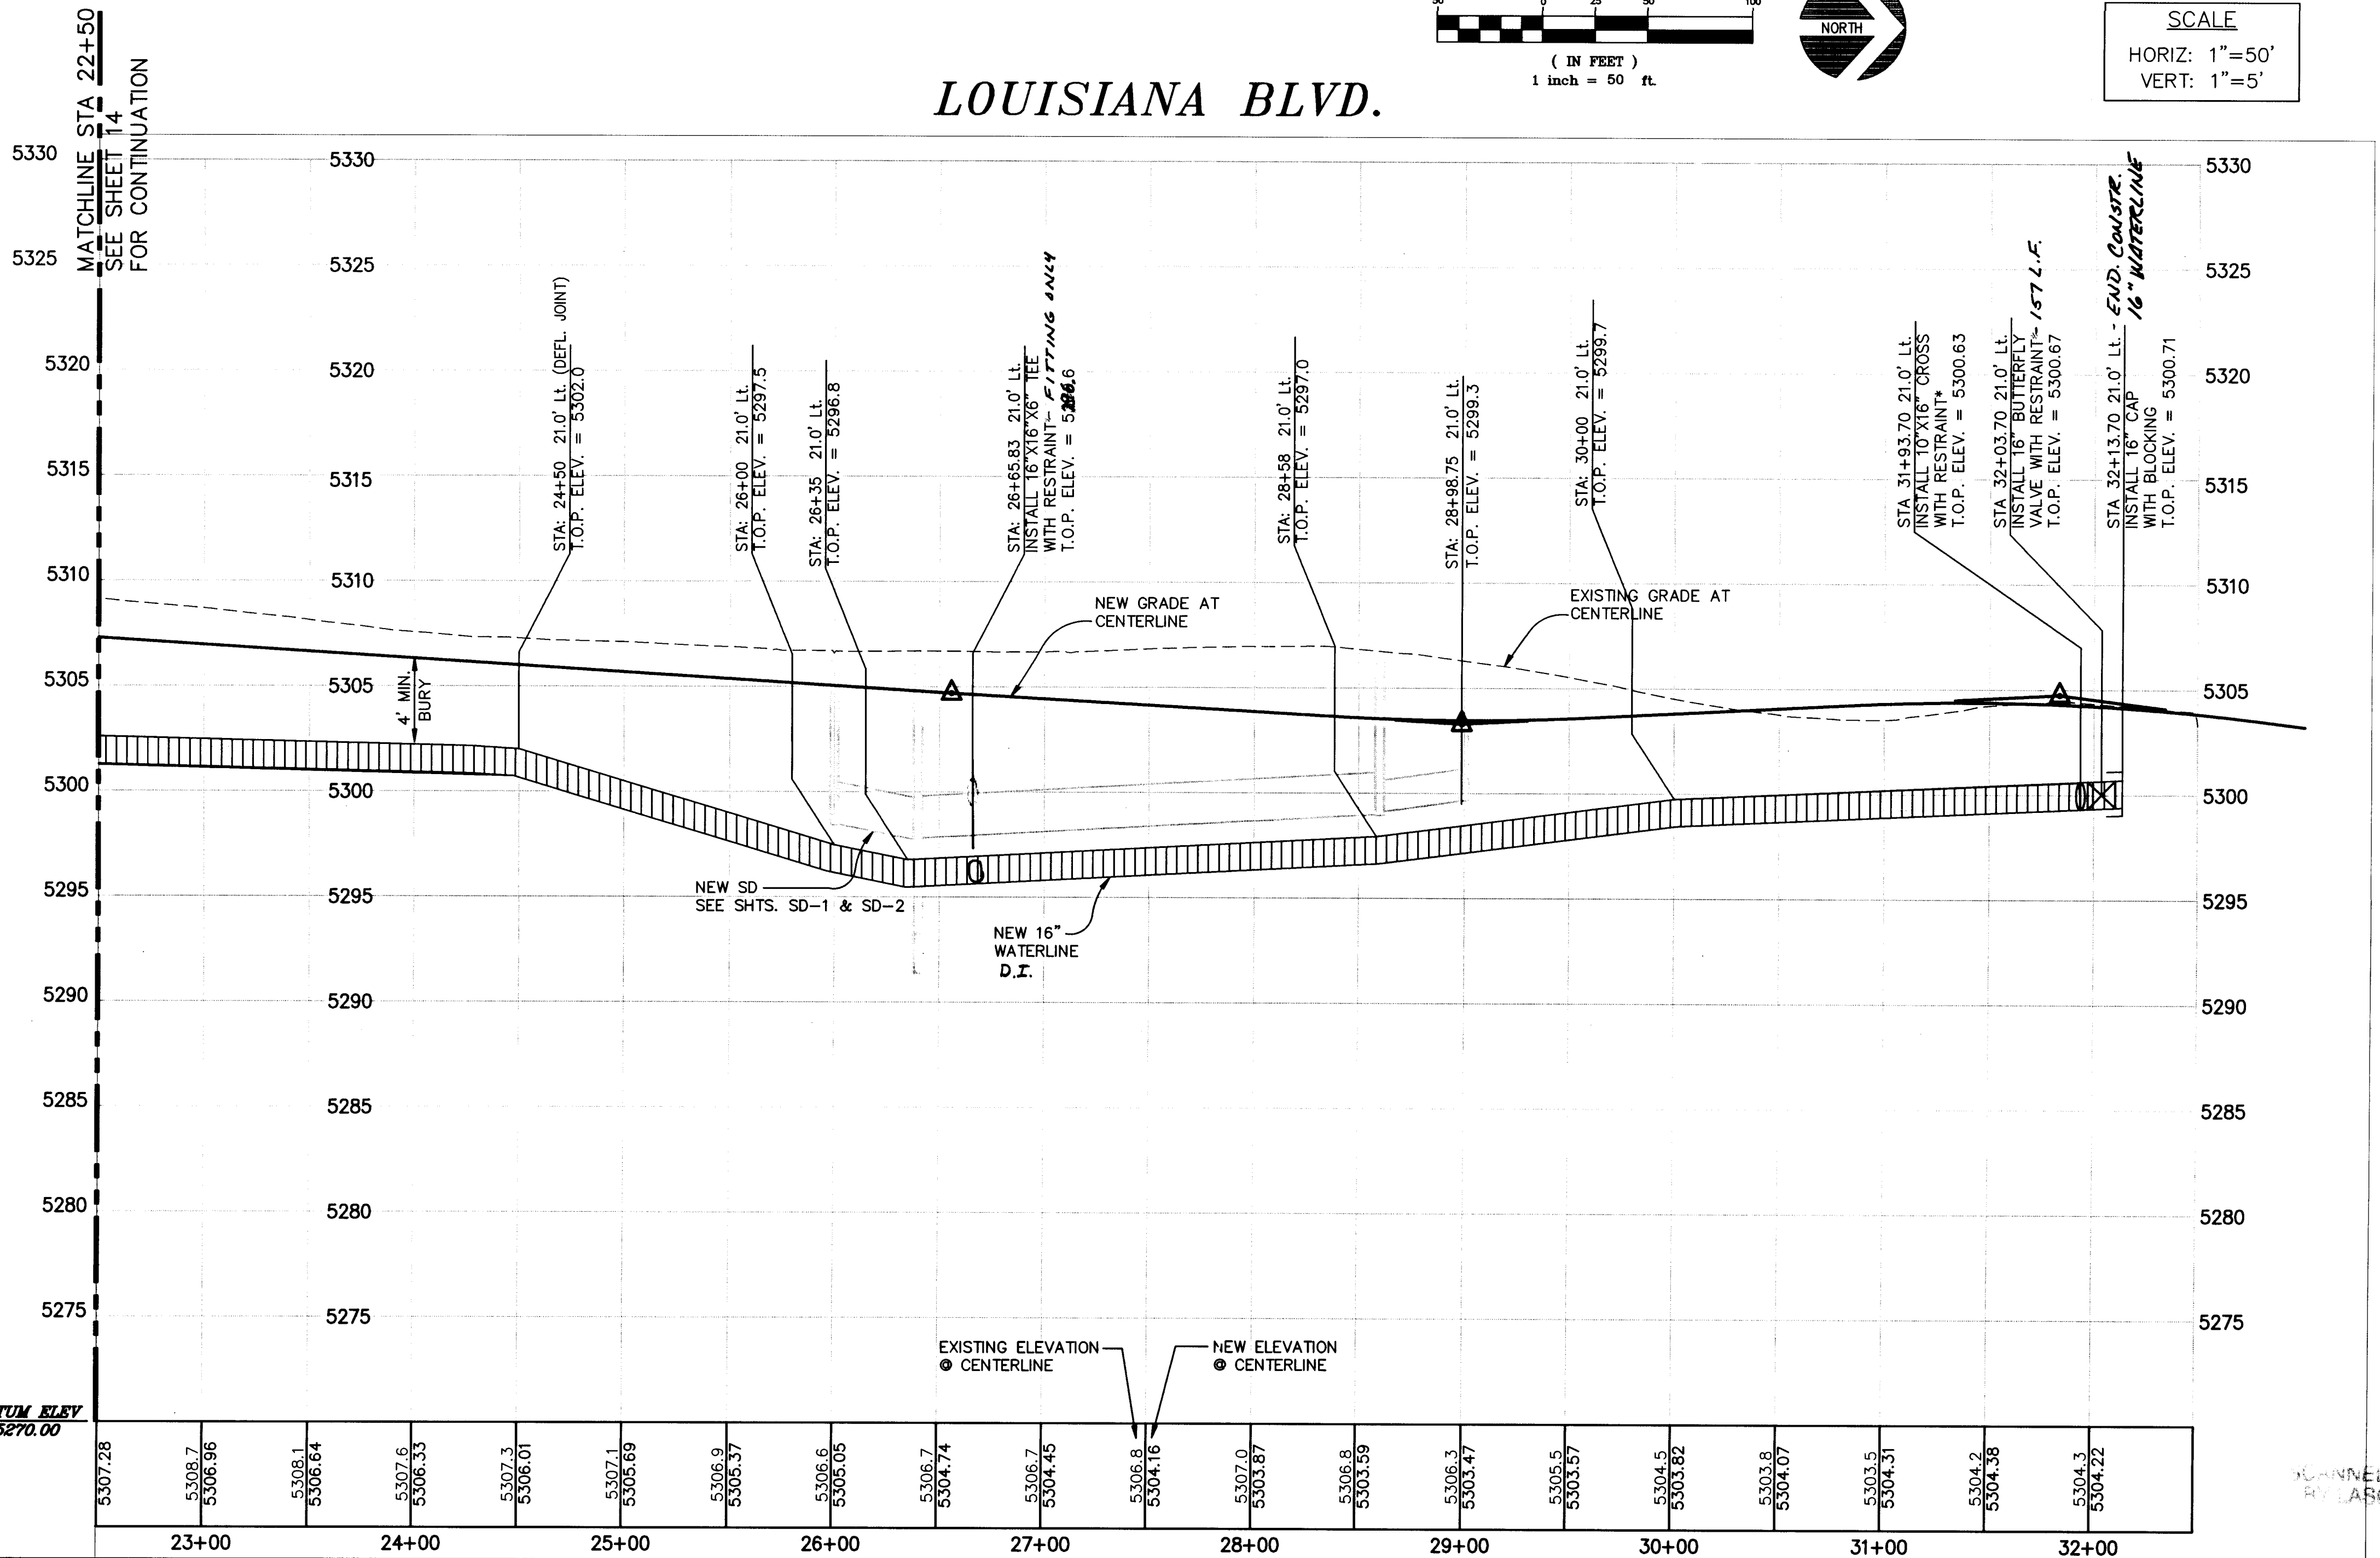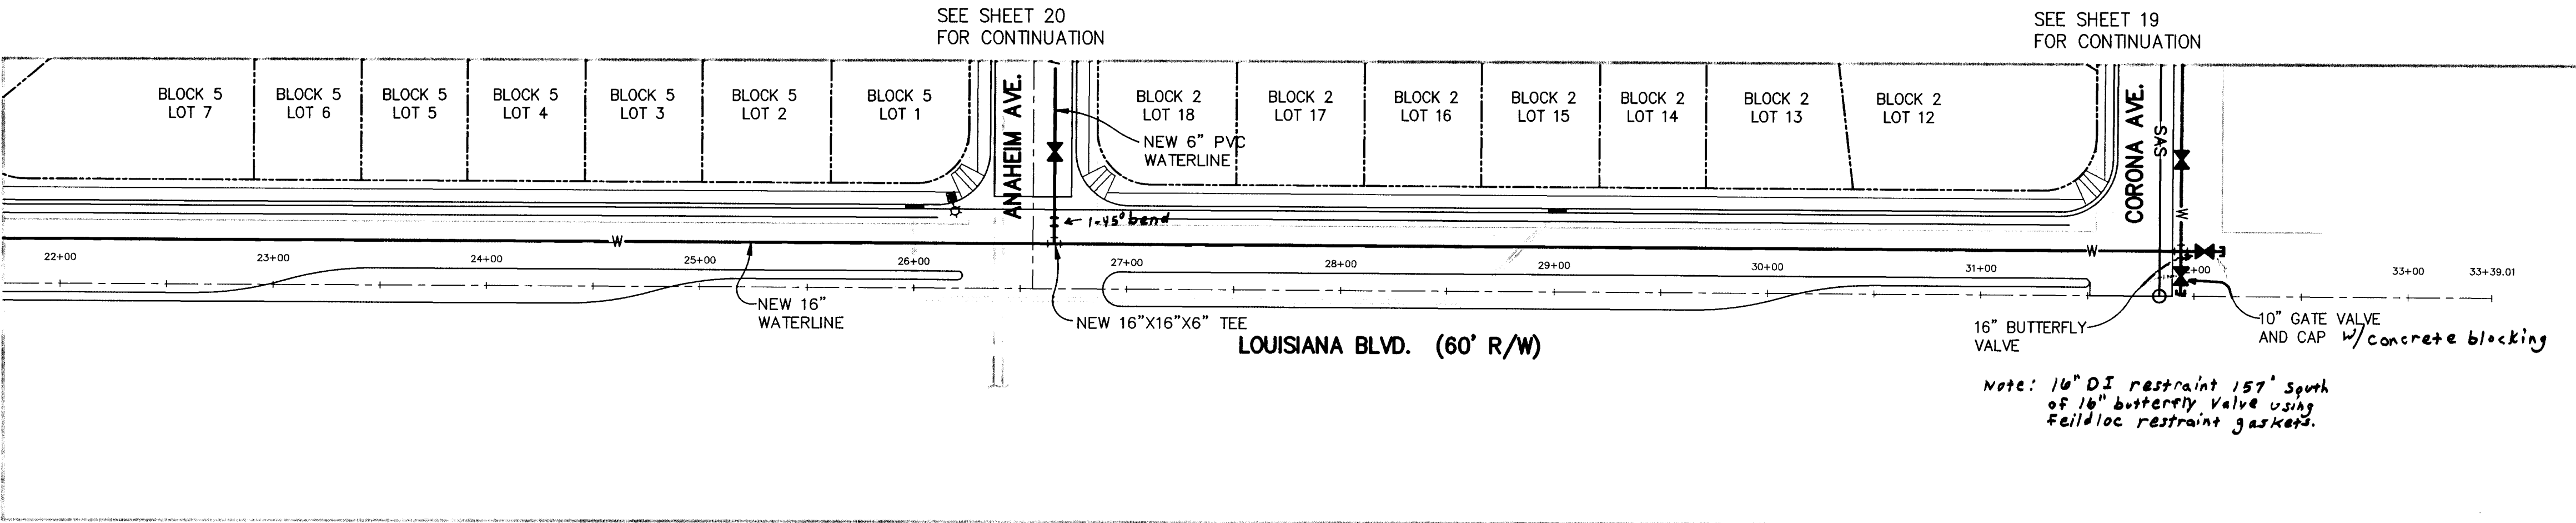

LEGEND

NEW CURB & GUTTER	=====
NEW SAS MAINLINE	— SAS —
NEW SAS SERVICE LINE	— S —
NEW SAS MANHOLE	○
NEW WATER MAINLINE	— W —
NEW WATER SERVICE LINE	— WS —
NEW GATE VALVE	⋈
NEW FIRE HYDRANT	⋈
NEW STREET LIGHT	⋈
NEW VALLEY GUTTER	=====

- WATER AND SEWER NOTES
1. CONSTRUCT 4" TYPE "E" MANHOLES PER STD. DWG.# 2102.
 2. CONSTRUCT SAS SERVICE LINES PER STD. DWG.# 2125.
 3. CONSTRUCT ALL CONCRETE BLOCKING PER STD. DWG.# 2320. CONCRETE BLOCKING SHALL BE UTILIZED ONLY WHERE SPECIFICALLY CALLED OUT ON PLAN.
 4. CONSTRUCT ALL VALVE BOXES PER NEW C.O.A. VALVE BOX DETAIL WITH NON-TAPERED CONCRETE COLLAR NO. 2325.
 5. CONSTRUCT ALL FIRE HYDRANTS PER DESIGNATED DEPTHS AND LENGTHS PER STD. DWG.# 2340. USE FULL RESTRAINT ON FIRE HYDRANT LEGS FROM MAIN TO FIRE HYDRANT FLANGE.
 6. CONSTRUCT ALL SINGLE AND DOUBLE WATER SERVICE LINES PER STD. DWG.# 2361, 2362 AND 2363.
 7. SEE SHEET 4 FOR SAS AND WATER SERVICE INFORMATION.
 - *8. RESTRAINT DISTANCES FOR PIPE FITTINGS SHALL BE DEFINED BY TABLE ON SHEET 4.
 9. ALL WATERLINES SHALL BE C-900 PVC UNLESS OTHERWISE NOTED.

ENGINEER'S SEAL

Terry O. Brown

9/16/95

REMARKS

DESIGN

NO. DATE

DESIGNED BY: TOB

DRAWN BY: TOB

CHECKED BY: TOB

DATE: 08/95

DATE: 08/95

DATE: 08/95

CITY OF ALBUQUERQUE

PUBLIC WORKS DEPARTMENT

ENGINEERING GROUP

TITLE: LA CUEVA OESTE, UNIT 1

UTILITY PLAN AND PROFILE

LOUISIANA BLVD. — STA: 22+50 TO STA: 33+39.01

APPROVALS ENGINEER DATE APPROVALS ENGINEER DATE

DRC CHAIRMAN S. A. Bailey 10-3-95 WATER



TRANSPORTATION N/A 8-17-95 WASTE WATER

HYDROLOGY N/A 9-15-95

PROJECT NO. 5232.90

MAP NO. C-18-Z

SHEET 15 OF 29

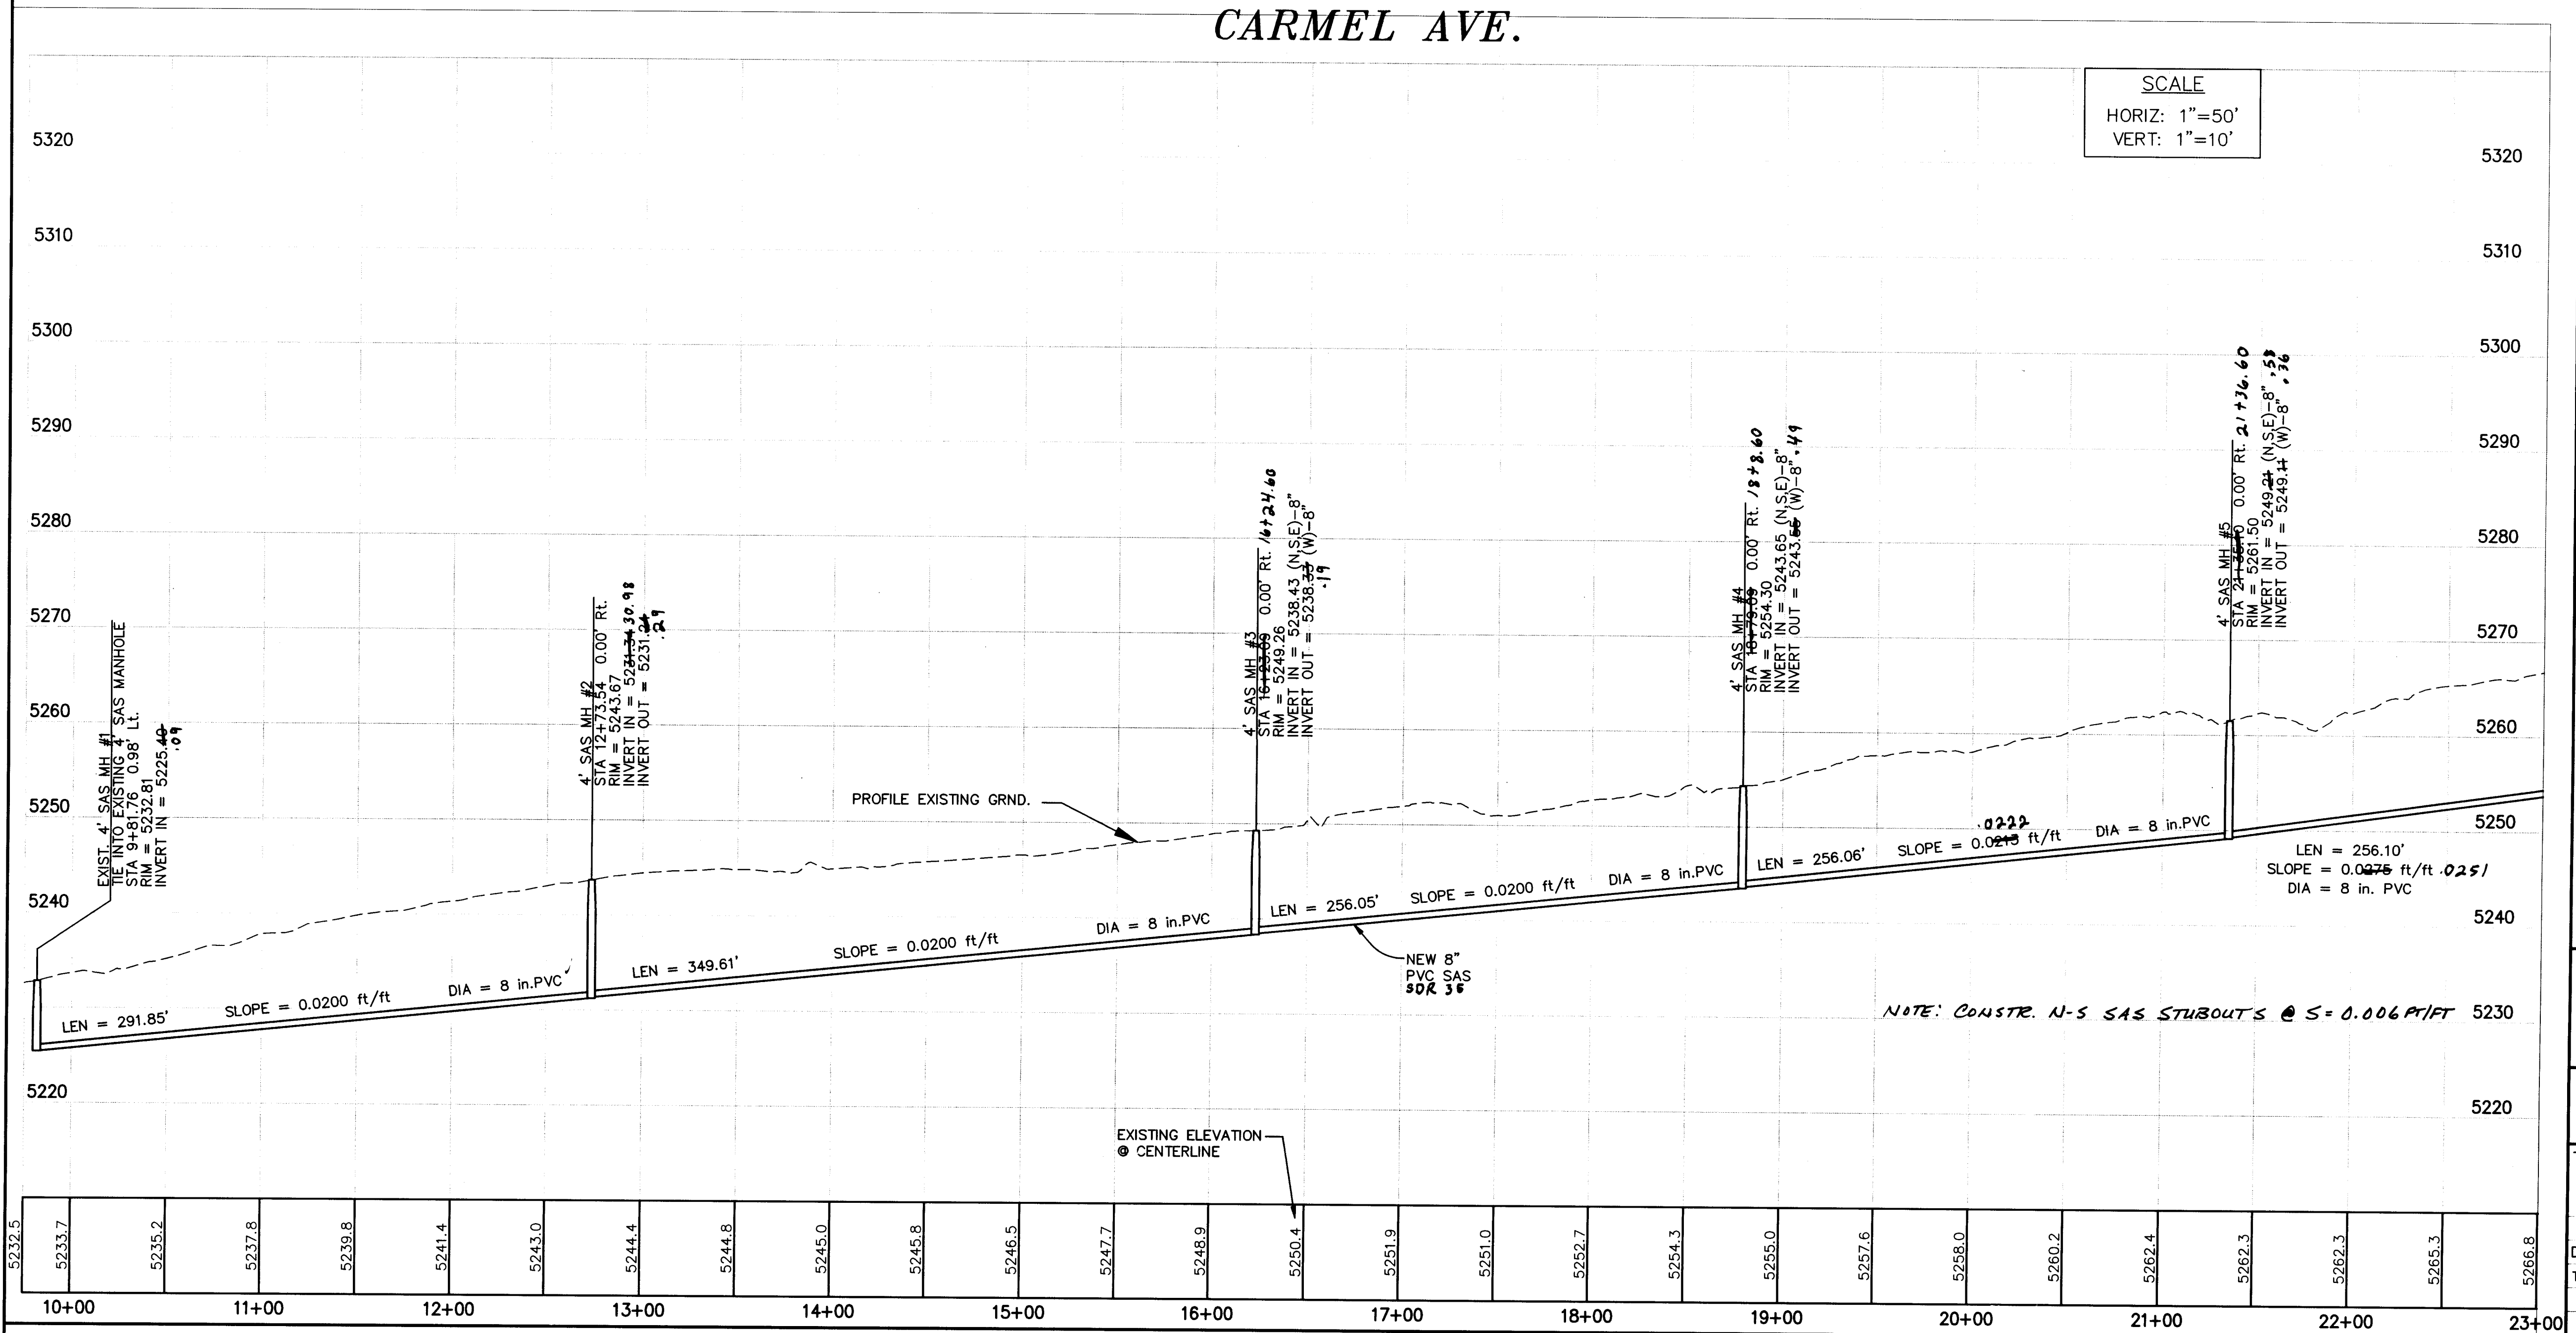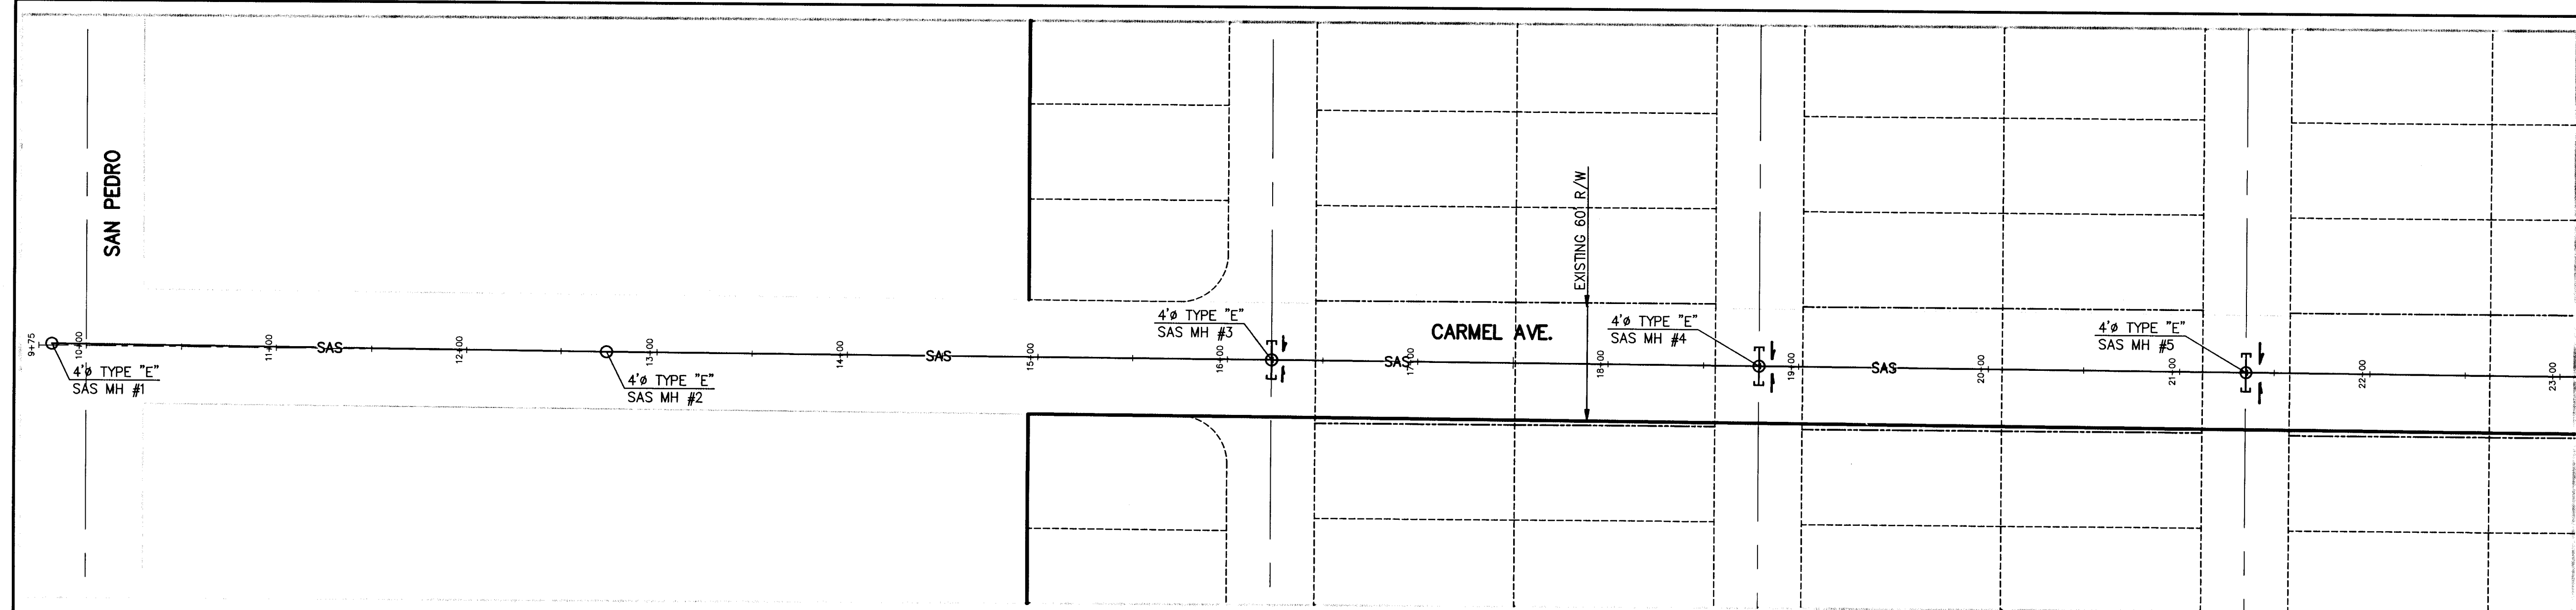

LEGEND

NEW CURB & GUTTER

NEW SAS MAINLINE

NEW SAS SERVICE LINE

NEW SAS MANHOLE

NEW WATER MAINLINE

NEW WATER SERVICE LINE

NEW GATE VALVE

NEW FIRE HYDRANT

NEW STREET LIGHT

NEW VALLEY GUTTER

WATER AND SEWER NOTES

1. CONSTRUCT 4' TYPE "E" MANHOLES PER STD. DWG.# 2102.

2. CONSTRUCT SAS SERVICE LINES PER STD. DWG.# 2125.

3. CONSTRUCT ALL CONCRETE BLOCKING PER STD. DWG.# 2320. CONCRETE BLOCKING SHALL BE UTILIZED ONLY WHERE SPECIFICALLY CALLED OUT ON PLAN.

4. CONSTRUCT ALL VALVE BOXES PER NEW C.O.A. VALVE BOX DETAIL WITH NON-FACED CONCRETE COLLAR. ~~NO. 2325.~~

5. CONSTRUCT ALL FIRE HYDRANTS PER DESIGNATED DEPTHS AND LENGTHS PER STD. DWG.# 2340. USE FULL RESTRAINT ON FIRE HYDRANT LEGS FROM MAIN TO FIRE HYDRANT FLANGE.

6. CONSTRUCT ALL SINGLE AND DOUBLE WATER SERVICE LINES PER STD. DWG.# 2361, 2362 AND 2363.

7. SEE SHEET 4 FOR SAS AND WATER SERVICE INFORMATION.

*8. RESTRAINT DISTANCES FOR PIPE FITTINGS SHALL BE DEFINED BY TABLE ON SHEET 4.

9. ALL WATERLINES SHALL BE C-900 PVC UNLESS OTHERWISE NOTED.

SCALE

HORIZ: 1"=50'

VERT: 1"=10'

GRAPHIC SCALE

1 inch = 50 ft.

AS BUILT INFORMATION

CONTRACTOR: New Concepts

WORK: C.O.A.

DATE: 12/19

STAMPED BY: L. Romera

DATE: 3/96

FIELD LOCATION BY: L.R.

DATE: 7/96

DRAWINGS: L.R.

CORRECTED BY: L.R.

DATE: 4/96

RECORDED BY: L.R.

DATE: 4/96

BENCH MARKS

ACS STA. No. 1-C19

Y=1518845.74

X=404941.91

Z=5318.195

SURVEY INFORMATION

FIELD NOTES

BY: Terry O. Brown

NO. 8/16/95

ENGINEER'S SEAL

Terry O. Brown

8/16/95

REMARKS

REVISIONS

DESIGN

DATE: 08/95

DATE: 08/95

DATE: 08/95

CITY OF ALBUQUERQUE

PUBLIC WORKS DEPARTMENT

ENGINEERING GROUP

TITLE:

LA CUEVA OESTE, UNIT 1

UTILITY PLAN AND PROFILE

CARMEL AVE. - STA: 9+75 TO STA: 23+00

APPROVALS

ENGINEER: [Signature]

DATE: 10-3-95

APPROVALS: [Signature]

DATE: 8-17-95

WASTE WATER: [Signature]

DATE: 8-31-95

PROJECT NO.

5232.90

MAP NO.


C-18-Z

SHEET

16

OF


29

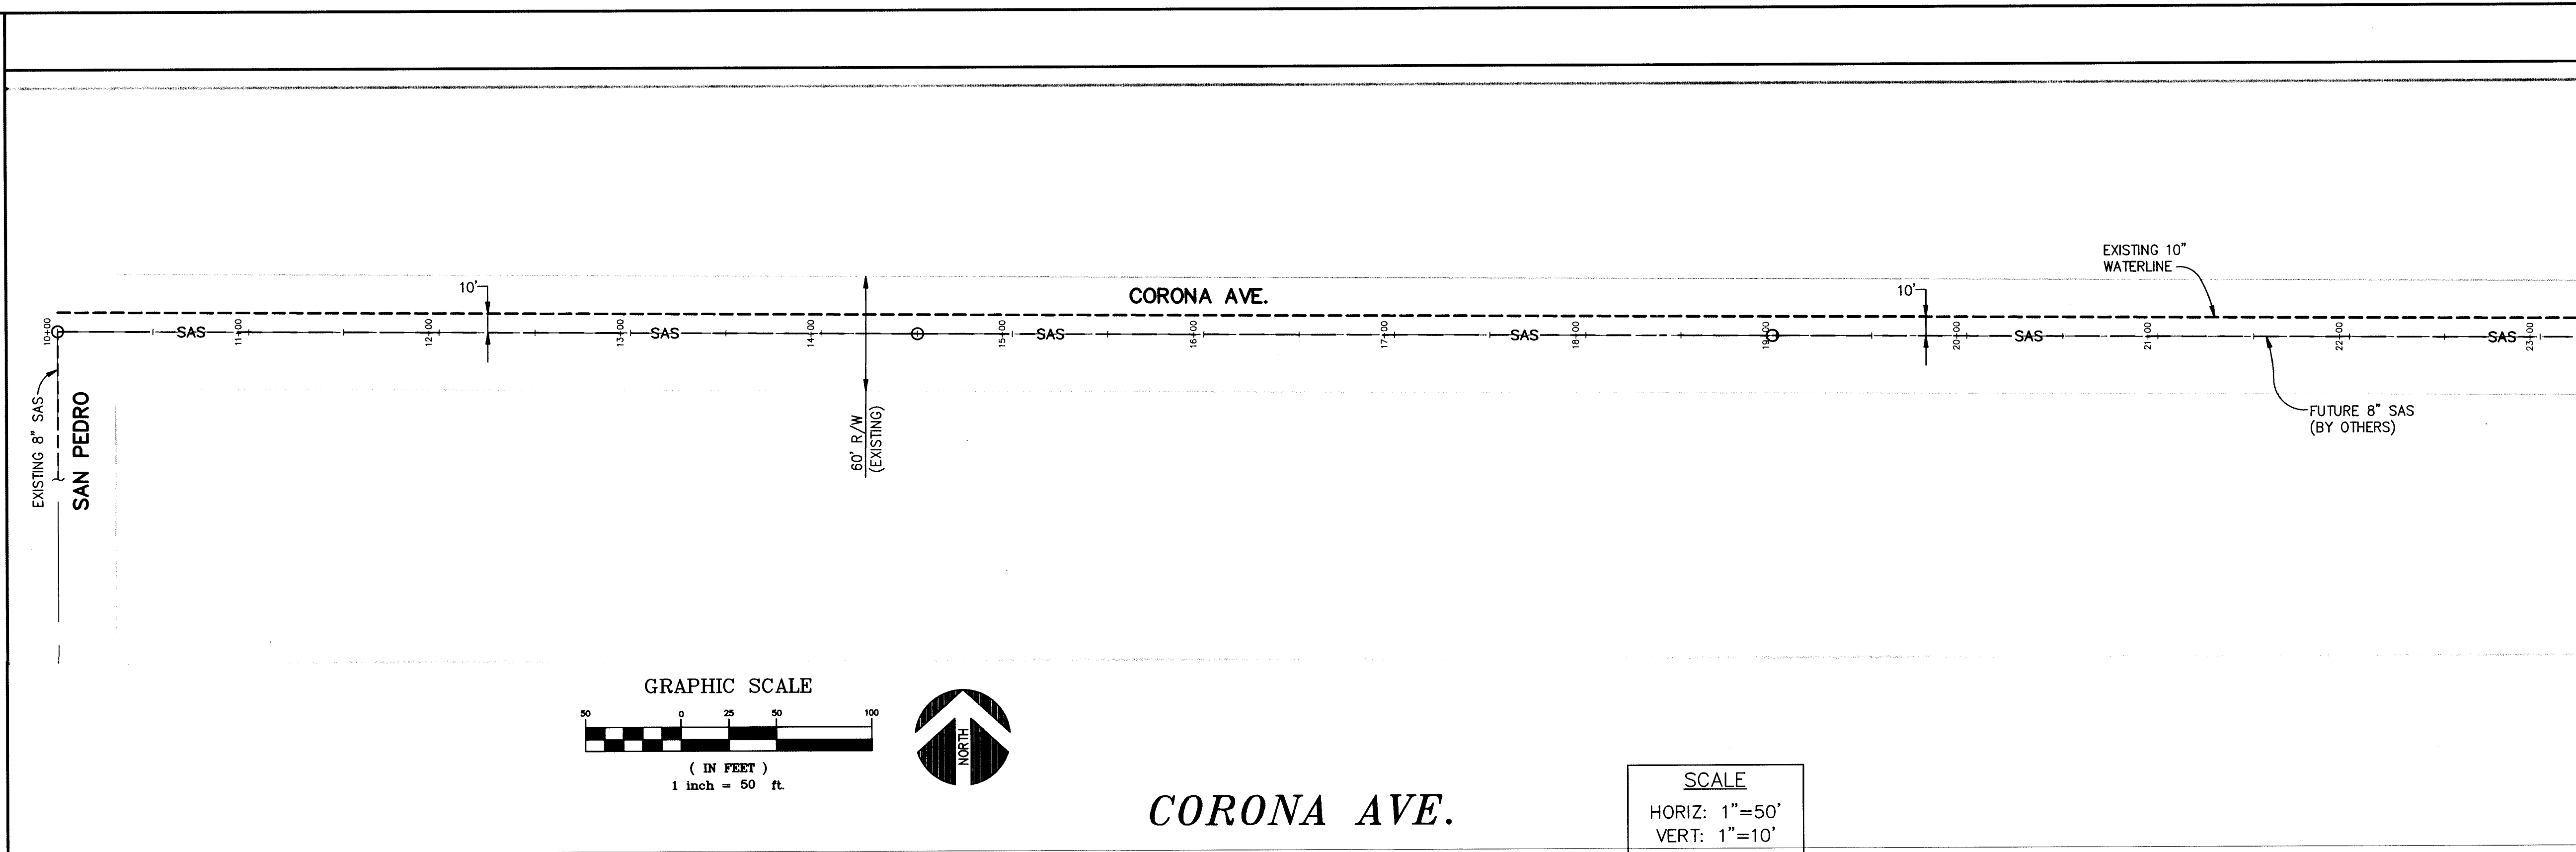

LEGEND

NEW CURB & GUTTER	=====
NEW SAS MAINLINE	--- SAS ---
NEW SAS SERVICE LINE	--- S ---
NEW SAS MANHOLE	○
NEW WATER MAINLINE	--- W ---
NEW WATER SERVICE LINE	--- W ---
NEW GATE VALVE	⊗
NEW FIRE HYDRANT	⊗
NEW STREET LIGHT	⊗
NEW VALLEY GUTTER	=====

- WATER AND SEWER NOTES
- CONSTRUCT 4'ø TYPE "E" MANHOLES PER STD. DWG.# 2102.
 - CONSTRUCT SAS SERVICE LINES PER STD. DWG.# 2125.
 - CONSTRUCT ALL CONCRETE BLOCKING PER STD. DWG.# 2320. CONCRETE BLOCKING SHALL BE UTILIZED ONLY WHERE SPECIFICALLY CALLED OUT ON PLAN.
 - CONSTRUCT ALL VALVE BOXES PER NEW C.O.A. VALVE BOX DETAIL WITH NON-TAPERED CONCRETE COLLAR #2325.
 - CONSTRUCT ALL FIRE HYDRANTS PER DESIGNATED DEPTHS AND LENGTHS PER STD. DWG.# 2340. USE FULL RESTRAINT ON FIRE HYDRANT LEGS FROM MAIN TO FIRE HYDRANT FLANGE.
 - CONSTRUCT ALL SINGLE AND DOUBLE WATER SERVICE LINES PER STD. DWG.# 2361, 2362 AND 2363.
 - SEE SHEET 4 FOR SAS AND WATER SERVICE INFORMATION.
 - RESTRRAINT DISTANCES FOR PIPE FITTINGS SHALL BE DEFINED BY TABLE ON SHEET 4.
 - ALL WATERLINES SHALL BE C-900 PVC UNLESS OTHERWISE NOTED.

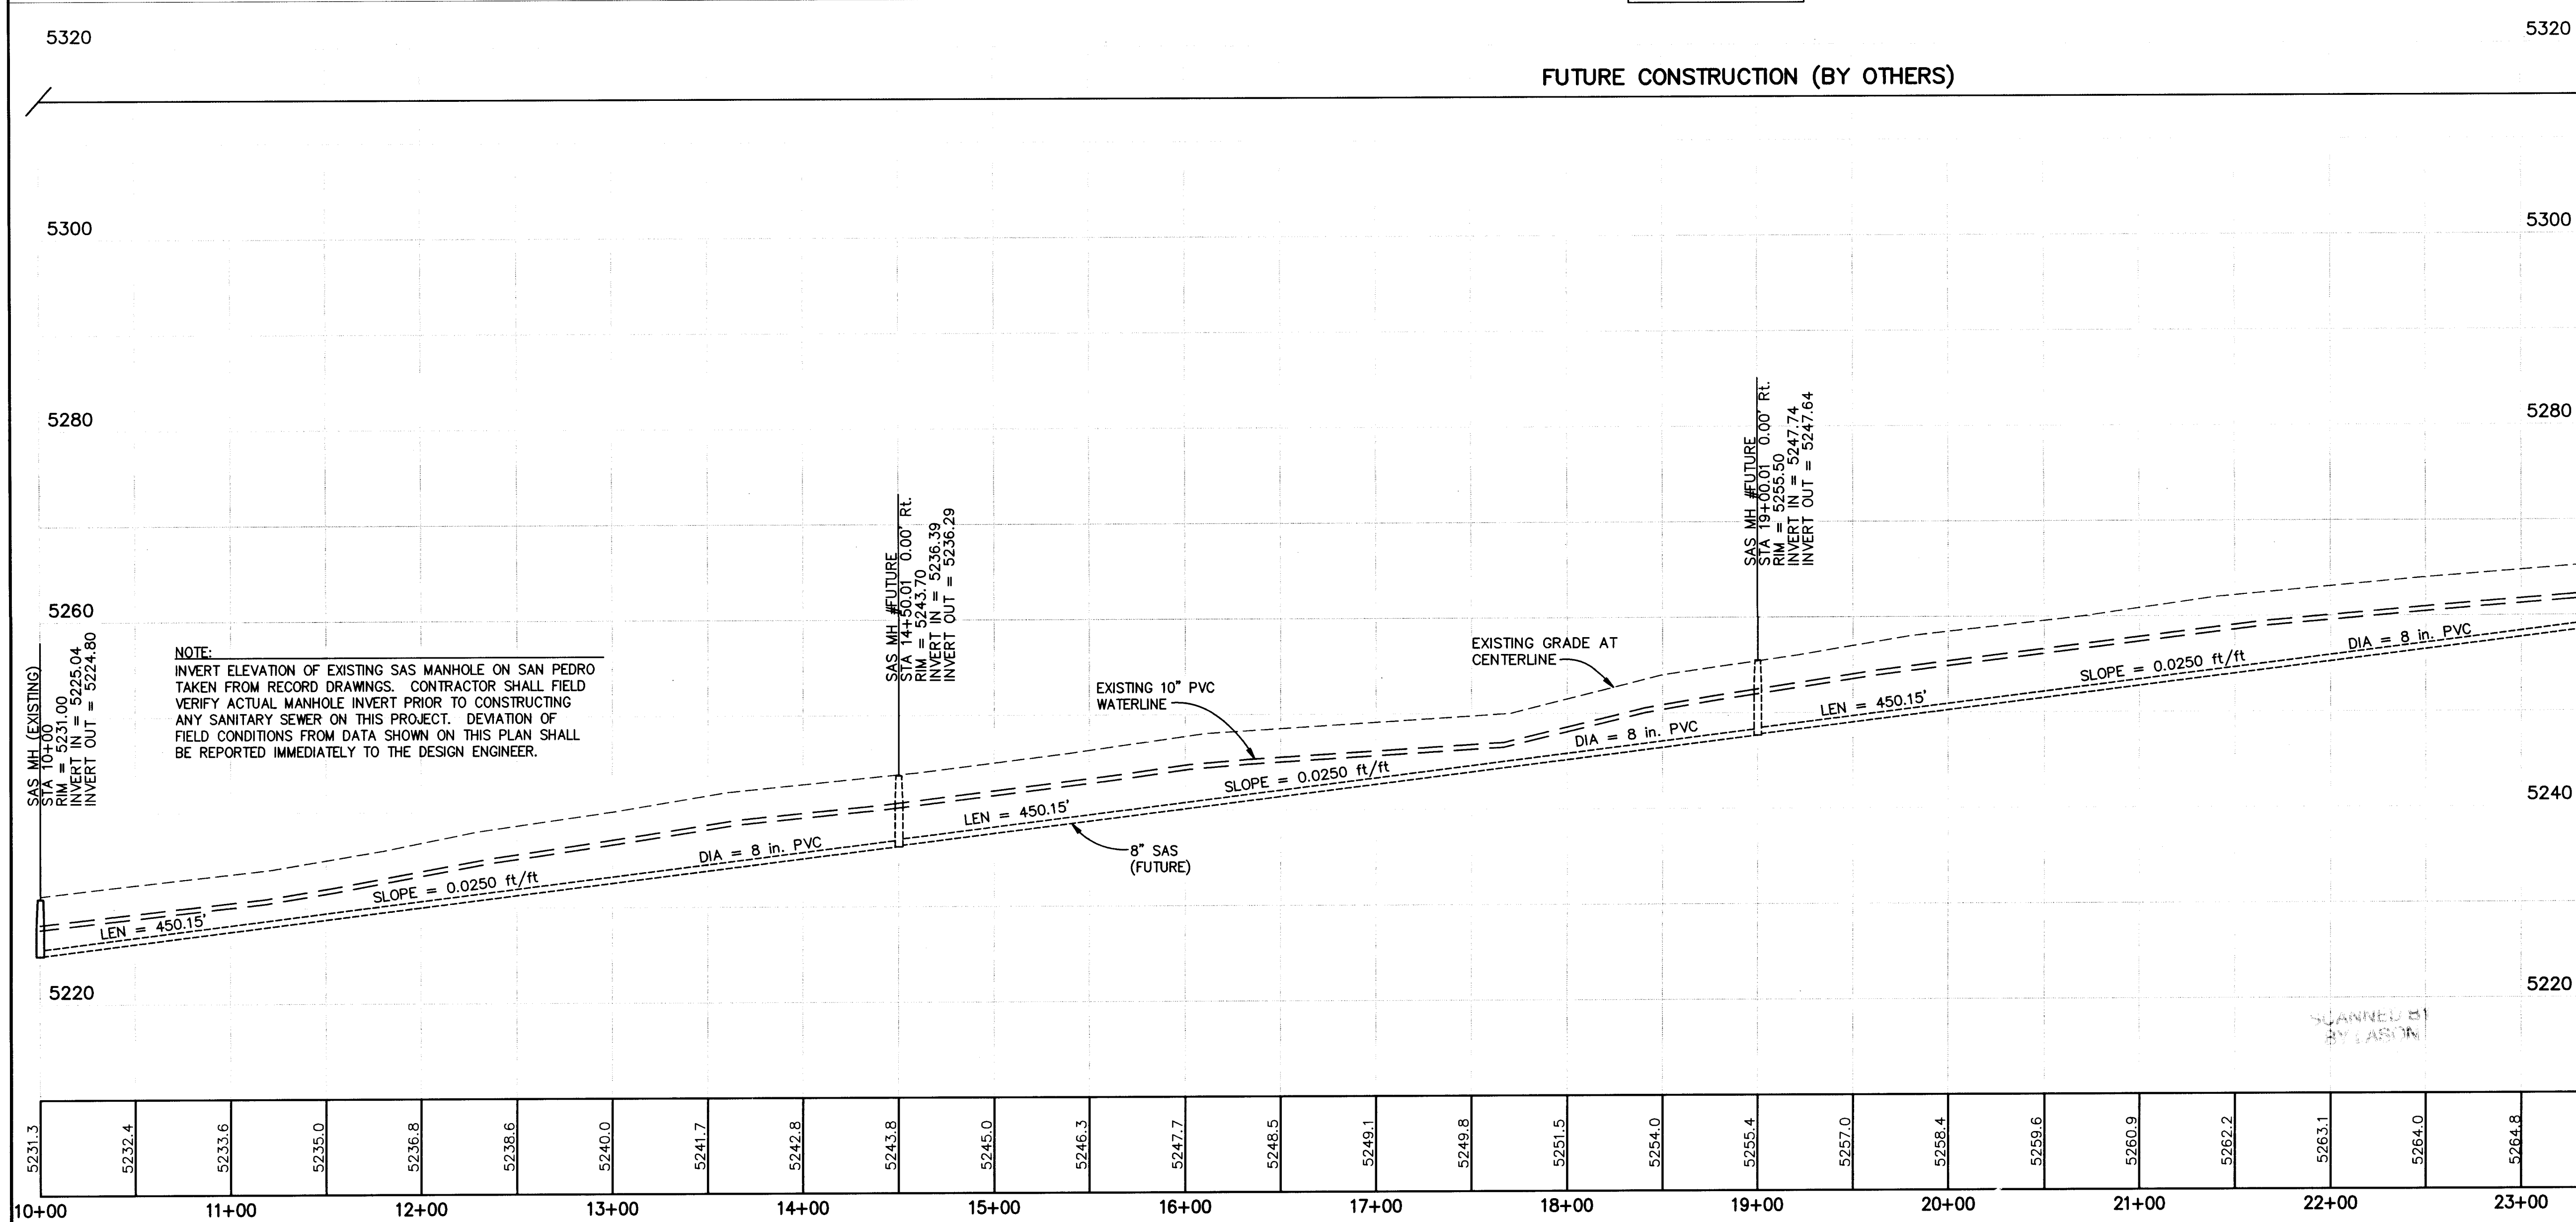

AS BUILT INFORMATION

CONTRACTOR New Concept
STAMPED BY C.O.A. DATE 12/19
INSPECTOR'S DATE 1/16
FIELD VERIFICATION BY L. R. DATE 1/16
CORRECTED BY L. R. DATE 1/16
MICRO-FILM INFORMATION
RECORDED BY NO. DATE

BENCH MARKS

ACS STA. No. 1-C19
Y=1518845.74
X=404941.91
Z=5318.195

SURVEY INFORMATION

FIELD NOTES BY NO. DATE

ENGINEER'S SEAL

BY Terry O. Brown
8/16/95

REMARKS
DESIGN
NO. DATE
DESIGNED BY: TOB
DRAWN BY: TOB
CHECKED BY: TOB

20-15-2332.90-18-95



Terry O. Brown, P.E.
P. O. Box 92051
Albuquerque, NM 87199
(505) 883-8807

CITY OF ALBUQUERQUE
PUBLIC WORKS DEPARTMENT
ENGINEERING GROUP

TITLE:
LA CUEVA OESTE, UNIT 1
UTILITY PLAN AND PROFILE
CORONA AVE. - STA:10+00 TO STA:23+50

APPROVALS	ENGINEER	DATE	APPROVALS	ENGINEER	DATE
DRC CHAIRMAN	By: [Signature]	10-3-95	WATER		
TRANSPORTATION	N/A RHO	8-17-95	WASTE WATER	By: [Signature]	8-17-95
HYDROLOGY	N/A Sme	9-15-95			


PROJECT NO. 5232.90 MAP NO. C-18-Z SHEET 18 OF 29

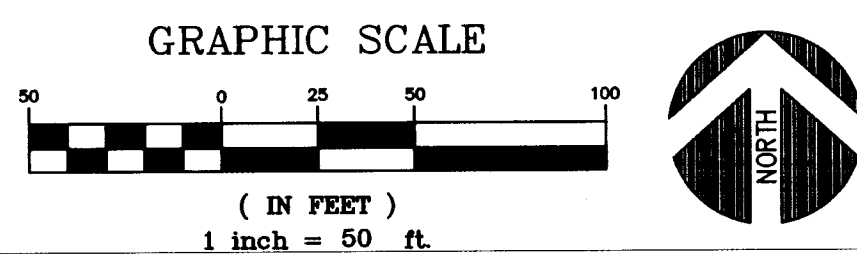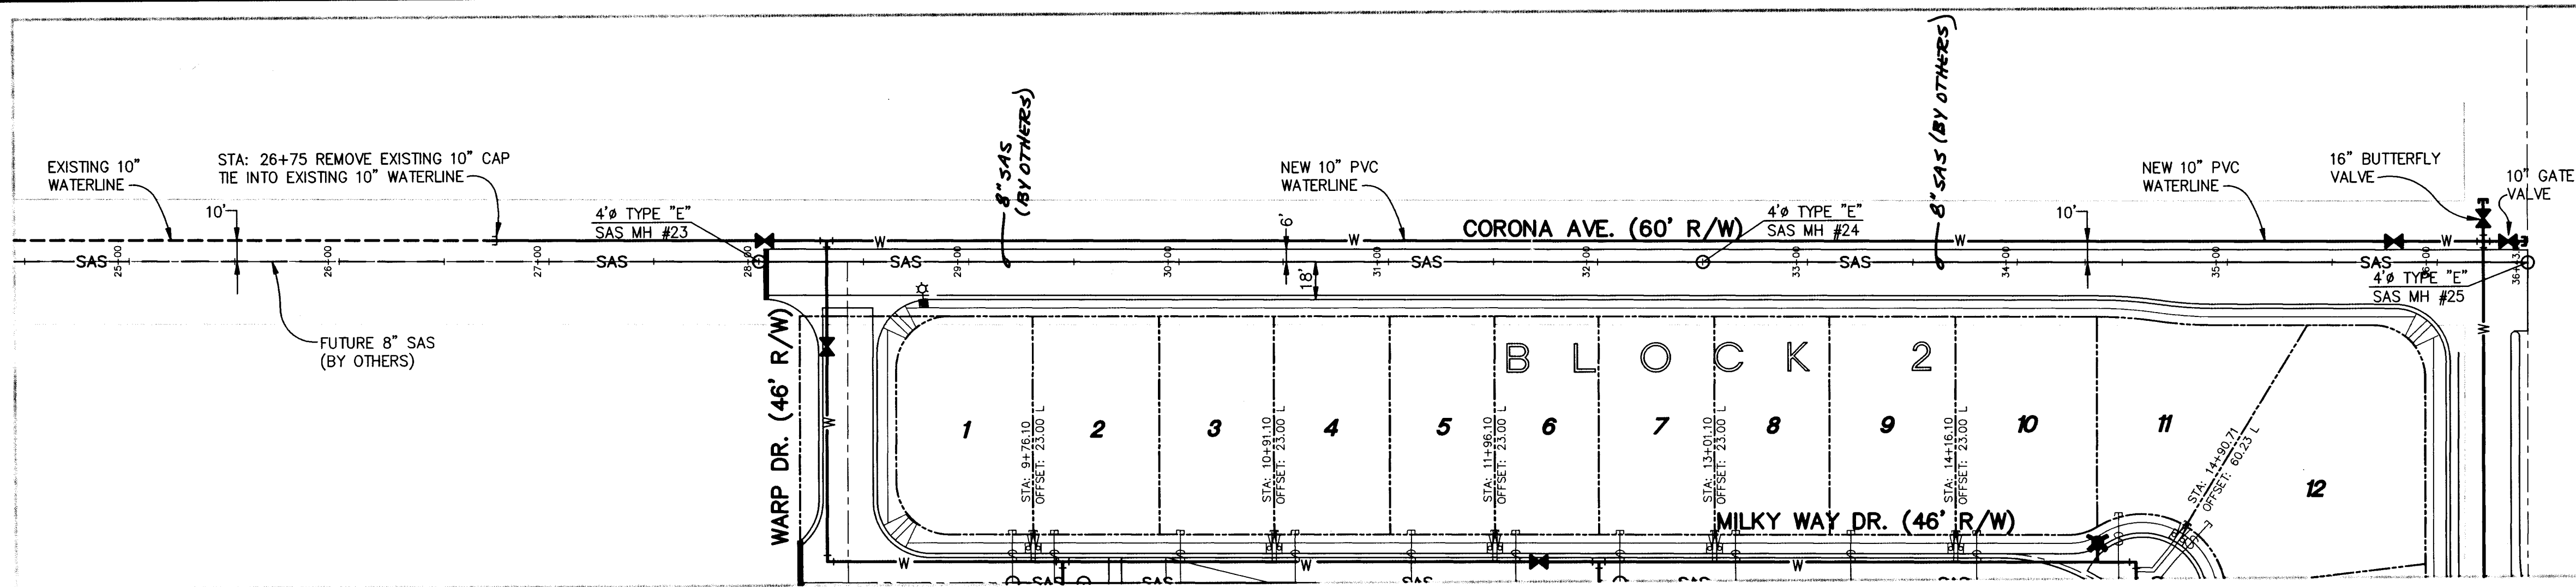

CORONA AVE.

SCALE

HORIZ: 1"=50'
VERT: 1"=10'

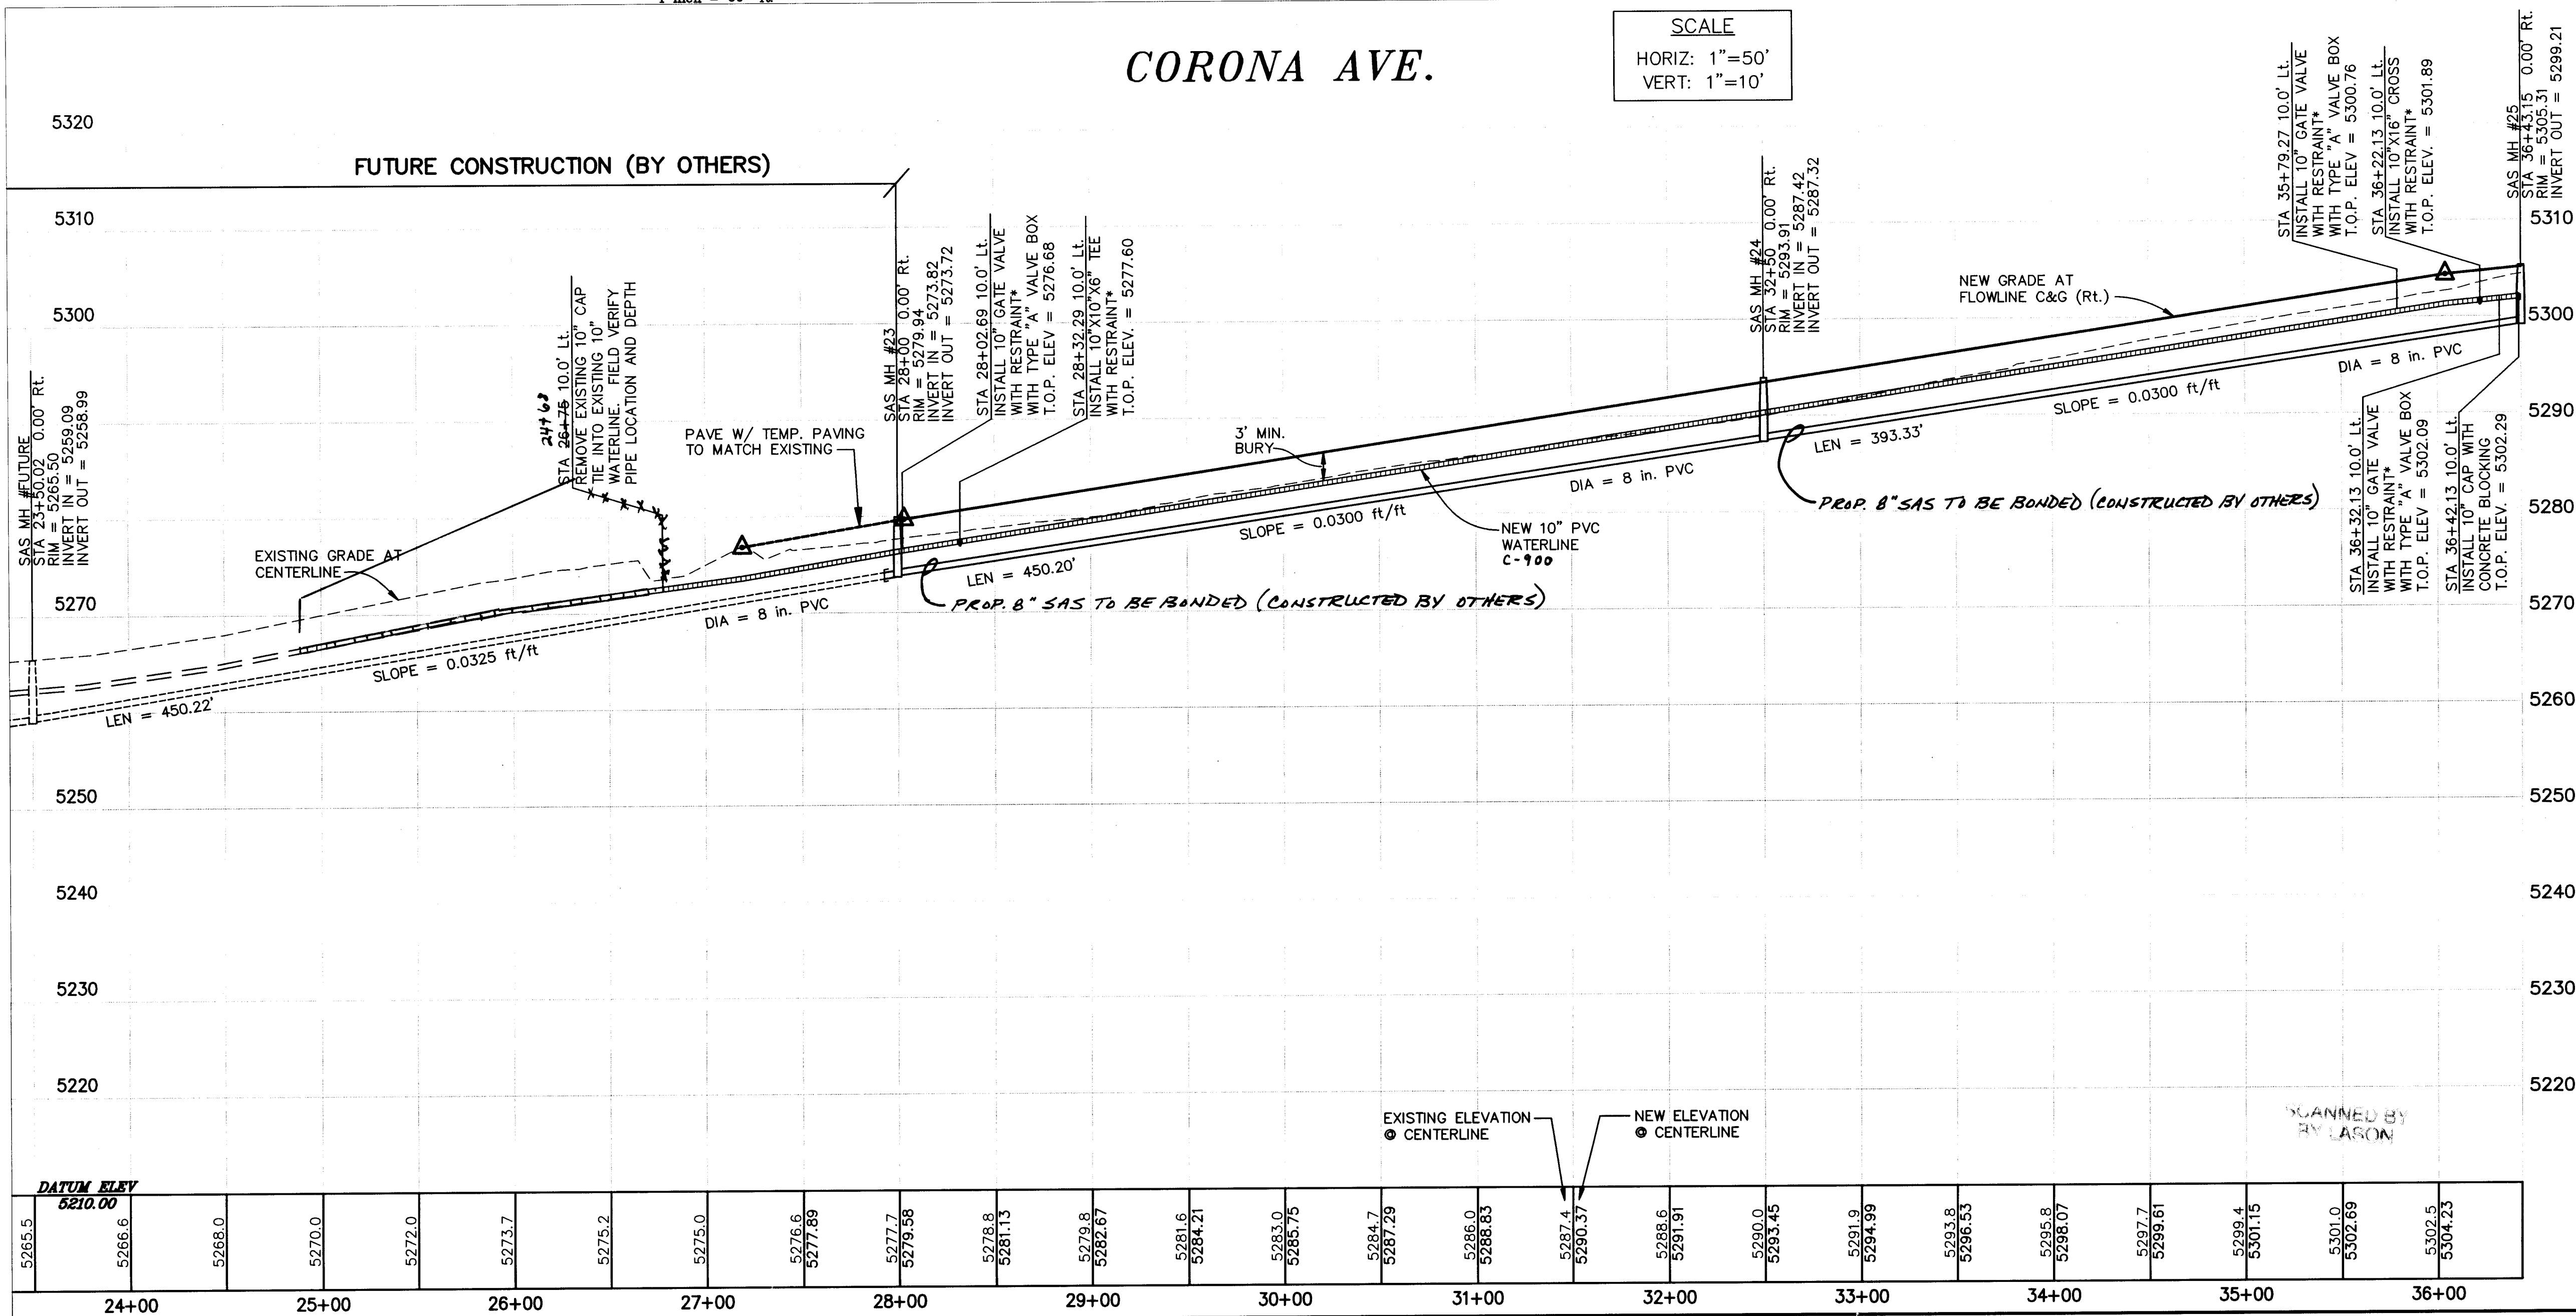

LEGEND

NEW CURB & GUTTER	---
NEW SAS MAINLINE	— SAS —
NEW SAS SERVICE LINE	— S —
NEW SAS MANHOLE	○
NEW WATER MAINLINE	— W —
NEW WATER SERVICE LINE	— W —
NEW GATE VALVE	⊗
NEW FIRE HYDRANT	⊗
NEW STREET LIGHT	⊗
NEW VALLEY GUTTER	---

- WATER AND SEWER NOTES
1. CONSTRUCT 4" TYPE "E" MANHOLES PER STD. DWG.# 2102.
 2. CONSTRUCT SAS SERVICE LINES PER STD. DWG.# 2125.
 3. CONSTRUCT ALL CONCRETE BLOCKING PER STD. DWG.# 2320. CONCRETE BLOCKING SHALL BE UTILIZED ONLY WHERE SPECIFICALLY CALLED OUT ON PLAN.
 4. CONSTRUCT ALL VALVE BOXES PER NEW C.O.A. VALVE BOX DETAIL WITH NON-TAPERED CONCRETE COLUMNS NO. 2325.
 5. CONSTRUCT ALL FIRE HYDRANTS PER DESIGNATED DEPTHS AND LENGTHS PER STD. DWG.# 2340. USE FULL RESTRAINT ON FIRE HYDRANT LEGS FROM MAIN TO FIRE HYDRANT FLANGE.
 6. CONSTRUCT ALL SINGLE AND DOUBLE WATER SERVICE LINES PER STD. DWG.# 2361, 2362 AND 2363.
 7. SEE SHEET 4 FOR SAS AND WATER SERVICE INFORMATION.
 - *8. RESTRAINT DISTANCES FOR PIPE FITTINGS SHALL BE DEFINED BY TABLE ON SHEET 4.
 9. ALL WATERLINES SHALL BE C-900 PVC UNLESS OTHERWISE NOTED.

AS BUILT INFORMATION

CONTRACTOR: New Concepts
STAMPED BY: C.O.A.
INSPECTOR'S FIELD VERIFICATION BY: L. Romero
DATE: 12/15/95
DATE: 3/16/96
DATE: 9/16/96
DATE: 4/16/96

BENCH MARKS


ACS STA. No. 1-C19
Y=1518845.74
X=404941.91
Z=5318.195

SURVEY INFORMATION

FIELD NOTES BY: [Signature]
NO. 8/16/95

ENGINEER'S SEAL

BY: [Signature]
DATE: 08/95
DESIGNED BY: TOB
DRAWN BY: TOB
CHECKED BY: TOB

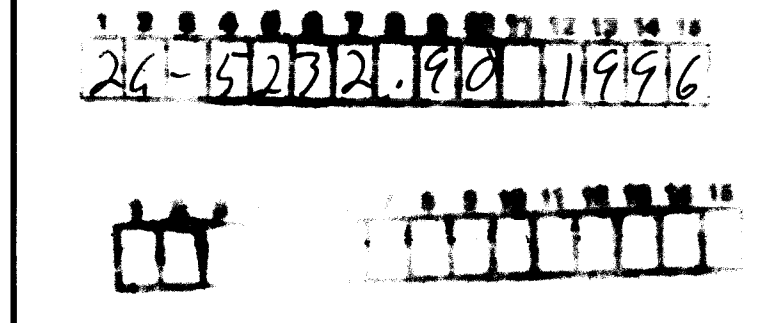







Terry O. Brown, P.E.
P. O. Box 92051
Albuquerque, NM 87199
(505) 883-8807

CITY OF ALBUQUERQUE
PUBLIC WORKS DEPARTMENT
ENGINEERING GROUP

TITLE: LA CUEVA OESTE, UNIT 1
UTILITY PLAN AND PROFILE
CORONA AVE. - STA: 23+50 TO STA: 36+43.15

APPROVALS	ENGINEER	DATE	APPROVALS	ENGINEER	DATE
DRC CHAIRMAN	[Signature]	10-3-95	WATER	[Signature]	8/31/95
TRANSPORTATION	N/A RHO	8-12-95	WASTE WATER	[Signature]	8/31/95
HYDROLOGY	N/A SMC	7-15-95			

PROJECT NO. 5232.90
MAP NO. C-18-Z
SHEET 19 OF 29

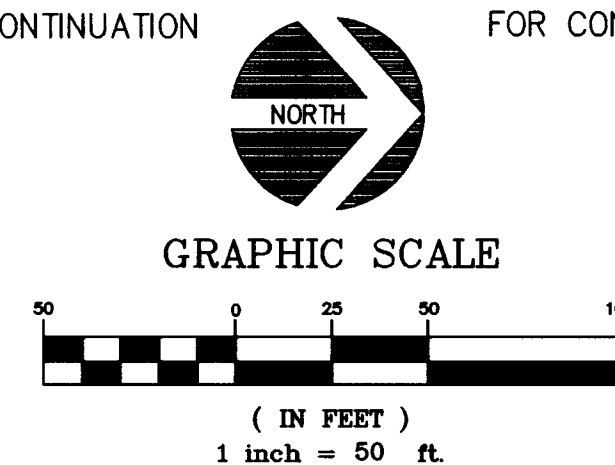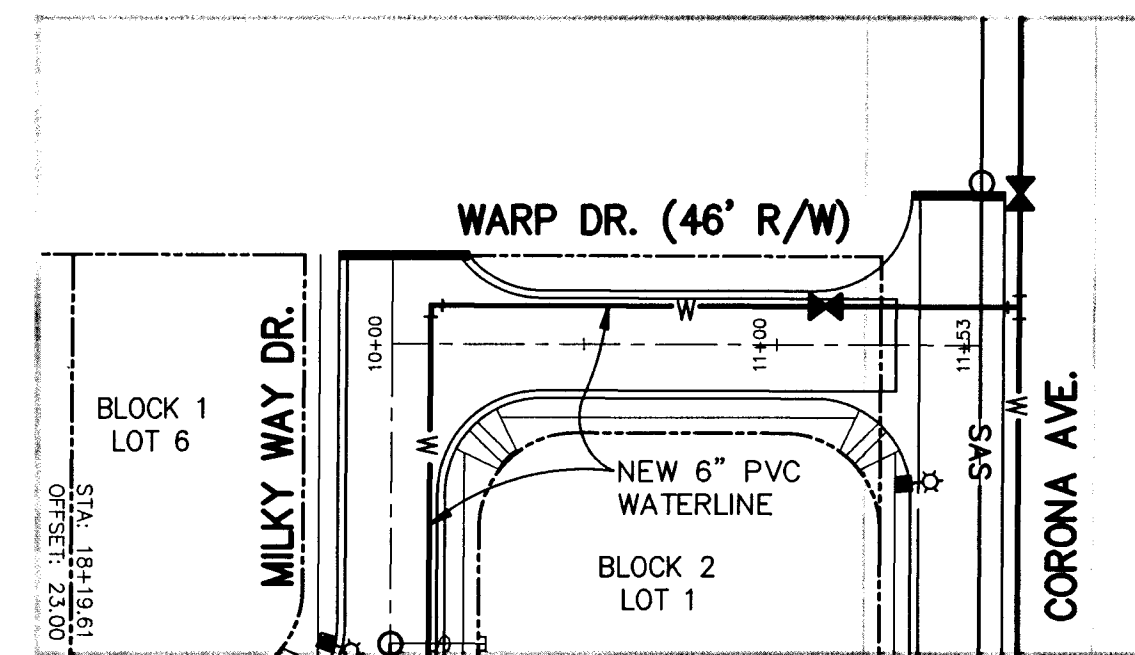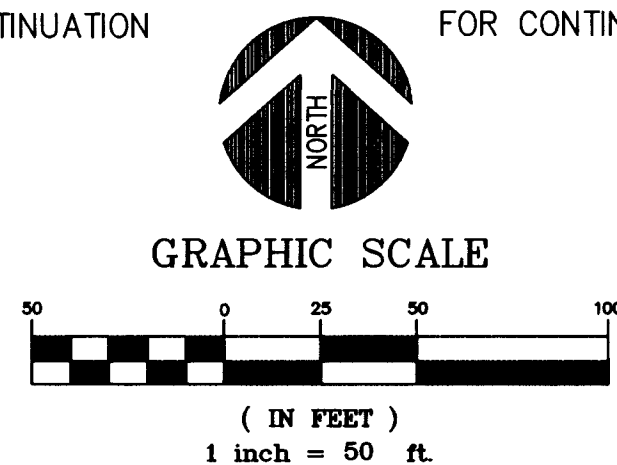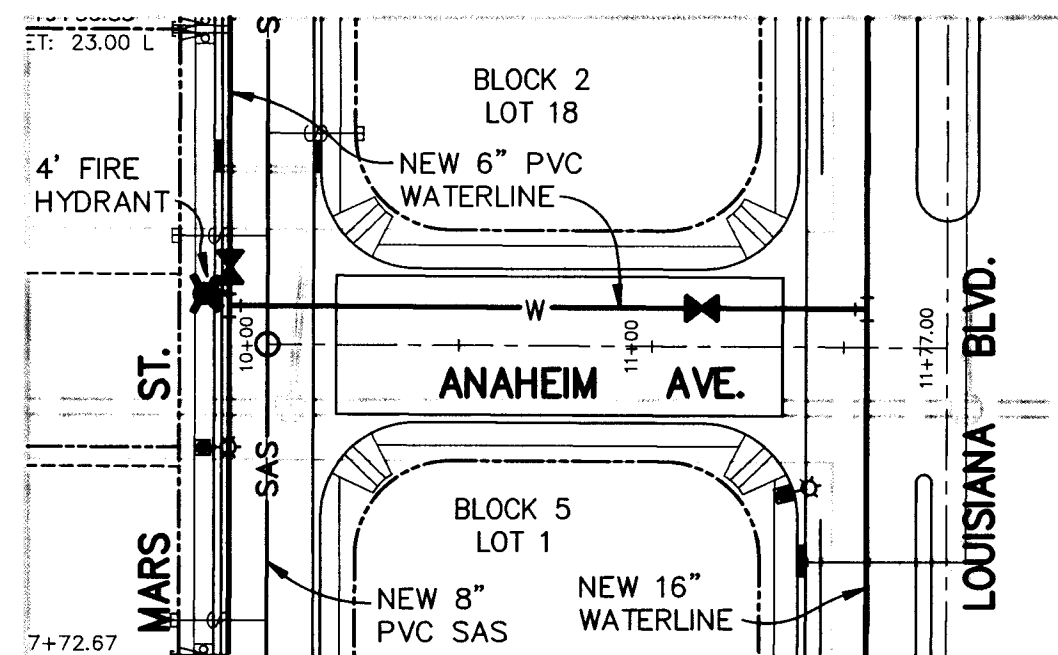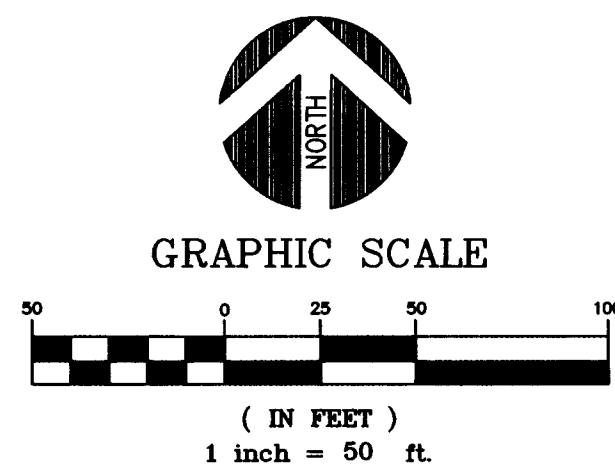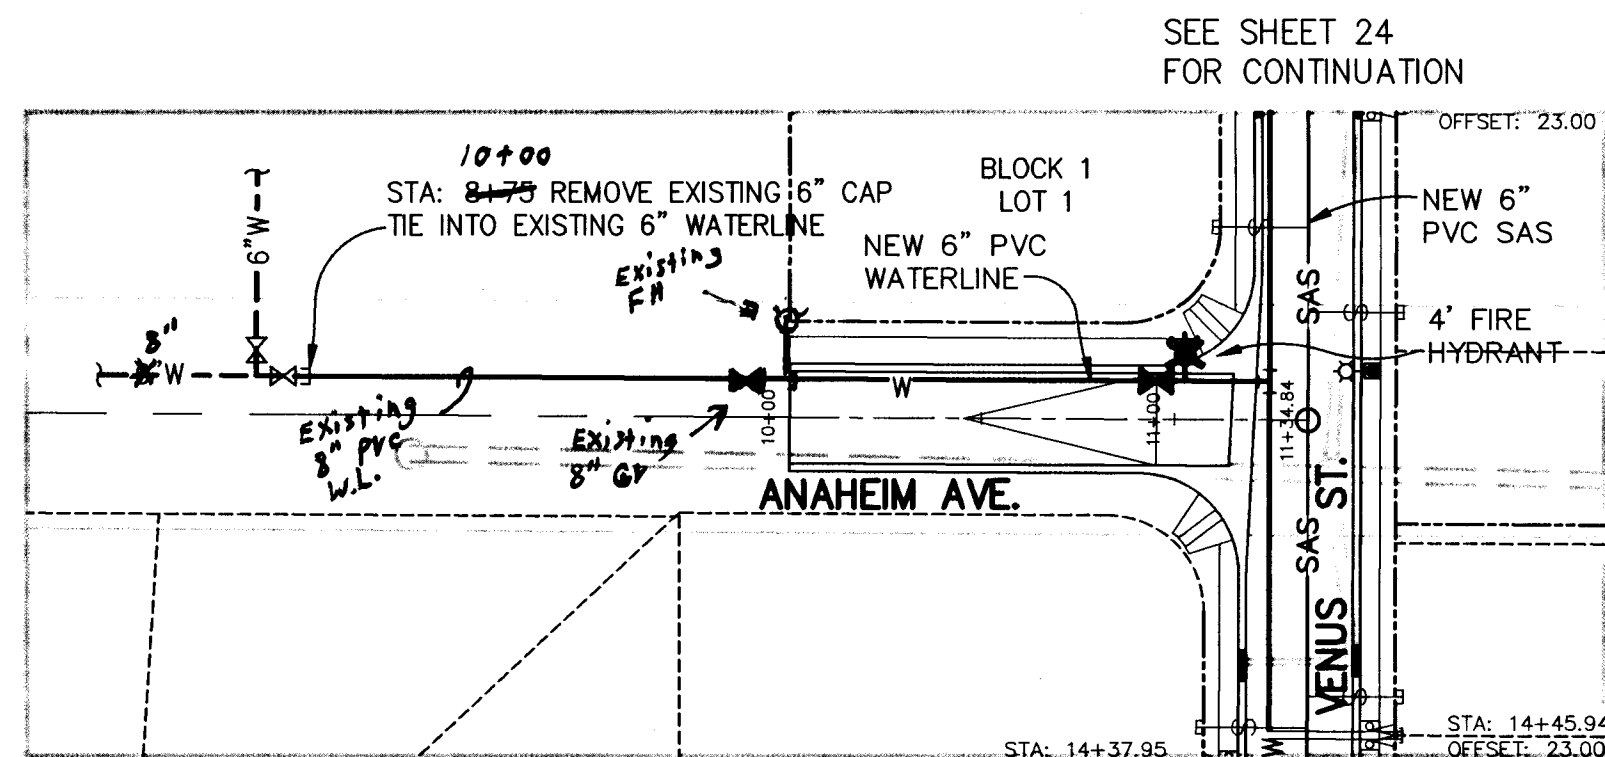

LEGEND

NEW CURB & GUTTER	---
NEW SAS MAINLINE	— SAS —
NEW SAS SERVICE LINE	— S —
NEW SAS MANHOLE	○
NEW WATER MAINLINE	— W —
NEW WATER SERVICE LINE	— WS —
NEW GATE VALVE	✕
NEW FIRE HYDRANT	✕
NEW STREET LIGHT	⊙
NEW VALLEY GUTTER	U

WATER AND SEWER NOTES

- CONSTRUCT 4" TYPE "E" MANHOLES PER STD. DWG.# 2102.
- CONSTRUCT SAS SERVICE LINES PER STD. DWG.# 2125.
- CONSTRUCT ALL CONCRETE BLOCKING PER STD. DWG.# 2320. CONCRETE BLOCKING SHALL BE UTILIZED ONLY WHERE SPECIFICALLY CALLED OUT ON PLAN.
- CONSTRUCT ALL VALVE BOXES PER NEW C.O.A. VALVE BOX DETAIL ~~MANHOLE-PAVED CONCRETE-604-AS~~ NO. 2325.
- CONSTRUCT ALL FIRE HYDRANTS PER DESIGNATED DEPTHS AND LENGTHS PER STD. DWG.# 2340. USE FULL RESTRAINT ON FIRE HYDRANT LEGS FROM MAIN TO FIRE HYDRANT FLANGE.
- CONSTRUCT ALL SINGLE AND DOUBLE WATER SERVICE LINES PER STD. DWG.# 2361, 2362 AND 2363.
- SEE SHEET 4 FOR SAS AND WATER SERVICE INFORMATION.
- RESTRAINT DISTANCES FOR PIPE FITTINGS SHALL BE DEFINED BY TABLE ON SHEET 4.
- ALL WATERLINES SHALL BE C-900 PVC UNLESS OTHERWISE NOTED.

AS BUILT INFORMATION

CONTRACTOR	NEW CONCEPTS
WORK BY	COA
INSPECTOR'S	DATE 5/1/95
ACCEPTANCE BY	DATE 5/1/95
VERIFICATION BY	DATE 5/1/95
DRAWINGS	DATE 5/1/95
REVISIONS	DATE 5/1/95
RECORDED BY	DATE
NO.	

BENCH MARKS

ACS STA. No. 1-C19	DATE
Y=1518845.74	
X=404941.91	
Z=5318.195	

SURVEY INFORMATION

FIELD NOTES	BY
NO.	


ENGINEER'S SEAL

Terry O. Brown

8/16/95

REVISIONS

NO.	DATE	REMARKS
DESIGNED BY:	TOB	DATE: 08/95
DRAWN BY:	TOB	DATE: 08/95
CHECKED BY:	TOB	DATE: 08/95

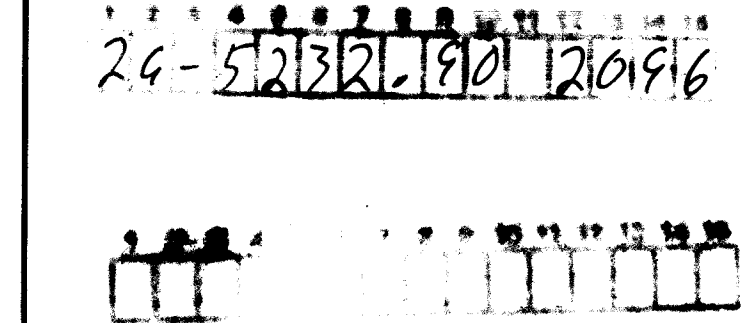

Terry O. Brown, P.E.
P. O. Box 92051
Albuquerque, NM 87199
(505) 883-8807

CITY OF ALBUQUERQUE
PUBLIC WORKS DEPARTMENT
ENGINEERING GROUP


TITLE: LA CUEVA OESTE, UNIT 1
UTILITY PLAN AND PROFILE
ANAHEIM AVE. (WEST), ANAHEIM AVE. (EAST) & WARP DR.

APPROVALS	ENGINEER	DATE	APPROVALS	ENGINEER	DATE
DRG CHAIRMAN	3/4/95	10-3-95	WATER		
TRANSPORTATION	8/17/95	8-17-95	WASTE WATER		
HYDROLOGY	N/A	9-15-95			

PROJECT NO.	5232.90	MAP NO.	C-18-Z	SHEET	20	OF	29
-------------	---------	---------	--------	-------	----	----	----


ANAHEIM AVE. (WEST)

SCALE
HORIZ: 1"=50'
VERT: 1"=10'

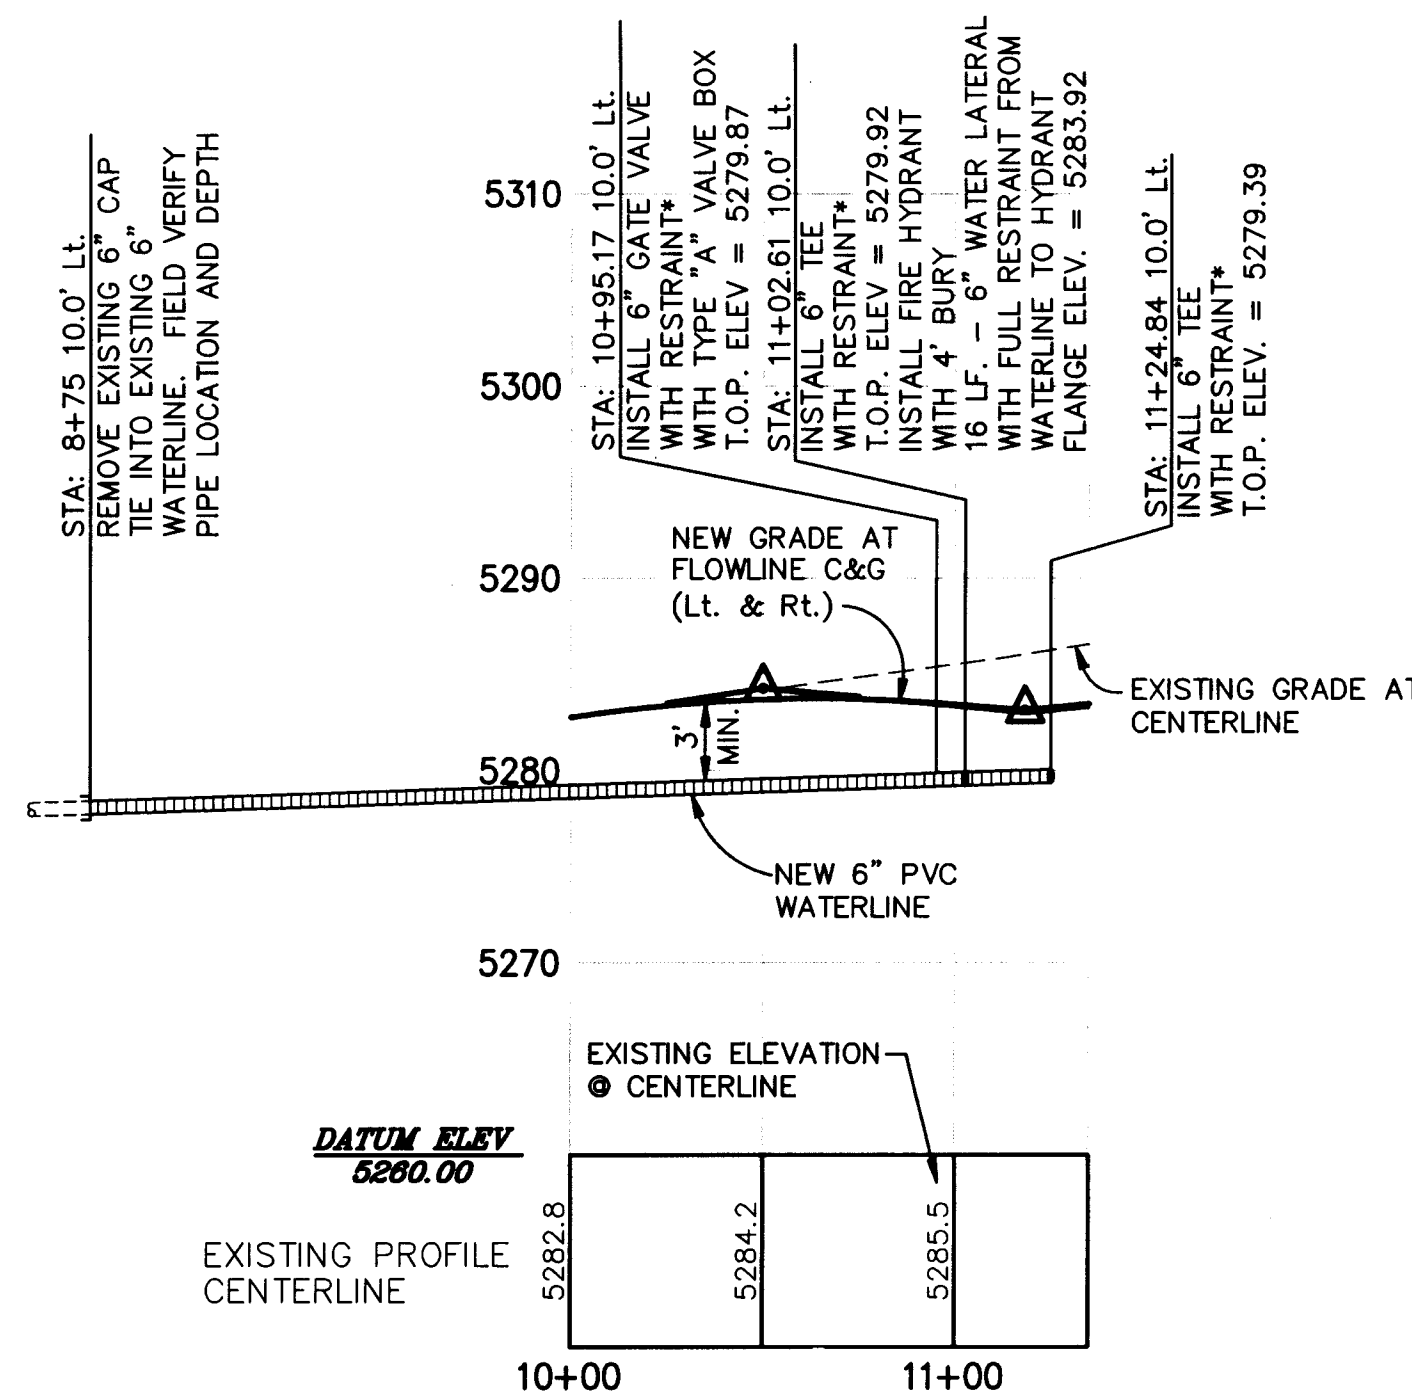


ANAHEIM AVE. (EAST)



SCALE
HORIZ: 1"=50'
VERT: 1"=10'

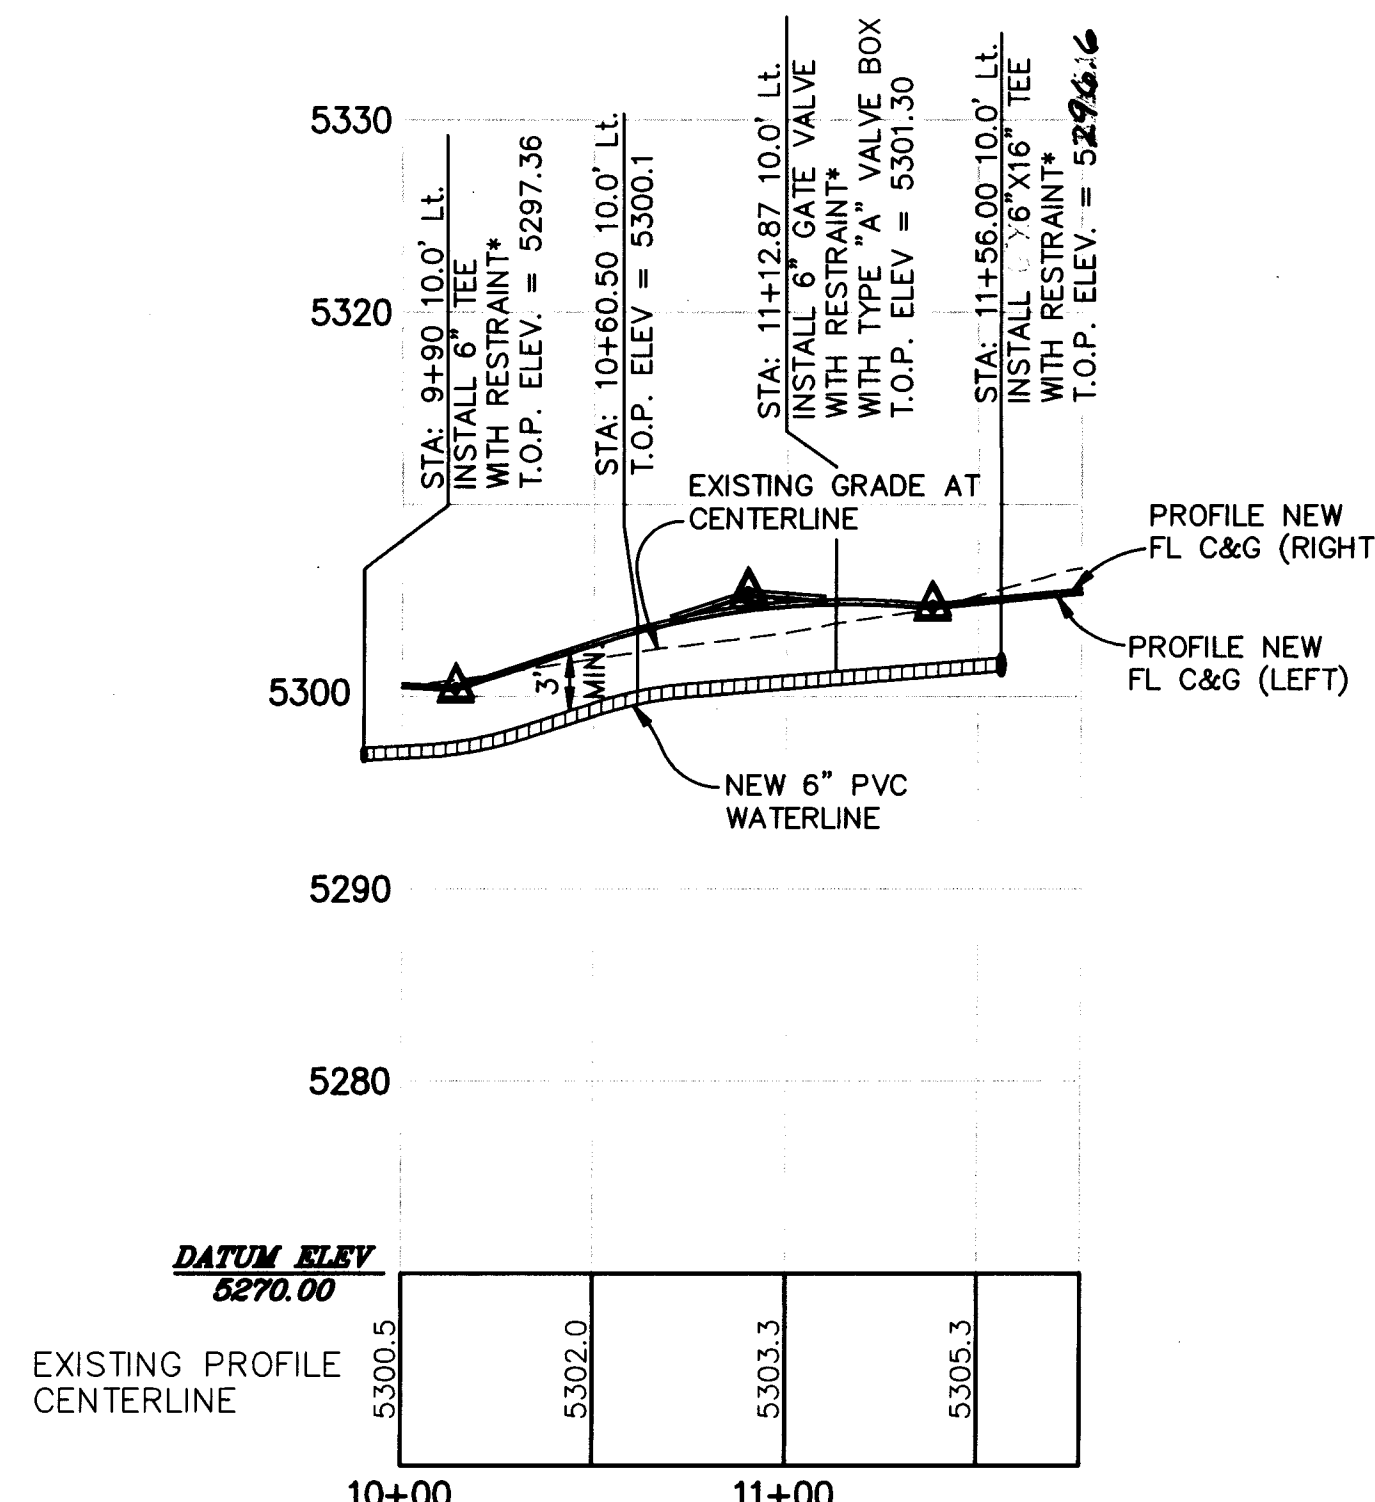


WARP DR.

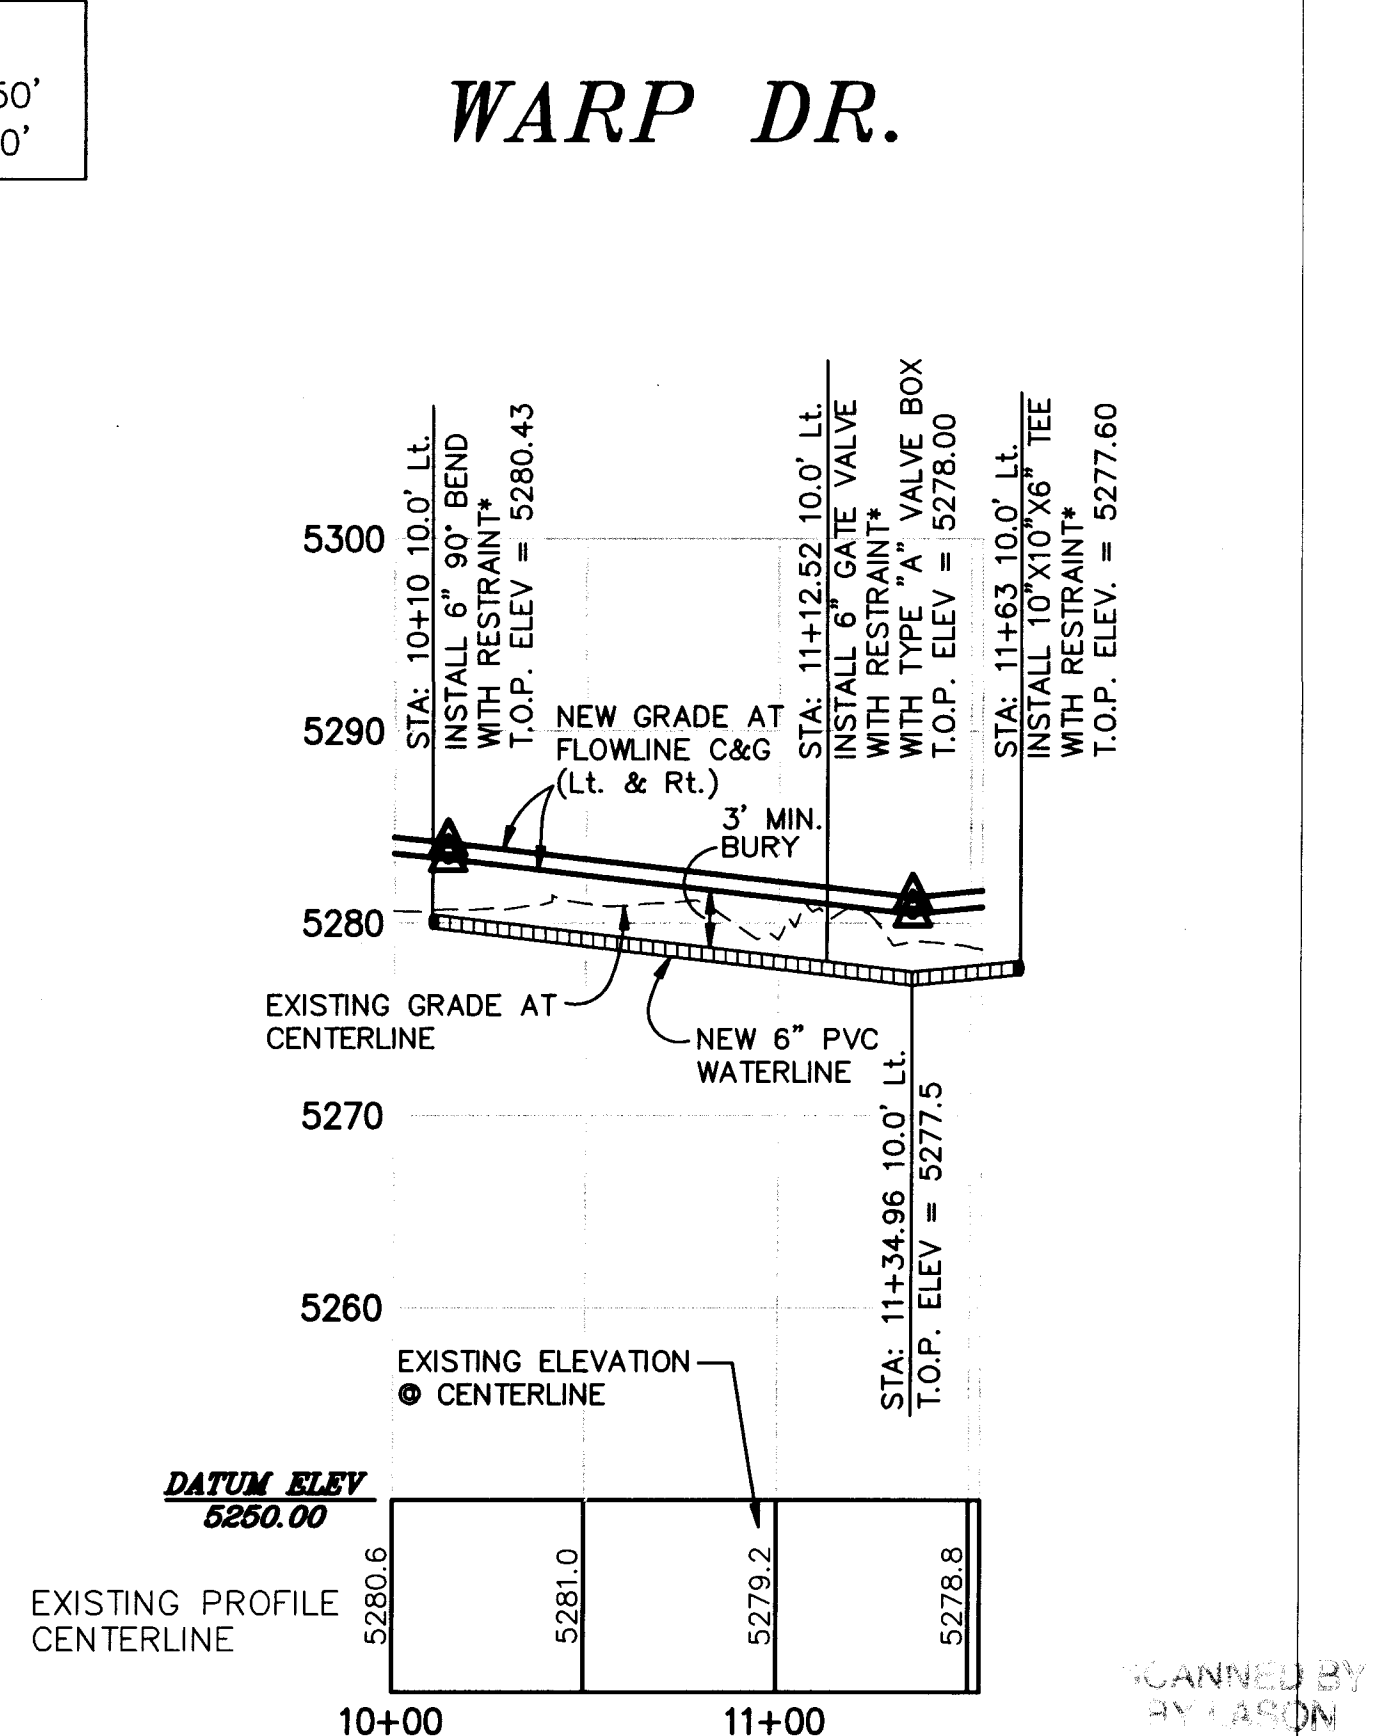

SCANNED BY: JASON

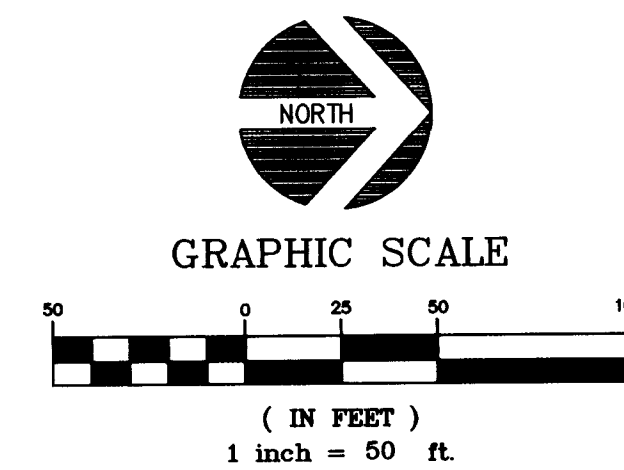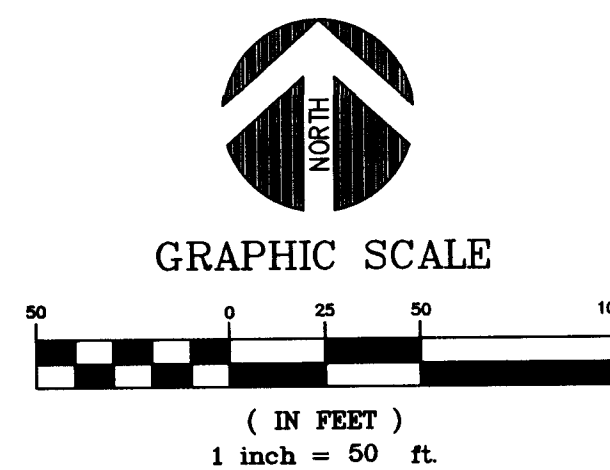

SCALE
HORIZ: 1"=50'
VERT: 1"=10'

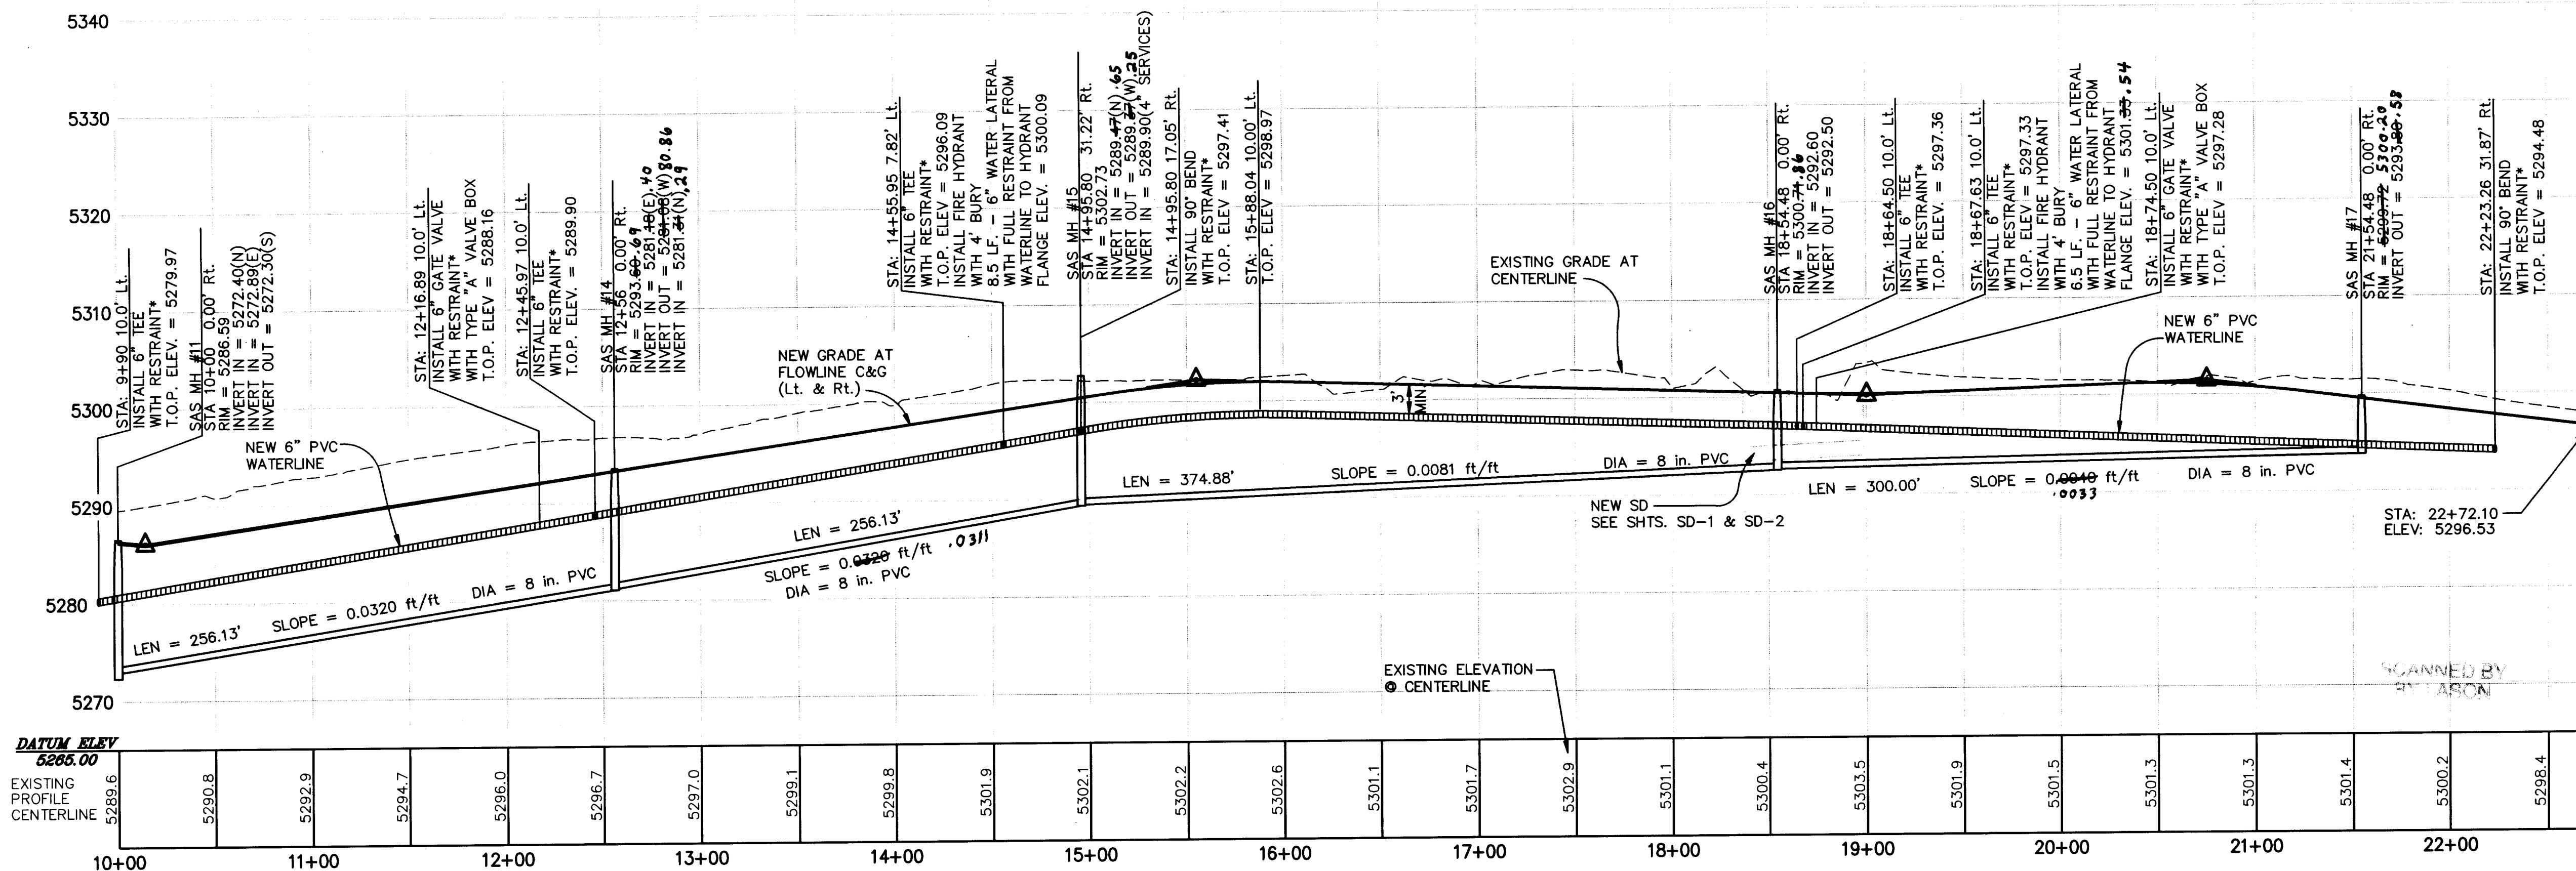

LC_UPP.DWG / VIEW:R:7

NEW CURB & GUTTER	
NEW SAS MAINLINE	 SAS
NEW SAS SERVICE LINE	 S
NEW SAS MANHOLE	
NEW WATER MAINLINE	 W
NEW WATER SERVICE LINE	
NEW GATE VALVE	
NEW FIRE HYDRANT	
NEW STREET LIGHT	
NEW VALLEY GUTTER	

1. CONSTRUCT 4" TYPE "E" MANHOLES PER STD. DWG.# 2102.
2. CONSTRUCT SAS SERVICE LINES PER STD. DWG.# 2125.
3. CONSTRUCT ALL CONCRETE BLOCKING PER STD. DWG.# 2320. CONCRETE BLOCKING SHALL BE UTILIZED ONLY WHERE SPECIFICALLY CALLED OUT ON PLAN.
4. CONSTRUCT ALL VALVE BOXES PER ~~NEW~~ C.O.A. VALVE BOX DETAIL ~~WITH 10" TAPERED CONCRETE COLLAR~~ *N/O 2325.*
5. CONSTRUCT ALL FIRE HYDRANTS PER DESIGNATED DEPTHS AND LENGTHS PER STD. DWG.# 2340. USE FULL RESTRAINT ON FIRE HYDRANT LEGS FROM MAIN TO FIRE HYDRANT FLANGE.
6. CONSTRUCT ALL SINGLE AND DOUBLE WATER SERVICE LINES PER STD. DWG.# 2361, 2362 AND 2363.
7. SEE SHEET 4 FOR SAS AND WATER SERVICE INFORMATION.
- *8. RESTRAINT DISTANCES FOR PIPE FITTINGS SHALL BE DEFINED BY TABLE ON SHEET 4.
9. ALL WATERLINES SHALL BE C-900 PVC UNLESS OTHERWISE NOTED.

AS BUILT INFORMATION	
CONTRACTOR	New Concepts
WORK BY	COA
DATE	12/10/85
ACCEPTANCE BY	L. Romero
DATE	3/16/86
FIELD VERIFICATION BY	L.R.
DATE	3/16/86
DRAWINGS CORRECTED BY	L.R.
DATE	4/1/86
MICRO-FILM INFORMATION	
RECORDED BY	DATE
NO.	

BENCH MARKS

ACS STA. No. 1-C19
Y=1518845.74
X=404941.91
Z=5318.195

SURVEY INFORMATION
FIELD NOTES
D. BY DATE

ENGINEER'S SEAL

[illegible][illegible]


NO.	DATE	DESIGNED BY: TOB
		DRAWN BY: TOB
		CHECKED BY: TOB

CITY OF ALBUQUERQUE
PUBLIC WORKS DEPARTMENT
ENGINEERING GROUP


TITLE:	LA CUEVA OESTE, UNIT 1 UTILITY PLAN AND PROFILE TAURUS DR. / MARS ST.
--------	---

APPROVALS	ENGINEER	DATE	APPROVALS	ENGINEER	DATE
DRC CHAIRMAN	<i>SA Koolah</i>	10-3-95	WATER	<i>SA Koolah</i>	8/31/95
TRANSPORTATION	<i>N/A RHD</i>	8-17-95	WASTE WATER		
HYDROLOGY	<i>N/A SMC</i>	9-15-95			

PROJECT NO.	5232.90	MAP NO.	C-18-Z	SHEET	21	OF	29
----------------	---------	---------	--------	-------	----	----	----

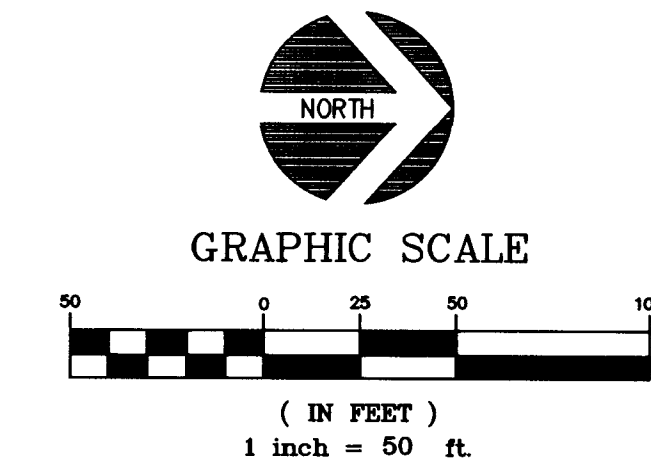


LEGEND			AS BUILT INFORMATION			BENCH MARKS			SURVEY INFORMATION			ENGINEER'S SEAL			REMARKS			DESIGN		
NEW CURB & GUTTER			CONTRACTOR	New Concepts		DATE	12/15/95		NO.			BY			REVISIONS			DESIGNED BY: TOB		
NEW SAS MAINLINE			WORK	C o A		DATE	3/96		NO.			BY			REVISIONS			DRAWN BY: TOB		
NEW SAS SERVICE LINE			ISSUED BY	L. Romero		DATE	3/96		NO.			BY			REVISIONS			CHECKED BY: TOB		
NEW SAS MANHOLE			ACCEPTANCE BY	L. A.		DATE	4/16		NO.			BY			REVISIONS					
NEW WATER MAINLINE			FIELD	DRAWINGS		DATE			NO.			BY			REVISIONS					
NEW WATER SERVICE LINE			CORRECTED BY	L. A.		DATE			NO.			BY			REVISIONS					
NEW GATE VALVE			MICRO-FILM INFORMATION			DATE			NO.			BY			REVISIONS					
NEW FIRE HYDRANT			RECORDED BY			DATE			NO.			BY			REVISIONS					
NEW STREET LIGHT			NO.			DATE			NO.			BY			REVISIONS					
NEW VALLEY GUTTER						DATE			NO.			BY			REVISIONS					
WATER AND SEWER NOTES			DATE			NO.			BY			REVISIONS			DESIGN					
1. CONSTRUCT 4'ø TYPE "E" MANHOLES PER STD. DWG.# 2102.			ACS STA. NO. 1-C19			Y=1518845.74			X=404941.91			Z=5318.195								
2. CONSTRUCT SAS SERVICE LINES PER STD. DWG.# 2125.			DATE			NO.			BY			REVISIONS			DESIGN					
3. CONSTRUCT ALL CONCRETE BLOCKING PER STD. DWG.# 2320. CONCRETE BLOCKING SHALL BE UTILIZED ONLY WHERE SPECIFICALLY CALLED OUT ON PLAN.			DATE			NO.			BY			REVISIONS			DESIGN					
4. CONSTRUCT ALL VALVE BOXES PER NEW C.O.A. VALVE BOX DETAIL WITH NON-TAPERED CONCRETE COLLARS NO. 2325.			DATE			NO.			BY			REVISIONS			DESIGN					
5. CONSTRUCT ALL FIRE HYDRANTS PER DESIGNATED DEPTHS AND LENGTHS PER STD. DWG.# 2340. USE FULL RESTRAINT ON FIRE HYDRANT LEGS FROM MAIN TO FIRE HYDRANT FLANGE.			DATE			NO.			BY			REVISIONS			DESIGN					
6. CONSTRUCT ALL SINGLE AND DOUBLE WATER SERVICE LINES PER STD. DWG.# 2361, 2362 AND 2363.			DATE			NO.			BY			REVISIONS			DESIGN					
7. SEE SHEET 4 FOR SAS AND WATER SERVICE INFORMATION.			DATE			NO.			BY			REVISIONS			DESIGN					
*8. RESTRAINT DISTANCES FOR PIPE FITTINGS SHALL BE DEFINED BY TABLE ON SHEET 4.			DATE			NO.			BY			REVISIONS			DESIGN					
9. ALL WATERLINES SHALL BE C-900 PVC UNLESS OTHERWISE NOTED.			DATE			NO.			BY			REVISIONS			DESIGN					
Terry O. Brown, P.E. P. O. Box 92051 Albuquerque, NM 87199 (505) 883-8807			NO.			DATE			NO.			DATE			DESIGNED BY: TOB					
CITY OF ALBUQUERQUE PUBLIC WORKS DEPARTMENT ENGINEERING GROUP			NO.			DATE			NO.			DATE			DESIGNED BY: TOB					
TITLE: LA CUEVA OESTE, UNIT 1 UTILITY PLAN AND PROFILE NEPTUNE DR.			NO.			DATE			NO.			DATE			DESIGNED BY: TOB					
APPROVALS	ENGINEER	DATE	APPROVALS	ENGINEER	DATE	APPROVALS	ENGINEER	DATE	APPROVALS	ENGINEER	DATE	APPROVALS	ENGINEER	DATE	APPROVALS	ENGINEER	DATE			
DRC CHAIRMAN	3.6 - using	10-3-95	WATER			WASTE WATER	8/31/95													
TRANSPORTATION	N/A RHD	8-12-95																		
HYDROLOGY	N/A SMC	7-15-95																		
PROJECT NO.	5232.90		MAP NO.	C-18-Z		SHEET	OF		23		29									

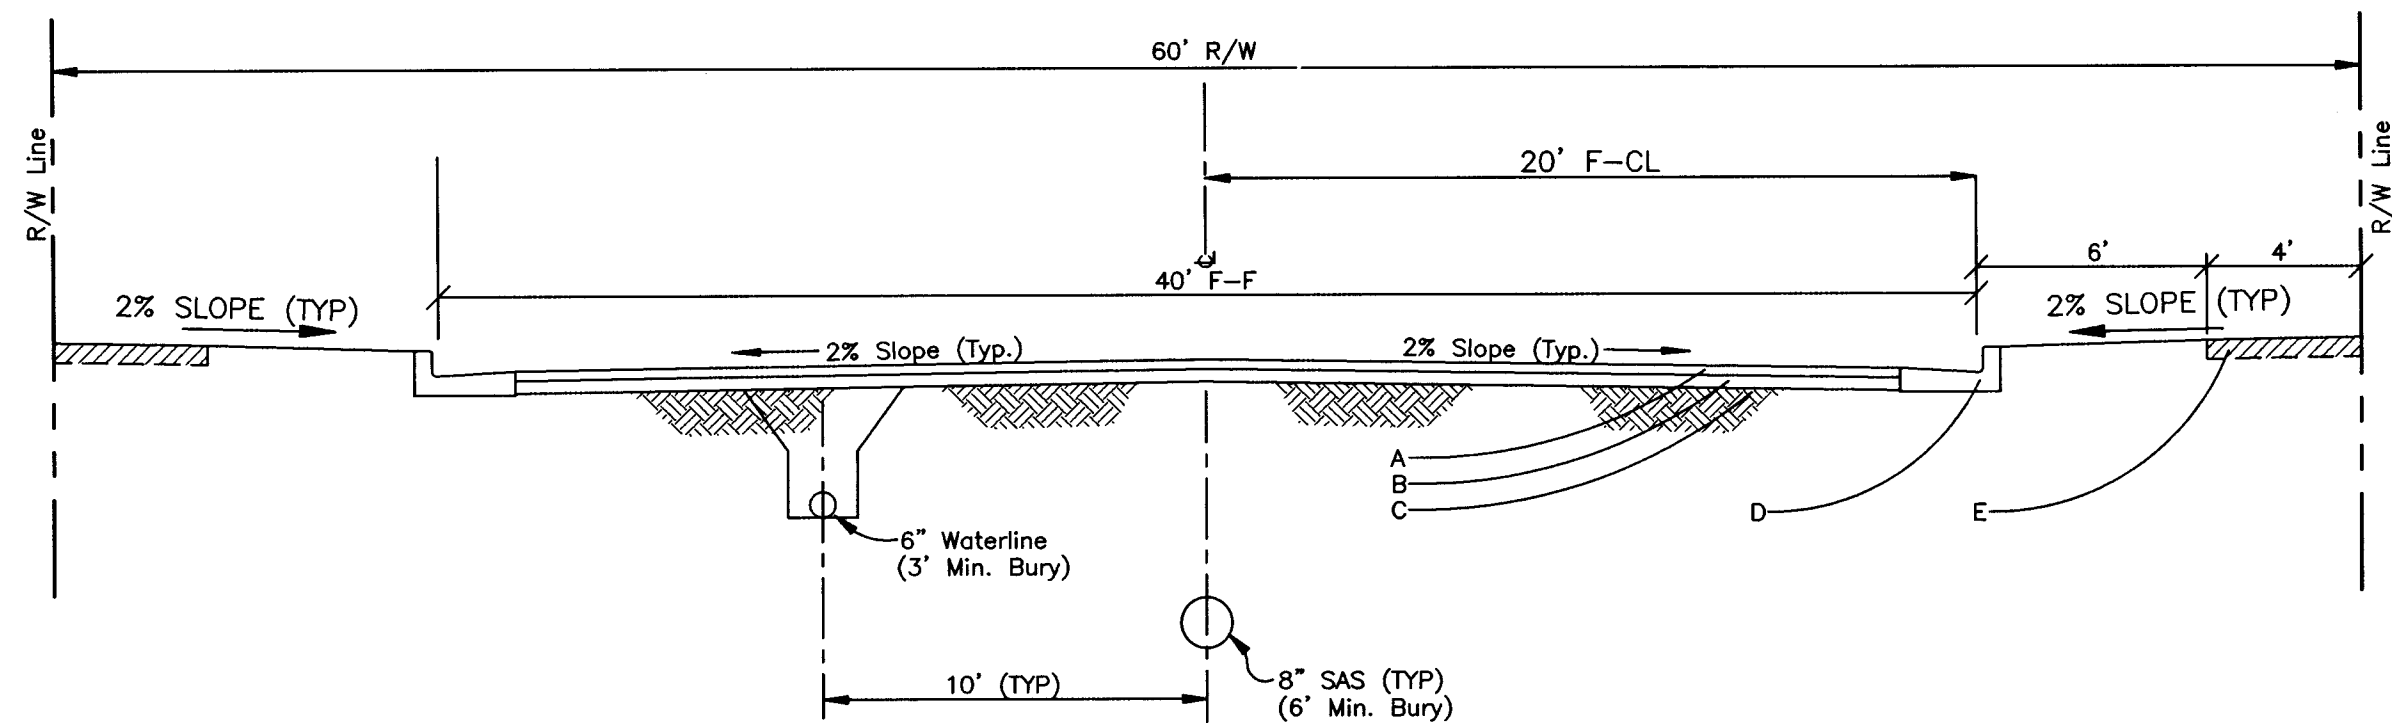


Detail Notes for Typical Residential Street
 A - A.C. Pavement
 B - 12" Compacted Subgrade Material (95% Compaction)
 C - Compacted Subgrade (90% Compaction)
 D - P.C.C. Standard Curb & Gutter
 E - 4" Thick by 4' Wide P.C.C. Sidewalk

Section A-A (40' F-F STREET WIDTH)

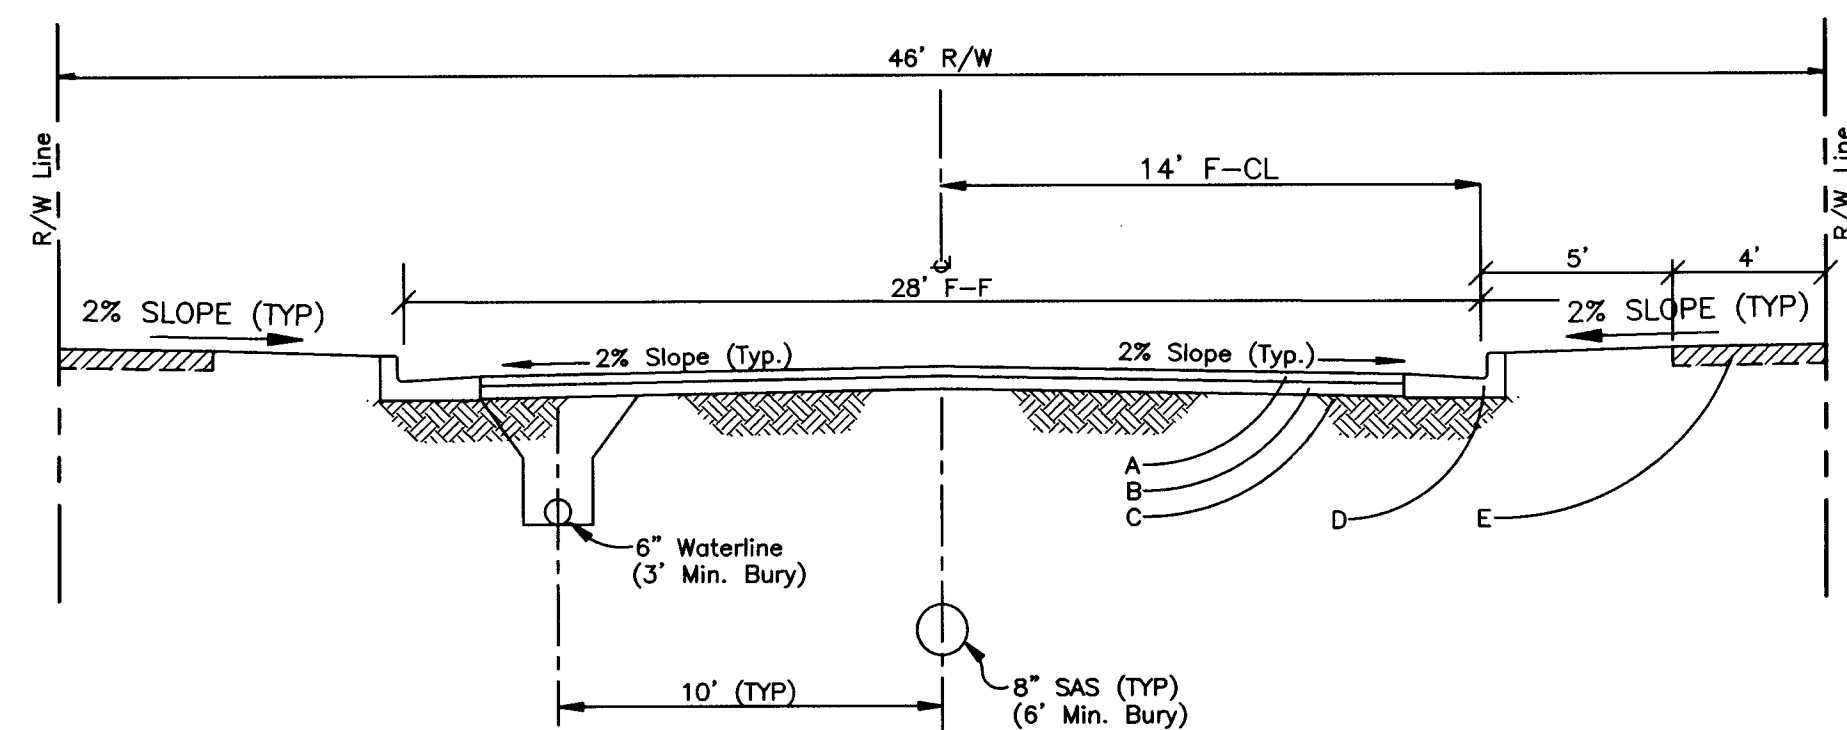


Detail Notes for Typical Residential Street
 A - A.C. Pavement
 B - 12" Compacted Subgrade Material (95% Compaction)
 C - Compacted Subgrade (90% Compaction)
 D - P.C.C. Standard Curb & Gutter
 E - 4" Thick by 4' Wide P.C.C. Sidewalk

Section B-B (28' F-F STREET WIDTH)

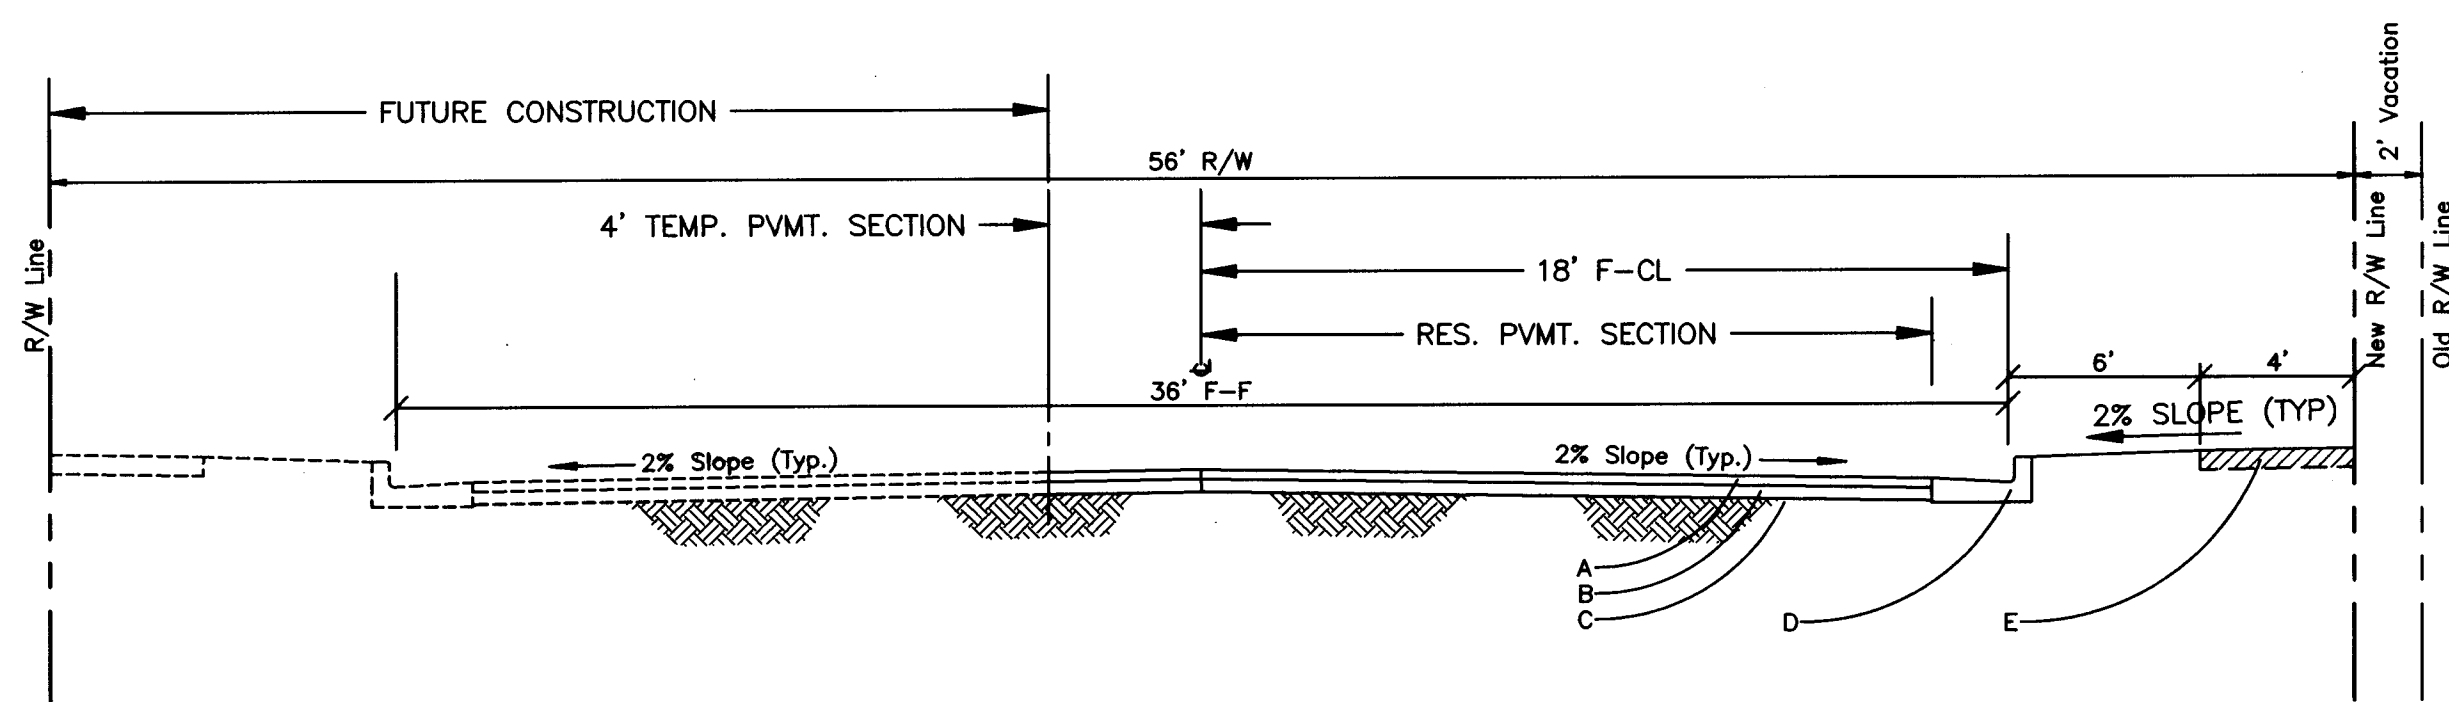


Detail Notes for Typical Residential Street
 A - A.C. Pavement
 B - 12" Compacted Subgrade Material (95% Compaction)
 C - Compacted Subgrade (90% Compaction)
 D - P.C.C. Standard Curb & Gutter
 E - 4" Thick by 4' Wide P.C.C. Sidewalk

Section C-C (36 F-F STREET WIDTH - HALF STREET)

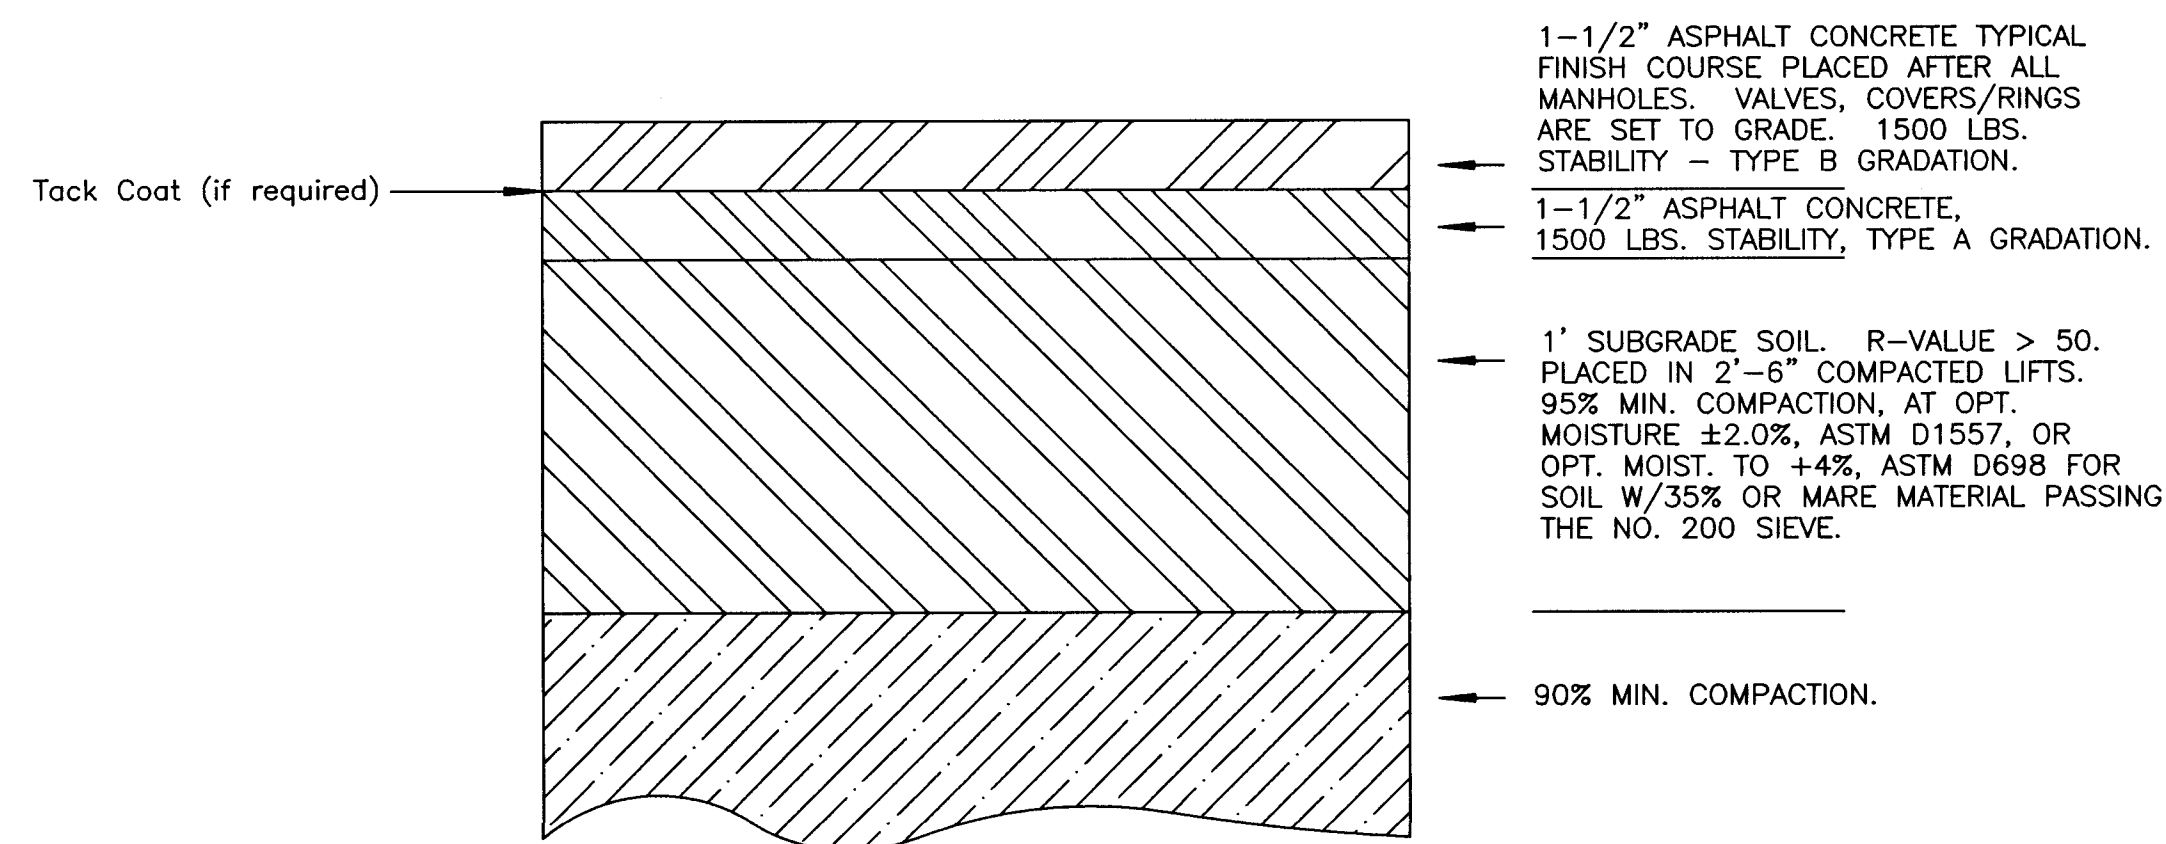


Typical Residential Street Pavement Section (Asphaltic Concrete Pavement)

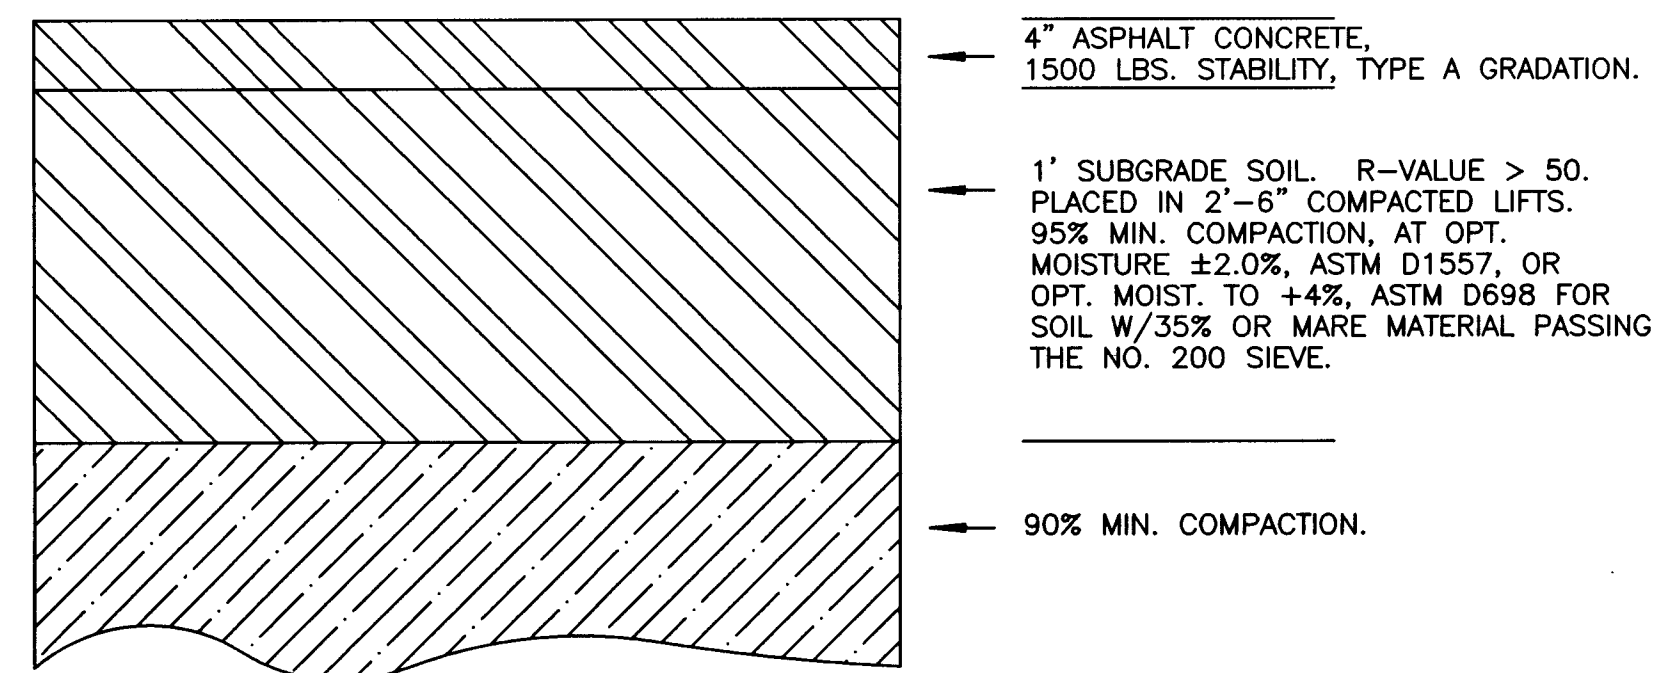


Typical Temporary Street Pavement Section (Asphaltic Concrete Pavement)

AS BUILT INFORMATION CONTRACTOR: <i>New Concept</i> DESIGNED BY: <i>C.O.A.</i> DATE: <i>11/11</i> INSPECTOR'S: <i>L. Romero</i> DATE: <i>1/16</i> VERIFICATION BY: <i>L. R.</i> DATE: <i>1/16</i> DRAWN BY: <i>L. R.</i> DATE: <i>1/16</i> CHECKED BY: <i>L. R.</i> DATE: <i>1/16</i> MICRO-FILM INFORMATION RECORDED BY: <i>L. R.</i> DATE: <i>1/16</i> NO.		
BENCH MARKS ACS STA. No. 1-C19 Y=1518845.74 X=404941.91 Z=5318.195		
SURVEY INFORMATION FIELD NOTES BY: <i>Terry O. Brown</i> NO. <i>8/16/95</i>		
ENGINEER'S SEAL <i>Terry O. Brown</i> 8/16/95		
BY: <i>Terry O. Brown</i> DATE: 08/95 NO. DATE: 08/95 REMARKS: <i>REVISED DESIGN</i> DESIGNED BY: TOB DATE: 08/95 DRAWN BY: TOB DATE: 08/95 CHECKED BY: TOB		

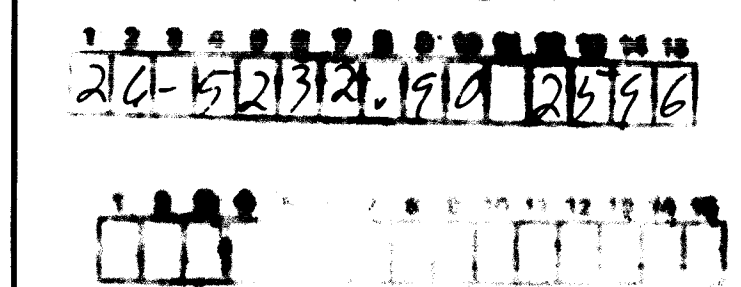

Terry O. Brown, P.E.
 P. O. Box 92051
 Albuquerque, N.M. 87199
 (505) 883-8807

CITY OF ALBUQUERQUE PUBLIC WORKS DEPARTMENT ENGINEERING GROUP					
TITLE: LA CUEVA OESTE, UNIT 1 STREET DETAILS					
APPROVALS	ENGINEER	DATE	APPROVALS	ENGINEER	DATE
DRC CHAIRMAN	<i>3/1/95</i>	<i>10-3-95</i>	WATER	<i>N/A</i>	<i>8/31/95</i>
TRANSPORTATION	<i>R. Ponce</i>	<i>8-17-95</i>	WASTE WATER	<i>N/A</i>	<i>8/31/95</i>
HYDROLOGY	<i>N/A</i>	<i>9-15-95</i>			
PROJECT NO. 5232.90		MAP NO. C-18-Z		SHEET 25 OF 29	

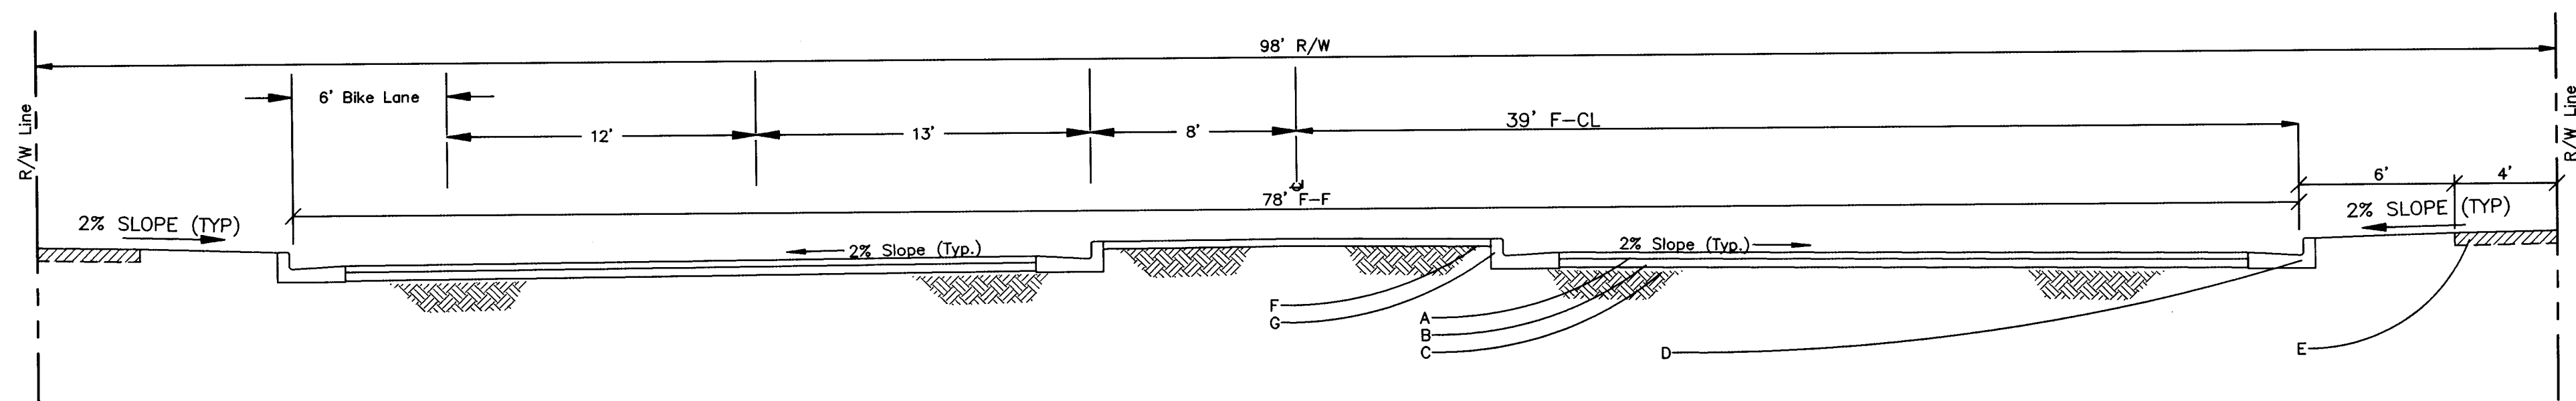

Detail Notes for Typical Arterial Street

- A - A.C. Pavement
- B - 12" Compacted Subgrade Material (95% Compaction)
- C - Compacted Subgrade (90% Compaction)
- D - P.C.C. Standard Curb & Gutter
- E - 4" Thick by 4" Wide P.C.C. Sidewalk
- F - Raised Median
- F - Median Curb and Gutter (P.C.C.)

N.I.C. (BY OTHERS)
LOUISIANA BLVD. STREET SECTION

20-5232.90-18-2696

Terry O. Brown, P.E.
P. O. Box 92051
Albuquerque, N.M. 87199
(505) 883-8807

CITY OF ALBUQUERQUE
PUBLIC WORKS DEPARTMENT
ENGINEERING GROUP

TITLE: LA CUEVA OESTE, UNIT 1
STREET / DRAINAGE DETAILS

APPROVALS	ENGINEER	DATE	APPROVALS	ENGINEER	DATE
DRC CHAIRMAN	<i>[Signature]</i>	10-3-95	WATER	<i>[Signature]</i>	8/31/95
TRANSPORTATION	<i>[Signature]</i>	8-17-95	WASTE WATER	<i>[Signature]</i>	8/31/95
HYDROLOGY	<i>[Signature]</i>	7-15-95			

PROJECT NO. 5232.90 MAP NO. C-18-Z SHEET 26 OF 29

AS BUILT INFORMATION	
CONTRACTOR	New Concept
STAKED BY	C.O.A.
INSPECTOR'S	DATE
FIELD	DATE
VERIFICATION BY	DATE
COMPARISON BY	DATE
RECORDED BY	DATE

BENCH MARKS	
ACS STA. No.	1-C19
Y=	1518845.74
X=	404941.91
Z=	5318.195

SURVEY INFORMATION	
FIELD NOTES	DATE
BY	

ENGINEER'S SEAL
Terry O. Brown
8/16/95


REMARKS	
DESIGNED BY: TOB	DATE: 08/95
DRAWN BY: TOB	DATE: 08/95
CHECKED BY: TOB	DATE: 08/95

SCANNED BY
BY LASON

→ SPECIAL DESIGN REQUIRED FOR EACH INDIVIDUAL CASE

7. ~~Slope~~ of Standard City Wheelchair Ramp according to City of Albuquerque Standard Drawing No. 2441.
1. ~~Slope~~ of Standard City Wheelchair Ramp according to City of Albuquerque Standard Drawing No. 2441 modified to extend lateral slope areas to align with the P.C. or P.T. of the curb return
Maximum slope allowed is 8.33%.

USE MODIFIED C.O.A. DRAWING
(SEE THIS SHEET)

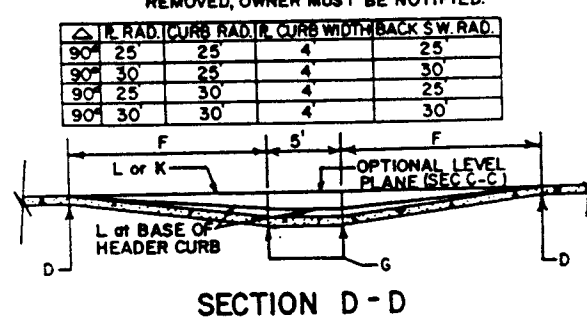

STANDARD WHEELCHAIR RAMP LATERAL SLOPES SHALL EXTEND 9.5' EITHER SIDE OF CENTERLINE. IN CASES OF MODIFIED WHEELCHAIR RAMP, THE LATERAL SLOPE AREA SHALL BE EXTENDED TO ALIGN WITH THE PC OR PT OF THE CURB RETURN (SEE ABOVE). IN NO CASE SHALL THE SLOPE OF THE WHEELCHAIR RAMP EXCEED 12:1.

TITLE: LA CUEVA OESTE, UNIT 1
WHEELCHAIR RAMP DESIGN SHEET

APPROVALS	ENGINEER	DATE	APPROVALS	ENGINEER	DATE
DRC CHAIRMAN	B. J. Gentry	10-3-95	WATER	N/A	6/31/9
TRANSPORTATION	N/A LHO	8-17-95	WASTE WATER	N/A	6/31/9
HYDROLOGY	N/A SMC	9-15-95			

PROJECT NO. 5232.90	MAP NO. C-18	SHEET 27 ^{OF} 29
------------------------	-----------------	------------------------------

SURVEY INFORMATION

BY _____ DATE _____

NO.

TR N



SHI

1

DESIGNED BY: TOB

81

OF

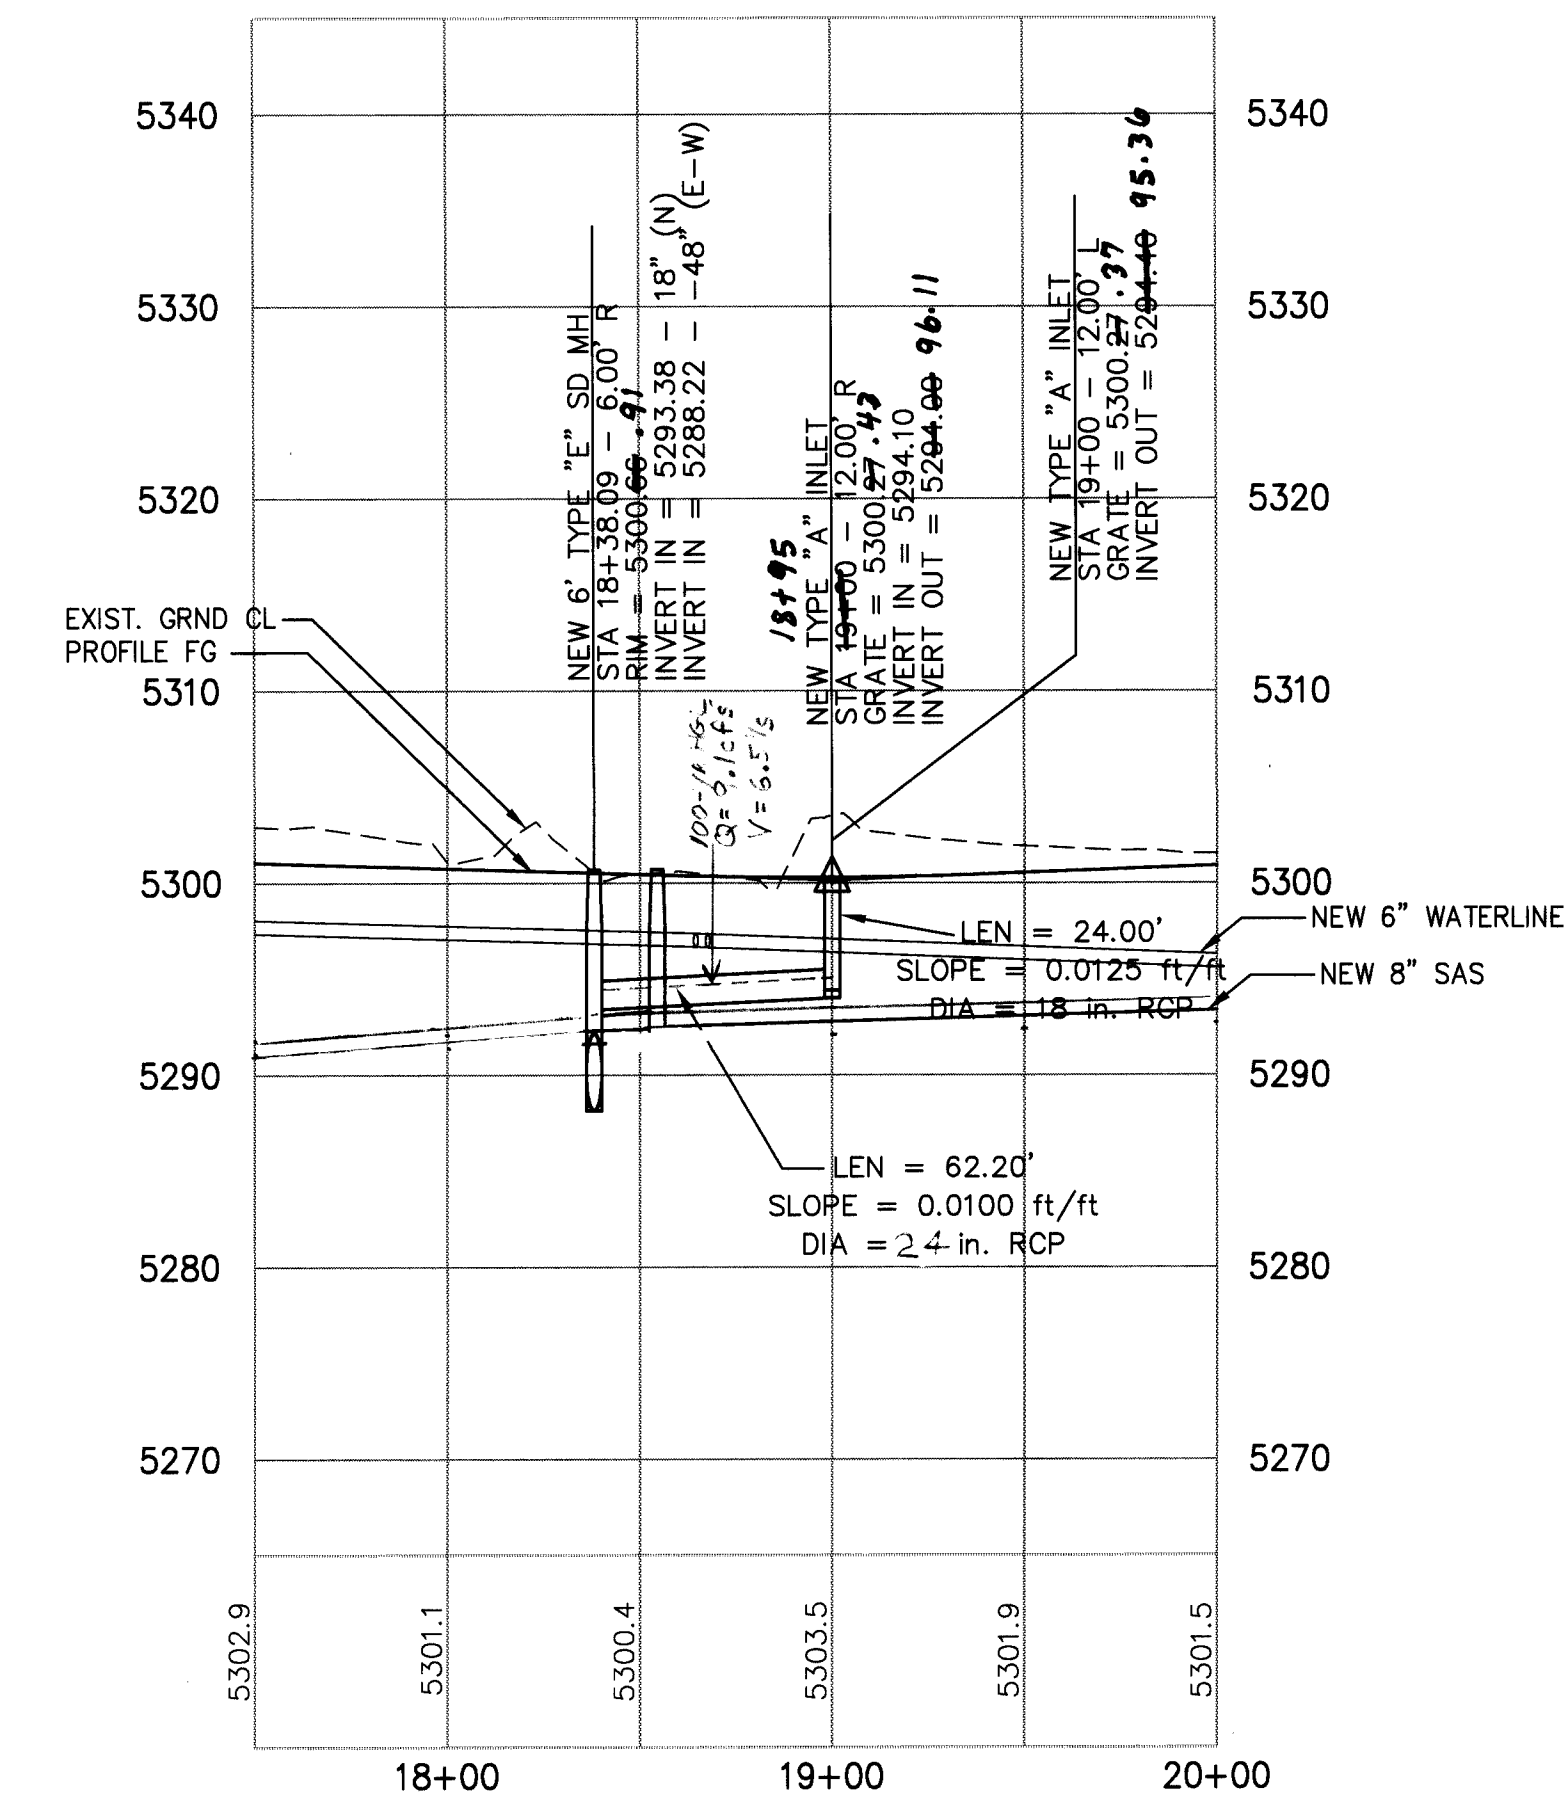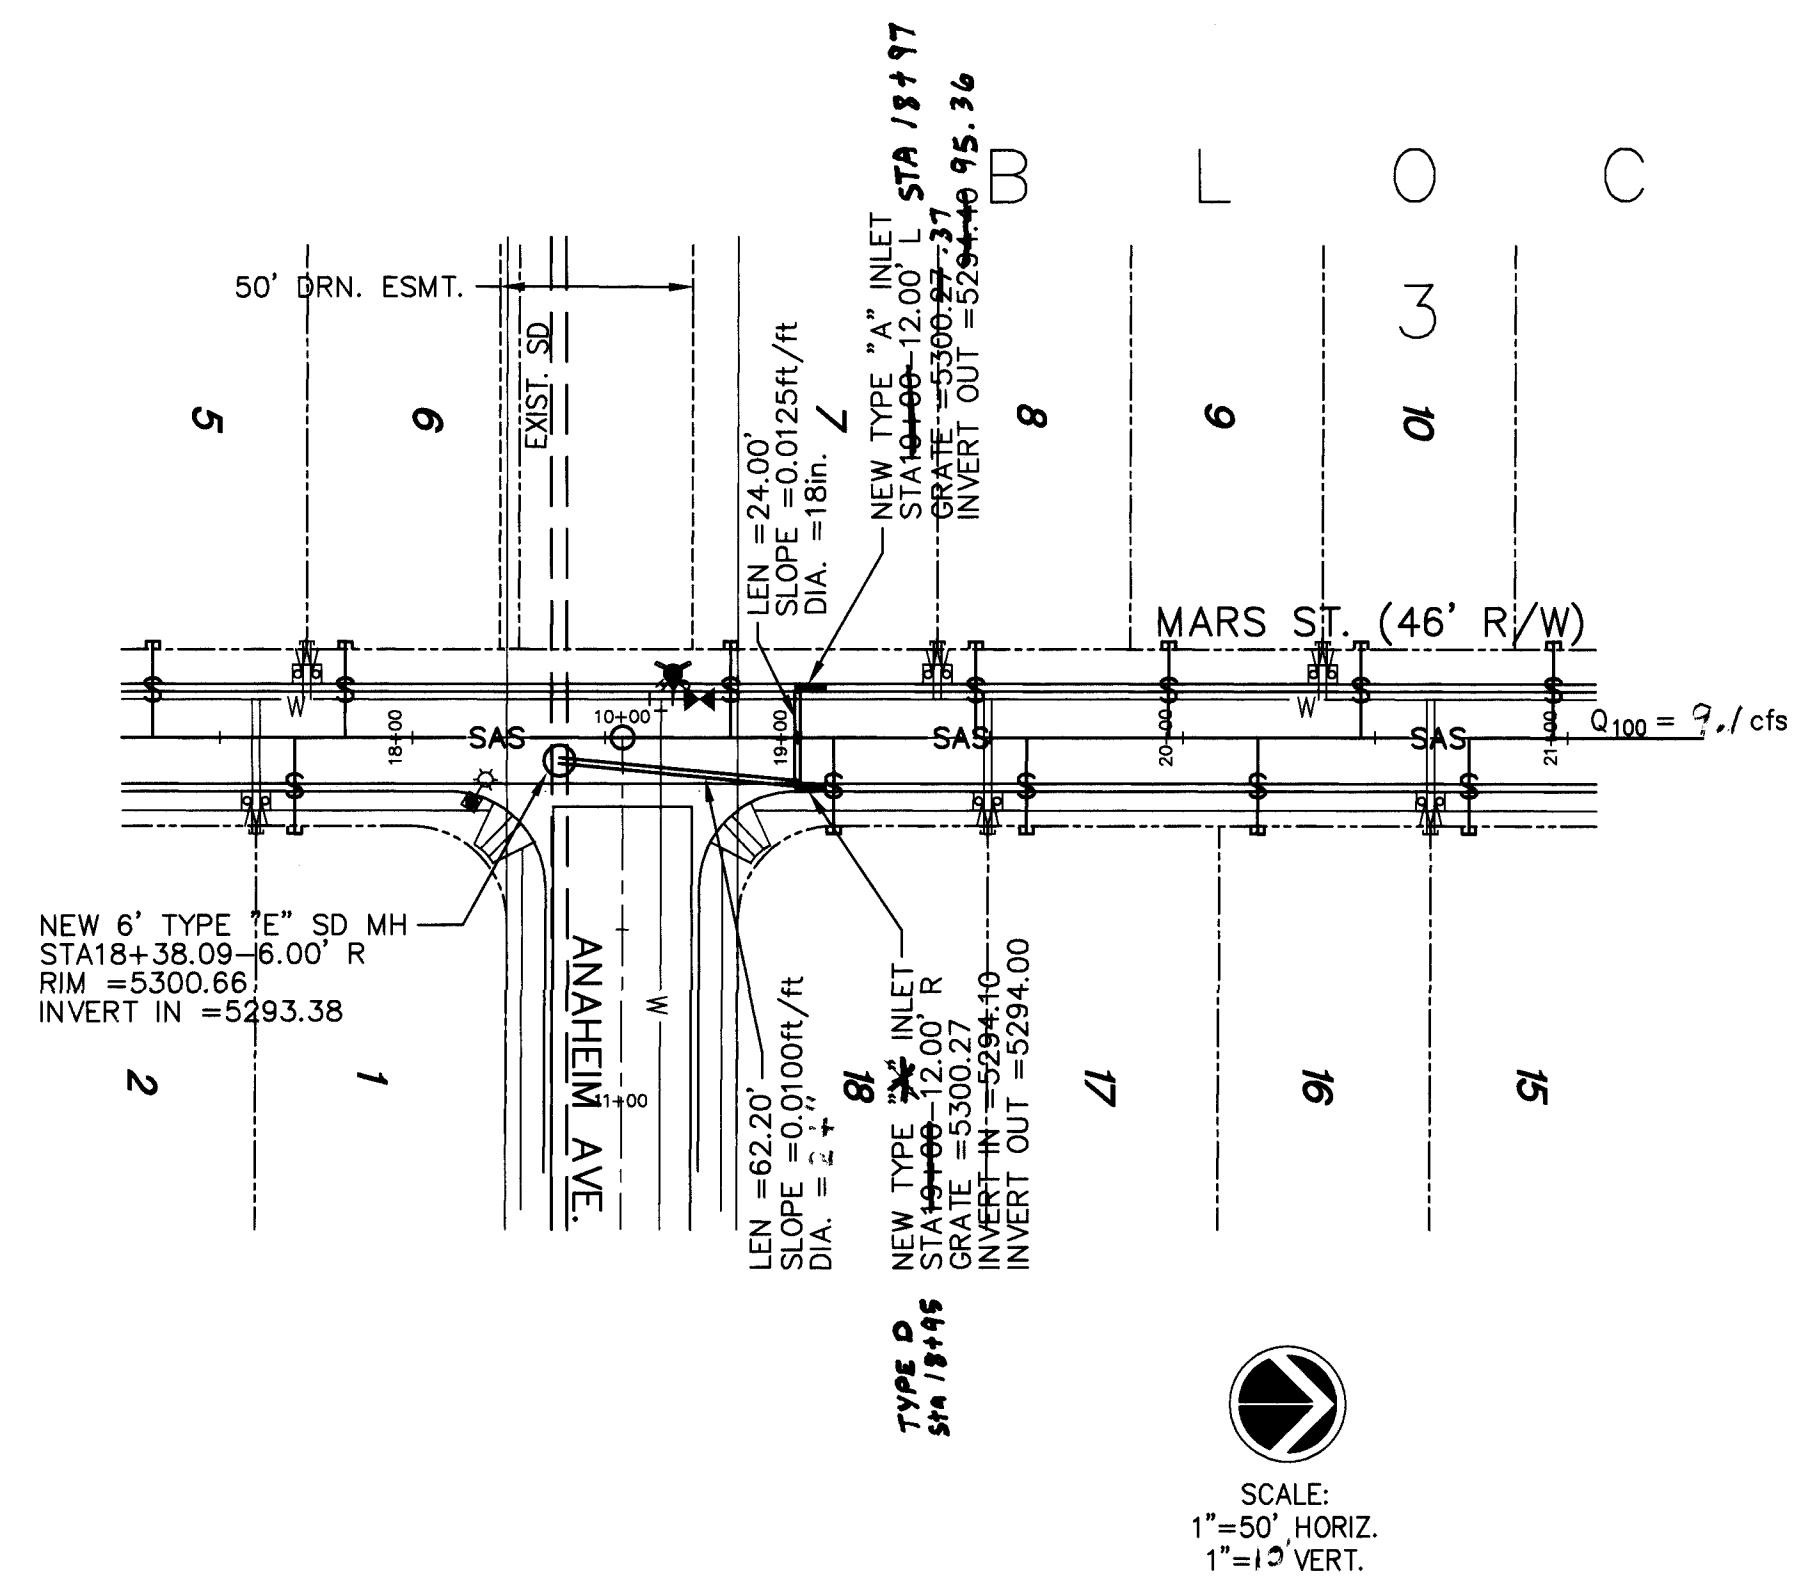

STORM DRAIN NOTES:







1. UNLESS OTHERWISE STATED, ALL STORM DRAIN PIPES SHALL BE CLASS III RCP.

2. THE FOLLOWING C.O.A. STD. DRAWINGS SHALL APPLY:

2201
2202
2205
2206
2207
2215
2216
2220
2236
2101
2102
2107
2110

3. ALL STORM DRAIN IMPROVEMENTS SHOWN SHALL BE CONSTRUCTED WITH PHASE 1. HOWEVER, LOUISIANA BLVD. WILL BE CONSTRUCTED IN THE FUTURE BY SEPARATE CITY OF ALBUQUERQUE CONSTRUCTION CONTRACT. THE CONTRACTOR SHALL GRADE EXISTING BAR SITCHES TO DRAIN TO THE NEW STORM DRAIN INLETS.

UNIT 1 AND PROFILE MARS ST.			ENGINEER'S SEAL			SURVEY INFORMATION			BENCH MARKS			AS BUILT INFORMATION		
DESIGNED BY: DSD						FIELD NOTES			ACS STA. No. 1-C19					
DATE: 8/95						NO.			BY			DATE		
DRAWN BY: TB/PC						REMARKS			X = 1518845.71			WORK STAGED BY: COA DATE 12/195		
CHECKED BY: DSD						REVISIONS			Y = 404941.91			ACCEPTANCE BY: L. Romero DATE 3/96		
			DESIGN						Z = 5318.195			FIELD DRAWINGS CORRECTED BY: L. R. DATE 4/96		
			DATE: 8/95									MICRO-FILM INFORMATION		
			DATE: 8/95									RECORDED BY		
			DATE: 8/95									NO.		

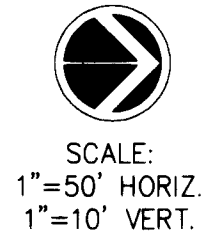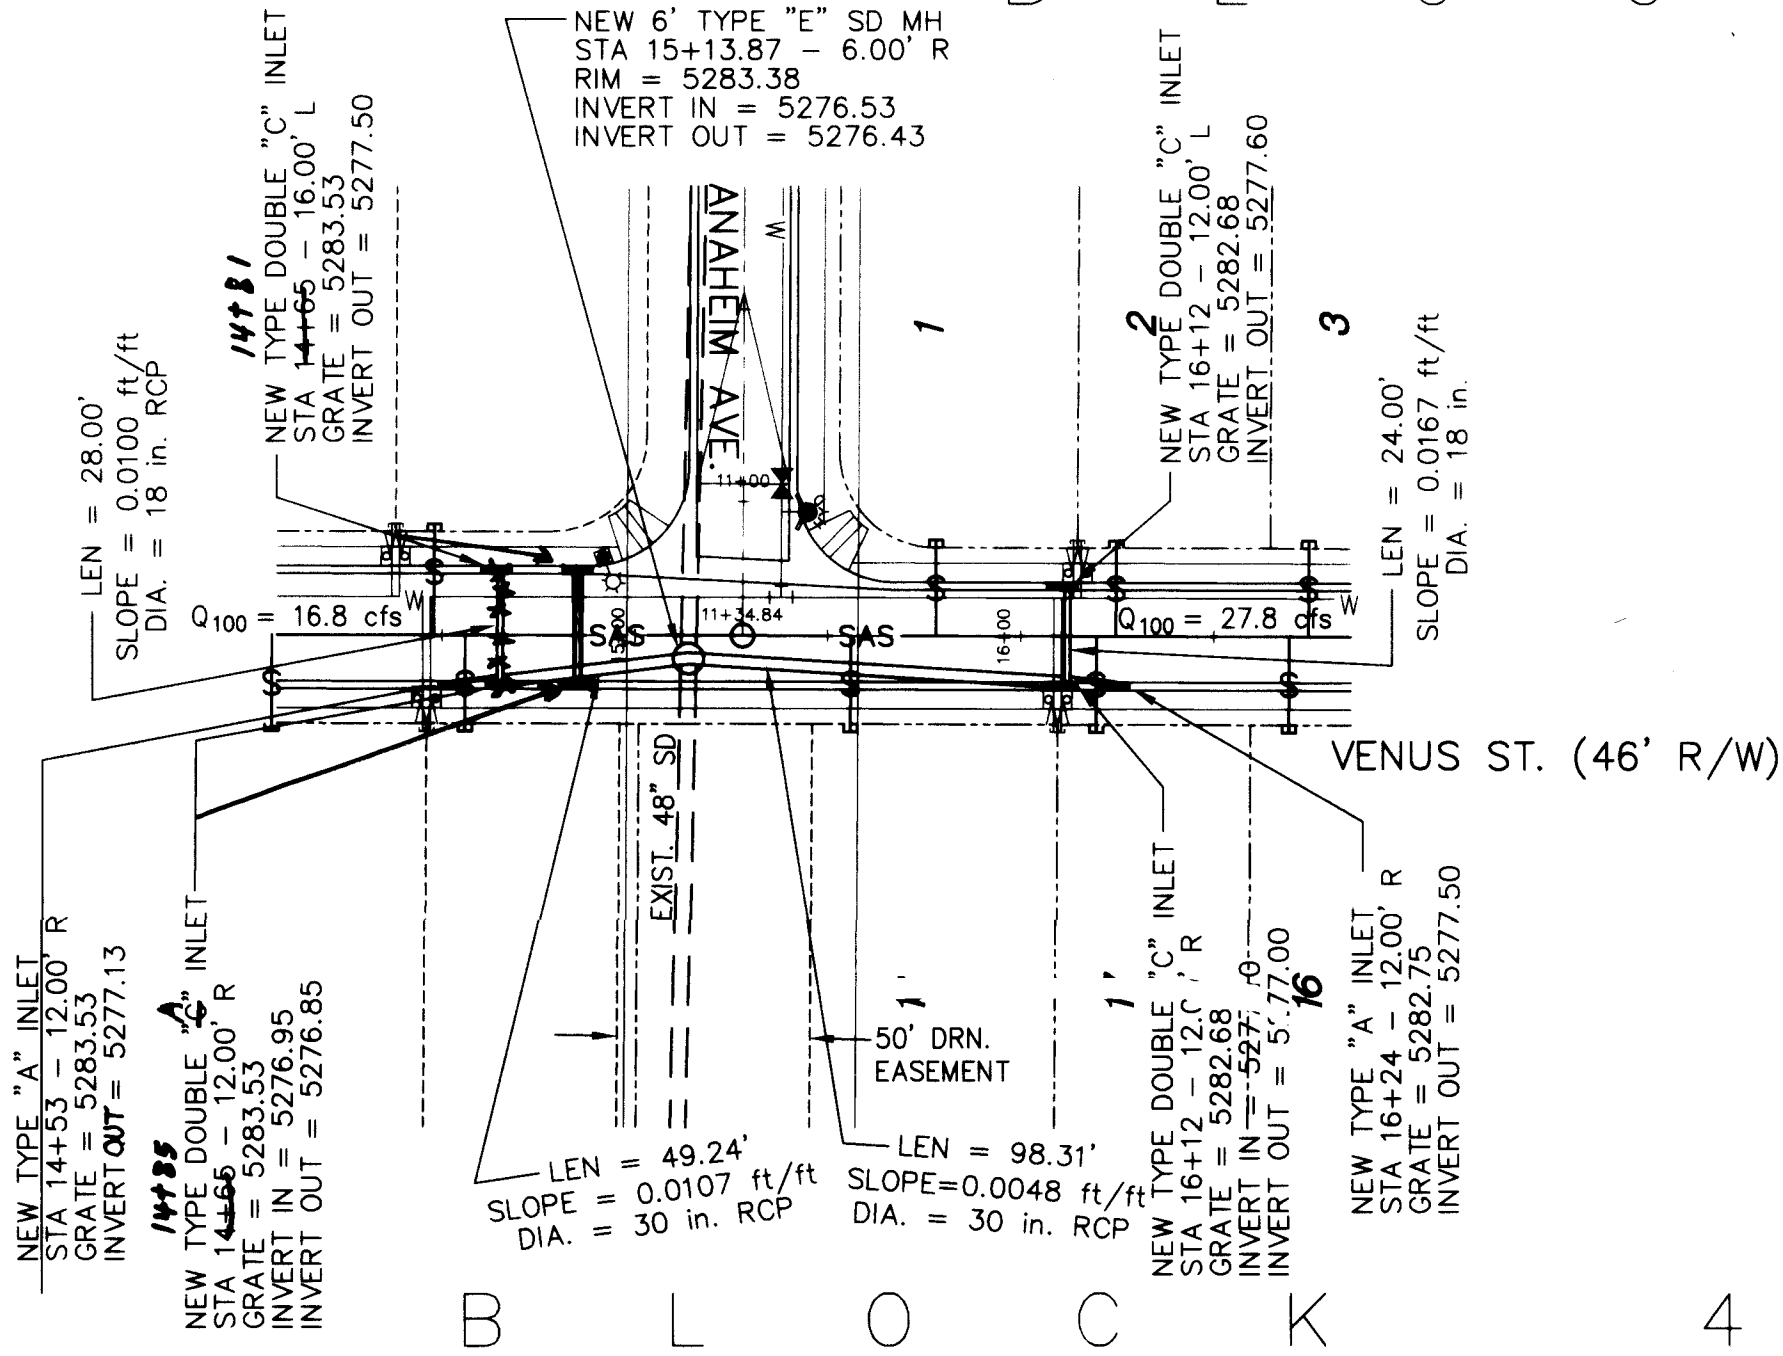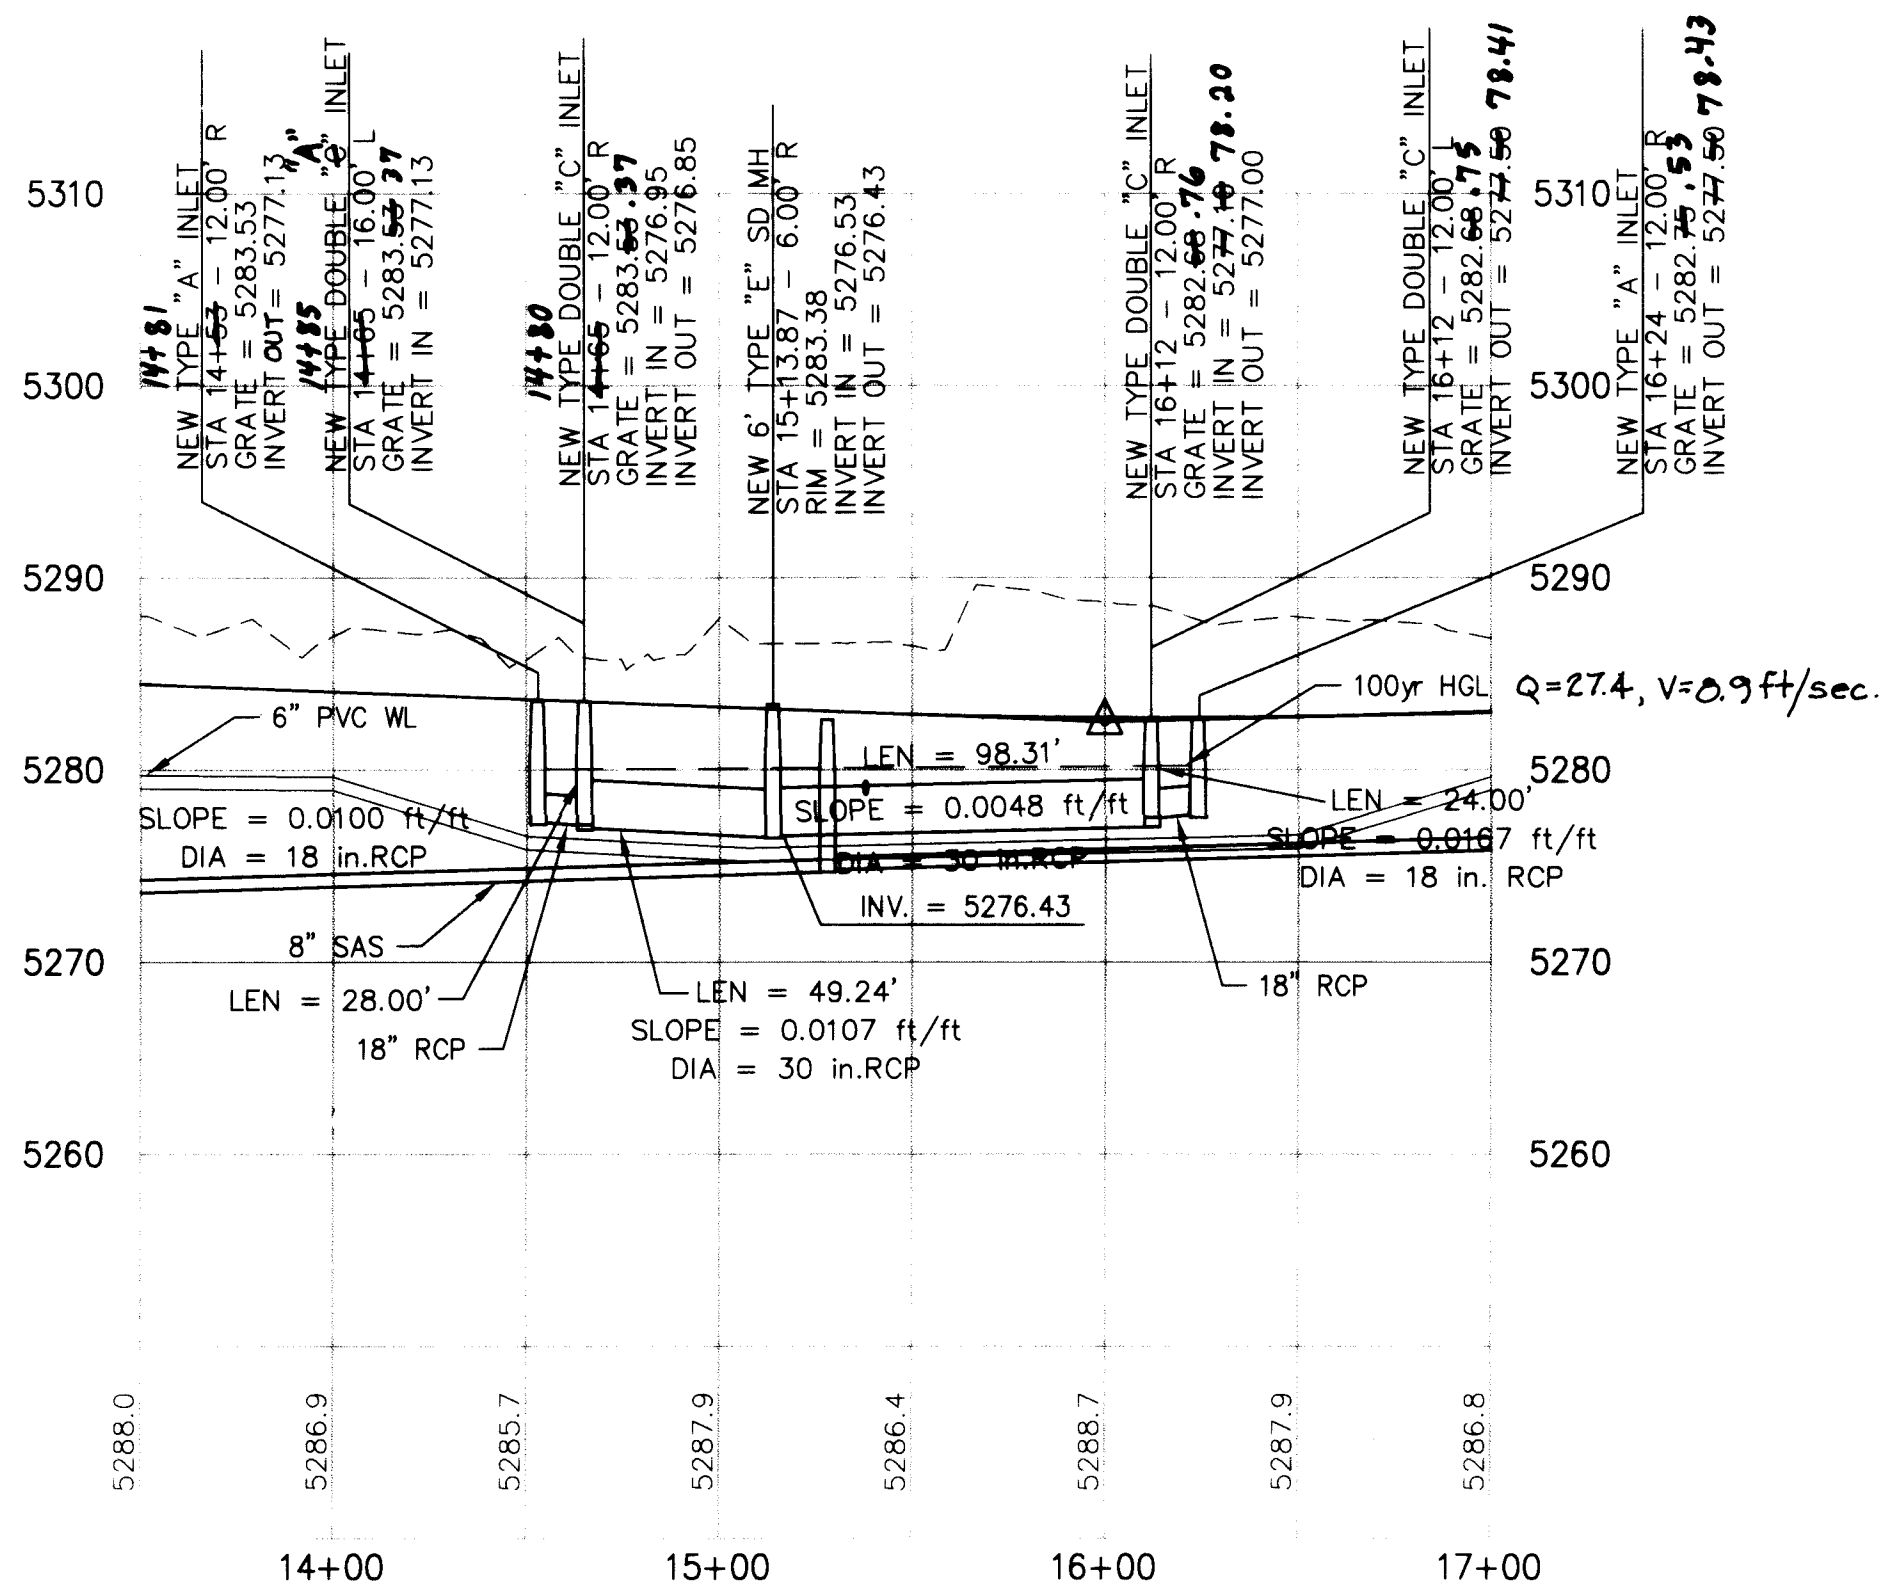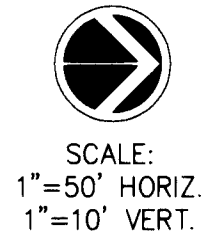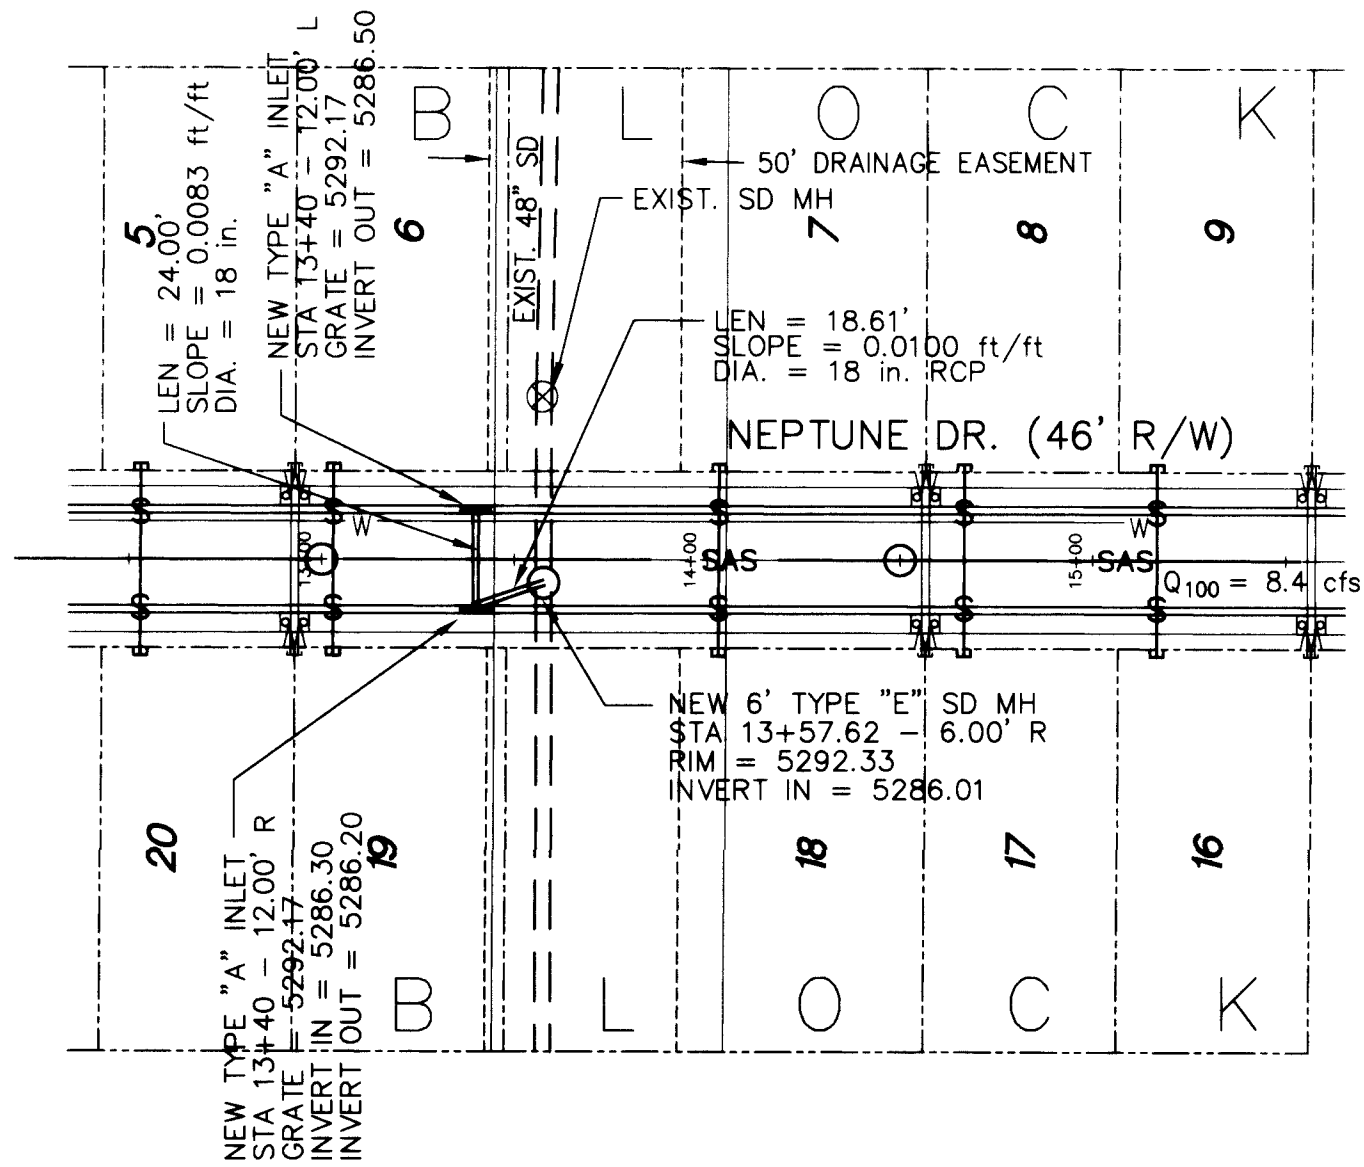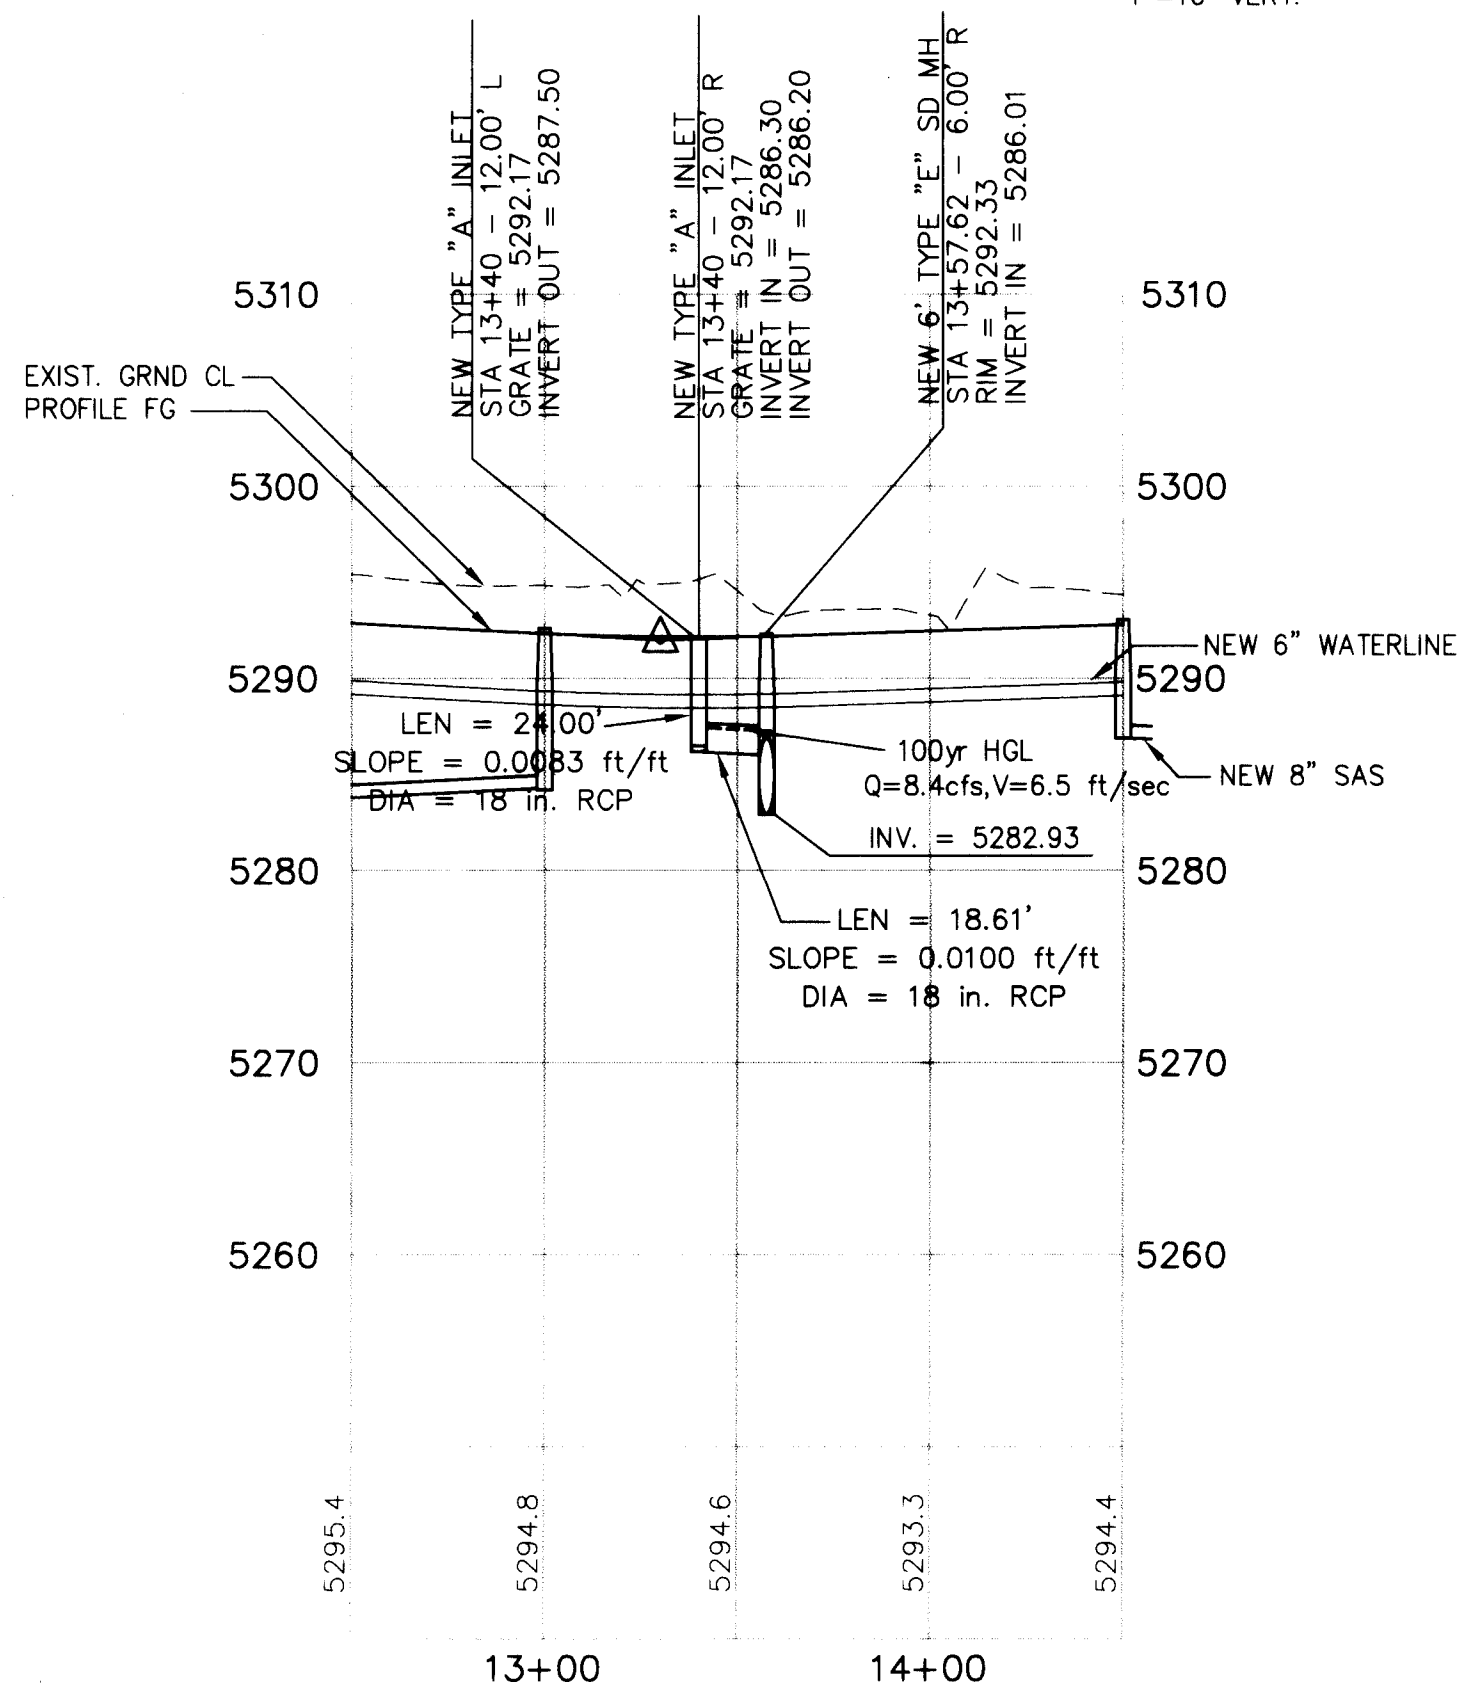

- STORM DRAIN LEGEND**
- PROPOSED STORM DRAIN
 - EXISTING STORM DRAIN
 - EXISTING MANHOLE
 - PROPOSED MANHOLE
 - PROPOSED INLET
 - PROPOSED INLET
- STORM DRAIN NOTES**
- UNLESS OTHERWISE STATED, ALL STORM DRAIN PIPES SHALL BE CLASS III RCP.
 - THE FOLLOWING C.O.A. STD. DRAWINGS SHALL APPLY:

- 2201
2202
2205
2206
2207
2215
2216
2220
2236
2101
2102
2107
2110

Resource Technology, Inc.
ENGINEERS AND ENVIRONMENTAL SCIENTISTS
CIVIL, ENVIRONMENTAL, WATER RESOURCES, RECREATION, PLANNING
2129 Osuna Road NE, Suite 200 - Albuquerque, New Mexico
(505) 345-3115

CITY OF ALBUQUERQUE
PUBLIC WORKS DEPARTMENT
ENGINEERING GROUP

TITLE: LA CUEVA OESTE, UNIT 1
STORM DRAINAGE PLAN AND PROFILE
NEPTUNE ST. AND VENUS ST.

APPROVALS	ENGINEER	DATE	APPROVALS	ENGINEER	DATE
DRC CHAIRMAN	B. G. Gentry	10-3-95	WATER		
TRANSPORTATION	N/A	9-15-95	WASTE WATER	N/A	8/31/95
HYDROLOGY	J. Calogian	9-15-95			

PROJECT NO.	MAP NO.	SHEET OF
5232.90	C-18	29 (2SD) 29

AS BUILT INFORMATION		BENCH MARKS		SURVEY INFORMATION		ENGINEER'S SEAL	
CONTRACTOR	NEW CONCEPT	ACS STA. No. 1-C19		FIELD NOTES			
WORK ORDER NO.	C.O.A.	X = 1518845.74		DATE			
INSPECTOR'S ACCEPTANCE BY	L. B. B.	Y = 404941.91		BY			
DATE	1/16	Z = 5318.195		NO.			
VERIFICATION BY	L. B.						
DATE	1/16						
DRAWINGS CORRECTED BY	L. B.						
DATE	1/16						
MICRO-FILM INFORMATION		REVISIONS		DESIGN		DATE	
RECORDED BY		NO.	DATE	NO.	DATE	DESIGNED BY: DSD	8/95
NO.						DRAWN BY: TB/PG	8/95
						CHECKED BY: DSD	8/95

SCANNED BY
BY LASON

DRN_SHT1.DWG