



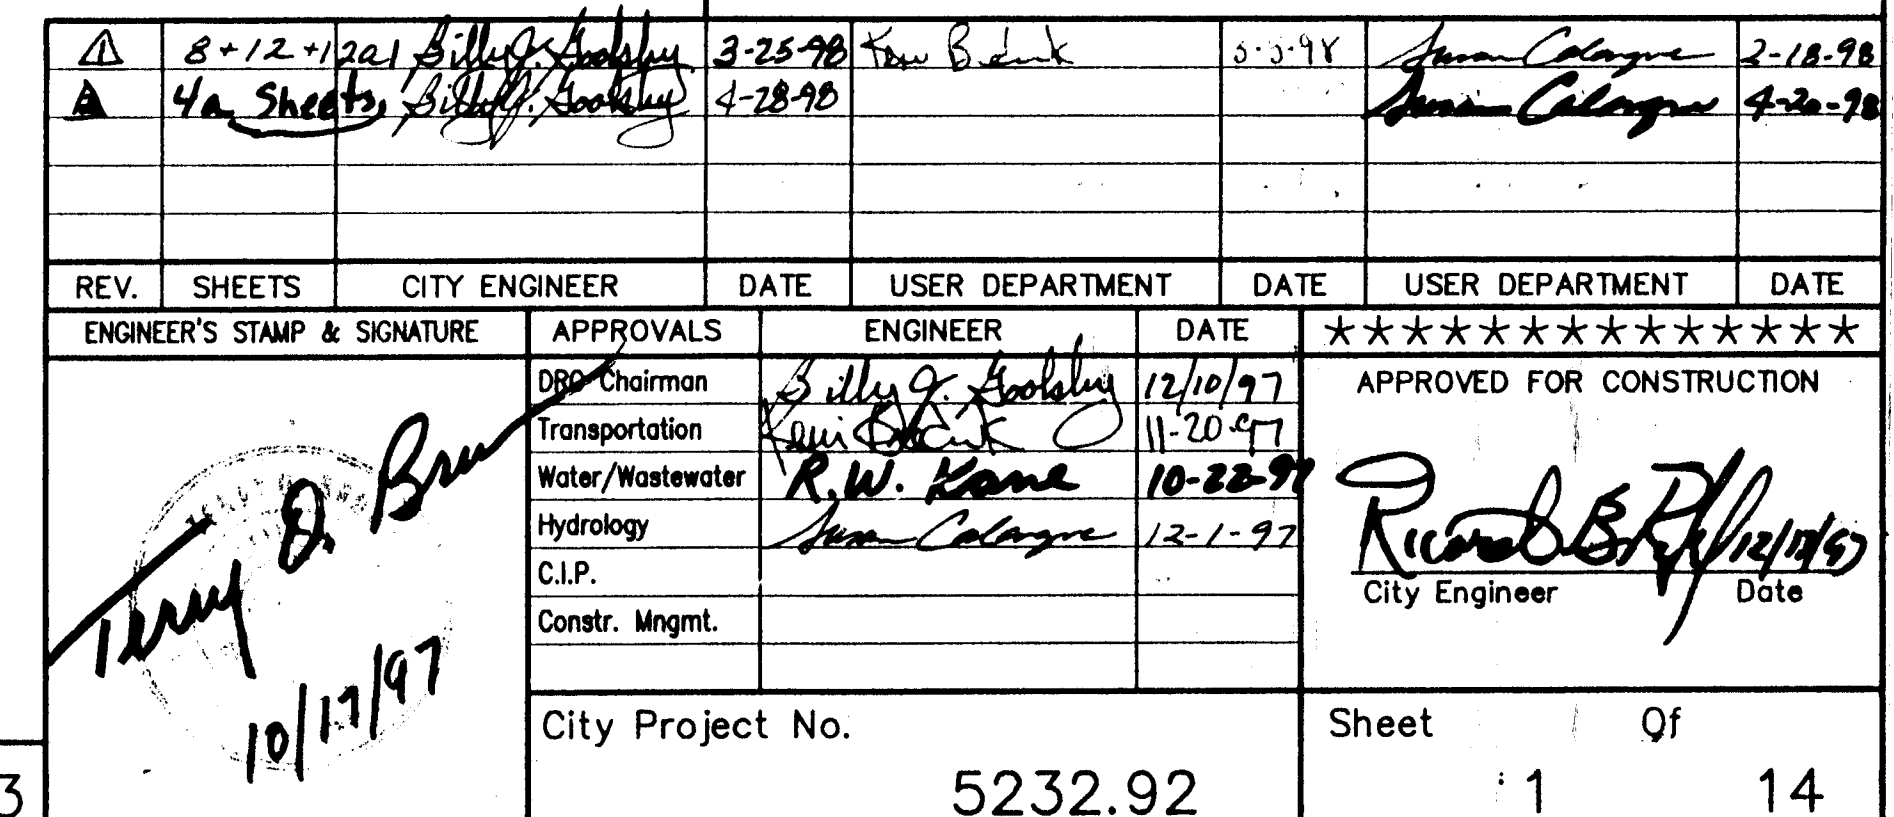

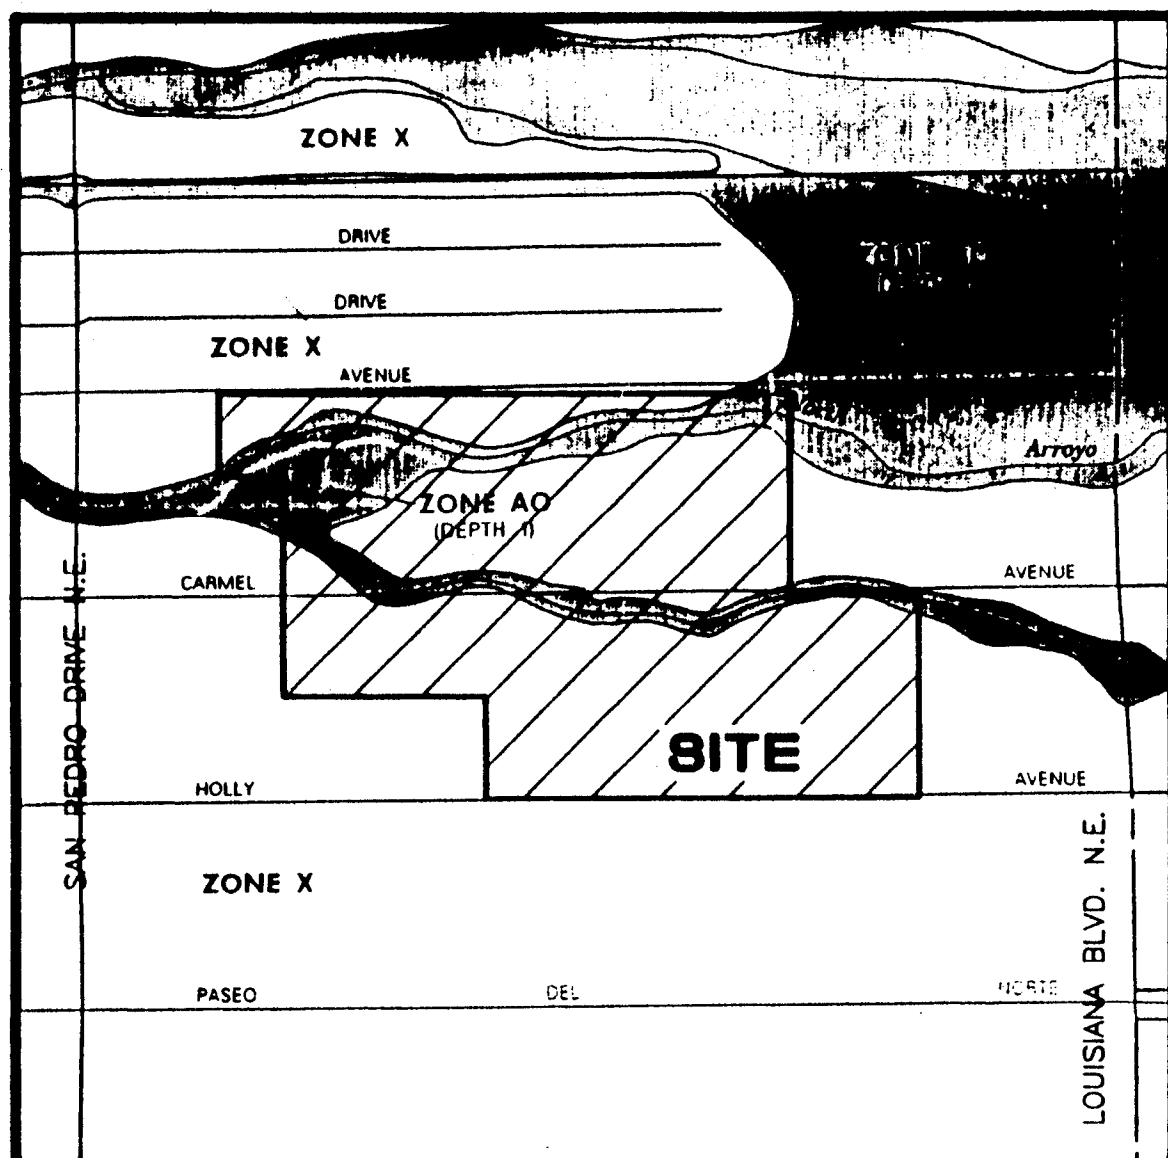

F.I.R.M. MAP
SCALE: 1" = 500'

PANEL 137 OF 825

DESCRIPTION

A certain tract of land located within the Corporate Limits of the City of Albuquerque, New Mexico, comprising Lots 3-11, inclusive, Lots 22-29, inclusive, Block 33, and Lots 4-13, inclusive, Lots 20-26, inclusive, Block 34, Tract A, Unit B, North Albuquerque Acres as the same are shown on the plat filed in the office of the County Clerk of Bernalillo County, New Mexico on April 24, 1935, Book D, Page 130.

KEYED NOTES

- (A) FOUND REBAR W/CAP STAMPED "LS 10042", TAGGED W/WASHER STAMPED "NMPS 11184"
- (B) FOUND #5 REBAR (NO I.D.), TAGGED WITH WASHER STAMPED "NMPS 11184"
- (C) FOUND REBAR W/CAP (NO I.D.), TAGGED WITH WASHER STAMPED "NMPS 11184"
- (D) FOUND REBAR W/CAP STAMPED "NEW MEXICO PS 11184"
- (E) SET #5 REBAR W/CAP STAMPED "NEW MEXICO PS 11184"

- (1) 10' PUBLIC UTILITY EASEMENT GRANTED BY THIS PLAT
- (2) 20' PUBLIC DRAINAGE EASEMENT GRANTED BY THIS PLAT
- (3) 25' NON-VEHICULAR PRIVATE ACCESS AND PUBLIC UTILITY EASEMENT GRANTED BY THIS PLAT
- (4) PEDESTRIAN ACCESS EASEMENT GRANTED BY THIS PLAT
- (5) 5' PRIVATE DRAINAGE EASEMENT GRANTED BY THIS PLAT
- (6) 25' NON-VEHICULAR PRIVATE ACCESS, PUBLIC STORM DRAINAGE, PUBLIC SANITARY SEWER AND PUBLIC UTILITY EASEMENT GRANTED BY THIS PLAT
- (7) PRIVATE LANDSCAPE EASEMENT GRANTED BY THIS PLAT
- (8) 4' VACATION OF A PORTION OF ANAHEIM AVENUE N.E. BY V-96-11
- (9) 2' VACATION OF A PORTION OF HOLLY AVENUE N.E. BY V-96-11
- (10) VACATION OF A PORTION OF CARMEL AVENUE N.E. BY V-96-11

NOTES:


1. A boundary survey was performed in April, 1997 to determine the perimeter of the property to be platted. Property corners were found or set as indicated.
2. All distances are ground distances.
3. Site located within projected Section 13, Township 11 North, Range 3 East, N.M.P.M.
4. Bearings shown hereon are New Mexico State Plane Grid Bearings, Central Zone.
5. Street mileage created by this plat = 1.26 miles (full-width) and 0.06 miles (half-width).
6. Upon completion of the construction of the streets, City of Albuquerque approved centerline monuments shall be placed at all intersections or as otherwise indicated in lieu of subdivision block corner monumentation. Location of said monuments are designated with a "C" symbol.
7. Manholes will be offset at points of curvature, points of tangency, street intersections, and other angle points where practical to allow use of centerline monumentation.

APPROVED FOR STREET NAMES AND MONUMENTATION:

W. C. C. C.
City Surveyor, City of Albuquerque

052297
Date

DRAINAGE NOTE:
A portion of this subdivision is within a 100-year flood plain as shown on the National Flood Insurance Program "Flood Insurance Rate Map". A Letter of Map Revision (LOMR) will be requested from the Federal Emergency Management Agency (FEMA) to remove the existing flood plain. Until the LOMR is issued by FEMA, property owners may be required to purchase flood insurance.

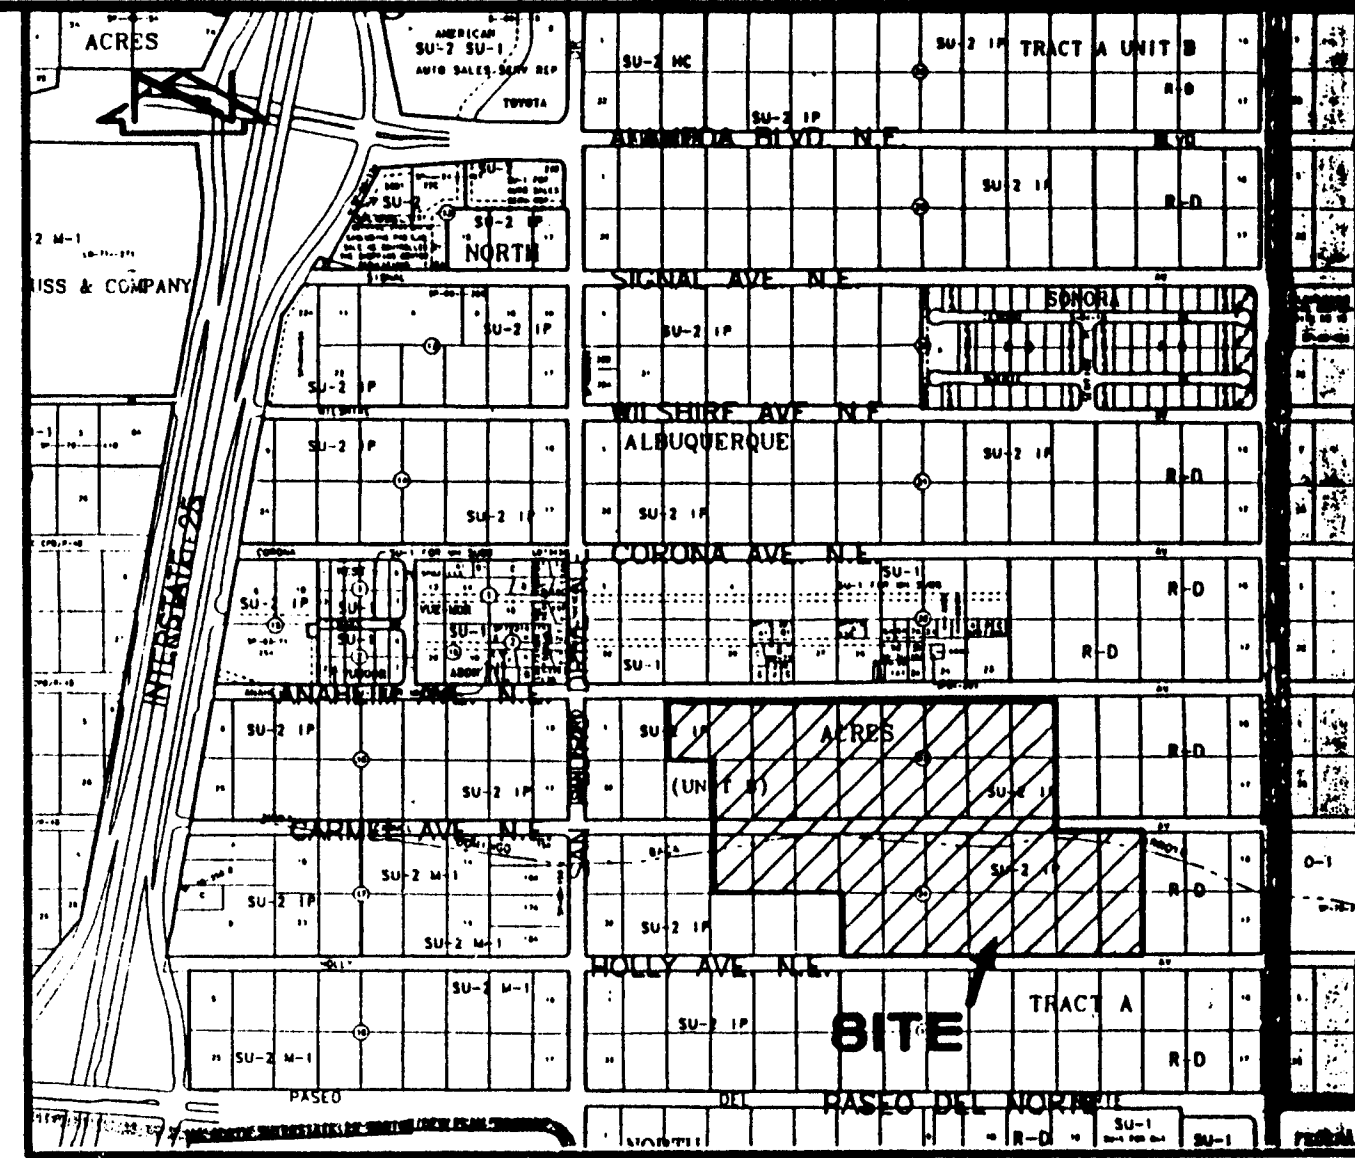

VICINITY MAP
SCALE: 1" = 750'

C-18

BOUNDARY TABLES

LINE	DIRECTION	DISTANCE
BL1	N 01°17'27" W	60.00'
L1	N 89°39'54" W	11.05'
L2	S 89°39'30" E	49.87'
L3	S 89°40'12" E	13.70'
L4	N 89°39'30" W	13.12'
L5	S 89°39'30" E	13.12'
L6	N 00°20'29" E	11.00'
L7	S 89°39'31" E	9.18'
L8	N 00°20'29" E	1.11'
L9	S 00°20'29" W	1.48'
L10	N 00°20'29" E	5.14'
L11	N 60°25'07" E	20.73'
L12	N 00°20'29" E	26.00'
L13	S 89°39'31" E	7.04'
L14	N 00°21'54" E	39.00'
L15	N 00°09'02" E	26.19'
L16	S 89°47'47" E	3.24'
L17	N 00°21'55" E	31.16'
L18	N 89°39'31" W	2.18'
L19	S 00°20'29" W	13.00'
L20	N 00°13'14" W	16.25'
L21	N 00°13'14" W	21.63'
L22	S 01°17'27" E	6.48'
L23	N 00°05'29" E (NR)	14.44'
L24	S 00°13'14" E	23.12'
L25	S 00°07'42" W	22.78'
L26	N 00°07'42" E	29.46'
L27	N 89°40'06" W	19.82'
L28	N 00°07'42" E	4.54'
L29	N 00°13'14" W	15.76'
L30	N 01°17'27" W	7.51'
L31	N 00°20'29" E	6.33'
L32	N 89°40'52" E	34.51'
L33	S 89°39'31" E	16.09'
L34	N 00°20'29" E	1.48'

CURVE	RADIUS	LENGTH	CHORD	CH. BEARING	DELTA
CL1	NOT USED				
CL2	NOT USED				
CL3	378.75'	75.50'	75.37'	N 83°56'52" W	11°25'16"
CL4	378.75'	75.50'	75.37'	S 83°56'52" E	11°25'16"
CL5	378.72'	75.50'	75.37'	N 84°37'50" E	11°25'18"
CL6	378.72'	75.50'	75.37'	N 84°37'50" E	11°25'18"
CL7	75.00'	117.81'	106.07'	S 44°39'31" E	90°00'00"
CL8	279.02'	47.30'	47.25'	S 84°48'48" E	09°42'48"
CL9	279.02'	47.30'	47.25'	N 84°48'48" W	09°42'48"
CL10	75.00'	117.81'	106.07'	N 44°39'31" W	90°00'00"
C1	25.00'	0.68'	0.68'	N 88°53'58" W	01°32'56"
C2	45.00'	36.36'	35.36'	S 64°59'32" E	46°17'24"
C3	25.00'	20.19'	19.65'	S 64°59'04" E	46°16'24"
C4	45.00'	38.43'	37.27'	N 67°23'58" E	48°55'36"
C5	45.00'	38.49'	37.32'	N 18°26'07" E	49°00'05"
C6	45.00'	38.27'	37.13'	S 30°25'50" E	48°43'48"
C7	45.00'	43.29'	41.64'	N 82°21'15" W	55°07'03"
C8	45.00'	21.66'	21.45'	N 56°17'50" E	27°34'47"
C9	25.00'	20.87'	20.27'	S 66°25'07" W	47°49'21"
C10	25.00'	39.27'	35.36'	S 44°39'51" E	90°00'42"
C11	25.00'	39.27'	35.36'	N 45°20'30" E	90°00'00"
C12	25.00'	20.87'	20.27'	S 65°44'49" E	47°49'21"
C13	45.00'	22.27'	22.05'	N 56°00'59" W	28°21'41"
C14	45.00'	45.39'	43.49'	N 80°54'22" E	57°47'37"
C15	45.00'	40.58'	39.22'	N 26°10'32" E	51°40'04"
C16	45.00'	40.58'	39.22'	N 25°29'33" W	51°40'04"
C17	45.00'	45.39'	43.49'	S 80°13'23" E	57°47'36"
C18	45.00'	22.27'	22.05'	N 56°41'59" E	28°21'40"
C19	25.00'	20.87'	20.27'	S 66°25'49" W	47°49'21"
C20	25.00'	39.27'	35.36'	S 44°39'30" E	90°00'00"
C21	25.00'	39.27'	35.36'	N 45°20'47" E	90°00'35"
C22	25.00'	39.26'	35.35'	N 45°20'09" E	89°59'18"
C23	256.02'	36.87'	36.84'	S 85°32'40" E	08°15'04"
C24	52.00'	81.68'	73.54'	N 44°39'30" W	89°59'58"
C25	25.00'	39.27'	35.36'	N 45°20'29" E	90°00'00"
C26	25.00'	39.27'	35.36'	N 44°39'51" W	90°00'42"
C27	302.02'	51.20'	51.14'	S 84°48'48" E	09°42'48"
C28	256.02'	6.53'	6.53'	N 80°41'16" W	01°27'44"
C29	401.72'	14.82'	14.82'	N 89°17'04" E	02°06'51"
C30	40.00'	29.19'	28.55'	N 79°02'46" E	41°49'04"
C31	25.00'	14.05'	13.87'	N 74°14'22" E	32°12'15"
C32	40.00'	39.85'	38.22'	S 51°30'23" E	57°04'39"
C33	40.00'	38.76'	37.26'	N 04°47'21" E	55°30'48"
C34	25.00'	14.05'	13.87'	N 16°26'37" E	32°12'15"
C35	25.00'	39.27'	35.35'	S 44°39'13" E	89°59'25"
C36	25.00'	39.26'	35.35'	N 45°20'09" E	89°59'18"
C37	25.00'	42.91'	37.83'	S 48°49'52" E	98°20'43"
C38	355.72'	19.10'	19.10'	N 80°27'29" E	03°04'35"
C39	401.72'	23.40'	23.40'	N 80°35'19" E	03°20'14"
C40	NOT USED				
C41	NOT USED				
C42	25.00'	39.27'	35.36'	S 44°39'31" E	90°00'00"
C43	25.00'	39.27'	35.36'	N 45°20'29" E	90°00'00"
C44	25.00'	39.27'	35.36'	S 44°39'31" E	90°00'00"
C45	98.00'	51.92'	51.31'	N 14°50'06" W	30°21'11"
C46	98.00'	102.02'	97.48'	S 59°50'06" E	59°38'49"
C47	25.00'	39.27'	35.36'	S 44°39'31" E	90°00'00"


CURVE	RADIUS	LENGTH	CHORD	CH. BEARING	DELTA
C48	401.72'	60.44'	60.38'	N 83°55'03" E	08°37'11"
C49	401.72'	4.82'	4.82'	S 79°15'49" W	00°41'16"
C50	355.72'	43.71'	43.68'	N 82°26'24" E	07°02'25"
C51	355.72'	27.20'	27.19'	S 88°09'03" W	04°22'53"
C52	355.75'	42.92'	42.90'	S 86°12'07" E	06°54'47"
C53	355.75'	27.99'	27.98'	S 80°29'29" E	04°30'29"
C54	401.75'	17.65'	17.65'	S 79°29'46" E	02°31'03"
C55	401.75'	45.25'	45.22'	N 83°58'52" W	06°27'10"
C56	401.75'	17.19'	17.18'	N 88°25'59" W	02°27'03"
C57	NOT USED				
C58	NOT USED				
C59	NOT USED				
C60	401.72'	55.19'	55.14'	N 86°11'34" E	07°52'17"
C61	401.72'	1.49'	1.49'	S 89°45'54" E	00°12'47"
C62	401.75'	22.01'	22.01'	S 88°05'20" E	03°08'21"
C63	401.75'	50.38'	50.35'	S 82°55'37" E	07°11'06"
C64	401.75'	7.69'	7.69'	S 78°47'09" E	01°05'50"
C65	355.75'	19.10'	19.10'	S 79°46'32" E	03°04'36"
C66	25.00'	42.91'	37.83'	N 49°30'50" E	98°20'40"
C67	52.00'	81.68'	73.54'	S 44°39'31" E	90°00'00"
C68	25.00'	39.27'	35.36'	N 45°20'29" E	90°00'00"
C69	NOT USED				
C70	25.00'	19.06'	18.61'	S 21°30'14" E	43°41'27"
C71	40.00'	29.13'	28.49'	S 22°29'20" E	41°43'16"
C72	40.00'	32.10'	31.25'	S 21°21'51" W	45°59'06"
C73	40.00'	32.10'	31.25'	S 67°20'57" W	45°59'06"
C74	40.00'	33.65'	32.67'	N 65°33'25" W	48°12'11"
C75	40.00'	30.55'	29.82'	N 19°34'19" W	43°46'00"
C76	40.00'	29.13'	28.49'	N 23°10'19" E	41°43'16"
C77	25.00'	19.06'	18.61'	N 22°11'13" E	43°41'27"
C78	25.00'	39.27'	35.36'	N 44°39'51" W	90°00'42"
C79	25.00'	39.02'	35.18'	S 44°56'22" E	89°26'17"
C80	NOT USED				
C81	25.00'	39.52'	35.53'	S 45°03'38" W	90°33'43"
C82	25.00'	39.28'	35.36'	N 44°38'48" W	90°01'24"
C83	25.00'	2.17'	2.17'	N 02°51'13" E	04°58'37"
C84	25.00'	13.92'	13.74'	N 21°17'18" E	31°53'35"
C85	40.00'	35.00'	33.89'	N 12°10'15" E	50°07'42"
C86	40.00'	50.88'	47.52'	S 49°19'58" E	72°52'43"
C87	40.00'	56.30'	51.77'	S 53°54'19" W	80°38'42"
C88	40.00'	42.32'	40.37'	S 16°43'27" E	60°36'51"
C89	25.00'	9.29'	9.24'	S 36°22'51" E	21°18'03"
C90	25.00'	11.39'	11.29'	N 12°40'58" W	26°05'44"
C91	25.00'	39.26'	35.35'	N 45°21'12" E	89°58'35"
C92	25.00'	39.02'	35.18'	N 44°56'22" W	89°26'17"
C93	25.00'	39.36'	35.42'	S 45°14'06" W	90°12'48"
C94	25.00'	39.52'	35.53'	N 45°03'38" E	90°33'44"
C95	NOT USED				
C96	25.00'	39.18'	35.29'	N 44°45'54" W	89°47'12"
C97	25.00'	39.31'	35.38'	S 45°23'13" W	90°05'27"
C98	302.02'	22.39'	22.38'	S 87°32'47" E	04°14'50"
C99	302.02'	28.81'	28.80'	S 82°41'23" E	05°27'58"
C100	256.02'	11.79'	11.59'	N 83°29'39" W	07°04'30"
C101	256.02'	11.79'	11.79'	N 88°21'03" W	02°38'19"
C102	25.00'	39.26'	35.35'	N 45°20'09" E	89°59'18"
C103	25.00'	39.23'	35.33'	S 44°36'47" E	89°54'33"

AS-BUILT

SURVEYORS CERTIFICATION

I, Charles G. Cala, Jr., a registered Professional Surveyor under the laws of the State of New Mexico do hereby certify that I conducted and am responsible for this plat, shows all easements made known to me by this owner, utility companies, or other parties expressing an interest; meets the minimum requirement for Monumentation and surveys of the Albuquerque Subdivision Ordinance; complies with the minimum standards for surveying in the State of New Mexico, and is true and correct to the best of my knowledge and belief.

Charles G. Cala, Jr.
Charles G. Cala, Jr., NMPS 11184

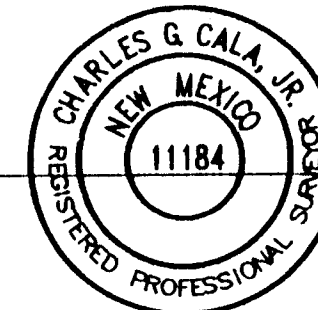

5-21-1997
Date

The purpose of this plat is to:

- a. Dedicate public street rights-of-way as shown.
- b. Incorporate the vacated portions of Holy Avenue N.E., Anaheim Avenue N.E. and Carmel Avenue N.E. vacated by V-96-11.
- c. Grant the necessary easements as shown.
- d. Create 200 residential lots within Units 2, 3a, 3b, 3c and 4, La Cueva Oeste.




JEFF MORTENSEN & ASSOCIATES, INC.
6800-71 HENRY PARK BLVD. N.E.
ALBUQUERQUE, NEW MEXICO 87109
ENGINEERS SURVEYORS (CNS) 545-4226

PRELIMINARY MASTER PLAN PLAT

LA CUEVA OESTE UNITS 2, 3a, 3b, 3c AND 4

DESIGNED BY	NO.	DATE	BY	REVISIONS	JOB NO.
T.O.B.					961193
SURVEYED BY					DATE
R.J.E.					05-1997
DRAWN BY					SHEET
T.M.T.					2 OF 14
APPROVED BY					
C.G.C.					

DATA MODIFIED 06/11/97 13:23:23 1997 -TNT

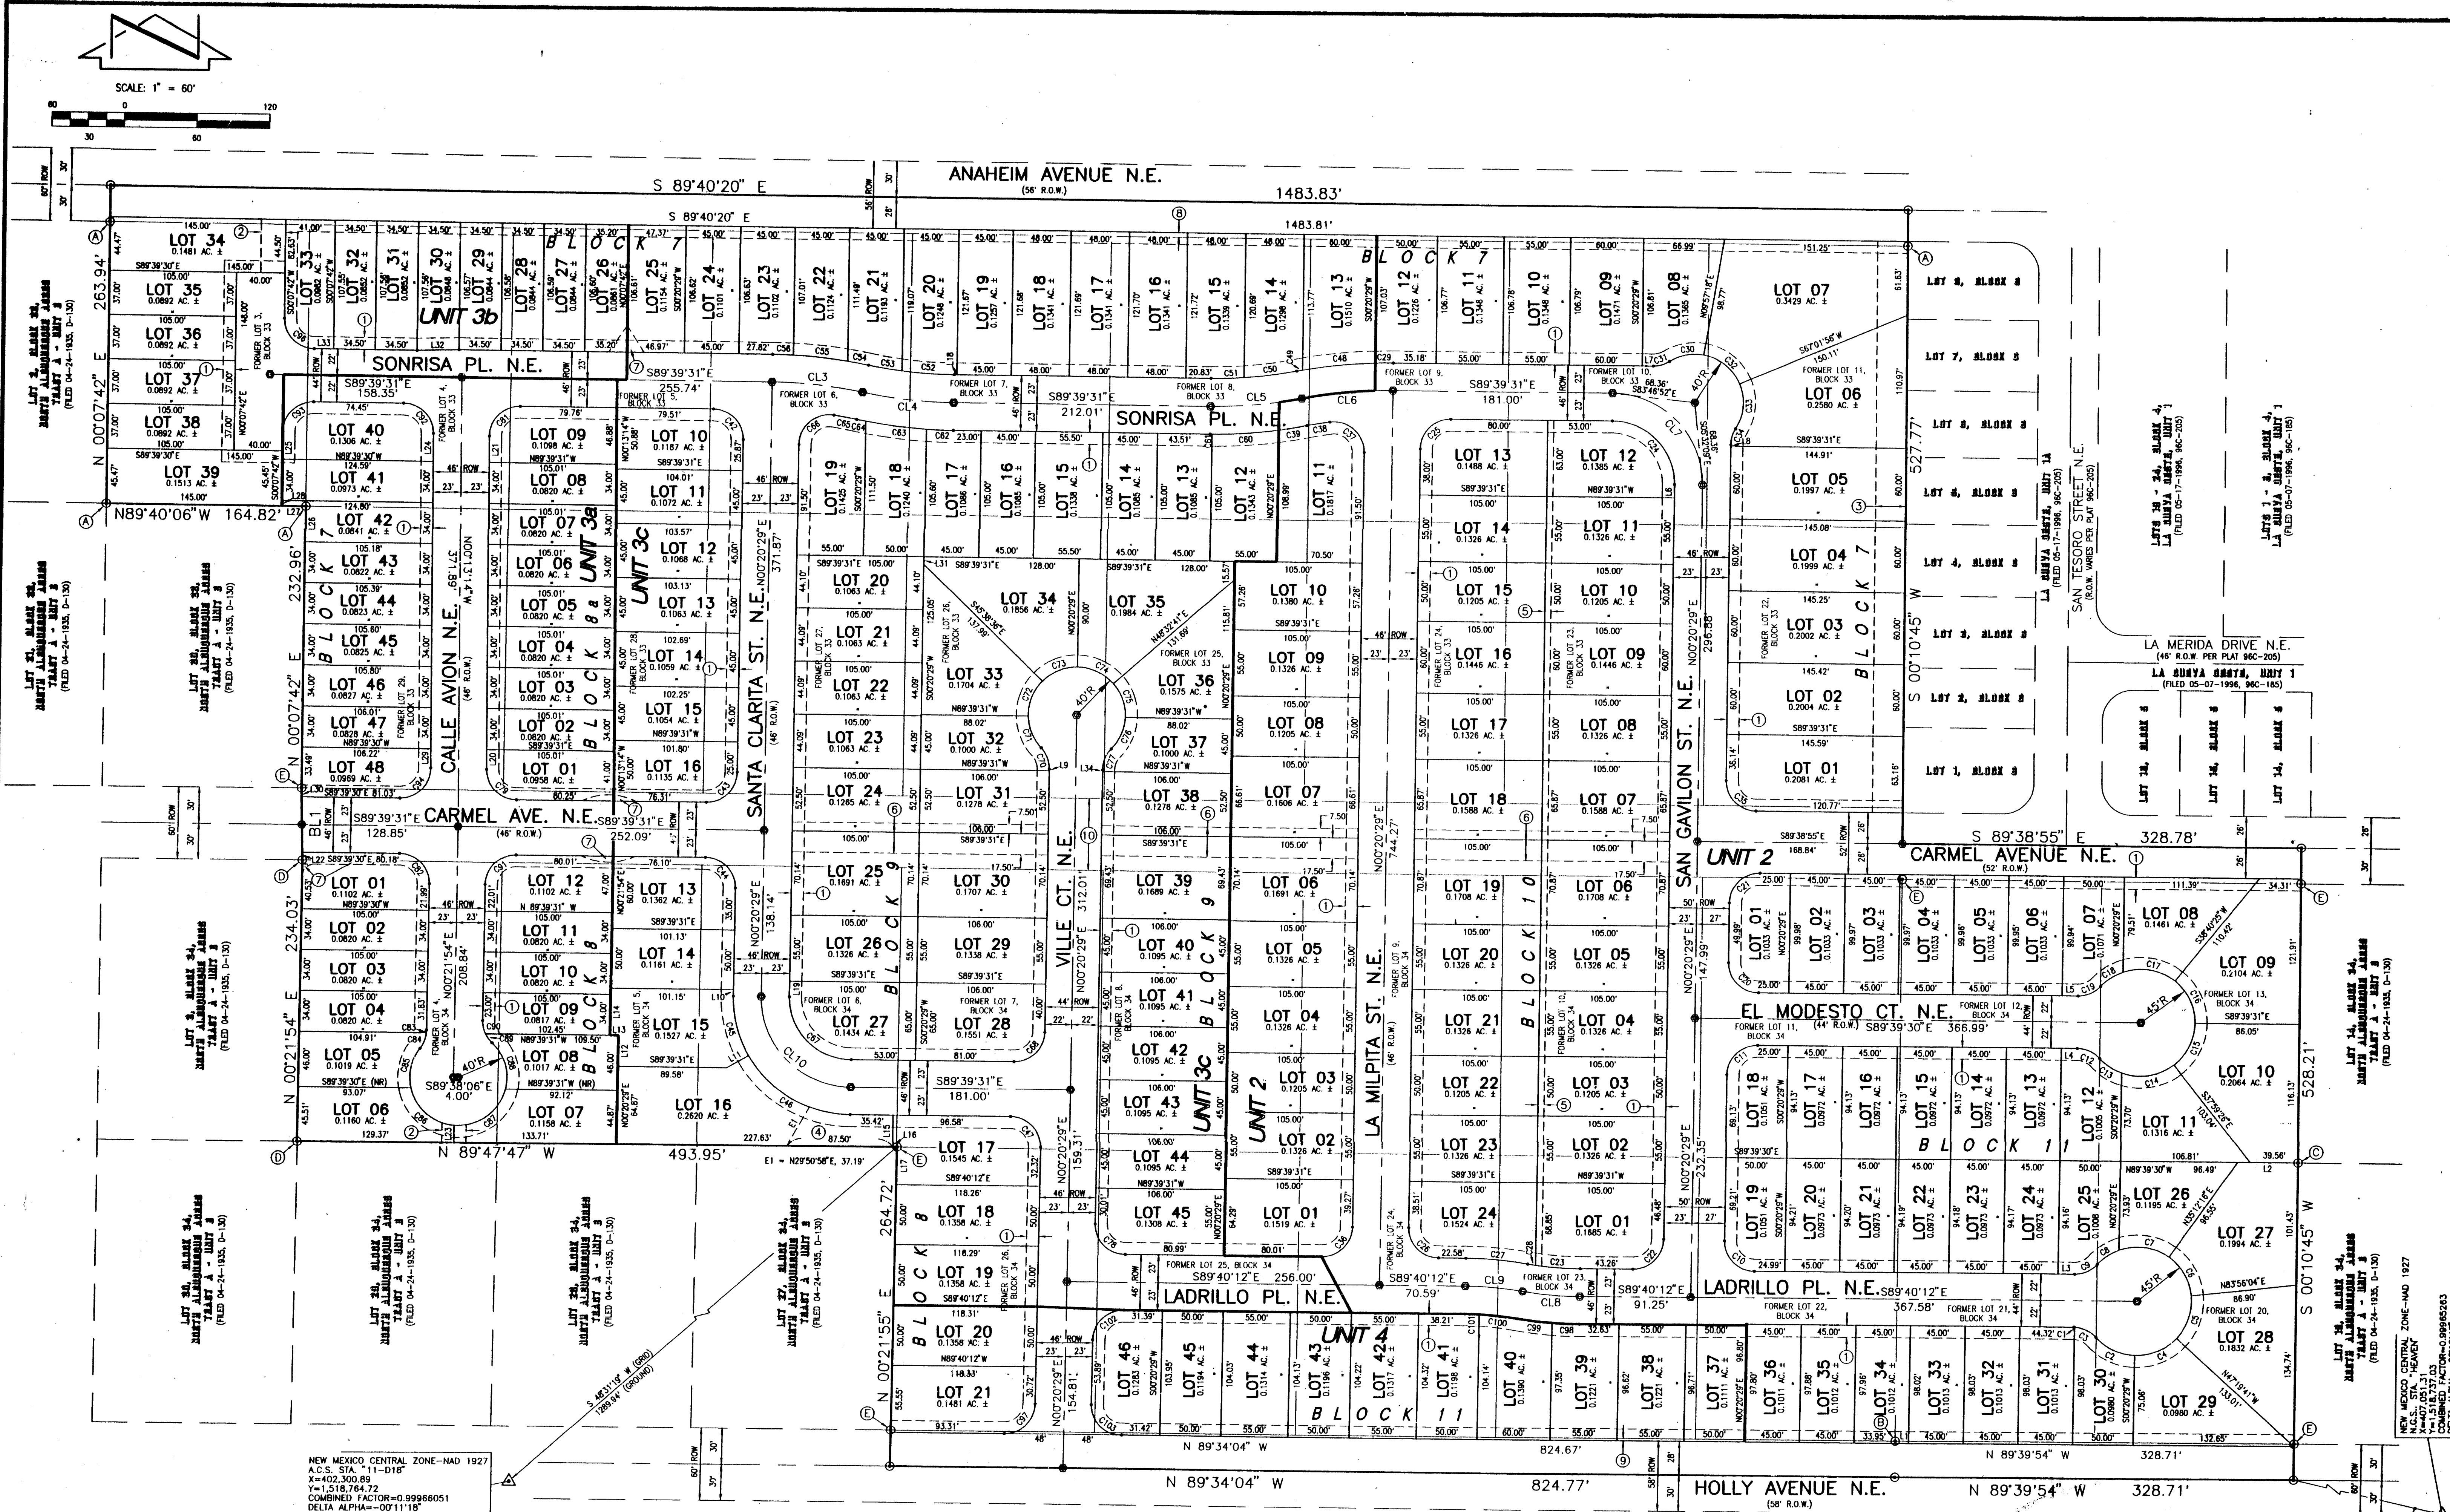


JEFF MORTENSON & ASSOCIATES, INC.
2015 S. MURRAY PARK BLVD. N.E.
ALBUQUERQUE, N.M. 87102
ENGINEERS & SURVEYORS (CNS) 345-4250

PRELIMINARY MASTER PLAN PLAT
LA CUEVA OESTE UNITS 2, 3a, 3b, 3c AND 4

SCANNED BY
BY LASON

DESIGNED BY	T.O.B.	DATE	BY	REVISIONS	JOB NO.
SURVEYED BY	R.J.E.				961198
DRAWN BY	T.N.T.				DATE
APPROVED BY	C.G.C.				05-1997
					SHEET
					3 of 14

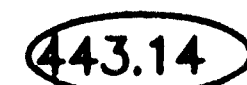

SCANNED BY
BY LASON



- NOTES:

1. FOR UNIT 2 FINISHED PAD AND RETAINING WALL ELEVATIONS, SEE SHT 4.
2. FOR UNIT 3 FINISHED PAD AND RETAINING WALL ELEVATIONS, SEE SHT 4a.
3. FOR TYPICAL LOT DRAINAGE DETAILS, SEE SHTS 5 AND 5a.
4. FOR PRIVATE DRAINAGE EASEMENT LOCATIONS, SEE SHTS. 4 AND 4a.
5. FOR CARMEL STORM DRAIN EASEMENT, SEE SHTS 23 AND 23a.
6. FOR SAN PEDRO STORM DRAIN, SEE Exhibit 5, 8/9c D.Rep.
7. FOR HOLLY STORM DRAIN, SEE Exhibit 6, 8/9c D.Rep.
8. EXISTING UTILITY LOCATIONS SHOWN ARE APPROXIMATE ONLY.
9. INTERIM POND DETAILS, SEE SHT. 23b.

AS-BUILT

Resource Technology, Inc.
ENGINEERS AND ENVIRONMENTAL SCIENTISTS
CIVIL • ENVIRONMENTAL • WATER RESOURCES • RECREATION • PLANNING
1730-B Randolph Rd. SE, Albuquerque, NM 87108
(808) 243-7300

CITY OF ALBUQUERQUE
PUBLIC WORKS DEPARTMENT
ENGINEERING DEVELOPMENT GROUP

TITLE: LA CUEVA OESTE
SITE PLAN
UNITS 2, 3a, 3b, 3c & 4

Design Review Committee	City Engineer Approval
-------------------------	------------------------

Approved
@ DRB


City Project No. 5232.91

Zone Map No. C-18


84	2614
----	------

DESIGNED BY		DSO	DATE	MAY 1987
DRAWN BY		PMT	DATE	MAY 1987
CHECKED BY		DSO	DATE	MAY 1987
REVISIONS				
NO.	DATE	REMARKS	BY	
DESIGN				
ENGINEERS SEAL		SURVEY INFORMATION		
 6/10/97		FIELD NOTES		BENCH MARKS
		NO.	BY DATE	
		STATION NAME		AS BUILT INFORMATION
		CONTRACTOR		
		WORK ORDER NO.		
		APPROVED BY		
		DATE		
		ACCEPTANCE BY		CONTRACTOR NEW CONCEPTS
		DATE		
		VERIFICATION BY		
		DATE		
		DRAWINGS BY		
		DATE		MICRO-FILM INFORMATION
		RECORDED BY		
		DATE		
		NORTHING		
		EASTING		
		ELEVATION		


EXHIBIT 2A (REVISED)	CHECKED BY DSD
----------------------	----------------

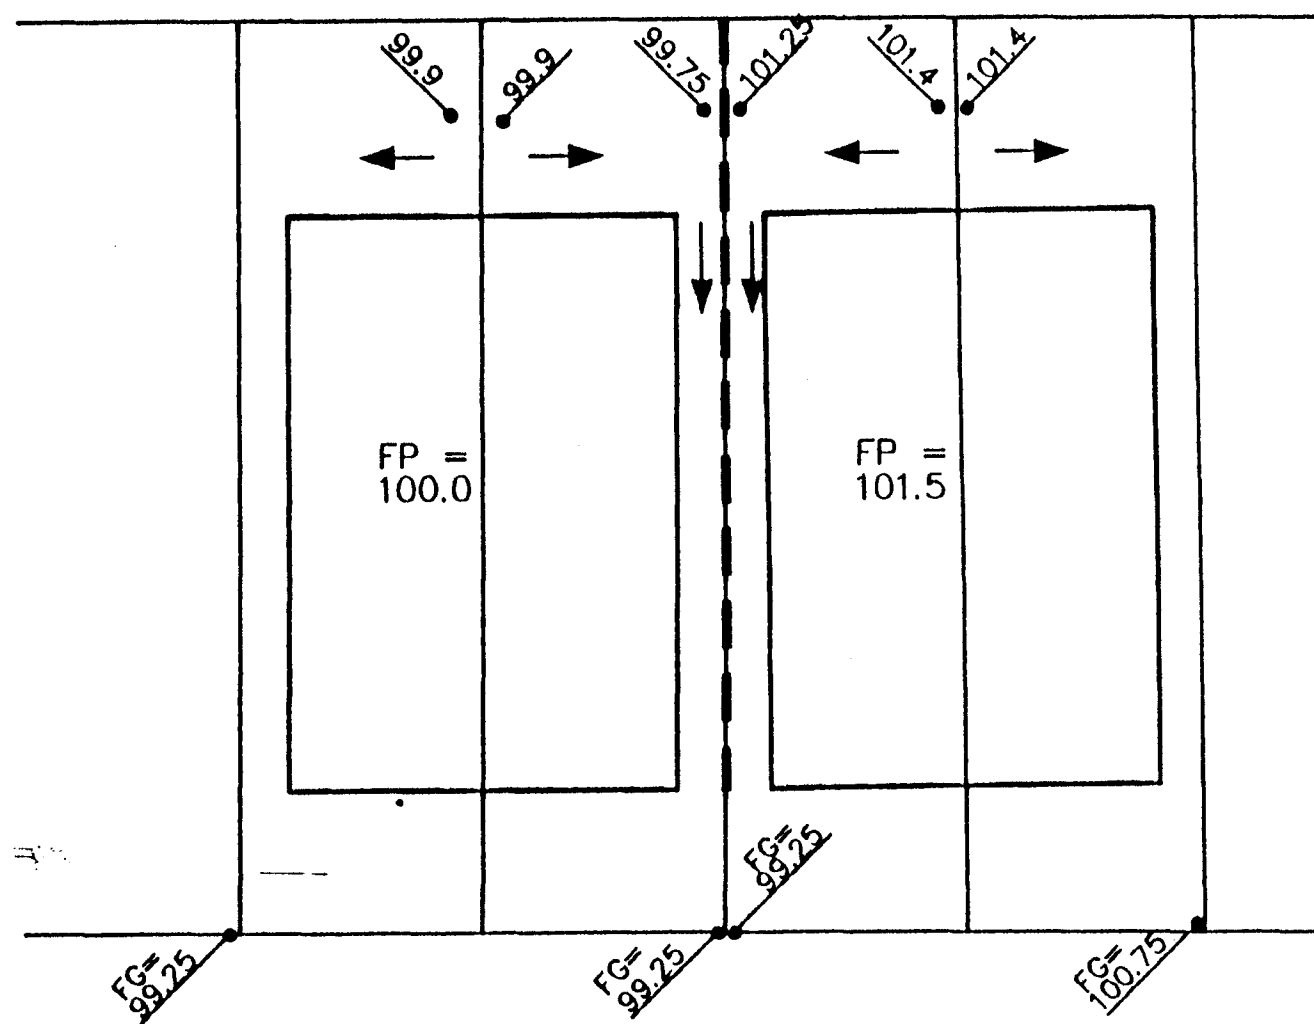


CASE 3a

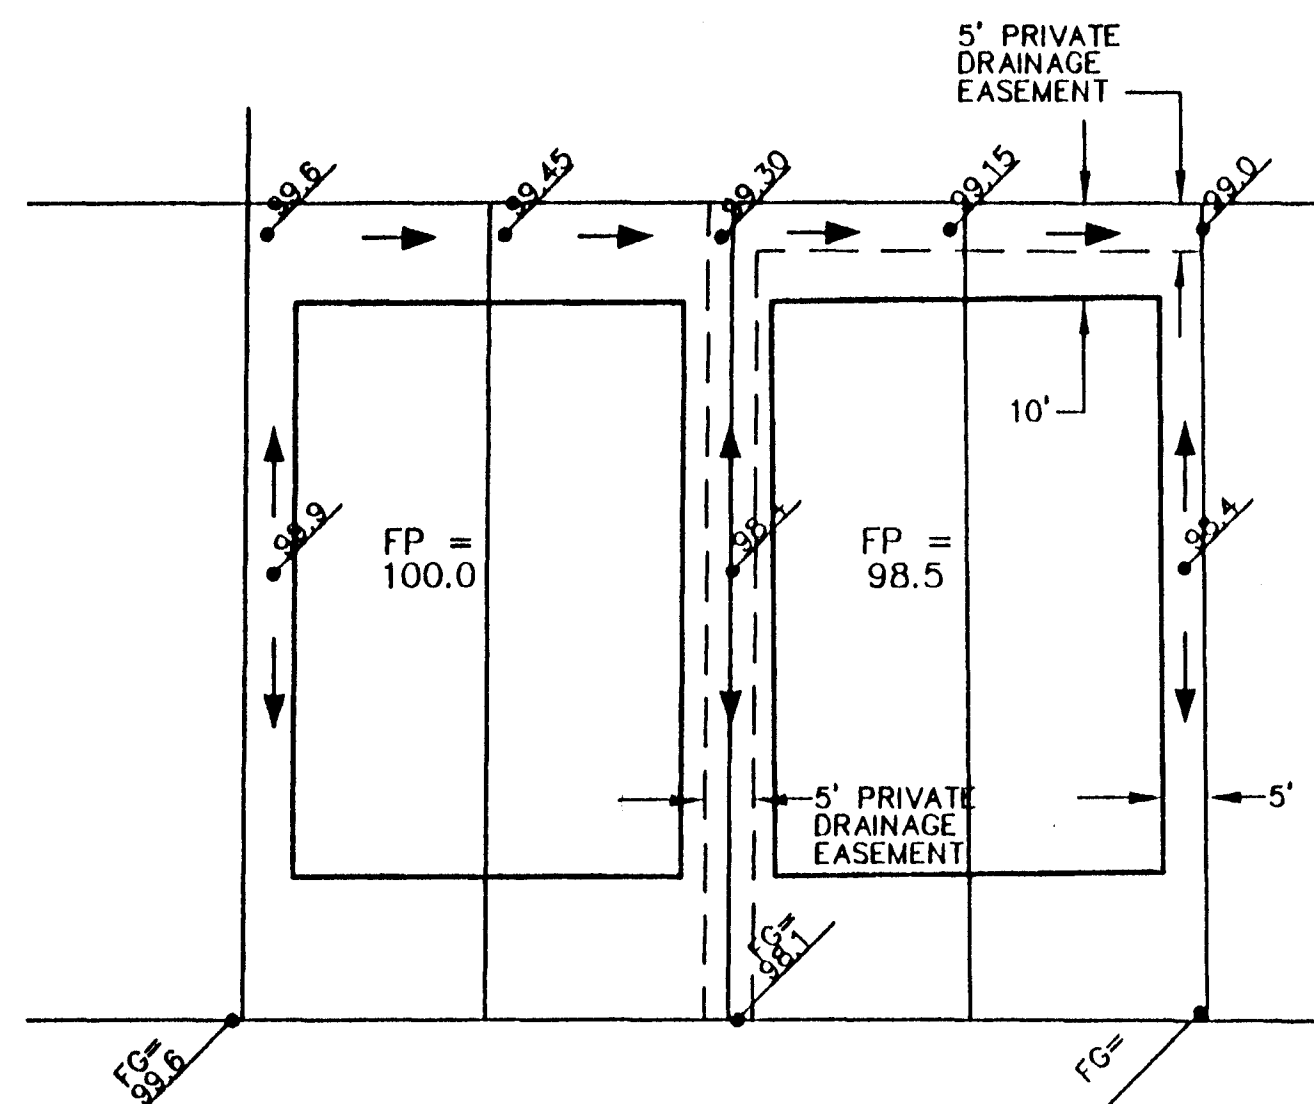

CASE 3b

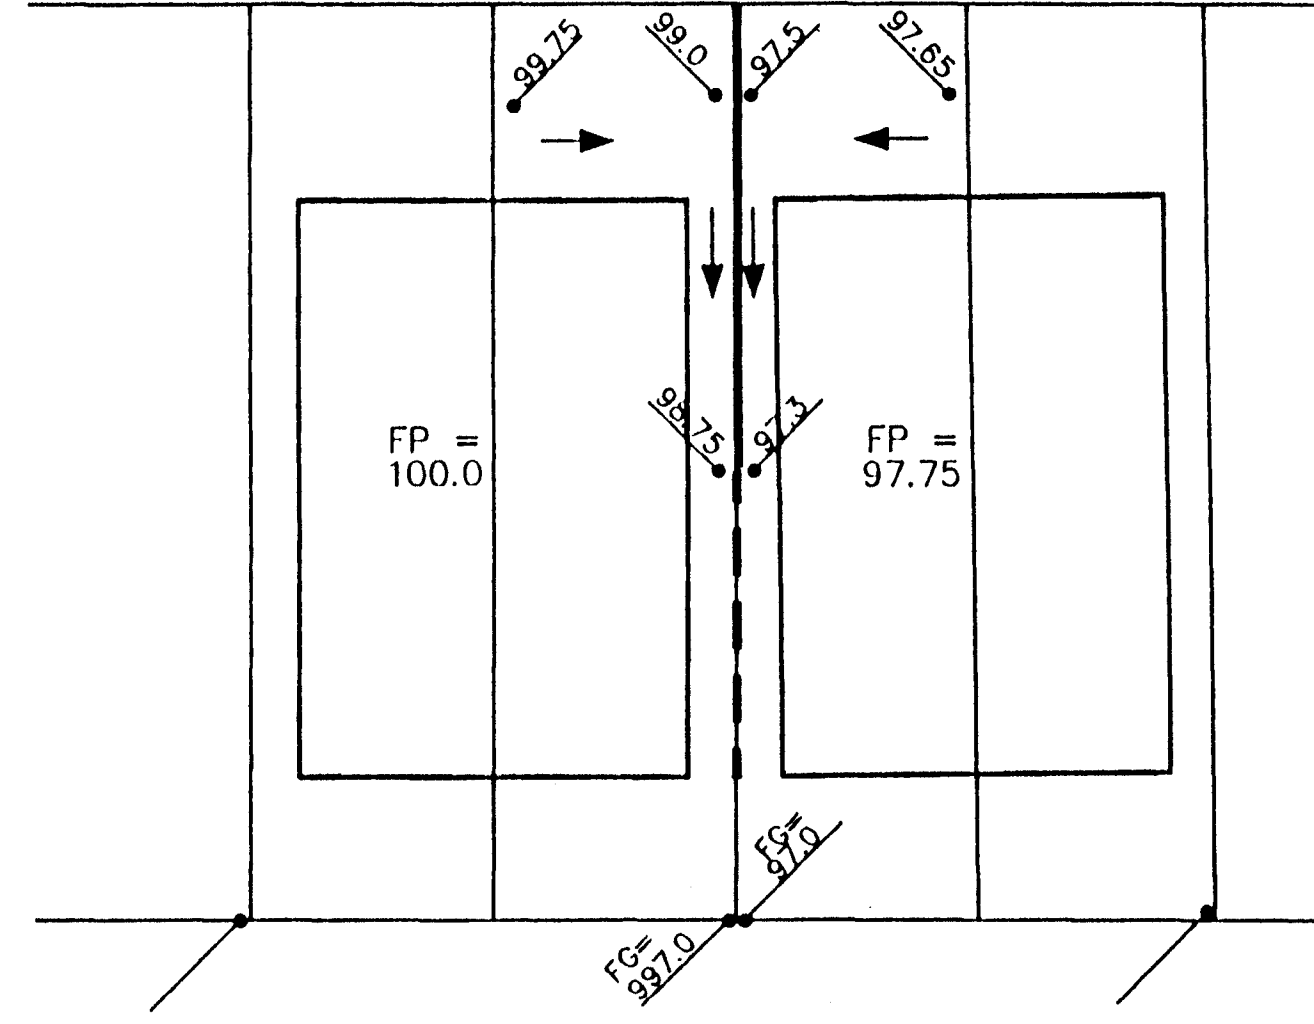





CASE 1

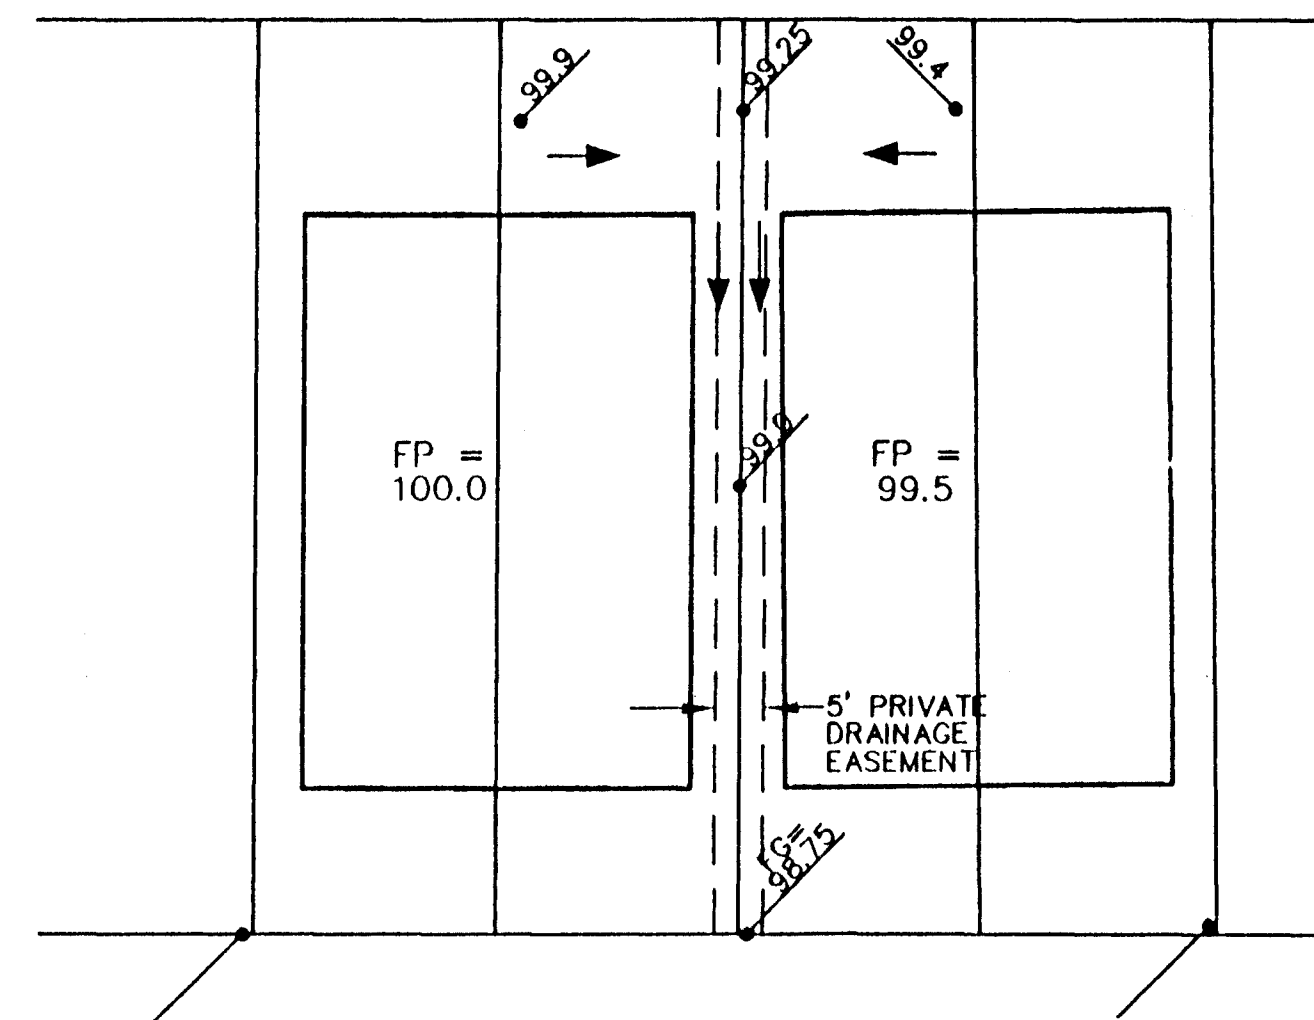

CASE 2

LEGEND

- SPOT ELEVATION
- DIRECTION OF FLOW
- GARDEN WALL
- RETAINING WALL
- HOUSE PAD
- DRAINAGE EASEMENT
- FINISHED PAD ELEVATION
- TOP OF WALL
- BOTTOM OF WALL
- FLOWLINE

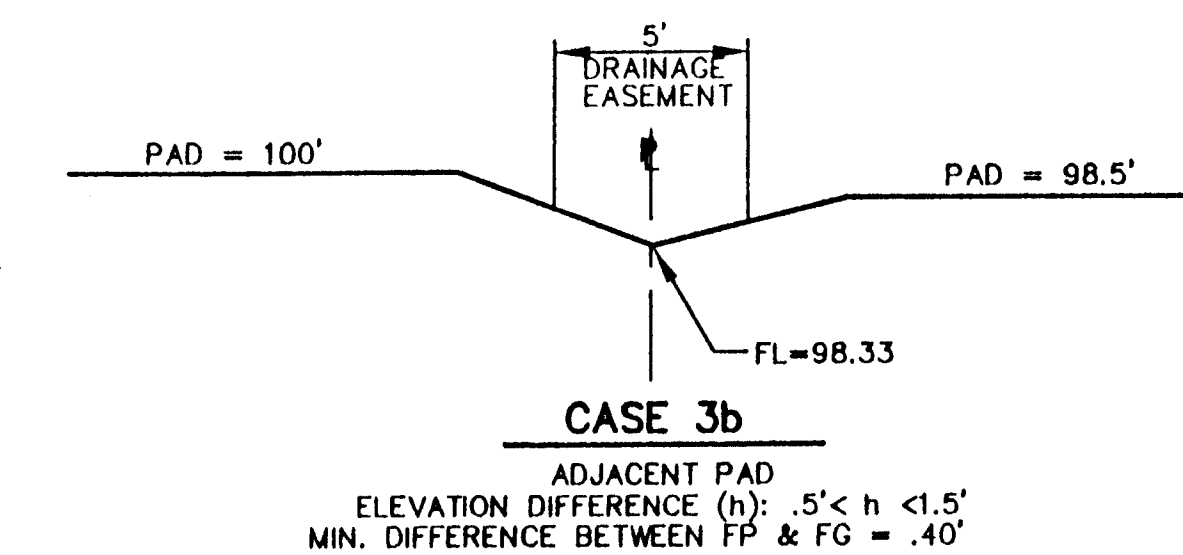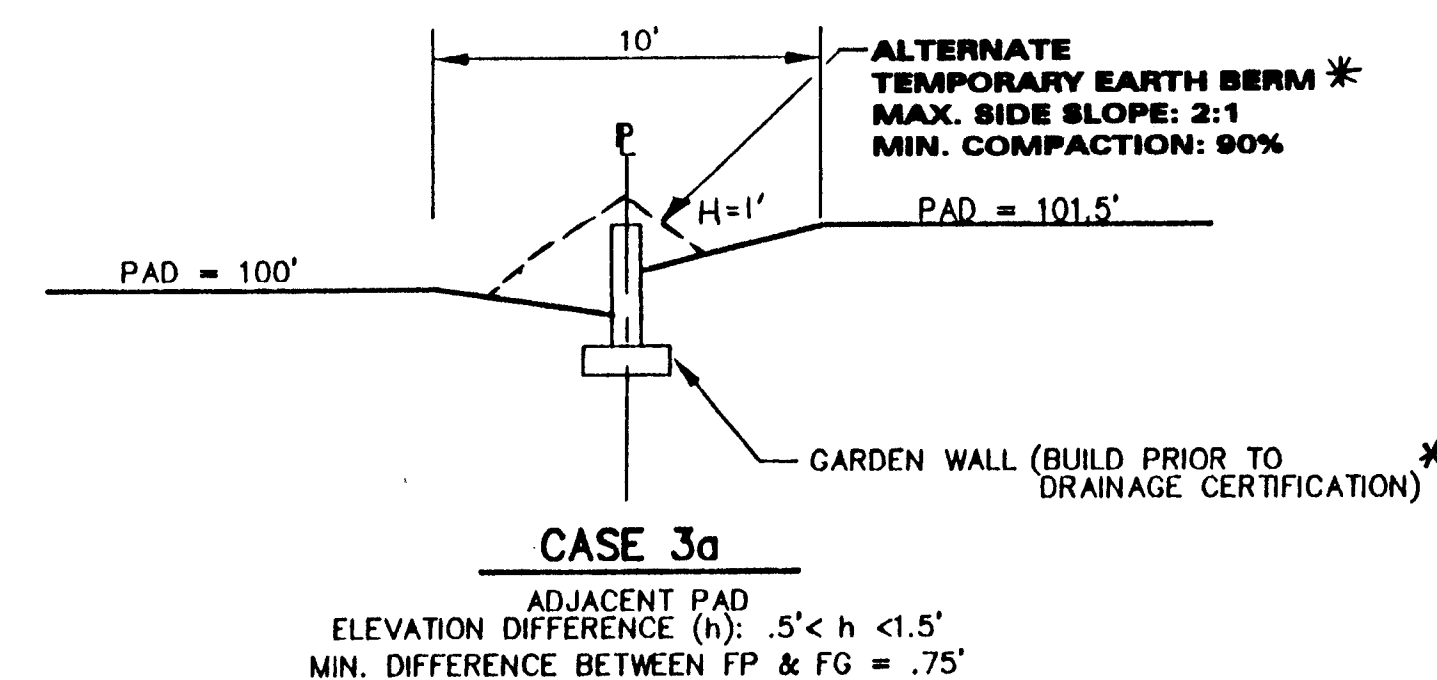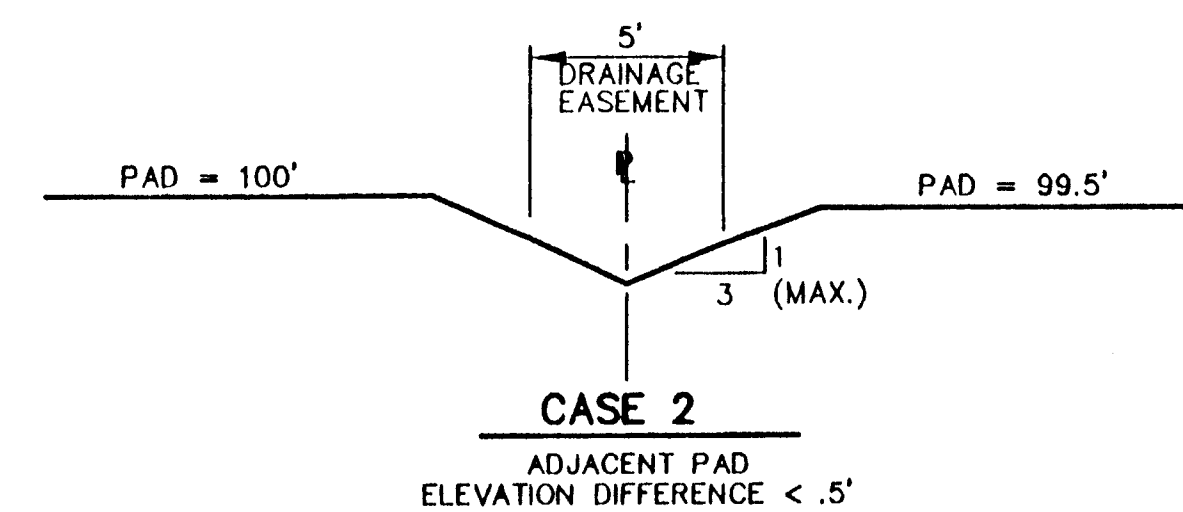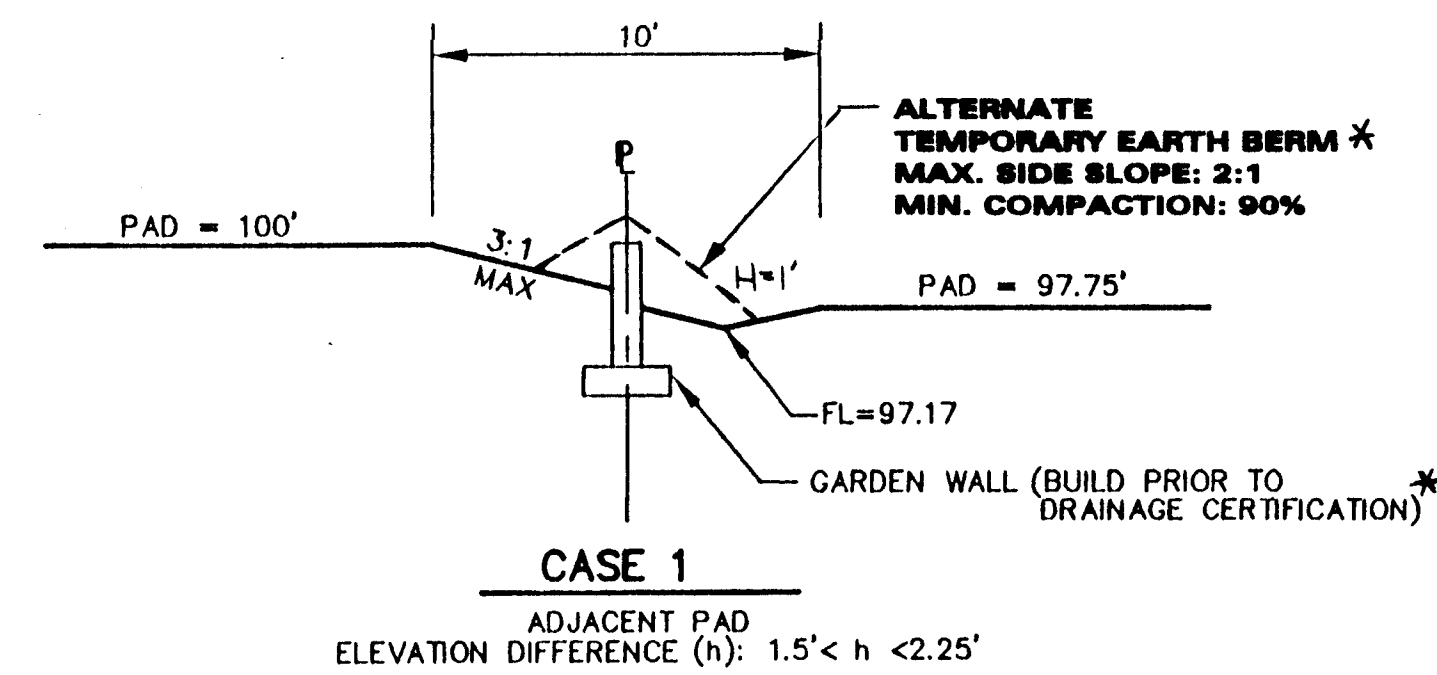

TYPICAL LOT DRAINAGE DETAILS
AT FRONT (STREET SIDE) EDGE OF PAD
FINISHED FLOOR ± .33' ABOVE PAD ELEVATION

* IF TEMPORARY EARTH BERM IS BUILT INSTEAD OF GARDEN WALL, TO FACILITATE CONSTRUCTION, IT MUST BE REPLACED WITH GARDEN WALL BY HOME BUILDER, PRIOR TO OCCUPANCY. THE WALLS SHOWN AS REQUIRED FOR DRAINAGE ARE THE ULTIMATE RESPONSIBILITY OF THE DEVELOPER, DEVELOPMENT SERVICES CO. LTD.

AS-BUILT


Resource Technology, Inc.
ENGINEERS AND ENVIRONMENTAL SCIENTISTS
CIVIL • ENVIRONMENTAL • WATER RESOURCES • RECREATION • PLANNING
1720-B Randolph Rd. SE, Albuquerque, NM 87108
(505) 243-7300

CITY OF ALBUQUERQUE
PUBLIC WORKS DEPARTMENT
ENGINEERING DEVELOPMENT GROUP
TITLE: LA CUEVA OESTE, UNIT 3a, 3b & 3c
ATTACHED DWELLING UNIT
TYPICAL LOT DRAINAGE

APPROVE	City Engineer Approval	Mo./Day/Yr.	Mo./Day/Yr.
JUL 23 1997			
DESIGN REVIEW COMMITTEE			
City Project No. 5232.91	Zone Map No. C-18	5X	2614

AS-BUILT INFORMATION		BENCH MARKS		SURVEY INFORMATION	
CONTRACTOR	ALBU CARPENTRY	NO.	DATE	NO.	DATE
WORK STARTED BY	CDA				
DATE	5-29-98				
FIELD VERIFICATION BY	CDA				
DATE	5-29-98				
FIELD VERIFICATION BY	CDA				
DATE	5-29-98				
RECORDED BY	CDA				
DATE	5-29-98				
MICRO-FILM INFORMATION					
RECORDED BY					
DATE					

EXHIBIT 2E (NEW)

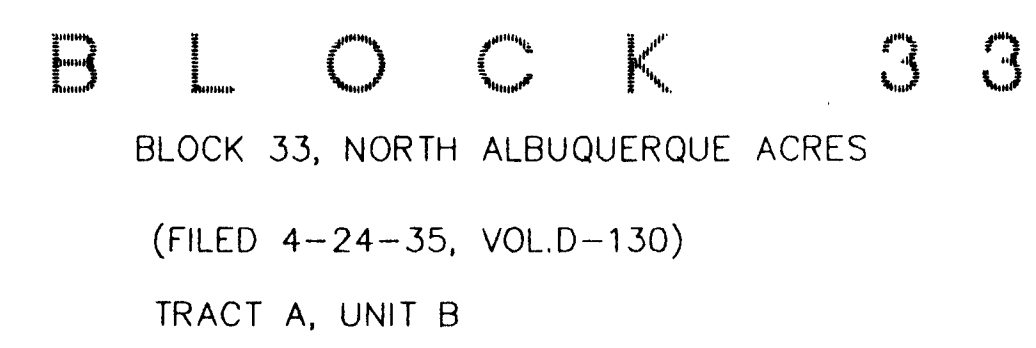


B L O C K 3 4 24-5232, 92 0698

- CROWN TO NO CROWN TRANSITION (50' LEN) PER STD.
-  CONSTRUCTION KEYED NOTES:
- 1 CONSTRUCT P.C.C. SIDEWALK, 4" THICK, TRANSITIONS TO HANDICAP ACCESS RAMPS AND P.C.C. RAMP PER STD. DWG. # 2441, CASE NO. 2. LENGTH OF RAMPS MAY VARY AS NEEDED, SLOPE NOT TO EXCEED 12:1.
 - 2 CONSTRUCT P.C.C. VALLEY GUTTER AND GUTTER AND CURB PER STD. DWG. # 2422, 10' WIDE WITH $3/4"$ INVERT DEPTH.
 - 3 CROWN TO NO CROWN TRANSITION (50' LEN) PER STD. DWG. # 2401.
 - 4 4' WIDE P.C.C. SIDEWALK (NOT IN THIS CONTRACT).
 - 5 CONSTRUCT CONCRETE CUTOFF WALL PER STD. DWG. # 2415.

Tony O. Brown, P.E.
P. O. Box 92051
Albuquerque, NM 87199
(505) 883-8807



TITLE: LA CUEVA OESTE, UNIT 3a
PAVING MASTER PLAN

Design Review Committee 	City Engineer Approval	Last Design Update	Ms./Day/Yr.	Ms./Day/Yr.
City Project No. 5232.92	Zone Map No. C-18-Z	Sheet 6	Of 14	

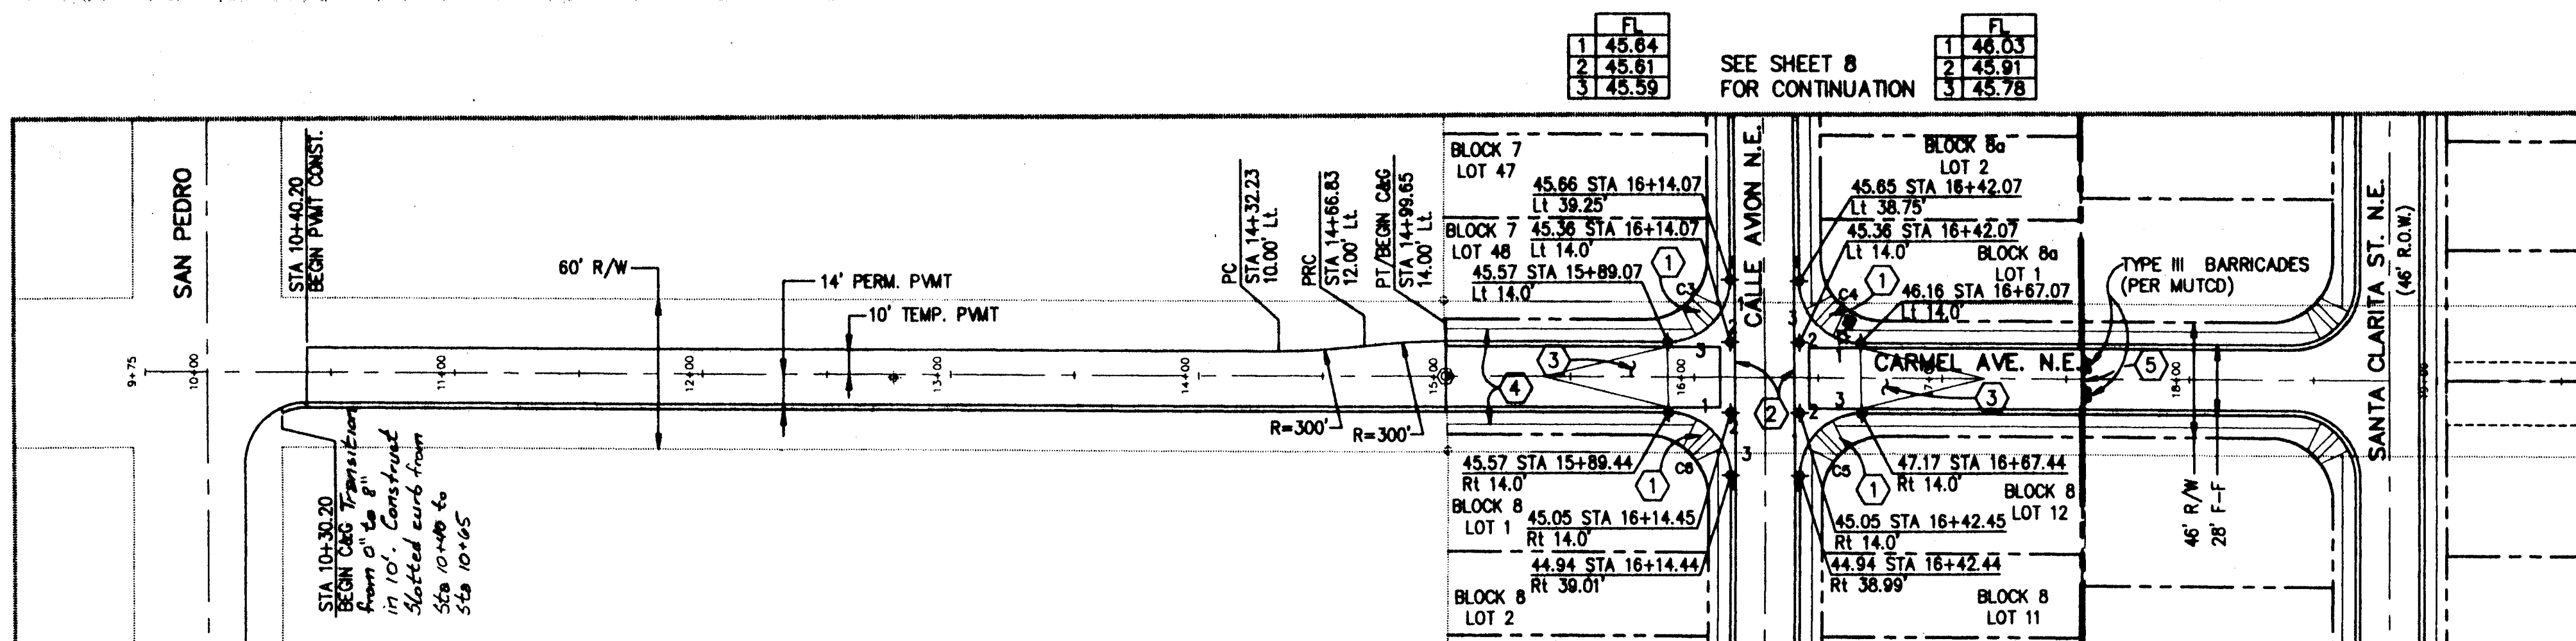

CURVE DATA AT FACE OF CURB						
CURVE	LENGTH	RADIUS	DELTA	TANGENT	CHORD LEN	CHORD DIR
C1	39.52	25.00	90°33'43"	25.25	35.53	S45°03'38"W
C2	39.02	25.00	89°26'17"	24.76	35.18	N44°56'22"E
C3	39.52	25.00	90°33'43"	25.25	35.53	N45°03'38"E
C4	39.02	25.00	89°26'17"	24.76	35.18	S44°56'22"W
C5	39.26	25.00	89°58'35"	24.99	35.35	S45°21'12"W
C6	39.26	25.00	90°01'25"	25.01	35.36	N44°38'48"W
C7	20.84	25.00	44°13'12"	10.97	20.32	N22°26'30"E
C8	25.60	25.00	54°18'53"	13.85	24.65	S26°47'32"E
C9	160.42	35.00	278°32'05"	28.42	43.07	N85°19'04"E

CARMEL AVE.

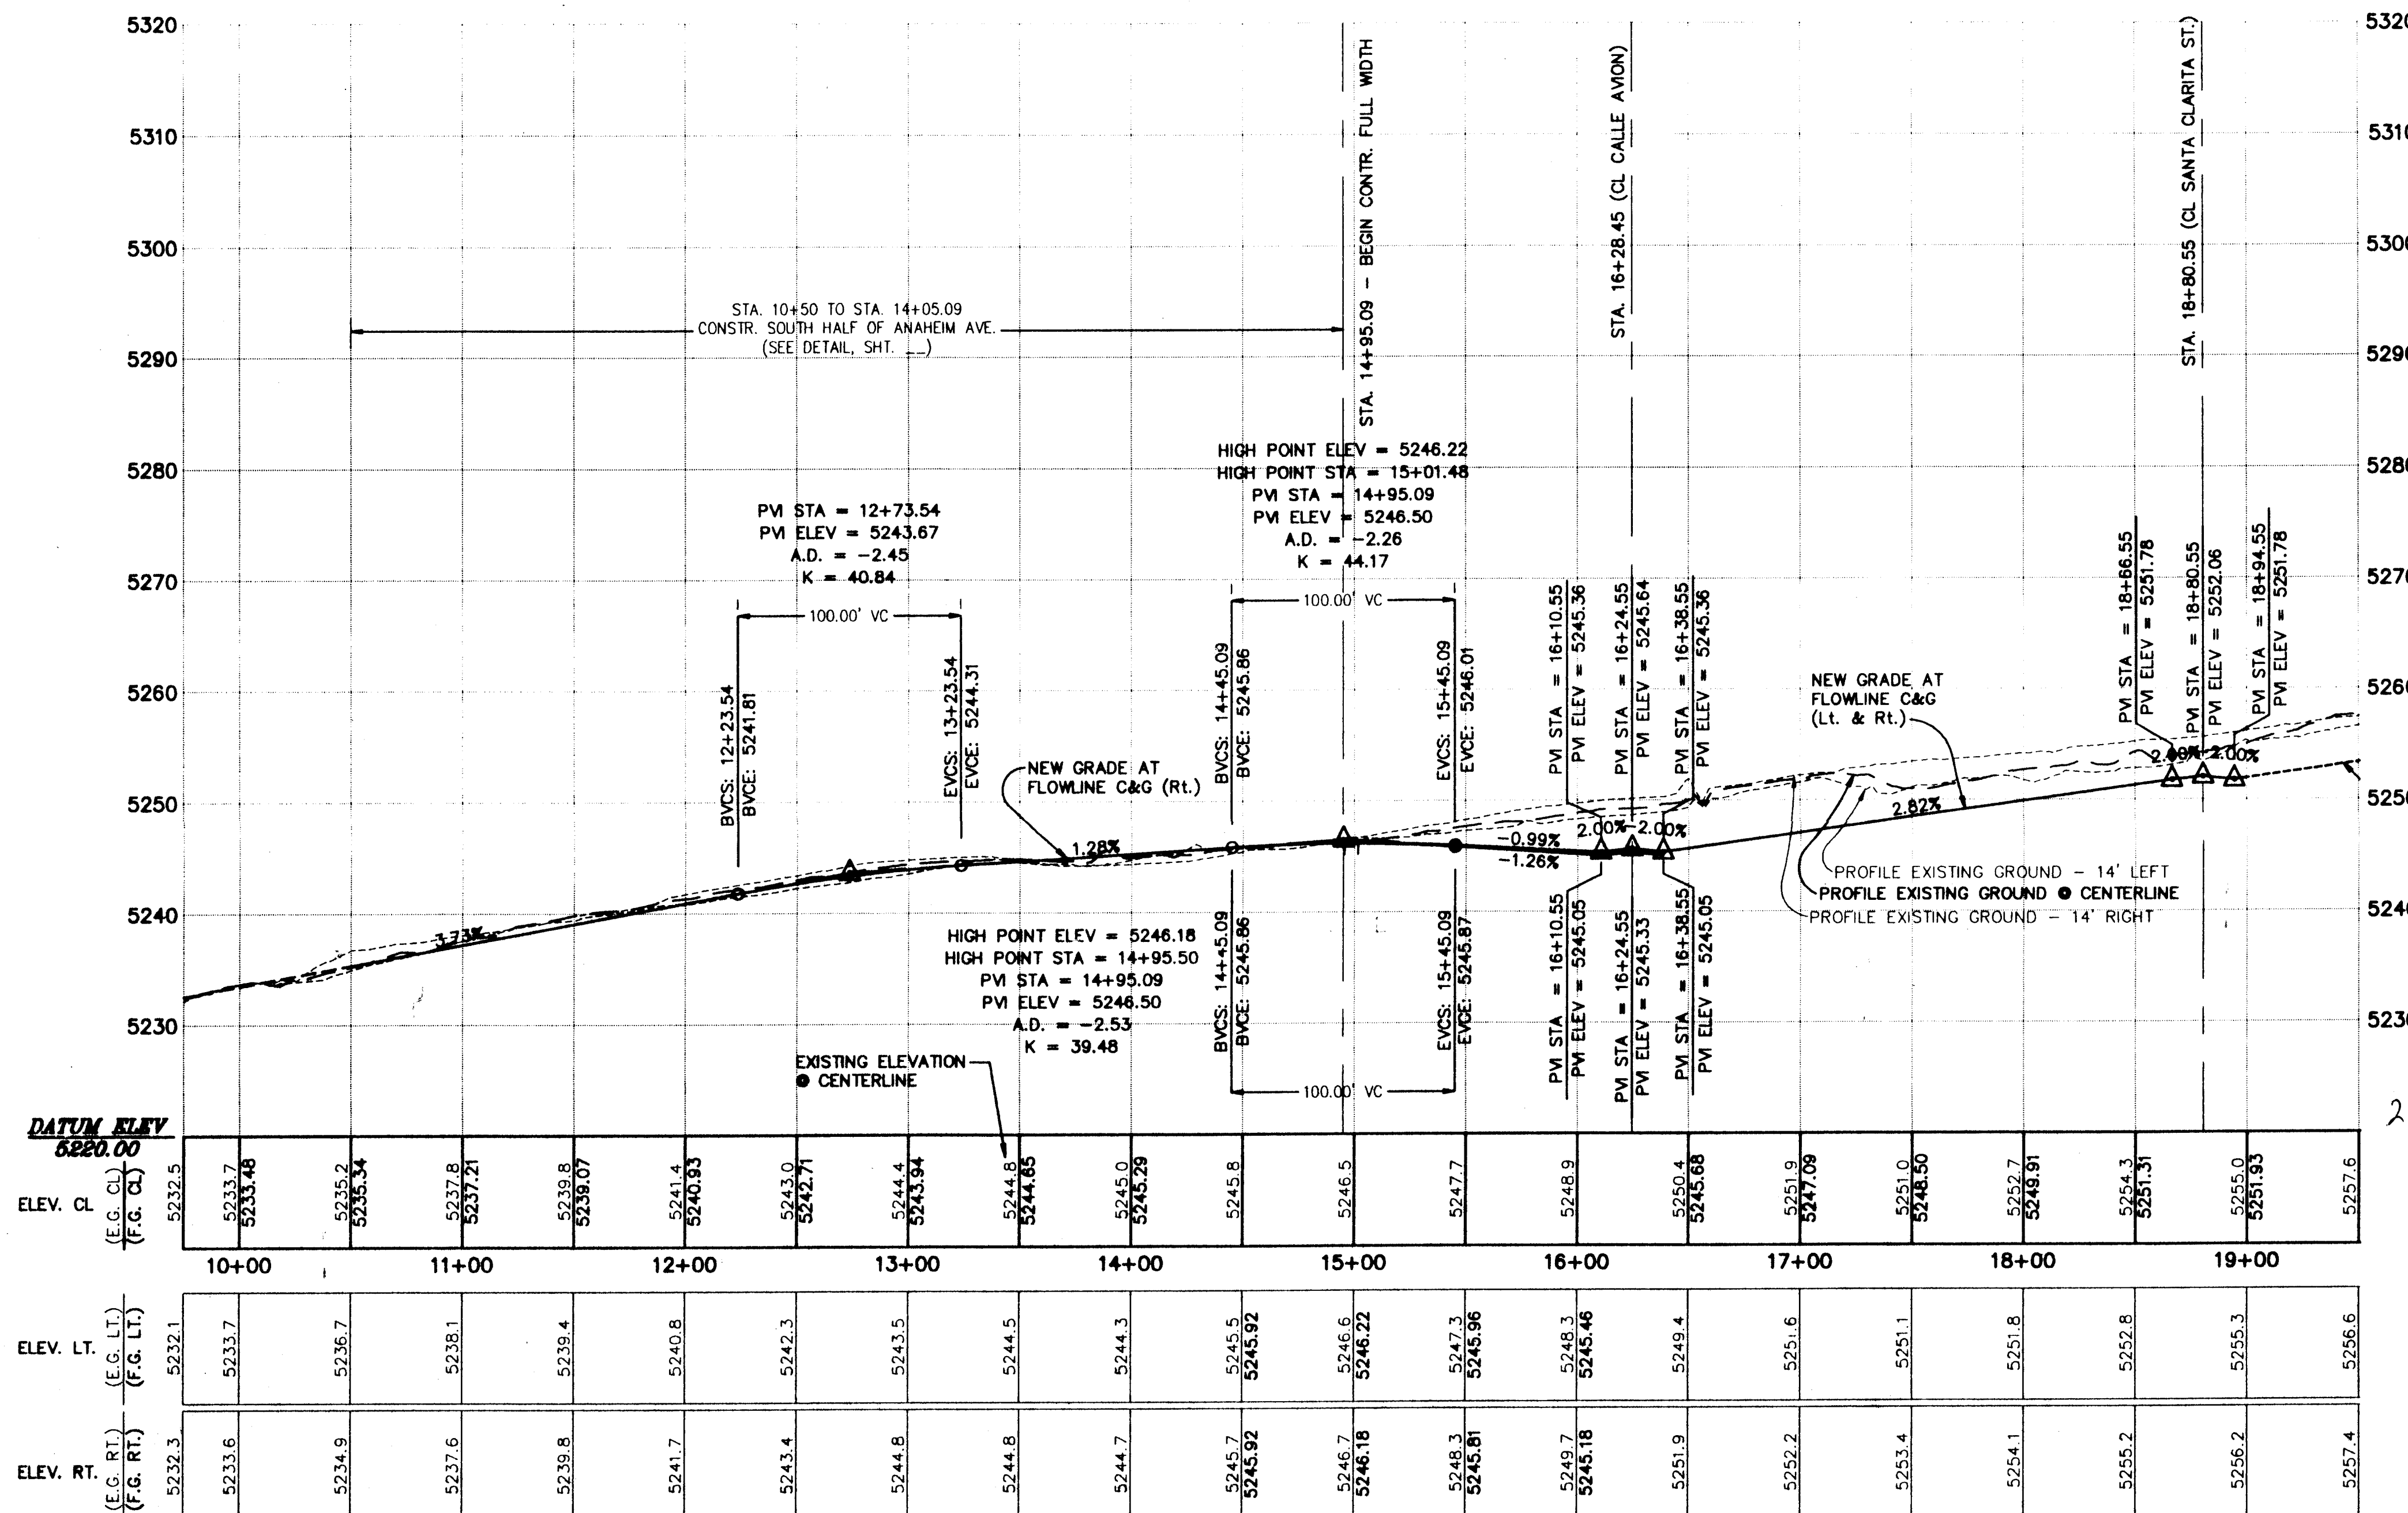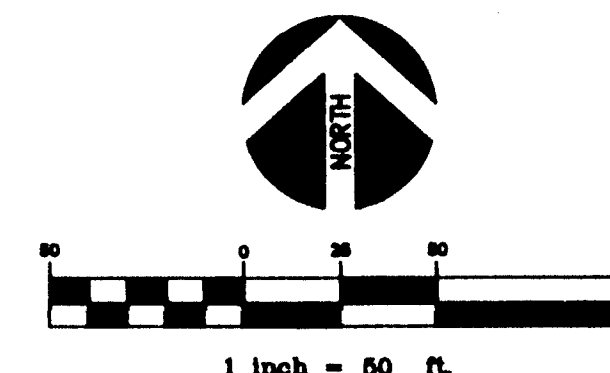

SCALE
HORIZ: 1"=50'
VERT: 1"=10'

NOTES:

- NEW ELEVATIONS SHOWN ARE FLOWLINE OF CURB AND GUTTER UNLESS OTHERWISE NOTED.
- THE FOLLOWING CITY OF ALBUQUERQUE STANDARD DETAIL DRAWINGS APPLY TO THIS SHEET:
 - DWG 2401 - TYP. RES. STREET INTERS.
 - DWG 2405 - RESIDENTIAL STREET SECTION
 - DWG 2415 - CURB AND GUTTER
 - DWG 2418 - MOUNTABLE TO STANDARD CURB TRANSITION
 - DWG 2420 - CONCRETE VALLEY GUTTER
 - DWG 2430 - SIDEWALK DETAILS
 - DWG 2440 - WHEEL CHAIR RAMP
 - DWG 2441 - WHEEL CHAIR RAMP
 - DWG 2250 - REMOVABLE POSTS
- SEE PLAT, SHEETS 2 & 3, FOR RIGHT OF WAY WIDTHS AND STREET CENTERLINE BEARING & DISTANCE INFORMATION.

CONSTRUCTION KEYED NOTES:

- CONSTRUCT P.C.C. SIDEWALK, 4" THICK, TRANSITIONS TO HANDICAP ACCESS RAMPS AND P.C.C. RAMP PER STD. DWG. # 2441. CASE NO. 2.
- CONSTRUCT P.C.C. VALLEY GUTTER AND GUTTER AND CURB PER STD. DWG. # 2420. 16" WIDE WITH 1/2" INVERT DEPTH.
- CROWN TO NO CROWN TRANSITION (50' LEN) PER STD. DWG. # 2401.
- 4" WIDE P.C.C. SIDEWALK (NOT IN THIS CONTRACT).
- CONSTRUCT CONCRETE CUTOFF WALL PER STD. DWG. # 2415.

AS-BUILT

Tom O. Brown, P.E.
P. O. Box 92051
Albuquerque, NM 87199
(505) 883-8807

CITY OF ALBUQUERQUE
PUBLIC WORKS DEPARTMENT
ENGINEERING DEVELOPMENT GROUP

TITLE: LA CUEVA OESTE, UNIT 3a
PAVING PLAN AND PROFILE
CARMEL AVE. (Sta. 9+75 to Sta. 18+80.55)

City Engineer Approval	City Project No.	Zone Map No.	Sheet	Of
	5232.92	C-18-Z	7	14

City Project No. 5232.92 Zone Map No. C-18-Z Sheet 7 Of 14

NOTE: 


STA. 10+00 TO STA. 14+75 (LT. & RT.) - CONSTR. P.C.C. MOUNTABLE ROLL CURB (CITY STD. DWG. #2415).
STA. 14+75 TO STA. 14+80 (LT. & RT.) - TRANSITION FROM MOUNTABLE ROLL CURB TO STD. C&G (CITY STD. DWG. #2415).

STA. 15+67.93 TO STA. 15+75 (LT. & RT.) - TRANSITION FROM P.C.C. STD. C&G TO MOUNTABLE ROLL CURB.
STA. 15+75 TO STA. 18+54 (LT. & RT.) - CONSTR. P.C.C. MOUNTABLE ROLL CURB (CITY STD. DWG. #2415).
STA. 18+54 TO STA. 18+61 (LT. & RT.) - TRANSITION FROM MOUNTABLE ROLL CURB TO STD. C&G (CITY STD. DWG. #2415).

ALL CURB AND GUTTER ON CARMEL AVE. SHALL BE P.C.C. STD. C&G (CITY STD. DWG. #2415).

CURVE DATA AT FACE OF CURB						
CURVE	LENGTH	RADIUS	DELTA	TANGENT	CHORD LEN	CHORD DIR
C1	39.52	25.00	90°33'43"	25.25	35.53	S45°03'38"V
C2	39.02	25.00	89°26'17"	24.76	35.18	N44°56'22"V
C3	39.52	25.00	90°33'43"	25.25	35.53	N45°03'38"E
C4	39.02	25.00	89°26'17"	24.76	35.18	S44°56'22"E
C5	39.26	25.00	89°58'35"	24.99	35.35	S45°21'12"V
C6	39.28	25.00	90°01'25"	25.01	35.36	N44°38'48"V
C7	20.84	25.00	44°13'12"	10.97	20.32	N22°28'30"E
C8	25.60	25.00	54°18'53"	13.85	24.65	S26°47'32"E
C9	160.42	35.00	278°32'05"	28.42	43.07	N65°19'04"E

CALLE AVION N.E.

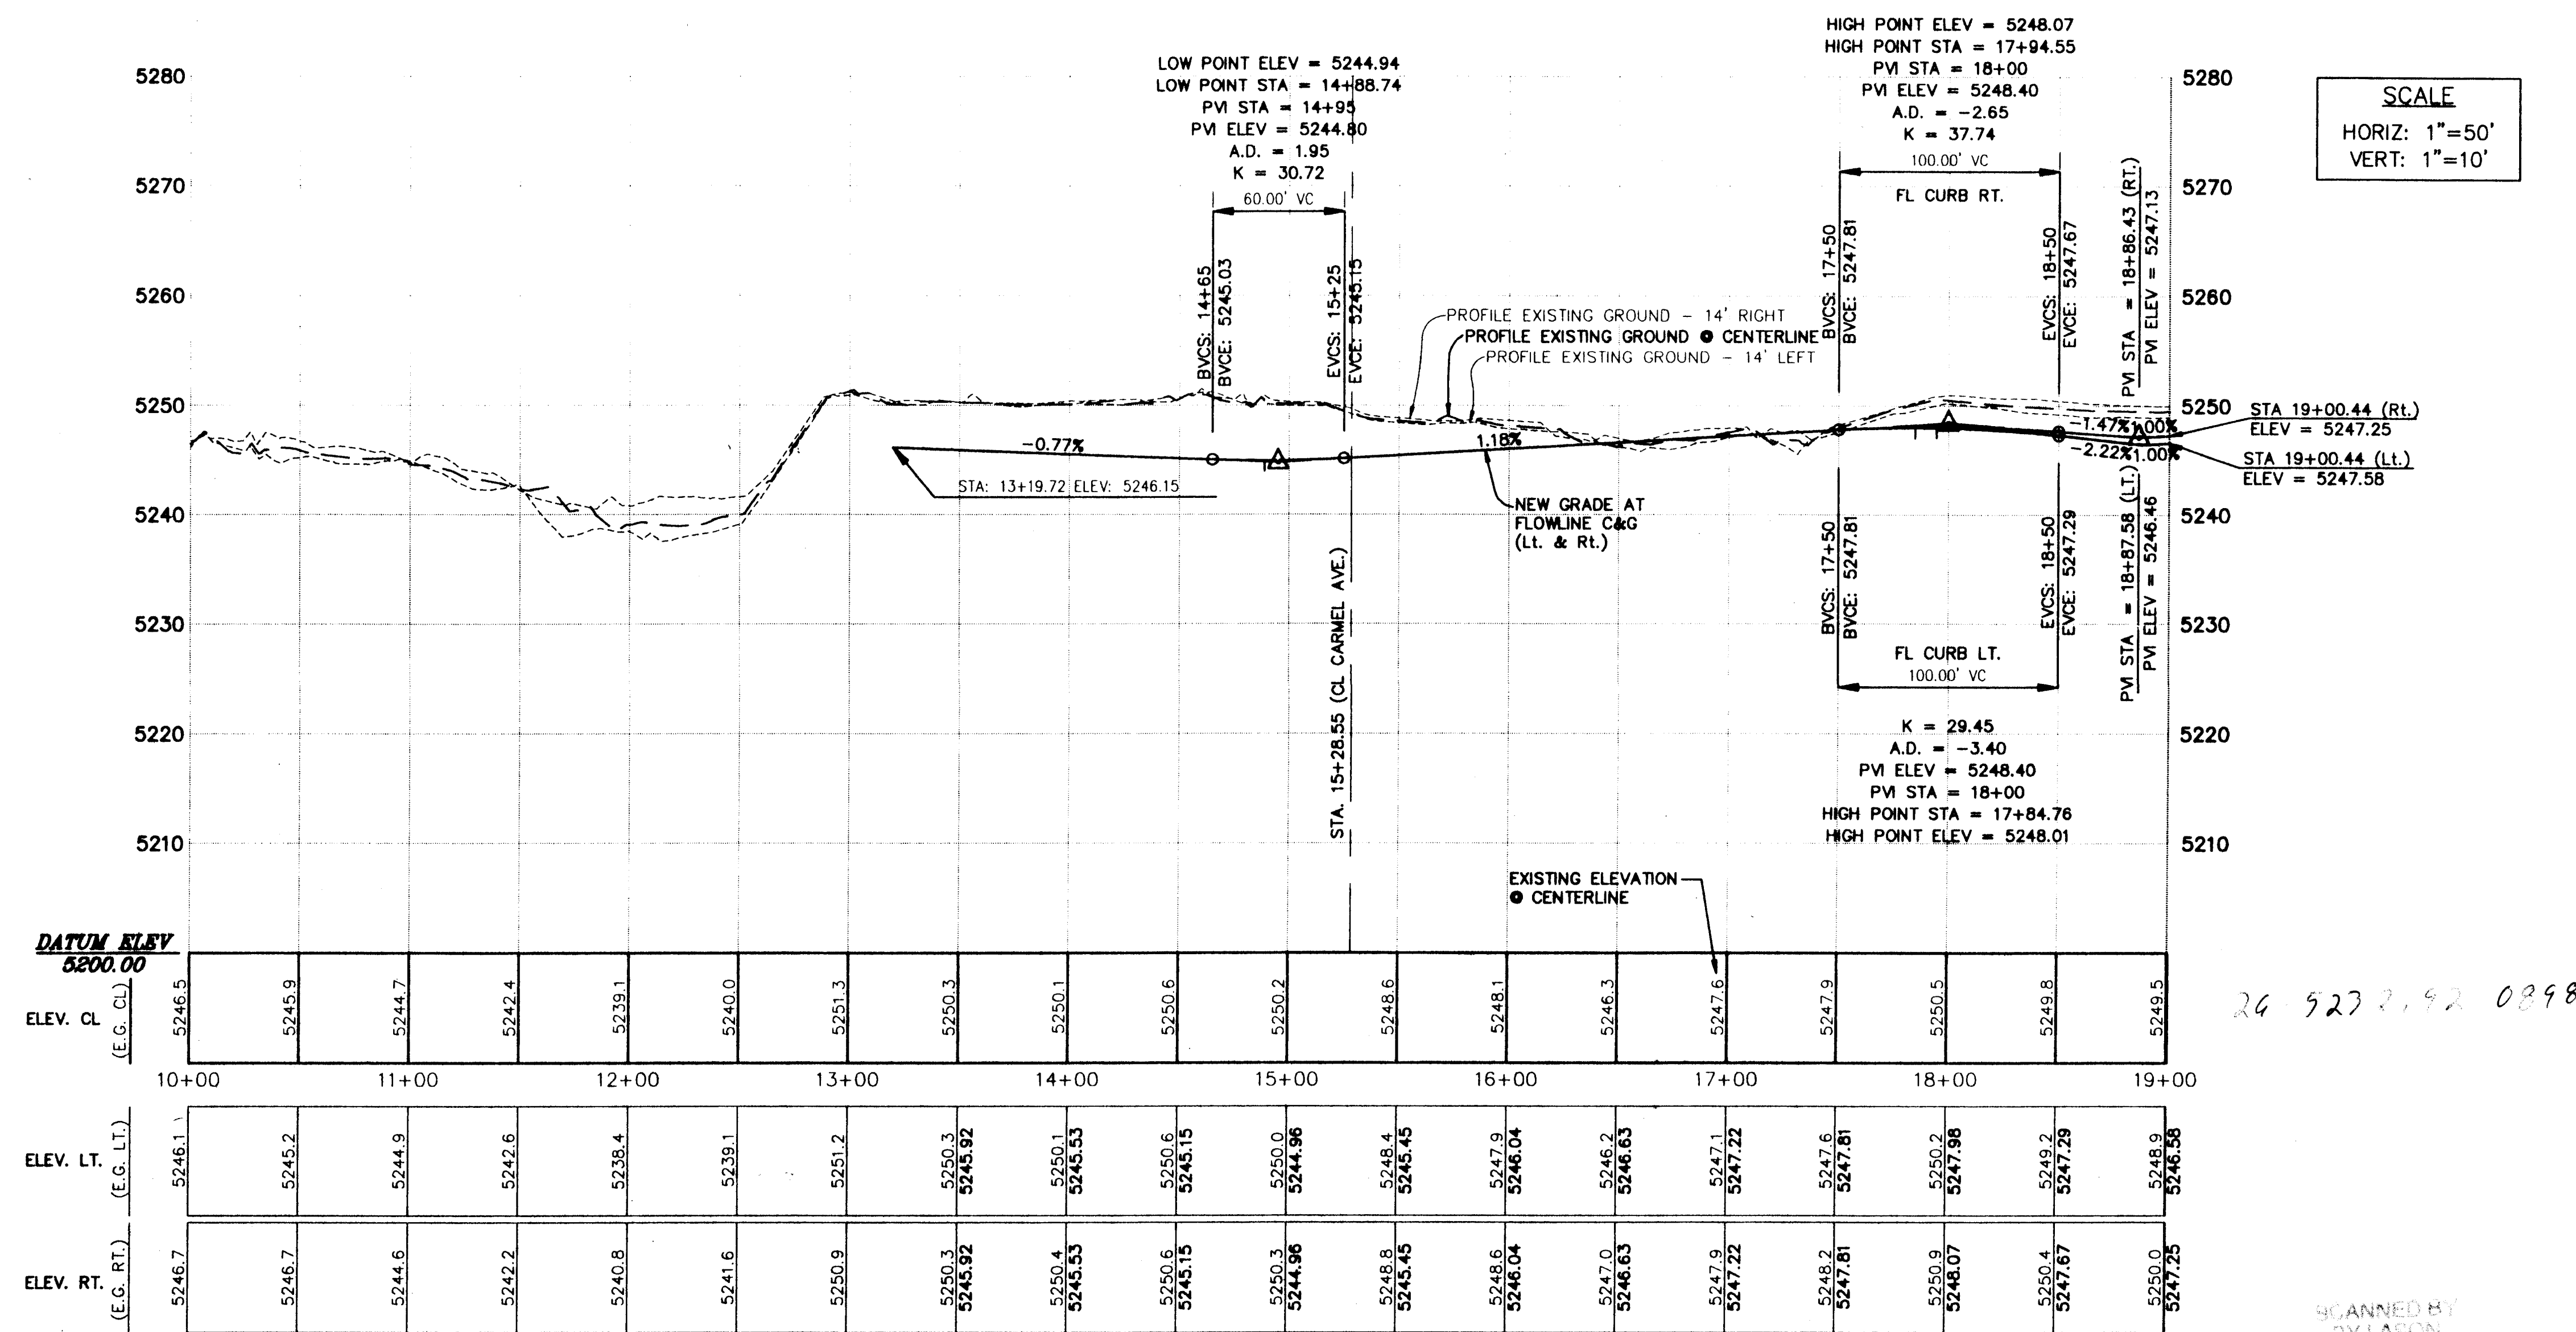

NOTES:

- NEW ELEVATIONS SHOWN ARE FLOWLINE OF CURB AND GUTTER UNLESS OTHERWISE NOTED.
- THE FOLLOWING CITY OF ALBUQUERQUE STANDARD DETAIL DRAWINGS APPLY TO THIS SHEET:
DWG 2401 - TYP. RES. STREET INTERS.
DWG 2405 - RESIDENTIAL STREET SECTION
DWG 2415 - CURB AND GUTTER
DWG 2418 - MOUNTABLE TO STANDARD CURB TRANSITION
DWG 2420 - CONCRETE VALLEY GUTTER
DWG 2430 - SIDEWALK DETAILS
DWG 2440 - WHEEL CHAIR RAMP
DWG 2441 - WHEEL CHAIR RAMP
DWG 2250 - REMOVABLE POSTS
- SEE PLAT, SHEETS 2 & 3, FOR RIGHT OF WAY WIDTHS AND STREET CENTERLINE BEARING & DISTANCE INFORMATION.

CONSTRUCTION KEYED NOTES:

- CONSTRUCT P.C.C. SIDEWALK, 4" THICK, TRANSITIONS TO HANDICAP ACCESS RAMPS AND P.C.C. RAMP PER STD. DWG. # 2441. CASE NO. 2.
- CONSTRUCT P.C.C. VALLEY GUTTER AND GUTTER AND CURB PER STD. DWG. # 2420. 10' WIDE WITH 1/2" INVERT DEPTH.
- CROWN TO NO CROWN TRANSITION (50' LEN) PER STD. DWG. # 2401.
- 4' WIDE P.C.C. SIDEWALK (NOT IN THIS CONTRACT).
- CONSTRUCT CONCRETE CUTOFF WALL PER STD. DWG. # 2415.

AS-BUILT

Tony O. Brown, P.E.

P. O. Box 92051
Albuquerque, NM 87199
(505) 883-8807

CITY OF ALBUQUERQUE PUBLIC WORKS DEPARTMENT ENGINEERING DEVELOPMENT GROUP	
TITLE: LA CUEVA OESTE, UNIT 3a PAVING PLAN AND PROFILE CALLE AVION N.E. (Sta. 13+19.71 to Sta. 19+00.44)	
City Engineer Approval	City Project No. 5232.92
Zone Map No. C-18-Z	Sheet 8 of 14

SANITARY SEWER SERVICE TABLE - LA CUEVA OESTE, UNIT 3a						
Block 7						
Lot No.	Street	SAS Serv Sta.	Offset to PL	Elev. FL Curb	Elev. SAS	Inv. @ PL
40	CALLE AVION N.E.	18+38.85	23' Lt.	5247.81		5243.81
41	CALLE AVION N.E.	18+04.85	23' Lt.	5248.06		5244.06
42	CALLE AVION N.E.	17+70.85	23' Lt.	5248.00		5244.00
43	CALLE AVION N.E.	17+36.85	23' Lt.	5247.65		5243.65
44	CALLE AVION N.E.	17+02.85	23' Lt.	5247.25		5243.25
45	CALLE AVION N.E.	16+68.85	23' Lt.	5246.85		5242.85
46	CALLE AVION N.E.	16+34.85	23' Lt.	5246.45		5242.45
47	CALLE AVION N.E.	16+00.85	23' Lt.	5246.05		5242.05
48	CALLE AVION N.E.	15+74.60	23.08' Lt.	5245.74		5241.74
Block 8						
Lot No.	Street	SAS Serv Sta.	Offset to PL	Elev. FL Curb	Elev. SAS	Inv. @ PL
1	CALLE AVION N.E.	14+79.05	23' Lt.	5244.96		5240.96
2	CALLE AVION N.E.	14+47.05	23' Lt.	5245.17		5241.17
3	CALLE AVION N.E.	14+13.05	23' Lt.	5245.43		5241.43
4	CALLE AVION N.E.	13+79.05	23' Lt.	5245.70		5241.70
5	CALLE AVION N.E.	13+45.05	27.07' Lt.	5245.96		5241.96
6	CALLE AVION N.E.	n/a	31.11' Lt.	5246.30		5242.30
7	CALLE AVION N.E.	n/a	39.12' Rt.	5246.30		5242.30
8	CALLE AVION N.E.	13+48.05	32.20' Rt.	5245.94		5241.94
9	CALLE AVION N.E.	13+82.05	23' Rt.	5245.67		5241.67
10	CALLE AVION N.E.	14+16.05	23' Rt.	5245.41		5241.41
11	CALLE AVION N.E.	14+50.05	23' Rt.	5245.15		5241.15
12	CALLE AVION N.E.	14+82.05	23' Rt.	5244.95		5240.95
Block 9a						
Lot No.	Street	SAS Serv Sta.	Offset to PL	Elev. FL Curb	Elev. SAS	Inv. @ PL
1	CALLE AVION N.E.	15+77.60	23' Rt.	5245.77		5241.77
2	CALLE AVION N.E.	16+03.85	23' Rt.	5246.08		5242.08
3	CALLE AVION N.E.	16+37.85	23' Rt.	5246.49		5242.49
4	CALLE AVION N.E.	16+71.85	23' Rt.	5246.89		5242.89
5	CALLE AVION N.E.	17+05.85	23' Rt.	5247.29		5243.29
6	CALLE AVION N.E.	17+39.85	23' Rt.	5247.69		5243.69
7	CALLE AVION N.E.	17+73.85	23' Rt.	5248.02		5244.02
8	CALLE AVION N.E.	18+07.85	23' Rt.	5248.05		5244.05
9	CALLE AVION N.E.	18+41.85	23' Rt.	5247.77		5243.77

RESTRAINED JOINT LENGTHS L _r FOR TEES, (F.T.)				
ALL JOINTS AT THE TEE MUST BE RESTRAINED.				
SIZE	MINIMUM RUN LENGTH		MINIMUM RUN LENGTH	
	RUN	BRANCH	RUN	BRANCH
12x12x12	15	17	18	3
12x12x10	10	18	13	1
12x12x8	6	19	8	5
12x12x6	3	19	5	1
12x12x4	1	19	2	6
10x10x10	12	18	15	5
10x10x8	8	15	10	4
10x10x6	4	16	6	1
10x10x4	2	4	3	1
8x8x8	9	20	13	3
8x8x6	5	17	7	5
8x8x4	2	15	3	7
6x6x6	6	20	10	2
6x6x4	2	20	4	7

DEPTH OF BURY	3.0 FT. MINIMUM
FACTORIAL OF SAFETY	1.25
MATERIAL	PVC PIPE
SOIL TYPE	GM/GM - SILTY GRAVELS & SILTY SANDS, GRAVEL-SAND-SILT MIXTURES.
TEST PRESSURE	150 PSI
TRENCH TYPE 4	PIPE BEDDED IN SAND, GRAVEL, OR CRUSHED STONE TO DEPTH OF 1/8 PIPE DIAMETER, 4 INCH MINIMUM; BACKFILL COMPACTED TO TOP OF PIPE

<u>LEGEND</u>	
NEW CURB & GUTTER	
NEW SAS MAINLINE	
NEW SAS SERVICE LINE	
NEW SAS MANHOLE	
NEW WATER MAINLINE	
NEW WATER SERVICE LINE	
NEW GATE VALVE	
NEW FIRE HYDRANT	
NEW STREET LIGHT	
NEW VALLEY GUTTER	


1. CONSTRUCT 4" TYPE "C" MANHOLES PER STD. DWG. # 2101.
2. CONSTRUCT SAS SERVICE LINES PER STD. DWG. # 2125.
3. CONSTRUCT ALL CONCRETE BLOCKING PER STD. DWG. # 2320.
4. CONSTRUCT ALL VALVE BOXES PER NEW C.O.A. VALVE BOX DETAIL WITH NON-TAPERED CONCRETE COLLAR.
5. CONSTRUCT ALL FIRE HYDRANTS PER DESIGNATED DEPTHS AND LENGTHS PER STD. DWG. # 2340.
6. CONSTRUCT ALL SINGLE AND DOUBLE WATER SERVICE LINES PER STD. DWG. # 2361, 2362 AND 2363.
- *7. RESTRAINT DISTANCES FOR PIPE FITTINGS SHALL BE DEFINED BY TABLE ON THIS SHEET.
8. ALL WATERLINES SHALL BE C-900 PVC UNLESS OTHERWISE NOTED.
9. CONTRACTOR SHALL SUPPORT ALL EXISTING UNDERGROUND UTILITY LINES WHICH BECOME EXPOSED DURING CONSTRUCTION. PAYMENT FOR SUPPORTING WORK SHALL BE INCIDENTAL TO WATERLINE AND/OR SEWER LINE COSTS.
10. PROPOSED WATERLINE MATERIALS SHALL BE EITHER P.V.C. PIPE MEETING AWWA C-900 REQUIREMENTS (6"-12" DIA.) OR DUCTILE IRON PIPE, THICKNESS CLASS 50 (6"-16" DIA.).
11. EXISTING CURB AND GUTTER NOT CALLED OUT TO BE REMOVED UNDER THE CONTRACT WHICH IS DAMAGED OR DISPLACED BY THE CONTRACTOR SHALL BE REMOVED AND REPLACED BY THE CONTRACTOR AT HIS OWN EXPENSE.
12. THE CONTRACTOR SHALL SUPPORT AND MAINTAIN THE INTEGRITY OF ALL UTILITIES AT NO ADDITIONAL COST TO THE OWNER. ANY UTILITY RELOCATION THAT IS NECESSARY IS TO BE COORDINATED WITH THE UTILITY OWNER AND SHALL BE PAID FOR AS OUTLINED IN THE SPECIAL PROVISIONS OF THE CONTRACT DOCUMENTS.
13. SAS SERVICE INV. AT PROPERTY LINE SHALL BE 4' MIN. BELOW FLOWLINE OF CURB. SAS SERVICES AT IDENTICAL STATIONS SHALL BE OFFSET 1.5' NORTH & SOUTH (OR EAST & WEST) AT THE TIE INTO MAIN
14. SEE THIS SHEET FOR SAS AND WATER SERVICE INFORMATION.
15. PNM (PUBLIC SERVICE CO. OF NEW MEXICO) WILL PROVIDE AT NO COST TO THE CITY OR TO THE CONTRACTOR THE REQUIRED PERSONNEL FOR INSPECTION OR OBSERVATION DEEMED NECESSARY BY PNM WHEN THE CONTRACTOR IS EXPOSING PNM'S CABLES. HOWEVER, THE CONTRACTOR SHALL BE OBLIGATED TO THE TOTAL COST ASSOCIATED WITH REPAIRS TO ANY DAMAGED CABLES OR FOR ANY COST ASSOCIATED WITH SUPPORTING OR RELOCATING THE POLES AND CABLES DURING CONSTRUCTION.


RESTRAINED JOINT LENGTHS L_r FOR HORIZONTAL BENDS, VALVES, AND DEAD ENDS, (FT.)					
SIZE	HORIZONTAL BENDS				VALVES & DEAD ENDS
	90°	45°	22-1/2°	11-1/4°	
12	30	12	6	3	85
10	26	11	5	3	72
8	22	9	4	2	60
6	17	7	3	2	46
4	12	5	2	1	32

RESTRAINED JOINT LENGTHS, L _r , FOR REDUCERS, (FT.) MINIMUM, UNOBSTRUCTED, STRAIGHT-RUN LENGTH: RESTRAIN EITHER LARGE PIPE, OR SMALL PIPE.						
SIZE	LARGE SIDE	SMALL SIDE	SIZE	LARGE SIDE	SMALL SIDE	
12 x 10	25	30	10 x 6	44	73	
12 x 8	45	68	10 x 4	58	141	
12 x 6	62	121	8 x 6	25	33	
12 x 4	74	213	8 x 4	43	83	
10 x 8	24	30	6 x 4	24	35	


AS-BUILT

CITY OF ALBUQUERQUE
PUBLIC WORKS DEPARTMENT
ENGINEERING DEVELOPMENT GROUP

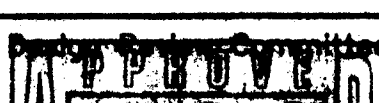
	City Engineer Approval		Last Design Update 	Mo./Day/Yr.	Mo./Day/Yr.
DESIGN REVIEW COMMITTEE	City Project No.	Zone Map No.	Sheet	Of	
	5232 92	C-18-N	9	14	

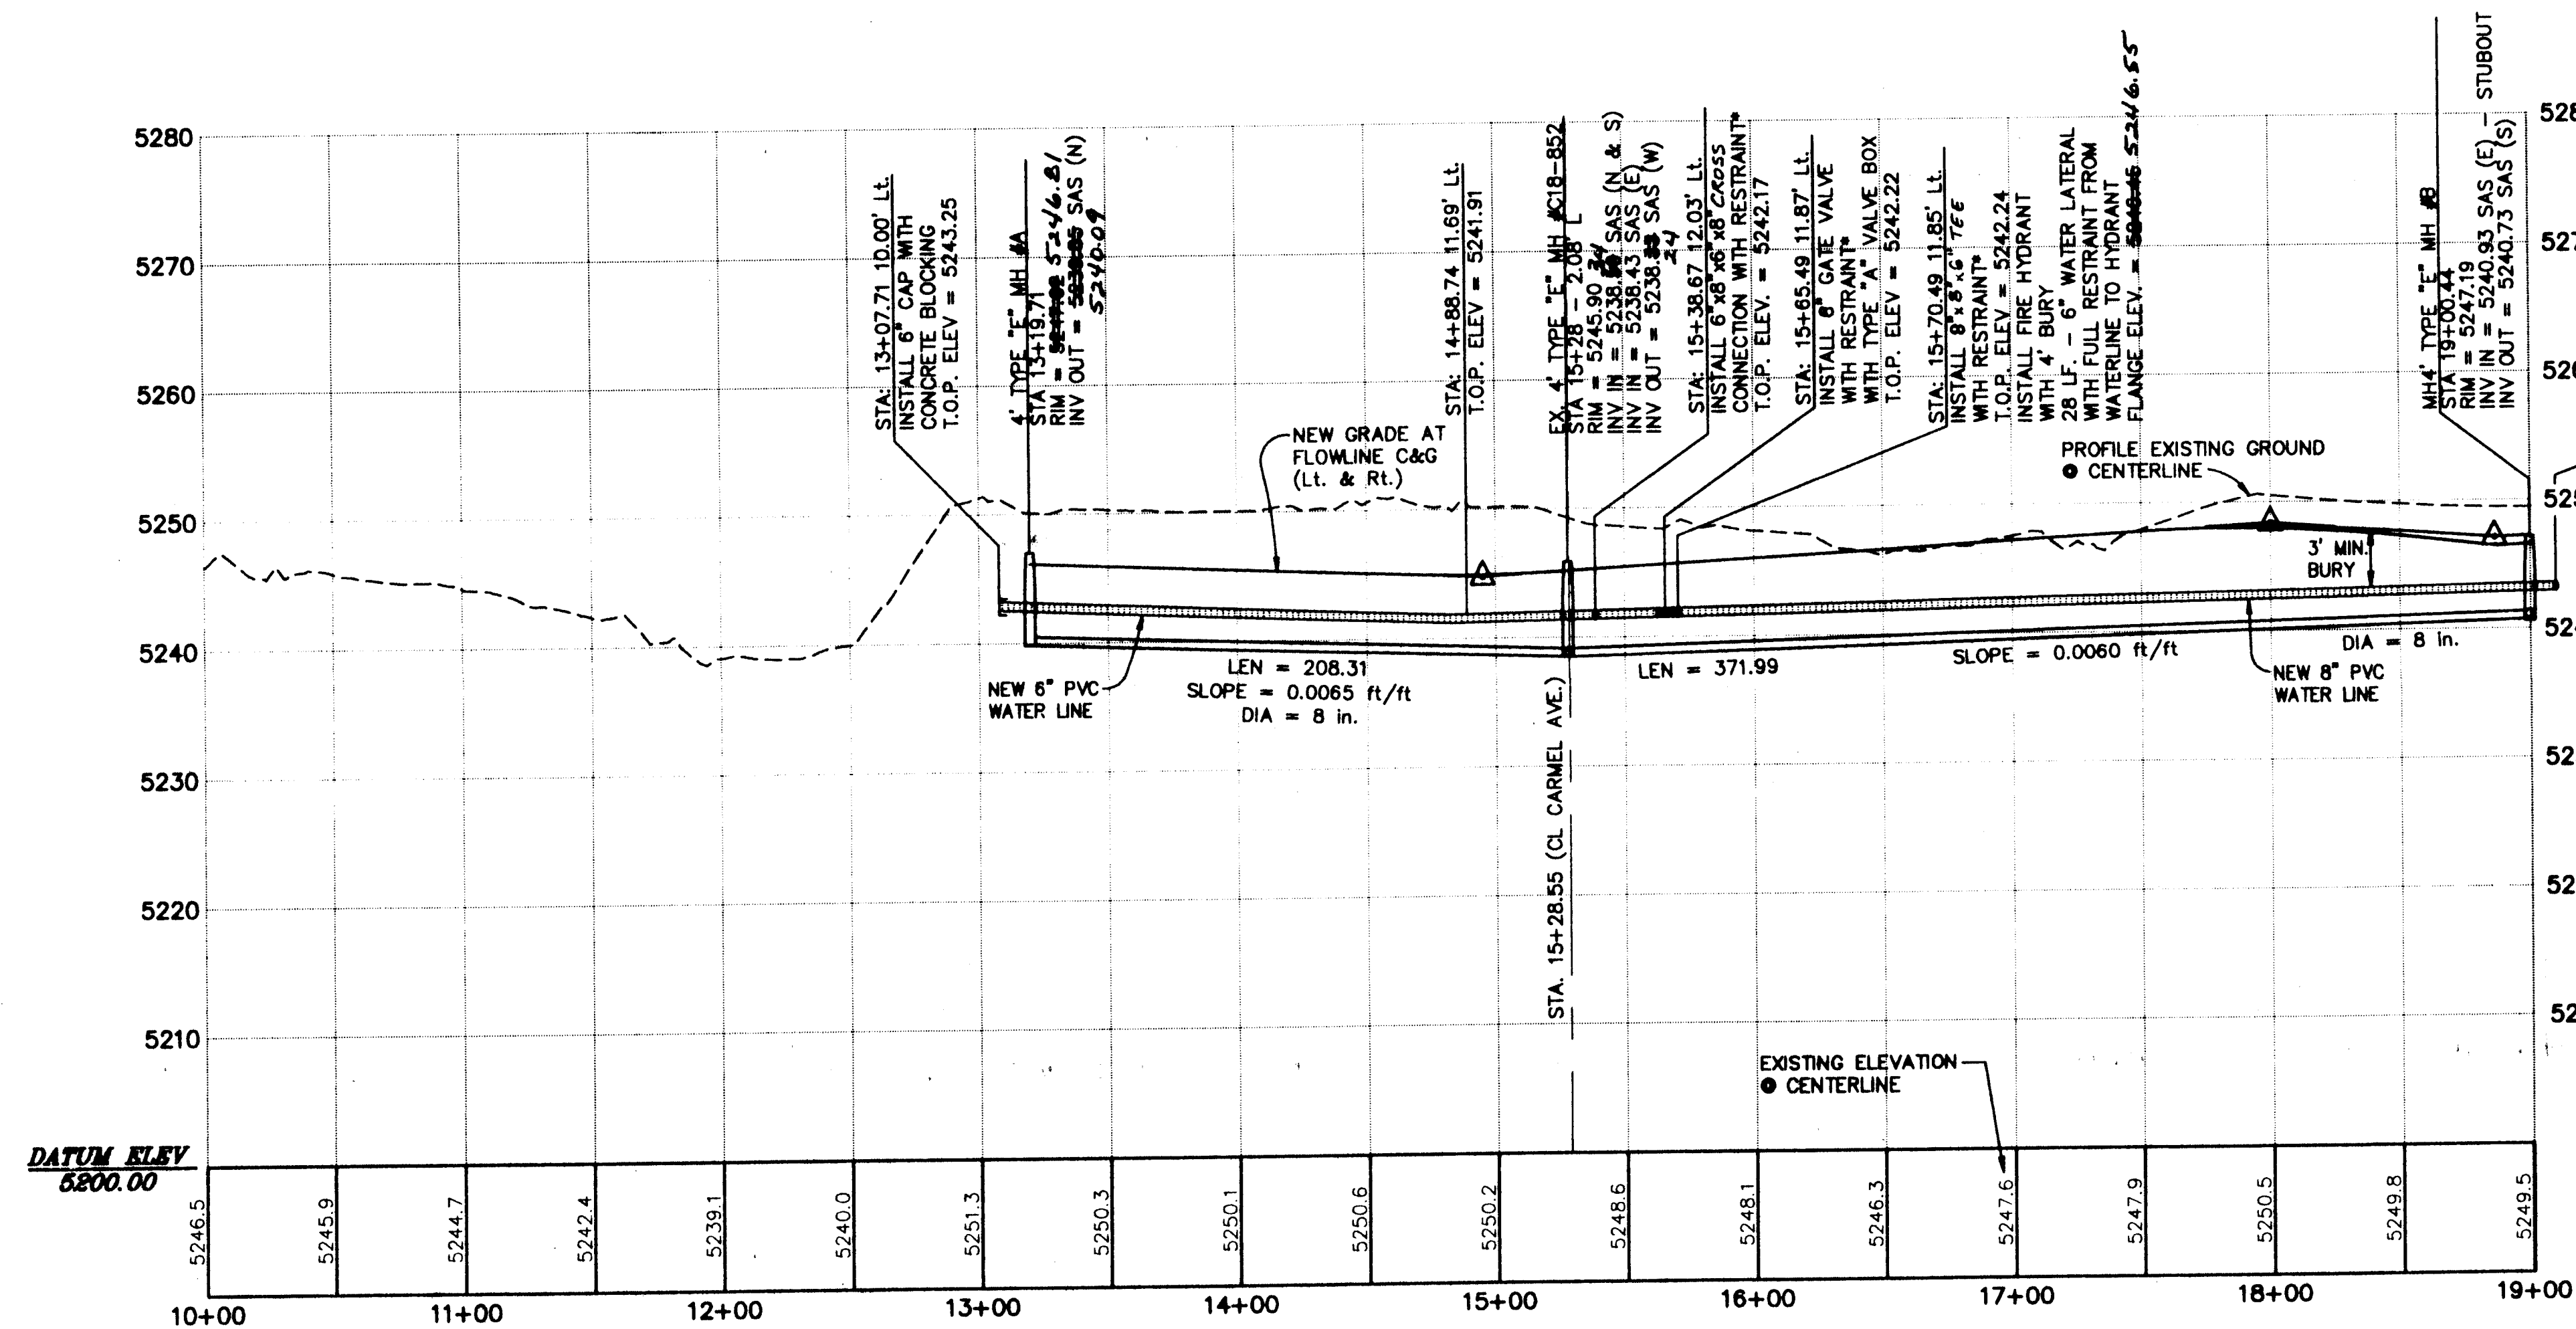

CALLE AVION N.E.

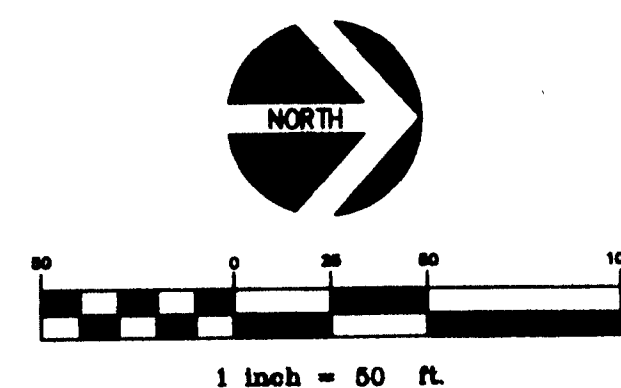

SCALE
HORIZ: 1"=50'
VERT: 1"=10'

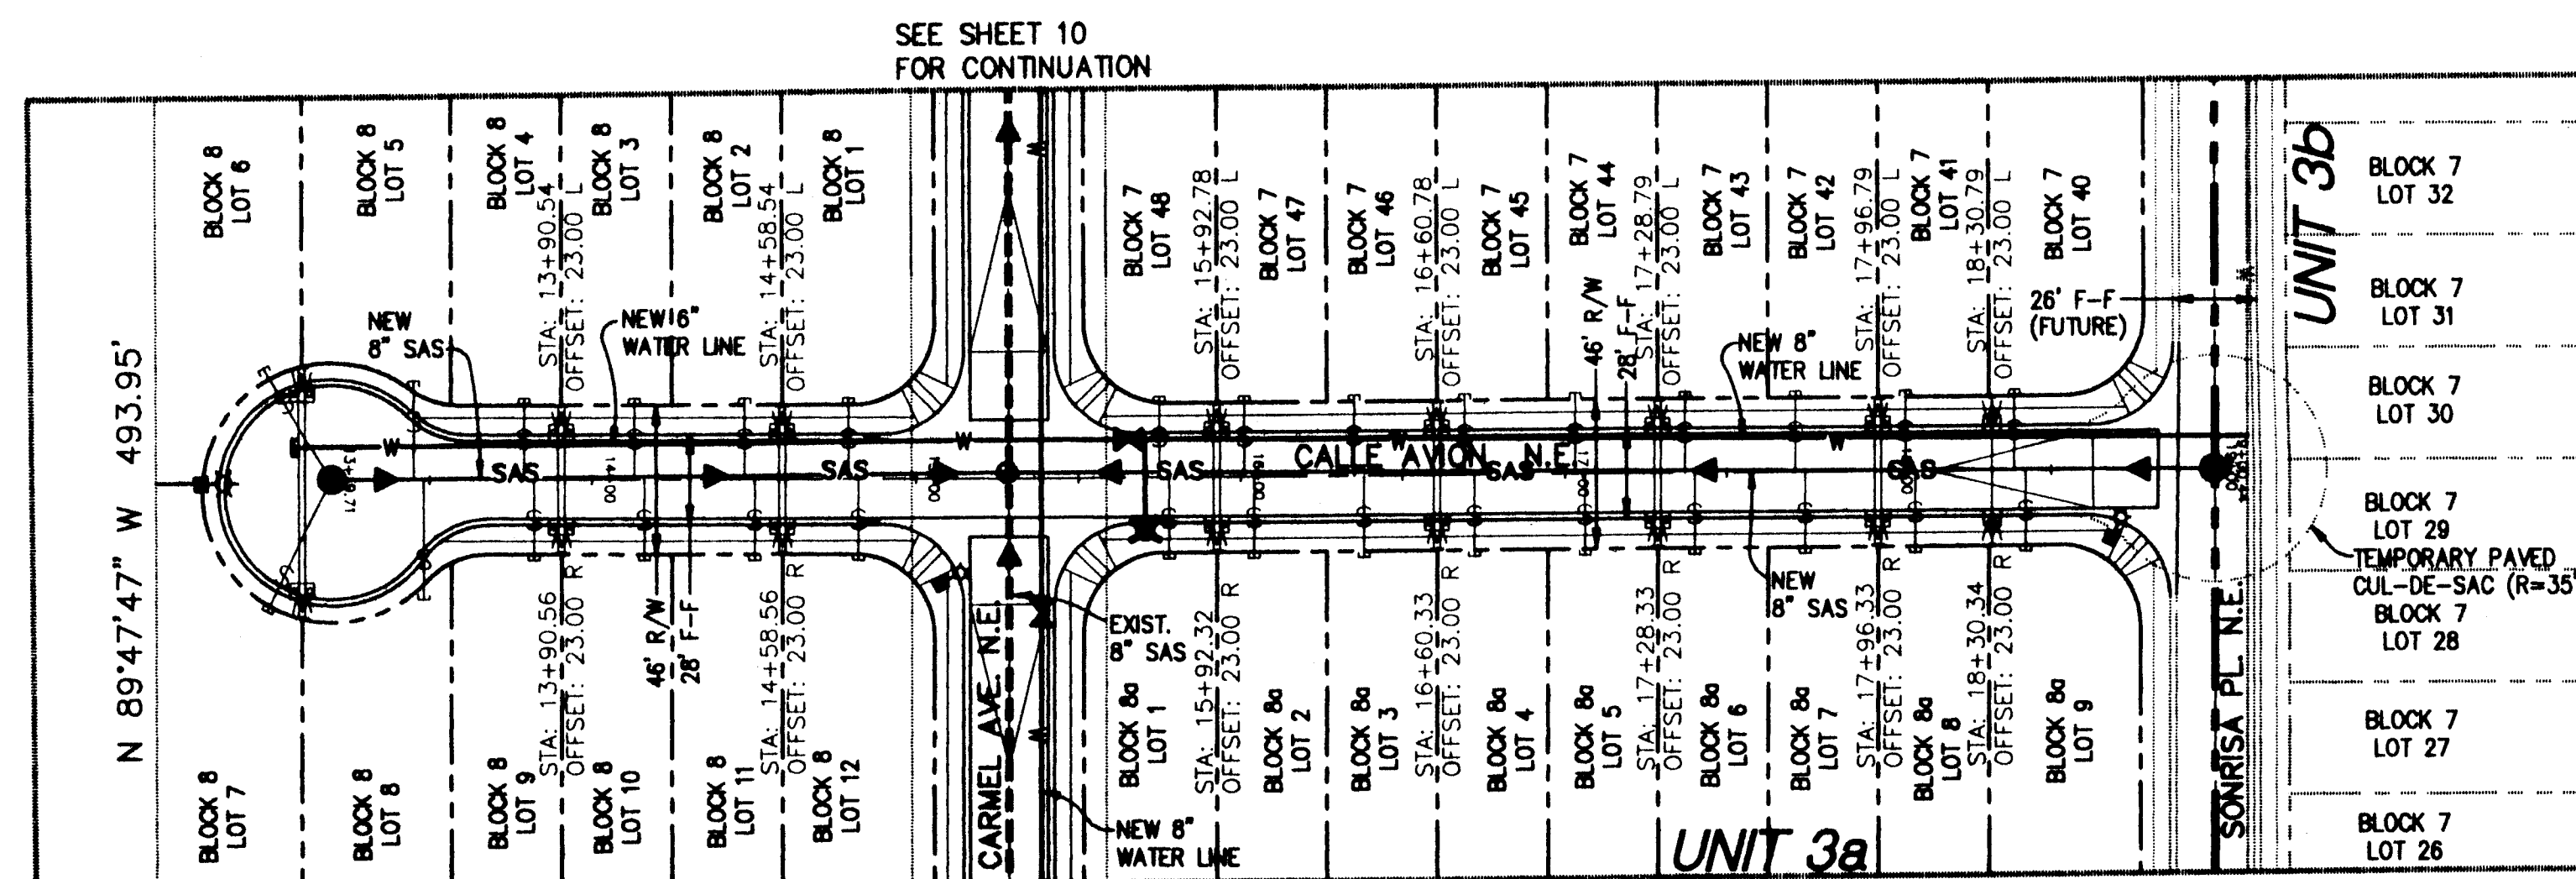


LEGEND	
NEW CURB & CUTTER	---
NEW SAS MAINLINE	---
NEW SAS SERVICE LINE	---
NEW SAS MANHOLE	○
NEW WATER MAINLINE	---
NEW WATER SERVICE LINE	---
NEW GATE VALVE	✕
NEW FIRE HYDRANT	✕
NEW STREET LIGHT	✕
NEW VALLEY GUTTER	---

- WATER AND SEWER NOTES**
- CONSTRUCT 4" TYPE "E" MANHOLES PER STD. DWG. # 2102.
 - CONSTRUCT SAS SERVICE LINES PER STD. DWG. # 2125.
 - CONSTRUCT ALL CONCRETE BLOCKING PER STD. DWG. # 2320. CONCRETE BLOCKING SHALL BE UTILIZED ONLY WHERE SPECIFICALLY CALLED OUT ON PLAN.
 - CONSTRUCT ALL VALVE BOXES PER NEW C.O.A. VALVE BOX DETAIL WITH NON-TAPERED CONCRETE COLLAR.
 - CONSTRUCT ALL FIRE HYDRANTS PER DESIGNATED DEPTHS AND LENGTHS PER STD. DWG. # 2340. USE FULL RESTRAINT ON FIRE HYDRANT LEGS FROM MAIN TO FIRE HYDRANT FLANGE.
 - CONSTRUCT ALL SINGLE AND DOUBLE WATER SERVICE LINES PER STD. DWG. # 2361, 2362 AND 2363.
 - SEE SHEET 9 FOR SAS AND WATER SERVICE INFORMATION.
 - RESTRAINT DISTANCES FOR PIPE FITTINGS SHALL BE DEFINED BY TABLE ON SHEET 9.
 - ALL WATERLINES SHALL BE C-900 PVC UNLESS OTHERWISE NOTED.


AS-BUILT

Tony O. Brown, P.E.
P. O. Box 92051
Albuquerque, NM 87199
(505) 883-8807


CITY OF ALBUQUERQUE PUBLIC WORKS DEPARTMENT ENGINEERING DEVELOPMENT GROUP	
TITLE: LA CUEVA OESTE, UNIT 3a UTILITY PLAN AND PROFILE CALLE AVION N.E. (Sta. 13+19.71 to Sta. 19+00.44)	
DESIGNED BY: TOB	DATE: 10/97
DRAWN BY: TOB	DATE: 10/97
CHECKED BY: TOB	DATE: 10/97
REMARKS	REVISIONS
NO.	DATE
1	10/97
2	10/97
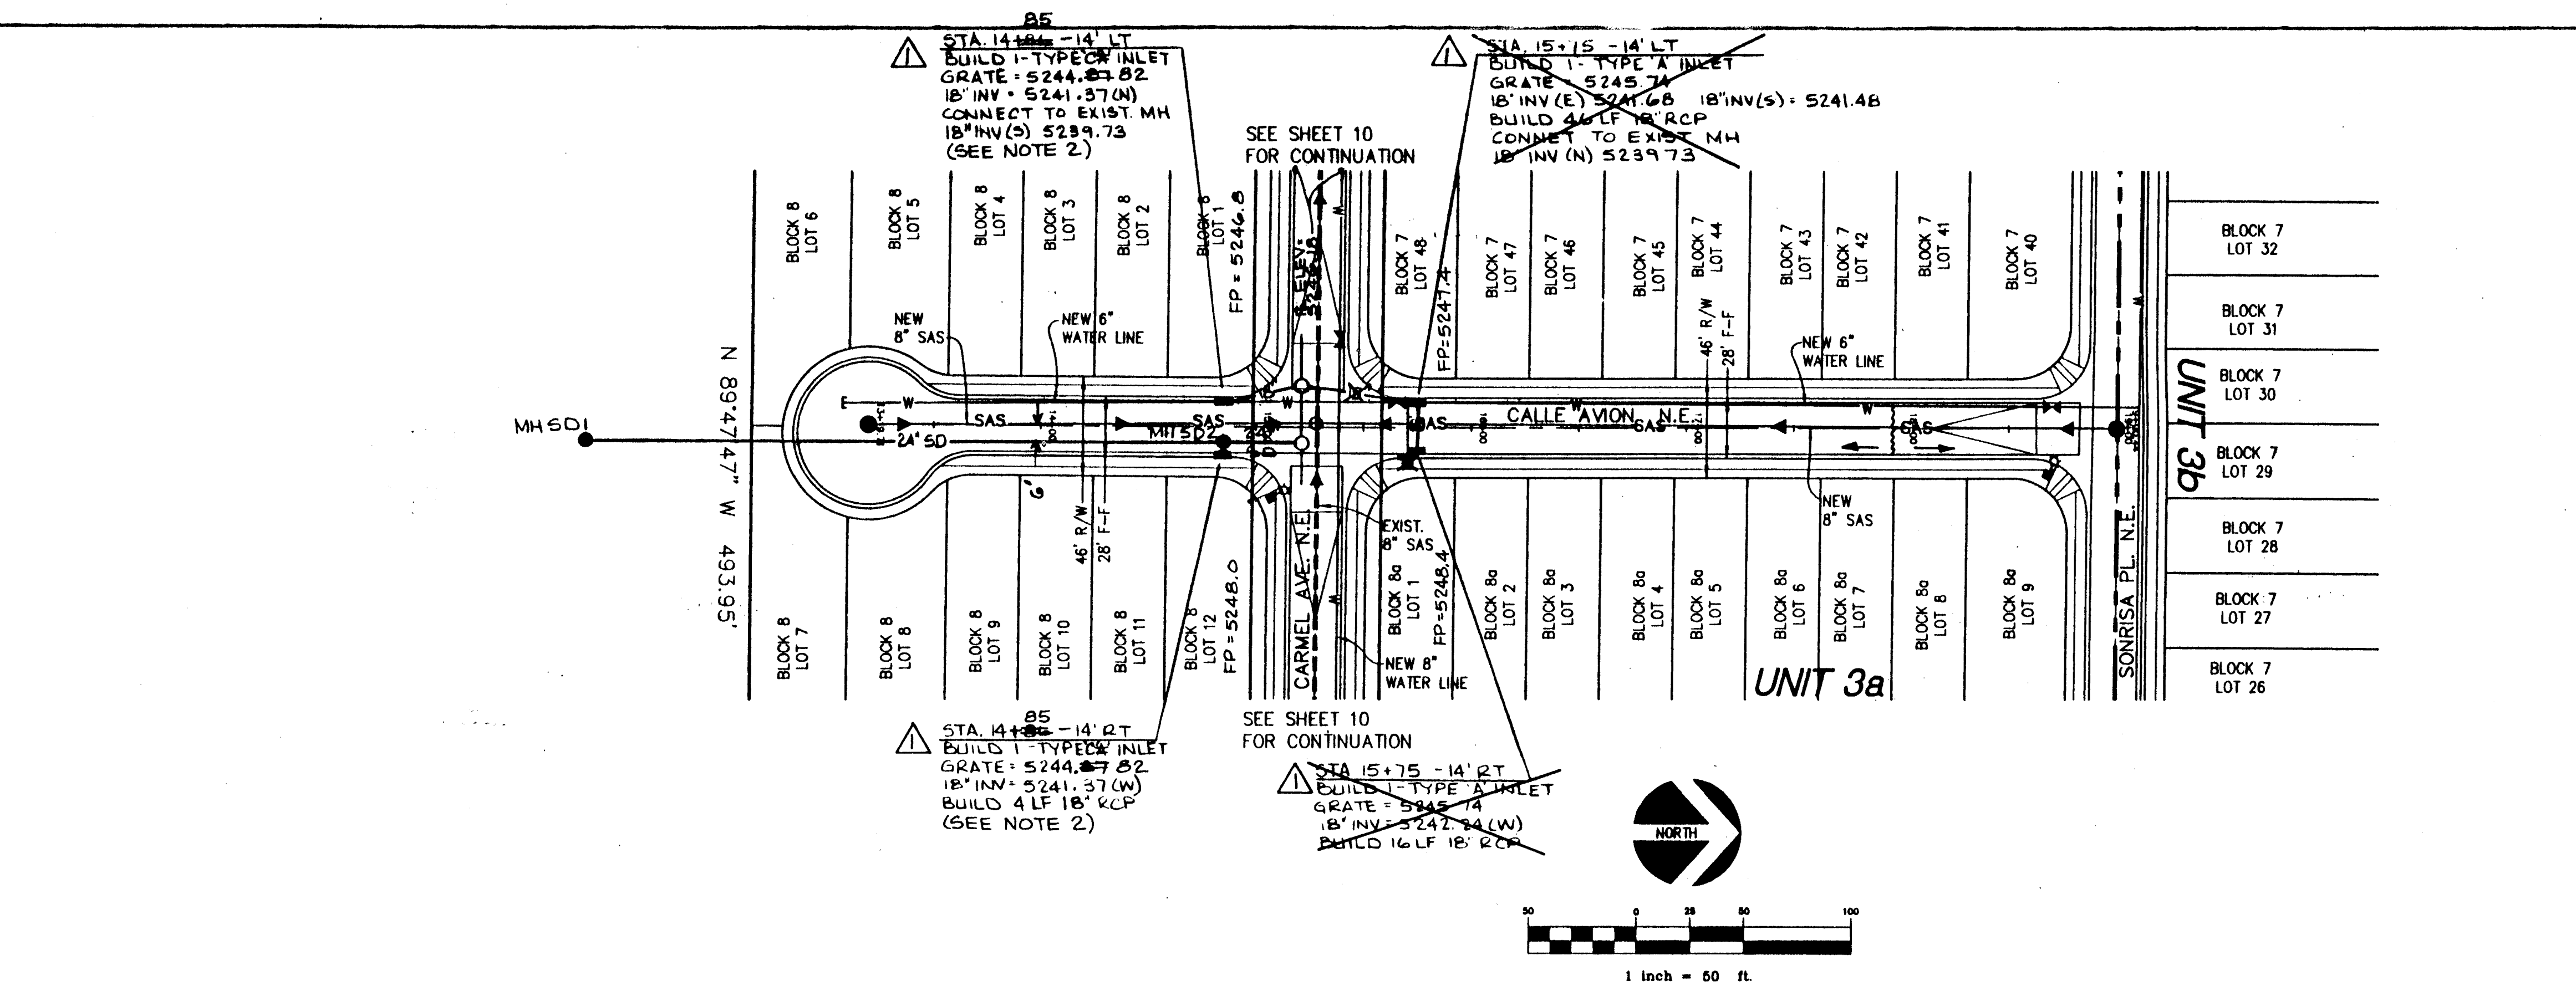

CALLE AVION N.E.

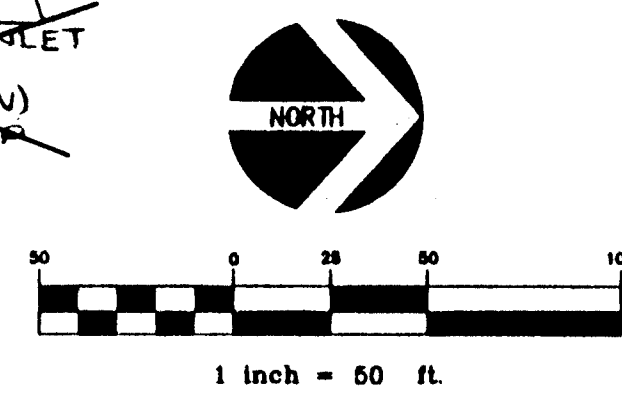

SCALE
HORIZ: 1"=50'
VERT: 1"=10'

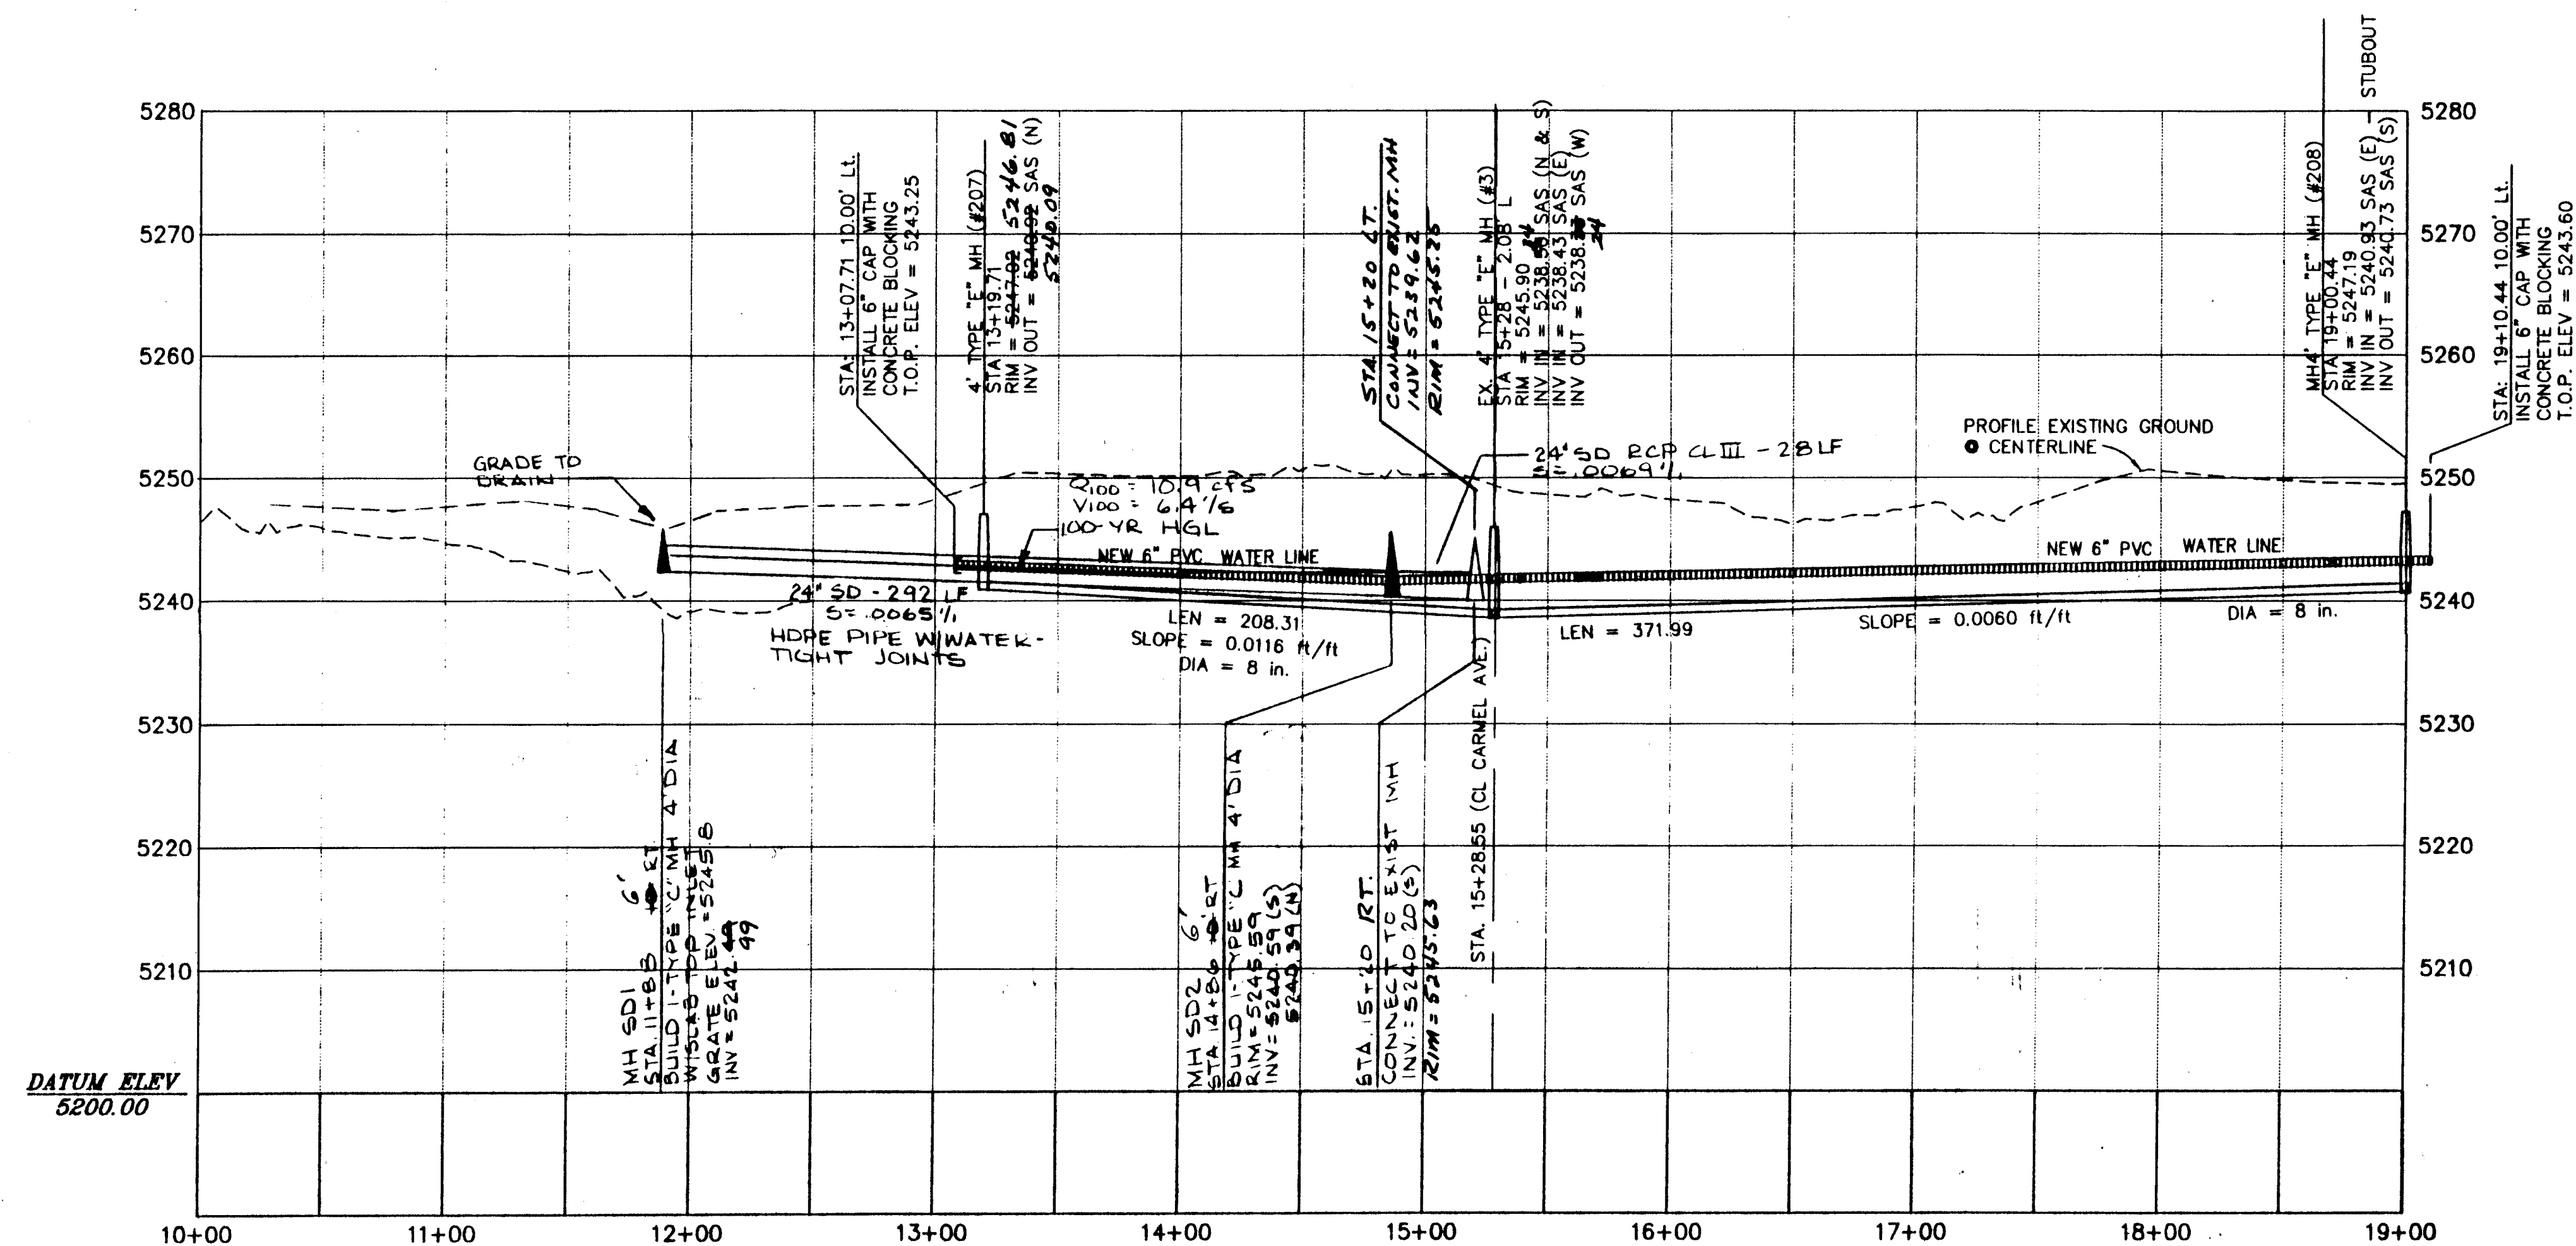

LEGEND		AS-BUILT INFORMATION	
NEW CURB & GUTTER	---	CONTRACTOR	NEW CONSTRUCTION
NEW SD LINE	SD	DATE	5-28-98
NEW SAS MAINLINE	SAS	DATE	5-28-98
NEW SAS MANHOLE	●	DATE	5-28-98
NEW WATER MAINLINE	W	DATE	5-28-98
NEW GATE VALVE	⋈	DATE	5-28-98
NEW FIRE HYDRANT	⋈	DATE	5-28-98
NEW STREET LIGHT	⋈	DATE	5-28-98
NEW VALLEY GUTTER	---	DATE	5-28-98

STORM DRAIN NOTES

1. SEE PAVING P.P. FOR STREET GRADES.

2. STA. 14+85, LT. & RT. TYPE 'C' INLETS ARE TO HAVE 5' GUTTER TRANSITION ON SOUTH SIDE AND 3' ON NORTH SIDE. STATIONING IS TO CENTER OF GRATE ALONG FLOWLINE. APPROX. 1' OF NORTH SIDE GUTTER TRANSITION ON BOTH INLETS WILL BE PAST CURB RETURN.

SURVEY INFORMATION		ENGINEER'S SEAL	
NO.	DATE	NO.	DATE
1	5-28-98	1	5-28-98
2	5-28-98	2	5-28-98
3	5-28-98	3	5-28-98
100	5-28-98	100	5-28-98

24-5232.92 1/21/98

AS-BUILT

Resource Technology, Inc.
ENGINEERS AND ENVIRONMENTAL SCIENTISTS
1730-B Randolph Rd. SE Albuquerque, New Mexico 87108
Telephone: (505) 243-7300
CIVIL - ENVIRONMENTAL - WATER RESOURCES - RECREATION - PLANNING

CITY OF ALBUQUERQUE
PUBLIC WORKS DEPARTMENT
ENGINEERING DEVELOPMENT GROUP

TITLE: LA CUEVA OESTE, UNIT 3a
STORM DRAIN PLAN AND PROFILE
CALLE AVION N.E.



DESIGNED BY: DSD DATE: 08/97
DRAWN BY: PNT DATE: 08/97
CHECKED BY: DSC DATE: 08/97

APPROVED
MAY 25 1998
DESIGN REVIEW COMMITTEE

City Engineer Approval

Zone Map No. 5232.92
Sheet 12 of 14

DWG: C:\PROJ\ESTER\85-330\CA\PROJ\ESTER\85-330\CA\MP1
TIME: 09-27-97 08:45:54

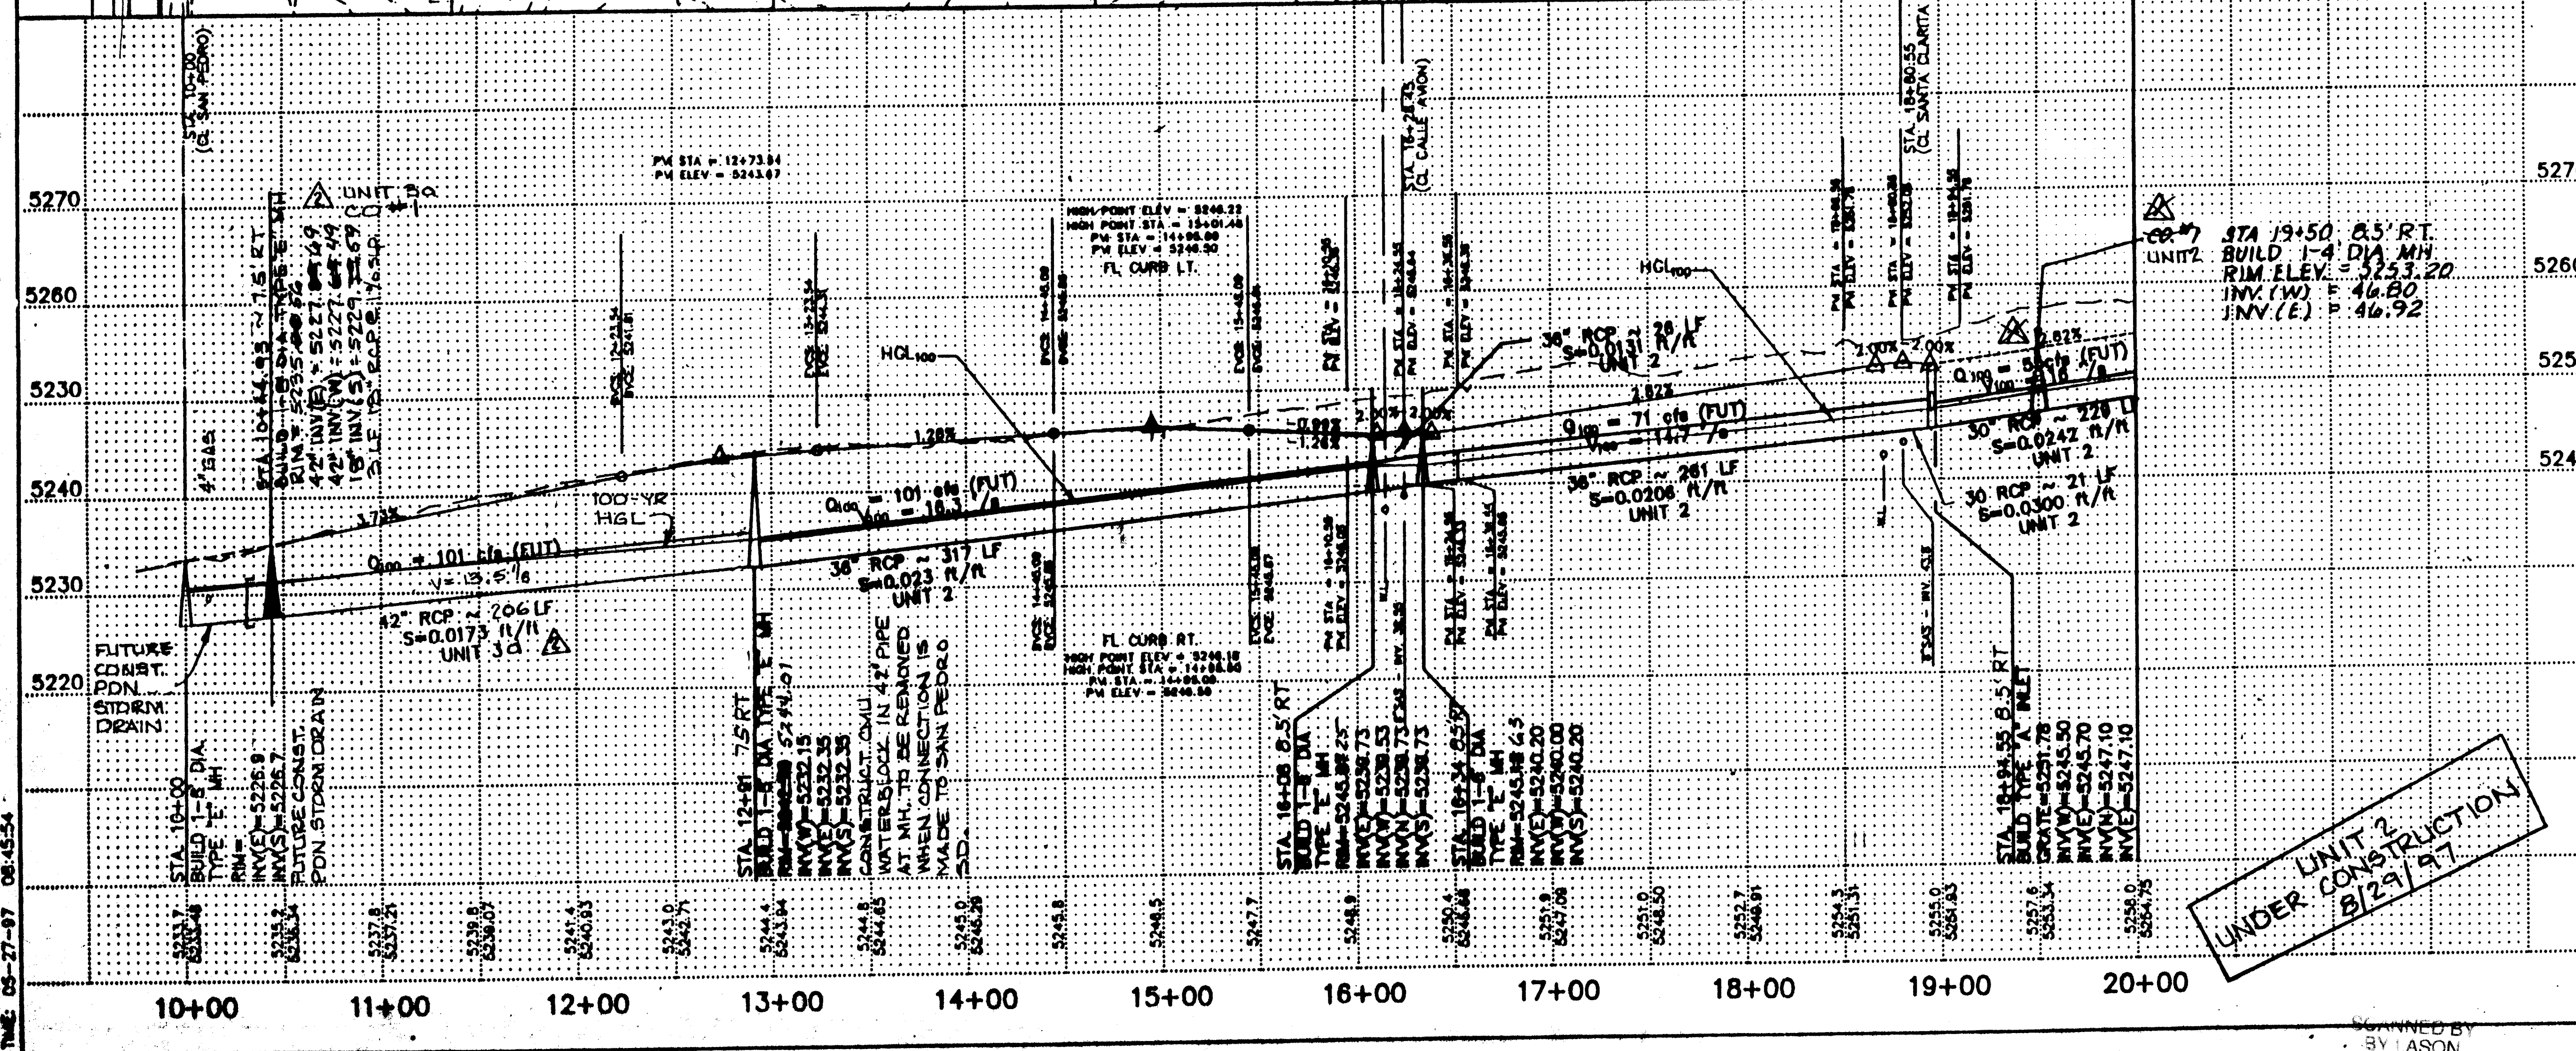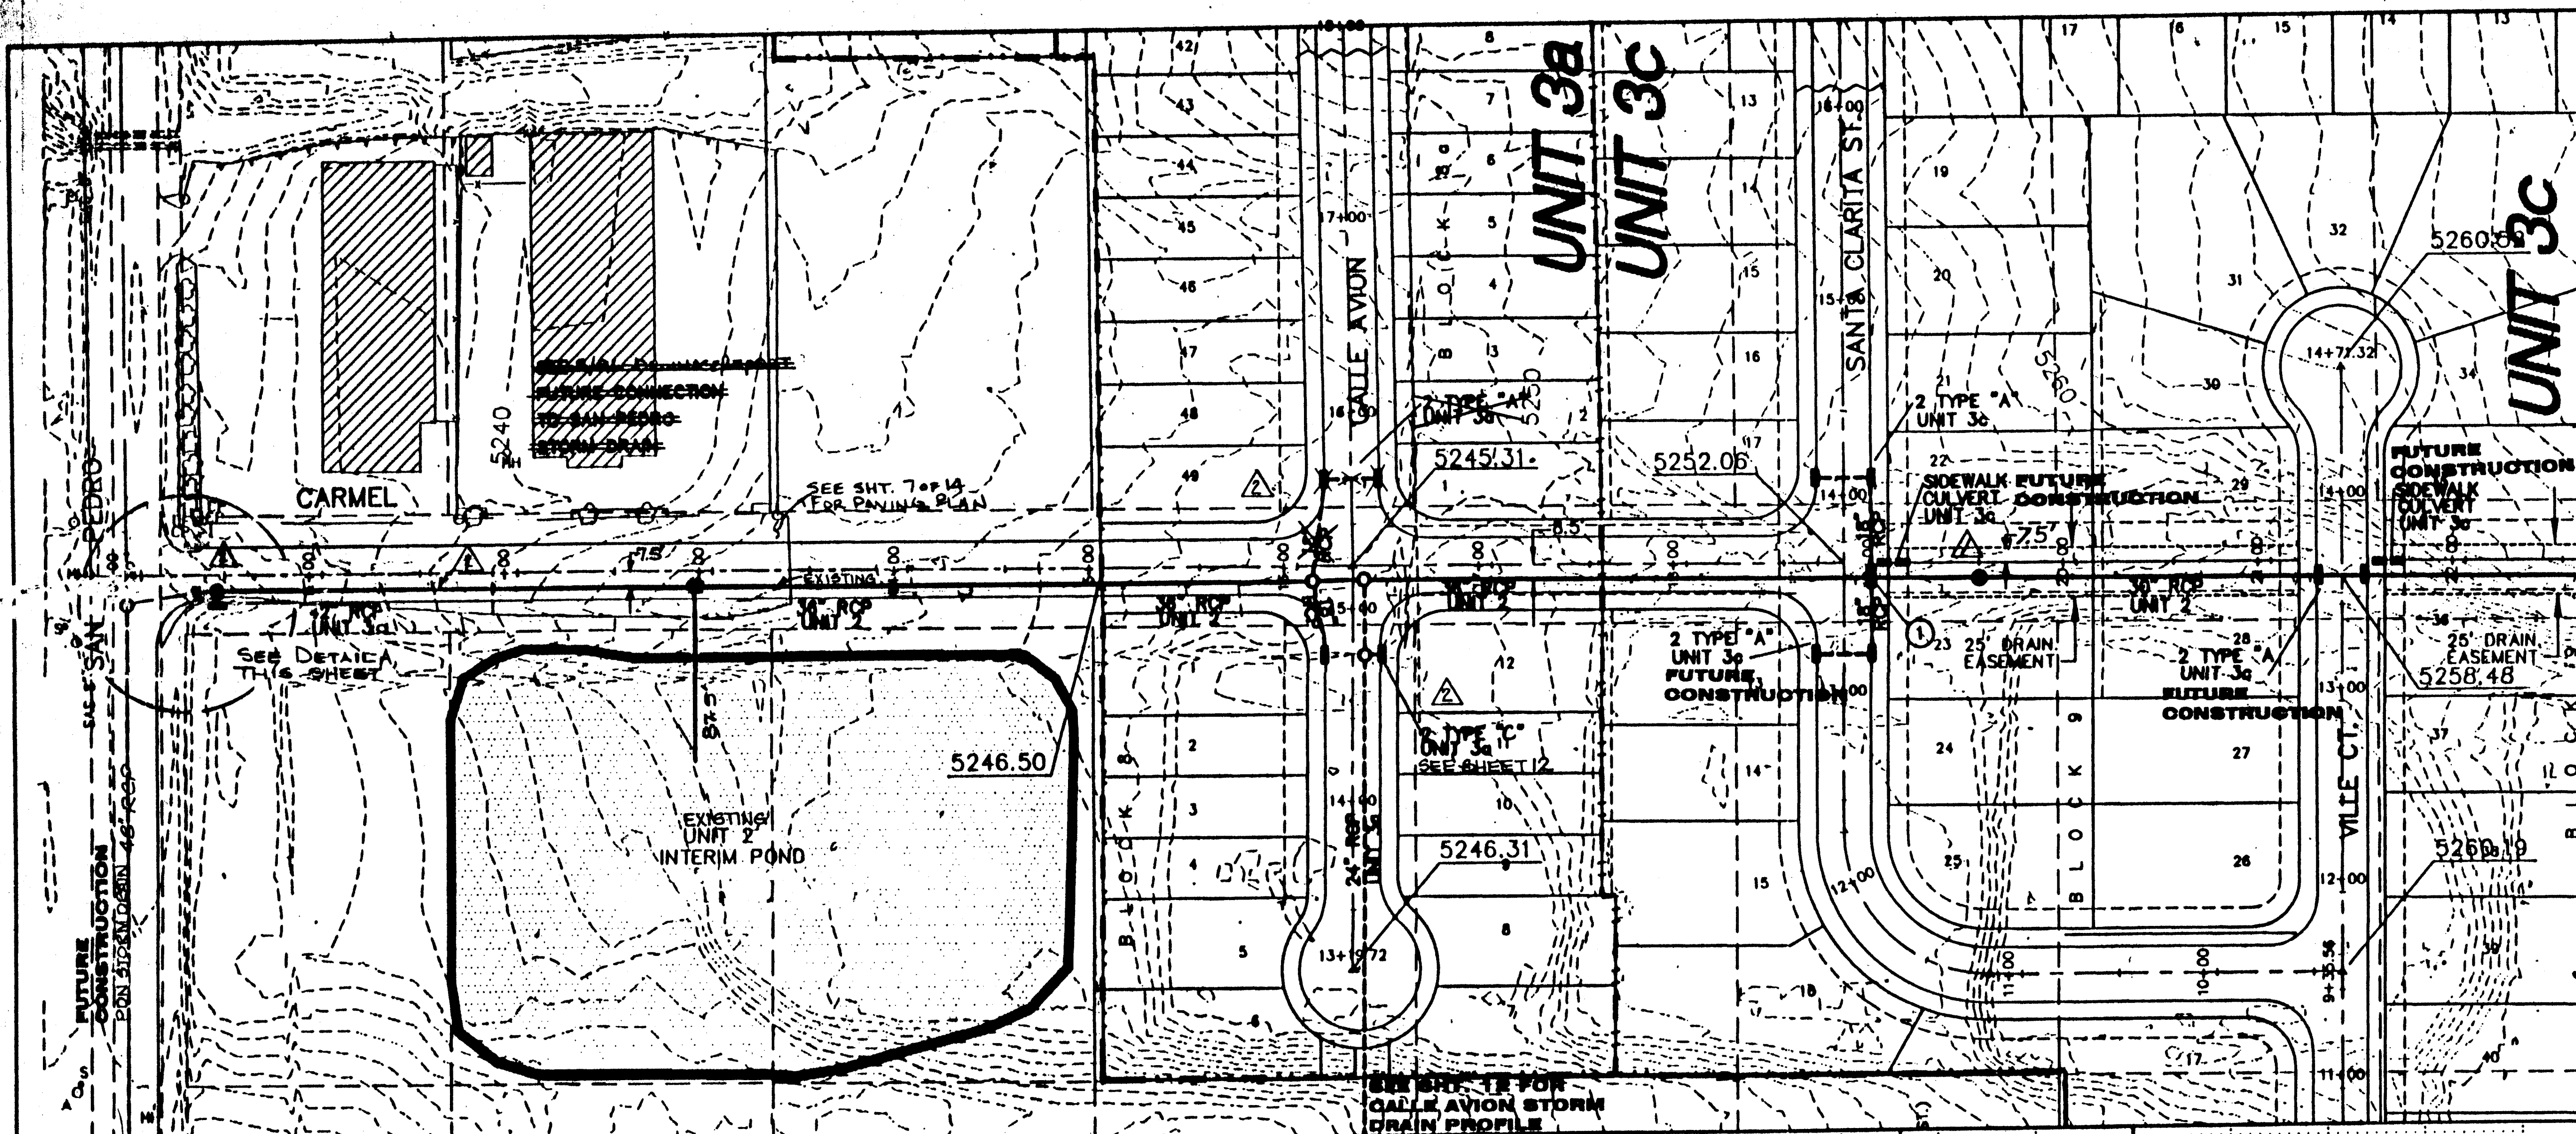

AS-BUILT INFORMATION

CONTRACTOR	DATE	BY	REVISIONS
NEW CONSTRUCTION	05/28/98	DS	1
REVISIONS	05/28/98	DS	2
REVISIONS	05/28/98	DS	3
REVISIONS	05/28/98	DS	4
REVISIONS	05/28/98	DS	50

LEGEND

UNIT 2 STORM DRAIN
UNIT 3 STORM DRAIN
UNIT BOUNDARY

AS-BUILT

SCALE: 1" = 50' HORIZ.
1" = 10' VERT.

CITY OF ALBUQUERQUE
PUBLIC WORKS DEPARTMENT
ENGINEERING DEVELOPMENT GROUP

TITLE: LA CUEVA OESTE UNIT 2 & 3
CARMEL AVE.
SD PLAN & PROFILE

City Engineer Approval

City Project No. 5232.912
Zone Map No. C-18
Scale 1" = 50'

DESIGNED BY DS
DRAWN BY DS
CHECKED BY DS
DATE MAY 1997

REVISIONS

NO.	DATE	REVISIONS	BY
1	05/28/98	1	DS
2	05/28/98	2	DS
3	05/28/98	3	DS
50	05/28/98	50	DS

NOTES:






1) TYPE "A" INLETS TO BE BUILT OVER THE STORM DRAIN TRUNK LINE AT SANTA CLARITA AS PART OF UNIT 2 CONSTRUCTION

DETAIL A

STA 19+50.85 RT.
BUILD 1-4 DIA. MH.
RIM ELEV. = 5253.20
INV. (W) = 46.80
INV. (E) = 46.92


UNIT 2 UNDER CONSTRUCTION 8/29/97


DWG: C:\PROJ\OESTE\95-330\CA\PROJ\OESTE\95-330\MISCDET
TIME: 06-09-97 09:51:44

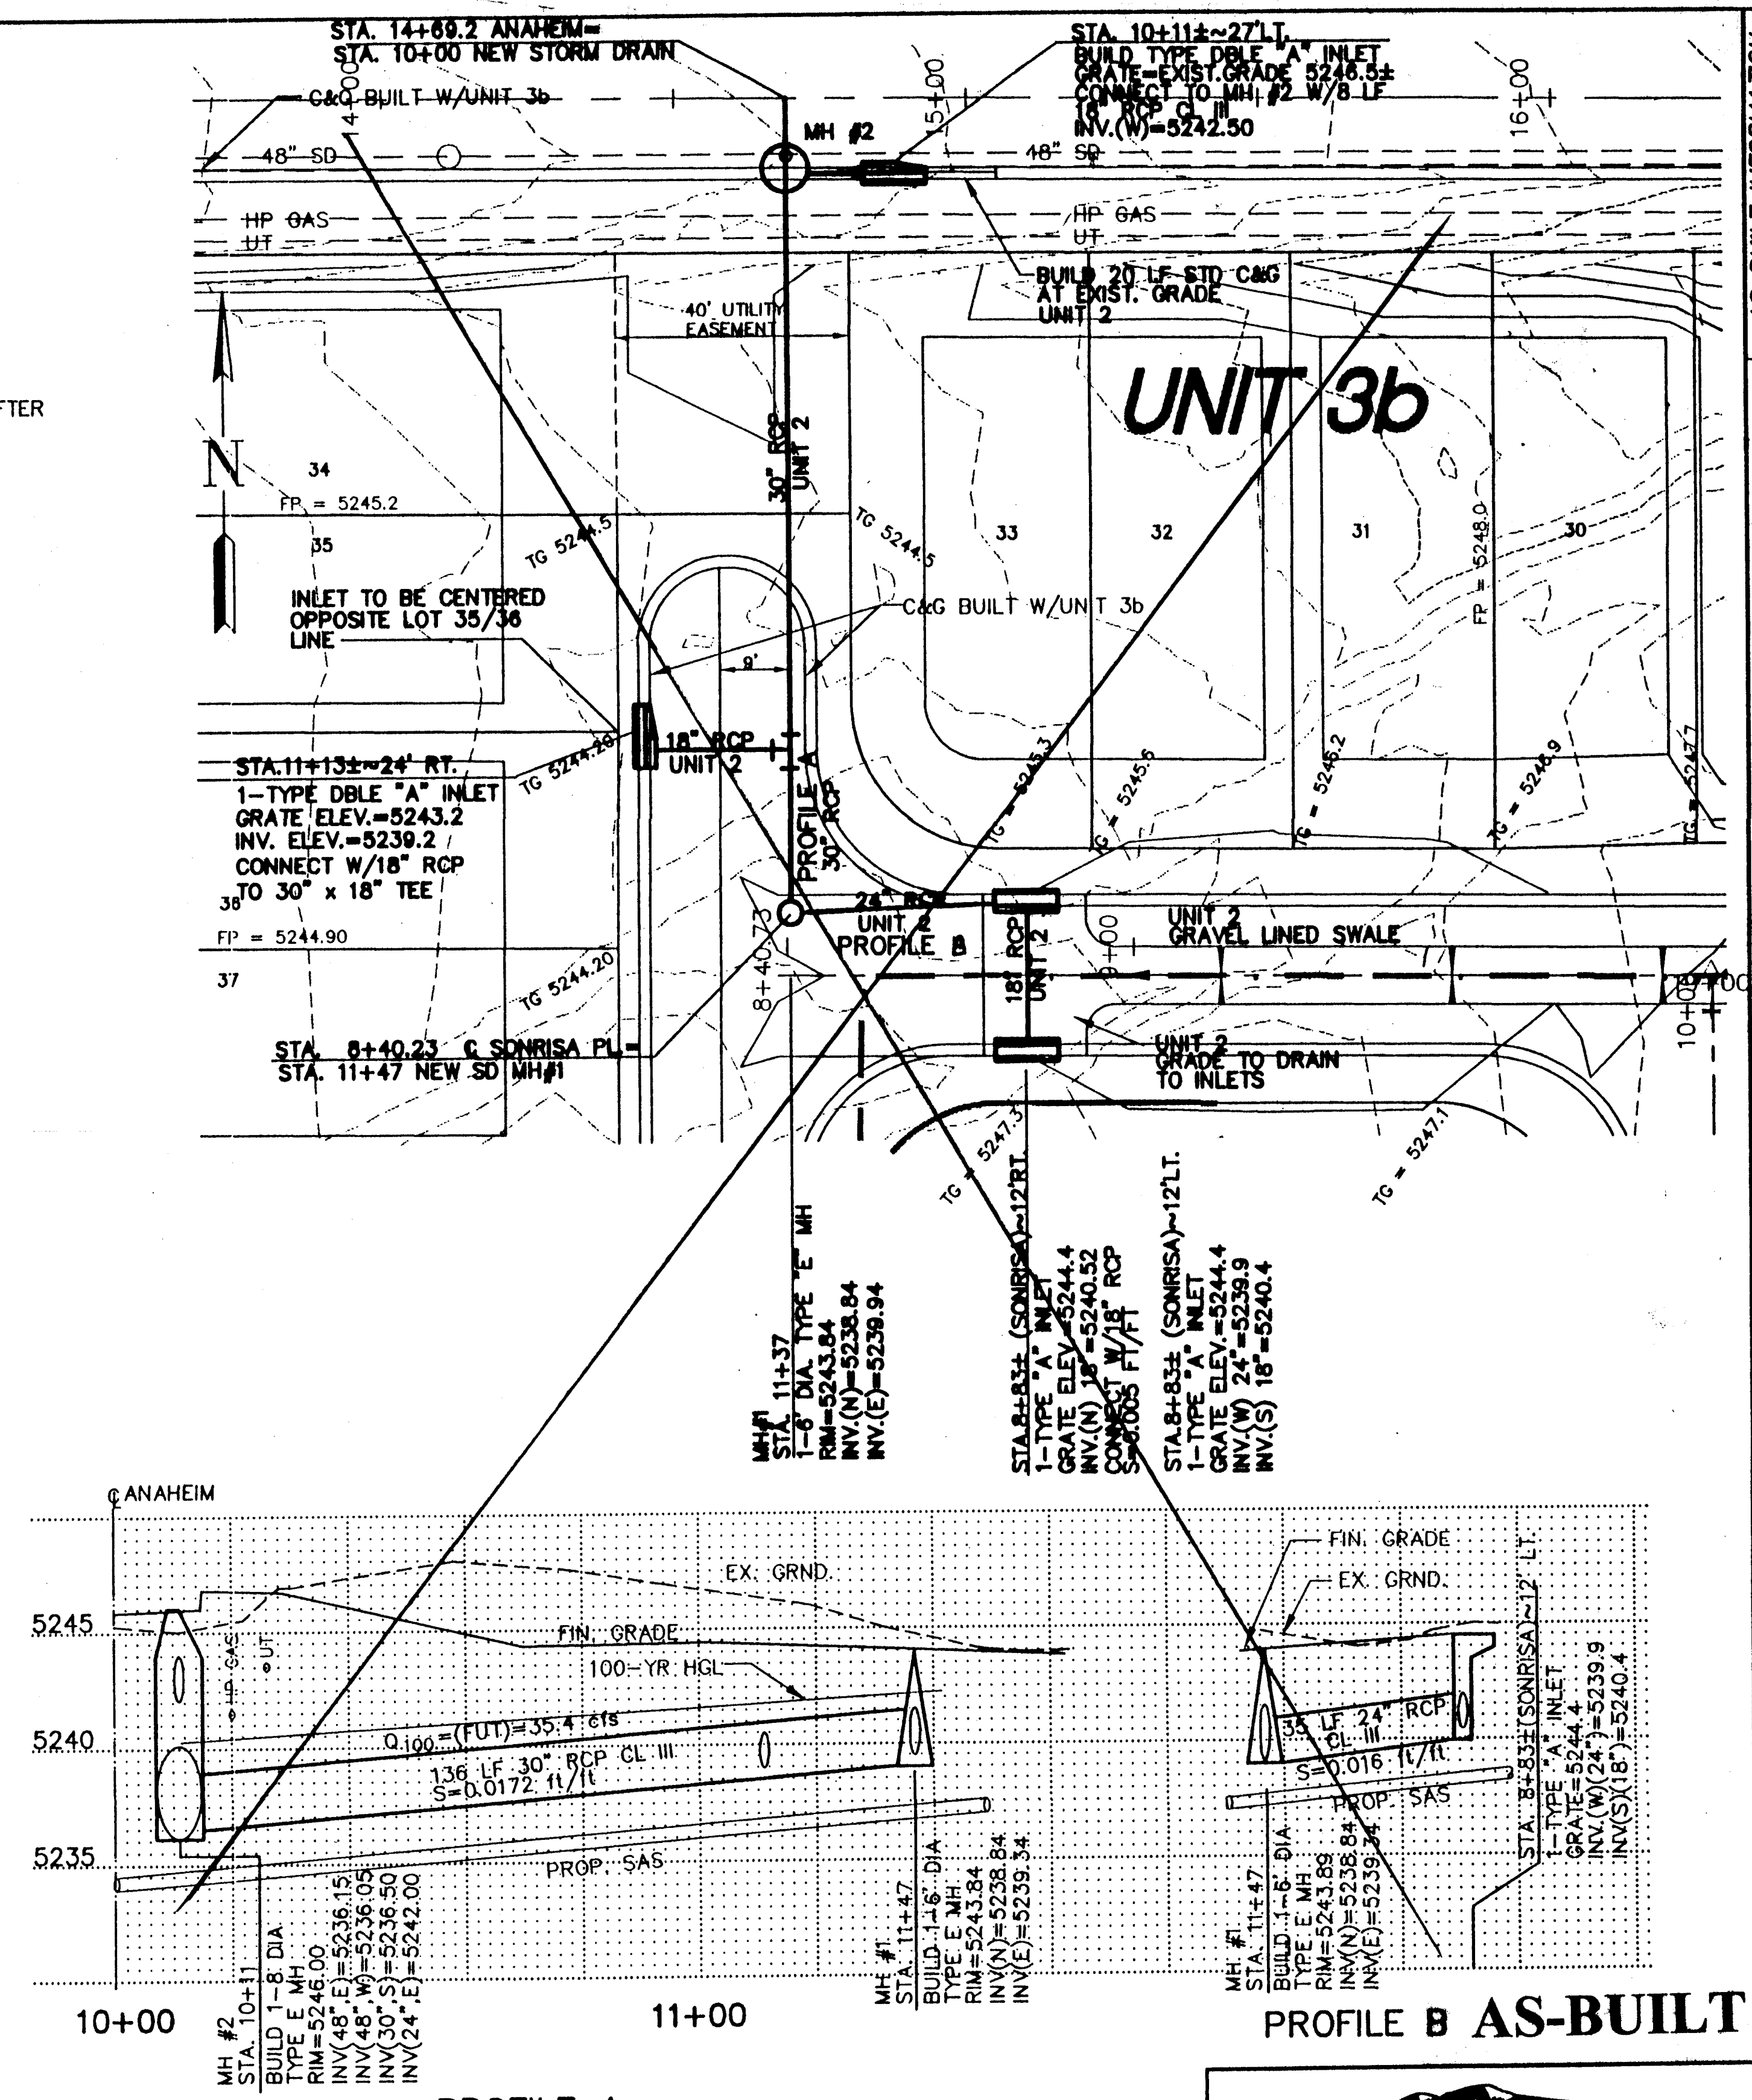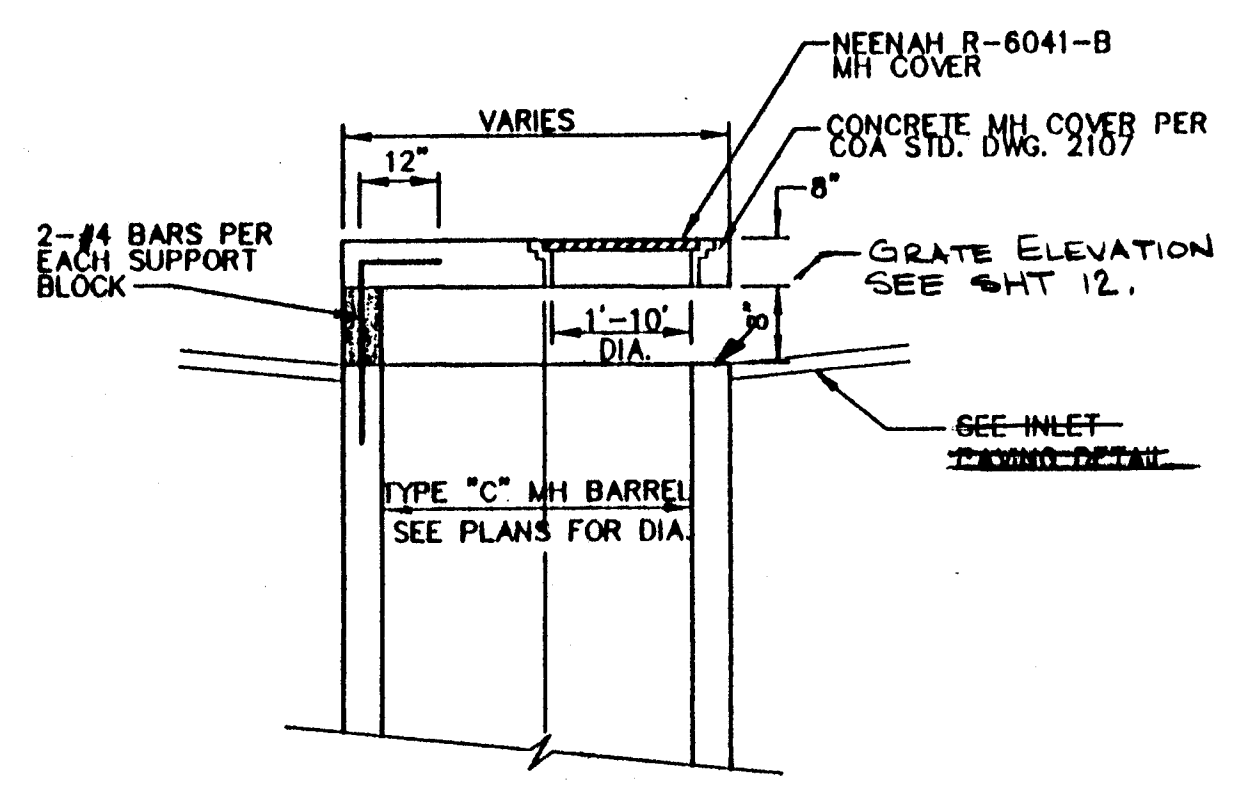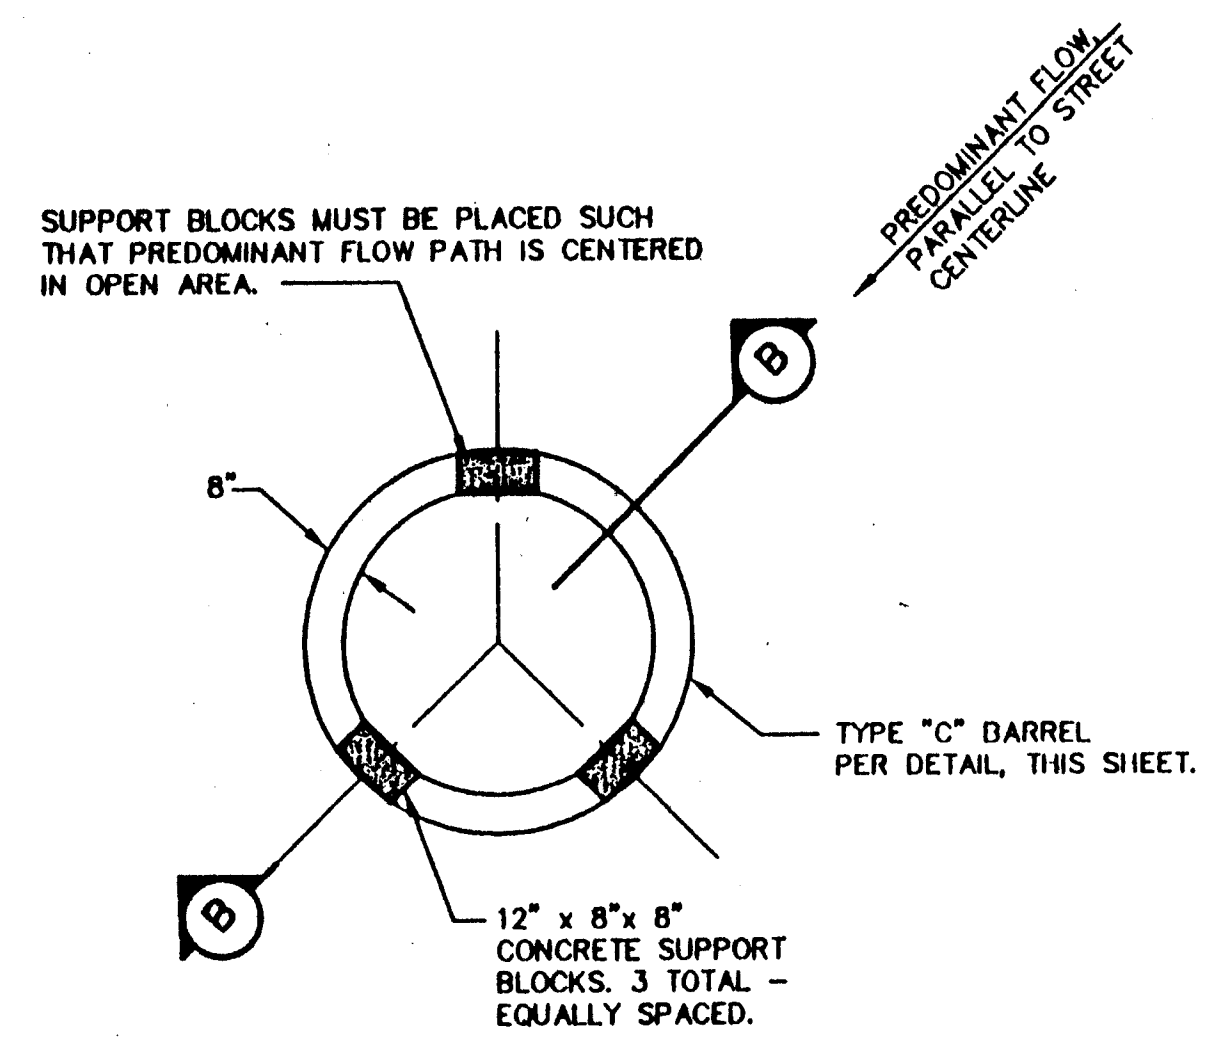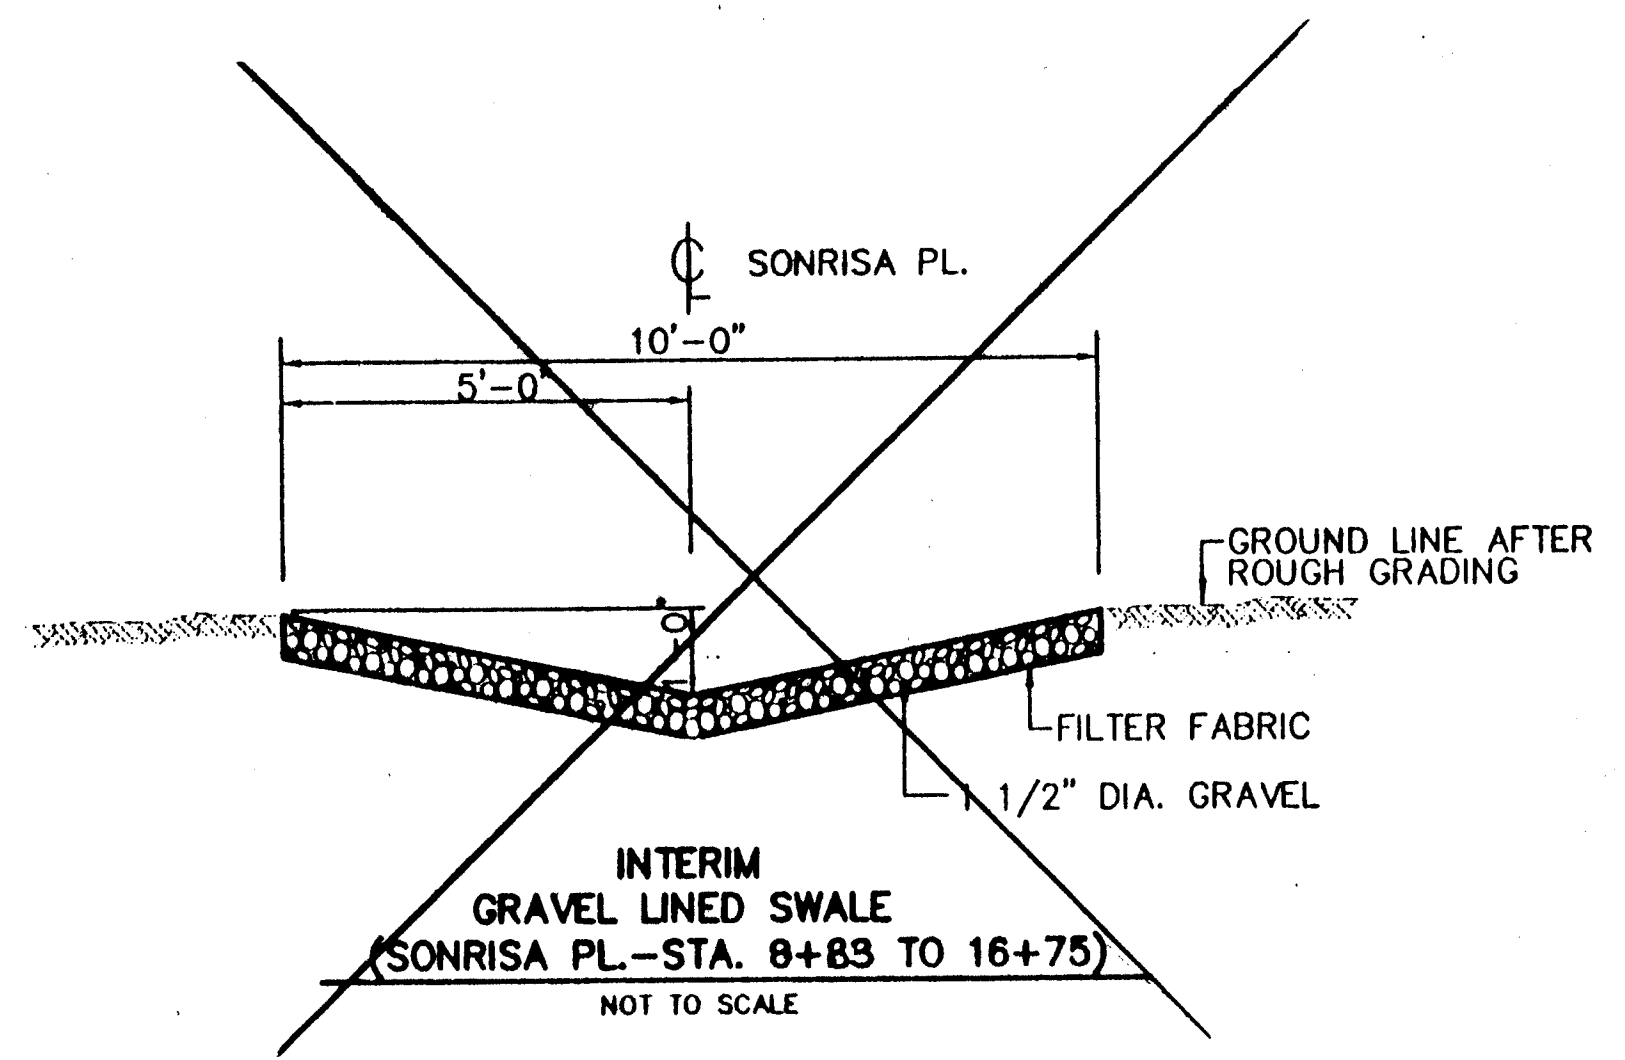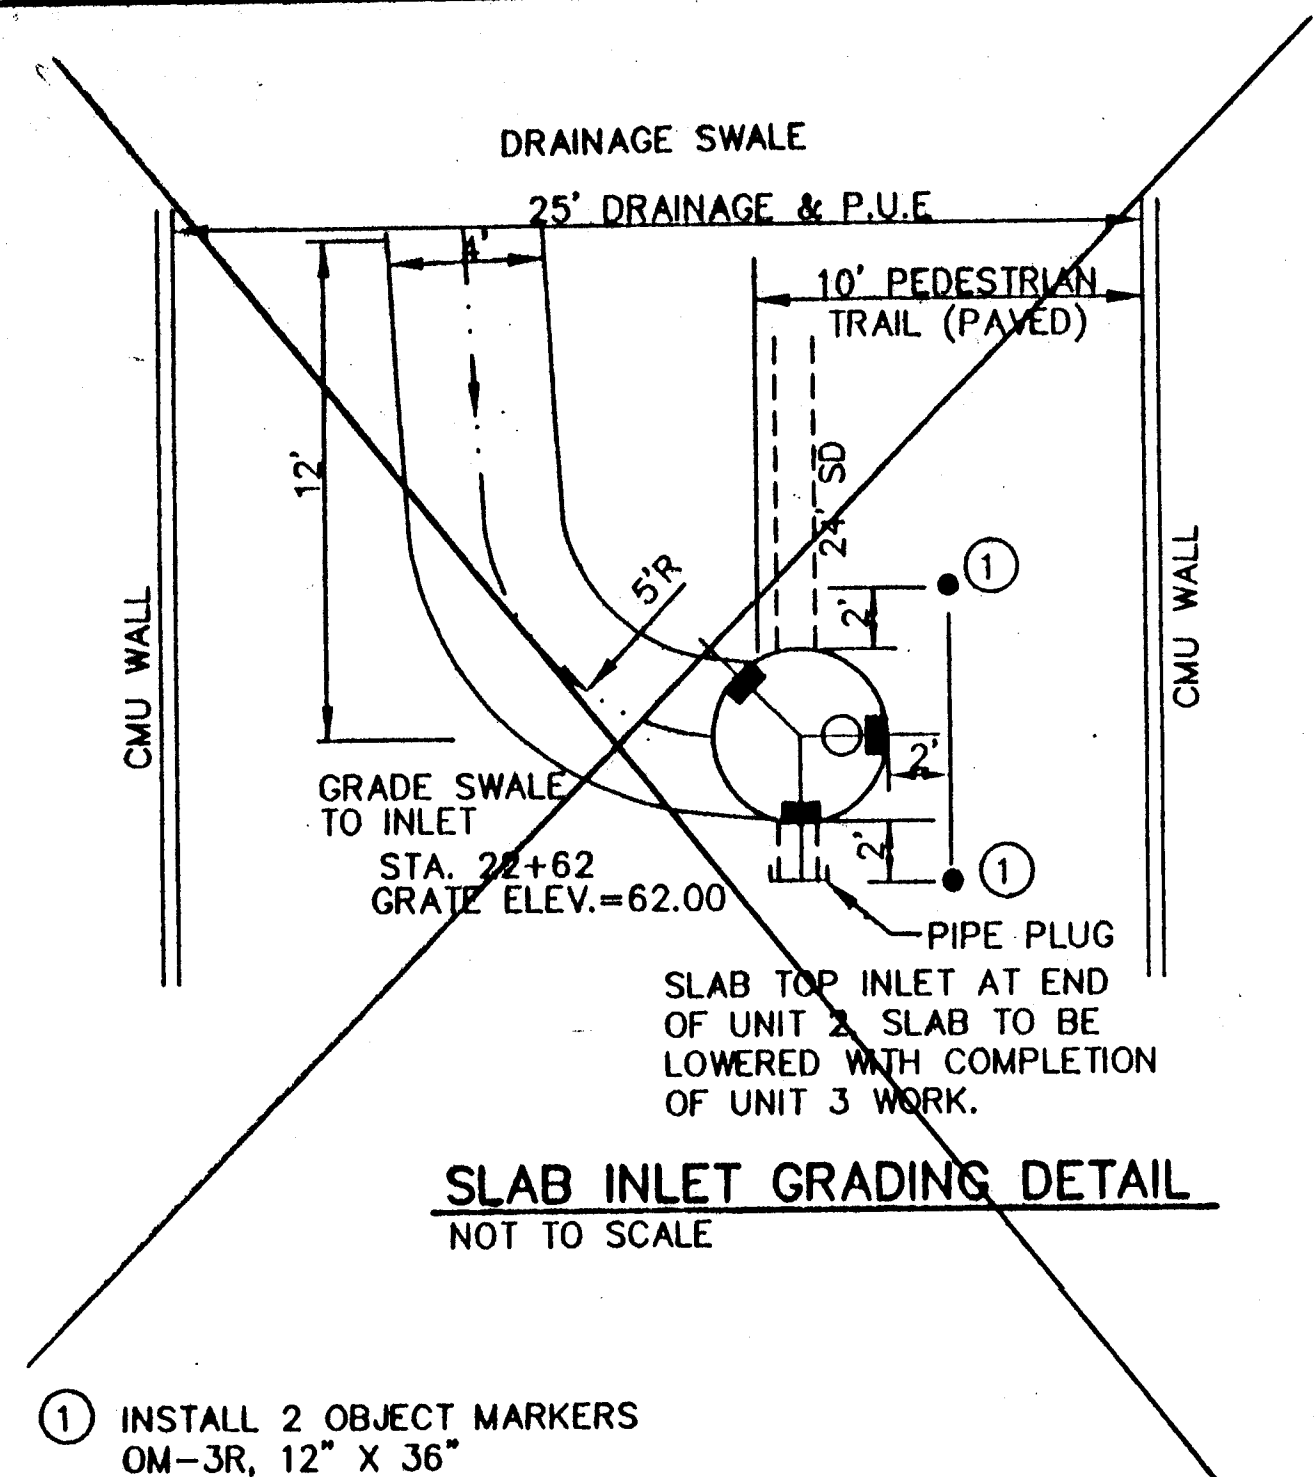

CITY OF ALBUQUERQUE PUBLIC WORKS DEPARTMENT ENGINEERING DEVELOPMENT GROUP	
TITLE: LA CUEVA OESTE, UNIT 3a MISCELLANEOUS DRAINAGE DETAILS	
DESIGNED BY: DSD	DATE: SEPT. 1996
DRAWN BY: PMT	DATE: SEPT. 1996
CHECKED BY: DSD	DATE: SEPT. 1996
NO.	DATE
REMARKS	BY
DESIGN	
City Project No. 5232.942	
Zone Map No. C-18	
2413 2614	


AS-BUILT INFORMATION	
CONTRACTOR: NEW CONCEPTS	DATE: 5-27-98
DESIGNED BY: CDA	DATE: 5-27-98
DRAWN BY: CDA	DATE: 5-27-98
CHECKED BY: CDA	DATE: 5-27-98
RECORDED BY: CDA	DATE: 5-27-98
MICRO-FILM INFORMATION	
NO.	DATE

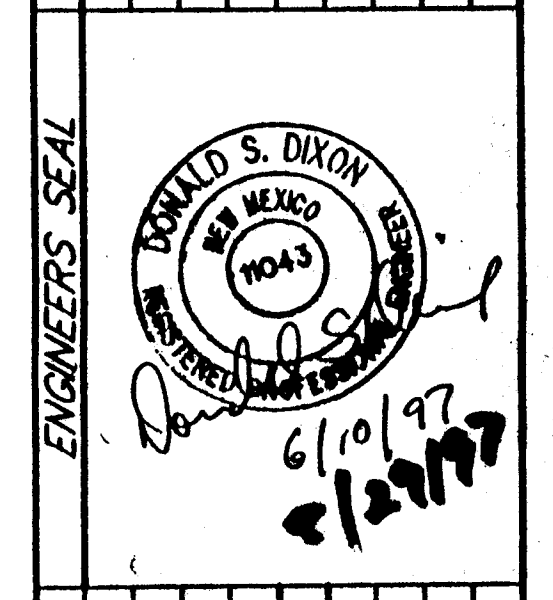

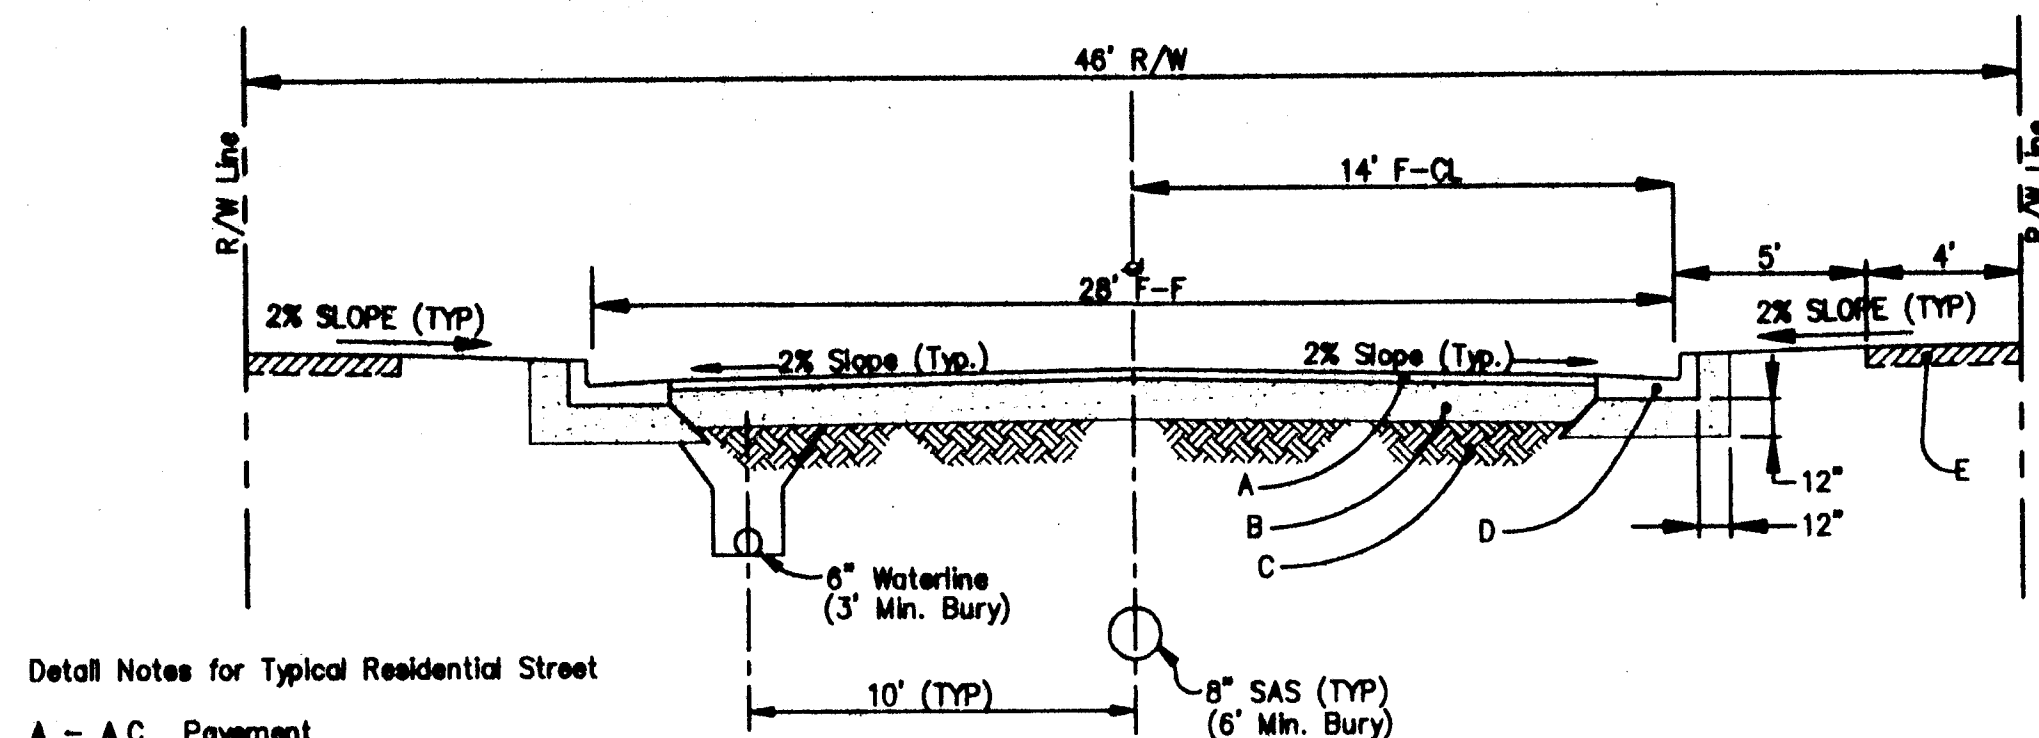


Detail Notes for Typical Residential Street
 A - A.C. Pavement
 B - 12" Compacted Subgrade Material (95% Compaction)
 C - Compacted Subgrade (90% Compaction)
 D - P.C.C. Standard Curb & Gutter per std. dwg. 2415
 E - 4" Thick by 4' Wide P.C.C. Sidewalk per std. dwg. 2430

Section A-A (28' F-F STREET WIDTH)

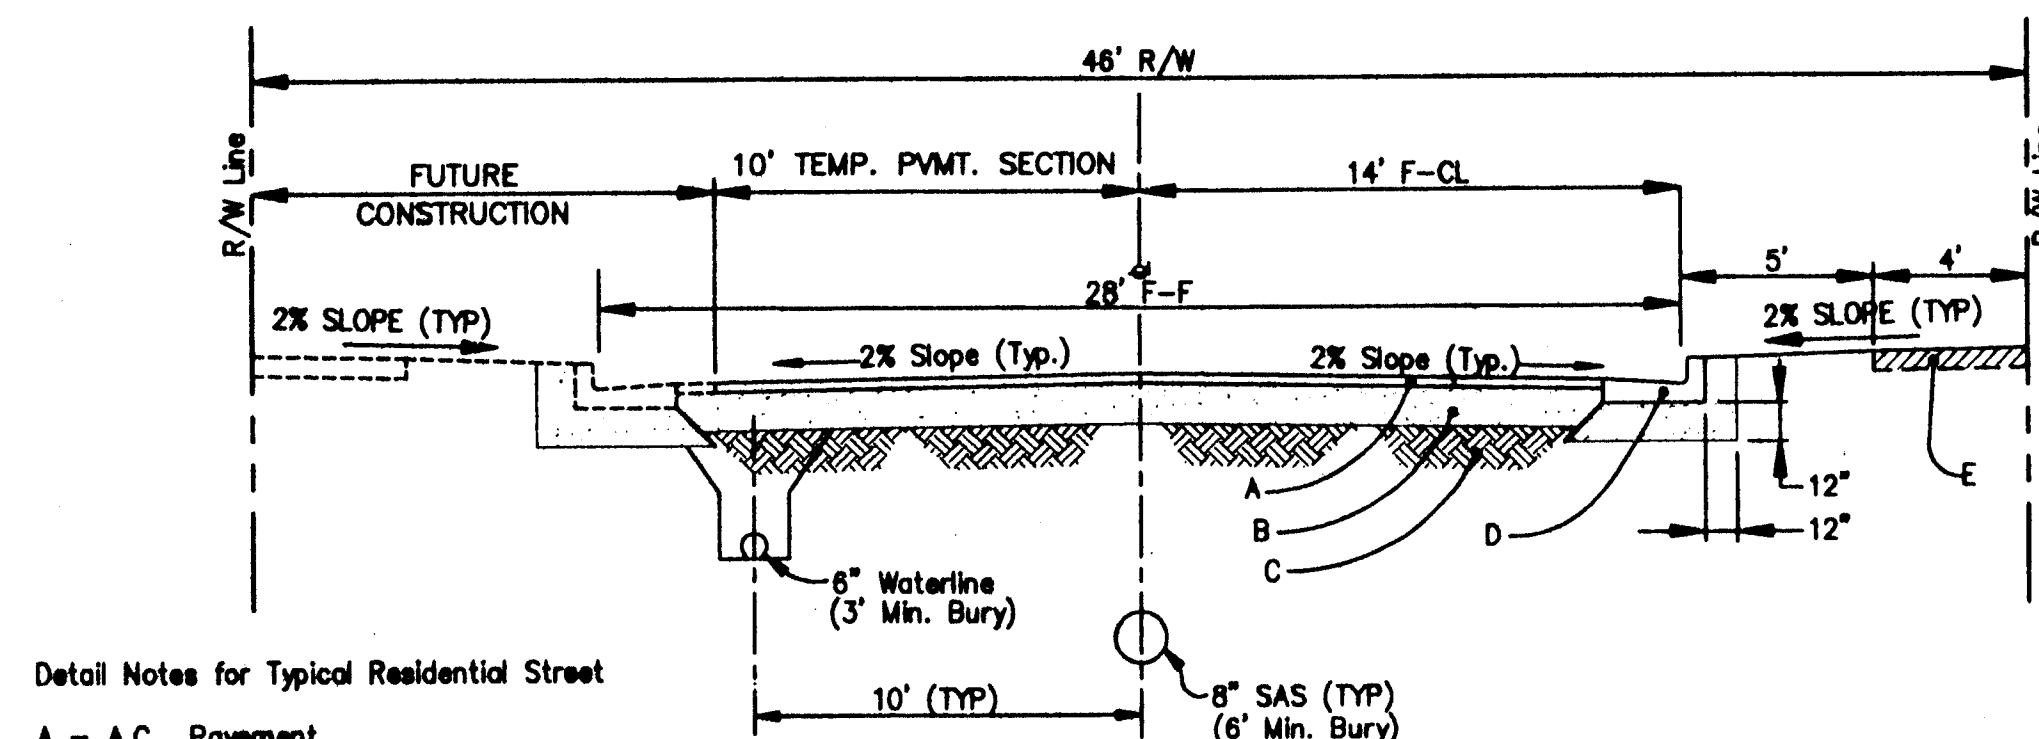


Detail Notes for Typical Residential Street
 A - A.C. Pavement
 B - 12" Compacted Subgrade Material (95% Compaction)
 C - Compacted Subgrade (90% Compaction)
 D - P.C.C. Standard Curb & Gutter per std. dwg. 2415
 E - 4" Thick by 4' Wide P.C.C. Sidewalk per std. dwg. 2430

Section B-B (28' F-F STREET WIDTH - HALF STREET)

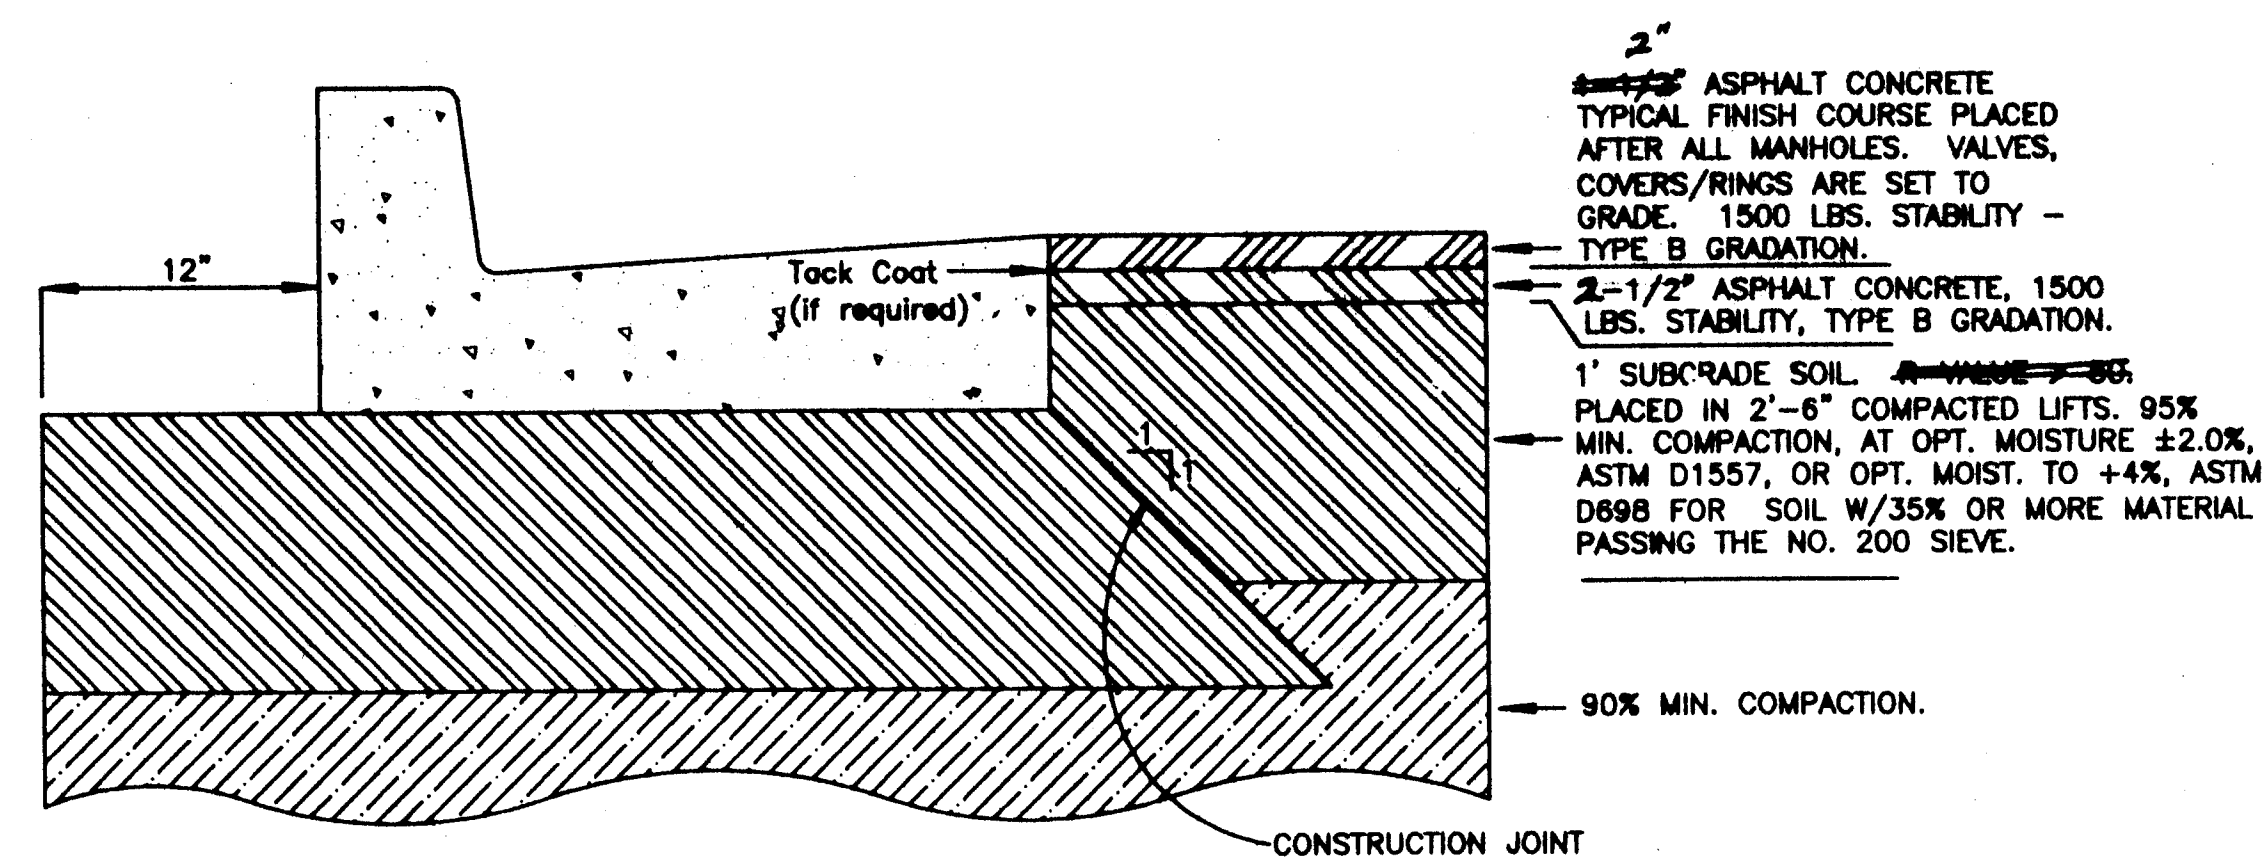

Typical Residential Street Pavement Section
 (Asphaltic Concrete Pavement)

C.O.A. STD. DWG # 2405

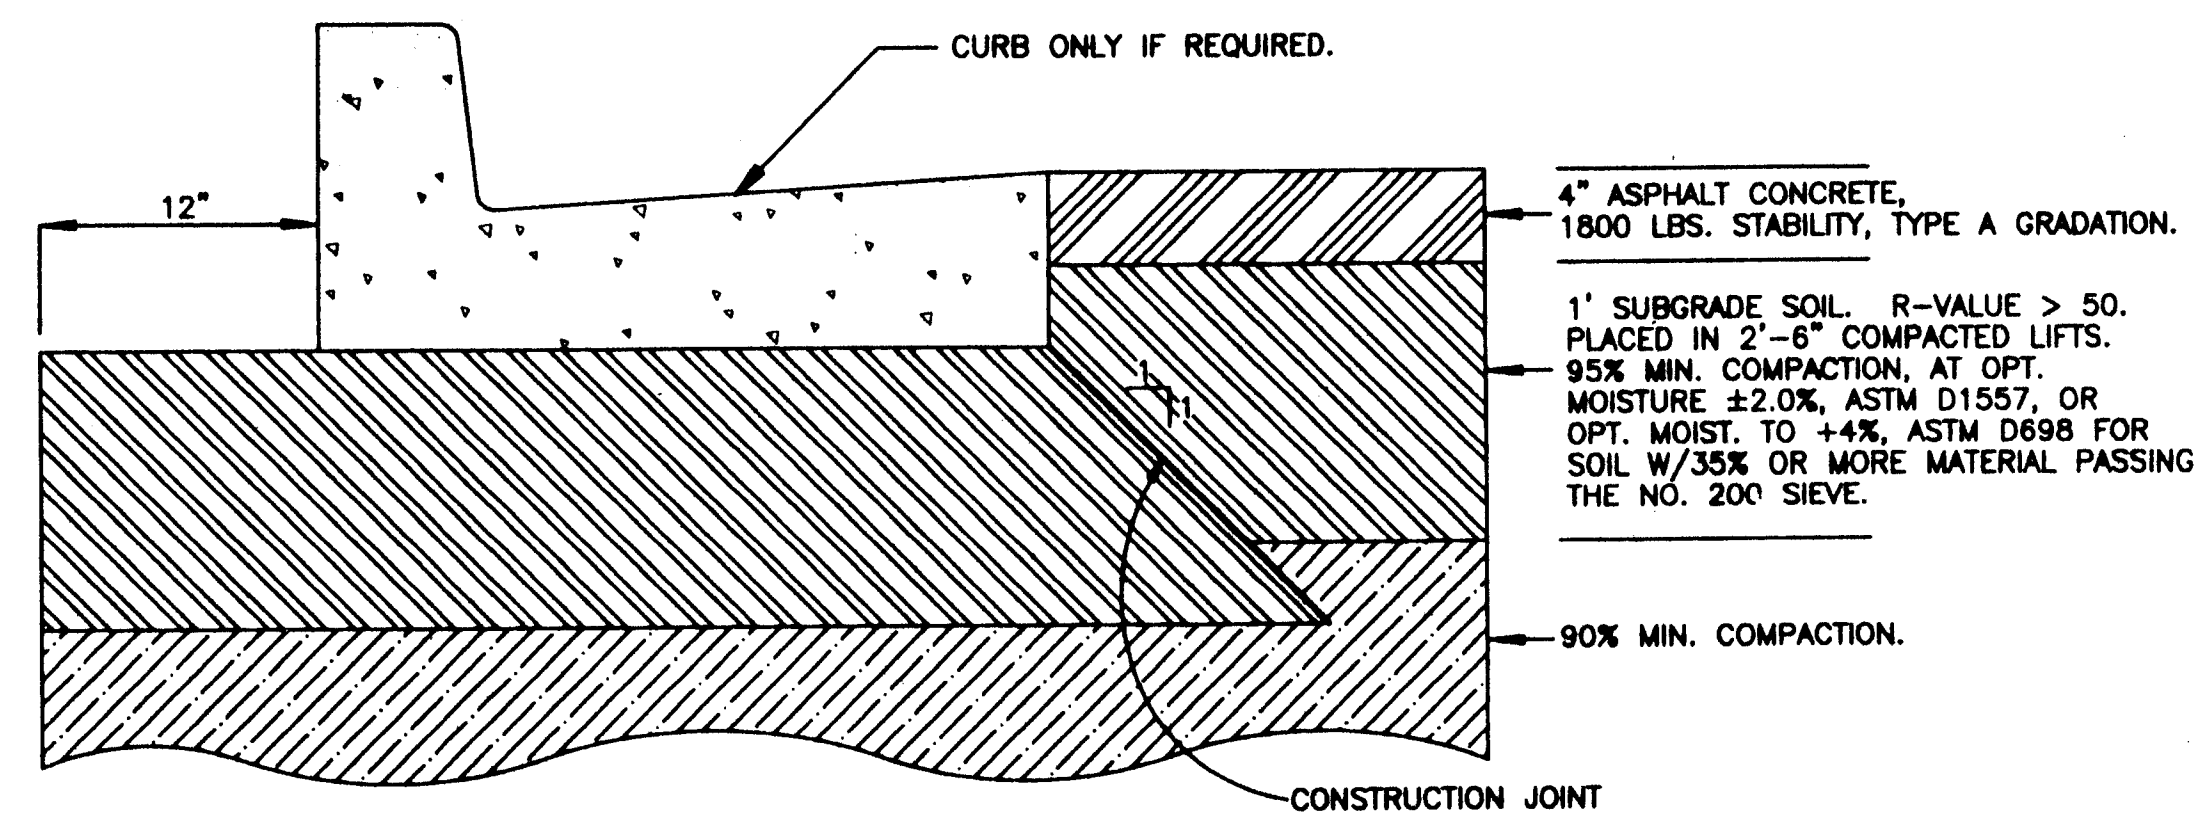

Typical Temporary Street Pavement Section
 (Asphaltic Concrete Pavement)

Pavement design based on R-Value of 50 or greater. If an R-Value of less than 50 is encountered in the field during construction, contact the Engineer for pavement redesign.

26-5252.92 17498

AS-BUILT

Tom O. Brown, P.E.

P. O. Box 92051
 Albuquerque, NM 87199
 (505) 883-8807

CITY OF ALBUQUERQUE PUBLIC WORKS DEPARTMENT ENGINEERING DEVELOPMENT GROUP	
TITLE: LA CUEVA OESTE, UNIT 3a STREET DETAILS	
DESIGNED BY: TOB	DATE: 10/97
DRAWN BY: TOB	DATE: 10/97
CHECKED BY: TOB	DATE: 10/97
REMARKS	REVISIONS
NO.	DATE
1	10/97
2	10/97
City Project No.	Zone Map No.	Sheet	Of
5232.92	C-18-Z	14	14