


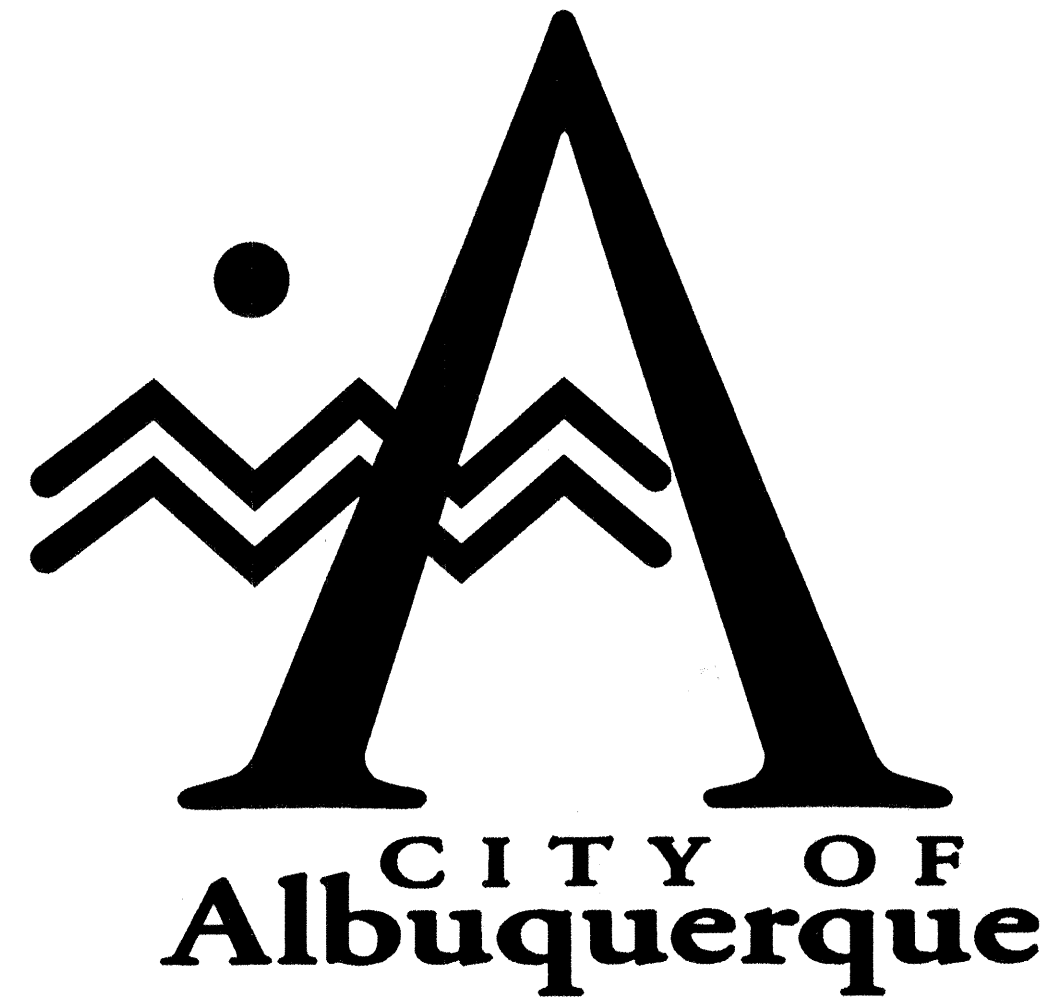

LA CUEVA OESTE

UNIT 3C

Albuquerque, New Mexico
July 1998

Prepared for:
Development Services, Ltd.
P.O. Box 30107
Albuquerque, NM 87190-0107

Prepared by:
Terry O. Brown, P.E.
P.O. Box 92051
Albuquerque, NM 87199



INDEX TO DRAWINGS

SHEET	DESCRIPTION	SHEET	DESCRIPTION
1	COVER SHEET & GENERAL NOTES	12	PAVING PLAN AND PROFILE ANAHEIM AVE. (Sta. 13+30.36 to Sta. 19+50.00)
2	PLAT	13	PAVING PLAN AND PROFILE ANAHEIM AVE. (Sta. 19+50.00 to Sta. 28+16.34)
3	PLAT	14	ANAHEIM AVE. PAVING CROSS-SECTION VIEWS
4	SITE PLAN	15	UTILITY MASTER PLAN & UTILITY TABLES
5	GRADING PLAN	16	UTILITY PLAN AND PROFILE SONRISA PL. N.E. (Sta. 11+28.27 to Sta. 17+55.18)
6	TYPICAL LOT DRAINAGE DETAILS	17	UTILITY PLAN AND PROFILE SANTA CLARITA ST. N.E. (Sta. 9+35.56 to Sta. 17+44.38)
7	PAVING MASTER PLAN	18	UTILITY PLAN AND PROFILE VILLE CT. N.E. (Sta. 8+44.00 to Sta. 14+71.32)
8	PAVING PLAN AND PROFILE SONRISA PL. N.E. (Sta. 11+28.27 to Sta. 17+55.18)	19	STREET DETAILS
9	PAVING PLAN AND PROFILE SANTA CLARITA ST. N.E. (Sta. 9+35.56 to Sta. 17+44.38)		
10	PAVING PLAN AND PROFILE VILLE CT. N.E. (Sta. 8+44.00 to Sta. 14+71.32)		
11	PAVING PLAN AND PROFILE CARMEL AVE. (Sta. 17+56.46 to Sta. 18+80.55) LADRILLO PL. (Sta. 10+00.00 to Sta. 17+32.69)		

STANDARD CITY OF ALBUQUERQUE SHEETS:
19a TYPICAL TRAFFIC CONTROL AND SIGNING EXAMPLES (REF. M.U.T.C.D.)
19b SIGNING AND CONSTRUCTION TRAFFIC CONTROL STANDARDS

I, Terry O. Brown, a registered Professional Engineer in the State of New Mexico, do hereby certify that these record drawings were prepared under my supervision based on data received from the City of Albuquerque Construction Inspector.

Terry O. Brown 4/11/99

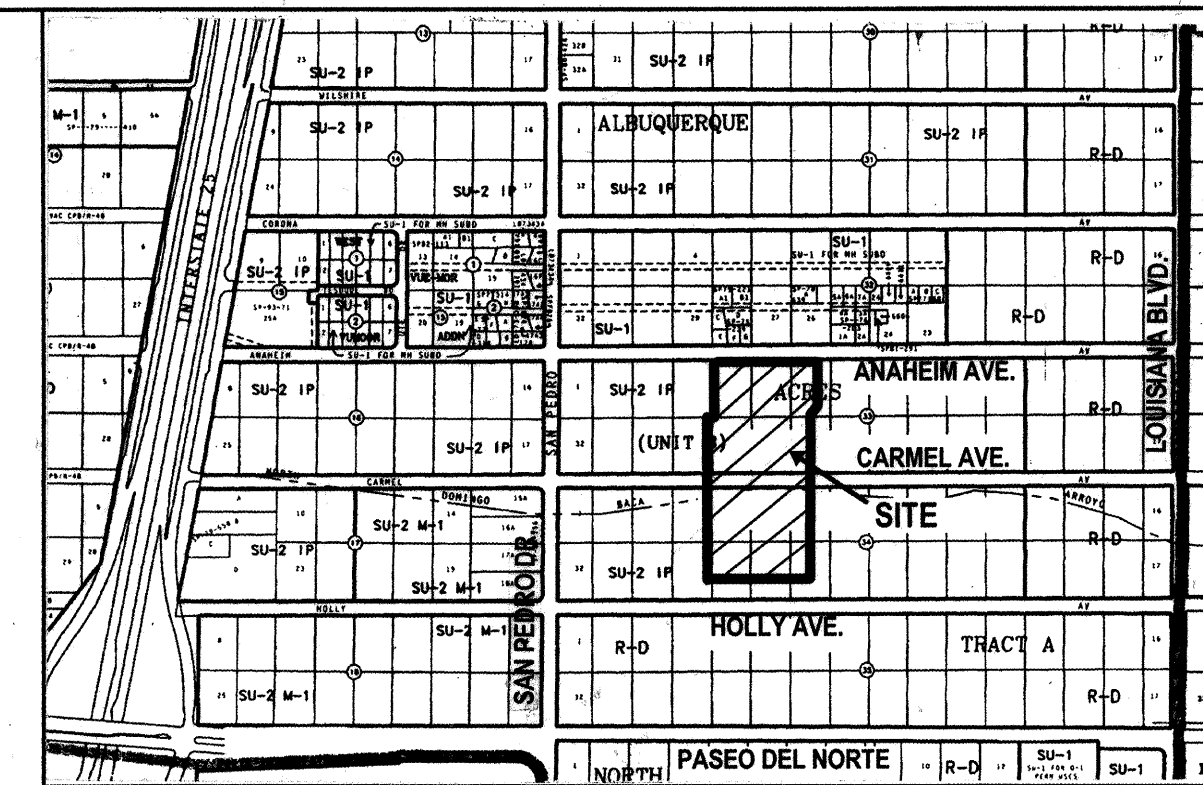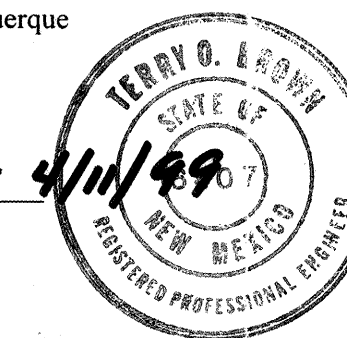

VICINITY MAP C-18-Z

GENERAL NOTES:

- CITY OF ALBUQUERQUE SPECIFICATIONS FOR PUBLIC WORKS CONSTRUCTION, 1986 EDITION AS AMENDED THROUGH UPDATE 6, WILL BE REFERRED TO HEREIN AS THE "STANDARD SPECIFICATIONS".
- TWO (2) WORKING DAYS PRIOR TO ANY EXCAVATION, CONTRACTOR SHALL CONTACT NEW MEXICO ONE CALL SYSTEM @ 260-1990 FOR LOCATION OF EXISTING UTILITIES.
- PRIOR TO CONSTRUCTION, THE CONTRACTOR SHALL EXCAVATE & VERIFY THE HORIZONTAL AND VERTICAL LOCATIONS OF ALL OBSTRUCTIONS. SHOULD A CONFLICT EXIST, THE CONTRACTOR SHALL NOTIFY THE ENGINEER OR THE SURVEYOR SO THAT THE CONFLICT CAN BE RESOLVED WITH MINIMUM DELAY.
- ALL EXISTING SIGNS, MARKERS, DELINEATORS, ETC., WITHIN THE CONSTRUCTION LIMITS SHALL BE REMOVED, STORED AND RESET BY THE CONTRACTOR.
- THE CONTRACTOR SHALL NOTIFY THE ENGINEER NOT LESS THAN SEVEN (7) DAYS PRIOR TO STARTING WORK IN ORDER THAT THE ENGINEER MAY TAKE NECESSARY MEASURES TO INSURE THE PRESERVATION OF SURVEY MONUMENTS. CONTRACTOR SHALL NOT DISTURB PERMANENT SURVEY MONUMENTS WITHOUT THE CONSENT OF THE ENGINEER AND SHALL NOTIFY THE ENGINEER AND BEAR THE EXPENSE OF REPLACING ANY THAT MAY BE DISTURBED WITHOUT PERMISSION. REPLACEMENT SHALL BE DONE ONLY BY THE CITY SURVEYOR. WHEN A CHANGE IS MADE IN THE FINISHED ELEVATIONS OF THE PAVEMENT OF ANY ROADWAY IN WHICH A PERMANENT SURVEY MONUMENT IS LOCATED, CONTRACTOR SHALL, AT HIS OWN EXPENSE, ADJUST THE MONUMENT COVER TO THE NEW GRADE UNLESS OTHERWISE SPECIFIED. REFER TO SECTION 4.4 OF THE GENERAL CONDITIONS OF THE STANDARD SPECIFICATIONS.
- FIVE (5) WORKING DAYS PRIOR TO BEGINNING CONSTRUCTION THE CONTRACTOR SHALL SUBMIT TO THE CONSTRUCTION COORDINATION DIVISION A DETAILED CONSTRUCTION SCHEDULE. TWO (2) WORKING DAYS PRIOR TO CONSTRUCTION THE CONTRACTOR SHALL OBTAIN A BARRICADING PERMIT FROM THE CONSTRUCTION COORDINATION DIVISION. CONTRACTOR SHALL NOTIFY BARRICADE ENGINEER (768-2551) PRIOR TO OCCUPYING AN INTERSECTION.
- ANY WORK OCCURRING WITHIN AN ARTERIAL ROADWAY REQUIRES 24 HOURS CONSTRUCTION.

FOR INFORMATION ONLY

AS-BUILT


Terry O. Brown, P.E.
P. O. Box 92051
Albuquerque, NM 87199
(505) 883-8807

REV.	SHEETS	CITY ENGINEER	DATE	USER DEPARTMENT	DATE	USER DEPARTMENT	DATE
ENGINEER'S STAMP & SIGNATURE	APPROVALS	ENGINEER	DATE	*****	APPROVED FOR CONSTRUCTION		
	DRC Chairman	<i>Billy G. Goodley</i>	10-5-98				
	Transportation	<i>R.W. Kame</i>	9-25-98				
	Water/Wastewater	<i>R.W. Kame</i>	9-2-98				
	Hydrology	<i>John Delaney</i>	9-23-98				
	C.I.P.						
Constr. Mngmt.							
Constr. Coord.		<i>John Delaney</i>	8-17-98				
City Project No.							

DRB CASE #97-293

5232.94

Sheet 1 Of 19

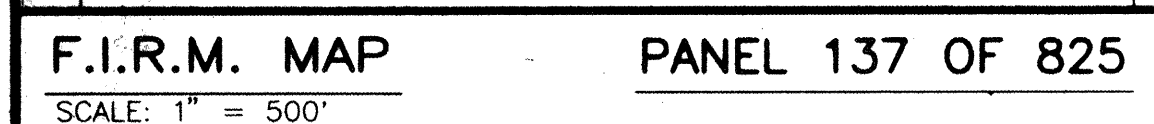

A certain tract of land located within the Corporate Limits of the City of Albuquerque, New Mexico, comprising Lots 3-11, inclusive, Lots 22-29, inclusive, Block 33, and Lots 4-13, inclusive, Lots 20-26, inclusive, Block 34, Tract A, Unit B, North Albuquerque Acres as the same are shown on the plat filed in the office of the County Clerk of Bernalillo County, New Mexico on April 24, 1935, Book D, Page 130.

- (A) FOUND REBAR W/CAP STAMPED "LS 10042",
TAGGED W/ WASHER STAMPED "NMPS 11184"
- (B) FOUND #5 REBAR (NO I.D.), TAGGED WITH
WASHER STAMPED "NMPS 11184"
- (C) FOUND REBAR W/CAP (NO I.D.), TAGGED
WITH WASHER STAMPED "NMPS 11184"
- (D) FOUND REBAR W/CAP STAMPED "NEW MEXICO
PS 11184"
- (E) SET #5 REBAR W/CAP STAMPED "NEW MEXICO
PS 11184"

- ① 10' PUBLIC UTILITY EASEMENT GRANTED BY THIS PLAT
- ② 20' PUBLIC DRAINAGE EASEMENT GRANTED BY THIS PLAT
- ③ 25' NON-VEHICULAR PRIVATE ACCESS AND PUBLIC UTILITY EASEMENT GRANTED BY THIS PLAT
- ④ PEDESTRIAN ACCESS EASEMENT GRANTED BY THIS PLAT
- ⑤ 5' PRIVATE DRAINAGE EASEMENT GRANTED BY THIS PLAT
- ⑥ 25' NON-VEHICULAR PRIVATE ACCESS, PUBLIC STORM DRAINAGE, PUBLIC SANITARY SEWER AND PUBLIC UTILITY EASEMENT GRANTED BY THIS PLAT
- ⑦ PRIVATE LANDSCAPE EASEMENT GRANTED BY THIS PLAT
- ⑧ 4' VACATION OF A PORTION OF ANAHEIM AVENUE N.E. BY V-96-11
- ⑨ 2' VACATION OF A PORTION OF HOLLY AVENUE N.E. BY V-96-11
- ⑩ VACATION OF A PORTION OF CARMEL AVENUE N.E. BY V-96-11

1. A boundary survey was performed in April, 1997 to determine the perimeter of the property to be platted. Property corners were found or set as indicated.
2. All distances are ground distances.
3. Site located within projected Section 13, Township 11 North, Range 3 East, N.M.P.M.
4. Bearings shown hereon are New Mexico State Plane Grid Bearings, Central Zone.
5. Street mileage created by this plat = 1.26 miles (full-width) and 0.06 miles (half-width).
6. Upon completion of the construction of the streets, City of Albuquerque approved centerline monuments shall be placed at all intersections or as otherwise indicated in lieu of subdivision block corner monumentation. Location of said monuments are designated with a "C" symbol.
7. Manholes will be offset at points of curvature, points of tangency, street intersections, and other angle points where practical to allow use of centerline monumentation.

Wendell C. Mel
City Surveyor, City of Albuquerque

052297
Date

DRAINAGE NOTE:
A portion of this subdivision is within a 100-year flood plain as shown on the National Flood Insurance Program "Flood Insurance Rate Map". A Letter of Map Revision (LOMR) will be requested from the Federal Emergency Management Agency (FEMA) to remove the existing flood plain. Until the LOMR is issued by FEMA, property owners may be required to purchase flood insurance.



LINE	DIRECTION	DISTANCE
BL1	N 0°11'27.2" W	60.00'
L1	N 89°39'54" W	11.05'
L2	S 89°39'30" E	49.87'
L3	S 89°40'12" E	13.70'
L4	N 89°39'30" W	13.12'
L5	S 89°39'30" E	13.12'
L6	N 00°20'29" E	11.00'
L7	S 89°39'31" E	9.18'
L8	N 00°20'29" E	1.11'
L9	S 00°20'29" W	1.48'
L10	N 00°20'29" E	5.14'
L11	N 60°25'07" E	20.73'
L12	N 00°20'29" E	26.00'
L13	S 89°39'31" E	7.04'
L14	N 00°21'54" E	39.00'
L15	N 00°09'02" E	26.19'
L16	S 89°47'47" E	3.24'
L17	N 00°21'55" E	31.16'
L18	N 89°39'31" W	2.18'
L19	S 00°20'29" W	13.00'
L20	N 00°13'14" W	16.25'
L21	N 00°13'14" W	21.63'
L22	S 01°17'27" E	6.48'
L23	N 00°05'29" E (NR)	14.44'
L24	S 00°13'14" E	23.12'
L25	S 00°07'42" W	22.78'
L26	N 00°07'42" E	29.46'
L27	N 89°40'06" W	19.82'
L28	N 00°07'42" W	5.54'
L29	N 00°13'14" W	15.76'
L30	N 01°17'27" W	7.51'
L31	N 00°20'29" E	6.33'
L32	N 88°40'52" E	34.51'
L33	S 89°39'31" E	16.09'
L34	N 00°20'29" E	1.48'

CURVE	RADIUS	LENGTH	CHORD	CH. BEARING	DELTA
CL1	NOT USED				
CL2	NOT USED				
CL3	378.75'	75.50'	75.37'	N 83°56'52" W	11°25'16"
CL4	378.75'	75.50'	75.37'	S 83°56'52" E	11°25'16"
CL5	378.72'	75.50'	75.37'	N 84°37'50" E	11°25'18"
CL6	378.72'	75.50'	75.37'	N 84°37'50" E	11°25'18"
CL7	75.00'	117.81'	106.07'	S 44°39'31" E	90°00'00"
CL8	279.02'	47.30'	47.25'	S 84°48'48" E	09°42'48"
CL9	279.02'	47.30'	47.25'	N 84°48'48" W	09°42'48"
CL10	75.00'	117.81'	106.07'	N 44°39'31" W	90°00'00"
C1	25.00'	0.68'	0.68'	N 88°53'58" W	01°32'56"
C2	45.00'	36.36'	35.38'	S 64°59'32" E	46°17'24"
C3	25.00'	20.19'	19.65'	S 64°59'04" E	46°16'24"
C4	45.00'	38.43'	37.27'	N 67°23'58" E	48°55'36"
C5	45.00'	38.49'	37.32'	N 18°26'07" E	49°00'05"
C6	45.00'	38.27'	37.13'	S 30°25'50" E	48°43'48"
C7	45.00'	43.29'	41.64'	N 82°21'15" W	55°07'03"
C8	45.00'	21.66'	21.45'	N 56°17'50" E	27°34'47"
C9	25.00'	20.87'	20.27'	S 66°25'07" W	47°49'21"
C10	25.00'	39.27'	35.36'	S 44°39'51" E	90°00'42"
C11	25.00'	39.27'	35.36'	N 45°20'30" E	90°00'00"
C12	25.00'	20.87'	20.27'	S 65°44'49" E	47°49'21"
C13	45.00'	22.27'	22.05'	N 56°00'59" W	28°21'41"
C14	45.00'	45.39'	43.49'	N 80°54'22" E	57°47'37"
C15	45.00'	40.58'	39.22'	N 26°10'32" E	51°40'04"
C16	45.00'	40.58'	39.22'	N 25°29'33" S	51°40'04"
C17	45.00'	45.39'	43.49'	S 30°13'52" E	57°47'37"
C18	45.00'	22.27'	22.05'	N 56°41'58" E	28°21'40"
C19	25.00'	20.87'	20.27'	S 66°25'49" W	47°49'21"
C20	25.00'	39.27'	35.36'	S 44°39'30" E	90°00'00"
C21	25.00'	39.27'	35.36'	N 45°20'47" E	90°00'35"
C22	25.00'	39.26'	35.35'	N 45°20'09" E	89°59'18"
C23	256.02'	36.87'	36.84'	S 85°32'40" E	08°15'04"
C24	52.00'	81.68'	73.54'	N 44°39'30" W	89°59'59"
C25	25.00'	39.27'	35.36'	N 45°20'29" E	90°00'00"
C26	25.00'	39.27'	35.36'	N 44°39'51" W	90°00'42"
C27	302.02'	51.20'	51.14'	S 84°48'48" E	09°42'48"
C28	256.02'	6.53'	6.53'	N 80°41'16" W	01°27'44"
C29	401.72'	14.82'	14.82'	N 89°17'04" E	02°06'51"
C30	40.00'	29.19'	28.55'	N 79°02'46" E	41°49'04"
C31	25.00'	14.05'	13.87'	N 74°14'22" E	32°12'15"
C32	40.00'	39.85'	38.22'	S 51°30'23" E	57°04'39"
C33	40.00'	38.76'	37.26'	N 04°47'21" E	55°30'48"
C34	25.00'	14.05'	13.87'	N 16°26'37" E	32°12'15"
C35	25.00'	39.27'	35.35'	S 44°39'15" E	89°59'25"
C36	25.00'	39.26'	35.35'	N 45°20'09" E	89°59'18"
C37	25.00'	42.91'	37.83'	S 48°49'22" E	98°20'43"
C38	355.72'	19.10'	19.10'	N 80°27'29" E	03°04'35"
C39	401.72'	23.40'	23.40'	N 80°35'19" E	03°20'14"
C40	NOT USED				
C41	NOT USED				
C42	25.00'	39.27'	35.36'	S 44°39'31" E	90°00'00"
C43	25.00'	39.27'	35.36'	N 45°20'29" E	90°00'00"
C44	25.00'	39.27'	35.36'	S 44°39'31" E	90°00'00"
C45	98.00'	51.92'	51.31'	N 14°50'06" W	30°21'11"
C46	98.00'	102.02'	97.48'	S 59°50'06" E	59°38'49"
C47	25.00'	39.27'	35.36'	S 44°39'31" E	90°00'00"

CURVE	RADIUS	LENGTH	CHORD	CH. BEARING	DELTA
C48	401.72'	60.44'	60.38'	N 83°53'03" E	08°37'11"
C49	401.72'	4.82'	4.82'	S 78°15'49" W	0°04'11"
C50	355.72'	43.71'	43.68'	N 82°26'24" E	0°02'25"
C51	355.72'	27.20'	27.19'	S 88°09'03" W	04°22'53"
C52	355.72'	22.99'	22.99'	S 86°12'07" E	06°54'47"
C53	355.75'	22.99'	22.98'	S 80°29'29" E	04°30'29"
C54	401.75'	17.65'	17.65'	S 79°29'46" E	02°31'03"
C55	401.75'	45.25'	45.22'	N 83°58'52" W	06°27'10"
C56	401.75'	17.19'	17.18'	N 88°25'59" W	02°27'03"
C57	NOT USED				
C58	NOT USED				
C59	NOT USED				
C60	401.72'	55.19'	55.14'	N 86°11'34" E	0°52'17"
C61	401.72'	1.49'	1.49'	S 89°45'54" E	0°01'24"
C62	401.75'	22.01'	22.01'	S 88°05'20" E	03°08'21"
C63	401.75'	50.38'	50.35'	S 82°55'37" E	0°27'11"
C64	401.75'	7.69'	7.69'	S 78°47'09" E	0°05'50"
C65	355.75'	19.10'	19.10'	S 79°46'32" E	03°04'36"
C66	25.00'	42.91'	37.83'	N 49°30'50" E	98°20'40"
C67	52.00'	81.68'	73.54'	S 44°39'31" E	90°00'00"
C68	25.00'	39.27'	35.36'	N 45°20'29" E	90°00'00"
C69	NOT USED				
C70	25.00'	19.06'	18.61'	S 21°30'14" E	43°41'27"
C71	40.00'	29.13'	28.49'	S 22°29'20" E	41°43'16"
C72	40.00'	32.10'	31.25'	S 21°21'51" W	45°59'06"
C73	40.00'	32.10'	31.25'	S 67°20'57" W	45°59'06"
C74	40.00'	33.65'	32.67'	N 65°33'25" W	48°12'11"
C75	40.00'	30.55'	29.82'	N 19°34'19" W	43°46'00"
C76	40.00'	29.13'	28.49'	S 23°10'19" E	41°43'16"
C77	25.00'	19.06'	18.61'	N 22°11'13" E	43°41'27"
C78	25.00'	39.27'	35.36'	S 44°39'51" W	90°00'42"
C79	25.00'	39.02'	35.18'	S 44°56'22" E	89°26'17"
C80	NOT USED				
C81	25.00'	39.52'	35.53'	S 45°03'38" W	90°33'43"
C82	25.00'	39.28'	35.36'	N 44°38'48" W	90°01'24"
C83	25.00'	2.17'	2.17'	N 02°51'13" E	04°58'37"
C84	25.00'	13.92'	13.74'	N 21°17'18" E	31°53'35"
C85	40.00'	35.00'	33.89'	N 12°10'15" E	50°07'42"
C86	40.00'	50.88'	47.52'	S 49°19'58" E	72°52'43"
C87	40.00'	56.30'	51.77'	S 53°54'19" W	80°38'42"
C88	40.00'	42.32'	40.37'	S 16°43'27" E	60°36'51"
C89	25.00'	9.29'	9.24'	S 36°22'51" E	21°18'03"
C90	25.00'	11.39'	11.29'	N 12°40'58" W	26°05'44"
C91	25.00'	39.26'	35.35'	N 45°21'12" E	89°58'35"
C92	25.00'	39.02'	35.18'	N 44°56'22" W	89°26'17"
C93	25.00'	39.36'	35.42'	S 45°14'06" E	90°12'48"
C94	25.00'	39.52'	35.53'	S 45°03'38" E	90°33'44"
C95	NOT USED				
C96	25.00'	39.18'	35.29'	N 44°45'24" E	89°47'12"
C97	25.00'	39.31'	35.38'	S 45°23'13" W	90°05'27"
C98	302.02'	22.39'	22.38'	S 87°32'47" E	04°14'50"
C99	302.02'	28.81'	28.80'	S 82°41'23" E	05°27'58"
C100	256.02'	31.61'	31.59'	N 83°29'39" W	07°04'30"
C101	256.02'	11.79'	11.79'	N 88°21'03" W	02°38'19"
C102	256.02'	39.26'	35.35'	N 45°20'09" E	89°59'18"
C103	25.00'	39.23'	35.33'	S 44°36'47" E	89°54'33"

SCANNED BY
MESA REPRO

AS-BUILT

FOR INFORMATION ONLY

SURVEYORS CERTIFICATION

I, Charles G. Colo, Jr., a registered Professional Surveyor under the laws of the State of New Mexico, do hereby certify that I am the conductor and am responsible for this plat, that all measurements were made by me or under my direct supervision, that I am duly qualified to make the same, that I am not known to be in any interest in the land surveyed, that I am not a partner, agent, or employee of anyone known to be the owner, utility companies, or other parties expressing an interest; meets the minimum requirement for Monumentation and surveys of the Albuquerque Subdivision Ordinance; complies with the minimum standards for surveying in the State of New Mexico, and is true and correct to the best of my knowledge and belief.

Charles G. Cala, Jr., NMPS 11184



5-21-1997

Date _____

Sheet

2^{Of} 19

JOB NO.

961193

761173

DATE 05-1997

03-1997

SHEET 11 OF 26

	1	2	3	466
--	---	---	---	---	---	---	---	---	---	----	----	-----	-----	




JEFF MORTENSEN & ASSOCIATES, INC.
☐ 6010-B MIDWAY PARK BLVD. N.E.
☐ ALBUQUERQUE ☐ NEW MEXICO 87109
☐ ENGINEERS ☐ SURVEYORS (505) 345-4250

PRELIMINARY MASTER PLAN PLAT

LA CUEVA OESTE UNITS 2, 3a, 3b, 3c AND 4

DESIGNED BY	T.O.B.	NO.	DATE	BY	REVISIONS	JOB NO.	961193
SURVEYED BY	R.J.E.					DATE	05-1997
DRAWN BY	T.N.T.					SHEET	X OF 2
APPROVED BY	C.G.C.						

ALL LOTS CREATED BY THIS
PLAT SHALL HAVE A P1
DESIGNATION.

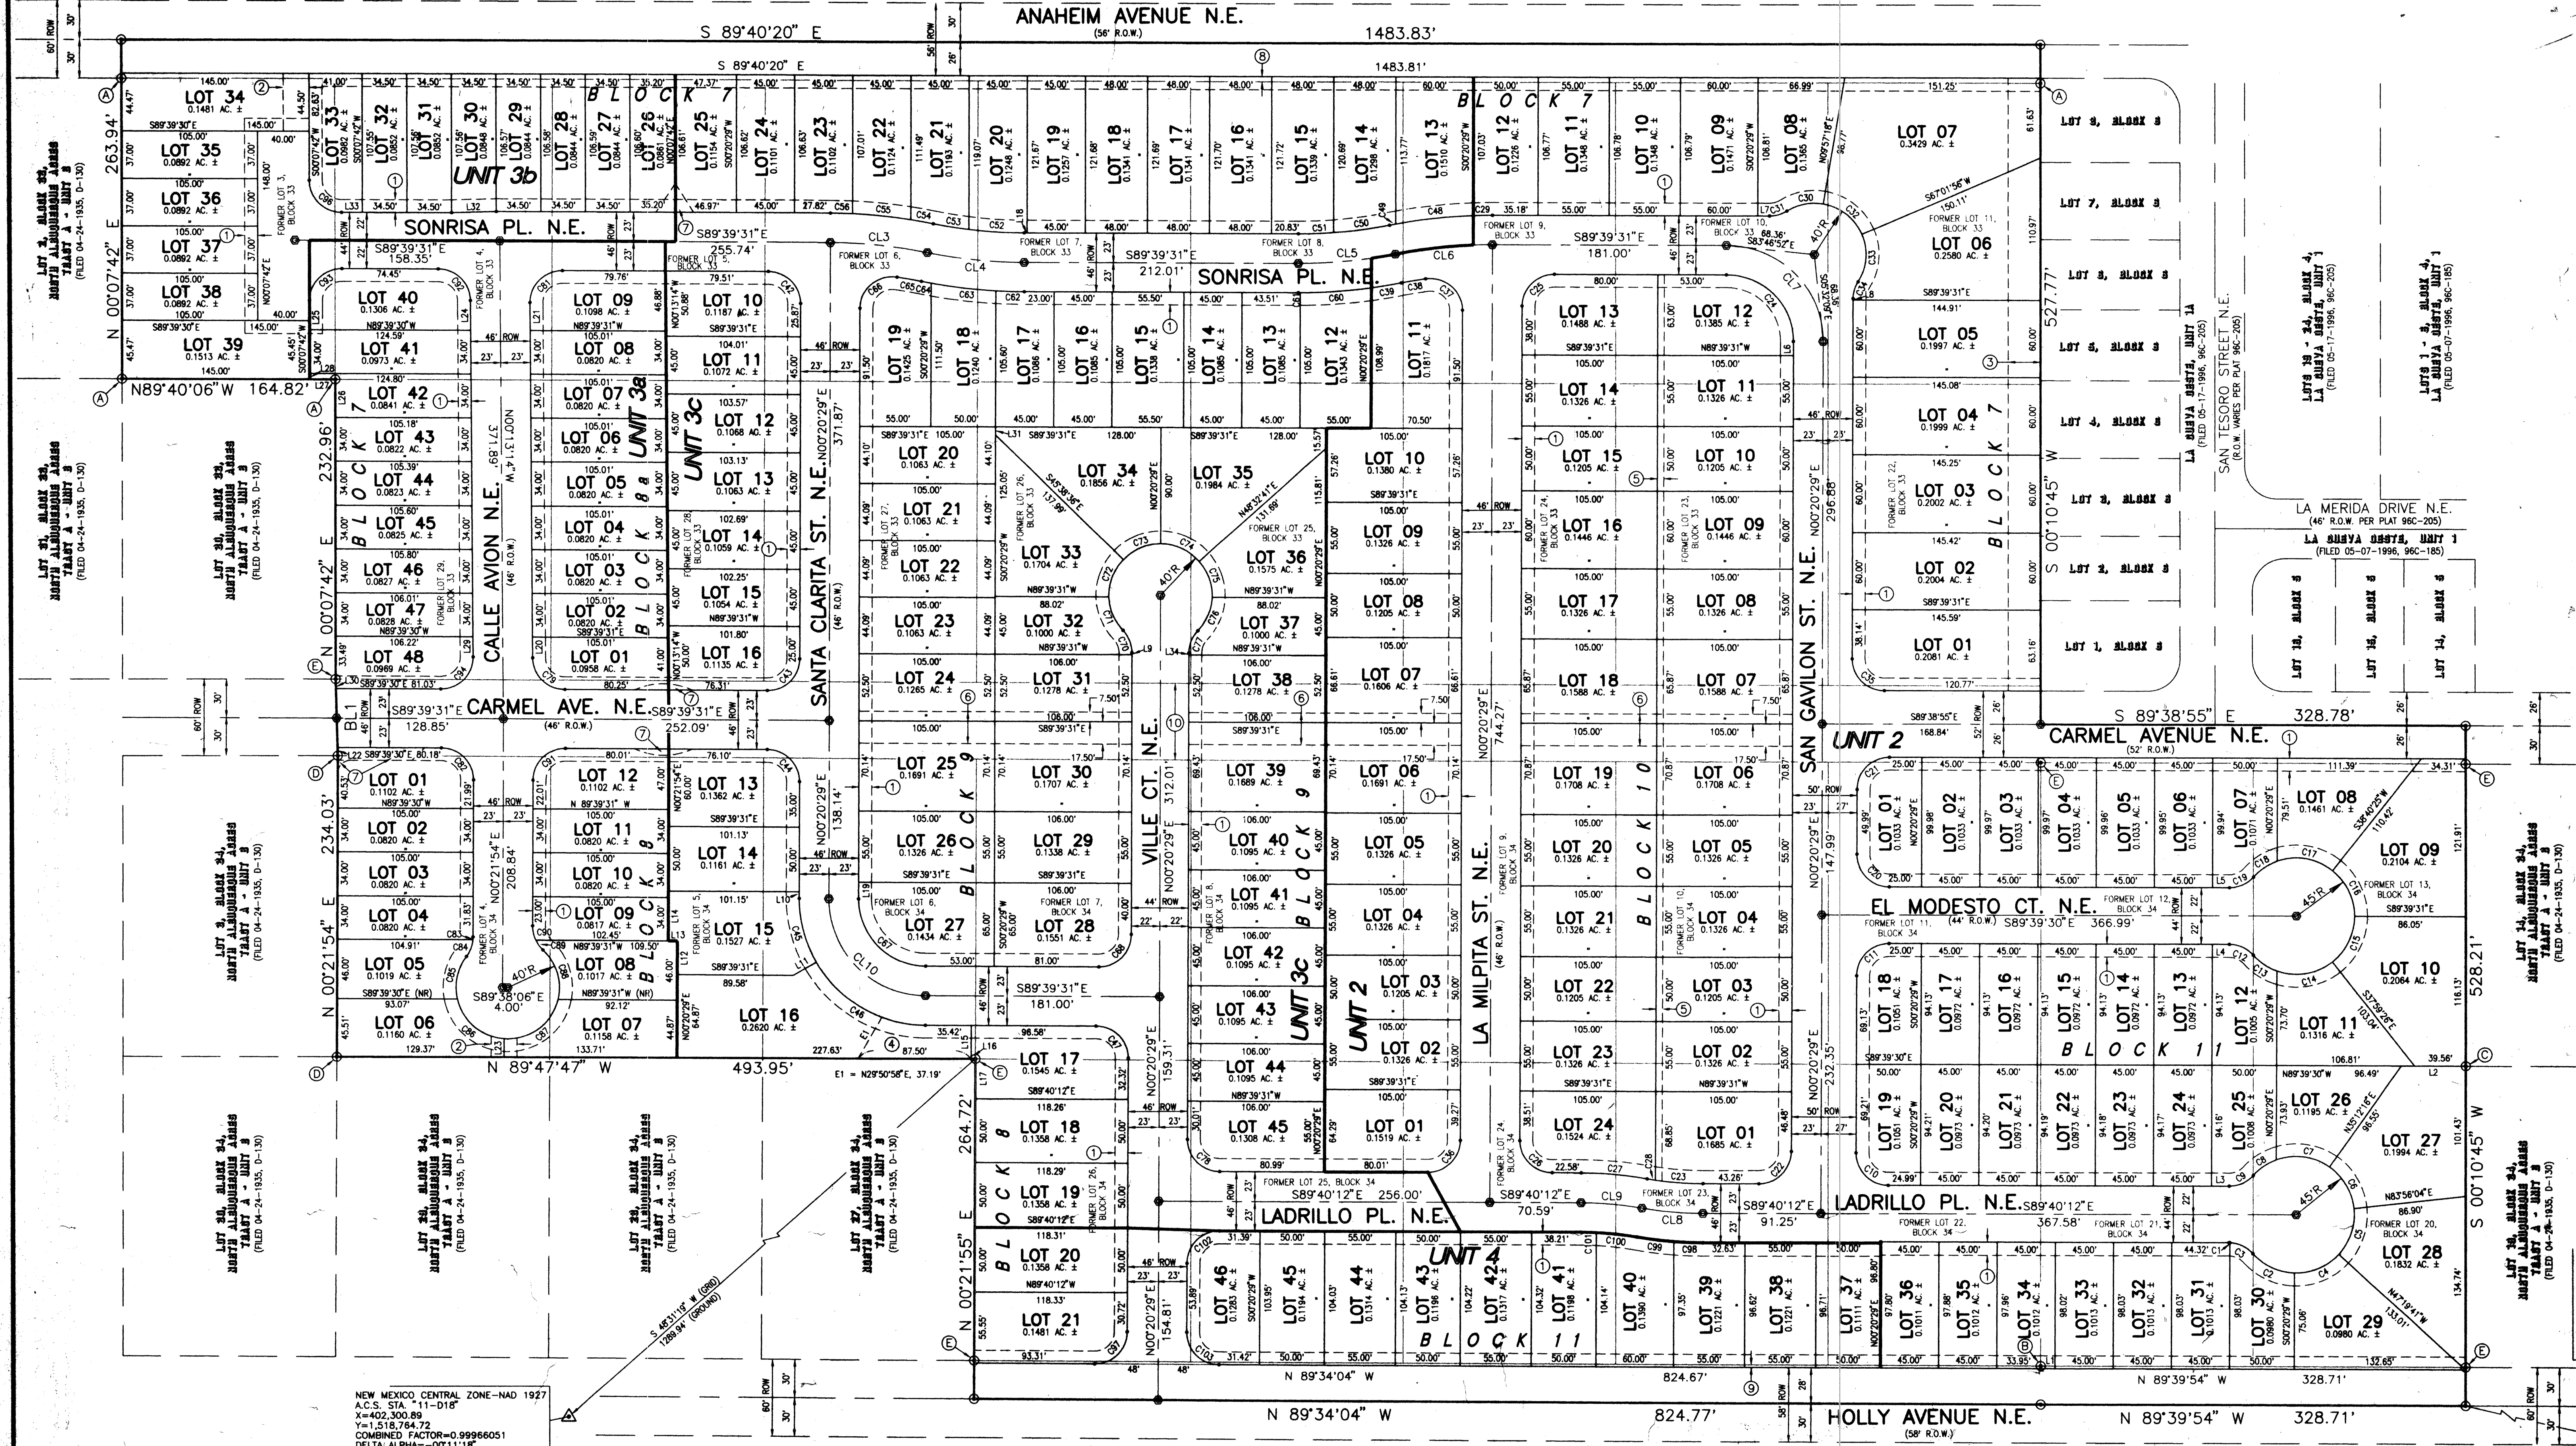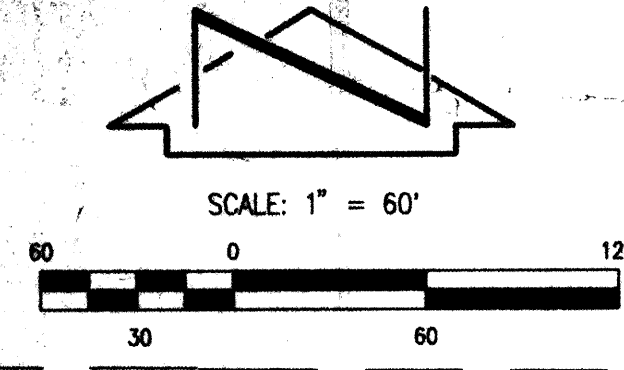

NEW MEXICO CENTRAL ZONE-NAD 1927
A.C.S. STA. 11-D18
X=402,300.89
Y=518,764.72
COMBINED FACTOR=0.99966051
DELTA ALPHA=-00'11.18"

NEW MEXICO CENTRAL ZONE-NAD 1927
N.G.S. STA. "HEAVY"
X=402,300.89
Y=518,764.72
COMBINED FACTOR=0.99966051
DELTA ALPHA=-00'11.18"



JEFF MORTENSEN & ASSOCIATES, INC.
4000 S. MIDWAY PARK BLVD. N.E.
ALBUQUERQUE, N.M. 87109
ENGINEERS & SURVEYORS (505) 345-4250


PRELIMINARY MASTER PLAN PLAT
LA CUEVA OESTE UNITS 2, 3a, 3b, 3c AND 4

FOR INFORMATION ONLY AS-BUILT



DESIGNED BY	NO.	DATE	BY	REVISIONS	JOB NO.
T.O.B.					961198
SURVEYED BY					DATE
R.J.E.					05-1997
DRAWN BY					SHEET
T.N.T.					2 OF 2
APPROVED BY					
C.G.C.					

SCANNED BY
MESA REPORT

C:\P\LA CUEVA OESTE\AS-BUILT\LA CUEVA OESTE (AS-BUILT).DWG
05-05-97 15:00:00

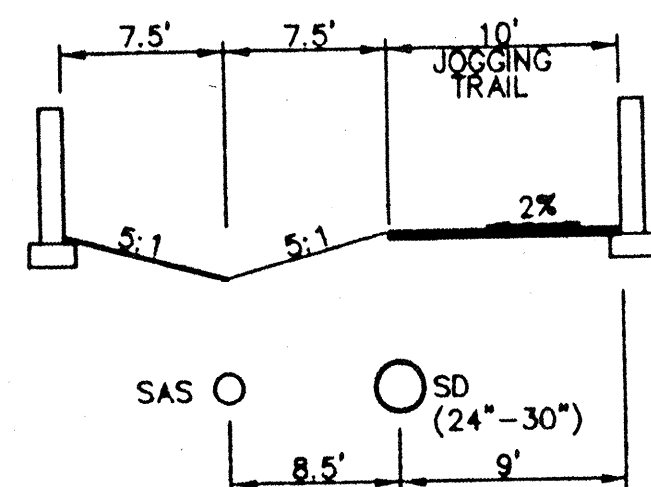

SECTION A-A
NO SCALE

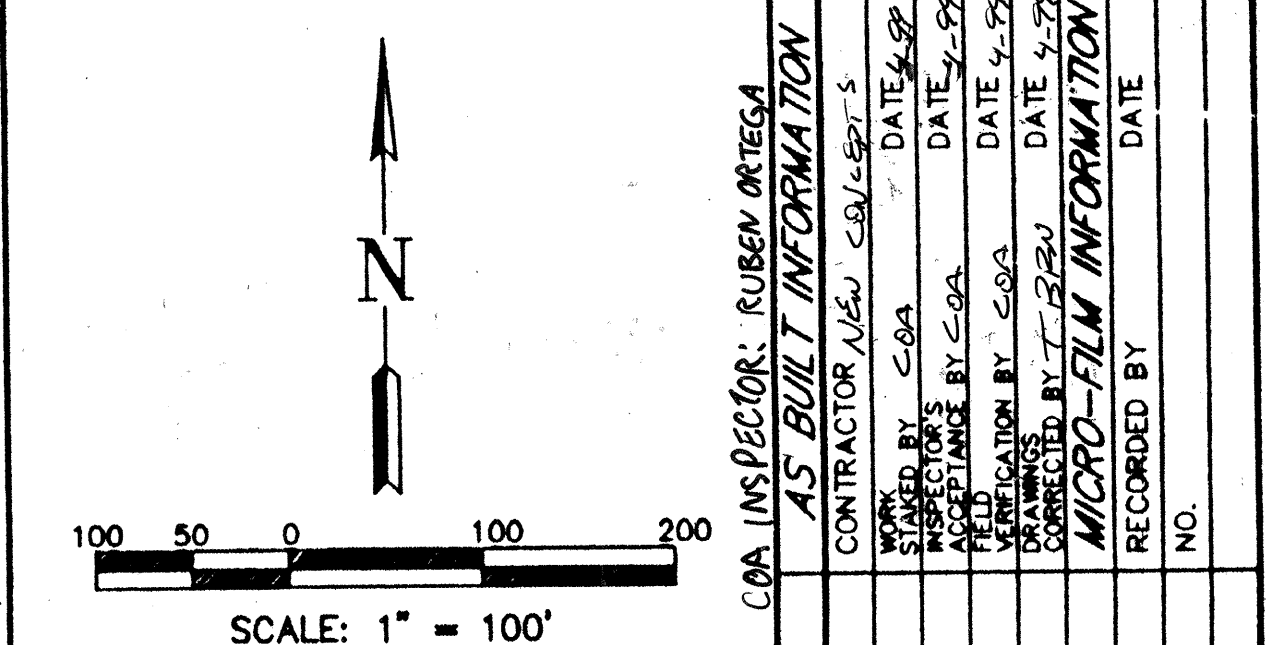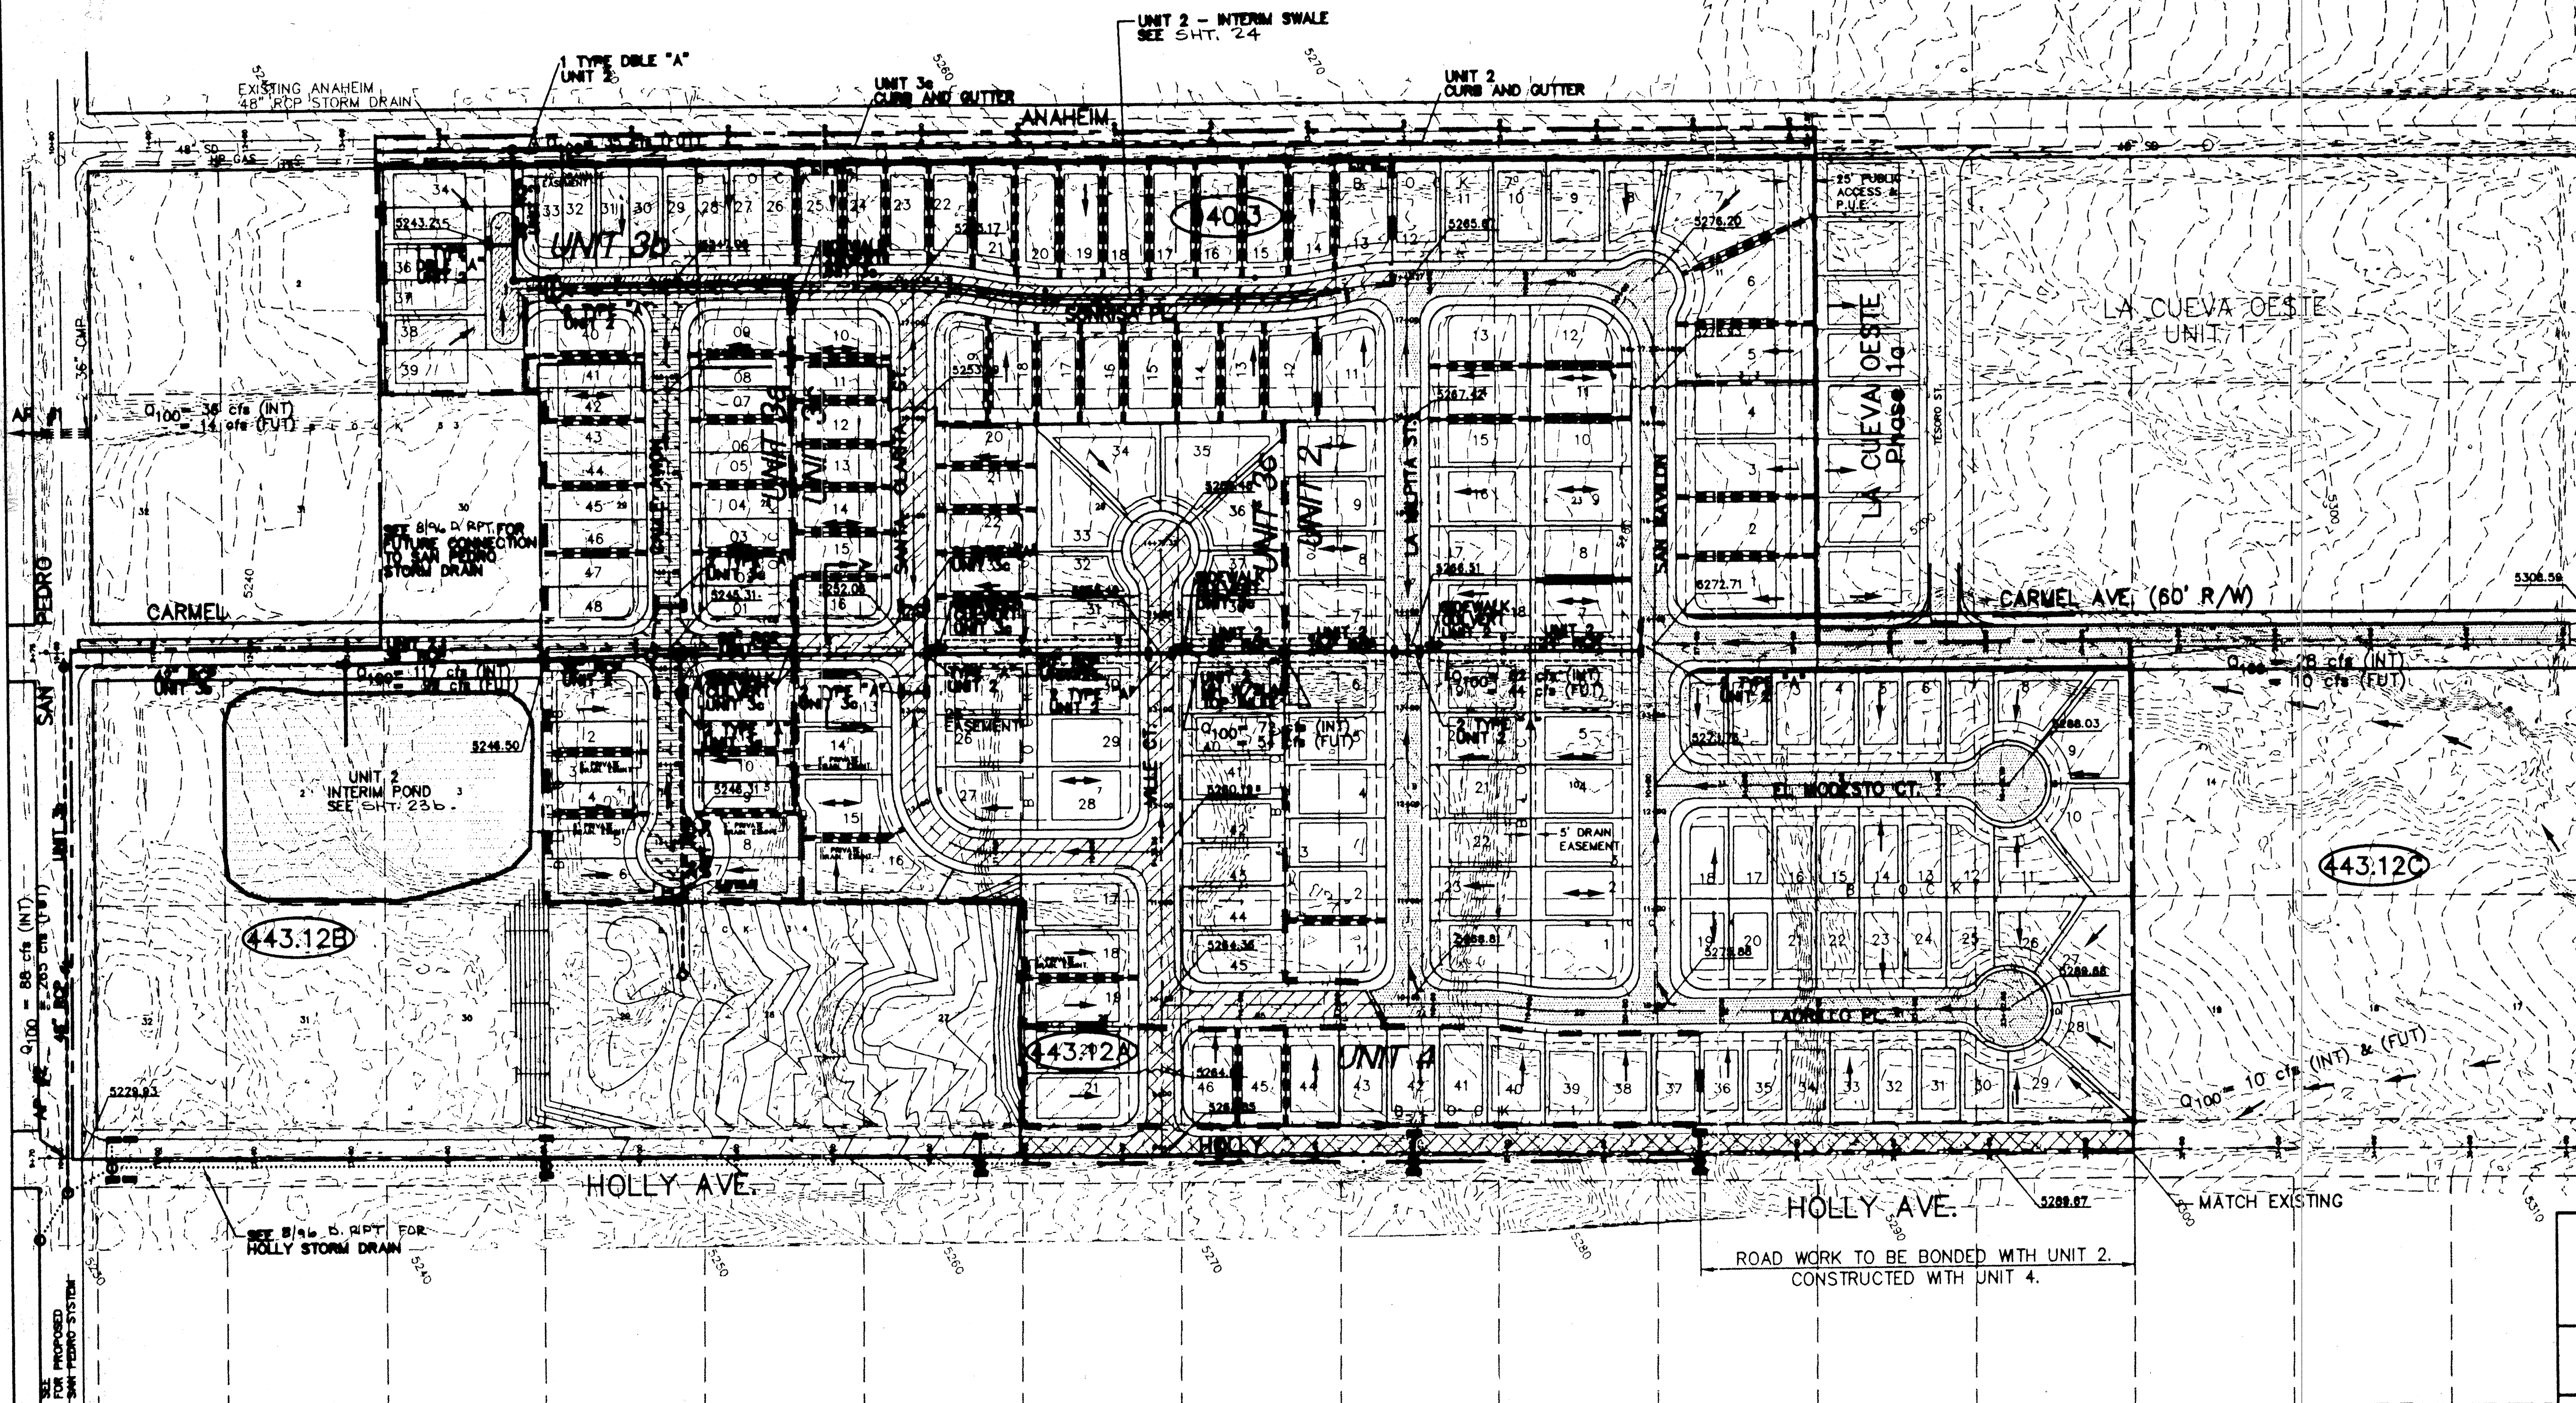

LEGEND	
UNIT 2 PAVING	[Pattern]
UNIT 3a PAVING	[Pattern]
UNIT 3b PAVING	[Pattern]
UNIT 3c PAVING	[Pattern]
UNIT 4 PAVING	[Pattern]
UNIT 2 STORM DRAIN	[Pattern]
UNIT 3 STORM DRAIN	[Pattern]
UNIT 4 STORM DRAIN	[Pattern]
STORM DRAIN BY OTHERS	[Pattern]
FLOW ARROW	[Arrow]
UNIT BOUNDARY	[Line]
DRAINAGE BASIN BOUNDARY	[Line]
BASIN DESIGNATION	940.2

- NOTES:
- FOR UNIT 2 FINISHED PAD AND RETAINING WALL ELEVATIONS, SEE SHT 4.
 - FOR UNIT 3 FINISHED PAD AND RETAINING WALL ELEVATIONS, SEE SHT 4a.
 - FOR TYPICAL LOT DRAINAGE DETAILS, SEE SHTS 5 AND 5a.
 - FOR PRIVATE DRAINAGE EASEMENT LOCATIONS, SEE SHTS. 4 AND 4a.
 - FOR CARMEL STORM DRAIN EASEMENT, SEE SHTS 23 AND 23a.
 - FOR SAN PEDRO STORM DRAIN, SEE Exhibit 5, 2/96 D.Rep.
 - FOR HOLLY STORM DRAIN, SEE Exhibit 6, 8/96 D.Rep.
 - EXISTING UTILITY LOCATIONS SHOWN ARE APPROXIMATE ONLY.
 - INTERIM POND DETAILS, SEE SHT. 23b.


CITY OF ALBUQUERQUE PUBLIC WORKS DEPARTMENT ENGINEERING DEVELOPMENT GROUP	
TITLE: LA CUEVA OESTE SITE PLAN UNITS 2, 3a, 3b, 3c & 4	
Design Review Committee	City Engineer Approval
City Project No. 5232.94	Zone Map No. C-18
Sheet 4	Of 19

FOR INFORMATION ONLY
=FOR INFORMATION ONLY=


AS-BUILT

EXHIBIT 2A (REVISED)


SCANNED BY
MESA REPRO

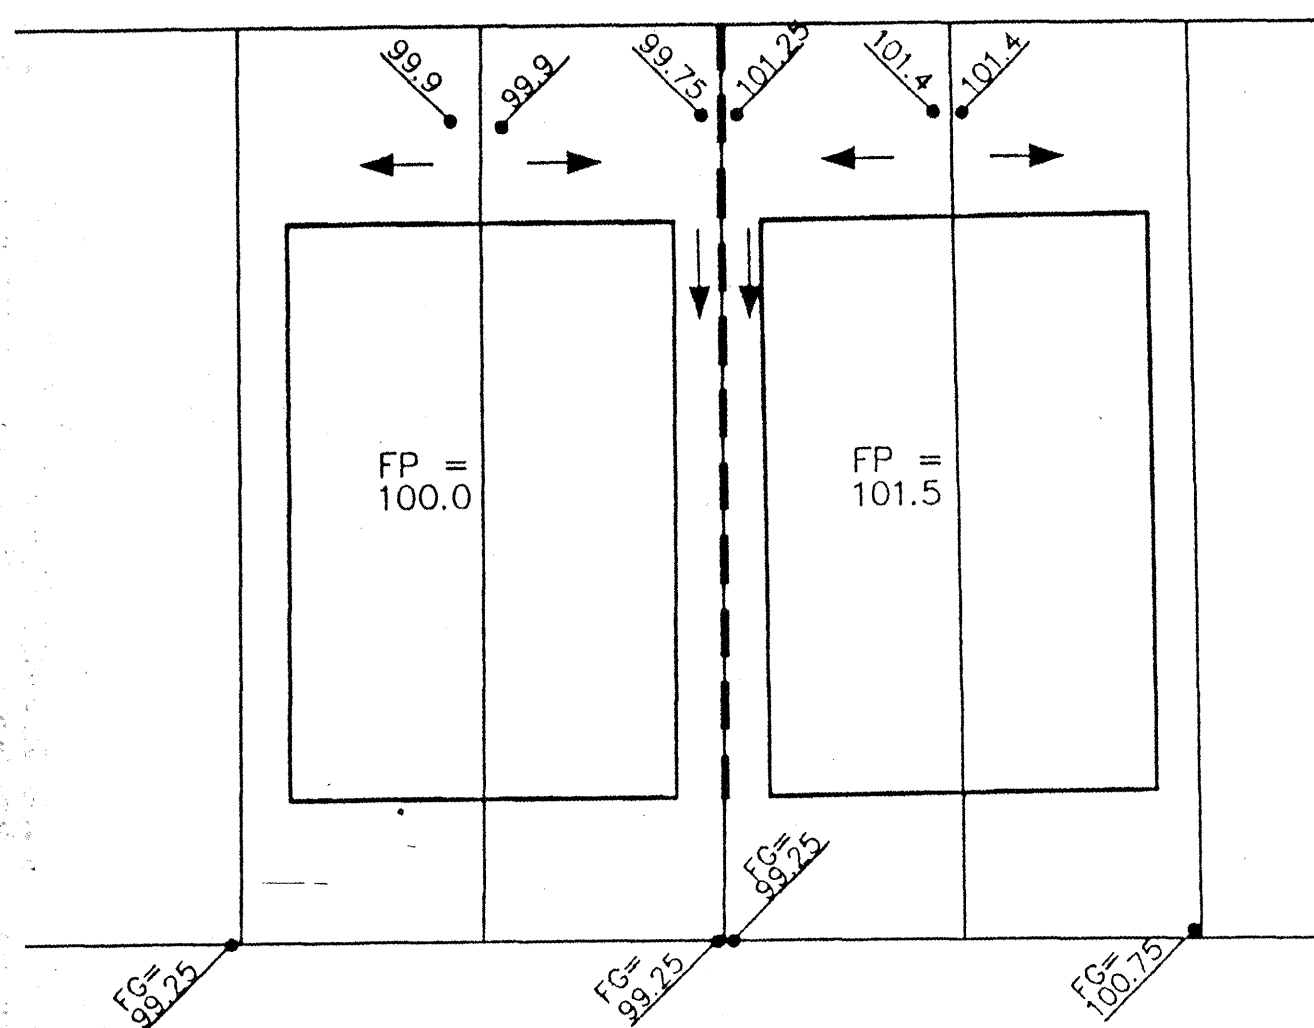


CASE 3a

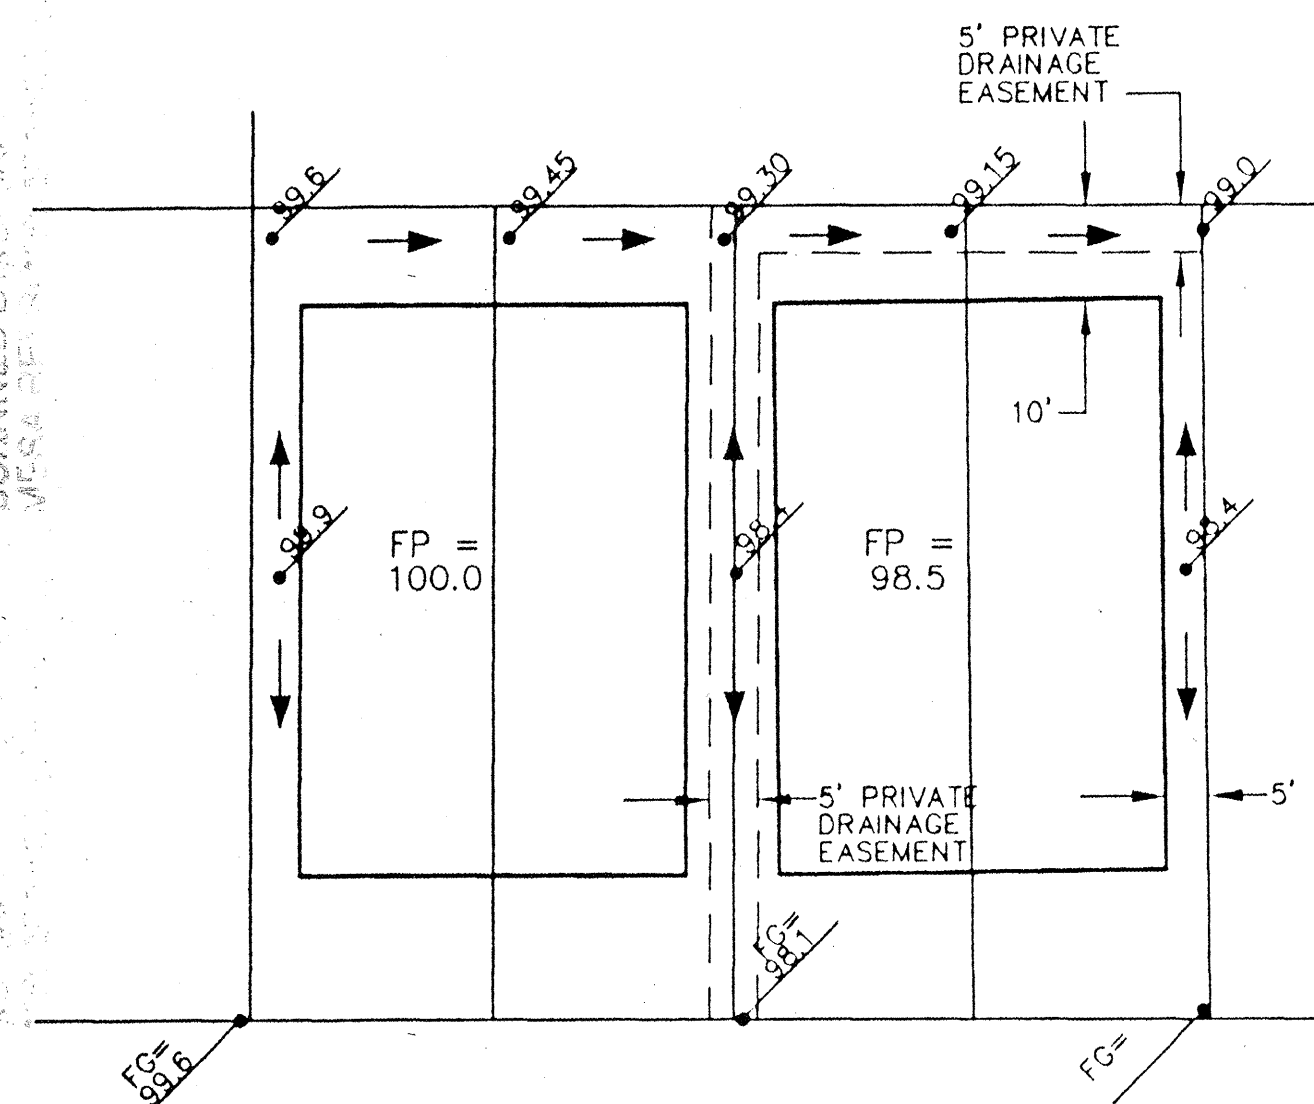

CASE 3b

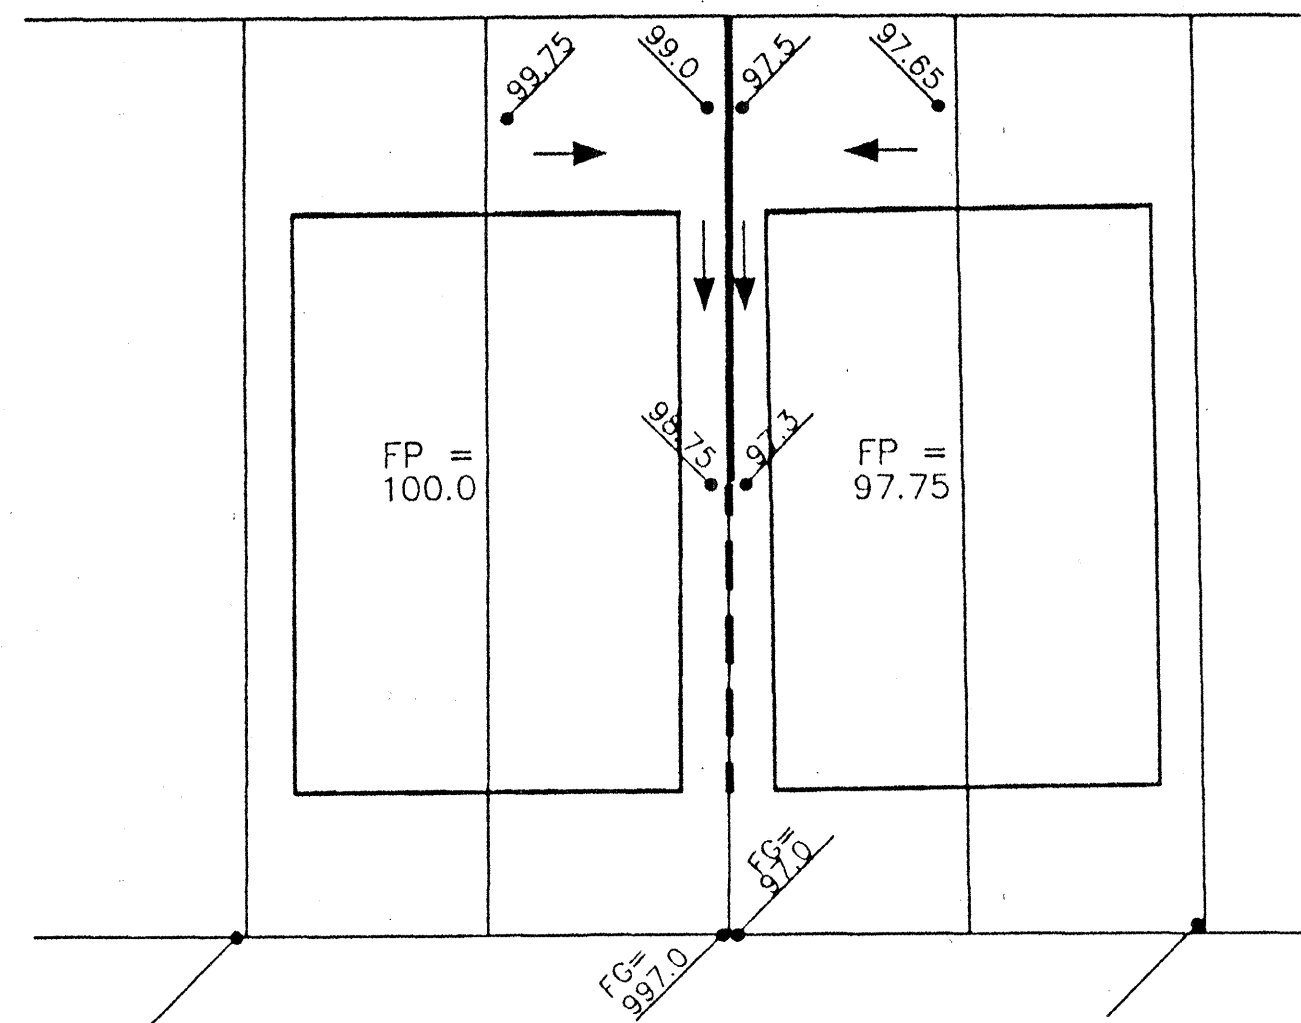


CASE 1

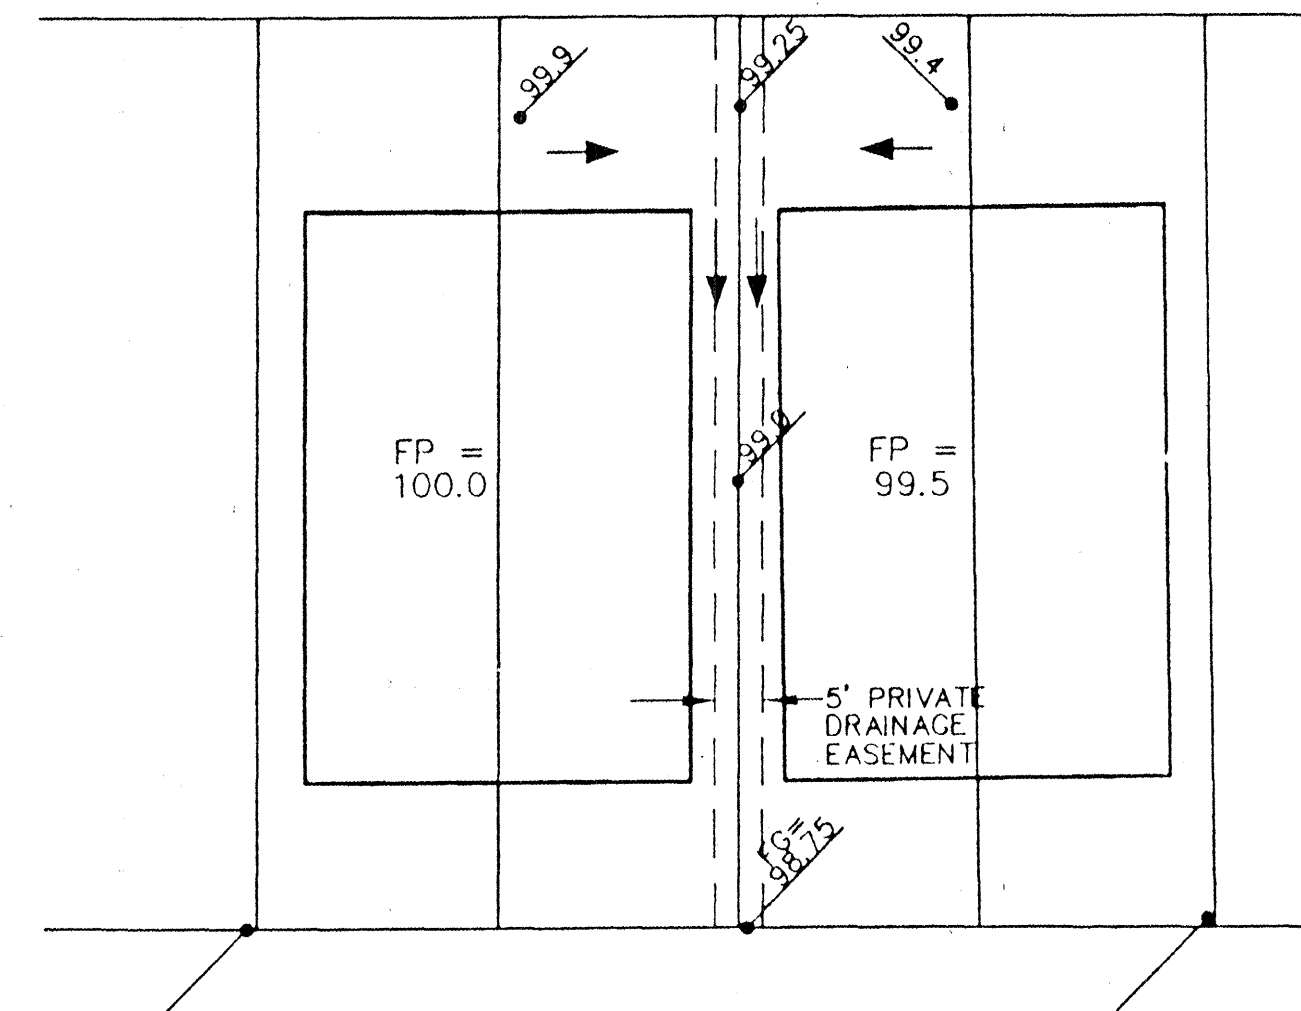

CASE 2


LEGEND

- SPOT ELEVATION
- DIRECTION OF FLOW
- GARDEN WALL
- RETAINING WALL
- HOUSE PAD
- DRAINAGE EASEMENT
- FP = 5276.9 FINISHED PAD ELEVATION
- TW TOP OF WALL
- BW BOTTOM OF WALL
- FL FLOWLINE

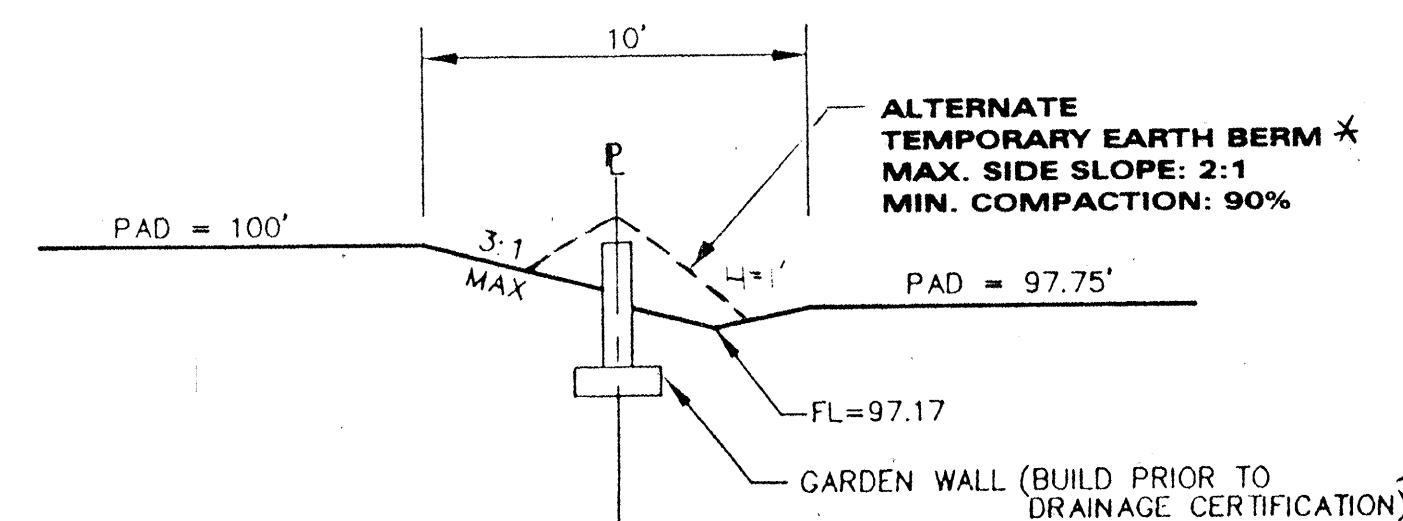


CASE 1

ADJACENT PAD
ELEVATION DIFFERENCE (h): 1.5' < h < 2.25'

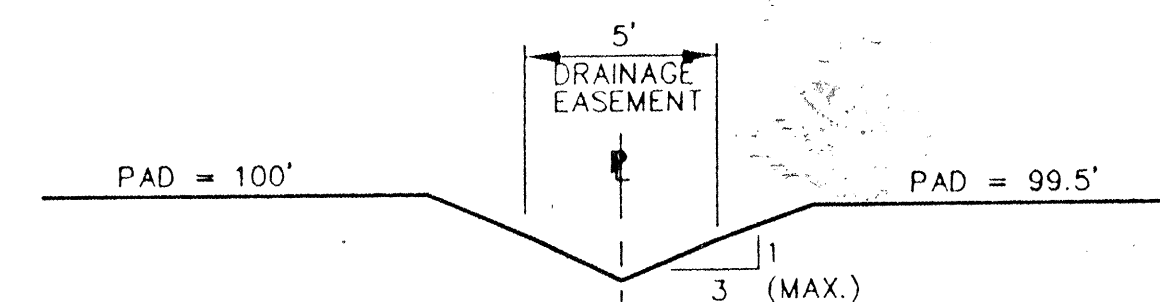


CASE 2

ADJACENT PAD
ELEVATION DIFFERENCE < .5'

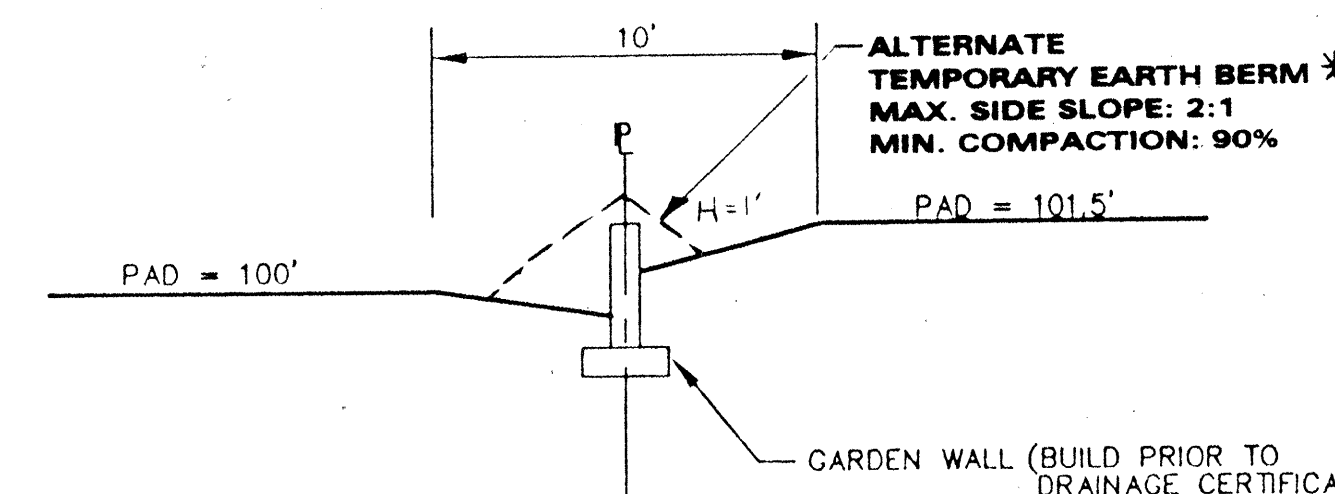

CASE 3a

ADJACENT PAD
ELEVATION DIFFERENCE (h): .5' < h < 1.5'
MIN. DIFFERENCE BETWEEN FP & FG = .75'

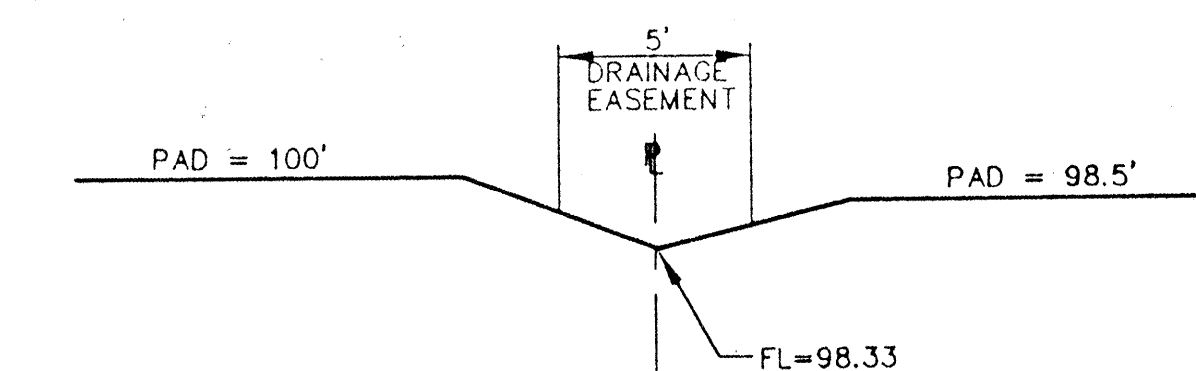

CASE 3b

ADJACENT PAD
ELEVATION DIFFERENCE (h): .5' < h < 1.5'
MIN. DIFFERENCE BETWEEN FP & FG = .40'

TYPICAL LOT DRAINAGE DETAILS

AT FRONT (STREET SIDE) EDGE OF PAD
FINISHED FLOOR ± .33' ABOVE PAD ELEVATION

* IF TEMPORARY EARTH BERM IS BUILT
INSTEAD OF GARDEN WALL, TO FACILITATE
CONSTRUCTION, IT MUST BE REPLACED
WITH GARDEN WALL BY HOME BUILDER,
PRIOR TO OCCUPANCY. THE WALLS SHOWN
AS REQUIRED FOR DRAINAGE ARE THE
ULTIMATE RESPONSIBILITY OF THE
DEVELOPER, DEVELOPMENT SERVICES CO.
LTD.

FOR INFORMATION ONLY

AS-BUILT

Resource Technology, Inc.
ENGINEERS AND ENVIRONMENTAL SCIENTISTS
CIVIL - ENVIRONMENTAL - WATER RESOURCES - RECREATION - PLANNING
1720-B Randolph Rd. SE, Albuquerque, NM 87106
(505) 243-7300

CITY OF ALBUQUERQUE
PUBLIC WORKS DEPARTMENT
ENGINEERING DEVELOPMENT GROUP
TITLE: LA CUEVA OESTE, UNIT 3a, 3b & 3c
ATTACHED DWELLING UNIT
TYPICAL LOT DRAINAGE

APPROVED
JUN 23 1997
DESIGN
REVIEW COMMITTEE

City Engineer Approval

City Project No. 5232.94

Zone Map No. C-18

Sheet 6 Of 19


AS BUILT INFORMATION		BENCH MARKS		SURVEY INFORMATION		ENGINEER'S SEAL		REVISIONS		DESIGN		CHECKED BY		DATE	
CONTRACTOR	ALBUQUERQUE	WORK	DATE	NO.	BY	DATE	NO.	BY	DATE	NO.	BY	DATE	NO.	BY	DATE
STAGED BY	CDA	DATE	4-2-97												
APPROVED BY	CDA	DATE	4-2-97												
FIELD	CDA	DATE	4-2-97												
REVISIONS	CDA	DATE	4-2-97												
CORRECTED BY	T-B&J	DATE	4-2-97												
RECORDED BY		DATE													
NO.															

EXHIBIT 2E (NEW)

SCANNED BY
MESA REPRO

TO PROPERTY LINE
STA: 13+35±

TO PROPERTY LINE
STA: 28+18±

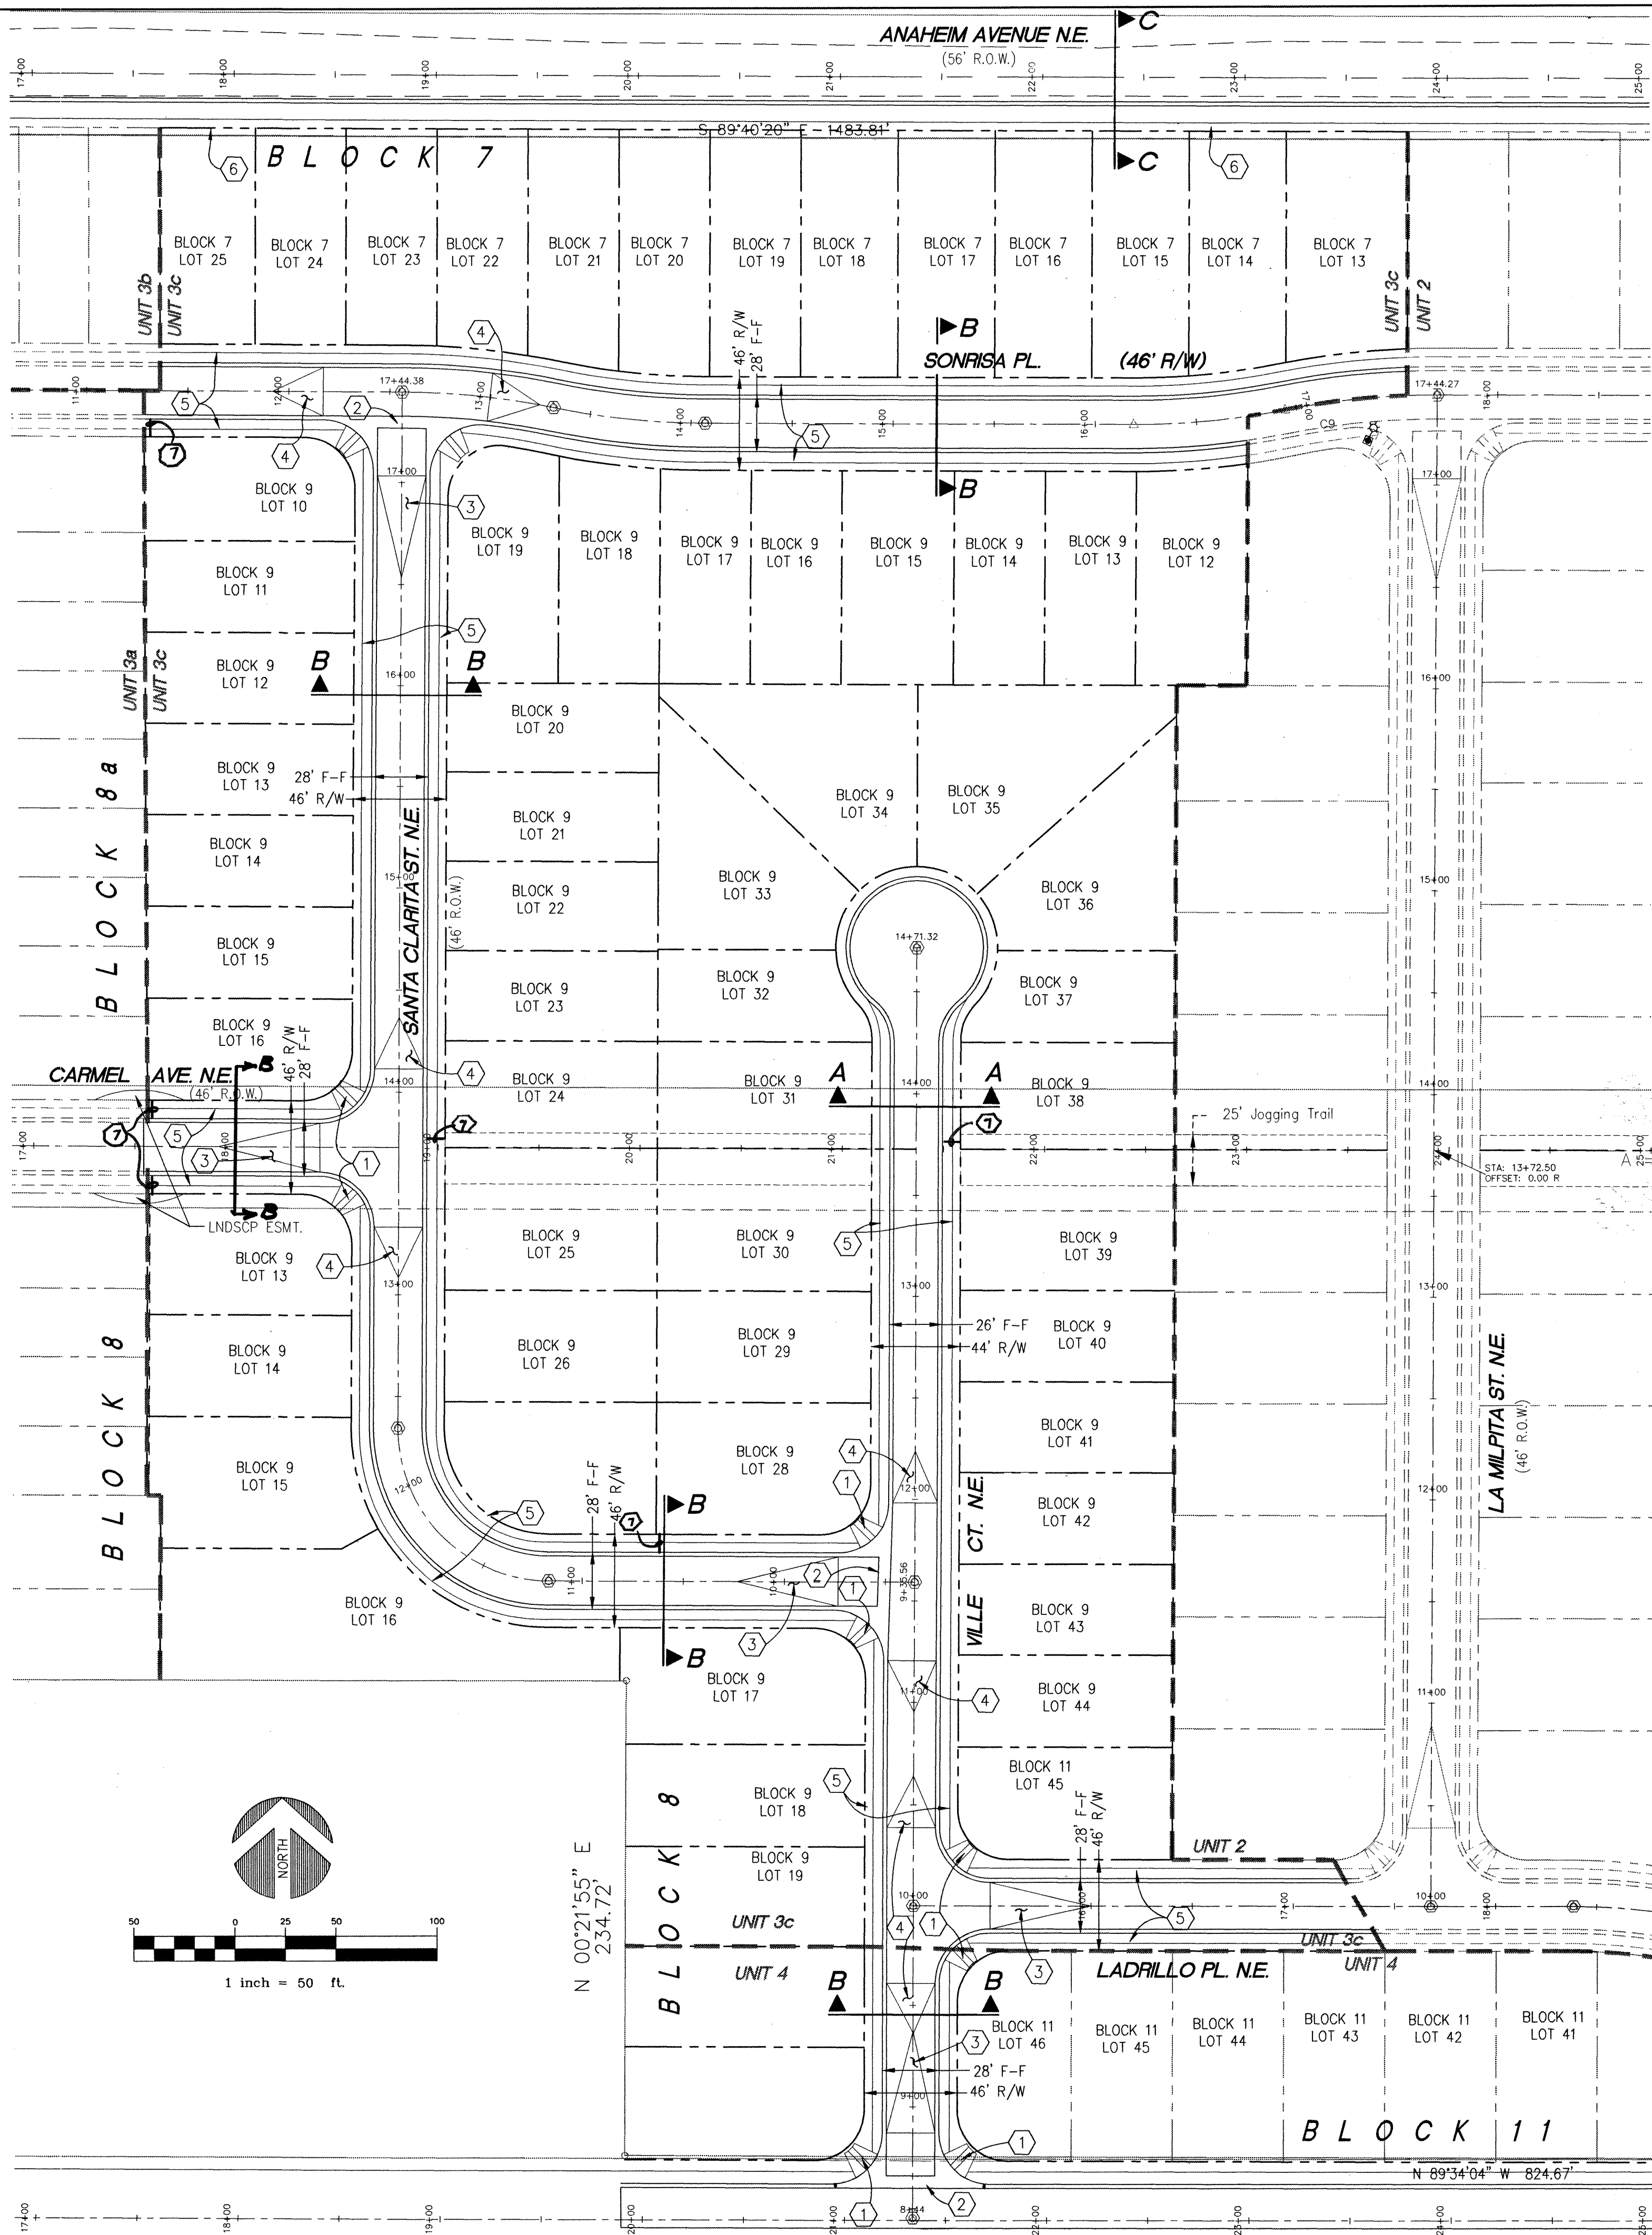

NOTES:

- SEE PLAT, SHEETS 2 & 3, FOR RIGHT-OF-WAY WIDTHS AND STREET CENTERLINE BEARING & DISTANCE INFORMATION.
- CONTRACTOR SHALL CONDUCT OPERATIONS IN A MANNER WHICH WILL MINIMIZE INTERFERENCE WITH LOCAL TRAFFIC. CONTRACTOR SHALL COMPLY WITH ALL APPLICABLE LAWS, ORDINANCES, RULES, REGULATIONS, AND ORDERS OF ANY PUBLIC BODY HAVING JURISDICTION FOR THE SAFETY OF PERSONS OR PROPERTY, AND TO PROTECT THEM FROM DAMAGE, INJURY, OR LOSS. CONTRACTOR SHALL ERECT AND MAINTAIN, AS REQUIRED BY THE CONDITIONS AND PROGRESS OF THE WORK, ALL NECESSARY SAFEGUARDS FOR SAFETY CONTINUOUSLY AND NOT LIMITED TO NORMAL WORKING HOURS, THROUGHOUT THE DURATION OF THE PROJECT. CONTRACTOR SHALL ADHERE TO SECTION 19 (CONSTRUCTION TRAFFIC CONTROL) OF THE GENERAL CONDITIONS OF THE CITY OF ALBUQUERQUE STANDARD SPECIFICATIONS FOR PUBLIC WORKS CONSTRUCTION, 1986 EDITION W/ UPDATE #6.
- THE CONTRACTOR AGREES THAT HE SHALL ASSUME THE SOLE AND COMPLETE RESPONSIBILITY FOR THE JOB SITE CONDITIONS DURING THE COURSE OF CONSTRUCTION OF THIS PROJECT, INCLUDING SAFETY OF ALL PERSONS AND PROPERTY; THAT THIS REQUIREMENT SHALL APPLY CONTINUOUSLY AND NOT BE LIMITED TO NORMAL WORKING HOURS; AND THAT THE CONTRACTOR SHALL DEFEND, INDEMNIFY, AND HOLD HARMLESS THE OWNER & ENGINEER FROM ANY AND ALL LIABILITY REAL OR ALLEGED, IN CONNECTION WITH THE PERFORMANCE OF WORK ON THIS PROJECT, EXCEPTING LIABILITY ARISING FROM THE SOLE NEGLIGENCE OF THE OWNER OR ENGINEER.
- ALL STREET STRIPING ALTERED OR DESTROYED SHALL BE REPLACED WITH REFLECTORIZED PLASTIC PAVEMENT MARKING BY CONTRACTOR TO LOCATION AS EXISTING OR AS INDICATED BY THIS PLAN SET.
- CONTRACTOR SHALL PROMPTLY CLEAN UP ANY MATERIAL EXCAVATED WITHIN THE PUBLIC RIGHT-OF-WAY SO THAT THE EXCAVATED MATERIAL IS NOT SUSCEPTIBLE TO BEING WASHED DOWN THE STREET.
- ALL WORK ON THIS PROJECT SHALL BE PERFORMED IN ACCORDANCE WITH APPLICABLE FEDERAL, STATE, AND LOCAL LAWS, RULES, AND REGULATIONS CONCERNING CONSTRUCTION SAFETY AND HEALTH.
- SEE SHEET 19 FOR CROSS SECTIONS AND PAVING SECTIONS.

CONSTRUCTION KEYED NOTES:

- CONSTRUCT P.C.C. SIDEWALK, 4" THICK, TRANSITIONS TO HANDICAP ACCESS RAMPS AND P.C.C. RAMP PER STD. DWG. # 2441, CASE NO. 2. LENGTH OF RAMPS MAY VARY AS NEEDED, SLOPE NOT TO EXCEED 12:1.
- CONSTRUCT P.C.C. VALLEY GUTTER AND GUTTER AND CURB PER STD. DWG. # 2420, 6" WIDE WITH 1 1/2" INVERT DEPTH.
- CROWN TO NO CROWN TRANSITION (50' LEN).
- CROWN TO HALF CROWN TRANSITION (25' LEN).
- 4' WIDE P.C.C. SIDEWALK (NOT IN THIS CONTRACT).
- 4' WIDE P.C.C. SIDEWALK (TO BE INCLUDED IN THIS CONTRACT).
- SDWLK. DRN. PER STD. DWG # 2236.

FOR INFORMATION ONLY

AS-BUILT

Terry O. Brown, P.E.

P. O. Box 92051
Albuquerque, NM 87199
(505) 883-8807

CITY OF ALBUQUERQUE
PUBLIC WORKS DEPARTMENT
ENGINEERING DEVELOPMENT GROUP

TITLE: LA CUEVA OESTE, UNIT 3c
PAVING MASTER PLAN



City Engineer Approval

Last Design Update

Mo./Day/Yr.

Mo./Day/Yr.

City Project No.

5232.94

Zone Map No.

C-18-Z

Sheet

Of

19


AS-BUILT INFORMATION	
CONTRACTOR	ALBAJ CONSULTANTS
WORKED BY	COA
INSPECTED BY	COA
ACCEPTANCE BY	COA
VERIFICATION BY	COA
DRAWINGS	COA
CHECKED BY	COA
RECORDED BY	COA
DATE	DATE

BENCH MARKS	
CONTRACTOR	ALBAJ CONSULTANTS
WORKED BY	COA
INSPECTED BY	COA
ACCEPTANCE BY	COA
VERIFICATION BY	COA
DRAWINGS	COA
CHECKED BY	COA
RECORDED BY	COA
DATE	DATE

SURVEY INFORMATION	
ACS STA. No. 1-C19	DATE
Y=1518845.74	BY
X=404941.91	NO.
Z=5318.195	

ENGINEER'S SEAL	
DATE	BY
REMARKS	
DESIGN	
DATE: 07/98	
DATE: 07/98	
DATE: 07/98	


REVISIONS	
NO.	DATE
DESIGNED BY: TOB	DATE: 07/98
DRAWN BY: TOB	DATE: 07/98
CHECKED BY: TOB	DATE: 07/98

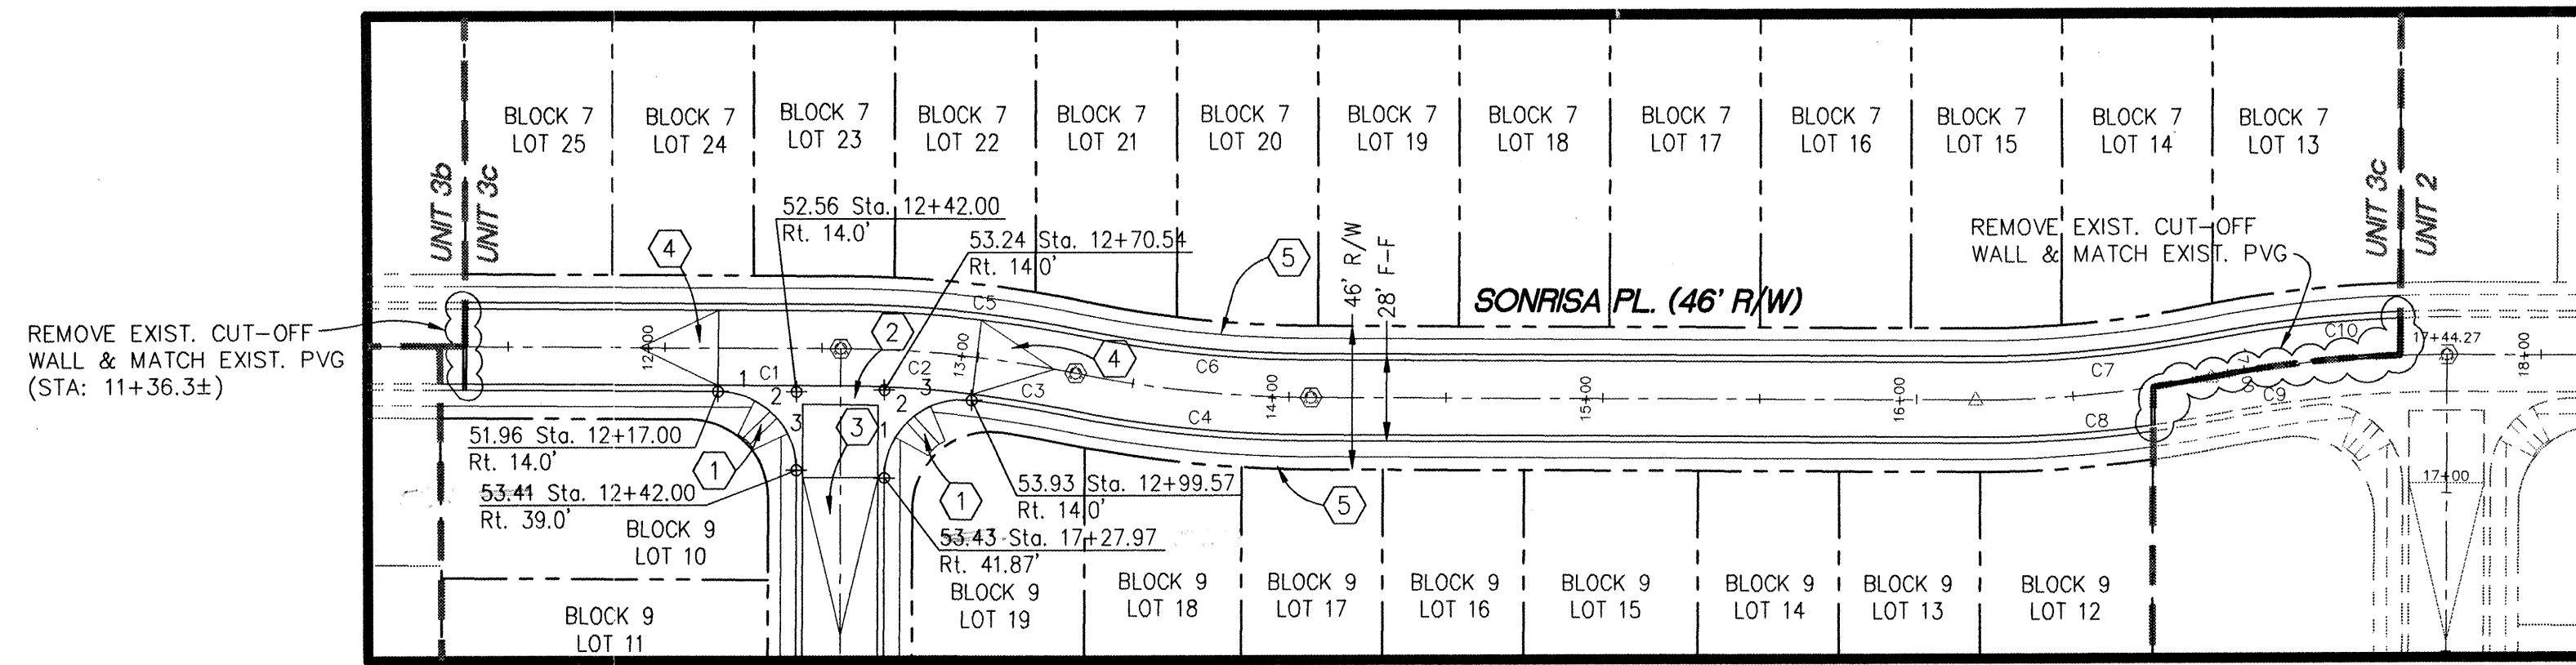


SEE SHEET 9
FOR CONTINUATION

	FL
1	52.32
2	52.69
3	53.05

CURVE DATA AT FACE OF CURB						
CURVE	LENGTH	RADIUS	DELTA	TANGENT	CHORD LEN	CHORD DIR
C1	39.27	25.00	90°00' 00"	25.00	35.36	N 44°39' 31" W
C2	42.15	25.00	96°35' 29"	28.06	37.33	S 48°38' 14" W
C3	30.75	364.75	04°49' 47"	15.38	30.74	N 80°39' 08" W
C4	78.29	392.75	11°25' 16"	39.27	78.16	S 83°56' 52" E
C5	78.29	392.75	11°25' 16"	39.28	78.16	N 83°56' 52" W
C6	72.71	364.75	11°25' 16"	36.48	72.59	S 83°56' 52" E
C7	72.71	364.72	11°25' 18"	36.47	72.58	N 84°37' 50" E
C8	78.29	392.72	11°25' 18"	39.27	78.16	N 84°37' 50" E
C9	30.74	364.72	04°49' 46"	15.38	30.73	S 81°20' 05" W
C10	78.29	392.72	11°25' 18"	39.27	78.16	S 84°37' 50" W

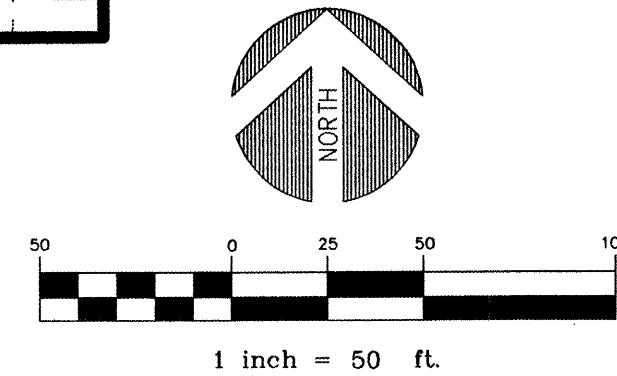

SONRISA PL. N.E.

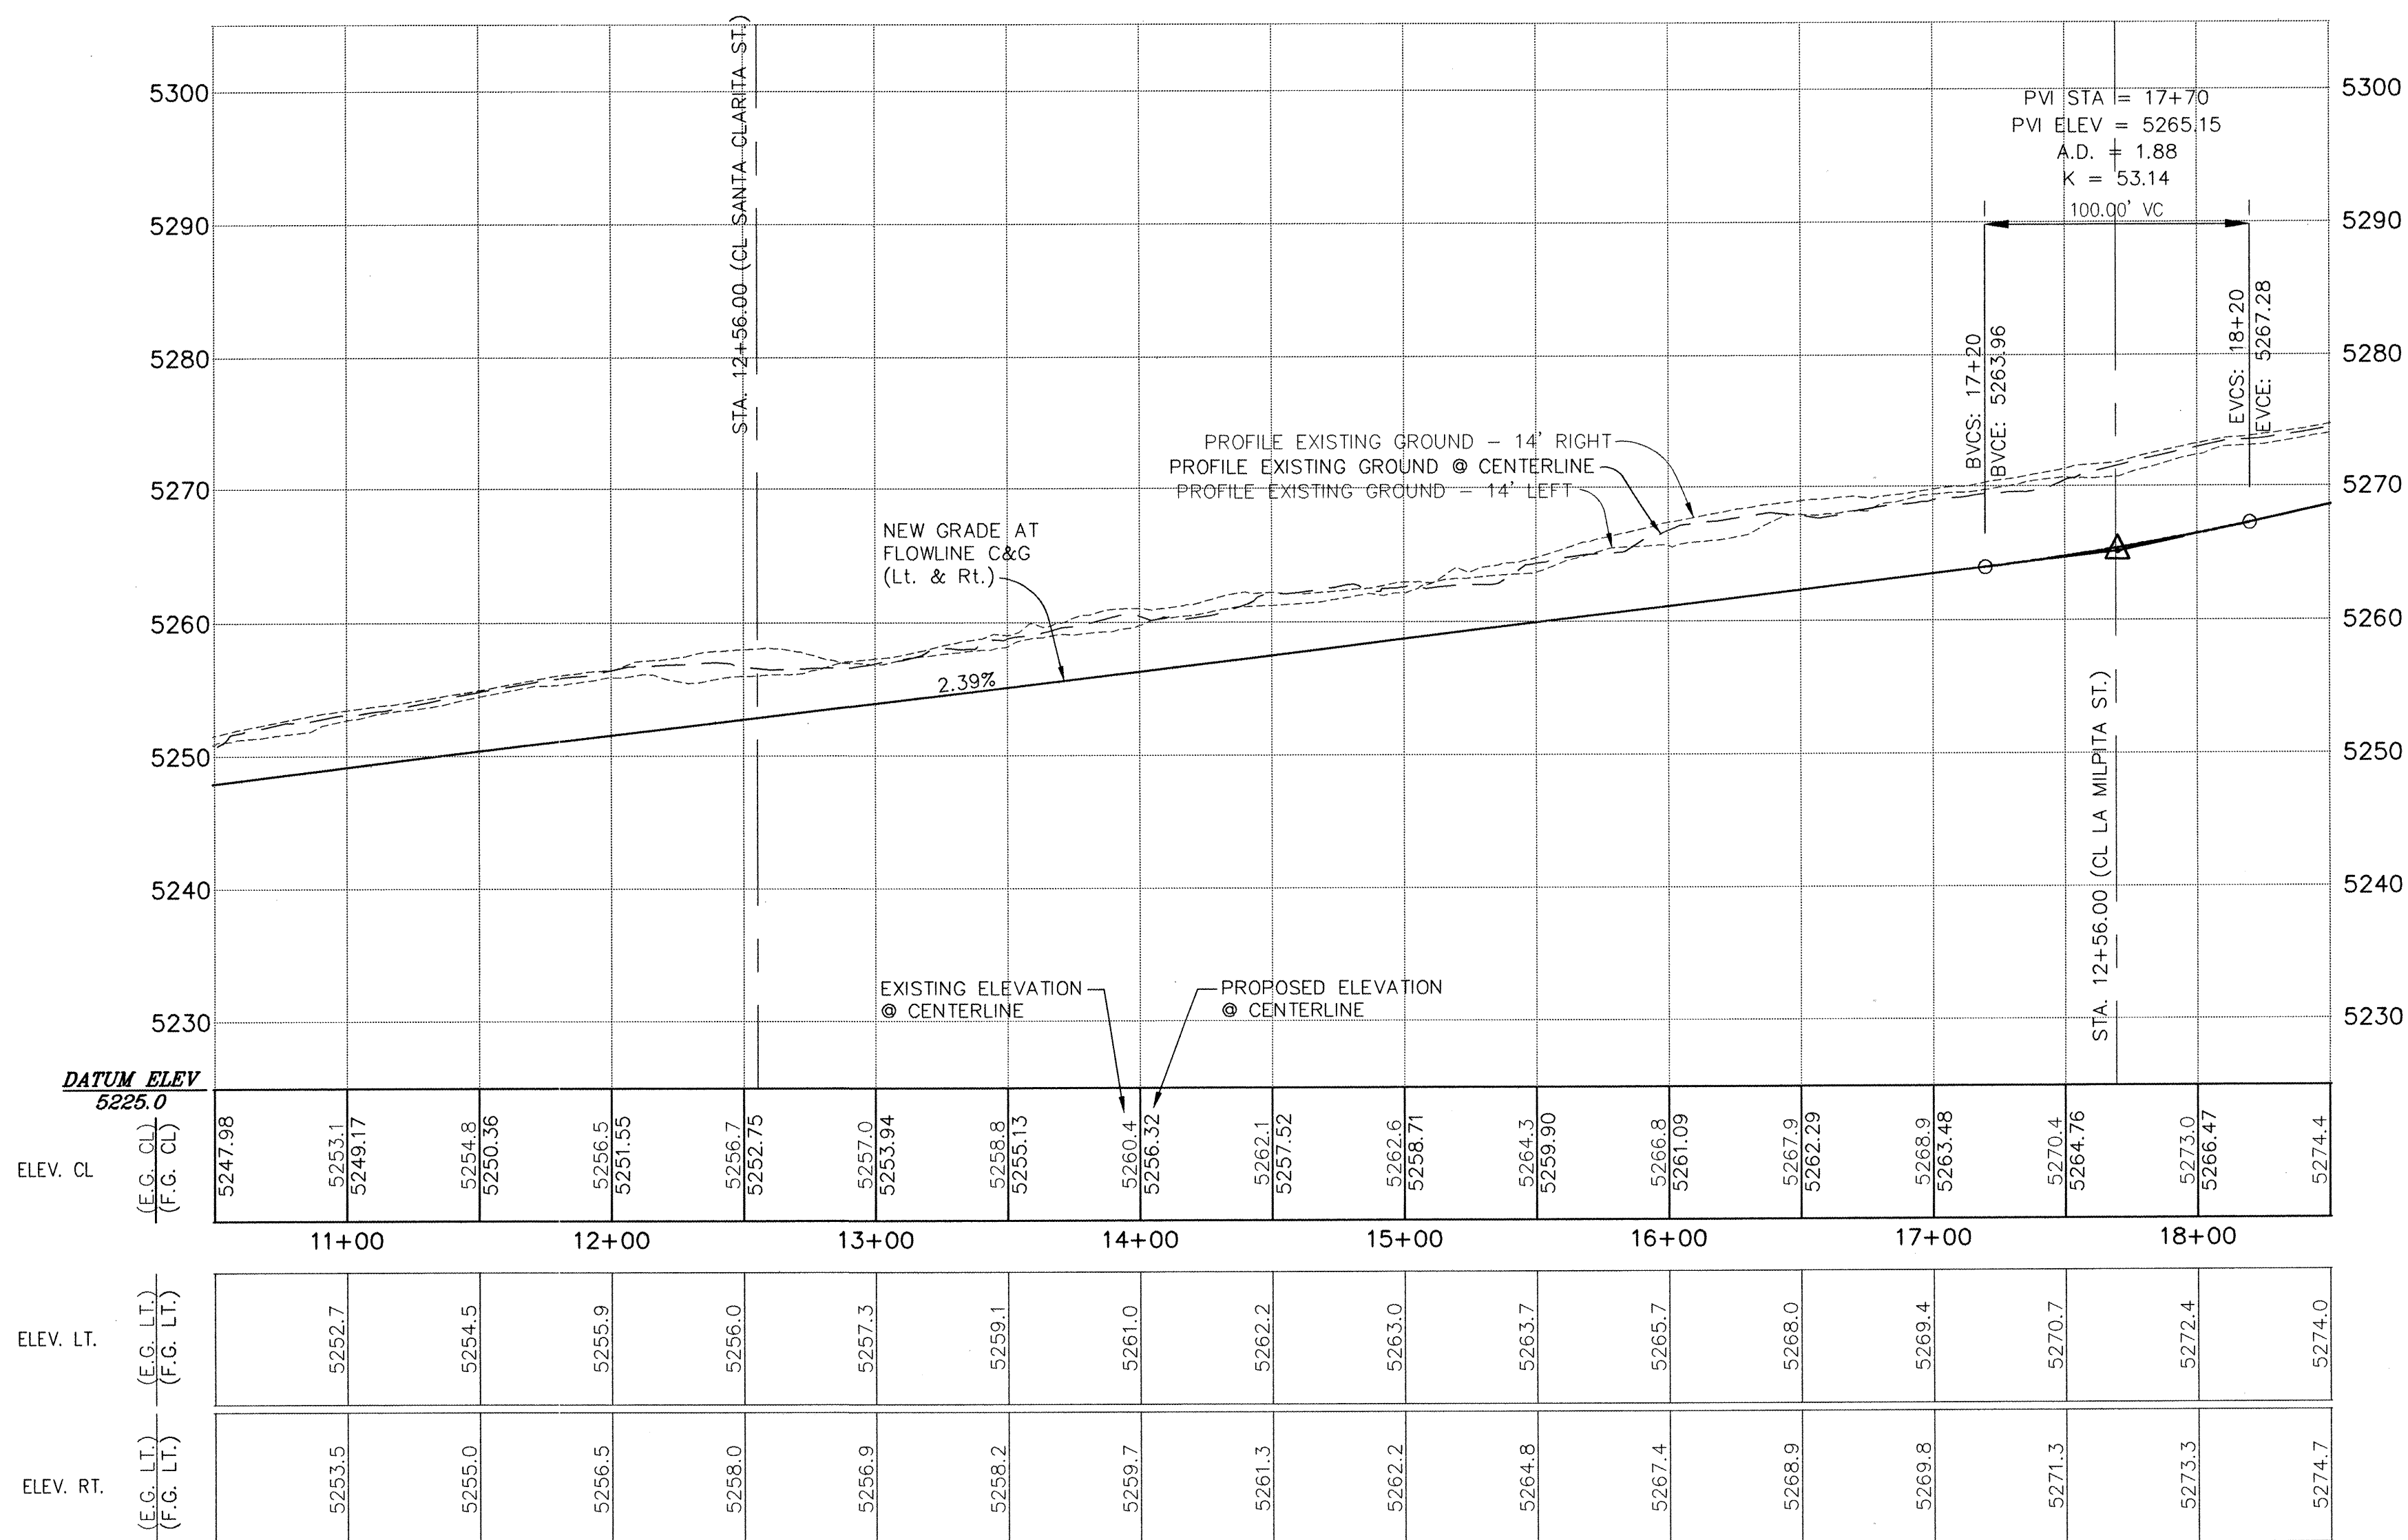

SCALE
HORIZ: 1"=50'
VERT: 1"=10'

NOTES:

1. NEW ELEVATIONS SHOWN ARE FLOWLINE OF CURB AND GUTTER UNLESS OTHERWISE NOTED.
2. THE FOLLOWING CITY OF ALBUQUERQUE STANDARD DETAIL DRAWINGS APPLY TO THIS SHEET:
 - DWG 2401 - TYP. RES. STREET INTERS.
 - DWG 2405 - RESIDENTIAL STREET SECTION
 - DWG 2415 - CURB AND GUTTER
 - DWG 2418 - MOUNTABLE TO STANDARD CURB TRANSITION
 - DWG 2420 - CONCRETE VALLEY GUTTER
 - DWG 2430 - SIDEWALK DETAILS
 - DWG 2440 - WHEEL CHAIR RAMP
 - DWG 2441 - WHEEL CHAIR RAMP
 - DWG 2250 - REMOVABLE POSTS
3. SEE PLAT, SHEETS 2 & 3, FOR RIGHT OF WAY WIDTHS AND STREET CENTERLINE BEARING & DISTANCE INFORMATION.

 CONSTRUCTION KEYED NOTES:

- 1 CONSTRUCT P.C.C. RAMP PER STD. DWG.# 2441. CASE NO. 2. LENGTH OF RAMPS MAY VARY AS NEEDED, SLOPE NOT TO EXCEED 12:1.
- 2 CONSTRUCT P.C.C. VALLEY GUTTER AND GUTTER AND CURB PER STD. DWG.# 2420, 6' WIDE WITH 1 1/2" INVERT DEPTH.
- 3 CROWN TO NO CROWN TRANSITION (50' LEN).
- 4 CROWN TO HALF CROWN TRANSITION (25' LEN).
- 5 4' WIDE P.C.C. SIDEWALK (NOT IN THIS CONTRACT).

[illegible]

FOR INFORMATION ONLY

AS-BUILT

Terry O. Brown, P.E.

P. O. Box 92051

Albuquerque, NM 87199

(505) 883-8807

CITY OF ALBUQUERQUE
PUBLIC WORKS DEPARTMENT
ENGINEERING DEVELOPMENT GROUP

TITLE: LA CUEVA OESTE, UNIT 3c
PAVING PLAN AND PROFILE
- SONRISA PL. N.E. (Sta. 11+28.27 to Sta. 17+55.18)

Design Review Committee

APPROVED

DESIGN REVIEW COMMITTEE

City Engineer Approval


Lost Design Update

Mo./Day/Yr.	Mo./Day/Yr.

City Project No.	5232.94	Zone Map No.	C-18-Z	Sheet	8	Of	19
------------------	---------	--------------	--------	-------	---	----	----


LC3C_PP.DWG

SCANNED BY
MESA REPRO
08/20/1998

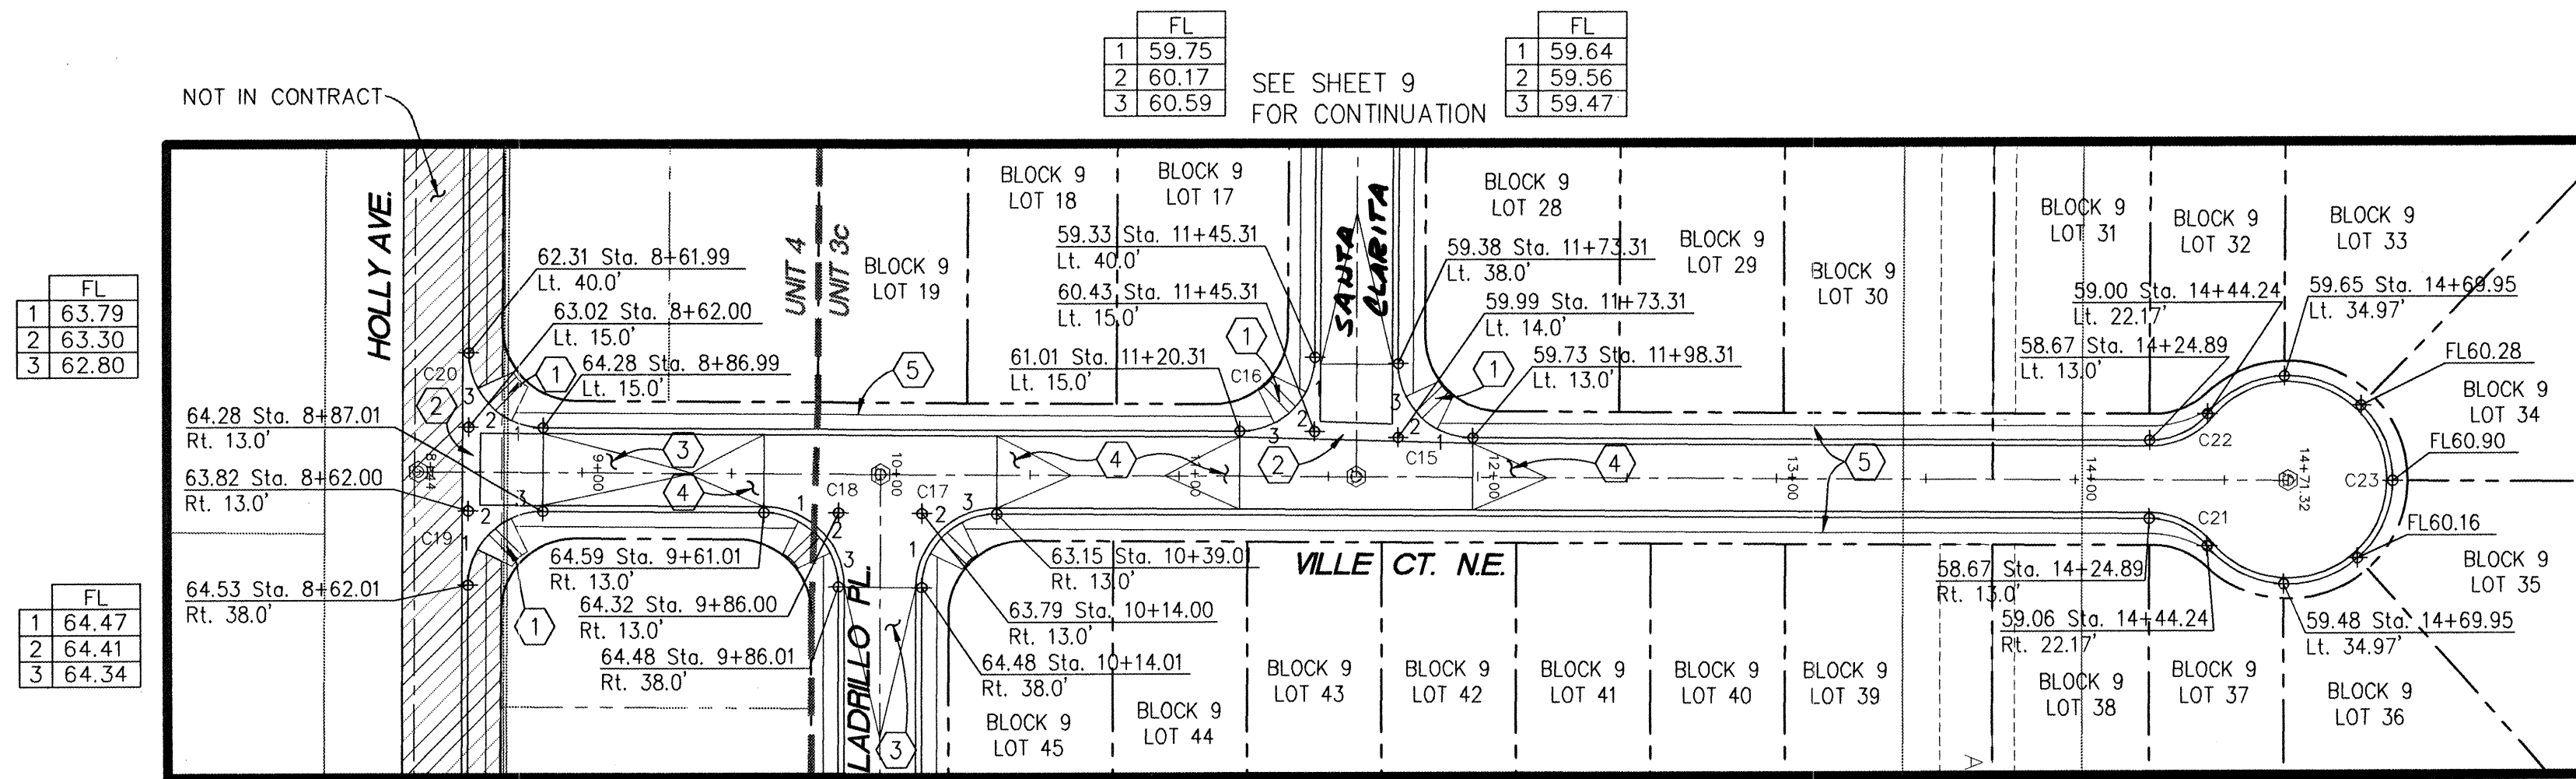


CURVE DATA AT FACE OF CURB

CURVE	LENGTH	RADIUS	DELTA	TARGET	CHORD LEN	CHORD DIR
C15	39.27	25.00	90°00'00"	25.00	35.36	N 45°20'29" E
C16	39.27	25.00	90°00'00"	25.00	35.36	N 44°39'31" W
C17	39.27	25.00	90°00'42"	25.01	35.36	S 44°39'51" E
C18	39.26	25.00	89°59'18"	24.99	35.35	S 45°20'09" W
C19	39.27	25.00	90°00'42"	25.01	35.36	S 44°39'51" E
C20	39.26	25.00	89°59'18"	24.99	35.35	N 45°20'09" E
C21	22.12	25.00	50°42'13"	11.85	21.41	S 25°41'36" W
C22	22.12	25.00	50°42'12"	11.85	21.41	N 25°00'37" W
C23	171.90	35.00	281°24'25"	28.64	44.33	N 89°39'31" W

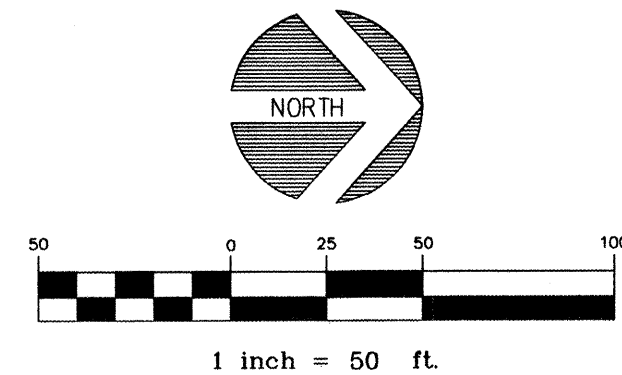

SCALE
HORIZ: 1"=50'
VERT: 1"=10'

VILLE CT. N.E.

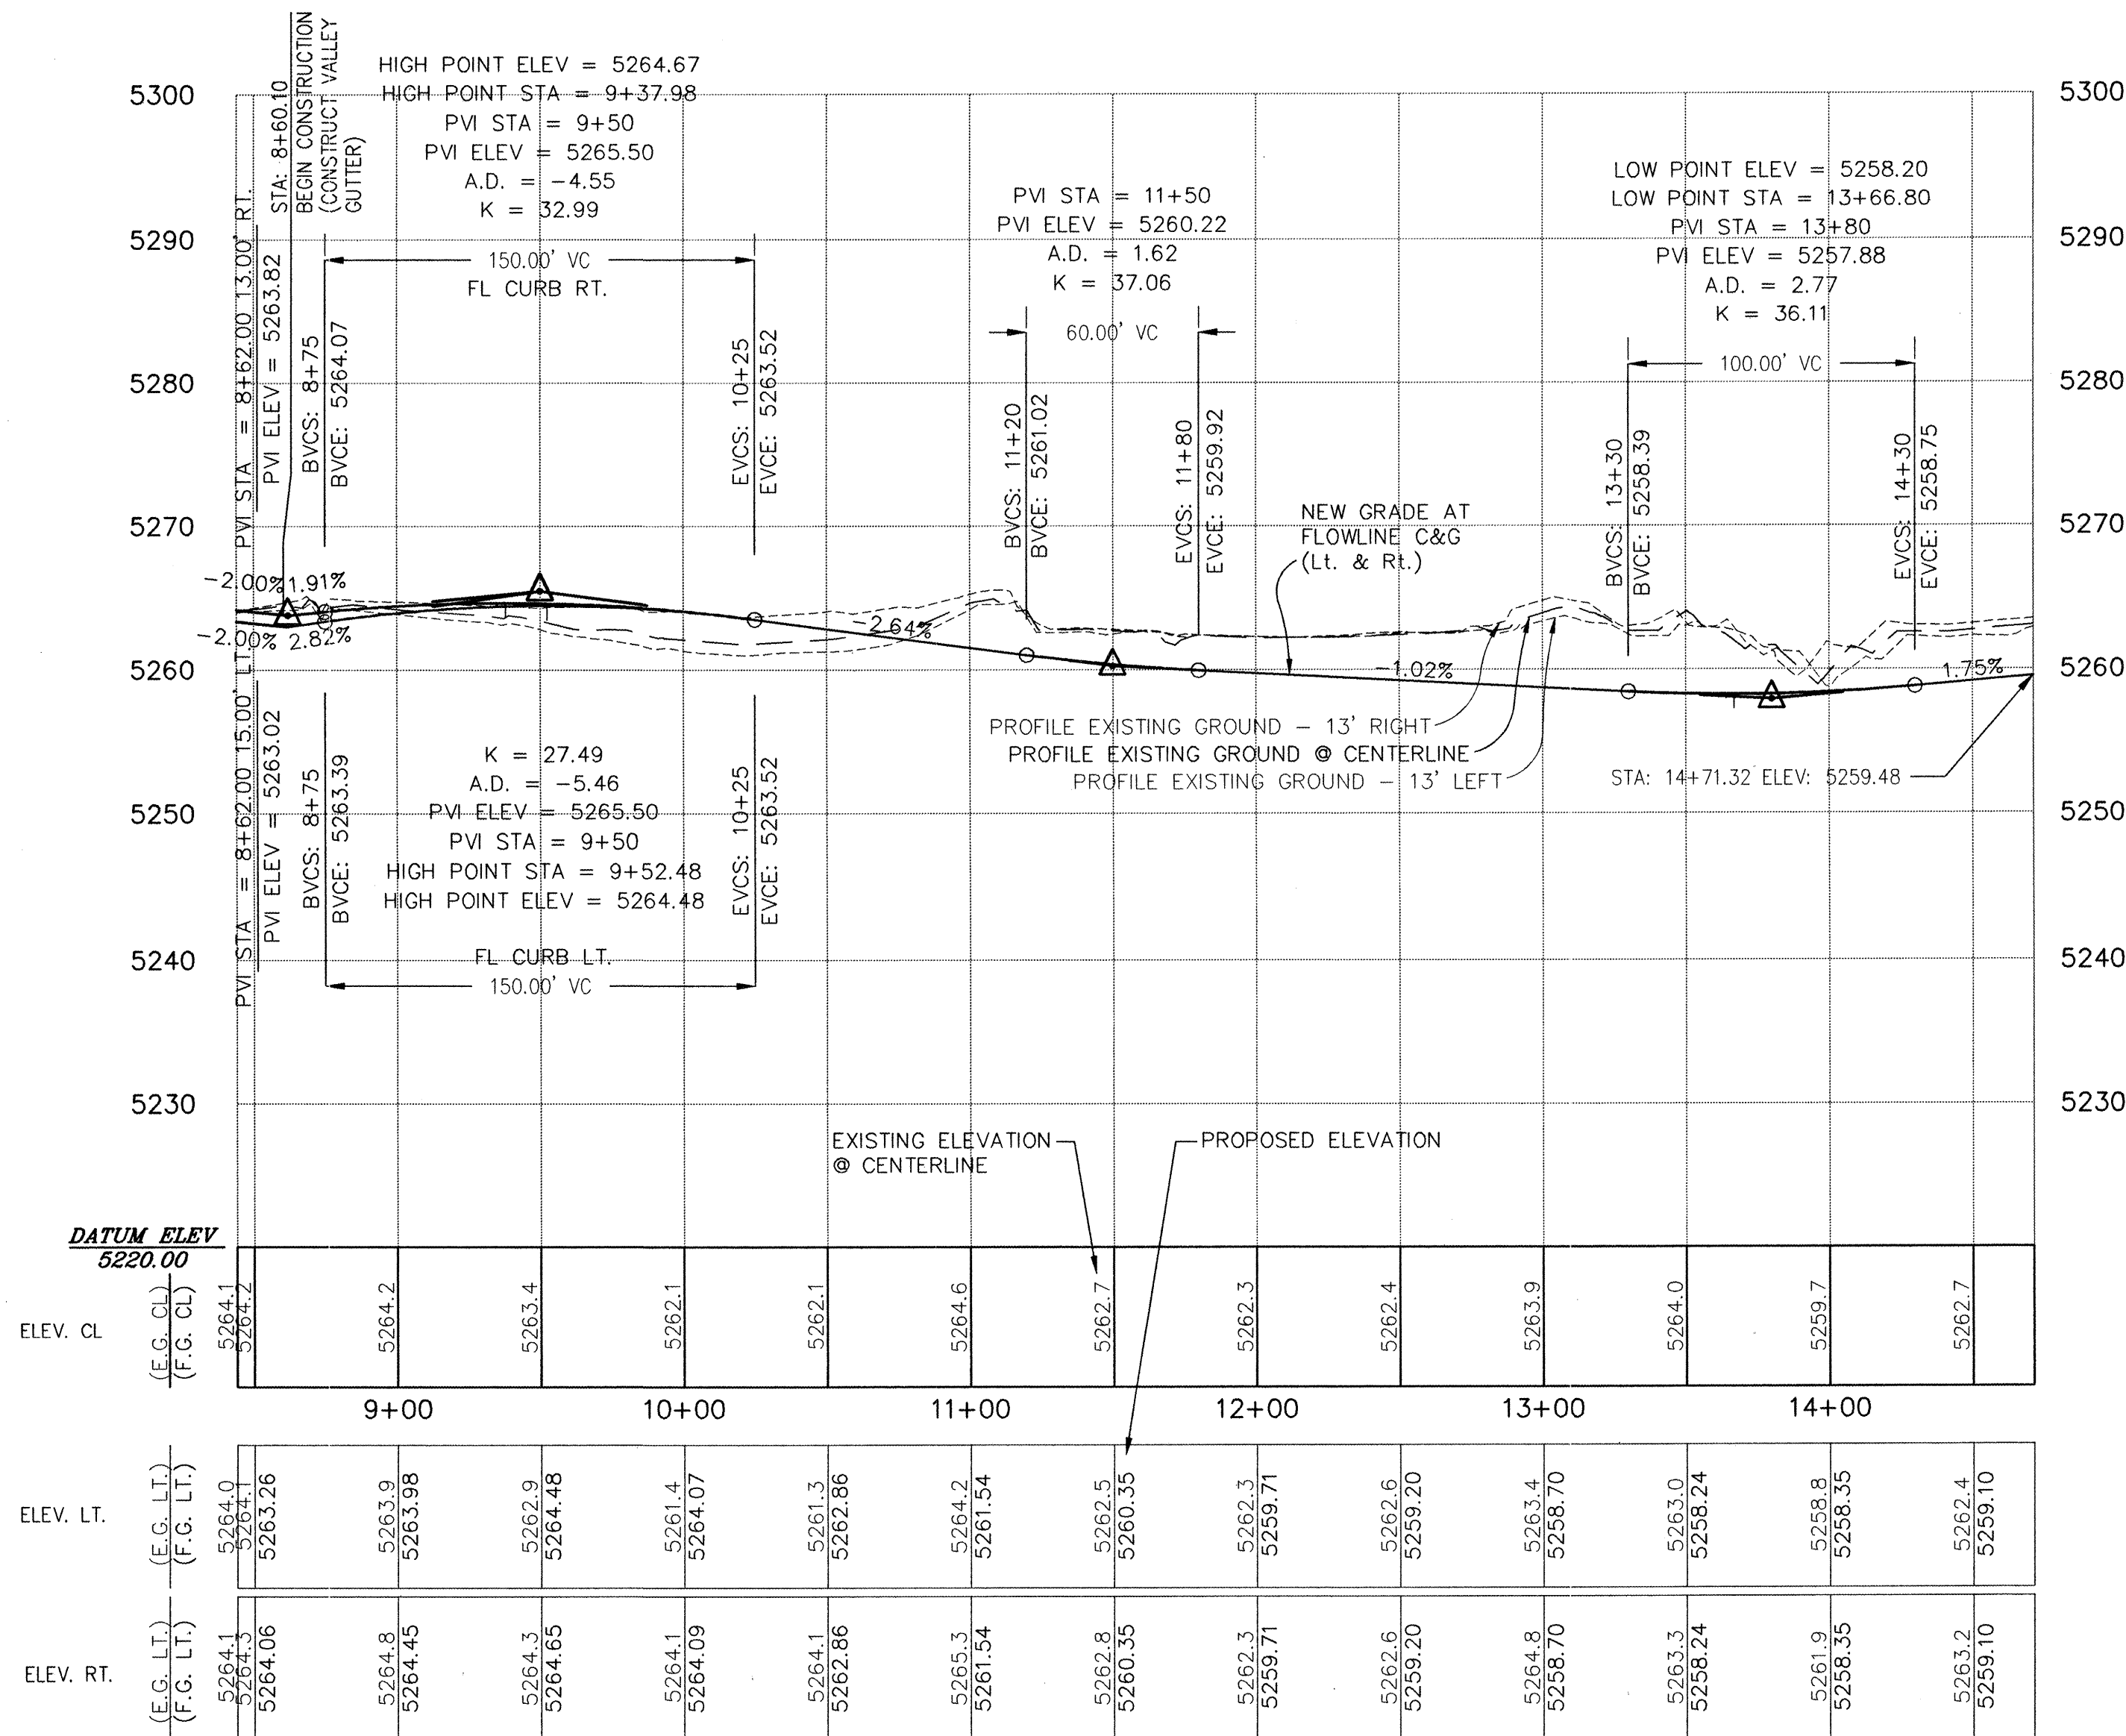

NOTES:

- NEW ELEVATIONS SHOWN ARE FLOWLINE OF CURB AND GUTTER UNLESS OTHERWISE NOTED.
- THE FOLLOWING CITY OF ALBUQUERQUE STANDARD DETAIL DRAWINGS APPLY TO THIS SHEET:
DWG 2401 - TYP. RES. STREET INTERS.
DWG 2405 - RESIDENTIAL STREET SECTION
DWG 2415 - CURB AND GUTTER
DWG 2418 - MOUNTABLE TO STANDARD CURB TRANSITION
DWG 2420 - CONCRETE VALLEY GUTTER
DWG 2430 - SIDEWALK DETAILS
DWG 2440 - WHEEL CHAIR RAMP
DWG 2441 - WHEEL CHAIR RAMP
DWG 2250 - REMOVABLE POSTS
- SEE PLAT, SHEETS 2 & 3, FOR RIGHT OF WAY WIDTHS AND STREET CENTERLINE BEARING & DISTANCE INFORMATION.

CONSTRUCTION KEYED NOTES:

- CONSTRUCT P.C.C. RAMP PER STD. DWG.# 2441. CASE NO. 2. LENGTH OF RAMP MAY VARY AS NEEDED, SLOPE NOT TO EXCEED 12:1.
- CONSTRUCT P.C.C. VALLEY GUTTER AND GUTTER AND CURB PER STD. DWG.# 2420, 6' WIDE WITH 1 1/2" INVERT DEPTH.
- CROWN TO NO CROWN TRANSITION (50' LEN).
- CROWN TO HALF CROWN TRANSITION (25' LEN).
- 4' WIDE P.C.C. SIDEWALK (NOT IN THIS CONTRACT).

AS BUILT INFORMATION		BENCH MARKS		SURVEY INFORMATION		ENGINEER'S SEAL		REVISIONS		DESIGN	
CONTRACTOR	WORK ORDER	DATE	NO.	DATE	NO.	DATE	NO.	DATE	NO.	DATE	NO.
ALBUQUERQUE	1518845.74	4-98	1	4-98	1	4-98	1	4-98	1	4-98	1
INSPECTOR	404941.91	4-98	1	4-98	1	4-98	1	4-98	1	4-98	1
VERIFICATION BY	5318.195	4-98	1	4-98	1	4-98	1	4-98	1	4-98	1
RECORDED BY		4-98	1	4-98	1	4-98	1	4-98	1	4-98	1
NO.		4-98	1	4-98	1	4-98	1	4-98	1	4-98	1

8/31/98

AS-BUILT

Terry O. Brown, P.E.

P. O. Box 92051
Albuquerque, NM 87199
(505) 883-8807


CITY OF ALBUQUERQUE
PUBLIC WORKS DEPARTMENT
ENGINEERING DEVELOPMENT GROUP

TITLE: LA CUEVA OESTE, UNIT 3c
PAVING PLAN AND PROFILE
VILLE CT. N.E. (Sta. 8+44.00 to Sta. 14+71.32)

Design Review Committee City Engineer Approval


Mo./Day/Yr. Mo./Day/Yr.

City Project No. 5232.94 Zone Map No. C-18-Z Sheet 10 of 19

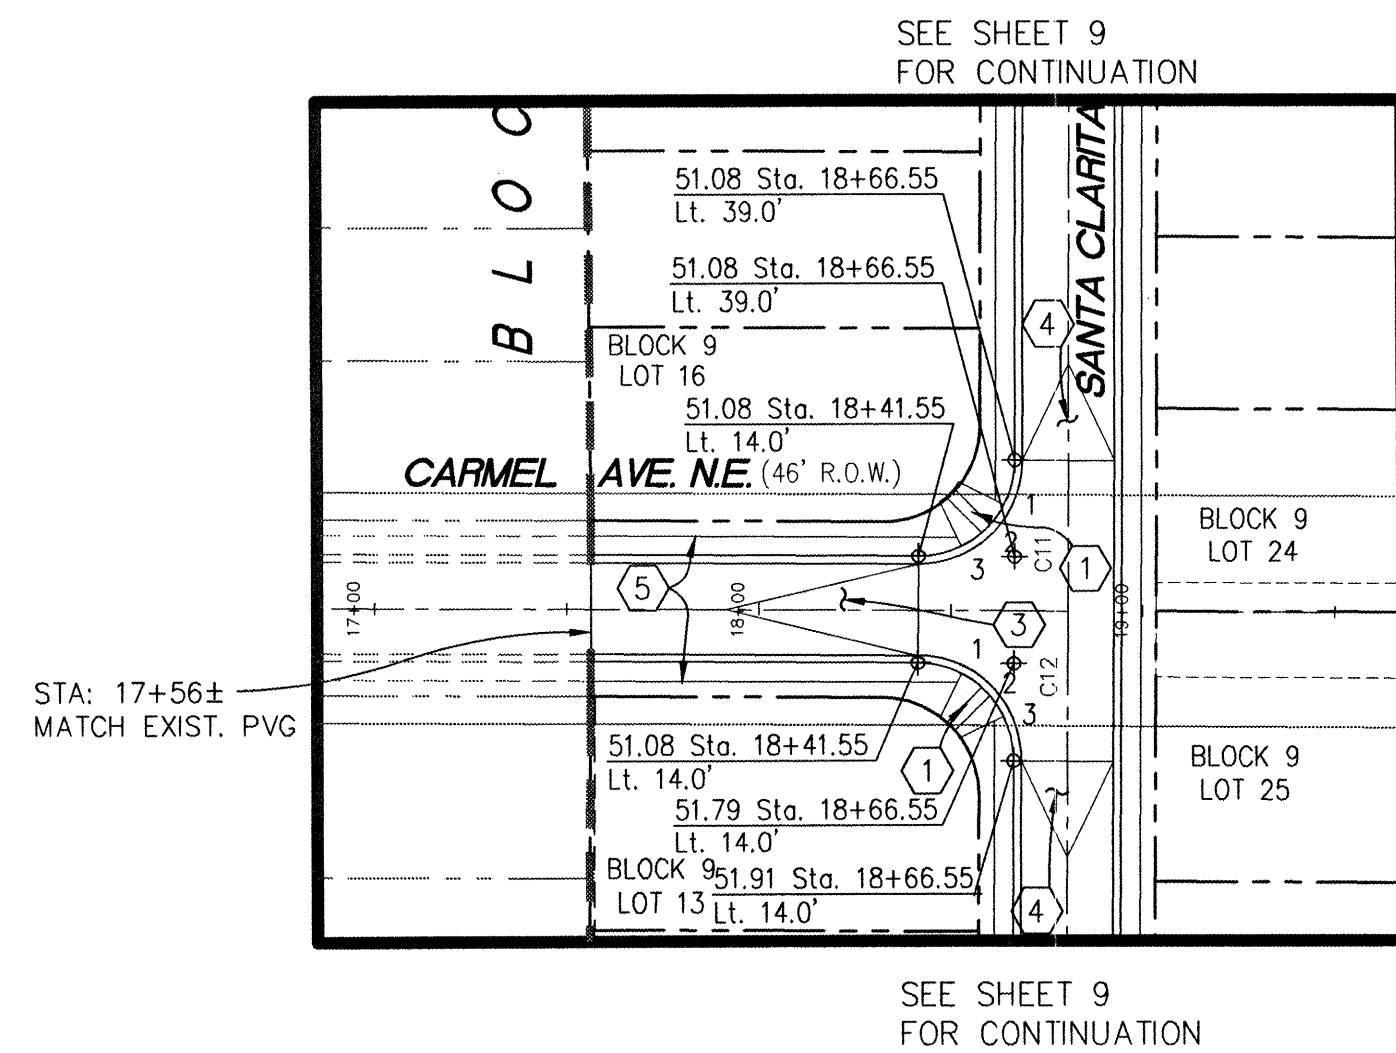


FL
1 51.82
2 51.57
3 51.33

FL
1 51.29
2 51.50
3 51.70

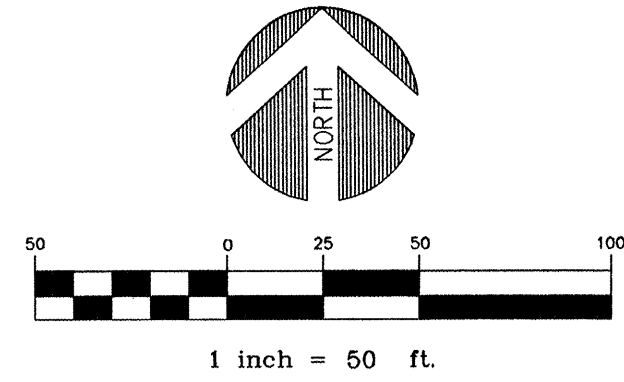


CURVE DATA AT FACE OF CURB						
CURVE	LENGTH	RADIUS	DELTA	TANGENT	CHORD LEN	CHORD DIR
C11	39.27	25.00	90°00'00"	25.00	35.36	N 45°20'29" E
C12	39.27	25.00	90°00'00"	25.00	35.36	N 44°39'31" W
C17	39.27	25.00	90°00'42"	25.01	35.36	S 44°39'51" E
C18	39.26	25.00	89°59'18"	24.99	35.35	S 45°20'09" W

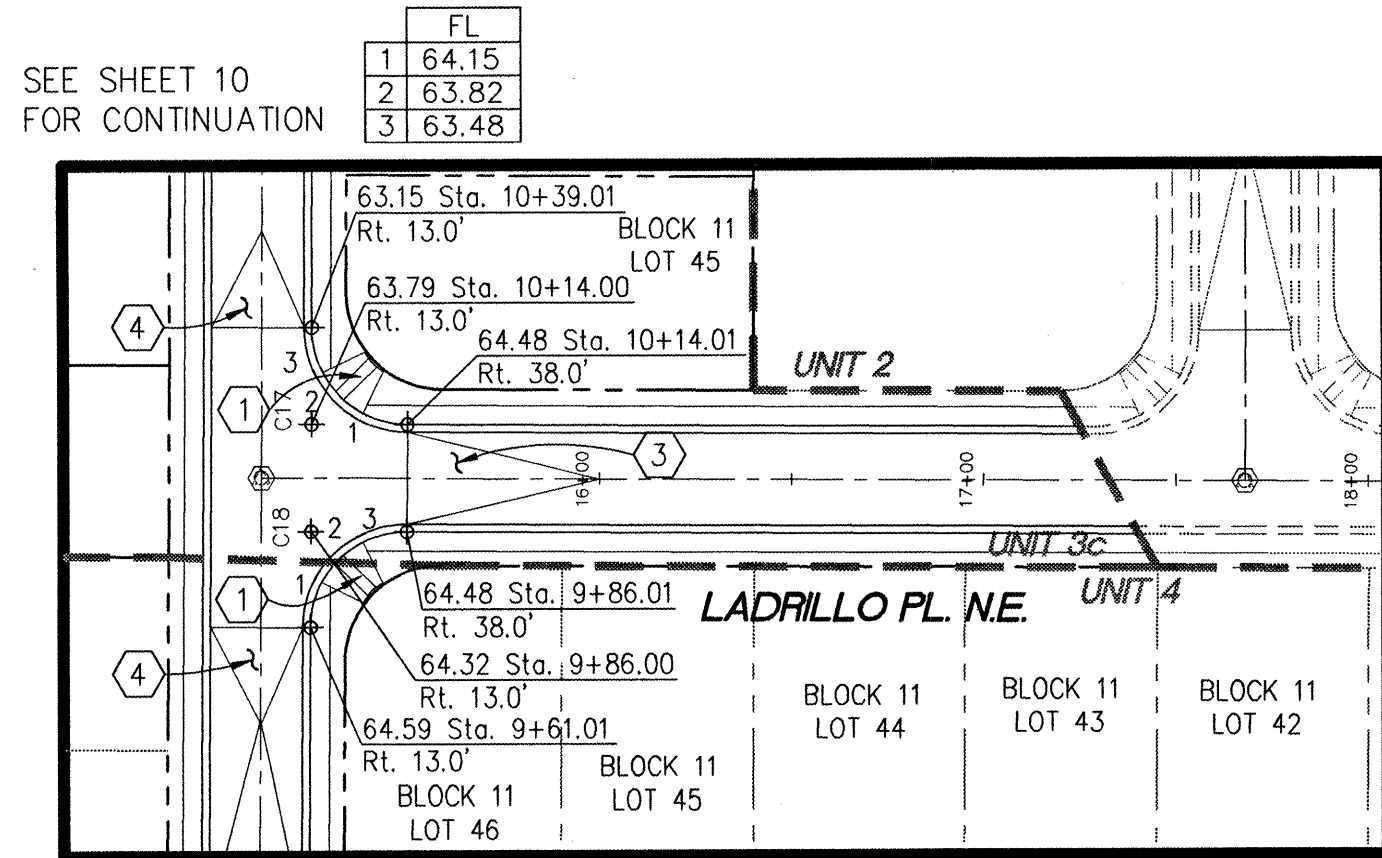


FL
1 64.56
2 64.54
3 64.51

CARMEL AVE. N.E.

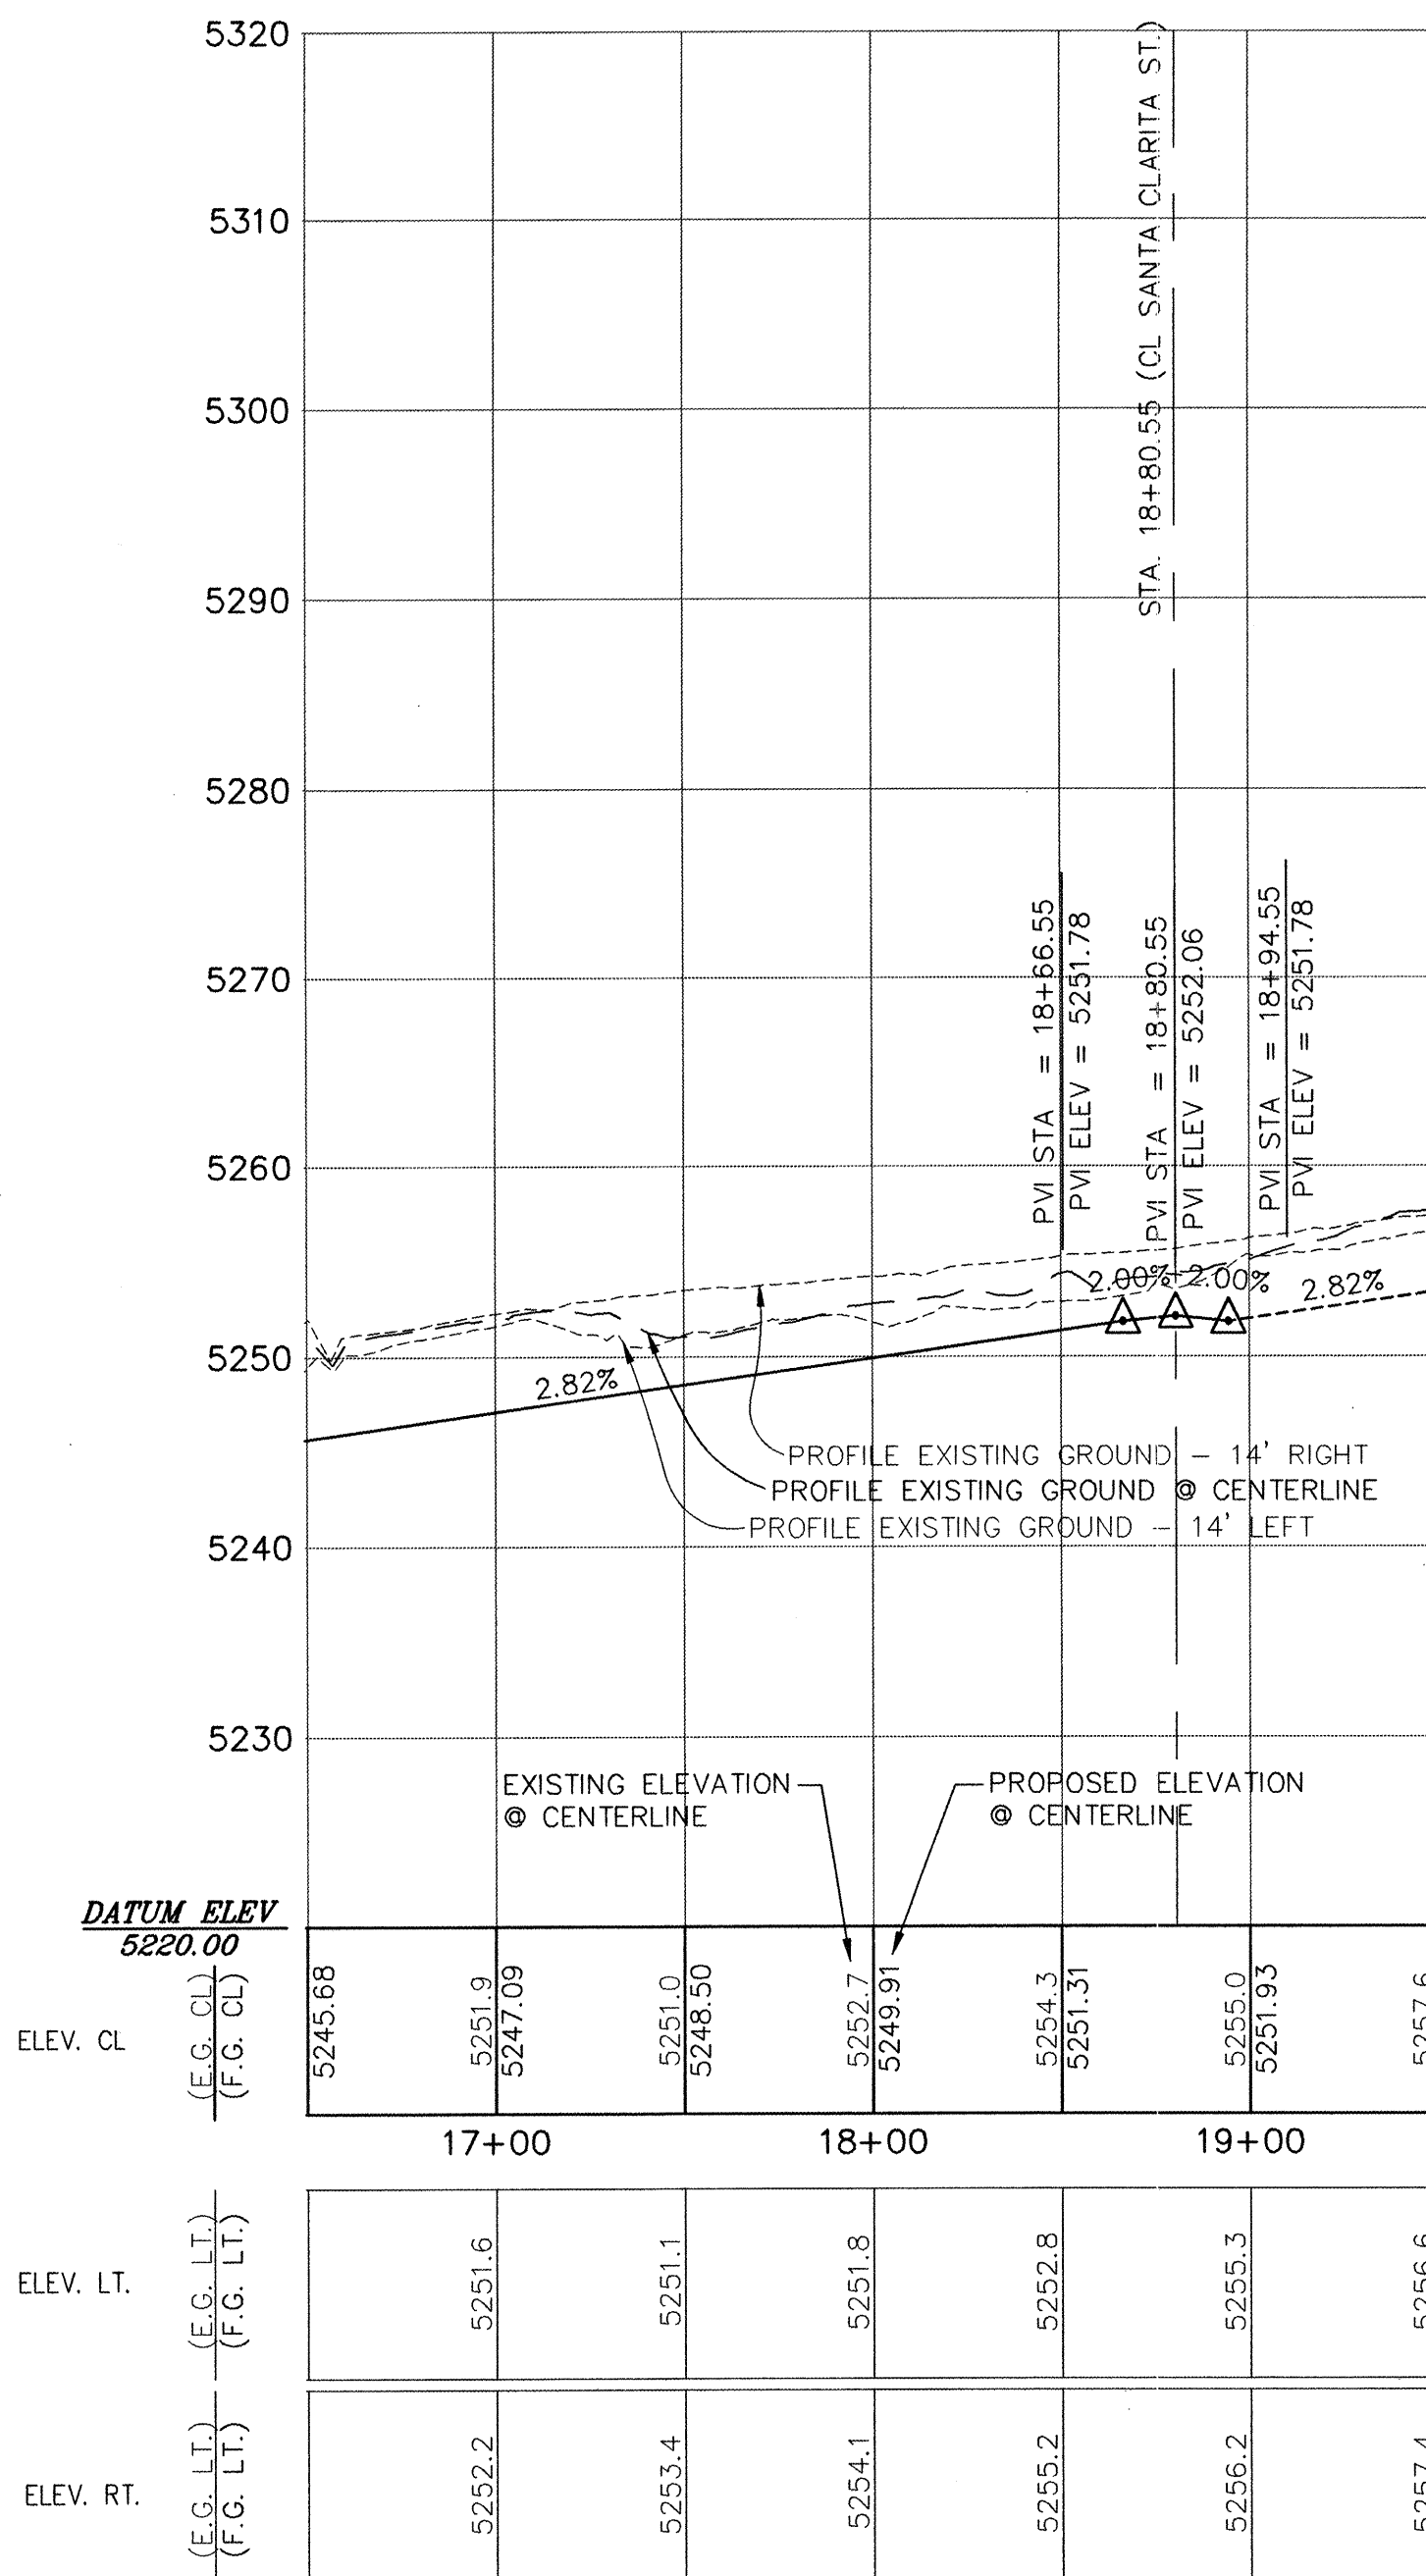

SCALE
HORIZ: 1"=50'
VERT: 1"=10'

LADRILLO PL. N.E.

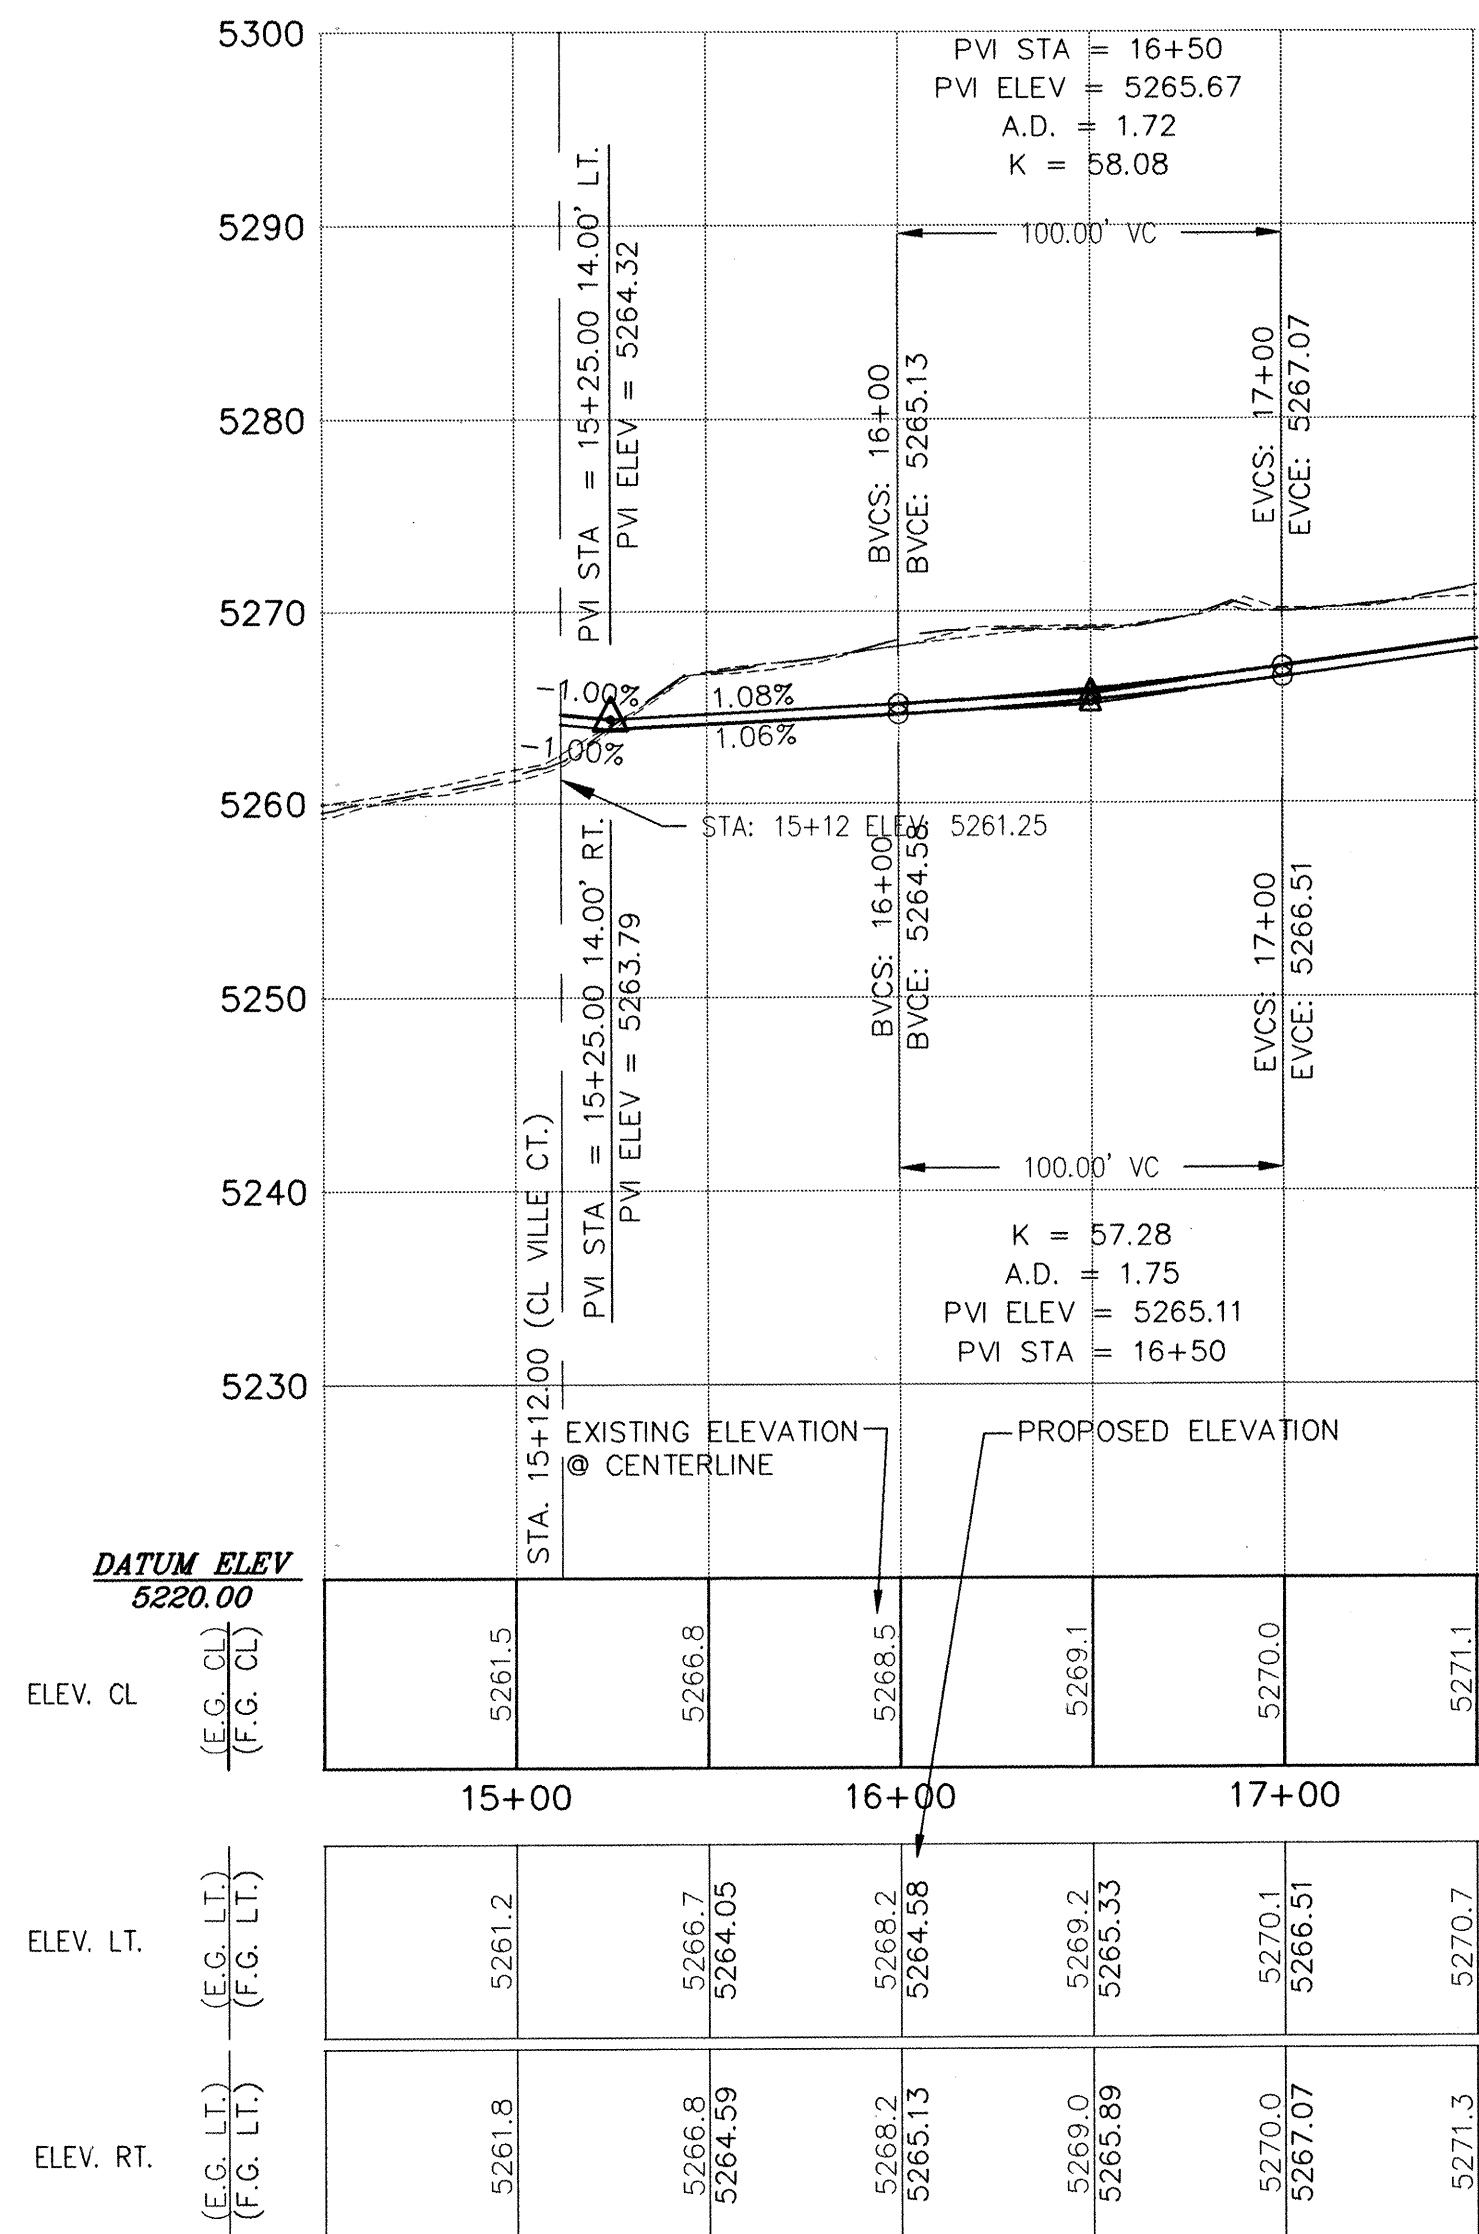

NOTES:

- NEW ELEVATIONS SHOWN ARE FLOWLINE OF CURB AND GUTTER UNLESS OTHERWISE NOTED.
- THE FOLLOWING CITY OF ALBUQUERQUE STANDARD DETAIL DRAWINGS APPLY TO THIS SHEET:
DWG 2401 - TYP. RES. STREET INTERS.
DWG 2405 - RESIDENTIAL STREET SECTION
DWG 2415 - CURB AND GUTTER
DWG 2418 - MOUNTABLE TO STANDARD CURB TRANSITION
DWG 2420 - CONCRETE VALLEY GUTTER
DWG 2430 - SIDEWALK DETAILS
DWG 2440 - WHEEL CHAIR RAMP
DWG 2441 - WHEEL CHAIR RAMP
DWG 2250 - REMOVABLE POSTS
- SEE PLAT, SHEETS 2 & 3, FOR RIGHT OF WAY WIDTHS AND STREET CENTERLINE BEARING & DISTANCE INFORMATION.

CONSTRUCTION KEYED NOTES:

- CONSTRUCT P.C.C. RAMP PER STD. DWG.# 2441. CASE NO. 2. LENGTH OF RAMP MAY VARY AS NEEDED, SLOPE NOT TO EXCEED 12:1.
- CONSTRUCT P.C.C. VALLEY GUTTER AND GUTTER AND CURB PER STD. DWG.# 2420, 6' WIDE WITH 1 1/2" INVERT DEPTH.
- CROWN TO NO CROWN TRANSITION (50' LEN).
- CROWN TO HALF CROWN TRANSITION (25' LEN).
- 4' WIDE P.C.C. SIDEWALK (NOT IN THIS CONTRACT).

AS-BUILT INFORMATION		BENCH MARKS		SURVEY INFORMATION		ENGINEER'S SEAL		REVISIONS		DESIGN	
CONTRACTOR	DATE	NO.	DATE	NO.	DATE	NO.	DATE	NO.	DATE	NO.	DATE
WORKED BY	DATE	NO.	DATE	NO.	DATE	NO.	DATE	NO.	DATE	NO.	DATE
INSPECTED BY	DATE	NO.	DATE	NO.	DATE	NO.	DATE	NO.	DATE	NO.	DATE
ACCEPTANCE BY	DATE	NO.	DATE	NO.	DATE	NO.	DATE	NO.	DATE	NO.	DATE
VERIFICATION BY	DATE	NO.	DATE	NO.	DATE	NO.	DATE	NO.	DATE	NO.	DATE
DRAWINGS	DATE	NO.	DATE	NO.	DATE	NO.	DATE	NO.	DATE	NO.	DATE
CONSTRUCTION	DATE	NO.	DATE	NO.	DATE	NO.	DATE	NO.	DATE	NO.	DATE
RECORD BY	DATE	NO.	DATE	NO.	DATE	NO.	DATE	NO.	DATE	NO.	DATE

AS-BUILT

Terry O. Brown, P.E.



P. O. Box 92051
Albuquerque, NM 87199
(505) 883-8807

CITY OF ALBUQUERQUE
PUBLIC WORKS DEPARTMENT
ENGINEERING DEVELOPMENT GROUP

TITLE: LA CUEVA OESTE, UNIT 3c, PAVING PLAN AND PROFILE
CARMEL AVE. (Sta. 17+56.46 to Sta. 18+80.55)
LADRILLO PL. (Sta. 10+00.00 to Sta. 17+32.69)

Design Review Committee	City Engineer Approval	Mo./Day/Yr.	Mo./Day/Yr.
City Project No.	Zone Map No.	Sheet	Of
5232.94	C-18-Z	11	19

SEE SHEET 12 OF 19 FOR ANAHEIM AVE. TYPICAL SECTION

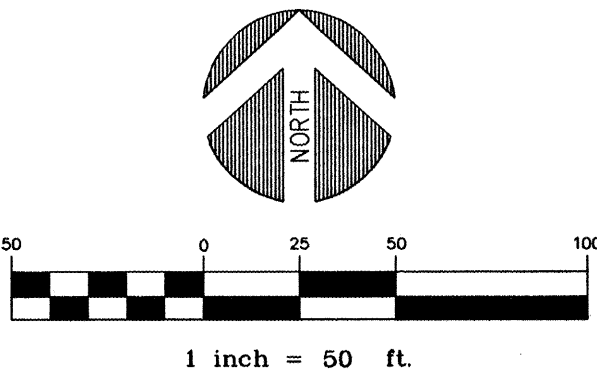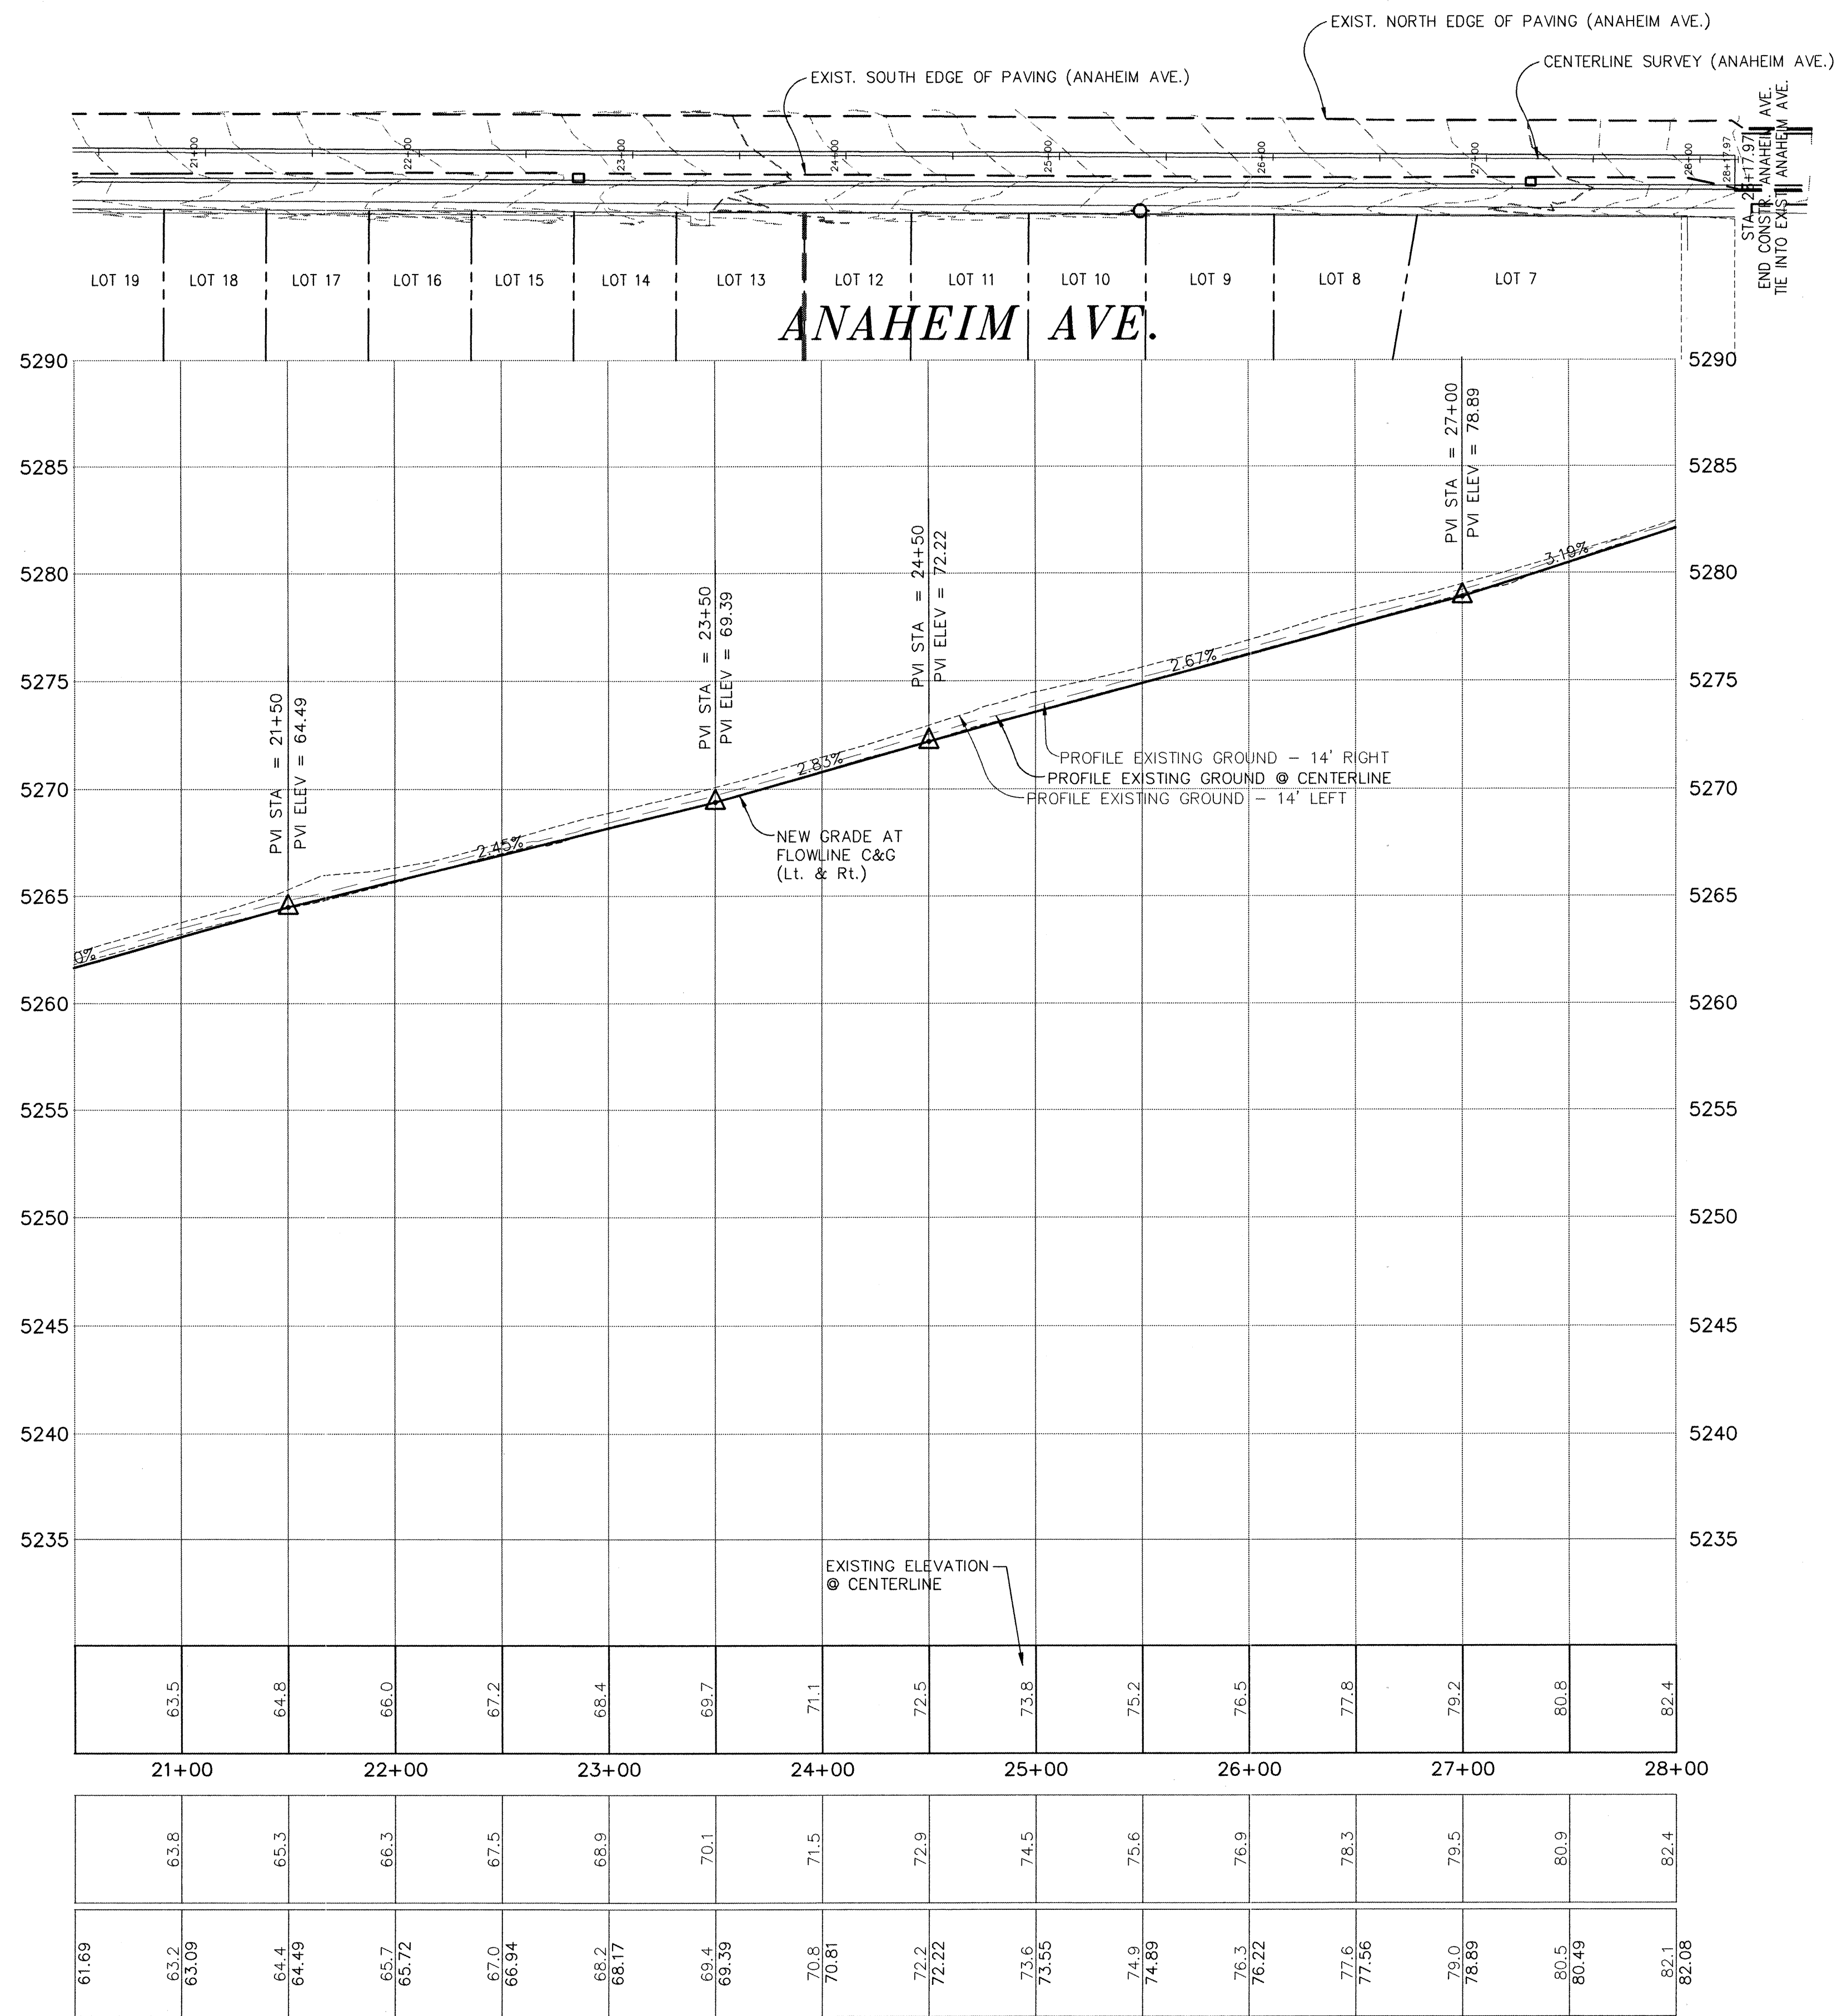

SCALE
HORIZ: 1"=50'
VERT: 1"=5'

- NOTES:
- NEW ELEVATIONS SHOWN ARE FLOWLINE OF CURB AND GUTTER UNLESS OTHERWISE NOTED.
 - THE FOLLOWING CITY OF ALBUQUERQUE STANDARD DETAIL DRAWINGS APPLY TO THIS SHEET:
 - DWG 2401 - TYP. RES. STREET INTERS.
 - DWG 2405 - RESIDENTIAL STREET SECTION
 - DWG 2415 - CURB AND GUTTER
 - DWG 2418 - MOUNTABLE TO STANDARD CURB TRANSITION
 - DWG 2420 - CONCRETE VALLEY GUTTER
 - DWG 2430 - SIDEWALK DETAILS
 - DWG 2440 - WHEEL CHAIR RAMP
 - DWG 2441 - WHEEL CHAIR RAMP
 - DWG 2250 - REMOVABLE POSTS
 - SEE PLAT, SHEETS 2 & 3, FOR RIGHT OF WAY WIDTHS AND STREET CENTERLINE BEARING & DISTANCE INFORMATION.

- CONSTRUCTION KEYED NOTES:
- CONSTRUCT P.C.C. SIDEWALK, 4" THICK, TRANSITIONS TO HANDICAP ACCESS RAMPS AND P.C.C. RAMP PER STD. DWG.# 2441, CASE NO. 2. LENGTH OF RAMPS MAY VARY AS NEEDED, SLOPE NOT TO EXCEED 12:1.
 - CONSTRUCT P.C.C. VALLEY GUTTER AND GUTTER AND CURB PER STD. DWG.# 2420, 6' WIDE WITH 1 1/2" INVERT DEPTH.
 - CROWN TO NO CROWN TRANSITION (50' LEN).
 - CROWN TO HALF CROWN TRANSITION (25' LEN).
 - 4' WIDE P.C.C. SIDEWALK (NOT IN THIS CONTRACT).

AS-BUILT INFORMATION			
CONTRACTOR	NEW CONCEPTS	DATE	4/99
STAMPED BY	CWA	DATE	4/99
INSPECTOR'S FIELD	CWA	DATE	4/99
VERIFICATION BY	CWA	DATE	4/99
CORRECTED BY	T. BROWN	DATE	4/99
MICRO-FILM INFORMATION			
RECORDED BY		DATE	
NO.			

SURVEY INFORMATION			
NO.	FIELD NOTES	DATE	
		BY	
		ACS STA. No. 1-C19	
		Y=1518845.74	
		X=404941.91	
		Z=5318.195	

ENGINEER'S SEAL	

NO.	DATE	REMARKS	BY	DESIGN	DATE: 07/98
					DRAWN BY: TOB
					DATE: 07/98
					DATE: 07/98

AS-BUILT

Terry O. Brown, P.E.
P. O. Box 92051
Albuquerque, NM 87199
(505) 883-8807

CITY OF ALBUQUERQUE
PUBLIC WORKS DEPARTMENT
ENGINEERING DEVELOPMENT GROUP


TITLE: LA CUEVA OESTE, UNIT 3c
PAVING PLAN AND PROFILE
ANAHEIM AVE. (Sta. 20+50.00 to Sta. 28+16.34)

Design Review Committee	City Engineer Approval	Mo./Day/Yr.	Mo./Day/Yr.
DESIGN REVIEW COMMITTEE			

The Contractor shall be responsible for timing and coordination of water shutoff. At least five (5) working days prior to construction, Contractor shall contact the Water Systems Division (857-8200) to initiate implementation of the non-pressurized connection plan. In order to complete this connection, the following four (4) valves must be closed by Water Systems Division personnel:

- Close valve located on Carmel Ave. west of Call Avion.
- Close valve located on Ville Ct. north of Holly Ave.
- Close Valve on Ladrillo Pl. west of La Milpita St.
- Close Valve on Sonrisa Pl. west of La Milpita St.

LA CUEVA OESTE, UNIT 3c

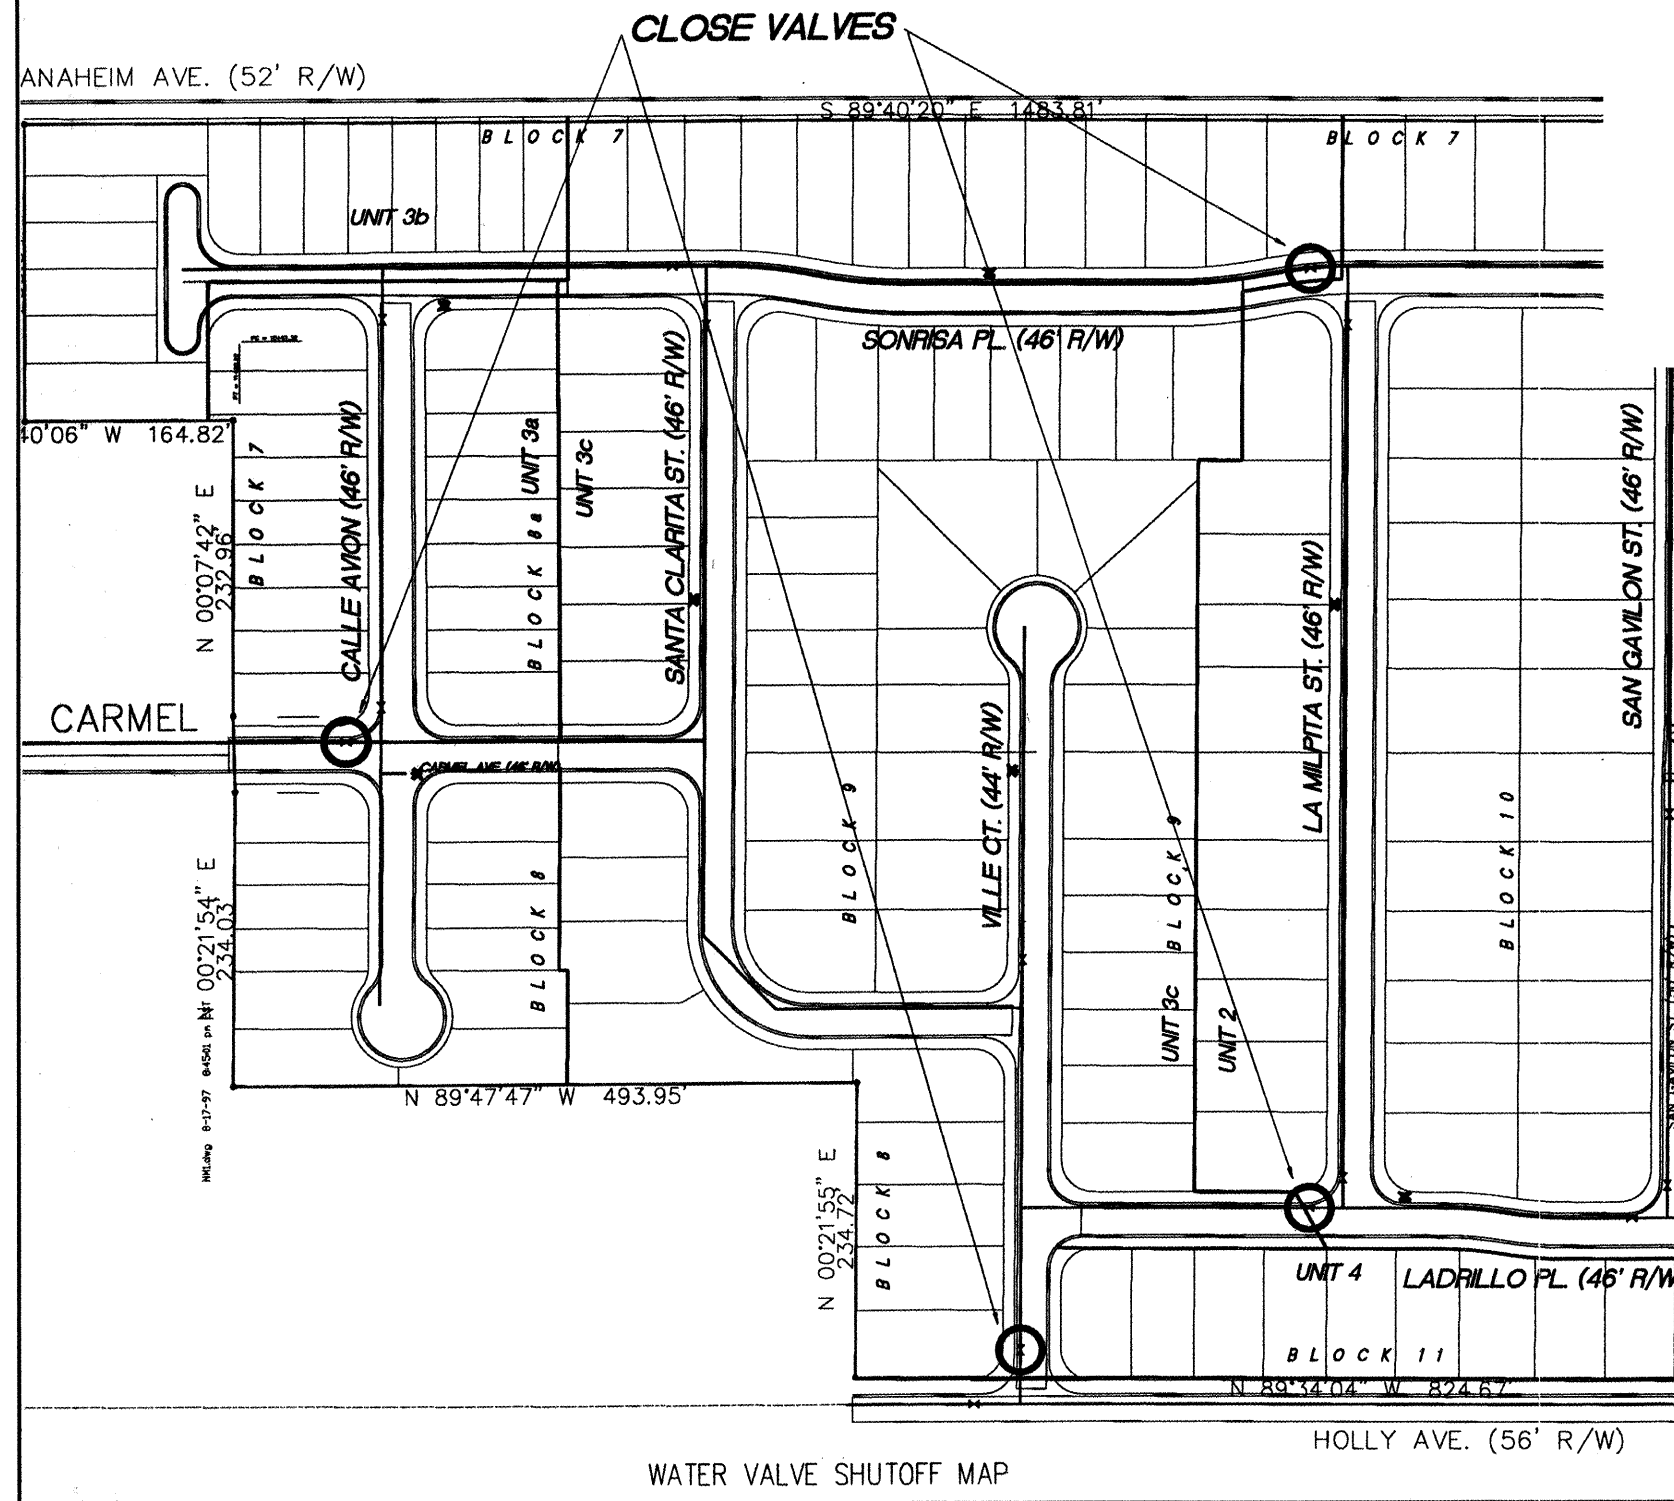

RESTRAINED JOINT LENGTHS Lr, FOR HORIZONTAL BENDS, VALVES, AND DEAD ENDS, (FT.)					
SIZE	HORIZONTAL BENDS				VALVES & DEAD ENDS
	90°	45°	22-1/2°	11-1/4°	
12	30	12	6	3	85
10	26	11	5	3	72
8	22	9	4	2	60
6	17	7	3	2	46
4	12	5	2	1	32


RESTRAINED JOINT LENGTHS Lr, FOR REDUCERS, (FT.)					
MINIMUM, UNOBSTRUCTED, STRAIGHT-RUN LENGTH: RESTRAIN EITHER LARGE PIPE, OR SMALL PIPE.					
SIZE	LARGE SIDE	SMALL SIDE	SIZE	LARGE SIDE	SMALL SIDE
12 x 10	25	30	10 x 6	44	73
12 x 8	45	68	10 x 4	58	141
12 x 6	62	121	8 x 6	25	33
12 x 4	74	213	8 x 4	43	83
10 x 8	24	30	6 x 4	24	35

RESTRAINED JOINT LENGTHS Lr, FOR TEES, (FT.)					
ALL JOINTS AT THE TEE MUST BE RESTRAINED.					
SIZE	MINIMUM RUN LENGTH		MINIMUM RUN LENGTH		
	RUN	BRANCH	RUN	BRANCH	
12x12x12	15	17	18	3	
12x12x10	10	18	13	1	
12x12x8	6	19	8	5	
12x12x6	3	19	5	1	
12x12x4	1	19	2	6	
10x10x10	12	18	15	5	
10x10x8	8	15	10	4	
10x10x6	4	16	6	1	
10x10x4	2	4	3	1	
8x8x8	9	20	13	3	
8x8x6	5	17	7	5	
8x8x4	2	15	3	7	
6x6x6	6	20	10	2	
6x6x4	2	20	4	7	

NOTE - THIS TABLE IS BASED UPON THE FOLLOWING CRITERIA:

DEPTH OF BURY	3.0 FT. MINIMUM
FACTOR OF SAFETY	1.25
MATERIAL	PVC PIPE
SOIL TYPE	GM/SM - SILTY GRAVELS & SILTY SANDS, GRAVEL-SAND-SILT MIXTURES.
TEST PRESSURE	150 PSI
TRENCH TYPE 4	PIPE BEDDED IN SAND, GRAVEL, OR CRUSHED STONE TO DEPTH OF 1/8 PIPE DIAMETER, 4 INCH MINIMUM; BACKFILL COMPACTED TO TOP OF PIPE

DIFFERENT CRITERIA, E.G., DUCTILE IRON PIPE, GREATER DEPTH OF BURY, ETC., WILL REQUIRE DIFFERENT RESTRAINED LENGTHS. THESE MUST BE CALCULATED BY A QUALIFIED PROFESSIONAL ENGINEER AND APPROVED BY THE PUBLIC WORKS DEPARTMENT.

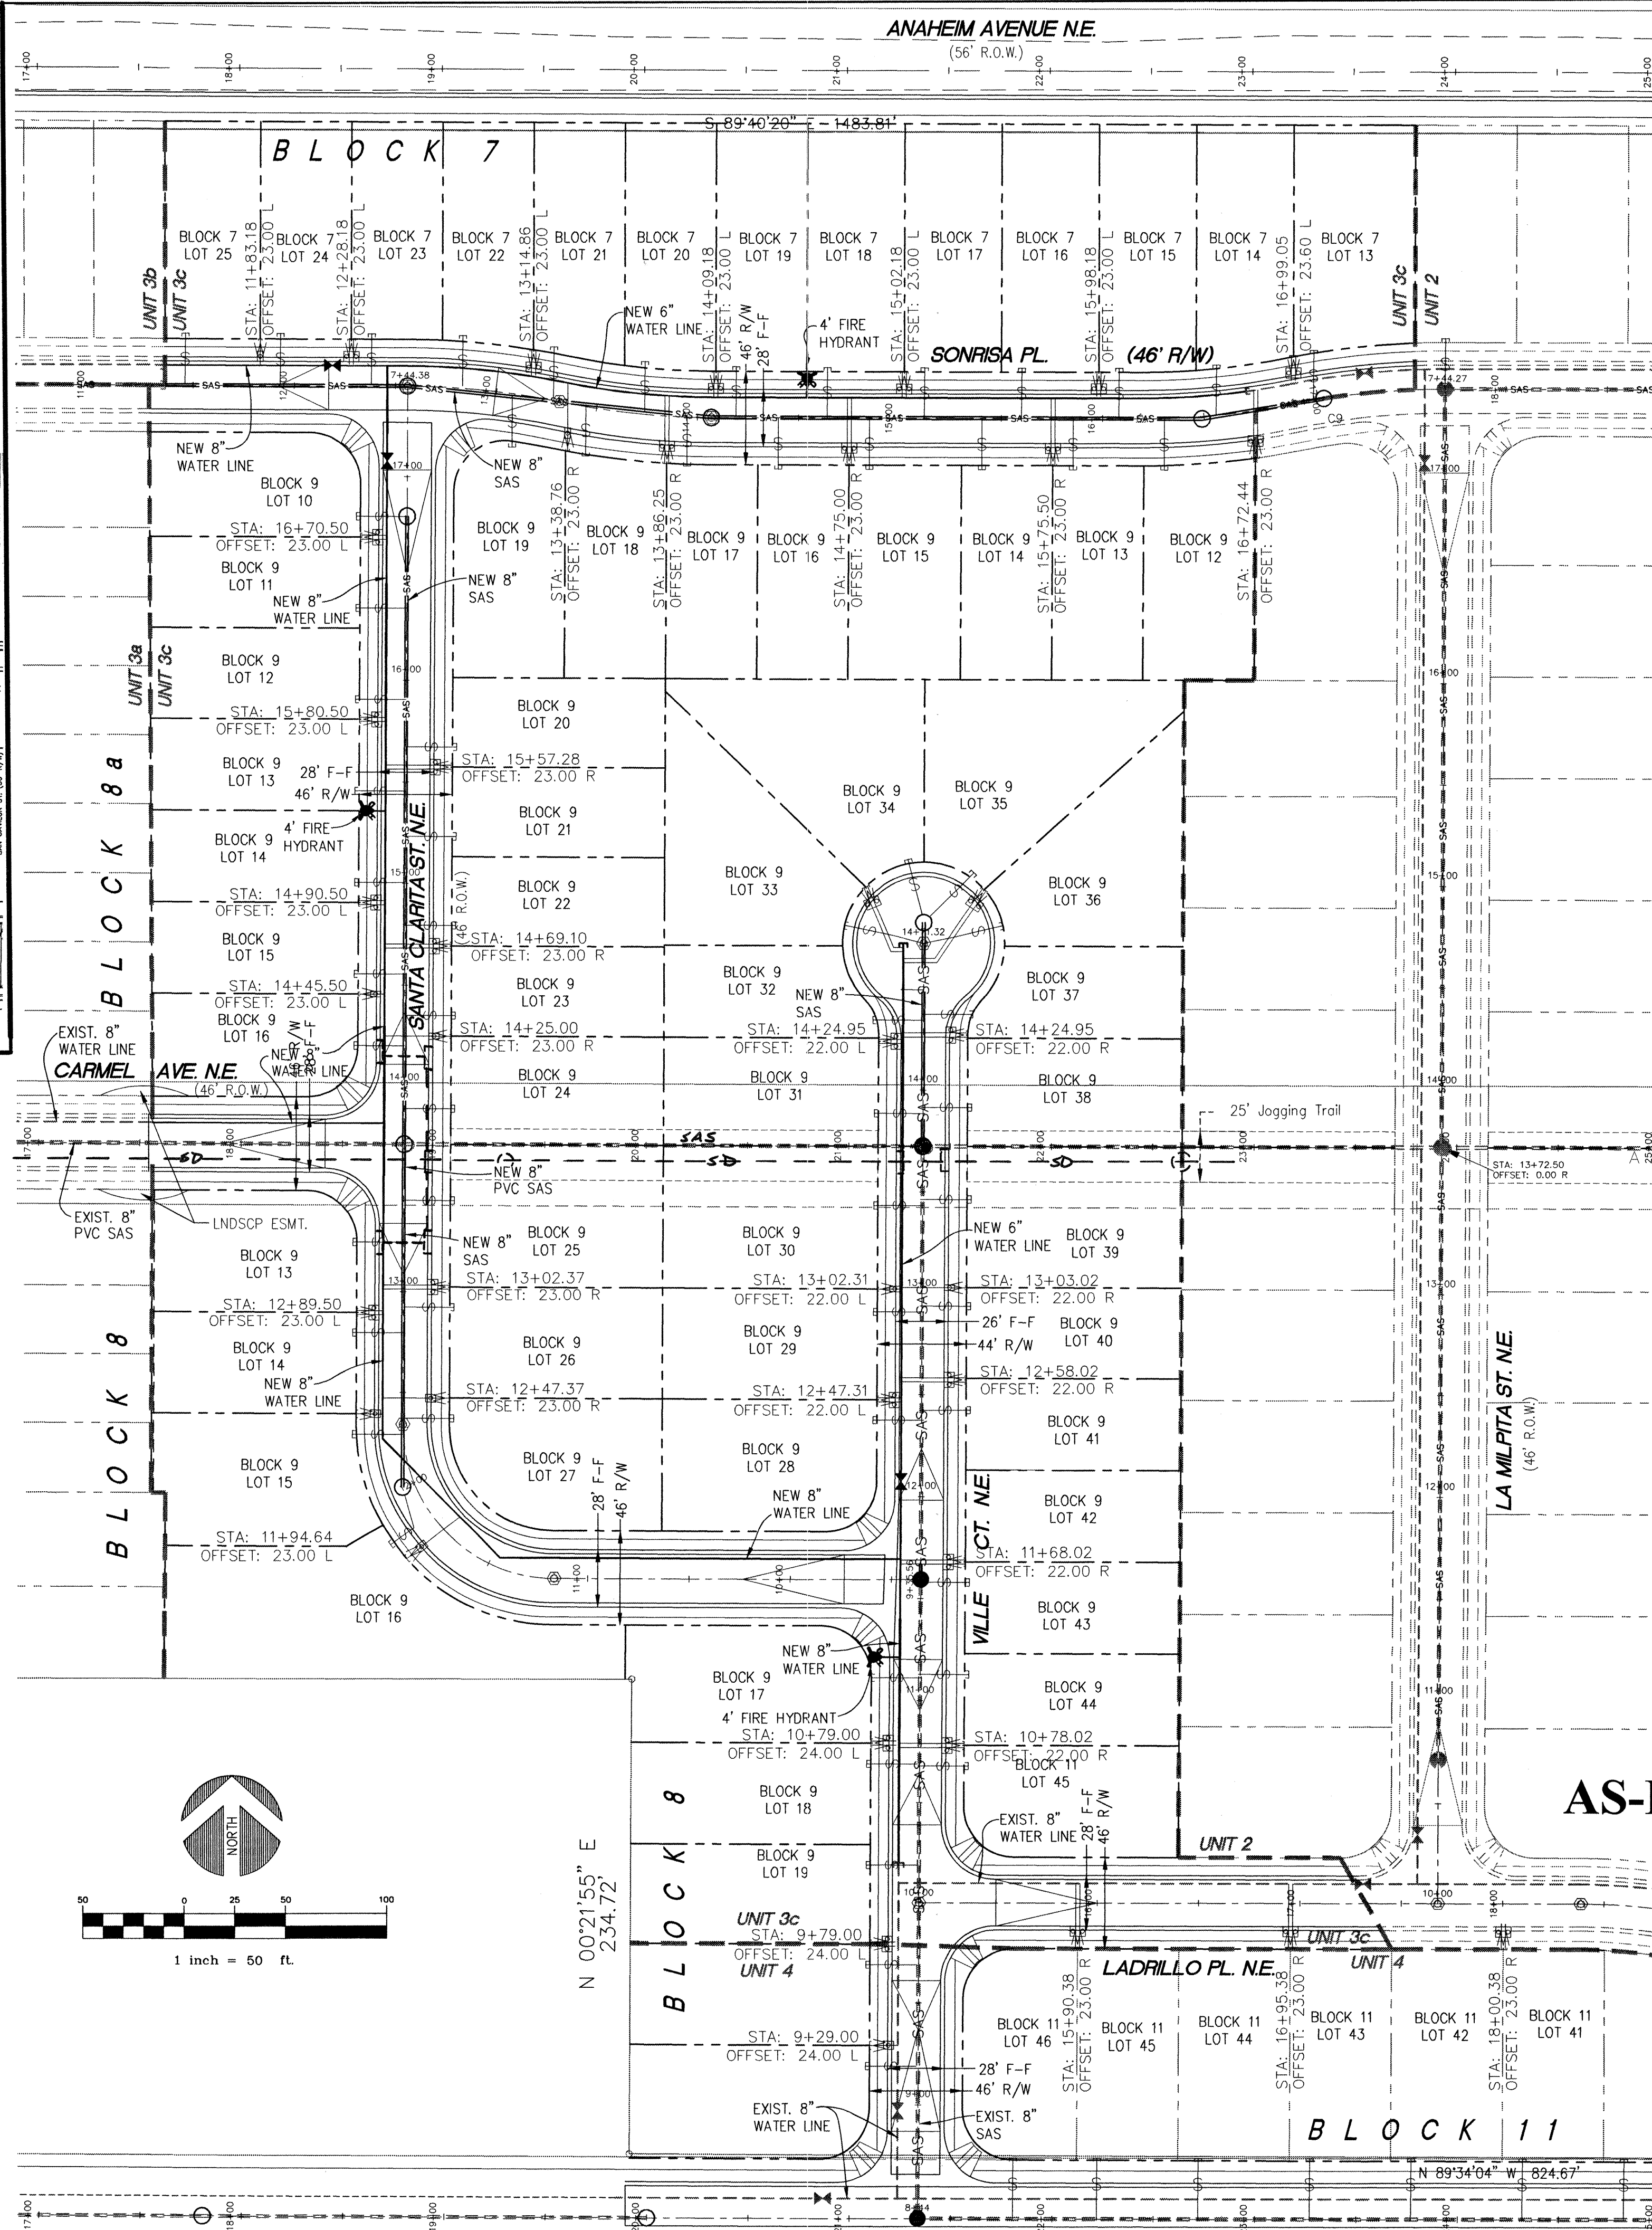

AS-BUILT

FOR INFORMATION ONLY

LEGEND	
NEW CURB & GUTTER	---
NEW SAS MAINLINE	---
NEW SAS SERVICE LINE	---
NEW SAS MANHOLE	●
NEW WATER MAINLINE	---
NEW WATER SERVICE LINE	---
NEW GATE VALVE	✕
NEW FIRE HYDRANT	✕
NEW STREET LIGHT	✕
NEW VALLEY GUTTER	---

WATER AND SEWER NOTES

1. CONSTRUCT 4" TYPE "C" MANHOLES PER STD. DWG.# 2101.
2. CONSTRUCT SAS SERVICE LINES PER STD. DWG.# 2125.
3. CONSTRUCT ALL CONCRETE BLOCKING PER STD. DWG.# 2320.
4. CONSTRUCT ALL VALVE BOXES PER NEW C.O.A. VALVE BOX DETAIL WITH NON-TAPERED CONCRETE COLLAR.
5. CONSTRUCT ALL FIRE HYDRANTS PER DESIGNATED DEPTHS AND LENGTHS PER STD. DWG.# 2340.
6. CONSTRUCT ALL SINGLE AND DOUBLE WATER SERVICE LINES PER STD. DWG.# 2361, 2362 AND 2363.
7. RESTRAINT DISTANCES FOR PIPE FITTINGS SHALL BE DEFINED BY TABLE ON THIS SHEET.
8. ALL WATERLINES SHALL BE C-900 PVC UNLESS OTHERWISE NOTED.
9. CONTRACTOR SHALL SUPPORT ALL EXISTING UNDERGROUND UTILITY LINES WHICH BECOME EXPOSED DURING CONSTRUCTION. PAYMENT FOR SUPPORTING WORK SHALL BE INCIDENTAL TO WATERLINE AND/OR SEWER LINE COSTS.
10. PROPOSED WATERLINE MATERIALS SHALL BE EITHER P.V.C. PIPE MEETING AWWA C-900 REQUIREMENTS (6"-12" DIA.) OR DUCTILE IRON PIPE, THICKNESS CLASS 50 (6"-16" DIA.).
11. EXISTING CURB AND GUTTER NOT CALLED OUT TO BE REMOVED UNDER THE CONTRACT WHICH IS DAMAGED OR DISPLACED BY THE CONTRACTOR SHALL BE REMOVED AND REPLACED BY THE CONTRACTOR AT HIS OWN EXPENSE.
12. THE CONTRACTOR SHALL SUPPORT AND MAINTAIN THE INTEGRITY OF ALL UTILITIES AT NO ADDITIONAL COST TO THE OWNER. ANY UTILITY RELOCATION THAT IS NECESSARY IS TO BE COORDINATED WITH THE UTILITY OWNER AND SHALL BE PAID FOR AS OUTLINED IN THE SPECIAL PROVISIONS OF THE CONTRACT DOCUMENTS.
13. SAS SERVICE INV. AT PROPERTY LINE SHALL BE 4' MIN. BELOW FLOWLINE OF CURB. SAS SERVICES AT IDENTICAL STATIONS SHALL BE OFFSET 1.5' NORTH & SOUTH (OR EAST & WEST) AT TIE INTO MAIN.
14. SEE THIS SHEET FOR SAS AND WATER SERVICE STATIONING INFORMATION.
15. PNW (PUBLIC SERVICE CO. OF NEW MEXICO) WILL PROVIDE AT NO COST TO THE CITY OR TO THE CONTRACTOR THE REQUIRED PERSONNEL FOR INSPECTION OR OBSERVATION DEEMED NECESSARY BY PNW WHILE THE CONTRACTOR IS EXPOSING PNW'S CABLES. HOWEVER, THEN CONTRACTOR SHALL BE CHARGED THE TOTAL COST ASSOCIATED WITH REPAIRS TO ANY DAMAGES CABLES OR FOR ANY COST ASSOCIATED WITH SUPPORTING OR RELOCATING THE POLES AND CABLES DURING CONSTRUCTION.

WATER VALVE SHUTOFF REQUIREMENTS:

THE CONTRACTOR SHALL BE RESPONSIBLE FOR TIMING AND COORDINATION OF WATER SHUTOFF. AT LEAST FIVE (5) WORKING DAYS PRIOR TO CONSTRUCTION, CONTRACTOR SHALL CONTACT THE WATER SYSTEMS DIVISION (857-8200) TO INITIATE IMPLEMENTATION OF THE NON-PRESSURIZED CONNECTION PLAN. IN ORDER TO COMPLETE THIS CONNECTION, THE FOLLOWING VALVES MUST BE CLOSED BY WATER SYSTEMS PERSONNEL:

1. CLOSE EXISTING WATER VALVE ON SONRISA PLACE JUST WEST OF LA MILPITA ST.
2. CLOSE EXISTING WATER VALVE ON SONRISA PLACE JUST WEST OF CALLE AVION.
3. CLOSE EXISTING WATER VALVE ON CALLE AVION JUST SOUTH OF SONRISA PLACE.
4. CLOSE EXISTING WATER VALVE ON LADRILLO PLACE JUST WEST OF LA MILPITA ST.
5. CLOSE EXISTING WATER VALVE ON HOLLY AVE. JUST WEST OF LOUISIANA BLVD.

(SEE WATER VALVE SHUTOFF MAP - THIS SHEET.)

Terry O. Brown, P.E.
P. O. Box 92051
Albuquerque, NM 87199
(505) 883-8807

CITY OF ALBUQUERQUE
PUBLIC WORKS DEPARTMENT
ENGINEERING DEVELOPMENT GROUP

TITLE: LA CUEVA OESTE, UNIT 3c
UTILITY MASTER PLAN & UTILITY TABLES




City Engineer Approval


City Project No.	5232.94	Zone Map No.	C-18-Z	Sheet	15	Of	19
------------------	---------	--------------	--------	-------	----	----	----

AS-BUILT INFORMATION		BENCH MARKS		SURVEY INFORMATION		ENGINEER'S SEAL		REVISIONS		DESIGN	
CONTRACTOR	DATE	NO.	DATE	NO.	DATE	NO.	DATE	NO.	DATE	NO.	DATE
WORK	DATE	NO.	DATE	NO.	DATE	NO.	DATE	NO.	DATE	NO.	DATE
STAKED BY	DATE	NO.	DATE	NO.	DATE	NO.	DATE	NO.	DATE	NO.	DATE
ACCEPTANCE BY	DATE	NO.	DATE	NO.	DATE	NO.	DATE	NO.	DATE	NO.	DATE
FIELD	DATE	NO.	DATE	NO.	DATE	NO.	DATE	NO.	DATE	NO.	DATE
DRAWINGS	DATE	NO.	DATE	NO.	DATE	NO.	DATE	NO.	DATE	NO.	DATE
CORRECTED BY	DATE	NO.	DATE	NO.	DATE	NO.	DATE	NO.	DATE	NO.	DATE
MICRO-FILM INFORMATION	DATE	NO.	DATE	NO.	DATE	NO.	DATE	NO.	DATE	NO.	DATE
RECORDED BY	DATE	NO.	DATE	NO.	DATE	NO.	DATE	NO.	DATE	NO.	DATE
NO.	DATE	NO.	DATE	NO.	DATE	NO.	DATE	NO.	DATE	NO.	DATE

SEE SHEET 18
FOR CONTINUATION

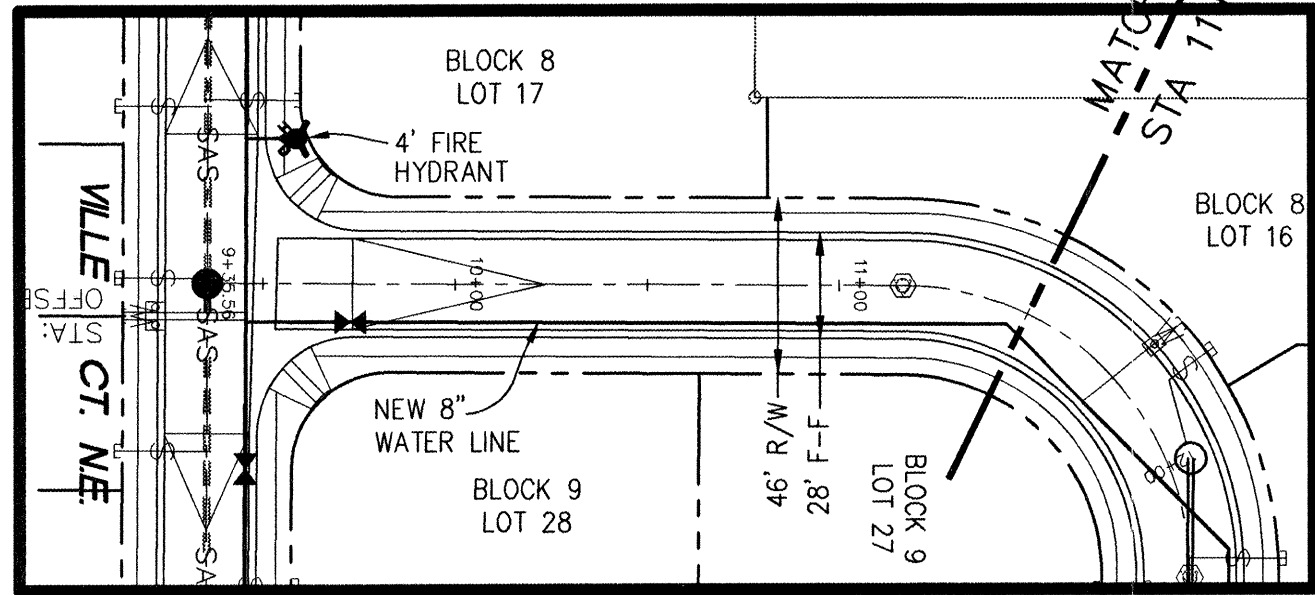


SEE SHEET 18
FOR CONTINUATION

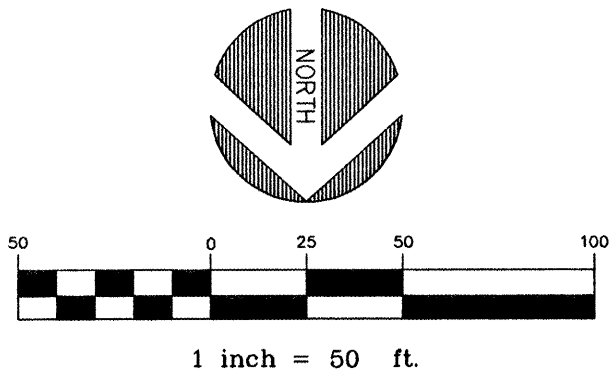


SANITARY SEWER SERVICE TABLE - LA CUEVA OESTE, UNIT 3c

Block 8						
Lot No.	Street	SAS Serv Sta.	Offset to PL	Elev. FL Curb	Elev. SAS Inv. @ PL	
13	SANTA CLARITA ST.	13+14.50	23' Lt.	5251.99	5247.99	
14	SANTA CLARITA ST.	12+79.51	23' Lt.	5252.37	5248.37	
15	SANTA CLARITA ST.	12+30.65	23' Lt.	5253.10	5249.10	
16	SANTA CLARITA ST.	11+79.30	23' Lt.	5254.35	5250.35	
Block 8a						
10	SANTA CLARITA ST.	16+80.51	23' Lt.	5253.59	5249.59	
11	SANTA CLARITA ST.	16+35.51	23' Lt.	5253.90	5249.90	
12	SANTA CLARITA ST.	15+90.51	23' Lt.	5253.95	5249.95	
13	SANTA CLARITA ST.	15+45.51	23' Lt.	5253.55	5249.55	
14	SANTA CLARITA ST.	15+00.51	23' Lt.	5253.05	5249.05	
15	SANTA CLARITA ST.	14+55.50	23' Lt.	5252.55	5248.55	
16	SANTA CLARITA ST.	14+20.50	23' Lt.	5252.16	5248.16	

SEE SHEET 18
FOR CONTINUATION

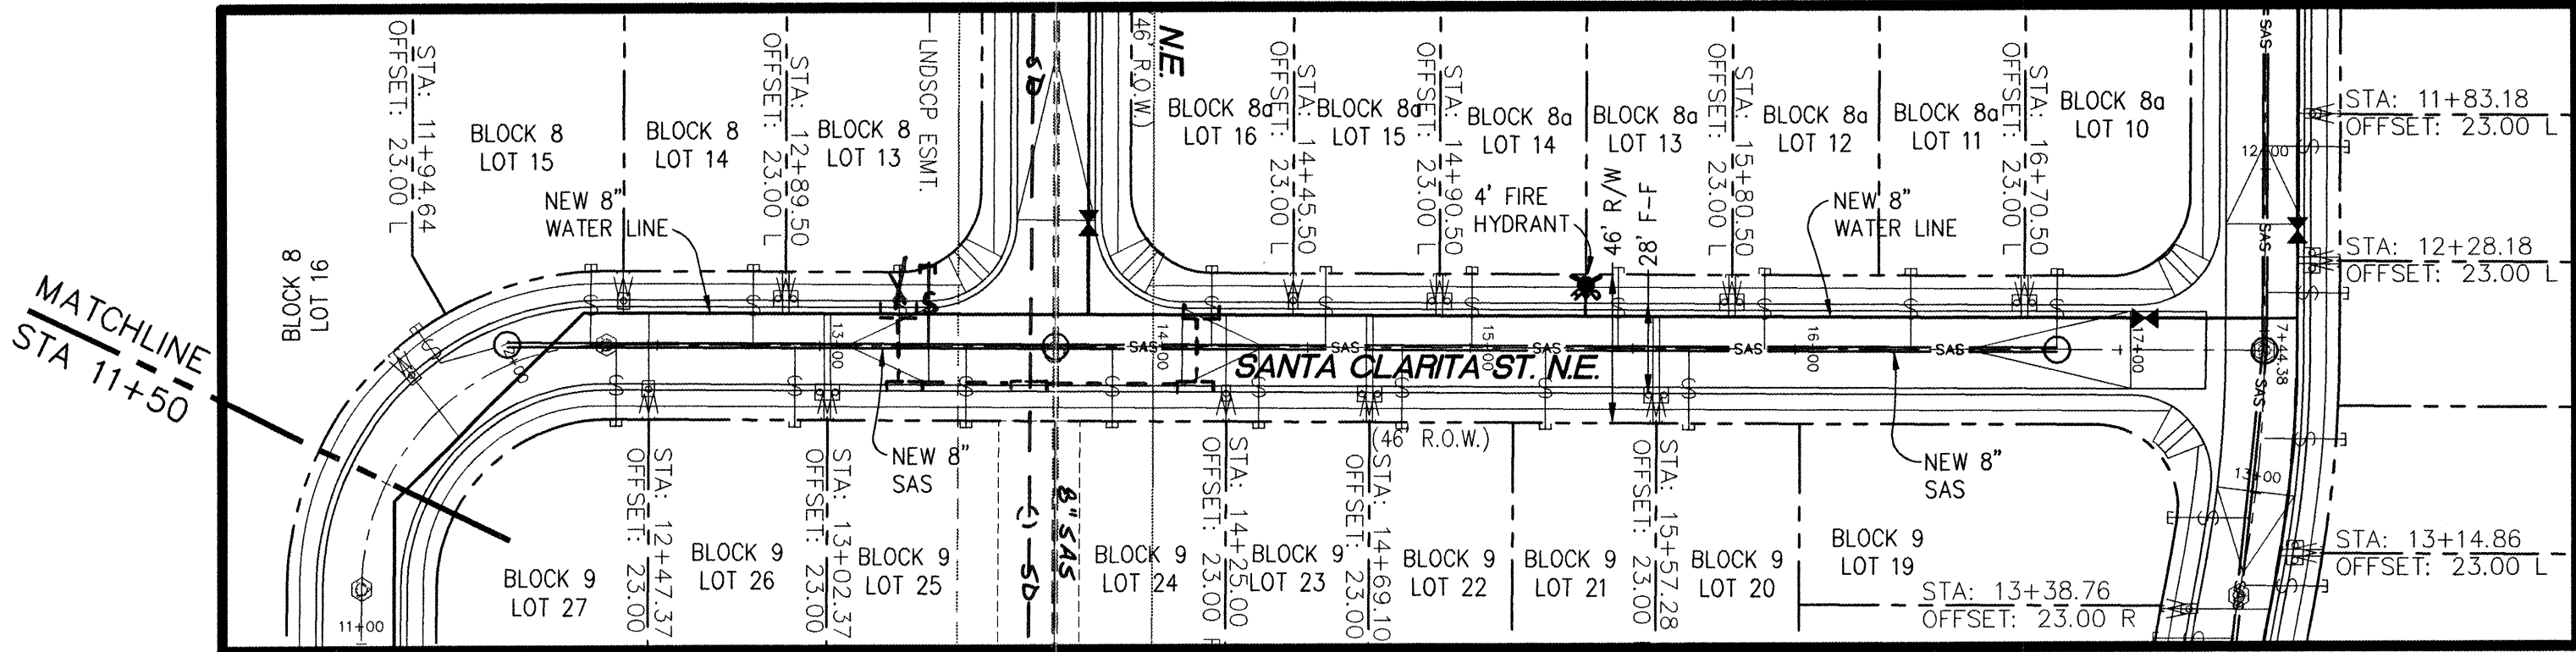

SEE SHEET 16
FOR CONTINUATION

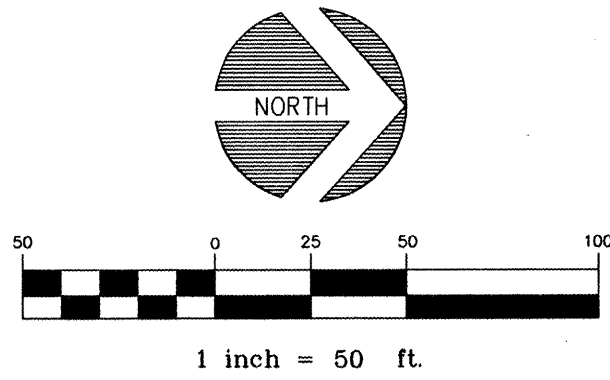


SANITARY SEWER SERVICE TABLE - LA CUEVA OESTE, UNIT 3c

Block 9						
Lot No.	Street	SAS Serv Sta.	Offset to PL	Elev. FL Curb	Elev. SAS Inv. @ PL	
20	SANTA CLARITA ST.	15+67.28	23' Rt.	5253.78	5249.78	
21	SANTA CLARITA ST.	15+23.19	23' Rt.	5253.30	5249.30	
22	SANTA CLARITA ST.	14+79.10	23' Rt.	5252.81	5248.81	
23	SANTA CLARITA ST.	14+35.00	23' Rt.	5252.32	5248.32	
24	SANTA CLARITA ST.	13+90.00	23' Rt.	5251.86	5247.86	
25	SANTA CLARITA ST.	13+45.00	23' Rt.	5251.83	5247.83	
26	SANTA CLARITA ST.	12+92.37	23' Rt.	5252.26	5248.26	
27	SANTA CLARITA ST.	12+37.37	23' Rt.	5252.97	5248.97	

TYPICALLY, SAS SERVICE FL SHOULD BE 4 FEET BELOW FL OF GUTTER AT PROPERTY LINE.

SANTA CLARITA ST. N.E.

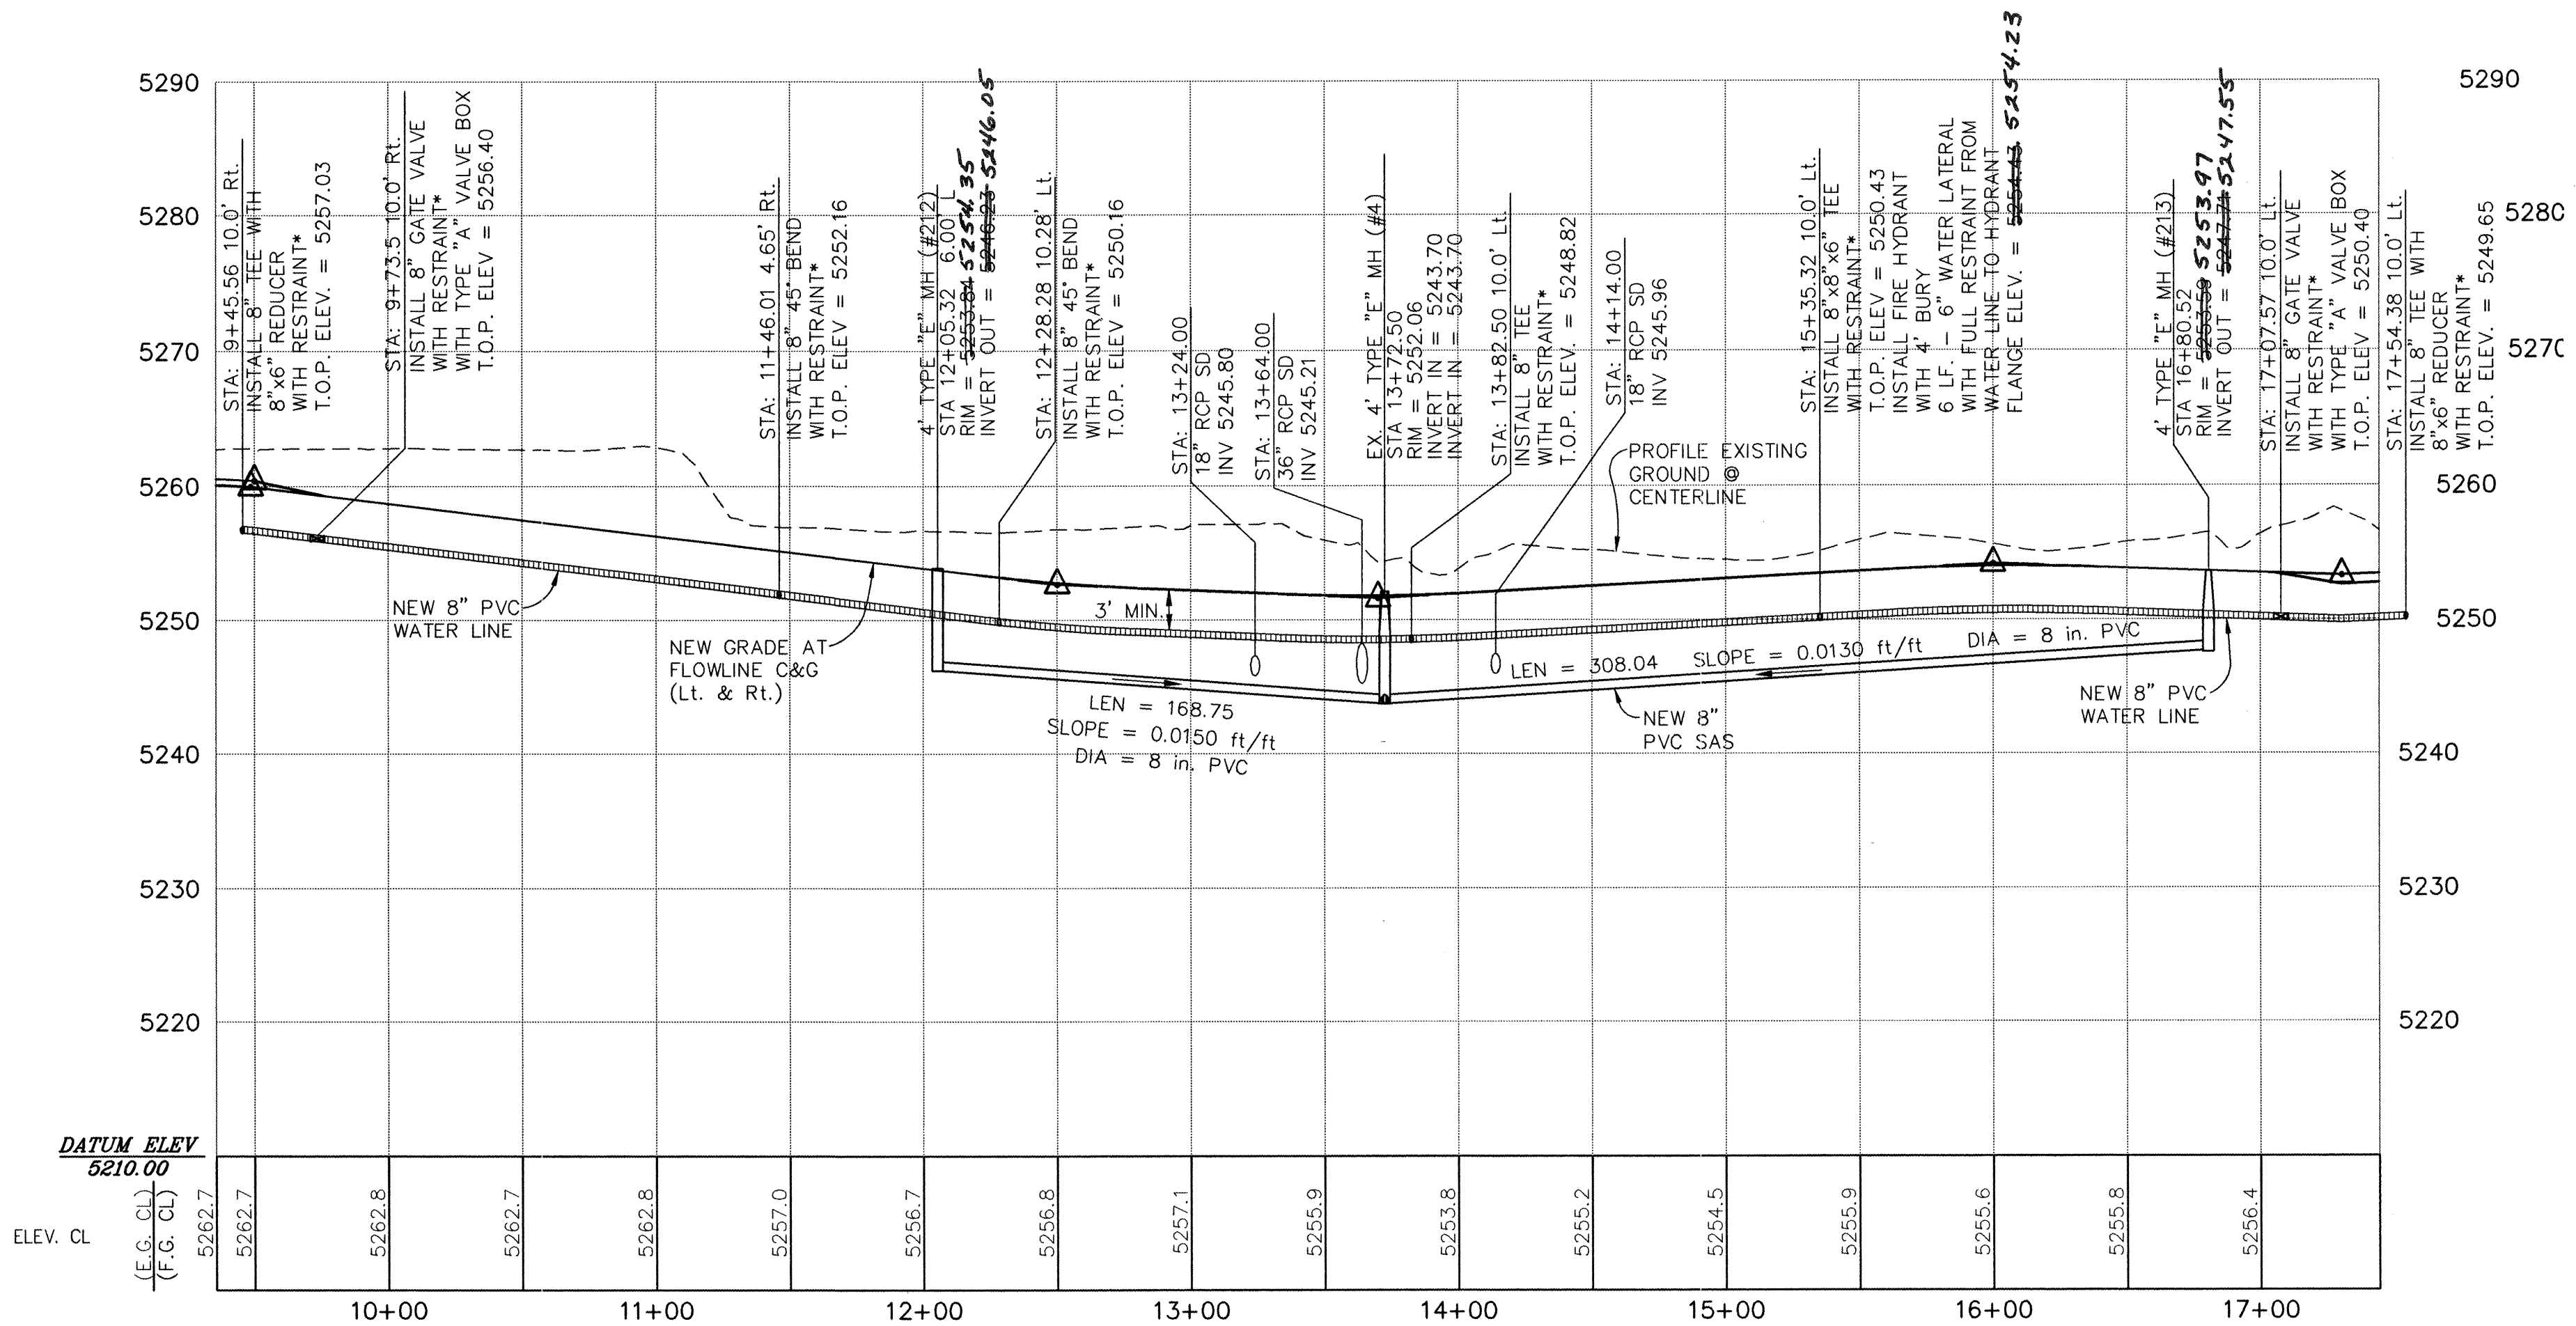

SCALE
HORIZ: 1"=50'
VERT: 1"=10'



FOR INFORMATION ONLY

AS-BUILT

Terry O. Brown, P.E.
P. O. Box 92051
Albuquerque, NM 87199
(505) 883-8807

CITY OF ALBUQUERQUE PUBLIC WORKS DEPARTMENT ENGINEERING DEVELOPMENT GROUP			
TITLE: LA CUEVA OESTE, UNIT 3c UTILITY PLAN AND PROFILE SANTA CLARITA ST. N.E. (Sta. 9+35.56 to Sta. 17+44.38)			
Design Review Committee	City Engineer Approval	Mo./Day/Yr.	Mo./Day/Yr.
APPROVED			
DESIGN REVIEW COMMITTEE			
City Project No.	Zone Map No.	Sheet	Of
5232.94	C-18-Z	17	19

LC3C_UPP.DWG

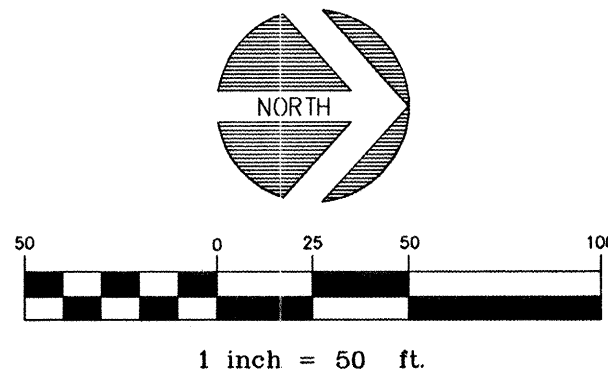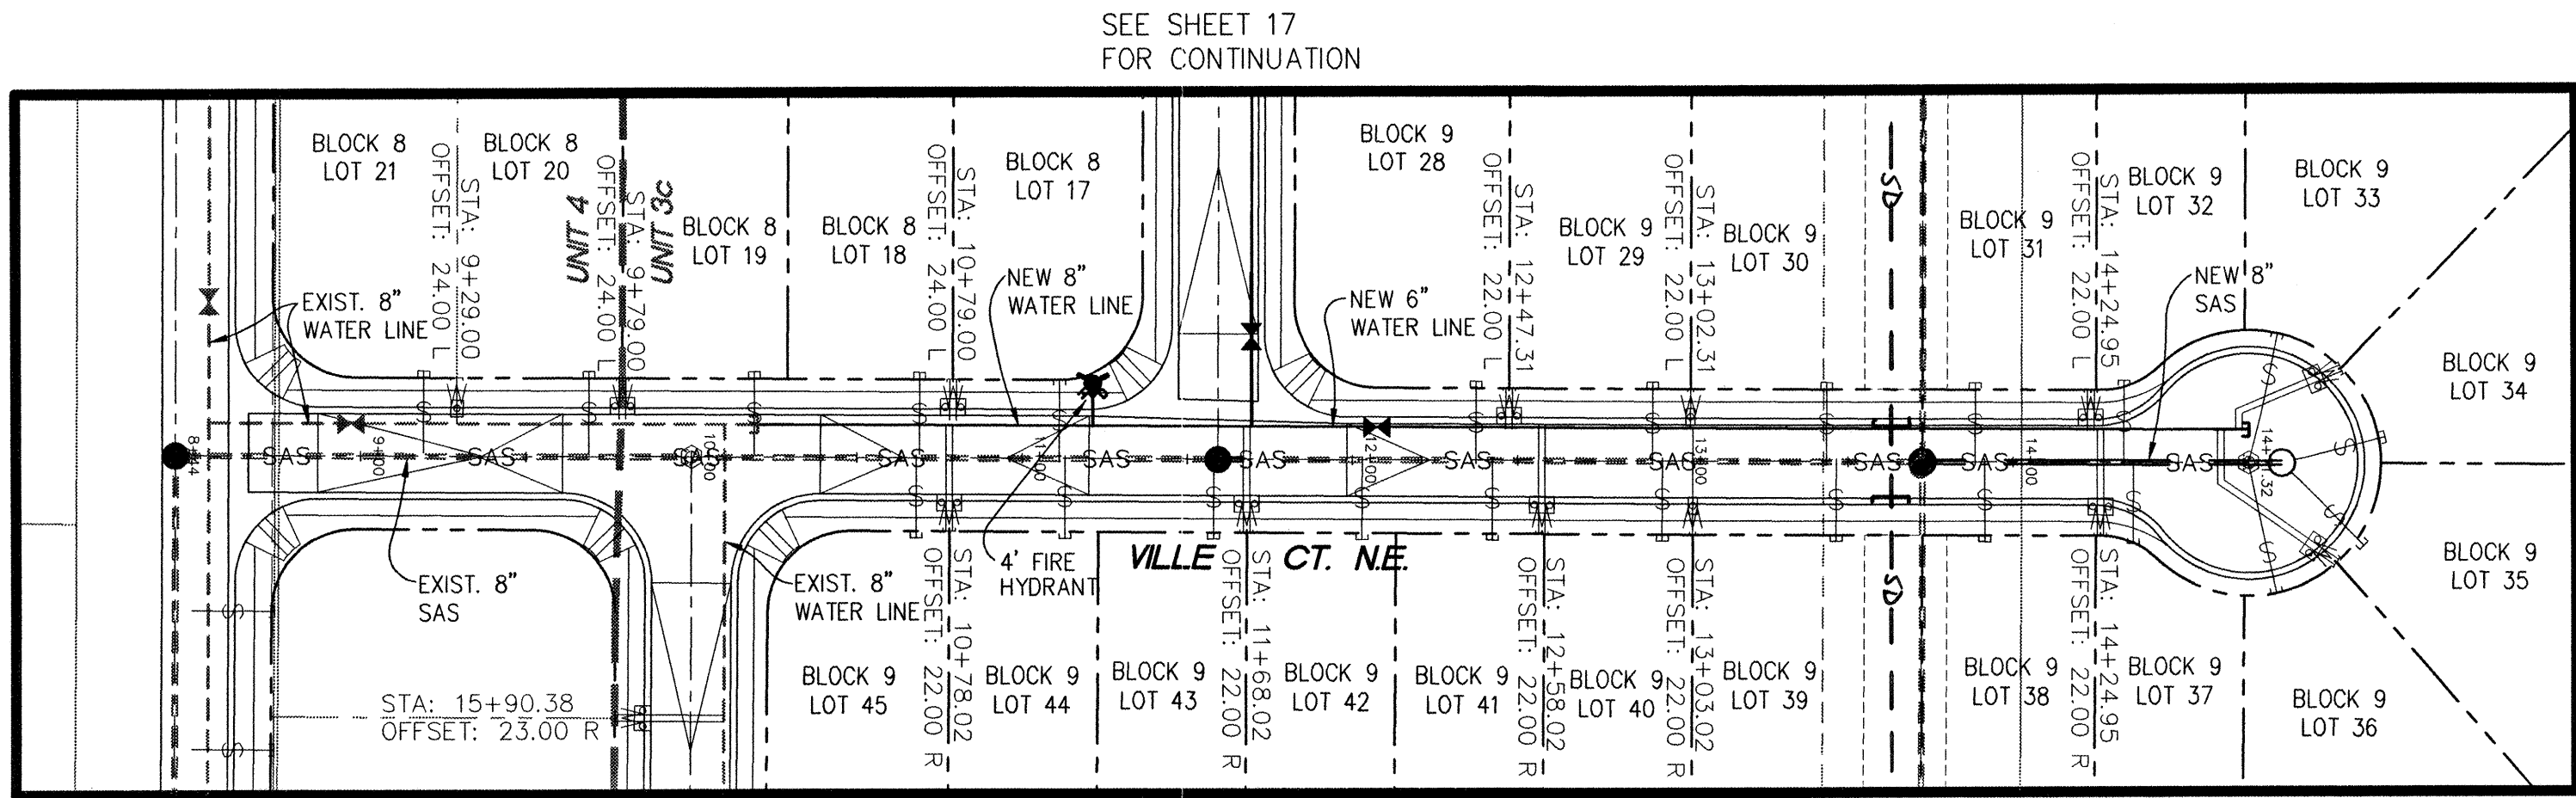



SANITARY SEWER SERVICE TABLE - LA CUEVA OESTE, UNIT 3c					
Block 8					
Lot No.	Street	SAS Serv Sta.	Offset to PL	Elev. FL Curb	Elev. SAS Inv. @ PL
17	VILLE CT.	11+11.33	24' Lt.	5261.24	5257.24
18	VILLE CT.	10+69.00	24' Lt.	5262.36	5258.36
19	VILLE CT.	10+19.00	24' Lt.	5263.67	5259.67
20	VILLE CT.	9+69.00	24' Lt.	5264.52	5260.52
21	VILLE CT.	9+19.00	24' Lt.	5264.61	5260.61
Block 9					
28	VILLE CT.	12+37.31	22' Lt.	5259.33	5255.33
29	VILLE CT.	12+90.81	22' Lt.	5258.79	5254.79
30	VILLE CT.	13+43.45	22' Lt.	5258.28	5254.28
31	VILLE CT.	13+88.45	22' Lt.	5258.27	5254.27
32	VILLE CT.	14+33.50	23' Lt.	5258.82	5254.82
33	VILLE CT.	N/A	N/A	N/A	5255.00
34	VILLE CT.	N/A	N/A	N/A	5255.00

VILLE CT. N.E.


SANITARY SEWER SERVICE TABLE - LA CUEVA OESTE, UNIT 3c					
Block 9					
Lot No.	Street	SAS Serv Sta.	Offset to PL	Elev. FL Curb	Elev. SAS Inv. @ PL
35	VILLE CT.	N/A	N/A	N/A	5255.00
36	VILLE CT.	N/A	N/A	N/A	5255.00
37	VILLE CT.	14+36.45	24.3' Lt.	5258.87	5254.87
38	VILLE CT.	13+91.45	22' Lt.	5258.29	5254.29
39	VILLE CT.	13+46.45	22' Lt.	5258.26	5254.26
40	VILLE CT.	12+93.81	22' Lt.	5258.76	5254.76
41	VILLE CT.	12+42.31	22' Lt.	5259.28	5255.28
42	VILLE CT.	12+01.14	22' Lt.	5259.70	5255.70
43	VILLE CT.	11+58.02	22' Lt.	5260.21	5256.21
44	VILLE CT.	11+13.02	22' Lt.	5261.20	5257.20
45	VILLE CT.	10+68.02	22' Lt.	5262.39	5258.39

TYPICALLY, SAS SERVICE FL SHOULD BE 4 FEET BELOW FL OF GUTTER AT PROPERTY LINE.

SCALE
HORIZ: 1"=50'
VERT: 1"=10'

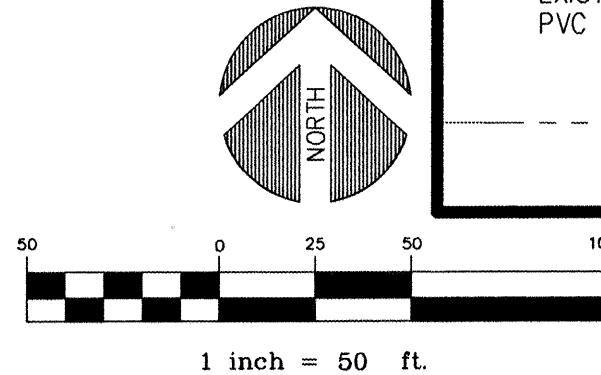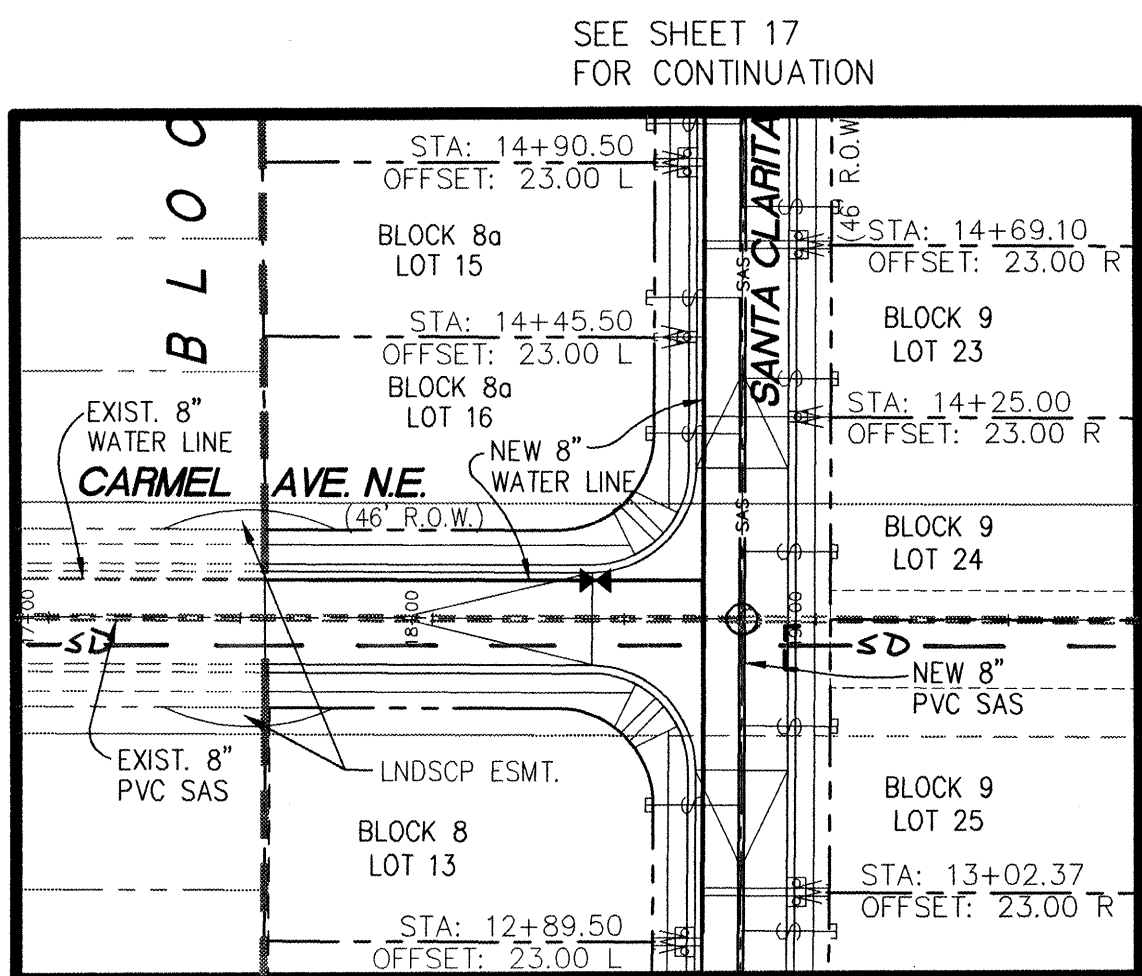

SEE SHEET 17 FOR CONTINUATION

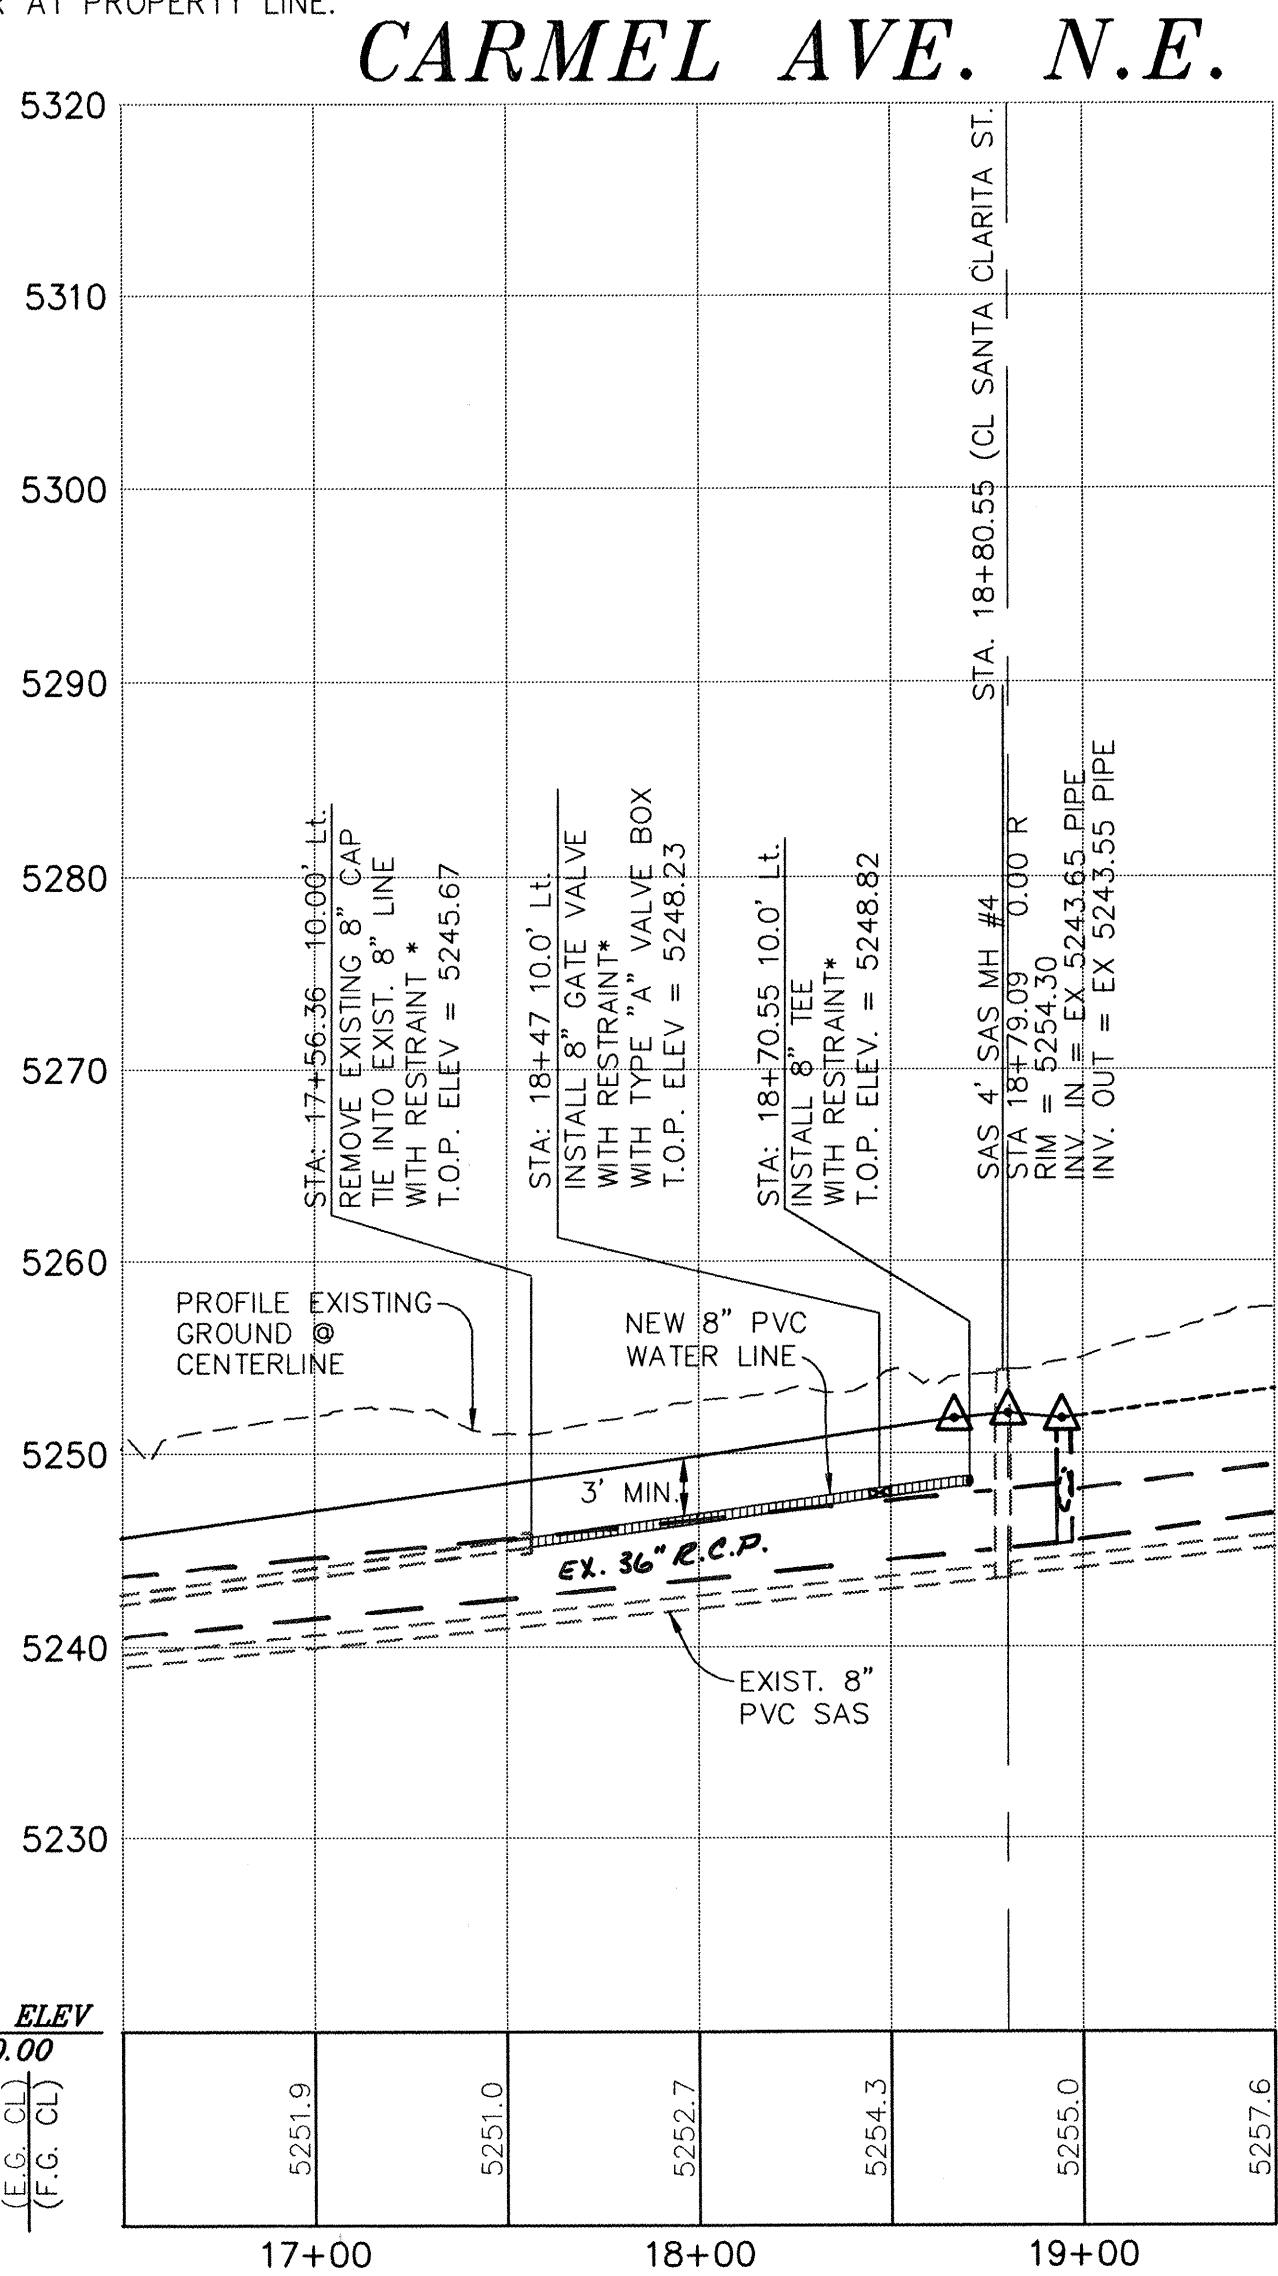

LEGEND	
NEW CURB & GUTTER	---
NEW SAS MAINLINE	---
NEW SAS SERVICE LINE	---
NEW SAS MANHOLE	●
NEW WATER MAINLINE	---
NEW WATER SERVICE LINE	---
NEW GATE VALVE	✕
NEW FIRE HYDRANT	✕
NEW STREET LIGHT	✕
NEW VALLEY GUTTER	---

WATER AND SEWER NOTES

- CONSTRUCT 4" TYPE "E" MANHOLES PER STD. DWG. # 2102.
- CONSTRUCT SAS SERVICE LINES PER STD. DWG. # 2125.
- CONSTRUCT ALL CONCRETE BLOCKING PER STD. DWG. # 2320. CONCRETE BLOCKING SHALL BE UTILIZED ONLY WHERE SPECIFICALLY CALLED OUT ON PLAN.
- CONSTRUCT ALL VALVE BOXES PER NEW C.O.A. VALVE BOX DETAIL WITH NON-TAPERED CONCRETE COLLAR.
- CONSTRUCT ALL FIRE HYDRANTS PER DESIGNATED DEPTHS AND LENGTHS PER STD. DWG. # 2340. USE FULL RESTRAINT ON FIRE HYDRANT LEGS FROM MAIN TO FIRE HYDRANT FLANGE.
- CONSTRUCT ALL SINGLE AND DOUBLE WATER SERVICE LINES PER STD. DWG. # 2361, 2362 AND 2363.
- SEE SHEET 9 FOR SAS AND WATER SERVICE INFORMATION.
- RESTRAINT DISTANCES FOR PIPE FITTINGS SHALL BE DEFINED BY TABLE ON SHEET 9.
- ALL WATERLINES SHALL BE C-900 PVC UNLESS OTHERWISE NOTED.

AS-BUILT INFORMATION		BENCH MARKS		SURVEY INFORMATION		ENGINEER'S SEAL	
CONTRACTOR	DATE	ACCS STA. No.	1-C19	DATE	BY	REMARKS	DATE
WORKMAN	DATE	Y=1518845.74					
INSPECTOR'S	DATE	X=404941.91					
FIELD ENGINEER	DATE	Z=5318.195					
VERIFICATION BY	DATE						
CORRECTED BY	DATE						
RECORDED BY	DATE						
NO.							

FOR INFORMATION ONLY

AS-BUILT

Terry O. Brown, P.E.

P. O. Box 92051
Albuquerque, NM 87199
(505) 883-8807

CITY OF ALBUQUERQUE
PUBLIC WORKS DEPARTMENT
ENGINEERING DEVELOPMENT GROUP

TITLE: LA CUEVA OESTE, UNIT 3c, UTILITY PLAN AND PROFILE
VILLE CT. N.E. (Sta. 8+44.00 to Sta. 14+71.32)
CARMEL AVE. (Sta. 17+56.46 to Sta. 18+80.55)

Design Review Committee

City Engineer Approval


Mo./Day/Yr.

Mo./Day/Yr.

DESIGNED BY: TOB
DRAWN BY: TOB
CHECKED BY: TOB

DATE: 07/98
DATE: 07/98
DATE: 07/98


Sheet 18 Of 19

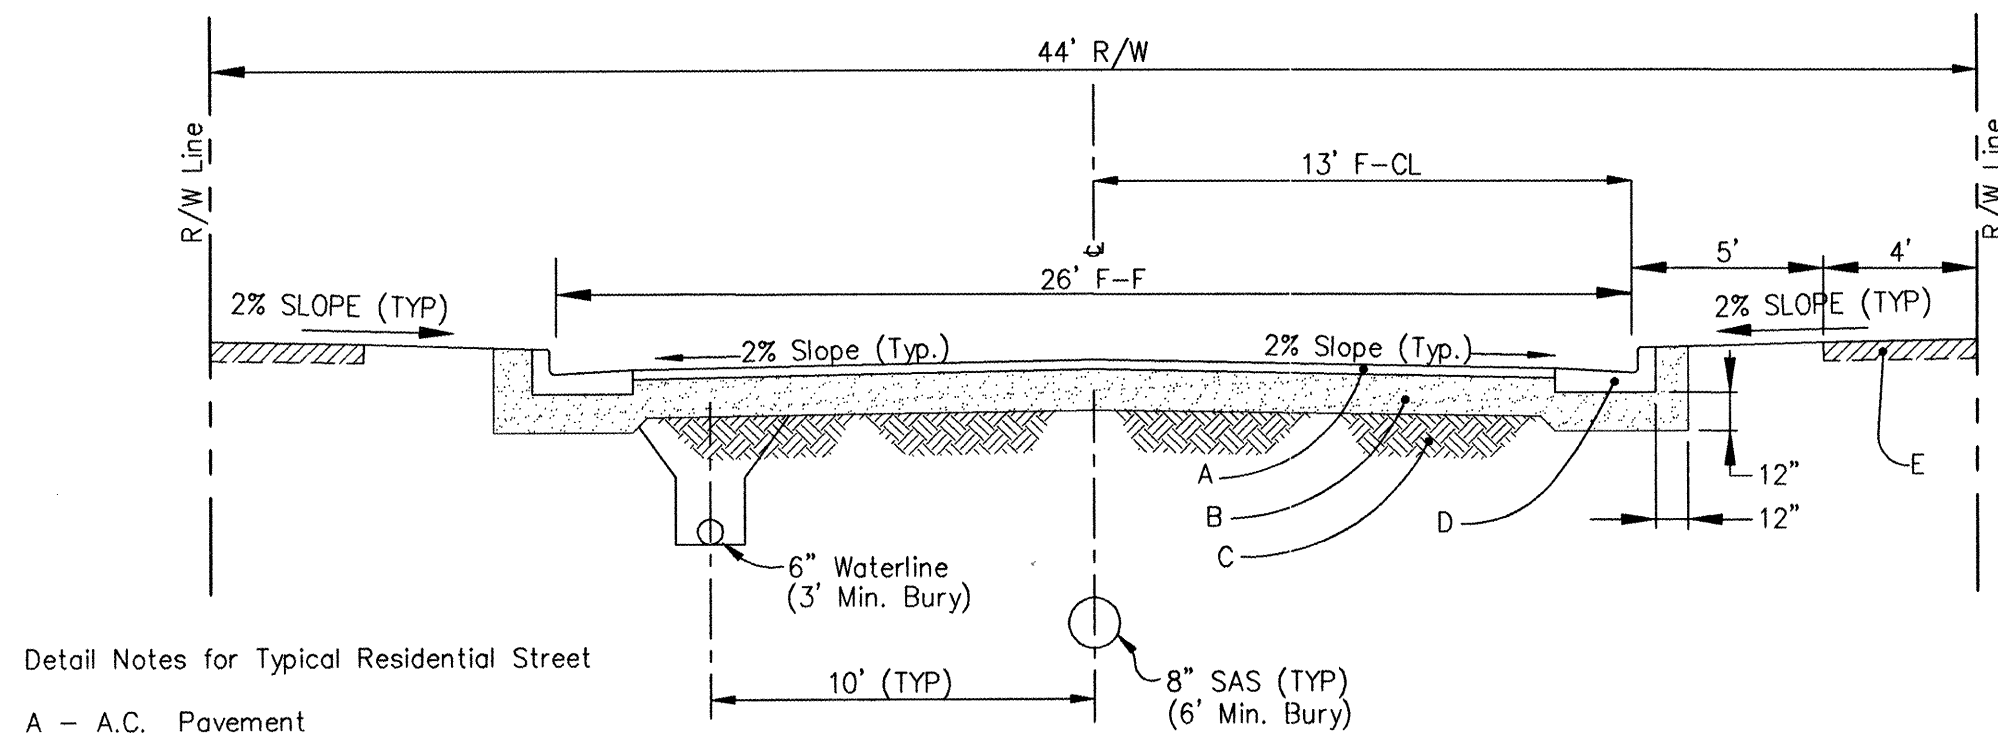

Detail Notes for Typical Residential Street

A - A.C. Pavement
 B - 12" Compacted Subgrade Material (95% Compaction)
 C - Compacted Subgrade (90% Compaction)
 D - P.C.C. Standard Curb & Gutter per std. dwg. 2415
 E - 4" Thick by 4' Wide P.C.C. Sidewalk per std. dwg. 2430


Section A-A (26' F-F STREET WIDTH)

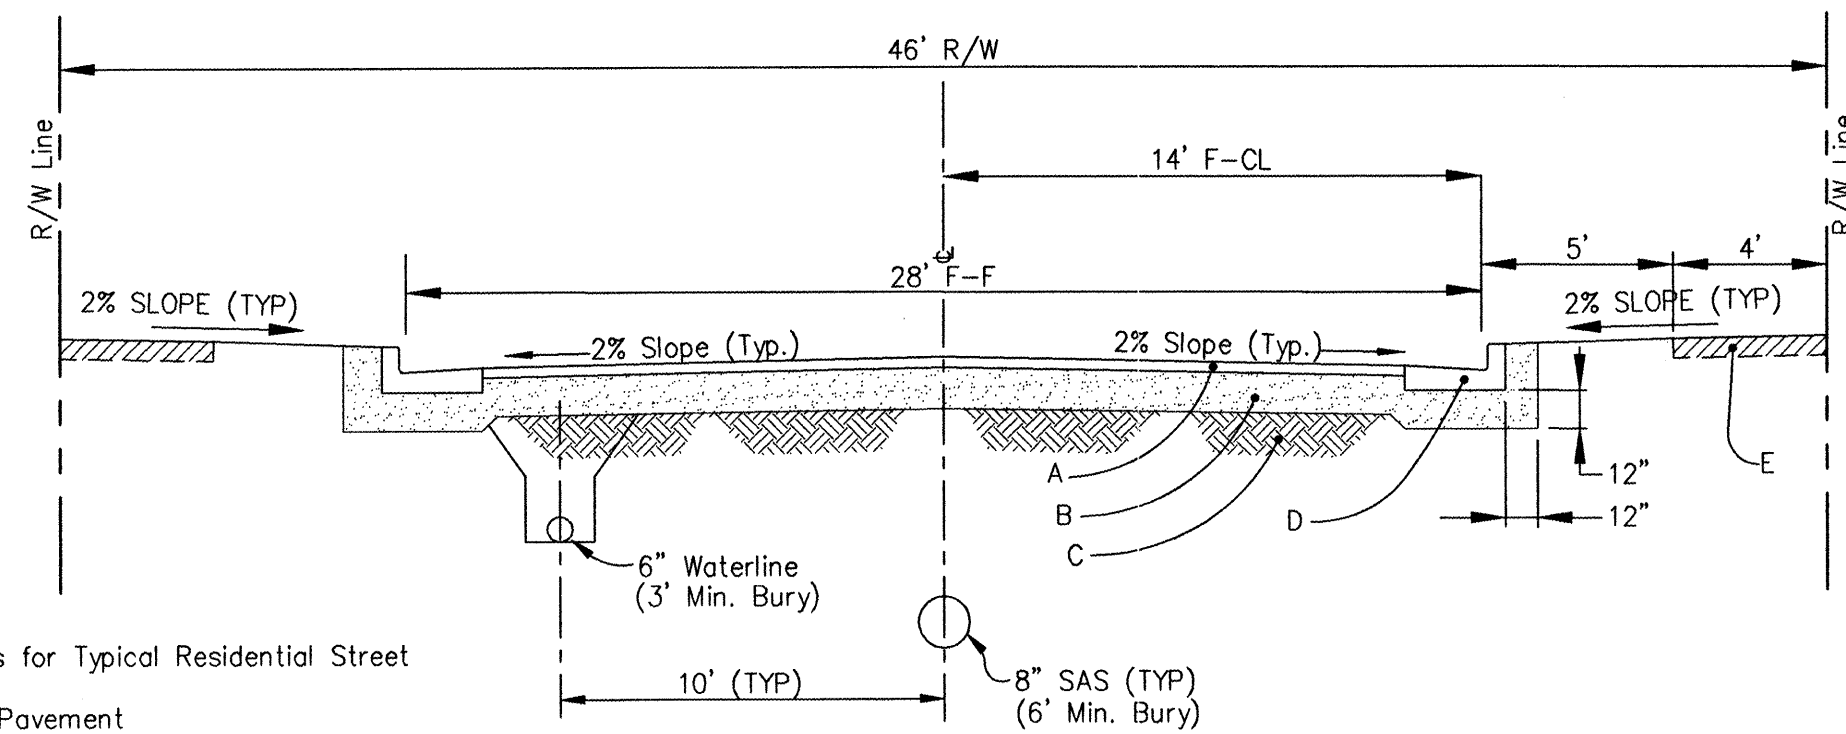

Detail Notes for Typical Residential Street

A - A.C. Pavement
 B - 12" Compacted Subgrade Material (95% Compaction)
 C - Compacted Subgrade (90% Compaction)
 D - P.C.C. Standard Curb & Gutter per std. dwg. 2415
 E - 4" Thick by 4' Wide P.C.C. Sidewalk per std. dwg. 2430


Section B-B (28' F-F STREET WIDTH)

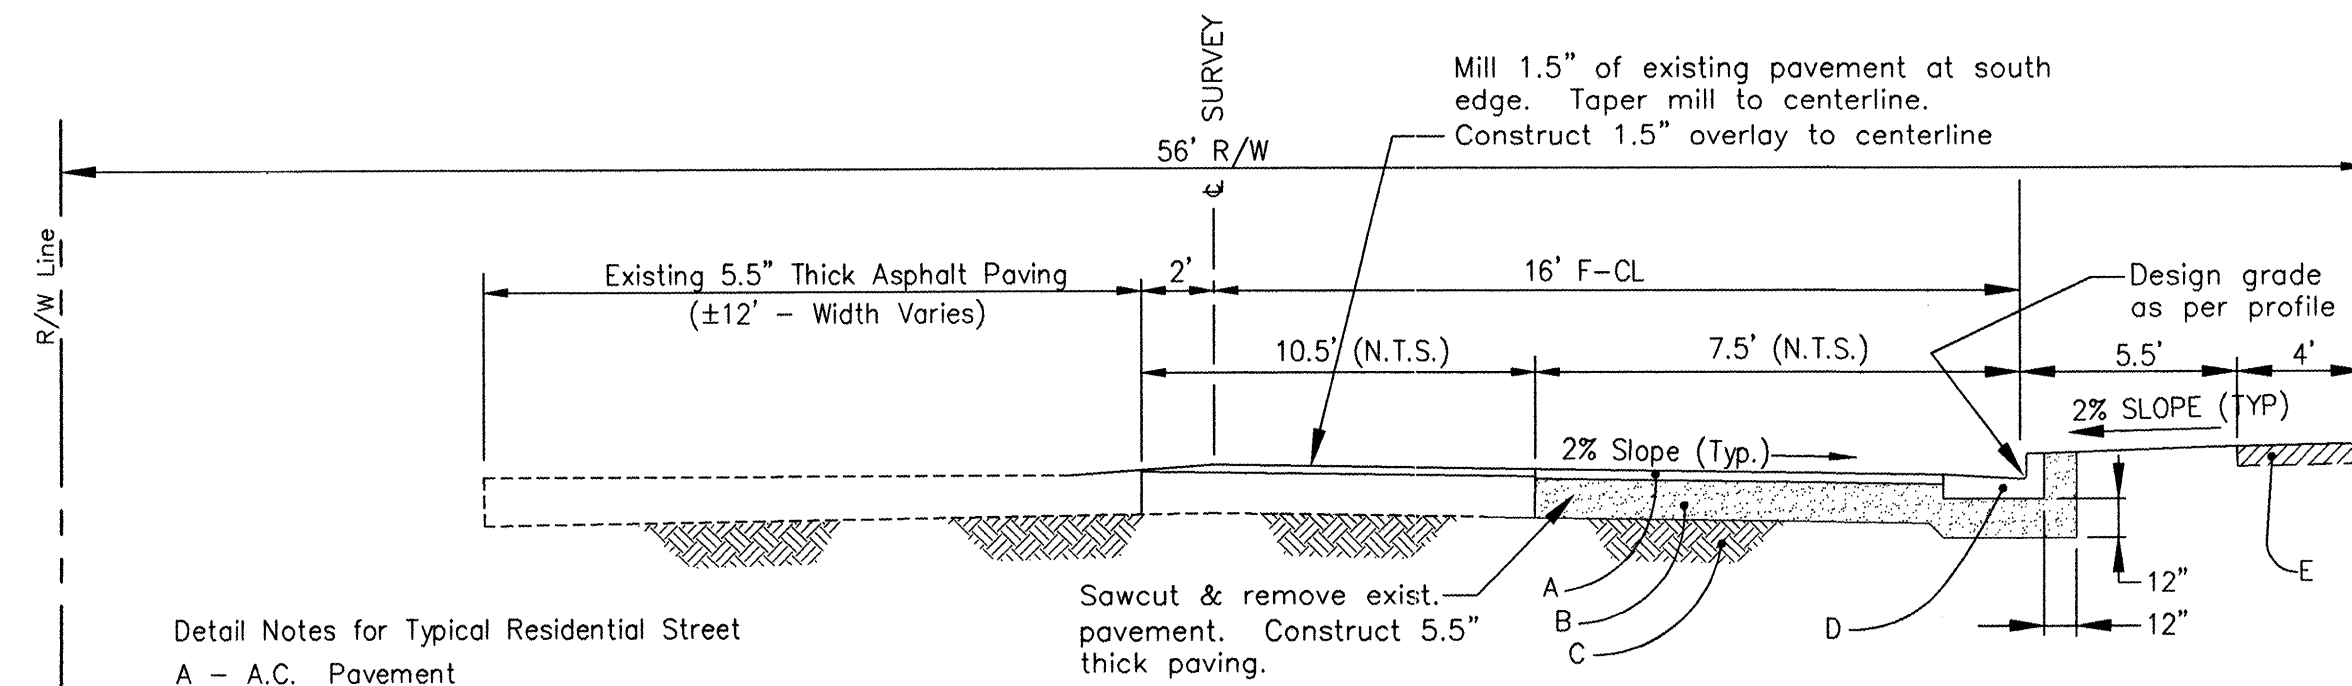

Detail Notes for Typical Residential Street


A - A.C. Pavement
 B - Compacted Gravel Base Course Material (95% Compaction)
 C - Compacted Subgrade (95% Compaction)
 D - P.C.C. Standard Curb & Gutter per std. dwg. 2415
 E - 4" Thick by 4' Wide P.C.C. Sidewalk per std. dwg. 2430

Section C-C (ANAHEIM)

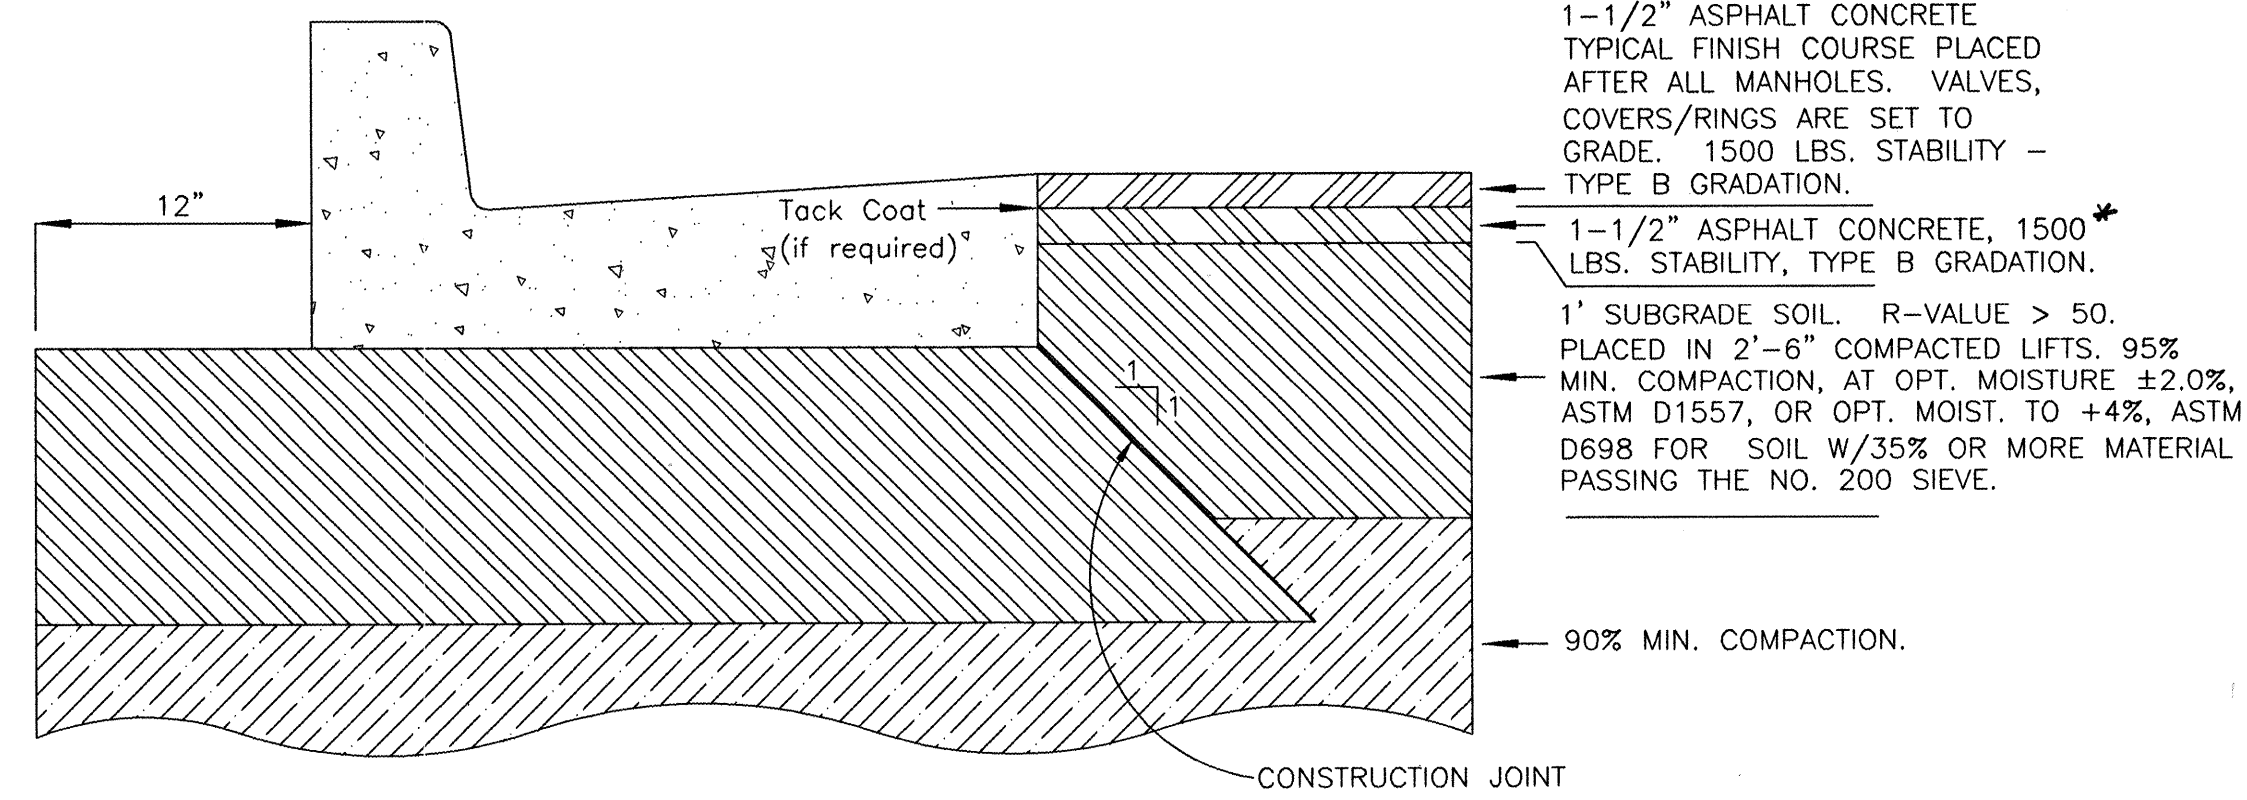

Typical Residential Street Pavement Section
 (Asphaltic Concrete Pavement)

C.O.A. STD. DWG # 2405

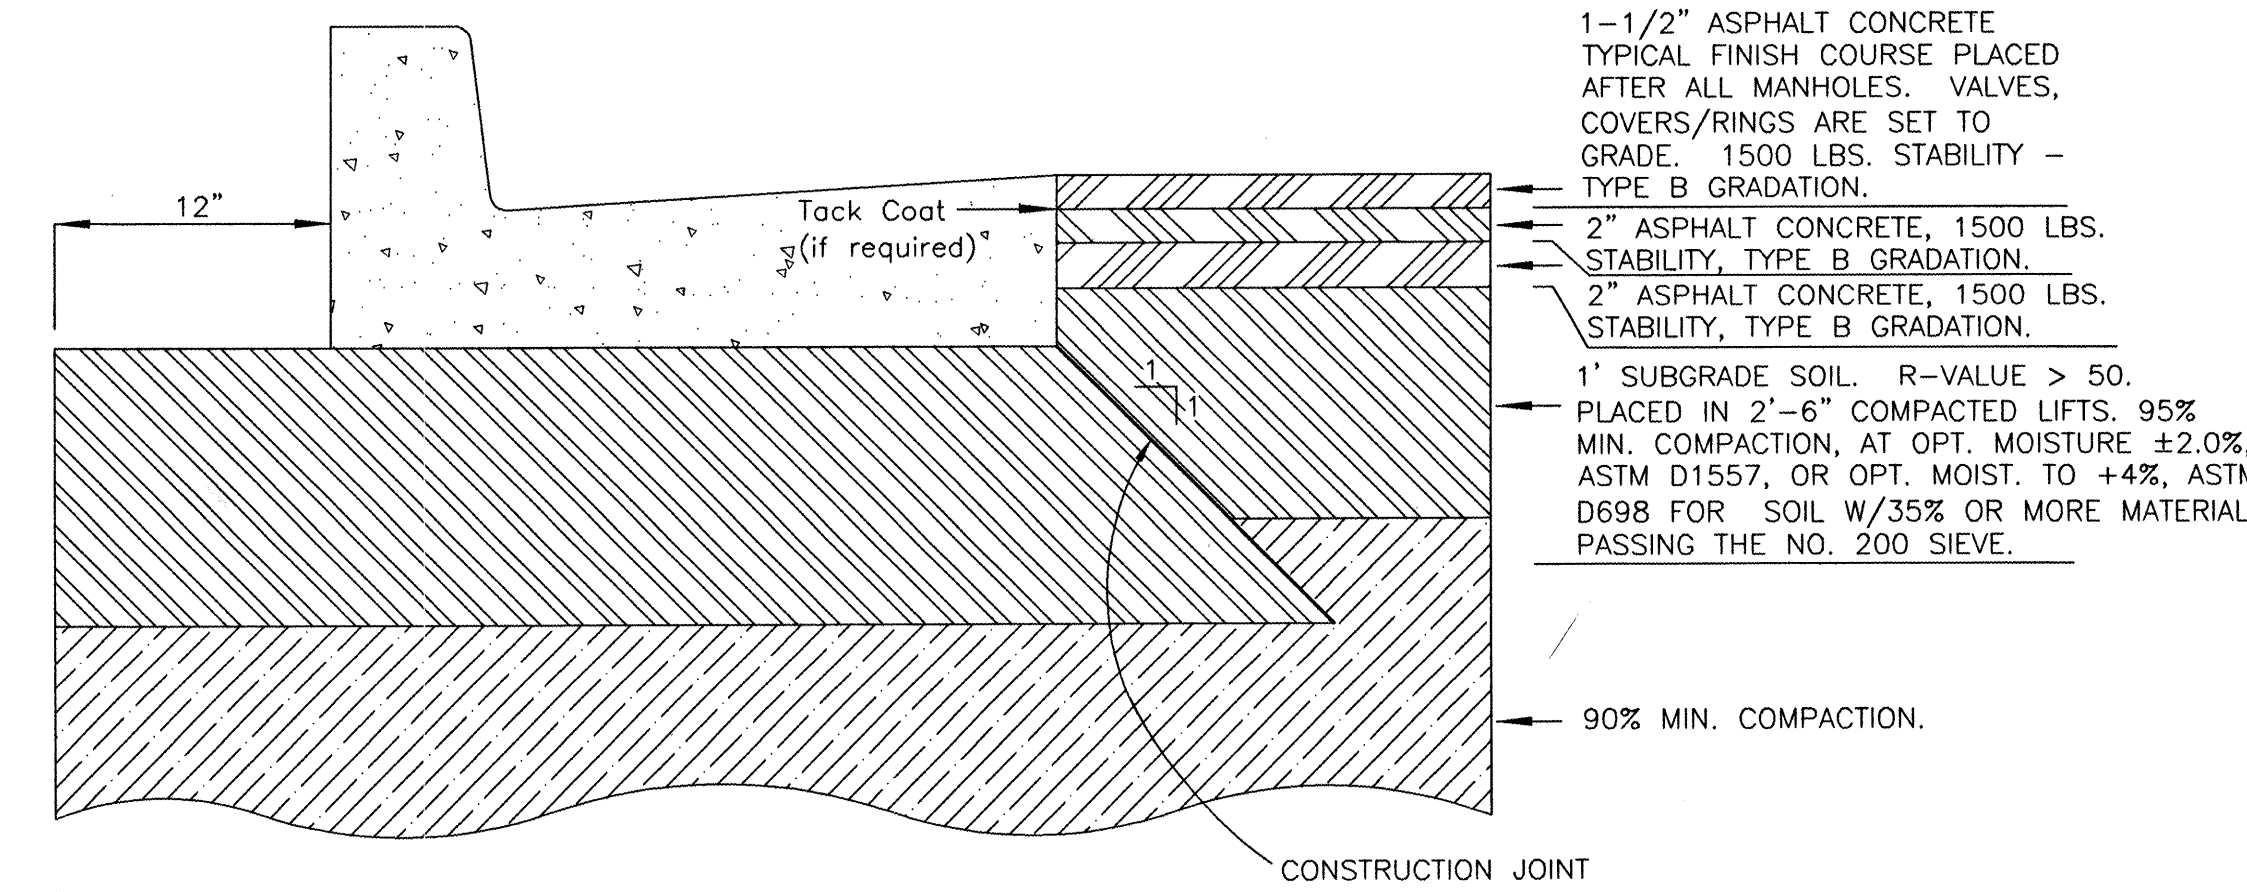

Residential Paving Section for Anaheim Ave.
 (Asphaltic Concrete Pavement)
 (NOT IN CONTRACT)

* DUE TO EXISTING R-VALUES OF LESS THAN 50 FOUND ON THIS PROJECT, ALL RESIDENTIAL STREETS IN THIS DEVELOPMENT **SOUTH OF SONRISA PL.** SHALL BE CONSTRUCTED WITH TWO (2) - 1-1/2" LIFTS FOR ASPHALT BASE COURSE (TOTAL ASPHALT PAVING SHALL BE 4-1/2" THICK).

AS-BUILT INFORMATION		BENCH MARKS		SURVEY INFORMATION		ENGINEER'S SEAL	
CONTRACTOR	DATE	CONTRACTOR	DATE	NO.	BY	REMARKS	DATE
ACS STA. No. 1-C19	Y=1518845.74						
	X=404941.91						
	Z=5318.195						
MICRO-FILM INFORMATION		REVISIONS		DESIGN		DATE	
RECORDED BY	DATE	NO. <td>DATE</td> <td>DESIGNED BY: TOB</td> <td>DATE: 07/98</td> <td>DRAWN BY: TOB</td> <td>DATE: 07/98</td>	DATE	DESIGNED BY: TOB	DATE: 07/98	DRAWN BY: TOB	DATE: 07/98
				CHECKED BY: TOB	DATE: 07/98		

FOR INFORMATION ONLY

AS-BUILT

Terry O. Brown, P.E.

P. O. Box 92051
 Albuquerque, NM 87199
 (505) 883-8807

CITY OF ALBUQUERQUE
 PUBLIC WORKS DEPARTMENT
 ENGINEERING DEVELOPMENT GROUP

TITLE: LA CUEVA OESTE, UNIT 3c
 STREET DETAILS

Design Review Committee	City Engineer Approval	Mo./Day/Yr.	Mo./Day/Yr.
APPROVED			
DESIGN REVIEW COMMITTEE			
City Project No.	Zone Map No.	Sheet	Of
5232.94	C-18-Z	19	19

LC30_DET.DWG

CONSTRUCTION TRAFFIC CONTROL GENERAL NOTES

1. CONTRACTOR MUST OBTAIN FROM CONSTRUCTION COORDINATION AN EXCAVATION/BARRICADING PERMIT BEFORE ENGAGING IN ANY CONSTRUCTION, MAINTENANCE OR REPAIR WORK IN ANY OF THE CITY OF ALBUQUERQUE'S RIGHTS-OF-WAY. EMERGENCY WORK THAT WOULD PRESERVE LIFE OR PROPERTY IS EXCLUDED WITH THE UNDERSTANDING, THAT A PERMIT SHALL BE OBTAINED WITHIN 24 TO 48 HOURS.

2. CONTRACTOR SHALL AT THE TIME OF PERMIT REQUEST, SUBMIT FOR APPROVAL BY CONSTRUCTION COORDINATION, A TRAFFIC CONTROL PLAN DETAILING ALL EXISTING TOPOGRAPHY SUCH AS LANE WIDTHS, DRIVEWAYS, AND BUSINESS/RESIDENTIAL ACCESSES. THE TRAFFIC CONTROL PLAN SHALL INCLUDE ALL PHASES OF WORK AND SCHEDULES INVOLVED IN THE CONSTRUCTION PROJECT. ANY SEPARATE PHASES OF A CONSTRUCTION PROJECT SHALL BE GIVEN AN INDIVIDUAL PERMIT EACH. BLANKET PERMITS WILL NOT BE ISSUED.

3. THESE TYPICAL TRAFFIC CONTROL PLANS DO NOT REFLECT THE EXISTING TOPOGRAPHY SUCH AS DRIVEWAYS, LANE WIDTHS, AND BUSINESS/RESIDENTIAL ACCESSES. EVERY LOCATION THAT REQUIRES CONSTRUCTION TRAFFIC CONTROL SHALL HAVE A DETAILED TRAFFIC CONTROL PLAN SHOWING ALL EXISTING TOPOGRAPHY.

4. CONSTRUCTION SHALL NOT BEGIN UNLESS A TRAFFIC CONTROL PLAN HAS BEEN APPROVED AND VERIFIED BY CONSTRUCTION COORDINATION.

5. CONSTRUCTION COORDINATION SHALL BE NOTIFIED 48 HOURS PRIOR TO ANY TRAFFIC CONTROL CHANGES NEEDED BY CONTRACTOR, THAT WERE NOT PREVIOUSLY APPROVED. THESE TRAFFIC CONTROL CHANGES SHALL BE REQUESTED IN WRITING ACCOMPANIED WITH A TRAFFIC CONTROL PLAN REFLECTING SUCH CHANGES.

6. ALL CONSTRUCTION TRAFFIC CONTROL DEVICES SHALL COMPLY TO THE MANUAL ON UNIFORM TRAFFIC CONTROL DEVICES (MUTCD), LATEST EDITION. IT IS THE RESPONSIBILITY OF THE CONTRACTOR TO INSTALL, SERVICE AND MAINTAIN ALL TRAFFIC CONTROL DEVICES. TRAFFIC CONTROL DEVICES SHALL NOT BE REMOVED OR ALTERED IN ANY WAY WITHOUT THE APPROVAL OF CONSTRUCTION COORDINATION, PER SECTION 6A-4 OF THE MUTCD, LATEST EDITION.

7. THE CONSTRUCTION TRAFFIC CONTROL INITIAL SET-UP SHALL BE BY AN AMERICAN TRAFFIC SAFETY SERVICES ASSOCIATION (ATSSA) CERTIFIED WORKSITE TRAFFIC SUPERVISOR. THE MAINTENANCE AND SERVICING SHALL ALSO BE DONE BY AN ATSSA CERTIFIED WORKSITE TRAFFIC SUPERVISOR OR EQUIVALENT.

8. CONTRACTOR IS RESPONSIBLE TO MAINTAIN AND SERVICE ALL TRAFFIC CONTROL DEVICES 24 HOURS A DAY, 7 DAYS A WEEK THROUGHOUT LENGTH OF PROJECT. CONTRACTOR IS RESPONSIBLE THAT ALL TRAFFIC CONTROL DEVICES COMPLY WITH THE MUTCD, LATEST EDITION.

9. ALL ADVANCE WARNING SIGNS SHALL BE DOUBLE INDICATED WHENEVER THERE ARE MULTI-LANE TRAFFIC IN ANY ONE GIVEN DIRECTION AND THERE IS SUFFICIENT MEDIAN SPACE.

10. ALL BARRICADES IN ALL TAPERS AND TANGENTS SHALL BE PLACED APART, A DISTANCE MEASURED IN FEET, EQUAL TO THAT OF THE POSTED SPEED LIMIT. NO EXCEPTIONS UNLESS APPROVED BY CONSTRUCTION COORDINATION PER MUTCD SECTION 6A-4.

11. ALL WORK IN ARTERIAL ROADWAYS SHALL BE ON A CONTINUOUS 24 HOUR PER DAY BASIS UNTIL COMPLETED.

12. CONTRACTOR IS RESPONSIBLE TO PROVIDE CONSTRUCTION COORDINATION, A WEEKLY LOG OF DAILY INSPECTIONS OF BARRICADE AND MAINTENANCE SCHEDULES ON PROJECTS THAT ARE OVER ONE WEEK DURATION.

13. EQUIPMENT OR MATERIALS SHALL NOT BE STORED WITHIN 15 FEET OF A TRAVELLED TRAFFIC LANE DURING NON-WORKING HOURS WITHOUT THE APPROVAL OF CONSTRUCTION COORDINATION.

14. CONTRACTOR SHALL PROVIDE AND MAINTAIN A SAFE AND ADEQUATE MEANS OF CHANNELIZING PEDESTRIAN TRAFFIC AROUND AND THROUGH THE CONSTRUCTION AREA.

15. CONTRACTOR IS RESPONSIBLE FOR OBLITERATION OF ANY CONFLICTING STRIPING AND RESPONSIBLE FOR ALL TEMPORARY STRIPING.

16. CONTRACTOR SHALL MAINTAIN ACCESS TO ALL FACILITIES, BUSINESSES AND/OR RESIDENTS AT ALL TIMES.

17. CONTRACTOR SHALL PROVIDE ACCESS SIGNS FOR BUSINESSES LOCATED WITHIN THE CONSTRUCTION AREA UNDER THE SUPERVISION OF CONSTRUCTION COORDINATION. EACH ACCESS SIGN SHALL HAVE 5 INCH, WHITE OPAQUE LETTERING ON BLUE REFLECTORIZED BACKGROUND. ACCESS SIGNS SHALL BE CONSIDERED INCIDENTAL TO THE BID AND NOT PART OF THE CONTRACT UNLESS OTHERWISE STATED. NO MORE THAN 3 BUSINESSES SHALL BE LISTED ON A ACCESS SIGN. SHOPPING CENTERS AND MALLS SHALL BE LISTED AS SUCH.

18. ALL ADVANCE WARNING SIGNS SHALL MEET THE MINIMUM REFLECTIVE INTENSITY REQUIREMENTS SET FORTH BY THE CITY OF ALBUQUERQUE. CONSTRUCTION COORDINATION SHALL DETERMINE ALL REQUIREMENTS AND APPROVE OR DISAPPROVE ANY ADVANCE WARNING SIGN PER SECTION 6A-4 OF THE MUTCD, LATEST EDITION.

19. 48 HOURS PRIOR TO OCCUPYING OR CLOSING OF A RIGHT-OF-WAY, CONTRACTOR SHALL NOTIFY: POLICE, FIRE DEPARTMENT, SCHOOLS, HOSPITALS, TRANSIT AUTHORITY, BUSINESSES AND/OR RESIDENTS THAT WILL BE AFFECTED BY THE CONSTRUCTION.

20. ANY FIELD ADJUSTMENTS SHALL BE APPROVED BY CONSTRUCTION COORDINATION.

21. EXCAVATIONS SHALL BE PLATED, TEMPORARILY PATCHED OR RESURFACED PRIOR TO OPENING OF TRAFFIC. A MINIMUM OF 11 FEET SHALL BE PROVIDED FOR TRAFFIC IN ANY GIVEN DIRECTION. CONTRACTOR IS RESPONSIBLE FOR ANY WORK INVOLVED IN SATISFYING THESE REQUIREMENTS.

22. CONTRACTOR SHALL AT ALL TIMES COMPLY WITH THE FOLLOWING:
1. STANDARDS AND REQUIREMENTS SET FORTH IN THE MANUAL ON UNIFORM TRAFFIC CONTROL DEVICES, LATEST EDITION.
2. THE CITY OF ALBUQUERQUE TRAFFIC CODE, LATEST EDITION.
3. SECTION 19 OF THE CITY OF ALBUQUERQUE'S STANDARD SPECIFICATIONS FOR PUBLIC WORK CONSTRUCTION, AS WELL AS OTHER SECTIONS.


23. FAILURE TO COMPLY WITH ANY OF THE ABOVE MENTIONED, WILL BE ADEQUATE CAUSE TO CEASE ALL WORK ON ANY CONSTRUCTION PROJECT. WORK WILL NOT RESUME UNTIL ALL REQUIREMENTS ARE ADDRESSED AND APPROVED BY CONSTRUCTION COORDINATION.

24. ALL TRAFFIC CONTROL DEVICES SHALL BE KEPT IN NEW-CLEAN CONDITION. WASHING OF EQUIPMENT IS INCIDENTAL TO ITS PLACEMENT AND MAINTENANCE.


25. TRAFFIC CONTROL STANDARDS APPLY ONLY WHERE THE CONSTRUCTION TRAFFIC CONTROL PLANS ARE NOT SPECIFIC.

26. ADVANCE WARNING SIGNS SHALL BE 36"x36" MIN. WITH SUPER ENGINEERING GRADE SHEETING OR BETTER. MOUNTING HEIGHT AT TOP OF SIGN SHALL BE THE SAME AS FOR A 48" SIGN AS INDICATED IN THE M.U.T.C.D.

27. CONTRACTOR SHALL MAINTAIN A GRAFFITI-FREE WORKSITE. ALL GRAFFITI SHALL BE PROMPTLY REMOVED FROM ALL EQUIPMENT, BOTH PERMANENT AND TEMPORARY.

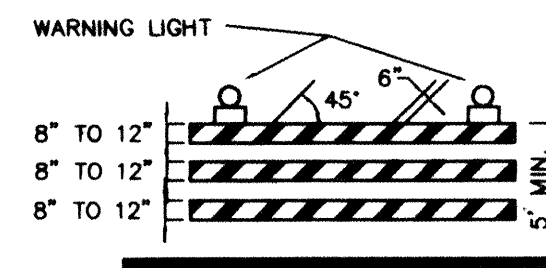


TYPE III BARRICADE

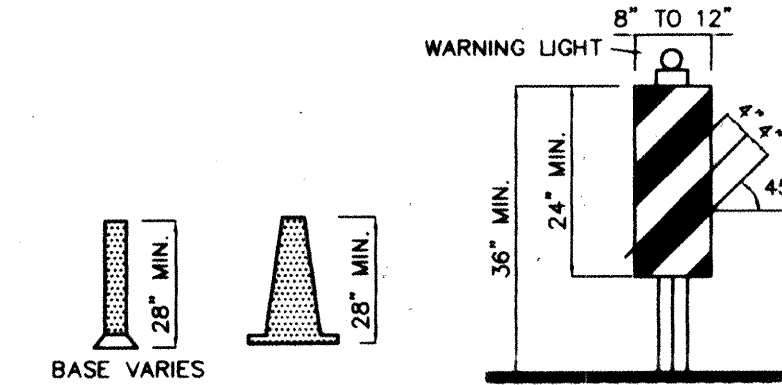

VERTICAL PANEL

CONES

HIGH LEVEL WARNING DEVICE

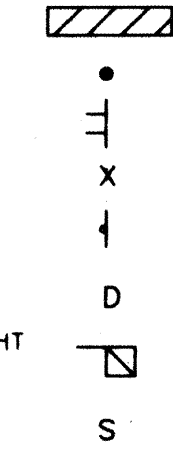

WORK AREA
BARRICADE - TYPE I, TYPE II, OR BARREL
BARRICADE - TYPE III
VERTICAL PANEL
WARNING SIGN
DISTANCE BETWEEN SIGNS - A DISTANCE MEASURED IN FEET EQUAL TO A VALUE OF TEN TIMES THE SPEED LIMIT OF THE STREET
FLAGMAN POSITION
SPACING BETWEEN BARRICADES- A DISTANCE MEASURED IN FEET EQUAL TO THE SPEED LIMIT OF THE STREET
TAPER LENGTH - SEE CHART BELOW
THE TANGENT LENGTH IS EQUAL TO THE TAPER LENGTH FOR A GIVEN STREET.

TAPER REQUIREMENTS

SPEED LIMIT (MPH)	TAPER LENGTH (L) (FEET)			MINIMUM NUMBER OF DEVICES FOR TAPER	MAXIMUM DEVICE SPACING IN FEET	
	10' LANE	11' LANE	12' LANE		ALONG TAPER	AFTER TAPER
20	70	75	80	5	20	20
25	105	115	125	6	25	25
30	150	165	180	7	30	30
35	205	225	245	8	35	35
40	270	295	320	9	40	40
45	450	495	540	13	45	45
50	500	550	600	13	50	50
55	550	605	660	13	55	55

RECOMMENDED SIGN SPACING(D) FOR ADVANCE WARNING SIGN SERIES

SPEED MILES PER HOUR	MINIMUM DISTANCE IN FEET	
	BETWEEN SIGNS	FROM LAST SIGN TO TAPER
0-20	10 X SPEED LIMIT	10 X SPEED LIMIT
25-30	10 X SPEED LIMIT	10 X SPEED LIMIT
30-35	10 X SPEED LIMIT	10 X SPEED LIMIT
40-45	10 X SPEED LIMIT	10 X SPEED LIMIT
50-60	10 X SPEED LIMIT	10 X SPEED LIMIT

TAPER CRITERIA

TYPE OF TAPER	TAPER LENGTH
UPSTREAM TAPER:	
MERGING TAPER	L MINIMUM
SHIFTING TAPER	1/2 L MINIMUM
SHOULDER TAPER	1/2 L MINIMUM
TWO-WAY TRAFFIC TAPER	100 FEET MAXIMUM
DOWNSIDE TAPERS	100 FEET PER LANE

TAPER LENGTH COMPUTATION

SPEED LIMIT
40 MPH OR LESS $L = \frac{WS^2}{60}$
45 MPH OR GREATER $L = W \times S$
L = TAPER LENGTH
W = WIDTH OF OFFSET IN FEET
S = POSTED SPEED OR OFF-PEAK 85-PERCENTILE SPEED IN MPH


FOR INFORMATION ONLY

AS-BUILT

CITY OF ALBUQUERQUE
PUBLIC WORKS DEPARTMENT
ENGINEERING DEVELOPMENT GROUP

TITLE: SIGNING AND CONSTRUCTION TRAFFIC CONTROL STANDARDS	
DESIGN REVIEW COMMITTEE	CITY ENGINEER APPROVAL
LAST UPDATE	
PROJECT NO. 5232.94	
MAP NO. C-18	SHEET 19b OF 19

SIGN FACE DETAILS

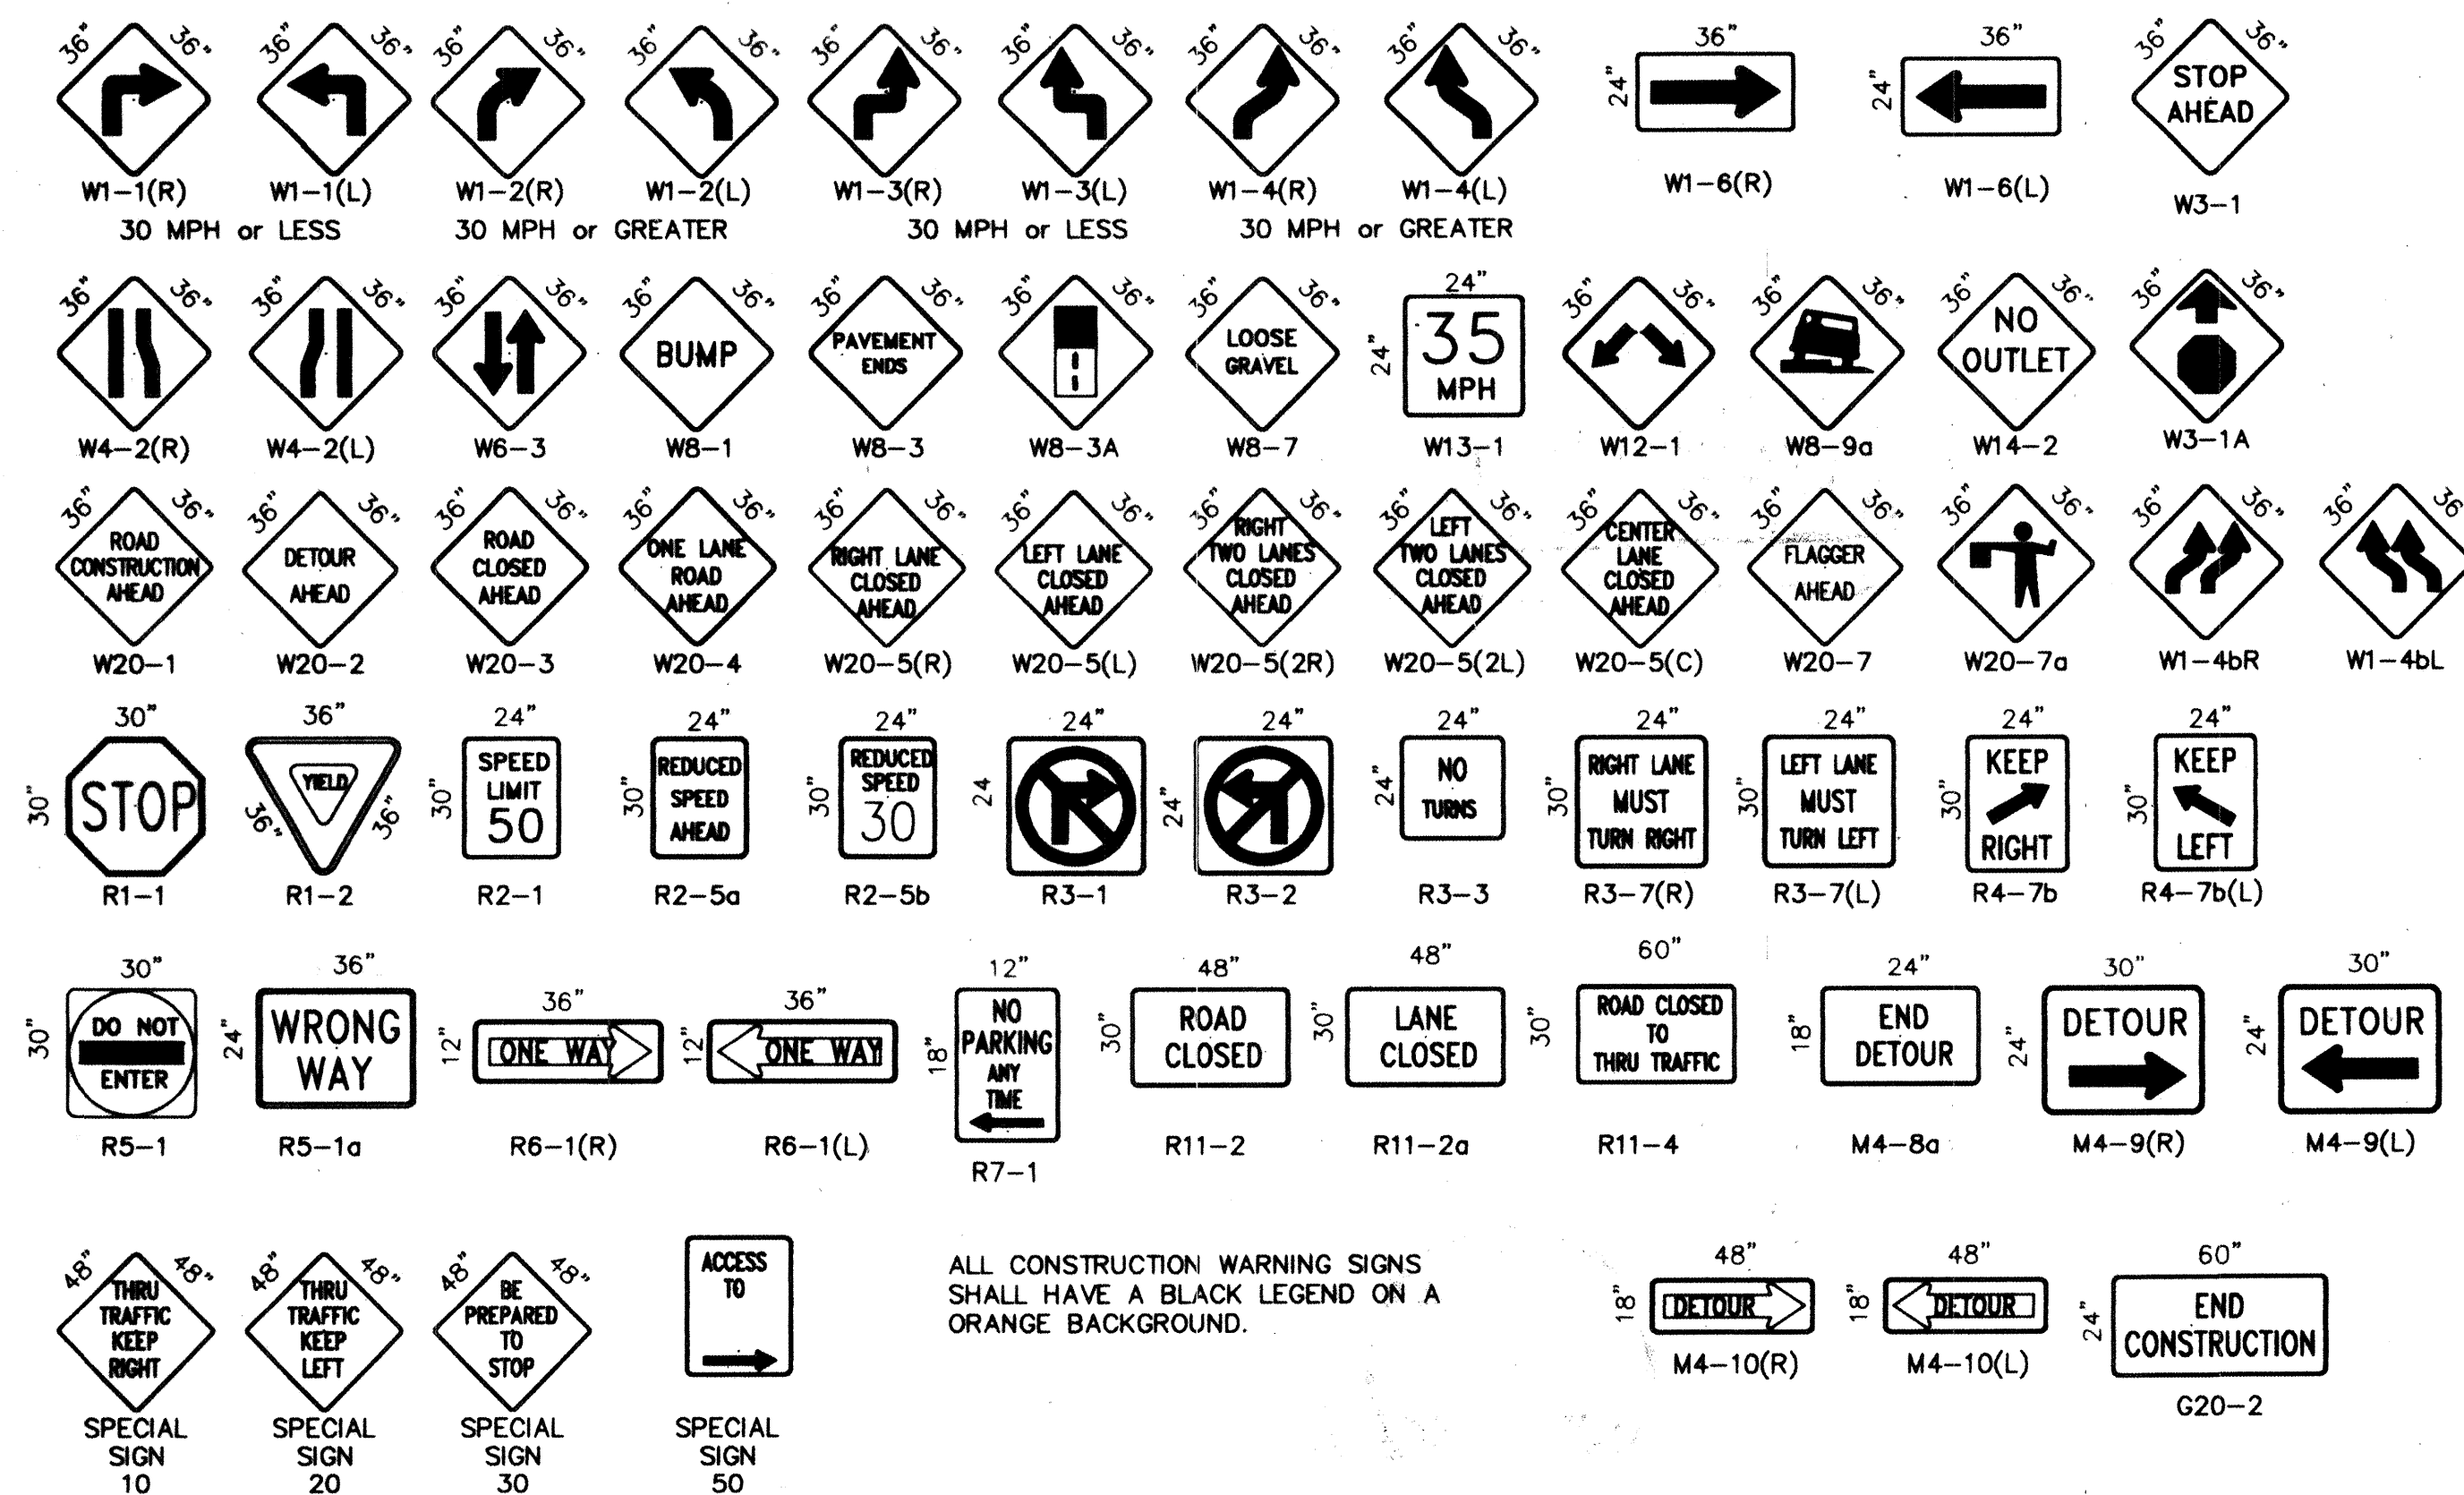

ALL CONSTRUCTION WARNING SIGNS SHALL HAVE A BLACK LEGEND ON A ORANGE BACKGROUND.