


LAS COLINAS

SEWER AND WATERLINE EXTENSIONS WITHIN LAS COLINAS LANE, NE

INDEX

SHEET 1	COVER SHEET
SHEET 2	SEWER & WATERLINE PLAN & PROFILE
SHEET 3	SEWER & WATERLINE PLAN & PROFILE PAVING SECTIONS

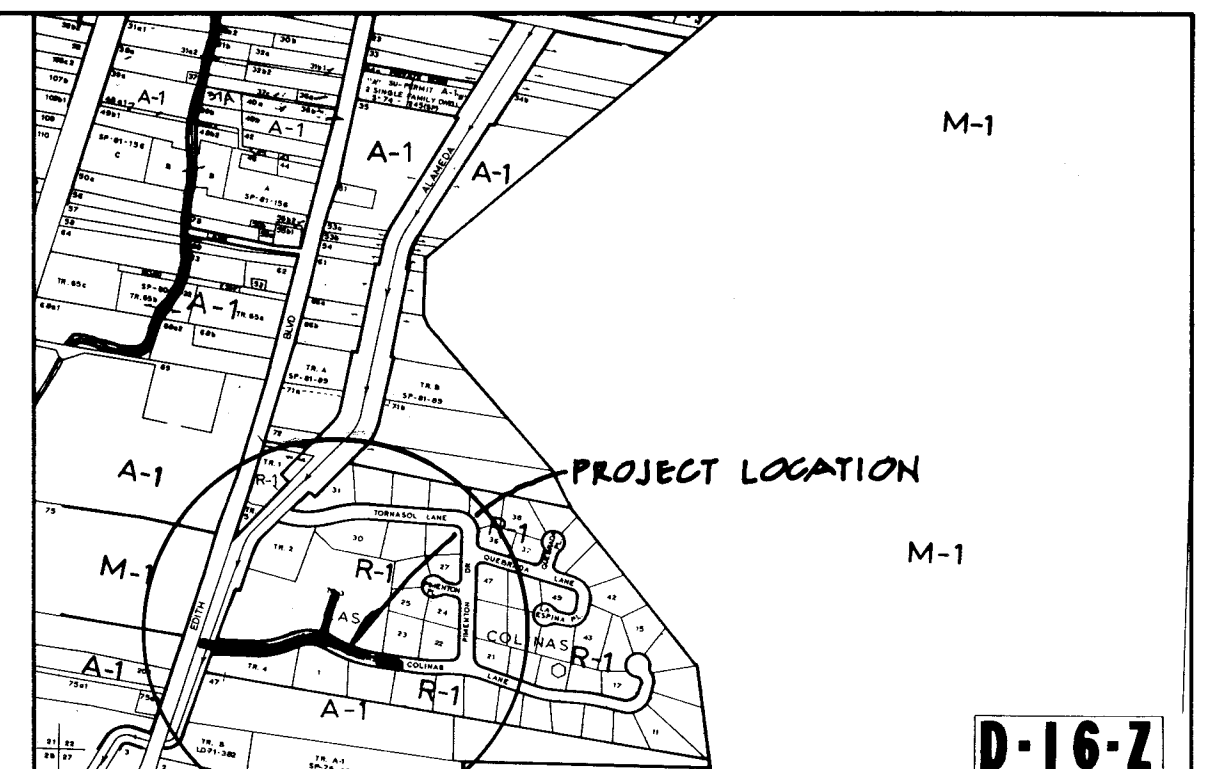

NOTICE TO CONTRACTORS


- ALL WORK DETAILED ON THESE PLANS TO BE PERFORMED UNDER CONTRACT SHALL, EXCEPT AS OTHERWISE STATED OR PROVIDED HEREON, BE CONSTRUCTED IN ACCORDANCE WITH THE CITY OF ALBUQUERQUE STANDARD SPECIFICATIONS FOR PUBLIC WORKS CONSTRUCTION, 1986 EDITION, AS AMENDED THROUGH UPDATE 16.
- TWO WORKING DAYS PRIOR TO ANY EXCAVATION, THE CONTRACTOR MUST CONTACT NEW MEXICO ONE CALLS SYSTEM (260-1990) FOR LOCATION OF EXISTING UTILITIES.
- PRIOR TO CONSTRUCTION, THE CONTRACTOR SHALL EXCAVATE AND VERIFY THE HORIZONTAL AND VERTICAL LOCATIONS OF ALL OBSTRUCTIONS. SHOULD A CONFLICT EXIST, THE CONTRACTOR SHALL NOTIFY THE ENGINEER OR SURVEYOR IMMEDIATELY SO THAT THE CONFLICT CAN BE RESOLVED WITH A MINIMUM OF DELAY.
- THREE (3) WORKING DAYS PRIOR TO BEGINNING CONSTRUCTION, THE CONTRACTOR SHALL SUBMIT TO CONSTRUCTION COORDINATIONS DIVISION A DETAILED CONSTRUCTION SCHEDULE. TWO (2) WORKING DAYS PRIOR TO CONSTRUCTION, THE CONTRACTOR SHALL OBTAIN A BARRICADING PERMIT FROM THE CONSTRUCTION COORDINATIONS DIVISION. CONTRACTOR SHALL NOTIFY BARRICADE ENGINEER (768-2551) PRIOR TO OCCUPYING AN INTERSECTION. REFER TO SECTION 19 OF THE GENERAL CONDITIONS OF THE STANDARD SPECIFICATIONS.
- ALL STREET STRIPING ALTERED OR DESTROYED SHALL BE REPLACED IN KIND BY CONTRACTOR TO LOCATION AND IN KIND AS EXISTING OR AS INDICATED BY THIS PLAN SHEET.
- CONTRACTOR SHALL NOTIFY THE ENGINEER NOT LESS THAN SEVEN (7) DAYS PRIOR TO STARTING WORK IN ORDER THAT THE ENGINEER MAY TAKE NECESSARY MEASURES TO INSURE THE PRESERVATION OF SURVEY MONUMENTS. CONTRACTOR SHALL NOT DISTURB PERMANENT SURVEY MONUMENTS WITHOUT THE CONSENT OF THE ENGINEER AND SHALL NOTIFY THE ENGINEER AND BEAR THE EXPENSE OF REPLACING ANY THAT MAY BE DISTURBED WITHOUT PERMISSION. REPLACEMENT SHALL BE DONE ONLY BY THE CITY SURVEYOR. WHEN A CHANGE IS MADE IN THE FINISHED ELEVATIONS OF THE PAVEMENT OF ANY ROADWAY IN WHICH A PERMANENT SURVEY MONUMENT IS LOCATED, CONTRACTOR SHALL, AT HIS OWN EXPENSE, ADJUST THE MONUMENT COVER TO THE NEW GRADE UNLESS OTHERWISE SPECIFIED. REFER TO SECTION 4.4 OF THE GENERAL CONDITIONS OF THE STANDARD SPECIFICATIONS.
- ANY WORK WITHIN AN ARTERIAL ROADWAY WILL REQUIRE TWENTY-FOUR (24) HOUR CONSTRUCTION.

THE FOLLOWING NOTES ALSO APPLY WHEN CHECKED

- ☐ ALL UTILITIES AND UTILITY SERVICE LINES SHALL BE INSTALLED PRIOR TO PAVING.
- ☐ BACKFILL COMPACTION SHALL BE ACCORDING TO SPECIFIED STREET USE.
- ☐ TACK COAT REQUIREMENTS SHALL BE DETERMINED BY THE CITY ENGINEER.
- ☐ SIDEWALKS AND WHEELCHAIR RAMPS WITHIN THE CURB RETURNS SHALL BE CONSTRUCTED WHEREVER A NEW CURB RETURN IS CONSTRUCTED.
- ☐ IF CURB IS DEPRESSED FOR A DRIVEPAD, THE DRIVEPAD SHALL BE CONSTRUCTED PRIOR TO ACCEPTANCE OF CURB AND GUTTER.
- ☐ ALL STORM DRAINAGE FACILITIES SHALL BE COMPLETED PRIOR TO FINAL ACCEPTANCE.

WATER SHUTOFF REQUIREMENTS:

THE CONTRACTOR SHALL BE RESPONSIBLE FOR TIMING AND COORDINATION OF WATER SHUTOFF. AT LEAST FIVE (5) WORKING DAYS PRIOR TO CONSTRUCTION, CONTRACTOR SHALL CONTACT THE WATER SYSTEMS DIVISION, 857-8200, TO INITIATE IMPLEMENTATION OF THE NON-PRESSURIZED CONNECTION PLAN. IN ORDER TO COMPLETE THIS THE FOLLOWING VALVES MUST BE CLOSED BY WATER SYSTEMS PERSONNEL.

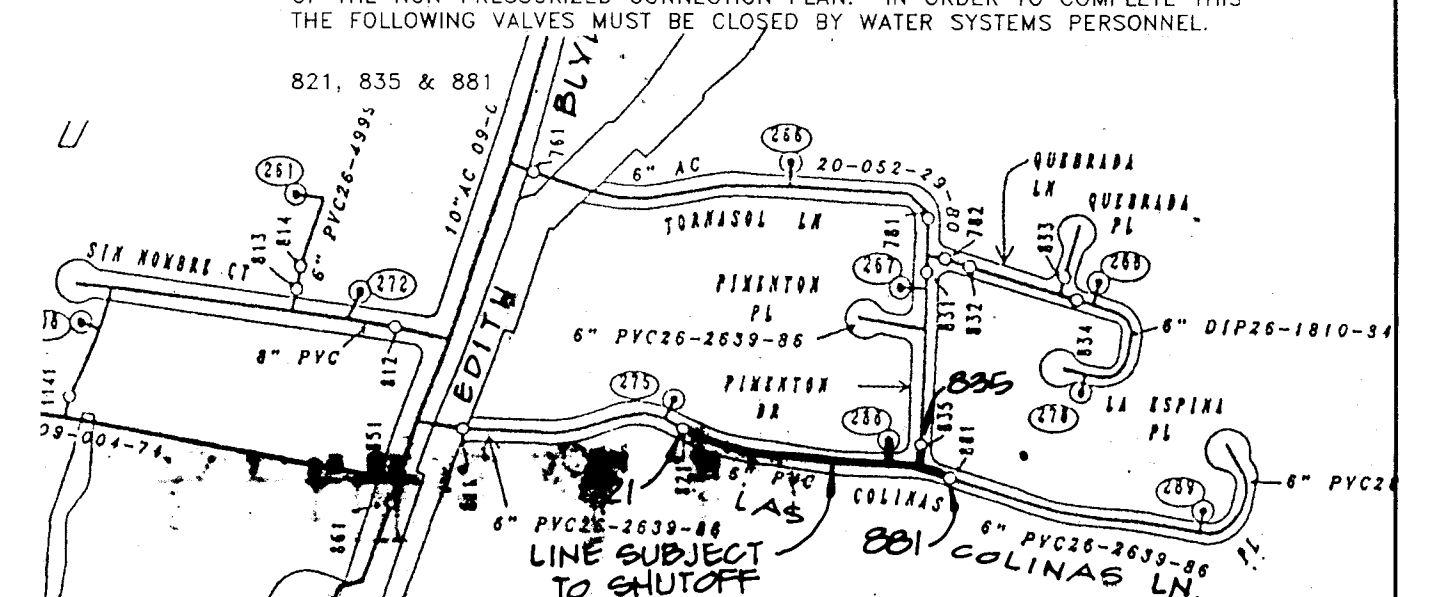

REV.	SHEETS	CITY ENGINEER	DATE	USER DEPT.	DATE	USER DEPT.	DATE

APPROVAL OF REVISIONS

APPROVED :
BERNALILLO COUNTY P.W.D

Edward P. ...
DATE 12-2-95

SCANNED BY
BY LASON


HALL ENGINEERING COMPANY INC.
ENGINEERING • SURVEYING • PLANNING • CONSTRUCTION
6840 2ND ST., NW, SUITE 306 • ALBUQUERQUE, NEW MEXICO 87107
PHONE (505) 345-1064 FAX (505) 344-5404

APPROVED FOR
CONSTRUCTION

Richard V. Hall
1/25/96 C.E.

5234.90

SHEET 1 OF 3

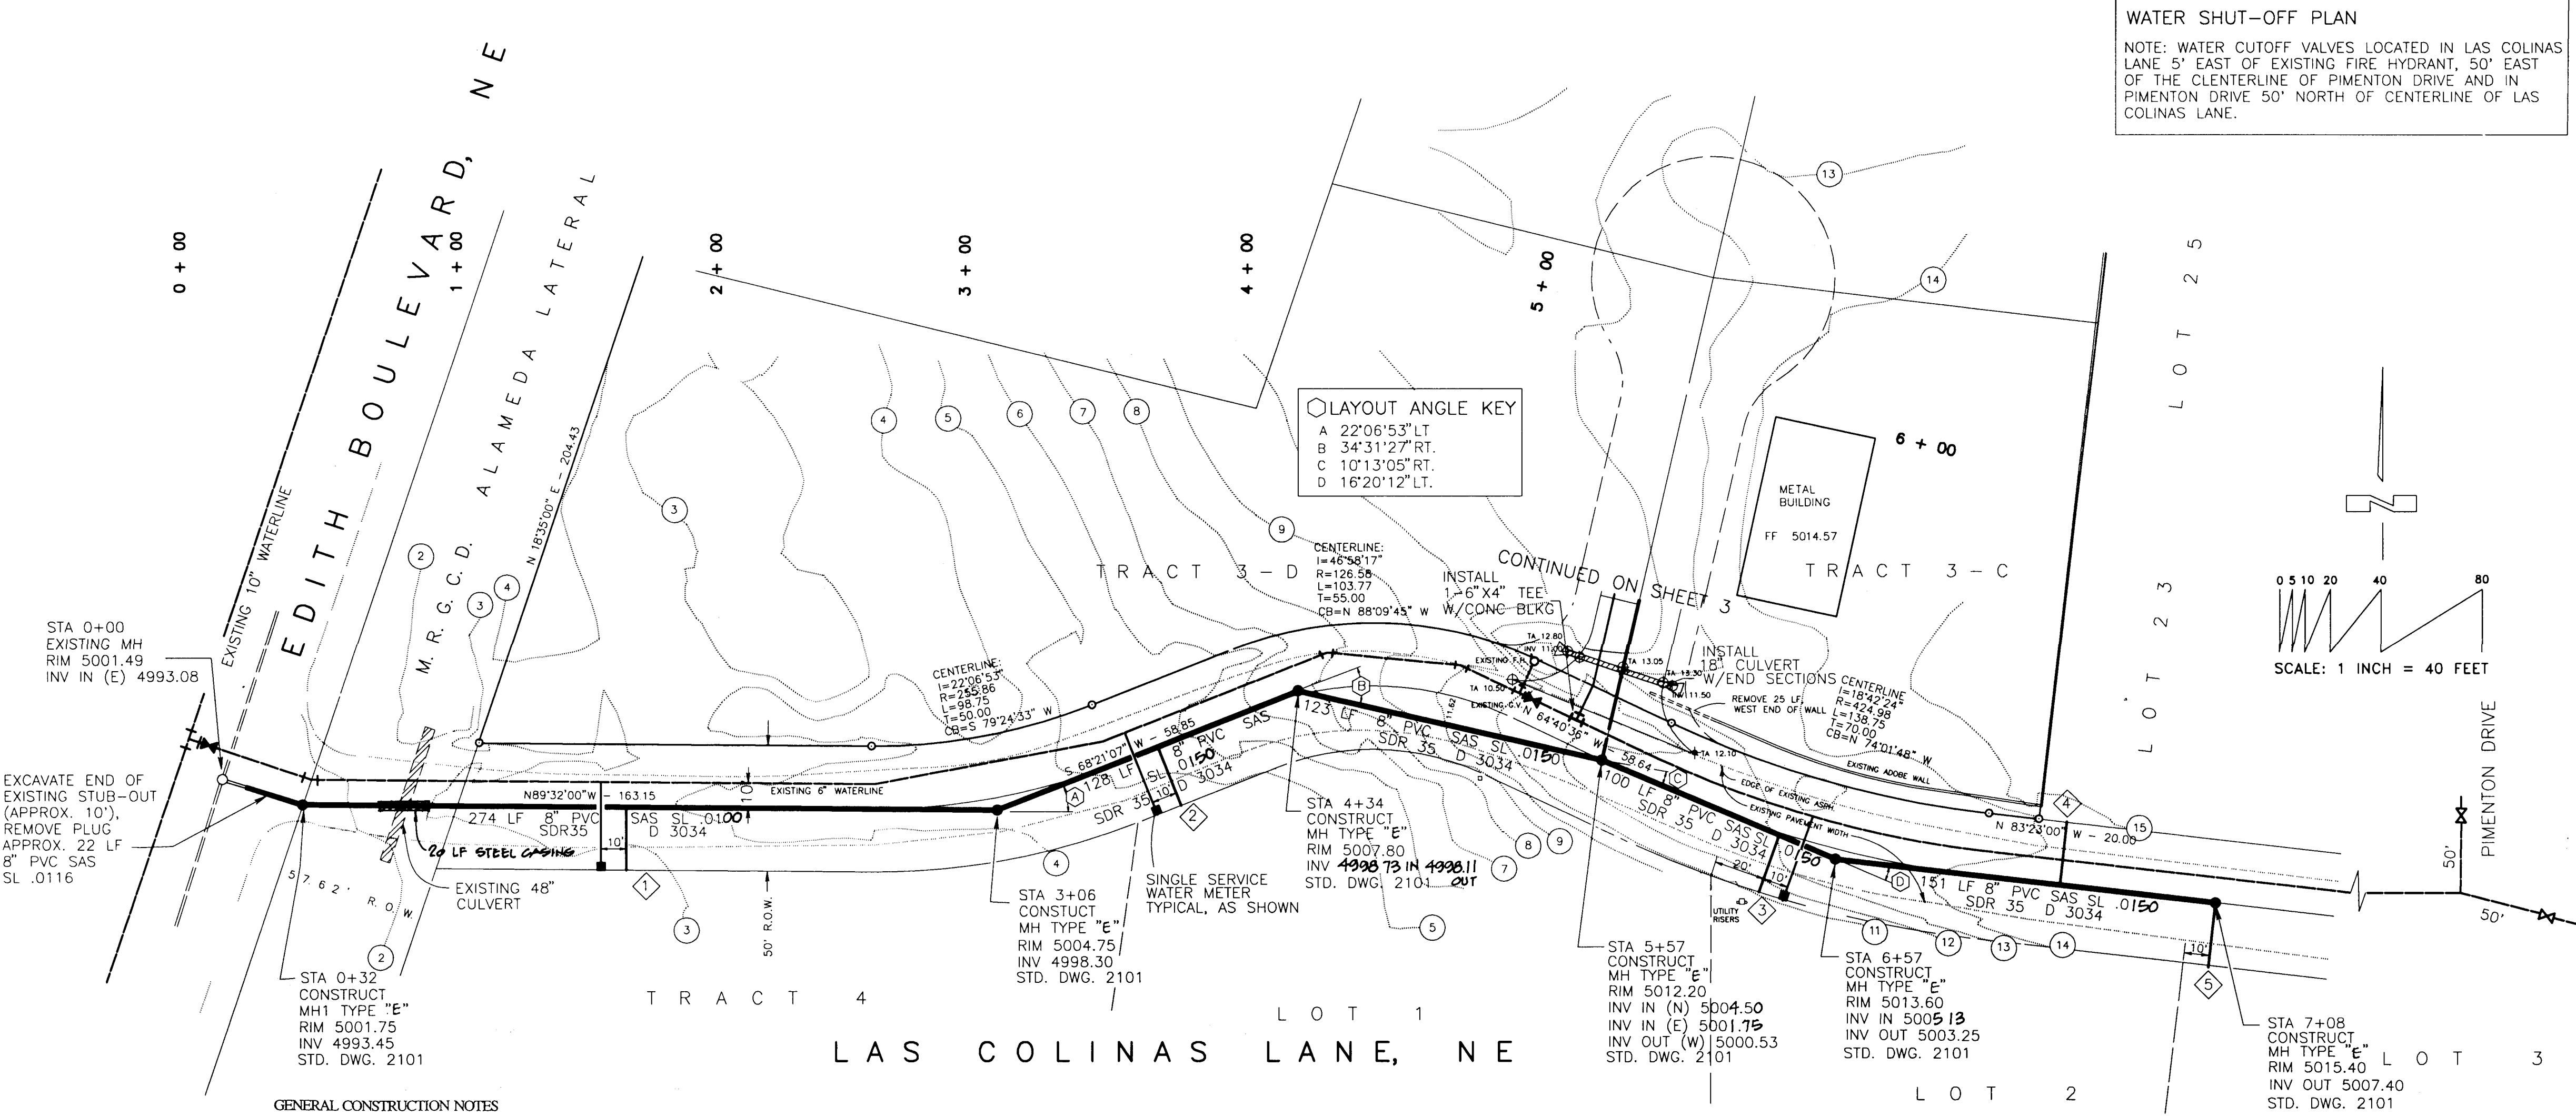

SEWER TAPS	SERVICE TO:	END INV.ELEV.
1	STA 1+60 25'RT TRACT 4	4995.90
2	STA 3+74 25'RT LOT 1	4998.40
3	STA 6+33 24'RT LOT 2	5003.80
4	STA 6+47 25'LT LOT 23	5008.50
5	STA 7+08 25'RT LOT 3	5008.60

AS-BUILT INFORMATION	CONTRACTOR	DATE
WORK BY		
INSPECTED BY		
ACCEPTANCE BY		
FIELD BY		
REVISION BY		
CORRECTED BY		
RECORDED BY		
NO.		

SURVEY INFORMATION	FIELD NOTES	DATE
NO.		
BY		
DATE		
DATE		
ENGINEER'S SEAL	REVISIONS	DATE
NO.		
DATE		
DATE		
REVISIONS	DATE
NO.	
DATE	
DATE	
REVISIONS	DATE
NO.	
DATE	
DATE	
HALL ENGINEERING COMPANY INC.
ENGINEERING • SURVEYING • PLANNING • CONSTRUCTION
8840 2ND ST., NW, SUITE 308 • ALBUQUERQUE, NEW MEXICO 87107
PHONE (505) 345-1064 FAX (505) 345-2404


CITY OF ALBUQUERQUE
PUBLIC WORKS DEPARTMENT
ENGINEERING GROUP

TITLE: SEWER AND WATERLINE
PLAN AND PROFILE



APPROVALS	ENGINEER	DATE	APPROVALS	ENGINEER	DATE
D.R.C. Chairman	B. J. Smith	12-15-95	Liquid Waste	R.W. Kane	10-25-95
Hydrology	M.A. Rios	12-15-95	Traffic	R.W. Kane	10-25-95
Water	R.W. Kane	10-25-95			

DRAWING NO.	5234.90	MAP NO.	D-16	SHEET	2	OF	3
-------------	---------	---------	------	-------	---	----	---


WATER SHUT-OFF PLAN
NOTE: WATER CUTOFF VALVES LOCATED IN LAS COLINAS LANE 5' EAST OF EXISTING FIRE HYDRANT, 50' EAST OF THE CENTERLINE OF PIMENTON DRIVE AND IN PIMENTON DRIVE 50' NORTH OF CENTERLINE OF LAS COLINAS LANE. SEE SHEET 2 OF 3

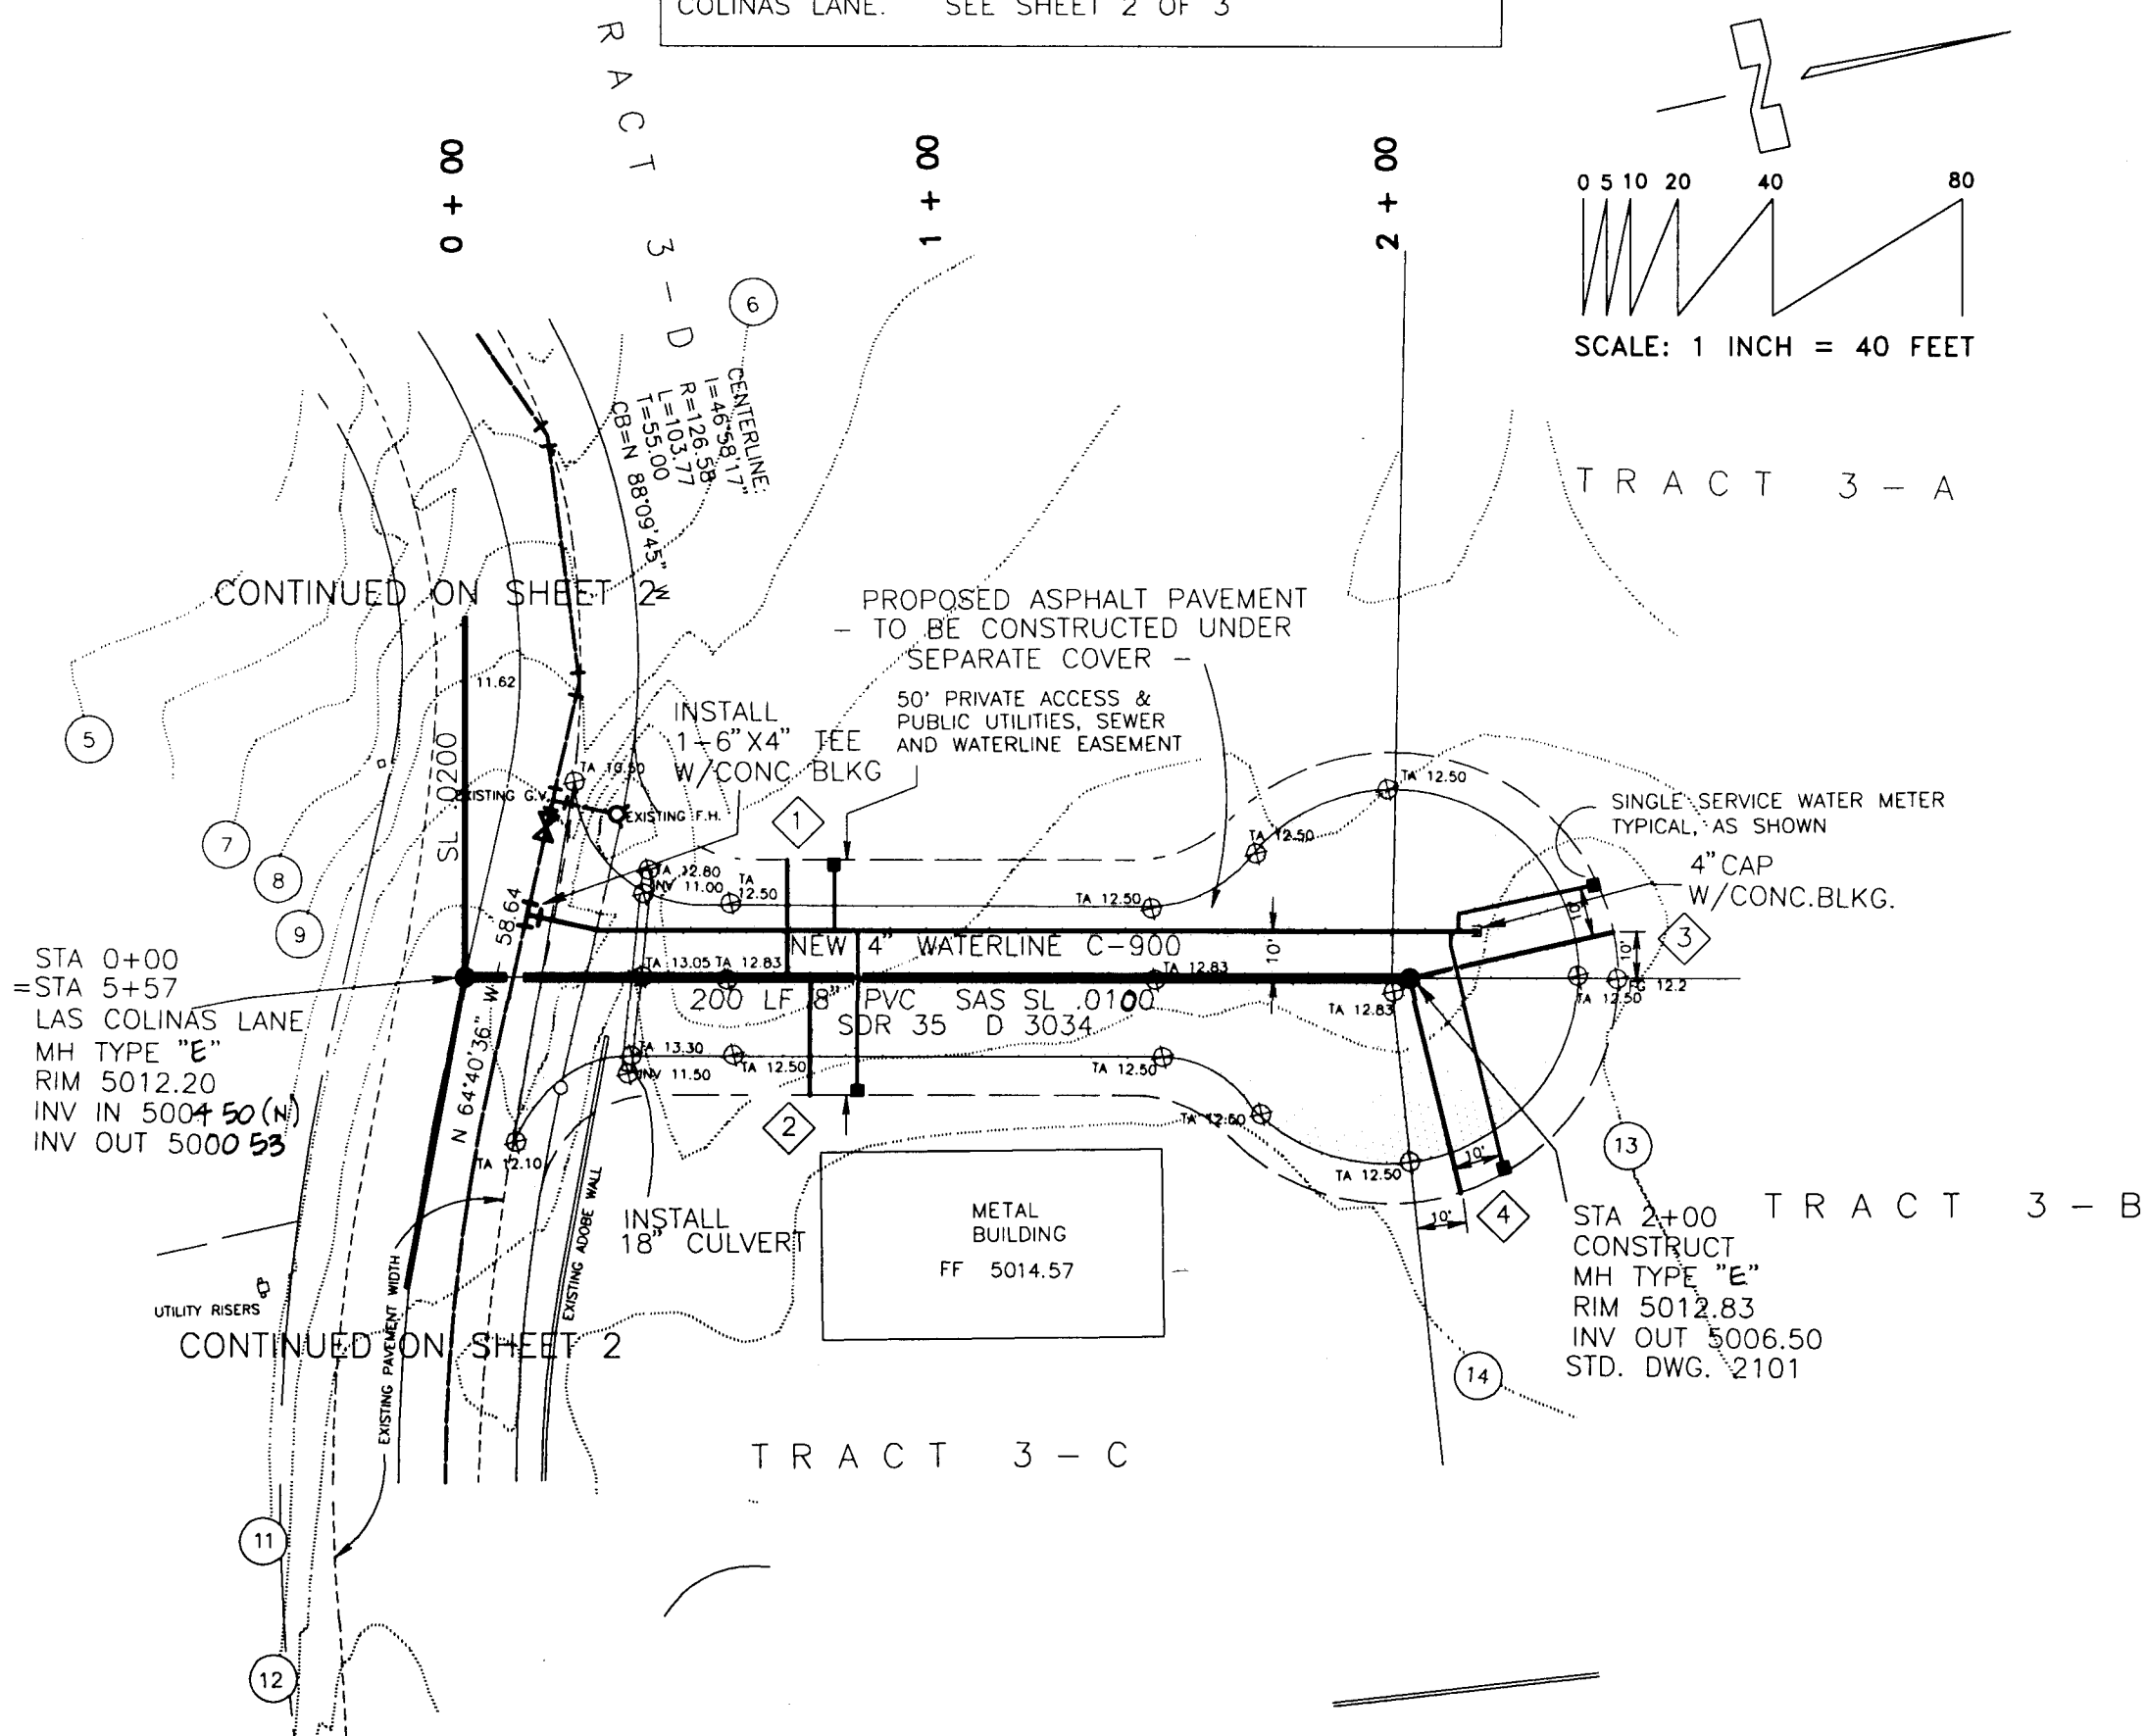


LOT 25

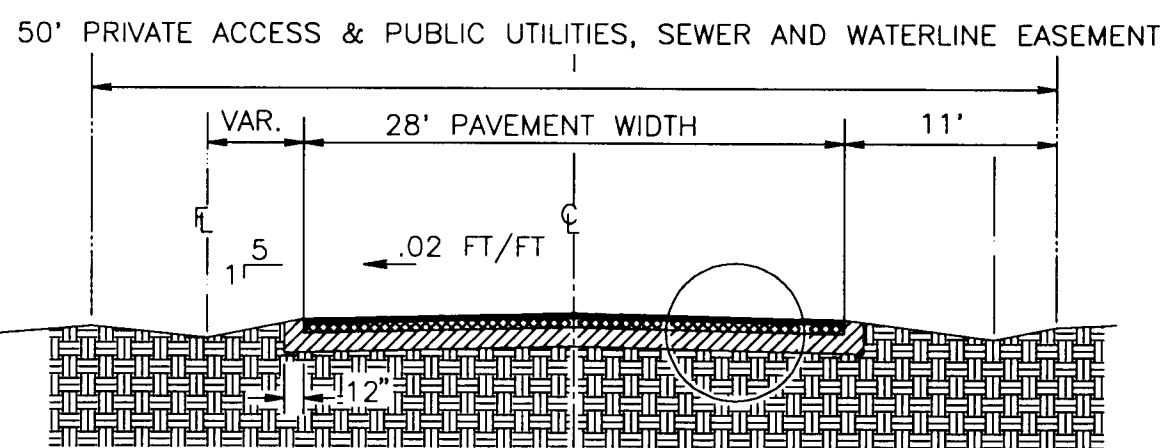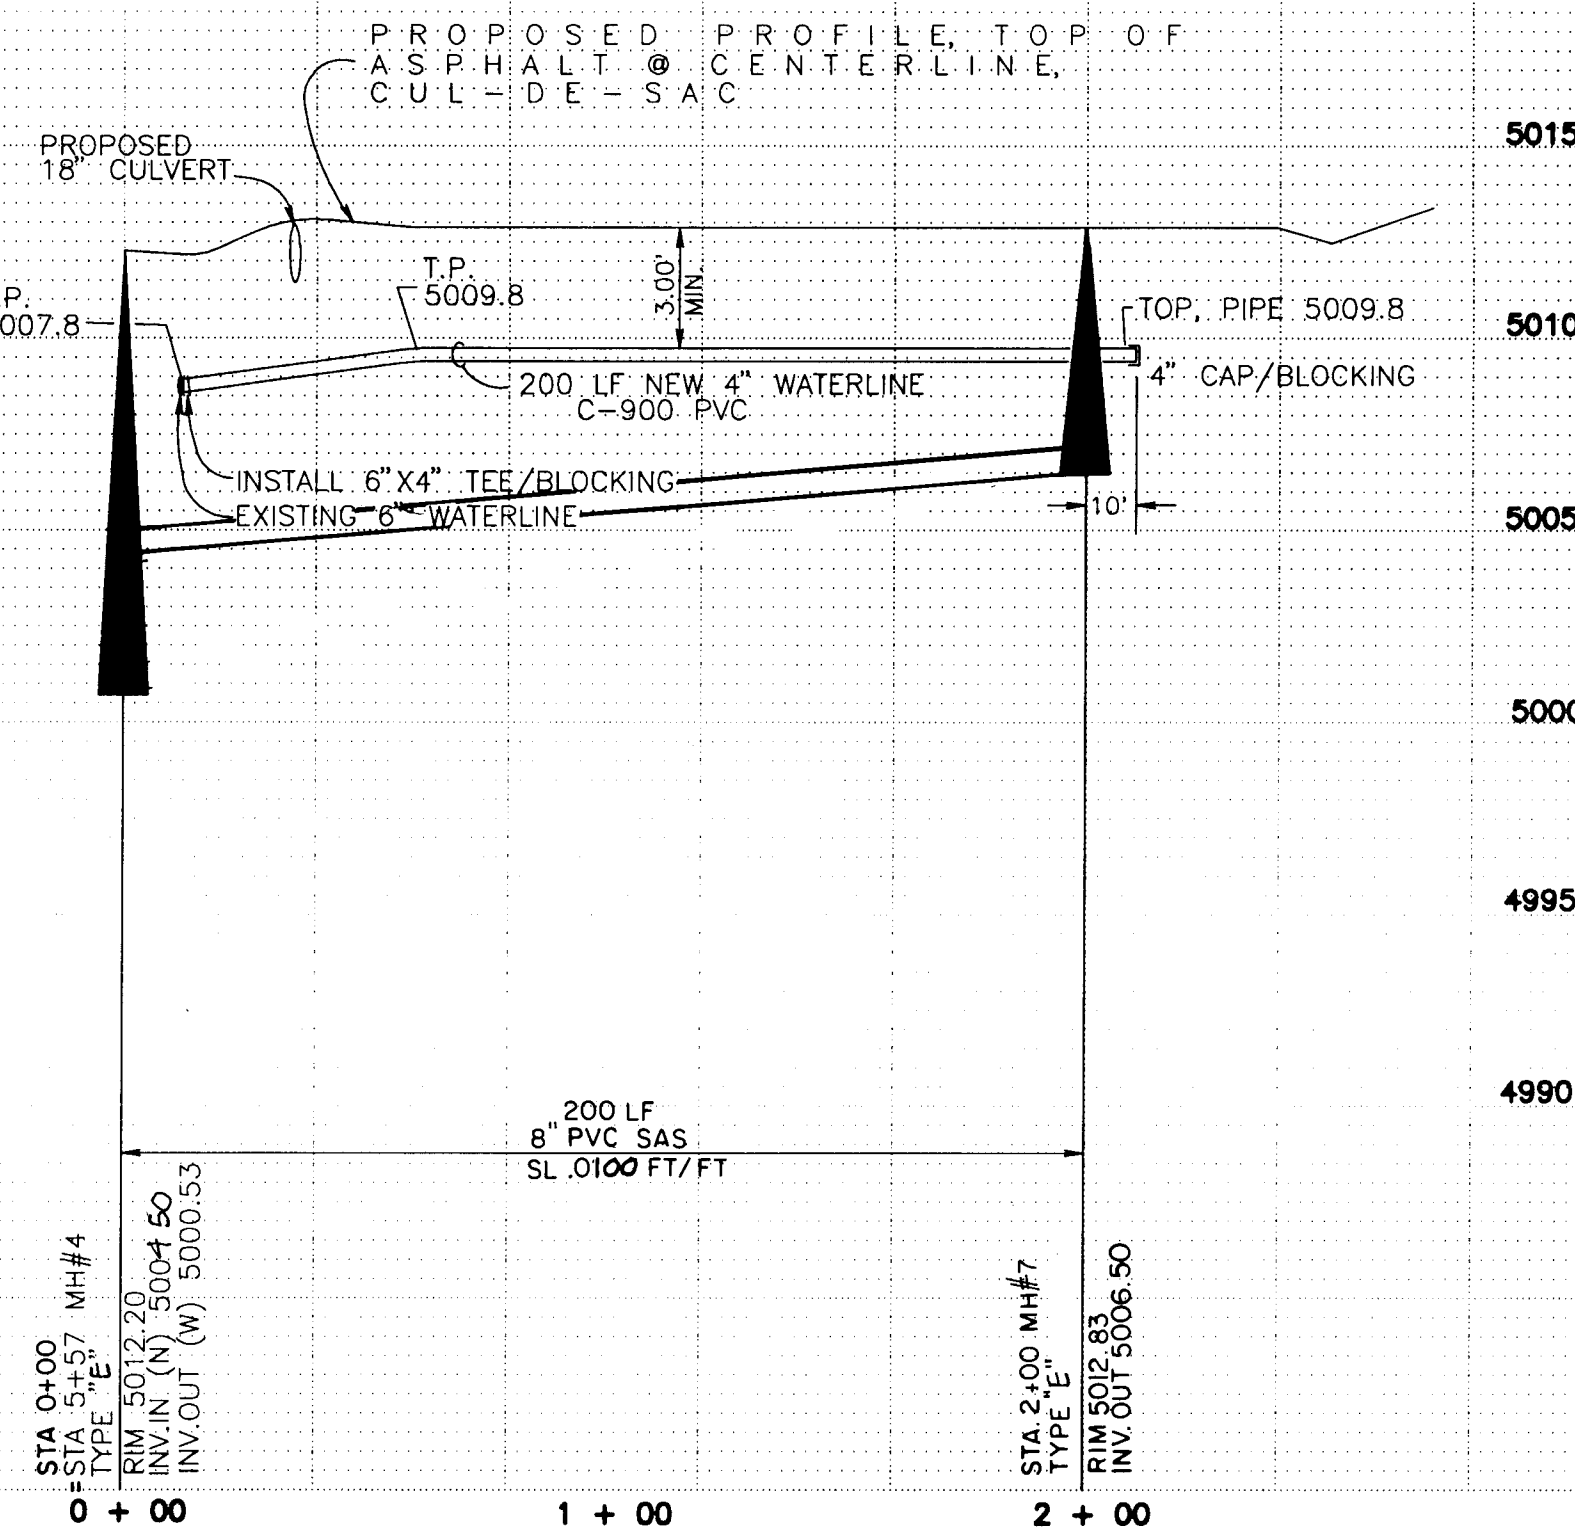


STREET SECTION
1" = 10'

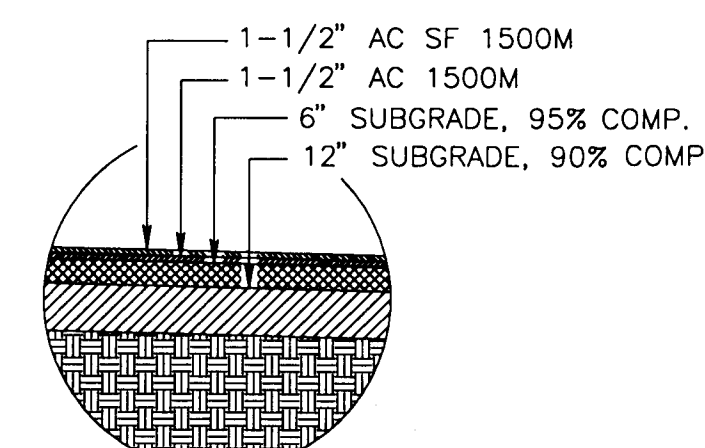

PAVING SECTION

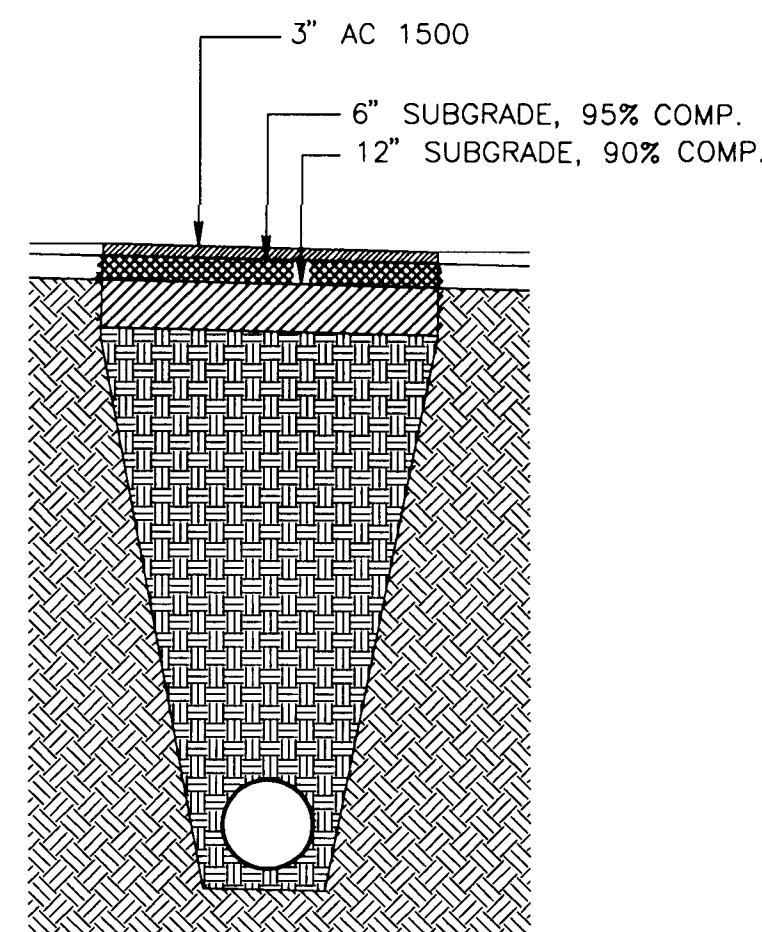

REPLACEMENT, LAS COLINAS

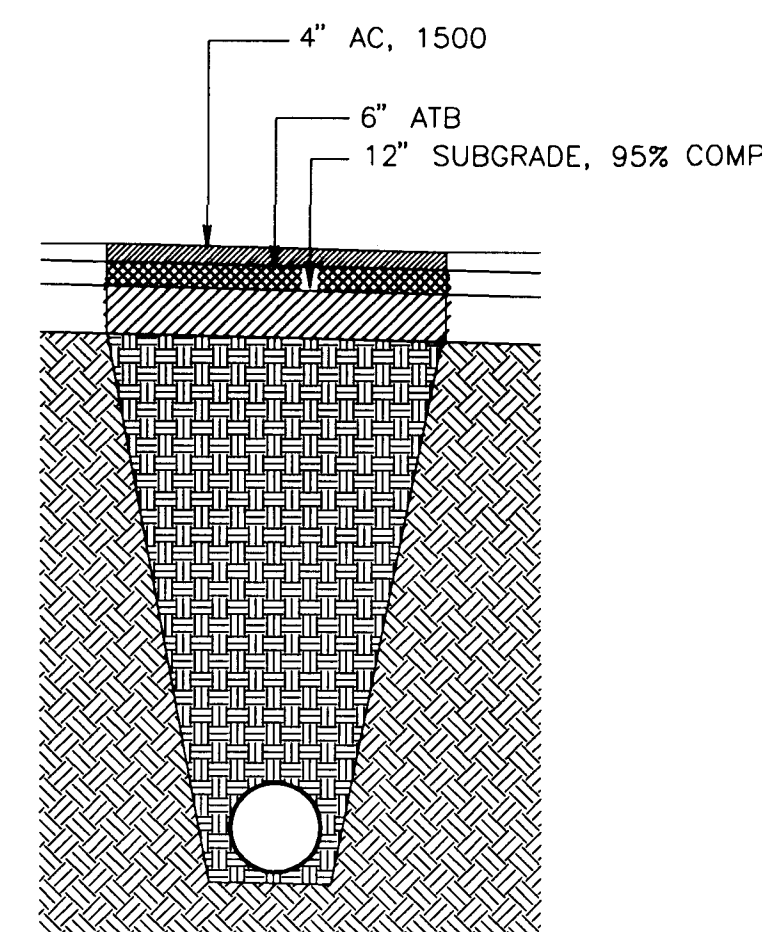

REPLACEMENT, EDITH BLVD.

SEWER TAPS	SERVICE	END
TO:	INV. ELEV.	
1	STA 1+68 LT	TRACT 3-D 5005.57
2	STA 1+73 RT	TRACT 3-C 5005.65
3	STA 2+00 --	TRACT 3-A 5007.83
4	STA 2+00 --	TRACT 3-B 5007.83

AS-BUILT INFORMATION		BENCH MARK		SURVEY INFORMATION		ENGINEER'S SEAL	
CONTRACTOR	WORK	11-D16 AC BRASS TABLET SET IN TOP OF CONCRETE POST IN NORTHWEST QUADRANT OF INTERSECTION OF EDITH BOULEVARD AND RANCHITOS ROAD, NE	DATE	NO.	BY		
DATE	INSPECTOR'S	DATE	DATE	DATE	DATE		
DATE	ACCEPTANCE BY:	DATE	DATE	DATE	DATE		
DATE	VERIFICATION BY:	DATE	DATE	DATE	DATE		
DRAWINGS		CORRECTED BY:		REMARKS		DESIGN	
NO.		NO.		NO.		NO.	
DATE		DATE		DATE		DATE	
RECORDED BY:		RECORDED BY:		RECORDED BY:		RECORDED BY:	
NO.		NO.		NO.		NO.	

HALL ENGINEERING COMPANY INC.
ENGINEERING • SURVEYING • PLANNING • CONSTRUCTION
6840 2ND ST. NW, SUITE 306 • ALBUQUERQUE, NEW MEXICO 87107
PHONE (505) 345-1064 FAX (505) 344-5404

CITY OF ALBUQUERQUE
PUBLIC WORKS DEPARTMENT
ENGINEERING GROUP


TITLE: SEWER AND WATERLINE PLAN AND PROFILE
PAVING SECTIONS

APPROVALS	ENGINEER	DATE	APPROVALS	ENGINEER	DATE
D.R.C. Chairman	<i>B.G. Soley</i>	12-15-95	Liquid Waste	<i>R.W. Kane</i>	10-25-95
Hydrology	<i>NIA</i>	9-22-95	Traffic	<i>NIA</i>	9-22-95
			Water	<i>R.W. Kane</i>	10-25-95

DRAWING NO.	5234.90	MAP NO.	D-16	SHEET	3	OF	3
-------------	---------	---------	------	-------	---	----	---

SCANNED BY
BY LASON

LEGEND

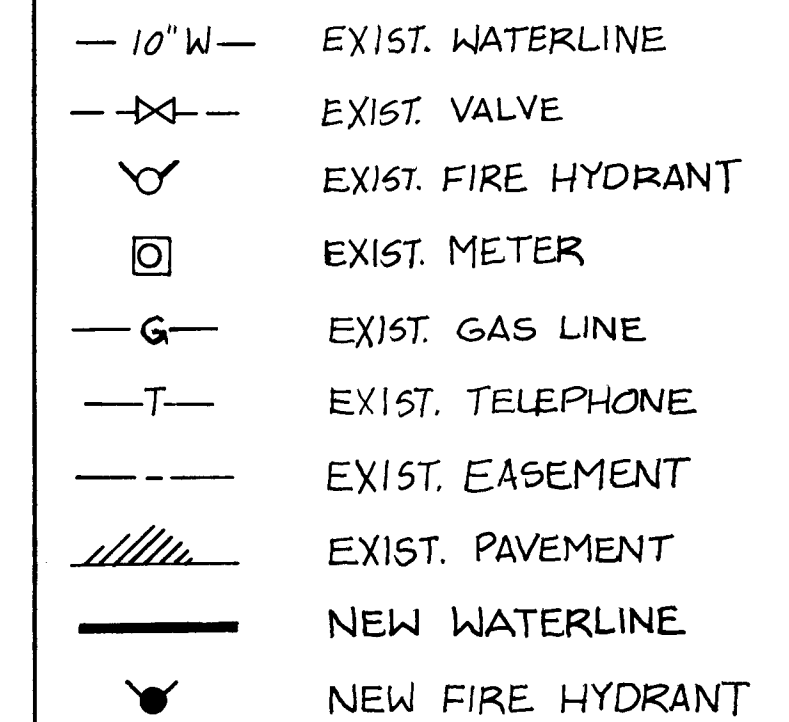

20 10 0 20 40

1" = 20'

CITY OF ALBUQUERQUE
PUBLIC WORKS DEPARTMENT
ENGINEERING GROUP

TITLE: **WATERLINE REMOVALS
AND CONSTRUCTION**

APPROVALS	ENGINEER	DATE	APPROVALS	ENGINEER	DATE
DRC CHAIRMAN			WATER		
TRANSPORTATION			WASTE WATER		
HYDROLOGY					

PROJECT NO.	5323.90	MAP NO.	G-15	SHEET	1	OF	1
-------------	---------	---------	------	-------	---	----	---

AS-BUILT

SIGN ALG
DATE 12/11/95

1	2	3	4	5	6	7	8	9	10	11	12	13	14	15
2	0	-	5	3	2	3	.	9	0		0	1	9	5

APPROVAL OF AS BUILT DRAWINGS
CHIEF CONSTRUCTION ENGINEER
DATE 1/15

SCANNED BY
BY LASON

WATERLINE REMOVAL PLAN: RECREATION CENTER ADDITION

SCALE: 1" = 20'