

G-22

WATER VALVE SHUTOFF PLAN REQUIREMENTS

- GENERAL NOTES:

- WATERLINE CONSTRUCTION NOTES:

- SANITARY SEWER CONSTRUCTION NOTES:

- 

JEFF MORTENSEN & ASSOCIATES, INC.
☐ 6010-B MIDWAY PARK BLVD. N.E.
☐ ALBUQUERQUE ☐ NEW MEXICO 87109
☐ ENGINEERS ☐ SURVEYORS (505) 345-4250

CITY OF ALBUQUERQUE
PUBLIC WORKS DEPARTMENT
ENGINEERING GROUP


TITLE: LIFE PERSPECTIVES HEALTHCARE
WATERLINE EXTENSION
STA. 10+00 TO STA. 11+10.50

APPROVALS	ENGINEER	DATE	APPROVALS	ENGINEER	DATE
DRC CHAIRMAN	<i>B.G. Lordeley</i>	7-24-95	WATER	<i>R.W. Kane</i>	7-17-95
TRANSPORTATION	<i>R.W. Kane</i>	7-19-95	WASTE WATER	<i>R.W. Kane</i>	7-17-95
HYDROLOGY	<i>N.A. Bm</i>	3/19/96			

PROJECT NO.	5245.90	MAP NO.	G-22	SHEET 1 OF 1
-------------	---------	---------	------	--------------

SURVEY INFORMATION			BENCH MARKS		AS BUILT INFORMATION	
NO.	BY	DATE	A.C.S. BENCHMARK "2-C21-A" A. STANDARD A.C.S. BRASS TABLET		CONTRACTOR	
N/A	J.M.A.	09/94	STAMPED "ACS 2-C21-A 1978" DRILLED INTO THE TOP OF THE CONCRETE CURB IN THE SOUTH MEDIAN OF THE INTERSECTION OF COMANCHE ROAD N.E. AND JUAN TABO BLVD. N.E.		WORK STARTED BY	SUNDANCE MECH & UTIL CORP.
			ELEVATION = 5704.17 FEET (M.S.L.D.)		ACCEPTANCE BY	DATE 10/7/95
					FIELD ACTION BY	DATE 02/96
					DRAWINGS CORRECTED BY	DATE 02/96
					MICRO-FILM INFORMATION	
					RECORDED BY	DATE
					NO.	

SEAI

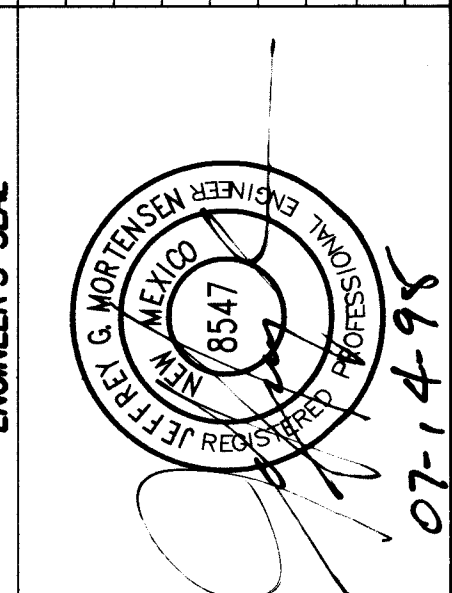

AS-BUILT & CERTIFY	12/95	M.D.S.
REMARKS	NO.	DATE
DESIGN	BY	
DESIGNED BY	C.R.B.	DATE 06-95
DRAWN BY	T.N.T.	DATE 06-95
CHECKED BY	J.G.M.	DATE 06-95

C:\DATA\ACADWG\40583\40586U1 Fri Jul 14 09:47:15 1995