

PUBLIC IMPROVEMENT PLANS
FOR THE
LIUM AT HIGH DESERT-
ALBUQUERQUE, NEW MEXICO

JULY 1995

PREPARED FOR:
CHAMA DEVELOPMENT CO.
1401 CENTRAL AVENUE NW
ALBUQUERQUE, NM 87102

PREPARED BY:
ISAACSON & ARFMAN, P.A.
128 MONROE ST. NE
ALBUQUERQUE, NM 87108

INDEX TO DRAWINGS


SHEET NO.	TITLE
1	TITLE SHEET
2-3	SUBDIVISION PLAT
4A&4B	GRADING/DRAINAGE PLAN
5	MASTER PAVING & STORM DRAINAGE PLAN
6	MASTER UTILITY PLAN
	<u>PAVING PLAN & PROFILE SHEETS</u>
7	DESERT MARIGOLD LANE
8	SILVER LEAF TRAIL
9	TRILLIUM TRAIL & WILDFLOWER TRAIL
10	TRILLIUM TRAIL
11	PURPLE ASTER LANE
	<u>UTILITY PLAN & PROFILE SHEETS</u>
12	DESERT MARIGOLD LANE & NW SAS CONNECTION
13	SILVER LEAF TRAIL
14	TRILLIUM TRAIL & WILDFLOWER TRAIL & SE WATERLINE CONNECTION
15	TRILLIUM TRAIL
16	PURPLE ASTER LANE
17	SILVER LEAF TRAIL - STORM DRAIN
18	OFF-SITE STORM DRAIN
19	DETAILS

SURVEYOR'S CERTIFICATION

"I, Timothy Aldrich, a duly qualified Registered Professional Land Surveyor under the Laws of the State of New Mexico, do hereby certify that the "as-built" information shown on these drawings was obtained from field construction and "as-built" surveys performed by me, or under my supervision, that the "as-built" information shown on these drawings was accurate, or under my supervision and that this "as-built" information is true and correct to the best of my knowledge. Timothy Aldrich Land Surveying, Inc., is not responsible for any of the design, concepts, calculations, engineering and/or intent of the record drawings.

Timothy Aldrich N.M.P.S. 7719

05-06-96
Date


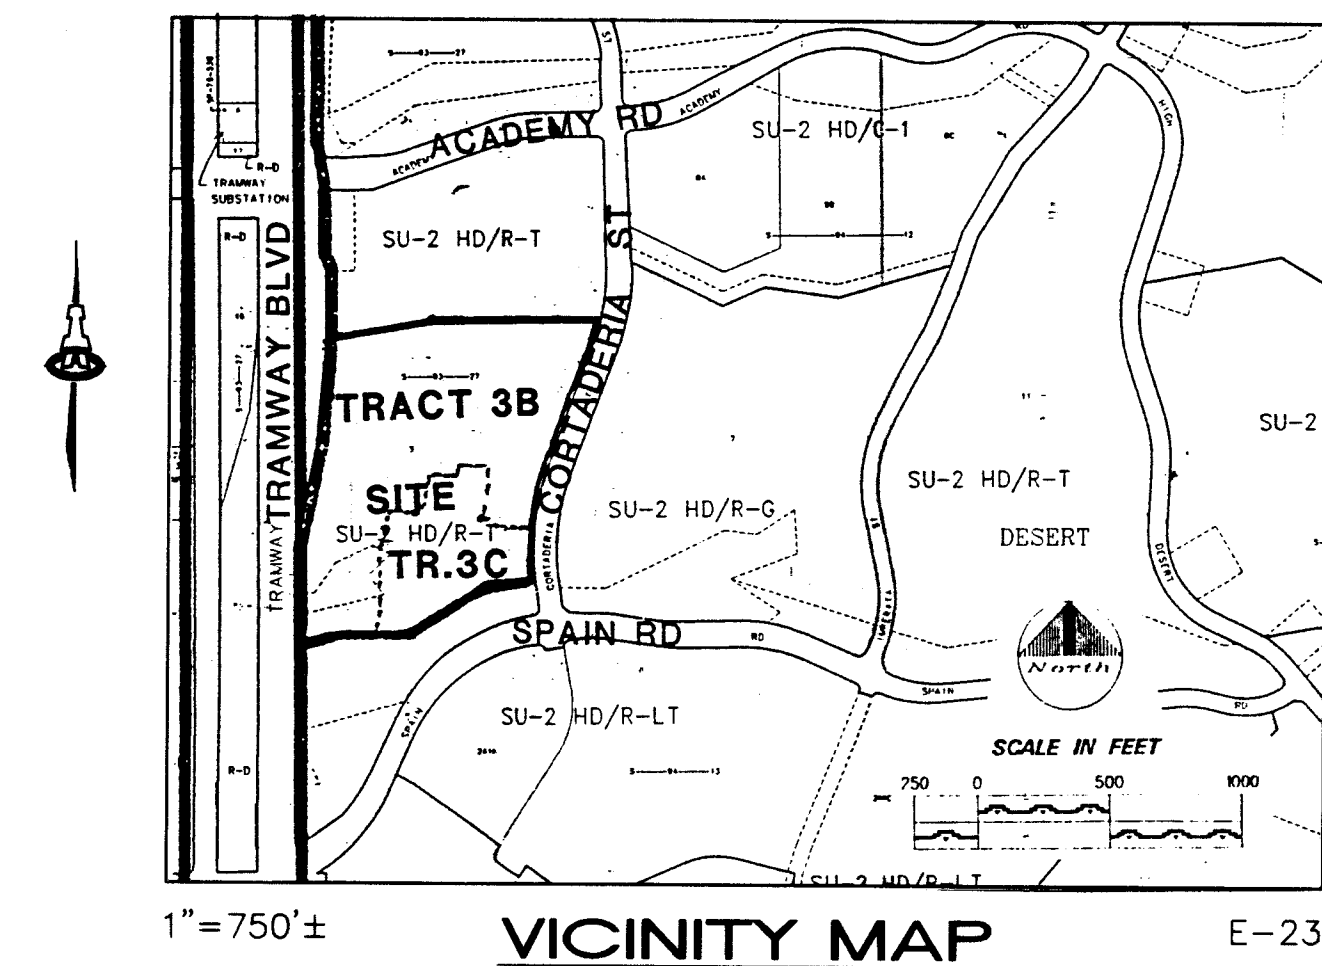



GENERAL NOTES

1. All work detailed on these plans to be performed under contract shall, except as otherwise stated or provided for herein, be constructed in accordance with the City of Albuquerque Standard Specifications for Public Works Construction 1986 Edition as amended with Update No. 5.
2. All work on this project shall be performed in accordance with applicable federal, state, and local laws, rules, and regulations concerning construction safety and health.
3. Prior to construction, the Contractor shall excavate & verify the horizontal and vertical locations of all obstructions. Should a conflict exist, the Contractor shall notify the Engineer so that the conflict can be resolved with minimum delay.
4. Two (2) working days prior to any excavation, Contractor must contact Line Locating Service ☎ 260-1990 for location of existing utilities.
5. Contractor shall conduct his operations in a manner which will minimize interference with local traffic. Contractor shall comply with all applicable laws, ordinances, rules, regulations, and orders of any public body having jurisdiction for the safety of persons or property, and to protect them from damage, injury, or loss. Contractor shall erect and maintain, as required by the conditions and progress of the work, all necessary safeguards for safety continuously and not limited to normal working hours, throughout the duration of the project. Contractor shall adhere to Section 19 of the General Conditions of the City of Albuquerque Standard Specifications for Public Works Construction, 1986, as amended with Update No. 5.
6. The Contractor agrees that he shall assume the sole and complete responsibility for the job site conditions during the course of construction of this project, including safety of all persons and property; that this requirement shall apply continuously and not be limited to normal working hours; and that the Contractor shall defend, indemnify, and hold harmless the Owner & Engineer from any and all liability real or alleged, in connection with the performance of work on this project, excepting liability arising from the sole negligence of the Owner or Engineer.
7. **TRAFFIC CONTROL:** Three (3) working days prior to beginning construction the Contractor shall submit to the Construction Coordination Division a detailed construction schedule. Two (2) working days prior to construction, the Contractor shall obtain a barricading permit from the Construction Coordination Division. Contractor shall notify Barricade Engineer (768-2551) prior to occupying an intersection. See section 19 of the specifications. All street striping altered or destroyed shall be replaced by Contractor to location and in kind as existing at no additional cost to the Owner.
8. When abutting existing pavement to new, sawcut existing pavement to a straight edge and at a right angle, or as approved by the field Engineer. Removal of broken or cracked pavement will also be required.
9. Existing curb and gutter not to be removed under the contract which is damaged or displaced by the Contractor shall be removed and replaced by the Contractor at his expense.
10. All final backfill for trenches shall be compacted to a minimum 90% maximum density per ASTM D-1557 and as directed by section 701.14.2 and standard drawing number 2315.
11. The Contractor shall promptly clean up any material excavated within the public right-of-way or private roadway easements so that the excavated material is not susceptible to being washed down the street or into any public drainage facility.
12. Proposed waterline materials shall be either PVC pipe meeting AWWA C900 requirements (6"-12") or ductile iron pipe, thickness class 50 (6"-16").
13. All sanitary sewer line stationing refers to sanitary sewer centerline stationing.
14. All fittings on waterlines shall have restrained joints as noted on the plans.
15. Contractor shall support all existing, underground utility lines which become exposed during construction. Payment for supporting work shall be incidental to water-line and/or sewerline costs.
16. Contractor shall assist the Engineer/Inspector in the recording of data on all utility lines and accessories as required by the City of Albuquerque for the preparation of record drawings. Contractor shall not cover utility lines and accessories until all data has been recorded.
17. The Contractor is responsible for protecting and maintaining all existing monumentation controls. In the event of inadvertent destruction or alteration, the Contractor must immediately notify the City Chief Surveyor.
18. PNM will provide at no cost to the City or the Contractor the required personnel for inspection or observation whenever necessary by PNM while the Contractor is exposing PNM's cables. However, the Contractor shall be charged the total cost associated with repairs to any damaged cables or for any cost associated with supporting or relocating the poles and cables during construction.
19. **WARNING--EXISTING UTILITY LINE LOCATIONS** are shown in an approximate manner only, and such lines may exist where none are shown. The location of any such existing lines is based upon information provided by the utility company, the Owner, or by others, and the information may be incomplete or may be obsolete by the time construction commences.

The Engineer has undertaken no field verification of the location, depth, size, or type of existing underground utility lines, makes no representation pertaining thereto, and assumes no responsibility or liability therefor. The Contractor shall inform itself of the location of any utility line in or near the area of the work in advance of and during excavation work. The Contractor is fully responsible for any and all damage caused by its failure to locate, identify, and preserve any and all existing utilities. The Contractor shall comply with State statutes, municipal and local ordinances, rules and regulations pertaining to the location of these lines and facilities, in planning and conducting excavation, whether by calling or notifying the utilities, complying with "Blue Stakes" procedures, or otherwise.
20. Any work occurring within an arterial roadway requires 24 hr. construction.

2	3	4	5	6	7	8	9	10	11	12	13	14	15
2	6	-	5	2	5	1	.	9	0		0	1	9

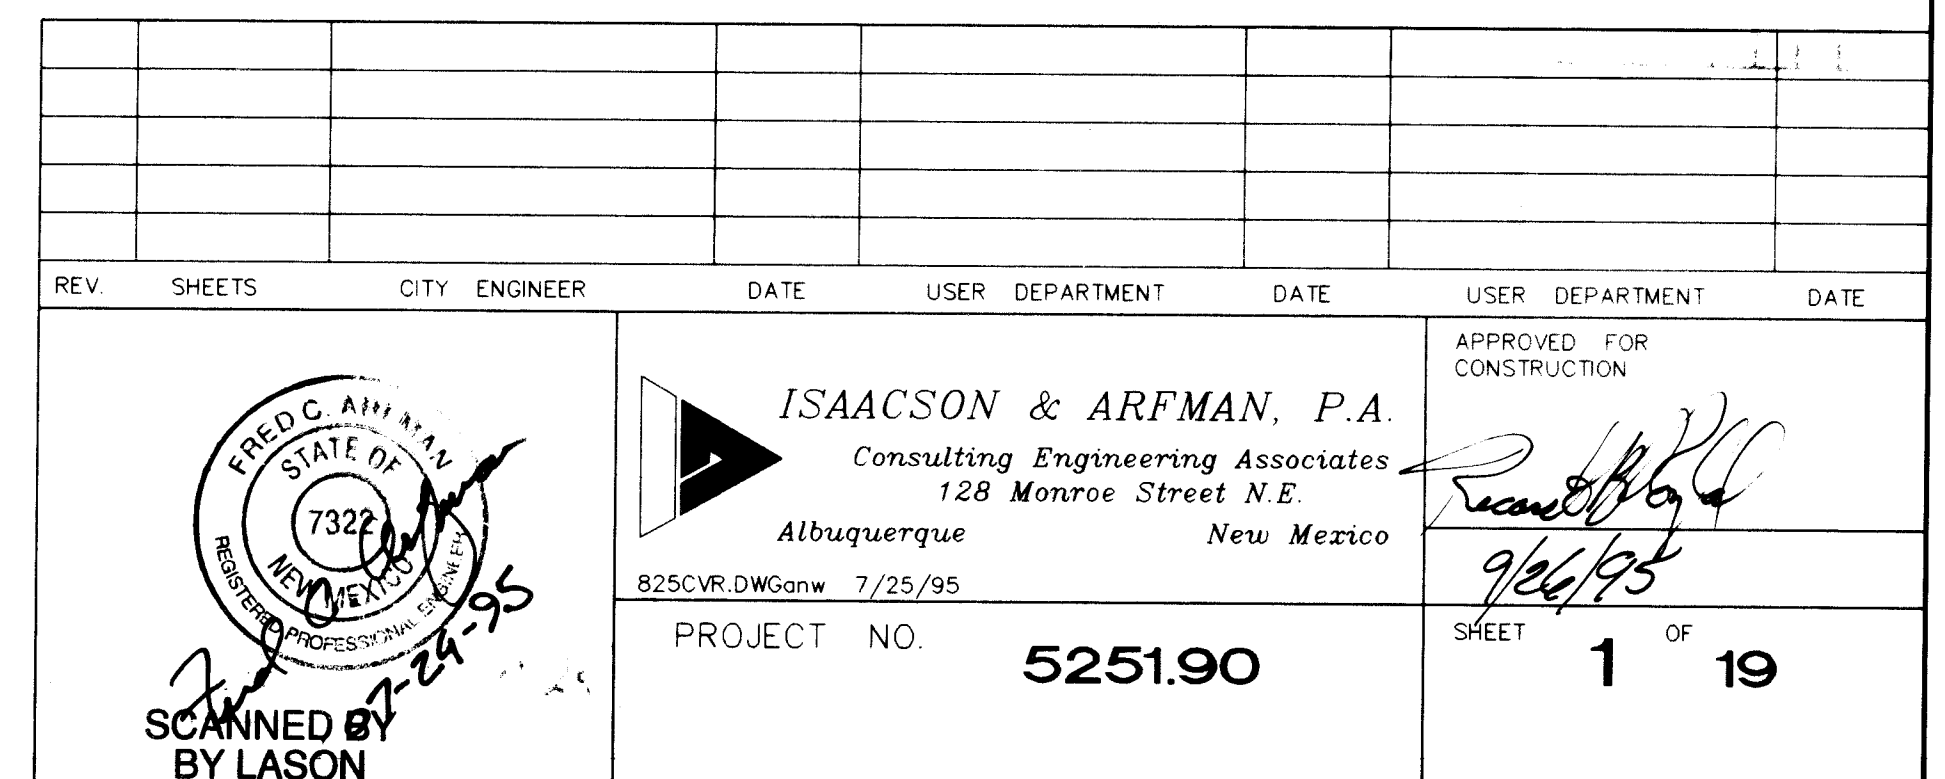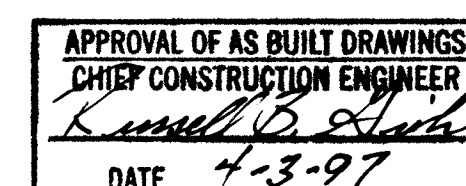

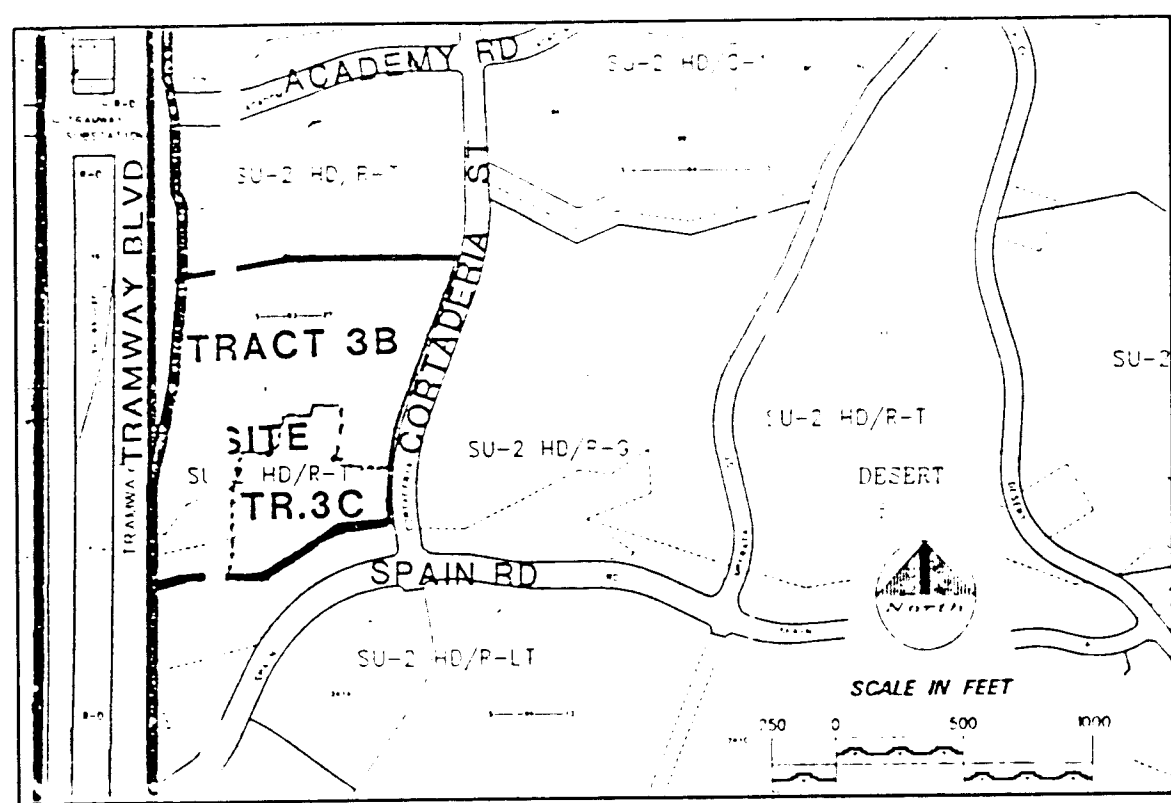

ZONE ATLAS E-23

VICINITY MAP

SCALE: 1"=750'±

SUBMISSION DATA / NOTES

- BEARINGS ARE GRID BASED ON THE NEW MEXICO STATE PLANE COORDINATE SYSTEM (CENTRAL ZONE).
- DISTANCES ARE GROUND DISTANCES.
- BEARINGS AND DISTANCES IN PARENTHESIS ARE RECORD.
- BASIS OF BOUNDARY ARE THE FOLLOWING PLATS OF RECORD ENTITLED:
 - "PLAT OF TRACTS 3A, 3B, 3C AND 3D, HIGH DESERT" (2-9-95, 95C-47)
 - "PLAT OF HIGH DESERT" (11-23-93, 93C-325)
- ALL BEING RECORDS OF BERNALILLO COUNTY, NEW MEXICO.
- FIELD SURVEY PERFORMED APRIL 12, 1995.
- GROSS ACREAGE: 25.0898 ACRES.
- NUMBER OF EXISTING TRACTS: 2
- NUMBER OF LOTS/TRACTS CREATED: 72 LOTS/2 TRACTS.
- MILEAGE OF PUBLIC STREETS CREATED: 0 MILES.
- MILEAGE OF PRIVATE ROADWAYS CREATED: 0.494 MILES.
- CITY STANDARD UTILITY NOTE II:
 - "CITY OF ALBUQUERQUE WATER AND SANITARY SEWER SERVICE TO THE TRILLIUM SUBDIVISION, PHASE ONE, MUST BE VERIFIED AND COORDINATED WITH THE PUBLIC WORKS DEPARTMENT, CITY OF ALBUQUERQUE."
- CENTERLINE (IN LIEU OF R/W MONUMENTATION) TO BE INSTALLED AT ALL CENTERLINE PC'S, PT'S, ANGLE POINTS AND STREET INTERSECTIONS PRIOR TO ACCEPTANCE OF SUBDIVISION STREET IMPROVEMENTS AND WILL CONSIST OF A STANDARD FOUR-INCH (4") ALUMINUM ALLOY CAP STAMPED "CITY OF ALBUQUERQUE", "CENTERLINE MONUMENTATION", "SURVEY MARKER", "DO NOT DISTURB", "PLS #7719".
- TITLE REPORT: NONE PROVIDED

FREE CONSENT / DEDICATION

THE UNDERSIGNED OWNER(S) AND PROPRIETOR(S) OF THE PROPERTY DESCRIBED HEREON DO HEREBY CONSENT TO THE PLATTING OF SAID PROPERTY AS SHOWN HEREON AND DO HEREBY GRANT THOSE EASEMENTS AS SHOWN HEREON IN ACCORDANCE WITH THEIR APPLICABLE DEDICATION AS SHOWN HEREON AND THE SAME IS WITH THE FREE CONSENT AND IN ACCORDANCE WITH THEIR DESIRES AND DO HEREBY REPRESENT THAT THE UNDERSIGNED INDIVIDUAL(S) ARE AUTHORIZED TO SO ACT.

TRILLIUM DEVELOPMENT LTD., CO.

GREG ANIXTER, MANAGER OF
TRILLIUM DEVELOPMENT LTD., CO.

8/24/95

DATE

825PT1.DWGaw 08/21/95

State of New Mexico) SS
County of Bernalillo)
This instrument was filed for record on

1-023-062-043160-20201
1-023-062-043160-20201
1-023-062-043160-20201

HIGH DESERT INVESTMENTS

Sante Orkell

LEGAL DESCRIPTION

A tract of land situate within the Elena Gallegos Grant in projected Section 26, Township 11 North, Range 4 East, New Mexico Principal Meridian, City of Albuquerque, Bernalillo County, New Mexico being all of TRACTS 3B AND 3C, HIGH DESERT as the same is shown on the plat entitled "TRACTS 3A, 3B, 3C AND 3D, HIGH DESERT" filed in the office of the County Clerk of Bernalillo County, New Mexico on February 9, 1995 in Volume 95C, Folio 47 and being more particularly described as follows:

BEGINNING at the northwest corner of the herein described tract, said point being common with the southwest corner of said TRACT 3A, and further being on the east right-of-way line of Tramway Boulevard N.E. from whence the NGS/ACS Monument "TUMBLE" bears N 16°13'13" W, 3446.18 feet;

THENCE leaving said east right-of-way line along a line common with the south line of said TRACT 3A N 82°08'40" E, 359.98 feet to a point;

THENCE continuing along said south line N 89°07'30" E, 730.30 feet to the northeast corner, said point being common with the southeast corner of said TRACT 3A, and further being on the west right-of-way line of Cortaderia Street N.E.;

THENCE along said west right-of-way line 102.57 feet along a curve to the right, whose radius is 773.43 feet and whose long chord bears S 17°13'30" W, 102.49 feet through a central angle of 07°35'53" to a point of tangency;

THENCE continuing S 21°01'26" W, 490.92 feet to a point of curvature;

THENCE continuing 457.47 feet along a curve to the left, whose radius is 916.43 feet and whose long chord bears S 06°43'25" W, 452.73 feet through a central angle of 28°36'04" to the southeast corner, said point being common with the northeast corner of said TRACT 3D;

THENCE leaving said west right-of-way line along a line common with the north line of said TRACT 3D S 80°47'48" W, 229.89 feet to a point;

THENCE continuing along said north line S 57°37'18" W, 313.79 feet to a point;

THENCE continuing N 89°59'49" W, 275.02 feet to a point;

THENCE continuing S 73°36'48" W, 176.93 feet to southwest corner, said point being common with the northwest corner of said TRACT 3D and further being on the east right-of-way line of Tramway Boulevard N.E.;

THENCE along said east right-of-way line N 00°00'53" E, 484.98 feet to a point;

THENCE continuing N 13°40'07" E, 304.88 feet to a point;

THENCE continuing N 05°21'33" E, 217.57 feet to a point;

THENCE continuing N 06°08'45" E, 107.83 feet to a point;

THENCE continuing N 03°12'15" E, 95.20 feet to the point of beginning and containing 25.0898 acres more or less.

DISCLOSURE STATEMENT

THE INTENT OF THIS PLAT IS TO SUBDIVIDE TRACT 3B INTO 72 RESIDENTIAL LOTS, TO GRANT TRACT 3B-1, TO GRANT EASEMENTS FOR PRIVATE ROADWAYS, OPEN SPACE, STORM DRAINAGE, LANDSCAPING AND PEDESTRIAN ACCESS AS SHOWN TO THE HIGH DESERT RESIDENTIAL HOME OWNERS ASSOCIATION INC., AND TO GRANT PUBLIC UTILITY EASEMENTS AS SHOWN.


ACKNOWLEDGEMENT

STATE OF NEW MEXICO) SS
COUNTY OF BERNALILLO)

THIS INSTRUMENT WAS ACKNOWLEDGED BEFORE ME ON
August 22, 1995, BY GREG ANIXTER, AS
MANAGER OF TRILLIUM DEVELOPMENT LTD., CO., A NEW MEXICO
LIMITED LIABILITY COMPANY, ON BEHALF OF SAID COMPANY.

MY COMMISSION EXPIRES: 4/22/99

Ruth J. Lopez
NOTARY PUBLIC

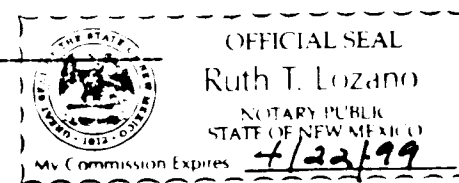

95105009

PLAT OF

THE TRILLIUM AT HIGH DESERT UNIT ONE

BEING A REPLAT OF TRACT 3B AND 3C HIGH DESERT

WITHIN THE ELENA GALLEGOS GRANT PROJECTED SECTION 26

TOWNSHIP 11 NORTH, RANGE 4 EAST, N.M.P.M.

CITY OF ALBUQUERQUE BERNALILLO COUNTY, NEW MEXICO

AUGUST 1995

APPROVALS S-95-8

DRB NO. 94-526

Public Service Company of New Mexico
GAS COMPANY OF NEW MEXICO

Norma S Carrillo
U.S. WEST COMMUNICATIONS

Walter Watson
JONES INTERCABLE

Walter Watson
CITY SURVEYOR, ENGR. DIV., P.W.D.

Robert W. Kane
TRAFFIC ENGINEERING, TRANS. DEV. DIV., P.W.D.

Robert W. Kane
PARKS & GENERAL SERVICES DEPARTMENT

Robert W. Kane
UTILITY DEVELOPMENT DIV., P.W.D.

Robert W. Kane
REAL PROPERTY DIVISION, D.E.M.

Robert W. Kane
A.M.A.F.C.A.

Robert W. Kane
CITY ENGINEER, PUBLIC WORKS DEPT.

Robert W. Kane
CITY ENGINEER, PUBLIC WORKS DEPT.


APPROVAL AND CONDITIONAL ACCEPTANCE AS SPECIFIED BY THE ALBUQUERQUE SUBDIVISION ORDINANCE, ARTICLE XI OF THE REVISED ORDINANCES OF ALBUQUERQUE, N.M.

Jack Ford
CITY PLANNER, ALBUQUERQUE PLANNING DIVISION

SURVEYOR'S CERTIFICATION

"I, Timothy Aldrich, a duly qualified Registered Professional Land Surveyor under the laws of the State of New Mexico, do hereby certify that this plat and description were prepared by me or under my supervision, shows all easements as shown on the plat of record or made known to me by the owners and/or proprietors of the subdivision shown hereon, utility companies and other parties expressing an interest and meets the minimum requirements for monumentation and surveys of the Albuquerque Subdivision Ordinance, and further meets the Minimum Standards for Land Surveying in the State of New Mexico (Effective November 1, 1989 and revisions effective December 25, 1991 and February 2, 1994), and is true and correct to the best of my knowledge and belief."

Timothy Aldrich, P.S. No. 7719
08-21-95

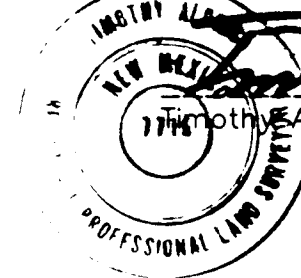

SHEET 1 OF 4

SCANNED BY BY LASON

PLAT OF

95105009

THE TRILLIUM AT HIGH DESERT UNIT ONE


BEING A REPLAT OF TRACT 3B AND 3C HIGH DESERT

WITHIN THE ELENA GALLEGOS GRANT PROJECTED SECTION 26

TOWNSHIP 11 NORTH, RANGE 4 EAST, N.M.P.M.

CITY OF ALBUQUERQUE BERNALILLO COUNTY, NEW MEXICO

AUGUST 1995


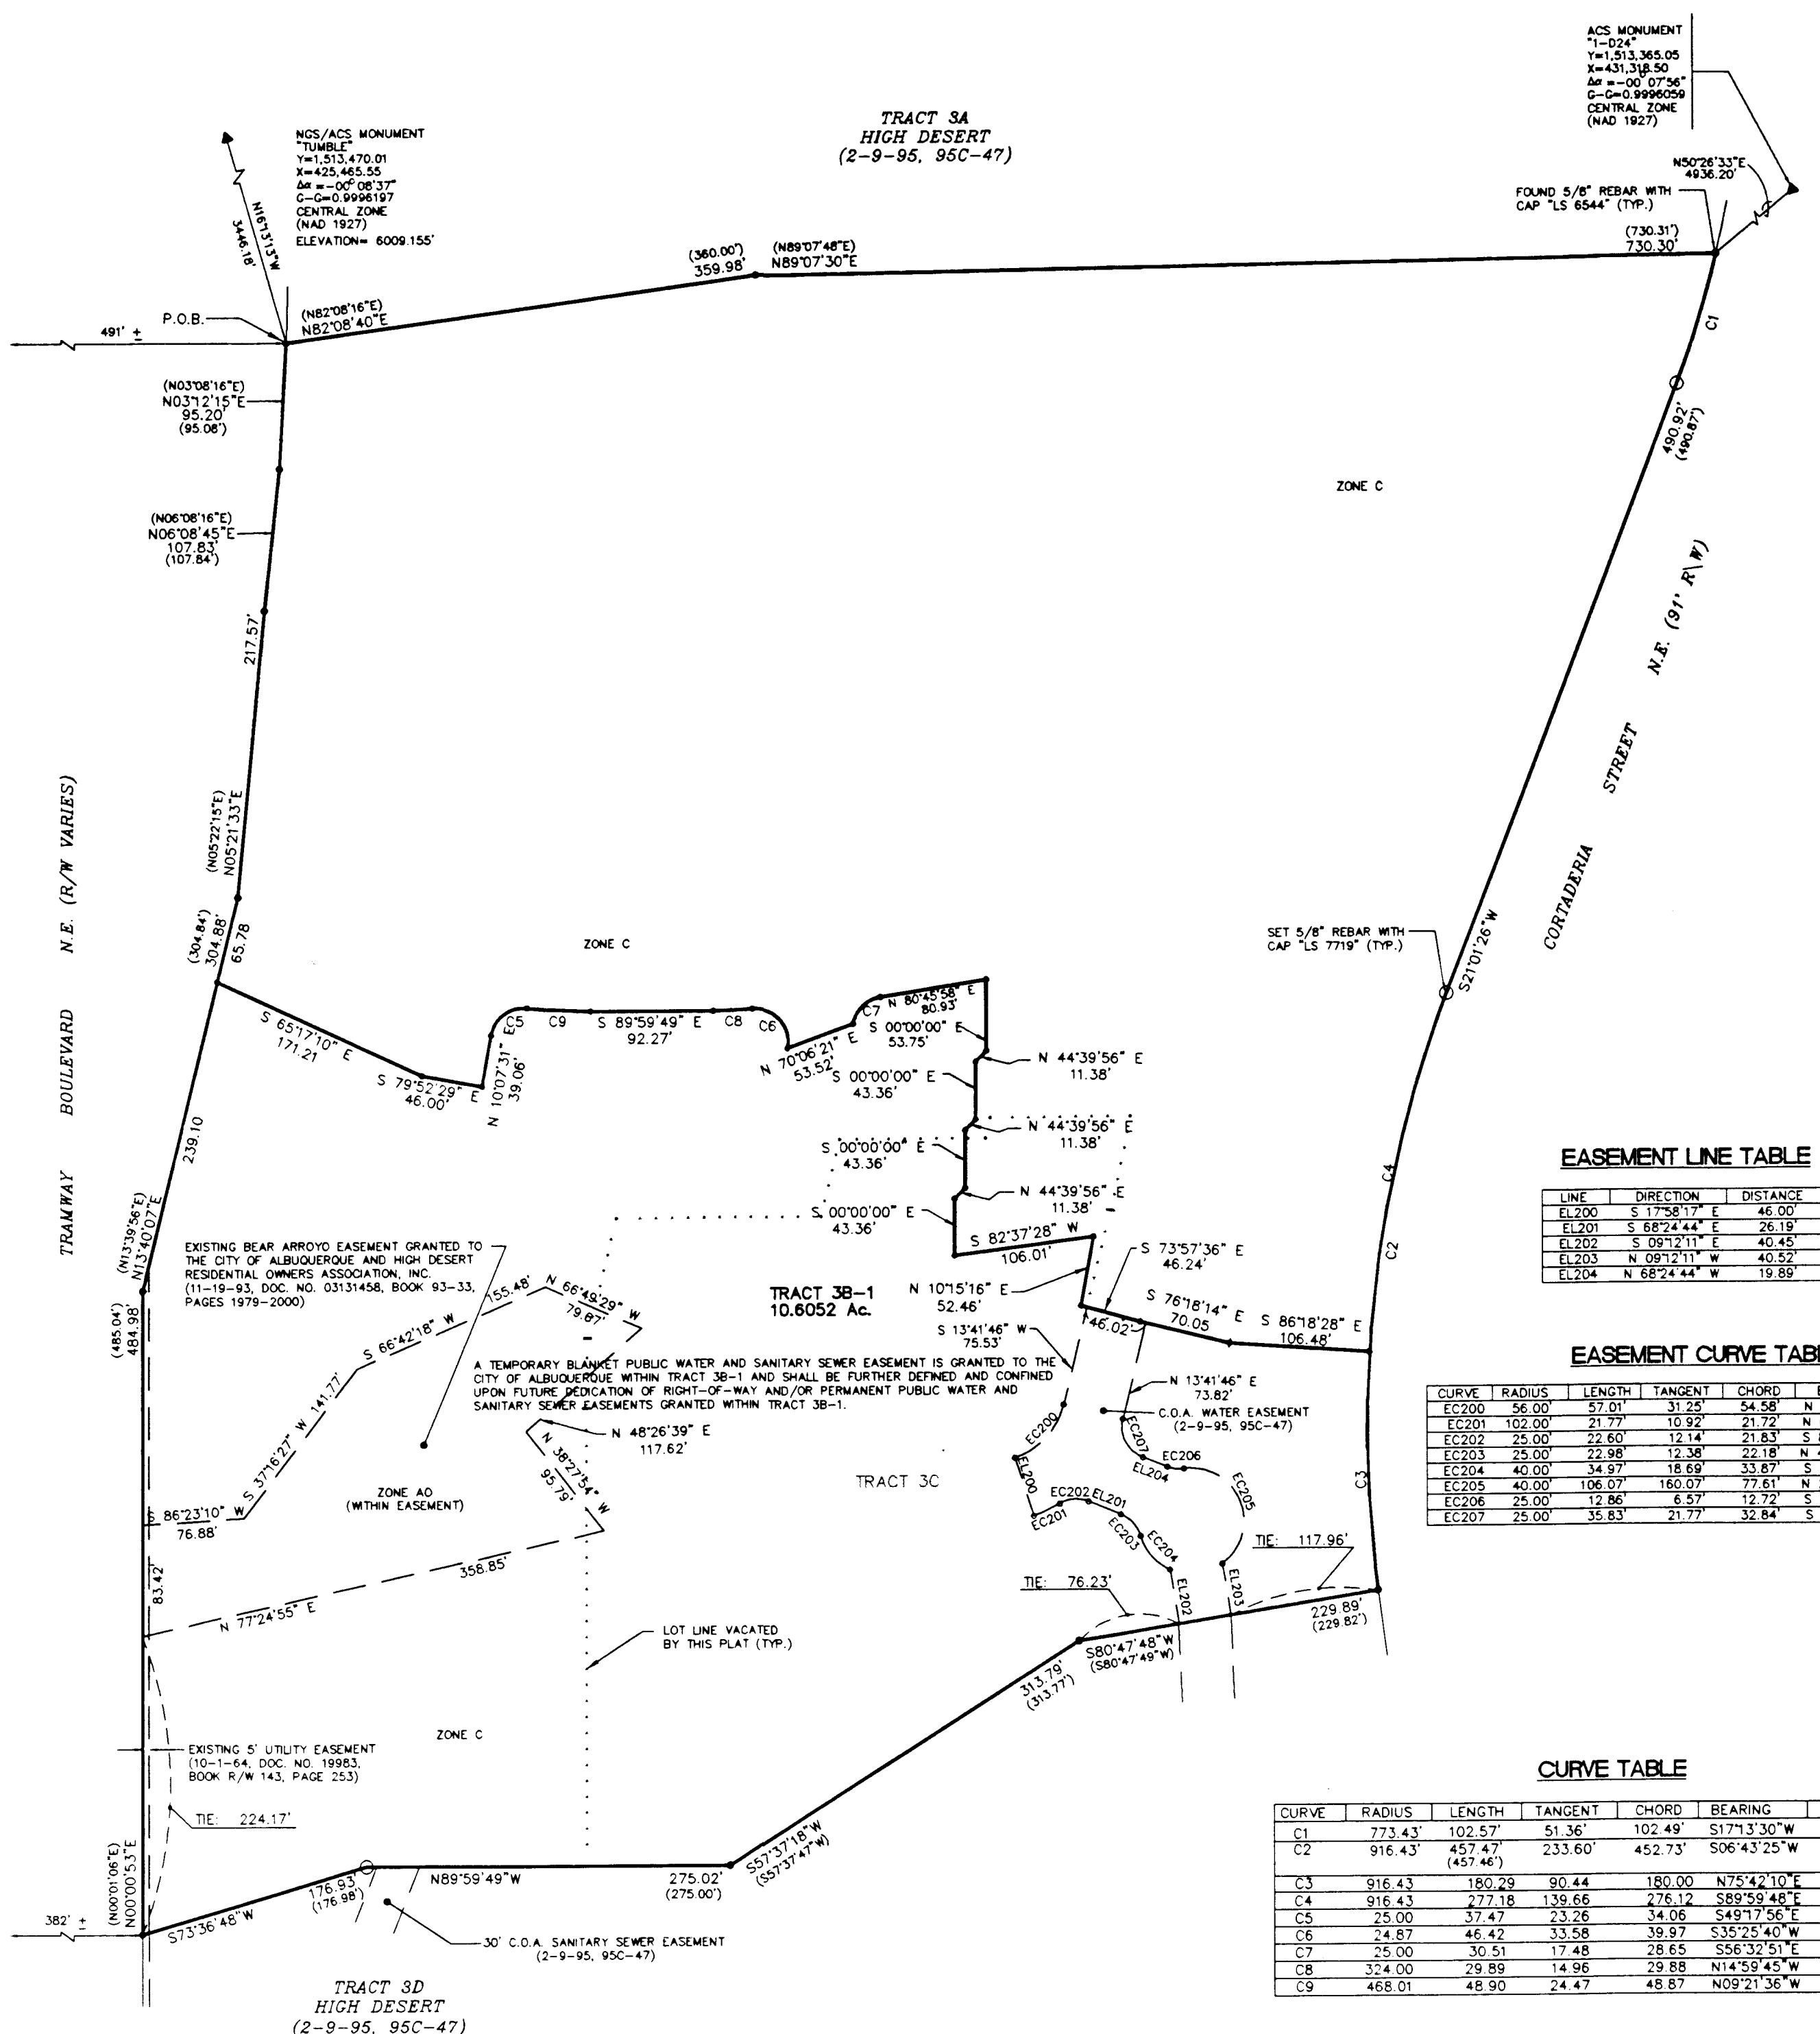



LINE	DIRECTION	DISTANCE
EL200	S 17°58'17" E	46.00
EL201	S 18°24'44" E	26.19
EL202	S 09°12'11" E	40.45
EL203	N 09°12'11" E	40.50
EL204	N 68°44'44" W	19.89

CURVE	RADIUS	LENGTH	TANGENT	CHORD	BEARING	DELTA
EC200	100.00	31.77	10.92	21.72	N 65°54'55" E	121°53'35"
EC201	100.00	21.77	10.92	21.72	N 65°54'55" E	121°53'35"
EC202	25.00	22.60	12.14	21.83	S 85°41'42" W	51°47'09"
EC203	25.00	22.60	12.14	21.83	N 42°04'24" W	52°40'59"
EC204	40.00	34.97	18.69	33.87	S 40°46'59" E	50°05'49"
EC205	40.00	106.07	186.07	77.81	N 21°54'43" W	151°56'19"
EC206	25.00	12.86	6.97	12.72	S 83°08'48" E	29°28'09"
EC207	25.00	35.83	21.77	32.84	S 27°21'34" E	82°06'20"

CURVE	RADIUS	LENGTH	TANGENT	CHORD	BEARING	DELTA
C1	773.43	102.57	51.36	102.49	S 17°13'30" W	07°35'53"
C2	916.43	457.47	233.60	452.73	S 06°43'25" W	28°36'04"
C3	916.43	180.42	90.44	180.00	N 75°42'10" E	111°18'18"
C4	916.43	221.18	138.66	276.12	S 89°59'48" E	171°19'46"
C5	25.00	37.47	23.26	34.06	S 49°17'06" E	82°01'49"
C6	24.87	46.42	33.58	39.97	S 35°25'40" W	106°30'59"
C7	25.00	30.51	17.48	28.65	S 84°32'51" E	69°54'56"
C8	324.00	29.89	14.96	29.88	N 14°59'45" W	05°17'10"
C9	468.01	48.90	24.47	48.87	N 09°21'36" W	05°59'10"


In approving this plat, PNMGAS CO did not conduct a Title Search of the properties shown hereon. Consequently, PNMGAS CO does not waive or release any government or easement rights which may have been granted by prior plat, replat, or other document which are not shown on this plat.

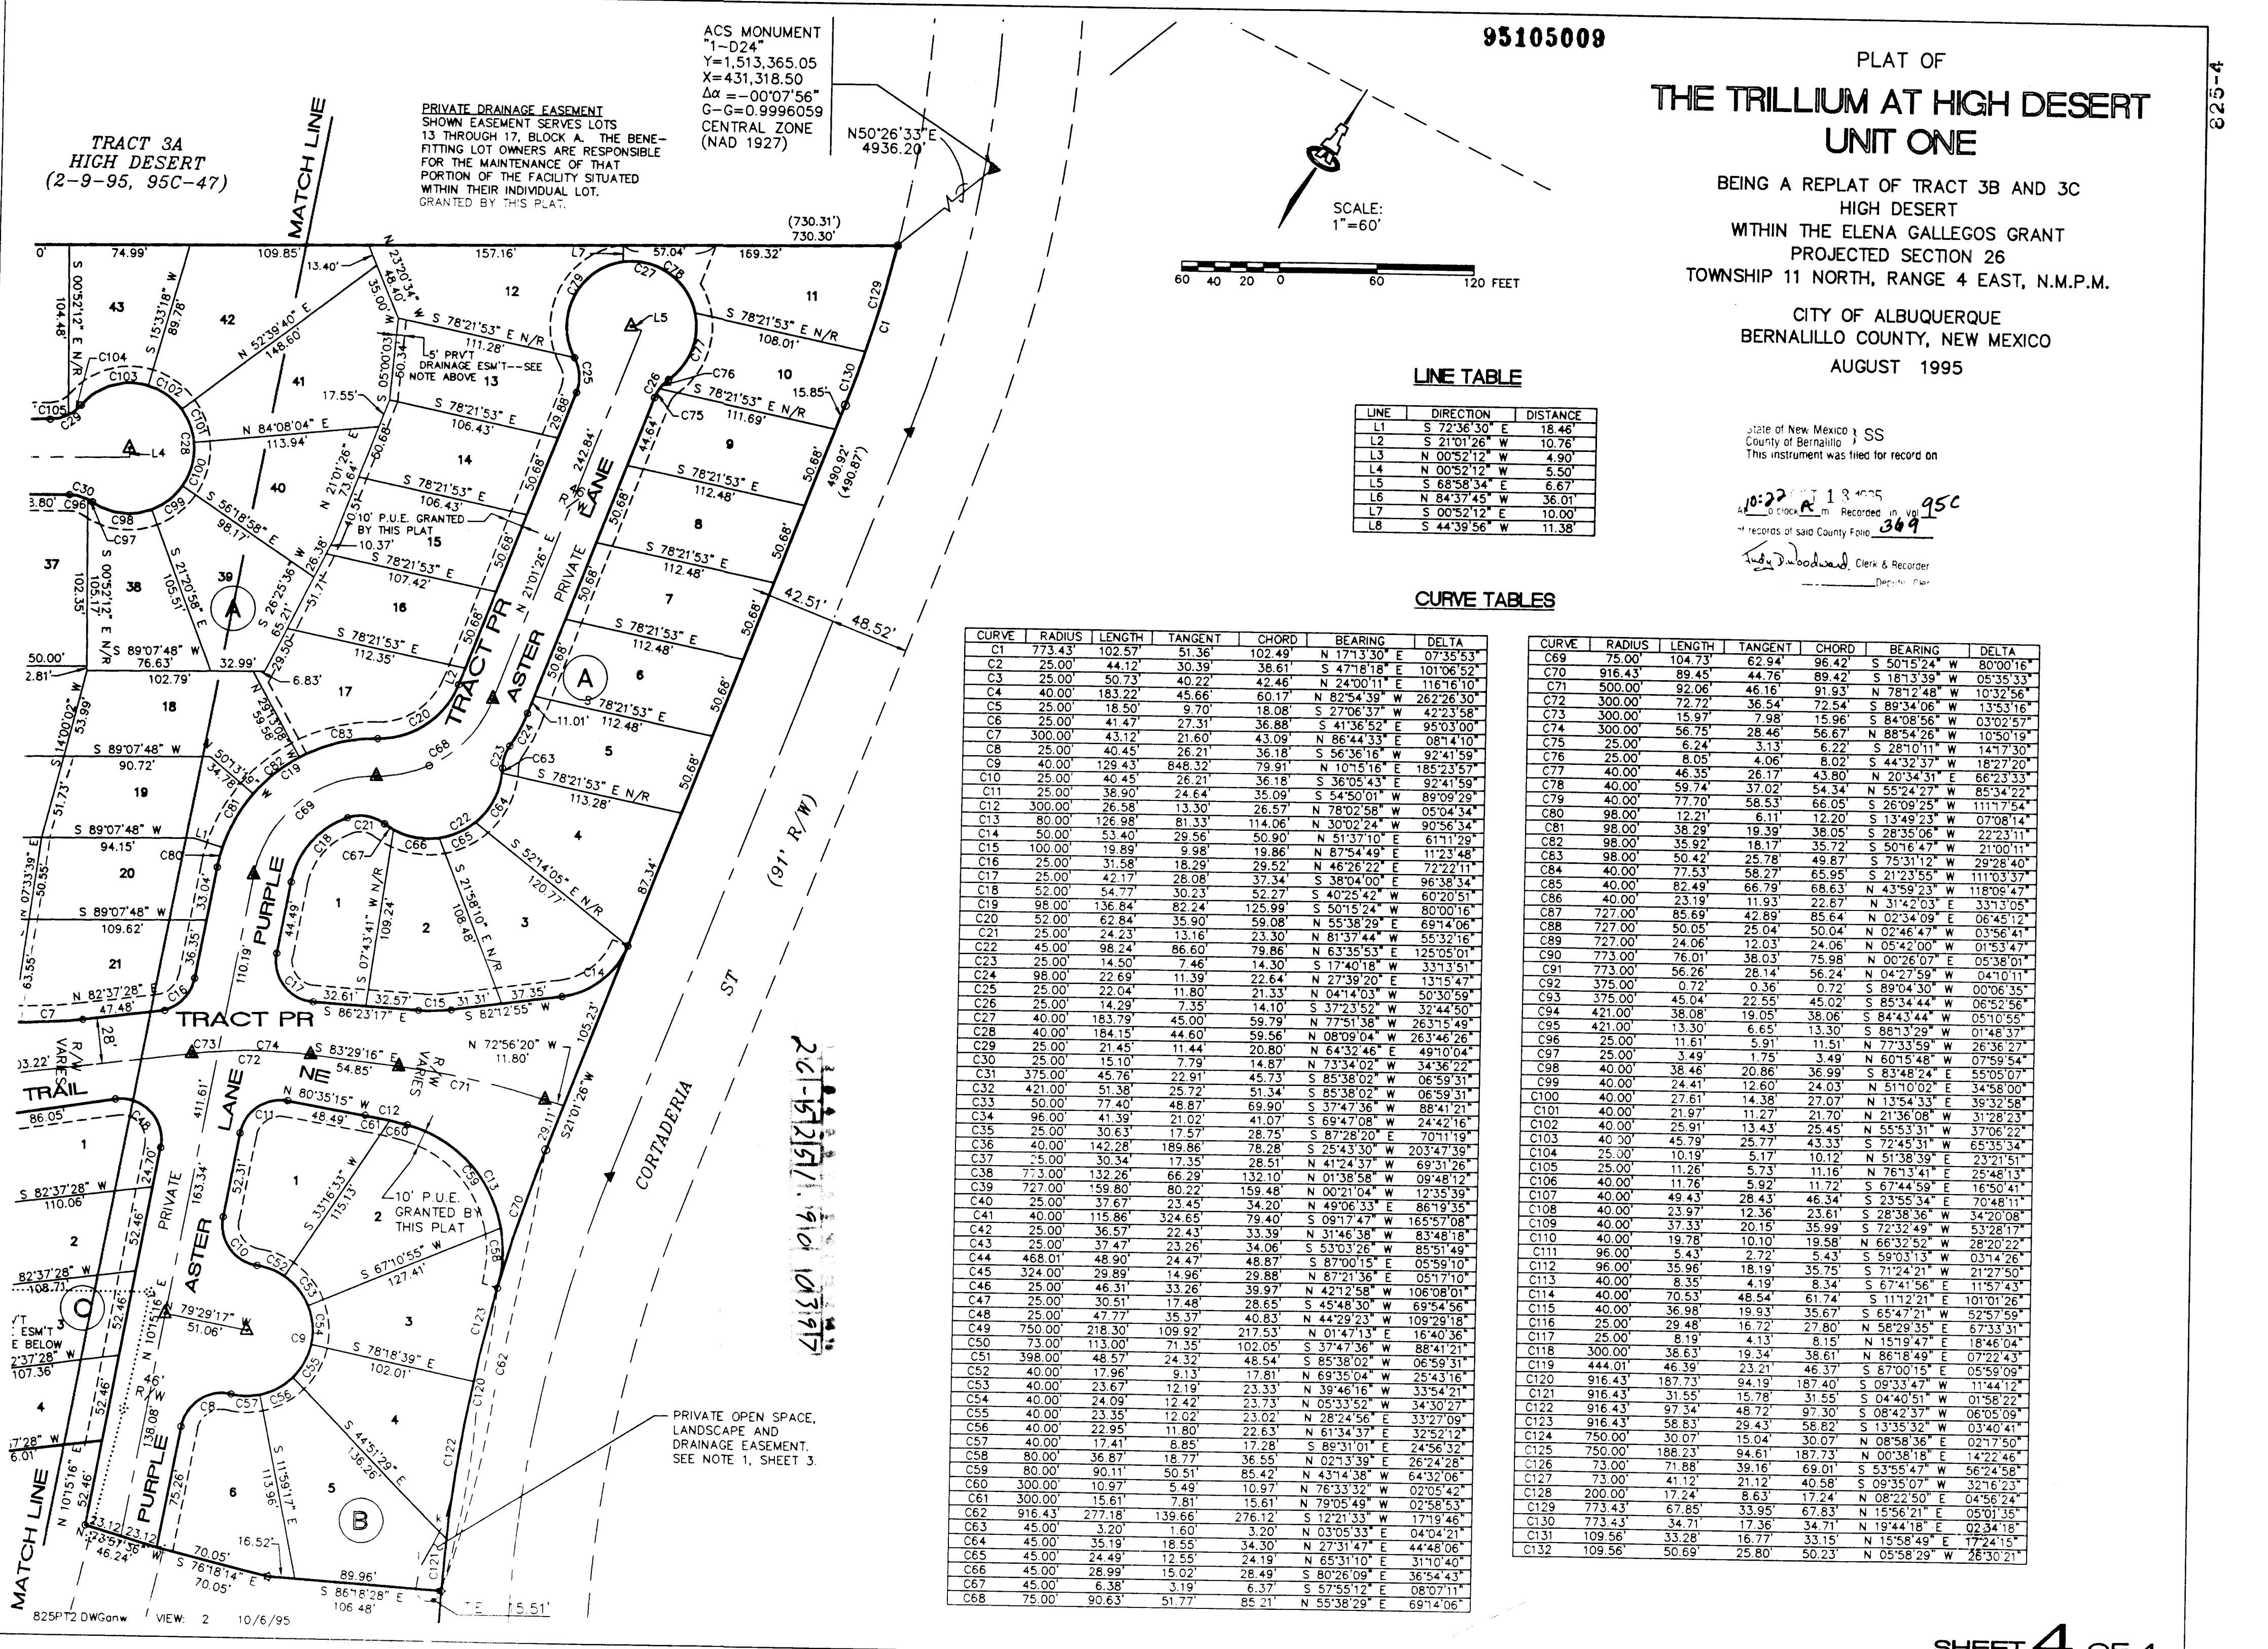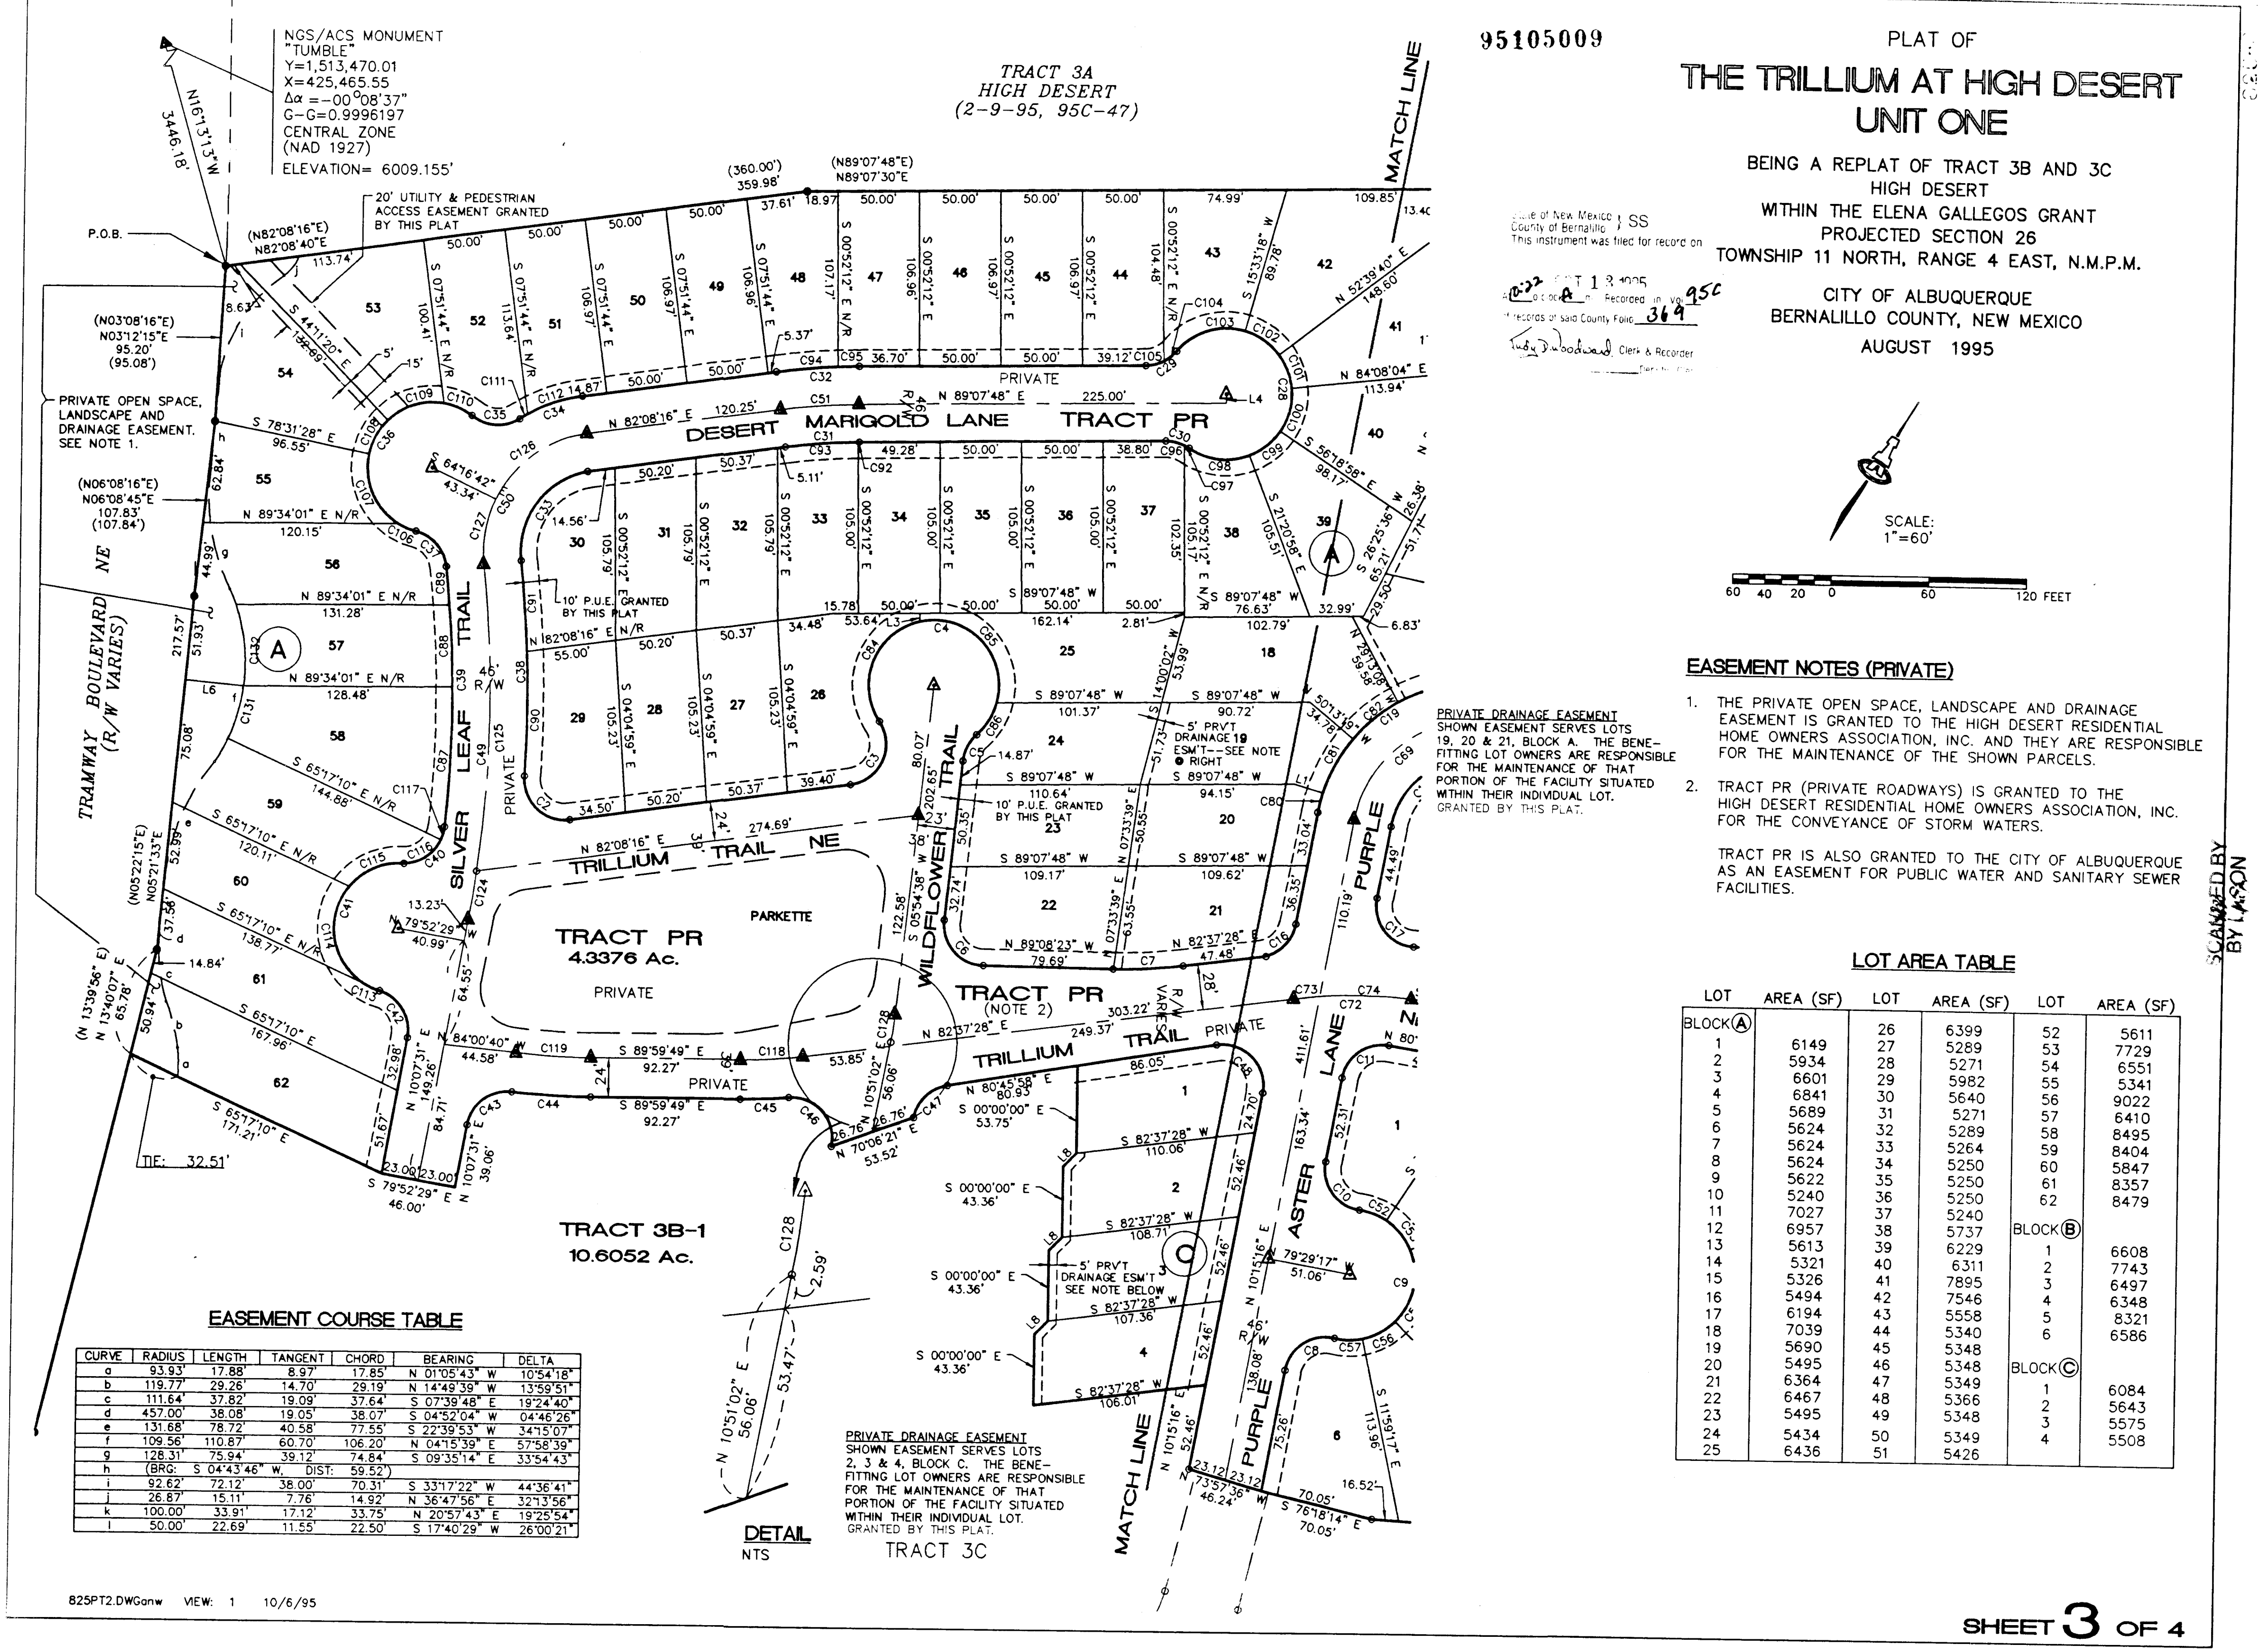

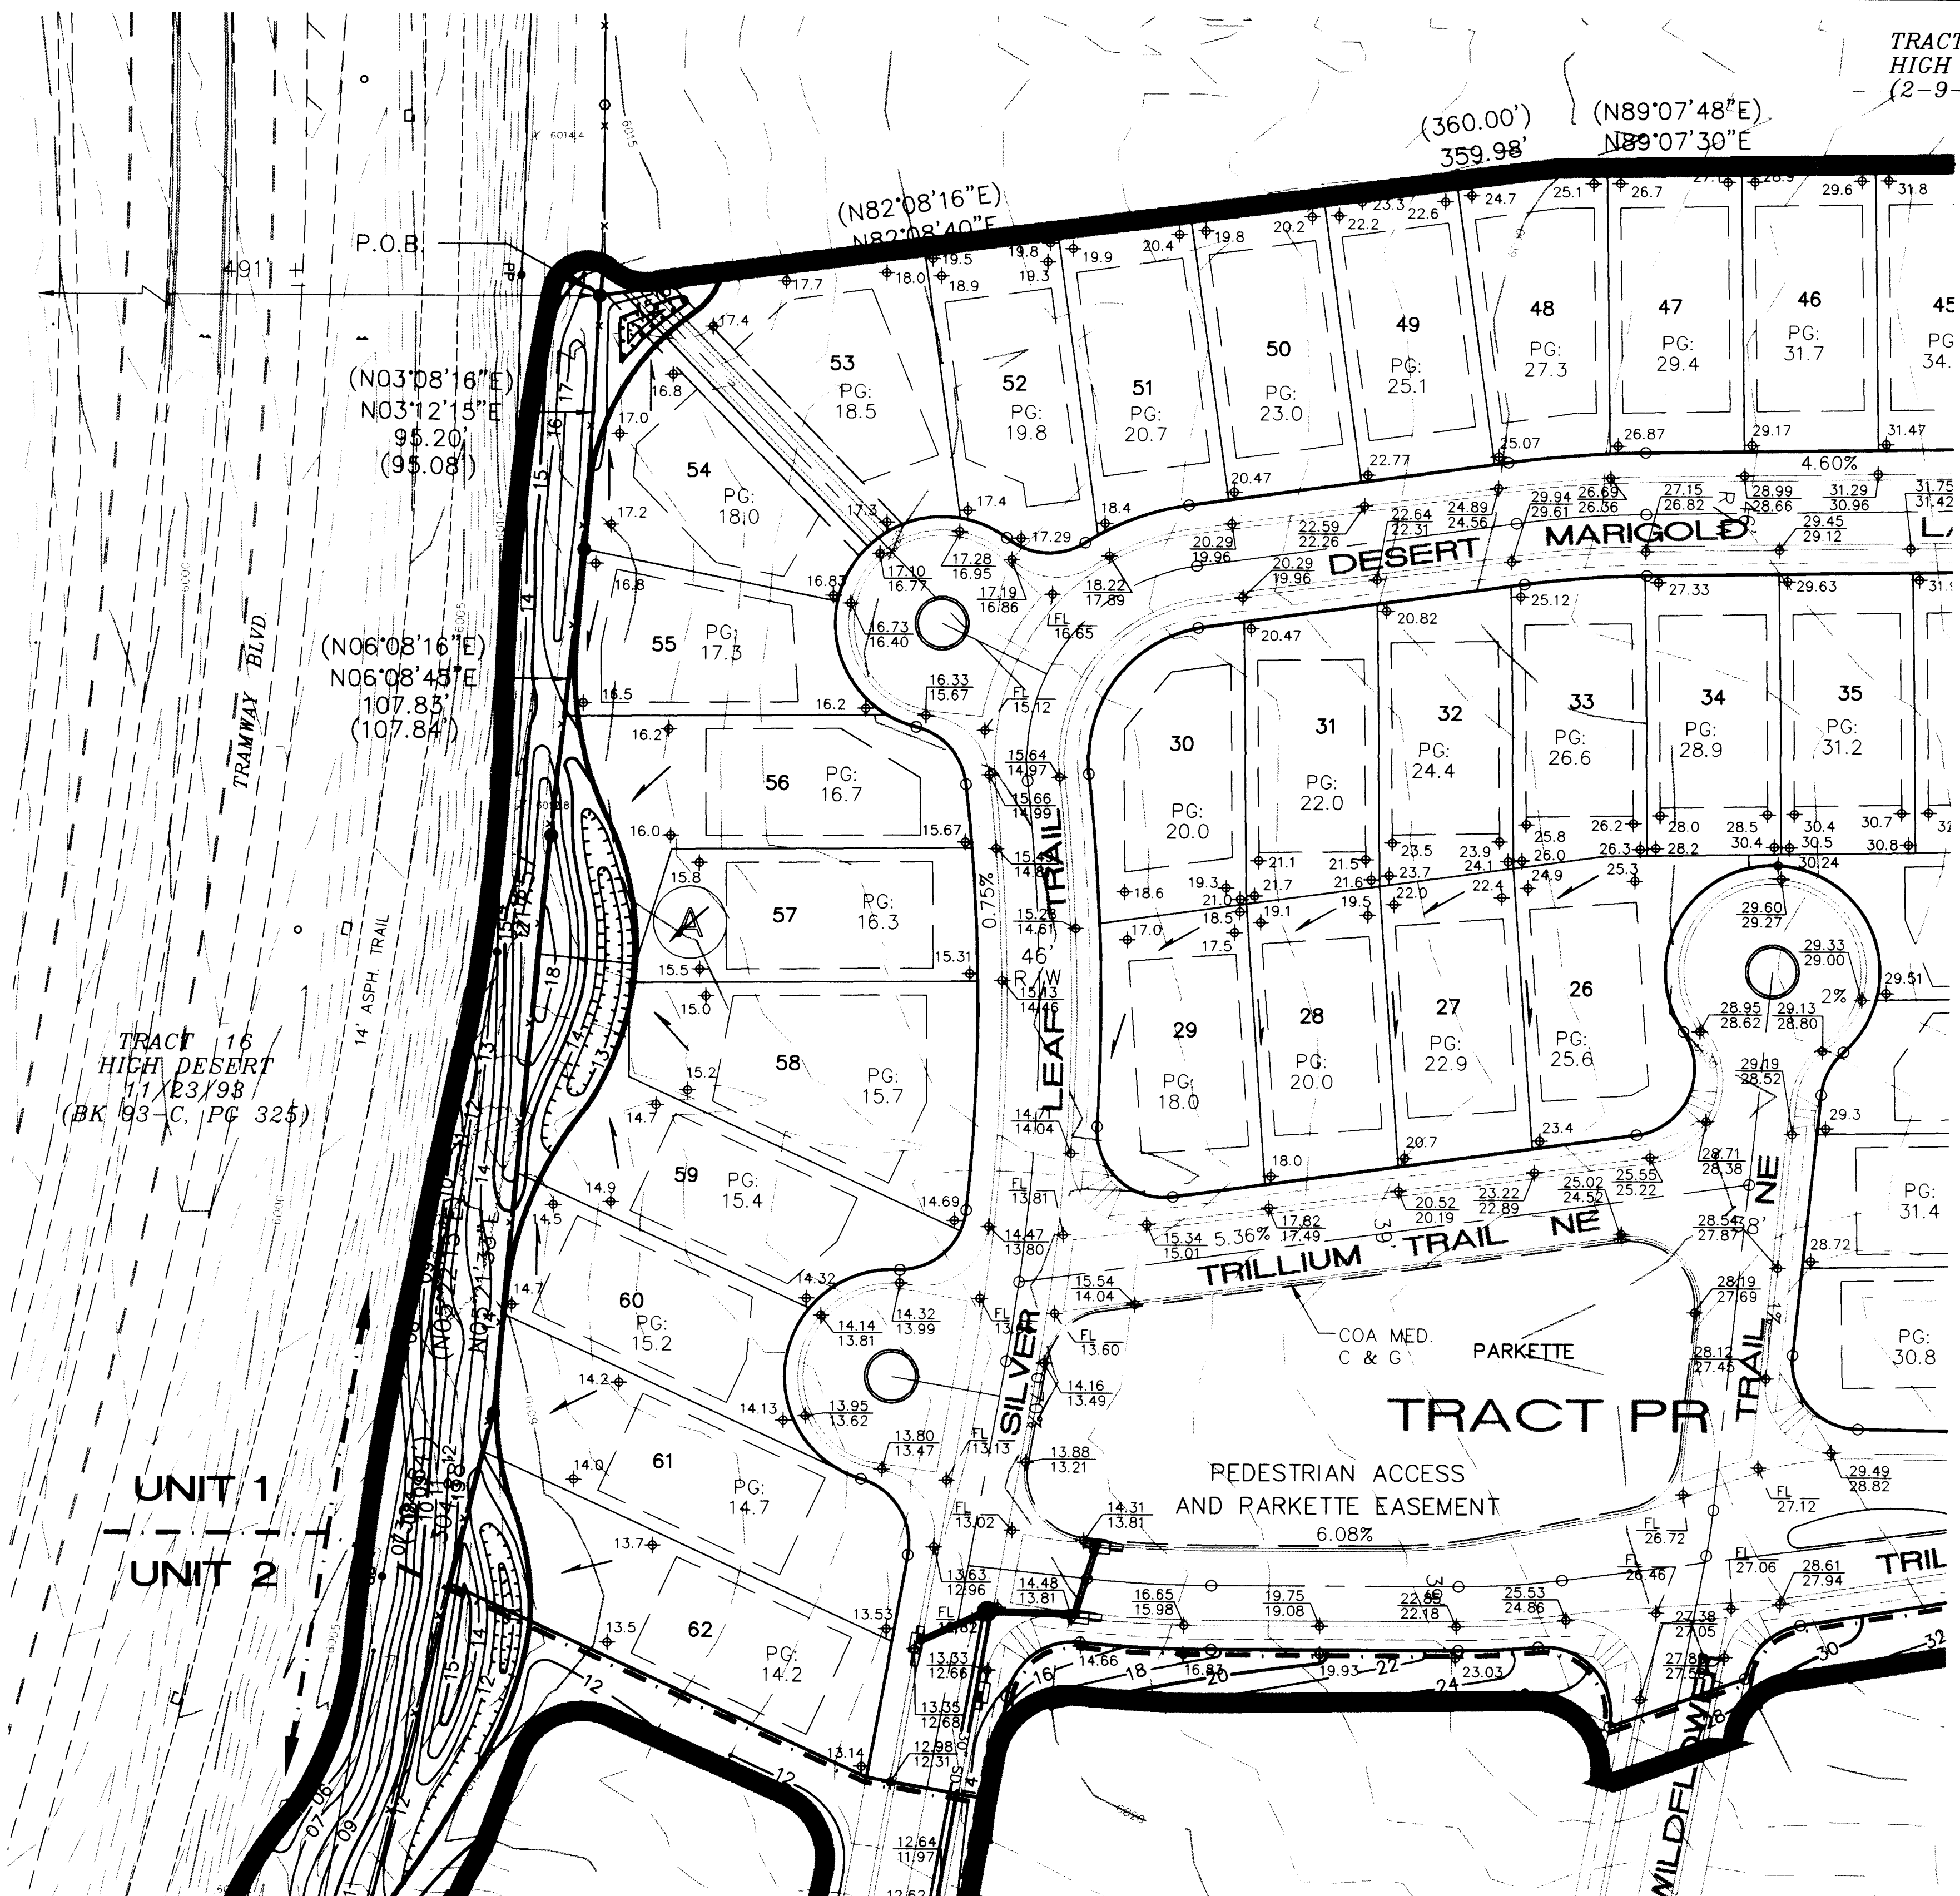


TRACT 3A
HIGH DESERT
(2-9-95, 95C-47)

- LEGEND**
- EXISTING CONTOUR
 - PROPOSED CONTOUR
 - PROPOSED SPOT ELEVATION
 - FLOW ARROW
 - SIDEWALK CULVERT
 - TOP OF CURB ELEVATION FLOWLINE
 - LIMITS OF UNIT ONE GRADING & EROSION CONTROL BERM.

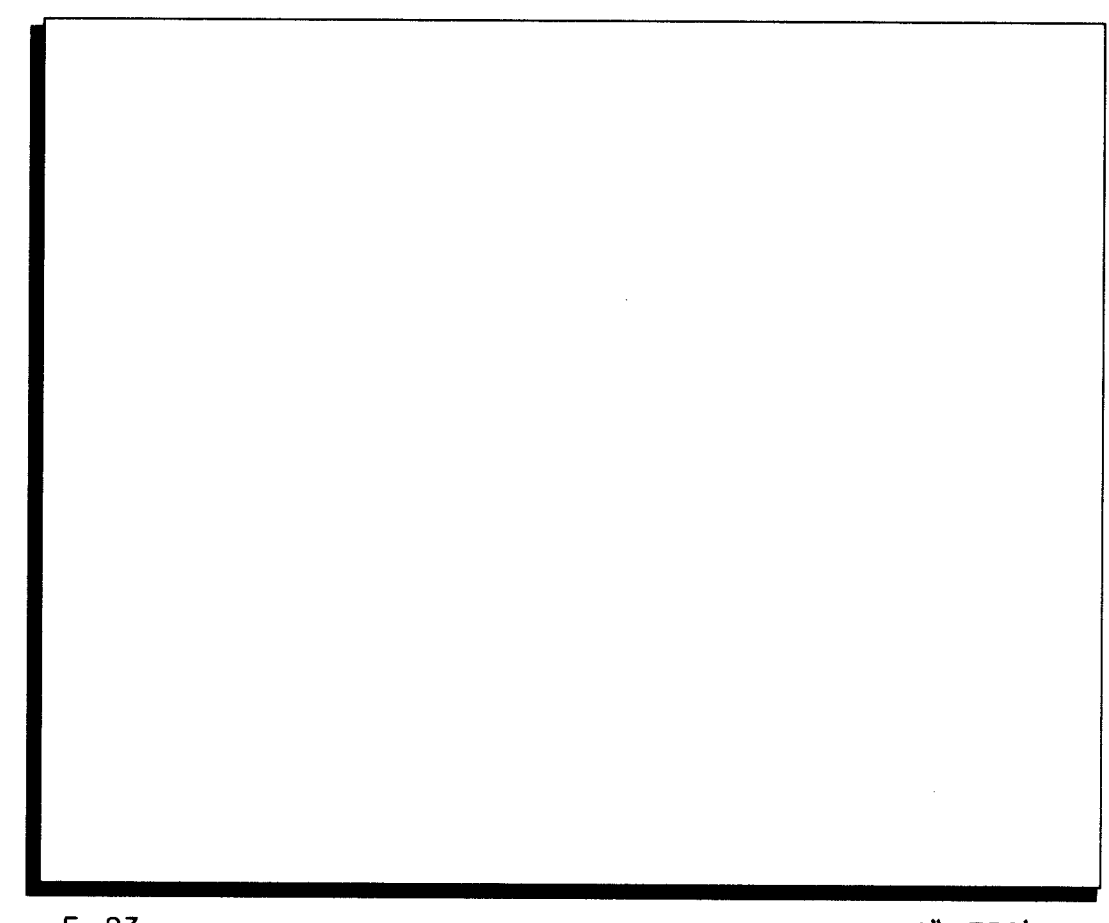

VICINITY MAP

SCALE: 1"=40'

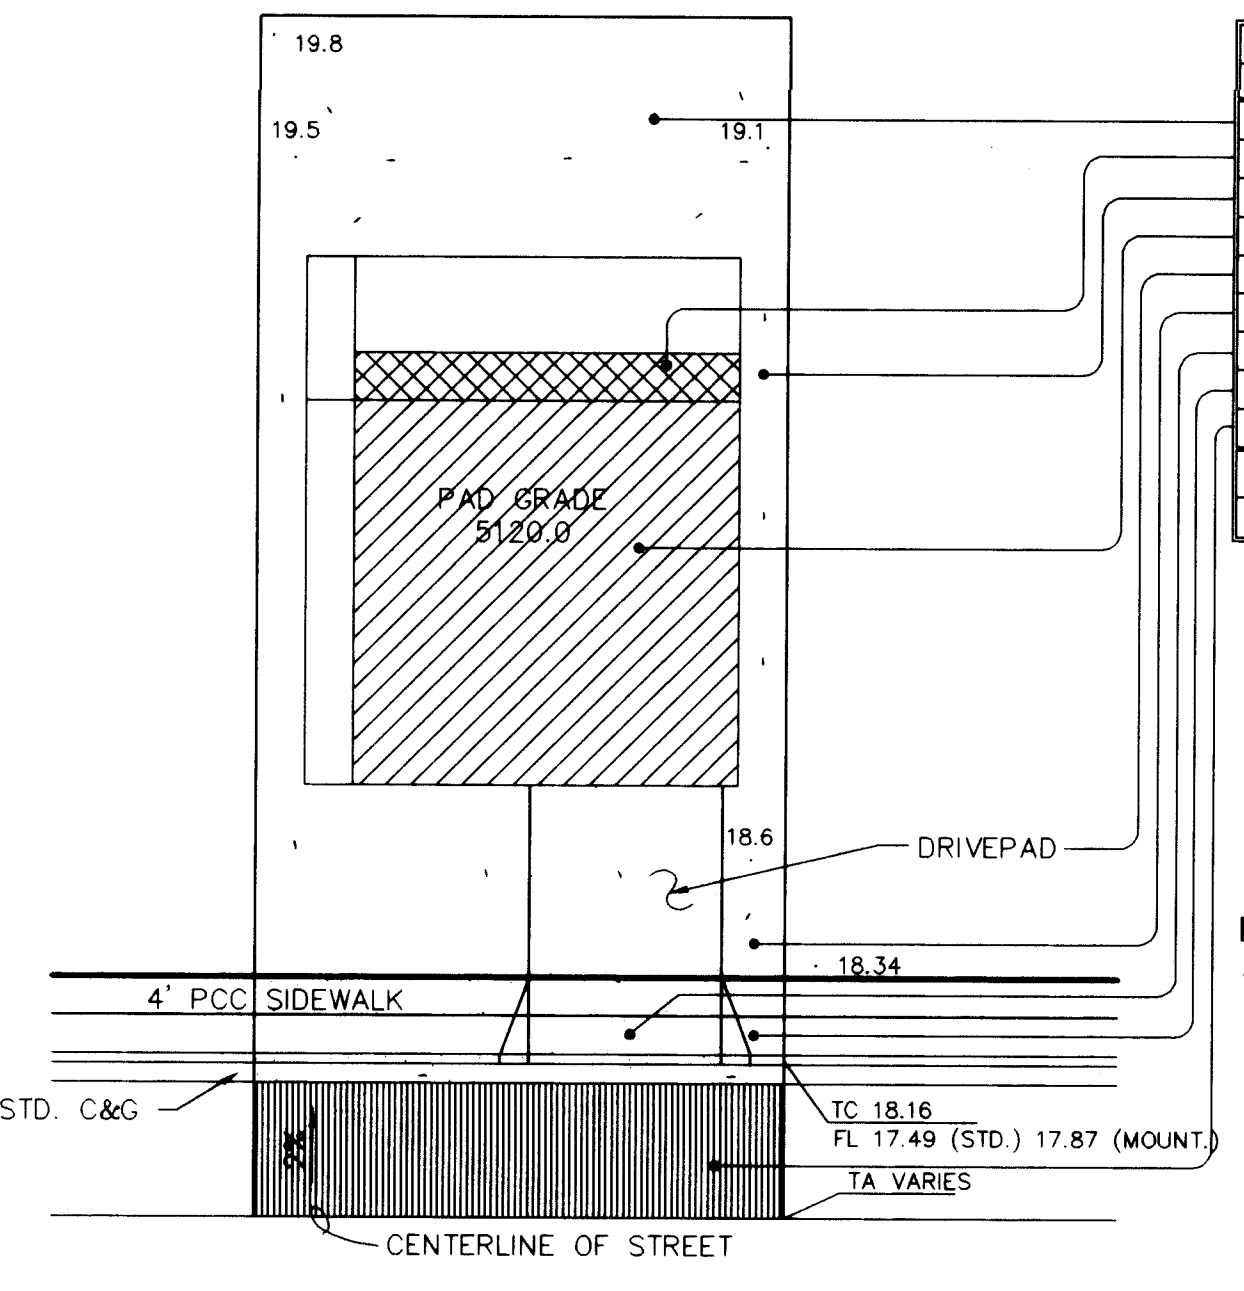

LAND TREATMENT (AREA S.F.)			
B	C	D	COMMENT
1,870			REAR YARD
	200		WALKS/PATIO
338	337		SIDE YARDS
	1,600		HOUSE/GARAGE
350	350		DRVPD & WALK
	358		FRONT YARD
	152		SDWK & DRPD.
		920	COMP. R/W
2,558	839	3,478	TOTALS (S.F.)
37.2%	12.2%	50.6%	% OF TOTAL AREA

LAND TREATMENTS AND TYPICAL LOT GRADING PLAN
1"=20'

ENGINEER'S CERTIFICATION

APPROVAL FOR ROUGH GRADING (±0.1')

CONDITION: TOP SOIL DISTURBANCE PERMIT REQUIRED PRIOR TO COMMENCING EARTHWORK OPERATIONS

HYDROLOGY DIVISION
PUBLIC WORKS DEPARTMENT
CITY OF ALBUQUERQUE

ISAACSON & ARFMAN, P.A.
Consulting Engineering Associates
128 Monroe Street N.E.
Albuquerque, New Mexico


CITY OF ALBUQUERQUE
PUBLIC WORKS DEPARTMENT
ENGINEERING GROUP

TITLE: THE TRILLIUM AT HIGH DESERT
UNIT ONE
GRADING PLAN

APPROVALS	ENGINEER	DATE	APPROVALS	ENGINEER	DATE
DRC CHAIRMAN	8-21-95	8-21-95	WATER	N/A R/W	7-27-95
TRANSPORTATION	7-27-95	7-27-95	WASTE WATER	N/A R/W	7-27-95
HYDROLOGY	8-7-95	8-7-95			


TYPICAL LOT GRADING SHOWING COMPACTION ZONE
1"=20'

SCANNED BY LASON

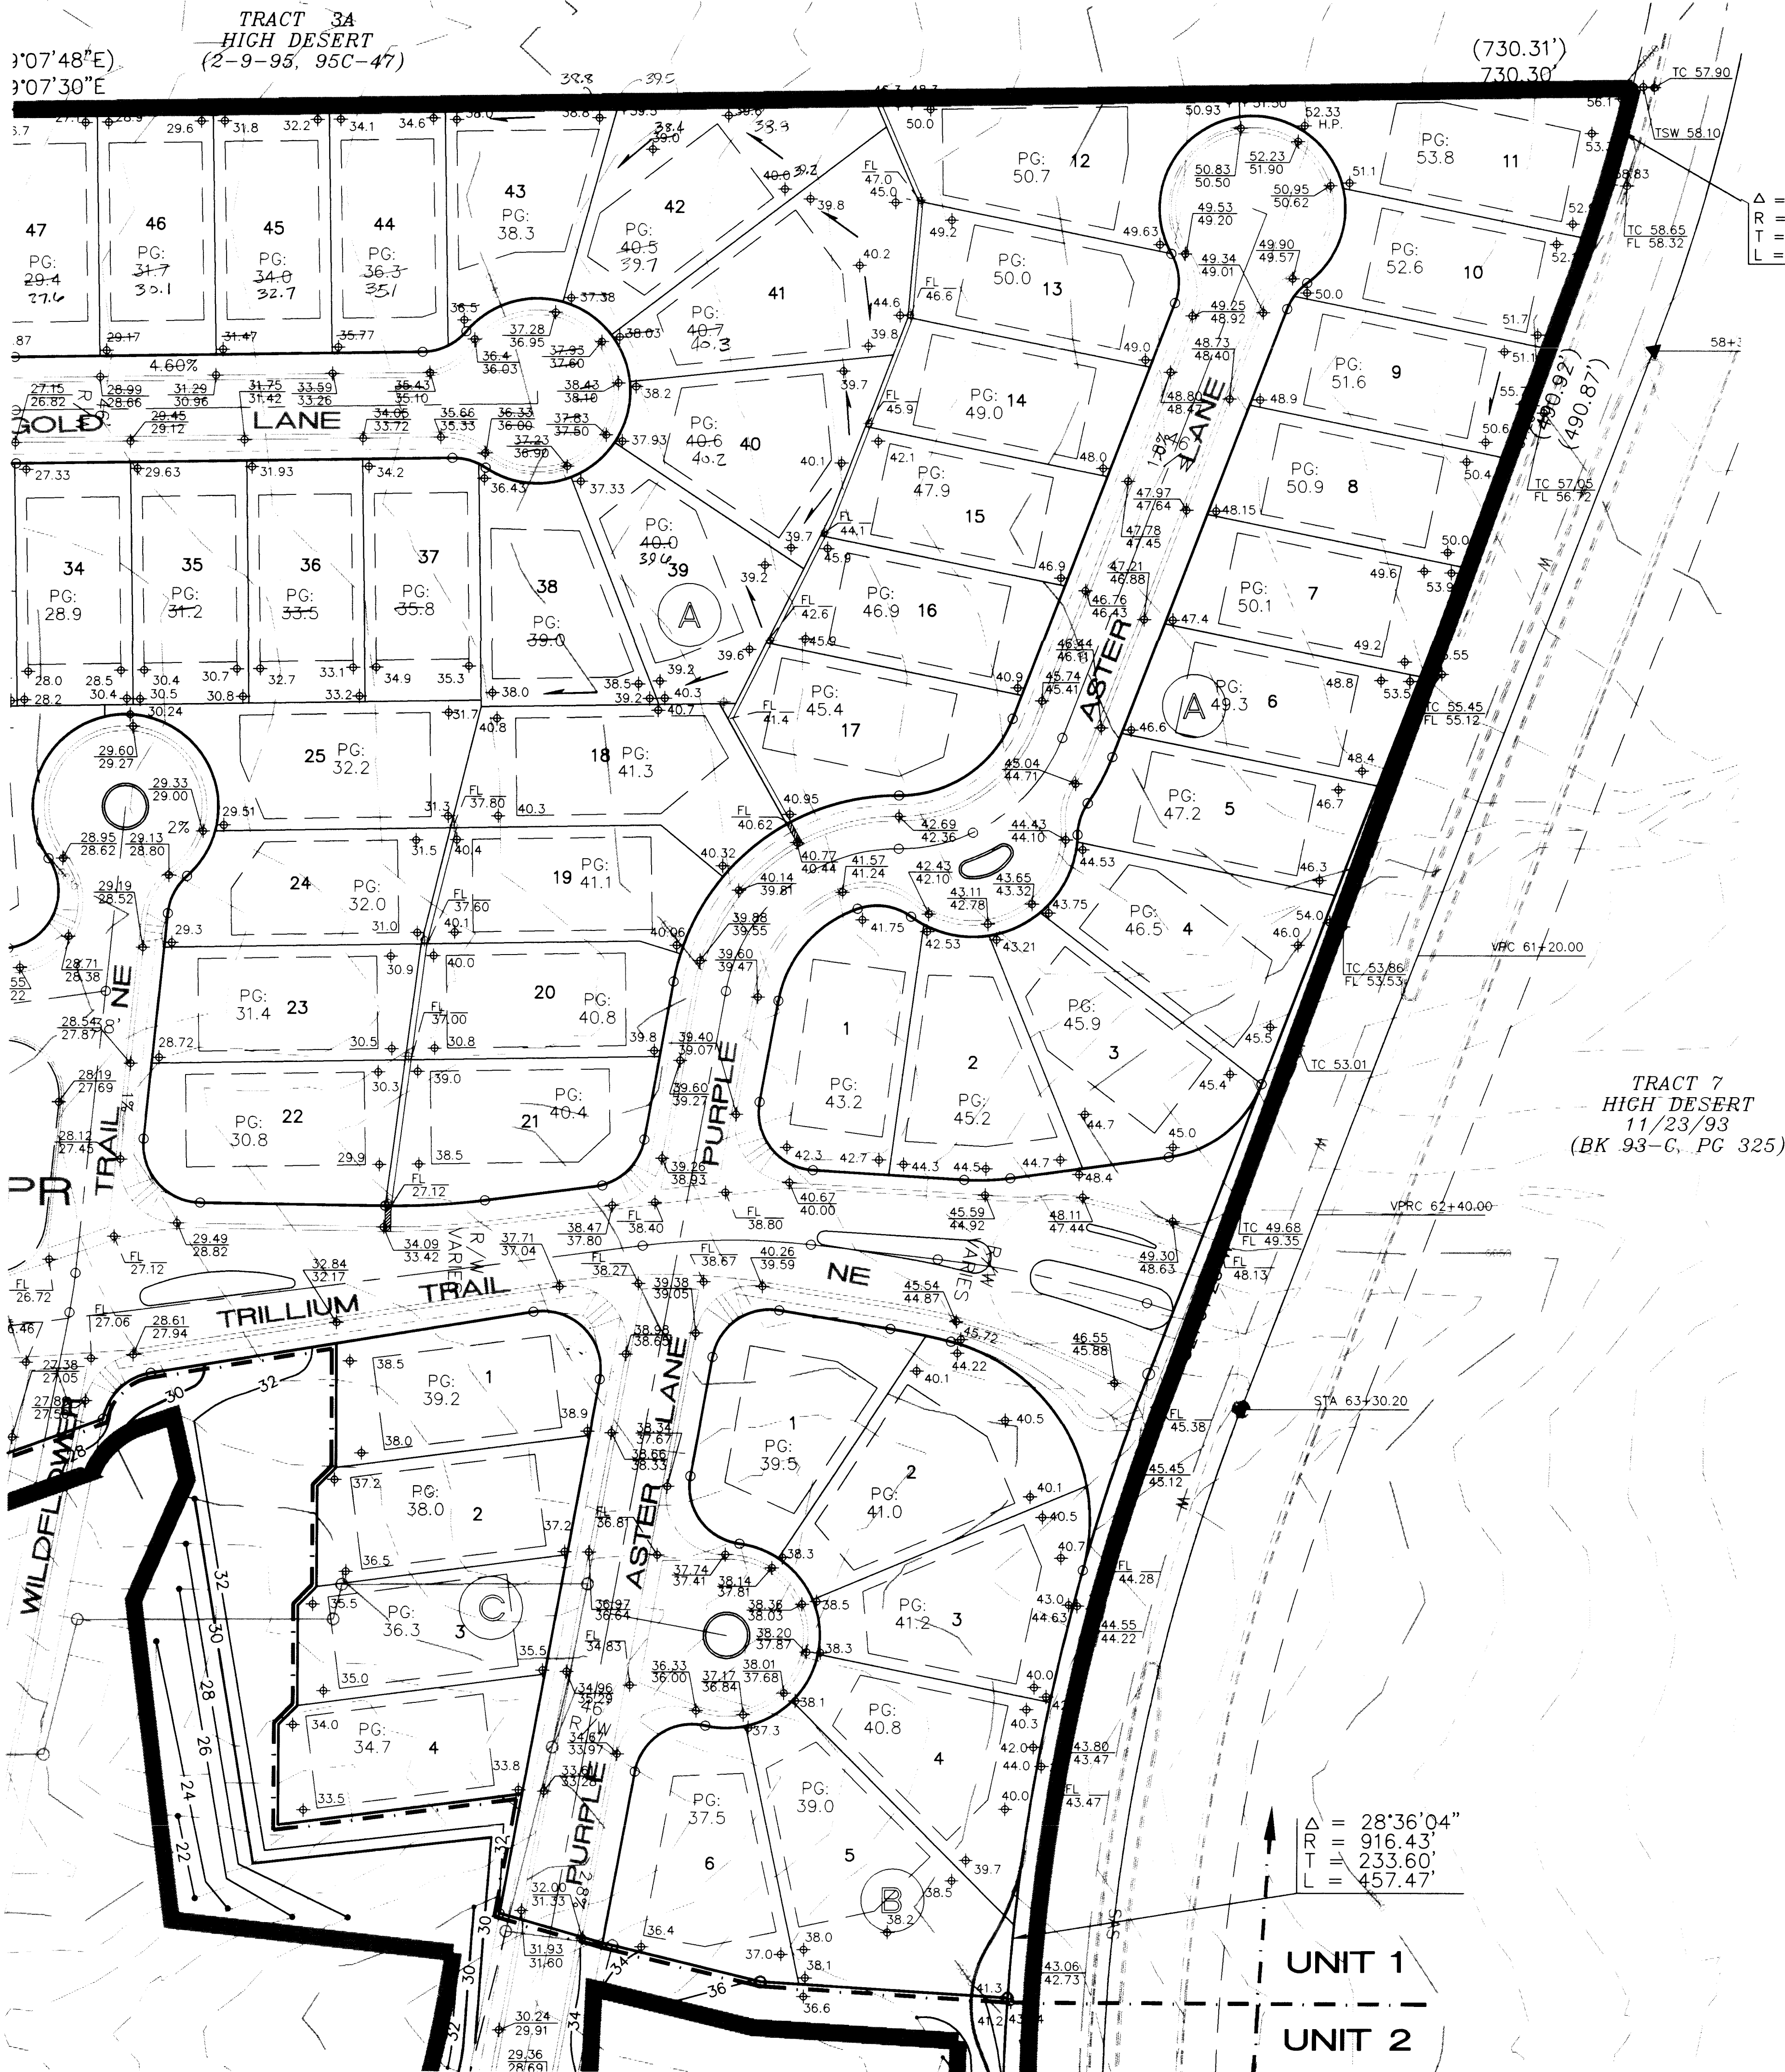

LEGEND

- EXISTING CONTOUR
- PROPOSED CONTOUR
- PROPOSED SPOT ELEVATION
- FLOW ARROW
- SIDEWALK CULVERT
- TOP OF CURB ELEVATION
- FLOWLINE
- LIMITS OF UNIT ONE GRADING & EROSION CONTROL BERM.

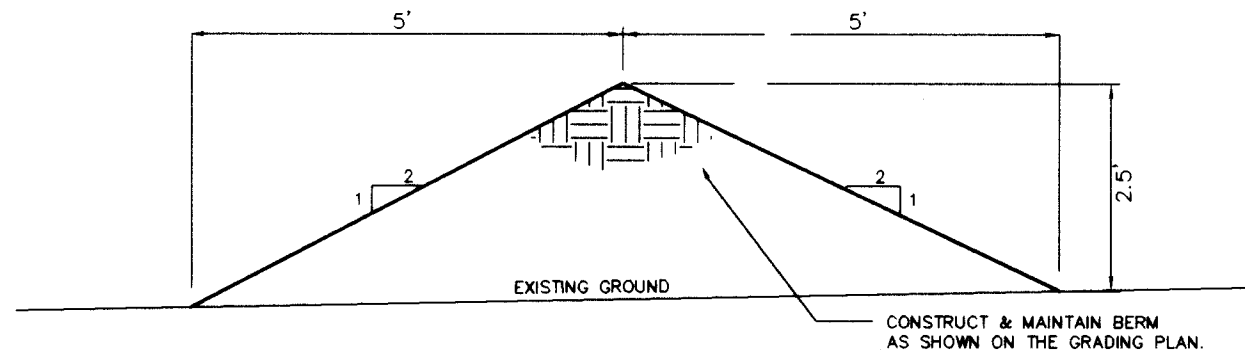


EROSION CONTROL BERM
NTS

EROSION CONTROL


- CONTRACTOR SHALL BUILD EROSION CONTROL BERM ALONG PROPERTY LINES AS SHOWN AS PART OF THE GRADING PROCESS.
- THE CONTRACTOR SHALL SECURE "TOPSOIL DISTURBANCE PERMIT" FROM THE CITY ENVIRONMENTAL HEALTH DEPARTMENT PRIOR TO BEGINNING CONSTRUCTION. AN EXCAVATION PERMIT IS REQUIRED FOR ALL WORK WITHIN PUBLIC RIGHT-OF-WAY.

GRADING/DRAINAGE NOTES:

- ISAACSON & ARFMAN, P.A. (THE ENGINEER) HAS PREPARED THIS GRADING PLAN TO ESTABLISH FINAL SURFACE GRADES FOR BOTH THE PROPOSED INDIVIDUAL RESIDENTIAL LOTS AND THE PUBLIC RIGHTS-OF-WAY.
- THE EARTHWORK CONTRACTOR (CONTRACTOR) IS REQUIRED TO REVIEW THE FOLLOWING: GEOTECHNICAL ENGINEERING EVALUATION FOR TRACT 38 HIGH DESERT DEVELOPMENT, PREPARED BY GEO-TEST, DATED DECEMBER 19, 1994, FOR CHAMA DEVELOPMENT CORP. COPIES OF THIS DOCUMENT MAY BE REVIEWED AT THE OFFICE OF ISAACSON & ARFMAN, P.A., 128 MONROE STREET NE, ALBUQUERQUE, NEW MEXICO, (505) 268-8828. THE EARTHWORK CONTRACTOR'S BID SHALL INCLUDE ALL COSTS ASSOCIATED WITH THE IMPLEMENTATION OF ALL RECOMMENDATIONS CONTAINED IN THESE STUDIES.

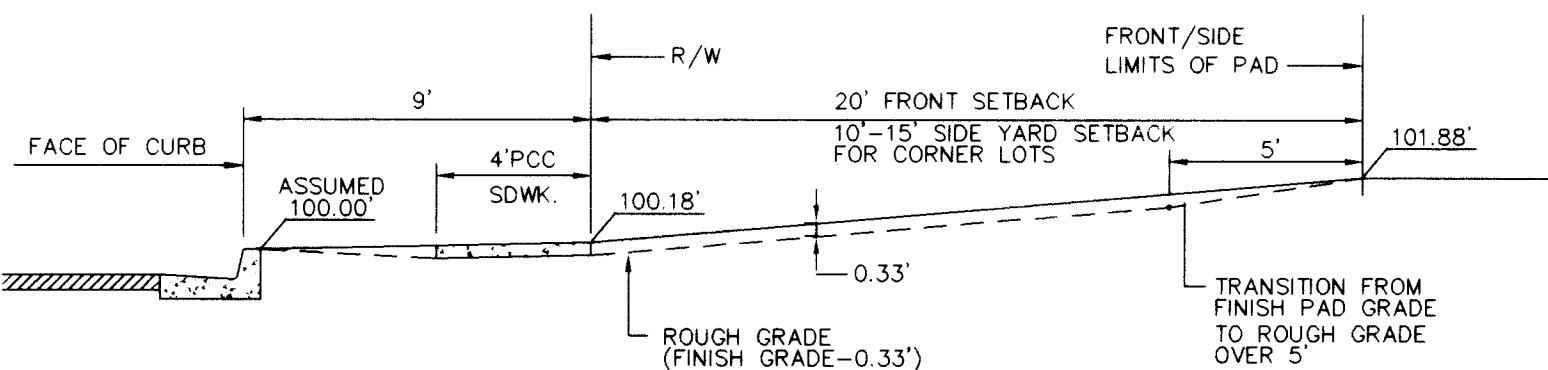

FRONT/SIDE YARD GRADING
1"=5'-0"

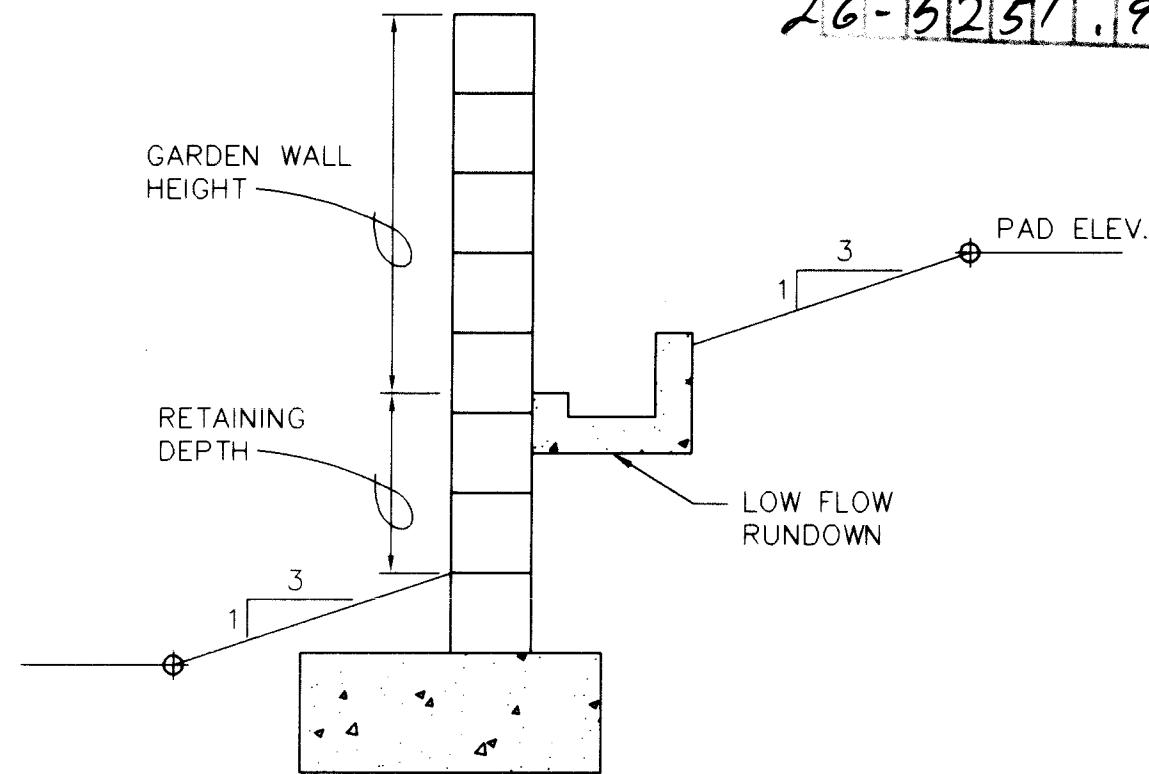

SIDEYARD SWALE
NTS

SCANNED BY
BY LASON

AS-BUILT INFORMATION		BENCH MARKS		SURVEY INFORMATION		ENGINEER'S SEAL		REVISIONS		DESIGNED BY		DRAWN BY		DATE	
CONTRACTOR	ISAACSON & ARFMAN, P.A.	DATE	11/23/93	NO.	1	NO.	1	NO.	1	DESIGNED BY	JRL	DATE	6/95	DATE	6/95
INSPECTOR	ALBANY, INC.	DATE	11/23/93	NO.	2	NO.	2	NO.	2	DESIGNED BY	JRL	DATE	6/95	DATE	6/95
FIELD	ALBANY, INC.	DATE	11/23/93	NO.	3	NO.	3	NO.	3	DESIGNED BY	JRL	DATE	6/95	DATE	6/95
VERIFICATION	ALBANY, INC.	DATE	11/23/93	NO.	4	NO.	4	NO.	4	DESIGNED BY	JRL	DATE	6/95	DATE	6/95
CORRECTED BY	ALBANY, INC.	DATE	11/23/93	NO.	5	NO.	5	NO.	5	DESIGNED BY	JRL	DATE	6/95	DATE	6/95
MICRO-FILM	ALBANY, INC.	DATE	11/23/93	NO.	6	NO.	6	NO.	6	DESIGNED BY	JRL	DATE	6/95	DATE	6/95
INFORMATION		DATE		NO.		NO.		NO.		DESIGNED BY	JRL	DATE	6/95	DATE	6/95

26-5251-190 11/23/93



ISAACSON & ARFMAN, P.A.
Consulting Engineering Associates
128 Monroe Street N.E.
Albuquerque New Mexico
825GRD2B.DWG
8/1/95

CITY OF ALBUQUERQUE
PUBLIC WORKS DEPARTMENT
ENGINEERING GROUP


TITLE: THE TRILLIUM AT HIGH DESERT
UNIT ONE
GRADING PLAN

APPROVALS	ENGINEER	DATE	APPROVALS	ENGINEER	DATE
DRC CHAIRMAN	B. J. Babbitt	8-21-95	WATER	N/A RUL	8-21-95
TRANSPORTATION	N/A RUL	8-21-95	WASTE WATER	N/A RUL	8-21-95
HYDROLOGY	N/A RUL	8-21-95			


PROJECT NO.	5251.90	MAP NO.	E-23	SHEET	4B	OF	19
-------------	---------	---------	------	-------	----	----	----

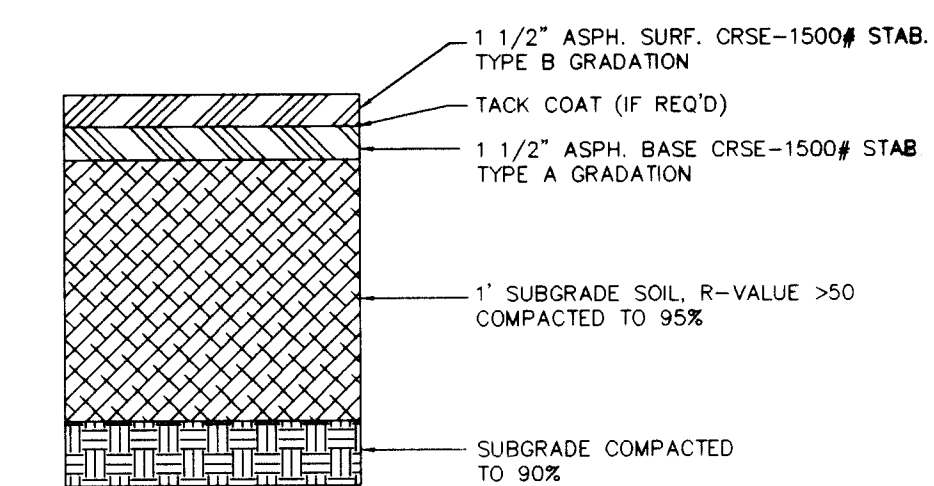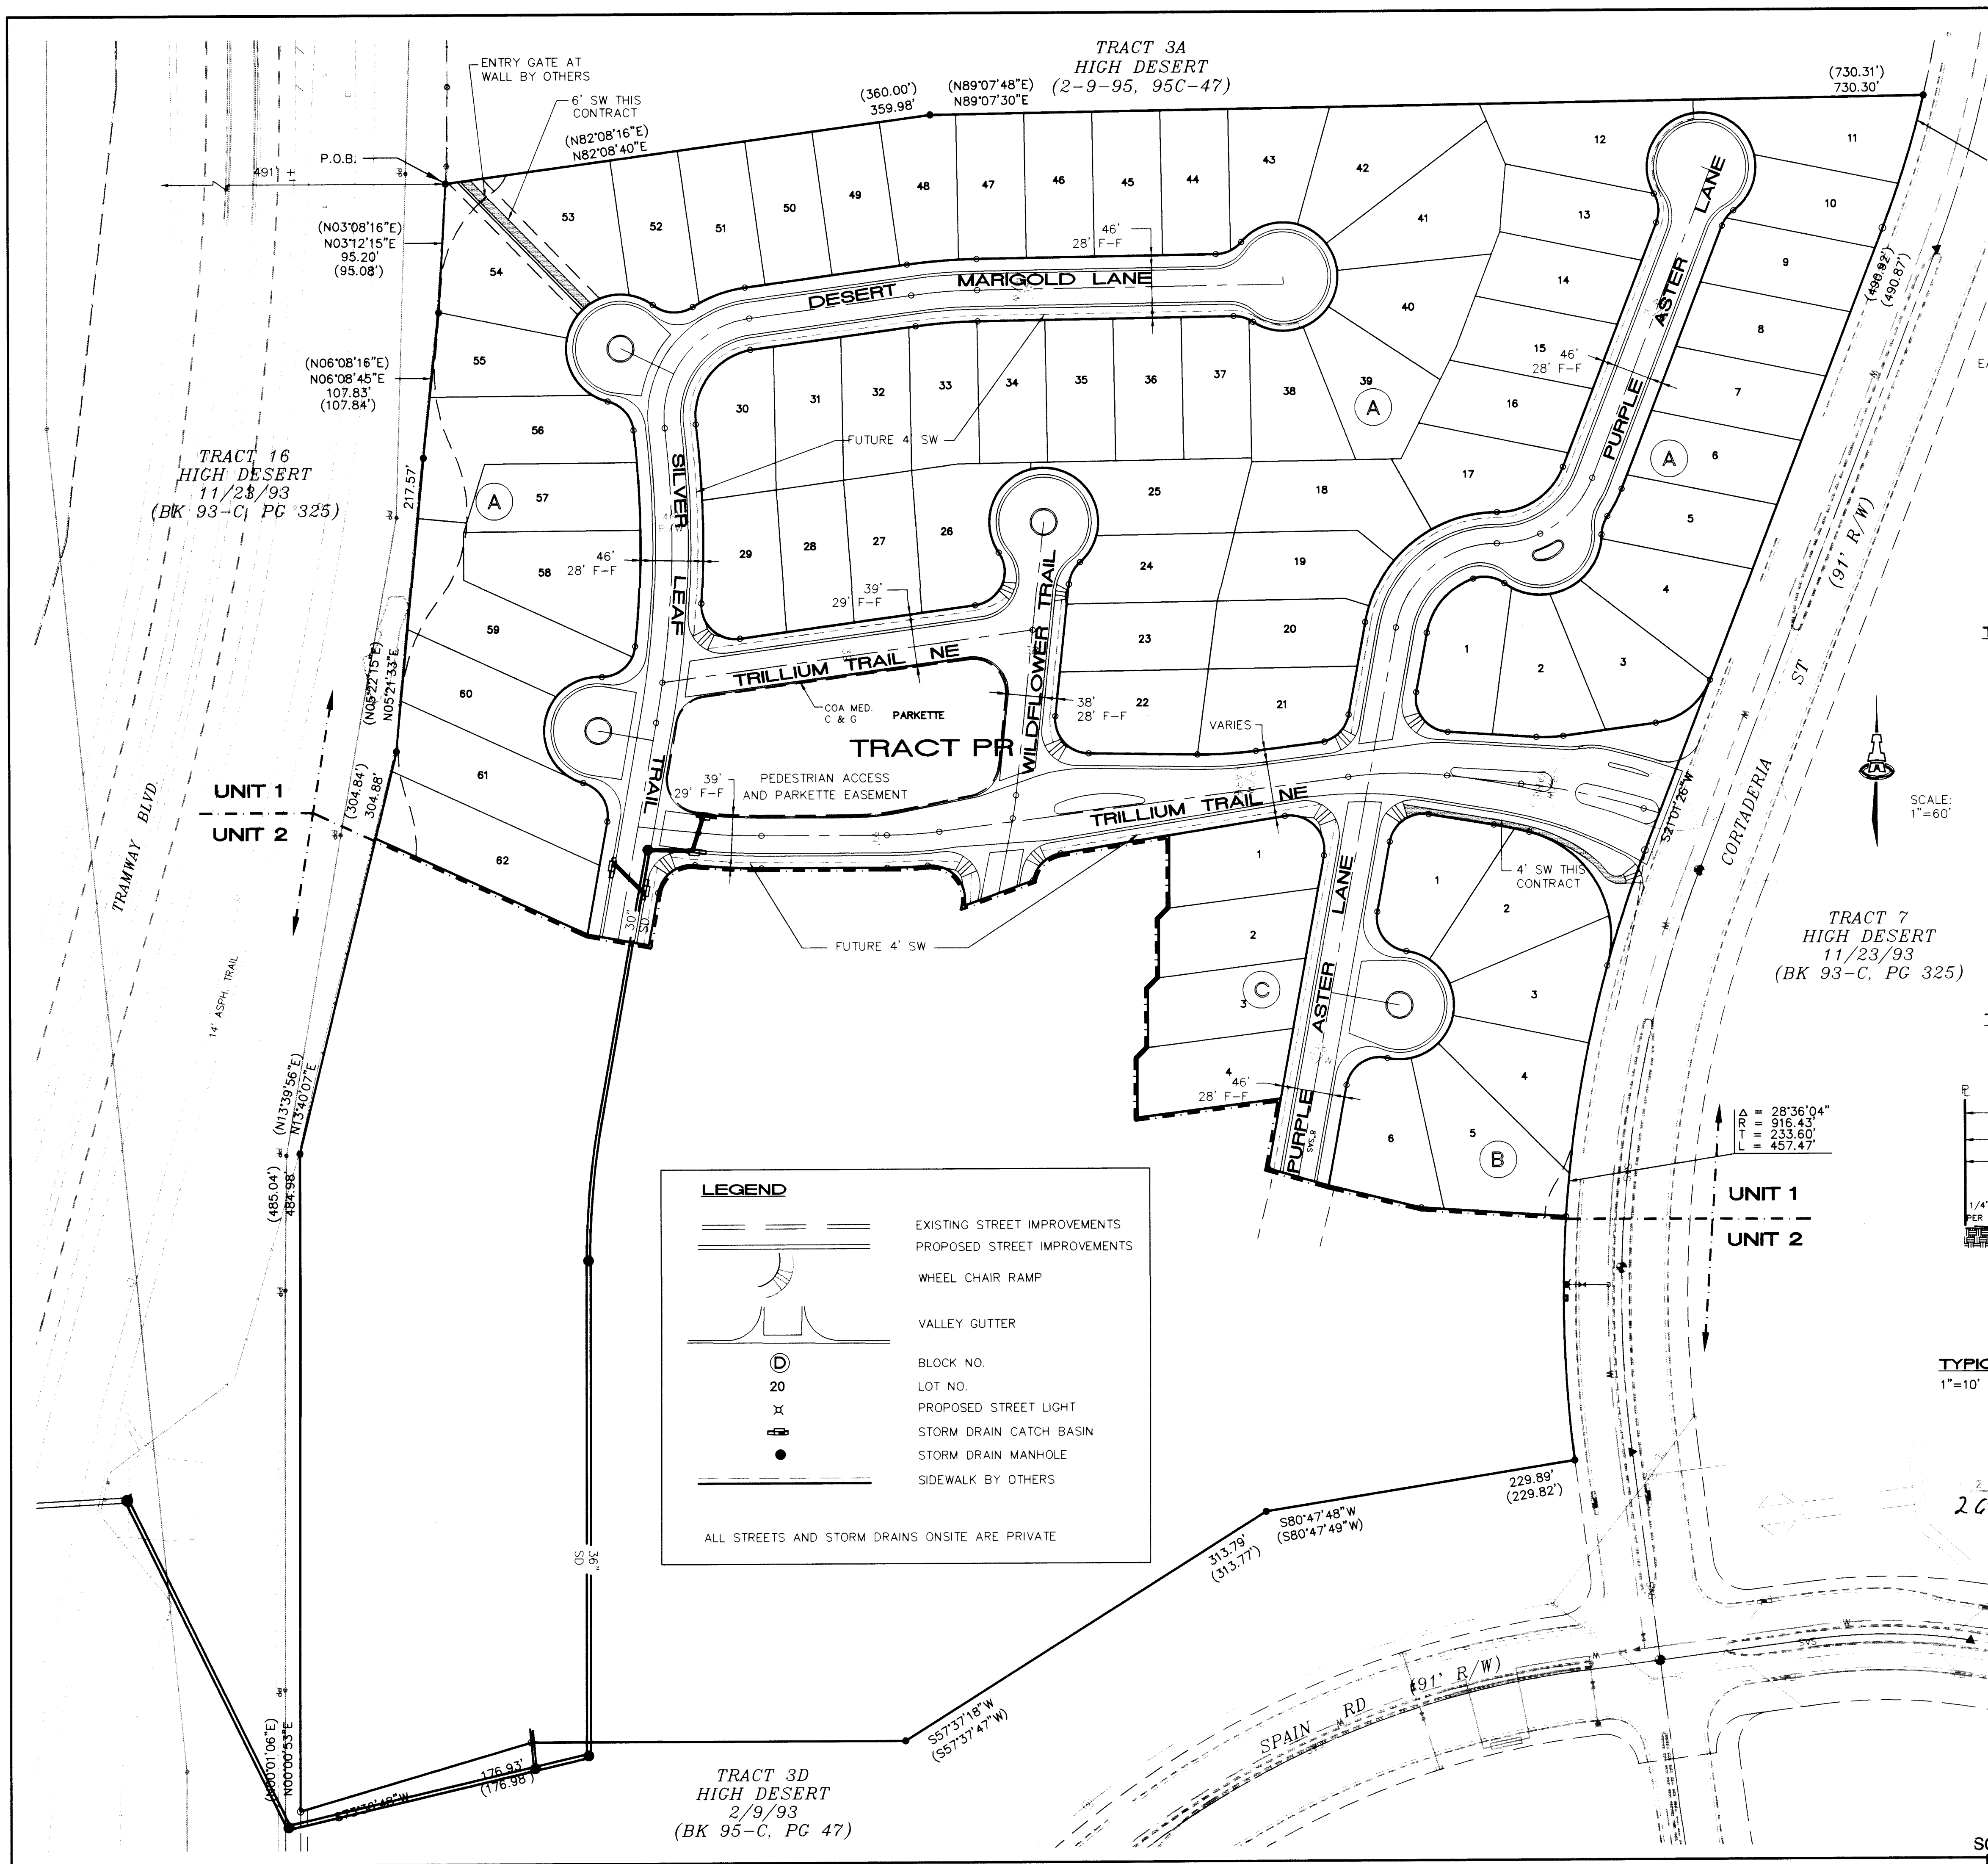


RESIDENTIAL PAVING SECTION
NTS

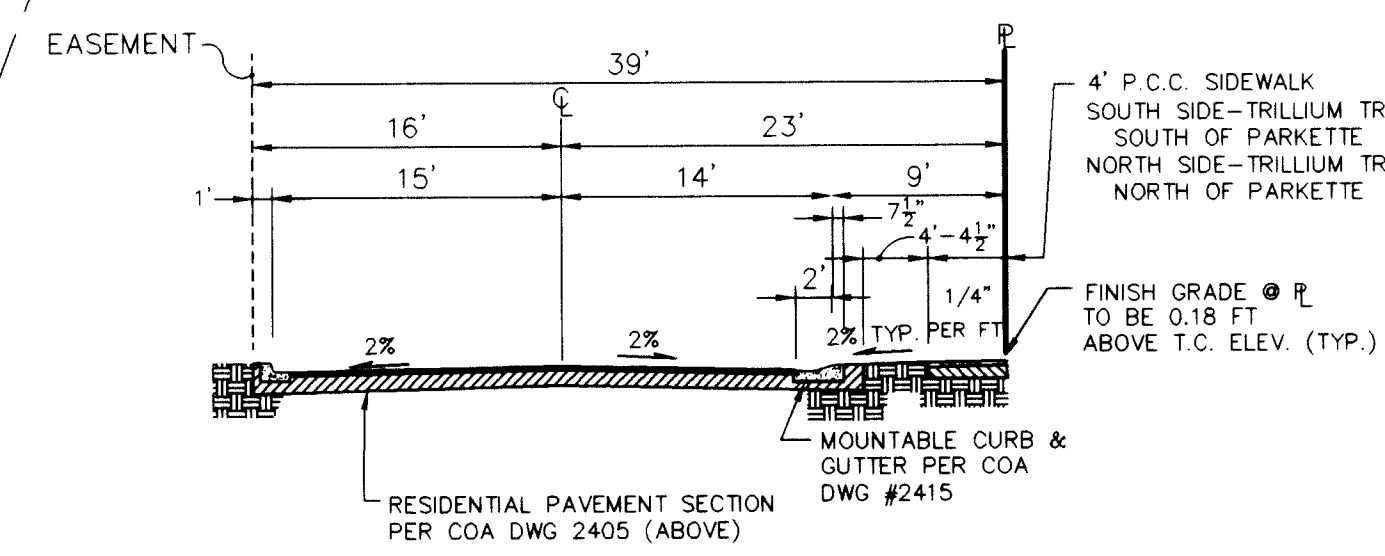

SECTION A1
TYPICAL 39' RESIDENTIAL STREET SECTION
1"=10'
TRILLIUM TRAIL-WEST OF WILDFLOWER TR.

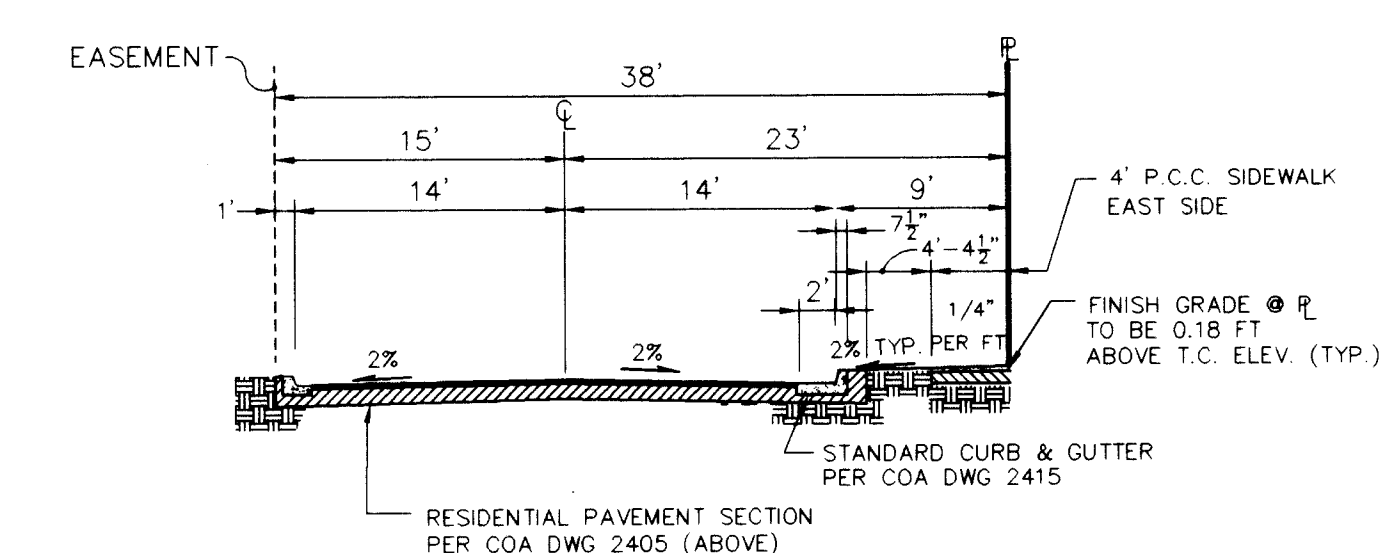

SECTION A2
TYPICAL 38' RESIDENTIAL STREET SECTION
1"=10'
WILDFLOWER TRAIL

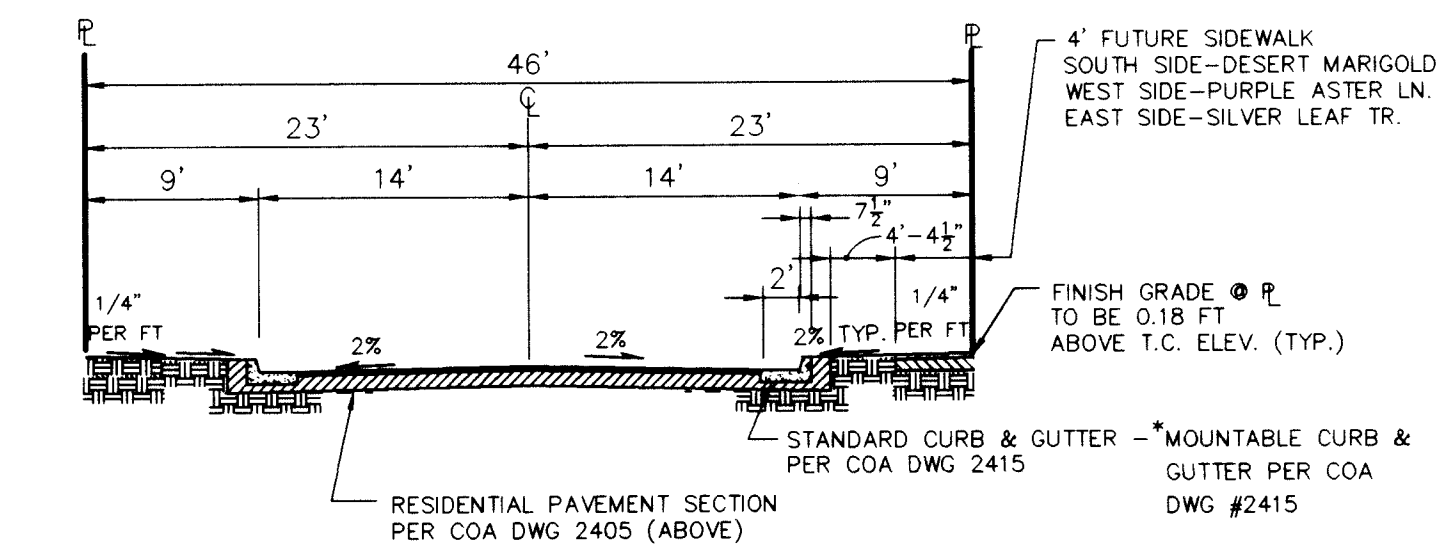

SECTION A
TYPICAL 46' RESIDENTIAL STREET SECTION
1"=10'
DESERT MARIGOLD LANE*
PURPLE ASTER LANE
SILVER LEAF TRAIL

26-52571.90 0597

ISAACSON & ARFMAN, P.A.
Consulting Engineering Associates
Albuquerque New Mexico


825PMSTR.DWGonw 8/1/95

CITY OF ALBUQUERQUE
PUBLIC WORKS DEPARTMENT
ENGINEERING GROUP

TITLE: THE TRILLIUM AT HIGH DESERT
MASTER PAVING & STORM DRAINAGE PLAN

APPROVALS	ENGINEER	DATE	APPROVALS	ENGINEER	DATE
DRC CHAIRMAN	<i>[Signature]</i>	8-21-95	WATER	N/A RWK	8-2-95
TRANSPORTATION	<i>[Signature]</i>	8-2-95	WASTE WATER	N/A RWK	8-2-95
HYDROLOGY	<i>[Signature]</i>	8-2-95			
PROJECT NO.	5251.90	MAP NO.	E-23	SHEET	5 OF 19

SCANNED BY
BY LASON

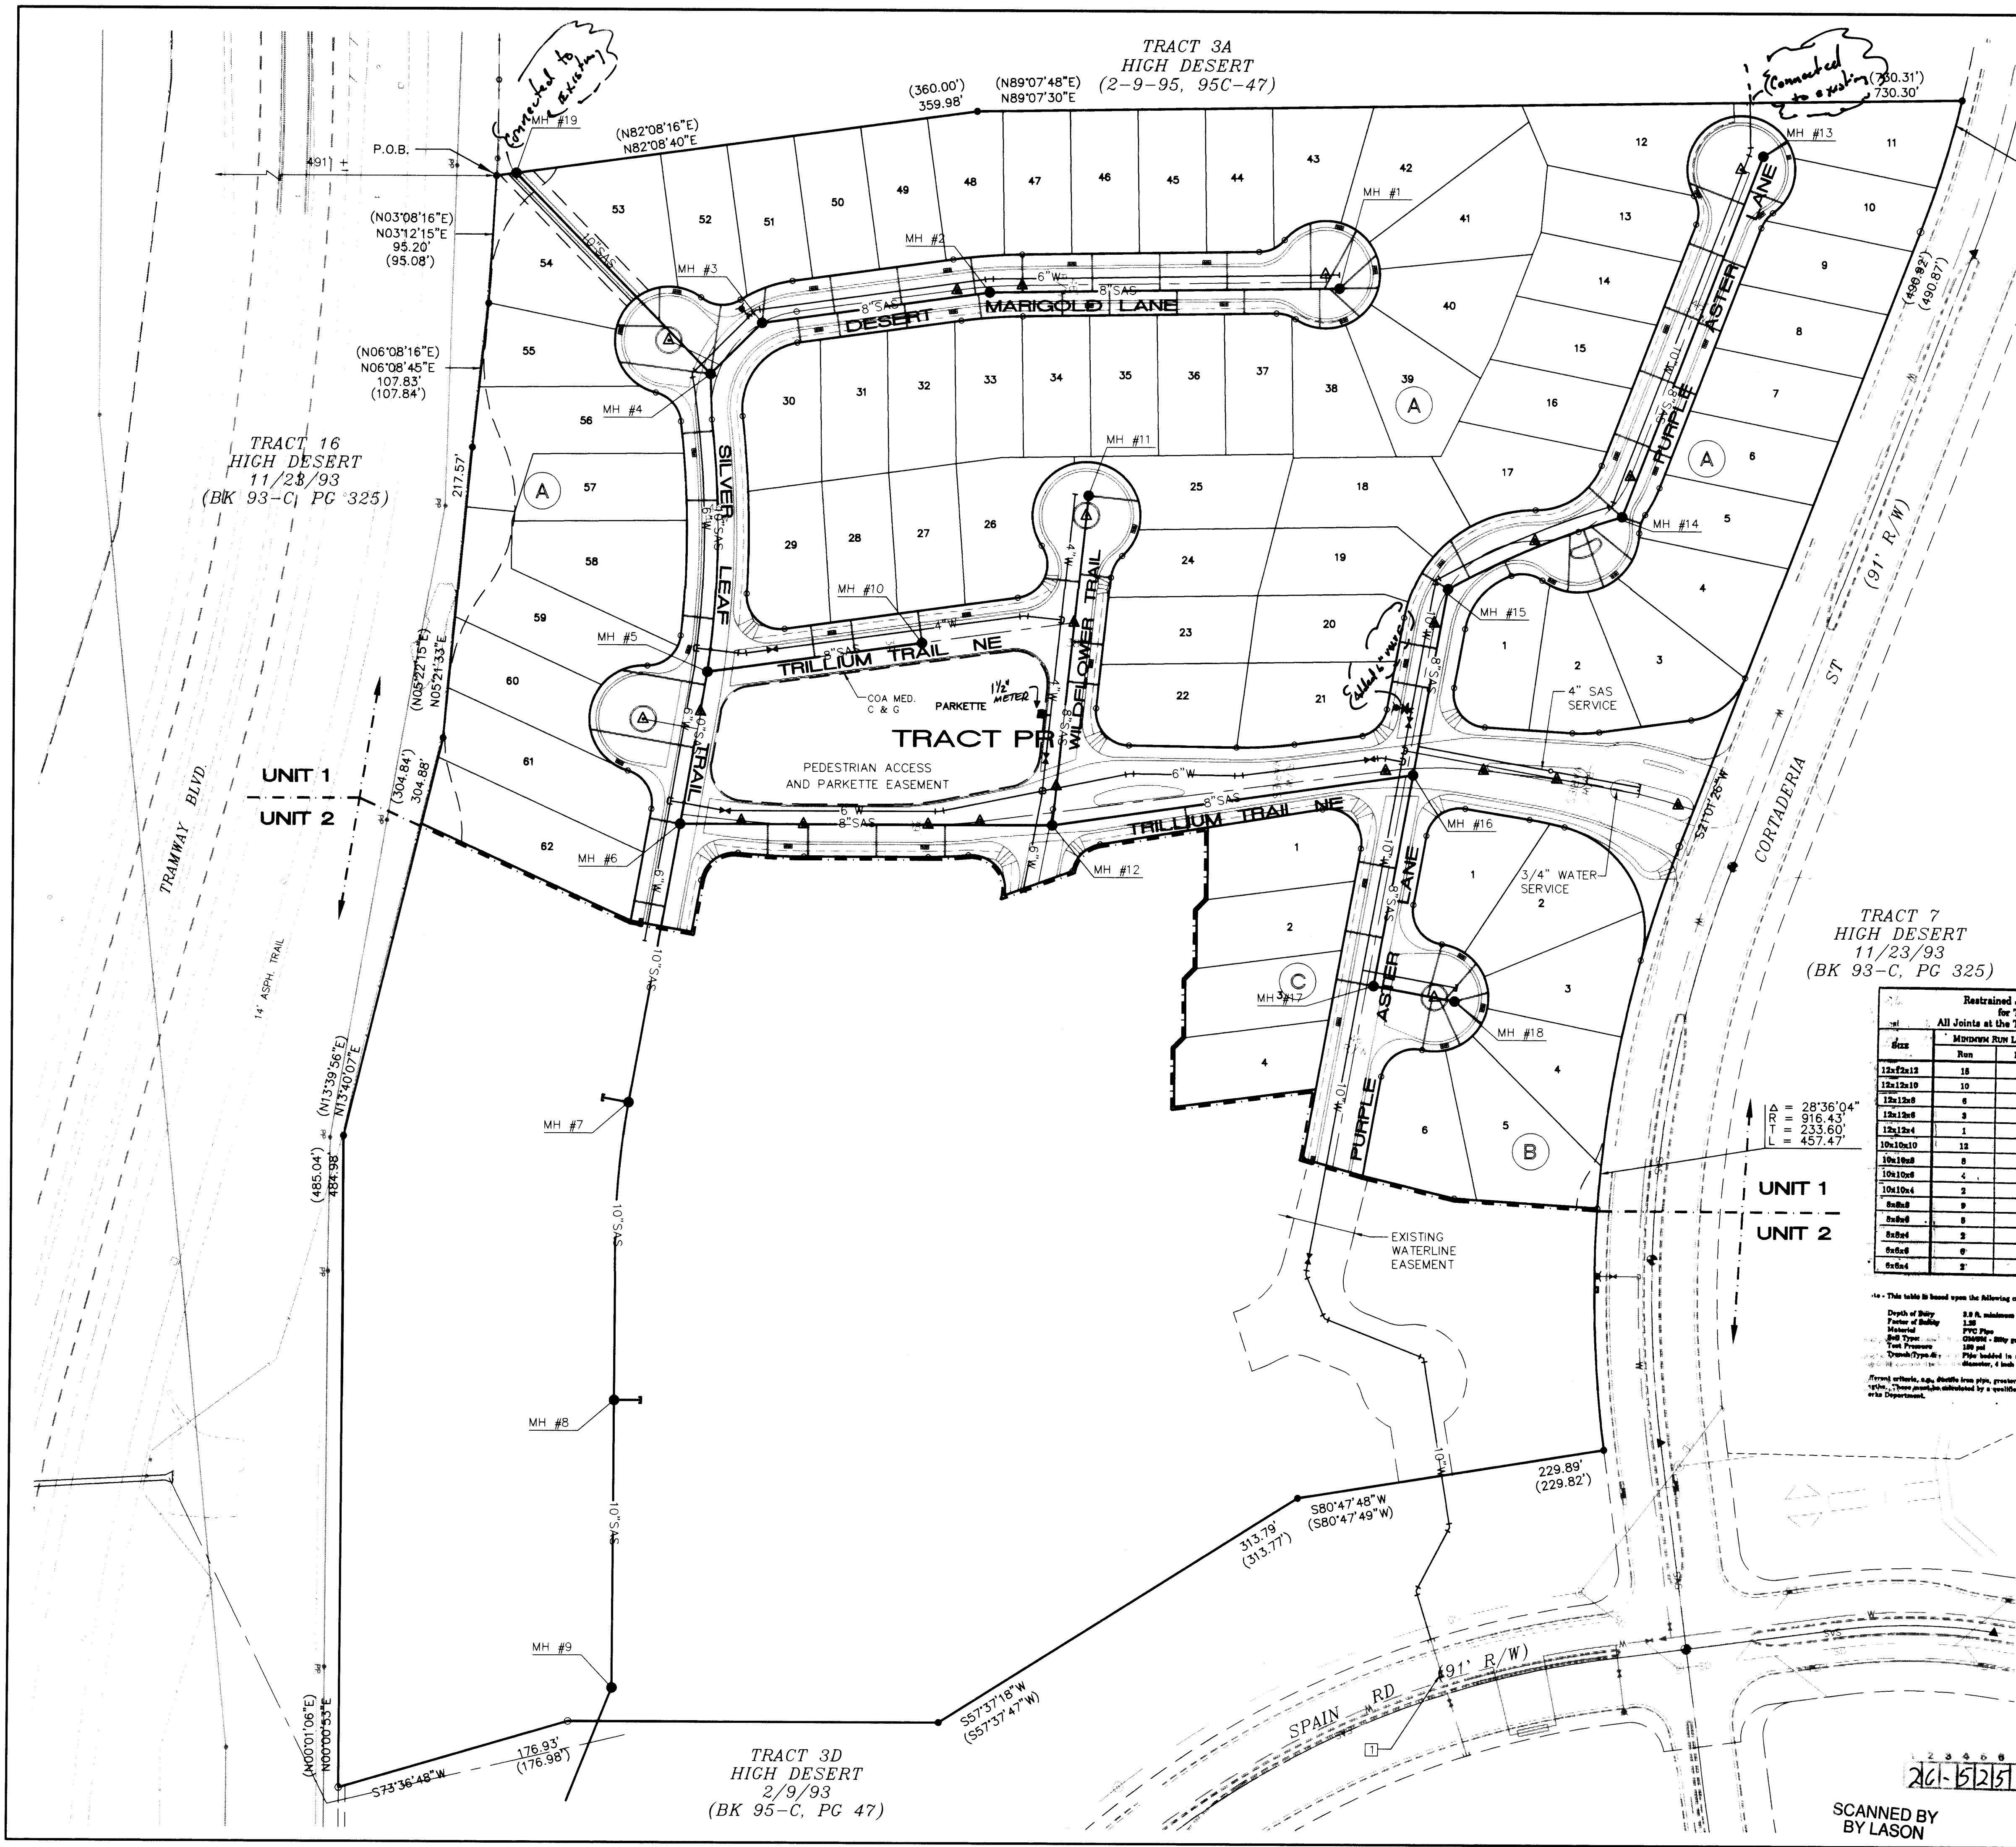

- LEGEND**
- SINGLE WATER METER & BOX
 - DOUBLE WATER METER & BOX
 - GATE VALVE W/ TYPE 'A' VALVE BOX
 - FIRE HYDRANT
 - SAS MANHOLE
 - WATER LINE W/ FITTING

SCALE:
1"=60'

WATER SHUT-OFF

SHUT OFF VALVE TO PROVIDE NON-PRESSURE CONNECTIONS.

THE CONTRACTOR SHALL CONTACT WATER SYSTEMS DIVISION (857-8200) 3 WORKING DAYS PRIOR TO NEEDING SHUT-OFF OR TURN-ON OF VALVES. ONLY CITY WATER SYSTEMS PERSONNEL ARE ALLOWED TO OPERATE VALVES.

LANDSCAPE IRRIGATION

CONTRACTOR TO COORDINATE WITH OWNER & LANDSCAPE CONTRACTOR FOR SIZE AND PLACEMENT OF LANDSCAPE IRRIGATION METER(S).

TRACT 7
HIGH DESERT
11/23/93
(BK 93-C, PG 325)

Restrained Joint Lengths, L_r,
for TRS, (ft.)
All Joints at the Tee must be restrained.

Size	Minimum Run Length		Minimum Branch Length	
	Run	Branch	Run	Branch
12x12x12	15	17	18	3
12x12x10	10	18	13	1
12x12x8	8	19	8	8
12x12x6	3	19	5	1
12x12x4	1	19	2	6
10x10x10	12	18	15	8
10x10x8	8	15	10	4
10x10x6	4	16	6	1
10x10x4	2	4	3	1
8x8x8	9	20	13	8
8x8x6	8	17	7	6
8x8x4	3	18	3	7
8x8x2	0	20	10	3
6x6x4	2	20	4	7

- This table is based upon the following criteria:
Depth of Bury: 2.5 ft. minimum
Type of Bury: L.S.
Material: PVC Pipe
Bed: 180 psi
Ground: 8" billy gravel and city sand, gravel-sand-silt mixture.
Trench Type: A
Drainage: 180 psi
Pipe: 180 psi
Note: Pipe installed in sand, gravel, or crushed stone to depth of 18" pipe diameter. If both materials, install compacted to top of pipe.
Other criteria, e.g., flexible iron pipe, greater depth of bury, etc., will require different restrained lengths. These provisions calculated by a qualified Professional Engineer and approved by the Public Works Department.

**RESTRAINED JOINT LENGTHS
FOR WATERLINE FITTINGS**

Restrained Joint Lengths, L_r,
for Horizontal Bends, Valves,
and Dead Ends, (ft.)

Size	Horizontal Bend				Valve & Dead End
	90°	45°	22 1/2°	11 1/4°	
12	30	18	8	3	85
10	26	15	8	3	72
8	22	12	8	3	60
6	17	7	3	3	48
4	12	8	3	1	32

Restrained Joint Lengths, L_r,
Minimum, unrestrained, straight-run lengths.
Restrained either large pipe, or small pipe.

Size	Large Size		Small Size	
	Large Size	Small Size	Large Size	Small Size
12 x 10	25	30	10 x 8	44
12 x 8	45	60	10 x 4	88
12 x 6	65	121	8 x 6	38
12 x 4	74	215	6 x 4	49
10 x 8	24	30	6 x 4	34

ISAACSON & ARFMAN, P.A.
Consulting Engineering Associates
128 Monroe Street N.E.
Albuquerque New Mexico


825UMSTR.DWGaw 8/1/95

CITY OF ALBUQUERQUE
PUBLIC WORKS DEPARTMENT
ENGINEERING GROUP

TITLE: **THE TRILLIUM AT HIGH DESERT
MASTER UTILITY PLAN**

APPROVALS	ENGINEER	DATE	APPROVALS	ENGINEER	DATE
DRC CHAIRMAN	<i>[Signature]</i>	8-21-95	WATER	<i>[Signature]</i>	8-2-95
TRANSPORTATION	<i>[Signature]</i>	8-23-95	WASTE WATER	<i>[Signature]</i>	8-2-95
HYDROLOGY	<i>[Signature]</i>	8-1-95			

PROJECT NO. **5251.90** MAP NO. **E-23** SHEET **6** OF **19**

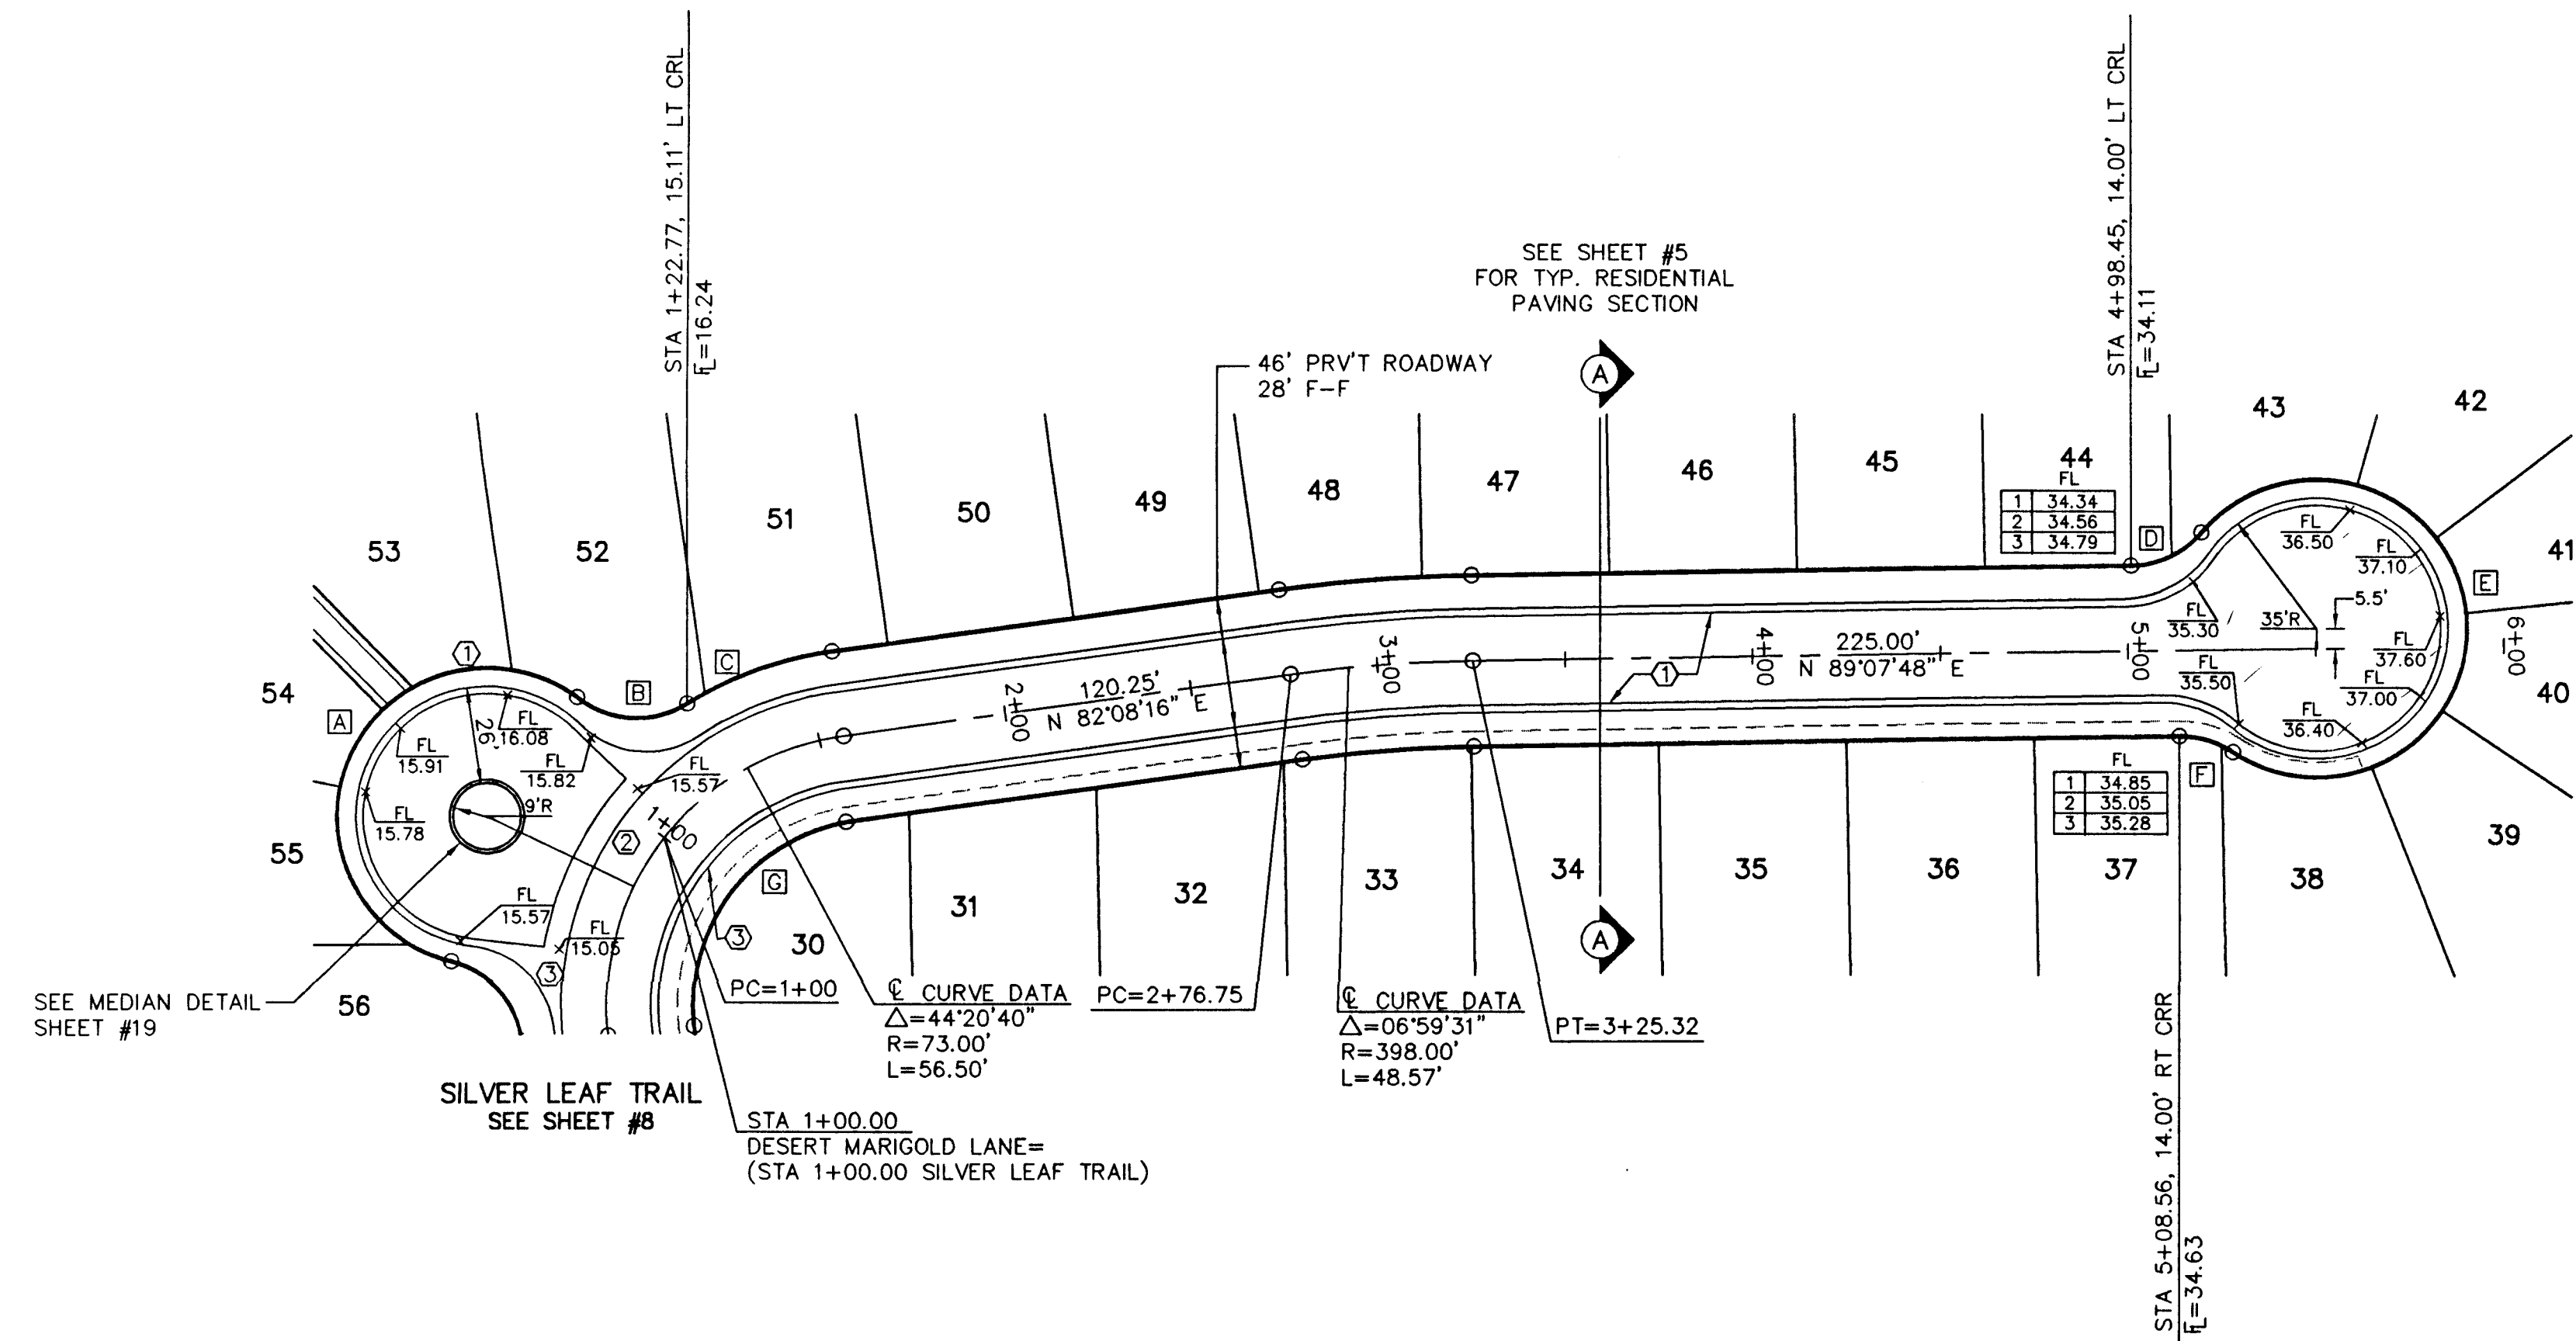

FACE OF CURB CURVE TABLE


CURVE	DELTA	RADIUS	LENGTH
A	217°14'59"	35.00'	132.71'
B	76°40'02"	25.00'	33.45'
C	24°58'19"	87.00'	37.92'
D	54°07'51"	29.00'	27.40'
E	274°51'32"	35.00'	167.90'
F	40°43'42"	29.00'	20.61'
G	88°41'21"	59.00'	91.33'

DESERT MARIGOLD LANE

CURB TRANSITIONS

STA	OFFSET	TYPE	METHOD
1+00.00	14.00' RT	STANDARD TO MOUNTABLE	10' TRANSITION CENTERED @ MIDDLE OF CURVE

SCALES:
1"=40' HOR
1"=10' VERT.

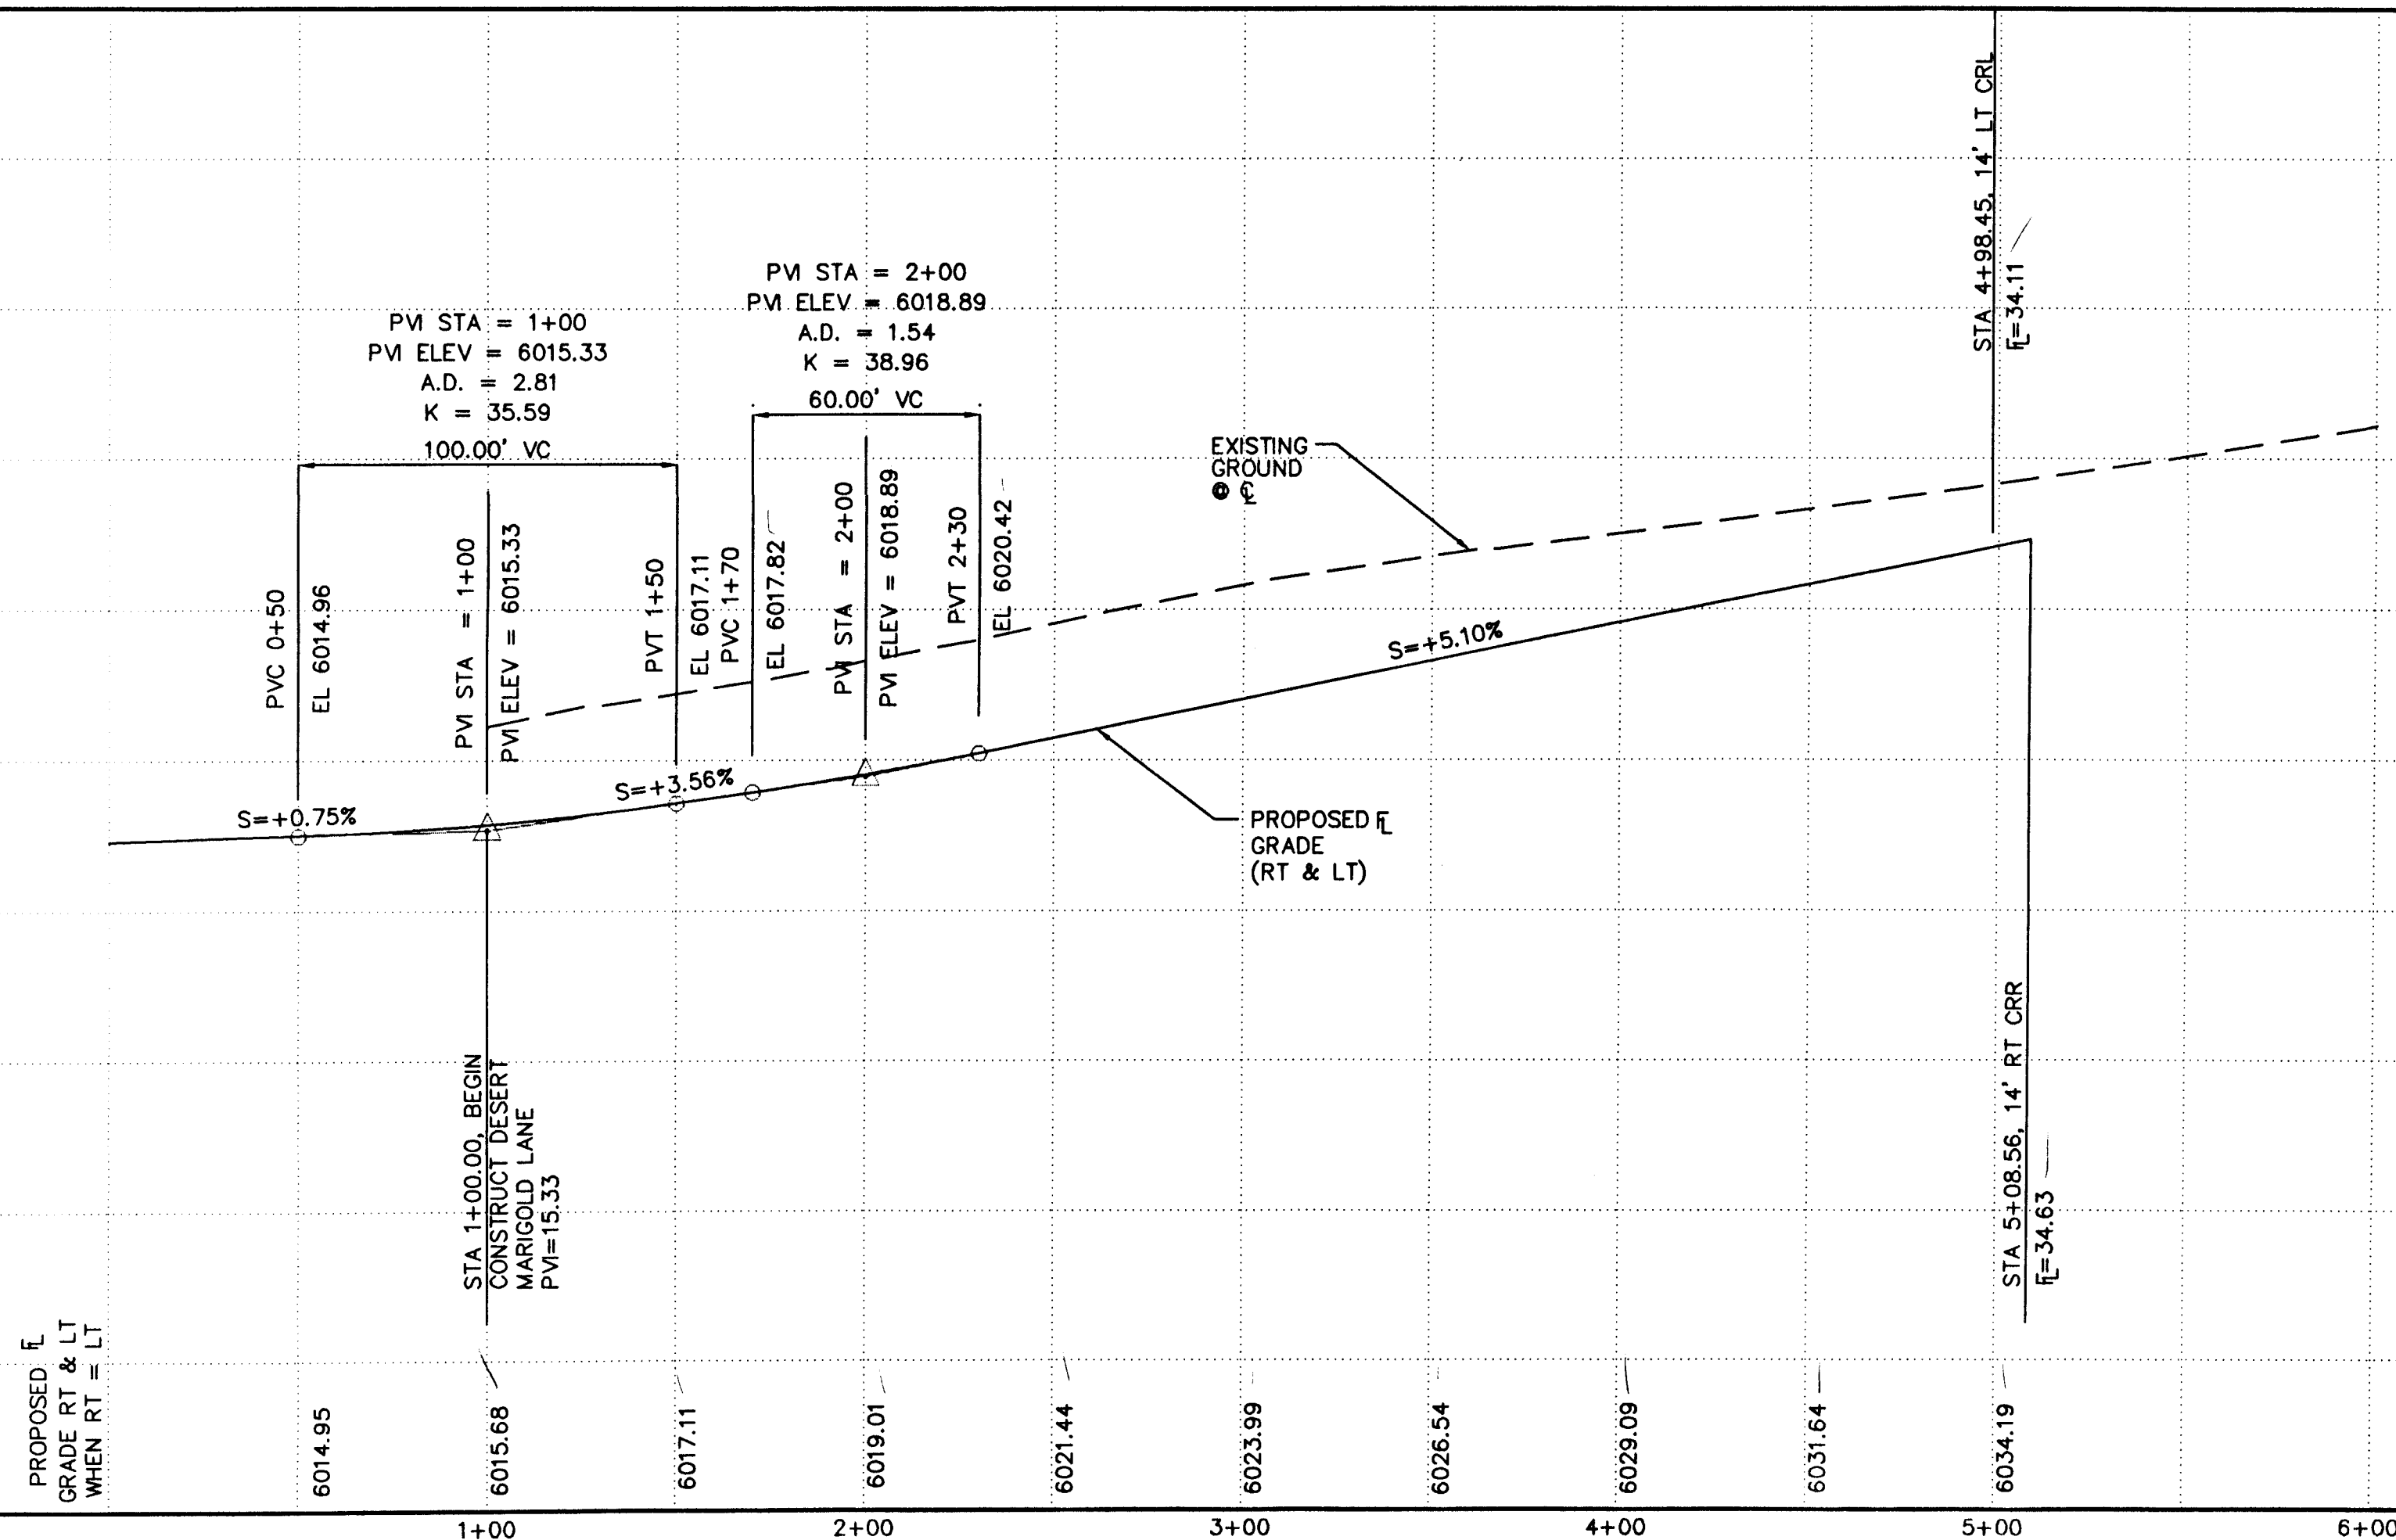

KEYED CONSTRUCTION NOTES

- MOUNTABLE CURB & GUTTER PER COA STD DWG #2415.
- CONSTRUCT PCC VALLEY GUTTER 6' WIDE, 3/4" INVERT PER COA STD DWG #2420.
- TRANSITION FROM MOUNTABLE TO STD CURB & GUTTER.

AS-BUILT INFORMATION	BENCH MARKS	SURVEY INFORMATION	FIELD NOTES
CONTRACTOR: ALSA INC DESIGNED BY: ALSA INC CHECKED BY: ALSA INC DATE: 7/25/95	NGS/ACS BRASS TABLE "TUMBLE" NW OF ACADEMY ROAD AND TRAMWAY BLVD. ELEV. = 6009.155	DATE: 7/25/95 BY: ALSA INC	NO. 1

ENGINEER'S SEAL	REVISIONS	DESIGN	DATE
	NO. 1	DATE: 7/25/95	DATE: 7/25/95
DESIGNED BY: JRL	DATE: 6/95	DRAWN BY: WDE	DATE: 6/95
CHECKED BY: I & A	DATE: 7/95		

ISAACSON & ARFMAN, P.A.
Consulting Engineering Associates
128 Monroe Street N.E.
Albuquerque New Mexico


825PV3.DWG 7/25/95

CITY OF ALBUQUERQUE
PUBLIC WORKS DEPARTMENT
ENGINEERING GROUP

TITLE: **THE TRILLIUM AT HIGH DESERT
DESERT MARIGOLD LANE
PAVING PLAN & PROFILE**

APPROVALS	ENGINEER	DATE	APPROVALS	ENGINEER	DATE
DRG CHAIRMAN	ALSA INC	8-21-95	WATER	N/A	RWK 7-27-95
TRANSPORTATION	ALSA INC	7-27-95	WASTE WATER	N/A	RWK 7-27-95
HYDROLOGY	N/A	8-9-95			


PROJECT NO. 5251.90	MAP NO. E-23	SHEET 7 OF 19
----------------------------	---------------------	-----------------------------

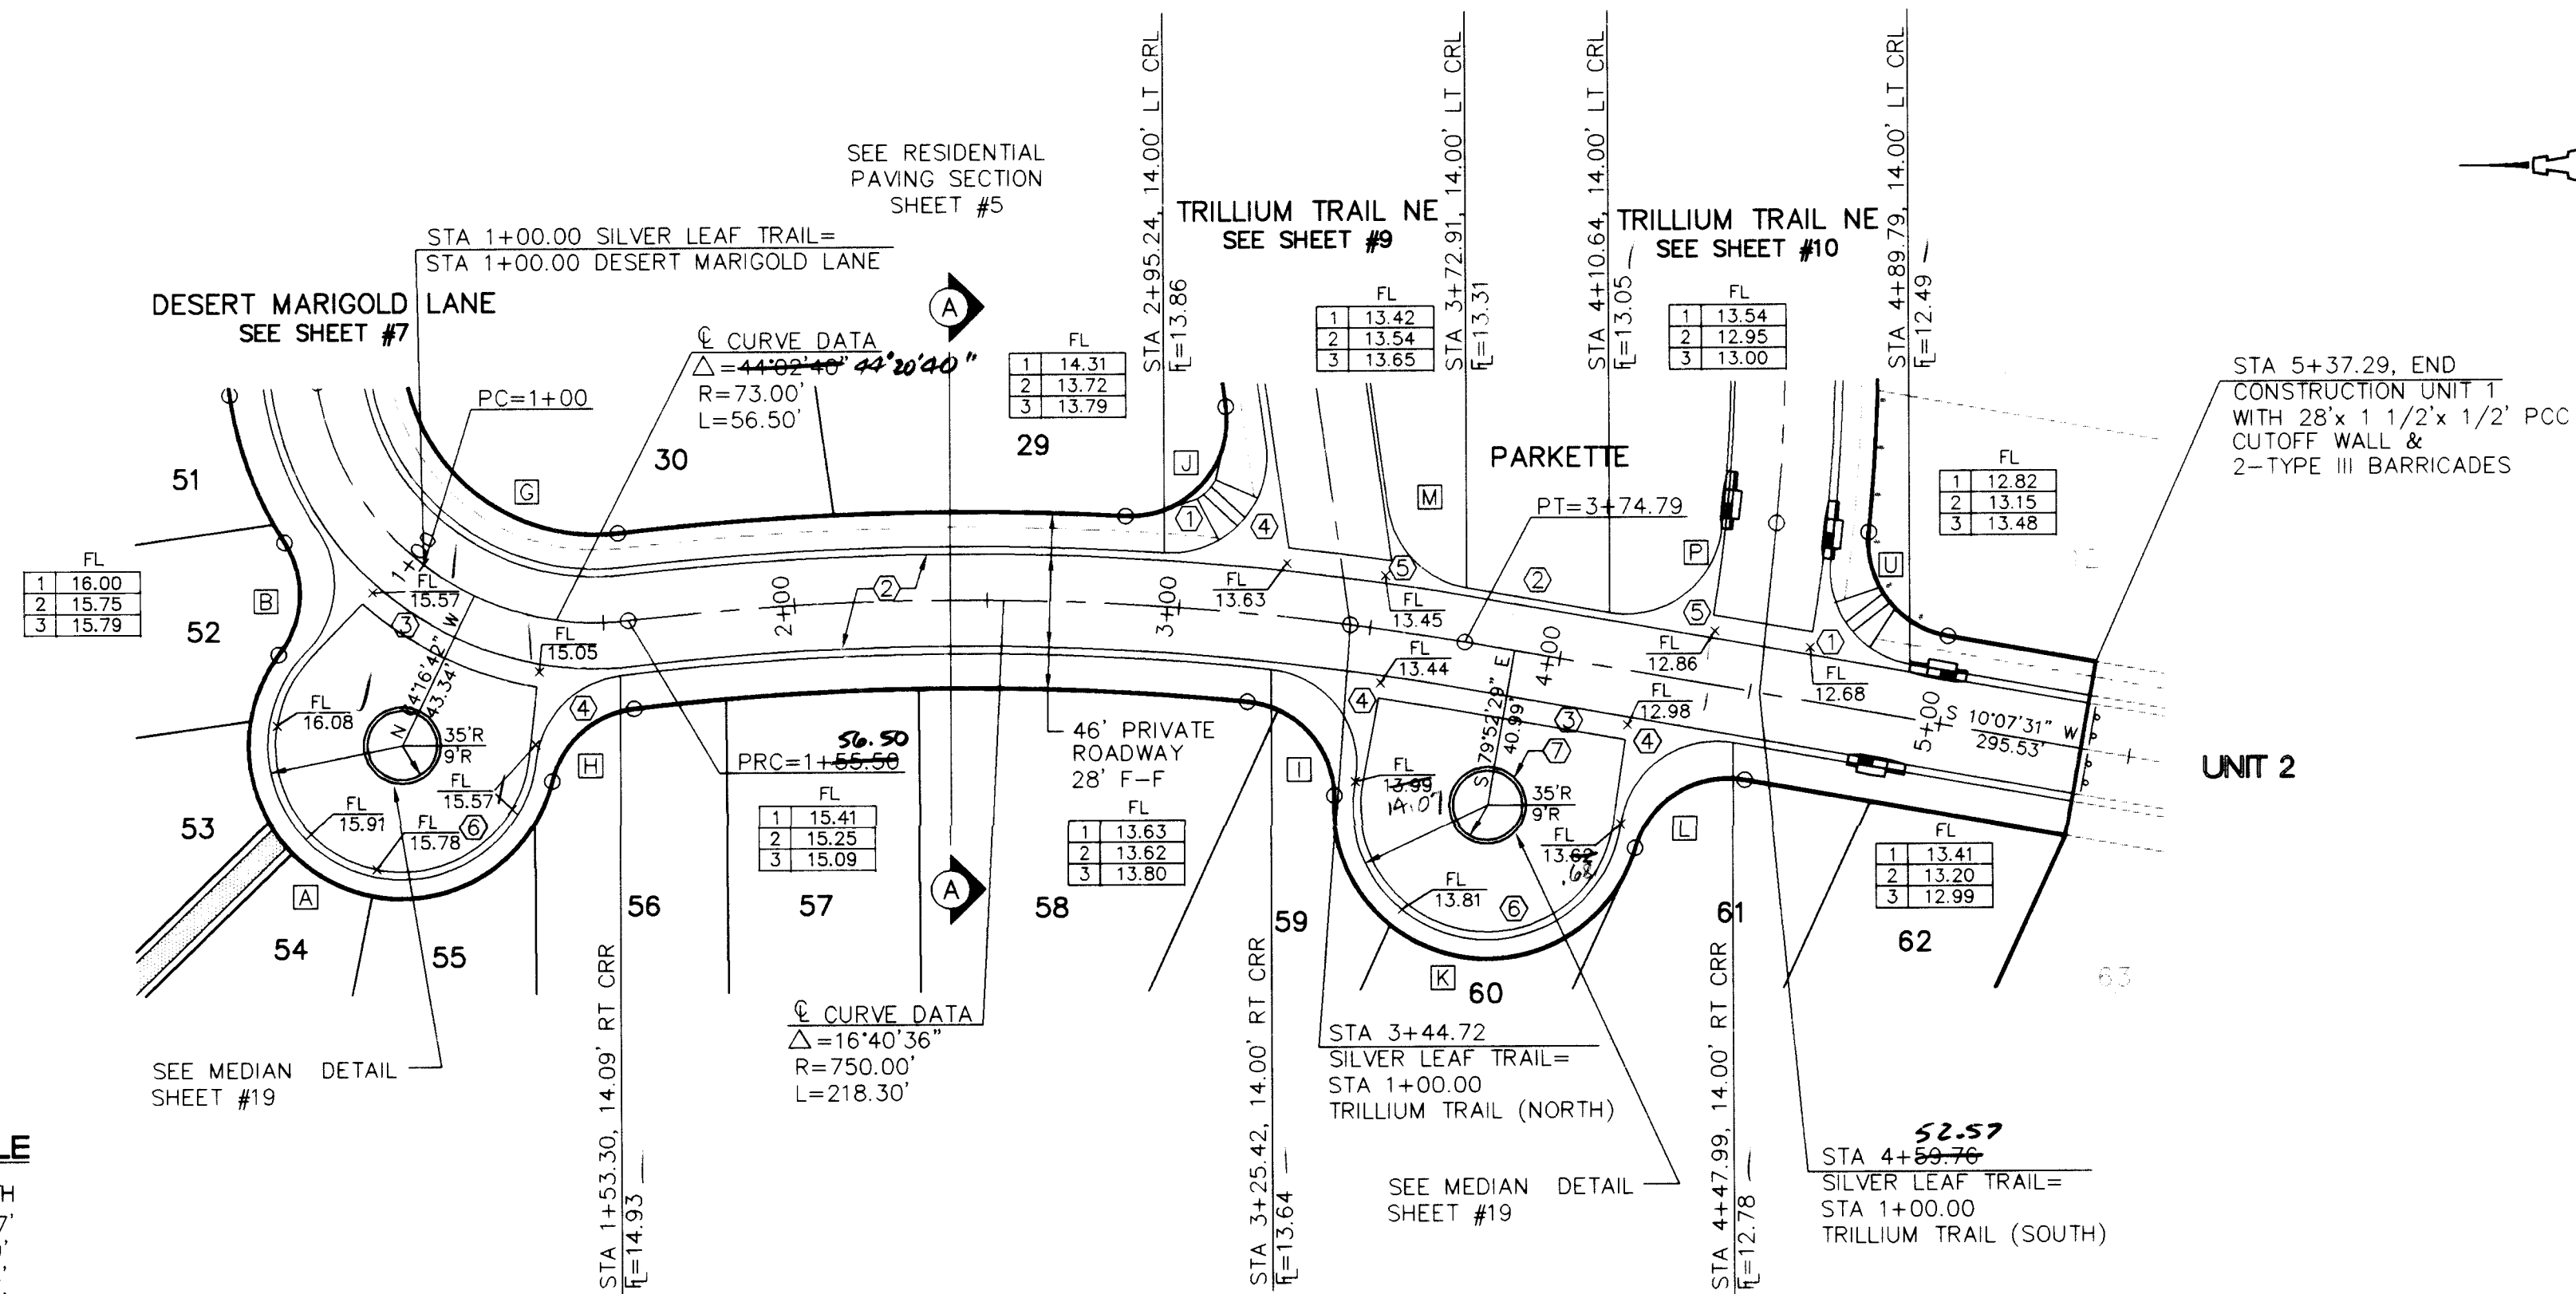

FACE OF CURB CURVE TABLE				
CURVE	DELTA	RADIUS	LENGTH	
A	218°19'38"	35.00'	133.37'	
B	78°48'19"	25.00'	34.39'	
G	88°41'21"	59.00'	91.33'	
H	76°33'32"	25.00'	33.41'	
I	94°11'51"	25.00'	41.10'	
J	101°54'36"	25.00'	44.47'	
K	182°19'21"	35.00'	111.37'	
L	91°53'48"	25.00'	40.10'	
M	72°00'45"	25.00'	31.42'	
P	93°45'37"	25.00'	40.91'	
U	86°51'15"	25.00'	37.90'	

SILVER LEAF TRAIL

SCALES:
1"=40' HOR
1"=10' VERT.

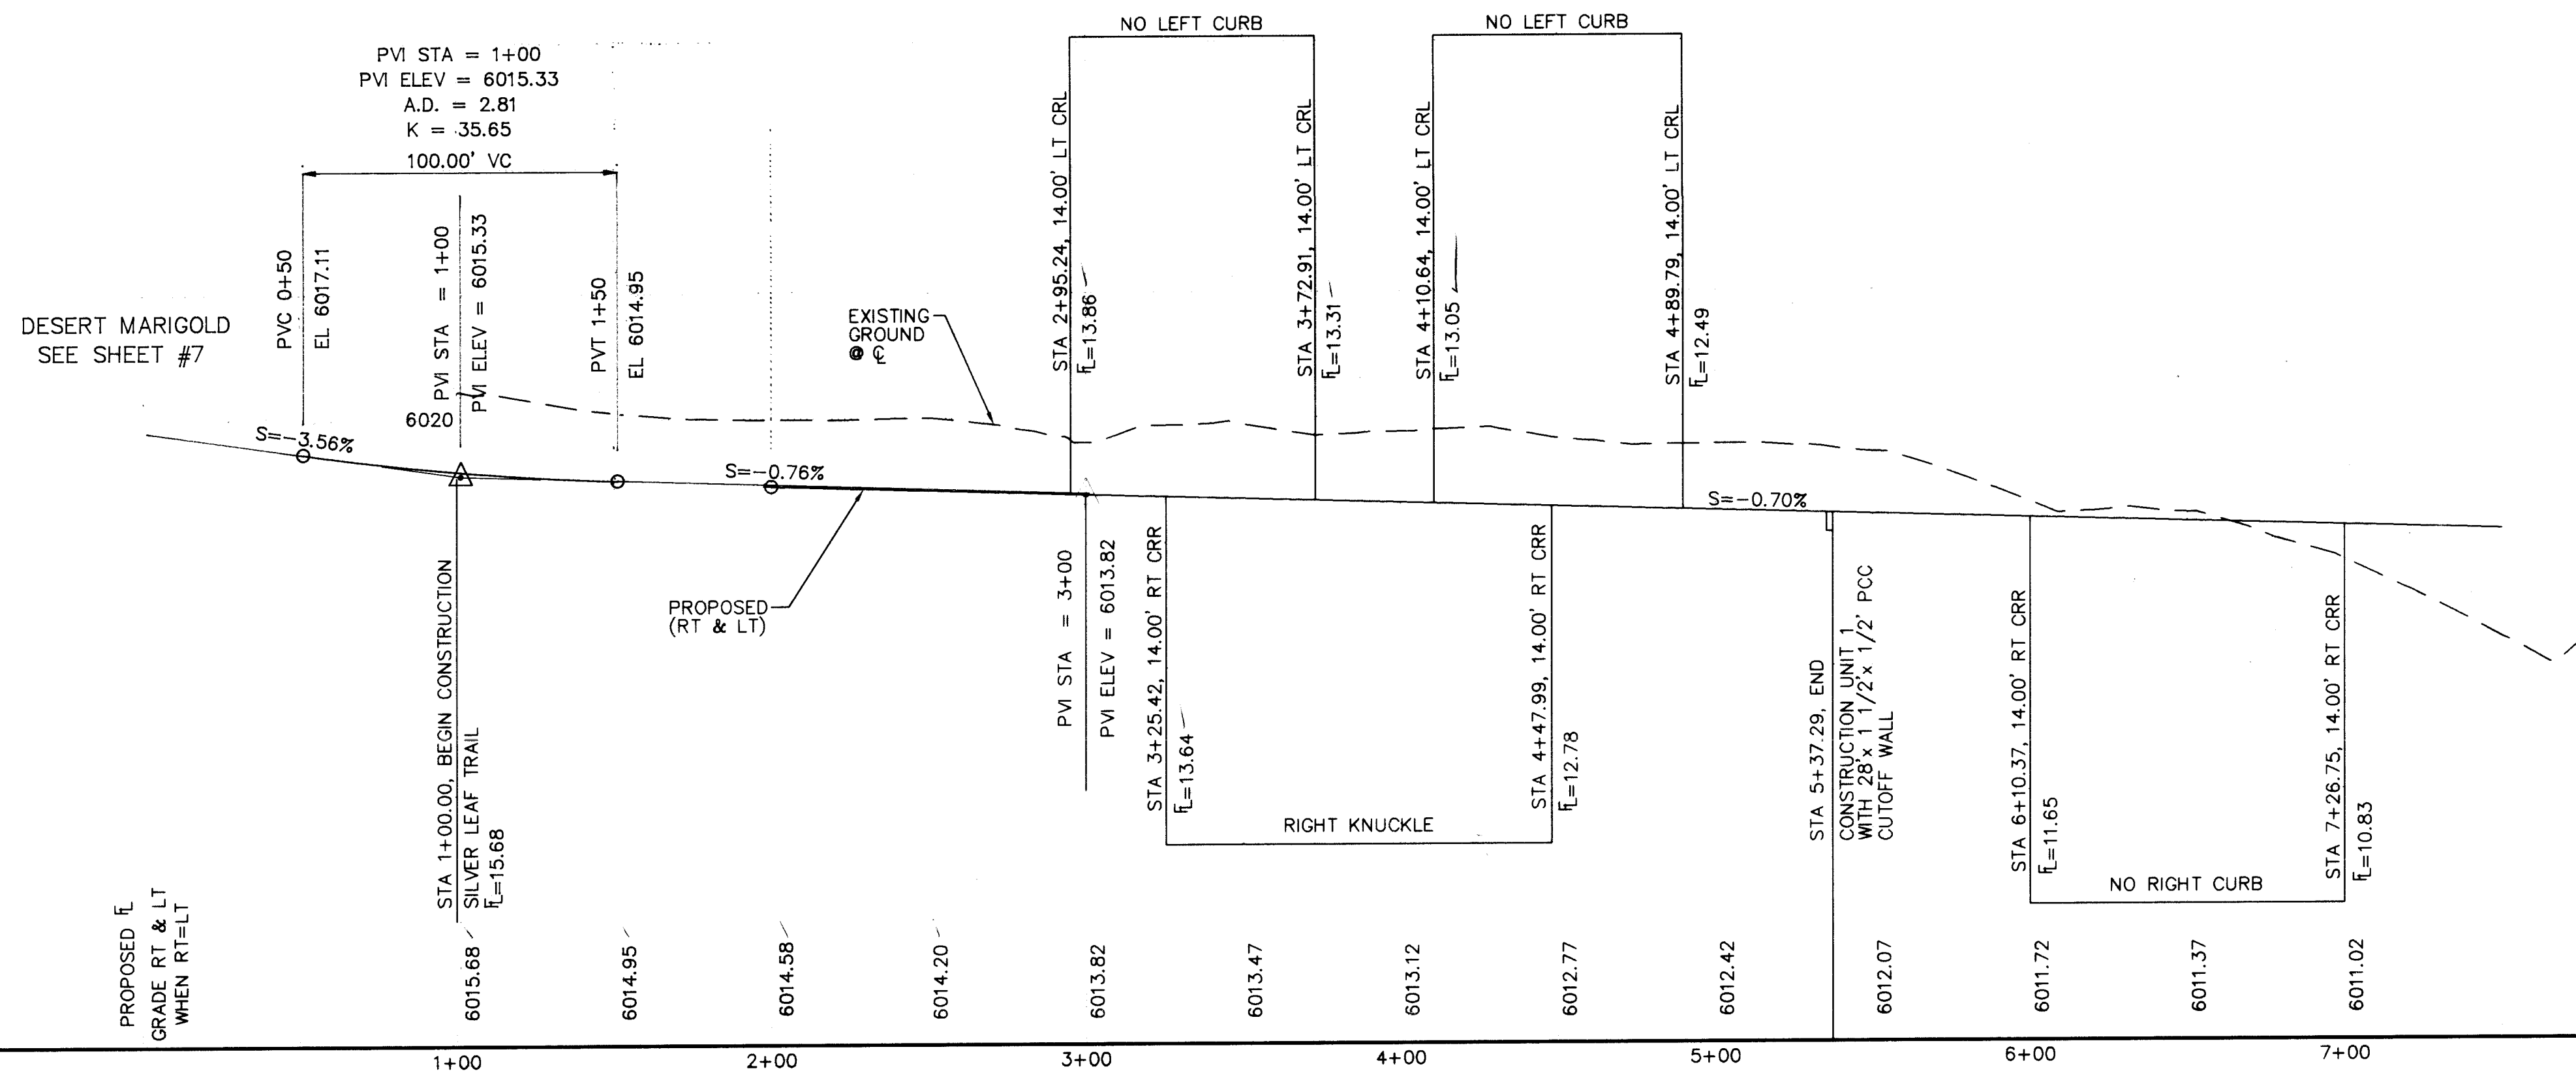


KEYED CONSTRUCTION NOTES

1. CONSTRUCT HANDICAP RAMPS PER SW DETAIL SHEET #19.
2. STD CURB & GUTTER PER COA STD DWG #2415.
3. CONSTRUCT PCC VALLEY GUTTER 6" WIDE, 3/4" INVERT PER COA STD DWG #2420.
4. TRANSITION FROM MOUNTABLE TO STD. CURB & GUTTER.
5. TRANSITION FROM MOUNTABLE TO STD. CURB & GUTTER.
6. MOUNTABLE CURB & GUTTER PER COA STD DWG #2415.
7. MEDIAN CURB & GUTTER PER COA STD DWG #2415.

CURB TRANSITIONS

STA	OFFSET	TYPE	METHOD
1+37.68	36.96' RT	MOUNTABLE TO STANDARD	10' TRANSITION BEGINNING 10' BEFORE PC OF CURVE [H]
3+14.07	23.50' LT	STANDARD TO MOUNTABLE	THRU HC RAMP DWG #2416
3+44.29	21.75' RT	STANDARD TO MOUNTABLE	10' TRANSITION CENTERED @ MIDDLE OF CURVE [I]
3+58.59	18.96' LT	MEDIAN TO STANDARD	10' TRANSITION CENTERED @ MIDDLE OF CURVE [M]
4+30.02	21.62' RT	MOUNTABLE TO STANDARD	10' TRANSITION CENTERED @ MIDDLE OF CURVE [I]
4+72.60	20.84' LT	STANDARD TO MEDIAN	10' TRANSITION CENTERED @ MIDDLE OF CURVE [P]

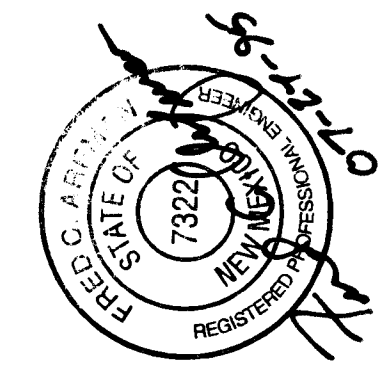


ISAACSON & ARFMAN, P.A.
Consulting Engineering Associates
128 Monroe Street N.E.
Albuquerque New Mexico
825PV4.DWGwde 07/25/95

CITY OF ALBUQUERQUE
PUBLIC WORKS DEPARTMENT
ENGINEERING GROUP

TITLE: THE TRILLIUM AT HIGH DESERT
SILVER LEAF TRAIL
PAVING PLAN & PROFILE

APPROVALS	ENGINEER	DATE	APPROVALS	ENGINEER	DATE
DRG CHAIRMAN	R. R. R. R.	8-21-95	WATER	N/A RWE	7-27-95
TRANSPORTATION	R. R. R. R.	7-27-95	WASTE WATER	N/A RWE	7-27-95
HYDROLOGY	N/A SNA	8-9-95			

PROJECT NO. 5251.90 MAP NO. E-23 SHEET 8 OF 19

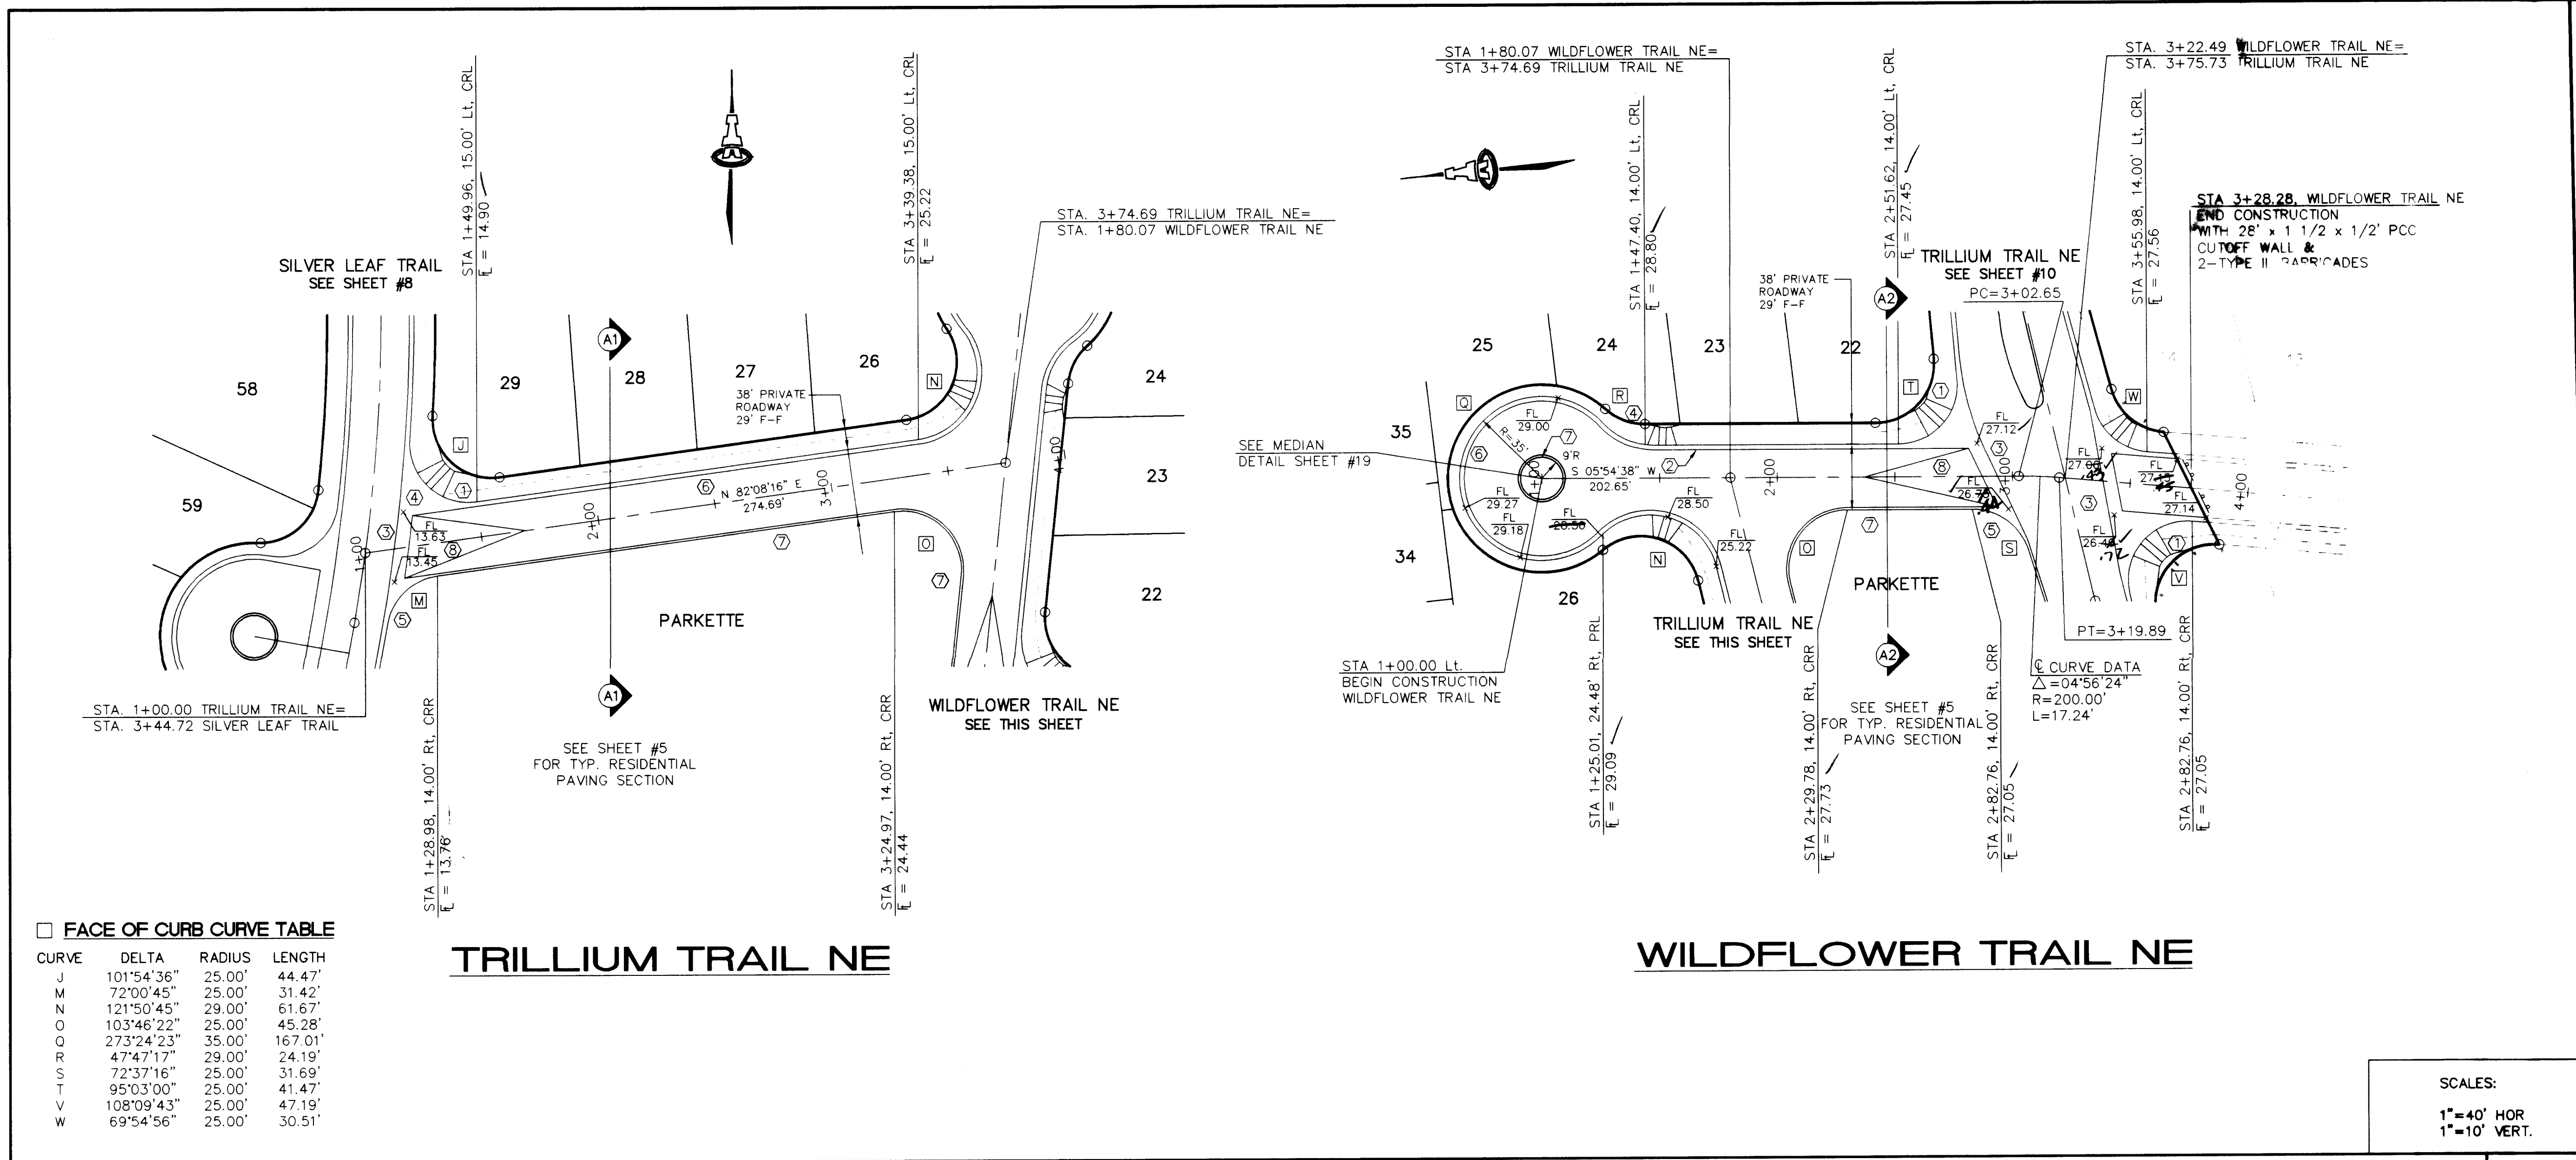

1. CONSTRUCTION: ANTI-CAP RAMP PER SW D SHEET #19.

2. STD GUTTER PER COA STD DWG

3. KEY CONSTRUCTION NOTES

- 6" W 1" INVERT PER COA STD
- CONSTRUCT HANDICAP RAMPS PER SW DETAIL SHEET #19.
- TRANS. FROM MOUNTABLE TO STD CURB & GUTTER PER COA STD DWG #2415.
- TRANS. FROM MOUNTABLE TO STANDARD VALLEY GUTTER PER COA STD DWG #2415.
- TRANS. FROM MOUNTABLE TO 6" WIDE, 3/4" INVERT PER COA STD DWG #2415.
- TRANS. FROM MOUNTABLE TO COA STD DWG #2415.
- TRANS. FROM MOUNTABLE TO MEDIAN CURB & GUTTER PER COA STD DWG #2415.
- TRANS. FROM MOUNTABLE TO STD. CURB & GUTTER PER COA STD DWG #2415.
- TRANS. FROM MOUNTABLE TO MEDIAN CURB & GUTTER PER COA STD DWG #2415.
- CROWN - NO CROWN TRANSITION 50' MIN LENGTH.

CURB TRANSITIONS

STA	OFFSET	TYPE	METHOD
TRILLIUM TRAIL			
1+30.55	24.25' LT	STANDARD TO MOUNTABLE	THRU HC RAMP DWG #2416
1+14.28	18.78' RT	STANDARD TO MEDIAN	10' TRANSITION CENTERED @ MIDDLE OF CURVE [M]
WILDFLOWER TRAIL			
1+53.40	16.79' LT	MOUNTABLE TO STANDARD	10' TRANSITION CENTERED @ MIDDLE OF CURVE [R]
2+97.56	18.85' RT	MEDIAN TO STANDARD	10' TRANSITION CENTERED @ MIDDLE OF CURVE [S]

SCALES: 1"=40' HOR, 1"=10' VERT.

ENGINEER'S SEAL

NO. DATE REMARKS REVISIONS

DESIGNED BY JRL DATE 6/95

DRAWN BY WDE DATE 6/95

CHECKED BY I & A DATE 7/95

ISAACSON & ARFMAN, P.A. Consulting Engineering Associates 128 Monroe Street N.E. Albuquerque New Mexico


825P2.DWGwde 07/25/95



CITY OF ALBUQUERQUE PUBLIC WORKS DEPARTMENT ENGINEERING GROUP

TITLE: THE TRILLIUM AT HIGH DESERT TRAIL AND WILDFLOWER TRAIL PAVING PLAN & PROFILE

APPROVALS	ENGINEER	DATE	APPROVALS	ENGINEER	DATE
DRC CHAIRMAN	8/21/95	WATER	N/A	RWE	7-27-95
TRANSPORTATION	8-21-95	WASTE WATER	N/A	RWE	7-27-95
HYDROLOGY	8-9-95				

PROJECT NO. 5251.90 MAP NO. E-23 SHEET 9 OF 19

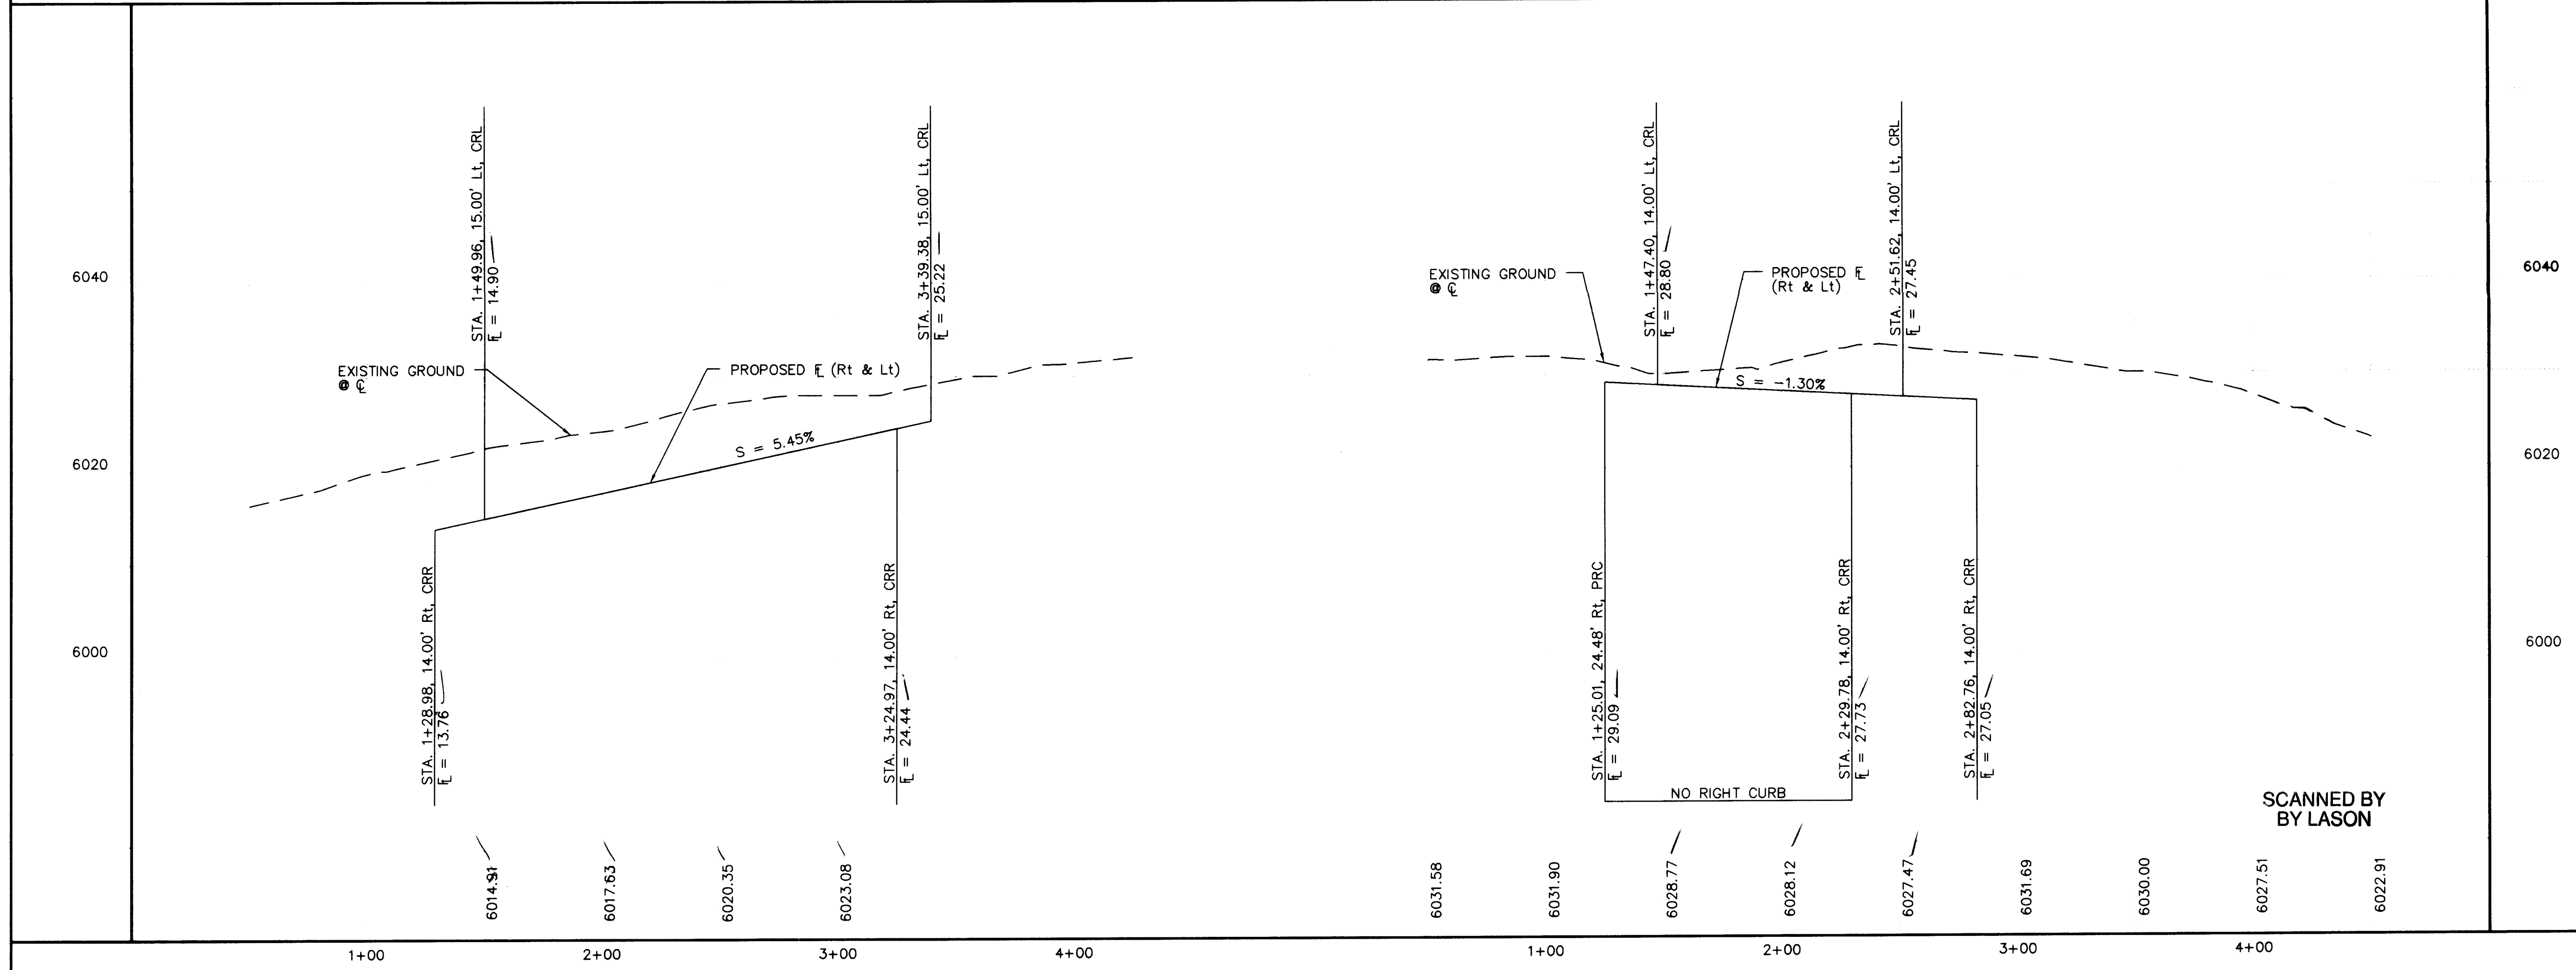

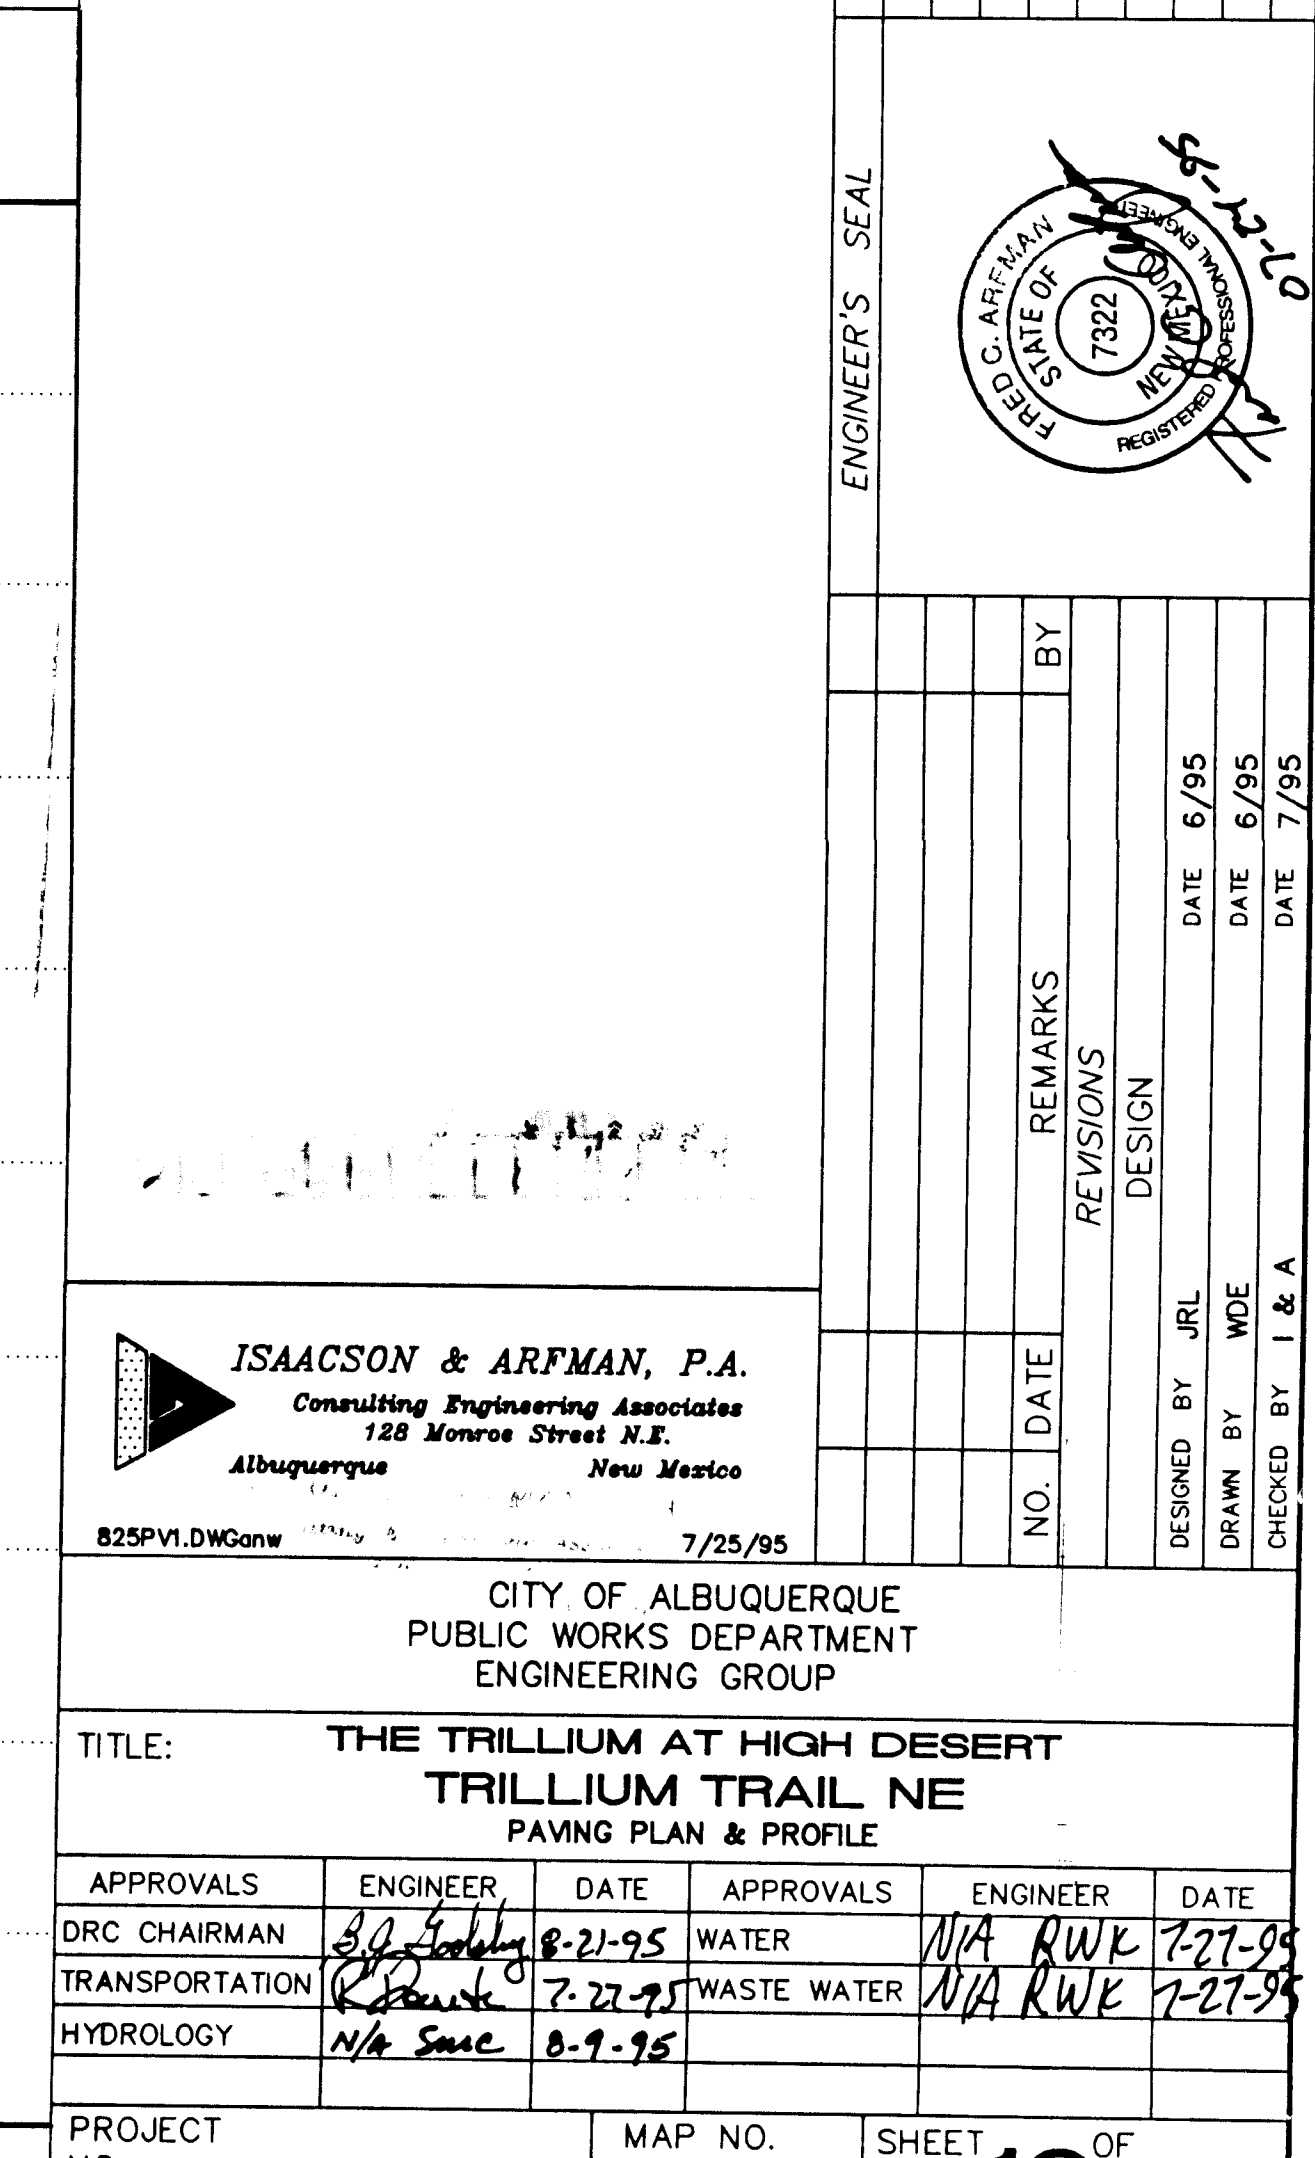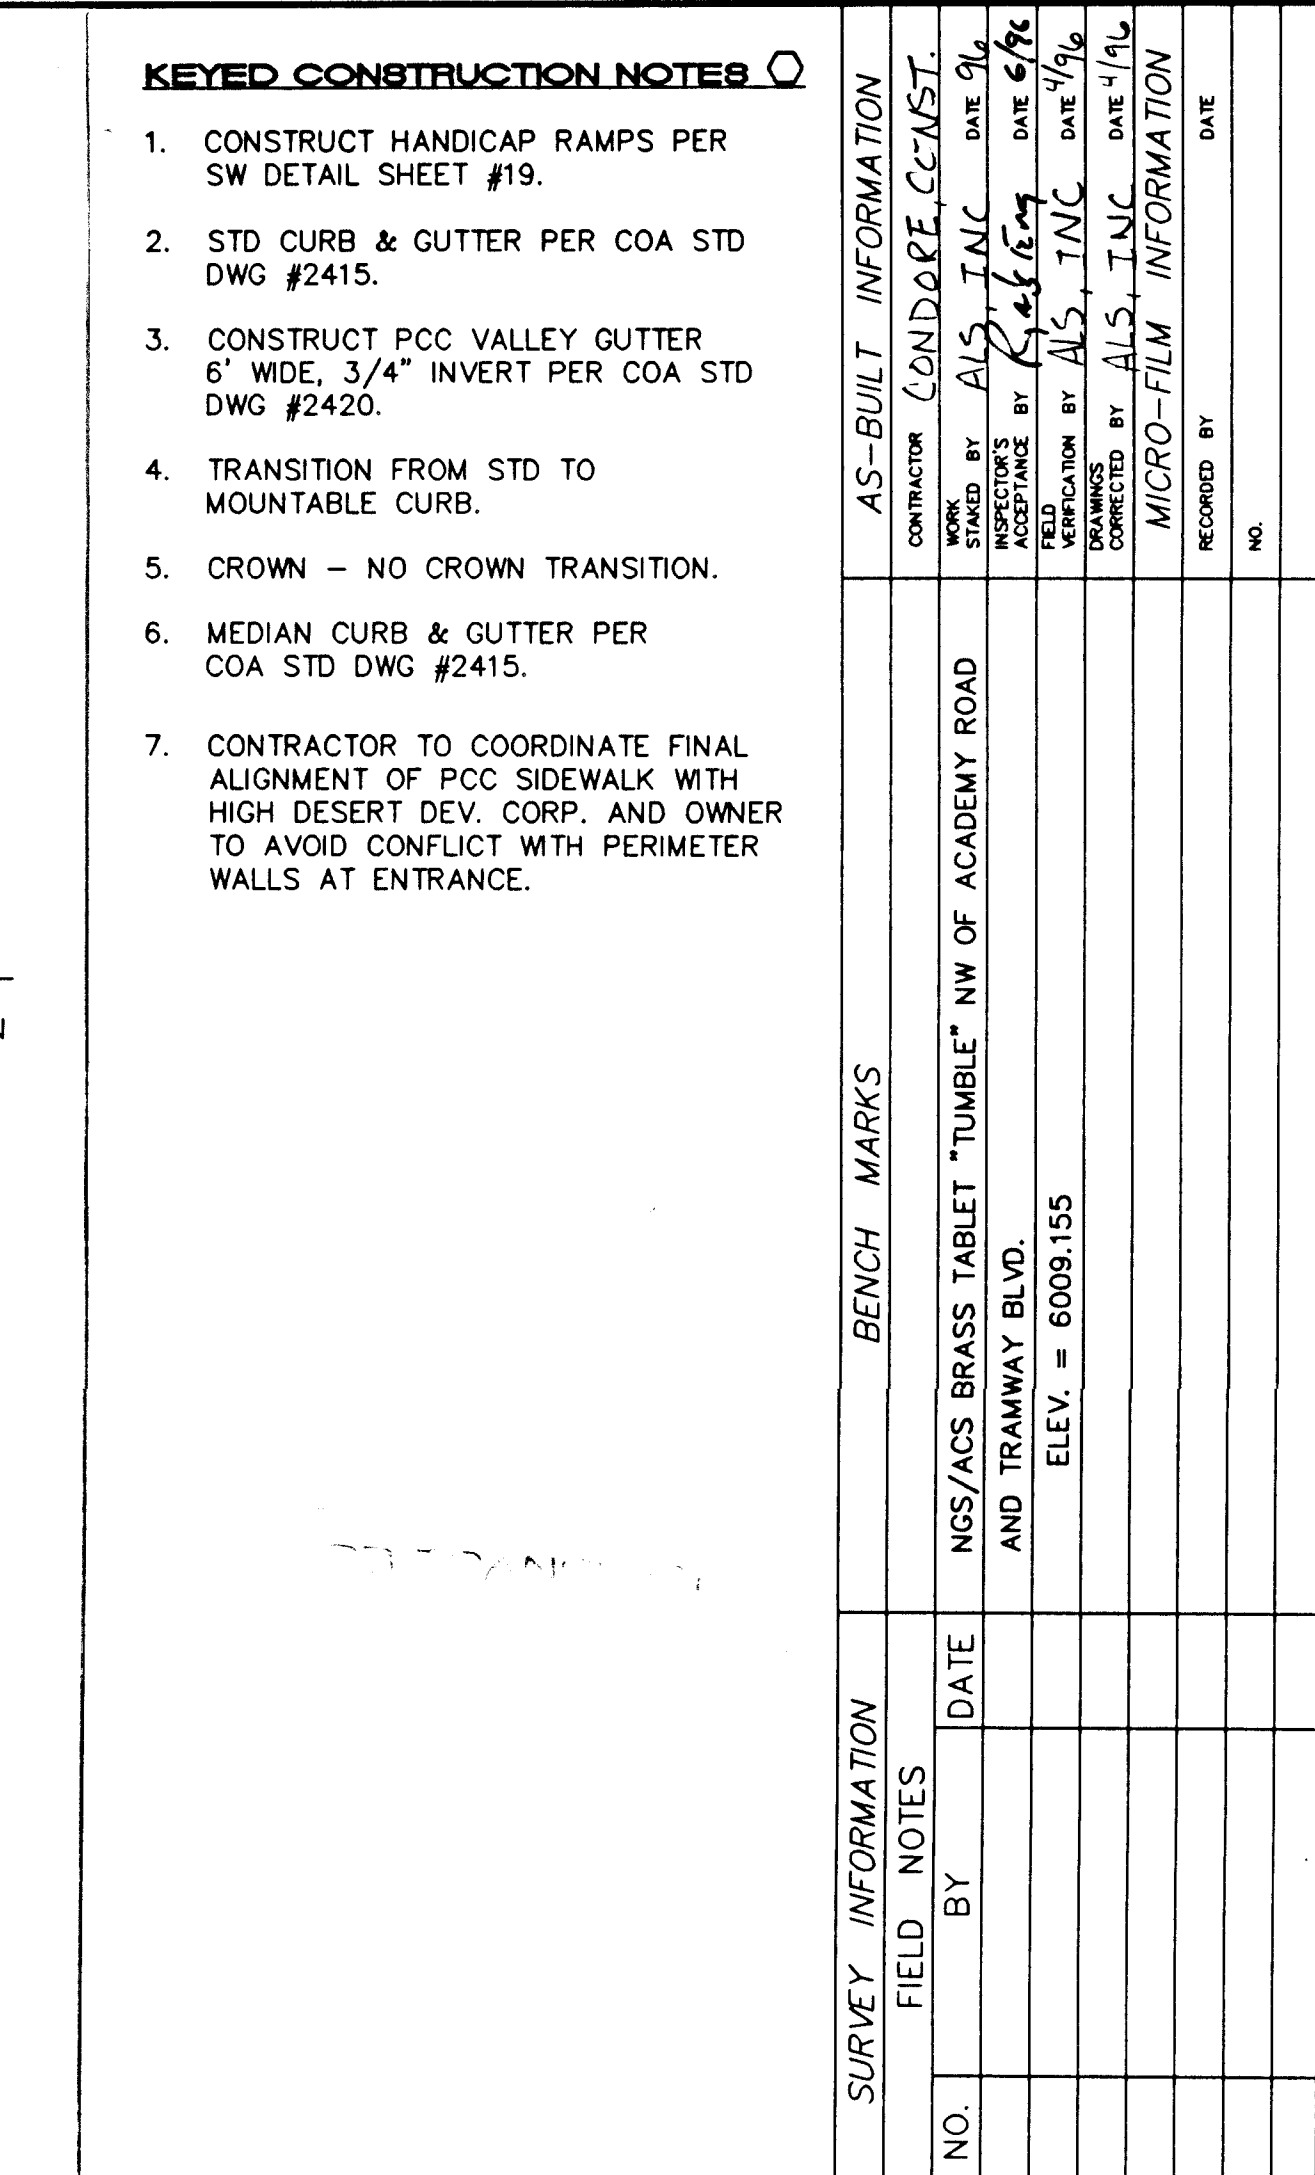

STA 1+00.00, 0' LT
BEGIN CONSTRUCTION
PURPLE ASTER LANE

STA 1+40.36, 14.00' LT, CRL
FL=49.01

STA 1+52.69, 14.00' RT, CRR
FL=48.82

STA 3+56.84, 14.00' LT, CRL
FL=44.98

STA 4+00.47, 15.00' LT
C MEDIAN

STA 4+63.76, 14.00' LT
FL=40.91

STA 5+89.77, 14.00' LT, CRL
FL=39.07

STA 6+48.39, PURPLE ASTER LANE=
STA 6+41.06 TRILLIUM TRAIL

STA 6+85.85, 14.00' LT, CRL
FL=38.87

STA 7+53.18, 14.00' LT, CRL
FL=38.62

STA 8+70.73, 14.00' LT, CRL
FL=33.90

STA 9+49.81, PURPLE ASTER LANE
END CONSTRUCTION UNIT ONE W/
28'x1 1/2'x1/2' PCC CUTOFF WALL

UNIT TWO

□ FACE OF CURB CURVE TABLE

CURVE	DELTA	RADIUS	LENGTH
AA	89°09'29"	25.00'	38.90'
AB	101°35'49"	25.00'	44.33'
AC	203°11'38"	35.00'	124.12'
AD	101°35'49"	25.00'	44.33'
AK	63°19'04"	29.00'	32.05'
AL	135°24'04"	40.00'	94.53'
AM	36°40'38"	29.00'	18.56'
AN	69°14'06"	61.00'	73.71'
AO	55°24'44"	29.00'	28.05'
AP	274°30'32"	35.00'	167.69'
AQ	39°05'49"	29.00'	19.79'
X	72°22'11"	25.00'	31.58'
Y	109°29'18"	25.00'	47.77'
Z	96°38'34"	25.00'	42.17'


SEE SHEET #5
FOR TYP. RESIDENTIAL
PAVING SECTION

PURPLE ASTER LANE

CURB TRANSITIONS

STA	OFFSET	TYPE	METHOD
6+08.44	22.38' LT	MOUNTABLE TO STANDARD	THRU HC RAMP DWG #2416
6+28.93	18.82' RT	MOUNTABLE TO STANDARD	THRU HC RAMP DWG #2416
7+72.56	23.20' LT	STANDARD TO MOUNTABLE	10' TRANSITION CENTERED @ MIDDLE OF CURVE AB
8+51.36	23.20' LT	MOUNTABLE TO STANDARD	10' TRANSITION CENTERED @ MIDDLE OF CURVE AD

SCALES:
1"=40' HOR.
1"=10' VERT.

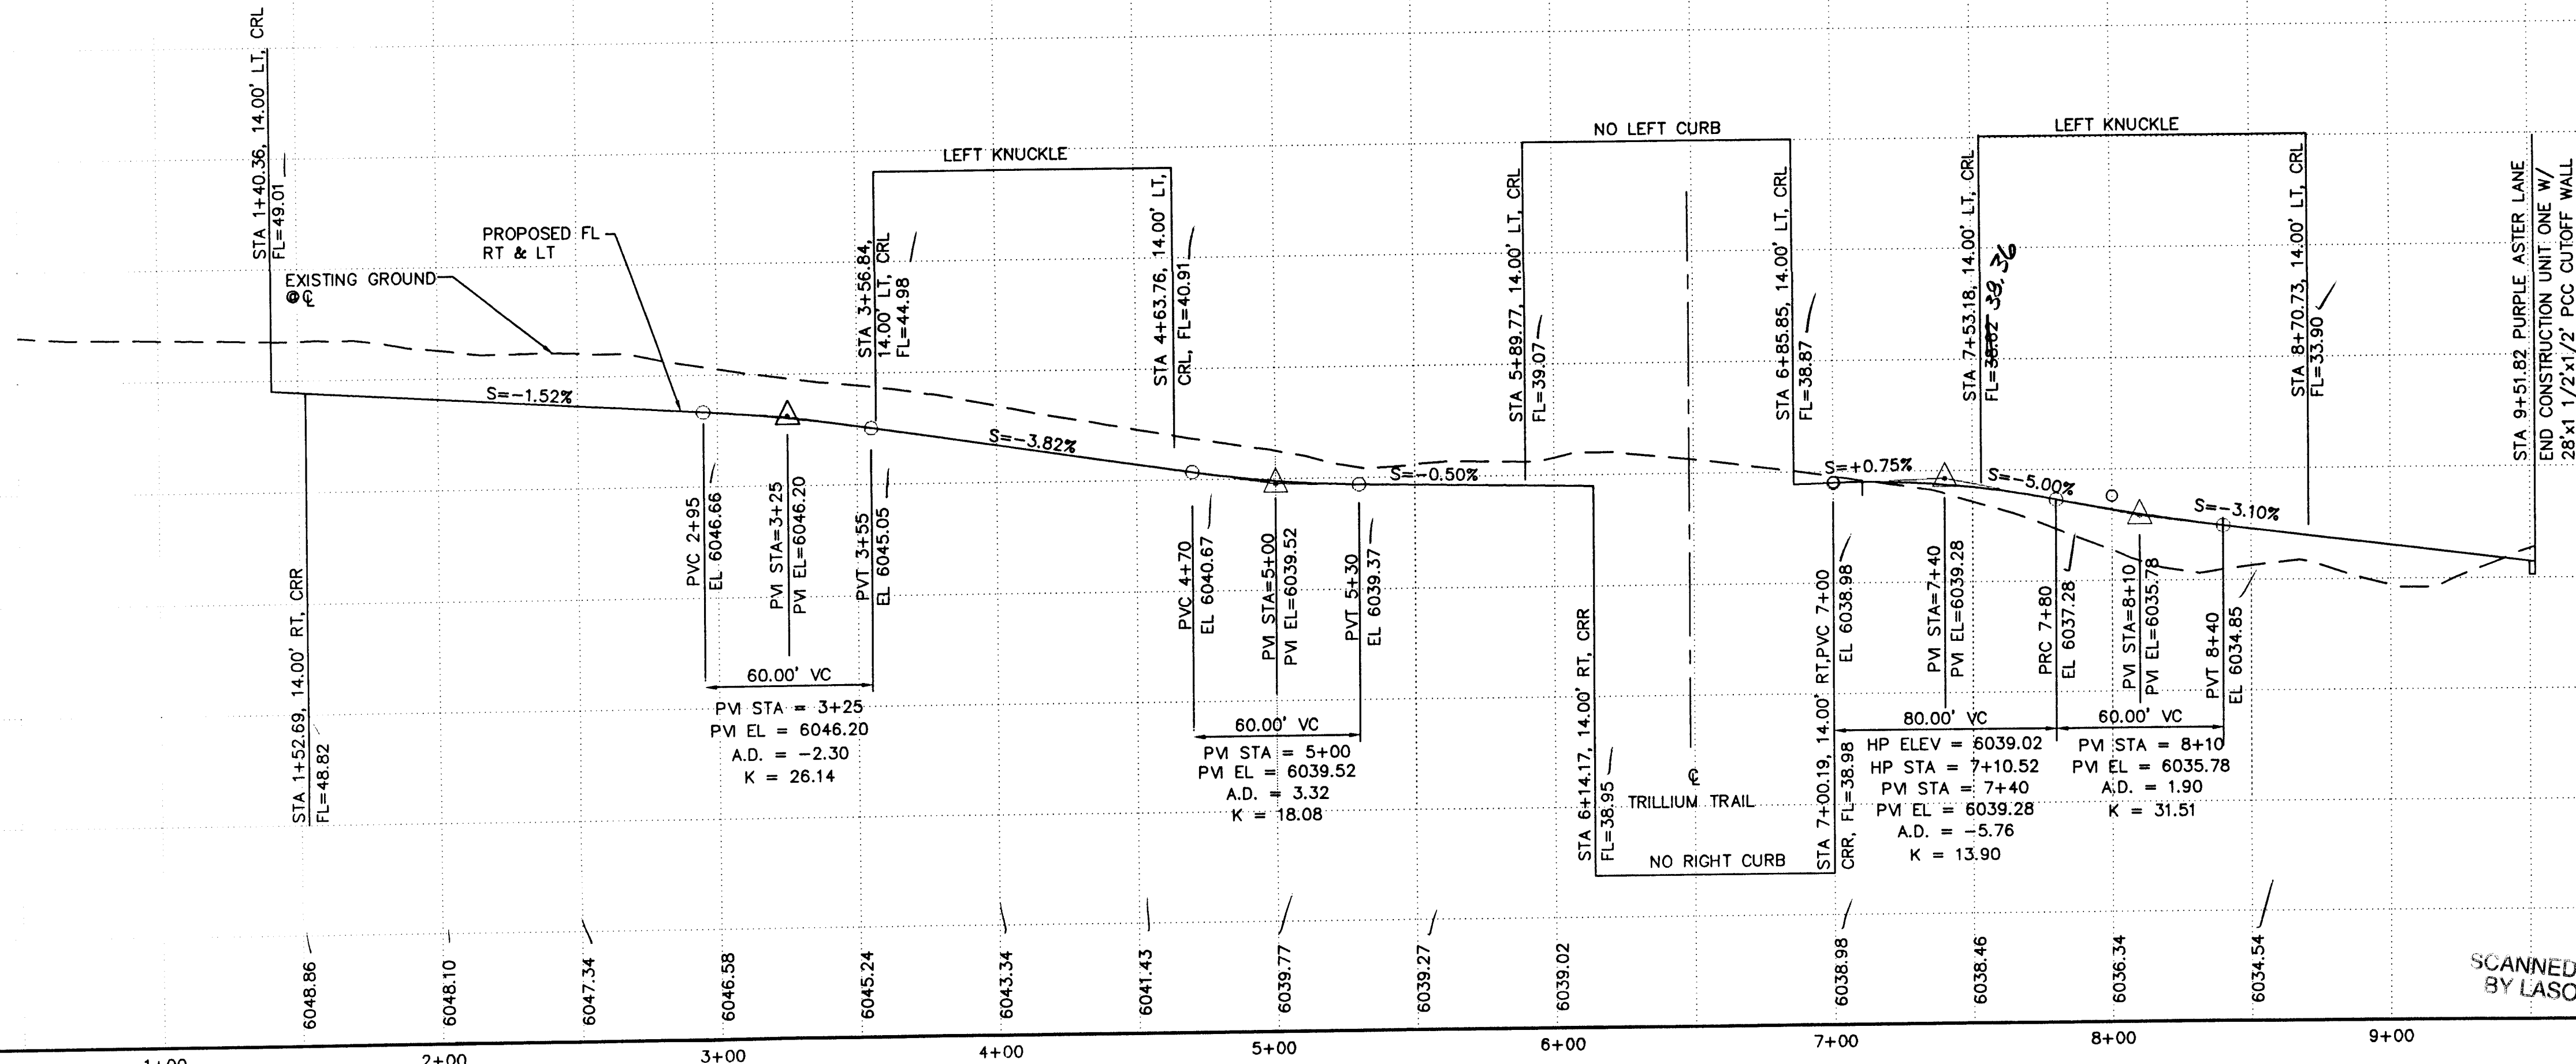


KEYED CONSTRUCTION NOTES

- CONSTRUCT HANDICAP RAMPS PER SW DETAIL SHEET #19.
- STD CURB & GUTTER PER COA STD DWG #2415.
- CONSTRUCT PCC VALLEY GUTTER 6' WIDE, 3/4" INVERT PER COA STD DWG #2420.
- TRANSITION FROM MOUNTABLE TO STD CURB & GUTTER.
- MOUNTABLE CURB & GUTTER PER COA STD DWG #2415.
- MEDIAN CURB & GUTTER PER COA STD DWG #2415.
- CROWN - NO CROWN TRANSITION 50' MIN. LENGTH.

AS-BUILT INFORMATION		BENCH MARKS		SURVEY INFORMATION		ENGINEER'S SEAL	
CONTRACTOR	DATE	NO.	FIELD NOTES	DATE	BY	NO.	REMARKS
ALS, INC.	DATE 9/95						
SUPPLIER	DATE						
ALS, INC.	DATE 9/95						
APPROVED BY	DATE						
ALS, INC.	DATE 9/95						
DESIGNED BY	DATE						
ALS, INC.	DATE 9/95						
CHECKED BY	DATE						
ALS, INC.	DATE 9/95						
RECORDED BY	DATE						
ALS, INC.	DATE 9/95						

NO. 5251.90 MAP NO. E-23 SHEET 11 OF 19

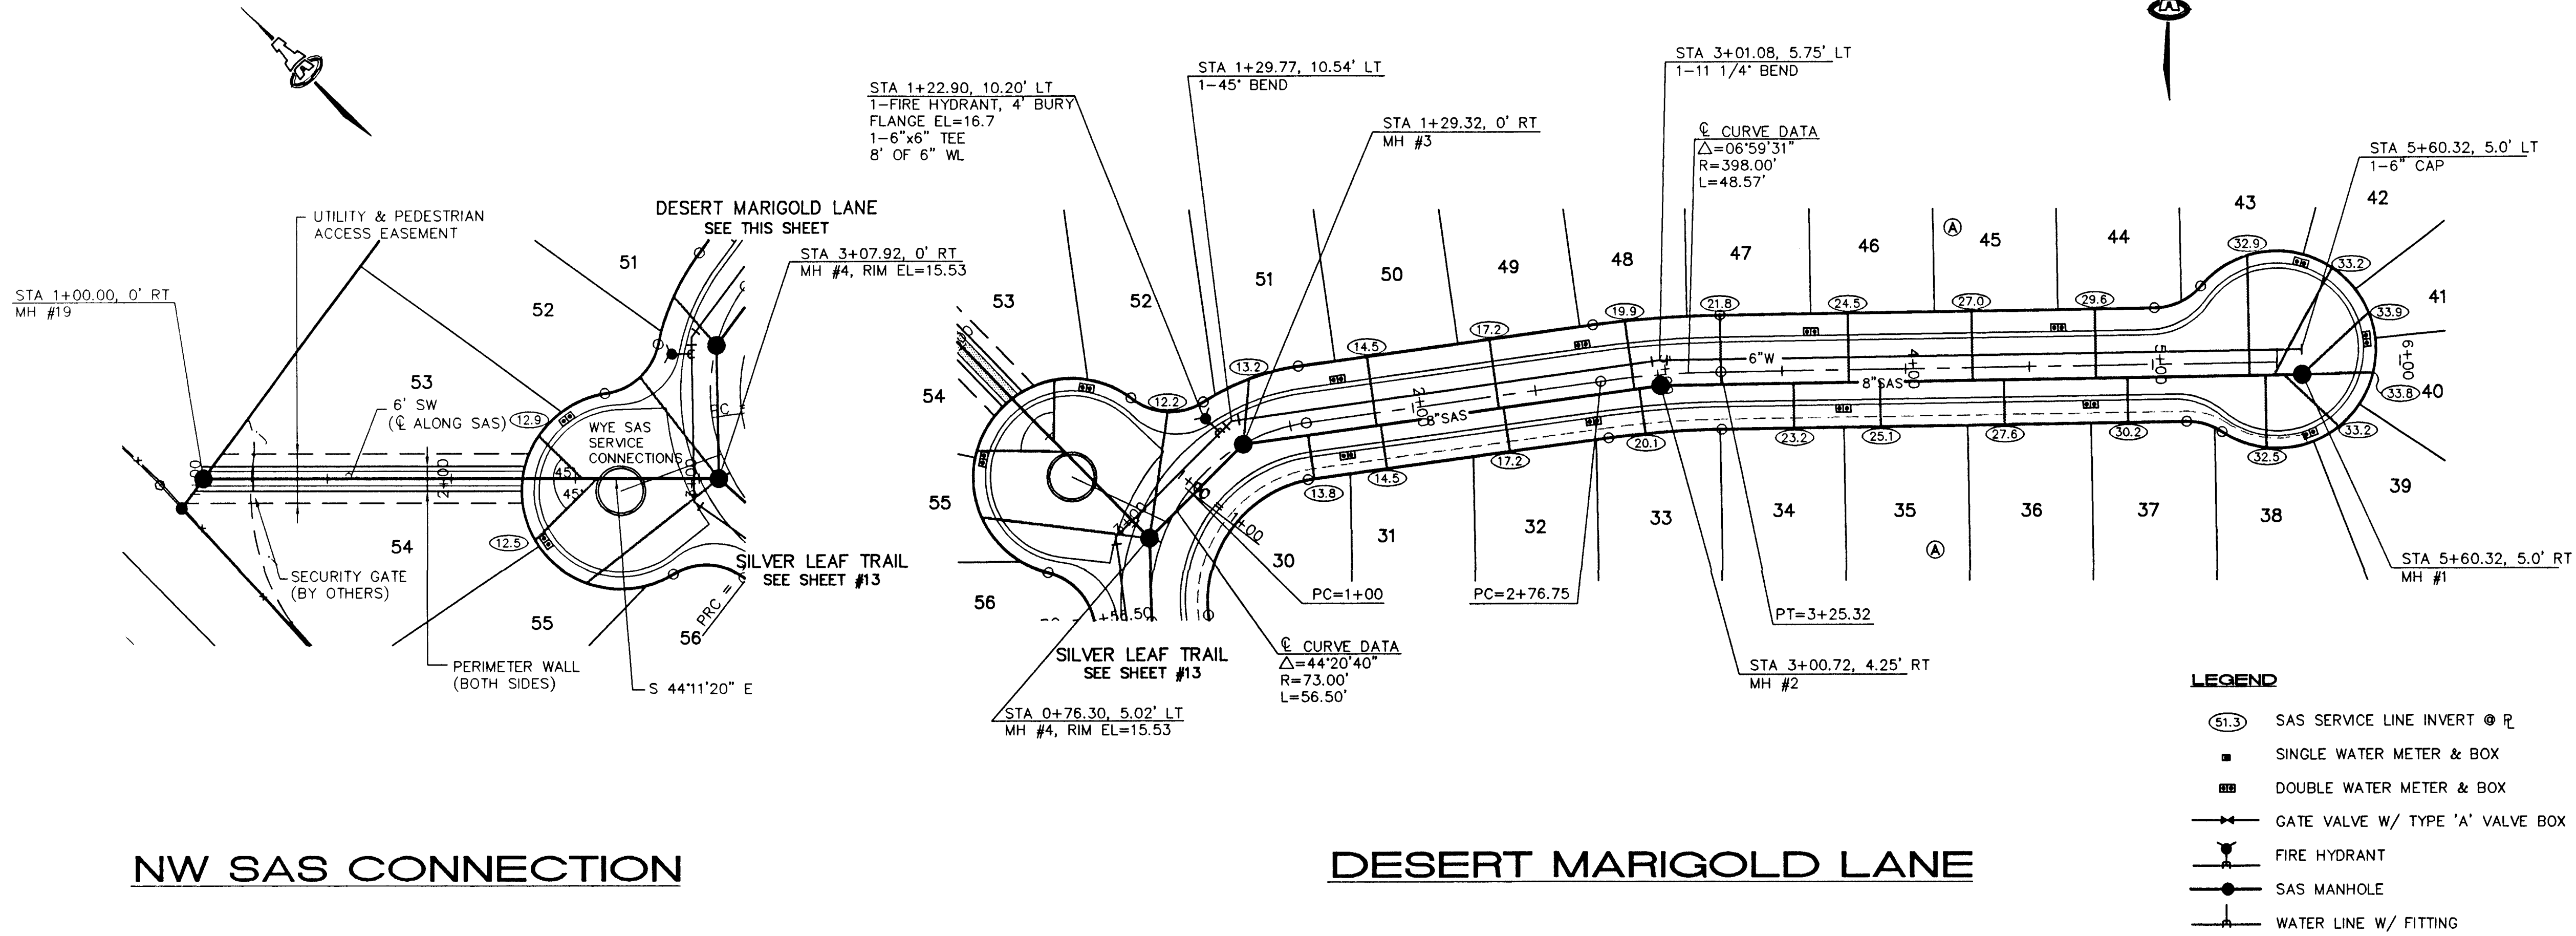


- GENERAL NOTES**
1. CONSTRUCT SAS SERVICES PER COA STD DWG #2125.
 2. CONSTRUCT FIRE HYDRANTS PER DESIGNATED DEPTHS & LENGTHS PER COA STD DWG #2340.
 3. CONSTRUCT ALL SINGLE & DOUBLE WATER SERVICES PER COA STD DWG'S #2361, #2362, & #2363.
 4. SEE SHEET #6 FOR WATER SHUT-OFF PLAN.
 5. SEE SHEET #6 FOR RESTRAINED JOINT LENGTHS FOR WATER LINE FITTINGS.

SAS SERVICE TABLE			
LOT NO.	STA.	INV.	R/W
BLOCK A			
30	1+56.50	15.4	
31	1+86.06	16.7	
32	2+36.26	19.0	
33	2+91.93	21.6	
34	3+54.60	24.5	
35	3+89.60	26.1	
36	4+39.60	28.4	
37	4+89.60	30.7	
38	15' FROM PL	32.5	
39		33.2	
40		33.8	
41		33.9	
42		33.2	
43		32.9	
44	4+77.02	30.1	
45	4+27.02	27.8	
46	3+77.02	25.5	
47	3+25.32	23.1	
48	2+89.04	21.5	
49	2+34.37	18.9	
50	1+84.37	16.6	
51	1+40.76	14.7	
52	1+14.66	13.5	
53	2+35.35	12.9	
54	2+33.71	12.5	

- LEGEND**
- (51.3) SAS SERVICE LINE INVERT @ R
 - SINGLE WATER METER & BOX
 - DOUBLE WATER METER & BOX
 - GATE VALVE W/ TYPE 'A' VALVE BOX
 - ⊕ FIRE HYDRANT
 - SAS MANHOLE
 - WATER LINE W/ FITTING

SCALES:
1"=40' HOR
1"=10' VERT.

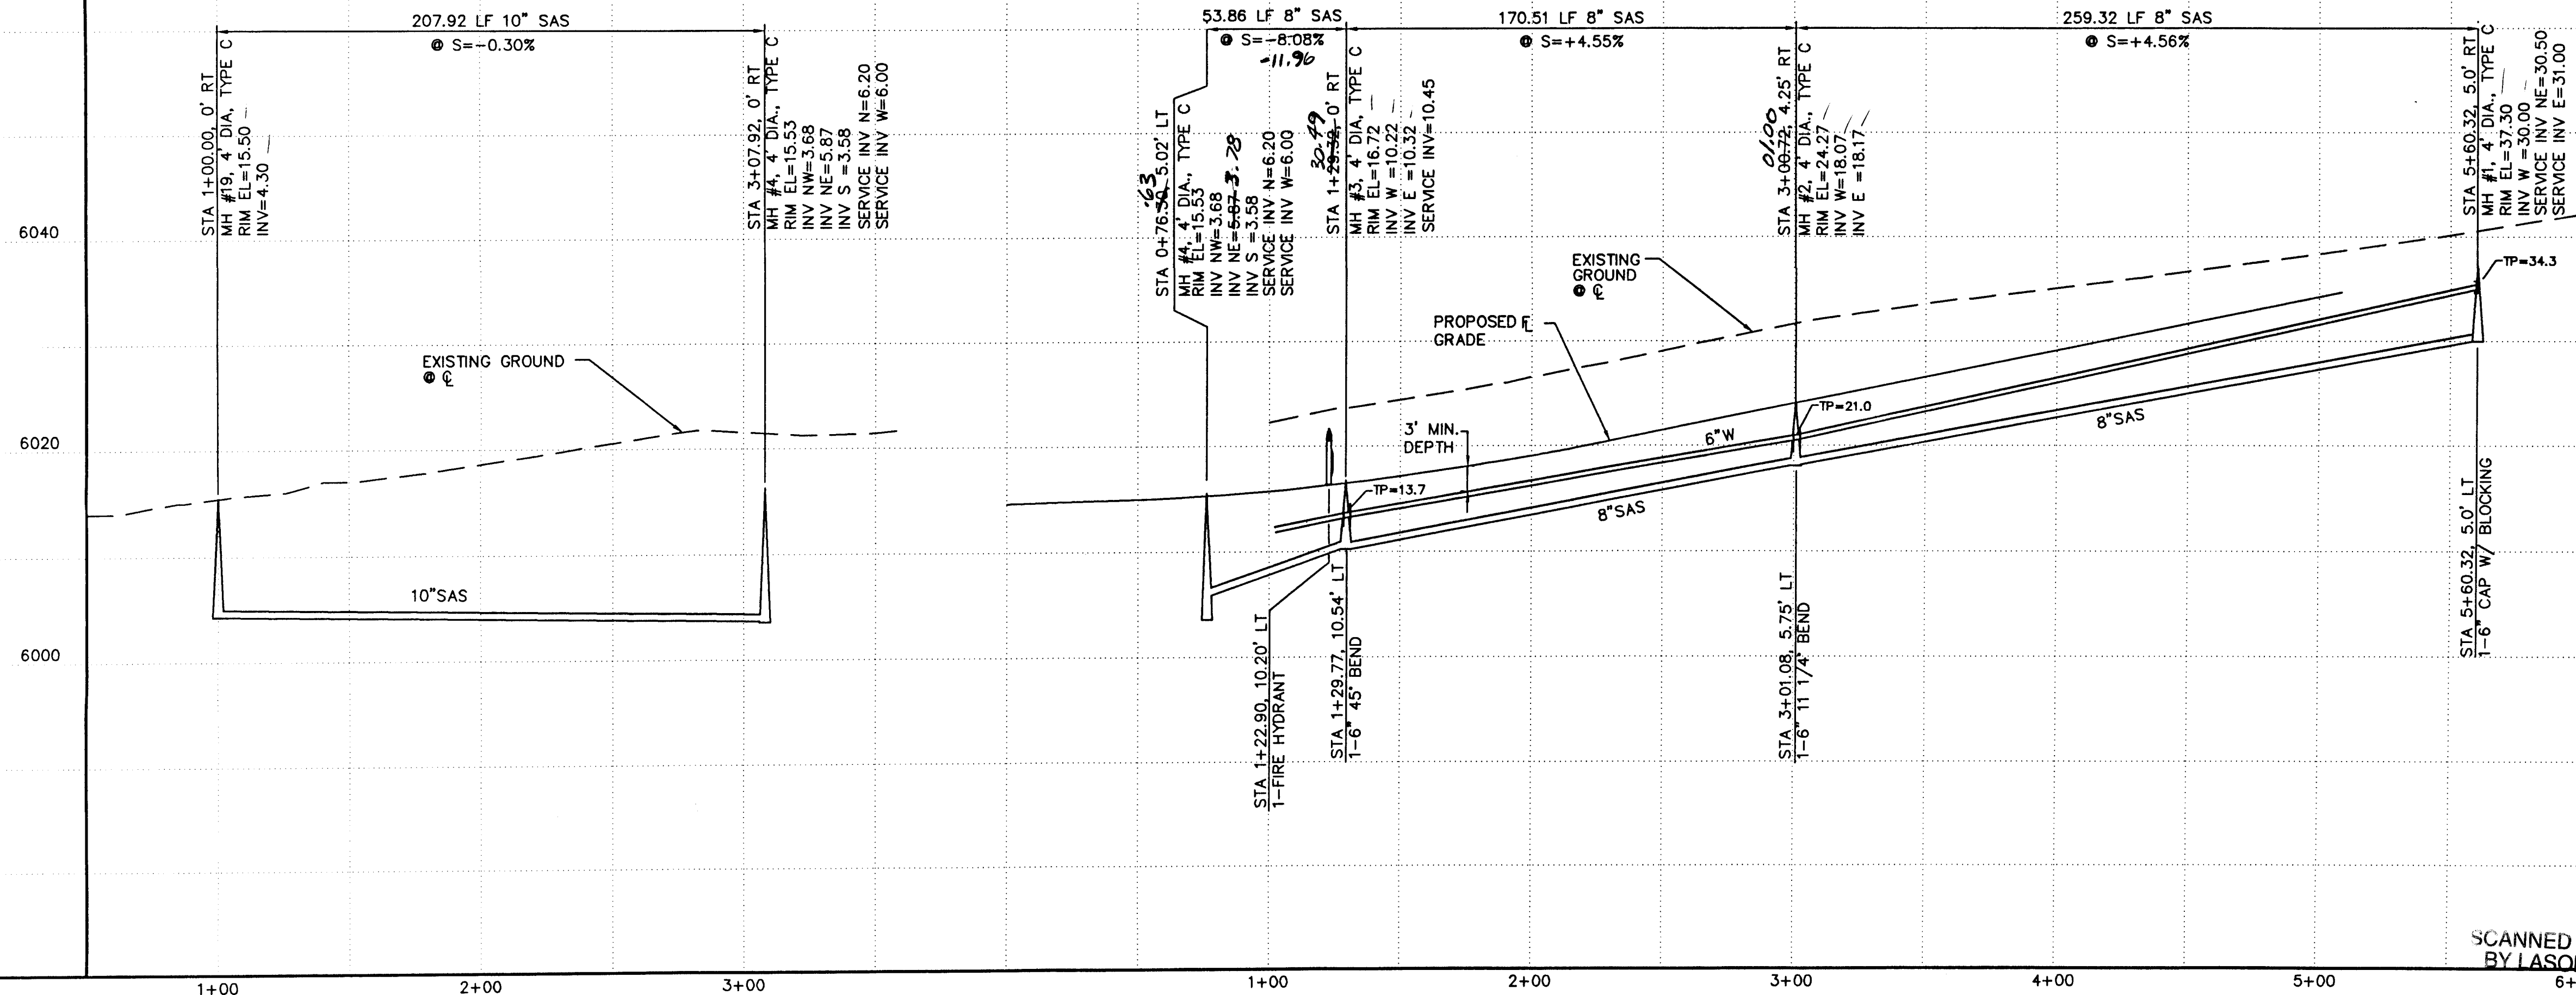

ENGINEER'S SEAL

NO. DATE BY

REMARKS

DESIGN

REVISIONS

DESIGNED BY JRL DATE 6/95

DRAWN BY WOE DATE 6/95

CHECKED BY I & A DATE 7/95

ISAACSON & ARFMAN, P.A.

Consulting Engineering Associates

128 Monroe Street N.E.

Albuquerque New Mexico

825UTL3.DWGaw 7/20/95

CITY OF ALBUQUERQUE

PUBLIC WORKS DEPARTMENT

ENGINEERING GROUP

TITLE: THE TRILLIUM AT HIGH DESERT

DESERT MARIGOLD LANE & NW SAS CONN.


UTILITY PLAN & PROFILE

APPROVALS	ENGINEER	DATE	APPROVALS	ENGINEER	DATE
DRC CHAIRMAN	J.R. L...	8-21-95	WATER	R.W. K...	7-27-95
TRANSPORTATION	R. S...	7-7-95	WASTE WATER	R.W. K...	7-27-95
HYDROLOGY	N/A SMC	8-9-95			

PROJECT NO. 5251.90

MAY NO. E-23

SHEET 12 OF 19

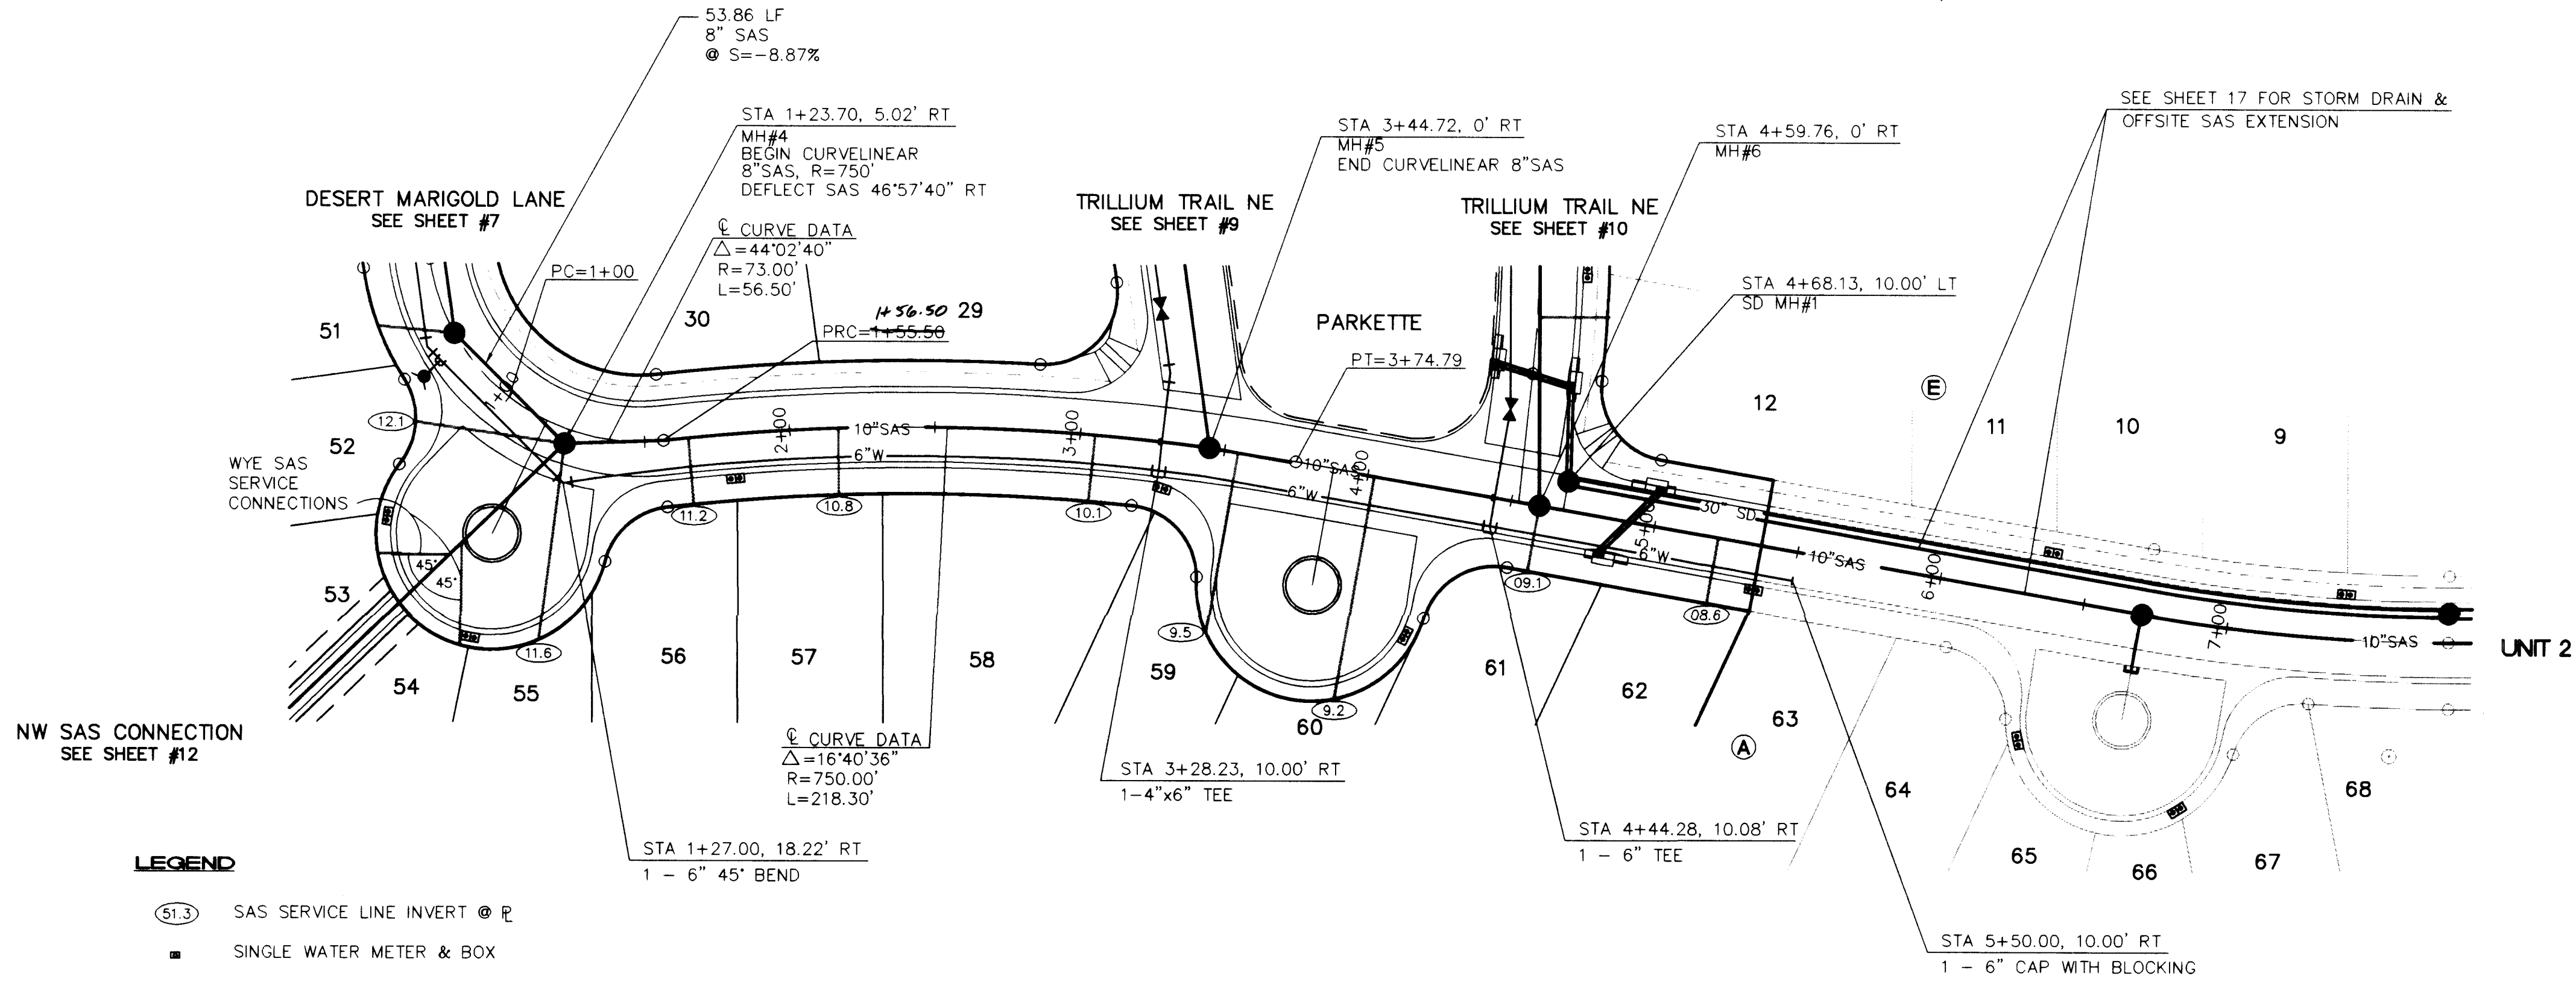

- LEGEND**
- ST.3 SAS SERVICE LINE INVERT @ P
 - SINGLE WATER METER & BOX
 - DOUBLE WATER METER & BOX
 - GATE VALVE W/ TYPE 'A' VALVE BOX
 - FIRE HYDRANT
 - SAS MANHOLE
 - WATER LINE W/ FITTING

SILVER LEAF TRAIL

SCALES:
1"=40' HOR
1"=10' VERT.


- GENERAL NOTES**
- CONSTRUCT SAS SERVICES PER COA STD DWG #2125.
 - CONSTRUCT FIRE HYDRANTS PER DESIGNATED DEPTHS & LENGTHS PER COA STD DWG #2340.
 - CONSTRUCT ALL SINGLE & DOUBLE WATER SERVICES PER COA STD DWG'S #2361, #2362, & #2363.
 - SEE SHEET #6 FOR WATER SHUT-OFF PLAN.
 - SEE SHEET #6 FOR RESTRAINED JOINT LENGTHS FOR WATER LINE FITTINGS.

SAS SERVICE TABLE

LOT NO.	STA.	INV. @ R/W
BLOCK A		
52	MH #4	13.5
55	MH #4	11.6
56	STA 1+64.58	11.2
57	STA 2+16.21	10.8
58	STA 3+04.61	10.4
59	STA 3+53.17	9.5
60	STA 4+02.57	9.2
61	MH #6	9.1
62	STA 5+22.29	8.6

AS-BUILT INFORMATION		CONTRACTOR		DATE	
CONTRACTOR	CONDORE CONST.	STANDARD BY	ALB	DATE	9/96
INSPECTOR'S	ALB	FIELD	ALB	DATE	6/96
VERIFICATION BY	ALB	DATE	4/96		
CONNECTIONS	ALB	DATE	4/96		
RECORDED BY	ALB	DATE	4/96		
MICRO-FILM INFORMATION		DATE		NO.	


BENCH MARKS		SURVEY INFORMATION		FIELD NOTES	
NGS/ACS BRASS TABLET "TUMBLE" NW OF ACADEMY ROAD AND TRAMWAY BLVD.	ELEV. = 6009.155	DATE	BY	NO.	

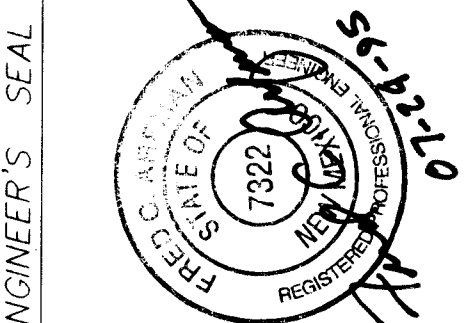


REVISIONS		REMARKS		BY	
NO.	DATE	NO.	DATE	NO.	DATE
DESIGNED BY	JRL	DATE	6/95	DRAWN BY	WDE
CHECKED BY	I & A	DATE	6/95		

ISAACSON & ARFMAN, P.A.
Consulting Engineering Associates
128 Monroe Street N.E.
Albuquerque New Mexico

CITY OF ALBUQUERQUE PUBLIC WORKS DEPARTMENT ENGINEERING GROUP					
TITLE: THE TRILLIUM AT HIGH DESERT SILVER LEAF TRAIL UTILITY PLAN & PROFILE					
APPROVALS	ENGINEER	DATE	APPROVALS	ENGINEER	DATE
DRC CHAIRMAN	ALB	8-21-95	WATER	R.W. Kane	7-27-95
TRANSPORTATION	N/A RHO	7-27-95	WASTE WATER	R.W. Kane	7-27-95
HYDROLOGY	N/A SMC	8-4-95			
PROJECT NO.	5251.90	MAP NO.	E-23	SHEET	13 OF 19

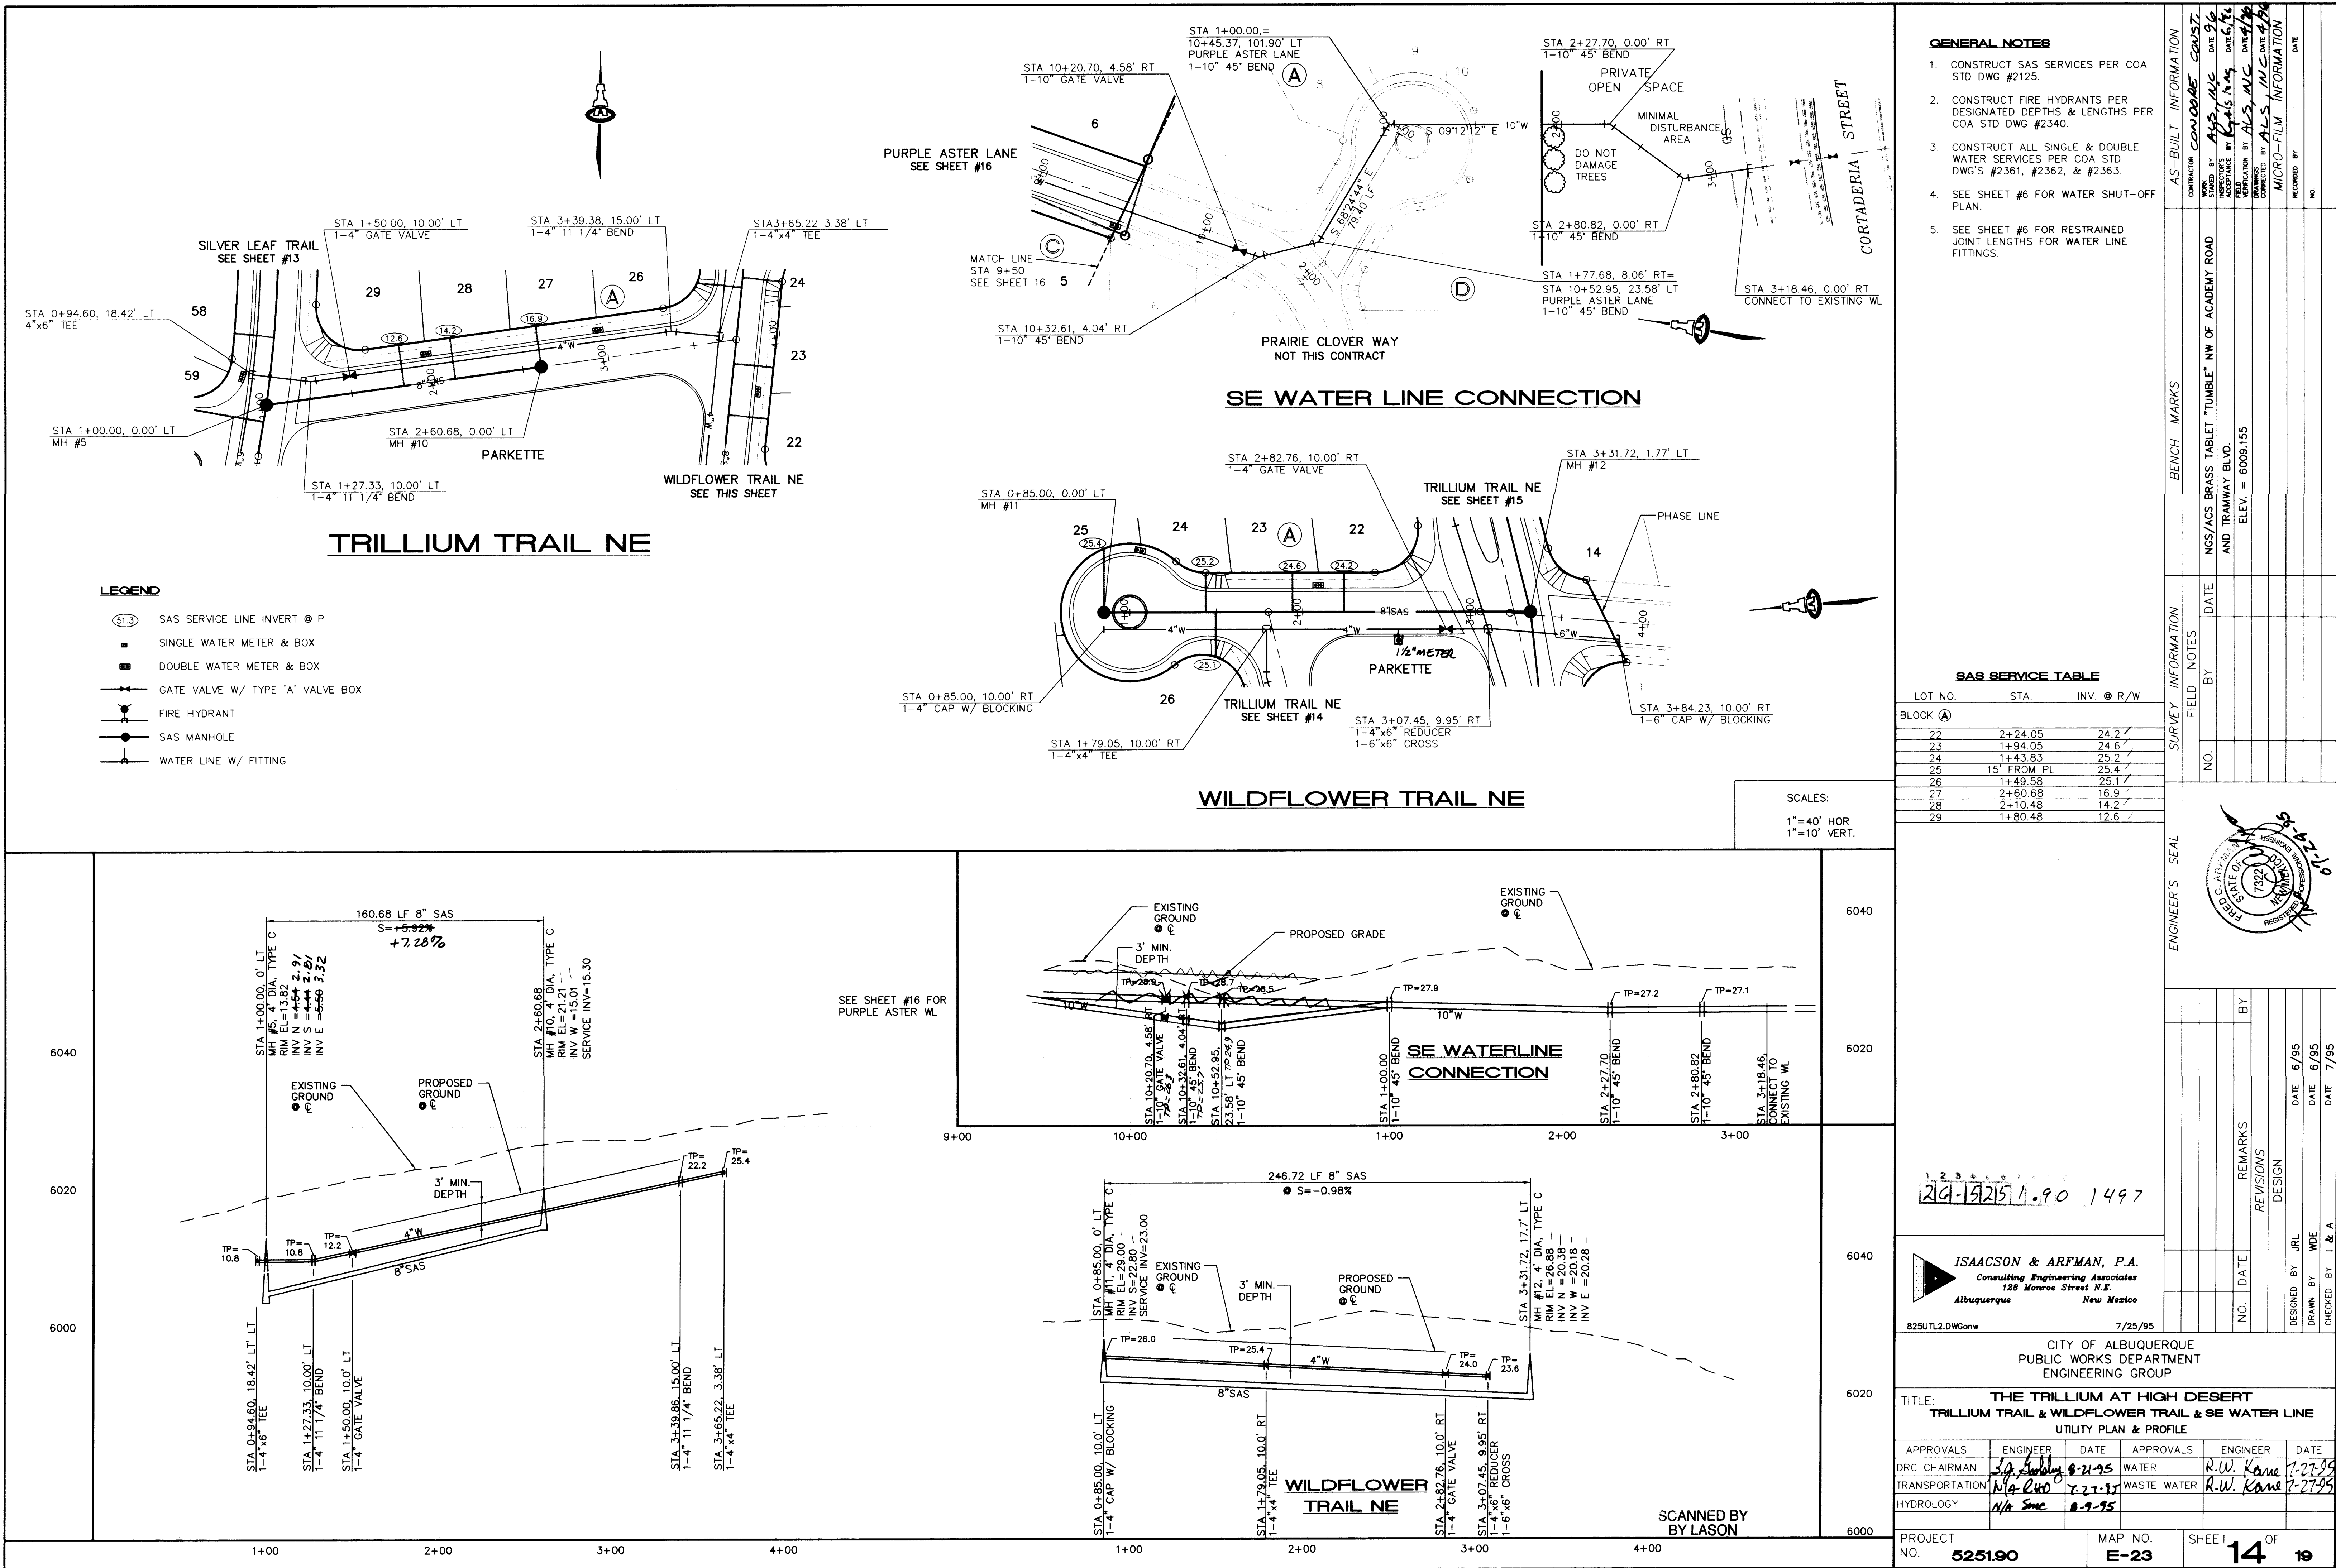

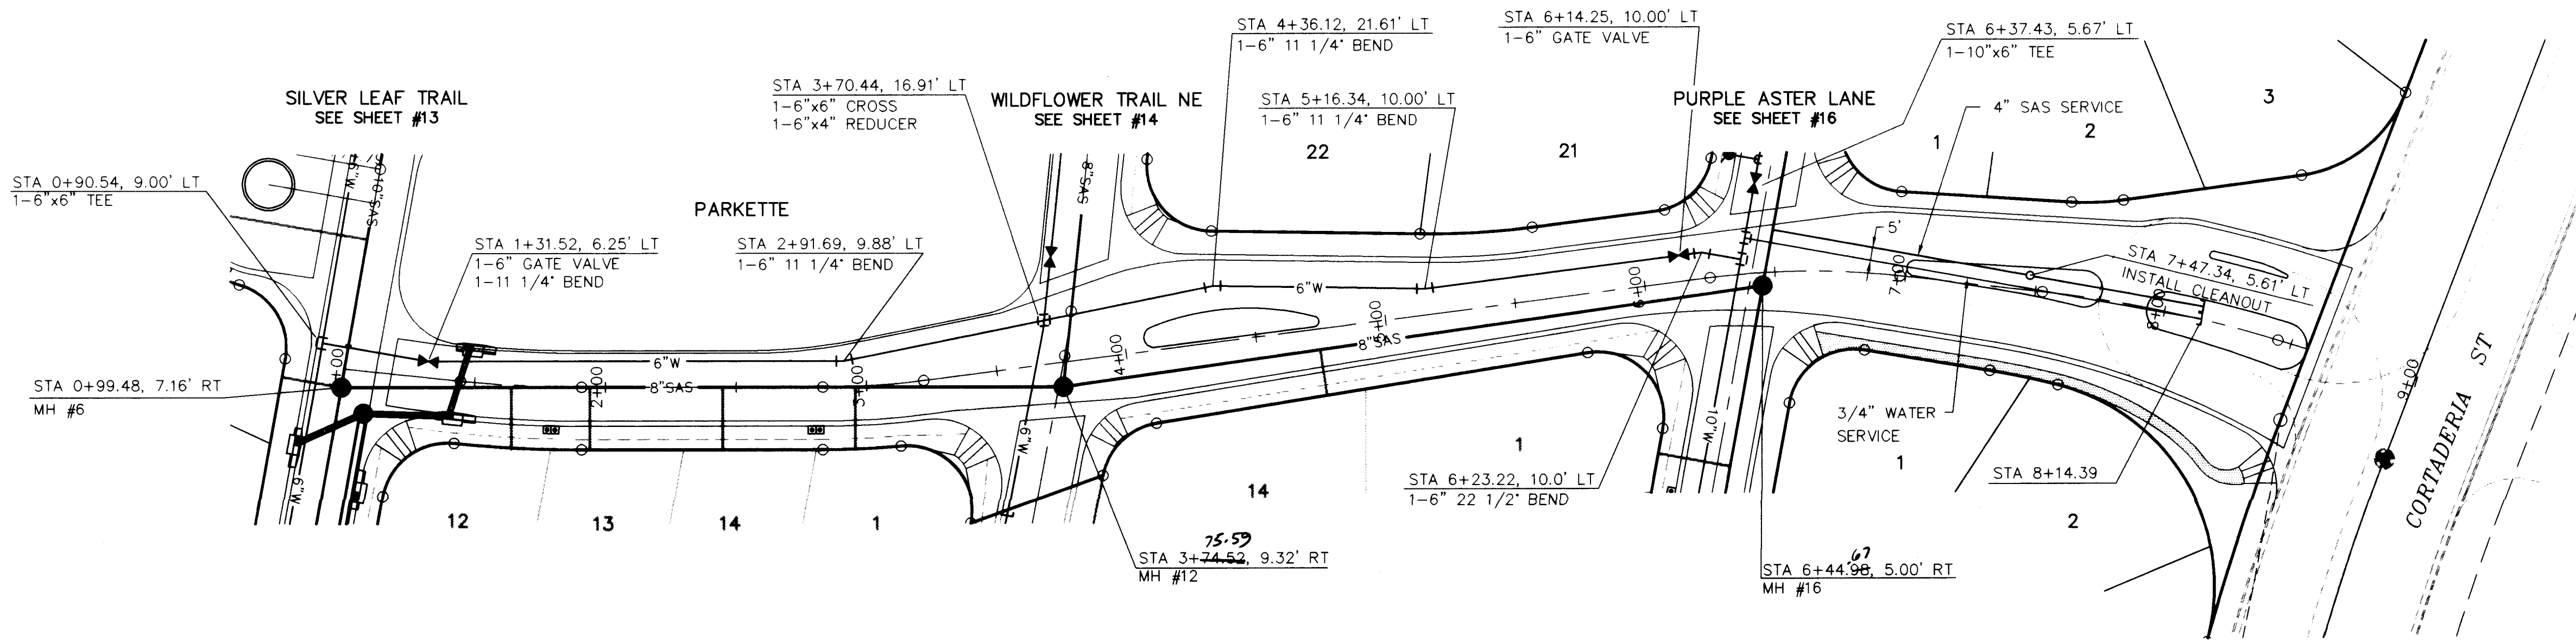

TRILLIUM TRAIL NE

LEGEND


- ⑤1.3 SAS SERVICE LINE INVERT @ R
- SINGLE WATER METER & BOX
- DOUBLE WATER METER & BOX
- GATE VALVE W/ TYPE 'A' VALVE BOX
- FIRE HYDRANT
- SAS MANHOLE
- WATER LINE W/ FITTING

SCALES:
1"=40' HOR.
1"=10' VERT.

SAS SERVICE TABLE

LOT NO.	STA.	INV. @ R/W
BLOCK C		
1	2+94.75	19.6
12	1+65.52	11.9
13	1+94.12	13.6
14	2+44.88	16.6
BLOCK C		
14	4+73.71	26.5

GUARD SHACK 8+14.39 41.40

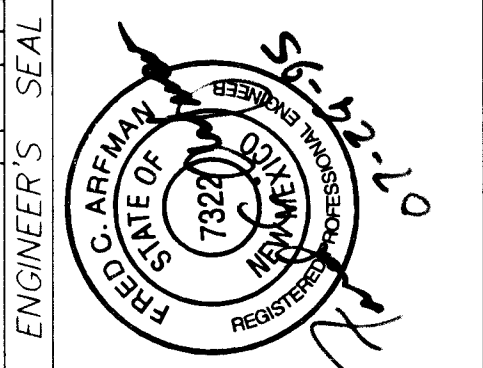

2015 12 15 90 1597

ISAACSON & ARFMAN, P.A.
Consulting Engineering Associates
128 Monroe Street N.E.
Albuquerque New Mexico

825UTL1.DWG 7/2/95


CITY OF ALBUQUERQUE
PUBLIC WORKS DEPARTMENT
ENGINEERING GROUP

TITLE: **THE TRILLIUM AT HIGH DESERT
TRILLIUM TRAIL NE
UTILITY PLAN & PROFILE**

APPROVALS	ENGINEER	DATE	APPROVALS	ENGINEER	DATE
DRC CHAIRMAN	30.4.2009	8-21-95	WATER	R.W. Kane	7-27-95
TRANSPORTATION	NA RHO	7-27-95	WASTE WATER	R.W. Kane	7-27-95
HYDROLOGY	NA SMC	8-9-95			

PROJECT NO. **5251.90** MAP NO. **E-23** SHEET **15** OF **19**

SCANNED BY
BY LASON

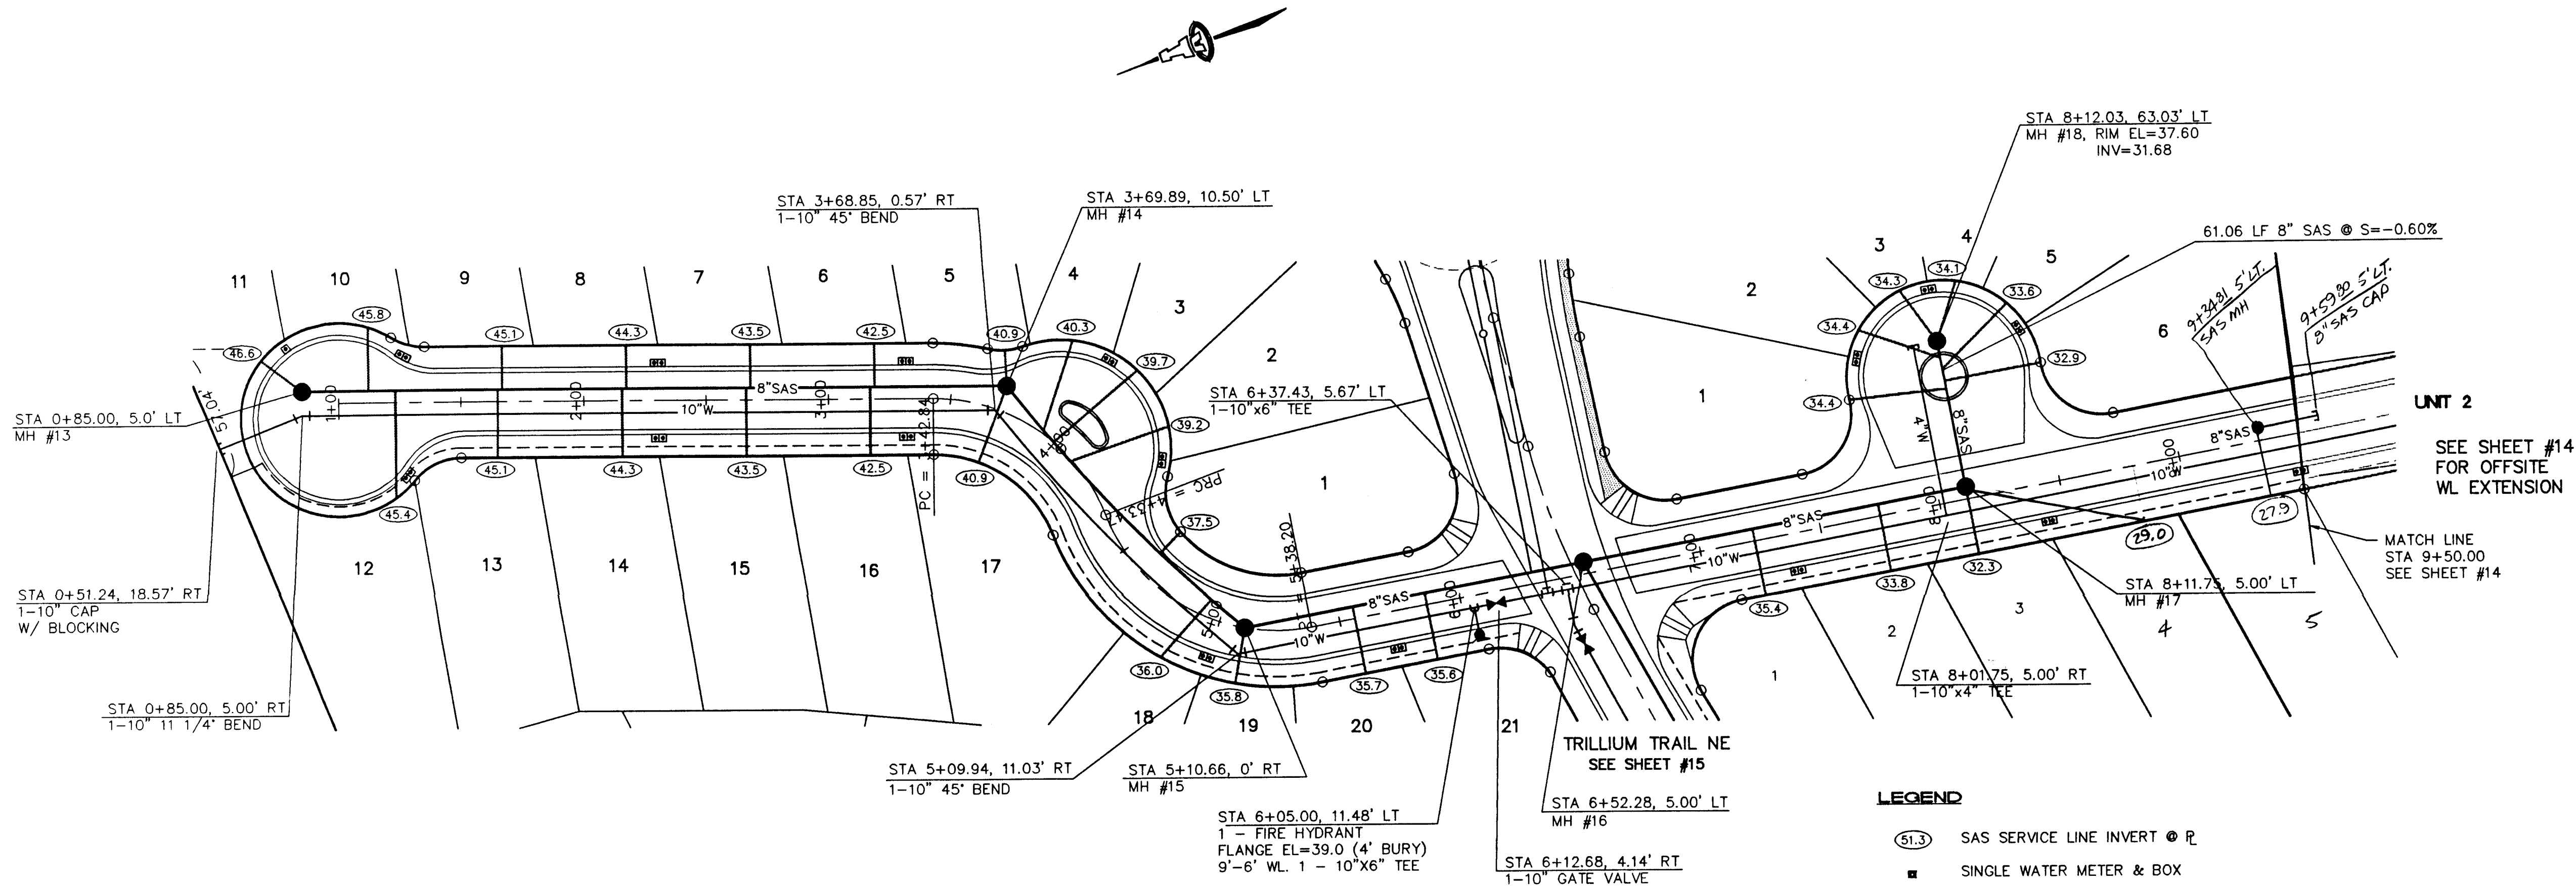

PURPLE ASTER LANE

- LEGEND**
- (S) SAS SERVICE LINE INVERT @ R
 - SINGLE WATER METER & BOX
 - DOUBLE WATER METER & BOX
 - ⌵ GATE VALVE W/ TYPE 'A' VALVE BOX
 - ⊙ FIRE HYDRANT
 - SAS MANHOLE
 - WATER LINE W/ FITTING

SCALES:
1"=40' HOR
1"=10' VERT.

GENERAL NOTES

1. CONSTRUCT SAS SERVICES PER COA STD DWG #2125.
2. CONSTRUCT FIRE HYDRANTS PER DESIGNATED DEPTHS & LENGTHS PER COA STD DWG #2340.
3. CONSTRUCT ALL SINGLE & DOUBLE WATER SERVICES PER COA STD DWG'S #2361, #2362, & #2363.
4. SEE SHEET #6 FOR WATER SHUT-OFF PLAN.
5. SEE SHEET #6 FOR RESTRAINED JOINT LENGTHS FOR WATER LINE FITTINGS.

SAS SERVICE TABLE

LOT NO. STA. INV. @ R/W

BLOCK (A)		
1	4+60.56	39.0
2	15' FROM PL	39.8
3	"	40.5
4	"	41.1
5	3+69.89	41.4
6	3+18.83	42.4
7	2+68.15	43.1
8	2+17.48	43.9
9	1+66.80	44.6
10	1+12.19	44.5
11	15' FROM PL	46.6
12	1+23.24	45.4
13	1+65.05	44.7
14	2+15.72	43.9
15	2+66.40	43.2
16	3+17.08	42.4
17	3+69.89	41.4
18	4+93.27	39.2
19	5+10.66	37.7
20	5+56.23	36.5
21	5+86.23	35.7

BLOCK (B)		
1	15' FROM PL	34.4
2	"	34.4
3	"	34.3
4	"	34.1
5	"	33.6
6	"	32.9

BLOCK (C)		
1	7+22.62	35.6
2	7+75.08	34.9
3	8+11.75	33.5

ISAACSON & ARFMAN, P.A.
Consulting Engineering Associates
128 Monroe Street N.E.
Albuquerque New Mexico

825UTL7.DWGonw 6/29/95


CITY OF ALBUQUERQUE
PUBLIC WORKS DEPARTMENT
ENGINEERING GROUP

TITLE: **THE TRILLIUM AT HIGH DESERT
PURPLE ASTER LANE
UTILITY PLAN & PROFILE**

APPROVALS	ENGINEER	DATE	APPROVALS	ENGINEER	DATE
DRC CHAIRMAN	<i>B.G. Embury</i>	8-21-95	WATER	<i>R.W. Kane</i>	7-27-95
TRANSPORTATION	<i>M.A. RHO</i>	7-27-95	WASTE WATER	<i>R.W. Kane</i>	7-27-95
HYDROLOGY	<i>N.A. Sme</i>	8-9-95			





PROJECT NO. **5251.90** MAP NO. **E-23** SHEET **16** OF **19**

AS-BUILT INFORMATION		CONTRACTOR		DATE	
CONTRACT	CONDORE CONDST.	WORK	BY <i>ALS, INC.</i>	DATE	7/95
DESIGNED BY	ALS, INC.	DATE	7/95		
FIELD ACCEPTANCE BY	<i>ALS, INC.</i>	DATE	7/95		
REVISIONS	BY <i>ALS, INC.</i>	DATE	7/95		
CORRECTED BY	<i>ALS, INC.</i>	DATE	7/95		
MICRO-FILM INFORMATION		RECORDED BY		NO.	

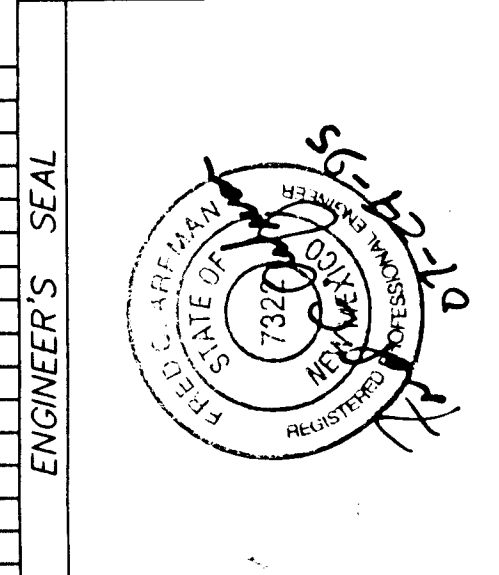

REVISIONS		BY		DATE	
NO.	DATE	REMARKS	DESIGN	DATE	DATE
1	6/95				
2	6/95				
3	7/95				

SCANNED BY
BY LASON

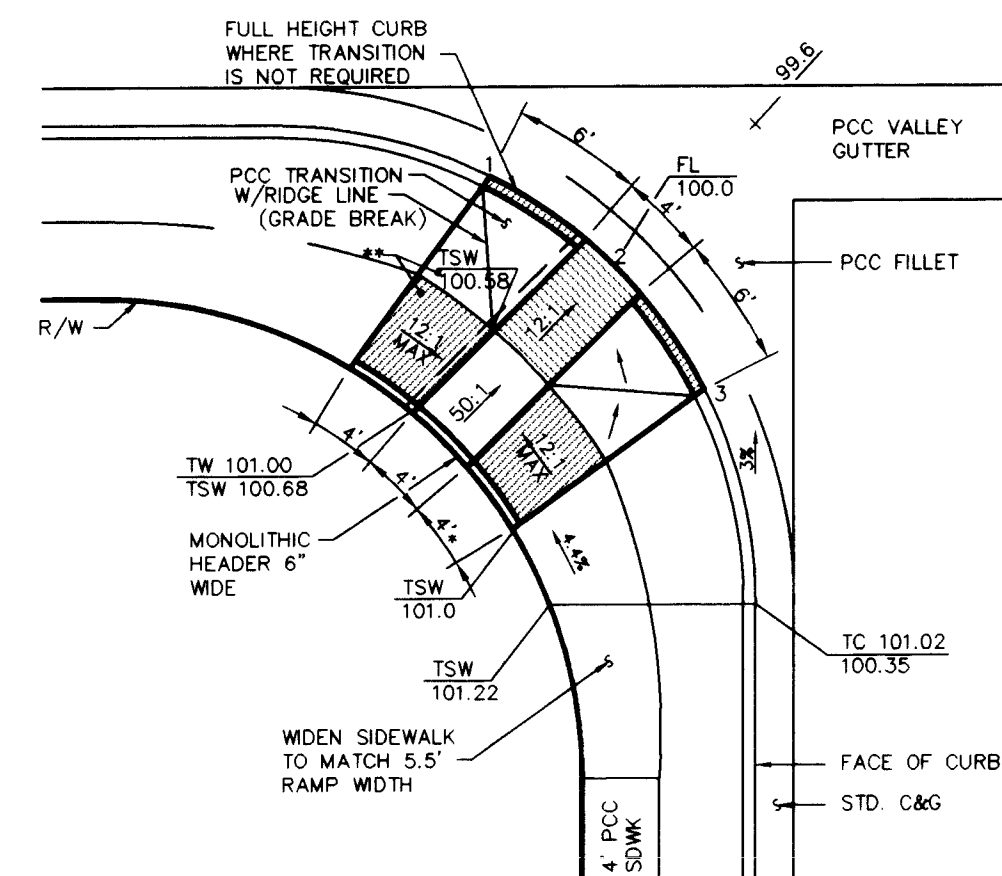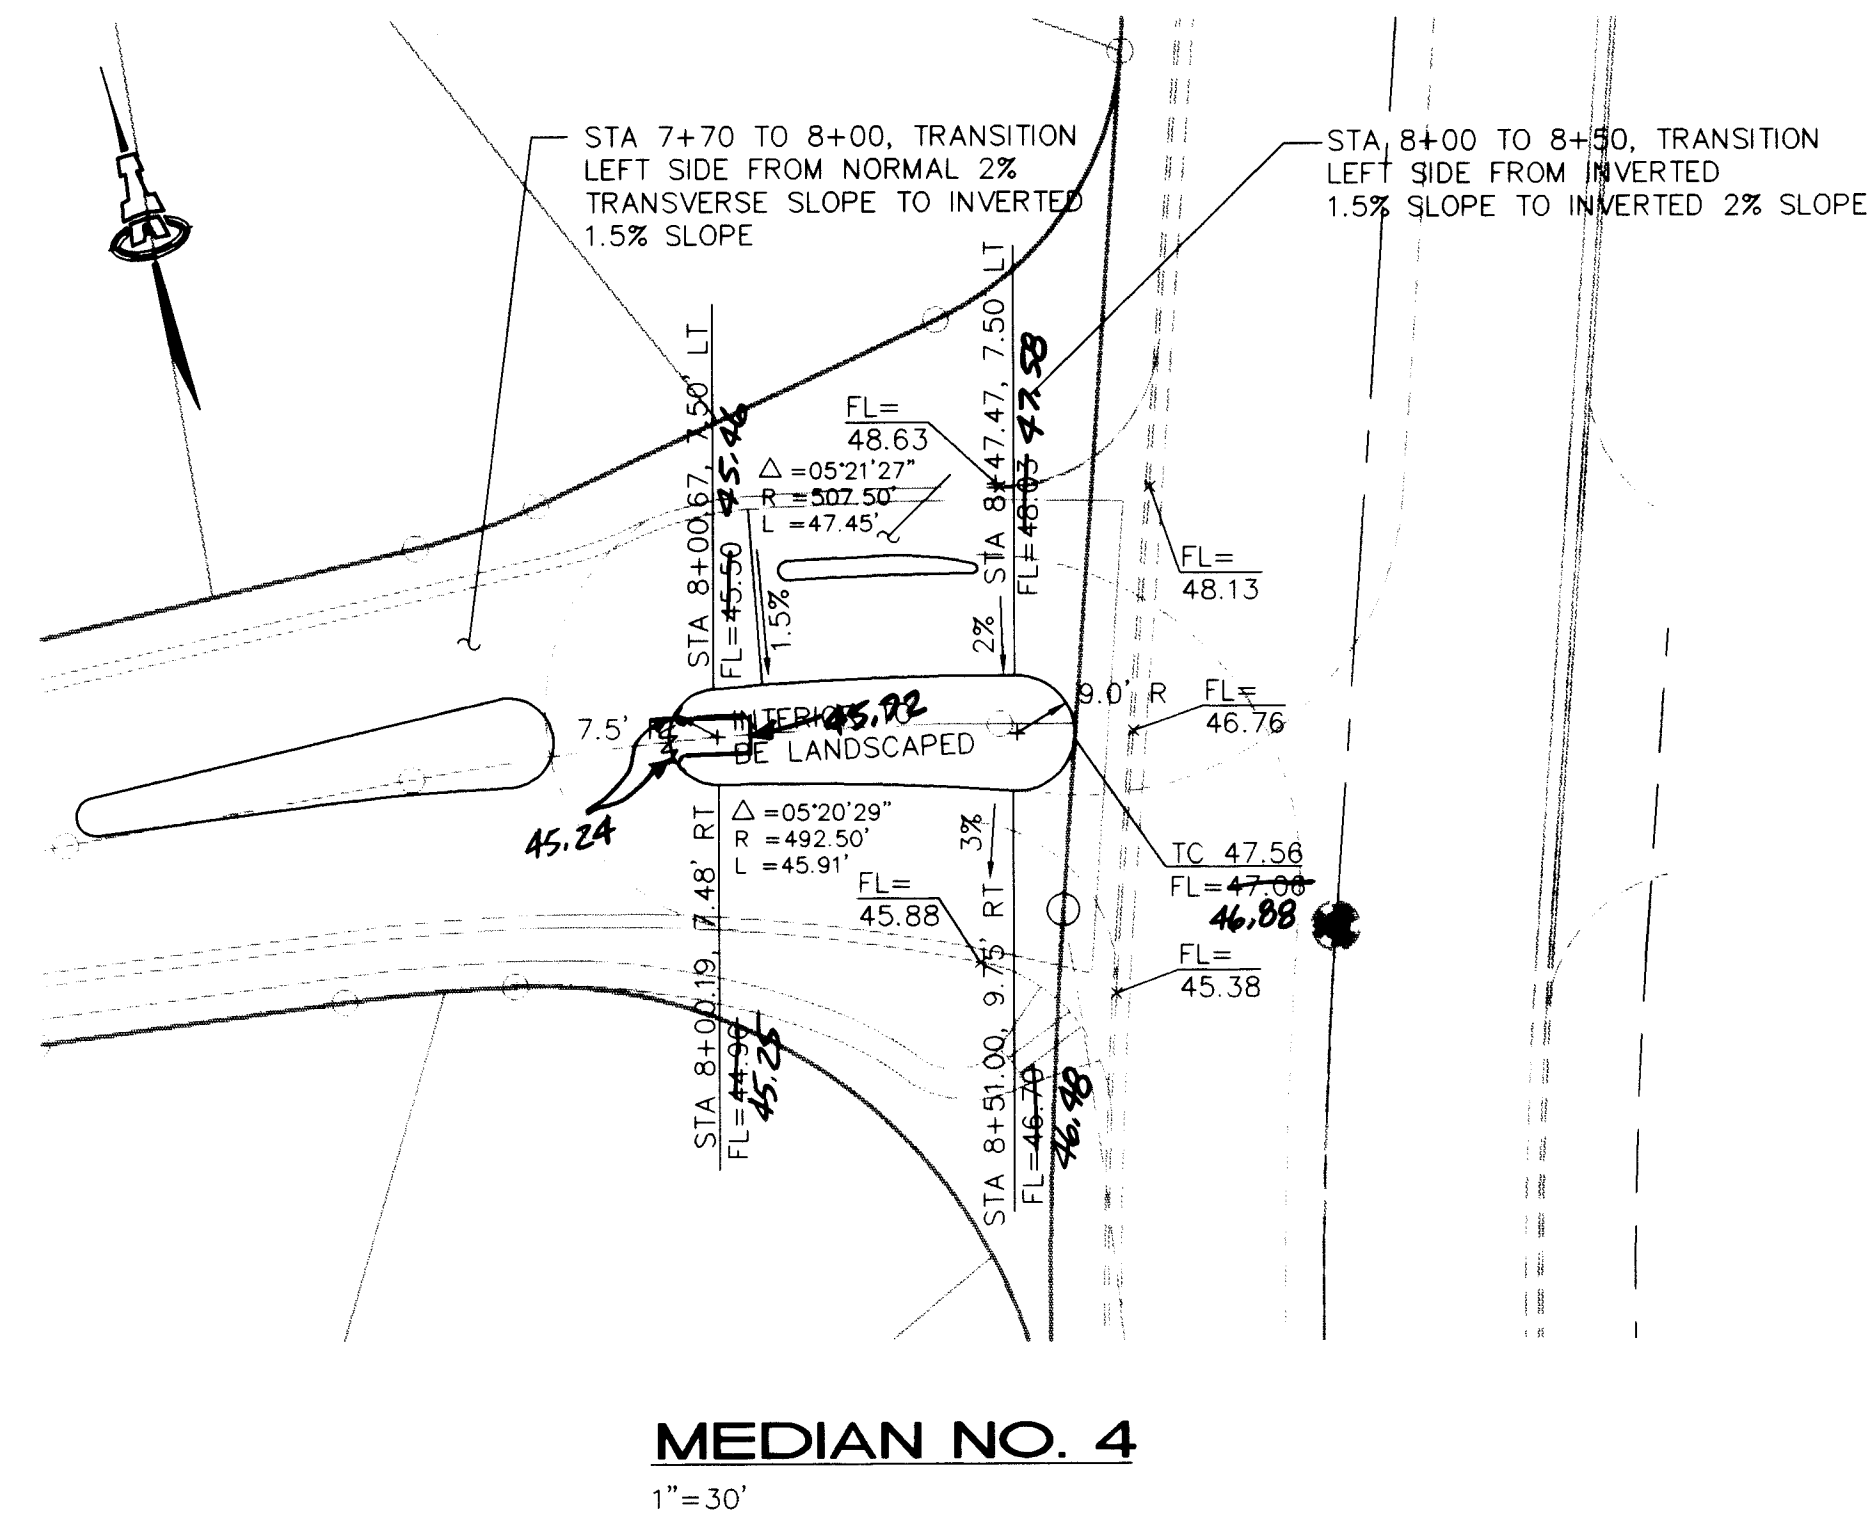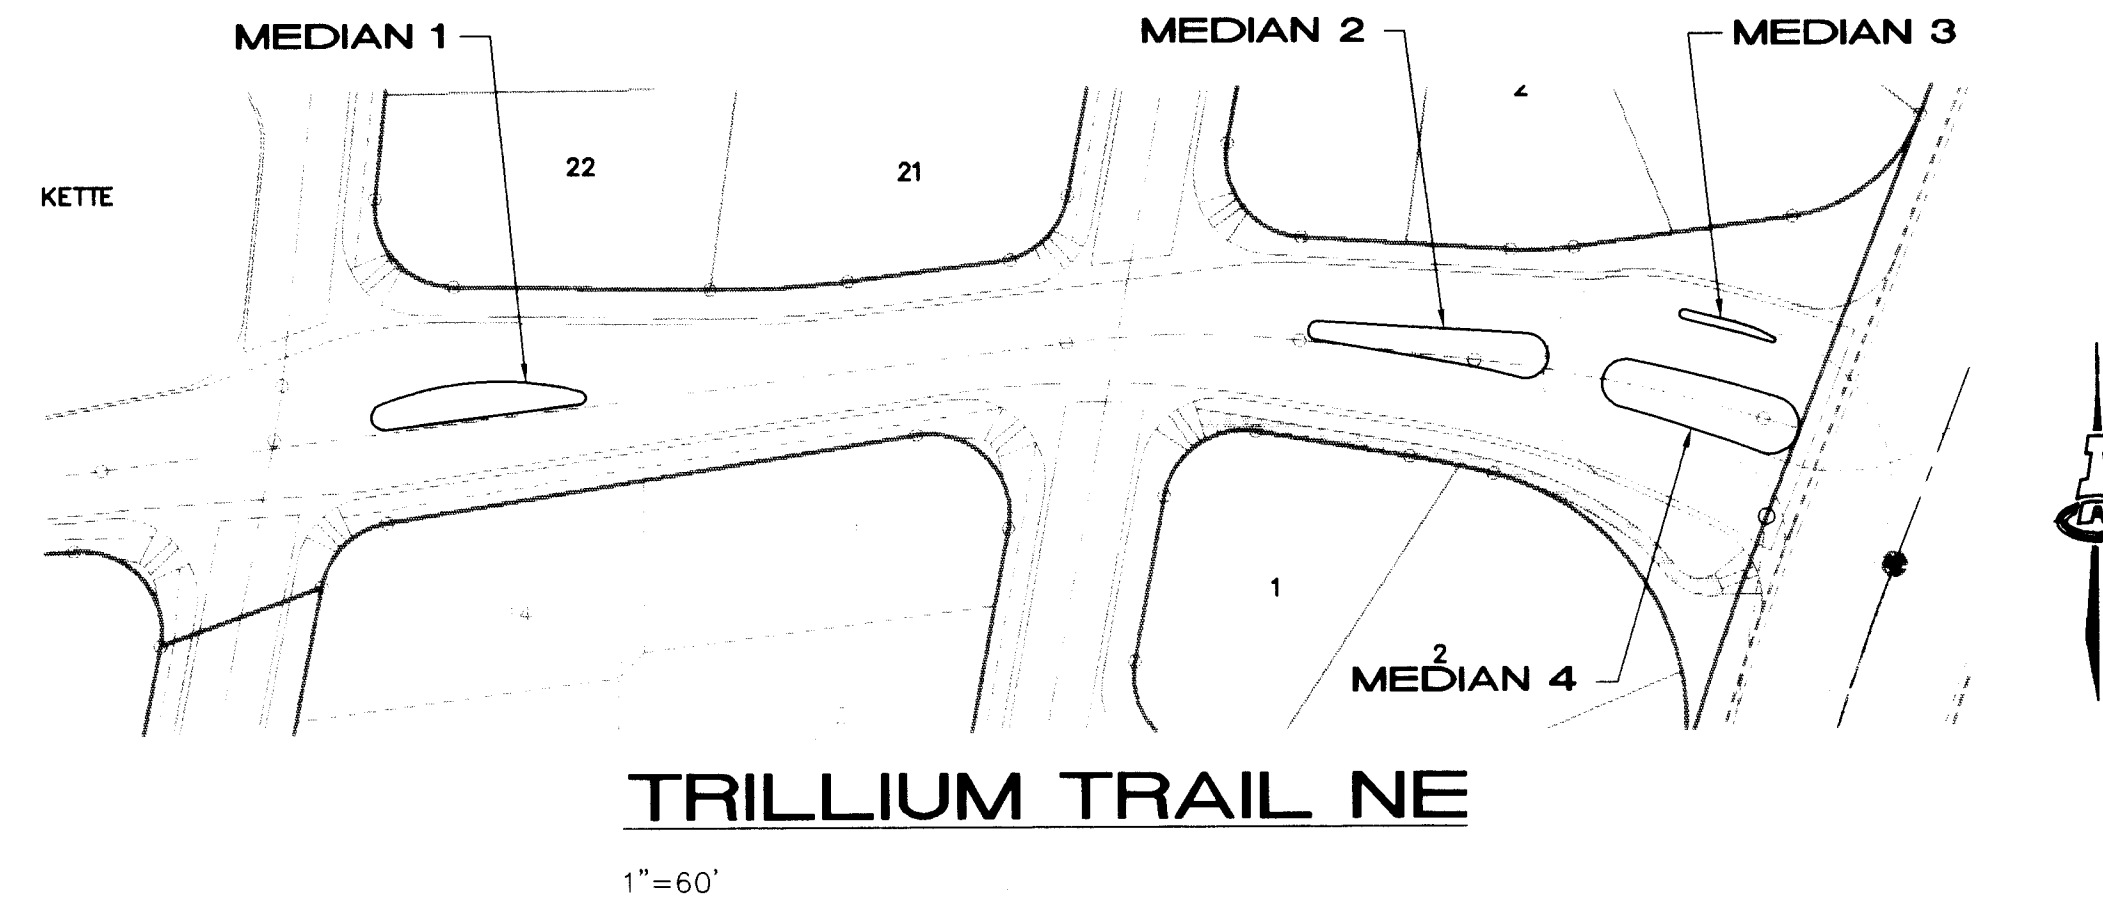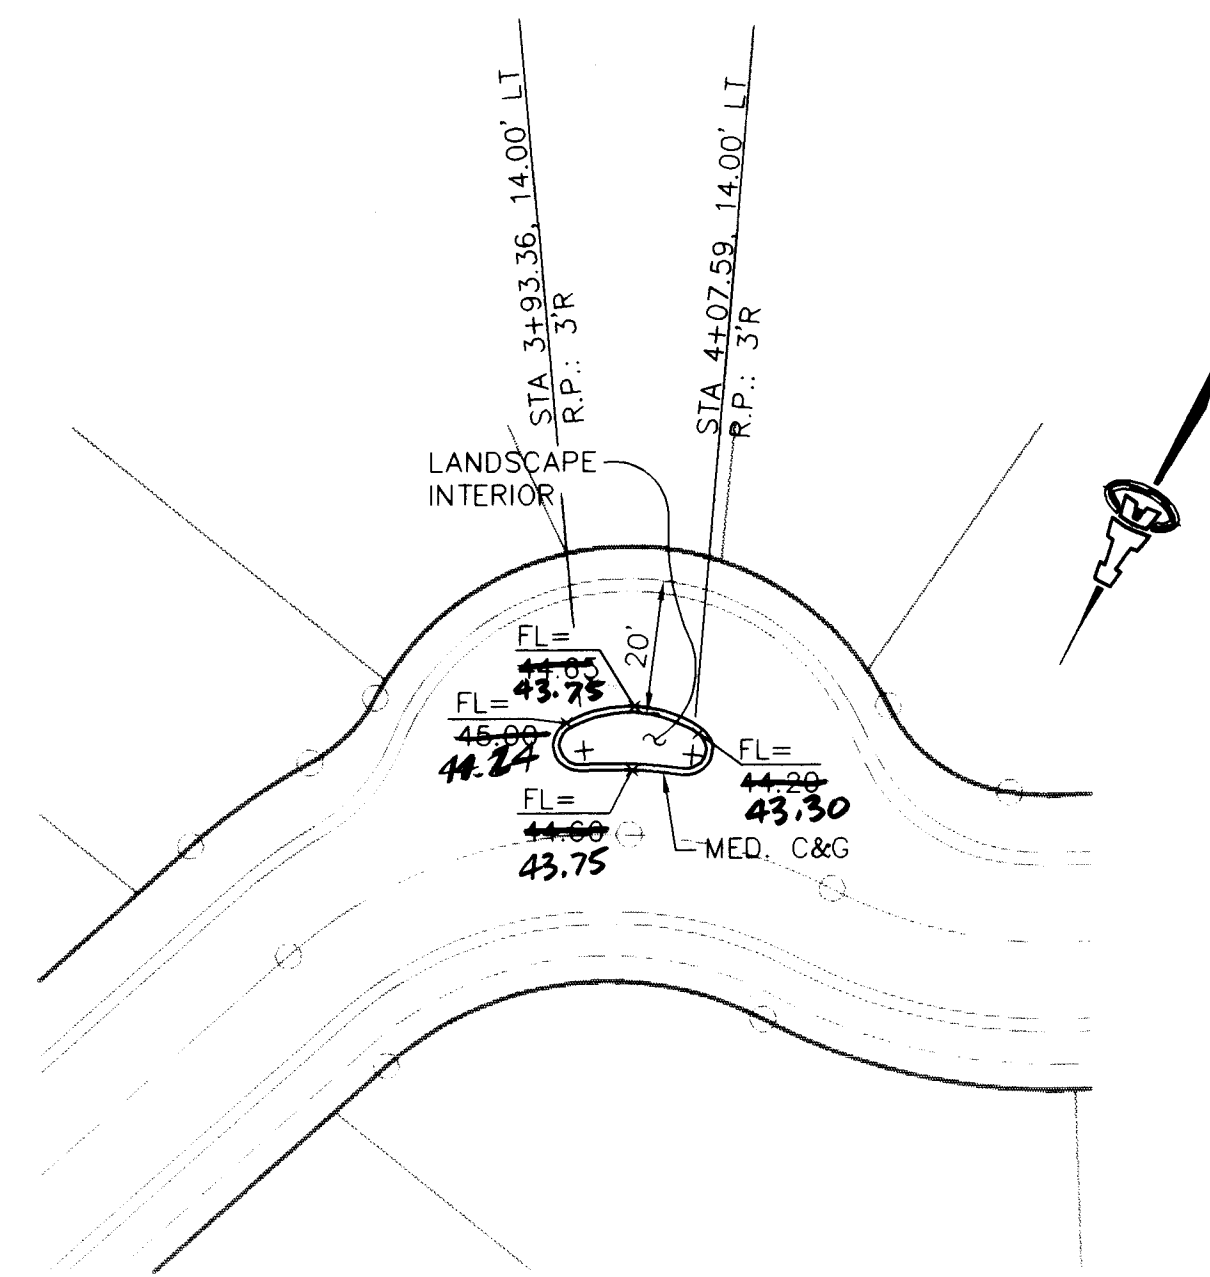

.. SIDEWALK RAMP & TRANSITION NOT TO BE BUILT ON THE STREET SIDE WHERE THE SIDEWALKS HAVE BEEN PERMANENTLY DEFERRED. CONSTRUCT MONOLITHIC HEADER CURB ALONG RAMP EDGE.

MEDIAN NOTES

1. ALL MEDIAN TO BE CONSTRUCTED WITH C.O.A. MEDIAN CURB & GUTTER DWG #2415.
2. ALL MEDIAN TO BE LANDSCAPED. NOT PART OF THIS CONTRACT.
3. CONTRACTOR TO COORDINATE WITH OWNER'S LANDSCAPE CONTRACTOR TO ENSURE ALL IRRIGATION AND POWER STUBS AND/OR CONDUIT IS PLACED TO SERVE MEDIANS.

APPROVALS		ENGINEER		DATE	
ER		N/A		RWE 7-27-99	
TE WATER		N/A		RWE 7-27-99	
HIGH DESERT		S			
QUERQUE		PARTMENT		OUP	
95		7		ENGINEER'S SEAL	
				SURVEY INFORMATION	
				FIELD NOTES	
				BENCH MARKS	
				AS-BUILT INFORMATION	
				CONTRACTOR	
				CONCRETE CONSTR.	
				WORK	
				STARTED BY	
				DATE 9/6	
				NGS/ACS BRASS TABLET "TUMBLE" NW OF ACADEMY ROAD	
				AND TRAMWAY BLVD.	
				ELEV. = 6009.155	
				FIELD LOCATION BY	
				DATE 4/96	
				DRAWINGS	
				CORRECTED BY	
				ALC, INC	
				DATE 4/96	
				MICRO-FILM INFORMATION	
				RECORDED BY	
				DATE	
				NO.	

SCANNED BY
BY LASON