

CONSTRUCTION PLANS
FOR
PARADISE SKIES

AUGUST 1995

PHASE *II* II

INDEX TO DRAWINGS

1. TITLE SHEET

2. PLAT UNIT 1, PAGE 2A & 2B

3. PLAT UNIT 2, PAGE 3A & 3B

4. GRADING PLAN-A

5. GRADING PLAN-B

6. MASTER PAVING PLAN

7. UNSER BOULEVARD-PAVING PLAN
STA 10+22.07 TO 23+55.08

7a. UNSER BOULEVARD/IRVING INTERSECTION

8. UNSER BOULEVARD-PAVING PLAN
STA 23+55.08 TO 33+83.75

9. BANDELIER DRIVE-PAVING PLAN
STA 1+00 TO 10+14.18

10. BANDELIER DRIVE-PAVING PLAN
STA 10+14.18 TO 19+47.06

11. McMAHON BOULEVARD-PAVING PLAN
STA 1+00 TO 8+09.71

12. TAURUS AVENUE-PAVING PLAN
STA 1+00 TO 6+72.32

13. CAPRICORN PLACE-PAVING PLAN
STA 1+00 TO 8+15.02

14. CAPRICORN PLACE-PAVING PLAN
STA 8+15.02 TO 17+18.48

15. SAGITTARIUS AVENUE-PAVING PLAN
STA 1+00 TO 6+17.63

16. AQUARIUS AVENUE-PAVING PLAN
STA 1+00 TO 5+68.38

17. SCORPIO AVENUE PLAN
STA 1+00 TO 4+59.74

18. GEMINI AVENUE PLAN
STA 1+00 TO 5+52.86

19. VIRGO STREET-PAVING PLAN
STA 1+00 TO 11+07.95
20. VIRGO STREET-PAVING PLAN
STA 11+07.95 TO 20+82.43

21. VIRGO COURT & GEMINI COURT-PAVING PLAN
STA 1+00 TO 2+57.78
STA 1+00 TO 2+12.78

22. PISCES COURT-PAVING PLAN
STA 1+00 TO 6+54.00

23. RETAINING WALL PLAN
STA 1+00 TO 3+57.16

24. RETAINING WALL PLAN
STA 1+00 TO 8+23.79

25. RETAINING WALL PLAN
STA 8+23.79 TO 14+79.85

26. MASTER UTILITY PLAN

27. BANDELIER DRIVE-UTILITY PLAN
STA 1+00 TO 10+14.18

28. BANDELIER DRIVE-UTILITY PLAN
STA 10+14.18 TO 19+47.06

29. TAURUS AVENUE-UTILITY PLAN
STA 1+00 TO 6+92.80

30. CAPRICORN PLACE-UTILITY PLAN
STA 1+00 TO 8+15.02

31. CAPRICORN PLACE-UTILITY PLAN
STA 8+15.02 TO 17+18.48

32. AQUARIUS AVENUE & SAGITTARIUS AVENUE-UTILITY PLAN
STA 0+58.38 TO 5+68.38
STA 1+00 TO 6+00.96

33. GEMINI AVENUE & SCORPIO AVENUE-UTILITY PLAN
STA 1+00 TO 5+52.86
STA 1+00 TO 4+59.74

34. VIRGO STREET-UTILITY PLAN
STA 0+40 TO 11+07.95
35. VIRGO STREET-UTILITY PLAN
STA 11+07.95 TO 20+82.43

36. VIRGO COURT & GEMINI COURT-UTILITY PLAN
STA 1+00 TO 2+57.78
STA 1+00 TO 2+12.78

37. PISCES COURT-UTILITY PLAN
STA 1+00 TO 6+54.00

38. OFF-SITE SANITARY SEWER PLAN
STA 1+00 TO 9+75.30

39. MASTER STORM SEWER PLAN

40. AQUARIUS AVENUE & BANDELIER DRIVE-STORM SEWER PLAN
STA 1+00 TO 5+68.38
STA 1+00 TO 1+89.00

41. VIRGO STREET-STORM SEWER PLAN
STA 0+00 TO 12+06.17

42. STORM SEWER IMPROVEMENTS/
CONNECTION TO CALABACILLAS
ENERGY DISSIPATOR

43. MISCELLANEOUS DETAILS

RECORD DRAWING

DATE:
12/18/96

DRAFTED BY:
TierraWest Dev.

THESE RECORD DRAWINGS HAVE BEEN PREPARED, IN PART, ON THE BASIS OF INFORMATION COMPILED AND FURNISHED BY OTHERS. THE ENGINEER WILL NOT BE RESPONSIBLE FOR ANY ERRORS OR OMISSIONS WHICH HAVE BEEN INCORPORATED INTO THIS DOCUMENT AS A RESULT.

APPROVAL OF AS BUILT DRAWINGS
CHIEF CONSTRUCTION ENGINEER
James P. ...
DATE 6-13-97

APPROVED FOR
CONSTRUCTION
...
CITY ENGINEER
DATE 5/28/96


SCANNED BY
BY LASON

TIERRA WEST DEVELOPMENT
MANAGEMENT SERVICES
4421 McLEOD ROAD, N.E., SUITE D
ALBUQUERQUE, NEW MEXICO 87109
(505)683-7592

REV	SHEETS	CITY ENGINEER	DATE	USER DEPT.	DATE	USER DEPT.	DATE

City Proj. No. 5279.901 SHEET 1 OF 43

PROJECT NO. 5279.90

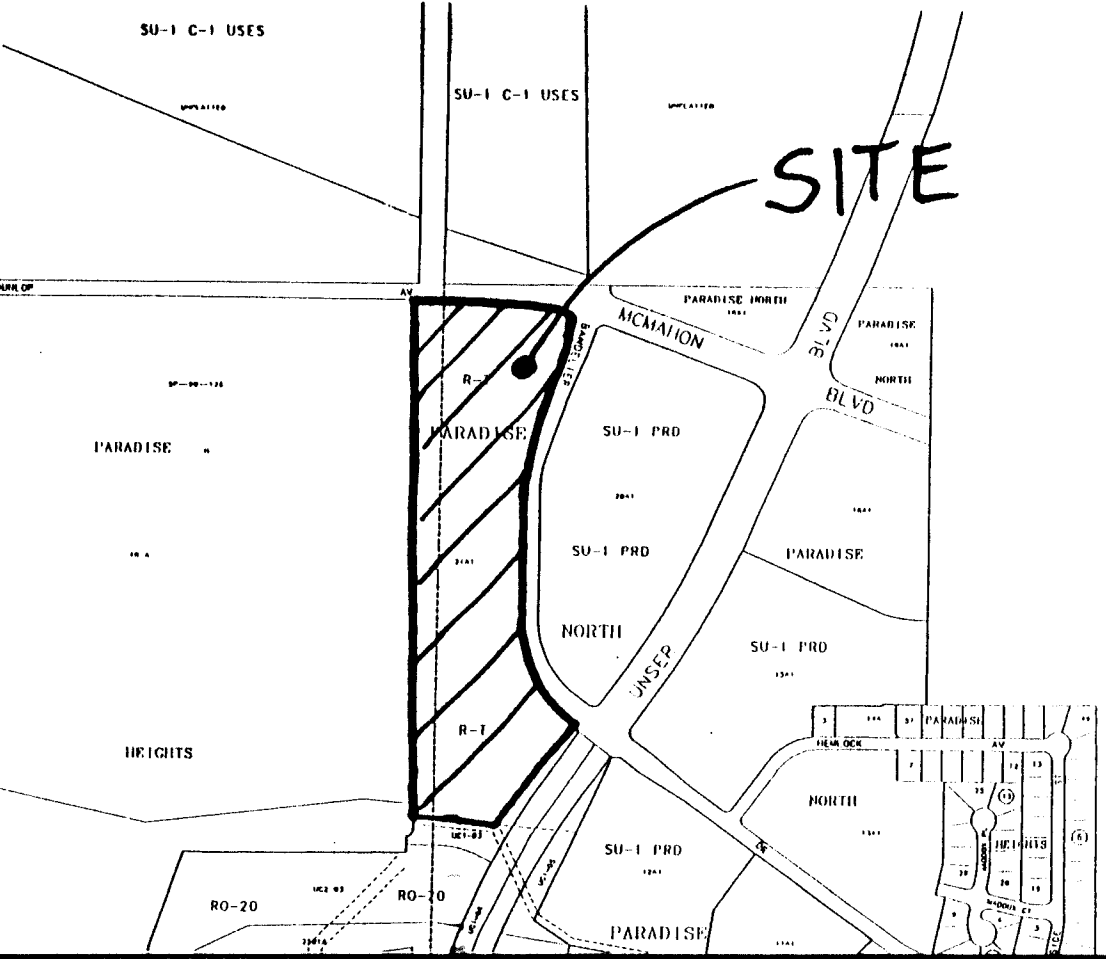

VICINITY MAP ZONE ATLAS A-11-Z
SCALE NONE

NOTICE TO CONTRACTORS

1. ALL WORK DETAILED ON THESE PLANS TO BE PERFORMED UNDER CONTRACT SHALL, EXCEPT AS OTHERWISE STATED OR PROVIDED FOR HEREON, BE CONSTRUCTED IN ACCORDANCE WITH THE CITY OF ALBUQUERQUE STANDARD SPECIFICATIONS FOR PUBLIC WORKS CONSTRUCTION, 1988 EDITION (UPDATE #6) & NM UTILITIES INC. SPECIFICATIONS FOR WATER AND WASTE WATER FACILITIES, LATEST REV.
2. TWO WORKING DAYS PRIOR TO ANY EXCAVATION, THE CONTRACTOR MUST CONTACT NEW MEXICO ONE CALLS SYSTEM (280-1990) FOR LOCATION OF EXISTING UTILITIES.
3. NOTIFY NEW MEXICO UTILITIES 3 DAYS PRIOR TO UTILITY CONSTRUCTION.
4. PRIOR TO CONSTRUCTION, THE CONTRACTOR SHALL EXCAVATE AND VERIFY THE HORIZONTAL AND VERTICAL LOCATIONS OF ALL OBSTRUCTIONS. SHOULD A CONFLICT EXIST, THE CONTRACTOR SHALL NOTIFY THE ENGINEER OR SURVEYOR IMMEDIATELY SO THAT THE CONFLICT CAN BE RESOLVED WITH A MINIMUM AMOUNT OF DELAY.
5. THREE(3) WORKING DAYS PRIOR TO BEGINNING OF CONSTRUCTION, THE CONTRACTOR SHALL SUBMIT TO CONSTRUCTION COORDINATIONS DIVISION A DETAILED CONSTRUCTION SCHEDULE. TWO(2) WORKING DAYS PRIOR TO CONSTRUCTION, THE CONTRACTOR SHALL OBTAIN A BARRICADING PERMIT FROM THE CONST. COORDINATION DIVISION. CONTRACTOR SHALL NOTIFY BARRICADE ENGINEER (768-2551) PRIOR TO OCCUPYING AN INTERSECTION. REFER TO STANDARD SPECIFICATIONS.
6. ALL STREET STRIPING ALTERED OR DESTROYED SHALL BE REPLACED IN KIND BY CONTRACTOR TO LOCATION AND IN KIND AS EXISTING OR AS INDICATED BY THIS PLAN SET.
7. CONTRACTOR SHALL NOTIFY THE ENGINEER NOT LESS THAN SEVEN(7) DAYS PRIOR TO STARTING WORK IN ORDER THAT THE ENGINEER MAY TAKE NECESSARY MEASURES TO INSURE THE PRESERVATION OF SURVEY MONUMENTS. CONTRACTOR SHALL NOT DISTURB PERMANENT SURVEY MONUMENTS WITHOUT THE CONSENT OF THE ENGINEER AND SHALL NOTIFY THE ENGINEER AND BEAR THE EXPENSE OF REPLACING ANY THAT MAY BE DISTURBED WITHOUT PERMISSION. REPLACEMENT SHALL BE DONE ONLY BY THE CITY SURVEYOR. WHEN A CHANGE IS MADE IN THE FINISHED ELEVATIONS OF THE PAVEMENT OF ANY ROADWAY IN WHICH A PERMANENT SURVEY MONUMENT IS LOCATED, CONTRACTOR SHALL, AT HIS OWN EXPENSE, ADJUST THE MONUMENT COVER TO THE NEW GRADE UNLESS OTHERWISE SPECIFIED. REFER TO SECTION 4.4 OF THE GENERAL CONDITIONS OF THE STANDARD SPECIFICATIONS.
8. ANY WORK AFFECTING AN ARTERIAL ROADWAY REQUIRES 24 HOUR CONSTRUCTION.
- THE FOLLOWING NOTES ALSO APPLY WHEN CHECKED
- ☒ ALL UTILITIES AND UTILITY SERVICE LINES SHALL BE INSTALLED PRIOR TO PAVING.


☒ BACKFILL COMPACTION SHALL BE ACCORDING TO SPECIFIED STREET USE.

☐ TACK COAT REQUIREMENTS SHALL BE DETERMINED BY THE CITY ENGINEER.

☒ SIDEWALKS AND WHEELCHAIR RAMPS WITHIN THE CURB RETURNS SHALL BE CONSTRUCTED WHEREVER A NEW CURB RETURN IS CONSTRUCTED.

☐ IF CURB IS DEPRESSIONED FOR A DRIVEPAD, THE DRIVEPAD SHALL BE CONSTRUCTED PRIOR TO ACCEPTANCE OF CURB AND GUTTER.

☒ ALL STORM DRAINAGE FACILITIES SHALL BE COMPLETED PRIOR TO FINAL ACCEPTANCE.

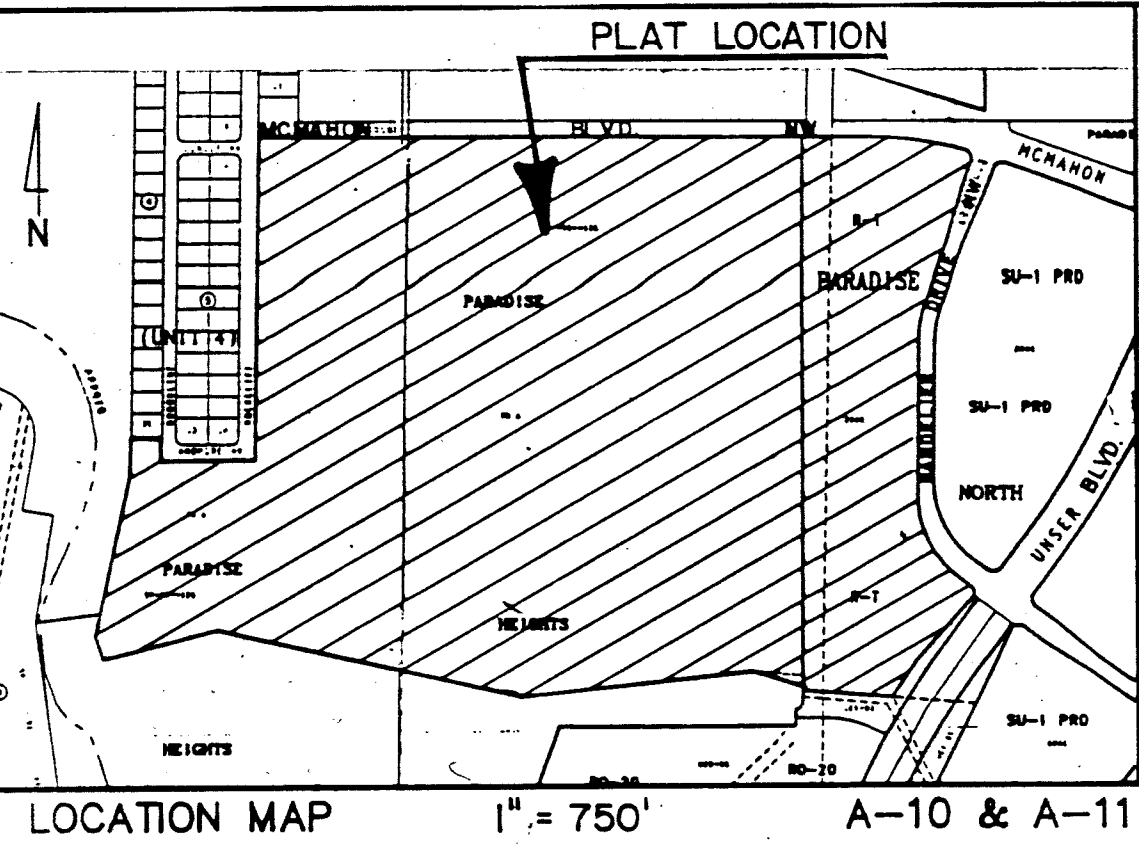

PUBLIC UTILITY EASEMENTS:

PUBLIC UTILITY EASEMENTS shown on this plat are granted for the common and joint use of:

1. The Public Service Company of New Mexico for the installation, maintenance, and service of overhead and underground electrical lines, transformers, poles and any other equipment, fixtures, structures and related facilities reasonably necessary to provide electrical services.
2. The Gas Company of New Mexico for installation, maintenance, and service of natural gas lines, valves and other equipment and facilities reasonably necessary to provide natural gas services.
3. U.S. West for installation, maintenance and service of all buried and aerial communication lines and other related equipment and facilities reasonably necessary to provide communication services, including but not limited to above ground pedestals and enclosures.
4. Jones Interchange for the installation, maintenance, and service of such lines, cable, and other related equipment and facilities reasonably necessary to provide Cable TV services.

Included is the right to build, rebuild, construct, reconstruct, locate, relocate, change, remove, modify, renew, operate, and maintain facilities for the purposes described above, together with free access to, from, and over said easements, including sufficient working area space for electric transformers, with the right and privilege to trim and remove trees, shrubs or bushes which interfere with the purposes set forth herein. No building, sign, pool (aboveground or subsurface), hot tub, concrete or wood pool decking, or other structure shall be erected or constructed on said easements, nor shall any well be drilled or operated thereon. Property owners shall be solely responsible for correcting any violations of the National Electrical Safety Code caused by construction of pools, decking, or any structures adjacent to within or near easements shown on this plat.

In approving this plat, the utility companies listed above did not conduct a title search of the properties shown hereon. Consequently, the utility companies do not waive or release any easement or easement rights which may have been granted by prior plat, replat or other document and which are not shown on this plat.

NOTES:

These properties are within the New Mexico Utilities, Inc. franchise area. Water and sanitary sewer system capabilities are based on New Mexico Utilities, Inc. facilities, and not the City of Albuquerque. Water and sanitary sewer infrastructure improvements must, however, be approved by both City of Albuquerque and New Mexico Utilities, Inc.

FREE CONSENT AND DEDICATION

The subdivision hereon described is with the free consent and in accordance with the desires of the undersigned owner(s) and/or proprietor(s) thereof and said owner(s) and/or proprietor(s) do hereby dedicate all streets and public right-of-ways shown hereon to the City of Albuquerque in fee simple with warranty covenants and do hereby grant: all access, utility and drainage easements, shown hereon, whether public or private, including the right to construct, operate, inspect, and maintain facilities therein; and all public utility easements shown hereon for the common and joint use of gas, electrical power and communication services for buried distribution lines, conduits, and pipes for underground utilities where shown or indicated, and including the right of ingress and egress for construction and maintenance, and the right to trim interfering trees and shrubs. Said owner(s) and/or proprietor(s) do hereby consent to all of the foregoing and do hereby certify that this subdivision is their free act and deed.

Owner:

Horace Griffin Pickard, Jr., Trustee for
Pickard Irrevocable Trust I, Trust dated December 29, 1993

STATE OF NEW MEXICO)
BERNALILLO COUNTY)

On this 12th day of June, 1995, this instrument was acknowledged before me by Horace Griffin Pickard, Jr., for Pickard Irrevocable Trust I, as its Trustee.

Carol Raschen
Notary Public



DESCRIPTION

A tract of land situated within the Town of Alameda Grant, projected Section 2 and 3, Township 11 North, Range 2 East, N.M.P.M., Bernalillo County, New Mexico, being all of Tract 21A-1, Paradise North as the same is shown and designated on said plat filed for record in the office of the County Clerk of Bernalillo County, New Mexico on August 8, 1990 in Volume 90C, Folio 182, together with all of Tract A, Paradise Heights, Unit 3-A as the same is shown and designated on said plat filed for record in the office of the County Clerk of Bernalillo County, New Mexico on July 25, 1990 in Volume 90C, Folio 169, and being more particularly described as follows:

BEGINNING at the northwest corner of the herein described tract said point being common with the northwest corner of said TRACT A from whence ACS Monument "SANDBERN" bears N 45°54'17" W, 1112.89 feet;

Thence along a curve to the right through a central angle of 04°15'08" on an arc distance of 99.30 feet, a radius of 1336.00 feet and a chord bearing of N 87°48'13" E, a distance of 99.28 feet to a point of tangency;

Thence N 89°55'47" E, a distance of 996.96 feet to a point;

Thence S 89°48'34" E, a distance of 965.74 feet to a point;

Thence S 89°48'48" E, a distance of 236.58 feet to a point of curvature;

Thence along a curve to the right through a central angle of 15°48'12" on an arc distance of 372.36 feet, a radius of 1350.00 feet and a chord bearing of S 81°54'42" E, a distance of 371.18 feet to a point of compound curvature;

Thence along a curve to the right through a central angle of 93°24'02" on an arc distance of 57.06 feet, a radius of 35.00 feet and a chord bearing of S 27°18'35" E, a distance of 50.94 feet to a point of tangency;

Thence S 19°23'26" W, a distance of 100.00 feet to a point;

Thence S 15°39'49" W, a distance of 200.00 feet to a point;

Thence S 19°23'26" W, a distance of 249.08 feet to a point of curvature;

Thence along a curve to the left through a central angle of 19°04'47" on an arc distance of 136.53 feet, a radius of 410.00 feet and a chord bearing of S 09°51'03" W, a distance of 135.90 feet to a point of tangency;

Thence S 00°18'39" W, a distance of 565.35 feet to a point of curvature;

Thence along a curve to the left through a central angle of 48°41'26" on an arc distance of 326.97 feet, a radius of 384.75 feet and a chord bearing of S 24°02'04" E, a distance of 317.21 feet to a point of compound curvature;

Thence along a curve to the left through a central angle of 05°16'38" on an arc distance of 38.96 feet, a radius of 423.00 feet and a chord bearing of S 51°01'06" E, a distance of 38.95 feet to a point of tangency;

Thence S 53°39'25" E, a distance of 85.00 feet to a point;

Thence S 02°03'22" W, a distance of 26.63 feet to a point;

Thence S 41°04'00" W, a distance of 325.73 feet to a point;

Thence S 33°10'22" W, a distance of 156.79 feet to the southeast corner;

Thence N 85°11'30" W, a distance of 354.68 feet to a point;

Thence N 85°11'12" W, a distance of 195.35 feet to a point;

Thence S 83°48'53" W, a distance of 866.55 feet to a point;

Thence N 77°04'55" W, a distance of 1172.64 feet to a point;

Thence S 76°01'50" W, a distance of 443.06 feet to the southwest corner;

Thence N 19°21'04" W, a distance of 82.05 feet to a point;

Thence N 11°18'56" E, a distance of 629.07 feet to a point;

Thence N 00°14'59" E, a distance of 143.69 feet to a point;

Thence S 89°45'01" E, a distance of 120.15 feet to a point;

Thence S 00°14'59" W, a distance of 84.89 feet to a point;

Thence S 89°45'29" E, a distance of 120.15 feet to a point;

Thence N 00°14'31" E, a distance of 143.69 feet to a point;

Thence N 00°14'31" W, a distance of 84.89 feet to a point;

Thence S 89°30'12" E, a distance of 354.94 feet to a point;

Thence S 89°30'12" W, a distance of 354.94 feet to a point;

Thence N 77°04'55" W, a distance of 1172.64 feet to a point;

Thence S 83°48'53" W, a distance of 866.55 feet to a point;

Thence N 85°11'12" W, a distance of 195.35 feet to a point;

Thence N 85°11'30" W, a distance of 354.68 feet to a point;

Thence S 33°10'22" W, a distance of 156.79 feet to a point;

Thence S 53°39'25" E, a distance of 85.00 feet to a point;

Thence S 02°03'22" W, a distance of 26.63 feet to a point;

Thence S 41°04'00" W, a distance of 325.73 feet to a point;

Thence S 89°45'01" E, a distance of 120.15 feet to a point;

Thence S 00°14'59" W, a distance of 84.89 feet to a point;

Thence S 89°45'29" E, a distance of 120.15 feet to a point;

Thence N 00°14'31" E, a distance of 143.69 feet to a point;


Thence N 00°14'31" W, a distance of 84.89 feet to a point;

Thence S 89°30'12" E, a distance of 354.94 feet to a point;

Thence S 89°30'12" W, a distance of 354.94 feet to a point;


Thence N 77°04'55" W, a distance of 1172.64 feet to a point;

PLAT FOR
PARADISE SKIES, UNIT 1
WITHIN THE
TOWN OF ALAMEDA GRANT
PROJECTED SECTION 2 & 3
TOWNSHIP 11 NORTH, RANGE 2 EAST, N.M.P.M.
CITY OF ALBUQUERQUE
BERNALILLO COUNTY, NEW MEXICO
JUNE, 1995

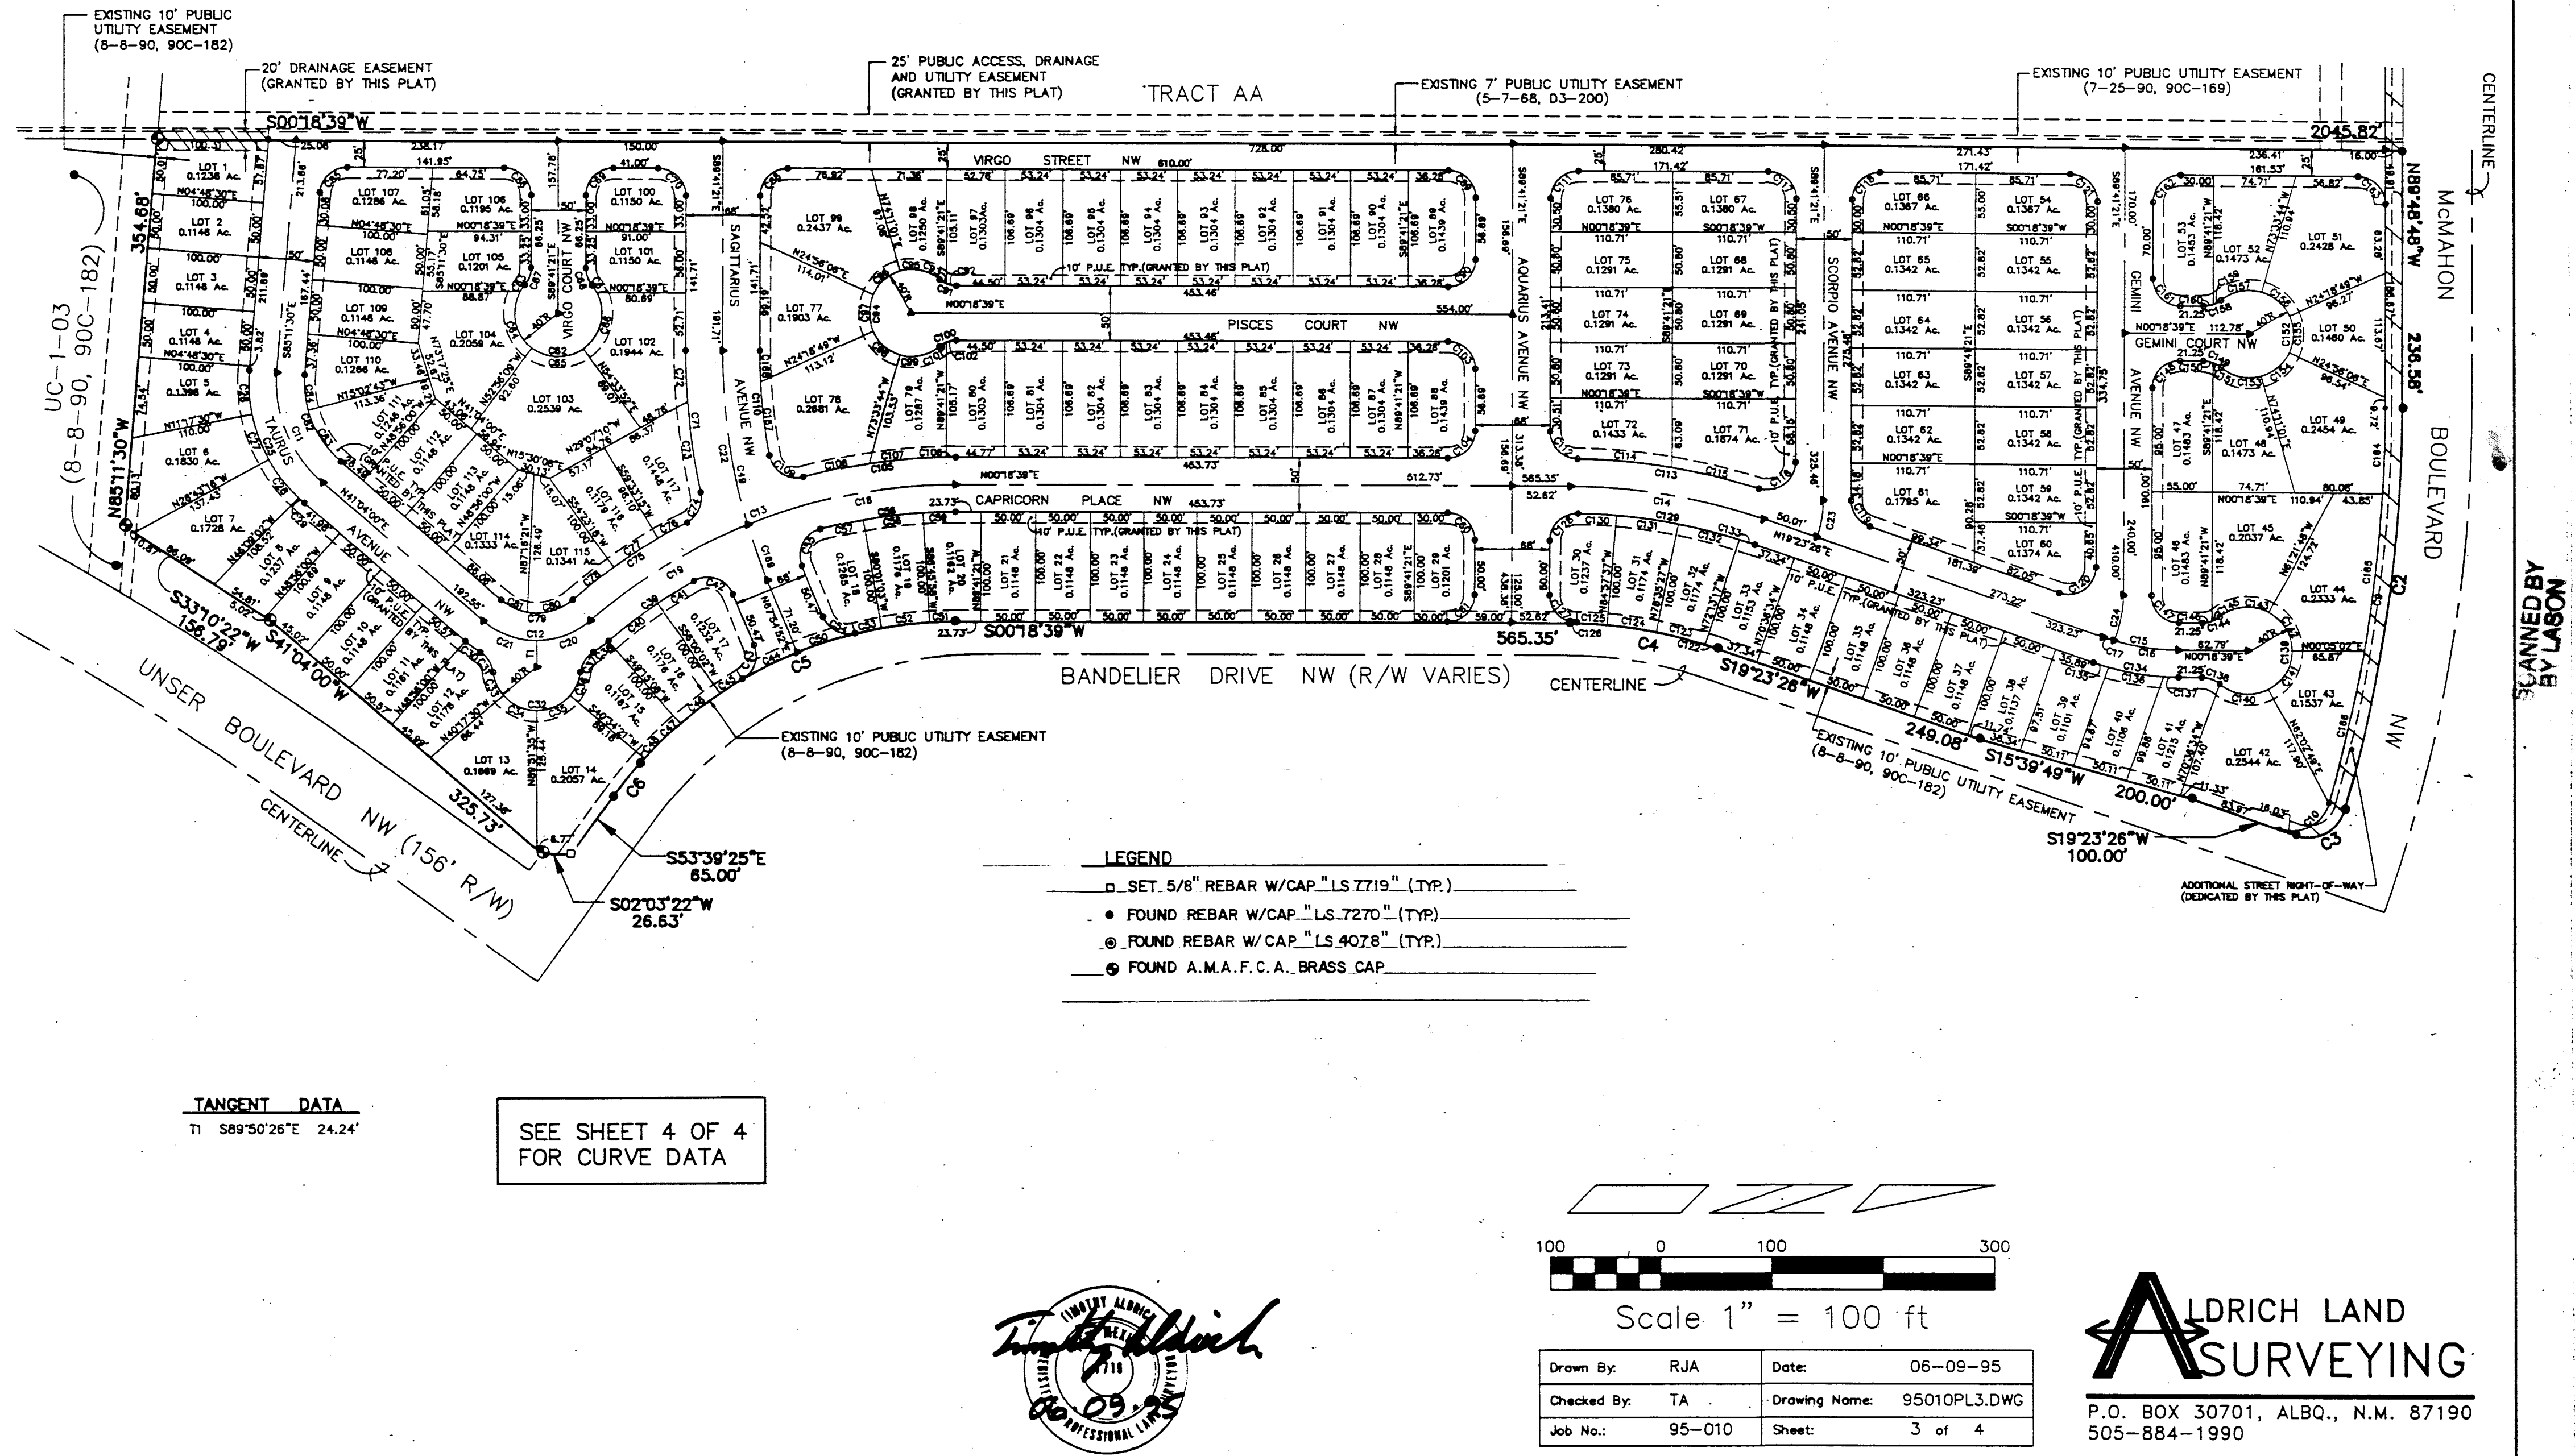

PLAT FOR
PARADISE SKIES, UNIT 1
WITHIN THE
TOWN OF ALAMEDA GRANT
PROJECTED SECTION 2 & 3
TOWNSHIP 11 NORTH, RANGE 2 EAST, N.M.P.M.
CITY OF ALBUQUERQUE
BERNALILLO COUNTY, NEW MEXICO
JUNE, 1995

CURVE							(CONTINUED)							(CONTINUED)						
CURVE	LENGTH	DELTA	RADIUS	TANGENT	DIRECTION	CHORD	C57	40.02	04°43'48"	484.75	20.02	N12°20'51"	40.01	C113	166.83	17°04'10"	560.00	84.04	N09°28'14"	166.22
C1	99.30	04°15'08"	1338.00	49.67	N87°48'13"E	99.28	C58	57.10	06°44'55"	484.75	28.58	N06°36'30"	57.06	C114	86.40	08°50'25"	560.00	43.29	N05°22'12"	86.32
C2	372.33	15°48'12"	1350.00	187.37	S81°54'42"E	371.18	C59	29.99	03°32'41"	484.75	15.00	N01°27'42"	29.99	C115	80.43	08°13'44" <th>560.00</th> <th>40.28</th> <th>N13°53'27"</th> <th>80.37</th>	560.00	40.28	N13°53'27"	80.37
C3	57.06	93°24'02"	35.00	37.14	S27°18'35"E	50.94	C60	39.27	90°00'00" <th>25.00</th> <th>25.00</th> <th>N45°18'39"</th> <th>39.27</th> <td>C116</td> <td>46.99</td> <td>10°41'40"<th>25.00</th><th>24.22</th><th>N35°50'51"</th><th>40.37</th></td>	25.00	25.00	N45°18'39"	39.27	C116	46.99	10°41'40" <th>25.00</th> <th>24.22</th> <th>N35°50'51"</th> <th>40.37</th>	25.00	24.22	N35°50'51"	40.37
C4	136.53	18°04'47"	410.00	68.80	S09°51'03"W	135.90	C61	39.27	90°00'00" <th>25.00</th> <th>25.00</th> <th>N44°41'21"</th> <th>39.27</th> <td>C117</td> <td>39.27</td> <td>90°00'00"<th>25.00</th><th>25.00</th><th>N45°18'39"</th><th>39.27</th></td>	25.00	25.00	N44°41'21"	39.27	C117	39.27	90°00'00" <th>25.00</th> <th>25.00</th> <th>N45°18'39"</th> <th>39.27</th>	25.00	25.00	N45°18'39"	39.27
C5	326.87	45°41'26"	384.75	174.09	S24°02'04"E	317.21	C62	181.12	25°25'49"	40.00	181.12	N00°16'39"	61.54	C118	39.27	90°00'00" <th>25.00</th> <th>25.00</th> <th>N44°41'21"</th> <th>39.27</th>	25.00	25.00	N44°41'21"	39.27
C6	38.96	05°16'38"	423.00	19.49	S51°01'06"E	38.95	C63	7.03	10°41'17"	40.00	3.92	N53°03'35"	7.02	C119	38.94	10°55'13"	25.00	17.81	N45°18'39"	38.94
C7	152.98	06°44'21"	35.00	33.05	N42°41'08"E	45.07	C64	57.87	82°53'26"	40.00	35.32	N78°30'34"	52.95	C120	47.60	10°50'47"	25.00	35.10	N35°08'57"	40.73
C8	66.32	02°52'28"	1322.00	33.12	N88°29'33"E	66.31	C65	50.61	72°29'59"	40.00	29.33	N00°46'00"	47.50	C121	39.27	90°00'00"	25.00	25.00	N45°18'39"	39.27
C9	366.37	15°48'41"	1354.00	184.65	S81°55'15"E	365.81	C66	57.43	82°15'46"	40.00	34.83	N78°34'00"	52.22	C122	11.54	01°36'43"	410.00	5.77	N18°35'04"	11.53
C10	57.06	93°26'33"	35.00	37.17	S27°19'50"E	50.96	C67	8.17	11°42'22"	40.00	4.10	N56°25'56"	8.16	C123	45.58 <th>06°22'10"</th> <th>410.00</th> <th>22.81</th> <th>N14°35'28"</th> <th>45.56</th>	06°22'10"	410.00	22.81	N14°35'28"	45.56
C11	112.96	03°44'30"	120.00	60.80	N87°56'15"E	108.48	C68	17.33	39°42'54"	25.00	9.03	N70°27'12"	16.98	C124	45.58 <th>06°22'10"</th> <th>410.00</th> <th>22.81</th> <th>N08°13'08"</th> <th>45.56</th>	06°22'10"	410.00	22.81	N08°13'08"	45.56
C12	107.10	81°48'53"	75.00	64.98	N00°09'34"E	98.23	C69	39.27	90°00'00"	25.00	25.00	N44°41'21"	39.27	C125	27.82 <th>03°53'17"</th> <th>410.00</th> <th>13.92</th> <th>N03°05'44"</th> <th>27.82</th>	03°53'17"	410.00	13.92	N03°05'44"	27.82
C13	365.29	41°03'32"	509.75	190.89	N20°13'07"W	357.53	C70	39.27	90°00'00"	25.00	25.00	N45°18'39"	39.27	C126	6.01	00°50'26"	410.00	3.01	N00°41'52"	6.01
C14	178.16	18°04'47"	535.00	89.81	N09°51'03"E	177.34	C71	130.78	12°48'47"	584.75	65.65	N83°54'16"	130.50	C127	38.90	89°09'34"	25.00	24.64	N45°43'52"	38.90
C15	70.16	18°04'47"	210.70	35.41	N09°51'03"E	69.84	C72	46.91	04°35'45"	584.75	23.47	N88°01'47"	46.90	C128	38.90	89°09'34"	25.00	24.64	N44°84'14"	38.90
C16	58.58	18°12'08"	210.70	28.98	N08°24'43"E	58.38	C73	83.87	08°13'02"	584.75	42.01	N81°36'23"	83.80	C129	163.12	18°19'33"	510.00	82.26	N10°13'40"	162.43
C17	10.58	02°52'39"	210.70	5.29	N17°57'07"E	10.58	C74	32.83	75°14'29"	25.00	19.27	N45°23'23"	32.82	C130	35.38 <th>03°58'23"</th> <th>510.00</th> <th>17.70</th> <th>N03°05'04"</th> <th>35.37</th>	03°58'23"	510.00	17.70	N03°05'04"	35.37
C18	196.62	22°05'02"	509.75	99.55	N10°44'32"W	195.41	C75	125.88	13°29'14"	534.75	63.23	N34°00'16"	125.59	C131	56.70	06°22'10"	510.00	28.38	N08°13'08"	56.67
C19	168.67	18°57'30"	509.75	85.11	N31°16'07"W	167.90	C76	28.73	03°11'06"	534.75	14.87	N26°51'12"	28.72	C132	56.70	06°22'10"	510.00	28.38	N14°35'28"	56.67
C20	52.55	40°34'02"	75.00	27.97 <th>N20°13'07"W</th> <th>52.42<td>C77</td><td>46.21</td><th>05°08'57"</th><th>534.75</th><th>24.12</th><th>N33°01'43"</th><th>46.20</th><td>C133</td><td>14.35</td><th>01°36'43"</th><th>510.00</th><th>7.17</th><th>N18°35'04"</th><th>14.35</th></th>	N20°13'07"W	52.42 <td>C77</td> <td>46.21</td> <th>05°08'57"</th> <th>534.75</th> <th>24.12</th> <th>N33°01'43"</th> <th>46.20</th> <td>C133</td> <td>14.35</td> <th>01°36'43"</th> <th>510.00</th> <th>7.17</th> <th>N18°35'04"</th> <th>14.35</th>	C77	46.21	05°08'57"	534.75	24.12	N33°01'43"	46.20	C133	14.35	01°36'43"	510.00	7.17	N18°35'04"	14.35
C21	52.55	40°34'26"	75.00	27.97 <th>N20°26'47"E</th> <th>52.42<td>C78</td><td>94.94</td><th>05°08'11"</th><th>534.75</th><th>23.98</th><th>N38°10'47"</th><th>94.92</th><td>C134</td><td>78.49</td><th>18°04'47"</th><th>235.70</th><th>39.61</th><th>N09°51'03"</th><th>78.13</th></th>	N20°26'47"E	52.42 <td>C78</td> <td>94.94</td> <th>05°08'11"</th> <th>534.75</th> <th>23.98</th> <th>N38°10'47"</th> <th>94.92</th> <td>C134</td> <td>78.49</td> <th>18°04'47"</th> <th>235.70</th> <th>39.61</th> <th>N09°51'03"</th> <th>78.13</th>	C78	94.94	05°08'11"	534.75	23.98	N38°10'47"	94.92	C134	78.49	18°04'47"	235.70	39.61	N09°51'03"	78.13
C22	215.30	22°23'47"	550.75	109.04	N79°06'46"E	213.93	C79	71.40	81°48'31"	50.00	43.32	N00°00'04"	65.48	C135	14.12	03°25'58"	235.70	7.08	N17°40'51"	14.12
C23	34.29	18°04'47"	102.86	17.36	S80°08'57"E	34.13	C80	44.05	50°29'19"	50.00	23.58	N15°30'13"	42.65	C136	50.81	12°21'04"	235.70	25.50	N09°46'55"	50.71
C24	42.86	23°51'01"	102.86	21.74	S77°45'50"E	42.55	C81	27.34	31°19'13"	50.00	14.02	N25°41'15"	27.00	C137	13.56 <th>03°17'44"</th> <th>235.70</th> <th>6.78</th> <th>N01°57'31"</th> <th>13.56</th>	03°17'44"	235.70	6.78	N01°57'31"	13.56
C25	136.01	03°44'30"	145.00	73.47	N67°56'15"E	131.07	C82	89.11	33°44'30"	95.00	48.14	N67°56'15"	85.88	C138	17.33	39°42'54"	25.00	9.03	N70°27'12"	16.98
C26	40.74	18°06'00"	145.00	20.51	N86°45'30"E	40.61	C83	56.19	33°53'17"	95.00	28.84	N60°00'39"	55.57	C139	181.12	25°25'49"	40.00	191.12	N00°16'39"	61.54
C27	44.11	17°25'46"	145.00	22.23	N52°33'51"E	43.94	C84	32.83	18°51'11"	95.00	16.83	N84°52'24"	32.72	C140	47.46	06°26'44"	40.00	26.97	N02°22'22"	47.42
C28	44.11	17°25'46"	145.00	22.23	N42°27'29"E	43.94	C85	37.31	85°30'08"	25.00	23.11	N42°26'25"	33.94	C141	43.26	61°57'47"	40.00	24.02	N58°56'04"	41.18
C29	7.04	02°46'38"	145.00	3.52	N57°14'38"E	7.04	C86	39.27	90°00'00"	25.00	25.00	N45°18'39"	39.27	C142	42.80	61°57'47"	40.00	23.77	N02°22'22"	42.78
C30	17.15	09°49'41"	100.00	8.60	N36°09'10"E	17.15	C87	17.33	39°42'54"	25.00	9.03	N70°27'12"	16.98	C143	47.50	68°02'28"	40.00	27.00	N05°23'02"	44.78
C31	22.69	52°00'38"	25.00	12.20	N57°14'38"E	21.92	C88	39.27	90°00'00"	25.00	25.00	N44°41'21"	39.27	C144	17.33	39°42'54"	25.00	9.03	N70°27'12"	16.98
C32	116.02	18°07'47"	40.00	130.05	N00°09'34"E	78.42	C89	39.27	90°00'00"	25.00	25.00	N45°18'39"	39.27	C145	8.39	19°15'37"	25.00	4.52	N10°33'07"	8.89
C33	23.42	33°32'27"	40.00	12.05	N66°28'44"E	23.08	C90	39.27	90°00'00"	25.00	25.00	N44°41'21"	39.27	C146	8.94	20°29'56"	25.00	4.52	N09°55'09"	8.89
C34	34.61	49°34'05"	40.00	18.47	N24°38'37"W	33.54	C91	8.39	18°13'25"	25.00	4.23	N20°25'16"	8.35	C147	39.27	90°00'00"	25.00	25.00	N45°18'39"	39.27
C35	23.39	33°30'10"	40.00	12.04	N66°10'45"W	23.06	C92	8.84	20°29'56"	25.00	4.52	N10°33'07"	8.80	C148	39.27	90°00'00"	25.00	25.00	N44°41'21"	39.27
C36	22.69	52°00'38"	25.00	12.20	N56°35'31"W	21.92	C93	8.39	18°13'25"	25.00	4.23	N20°25'16"	8.35	C149	17.33	39°42'54"	25.00	9.03	N70°27'12"	16.98
C37	17.15	09°49'41"	100.00	8.60	N36°09'10"E	17.15	C94	181.12	25°25'49"	40.00	181.12	N00°16'39"	61.54	C150	8.94	20°29'56"	25.00	4.52	N10°33'07"	8.89
C38	34.61	49°34'05"	40.00	18.47	N24°38'37"W	33.54	C95	38.98	55°10'07"	40.00	21.20	N12°02'31"	37.47	C151	8.39	19°15'37"	25.00	4.24	N02°22'22"	8.35
C39	23.39	33°30'10"	40.00	12.04	N66°10'45"W	23.06	C96	34.38	49°14'55"	40.00	18.33	N40°26'26"	33.33	C152	8.39	19°15'37"	25.00	4.24	N08°52'22"	8.35
C40	22.69	52°00'38"	25.00	12.20	N56°35'31"W	21.92	C97	34.38	49°14'55"	40.00	18.33	S89°41'21"	33.33	C153	38.98	55°50'32"	40.00	21.20	N12°06'17"	37.46
C41	38.42	04°32'28"	25.00	21.63	N71°13'44"W	38.41 <td>C98</td> <td>34.38</td> <th>49°14'55"</th> <th>40.00</th> <th>18.33</th> <th>N41°03'44"</th> <th>33.33</th> <td>C154</td> <td>58.49</td> <th>89°41'55"</th> <th>40.00</th> <th>18.33</th> <th>N40°26'26"</th> <th>58.33</th>	C98	34.38	49°14'55"	40.00	18.33	N41°03'44"	33.33	C154	58.49	89°41'55"	40.00	18.33	N40°26'26"	58.33
C42	35.86	08°14'16"	384.75 <th>27.85</th> <th>N26°15'30"W</th> <th>35.53</th> <td>C99</td> <td>34.38</td> <th>49°14'55"</th> <th>40.00</th> <th>18.33</th> <th>N41°03'44"</th> <th>33.33</th> <td>C155</td> <td>34.38</td> <th>49°14'55"</th> <th>40.00</th> <th>18.33</th> <th>N41°03'44"</th> <th>33.33</th>	27.85	N26°15'30"W	35.53	C99	34.38	49°14'55"	40.00	18.33	N41°03'44"	33.33	C155	34.38	49°14'55"	40.00	18.33	N41°03'44"	33.33
C43	45.59	08°16'44"	384.75 <th>27.85</th> <th>N32°10'55"W</th> <th>44.41</th> <td>C100</td> <td>24.41</td> <th>03°38'06"</th> <th>384.75</th> <th>12.21</th> <th>N37°22'25"</th> <th>24.29</th> <td>C156</td> <td>45.39</td> <th>08°16'44"</th> <th>384.75</th> <th>27.85</th> <th>N41°03'44"</th> <th>45.33</th>	27.85	N32°10'55"W	44.41	C100	24.41	03°38'06"	384.75	12.21	N37°22'25"	24.29	C156	45.39	08°16'44"	384.75	27.85	N41°03'44"	45.33
C44	24.41	03°38'06"	384.75	12.21	N37°22'25"W	24.29	C101	8.33	20°27'27"	25.00	4.51	N09°52'20"	8.88	C157	15.65	00°50'30"	384.75	8.87	N71°30'46"	15.65
C45	45.32	06°44'21"	384.75	22.69	N44°08'54"W	45.57	C102	8.33	20°27'27"	25.00	4.51	N09°52'20"	8.88	C158	17.33	39°42'54"	25.00	9.03	N70°27'12"	16.98
C46	15.65	00°50'30"	384.75	8.87	N71°30'46"W	15.65	C103	39.27	90°00'00"	25.00	25.00	N44°41'21"	39.27	C159	15.65	00°50'30"	384.75	8.87	N71°30'46"	15.65
C47	48.42	16°47'30"	550.75	81.29	N81°24'54"E	48.04	C104	39.27	90°00'00"	25.00	25.00	N44°41'21"	39.27	C160	8.84	20°29'56"	25.00	4.52	N09°55'49"	8.89
C48	181.42	08°16'44"	550.75	22.85	N17°36'46"W	181.42	C105	142.78	15°17'52"	534.75	71.82	N07°20'17"	142.35	C161	8.84	20°29'56"	25.00	4.52	N09°55'49"	8.89
C49	23.80	03°32'41"	384.75	11.81	N01°27'42"W	23.80	C106	8.48	00°50'30"	534.75	4.24	N00°09'34"	8.48	C162	39.27	90°00'00"	25.00	25.00	N45°18'39"	39.27
C50	45.32	06°44'21"	384.75	22.69	N06°36'30"W	45.29	C107	72.87	07°49'05"	534.75	36.54	N04°30'26"	72.91	C163	39.27	90°00'00"	25.00	25.00	N44°41'21"	39.27
C51	23.80	03°32'41"	384.75	11.81	N01°27'42"W	23.80	C108	61.33	06°34'15"	534.75	30.70	N11°42'05"	61.29	C164	39.27	90°00'00"	25.00	25.00	N44°41'21"	39.27
C52	25.88	03°16'27"	384.75	12.85	N11°53'41"W	25.88	C109	41.27	04°34'11"	534.75	21.06	N17°18'03"	41.27	C165	145.22	89°57'33"	25.00	24.95	N45°14'56"	145.32
C53	35.66.																			

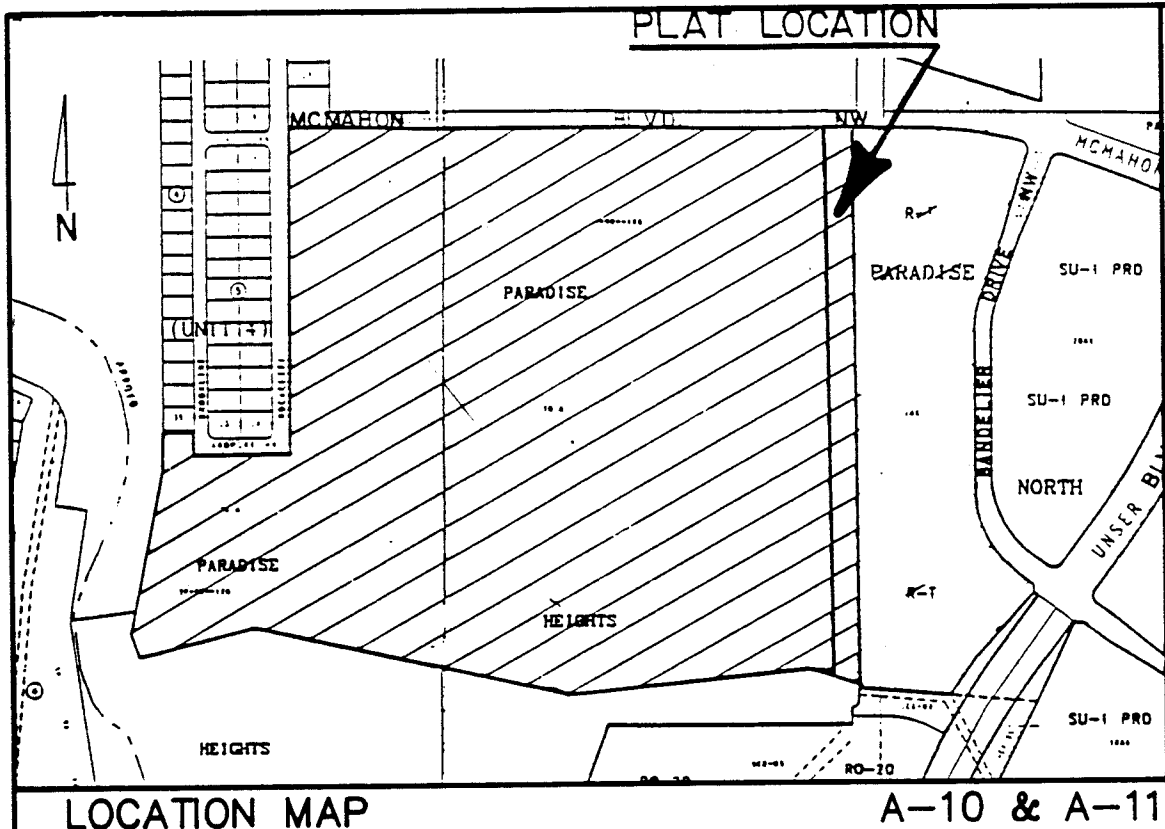

PURPOSE OF PLAT

- Subdivide into 35 residential lots and 1 tract (future Unit 3).
- Dedicate public drainage, utility and street right-of-way.
- Grant public utility easements.
- Grant waterline easement.

SUBDIVISION DATA

- DRB Case No.: 94-107
- Zone Atlas Index No.: A-10 & A-11
- Total Number of Existing Lots: 0
- Total Number of Existing Tracts: 1
- Total Number of Lots created: 35
- Total Number of Tracts created: 1 (future Unit 3)
- Gross Subdivision Acreage: 104.5044
- Total Mileage of Full Width Streets Created: 0.0714
- Total Mileage of Half Width Streets Created: 0.3259

NOTES

- Bearings are New Mexico State Plane Grid Bearings (Central Zone).
- Distances are ground distances.
- Bearings and distances are field and record.
- Boundaries are the following plots (and documents) of record entitled:
PARADISE NORTH (08-08-90, 90C-182)
PARADISE HEIGHTS, UNIT 3-A (07-25-90, 90C-169)
PARADISE SKIES, UNIT 1
all being records of Bernalillo County, New Mexico.
- Field Survey performed October, 1995.
- Centerline (in lieu of R/W) monumentation to be installed at all centerline P.C.'s, P.T.s, angle points and street intersections as shown hereon, and will consist of a four inch (4") aluminum alloy cap stamped "City of Albuquerque, Centerline Monument", "Do Not Disturb", "PLS # 7719".
- Utility Council Location System Log No. 95100913260444
- Title Report provided by Albuquerque Title Company, Commitment No. 13663005
- This property is apparently affected by reservations, restrictions and agreements contained within easements, documents and memorandums as listed within the above mentioned Title Report.

PUBLIC UTILITY EASEMENTS:

PUBLIC UTILITY EASEMENTS shown on this plat are granted for the common and joint use of:

- P.N.M. Electric Services Division for the installation, maintenance, and service of overhead and underground electrical lines, transformers, poles and any other equipment, fixtures, structures and related facilities reasonably necessary to provide electrical services.
 - P.N.M. Gas Services Division for installation, maintenance, and service of natural gas lines, valves and other equipment and facilities reasonably necessary to provide natural gas services.
 - U.S. West for installation, maintenance and service of all buried and aerial communication lines and other related equipment and facilities reasonably necessary to provide communication services, including but not limited to above ground pedestals and enclosures.
 - Jones Interco for the installation, maintenance, and service of such lines, cable, and other related equipment and facilities reasonably necessary to provide Cable TV services.
- Included, is the right to build, rebuild, construct, reconstruct, locate, relocate, change, remove, modify, renew, operate, and maintain facilities for the purposes described above, together with the access to, from, and over said easements, including sufficient working area space for electric transformers, with the right and privilege to trim and remove trees, shrubs or bushes which interfere with the purposes set forth herein. No building, sign, pool (aboveground or subsurface), hot tub, concrete or wood pool decking, or other structure shall be erected or constructed on said easements, nor shall any well be drilled or operated thereon. Property owners shall be solely responsible for correcting any violations of the National Electrical Safety Code caused by construction of pools, decking, or any structures adjacent to within or over easements shown on this plat.
- In approving this plat, the utility companies listed above did not conduct a title search of the properties shown hereon. Consequently, the utility companies do not waive or release any easement or easement rights which may have been granted by prior plat, report or other document and which are not shown on this plat.

NOTE:

These properties are within the New Mexico Utilities, Inc. franchise area. Water and sanitary sewer system capabilities are based on New Mexico Utilities, Inc. facilities, and not the City of Albuquerque. Water and sanitary sewer infrastructure improvements must, however, be approved by both City of Albuquerque and New Mexico Utilities, Inc.

FREE CONSENT AND DEDICATION

The subdivision hereon described is with the free consent and in accordance with the desires of the undersigned owner(s) and/or proprietor(s) hereof and said owner(s) and/or proprietor(s) do hereby dedicate all streets and public right-of-ways shown hereon to the City of Albuquerque in fee simple with warranty covenants and do hereby grant all access, utility and drainage easements, shown hereon, whether public or private, including the right to construct, operate, inspect, and maintain facilities thereon; and all public utility easements shown hereon for the common and joint use of gas, electrical power and communication services for buried distribution lines, conduits, and pipes for underground utilities where shown or indicated, and including the right of ingress and egress for construction and maintenance, and the right to trim interfering trees and shrubs. Said owner(s) and/or proprietor(s) do hereby consent to all of the foregoing and do hereby certify that this subdivision is their free act and deed.

Owner:
[Signature]
Hector J. Pickett, Jr., President of
Santitas Homes, Inc.
STATE OF NEW MEXICO
BERNALILLO COUNTY
On this 17th day of March, 1996, this instrument was acknowledged before me by Hector Griffin Pickett, Jr., President of Santitas Homes, Inc.
[Signature]
Notary Public, Commission Expires 3-26-2000

New Mexico Utilities, Inc. For the installation, maintenance and service of underground water and sanitary sewer lines necessary to provide service.

DESCRIPTION

A tract of land situated within the Town of Alameda Grant, projected Section 2 and 3, Township 11 North, Range 2 East, N.M.P.M., Bernalillo County, New Mexico, being all of Tract AA, Paradise Skies as the same is shown and designated on said plat filed for record in the office of the County Clerk of Bernalillo County, New Mexico on 1995 in Volume 1, Folio from whence ACS Monument "1-A11" bears N 59°13'1" E, 622.10 feet;

BEGINNING at the southeast corner of the herein described tract said point being common with the southwest corner of LOT 1, PARADISE SKIES, UNIT 1 at the same is shown and designated on said plat filed for record in the office of the County Clerk of Bernalillo County, New Mexico on 1995 in Volume 1, Folio from whence ACS Monument "1-A11" bears N 59°13'1" E, 622.10 feet;

Thence N 85°11'12" W, a distance of 195.35 feet to a point;

Thence S 83°45'53" W, a distance of 866.55 feet to a point;

Thence N 77°04'55" W, a distance of 1172.64 feet to a point;

Thence S 78°01'50" W, a distance of 443.06 feet to the southwest corner;

Thence N 19°21'04" W, a distance of 82.05 feet to a point;

Thence S 89°45'01" E, a distance of 120.15 feet to a point;

Thence S 89°45'01" E, a distance of 120.15 feet to a point;

Thence S 00°14'59" W, a distance of 143.69 feet to a point;

Thence S 89°29'44" E, a distance of 354.94 feet to a point;

Thence N 00°18'58" E, a distance of 1167.66 feet to a point of curvature;

Thence along a curve to the right through a central angle of 89°44'21" on arc distance of 52.88 feet, a radius of 35.00 feet and a chord bearing of N 43°41'09" E, a distance of 48.07 feet to a point of compound curvature;

Thence along a curve to the right through a central angle of 02°52'28" on arc distance of 68.32 feet, a radius of 1322.00 feet and a chord bearing of N 88°29'33" E, a distance of 66.31 feet to a point of tangency;

Thence N 89°51'17" E, a distance of 996.96 feet to a point;

Thence S 89°48'34" E, a distance of 965.67 feet to the northeast corner;

Thence S 00°18'58" W, a distance of 2029.82 feet to the point of beginning and containing 104.5044 acres more or less.

PLAT FOR
PARADISE SKIES, UNIT 2
WITHIN THE
TOWN OF ALAMEDA GRANT
PROJECTED SECTION 2 & 3
TOWNSHIP 11 NORTH, RANGE 2 EAST, N.M.P.M.
CITY OF ALBUQUERQUE
BERNALILLO COUNTY, NEW MEXICO
OCTOBER, 1995

APPROVED AND ACCEPTED BY:

Subdivision Case No. _____ Date _____
Planning Director, City of Albuquerque, N.M. _____ Date _____
City Engineering Dir., City of Albuquerque, N.M. _____ Date _____
Albuquerque Metropolitan Arroyo Flood Control Authority _____ Date _____
Traffic Div., City of Albuquerque, N.M. _____ Date _____
Public Utilities Dept., City of Albuquerque, N.M. _____ Date _____
Public Works Dept., City of Albuquerque, N.M. _____ Date _____
City Engineer, City of Albuquerque, N.M. _____ Date _____
Property Manager, City of Albuquerque, N.M. _____ Date _____
County Engineer, Bernalillo County, N.M. _____ Date _____
P.N.M. Gas Services Division _____ Date _____
U.S. West _____ Date _____
N.M. Electric Services Division _____ Date _____
Jones Interco, Inc. _____ Date _____
New Mexico Utilities, Inc. _____ Date _____


SURVEYOR'S CERTIFICATION

"I, Timothy Aldrich, a duly qualified Registered Professional Land Surveyor under the laws of the State of New Mexico, do hereby certify that this plat and description were prepared by me or under my supervision, shows all easements as shown on the plat of record or made known to me by the owners and/or proprietors of the subdivision shown hereon, utility companies and other parties expressing an interest and meets the minimum requirements for monumentation and surveys of the Albuquerque Subdivision Ordinance, and further meets the minimum Standards for Land Surveying in the State of New Mexico (Effective November 1, 1989 and revisions effective November 25, 1991 and February 3, 1994), and is true and correct to the best of my knowledge and belief."





ALDRICH LAND
SURVEYING
P.O. BOX 30701, ALBU., N.M. 87190
505-884-1990

Δ - REVISED 1-24-96
Drawn By: RJA Date: 10-16-95
Checked By: TA Drawing Name: 9510BPL1.DWG
Job No.: 95-108 Sheet: 1 of 3

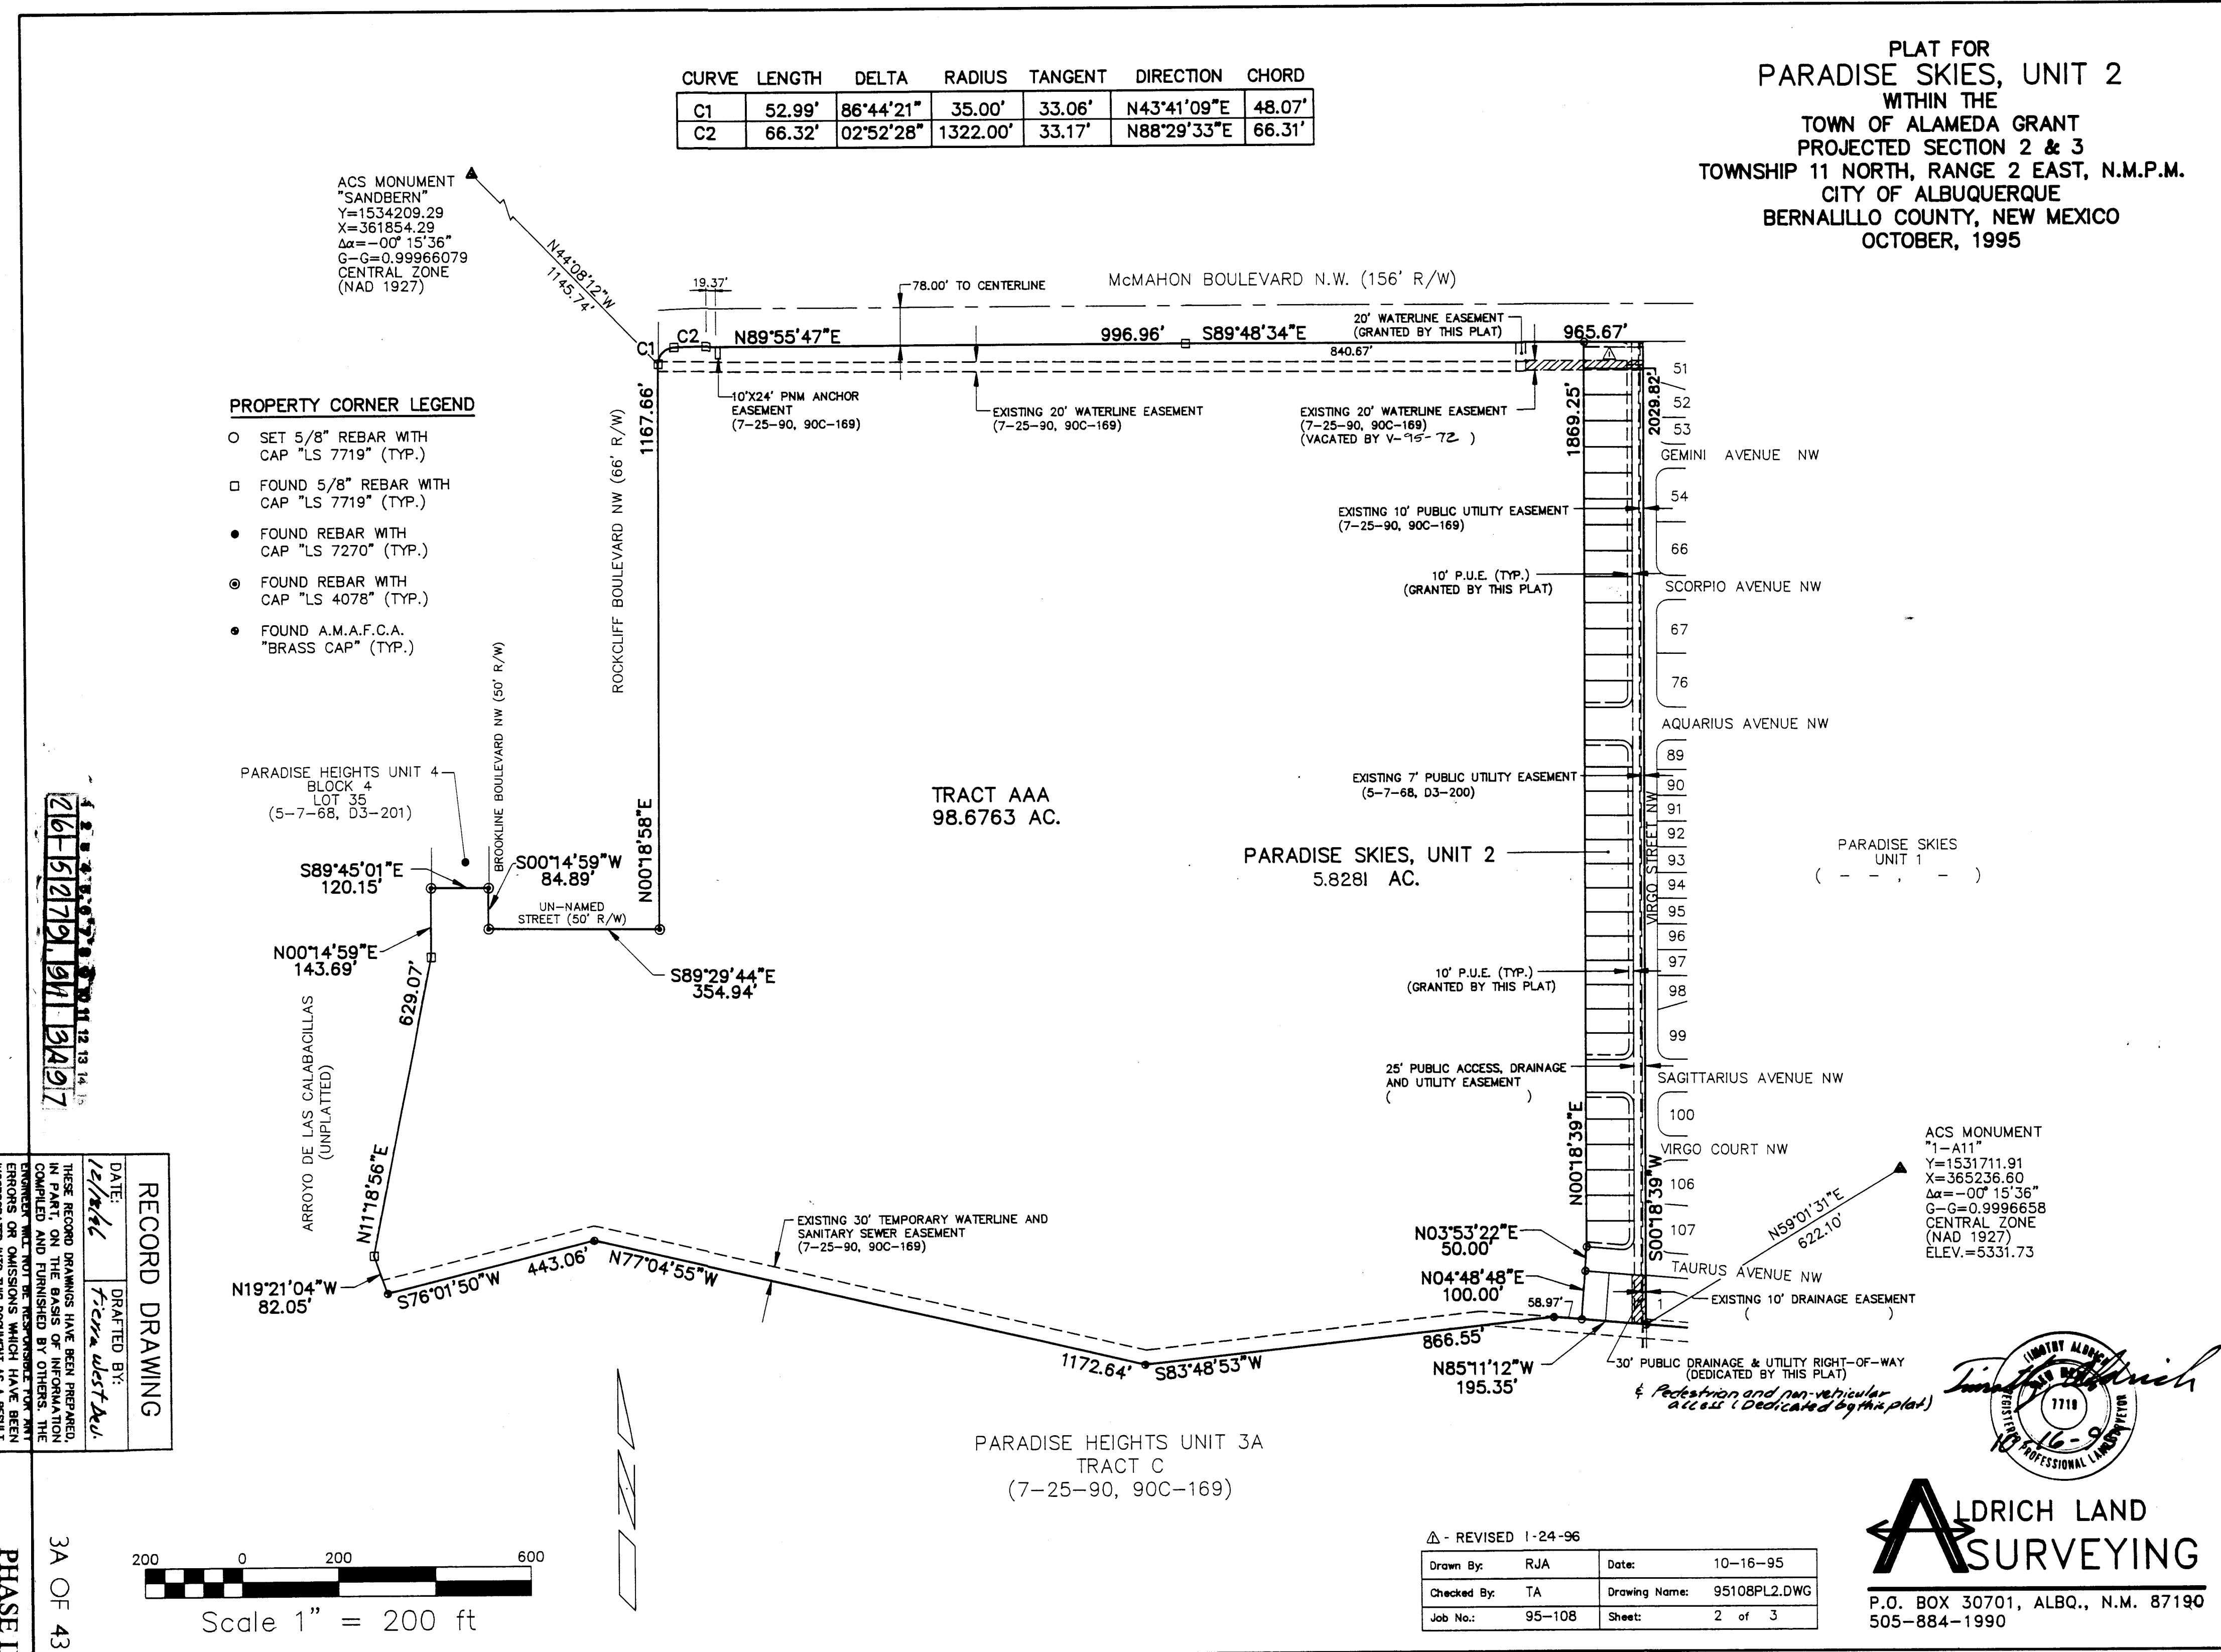


PLAT FOR
PARADISE SKIES, UNIT 2
WITHIN THE
TOWN OF ALAMEDA GRANT
PROJECTED SECTION 2 & 3
TOWNSHIP 11 NORTH, RANGE 2 EAST, N.M.P.M.
CITY OF ALBUQUERQUE
BERNALILLO COUNTY, NEW MEXICO
OCTOBER, 1995

CURVE	LENGTH	DELTA	RADIUS	TANGENT	DIRECTION	CHORD
C1	41.23'	94°30'09"	25.00'	27.05'	N47°33'44"E	36.72'
C2	39.27'	90°00'00"	25.00'	25.00'	N44°41'21"W	35.36'
C3	39.27'	90°00'00"	25.00'	25.00'	N45°18'39"E	35.36'
C4	39.27'	90°00'00"	25.00'	25.00'	N44°41'21"W	35.36'
C5	39.27'	90°00'00"	25.00'	25.00'	N45°18'39"E	35.36'
C6	39.27'	90°00'00"	25.00'	25.00'	N44°41'21"W	35.36'

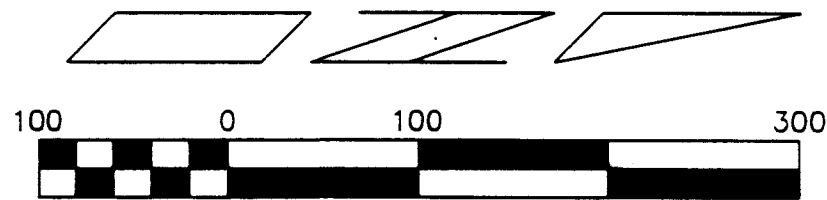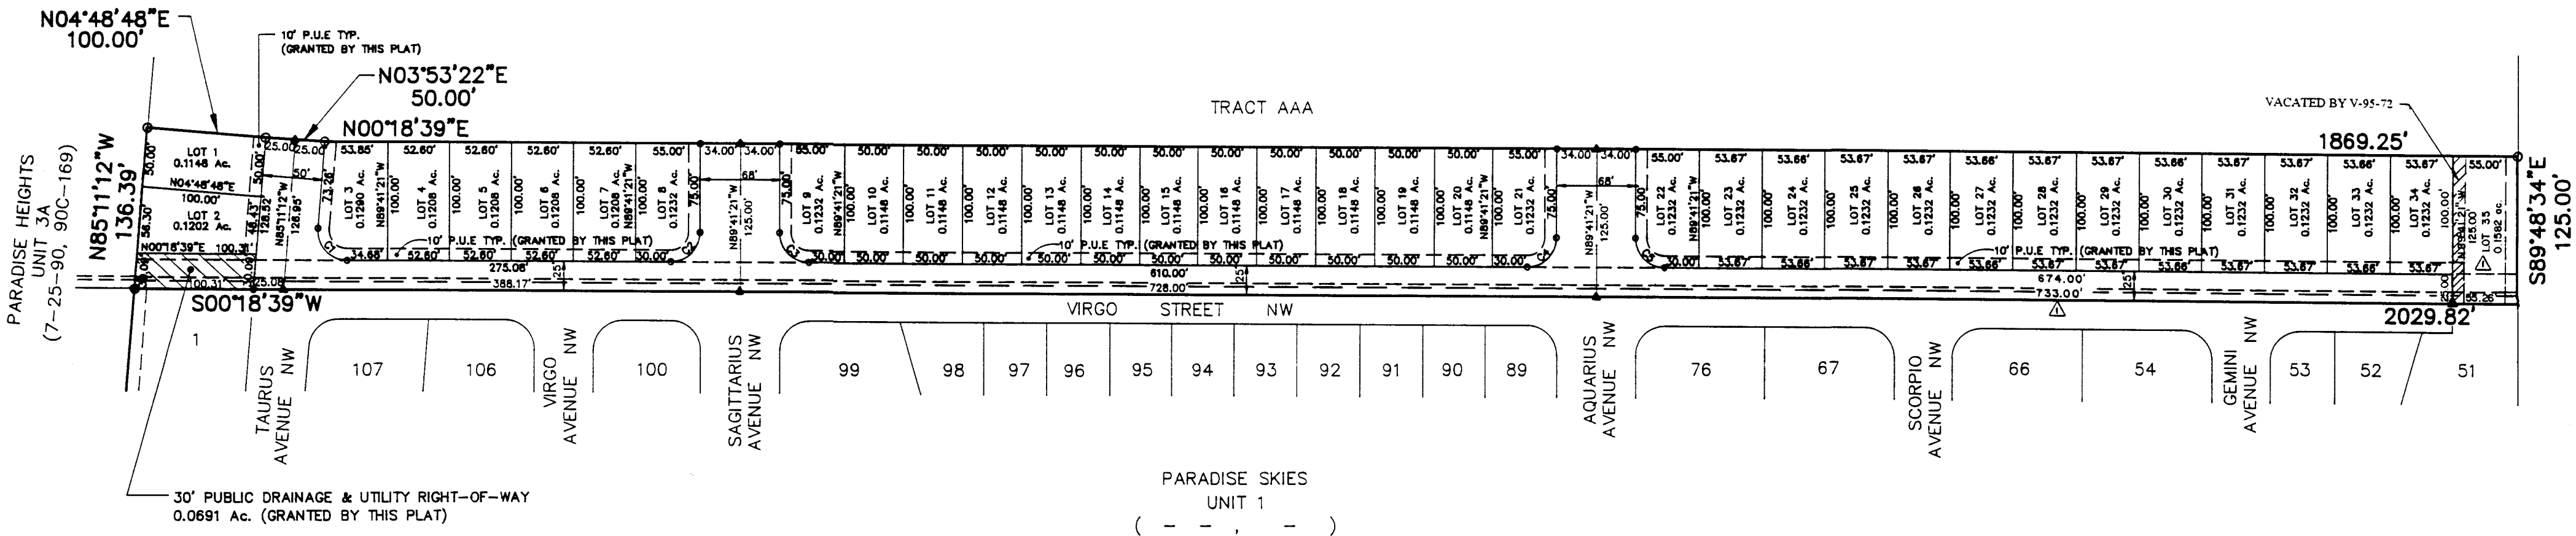

Drawn By:	RJA	Date:	10-16-95
Checked By:	TA	Drawing Name:	95108PL3.DWG
Job No.:	95-108	Sheet:	3 of 3

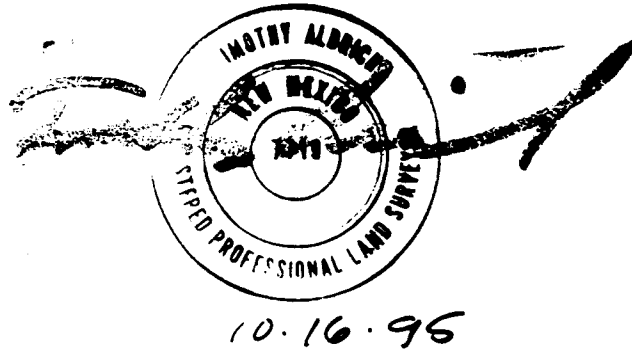


ALDRICH LAND
SURVEYING

P.O. BOX 30701, ALBQ., N.M. 87190
505-684-1990

SCANNED BY
BY LASON





RECORD DRAWING	
DATE: 12/18/96	DRAFTED BY: Tierra Mott
THESE RECORD DRAWINGS HAVE BEEN PREPARED, CHECKED, AND APPROVED BY THE SURVEYOR. ANY ERRORS OR OMISSIONS WHICH HAVE BEEN INCORPORATED INTO THIS DOCUMENT AS A RESULT.	

26-5279.9/1 3897

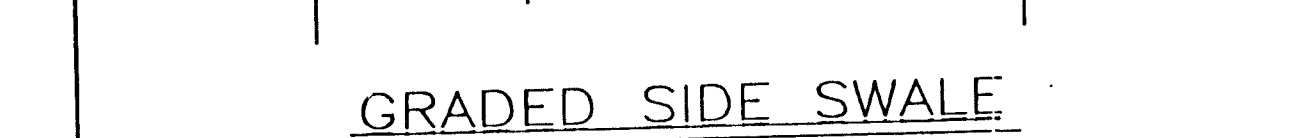

QUERQUE DEPARTMENT & GROUP		
SKIES LAN-A		
APPROVALS	ENGINEER	DATE
WATER	N/A RWC	11-30
WASTE WATER	N/A RWC	11-30
0. - 11	SHEET	OF 43
PHASE II		

I certify that the grades shown on this plan have been built in substantial accordance with approved grading and drainage plan dated 11-15-95. Survey information was supplied by 304 in accordance with normal surveying practices.

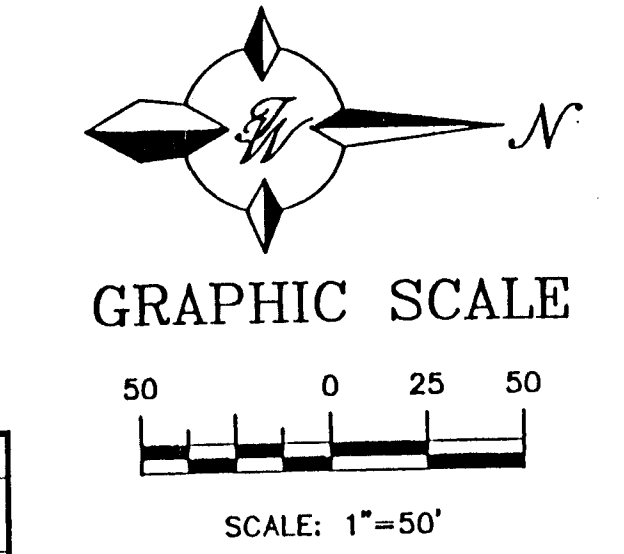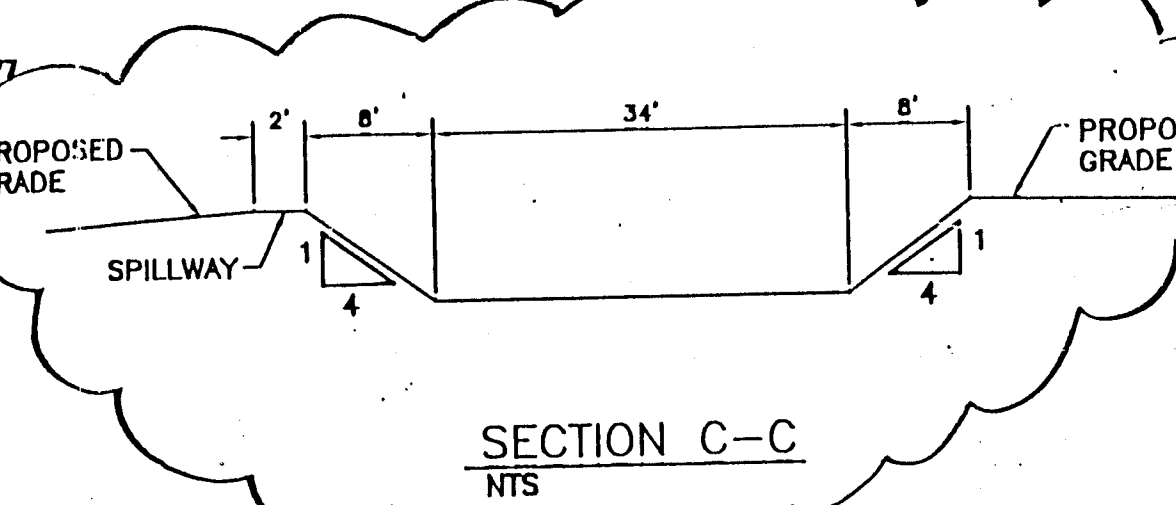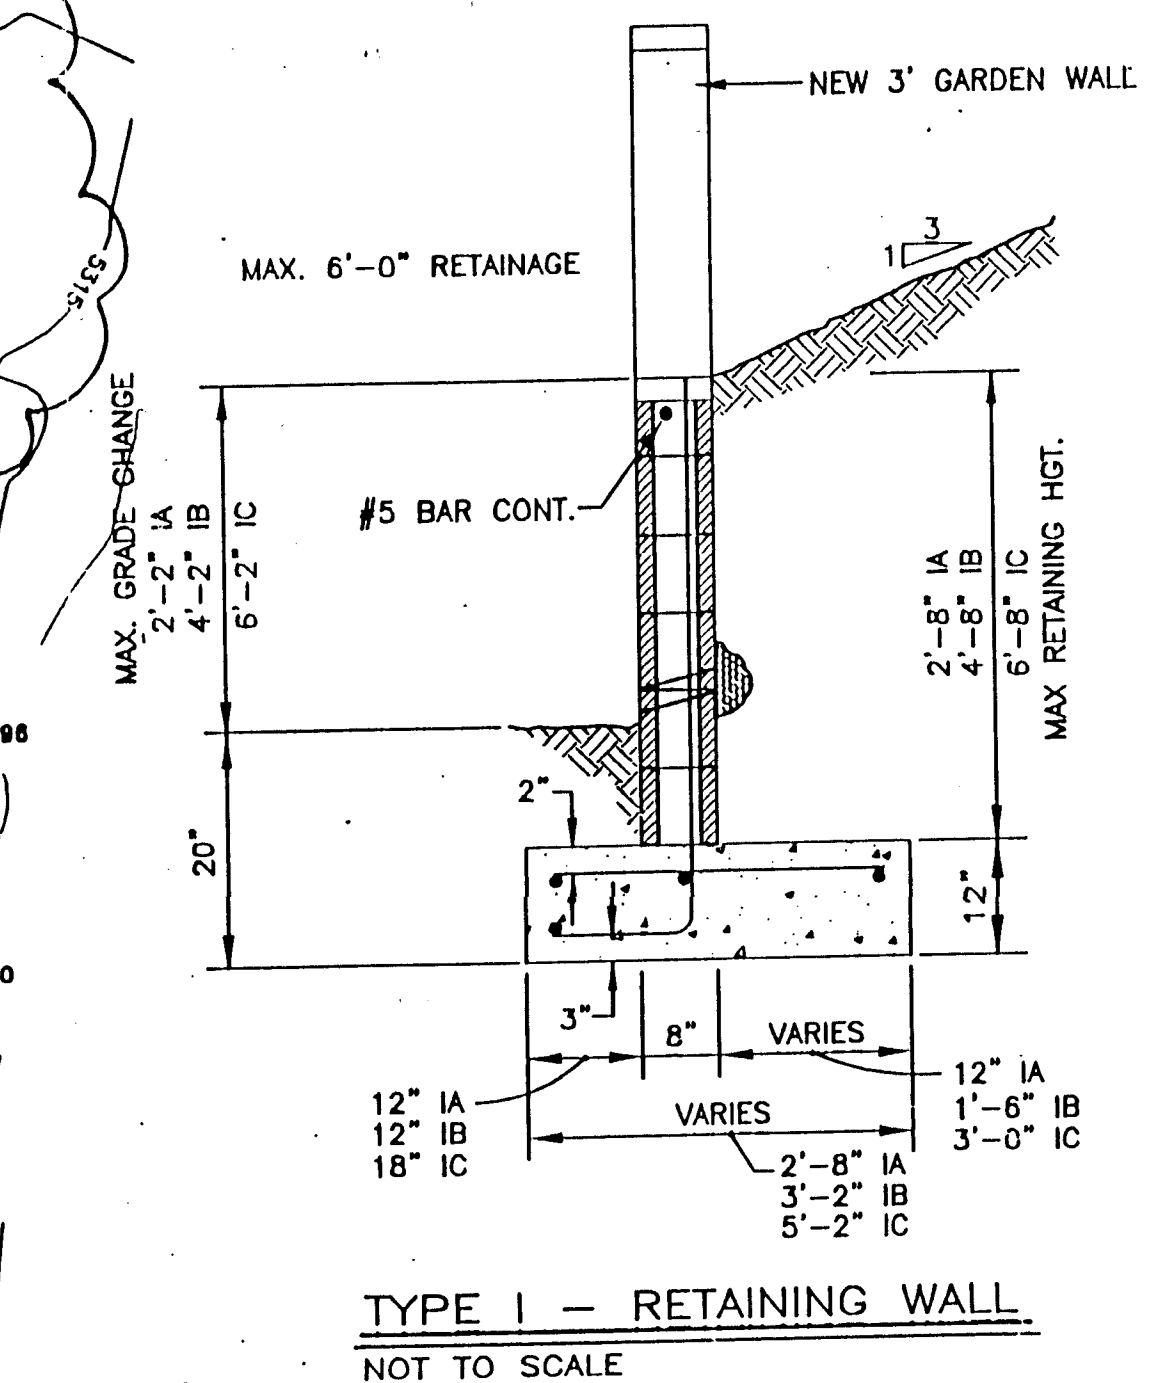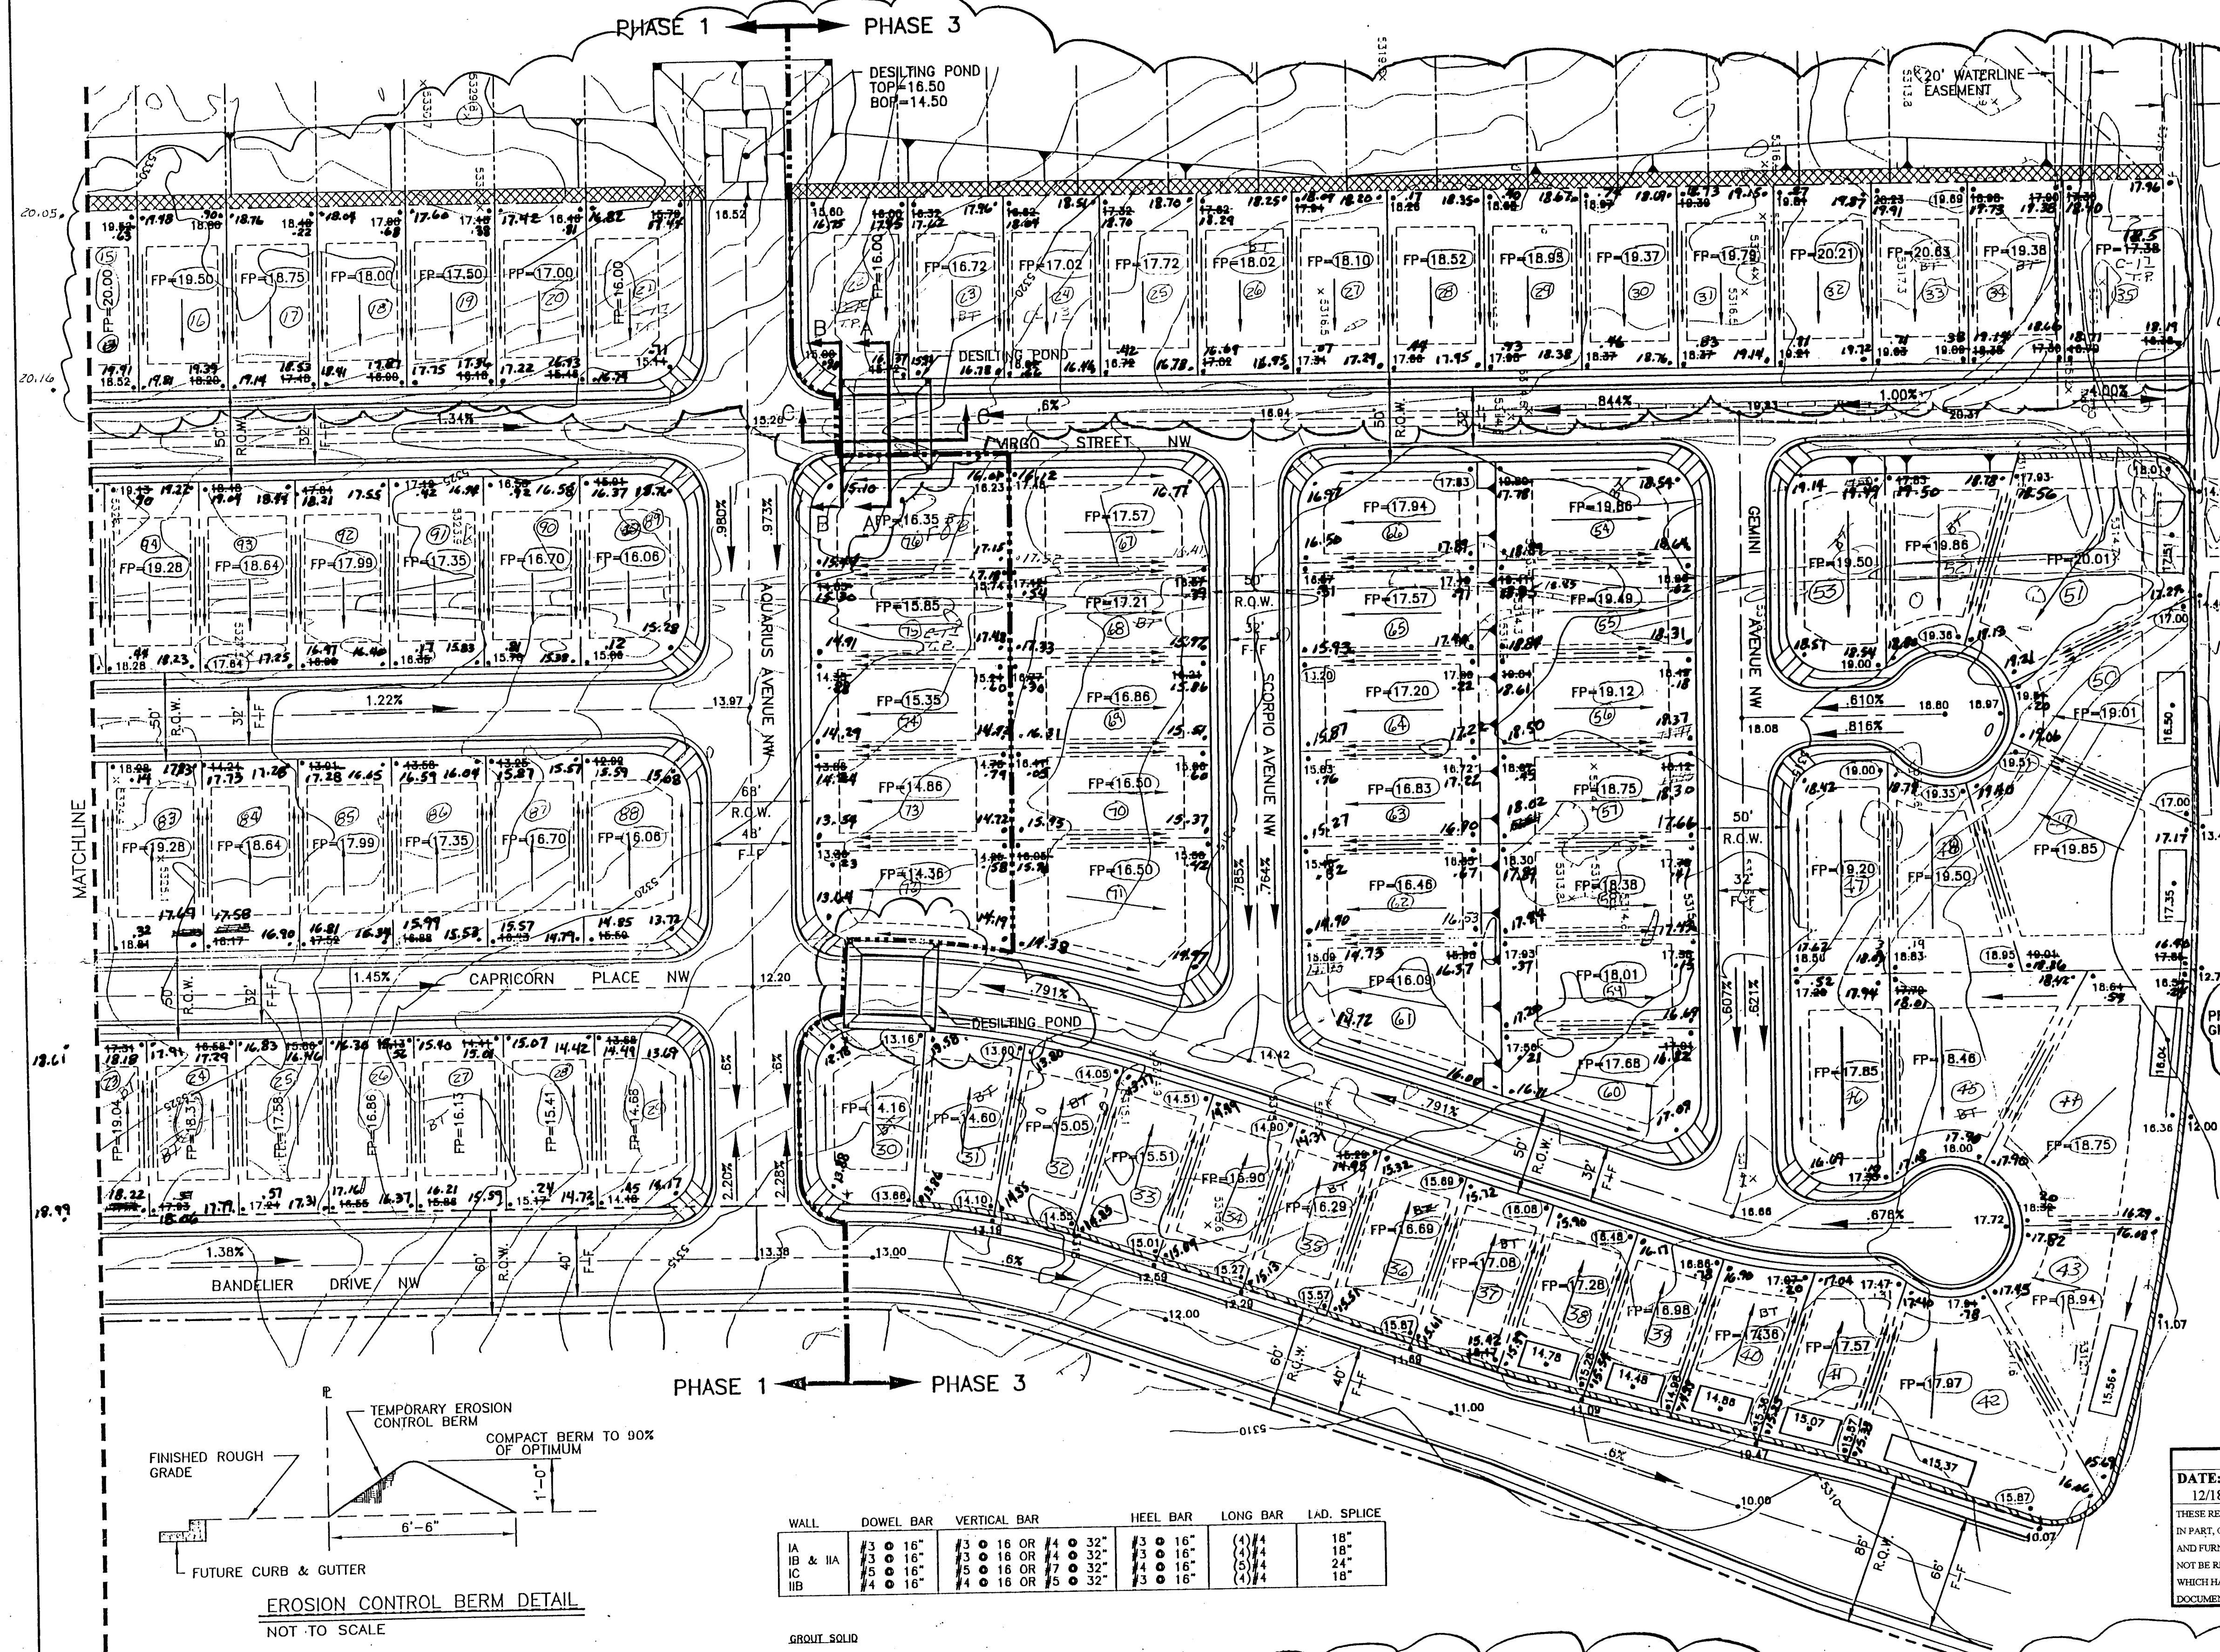

RECORD DRAWING
DATE: 12/18/96
DRAFTED BY: TERRA WEST DEV.
THESE RECORD DRAWINGS HAVE BEEN PREPARED, IN PART, ON THE BASIS OF INFORMATION COMPILED AND FURNISHED BY OTHERS. THE ENGINEER WILL NOT BE RESPONSIBLE FOR ANY ERRORS OR OMISSIONS WHICH HAVE BEEN INCORPORATED INTO THE DOCUMENT AS A RESULT.

TERRA WEST DEVELOPMENT
MANAGEMENT SERVICES
4421 MCLEOD ROAD N.E., SUITE D
ALBUQUERQUE, NEW MEXICO 87109
(505)883-7592

CITY OF ALBUQUERQUE
PUBLIC WORKS DEPARTMENT
ENGINEERING GROUP

TITLE: **PARADISE SKIES GRADING PLAN-B**

APPROVALS	ENGINEER	DATE	APPROVALS	ENGINEER	DATE
DRC CHAIRMAN			WATER	MIA RWE	11-30-95
TRANSPORTATION			WASTE WATER	MIA RWE	11-30-95
HYDROLOGY					

PROJECT NO.	5279.90	MAP NO.	A-11	SHEET	5	OF	43
-------------	---------	---------	------	-------	---	----	----

PHASE II



- EROSION CONTROL PLAN NOTES**
- CONTRACTOR IS RESPONSIBLE FOR OBTAINING A TOPSOIL DISTURBANCE PERMIT PRIOR TO BEGINNING WORK.
 - CONTRACTOR IS RESPONSIBLE FOR CLEANING ALL SEDIMENT OUT OF EXISTING RIGHT-OF-WAY.
 - CONTRACTOR IS RESPONSIBLE FOR CLEANING UP ANY SEDIMENT THAT GETS INTO EXISTING RIGHT-OF-WAY.
 - EROSION CONTROL BERM IS REQUIRED ALONG THE EAST BOUNDARY LINE TO DIVERT RUNOFF TO NEW DESILTING POND ON THE EAST SIDE OF AQUARIUS AVE.
 - EROSION CONTROL BERM MUST BE IN PLACE PRIOR TO ANY CONSTRUCTION ON SITE.

WALL	DOWEL BAR	VERTICAL BAR	HEEL BAR	LONG BAR	L.D. SPLICE
IA	3 # 16"	3 # 16 OR # 4 32"	3 # 16"	(4) # 4	18"
IB & IIA	3 # 16"	3 # 16 OR # 4 32"	3 # 16"	(4) # 4	18"
IC	5 # 16"	5 # 16 OR # 4 32"	3 # 16"	(5) # 4	24"
IIIB	4 # 16"	4 # 16 OR # 5 32"	3 # 16"	(4) # 4	18"


GROUT SOLID
8" CMU,
3" - 32" SOIL WGT. - 110 PCF
ALLOW = 1500PSF

DEVELOPER:
IA 2'-8" RETAINED HGT 2'-2" GRADE CHANGE
IB 4'-8" RETAINED HGT 4'-2" GRADE CHANGE
IC 6'-8" RETAINED HGT 6'-2" GRADE CHANGE


- GENERAL NOTES:**
- ALL CONCRETE IS TO BE 4000 PSI @ 28 DAYS.
 - MINIMUM COMPACTION UNDER FOOTINGS IS TO BE 95% PER ASTM D 1557 FOR A DEPTH OF 12" MOISTURE CONTENT IS TO BE $\pm 2.0\%$.
 - BACKFILL AGAINST WALLS IS TO BE HAND-PLACED AND COMPACTED.
 - ALL BARS ARE TO BE GRADE 60, ASTM 615.
 - TRUSS TYPE DWR-G WALL EVERY OTHER COURSE.

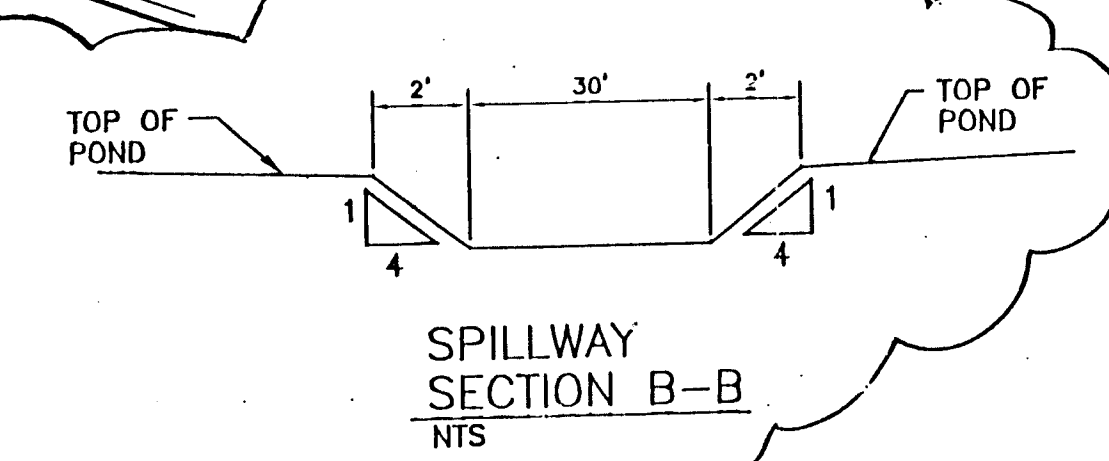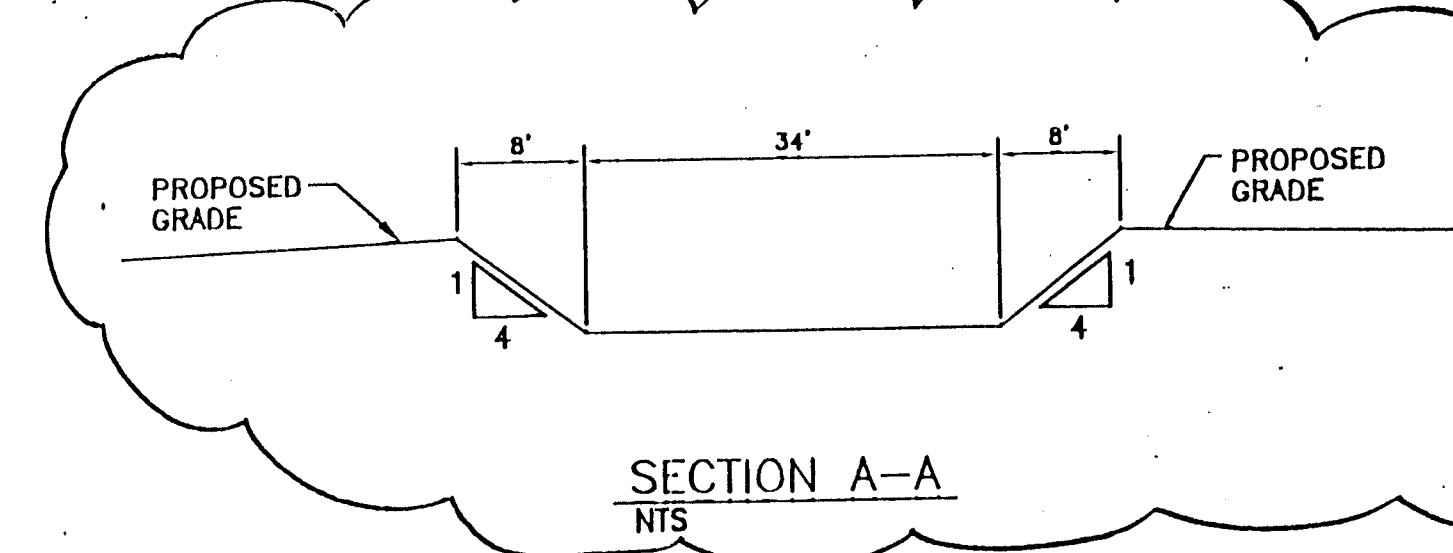


SCANNED BY LASON
26-13279 91 10307

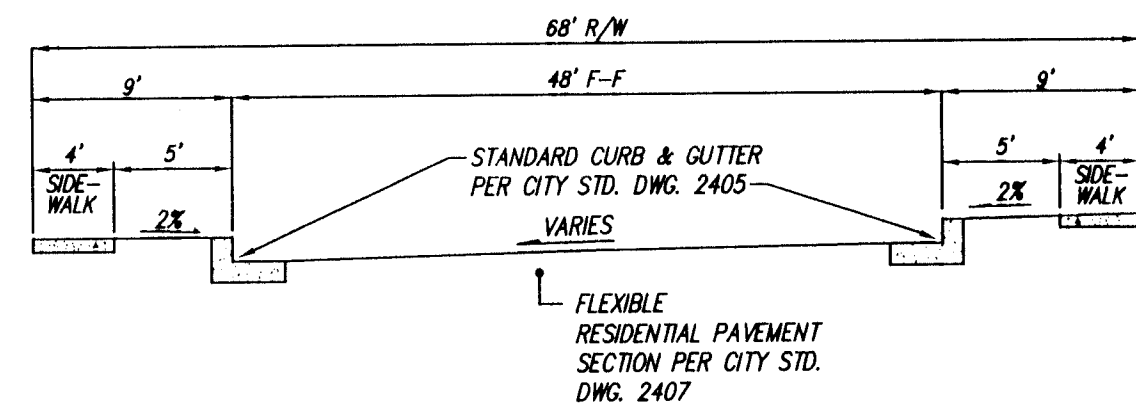


SECTION A-A
SAGITARIUS & AQUARIUS AVENUE SECTION
N.T.S.

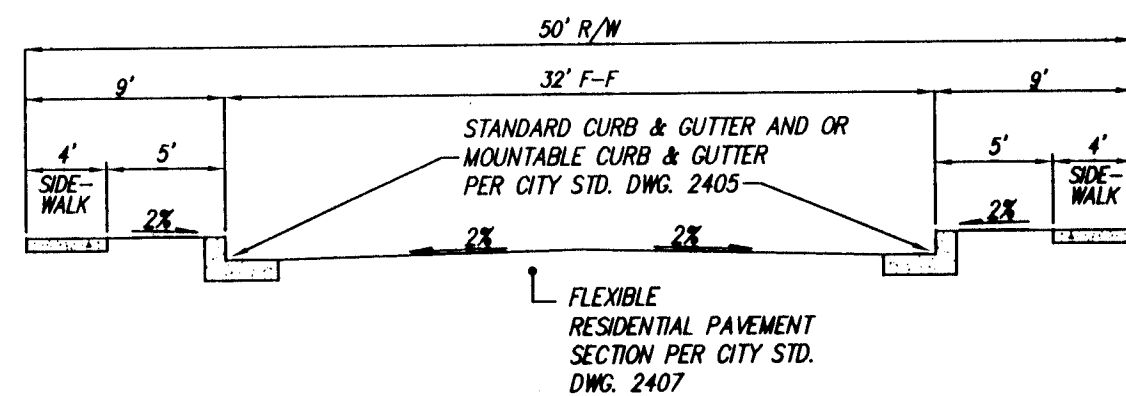


SECTION B-B
TYPICAL 32' STREET SECTION
N.T.S.

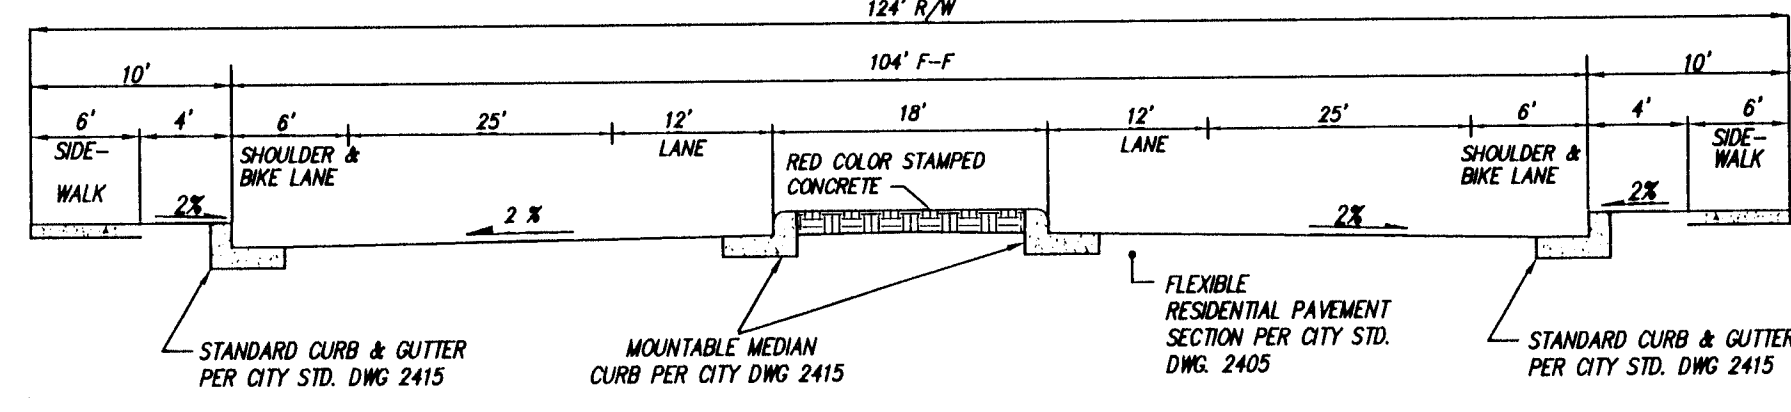


SECTION D-D
McMAHON BOULEVARD SECTION
(TO BE BONDED)
N.T.S.

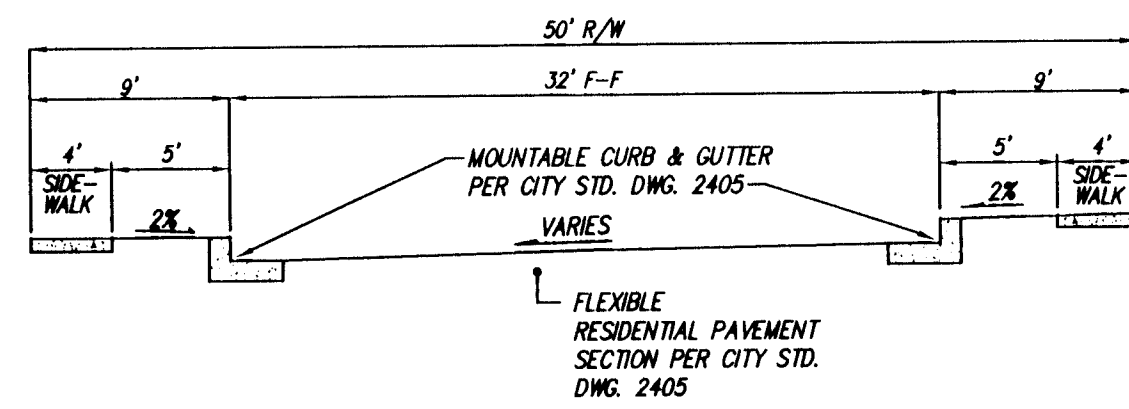


SECTION C-C
TYPICAL 32' STREET SECTION
N.T.S.

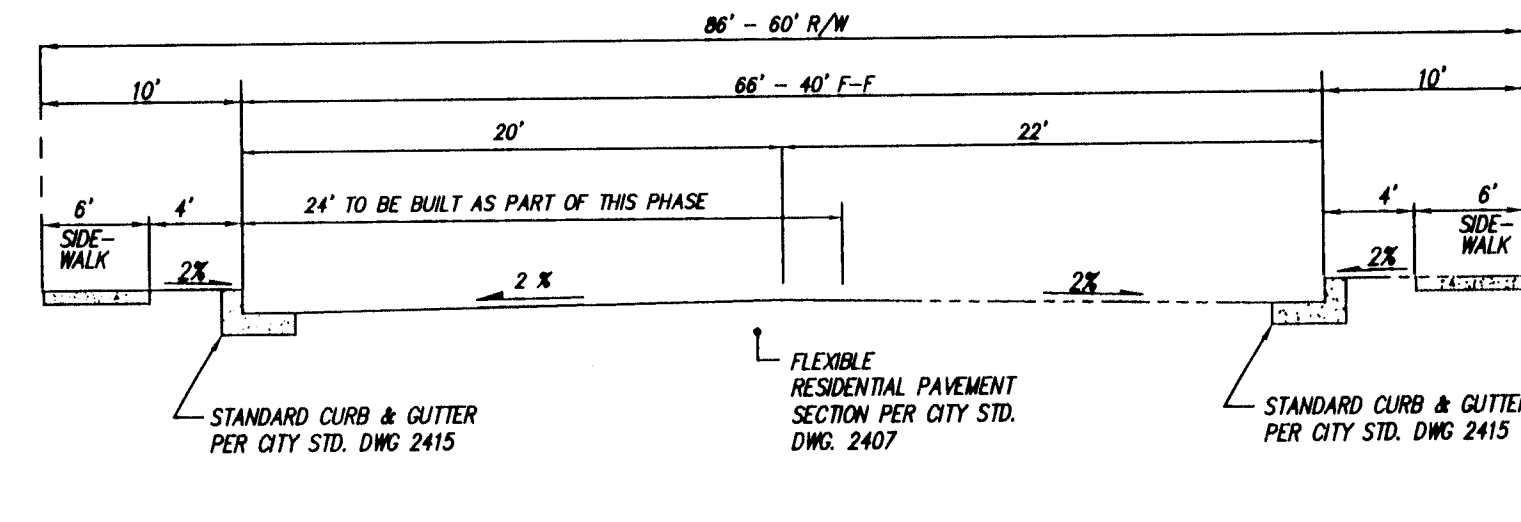

SECTION E-E
BANDELIER DRIVE SECTION
N.T.S.

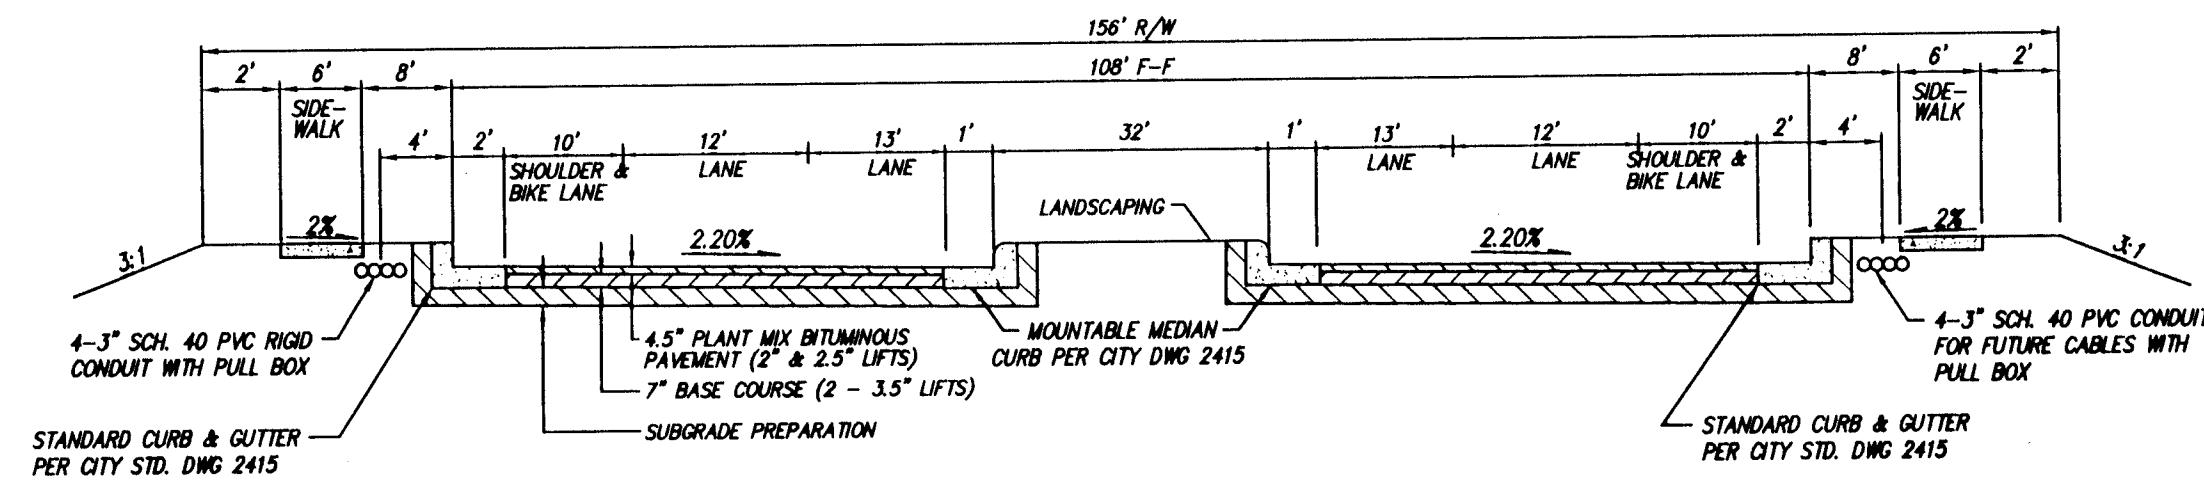


SECTION F-F
UNSER BOULEVARD SECTION
N.T.S.

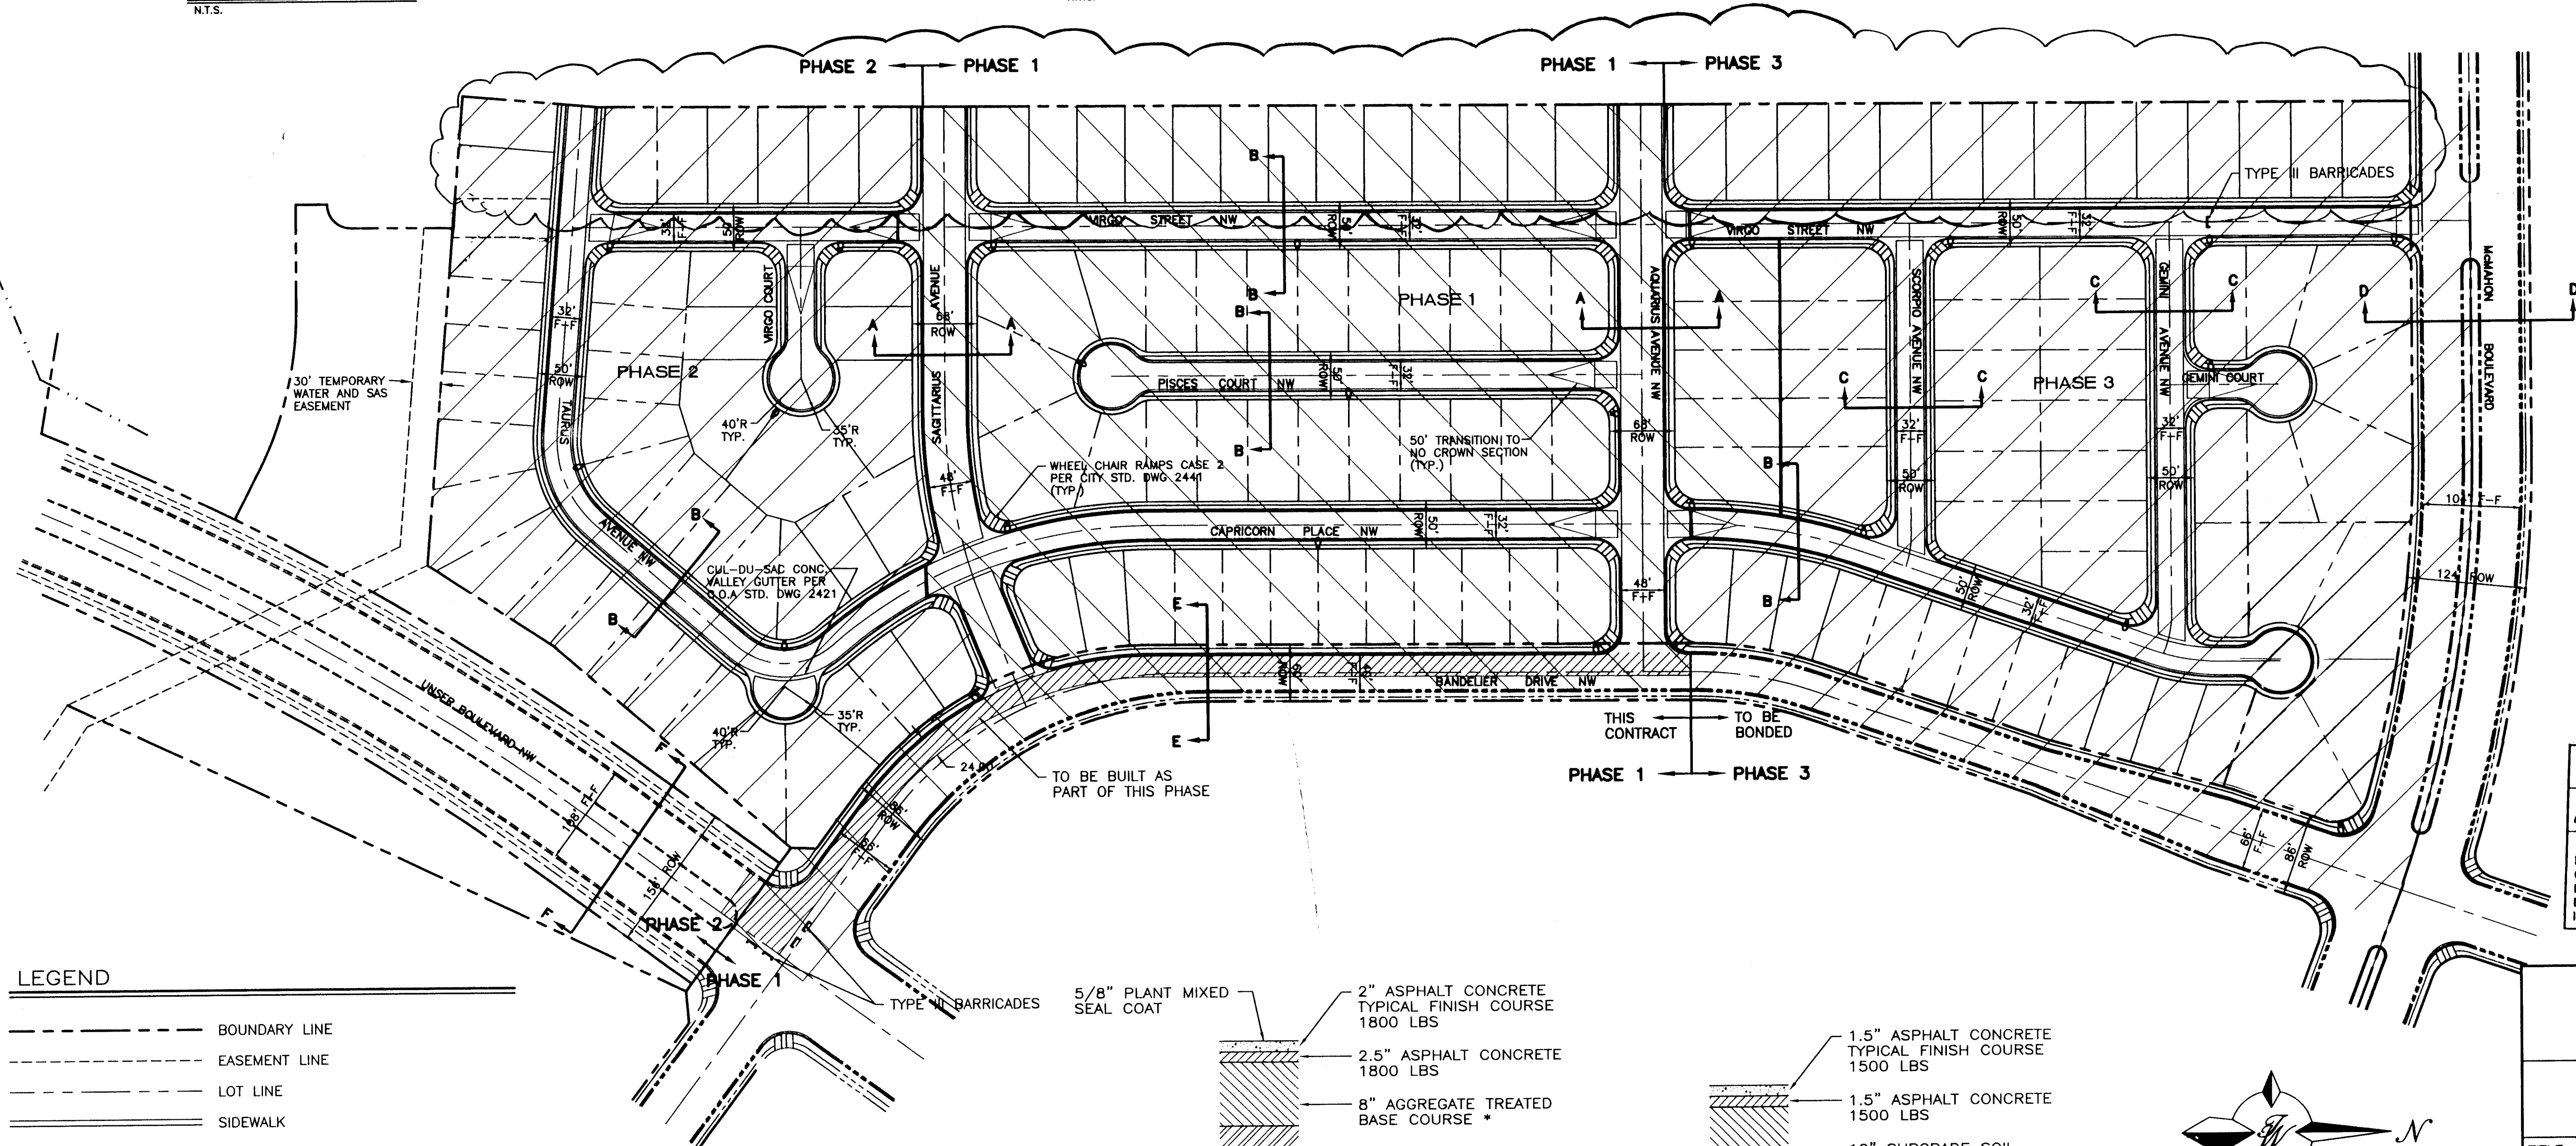


- LEGEND**
- BOUNDARY LINE
 - EASEMENT LINE
 - LOT LINE
 - SIDEWALK
 - MOUNTABLE CURB AND GUTTER
 - STANDARD CURB AND GUTTER
 - FUTURE STANDARD CURB AND GUTTER
 - CENTER LINE
 - PROPOSED STREET LIGHTS

NOTE:
ALL CURBS ARE MOUNTABLE CURB AND GUTTER
UNLESS OTHERWISE SHOWN.

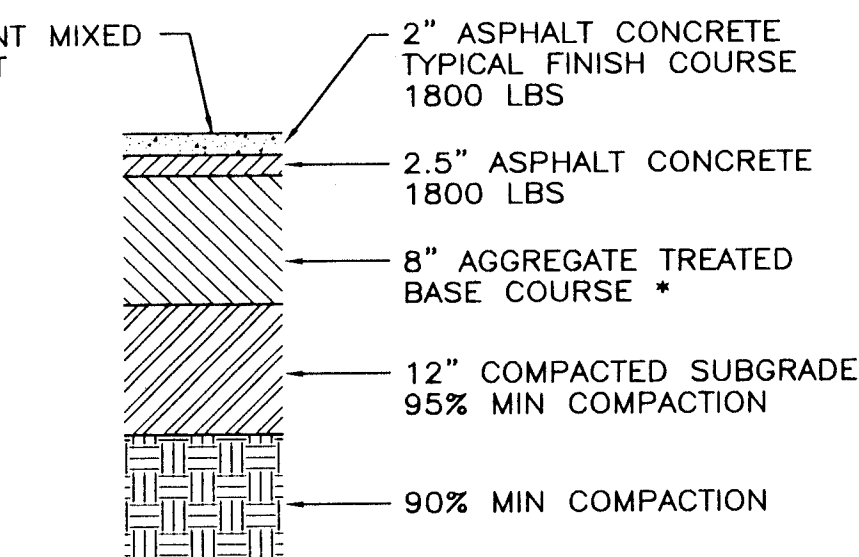


PAVING SECTION FOR SECTIONS A-A AND E-E
N.T.S.

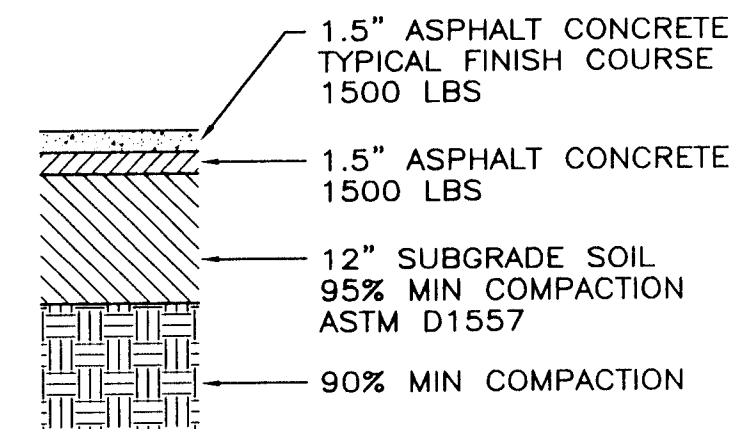


PAVING SECTION FOR SECTIONS B-B AND C-C
N.T.S.

* BASE COURSE SHOULD BE CLASS I OR II MATERIAL
AS DETAILED IN SECTION 302 OF THE "CITY OF ALBUQ.
STANDARD SPECIFICATIONS FOR PUBLIC WORKS
CONSTRUCTION."

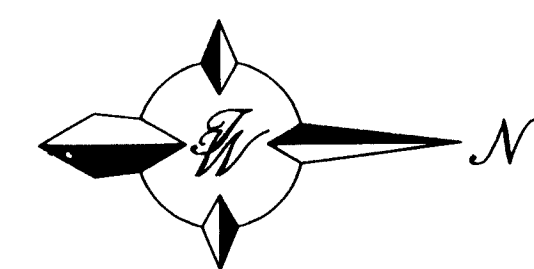

GRAPHIC SCALE

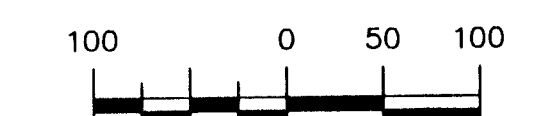

SCALE: 1"=100'

40\930064\9364MP.DWG
BY LASON

RECORD DRAWING

DATE: 12/19/96 DRAFTED BY: Tierra West Dev.

THESE RECORD DRAWINGS HAVE BEEN PREPARED, IN PART, ON THE BASIS OF INFORMATION COMPILED AND FURNISHED BY OTHERS. THE ENGINEER WILL NOT BE RESPONSIBLE FOR ANY ERRORS OR OMISSIONS WHICH HAVE BEEN INCORPORATED INTO THIS DOCUMENT AS A RESULT.

TIERRA WEST DEVELOPMENT
MANAGEMENT SERVICES
4421 McLEOD ROAD N.E., SUITE D
ALBUQUERQUE, NEW MEXICO 87109
(505)883-7592

CITY OF ALBUQUERQUE
PUBLIC WORKS DEPARTMENT
ENGINEERING GROUP

TITLE: PARADISE SKIES MASTER PAVING PLAN					
APPROVALS	ENGINEER	DATE	APPROVALS	ENGINEER	DATE
DRC CHAIRMAN	<i>[Signature]</i>	12-29-95	WATER	N/A R/WK	11-30-95
TRANSPORTATION	<i>[Signature]</i>	11-30-95	WASTE WATER	N/A R/WK	11-30-95
HYDROLOGY	<i>[Signature]</i>	12-29-95			
PROJECT NO.	5279.91	MAP NO.	A-11-Z	SHEET OF	6 43

1 2 3 4 5 6 7 8 9 10 11 12 13 14 15
26-5279.91 06/97


PHASE II


AS BUILT INFORMATION					
CONTRACTOR	SPARLING CONSTRUCTION INC.	WORK	DATE	DATE	DATE
STAMPED BY	JEFF MORTENSEN	DATE	5/0/95	DATE	5/0/95
ACCEPTANCE	BY COMM. SCIENCE	DATE	12/18/96	DATE	12/18/96
FIELD	NO. 121596	DATE	12/15/96	DATE	12/15/96
DRAWINGS	BY TIERRA WEST DEV.	DATE	12/15/96	DATE	12/15/96
MICRO-FILM INFORMATION					
RECORDED BY		NO.		DATE	
DELTA	-00'15"36"	ELEV	5331.73		


SURVEY INFORMATION					
ACS "1-A11"	CENTRAL STATION DATA	DATE			
NM STATE PLANE COORDINATES	CENTRAL ZONE	X=	365236.60	Y=	1531711.91
G-G=	0.9996658	DELTA	-00'15"36"	ELEV	5331.73



ENGINEER'S SEAL					
NO.	DATE	REMARKS	BY	DATE	DATE
		DESIGN		7/95	7/95
		REVISIONS		7/95	7/95
		DESIGNED BY	RRB		
		DRAWN BY	BDG		
		CHECKED BY	RRB		

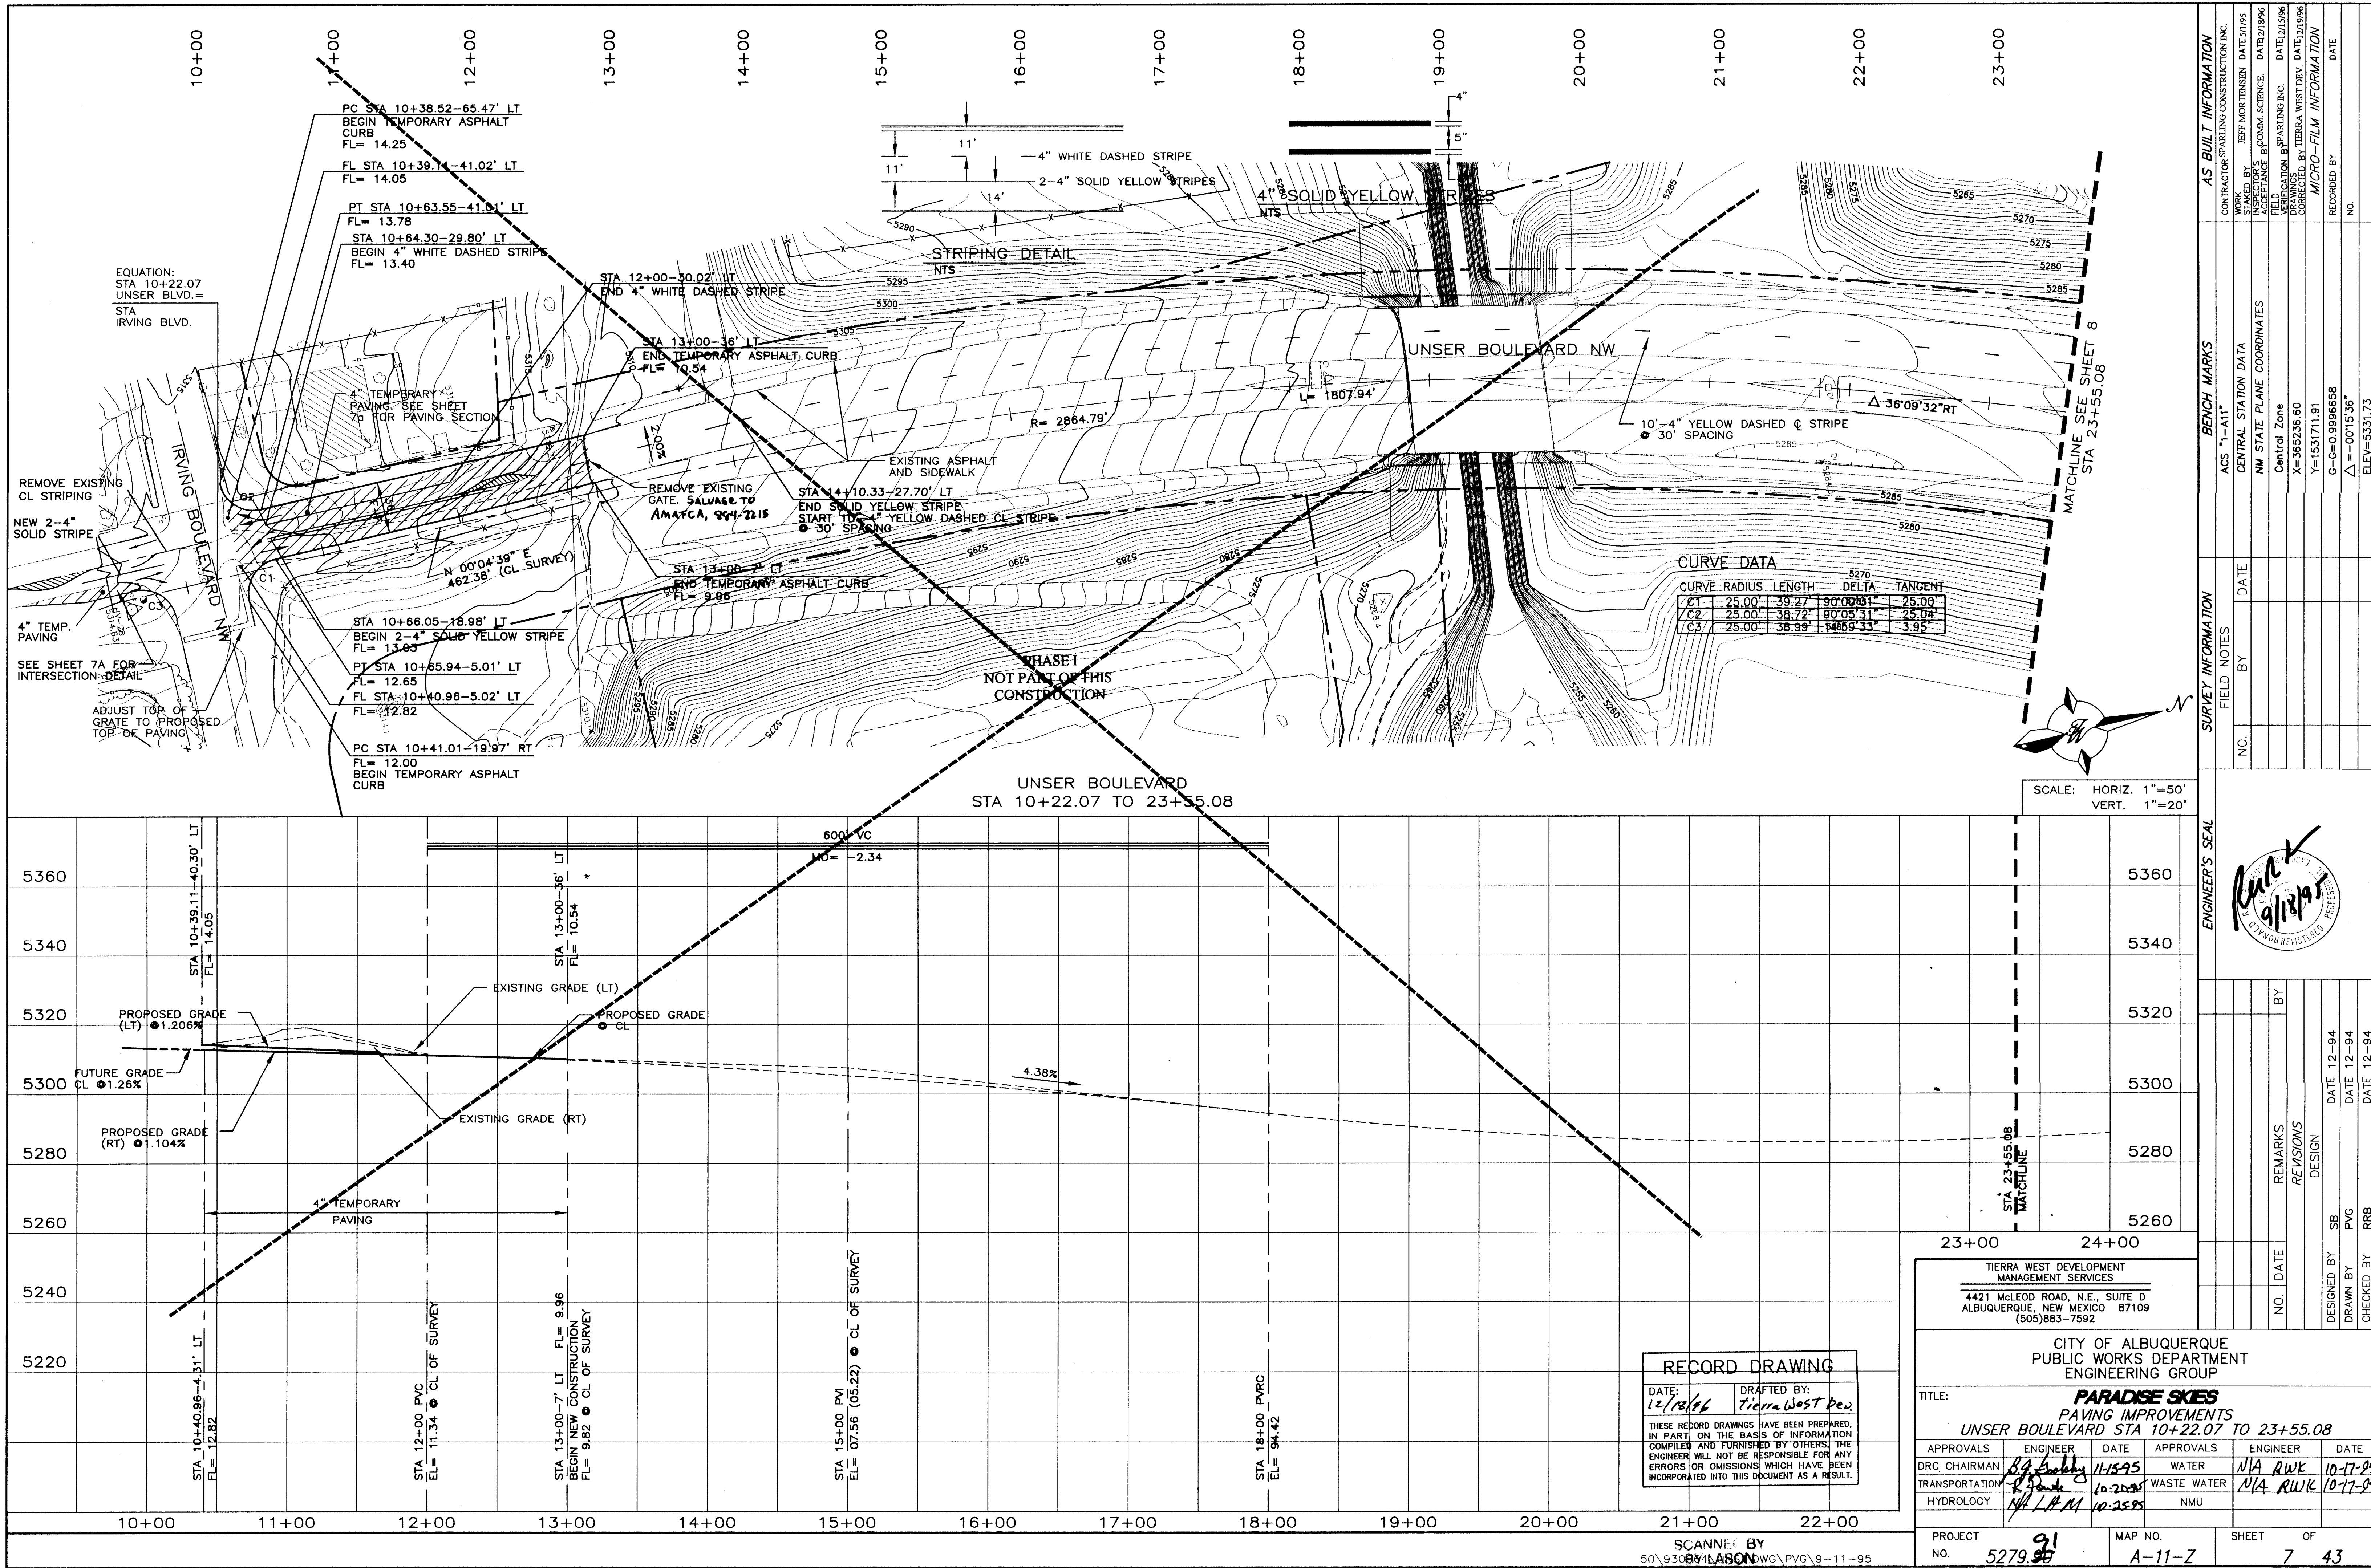

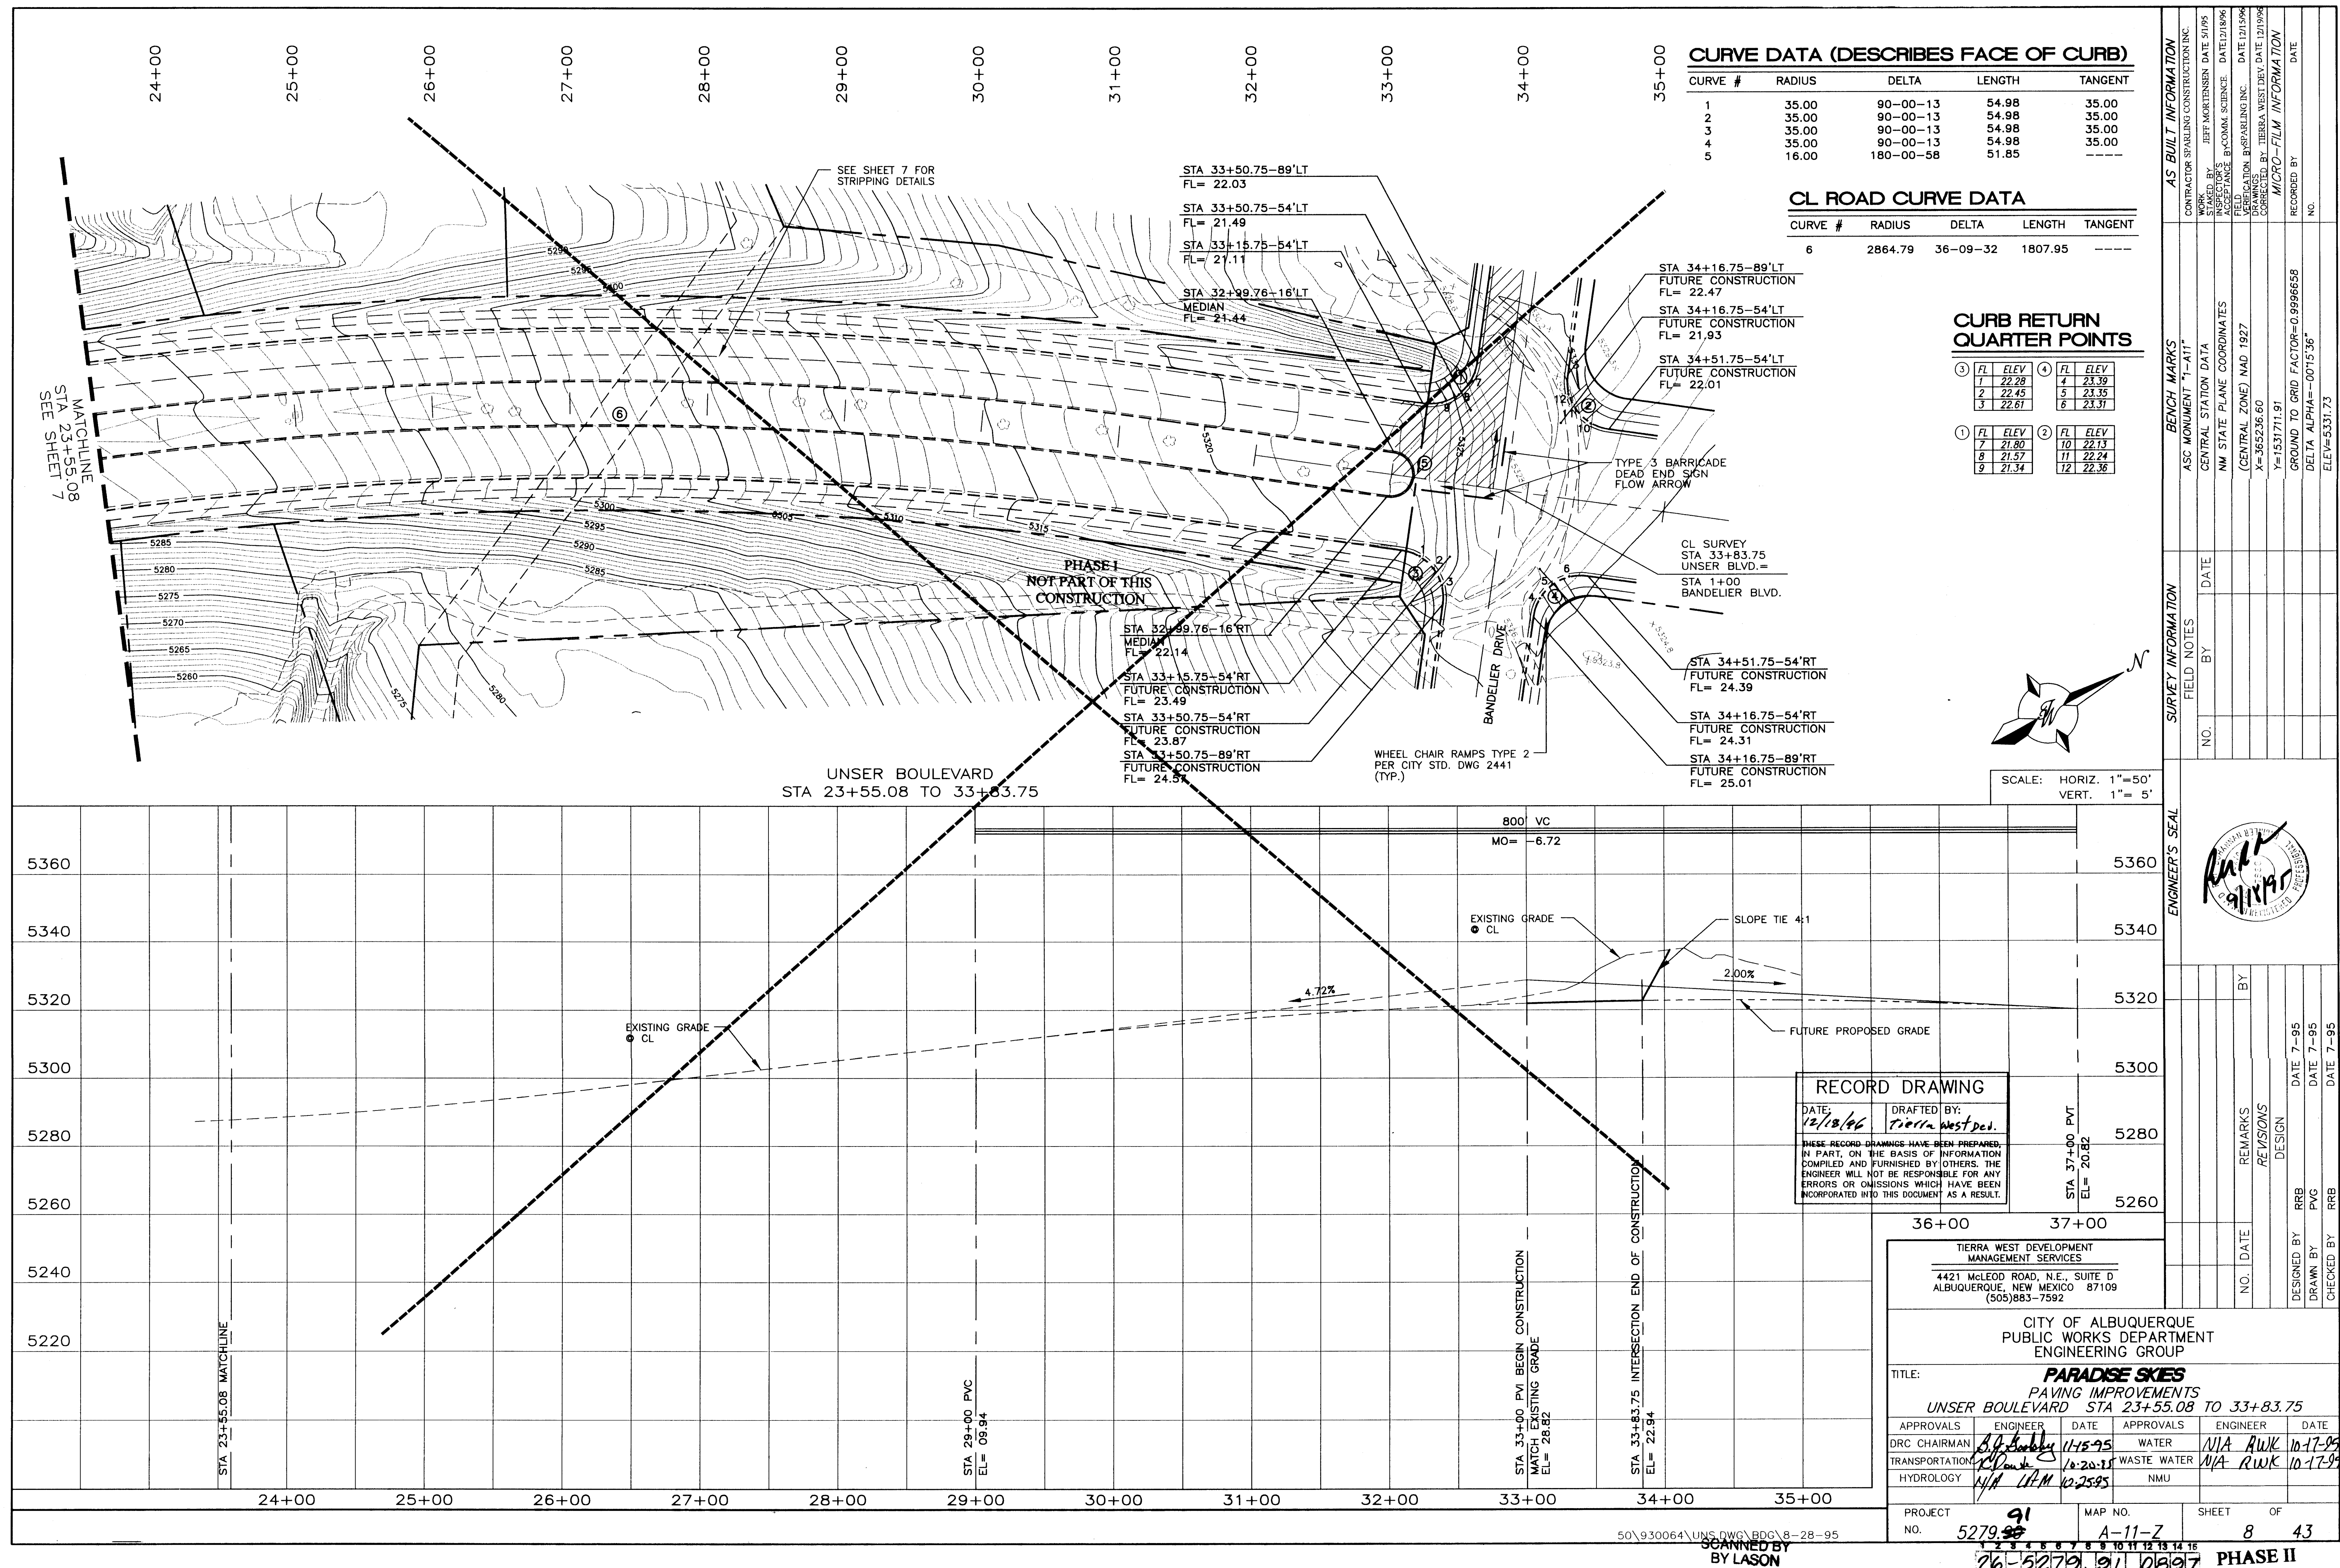


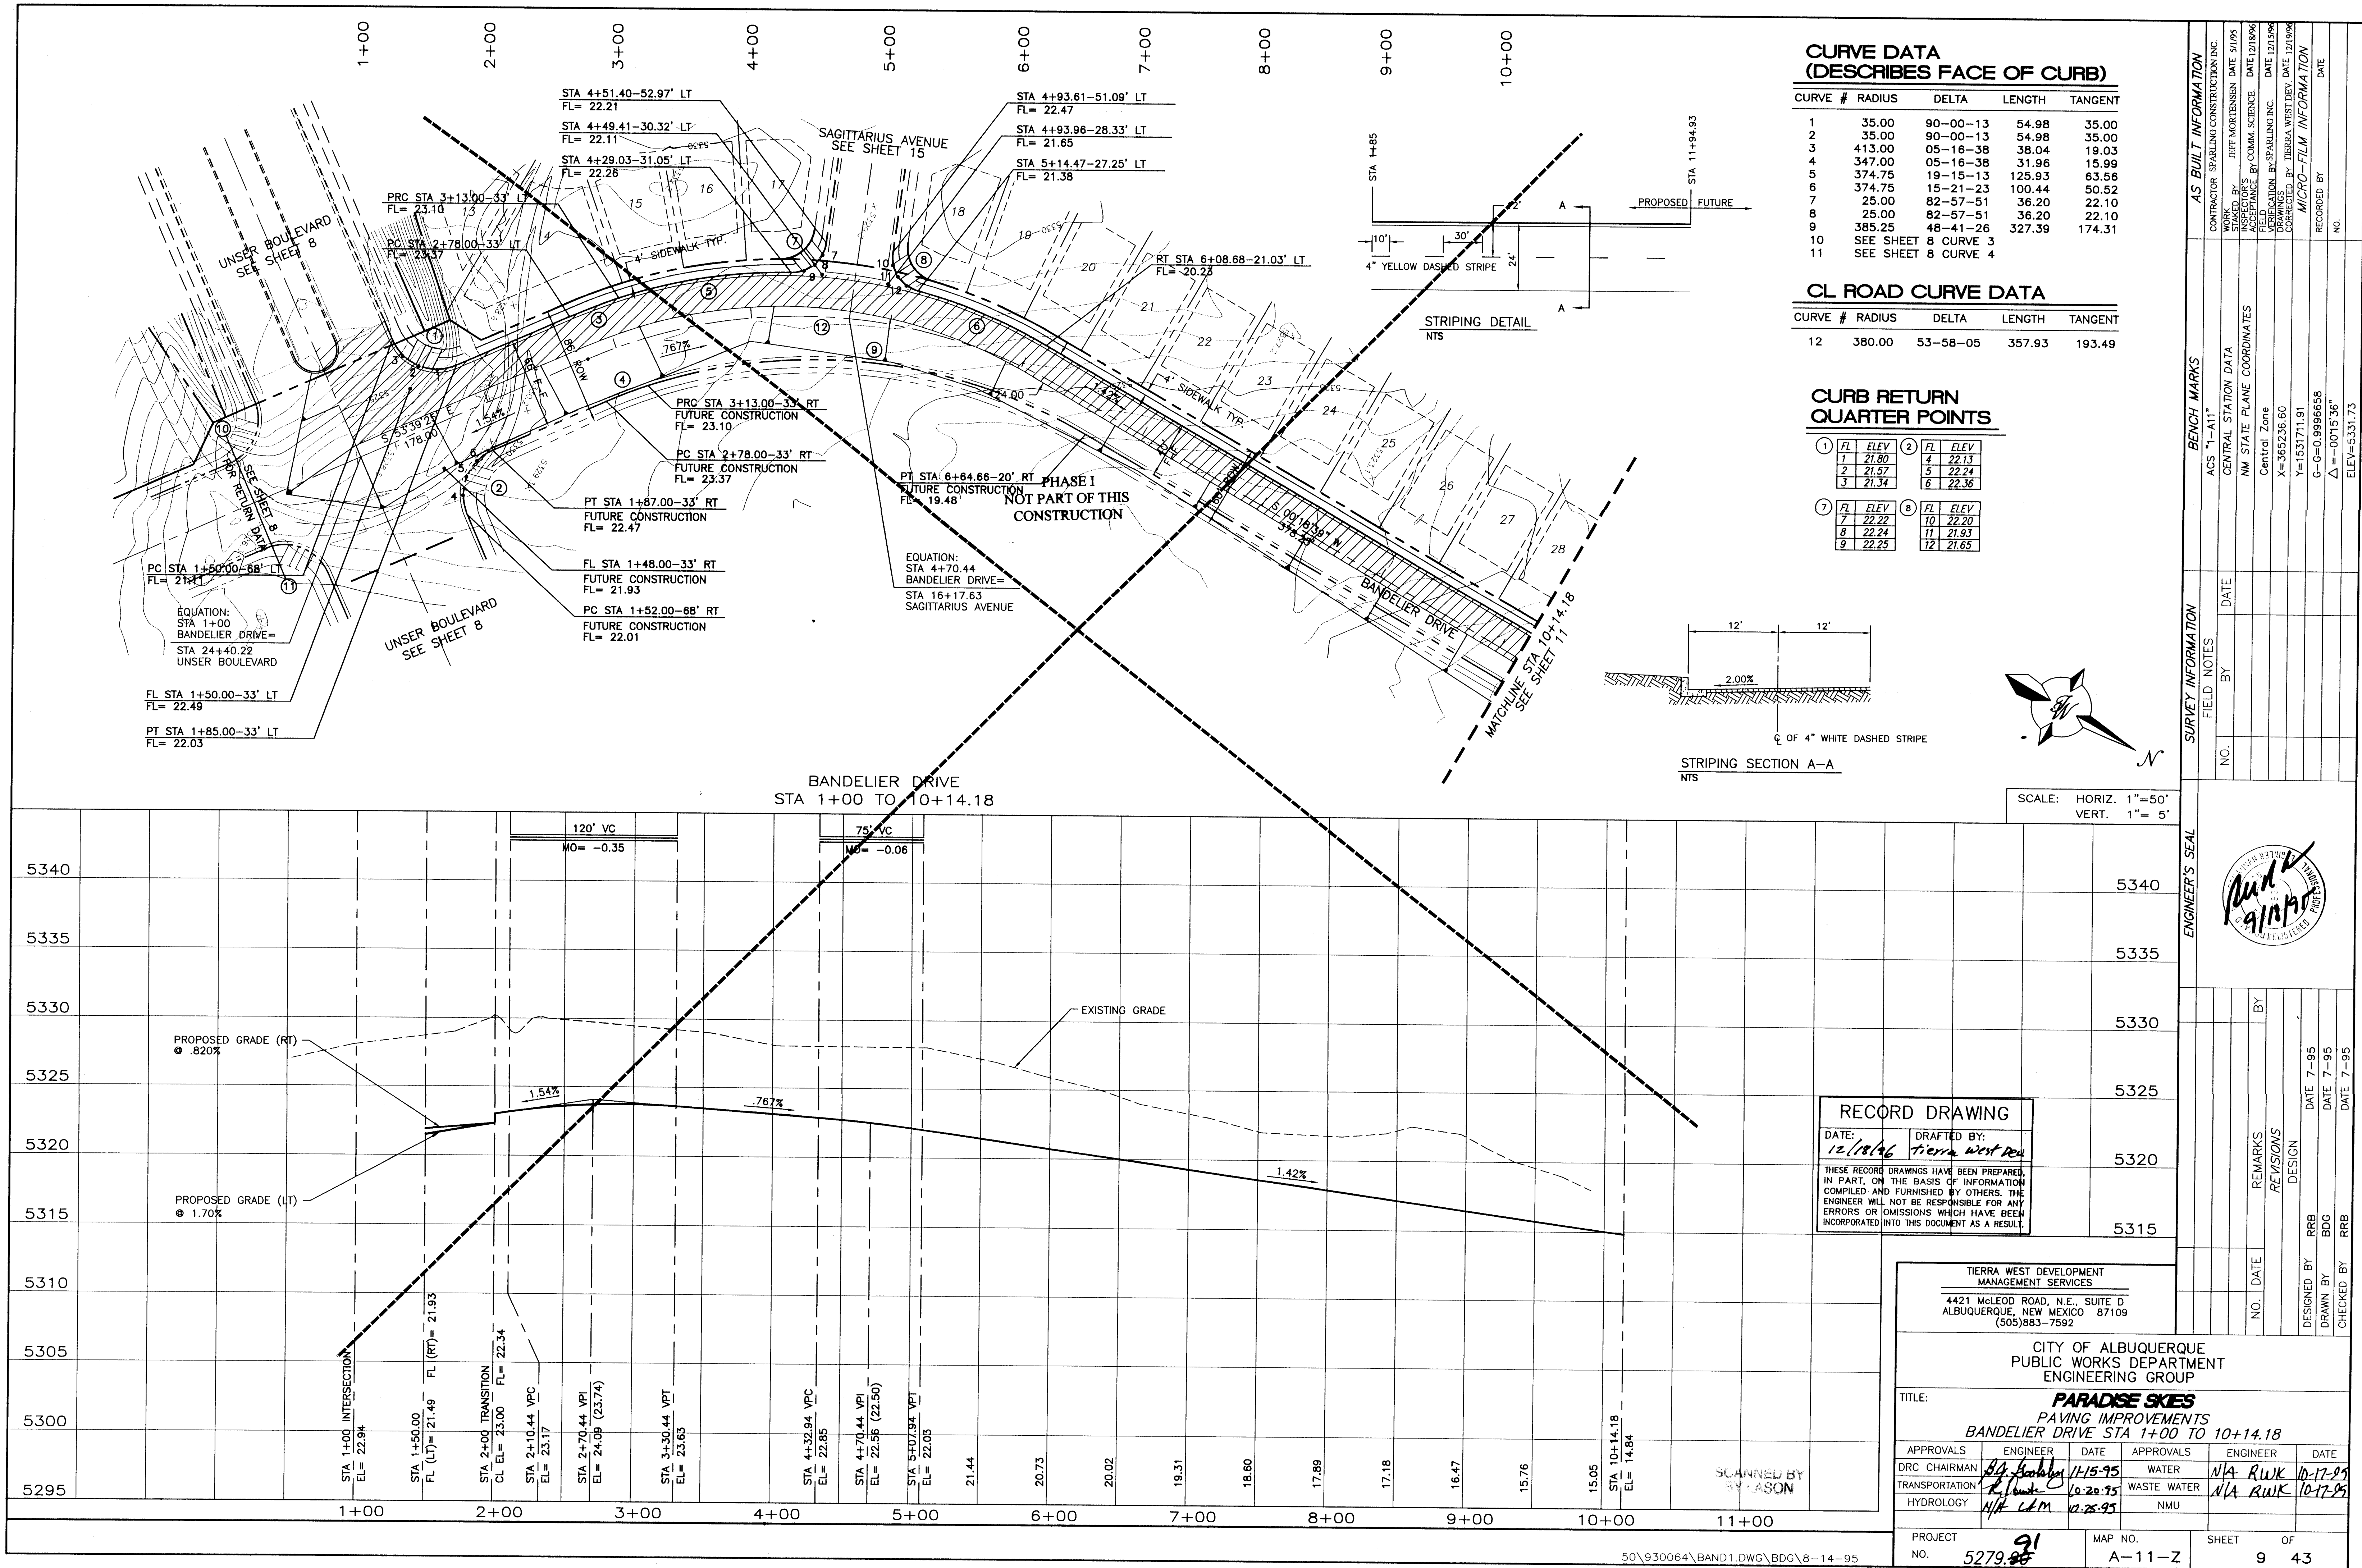

50\930064\BAND1.DWG\BDG\8-14-95

21615279.91 0997

PHASE II

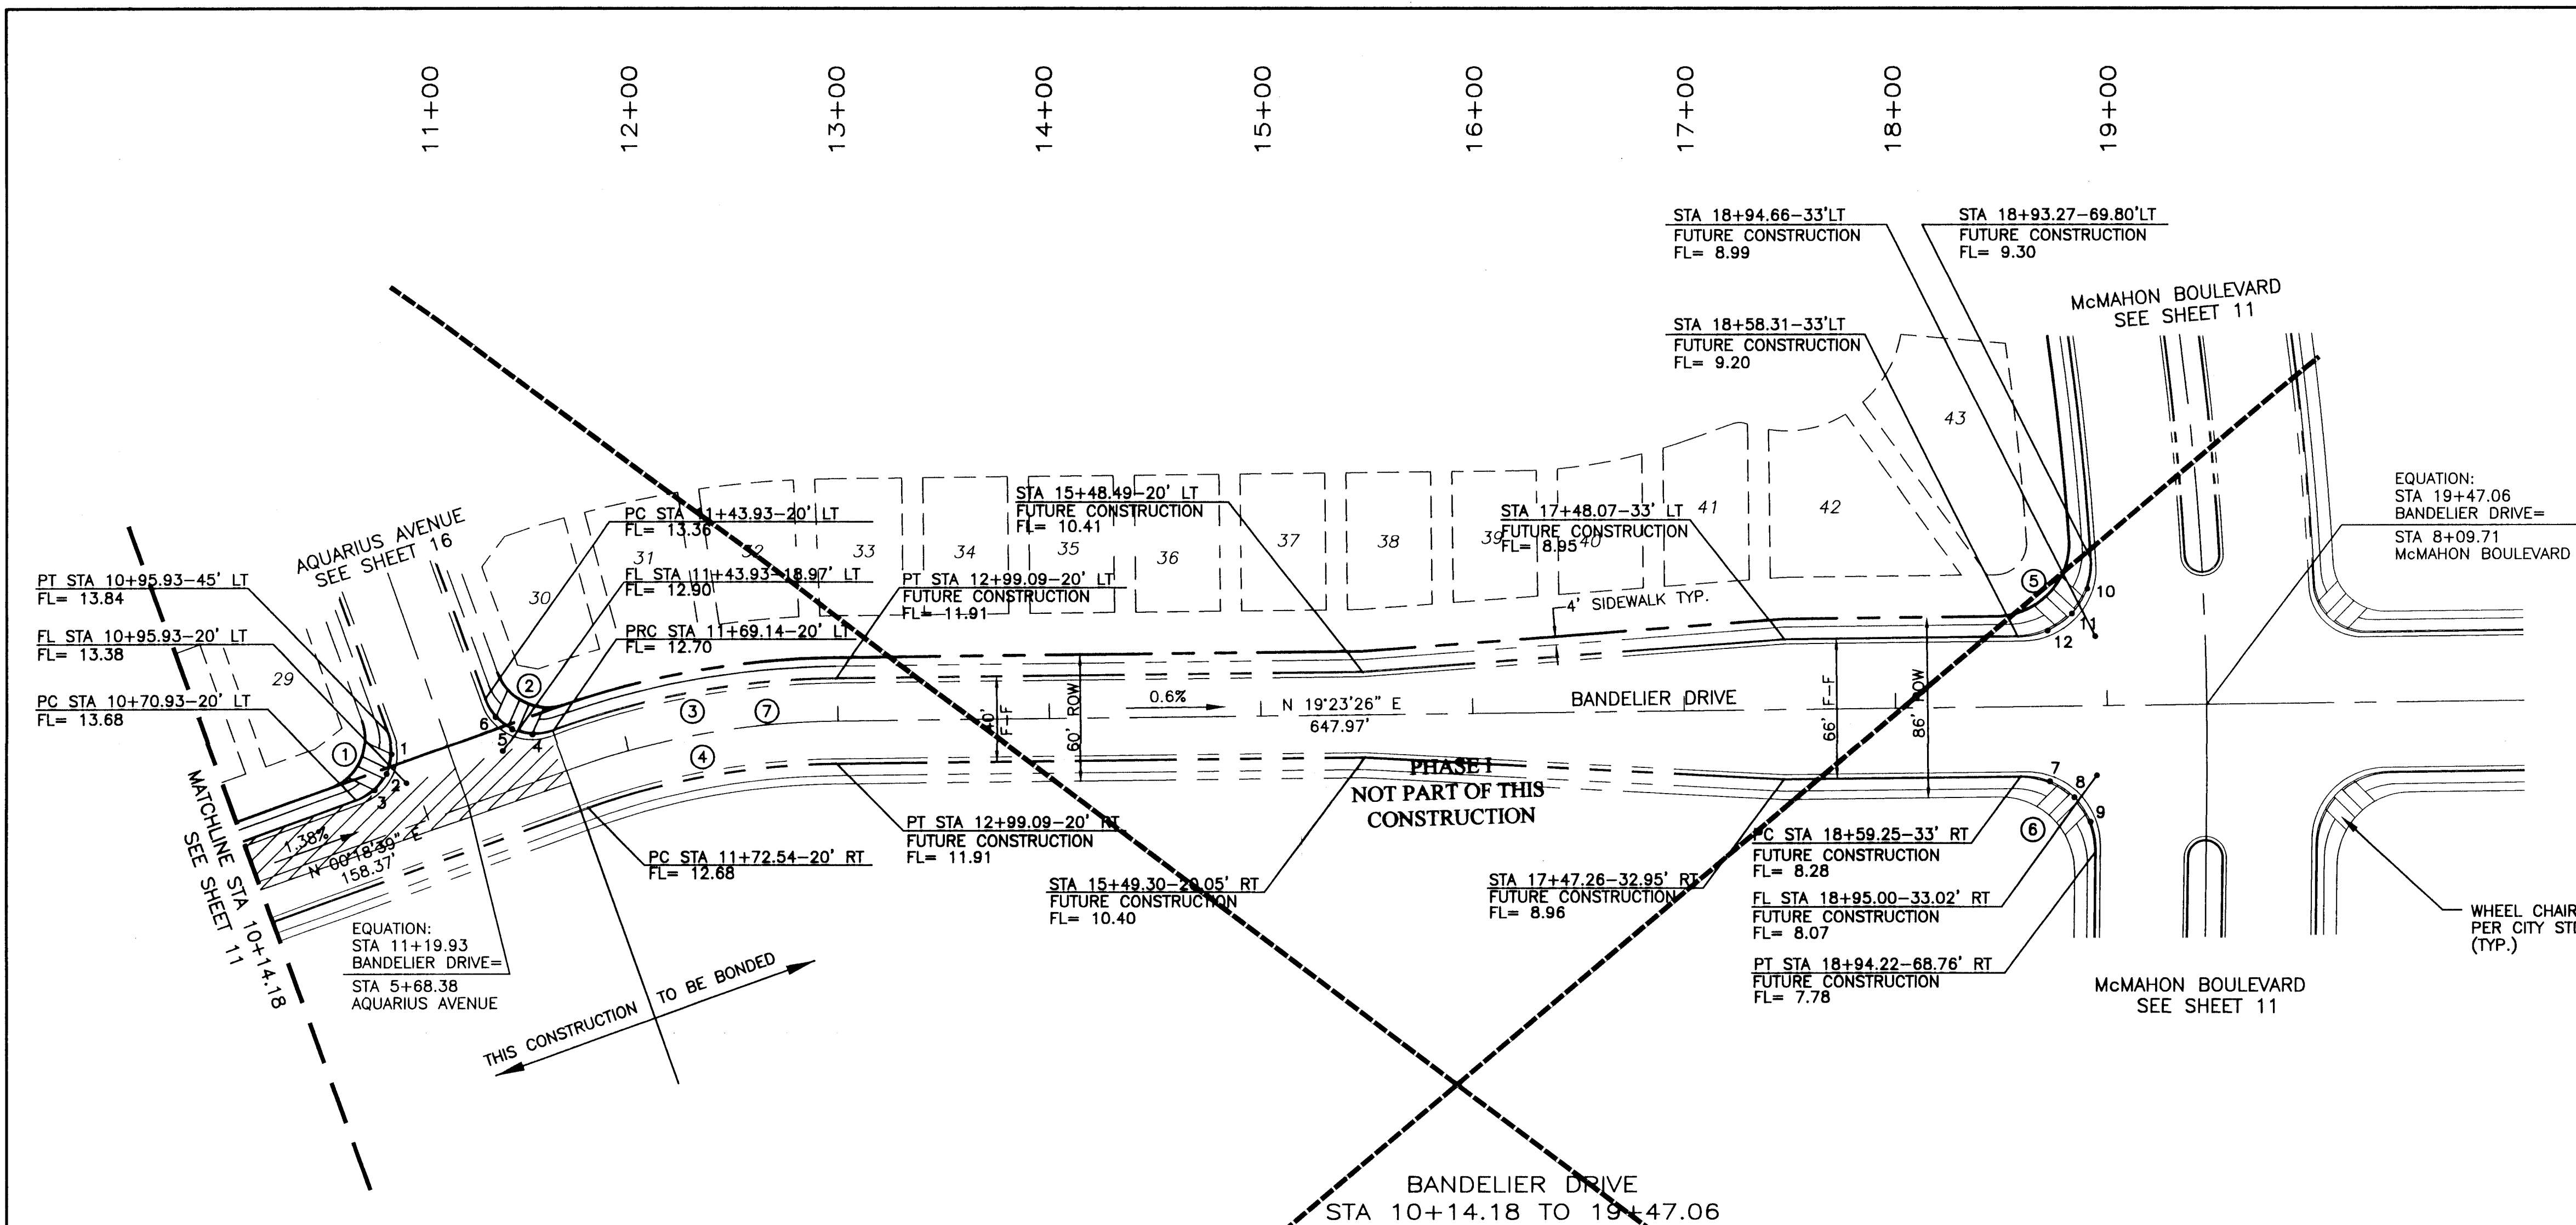

CL ROAD CURVE DATA

CURVE #	RADIUS	DELTA	LENGTH	TANGENT
7	25.00	19-04-46	126.54	63.86


CURVE DATA
(DESCRIBES FACE OF CURB)

CURVE #	RADIUS	DELTA	LENGTH	TANGENT
1	25.00	90-00-01	39.27	25.00
2	25.00	90-28-53	39.48	25.21
3	400.00	19-34-05	136.61	68.98
4	360.00	19-04-46	119.88	60.50
5	35.00	92-56-02	56.77	36.84
6	35.00	91-11-55	55.71	35.74


CURB RETURN
QUARTER POINTS

①	FL	ELEV	②	FL	ELEV
1	13.80		4	12.87	
2	13.76		5	13.03	
3	13.72		6	13.20	
⑥	FL	ELEV	⑦	FL	ELEV
7	1.00		10	9.28	
8	1.00		11	9.25	
9	1.00		12	9.23	

NOTE:
SEE SHEET 10 FOR STRIPING DETAILS

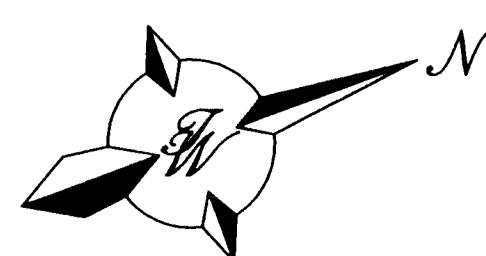

SCALE: HORIZ. 1"=50'
VERT. 1"= 5'

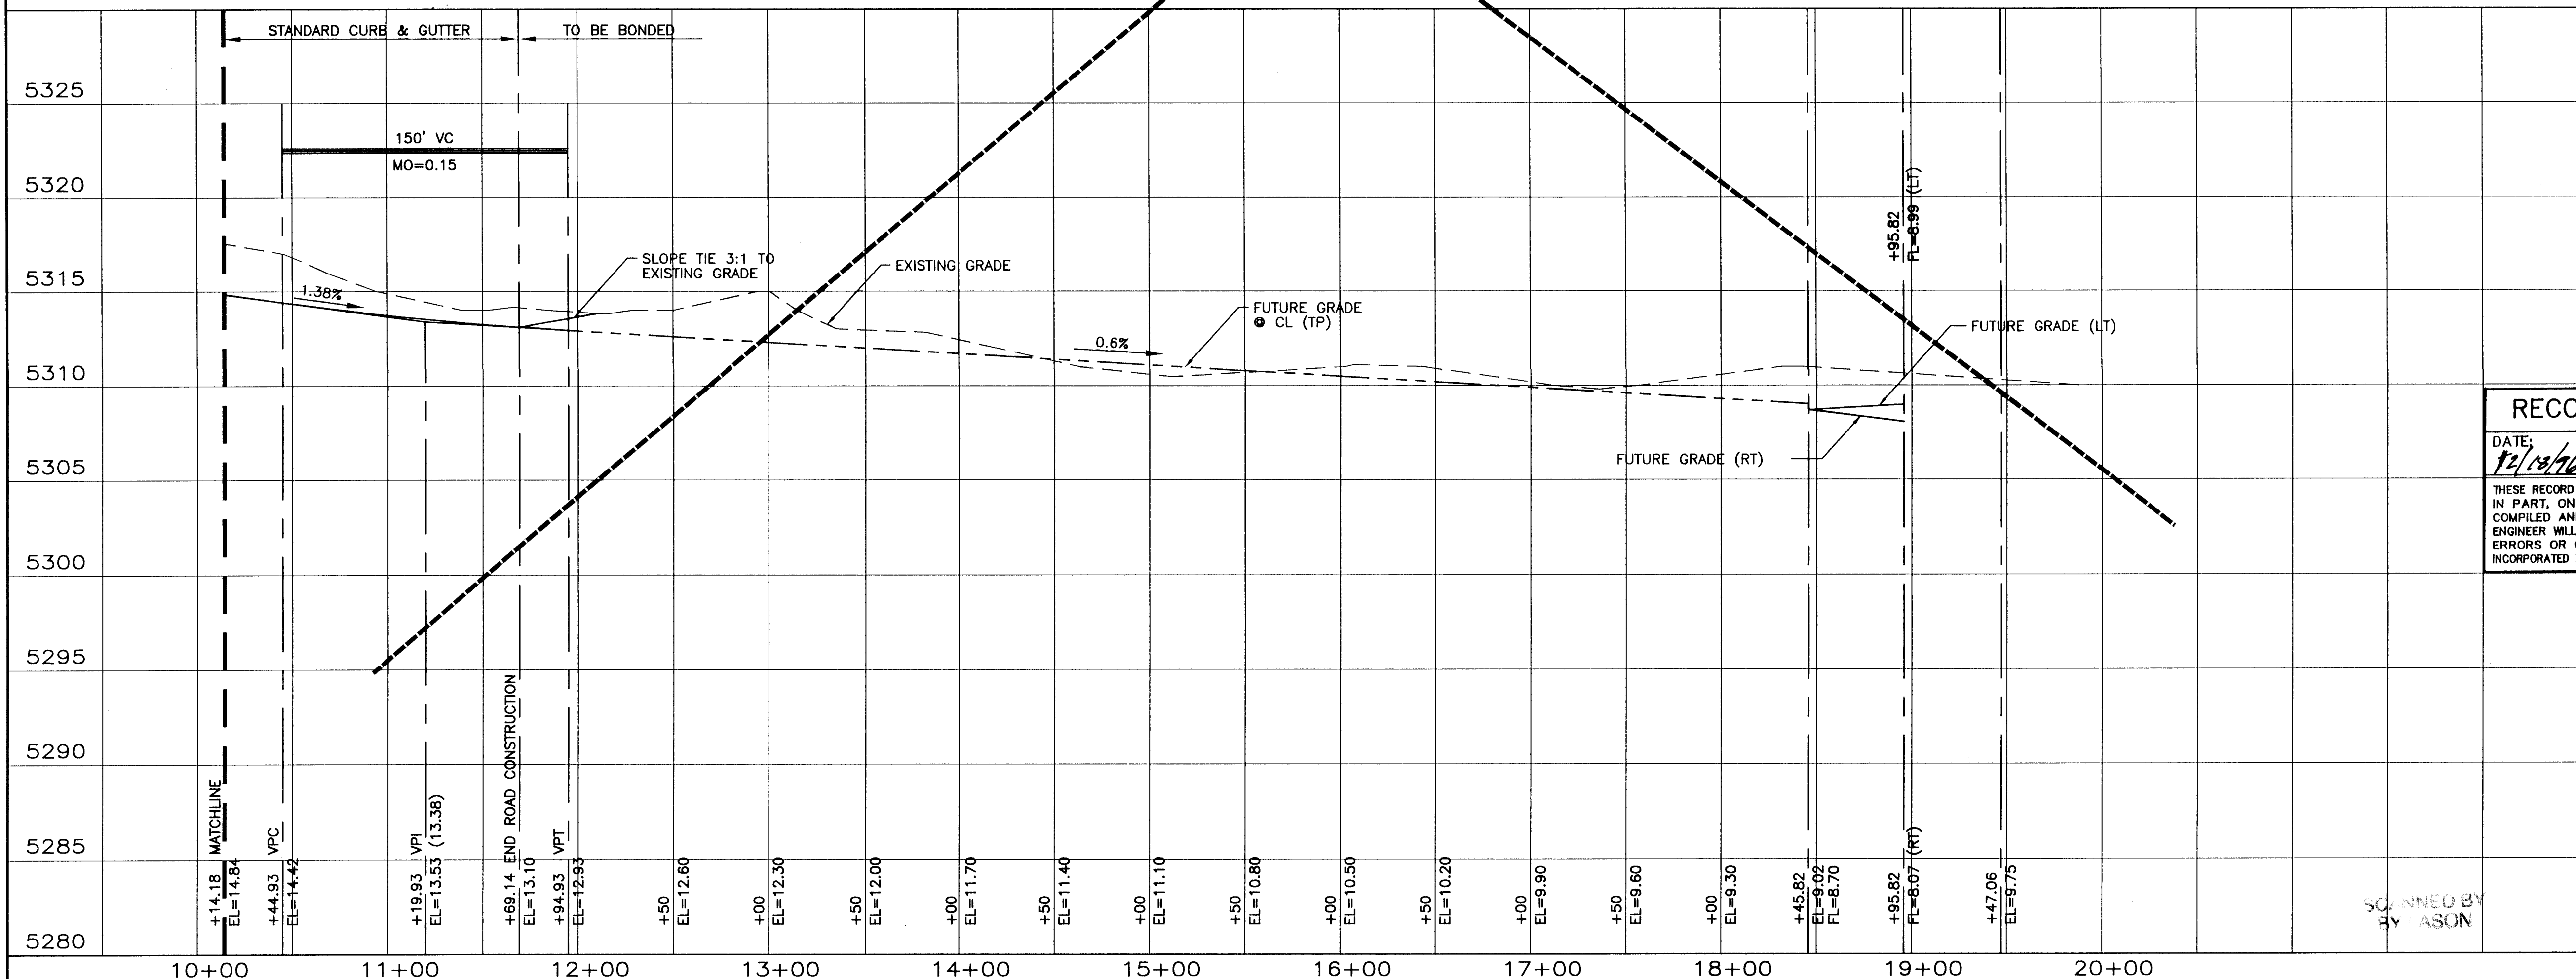

RECORD DRAWING
DATE: 12/13/96
DRAFTED BY: Tierra West Dev.
THESE RECORD DRAWINGS HAVE BEEN PREPARED, IN PART, ON THE BASIS OF INFORMATION COMPILED AND FURNISHED BY OTHERS. THE ENGINEER WILL NOT BE RESPONSIBLE FOR ANY ERRORS OR OMISSIONS WHICH HAVE BEEN INCORPORATED INTO THIS DOCUMENT AS A RESULT.

TIERRA WEST DEVELOPMENT
MANAGEMENT SERVICES
4421 McLEOD ROAD, N.E., SUITE D
ALBUQUERQUE, NEW MEXICO 87109
(505)883-7592

CITY OF ALBUQUERQUE
PUBLIC WORKS DEPARTMENT
ENGINEERING GROUP

TITLE: **PARADISE SKIES**
PAVING IMPROVEMENTS
BANDELIER DRIVE STA 10+14.18 TO 19+47.06

APPROVALS	ENGINEER	DATE	APPROVALS	ENGINEER	DATE
DRC CHAIRMAN	11/15/95	11/15/95	WATER	N/A RWK	10-17-95
TRANSPORTATION	10-20-95	10-20-95	WASTE WATER	N/A RWK	10-17-95
HYDROLOGY	N/A LRM	10-25-95	NMU		

PROJECT NO. 5279.91
MAP NO. A-11-Z
SHEET 10 OF 43

AS BUILT INFORMATION		BENCH MARKS		SURVEY INFORMATION		ENGINEER'S SEAL	
CONTRACTOR	SPARLING CONSTRUCTION INC.	ACS	"1-A11"	NO.	BY	DATE	
WORK STARTED BY	JEFF MORTENSEN	CENTRAL STATION DATA		NO.	BY	DATE	
FIELD ACCEPTANCE	DATE 5/1/95	NW STATE PLANE COORDINATES		NO.	BY	DATE	
FIELD CORRECTION	DATE 12/18/96	Central Zone		NO.	BY	DATE	
DRAWINGS		X=365236.60		REVISIONS		DESIGN	
CORRECTED BY		Y=1531711.91		NO.		DATE	
MICRO-FILM INFORMATION		G=0.9996658		DESIGNED BY		DATE	
RECORDED BY		Δ=-0015'36"		DRAWN BY		DATE	
NO.		ELEV=5331.73		CHECKED BY		DATE	

EQUATION:
STA 1+00
McMAHON BOULEVARD=
STA 20+82.43
VIRGO STREET
CL EL= 15.48

STA 0+50.68-8.50' LT
MEDIAN
TC= 16.13
FL= 15.80

STA 0+50.68-8.50' RT
MEDIAN
TC= 16.13
FL= 15.80

STA 0+58.95-52' RT
FL= 14.85

STA 0+84.00-52' RT
FL= 14.58

STA 0+84.00-77' RT
FL= 14.58

STA 1+49.31-8.50' LT
MEDIAN
TC= 15.24
FL= 14.91

PT STA 3+36.45-52' RT
FUTURE CONSTRUCTION
FL= 12.09

STA 1+49.31-8.50' RT
MEDIAN
TC= 15.24
FL= 14.91

STA 1+40.83-52' RT
FL= 14.03

STA 1+15.83-52' RT
FL= 14.28

STA 1+15.83-76.95' RT
FL= 14.20

STANDARD CURB &
GUTTER PER CITY
STD. DWG 2405

STANDARD CURB &
GUTTER PER CITY
STD. DWG 2405

STA 7+38.38-8.50' LT
MEDIAN
TC= 10.49
FL= 10.16

STA 7+38.38-8.50' RT
MEDIAN
TC= 10.49
FL= 10.16

PRC STA 7+37.21-52' RT
FL= 9.30

FL STA 7+75.44-52' RT
FL= 8.99

PT STA 7+74.50-88.33' RT
FL= 9.20

PRC STA 7+54.12-52' LT
FUTURE CONSTRUCTION
FL= 9.16

FL STA 7+77.88-52' LT
FUTURE CONSTRUCTION
FL= 8.97

PT STA 7+78.39-76.24' LT
FUTURE CONSTRUCTION
FL= 9.12

EQUATION:
STA 8+09.71
McMAHON BOULEVARD=
STA 19+47.06
BANDELIER DRIVE
CL EL= 9.75

WHEEL CHAIR RAMPS TYPE 2
PER CITY STD. DWG 2441
(TYP.)

STA 8+79.58-51.35' RT
FL= 9.20

STA 8+41.80-49.35' RT
FL= 8.99

STA 8+44.59-51.35' RT
FL= 9.30

McMAHON BOULEVARD
STA 1+00 TO 8+09.71

CURB RETURN QUARTER POINTS

1	FL	ELEV	2	FL	ELEV
1	14.78		4	14.91	
2	14.72		5	14.62	
3	14.65		6	14.32	

5	FL	ELEV	6	FL	ELEV
7	9.13		10	9.28	
8	9.14		11	9.25	
9	9.15		12	9.23	

8	FL	ELEV
13	8.16	
14	8.03	
15	7.91	


CL ROAD CURVE DATA

CURVE #	RADIUS	DELTA	LENGTH	TANGENT
8	1412.00	19-12-14	473.26	238.87

CURVE DATA (DESCRIBES FACE OF CURB)


CURVE #	RADIUS	DELTA	LENGTH	TANGENT
1	SEE SHEET 20, CURVE 9			
2	SEE SHEET 20, CURVE 10			
3	1464.00	16-58-18	433.65	218.42
4	1360.00	16-15-44	386.01	194.31
5	25.00	87-46-38	38.30	24.05
6	35.00	92-56-02	56.77	36.84
7	35.00	91-11-55	55.71	35.74

NOTE:
THIS WILL NOT BE BUILT AS PART
OF THIS PHASE.

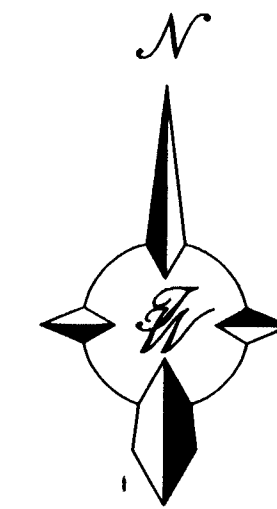

INFORMATION ONLY

SCALE: HORIZ. 1"=50'
VERT. 1"= 5'

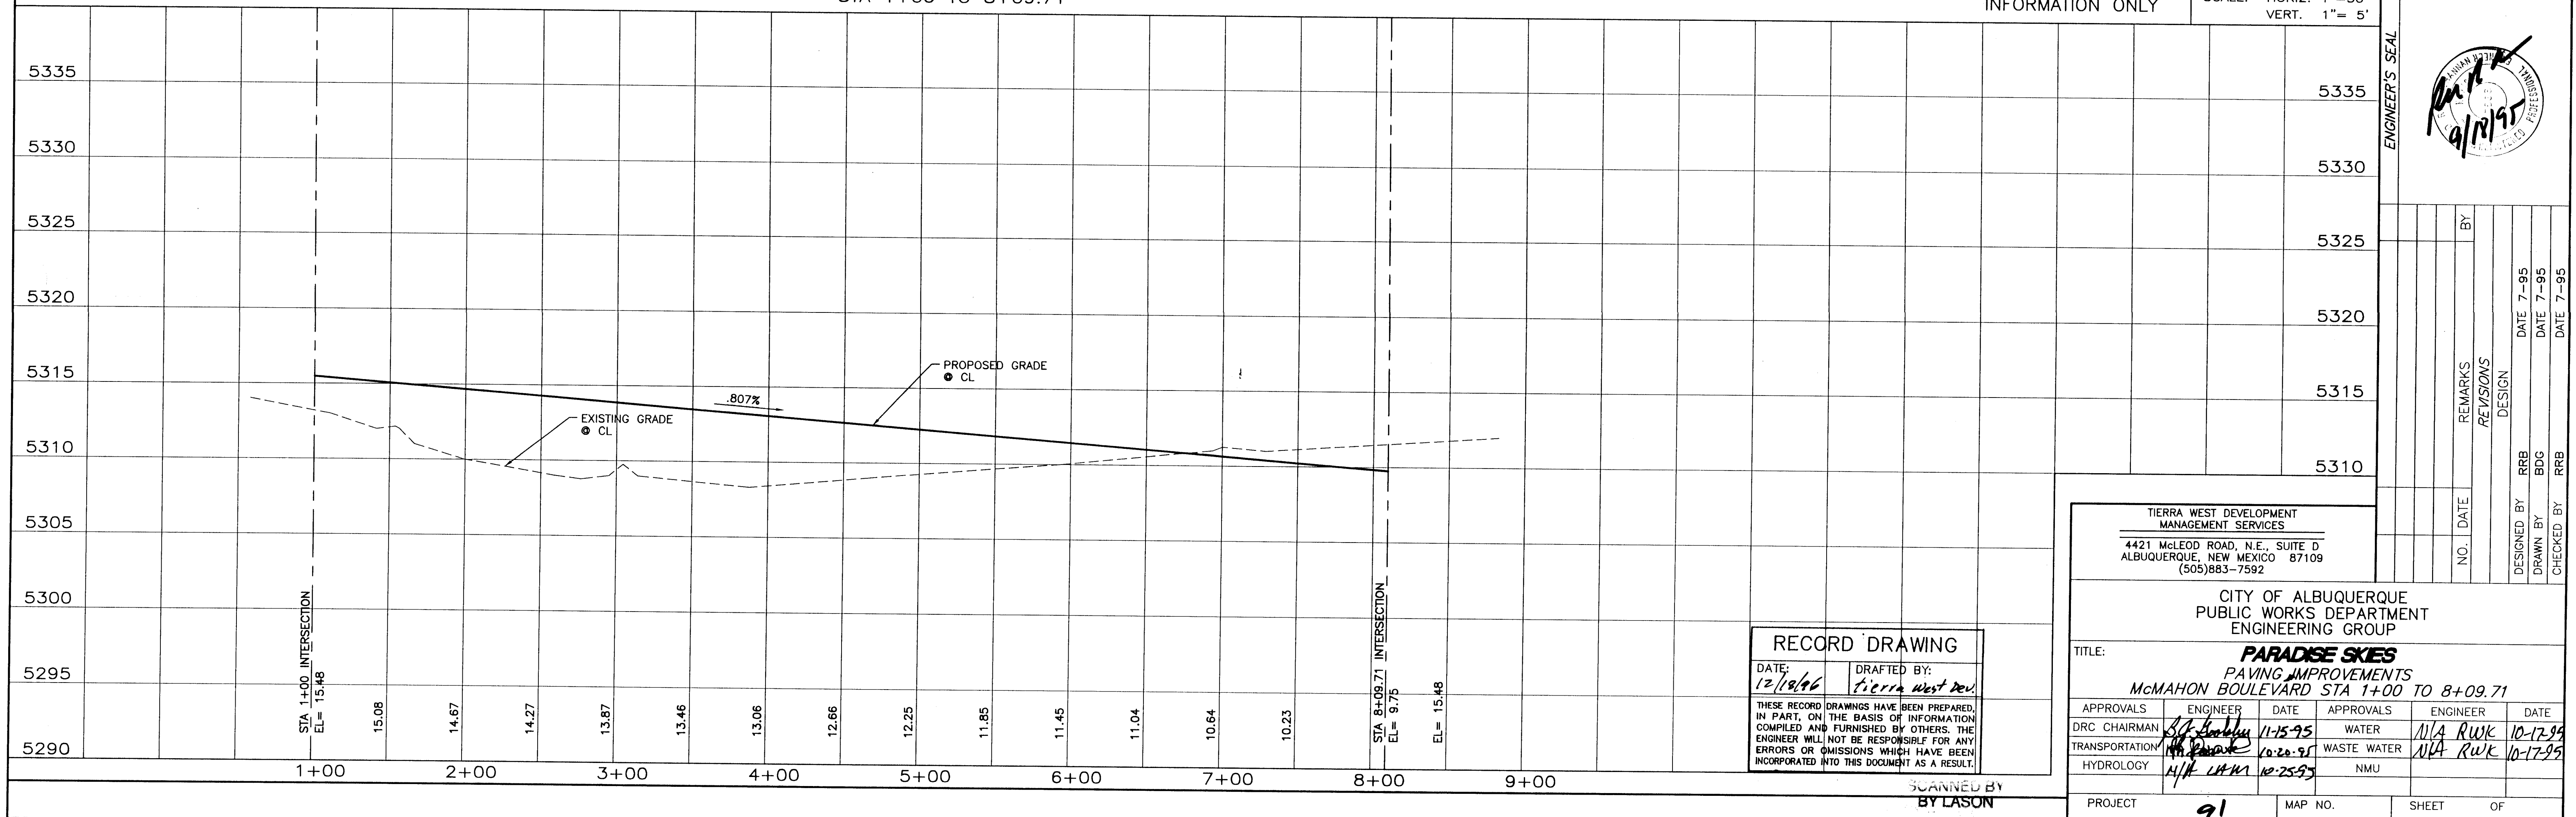

RECORD DRAWING	
DATE: 12/19/96	DRAFTED BY: Tierra West Dev
THESE RECORD DRAWINGS HAVE BEEN PREPARED, IN PART, ON THE BASIS OF INFORMATION COMPILED AND FURNISHED BY OTHERS. THE ENGINEER WILL NOT BE RESPONSIBLE FOR ANY ERRORS OR OMISSIONS WHICH HAVE BEEN INCORPORATED INTO THIS DOCUMENT AS A RESULT.	

SCANNED BY
BY LASON


50/930064/MC.DWG/BDG/9-13-95

TIERRA WEST DEVELOPMENT MANAGEMENT SERVICES 4421 McLEOD ROAD, N.E., SUITE D ALBUQUERQUE, NEW MEXICO 87109 (505)883-7592					
CITY OF ALBUQUERQUE PUBLIC WORKS DEPARTMENT ENGINEERING GROUP					
TITLE: PARADISE SKIES PAVING IMPROVEMENTS McMAHON BOULEVARD STA 1+00 TO 8+09.71					
APPROVALS	ENGINEER	DATE	APPROVALS	ENGINEER	DATE
DRC CHAIRMAN	11/15/95	11/15/95	WATER	N/A RWK	10-12-99
TRANSPORTATION	10-20-95	10-20-95	WASTE WATER	N/A RWK	10-17-99
HYDROLOGY	11/11/96	10-25-95	NMU		
PROJECT NO.	5279.86	MAP NO.	A-11-Z	SHEET	11 OF 43

1 2 3 4 5 6 7 8 9 10 11 12 13 14 15
26-5279.197 11/11/97

PHASE II

AS BUILT INFORMATION		BENCH MARKS		SURVEY INFORMATION		ENGINEER'S SEAL	
CONTRACTOR	SPARLING CONSTRUCTION INC.	ACS "1-A11"	CENTRAL STATION DATA	NO.	DATE	REMARKS	DESIGN
DESIGNED BY	JEFF MORTENSEN DATE 5/1/95	NO.	NM STATE PLANE COORDINATES	NO.	DATE		
ACCEPTANCE	BY CORAM SCIENCE DATE 12/18/96		Central Zone				
VERIFICATION	BY SPARLING INC. DATE 12/15/96		X=365236.60				
DRAWINGS	BY TIERRA WEST DEV. DATE 12/19/96		Y=1531711.91				
MICRO-FILM INFORMATION			G-G=0.999658				
RECORDED BY			Δ = -0015'36"				
DATE			ELEV=5331.73				

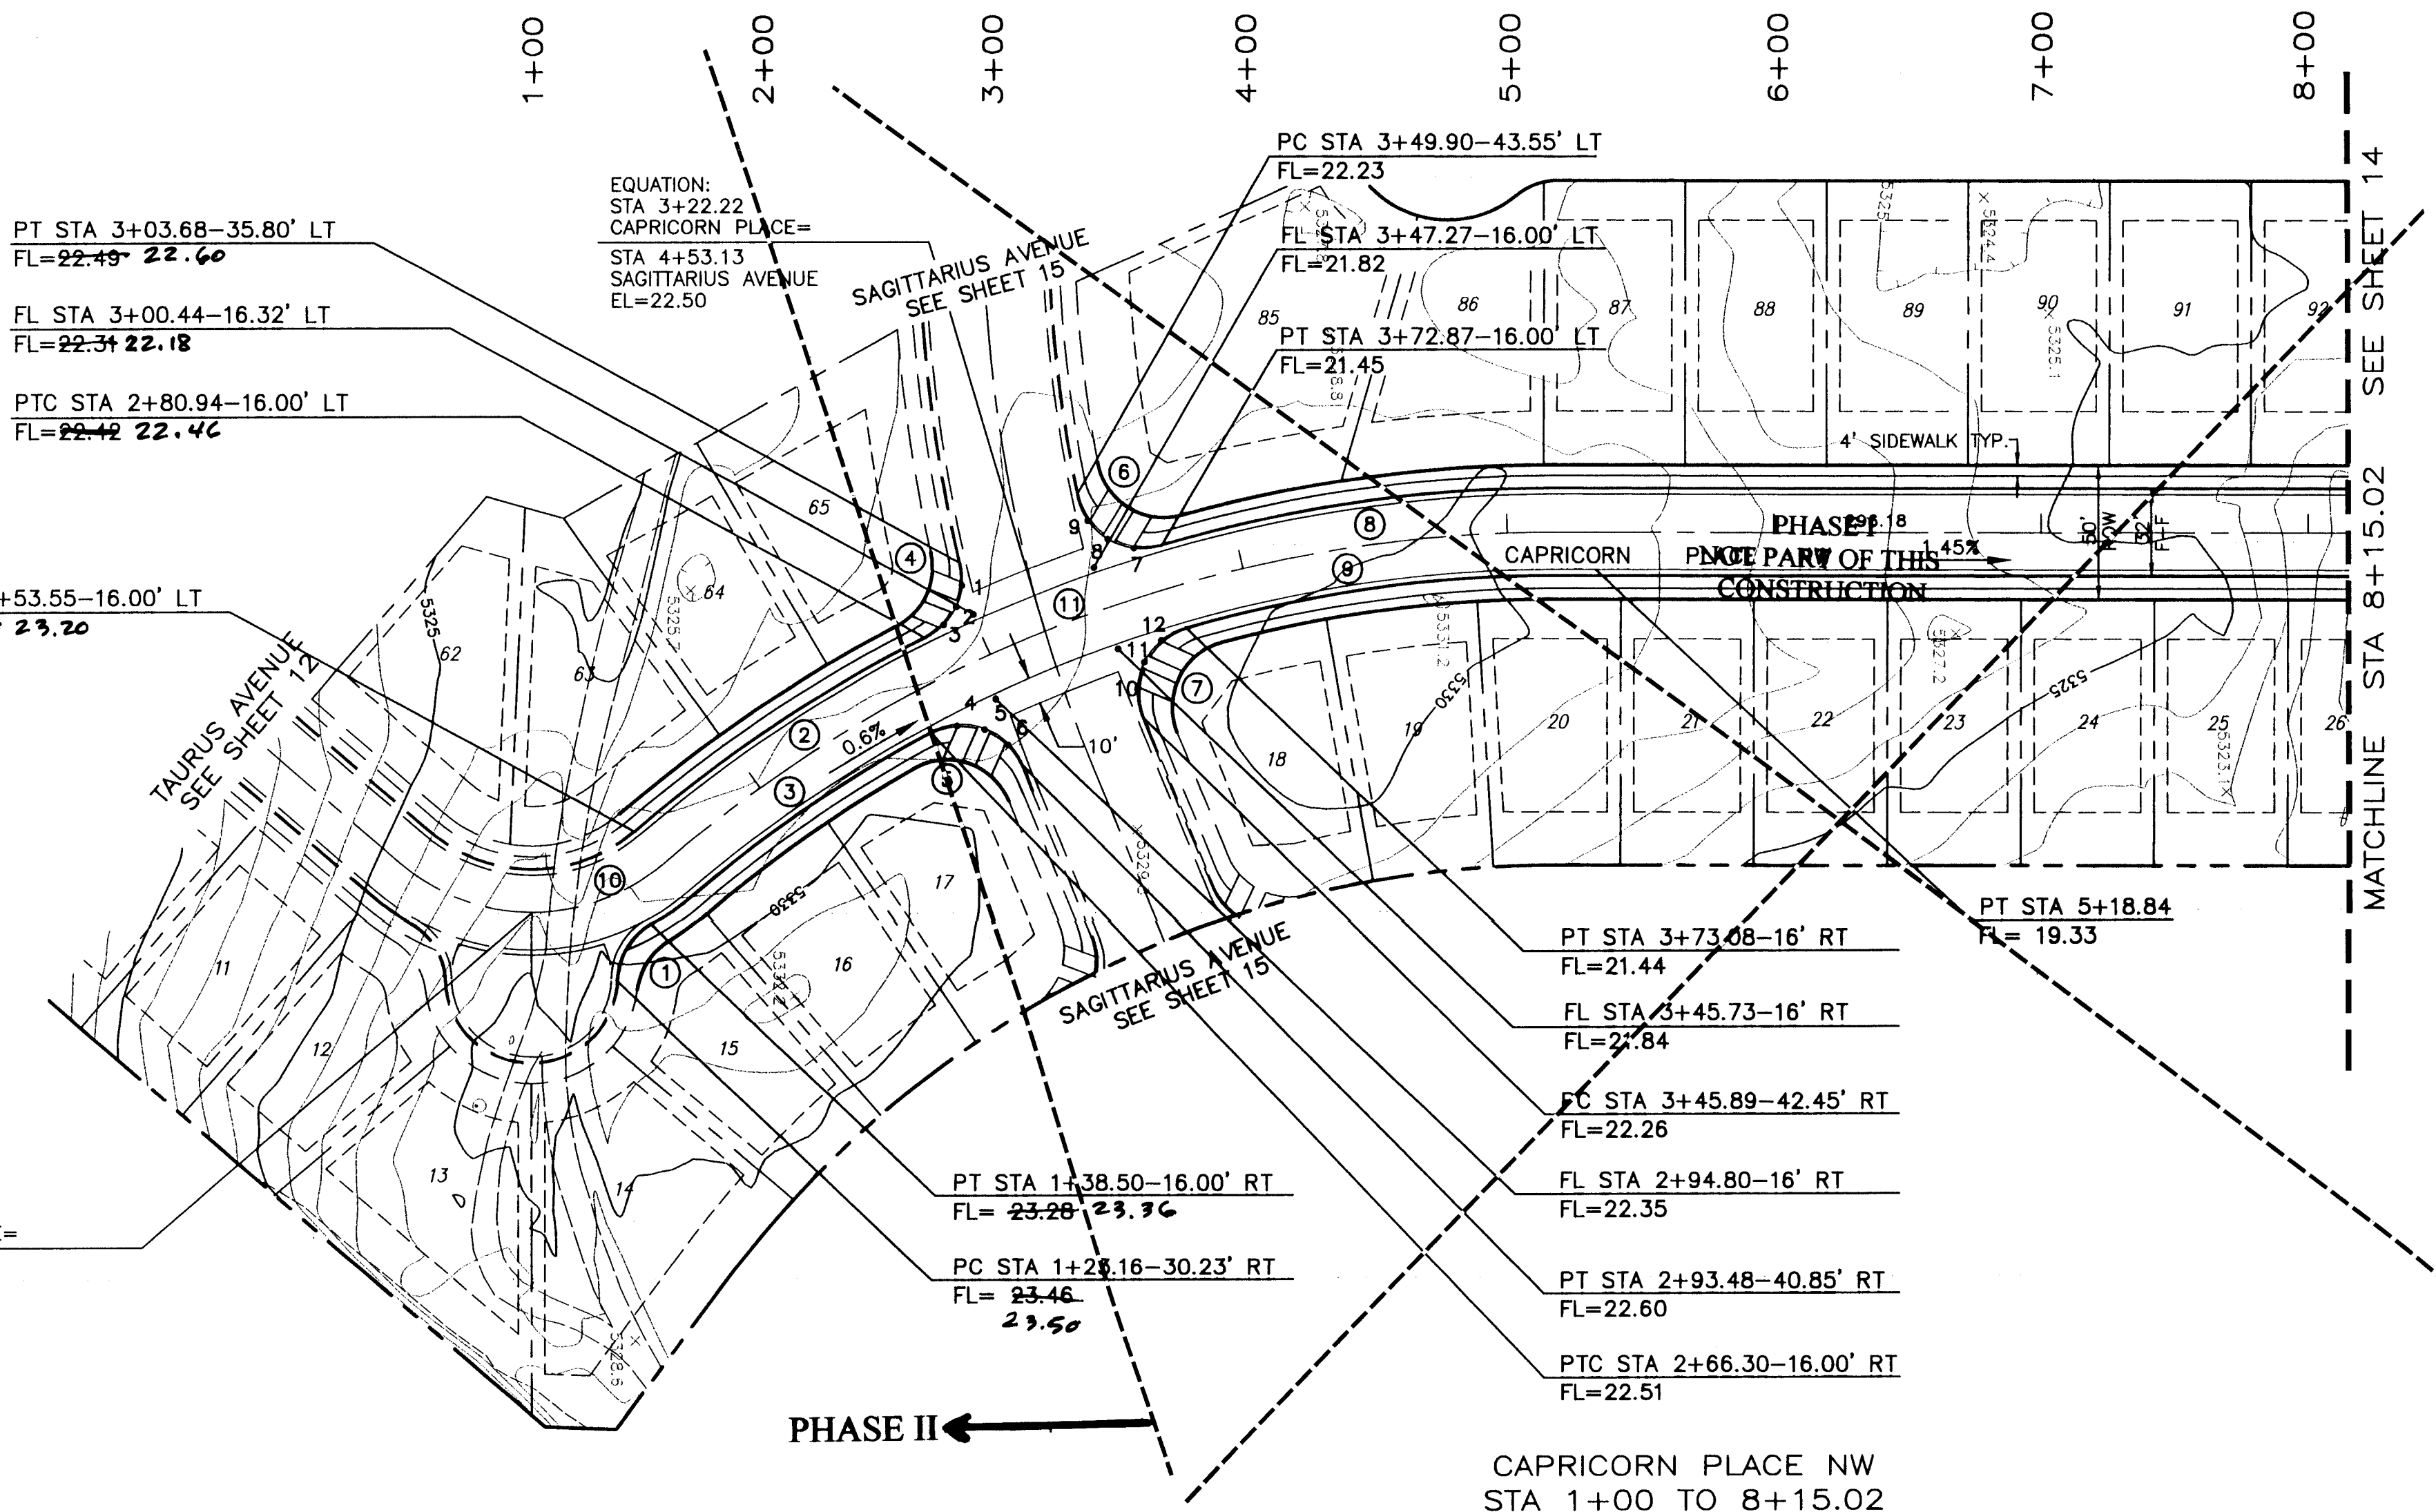

CURVE DATA (DESCRIBES FACE OF CURB)				
CURVE #	RADIUS	DELTA	LENGTH	TANGENT
1	25.00	60-30-15	26.40	14.58
2	525.75	14-19-07	131.39	66.04
3	493.75	12-40-22	109.21	54.83
4	25.00	76-42-27	33.47	19.78
5	25.00	96-58-02	42.31	28.24
6	25.00	94-33-39	41.26	27.07
7	25.00	94-50-09	41.38	27.20
8	525.75	16-24-24	150.55	75.79
9	493.75	16-22-58	141.18	71.07

CL ROAD CURVE DATA				
CURVE #	RADIUS	DELTA	LENGTH	TANGENT
10	75.00	40-54-33	53.55	27.97
11	509.75	41-03-30	365.29	190.88

CURB RETURN QUARTER POINTS


④	FL	ELEV
1	22.47	
2	22.46	
3	22.44	

⑤	FL	ELEV
4	22.66	
5	22.60	
6	22.48	


⑥	FL	ELEV
7	21.65	
8	21.84	
9	22.04	

⑦	FL	ELEV
10	22.06	
11	21.85	
12	21.65	

NOTES:
ALL WHEEL CHAIR RAMPS TO BE
TYPE 2 PER CITY STD. DWG 2441

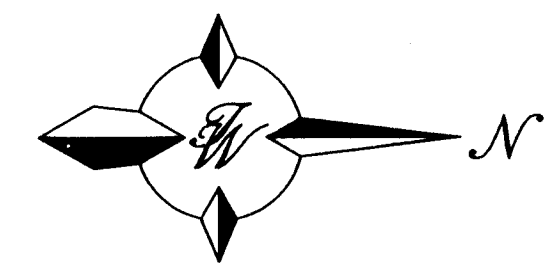


SCALE: HORIZ. 1"=50'
VERT. 1"= 5'

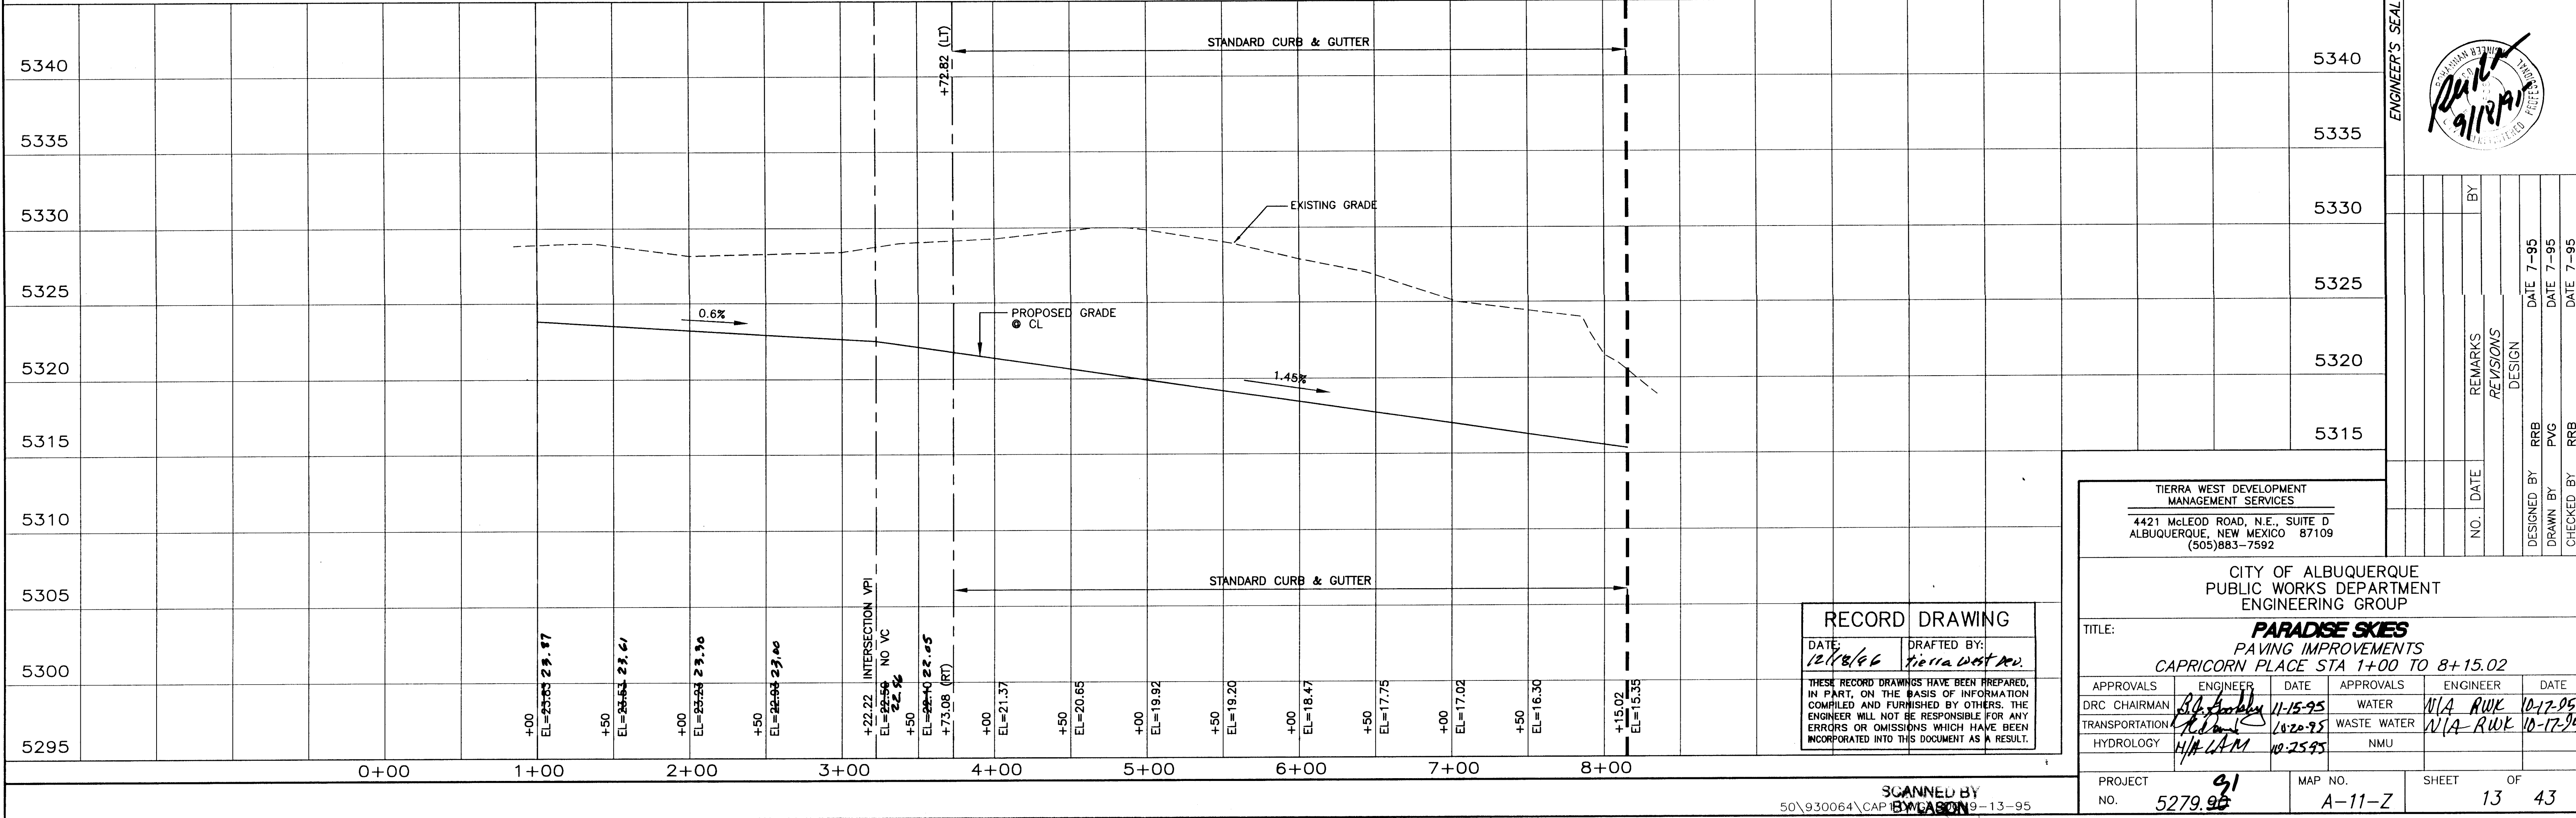

RECORD DRAWING	
DATE	DRAFTED BY:
12/18/96	Tierra West Dev.

TIERRA WEST DEVELOPMENT MANAGEMENT SERVICES 4421 McLEOD ROAD, N.E., SUITE D ALBUQUERQUE, NEW MEXICO 87109 (505)883-7592			
CITY OF ALBUQUERQUE PUBLIC WORKS DEPARTMENT ENGINEERING GROUP			
TITLE: PARADISE SKIES PAVING IMPROVEMENTS CAPRICORN PLACE STA 1+00 TO 8+15.02			
APPROVALS	ENGINEER	DATE	APPROVALS
DRC CHAIRMAN	12/15/95	12/15/95	WATER
TRANSPORTATION	12/20/95	12/20/95	WASTE WATER
HYDROLOGY	12/25/95	12/25/95	NMU
PROJECT NO.	5279.91	MAP NO.	A-11-Z
SHEET 13		OF 43	

SCANNED BY
50\930064\CAPRICORN-13-95

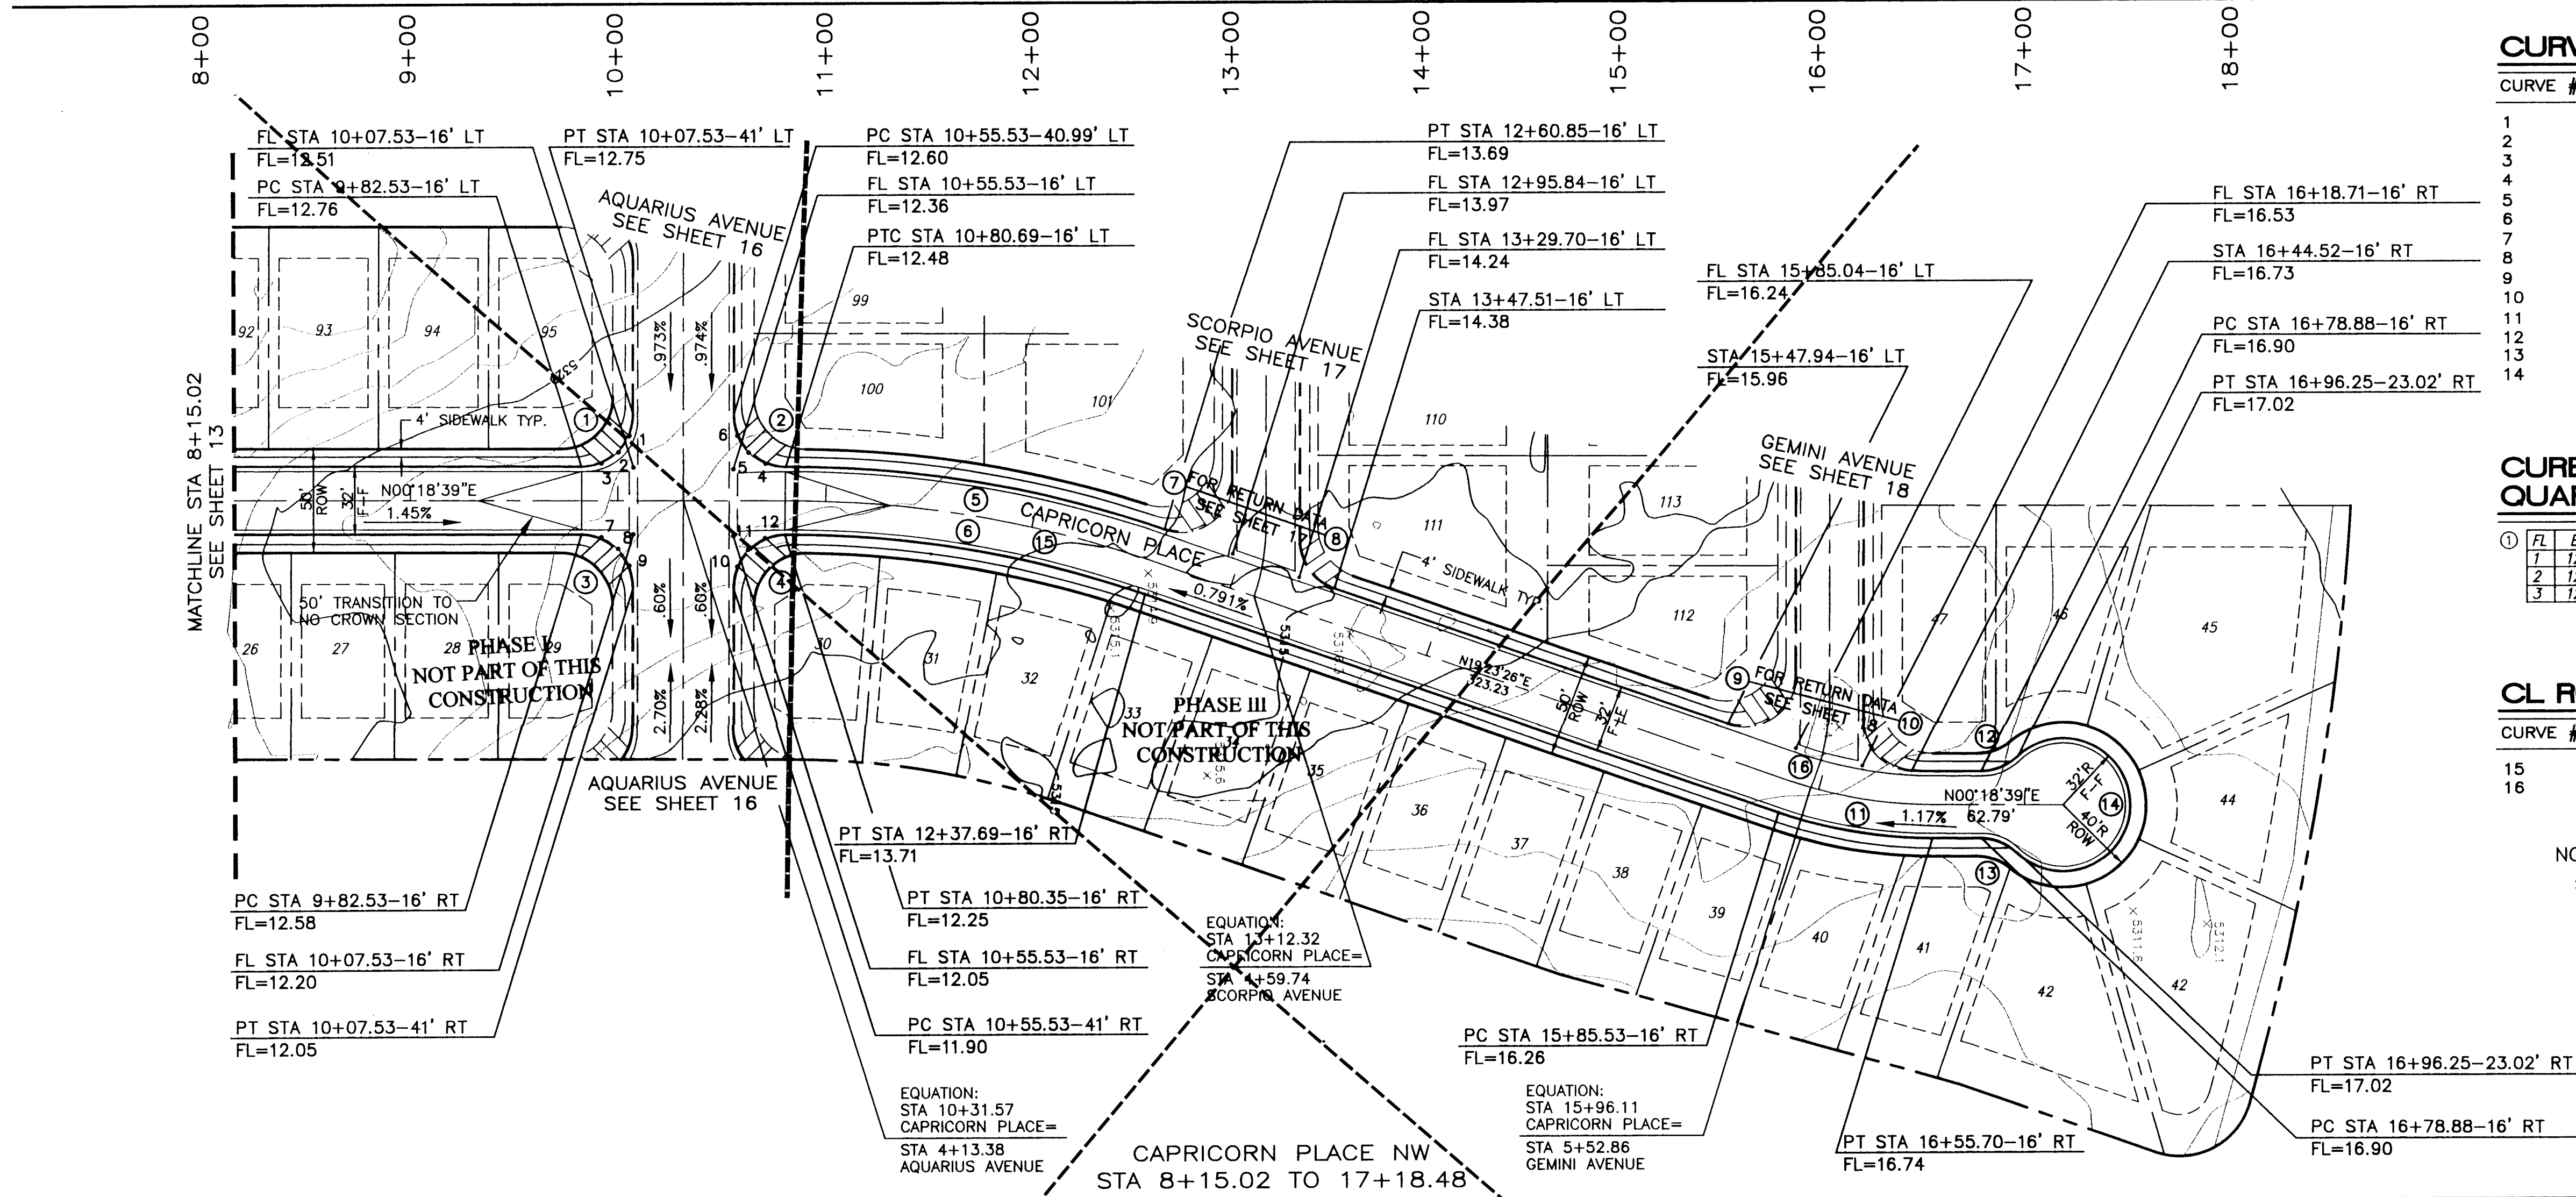

CURVE DATA (DESCRIBES FACE OF CURB)

CURVE #	RADIUS	DELTA	LENGTH	TANGENT
1	25.00	90-00-00	39.27	25.00
2	25.00	90-22-00	39.43	25.16
3	25.00	90-00-00	39.27	25.00
4	25.00	89-35-15	39.09	24.82
5	551.00	19-17-02	185.45	93.61
6	519.00	19-29-57	176.63	89.18
7	SEE SHEET 17, CURVE 4			
8	SEE SHEET 17, CURVE 3			
9	SEE SHEET 18, CURVE 6			
10	SEE SHEET 18, CURVE 5			
11	226.70	19-04-45	75.49	38.10
12	25.00	44-00-11	19.20	10.10
13	25.00	44-00-11	19.20	10.10
14	32.00	268-00-03	149.68	---


CURB RETURN QUARTER POINTS

FL	ELEV	FL	ELEV	FL	ELEV	FL	ELEV
1	12.63	4	12.42	7	12.39	10	11.98
2	12.58	5	12.45	8	12.26	11	12.06
3	12.64	6	12.48	9	12.13	12	12.15


CL ROAD CURVE DATA

CURVE #	RADIUS	DELTA	LENGTH	TANGENT
15	535.00	19-04-48	178.16	89.91
16	210.70	19-04-43	70.16	35.41

NOTES:
ALL WHEEL CHAIR RAMPS ARE TO BE
TYPE 2 PER CITY STD. DWG 2441

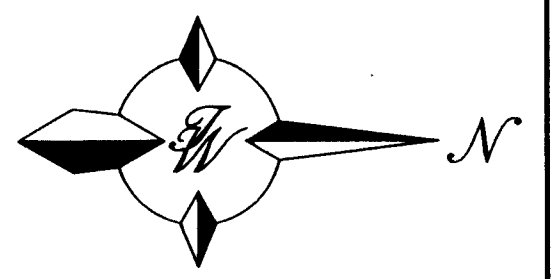

SCALE: HORIZ. 1"=50'
VERT. 1"= 5'

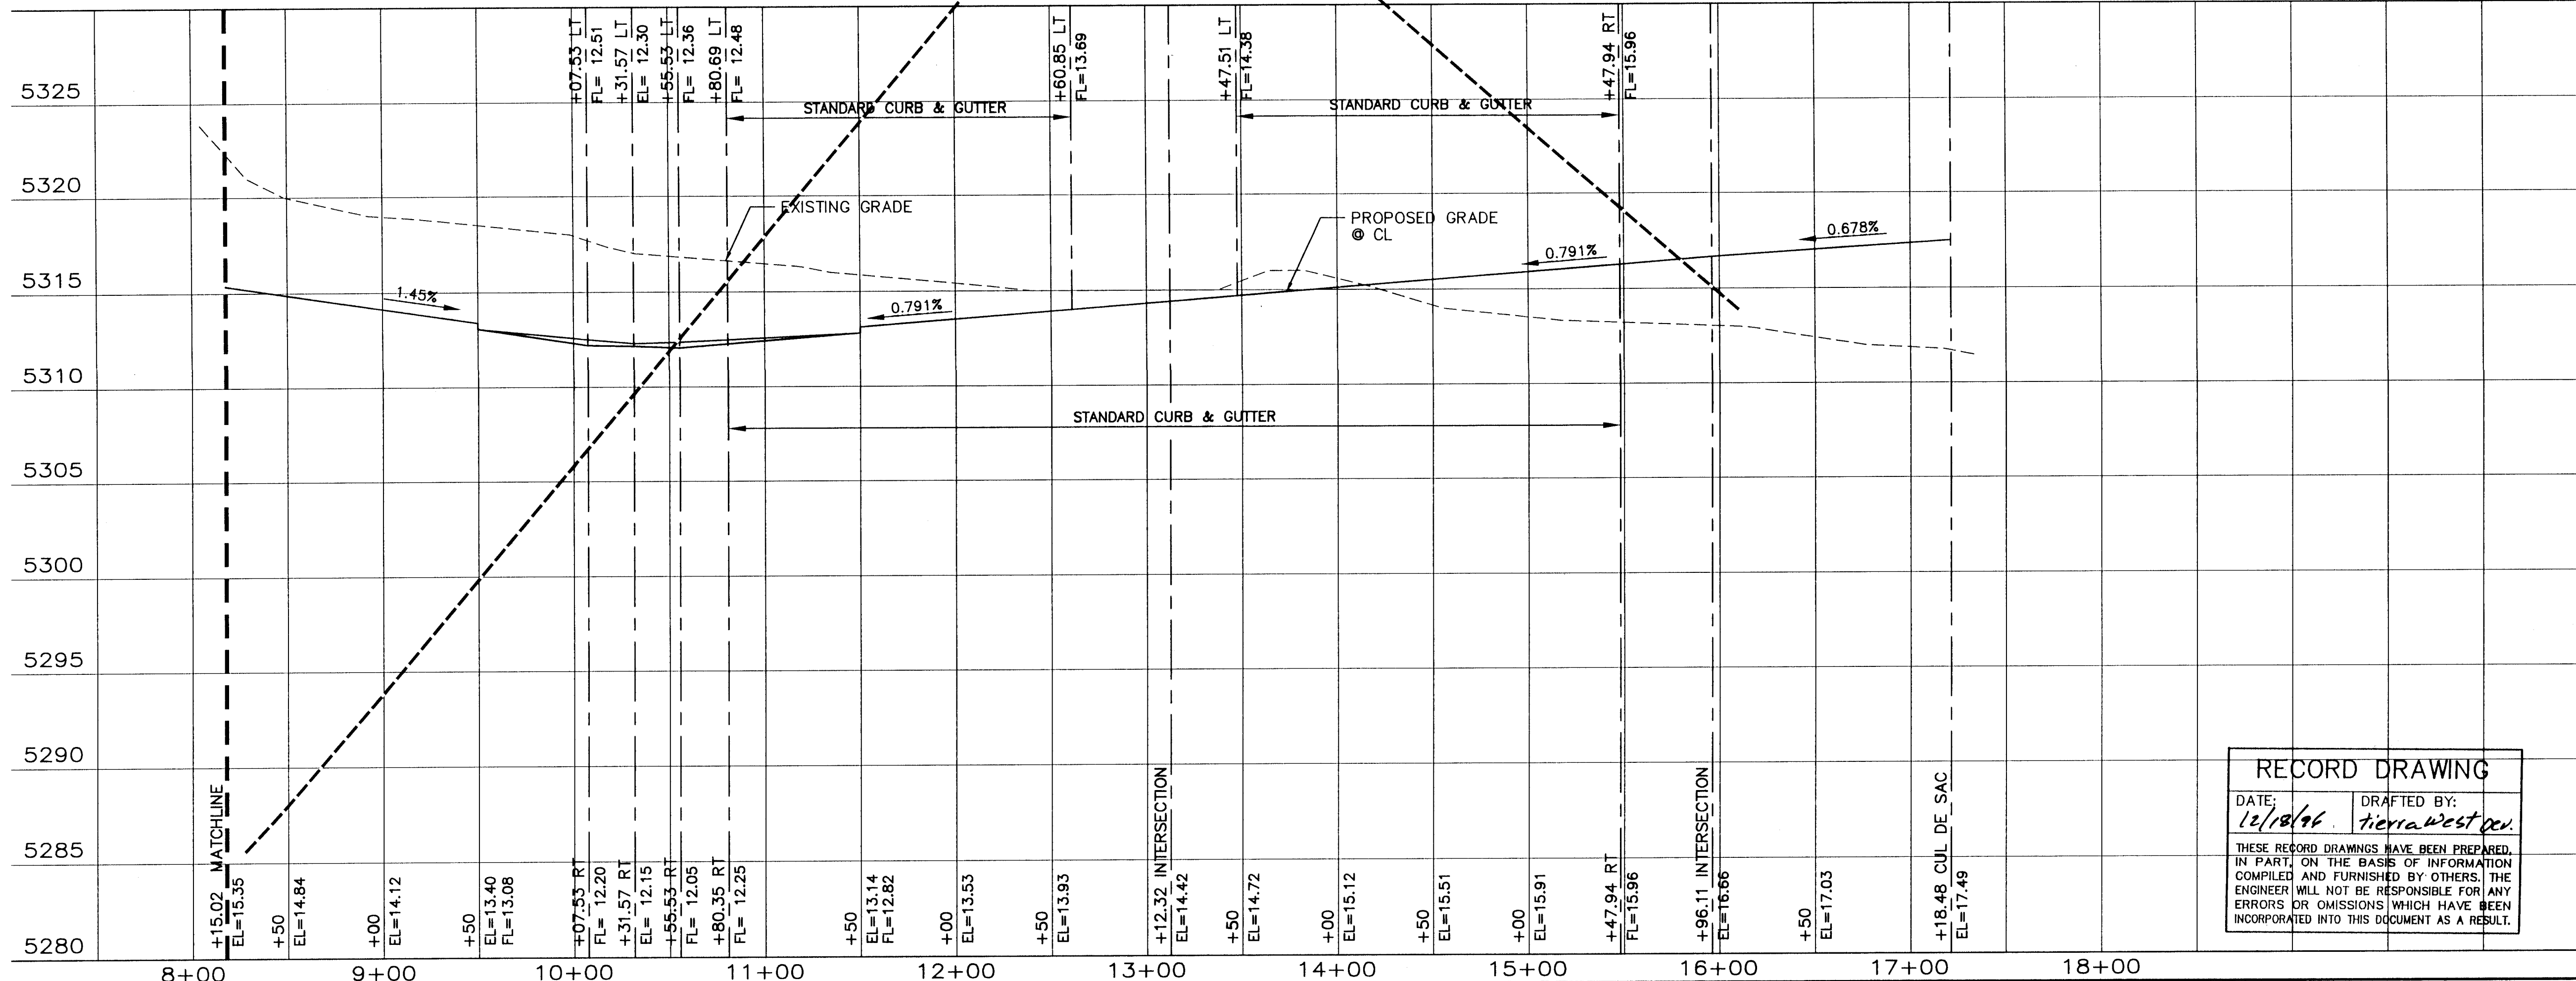


RECORD DRAWING

DATE: 12/18/96 DRAFTED BY: terra west per.
THESE RECORD DRAWINGS HAVE BEEN PREPARED, IN PART, ON THE BASIS OF INFORMATION COMPILED AND FURNISHED BY OTHERS. THE ENGINEER WILL NOT BE RESPONSIBLE FOR ANY ERRORS OR OMISSIONS WHICH HAVE BEEN INCORPORATED INTO THIS DOCUMENT AS A RESULT.

TIERRA WEST DEVELOPMENT MANAGEMENT SERVICES 4421 McLEOD ROAD, N.E., SUITE D ALBUQUERQUE, NEW MEXICO 87109 (505)883-7592			
CITY OF ALBUQUERQUE PUBLIC WORKS DEPARTMENT ENGINEERING GROUP			
TITLE: PARADISE SKIES PAVING IMPROVEMENTS CAPRICORN PLACE STA 8+15.02 TO 17+18.48			
APPROVALS	ENGINEER	DATE	APPROVALS
DRC CHAIRMAN	<i>[Signature]</i>	11-15-95	WATER
TRANSPORTATION	<i>[Signature]</i>	10-28-95	WASTE WATER
HYDROLOGY	<i>[Signature]</i>	10-25-95	NMU
DESIGNED BY	RRB	DATE 7-95	
DRAWN BY	pvg	DATE 7-95	
CHECKED BY	RRB	DATE 7-95	
PROJECT NO.	5279.91	MAP NO.	A-11-Z
SHEET 14		OF 43	

SCANNED BY: BY: JASON
50\930064\CAP2\13-95

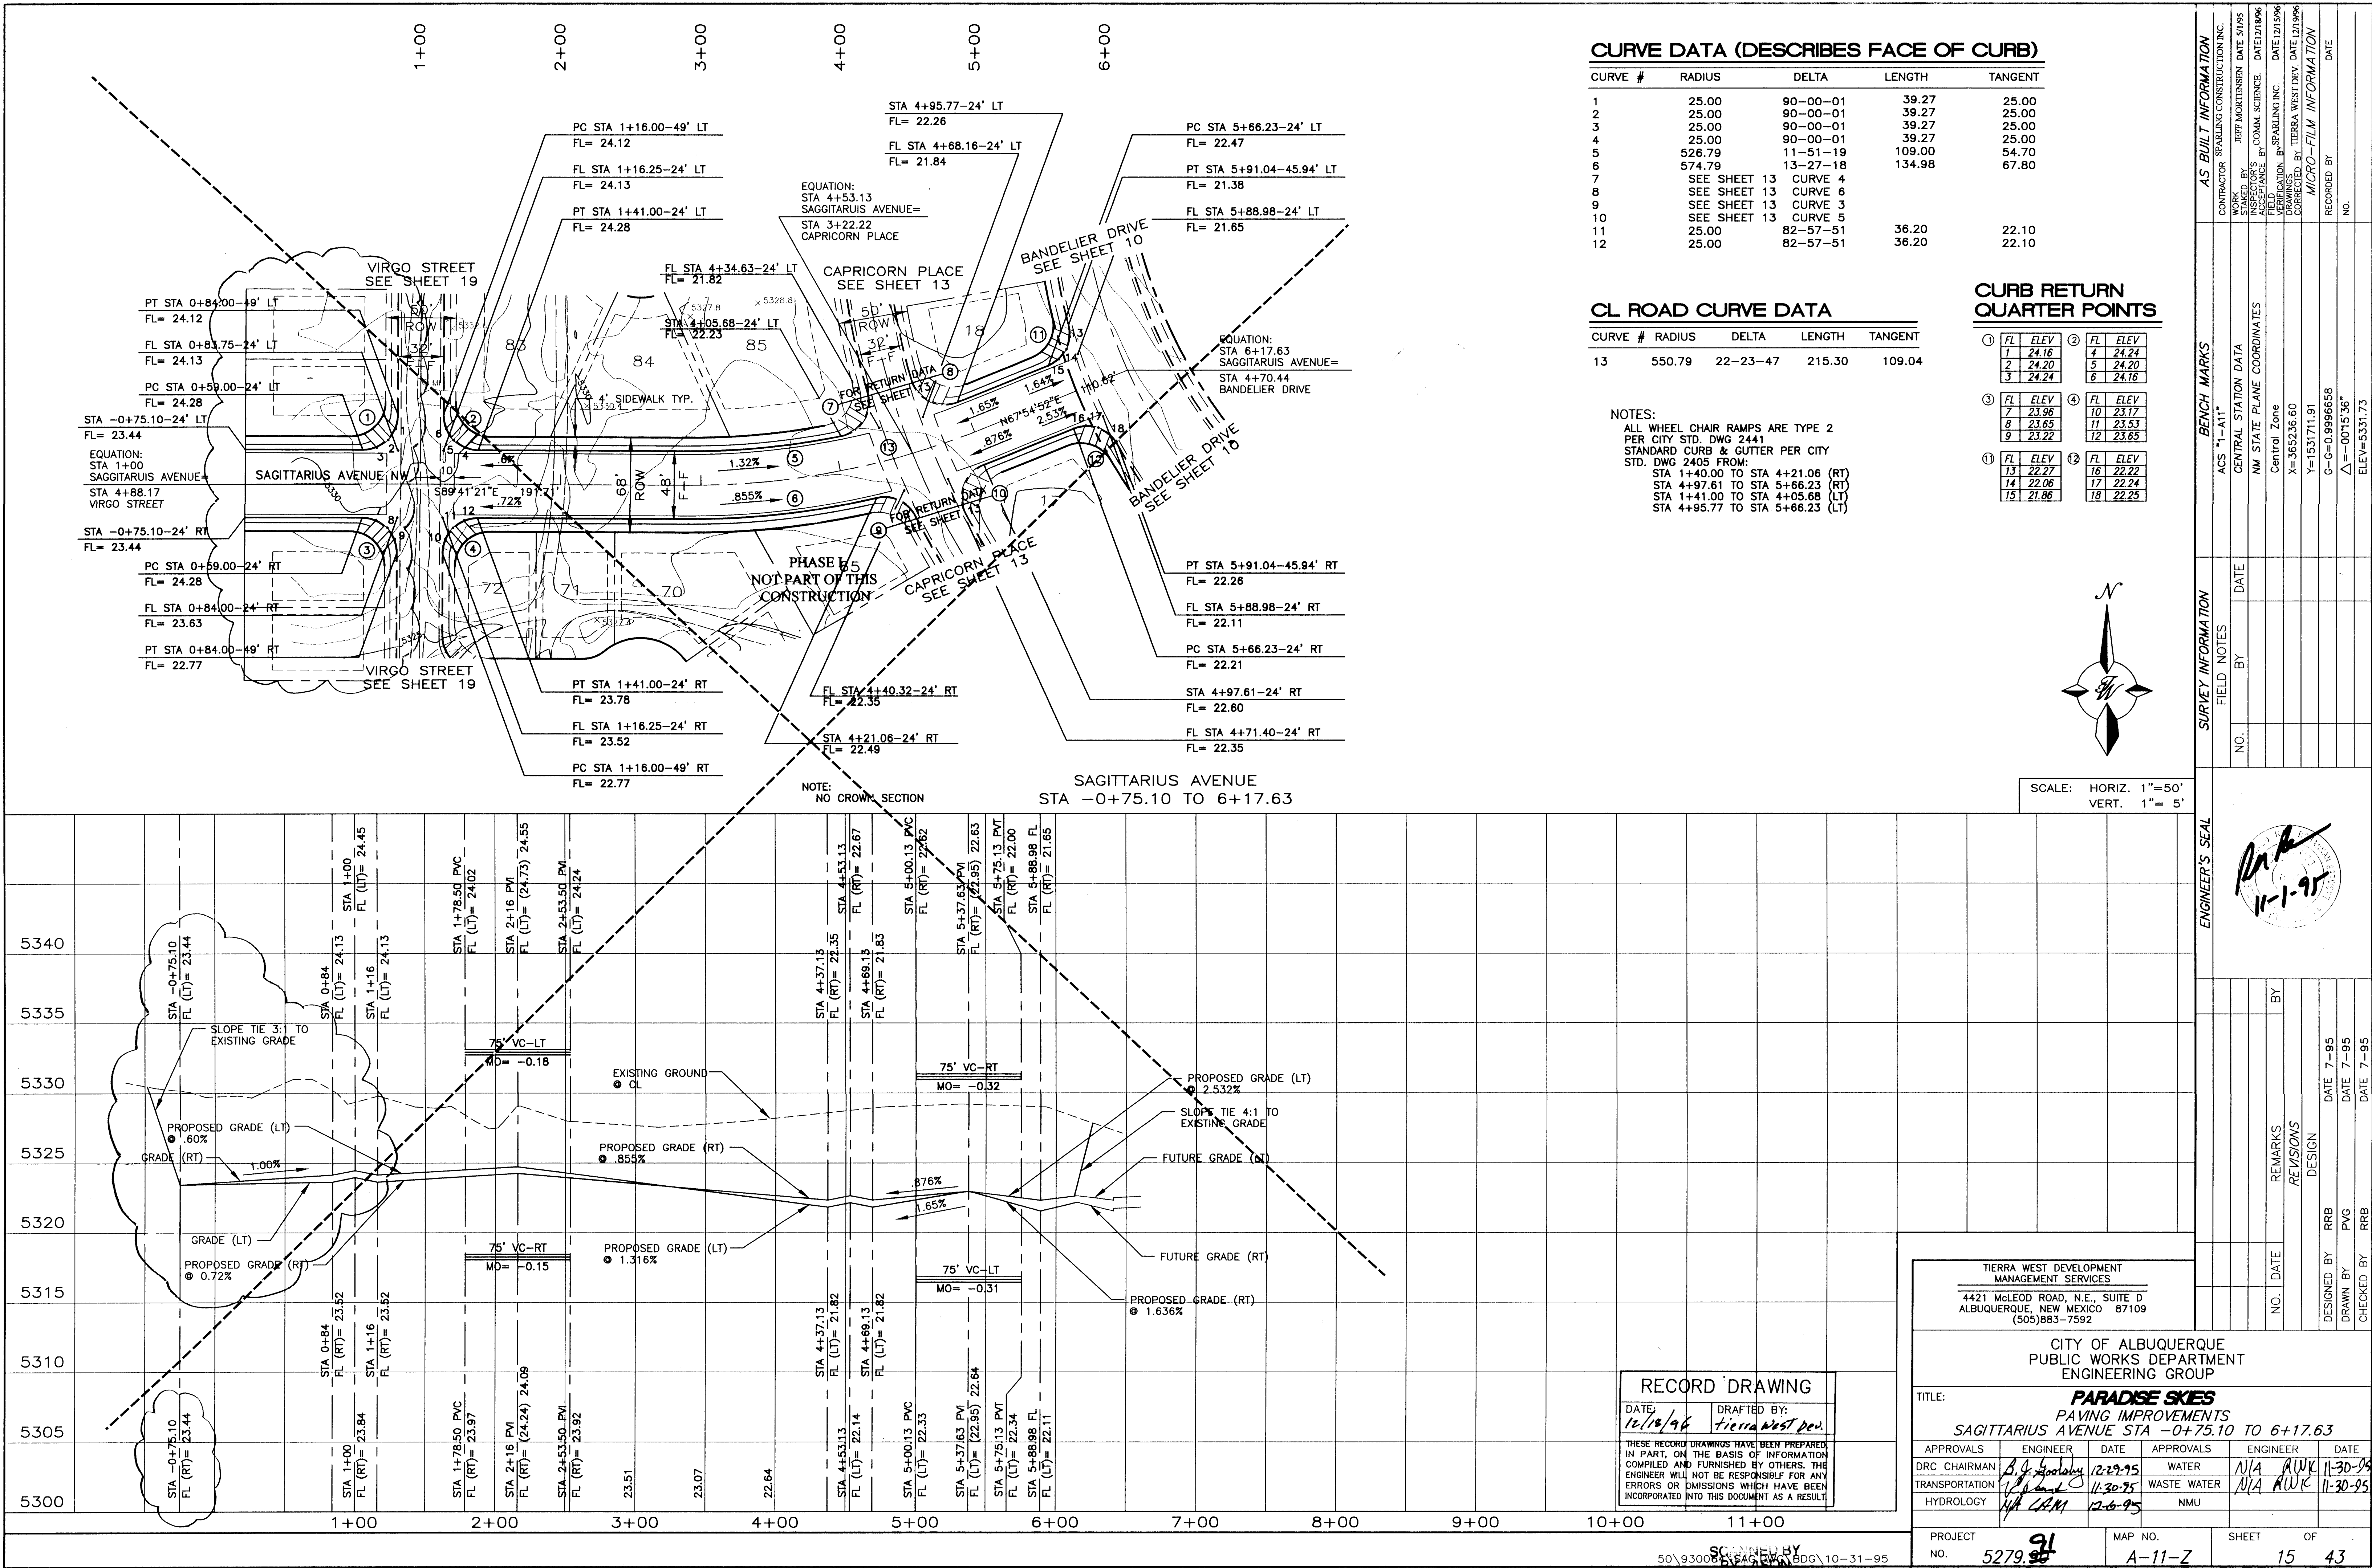

CURVE DATA (DESCRIBES FACE OF CURB)

CURVE #	RADIUS	DELTA	LENGTH	TANGENT
1	25.00	90-00-01	39.27	25.00
2	25.00	90-00-01	39.27	25.00
3	25.00	90-00-01	39.27	25.00
4	25.00	90-00-01	39.27	25.00
5	526.79	11-51-19	109.00	54.70
6	574.79	13-27-18	134.98	67.80
7	SEE SHEET 13	CURVE 4		
8	SEE SHEET 13	CURVE 6		
9	SEE SHEET 13	CURVE 3		
10	SEE SHEET 13	CURVE 5		
11	25.00	82-57-51	36.20	22.10
12	25.00	82-57-51	36.20	22.10


CL ROAD CURVE DATA

CURVE #	RADIUS	DELTA	LENGTH	TANGENT
13	550.79	22-23-47	215.30	109.04

CURB RETURN QUARTER POINTS

FL	ELEV	FL	ELEV
1	24.16	4	24.24
2	24.20	5	24.20
3	24.24	6	24.16
7	23.96	10	23.17
8	23.65	11	23.53
9	23.22	12	23.65
13	22.27	16	22.22
14	22.06	17	22.24
15	21.86	18	22.25

NOTES:
ALL WHEEL CHAIR RAMPS ARE TYPE 2
PER CITY STD. DWG 2441
STANDARD CURB & GUTTER PER CITY
STD. DWG 2405 FROM:
STA 1+40.00 TO STA 4+21.06 (RT)
STA 4+97.61 TO STA 5+66.23 (RT)
STA 1+41.00 TO STA 4+05.68 (LT)
STA 4+95.77 TO STA 5+66.23 (LT)

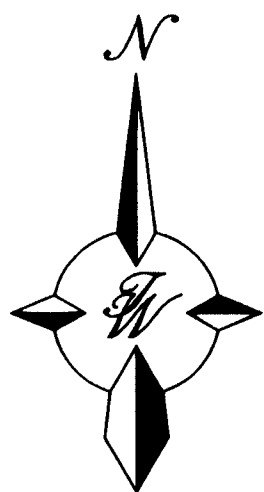

SCALE: HORIZ. 1"=50'
VERT. 1"= 5'

RECORD DRAWING

DATE: 12/18/96 DRAFTED BY: Tierra West Dev.

THESE RECORD DRAWINGS HAVE BEEN PREPARED IN PART, ON THE BASIS OF INFORMATION COMPILED AND FURNISHED BY OTHERS. THE ENGINEER WILL NOT BE RESPONSIBLE FOR ANY ERRORS OR OMISSIONS WHICH HAVE BEEN INCORPORATED INTO THIS DOCUMENT AS A RESULT


TIERRA WEST DEVELOPMENT
MANAGEMENT SERVICES
4421 MCLEOD ROAD, N.E., SUITE D
ALBUQUERQUE, NEW MEXICO 87109
(505) 883-7592

CITY OF ALBUQUERQUE
PUBLIC WORKS DEPARTMENT
ENGINEERING GROUP

TITLE: **PARADISE SKIES**
PAVING IMPROVEMENTS
SAGITTARIUS AVENUE STA -0+75.10 TO 6+17.63

APPROVALS	ENGINEER	DATE	APPROVALS	ENGINEER	DATE
DRC CHAIRMAN	<i>[Signature]</i>	12-29-95	WATER	N/A	11-30-95
TRANSPORTATION	<i>[Signature]</i>	11-30-95	WASTE WATER	N/A	11-30-95
HYDROLOGY	<i>[Signature]</i>	12-6-95	NMU		

PROJECT NO.	5279.24	MAP NO.	A-11-Z	SHEET OF	15 43
-------------	---------	---------	--------	----------	-------

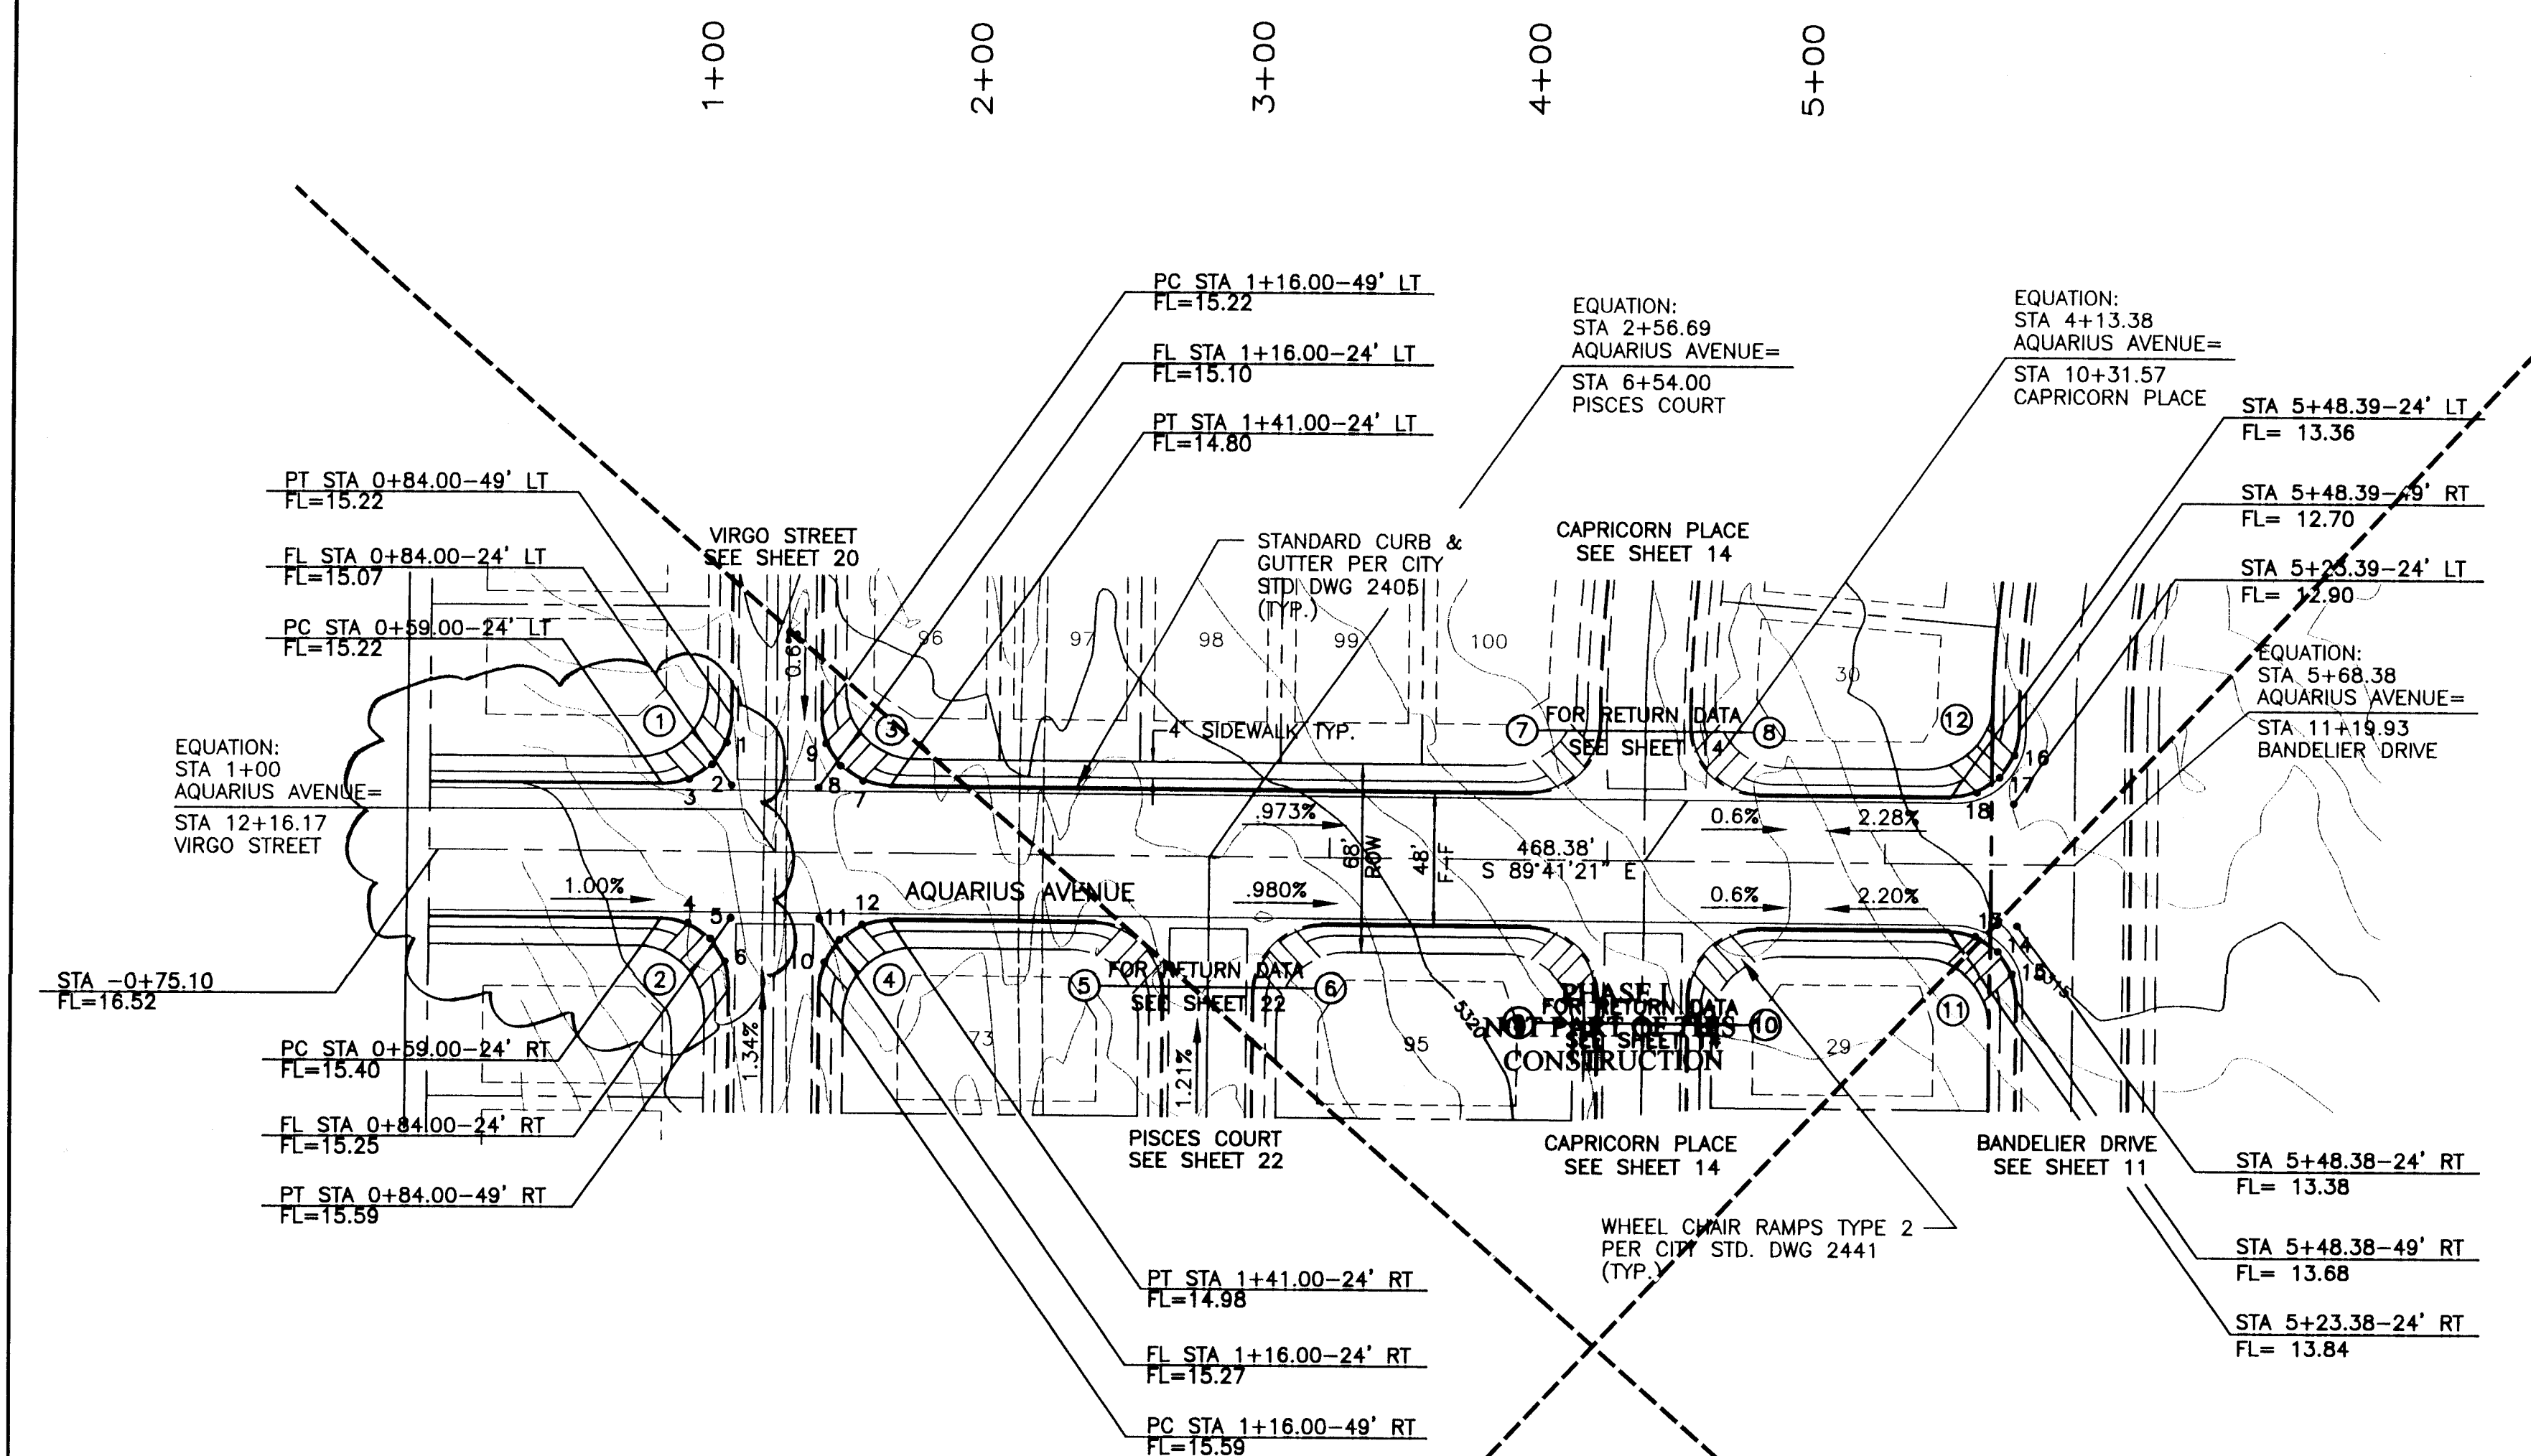



CURVE DATA
(DESCRIBES FACE OF CURB)

CURVE #	RADIUS	DELTA	LENGTH	TANGENT
1	25.00	90-00-01	39.27	25.00
2	25.00	90-00-01	39.27	25.00
3	25.00	90-00-01	39.27	25.00
4	25.00	90-00-01	39.27	25.00
5	SEE SHEET 22	CURVE 4		
6	SEE SHEET 22	CURVE 5		
7	SEE SHEET 14	CURVE 3		
8	SEE SHEET 14	CURVE 4		
9	SEE SHEET 14	CURVE 1		
10	SEE SHEET 14	CURVE 2		
11	25.00	90-00-01	39.27	25.00
12	25.00	90-28-53	39.48	25.21

CURB RETURN
QUARTER POINTS

FL	ELEV	FL	ELEV
1	15.22	4	15.45
2	15.22	5	15.50
3	15.22	6	15.54
7	14.91	10	15.44
8	15.01	11	15.29
9	15.12	12	15.13
13	13.80	16	12.87
14	13.76	17	13.03
15	13.72	18	13.20

AQUARIUS AVENUE
STA 1+00 TO 5+68.38
(NO CROWN SECTION)

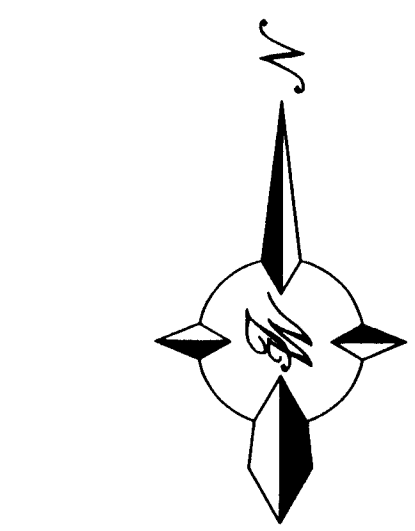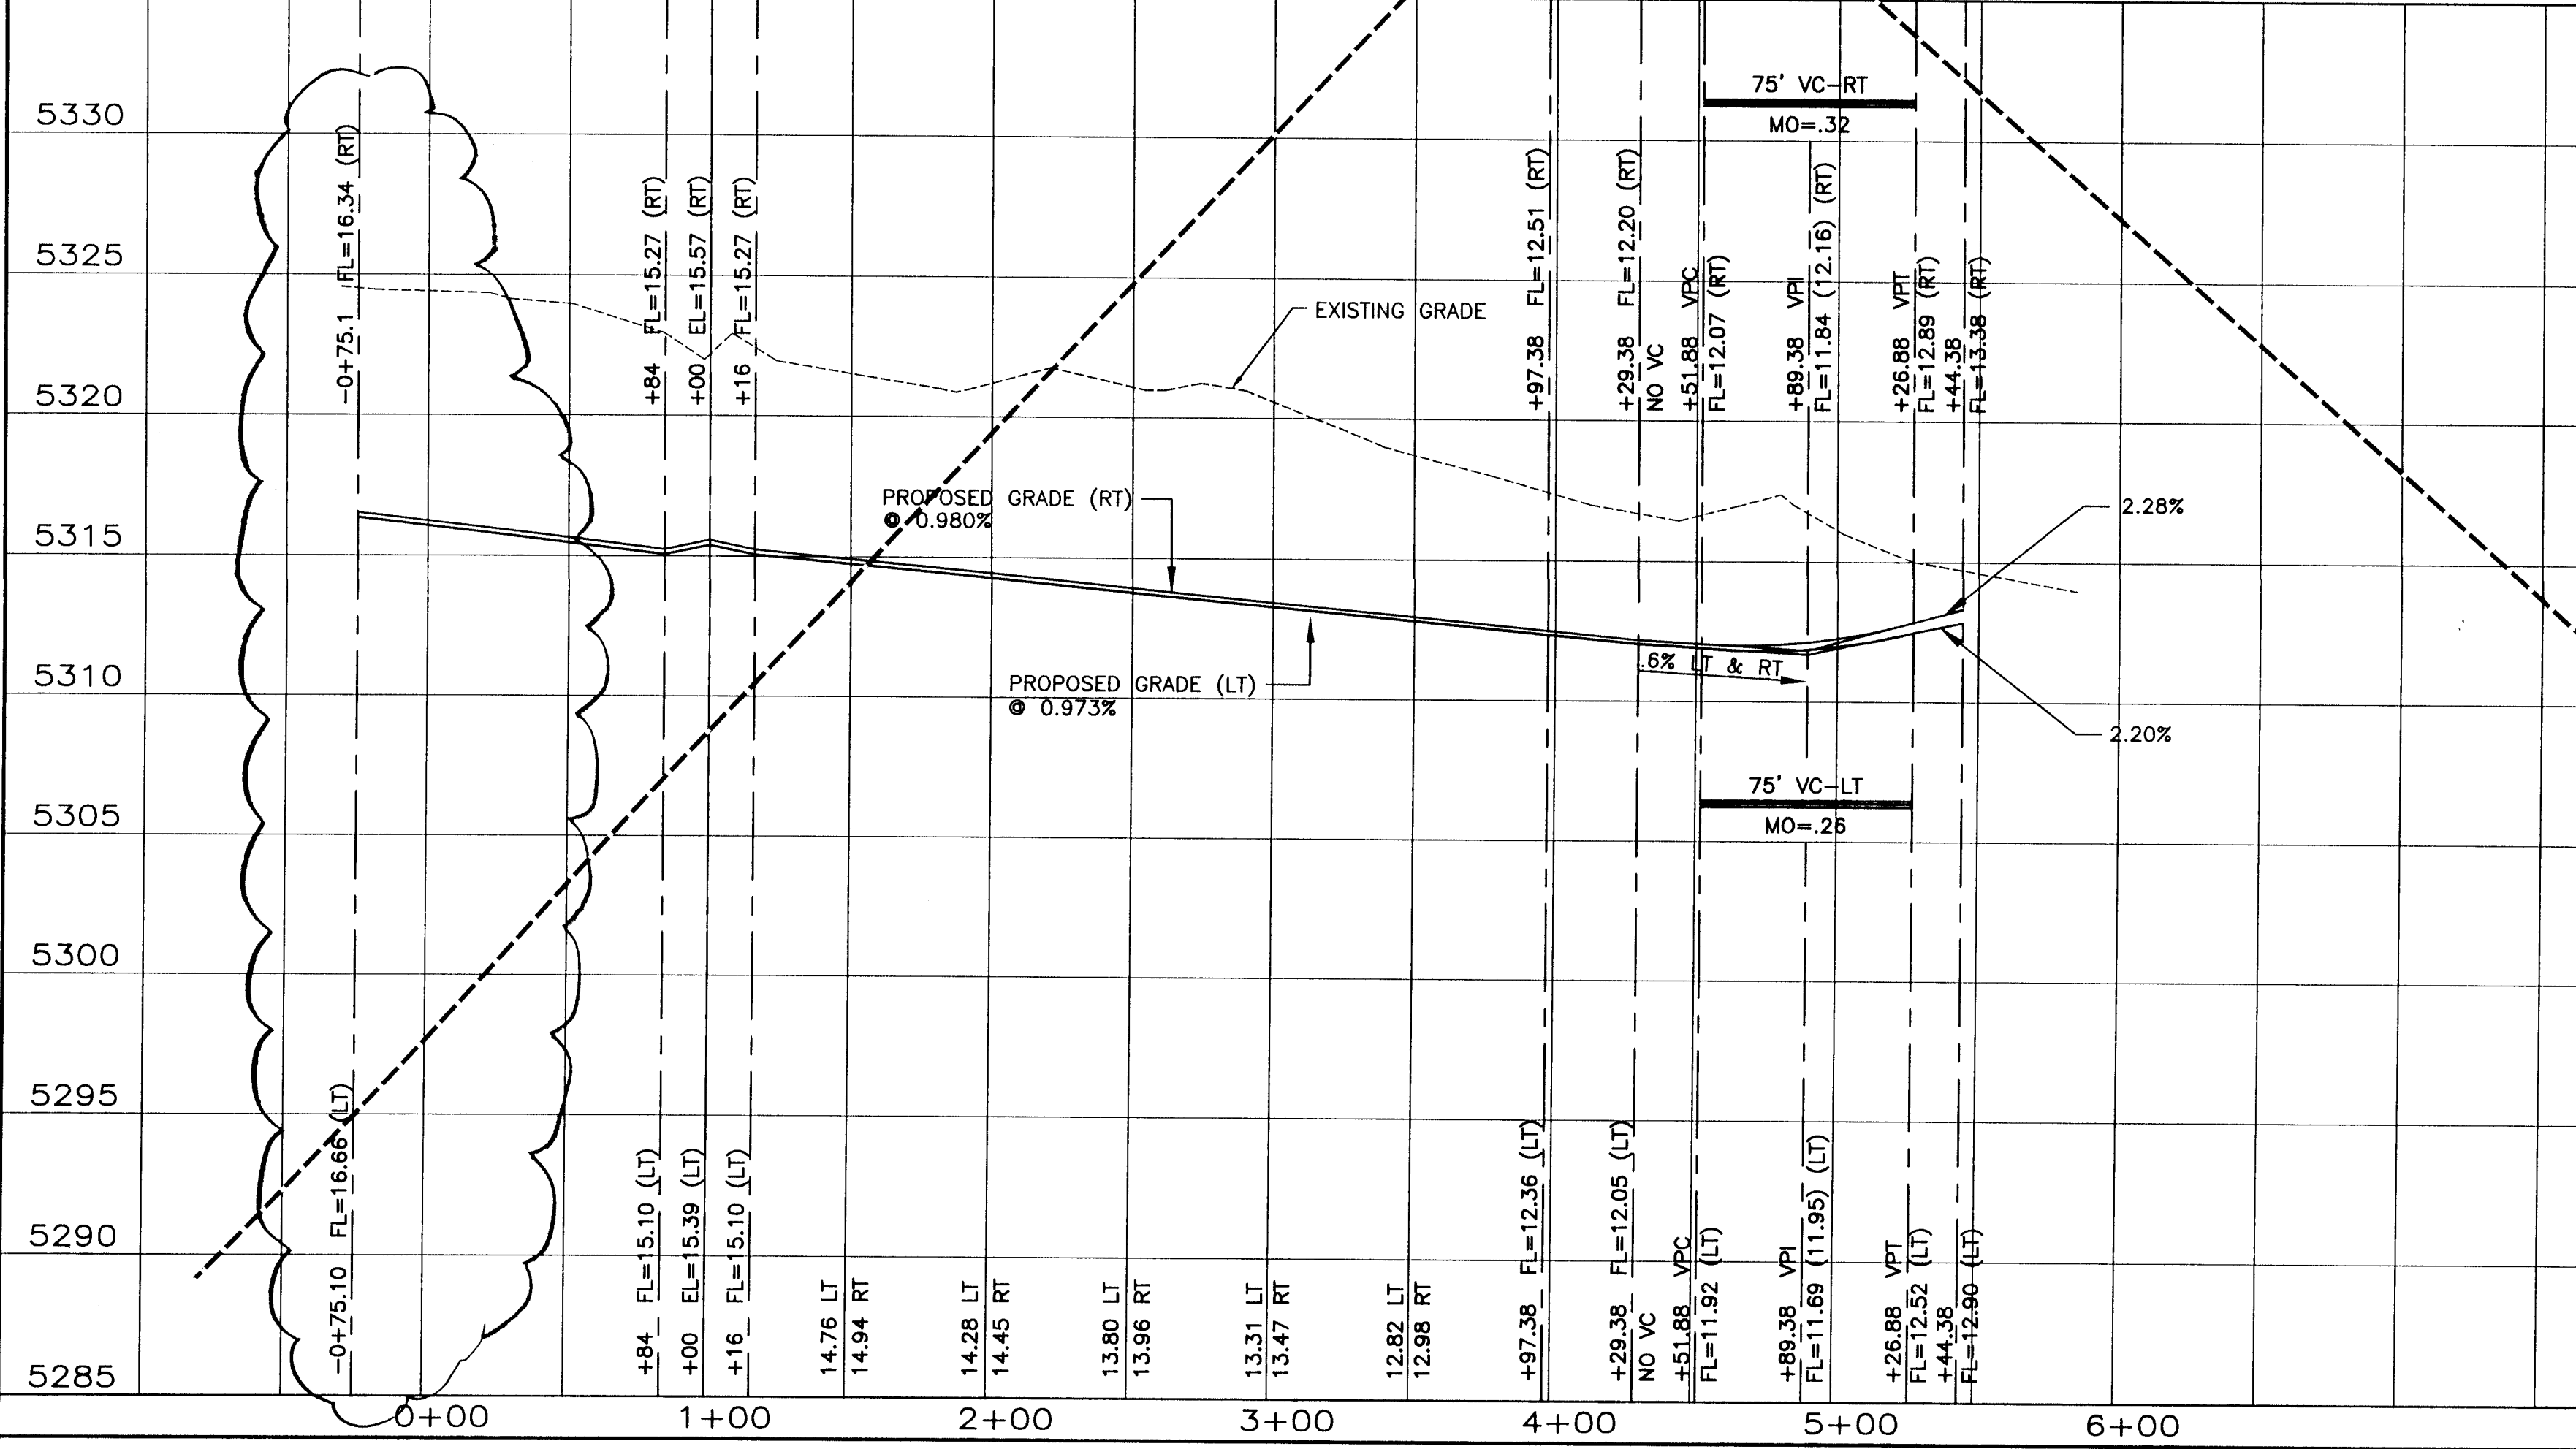

SCALE: HORIZ. 1"=50'
VERT. 1"= 5'

RECORD DRAWING
DATE: 12/12/96
DRAFTED BY: Tierra West Dev.
THESE RECORD DRAWINGS HAVE BEEN PREPARED, IN PART, ON THE BASIS OF INFORMATION COMPILED AND FURNISHED BY OTHERS. THE ENGINEER WILL NOT BE RESPONSIBLE FOR ANY ERRORS OR OMISSIONS WHICH HAVE BEEN INCORPORATED INTO THIS DOCUMENT AS A RESULT.

TIERRA WEST DEVELOPMENT MANAGEMENT SERVICES 4421 McLEOD ROAD, N.E., SUITE D ALBUQUERQUE, NEW MEXICO 87109 (505)883-7592					
CITY OF ALBUQUERQUE PUBLIC WORKS DEPARTMENT ENGINEERING GROUP					
TITLE: PARADISE SKIES PAVING IMPROVEMENTS AQUARIUS AVENUE STA 1+00 TO 5+68.38					
APPROVALS	ENGINEER	DATE	APPROVALS	ENGINEER	DATE
DRC CHAIRMAN	<i>B. J. Padilla</i>	12-29-95	WATER	<i>N/A</i>	11-30-95
TRANSPORTATION	<i>N/A</i>	11-30-95	WASTE WATER	<i>N/A</i>	11-30-95
HYDROLOGY	<i>N/A</i>	12-5-95	NMU		
PROJECT NO.	5279.31	MAP NO.	A-11-Z	SHEET	16 OF 43

CONTRACTOR: SPARKLING CONSTRUCTION INC.		DATE: 5/05	
INSPECTOR: JEFF MORTENSEN		DATE: 12/18/95	
FIELD ENGINEER: COMM. SCIENCE		DATE: 12/18/95	
VERIFICATION: BY SPARKLING INC.		DATE: 12/18/95	
CORRECTED BY: TERRA WEST DEV.		DATE: 12/18/95	
MICRO-FILM INFORMATION		RECORDED BY: DATE:	
NO.		ELEV=5331.73	


NO.		DATE	
BY		DATE	
REMARKS		DATE	
DESIGNED BY		DATE	
DRAWN BY		DATE	
CHECKED BY		DATE	

NO.		DATE	
REVISIONS		DATE	
DESIGN		DATE	
RRB		DATE	
BDG		DATE	
RRB		DATE	

50\930064\AS\10-31-95
BY: JASON

1 2 3 4 5 6 7 8 9 10 11 12 13 14 15
26-5279.31 1697

PHASE II

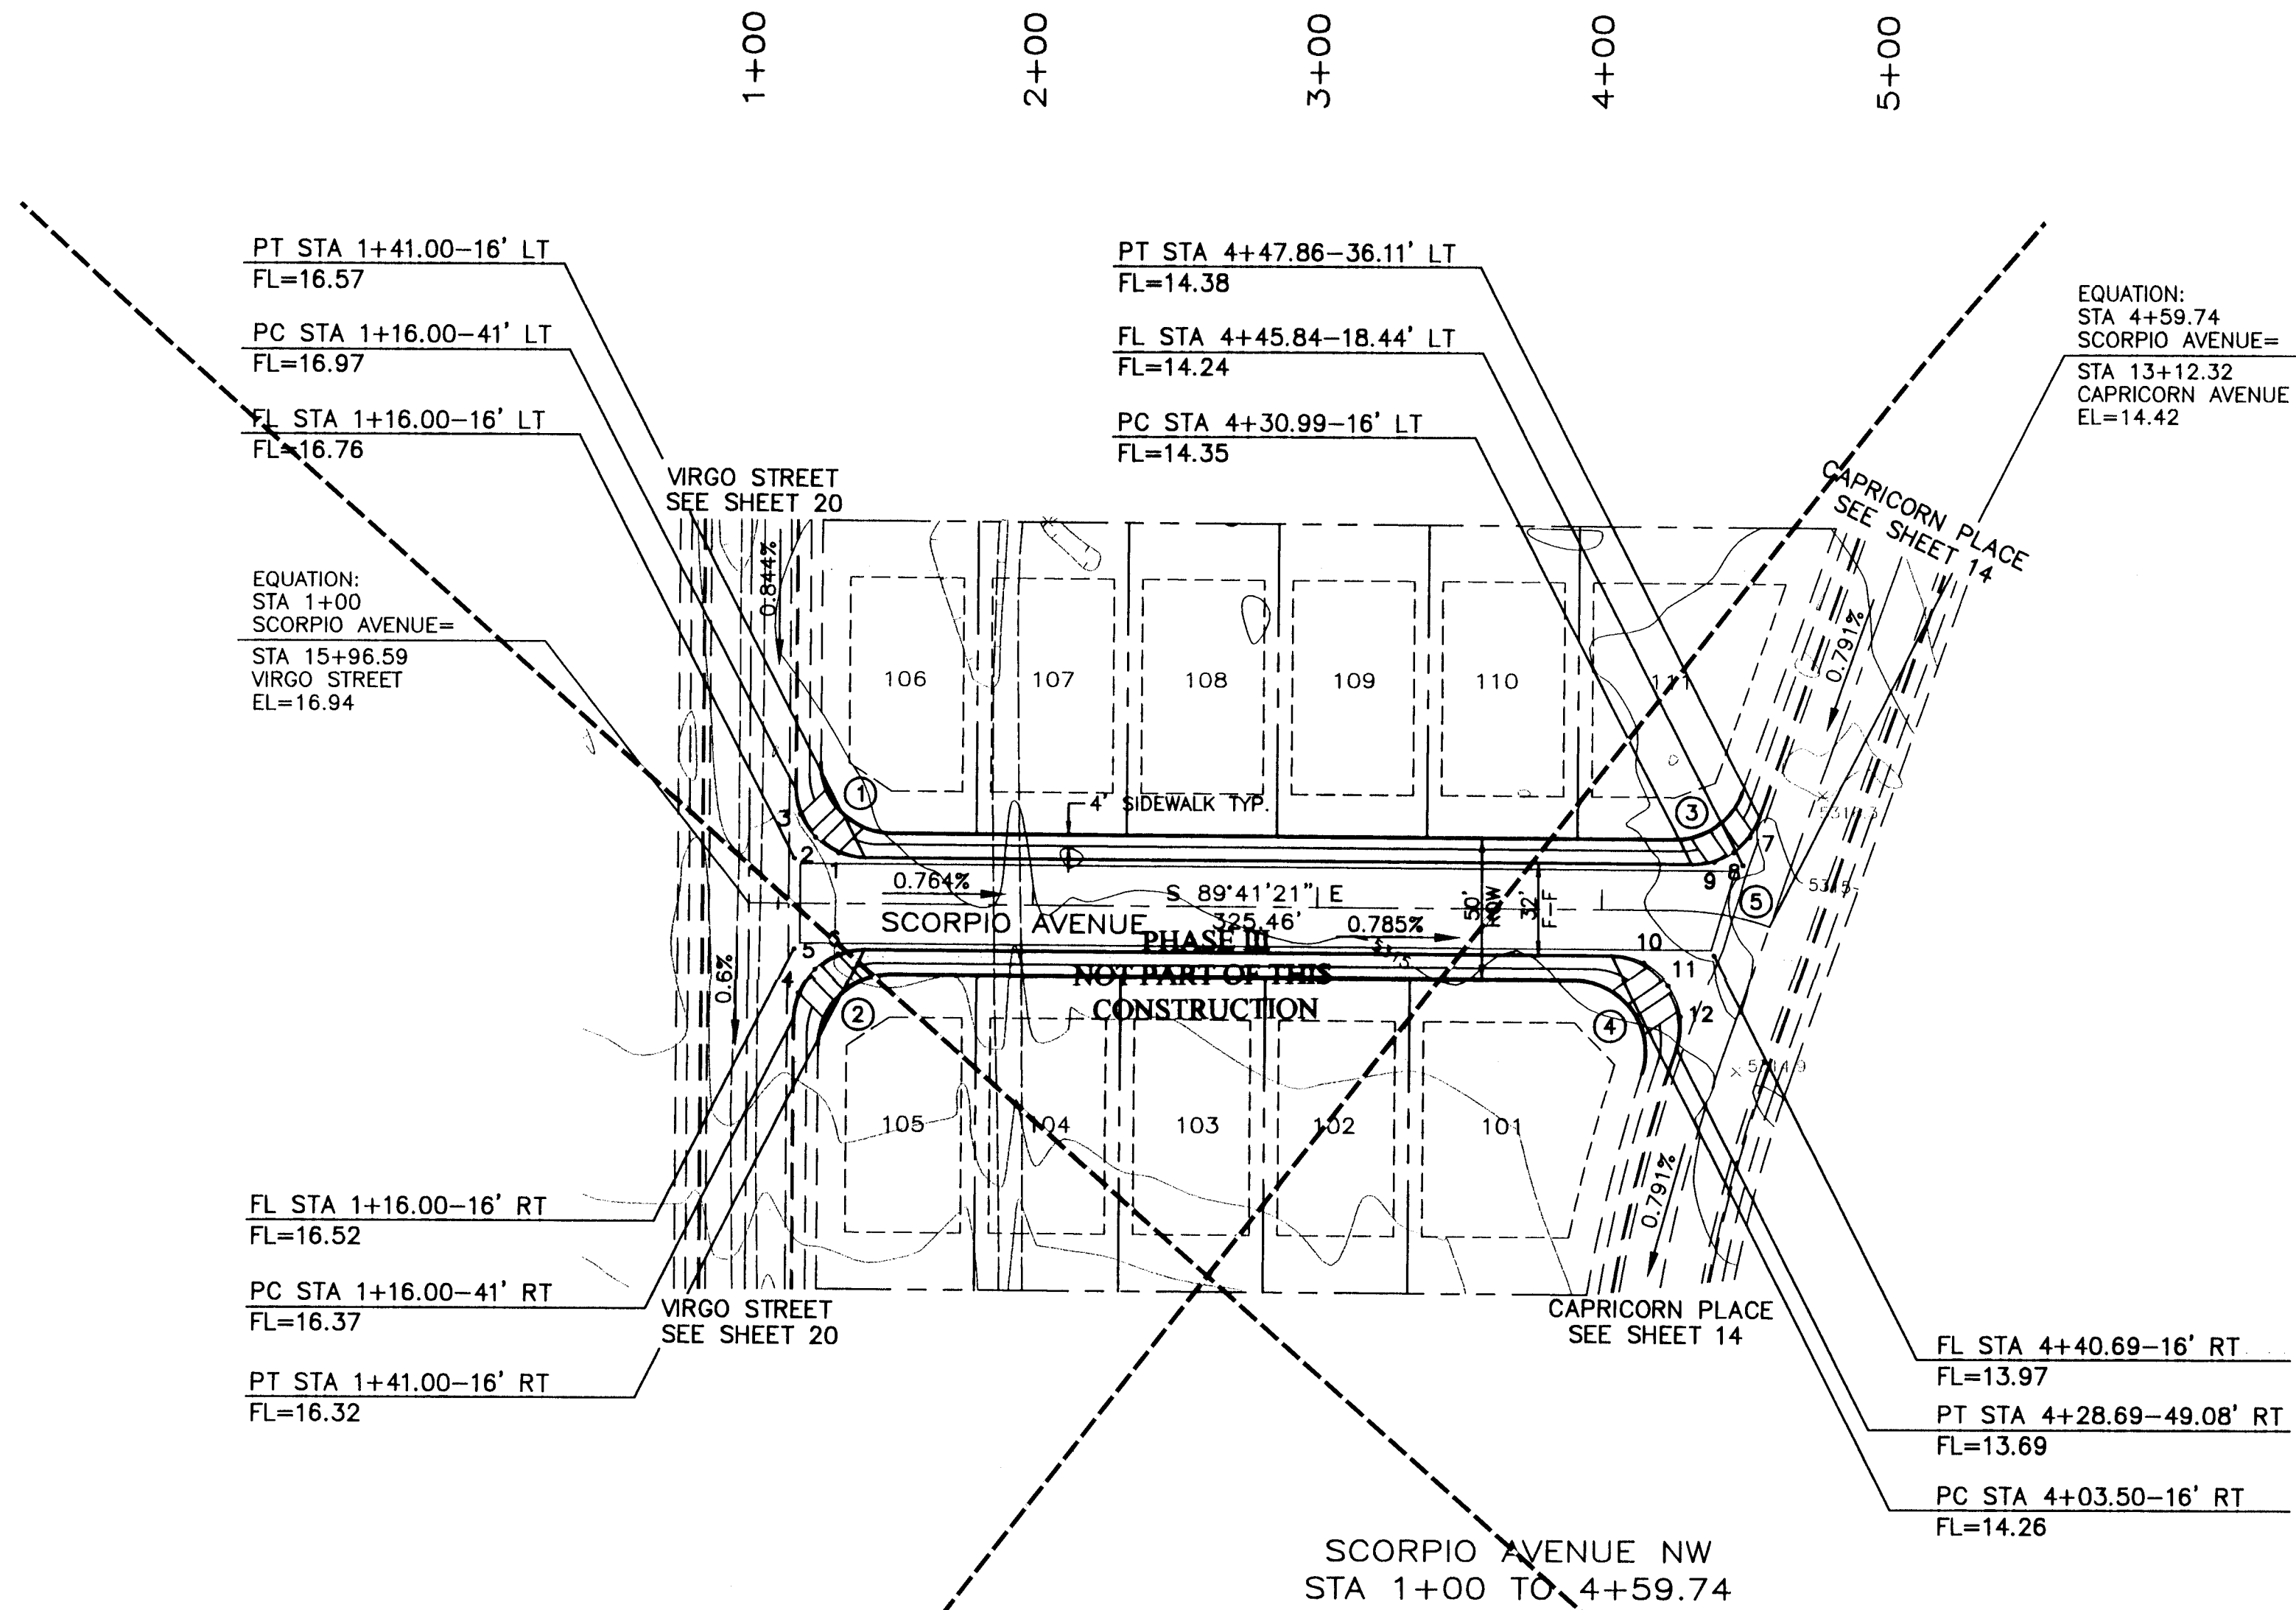

CURVE DATA (DESCRIBES FACE OF CURB)


CURVE #	RADIUS	DELTA	LENGTH	TANGENT
1	25.00	90-00-01	39.27	25.00
2	25.00	90-00-01	39.27	25.00
3	25.00	70-54-33	30.94	17.80
4	25.00	108-55-51	47.53	35.00

CURB RETURN QUARTER POINTS


1	FL	ELEV	2	FL	ELEV	3	FL	ELEV	4	FL	ELEV
1	16.67		4	16.45		7	14.31		10	14.12	
2	16.77		5	16.43		8	14.30		11	13.97	
3	16.87		6	16.42		9	14.30		12	13.83	

CL ROAD CURVE DATA

CURVE #	RADIUS	DELTA	LENGTH	TANGENT
5	102.84	19-06-15	34.29	17.31

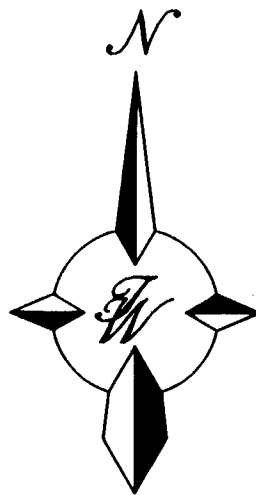


SCALE: HORIZ. 1"=50'
VERT. 1"= 5'

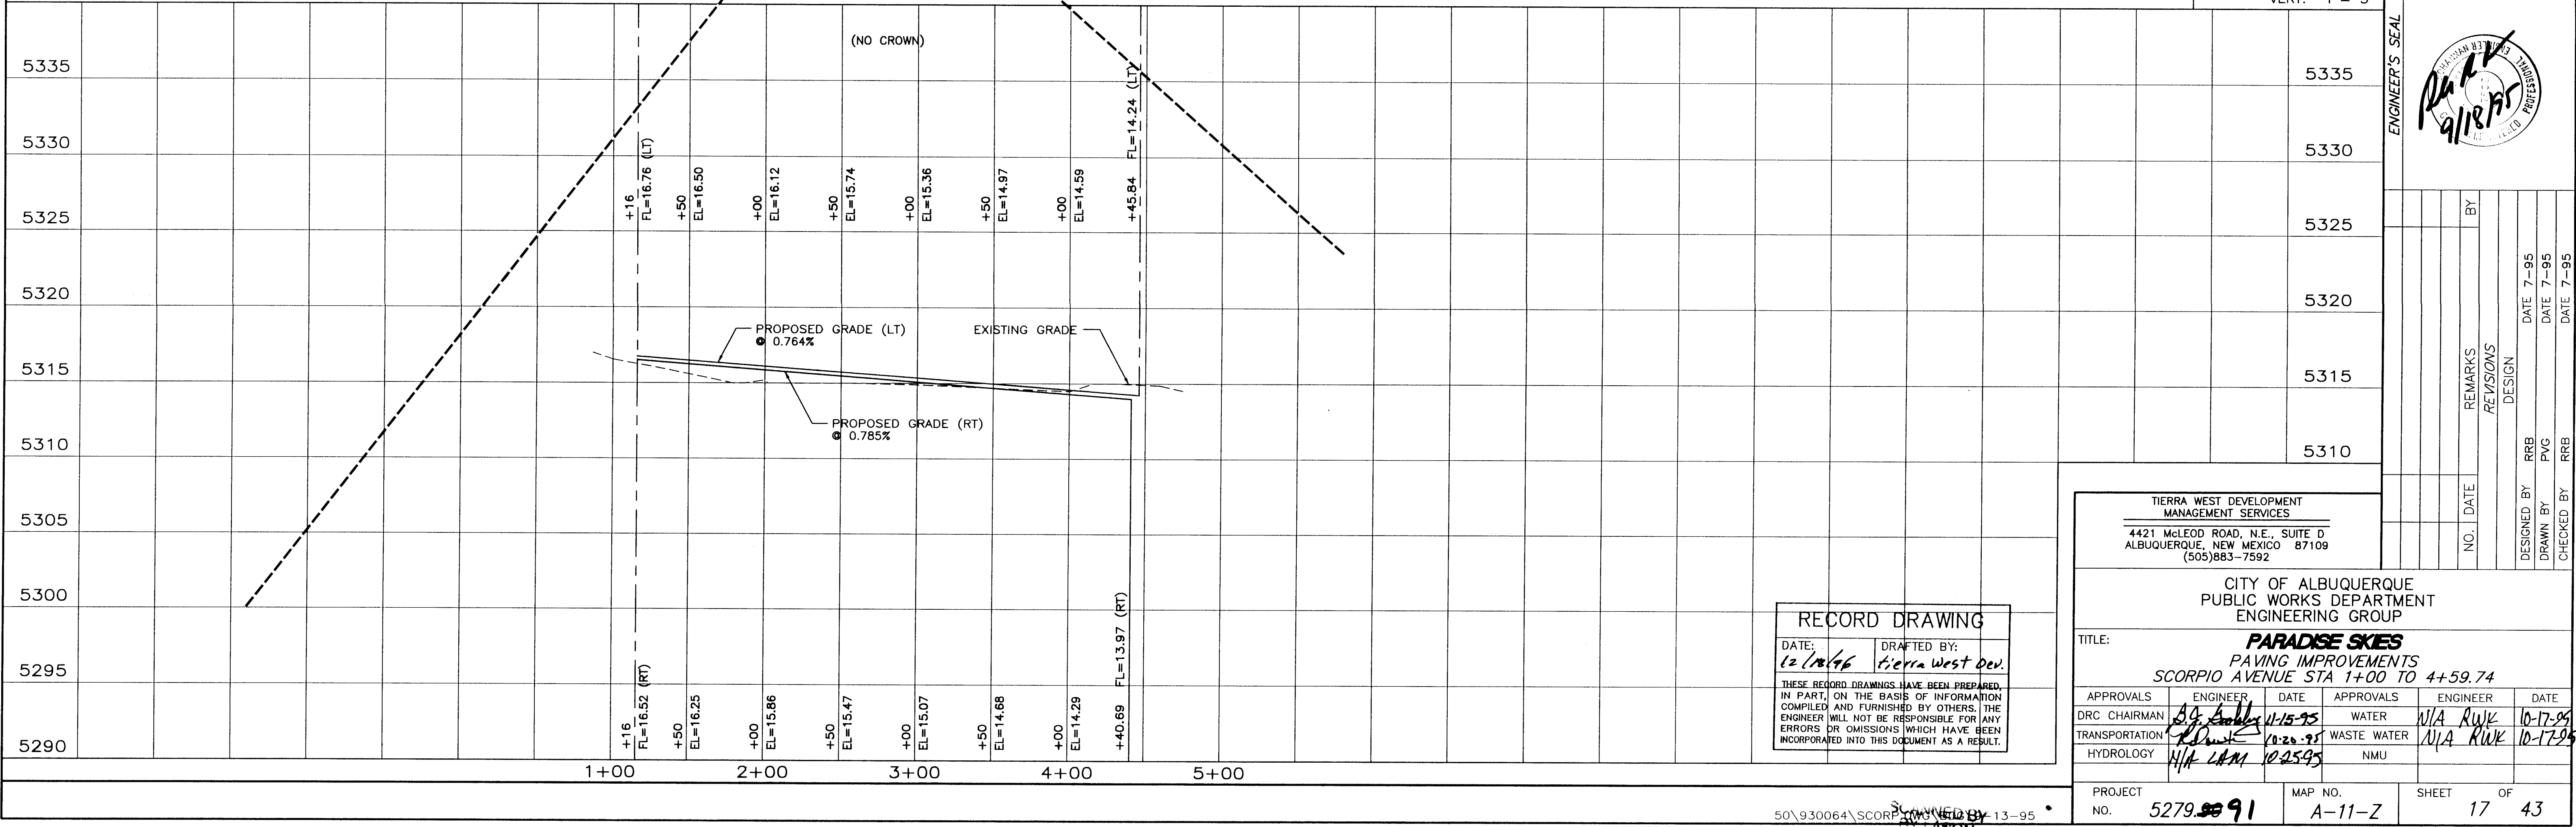

RECORD DRAWING
DATE: 12/18/96
DRAFTED BY: Tierra West Dev.
THESE RECORD DRAWINGS HAVE BEEN PREPARED IN PART, ON THE BASIS OF INFORMATION COMPILED AND FURNISHED BY OTHERS. THE ENGINEER WILL NOT BE RESPONSIBLE FOR ANY ERRORS OR OMISSIONS WHICH HAVE BEEN INCORPORATED INTO THIS DOCUMENT AS A RESULT.

TIERRA WEST DEVELOPMENT MANAGEMENT SERVICES 4421 McLEOD ROAD, N.E., SUITE D ALBUQUERQUE, NEW MEXICO 87109 (505)883-7592			
CITY OF ALBUQUERQUE PUBLIC WORKS DEPARTMENT ENGINEERING GROUP			
TITLE: PARADISE SKIES PAVING IMPROVEMENTS SCORPIO AVENUE STA 1+00 TO 4+59.74			
APPROVALS	ENGINEER	DATE	APPROVALS
DRC CHAIRMAN	12/15/95		WATER
TRANSPORTATION	10/20/95		WASTE WATER
HYDROLOGY	10/25/95		NMU
DESIGNED BY	RRB	DATE	7-95
DRAWN BY	PVG	DATE	7-95
CHECKED BY	RRB	DATE	7-95
PROJECT NO.	5279-091	MAP NO.	A-11-Z
SHEET 17		OF 43	

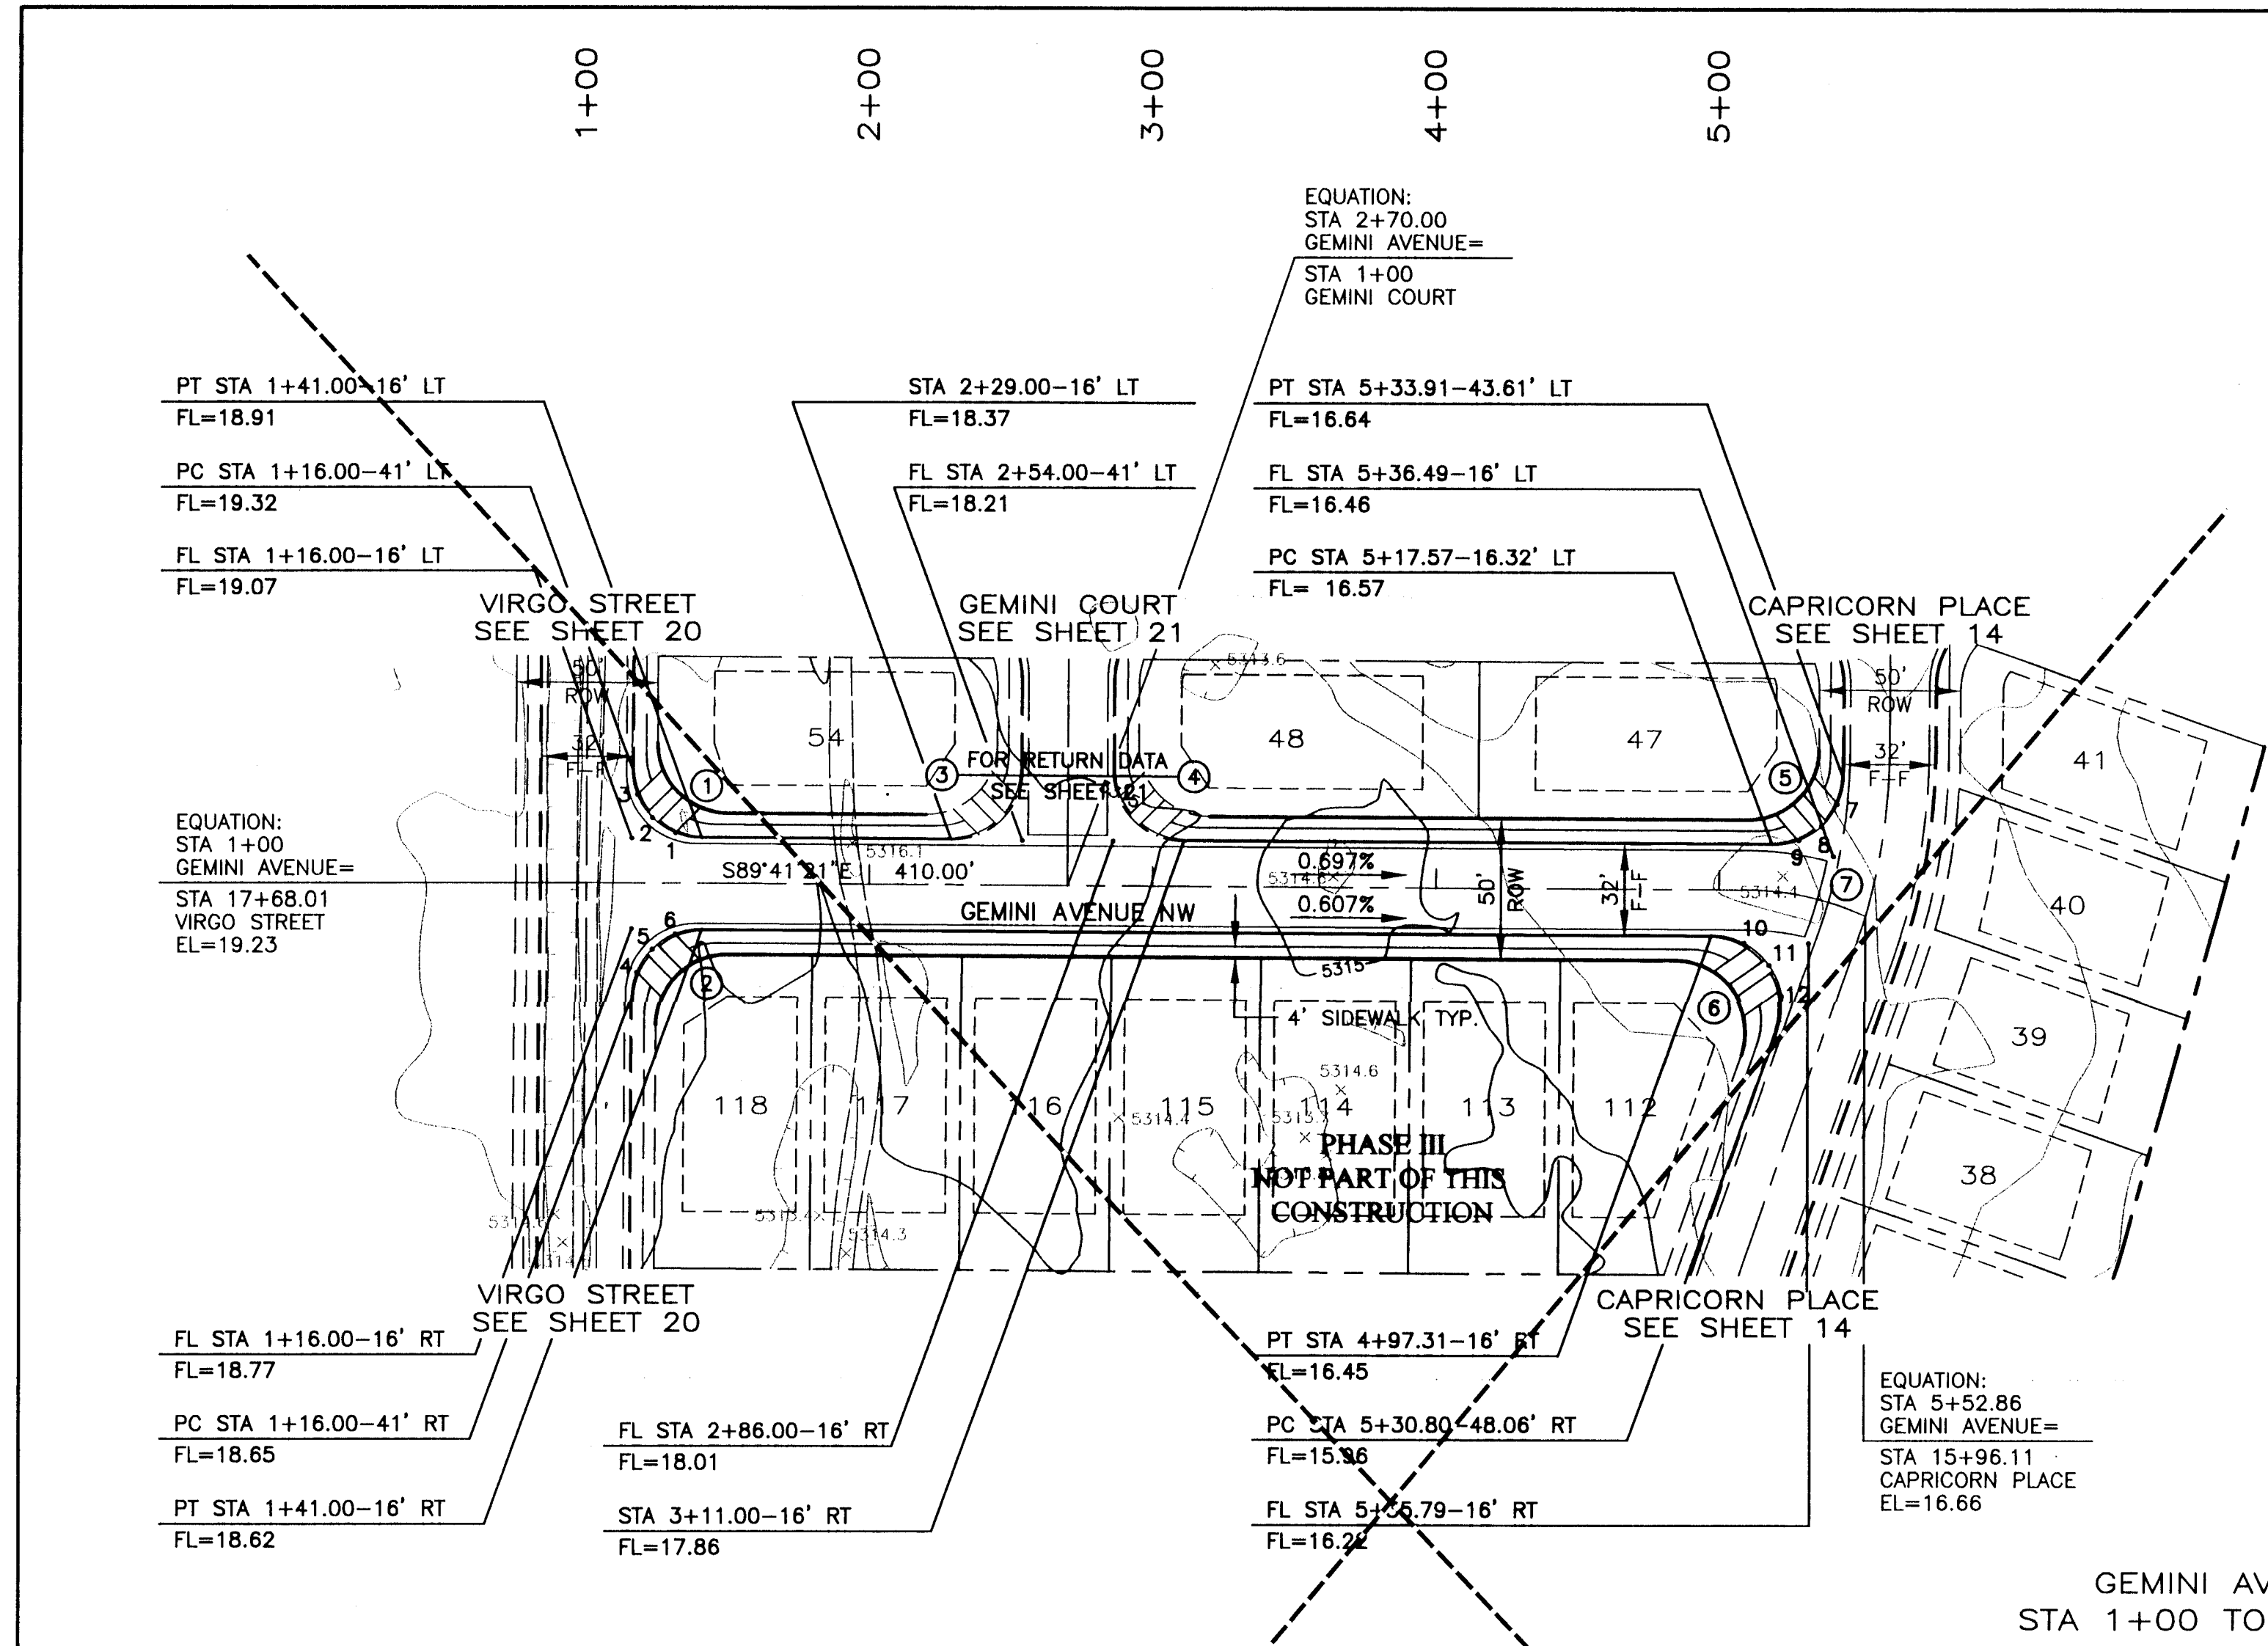

CURVE DATA (DESCRIBES FACE OF CURB)

CURVE #	RADIUS	DELTA	LENGTH	TANGENT
1	25.00	90-00-01	39.27	25.00
2	25.00	90-00-01	39.27	25.00
3	SEE SHEET 21	CURVE 1		
4	SEE SHEET 21	CURVE 2		
5	25.00	86-57-07	37.94	23.70
6	25.00	109-05-28	47.60	35.11


CL ROAD CURVE DATA

CURVE #	RADIUS	DELTA	LENGTH	TANGENT
7	102.96	23-51-04	42.86	21.74


CURB RETURN QUARTER POINTS

①	FL	ELEV	②	FL	ELEV
1	19.30		4	18.57	
2	19.42		5	18.57	
3	19.53		6	18.58	
⑤	FL	ELEV	⑥	FL	ELEV
7	1.00		10	1.00	
8	1.00		11	1.00	
9	1.00		12	1.00	

- NOTES:
1. ALL WHEEL CHAIR RAMPS ARE TO BE TYPE 2 PER CITY STD. DWG 2441.
 2. NO CROWN

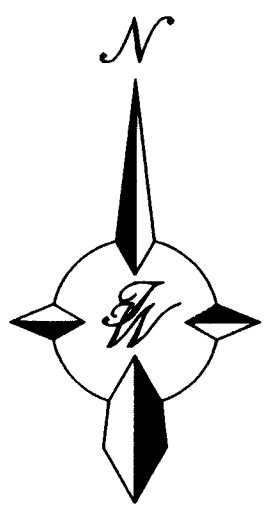

SCALE: HORIZ. 1"=50'
VERT. 1"= 5'

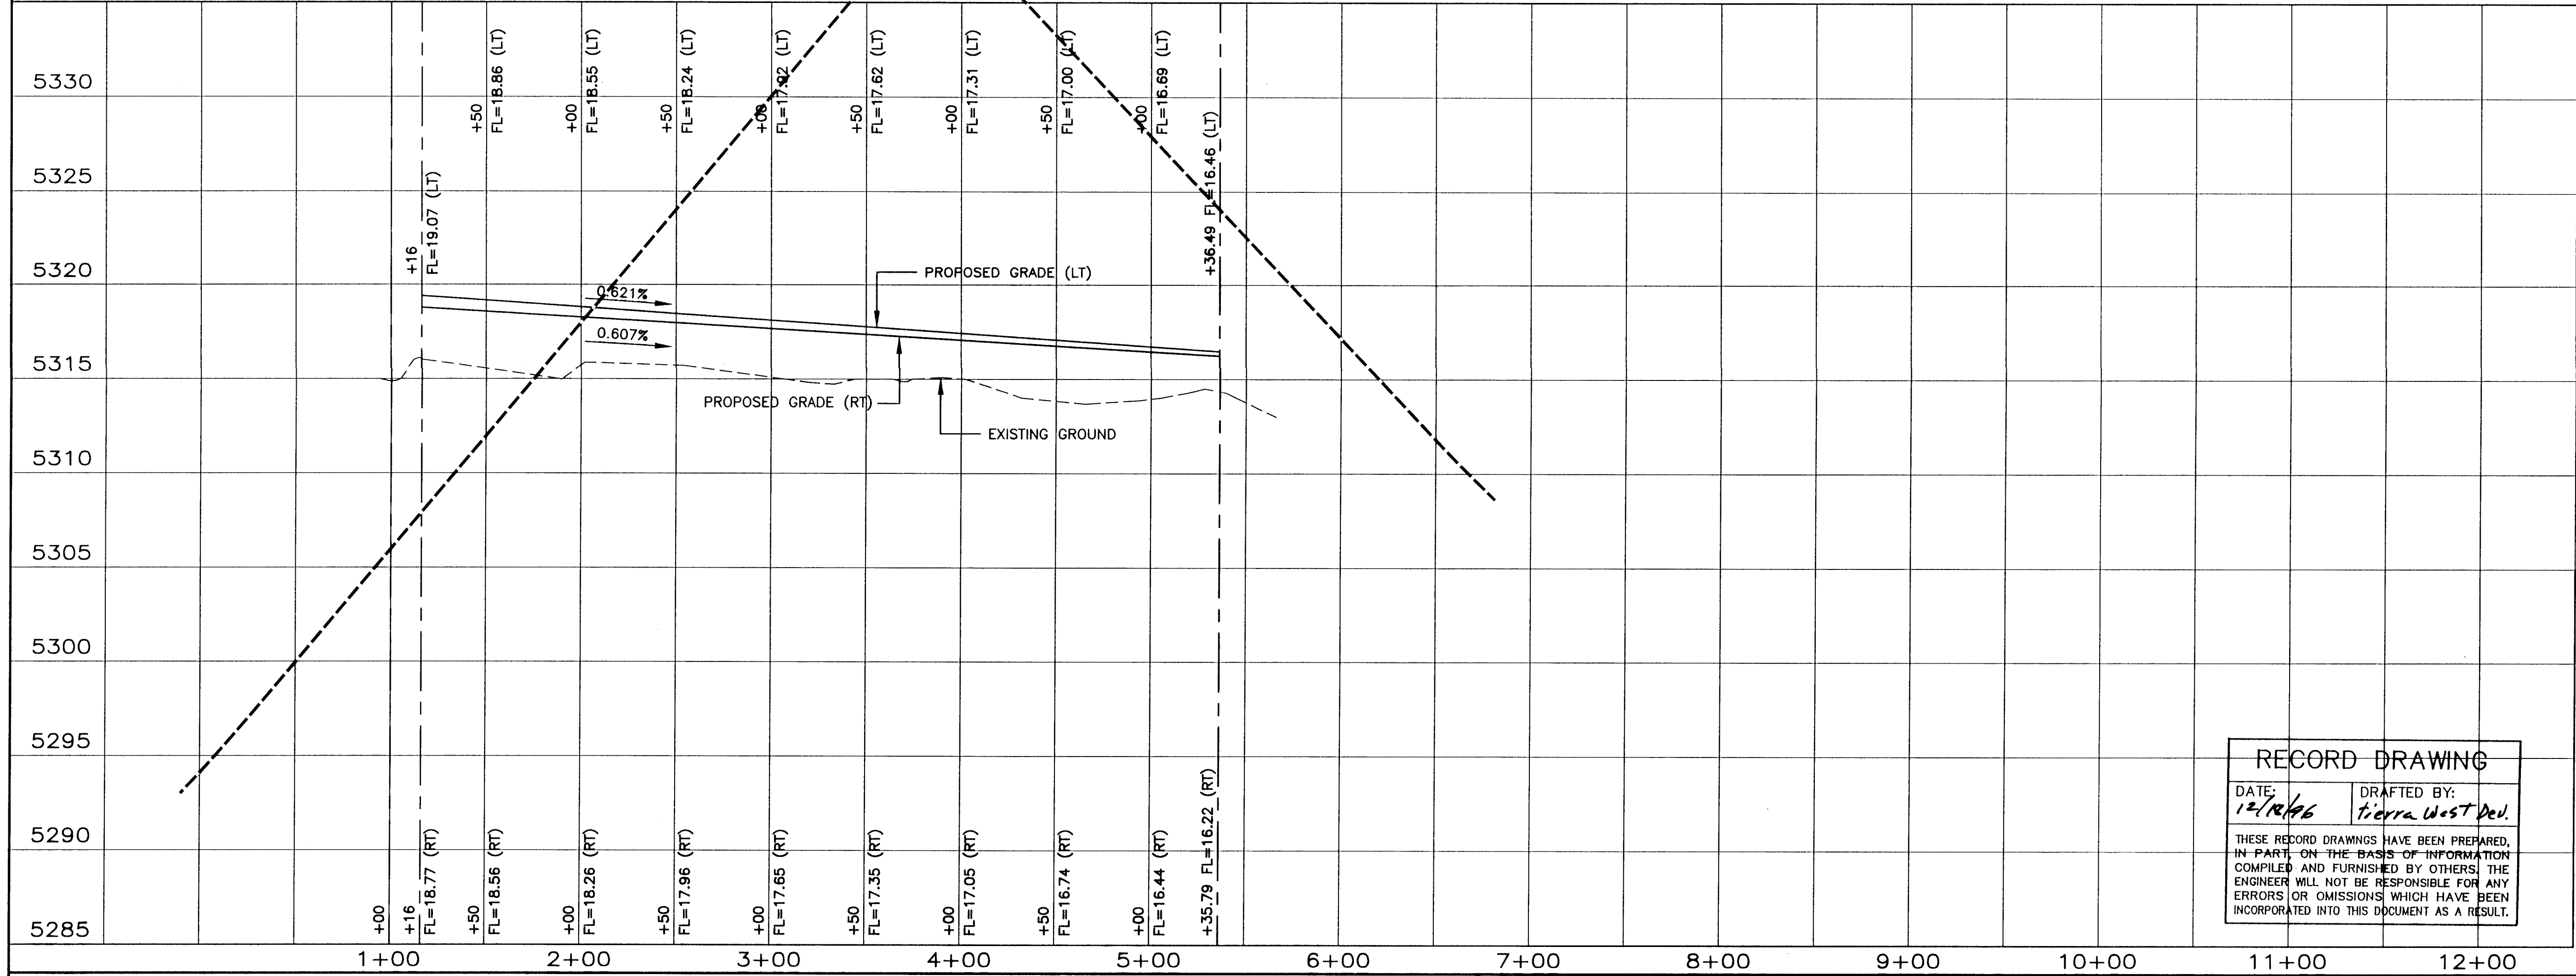

RECORD DRAWING

DATE: 12/10/06 DRAFTED BY: Tierra West Dev.
THESE RECORD DRAWINGS HAVE BEEN PREPARED, IN PART, ON THE BASIS OF INFORMATION COMPILED AND FURNISHED BY OTHERS. THE ENGINEER WILL NOT BE RESPONSIBLE FOR ANY ERRORS OR OMISSIONS WHICH HAVE BEEN INCORPORATED INTO THIS DOCUMENT AS A RESULT.


13+00				14+00			
TIERRA WEST DEVELOPMENT MANAGEMENT SERVICES 4421 McLEOD ROAD, N.E., SUITE D ALBUQUERQUE, NEW MEXICO 87109 (505)883-7582							
CITY OF ALBUQUERQUE PUBLIC WORKS DEPARTMENT ENGINEERING GROUP							
TITLE: PARADISE SKIES PAVING IMPROVEMENTS GEMINI AVENUE STA 1+00 TO 5+52.86							
APPROVALS	ENGINEER	DATE	APPROVALS	ENGINEER	DATE		
TRANSPORTATION	DR. J. J. J. 11-15-95		WATER	N/A RWK	10-17-95		
HYDROLOGY	N/A LAM 10-25-95		WASTE WATER	N/A RWK	10-17-95		
PROJECT NO. 5279.90 91		MAP NO. A-11-Z		SHEET 18		OF 43	

50\930064\GEM.DWG\BDG\9-13-95

SCANNED BY LASON

26-5279.91 1897

PHASE II

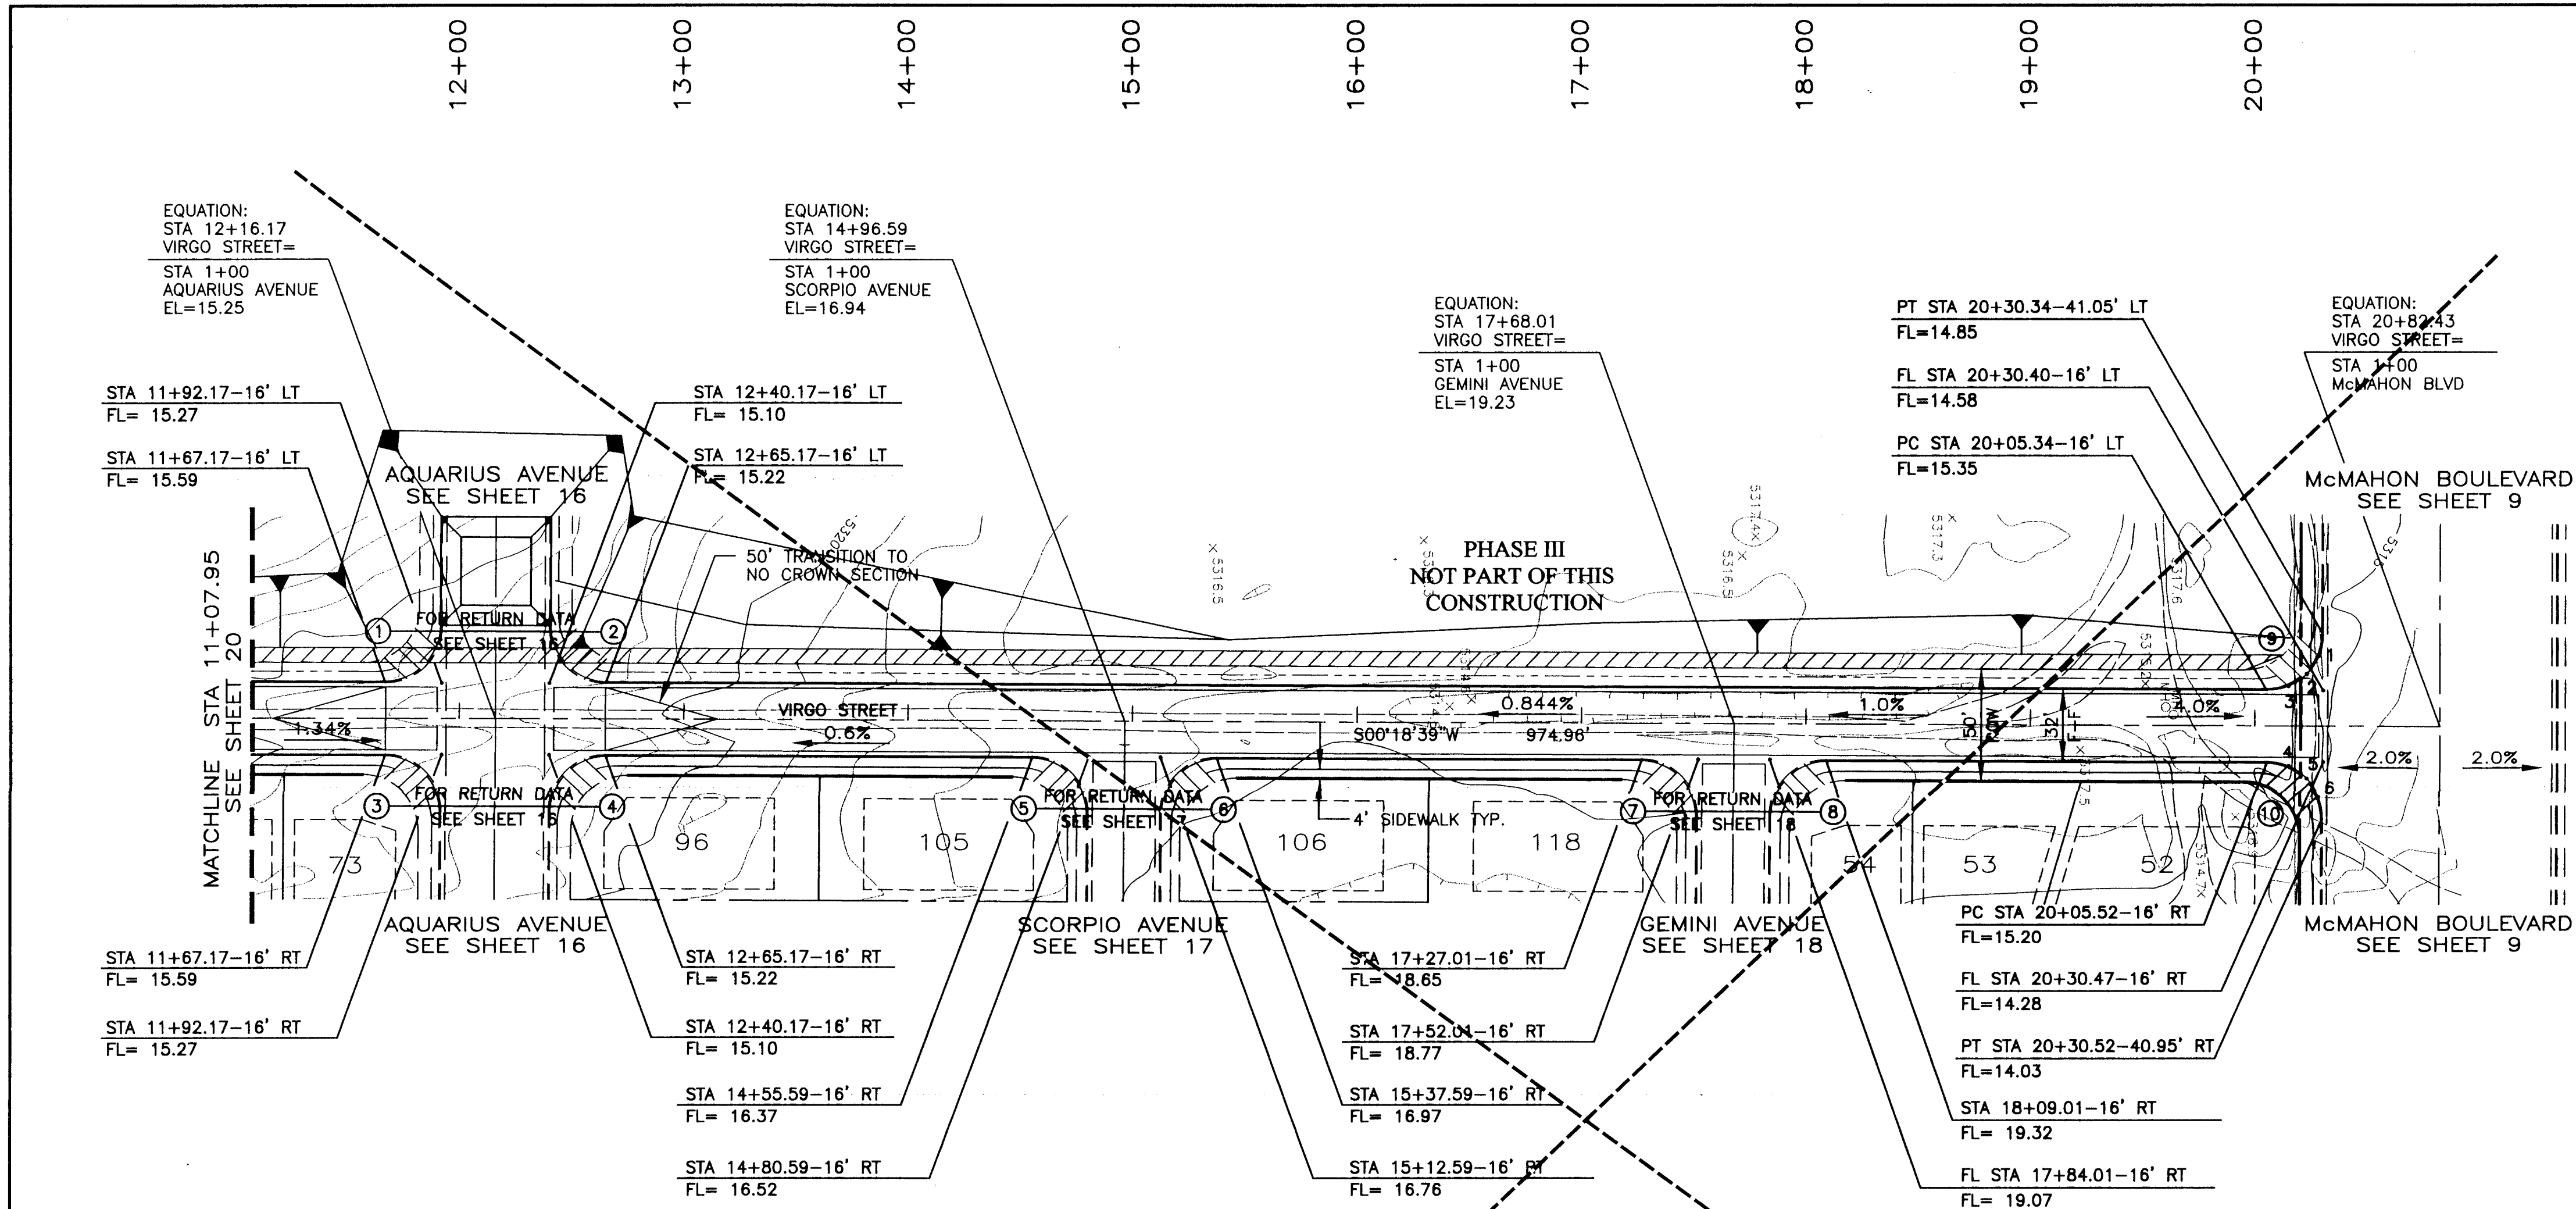


CURVE DATA (DESCRIBES FACE OF CURB)

CURVE #	RADIUS	DELTA	LENGTH	TANGENT
1	SEE SHEET 16	CURVE 2		
2	SEE SHEET 16	CURVE 1		
3	SEE SHEET 16	CURVE 4		
4	SEE SHEET 16	CURVE 3		
5	SEE SHEET 17	CURVE 2		
6	SEE SHEET 17	CURVE 1		
7	SEE SHEET 18	CURVE 2		
8	SEE SHEET 18	CURVE 1		
9	25.00	90-06-53	39.32	25.05
10	25.00	89-53-08	39.22	24.95


CURB RETURN QUARTER POINTS

FL	ELEV	FL	ELEV
1	14.98	4	14.91
2	15.10	5	14.62
3	15.23	6	14.32

NOTES:
ALL WHEEL CHAIR RAMPS ARE TO BE TYPE 2 PER CITY STD. DWG 2441

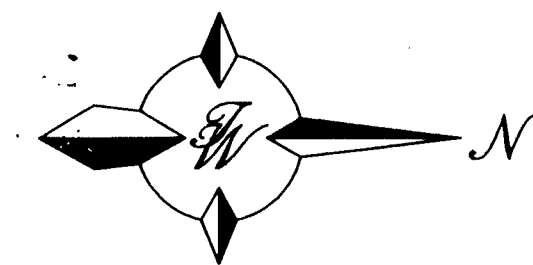

SCALE: HORIZ. 1"=50'
VERT. 1"= 5'

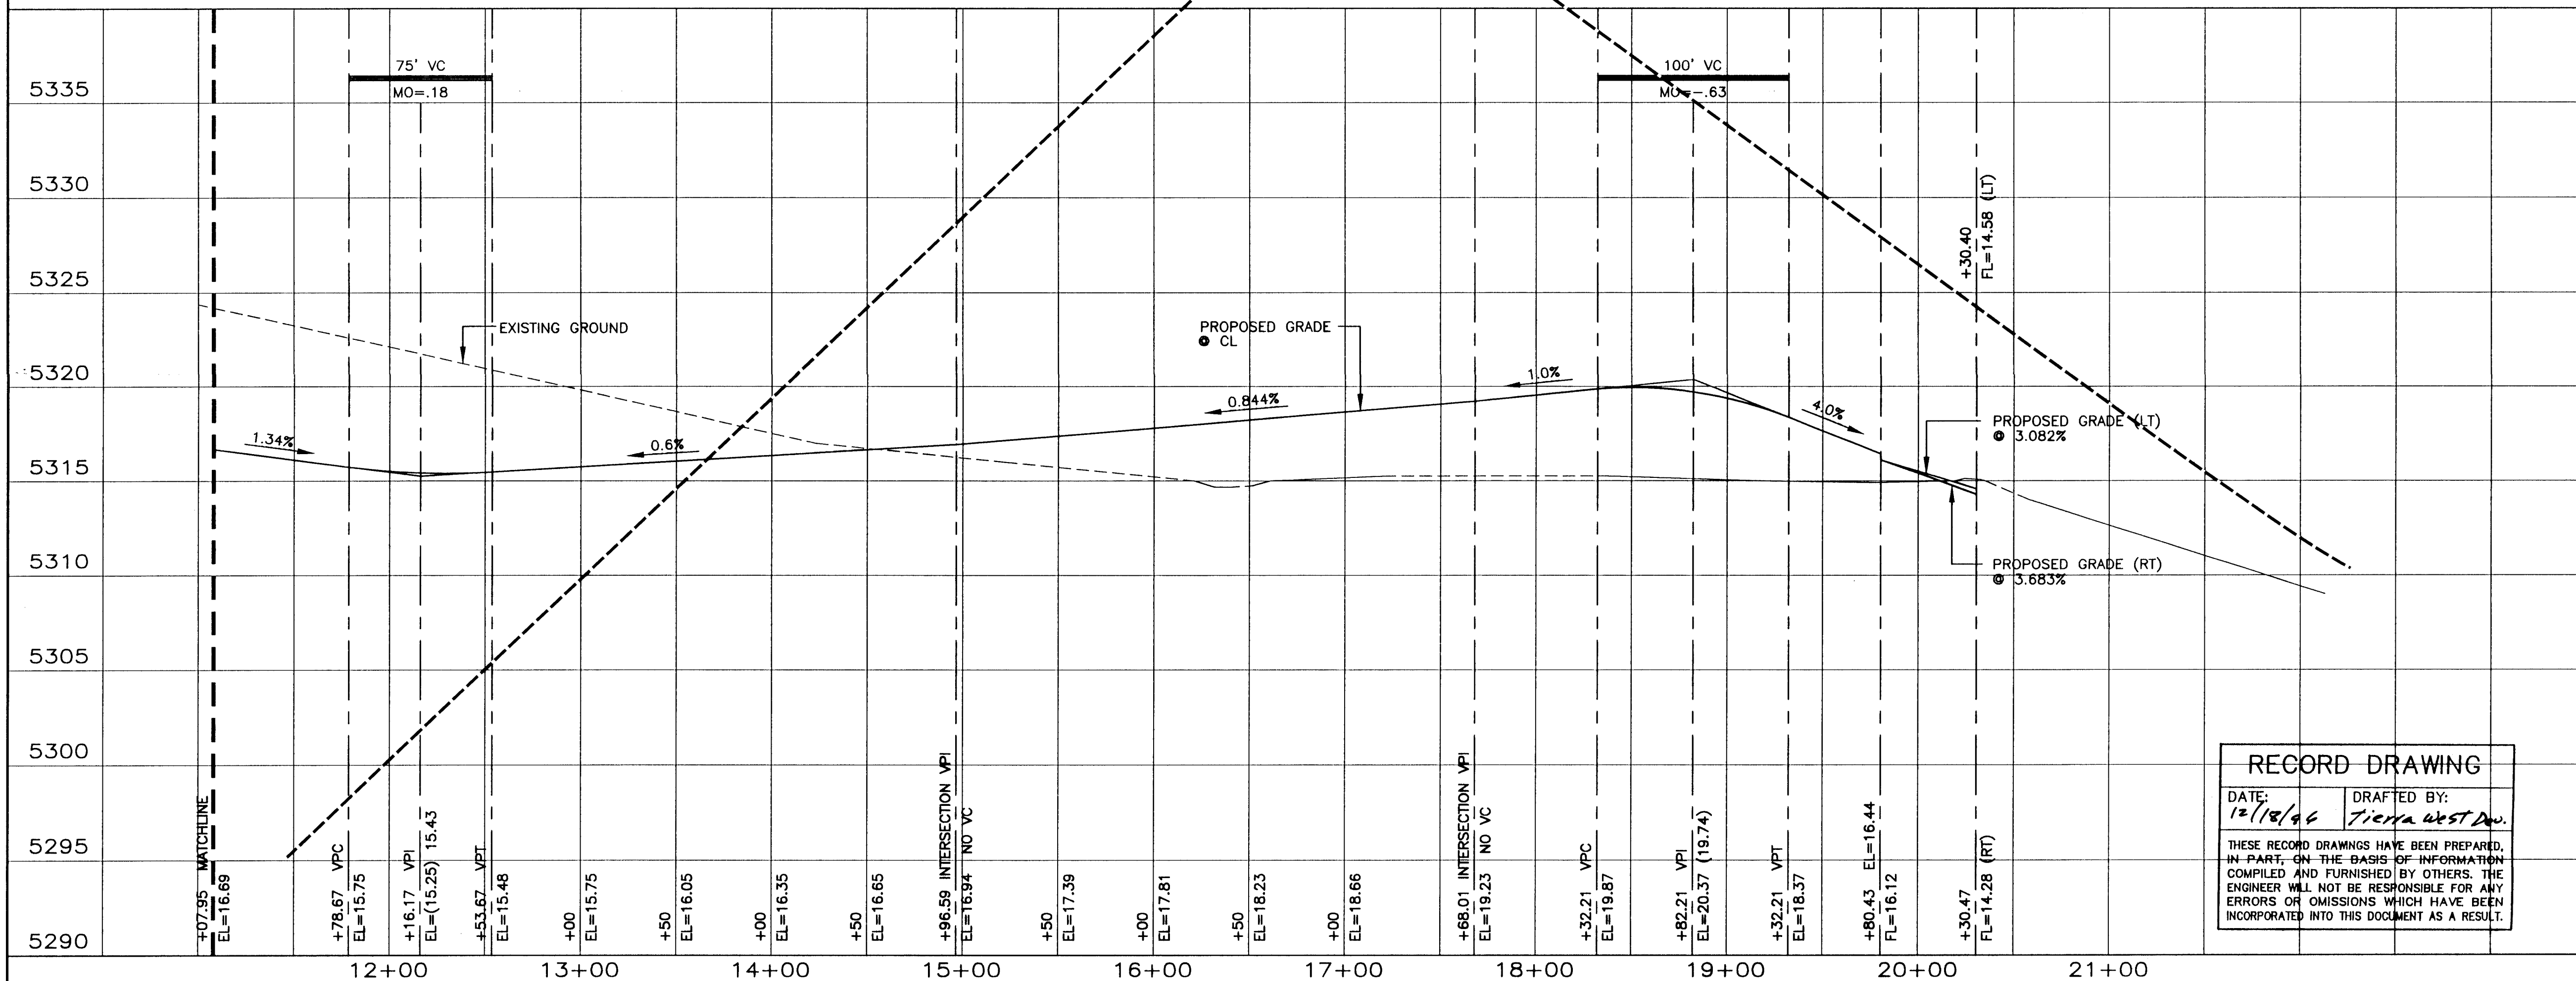





RECORD DRAWING
DATE: 12/18/96
DRAFTED BY: Tierra West Dev.
THESE RECORD DRAWINGS HAVE BEEN PREPARED, IN PART, ON THE BASIS OF INFORMATION COMPILED AND FURNISHED BY OTHERS. THE ENGINEER WILL NOT BE RESPONSIBLE FOR ANY ERRORS OR OMISSIONS WHICH HAVE BEEN INCORPORATED INTO THIS DOCUMENT AS A RESULT.

TIERRA WEST DEVELOPMENT MANAGEMENT SERVICES 4421 McLEOD ROAD, N.E., SUITE D ALBUQUERQUE, NEW MEXICO 87109 (505)883-7592			
CITY OF ALBUQUERQUE PUBLIC WORKS DEPARTMENT ENGINEERING GROUP			
TITLE: PARADISE SKIES PAVING IMPROVEMENTS VIRGO STREET STA 11+07.95 TO 20+82.43			
APPROVALS	ENGINEER	DATE	APPROVALS
DRC CHAIRMAN	12/18/96	11-5-95	WATER
TRANSPORTATION	12/18/96	10-20-95	WASTE WATER
HYDROLOGY	N/A	10-25-95	NMU
DESIGNED BY	RRB	DATE	7-95
DRAWN BY	PVG	DATE	7-95
CHECKED BY	RRB	DATE	7-95
PROJECT NO.	5279.95-91	MAP NO.	A-11-Z
SHEET 20		OF 43	


50\930064\930064\9-13-95
SCANNED BY LASON

26-5279.91 10/27

PHASE II

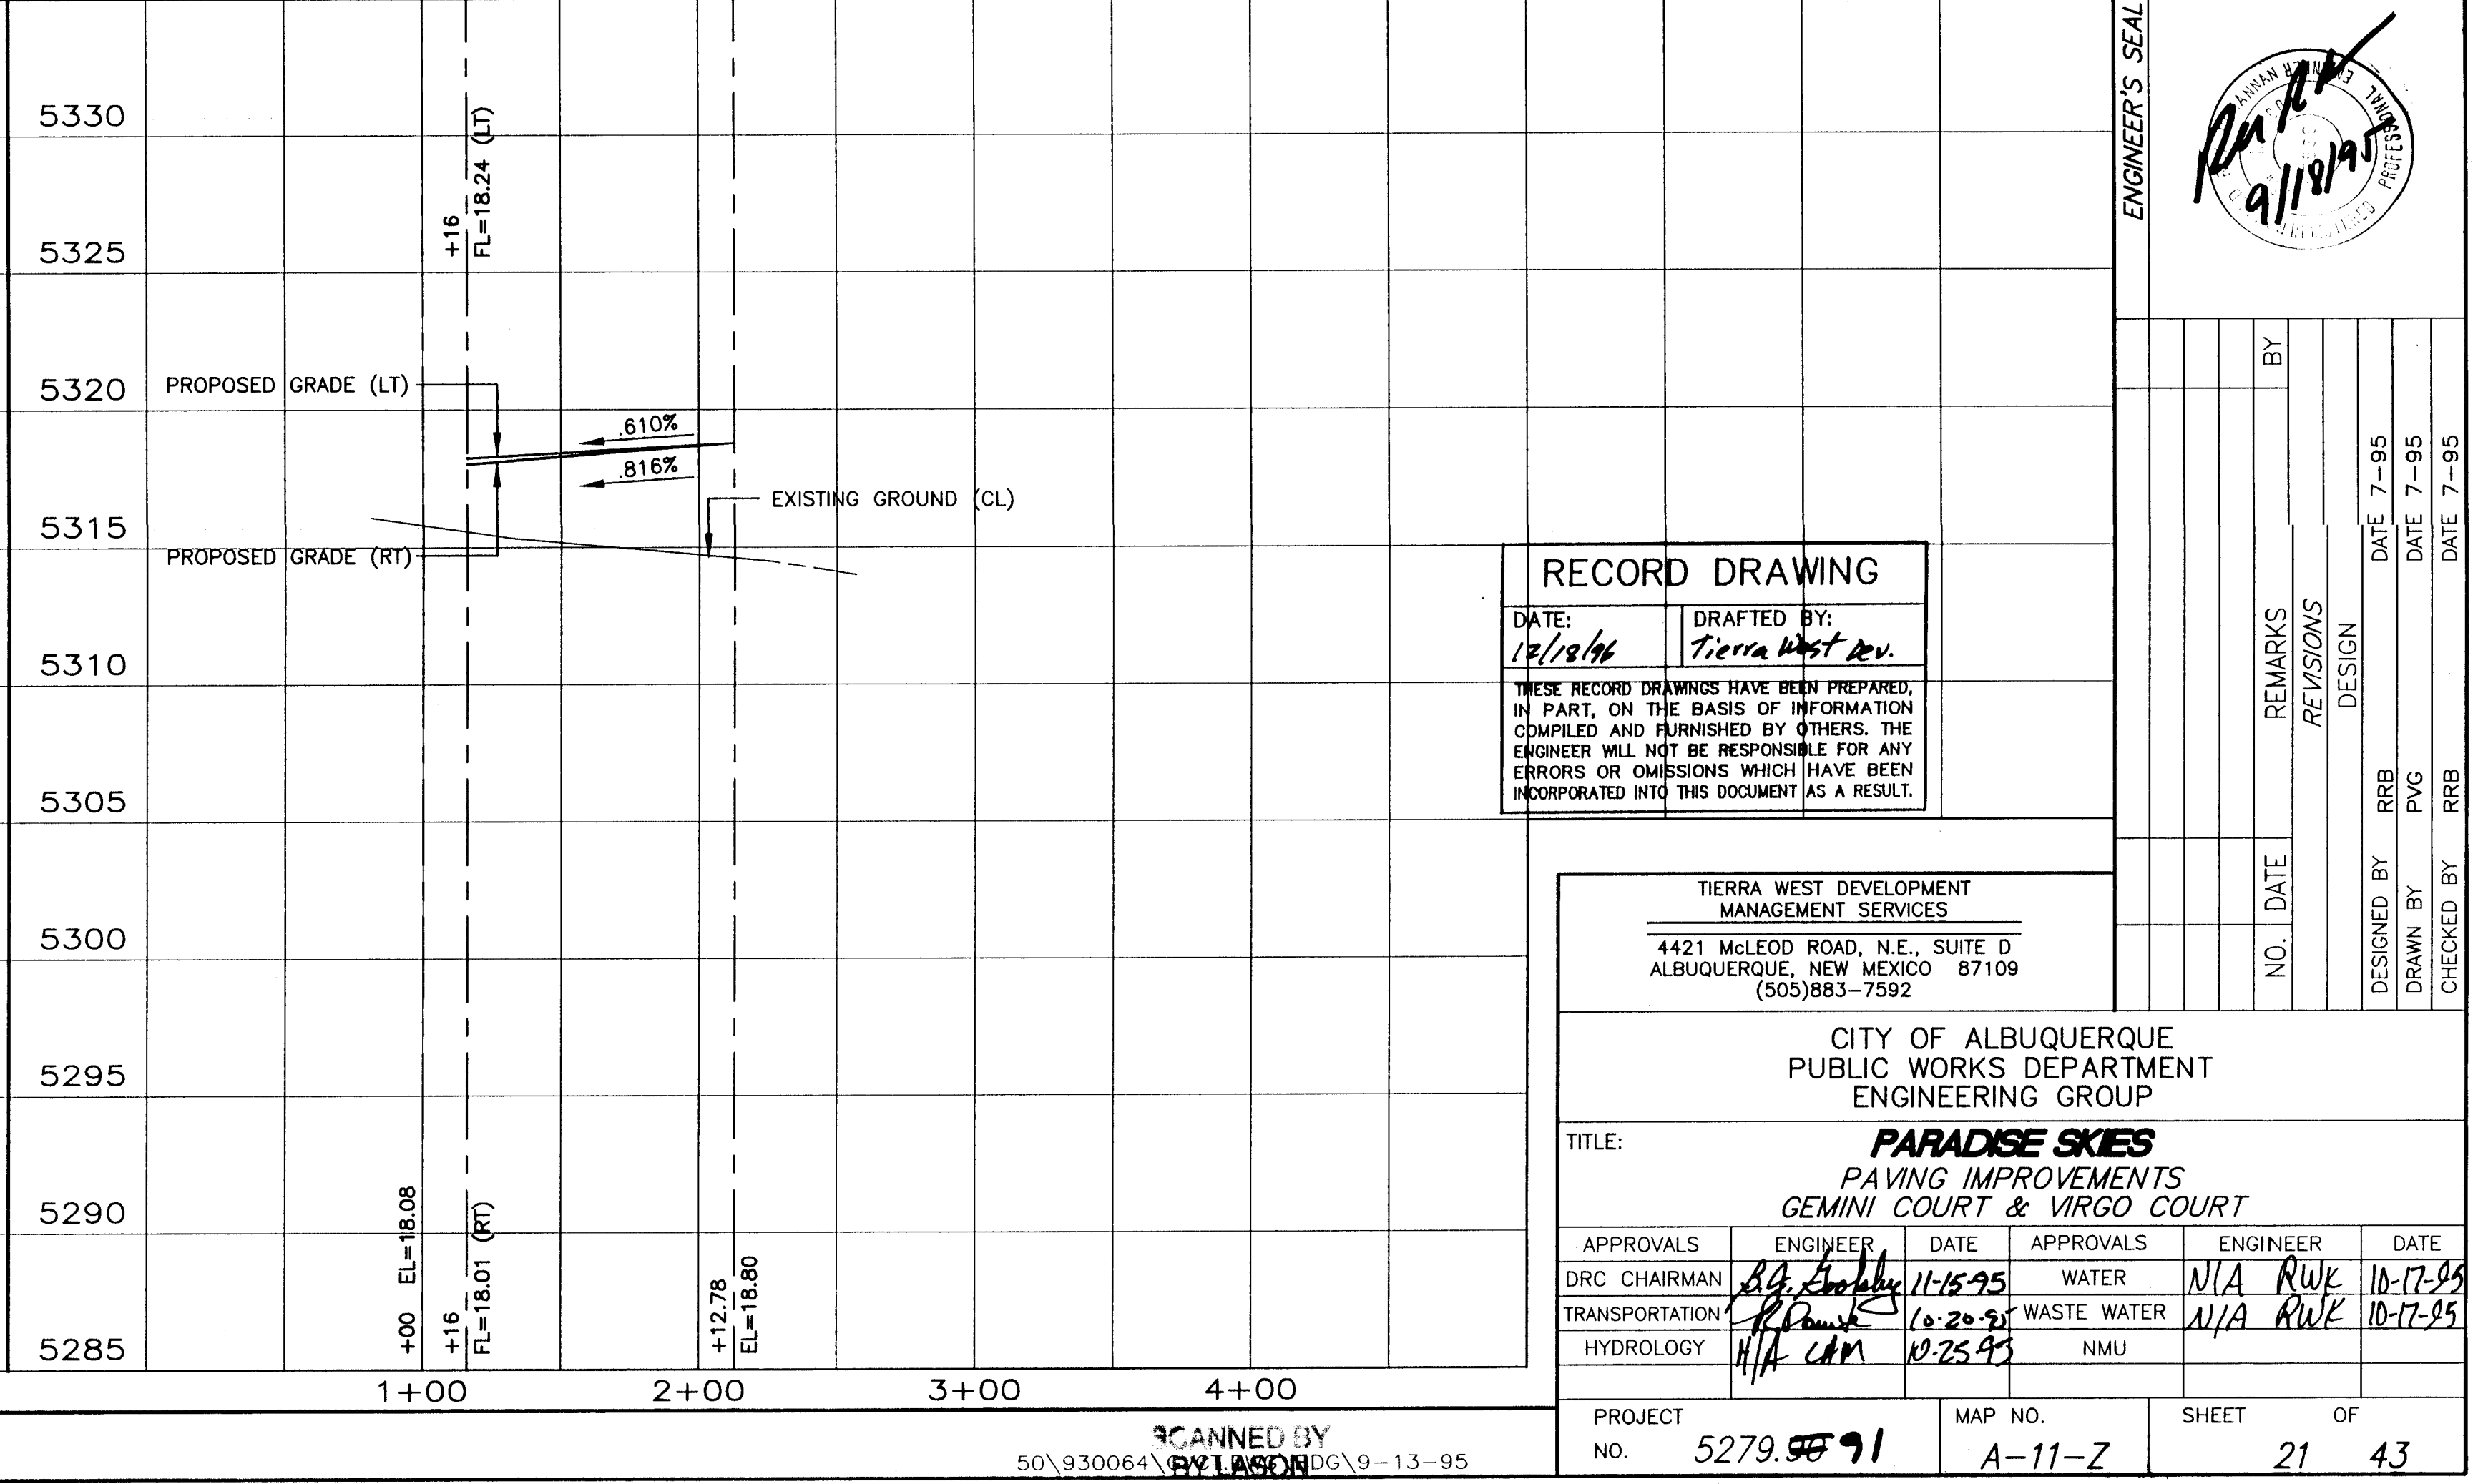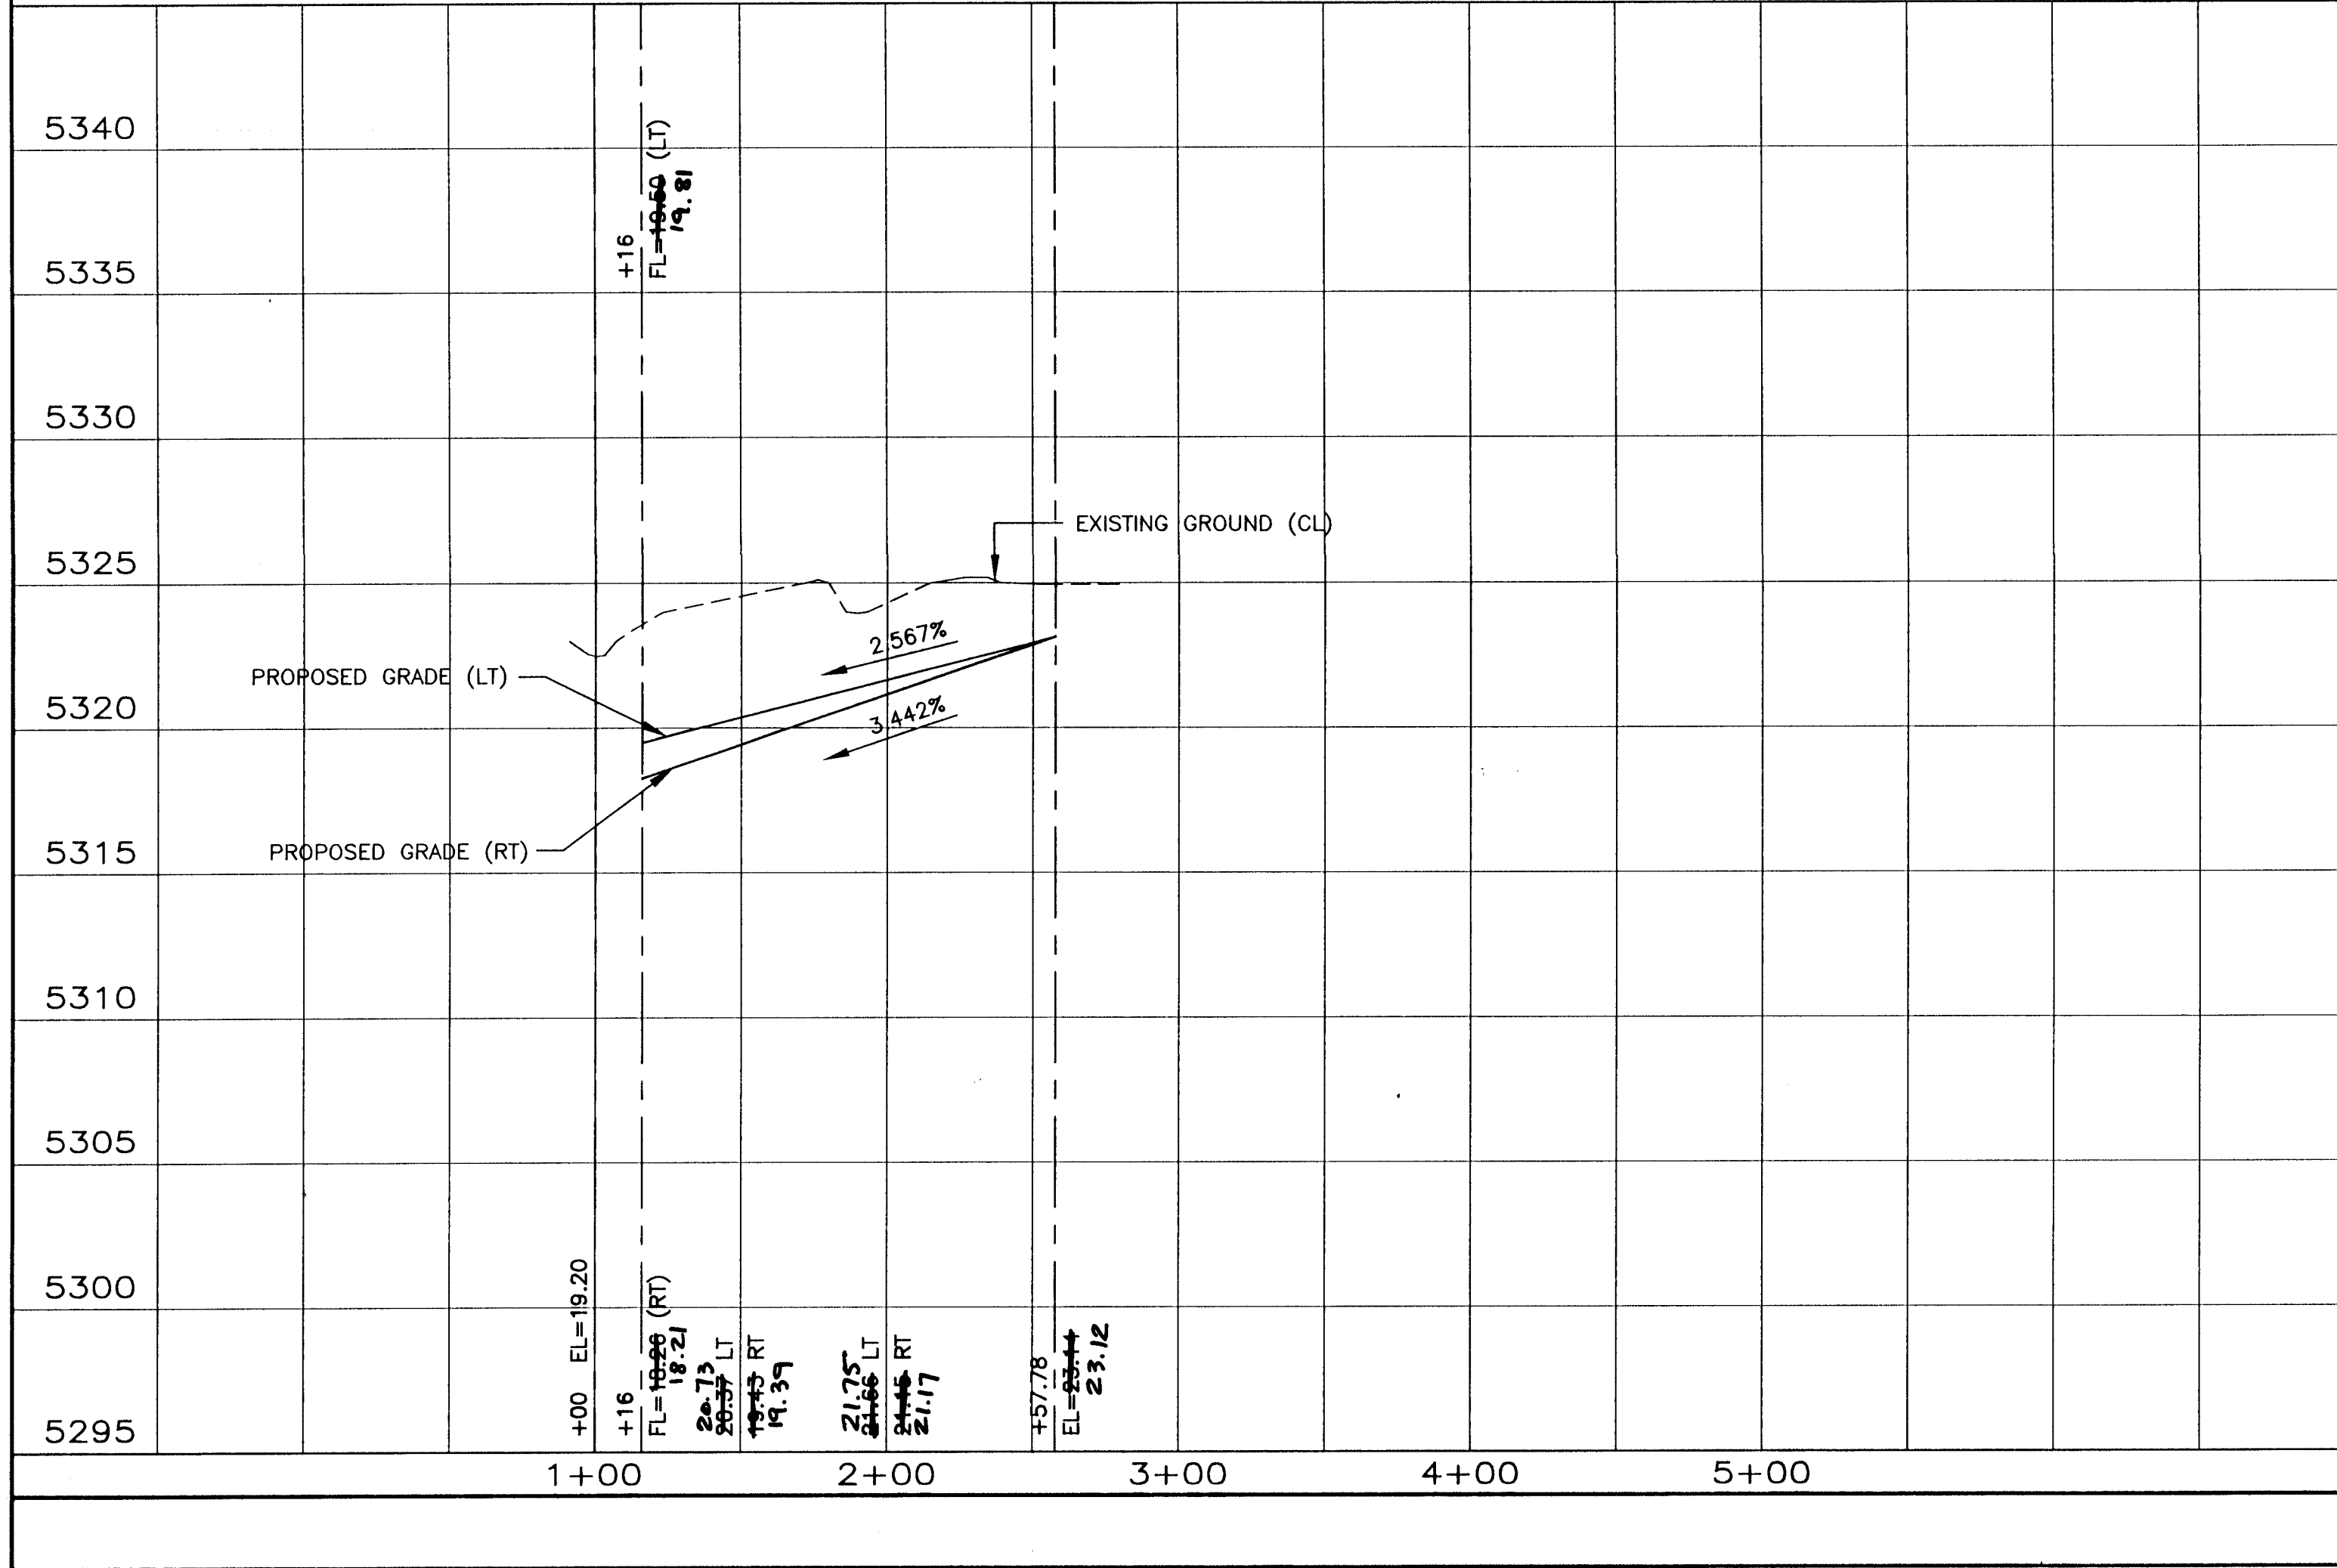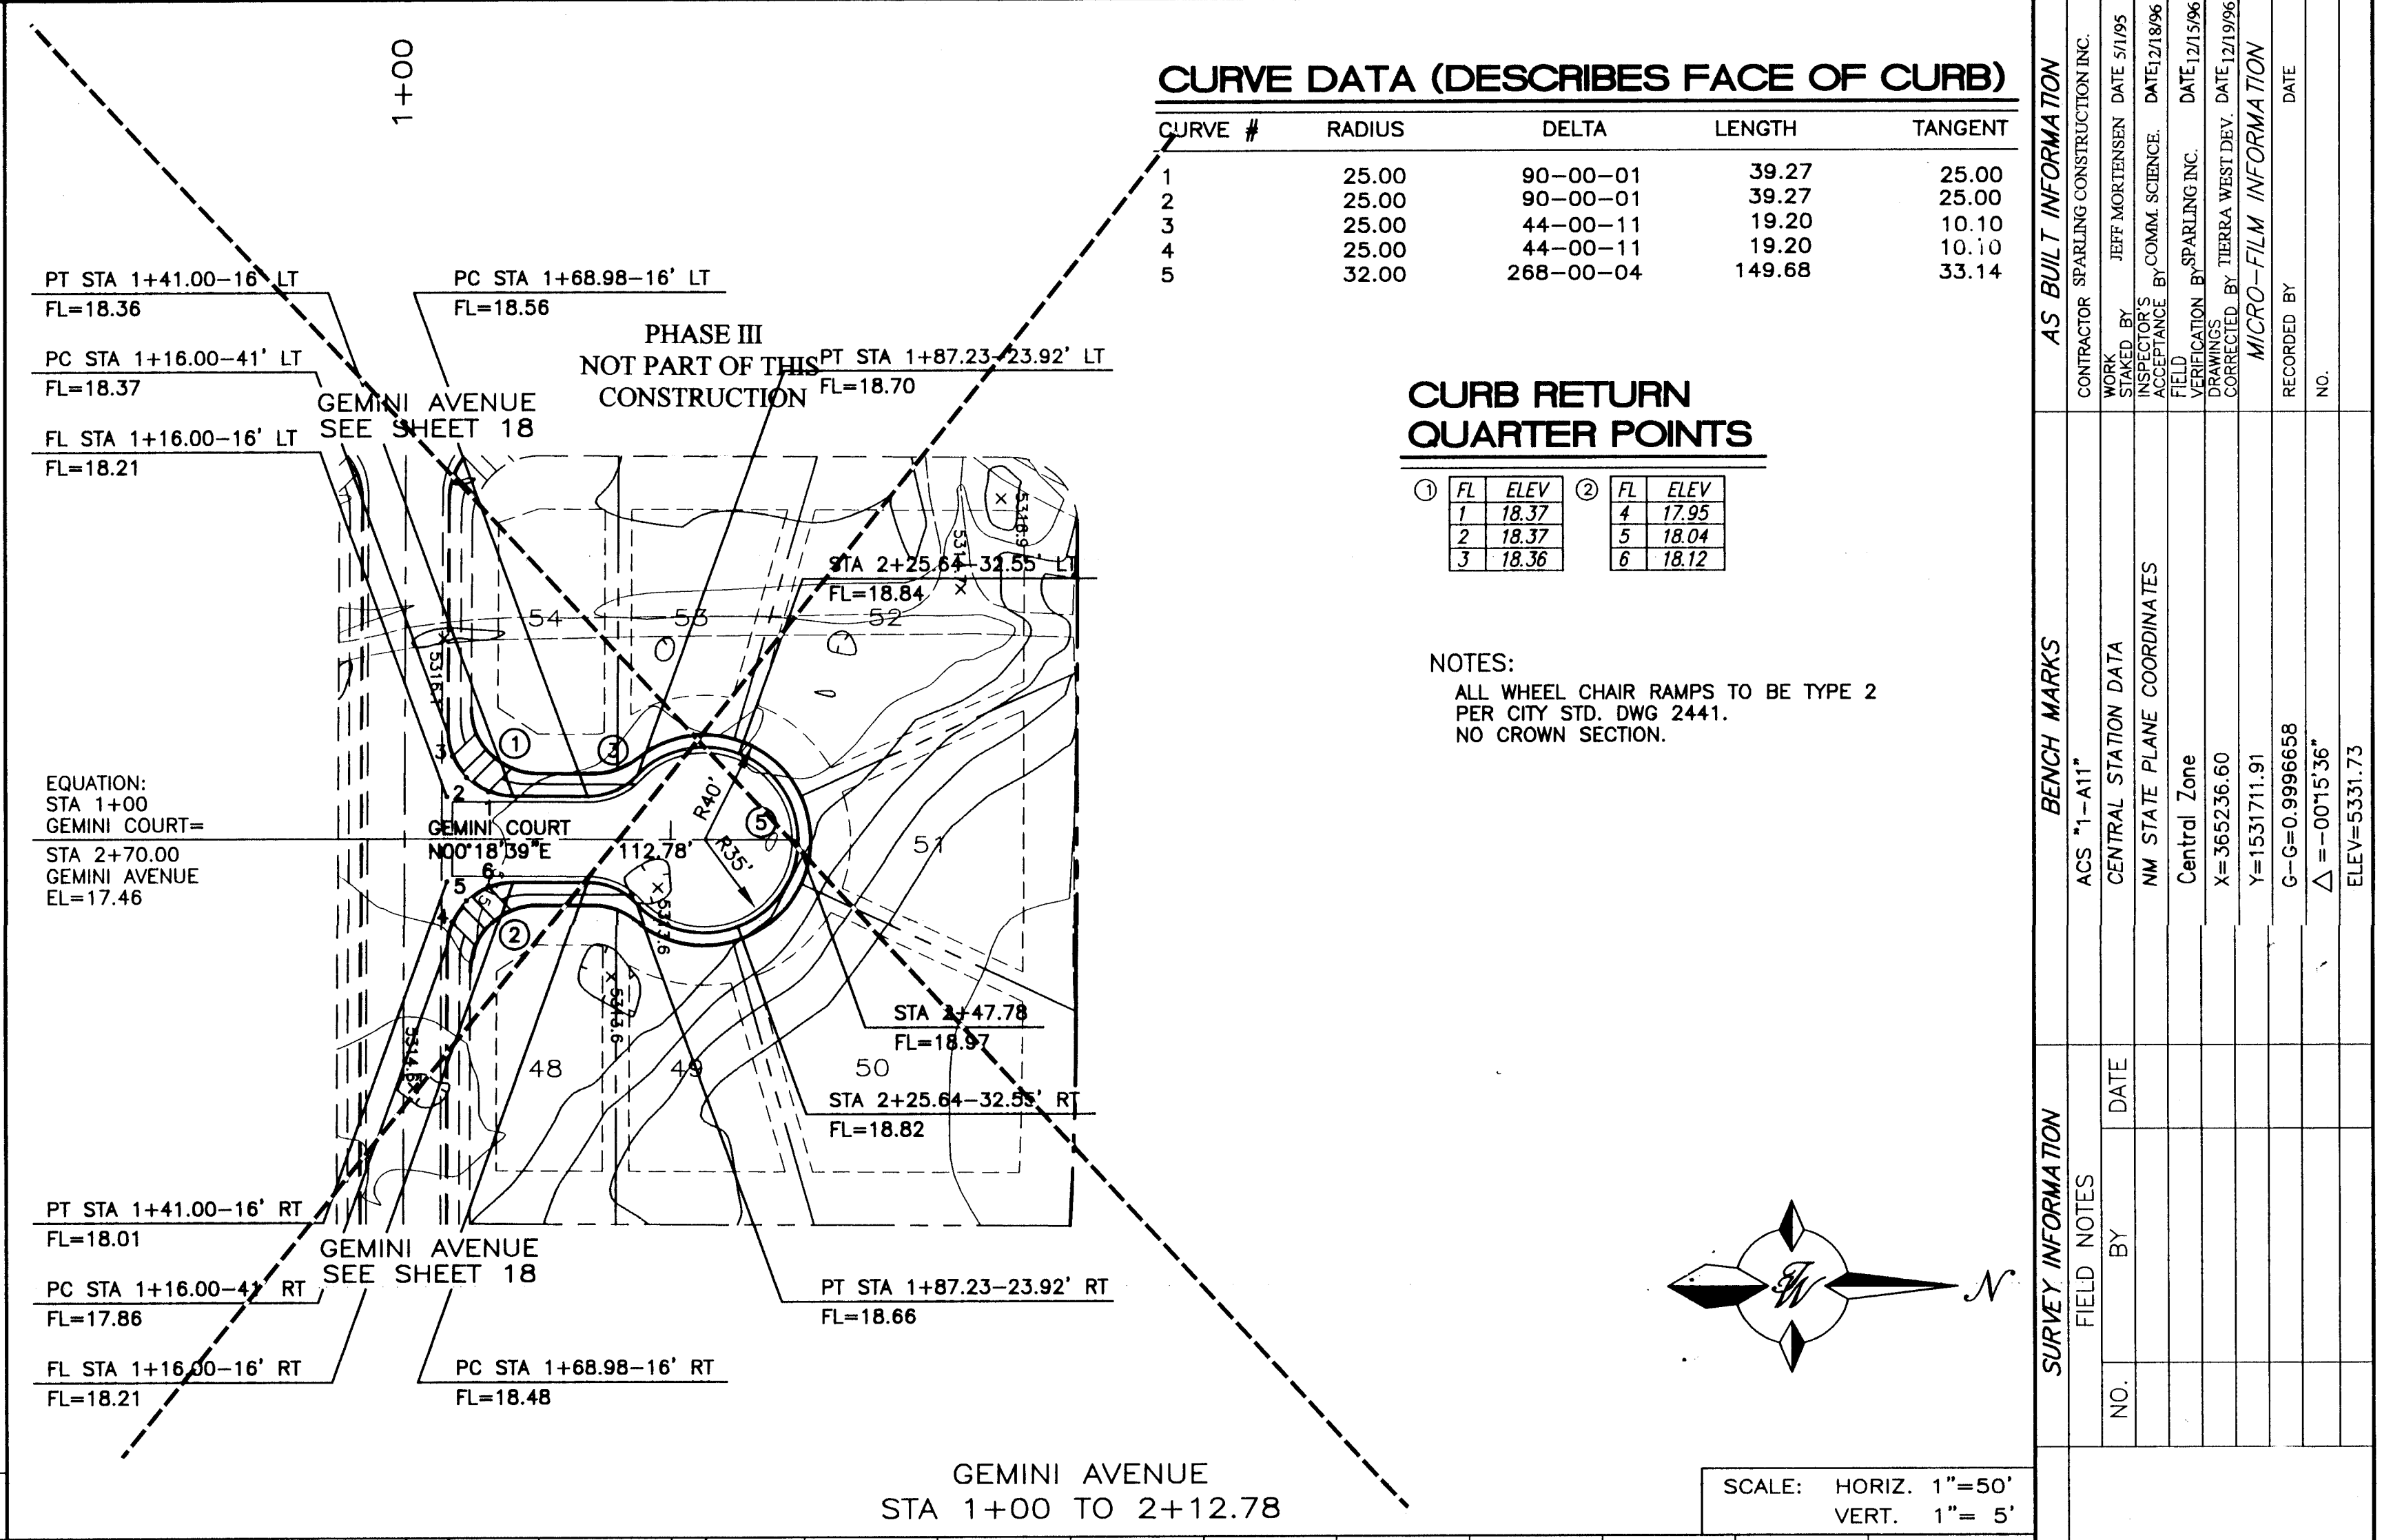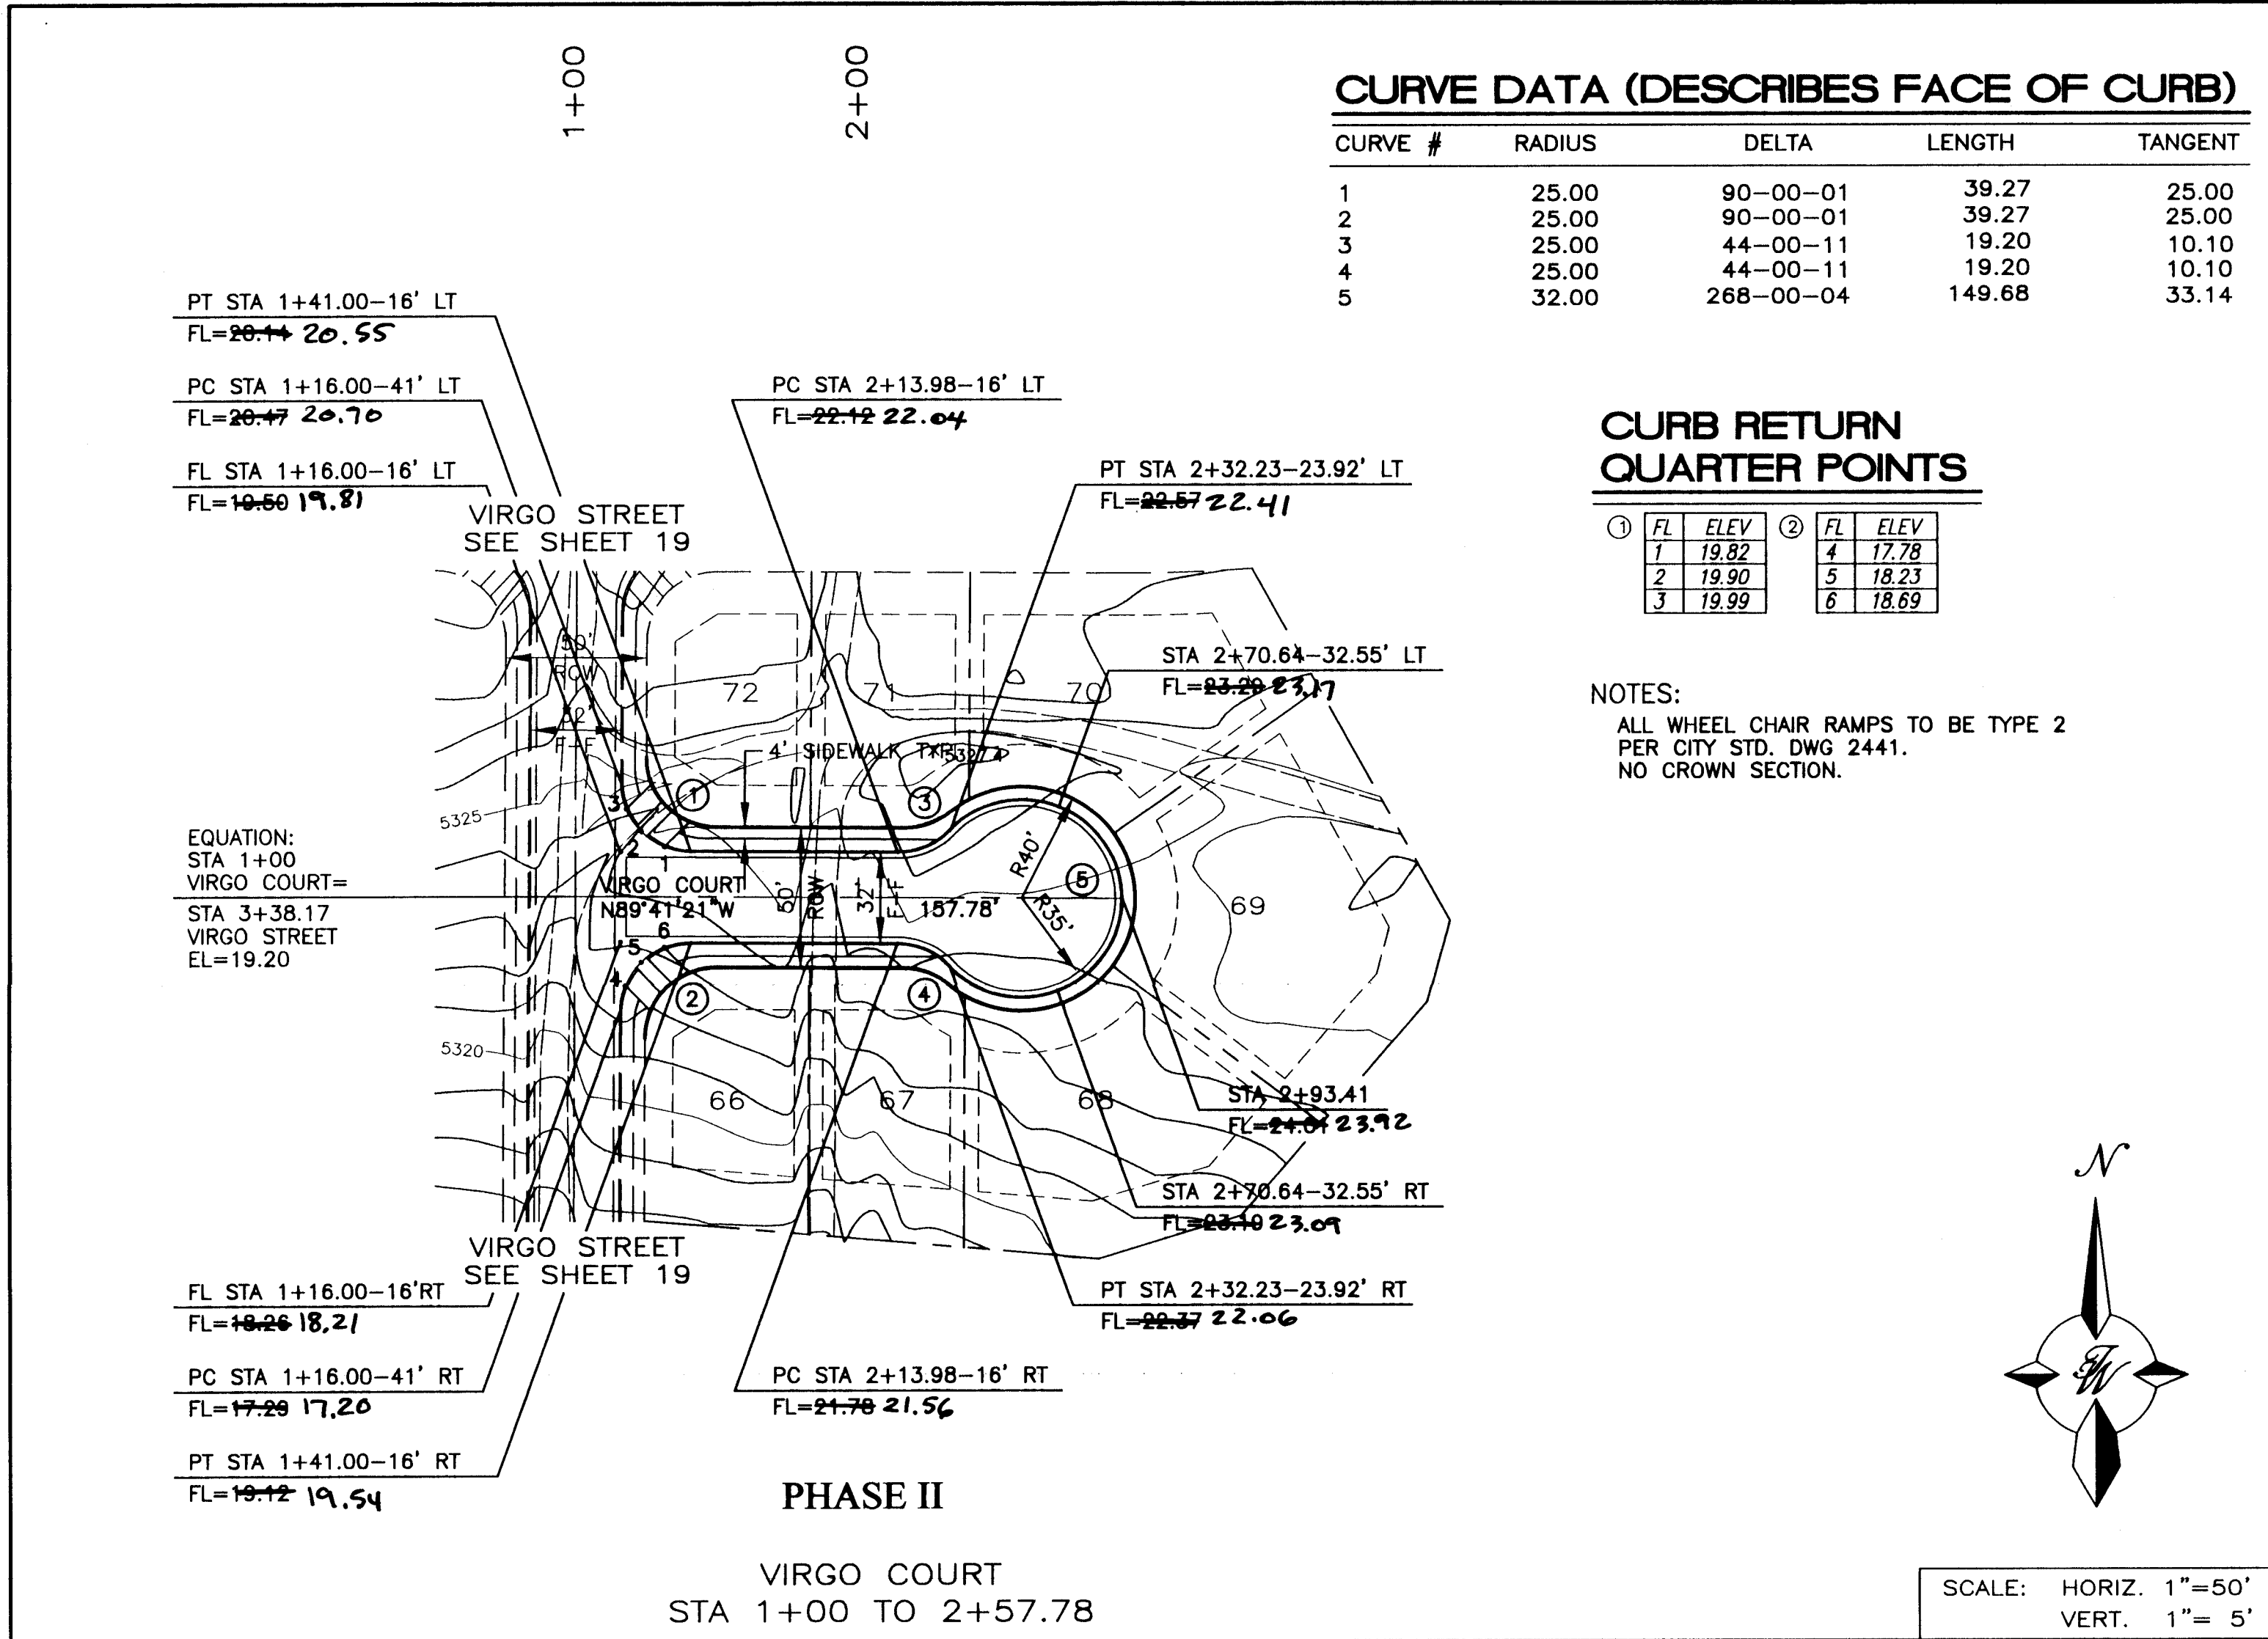



AS BUILT INFORMATION				BENCH MARKS				SURVEY INFORMATION				ENGINEER'S SEAL			
CONTRACTOR	SPARLING CONSTRUCTION INC.	WORKS BY	JEFF MORTENSEN	DATE	5/0/95	CENTRAL STATION DATA		FIELD NOTES	DATE	BY	NO.	NO.	DATE	BY	NO.
INSPECTOR'S ACCEPTANCE	DATE	12/18/96	INSPECTION BY	COMAL SCIENCE	DATE	NM STATE PLANE COORDINATES									
FIELD VERIFICATION	DATE	12/15/96	FIELD VERIFICATION	DATE	12/15/96	Central Zone									
DRAWINGS	DATE	12/15/96	DRAWINGS	DATE	12/15/96	X=365236.60									
CORRECTED BY	DATE	12/15/96	CORRECTED BY	DATE	12/15/96	Y=1531711.91									
MICRO-FILM INFORMATION			MICRO-FILM INFORMATION			G-G=0.9996658									
RECORDED BY			RECORDED BY			Δ=-0.015'36"									
NO.			NO.			ELEV=5331.73									

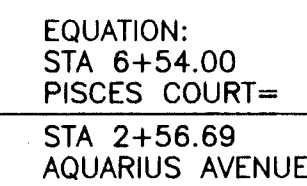


(2)	<table><tr><th>FL</th><th>ELEV</th></tr><tr><td>1</td><td>19.78</td></tr><tr><td>2</td><td>19.91</td></tr><tr><td>3</td><td>20.03</td></tr></table>	FL	ELEV	1	19.78	2	19.91	3	20.03	(3)	<table><tr><th>FL</th><th>ELEV</th></tr><tr><td>4</td><td>20.03</td></tr><tr><td>5</td><td>19.91</td></tr><tr><td>6</td><td>19.78</td></tr></table>	FL	ELEV	4	20.03	5	19.91	6	19.78
FL	ELEV																		
1	19.78																		
2	19.91																		
3	20.03																		
FL	ELEV																		
4	20.03																		
5	19.91																		
6	19.78																		
(4)	<table><tr><th>FL</th><th>ELEV</th></tr><tr><td>7</td><td>14.26</td></tr><tr><td>8</td><td>14.22</td></tr><tr><td>9</td><td>14.18</td></tr></table>	FL	ELEV	7	14.26	8	14.22	9	14.18	(5)	<table><tr><th>FL</th><th>ELEV</th></tr><tr><td>10</td><td>13.90</td></tr><tr><td>11</td><td>13.76</td></tr><tr><td>12</td><td>13.63</td></tr></table>	FL	ELEV	10	13.90	11	13.76	12	13.63
FL	ELEV																		
7	14.26																		
8	14.22																		
9	14.18																		
FL	ELEV																		
10	13.90																		
11	13.76																		
12	13.63																		

SURVEY INFORMATION			BENCH MARKS		AS BUILT INFORMATION	
FIELD NOTES						
NO.	BY	DATE	ACS "1-A11"		CONTRACTOR SPARLING CONSTRUCTION INC.	
			CENTRAL STATION DATA		WORK ORDER BY: JEFF MORTENSEN DATE 5/1/05	
			NM STATE PLANE COORDINATES		INSPECTOR'S ACCEPTANCE BY: COMM. SCHOEN DATE 2/18/06	
			Central Zone		FIELD REPLICATION BY: SPARLING INC. DATE 12/15/06	
			X = 365236.60		DRAWINGS CORRECTED BY: TERRA WEST DBV DATE 12/19/06	
			Y = 1531711.91		MICRO-FILM INFORMATION	
			G = 0.9996658		RECORDED BY: DATE	
			$\Delta = -0015'36"$		NO.	
			ELEV = 5331.73			

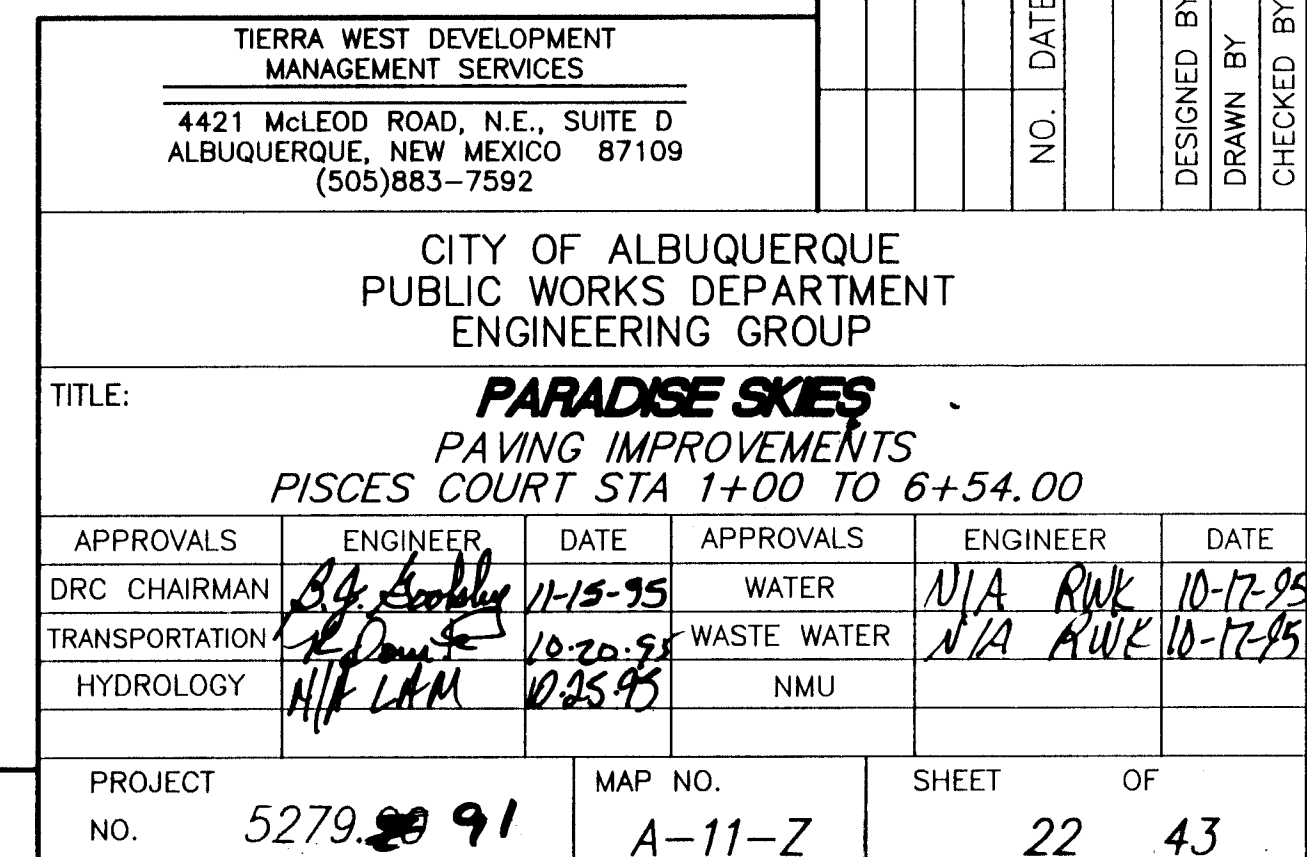

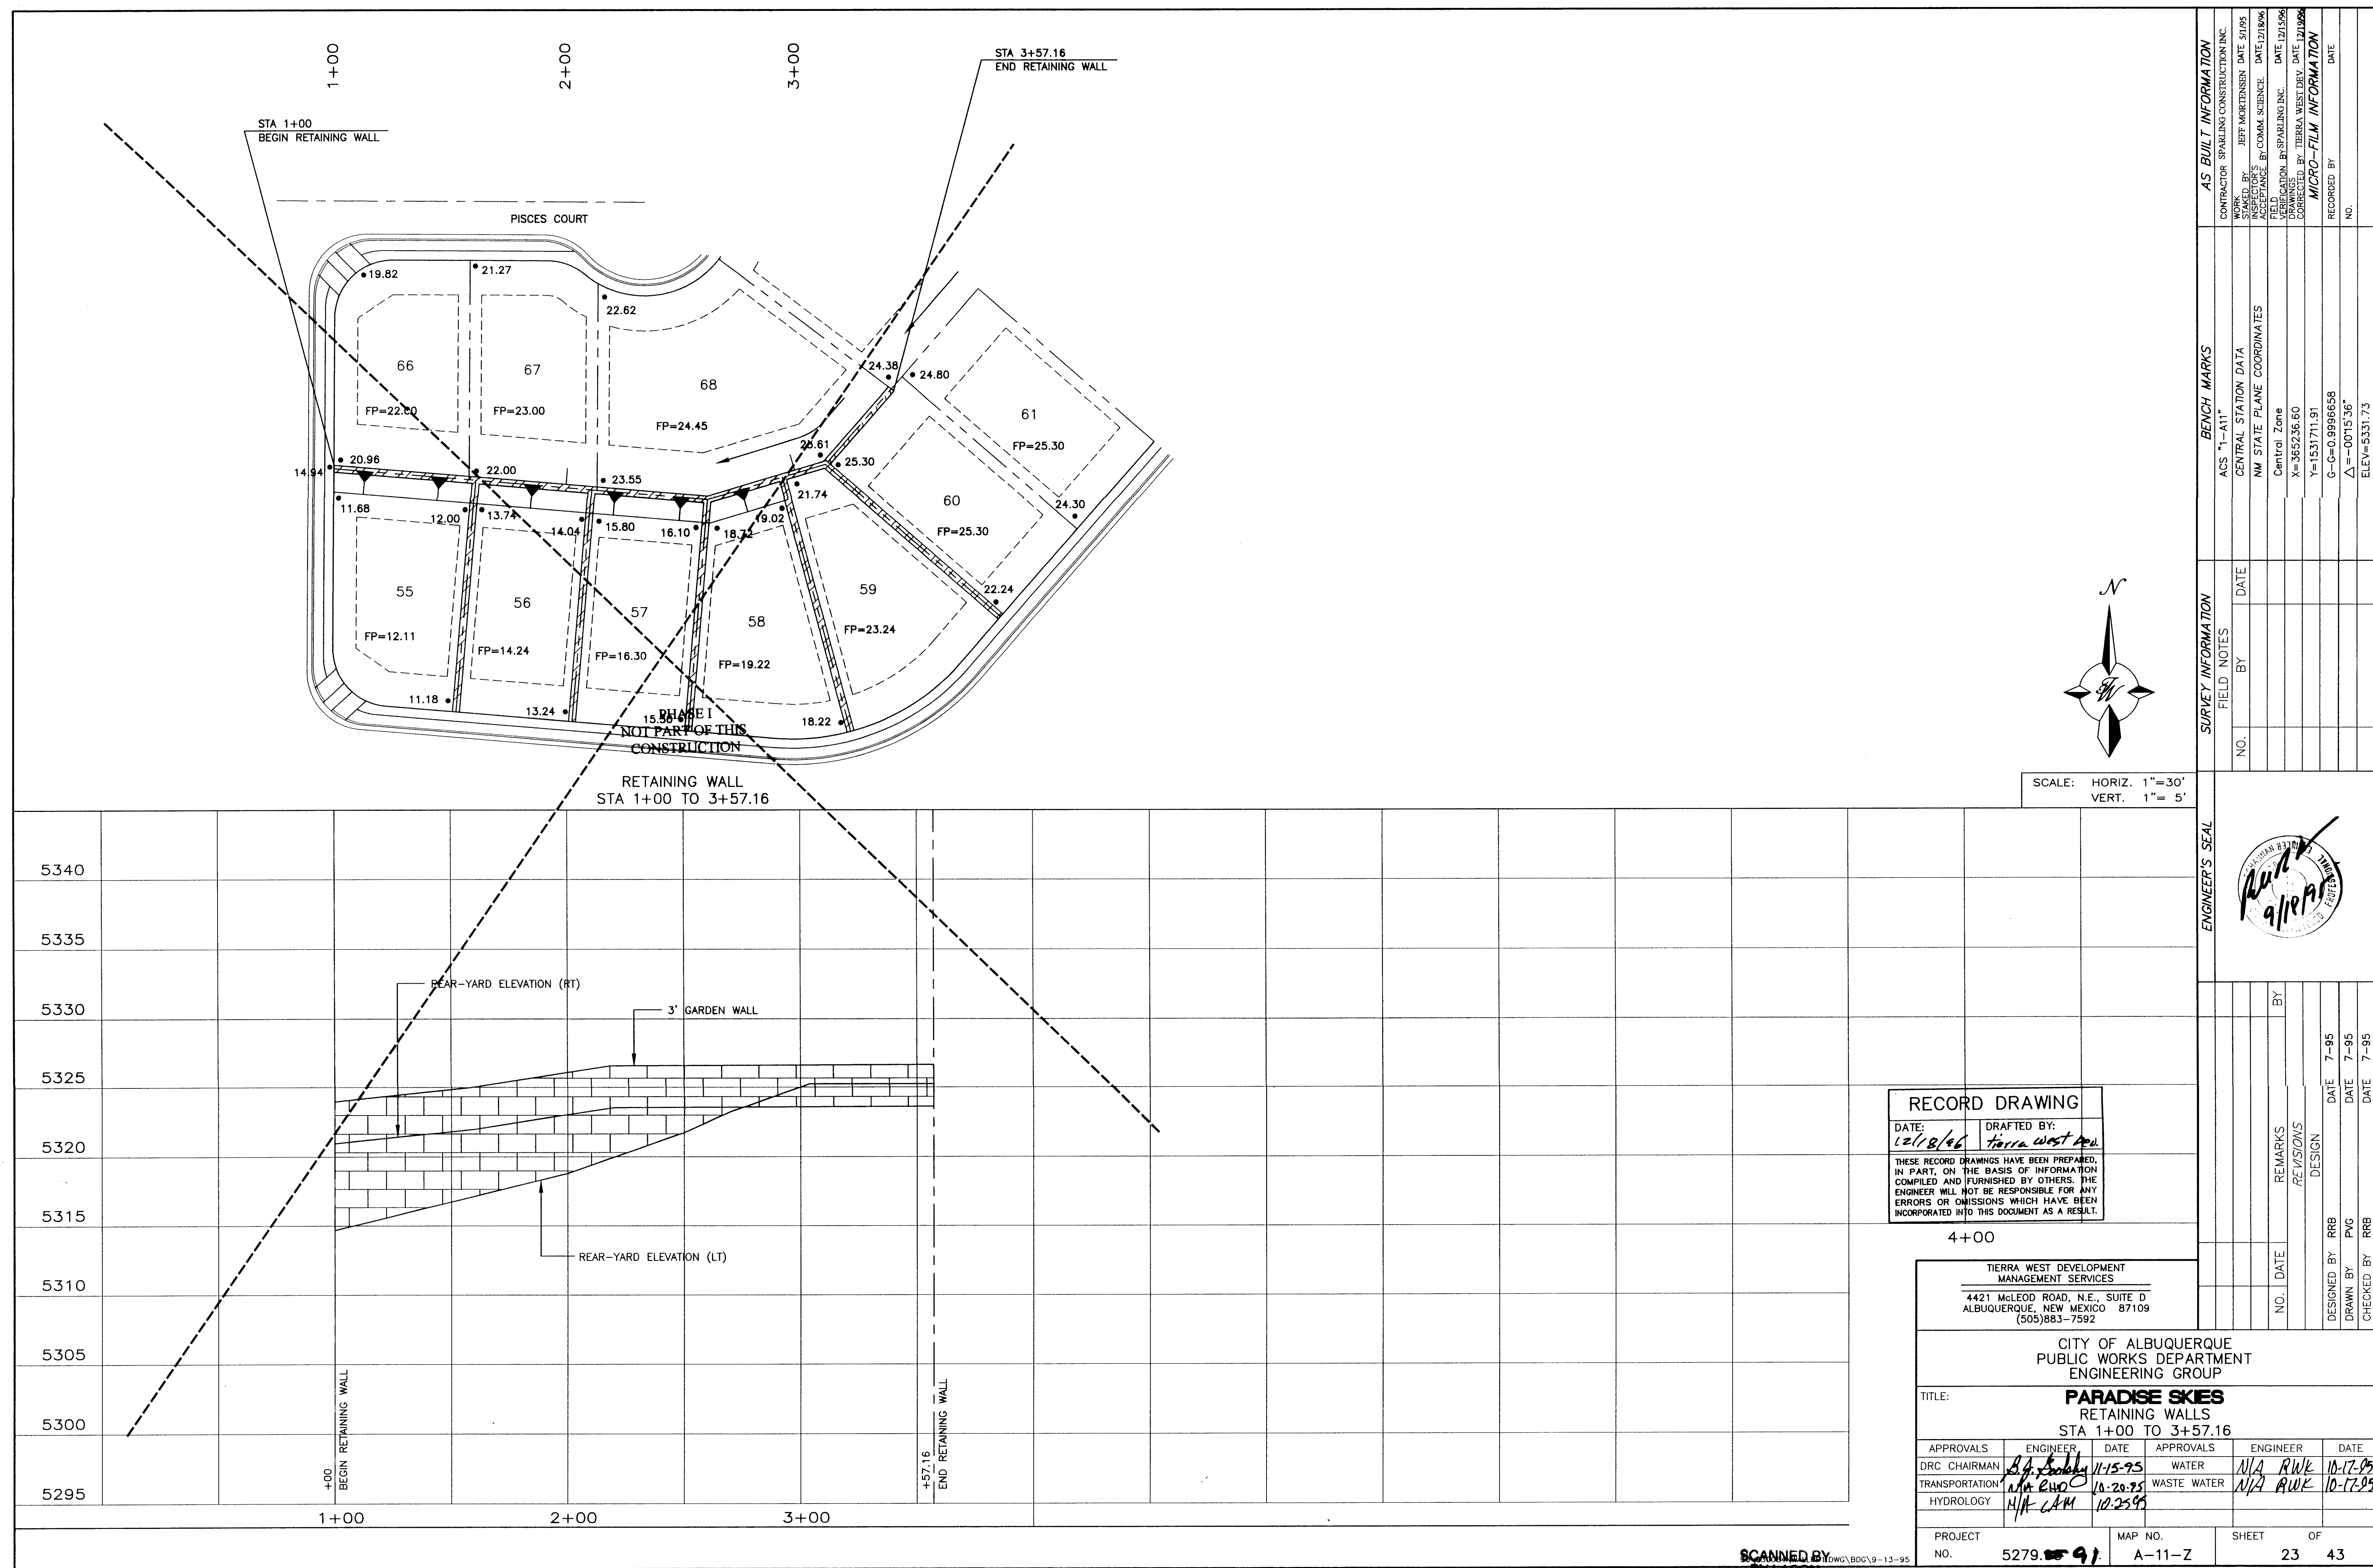


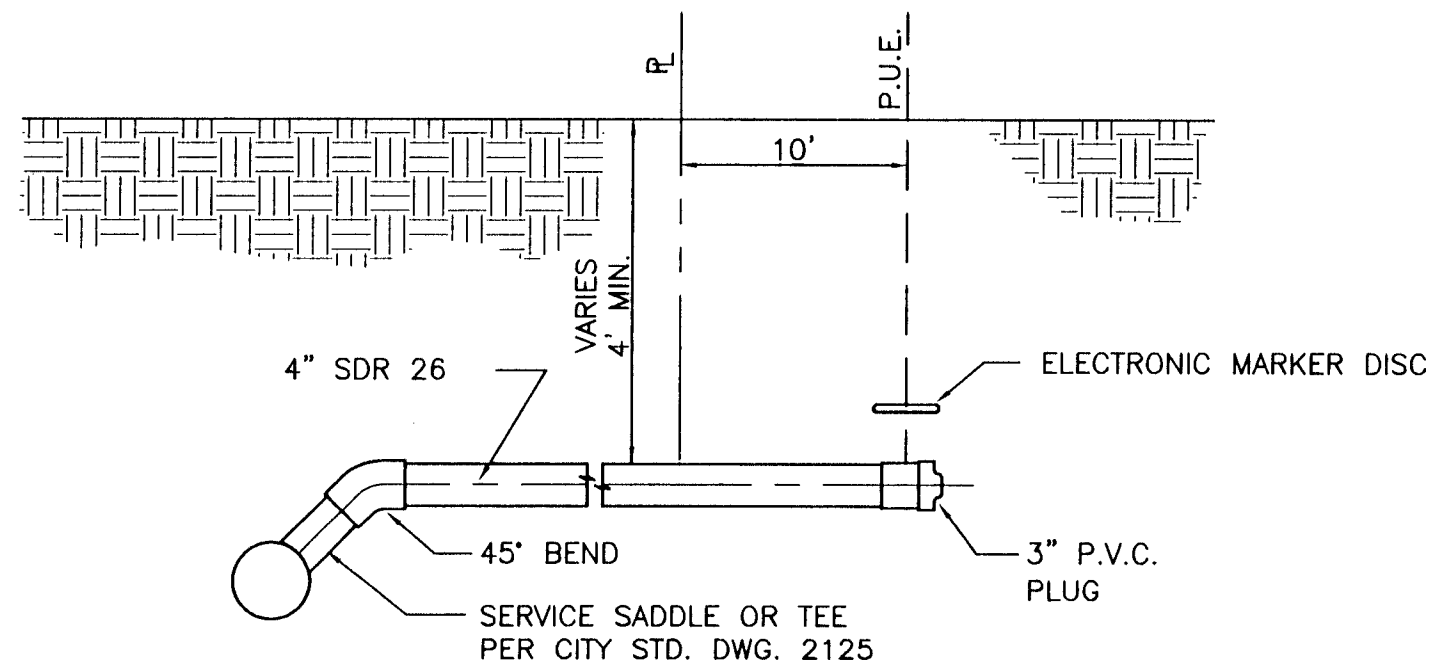


**TYP. SANITARY SYSTEM
SERVICE CONNECTION**
NO SCALE

LEGEND

--- BOUNDARY LINE	● SANITARY SEWER MANHOLE
--- EASEMENT LINE	--- SANITARY SEWER SERVICE CONNECTION
--- LOT LINE	▼ FIRE HYDRANT
--- SETBACK LINE	⋈ GATE VALVE
--- SIDEWALK	▲ REDUCER
--- CURB AND GUTTER	U TEE
--- EXISTING CURB AND GUTTER	□ CROSS
--- FUTURE CURB AND GUTTER	⌒ BEND
--- CENTER LINE	⌒ CAP
--- SANITARY SEWER LINE	≡ DOUBLE WATER SERVICE CONNECTION
--- WATER LINE	--- SINGLE WATER SERVICE CONNECTION
--- STORM DRAIN LINE	⊙ STORM DRAIN MANHOLE
--- EXISTING WATER LINE	⌒ STORM DRAIN INLET
--- EXISTING STORM DRAIN LINE	▶ DIRECTION OF FLOW

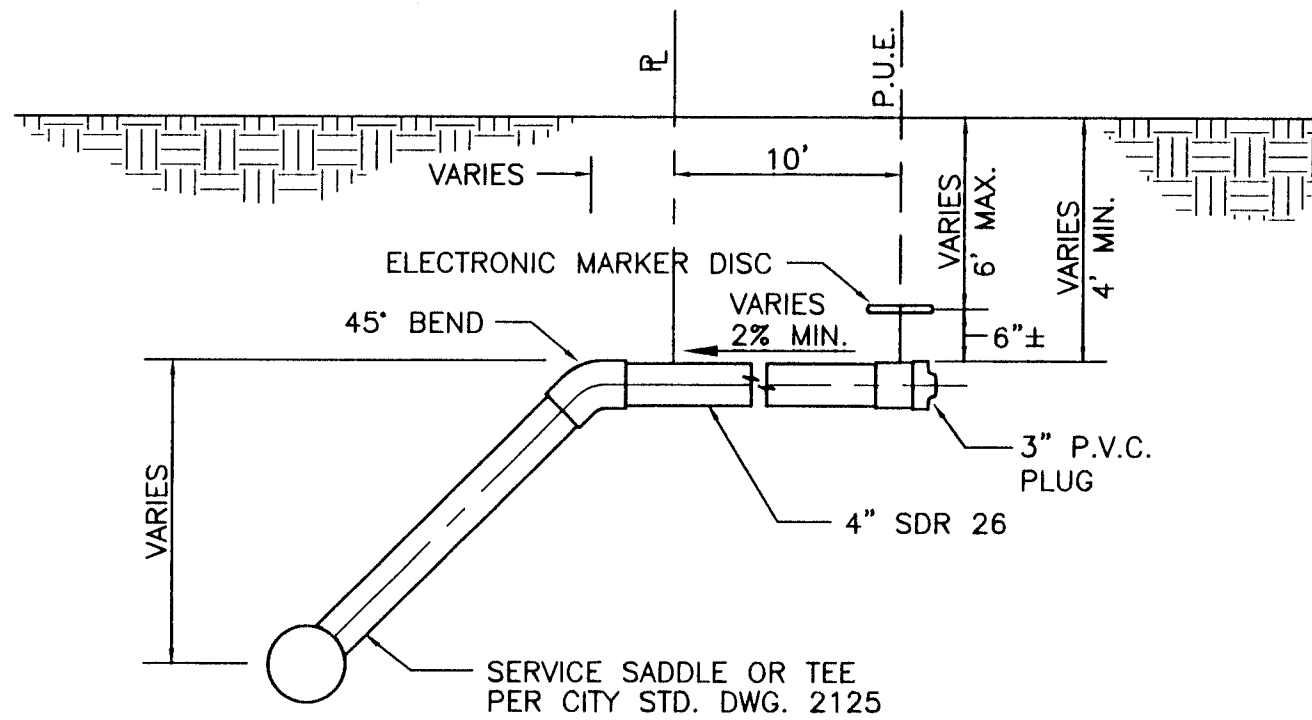


**TYP. SANITARY SYSTEM
SERVICE CONNECTION
FOR DEEP SANITARY SEWERS**
NO SCALE

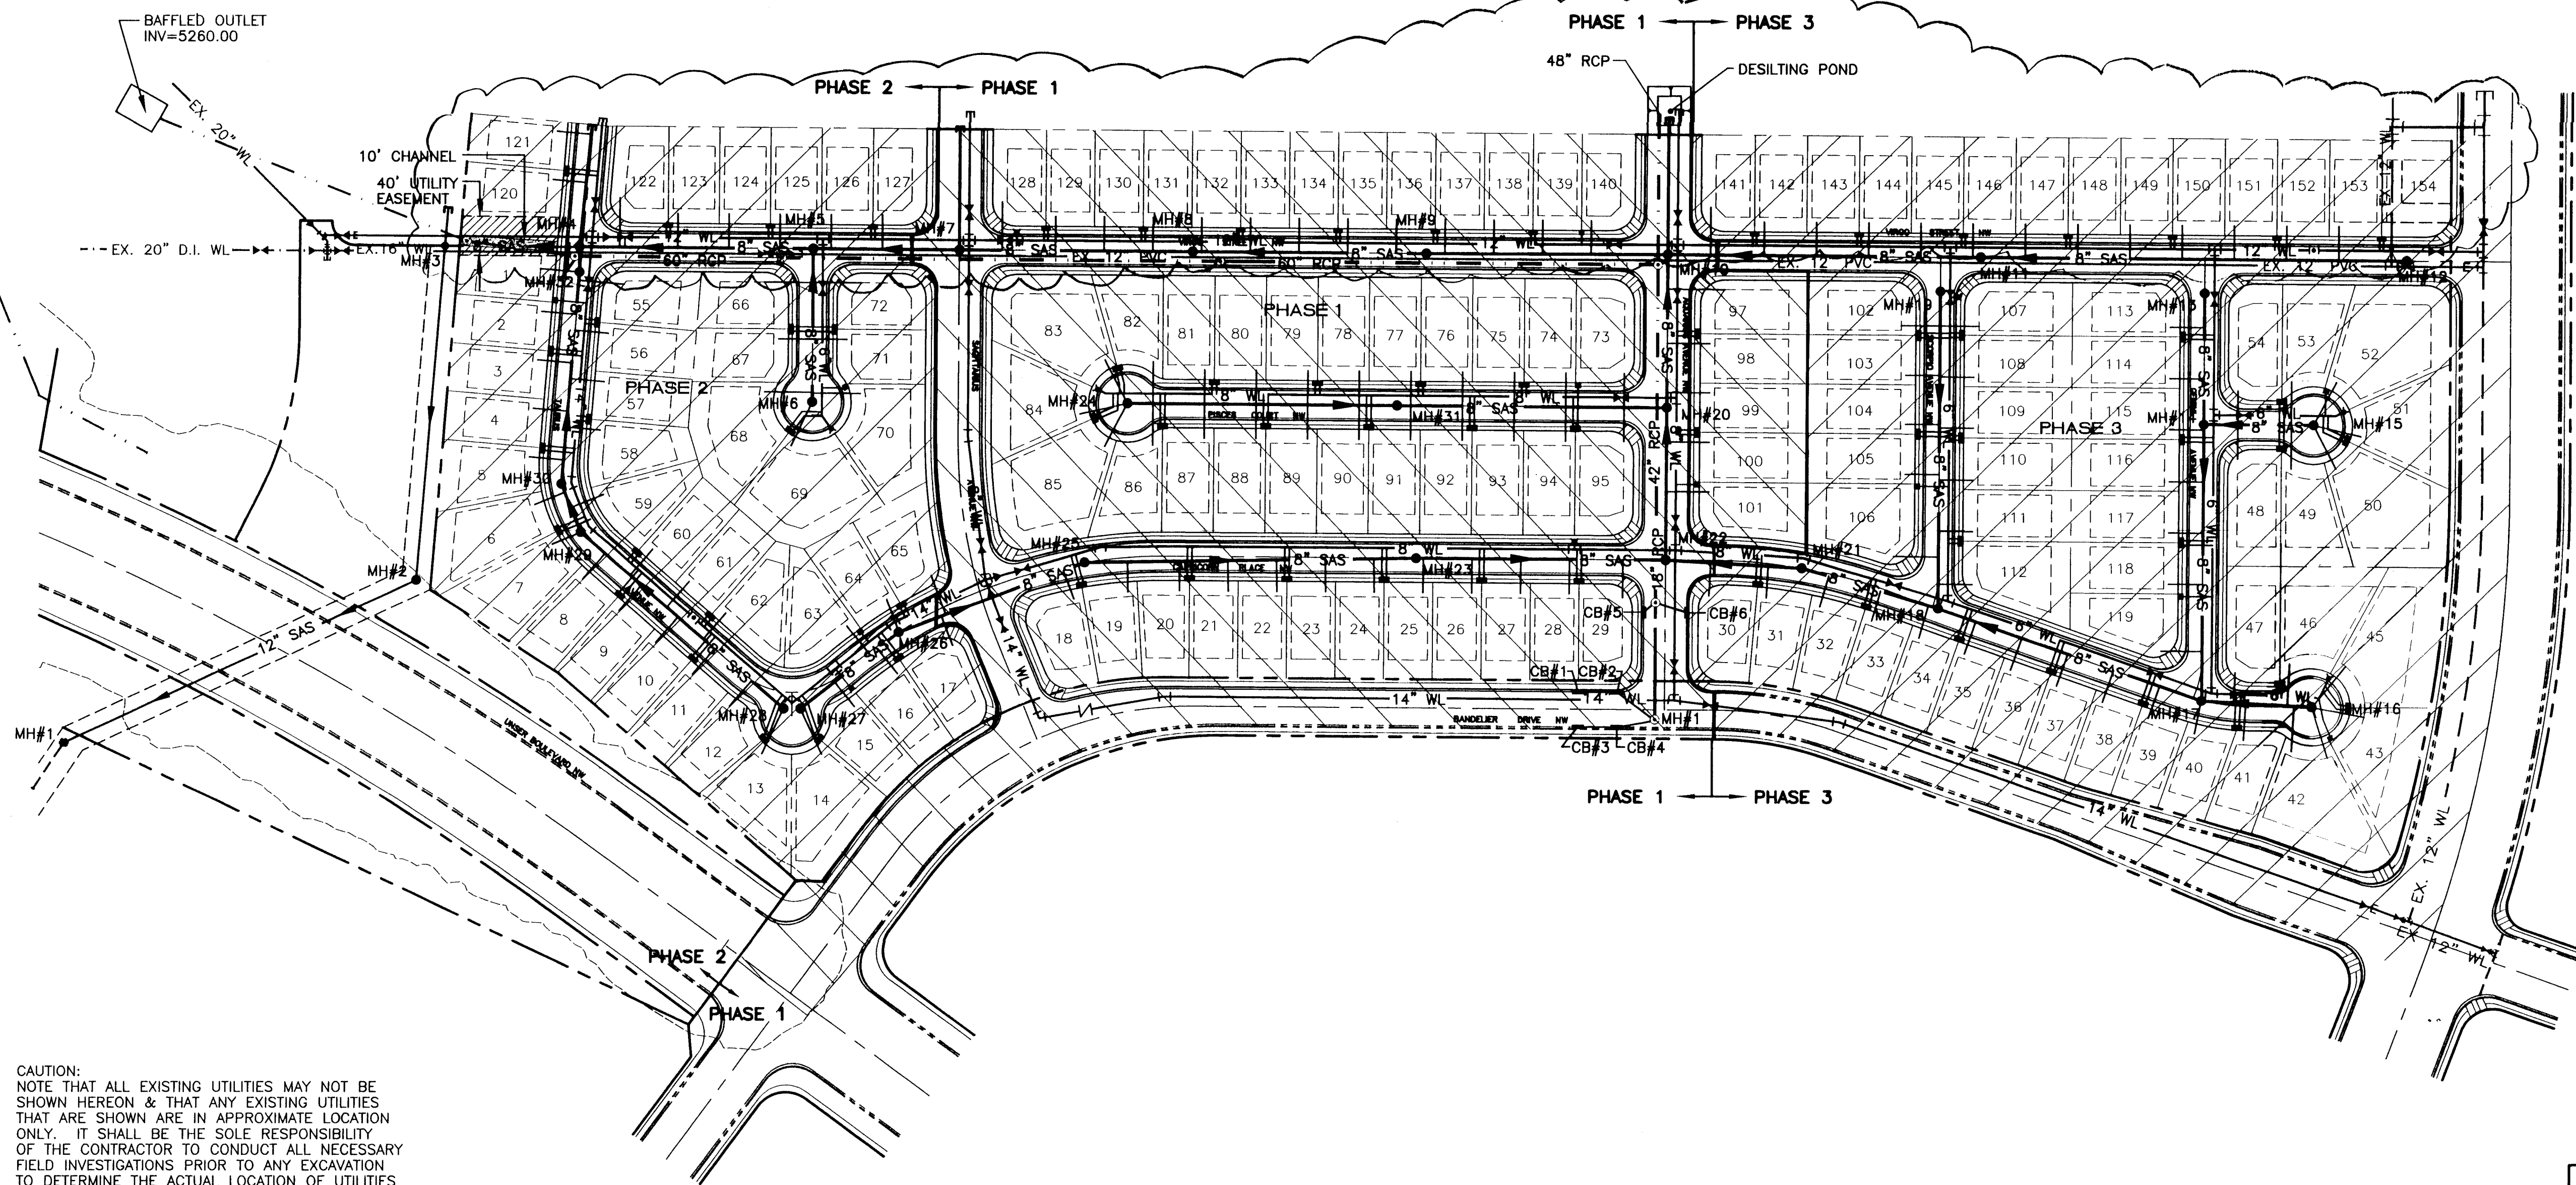

CAUTION:
NOTE THAT ALL EXISTING UTILITIES MAY NOT BE SHOWN HEREON & THAT ANY EXISTING UTILITIES THAT ARE SHOWN ARE IN APPROXIMATE LOCATION ONLY. IT SHALL BE THE SOLE RESPONSIBILITY OF THE CONTRACTOR TO CONDUCT ALL NECESSARY FIELD INVESTIGATIONS PRIOR TO ANY EXCAVATION TO DETERMINE THE ACTUAL LOCATION OF UTILITIES & OTHER IMPROVEMENTS.


GENERAL NOTES:

1. WATERLINES ARE PVC C-900 PIPE.
2. SANITARY SEWER LINES ARE PVC SDR35 PIPE (TYP).
3. WATERLINES AND SANITARY SEWER LINES ARE 10' APART (TYP).
4. NEED TO CONTACT NEW MEXICO UTILITIES 14 DAYS IN ADVANCE FOR WATERLINE SHUT-OFF.
5. ALL WATERLINE SERVICES ARE COPPERLINE SERVICES.

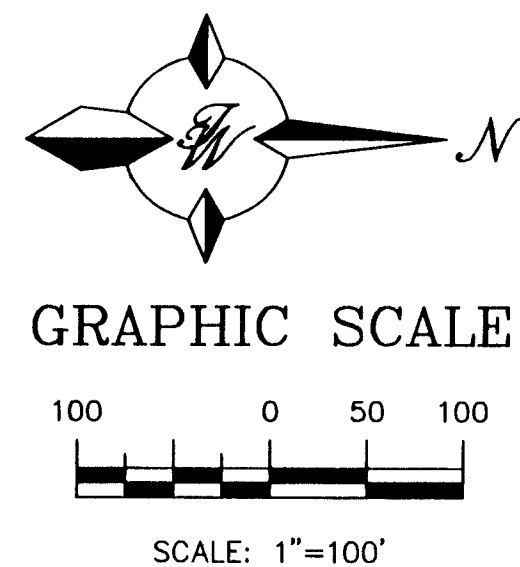

AS BUILT INFORMATION			BENCH MARKS			SURVEY INFORMATION			ENGINEER'S SEAL		
CONTRACTOR	SPARKLING CONSTRUCTION INC.	DATE	11-11-11	ACCS	11-11-11	FIELD NOTES	NO.	BY	DATE	NO.	BY
WORK	JEFF MORTENSEN	DATE	11/19/95	CENTRAL STATION DATA	DATE	NO.	BY	DATE	NO.	BY	DATE
INSPECTOR	JEFF MORTENSEN	DATE	11/19/95	NM STATE PLANE COORDINATES	DATE	NO.	BY	DATE	NO.	BY	DATE
ACCEPTANCE	JEFF MORTENSEN	DATE	11/19/95	CENTRAL ZONE	DATE	NO.	BY	DATE	NO.	BY	DATE
VERIFICATION	JEFF MORTENSEN	DATE	11/19/95	X=365236.60	DATE	NO.	BY	DATE	NO.	BY	DATE
DRAWINGS	JEFF MORTENSEN	DATE	11/19/95	Y=1531711.91	DATE	NO.	BY	DATE	NO.	BY	DATE
CORRECTIONS	JEFF MORTENSEN	DATE	11/19/95	G=0.9996658	DATE	NO.	BY	DATE	NO.	BY	DATE
RECORDED BY	JEFF MORTENSEN	DATE	11/19/95	Δ=-00'15.36"	DATE	NO.	BY	DATE	NO.	BY	DATE
NO.	JEFF MORTENSEN	DATE	11/19/95	ELEV=5331.73	DATE	NO.	BY	DATE	NO.	BY	DATE

[Signature]
11-1-95

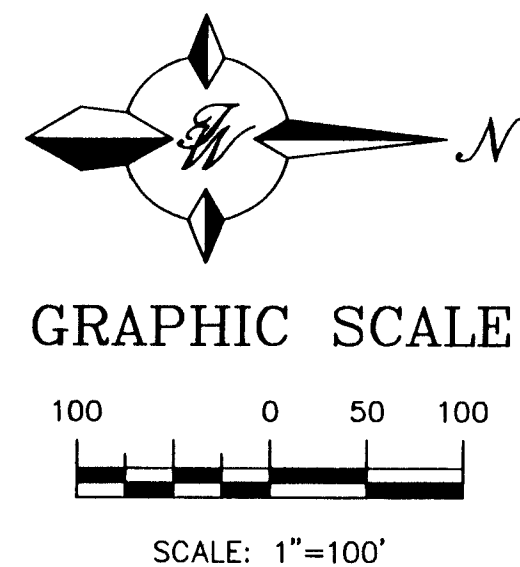

TIERRA WEST DEVELOPMENT
MANAGEMENT SERVICES
4421 MCLEOD ROAD N.E., SUITE D
ALBUQUERQUE, NEW MEXICO 87109
(505)883-7592

CITY OF ALBUQUERQUE
PUBLIC WORKS DEPARTMENT
ENGINEERING GROUP

**PARADISE SKIES
MASTER UTILITY PLAN**

APPROVALS	ENGINEER	DATE	APPROVALS	ENGINEER	DATE
DRC CHAIRMAN	<i>[Signature]</i>	12-29-95	WATER	<i>[Signature]</i>	11-30-95
TRANSPORTATION	<i>[Signature]</i>	11-30-95	WASTE WATER	<i>[Signature]</i>	11-30-95
HYDROLOGY	<i>[Signature]</i>	12-6-95	AMAFCA		
PROJECT NO.	5279.0091	MAP NO.	A-11-Z	SHEET	26 OF 43


RECORD DRAWING

DATE:	12/18/06	DRAFTED BY:	Tierra West Dev.
THESE RECORD DRAWINGS HAVE BEEN PREPARED, IN PART, ON THE BASIS OF INFORMATION COMPILED AND FURNISHED BY OTHERS. THE ENGINEER WILL NOT BE RESPONSIBLE FOR ANY ERRORS OR OMISSIONS WHICH HAVE BEEN INCORPORATED INTO THIS DOCUMENT AS A RESULT.			


100\930064\9364MU.DWG\BDG\10-31-95


SCANNED BY
BY LASON

PHASE II
26-5279.91 26-5279.91 26-5279.91

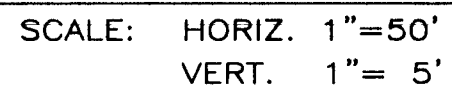

RETAINING WALL
STA 8+23.79 TO 14+79.85

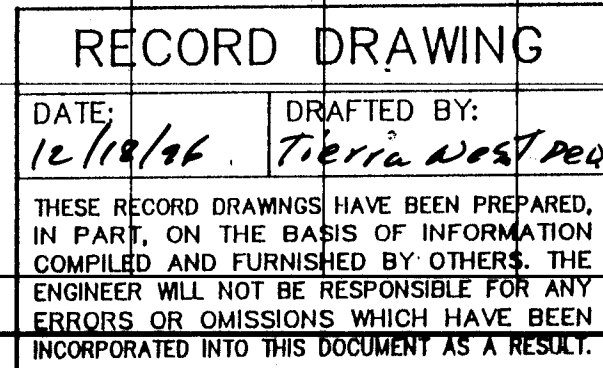
[illegible]

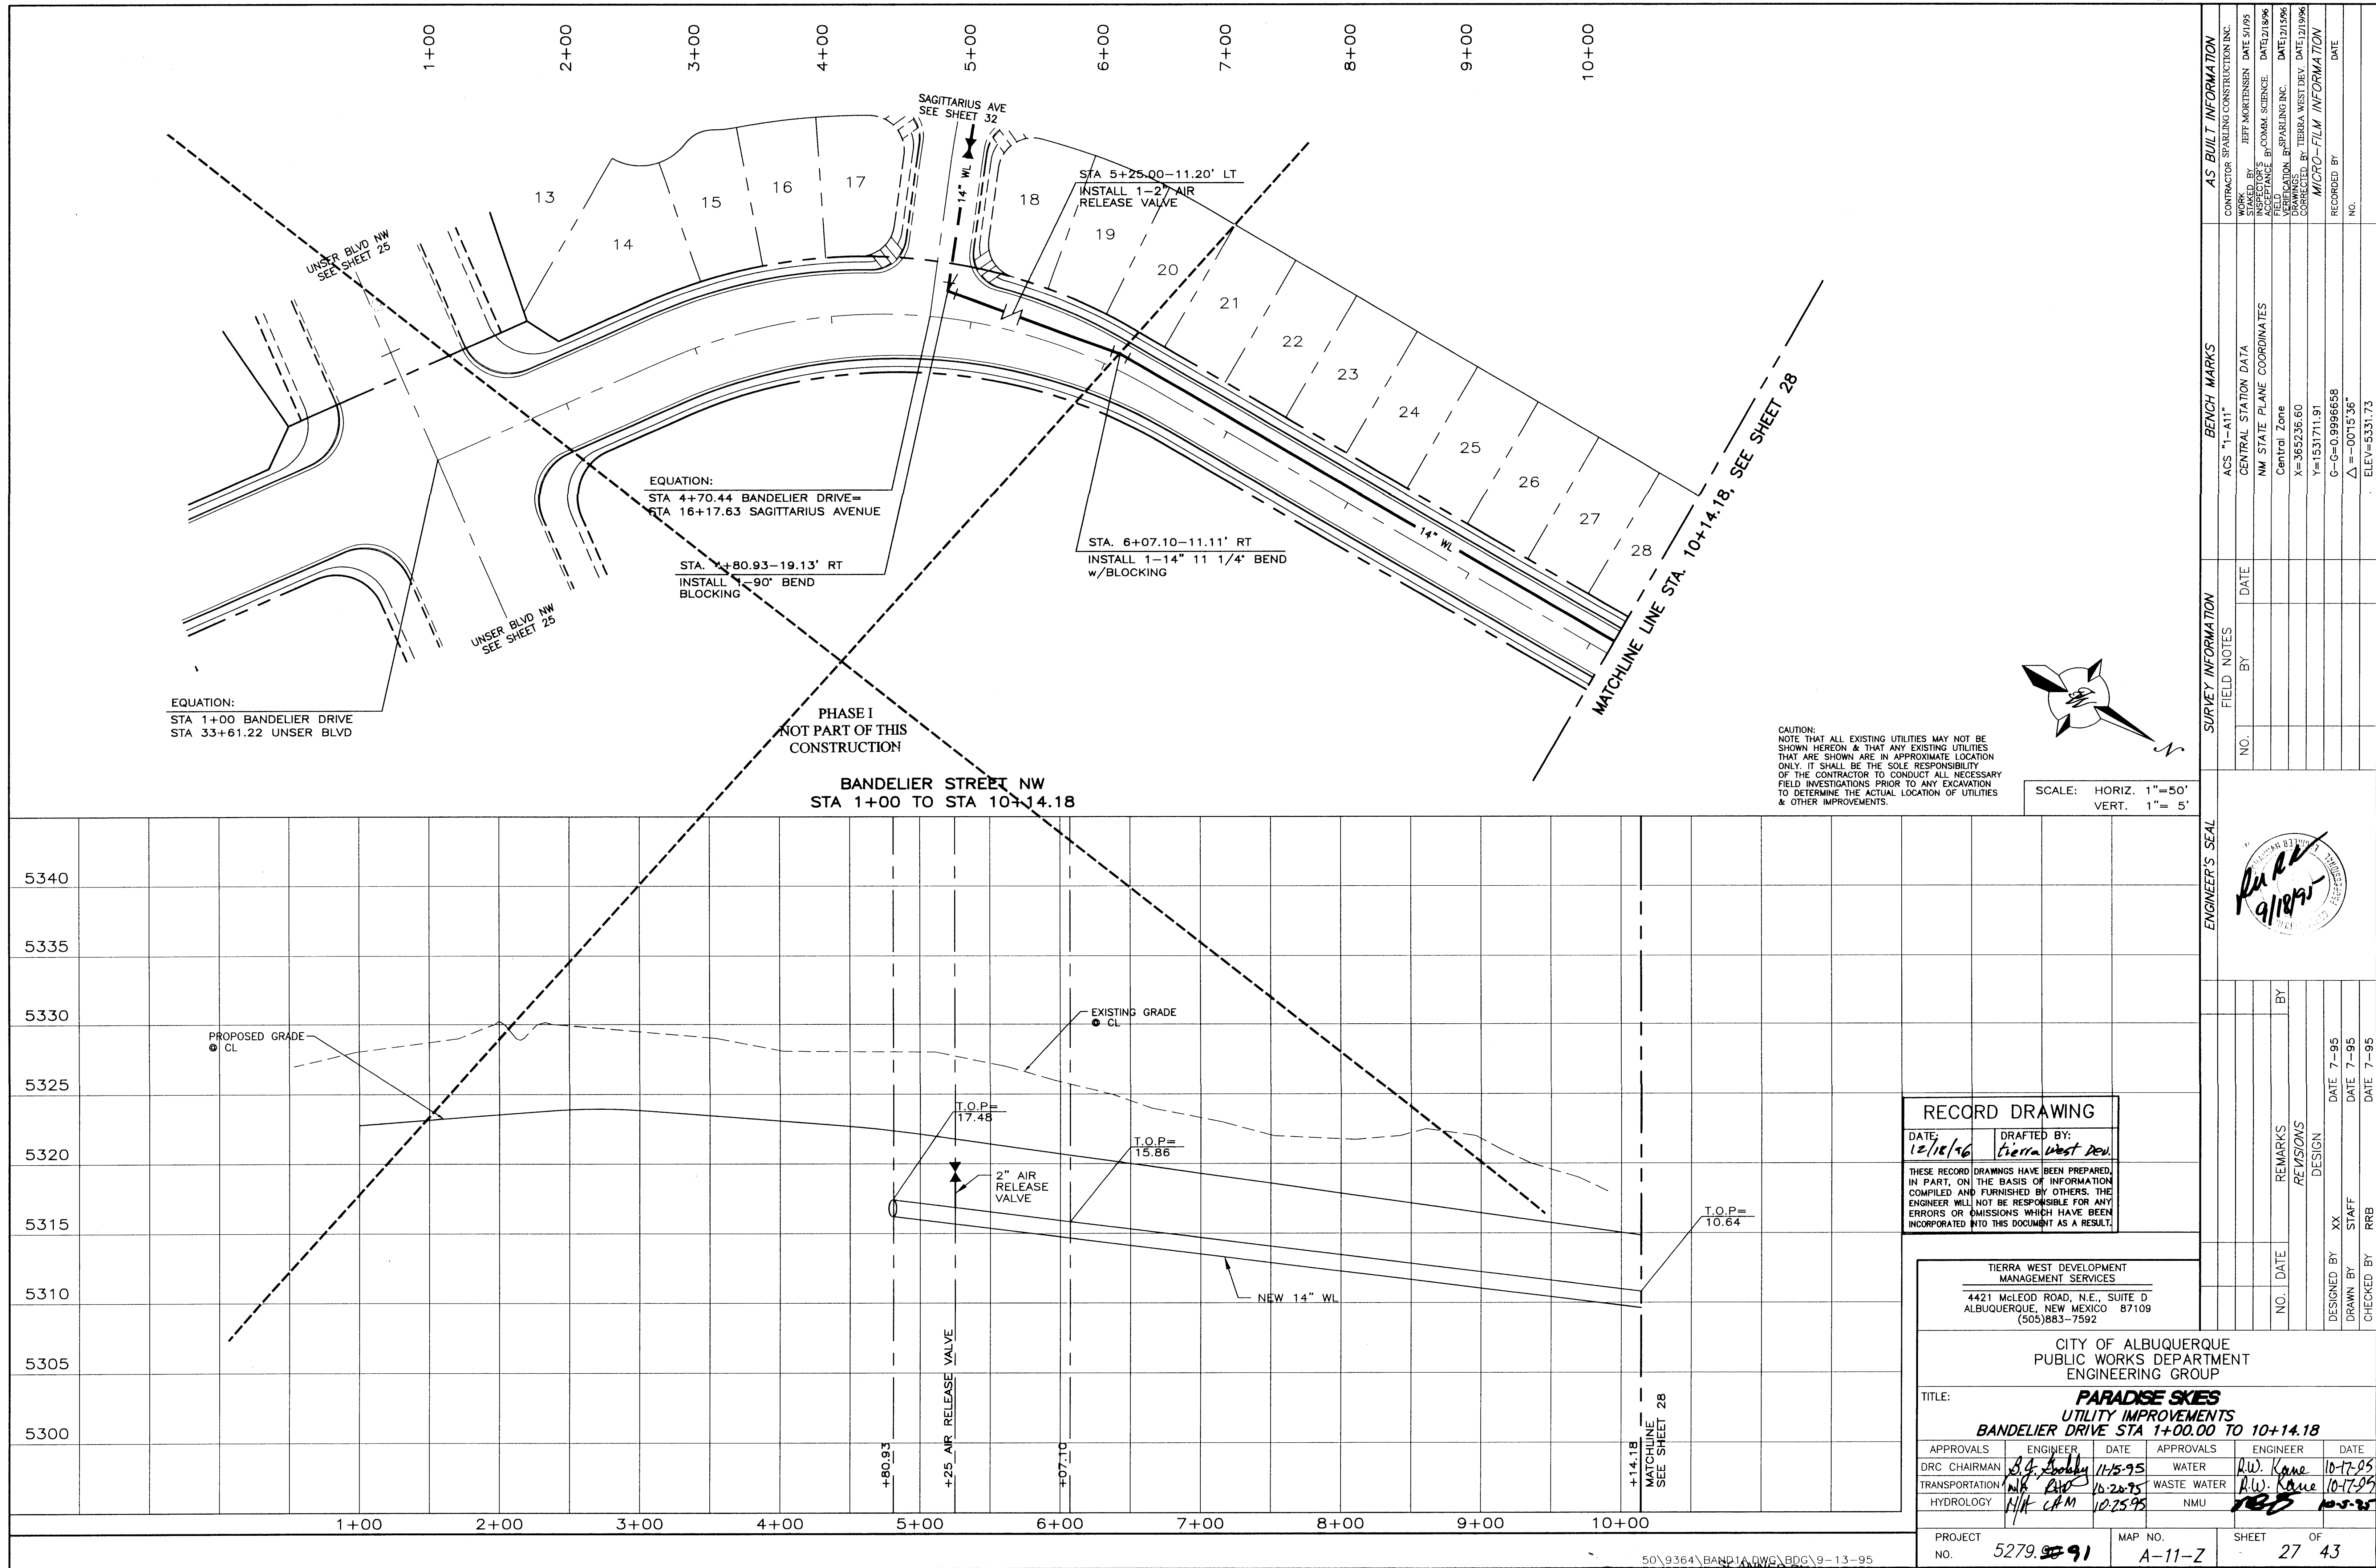

AS BUILT INFORMATION		BENCH MARKS		SURVEY INFORMATION		ENGINEER'S SEAL	
CONTRACTOR	SPARLING CONSTRUCTION INC.	ACS "1-A11"	CENTRAL STATION DATA	FIELD NOTES	DATE	NO.	BY
WORK	BY JEFF MORTENSEN DATE 5/1/95	NW STATE PLANE COORDINATES	Central Zone				
INSPECTOR'S	DATE 12/18/96	X=365236.60	Y=1531711.91				
ACCEPTANCE	DATE 12/15/96	G-G=0.9996658	Δ = -0.01536"				
VERIFICATION	DATE 12/15/96						
DRAWINGS							
CORRECTIONS							
BY TERRA WEST DEV.	DATE 12/18/96						
RECORDED BY							
NO.							



RECORD DRAWING		ENGINEER'S SEAL	
DATE:	12/18/96	BY	
DRAFTED BY:	Tierra West Dev.	REMARKS	
THESE RECORD DRAWINGS HAVE BEEN PREPARED, IN PART, ON THE BASIS OF INFORMATION COMPILED AND FURNISHED BY OTHERS. THE ENGINEER WILL NOT BE RESPONSIBLE FOR ANY ERRORS OR OMISSIONS WHICH HAVE BEEN INCORPORATED INTO THIS DOCUMENT AS A RESULT.		DESIGN	
NO.	DATE	DESIGNED BY	DATE 7-95
		DRAWN BY	DATE 7-95
		CHECKED BY	DATE 7-95

TIERRA WEST DEVELOPMENT MANAGEMENT SERVICES 4421 McLEOD ROAD, N.E., SUITE D ALBUQUERQUE, NEW MEXICO 87109 (505)883-7592			
CITY OF ALBUQUERQUE PUBLIC WORKS DEPARTMENT ENGINEERING GROUP			
TITLE: PARADISE SKIES UTILITY IMPROVEMENTS BANDELIER DRIVE STA 1+00.00 TO 10+14.18			
APPROVALS	ENGINEER	DATE	APPROVALS
DRC CHAIRMAN	11/15/95	11/15/95	ENGINEER
TRANSPORTATION	10/20/95	10/20/95	DATE
HYDROLOGY	10/25/95	10/25/95	
PROJECT NO.	5279.991	MAP NO.	A-11-Z
SHEET	27	OF	43

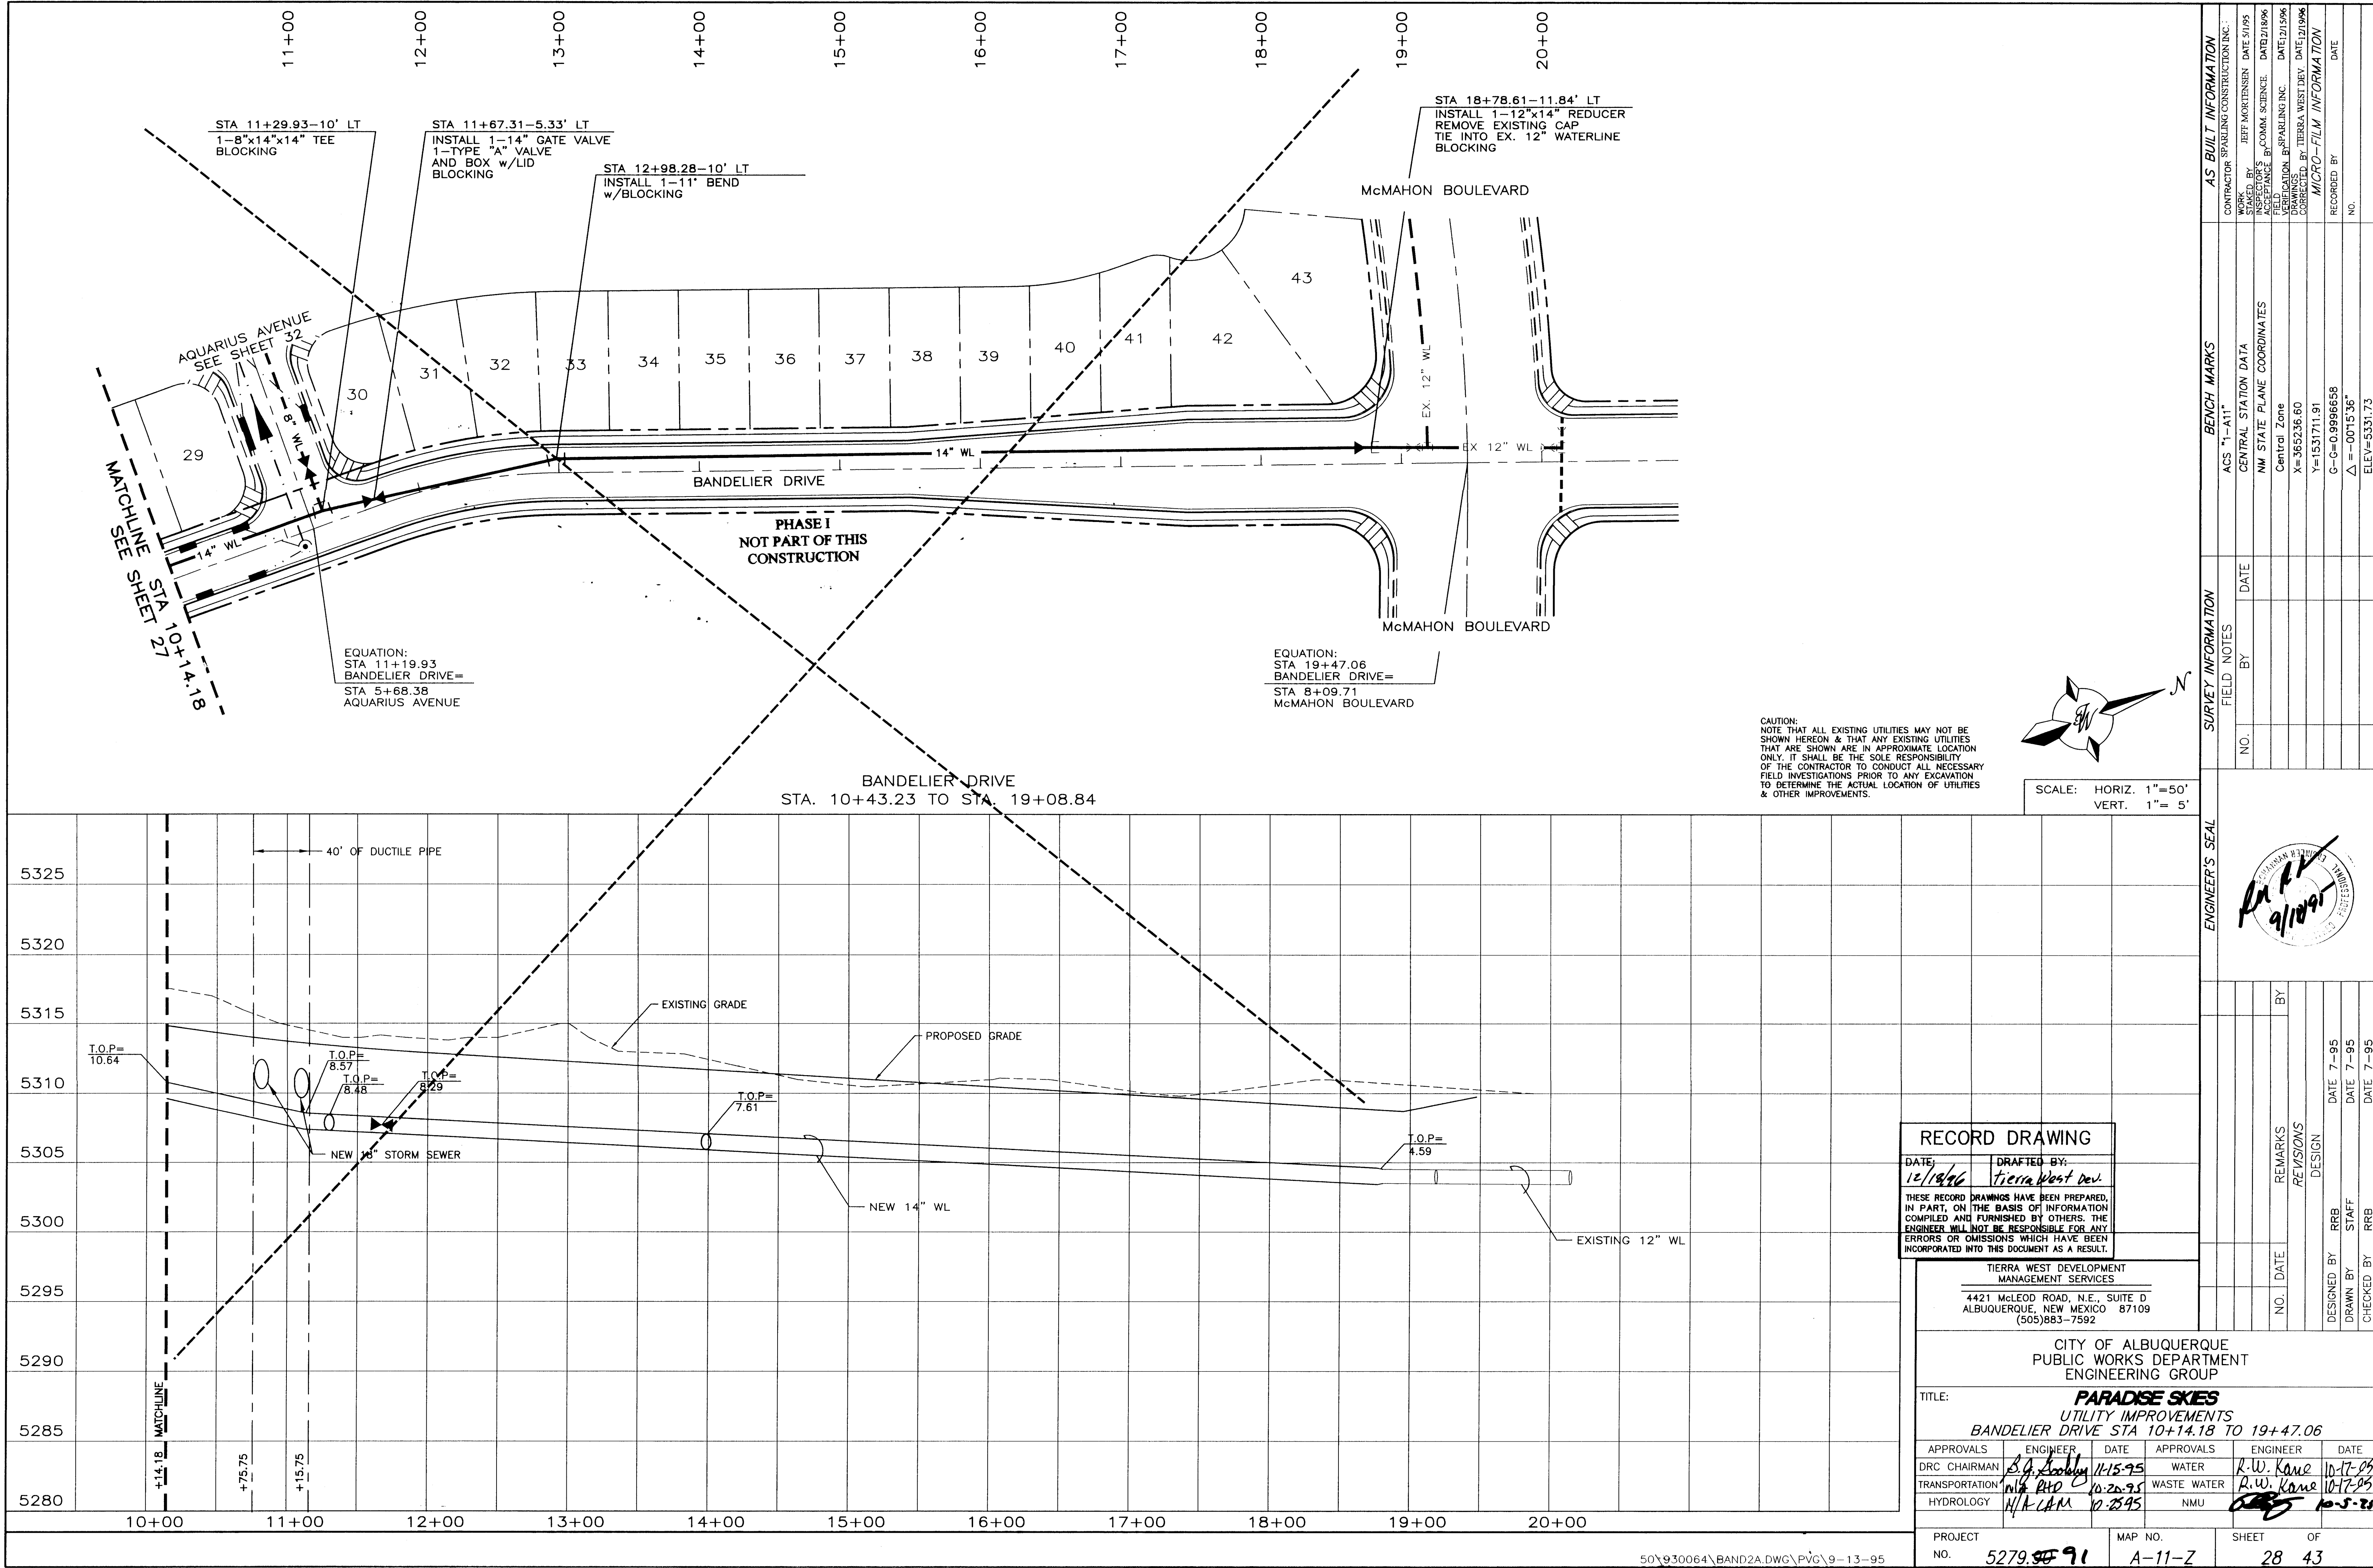

CAUTION:
NOTE THAT ALL EXISTING UTILITIES MAY NOT BE SHOWN HEREON & THAT ANY EXISTING UTILITIES THAT ARE SHOWN ARE IN APPROXIMATE LOCATION ONLY. IT SHALL BE THE SOLE RESPONSIBILITY OF THE CONTRACTOR TO CONDUCT ALL NECESSARY FIELD INVESTIGATIONS PRIOR TO ANY EXCAVATION TO DETERMINE THE ACTUAL LOCATION OF UTILITIES & OTHER IMPROVEMENTS.


SCALE: HORIZ. 1"=50'
VERT. 1"= 5'

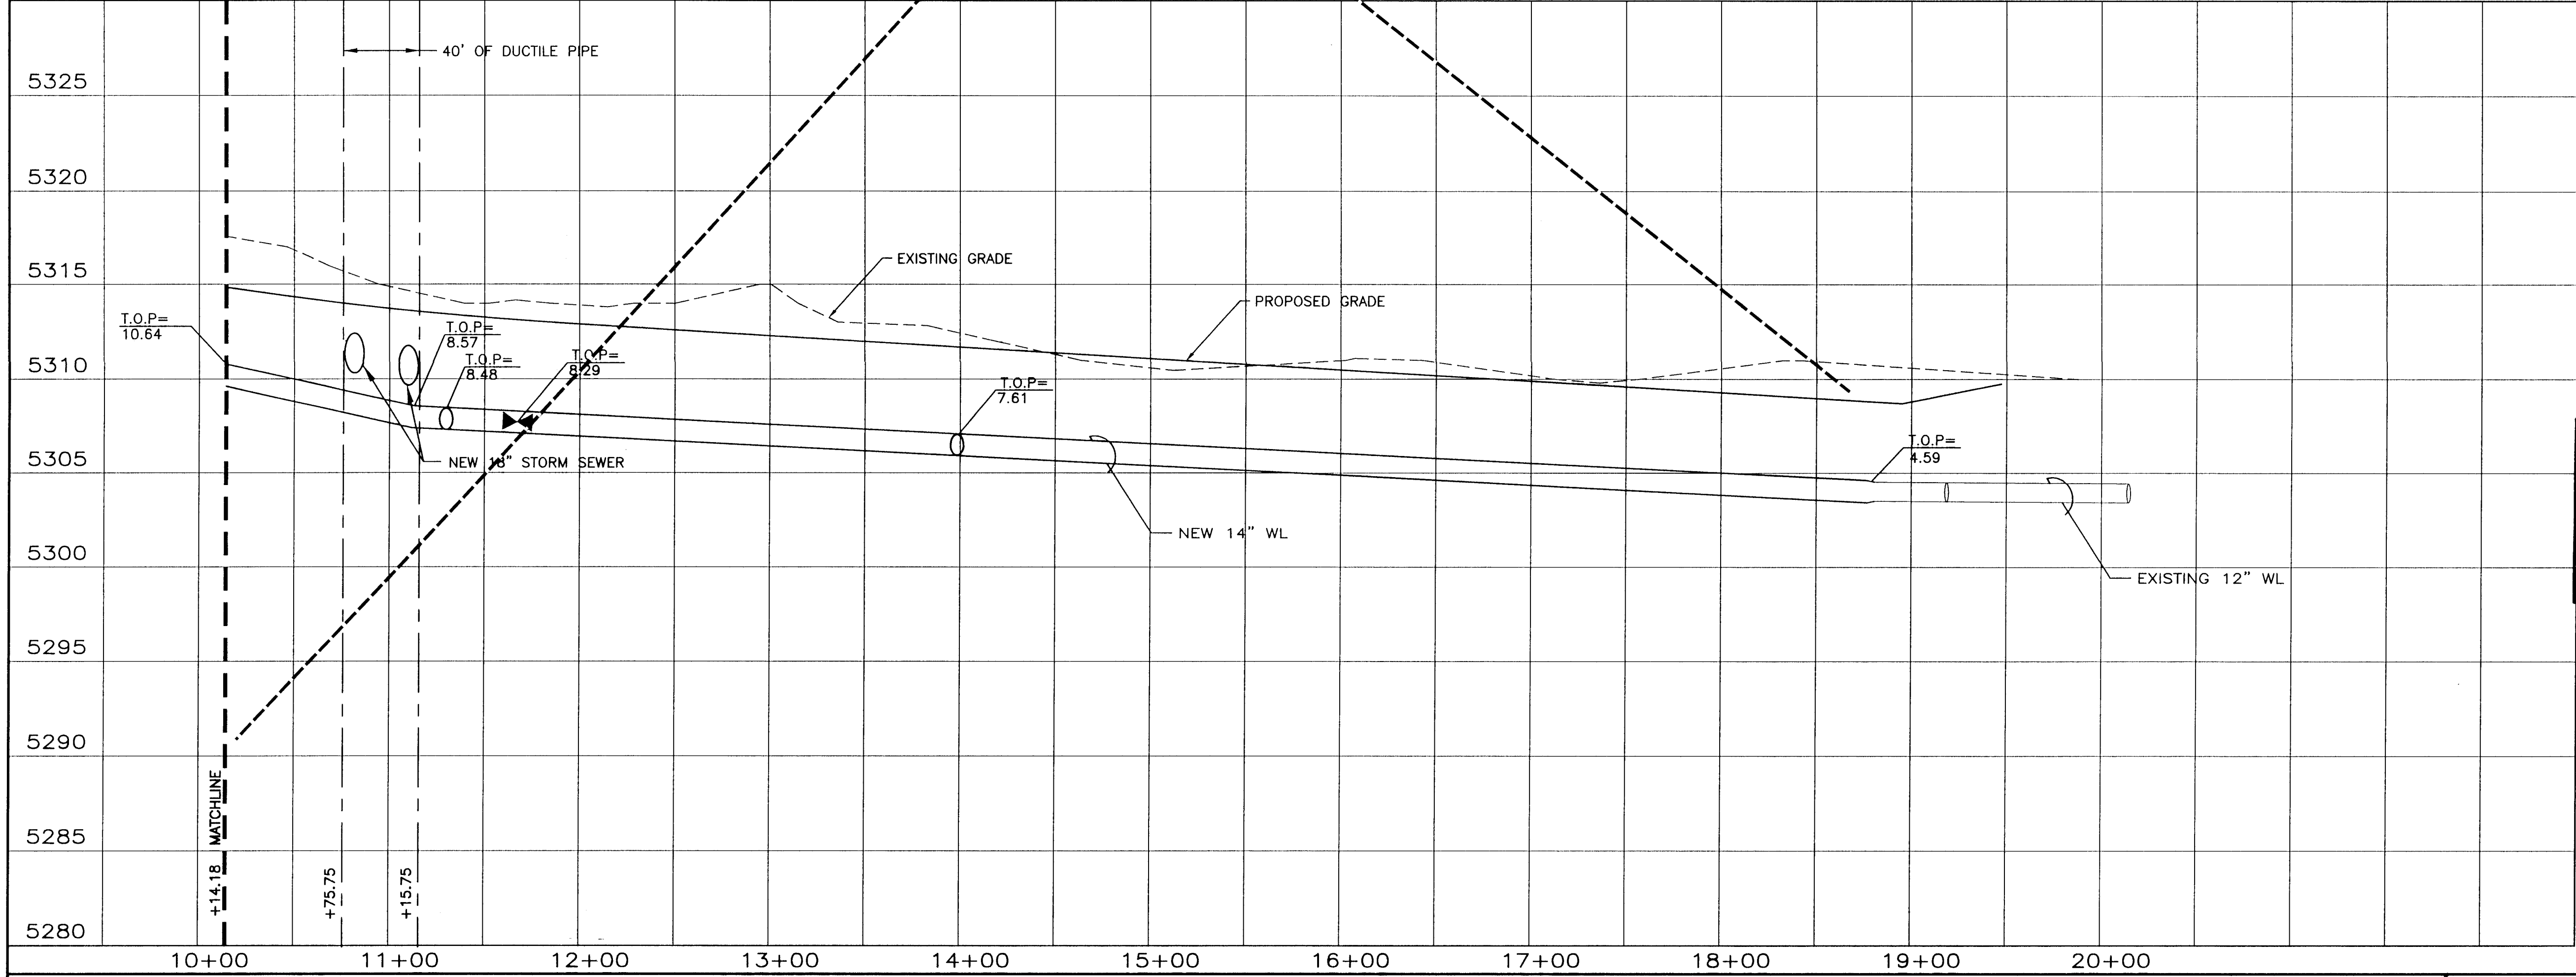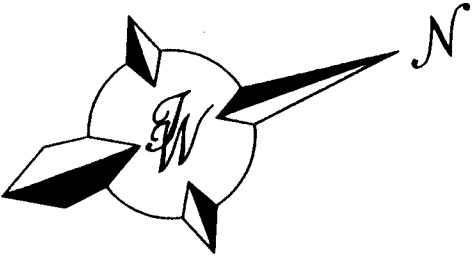


RECORD DRAWING		
DATE:	DRAFTED BY:	
12/18/96	Tierra West Dev.	
THESE RECORD DRAWINGS HAVE BEEN PREPARED, IN PART, ON THE BASIS OF INFORMATION COMPILED AND FURNISHED BY OTHERS. THE ENGINEER WILL NOT BE RESPONSIBLE FOR ANY ERRORS OR OMISSIONS WHICH HAVE BEEN INCORPORATED INTO THIS DOCUMENT AS A RESULT.		

TIERRA WEST DEVELOPMENT MANAGEMENT SERVICES 4421 MCLEOD ROAD, N.E., SUITE D ALBUQUERQUE, NEW MEXICO 87109 (505)883-7592		
CITY OF ALBUQUERQUE PUBLIC WORKS DEPARTMENT ENGINEERING GROUP		
TITLE: PARADISE SKIES UTILITY IMPROVEMENTS BANDELIER DRIVE STA 10+14.18 TO 19+47.06		
APPROVALS	ENGINEER	DATE
DRC CHAIRMAN	<i>R.W. Kane</i>	11-15-95
TRANSPORTATION	<i>N/A</i>	10-20-95
HYDROLOGY	<i>N/A</i>	10-25-95
APPROVALS	ENGINEER	DATE
WATER	<i>R.W. Kane</i>	10-17-95
WASTE WATER	<i>R.W. Kane</i>	10-17-95
NMU	<i>RRB</i>	10-5-95
PROJECT NO.	MAP NO.	SHEET OF
5279.9591	A-11-Z	28 43

AS BUILT INFORMATION			BENCH MARKS			SURVEY INFORMATION			ENGINEER'S SEAL		
CONTRACTOR	SPARKLING CONSTRUCTION INC.		ACS	"1-A1"		NO.	BY	DATE			
WORK	JEFF MONTGOMERY	DATE 5/1/95	CENTRAL STATION DATA								
STAKED BY	JEFF MONTGOMERY	DATE 5/1/95	NM STATE PLANE COORDINATES								
ACCEPTANCE	BY COMM. SCIENCE	DATE 2/18/96	Central Zone								
FIELD	ACCEPTANCE BY SPARKLING INC.	DATE 2/15/96	X=365236.60								
DRAWINGS	CORRECTED BY TIERRA WEST DEV.	DATE 12/19/96	Y=1531711.91								
MICRO-FILM INFORMATION			G-G=0.9996658								
RECORDED BY		DATE	Δ = -00'15.36"								
NO.			ELEV=5331.73								

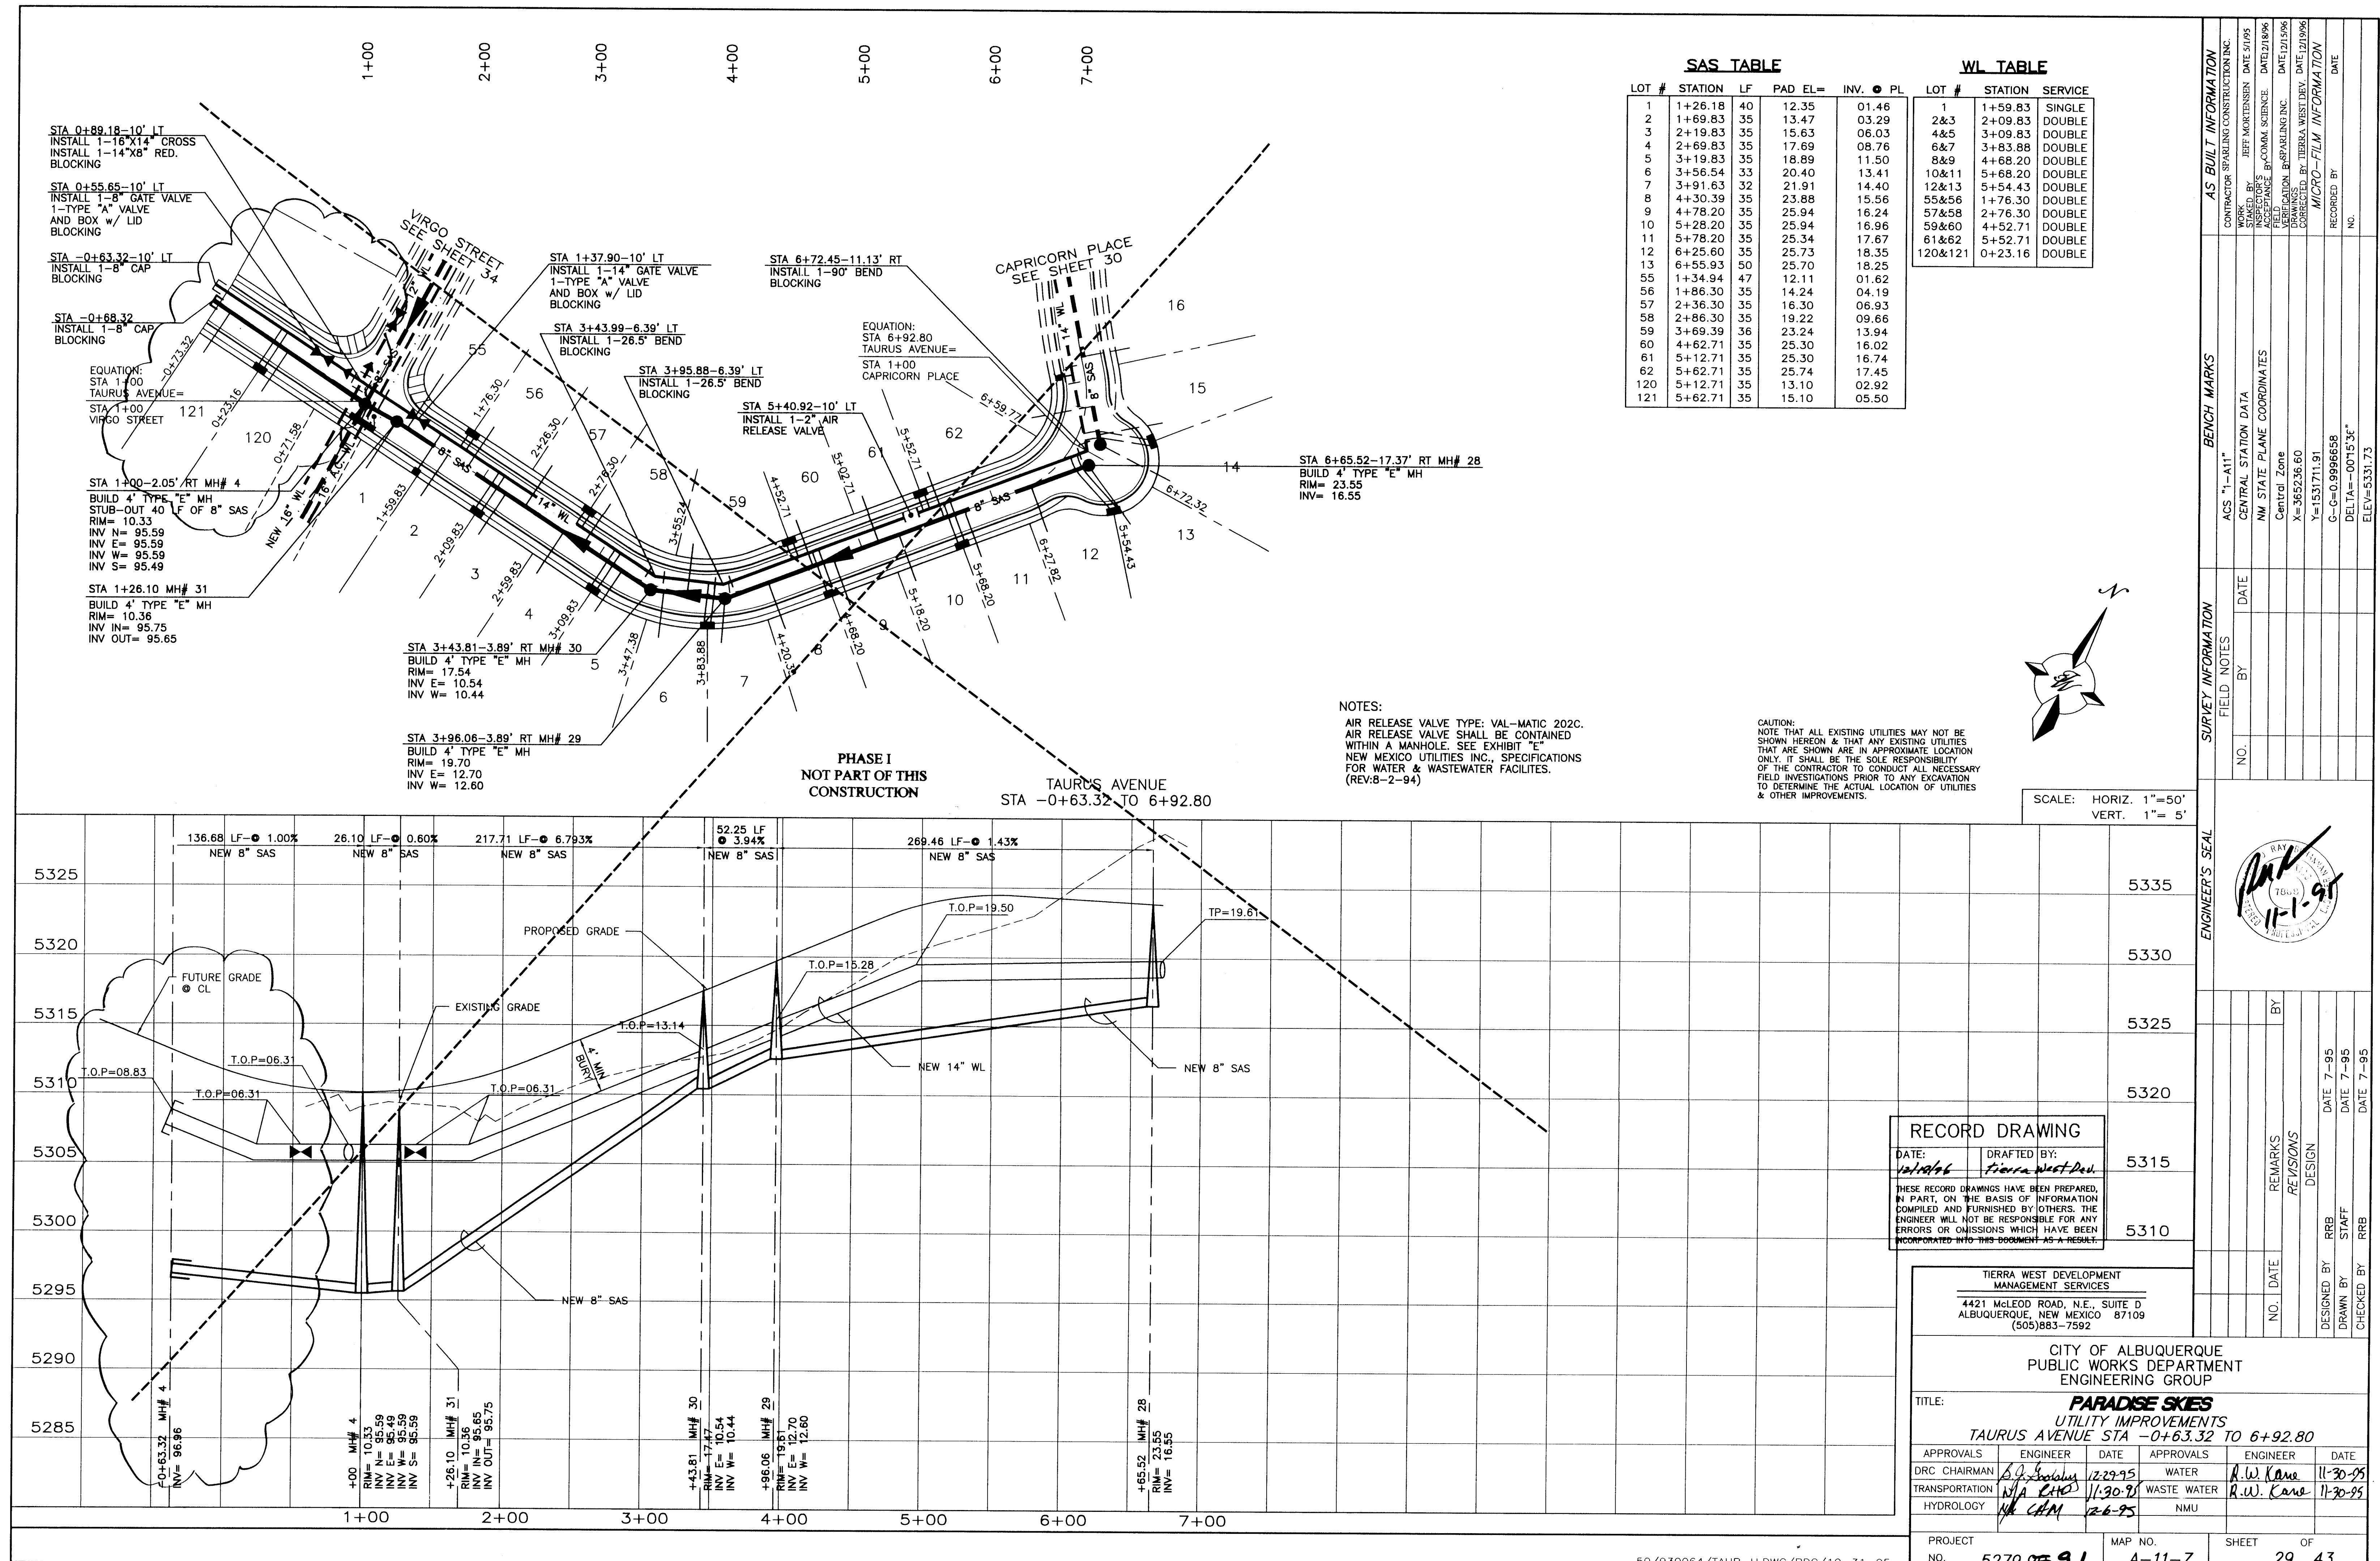


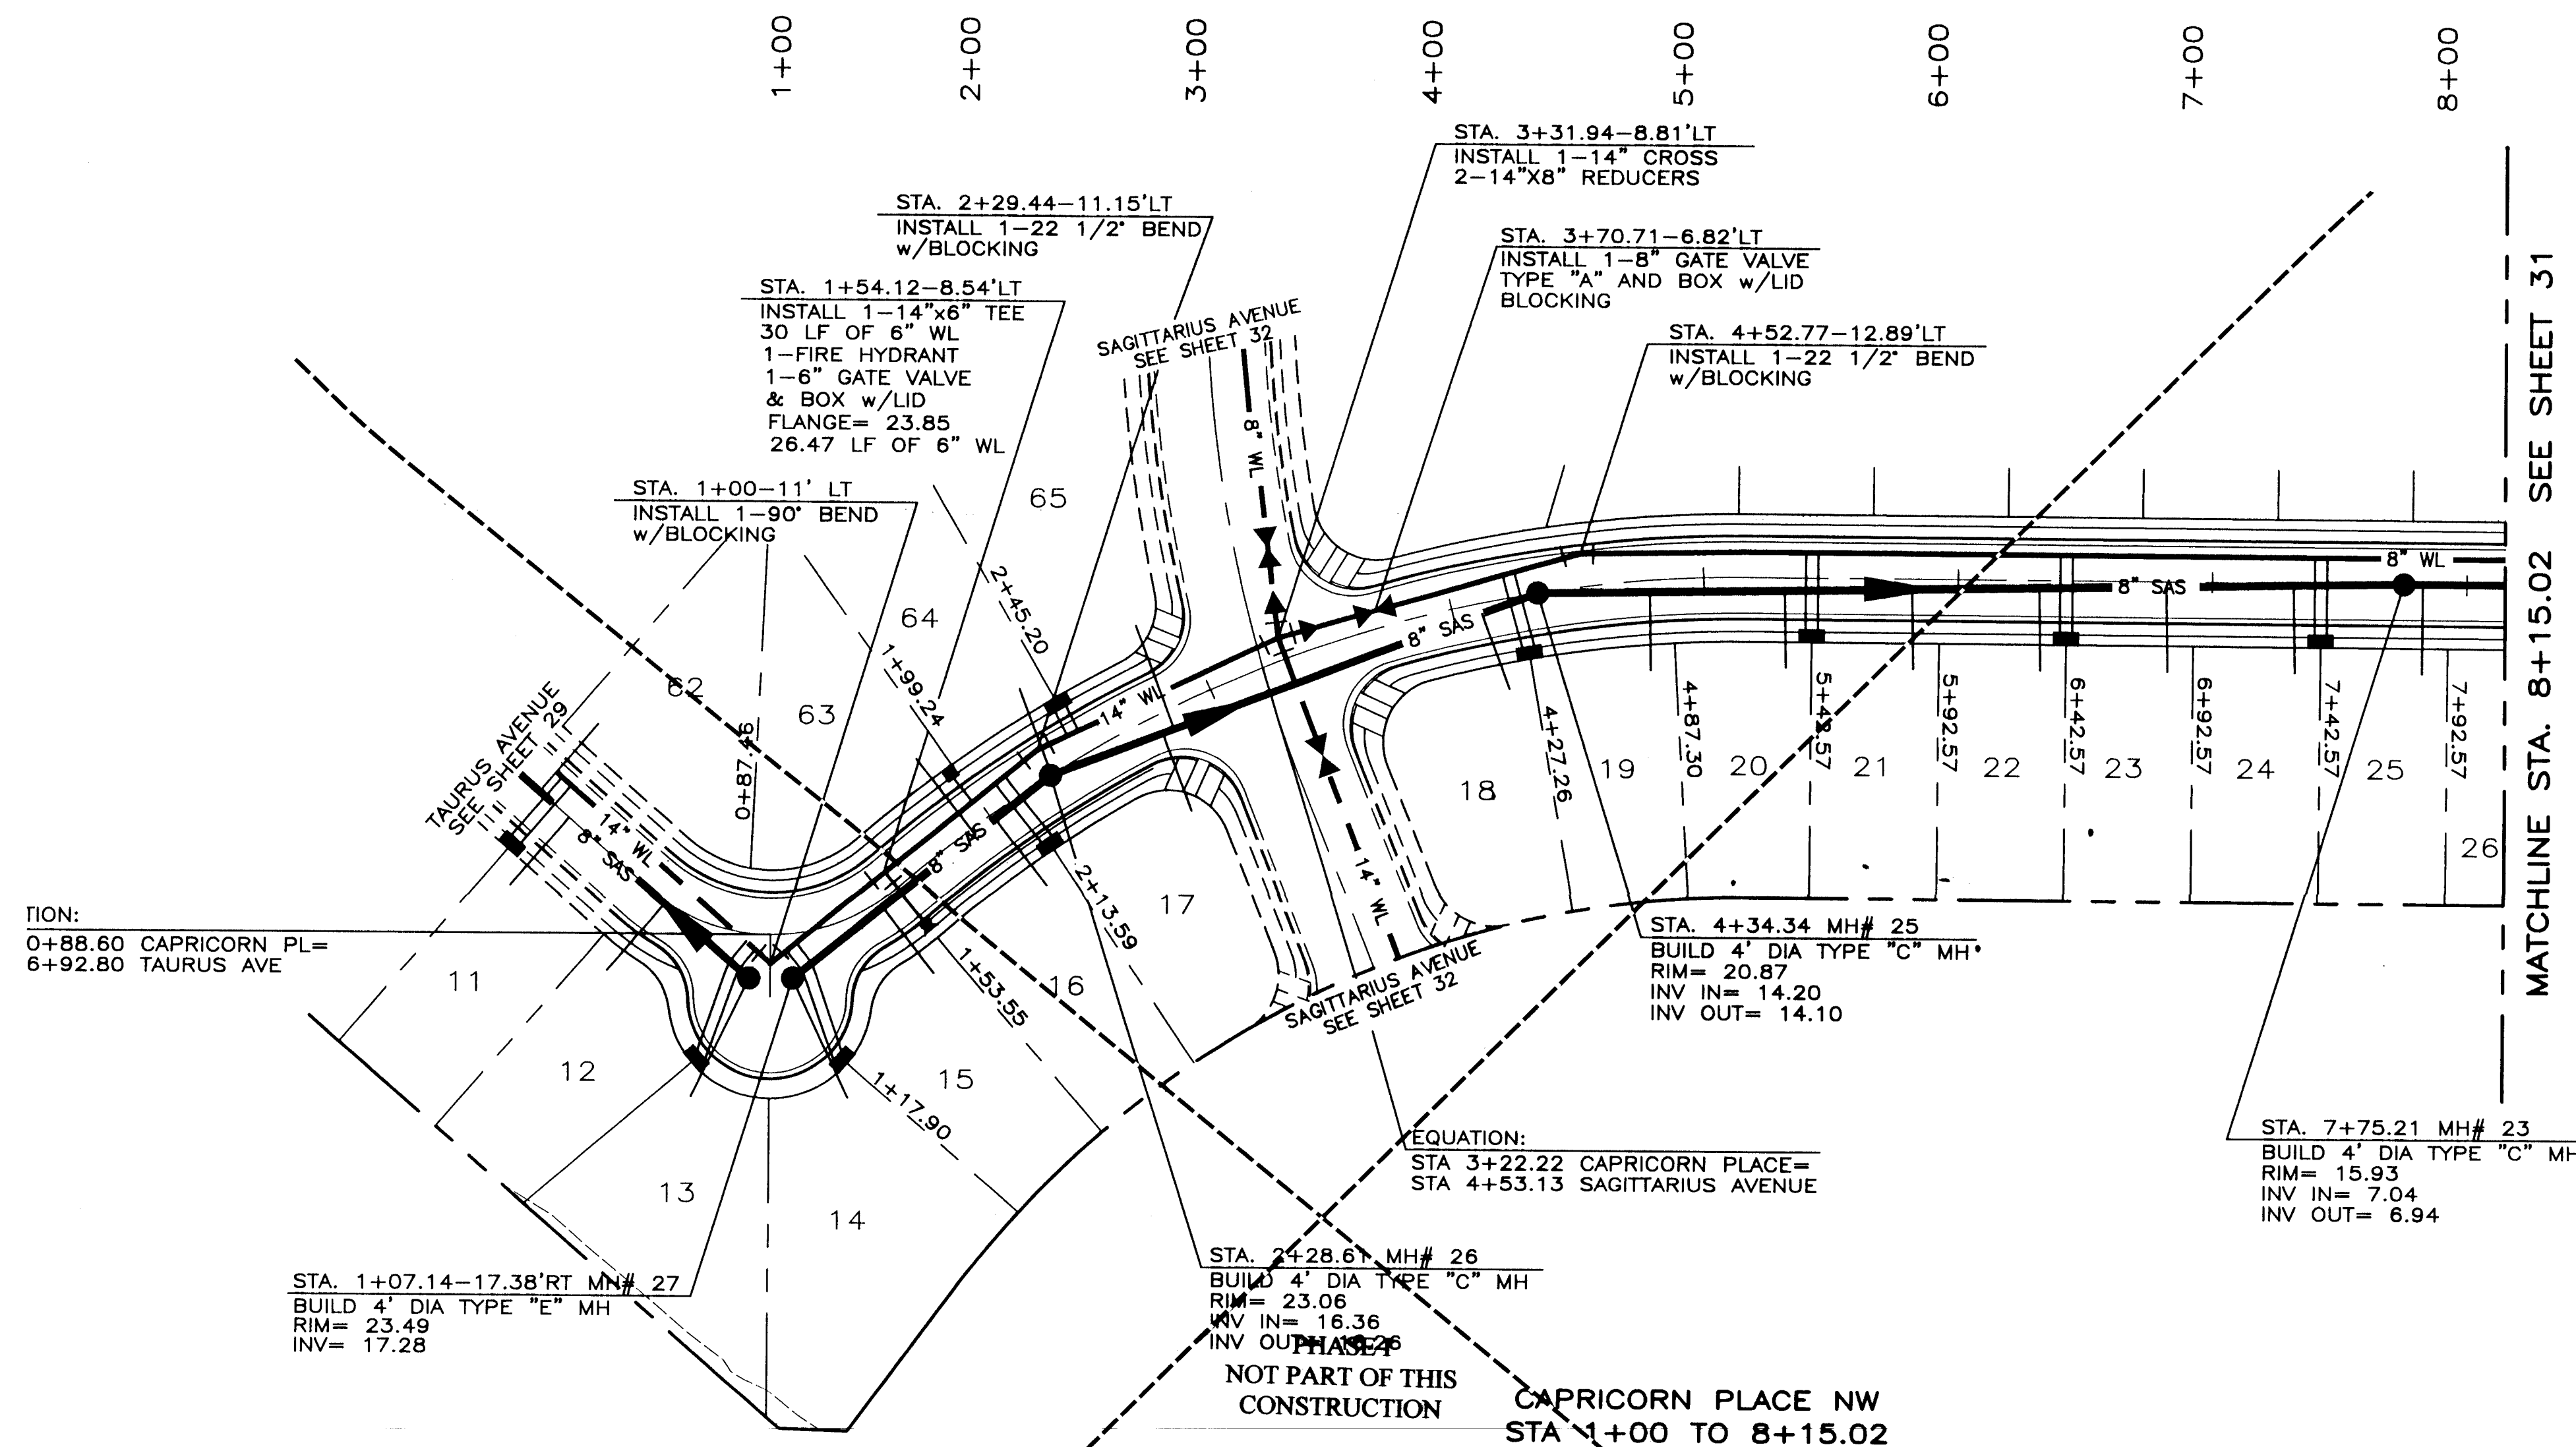


SAS TABLE				
LOT #	STATION	LF	PAD ELEV.	INV. • PL
14	1+16.41	51.59	25.57	19.52
15	1+46.72	32.48	24.68	19.33
16	2+02.85	32.86	24.34	18.93
17	2+71.72	32.25	23.84	18.27
18	4+16.52	31.25	22.30	16.92
19	4+76.56	30.56	22.10	15.92
20	5+32.57	30.01	21.27	15.29
21	5+82.57	31.04	20.49	14.68
22	6+32.57	32.07	19.76	14.08
23	6+82.57	33.09	19.04	13.47
24	7+32.57	34.12	18.31	12.85
25	7+82.57	35.00	17.58	12.50
63	1+89.89	37.63	25.10	19.01
64	2+29.19	35.79	24.42	18.10
65	2+84.44	43.03	24.15	18.22

WL TABLE		
LOT #	STATION	SERVICE
14&15	1+17.90	DOUBLE
16&17	2+13.59	DOUBLE
18&19	4+27.26	DOUBLE
20&21	5+42.57	DOUBLE
22&23	6+42.57	DOUBLE
24&25	7+42.57	DOUBLE
63	1+99.24	SINGLE
64&65	2+45.20	DOUBLE

CAUTION:
NOTE THAT ALL EXISTING UTILITIES MAY NOT BE SHOWN HEREON & THAT ANY EXISTING UTILITIES THAT ARE SHOWN ARE IN APPROXIMATE LOCATION ONLY. IT SHALL BE THE SOLE RESPONSIBILITY OF THE CONTRACTOR TO CONDUCT ALL NECESSARY FIELD INVESTIGATIONS PRIOR TO ANY EXCAVATION TO DETERMINE THE ACTUAL LOCATION OF UTILITIES & OTHER IMPROVEMENTS.

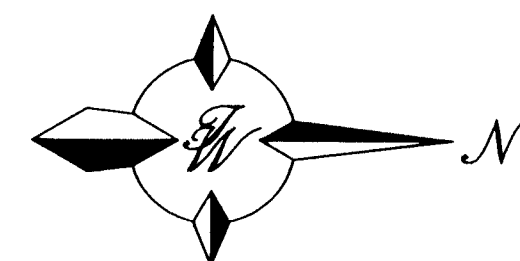

SCALE: HORIZ. 1"=50'
VERT. 1"= 5'

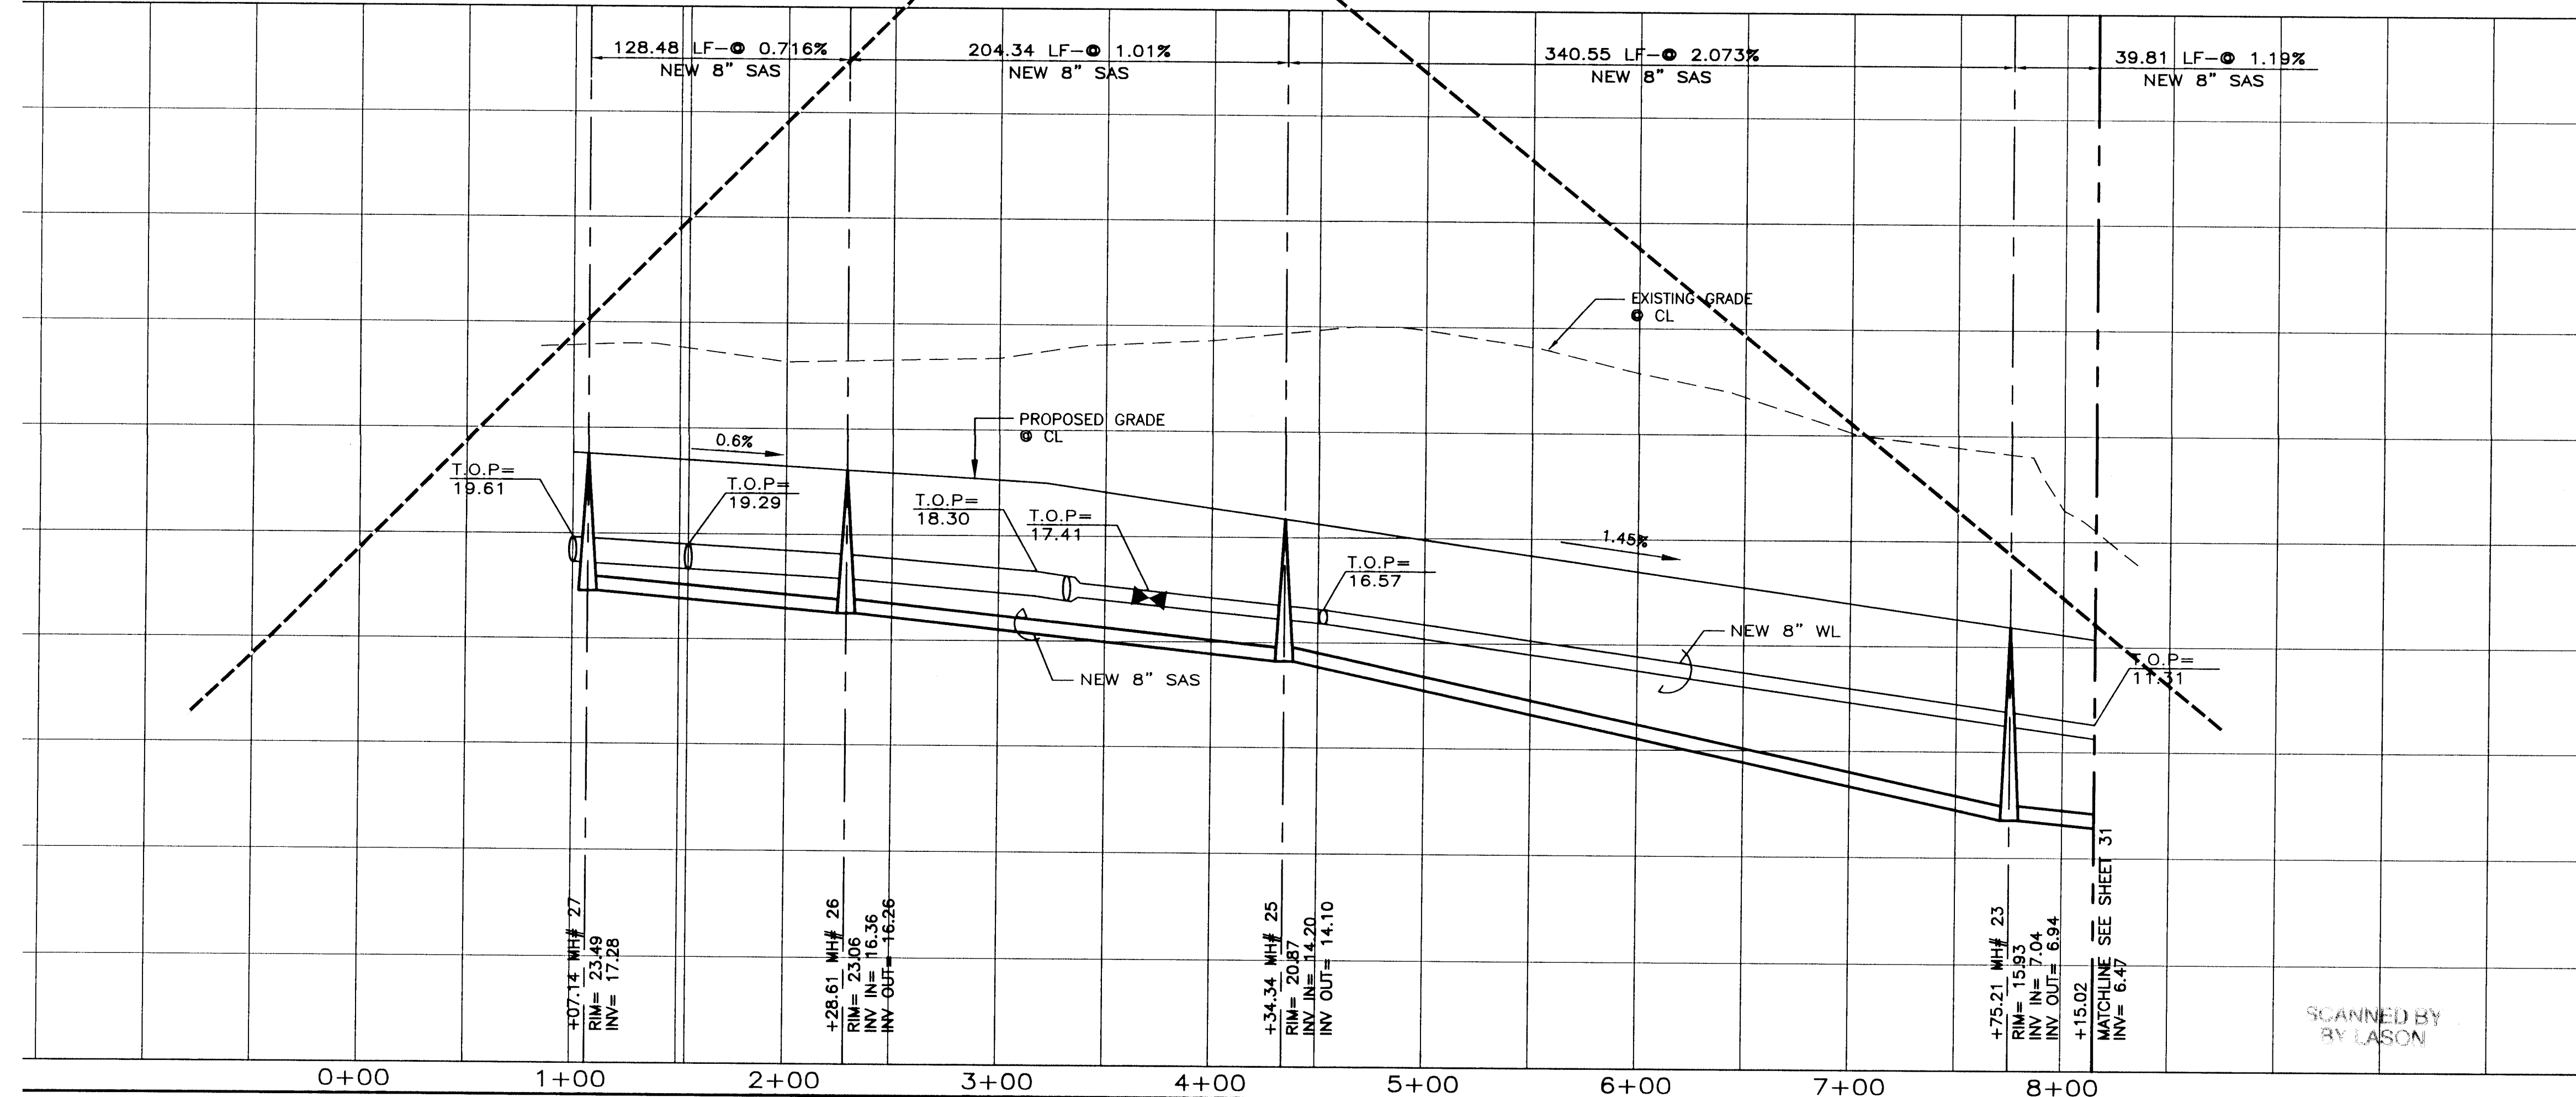

SCANNED BY
BY LASON


RECORD DRAWING	
DATE: 12/10/06	DRAFTED BY: Tierra West Dev.
THESE RECORD DRAWINGS HAVE BEEN PREPARED, IN PART, ON THE BASIS OF INFORMATION COMPILED AND FURNISHED BY OTHERS. THE ENGINEER WILL NOT BE RESPONSIBLE FOR ANY ERRORS OR OMISSIONS WHICH HAVE BEEN INCORPORATED INTO THIS DOCUMENT AS A RESULT.	
5340	
5335	
5330	
5325	
5320	
5315	

TERRA WEST DEVELOPMENT
MANAGEMENT SERVICES
4421 McLEOD ROAD, N.E., SUITE D
ALBUQUERQUE, NEW MEXICO 87109
(505)883-7592

CITY OF ALBUQUERQUE PUBLIC WORKS DEPARTMENT ENGINEERING GROUP			
TITLE: PARADISE SKIES UTILITY IMPROVEMENTS CAPRICORN PLACE STA 1+00 TO 8+15.02			
APPROVALS	ENGINEER	DATE	APPROVALS
DRC CHAIRMAN	<i>[Signature]</i>	11-15-95	WATER
TRANSPORTATION	<i>[Signature]</i>	10-20-95	WASTE WATER
HYDROLOGY	<i>[Signature]</i>	10-25-95	NMU
PROJECT NO.	5279.90 91	MAP NO.	A-11-Z
		SHEET	OF 30 43

50\9364\CAP1A.DWG\PGV\9-25-95

1 2 3 4 5 6 7 8 9 10 11 12 13 14 15
26-5279.91 11 10097 PHASE II

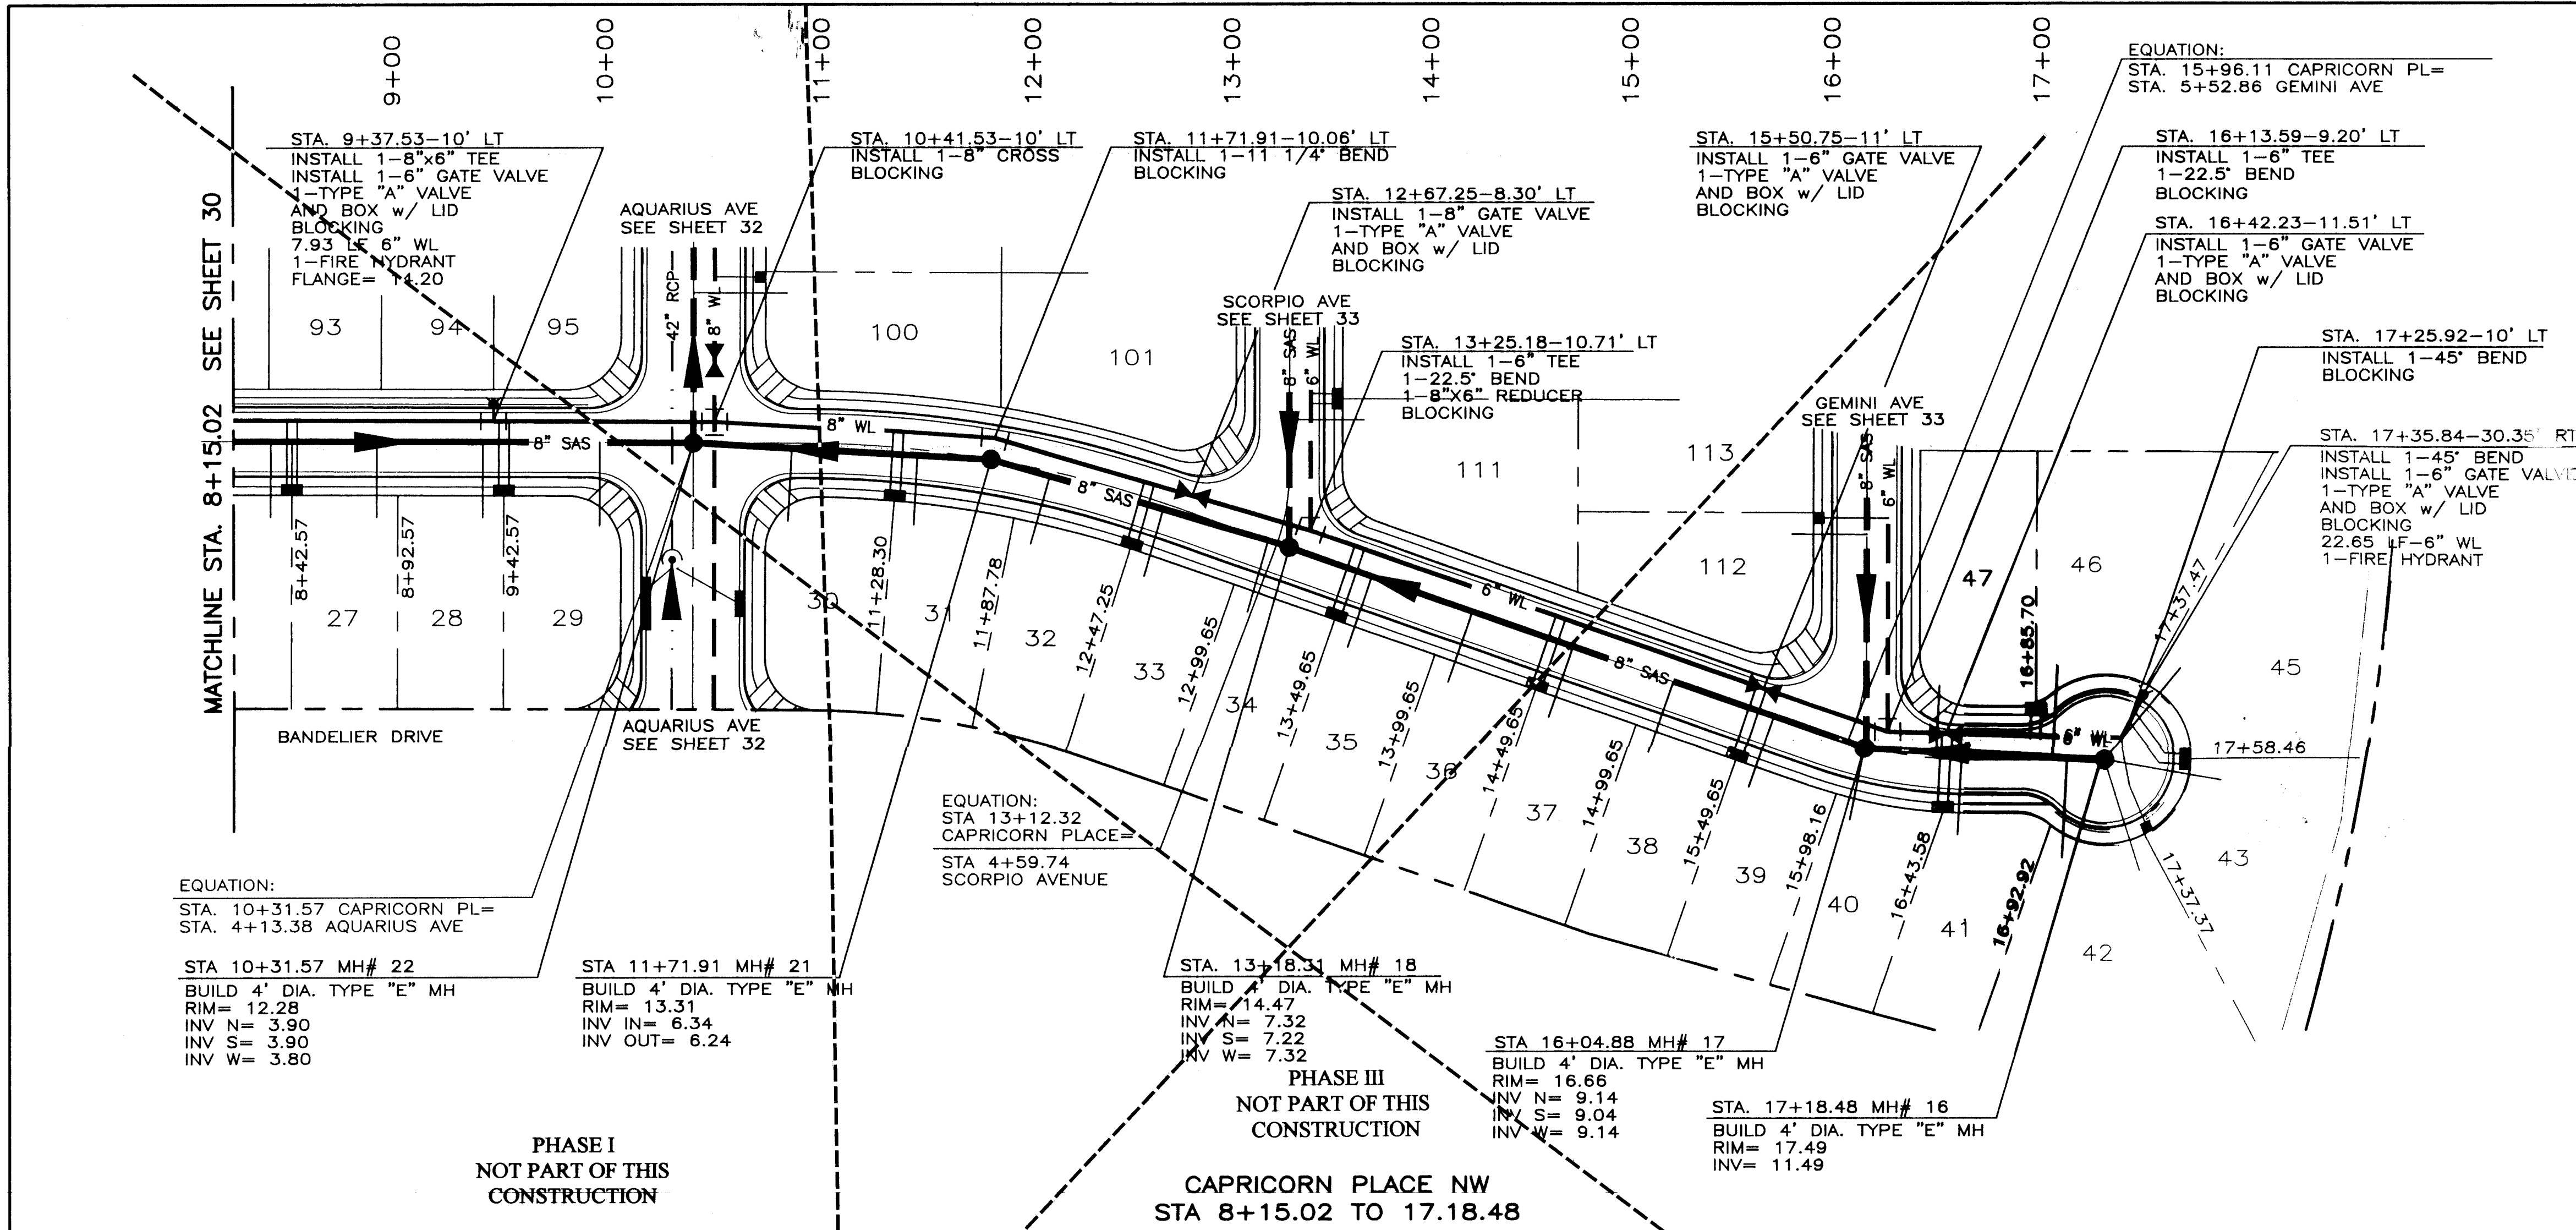


WL TABLE

LOT #	STATION	SERVICE
26&27	8+42.57	DOUBLE
28&29	9+42.57	DOUBLE
30&31	11+28.30	DOUBLE
32&33	12+47.25	DOUBLE
34&35	13+49.65	DOUBLE
36&37	14+49.65	DOUBLE
38&39	15+49.65	DOUBLE
40&41	16+43.58	DOUBLE
42	17+37.37	SINGLE
43&45	17+54.84	DOUBLE
46&47	16+85.70	DOUBLE


SAS TABLE

LOT #	STATION	LF	PAD EL=	INV. @ PL
26	8+32.57	35	16.86	11.20
27	8+82.57	35	16.13	10.34
28	9+32.57	35	15.41	9.48
29	9+82.57	38.62	14.68	8.62
30	10+76.25	35	14.16	8.04
31	11+39.00	32.26	14.60	8.42
32	11+98.48	32.54	15.05	8.87
33	12+57.95	32.03	15.51	9.23
34	13+09.65	34.82	15.90	9.54
35	13+59.65	35	16.29	9.93
36	14+09.65	35	16.69	10.23
37	14+59.65	35	17.08	10.53
38	15+09.65	35	17.28	10.84
39	15+59.65	35	16.98	11.14
40	16+06.25	34.27	17.36	12.00
41	16+50.82	38.15	17.57	12.46
42	16+98.32	46.66	17.97	13.45
43	17+72.55	50	18.94	13.49
45	17+52.96	50	18.75	13.49
46	16+95.70	43.38	18.46	13.57
47	16+36.91	31.25	17.85	12.18

CAUTION:
NOTE THAT ALL EXISTING UTILITIES MAY NOT BE SHOWN HEREON & THAT ANY EXISTING UTILITIES THAT ARE SHOWN ARE IN APPROXIMATE LOCATION ONLY. IT SHALL BE THE SOLE RESPONSIBILITY OF THE CONTRACTOR TO CONDUCT ALL NECESSARY FIELD INVESTIGATIONS PRIOR TO ANY EXCAVATION TO DETERMINE THE ACTUAL LOCATION OF UTILITIES & OTHER IMPROVEMENTS.

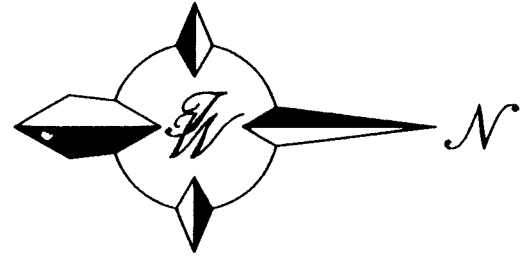


SCALE: HORIZ. 1"=50'
VERT. 1"= 5'

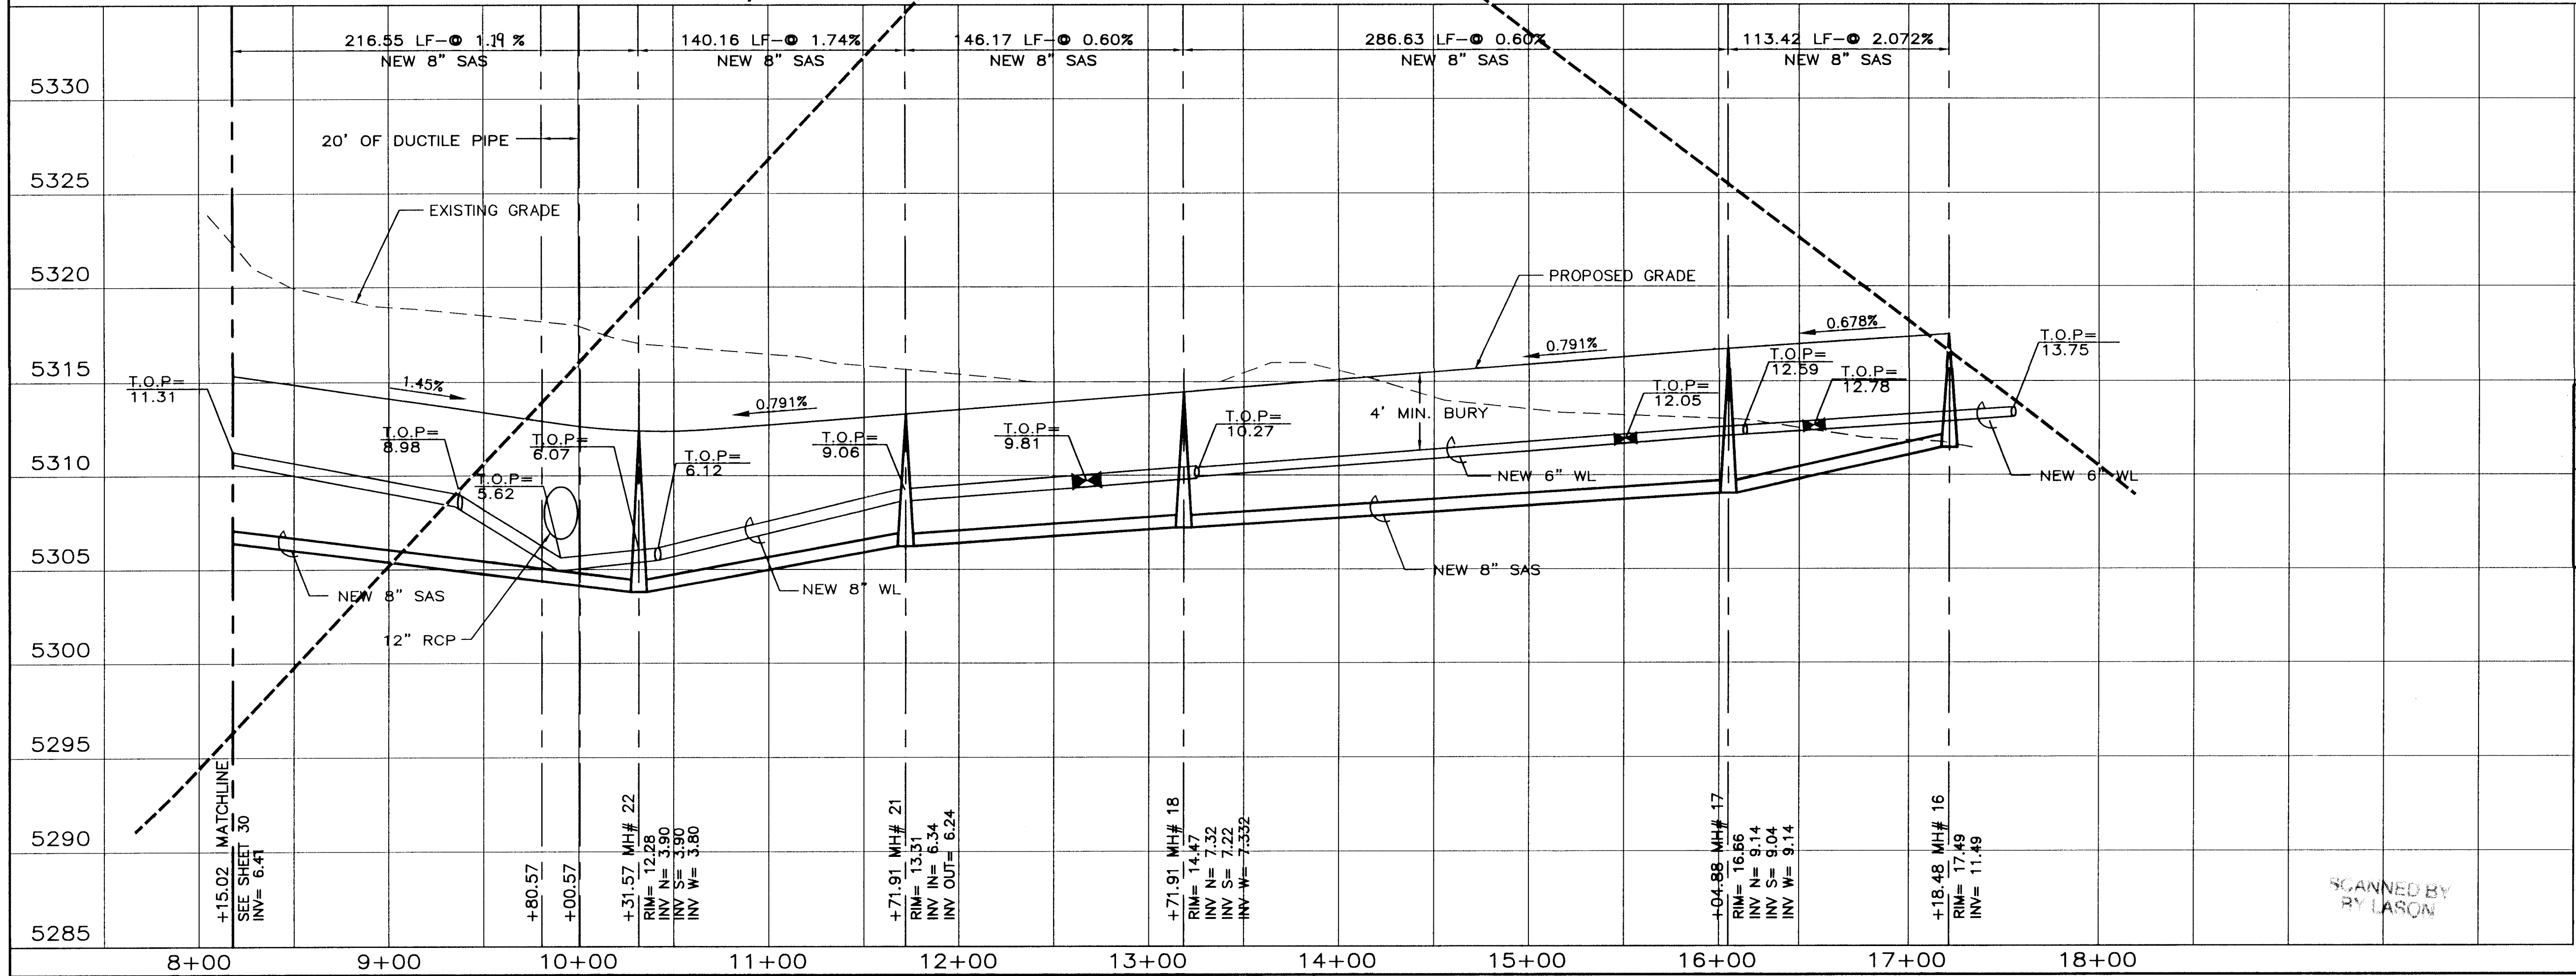

RECORD DRAWING
DATE: 12/14/96
DRAFTED BY: Tierra West Dev
THESE RECORD DRAWINGS HAVE BEEN PREPARED, IN PART, ON THE BASIS OF INFORMATION COMPILED AND FURNISHED BY OTHERS. THE ENGINEER WILL NOT BE RESPONSIBLE FOR ANY ERRORS OR OMISSIONS WHICH HAVE BEEN INCORPORATED INTO THIS DOCUMENT AS A RESULT.

TIERRA WEST DEVELOPMENT
MANAGEMENT SERVICES
4421 McLEOD ROAD, N.E., SUITE D
ALBUQUERQUE, NEW MEXICO 87109
(505)883-7592



CITY OF ALBUQUERQUE PUBLIC WORKS DEPARTMENT ENGINEERING GROUP			
TITLE: PARADISE SKIES UTILITY IMPROVEMENTS CAPRICORN PLACE STA 8+15.02 TO 17+18.48			
APPROVALS	ENGINEER	DATE	APPROVALS
DRC CHAIRMAN	B.G. Sakky	11-15-95	WATER
TRANSPORTATION	R.W. Kane	10-20-95	WASTE WATER
HYDROLOGY	M.A. Cam	11-25-95	NMU
DESIGNED BY	XX	DATE 7-95	STAFF
DRAWN BY	RRB	DATE 7-95	CHECKED BY
PROJECT NO.	5279.9071	MAP NO.	A-11-Z
SHEET	31	OF	43

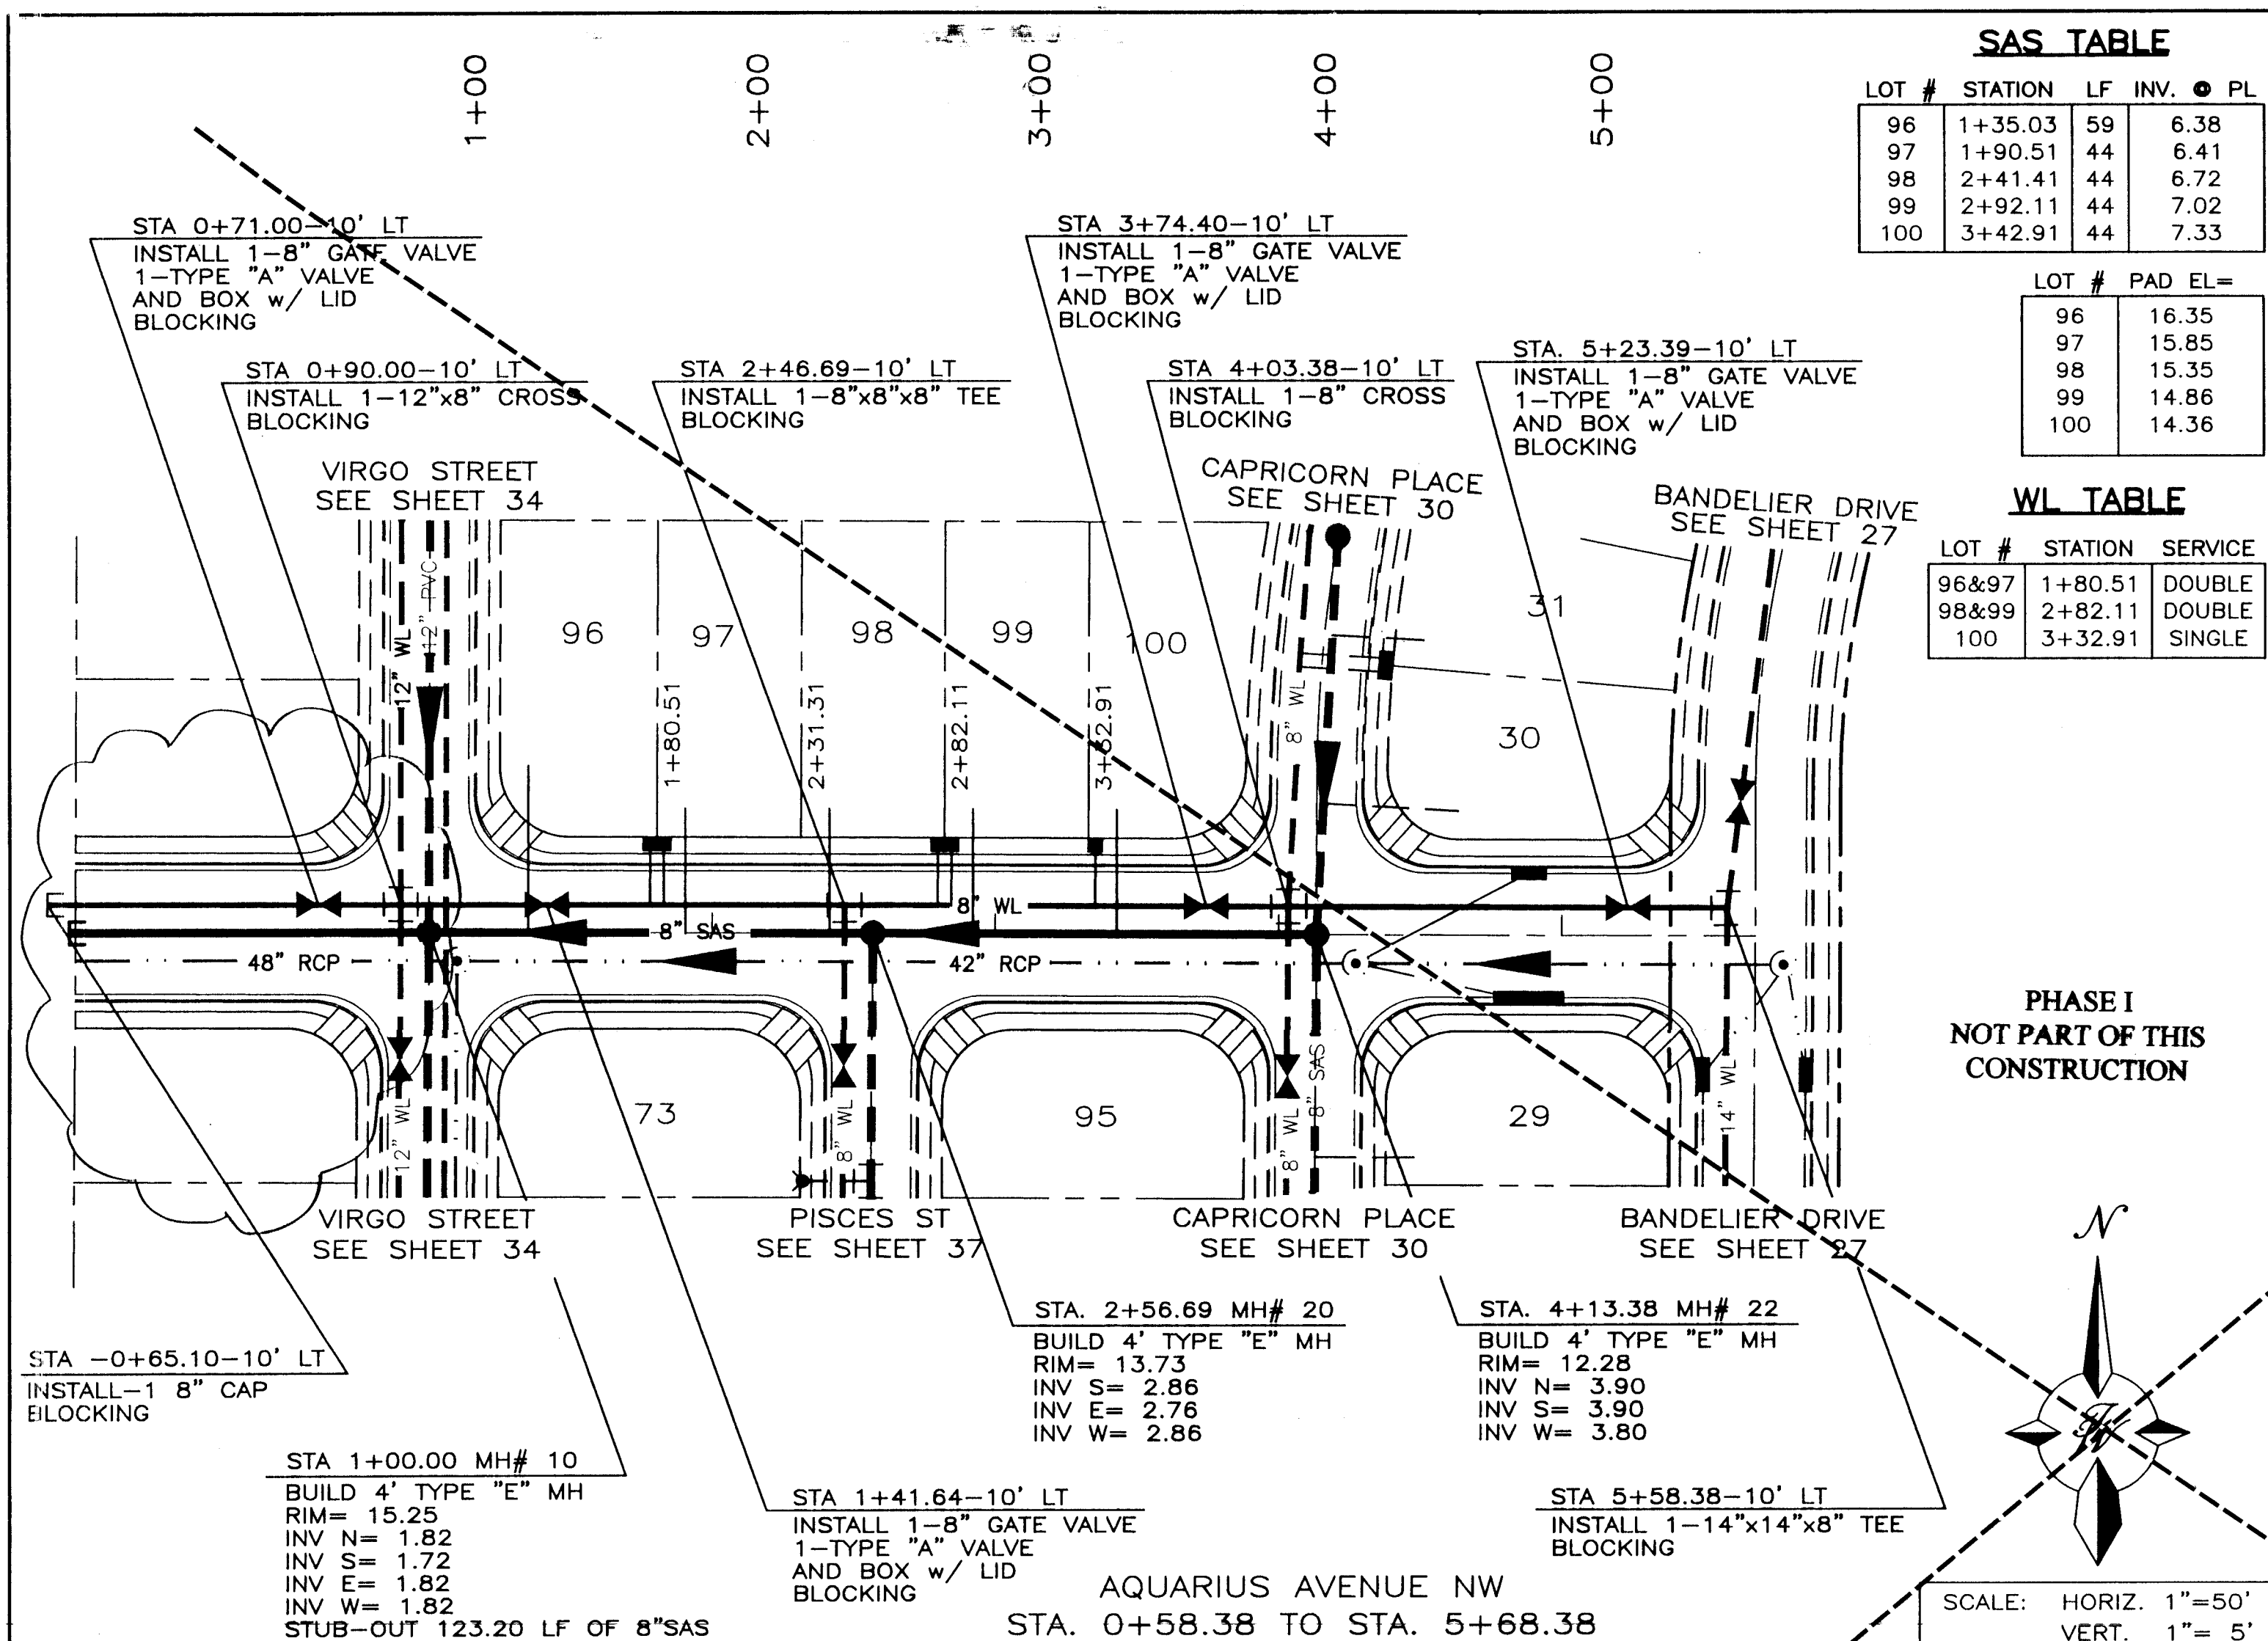

SAS TABLE				
LOT #	STATION	LF	INV.	PL
96	1+35.03	59	6.38	
97	1+90.51	44	6.41	
98	2+41.41	44	6.72	
99	2+92.11	44	7.02	
100	3+42.91	44	7.33	

LOT #	PAD EL=
96	16.35
97	15.85
98	15.35
99	14.86
100	14.36


WL TABLE			
LOT #	STATION	SERVICE	
96&97	1+80.51	DOUBLE	
98&99	2+82.11	DOUBLE	
100	3+32.91	SINGLE	

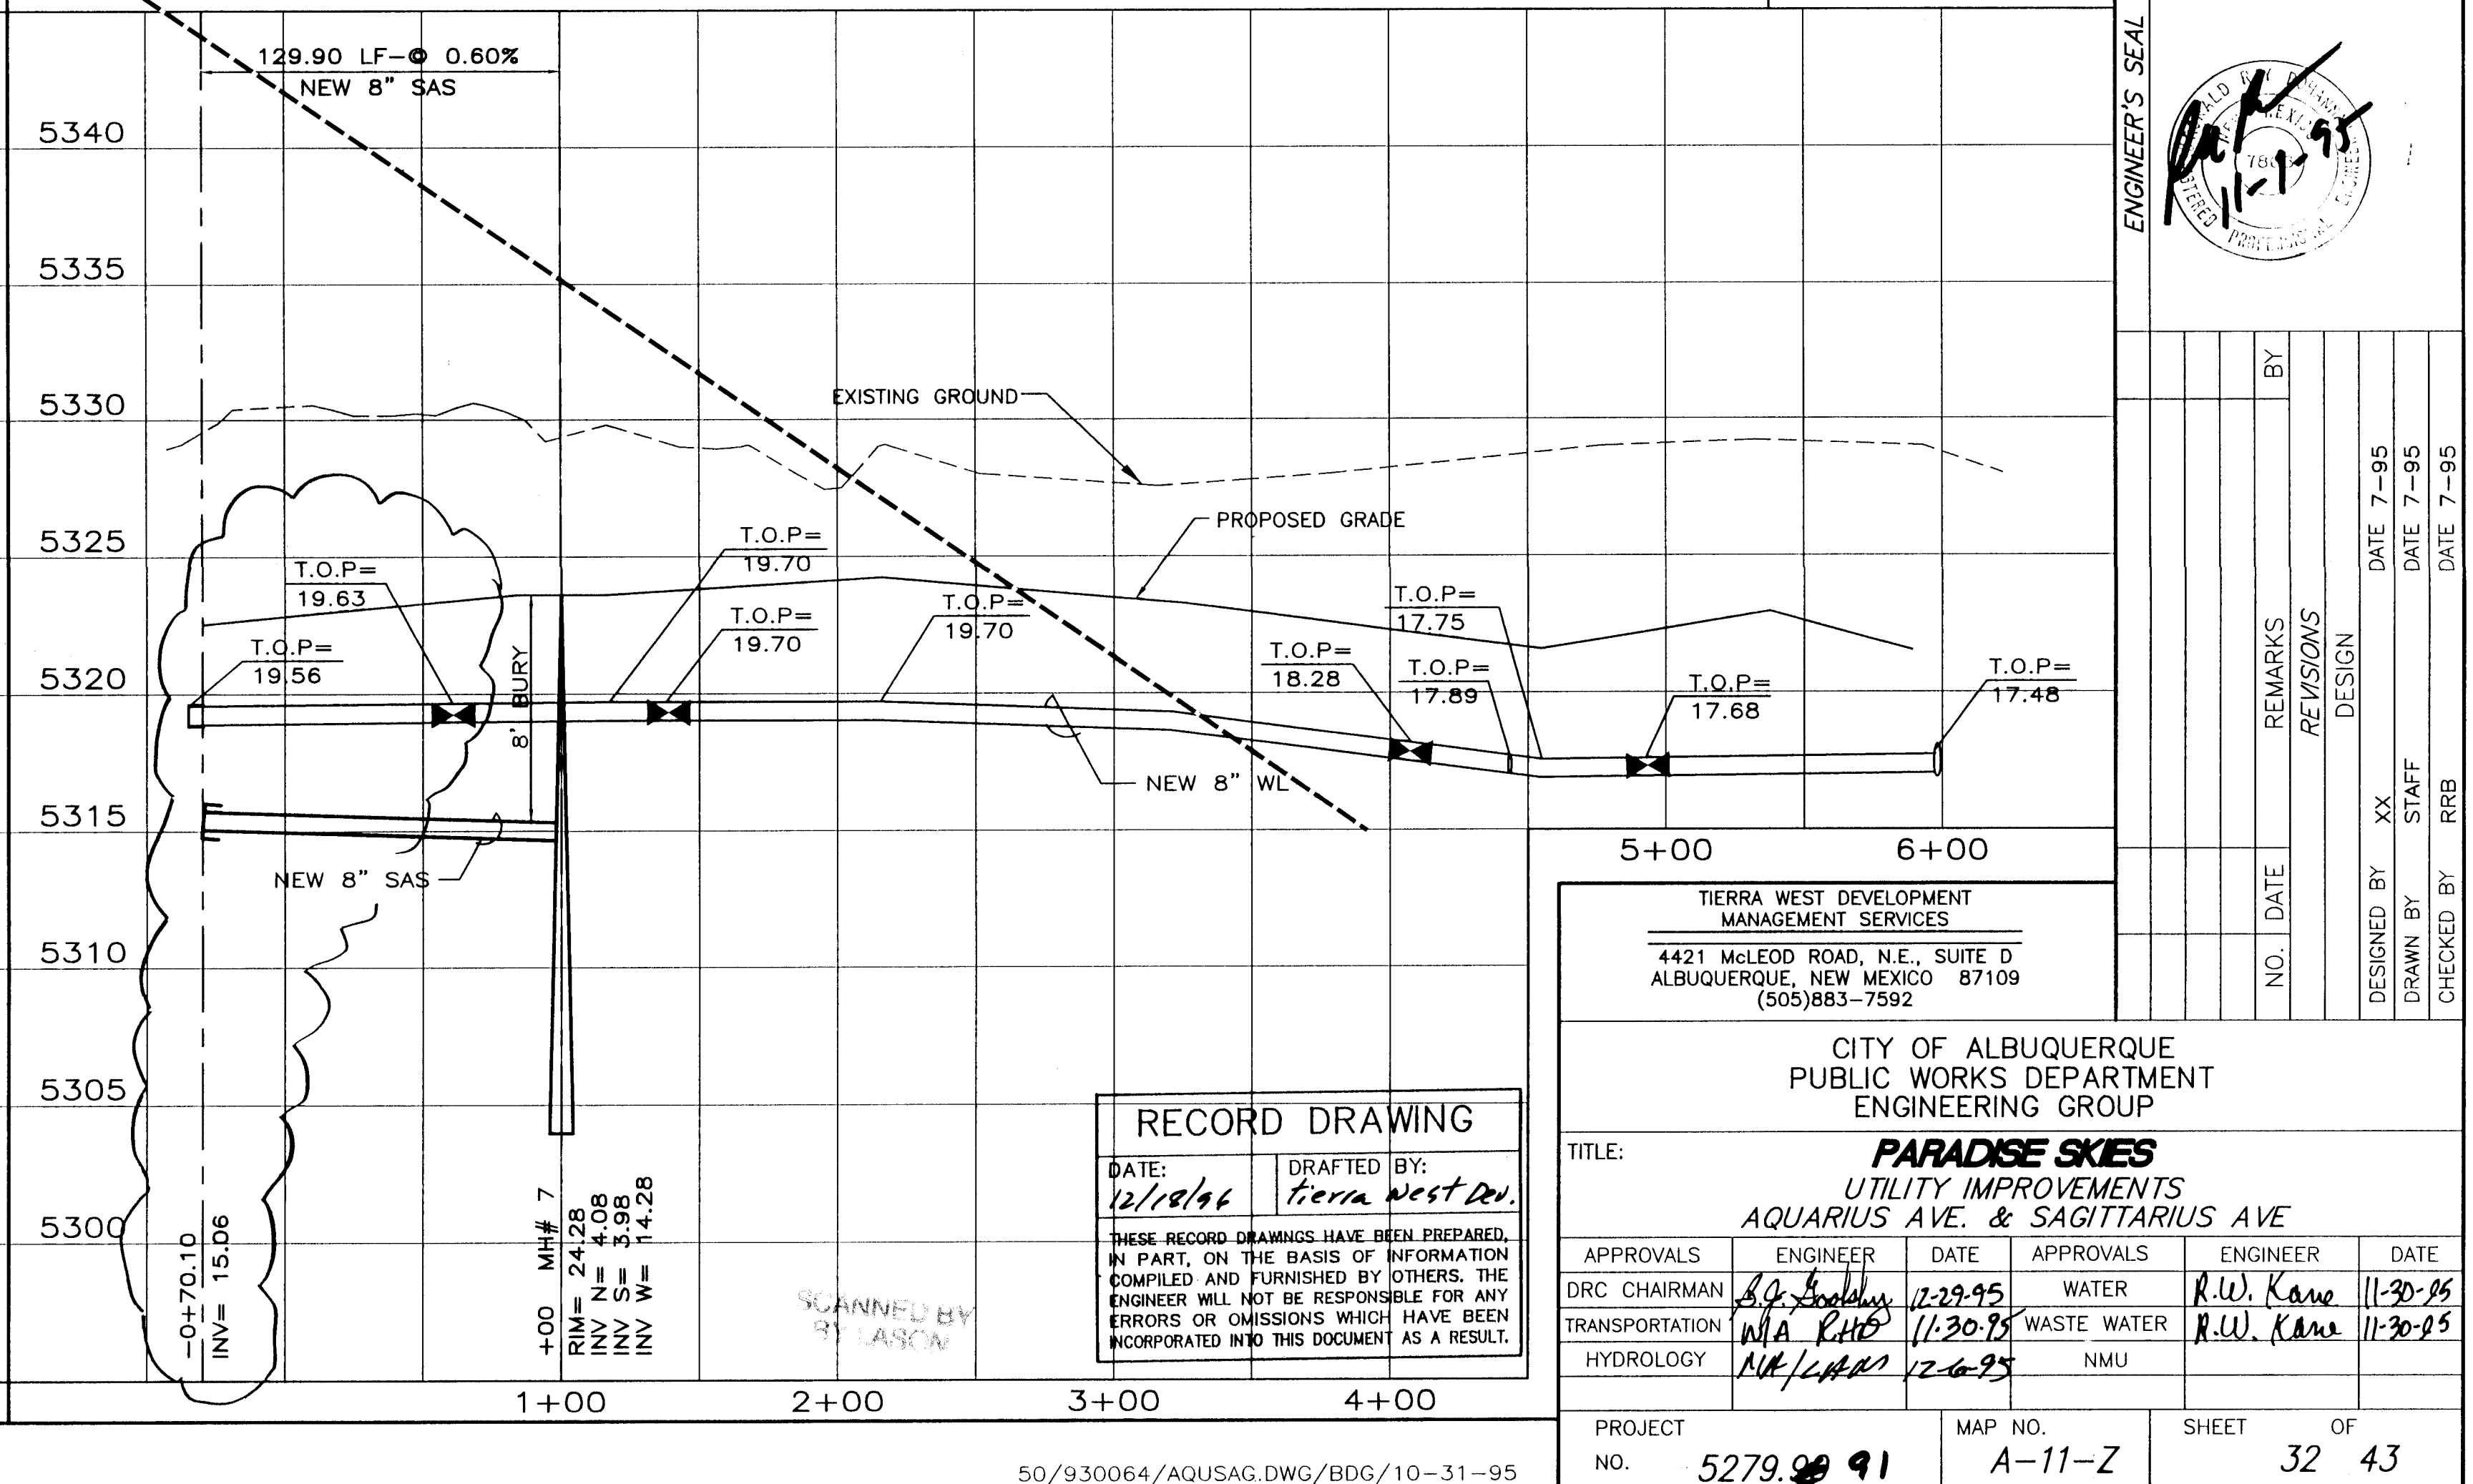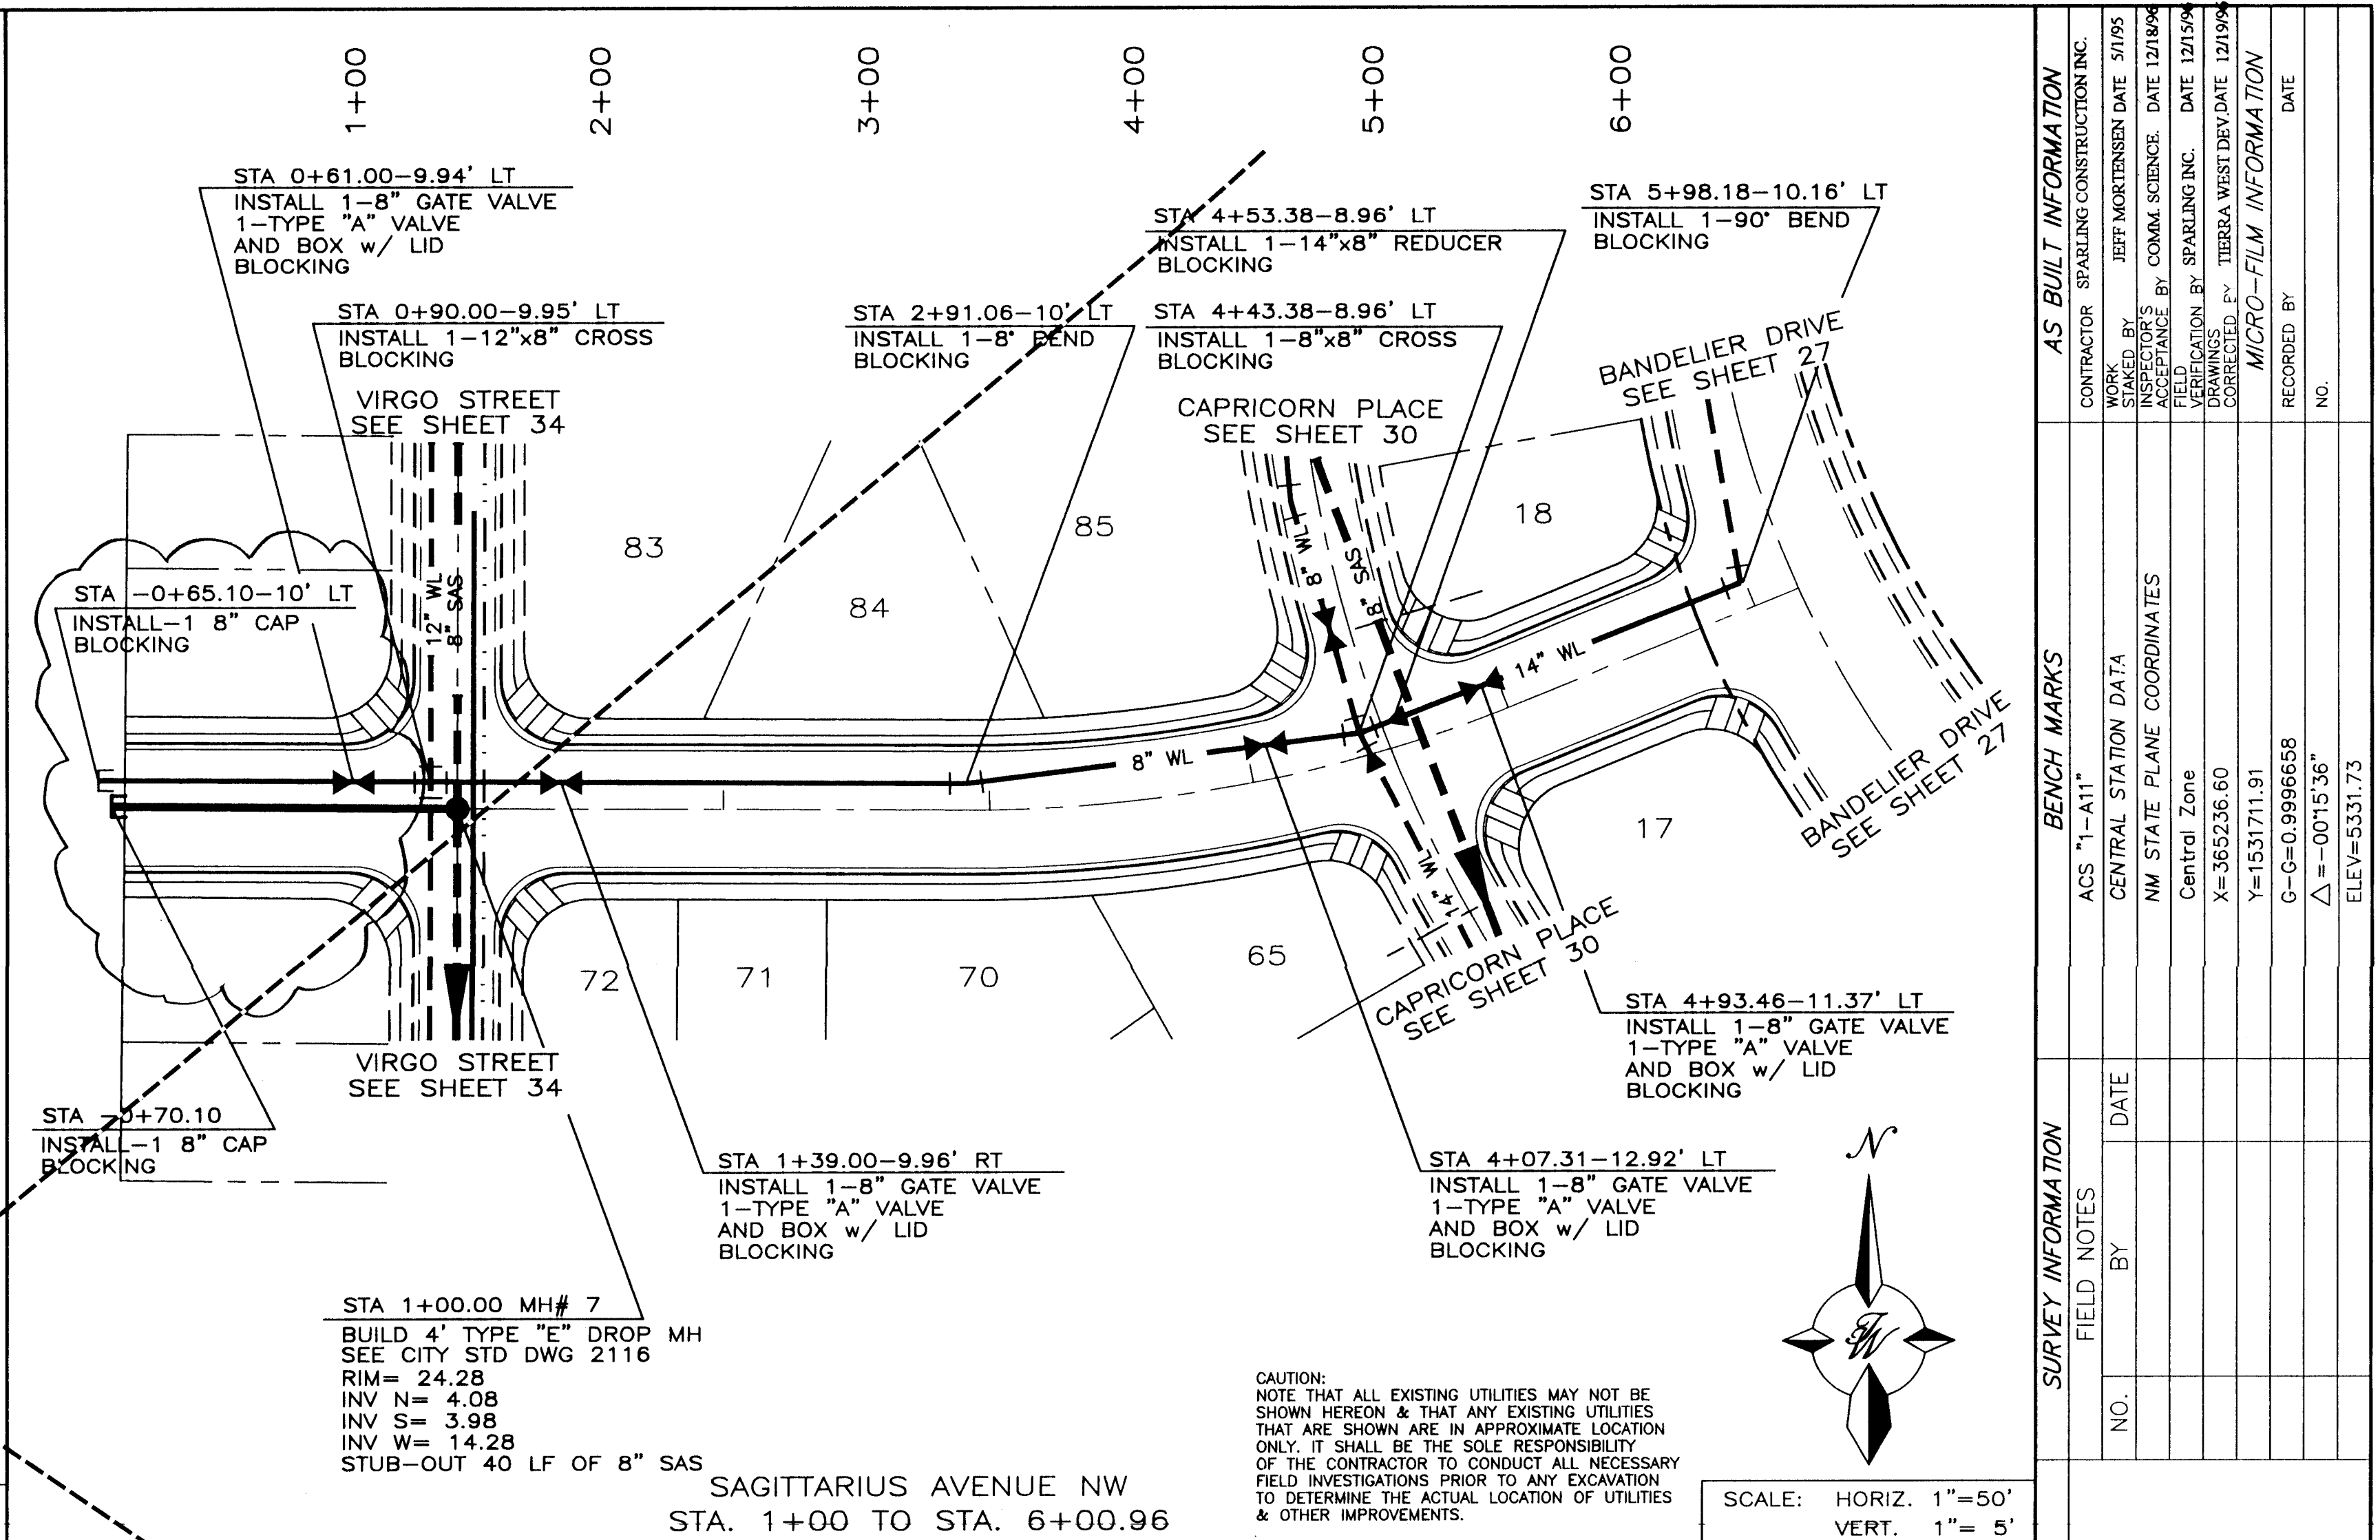

RECORD DRAWING
DATE: 12/10/96
DRAFTED BY: Tierra West Dev.
THESE RECORD DRAWINGS HAVE BEEN PREPARED, IN PART, ON THE BASIS OF INFORMATION COMPILED AND FURNISHED BY OTHERS. THE ENGINEER WILL NOT BE RESPONSIBLE FOR ANY ERRORS OR OMISSIONS WHICH HAVE BEEN INCORPORATED INTO THIS DOCUMENT AS A RESULT.

TIERRA WEST DEVELOPMENT MANAGEMENT SERVICES 4421 MCLEOD ROAD, N.E., SUITE D ALBUQUERQUE, NEW MEXICO 87109 (505)883-7592					
CITY OF ALBUQUERQUE PUBLIC WORKS DEPARTMENT ENGINEERING GROUP					
TITLE: PARADISE SKIES UTILITY IMPROVEMENTS AQUARIUS AVE. & SAGITTARIUS AVE					
APPROVALS	ENGINEER	DATE	APPROVALS	ENGINEER	DATE
DRC CHAIRMAN	<i>[Signature]</i>	12-29-95	WATER	<i>[Signature]</i>	11-30-95
TRANSPORTATION	<i>[Signature]</i>	11-30-95	WASTE WATER	<i>[Signature]</i>	11-30-95
HYDROLOGY	<i>[Signature]</i>	12-26-95	NMU		
PROJECT NO.	5279.99 91	MAP NO.	A-11-Z	SHEET	32 OF 43


AS BUILT INFORMATION		BENCH MARKS		SURVEY INFORMATION		ENGINEER'S SEAL	
CONTRACTOR	SPARKLING CONSTRUCTION INC.	ACS	11-A11	FIELD NOTES	DATE		
WORK	BY JEFF MORTENSEN DATE 5/19/95	CENTRAL STATION DATA		NO.			
INSPECTOR'S ACCEPTANCE	DATE 12/18/96	NM STATE PLANE COORDINATES		BY			
VERIFICATION BY	SPARKLING INC. DATE 12/15/96	Central Zone		REMARKS			
DRAWINGS	CORRECTED 2nd TIERA WEST DEV. DATE 12/19/96	X=365236.60		DESIGNED BY	XX	DATE 7-95	
		Y=1531711.91		DRAWN BY	STAFF	DATE 7-95	
		G-G=0.9996658		CHECKED BY	RRB	DATE 7-95	
		Δ=-0.015'36"					
		ELEV=5331.73					

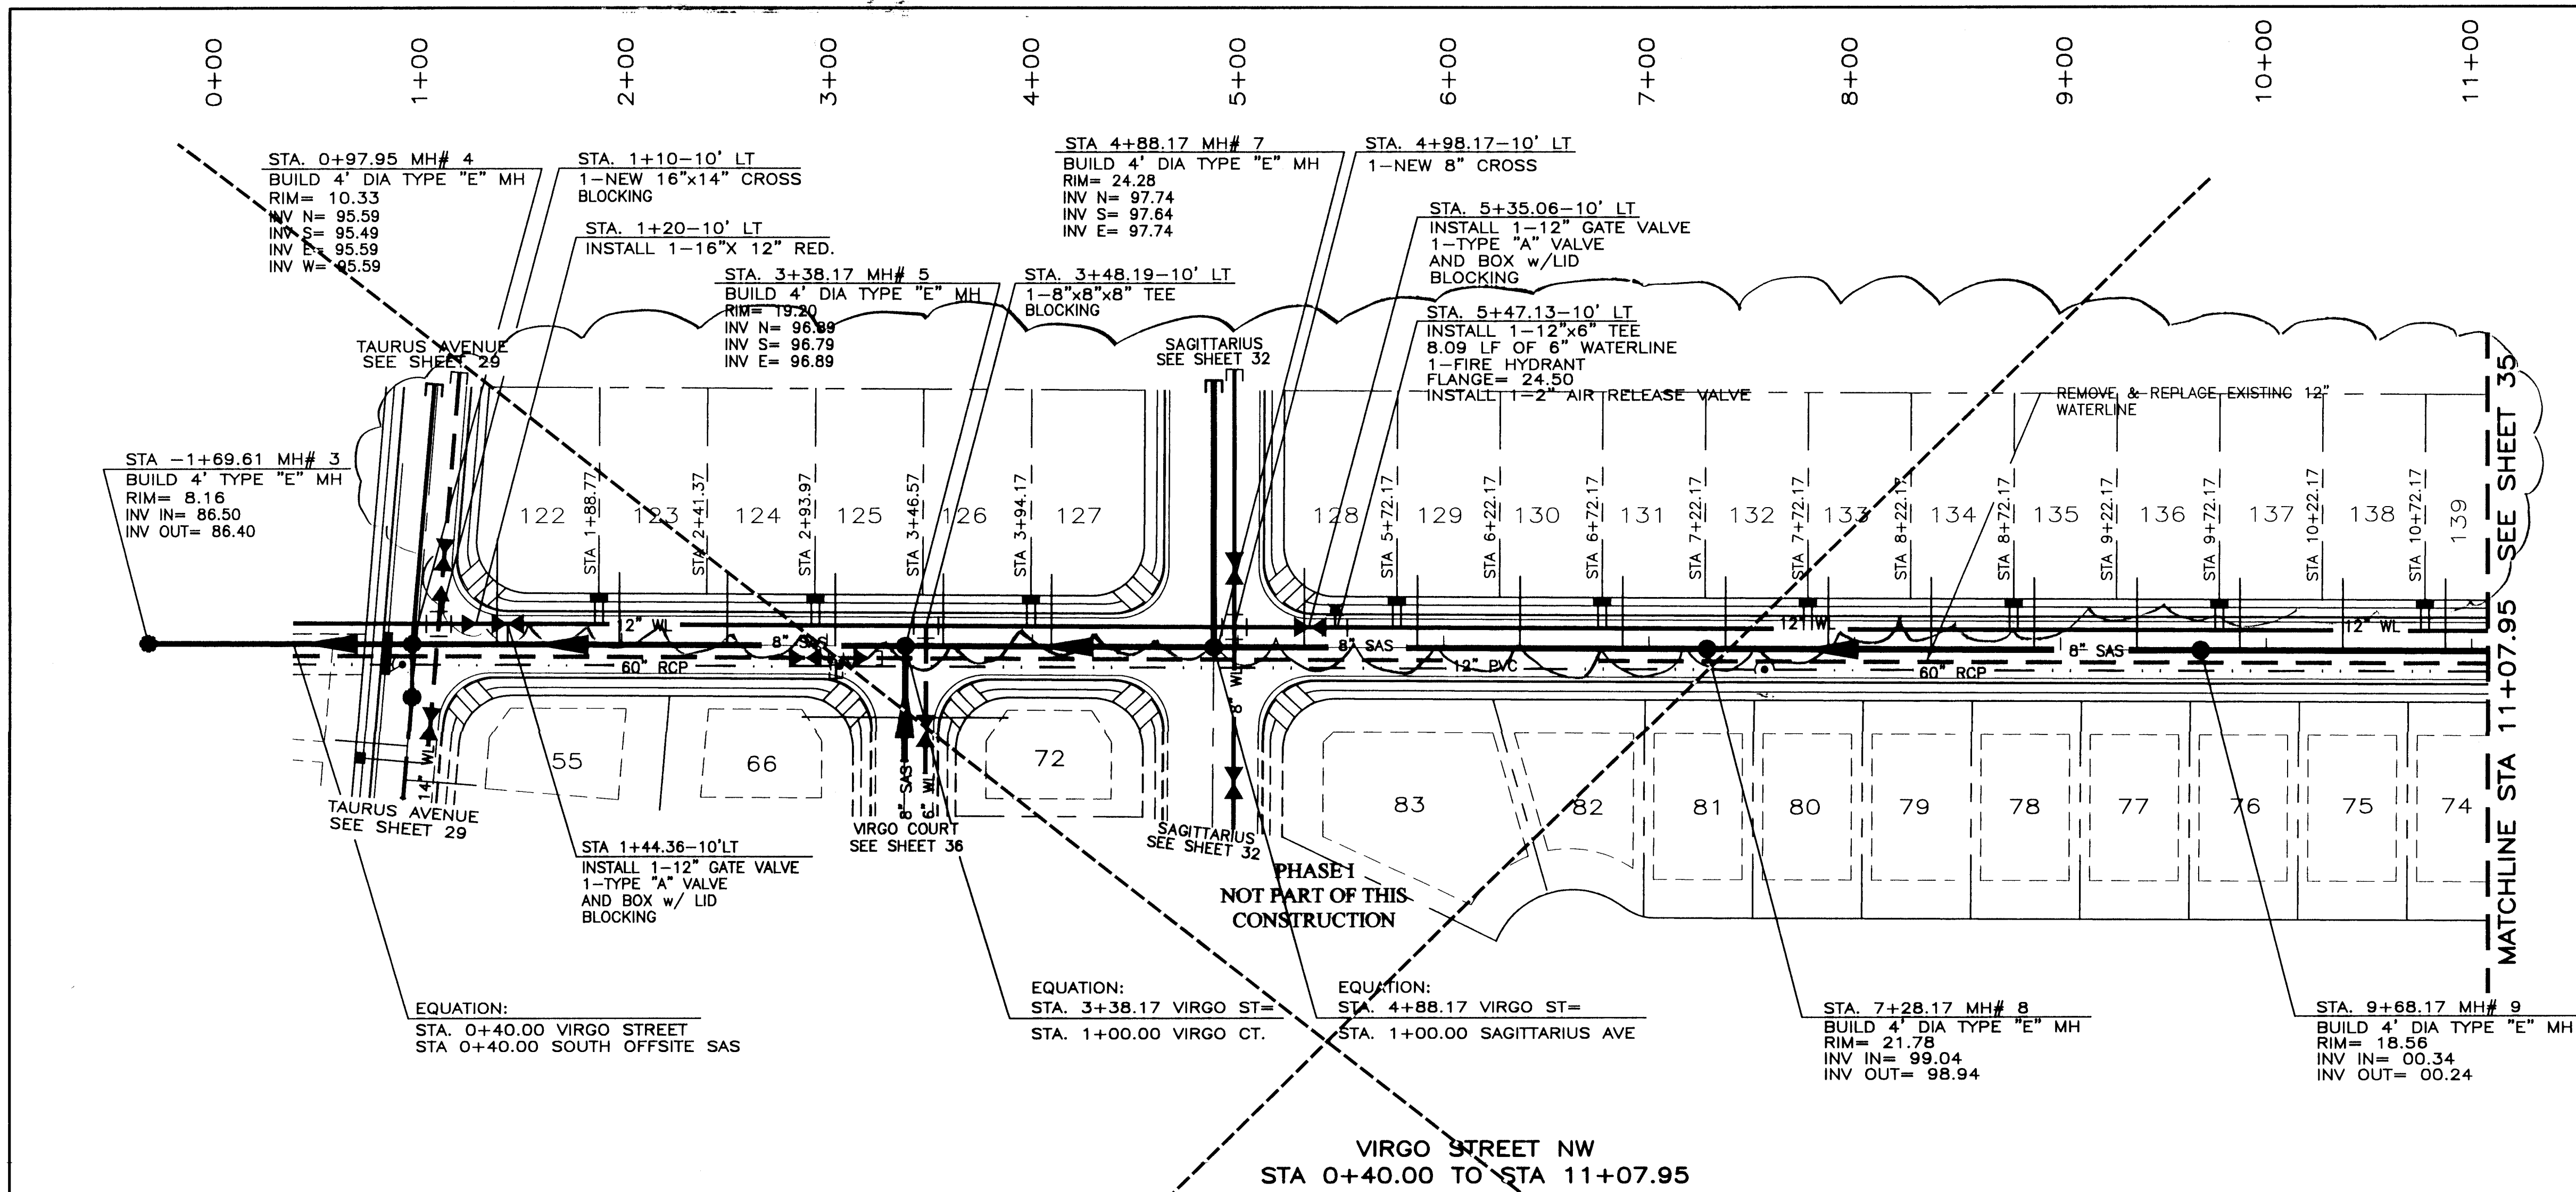


SAS TABLE				
LOT #	STATION	LF	PAD EL=	INV. ● PL
122	1+39.15	51	14.00	5.50
123	1+98.77	35	16.00	8.24
124	2+51.37	35	18.00	10.09
125	3+03.97	35	20.00	11.94
126	3+56.57	35	22.00	13.82
127	4+04.17	35	24.00	15.75
128	5+27.19	50	24.00	18.41
129	5+82.17	35	23.50	17.74
130	6+32.17	35	22.75	17.07
131	6+82.17	35	22.00	16.40
132	7+32.17	35	21.50	15.73
133	7+82.17	35	20.75	15.06
134	8+32.17	35	20.00	14.39
135	8+82.17	35	19.50	13.72
136	9+32.17	35	18.75	13.05
137	9+82.17	35	18.00	12.38
138	10+32.17	35	17.50	11.71
139	10+82.17	35	17.00	11.04

WL TABLE		
LOT #	STATION	SERVICE
122&123	1+94.17	DOUBLE
124&125	2+94.17	DOUBLE
126&127	3+94.17	DOUBLE
128&129	5+72.16	DOUBLE
130&131	6+72.16	DOUBLE
132&133	7+72.16	DOUBLE
134&135	8+72.16	DOUBLE
136&137	9+72.16	DOUBLE
138&139	10+72.16	DOUBLE

CAUTION:
NOTE THAT ALL EXISTING UTILITIES MAY NOT BE SHOWN HEREON & THAT ANY EXISTING UTILITIES THAT ARE SHOWN ARE IN APPROXIMATE LOCATION ONLY. IT SHALL BE THE SOLE RESPONSIBILITY OF THE CONTRACTOR TO CONDUCT ALL NECESSARY FIELD INVESTIGATIONS PRIOR TO ANY EXCAVATION TO DETERMINE THE ACTUAL LOCATION OF UTILITIES & OTHER IMPROVEMENTS.

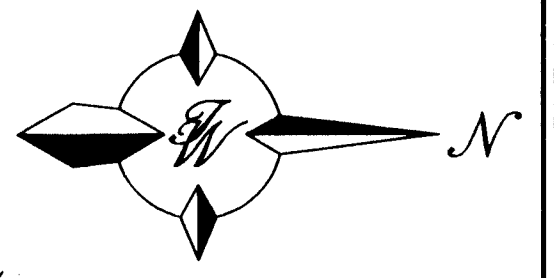


SCALE: HORIZ. 1"=50'
VERT. 1"= 5'

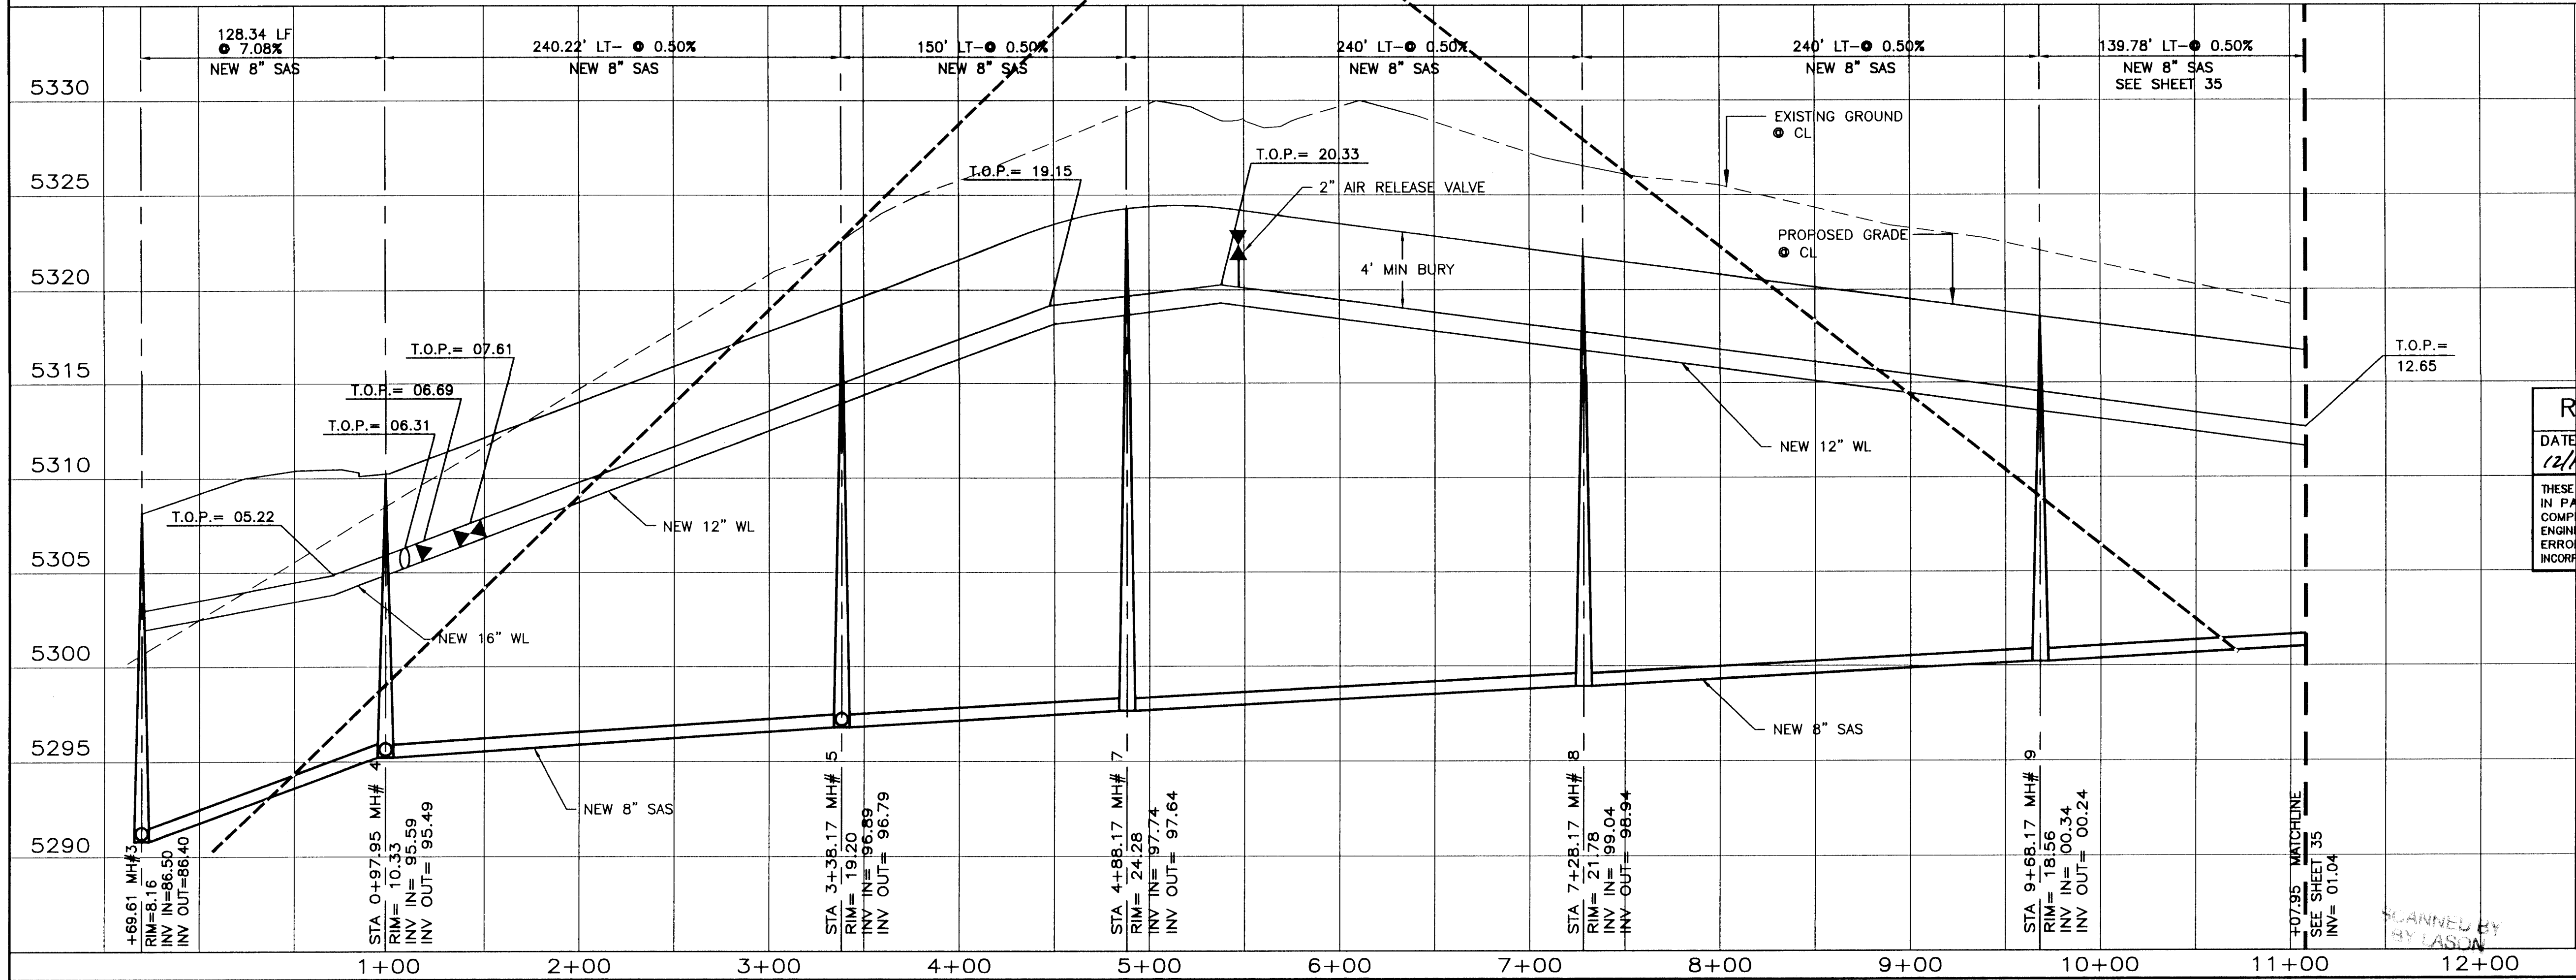

RECORD DRAWING	
DATE: 12/19/96	DRAFTED BY: Tierra West Dev
THESE RECORD DRAWINGS HAVE BEEN PREPARED, IN PART, ON THE BASIS OF INFORMATION COMPILED AND FURNISHED BY OTHERS. THE ENGINEER WILL NOT BE RESPONSIBLE FOR ANY ERRORS OR OMISSIONS WHICH HAVE BEEN INCORPORATED INTO THIS DOCUMENT AS A RESULT.	


TIERRA WEST DEVELOPMENT MANAGEMENT SERVICES 4421 McLEOD ROAD, N.E., SUITE D ALBUQUERQUE, NEW MEXICO 87109 (505)883-7592			
CITY OF ALBUQUERQUE PUBLIC WORKS DEPARTMENT ENGINEERING GROUP			
TITLE: PARADISE SKES UTILITY IMPROVEMENTS VIRGO STREET NW			
APPROVALS	ENGINEER	DATE	APPROVALS
DRC CHAIRMAN	<i>[Signature]</i>	12-29-95	WATER
TRANSPORTATION	<i>[Signature]</i>	11-30-95	WASTE WATER
HYDROLOGY	<i>[Signature]</i>	12-6-95	NMU
DESIGNED BY	XX	DATE 7-95	
DRAWN BY	STAFF	DATE 7-95	
CHECKED BY	RRB	DATE 7-95	
PROJECT NO.	5279-91	MAP NO.	A-11-Z
		SHEET	OF 34 43

50\930064\VRGO1A.DWG\BDG\11-1-95

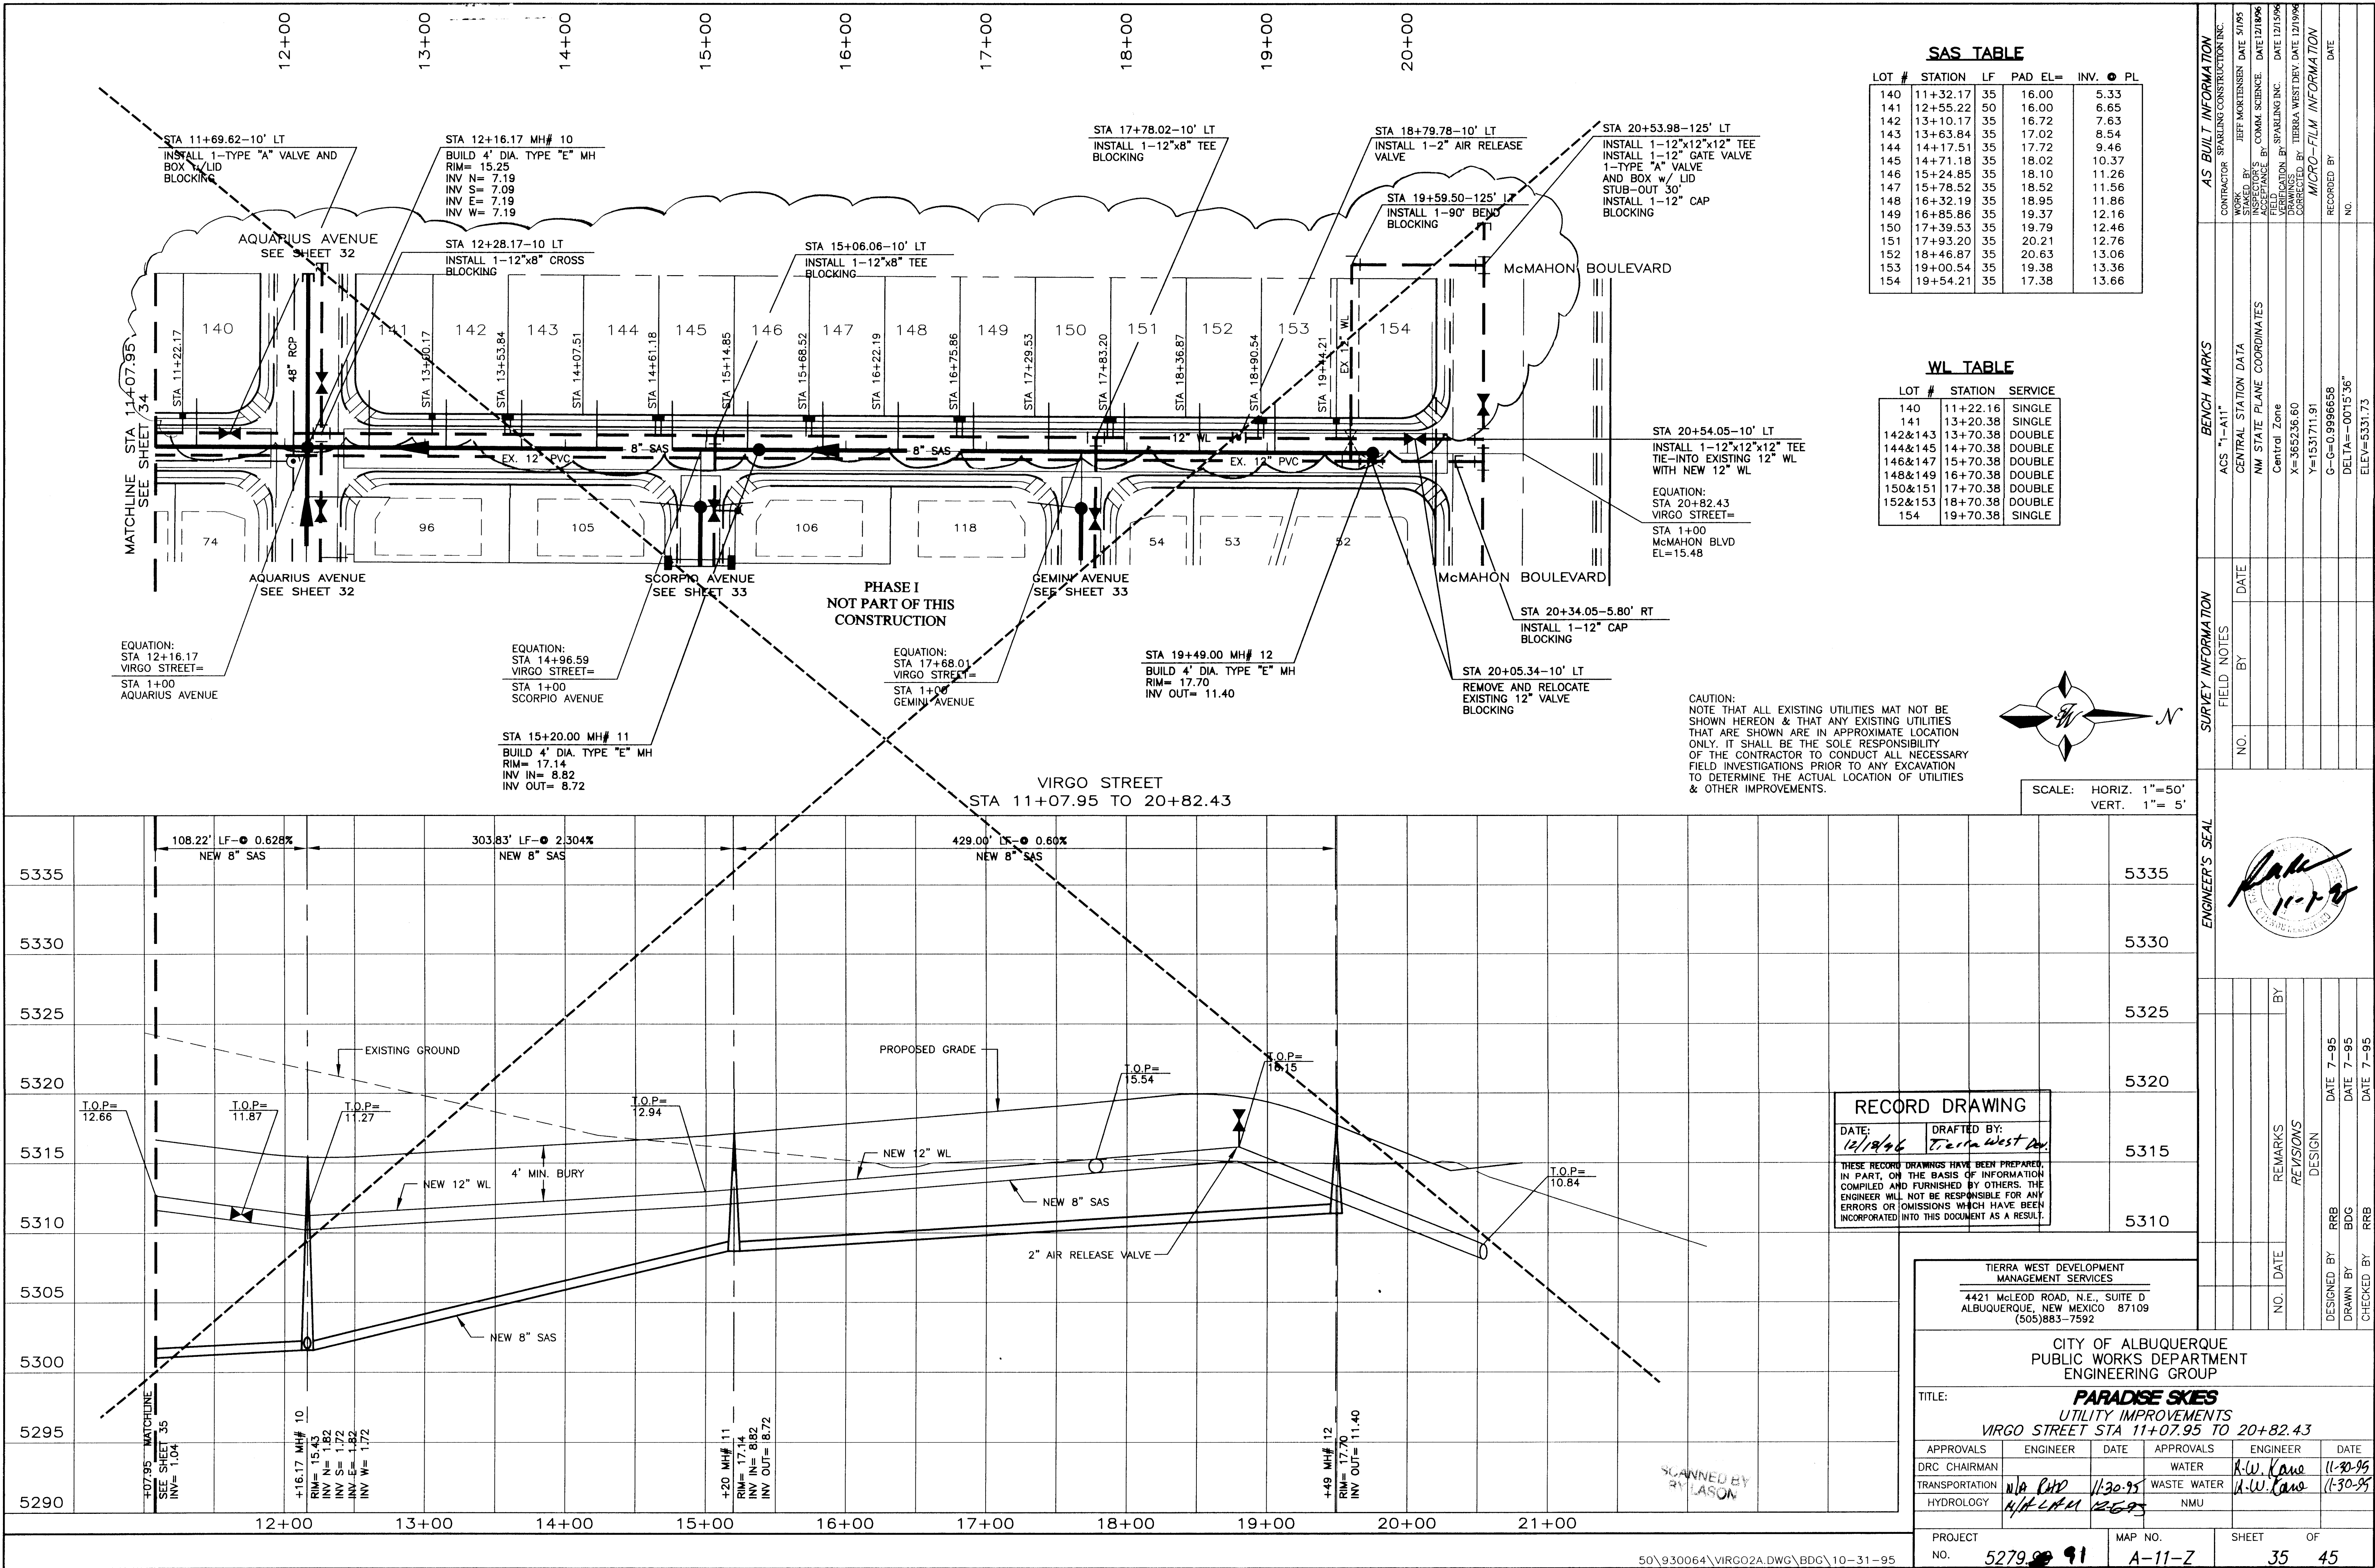

SAS TABLE				
LOT #	STATION	LF	PAD EL=	INV. ● PL
140	11+32.17	35	16.00	5.33
141	12+55.22	50	16.00	6.65
142	13+10.17	35	16.72	7.63
143	13+63.84	35	17.02	8.54
144	14+17.51	35	17.72	9.46
145	14+71.18	35	18.02	10.37
146	15+24.85	35	18.10	11.26
147	15+78.52	35	18.52	11.56
148	16+32.19	35	18.95	11.86
149	16+85.86	35	19.37	12.16
150	17+39.53	35	19.79	12.46
151	17+93.20	35	20.21	12.76
152	18+46.87	35	20.63	13.06
153	19+00.54	35	19.38	13.36
154	19+54.21	35	17.38	13.66

WL TABLE		
LOT #	STATION	SERVICE
140	11+22.16	SINGLE
141	13+20.38	SINGLE
142&143	13+70.38	DOUBLE
144&145	14+70.38	DOUBLE
146&147	15+70.38	DOUBLE
148&149	16+70.38	DOUBLE
150&151	17+70.38	DOUBLE
152&153	18+70.38	DOUBLE
154	19+70.38	SINGLE

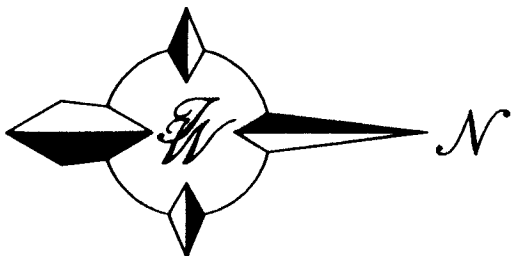

SCALE: HORIZ. 1"=50'
VERT. 1"=5'

RECORD DRAWING

DATE: 12/19/96 DRAFTED BY: Tierra West Dev.

THESE RECORD DRAWINGS HAVE BEEN PREPARED IN PART, ON THE BASIS OF INFORMATION COMPILED AND FURNISHED BY OTHERS. THE ENGINEER WILL NOT BE RESPONSIBLE FOR ANY ERRORS OR OMISSIONS WHICH HAVE BEEN INCORPORATED INTO THIS DOCUMENT AS A RESULT.


Tierra West Development Management Services
4421 McLeod Road, N.E., Suite D
Albuquerque, New Mexico 87109
(505)883-7592

CITY OF ALBUQUERQUE
PUBLIC WORKS DEPARTMENT
ENGINEERING GROUP


TITLE: PARADISE SKIES
UTILITY IMPROVEMENTS
VIRGO STREET STA 11+07.95 TO 20+82.43


APPROVALS ENGINEER DATE APPROVALS ENGINEER DATE
DRC CHAIRMAN WATER R.W. Kane 11-20-95
TRANSPORTATION W.A. RHD 11-30-95 WASTE WATER R.W. Kane 11-30-95
HYDROLOGY H.H. LAM 12-29-95 NMU

PROJECT NO. 5279.91 MAP NO. A-11-Z SHEET 35 OF 45

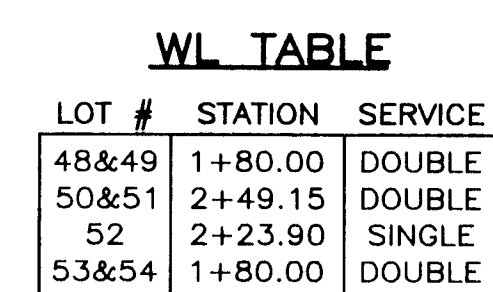

SCALE: HORIZ. 1"=50'
VERT. 1"= 5'

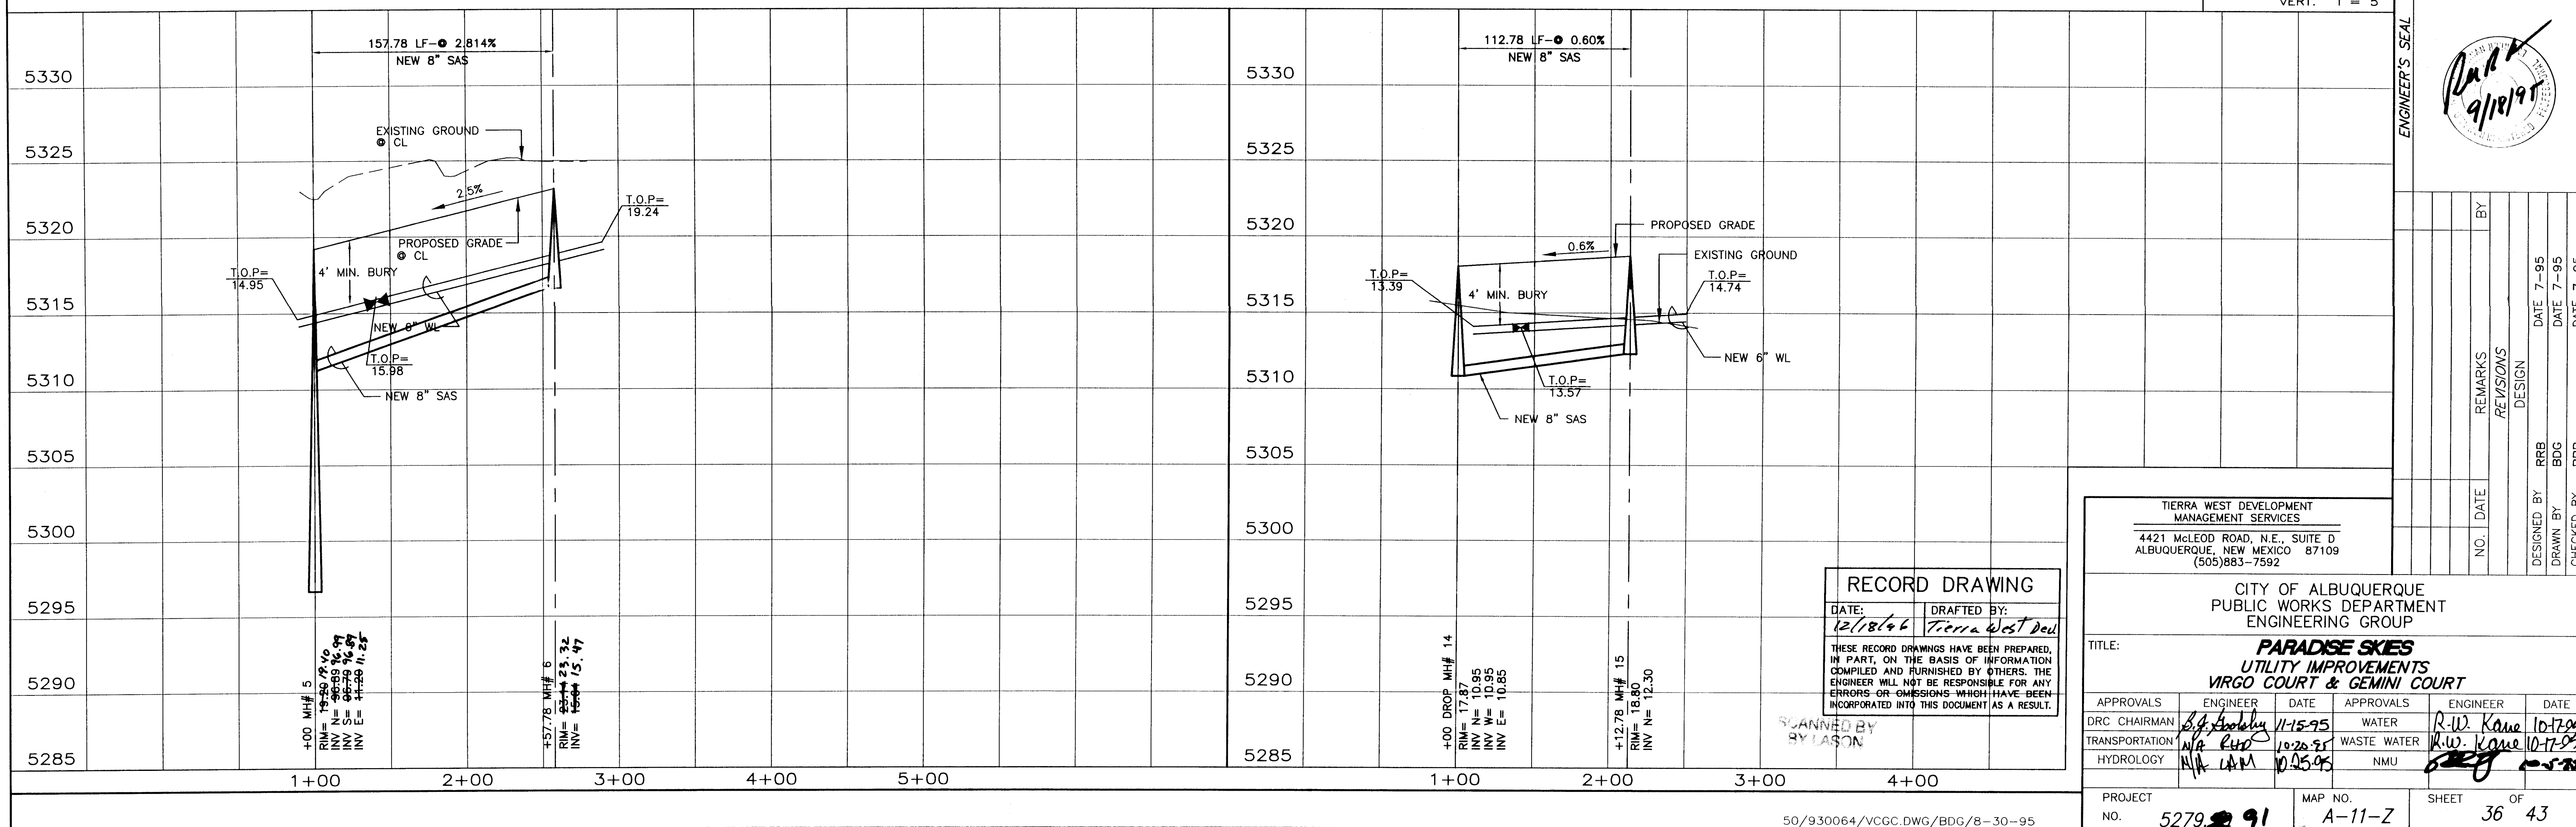


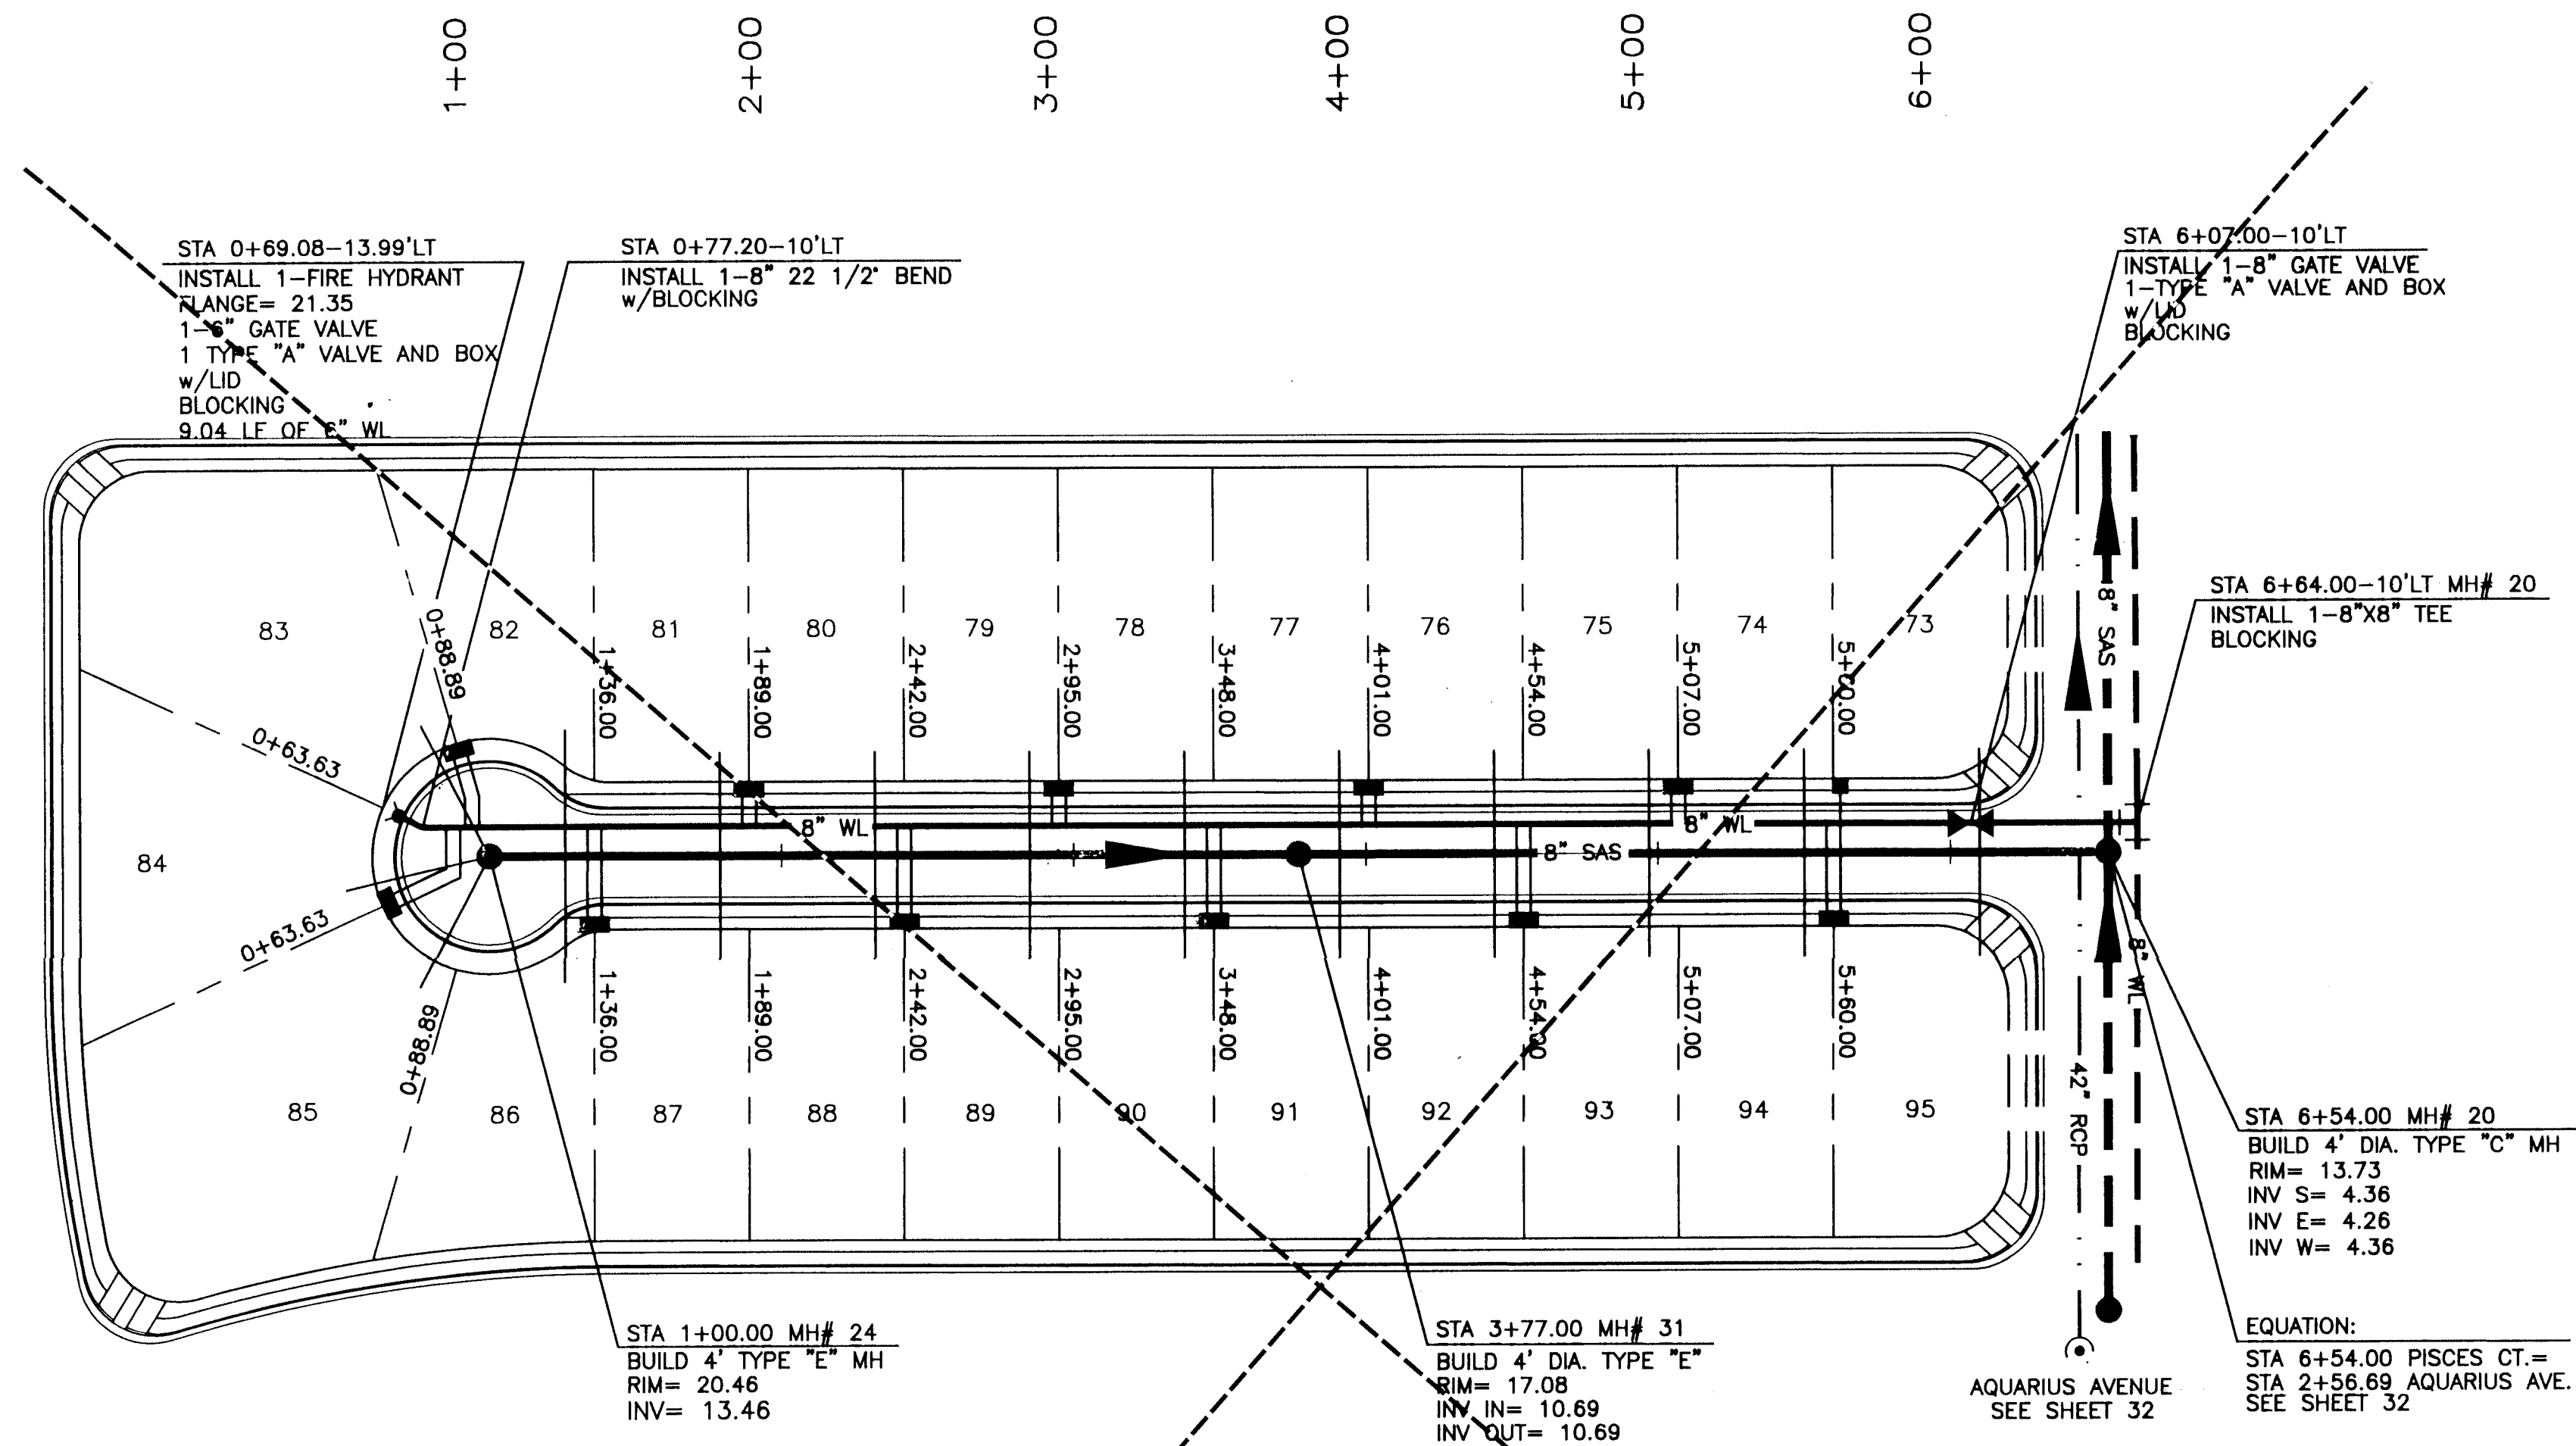


SAS TABLE					WL TABLE		
LOT #	STATION	LF	PAD EL=	INV. @ PL	LOT #	STATION	SERVICE
73	6+10.00	35	16.06	7.72	73	5+60.00	SINGLE
74	5+50.00	35	16.70	9.07	74&75	5+07.00	DOUBLE
75	4+97.00	35	17.35	10.26	76&77	4+01.00	DOUBLE
76	4+44.00	35	17.99	11.45	78&79	2+95.00	DOUBLE
77	3+91.00	35	18.64	12.65	80&81	1+89.00	DOUBLE
78	3+38.00	35	19.28	13.45	82&83	0+88.89	DOUBLE
79	2+85.00	35	19.93	13.98	84&85	0+63.63	DOUBLE
80	2+32.00	35	20.57	14.51	86&87	1+36.00	DOUBLE
81	1+79.00	35	21.22	15.04	88&89	2+42.00	DOUBLE
82	1+26.00	35	21.79	15.67	90&91	3+48.00	DOUBLE
83	0+76.78	50	22.72	15.46	92&93	4+54.00	DOUBLE
84	0+51.30	50	22.72	15.46	94&95	5+60.00	DOUBLE
85	0+76.78	50	22.72	15.46			
86	1+26.00	35	21.79	15.57			
87	1+79.00	35	21.22	15.04			
88	2+32.00	35	20.57	14.51			
89	2+85.00	35	19.93	13.98			
90	3+38.00	35	19.28	13.45			
91	3+91.00	35	18.64	12.65			
92	4+44.00	35	17.99	11.45			
93	4+97.00	35	17.35	10.26			
94	5+50.00	35	16.70	9.07			
95	6+10.00	35	16.06	7.72			

EQUATION:
STA 6+54.00 PISCES CT.=
STA 2+56.69 AQUARIUS AVE.
SEE SHEET 32

CAUTION:
NOTE THAT ALL EXISTING UTILITIES MAY NOT BE
SHOWN HEREON & THAT ANY EXISTING UTILITIES
THAT ARE SHOWN ARE IN APPROXIMATE LOCATION
ONLY. IT SHALL BE THE SOLE RESPONSIBILITY
OF THE CONTRACTOR TO CONDUCT ALL NECESSARY
FIELD INVESTIGATIONS PRIOR TO ANY EXCAVATION
TO DETERMINE THE ACTUAL LOCATION OF UTILITIES
& OTHER IMPROVEMENTS.

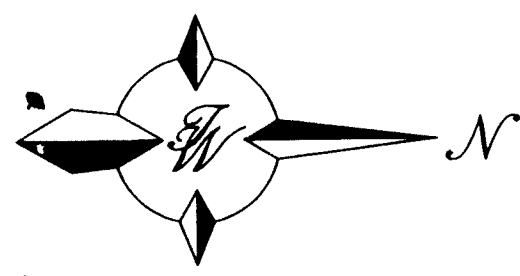

SCALE: HORIZ. 1"=50'
VERT. 1"= 5'

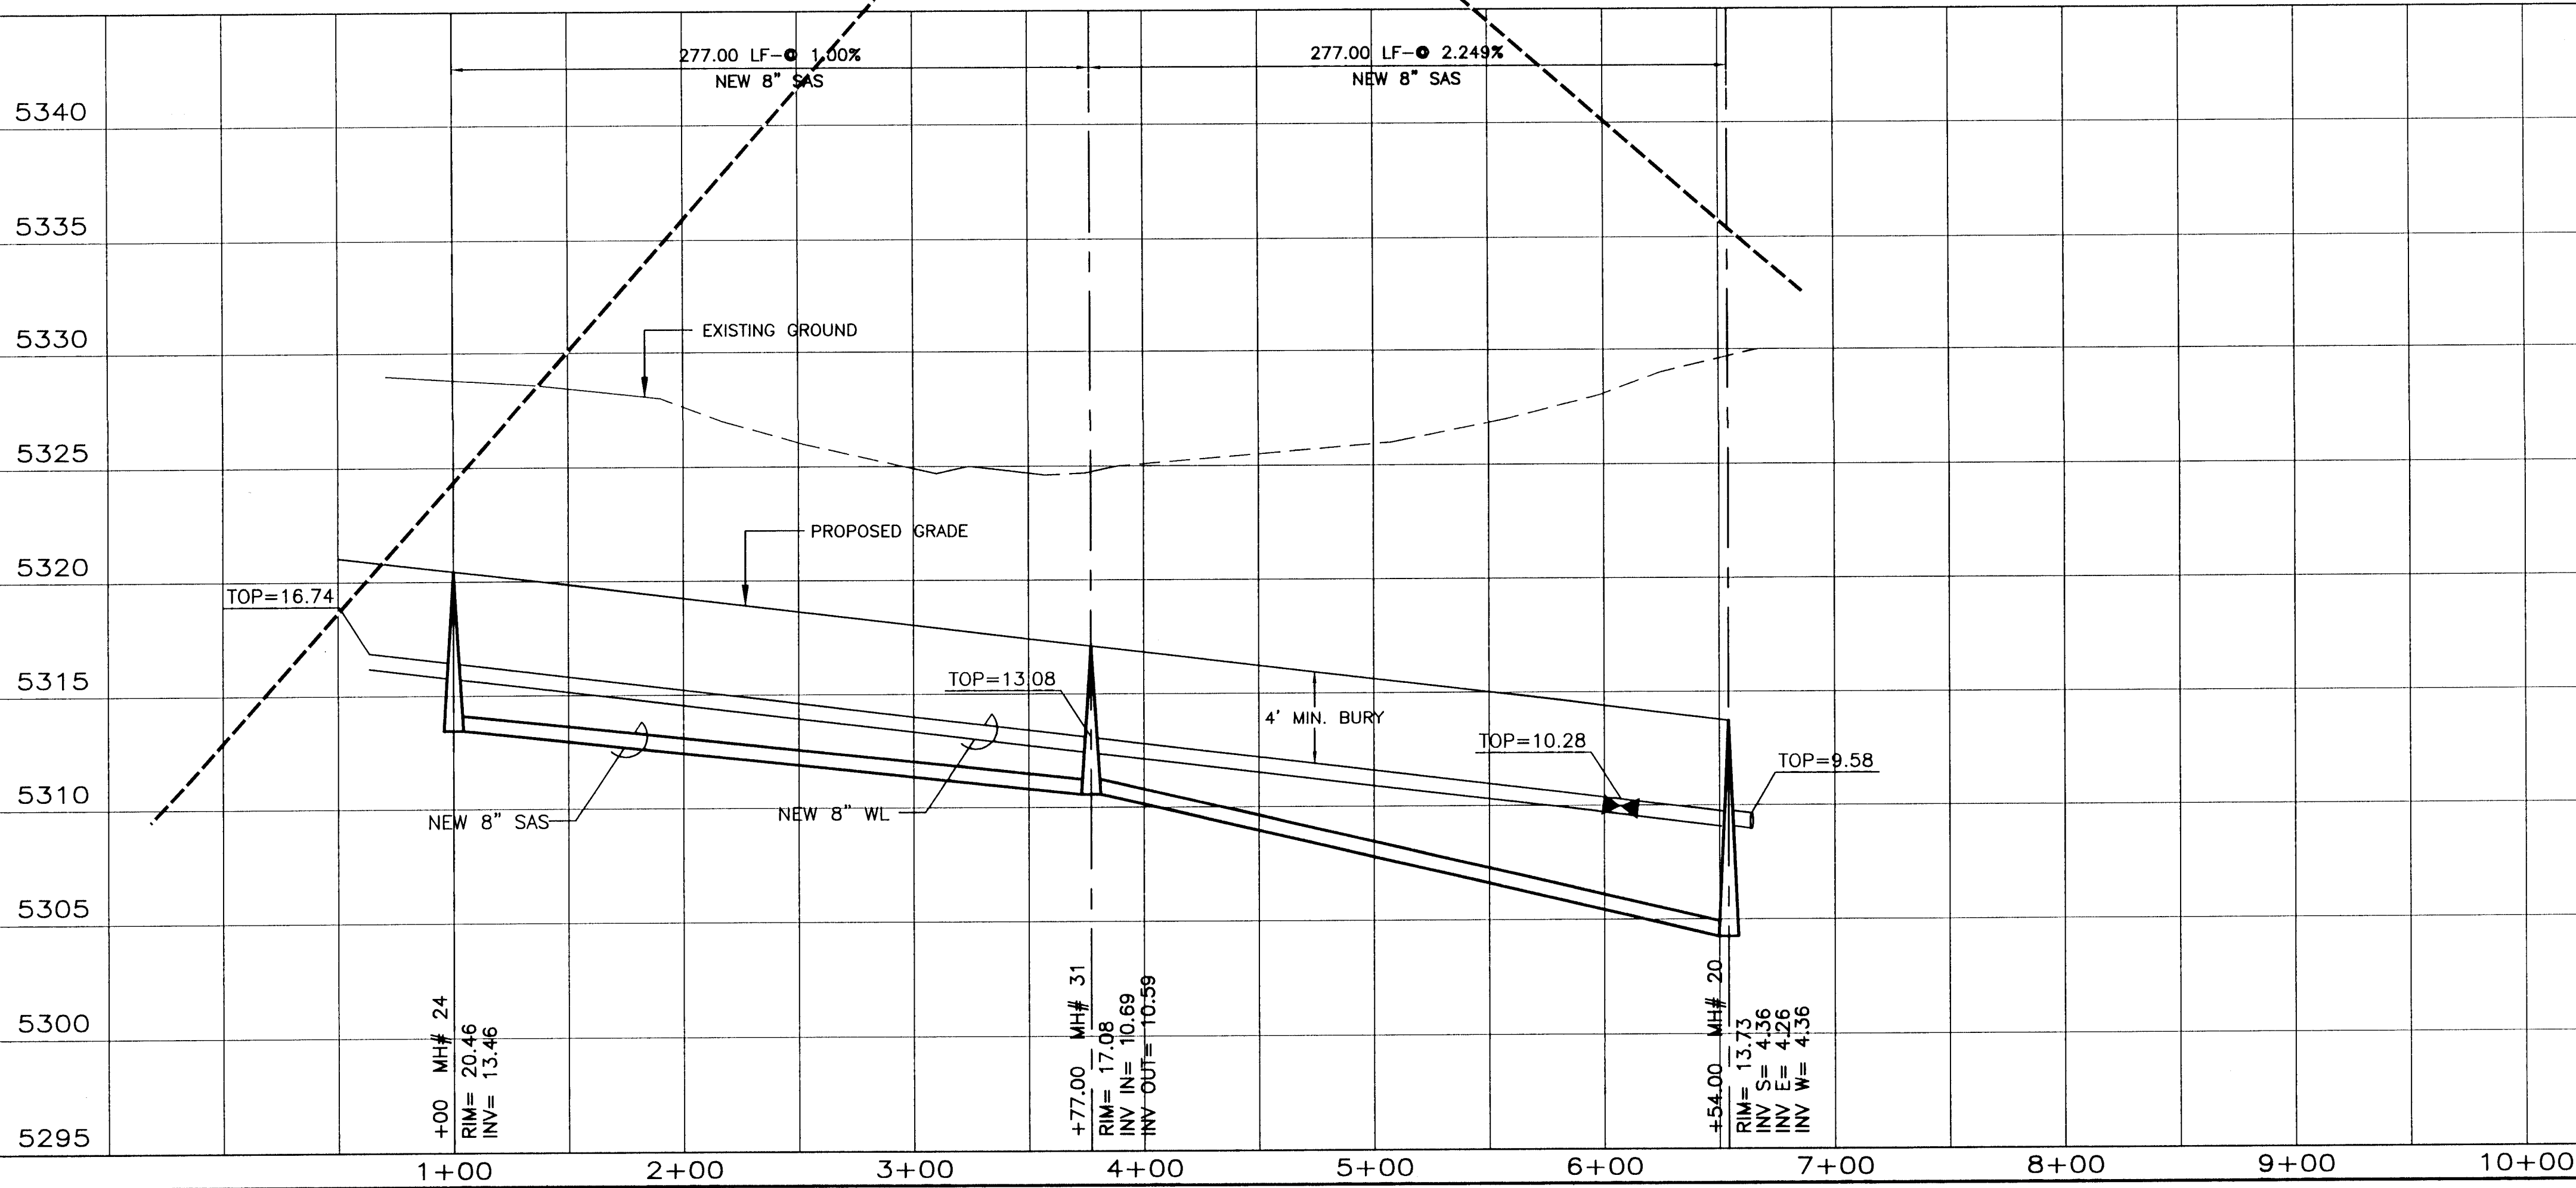

RECORD DRAWING


DATE: 12/18/11
DRAFTED BY: Tierra West Dev.
THESE RECORD DRAWINGS HAVE BEEN PREPARED
IN PART, ON THE BASIS OF INFORMATION
COMPILED AND FURNISHED BY OTHERS. THE
ENGINEER WILL NOT BE RESPONSIBLE FOR ANY
ERRORS OR OMISSIONS WHICH HAVE BEEN
INCORPORATED INTO THIS DOCUMENT AS A RESULT.

TIERRA WEST DEVELOPMENT MANAGEMENT SERVICES 4421 McLEOD ROAD, N.E., SUITE D ALBUQUERQUE, NEW MEXICO 87109 (505)883-7592					
CITY OF ALBUQUERQUE PUBLIC WORKS DEPARTMENT ENGINEERING GROUP					
TITLE: PARADISE SKIES UTILITY IMPROVEMENTS PISCES COURT NW STA 1+00 TO 6+54.00					
APPROVALS	ENGINEER	DATE	APPROVALS	ENGINEER	DATE
DRC CHAIRMAN	<i>[Signature]</i>	11/15/95	WATER	<i>[Signature]</i>	10/17/95
TRANSPORTATION	<i>[Signature]</i>	10/23/95	WASTE WATER	<i>[Signature]</i>	10/17/95
HYDROLOGY	<i>[Signature]</i>	10/23/95	NMU	<i>[Signature]</i>	10/23/95
DESIGNED BY	XX	DATE 7-95	DRAWN BY	STAFF	DATE 7-95
CHECKED BY	RRB	DATE 7-95			

50\9364\PISC-U.DWG\BDC\8-29-95

PROJECT NO. 5279.091
MAP NO. A-11-Z
SHEET 37 OF 43

PHASE II
26-5279.9113797

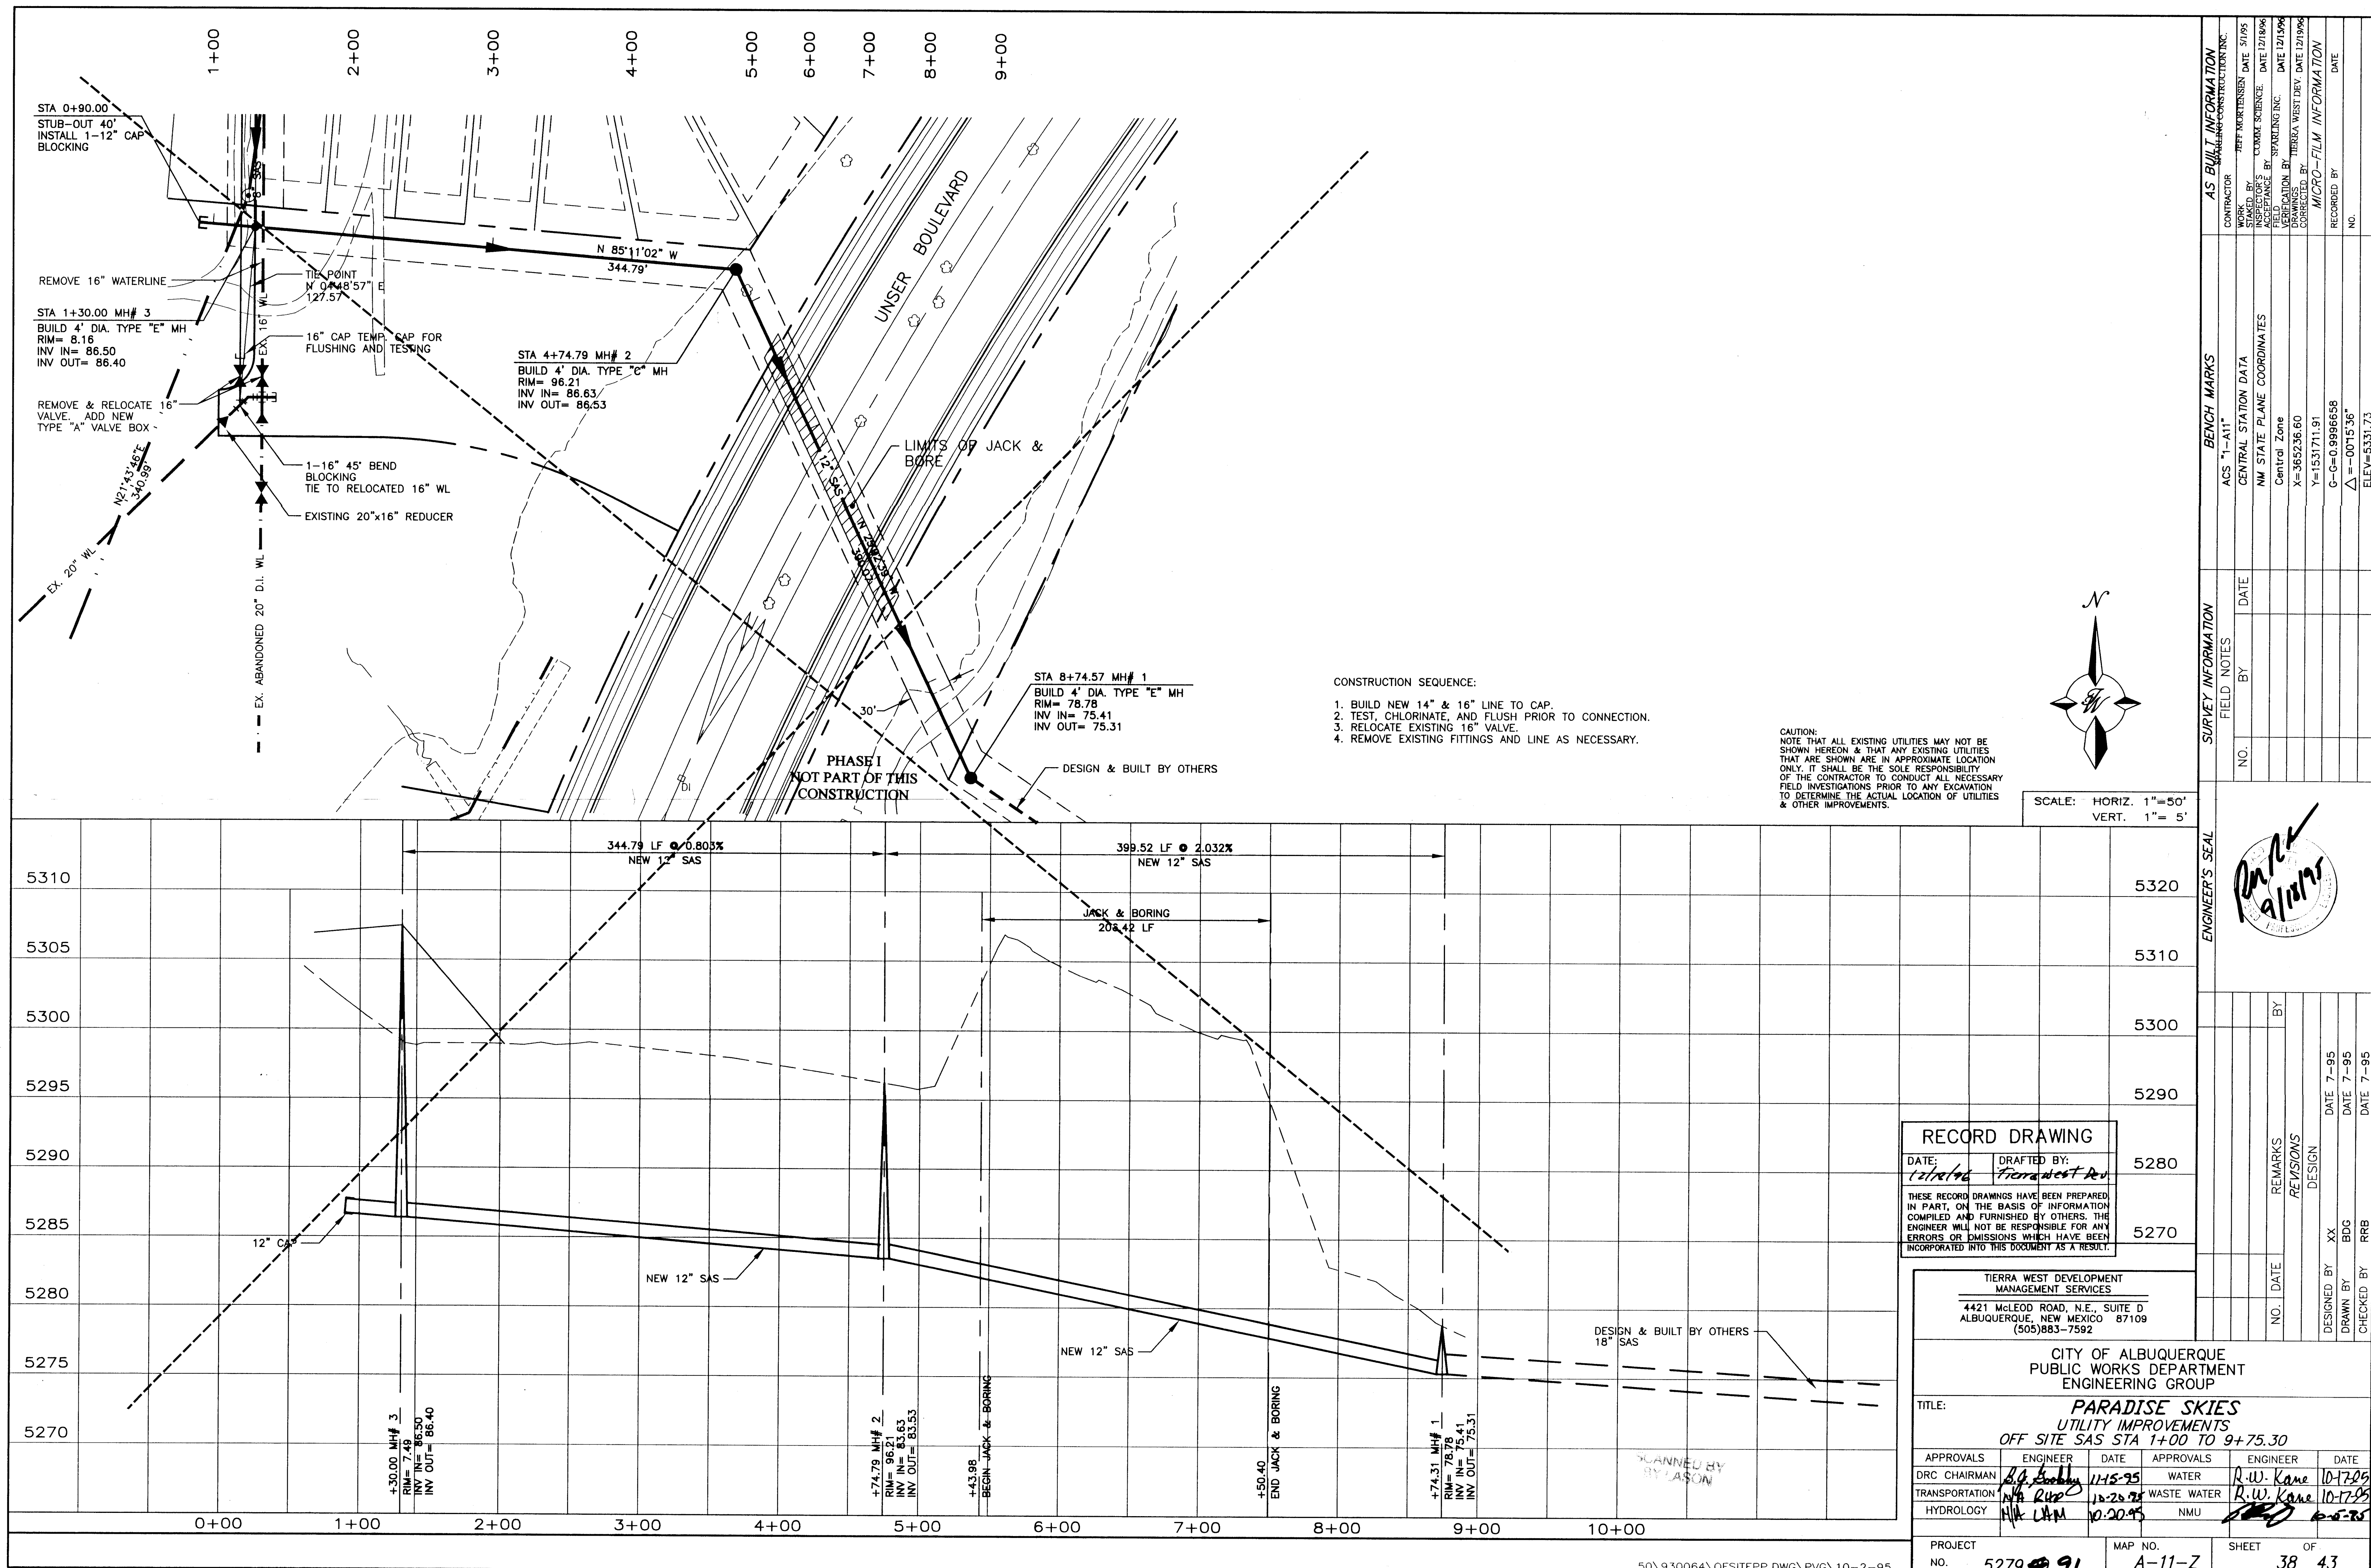

AS BUILT INFORMATION	
CONTRACTOR	TIERRA WEST DEVELOPMENT
WORK STAKED BY	JEFF MORTENSEN
INSPECTOR'S NAME	DATE 12/18/06
FIELD VERIFICATION BY	DATE 12/18/06
CORRECTED BY	DATE 12/18/06
MICRO-FILM INFORMATION	
RECORDED BY	DATE
NO.	

BENCH MARKS	
ACS "1-A11"	
CENTRAL STATION DATA	
NM STATE PLANE COORDINATES	
Central Zone	
X=365236.60	
Y=1531711.91	
G-G=0.9996658	
Δ=-0015'36"	
ELEV=5331.73	


SURVEY INFORMATION	
FIELD NOTES	
BY	DATE
NO.	

ENGINEER'S SEAL	
NO.	DATE
REMARKS	REVISIONS
DESIGNED BY	DATE 7-95
DRAWN BY	DATE 7-95
CHECKED BY	DATE 7-95


RECORD DRAWING	
DATE: 12/18/06	DRAFTED BY: J. Mortensen
THESE RECORD DRAWINGS HAVE BEEN PREPARED IN PART, ON THE BASIS OF INFORMATION COMPILED AND FURNISHED BY OTHERS. THE ENGINEER WILL NOT BE RESPONSIBLE FOR ANY ERRORS OR OMISSIONS WHICH HAVE BEEN INCORPORATED INTO THIS DOCUMENT AS A RESULT.	

TIERRA WEST DEVELOPMENT MANAGEMENT SERVICES 4421 McLEOD ROAD, N.E., SUITE D ALBUQUERQUE, NEW MEXICO 87109 (505)883-7592			
CITY OF ALBUQUERQUE PUBLIC WORKS DEPARTMENT ENGINEERING GROUP			
TITLE: PARADISE SKIES UTILITY IMPROVEMENTS OFF SITE SAS STA 1+00 TO 9+75.30			
APPROVALS	ENGINEER	DATE	APPROVALS
DRC CHAIRMAN	R. W. Kane	11-15-95	ENGINEER
TRANSPORTATION	W. R. Kane	10-28-95	WATER
HYDROLOGY	W. R. Kane	10-28-95	WASTE WATER
PROJECT NO. 5279.0 91		MAP NO. A-11-Z	SHEET 38 OF 43


BAFFLED OUTLET
SEE SHEET 43 FOR DETAILS
INV=5260.00

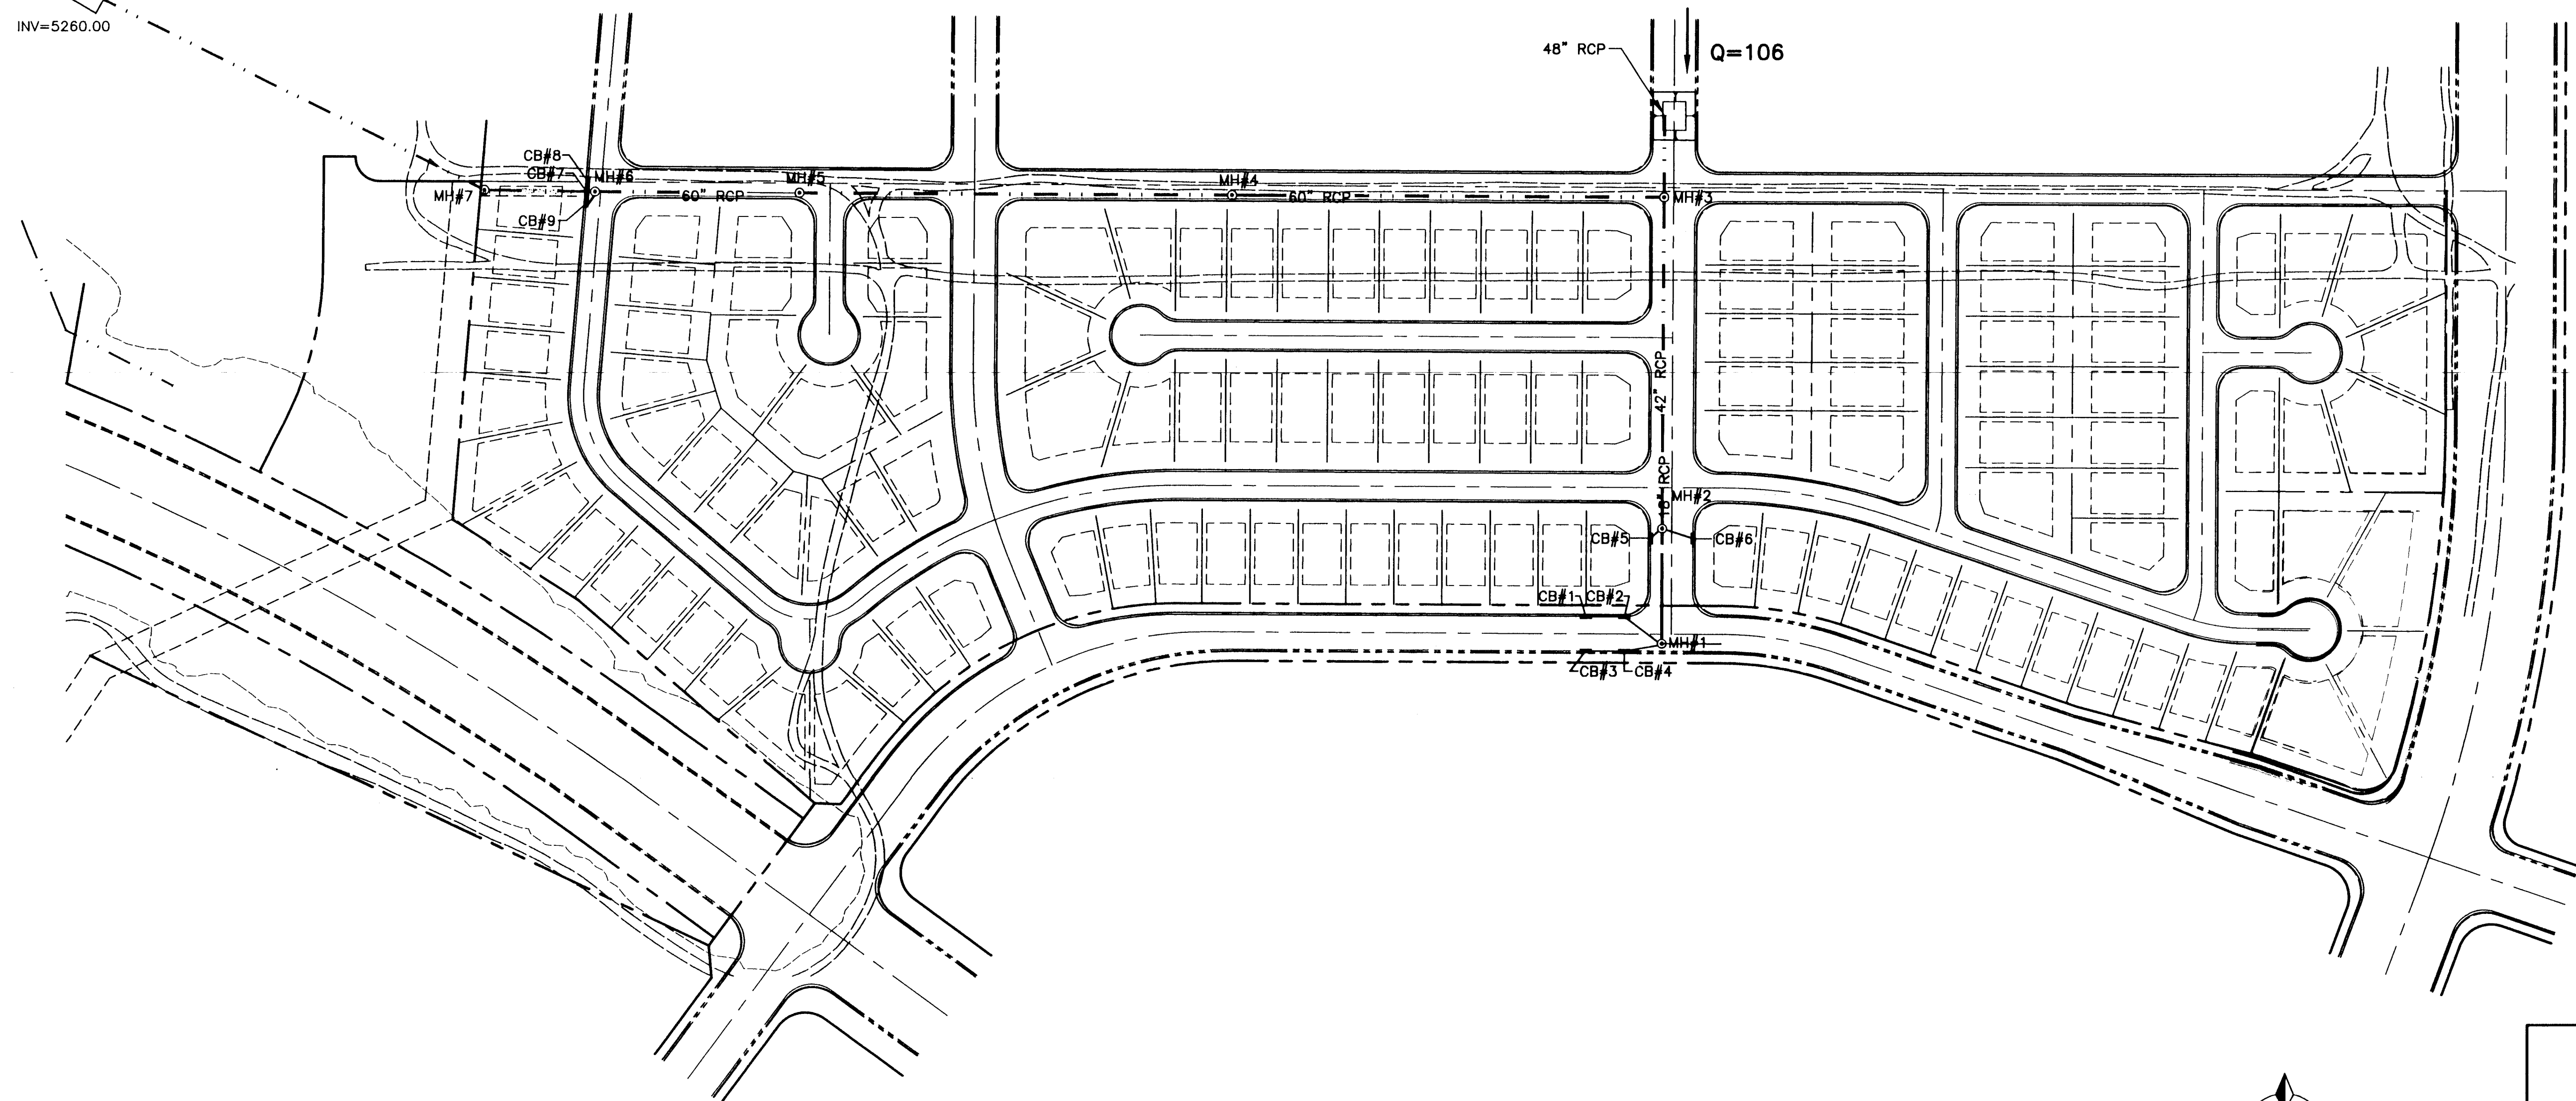

- LEGEND
- BOUNDARY LINE
 - EASEMENT LINE
 - LOT LINE
 - SETBACK LINE
 - SIDEWALK
 - MOUNTABLE CURB AND GUTTER
 - STANDARD CURB AND GUTTER
 - CENTER LINE
 - STORM DRAIN LINE
 - EXISTING STORM DRAIN LINE
 - STORM DRAIN MANHOLE
 - STORM DRAIN INLET

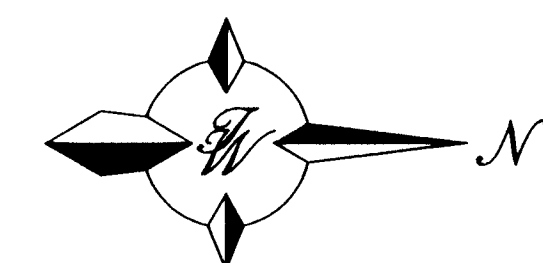

GRAPHIC SCALE

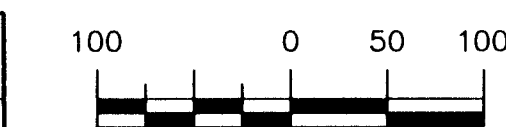

SCALE: 1"=100'

SCANNED BY
BY LASON

RECORD DRAWING	
DATE: 12/18/96	DRAFTED BY: Tierra West Dev.
THESE RECORD DRAWINGS HAVE BEEN PREPARED IN PART, ON THE BASIS OF INFORMATION COMPILED AND FURNISHED BY OTHERS. THE ENGINEER WILL NOT BE RESPONSIBLE FOR ANY ERRORS OR OMISSIONS WHICH HAVE BEEN INCORPORATED INTO THIS DOCUMENT AS A RESULT.	

40\930064\9364MSSP.DWG\PG\9-13-95


TERRA WEST DEVELOPMENT
MANAGEMENT SERVICES
4421 MCLEOD ROAD N.E., SUITE D
ALBUQUERQUE, NEW MEXICO 87109
(505)883-7592


CITY OF ALBUQUERQUE PUBLIC WORKS DEPARTMENT ENGINEERING GROUP					
TITLE: PARADISE SKIES MASTER STORM SEWER PLAN					
APPROVALS	ENGINEER	DATE	APPROVALS	ENGINEER	DATE
DRC CHAIRMAN	B.G. Leach	11/5/95	WATER	N/A RWR	10/17/95
TRANSPORTATION	M.P. RHO	10/20/95	WASTE WATER	N/A RWR	10/17/95
HYDROLOGY	John Williams	10/25/95	AMAFCA	John Williams	10/11/95
PROJECT NO.	5279.091	MAP NO.	A-11-Z	SHEET	OF
				39	43


1 2 3 4 5 6 7 8 9 10 11 12 13 14 15
24-5279.091 3997

PHASE II


AS BUILT INFORMATION		BENCH MARKS		SURVEY INFORMATION		ENGINEER'S SEAL	
CONTRACTOR	JEFF MORTENSEN	DATE	5/1/95	ACS "1-A11"	DATE		
INSPECTOR'S	COMAM. SCIENCE	DATE	12/18/96	NM STATE PLANE COORDINATES	BY		
FIELD CHECK	SPARLING INC.	DATE	12/15/96	CENTRAL ZONE	REMARKS		
VERIFICATION BY	TERRA WEST DEV.	DATE	12/19/96	X=365236.60	DESIGN		
DRAWINGS				Y=1531711.91			
COORDINATED BY				G-G=0.9996658	DESIGNED BY	RRB	DATE 7/95
				Δ = -00'15"36"	DRAWN BY	BDG	DATE 7/95
				ELEV=5331.73	CHECKED BY	RRB	DATE 7/95

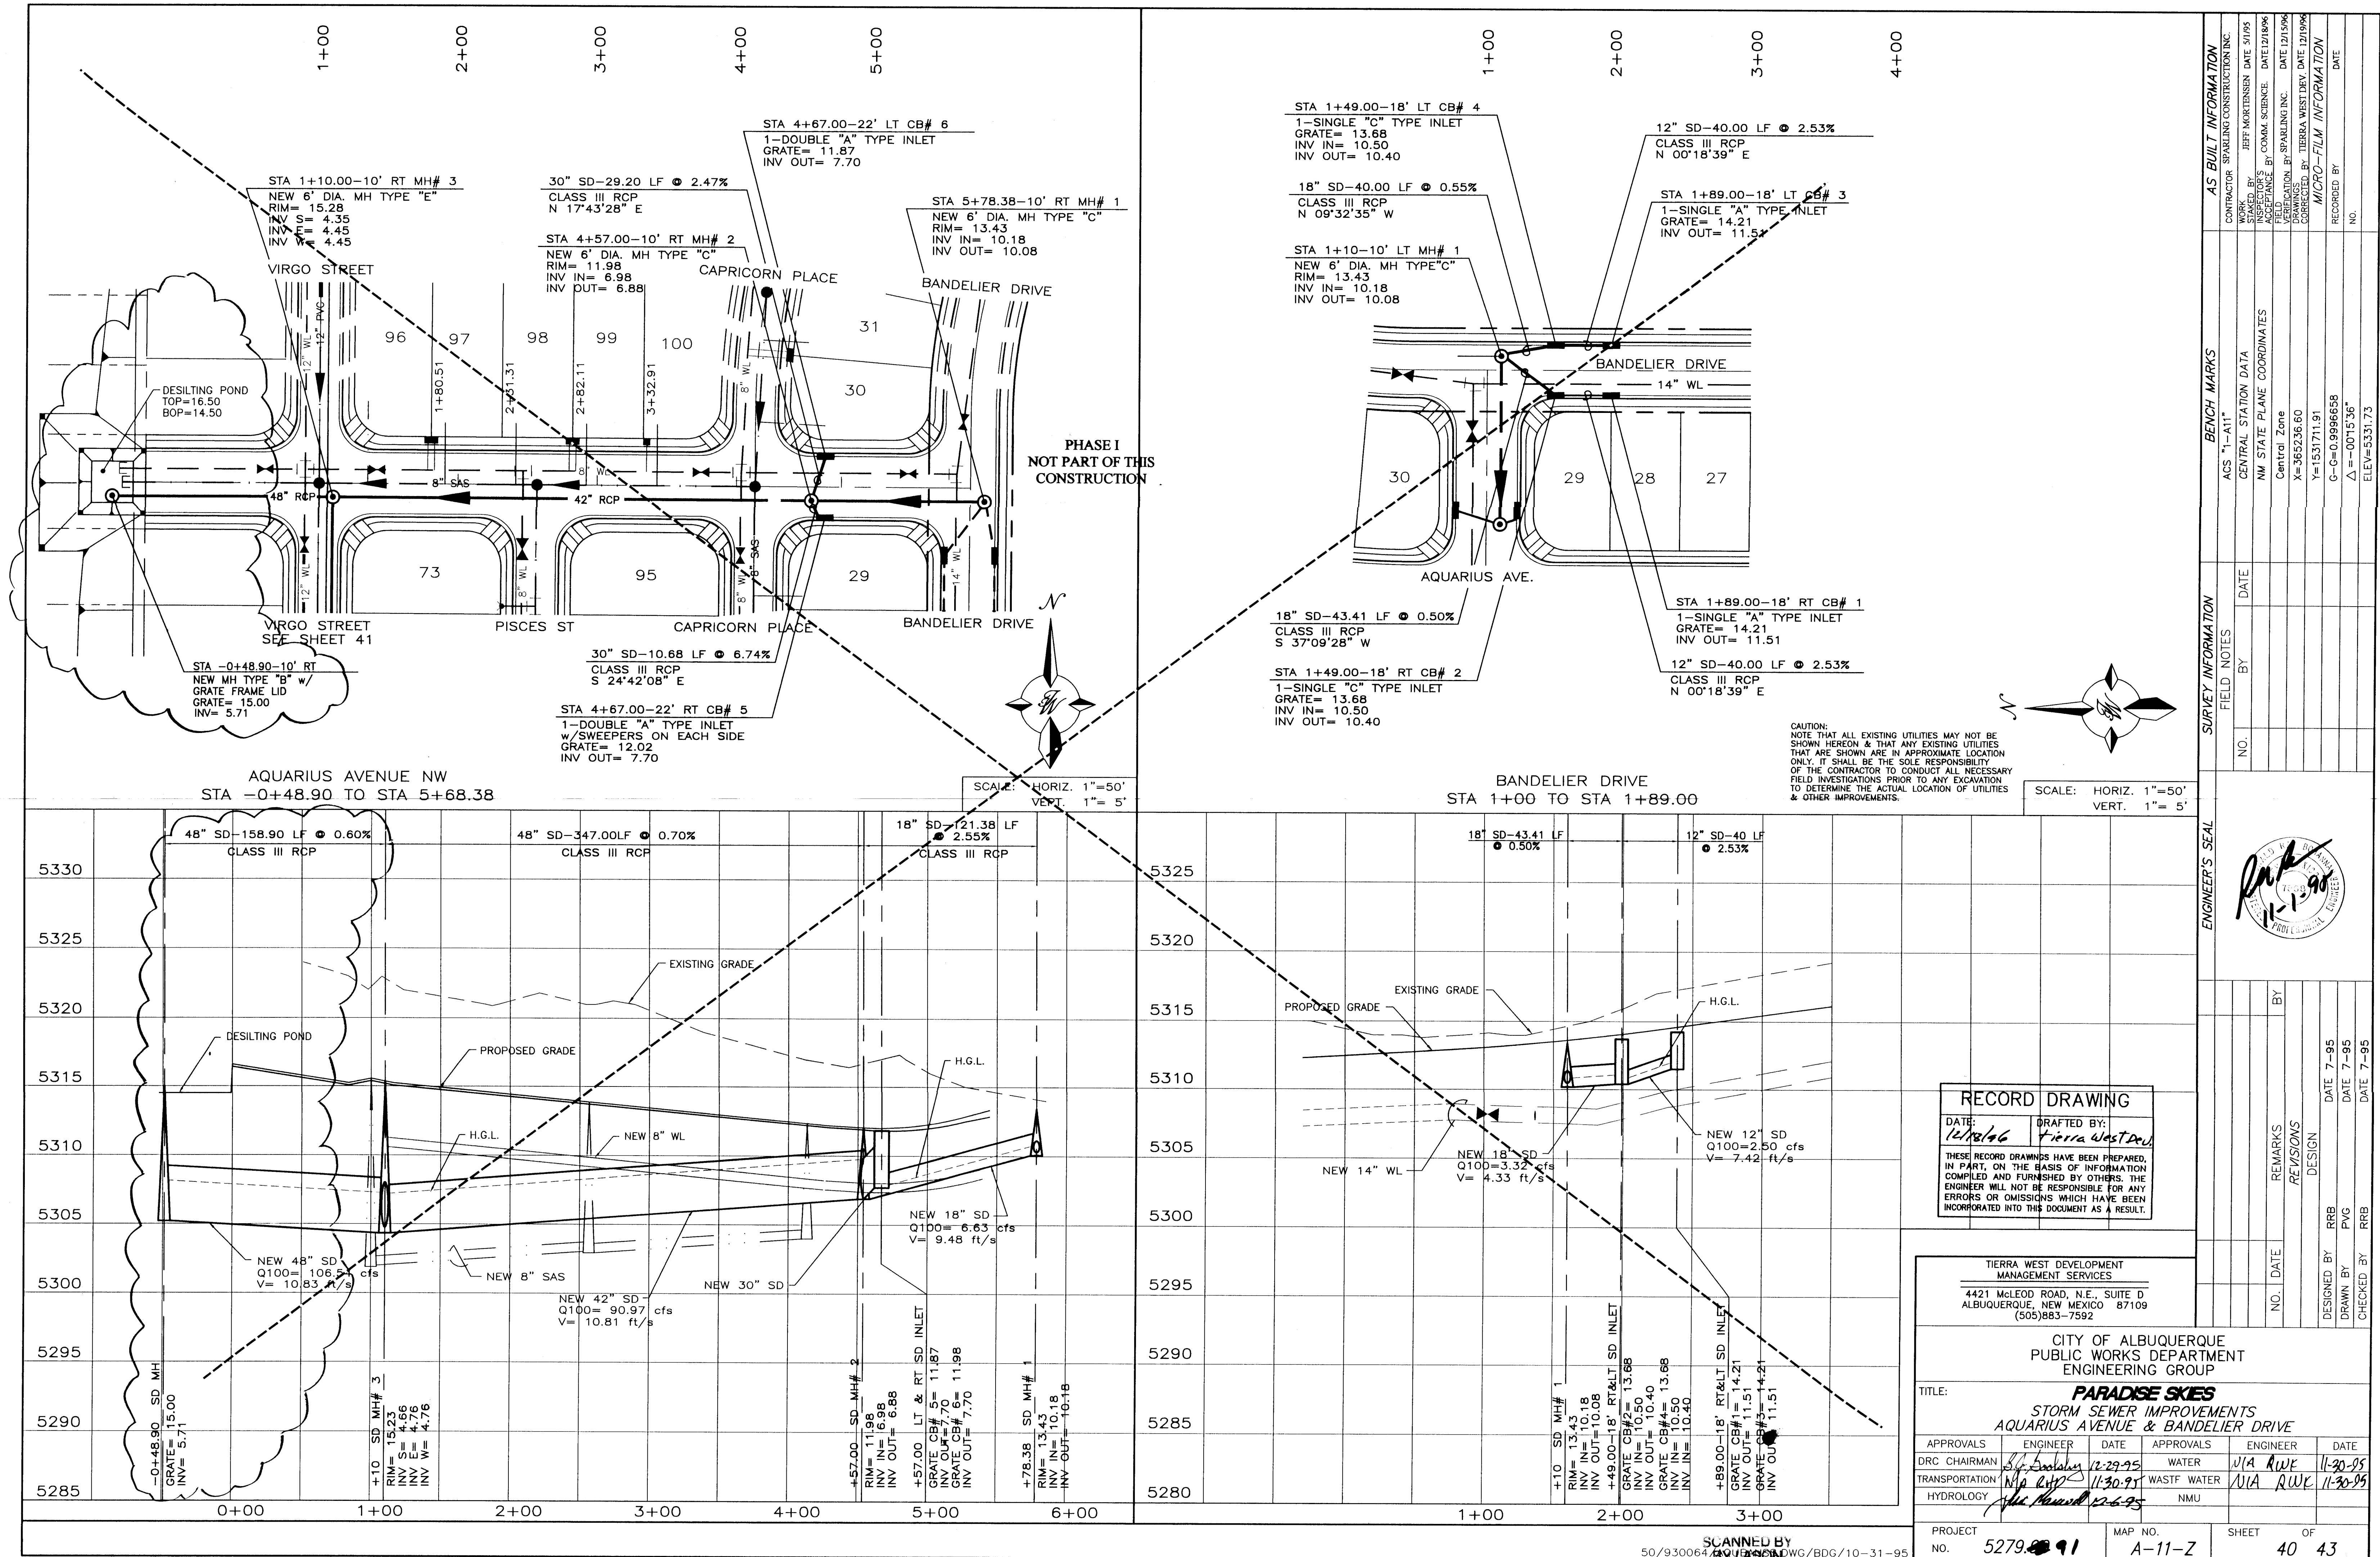

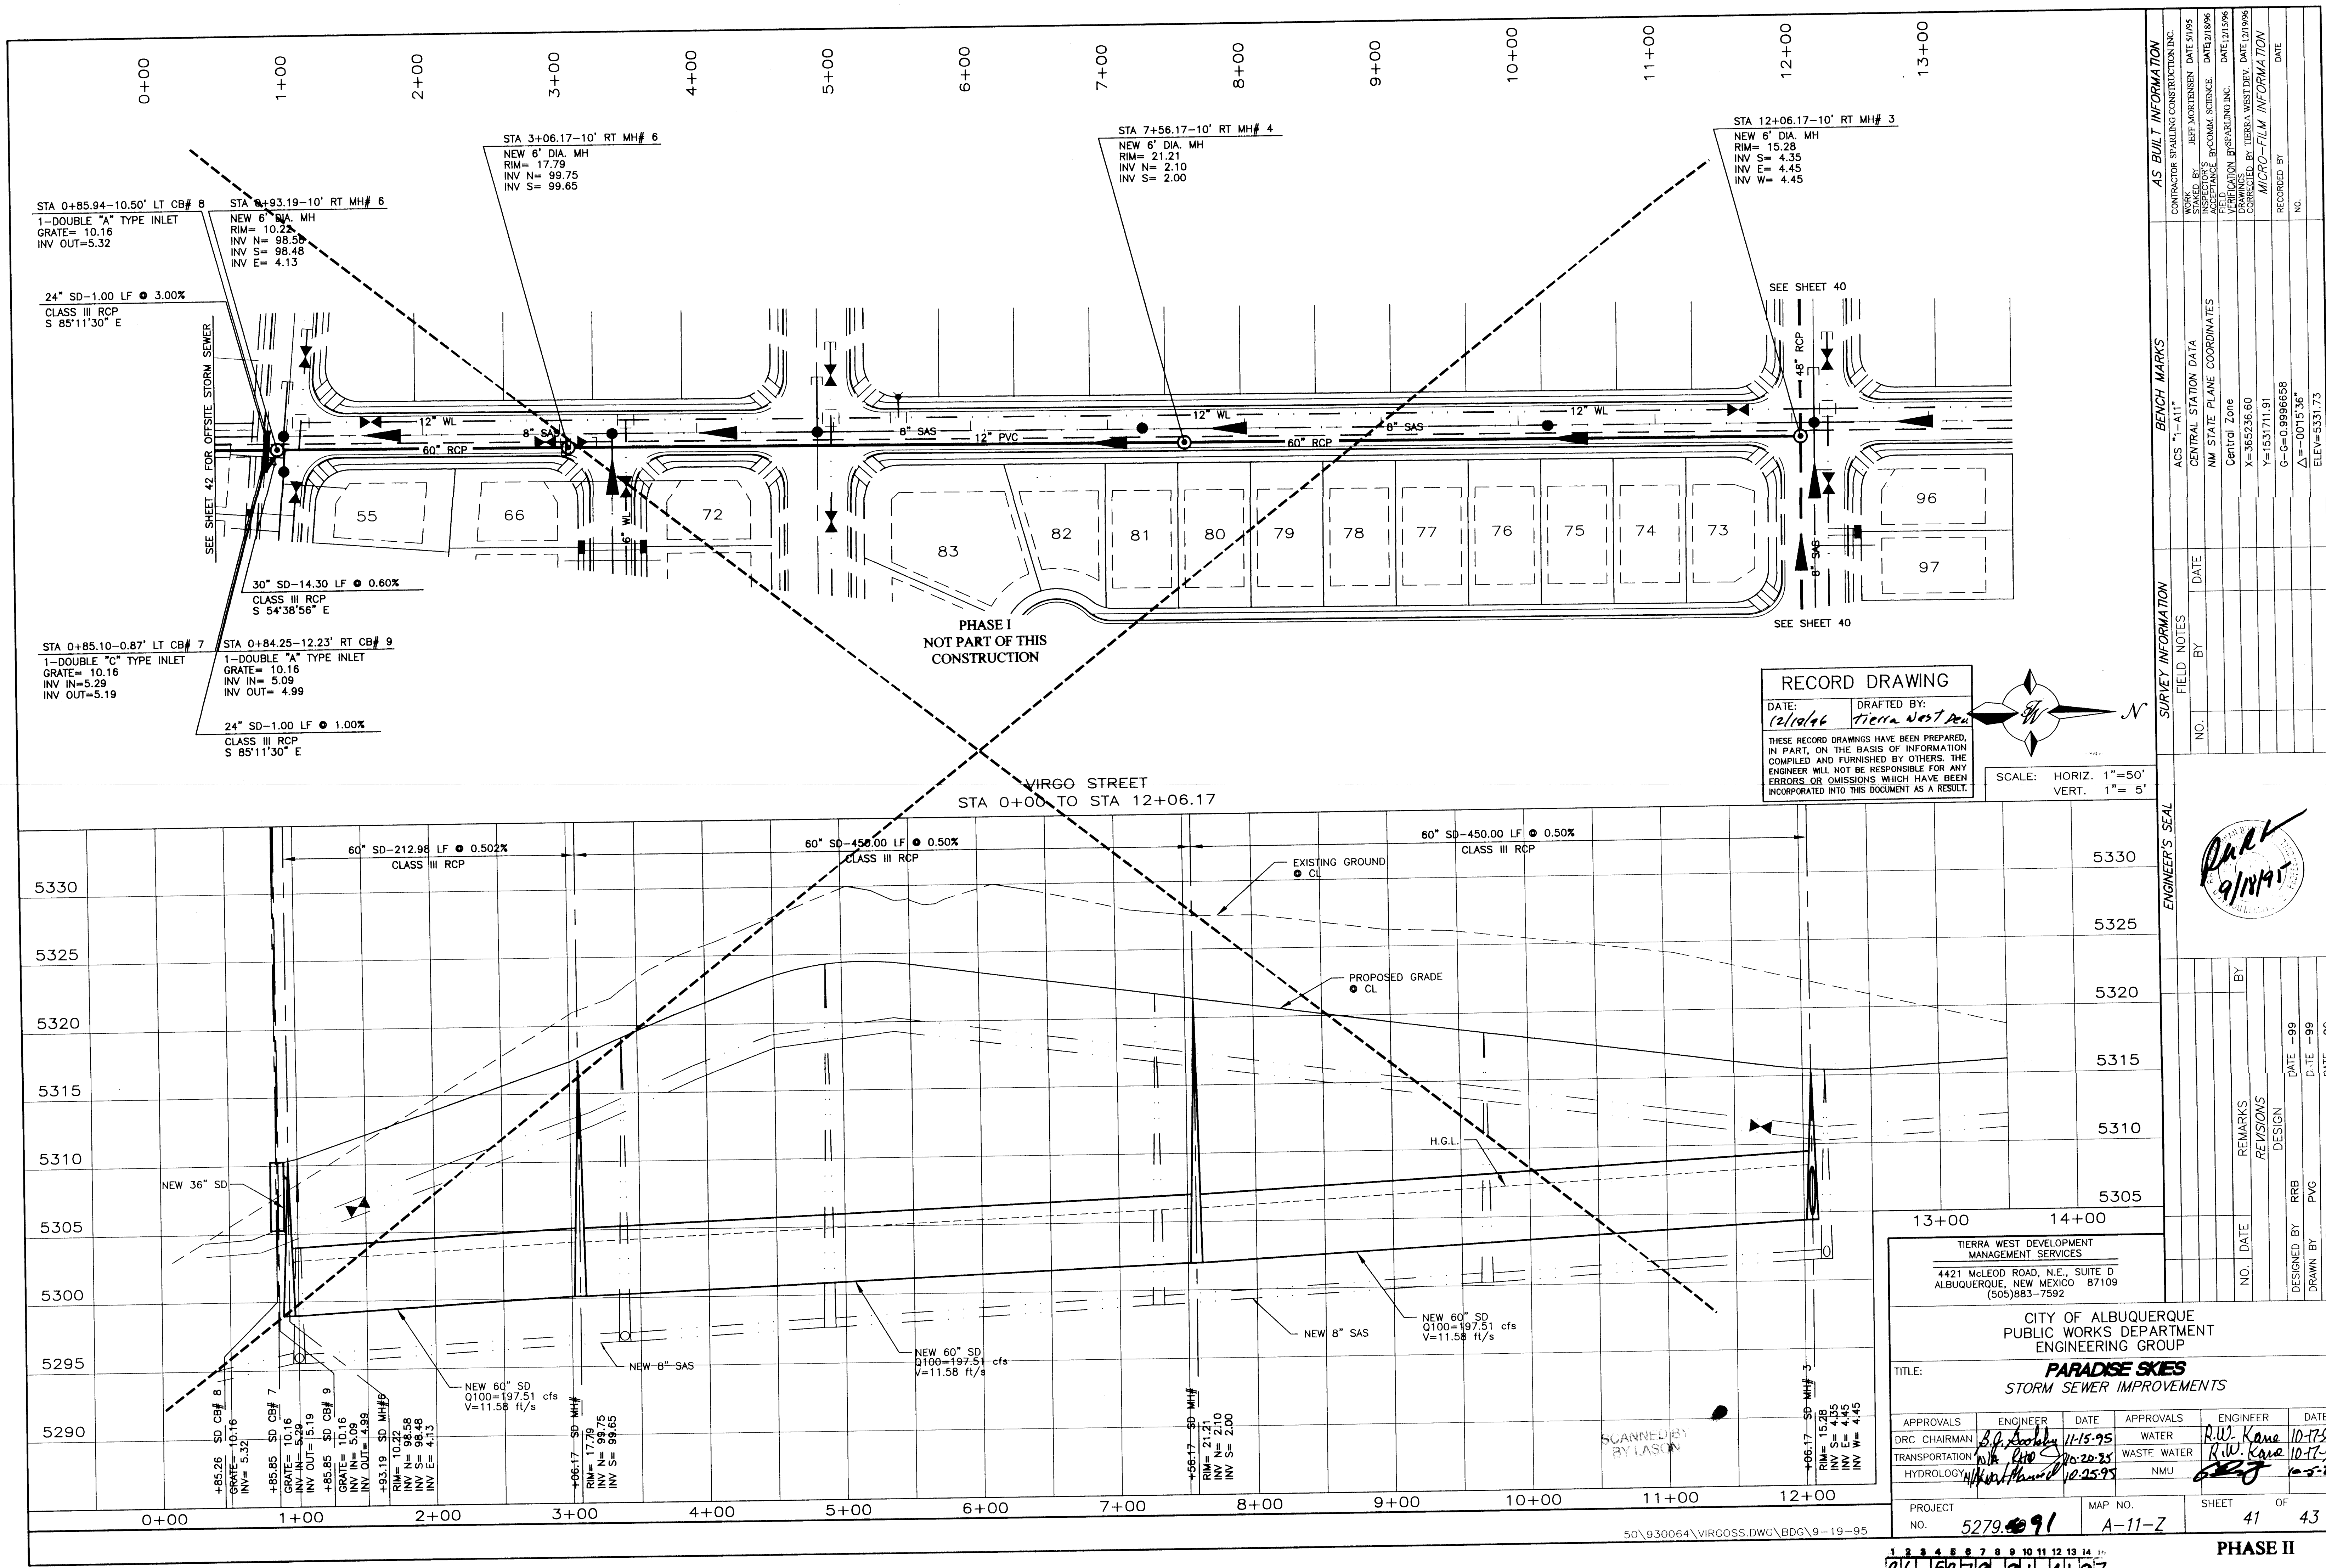


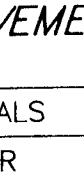QUERQUE REPARTMENT GROUP										SKIES IMPROVEMENTS									
APPROVALS					ENGINEER					DATE									
WATER					R.W. Kane					10-17-99									
WASTE WATER					R.W. Kane					10-17-99									
NMU										10-17-99									
11-Z					SHEET 41 OF 43														

ENGINEER'S SEAL			SURVEY INFORMATION			BENCH MARKS			AS BUILT INFORMATION		
50'	5'		NO.	BY	DATE	ACS "1-A1"	CENTRAL STATION DATA	WORK	CONTRACTOR SPARKLING CONSTRUCTION INC.		
						NW STATE PLANE COORDINATES		STAKED BY			
						Central Zone		JEFF MORTENSEN	DATE 5/1/95		
						X=365236.60		ACCEPTANCE	DATE 12/19/96		
						Y=1531711.91		FIELD VERIFICATION	BY COMM. SCIENCE		
								DATE 12/15/96			
								ADJUSTED	DATE 12/15/96		
								CORRECTED BY	TERRA WEST DEV.		
								DATE 12/19/96			
								MICRO-FILM INFORMATION			
								RECORDED BY	DATE		
								NO.			
								Δ = -0015.36"			
								ELEV=5331.73			

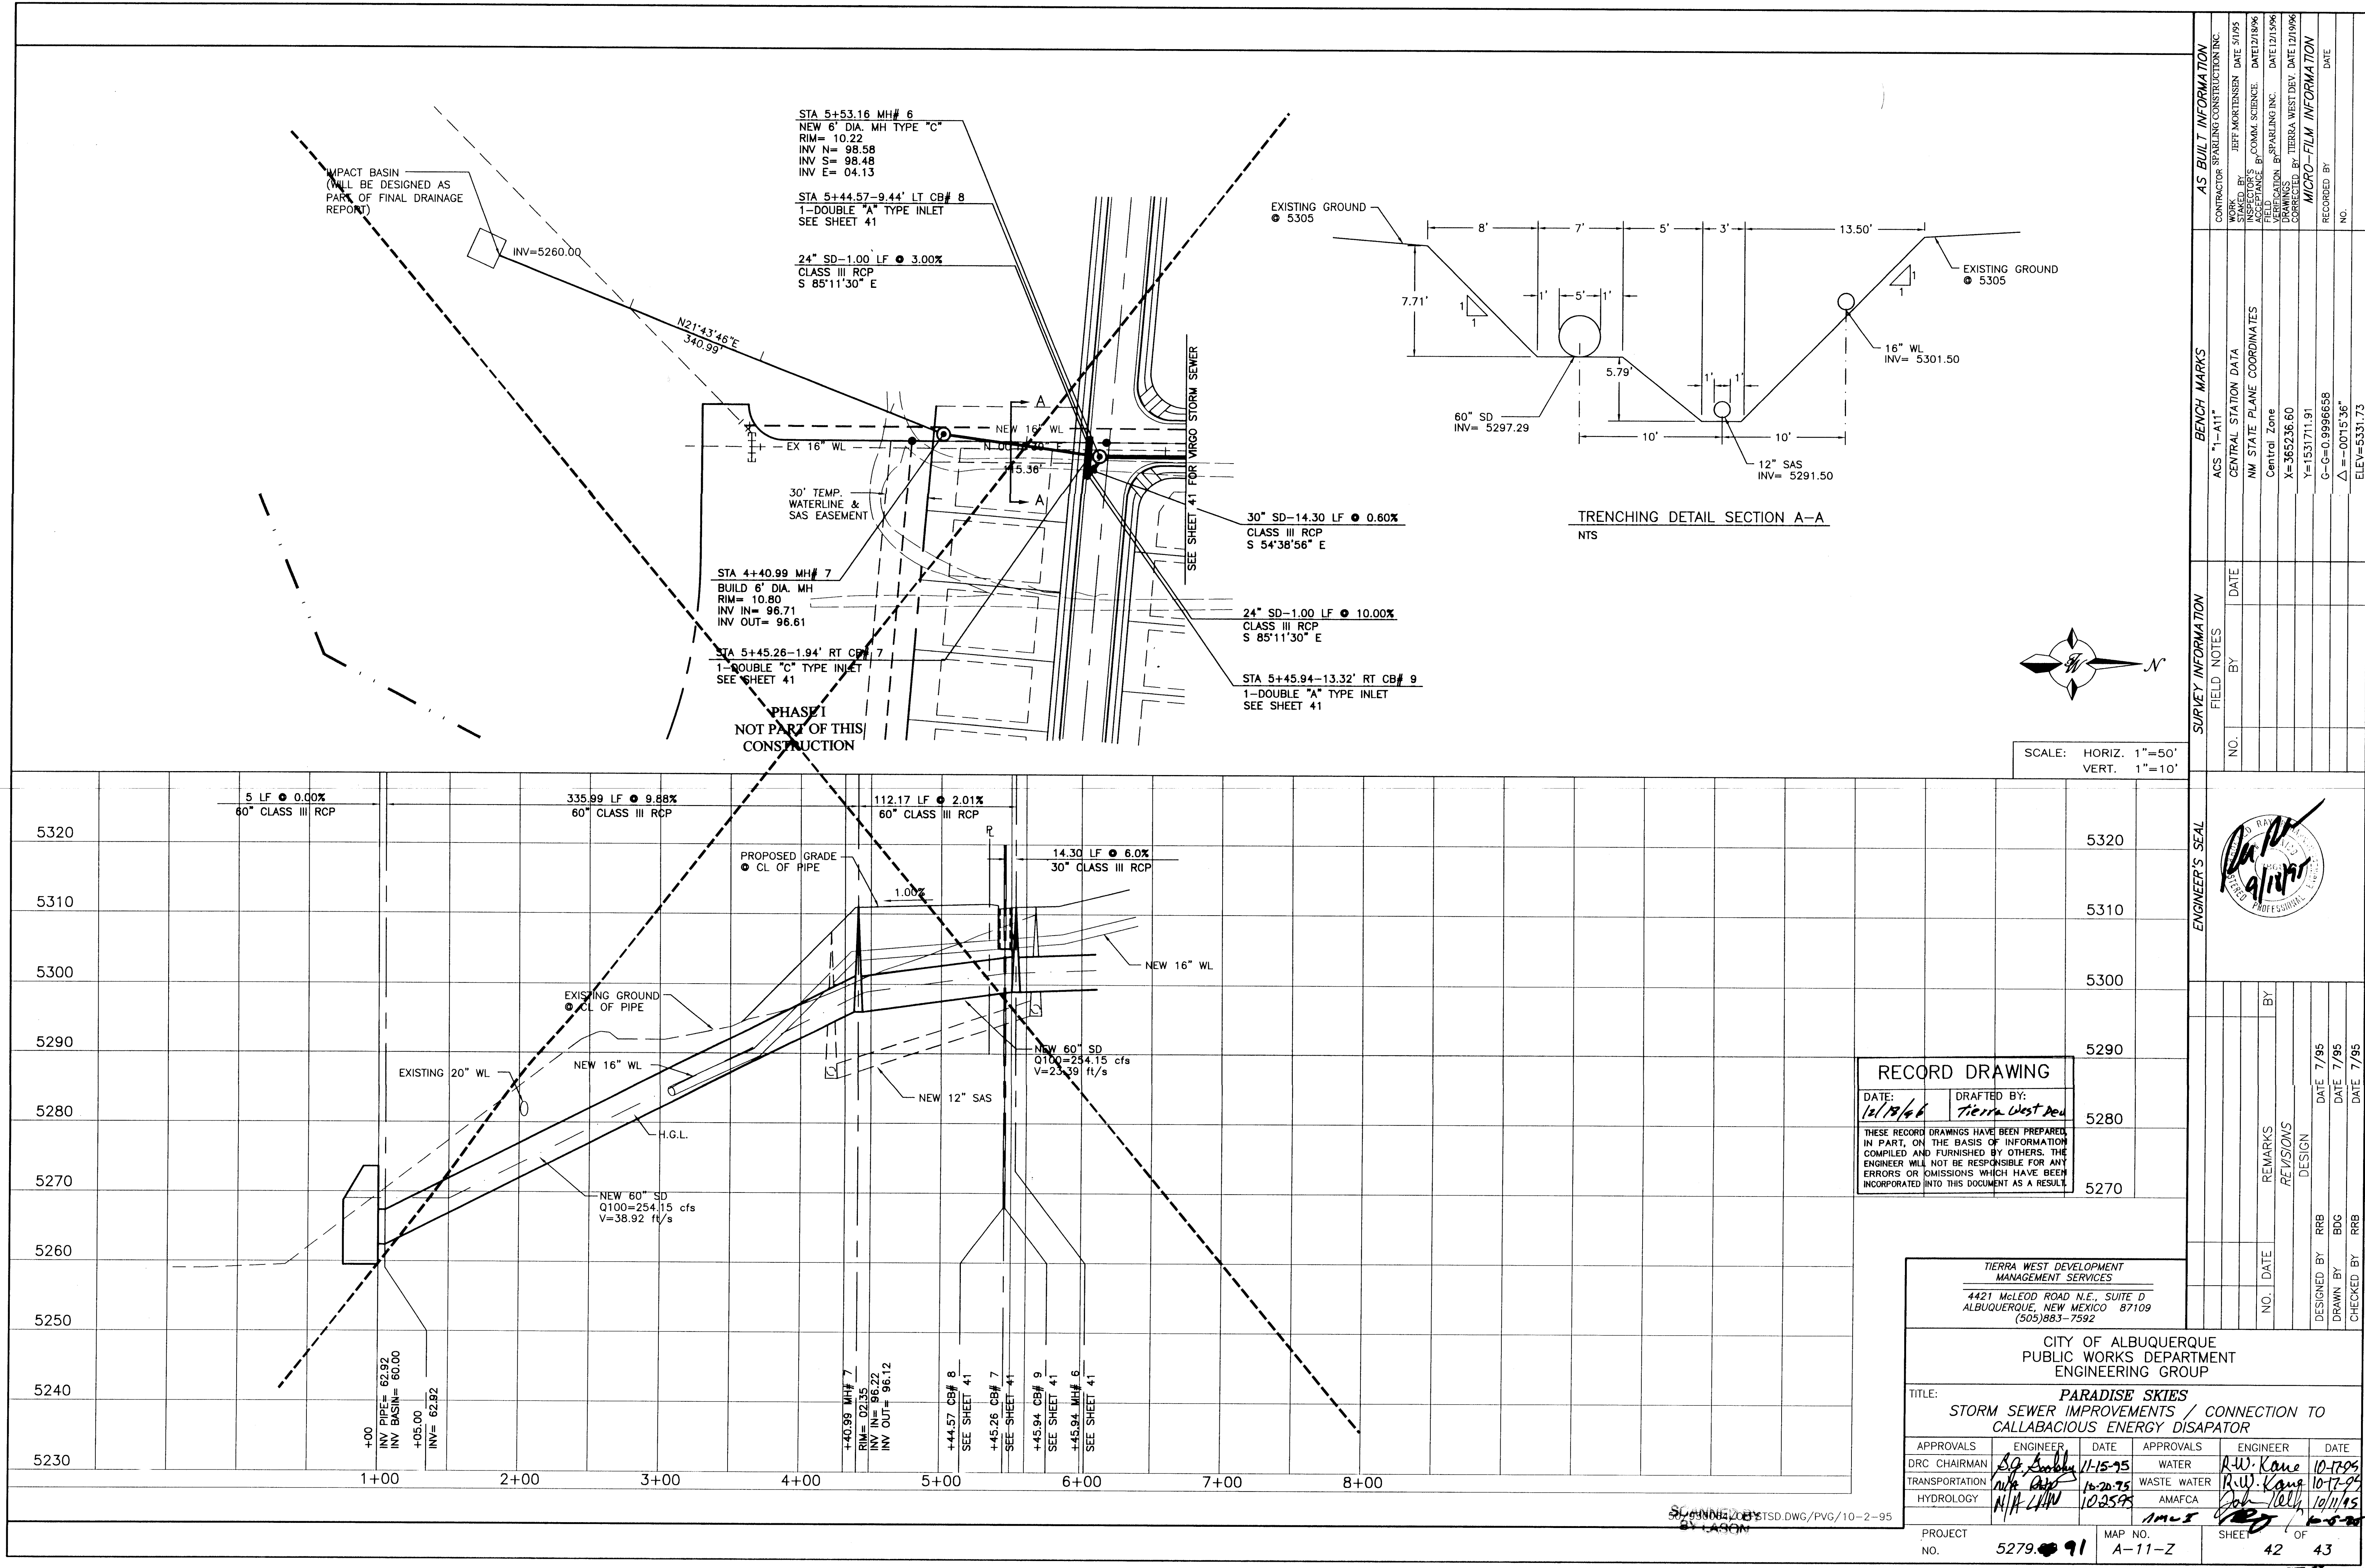

TRENCHING DETAIL SECTION A-A
NTS

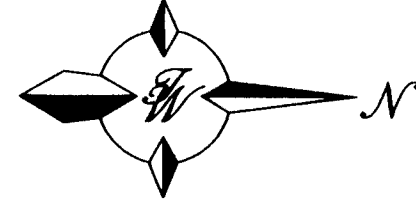

SCALE: HORIZ. 1"=50'
VERT. 1"=10'

RECORD DRAWING
DATE: 12/15/66
DRAFTED BY: Tierra West Dev
THESE RECORD DRAWINGS HAVE BEEN PREPARED IN PART, ON THE BASIS OF INFORMATION COMPILED AND FURNISHED BY OTHERS. THE ENGINEER WILL NOT BE RESPONSIBLE FOR ANY ERRORS OR OMISSIONS WHICH HAVE BEEN INCORPORATED INTO THIS DOCUMENT AS A RESULT.

TIERRA WEST DEVELOPMENT
MANAGEMENT SERVICES
4421 MCLEOD ROAD N.E., SUITE D
ALBUQUERQUE, NEW MEXICO 87109
(505)883-7592

CITY OF ALBUQUERQUE PUBLIC WORKS DEPARTMENT ENGINEERING GROUP			
TITLE: PARADISE SKIES STORM SEWER IMPROVEMENTS / CONNECTION TO CALLABACIOUS ENERGY DISAPATOR			
APPROVALS	ENGINEER	DATE	APPROVALS
DRC CHAIRMAN	<i>[Signature]</i>	11-15-95	WATER
TRANSPORTATION	<i>[Signature]</i>	10-20-95	WASTE WATER
HYDROLOGY	<i>[Signature]</i>	10-25-95	AMAFCA
DESIGNED BY RRB		DATE 7/95	DATE 7/95
DRAWN BY BDG		DATE 7/95	DATE 7/95
CHECKED BY RRB		DATE 7/95	DATE 7/95










SURVEY INFORMATION		BENCH MARKS		AS BUILT INFORMATION	
NO.	FIELD NOTES	ACS "1-A1"	CENTRAL STATION DATA	CONTRACTOR	STARTING CONSTRUCTION INC.
	BY		NW STATE PLANE COORDINATES	STARTED BY	JEFF MORTENSEN
	DATE		Central Zone	INSPECTOR'S	DATE 5/05
			X=365236.60	FIELD CHECKED BY	COMMA SCIENCE
			Y=153171.91	DATE 12/19/96	DATE 12/19/96
			G-C=0.9996658	VERIFICATION BY	TERRA WEST DEV.
			Δ=-0015'36"	DATE 12/19/96	DATE 12/19/96
			ELEV=5331.73	RECORDED BY	MICRO-FILM INFORMATION
				NO.	DATE

ENGINEER'S SEAL		REVISIONS	
		NO.	DATE
		1	7/95
		2	7/95
		3	7/95

SCANNED BY LASON
STANDARD DWG/PVG/10-2-95

26-5279.91 4297

PHASE II

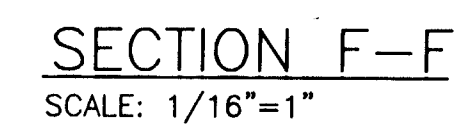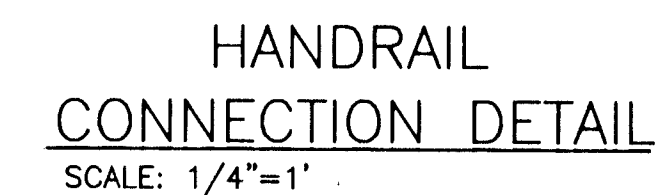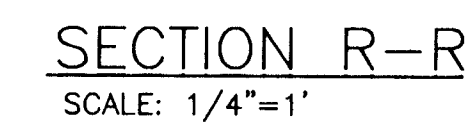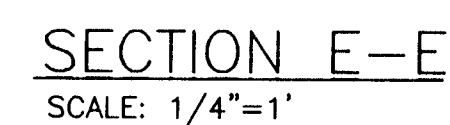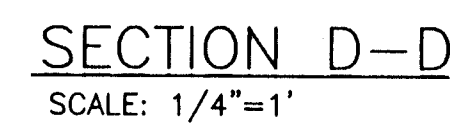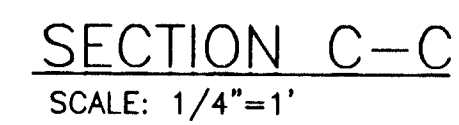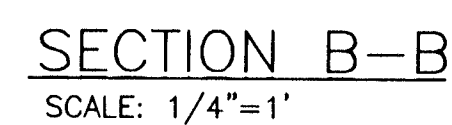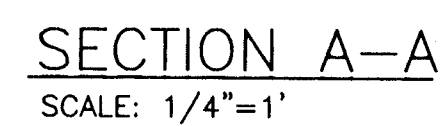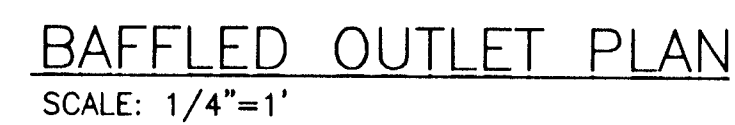

RECORD DRAWING	
DATE: 12/18/96	DRAFTED BY: Tierra West Dev.
THESE RECORD DRAWINGS HAVE BEEN PREPARED, IN PART, ON THE BASIS OF INFORMATION COMPILED AND FURNISHED BY OTHERS. THE ENGINEER WILL NOT BE RESPONSIBLE FOR ANY ERRORS OR OMISSIONS WHICH HAVE BEEN INCORPORATED INTO THIS DOCUMENT AS A RESULT.	

50\930064\MISCDET.DWG\PGV\8-7-95

CITY OF ALBUQUERQUE PUBLIC WORKS DEPARTMENT ENGINEERING GROUP		DESIGNED BY		DRAWN BY		CHECKED BY	
4421 McLEOD ROAD, N.E., SUITE D ALBUQUERQUE, NEW MEXICO 87109 (505)883-7592		NO.		DATE			
PARADISE SKIES BAFFLE OUTLET TYPE 11+							
APPROVALS	ENGINEER	DATE	APPROVALS	ENGINEER	DATE		
DRC CHAIRMAN	<i>B.G. Arceley</i>	<i>11-15-95</i>	WATER	<i>N/A RWE</i>	<i>10-17-95</i>		
TRANSPORTATION	<i>M.D. BLO</i>	<i>10-20-95</i>	WASTE WATER	<i>N/A RWE</i>	<i>10-17-95</i>		
HYDROLOGY	<i>W.D. LAM</i>	<i>10-25-95</i>	AMAFCA	<i>John Kelly</i>	<i>10/11/95</i>		
PROJECT NO.	5279- 00 91		MAP NO.	SHEET		OF	
			A-11-Z	43		43	

PHASE II