


CONSTRUCTION PLANS
FOR
CHAMISA RIDGE SUBDIVISION UNIT I
ALBUQUERQUE, NEW MEXICO

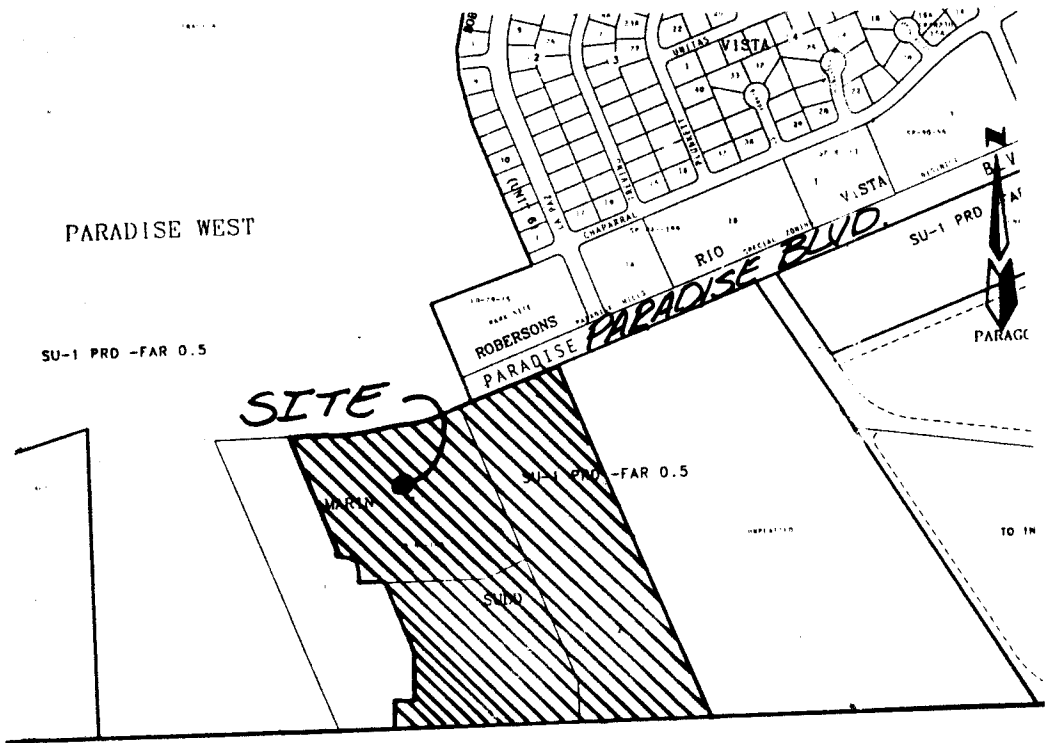

VICINITY MAP ZONE ATLAS B-10-Z
SCALE: NONE

GENERAL NOTES

NOTICE TO CONTRACTORS

- CITY OF ALBUQUERQUE SPECIFICATIONS FOR PUBLIC WORKS CONSTRUCTION, 1986 EDITION AS AMENDED THROUGH UPDATE 6, WILL BE REFERRED TO HEREIN AS THE "STANDARD SPECIFICATIONS".
- TWO WORKING DAYS PRIOR TO ANY EXCAVATION, CONTRACTOR MUST CONTACT NEW MEXICO ONE CALL SYSTEM (260-1990) AND DETERMINE LOCATION OF EXISTING UTILITIES.
- PRIOR TO ANY CONSTRUCTION, THE CONTRACTOR SHALL EXCAVATE AND VERIFY THE HORIZONTAL AND VERTICAL LOCATIONS OF ALL OBSTRUCTIONS. SHOULD A CONFLICT EXIST, THE CONTRACTOR SHALL NOTIFY THE ENGINEER OR THE SURVEYOR SO THAT THE CONFLICT CAN BE RESOLVED WITHOUT DELAY.
- ALL EXISTING SIGNS, MARKERS, DELINEATORS, ETC., WITHIN THE CONSTRUCTION LIMITS SHALL BE REMOVED, STORED AND RE-SET BY THE CONTRACTOR.
- THE CONTRACTOR SHALL NOTIFY THE ENGINEER NOT LESS THAN SEVEN DAYS (7) PRIOR TO STARTING WORK IN ORDER THAT THE ENGINEER MAY TAKE NECESSARY MEASURES TO INSURE THE PRESERVATION OF SURVEY MONUMENTS. CONTRACTOR SHALL NOT DISTURB PERMANENT SURVEY MONUMENTS WITHOUT THE CONSENT OF THE ENGINEER AND SHALL NOTIFY THE ENGINEER AND BEAR THE EXPENSE OF REPLACING ANY THAT MAY BE DISTURBED WITHOUT PERMISSION. REPLACEMENT SHALL BE DONE ONLY BY THE CITY SURVEYOR. WHEN A CHANGE IS MADE IN THE FINISHED ELEVATIONS OF THE PAVEMENT OF ANY ROADWAY IN WHICH A PERMANENT SURVEY MONUMENT IS LOCATED, CONTRACTOR SHALL, AT HIS OWN EXPENSE, ADJUST THE MONUMENT COVER TO THE NEW GRADE UNLESS OTHERWISE SPECIFIED. REFER TO SECTION 4.4 OF THE GENERAL CONDITIONS OF THE STANDARD SPECIFICATIONS.
- THREE (3) WORKING DAYS PRIOR TO BEGINNING CONSTRUCTION THE CONTRACTOR SHALL SUBMIT TO THE CONSTRUCTION CO-ORDINATION DIVISION A DETAILED CONSTRUCTION SCHEDULE. TWO (2) WORKING DAYS PRIOR TO CONSTRUCTION THE CONTRACTOR SHALL OBTAIN A BARRICADING PERMIT FROM THE CONSTRUCTION CO-ORDINATION DIVISION. CONTRACTOR SHALL NOTIFY BARRICADE ENGINEER (768-2551) PRIOR TO OCCUPYING AN INTERSECTION.
- ANY WORK OCCURRING WITHIN AN ARTERIAL ROADWAY REQUIRES 24 HOURS CONSTRUCTION.
- WATER AND SEWER FACILITIES SHALL BE CONSTRUCTED PER NMUI SPECIFICATIONS, INSPECTION AND APPROVAL.
- THE CONTRACTOR SHALL NOTIFY NMUI THREE (3) WORKING DAYS PRIOR TO BEGINNING WATER OR SEWER CONSTRUCTION AND SHALL COORDINATE SAID CONSTRUCTION WITH NMUI.

THE FOLLOWING NOTES ALSO APPLY WHEN CHECKED

- ☒ ALL UTILITIES AND UTILITY SERVICE LINES SHALL BE INSTALLED PRIOR TO PAVING.
- ☒ BACKFILL COMPACTION SHALL BE ACCORDING TO SPECIFIED STREET USE.
- ☐ TACK COAT REQUIREMENTS SHALL BE DETERMINED BY THE CITY ENGINEER.
- ☒ SIDEWALK AND WHEELCHAIR RAMPS WITHIN THE CURB RETURNS SHALL BE CONSTRUCTED WHEREVER A NEW CURB RETURN IS CONSTRUCTED.
- ☐ IF CURB IS DEPRESSED FOR A DRIVEPAD, THE DRIVEPAD SHALL BE CONSTRUCTED PRIOR TO ACCEPTANCE OF CURB AND GUTTER.
- ☒ ALL STORM DRAINAGE FACILITIES SHALL BE COMPLETED PRIOR TO FINAL ACCEPTANCE.
- ☒ THE REQUESTOR OR DEVELOPER SHALL BE RESPONSIBLE FOR REPAIR OR REPLACEMENT OF ALL CURB AND GUTTER OR SIDEWALK DAMAGE AFTER APPROVAL BY THE CITY ENGINEER OR WORK COMPLETED BY THE CONTRACTOR.

RECORD DRAWING

I hereby certify that the information contained on this drawing has been revised in accordance with information furnished by the Contractor and the Surveyor, Sparling Construction Co., and reflects the construction as actually accomplished. This plan as constructed is in substantial compliance with the Approved Plan.

Gregory J. Kranik, NMPE 11929

1 2 3 4 5 6 7 8 9 10 11 12 13 14 15
26-15286.90

CAUTION:
NOTE THAT ALL EXISTING UTILITIES MAY NOT BE SHOWN. ALL EXISTING SERVICE CONNECTIONS ARE NOT SHOWN. ANY EXISTING UTILITIES THAT ARE SHOWN ARE APPROXIMATE LOCATION ONLY. IT SHALL BE THE SOLE RESPONSIBILITY OF THE CONTRACTOR TO CONTACT ALL THE UTILITY OWNERS AND TO CONDUCT ALL NECESSARY FIELD INVESTIGATIONS PRIOR TO ANY EXCAVATIONS TO DETERMINE THE ACTUAL LOCATION OF UTILITIES AND OTHER IMPROVEMENTS.

dmg D. MARK GOODWIN & ASSOCIATES, P.A.
CONSULTING ENGINEERS & SURVEYORS
P. O. BOX 90606
ALBUQUERQUE, NEW MEXICO 87199
(505) 345-2010

APPROVAL OF AS BUILT DRAWINGS
CHIEF CONSTRUCTION ENGINEER
L. M. B. Smith
DATE 8-21-96

LEGEND


- CURB AND GUTTER
- CONCRETE
- ELECTRIC TRANSFORMER
- ELECTRIC PANEL
- SANITARY SEWER MANHOLE
- TELEPHONE MANHOLE
- ELECTRIC MANHOLE
- STORM SEWER MANHOLE
- WATER VALVE
- FIRE HYDRANT
- TELEPHONE BOX
- SPOT ELEVATION
- WATER METER
- CABLE T.V.
- POWER POLE
- ANCHOR
- LIGHT POLE
- TRAFFIC LIGHT
- CROSSWALK SIGNAL
- SPRINKLER CONTROL
- TRAFFIC CONTROL
- LIGHTING BOX

INDEX TO DRAWINGS

SHEET NO.	SHEET
1	TITLE SHEET
2-3	PLAT
4	GRADING & DRAINAGE PLAN
5	GRADING & DRAINAGE PLAN
6	MASTER PAVING PLAN
7-9	PAVING IMPROVEMENTS
10	MASTER UTILITY PLAN
11-15	UTILITY IMPROVEMENTS
16-17	PARADISE PAVING IMPROVEMENTS

I, David C. Clausen, New Mexico Registered Land Surveyor No. 6547, do hereby certify that the as-built information shown hereon is the result of a field survey performed by me or under my direct supervision, and that the same is true and correct.

David C. Clausen N.M.L.S. # 6547

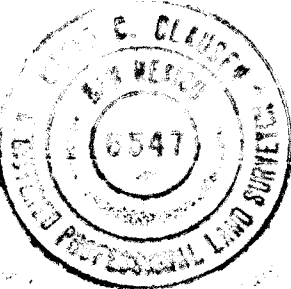


APPROVAL OF REVISIONS

	APPROVED FOR CONSTRUCTION
	PROJECT NO. 5286.90 SHEET 1 OF 17

SCANNED BY
BY LASON

MARIN/TITLE

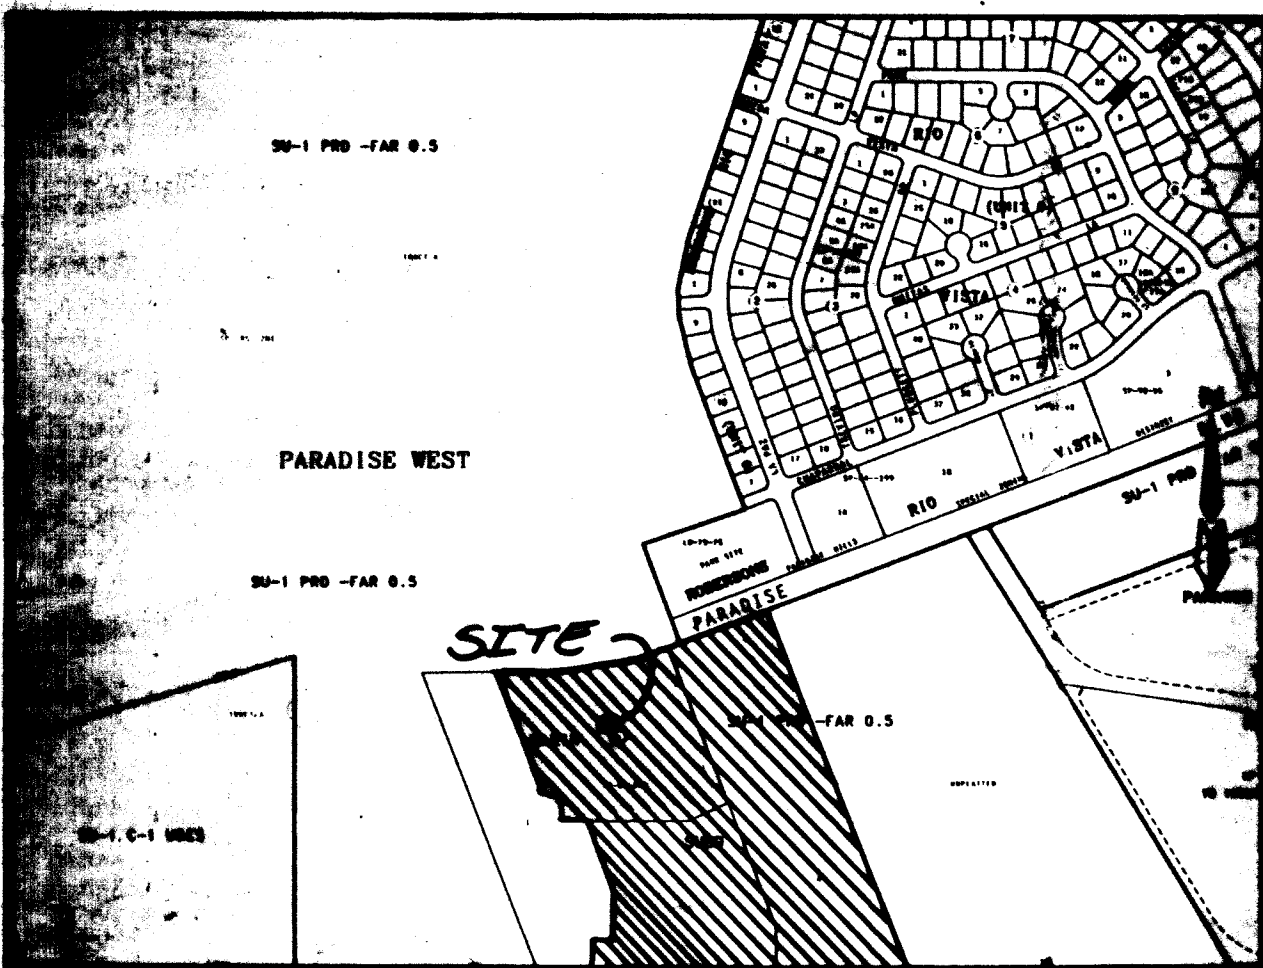

LOCATION MAP

ZONE ATLAS B-10

NOT TO SCALE

SUBDIVISION DATA

PLAT CASE NOS. DRB. 94-20, SP. V. 94-35
GROSS ACREAGE 31.2618
ZONE ATLAS NO. B-10
NO. OF EXISTING TRACTS/LOTS 3 TRACTS
NO. OF TRACTS/LOTS CREATED 27 LOTS
NO. OF TRACTS/LOTS ELIMINATED 3 TRACTS
MILES OF FULL WIDTH STREETS CREATED 0.4959
AREA DEDICATED TO CITY OF ALBUQUERQUE 2.1611 AC
DATE OF SURVEY 12/31/93
UTILITY CONTROL LOCATION SYSTEM LOG NUMBER: 94032110150167

NOTES

Bearings are grid, based on the New Mexico State Plane Coordinate System, Central Zone. Distances are ground distances. Bearings and distances are field and record.

Base of boundary is the plat of record entitled "MARIN SUBDIVISION, TRACTS 1 THROUGH 4" (3-6-85, C26-128), being records of Bernalillo County, New Mexico.

These properties are within the New Mexico Utilities, Inc. (NMU, Inc.) franchise area. Water and Sanitary Sewer System capabilities are based on NMU, Inc., not the City of Albuquerque. Water and Sanitary Sewer infrastructure improvements must, however, be approved by both the City of Albuquerque and NMU, Inc.

FREE CONSENT AND DEDICATION

Subdivision owner(s) and/or proprietor(s) of the said land and/or proprietor(s) do hereby dedicate the said land and/or proprietor(s) to the City of Albuquerque in fee simple with warranty of title and do hereby grant: all access, utility and drainage easements shown hereon including the right to construct, operate, inspect, and maintain facilities thereon; and all public utility easements shown hereon for the common and joint use of gas, electrical power and communication services for buried distribution lines, conduits, and pipes for underground utilities where shown or indicated, and including the right of ingress and egress for construction and maintenance, and the right to trim interfering trees and shrubs. Said owner(s) and/or proprietor(s) do hereby consent to all of the foregoing and do hereby certify that this subdivision is their free act and deed.

HARRY L. SILVERMAN, MANAGER, GELTMOORE LAND LTD., CO.

OWNER'S ACKNOWLEDGMENT

STATE OF NEW MEXICO }
COUNTY OF BERNALILLO } ss
This instrument was acknowledged before me on April 5, 1995
Susan K. Rasmussen
NOTARY PUBLIC MY COMMISSION EXPIRES 9-3-96

LEGAL DESCRIPTION

A tract of land situate within the Town of Alameda Grant within projected Section 10, Township 11 North, Range 2 East, New Mexico Principal Meridian within the City of Albuquerque, Bernalillo County, New Mexico being all of TRACTS 2, 3 and 4, MARIN SUBDIVISION as the same is shown and designated on said plat filed for record in the office of the County Clerk of Bernalillo County, New Mexico on March 6, 1985 in Volume C26, Folio 128 and being more particularly described as follows:

BEGINNING at the northeast corner of the herein described tract, said point being on the southerly right-of-way line of Paradise Boulevard NW from whence the Albuquerque Control Survey Monument "2-B11" bears N 67°07'54" E, 2715.23 feet;

THENCE leaving said right-of-way line S 21°11'56" E, 1492.07 feet to the southeast corner;

THENCE N 89°50'06" W, 1218.93 feet to the southeast corner, said point being common with the southeast corner of TRACT 1, MARIN SUBDIVISION;

THENCE along the easterly line of said TRACT 1 N 00°09'54" E, 100.00 feet to a point;

THENCE continuing S 89°50'06" E, 80.00 feet to a point;

THENCE continuing N 00°09'54" E, 152.89 feet to a point of curvature;

THENCE continuing 100.67 feet along a curve to the left whose radius is 270.00 feet through a central angle of 21°21'50" and whose long chord bears N 10°31'01" W, 100.09 feet to a point of tangency;

THENCE continuing N 21°11'56" W, 224.16 feet to a point;

THENCE continuing N 89°50'06" W, 102.16 feet to a point;

THENCE continuing N 00°09'54" E, 100.00 feet to a point;

THENCE continuing N 89°50'06" W, 80.00 feet to a point;

THENCE continuing N 00°09'54" E, 50.00 feet to a point;

THENCE continuing N 21°11'56" W, 475.19 feet to the northwest corner, said point being common with the northeast corner of said TRACT 1 and further being on the southerly line of TRACT 1, PARADISE WEST as the same is shown and designated on said plat filed for record in the office of the County Clerk of Bernalillo County, New Mexico as Document No. 85-56520;

THENCE along said southerly line S 89°51'41" E, 121.83 feet to a point of curvature;

THENCE continuing 611.57 feet along a curve to the left whose radius is 1677.90 feet through a central angle of 20°53'00" and whose long chord bears N 79°41'49" E, 608.19 feet to a point of tangency, said point being on the southerly right-of-way line of Paradise Boulevard NW;

THENCE leaving said southerly line along said right-of-way line N 69°15'19" E, 354.30 feet to the point of beginning and containing 31.2618 acres more or less.

PURPOSE OF PLAT

THE PURPOSE OF THIS PLAT IS TO COMBINE 3 EXISTING TRACTS INTO 27 RESIDENTIAL LOTS. THIS PLAT ALSO VACATES "VACATION ACT. NO. 94-35" VARIOUS ACCESS AND DRAINAGE EASEMENTS AND GRANTS ADDITIONAL RIGHT OF WAY TO PARADISE BLVD NW.

DEDICATION OF STREET RIGHTS-OF-WAY & TEMPORARY DRAINAGE EASEMENT.

SURVEYOR'S CERTIFICATION

I, Timothy Aldrich, a duly qualified Registered Professional Land Surveyor under the laws of the State of New Mexico, do hereby certify that this plat and description were prepared by me or under my supervision, shows all easements as shown on the plat of record or made known to me by the owners and/or proprietors of the subdivision shown hereon, utility companies and other parties expressing an interest and meets the minimum requirements for monumentation and surveys of the Albuquerque Subdivision Ordinance, and further meets the Minimum Standards for Land Surveying in the State of New Mexico (effective November 1, 1989 and revisions effective December 25, 1991 and February 2, 1994), and is true and correct to the best of my knowledge and belief.

TIMOTHY ALDRICH, P.S. 7719

4-11-95

Date

PLAT OF
CHAMISA RIDGE
SUBDIVISION
UNIT I

WITHIN ALAMEDA GRANT & PROJECTED SECTION 10
T 11 N, R 2 E, N.M.P.M.
CITY OF ALBUQUERQUE
BERNALILLO COUNTY, NEW MEXICO
APRIL 1995

APPROVED AND ACCEPTED BY:

APPROVAL AND CONDITIONAL ACCEPTANCE as specified by the Albuquerque Subdivision Ordinance, Article XI of Chapter 7 of the Revised Ordinances of Albuquerque, New Mexico.

Planning Director, City of Albuquerque, N.M. Date

City Engineering Div., City of Albuquerque, N.M. Date

Albuquerque Metropolitan Arroyo Flood Control Authority Date

Traffic Div., City of Albuquerque, N.M. Date

Water Utilities Dept., City of Albuquerque, N.M. Date

Parks and General Services, City of Albuquerque, N.M. Date

City Surveyor, City of Albuquerque, N.M. Date

Property Management, City of Albuquerque, N.M. Date

New Mexico Utilities, Inc. Date

Gas Company of New Mexico Date

U.S. West Telecommunications Date


Public Service Company of New Mexico Date

Jones Interchange, Inc. Date

CHAMISA RIDGE SUBDIVISION
UNIT I


D. MARK GOODWIN & ASSOCIATES, P.A.
CONSULTING ENGINEERS & SURVEYORS
P.O. BOX 90606
ALBUQUERQUE, NEW MEXICO 87199
(505) 345-2010





Designed: ALS Drawn: BJG Checked: ALS Sheet 1 of 3
Scale: 1"=100' Date: 4/3/95 Job: 93113

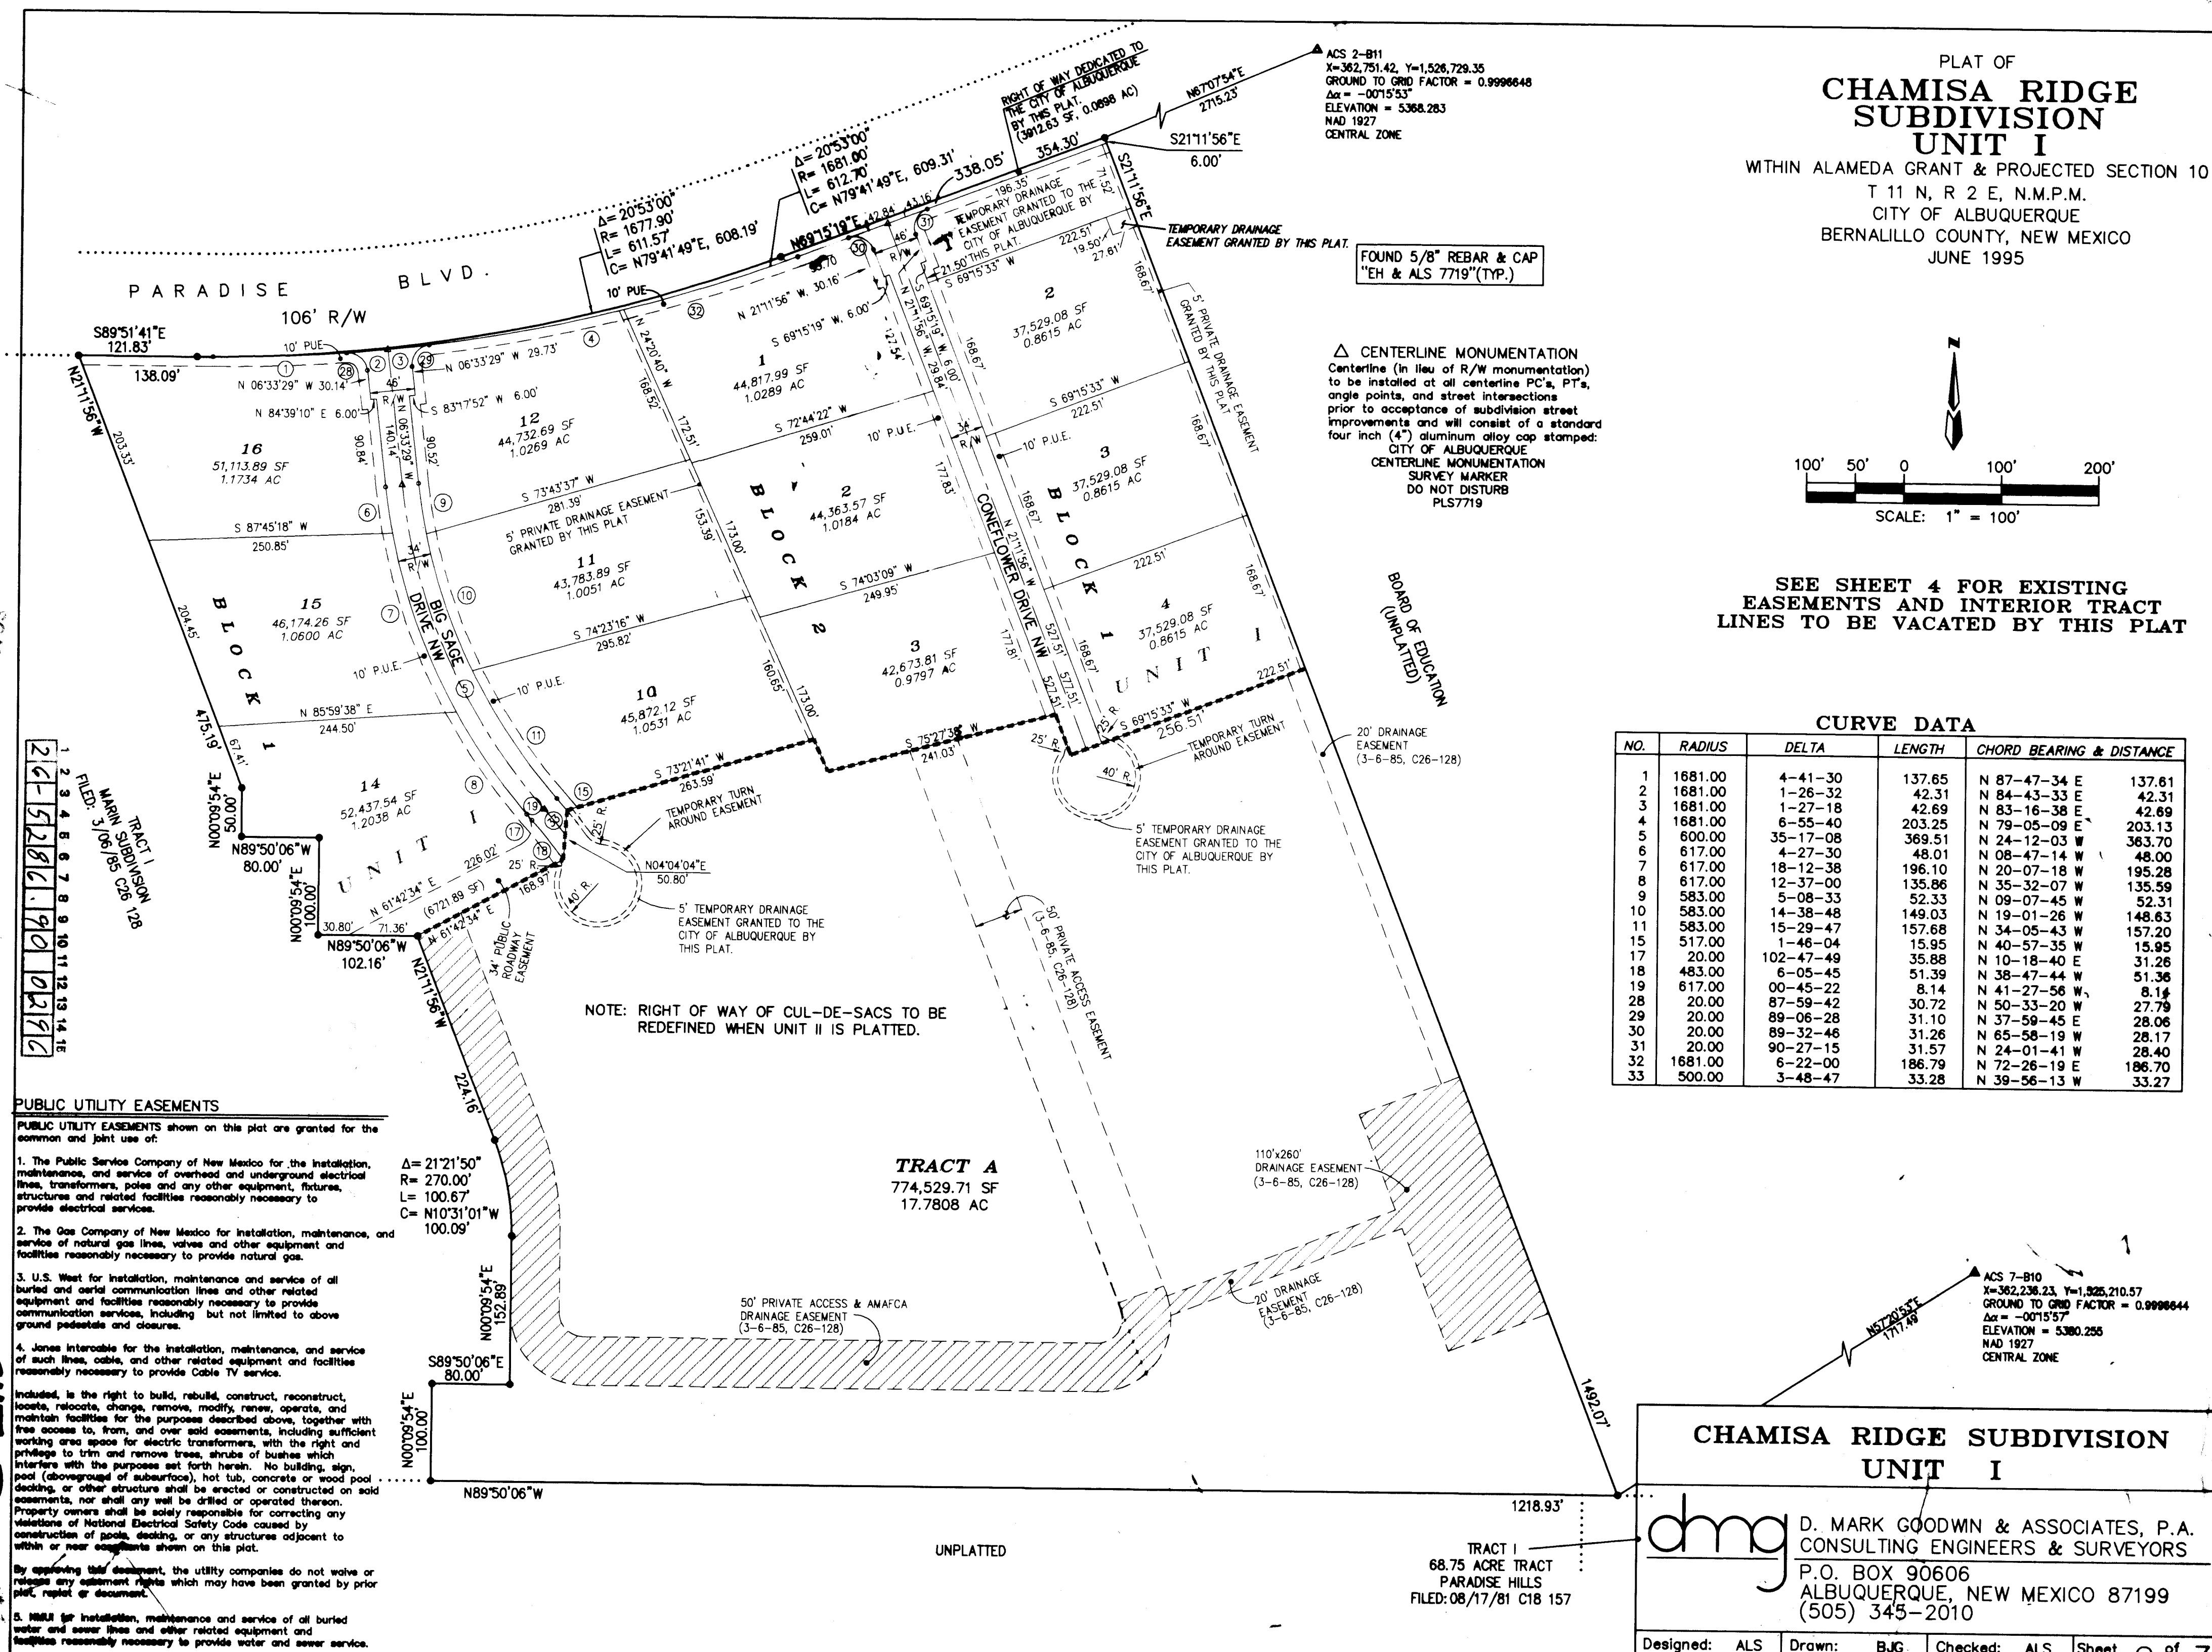

SHT 3 of 17

20-5286-90 0396

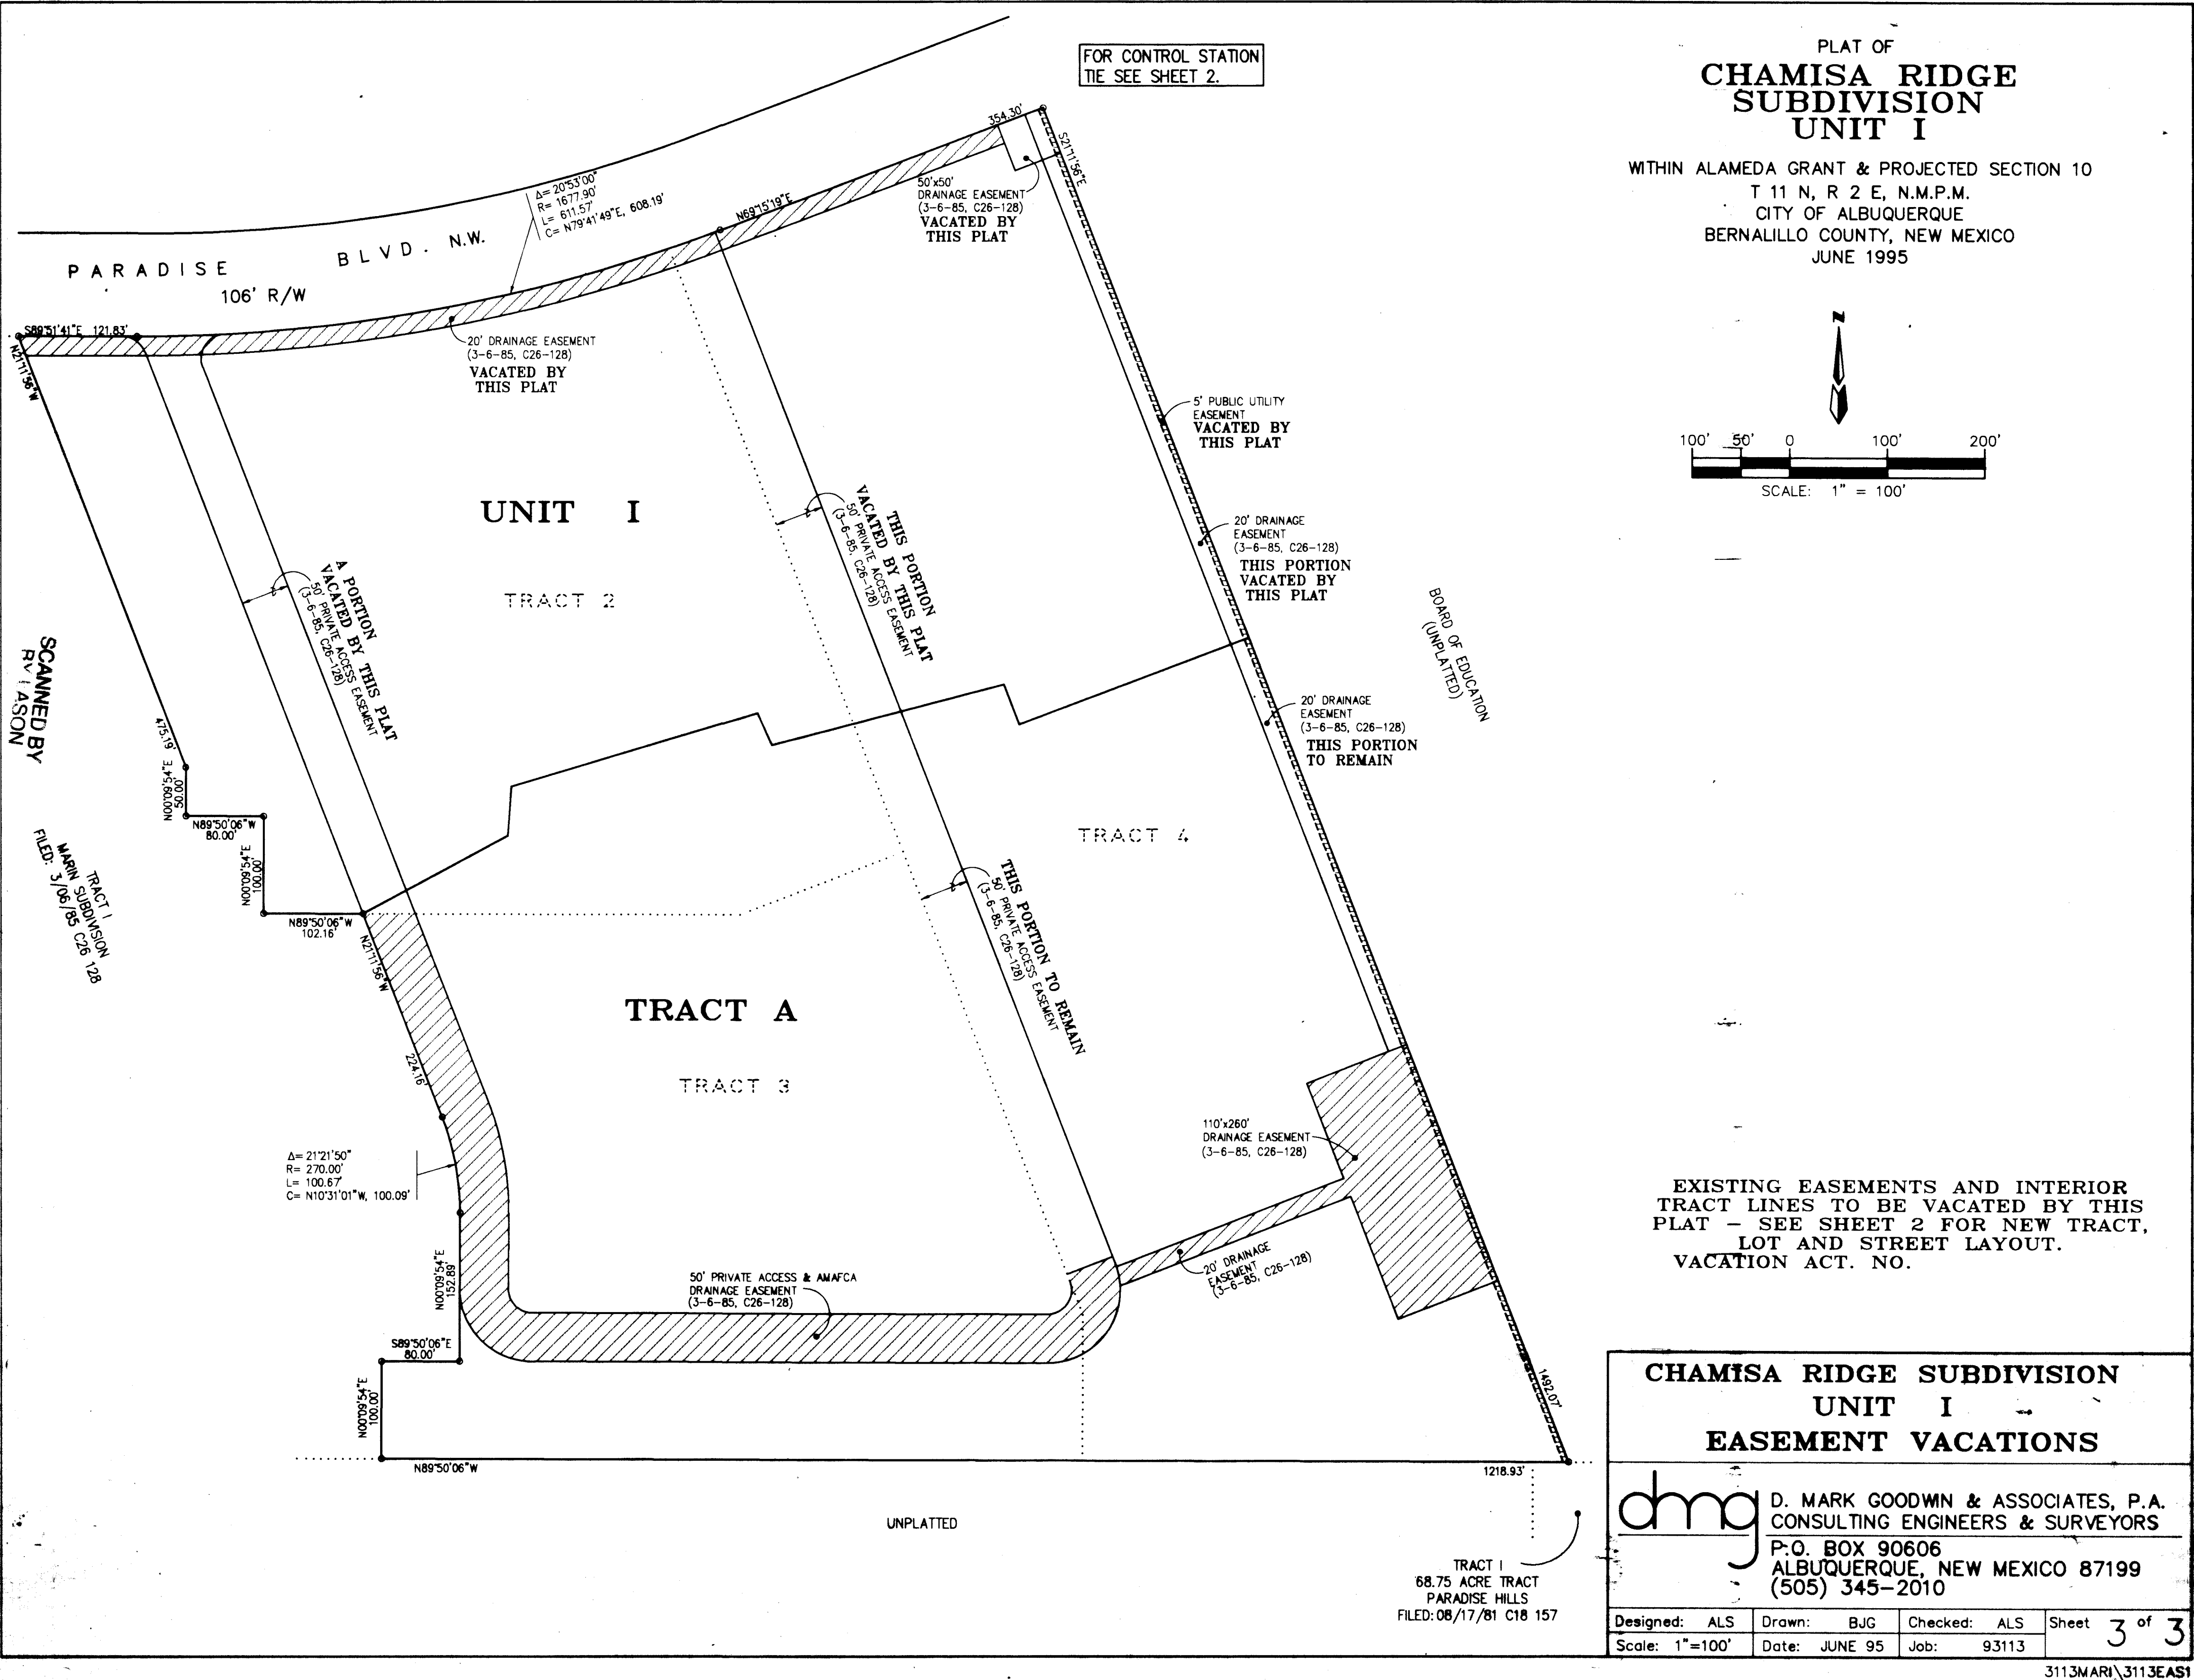

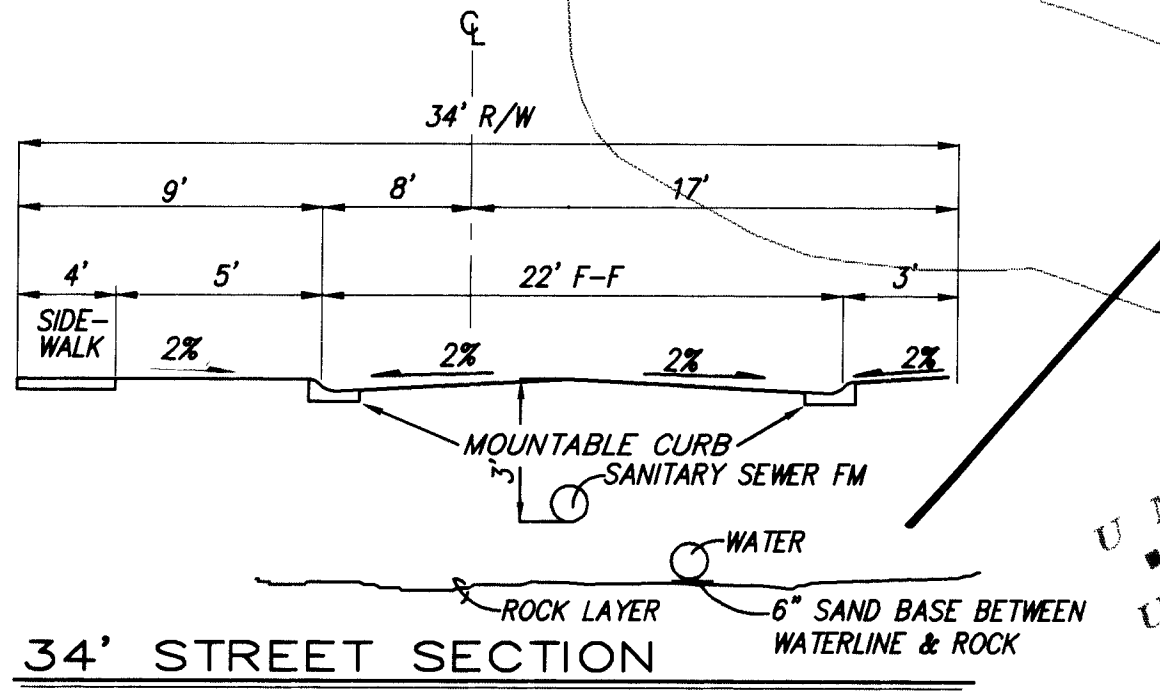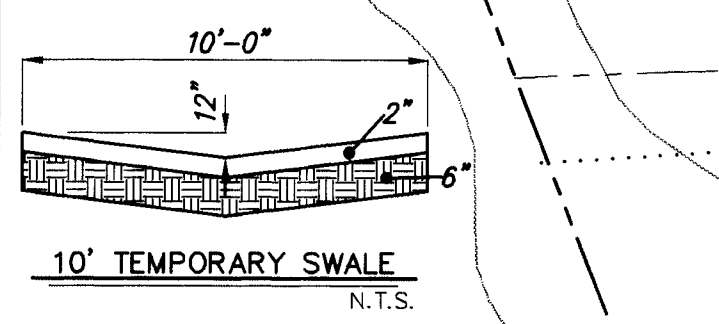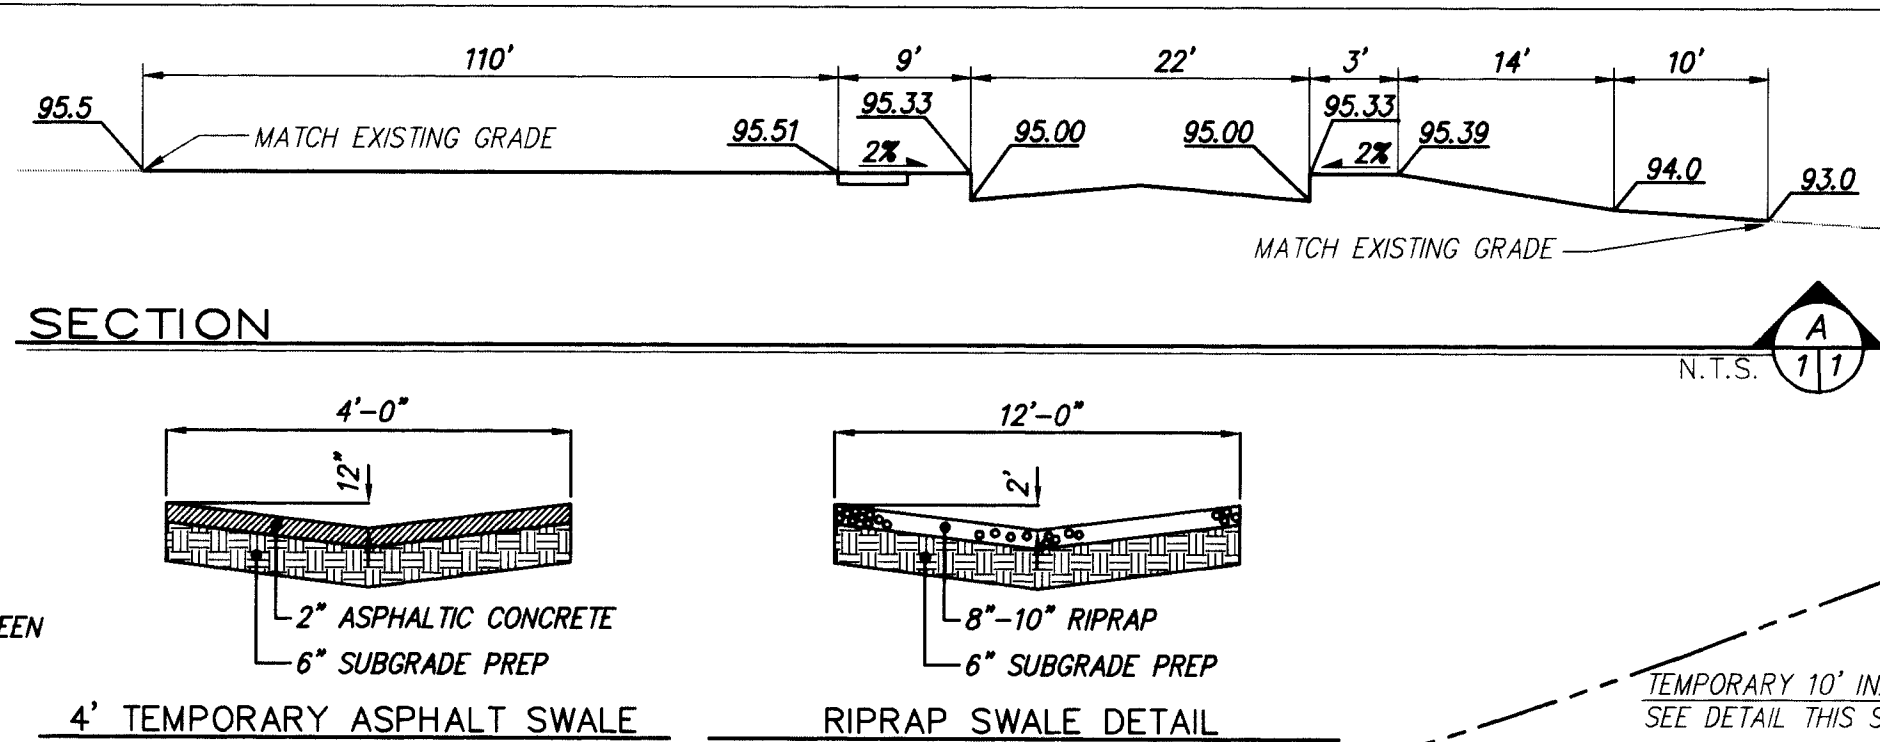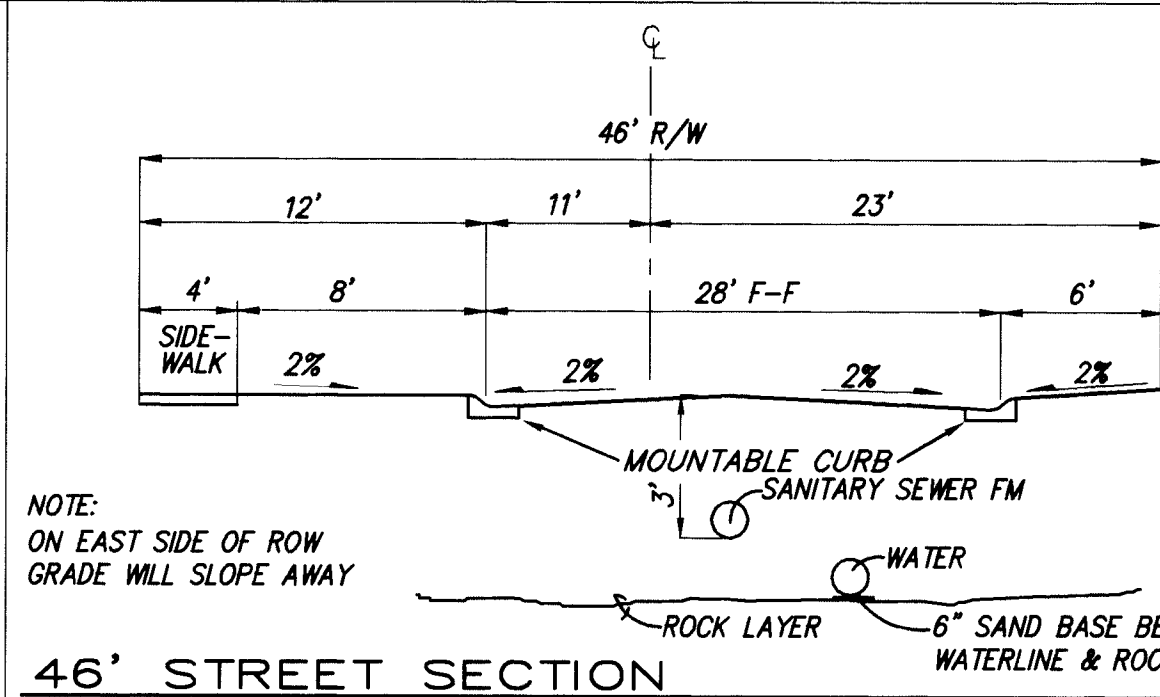

EROSION CONTROL NOTES


- CONTRACTOR IS RESPONSIBLE FOR OBTAINING A TOPSOIL DISTURBANCE PERMIT PRIOR TO WORK BEGINNING.
- CONTRACTOR IS RESPONSIBLE FOR KEEPING ALL SEDIMENT OUT OF EXISTING RIGHT-OF-WAY.
- CONTRACTOR IS RESPONSIBLE FOR CLEANING UP ANY SEDIMENT THAT GETS INTO EXISTING RIGHT-OF-WAY.
- EROSION CONTROL BERMS ARE REQUIRED ALONG PARADISE BLVD.
- ALL EROSION CONTROL BERMS MUST BE IN PLACE AND ENGINEER CERTIFIED PRIOR TO BUILDING PERMIT RELEASE.
- SEED ALL EXCESS DISTURBED AREAS PER C.O.A. SPECIFICATIONS SECTION 1012 "NATIVE SEEDING."



NOTES

- RIGHT OF WAY OF CUL-DE-SACS TO BE REDEFINED WHEN UNIT II IS PLATTED.
- SITE DOES NOT LIE WITHIN A 100 YEAR FLOOD ZONE.
- ALL LANDSCAPE AREAS ADJACENT TO BUILDING TO BE GRADED SUCH THAT ROOF RUNOFF DOES NOT POND.
- CONTRACTOR MUST OBTAIN A TOPSOIL DISTURBANCE PERMIT FROM THE ENVIRONMENTAL HEALTH DIVISION PRIOR TO CONSTRUCTION.
- CITY OF ALBUQUERQUE STANDARD SPECIFICATIONS FOR PUBLIC WORKS CONSTRUCTION, LATEST EDITION SHALL GOVERN ALL WORK.
- THE CONTRACTOR SHALL CONFORM TO ALL CITY, COUNTY, STATE AND FEDERAL DUST CONTROL MEASURES AND REQUIREMENTS AND WILL BE RESPONSIBLE FOR PREPARING AND OBTAINING ALL NECESSARY APPLICATIONS AND APPROVALS.
- THE CONTRACTOR SHALL ENSURE THAT NO SOIL ERODES FROM THE LOTS INTO PUBLIC RIGHT-OF-WAY. THIS CAN BE ACHIEVED BY CONSTRUCTING TEMPORARY BERMS AS PER DTL THIS SHT. AND WETTING THE SOIL TO KEEP IT FROM BLOWING.
- ALL CONCRETE CURBING TO BE 4000 PSI. @ 28 DAYS.

SCANNED BY
BY LASON

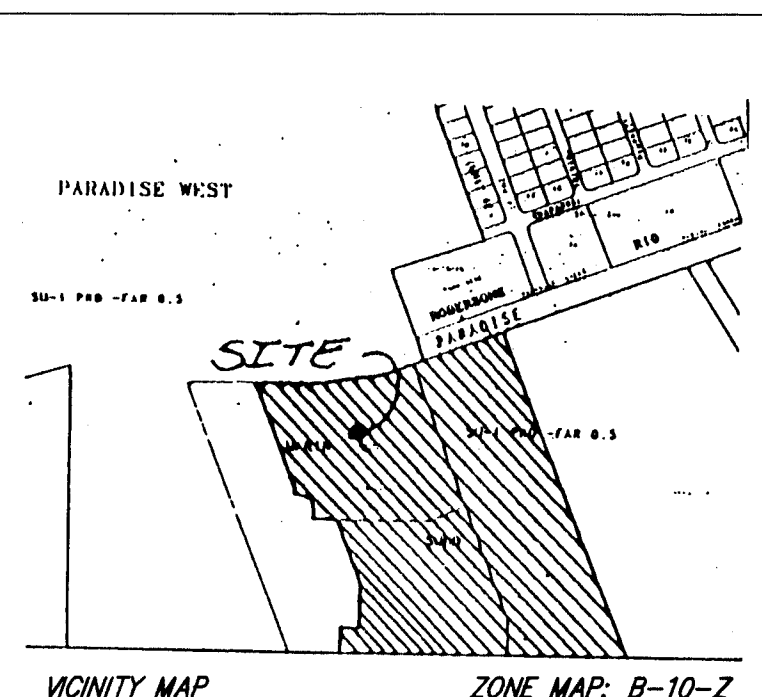

LEGAL DESCRIPTION

TRACTS 2, 3, 4 MARIN SUBDIVISION

NOTE:

ONCE DOWNSTREAM IMPROVEMENTS ARE IN PLACE THE POND WILL BE RETURNED TO THE NATURAL GRADE BEFORE CONSTRUCTION. THE CHANNEL WILL BE RECONSTRUCTED TO FLOW TO PARADISE BLVD.

LEGEND:

- F.P. = 5394.00 FINISHED PAD ELEVATION
- MOUNTABLE CURB & GUTTER
- 90 PROPOSED CONTOUR
- 5394 EXISTING CONTOUR
- 86.00 EXISTING SPOT ELEVATION
- PHASE LINE
- FLOW LEADER
- ROCK LAYER
- LIMITS OF GRADING

26-152816.1901019191

D. MARK GOODWIN & ASSOCIATES, P.A.
CONSULTING ENGINEERS & SURVEYORS
P.O. BOX 90606
ALBUQUERQUE, NEW MEXICO 87199
(505) 345-2010



CITY OF ALBUQUERQUE
PUBLIC WORKS DEPARTMENT
ENGINEERING GROUP

TITLE: CHAMISA RIDGE SUBDIVISION UNIT I
GRADING & DRAINAGE PLAN

APPROVALS	ENGINEER	DATE	APPROVALS	ENGINEER	DATE
DRC CHAIRMAN	11-7-95	WATER	N/A	RWK	10-6-95
TRANSPORTATION	10-6-95	WASTE WATER	N/A	RWK	10-6-95
HYDROLOGY	10-6-95				




PROJECT NO.	MAP NO.	SHEET OF
5286.90	B10	4 17

AS BUILT INFORMATION	
CONTRACTOR: STARLING	DATE: 3/96
STATIONED BY: CHURSEN	DATE: 3/96
DESIGNED BY: CHURSEN	DATE: 3/96
CHECKED BY: CHURSEN	DATE: 3/96
RECORDED BY: CHURSEN	DATE: 3/96
BENCH MARKS	
LOCATED AT THE INTERSECTION OF LA PAZ DR. AND CHAPARRAL DR.	
IN THE NORTHEAST QUADRANT OF THE INTERSECTION. A SHAPE	
CHISED ON TOP OF CURB AT THE N.E. CURB RETURN.	
ELEVATION = 5380.19	
SURVEY INFORMATION	
FIELD NOTES	NO.
BY	NO.
DATE	DATE
REMARKS	REVISIONS
DESIGNED BY	DATE
DRAWN BY	DATE
CHECKED BY	DATE

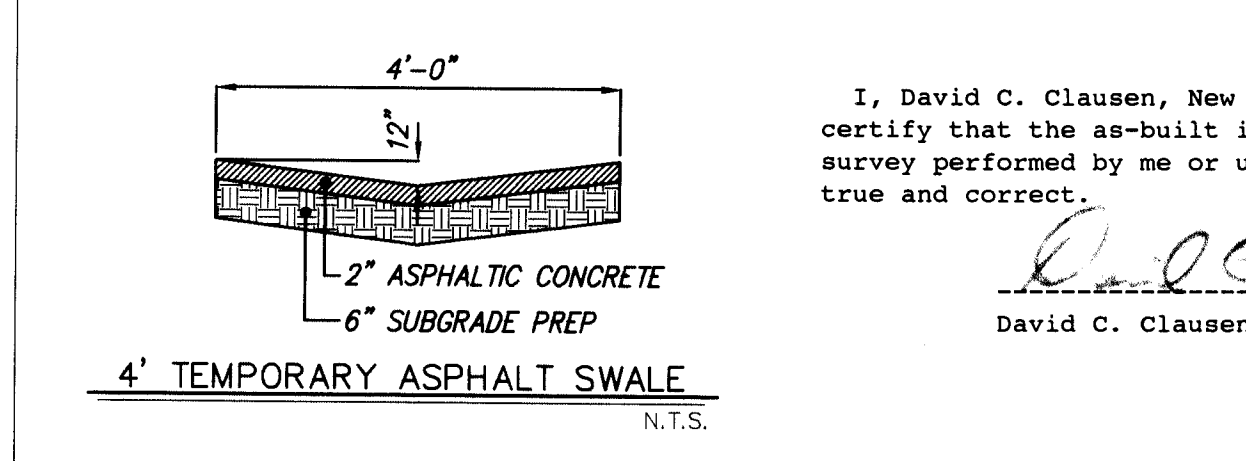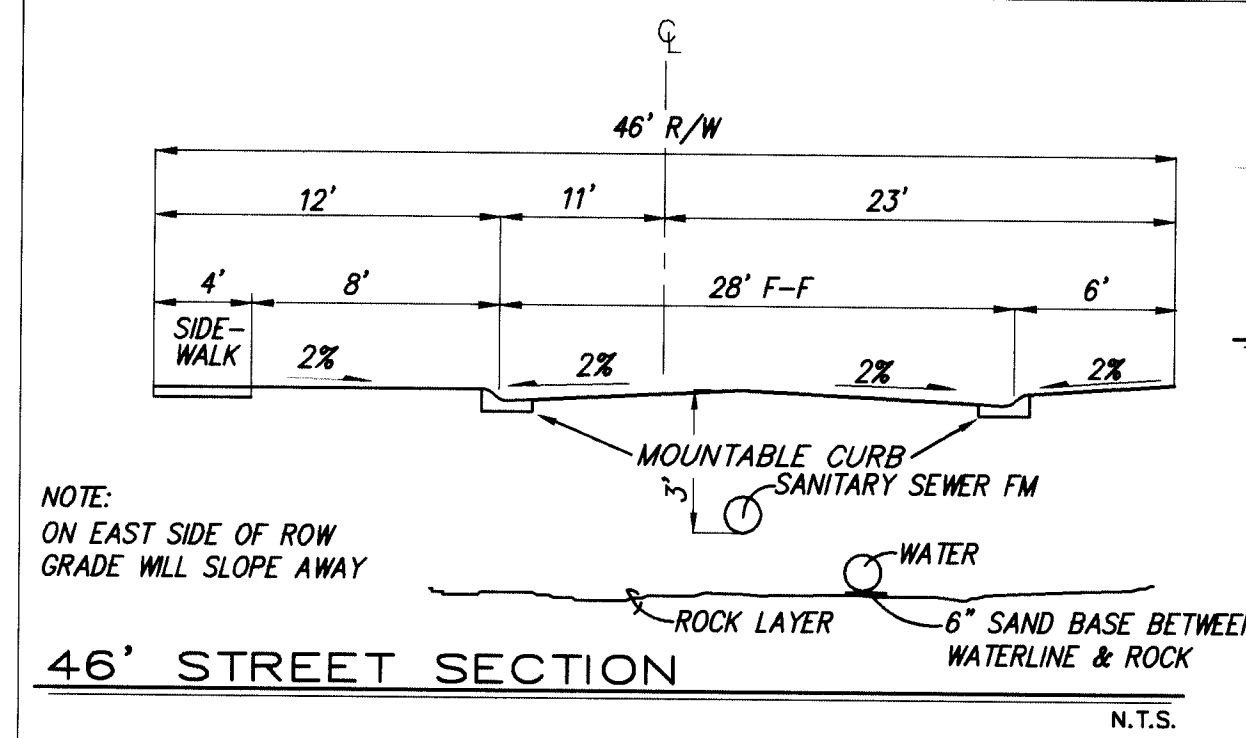

I, David C. Clausen, New Mexico Registered Land Surveyor No. 6547, do hereby certify that the as-built information shown hereon is the result of a field survey performed by me or under my direct supervision, and that the same is true and correct.


David C. Clausen N.M.L.S. # 6547

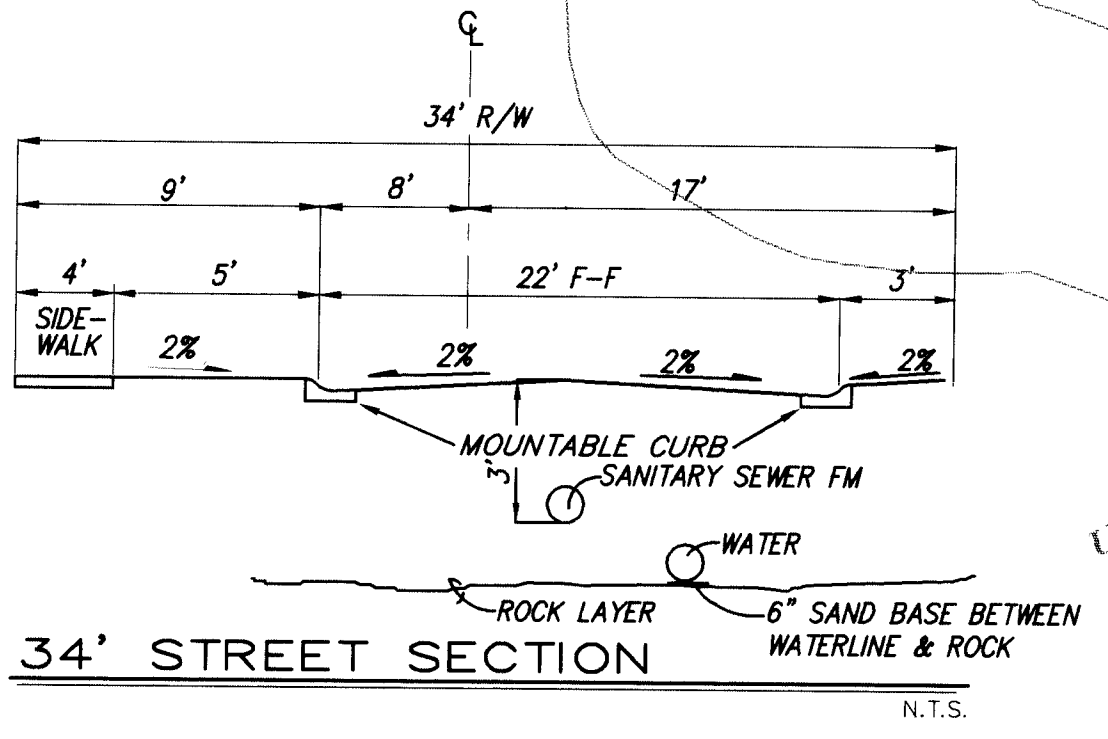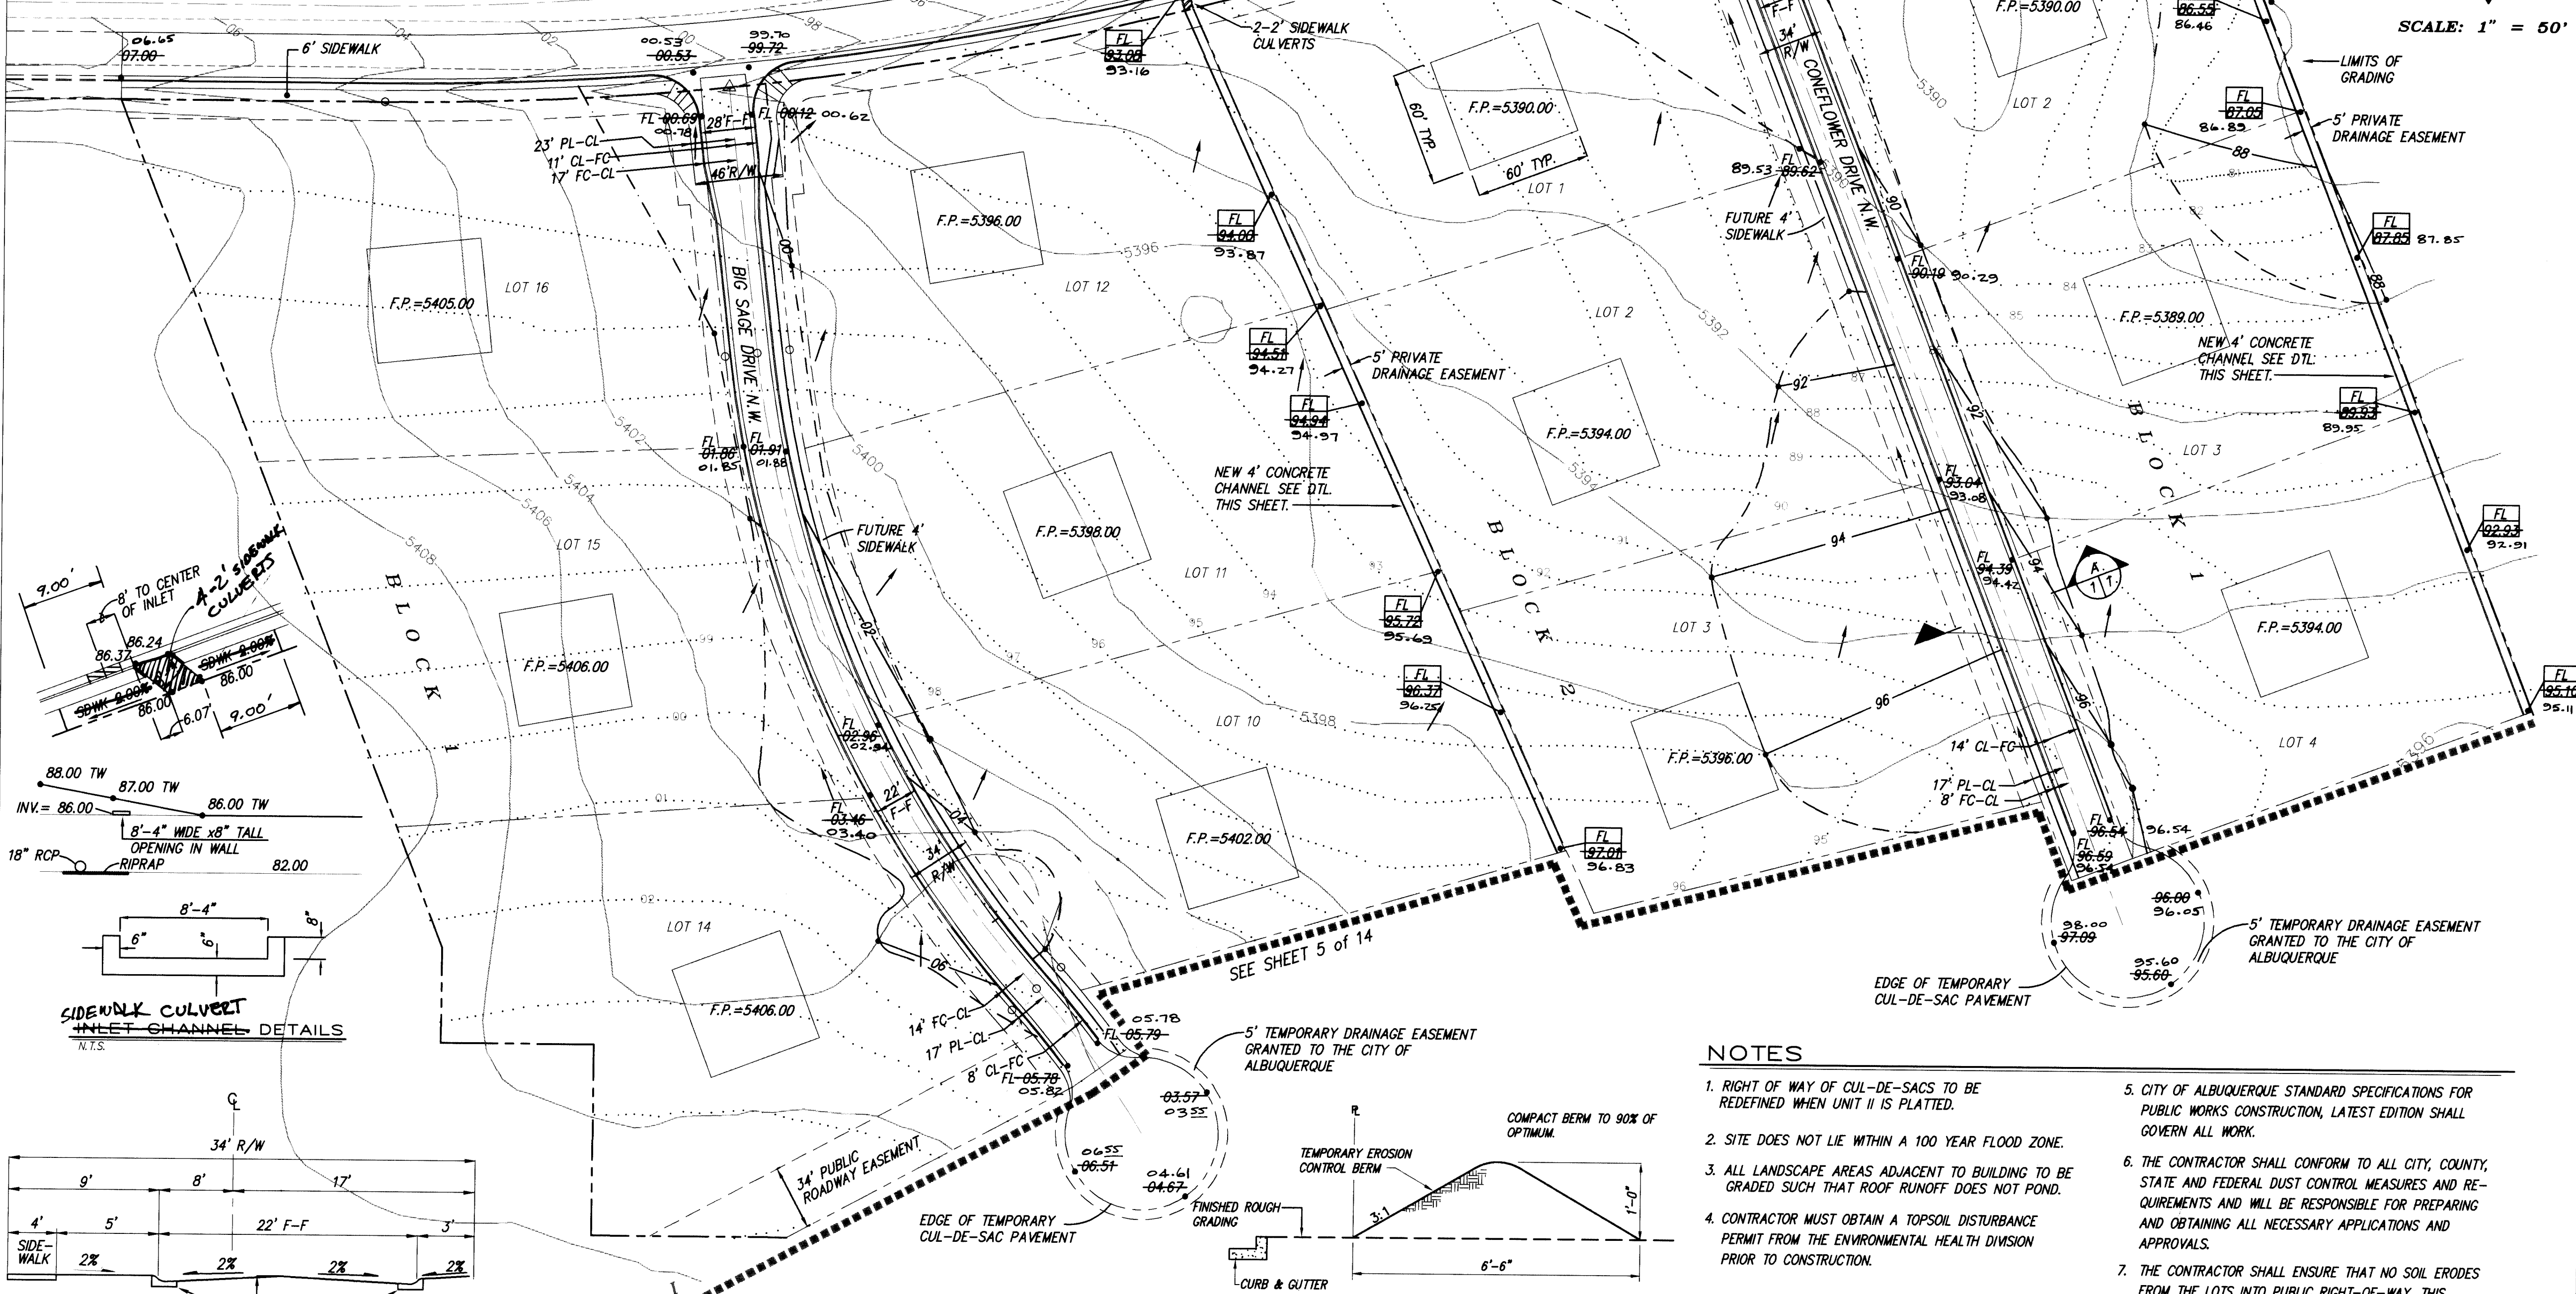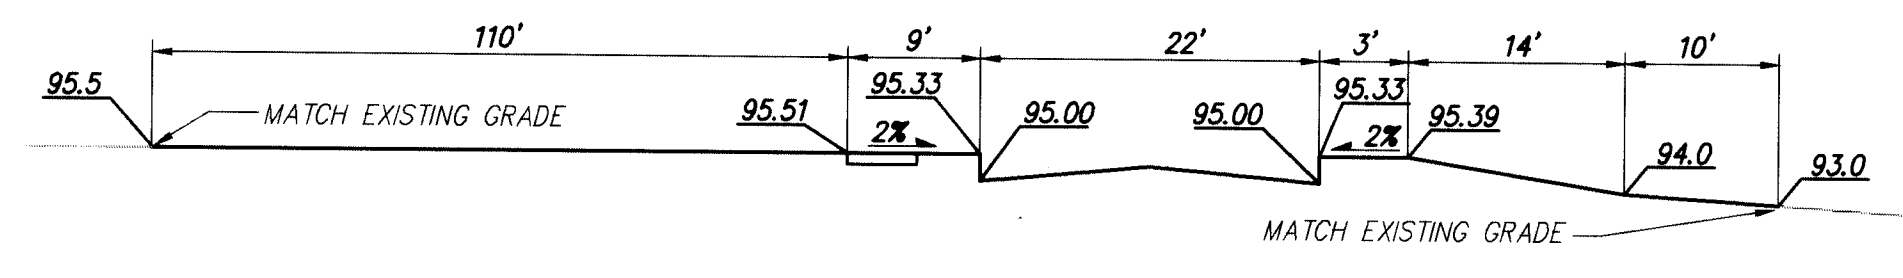

EROSION CONTROL NOTES


- CONTRACTOR IS RESPONSIBLE FOR OBTAINING A TOPSOIL DISTURBANCE PERMIT PRIOR TO WORK BEGINNING.
- CONTRACTOR IS RESPONSIBLE FOR KEEPING ALL SEDIMENT OUT OF EXISTING RIGHT-OF-WAY.
- CONTRACTOR IS RESPONSIBLE FOR CLEANING UP ANY SEDIMENT THAT GETS INTO EXISTING RIGHT-OF-WAY.
- EROSION CONTROL BERMS ARE REQUIRED ALONG PARADISE BLVD.
- ALL EROSION CONTROL BERMS MUST BE IN PLACE AND ENGINEER CERTIFIED PRIOR TO BUILDING PERMIT RELEASE.
- SEED ALL EXCESS DISTURBED AREAS PER C.O.A. SPECIFICATIONS SECTION 1012 "NATIVE SEEDING".

TEMPORARY EROSION CONTROL BERM DETAIL

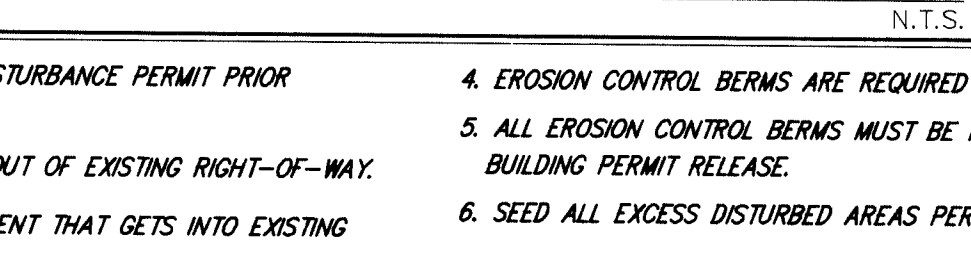

NOTES

- RIGHT OF WAY OF CUL-DE-SACS TO BE REDEFINED WHEN UNIT II IS PLATTED.
- SITE DOES NOT LIE WITHIN A 100 YEAR FLOOD ZONE.
- ALL LANDSCAPE AREAS ADJACENT TO BUILDING TO BE GRADED SUCH THAT ROOF RUNOFF DOES NOT POND.
- CONTRACTOR MUST OBTAIN A TOPSOIL DISTURBANCE PERMIT FROM THE ENVIRONMENTAL HEALTH DIVISION PRIOR TO CONSTRUCTION.
- CITY OF ALBUQUERQUE STANDARD SPECIFICATIONS FOR PUBLIC WORKS CONSTRUCTION, LATEST EDITION SHALL GOVERN ALL WORK.
- THE CONTRACTOR SHALL CONFORM TO ALL CITY, COUNTY, STATE AND FEDERAL DUST CONTROL MEASURES AND REQUIREMENTS AND WILL BE RESPONSIBLE FOR PREPARING AND OBTAINING ALL NECESSARY APPLICATIONS AND APPROVALS.
- THE CONTRACTOR SHALL ENSURE THAT NO SOIL ERODES FROM THE LOTS INTO PUBLIC RIGHT-OF-WAY. THIS CAN BE ACHIEVED BY CONSTRUCTING TEMPORARY BERMS AS PER DTL. THIS SHT. AND WETTING THE SOIL TO KEEP IT FROM BLOWING.
- ALL CONCRETE CURBING TO BE 4000 PSI @ 28 DAYS.

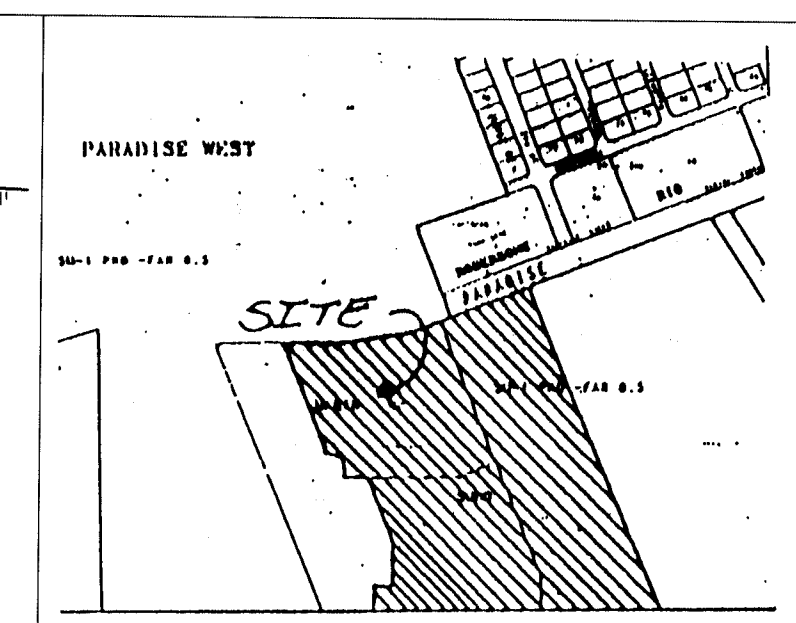

VICINITY MAP ZONE MAP: B-10-2

LEGAL DESCRIPTION
TRACTS 2, 3, 4 MARIN SUBDIVISION

NOTE:
ONCE DOWNSTREAM IMPROVEMENTS ARE IN PLACE THE POND WILL BE RETURNED TO THE NATURAL GRADE BEFORE CONSTRUCTION. THE CHANNEL WILL BE RECONSTRUCTED TO FLOW TO PARADISE BLVD. AND THE 10 LF OF 18\"/>

I hereby certify that the information furnished on this drawing has been revised in accordance with information furnished by the Contractor and the Surveyor, Sparling Construction Co., and reflects the construction as completed. This plan as constructed is in substantial compliance with the Approved Plan.

Gregory J. Krenik N.M.F.E. 11929

- LEGEND:
- F.P. = 5394.00 FINISHED PAD ELEVATION
 - MOUNTABLE CURB & GUTTER
 - 90— PROPOSED CONTOUR
 - 5394— EXISTING CONTOUR
 - 86.00— EXISTING SPOT ELEVATION
 - PHASE LINE
 - FLOW LEADER
 - ROCK LAYER
 - LIMITS OF GRADING

26-152816-190 1941916

dmg D. MARK GOODWIN & ASSOCIATES, P.A. CONSULTING ENGINEERS & SURVEYORS P.O. BOX 90606 ALBUQUERQUE, NEW MEXICO 87199 (505) 345-2010

CITY OF ALBUQUERQUE
PUBLIC WORKS DEPARTMENT
ENGINEERING GROUP


TITLE: CHAMISA RIDGE SUBDIVISION UNIT I
GRADING & DRAINAGE PLAN

APPROVALS	ENGINEER	DATE	APPROVALS	ENGINEER	DATE
DRC CHAIRMAN			WATER		
TRANSPORTATION		3-07-96	WASTE WATER		
HYDROLOGY		3-8-96			

PROJECT NO. 5286.90 MAP NO. B10 SHEET OF 4A 17

SCANNED BY
BY LASON

MARIN\GD50R

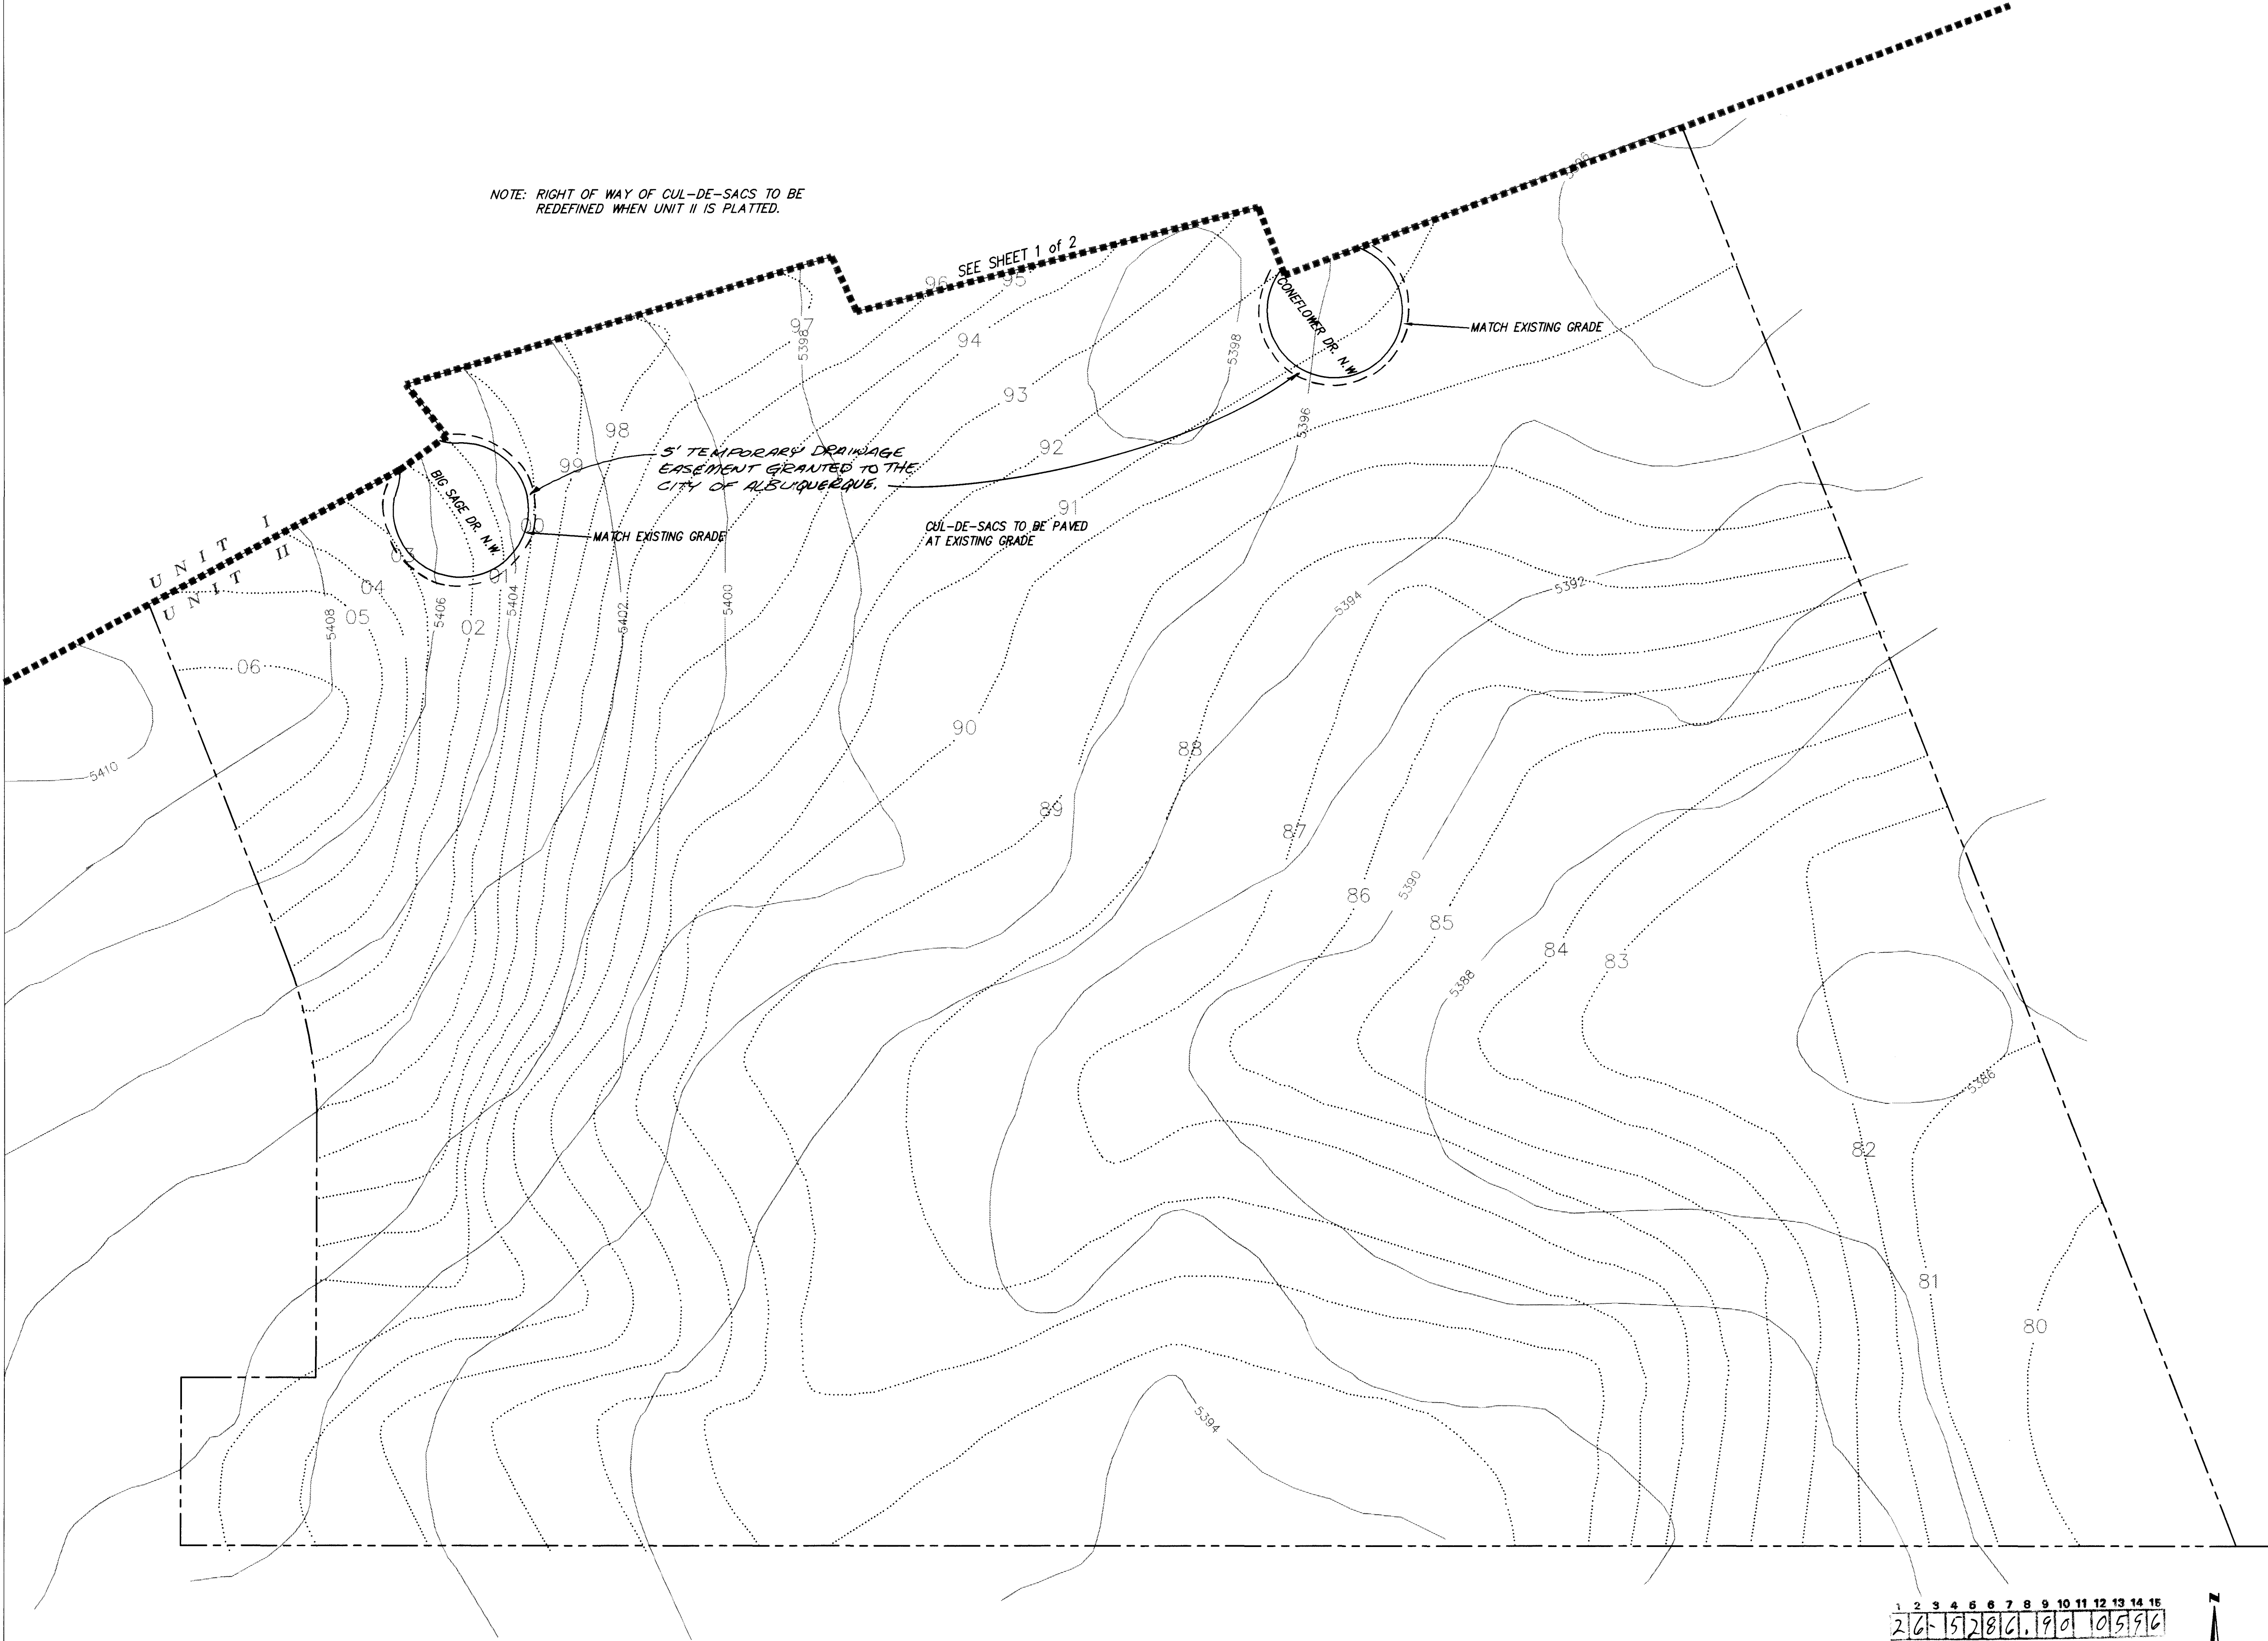

RECORD DRAWING

I hereby certify that the information contained on this drawing has been revised in accordance with information furnished by the Contractor and the Surveyor, Sparling Construction Co., and reflects the construction actually accomplished. This plan as shown is in substantial compliance with the approved plan.

Gregory J. Krenik, NMPE 11929

7-19-96

RECORD DRAFTER

LEGAL DESCRIPTION

TRACTS 2, 3, 4 MARIN SUBDIVISION

ENGINEER'S SEAL

LEGEND:

F.P. = 94 FINISHED PAD ELEVATION

— RUNDOWN CURB & GUTTER

—90— PROPOSED CONTOUR

—5394— EXISTING CONTOUR

x.86.00 EXISTING SPOT ELEVATION

— PHASE LINE

— ROCK LAYER

dmg D. MARK GOODWIN & ASSOCIATES, P.A.
CONSULTING ENGINEERS & SURVEYORS
P.O. BOX 90606
ALBUQUERQUE, NEW MEXICO 87199
(505) 345-2010

CITY OF ALBUQUERQUE
PUBLIC WORKS DEPARTMENT
ENGINEERING GROUP

TITLE: CHAMISA RIDGE SUBDIVISION UNIT I
GRADING & DRAINAGE PLAN

APPROVALS	ENGINEER	DATE	APPROVALS	ENGINEER	DATE
DRG CHAIRMAN	39. Barbary	11-2-95	WATER	N/A RWK	10-6-95
TRANSPORTATION	N/A PWC	10-6-95	WASTE WATER	N/A RWK	10-6-95
HYDROLOGY	PWC	10-6-95			

PROJECT NO.	5286.90	MAP NO.	B10	SHEET OF	5 17
-------------	---------	---------	-----	----------	------

SCANNED BY LASON

MARIN\GD50-2

AS BUILT INFORMATION


CONTRACTOR	Sparling	DATE	3/96
INSPECTOR	Clausen	DATE	7/96
ACCEPTANCE BY	MG A	DATE	7/96
VERIFICATION BY	Clausen	DATE	7/96
DRAWINGS	MG A	DATE	7/96
CORRECTED BY	MG A	DATE	7/96
MICRO-FILM INFORMATION		DATE	
RECORDED BY		DATE	
NO.		DATE	

BENCH MARKS

LOCATED AT THE INTERSECTION OF LA PAZ DR. AND CHAPARRAL DR. IN THE NORTHEAST QUADRANT OF THE INTERSECTION. A SQUARE CHISEL ON TOP OF CURB AT THE N.W. CORNER. ELEVATION = 5380.19

7-19-96

RECORD DRAFTER

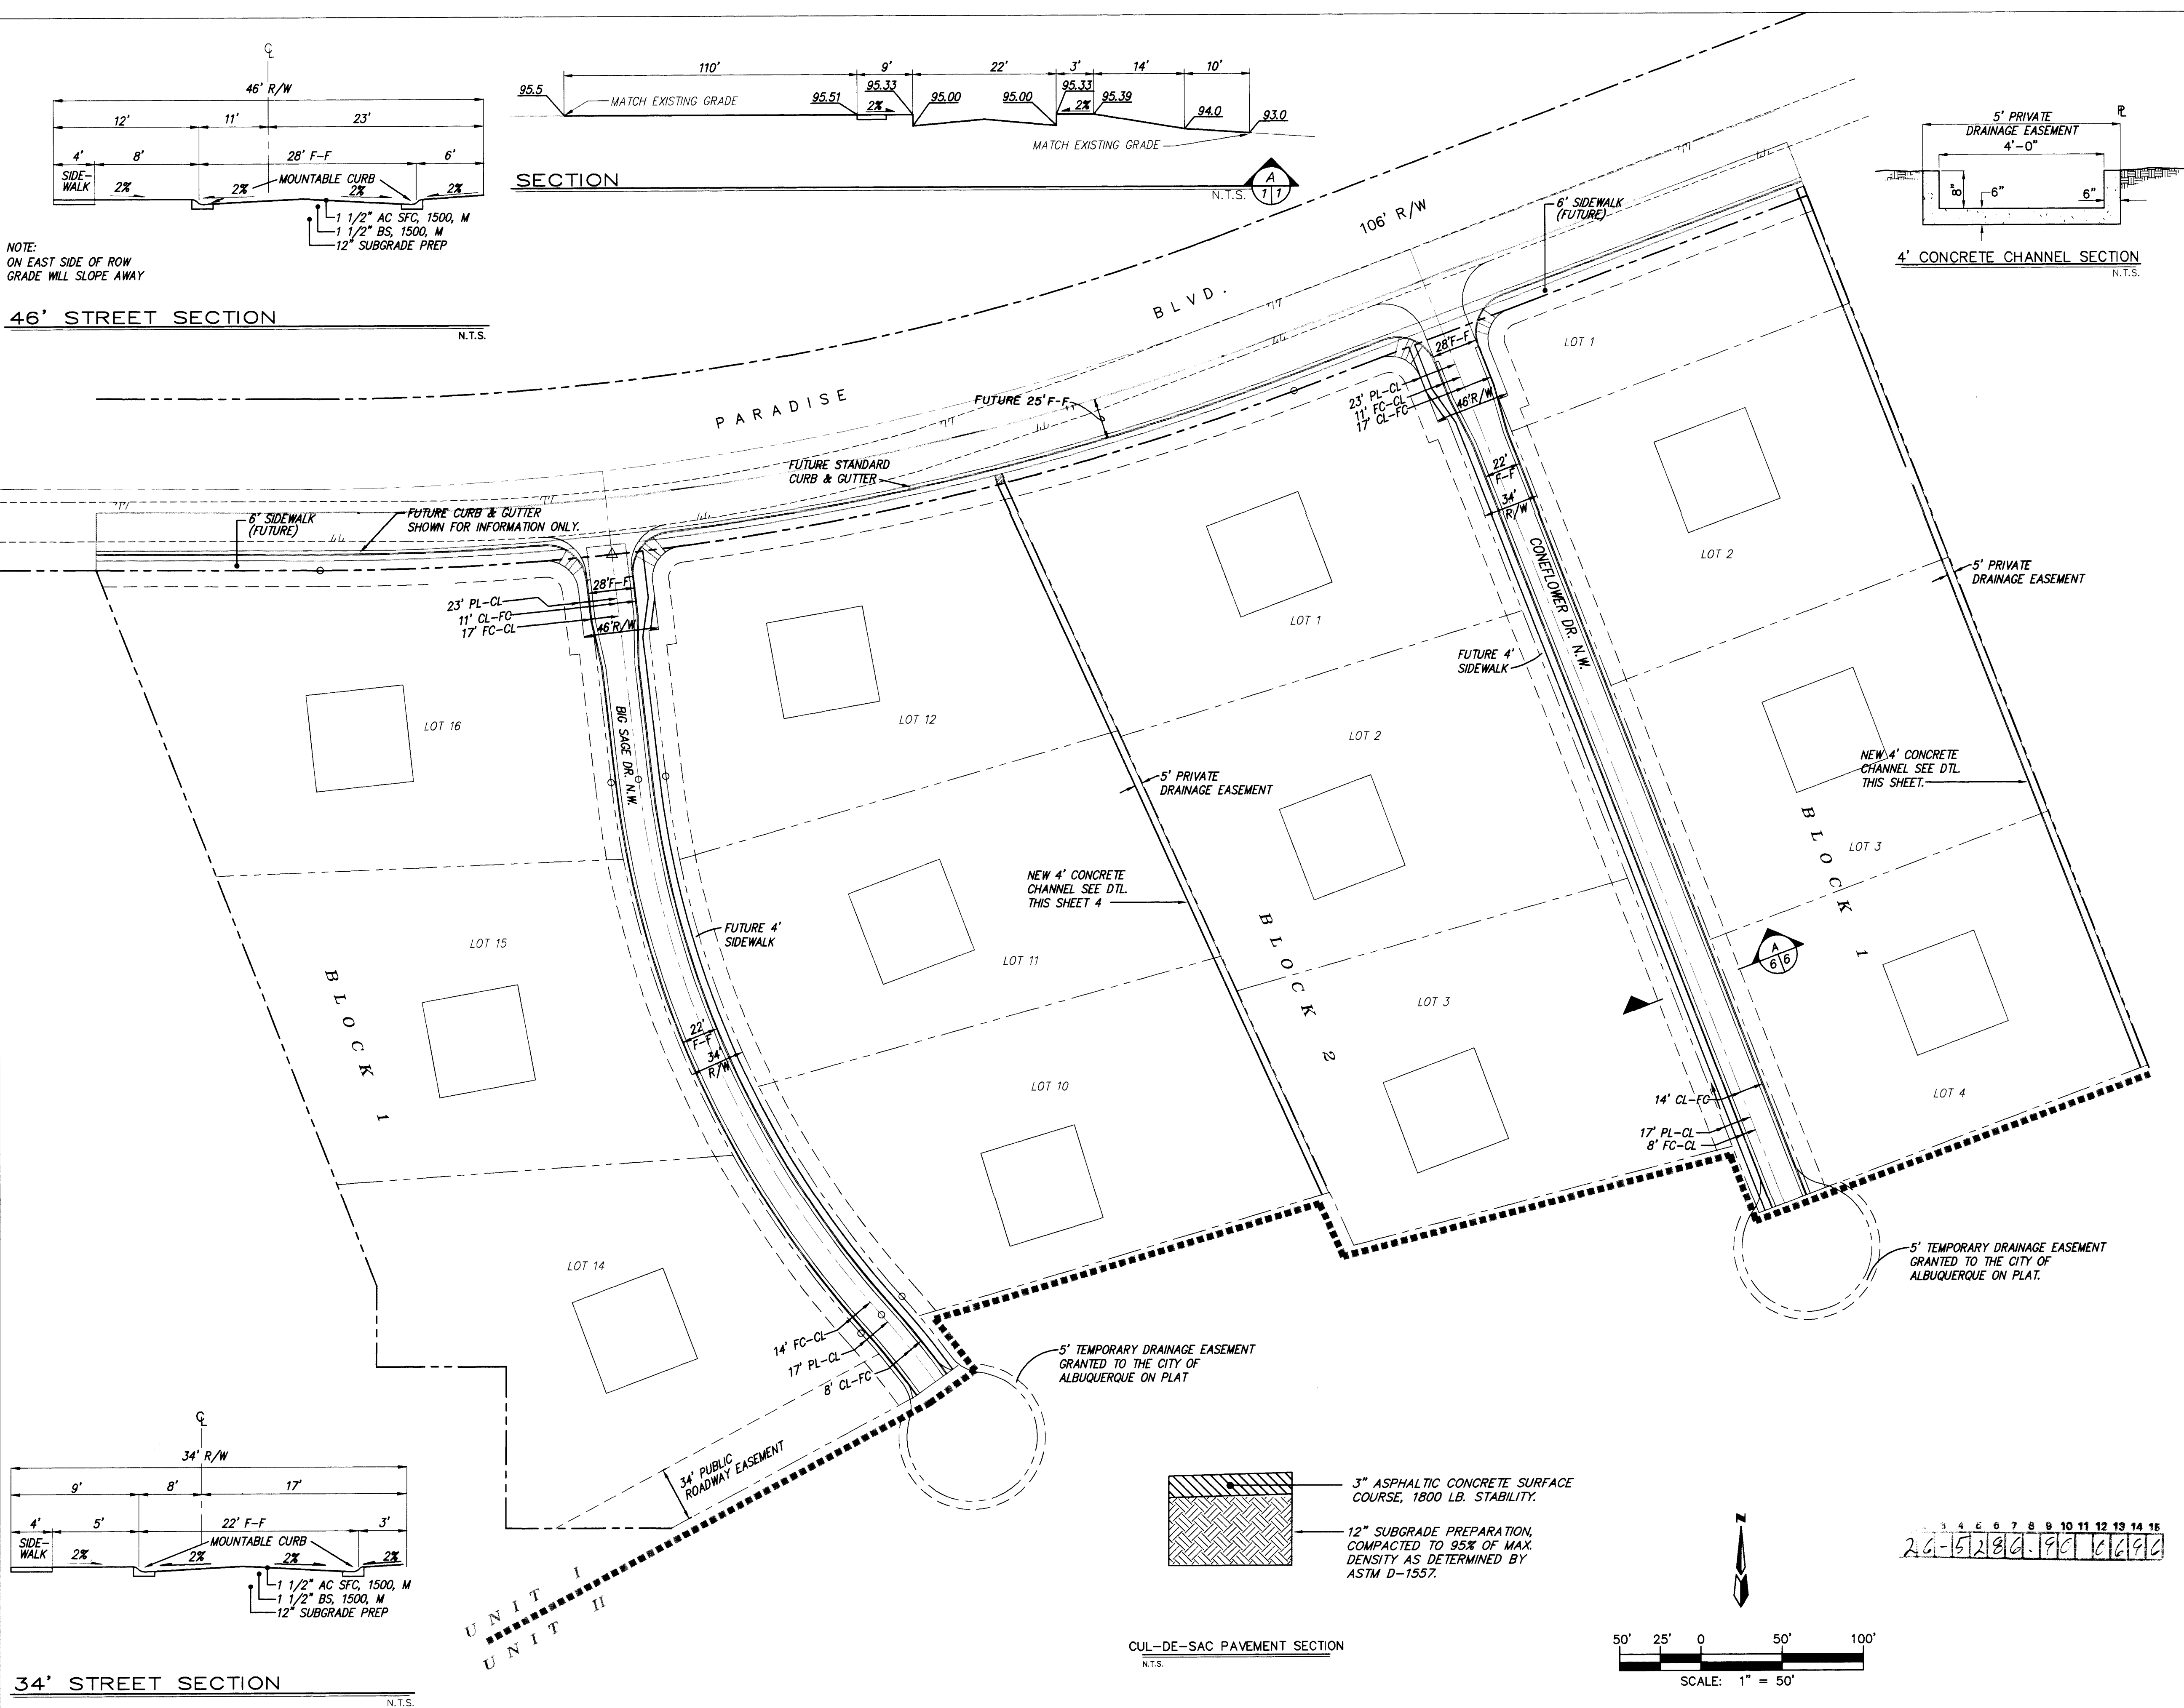

RECORD DRAWING

I hereby certify that the information contained on this drawing has been revised in accordance with information furnished by the City of Albuquerque, New Mexico, and by the Surveyor, ALS Inc., and reflects the construction as actually accomplished. This plan as constructed is in substantial compliance with the approved plan.

Mark Goodwin, N.M.P.E. 8848

LEGEND:

F.P. = 5394.00	FINISHED PAD ELEVATION
	MOUNTABLE CURB & GUTTER
	PHASE LINE



dmg D. MARK GOODWIN & ASSOCIATES, P.A.
CONSULTING ENGINEERS & SURVEYORS
P.O. BOX 90606
ALBUQUERQUE, NEW MEXICO 87199
(505) 345-2010

CITY OF ALBUQUERQUE PUBLIC WORKS DEPARTMENT ENGINEERING GROUP			
TITLE: CHAMISA RIDGE SUBDIVISION MASTER PAVING PLAN			
APPROVALS	ENGINEER	DATE	APPROVALS
DRC CHAIRMAN	<i>[Signature]</i>	11-7-95	WATER
TRANSPORTATION	<i>[Signature]</i>	10-25-95	WASTE WATER
HYDROLOGY	<i>[Signature]</i>	10-16-95	
PROJECT NO.	5286.90	MAP NO.	B10
SHEET	6	OF	17

AS BUILT INFORMATION			
CONTRACTOR	5 Daaling	DATE	3/96
WORK	PAVEMENT	DATE	3/96
REVISIONS	BY	DATE	7/96
ACCEPTANCE	BY	DATE	7/96
VEGETATION	BY	DATE	7/96
DRAWINGS	BY	DATE	7/96
CORRECTED	BY	DATE	7/96
MICRO-FILM INFORMATION			
RECORDED BY		DATE	
NO.			

SURVEY INFORMATION			
FIELD NOTES	DATE	BY	
NO.			

ENGINEER'S SEAL			
BY	DATE	REVISIONS	DESIGN
GAK	08/95		
JMB	08/95		
DWG	08/95		

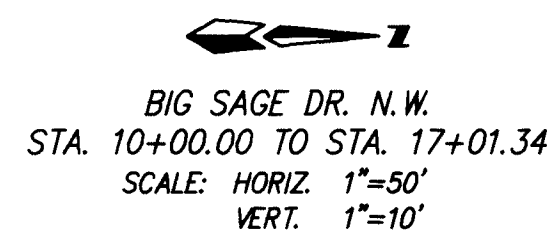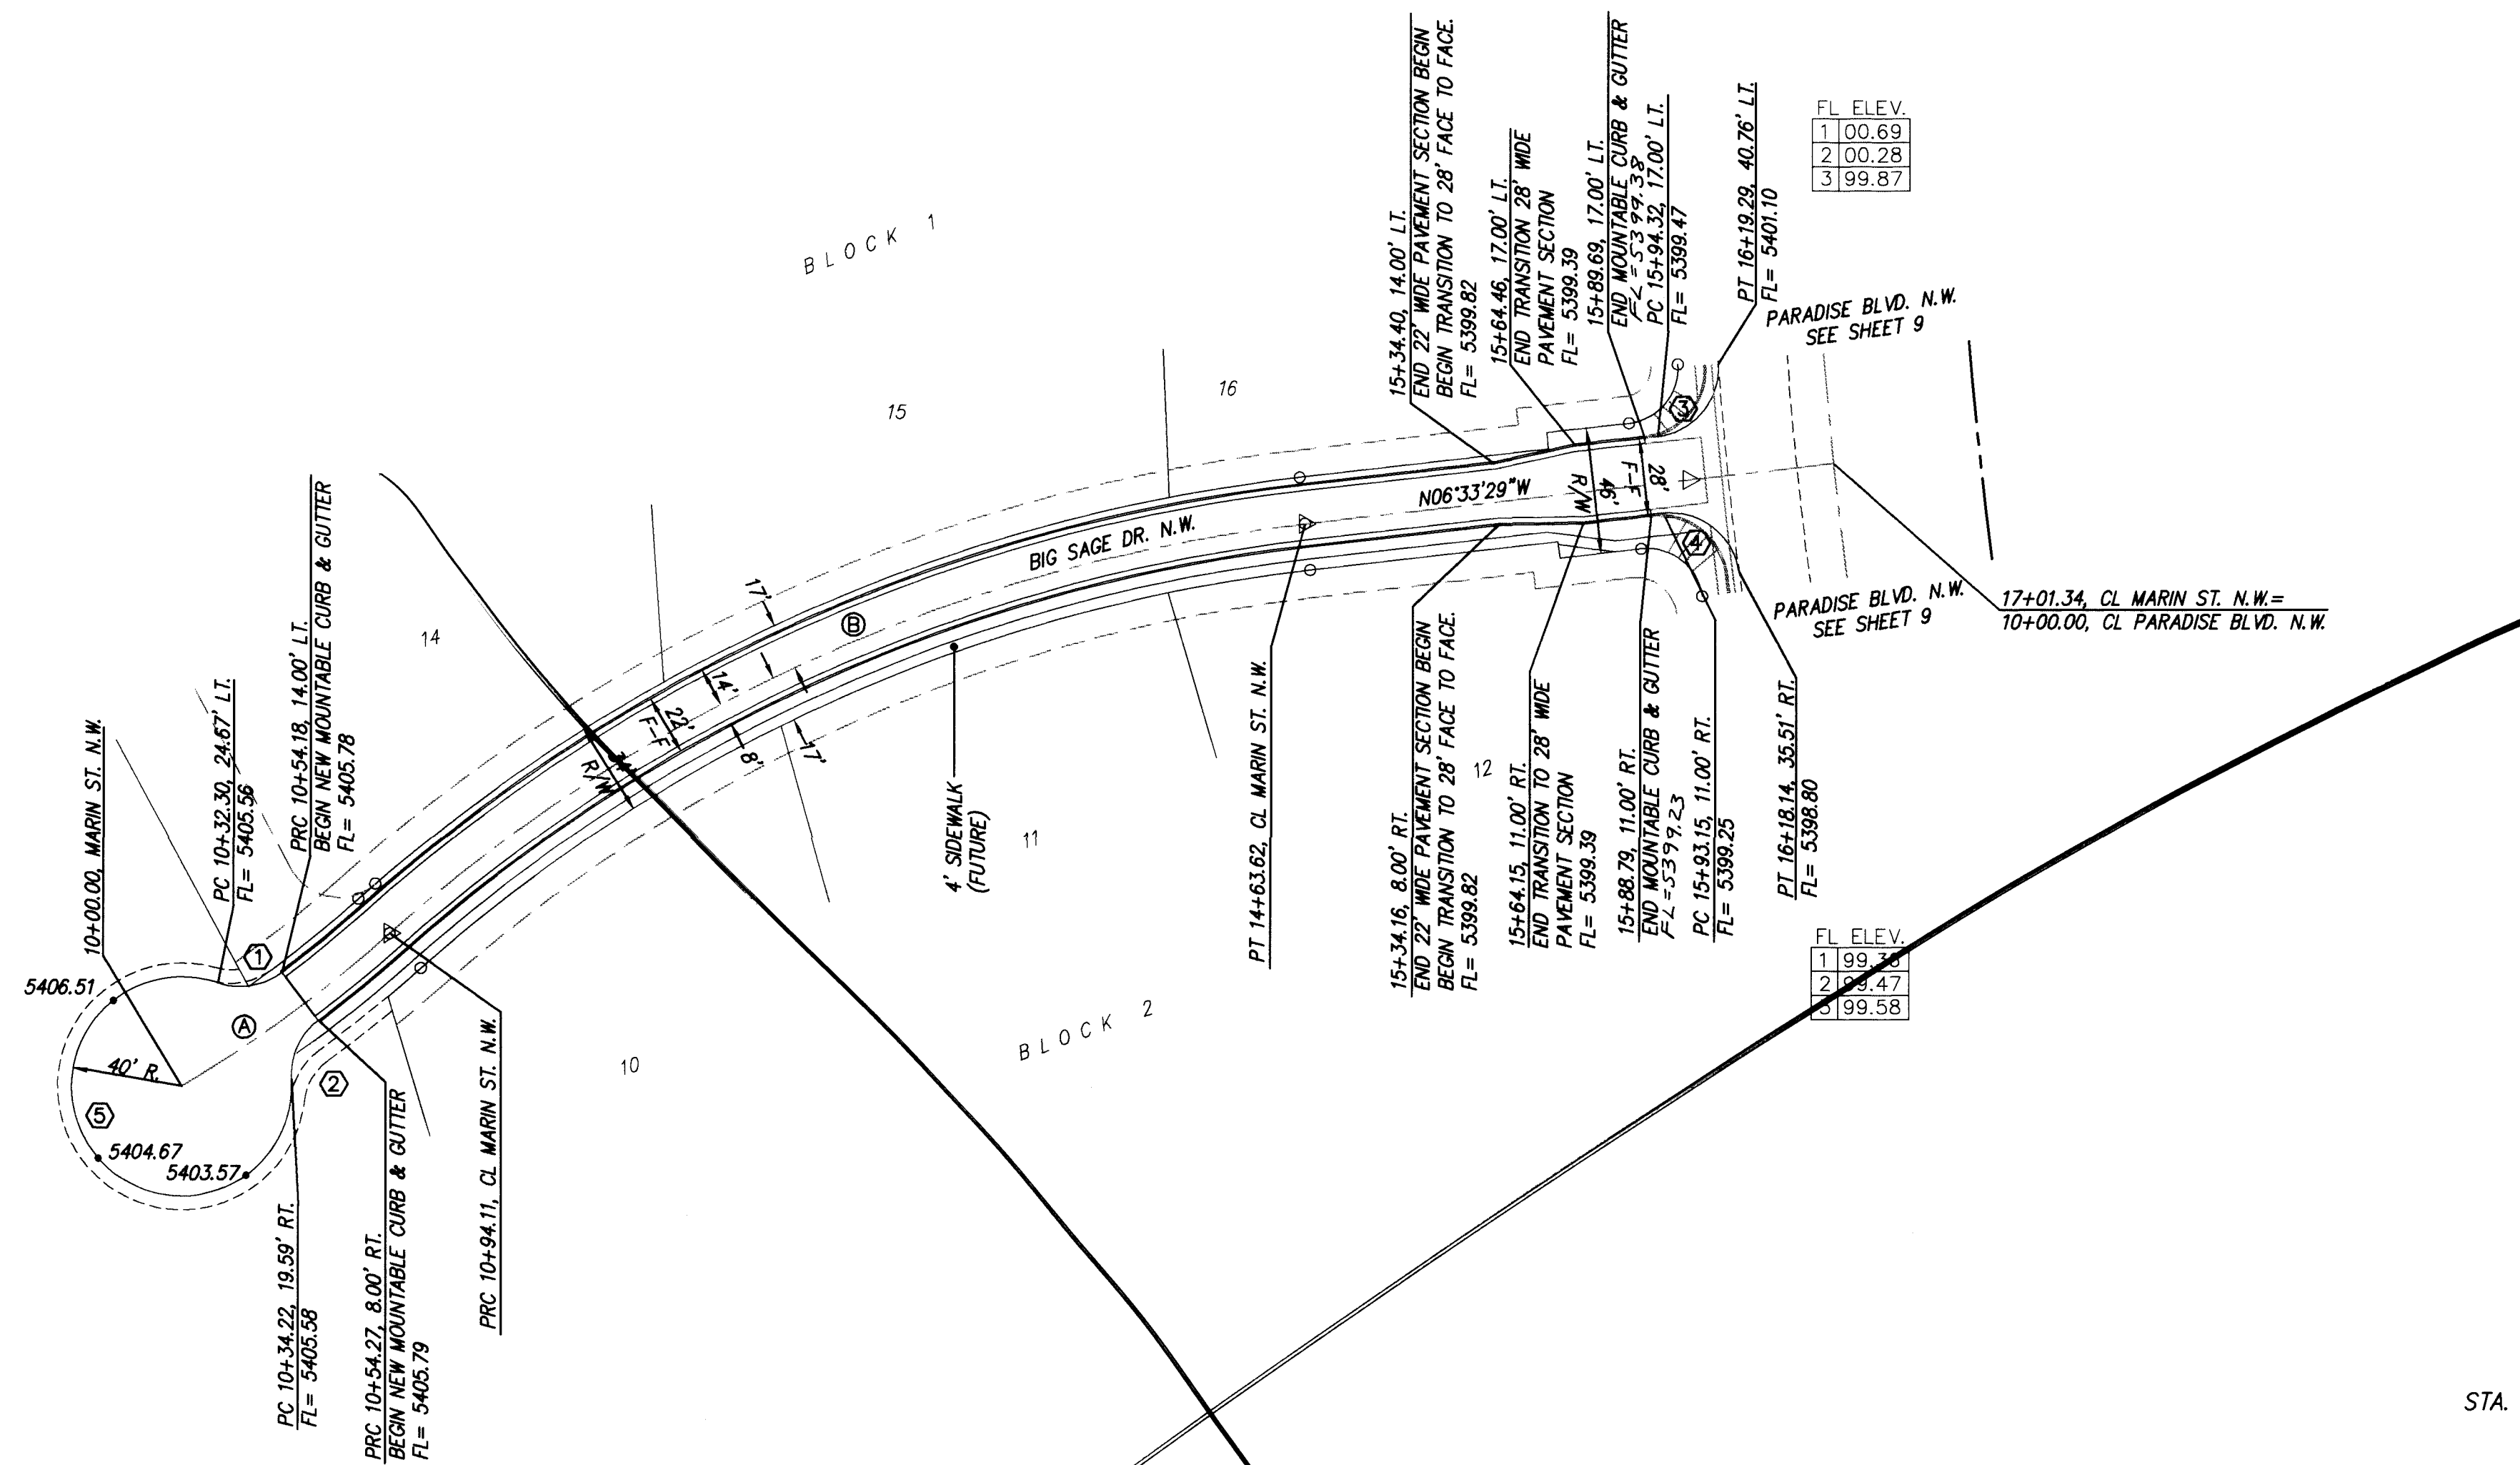

2	3	4	5	6	7	8	9	10	11	12	13	14	15	
2	6	-	5	2	8	6	.	9	0		0	7	9	6

	CITY OF ALBUQUERQUE PUBLIC WORKS DEPARTMENT ENGINEERING GROUP
TITLE:	CHAMISA RIDGE SUBDIVISION UNPAVED IMPROVEMENTS BIG SAGE DR. N.W.

PROJECT NO. 5286.90	MAP NO. B10	SHEET 7	OF 17
------------------------	----------------	------------	----------

[illegible]

MARIN/PP50-2


SEE SHF 7A

CURVE DATA - DESCRIBES CENTERLINE


Δ = 10-47-05	Δ = 35-17-08
R = 500.00'	R = 600.00'
L = 94.11'	L = 369.51'
T = 47.20'	T = 190.82'

CURVE DATA - DESCRIBES FACE OF CURB

Δ = 56-17-51	Δ = 56-25-49	Δ = 87-09-48
R = 25.00'	R = 25.00'	R = 25.00'
L = 24.56'	L = 24.62'	L = 38.03'
T = 13.38'	T = 13.41'	T = 23.79'
Δ = 88-52-50	Δ = 292-44-15	
R = 25.00'	R = 40.00'	
L = 37.78'	L = 204.37'	
T = 24.52'	T = N/A	

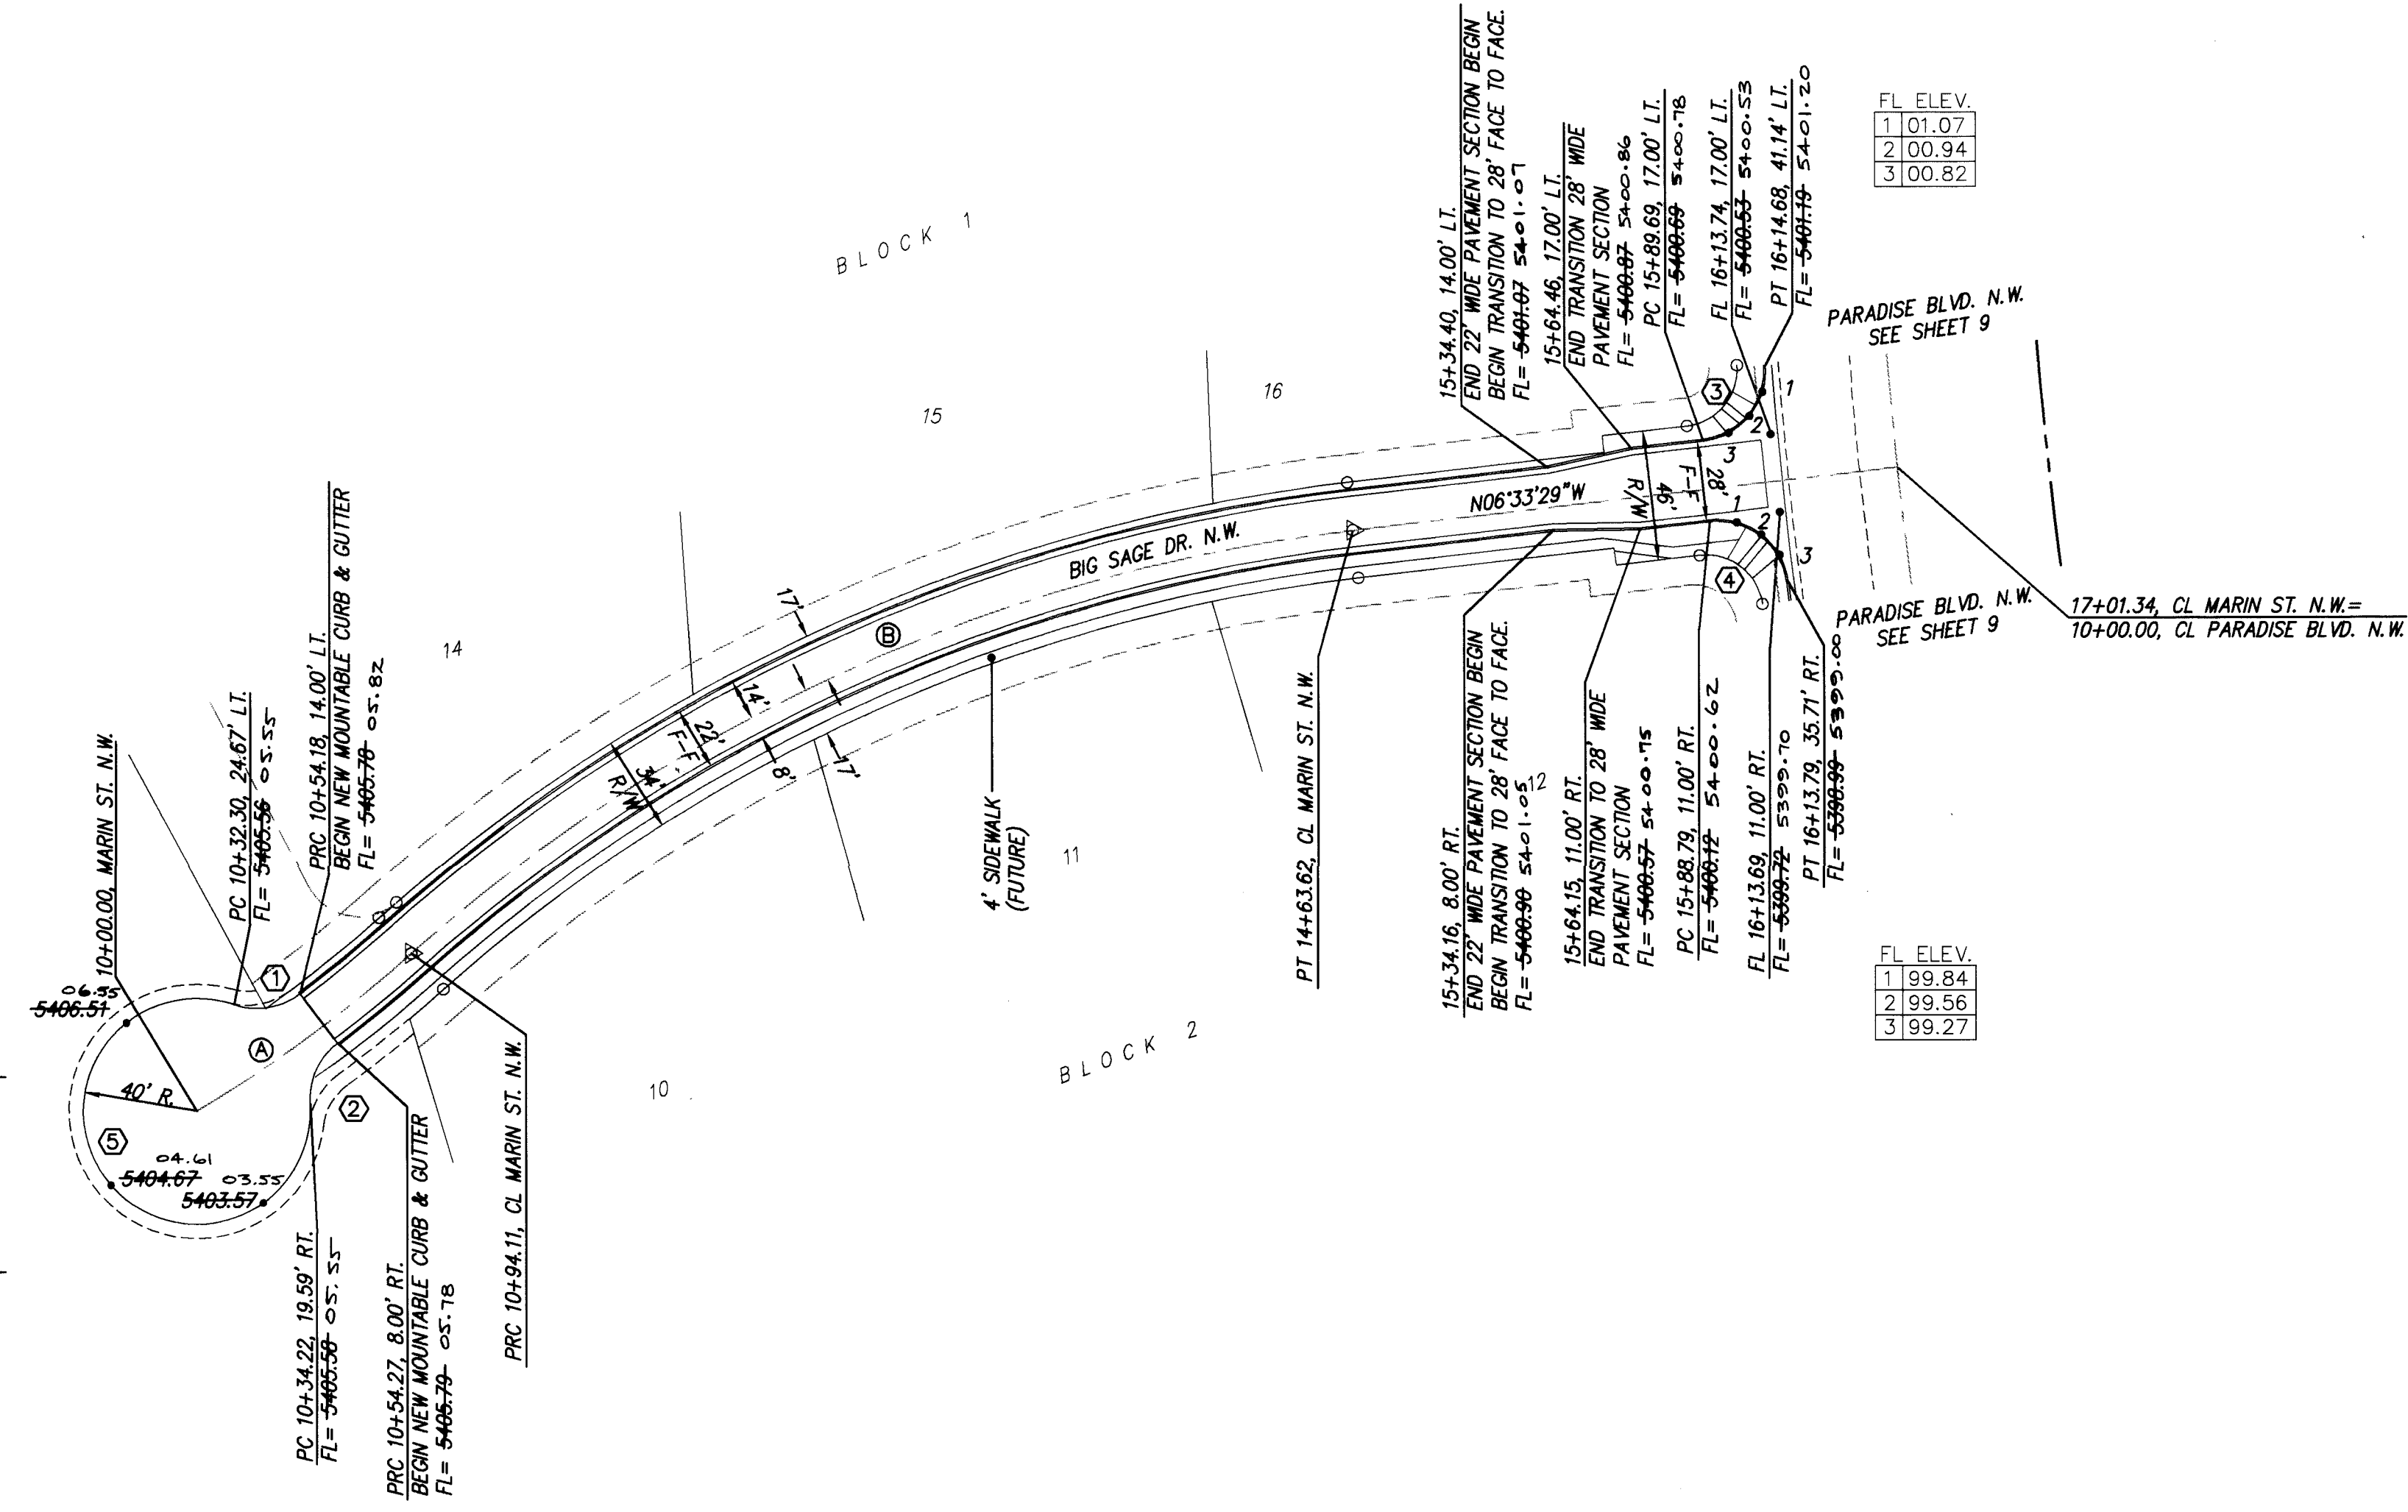

BIG SAGE DR. N.W.
STA. 10+00.00 TO STA. 17+01.34
SCALE: HORIZ. 1"=50'
VERT. 1"=10'

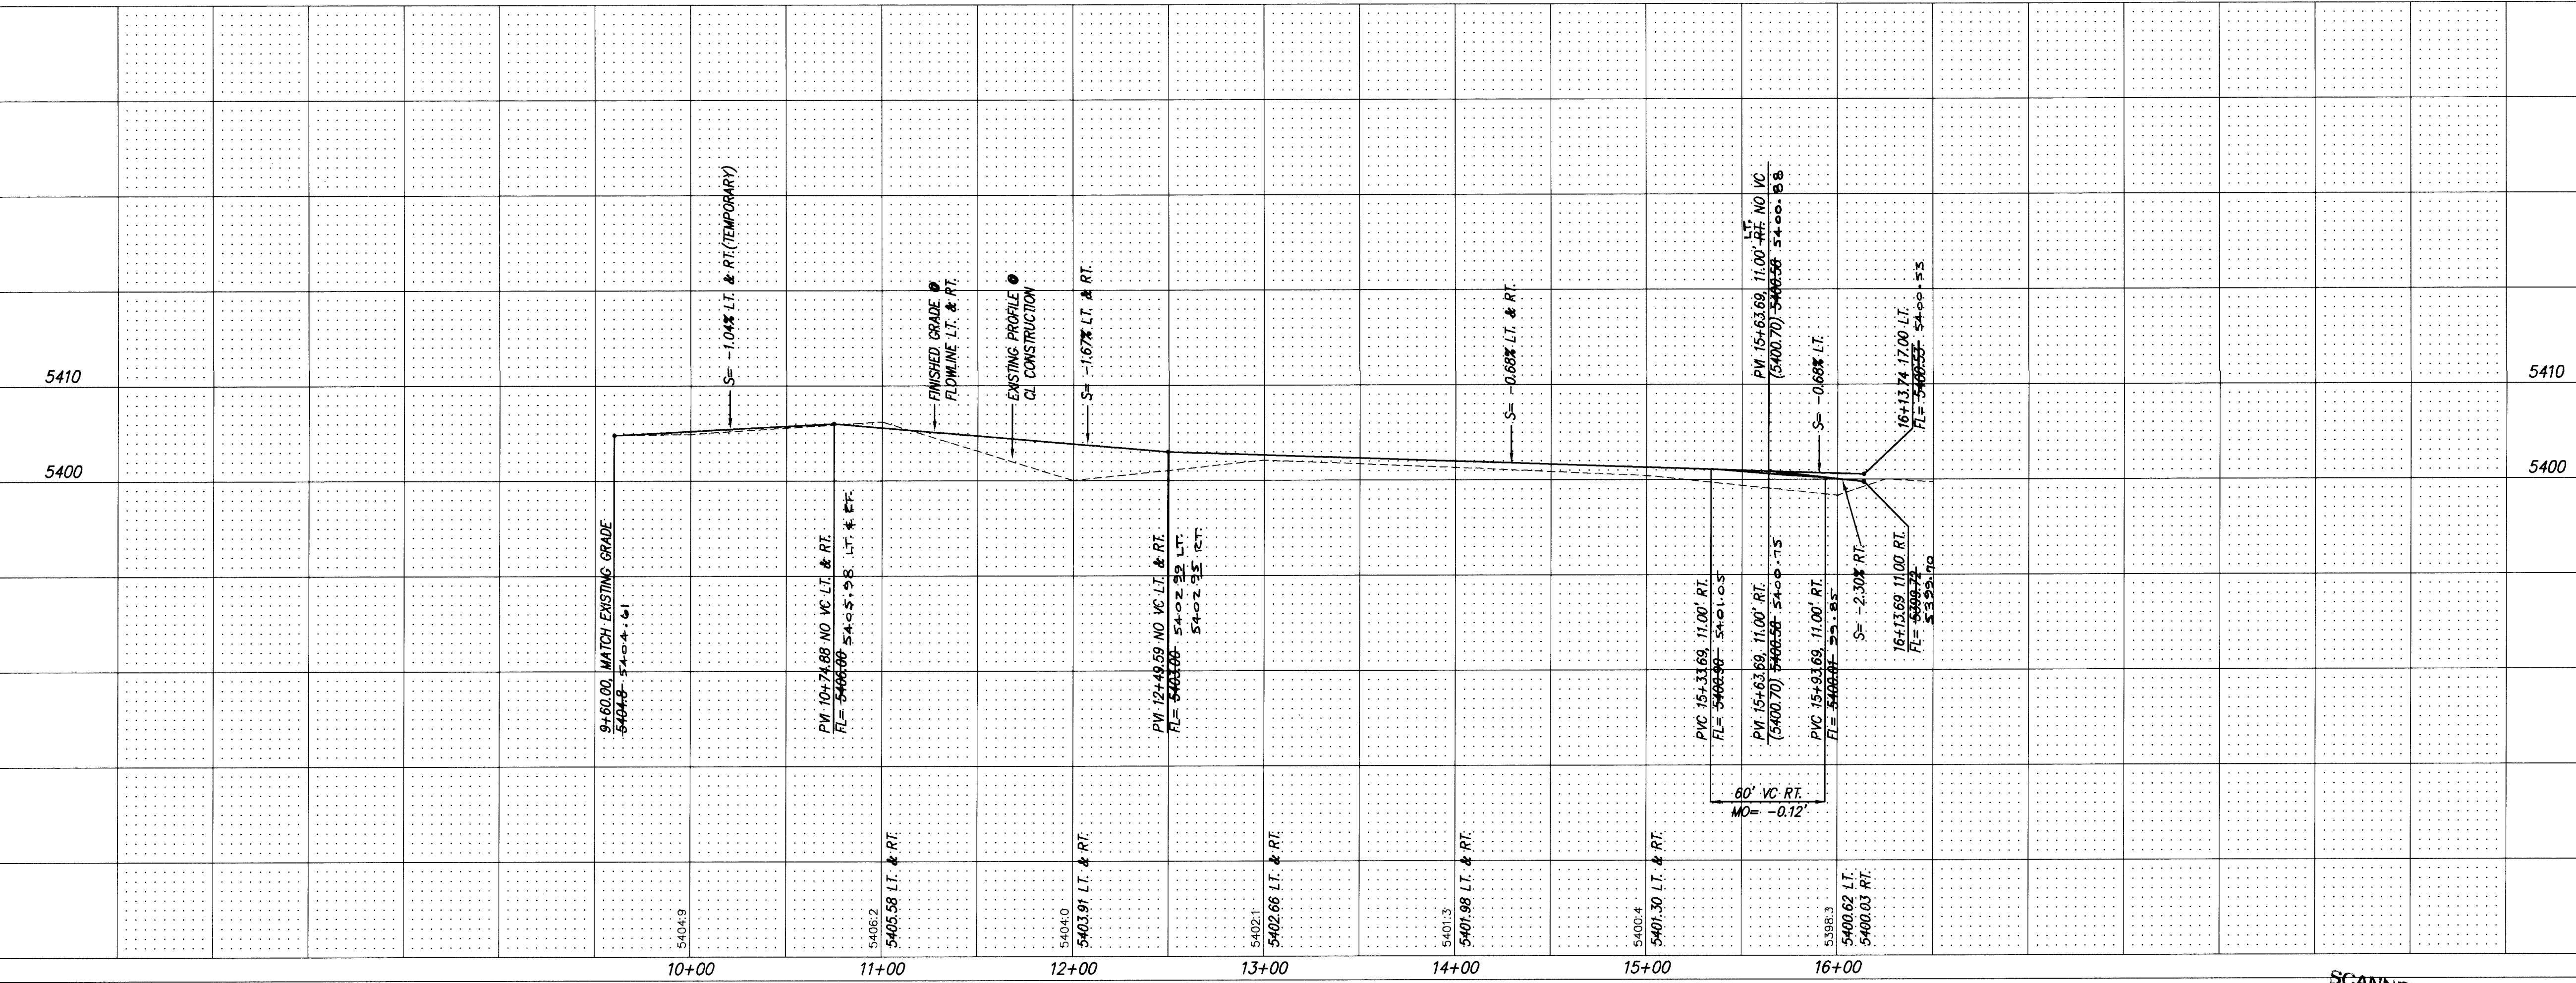

NOTES:
1. ALL STATIONING IS CENTERLINE STATIONING.

I hereby certify that the information contained on this drawing has been revised in accordance with information furnished by the contractor and the Surveyor, Sparring Construction Co., and reflects the construction as shown on this plan as constructed in substantial compliance with the Approved Plan.

Gregory J. Kenik, NMPE 11929


I, David C. Clausen, New Mexico Registered Land Surveyor No. 6547, do hereby certify the the as-built information shown herein is the result of a field survey performed by me or under my direct supervision, and that the same is true and correct.

David C. Clausen N.M.L.S. # 6547

26-151286.19017496

dmg D. MARK GOODWIN & ASSOCIATES, P.A.
CONSULTING ENGINEERS & SURVEYORS
P.O. BOX 90606
ALBUQUERQUE, NEW MEXICO 87199
(505) 345-2010

CITY OF ALBUQUERQUE PUBLIC WORKS DEPARTMENT ENGINEERING GROUP			
TITLE: CHAMISA RIDGE SUBDIVISION UNIT I PAVING IMPROVEMENTS BIG SAGE DR. N.W.			
APPROVALS	ENGINEER	DATE	APPROVALS
DRC CHAIRMAN	DATE	DATE	ENGINEER
TRANSPORTATION	DATE	DATE	ENGINEER
HYDROLOGY	DATE	DATE	ENGINEER
PROJECT NO. 5286.90		MAP NO. B10	SHEET 7A OF 7A

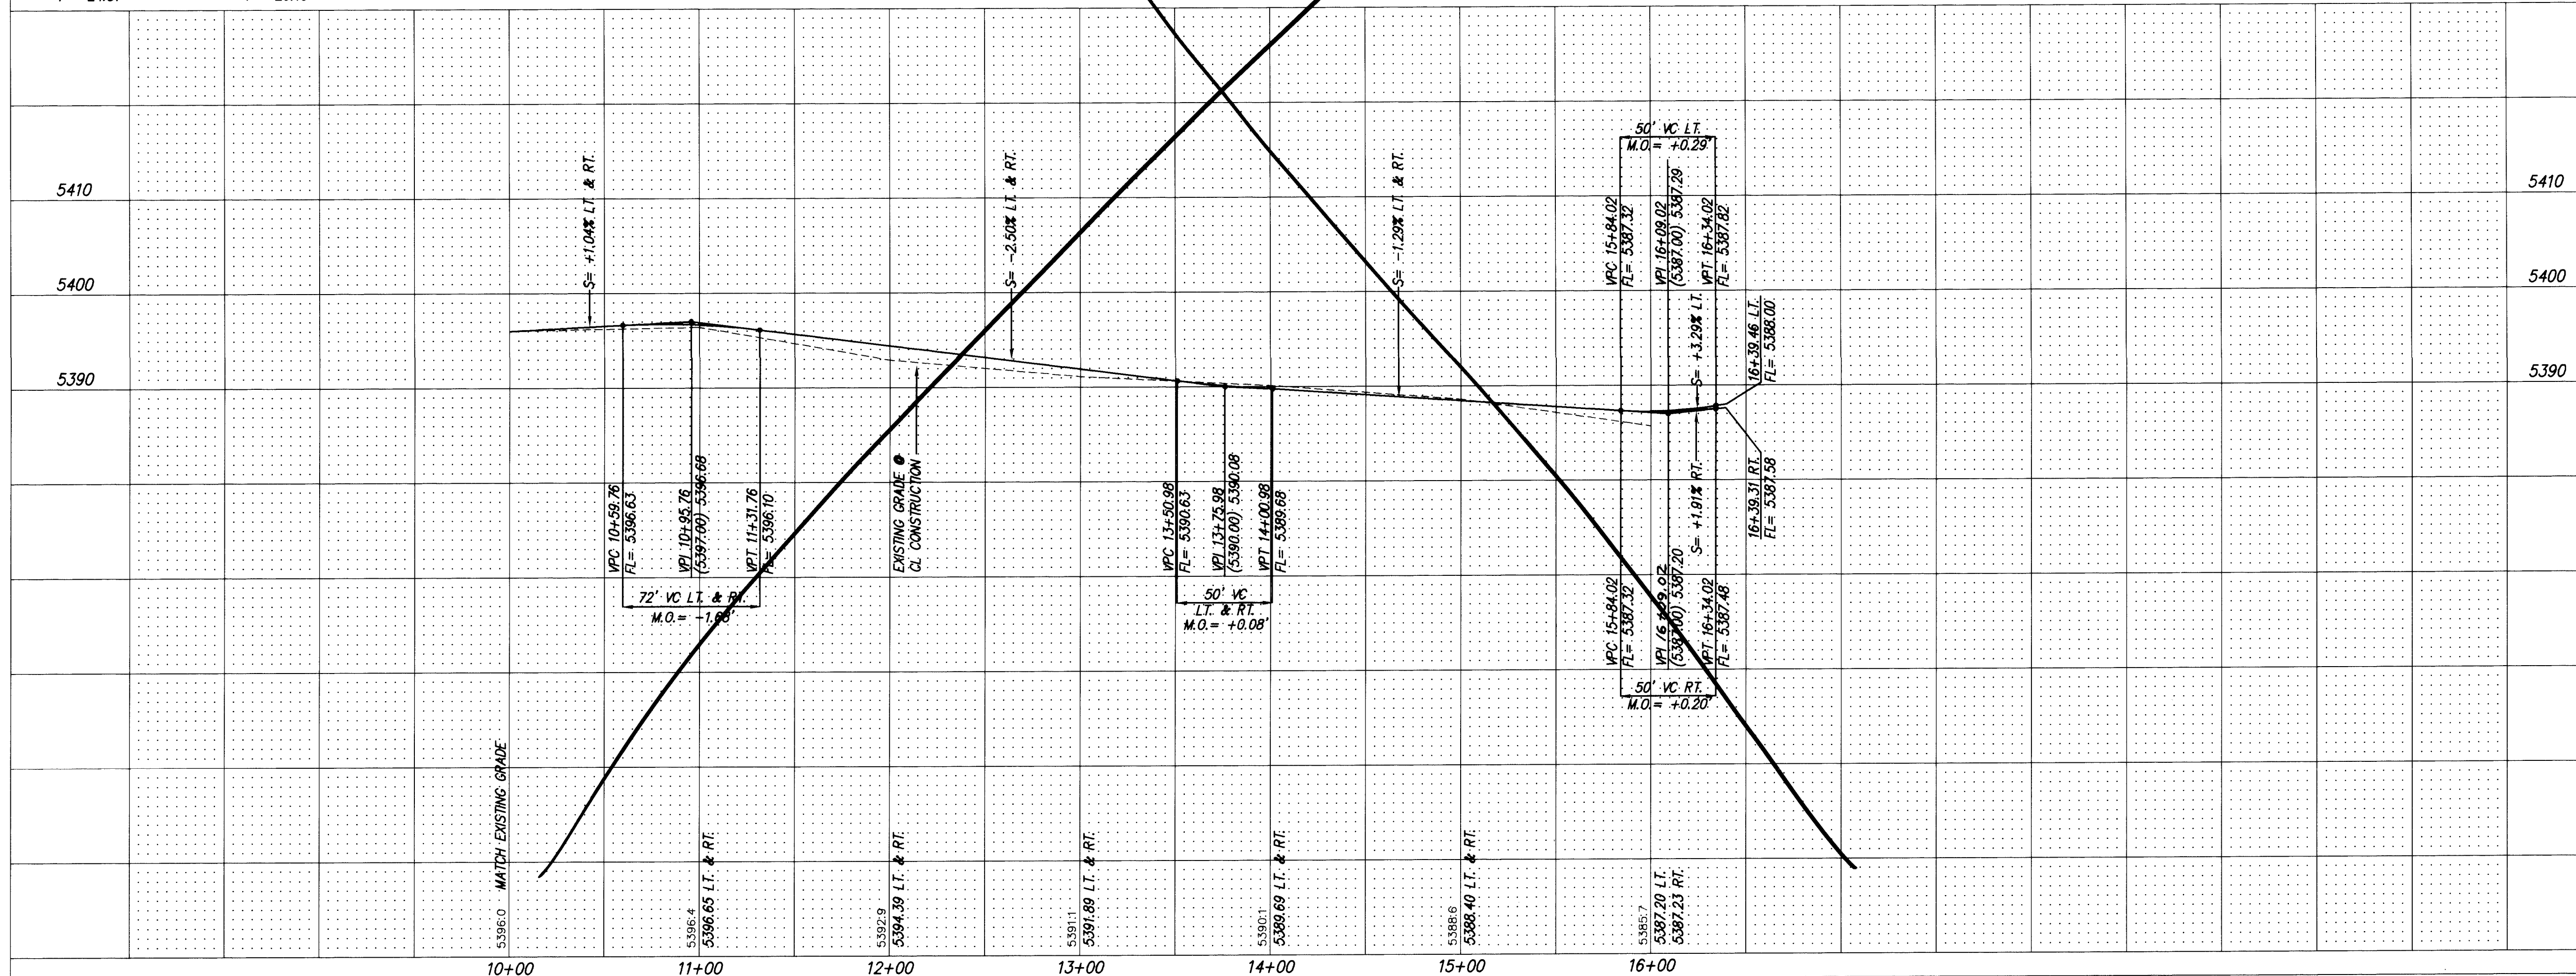

SCANNED BY
BY JASON

1	2	3	4	5	6	7	8	9	10	11	12	13	14	15
2	6	-	5	2	8	6	.	9	0		0	8	9	6

dmg D. MARK GOODWIN & ASSOCIATES, P.A.
CONSULTING ENGINEERS & SURVEYORS
P.O. BOX 90606
ALBUQUERQUE, NEW MEXICO 87199
(505) 345-2010

CITY OF ALBUQUERQUE
PUBLIC WORKS DEPARTMENT
ENGINEERING GROUP


TITLE: CHAMISA RIDGE SUBDIVISION U
PAVING IMPROVEMENTS
CONEFLOWER DRIVE N.W.

APPROVALS	ENGINEER	DATE	APPROVALS	ENGINEER	DATE
DRC CHAIRMAN	<i>B.G. Goshy</i>	11-7-95	WATER	N/A RWF	10-6-95
TRANSPORTATION	<i>R. Goshy</i>	10-6-95	WASTE WATER	N/A RWF	10-6-95
HYDROLOGY	<i>J.P.C.</i>	10-6-95			

PROJECT NO. 5286.90	MAP NO. B10	SHEET 8	OF 17
------------------------	----------------	------------	----------

SEE SH# 8A

CURVE DATA - DESCRIBES FACE OF CURB		
① Δ = 59-29-23 R = 25.00' L = 25.96' T = 14.28'	② Δ = 53-07-48 R = 25.00' L = 23.18' T = 12.50'	③ Δ = 292-37-12 R = 40.00' L = 204.29' T = N/A
④ Δ = 89-41-39 R = 25.00' L = 39.14' T = 24.87'	⑤ Δ = 90-18-11 R = 25.00' L = 39.40' T = 25.13'	

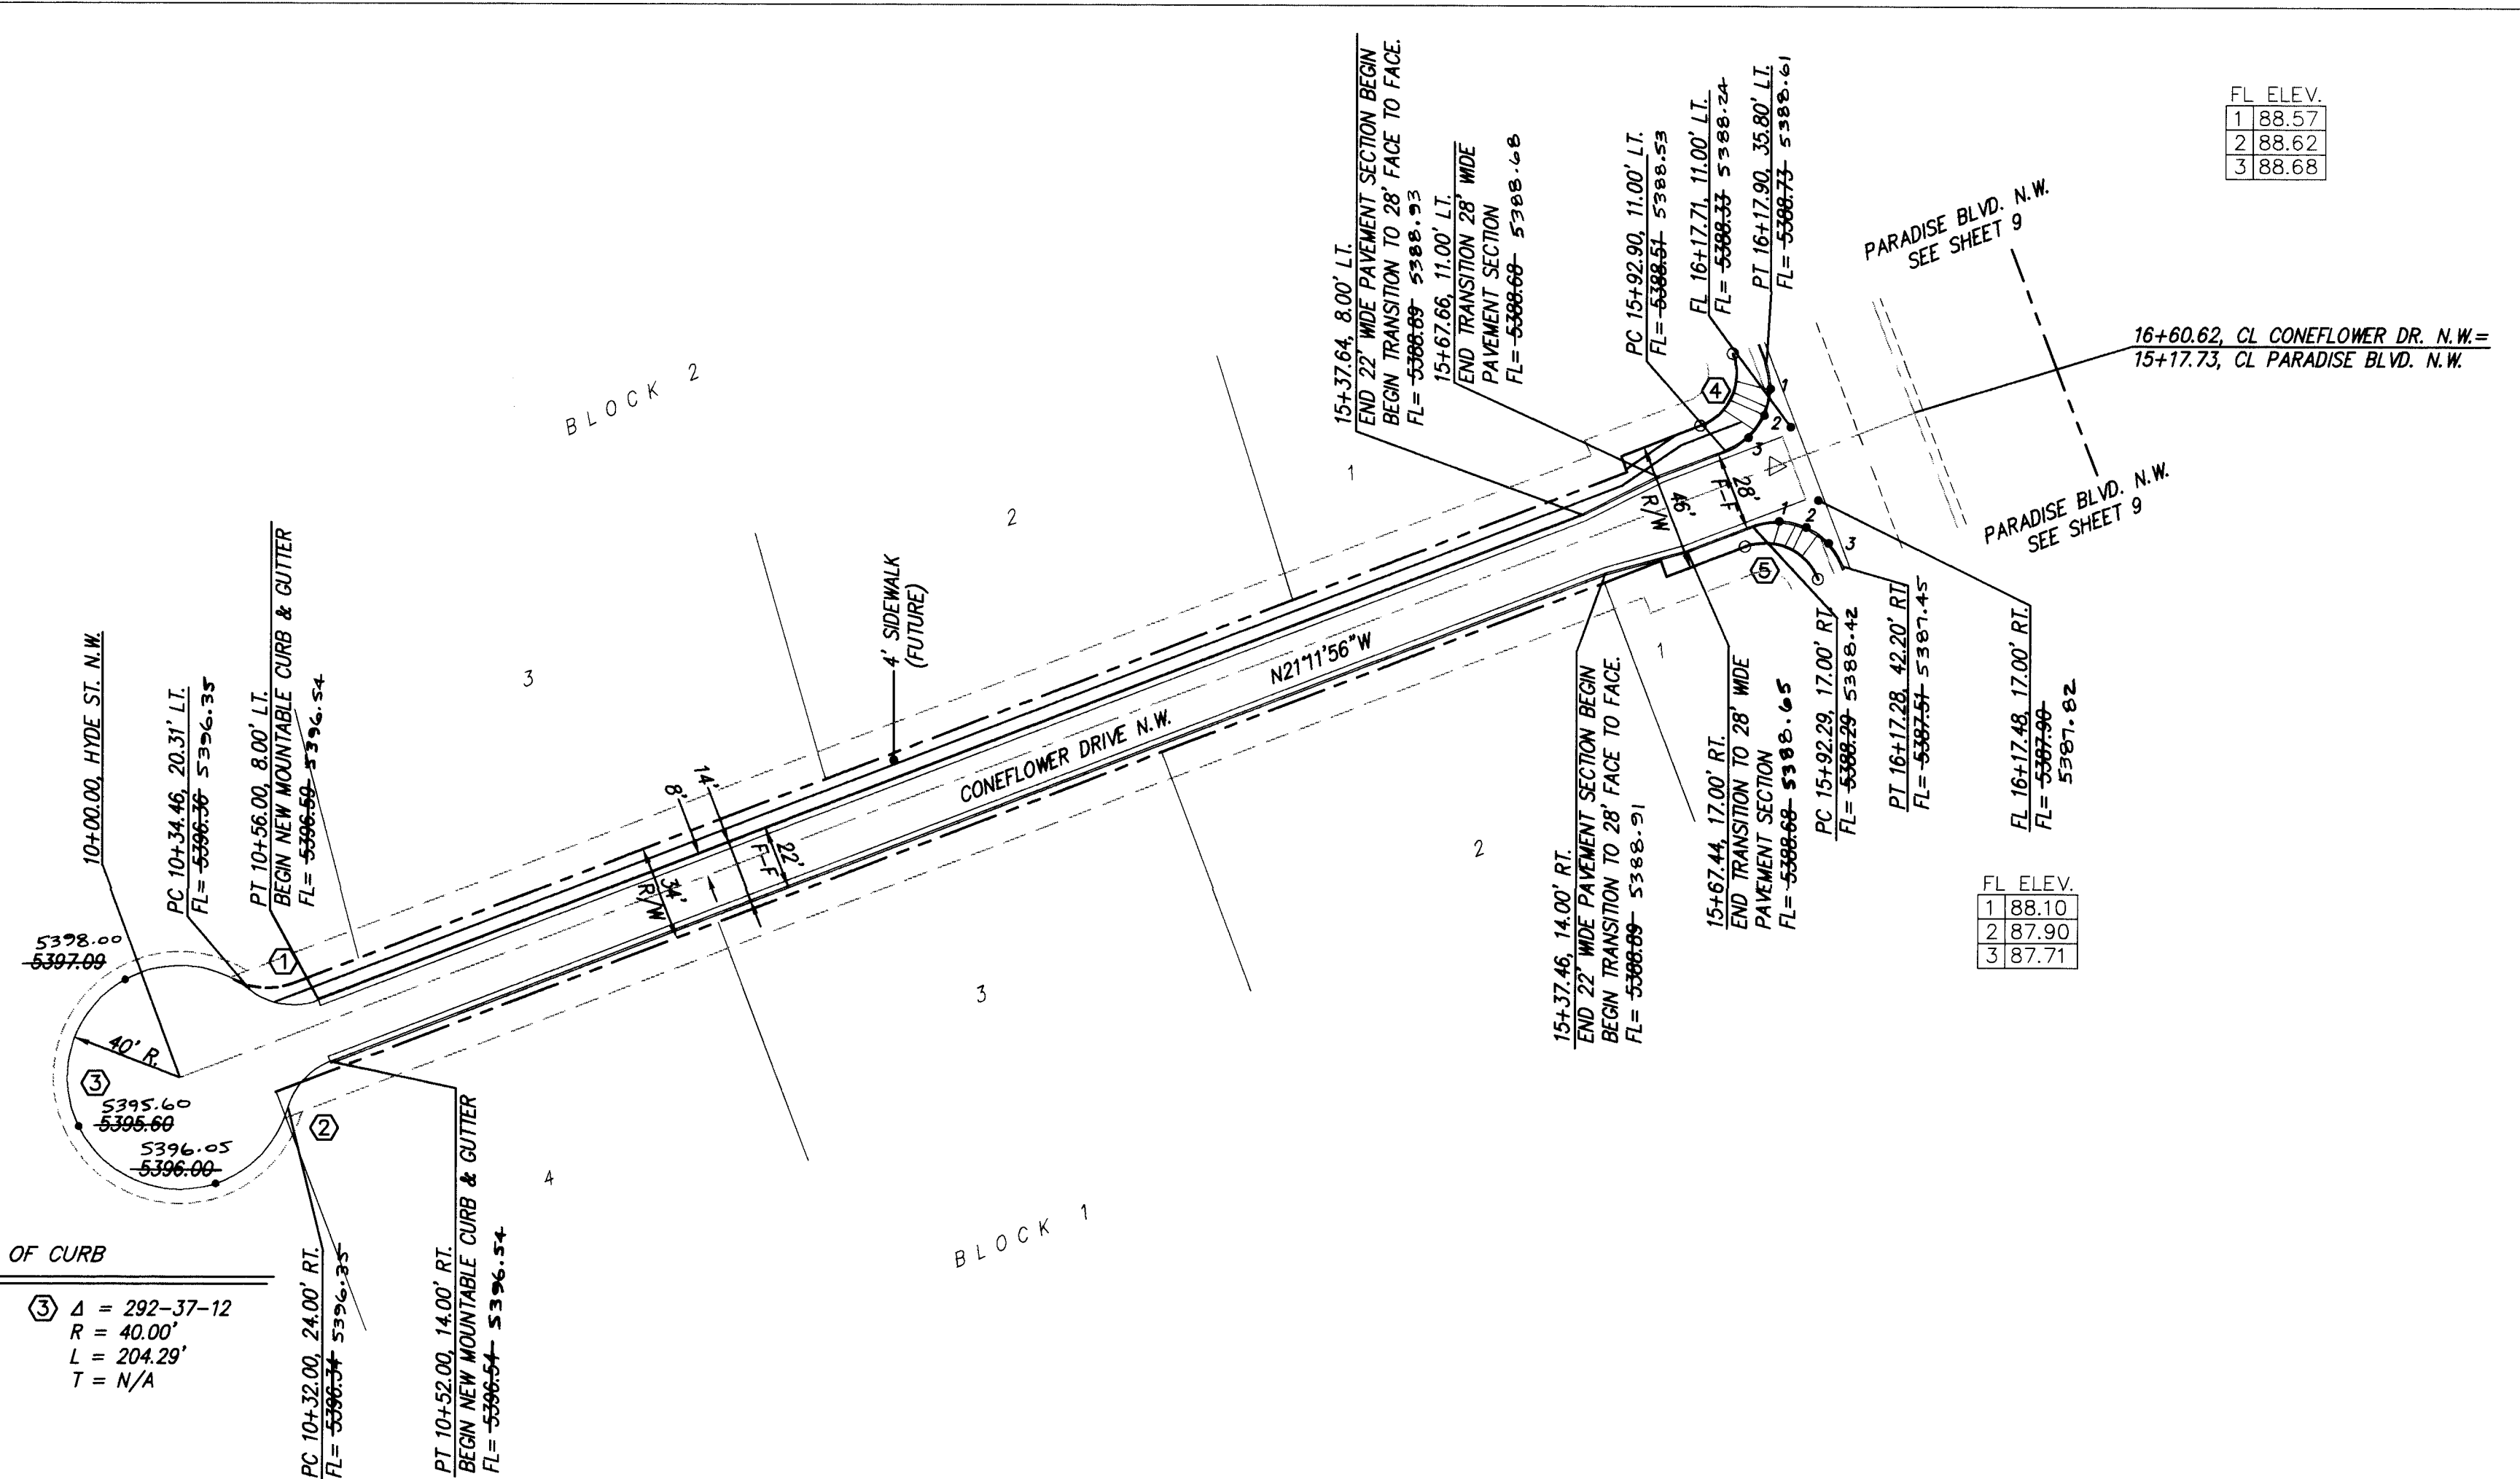

FL ELEV.	
1	88.10
2	87.90
3	87.71

FL ELEV.	
1	88.57
2	88.62
3	88.68

CONEFLOWER DRIVE N.W.
STA. 10+00.00 TO STA. 16+60.62
SCALE: HORIZ. 1"=50'
VERT. 1"=10'

I, David C. Clausen, New Mexico Registered Land Surveyor No. 6547, do hereby certify that the as-built information shown hereon is the result of a field survey performed by me or under my direct supervision, and that the same is true and correct.



David C. Clausen N.M.L.S. # 6547

RECORD DRAWING
I hereby certify that the information contained on this drawing has been revised in accordance with information furnished by the contractor and the Surveyor, Sparling Construction Co., and reflects the construction as actually accomplished. This plan as constructed is in substantial compliance with the approved plan.
Gregory A. Krenik, NMPE 11929

dmg D. MARK GOODWIN & ASSOCIATES, P.A.
CONSULTING ENGINEERS & SURVEYORS
P.O. BOX 90606
ALBUQUERQUE, NEW MEXICO 87199
(505) 345-2010

CITY OF ALBUQUERQUE PUBLIC WORKS DEPARTMENT ENGINEERING GROUP			
TITLE: CHAMISA RIDGE SUBDIVISION UNIT I PAVING IMPROVEMENTS CONEFLOWER DRIVE N.W.			
APPROVALS	ENGINEER	DATE	APPROVALS
DRC CHAIRMAN	SG Sparling	12-14-95	WATER
TRANSPORTATION	PL Kim	12-13-95	WASTE WATER
HYDROLOGY	VA JPC	12-13-95	
PROJECT NO.	5286.90	MAP NO.	B10
SHEET	8A	OF	75-17

SURVEY INFORMATION		BENCH MARKS		AS BUILT INFORMATION	
NO.	BY	DATE	THE STATION MARK IS A STANDARD ASC BASS TABLET, STAMPED "2-BIT", SET IN TOP OF A CONCRETE POST FLUSH WITH GROUND. TO REACH THE STATION FROM THE INTERSECTION OF CENTRAL AVE. AND COORS RD. N. (SR 440), GO NORTH ON COORS RD. 7.6 MILES TO PARADISE BLVD., THEN NW ON PARADISE BLVD. 2.75 MILES TO JUNCTION WITH CHAPARRAL RD., AND THE STATION ON THE RIGHT. X=362,751.42, Y=1,528,729.35	CONTRACTOR	SPARLING
				WORK	STAMPED BY
				INSPECTOR'S	DATE 3/96
				FIELD	DATE 7/96
				VERIFICATION BY	DATE 7/96
				CORRECTED BY	DATE 7/96
				MICRO-FILM INFORMATION	
				RECORDED BY	DATE
				NO.	

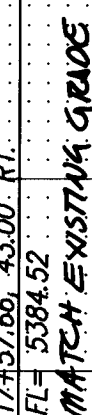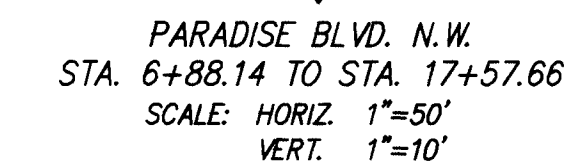


dmg D. MARK GOODWIN & ASSOCIATES, P.A.
CONSULTING ENGINEERS & SURVEYORS
P.O. BOX 90606
ALBUQUERQUE, NEW MEXICO 87199
(505) 345-2010

TITLE: CHAMISA RIDGE SUBDIVISION UNIT I
PAVING IMPROVEMENTS
PARADISE BLVD. N.W.

PROJECT NO. 5286.90	MAP NO. B10	SHEET 9	OF 17
------------------------	----------------	------------	----------

PROJECT NO. 5286.90	MAP NO. B10	SHEET 9	OF 17
------------------------	----------------	------------	----------

SEE SAT 9/1

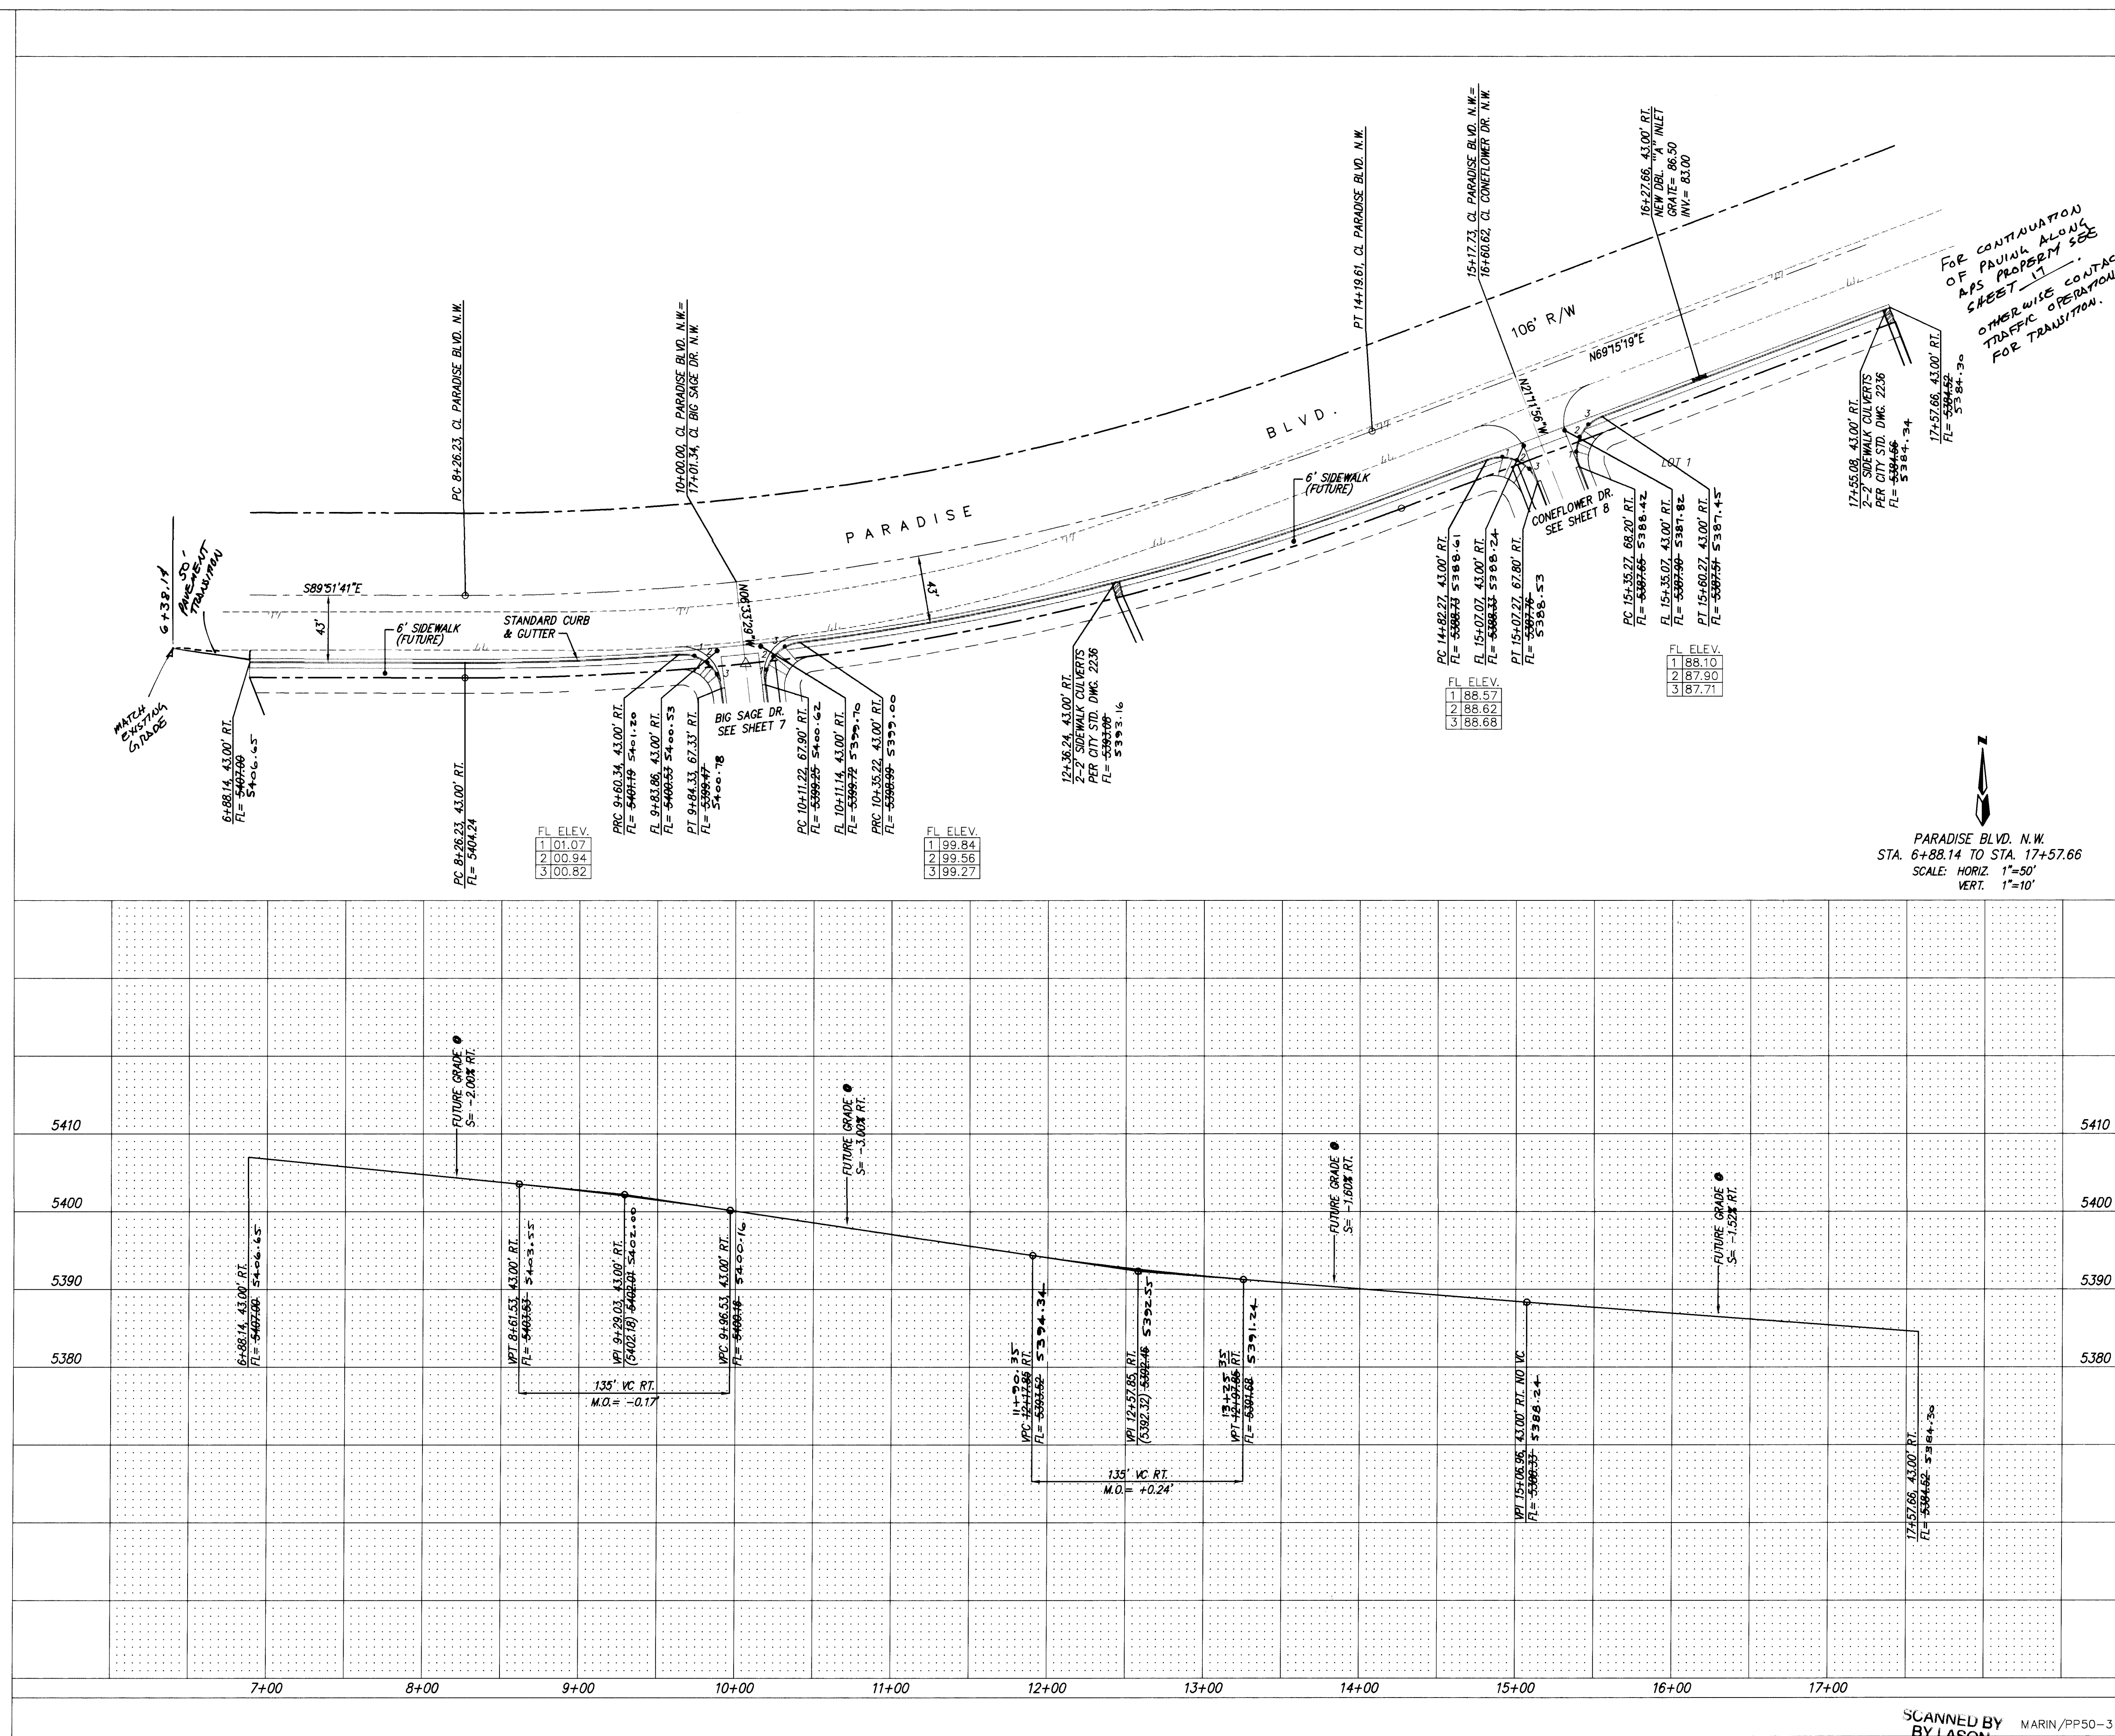

FOR CONTINUATION
OF PAVING ALONG
APS PROPERTY SEE
SHEET 17.
OTHERWISE CONTACT
TRAFFIC OPERATIONS
FOR TRANSITION.

RECORD DRAWING

I hereby certify that the information contained on this drawing has been revised in accordance with information furnished by the Contractor and the Surveyor, Sparling Construction Co., and reflects the construction actually accomplished. This plan as constructed is in substantial compliance with the Approved Plan.

[Signature]

[Stamp: City of San Francisco, Department of Public Works, dated JUN 10 1998]

I, David C. Clausen, New Mexico Registered Land Surveyor No. 6547, do hereby certify that the as-built information shown hereon is the result of a field survey performed by me or under my direct supervision, and that the same is true and correct.


David C. Clausen N.M.I.S. # 6547

CITY OF ALBUQUERQUE
PUBLIC WORKS DEPARTMENT
ENGINEERING GROUP


TITLE: CHAMISA RIDGE SUBDIVISION UNIT I PAVING IMPROVEMENTS PARADISE BLVD. N.W.					
APPROVALS	ENGINEER	DATE	APPROVALS	ENGINEER	DATE
DRC CHAIRMAN	<i>R.W. Kane</i>	<i>12-14-95</i>	WATER	<i>R.W. Kane</i>	<i>12-13-95</i>
TRANSPORTATION	<i>R.W. Kane</i>	<i>12-13-95</i>	WASTE WATER	<i>R.W. Kane</i>	<i>12-13-95</i>
HYDROLOGY	<i>NH</i>	<i>12-13-95</i>			
PROJECT NO.	5286.90		MAP NO.	B10	
			SHEET	OF	<i>15/17</i>
				9A	<i>DS</i>

SCANNED BY
BY LASON

ENGINEER'S SEAL										SURVEY INFORMATION				BENCH MARKS				AS BUILT INFORMATION			
										FIELD NOTES				THE STATION MARK IS A STANDARD ASC BASS TABLET, STAMPED "2-BIT", SET IN TOP OF A CONCRETE POST FLUSH WITH GROUND. TO REACH THE STATION FROM THE INTERSECTION OF CENTRAL AVE. AND COORS RD., N. (SR. 448), GO NORTH ON COORS RD. 7.6 MILES TO PARADISE BLVD., THEN NW ON PARADISE BLVD. 2.75 MILES TO JUNCTION WITH CHAPARRAL RD., AND THE STATION ON THE RIGHT. X=882,751.42, Y=1,526,729.35							
										NO.	BY	DATE									
														CONTRACTOR <u>Sparling</u> WORK STARTED BY <u>Clausen</u> DATE <u>3/90</u> ACCEPTANCE BY <u>MGA</u> DATE <u>7/90</u> FIELD LOCATION BY <u>Clausen</u> DATE <u>7/90</u> DRAWINGS CORRECTED BY _____ DATE <u>7/90</u> MICRO-FILM INFORMATION RECORDED BY _____ DATE _____ NO. _____							
DESIGNED BY <u>GAK</u> DATE <u>08/95</u> DRAWN BY <u>JMB</u> DATE <u>08/95</u> CHECKED BY <u>DWG</u> DATE <u>08/95</u>										REVISIONS				NO. DATE REMARKS BY <u>A</u> <u>12-13-95</u> <u>REPAIR SHEET-9</u> <u>GSK</u>							
SURFACE CURB SIDEWALK DRIVEWAY OTHER										DISTRICT TOWNSHIP COUNTY STATE											
PROJECT NUMBER 										PROJECT NAME 											
PREPARED BY <u>R.W. Kane</u>										REVIEWED BY <u>R.W. Kane</u>											
DATE <u>12-13-95</u>										DATE <u>12-13-95</u>											
SHEET <u>9A</u> OF <u>15</u>										TOTAL SHEETS <u>15</u>											

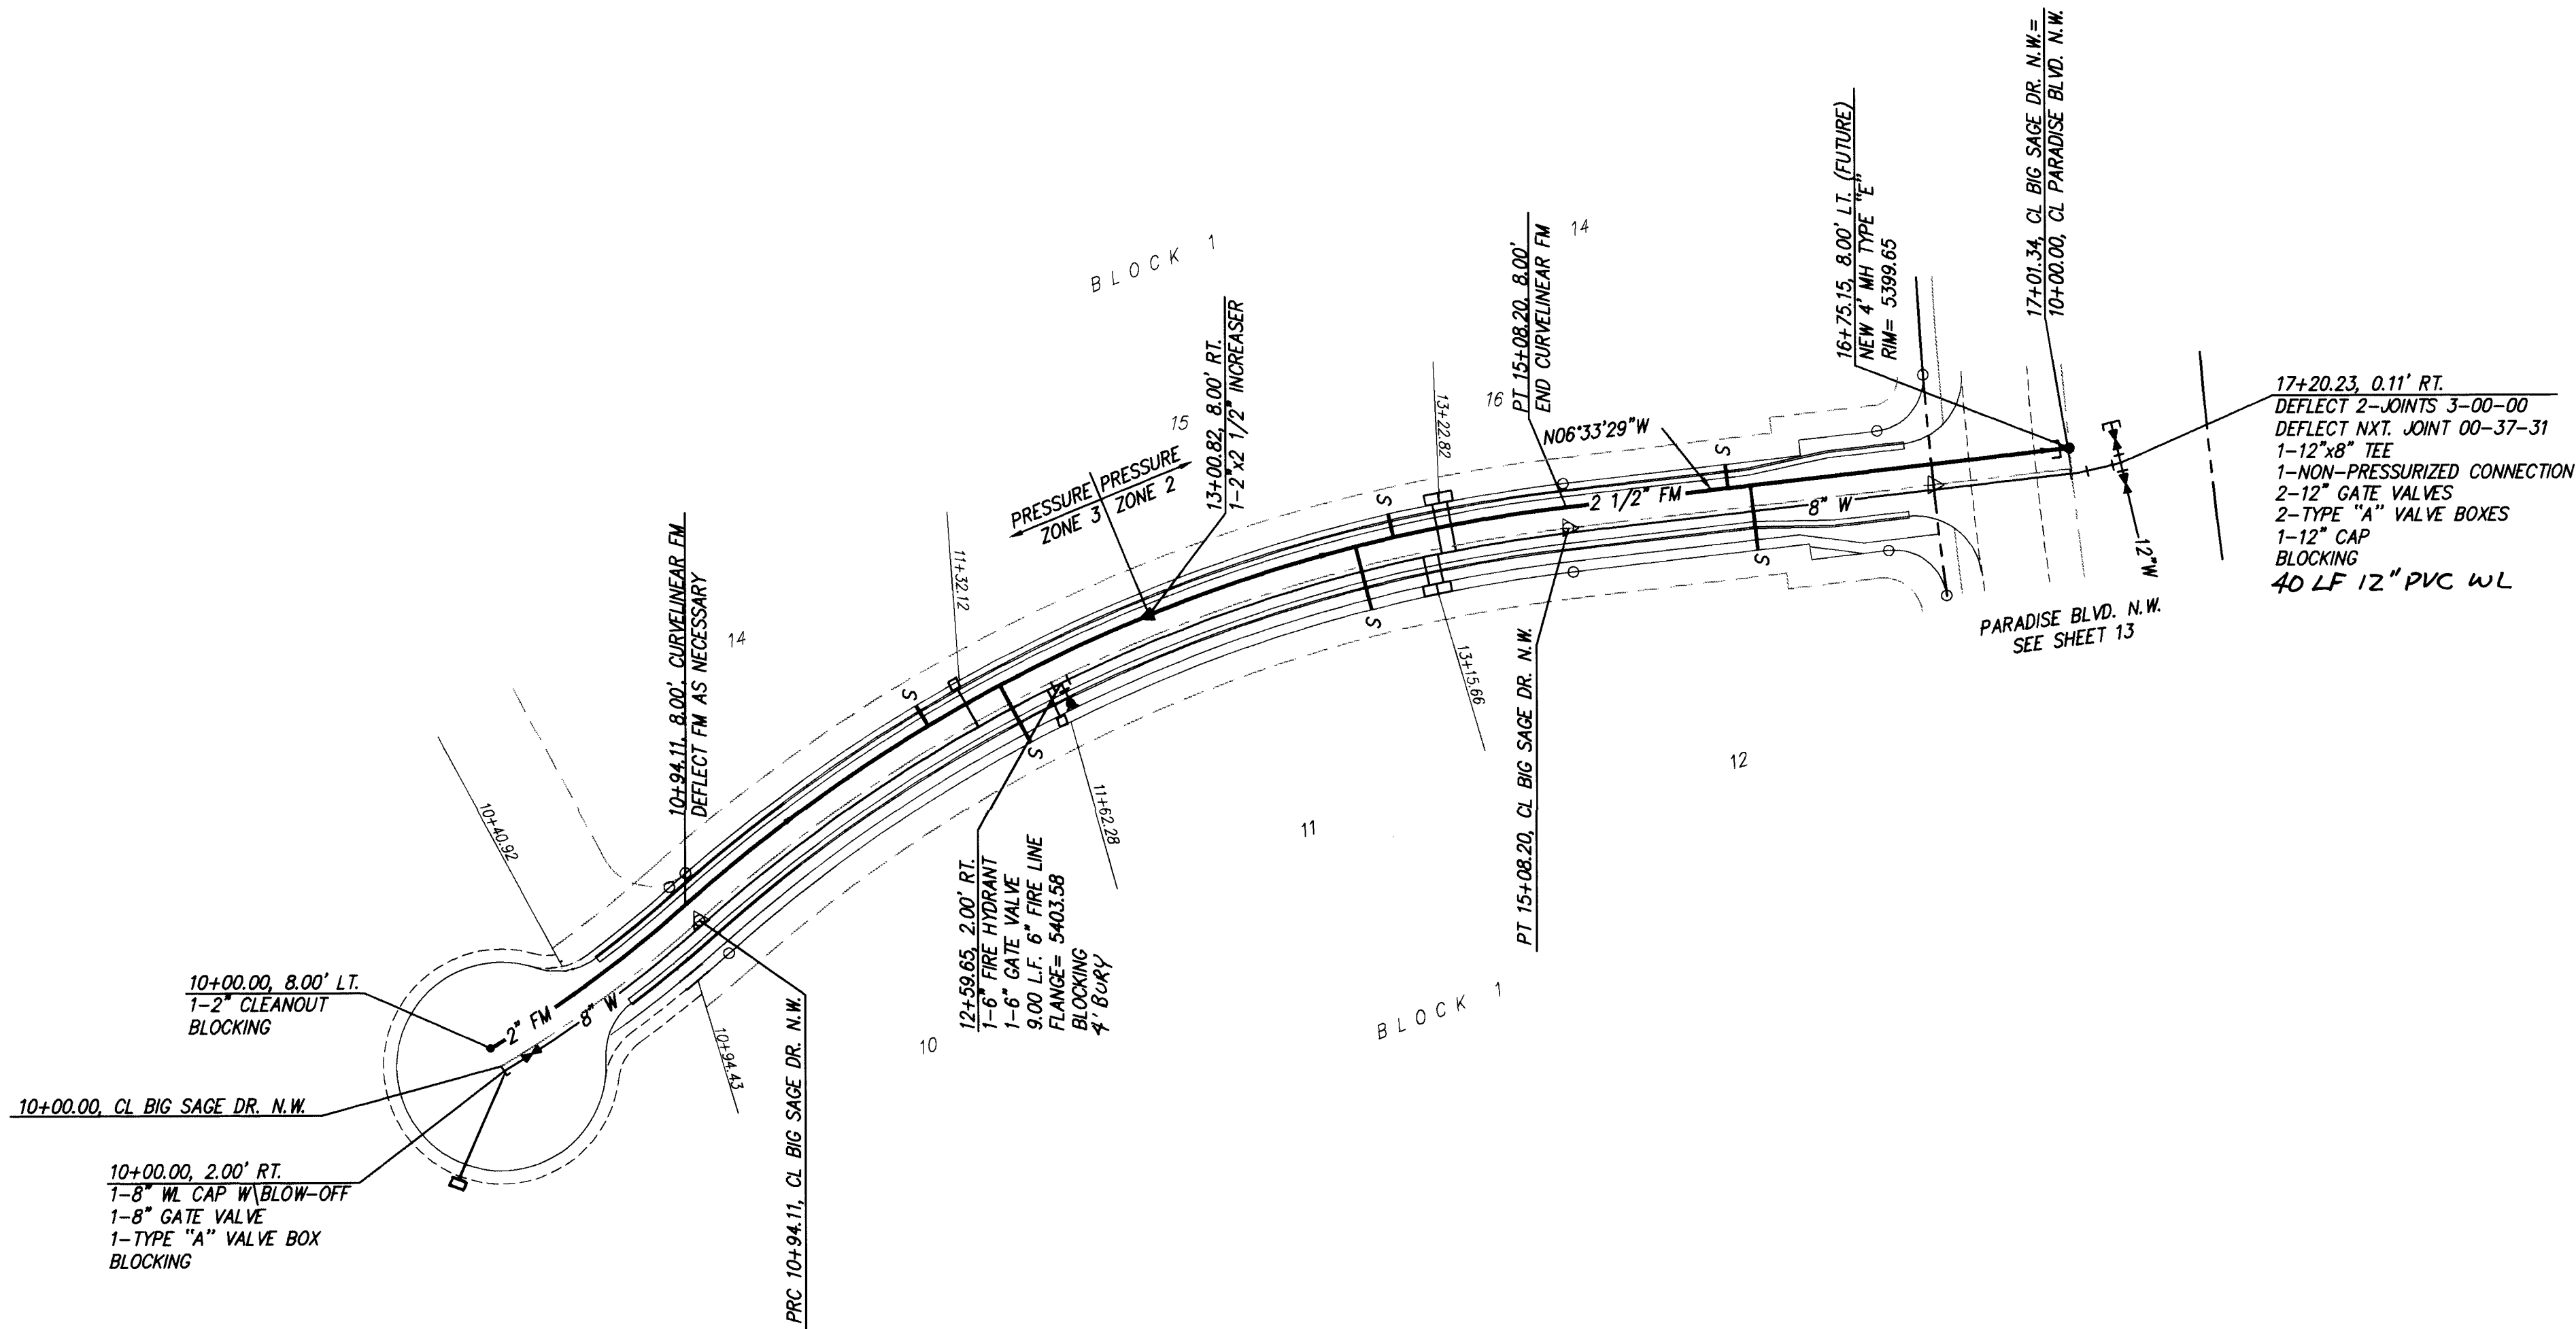

BIG SAGE DR. N.W.
STA. 10+00.00 TO STA. 17+20.23
SCALE: HORIZ. 1"=50'
VERT. 1"=10'

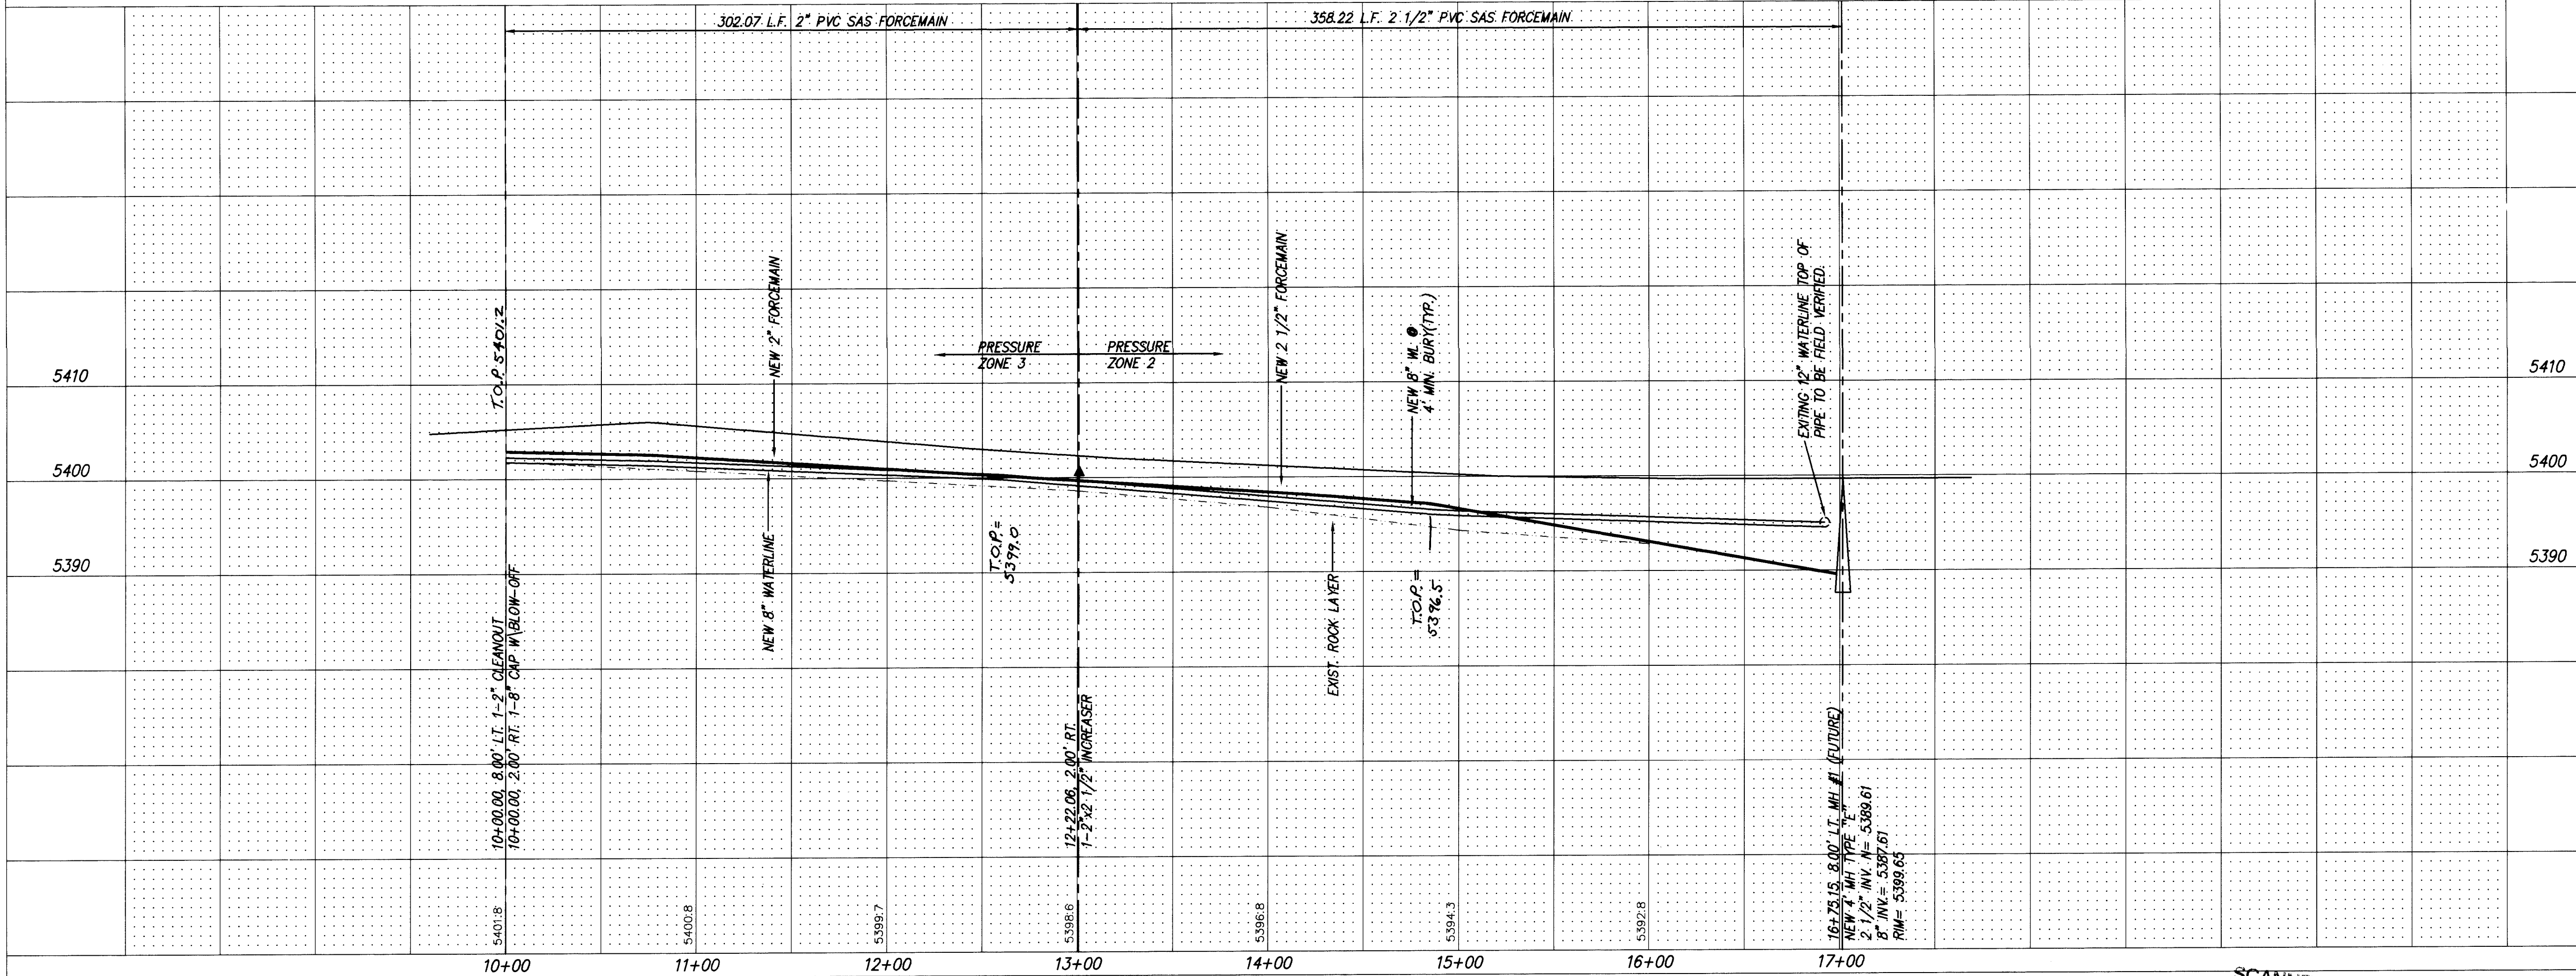


RECORD DRAWING
I hereby certify that the information contained on this drawing has been revised in accordance with the information furnished by the Contractor and the Surveyor, Spaulding Construction Co., and reflects the construction as actually completed. This plan as constructed is in substantial compliance with the Approved Plan.
Gregory J. Blank, NMPE 11929


I, David C. Clausen, New Mexico Registered Land Surveyor No. 6547, do hereby certify that the as-built information shown hereon is the result of a field survey performed by me or under my direct supervision, and that the same is true and correct.
David C. Clausen
N.M.L.S. # 6547

dmg D. MARK GOODWIN & ASSOCIATES, P.A.
CONSULTING ENGINEERS & SURVEYORS
P.O. BOX 90606
ALBUQUERQUE, NEW MEXICO 87199
(505) 345-2010

CITY OF ALBUQUERQUE PUBLIC WORKS DEPARTMENT ENGINEERING GROUP					
TITLE: CHAMISA RIDGE SUBDIVISION UNIT I UTILITY IMPROVEMENTS BIG SAGE DRIVE N.W.					
APPROVALS	ENGINEER	DATE	APPROVALS	ENGINEER	DATE
DRC CHAIRMAN	<i>R.W. Kane</i>	11-7-95	WATER	<i>R.W. Kane</i>	10-13-95
TRANSPORTATION	<i>NA</i>	10-10-95	WASTE WATER	<i>R.W. Kane</i>	10-13-95
HYDROLOGY	<i>NA</i>	10-16-95	N.M.U.I.	<i>NA</i>	10-16-95
PROJECT NO. 5286.90		MAP NO. B10		SHEET OF 11 17	

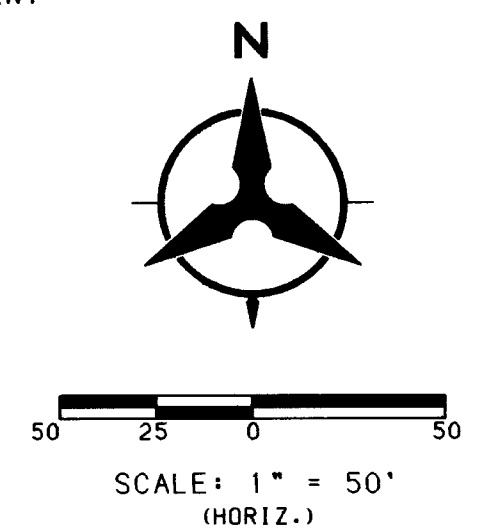

- I, David C. Clausen, New Mexico Registered Land Surveyor No. 6547, do hereby certify the as-built information shown hereon is the result of a field survey performed by me or under my direct supervision, and that the same is true and correct.

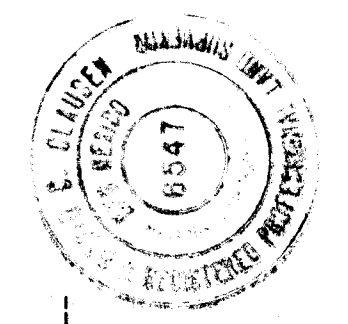

Direct. *David C. Clausen* N.M.I.S. # 6547
David C. Clausen

ENGINEER'S SEAL		SURVEY INFORMATION		BENCH MARKS		AS-BUILT INFORMATION	
		FIELD NOTES					
NO.	BY	DATE					
1	12/12	ADDITIONAL PARADE SAS SHEET	12/12/95		CONTRACTOR: Spaulding		3196
2	12/12	REMARKS	12/12/95		WORK STARTED BY: Clausen		3196
3	12/12	REVISIONS	12/12/95		ACCEPTANCE BY: MGA		DATE: 12/12/95
4	12/12	DESIGN	12/12/95		FIELD LOCATION BY: Clausen		DATE: 12/12/95
5	12/12	DESIGNED BY: TKM/PLL/BGF	12/12/95		DRAWINGS CORRECTED BY: MGA		DATE: 12/12/95
6	12/12	DRAWN BY: BS	12/12/95		GROUND-TO-GRID FACTOR = 0.9996640		
7	12/12	CHECKED BY: TKM	12/12/95		RECORDED BY: NO.		
8	12/12	DATE: 11/95	12/12/95		NGVD 1929 ELEVATION = 5419.522		
9	12/12	DATE: 11/95	12/12/95		DATE		

	BOHANNAN-HUSTON INC. ENGINEERS • PLANNERS • PHOTOGRAMMETRISTS • SURVEYORS • LANDSCAPE ARCHITECTS ALBUQUERQUE LAS CRUCES SANTA FE	
	CITY OF ALBUQUERQUE PUBLIC WORKS DEPARTMENT ENGINEERING GROUP	
	CHAMISA RIDGE SUBDIVISION UNIT I UTILITY IMPROVEMENTS PARADISE BLVD. STA. 19+00.00 - 26+30.00	

APPROVALS	ENGINEER	DATE	APPROVALS	ENGINEER	DATE
DRC	<i>S.D. Gubaly</i>	12-4-95	WATER	<i>R.W. Kane</i>	12-13-95
TRANSPORTATION	<i>W.D. Kane</i>	12-13-95	WASTE WATER	<i>R.W. Kane</i>	12-13-95
HYDROLOGY	<i>W.D. Kane</i>	12-13-95	TRAF. OPER.		
NMU	<i>W.D. Kane</i>	12-13-95			
DRAWING			MAP NO.	SHEET	OF 12


DRAWING NO.	5286.90	MAP NO.	B10	SHEET	14	OF 17	15
-------------	---------	---------	-----	-------	----	-------	----

COPYRIGHT BOHANNAN-HUSTON, INC. 1999


SCANNED BY
BY LASON

BHI JOB NO. XXXXX.XX



COPYRIGHT BOHANNAN-HUSTON, INC. 1995
DATE: NOVEMBER, 1995

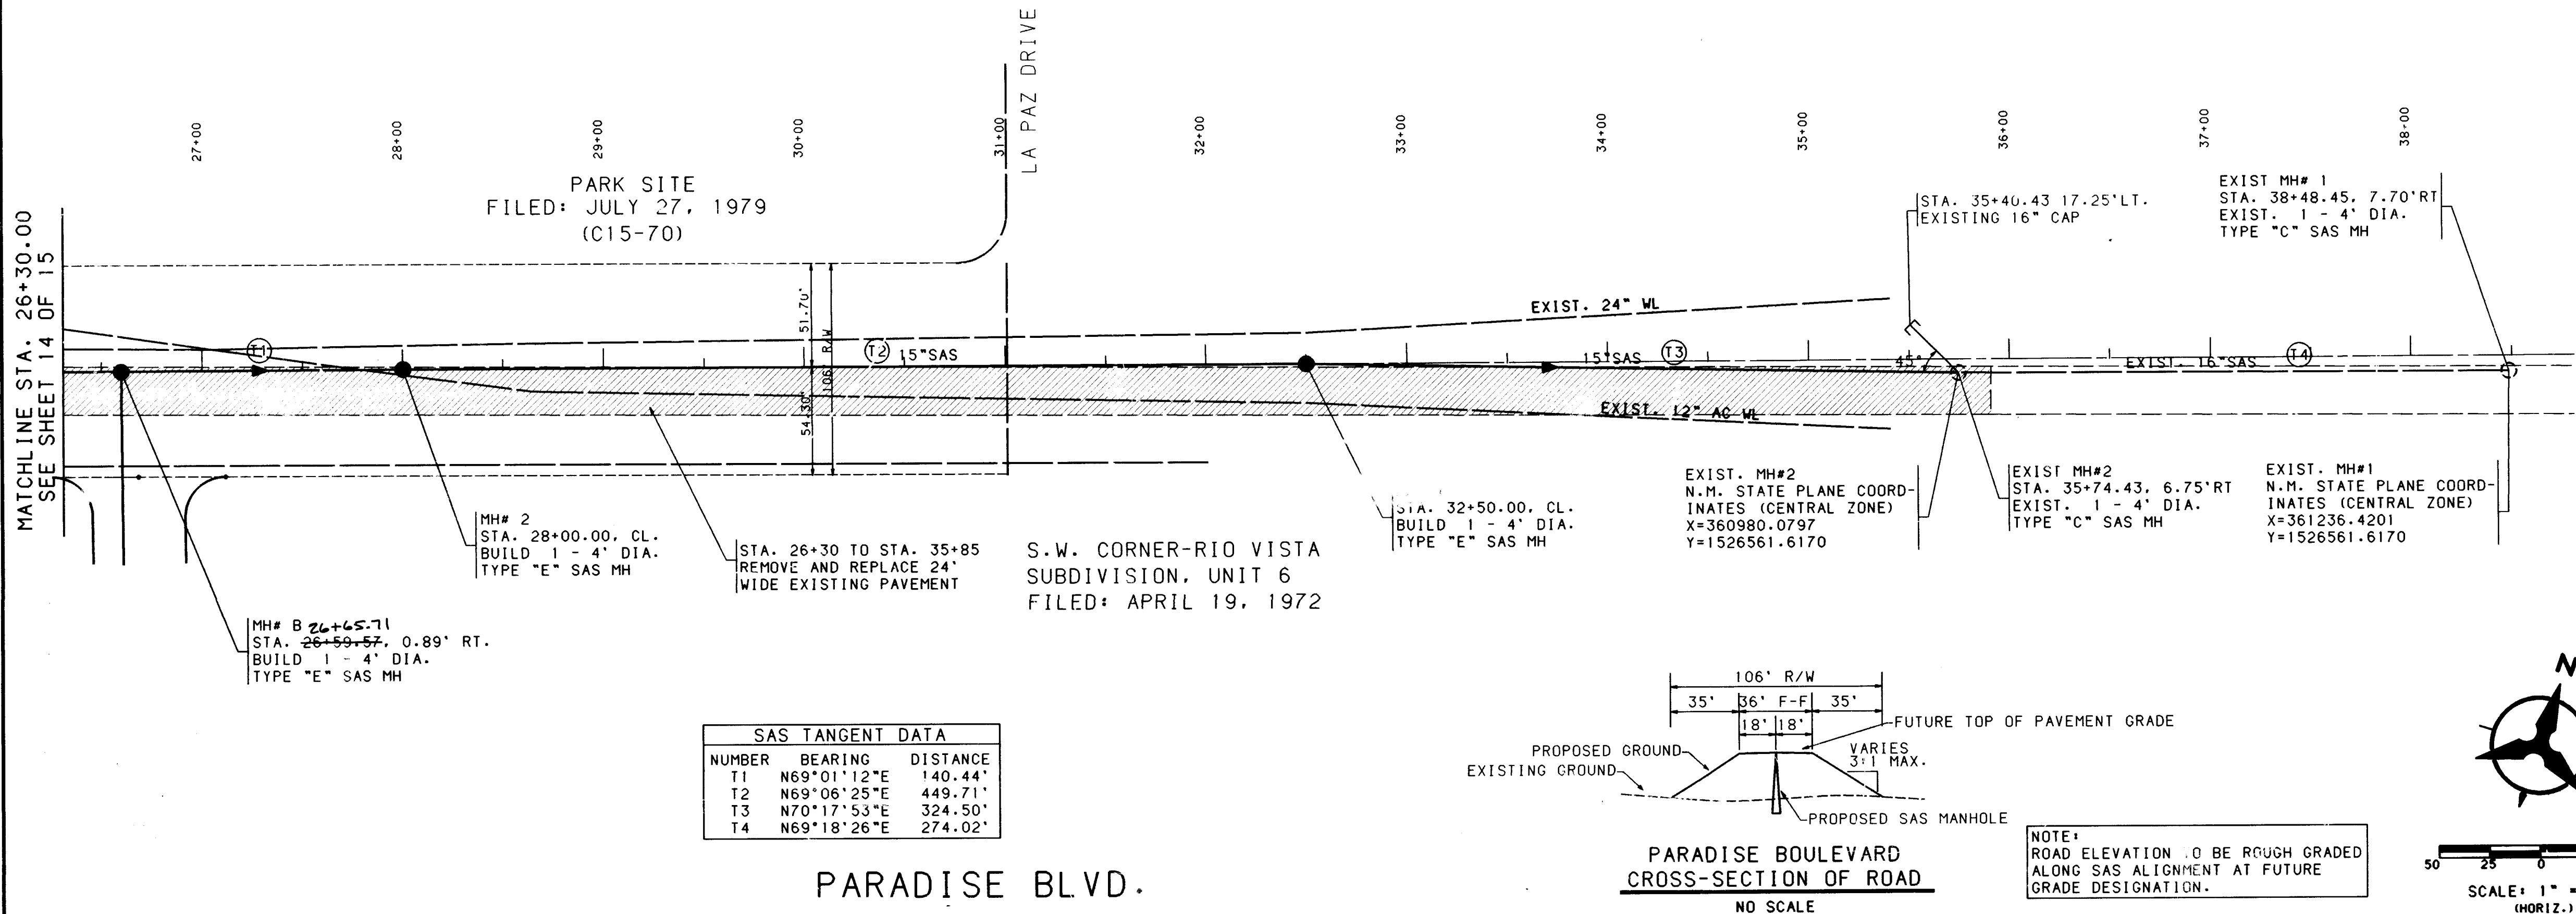

SAS TANGENT DATA		
NUMBER	BEARING	DISTANCE
T1	N69°01'12"E	140.44'
T2	N69°06'25"E	449.71'
T3	N70°17'53"E	324.50'
T4	N69°18'26"E	274.02'

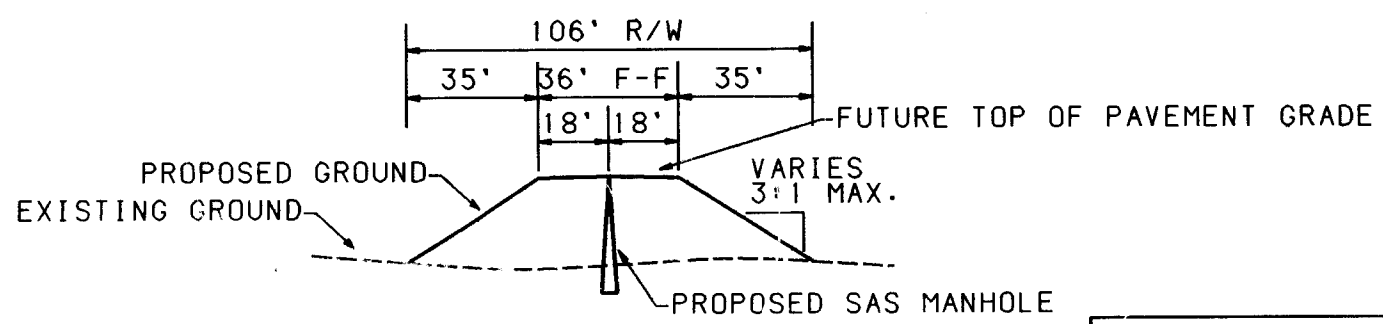

NOTE:
ROAD ELEVATION TO BE ROUGH GRADED
ALONG SAS ALIGNMENT AT FUTURE
GRADE DESIGNATION.

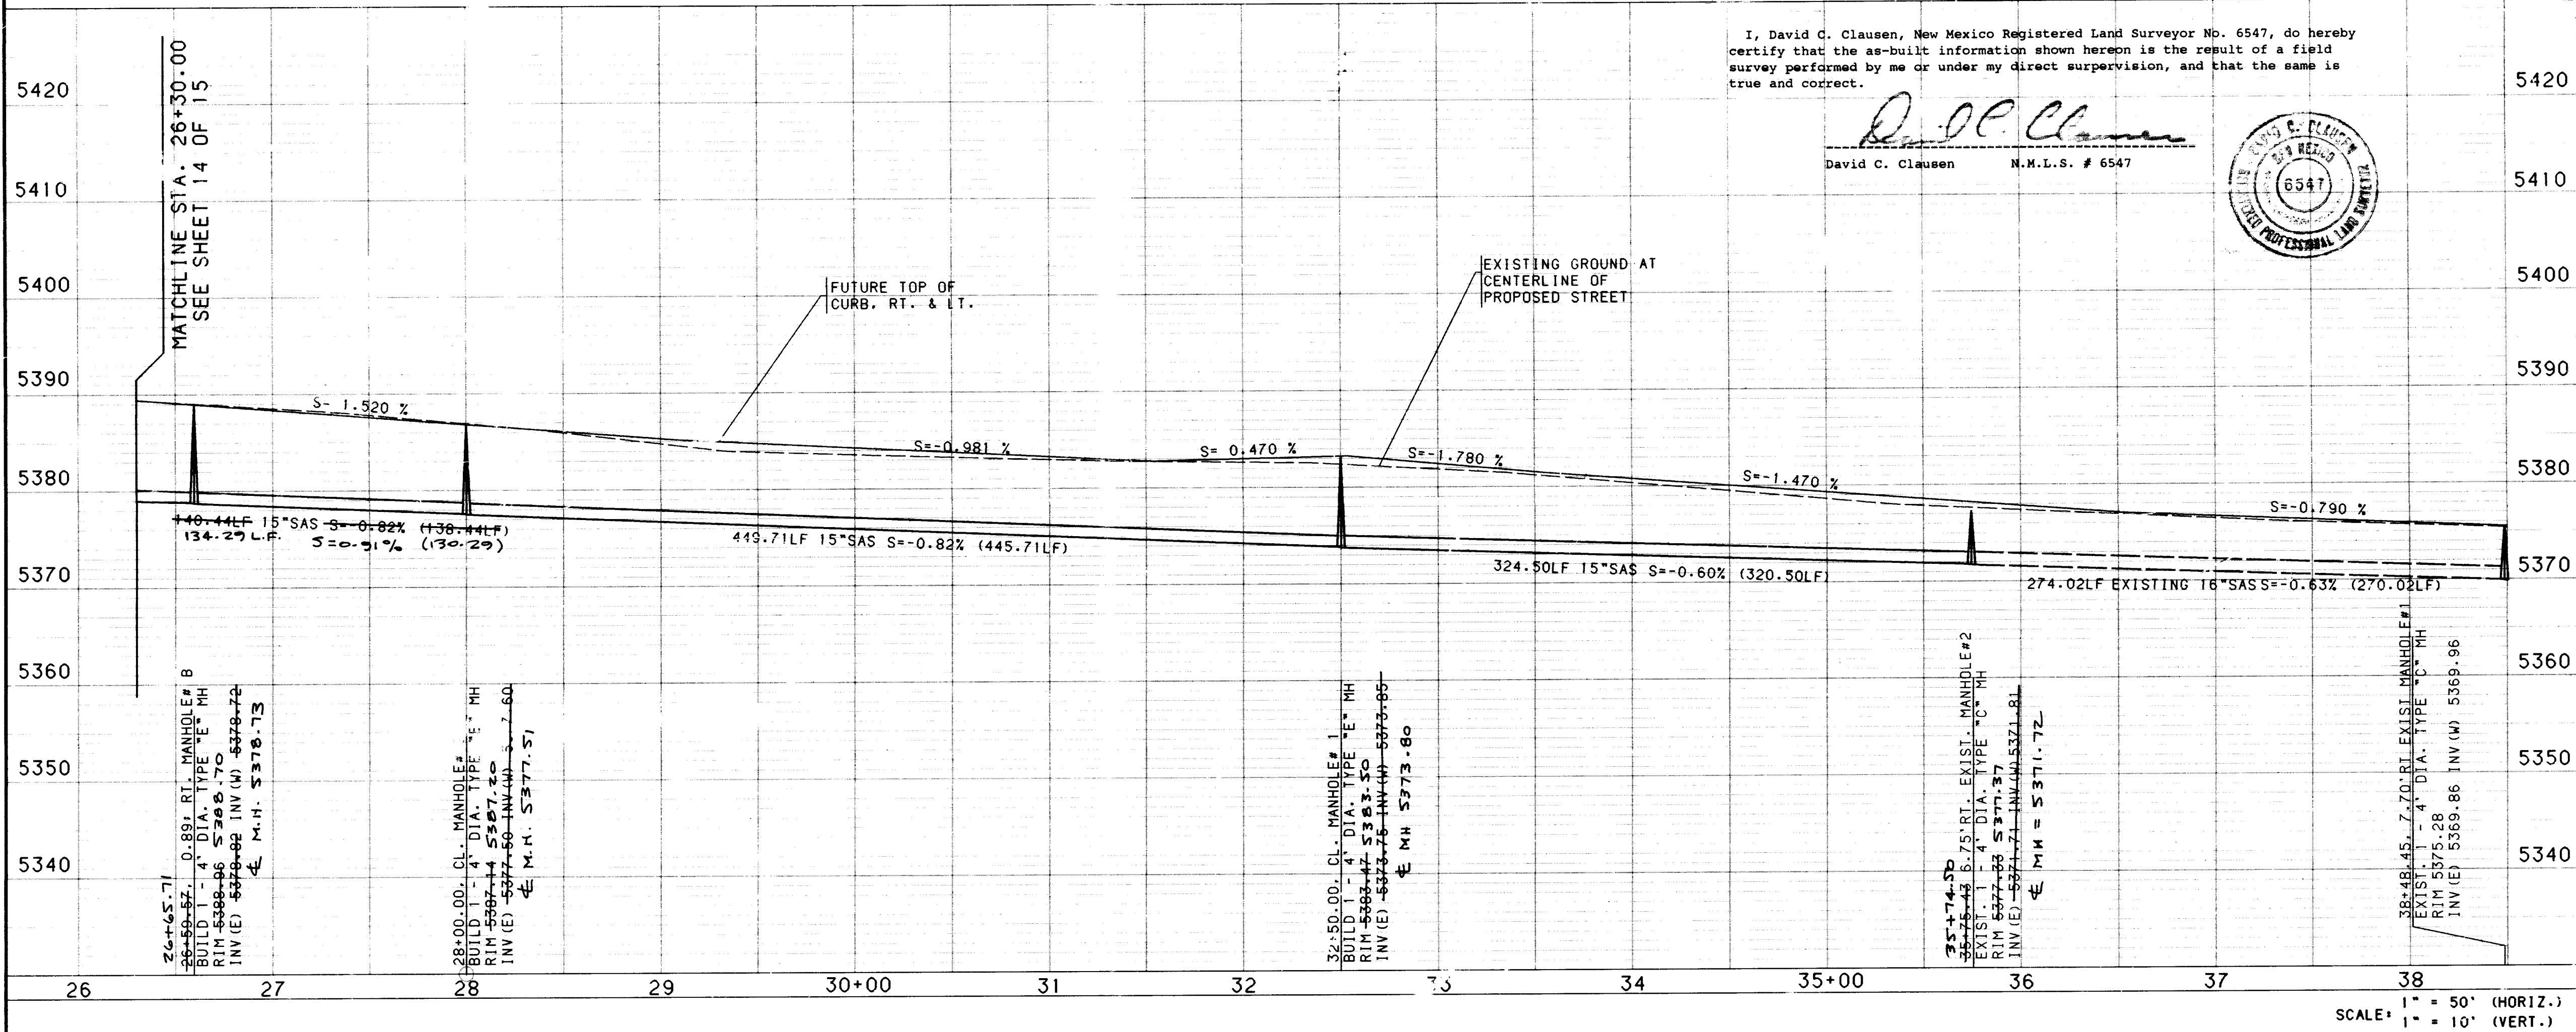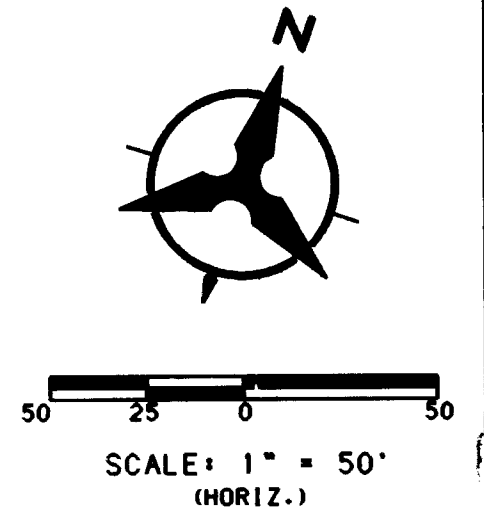

I, David C. Clausen, New Mexico Registered Land Surveyor No. 6547, do hereby certify that the as-built information shown hereon is the result of a field survey performed by me or under my direct supervision, and that the same is true and correct.

David C. Clausen N.M.L.S. # 6547

BOHANNAN-HUSTON INC.
ENGINEERS • PLANNERS • PHOTOGRAMMETRISTS • SURVEYORS • LANDSCAPE ARCHITECTS
ALBUQUERQUE LAS CRUCES SANTA FE

CITY OF ALBUQUERQUE
PUBLIC WORKS DEPARTMENT
ENGINEERING GROUP

CHAMISA RIDGE SUBDIVISION UNIT I
UTILITY IMPROVEMENTS
PARADISE BLVD. STA. 26+30.00 - 38+58.62

APPROVALS	ENGINEER	DATE	APPROVALS	ENGINEER	DATE
DRG. CHAIRMAN	<i>[Signature]</i>	12-14-95	WATER	<i>[Signature]</i>	12-13-95
TRANSPORTATION	<i>[Signature]</i>	12-13-95	WASTE WATER	<i>[Signature]</i>	12-13-95
HYDROLOGY	<i>[Signature]</i>	12-13-95	TRAF. OPER.		

DESIGNED BY TKM/PL/BCF

DRAWN BY BS

CHECKED BY TKM

DATE 11/95

DATE 11/95

DATE 11/95

MAP NO. 810

SHEET 15 OF 17

DRAWING NO. 5286.90

TRANSITION CURVE DATA

NUMBER	PI STA.	DELTA	TANGENT	ARC	RADIUS
C2	16+94.11	05°05'01.8"	49.37'	98.67'	1112.00'
C3	17+91.39	05°03'41.5"	48.11'	96.16'	1088.50'
C4	17+01.81	04°46'55.0"	45.43'	90.81'	1088.00'
C5	17+93.31	04°45'45.5"	46.22'	92.39'	1111.50'

TRANSITION CURVE DATA

NUMBER	PI STA.	DELTA	TANGENT	ARC	RADIUS
C1	22+77.49	20°52'60.0"	300.02'	593.38'	1628.00'

CENTERLINE TANGENT DATA

NUMBER	BEARING	DISTANCE
T1	S89°51'30"E	1877.47'
T2	N69°15'30"E	1341.22'

NOTE: CENTERLINE IS THE CENTERLINE OF THE 106' ROADWAY EASEMENT.

SEE SHEETS 1 - 13 OF 17 FOR ALTERNATE STATIONING.

NOTE: Sidewalk and Sidewalk culverts to be Built as shown on Sheet 17 of 17

CHAMISA RIDGE SUBDIVISION

TRACT 2
MARIN SUBDIVISION
FILED: MARCH 6, 1985
(C26-128)

TRACT 4
MARIN SUBDIVISION
FILED: MARCH 6, 1985
(C26-128)

VENTANA RANCH TRACT I

VENTANA RANCH TRACT J

VENTANA RANCH TRACT K

PARADISE BLVD.

BIG SAGE DR.
SEE SHEET 7A OF 17

INSTALL 4" DASHED YELLOW STRIPING W/ 30-10 SPACING

BUILD 2'-2" SIDEWALK CULVERTS PER STD. DWG. 2236
FL ELEV. -93.08 93.16

REMOVE 24' WIDE EXISTING PAVEMENT (SHADED AREA)

STA. 16+64.40 TO STA. 26+30

STA. 16+44.74: 10.42' RT. & STA. 16+56.38: 34.42' RT. TO STA. 17+43.91: 10.38' RT. & STA. 17+50.42: 34.38' RT. TRANSITION FROM EXISTING 24' PAVEMENT TO PROPOSED 23' PAVEMENT

RC 19+77.47 (* 8+26.23)

BUILD WHEELCHAIR RAMP PER STD. DWG. 2441 (TYPE I) TRANSITION FROM ROLL TYPE TO STD. C & G THRU RAMP PER STD DWG. 2418

CENTERLINE STRIPE FOR PAVEMENT

VENTANA RANCH TRACT I

VENTANA RANCH TRACT J

VENTANA RANCH TRACT K

CHAMISA RIDGE SUBDIVISION

TRACT 2
MARIN SUBDIVISION
FILED: MARCH 6, 1985
(C26-128)

TRACT 4
MARIN SUBDIVISION
FILED: MARCH 6, 1985
(C26-128)

PARADISE BLVD.

BIG SAGE DR.
SEE SHEET 7A OF 17

INSTALL 4" DASHED YELLOW STRIPING W/ 30-10 SPACING

BUILD 2'-2" SIDEWALK CULVERTS PER STD. DWG. 2236
FL ELEV. -93.08 93.16

REMOVE 24' WIDE EXISTING PAVEMENT (SHADED AREA)

STA. 16+64.40 TO STA. 26+30

STA

1, David C. Clausen, New Mexico Registered Land Surveyor No. 6547, do hereby certify the the as-built information shown hereon is the result of a field survey performed by me or under my direct supervision, and that the same is true and correct.

David C. Clausen N.M.L.S. # 6547

MATCHLINE STA. 26+30.00
(+ STA. 14+78.76)
SEE SHEET 17 OF 17

David C. Clausen	N.M.L.S. # 6547
------------------	-----------------

A circular postmark from Albuquerque, New Mexico. The text "ALBUQUERQUE" is curved along the top inner edge, "NEW MEXICO" is curved along the bottom inner edge, and "MAY 1941" is in the center. The number "1541" is printed below the circle.

MATCHLINE STA. 26+30.00
(* STA. 14+78.76)
SEE SHEET 17 OF 17

13. ALL STRIPING AND SIGNAGE SHALL CONFORM TO THE MANUAL OR UNIFORM TRAFFIC CONTROL DEVICES, PUBLISHED BY THE U.S. DEPARTMENT OF TRANSPORTATION, FEDERAL HIGHWAY ADMINISTRATION LATEST EDITION.
14. ALL NEW PAVEMENT MARKINGS INCLUDING DASH YELLOW CENTER STRIPE SHALL BE EITHER HOT OR COLD PLASTIC REFLECTORIZED MARKINGS UNLESS OTHERWISE NOTED.
15. COLD PLASTIC REFLECTORIZED PAVEMENT MARKINGS SHALL BE USED PROVIDED THAT INSTALLATION IS CARRIED OUT PER THE MANUFACTURER'S SPECIFICATIONS.
16. HOT PLASTIC REFLECTORIZED PAVEMENT MARKINGS WILL BE CONSIDERED BY THE CITY AS A SUBSTITUTE FOR COLD PLASTIC PROVIDED THAT INSTALLATION IS CARRIED OUT PER THE MANUFACTURER'S SPECIFICATIONS.

KEYED GENERAL NOTES

1. INSTALL CONCRETE VALLEY GUTTER
AS PER STD. DWG. 2420
2. STD. CURB & GUTTER
AS PER STD. DWG. 2415
3. BUILD 6' SIDEWALK
AS PER STD. DWG. 2430

 **BOHANNAN-HUSTON INC.**
ENGINEERS • PLANNERS • PHOTOGRAMMETRISTS • SURVEYORS • LANDSCAPE ARCHITECTS
ALBUQUERQUE LAS CRUCES SANTA FE

 CITY OF ALBUQUERQUE
PUBLIC WORKS DEPARTMENT
ENGINEERING GROUP

CHAMISA RIDGE SUBDIVISION UNIT I
PAVING PLAN & PROFILE
PARADISE BLVD. STA. 19+00.00 - 26+30.00

APPROVAL'S	ENGINEER	DATE	APPROVAL'S	ENGINEER	DATE
DRC CHAIRMAN	<i>Billy J. Walker</i>	5/31/96	WATER	N/A JWS	
TRANSPORTATION	<i>W. J. Walker</i>	5-28-96	WASTE WATER	N/A JWS	
HYDROLOGY	<i>W. J. Walker</i>	5-29-96	TRAF. OPER.		

DRAWING NO.	5286.90	MAP NO. B10	SHEET 16	OF 17
----------------	---------	----------------	-------------	----------

USERNAME: CDP5:[C9526201.CHAMISA]PARADISE-PAVL.GRE

SCANNED
BY LASON


BHI JOB NO. 95409C2454

20

26-5286.90 1696

COPYRIGHT BOHANNAN-HUSTON, INC. 199

DATE: NOVEMBER, 1995

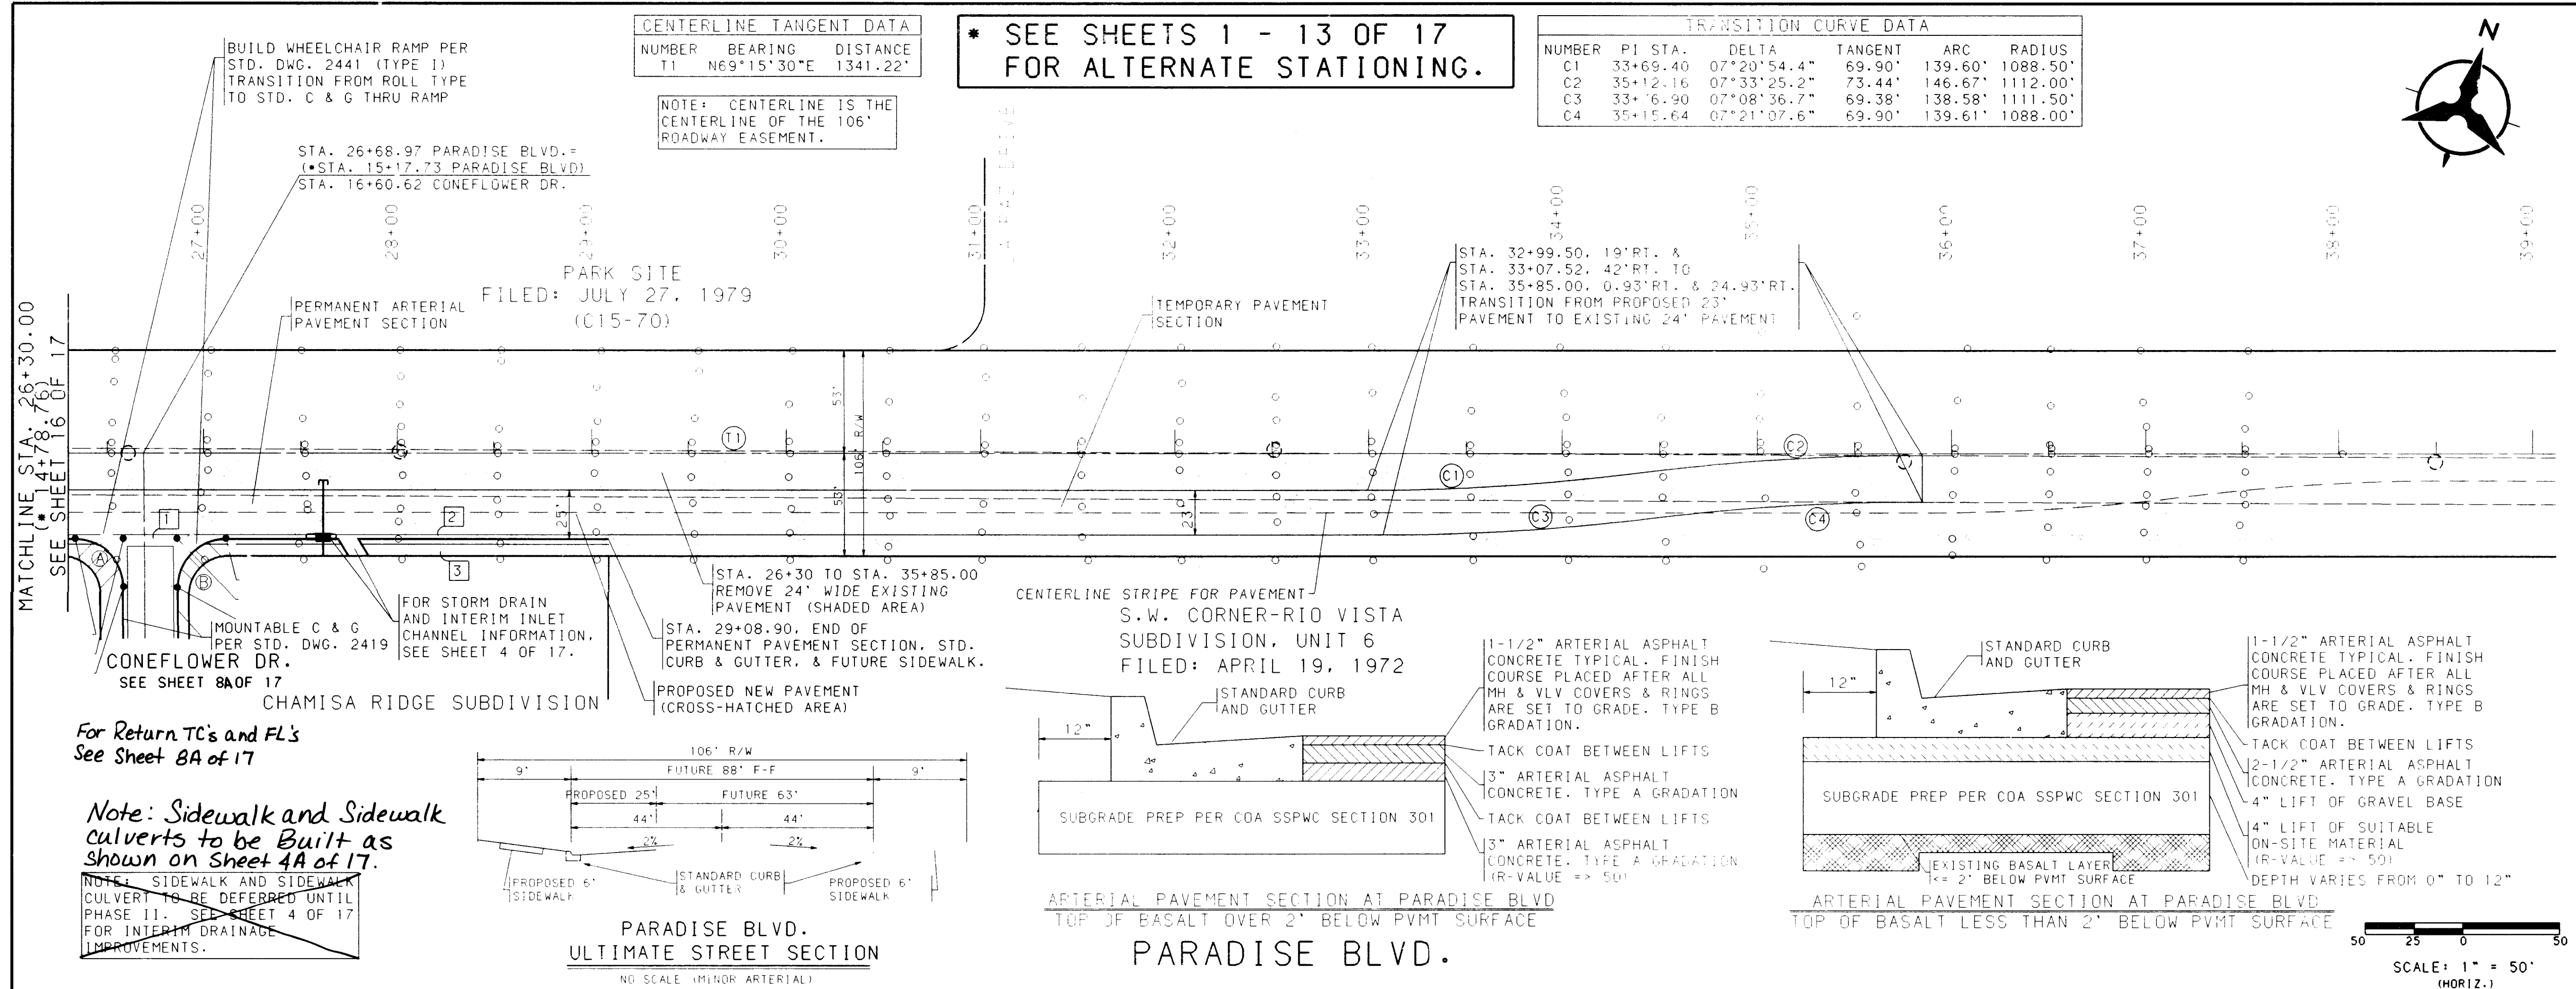

TRANSITION CURVE DATA					
NUMBER	PI STA.	DELTA	TANGENT	ARC	RADIUS
C1	33+69.40	07°20'54.4"	69.90'	139.60'	1088.50'
C2	35+12.16	07°33'25.2"	73.44'	146.67'	1112.00'
C3	33+6.90	07°08'36.7"	69.38'	138.58'	1111.50'
C4	35+15.64	07°21'07.6"	69.90'	139.61'	1088.00'

CENTERLINE TANGENT DATA		
NUMBER	BEARING	DISTANCE
T1	N69°15'30"E	1341.22'

NOTE: CENTERLINE IS THE CENTERLINE OF THE 106' ROADWAY EASEMENT.

* SEE SHEETS 1 - 13 OF 17 FOR ALTERNATE STATIONING.

NOTES

1. THE CONTRACTOR SHALL FIELD VERIFY ALL EXISTING UTILITY LOCATIONS AND NOTIFY THE ENGINEER IMMEDIATELY OF ANY DISCREPANCIES.
2. ALL CURB RETURN RADI SHALL BE 25' TO FACE OF CURB UNLESS OTHERWISE SPECIFIED.
3. ALL CURVE DATA AND DIMENSIONS REFER TO FACE OF CURB UNLESS OTHERWISE SPECIFIED.
4. GRADE ELEVATIONS, WHERE NOTED, ARE FOR TOP OF STANDARD CURB UNLESS OTHERWISE SPECIFIED.
5. CONTRACTOR IS TO INSTALL A 4"x4"x5" POST AND END AT THE END OF EACH SANITARY SEWER SERVICE.
6. CONTRACTOR IS RESPONSIBLE FOR REPAIR AND/OR REPLACEMENT OF ALL UTILITY CONDUITS AND EXISTING LINES.
7. ANY ADDITIONAL GRADING REQUIRED TO MATCH PROPOSED STREET GRADES SHALL BE INCIDENTAL TO PAVING ITEMS.
8. CONTRACTOR SHALL PROVIDE THE INSPECTORS, (CITY AND PRIVATE) WITH THE PROPOSED HYDROSTATIC TESTING PLAN. THE PLAN MUST BE APPROVED BEFORE TESTING OPERATIONS BEGIN.
9. CONTRACTOR SHALL PARK EQUIPMENT AND VEHICLES AS NOT TO INTERFERE WITH NORMAL ACTIVITIES OF RESIDENTS OR OTHER CONTRACTORS ON SITE.
10. ANY DAMAGE TO THE EXISTING FACILITIES (CURB AND GUTTER, PAVEMENT, CONDUITS, LANDSCAPING, UTILITY LINES, ETC.) DURING CONSTRUCTION SHALL BE REPLACED AT THE CONTRACTORS EXPENSE.
11. REMOVAL OF THE EXISTING CURB AND GUTTER SHALL BE AS PER COA STD. DWG. 2415 (SAW CUT ONLY).
12. WHEEL CHAIR RAMPS SHALL BE CONSTRUCTED PRIOR TO ACCEPTANCE OF CURB AND GUTTER.
13. ALL STRIPING AND SIGNAGE SHALL CONFORM TO THE MANUAL ON UNIFORM TRAFFIC CONTROL DEVICES. PUBLISHED BY THE U.S. DEPARTMENT OF TRANSPORTATION, FEDERAL HIGHWAY ADMINISTRATION LATEST EDITION.
14. ALL NEW PAVEMENT MARKINGS INCLUDING DASH YELLOW CENTERLINE STRIPE SHALL BE EITHER HOT OR COLD PLASTIC REFLECTORIZED MARKINGS UNLESS OTHERWISE NOTED.
15. COLD PLASTIC REFLECTORIZED PAVEMENT MARKINGS SHALL BE USED PROVIDED THAT INSTALLATION IS CARRIED OUT PER THE MANUFACTURER'S SPECIFICATIONS.
16. HOT PLASTIC REFLECTORIZED PAVEMENT MARKINGS WILL BE CONSIDERED BY THE CITY AS A SUBSTITUTE FOR COLD PLASTIC PROVIDED THAT INSTALLATION IS CARRIED OUT PER THE MANUFACTURER'S SPECIFICATIONS.

KEYED GENERAL NOTES

1. INSTALL CONCRETE VALLEY GUTTER AS PER STD. DWG. 2420
2. STD. CURB & GUTTER AS PER STD. DWG. 2415
3. BUILD 6' SIDEWALK AS PER STD. DWG. 2430

BOHANNAN-HUSTON INC.
ENGINEERS • PLANNERS • PHOTOGRAMMETRISTS • SURVEYORS • LANDSCAPE ARCHITECTS
ALBUQUERQUE LAS CRUCES SANTA FE

CITY OF ALBUQUERQUE
PUBLIC WORKS DEPARTMENT
ENGINEERING GROUP

CHAMISA RIDGE SUBDIVISION UNIT I
PAVING IMPROVEMENTS
PARADISE BLVD. STA. 26+30.00 - 38+58.62

APPROVALS	ENGINEER	DATE	APPROVALS	ENGINEER	DATE
DRG CHAIRMAN	J. J. Galy	5-31-96	WATER	W. J. Jue	
TRANSPORTATION	J. J. Galy	5-29-96	WASTE WATER	W. J. Jue	
HYDROLOGIST	J. J. Galy	5-29-96	TRAFFIC OPER		

DRAWING NO. 5295.90 MAP NO. B10 SHEET 17 OF 17

SCANNED BY: LASON

BOHANNAN-HUSTON, INC. 1993
DATE: NOVEMBER, 1996