


TIERRA OESTE UNIT 1
ALBUQUERQUE, NEW MEXICO
IMPROVEMENTS FOR
GRADING, PAVING AND UTILITIES

INDEX OF DRAWINGS

SHEET NO.	DESCRIPTION
1	TITLE SHEET
2 TO 4	SUBDIVISION PLAT (1,2,& 3 OF 3 SHEETS)
5 TO 6	GRADING PLAN (G1 & G2) & EROSION CONTROL
7	TYPICAL SECTIONS & RETAINING WALL DETAILS
PAVING PLAN AND PROFILES	
8	COMPOSITE PAVING PLAN
9	LADERA DRIVE
10	LADERA DRIVE
11	LADERA DRIVE
12	LADERA DRIVE
13	LADERA/UNSER TRAFFIC SIGNAL RELOCATION (NIC)
14	CASA ROJA PLACE
15	CASA ROJA PLACE
16	CASA NEGRA COURT/CASA GRIS COURT
17	CASA VERDE AVENUE/CASA AZUL COURT
18	LADERA DRIVE CONSTRUCTION TRAFFIC CONTROL PLAN
19	SIGNING AND CONSTRUCTION TRAFFIC CONTROL STANDARDS
20	TYPICAL TRAFFIC CONTROL & SIGNING EXAMPLES (REF. M.U.T.C.D.)
UTILITY PLAN AND PROFILES	
21	COMPOSITE UTILITY PLAN
22	CASA ROJA PLACE
23	CASA ROJA PLACE/UTILITY EASEMENT
24	CASA NEGRA COURT/CASA GRIS COURT
25	CASA VERDE AVENUE/CASA AZUL COURT
26	LADERA DRIVE
27	LADERA DRIVE
28	DRAINAGE EASEMENT & DRAINAGE DETAILS
29	DRAINAGE DETAILS
30	TYPICAL SECTIONS/DETAILS

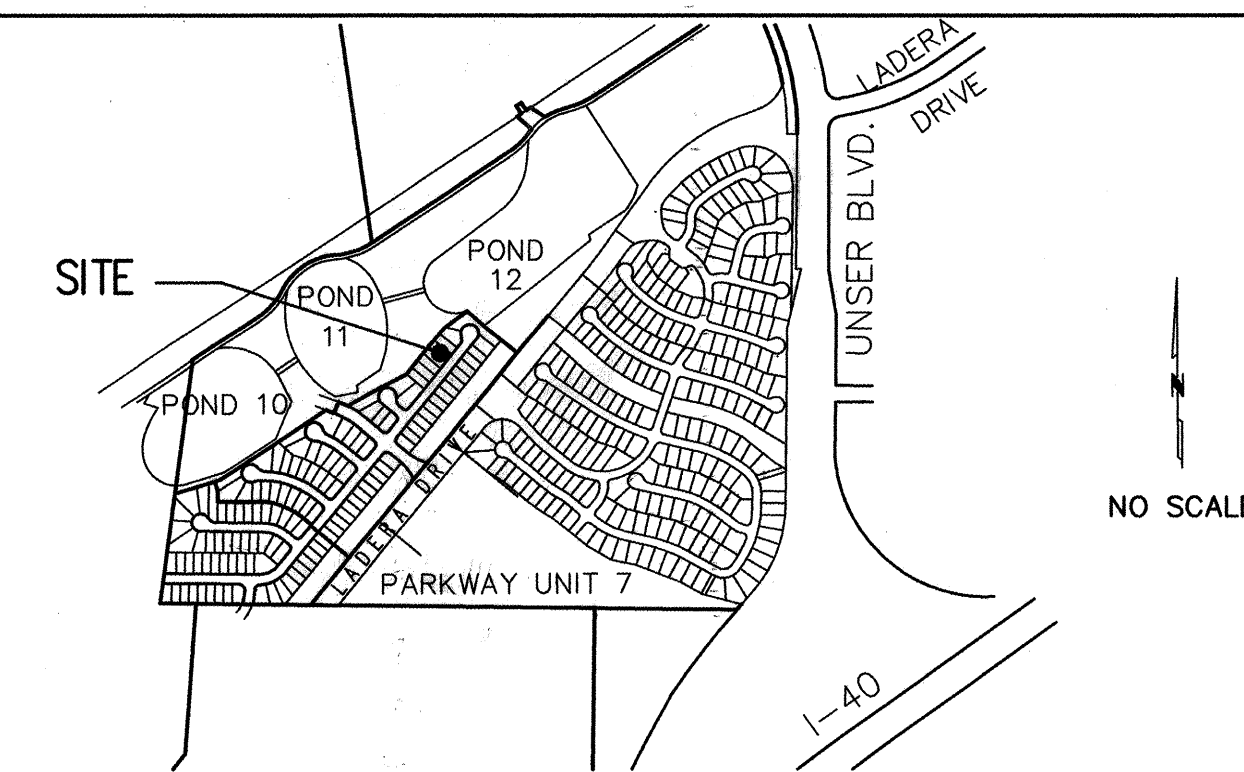

VICINITY MAP
ZONE ATLAS MAP H-9 & J-9

GENERAL NOTES

- ALL WORK DETAILED ON THESE PLANS TO BE PERFORMED UNDER CONTRACT SHALL, EXCEPT AS OTHERWISE STATED OR PROVIDED FOR HEREON, BE CONSTRUCTED IN ACCORDANCE WITH THE CITY OF ALBUQUERQUE STANDARD SPECIFICATIONS FOR PUBLIC WORKS CONSTRUCTION 1986 EDITION AS AMENDED WITH UPDATE NO. 6.
- PRIOR TO CONSTRUCTION, THE CONTRACTOR SHALL EXCAVATE AND VERIFY THE HORIZONTAL AND VERTICAL LOCATIONS OF ALL OBSTRUCTIONS. SHOULD A CONFLICT EXIST, THE CONTRACTOR SHALL NOTIFY THE ENGINEER SO THAT THE CONFLICT CAN BE RESOLVED WITH MINIMUM DELAY.
- TWO (2) WORKING DAYS PRIOR TO ANY EXCAVATION, CONTRACTOR MUST CONTACT LINE LOCATING SERVICE @ 260-1990 FOR LOCATION OF EXISTING UTILITIES.
- WARNING - EXISTING UTILITY LINE LOCATIONS ARE SHOWN IN AN APPROXIMATE MANNER ONLY, AND SUCH LINES MAY EXIST WHERE NONE ARE SHOWN. THE LOCATION OF ANY SUCH EXISTING LINES IS BASED UPON INFORMATION PROVIDED BY THE UTILITY COMPANY, THE OWNER, OR BY OTHERS, AND THE INFORMATION MAY BE INCOMPLETE OR MAY BE OBSOLETE BY THE TIME CONSTRUCTION COMMENCES.
 - THERE ARE EXISTING HIGH VOLTAGE LINES WITHIN THE PNM EASEMENT ADJACENT TO LADERA DRIVE. THESE LINES MUST REMAIN ENERGIZED AT ALL TIMES. CONTRACTOR SHALL COORDINATE WITH PNM PRIOR TO START OF CONSTRUCTION. CONTRACTOR IS ADVISED THAT OSHA REQUIRES A MINIMUM CLEARANCE OF 15' IN ALL DIRECTIONS FROM THE POWERLINE.
- THE ENGINEER HAS UNDERTAKEN NO FIELD VERIFICATION OF THE LOCATION, DEPTH, SIZE OR TYPE OF EXISTING UNDERGROUND UTILITY LINES, MAKES NO REPRESENTATION PERTAINING THEREFORE. THE CONTRACTOR SHALL INFORM ITSELF OF THE LOCATION OF ANY UTILITY LINE IN OR NEAR THE AREA OF WORK IN ADVANCE OF AND DURING EXCAVATION WORK. THE CONTRACTOR IS FULLY RESPONSIBLE FOR ANY AND ALL DAMAGE CAUSED BY ITS FAILURE TO LOCATE, IDENTIFY AND PRESERVE ANY AND ALL EXISTING UTILITIES. THE CONTRACTOR SHALL COMPLY WITH STATE STATUTES, MUNICIPAL AND LOCAL ORDINANCES, RULES AND REGULATIONS PERTAINING TO THE LOCATION OF THESE LINES AND FACILITIES, IN PLANNING AND CONDUCTING EXCAVATION, WHETHER BY CALLING OR NOTIFYING THE UTILITIES, COMPLYING WITH "BLUE STAKES" PROCEDURES, OR OTHERWISE.
- TRAFFIC CONTROL: FIVE (5) WORKING DAYS PRIOR TO BEGINNING CONSTRUCTION THE CONTRACTOR SHALL SUBMIT TO THE CONSTRUCTION COORDINATION DIVISION A DETAILED CONSTRUCTION SCHEDULE. TWO (2) WORKING DAYS PRIOR TO CONSTRUCTION THE CONTRACTOR SHALL OBTAIN A BARRICADING PERMIT FROM THE CONSTRUCTION COORDINATION DIVISION. CONTRACTOR SHALL NOTIFY BARRICADE ENGINEER (768-2551) PRIOR TO OCCUPYING AN INTERSECTION. SEE SECTION 19 OF THE SPECIFICATIONS. ALL STREET STRIPING ALTERED OR DESTROYED SHALL BE REPLACED BY CONTRACTOR TO LOCATION AND IN KIND AS EXISTING AT NO ADDITIONAL COST TO THE OWNER.
- THE CONTRACTOR SHALL PROMPTLY CLEAN UP ANY MATERIAL EXCAVATED WITHIN THE PUBLIC RIGHT-OF-WAY SO THAT THE EXCAVATED MATERIAL IS NOT SUSCEPTIBLE TO BEING WASHED DOWN THE STREET.
- THE CONTRACTOR IS RESPONSIBLE FOR PROTECTING AND MAINTAINING ALL EXISTING MONUMENTATION CONTROLS. IN THE EVENT OF INADVERTENT DESTRUCTION OR ALTERATION THE CONTRACTOR MUST IMMEDIATELY NOTIFY THE CITY CHIEF SURVEYOR.
- ANY WORK OCCURRING WITHIN AN ARTERIAL ROADWAY REQUIRES TWENTY-FOUR HOUR CONSTRUCTION.
- NOTIFY CITY OF ALBUQUERQUE WATER DEPARTMENT A MINIMUM OF 5 WORKING DAYS PRIOR TO MAKING CONNECTIONS TO EXISTING WATER LINES.
- ALL WHEELCHAIR RAMPS SHALL ADHERE TO CURRENT ADA REQUIREMENTS.

CINFRAN/HUITT-ZOLLARS
333 RIO RANCHO DR. N.E., STE. 101
RIO RANCHO, N.M., 87124
(505) 892-5141

LAND PLANNING / ENGINEERING / ENVIRONMENT / SUBDIVISION DEVELOPMENT / SURVEYING

APPROVAL OF RECORD DRAWINGS
CHIEF CONSTRUCTION ENGINEER
[Signature]
DATE 9/20/01


ENGINEER'S
CERTIFICATION

REGISTERED IN NEW MEXICO AS A PROFESSIONAL
ENGINEER NO. 9916 HERBY CERTIFY
THAT THIS PROJECT WAS CONSTRUCTED IN
SUBSTANTIAL COMPLIANCE WITH THIS PLAN,
EXCEPT AS NOTED. DATE 5-1-01

DRB Case#
94-443

REV.	21, 22, 25, 29	2/12/00	2/12/00	2/12/00	2/12/00	2/12/00	2/12/00	2/12/00	2/12/00
ENGINEERS STAMP & SIGNATURE	APPROVALS	ENGINEER	DATE	*****					
	DRC Chairman	<i>[Signature]</i>	2-27-00	APPROVED FOR CONSTRUCTION					
	Transportation	<i>[Signature]</i>	1-11-00						
	Water/Wastewater	<i>[Signature]</i>	1-11-00						
	Hydrology	<i>[Signature]</i>	1-11-00						
	Parks	<i>[Signature]</i>	1-11-00						
Constr. Mngmt.	<i>[Signature]</i>	1-28-00	City Engineer Date						
AMAFCA	<i>[Signature]</i>	1-28-00							
City Project No.	5297.90			Sheet 1 of 30					

SCANNED BY
MESA REPRO

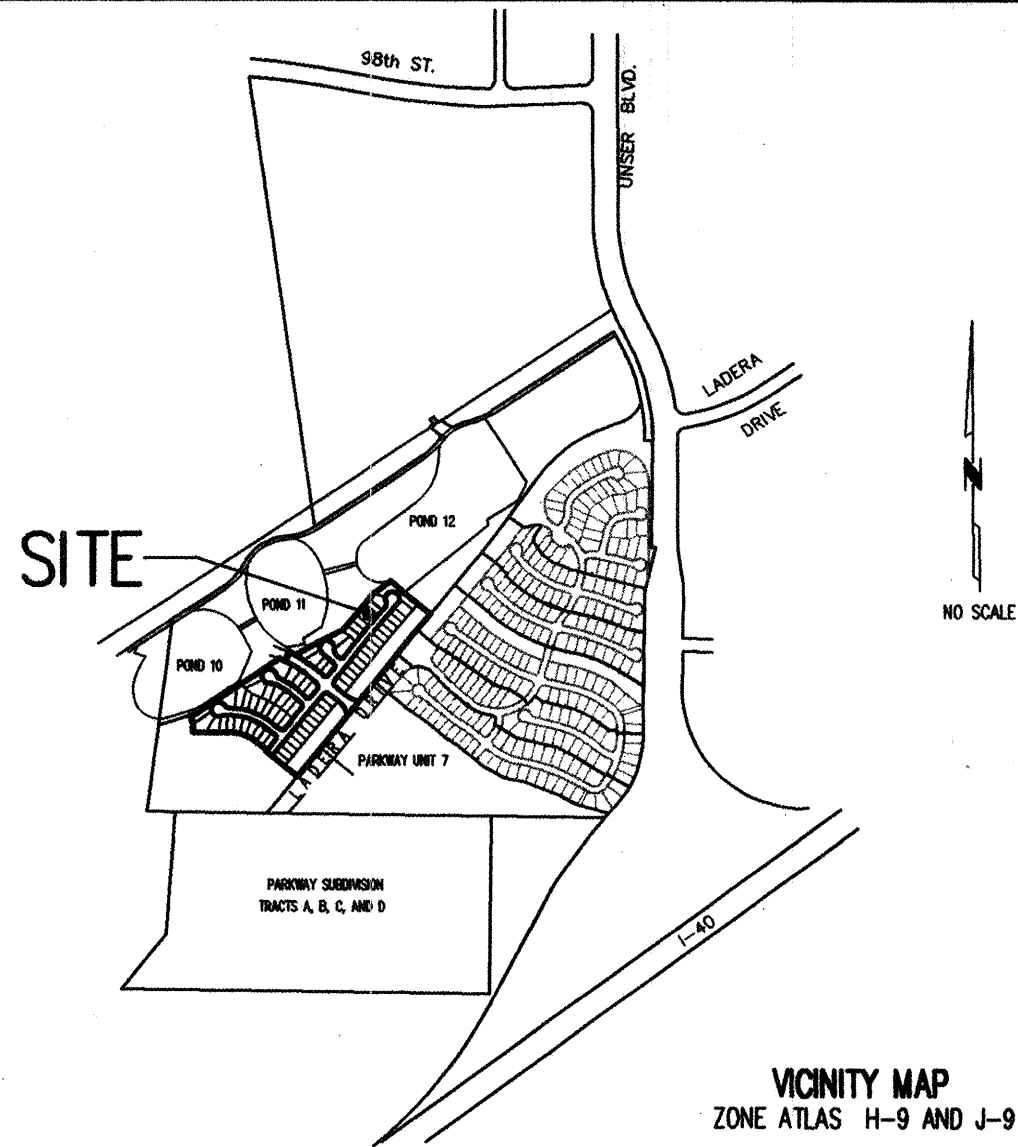

NOTES

- THE PURPOSE OF THIS PLAT IS TO SUBDIVIDE UNPLATTED LANDS OF WESTLAND DEVELOPMENT COMPANY. UNIT 1 CONTAINS 15.3476 ACRES, 72 SINGLE FAMILY RESIDENTIAL LOTS AND ADJOINING STREETS.
- ALL BEARINGS SHOWN HEREON ARE GRID BEARINGS BASED ON THE NEW MEXICO STATE PLANE COORDINATE SYSTEM, CENTRAL ZONE, MEAN DELTA ALPHA -00°16'45". BASIS OF BEARINGS IS THE PUBLISHED BEARING BETWEEN ACS "BH-40" AND ACS "3-H10" BEING N. 68°57'50" E. BASIS OF COORDINATES ARE THOSE PUBLISHED FOR ACS "BH-40". DISTANCES ARE HORIZONTAL GROUND DISTANCES IN FEET.
- BEARINGS AND DISTANCES SHOWN IN PARENTHESES ARE FROM RECORD PLATS.
- ALL LOT LINES ARE PERPENDICULAR OR RADIAL TO STREET LINES UNLESS OTHERWISE INDICATED.
- BENCHMARK FOR THIS PLAT IS THE CITY OF ALBUQUERQUE ACS MONUMENT "BH-40" ELEVATION = 5306.43 LOCATED APPROXIMATELY 623' NORTH OF AND 888' WEST OF THE NORTHWEST CORNER OF UNIT 2 BETWEEN TWO POWER POLES.
- ALL PROPERTY CORNERS ARE SET WITH A 5/8" X 24" REBAR WITH RED OR YELLOW PLASTIC CAP STAMPED LS 9243 SET FLUSH WITH THE GROUND.
- CENTERLINE (IN LIEU OF R/W) MONUMENTATION TO BE INSTALLED AT ALL CENTERLINE P.C.'S, P.T.'S, ANGLE POINTS AND STREET INTERSECTIONS PRIOR TO ACCEPTANCE OF SUBDIVISION STREET IMPROVEMENTS AND WILL CONSIST OF A FOUR INCH ALUMINUM ALLOY CAP STAMPED "CITY OF ALBUQUERQUE CENTERLINE MONUMENTATION SURVEY MARKER DO NOT DISTURB P.L.S. 9243". ▲ DENOTES CENTERLINE MONUMENT.
- A.M.A.F.C.A. POND BOUNDARIES ARE BASED ON FOUND BRASS CAP MONUMENTS STAMPED A.M.A.F.C.A. FLOOD CONTROL R/W (OFFSET BASELINE STATIONS 104+85.53 AND 143+27.18 BEING 174' RIGHT OF THE CONSTRUCTION BASELINE) AS SHOWN ON THE LADERA STORM DRAINAGE DIVERSION AND DETENTION FACILITY PLANS PROVIDED BY A.M.A.F.C.A.

EASEMENTS

PUBLIC UTILITY EASEMENTS SHOWN ON THIS PLAT ARE GRANTED FOR THE COMMON AND JOINT USE OF:

- THE PUBLIC SERVICE COMPANY OF NEW MEXICO FOR THE INSTALLATION, MAINTENANCE AND SERVICE OF OVERHEAD AND UNDERGROUND ELECTRICAL LINES, TRANSFORMERS, POLES AND ANY OTHER EQUIPMENT, FIXTURES, STRUCTURES AND RELATED FACILITIES REASONABLE NECESSARY TO PROVIDE ELECTRICAL SERVICE.
- THE GAS COMPANY OF NEW MEXICO FOR INSTALLATION, MAINTENANCE, AND SERVICE OF NATURAL GAS LINES, VALVES AND OTHER EQUIPMENT AND FACILITIES REASONABLE NECESSARY TO PROVIDE NATURAL GAS.
- USWEST FOR THE INSTALLATION, MAINTENANCE AND SERVICE OF ALL BURIED AND AERIAL COMMUNICATION LINES AND OTHER RELATED EQUIPMENT AND FACILITIES REASONABLE NECESSARY TO PROVIDE COMMUNICATION SERVICES, INCLUDING BUT NOT LIMITED TO, ABOVE GROUND PEDESTALS AND CLOSURES.
- JONES INTERCABLE FOR THE INSTALLATION, MAINTENANCE, AND SERVICE OF SUCH LINES, CABLE, AND OTHER RELATED EQUIPMENT AND FACILITIES REASONABLE NECESSARY TO PROVIDE CABLE TV SERVICE.

INCLUDED IS THE RIGHT TO BUILD, REBUILD, CONSTRUCT, RECONSTRUCT, LOCATE, RELOCATE, CHANGE, REMOVE, MODIFY, RENEW, OPERATE, AND MAINTAIN FACILITIES FOR THE PURPOSE DESCRIBED ABOVE. TOGETHER WITH FREE ACCESS TO, FROM, AND OVER SAID EASEMENTS, INCLUDING SUFFICIENT WORKING AREA SPACE FOR ELECTRIC TRANSFORMERS, WITH THE RIGHT AND PRIVILEGE TO TRIM AND REMOVE TREES, SHRUBS OR BUSHES WHICH INTERFERE WITH THE PURPOSES SET FORTH HEREIN, NO BUILDING, SIGN, POOL (ABOVEGROUND OR SUBSURFACE), HOT TUB, CONCRETE OR WOOD POOL DECKING, OR OTHER STRUCTURE SHALL BE ERRECTED OR CONSTRUCTED ON SAID EASEMENTS, NOR SHALL ANY WELL BE DRILLED OR OPERATED THEREON. PROPERTY OWNERS SHALL BE SOLELY RESPONSIBLE FOR CORRECTING ANY VIOLATIONS OF NATIONAL ELECTRICAL SAFETY CODE CAUSED BY CONSTRUCTION OF POOLS, DECKING, OR ANY STRUCTURES ADJACENT TO WITHIN OR NEAR EASEMENTS SHOWN ON THIS PLAT.

PNM AND USWEST COMMUNICATIONS DO NOT RELEASE ANY PREVIOUS EASEMENT RIGHT WHICH WAS GRANTED BY PRIOR PLATTING OR RECORD DOCUMENT UNLESS SPECIFICALLY NOTED HEREON.

EXISTING 100' WIDE PNM EASEMENT ALONG LADERA DRIVE OVERLAPS INTO THE BACK PROPERTY LINE OF LOTS 1 THRU 15 IN BLOCK 1 AND LOTS 12 IN BLOCK 2. THE 10 OR 11 FOOT EASEMENT BEING GRANTED AND SHOWN ALONG THE BACK OF THESE LOTS ENSURES THE INTEGRITY OF THE EXISTING 100 FOOT PNM RIGHT-OF-WAY EASEMENT.

DESCRIPTION

A PARCEL OF LAND BEING A PORTION OF UNPLATTED LANDS WITHIN PROJECTED SECTION 16, TOWNSHIP 10 NORTH, RANGE 2 EAST, NEW MEXICO PRINCIPAL MERIDIAN, CITY OF ALBUQUERQUE, TOWN OF ATRISCO GRANT, BERNALILLO COUNTY, NEW MEXICO, BEING MORE PARTICULARLY DESCRIBED AS FOLLOWS:

BEGINNING AT THE WESTERLY MOST CORNER OF THE PROPERTY HEREIN DESCRIBED FROM WHICH THE ALBUQUERQUE CITY SURVEY MONUMENT "BH-40", A FOUND BRASS CAP IN CONCRETE (NEW MEXICO STATE PLANE COORDINATES X=352,790.66 AND Y=1,492,346.53, CENTRAL ZONE) BEARS N.54°56'08"W. 1,085.20 FEET;
THENCE N.73°07'33"E. 23.84 FEET ACROSS UNPLATTED LANDS OF WESTLAND DEVELOPMENT COMPANY INC.;
THENCE N.56°44'12"E. 632.98 FEET;
THENCE S.59°30'00"E. 43.71 FEET;
THENCE N.20°30'00"E. 60.00 FEET ON A RADIAL LINE TO A POINT ON A NON-TANGENT CURVE;
THENCE 48.96 FEET SOUTHEASTERLY ON THE ARC OF SAID NON-TANGENT CURVE TO THE RIGHT HAVING A CENTRAL ANGLE OF 6°19'58", A RADIUS OF 443.00 FEET, AND A CHORD WHICH BEARS S.56°20'01"E. 48.94 FEET;
THENCE DEPARTING SAID CURVE ON A NON-TANGENT LINE BEARING N.61°00'00"E. 195.79 FEET;
THENCE N.63°40'00"E. 135.54 FEET;
THENCE N.39°25'48"E. 301.00 FEET;
THENCE N.53°22'34"E. 135.94 FEET TO A POINT ON THE SOUTHERLY BOUNDARY LINE OF A.M.A.F.C.A. POND 12 (LEGAL DESCRIPTION LD-2-IT) PER COURT JUDGEMENT FILED ON SEPTEMBER 28, 1978 IN VOL. MISC. 498, FOLIO 648-683;
THENCE S. 47°59'54"E. 111.00 FEET ON SAID POND 12 BOUNDARY LINE;
THENCE DEPARTING SAID POND 12 BOUNDARY LINE, S.50°34'12"E. 214.35 FEET TO A POINT ON THE WESTERLY RIGHT-OF-WAY LINE OF LADERA DRIVE N.W., ALSO BEING THE WESTERLY BOUNDARY OF PARKWAY UNIT 4 FILED ON JULY 23, 1993 IN VOL. 93C, FOLIO 218;
THENCE S.39°25'48"W. 1,078.42 FEET ON THE WESTERLY RIGHT-OF-WAY OF SAID LADERA DRIVE N.W. EXTENDED, A COMMON BOUNDARY LINE WITH THE WESTERLY BOUNDARY LINE OF PARKWAY UNIT 5 FILED ON OCTOBER 19, 1993 IN VOL. 93C, FOLIO 239, PARKWAY UNIT 6, FILED ON JANUARY 12, 1994 IN VOL. 94C, FOLIO 11 AND PARKWAY UNIT 7 FILED ON MARCH 9, 1995 IN VOL. 95C, FOLIO 82 TO THE NORTHWEST CORNER OF THE PLAT FOR PARKWAY SUBDIVISION TRACTS A, B, C, AND D FILED ON JULY 29, 1995 IN VOL. 95C, FOLIO 238;
THENCE 100.03 FEET ON THE NORTHWEST RIGHT-OF-WAY LINE OF SAID LADERA DRIVE ON THE ARC OF A CURVE TO THE RIGHT HAVING A CENTRAL ANGLE OF 52°28'28", RADIUS OF 1,047.00 FEET, AND A CHORD WHICH BEARS S.42°06'34"W. 99.98 FEET;
THENCE 108.04 FEET ON THE ARC OF A REVERSE CURVE TO THE LEFT HAVING A CENTRAL ANGLE OF 52°43'00", A RADIUS OF 1,153.00 FEET, AND A CHORD WHICH BEARS S.42°11'07"W. 108.80 FEET;
THENCE S.39°29'59"W. 23.98 FEET;
THENCE DEPARTING SAID PARKWAY BOUNDARY AND LADERA DRIVE RIGHT-OF-WAY LINE, N.50°34'12"W. 240.07 FEET ACROSS UNPLATTED LANDS OF SAID WESTLAND DEVELOPMENT COMPANY, INC.;
THENCE N.39°25'48"E. 7.00 FEET;
THENCE N.50°34'12"W. 67.34 FEET;
THENCE 203.71 FEET ON THE ARC OF A CURVE TO THE LEFT HAVING A CENTRAL ANGLE OF 38°46'35", A RADIUS OF 301.00 FEET, AND A CHORD WHICH BEARS N.69°57'30"W. 199.85 FEET;
THENCE N.89°20'47"W. 224.42 FEET;
THENCE N.0°39'15"E. 91.41 FEET;
THENCE N.16°52'27"W. 51.53 FEET TO THE OF BEGINNING.

PARCEL CONTAINS 15.3476 ACRES, MORE OR LESS, 72 LOTS, PARCELS A AND B, AND TRACTS A AND B.

DEDICATION AND FREE CONSENT

THE PROPERTY SHOWN HEREON IS SUBDIVIDED WITH THE FREE CONSENT AND IN ACCORDANCE WITH THE DESIRES OF THE UNDERSIGNED OWNER(S) AND/OR PROPRIETOR(S) THEREOF AND SAID OWNER(S) AND/OR PROPRIETOR(S) DO HEREBY DEDICATE ALL STREETS AND PUBLIC RIGHTS-OF-WAY SHOWN HEREON TO THE CITY OF ALBUQUERQUE IN FEE SIMPLE WITH WARRANTY COVENANTS AND DO HEREBY GRANT ALL ACCESS, UTILITY AND DRAINAGE EASEMENTS SHOWN HEREON INCLUDING THE RIGHT TO CONSTRUCT, OPERATE, INSPECT, AND MAINTAIN FACILITIES THEREIN; AND ALL PUBLIC UTILITY EASEMENTS SHOWN HEREON FOR THE COMMON AND JOINT USE OF GAS, ELECTRICAL, POWER AND COMMUNICATION SERVICES FOR BURIED DISTRIBUTION LINES, CONDUITS, AND PIPES FOR UNDERGROUND UTILITIES WHERE SHOWN OR INDICATED, AND INCLUDING THE RIGHT OF INGRESS AND EGRESS FOR CONSTRUCTION AND MAINTENANCE, AND THE RIGHT TO TRIM INTERFERING TREES AND SHRUBS. THE OWNER(S) AND/OR PROPRIETOR(S) DO HEREBY ACKNOWLEDGE SAID INSTRUMENT TO BE THEIR FREE ACT AND DEED.

WESTLAND DEVELOPMENT COMPANY, INC.
A NEW MEXICO CORPORATION

Barbara Page
BARBARA PAGE, PRESIDENT AND CHIEF EXECUTIVE OFFICER

(STATE OF NEW MEXICO)
(COUNTY OF BERNALILLO) SS

THIS INSTRUMENT WAS ACKNOWLEDGED BEFORE ME ON MARCH 8, 1996
BY BARBARA PAGE, PRESIDENT AND CHIEF EXECUTIVE OFFICER OF WESTLAND DEVELOPMENT COMPANY, INC.
ON BEHALF OF SAID CORPORATION.

BY: *Lynda G. Blair*
NOTARY PUBLIC

MY COMMISSION EXPIRES: 8/5/97

TREASURER'S CERTIFICATION

THIS IS TO CERTIFY THAT TAXES ARE CURRENT AND PAID ON UPC #

UPC # _____

BERNALILLO COUNTY TREASURERS OFFICE:

BY: _____ DATE: _____

NOTES

- CITY OF ALBUQUERQUE WATER AND SEWER SERVICE TO THESE LOTS MUST BE VERIFIED AND COORDINATED WITH THE PUBLIC WORKS DEPARTMENT, CITY OF ALBUQUERQUE.

A SUBDIVISION PLAT FOR TIERRA OESTE UNIT 1 A SUBDIVISION OF UNPLATTED LANDS WITHIN PROJECTED SECTION 16, T. 10 N., R. 2 E., N. M. P. M. TOWN OF ATRISCO GRANT CITY OF ALBUQUERQUE BERNALILLO COUNTY, NEW MEXICO MARCH, 1996

SUBDIVISION DATA

ZONE ATLAS NO. H-9-Z and J-9-Z	PLAT ACRES	15.3476
CASE NO. DRB-94-443	LOT ACRES	8.2801
NO. OF LOTS	PARCEL ACRES	0.3679
NO. OF PARCELS	TRACT ACRES	2.8012
NO. OF TRACTS	STREET ACRES	3.3984
STREET MILES (FULL)		
S.P. TALOS LOG NO. 96-03-12-0729-0015		

APPROVALS

SUBDIVISION CASE NO. _____
FILED _____ DOC. NO. _____
VOLUME _____ PAGE _____

PNM ELECTRIC SERVICES _____ DATE _____

PNM GAS SERVICES _____ DATE _____

USWEST COMMUNICATIONS, INC. _____ DATE _____

JONES INTERCABLE _____ DATE _____

CITY SURVEYOR, ENGINEERING DIVISION _____ DATE 021894

TRAFFIC ENGINEERING, TRANS. DIV. P.W.D. _____ DATE 3-19-96

PARKS AND GENERAL SERVICES _____ DATE _____

UTILITY DEVELOPMENT DIVISION _____ DATE 3-19-96

PROPERTY MANAGEMENT _____ DATE _____

ALBUQUERQUE METROPOLITAN ARROYO FLOOD CONTROL AUTHORITY _____ DATE _____

CITY ENGINEER, ENGINEERING DIVISION _____ DATE _____

CITY PLANNER, ALBUQUERQUE PLANNING DIVISION _____ DATE _____


SURVEYOR'S CERTIFICATION

I, DAN B. HOLMES, NEW MEXICO REGISTERED PROFESSIONAL LAND SURVEYOR NO. 9243, DO HEREBY CERTIFY THAT THE PLAT SHOWN HEREON WAS PREPARED UNDER MY DIRECT SUPERVISION, SHOWS ALL EASEMENTS MADE KNOWN TO ME BY THE OWNERS AND/OR PROPRIETORS OF THE SUBDIVISION SHOWN HEREON, UTILITY COMPANIES AND OTHER PARTIES EXPRESSING AN INTEREST. THIS PLAT MEETS THE MINIMUM REQUIREMENTS FOR MONUMENTATION AND SURVEYS OF THE ALBUQUERQUE SUBDIVISION ORDINANCE, AND THE "MINIMUM STANDARDS FOR LAND SURVEYS" AS ESTABLISHED BY THE STATE OF NEW MEXICO AND IS TRUE AND CORRECT TO THE BEST OF MY KNOWLEDGE AND BELIEF.

Dan B. Holmes
DAN B. HOLMES, P.S. NO. 9243
DATE 3-09-96



SHEET 1 OF 3

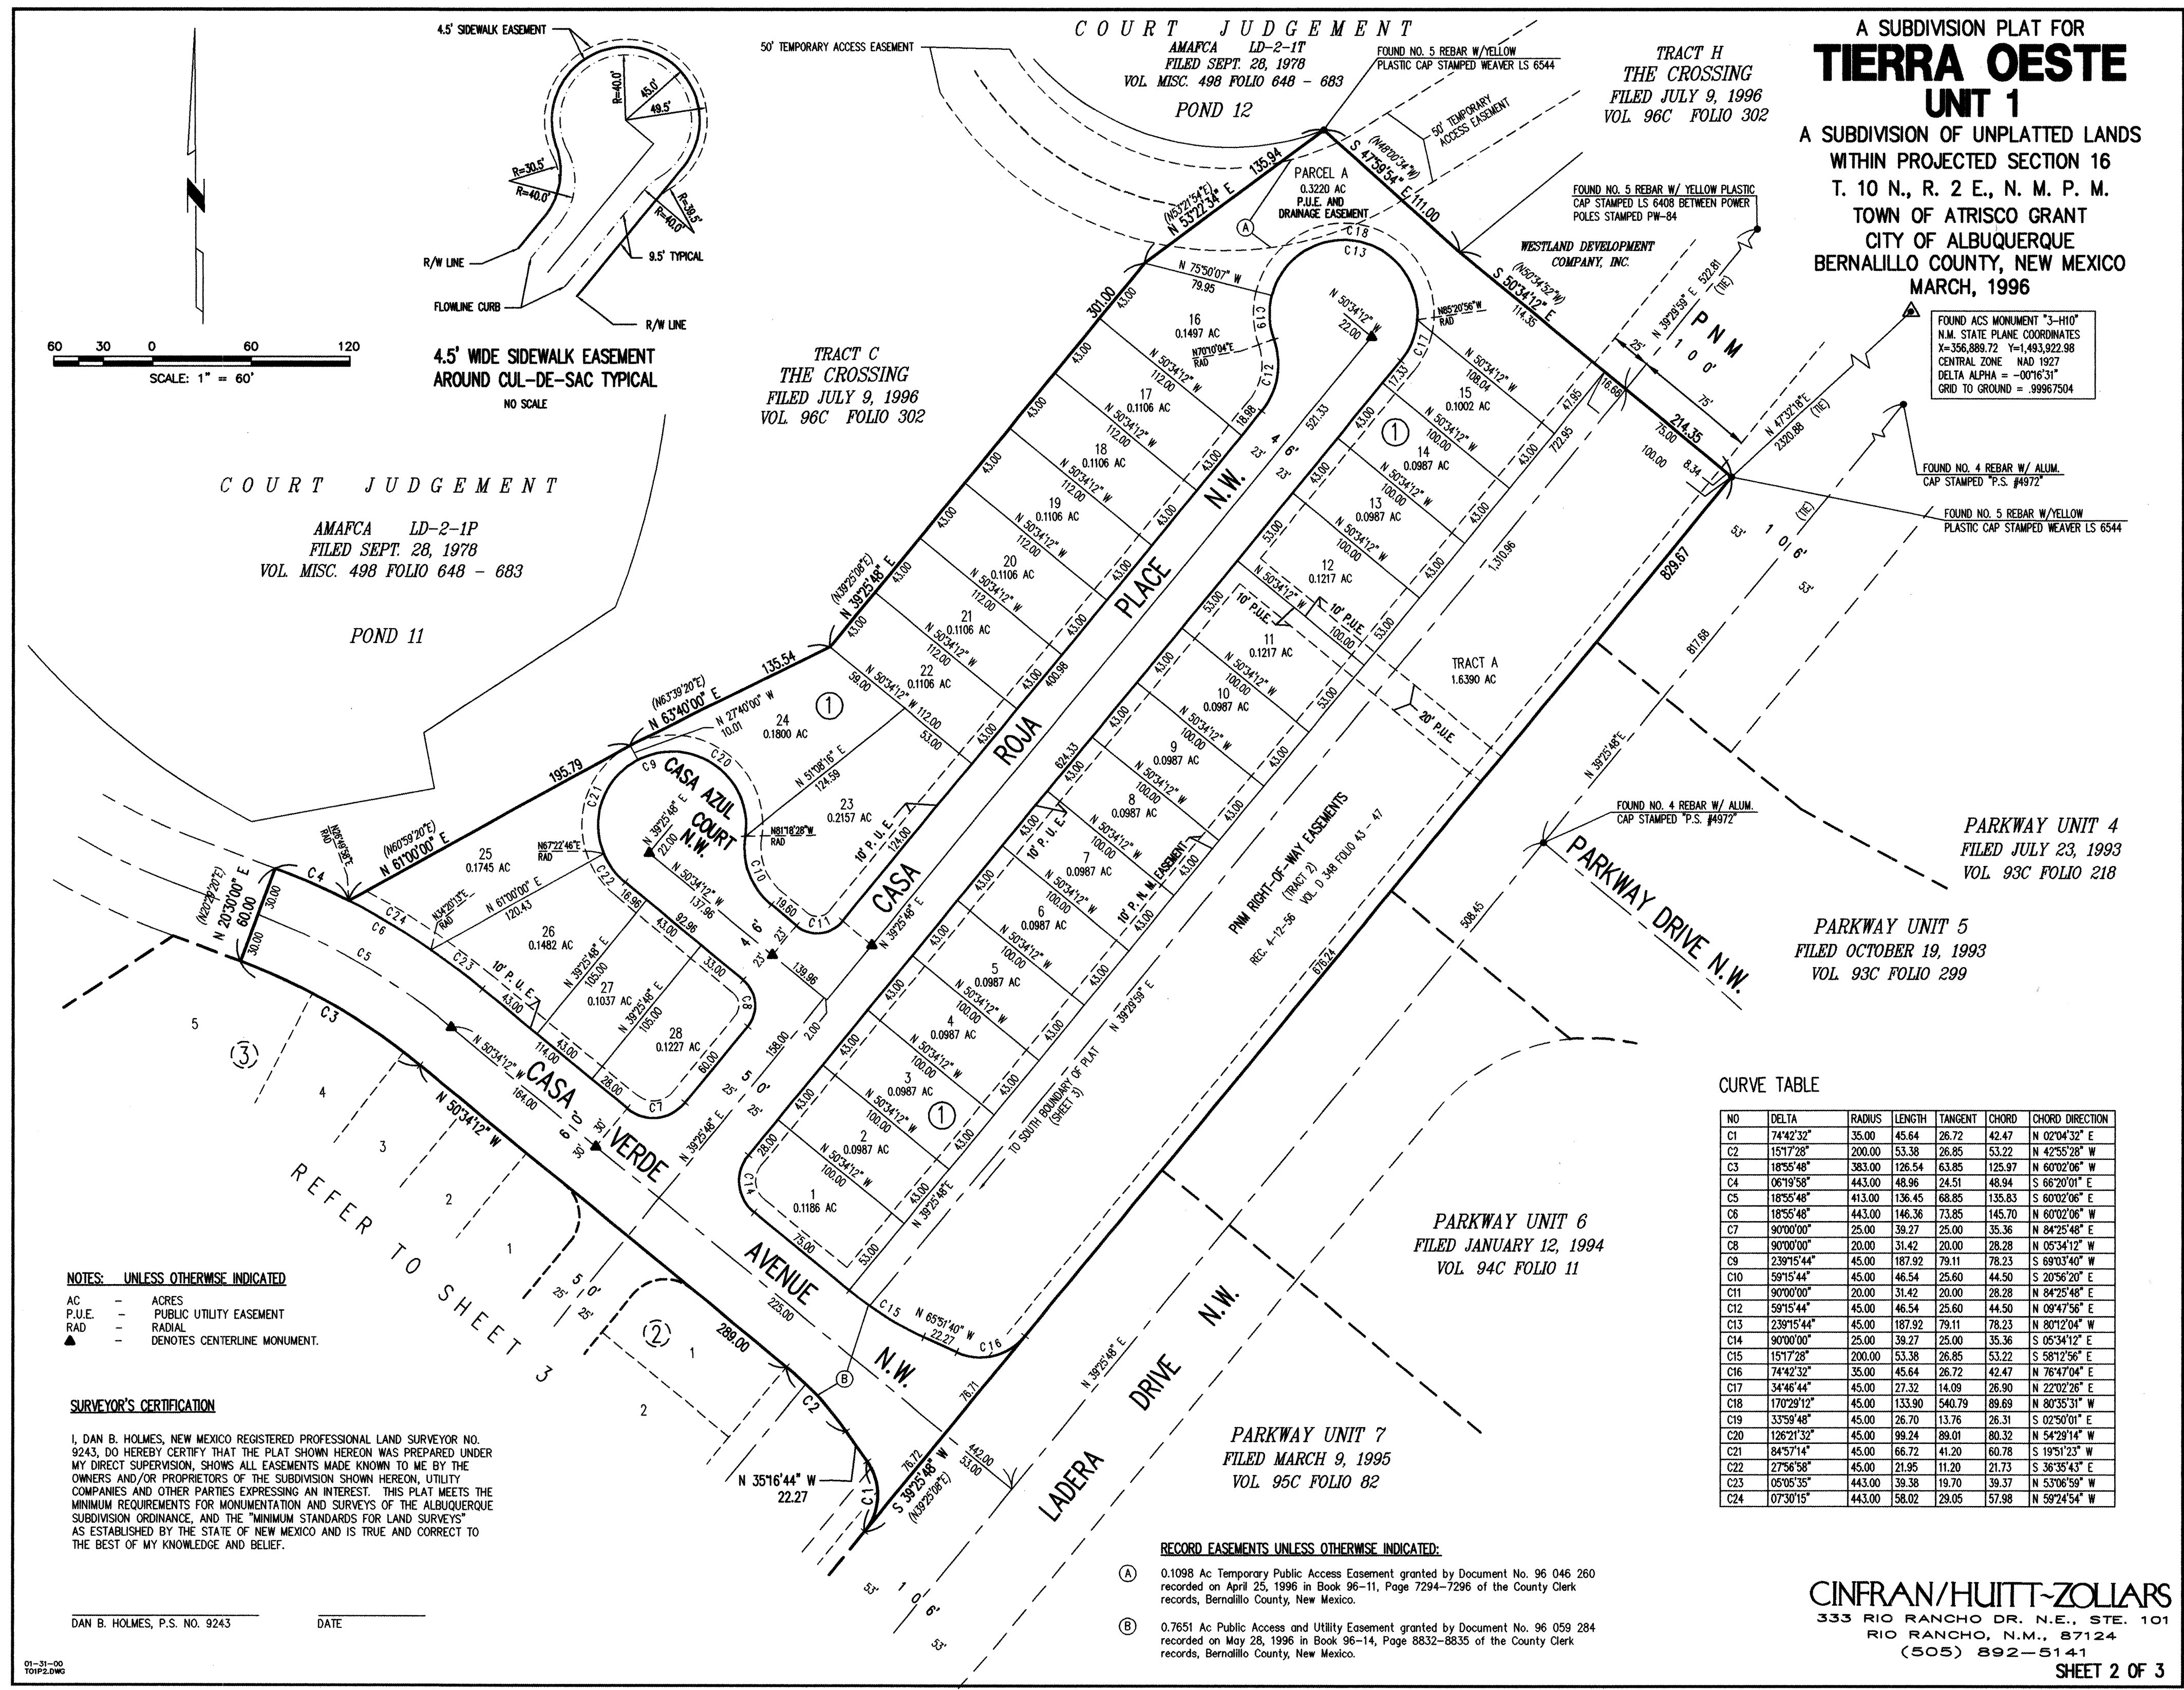

A SUBDIVISION PLAT FOR
**TIERRA OESTE
UNIT 1**

A SUBDIVISION OF UNPLATTED LANDS
WITHIN PROJECTED SECTION 16
T. 10 N., R. 2 E., N. M. P. M.
TOWN OF ATRISCO GRANT
CITY OF ALBUQUERQUE
BERNALILLO COUNTY, NEW MEXICO
MARCH, 1996

FOUND ACS MONUMENT "J-410"
N.M. STATE PLANE COORDINATES
X=356,888.72 Y=1,493,922.98
CENTRAL ZONE NAD 1927
DELTA ALPHA = -3076.51"
GRID TO GROUND = .99967504

FOUND NO. 4 REBAR W/ ALUM.
CAP STAMPED "P.S. #4972"

FOUND NO. 5 REBAR W/YELLOW
PLASTIC CAP STAMPED WEASER LS 6544

PARKWAY UNIT 4
FILED JULY 23, 1993
VOL. 93C FOLIO 218

PARKWAY UNIT 5
FILED OCTOBER 19, 1993
VOL. 93C FOLIO 299

PARKWAY UNIT 6
FILED JANUARY 12, 1994
VOL. 94C FOLIO 11

PARKWAY UNIT 7
FILED MARCH 9, 1995
VOL. 95C FOLIO 82

CURVE TABLE

NO	DELTA	RADIUS	LENGTH	TANGENT	CHORD	CHORD DIRECTION
C1	74°42'32"	35.00	45.64	26.72	42.47	N 02°04'32" E
C2	151°17'28"	200.00	53.38	26.85	53.22	N 42°55'28" W
C3	18°25'48"	383.00	126.54	63.85	125.97	N 60°02'06" W
C4	06°19'58"	443.00	48.96	24.51	48.94	S 66°20'01" E
C5	18°50'48"	413.00	136.45	68.85	135.83	S 60°02'06" E
C6	18°50'48"	443.00	146.36	73.85	145.70	N 60°02'06" W
C7	90°00'00"	25.00	39.27	25.00	35.36	N 84°25'48" E
C8	90°00'00"	20.00	31.42	20.00	28.28	N 05°34'12" W
C9	239°15'44"	45.00	187.92	79.11	78.23	S 69°03'40" W
C10	59°15'44"	45.00	46.54	25.60	44.50	S 20°56'20" E
C11	90°00'00"	20.00	31.42	20.00	28.28	N 84°25'48" E
C12	59°15'44"	45.00	46.54	25.60	44.50	N 09°47'56" E
C13	239°15'44"	45.00	187.92	79.11	78.23	N 80°12'04" W
C14	90°00'00"	25.00	39.27	25.00	35.36	S 05°34'12" E
C15	151°17'28"	200.00	53.38	26.85	53.22	S 58°12'56" E
C16	74°42'32"	35.00	45.64	26.72	42.47	N 76°07'04" E
C17	34°46'44"	45.00	27.32	14.08	26.90	N 22°02'28" E
C18	170°28'12"	45.00	133.90	540.79	89.69	N 80°35'31" W
C19	33°59'48"	45.00	26.70	13.76	26.31	S 02°50'01" E
C20	126°21'32"	45.00	99.24	89.01	80.32	N 54°28'14" W
C21	84°57'14"	45.00	66.72	41.20	60.78	S 19°51'23" W
C22	27°56'58"	45.00	21.95	11.20	21.73	S 36°35'43" E
C23	08°05'35"	443.00	39.38	19.70	39.37	N 53°06'59" W
C24	07°30'15"	443.00	58.02	29.05	57.88	N 59°24'54" W

CINFRAN/HUITT-ZOLLARS
333 RIO RANCHO DR. N.E., STE. 101
RIO RANCHO, N.M., 87124
(505) 892-5141
SHEET 2 OF 3

NOTES: UNLESS OTHERWISE INDICATED
AC - ACRES
P.U.E. - PUBLIC UTILITY EASEMENT
RAD - RADIAL
▲ - DENOTES CENTERLINE MONUMENT.

SURVEYOR'S CERTIFICATION
I, DAN B. HOLMES, NEW MEXICO REGISTERED PROFESSIONAL LAND SURVEYOR NO. 9243, DO HEREBY CERTIFY THAT THE PLAT SHOWN HEREON WAS PREPARED UNDER MY DIRECT SUPERVISION, SHOWS ALL EASEMENTS MADE KNOWN TO ME BY THE OWNERS AND/OR PROPRIETORS OF THE SUBDIVISION SHOWN HEREON, UTILITY COMPANIES AND OTHER PARTIES EXPRESSING AN INTEREST. THIS PLAT MEETS THE MINIMUM REQUIREMENTS FOR MONUMENTATION AND SURVEYS OF THE ALBUQUERQUE SUBDIVISION ORDINANCE, AND THE "MINIMUM STANDARDS FOR LAND SURVEYS" AS ESTABLISHED BY THE STATE OF NEW MEXICO AND IS TRUE AND CORRECT TO THE BEST OF MY KNOWLEDGE AND BELIEF.

DAN B. HOLMES, P.S. NO. 9243 DATE

RECORD EASEMENTS UNLESS OTHERWISE INDICATED:
A 0.1098 Ac Temporary Public Access Easement granted by Document No. 96 046 260 recorded on April 25, 1996 in Book 96-11, Page 7294-7296 of the County Clerk records, Bernalillo County, New Mexico.
B 0.7651 Ac Public Access and Utility Easement granted by Document No. 96 059 284 recorded on May 28, 1996 in Book 96-14, Page 8832-8835 of the County Clerk records, Bernalillo County, New Mexico.

NO	DELTA	RADIUS	LENGTH	TARGET	CHORO	CHORO DIRECTION
C1	18°55'48"	383.00	126.54	63.85	125.97	S 80°02'06" E
C2	15°17'28"	200.00	53.38	26.85	53.22	S 42°55'28" E
C3	74°42'32"	35.00	45.64	26.72	42.47	S 02°04'32" W
C4	38°46'35"	350.00	82.61	101.93	199.85	N 69°57'30" W
C5	18°55'48"	200.00	20.70	41.88	82.22	N 60°02'06" E
C6	38°46'35"	432.00	125.21	152.66	299.70	N 69°57'30" W
C7	38°46'35"	409.00	276.80	143.94	271.55	S 69°57'30" W
C8	25°31'34"	208.00	26.28	56.04	70.18	N 15°04'33" E
C9	57°49'19"	455.00	205.35	155.88	294.93	S 68°28'51" E
C10	18°55'48"	227.00	75.00	37.84	74.66	N 60°02'06" E
C11	25°31'34"	45.00	20.22	35.99	70.15	N 34°56'38" E
C12	17°43'00"	273.00	62.10	31.20	62.10	S 02°04'32" E
C13	90°00'00"	25.00	39.27	20.50	35.36	S 65°12" E
C14	90°00'00"	20.00	31.42	20.00	28.28	S 84°25'48" W
C15	01°53'17"	273.00	8.90	4.50	8.90	N 53°10'00" W
C16	08°52'35"	273.00	47.60	23.58	47.00	N 24°22'00" E
C17	25°31'34"	273.00	28.10	13.06	25.99	N 34°56'38" E
C18	51°53'07"	45.00	20.22	35.99	21.73	S 84°25'48" W
C19	10°07'01"	45.00	84.04	60.82	72.35	S 84°25'48" W
C20	87°36'16"	45.00	68.80	43.16	62.30	S 12°56'04" W
C21	44°40'31"	45.00	35.09	18.49	34.21	S 71°52'00" W
C22	18°17'51"	45.00	14.37	7.25	14.38	S 84°41'31" E
C23	24°44'00"	45.00	16.70	8.70	16.70	S 84°41'31" E
C24	15°48'00"	227.00	62.84	31.37	62.15	S 53°10'00" W
C25	03°31'38"	227.00	12.55	6.33	12.65	S 02°04'32" E


NOTES: UNLESS OTHERWISE INDICATED

SEE TYPICAL 4.5' WIDE SIDEWALK EASEMENT
DETAIL FOR CUL-DE-SACS ON SHEET 2.

AC - ACRES
P.U.E. - PUBLIC UTILITY EASEMENT
RAD - RADIAL
▲ - DENOTES CENTERLINE MONUMENT.

AMAFCA LD-2-1P
FILED SEPT. 28, 1978
VOL. MISC. 498 FOLIO 648 - 683
POND 11

A SUBDIVISION OF UNPLATTED LANDS
WITHIN PROJECTED SECTION 16
T. 10 N., R. 2 E., N. M. P. M.
TOWN OF ATRISCO GRANT
CITY OF ALBUQUERQUE
BERNALILLO COUNTY, NEW MEXICO
MARCH, 1996

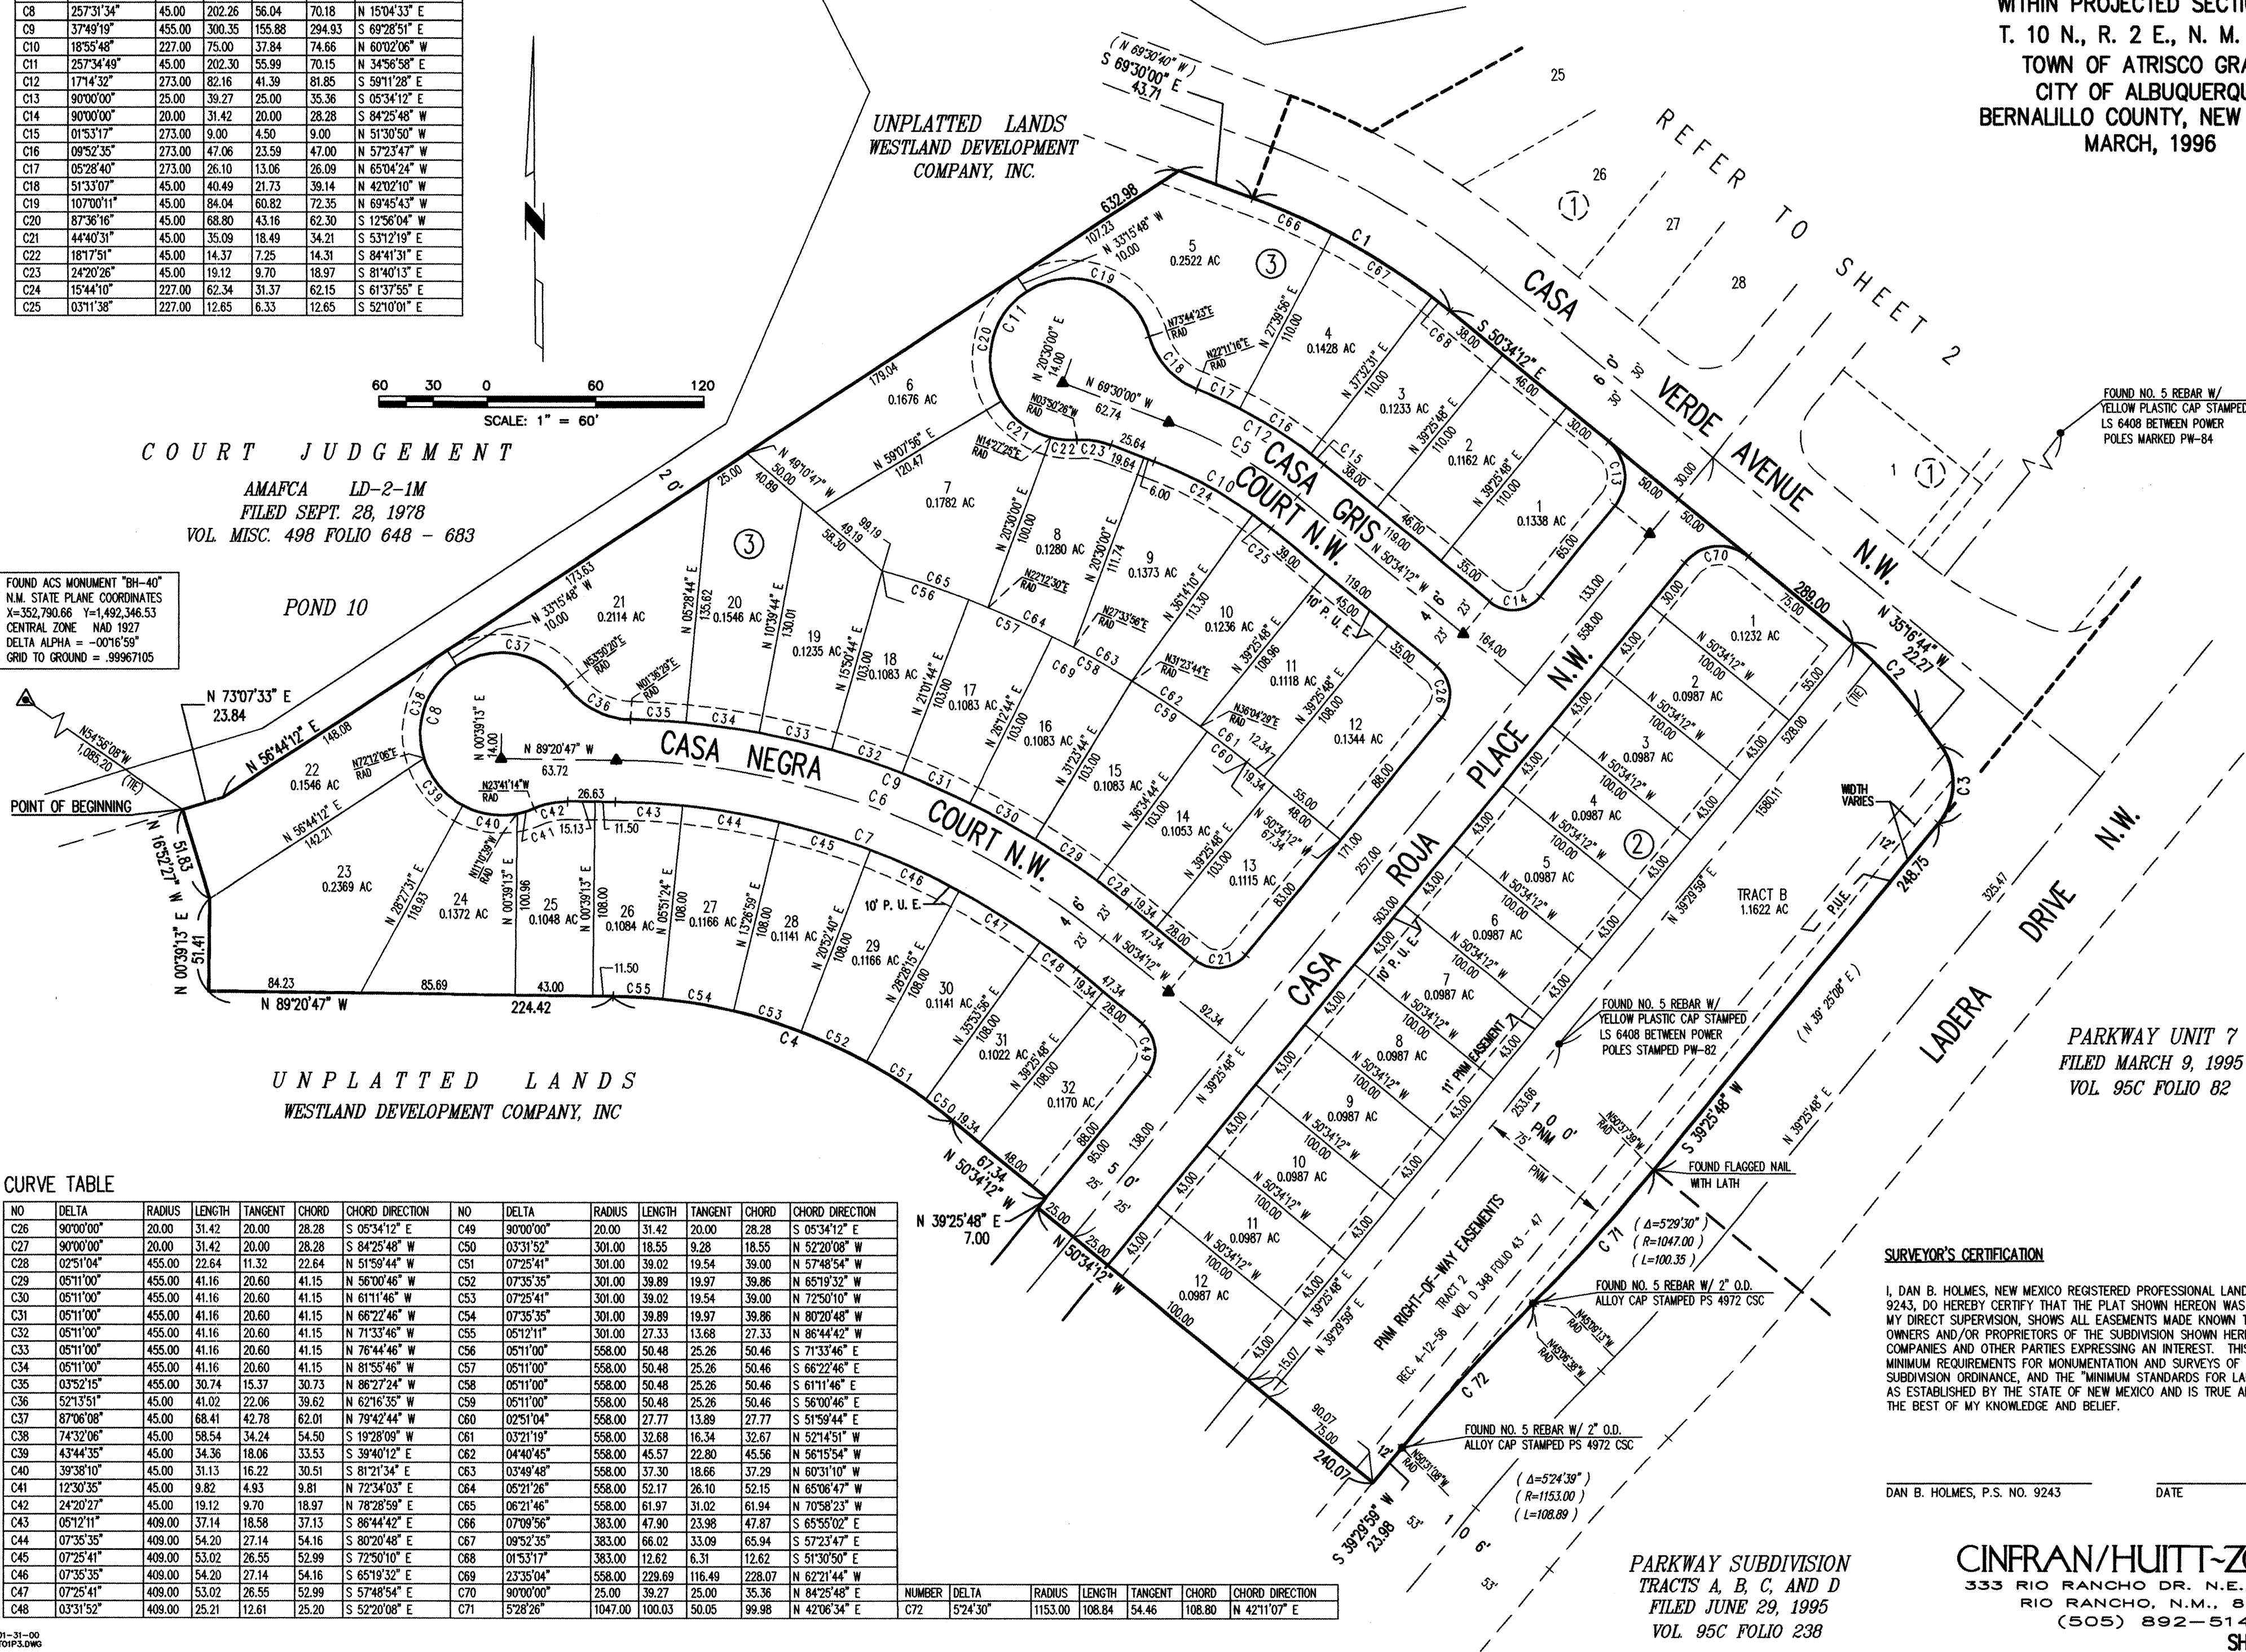

I, DAN B. HOLMES, NEW MEXICO REGISTERED PROFESSIONAL LAND SURVEYOR NO. 9243, DO HEREBY CERTIFY THAT THE PLAT SHOWN HEREON WAS PREPARED UNDER MY DIRECT SUPERVISION, SHOWS ALL EASEMENTS MADE KNOWN TO ME BY THE OWNERS AND/OR PROPRIETORS OF THE SUBDIVISION SHOWN HEREON, UTILITY COMPANIES AND OTHER PARTIES EXPRESSING AN INTEREST. THIS PLAT MEETS THE MINIMUM REQUIREMENTS FOR MONUMENTATION AND SURVEYS OF THE ALBUQUERQUE SUBDIVISION ORDINANCE, AND THE "MINIMUM STANDARDS FOR LAND SURVEYS" AS ESTABLISHED BY THE STATE OF NEW MEXICO AND IS TRUE AND CORRECT TO THE BEST OF MY KNOWLEDGE AND BELIEF.

DATA

CINFRAN/HUITT-ZOLLARS
333 RIO RANCHO DR. N.E., STE. 101
RIO RANCHO, N.M., 87124
(505) 892-5141
SHEET 3 OF 3

FRONT SETBACK - 20' TO FACE OF GARAGE
- 15' TO FACE OF STRUCTURE

SIDE YARD SETBACK - 5' (10' BETWEEN BUILDINGS)
- 10' IF ADJACENT TO STREET RIGHT-OF-WAY

REAR YARD SETBACK - 15'

1. THE TOLERANCES FOR ROUGH GRADING SHALL CONFORM TO THE FOLLOWING:
BUILDING PAD $\pm 0.1'$
STREET SUBGRADE $\pm 0.1'$
ALL OTHER AREAS $\pm 0.2'$
2. EARTHWORK OPERATIONS AND SPECIFICATIONS SHALL CONFORM TO REQUIREMENTS CONTAINED WITHIN THE GEOTECHNICAL INVESTIGATION PROVIDED BY THE OWNER.
3. ANY RETAINING WALLS TALLER THAN 18" WILL REQUIRE A BUILDING PERMIT FROM THE CITY OF ALBUQUERQUE CODE ADMINISTRATION DIVISION.

1. CONSTRUCT TEMPORARY SEDIMENT POND TO THE LIMITS SHOWN PRIOR TO PAVING CASA ROJA PLACE.

1. CONTRACTOR SHALL PROVIDE EROSION CONTROL BERMS OR SILT FENCES AT THE END OF CASA ROJA PLACE PRIOR TO DEMOLITION OF THE TEMPORARY SEDIMENT POND.

1. THE CONTRACTOR IS RESPONSIBLE FOR OBTAINING A TOPSOIL DISTURBANCE PERMIT FROM THE CITY OF ALBUQUERQUE ENVIRONMENTAL HEALTH DEPARTMENT PRIOR TO THE START OF CONSTRUCTION.
2. THE CONTRACTOR SHALL CONFORM TO ALL CITY, COUNTY, STATE, AND FEDERAL DUST CONTROL MEASURES AND REQUIREMENTS AND WILL BE RESPONSIBLE FOR PREPARING AND OBTAINING ALL NECESSARY APPLICATIONS AND APPROVALS.
3. THE CONTRACTOR SHALL ENSURE THAT NO SOIL ERODES FROM THE CONSTRUCTION SITE ONTO ADJACENT PUBLIC OR PRIVATE LANDS OR ONTO A PUBLIC RIGHT-OF-WAY. THIS RESULT MAY BE ACHIEVED BY CONSTRUCTING TEMPORARY EROSION CONTROL BERMS PER THE DETAIL ON THIS SHEET AND BY WETTING THE SOIL TO PREVENT IT FROM BLOWING.
4. EROSION CONTROL BERMS PER THE DETAIL ON THIS SHEET ARE REQUIRED AROUND THE ENTIRE SITE. BERMS AND SEDIMENT POND MUST BE IN PLACE AND ENGINEER CERTIFIED PRIOR TO BUILDING PERMIT RELEASE.
5. THE CONTRACTOR IS RESPONSIBLE FOR CLEANING UP ANY SEDIMENT THAT GETS INTO THE PUBLIC RIGHT-OF-WAY.
6. THE CONTRACTOR SHALL RESEED ALL DISTURBED SOILS OUTSIDE PLATTED LOTS AS SOON AS GRADING IS COMPLETED. RESEEDING TYPE SHALL MATCH EXISTING VEGETATION IN CONTENT AND DENSITY PER CITY OF ALBUQUERQUE STANDARD SPECIFICATION SECTION 1012.

	EXCAVATION	EMBANKMENT	
UNIT 1	18,310 C.Y.	25,080 C.Y.	6,770 C.Y. BORROW
POND	3,800 C.Y.	1,540 C.Y.	2,260 C.Y. EXCESS
UNIT 1 TOTALS	22,110 C.Y.	26,620 C.Y.	4,510 C.Y. BORROW

* 25% SHRINK FACTOR USED
IN THESE CALCULATIONS.

②
 2
 RIGHT-OF-WAY
 BLOCK NUMBER
 LOT NUMBER
 LOT LINE
 5520
 DASHED LINE
 EXISTING CONTOUR
 4.4
 FINISH CONTOUR
 FLOW ARROW
 TOP OF 4:1 SLOPE,
 UNLESS OTHERWISE SHOWN
 TOE OF SLOPE
 20.5
 FINISH GRADE ELEVATION
 20.5
 T.C.
 FINISH GRADE AT TOP BACK OF CURB
 20.5
 GUTTER FLOWLINE INTERSECTION
 20.5
 GUTTER FLOWLINE ELEVATION
 CURB LINE
 BUILDING PAD
 20.5
 N.G.
 NATURAL GROUND
 SHEET BREAK
 RETAINING STRUCTURE - INDICATES
 DIFFERENTIAL ELEVATION
 GREATER THAN 1.5'
 WATER BLOCK
 UNIT 2 LOT LINES (FUTURE)
 "UNIT 1/UNIT 2" CONSTRUCTION BOUNDARY

10' 60' TYP. FINISHED PAD 25' VARIES

5% 2% MIN. 2% MAX.

VARIES 5:1 MAX.

SCANNED BY
MESA REPRO

FINISHED
ROUGH
GRADE

BERM COMPACTED TO
90 % OF OPTIMUM.

3:1

3:1

6'-6"

1'-0"

R

②	AT	L.F.	LINEAL FEET
B.M.	BENCH MARK	M.H.	MANHOLE
C. & G.	CURB AND GUTTER	N.G.	NATURAL GROUND
C.F.	CURB FACE	O.C.	ON CENTER
E.L.	ELEVATION	P.	POINT
EX.	EXISTING	P.I.	POINT OF INTERSECTION
F-F	GUTTER FLOWLINE TO FINISHED DIMENSION	P.W.M.T.	PAVEMENT
F.P.	FINISHED PAD	R/W	RIGHT-OF-WAY
ℓ	FLOWLINE	SAS	SANITARY SEWER
G.B.	GRADE BREAK	SD	STORM DRAIN
INT.	INTERSECTION	S	SLOPE
INV. EL.	INVERT ELEVATION	T.C.	TOP OF CURB
L	LENGTH	T.P.	TOP OF PAVEMENT
		T.W.	TOP OF WALL

Diagram of a finished pad with dimensions and notes:



- Overall width: 33' TYP. (VARIES)
- Overall depth: 5' TYP.
- Left side wall height: 0.2' MIN.
- Right side wall height: 4' MIN.
- Left side wall note: CMU PRIVACY/RETAINING WALL--SEE PLANS FOR LOCATIONS
- Bottom slope note: SLOPE VARIES 5% MIN. 20% MAX.
- Right side wall note: REAR YARD SWALE 1% MIN
- Center label: FINISHED PAD


I, Grand Tassani
REGISTERED IN NEW MEXICO AS A PROFESSIONAL
ENGINEER NO. 9916, HERBY CERTIFY
THAT THIS PROJECT WAS CONSTRUCTED IN
SUBSTANTIAL COMPLIANCE WITH THIS PLAN,
EXCEPT AS NOTED. DATE 5-1-01

APPROVED FOR FINAL GRADING

NAME _____	DATE _____
------------	------------

5-6.DWG
1-15-95

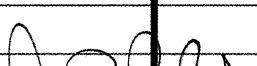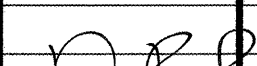CITY OF ALBUQUERQUE PUBLIC WORKS DEPARTMENT ENGINEERING GROUP					
TITLE:		TERRA OESTE LIMITED CO. GRADING PLAN & EROSION CONTROL TERRA OESTE UNIT I			
APPROVALS	ENGINEER	DATE	APPROVALS	ENGINEER	DATE
D.R.C. Chair					
Trans. Dev.					
Utility Dev.					
DRAWING		MAP NO.		SHEET	OF
NO. 5297.90		H-9&J-9		5	30
					29

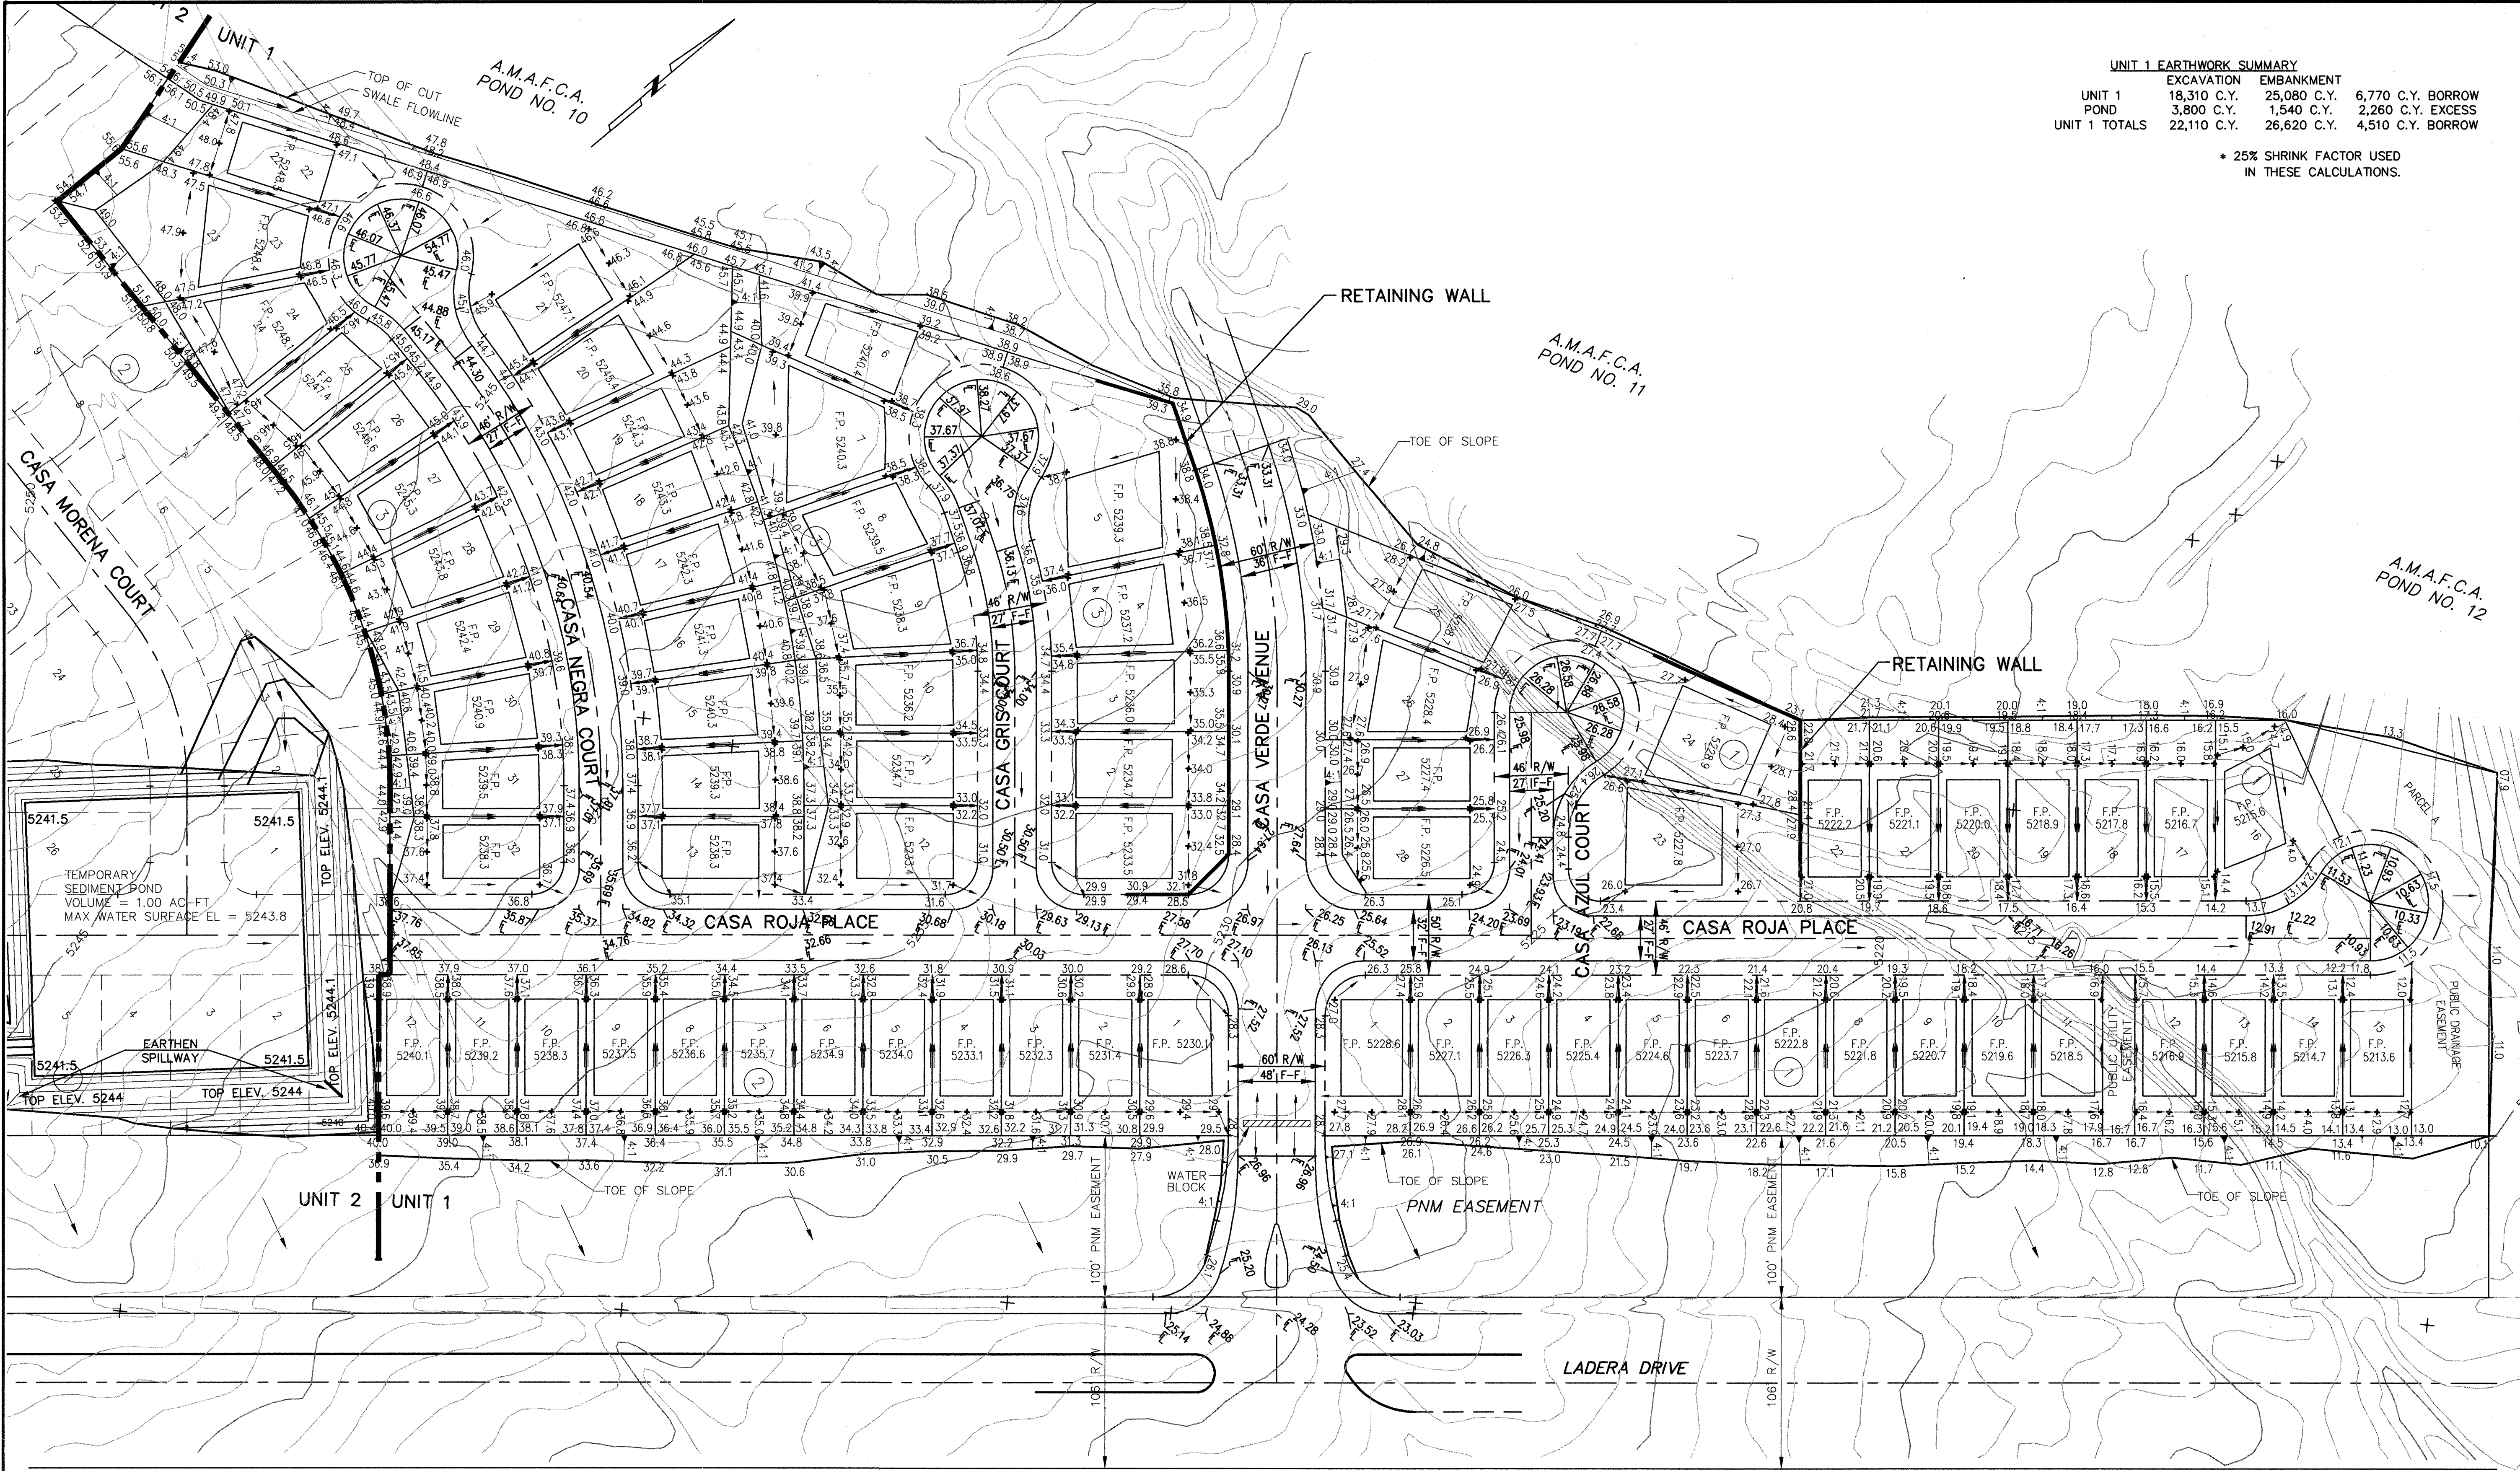


UNIT 1 EARTHWORK SUMMARY


	EXCAVATION	EMBANKMENT	
UNIT 1	18,310 C.Y.	25,080 C.Y.	6,770 C.Y. BORROW
POND	3,800 C.Y.	1,540 C.Y.	2,260 C.Y. EXCESS
UNIT 1 TOTALS	22,110 C.Y.	26,620 C.Y.	4,510 C.Y. BORROW

* 25% SHRINK FACTOR USED IN THESE CALCULATIONS.


--	--	
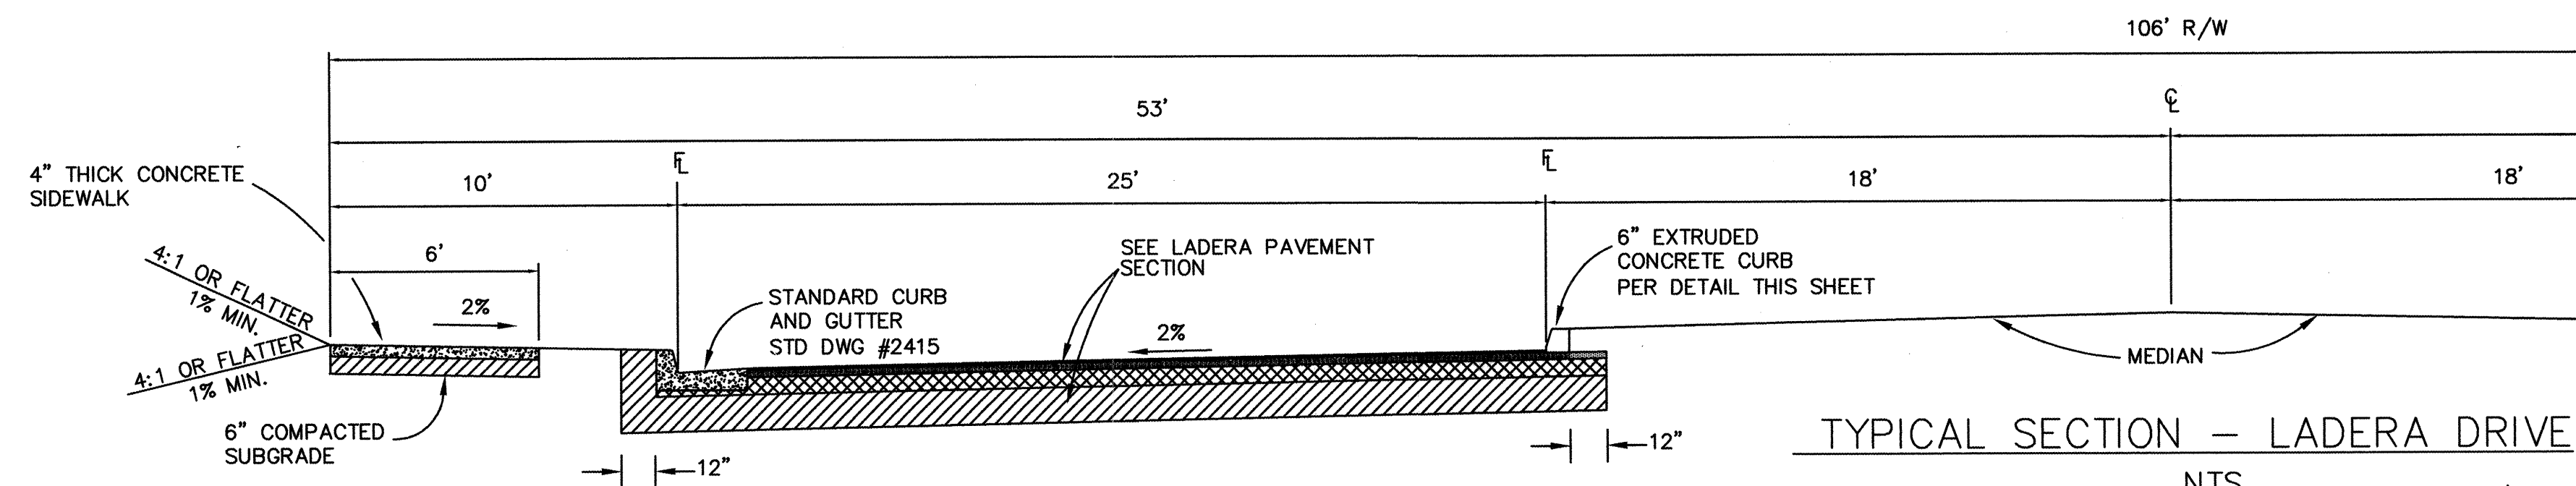


TYPICAL SECTION - LADERA DRIVE
NTS

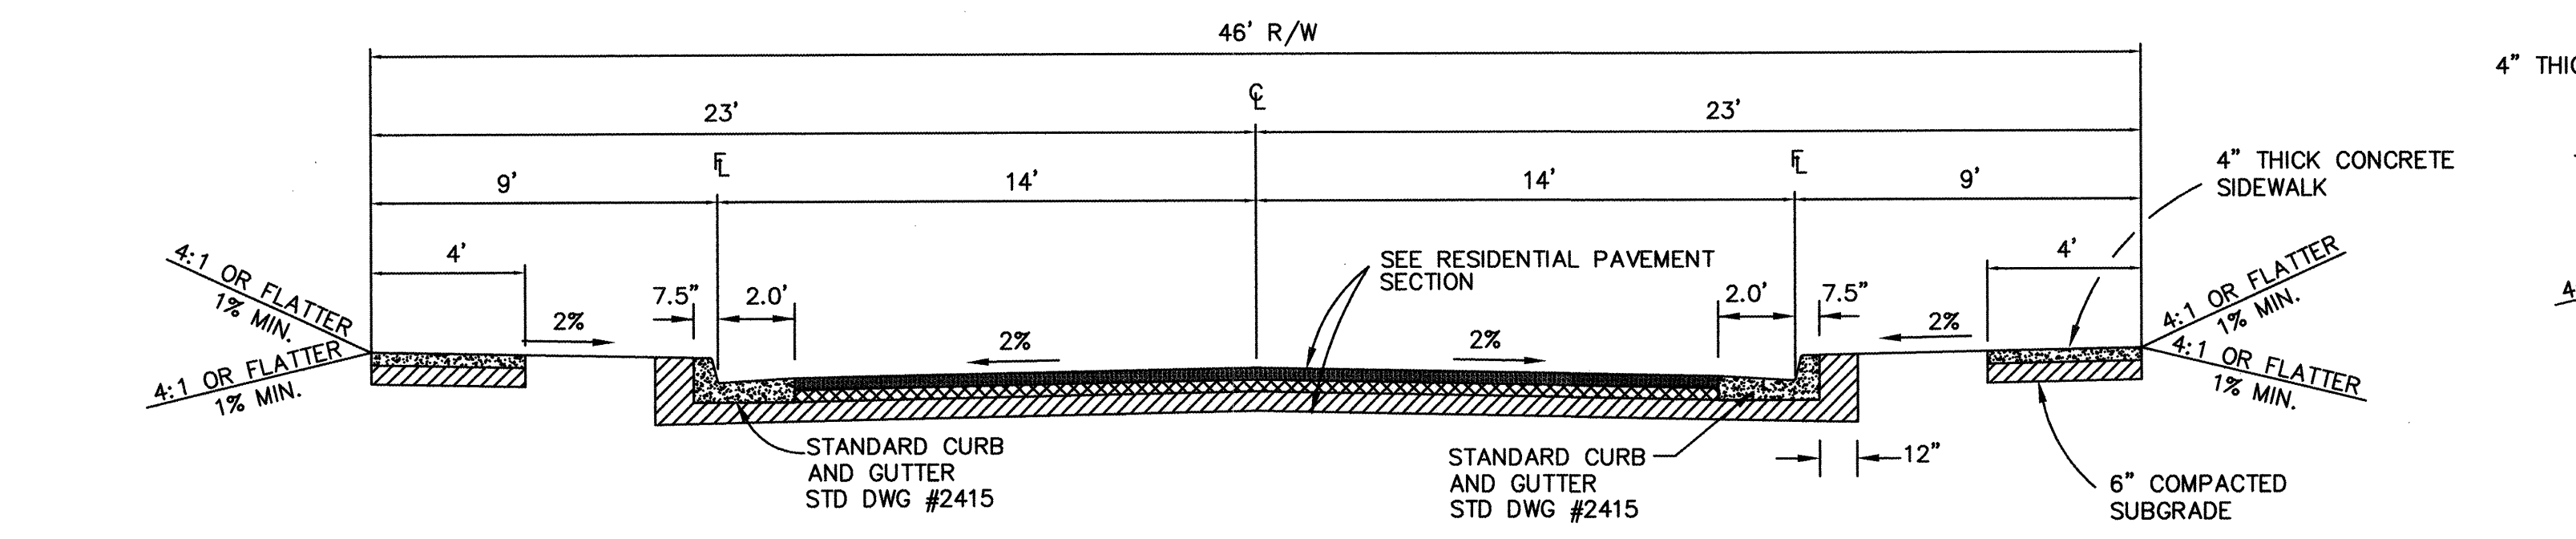


TYPICAL SECTION - CASA ROJA PLACE
STA. 10+00.00 TO STA. 15+21.33
NTS

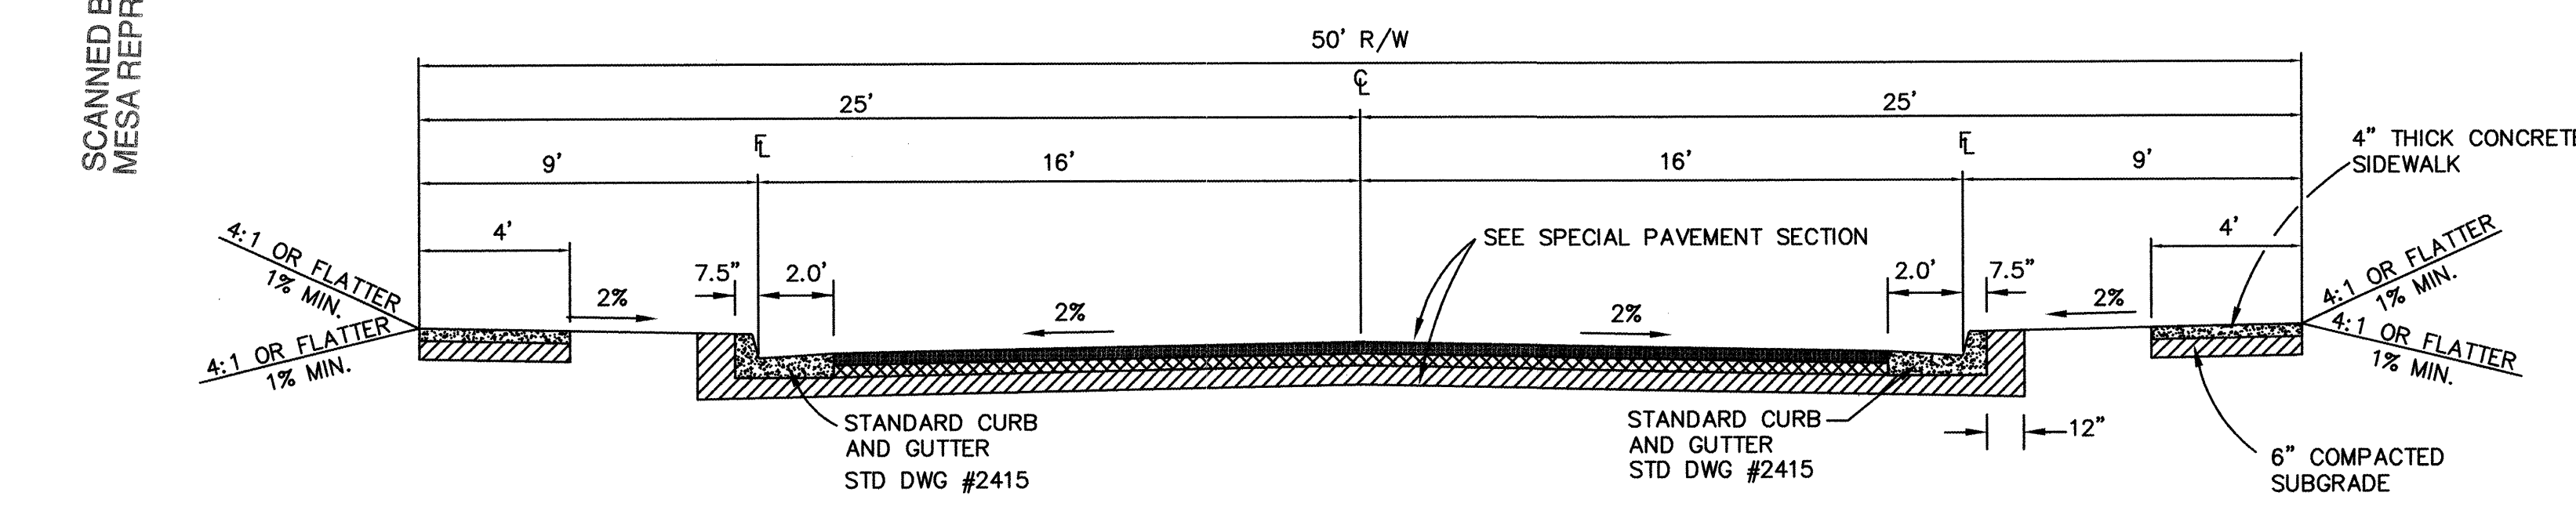


TYPICAL SECTION - CASA ROJA PLACE
STA. 18+63.89 TO STA. 25+72.89
NTS

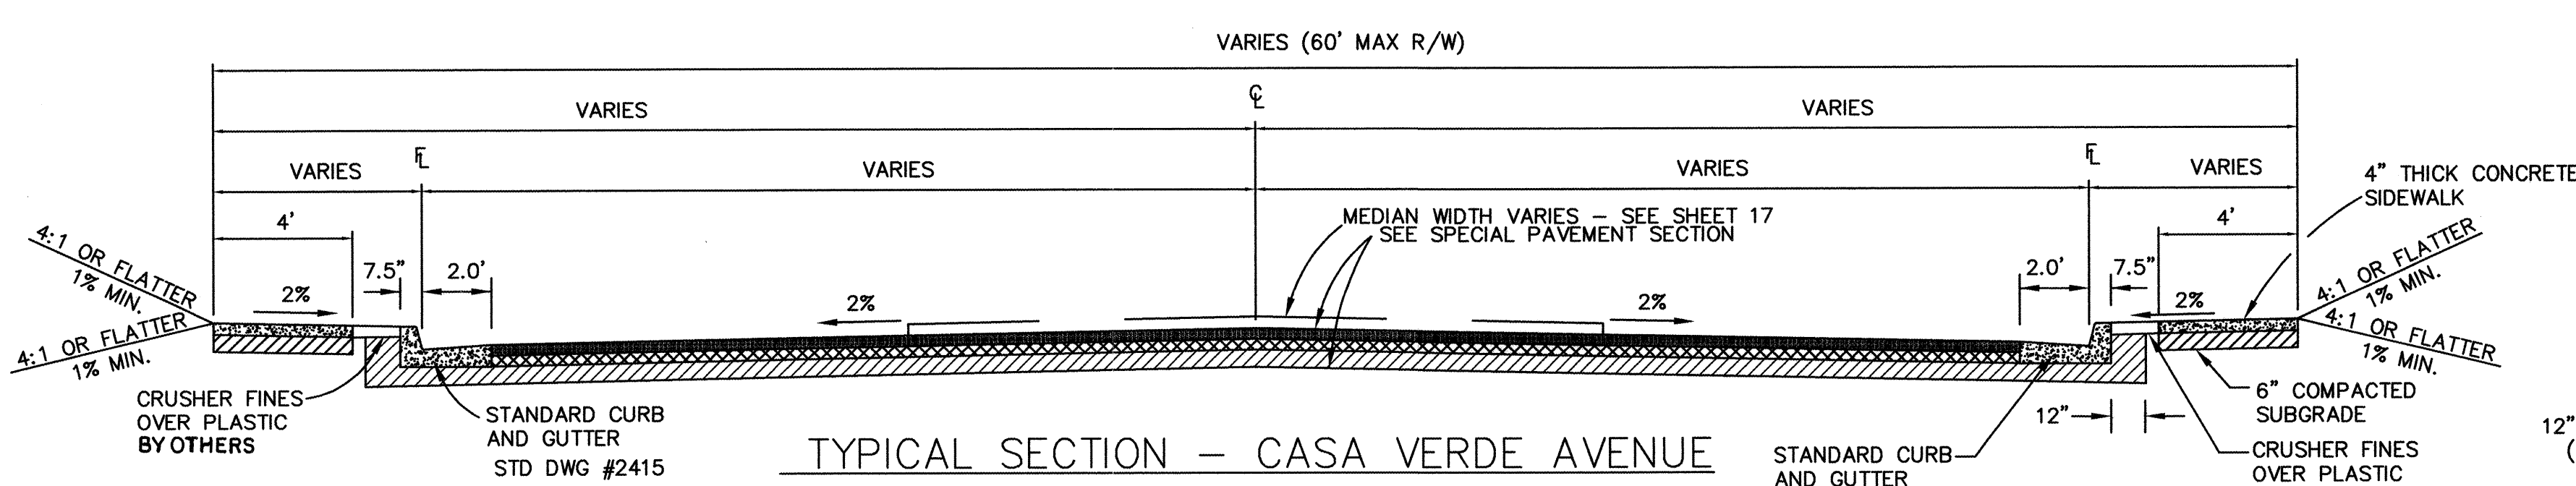


TYPICAL SECTION - CASA VERDE AVENUE
STA. 11+37.22 TO STA. 12+78.00
NTS

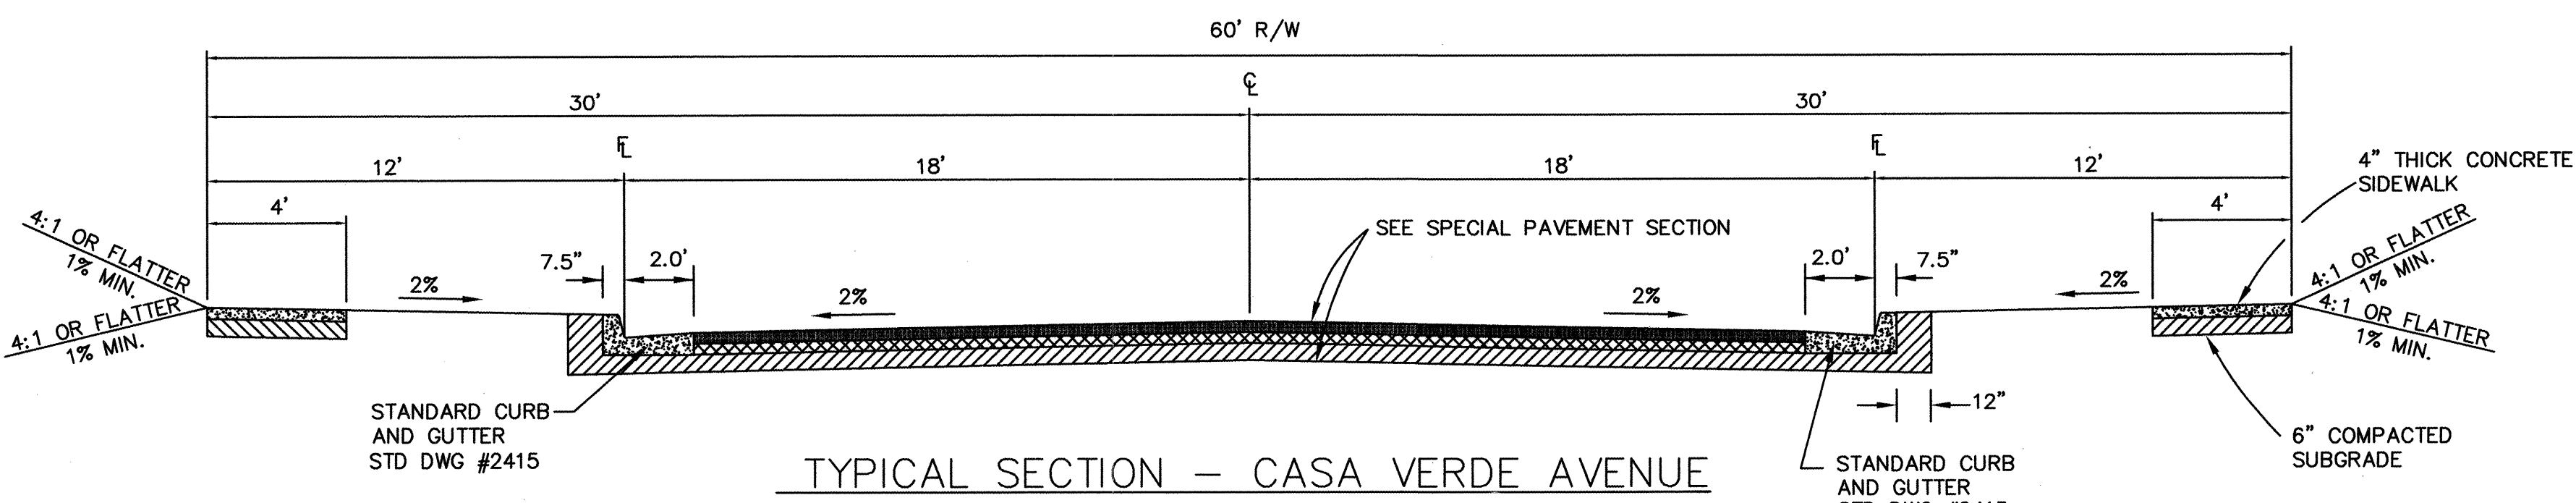


TYPICAL SECTION - CASA VERDE AVENUE
STA. 6+99.55 TO STA. 11+37.22
NTS

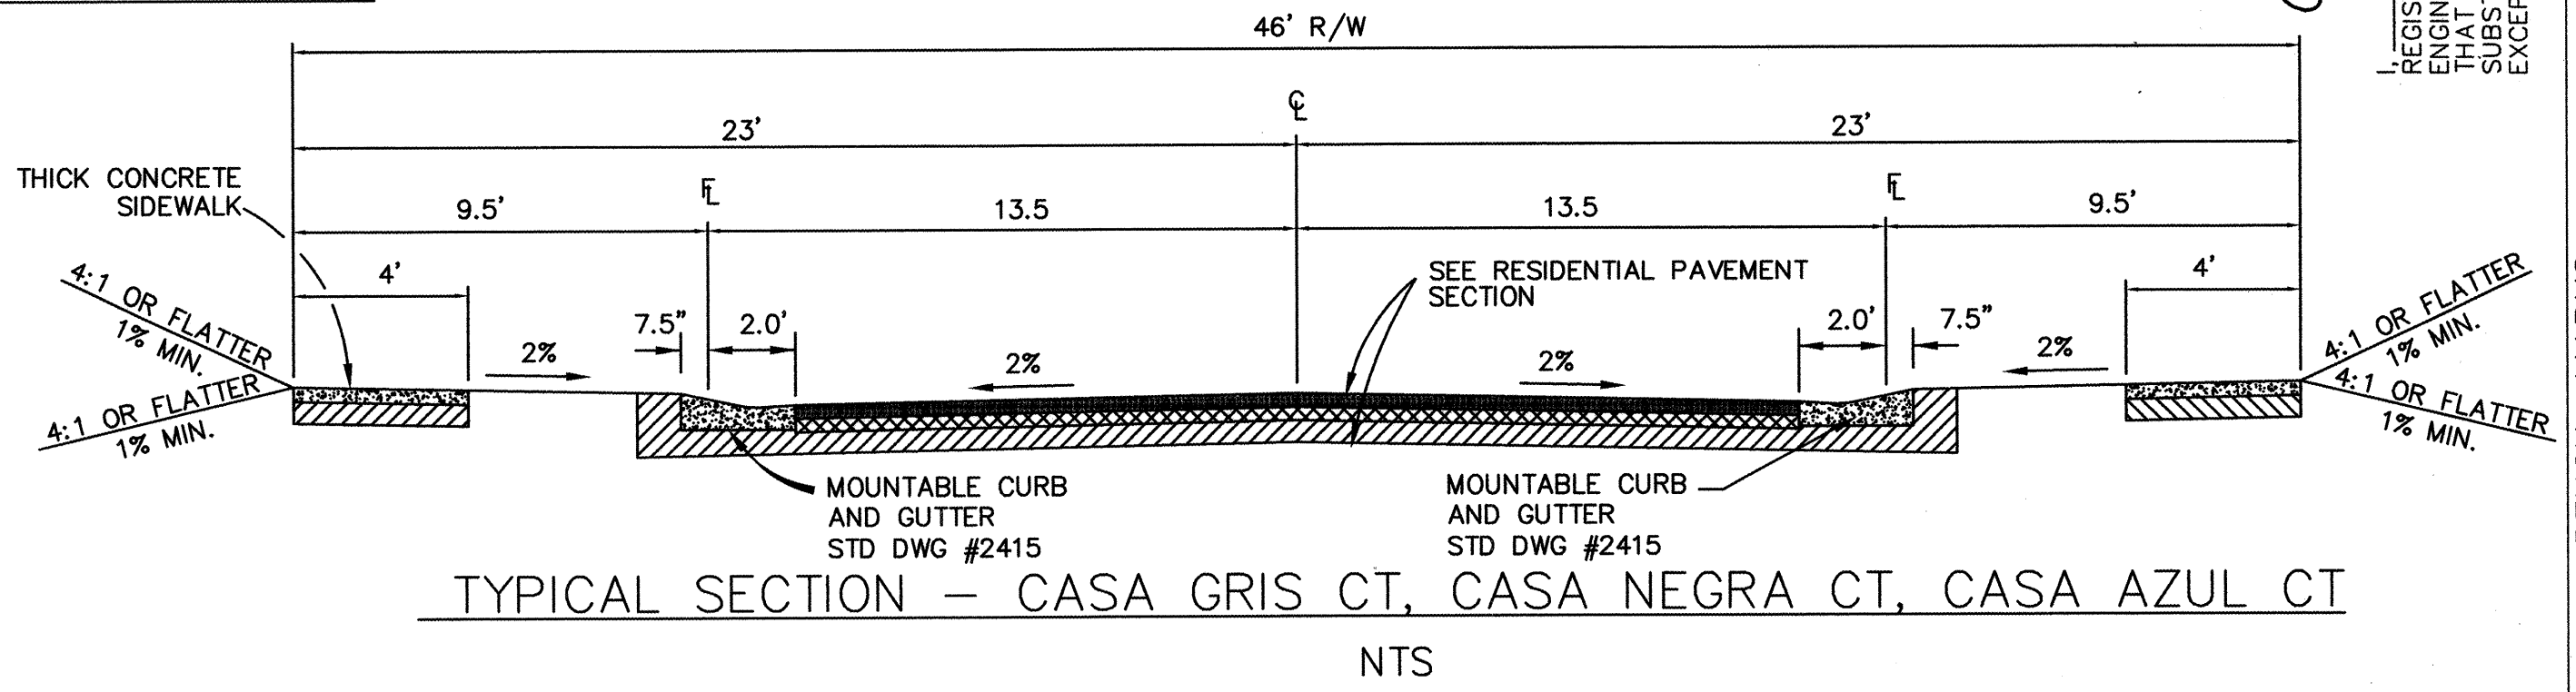

TYPICAL SECTION - CASA GRIS CT, CASA NEGRA CT, CASA AZUL CT
NTS

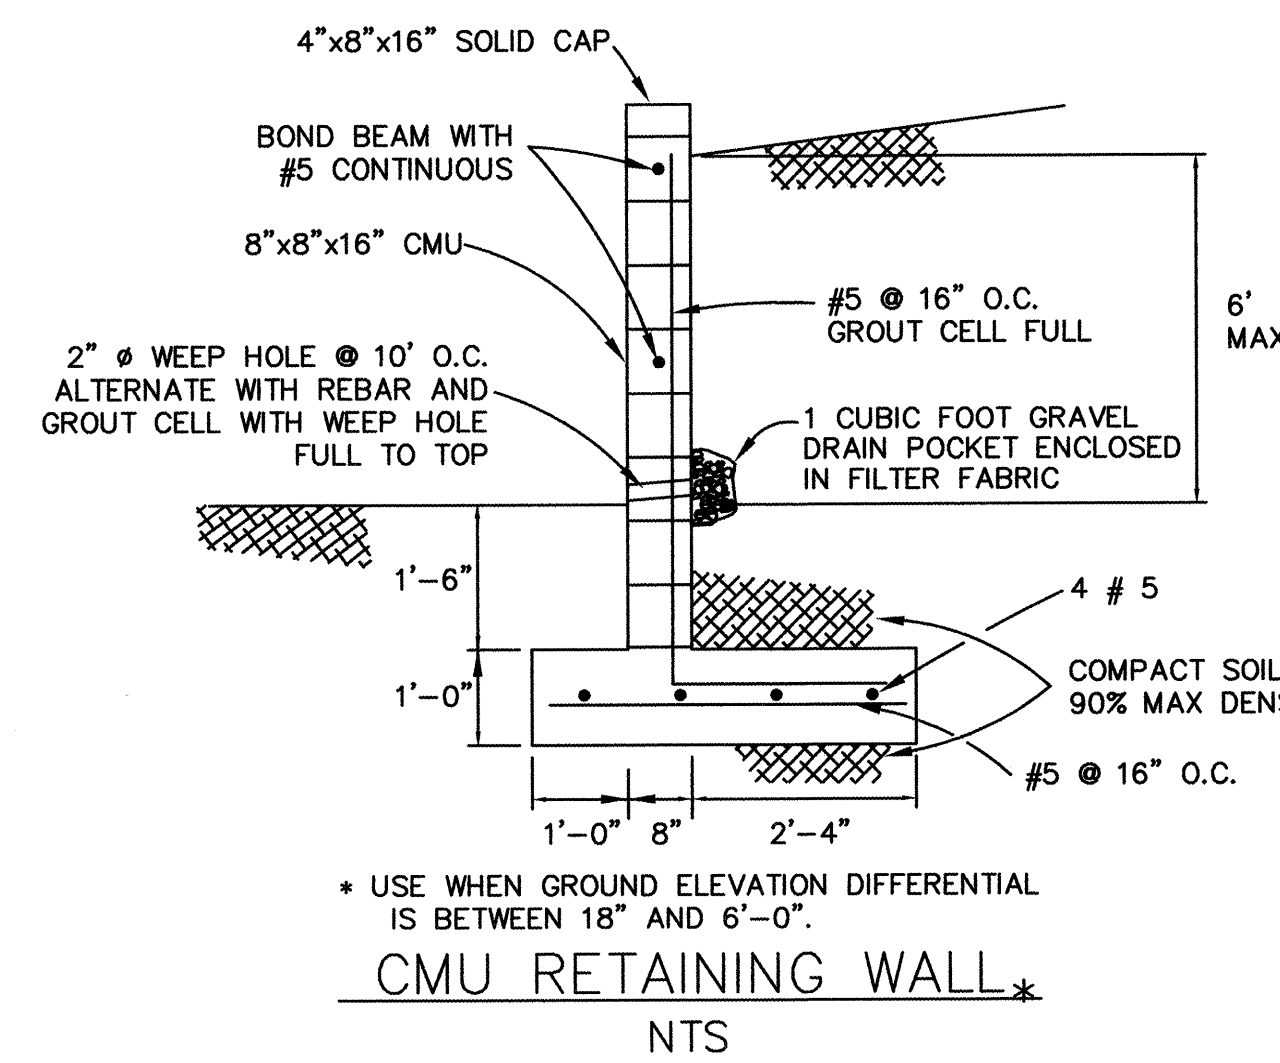


CMU RETAINING WALL
NTS

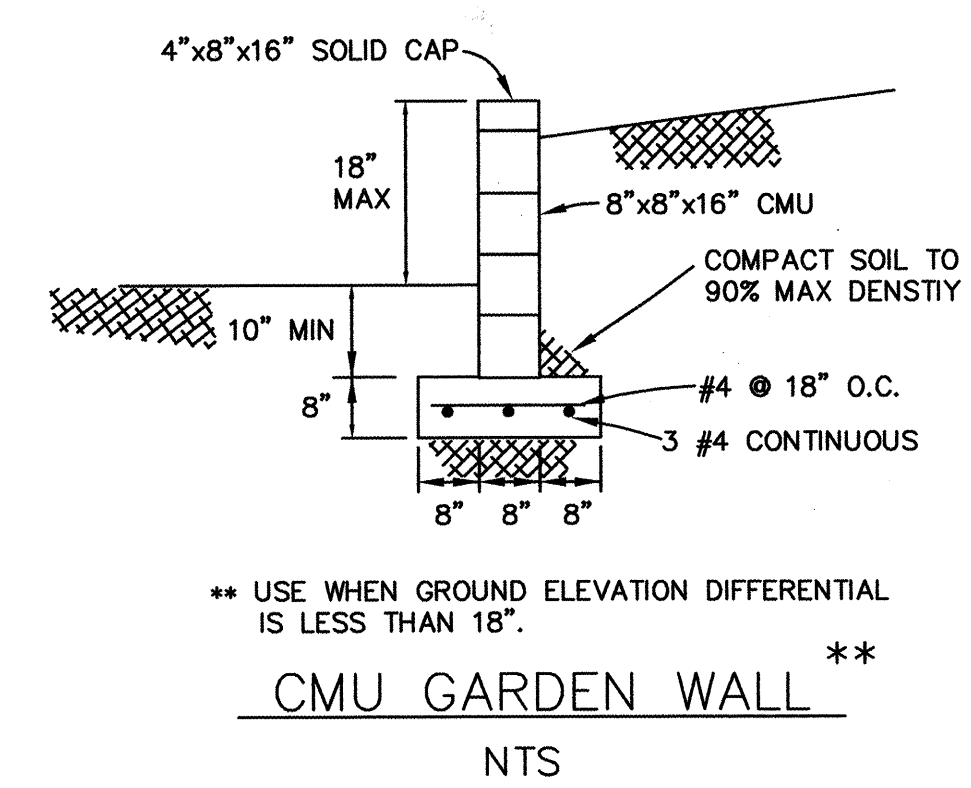


CMU GARDEN WALL
NTS


6" EXTRUDED CONCRETE CURB
NTS

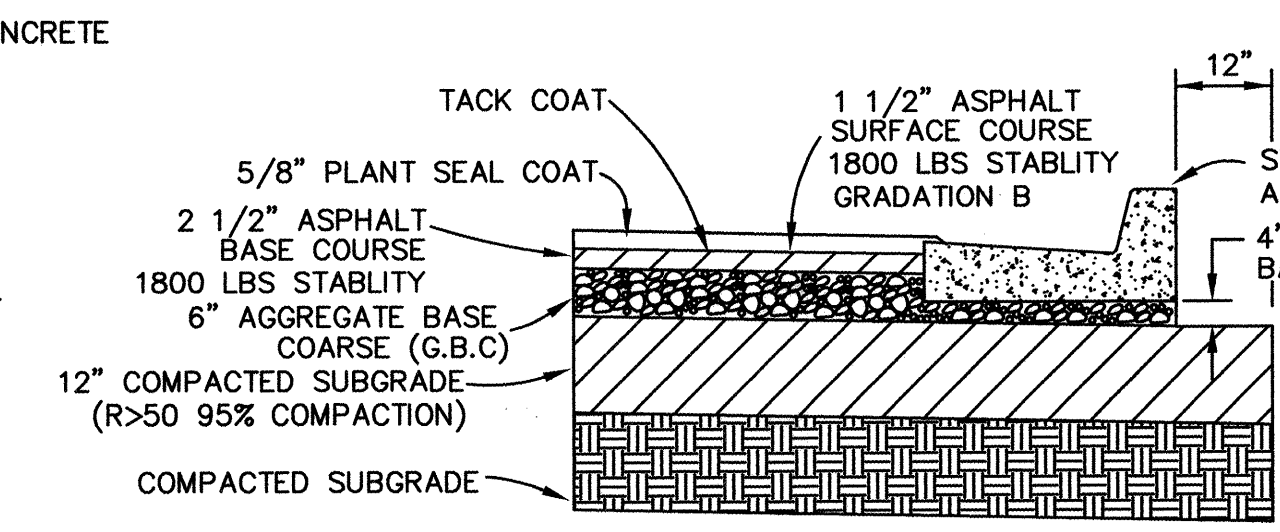

LADERA DRIVE PAVEMENT SECTION
NTS

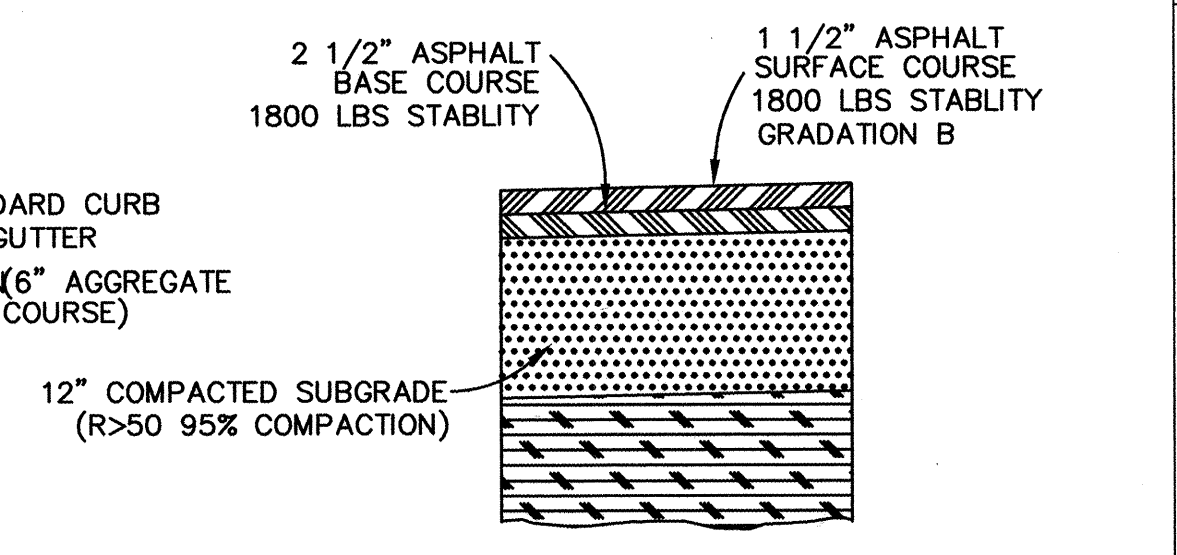

SPECIAL PAVEMENT SECTION
NTS

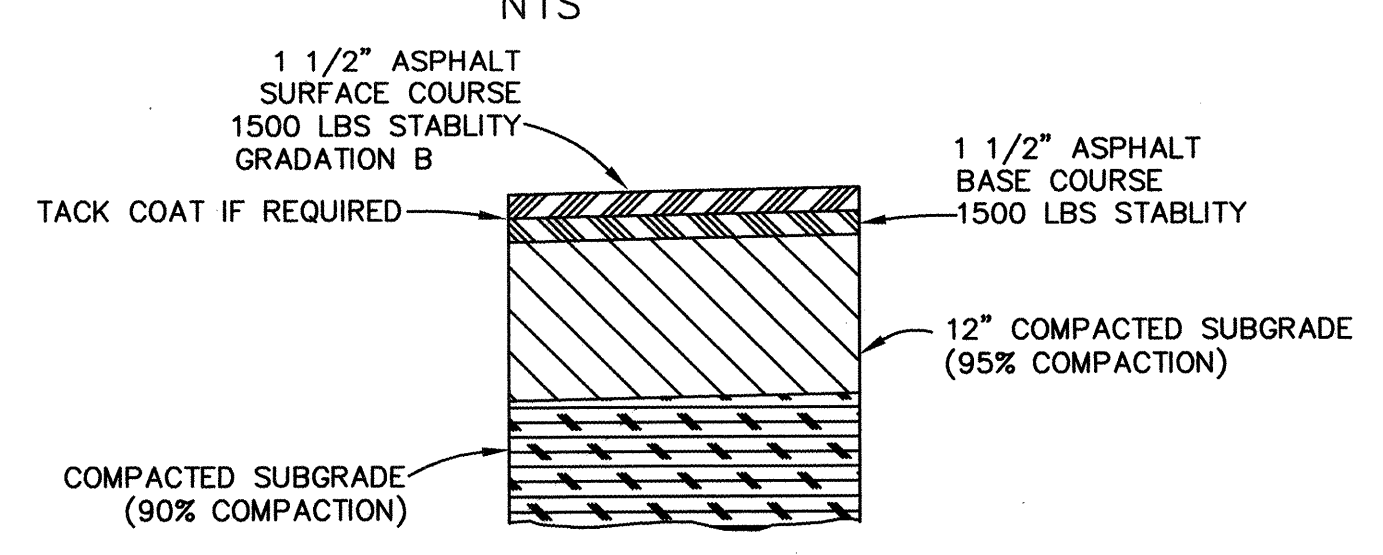


RESIDENTIAL PAVEMENT SECTION
STD. DRAWING NO. 2405
NTS

ENGINEER'S
CERTIFICATION

REGISTERED IN NEW MEXICO AS A PROFESSIONAL
ENGINEER NO. 14424 DATE 4-01
THIS PROJECT WAS CONSTRUCTED IN
SUBSTANTIAL COMPLIANCE WITH THIS PLAN,
EXCEPT AS NOTED. DATE 9-01

AS BUILT INFORMATION				BENCH MARKS				SURVEY INFORMATION				ENGINEER'S SEAL			
CONTRACTOR	McKenley Concrete & Co.	WORK BY	DATE	ALBUQUERQUE ACS MONUMENT "BH-40"	LOCATED APPROXIMATELY 623' NORTH OF	AND 888' WEST OF THE NORTHWEST	CORNER OF UNIT 1 BETWEEN TWO POWER	NO.	DATE	BY	FIELD NOTES	NO.	DATE	BY	REMARKS
DESIGNED BY	WLB	DATE	2MAY96												
DRAWN BY	GMA	DATE	2MAY96												
CHECKED BY	RG	DATE	20C99												
REVISIONS															
NO.	DATE	BY	REVISIONS												
DESIGNED	WLB	DATE	2MAY96												
DRAWN	GMA	DATE	2MAY96												
CHECKED	RG	DATE	20C99												

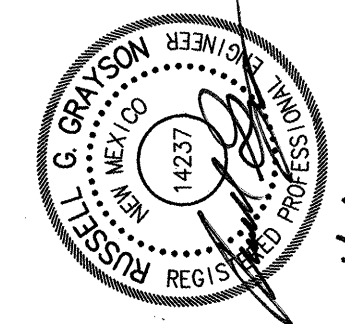



LAND PLANNING / ENGINEERING / ENVIRONMENT / SUBDIVISION DEVELOPMENT / SURVEYING

CITY OF ALBUQUERQUE
PUBLIC WORKS DEPARTMENT
ENGINEERING DEVELOPMENT GROUP

TITLE: WESTLAND DEVELOPMENT CO., INC.
TYPICAL SECTIONS AND RETAINING WALLS DETAILS
TIERRA OESTE UNIT 1


Design Review Committee: FEB 27 2000
City Engineer Approval: AUG 16 2000

City Project No. 5297.90
Zone Map No. J-9-Z
Sheet 7 Of 30

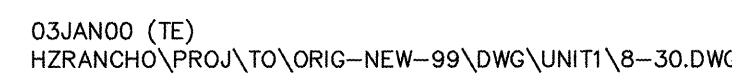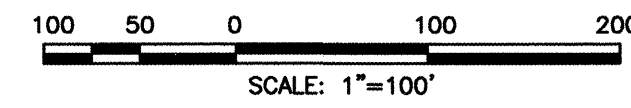




PROJECT DEPARTMENT CONTRACT GROUP CONTRACT CO., INC. PLAN SHEET 1		ENGINEER'S SEAL  1/13/00		SURVEY INFORMATION FIELD NOTES NO. BY DATE		BENCH MARKS ALBUQUERQUE ACS MONUMENT "BH-40" LOCATED APPROXIMATELY 623' NORTH OF AND 888' WEST OF THE NORTHWEST CORNER OF UNIT 1 BETWEEN TWO POWER POLES. ELEVATION = 5305.43		AS BUILT INFORMATION CONTRACTOR <i>Mekahdy Concrete &</i> STAGED BY <i>Mark Zickler</i> DATE INSPECTOR'S <i>Jeffrey</i> DATE ACCEPTANCE BY <i>Mark Zickler</i> DATE <i>4-01</i> VERIFICATION BY <i>Built on Soil</i> DATE <i>3-01</i> DRAWINGS MICRO-FILM INFORMATION RECORDED BY DATE NO.	
REMARKS REVISIONS DESIGN		NO. DATE DESIGNED WLB DATE 2MAY96 DRAWN BY GMA DATE 2MAY96 CHECKED BY RGG DATE 2DEC99							

MATCHLINE SHEET 10 STA 26+00.00

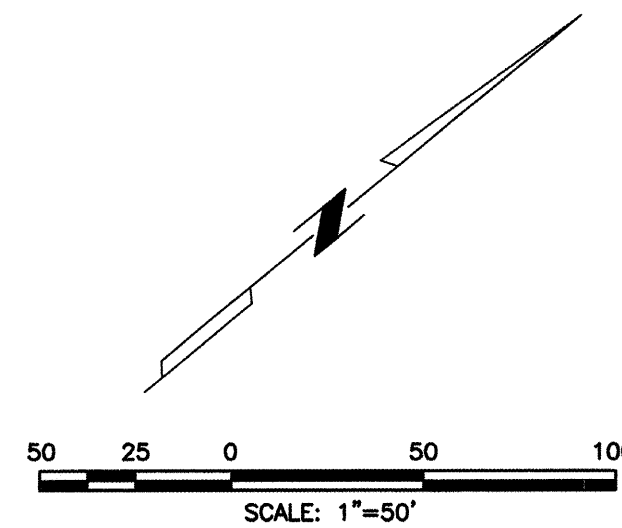


BUILD NOTES

- (C1) ℓ CURVE DATA
 $\Delta = 59^{\circ}59'29''$
 $R = 50.00'$
 $T = 28.86'$
 $L = 52.35'$
- (C2) ℓ CURVE DATA
 $\Delta = 59^{\circ}59'29''$
 $R = 50.00'$
 $T = 28.86'$
 $L = 52.35'$
- (C3) ℓ CURVE DATA
 $\Delta = 180^{\circ}00'00''$
 $R = 12.45'$
 $T = -$
 $L = 39.12'$
- (C4) ℓ CURVE DATA
 $\Delta = 13^{\circ}52'24''$
 $R = 150.00'$
 $T = 18.25'$
 $L = 36.32'$
- (C5) ℓ CURVE DATA
 $\Delta = 19^{\circ}02'42''$
 $R = 150.00'$
 $T = 25.16'$
 $L = 49.86'$

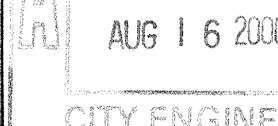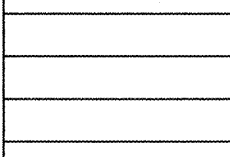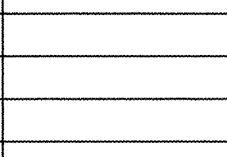CITY OF ALBUQUERQUE PUBLIC WORKS DEPARTMENT ENGINEERING DEVELOPMENT GROUP				
TITLE: WESTLAND DEVELOPMENT CO., INC. PAVING PLAN AND PROFILE - LADERA DRIVE TIERRA OESTE UNIT 1				
Design Review Committee 	City Engineer Approval 	Transit Design Update 	No./Day/Yr. 	No./Day/Yr. 
City Project No. 5297.90	Zone Map No. J-9-Z	Sheet 11	Of 30	



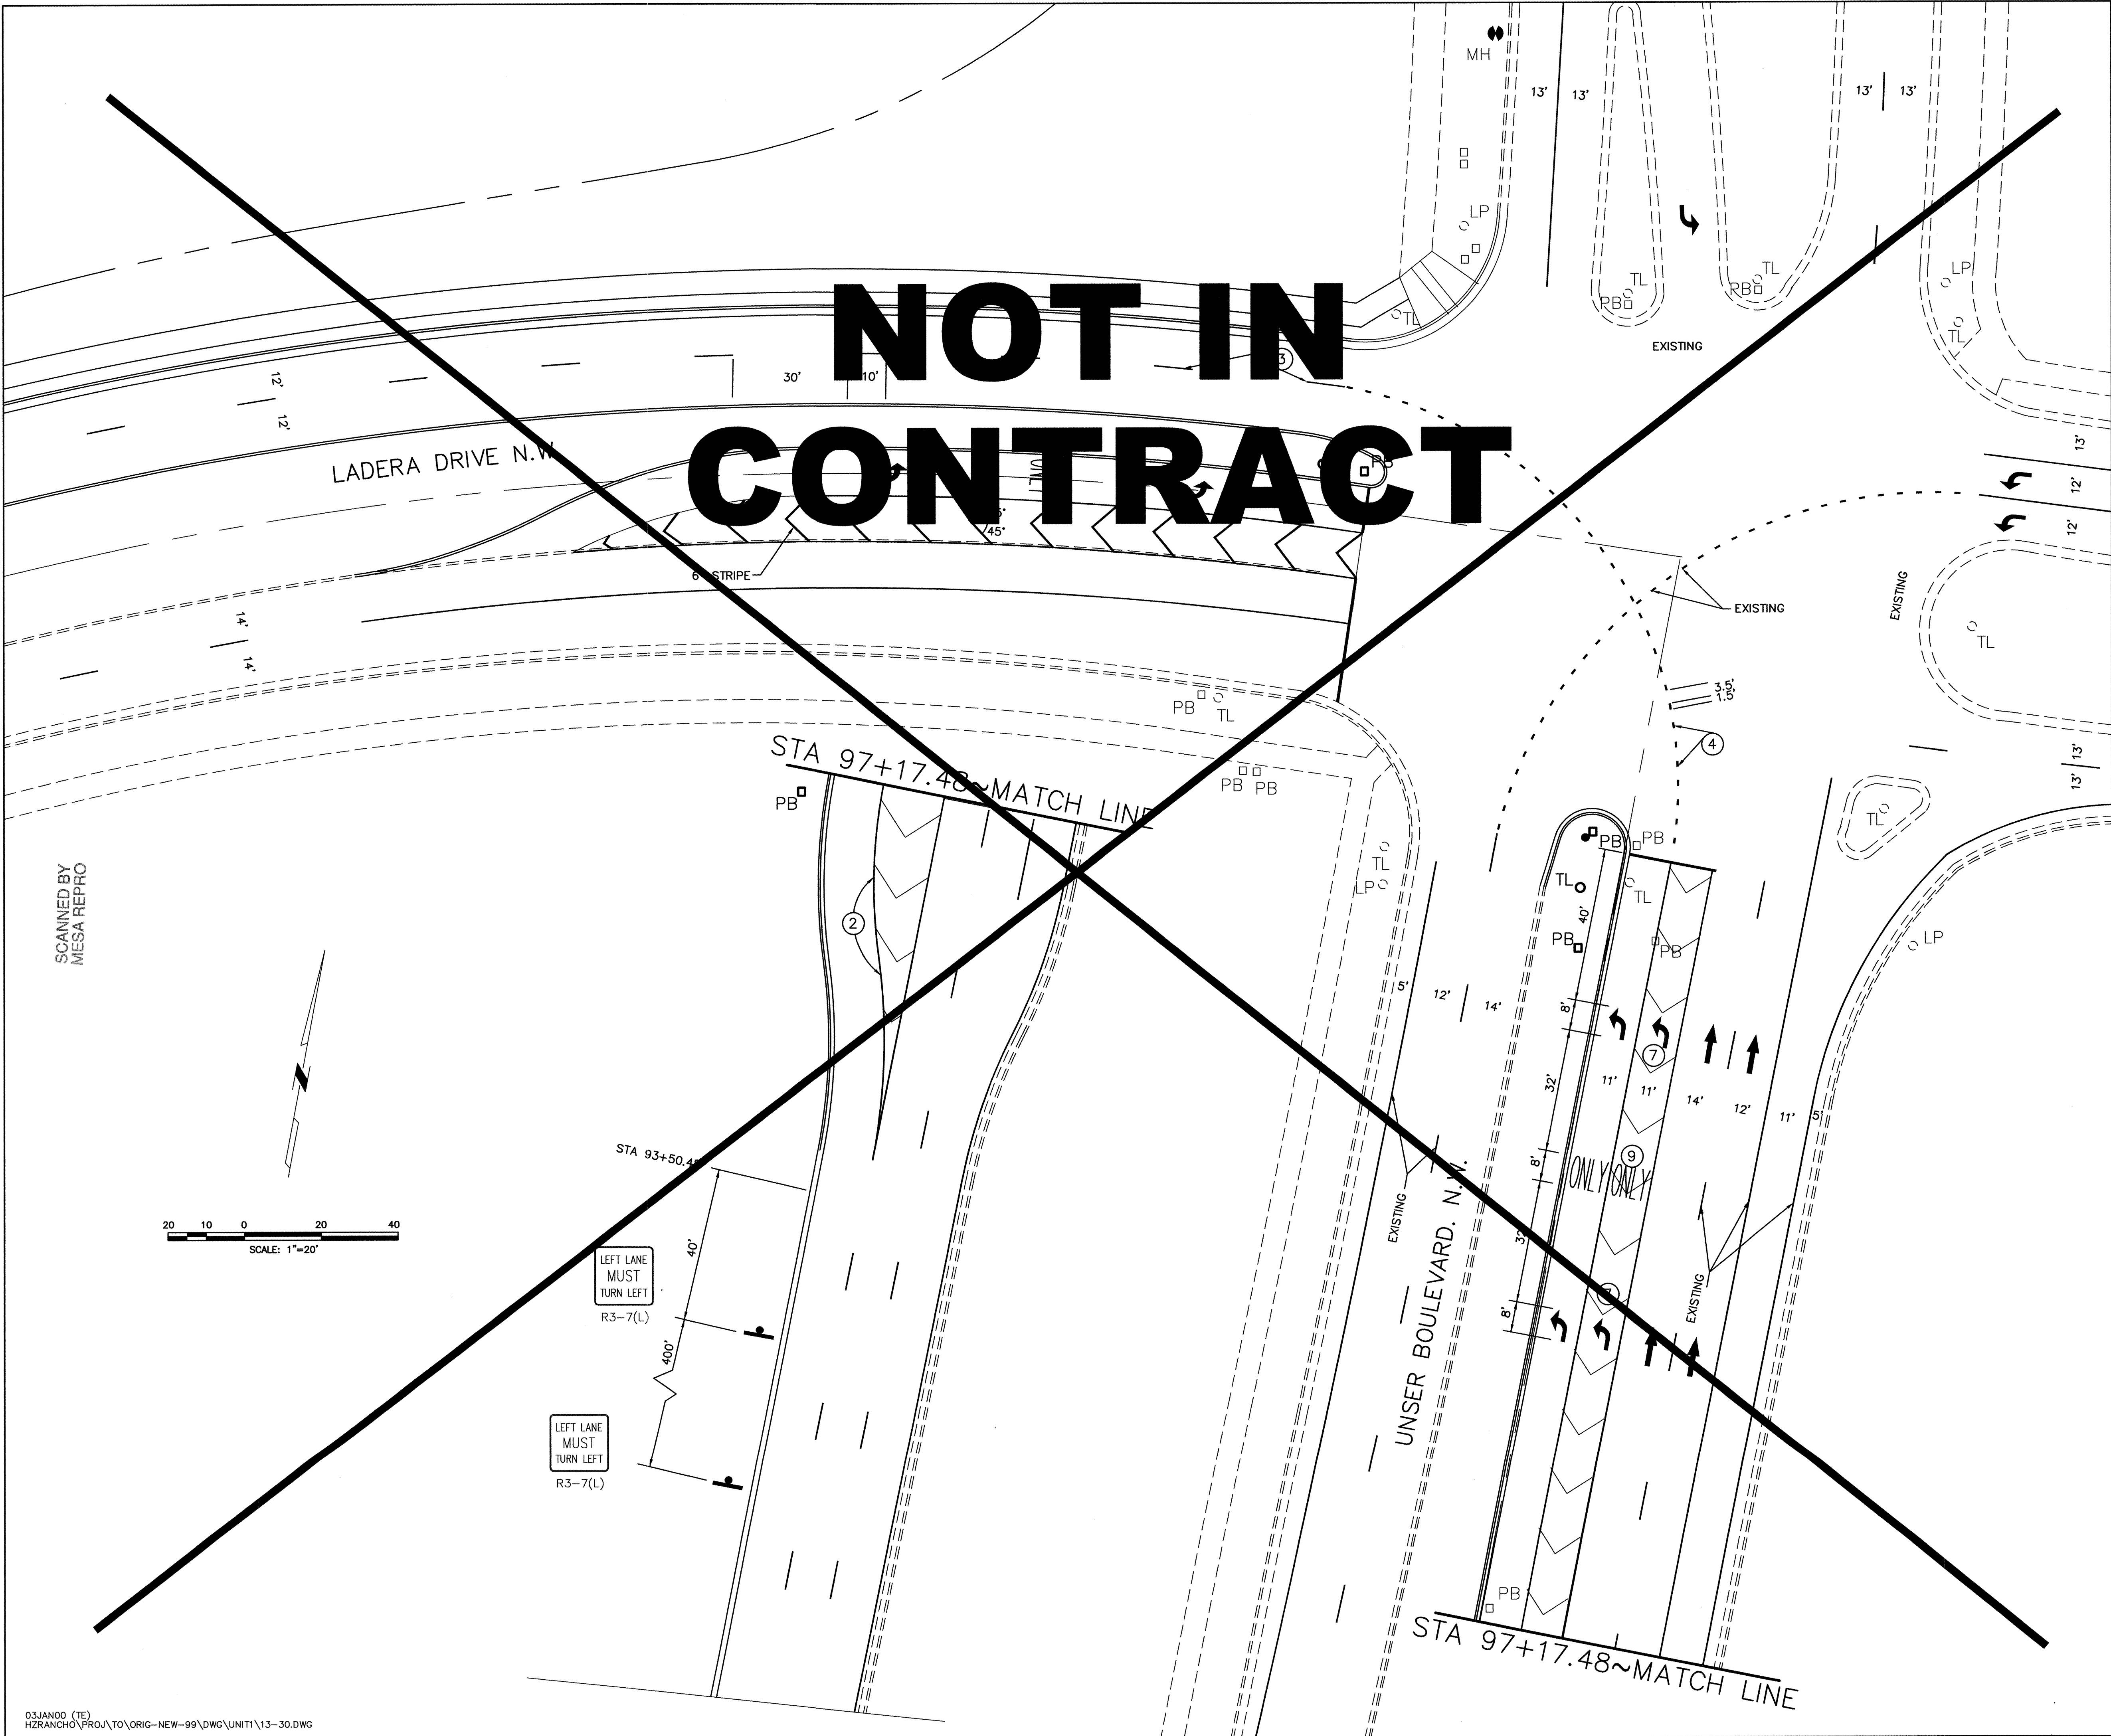

KEYED NOTES

- REFLECTORIZED WHITE PLASTIC PAVEMENT MARKING, 4", SOLID
- REMOVE 4" REFLECTORIZED WHITE PLASTIC PAVEMENT MARKING
- REFLECTORIZED WHITE PLASTIC PAVEMENT MARKING, 4", DASHED
- PLASTIC 4", WHITE, DASHED REFLECTIVE LANE DELINEATOR
- REFLECTORIZED PLASTIC ARROW THRU
- REFLECTORIZED PLASTIC ARROW LEFT
- REFLECTORIZED PLASTIC WORD ONLY

LEGEND

EXISTING	PROPOSED
PULLBOX	PB
SIGNAL	TL

CINFRAN/HUITT-ZOLLARS

333 RIO RANCHO DR. N.E., STE. 101
RIO RANCHO, N.M., 87124
(505) 892-0141

LAND PLANNING / ENGINEERING / ENVIRONMENT / SUBDIVISION DEVELOPMENT / SURVEYING

CITY OF ALBUQUERQUE
PUBLIC WORKS DEPARTMENT
ENGINEERING DEVELOPMENT GROUP

TITLE: WESTLAND DEVELOPMENT CO., INC.
TRAFFIC SIGNAL RELOCATION
TIERRA OESTE UNIT 1

Design Review Committee	City Engineer Approval	Least Design Update	No./Day/Yr.	No./Day/Yr.
N/A				

City Project No.	Zone Map No.	Sheet	Of
5297.90	H-9-Z	13	30

ENGINEER'S SEAL

REGISTERED PROFESSIONAL ENGINEER
STATE OF NEW MEXICO
1/3/00

AS BUILT INFORMATION


CONTRACTOR	Materials Concrete Co.
WORK STATED BY	Huitt Zollars
DATE	DATE
ACCEPTANCE BY	Huitt Zollars
DATE	DATE
FIELD LOCATION BY	Huitt Zollars
DATE	DATE
DRAWINGS	DATE
CORRECTED BY	Huitt Zollars
DATE	DATE
MICRO-FILM INFORMATION	RECORDED BY
NO.	DATE

SURVEY INFORMATION

NO.	BY	DATE


BENCH MARKS

ALBUQUERQUE ACS MONUMENT "3-H10"	LOCATED NORTHEAST OF THE INTER-SECTION OF UNSER BLVD. & LADERA DR. THE STATION MARK IS A STANDARD ACS CAP SET FLUSH IN THE CONCRETE SURFACE OF THE SPILLWAY. ELEVATION = 5193.38
----------------------------------	--

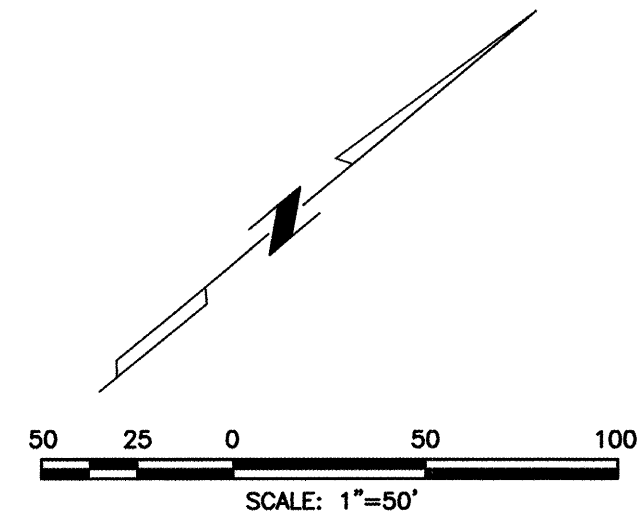

MATCHLINE SHEET 15

BEGIN CURB RETURN		RETURN $\overline{E}$	
STA. 23+66.89, 16.00' RT.		<u>CURVE DATA</u>	
PT.	$\overline{E}$ ELEV.	$\Delta = 90^{\circ}00'00''$	
RET.	27.58	$R = 30.00'$	
1	27.11	$T = 30.00'$	
2	26.83	$L = 47.12'$	
3	26.73		
RET.	26.81		
END CURB RETURN			
STA. 23+96.89, 46.00' RT.			

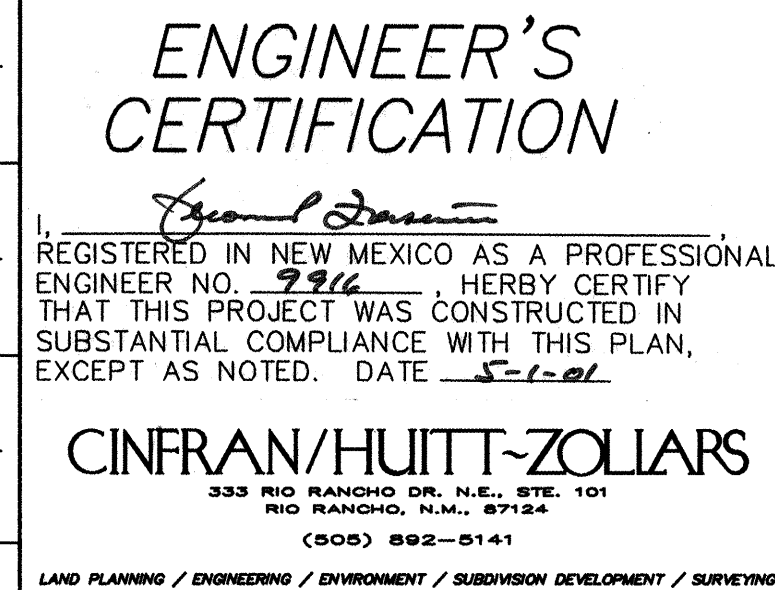


CITY OF ALBUQUERQUE PUBLIC WORKS DEPARTMENT ENGINEERING DEVELOPMENT GROUP	
TITLE:	WESTLAND DEVELOPMENT CO., INC. PAVING PLAN AND PROFILE - CASA ROJA TIERRA OESTE UNIT 1


Design Review Committee		City Engineer Approval		Mo./Day/Yr.		Mo./Day/Yr.	
APPROVED FEB 27 2000 DESIGN REVIEW COMMITTEE		APPROVED AUG 16 2000 CITY ENGINEER		Text Design Update			
City Project No. 5297.90		Zone Map No. J-9-Z		Sheet 14		Of 3	

SCANNED BY
MESA REPRO

MATCHLINE SHEET 14

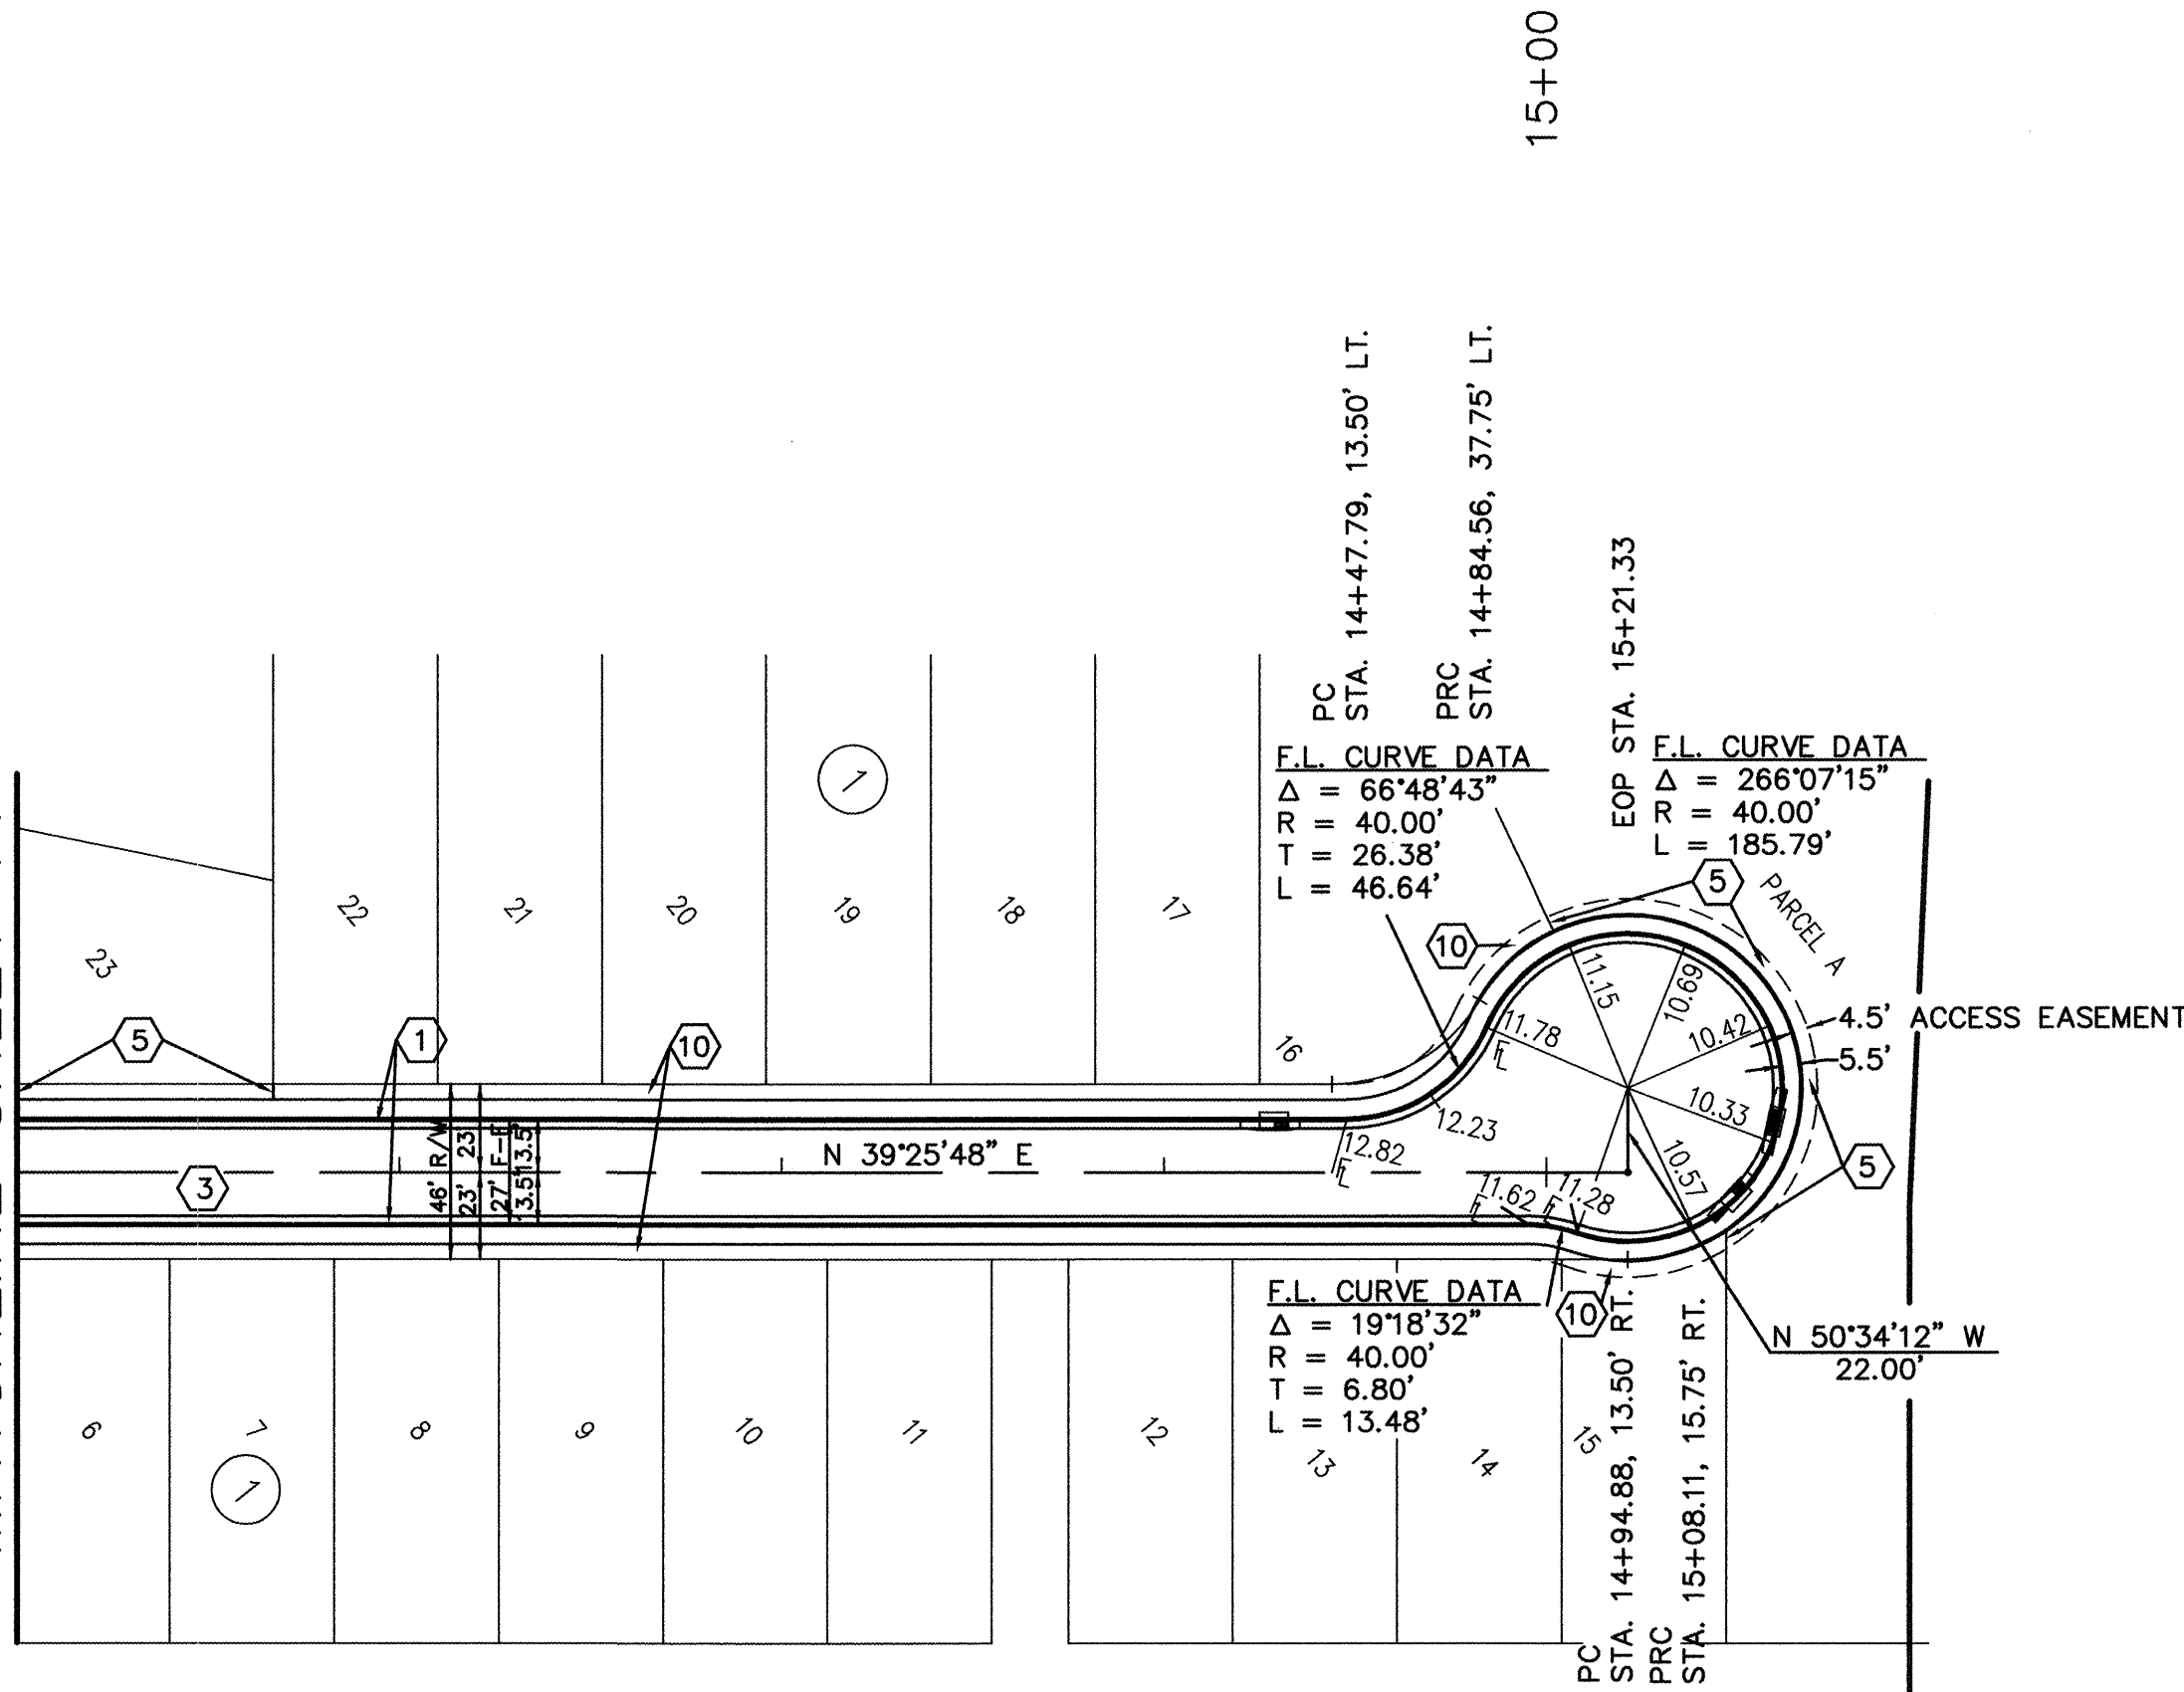

CASA ROJA PLACE

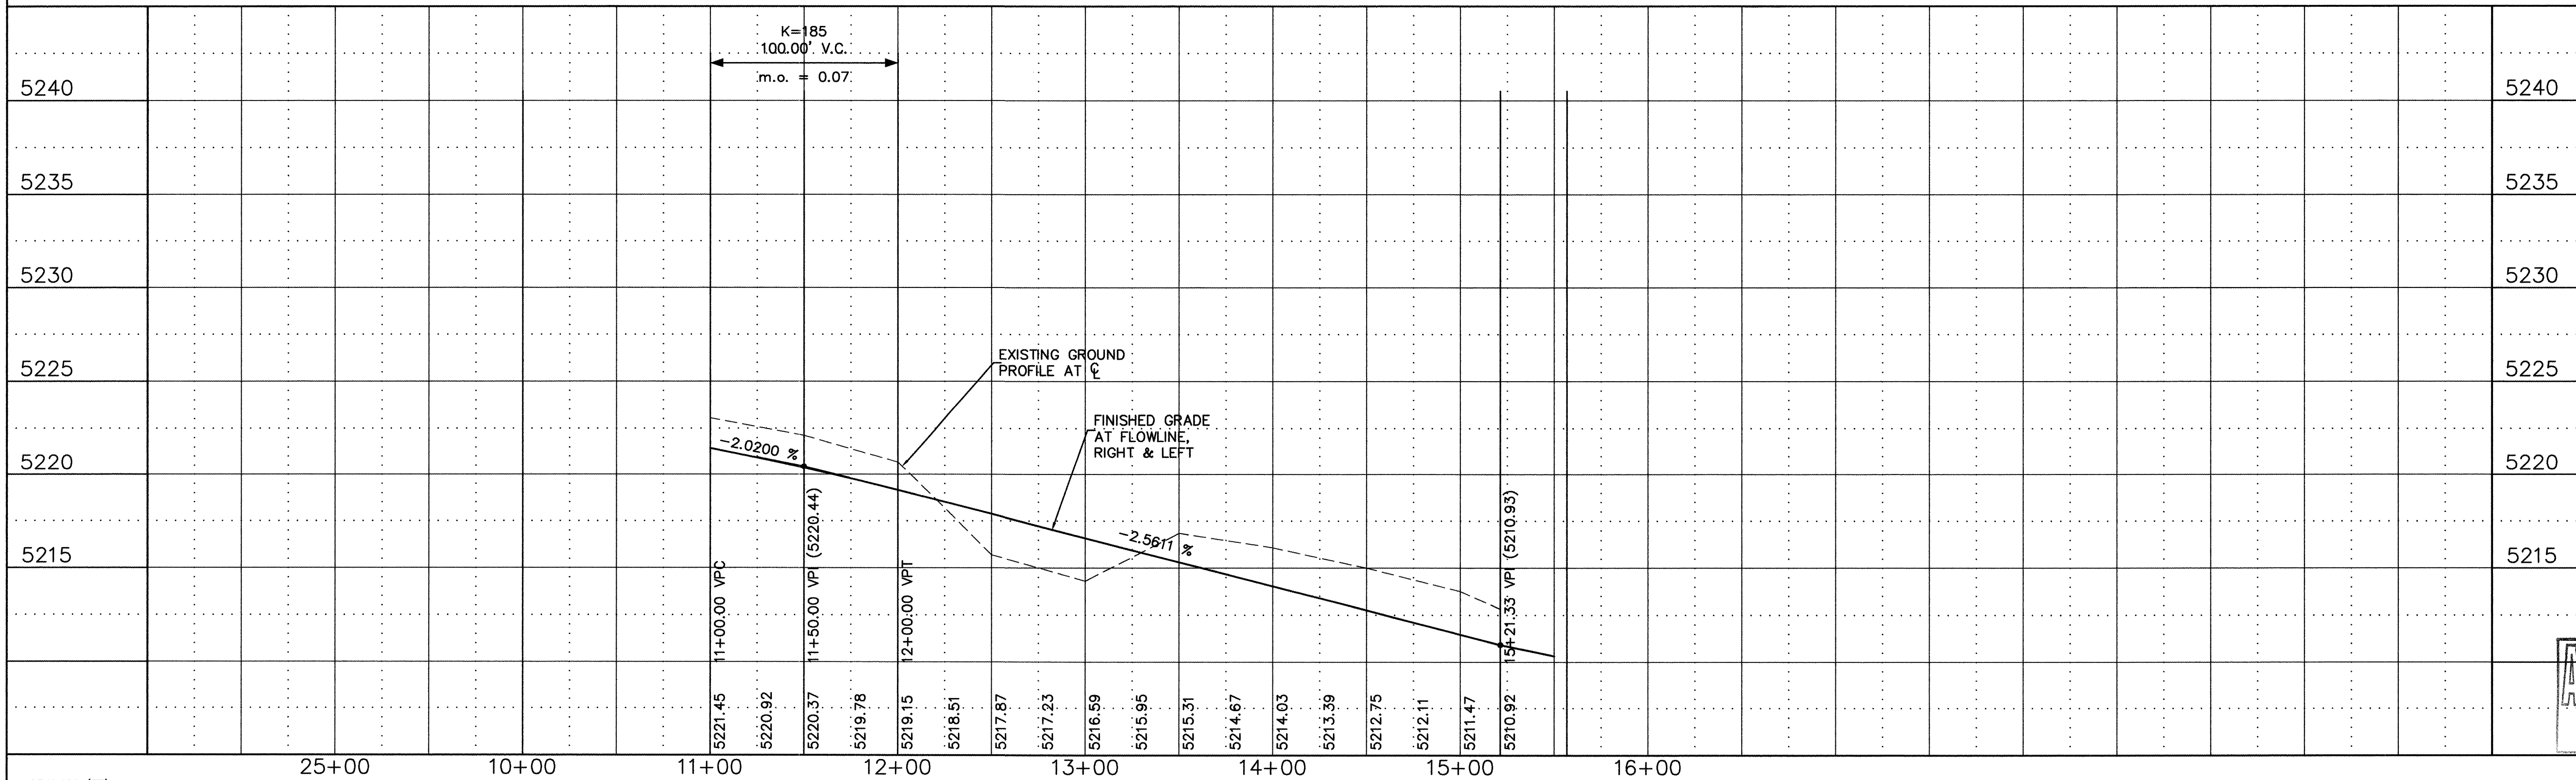

NOTES

SEE ROADWAY TYPICAL SECTIONS AND PAVEMENT SECTION ON SHEET 7.

BUILD NOTES

- BUILD STANDARD CURB AND GUTTER PER C.O.A. DWG #2415.
- BUILD RESIDENTIAL PAVEMENT SECTION PER DETAIL ON SHEET 7.
- BUILD 4' WIDE CONCRETE SIDEWALK PER C.O.A. DWG #2430
- DEFERRED 4' WIDE CONCRETE SIDEWALK PER C.O.A. DWG. #2430 (NOT IN THIS CONTRACT)

AS BUILT INFORMATION		BENCH MARKS		SURVEY INFORMATION		ENGINEER'S SEAL	
CONTRACTOR	DATE	ALBUQUERQUE ACS MONUMENT	DATE	FIELD NOTES	NO.	SEAL	REMARKS
McLarty Concrete Co.	4/24/2000	LOCATED APPROXIMATELY 623' NORTH OF AND 888' WEST OF THE NORTHWEST CORNER OF UNIT 1 BETWEEN TWO POWER POLES.	4/24/2000				REVISIONS
INSPECTED BY	DATE						DESIGN
ACCEPTANCE BY	DATE						WLB
VERIFICATION BY	DATE						GMA
DRAWINGS BY	DATE						CHECKED BY
CHECKED BY	DATE						DATE
RECORDED BY	DATE						DATE
NO.							DATE

11/3/00

REGISTERED PROFESSIONAL ENGINEER
G. GRAYSON
1437
REGISTERED PROFESSIONAL
11/3/00

ENGINEER'S CERTIFICATION

I, G. GRAYSON, REGISTERED IN NEW MEXICO AS A PROFESSIONAL ENGINEER NO. 9776, HERBY CERTIFY THAT THIS PROJECT WAS CONSTRUCTED IN SUBSTANTIAL COMPLIANCE WITH THIS PLAN, EXCEPT AS NOTED. DATE 5-1-01



CINFRAN/HUITT-ZOLLARS
333 RIO RANCHO DR. N.E., STE. 101
RIO RANCHO, N.M., 87124
(505) 892-5141

LAND PLANNING / ENGINEERING / ENVIRONMENT / SUBDIVISION DEVELOPMENT / SURVEYING

CITY OF ALBUQUERQUE
PUBLIC WORKS DEPARTMENT
ENGINEERING DEVELOPMENT GROUP
WESTLAND DEVELOPMENT CO., INC.
PAVING PLAN AND PROFILE - CASA ROJA
TIERRA OESTE UNIT 1

DESIGN REVIEW COMMITTEE
FEB 27 2000
CITY ENGINEER
AUG 16 2000

City Project No. 5297.90
Zone Map No. J-9-Z
Sheet 15 of 30

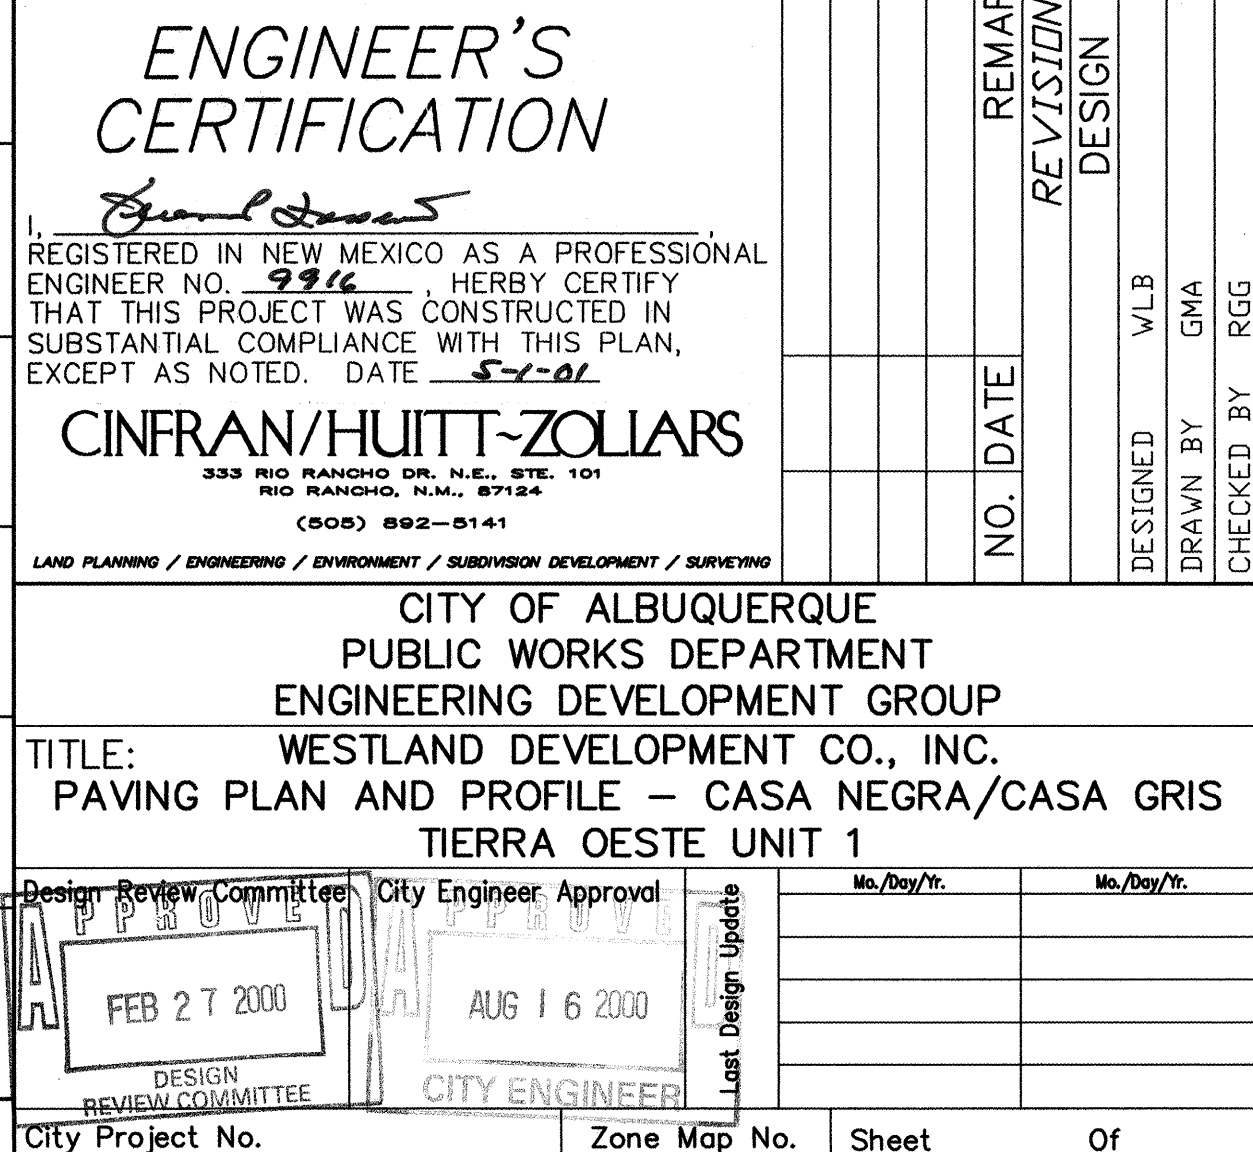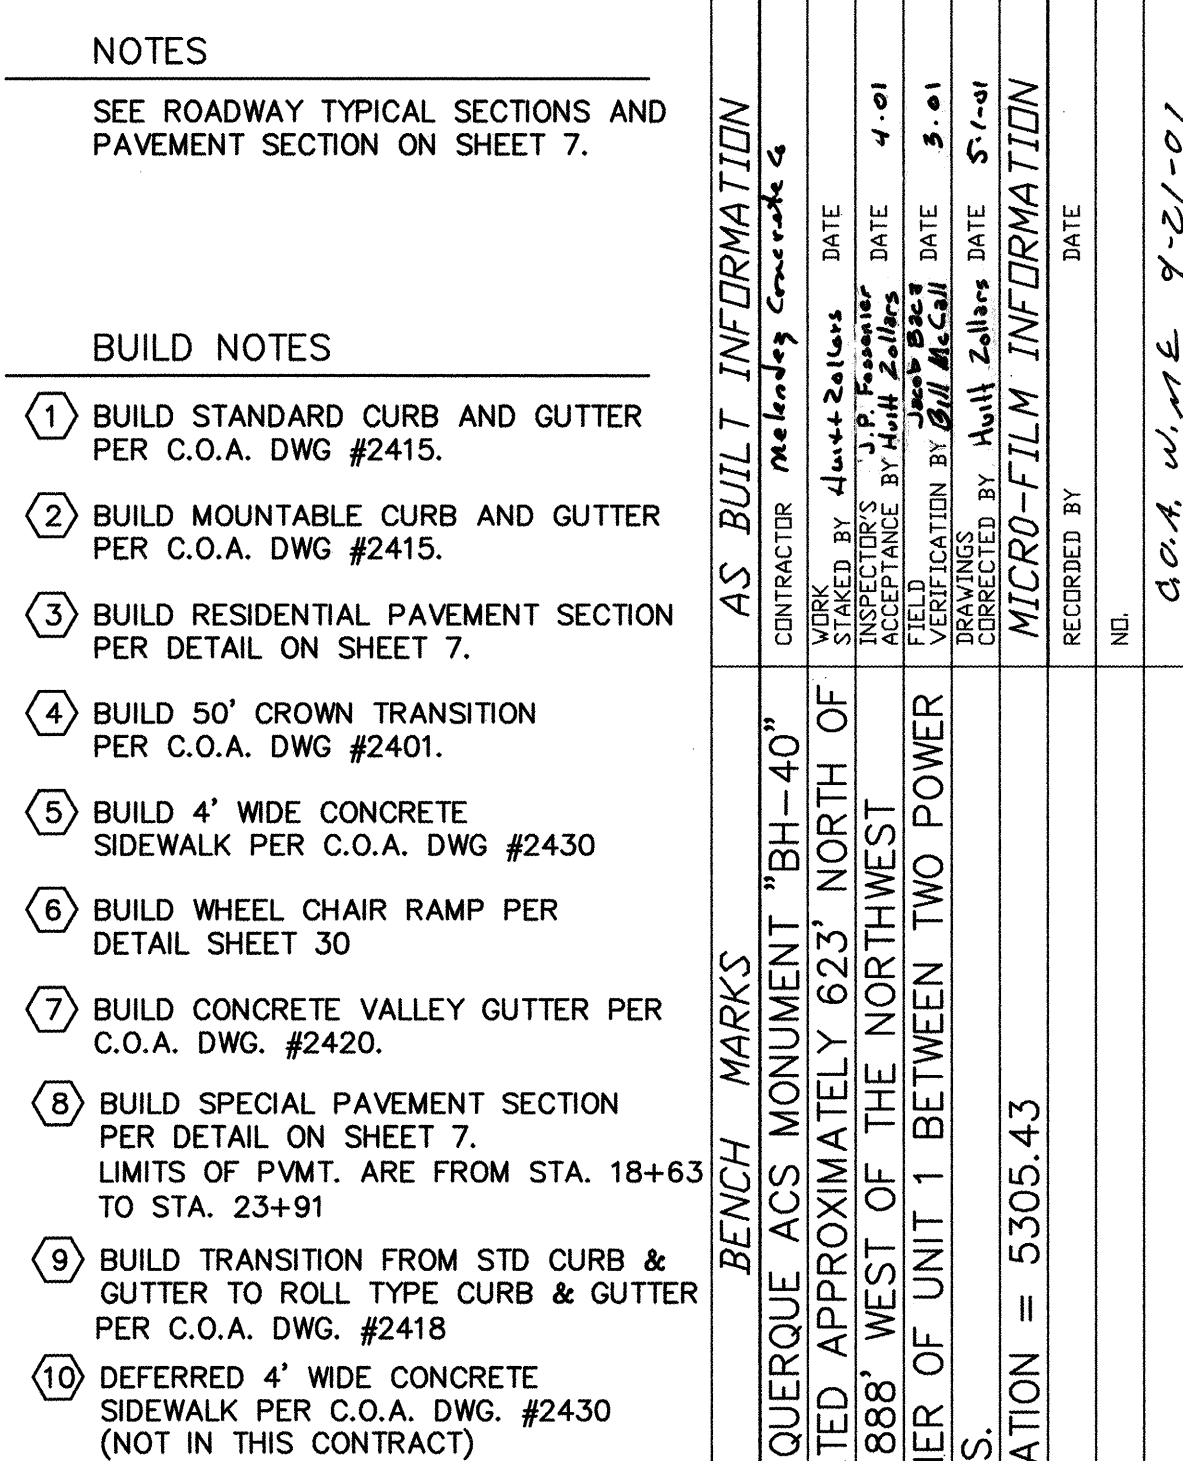




5297.50	0 0 2
---------	-------

QUE TMENT NT GROUP CO., INC. A VERDE/CASA AZUL T 1	
Mo./Day/Yr.	Mo./Day/Yr.
Sheet	Of
17	30

SCANNED BY
MESA REPRO

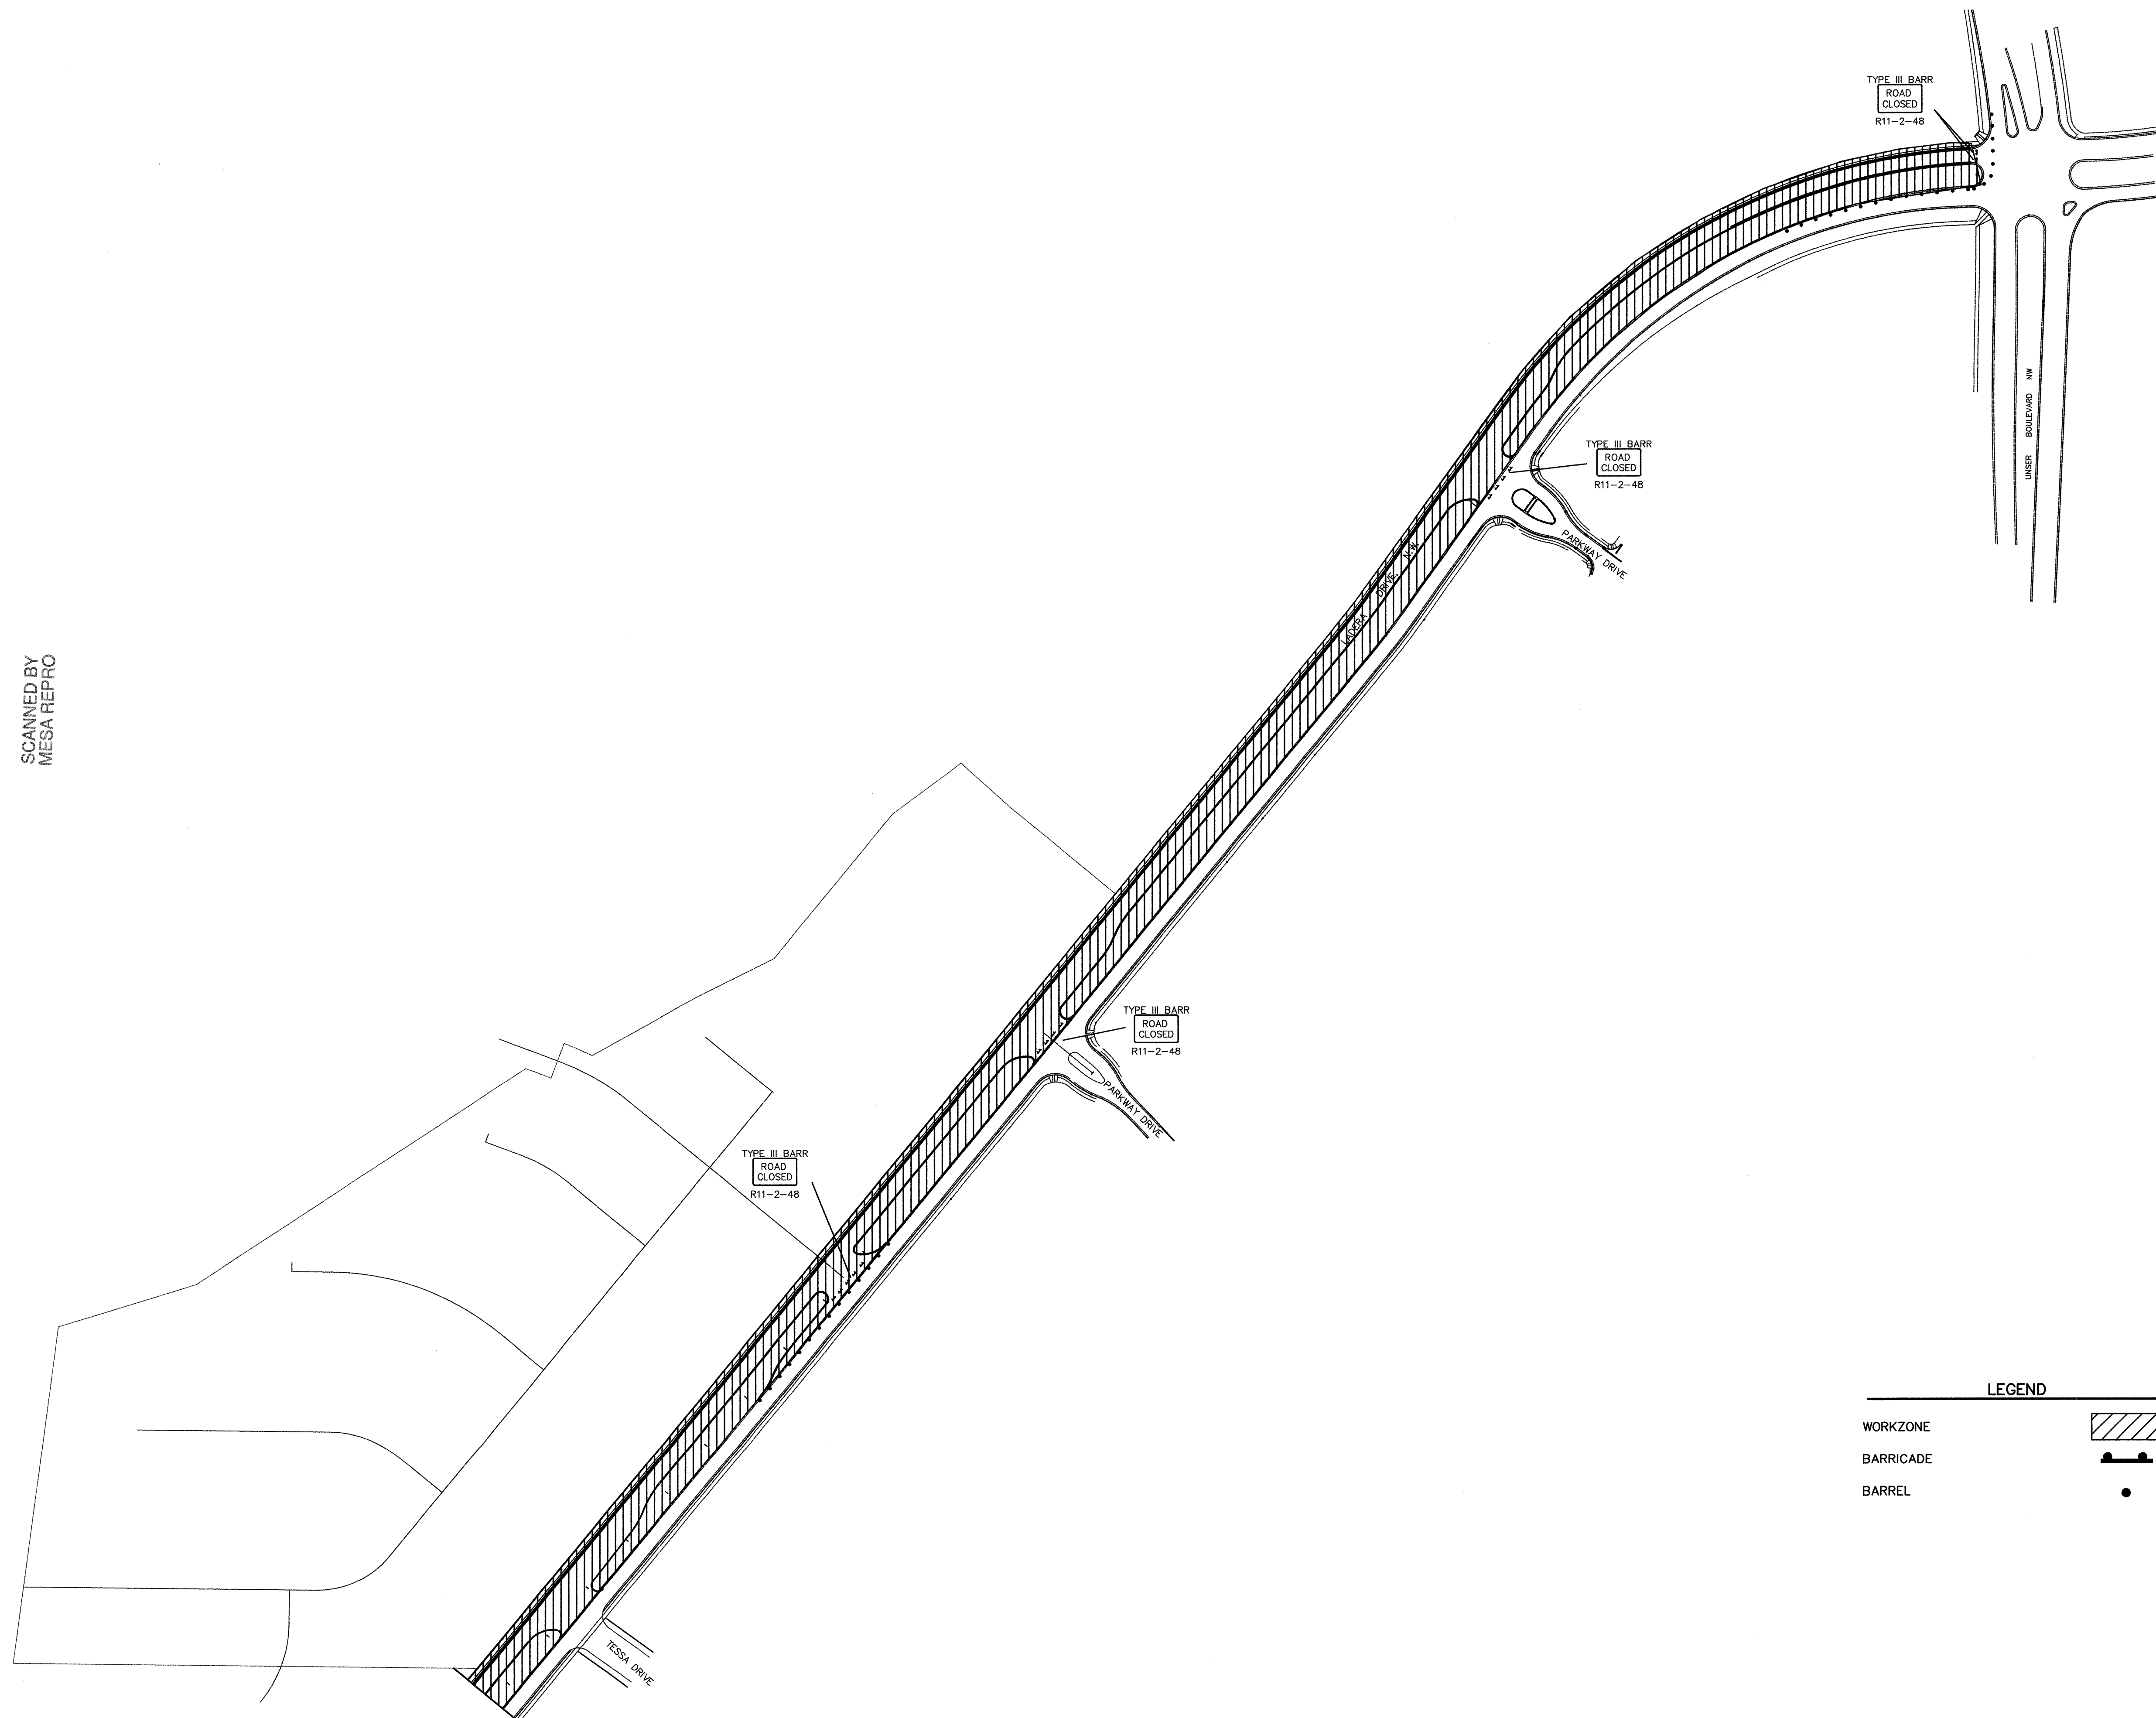

SEE SHEETS 19 & 20 FOR
INTERSECTION
CONSTRUCTION
SIGNING

LEGEND

WORKZONE
BARRICADE
BARREL

ENGINEER'S CERTIFICATION

I, Donald J. Lewis
REGISTERED IN NEW MEXICO AS A PROFESSIONAL
ENGINEER NO. 994, HERBY CERTIFY
THAT THIS PROJECT WAS CONSTRUCTED IN
SUBSTANTIAL COMPLIANCE WITH THIS PLAN,
EXCEPT AS NOTED. DATE 5-4-01

CINFRAN/HUITT-ZOLLARS
333 RIO RANCHO DR. N.E., STE. 101
RIO RANCHO, N.M., 87124
(505) 892-5141

LAND PLANNING / ENGINEERING / ENVIRONMENT / SUBDIVISION DEVELOPMENT / SURVEYING

CITY OF ALBUQUERQUE	
PUBLIC WORKS DEPARTMENT	
ENGINEERING DEVELOPMENT GROUP	
TITLE:	WESTLAND DEVELOPMENT CO., INC. LADERA DRIVE CONSTRUCTION TRAFFIC CONTROL PLAN TIERRA OESTE UNIT 1

Design Review Committee

FEB 27 2000

DESIGN
REVIEW COMMITTEE

City Engineer Approval

AUG 16 2000

CITY ENGINEER

Last Design Update

City Project No. 5297.90	Zone Map No. J-9-Z	Sheet 18	Of 30
-----------------------------	-----------------------	-------------	----------


ENGINEER'S SEAL		SURVEY INFORMATION		BENCH MARKS		AS BUILT INFORMATION	
		FIELD NOTES				CONTRACTOR	
		BY		DATE		STARTED BY	
		NO.				INSPECTOR'S	
						DATE	
						FILED PLACE	
						DATE	
						VERIFICATION BY	
						DATE	
						DRAWN BY	
						DATE	
						MICRO-FILM INFORMATION	
						RECORDED BY	
						DATE	
						ALBUQUERQUE ACS MONUMENT "BH-40"	CONTRACTOR
						LOCATED APPROXIMATELY 623' NORTH OF	STARTED BY
						AND 888' WEST OF THE NORTHWEST	INSPECTOR'S
						CORNER OF UNIT 1 BETWEEN TWO POWER	DATE
						POLES.	FILED PLACE
						ELEVATION = 5305.43	DATE
							VERIFICATION BY
							DATE
							DRAWN BY
							DATE
							MICRO-FILM INFORMATION
							RECORDED BY
							DATE

03JAN00 (TE)
HZRANCHO\PROJ\OT\ORIG-NEW-99\DWG\UNIT1\18-30.DWG


CONSTRUCTION TRAFFIC CONTROL GENERAL NOTES

- CONTRACTOR MUST OBTAIN FROM CONSTRUCTION COORDINATION AN EXCAVATION/BARRICADING PERMIT BEFORE ENGAGING IN ANY CONSTRUCTION, MAINTENANCE OR REPAIR WORK IN ANY OF THE CITY OF ALBUQUERQUE'S RIGHTS-OF-WAY. EMERGENCY WORK THAT WOULD PRESERVE LIFE OR PROPERTY IS EXCLUDED WITH THE UNDERSTANDING, THAT A PERMIT SHALL BE OBTAINED WITHIN 24 TO 48 HOURS.
- CONTRACTOR SHALL AT THE TIME OF PERMIT REQUEST, SUBMIT FOR APPROVAL BY CONSTRUCTION COORDINATION, A TRAFFIC CONTROL PLAN DETAILING ALL EXISTING TOPOGRAPHY SUCH AS LANE WIDTHS, DRIVEWAYS, AND BUSINESS/RESIDENTIAL ACCESSES. THE TRAFFIC CONTROL PLAN SHALL INCLUDE ALL PHASES OF WORK AND SCHEDULES INVOLVED IN THE CONSTRUCTION PROJECT. ANY SEPARATE PHASES OF A CONSTRUCTION PROJECT SHALL BE GIVEN AN INDIVIDUAL PERMIT EACH. BLANKET PERMITS WILL NOT BE ISSUED.
- THESE TYPICAL TRAFFIC CONTROL PLANS DO NOT REFLECT THE EXISTING TOPOGRAPHY SUCH AS DRIVEWAYS, LANE WIDTHS, AND BUSINESS/RESIDENTIAL ACCESSES. EVERY LOCATION THAT REQUIRES CONSTRUCTION TRAFFIC CONTROL SHALL HAVE A DETAILED TRAFFIC CONTROL PLAN SHOWING ALL EXISTING TOPOGRAPHY.
- CONSTRUCTION SHALL NOT BEGIN UNLESS A TRAFFIC CONTROL PLAN HAS BEEN APPROVED AND VERIFIED BY CONSTRUCTION COORDINATION.
- CONSTRUCTION COORDINATION SHALL BE NOTIFIED 48 HOURS PRIOR TO ANY TRAFFIC CONTROL CHANGES NEEDED BY CONTRACTOR, THAT WERE NOT PREVIOUSLY APPROVED. THESE TRAFFIC CONTROL CHANGES SHALL BE REQUESTED IN WRITING ACCOMPANIED WITH A TRAFFIC CONTROL PLAN REFLECTING SUCH CHANGES.
- ALL CONSTRUCTION TRAFFIC CONTROL DEVICES SHALL COMPLY TO THE MANUAL ON UNIFORM TRAFFIC CONTROL DEVICES (MUTCD), LATEST EDITION. IT IS THE RESPONSIBILITY OF THE CONTRACTOR TO INSTALL, SERVICE AND MAINTAIN ALL TRAFFIC CONTROL DEVICES. TRAFFIC CONTROL DEVICES SHALL NOT BE REMOVED OR ALTERED IN ANY WAY WITHOUT THE APPROVAL OF CONSTRUCTION COORDINATION, PER SECTION 6A-4 OF THE MUTCD, LATEST EDITION.
- THE CONSTRUCTION TRAFFIC CONTROL INITIAL SET-UP SHALL BE BY AN AMERICAN TRAFFIC SAFETY SERVICES ASSOCIATION (ATSSA) CERTIFIED WORKSITE TRAFFIC SUPERVISOR. THE MAINTENANCE AND SERVICING SHALL ALSO BE DONE BY AN ATSSA CERTIFIED WORKSITE TRAFFIC SUPERVISOR OR EQUIVALENT.
- CONTRACTOR IS RESPONSIBLE TO MAINTAIN AND SERVICE ALL TRAFFIC CONTROL DEVICES 24 HOURS A DAY, 7 DAYS A WEEK THROUGHOUT LENGTH OF PROJECT. CONTRACTOR IS RESPONSIBLE THAT ALL TRAFFIC CONTROL DEVICES COMPLY WITH THE MUTCD, LATEST EDITION.
- ALL ADVANCE WARNING SIGNS SHALL BE DOUBLE INDICATED WHENEVER THERE ARE MULTI-LANE TRAFFIC IN ANY ONE GIVEN DIRECTION AND THERE IS SUFFICIENT MEDIAN SPACE.
- ALL BARRICADES IN ALL TAPERS AND TANGENTS SHALL BE PLACED APART, A DISTANCE MEASURED IN FEET, EQUAL TO THAT OF THE POSTED SPEED LIMIT. NO EXCEPTIONS UNLESS APPROVED BY CONSTRUCTION COORDINATION PER MUTCD SECTION 6A-4.
- CONTRACTOR SHALL NOT BEGIN WORK BEFORE 7:00 A.M. OR END WORK AFTER 7:00 P.M. WITHOUT THE APPROVAL OF CONSTRUCTION COORDINATION.
- CONTRACTOR IS RESPONSIBLE TO PROVIDE CONSTRUCTION COORDINATION, A WEEKLY LOG OF DAILY INSPECTIONS OF BARRICADE AND MAINTENANCE SCHEDULES ON PROJECTS THAT ARE OVER ONE WEEK DURATION.
- EQUIPMENT OR MATERIALS SHALL NOT BE STORED WITHIN 15 FEET OF A TRAVELLED TRAFFIC LANE DURING NON-WORKING HOURS WITHOUT THE APPROVAL OF CONSTRUCTION COORDINATION.
- CONTRACTOR SHALL PROVIDE AND MAINTAIN A SAFE AND ADEQUATE MEANS OF CHANNELIZING PEDESTRIAN TRAFFIC AROUND AND THROUGH THE CONSTRUCTION AREA.
- CONTRACTOR IS RESPONSIBLE FOR OBLITERATION OF ANY CONFLICTING STRIPING AND RESPONSIBLE FOR ALL TEMPORARY STRIPING.
- CONTRACTOR SHALL MAINTAIN ACCESS TO ALL FACILITIES, BUSINESSES AND/OR RESIDENTS AT ALL TIMES.
- CONTRACTOR SHALL PROVIDE ACCESS SIGNS FOR BUSINESSES LOCATED WITHIN THE CONSTRUCTION AREA UNDER THE SUPERVISION OF CONSTRUCTION COORDINATION. EACH ACCESS SIGN SHALL HAVE 5 INCH, WHITE OPAQUE LETTERING ON BLUE REFLECTORIZED BACKGROUND. ACCESS SIGNS SHALL BE CONSIDERED INCIDENTAL TO THE BID AND NOT PART OF THE CONTRACT UNLESS OTHERWISE STATED. NO MORE THAN 3 BUSINESSES SHALL BE LISTED ON A ACCESS SIGN. SHOPPING CENTERS AND MALLS SHALL BE LISTED AS SUCH.
- ALL ADVANCE WARNING SIGNS SHALL MEET THE MINIMUM REFLECTIVE INTENSITY REQUIREMENTS SET FORTH BY THE CITY OF ALBUQUERQUE. CONSTRUCTION COORDINATION SHALL DETERMINE ALL REQUIREMENTS AND APPROVE OR DISAPPROVE ANY ADVANCE WARNING SIGN PER SECTION 6A-4 OF THE MUTCD, LATEST EDITION.
- 24 HOURS PRIOR TO OCCUPANCY OR CLOSING OF A RIGHT-OF-WAY, CONTRACTOR SHALL NOTIFY: POLICE, FIRE DEPARTMENT, SCHOOLS, HOSPITALS, TRANSIT AUTHORITY, BUSINESSES AND/OR RESIDENTS THAT WILL BE AFFECTED BY THE CONSTRUCTION.
- ANY FIELD ADJUSTMENTS SHALL BE APPROVED BY CONSTRUCTION COORDINATION.


- EXCAVATIONS SHALL BE PLATED, TEMPORARILY PATCHED OR RESURFACED PRIOR TO OPENING OF TRAFFIC. A MINIMUM OF 11 FEET SHALL BE PROVIDED FOR TRAFFIC IN ANY GIVEN DIRECTION. CONTRACTOR IS RESPONSIBLE FOR ANY WORK INVOLVED IN SATISFYING THESE REQUIREMENTS.
- CONTRACTOR SHALL AT ALL TIMES COMPLY WITH THE FOLLOWING:
 - STANDARDS AND REQUIREMENTS SET FORTH IN THE MANUAL ON UNIFORM TRAFFIC CONTROL DEVICES, LATEST EDITION.
 - THE CITY OF ALBUQUERQUE TRAFFIC CODE, LATEST EDITION.
 - SECTION 19 OF THE CITY OF ALBUQUERQUE'S STANDARD SPECIFICATIONS FOR PUBLIC WORK CONSTRUCTION, AS WELL AS OTHER SECTIONS.
- FAILURE TO COMPLY WITH ANY OF THE ABOVE MENTIONED, WILL BE ADEQUATE CAUSE TO CEASE ALL WORK ON ANY CONSTRUCTION PROJECT. WORK WILL NOT RESUME UNTIL ALL REQUIREMENTS ARE ADDRESSED AND APPROVED BY CONSTRUCTION COORDINATION.
- ALL TRAFFIC CONTROL DEVICES SHALL BE KEPT IN NEW-CLEAN CONDITION. WASHING OF EQUIPMENT IS INCIDENTAL TO ITS PLACEMENT AND MAINTENANCE.
- TRAFFIC CONTROL STANDARDS APPLY ONLY WHERE THE CONSTRUCTION TRAFFIC CONTROL PLANS ARE NOT SPECIFIC.
- ADVANCE WARNING SIGNS SHALL BE 36"x36" WITH SUPER ENGINEERING GRADE SHEETING OR BETTER.

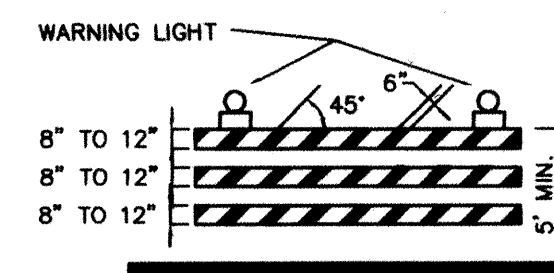


TYPE III BARRICADE

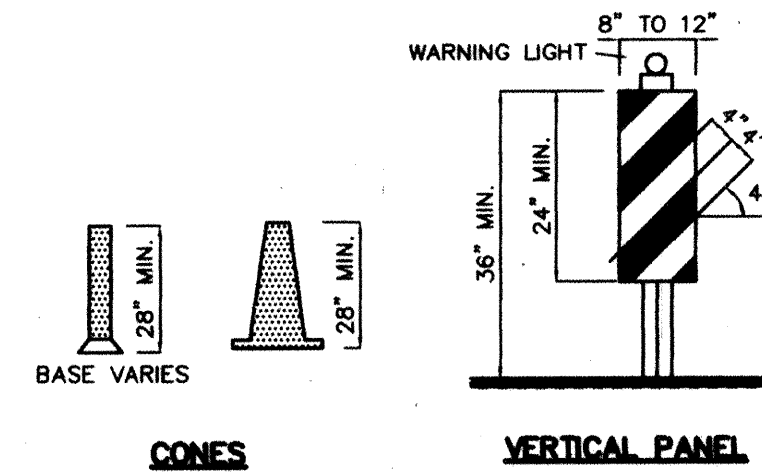

VERTICAL PANEL

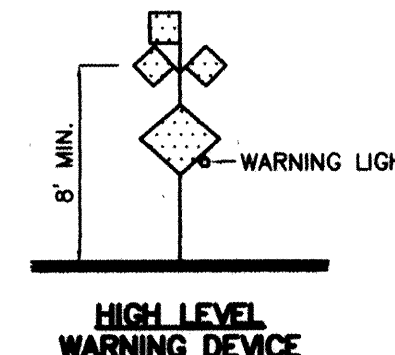

HIGH LEVEL WARNING DEVICE

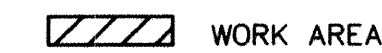

WORK AREA

BARRICADE - TYPE I, TYPE II, OR BARREL

BARRICADE - TYPE III

VERTICAL PANEL

WARNING SIGN

DISTANCE BETWEEN SIGNS - A DISTANCE MEASURED IN FEET EQUAL TO A VALUE OF TEN TIMES THE SPEED LIMIT OF THE STREET

FLAGMAN POSITION

SPACING BETWEEN BARRICADES- A DISTANCE MEASURED IN FEET EQUAL TO THE SPEED LIMIT OF THE STREET

TAPER LENGTH - SEE CHART BELOW

THE TANGENT LENGTH IS EQUAL TO THE TAPER LENGTH FOR A GIVEN STREET.

TAPER REQUIREMENTS

SPEED LIMIT (MPH)	TAPER LENGTH (L) (FEET)			MINIMUM NUMBER OF DEVICES FOR TAPER	MAXIMUM DEVICE SPACING IN FEET	
	10' LANE	11' LANE	12' LANE		ALONG TAPER	AFTER TAPER
20	70	75	80	5	20	20
25	105	115	125	6	25	25
30	150	165	180	7	30	30
35	205	225	245	8	35	35
40	270	295	320	9	40	40
45	450	495	540	13	45	45
50	500	550	600	13	50	50
55	550	605	660	13	55	55

RECOMMENDED SIGN SPACING(D) FOR ADVANCE WARNING SIGN SERIES

SPEED MILES PER HOUR	MINIMUM DISTANCE IN FEET	
	BETWEEN SIGNS	FROM LAST SIGN TO TAPER
0-20	10 X SPEED LIMIT	10 X SPEED LIMIT
25-30	10 X SPEED LIMIT	10 X SPEED LIMIT
30-35	10 X SPEED LIMIT	10 X SPEED LIMIT
40-45	10 X SPEED LIMIT	10 X SPEED LIMIT
50-60	10 X SPEED LIMIT	10 X SPEED LIMIT

TAPER CRITERIA

TYPE OF TAPER	TAPER LENGTH
---------------	--------------


UPSTREAM TAPER:	
MERGING TAPER	L MINIMUM
SHIFTING TAPER	1/2 L MINIMUM
SHOULDER TAPER	1/2 L MINIMUM
TWO-WAY TRAFFIC TAPER	100 FEET MAXIMUM
DOWNSTREAM TAPERS	100 FEET PER LANE

TAPER LENGTH COMPUTATION

SPEED LIMIT	
40 MPH OR LESS	$L = \frac{WS^2}{60}$
45 MPH OR GREATER	$L = W \times S$








L = TAPER LENGTH
W = WIDTH OF OFFSET IN FEET
S = POSTED SPEED OR OFF-PEAK 85-PERCENTILE SPEED IN MPH

SIGN FACE DETAILS

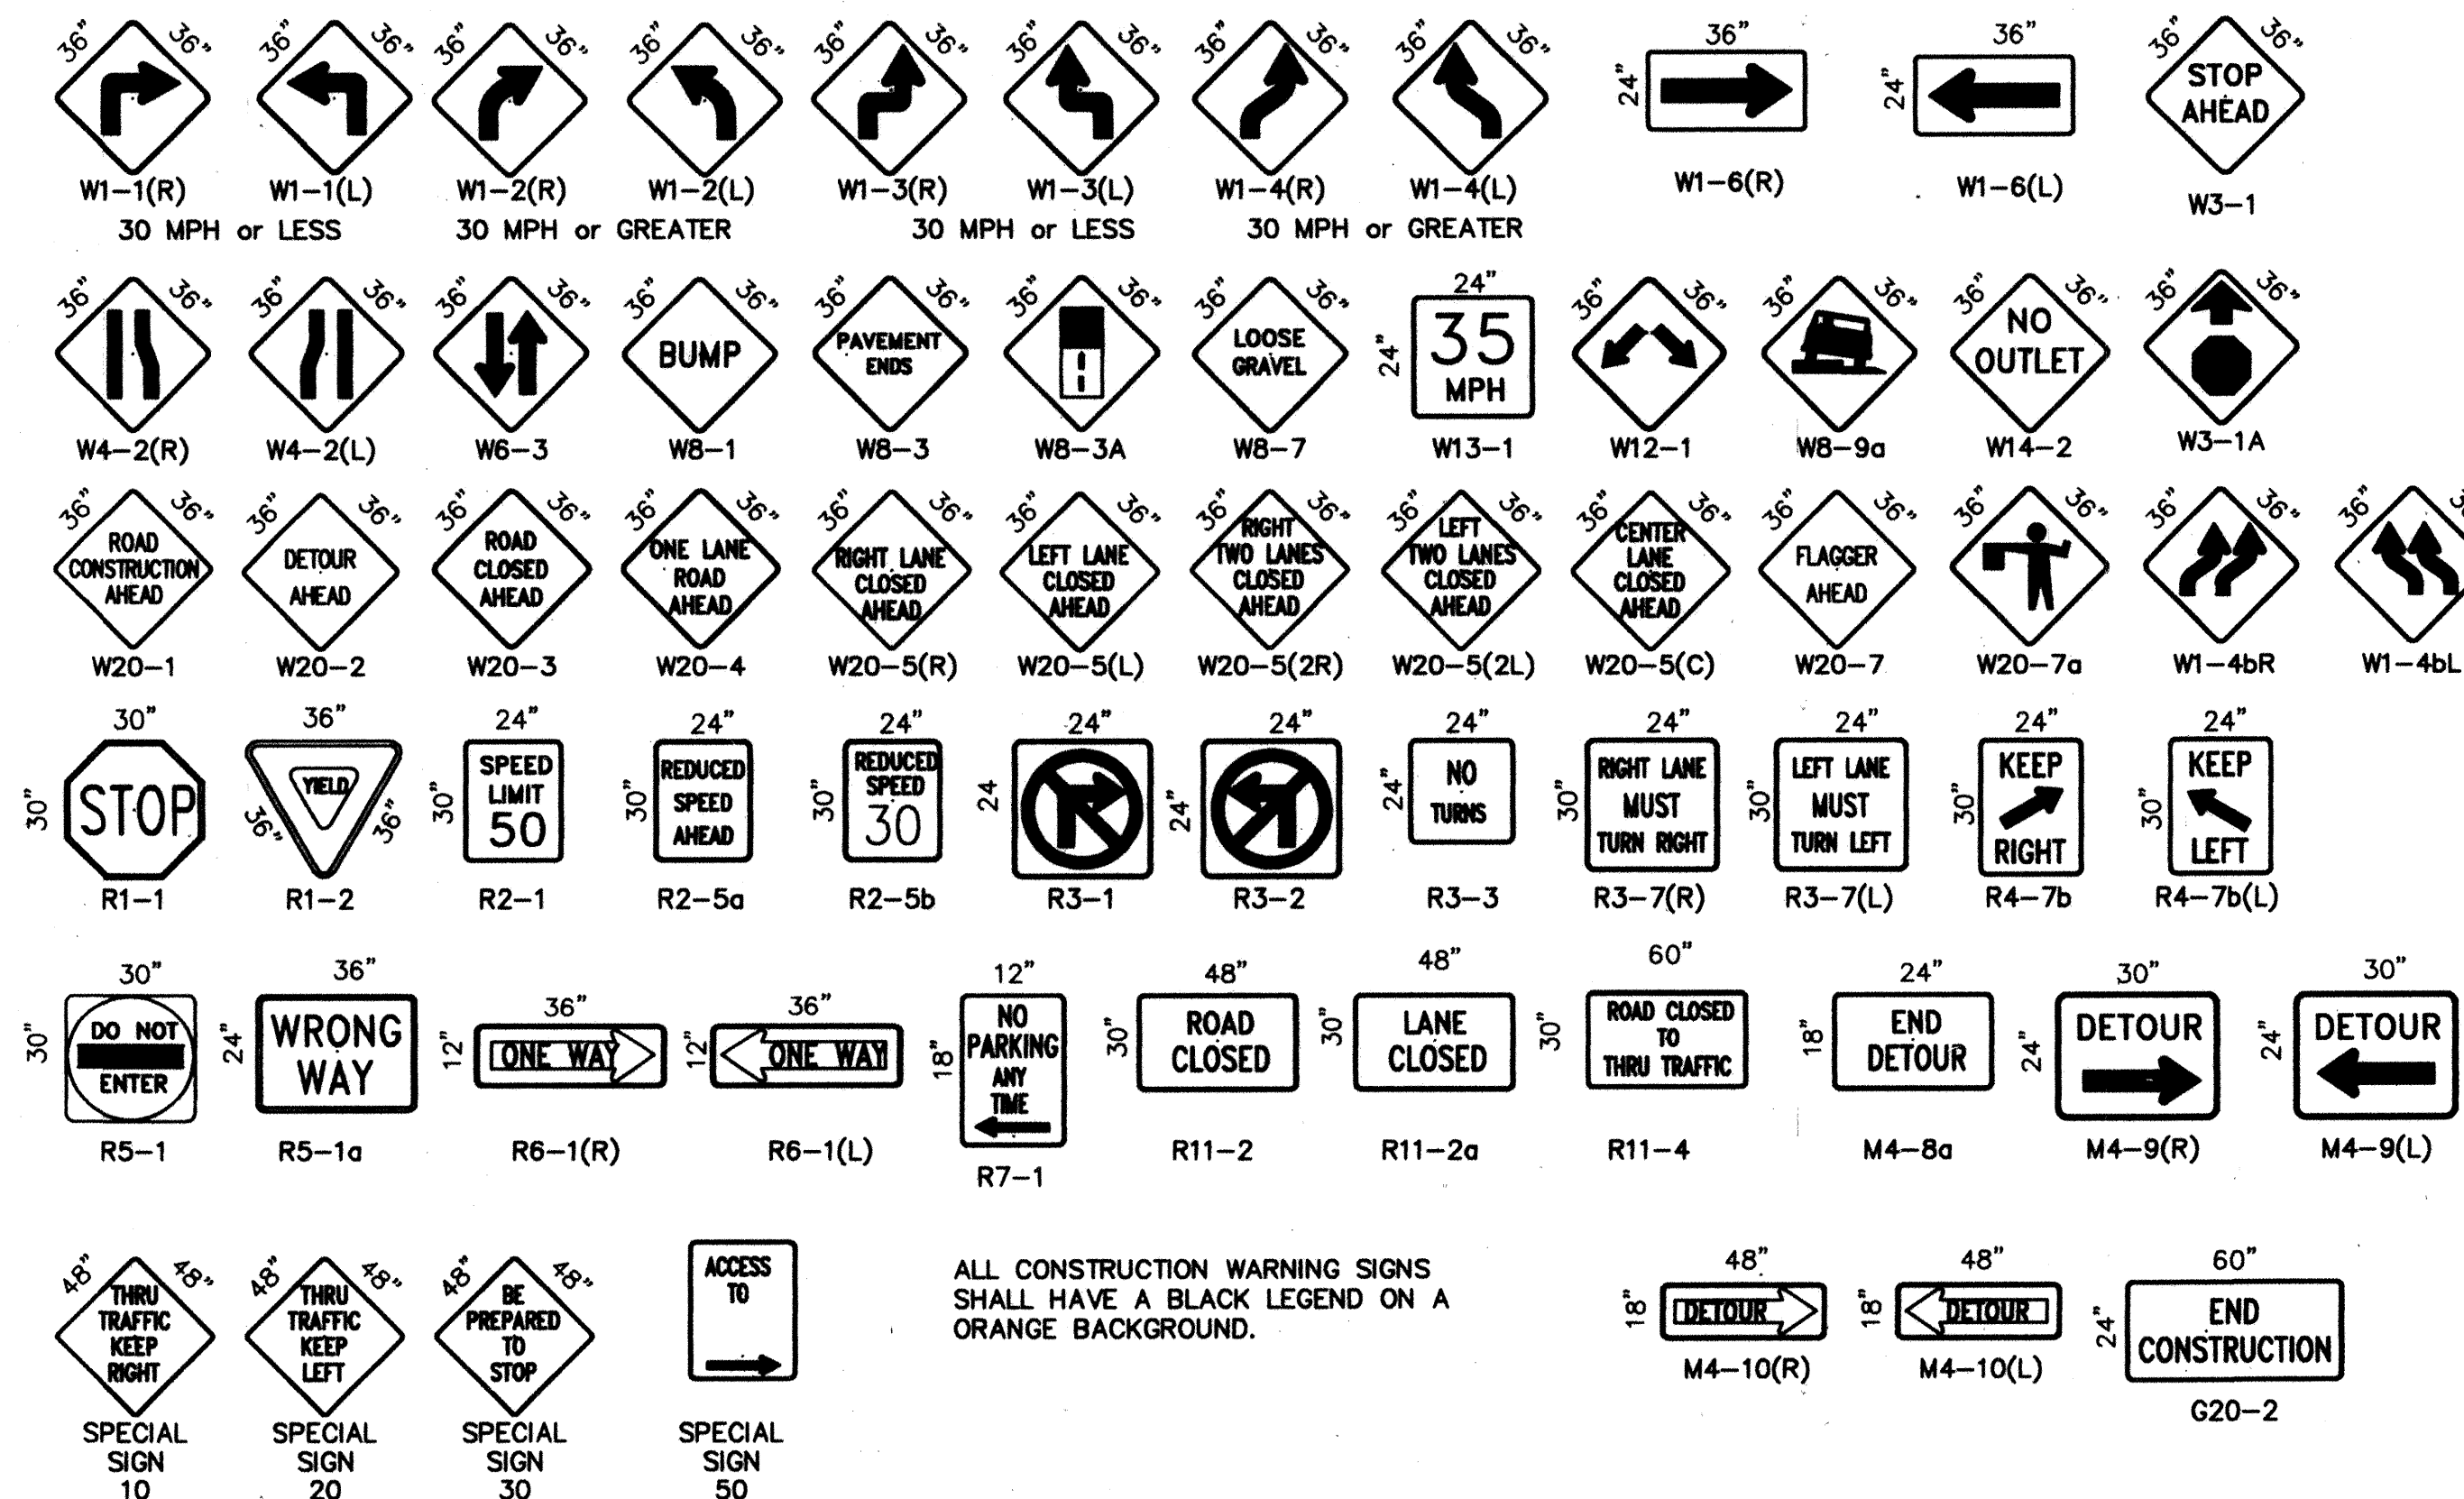

ALL CONSTRUCTION WARNING SIGNS SHALL HAVE A BLACK LEGEND ON A ORANGE BACKGROUND.


AS BUILT INFORMATION		BENCH MARKS		SURVEY INFORMATION		ENGINEER'S SEAL	
CONTRACTOR	DATE	NO.	BY	NO.	BY	NO.	BY
WORK	DATE	DATE	DATE	DATE	DATE	DATE	DATE
STANDARD BY	DATE	STANDARD BY	DATE	STANDARD BY	DATE	STANDARD BY	DATE
FIELD	DATE	FIELD	DATE	FIELD	DATE	FIELD	DATE
APPROVED BY	DATE	APPROVED BY	DATE	APPROVED BY	DATE	APPROVED BY	DATE
RECORDED BY	DATE	RECORDED BY	DATE	RECORDED BY	DATE	RECORDED BY	DATE
CITY OF ALBUQUERQUE ACS MONUMENT		CITY OF ALBUQUERQUE ACS MONUMENT		CITY OF ALBUQUERQUE ACS MONUMENT		CITY OF ALBUQUERQUE ACS MONUMENT	
"BH-40" LOCATED APPROXIMATELY		"BH-40" LOCATED APPROXIMATELY		"BH-40" LOCATED APPROXIMATELY		"BH-40" LOCATED APPROXIMATELY	
623' NORTH OF AND 888' WEST OF		623' NORTH OF AND 888' WEST OF		623' NORTH OF AND 888' WEST OF		623' NORTH OF AND 888' WEST OF	
THE NORTHWEST CORNER OF UNIT 1		THE NORTHWEST CORNER OF UNIT 1		THE NORTHWEST CORNER OF UNIT 1		THE NORTHWEST CORNER OF UNIT 1	
BETWEEN TWO POWER POLES		BETWEEN TWO POWER POLES		BETWEEN TWO POWER POLES		BETWEEN TWO POWER POLES	
ELEVATION = 5305.43		ELEVATION = 5305.43		ELEVATION = 5305.43		ELEVATION = 5305.43	
NO.		NO.		NO.		NO.	
BY		BY		BY		BY	
DATE		DATE		DATE		DATE	
REMARKS		REMARKS		REMARKS		REMARKS	
DESIGNED BY		DESIGNED BY		DESIGNED BY		DESIGNED BY	
DRAWN BY		DRAWN BY		DRAWN BY		DRAWN BY	
CHECKED BY		CHECKED BY		CHECKED BY		CHECKED BY	
CITY OF ALBUQUERQUE		CITY OF ALBUQUERQUE		CITY OF ALBUQUERQUE		CITY OF ALBUQUERQUE	
PUBLIC WORKS DEPARTMENT		PUBLIC WORKS DEPARTMENT		PUBLIC WORKS DEPARTMENT		PUBLIC WORKS DEPARTMENT	
ENGINEERING DEVELOPMENT GROUP		ENGINEERING DEVELOPMENT GROUP		ENGINEERING DEVELOPMENT GROUP		ENGINEERING DEVELOPMENT GROUP	
TITLE:		TITLE:		TITLE:		TITLE:	
SIGNING AND CONSTRUCTION TRAFFIC CONTROL STANDARDS		SIGNING AND CONSTRUCTION TRAFFIC CONTROL STANDARDS		SIGNING AND CONSTRUCTION TRAFFIC CONTROL STANDARDS		SIGNING AND CONSTRUCTION TRAFFIC CONTROL STANDARDS	
DESIGN REVIEW COMMITTEE		DESIGN REVIEW COMMITTEE		DESIGN REVIEW COMMITTEE		DESIGN REVIEW COMMITTEE	
CITY ENGINEER APPROVAL		CITY ENGINEER APPROVAL		CITY ENGINEER APPROVAL		CITY ENGINEER APPROVAL	
LAST UPDATE		LAST UPDATE		LAST UPDATE		LAST UPDATE	
PROJECT NO. 5297.90		PROJECT NO. 5297.90		PROJECT NO. 5297.90		PROJECT NO. 5297.90	
MAP NO. H-9&J-9		MAP NO. H-9&J-9		MAP NO. H-9&J-9		MAP NO. H-9&J-9	
SHEET 19 OF 30		SHEET 19 OF 30		SHEET 19 OF 30		SHEET 19 OF 30	

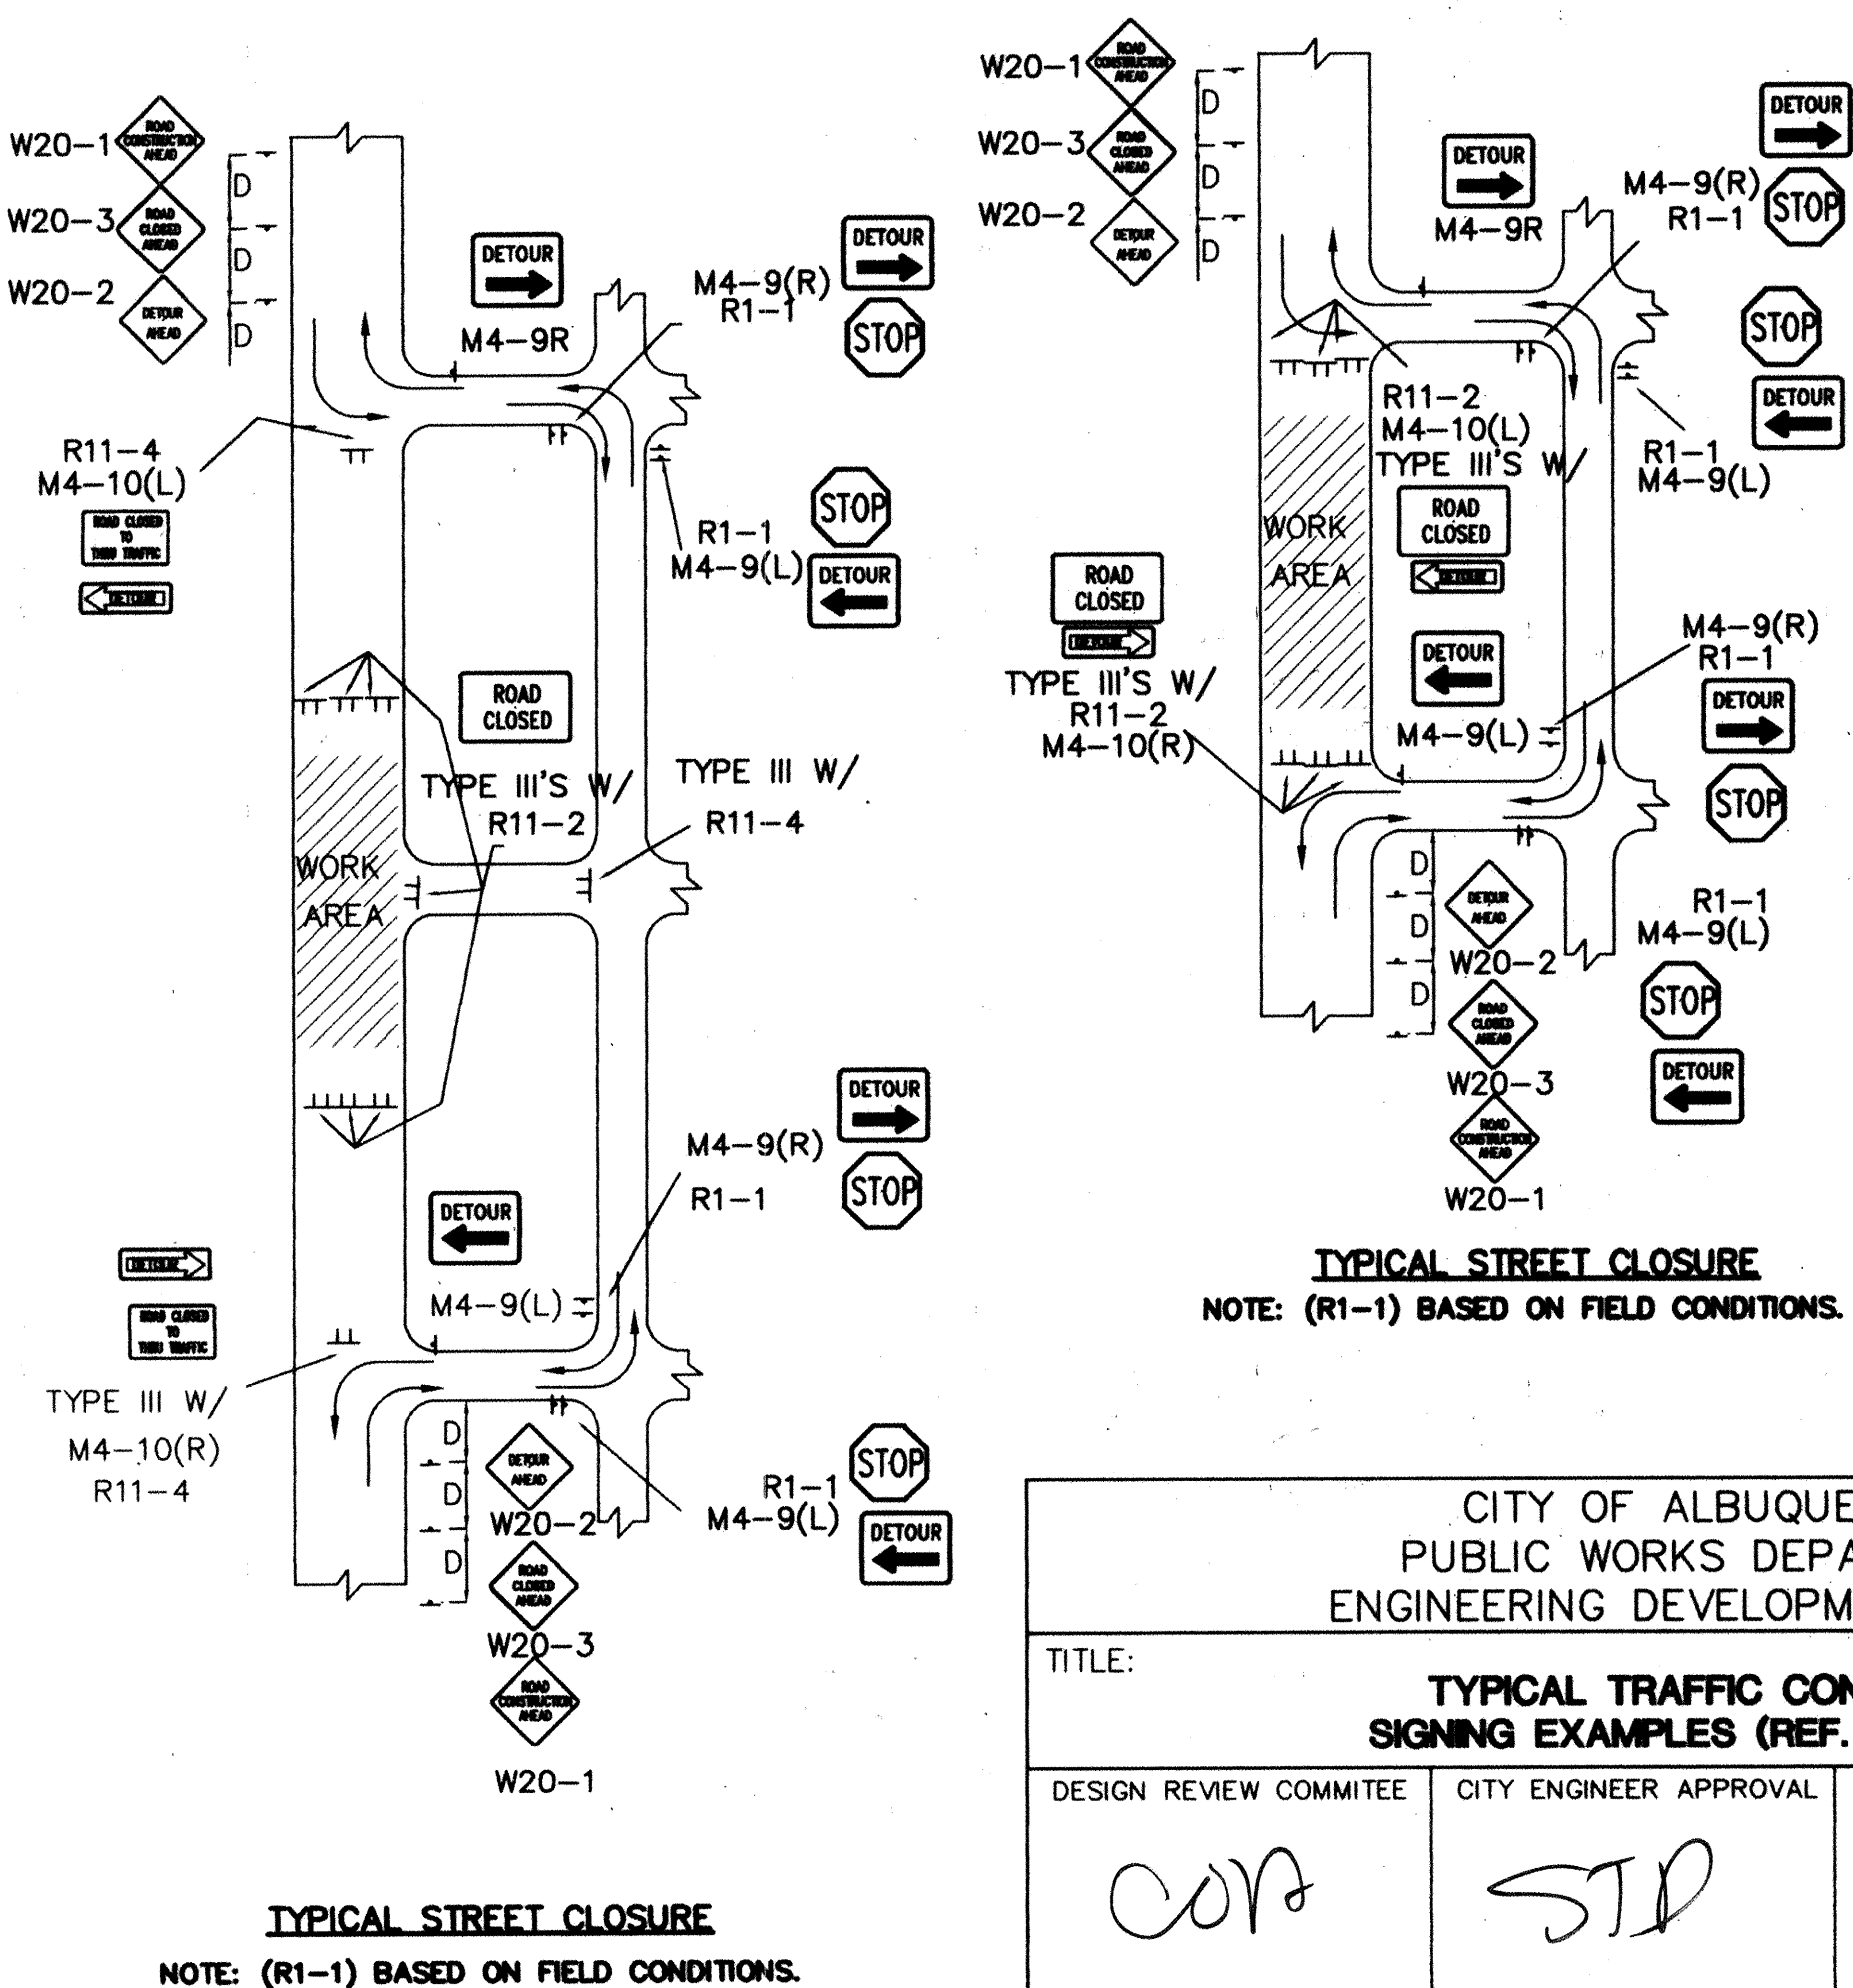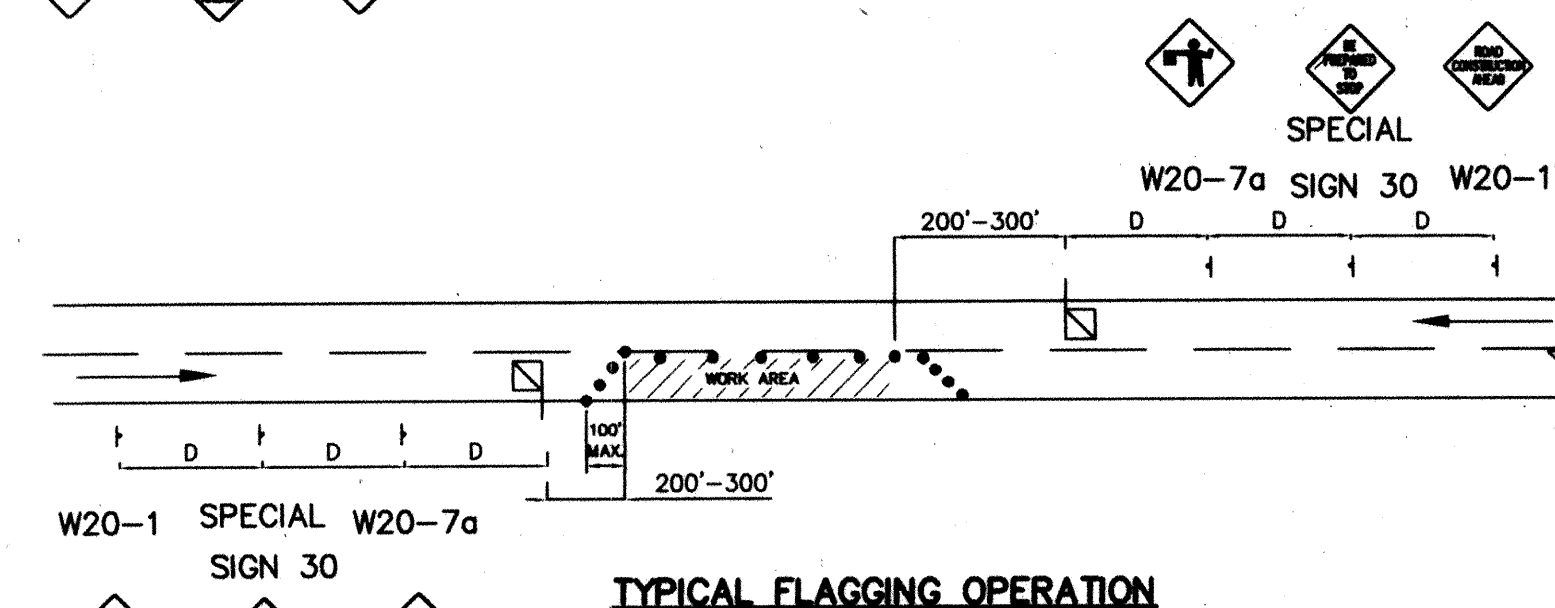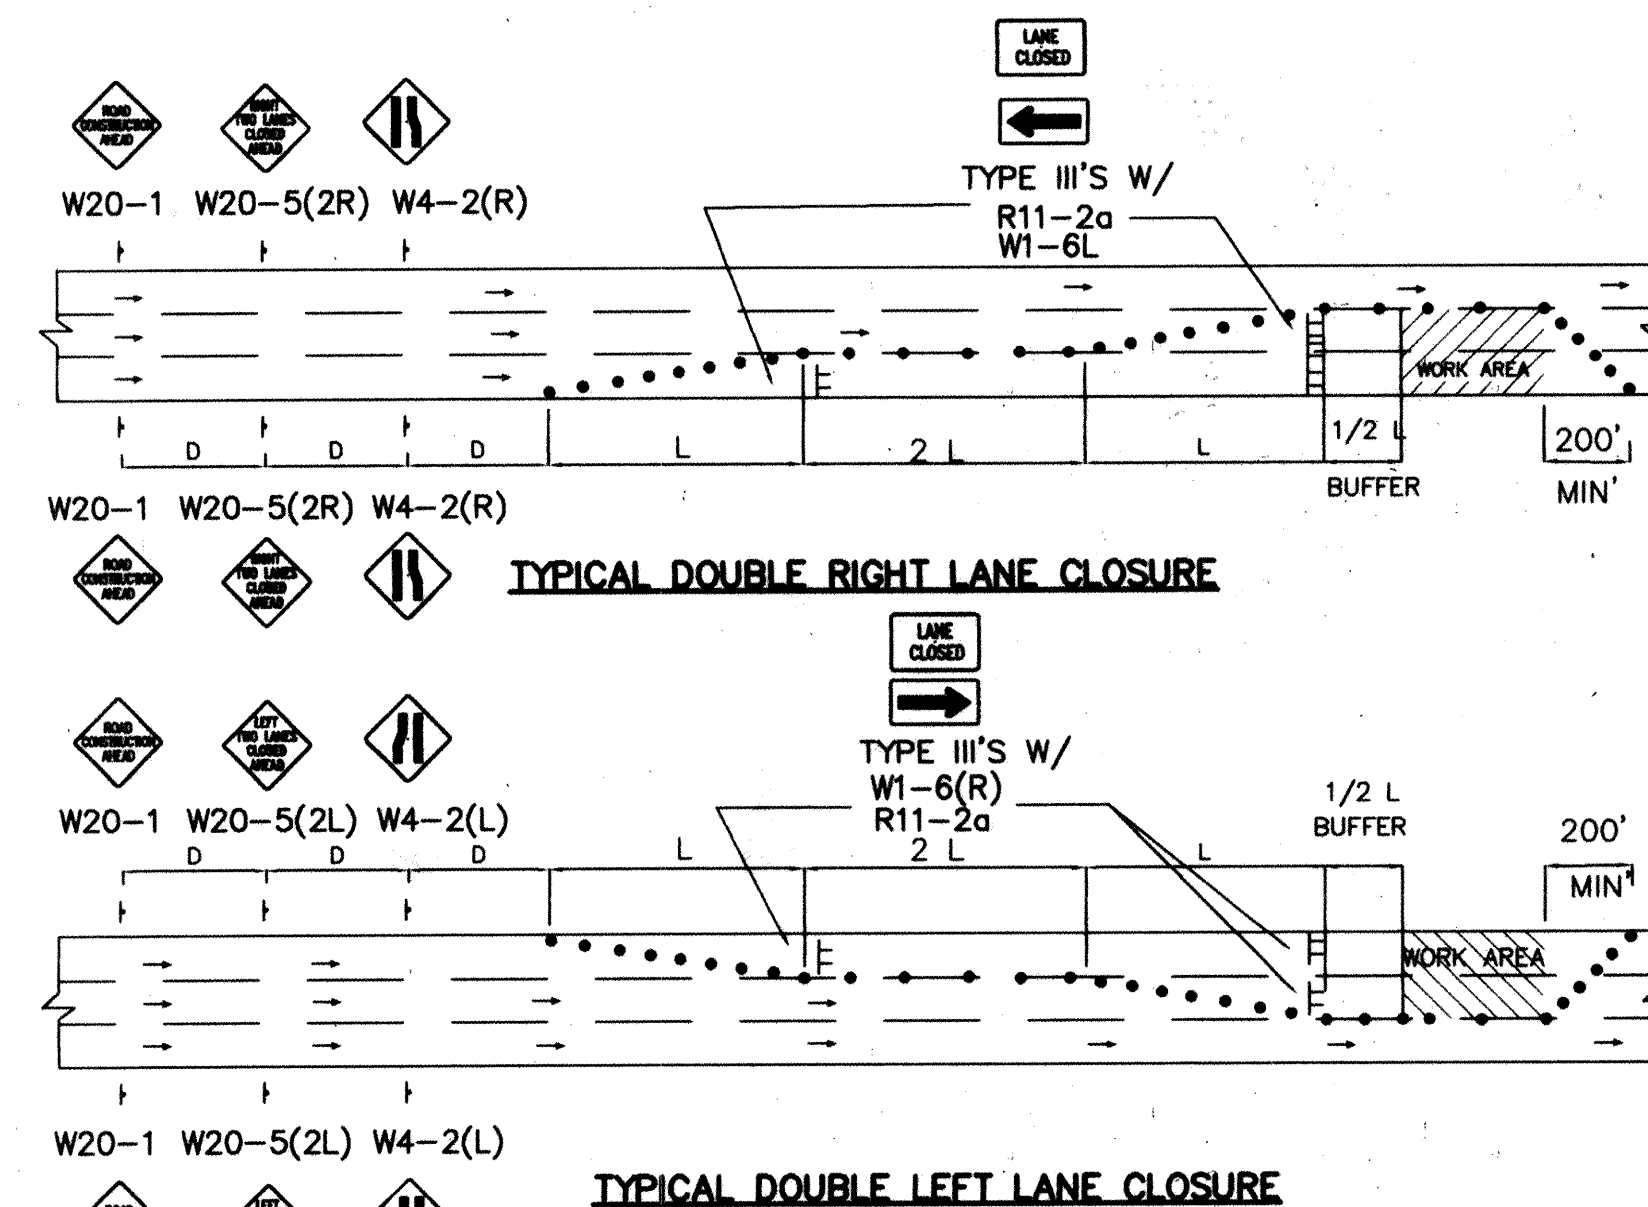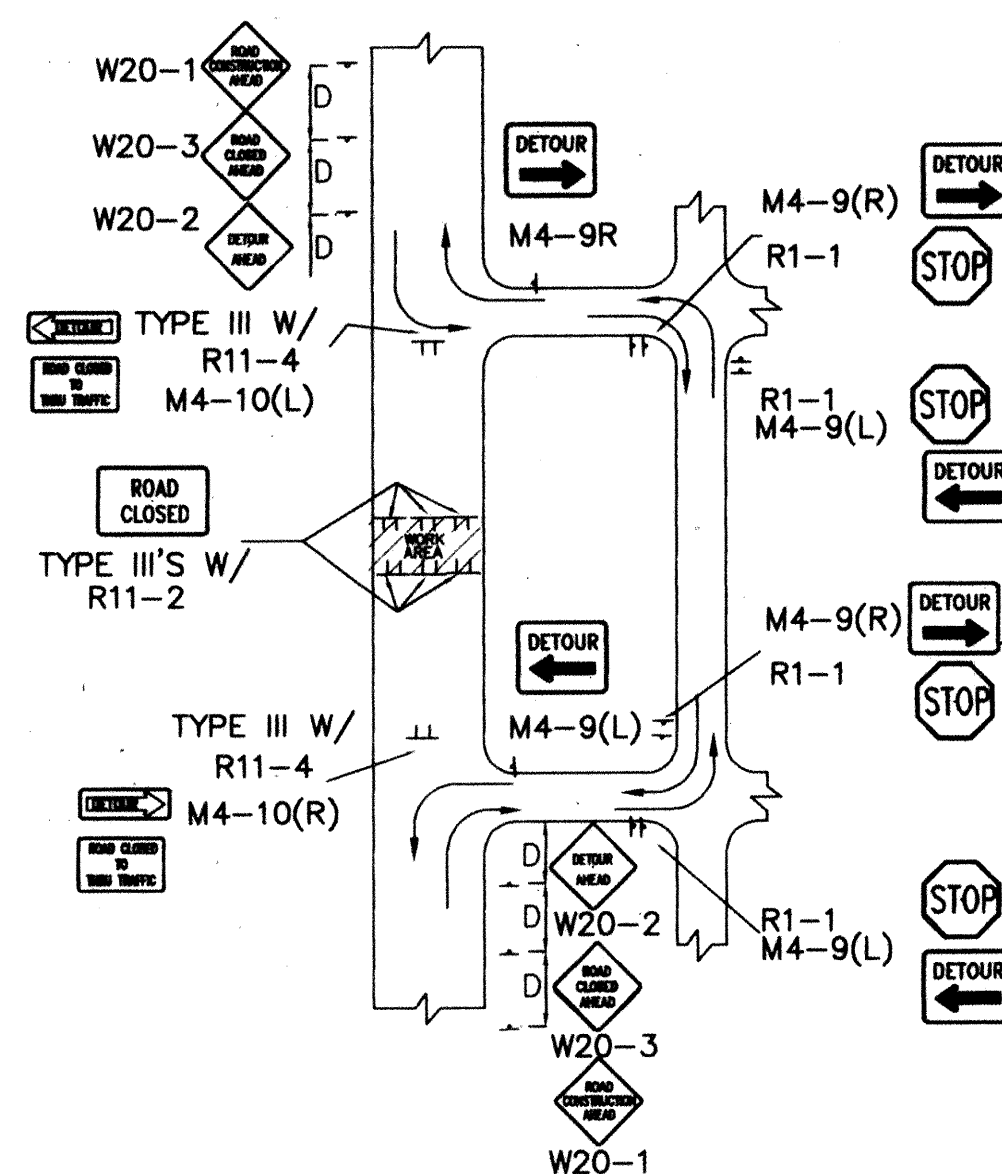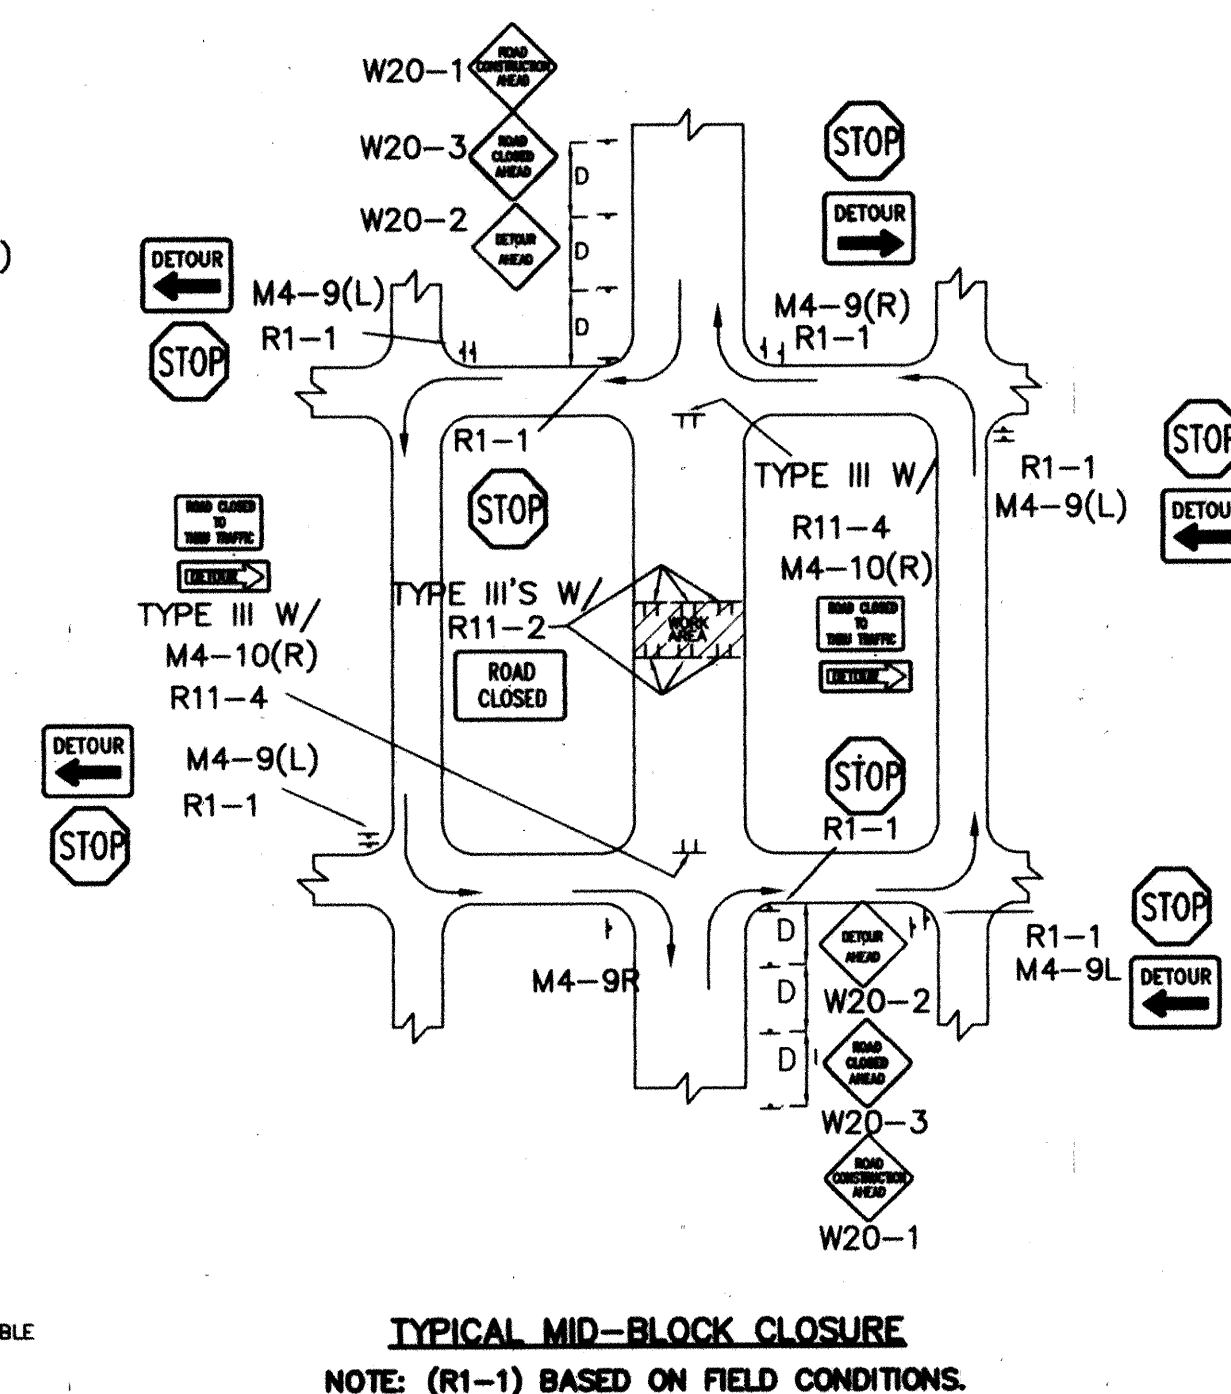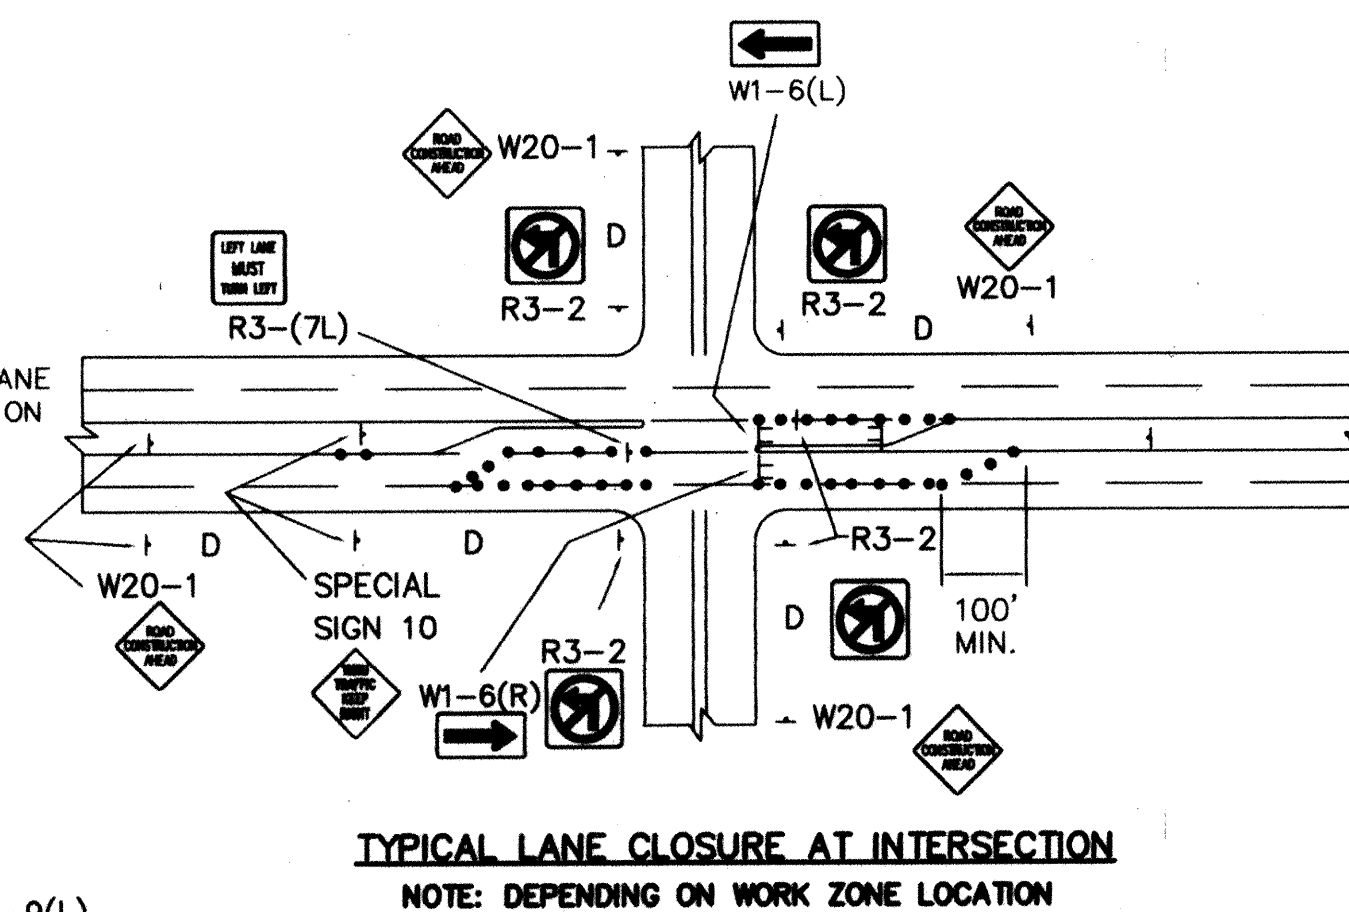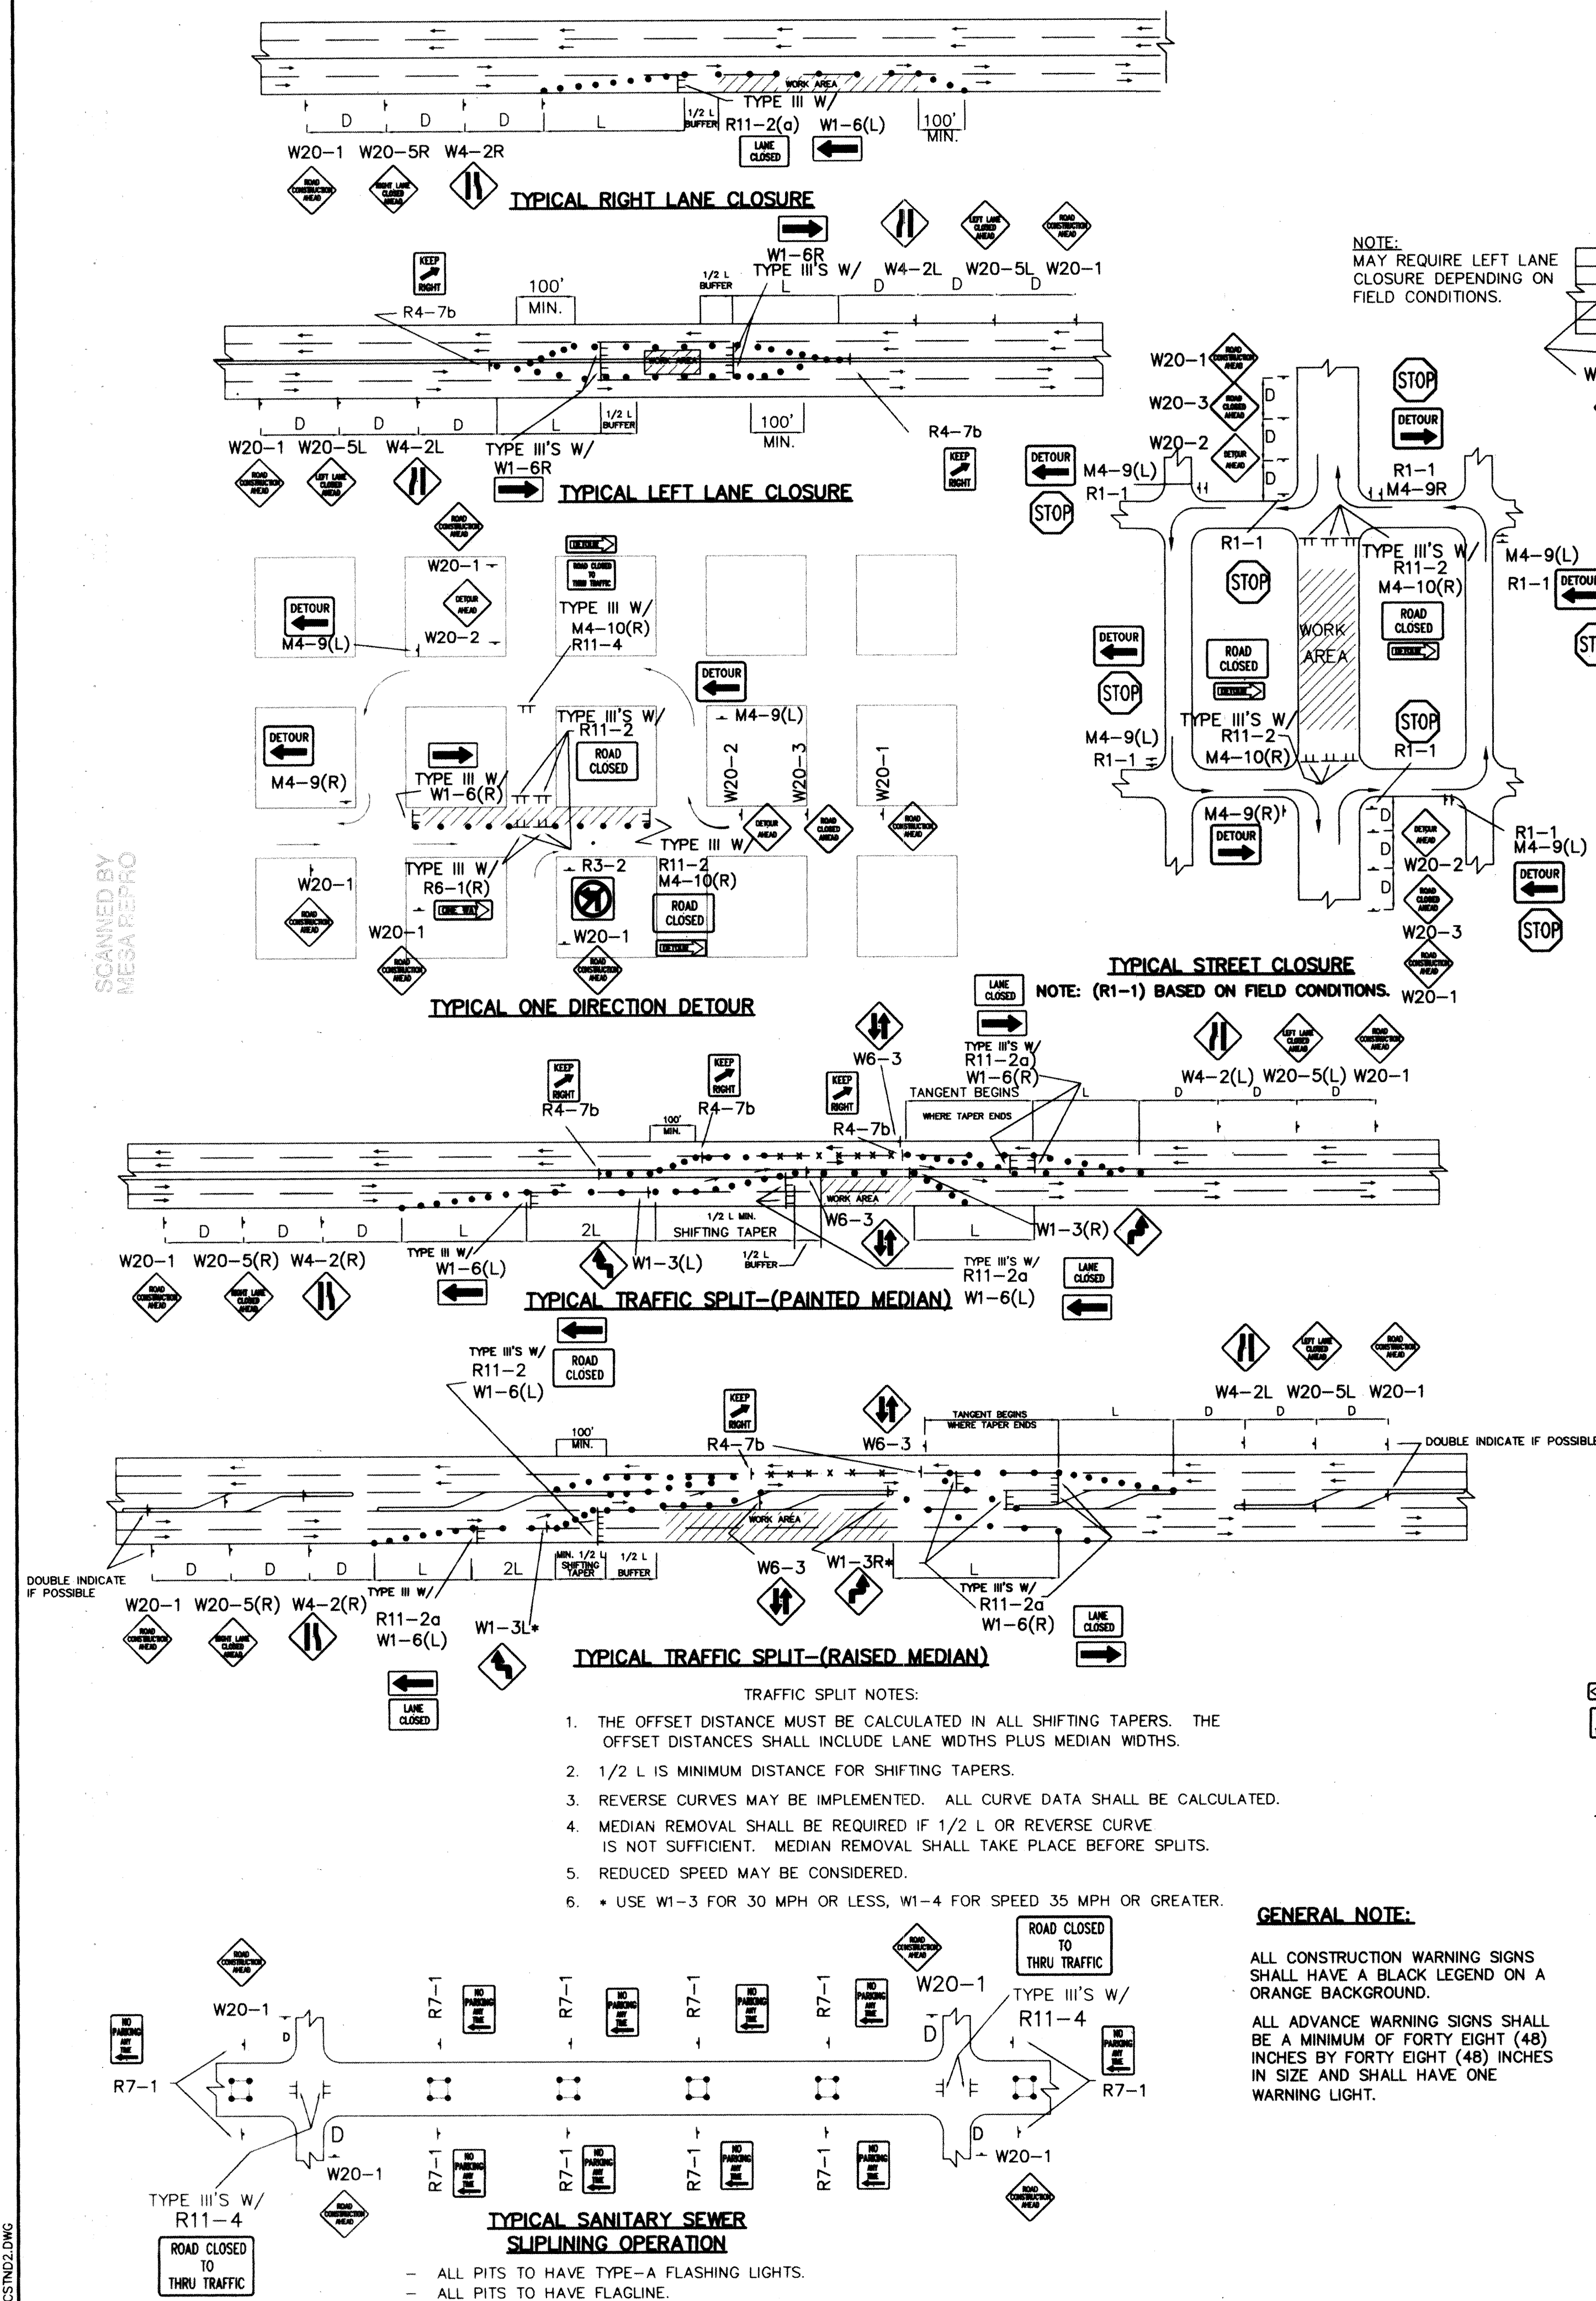[illegible]

SCANNED BY
MESA REPRO

SCALE 1"=100'

100 50 0 100 200
SCALE: 1"=100'

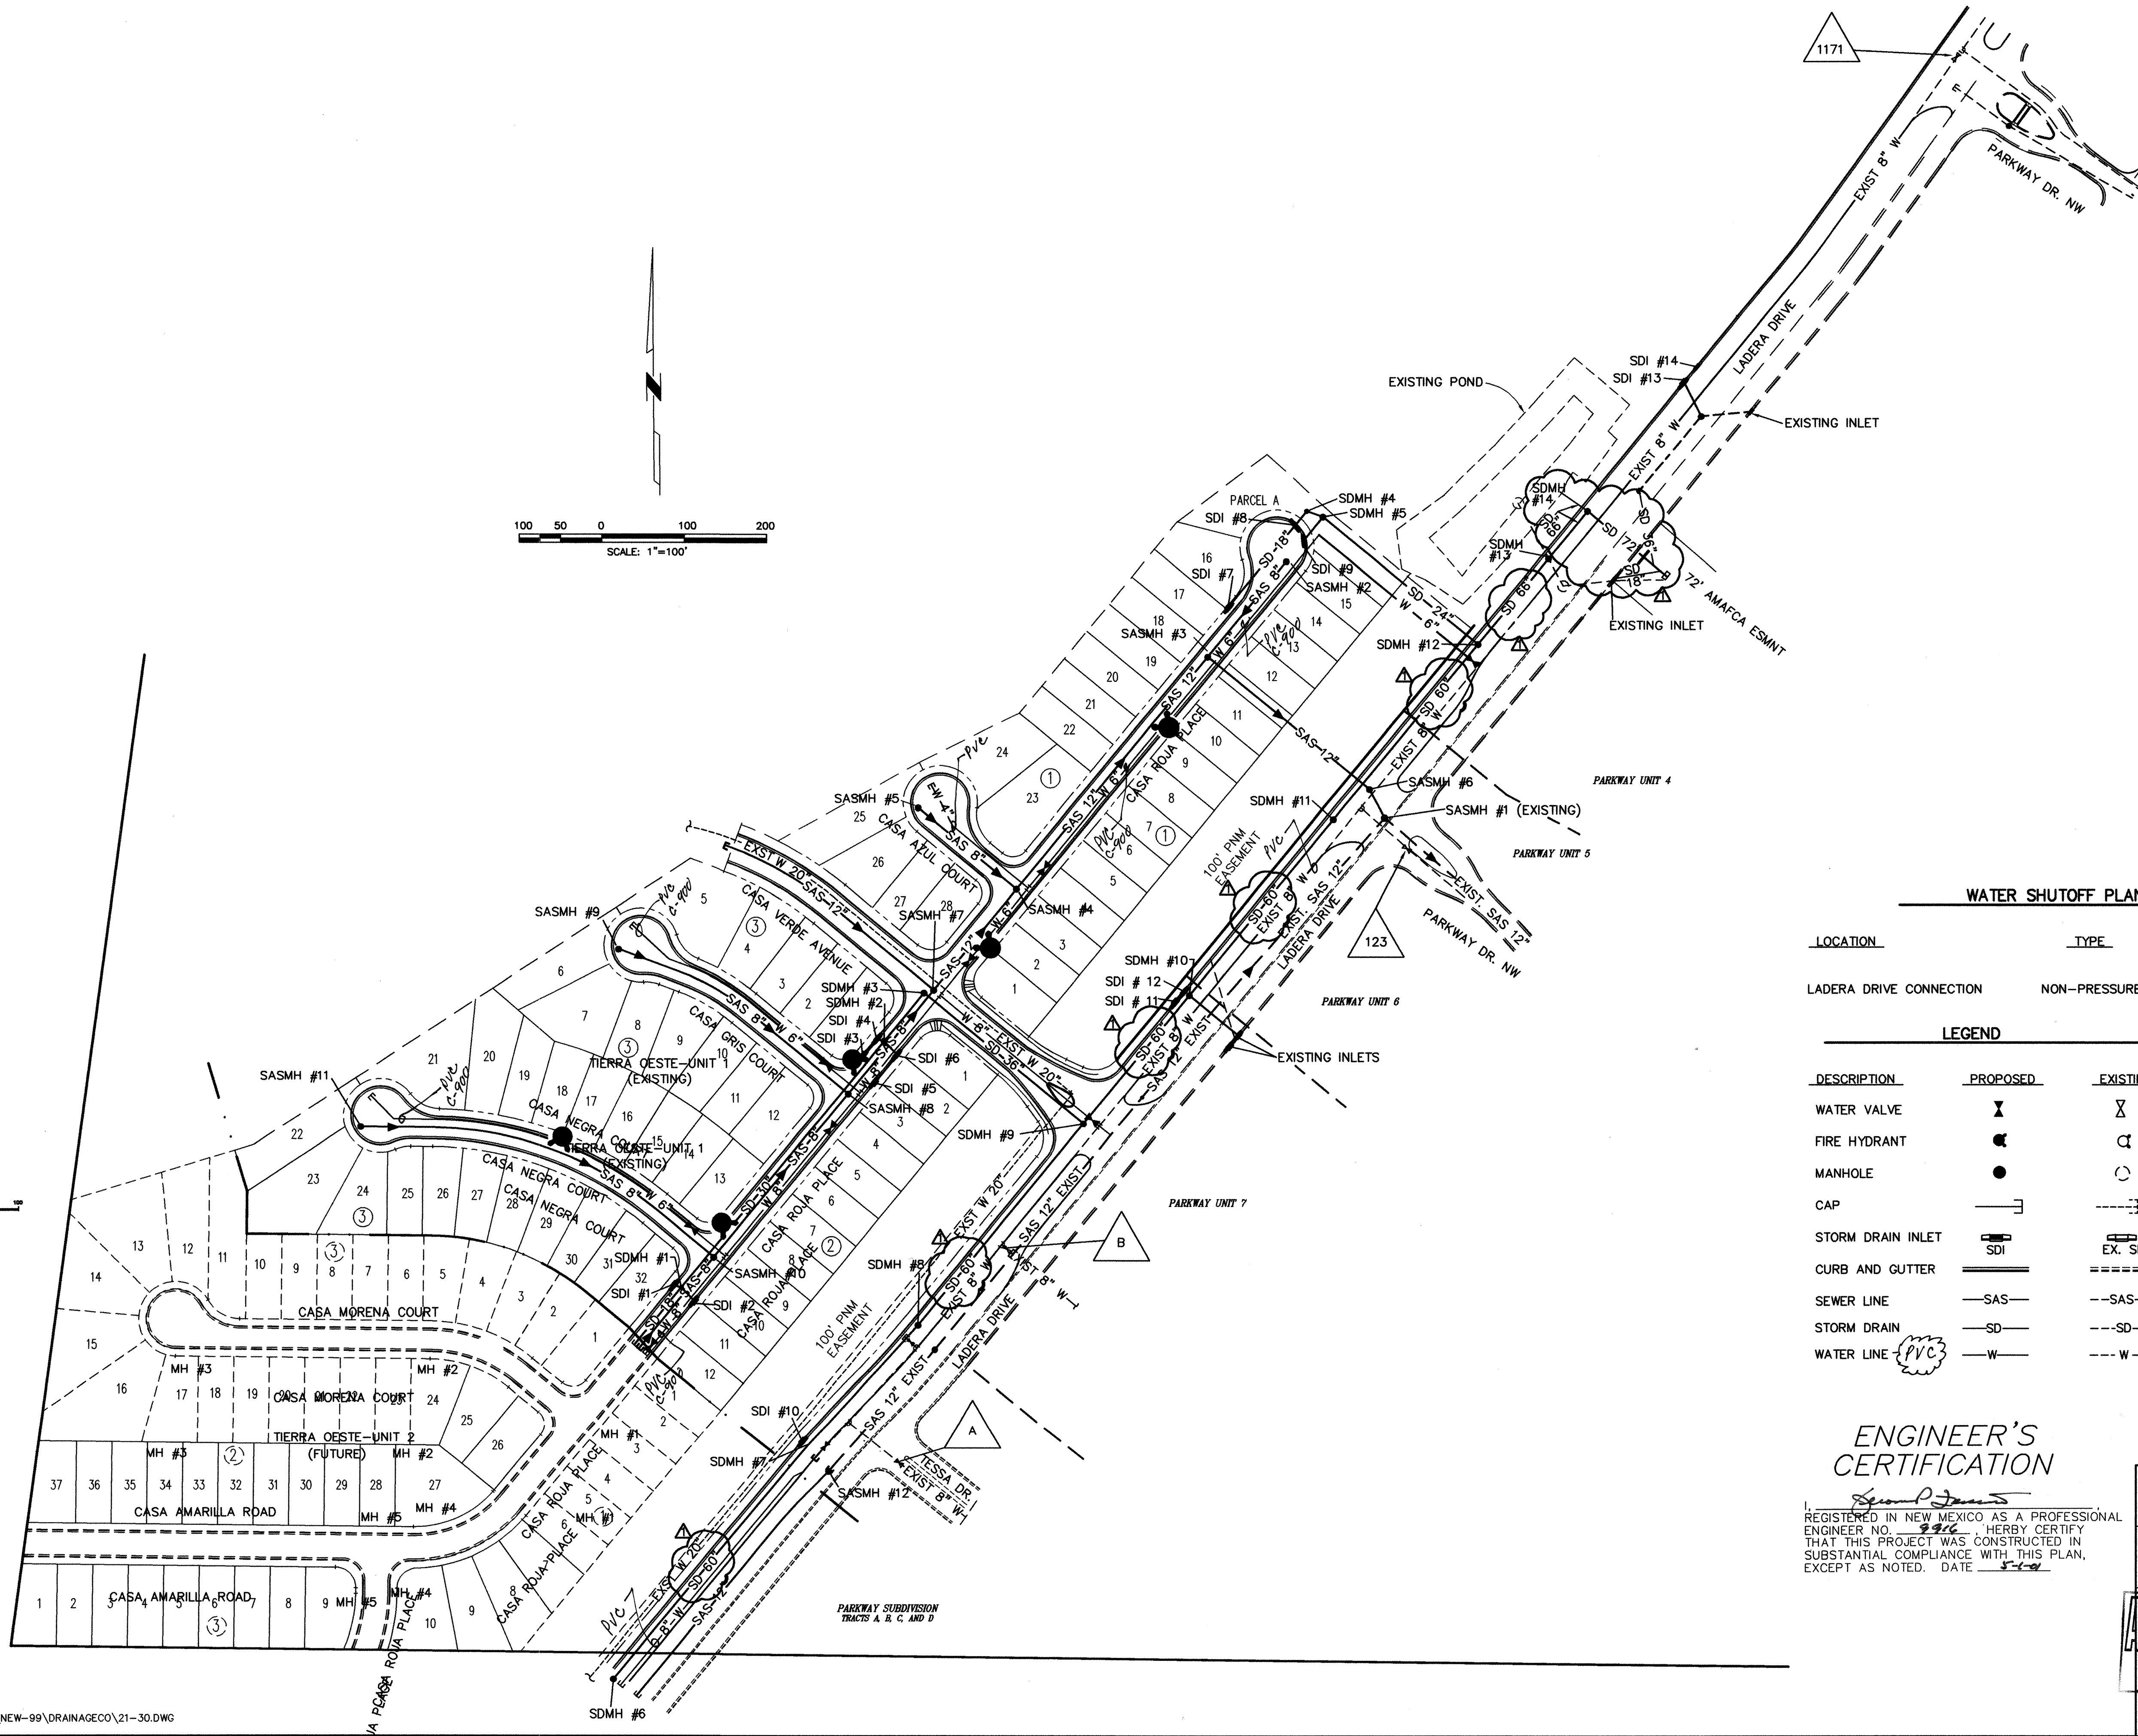

WATER SHUTOFF PLAN		
LOCATION	TYPE	CLOSE VALVE #'S
LADERA DRIVE CONNECTION	NON-PRESSURE	123 & 1171 & A & B

DESCRIPTION	PROPOSED	EXISTING
WATER VALVE		
FIRE HYDRANT		
MANHOLE		
CAP		
STORM DRAIN INLET		
CURB AND GUTTER		
SEWER LINE		
STORM DRAIN		
WATER LINE		

ENGINEER'S CERTIFICATION

I, David P. Jones
REGISTERED IN NEW MEXICO AS A PROFESSIONAL
ENGINEER NO. 9926 HERBY CERTIFY
THAT THIS PROJECT WAS CONSTRUCTED IN
SUBSTANTIAL COMPLIANCE WITH THIS PLAN,
EXCEPT AS NOTED. DATE 5-1-00

CINFRAN/HUITT-ZOLLARS
333 RIO RANCHO DR. N.E. STE. 101
RIO RANCHO, N.M. 87124
(505) 892-5141

CITY OF ALBUQUERQUE PUBLIC WORKS DEPARTMENT ENGINEERING DEVELOPMENT GROUP	
TITLE: WESTLAND DEVELOPMENT CO., INC. COMPOSITE UTILITY PLAN TIERRA OESTE UNIT 1	
DESIGN REVIEW COMMITTEE DEC 19 2000	CITY ENGINEER DEC 19 2000
City Project No. 5297.90	Zone Map No. H-9&J-9
Sheet 21	Of 30

ENGINEER'S SEAL		SURVEY INFORMATION		BENCH MARKS		AS BUILT INFORMATION	
		FIELD NOTES		ALBUQUERQUE ACS MONUMENT "BH-40"		CONTRACTOR Melendez Concrete Co.	
		NO.		DATE		WORK STAKED BY Huitt Zollars	
						ACCEPTANCE BY Huitt Zollars	
						DATE 4-01	
						FIELD VERIFICATION BY 2-01	
						DATE 5-1-01	
						CORRECTED BY Huitt Zollars	
						DATE 5-1-01	
						MICRO-FILM INFORMATION	
						RECORDED BY DATE	
						NO. DATE	
						9-21-01	


REGISTERED PROFESSIONAL ENGINEER
STATE OF NEW MEXICO
14237
RUSSELL G. GRAYSON

10/31/00


DESIGNED RGG		DATE 19MAR96	
DRAWN BY RGG		DATE 19MAR96	
CHECKED BY RGG		DATE 20EC99	

PLAN	
UNIT 1	
CONCRETE CO., INC.	
DEPARTMENT	
ALBUQUERQUE	

Sheet 21 Of 30	
Ms./Day/Yr.	
Ms./Day/Yr.	

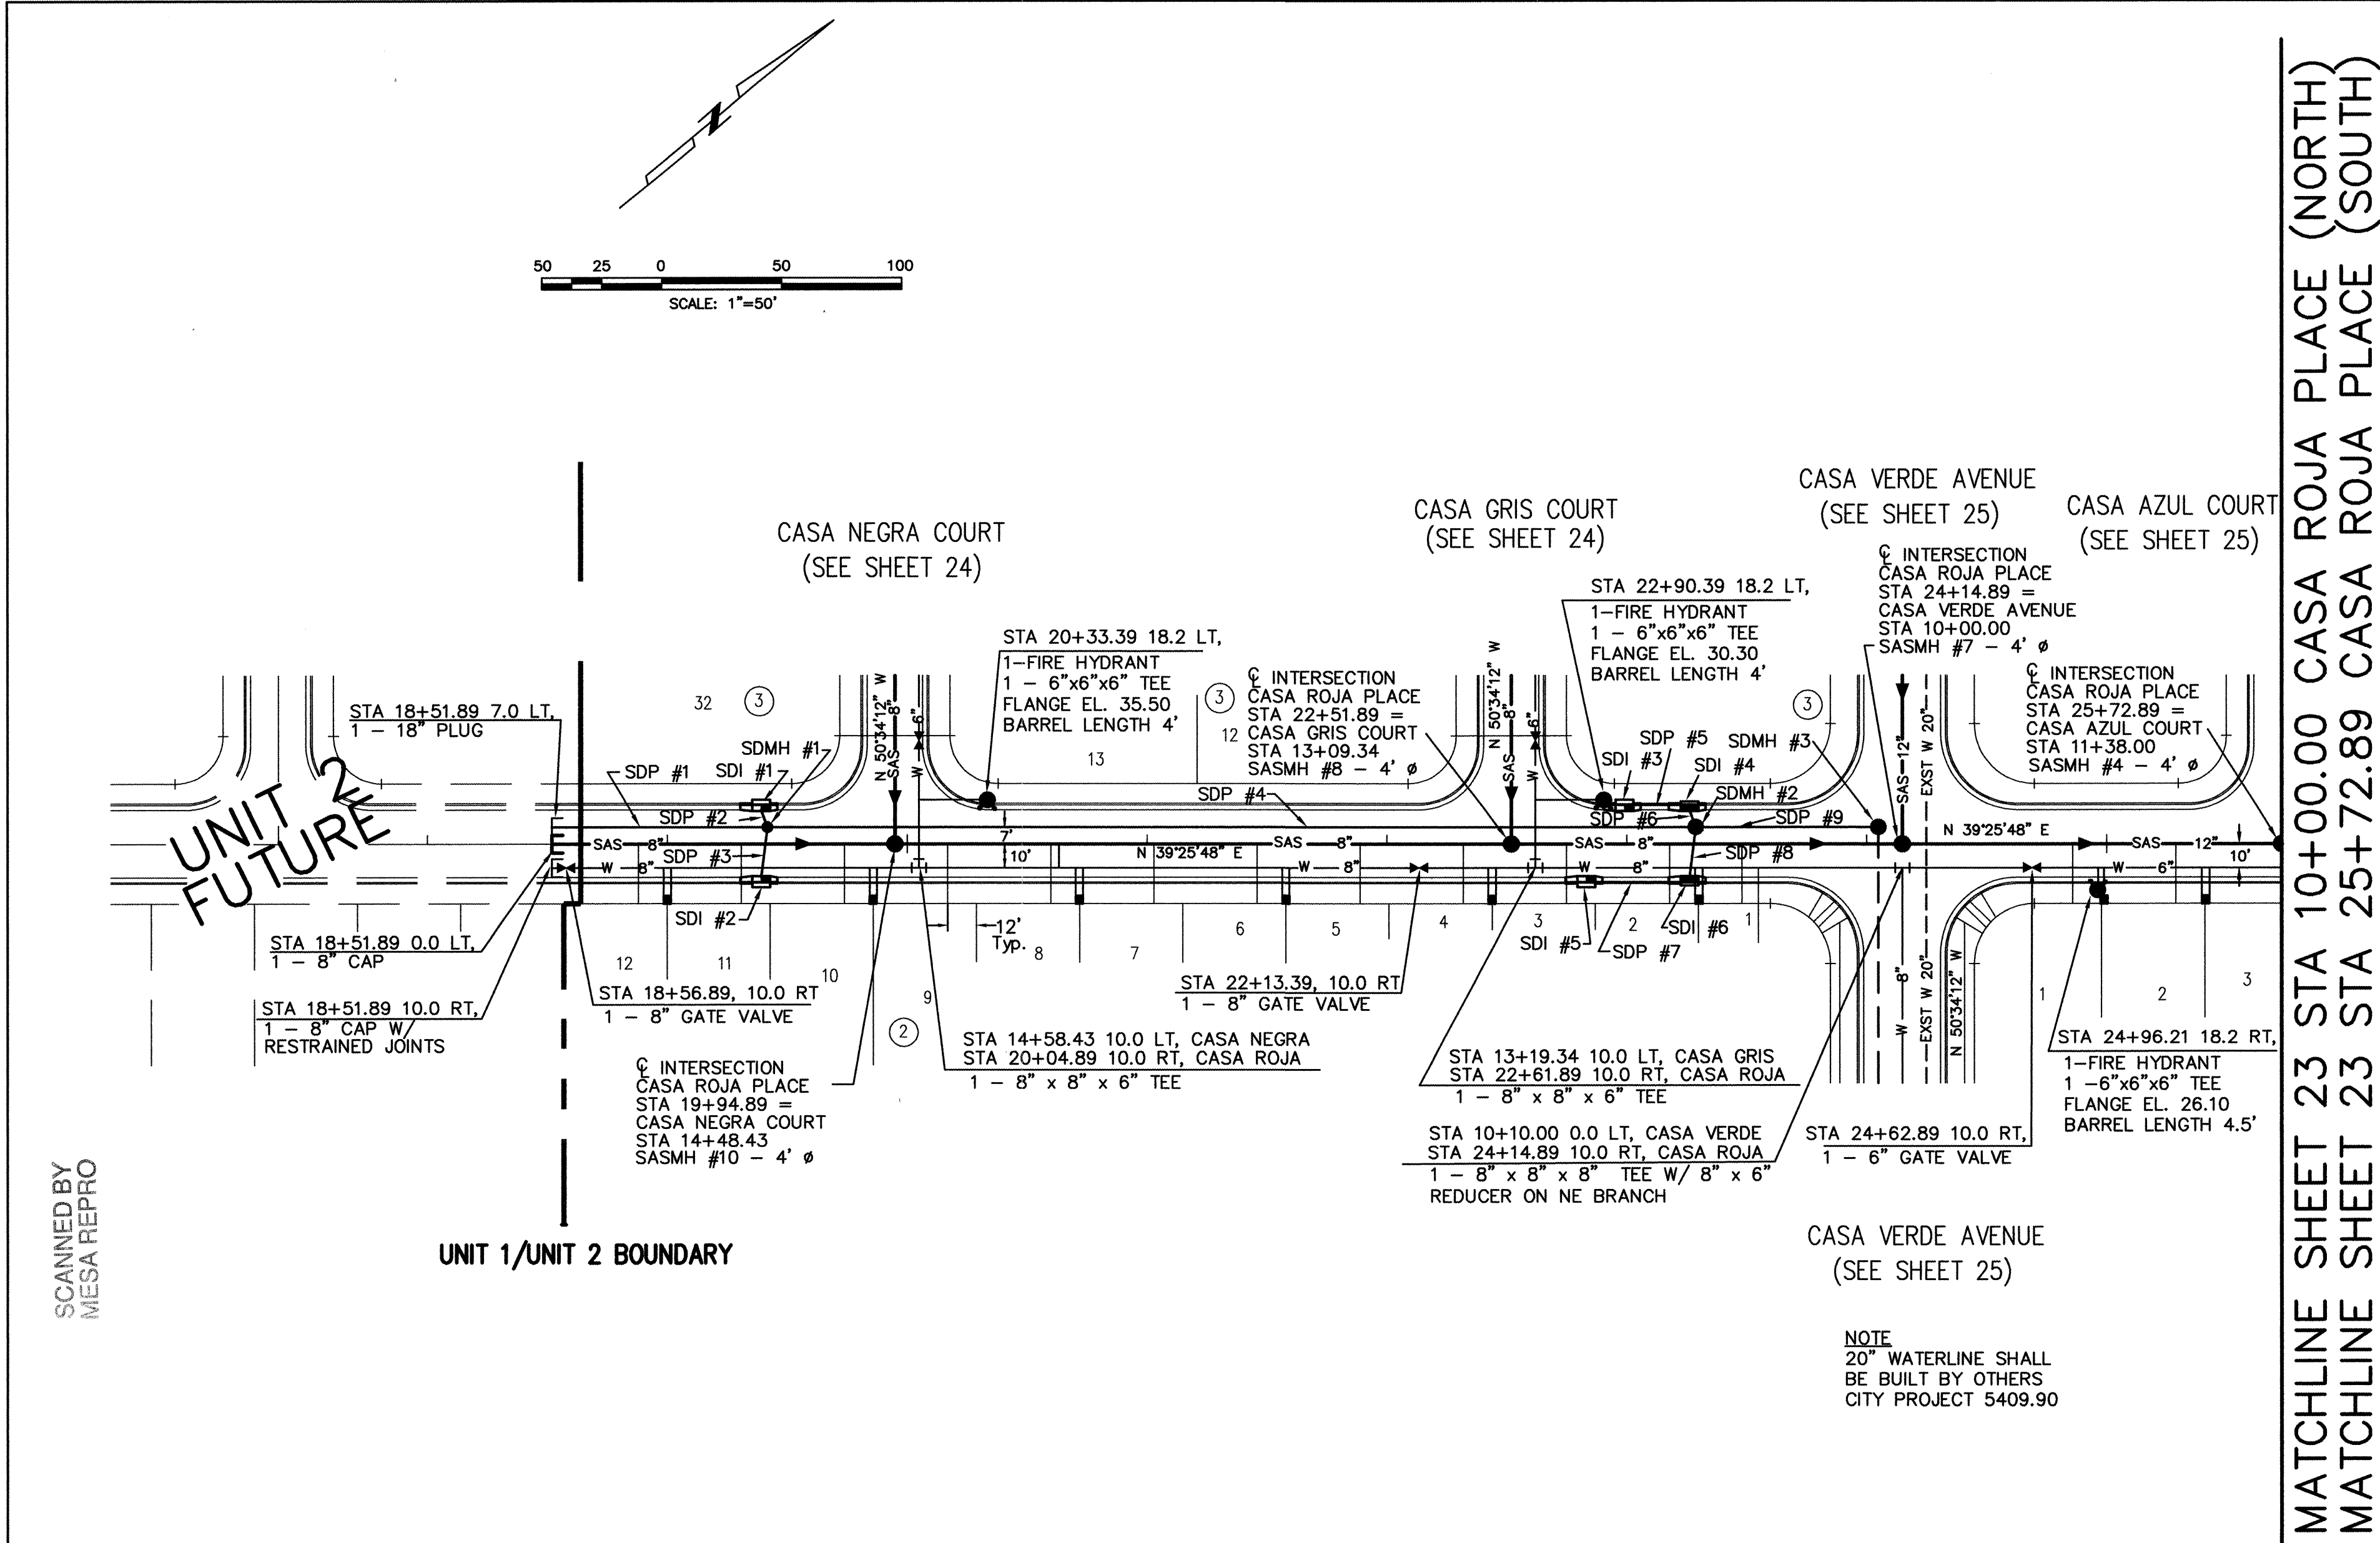

CASA ROJA PLACE (SOUTH)

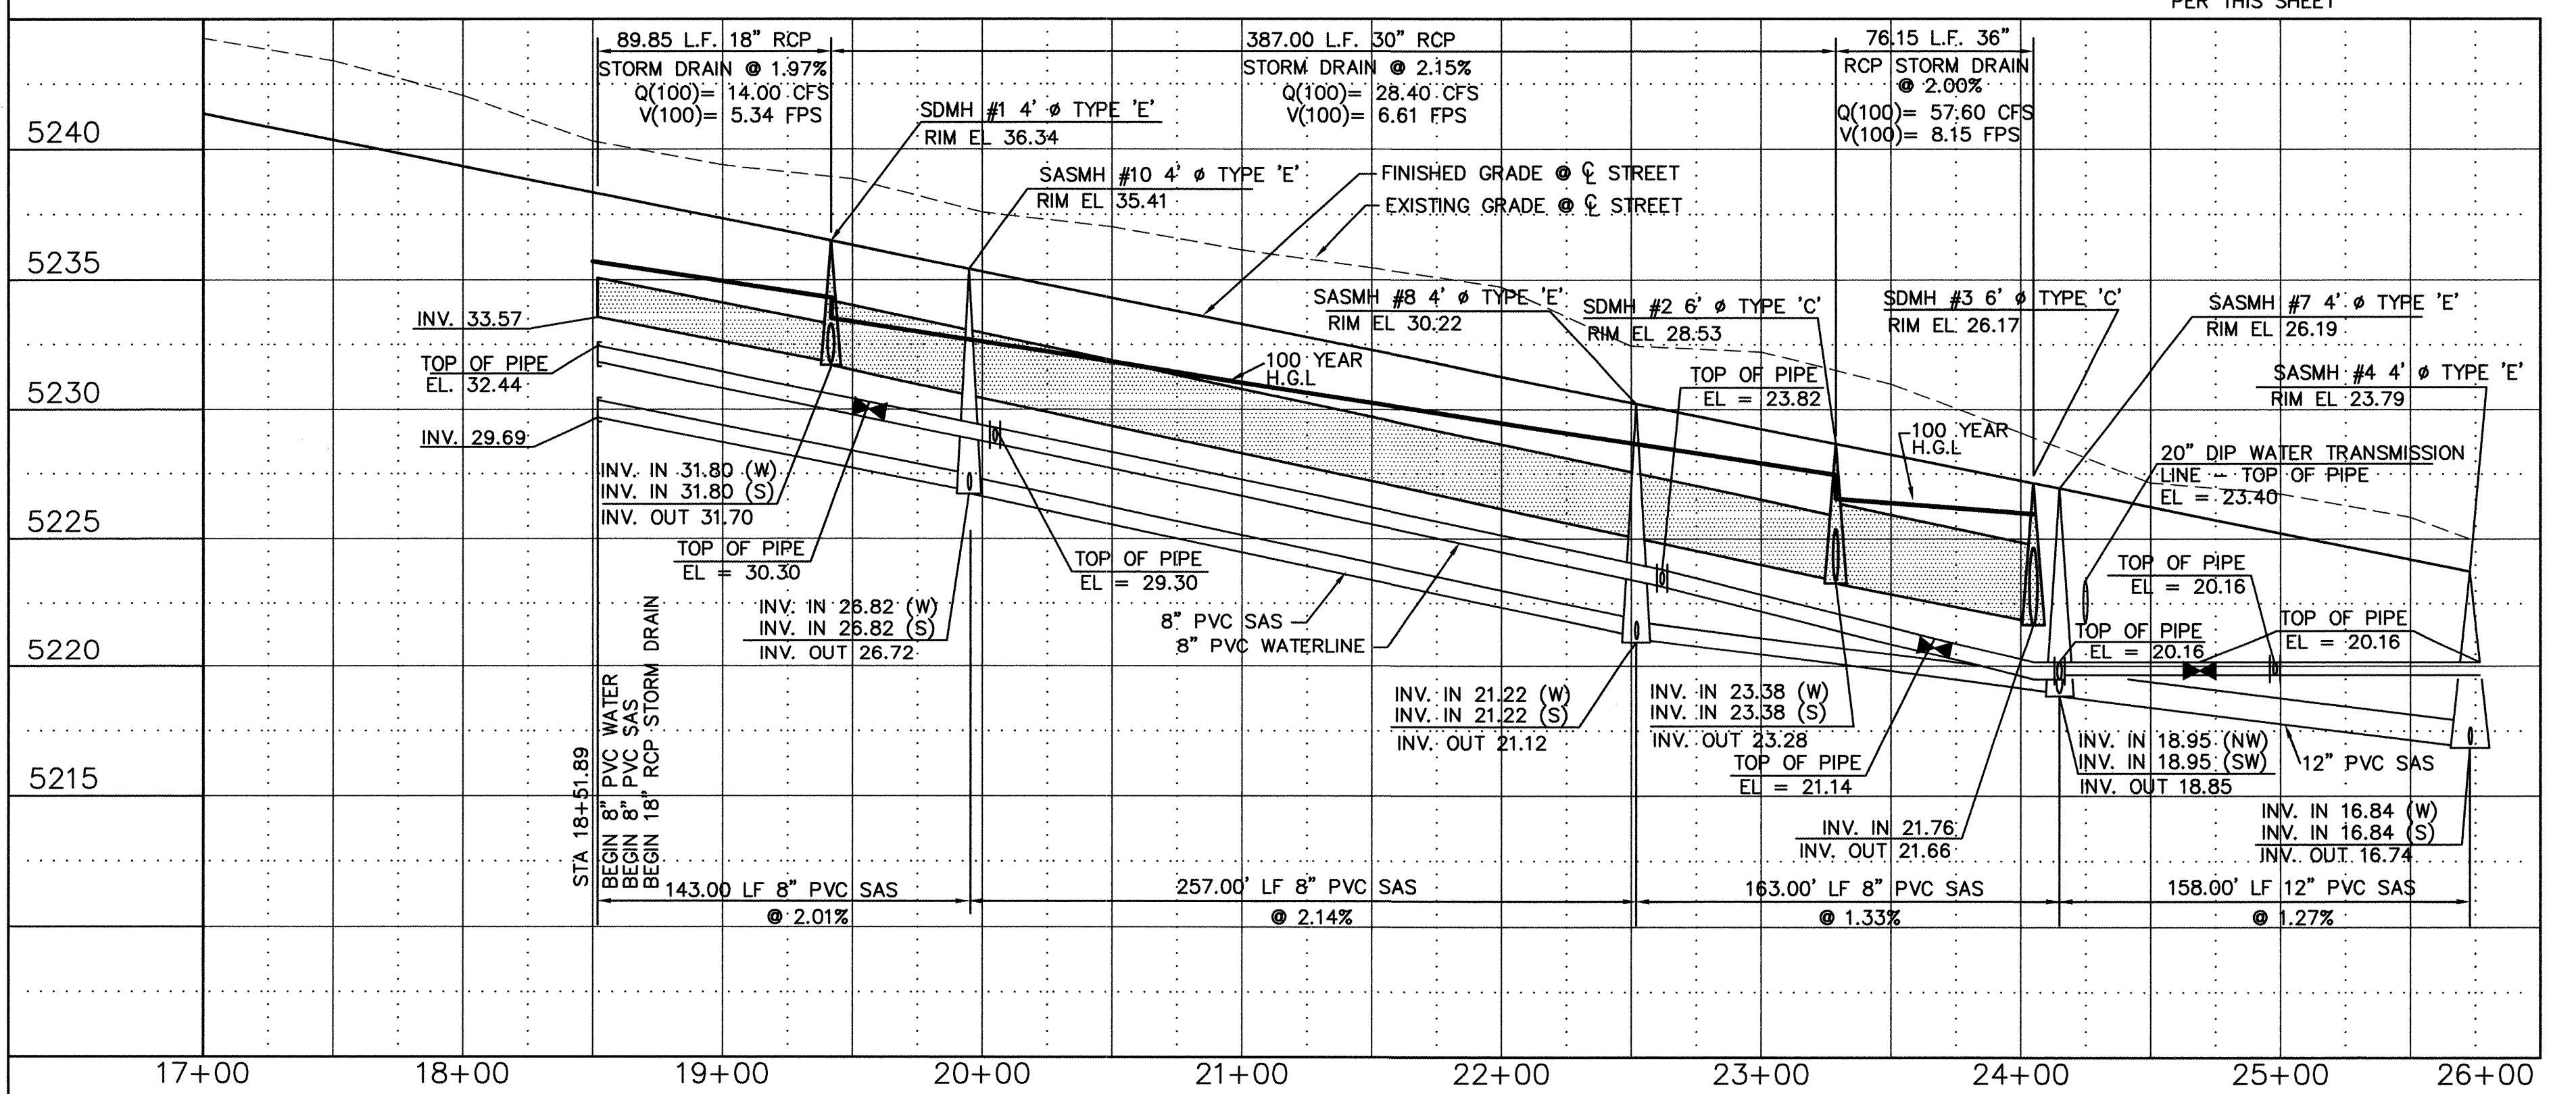

STORM DRAIN INLETS

SDI #	TYPE	STATION	OFFSET	EL.	INVERT IN	INVERT OUT
1	'A'	19+39.16	16.0 LT	36.22	-	32.22
2	'A'	19+39.16	16.0 RT	36.22	-	32.22
3	'A'	22+99.11	16.0 LT	28.95	-	24.91
4	DOUBLE 'C'	23+26.18	16.0 LT	28.40	23.90	23.80
5	'A'	22+83.16	16.0 RT	29.27	-	25.23
6	DOUBLE 'C'	23+26.18	16.0 RT	28.40	23.90	23.80

*NORMAL GUTTER EL

STORM DRAIN MANHOLES

SDMH #	DIAMETER	STATION	OFFSET	RIM EL.	INVERT IN	INVERT OUT
1	4'	19+41.74	7.0 LT	36.34	31.80	31.70
2	6'	23+28.74	7.0 LT	28.53	23.38	23.28
3	6'	24+04.89	7.0 LT	26.17	21.76	21.66


STORM DRAIN PIPE

SDP #	DIAMETER*	UPSTREAM			DOWNSTREAM			LENGTH	SLOPE
		STATION	OFFSET	INVERT	STATION	OFFSET	INVERT		
1	18"	18+51.89	7.0 LT	33.57	19+41.74	7.0 LT	31.80	89.85	1.97%
2	18"	19+39.16	14.0 LT	32.22	19+41.74	7.0 LT	31.80	7.45	5.64%
3	18"	19+39.16	14.0 RT	32.22	19+41.74	7.0 LT	31.80	21.15	2.00%
4	30"	19+41.74	7.0 LT	31.70	23+28.74	7.0 LT	23.38	387.00	2.15%
5	18"	23+02.34	16.0 LT	24.91	23+23.00	16.0 LT	23.90	20.66	4.89%
6	24"	23+26.18	14.0 LT	23.80	23+28.74	7.0 LT	23.38	7.45	5.64%
7	18"	22+86.39	16.0 RT	25.23	23+23.00	16.0 RT	23.90	36.60	3.63%
8	24"	23+26.18	14.0 RT	23.80	23+28.74	7.0 LT	23.38	21.15	1.99%
9	36"	23+28.74	7.0 LT	23.28	24+04.89	7.0 LT	21.76	76.15	2.00%

*ALL STORM DRAIN PIPE IS RCP CLASS IV


ENGINEER'S CERTIFICATION

REGISTERED IN NEW MEXICO AS A PROFESSIONAL ENGINEER NO. 9926 HERBY CERTIFY THAT THIS PROJECT WAS CONSTRUCTED IN SUBSTANTIAL COMPLIANCE WITH THIS PLAN, EXCEPT AS NOTED. DATE 1-1-00

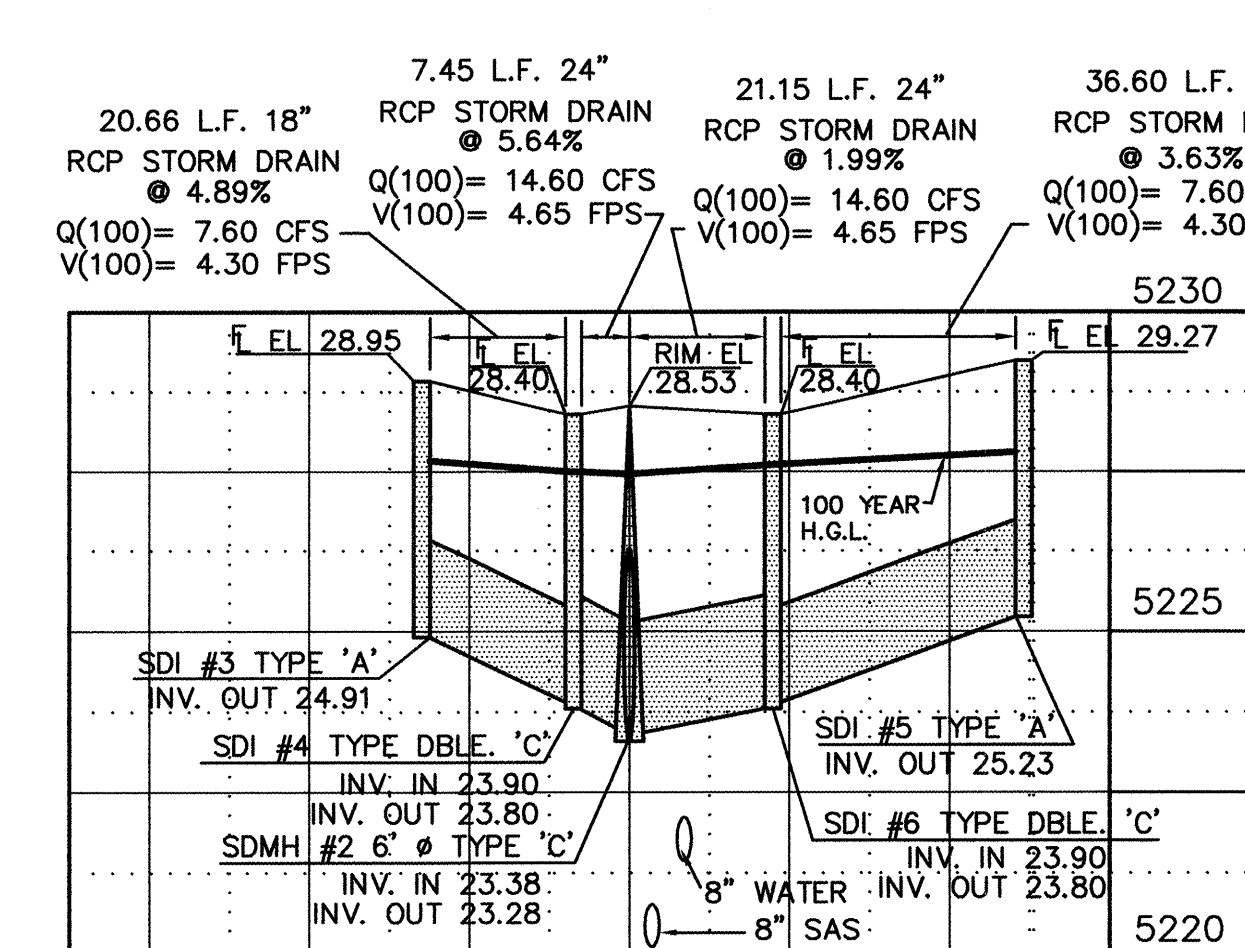

STA 23+28.74 - SDMH #2

SCALES: 1:30 HORIZ. 1:3 VERT.

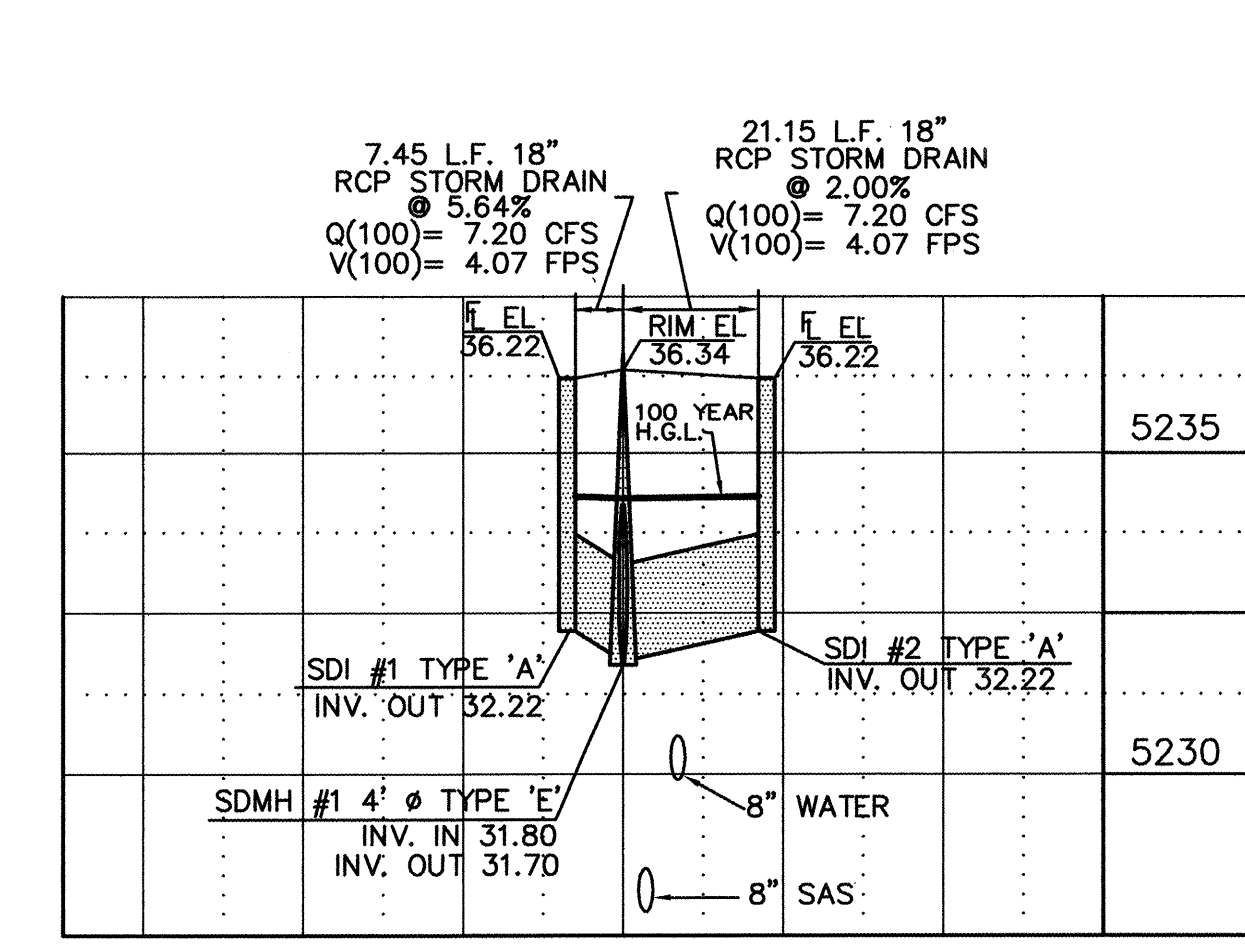

STA 19+41.74 - SDMH #1

SCALES: 1:30 HORIZ. 1:3 VERT.

GENERAL NOTES:

- CONTRACTOR SHALL SUPPORT ALL EXISTING UNDERGROUND UTILITY LINES WHICH BECOME EXPOSED DURING CONSTRUCTION. PAYMENT FOR SUPPORTING WORK SHALL BE INCIDENTAL TO WATERLINE AND/OR SEWERLINE COSTS.
- ALL WATERLINE AND SEWERLINE STATIONING REFERS TO STREET CENTERLINE STATIONING.
- ALL FITTINGS ON WATERLINE SHALL HAVE RESTRAINED JOINTS PER TABLE THIS SHEET.
- CONSTRUCT SAS SERVICES PER C.O.A. DWG #2125.
- CONSTRUCT FIRE HYDRANTS PER DESIGNATED DEPTHS AND LENGTHS PER C.O.A. DWG #2340.
- CONSTRUCT ALL WATER SERVICES PER C.O.A. DWGS #2361, #2362, AND #2363.
- UNLESS OTHERWISE NOTED, ALL SAS MANHOLES SHALL BE 4' DIAMETER, TYPE 'E' PER C.O.A. DWG #2102.
- ALL CURVILINEAR SEWERLINES AND WATERLINES SHALL BE BENT ALONG PIPE SEGMENTS WITH 0.0" DEFLECTION AT PIPE JOINTS.
- ALL SEWERLINES AND WATERLINES SHALL BE CONSTRUCTED OF PVC UNLESS SPECIFIED OTHERWISE.
- ALL STORM DRAINS SHALL BE CONSTRUCTED OF RCP-CLASS IV UNLESS SPECIFIED OTHERWISE.
- ALL ELEVATIONS ARE BASED ON A DATUM ELEVATION 5200 AS ESTABLISHED BY BENCH MARKS.

LEGEND

DESCRIPTION PROPOSED

WATER VALVE

FIRE HYDRANT

MANHOLE

CAP

DROP INLET

PIPE TEE

PIPE CROSS

PIPE BEND

WATER SERVICE SINGLE

WATER SERVICE DOUBLE

CURB AND GUTTER

SEWER LINE

STORM DRAIN

WATER LINE

RESTRAINED JOINT TABLE

JOINT	RESTRAIN LENGTH
4" GATE VALVE	61"
4" 22.5" HORIZ. BEND	21"
4" 45" VERT. OFFSET	21"
6" GATE VALVE	61"
6" 22.5" HORIZ. BEND	21"
6" 45" VERT. OFFSET	21"
8" X 8" X 4" TEE	BRANCH 21" RUN 21"
8" X 8" X 6" TEE	BRANCH 21" RUN 21"
8" X 8" X 8" TEE	BRANCH 21" RUN 21"
8" GATE VALVE	81"
8" 11.25" HORIZ. BEND	21"
8" 22.50" HORIZ. BEND	21"
8" 45" HORIZ. BEND	21"
8" 22.5" VERT. OFFSET	21"
8" 45" VERT. OFFSET	21"
8" CAP	RESTRAIN TO VALVE

SEWER SERVICE TABLE

CASA ROJA PLACE			
BLOCK 1			
STATION @ PL	LOT	INV. EL. @ PL	
STA 24+85.89	1	20.00	
STA 25+28.89	2	19.10	

BLOCK 2			
STATION @ PL	LOT	INV. EL. @ PL	
STA 18+87.89	12	32.60	
STA 19+30.89	11	31.70	
STA 19+73.89	10	30.80	
STA 20+16.89	9	29.90	
STA 20+59.89	8	29.10	
STA 21+02.89	7	28.20	
STA 21+45.89	6	27.30	
STA 21+88.89	5	26.50	
STA 22+31.89	4	25.60	
STA 22+74.89	3	24.70	
STA 23+17.89	2	23.90	
STA 23+48.00	1	22.80	

CINFRAN/HUITT-ZOLLARS

333 RIO RANCHO DR. N.E., STE. 101
RIO RANCHO, N.M., 87124
(505) 892-5141

LAND PLANNING / ENGINEERING / ENVIRONMENT / SUBDIVISION DEVELOPMENT / SURVEYING

CITY OF ALBUQUERQUE
PUBLIC WORKS DEPARTMENT
ENGINEERING DEVELOPMENT GROUP

TITLE: WESTLAND DEVELOPMENT CO., INC.
UTILITY PLAN & PROFILE - CASA ROJA PLACE
TIERRA OESTE UNIT 1

Design Review Committee City Engineer Approval

FEB 27 2000

AUG 16 2000


City Project No. 5297.90

Zone Map No. H-9&J-9

Sheet 22 of 30

MATCHLINE SHEET 22 STA 10+00.00 CASA ROJA (NORTH)
MATCHLINE SHEET 22 STA 25+72.89 CASA ROJA (SOUTH)

SCANNED BY
MESA REPRO

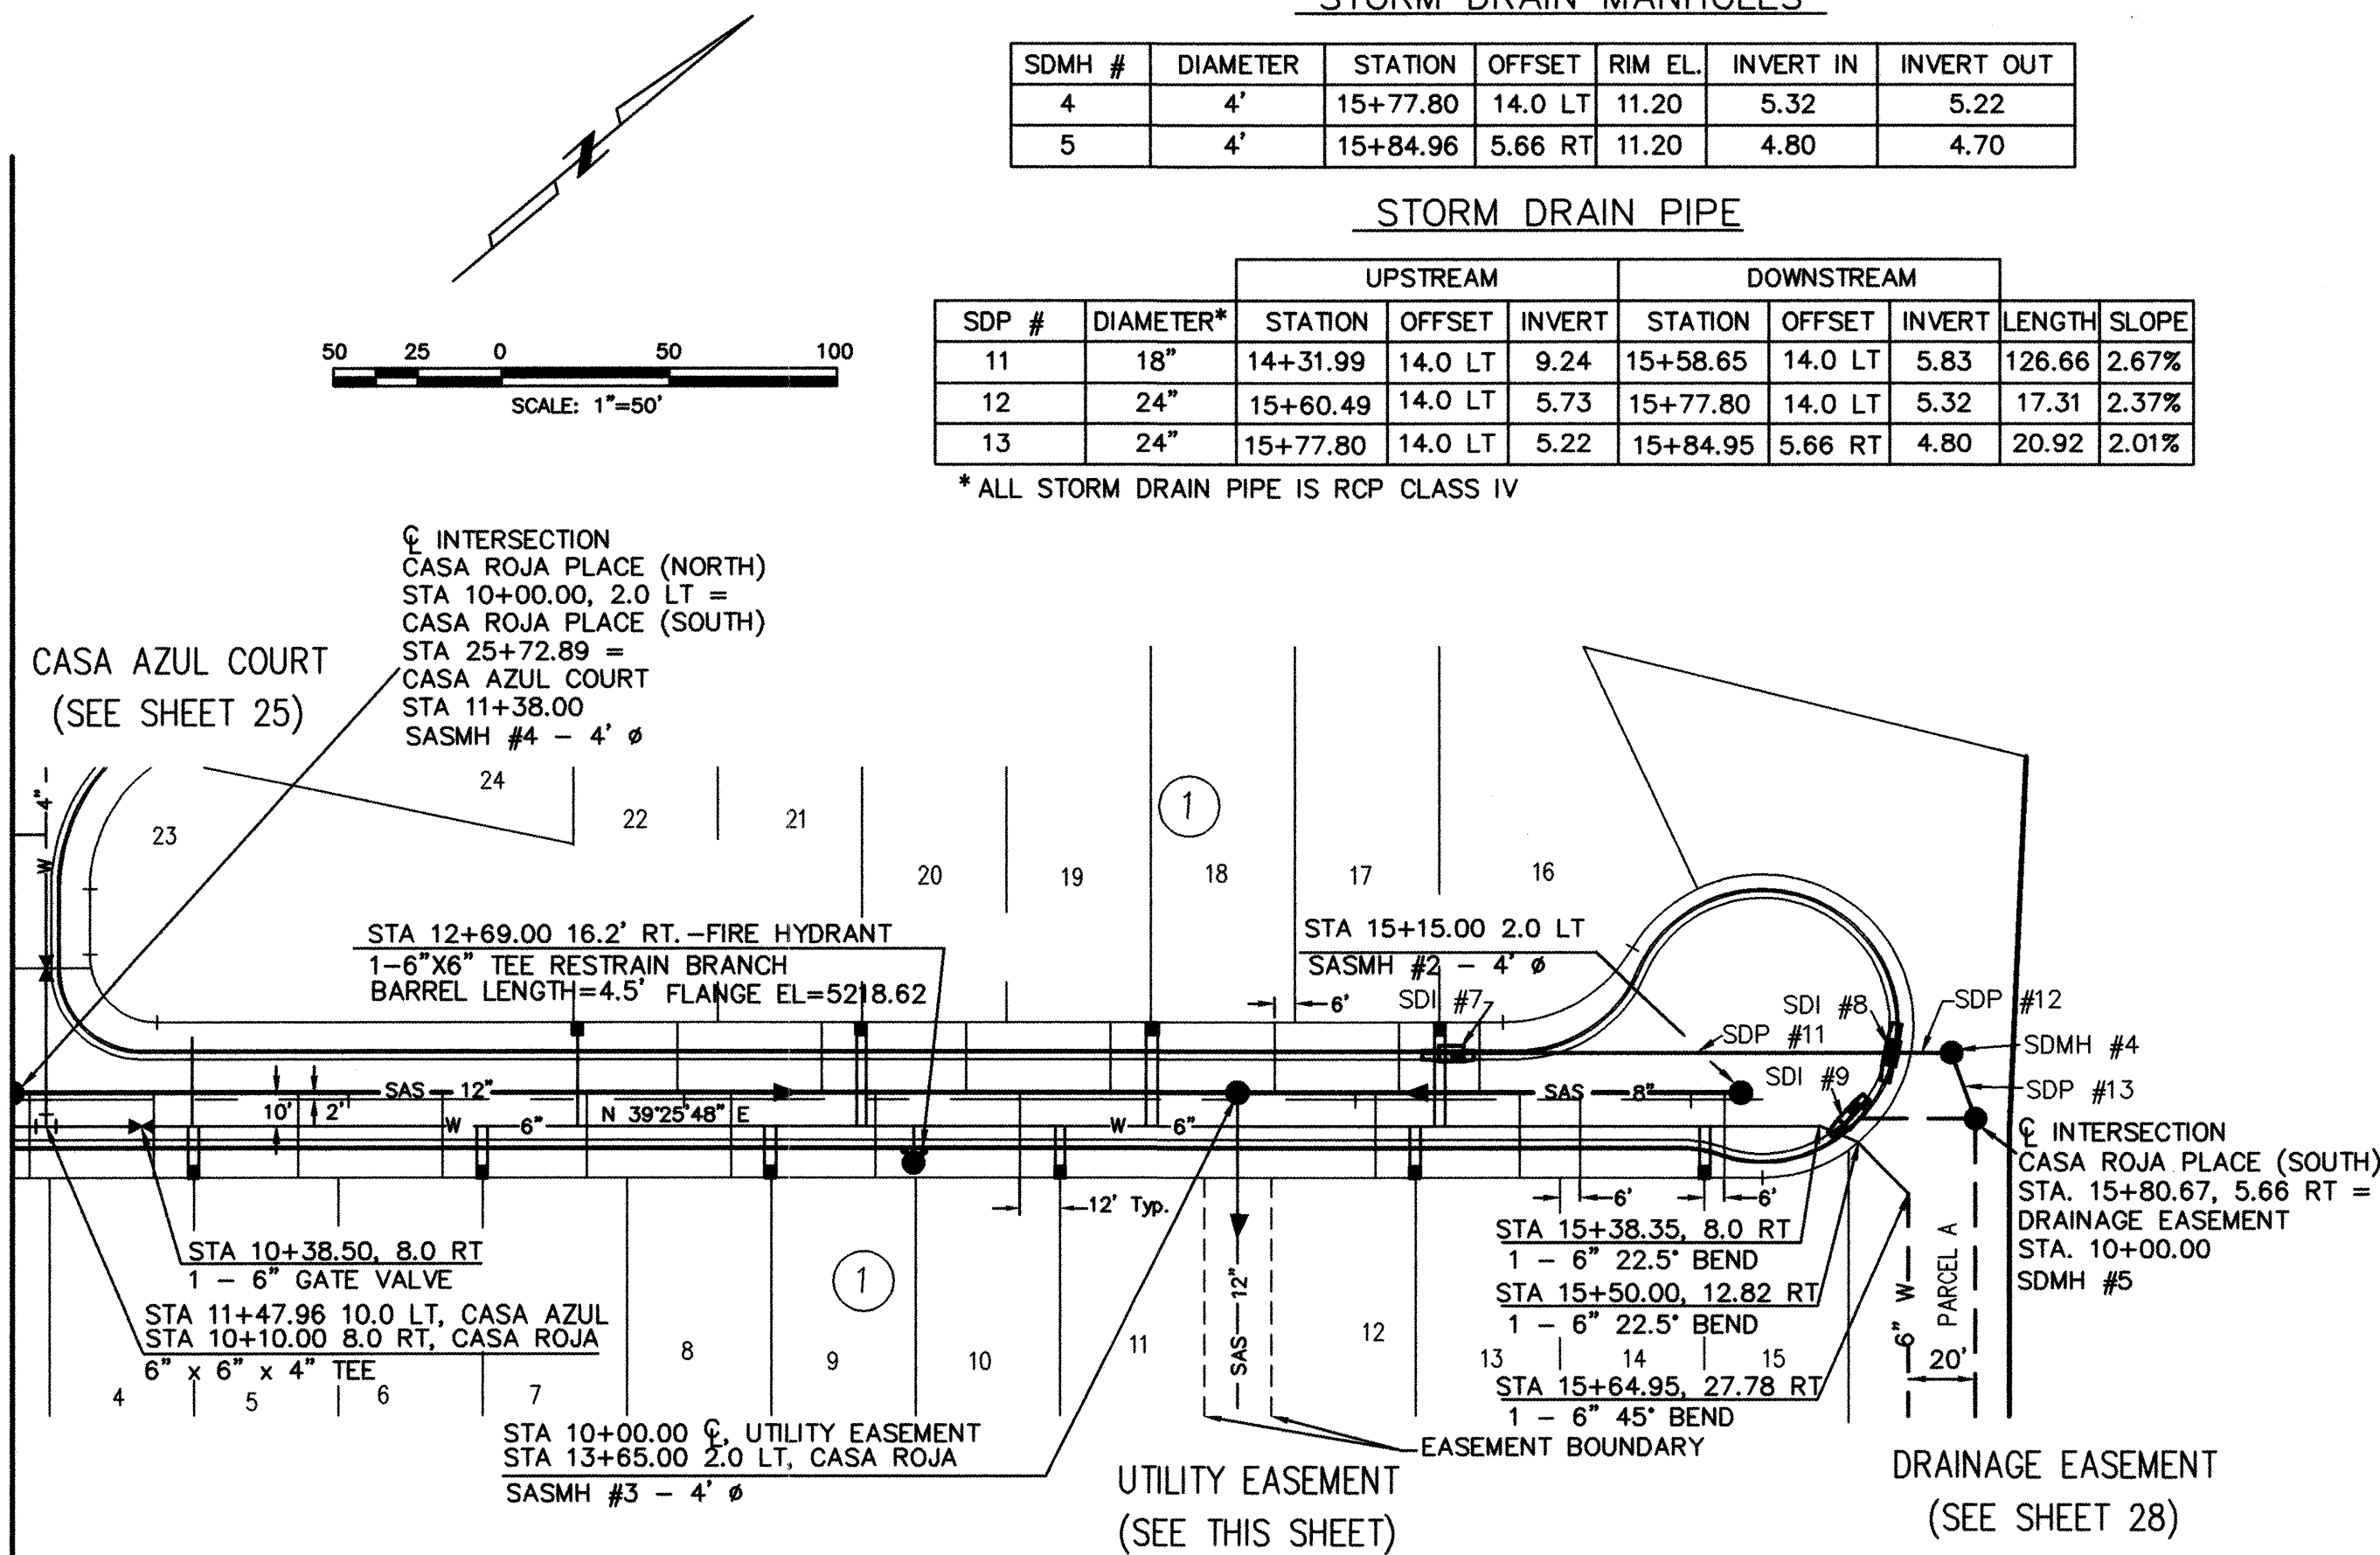

STORM DRAIN INLETS

SDI #	TYPE	STATION	OFFSET	EL. *	INVERT IN	INVERT OUT
7	'A'	14+28.77	14.0 LT	13.29	-	9.24
8	DOUBLE 'C'	15+60.50	14.0 LT	10.33	5.83	5.73


*NORMAL GUTTER EL

CASA ROJA PLACE (NORTH)

17.31 L.F. 24" RCP
STORM DRAIN @ 2.37%
Q(100)= 13.81 CFS
V(100)= 4.78 FPS

20.92 L.F. 24" RCP
STORM DRAIN @ 2.01%
Q(100)= 13.81 CFS
V(100)= 4.47 FPS

UTILITY EASEMENT

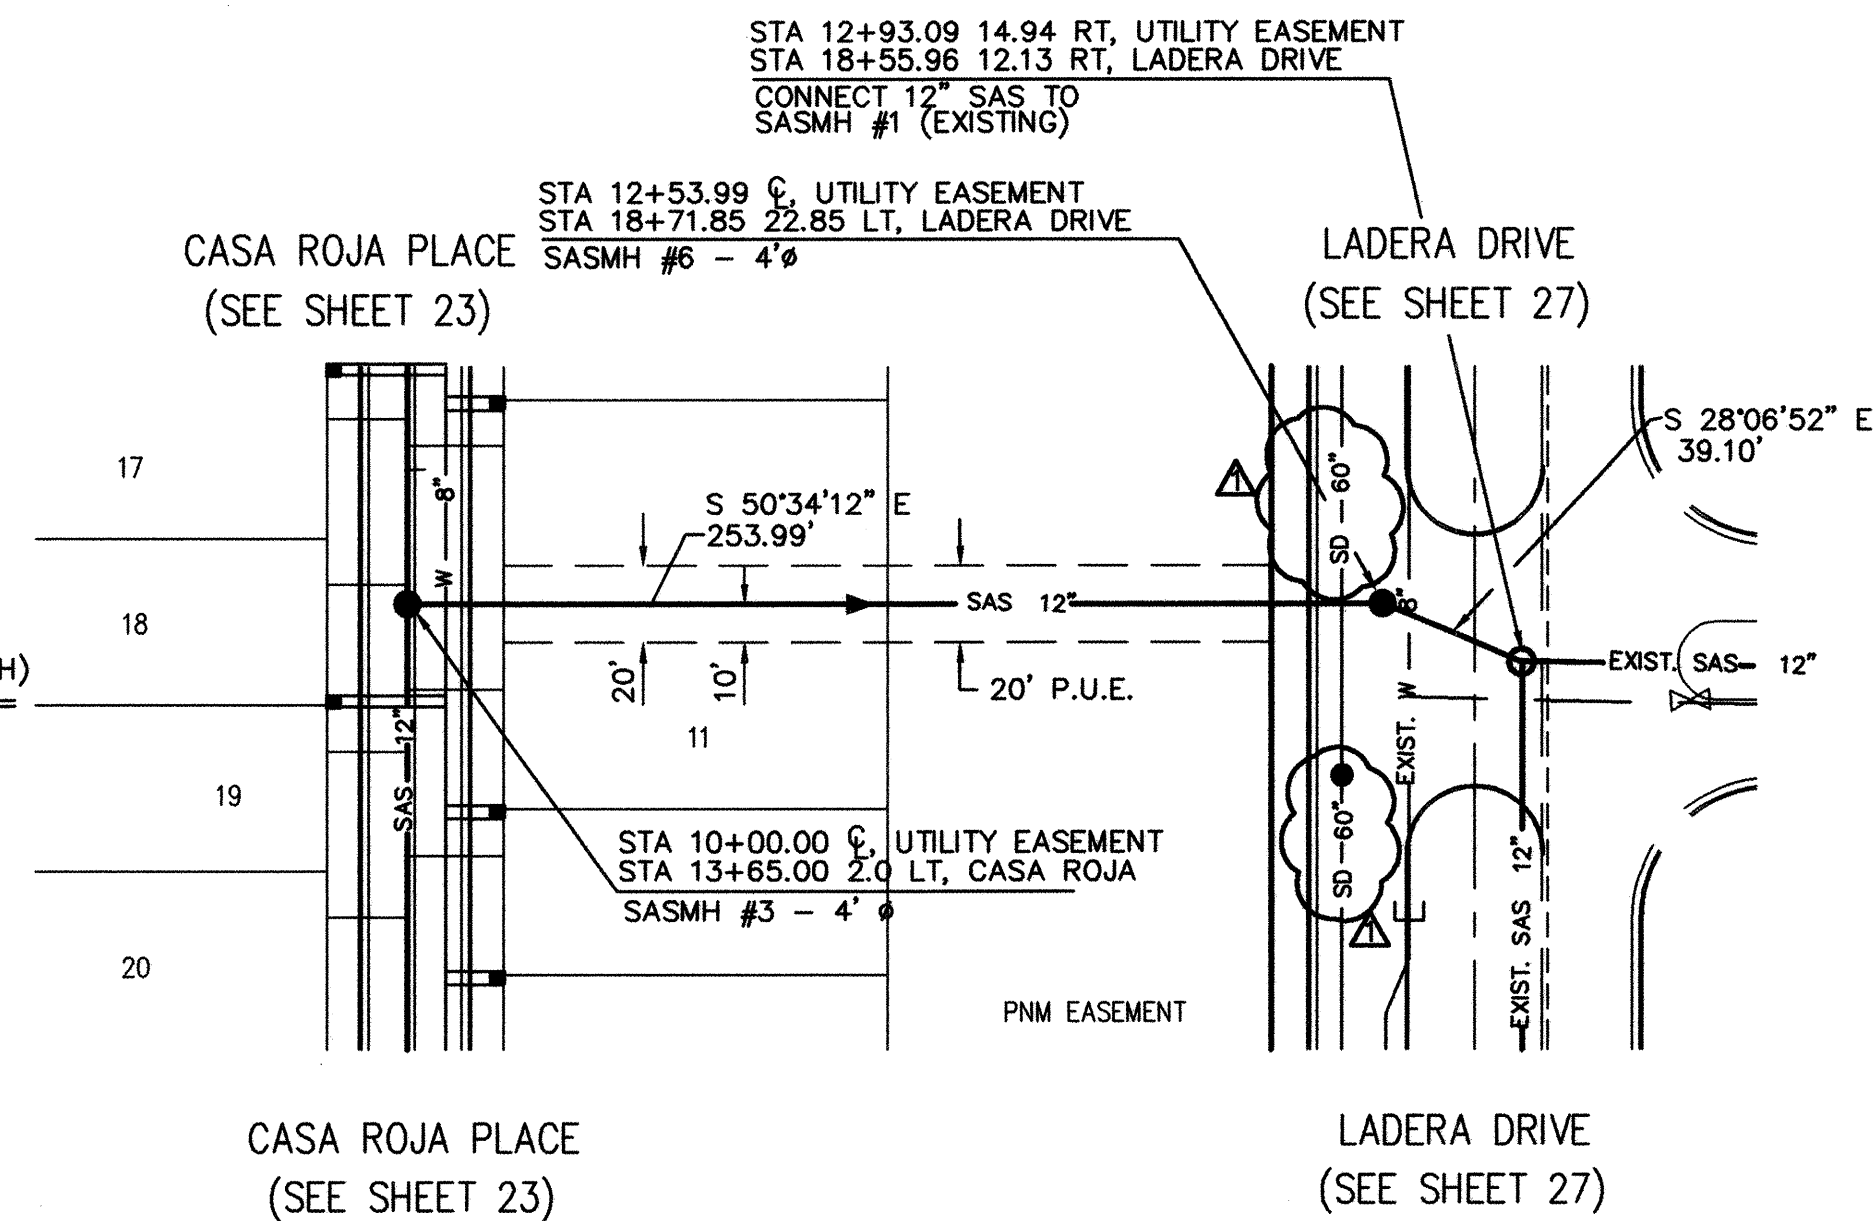

ENGINEER'S
CERTIFICATION

REGISTERED IN NEW MEXICO AS A PROFESSIONAL
ENGINEER NO. 9446 HERBY CERTIFY
THAT THIS PROJECT WAS CONSTRUCTED IN
SUBSTANTIAL COMPLIANCE WITH THIS PLAN,
EXCEPT AS NOTED. DATE 5-1-00

GENERAL NOTES:

- CONTRACTOR SHALL SUPPORT ALL EXISTING UNDERGROUND UTILITY LINES WHICH BECOME EXPOSED DURING CONSTRUCTION. PAYMENT FOR SUPPORTING WORK SHALL BE INCIDENTAL TO WATERLINE AND/OR SEWERLINE COSTS.
- ALL WATERLINE AND SEWERLINE STATIONING REFERS TO STREET CENTERLINE STATIONING.
- ALL FITTINGS ON WATERLINE SHALL HAVE RESTRAINED JOINTS PER TABLE THIS SHEET.
- CONSTRUCT SAS SERVICES PER C.O.A. DWG #2125.
- CONSTRUCT FIRE HYDRANTS PER DESIGNATED DEPTHS AND LENGTHS PER C.O.A. DWG #2340.
- CONSTRUCT ALL WATER SERVICES PER C.O.A. DWGS #2361, #2362, AND #2363.
- UNLESS OTHERWISE NOTED, ALL SAS MANHOLES SHALL BE 4' DIAMETER, TYPE 'E' PER C.O.A. DWG #2102.
- ALL CURVILINEAR SEWERLINES AND WATERLINES SHALL BE BENT ALONG PIPE SEGMENTS WITH 0.0" DEFLECTION AT PIPE JOINTS.
- ALL SEWERLINES AND WATERLINES SHALL BE CONSTRUCTED OF PVC UNLESS SPECIFIED OTHERWISE.
- ALL STORM DRAINS SHALL BE CONSTRUCTED OF RCP-CLASS IV UNLESS SPECIFIED OTHERWISE.
- ALL ELEVATIONS ARE BASED ON A DATUM ELEVATION 5200 AS ESTABLISHED BY BENCH MARKS.

LEGEND

DESCRIPTION	PROPOSED
WATER VALVE	
FIRE HYDRANT	
MANHOLE	
CAP	
DROP INLET	
PIPE TEE	
PIPE CROSS	
PIPE BEND	
WATER SERVICE SINGLE	
WATER SERVICE DOUBLE	
CURB AND GUTTER	
SEWER LINE	
STORM DRAIN	
WATER LINE	

RESTRAINED JOINT TABLE

JOINT	RESTRAIN LENGTH
4" GATE VALVE	61'
4" 22.5" HORIZ. BEND	21'
4" 45" VERT. OFFSET	21'
6" GATE VALVE	61'
6" 22.5" HORIZ. BEND	21'
6" 45" HORIZ. BEND	21'
6" 45" VERT. OFFSET	21'
8" X 8" X 4" TEE	BRANCH 21' RUN 21'
8" X 8" X 6" TEE	BRANCH 21' RUN 21'
8" X 8" X 8" TEE	BRANCH 21' RUN 21'
8" GATE VALVE	61'
8" 11.25" HORIZ. BEND	21'
8" 22.50" HORIZ. BEND	21'
8" 45" HORIZ. BEND	21'
8" 22.5" VERT. OFFSET	21'
8" 45" VERT. OFFSET	21'

SEWER SERVICE TABLE

CASA ROJA COURT (NORTH)			
BLOCK 1			
STATION	LOT	INV. EL. @ PL	
STA 10+05.00	3	19.00	
STA 10+42.00	4	18.30	
STA 10+85.00	5	17.40	
STA 11+28.00	6	16.50	
STA 11+71.00	7	15.60	
STA 11+98.00	22	15.20	
STA 12+14.00	8	14.50	
STA 12+41.00	21	14.00	
STA 12+57.00	9	13.38	
STA 12+84.00	20	12.50	
STA 13+00.00	10	12.30	
STA 13+27.00	19	11.80	
STA 13+43.00	11	11.15	
STA 13+76.00	18	10.60	
STA 14+06.00	12	9.80	
STA 14+13.00	17	9.55	
STA 14+37.00	16	9.00	
STA 14+49.00	13	7.60	
STA 14+92.00	14	7.40	
STA 15+10.00	15	8.00	



CINFRAN/HUITT-ZOLIARS

LAND PLANNING / ENGINEERING / ENVIRONMENT / SUBDIVISION DEVELOPMENT / SURVEYING

CITY OF ALBUQUERQUE
PUBLIC WORKS DEPARTMENT
ENGINEERING DEVELOPMENT GROUP

TITLE: WESTLAND DEVELOPMENT CO., INC.
UTILITY PLAN & PROFILE - CASA ROJA/UTIL. ESMT.
TIERRA OESTE UNIT 1

Design Review Committee	City Engineer Approval
APPROVE	APPROVE
DEC 19 2000	DEC 19 2000
DESIGN	CITY ENGINEER
City Project No.	Zone Map No.
5297.90	H-9&J-9
Sheet	Of
23	30

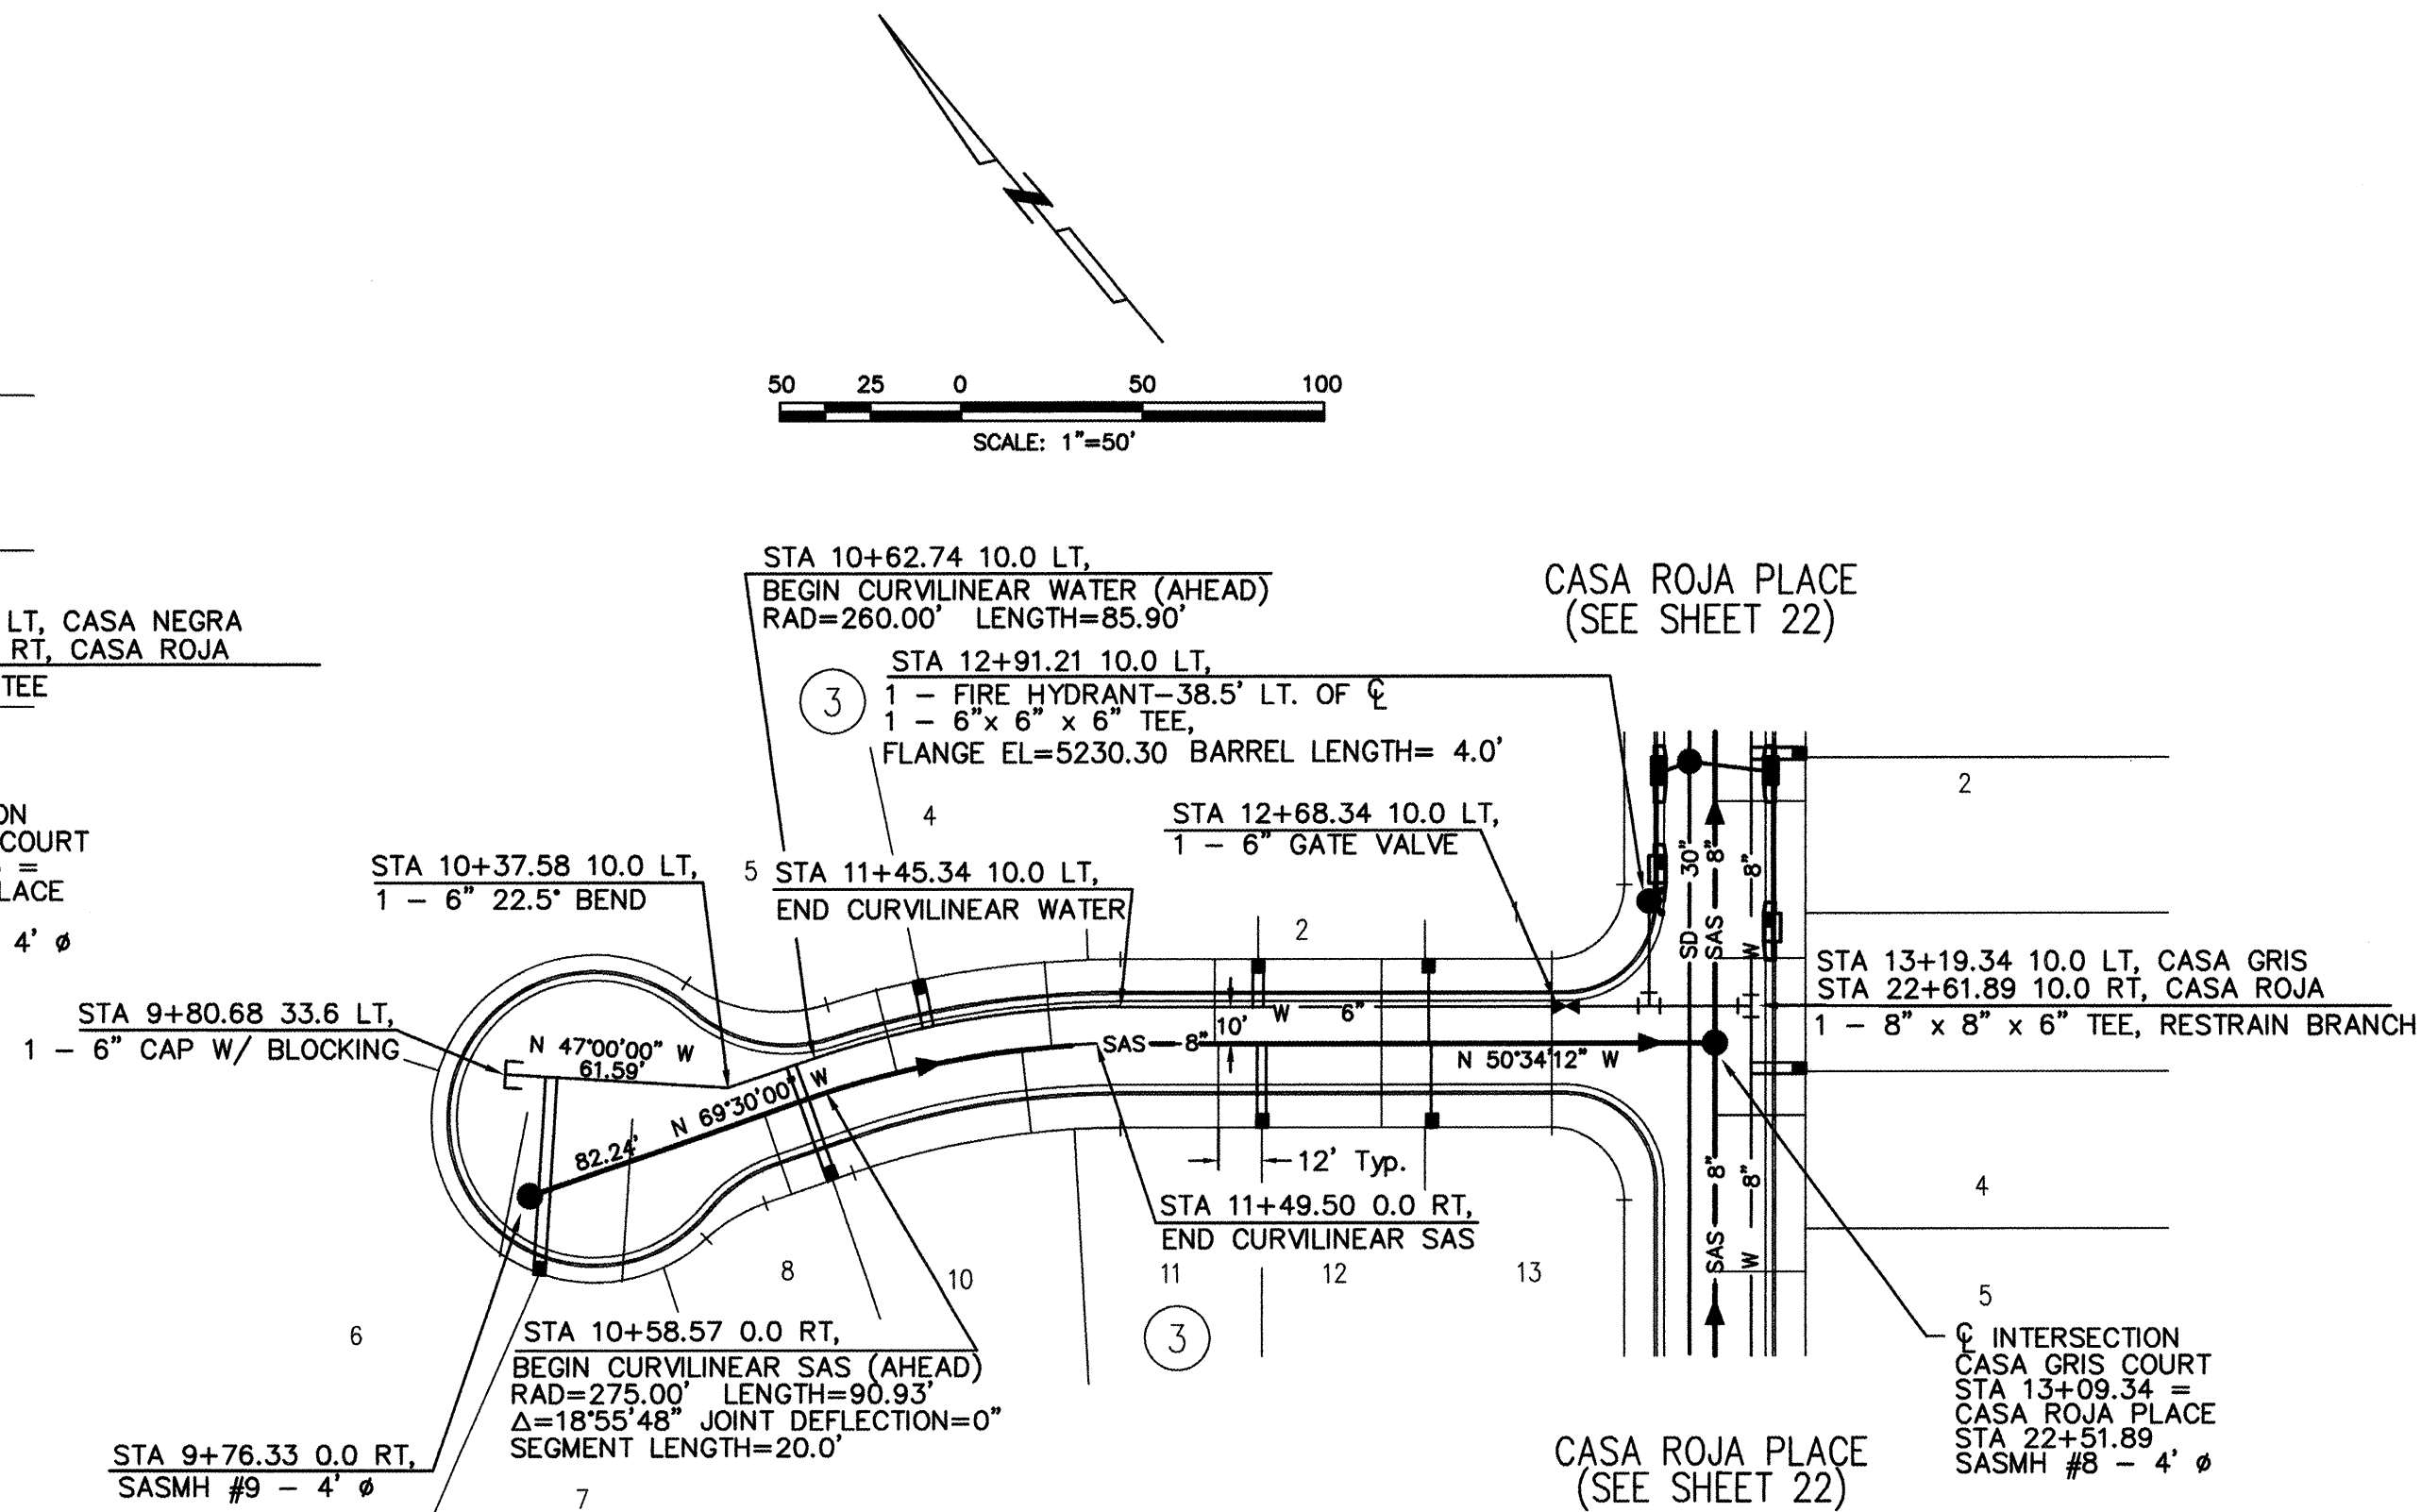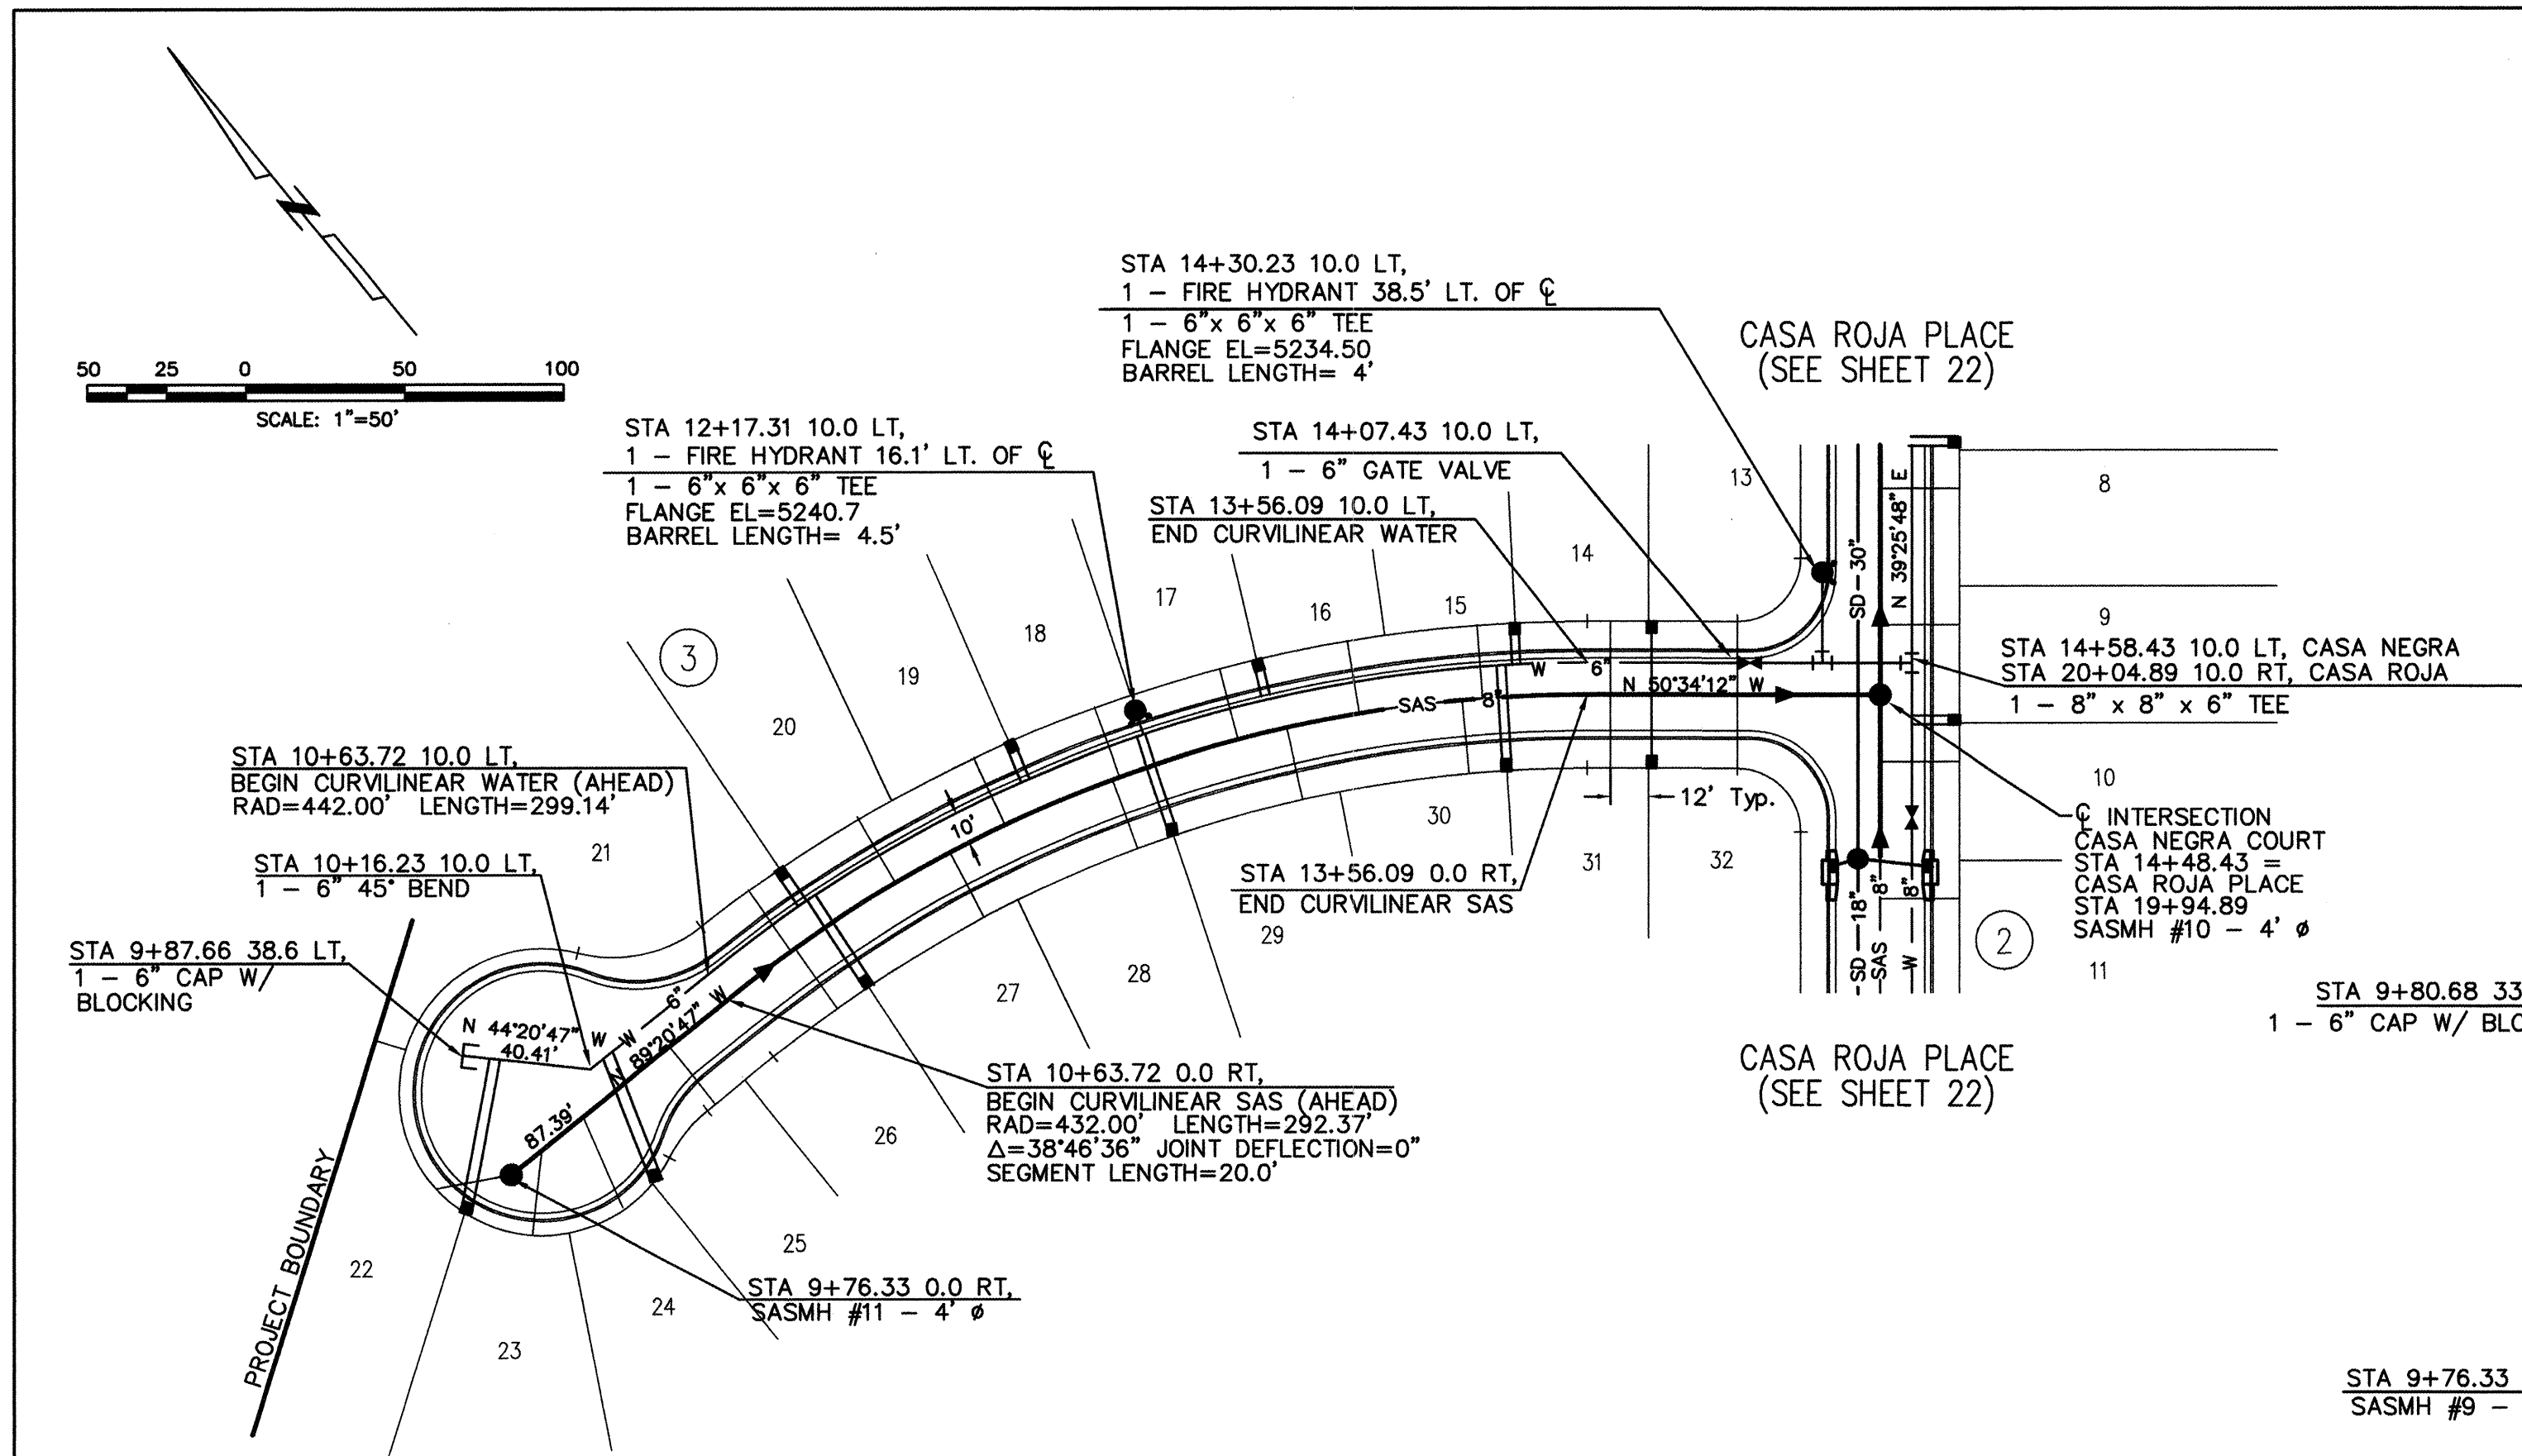

GENERAL NOTES:

- CONTRACTOR SHALL SUPPORT ALL EXISTING UNDERGROUND UTILITY LINES WHICH BECOME EXPOSED DURING CONSTRUCTION. PAYMENT FOR SUPPORTING WORK SHALL BE INCIDENTAL TO WATERLINE AND/OR SEWERLINE COSTS.
- ALL WATERLINE AND SEWERLINE STATIONING REFERS TO STREET CENTERLINE STATIONING.
- ALL FITTINGS ON WATERLINE SHALL HAVE RESTRAINED JOINTS PER TABLE THIS SHEET.
- CONSTRUCT SAS SERVICES PER C.O.A. DWG #2125.
- CONSTRUCT FIRE HYDRANTS PER DESIGNATED DEPTHS AND LENGTHS PER C.O.A. DWG #2340.
- CONSTRUCT ALL WATER SERVICES PER C.O.A. DWGS #2361, #2362, AND #2363.
- UNLESS OTHERWISE NOTED, ALL SAS MANHOLES SHALL BE 4' DIAMETER, TYPE 'E' PER C.O.A. DWG #2102.
- ALL CURVILINEAR SEWERLINES AND WATERLINES SHALL BE BENT ALONG PIPE SEGMENTS WITH 0.0" DEFLECTION AT PIPE JOINTS.
- ALL SEWERLINES AND WATERLINES SHALL BE CONSTRUCTED OF PVC UNLESS SPECIFIED OTHERWISE.
- ALL STORM DRAINS SHALL BE CONSTRUCTED OF RCP-CLASS IV UNLESS SPECIFIED OTHERWISE.
- ALL ELEVATIONS ARE BASED ON A DATUM ELEVATION 5200 AS ESTABLISHED BY BENCH MARKS.

LEGEND

DESCRIPTION	PROPOSED
WATER VALVE	⊥
FIRE HYDRANT	⊙
MANHOLE	⊙
CAP	⊥
DROP INLET	⊥ SDI
PIPE TEE	⊥
PIPE CROSS	⊥
PIPE BEND	⊥
WATER SERVICE SINGLE	—
WATER SERVICE DOUBLE	—
CURB AND GUTTER	—
SEWER LINE	—SAS—
STORM DRAIN	—SD—
WATER LINE	—W—

RESTRAINED JOINT TABLE

JOINT	RESTRAIN LENGTH
4" GATE VALVE	61'
4" 22.5° HORIZ. BEND	21'
4" 45° VERT. OFFSET	21'
6" GATE VALVE	61'
6" 22.5° HORIZ. BEND	21'
6" 45° HORIZ. BEND	21'
6" 45° VERT. OFFSET	21'
8" X 8" X 4" TEE	BRANCH 21' RUN 21'
8" X 8" X 6" TEE	BRANCH 21' RUN 21'
8" X 8" X 8" TEE	BRANCH 21' RUN 21'
8" GATE VALVE	81'
8" 11.25° HORIZ. BEND	21'
8" 22.50° HORIZ. BEND	21'
8" 45° HORIZ. BEND	21'
8" 22.5° VERT. OFFSET	21'
8" 45° VERT. OFFSET	21'

SEWER SERVICE TABLE

CASA GRIS COURT			
STATION	PL	LOT	INV EL. PL
STA 9+63.08	6	33.60	
STA 9+92.74	7	33.10	
STA 10+44.74	8	32.20	
STA 10+83.02	5	30.20	
STA 11+18.07	9	30.10	
STA 11+26.29	4	30.00	
STA 11+71.34	3	28.60	
STA 11+72.34	10	28.60	
STA 12+17.34	11	28.30	
STA 12+17.34	2	27.30	
STA 12+64.34	1	26.00	
STA 12+64.34	12	26.00	

SEWER SERVICE TABLE

CASA NEGRA			
STATION	PL	LOT	INV EL. PL
STA 9+55.07	22	41.90	
STA 9+69.51	23	41.40	
STA 9+97.22	24	41.10	
STA 10+40.23	25	40.60	
STA 10+88.71	21	39.20	
STA 10+90.28	26	39.10	
STA 11+27.83	20	38.20	
STA 11+47.53	27	37.80	
STA 11+66.88	19	37.20	
STA 12+03.54	28	36.30	
STA 12+05.96	18	36.20	
STA 12+45.04	17	35.20	
STA 12+60.79	29	34.90	
STA 12+84.12	16	34.20	
STA 13+16.79	30	33.40	
STA 13+23.20	15	33.20	
STA 13+63.43	14	32.10	
STA 14+03.43	13	31.20	
STA 14+03.43	32	31.20	

CINFRAN/HUITT-ZOLLARS

333 RIO RANCHO DR. N.E. STE. 101
RIO RANCHO, N.M. 87124
(505) 892-5141

CITY OF ALBUQUERQUE
PUBLIC WORKS DEPARTMENT
ENGINEERING DEVELOPMENT GROUP

TITLE: WESTLAND DEVELOPMENT CO., INC.
UTILITY PLAN & PROFILE - CASA NEGRA CT/CASA GRIS CT
TIERRA OESTE UNIT 1

Design/Review Committee: City Engineer Approval

FEB 27 2000

AUG 16 2000


City Project No. 5297.90

Zone Map No. H-9&J-9


Sheet 24

Of 30

CASA NEGRA COURT

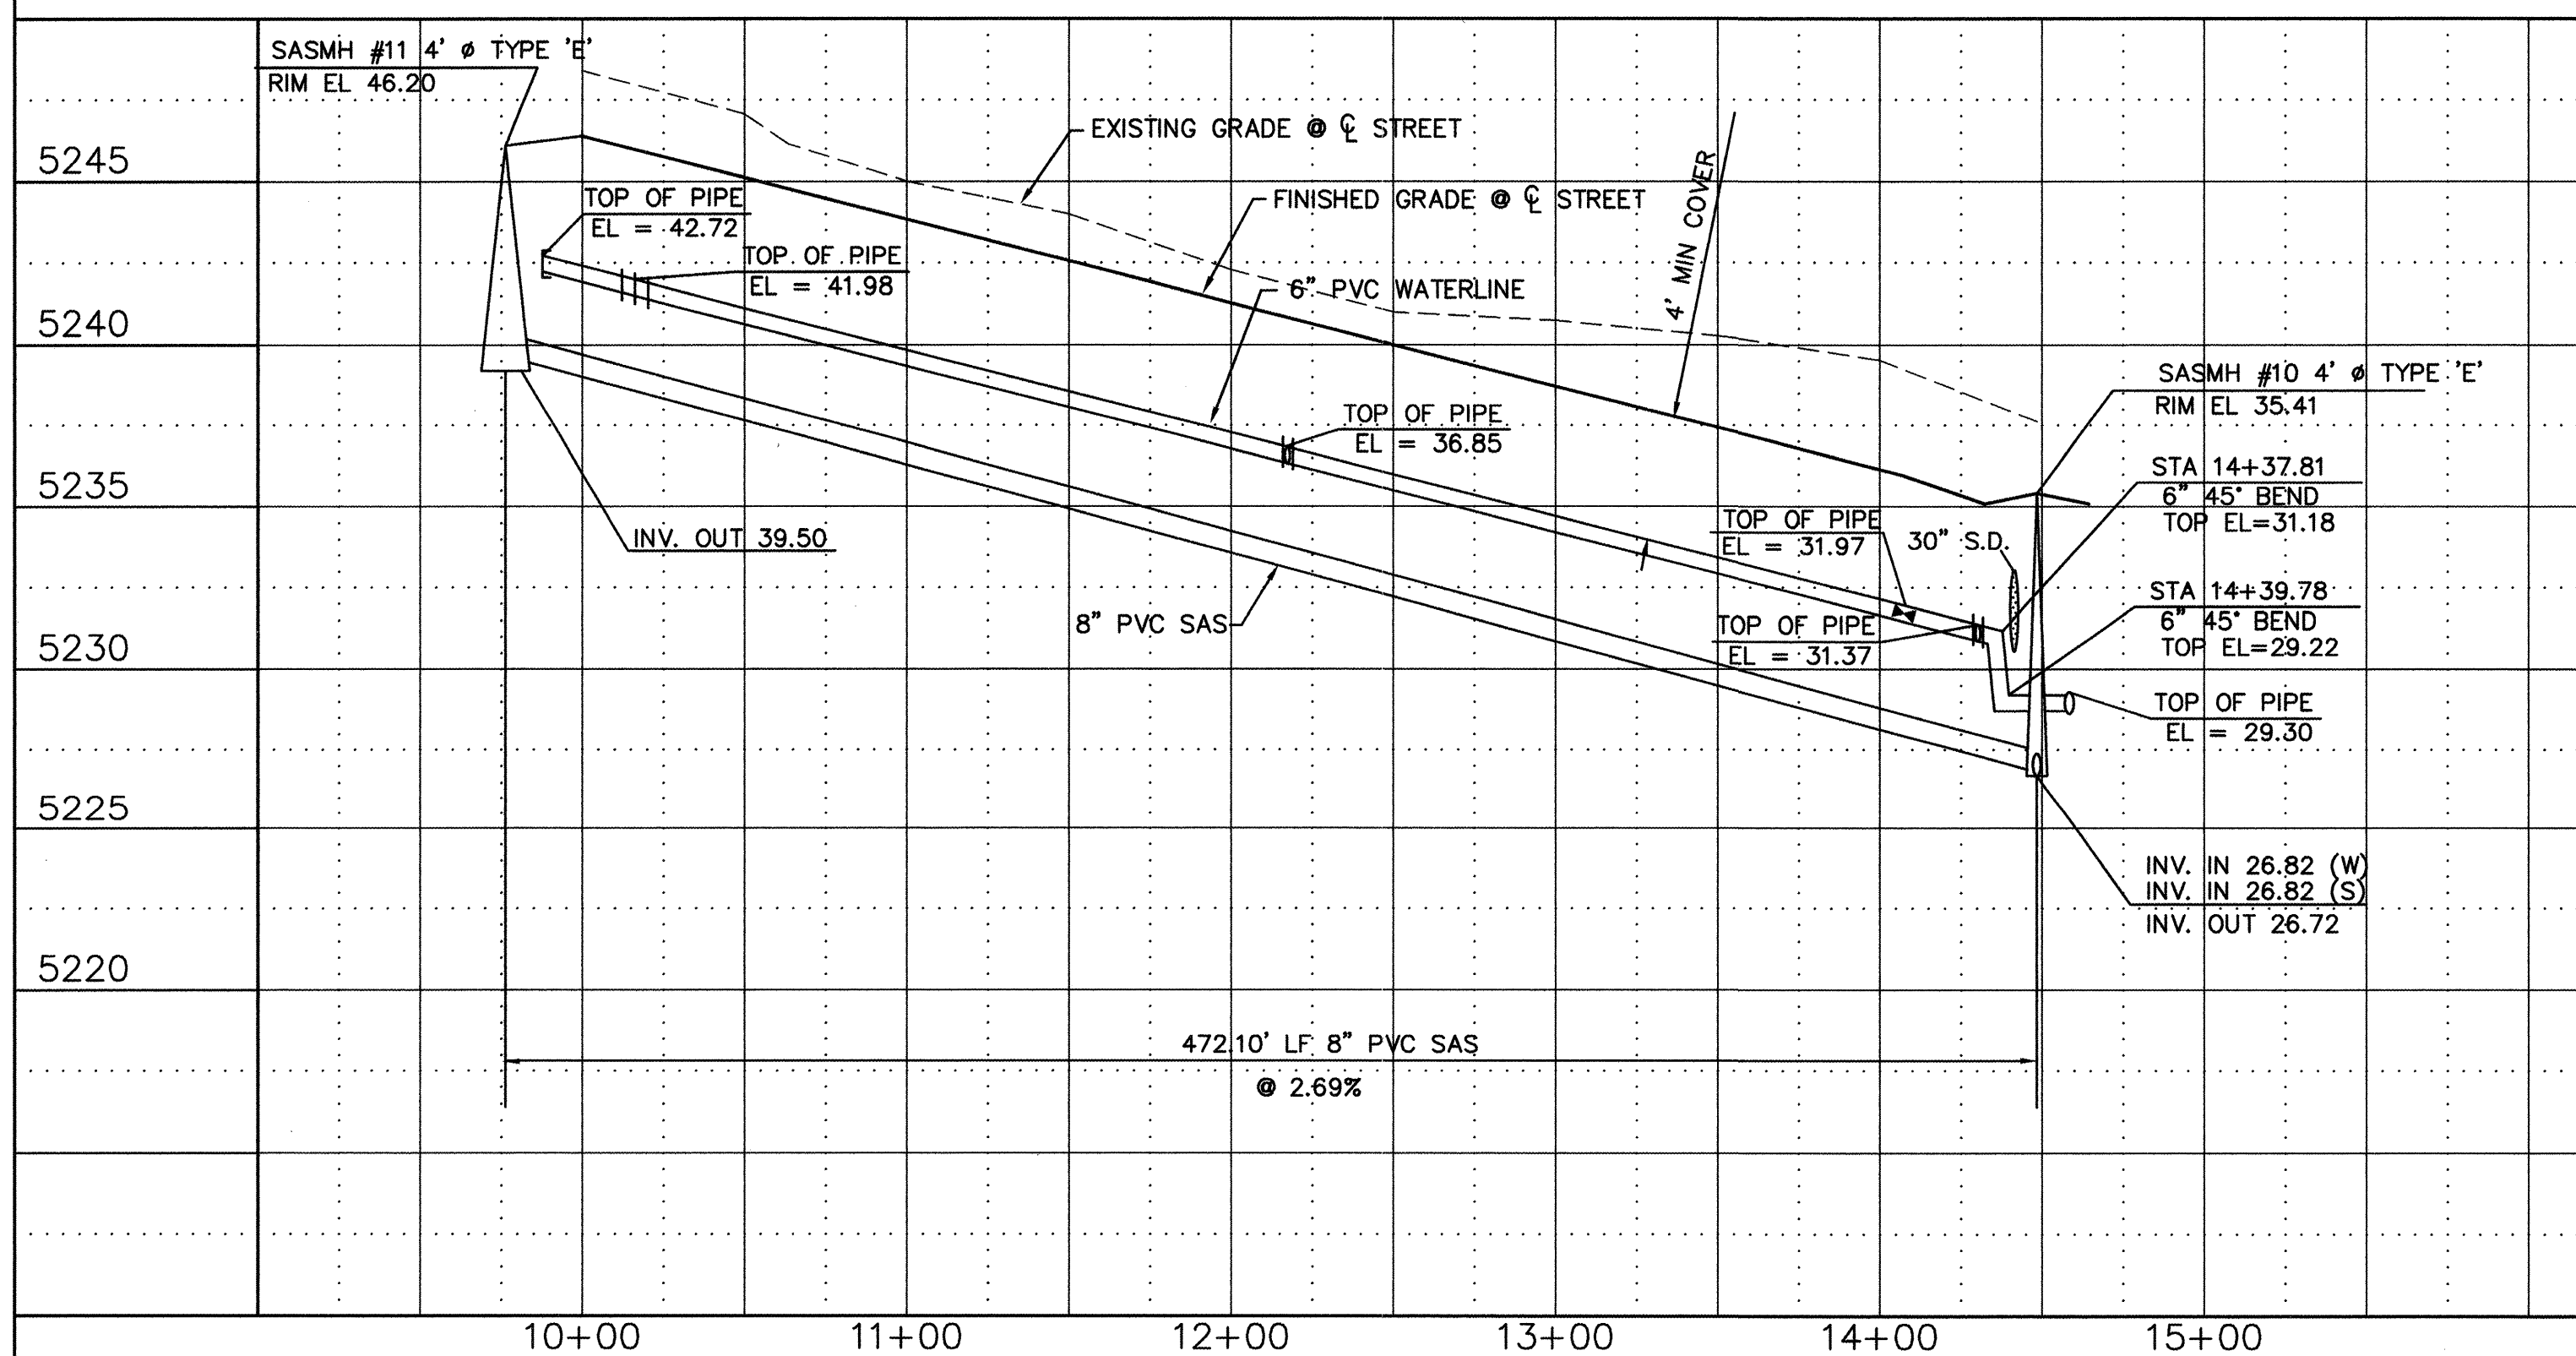

CASA GRIS COURT

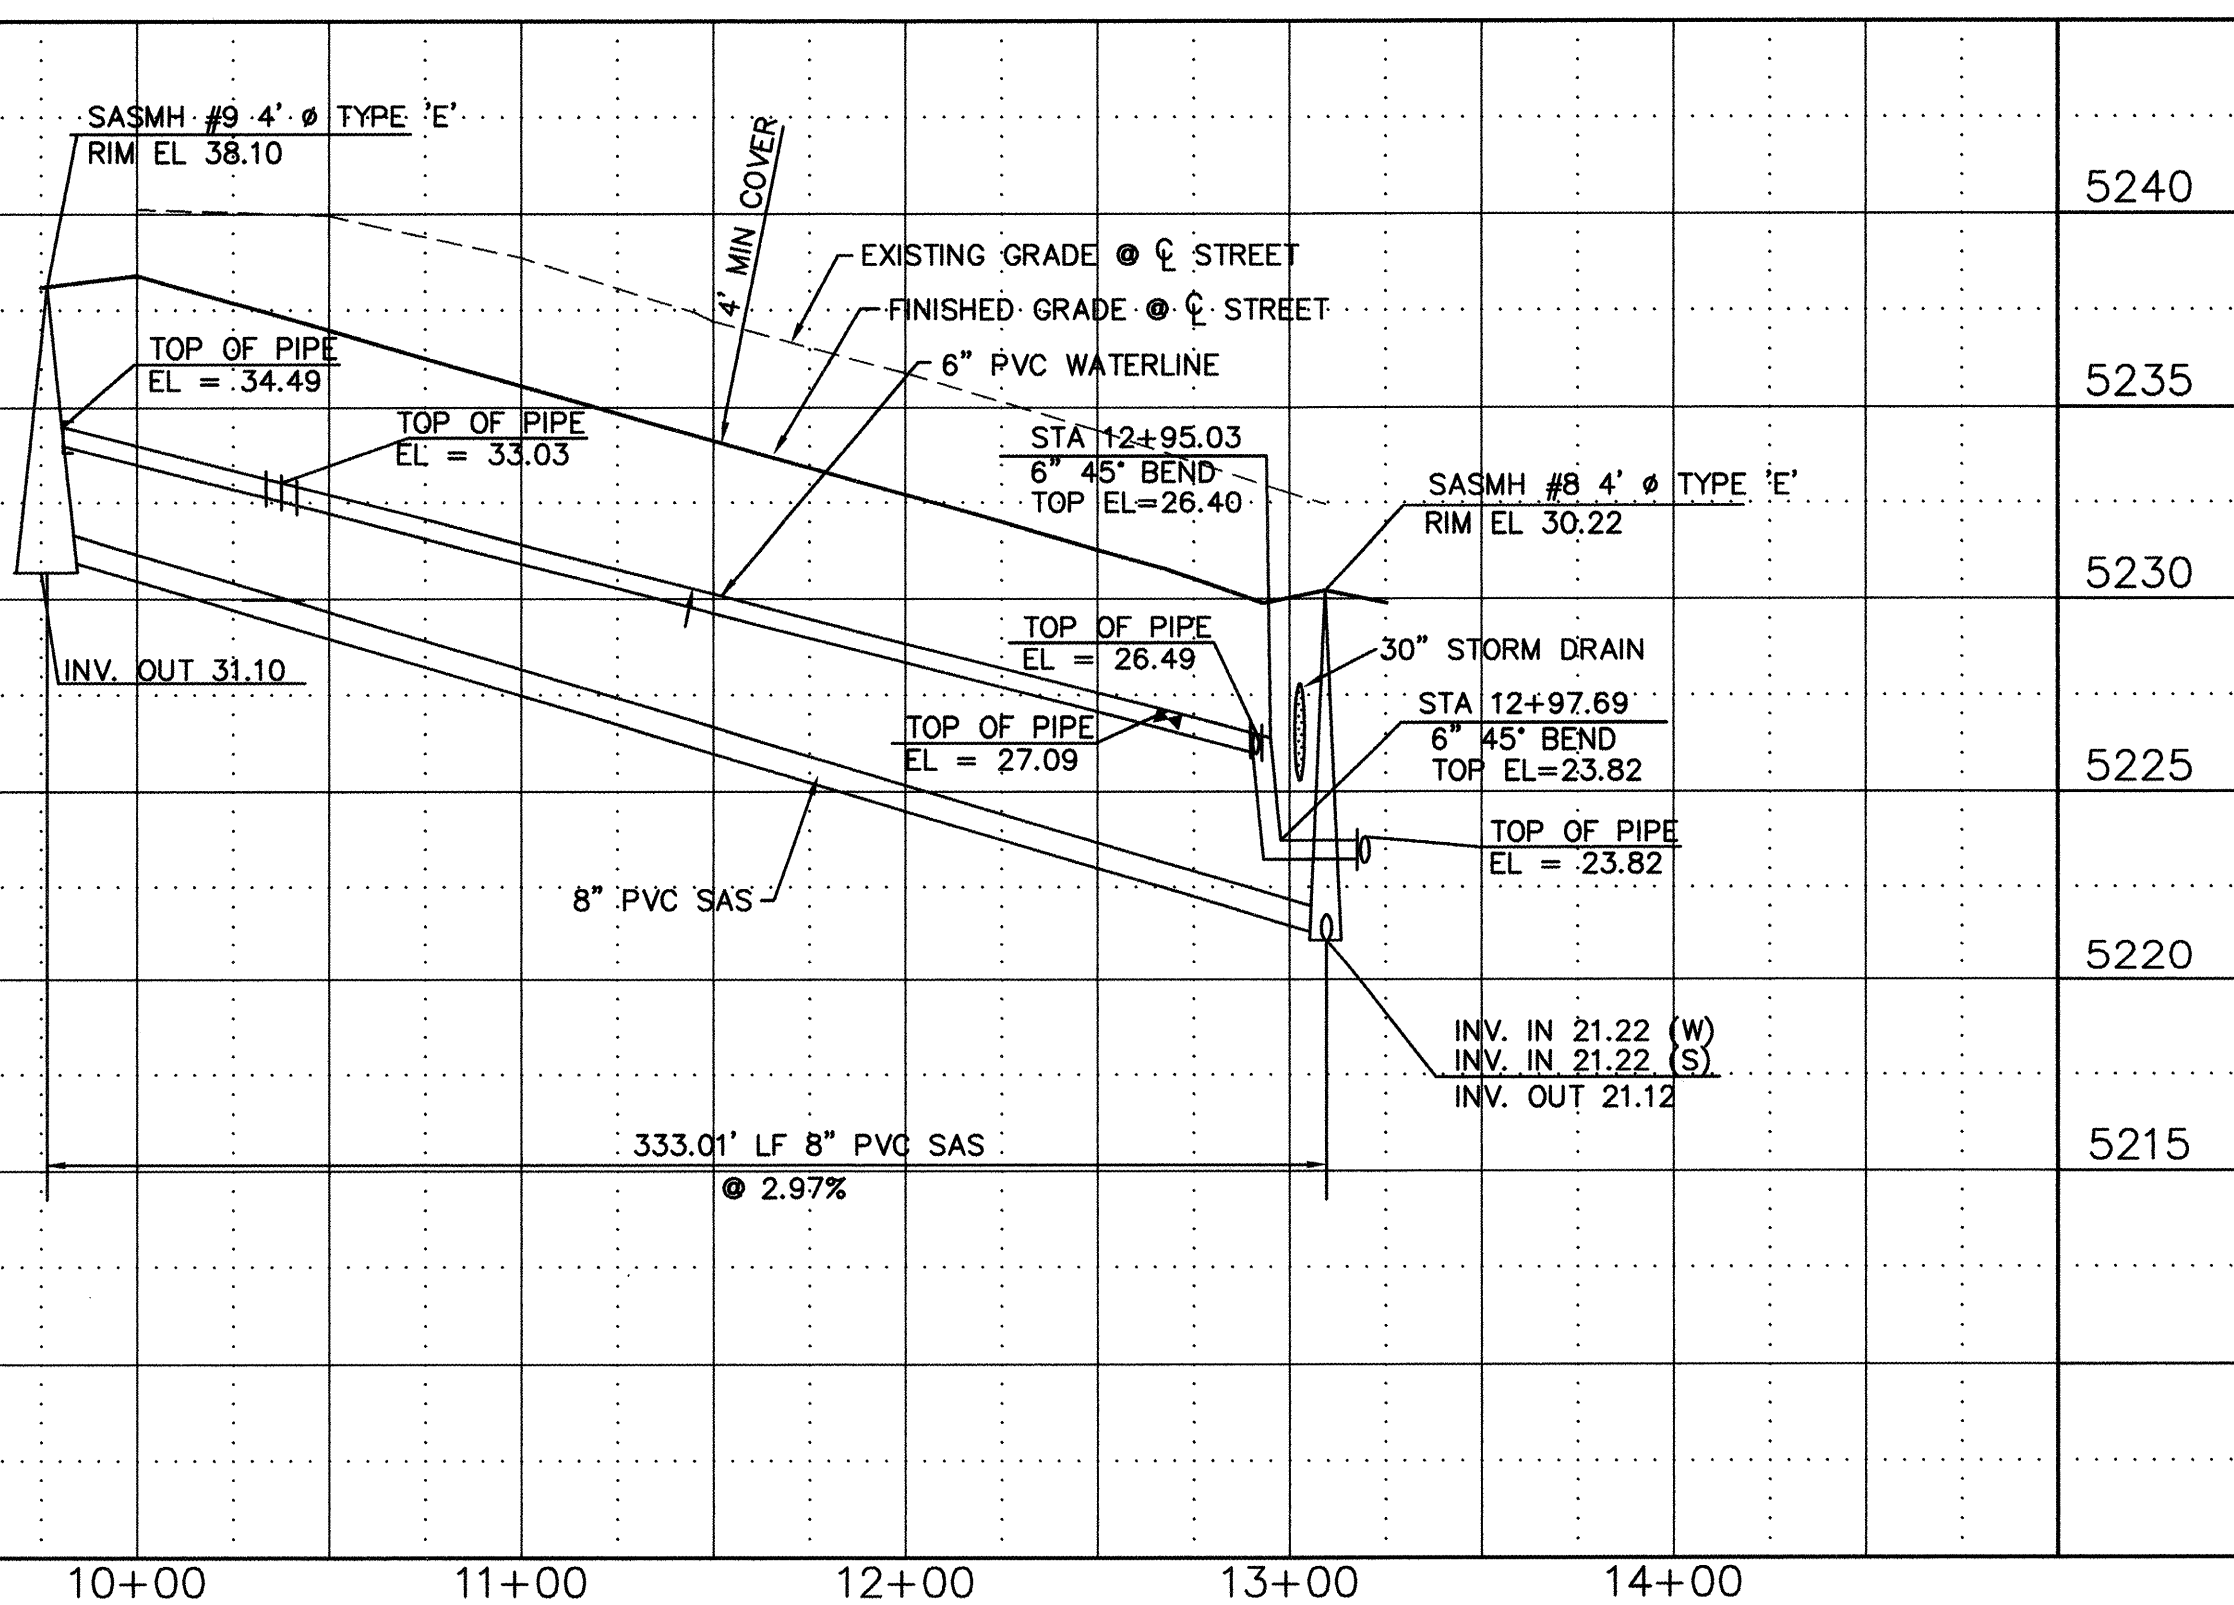

STORM DRAIN MANHOLES

SDMH #	DIAMETER	STATION	OFFSET	RIM EL.	INVERT IN	INVERT OUT
3	6"	9+93.00	10.0 RT	26.17	21.76	21.66
9	8"	12+43.50	10.0 RT	24.48	13.33	13.23

STORM DRAIN PIPE


UPSTREAM				DOWNSTREAM			
SDP #	DIAMETER*	STATION	OFFSET	INVERT	STATION	OFFSET	INVERT
10	36"	9+93.00	10.0 RT	21.66	12+43.50	10.0 RT	13.33
				250.50	3.33%		

* ALL STORM DRAIN PIPE IS RCP CLASS IV


CASA ROJA PLACE
(SEE SHEET 22)LADERA DRIVE
(SEE SHEET 26)NOTE:
20" WATERLINE SHALL
BE BUILT BY OTHERS
CITY PROJECT 5409.90

SCALE: 1"=50'

SCALE: 1"=50'

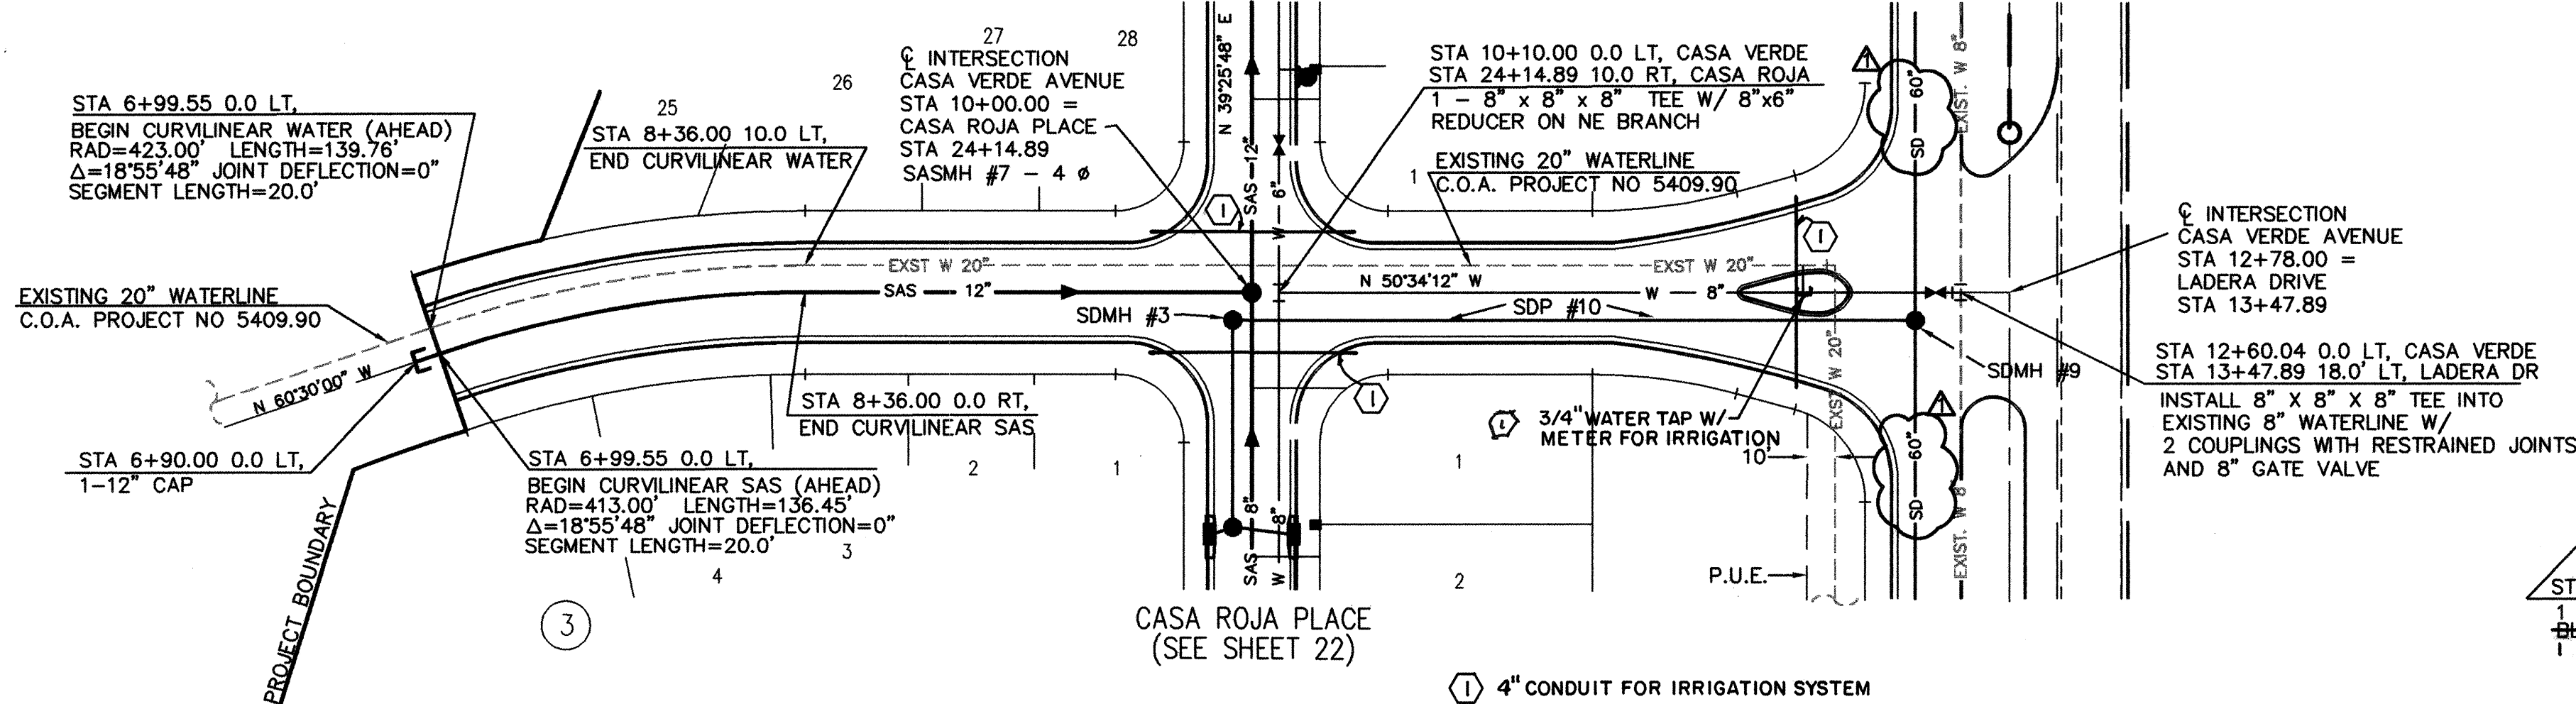

CASA VERDE AVENUE

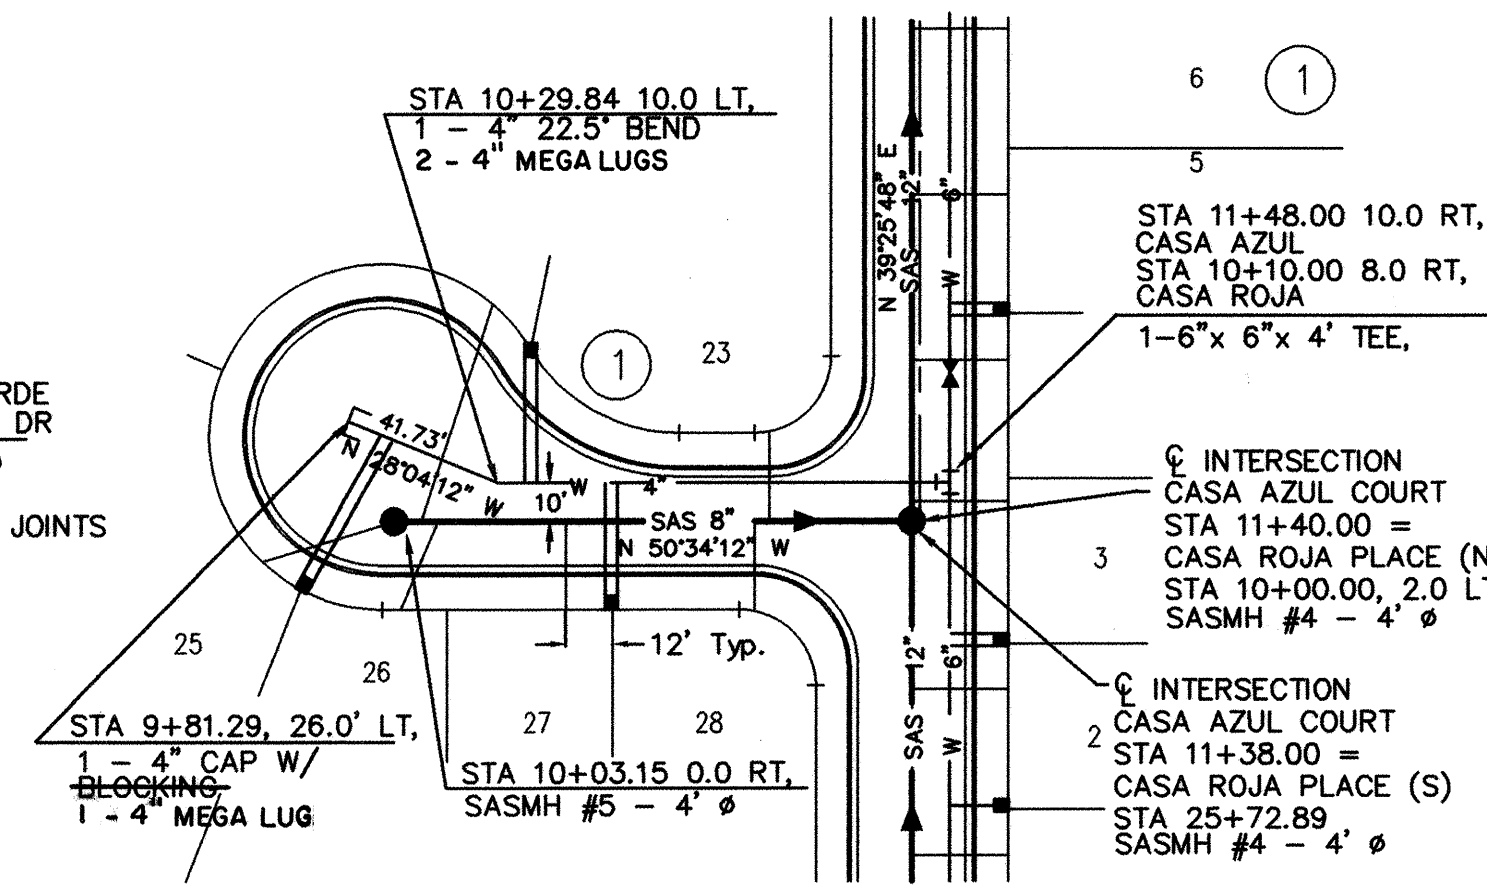LADERA DRIVE
(SEE SHEET 26)CASA ROJA PLACE
(SEE SHEET 23)CASA ROJA PLACE
(SEE SHEET 22)

GENERAL NOTES:

- CONTRACTOR SHALL SUPPORT ALL EXISTING UNDERGROUND UTILITY LINES WHICH BECOME EXPOSED DURING CONSTRUCTION. PAYMENT FOR SUPPORTING WORK SHALL BE INCIDENTAL TO WATERLINE AND/OR SEWERLINE COSTS.
- ALL WATERLINE AND SEWERLINE STATIONING REFERS TO STREET CENTERLINE STATIONING.
- ALL FITTINGS ON WATERLINE SHALL HAVE RESTRAINED JOINTS PER TABLE THIS SHEET.
- CONSTRUCT SAS SERVICES PER C.O.A. DWG #2125.
- CONSTRUCT FIRE HYDRANTS PER DESIGNATED DEPTHS AND LENGTHS PER C.O.A. DWG #2340.
- CONSTRUCT ALL WATER SERVICES PER C.O.A. DWGS #2361, #2362, AND #2363.
- UNLESS OTHERWISE NOTED, ALL SAS MANHOLES SHALL BE 4" DIAMETER, TYPE "E" PER C.O.A. DWG #2102.
- ALL CURVILINEAR SEWERLINES AND WATERLINES SHALL BE BENT ALONG PIPE SEGMENTS WITH 0.0" DEFLECTION AT PIPE JOINTS.
- ALL SEWERLINES AND WATERLINES SHALL BE CONSTRUCTED OF PVC UNLESS SPECIFIED OTHERWISE.
- ALL STORM DRAINS SHALL BE CONSTRUCTED OF RCP-CLASS IV UNLESS SPECIFIED OTHERWISE.
- ALL ELEVATIONS ARE BASED ON A DATUM ELEVATION 5200 AS ESTABLISHED BY BENCH MARKS.

LEGEND

DESCRIPTION	PROPOSED
WATER VALVE	⊥
FIRE HYDRANT	⊙
MANHOLE	⊙
CAP	⊥
DROP INLET	⊥ SDI
PIPE TEE	⊥
PIPE CROSS	⊥
PIPE BEND	⊥
WATER SERVICE SINGLE	⊥
WATER SERVICE DOUBLE	⊥
CURB AND GUTTER	⊥
SEWER LINE	—S—
STORM DRAIN	—SD—
WATER LINE	—W—

RESTRAINED JOINT TABLE

JOINT	RESTRAIN LENGTH
4" GATE VALVE	61'
4" 22.5" HORIZ. BEND	21'
4" 45" VERT. OFFSET	21'
6" GATE VALVE	61'
6" 22.5" HORIZ. BEND	21'
6" 45" HORIZ. BEND	21'
6" 45" VERT. OFFSET	21'
8" X 8" X 4" TEE	BRANCH 21' RUN 21'
8" X 8" X 6" TEE	BRANCH 21' RUN 21'
8" X 8" X 8" TEE	BRANCH 21' RUN 21'
8" GATE VALVE	81'
8" 11.25" HORIZ. BEND	21'
8" 22.50" HORIZ. BEND	21'
8" 45" HORIZ. BEND	21'
8" 22.5" VERT. OFFSET	21'
8" 45" VERT. OFFSET	21'

ENGINEER'S CERTIFICATION

I, James D. Huit, REGISTERED IN NEW MEXICO AS A PROFESSIONAL ENGINEER NO. 9266, HEREBY CERTIFY THAT THIS PROJECT WAS CONSTRUCTED IN SUBSTANTIAL COMPLIANCE WITH THIS PLAN, EXCEPT AS NOTED. DATE 5-1-01

SEWER SERVICE TABLE

CASA AZUL COURT			
STATION	PL	LOT	INV. EL. PL
STA 9+58.86	25	22.20	
STA 10+04.96	26	21.30	
STA 10+28.81	24	22.10	
STA 10+47.96	27	20.30	
STA 10+96.96	28	19.50	
STA 11+02.66	23	19.30	

CINFRAN/HUITT-ZOLIARS


LAND PLANNING / ENGINEERING / ENVIRONMENT / SUBDIVISION DEVELOPMENT / SURVEYING

CITY OF ALBUQUERQUE
PUBLIC WORKS DEPARTMENT
ENGINEERING DEVELOPMENT GROUP

TITLE: WESTLAND DEVELOPMENT CO., INC.
UTILITY PLAN & PROFILE - CASA VERDE/CASA AZUL CT
TIERRA OESTE UNIT 1

DESIGNED	DRAWN BY	CHECKED BY	DATE	REVISIONS
15/6/01	9/1/00	9/1/00	19MAR96	19MAR96
15/6/01	9/1/00	9/1/00	19MAR96	20DEC99

City Project No. 5297.90 Zone Map No. H-9&J-9 Sheet 25 of 30

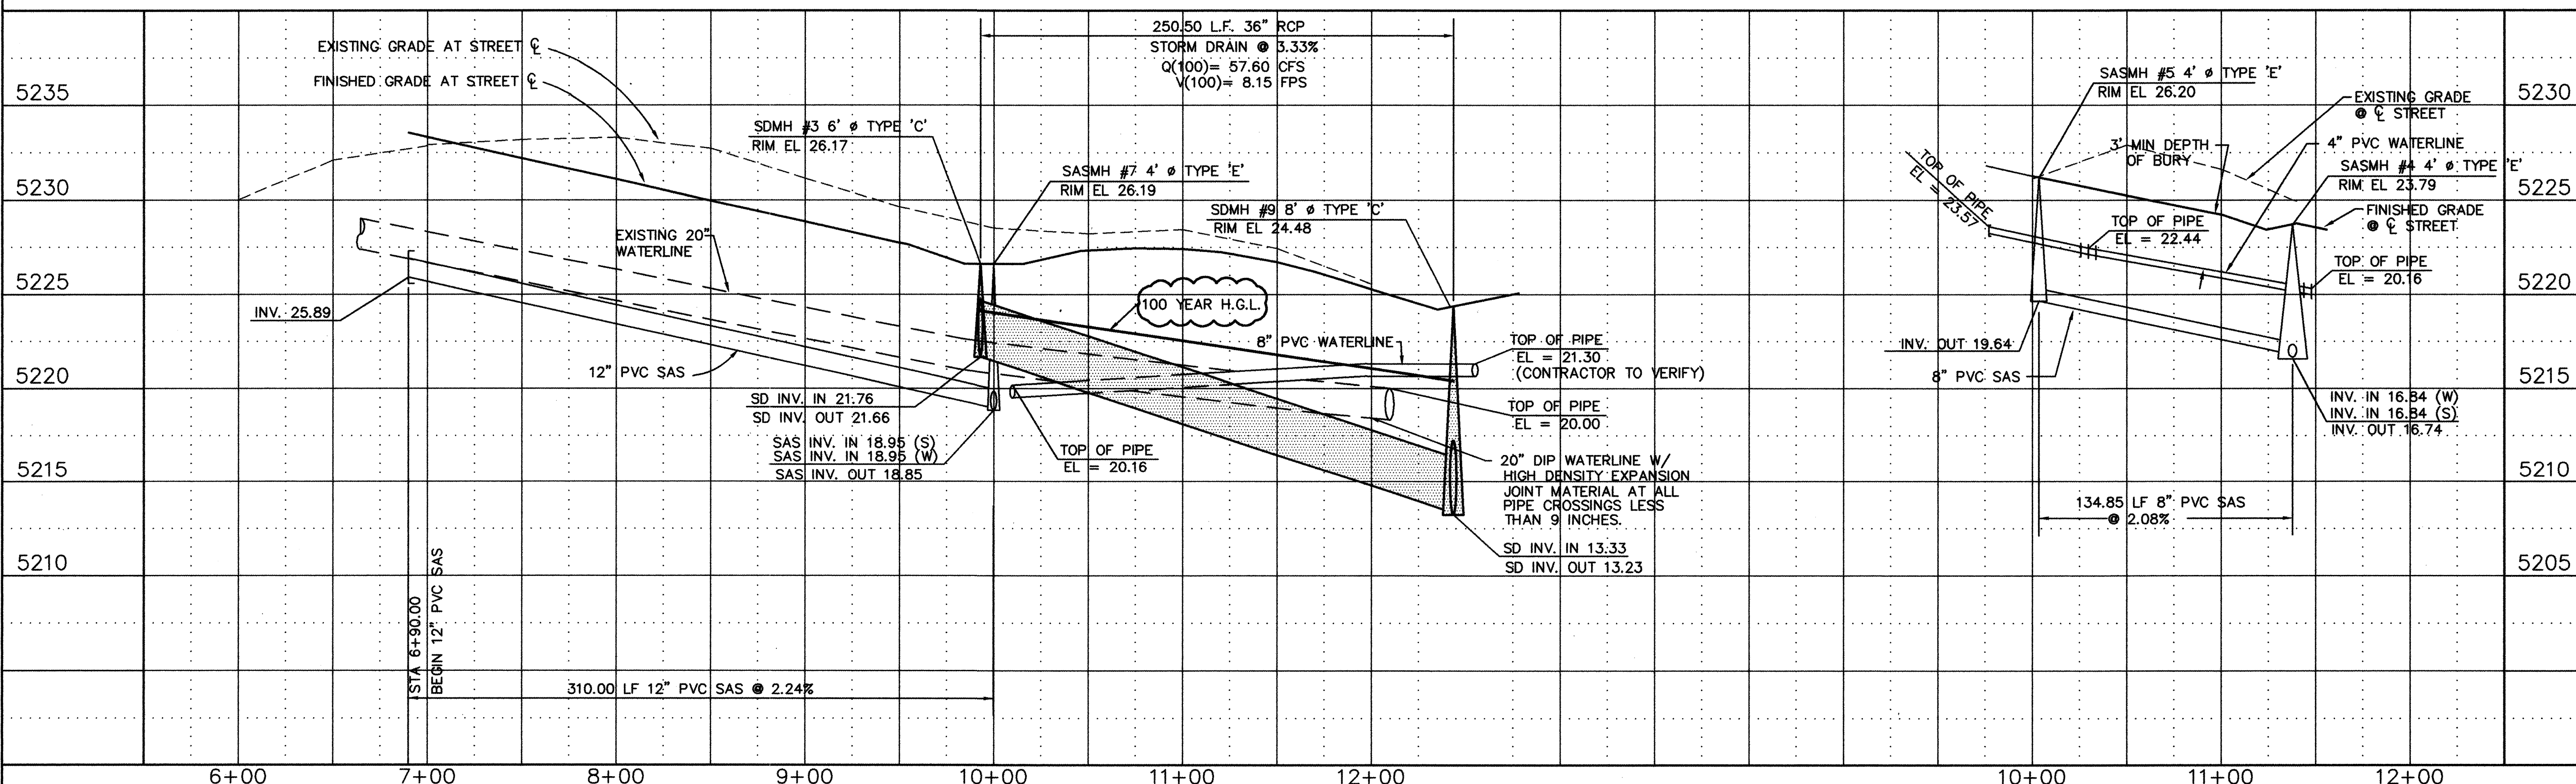SCANNED BY
MESA REPRO10AUG00 (JL)
H:\RANCHOS\PROJ\TO\NEW-99\DRAINAGE\CO\25-30.DWG

STORM DRAIN PIPE


SDP #	DIAMETER*	UPSTREAM			DOWNSTREAM			LENGTH	SLOPE
		STATION	OFFSET	INVERT	STATION	OFFSET	INVERT		
16	60"	4+53.49	34.5 LT	30.85	8+25.31	34.5 LT	23.77	371.82	1.90%
17	18"	8+25.31	41.0 LT	27.50	8+25.31	34.5 LT	27.37	6.50	2.00%
18	60"	8+25.31	34.5 LT	23.67	10+22.22	34.5 LT	19.96	196.58	1.89%
19	60"	10+22.22	34.5 LT	19.86	13+37.89	34.5 LT	13.33	315.67	2.07%
20	60"	13+37.89	34.5 LT	13.23	15+40.00	34.5 LT	8.73	202.11	2.23%
21	18"	14+75.00	41.0 LT	17.67	15+40.00	41.0 LT	15.83	65.00	2.83%
22	18"	15+40.00	41.0 LT	15.73	15+40.00	34.5 LT	15.60	6.50	2.00%
23	18"	15+29.54	41.0 RT	16.29	15+40.00	41.0 RT	15.83	9.83	4.68%
24	18"	15+40.00	41.0 RT	10.73	15+40.00	34.5 LT	9.22	75.50	2.00%
25	60"	15+40.00	34.5 LT	8.63	18+15.00	34.5 LT	97.60	275.00	4.01%

*ALL STORM DRAIN PIPE IS RCP CLASS IV


STORM DRAIN INLETS

SDI #	TYPE	STATION	OFFSET	EL*	INVERT IN	INVERT OUT
10	'A'	8+25.31	41.0 LT	31.60	-	27.50
11	'A'	14+75.00	41.0 LT	21.67	-	17.67
12	DOUBLE 'C'	15+40.00	41.0 LT	19.83	15.83	15.73
EXIST #1	'A'	15+29.54	41.0 RT	20.29	-	16.29
EXIST #2	'C'	15+40.00	41.0 RT	19.83	15.83	10.73

*NORMAL GUTTER EL

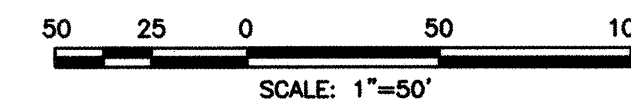CASA VERDE AVENUE
(SEE SHEET 25)

UNIT 2 (FUTURE)

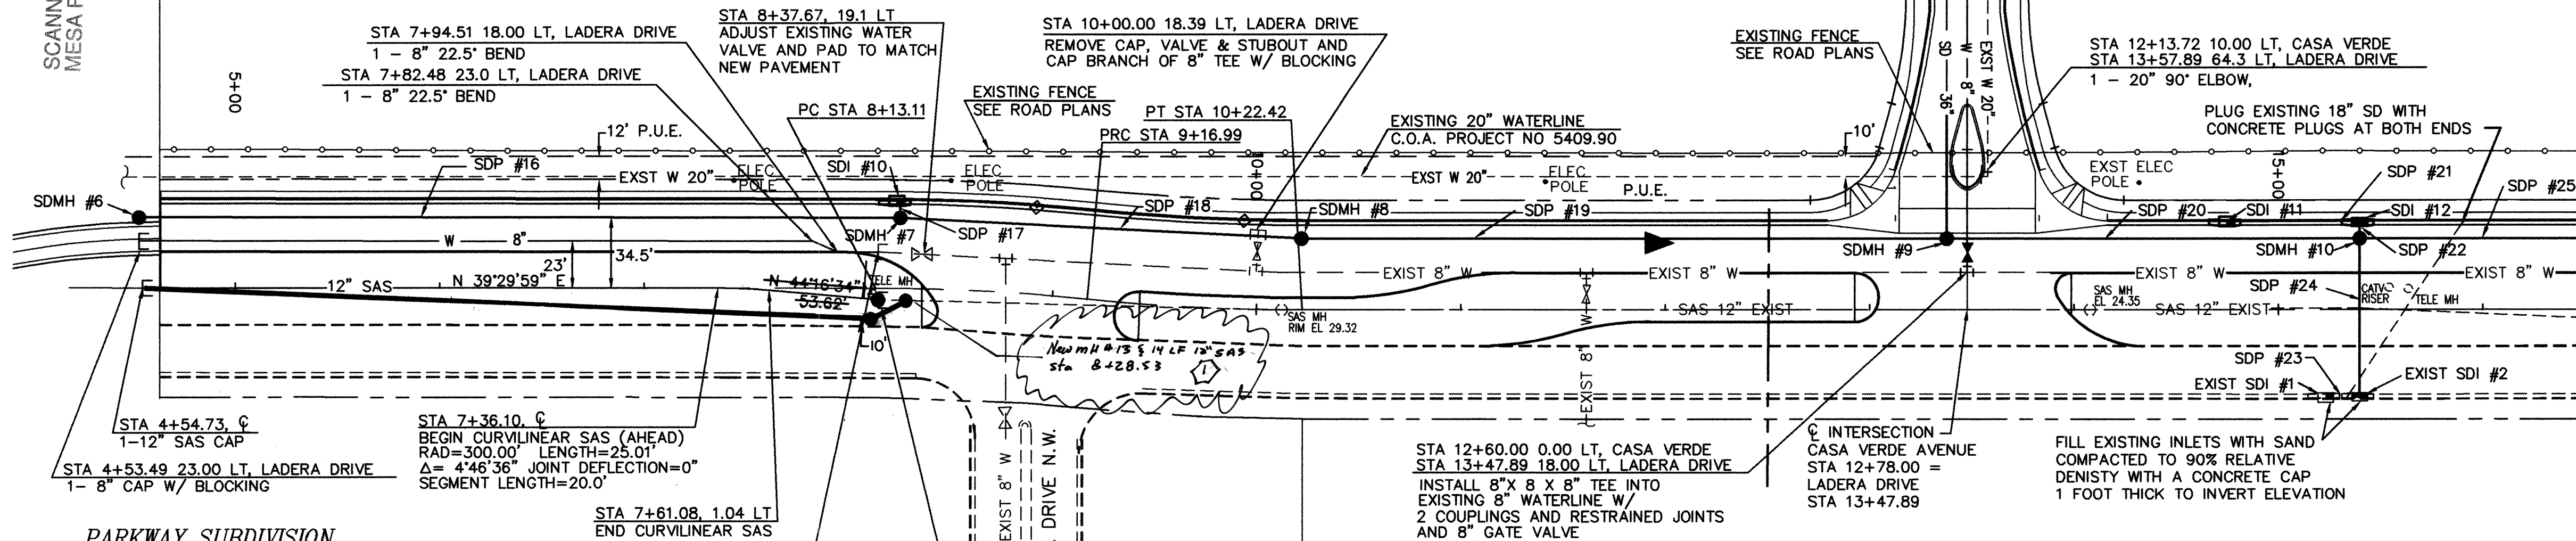PARKWAY SUBDIVISION
TRACTS A, B, C, AND D

STORM DRAIN MANHOLES-UNIT 2

SDMH #	DIAMETER	STATION	OFFSET	RIM EL	INVERT IN	INVERT OUT
6	8"	4+53.49	34.5 LT	38.95	-	30.85
7	8"	8+25.31	34.5 LT	31.77	23.77	23.67
8	8"	10+22.22	34.5 LT	27.96	19.96	19.86
9	8"	13+37.89	34.5 LT	24.48	13.33	13.23
10	8"	15+40.00	34.5 LT	20.00	8.32	8.22

PARKWAY UNIT 7

PARKWAY UNIT 6

LADERA DRIVE

GENERAL NOTES:

- CONTRACTOR SHALL SUPPORT ALL EXISTING UNDERGROUND UTILITY LINES WHICH BECOME EXPOSED DURING CONSTRUCTION. PAYMENT FOR SUPPORTING WORK SHALL BE INCIDENTAL TO WATERLINE AND/OR SEWERLINE COSTS.
- ALL WATERLINE AND SEWERLINE STATIONING REFERS TO STREET CENTERLINE STATIONING.
- ALL FITTINGS ON WATERLINE SHALL HAVE RESTRAINED JOINTS PER TABLE THIS SHEET.
- CONSTRUCT SAS SERVICES PER C.O.A. DWG #2125.
- CONSTRUCT FIRE HYDRANTS PER DESIGNATED DEPTHS AND LENGTHS PER C.O.A. DWG #2340.
- CONSTRUCT ALL WATER SERVICES PER C.O.A. DWGS #2361, #2362, AND #2363.
- UNLESS OTHERWISE NOTED, ALL SAS MANHOLES SHALL BE 4' DIAMETER, TYPE 'E' PER C.O.A. DWG #2102.
- ALL CURVILINEAR SEWERLINES AND WATERLINES SHALL BE BENT ALONG PIPE SEGMENTS WITH 0.0" DEFLECTION AT PIPE JOINTS.
- ALL SEWERLINES AND WATERLINES SHALL BE CONSTRUCTED OF PVC UNLESS SPECIFIED OTHERWISE.
- ALL STORM DRAINS SHALL BE CONSTRUCTED OF RCP-CLASS IV UNLESS SPECIFIED OTHERWISE.
- ALL ELEVATIONS ARE BASED ON A DATUM ELEVATION 5200 AS ESTABLISHED BY BENCH MARKS.

LEGEND

DESCRIPTION	PROPOSED
WATER VALVE	W
FIRE HYDRANT	F
MANHOLE	M
CAP	C
DROP INLET	DI
PIPE TEE	T
PIPE CROSS	C
PIPE BEND	B
WATER SERVICE SINGLE	WS
WATER SERVICE DOUBLE	WS
CURB AND GUTTER	CG
SEWER LINE	S
STORM DRAIN	SD
WATER LINE	W

RESTRAINED JOINT TABLE

JOINT	RESTRAIN LENGTH
4" GATE VALVE	61'
4" 22.5" HORZ. BEND	21'
4" 45" VERT. OFFSET	21'
6" GATE VALVE	61'
6" 22.5" HORZ. BEND	21'
6" 45" VERT. OFFSET	21'
8" X 8" X 4" TEE	BRANCH 21' RUN 21'
8" X 8" X 6" TEE	BRANCH 21' RUN 21'
8" X 8" X 8" TEE	BRANCH 21' RUN 21'
8" GATE VALVE	81'
8" 11.25" HORZ. BEND	21'
8" 22.50" HORZ. BEND	21'
8" 45" HORZ. BEND	21'
8" 22.5" VERT. OFFSET	21'
8" 45" VERT. OFFSET	21'

ENGINEER'S CERTIFICATION

I, James P. Zoliar, REGISTERED IN NEW MEXICO AS A PROFESSIONAL ENGINEER NO. 9212, HEREBY CERTIFY THAT THIS PROJECT WAS CONSTRUCTED IN SUBSTANTIAL COMPLIANCE WITH THIS PLAN, EXCEPT AS NOTED. DATE 1-1-01

CINFRAN/HUETT-ZOLIARS

333 RIO RANCHO DR. N.E. STE. 101
RIO RANCHO, N.M. 87124
(505) 892-0141

LAND PLANNING / ENGINEERING / ENVIRONMENT / SUBDIVISION DEVELOPMENT / SURVEYING

CITY OF ALBUQUERQUE

PUBLIC WORKS DEPARTMENT

ENGINEERING DEVELOPMENT GROUP

TITLE: WESTLAND DEVELOPMENT CO., INC.

UTILITY PLAN & PROFILE - LADERA DRIVE

TIERRA OESTE UNIT 1

DESIGN REVIEW COMMITTEE

APPROVE

DEC 9 2000

CITY ENGINEER

DESIGN REVIEW COMMITTEE

APPROVE

DEC 9 2000

CITY ENGINEER







DESIGN REVIEW COMMITTEE

APPROVE

DEC 9 2000

SCANNED BY
MESA REPRO


MATCHLINE SHEET 26
STA 16+50.00 LADERA DRIVE

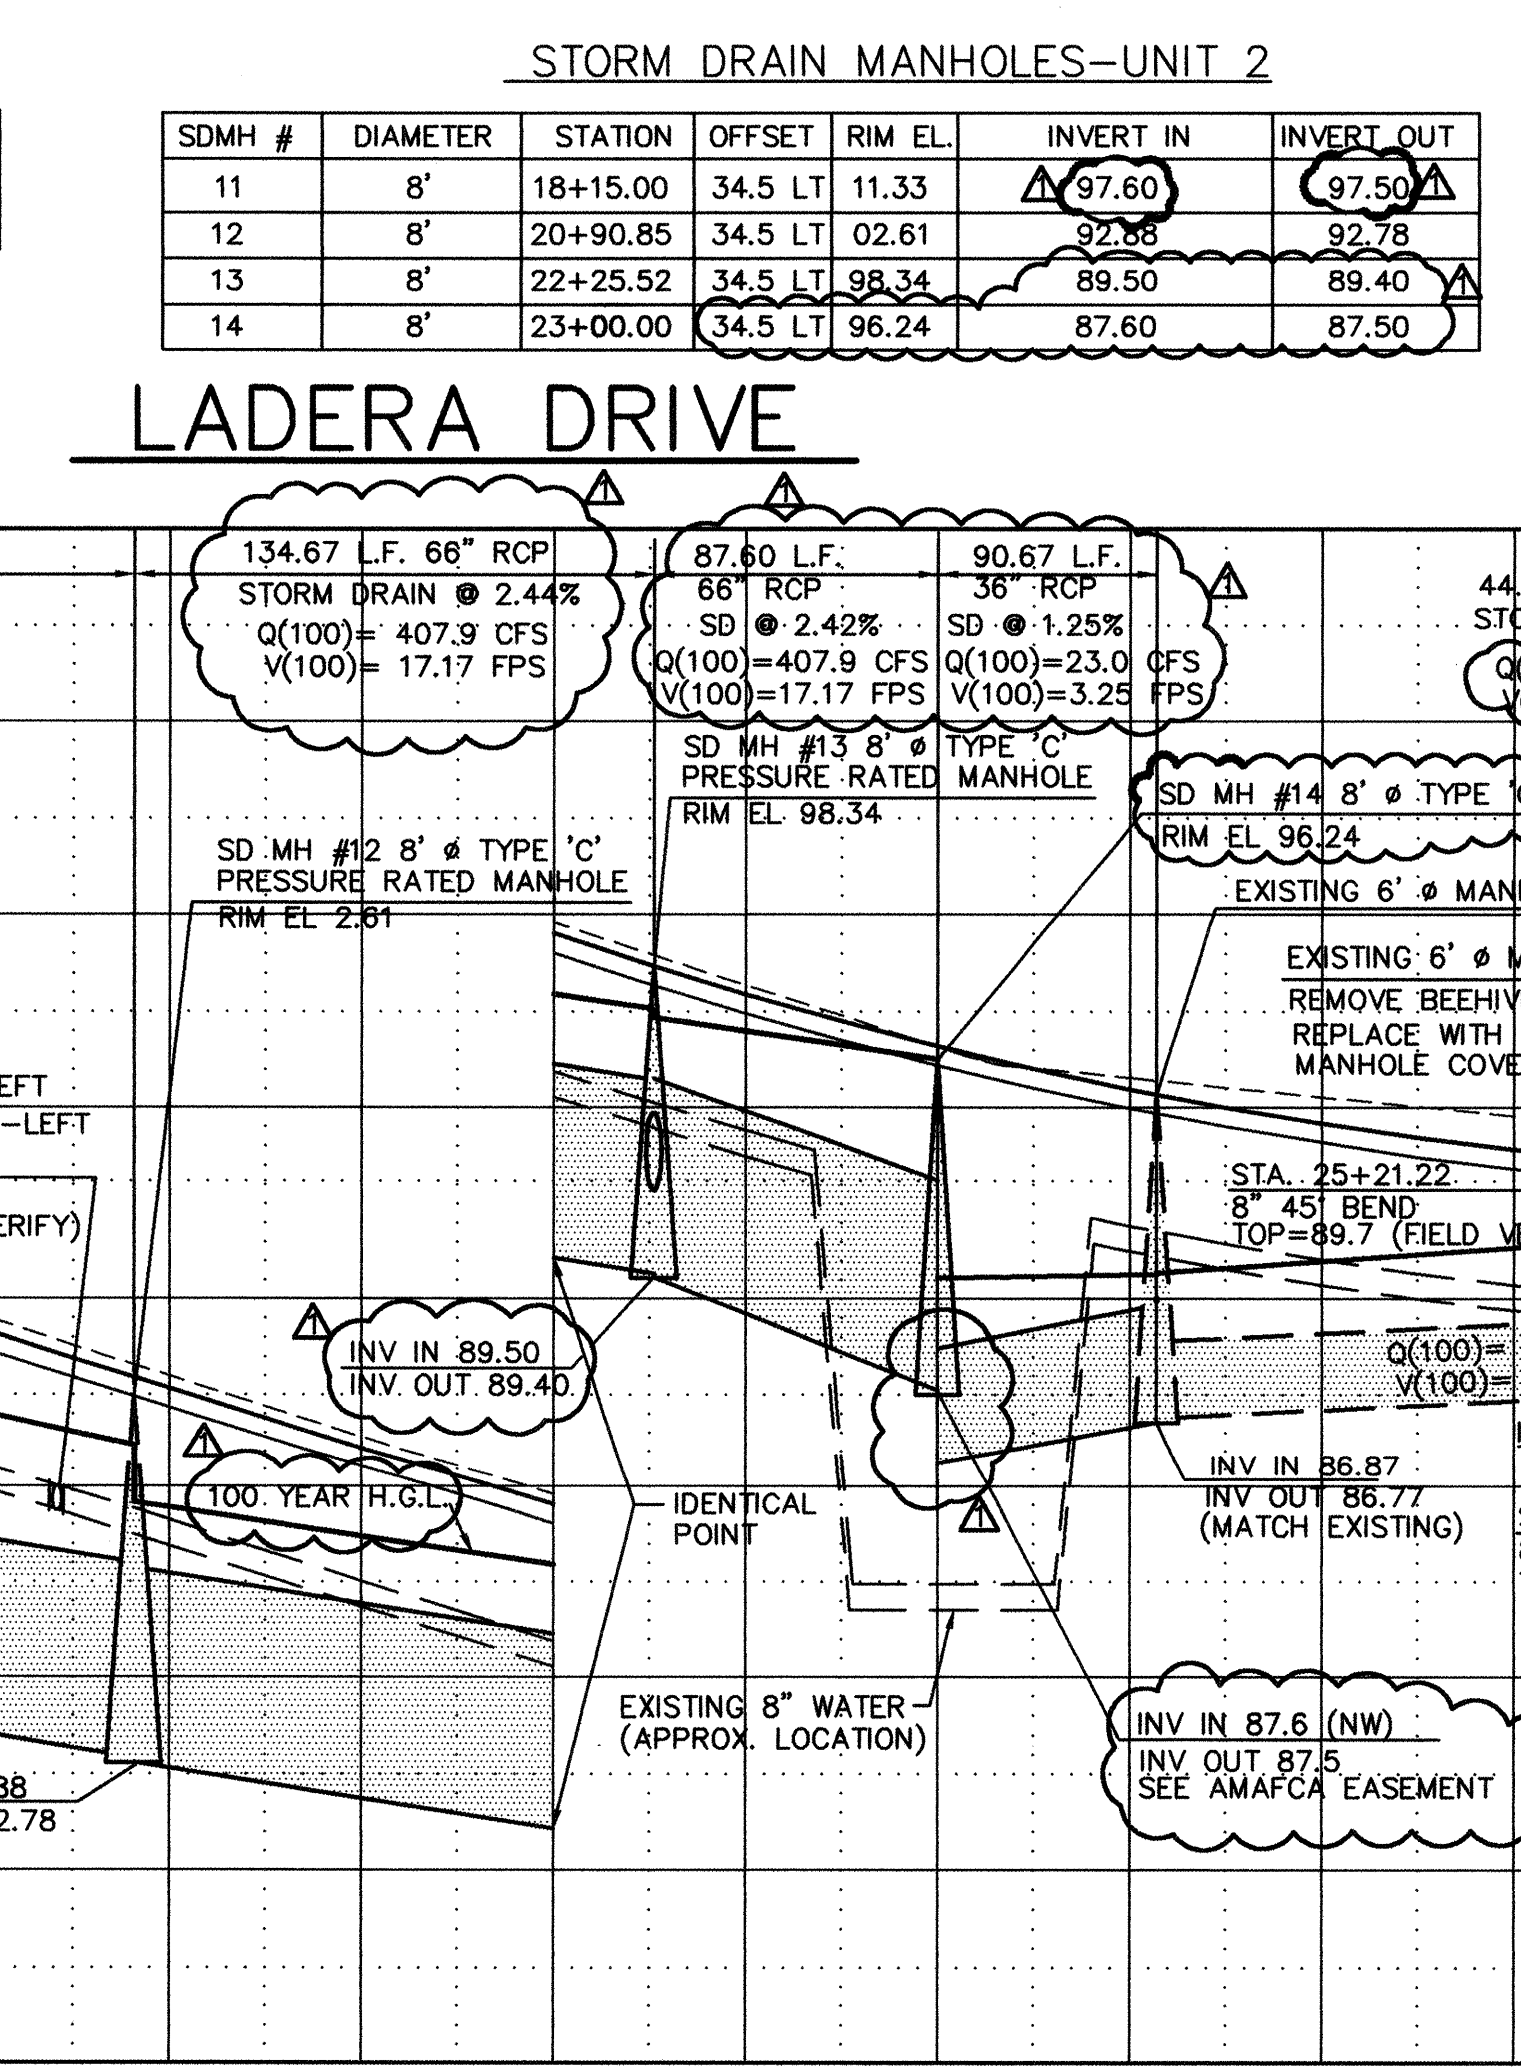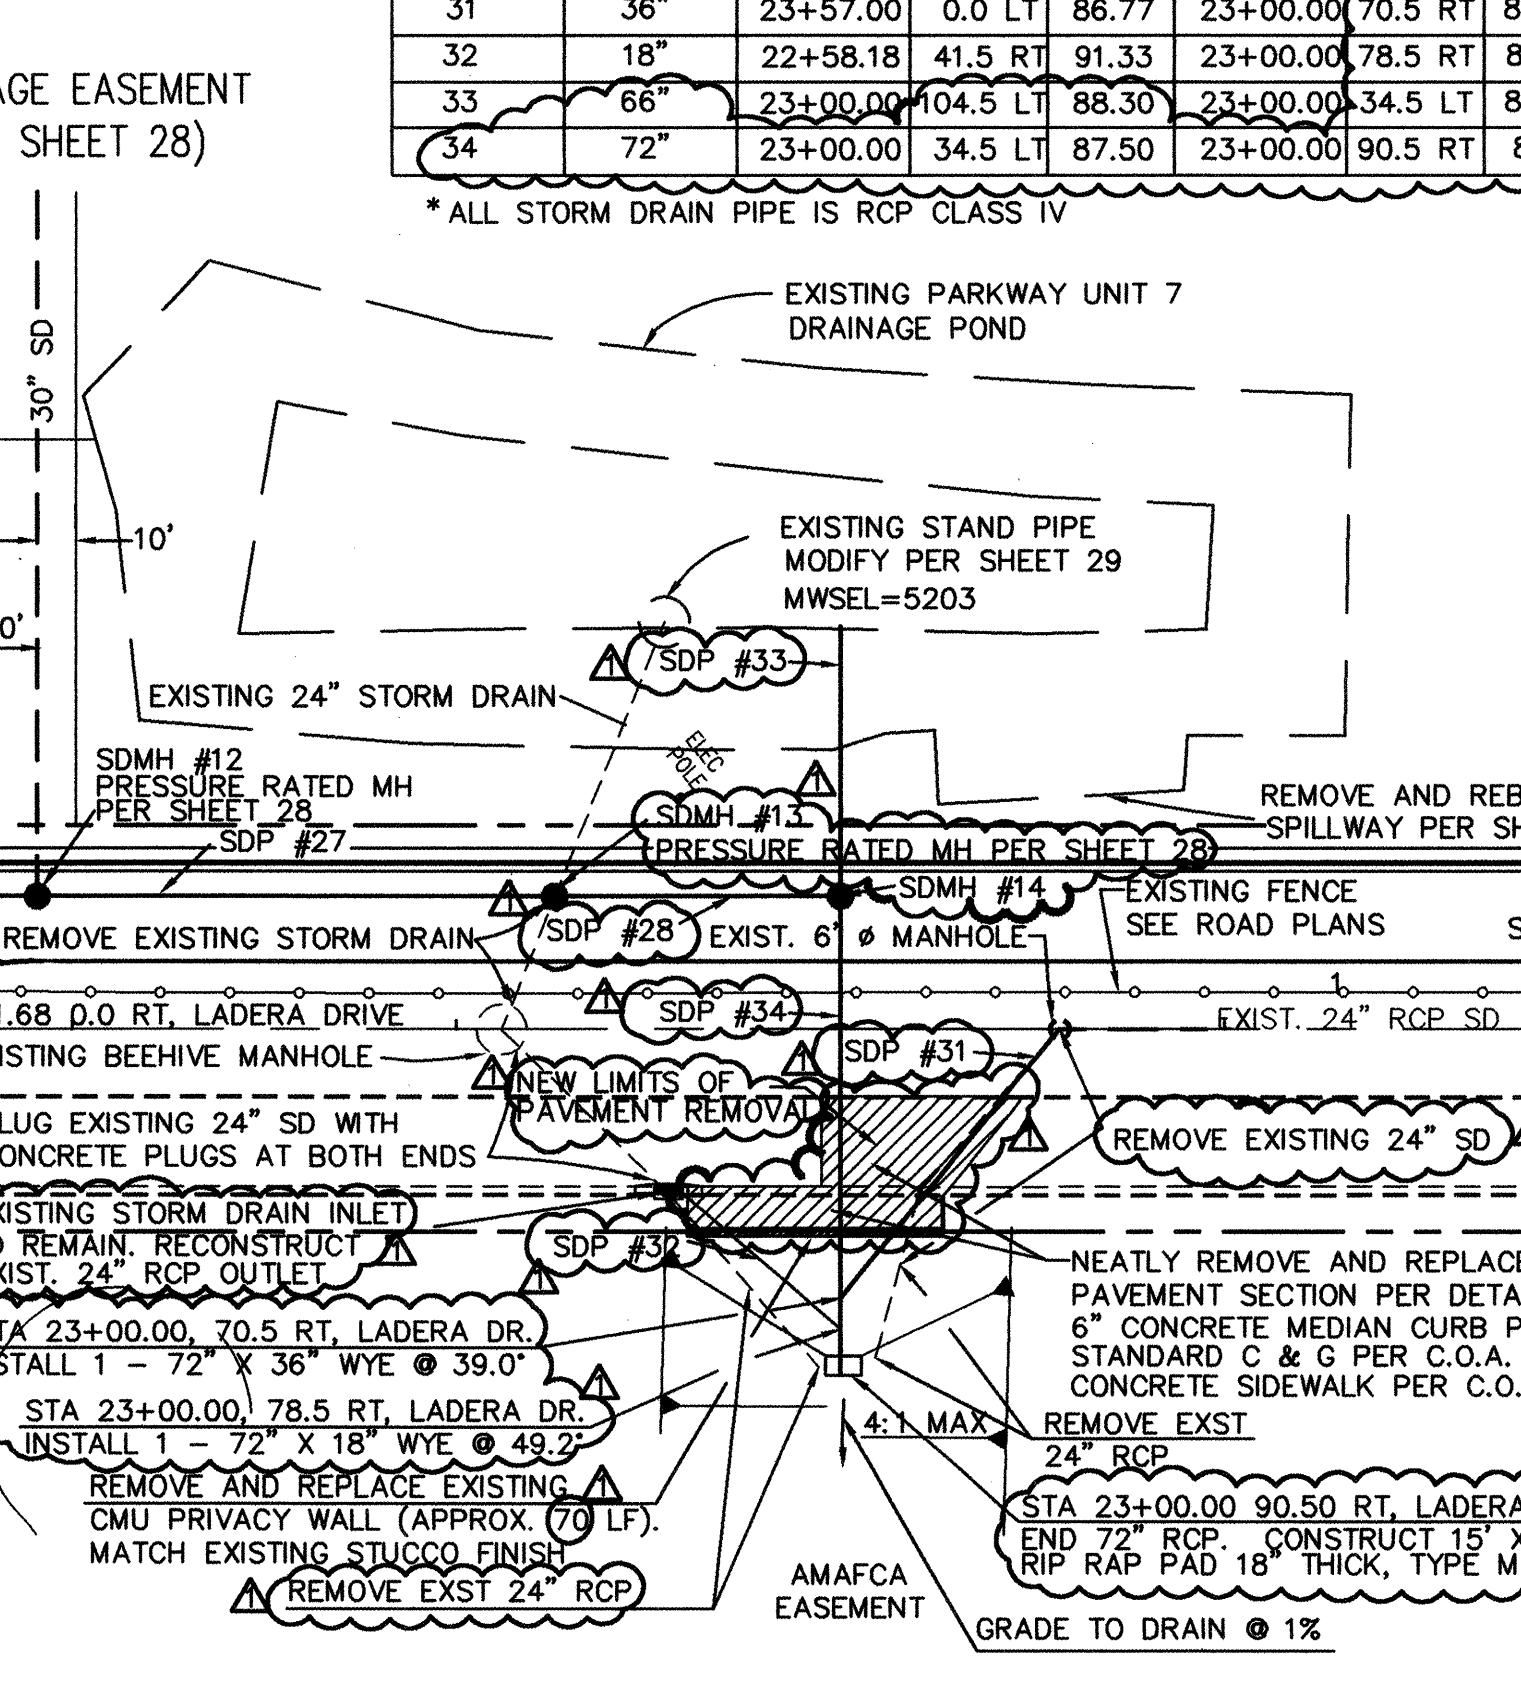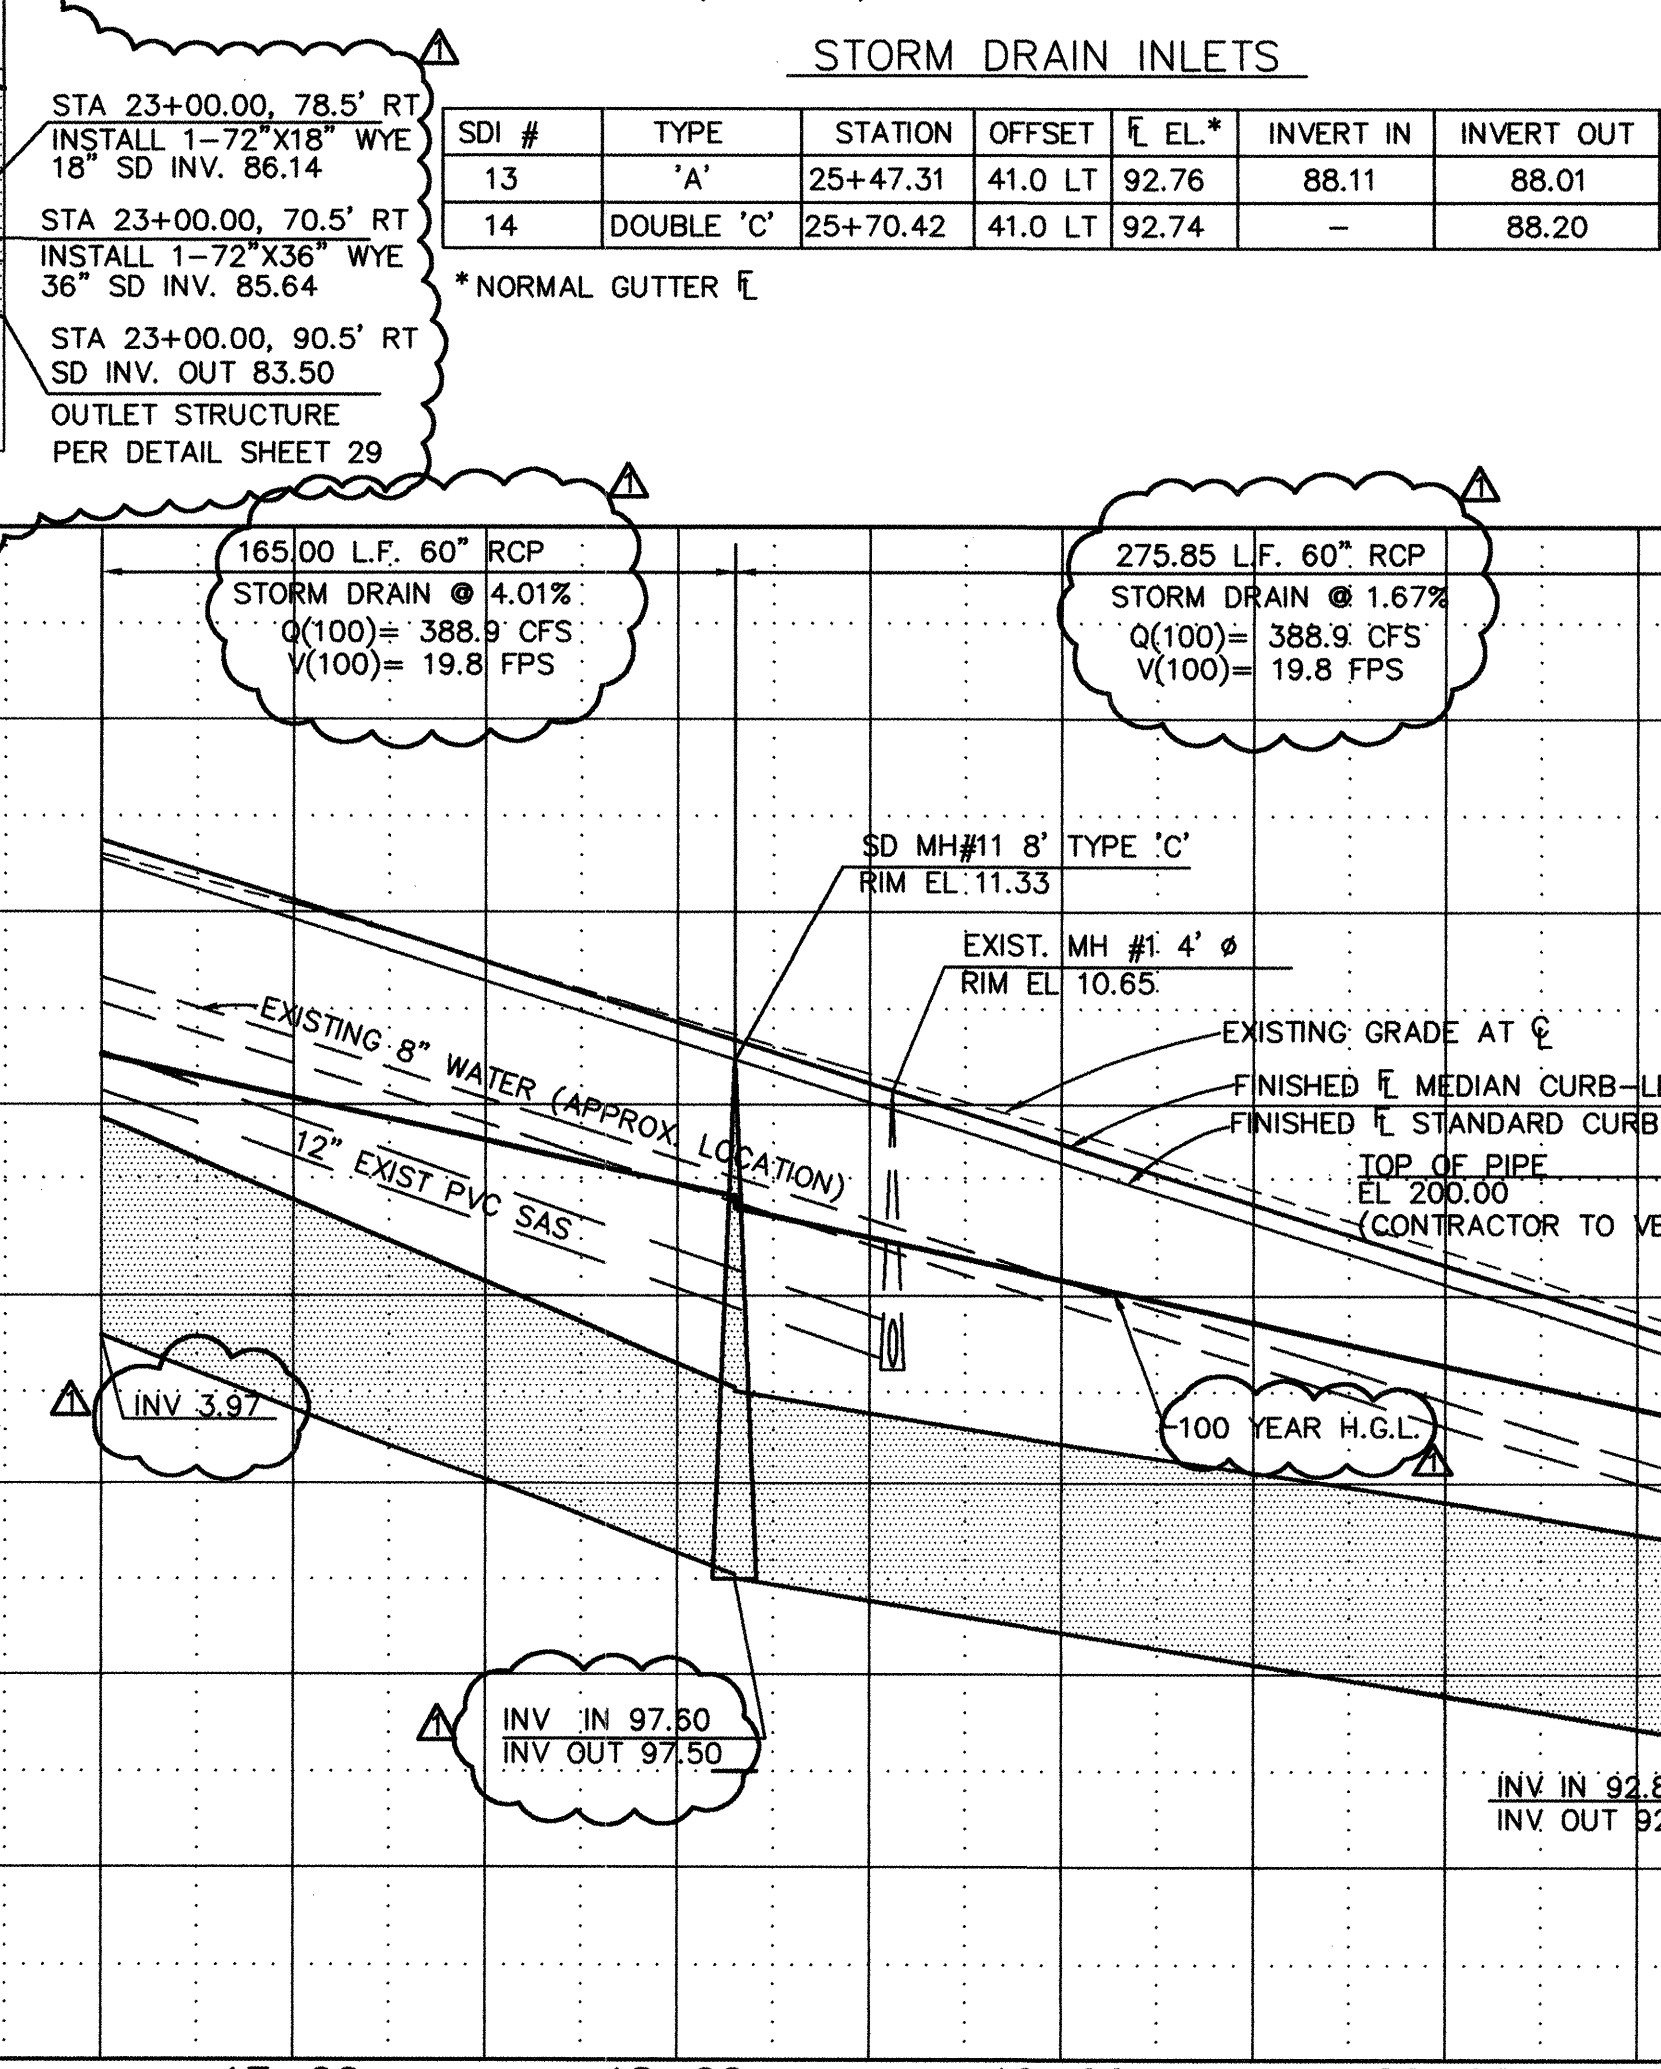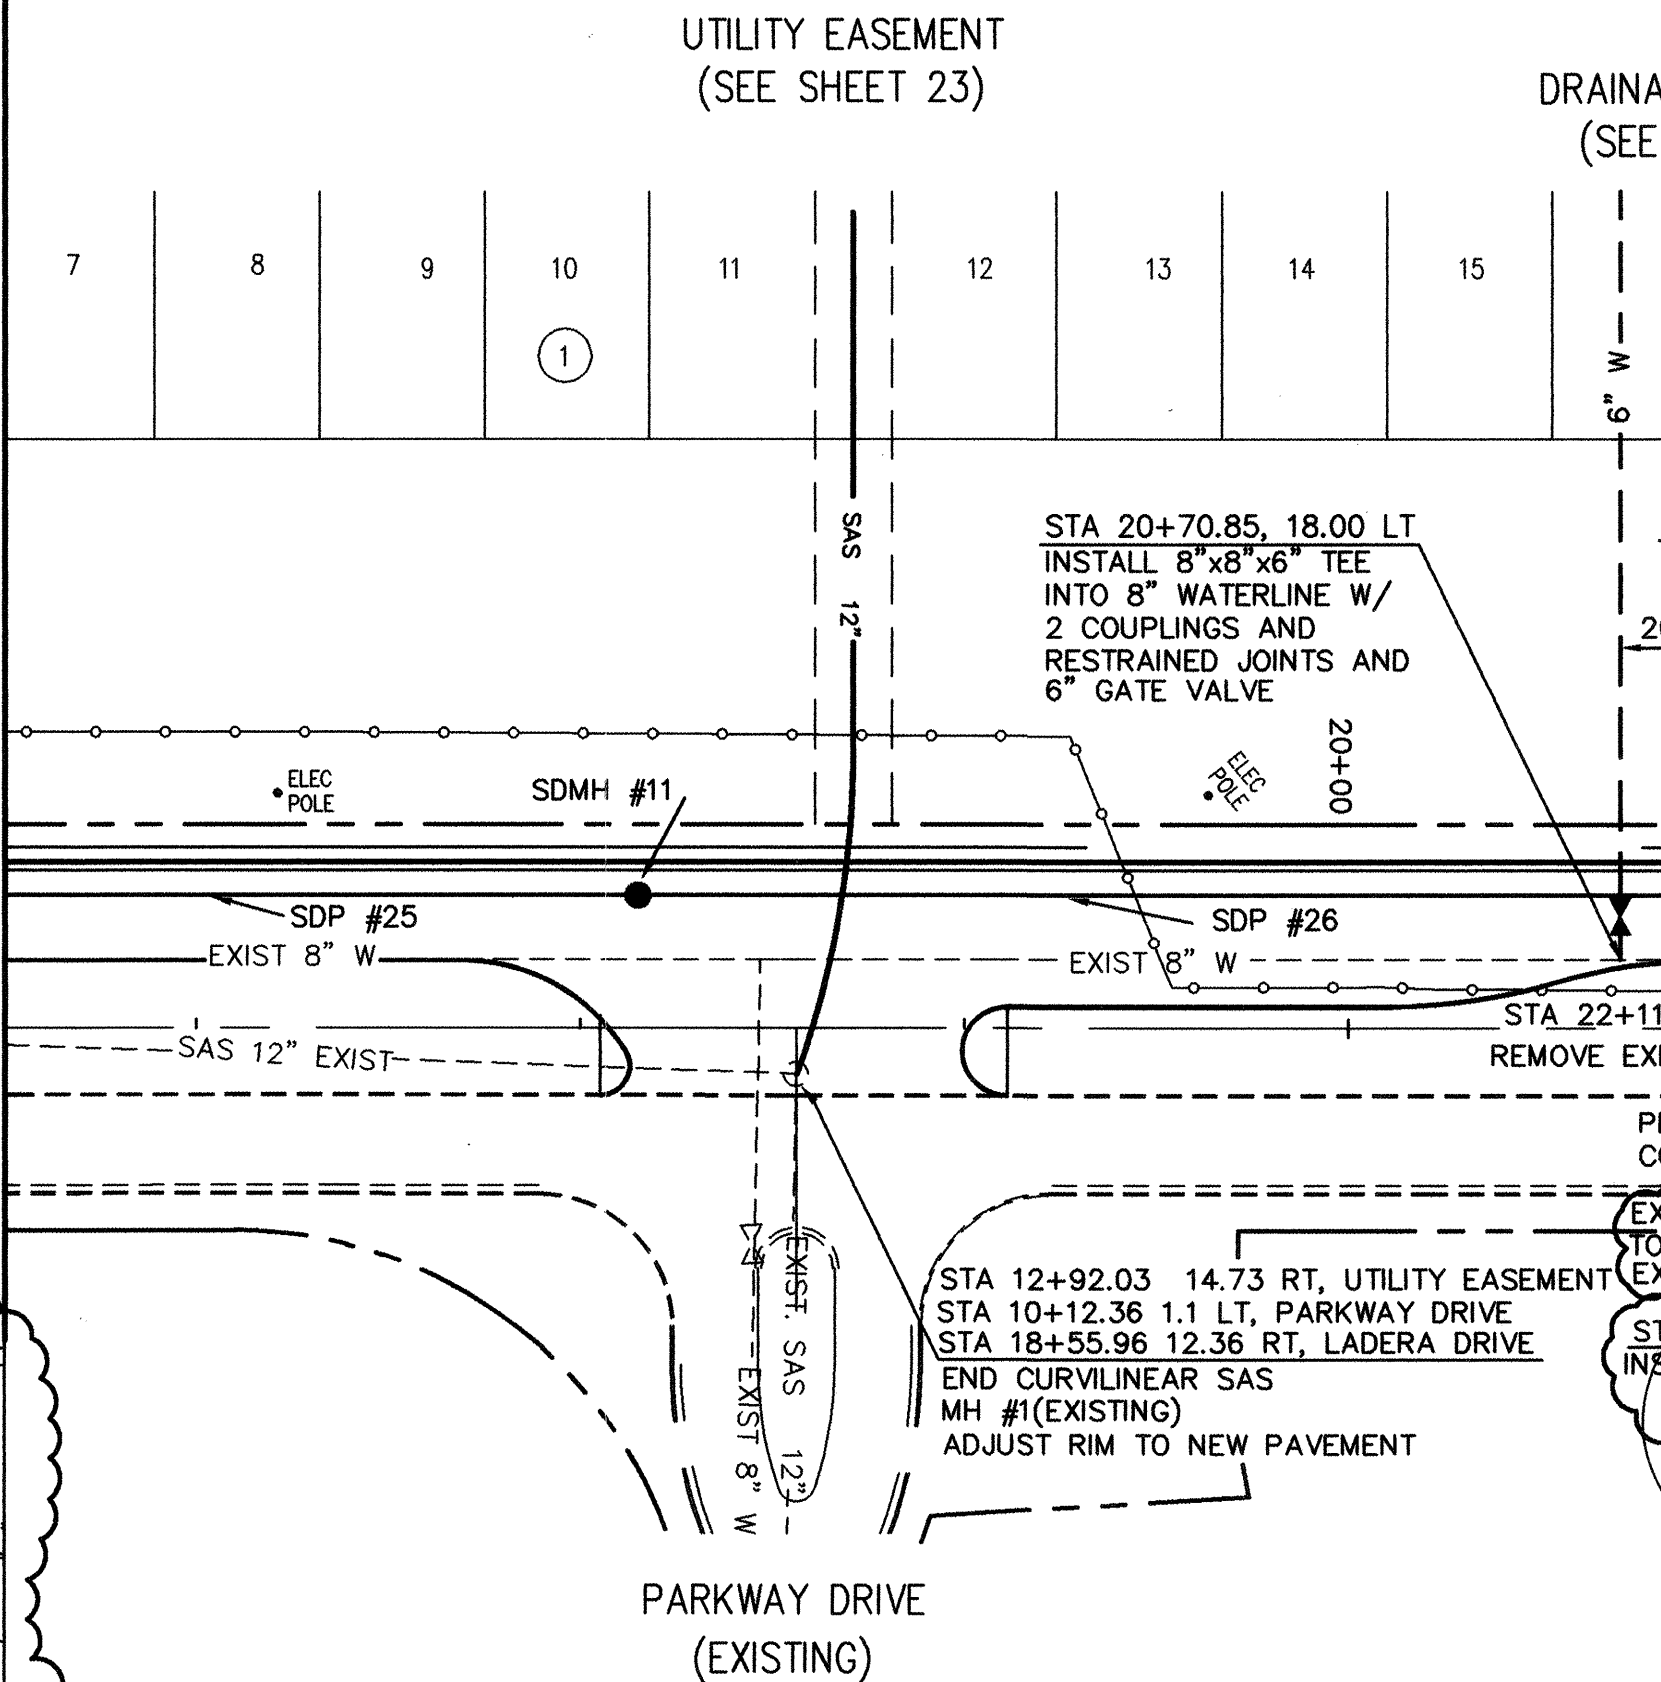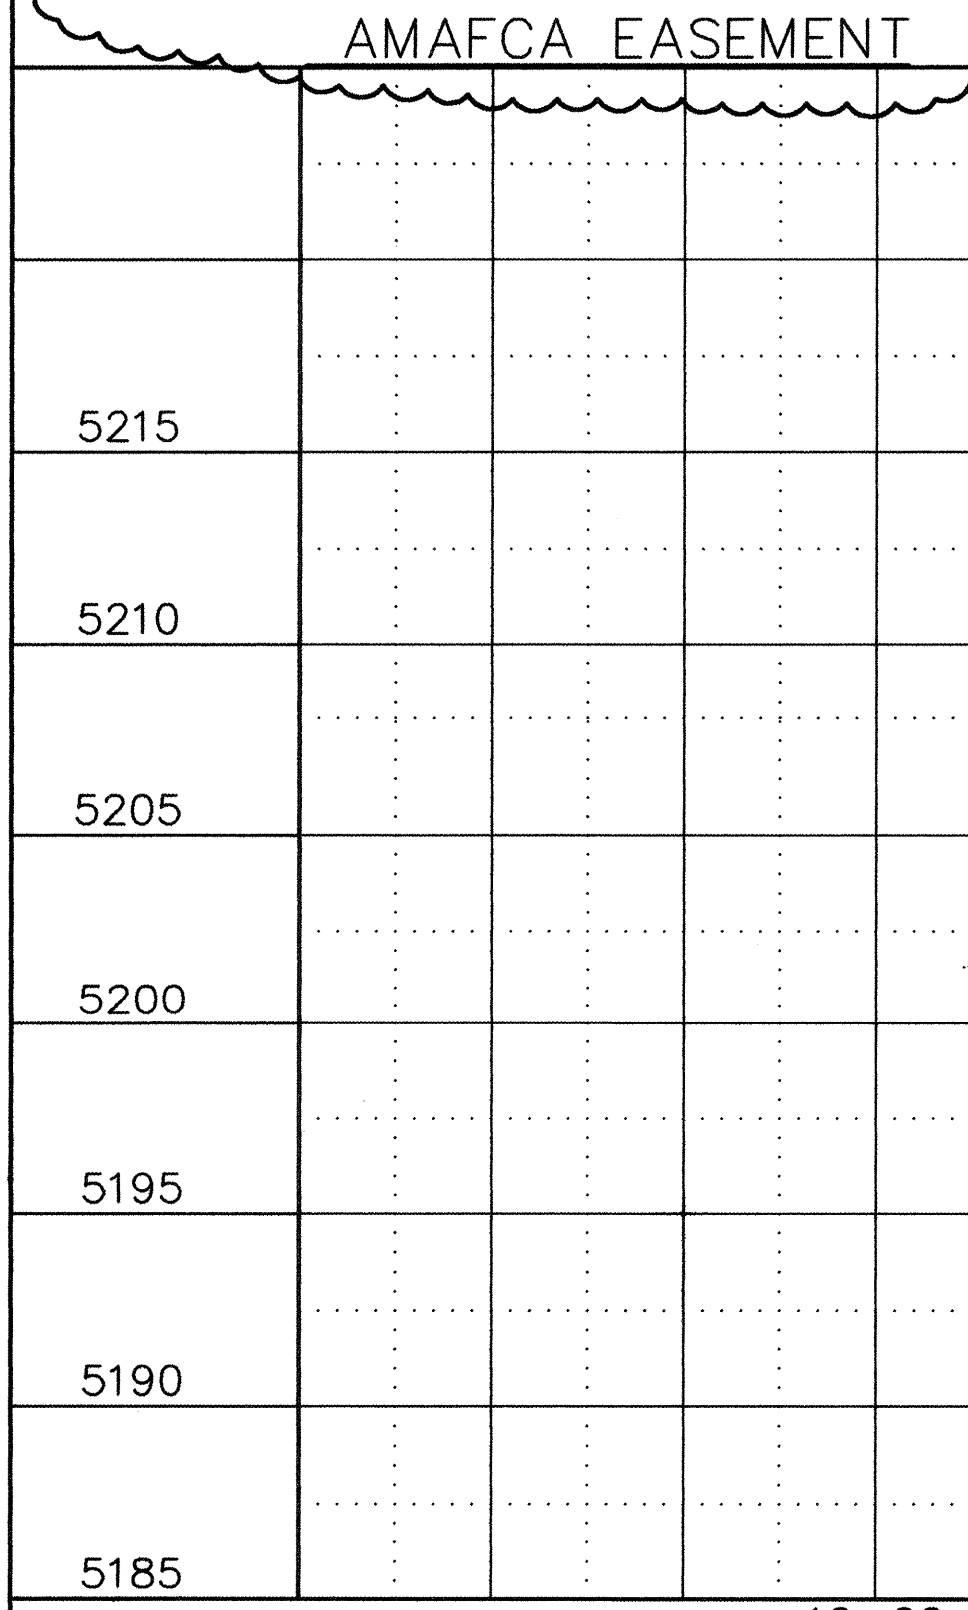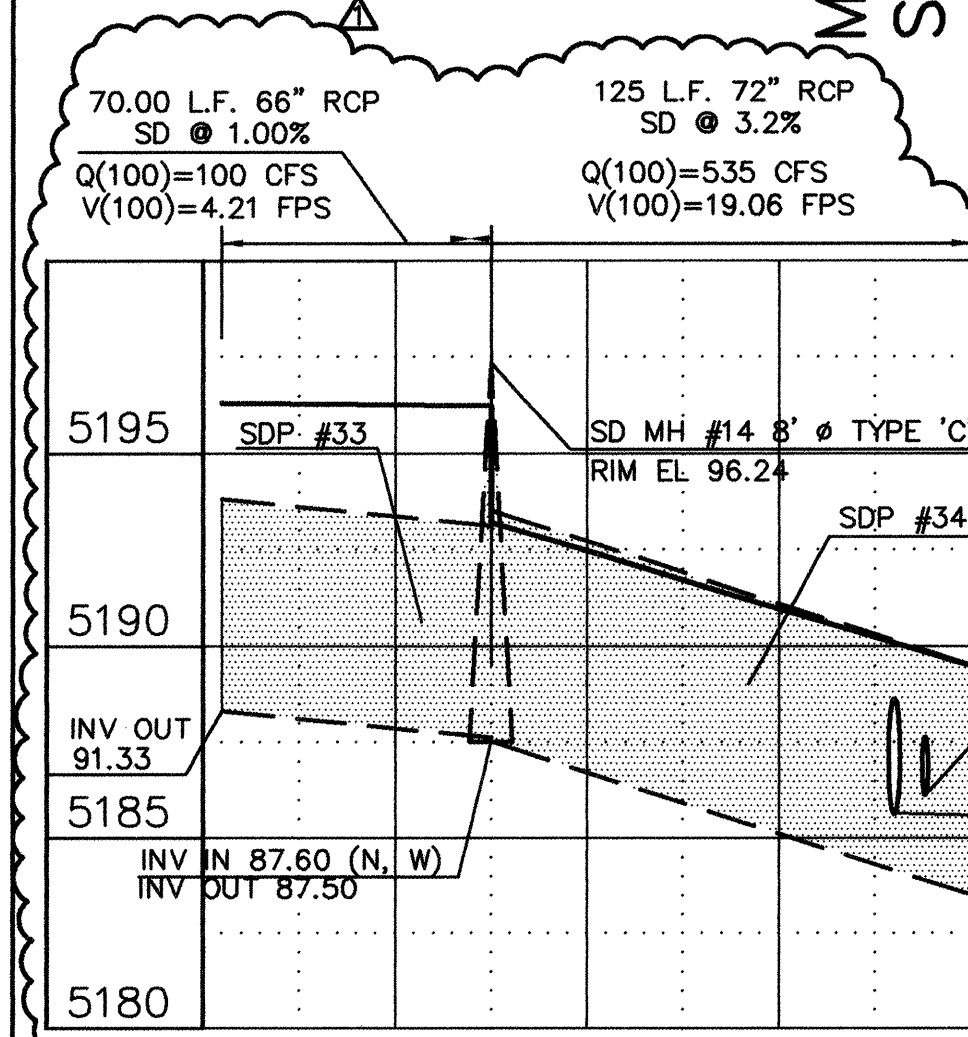

STORM DRAIN PIPE

SDP #	DIAMETER*	UPSTREAM			DOWNSTREAM			LENGTH	SLOPE
		STATION	OFFSET	INVERT	STATION	OFFSET	INVERT		
25	60"	15+40.00	34.5 LT	8.63	18+15.00	34.5 LT	97.60	275.00	4.01%
26	60"	18+15.00	34.5 LT	97.50	20+90.85	34.5 LT	92.88	275.85	1.67%
27	66"	20+90.85	34.5 LT	92.78	22+25.52	34.5 LT	89.50	134.67	2.44%
28	66"	22+25.52	34.5 LT	89.40	23+00.00	34.5 LT	87.60	74.48	2.42%
29	24"	25+44.96	41.0 LT	88.01	25+27.42	0.00	87.79	44.59	0.50%
30	24"	25+66.68	41.0 LT	88.20	25+48.18	43.0 LT	88.11	18.50	0.50%
31	36"	23+57.00	0.0 LT	86.77	23+00.00	70.5 RT	85.64	90.67	1.25%
32	18"	22+58.18	41.5 RT	91.33	23+00.00	78.5 RT	86.13	55.24	9.41%
33	66"	23+00.00	104.5 LT	88.30	23+00.00	34.5 LT	87.60	70.00	1.00%
34	72"	23+00.00	34.5 LT	87.50	23+00.00	90.5 RT	83.5	125.00	3.20%

* ALL STORM DRAIN PIPE IS RCP CLASS IV

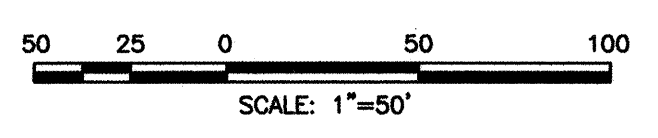

GENERAL NOTES:

- CONTRACTOR SHALL SUPPORT ALL EXISTING UNDERGROUND UTILITY LINES WHICH BECOME EXPOSED DURING CONSTRUCTION. PAYMENT FOR SUPPORTING WORK SHALL BE INCIDENTAL TO WATERLINE AND/OR SEWERLINE COSTS.
- ALL WATERLINE AND SEWERLINE STATIONING REFERS TO STREET CENTERLINE STATIONING.
- ALL FITTINGS ON WATERLINE SHALL HAVE RESTRAINED JOINTS PER TABLE THIS SHEET.
- CONSTRUCT SAS SERVICES PER C.O.A. DWG #2125.
- CONSTRUCT FIRE HYDRANTS PER DESIGNATED DEPTHS AND LENGTHS PER C.O.A. DWG #2340.
- CONSTRUCT ALL WATER SERVICES PER C.O.A. DWGS #2361, #2362, AND #2363.
- UNLESS OTHERWISE NOTED, ALL SAS MANHOLES SHALL BE 4' DIAMETER, TYPE 'E' PER C.O.A. DWG #2102.
- ALL CURVILINEAR SEWERLINES AND WATERLINES SHALL BE BENT ALONG PIPE SEGMENTS WITH 0.0" DEFLECTION AT PIPE JOINTS.
- ALL SEWERLINES AND WATERLINES SHALL BE CONSTRUCTED OF PVC UNLESS SPECIFIED OTHERWISE.
- ALL STORM DRAINS SHALL BE CONSTRUCTED OF RCP-CLASS IV UNLESS SPECIFIED OTHERWISE.
- ALL ELEVATIONS ARE BASED ON A DATUM ELEVATION 5200 AS ESTABLISHED BY BENCH MARKS.
- SEE SHEETS 19 AND 20 FOR INFORMATION REGARDING TRAFFIC CONTROL PLANS FOR THE CONSTRUCTION OF STORM DRAIN IMPROVEMENTS WITHIN THE EXISTING CONSTRUCTED PORTION OF LADERA DRIVE.

LEGEND

DESCRIPTION	PROPOSED
WATER VALVE	I
FIRE HYDRANT	II
MANHOLE	III
CAP	IV
DROP INLET	SDI
PIPE TEE	V
PIPE CROSS	VI
PIPE BEND	VII
WATER SERVICE SINGLE	VIII
WATER SERVICE DOUBLE	IX
CURB AND GUTTER	X
SEWER LINE	SAS
STORM DRAIN	SD
WATER LINE	W

RESTRAINED JOINT TABLE

JOINT	RESTRAIN LENGTH
4" GATE VALVE	6'
4" 22.5" HORIZ. BEND	21'
4" 45" VERT. OFFSET	21'
6" GATE VALVE	6'
6" 22.5" HORIZ. BEND	21'
6" 45" HORIZ. BEND	21'
6" 45" VERT. OFFSET	21'
8" X 8" X 4" TEE	BRANCH 21' RUN 21'
8" X 8" X 6" TEE	BRANCH 21' RUN 21'
8" X 8" X 8" TEE	BRANCH 21' RUN 21'
8" GATE VALVE	21'
8" 11.25" HORIZ. BEND	21'
8" 22.50" HORIZ. BEND	21'
8" 45" HORIZ. BEND	21'
8" 22.5" VERT. OFFSET	21'
8" 45" VERT. OFFSET	21'

ENGINEER'S CERTIFICATION

I, Donald S. Rios, REGISTERED IN NEW MEXICO AS A PROFESSIONAL ENGINEER NO. 2714, HEREBY CERTIFY THAT THIS PROJECT WAS CONSTRUCTED IN SUBSTANTIAL COMPLIANCE WITH THIS PLAN, EXCEPT AS NOTED. DATE 5-1-01

CINFRAN/HUITT-ZOLLARS
333 RIO RANCHO DR., S.E. SUITE 101
RIO RANCHO, N.M. 87124
(800) 892-5141


CITY OF ALBUQUERQUE
PUBLIC WORKS DEPARTMENT
ENGINEERING DEVELOPMENT GROUP

TITLE: WESTLAND DEVELOPMENT CO., INC.
UTILITY PLAN & PROFILE - LADERA DRIVE
TIERRA OESTE UNIT 1

DESIGN REVIEW COMMITTEE
CITY ENGINEER
DESIGN REVIEW COMMITTEE
CITY ENGINEER

DESIGNED BY: RGG
DRAWN BY: RGG
CHECKED BY: RGG

City Project No. 5297.90
Zone Map No. H-9&J-9
Sheet 27 of 30

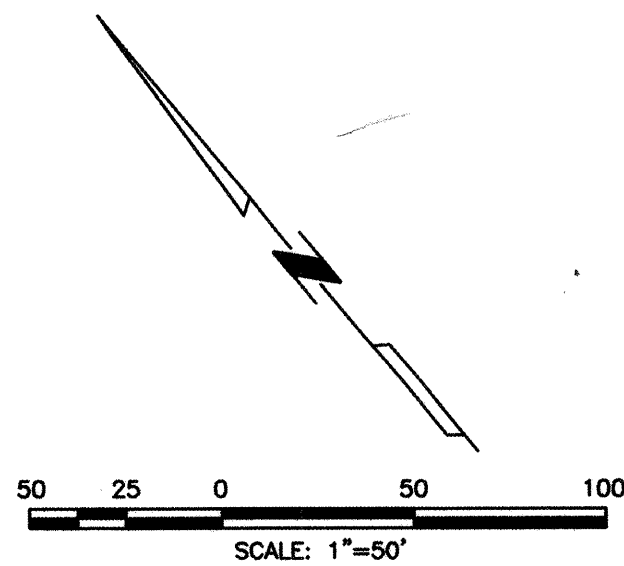


STORM DRAIN MANHOLES						
SDMH #	DIAMETER	STATION	OFFSET	RIM EL.	INVERT IN	INVERT OUT
5	4'	10+00.00	0.00	11.20	4.80	4.70
12	8'	12+34.09	0.00	02.61	98.08	92.78

STORM DRAIN PIPE							
UPSTREAM				DOWNSTREAM			
SDP #	DIAMETER*	STATION	OFFSET	INVERT	STATION	OFFSET	INVERT
14	18"	9+65.30	0.00	6.60	10+00.00	5.66	4.80
15	30"	10+00.00	0.00	4.70	12+34.09	0.00	98.08

* ALL STORM DRAIN PIPE IS RCP CLASS IV



LADERA DRIVE
(SEE SHEET 27)

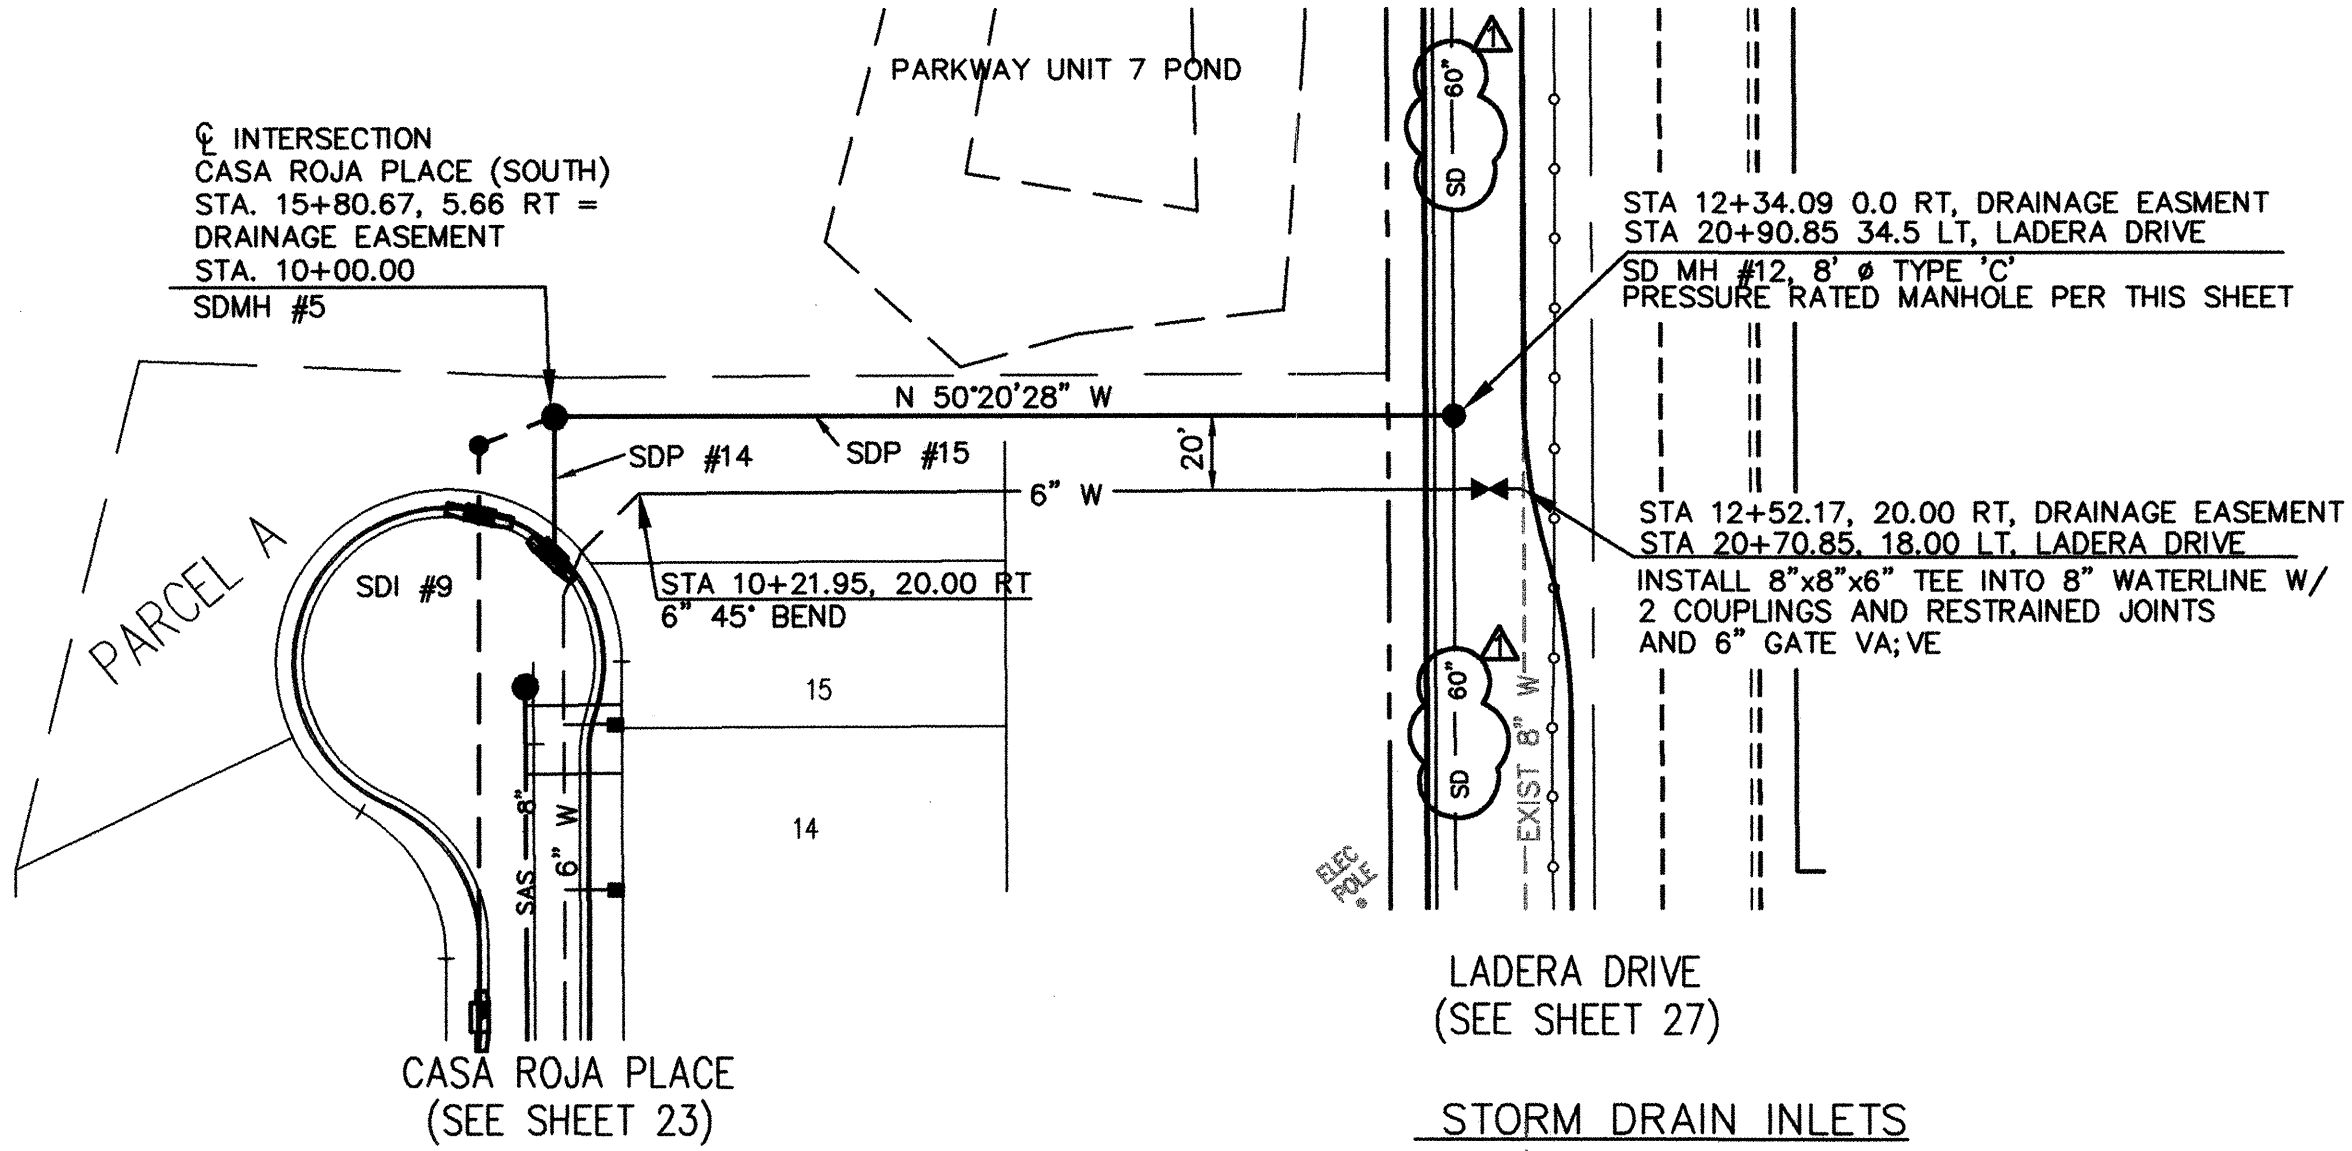

SDI #	TYPE	STATION*	OFFSET	FL EL.**	INVERT IN	INVERT OUT
9	'A'	15+49.50	5.66 RT	10.60	-	6.60


* CASA ROJA C STATION
** NORMAL GUTTER L

DRAINAGE EASEMENT

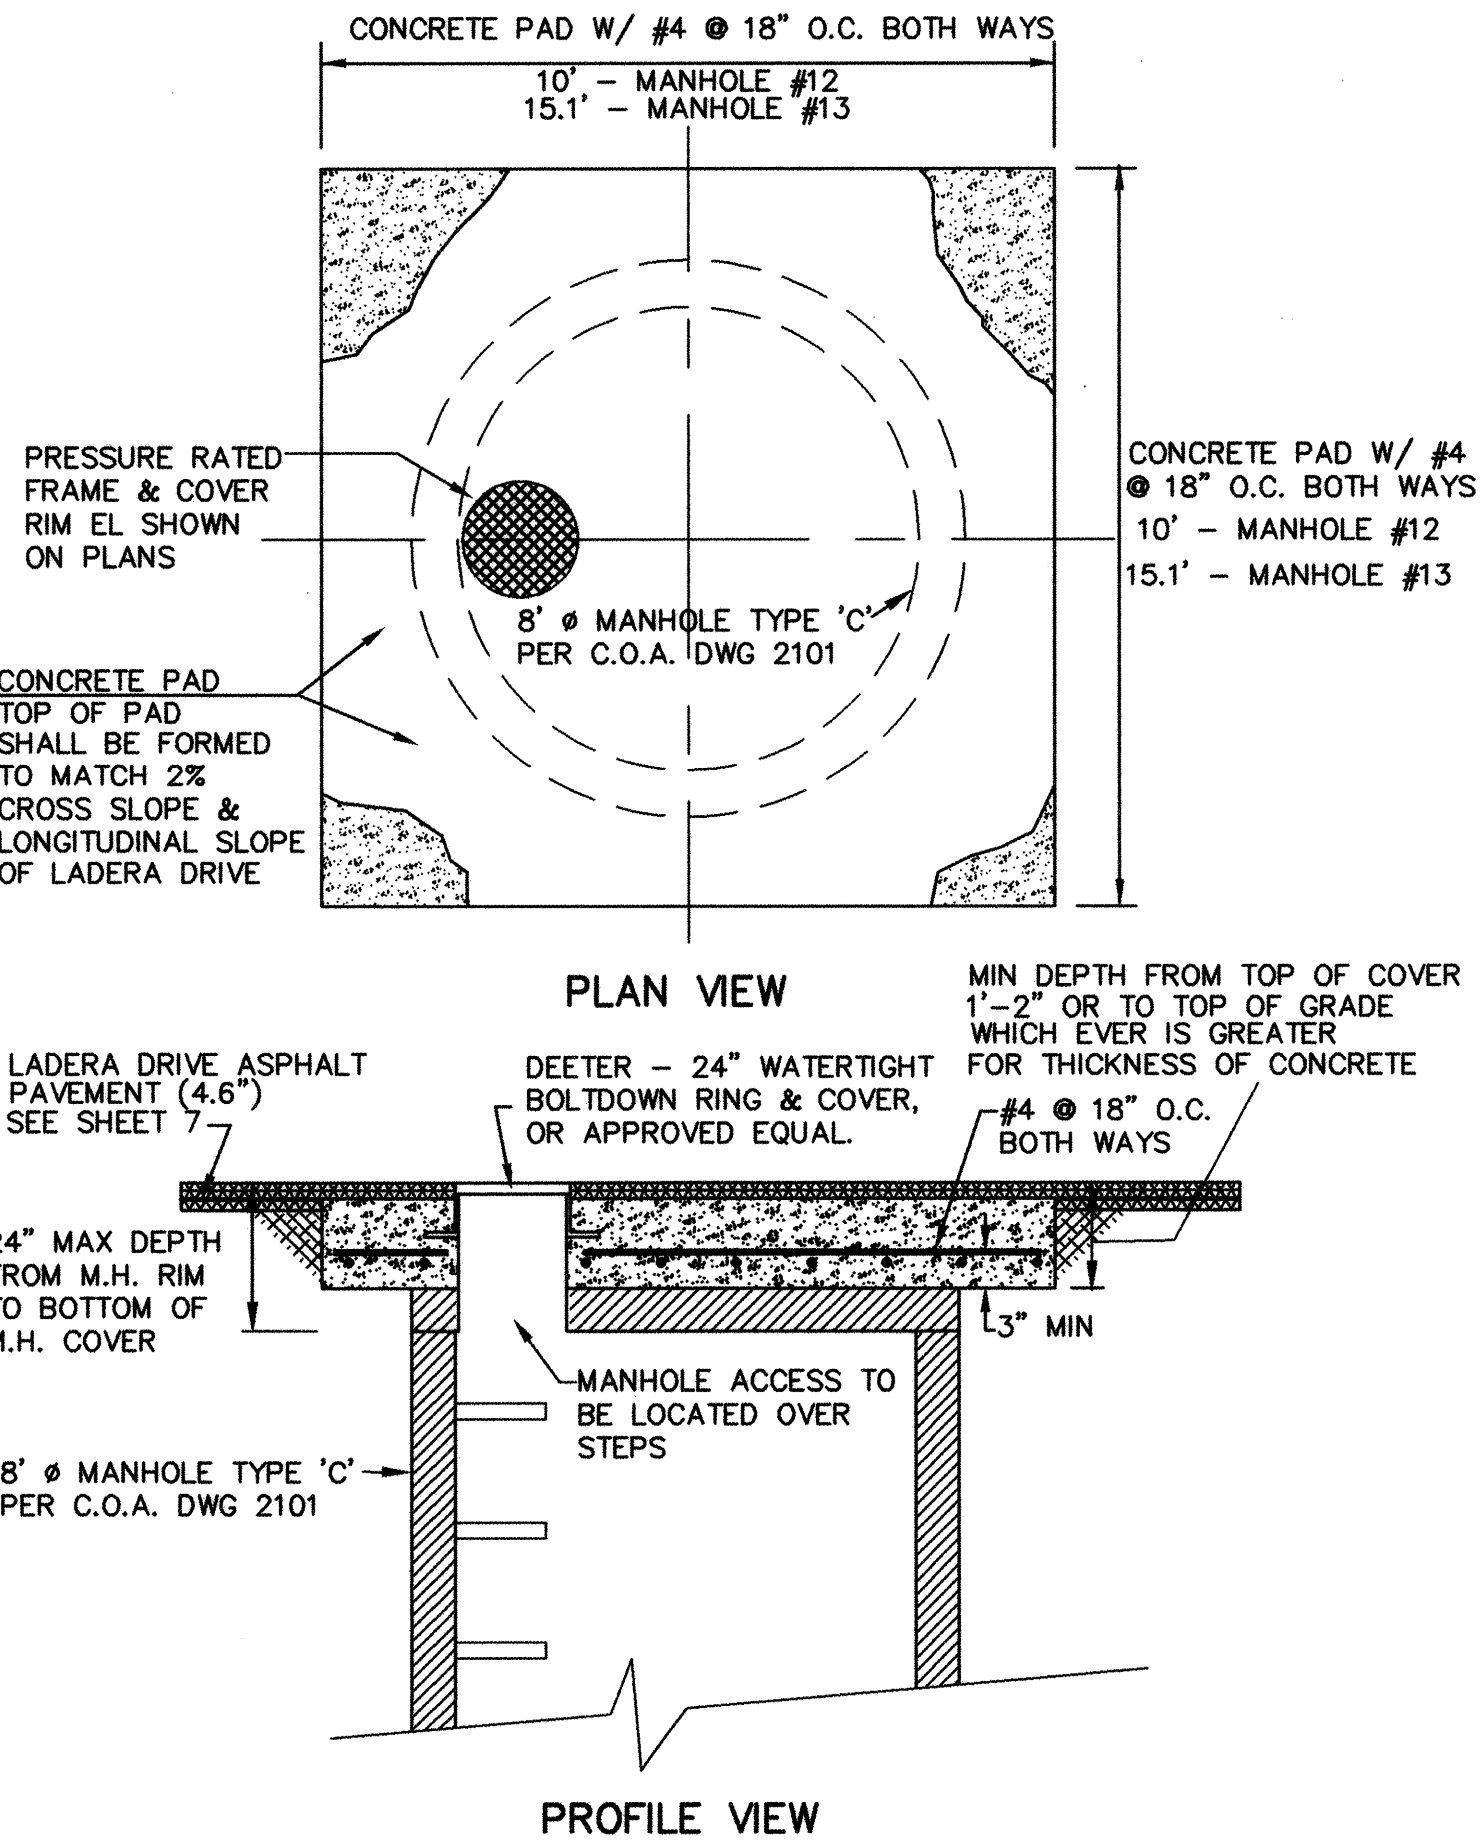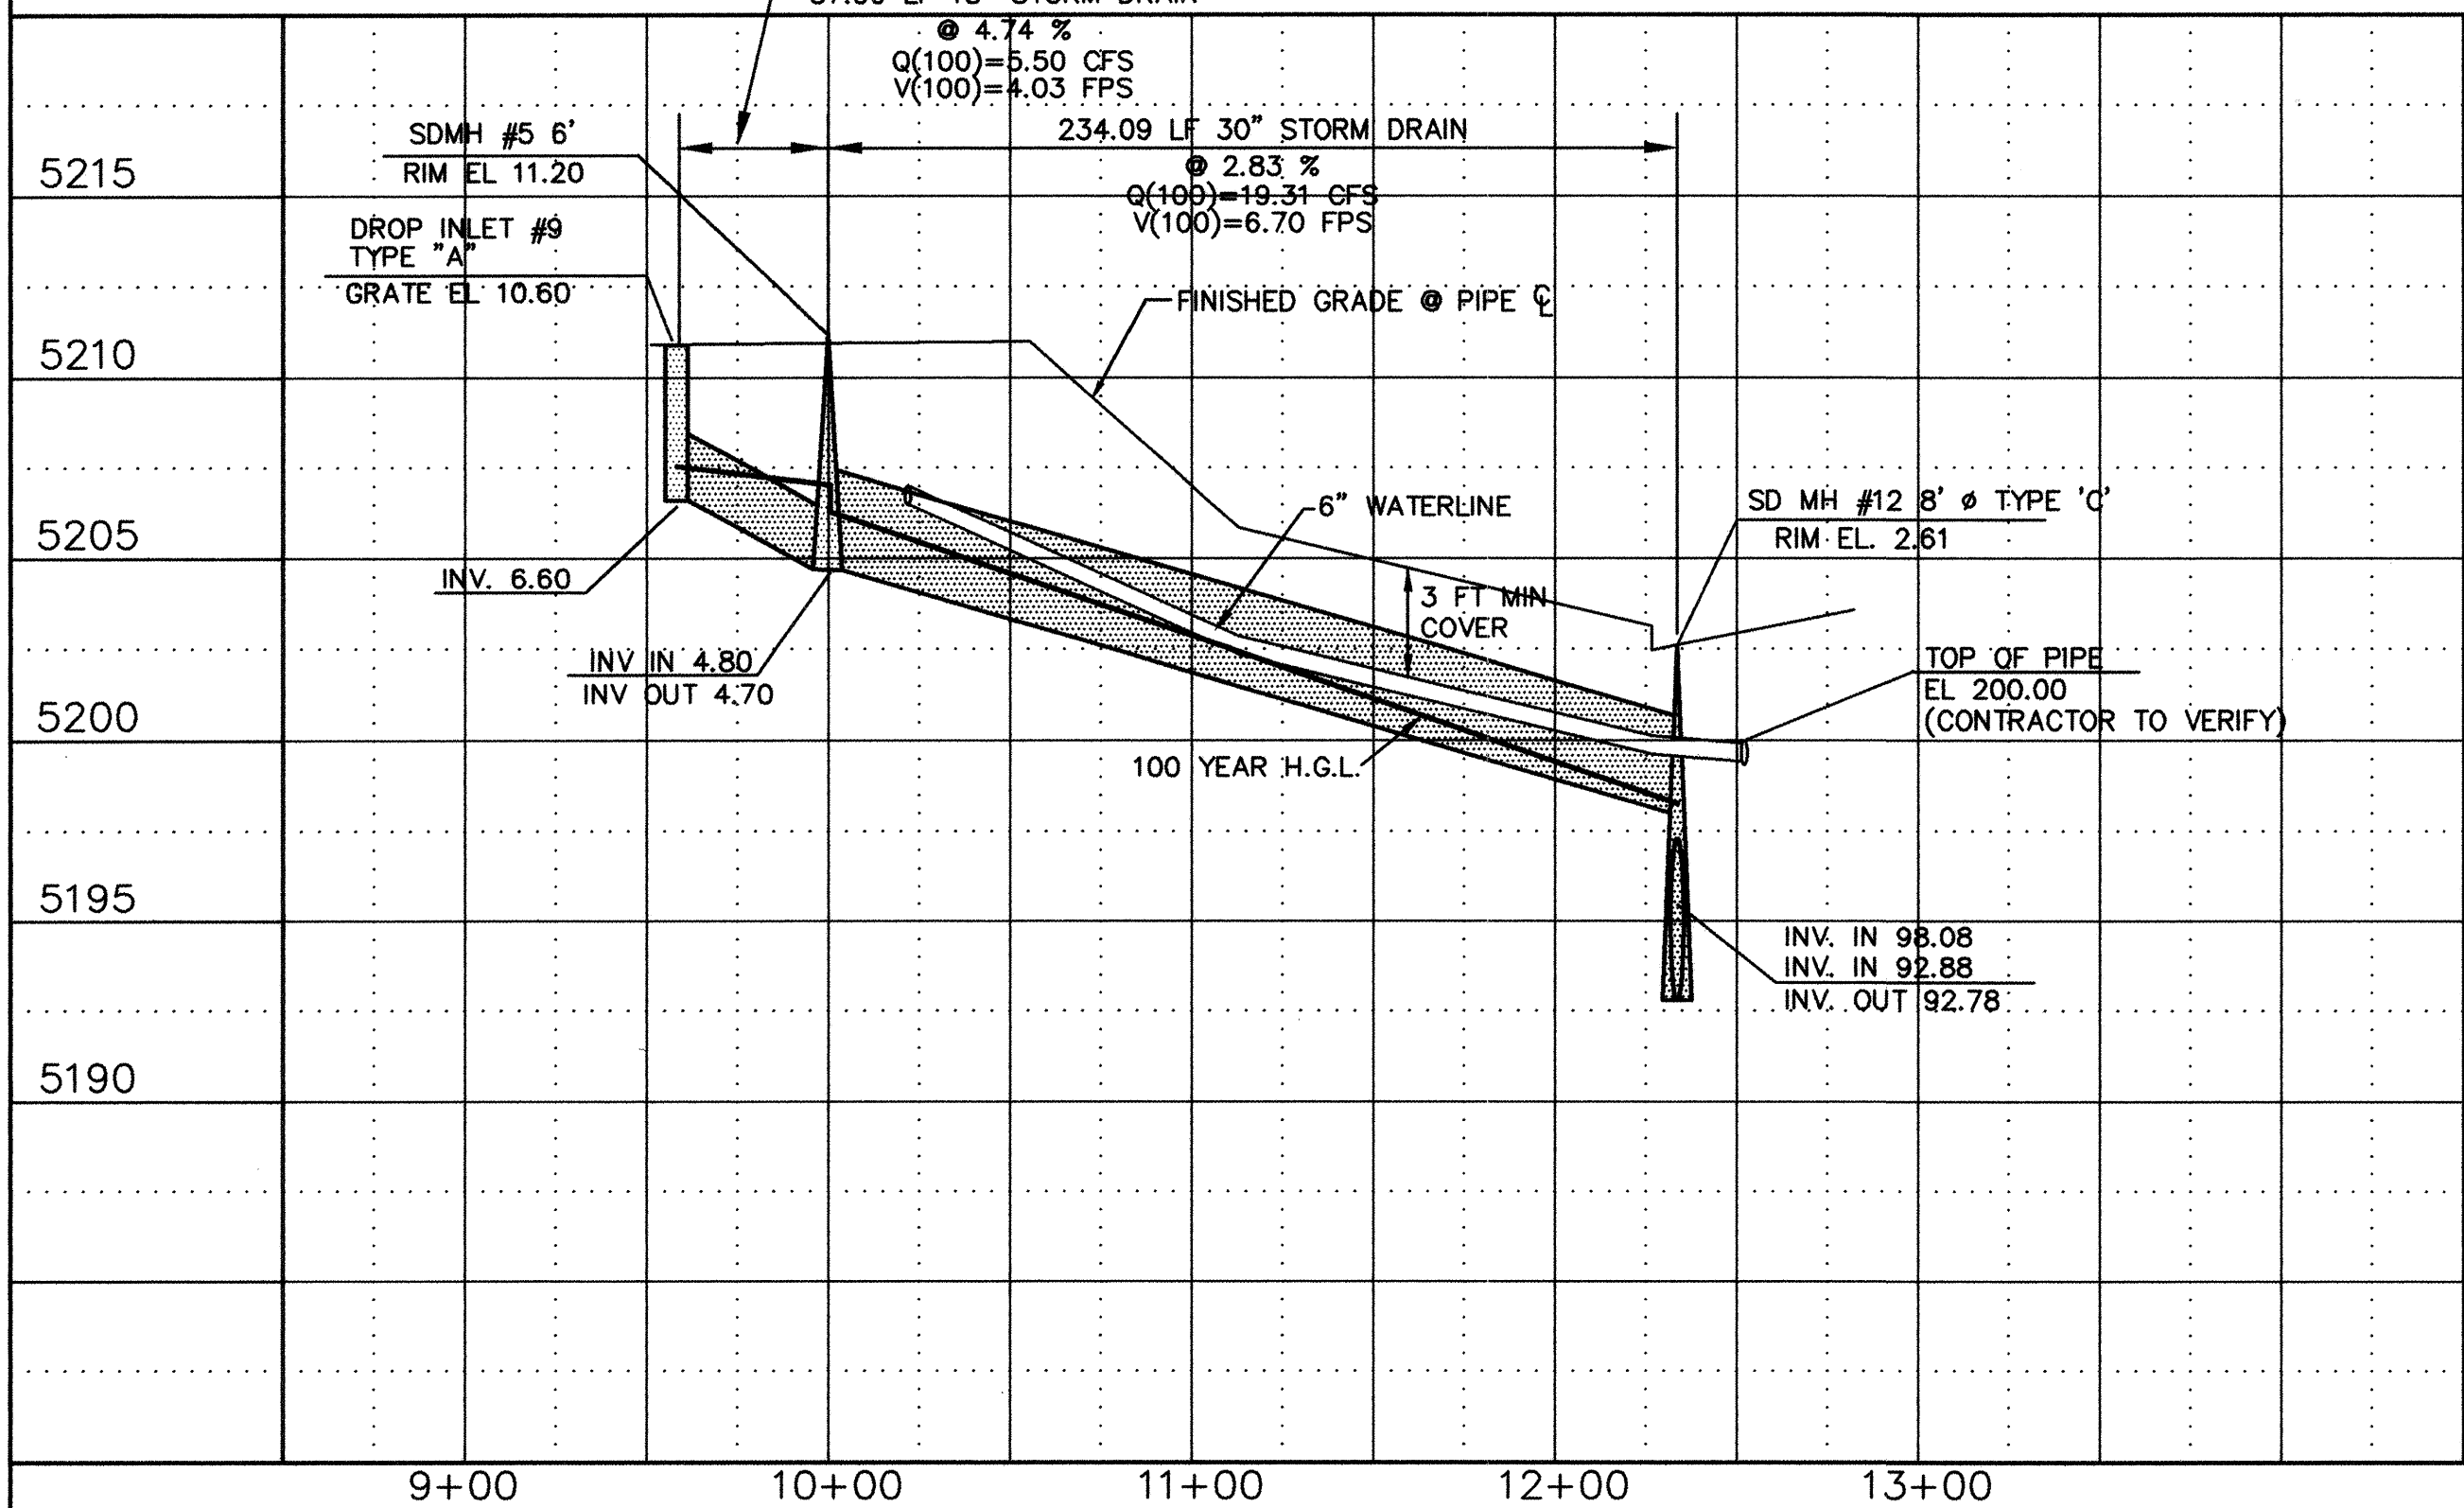


PRESSURE RATED MANHOLE

SDMH #12 AND #13

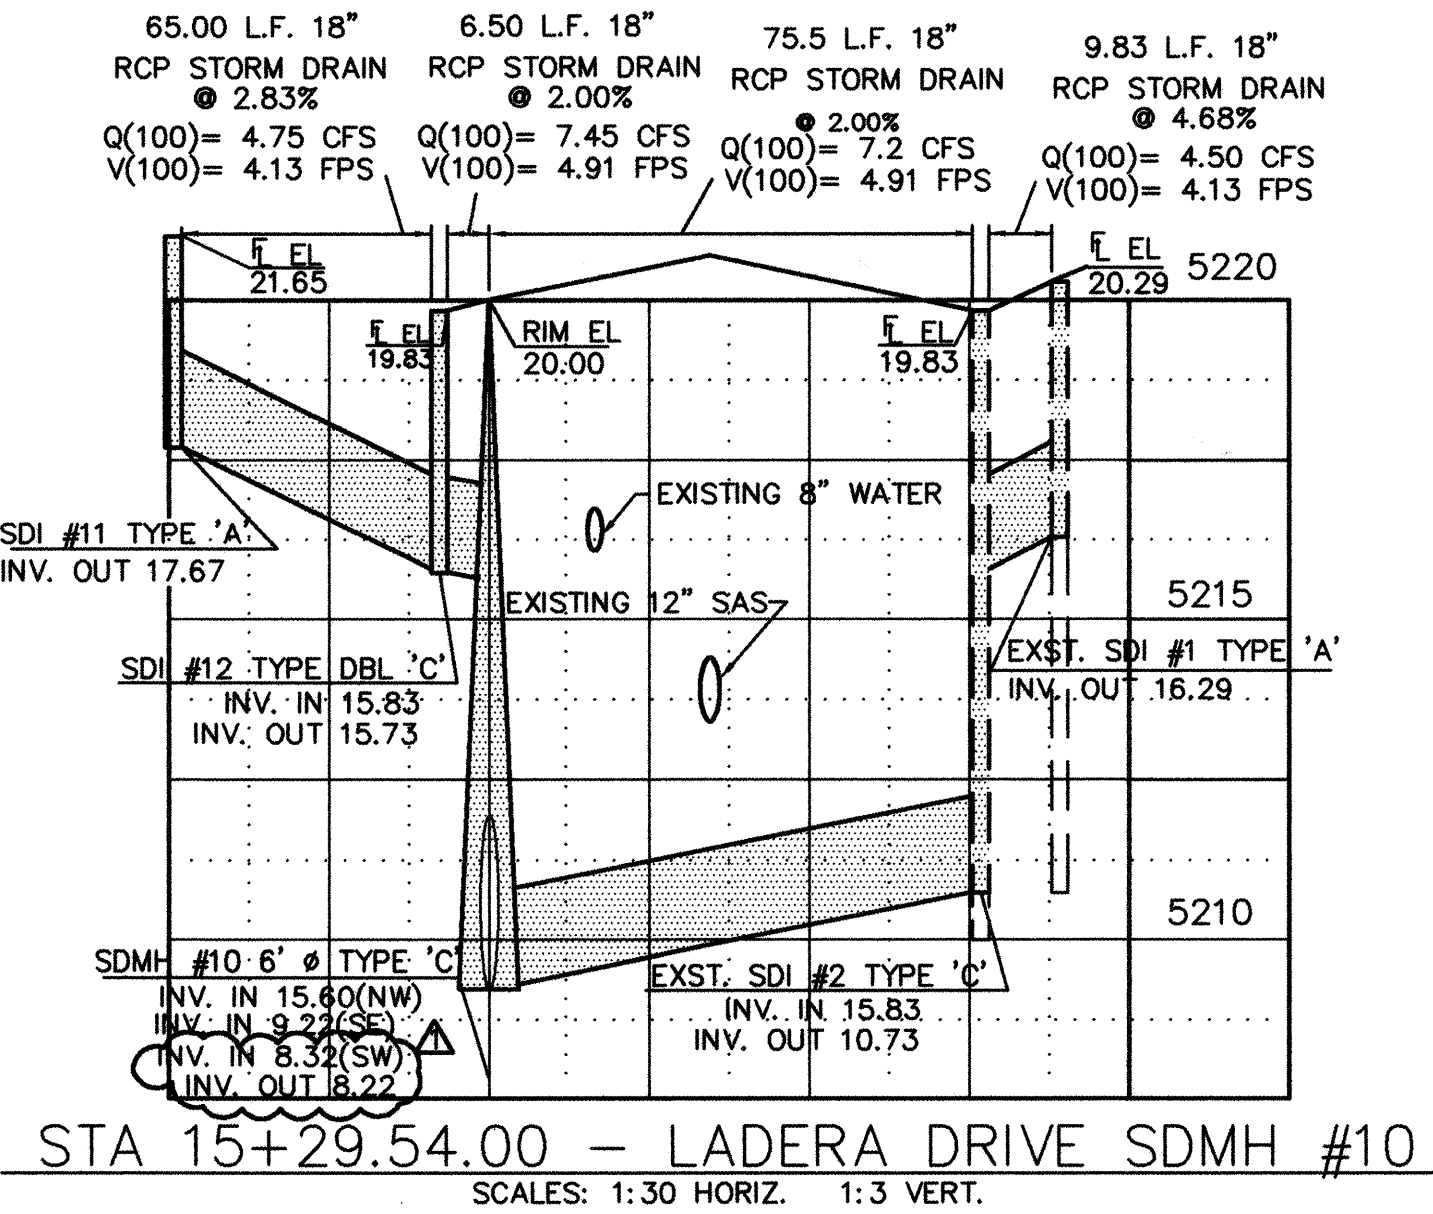

TOP VIEW

NOT TO SCALE

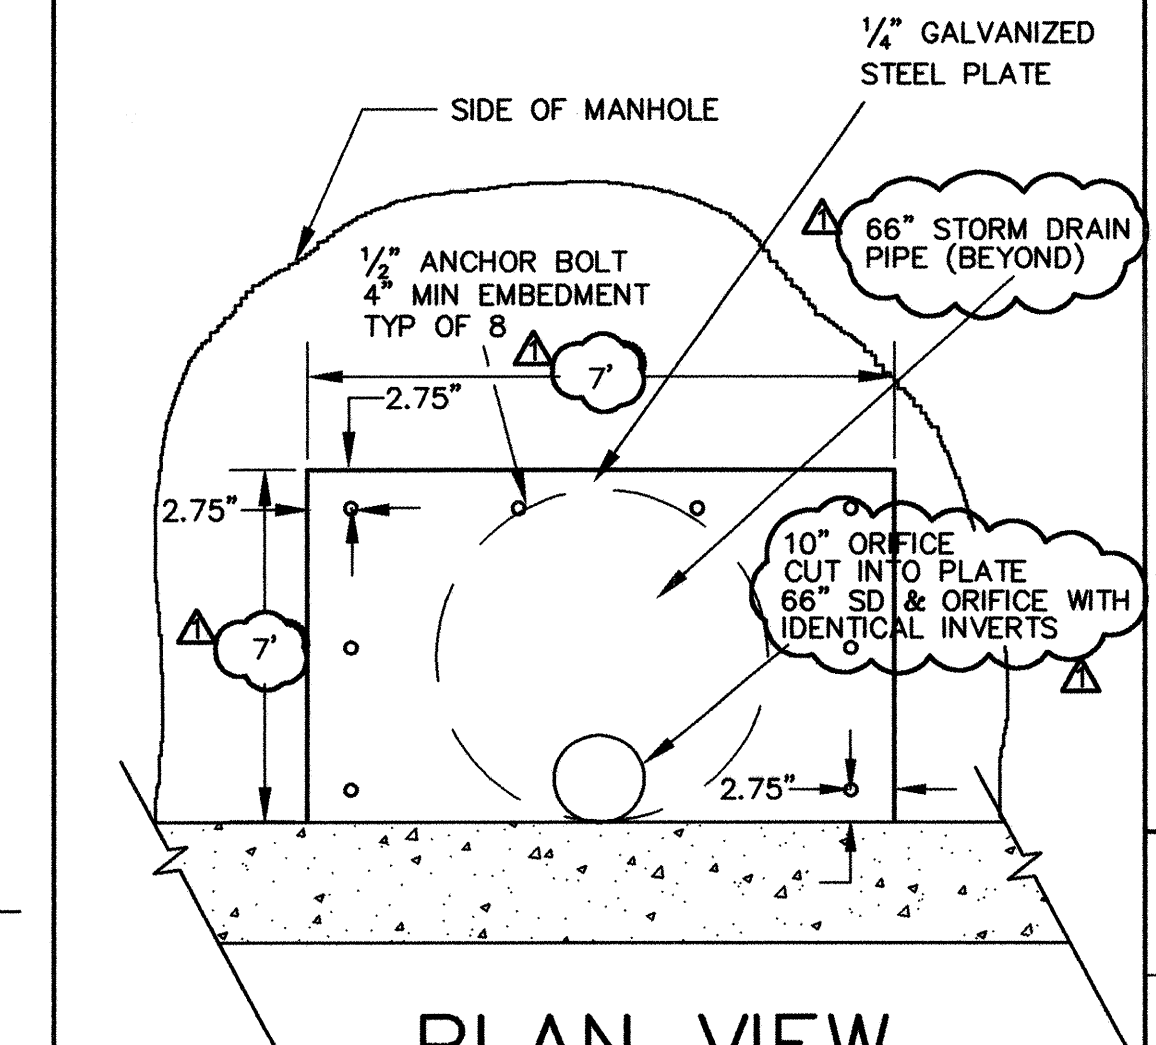

PLAN VIEW

ORIFICE DETAIL

SDMH #13

NOT TO SCALE


GENERAL NOTES:

1. CONTRACTOR SHALL SUPPORT ALL EXISTING UNDERGROUND UTILITY LINES WHICH BECOME EXPOSED DURING CONSTRUCTION. PAYMENT FOR SUPPORTING WORK SHALL BE INCIDENTAL TO WATERLINE AND/OR SEWERLINE COSTS.
2. ALL WATERLINE AND SEWERLINE STATIONING REFERS TO STREET CENTERLINE STATIONING.
3. ALL FITTINGS ON WATERLINE SHALL HAVE RESTRAINED JOINTS PER TABLE THIS SHEET.
4. CONSTRUCT SAS SERVICES PER C.O.A. DWG #2125.
5. CONSTRUCT FIRE HYDRANTS PER DESIGNATED DEPTHS AND LENGTHS PER C.O.A. DWG #2340.
6. CONSTRUCT ALL WATER SERVICES PER C.O.A. DWGS #2361, #2362, AND #2363.
7. UNLESS OTHERWISE NOTED, ALL SAS MANHOLES SHALL BE 4' DIAMETER, TYPE 'E' PER C.O.A. DWG #2102.
8. ALL CURVILINEAR SEWERLINES AND WATERLINES SHALL BE BENT ALONG PIPE SEGMENTS WITH 0.0" DEFLECTION AT PIPE JOINTS.
9. ALL SEWERLINES AND WATERLINES SHALL BE CONSTRUCTED OF PVC UNLESS SPECIFIED OTHERWISE.
10. ALL STORM DRAINS SHALL BE CONSTRUCTED OF RCP-CLASS IV UNLESS SPECIFIED OTHERWISE.
11. ALL ELEVATIONS ARE BASED ON A DATUM ELEVATION 5200 AS ESTABLISHED BY BENCH MARKS.

LEGEND

DESCRIPTION	PROPOSED
WATER VALVE	
FIRE HYDRANT	
MANHOLE	
CAP	
DROP INLET	
PIPE TEE	
PIPE CROSS	
PIPE BEND	
WATER SERVICE SINGLE	
WATER SERVICE DOUBLE	
CURB AND GUTTER	
SEWER LINE	
STORM DRAIN	
WATER LINE	

AS BUILT INFORMATION				BENCH MARKS				SURVEY INFORMATION				ENGINEER'S SEAL				
CONTRACTOR	DATE	BY	DATE	ALBUQUERQUE ACS MONUMENT	DATE	BY	DATE	NO.	FIELD NOTES	DATE	BY	NO.	NO.	DATE	BY	DATE
INSPECTOR	DATE	BY	DATE	LOCATED APPROXIMATELY 623' NORTH OF	DATE	BY	DATE									
FIELD	DATE	BY	DATE	AND 888' WEST OF THE NORTHWEST	DATE	BY	DATE									
VERIFICATION	DATE	BY	DATE	CORNER OF UNIT 1 BETWEEN TWO POWER	DATE	BY	DATE									
CORRECTED	DATE	BY	DATE	POLES.	DATE	BY	DATE									
MICRO-FILM INFORMATION				ELEVATION = 5305.43												
RECORDED BY																
DATE																
NO.																

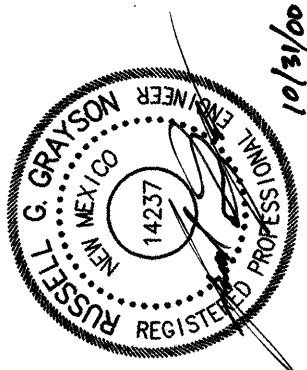

ENGINEER'S CERTIFICATION

I, Cinfran/Huitt-Zollars, REGISTERED IN NEW MEXICO AS A PROFESSIONAL ENGINEER NO. 14237, HEREBY CERTIFY THAT THIS PROJECT WAS CONSTRUCTED IN SUBSTANTIAL COMPLIANCE WITH THIS PLAN, EXCEPT AS NOTED. DATE 12-1-01

CINFRAN/HUITT-ZOLLARS
333 RIO RANCHO DR., N.E., STE. 101
RIO RANCHO, N.M., 87124
(505) 892-5141

CITY OF ALBUQUERQUE
PUBLIC WORKS DEPARTMENT
ENGINEERING DEVELOPMENT GROUP
WESTLAND DEVELOPMENT CO., INC.
UTILITY PLAN & PROFILE
TIERRA OESTE UNIT 1

TITLE: UTILITY PLAN & PROFILE
City Project No. 5297.90 Zone Map No. H-9&J-9 Sheet 28 Of 30






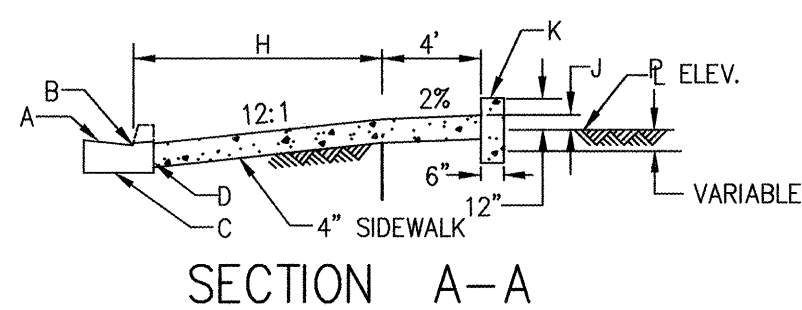


Diagram illustrating Case I: Insufficient Right-of-Way (R.O.W.) for Full Length Ramp. The diagram shows a street layout with a 4' sidewalk, a 6' sidewalk, and a drive-way. A ramp is shown with a 5' width and a 12% grade. The diagram includes labels for 'DRIVE PAD', 'DRIVEWAY', '4' SIDEWALK', '6' SIDEWALK', 'P RADIUS', 'BACK OF CURB RADIUS', 'SLOPE DOWN', and 'VARIES'. It also includes the formulas: $Y = 8' + (\text{ROAD GRADE IN FT/FT} \times 96)$ and $Y = 8' - (\text{ROAD GRADE IN FT/FT} \times 96)$.

1. WHEEL CHAIR RAMPS ARE NORMALLY TO BE LOCATED AT THE CENTER OF THE RETURN OR AS APPROVED BY THE ENGINEER.
2. SURFACE TEXTURE OF WHEEL CHAIR RAMPS SHALL BE OBTAINED BY HEAVY BROOMING (TEXTURE DEPTH 0.035"). TO BE UP TO THE SLOPE OF THE RAMP.
3. CUTTER FLOW LINE PROFILE SHALL BE MAINTAINED THROUGH THE AREA OF THE RAMP. DRAINAGE CATCH BASIN STRUCTURES SHALL NOT BE PLACED IN LINE WITH RAMPS.
4. SUBGRADE SHALL BE COMPACTED TO 95% D1557. CONCRETE SHALL MEET 3,000 PSI, 28 DAY STRENGTH.
5. USE 1/2" EXP. JT. WHERE SIDEWALK OR DRIVEPAD ABUTS BLDGS., FENCES, WALLS OR OTHER IMMovable OBJECTS.
6. ALL DRIVEPADS SHALL BE A MIN. OF 6.5' IN DEPTH OR SHALL BE CONSTRUCTED FROM CURB TO CURB TO PROP. LINE, WHICHEVER IS GREATER.
7. DRIVEPADS WIDER THAN 18" (NOMINAL) SHALL HAVE 1/2" EXP. AT MIDPOINT. DRIVEPADS WIDER THAN 36" SHALL HAVE 1/2" EXP. JT., 18" MAX BETWEEN JOINTS EQUALLY SPACED.

- A. SLOPE OF GUTTER DEPENDENT ON REQUIREMENTS FOR VALLEY GUTTER.
- B. 1/2" UP ABOVE FLOW LINE.
- C. CURB & GUTTER.
- D. 1/2: EXPANSION JOINT.
- E. RADIAL LINES CONCENTRIC WITH FLOW LINE RADIUS.
- F. 8" AT FACE OF CURB.
- G. CONTRACTION (DUMMY) JOINT.
- H. VARIES WITH AVAILABLE R.O.W.
- J. VARIABLE.
- K. HEADER CURB.
- L. 6" AT FACE OF CURB.
- M. BACK OF SIDEWALK RADIUS TO BE ESTABLISHED SO AS TO MAINTAIN 12' LENGTH OF RAMP.
- N. 4-1/2" MAX.
- O. 12:1 SLOPE MAXIMUM ON RAMP.

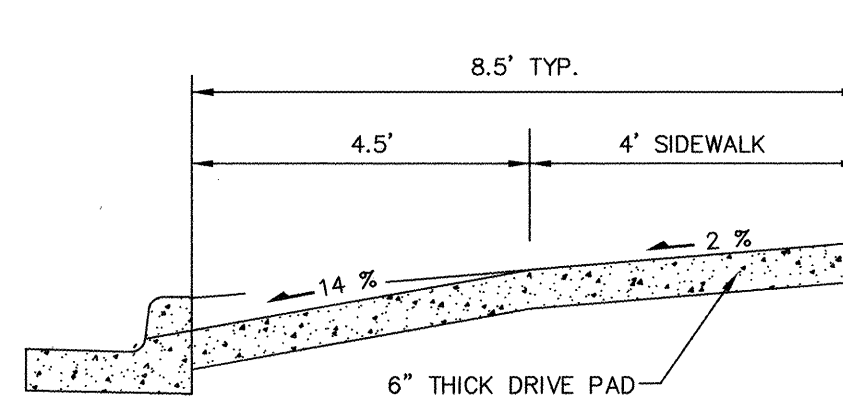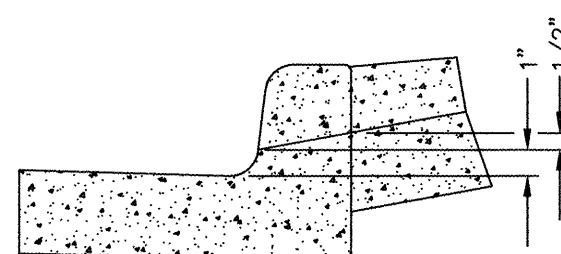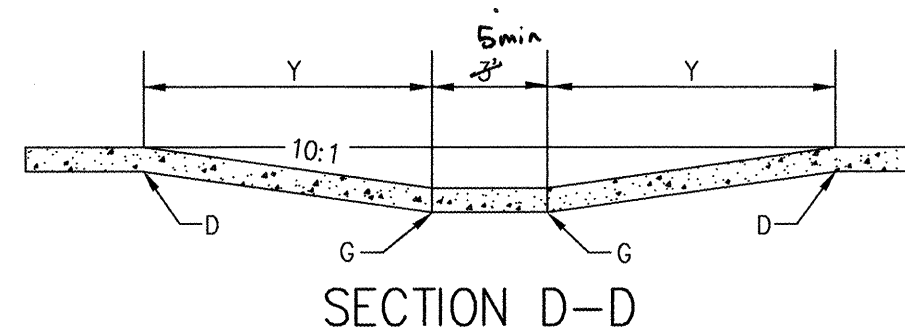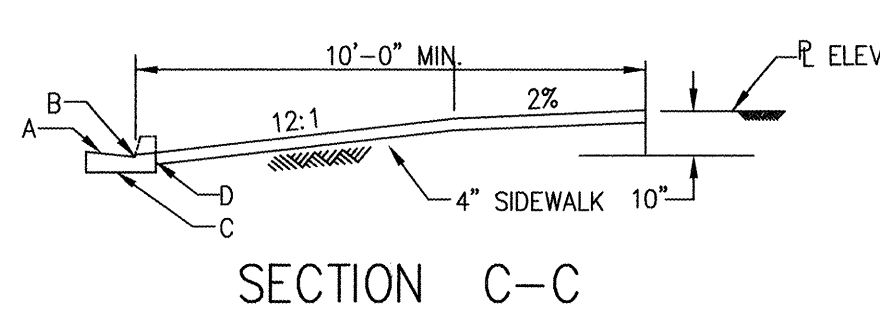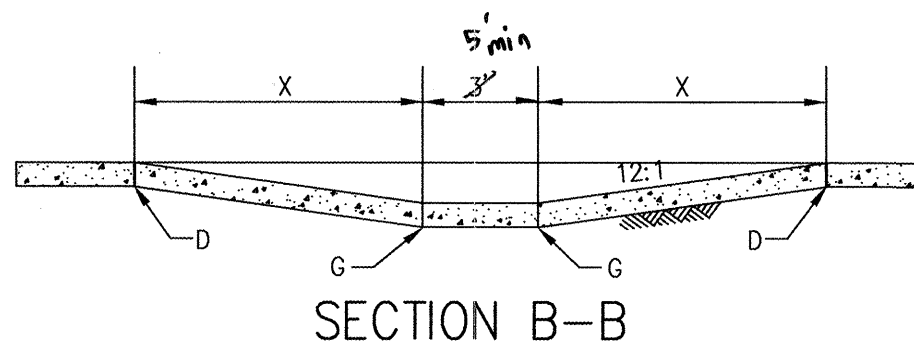

ENGINEER'S SEAL		SURVEY INFORMATION		BENCH MARKS		AS BUILT INFORMATION	
		FIELD NOTES		ALBUQUERQUE ACS MONUMENT "BH-40"		CONTRACTOR	
		NO.	BY	DATE	LOCATED APPROXIMATELY 623' NORTH OF	WORK STARTED BY	MELENDEZ CONCRETE Co.
					AND 888' WEST OF THE NORTHWEST	INSPECTOR'S	
					CORNER OF UNIT 1 BETWEEN TWO POWER	FIELD VERIFICATION BY	Holtz-Zellers DATE
					POLES.	DATE	4.01
					ELEVATION = 5305.43	VERIFICATION BY	Gregorio/Holtz DATE
						DATE	2.01
						CONTRACTED BY	Holtz-Zellers DATE
							5.01
						MICRO-FILM INFORMATION	
						RECORDED BY	DATE
						NO.	

1/31/00

REMARKS		DESIGN	
NO. DATE	REMARKS	DESIGNED	WLB DATE 2MAY96
		DRAWN BY	GMA DATE 2MAY96
		CHECKED BY	BOC DATE 02JUN96

UNIT 1

____ No./Day/Yr.

____ No./Day/Yr.

Sheet 30 Of 30