




I, Robert M. Oberdorfer, RLA, hereby certify that this project was constructed in general conformance with the approved plans and specifications. "As-built" information shown hereon reflects changes made during the course of the project, and is based upon change order records and information provided by the City of Albuquerque Public Works Department field inspector. No as-built information was provided by the contractor.

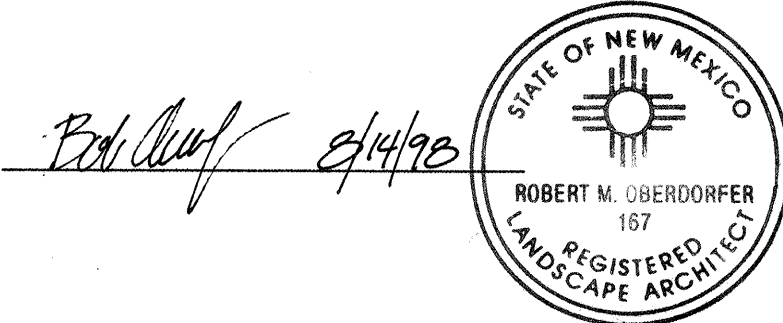

CONSTRUCTION PLANS FOR RIVERVIEW TRAIL

Golf Course Road to Rancho Solano Court

NOVEMBER 1996

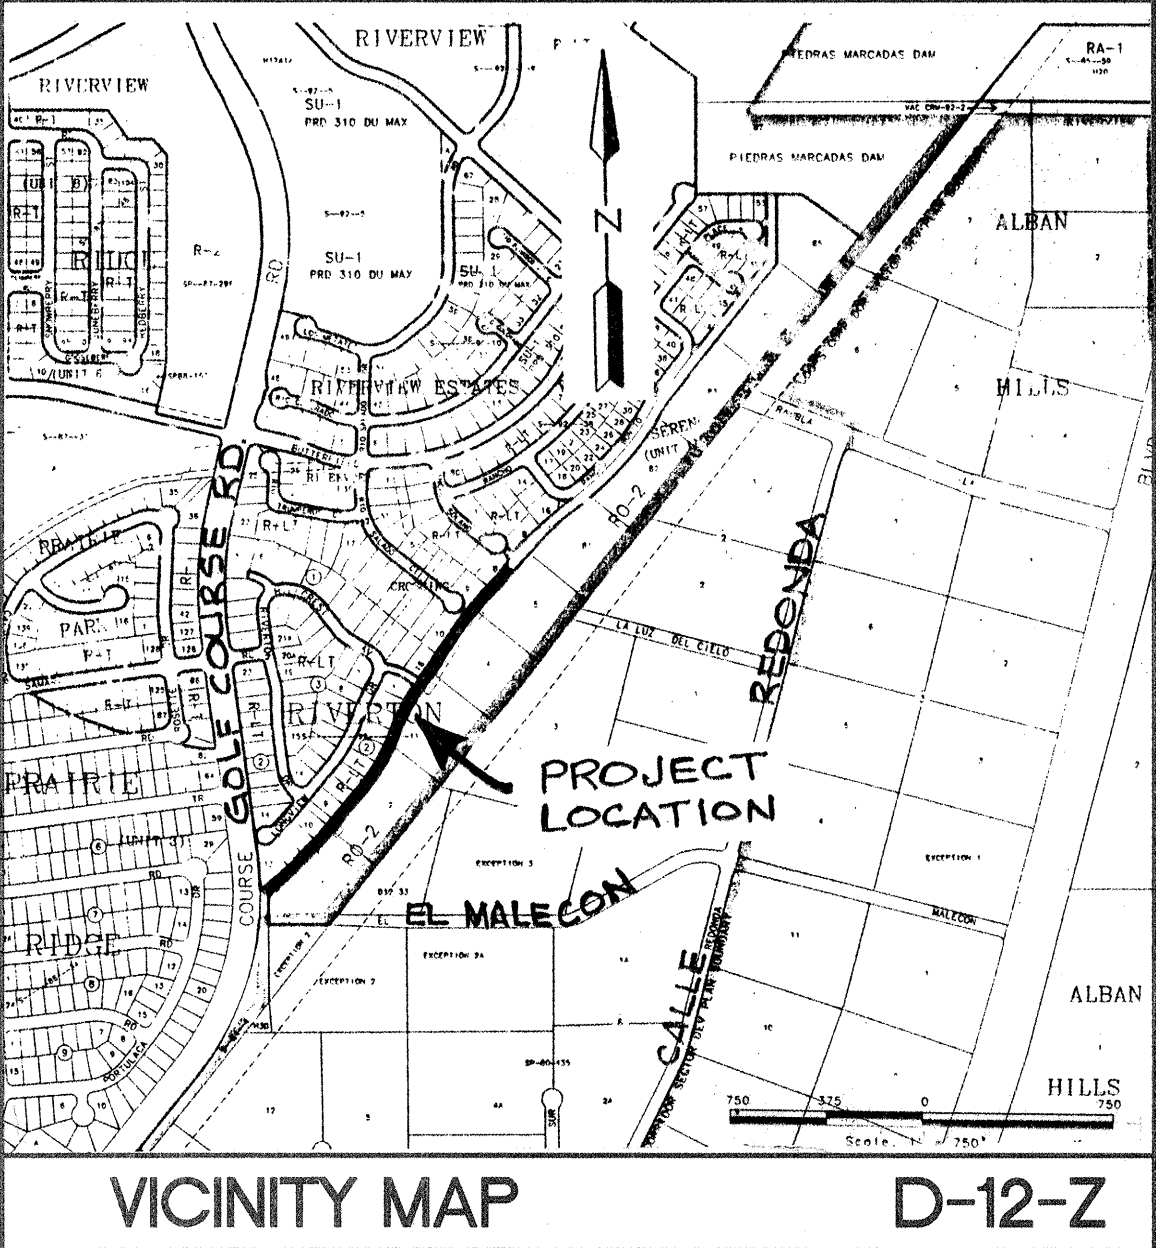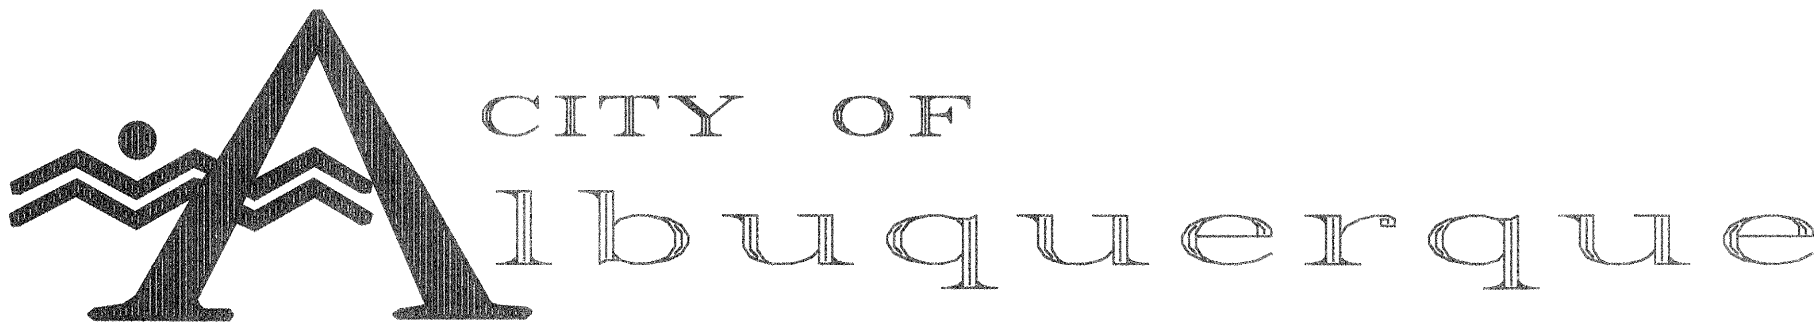

GENERAL NOTES

- ALL WORK DETAILED ON THESE PLANS SHALL BE CONSTRUCTED IN ACCORDANCE WITH THE CITY OF ALBUQUERQUE STANDARD SPECIFICATIONS FOR PUBLIC WORKS CONSTRUCTION, 1986 EDITION W/UPDATE #6.
- PRIOR TO CONSTRUCTION, THE CONTRACTOR SHALL EXCAVATE & VERIFY THE HORIZONTAL AND VERTICAL LOCATIONS OF ALL OBSTRUCTIONS. SHOULD A CONFLICT EXIST, THE CONTRACTOR SHALL NOTIFY THE ENGINEER SO THAT THE CONFLICT CAN BE RESOLVED WITH MINIMUM DELAY.
- ALL STATIONING REFERS TO TRAIL CENTERLINE STATIONING.
- EARTHWORK QUANTITIES ARE BASED ON EMBANKMENT VOLUMES COMPACTED IN PLACE. CONTRACTOR SHALL ALLOW FOR ADDITIONAL SHRINKAGE FOR BIDDING PURPOSES. SEE NOTE 4 ON SHEET 2 FOR FILL GRADATION.
- CONTRACTOR SHALL WARP SLOPES, AS NEEDED TO STAY WITHIN PUBLIC RIGHT-OF-WAY OR CONSTRUCTION LIMITS, OR TO MEET EXISTING OBSTACLES, AND PROMPTLY CLEAN UP ANY EXCESS EXCAVATED MATERIAL.
- THE CONTRACTOR SHALL BE RESTRICTED TO THE USE OF A 35 TON NON-VIBRATING ROLLER MAXIMUM TO OBTAIN THE REQUIRED COMPACTION IN EMBANKMENT AND SUBGRADE IN ANY AREAS WHERE THE USE OF HEAVIER EQUIPMENT COULD DAMAGE UNDERGROUND UTILITIES OR OTHER PERMANENT STRUCTURES.
- THE CONTRACTOR AGREES THAT HE SHALL ASSUME THE SOLE AND COMPLETE RESPONSIBILITY FOR THE JOB SITE CONDITIONS DURING THE COURSE OF CONSTRUCTION OF THIS PROJECT, INCLUDING SAFETY OF ALL PERSONS AND PROPERTY; THAT THIS REQUIREMENT SHALL APPLY CONTINUOUSLY AND NOT BE LIMITED TO NORMAL WORKING HOURS; AND THAT THE CONTRACTOR SHALL DEFEND, INDEMNIFY, AND HOLD HARMLESS THE OWNER & ENGINEER FROM ANY AND ALL LIABILITY REAL OR ALLEGED, IN CONNECTION WITH THE PERFORMANCE OF WORK ON THIS PROJECT, EXCEPTING LIABILITY ARISING FROM THE SOLE NEGLIGENCE OF THE OWNER OR ENGINEER.
- THE CONTRACTOR IS RESPONSIBLE FOR ANY DAMAGE CAUSED BY HIM TO EXISTING WALLS, FENCES, SIDEWALKS, ROAD SURFACES, MANHOLES, CURB AND GUTTER, ETC. DURING CONSTRUCTION AND SHALL REPAIR OR REPLACE SAME AT HIS OWN EXPENSE.
- ALL WORK ON THIS PROJECT SHALL BE PERFORMED IN ACCORDANCE WITH APPLICABLE FEDERAL, STATE, AND LOCAL LAWS, RULES, AND REGULATIONS CONCERNING CONSTRUCTION SAFETY AND HEALTH.
- THE CONTRACTOR IS RESPONSIBLE FOR PROTECTING AND MAINTAINING ALL EXISTING MONUMENTATION CONTROLS. IN THE EVENT OF INADVERTENT DESTRUCTION OR ALTERATION, THE CONTRACTOR MUST IMMEDIATELY NOTIFY THE CITY CHIEF SURVEYOR.
- WHEN ABUTTING NEW PAVEMENT TO EXISTING INTERSECTING ASPHALT, SAW CUT EXISTING PAVEMENT TO A STRAIGHT LINE AND AT RIGHT ANGLES TO REMOVE ANY BROKEN OR CRACKED PAVEMENT. NO DIRECT PAYMENT WILL BE MADE FOR SAW CUTTING.
- IT WILL BE THE CONTRACTOR'S RESPONSIBILITY TO SECURE AND SUPPLY WATER FOR THE PROJECT. THE COST WILL BE INCIDENTAL TO COMPLETION OF THE PROJECT AND NO SEPARATE PAYMENT WILL BE MADE THEREFORE.

UTILITIES

- TWO (2) WORKING DAYS PRIOR TO ANY EXCAVATION, CONTRACTOR SHALL CONTACT LINE LOCATING SERVICE @ 260-1990 FOR LOCATION OF EXISTING UTILITIES.

- CONTRACTOR SHALL SUPPORT ALL EXISTING UNDERGROUND UTILITY LINES WHICH BECOME EXPOSED DURING CONSTRUCTION. ANY DAMAGE RESULTING FROM CONSTRUCTION ACTIVITIES WILL BE REPAIRED AT THE CONTRACTOR'S EXPENSE.
- CONTRACTOR SHALL ASSIST THE ENGINEER/INSPECTOR IN THE RECORDING OF DATA ON ALL UTILITY LINES AND ACCESSORIES AS REQUIRED BY THE CITY OF ALBUQUERQUE FOR THE PREPARATION OF RECORD DRAWINGS. CONTRACTOR SHALL NOT COVER UTILITY LINES AND ACCESSORIES UNTIL ALL DATA HAS BEEN OBTAINED AND RECORDED.
- PNM (PUBLIC SERVICE CO. OF NEW MEXICO) WILL PROVIDE AT NO COST TO THE CITY OR TO THE CONTRACTOR THE REQUIRED PERSONNEL FOR INSPECTION OR OBSERVATION DEEMED NECESSARY BY PNM WHILE THE CONTRACTOR IS EXPOSING PNM'S CABLES. HOWEVER, THE CONTRACTOR SHALL BE CHARGED THE TOTAL COST ASSOCIATED WITH REPAIRS TO ANY DAMAGED CABLES OR FOR ANY COST ASSOCIATED WITH SUPPORTING OR RELOCATING THE POLES AND CABLES DURING CONSTRUCTION.
- ** WARNING ** - EXISTING UTILITY LINE LOCATIONS ARE SHOWN IN APPROXIMATE MANNER ONLY, AND SUCH LINES MAY EXIST WHERE NONE ARE SHOWN. THE LOCATION OF ANY SUCH EXISTING LINES IS BASED UPON INFORMATION PROVIDED BY THE UTILITY COMPANY, THE OWNER, OR BY OTHERS, AND THE INFORMATION MAY BE INCOMPLETE OR MAY BE OBSOLETE BY THE TIME CONSTRUCTION COMMENCES. (SEE NOTE 14)
- THE ENGINEER HAS UNDERTAKEN NO FIELD VERIFICATION OF THE LOCATION, DEPTH, SIZE, OR TYPE OF EXISTING UNDERGROUND UTILITY LINES, MAKES NO REPRESENTATION PERTAINING THERETO, AND ASSUMES NO RESPONSIBILITY OR LIABILITY THEREFOR. THE CONTRACTOR SHALL INFORM HIMSELF OF THE LOCATION OF ANY UTILITY LINE IN OR NEAR THE AREA OF THE WORK IN ADVANCE OF AND DURING EXCAVATION WORK. THE CONTRACTOR IS FULLY RESPONSIBLE FOR ANY AND ALL DAMAGE CAUSED BY ITS FAILURE TO LOCATE, IDENTIFY, AND PRESERVE ANY AND ALL EXISTING UTILITIES. THE CONTRACTOR SHALL COMPLY WITH STATE STATUTES, MUNICIPAL AND LOCAL ORDINANCES, RULES AND REGULATIONS PERTAINING TO THE LOCATION OF THESE LINES AND FACILITIES, IN PLANNING AND CONDUCTING EXCAVATION, WHETHER BY CALLING OR NOTIFYING THE UTILITIES, COMPLYING WITH "BLUE STAKES" PROCEDURES, OR OTHERWISE.
- TRAFFIC
- CONTRACTOR SHALL CONDUCT OPERATIONS IN A MANNER WHICH WILL MINIMIZE INTERFERENCE WITH LOCAL TRAFFIC. CONTRACTOR SHALL COMPLY WITH ALL APPLICABLE LAWS, ORDINANCES, RULES, REGULATIONS, AND ORDERS OF ANY PUBLIC BODY HAVING JURISDICTION FOR THE SAFETY OF PERSONS OR PROPERTY, AND TO PROTECT THEM FROM DAMAGE, INJURY, OR LOSS. CONTRACTOR SHALL ERECT AND MAINTAIN, AS REQUIRED BY THE CONDITIONS AND PROGRESS OF THE WORK, ALL NECESSARY SAFEGUARDS FOR SAFETY CONTINUOUSLY AND NOT LIMITED TO NORMAL WORKING HOURS, THROUGHOUT THE DURATION OF THE PROJECT. CONTRACTOR SHALL ADHERE TO SECTION 19 (CONSTRUCTION TRAFFIC CONTROL) OF THE GENERAL CONDITIONS OF THE CITY OF ALBUQUERQUE STANDARD SPECIFICATIONS FOR PUBLIC WORKS CONSTRUCTION, 1986 EDITION W/UPDATE #6.
- THREE (3) WORKING DAYS PRIOR TO BEGINNING CONSTRUCTION THE CONTRACTOR SHALL SUBMIT TO THE CONSTRUCTION COORDINATION DIVISION A DETAILED CONSTRUCTION SCHEDULE. TWO (2) WORKING DAYS PRIOR TO CONSTRUCTION THE CONTRACTOR SHALL OBTAIN A BARRICADING PERMIT FROM THE CONSTRUCTION COORDINATION DIVISION. CONTRACTOR SHALL NOTIFY BARRICADE ENGINEER (768-2551) PRIOR TO OCCUPYING AN INTERSECTION.
- ALL STREET STRIPING ALTERED OR DESTROYED SHALL BE REPLACED WITH PLASTIC REFLECTORIZED PAVEMENT MARKINGS BY CONTRACTOR TO LOCATION AS EXISTING OR AS INDICATED BY THIS PLAN SET.

- ALL SIGNS AND CODING WILL BE IN ACCORDANCE WITH THE "MANUAL OF UNIFORM TRAFFIC CONTROL DEVICES FOR STREETS AND HIGHWAYS" CURRENT EDITION, AS PUBLISHED BY THE U.S. DEPARTMENT OF TRANSPORTATION.
- ENVIRONMENTAL
- THE CONTRACTOR SHALL PROPERLY HANDLE AND DISPOSE OF ALL ASPHALT PAVEMENT MATERIAL REMOVED ON THE PROJECT BY: PLACING WITHIN NEW ROADWAY PRISM; RECYCLING; STOCKPILING; AND/OR, HAULING TO AN APPROVED LANDFILL; IN ACCORDANCE WITH THE REGULATIONS OF THE NEW MEXICO SOLID WASTE ACT.
- ITEMS DESIGNATED FOR REMOVAL WITHOUT SALVAGE, UNSUITABLE CONSTRUCTION MATERIALS AND DEBRIS FROM CLEARING AND GRUBBING, ARE TO BE PLACED IN AN ENVIRONMENTALLY SUITABLE DISPOSAL SITE DECIDED UPON BY THE CONTRACTOR AND COORDINATED WITH THE APPROPRIATE REGULATORY AGENCIES. THE CONTRACTOR SHALL NOTIFY THE PROJECT MANAGER IN WRITING OF THE DETAILS OF DISPOSAL OPERATIONS. BORROW MATERIAL, ROCK WASTE, VEGETATIVE DEBRIS, ETC. SHALL NOT BE PLACED IN WETLAND AREAS OR AREAS WHICH MAY IMPACT ENDANGERED SPECIES OR ARCHAEOLOGICAL RESOURCES. AN ARCHAEOLOGICAL SURVEY AND ENVIRONMENTAL CLEARANCE SHALL BE OBTAINED BY THE CONTRACTOR BEFORE DISPOSAL SITES ARE ACCEPTED.
- THE CONTRACTOR SHALL BE RESPONSIBLE FOR REPORTING AND CLEANUP OF SPILLS ASSOCIATED WITH PROJECT CONSTRUCTION AND SHALL REPORT AND RESPOND TO SPILLS OF HAZARDOUS MATERIALS SUCH AS GASOLINE, DIESEL, MOTOR OILS, SOLVENTS, CHEMICALS, TOXIC AND CORROSIVE SUBSTANCES, ETC. WHICH MAY BE A THREAT TO PUBLIC HEALTH OR THE ENVIRONMENT. THE CONTRACTOR SHALL BE RESPONSIBLE FOR REPORTING DISCOVERIES OF PAST SPILLS AND OF CURRENT SPILLS NOT ASSOCIATED WITH CONSTRUCTION. REPORTS SHALL BE MADE IMMEDIATELY TO THE NM ENVIRONMENT DEPARTMENT EMERGENCY RESPONSE AT 827-4308 OR 470-3657.
- THE AIR POLLUTION CONTROL REGULATIONS OF THE ALBUQUERQUE-BERNALILLO COUNTY AIR QUALITY CONTROL BOARD LIMIT EMISSIONS OF PARTICULATE MATTER AND THE USE OF CUT BACK ASPHALT. IT IS THE RESPONSIBILITY OF THE CONTRACTOR TO CLARIFY THESE RESTRICTIONS WITH THE ENVIRONMENTAL HEALTH DEPARTMENT PRIOR TO SUBMITTAL OF BIDS TO AVOID CONFLICT WITH THE REGULATIONS. CALL THE ENVIRONMENTAL HEALTH DEPARTMENT AT 768-2600.


REVEGETATION

- PRIOR TO SEEDING, CONTRACTOR SHALL DEEP RIP ALL AREAS OF HARD COMPACTED DIRT (HAUL ROADS, CONTRACTOR STORAGE AREAS, ETC.) WITHIN SEEDING LIMITS TO A DEPTH OF 8"-12" AND LEAVE SOIL ROUGH.


INDEX OF SHEETS

TITLE	SHEET
COVER SHEET AND GENERAL NOTES	1
PLAN AND PROFILE SHEETS	2 - 5
TYPICAL SECTIONS	6
DRIVEWAY DETAILS	7
MISCELLANEOUS DETAILS	8
CROSS-SECTIONS	9 - 11



FOR INFORMATION ONLY

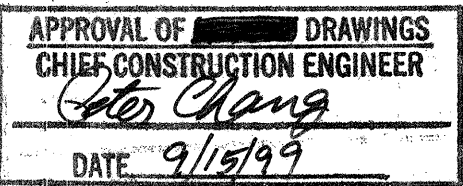

REV.	SHEET	CITY ENGINEER	DATE	USER DEPARTMENT	DATE	USER DEPARTMENT	DATE
ENGINEERS STAMP & SIGNATURE		APPROVALS		ENGINEER		DATE	
		ORC Chairman		Billy G. Gooden		4/8/97	
		Transportation		[Signature]		5/4/97	
		Water/Wastewater		[Signature]		2/21/97	
		Hydrology		[Signature]		3/6/97	
		Parks		[Signature]		4/1/97	
		Const. Mngmt.					
		AMAFCA					
		City Project No.		5312.90		Sheet 1 of 11	

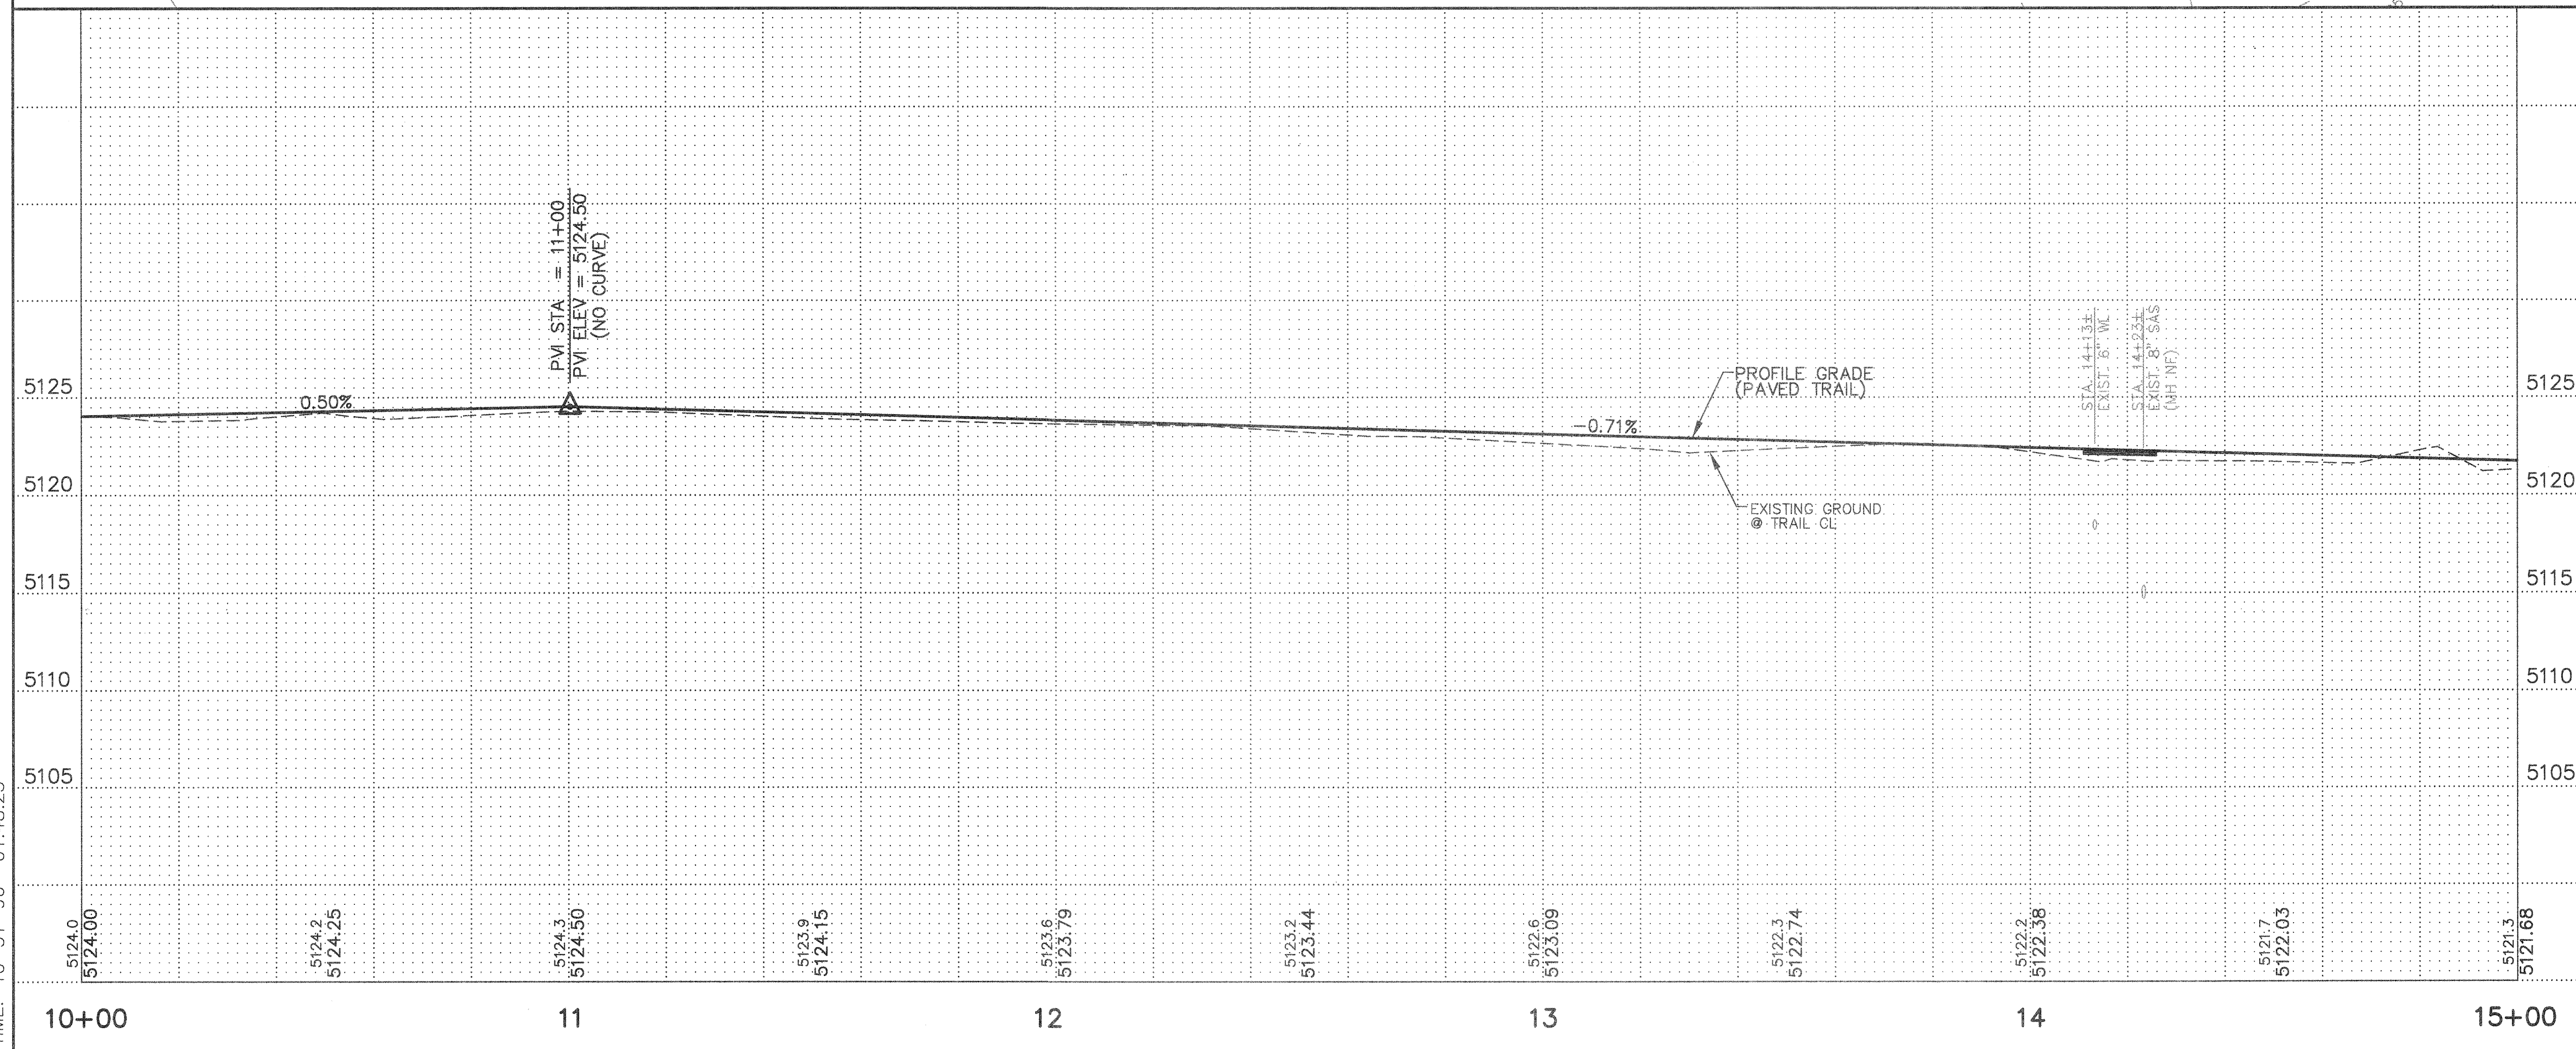



		City Engineer Approval		<table border="1"> <tr> <td>Mo./Day/Yr.</td> <td>Mo./Day/Yr.</td> </tr> <tr><td> </td><td> </td></tr> <tr><td> </td><td> </td></tr> <tr><td> </td><td> </td></tr> <tr><td> </td><td> </td></tr> <tr><td> </td><td> </td></tr> </table>		Mo./Day/Yr.	Mo./Day/Yr.										
Mo./Day/Yr.	Mo./Day/Yr.																
City Project No. 5312.90		Zone Map No. D - 12	Sheet 2 Of 11														

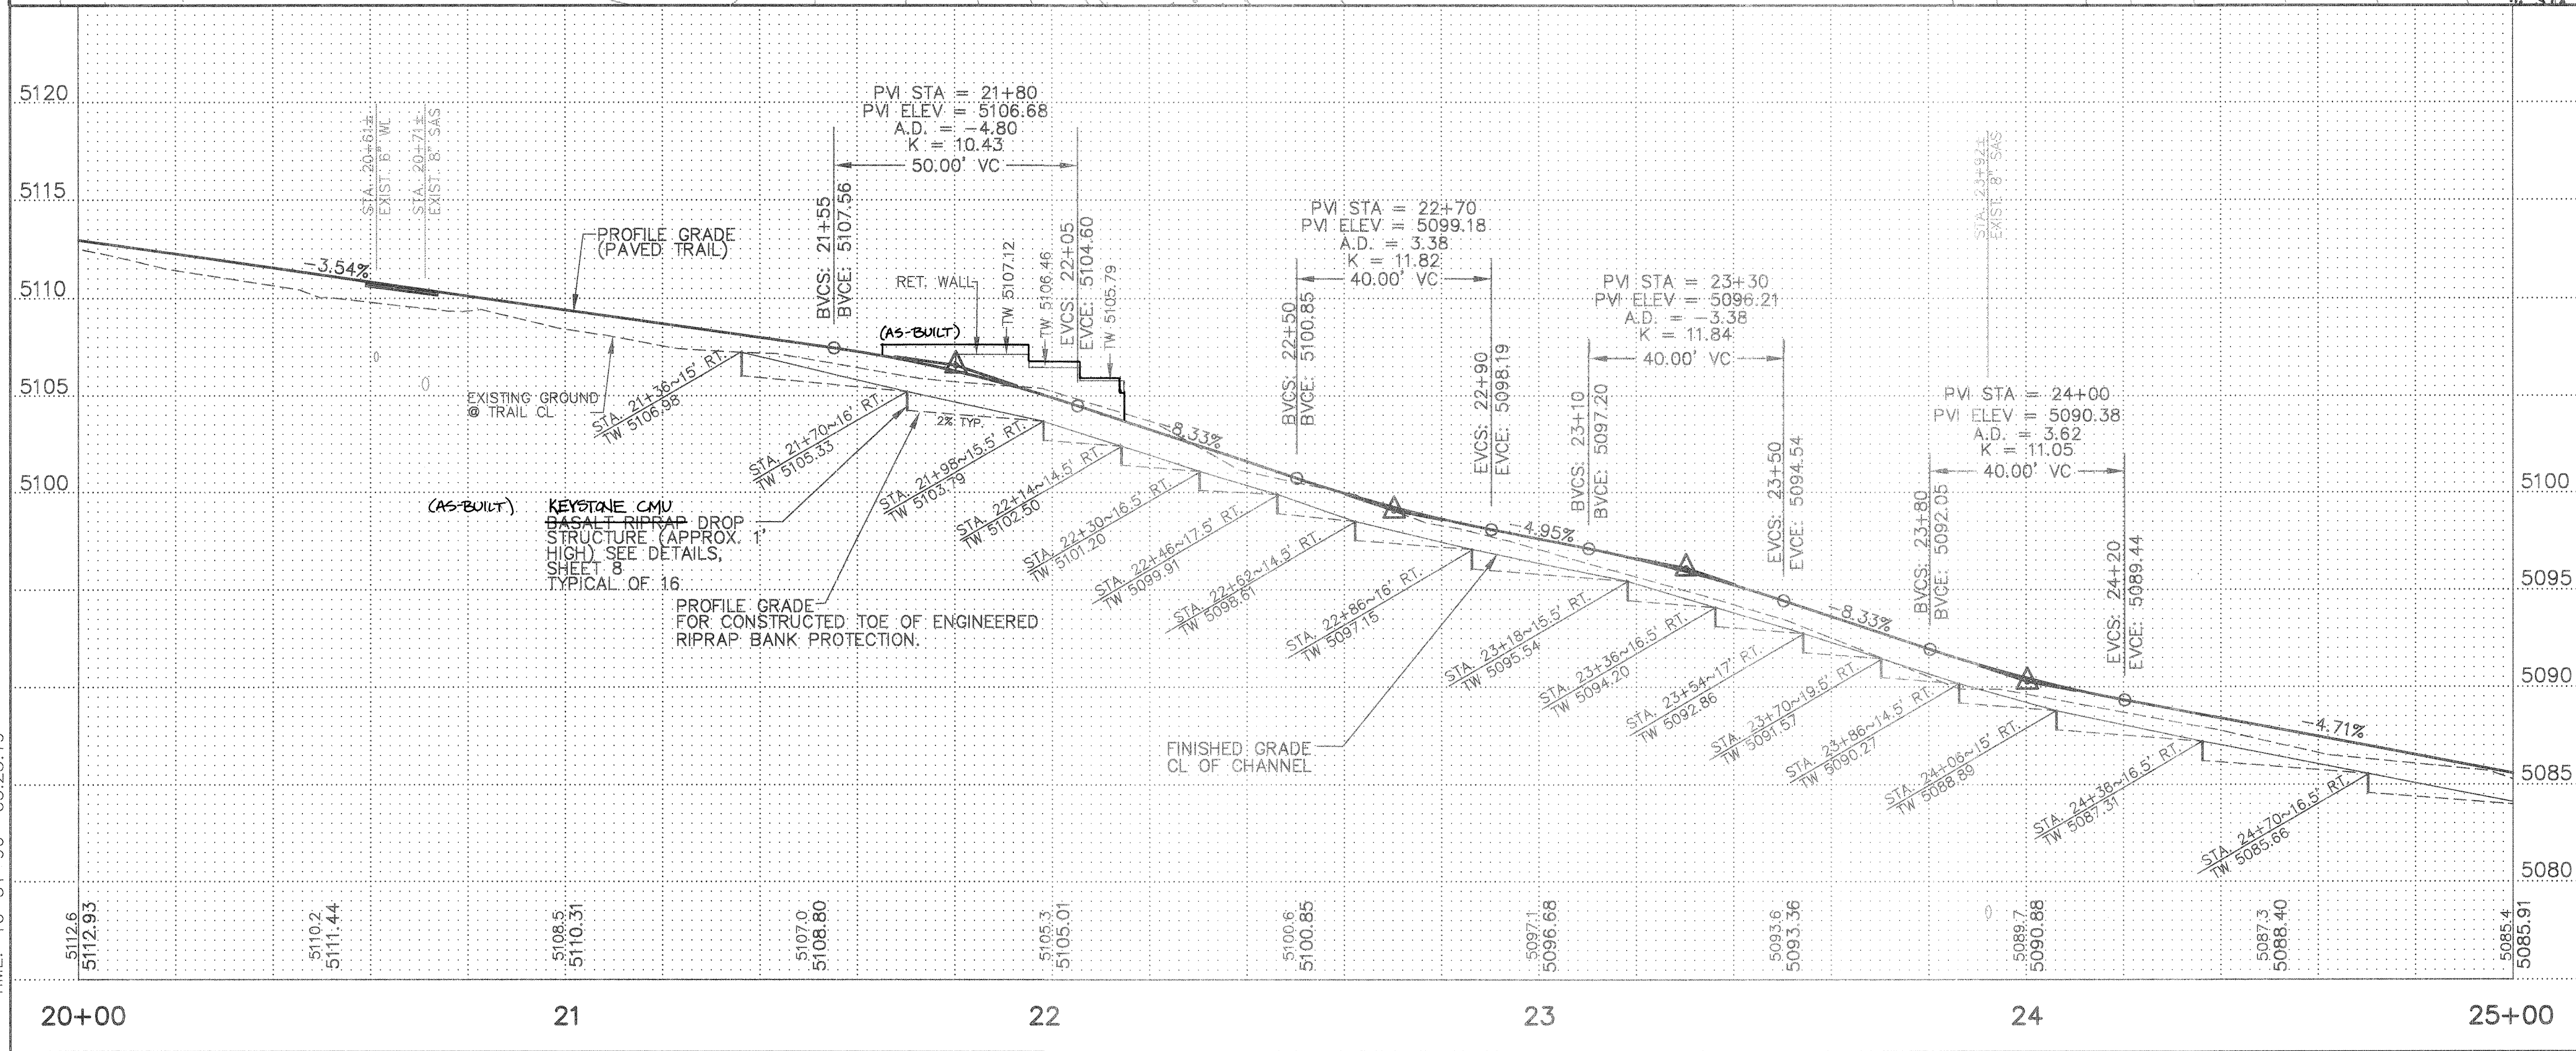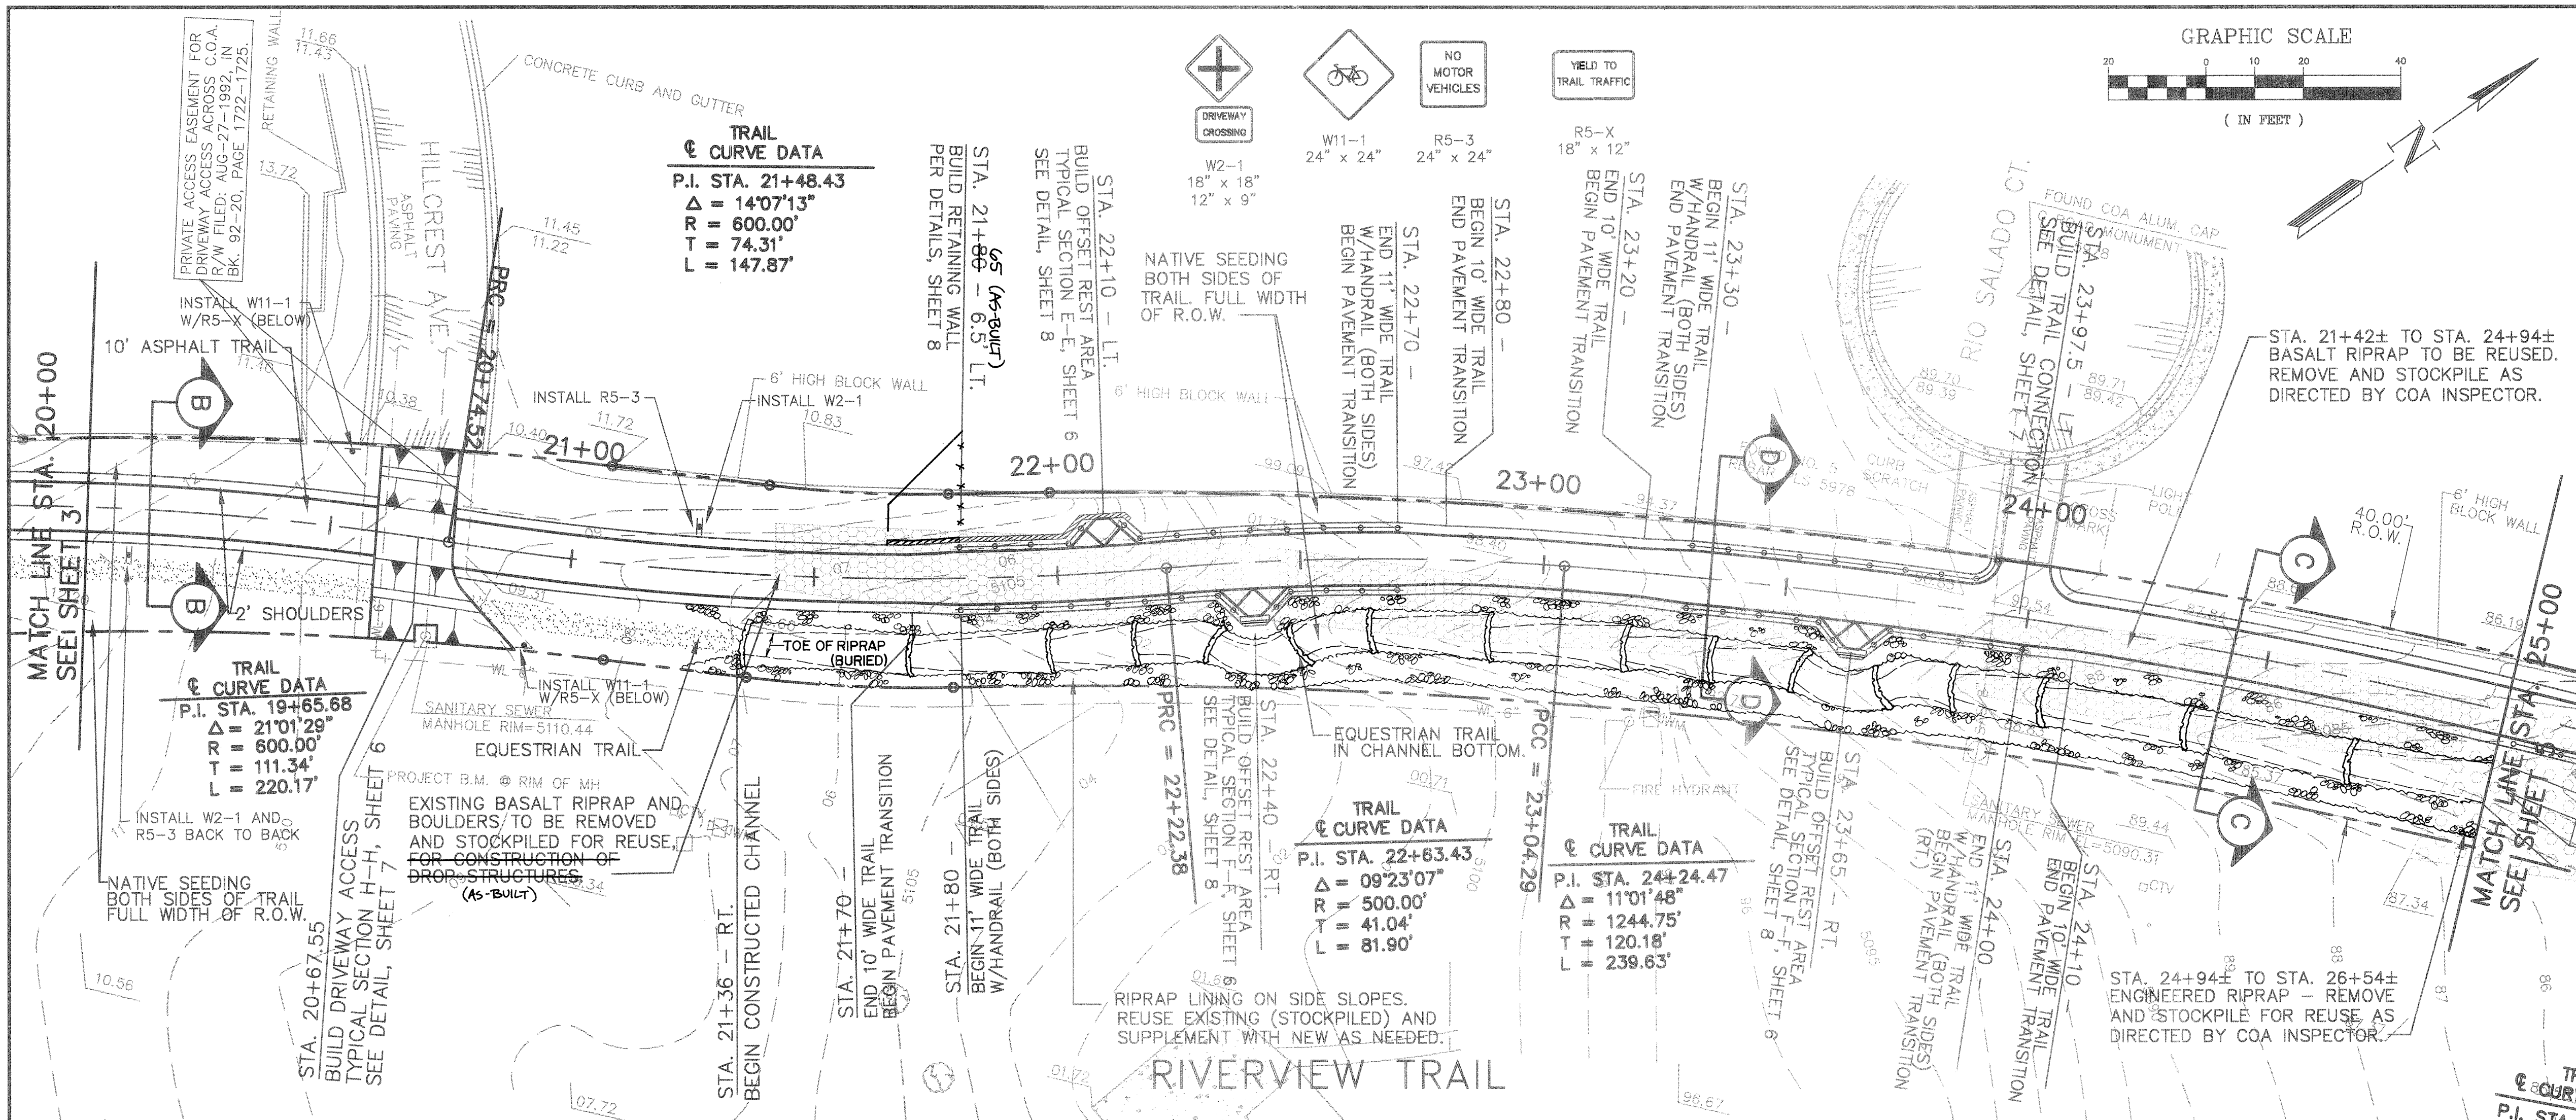

NOTES:

1. FOR TYPICAL SECTIONS, SEE SHEET 6.
 2. ENGINEERED RIPRAP AND BASALT RIPRAP TO BE STOCKPILED SEPARATELY. ENGINEERED RIPRAP TO BE REUSED AS CHANNEL SIDE SLOPE AND DESILTING BASIN LINING (SUPPLEMENT WITH NEW AS NECESSARY). ~~BASALT RIPRAP TO BE USED~~ FOR CONSTRUCTION OF DROP STRUCTURES (SEE DETAILS, SHEET 8). ANY REMAINING BASALT RIPRAP SHALL BE PLACED ON STEEPENED SLOPE WEST OF TRAIL BETWEEN STA. 21+00 AND STA. 22+50, AT DIRECTION OF LANDSCAPE ARCHITECT.
 3. CONSTRUCT DROP STRUCTURES AND SLOPE PROTECTION TO LINES AND GRADES SHOWN. AFTER CONSTRUCTION HAS BEEN COMPLETED AND APPROVED, CHANNEL SHALL BE BACKFILLED LEVEL WITH TOP OF EACH DROP STRUCTURE WITH CLEAN GRANULAR FILL.
 4. STA. 22+40 AND STA. 23+65 ~ OFFSET 12' RIGHT - INSTALL 6' BENCH (LANDSCAPE FORMS, INC. MODEL PK3005-B5-72 WITH EMBEDDED SUPPORT XQ-E AND "POLYSITE" RECYCLED PLASTIC SEAT INSERT. POWDERCOAT COLOR TO BE "GROTTO") INSTALL PER MANUFACTURER'S INSTRUCTIONS.
- (INSTALLED BENCHES: VICTOR-STANLEY MODEL 8, WITH RECYCLED PLASTIC TIMBER SLATS AND ARMRESTS)

  LEGEND

- | | |
|---|---------------------------|
|  | UNSPMP GRID MARKS |
|  | TELEPHONE PEDESTAL |
|  | CABLE TELEVISION BOX |
|  | ELECTRIC TRANSFORMER |
|  | FOUND PROPERTY CORNER |
|  | PROPERTY LINE PC/PT |
|  | EVERGREEN TREE |
|  | FLOW LINE |
|  | INTERMEDIATE CONTOUR |
|  | INDEX CONTOUR |
|  | SPOT ELEVATION |
|  | SANITARY SEWER MANHOLE |
|  | WATER VALVE |
|  | WATER METER |
|  | EDGE OF ASPHALT |
|  | ELEVATION AT TOP OF LINE |
|  | ELEVATION ON FLOW OF CURB |
|  | RIPRAP - BASALT |
|  | RIPRAP - ENGINEERED |
|  | NEW DROP STRUCTURE |
|  | NEW SIGN |
|  | NEW HANDRAIL |

SCALE: 1" = 20' HORIZ.
1" = 5' VERT.



CITY OF ALBUQUERQUE
CAPITAL IMPLEMENTATION PROGRAM
DESIGN AND DEVELOPMENT

TITLE:

STA. 20+00 TO STA. 25+00
PLAN AND PROFILE

Design Review Committee

City Engineer Approval

Mo./Day/Yr.

APPROVE

© 2006 The Authors
Journal compilation © 2006 Blackwell Publishing Ltd



--


DESIGN

DESIGN
REVIEW COMMITTEE

City Project No. 5210

Zone Mo

Sheet

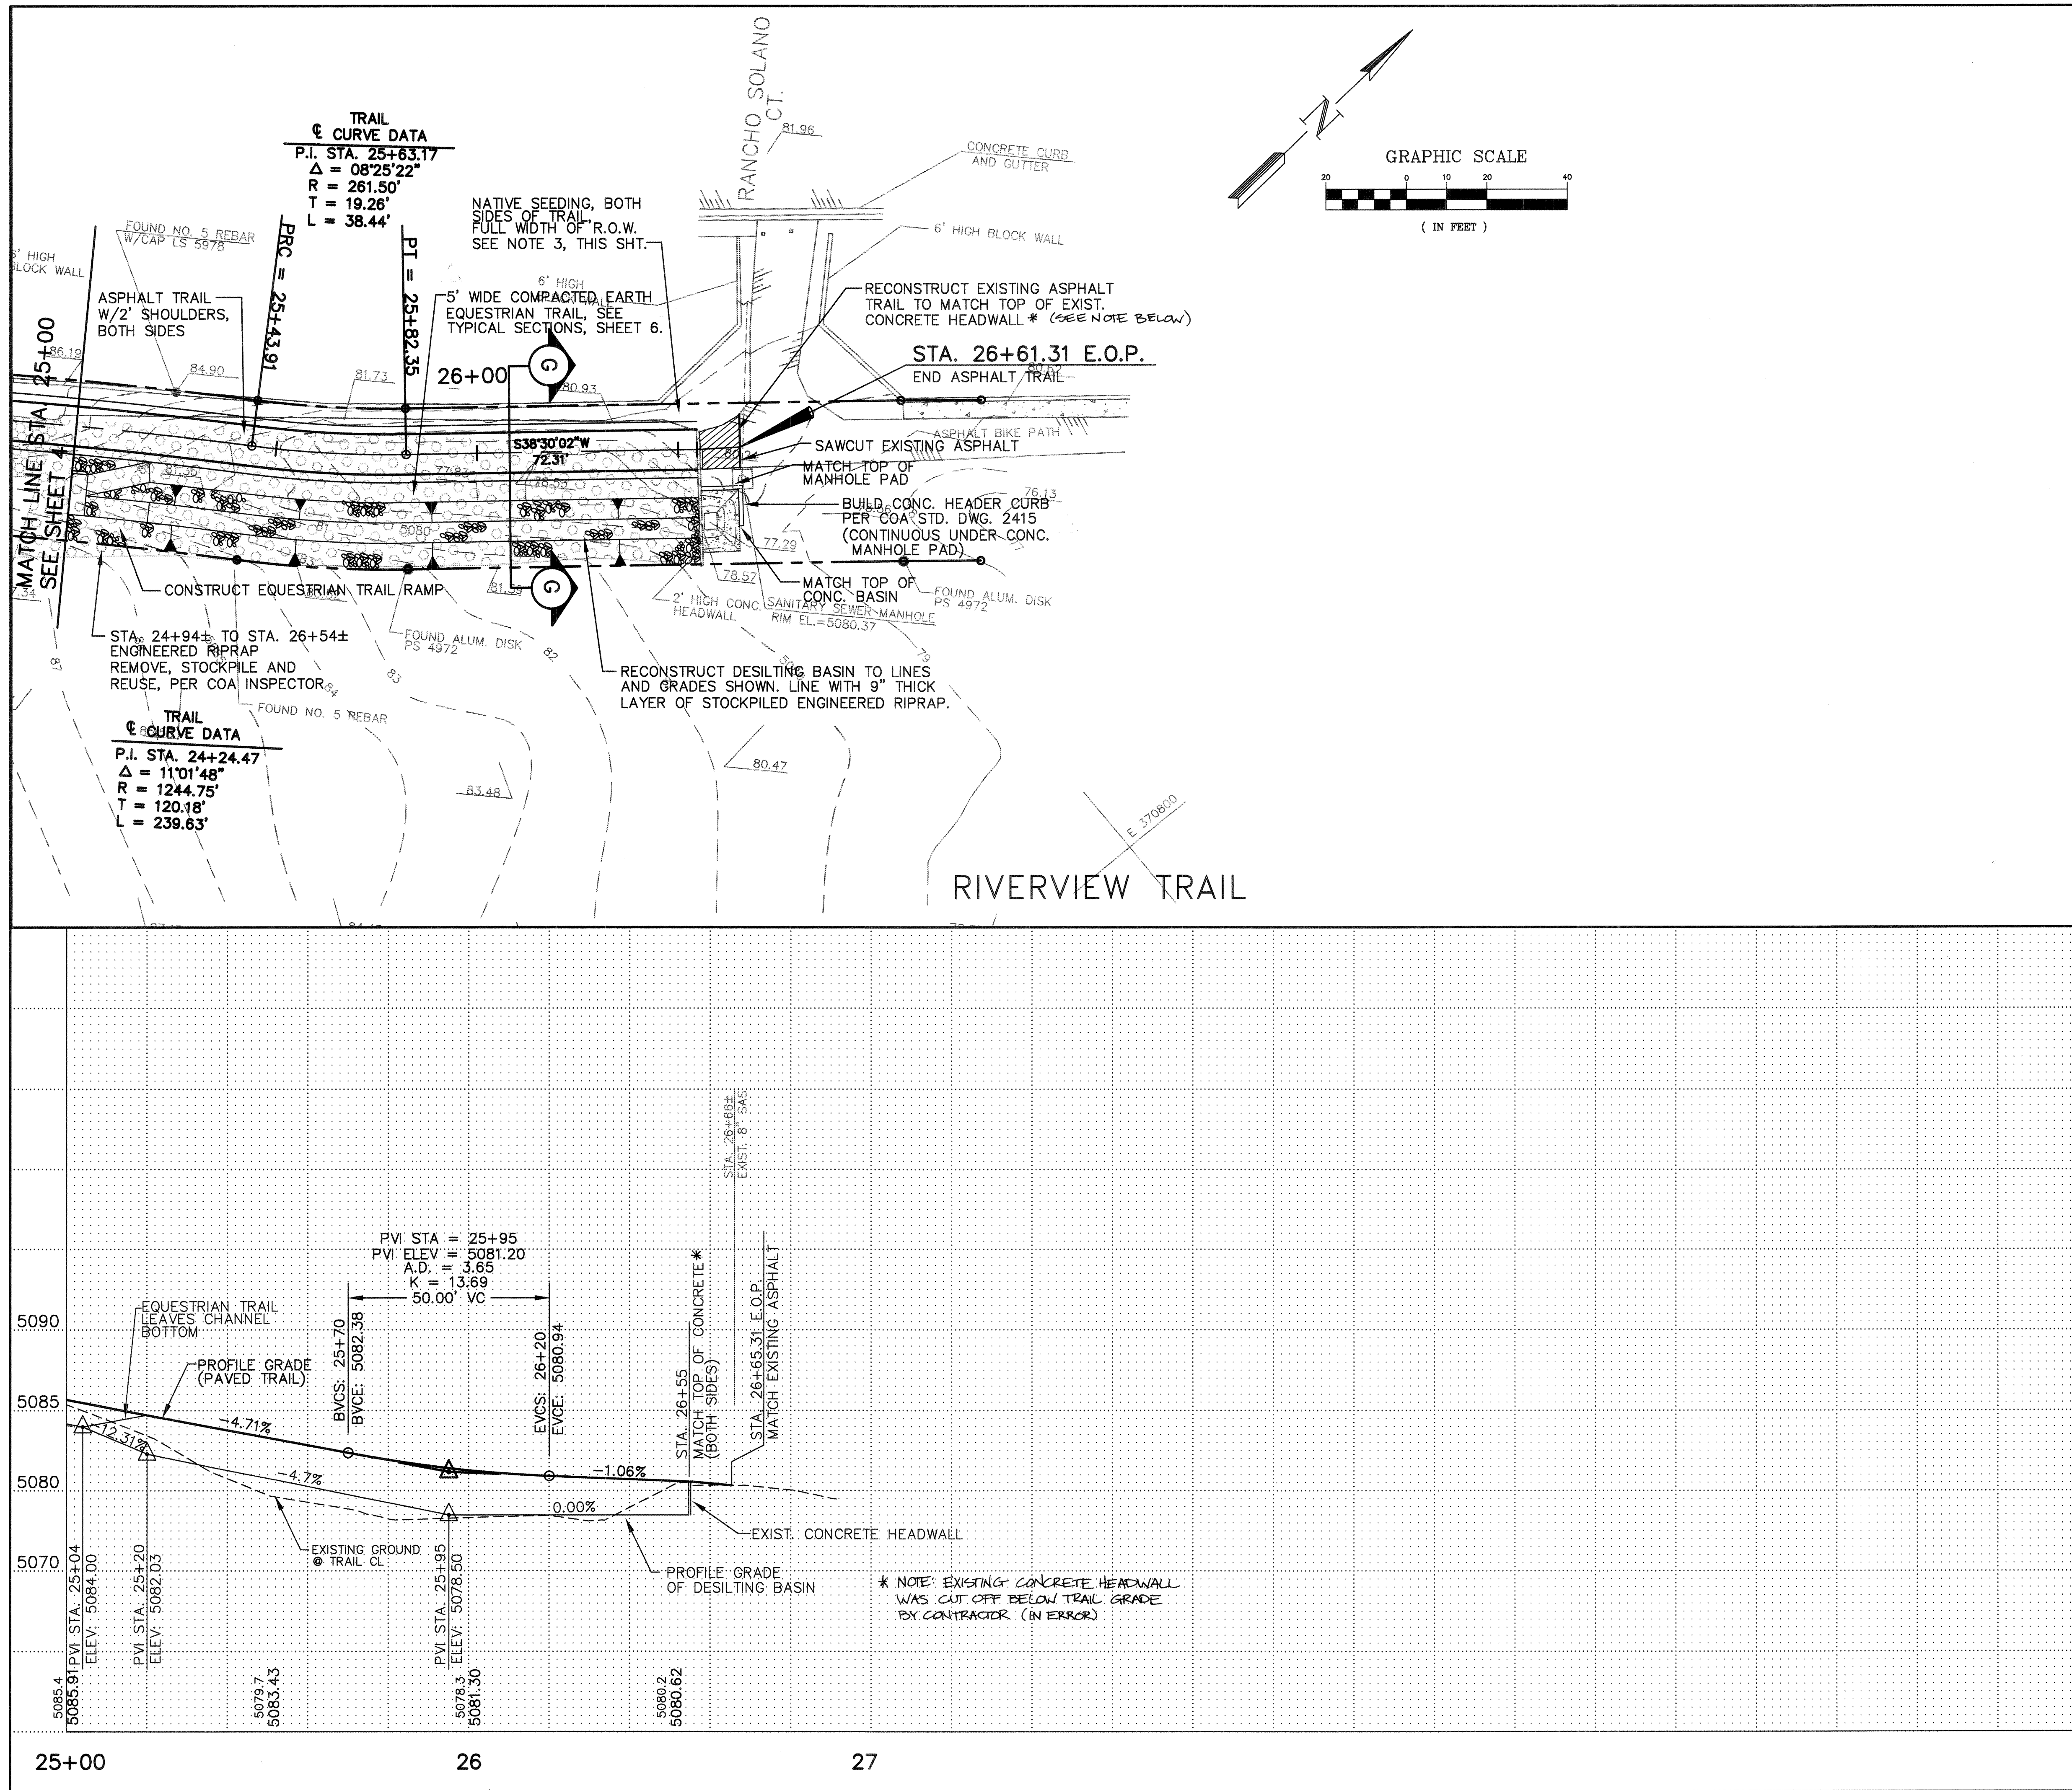

NOTES:

1. FOR TYPICAL SECTIONS, SEE SHEET 8.

2. ENGINEERED RIPRAP AND BASALT RIPRAP TO BE STOCKPILED SEPARATELY. ENGINEERED RIPRAP TO BE REUSED AS CHANNEL SIDE SLOPE AND DESILTING BASIN LINING (SUPPLEMENT WITH NEW AS NECESSARY). BASALT RIPRAP TO BE USED FOR CONSTRUCTION OF DROP STRUCTURES (SEE DETAILS, SHEET 8).

3. NATIVE SEEDING TO BE FULL WIDTH OF R.O.W., INCLUDING AREAS OF RIPRAP SLOPE PROTECTION, WHICH WILL BE SEEDED IN ACCORDANCE WITH SPECIFICATION FOR GRAVEL MULCH SEEDING - COA. STD. SPECIFICATION SECTION 1012.6.2.3.

LEGEND

- NMSP GRID MARKS
- TELEPHONE PEDESTAL
- CABLE TELEVISION BOX
- ELECTRIC TRANSFORMER
- FOUND PROPERTY CORNER
- PROPERTY LINE PC/PT
- EVERGREEN TREE
- FLOW LINE
- INTERMEDIATE CONTOUR
- INDEX CONTOUR
- SPOT ELEVATION
- SANITARY SEWER MANHOLE
- WATER VALVE
- WATER METER
- EDGE OF ASPHALT
- ELEVATION AT FLOW LINE
- ELEVATION ON TOP OF CURB
- RIPRAP - BASALT
- RIPRAP - ENGINEERED
- NEW DROP STRUCTURE
- NEW SIGN
- NEW HANDRAIL

SCALE: 1" = 20' HORIZ.
1" = 5' VERT.

Resource Technology, Inc.
ENGINEERS AND ENVIRONMENTAL SCIENTISTS
CIVIL, ENVIRONMENTAL, WATER RESOURCES, RECREATION PLANNING
2129 Osuna Road NE, Suite 200 - Albuquerque, New Mexico 87106
(505) 345-3115

CITY OF ALBUQUERQUE
CAPITAL IMPLEMENTATION PROGRAM
DESIGN AND DEVELOPMENT

TITLE: **RIVERVIEW TRAIL**
STA 25+00 TO STA. 26+61.31
PLAN AND PROFILE

Design Review Committee	City Engineer Approval	Mo./Day/Yr.	Mo./Day/Yr.
APPROVED			
DESIGN REVIEW COMMITTEE			

City Project No. **5312.90** Zone Map No. **D - 12** Sheet **5** Of **11**

AS BUILT INFORMATION

CONTRACTOR	DATE

BENCH MARKS

HORIZ. NM 448-N8 - A STANDARD NMSHC BRASS TABLET	DATE
LOCATED EAST SIDE OF COORS RD. (NM 448), APPROX.	

SURVEY INFORMATION

FIELD NOTES	DATE









ENGINEERS SEAL

NO.	BY

REVISIONS

NO.	DATE	REMARKS




DESIGNED BY RMO DATE AUG 1996
DRAWN BY PMT DATE AUG 1996
CHECKED BY RMO, GN DATE AUG 1996

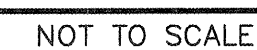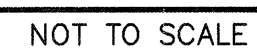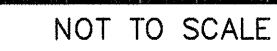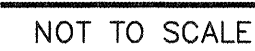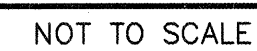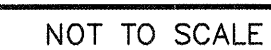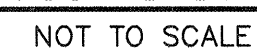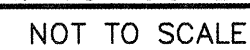

SCALE: NONE  Resource Technology, Inc. ENGINEERS AND ENVIRONMENTAL SCIENTISTS CIVIL • ENVIRONMENTAL • WATER RESOURCES • RECREATION • PLANNING 2128 Osuna Road NE, Suite 200 • Albuquerque, New Mexico (505) 345-3115		NO. DATE		DESIGNED BY	DRAWN BY	CHECKED BY
CITY OF ALBUQUERQUE CAPITAL IMPLEMENTATION PROGRAM DESIGN AND DEVELOPMENT						
TITLE: RIVERVIEW TRAIL						
TYPICAL SECTIONS						
Design Review Committee		City Engineer Approval		Mo./Day/Yr.		Mo./Day/Yr.
APPROVED MAY - 1999 DESIGN REVIEW COMMITTEE		Last Design Update				
City Project No.		Zone Map No.		Sheet		Of
5312.90		D - 12		6		11


	BENCH MARKS	AS BUILT INFORMATION
HORIZ: NM 448-N8 A STANDARD NMSHC BRASS TABLET LOCATED EAST SIDE OF COORS RD. (NM 448). APPROX. 800' SO. OF EL MALECON RD. NW NORTHING: 1514538.11 EASTING: 372524.25	CONTRACTOR WORK STAKED BY ACCEPTANCE BY FIELD CATION BY DRAWINGS CORRECTED BY	DATE DATE DATE DATE
VERT: D-111 A SQUARE " " CHISELED ON TOP OF CURB NSW CURB RET. AT THE INTER. OF TAYLOR RANCH DR. & HOMESTEAD CIR. ELEV. = 5133.30	RECORDED BY No.	DATE

[illegible][illegible]

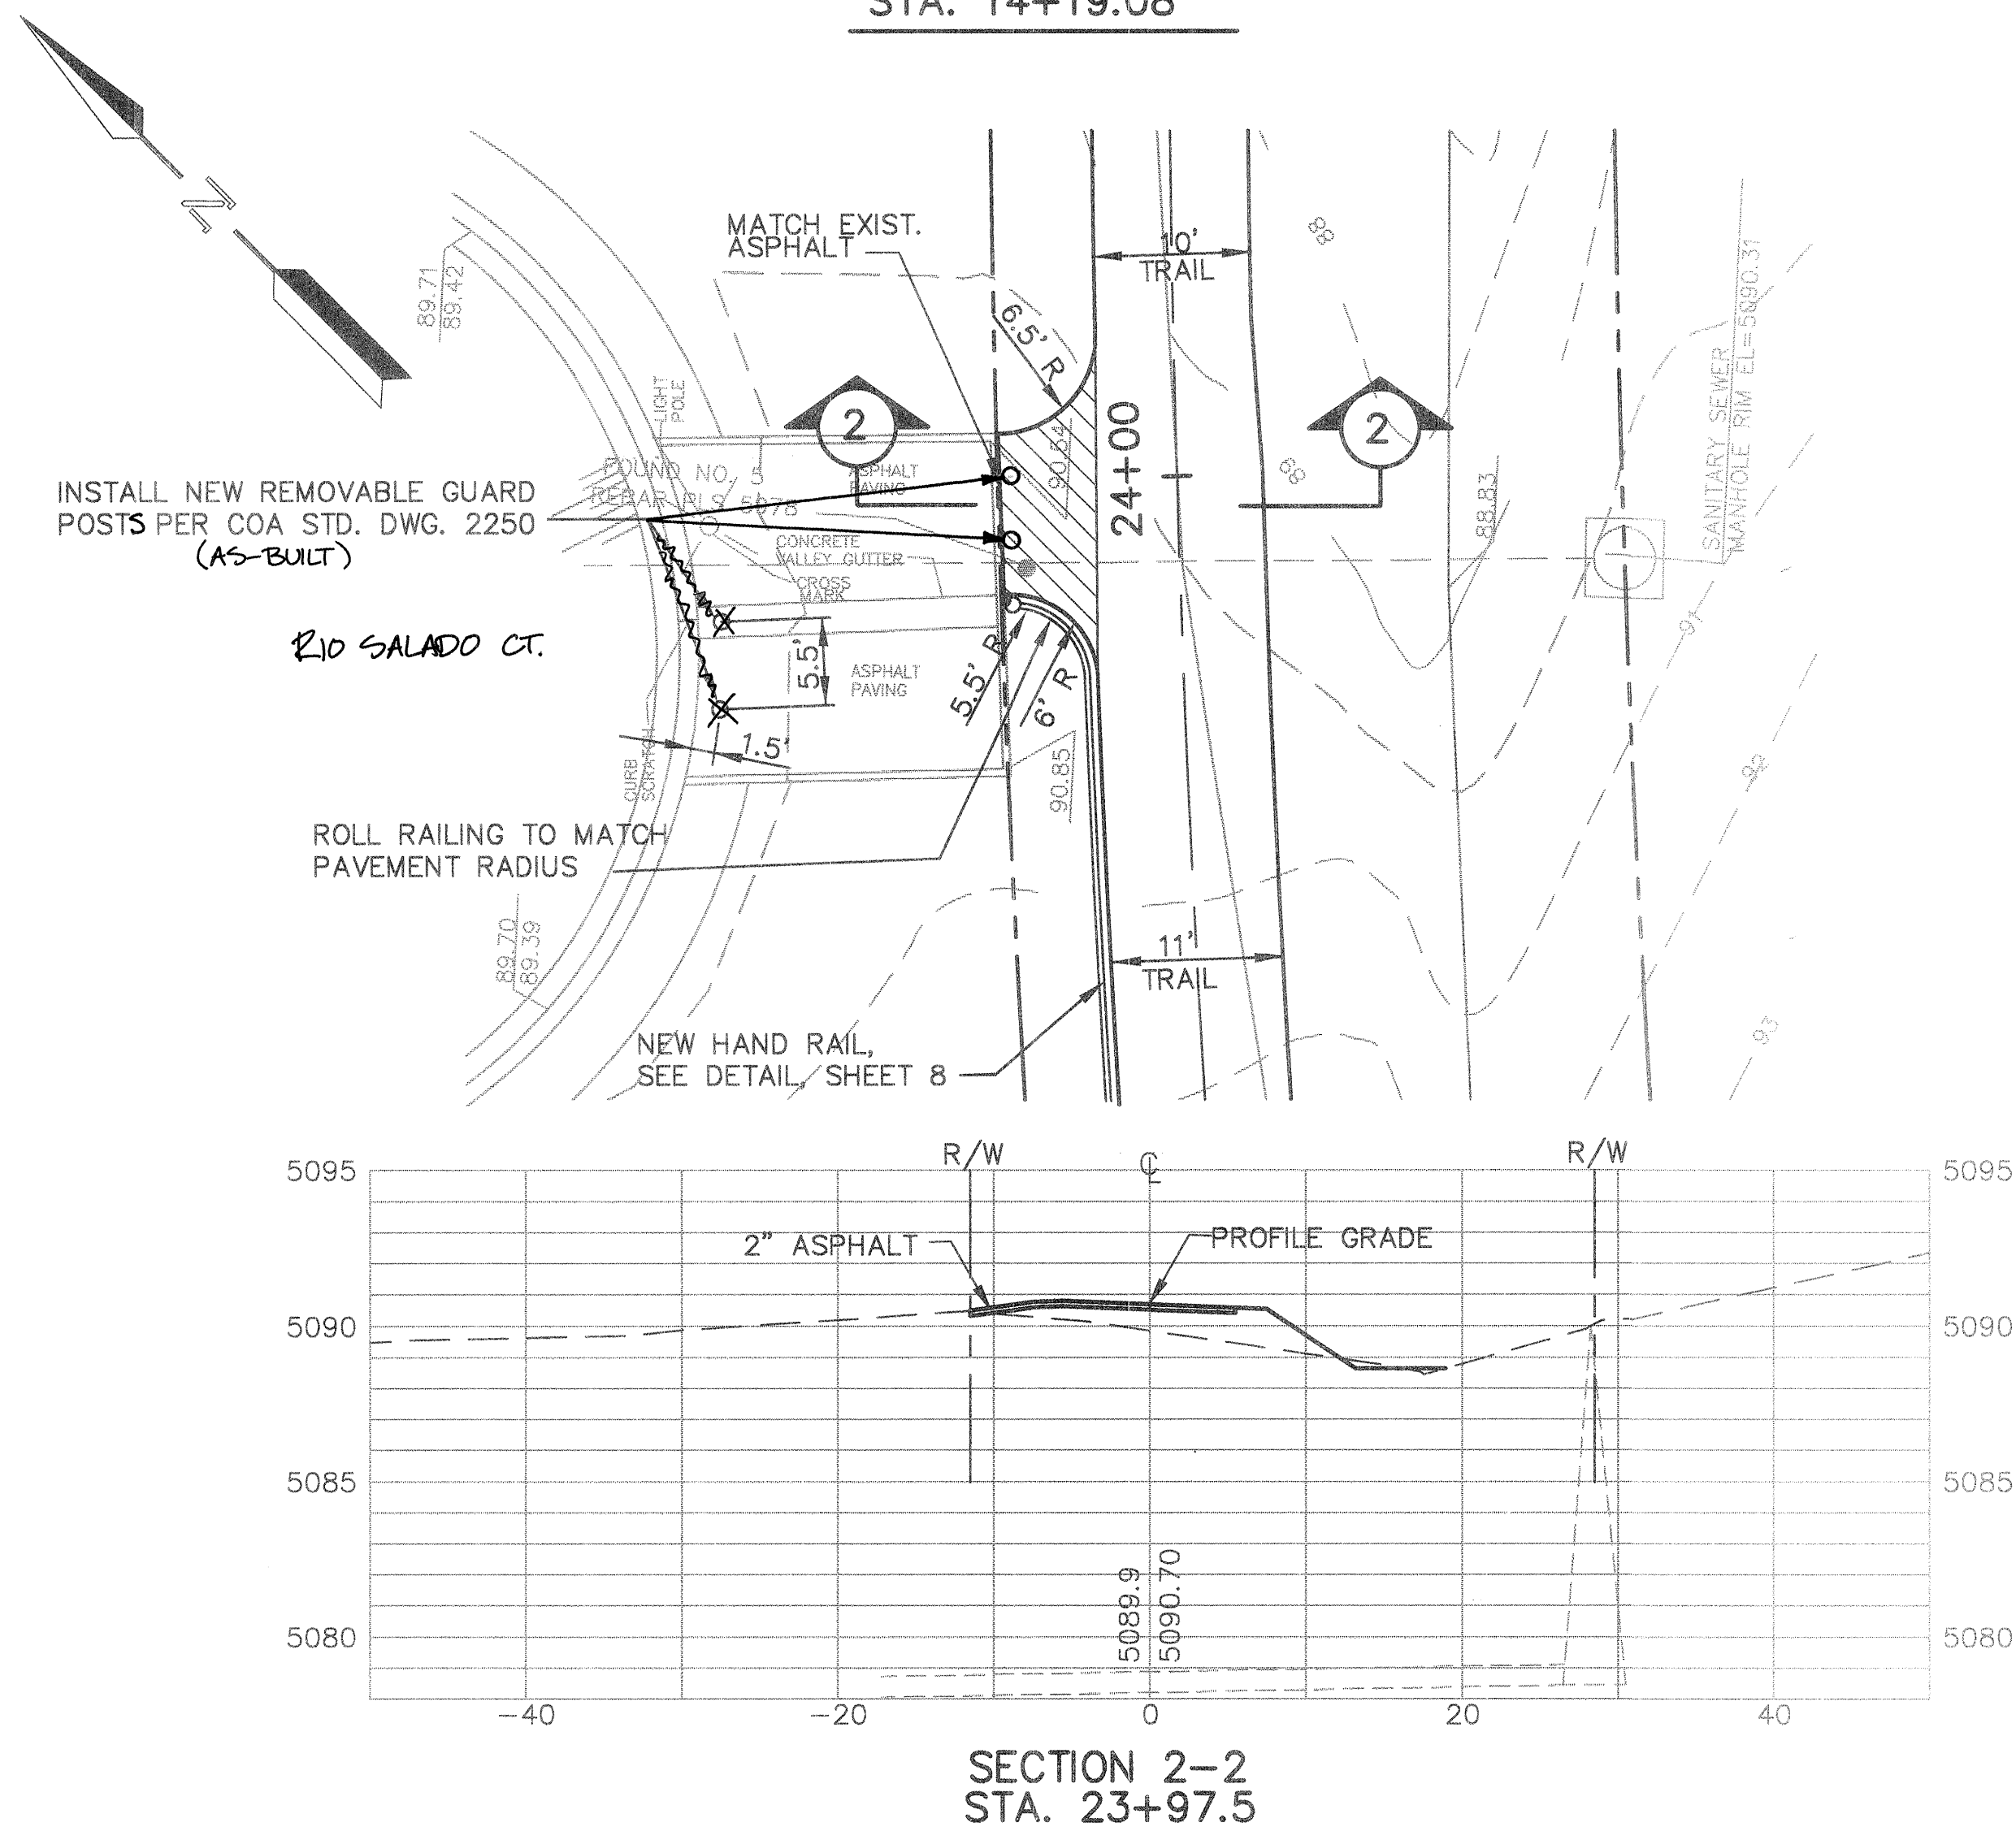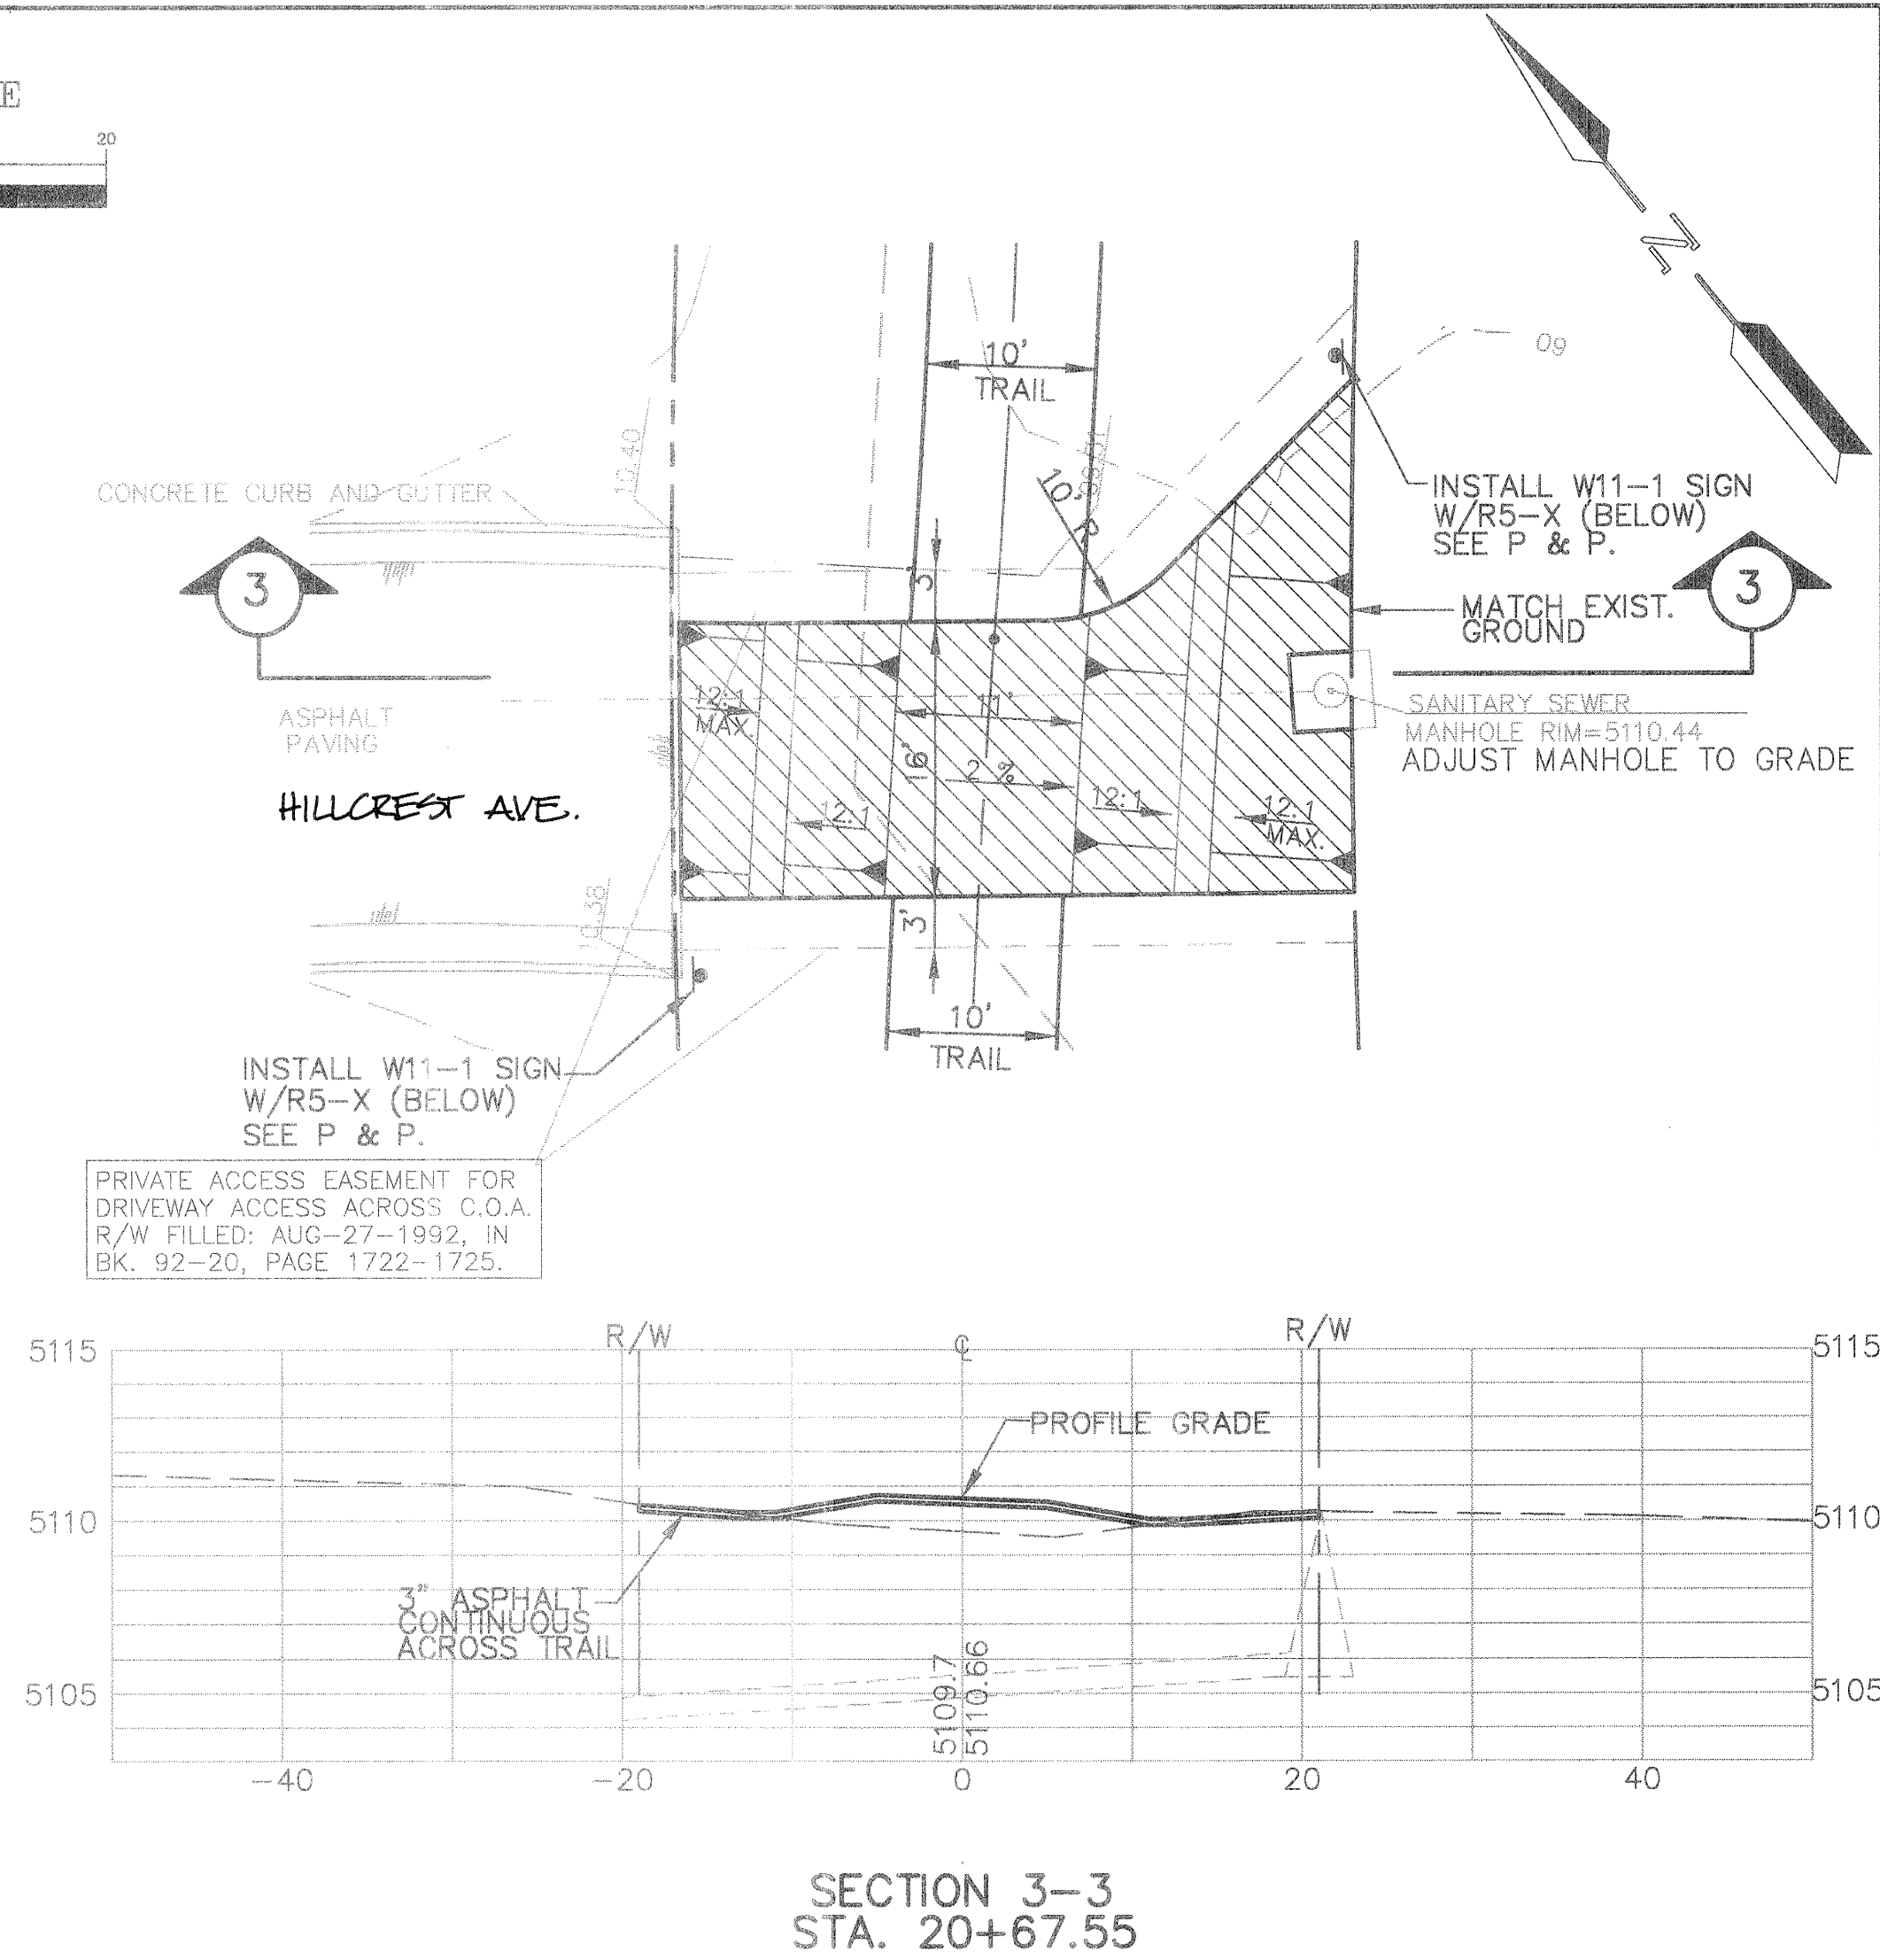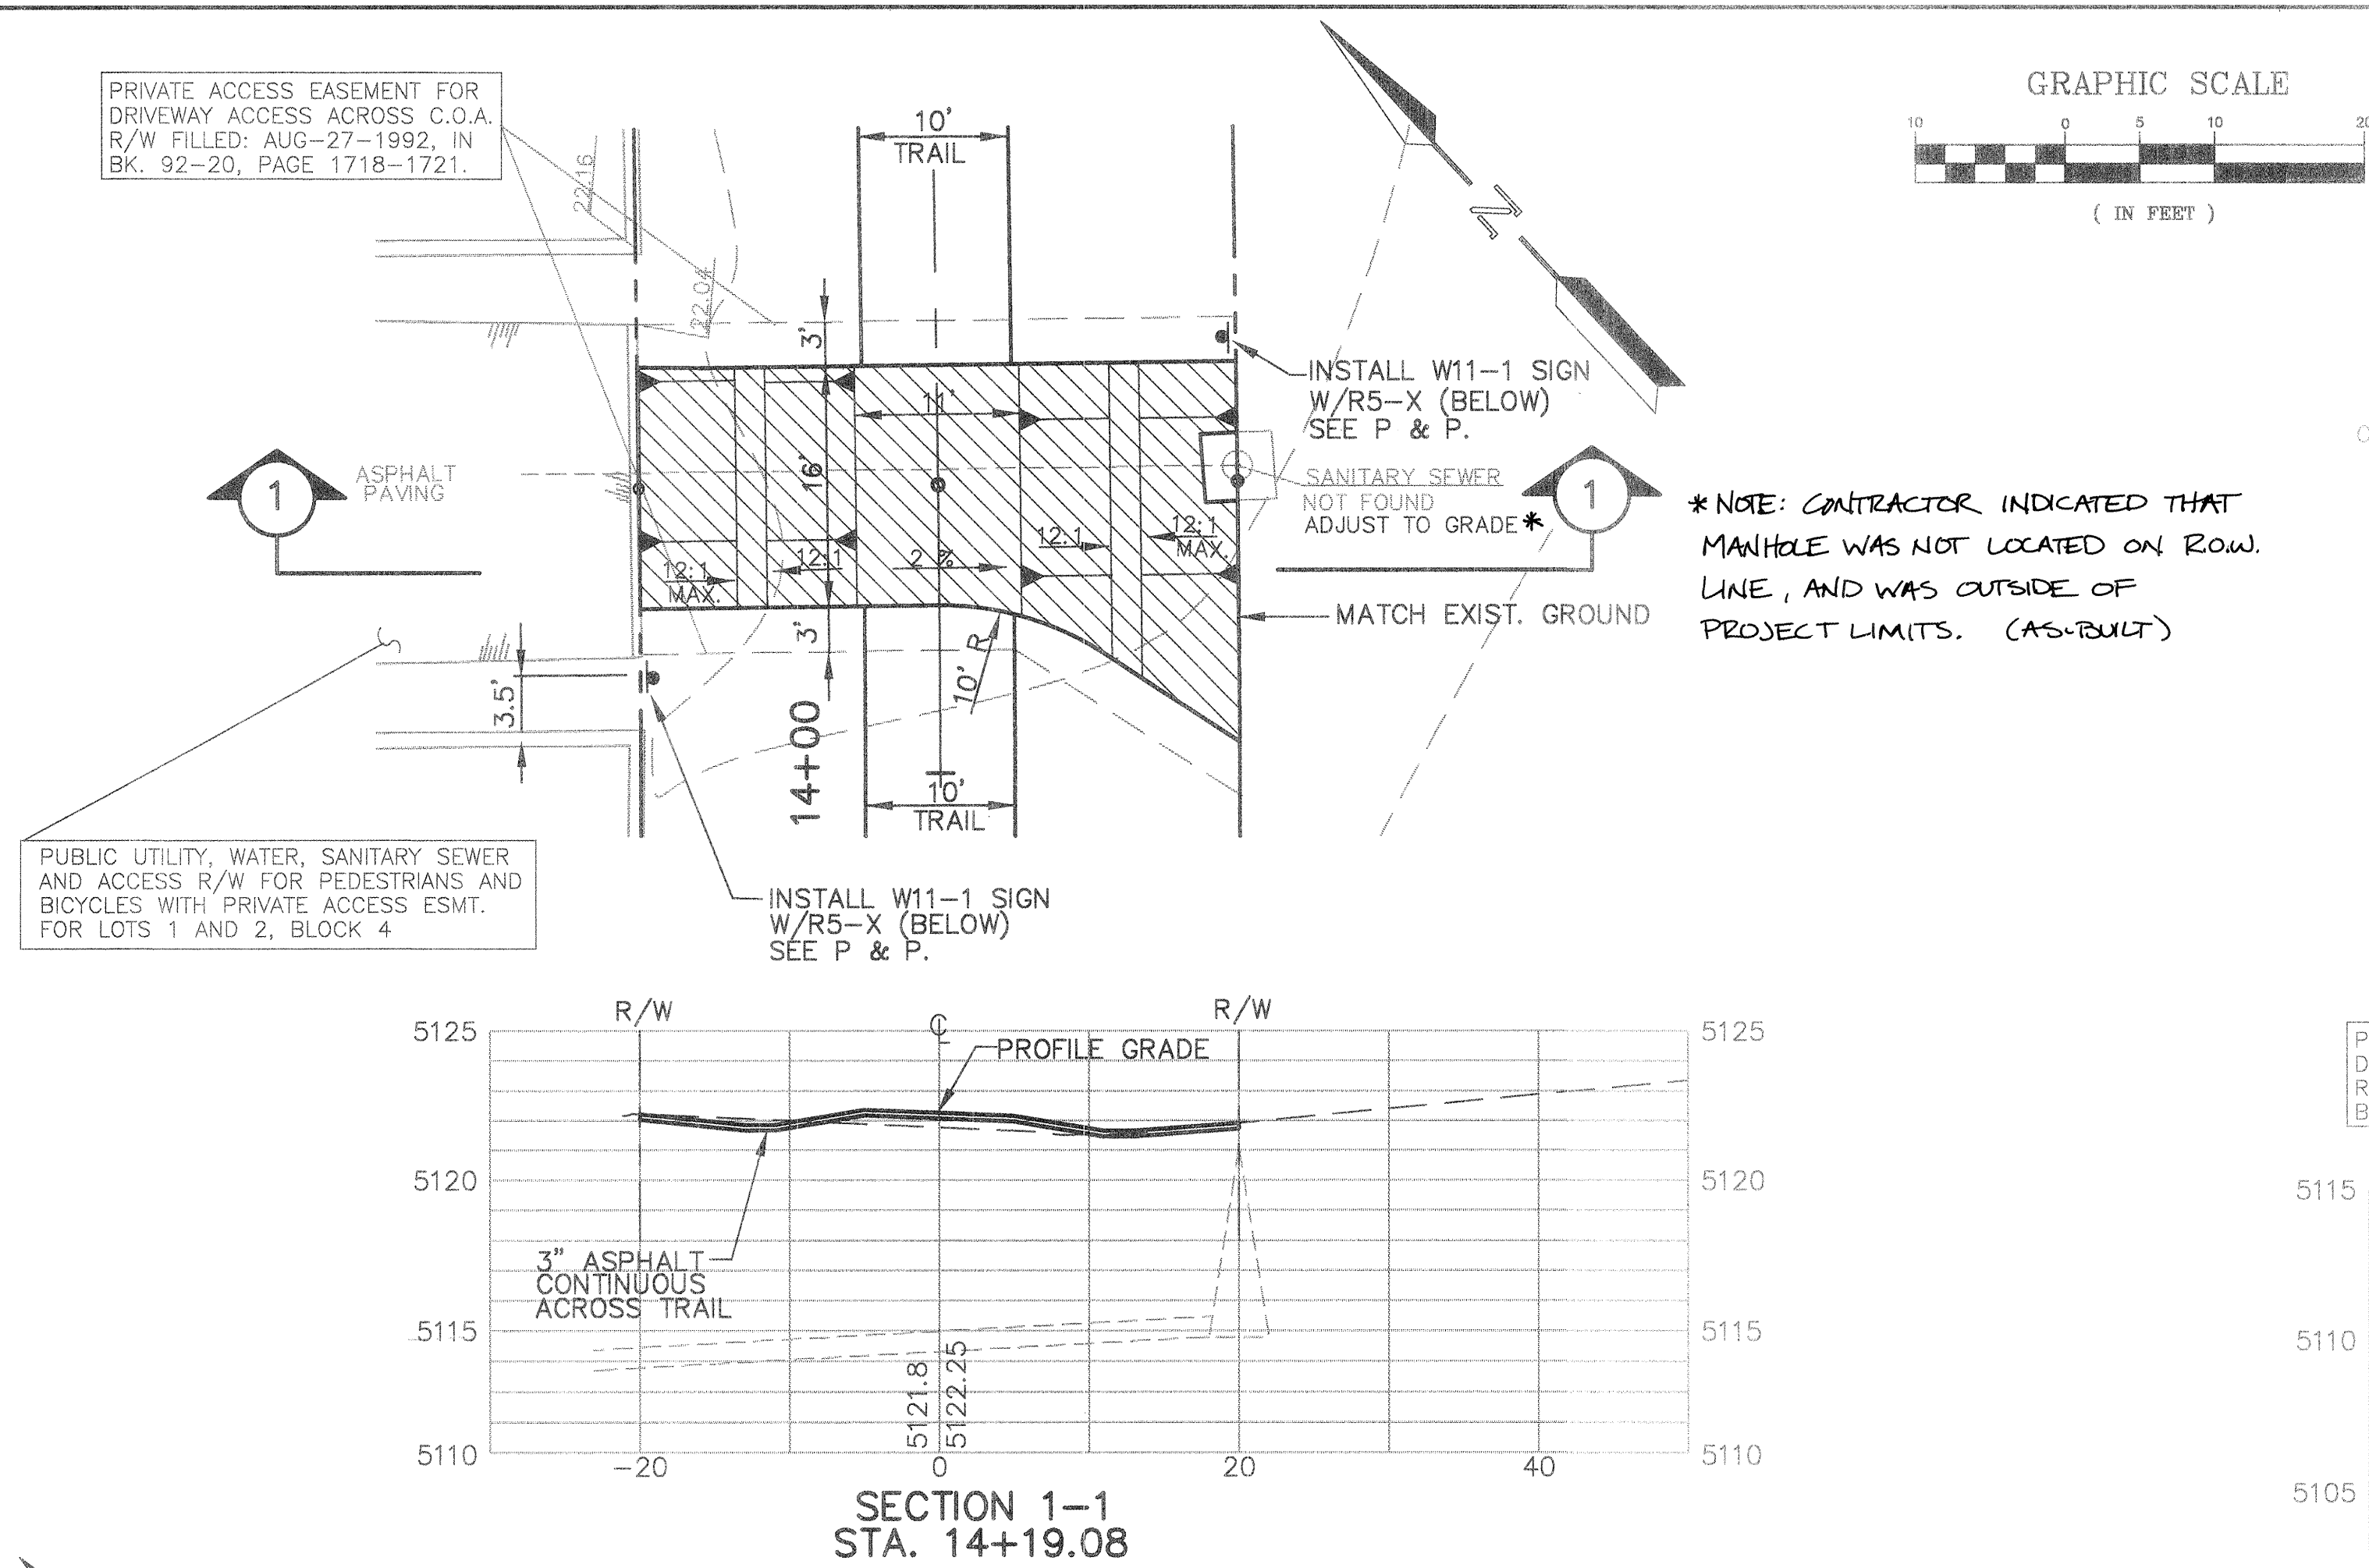

NOTE:

LEGEND

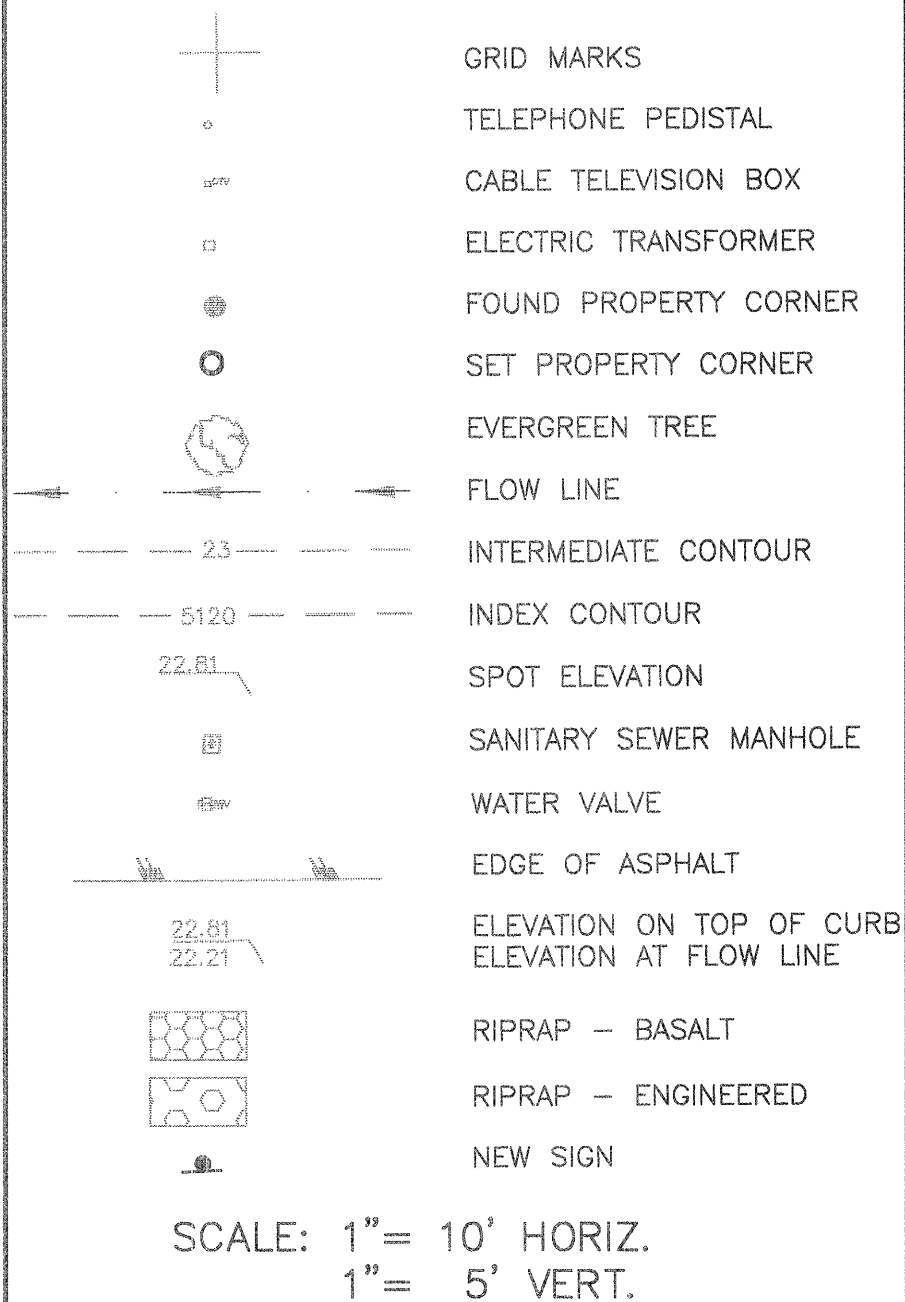

Resource Technology, Inc.
ENGINEERS AND ENVIRONMENTAL SCIENTISTS
CIVIL, ENVIRONMENTAL, WATER RESOURCES, RECREATION PLANNING
2129 Osuna Road NE, Suite 200 - Albuquerque, New Mexico
(505) 345-3115


CITY OF ALBUQUERQUE
CAPITAL IMPLEMENTATION PROGRAM
DESIGN AND DEVELOPMENT

TITLE: RIVERVIEW TRAIL
DRIVEWAY DETAILS


Design Review Committee	City Engineer Approval	Mo./Day/Yr.	Mo./Day/Yr.
APPROVED			
City Project No. 5312.90	Zone Map No. D-12	Sheet 7	Of 11

AS-BUILT INFORMATION				SURVEY INFORMATION				ENGINEER'S SEAL			
CONTRACTOR	HORIZ: NM 448-NB	BENCH MARKS	LOCATED EAST SIDE OF COORS RD. (NM 448), APPROX.	DATE	BY	NO.	REMARKS				
WORKED BY	800' SO. OF EL MALECON RD. NW	DATE		DATE	BY	NO.	REMARKS				
INSPECTED BY	NORTHING: 1514838.11	DATE		DATE	BY	NO.	REMARKS				
ACCEPTANCE BY	EASTING: 372524.25	DATE		DATE	BY	NO.	REMARKS				
DESIGNED BY	VERT: 2-D11 A SQUARE " " CHISELED ON TOP OF CURB	DATE		DATE	BY	NO.	REMARKS				
DRAWN BY	WSW CURB RET. AT THE INTER. OF TAYLOR RANCH DR. &	DATE		DATE	BY	NO.	REMARKS				
CHECKED BY	HOMESTEAD CIR. ELEV. = 5133.30	DATE		DATE	BY	NO.	REMARKS				
RECORDED BY		DATE		DATE	BY	NO.	REMARKS				


DWG: C:\DATA\93-200L\C\DATA\93-200L\TOPOWCL
TIME: 09-12-96 21:14:14

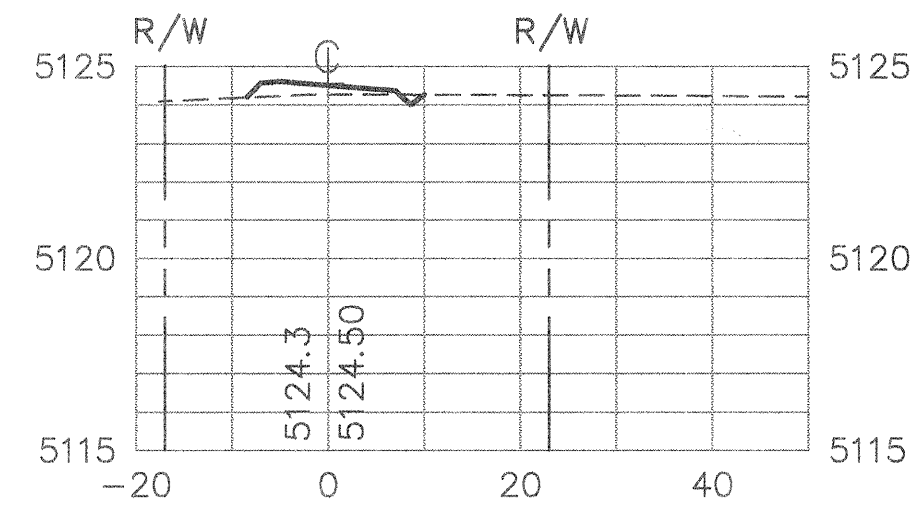


11+00

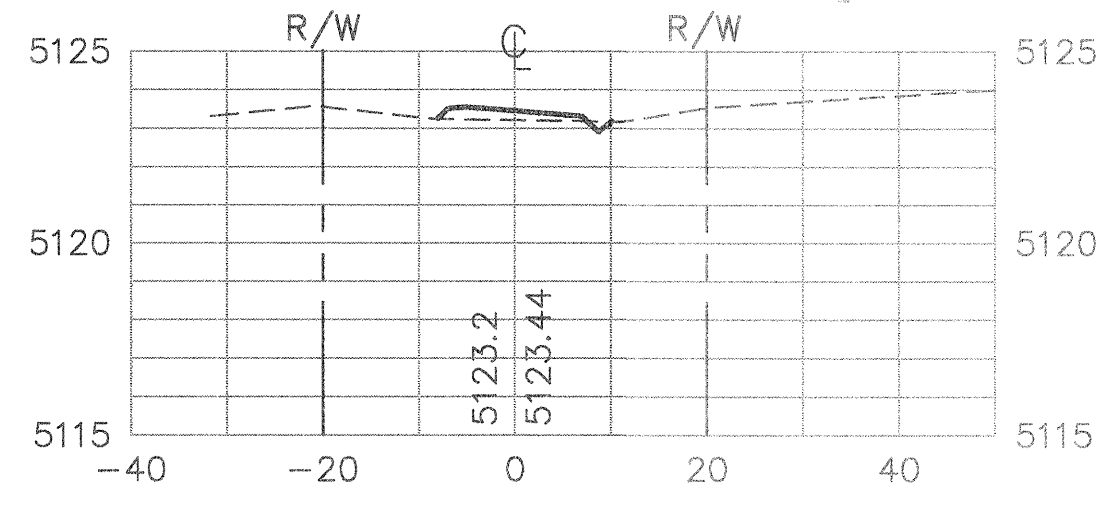


12+50

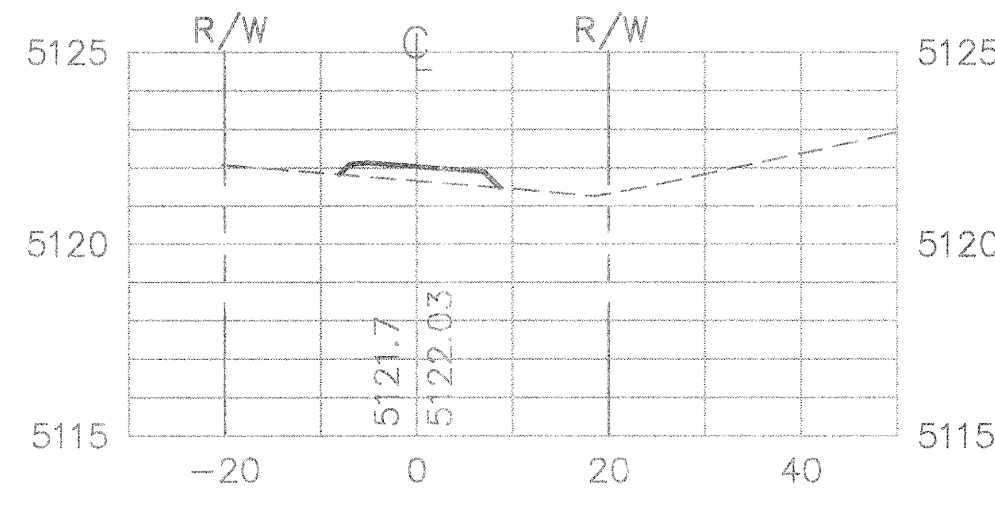


14+50

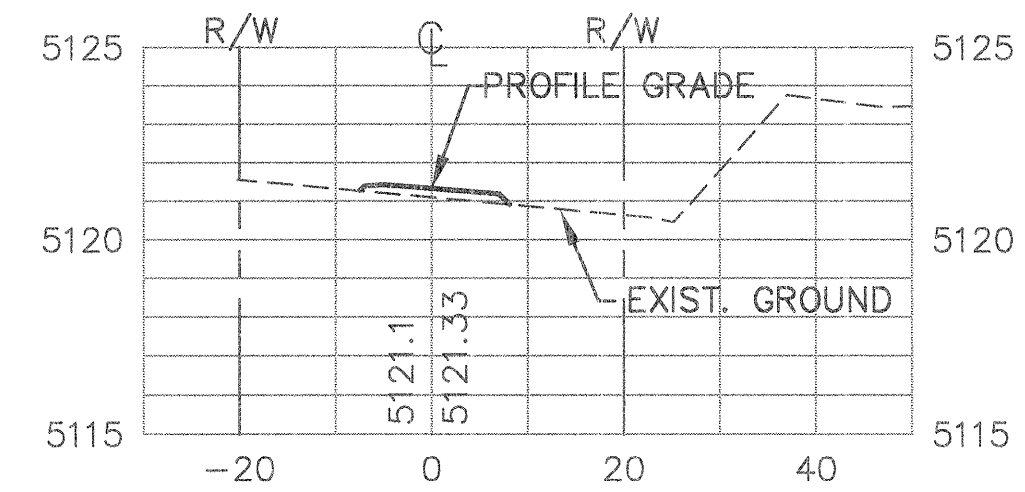


15+36.67

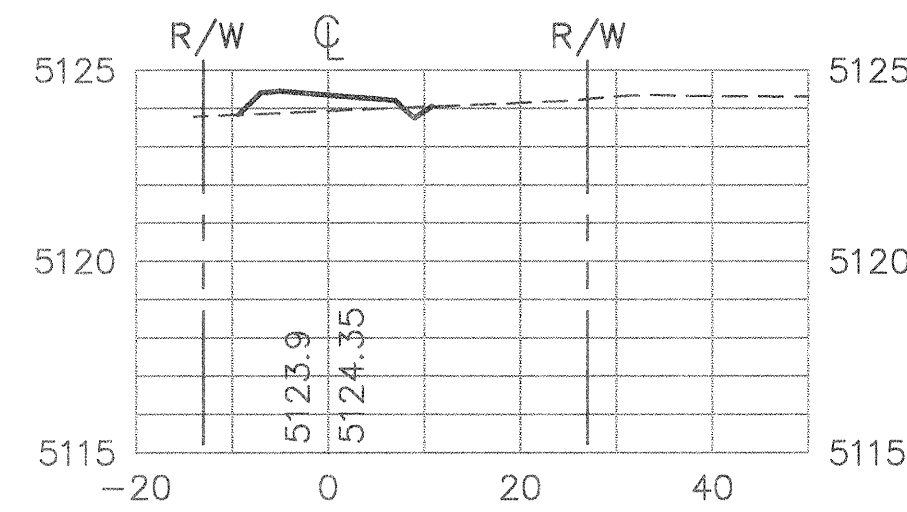


10+69.38

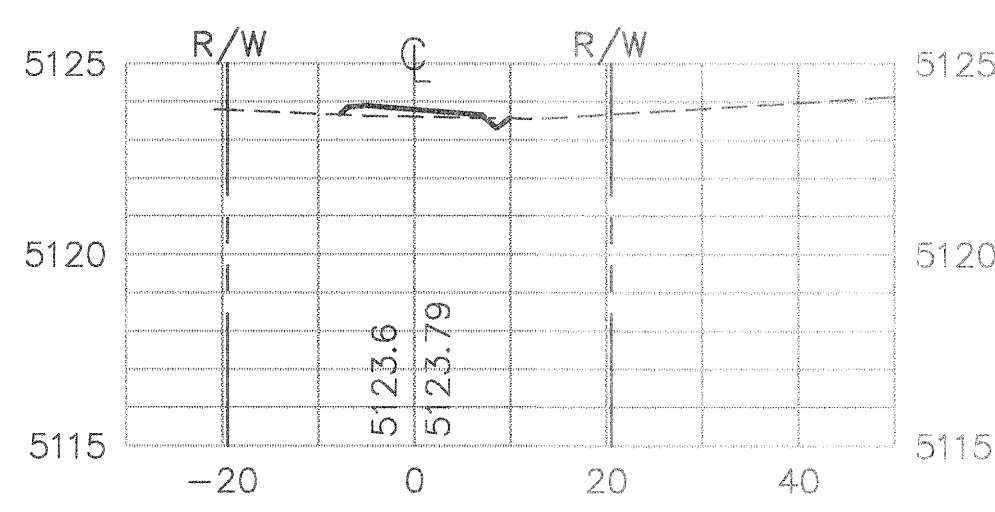


12+00

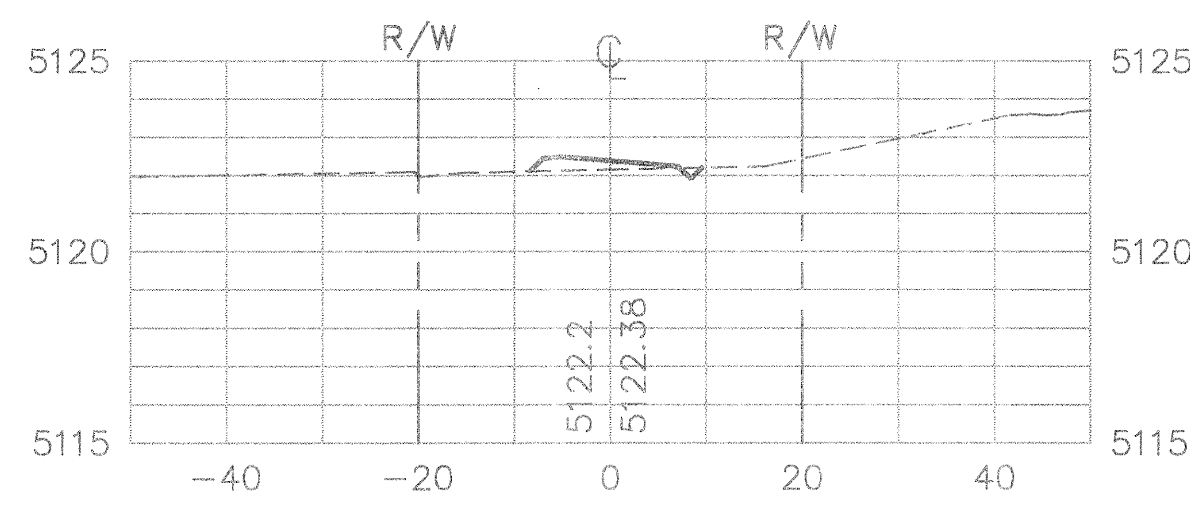


14+00

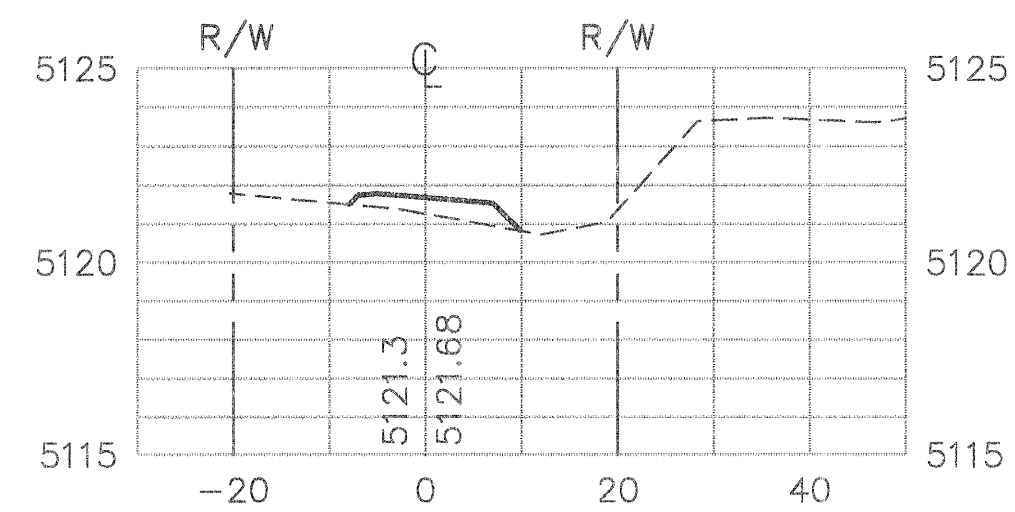


15+00

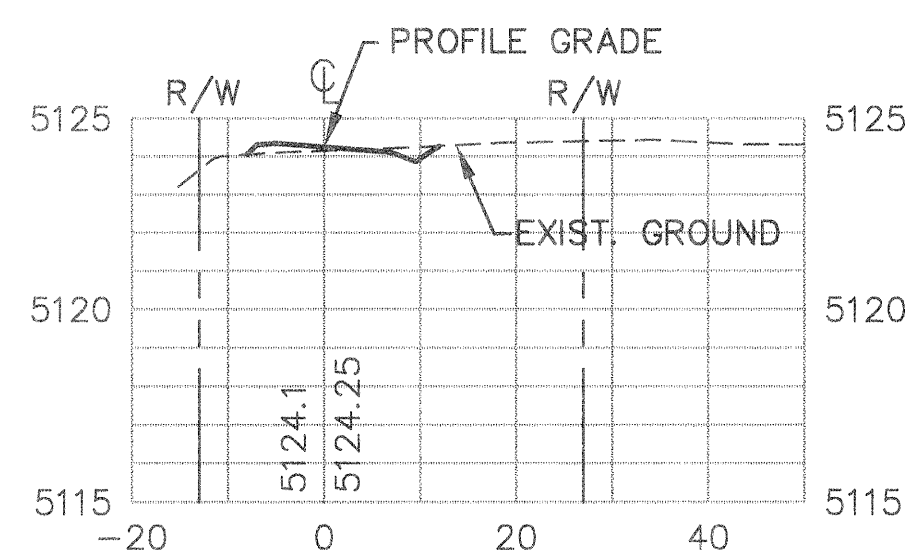


10+50

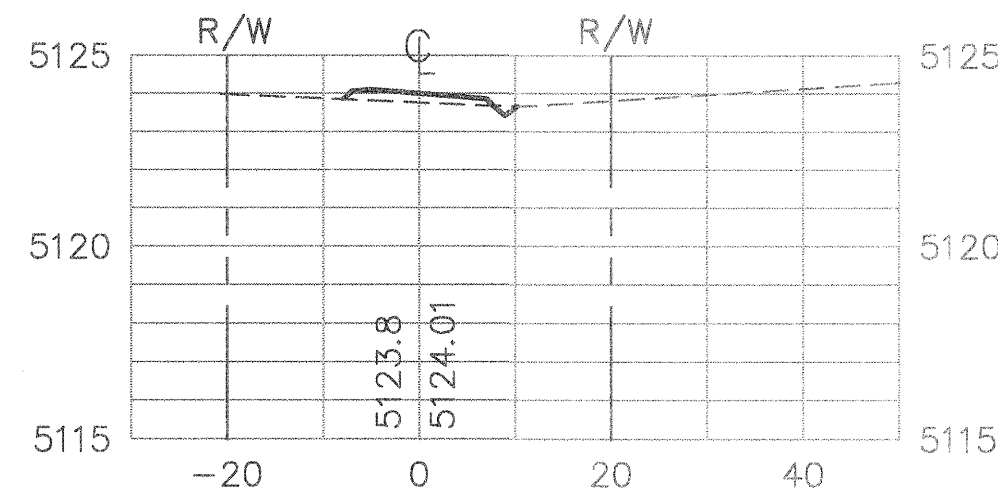


11+69.80

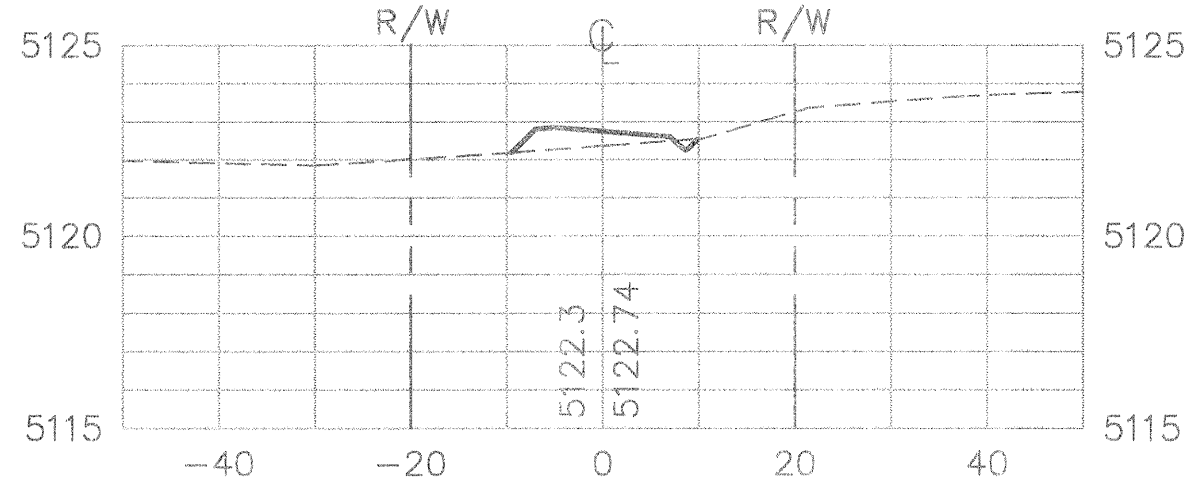


13+50

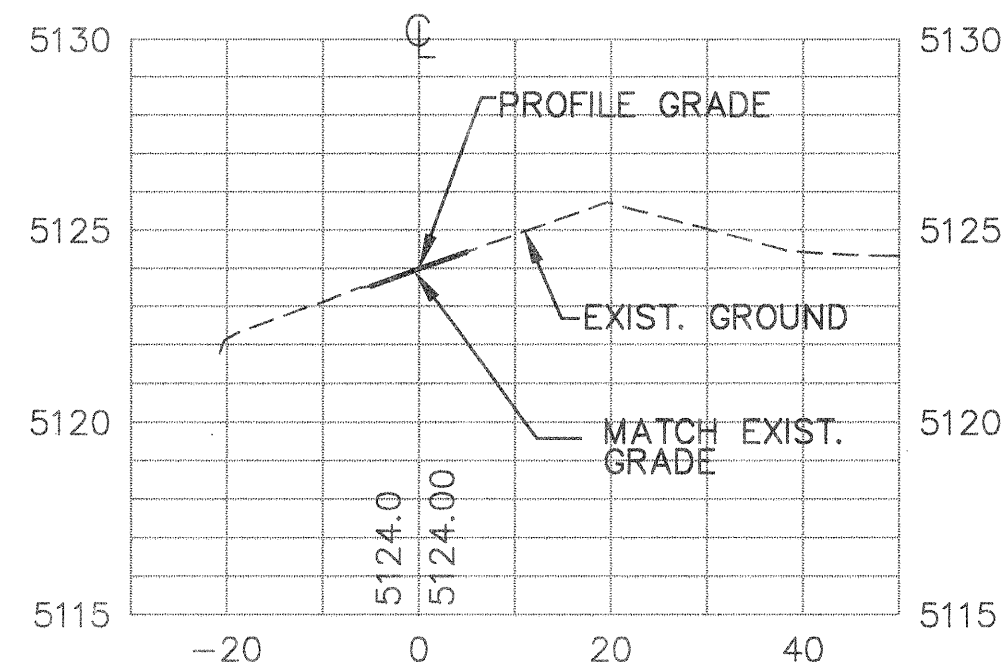

10+00

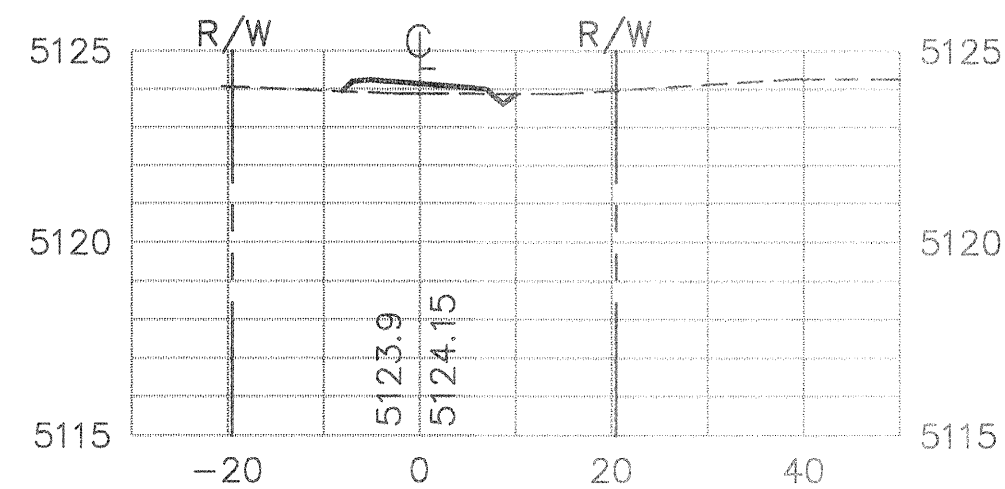

11+50

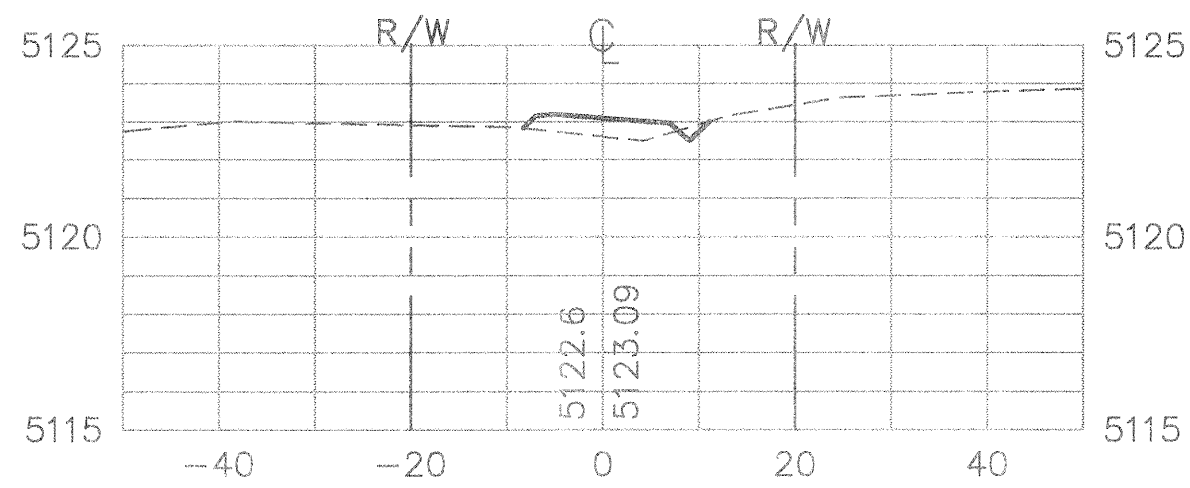

13+00

SCALE: 1" = 20' HORIZ.
1" = 5' VERT.



CITY OF ALBUQUERQUE
CAPITAL IMPLEMENTATION PROGRAM
DESIGN AND DEVELOPMENT

TITLE: RIVERVIEW TRAIL
CROSS SECTIONS
STA. 10+00 TO STA. 15+36.67


Design Review Committee City Engineer Approval



City Project No. 5312.90

Zone Map No. D-12

Sheet 9 of 11

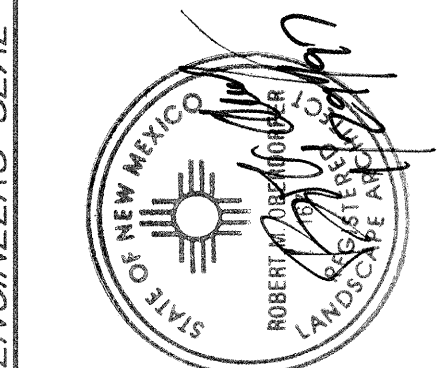

NO.	DATE	REMARKS	BY
		DESIGN	
		DESIGNED BY RMO	DATE AUG 1996
		DRAWN BY PMT	DATE AUG 1996
		CHECKED BY RMO, GN	DATE AUG 1996

NO.	BY	DATE

BENCH MARKS
HORIZ: NM 448-NB A STANDARD MNISHC BRASS TABLET
LOCATED EAST SIDE OF COORS RD. (NM 448), APPROX.
800' SO. OF EL MALECON RD. NW
NORTHING: 1514838.11
EASTING: 372524.25
VERT: 2-D11 A SQUARE " " CHISELED ON TOP OF CURB
WSW CURB RET. AT THE INTER. OF TAYLOR RANCH DR. &
HOMESTEAD CR. ELEV. = 5133.30

CONTRACTOR	WORKED BY	DATE
INSPECTOR'S	ACCEPTANCE BY	DATE
VERIFICATION BY	DATE	
DRAWING BY	DATE	
RECORDED BY	DATE	

AS BUILT INFORMATION
MICRO-FILM INFORMATION



SCALE: 1" = 20' HORIZ.
1" = 5' VERT.



CITY OF ALBUQUERQUE
CAPITAL IMPLEMENTATION PROGRAM
DESIGN AND DEVELOPMENT

TITLE: RIVERVIEW TRAIL
CROSS SECTIONS
STA. 15+50 TO STA. 21+50

City Engineer Approval

Design Review Committee

DESIGN
REVIEW COMMITTEE

City Project No. **5312.90**

Zone Map No. D - 12

Sheet 10 Of 11

[illegible]

