


JUNE 1997

PREPARED BY:
ISAACSON & ARFMAN, P.A.
128 MONROE ST. NE
ALBUQUERQUE, NM 87108

SHEET NO.	TITLE
1	TITLE SHEET
2-3	SUBDIVISION PLAT
4-5	GRADING & DRAINAGE PLAN
6	GRADING DETAILS
7	MASTER PAVING & STORM DRAINAGE PLAN
8	MASTER UTILITY PLAN
	<u>PLAN & PROFILE SHEETS</u>
9	LUZ DE LA LUNA PLACE PAVING/SD
10	LUZ DEL DIA DRIVE PAVING/SD
11	LUZ DEL SOL PLACE (STA 0+00.00 TO STA 9+50.00) PAVING
12	LUZ DEL SOL PLACE (STA 9+50.00 TO END) & LUZ DE LUMBRE ROAD PAVING
13	LUZ DE AMANECER DRIVE & LUZ DEL SOL COURT PAVING
14	LUZ DE LA LUNA PLACE UTILITIES
15	LUZ DEL DIA DRIVE UTILITIES
16	LUZ DEL SOL PLACE (STA 0+00.00 TO STA 9+50.00) UTILITIES
17	LUZ DEL SOL PLACE (STA 9+50.00 TO END) & LUZ DE LUMBRE ROAD LUZ DE LUMBRE ROAD UTILITIES
18	LUZ DE AMANECER DRIVE & LUZ DEL SOL COURT UTILITIES

Timothy Aldrich, P.S. No. 7219


01-29-98
Date

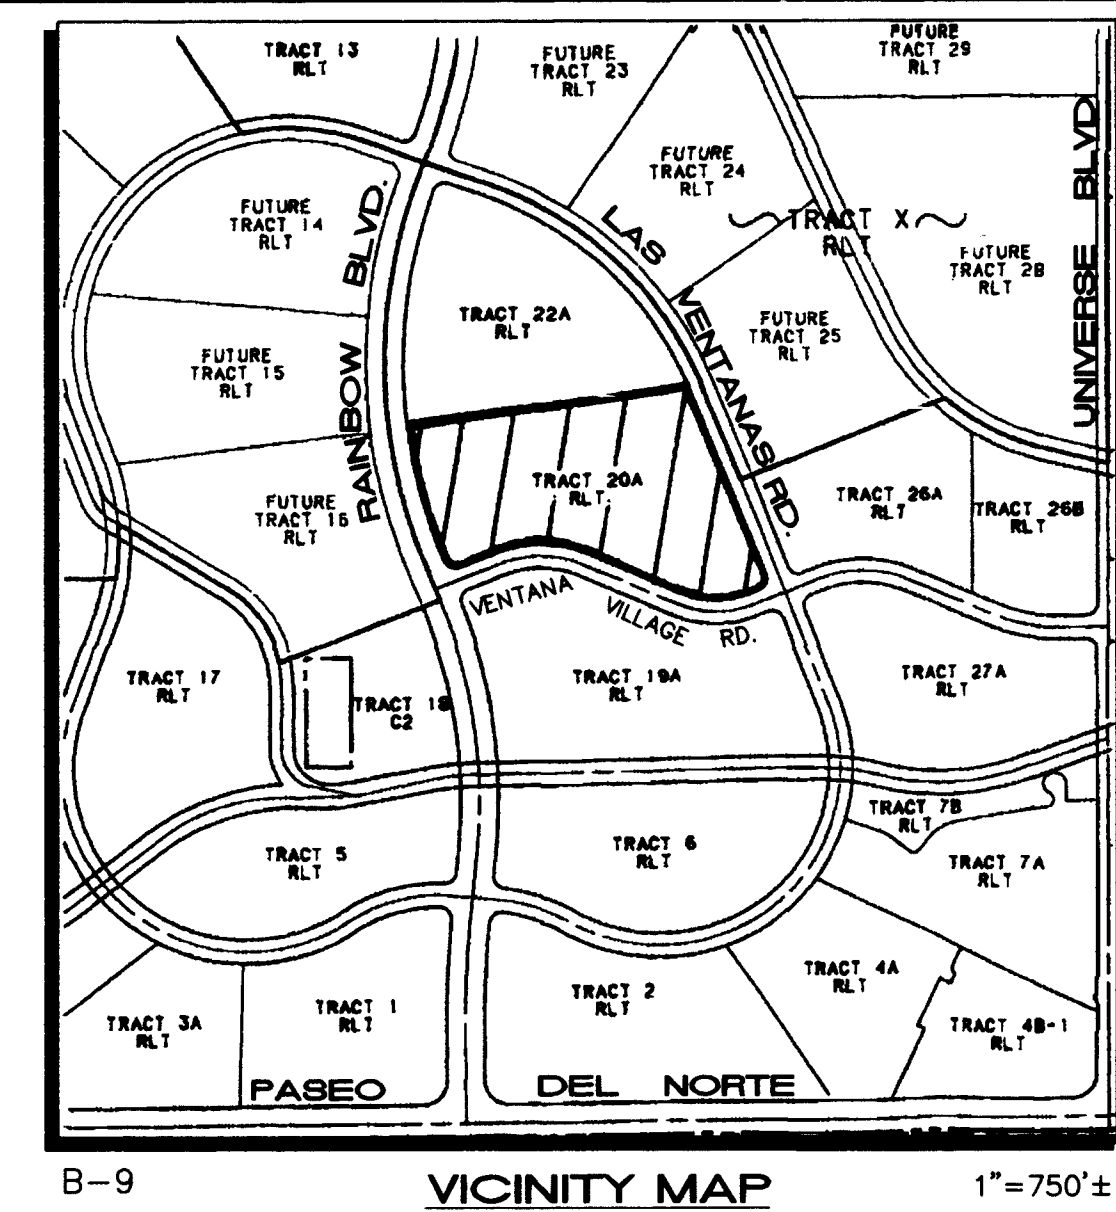

1. ALL WORK DETAILED ON THESE PLANS TO BE PERFORMED UNDER CONTRACT SHALL, EXCEPT AS OTHERWISE STATED OR PROVIDED FOR HEREON, BE CONSTRUCTED IN ACCORDANCE WITH THE CITY OF ALBUQUERQUE STANDARD SPECIFICATIONS FOR PUBLIC WORKS CONSTRUCTION 1986 EDITION AS AMENDED WITH UPDATE NO. 6.
2. ALL WORK ON THIS PROJECT SHALL BE PERFORMED IN ACCORDANCE WITH APPLICABLE FEDERAL, STATE, AND LOCAL LAWS, RULES, AND REGULATIONS CONCERNING CONSTRUCTION SAFETY AND HEALTH.
3. PRIOR TO CONSTRUCTION, THE CONTRACTOR SHALL EXCAVATE & VERIFY THE HORIZONTAL AND VERTICAL LOCATIONS OF ALL OBSTRUCTIONS. SHOULD A CONFLICT EXIST, THE CONTRACTOR SHALL NOTIFY THE ENGINEER SO THAT THE CONFLICT CAN BE RESOLVED WITH MINIMUM DELAY.
4. TWO (2) WORKING DAYS PRIOR TO ANY EXCAVATION, CONTRACTOR MUST CONTACT LINE LOCATING SERVICE @ 260-1990 FOR LOCATION OF EXISTING UTILITIES.
5. CONTRACTOR SHALL CONDUCT HIS OPERATIONS IN A MANNER WHICH WILL MINIMIZE INTERFERENCE WITH LOCAL TRAFFIC. CONTRACTOR SHALL COMPLY WITH ALL APPLICABLE LAWS, ORDINANCES, RULES, REGULATIONS, AND ORDERS OF ANY PUBLIC BODY HAVING JURISDICTION FOR THE SAFETY OF PERSONS OR PROPERTY, AND TO PROTECT THEM FROM DAMAGE, INJURY, OR LOSS. CONTRACTOR SHALL ERECT AND MAINTAIN, AS REQUIRED BY THE CONDITIONS AND PROGRESS OF THE WORK, ALL NECESSARY SAFEGUARDS FOR SAFETY CONTINUOUSLY AND NOT LIMITED TO NORMAL WORKING HOURS, THROUGHOUT THE DURATION OF THE PROJECT. CONTRACTOR SHALL ADHERE TO SECTION 19 OF THE GENERAL CONDITIONS OF THE CITY OF ALBUQUERQUE STANDARD SPECIFICATIONS FOR PUBLIC WORKS CONSTRUCTION, 1986, AS AMENDED WITH UPDATE NO. 6.
6. THE CONTRACTOR AGREES THAT HE SHALL ASSUME THE SOLE AND COMPLETE RESPONSIBILITY FOR THE JOB SITE CONDITIONS DURING THE COURSE OF CONSTRUCTION OF THIS PROJECT, INCLUDING SAFETY OF ALL PERSONS AND PROPERTY; THAT THIS REQUIREMENT SHALL APPLY CONTINUOUSLY AND NOT BE LIMITED TO NORMAL WORKING HOURS; AND THAT THE CONTRACTOR SHALL DEFEND, INDEMNIFY, AND HOLD HARMLESS THE OWNER & ENGINEER FROM ANY AND ALL LIABILITY REAL OR ALLEGED, IN CONNECTION WITH THE PERFORMANCE OF WORK ON THIS PROJECT, EXCEPTING LIABILITY ARISING FROM THE SOLE NEGLIGENCE OF THE OWNER OR ENGINEER.
7. TRAFFIC CONTROL: THREE (3) WORKING DAYS PRIOR TO BEGINNING CONSTRUCTION THE CONTRACTOR SHALL SUBMIT TO THE CONSTRUCTION COORDINATION DIVISION A DETAILED CONSTRUCTION SCHEDULE. TWO (2) WORKING DAYS PRIOR TO CONSTRUCTION, THE CONTRACTOR SHALL OBTAIN A BARRICADING PERMIT FROM THE CONSTRUCTION COORDINATION DIVISION. CONTRACTOR SHALL NOTIFY BARRICADE ENGINEER (768-2551) PRIOR TO OCCUPYING AN INTERSECTION. SEE SECTION 19 OF THE SPECIFICATIONS. ALL STREET STRIPING ALTERED OR DESTROYED SHALL BE REPLACED WITH PLASTIC REFLECTORIZED PAVEMENT MARKINGS BY CONTRACTOR TO LOCATION AS EXISTING OR AS SHOWN IN THIS PLAN SET AT NO ADDITIONAL COST TO THE OWNER.
8. WHEN ABUTTING EXISTING PAVEMENT TO NEW, SAWCUT EXISTING PAVEMENT TO A STRAIGHT EDGE AND AT A RIGHT ANGLE, OR AS APPROVED BY THE FIELD ENGINEER. REMOVAL OF BROKEN OR CRACKED PAVEMENT WILL ALSO BE REQUIRED.
9. EXISTING CURB AND GUTTER NOT TO BE REMOVED UNDER THE CONTRACT WHICH IS DAMAGED OR DISPLACED BY THE CONTRACTOR SHALL BE REMOVED AND REPLACED BY THE CONTRACTOR AT HIS EXPENSE.
10. ALL FINAL BACKFILL FOR TRENCHES SHALL BE COMPACTED TO A MINIMUM 90% MAXIMUM DENSITY PER ASTM D-1557 AND AS DIRECTED BY SECTION 701.14.2 AND STANDARD DRAWING NUMBER 2315.
11. THE CONTRACTOR SHALL PROMPTLY CLEAN UP ANY MATERIAL EXCAVATED WITHIN THE PUBLIC RIGHT-OF-WAY OR PRIVATE ROADWAY EASEMENTS SO THAT THE EXCAVATED MATERIAL IS NOT SUSCEPTIBLE TO BEING WASHED DOWN THE STREET OR INTO ANY PUBLIC DRAINAGE FACILITY.
12. ALL STATIONING REFERS TO ROAD C.
13. ALL UTILITY WORK SHALL BE CONSTRUCTED IN ACCORDANCE WITH NEW MEXICO UTILITIES, INC. SPECIFICATIONS FOR WATER AND WASTEWATER FACILITIES (MOST RECENT REVISIONS).
14. THE CONTRACTOR SHALL NOTIFY NEW MEXICO UTILITIES (898-2661) THREE WORKING DAYS PRIOR TO BEGINNING THE CONSTRUCTION OF THE UTILITIES.
15. CONTRACTOR SHALL SUPPORT ALL EXISTING, UNDERGROUND UTILITY LINES WHICH BECOME EXPOSED DURING CONSTRUCTION. PAYMENT FOR SUPPORTING WORK SHALL BE INCIDENTAL TO WATER-LINE AND/OR SEWERLINE COSTS.
16. CONTRACTOR SHALL ASSIST THE ENGINEER/INSPECTOR IN THE RECORDING OF DATA ON ALL UTILITY LINES AND ACCESSORIES AS REQUIRED BY THE CITY OF ALBUQUERQUE FOR THE PREPARATION OF RECORD DRAWINGS. CONTRACTOR SHALL NOT COVER UTILITY LINES AND ACCESSORIES UNTIL ALL DATA HAS BEEN RECORDED.
17. THE CONTRACTOR IS RESPONSIBLE FOR PROTECTING AND MAINTAINING ALL EXISTING MONUMENTATION CONTROLS. IN THE EVENT OF IN-ADVERTENT DESTRUCTION OR ALTERATION, THE CONTRACTOR MUST IMMEDIATELY NOTIFY THE CITY CHIEF SURVEYOR.
18. PNM WILL PROVIDE AT NO COST TO THE CITY OR THE CONTRACTOR THE REQUIRED PERSONNEL FOR INSPECTION OR OBSERVATION DEEMED NECESSARY BY PNM WHILE THE CONTRACTOR IS EXPOSING PNM'S CABLES. HOWEVER, THE CONTRACTOR SHALL BE CHARGED THE TOTAL COST ASSOCIATED WITH REPAIRS TO ANY DAMAGED CABLES OR FOR ANY COST ASSOCIATED WITH SUPPORTING OR RELOCATING THE POLES AND CABLES DURING CONSTRUCTION.
19. WARNING--EXISTING UTILITY LINE LOCATIONS ARE SHOWN IN AN APPROXIMATE MANNER ONLY, AND SUCH LINES MAY EXIST WHERE NONE ARE SHOWN. THE LOCATION OF ANY SUCH EXISTING LINES IS BASED UPON INFORMATION PROVIDED BY THE UTILITY COMPANY, THE OWNER, OR BY OTHERS, AND THE INFORMATION MAY BE INCOMPLETE OR MAY BE OBSOLETE BY THE TIME CONSTRUCTION COMMENCES.

THE ENGINEER HAS UNDERTAKEN NO FIELD VERIFICATION OF THE LOCATION, DEPTH, SIZE, OR TYPE OF EXISTING UNDERGROUND UTILITY LINES, MAKES NO REPRESENTATION PERTAINING THERETO, AND ASSUMES NO RESPONSIBILITY OR LIABILITY THEREFOR. THE CONTRACTOR SHALL INFORM ITSELF OF THE LOCATION OF ANY UTILITY LINE IN OR NEAR THE AREA OF THE WORK IN ADVANCE OF AND DURING EXCAVATION WORK. THE CONTRACTOR SHALL BE RESPONSIBLE FOR ANY AND ALL DAMAGE CAUSED BY ITS FAILURE TO LOCATE, IDENTIFY, AND PRESERVE ANY AND ALL EXISTING UTILITIES. THE CONTRACTOR SHALL COMPLY WITH STATE STATUTES, MUNICIPAL AND LOCAL ORDINANCES, RULES AND REGULATIONS PERTAINING TO THE LOCATION OF THESE LINES AND FACILITIES, IN PLANNING AND CONDUCTING EXCAVATION, WHETHER BY CALLING OR NOTIFYING THE UTILITIES, COMPLYING WITH "BLUE STAKES" PROCEDURES, OR OTHERWISE.
20. ANY WORK OCCURRING WITHIN AN ARTERIAL ROADWAY REQUIRES 24 HR. CONSTRUCTION.
21. ALL EXCAVATION, TRENCHING AND SHORING ACTIVITIES MUST BE ACCOMPLISHED IN ACCORDANCE WITH OSHA 29CFR 1926.650 SUBPART P.


1	2	3	4	5	6	7	8	9	10	11	12	13	14	15
26		5	3	1	6	.	9	7	9	8	B	0	9	

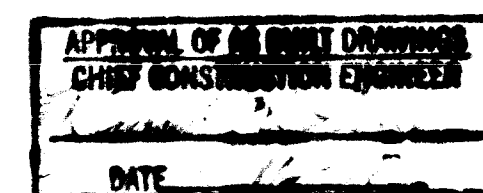

DRB NO. 97-57

 **ISAACSON & ARFMAN, P.A.**
Consulting Engineering Associates
 128 Monroe Street N.E.
 Albuquerque New Mexico
 84508 DWGcon 6/8/97

REV.	SHEETS	CITY ENGINEER	DATE	USER DEPARTMENT	DATE	USER DEPARTMENT	DATE	
ENGINEERS STAMP & SIGNATURE		APPROVALS	ENGINEER	DATE	*****			
 6-24-97		DRC Chairman	<i>Billy G. Graham</i>	6-24-97	APPROVED FOR CONSTRUCTION			
		Transportation						
		Water/Wastewater	<i>R. W. Kane</i>	6-24-97				
		Hydrology	<i>Steve Ziegenfuss</i>	6-24-97				
		Water CIP						
		Constr. Mngmt.						
		New Mexico Utilities	<i>[Signature]</i>	6-24-97				
City Project No.		5316.97		Sheet 1 Of 18				
SCANNED BY		BY: [Signature]						

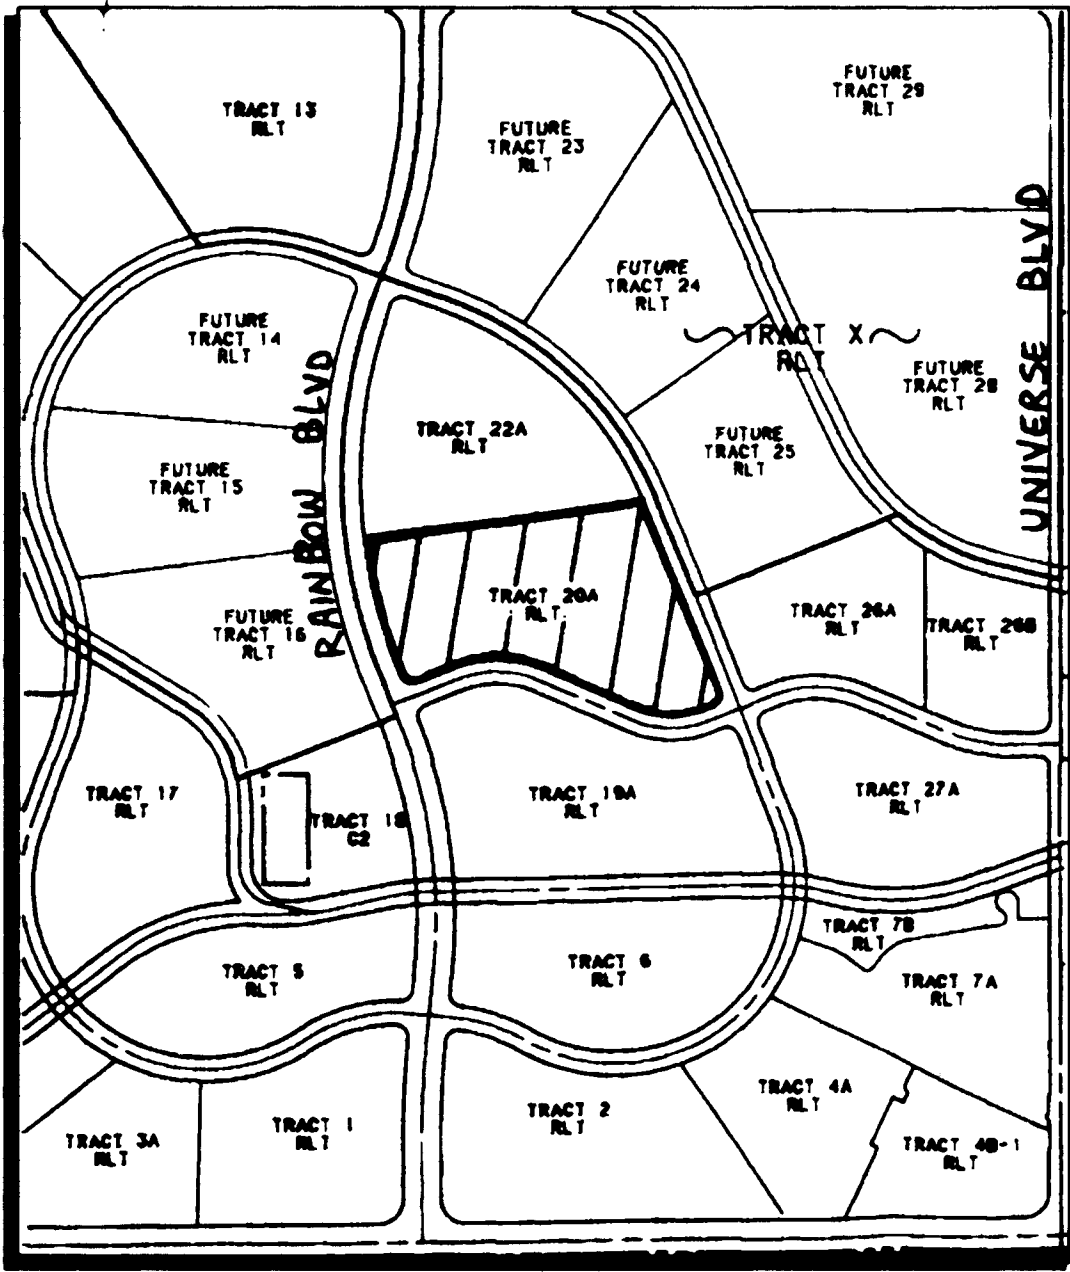

B-9
VICINITY MAP
1"=750'±

SUBDIVISION DATA / NOTES

- Total Number of Existing Tracts: 1
- Total Number of Lots created: 81
- Gross Subdivision Acreage: 24.0108 Ac.
- Total Mileage of Public Streets Created: 0.7088
- Bearings are New Mexico State Plane Grid Bearings (Central Zone).
- Distances are ground distances.
- Bearings and distances in brackets are record.
- All streets will meet City standards and will be public by plat dedication and be maintained by the City of Albuquerque. No lot shall have direct access to Rainbow Blvd, Ventana Village Rd or Las Ventanas Rd.
- All streets have right-of-way and paving widths per DPM standards.
- City Standard Utility Note 5.
- These properties are within the New Mexico Utilities, Inc. (NMUI) franchise area. Water and sanitary sewer capabilities are based on the NMUI facilities, not the City of Albuquerque. Water and sanitary sewer infrastructure improvements must, however, be approved by both the City of Albuquerque and NMUI.
- Basis of boundary is the following plat of record entitled:
BULK LAND PLAT FOR TRACTS 19A, 20A, 22A, 26A, 26B, & 27A VENTANA RANCH (2-26-97, DOC. NO. 97020144, VOL. 97C, FOLIO 63) (see continuation below).
- There shall be a minimum of 1,200 square feet of open space provided per dwelling unit on each lot within the subdivision.
- Δ = Set four inch (4") aluminum alloy cap stamped "City of Albuquerque", "Centerline Monumentation", "Survey Marker", "Do Not Disturb", PLS #7719.
- Unless shown otherwise all points are a set 5/8" rebar with cap marked "ALS LS #7719".
- Park dedication requirements for Tract 20A shall be met by a 2-acre neighborhood park to be dedicated within the abutting Tract 22A.
- (continued) Basis of boundary is also the following plat of record entitled:
PLAT OF VENTANA RANCH (11-30-95, DOC. NO. 95122531, VOL. 95C, FOLIO 430)

LEGAL DESCRIPTION

A certain tract of land situate within the Town of Alameda Grant, within projected Section 9, Township 11 North, Range 2 East, New Mexico Principal Meridian, Bernalillo County, Albuquerque, New Mexico, said tract being and comprising all of Tract numbered Twenty-A (20A) of BULK LAND PLAT FOR TRACTS 19A, 20A, 22A, 26A, 26B, & 27A VENTANA RANCH (A REPLAT OF TRACTS 19, 20, 21, 22, 26, 27 VENTANA RANCH) Albuquerque, New Mexico, as the same is shown and designated on the Plat thereof, recorded in the Office of the County Clerk of Bernalillo County, New Mexico on February 26, 1997 as Document No. 97020144 in Volume 97C, Folio 63 and being more particularly described by New Mexico State Plane Grid Bearings (Central Zone NAD 1927) and ground distances as follows:

BEGINNING at the southeast corner of said Tract numbered Twenty-A (20A), a point on the centerline of an existing 100 foot wide Public Roadway, Drainage, and Utility Easement recorded February 26, 1997 as Document No. 97020144 in Volume 97C, Folio 63, whence the Albuquerque City Survey (ACS) monument "1-B10", a brass tablet set in top of a concrete post, having New Mexico State Plane Coordinates, Central Zone (NAD 1927) of X=357,526.69 and Y=1,525,168.35 bears S 44°37'20" E, a distance of 1998.06 feet and from said point of beginning running thence along the southerly boundary line of said Tract numbered Twenty-A (20A) and also along said centerline, S 68°40'17" W, a distance of 150.00 feet to a point of curvature;

Thence, 321.56 feet along the arc of a curve to the right having a radius of 400.00 feet and a chord which bears N 88°17'56" W, a distance of 312.97 feet to a point of tangency.

LEGAL DESCRIPTION CONTINUED ON SHEET 4 OF 4.

DISCLOSURE STATEMENT

The intent of this plat is to subdivide the subject Tract 20A into 81 residential lots, to dedicate public right-of-way, and grant those easements necessary to serve the residential development

FREE CONSENT AND DEDICATION

The subdivision shown herein is with the free consent and in accordance with the desires of the undersigned Owner(s) and/or Proprietor(s) thereof and said Owner(s) and/or Proprietor(s) do hereby dedicate all streets and public rights-of-way shown herein to the City of Albuquerque in fee simple with warranty covenants and do hereby grant all access, utility and drainage easements shown herein including the right to construct, operate, inspect, and maintain facilities therein, and all public utility easements shown herein for the common and joint use of gas, electrical power and communication services for overhead and buried distribution lines, conduits, and pipes for underground and/or overhead utilities where shown or indicated, and including the right of ingress and egress for construction and maintenance, and the right to trim interfering trees and shrubs. Said Owner(s) and/or Proprietor(s) do hereby consent to all of the foregoing and do hereby certify that this subdivision is their free act and deed.

OWNER

PRESLEY HOMES, INC.

James S. Hicks
James S. Hicks
Vice President
Date: 5-23-97

ACKNOWLEDGEMENT

STATE OF NEW MEXICO)
COUNTY OF BERNALILLO)

This instrument was acknowledged before me on 5/23/97
1997, by James S. Hicks as Vice President of Presley Homes, Inc., a New Mexico corporation, on behalf of said corporation

My Commission Expires 8/30/98

Sharon K. Moore
Sharon K. Moore
Notary Public

in approving this plat, PNM (Public Service Co. of New Mexico) Gas, Electric, and Telephone Services, Inc. (PUE) and Albuquerque City Survey (ACS) monument "1-B10", a brass tablet set in top of a concrete post, having New Mexico State Plane Coordinates, Central Zone (NAD 1927) of X=357,526.69 and Y=1,525,168.35 bears S 44°37'20" E, a distance of 1998.06 feet and from said point of beginning running thence along the southerly boundary line of said Tract numbered Twenty-A (20A) and also along said centerline, S 68°40'17" W, a distance of 150.00 feet to a point of curvature;

APPROVALS S- DRB NO. 97-57

Paul R. Rhee
PUBLIC SERVICE CO. OF NM--ELECTRIC SERVICES DIV.
DATE: 6-6-97

Paul R. Rhee
PUBLIC SERVICE CO. OF NM--GAS SERVICES DIV.
DATE: 6-6-97

Naomi Laguna
US WEST COMMUNICATIONS
DATE: 6-4-97

Robert Watson
JONES INTERCABLE
DATE: 6-4-97

Willie Lee
CITY SURVEYOR, ENGR. DIV., P.W.D.
DATE: 052397

Michael J. Stang
TRAFFIC ENGINEERING, TRANS. DEV. DIV., P.W.D.
DATE: 6-03-97

Edward G. Stang
PARKS DESIGN & DEVELOPMENT / CIP
DATE: 6-2-97

UTILITY DEVELOPMENT DIV., P.W.D. DATE

REAL PROPERTY DIVISION, D.F.M. DATE

A.M.A.F.C.A. DATE

CITY ENGINEER, PUBLIC WORKS DEPT. DATE

Stang
NEW MEXICO UTILITIES, INC. DATE: 6-5-97

APPROVAL AND CONDITIONAL ACCEPTANCE AS SPECIFIED BY THE ALBUQUERQUE SUBDIVISION ORDINANCE, ARTICLE XI OF THE REVISED ORDINANCES OF ALBUQUERQUE, N.M.

CITY PLANNER, ALBUQUERQUE PLANNING DIVISION DATE

SURVEYOR'S CERTIFICATION

"I, Timothy Aldrich, a duly qualified Registered Professional Land Surveyor under the laws of the State of New Mexico, do hereby certify that this plat and description were prepared by me or under my supervision, shows all easements as shown on the plat of record or made known to me by the owners and/or proprietors of the subdivision shown herein, utility companies and other parties expressing an interest and meets the minimum requirements for monumentation and surveys of the Albuquerque Subdivision Ordinance, and further meets the Minimum Standards for Land Surveying in the State of New Mexico (Effective November 1, 1989 and revisions effective December 25, 1991 and February 2, 1994), and is true and correct to the best of my knowledge and belief."


Timothy Aldrich
Timothy Aldrich, P.S. No. 7719
Date: 05-23-97

SHEET 1 OF 4



**PLAT FOR
LUZ EN LA VENTANA
AT VENTANA RANCH**


REPLAT OF
TRACT 20A VENTANA RANCH
CITY OF ALBUQUERQUE
BERNALILLO COUNTY, NEW MEXICO
MAY 1997

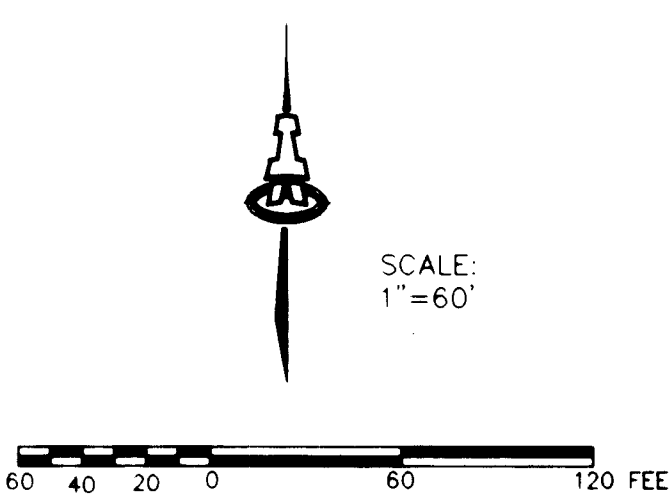

NOTES

- SEE SHEET 3 OF 4 FOR CURVE AND LINE TABLES.
- SEE SHEET 4 OF 4 FOR LOT AREA TABLE.
- ADDITIONAL RIGHT-OF-WAY FOR TRAIL ACCESS AND PUBLIC UTILITIES (AT THE ENDS OF CUL-DE-SACS ABUTTING RAINBOW BLVD) IS DEDICATED TO THE CITY OF ALBUQUERQUE BY THIS PLAT.

SHEET 2 OF 4

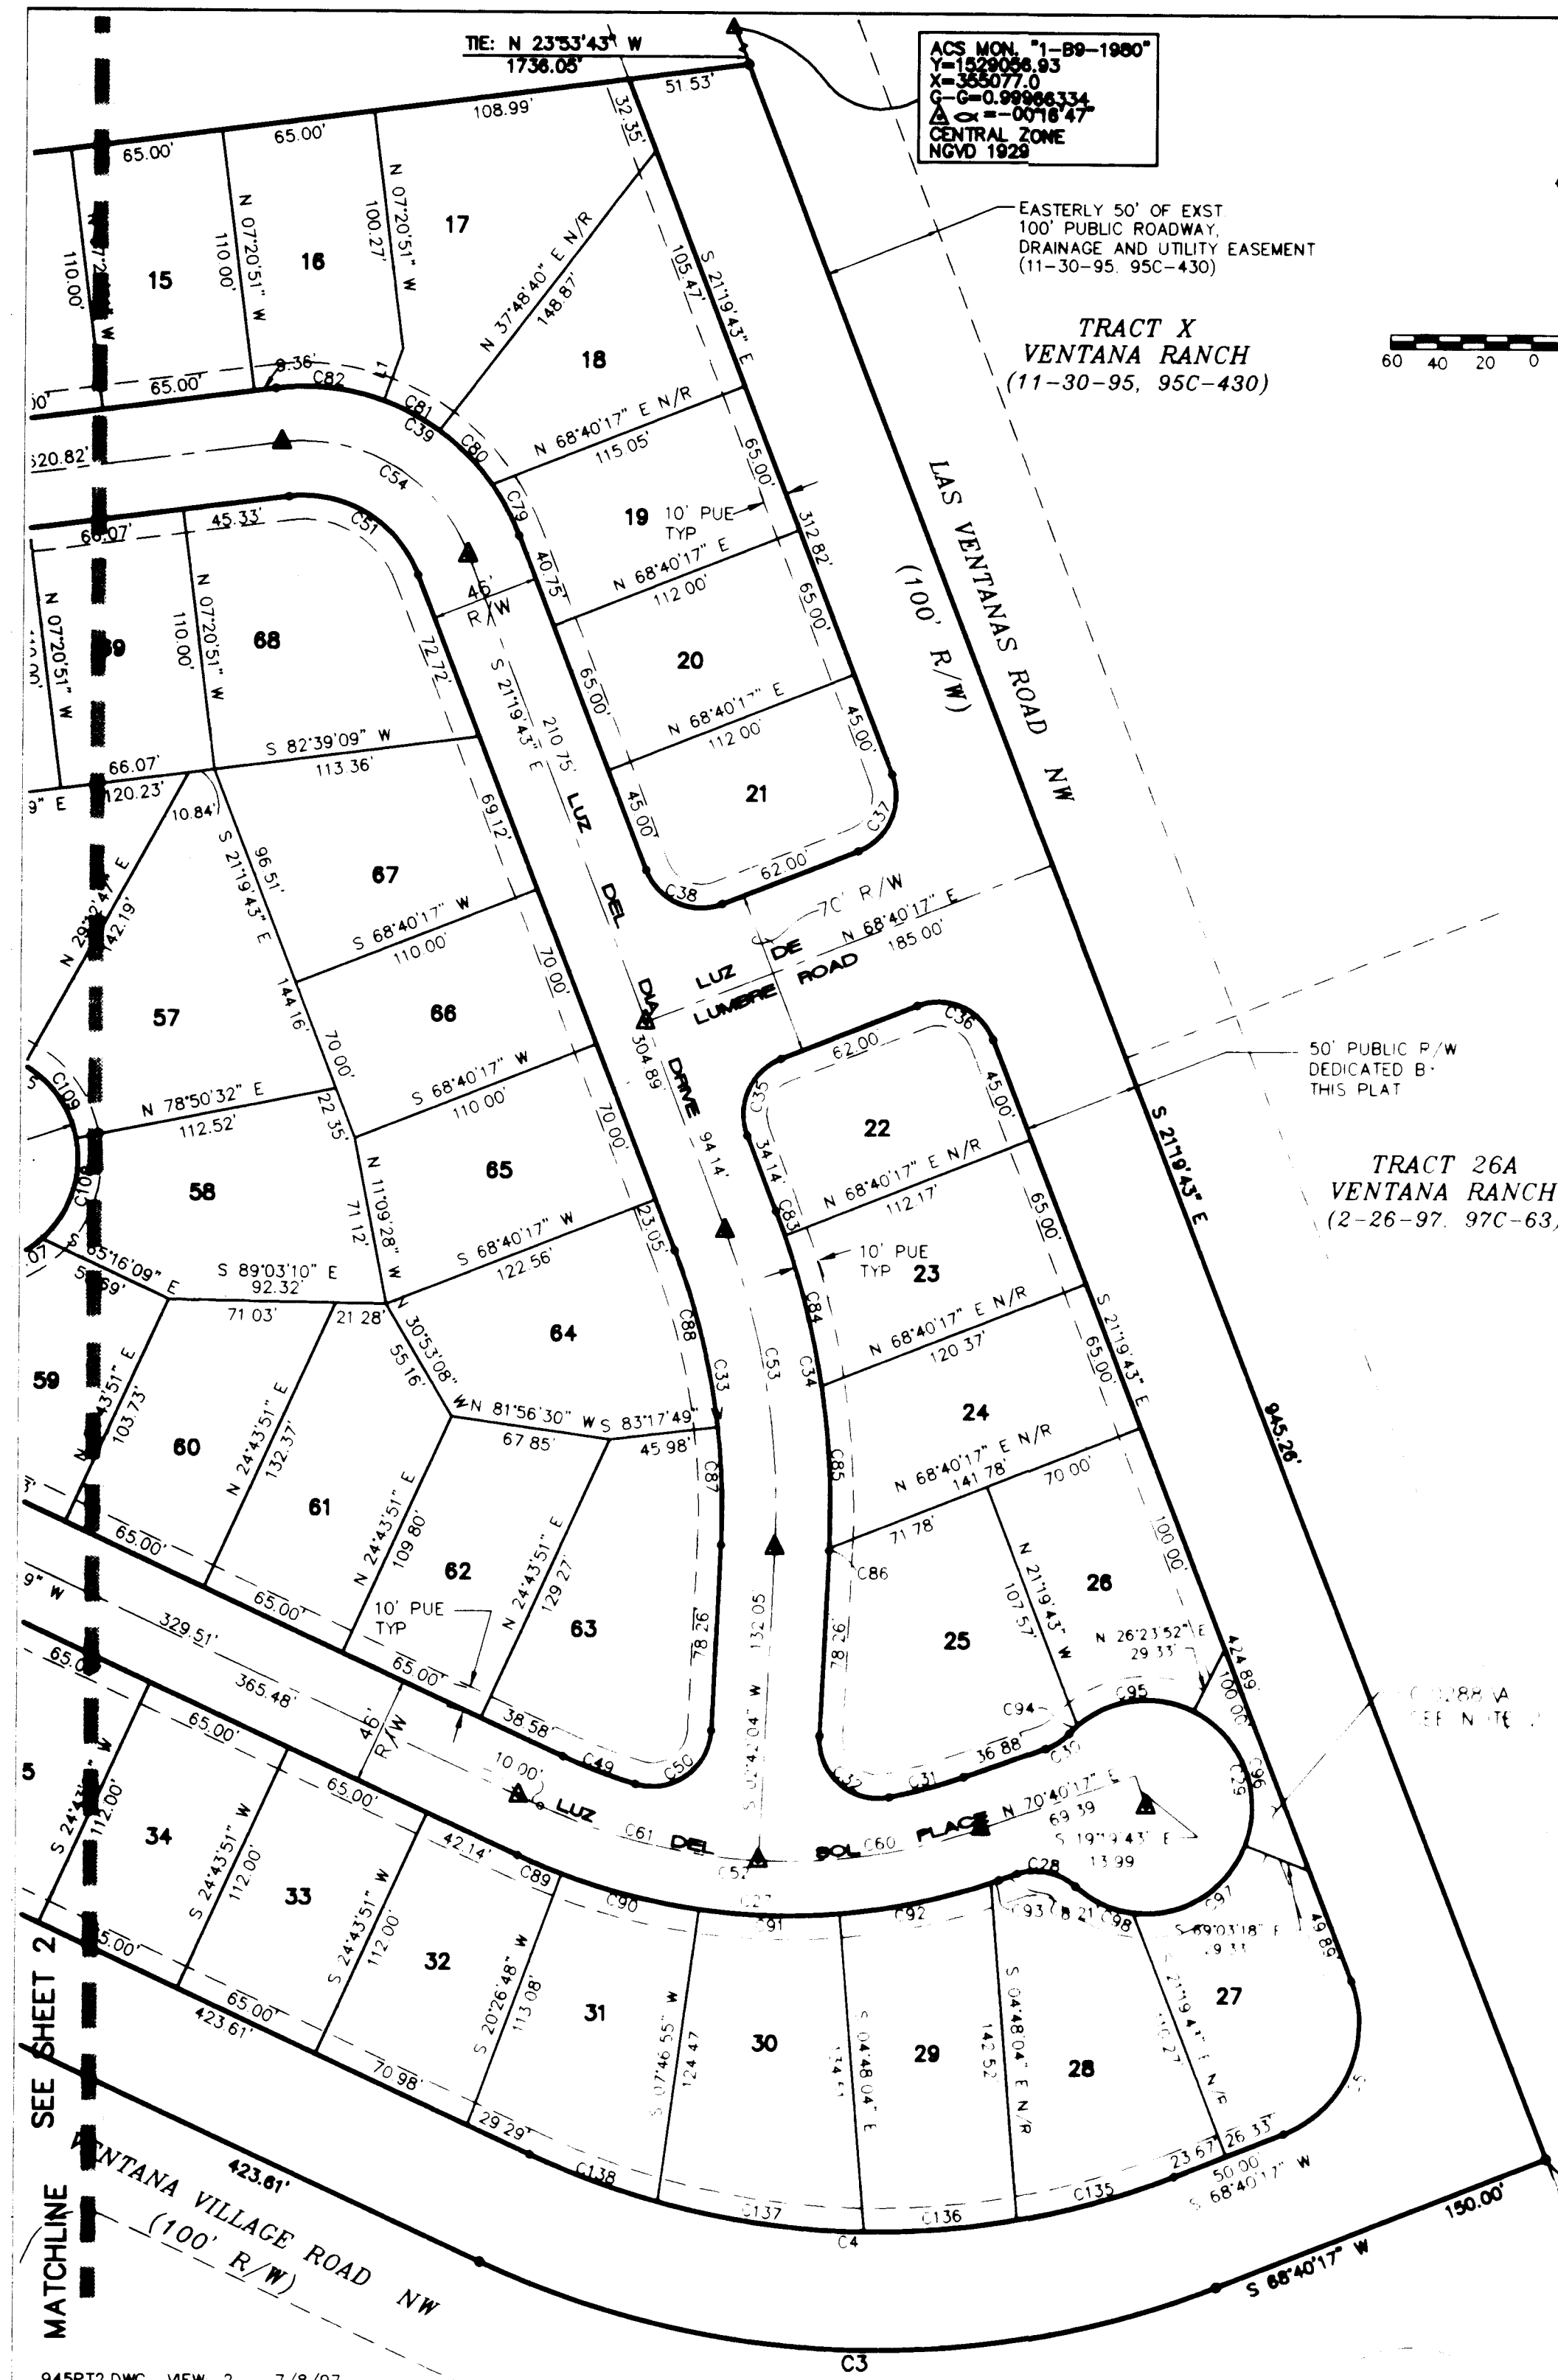

CURVE TABLE					
CURVE	RADIUS	LENGTH	TANGENT	CHORD	BEARING
C1	2250.01	576.81	289.99	575.23	N 13°59'04" W
C2	400.00	321.56	170.04	312.97	N 88°17'56" W
C3	400.00	321.56	170.04	312.97	S 88°17'56" E
C4	400.00	321.56	170.04	312.97	N 88°17'56" W
C5	400.00	321.56	170.04	312.97	S 88°17'56" E
C70	400.00	321.56	170.04	312.97	N 88°17'56" W

CURVE TABLE					
CURVE	RADIUS	LENGTH	TANGENT	CHORD	BEARING
C71	1123.00	15.75	7.88	15.75	S 70°14'50" W
C72	45.00	29.87	15.40	29.14	N 62°28'51" W
C73	45.00	29.87	15.40	29.14	S 62°28'51" E
C74	2172.01	100.54	50.27	111.80	S 08°25'23" E
C75	2172.01	100.54	50.27	111.80	N 08°25'23" W
C76	45.00	29.87	15.40	29.14	S 08°25'23" E
C77	45.00	29.87	15.40	29.14	N 08°25'23" W
C78	45.00	29.87	15.40	29.14	S 08°25'23" E
C79	45.00	29.87	15.40	29.14	N 08°25'23" W
C136	45.00	29.87	15.40	29.14	S 08°25'23" E

LINE TABLE		
LINE	DIRECTION	DISTANCE
L1	S 19°57'47" W	23.75
L2	N 07°47'07" W	23.75

- NOTES**
- SEE SHEET 4 OF 4 FOR LOT AREA TABLE.
 - ADDITIONAL RIGHT-OF-WAY FOR TRAIL ACCESS, PUBLIC UTILITIES AND PUBLIC DRAINAGE (AT THE END OF CUL-DE-SAC ABUTTING LAS VENTANAS ROAD) IS DEDICATED TO THE CITY OF ALBUQUERQUE BY THIS PLAT.

SHEET 3 OF 4

LEGAL DESCRIPTION—Continued from Sheet 1

Thence, N 65°16'09" W, a distance of 423.61 feet to a point of curvature;

Thence, 321.56 feet along the arc of a curve to the left having a radius of 400.00 feet and a chord which bears N 88°17'56" W, a distance of 312.97 feet to a point of tangency;

Thence, S 68°40'17" W, a distance of 300.00 feet to the southwest corner of said Tract numbered Twenty-A (20A), a point on the centerline of an existing 156 foot wide Public Roadway, Drainage and Utility Easement recorded November 30, 1995 as Document No. 95122531 in Volume 95C, Folio 430

Thence running along the westerly boundary line of said Tract numbered Twenty-A (20A) and also along said centerline, N 21°19'43" W, a distance of 135.19 feet to a point of curvature;

Thence, 576.81 feet along the arc of a curve to the right having a radius of 2250.01 feet and a chord which bears N 13°59'04" W, a distance of 575.23 feet to the northwest corner of said Tract numbered Twenty-A (20A)

Thence leaving said centerline and running, thence along the northerly boundary line of said Tract numbered Twenty-A (20A), N 82°39'09" E, a distance of 1284.52 feet to the northeast corner of said Tract numbered Twenty-A (20A), a point on the centerline of an existing 100 foot wide Public Roadway, Drainage and Utility Easement recorded November 30, 1995 as Document No. 95122531 in Volume 95C, Folio 430,

Thence running along the easterly boundary line of said Tract numbered Twenty-A (20A) and also along said centerline, S 21°19'43" E, a distance of 945.26 feet to the point and place of beginning.


Tract contains 24.0108 acres, more or less.

LOT AREA TABLE

LOT	AREA (SF)	LOT	AREA (SF)	LOT	AREA (SF)	LOT	AREA (SF)
1	8192	21	7572	41	7940	61	8370
2	8417	22	7572	42	7879	62	7770
3	8340	23	7490	43	8008	63	10489
4	7698	24	8443	44	8040	64	9334
5	7307	25	10195	45	8005	65	8140
6	7159	26	7619	46	10472	66	7700
7	7150	27	7764	47	9747	67	9110
8	7150	28	9761	48	9596	68	10644
9	7150	29	8983	49	9172	69	7267
10	7150	30	9627	50	10685	70	7150
11	7150	31	8702	51	9587	71	7332
12	7150	32	7485	52	10729	72	7696
13	7150	33	7280	53	8352	73	9418
14	7150	34	7280	54	9697	74	9045
15	7150	35	7280	55	11756	75	10218
16	7316	36	7280	56	11726	76	9331
17	10354	37	7291	57	11113	77	9057
18	8386	38	7747	58	9800	78	8942
19	7304	39	7747	59	8102	79	8860
20	7280	40	8394	60	7673	80	8023
						81	9616

TRACT X
VENTANA RANCH
(11-30-95, 95C-430)

TRACT 26A
VENTANA RANCH
(2-26-97, 97C-63)

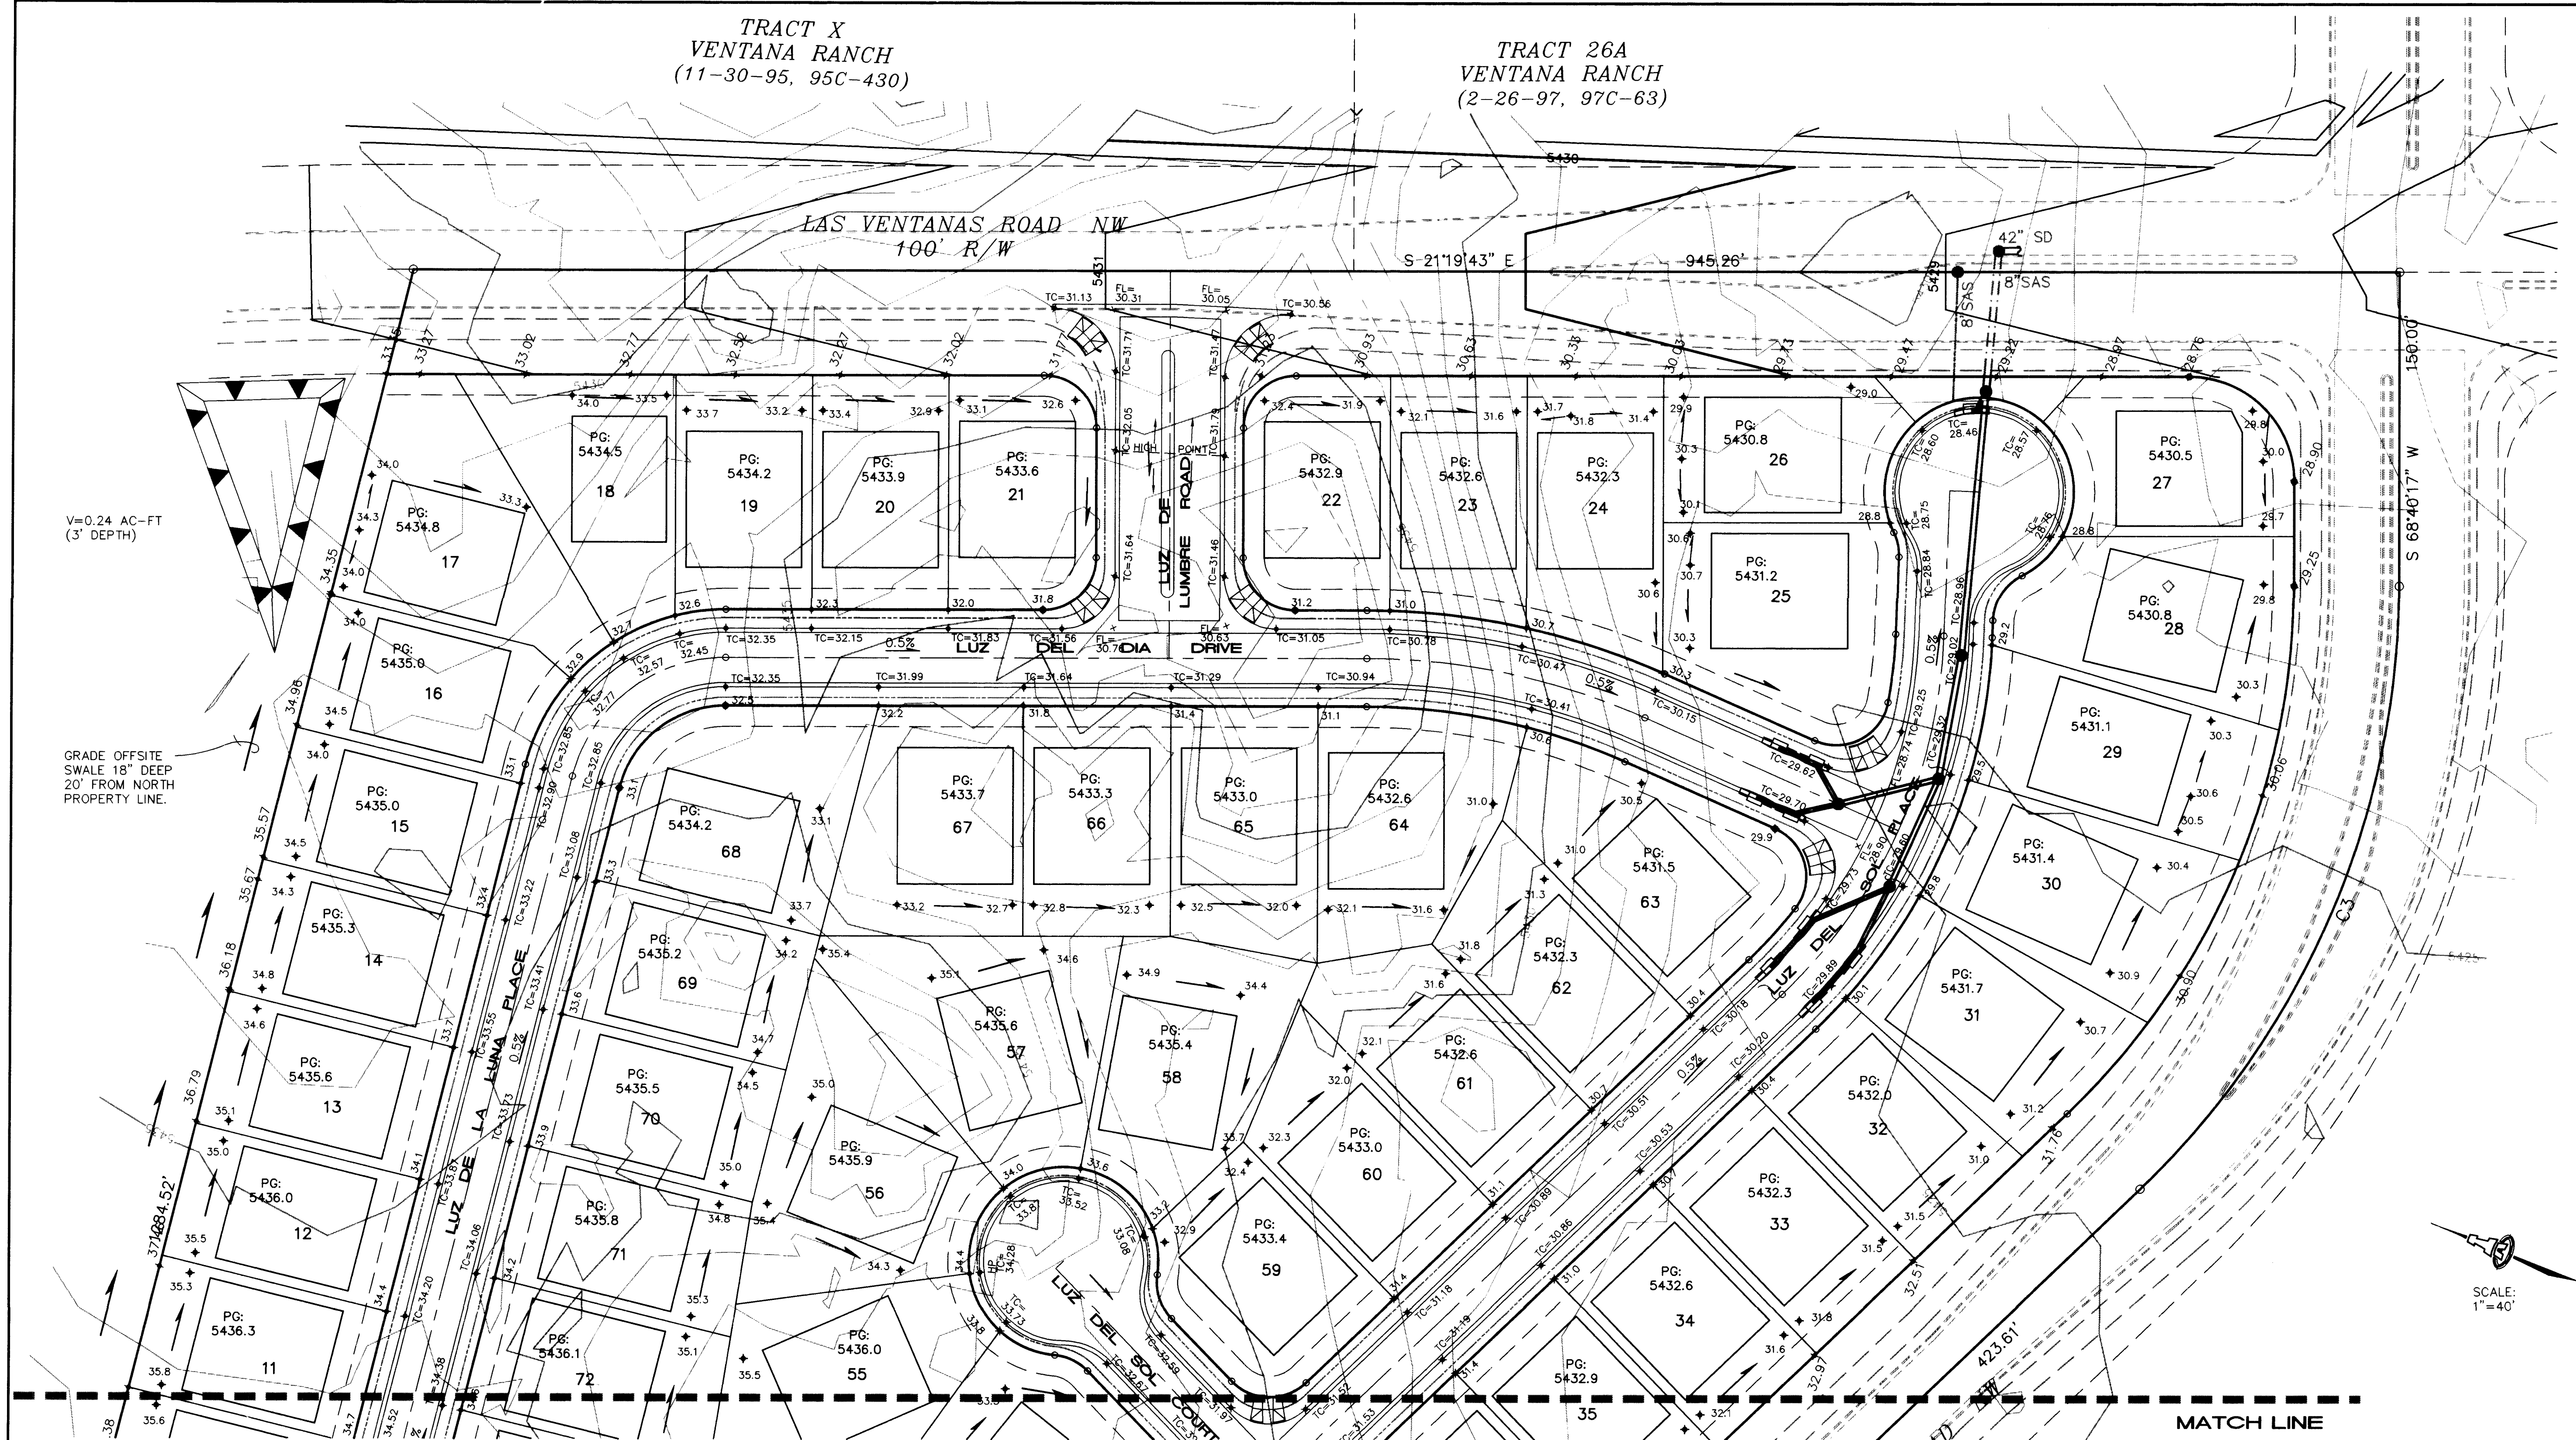

V=0.24 AC-FT
(3' DEPTH)

GRADE OFFSITE
SWALE 18" DEEP
20' FROM NORTH
PROPERTY LINE.

SCALE:
1"=40'

MATCH LINE

OFFSITE GRADING BERM
SCALE: 1"=2'


EROSION CONTROL

1. THE CONTRACTOR SHALL ENSURE THAT NO SOIL ERODES FROM THE SITE INTO THE PUBLIC RIGHT-OF-WAY OR ONTO PRIVATE PROPERTY. THIS CAN BE ACHIEVED BY CONSTRUCTING EROSION CONTROL BERMS (AS DETAILED AT RIGHT) AND WETTING THE SOIL TO KEEP IT FROM BLOWING.
2. THE CONTRACTOR SHALL SECURE "TOPSOIL DISTURBANCE PERMIT" FROM THE CITY ENVIRONMENTAL HEALTH DEPARTMENT PRIOR TO BEGINNING CONSTRUCTION. AN EXCAVATION PERMIT IS REQUIRED FOR ALL WORK WITHIN PUBLIC RIGHT-OF-WAY.
3. BUILD EROSION CONTROL BERM ALONG WEST, SOUTH, AND EAST PROPERTY LINES.
4. BUILD OFFSITE BERM AS SHOWN ALONG NORTH PROPERTY LINE (ON TR. 22A VENTANA RANCH). OFFSITE BERM SHALL DIRECT OFFSITE FLOWS TO SEDIMENTATION POND SHOWN.

EROSION CONTROL BERM

SCALE: 1"=2'

SCANNED BY
BY LASON

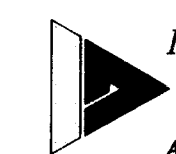

ISAACSON & ARFMAN, P.A.
Consulting Engineering Associates
128 Monroe Street N.E.
Albuquerque, New Mexico

945GRD.DWGonw VIEW: 1 5/14/97

CITY OF ALBUQUERQUE
PUBLIC WORKS DEPARTMENT
ENGINEERING GROUP

TITLE: LUZ EN LA VENTANA AT VENTANA RANCH
GRADING & DRAINAGE PLAN

Design Review Committee City Engineer Approval

Approved @
DRB

City Project No. 5316.97

Zone Map No. B-9

Sheet 5 Of 18

AS-BUILT INFORMATION
CONTRACTOR: SALLS BROS.
DRAWN BY: ALS, INC.
CHECKED BY: ALS, INC.
DATE: 5/97

BENCH MARKS
A STANDARD ACS BRASS TABLET, STAMPED "1-B10", SET IN TOP OF A CONCRETE POST FLUSH WITH GROUND UNDER NORTH-SOUTH POWER LINES APPROXIMATELY 0.90 MILES WEST OF PARADISE BLVD NW AND PARK LANE NW.
ELEVATION: 5419.522

SURVEY INFORMATION
FIELD NOTES
1 BHI

ENGINEER'S SEAL
SCOTT M. MOORE
NEW MEXICO
10519
6-24-97

REVISIONS
NO. DATE REMARKS BY
DESIGNED BY: SMM
DRAWN BY: ANW
CHECKED BY: SMM
DATE: 4/97
DATE: 4/97
DATE: 6/97

TRACT 22A
VENTANA RANCH
(2-26-1997, 97C-63)

LEGEND

- STD CURB & GUTTER
- VALLEY GUTTER & PCC FILLETS
- STORM DRAIN WITH MANHOLE
- FUTURE 4' PCC SW (SEE NOTE 3)
- PROPOSED STREET LIGHT

TRACT X
VENTANA RANCH
(11-30-95, 95C-430)

NOTES:

- IMPROVEMENTS SHOWN WITHIN VENTANA VILLAGE RD NW PER CITY PROJECT No. 5316.95
- IMPROVEMENTS SHOWN WITHIN LAS VENTANAS RD NW AND RAINBOW BLVD NW PER CITY PROJECT No. 5316.98.
- INTERIOR 4' PCC SIDEWALKS ARE DEFERRED TO BUILDING PERMIT PHASE.



TRACT 26A
VENTANA RANCH
(2-26-97, 97C-63)

TRACT Y
VENTANA RANCH
(11-30-95, 95C-430)


TRACT 19A
VENTANA RANCH
(2-26-97, 97C-63)

AS-BUILT INFORMATION		BENCH MARKS		SURVEY INFORMATION		ENGINEER'S SEAL		REVISIONS		DESIGNED BY		DRAWN BY		CHECKED BY	
CONTRACTOR	SUNANCE MECH.	DATE	9/7	1996	BH	1	1	NO.	DATE	DATE	4/97	DATE	4/97	DATE	6/97
WORK SHOWN BY	ALS, INC.	DATE	9/7												
ACCEPTANCE BY	C.O.A.	DATE	9/7												
REVISIONS	ALS, INC.	DATE	9/7												
DRAWINGS	ALS, INC.	DATE	9/7												
CORRECTED BY	ALS, INC.	DATE	9/7												
MICRO-FILM INFORMATION		RECORDED BY													
		ELEVATION:	5419.522												


SCOTT M. MCGEE
NEW MEXICO
10519
6-24-97

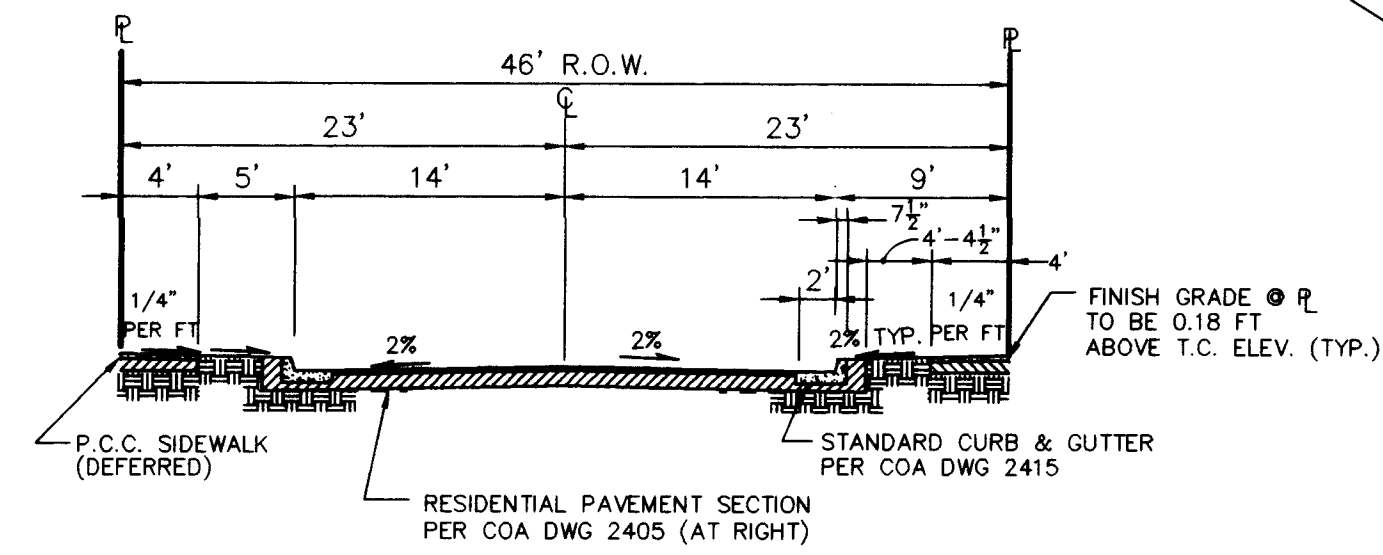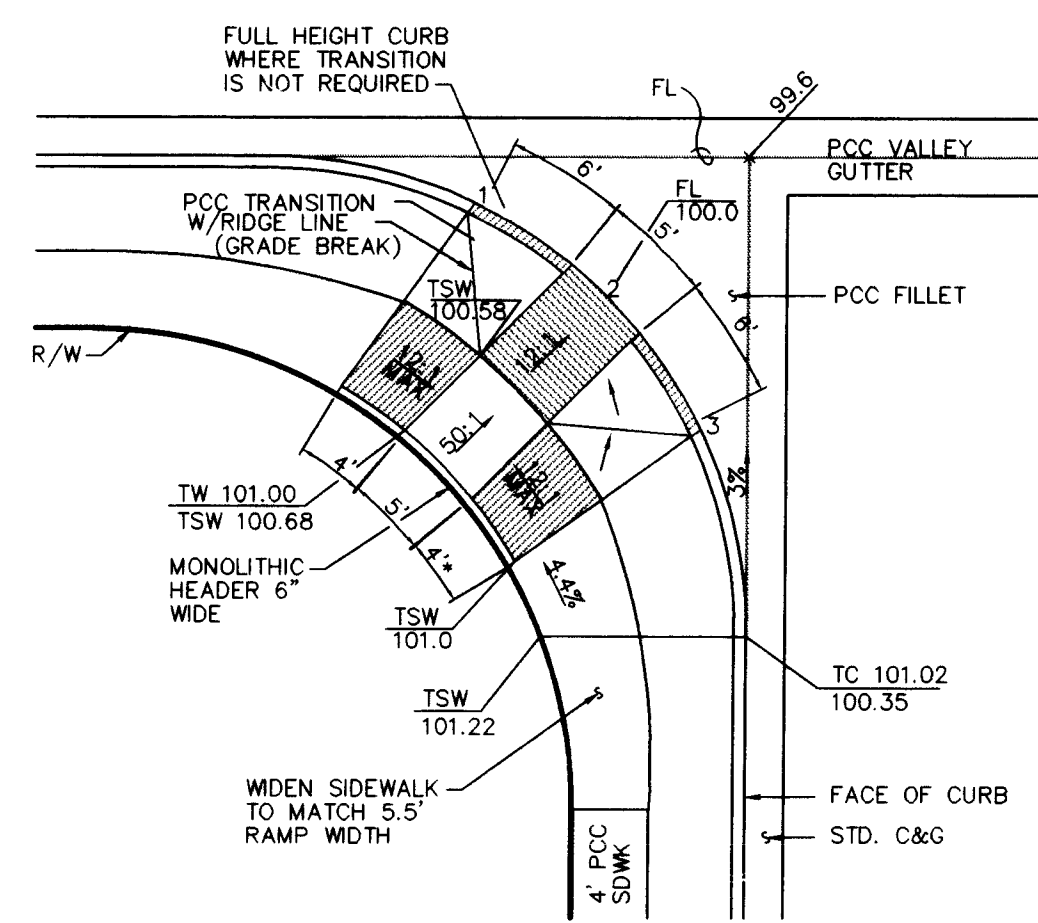

TYPICAL 46' R.O.W. RESIDENTIAL STREET SECTION A
1"=10'

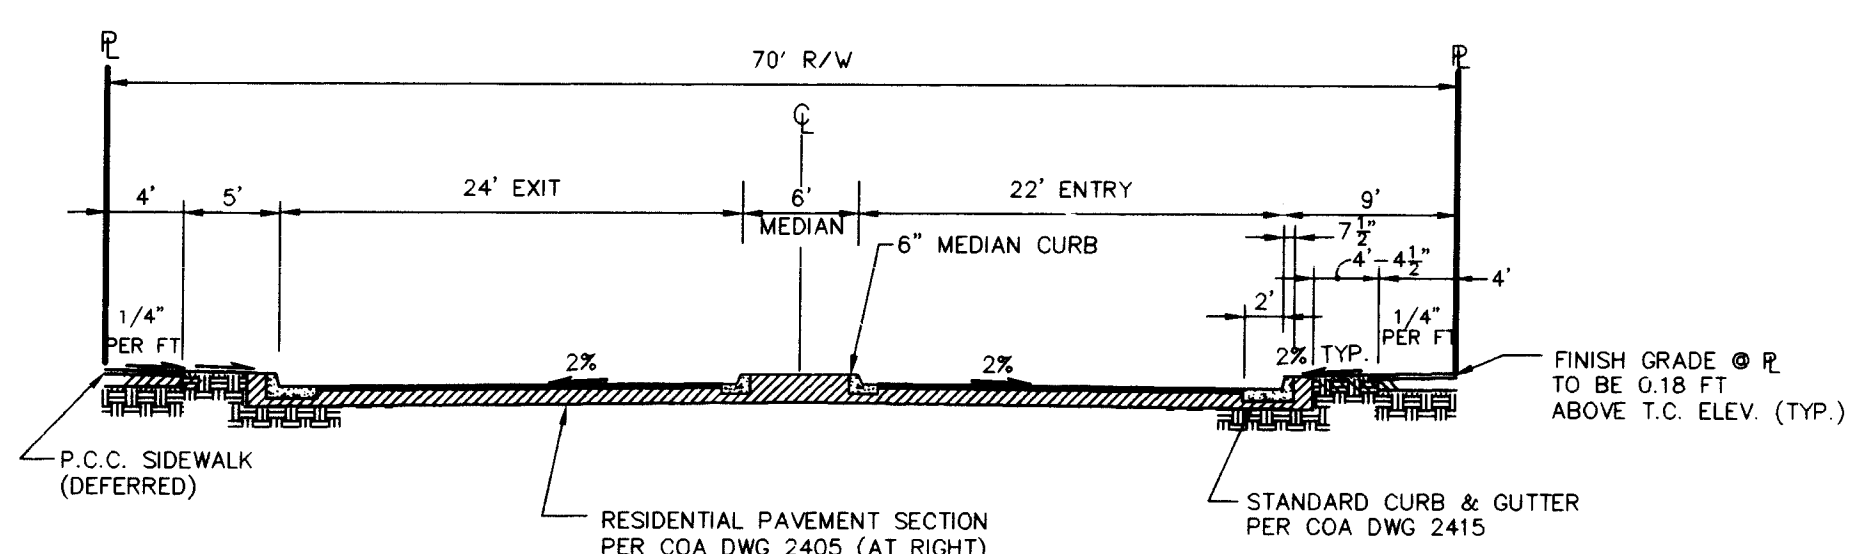

SECTION B
66' R.O.W. RESIDENTIAL STREET SECTION
1"=10'

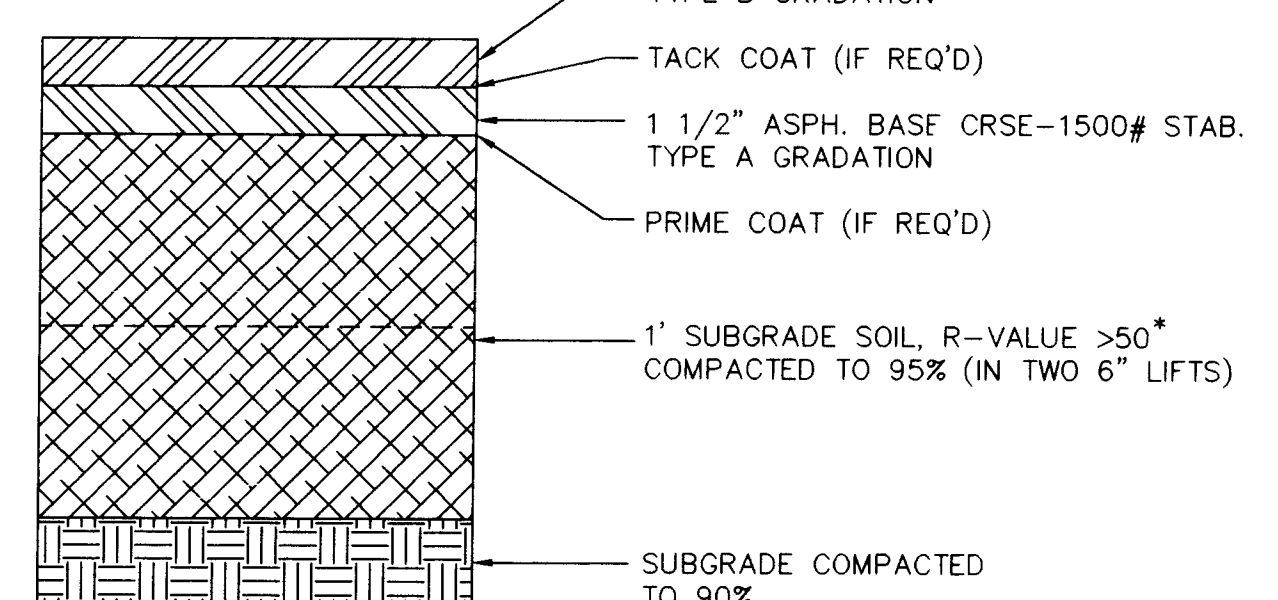

RESIDENTIAL PAVING SECTION
NTS

* CONTRACTOR SHALL BE REQUIRED TO VERIFY R-VALUE & IF LESS THAN 50, SUBGRADE MATERIAL SHALL BE REMOVED & REPLACED WITH SELECT MATERIAL (R50) AT ADDITIONAL COST TO OWNER.



ISAACSON & ARFMAN, P.A.
Consulting Engineering Associates
128 Monroe Street N.E.
Albuquerque, New Mexico 87102
945PMSTR.DWGonw 6/10/97

CITY OF ALBUQUERQUE
PUBLIC WORKS DEPARTMENT
ENGINEERING GROUP

TITLE: **LUZ EN LA VENTANA AT VENTANA RANCH
MASTER PAVING & STORM DRAIN PLAN**

Design Review Committee	City Engineer Approval	Mo./Day/Yr.	Mo./Day/Yr.

City Project No. **5316.97** Zone Map No. **B-9** Sheet **7** Of **18**

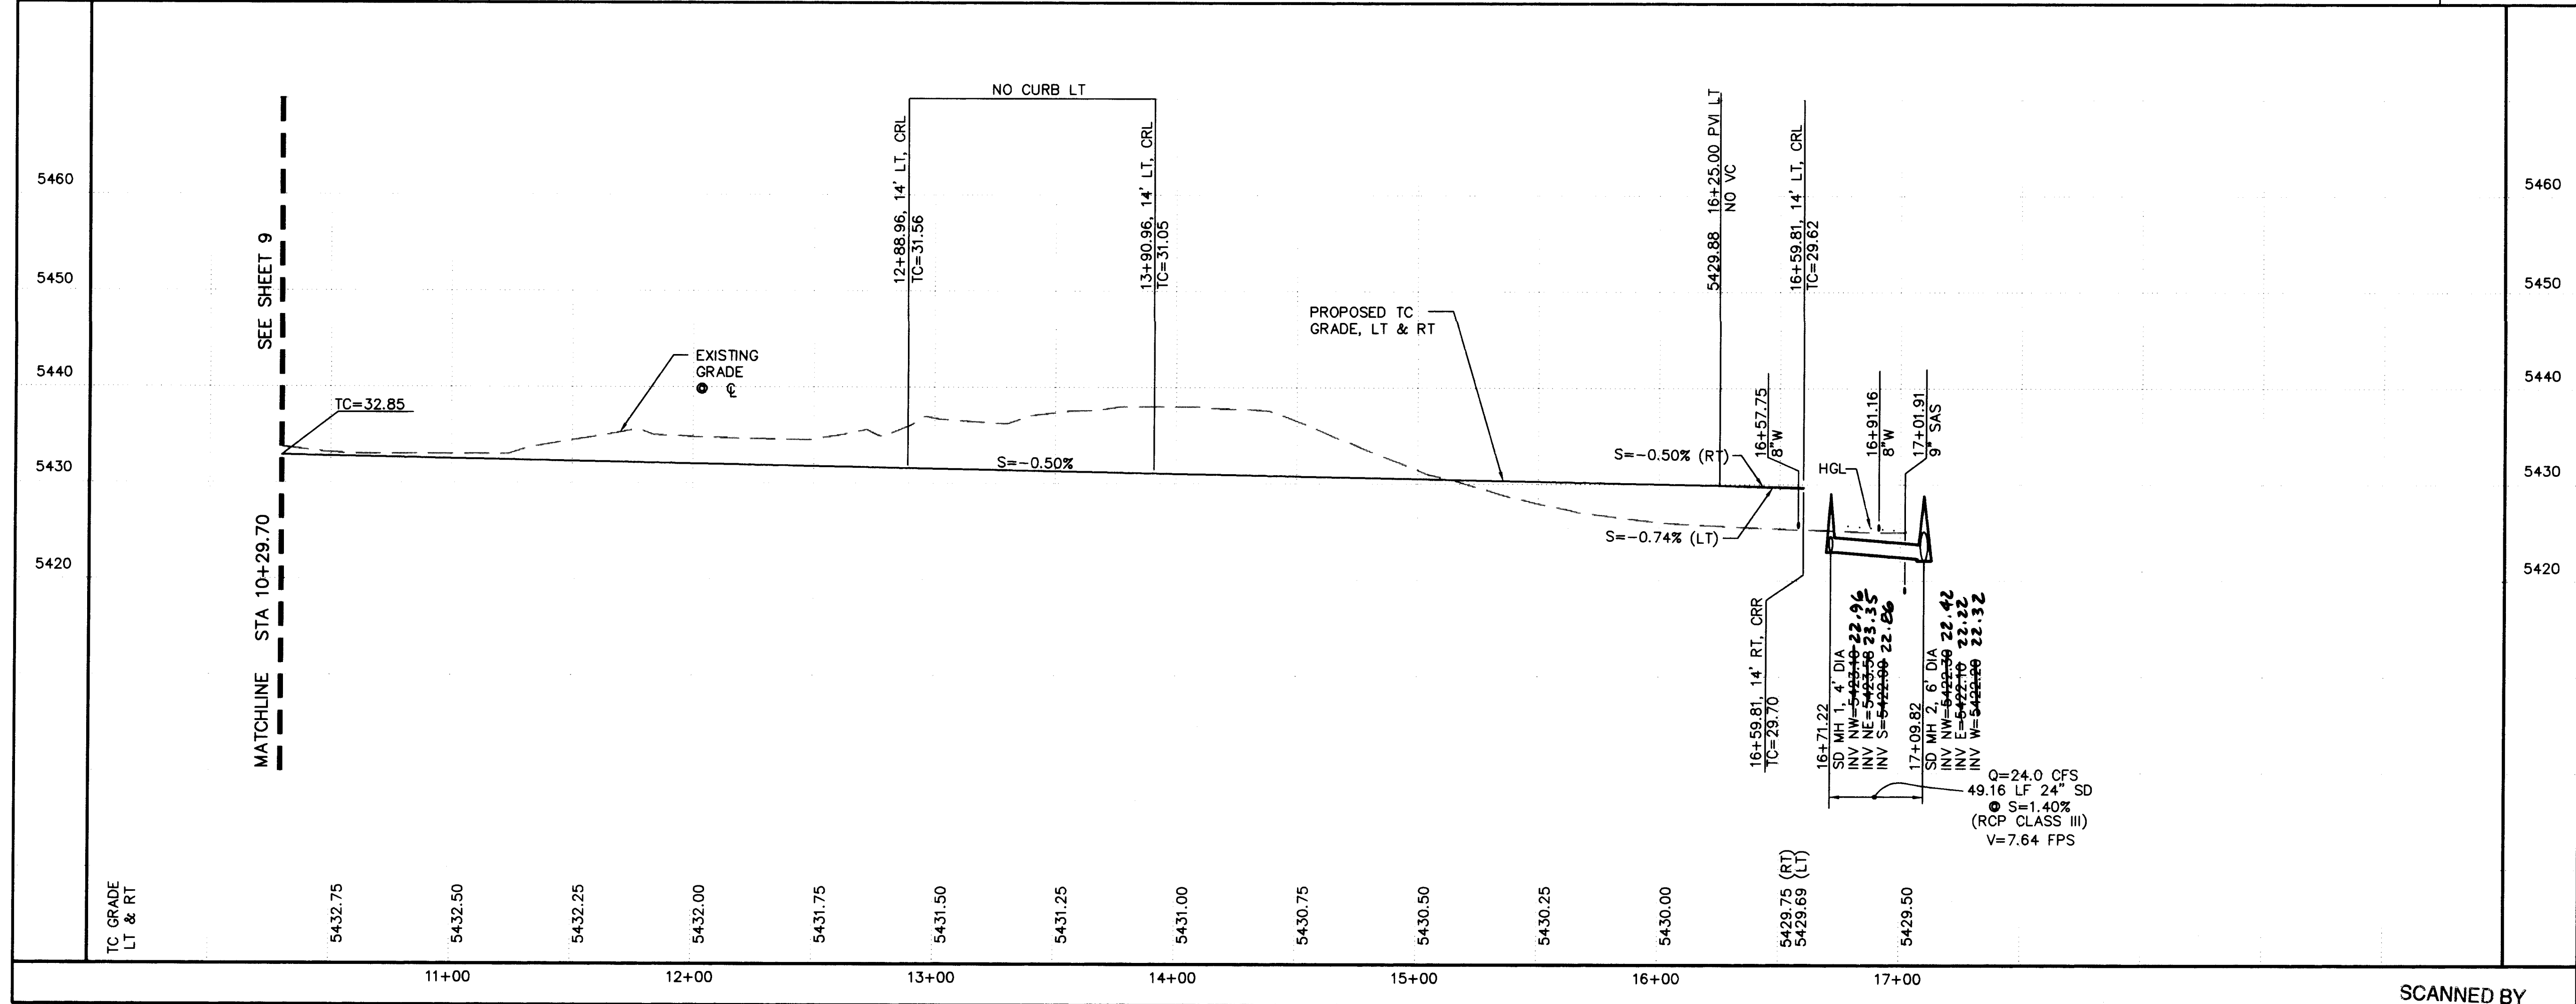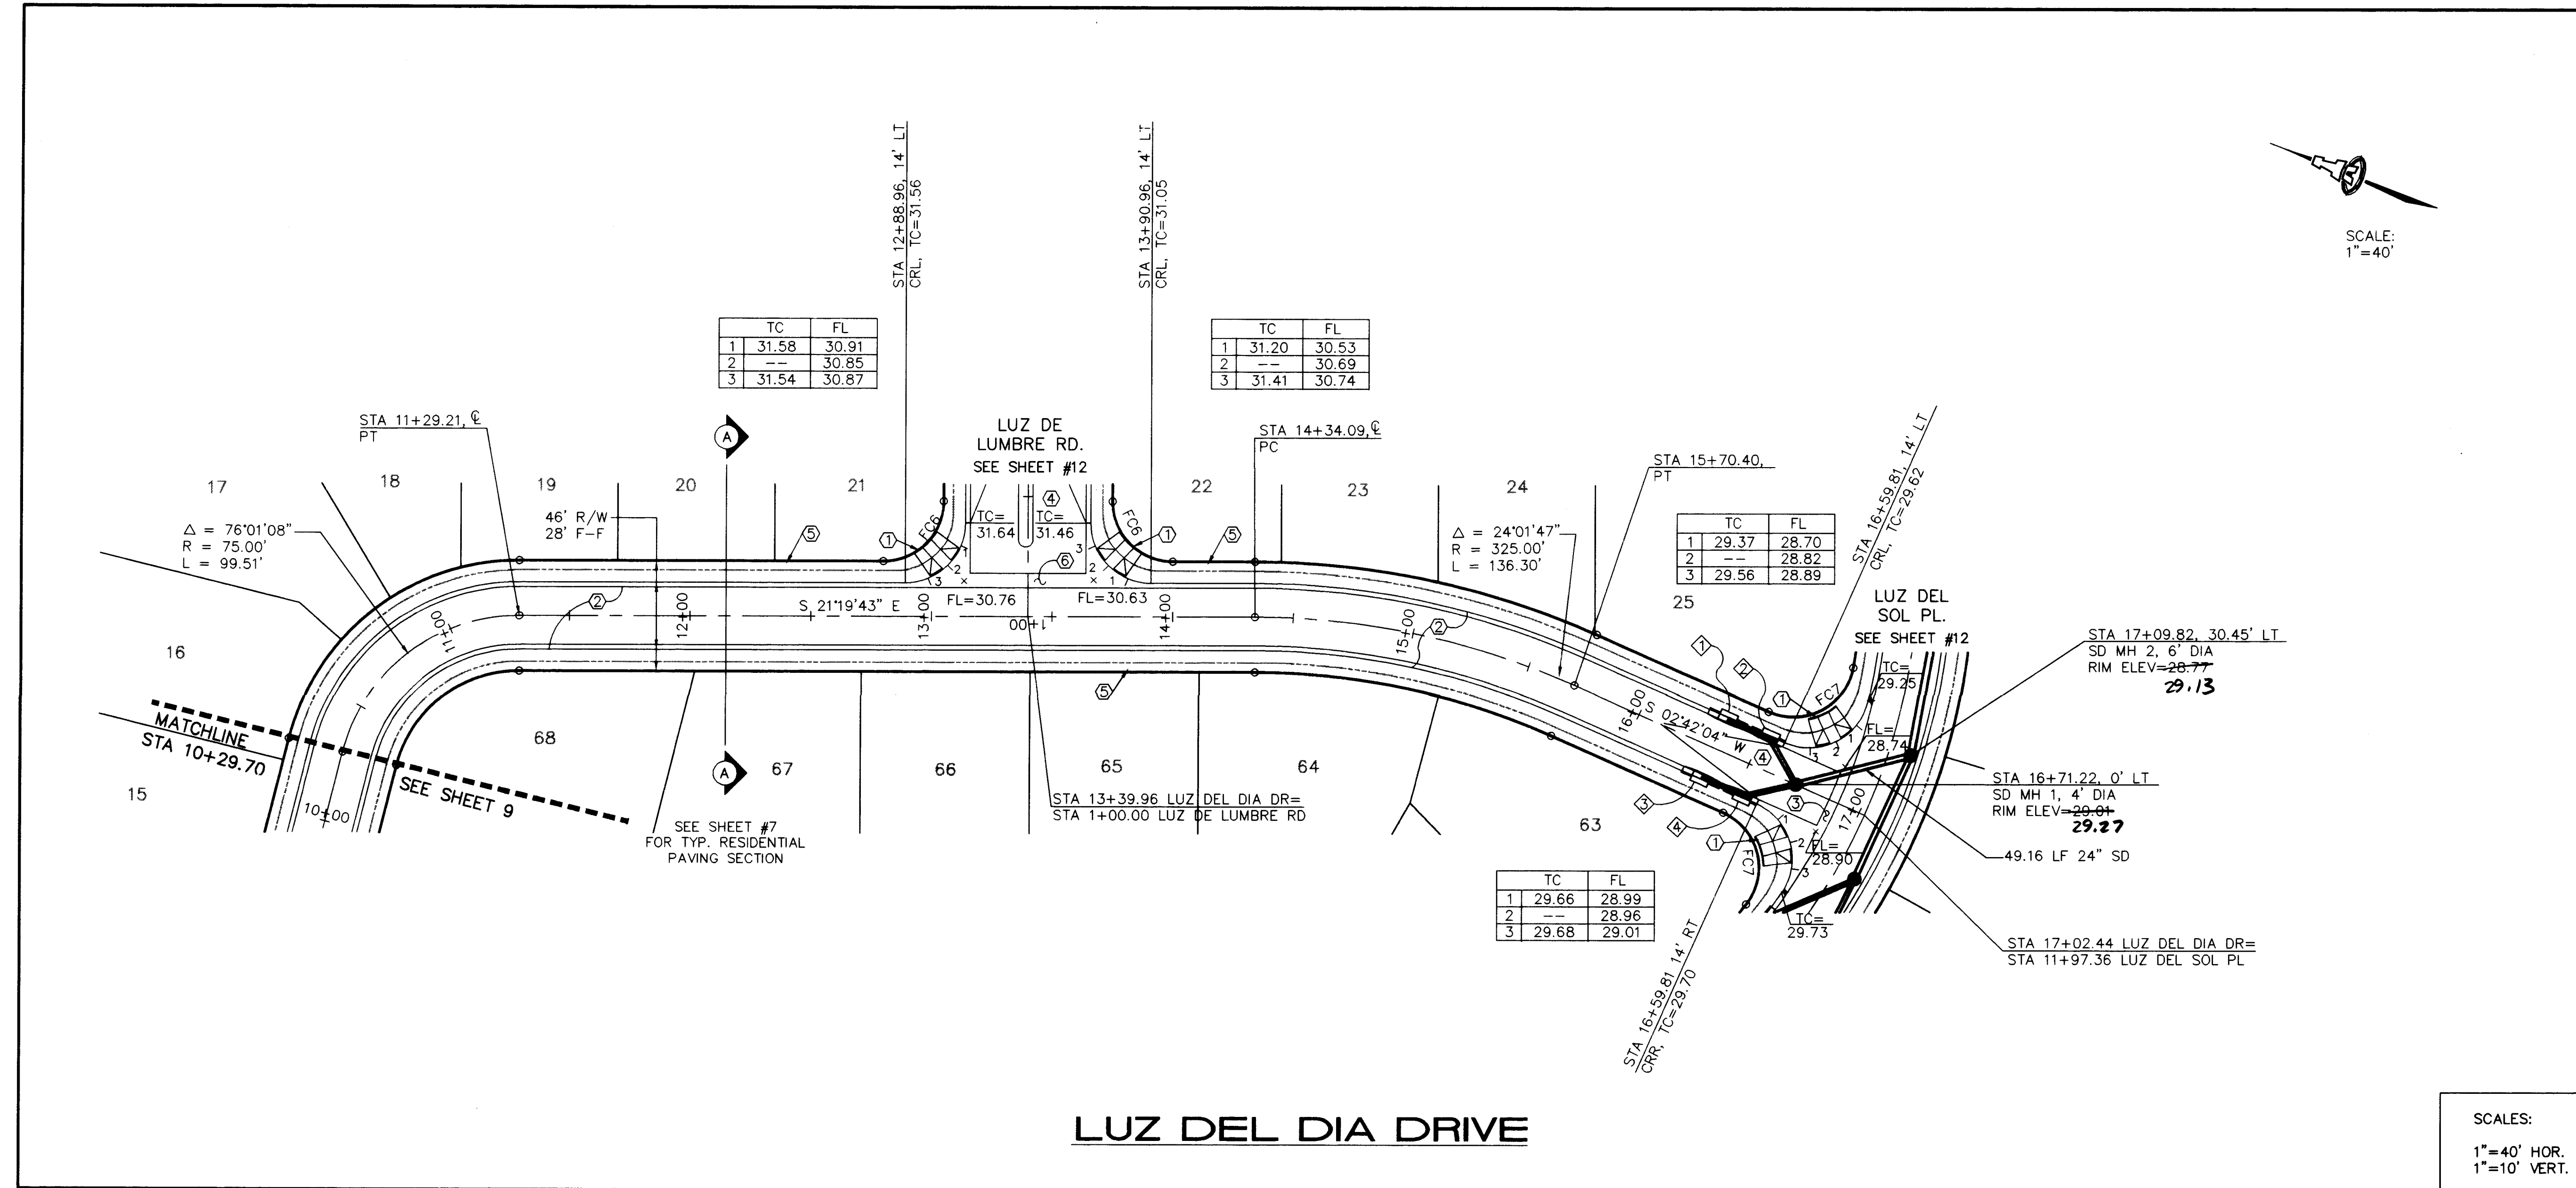

KEYED CONSTRUCTION NOTES

- CONSTRUCT HANDICAP RAMP PER DETAIL ON SHEET #7.
- STANDARD CURB & GUTTER PER COA STD DWG #2415.
- CONSTRUCT PCC VALLEY GUTTER 6' WIDE, 1 1/2" INVERT PER COA STD DWG #2420.
- CROWN TO NO CROWN TRANSITION 50' MIN. LENGTH.
- FUTURE 4' SIDEWALK PER STD DWG 2430.
- CONSTRUCT PCC VALLEY GUTTER 6' WIDE, 1 1/2" INVERT PER COA STD DWG #2420.

FACE OF CURB CURVE TABLE

CURVE	RADIUS	LENGTH	DELTA
FC6	25.00'	39.27'	90°00'00"
FC7	25.00'	43.92'	100°39'05"

STORM DRAIN INLET INFORMATION

INLET NO.	INLET TYPE	STATION* & OFFSET	TC EL TOP GRATE	INV IN	INV OUT
1	SINGLE 'A'	16+36.06, 14' LT	29.80	---	---
2	DOUBLE 'C'	16+55.06, 14' LT	29.65	24.96	24.96
3	SINGLE 'A'	16+36.06, 14' RT	29.82	---	---
4	DOUBLE 'C'	16+55.06, 14' RT	29.72	24.97	24.97

CONNECTOR PIPE INFORMATION

FROM-TO INLET NO.	DIA. (IN)	LENGTH (FT)	SLOPE (FT/FT)
1-2	18	16.0	.0200
2-MH 1	18	20.0	.0400
3-4	18	16.0	.0400
4-MH 1	18	20.0	.0180

ISAACSON & ARFMAN, P.A.
Consulting Engineering Associates
128 Monroe Street N.E.
Albuquerque New Mexico
945PV2.DWGanw 6/10/97

**CITY OF ALBUQUERQUE
PUBLIC WORKS DEPARTMENT
ENGINEERING GROUP**

**TITLE: LUZ EN LA VENTANA AT VENTANA RANCH
LUZ DEL DIA DR
PAVING PLAN & PROFILE**

Design Review Committee City Engineer Approval


City Project No. **5316.97** Zone Map No. **B-9** Sheet **10** Of **18**

REVISIONS

NO.	DATE	REMARKS
1	4/97	DESIGN
2	4/97	ANW
3	6/97	SMM

AS-BUILT INFORMATION

CONTRACTOR	DATE	BY
SUNSHINE HIGHWAY	4/97	ALV, INC.
STANDARD BY	4/97	C.O.A.
FIELD VERIFICATION BY	4/97	ALV, INC.
CORRECTED BY	4/97	ALV, INC.
RECORDED BY	4/97	MICRO-FILM INFORMATION

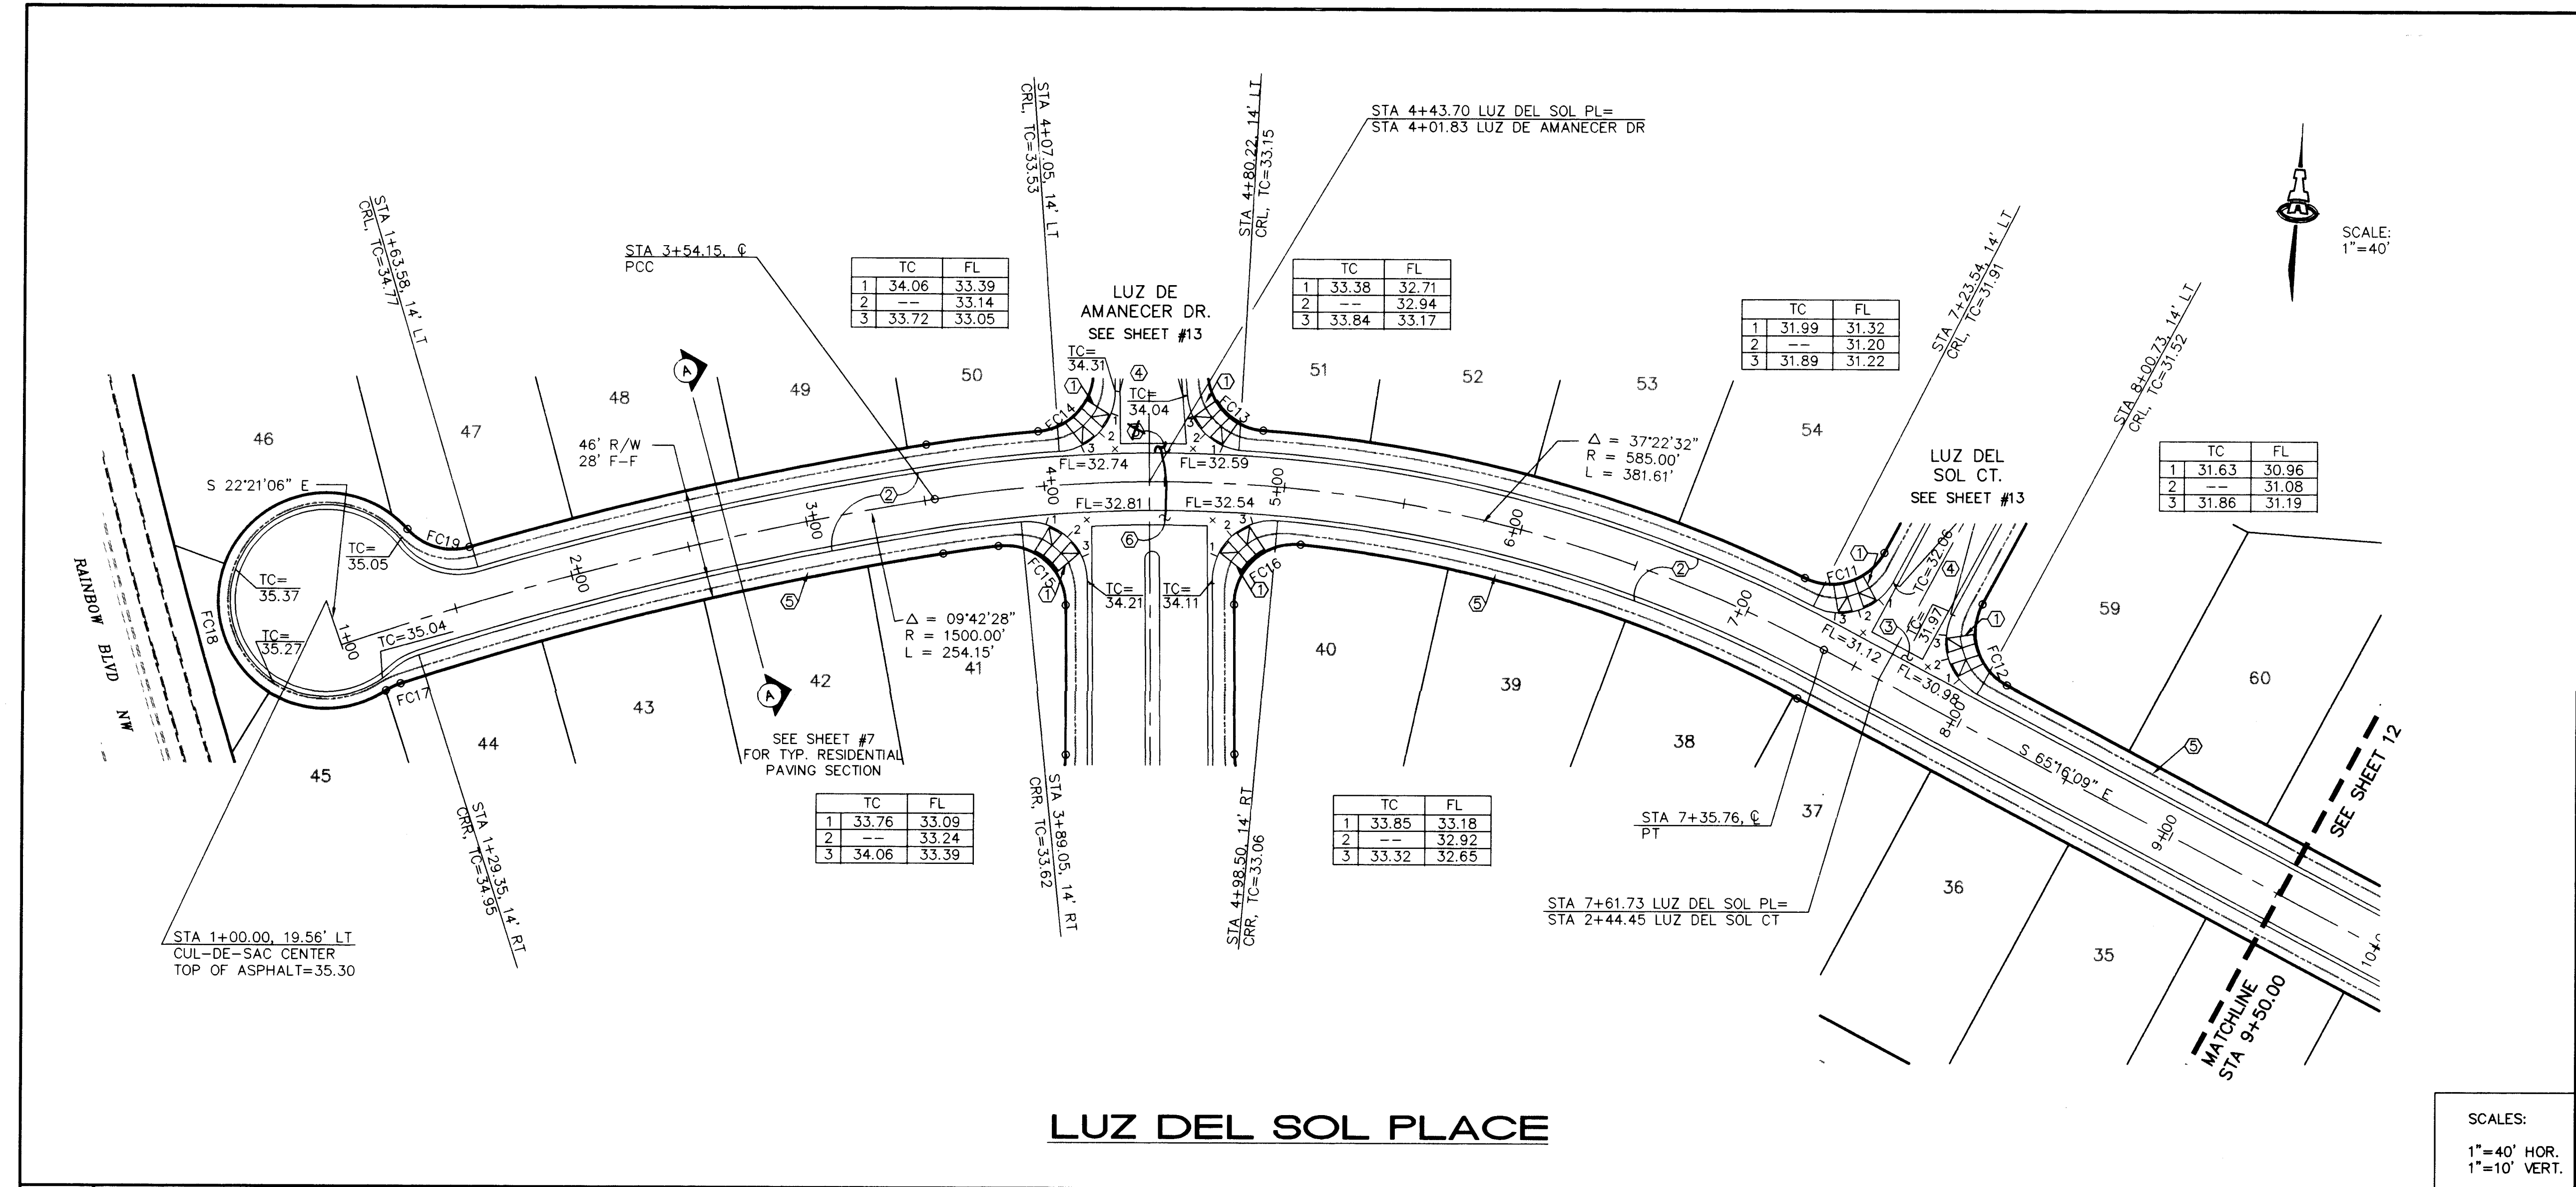


KEYED CONSTRUCTION NOTES

1. CONSTRUCT HANDICAP RAMP PER DETAIL ON SHEET #7.
2. STANDARD CURB & GUTTER PER COA STD DWG #2415.
3. CONSTRUCT PCC VALLEY GUTTER 4' WIDE, 1 1/2" INVERT PER COA STD DWG #2421.
4. CROWN TO NO CROWN TRANSITION 50' MIN. LENGTH.
5. FUTURE 4' SIDEWALK PER STD DWG 2430.
6. CONSTRUCT PCC VALLEY GUTTER 6' WIDE, 1 1/2" INVERT PER COA STD DWG #2420.

FACE OF CURB CURVE TABLE

CURVE	RADIUS	LENGTH	DELTA
FC11	25.00'	38.75'	88°48'14"
FC12	25.00'	39.27'	90°00'00"
FC13	25.00'	35.92'	82°19'14"
FC14	25.00'	37.75'	86°30'31"
FC15	25.00'	41.56'	95°15'15"
FC16	25.00'	41.65'	95°27'54"
FC17	29.00'	12.92'	25°31'28"
FC18	40.00'	192.52'	275°45'36"
FC19	29.00'	34.89'	68°55'42"

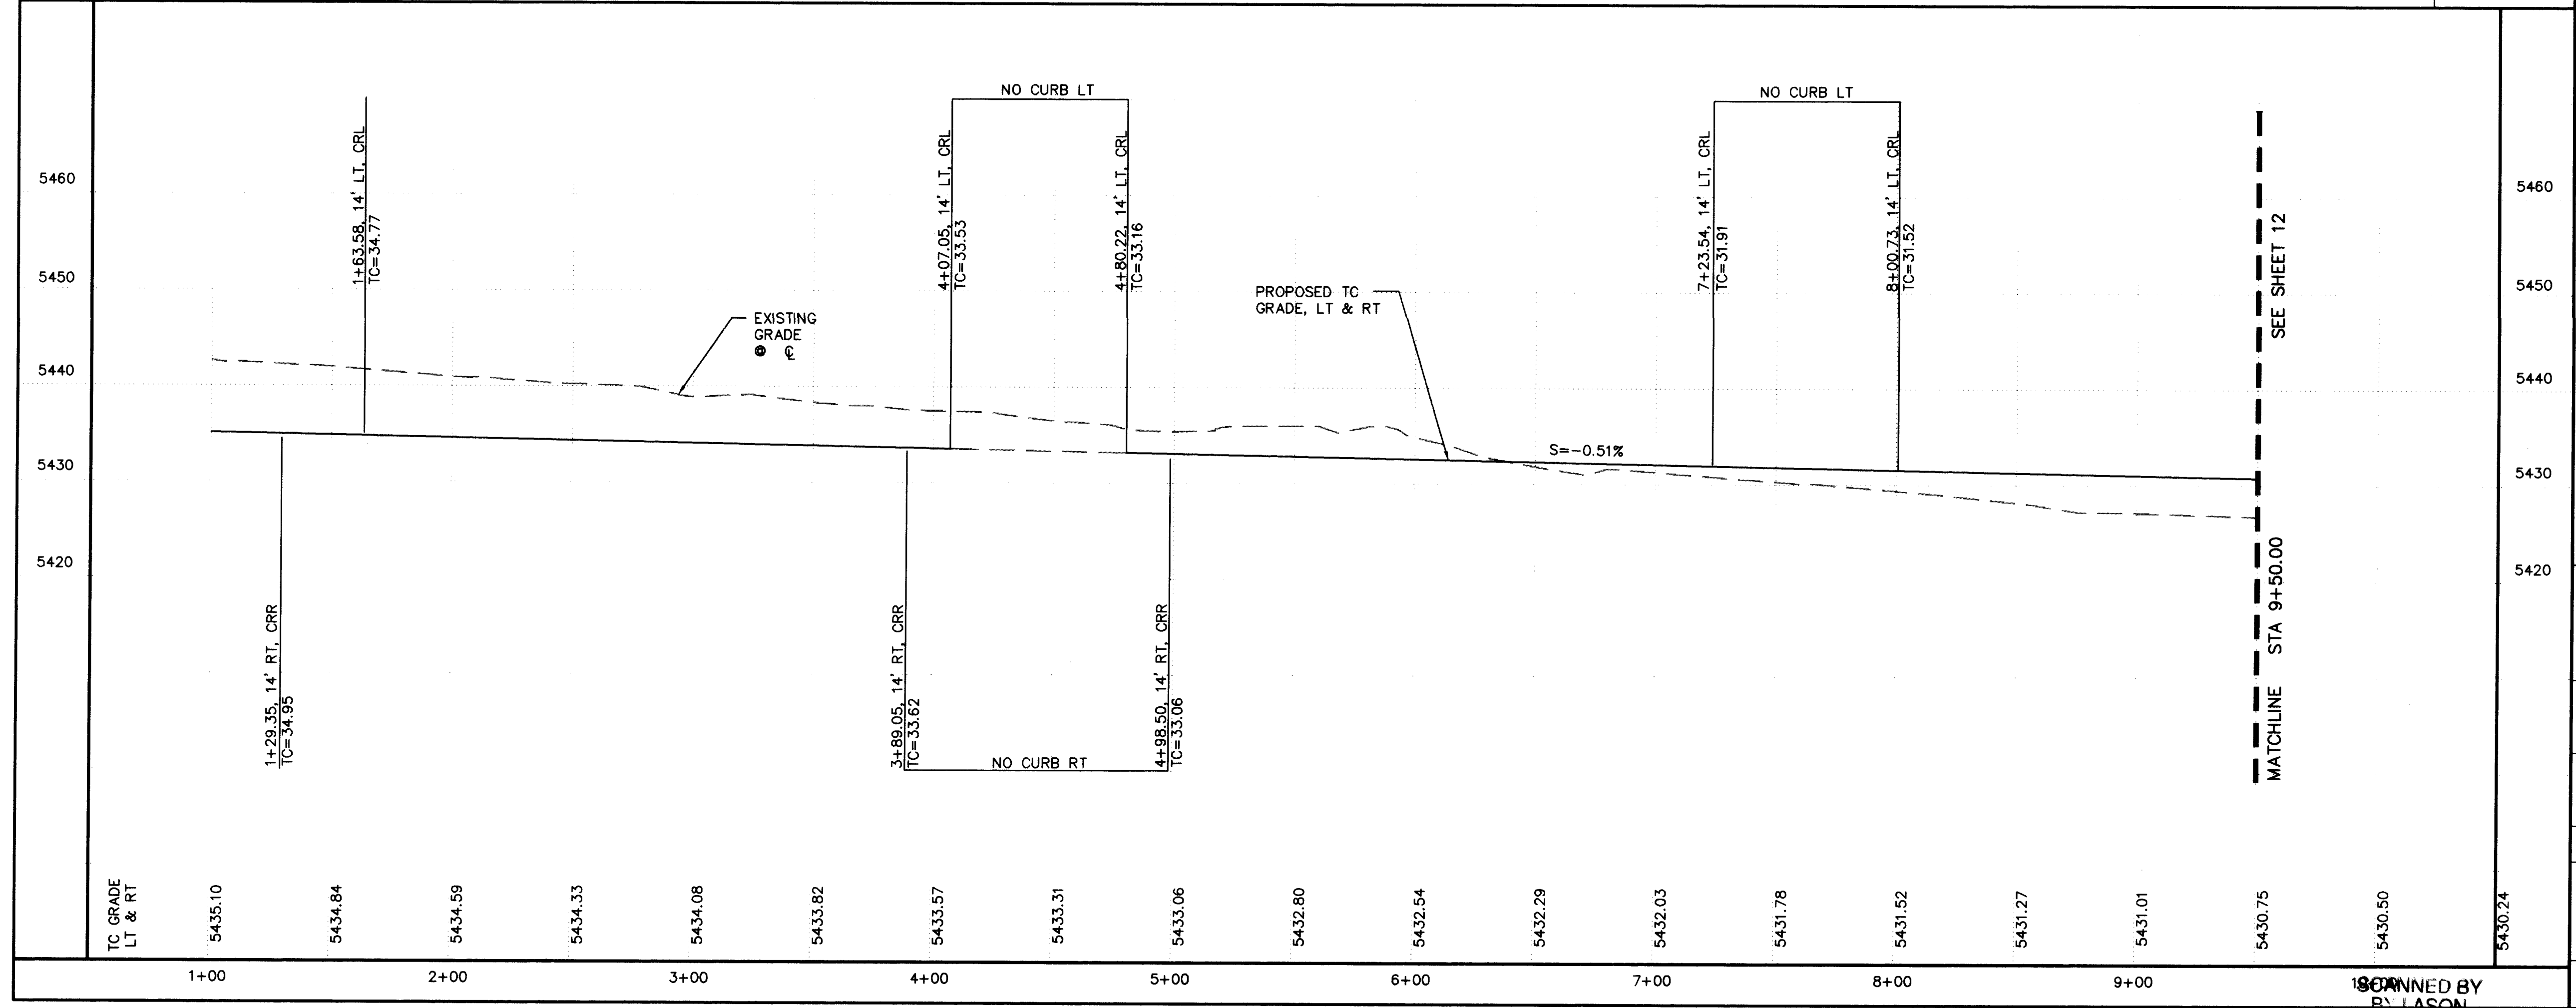


NO.	DATE	REMARKS	BY
1	6/10/97	DESIGN	SAW
2	6/10/97	DESIGN	ANW
3	6/10/97	DESIGN	SAW

ISAACSON & ARFMAN, P.A.
Consulting Engineering Associates
128 Monroe Street N.E.
Albuquerque, New Mexico 87102
945PV3.DWG
6/10/97

CITY OF ALBUQUERQUE
PUBLIC WORKS DEPARTMENT
ENGINEERING GROUP

TITLE: LUZ EN LA VENTANA AT VENTANA RANCH
LUZ DEL SOL PL
PAVING PLAN & PROFILE

City Project No. 5316.97
Zone Map No. B-9
Sheet 11 Of 18

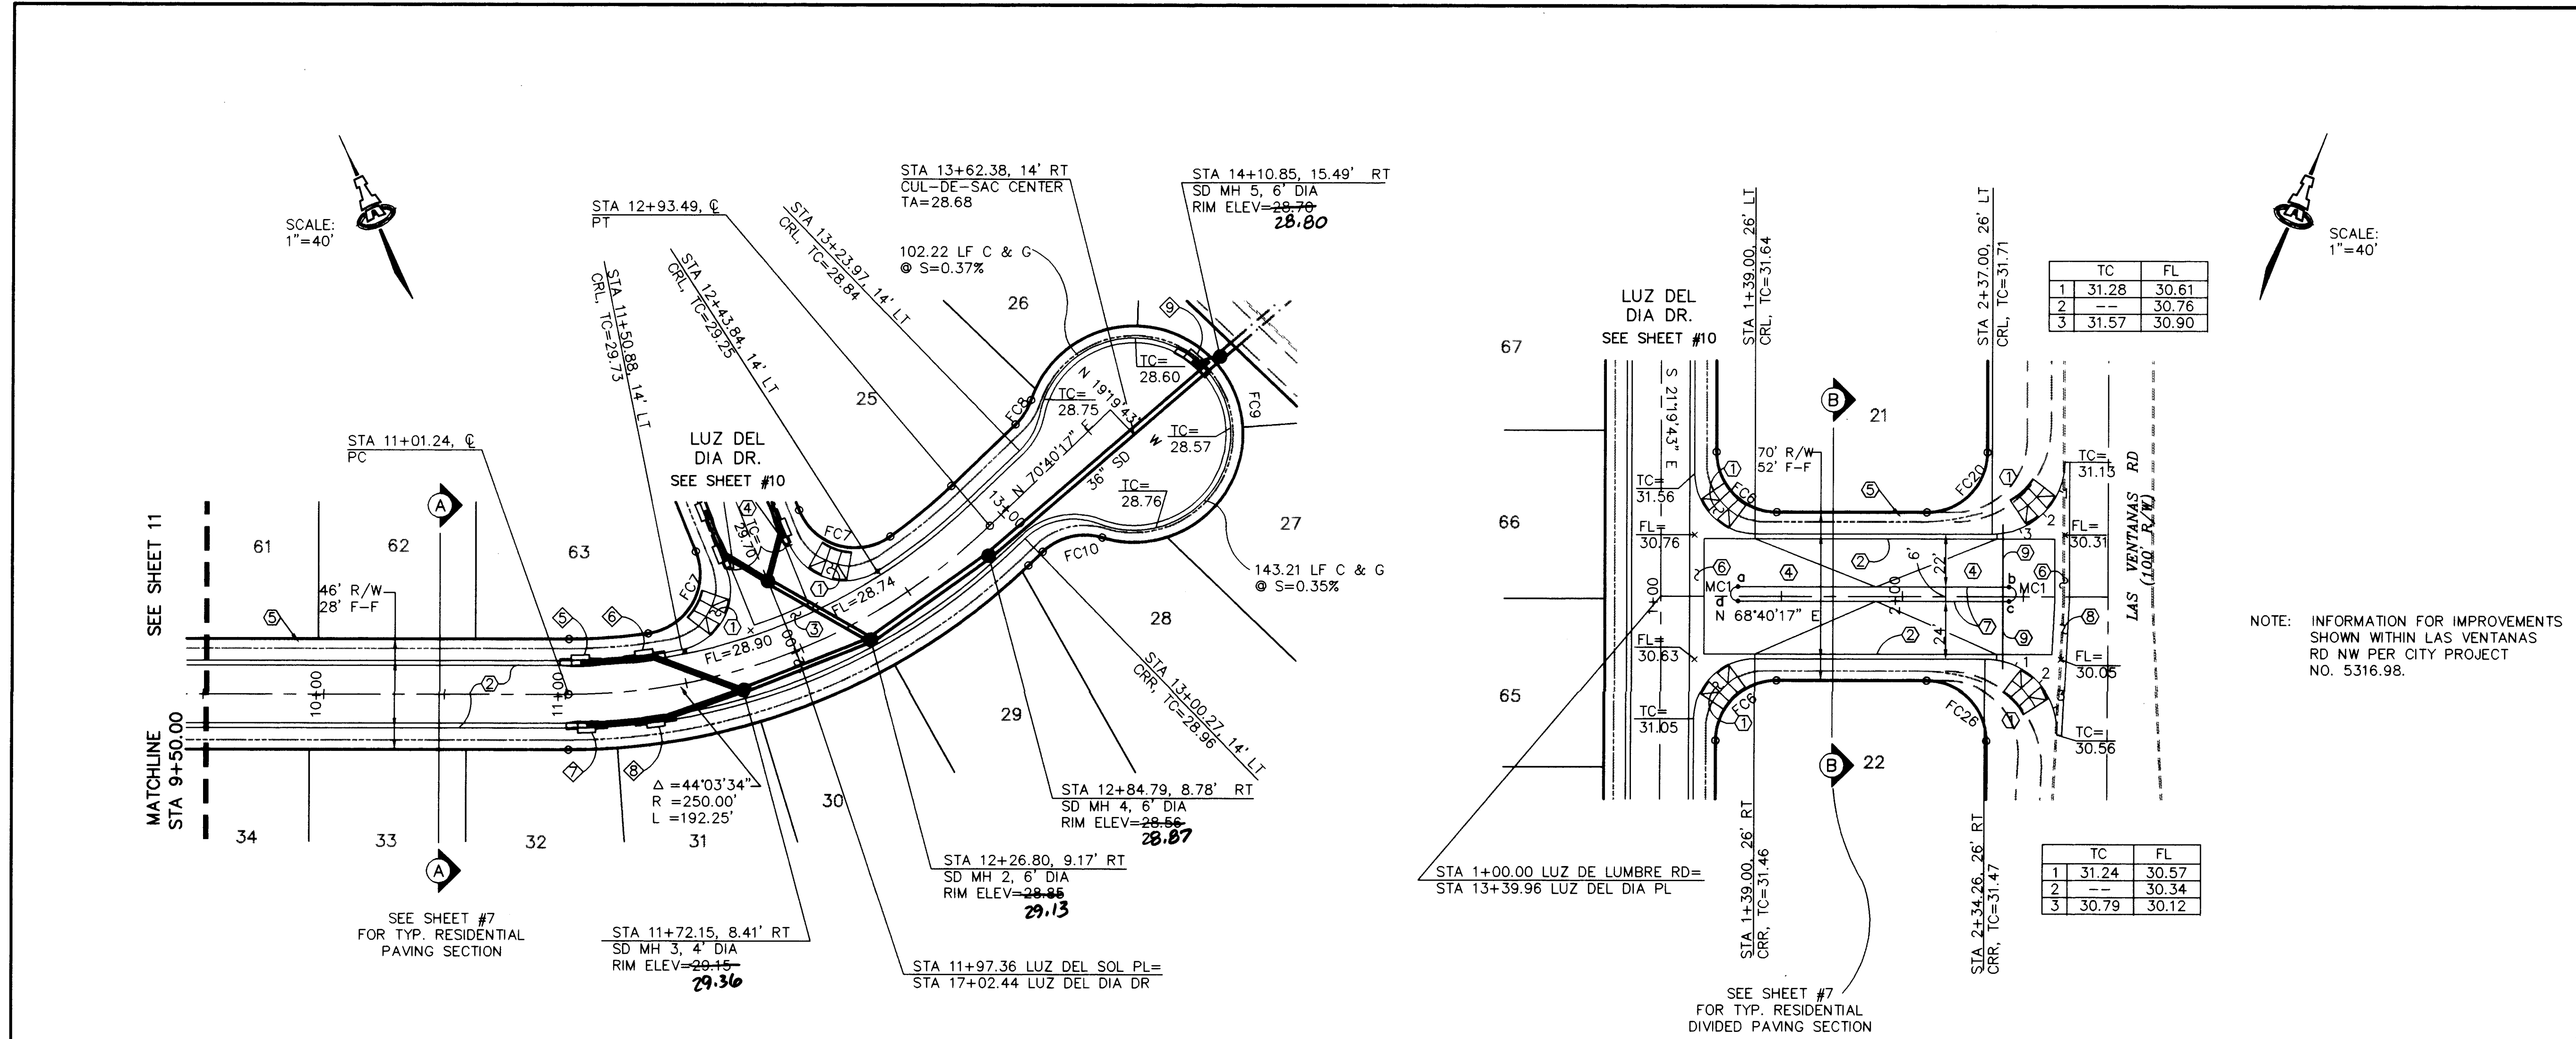

KEYED CONSTRUCTION NOTES

- CONSTRUCT HANDICAP RAMP PER DETAIL ON SHEET #7.
- STANDARD CURB & GUTTER PER COA STD DWG #2415.
- CONSTRUCT PCC VALLEY GUTTER 6' WIDE, 1 1/2" INVERT PER COA STD DWG #2420.
- CROWN TO NO CROWN TRANSITION 50' MIN. LENGTH.
- FUTURE 4' SIDEWALK PER STD DWG 2430.
- CONSTRUCT PCC VALLEY GUTTER 6' WIDE, 1 1/2" INVERT PER COA STD DWG #2420.
- MEDIAN CURB & GUTTER PER COA STD DWG #2415.
- REMOVE & DISPOSE OF 114 LF TEMP. ASPHALT CURB AND AN ADJACENT 1' STRIP OF EXST. ASPHALT.
- PLACE 2 30"x4" PVC CONDUITS @ 36" COVER AS SHOWN.

FACE OF CURB CURVE TABLE

CURVE	RADIUS	LENGTH	DELTA
FC6	25.00'	39.27'	90°00'00"
FC7	25.00'	43.92'	100°39'05"
FC8	29.00'	17.33'	34°18'49"
FC9	40.00'	195.10'	279°27'11"
FC10	28.00'	32.97'	65°08'22"
FC20	30.00'	47.12'	89°59'48"
FC26	30.00'	48.62'	92°52'04"

MEDIAN INFORMATION

POINT	STATION, OFFSET	TC	DISTANCE
a	1+32.00, 4' LT	31.36	FROM a-b
b	2+44.00, 4' LT	31.30	112.00'
c	2+44.00, 2' RT	31.27	FROM c-d
d	1+32.00, 2' RT	31.33	112.00'

MEDIAN CURVE TABLE

CURVE	RADIUS	LENGTH	DELTA
MC1*	3.00'	9.42'	180°00'00"

* PAINT MEDIAN NOSES YELLOW--INCIDENTAL TO CURB & GUTTER COST

STORM DRAIN INLET INFORMATION

INLET NO.	INLET TYPE	STATION* & OFFSET	TC EL TOP GRATE	INV IN	INV OUT
5	SGL 'A'	11+08.13, 14' LT	29.95	29.95	29.95
6	DBL 'C'	11+36.17, 14' LT	29.81	29.81	29.81
7	SGL 'A'	11+10.02, 14' RT	29.94	29.94	29.94
8	DBL 'C'	11+37.18, 14' RT	29.80	29.80	29.80
9	SGL 'A' DBL THROAT	14+02.66, 10.53' RT	28.46	28.46	28.46

* STATIONING IS TO MIDPOINT OF GRATE @ FACE OF CURB

CONNECTOR PIPE INFORMATION

FROM-TO INLET NO.	DIA. (IN)	LENGTH (FT)	SLOPE (FT/FT)
5-6	18	23.6	0.0275
6-MH 3	18	40.3	0.0149
7-8	18	25.6	0.0215
8-MH 3	18	35.2	0.0340
9-MH 5	18	9.6	0.0417

ISAACSON & ARFMAN, P.A.
Consulting Engineering Associates
128 Monroe Street N.E.
Albuquerque, New Mexico
6/16/97

CITY OF ALBUQUERQUE
PUBLIC WORKS DEPARTMENT
ENGINEERING GROUP



TITLE: LUZ EN LA VENTANA AT VENTANA RANCH
LUZ DEL SOL PL & LUZ DE LUMBRE RD
PAVING PLAN & PROFILE

Design Review Committee	City Engineer Approval	Mo./Day/Yr.	Mo./Day/Yr.
By: [Signature]	By: [Signature]		


City Project No. **5316.97** Zone Map No. **B-9** Sheet **12** Of **18**

LUZ DEL SOL PLACE

LUZ DE LUMBRE ROAD

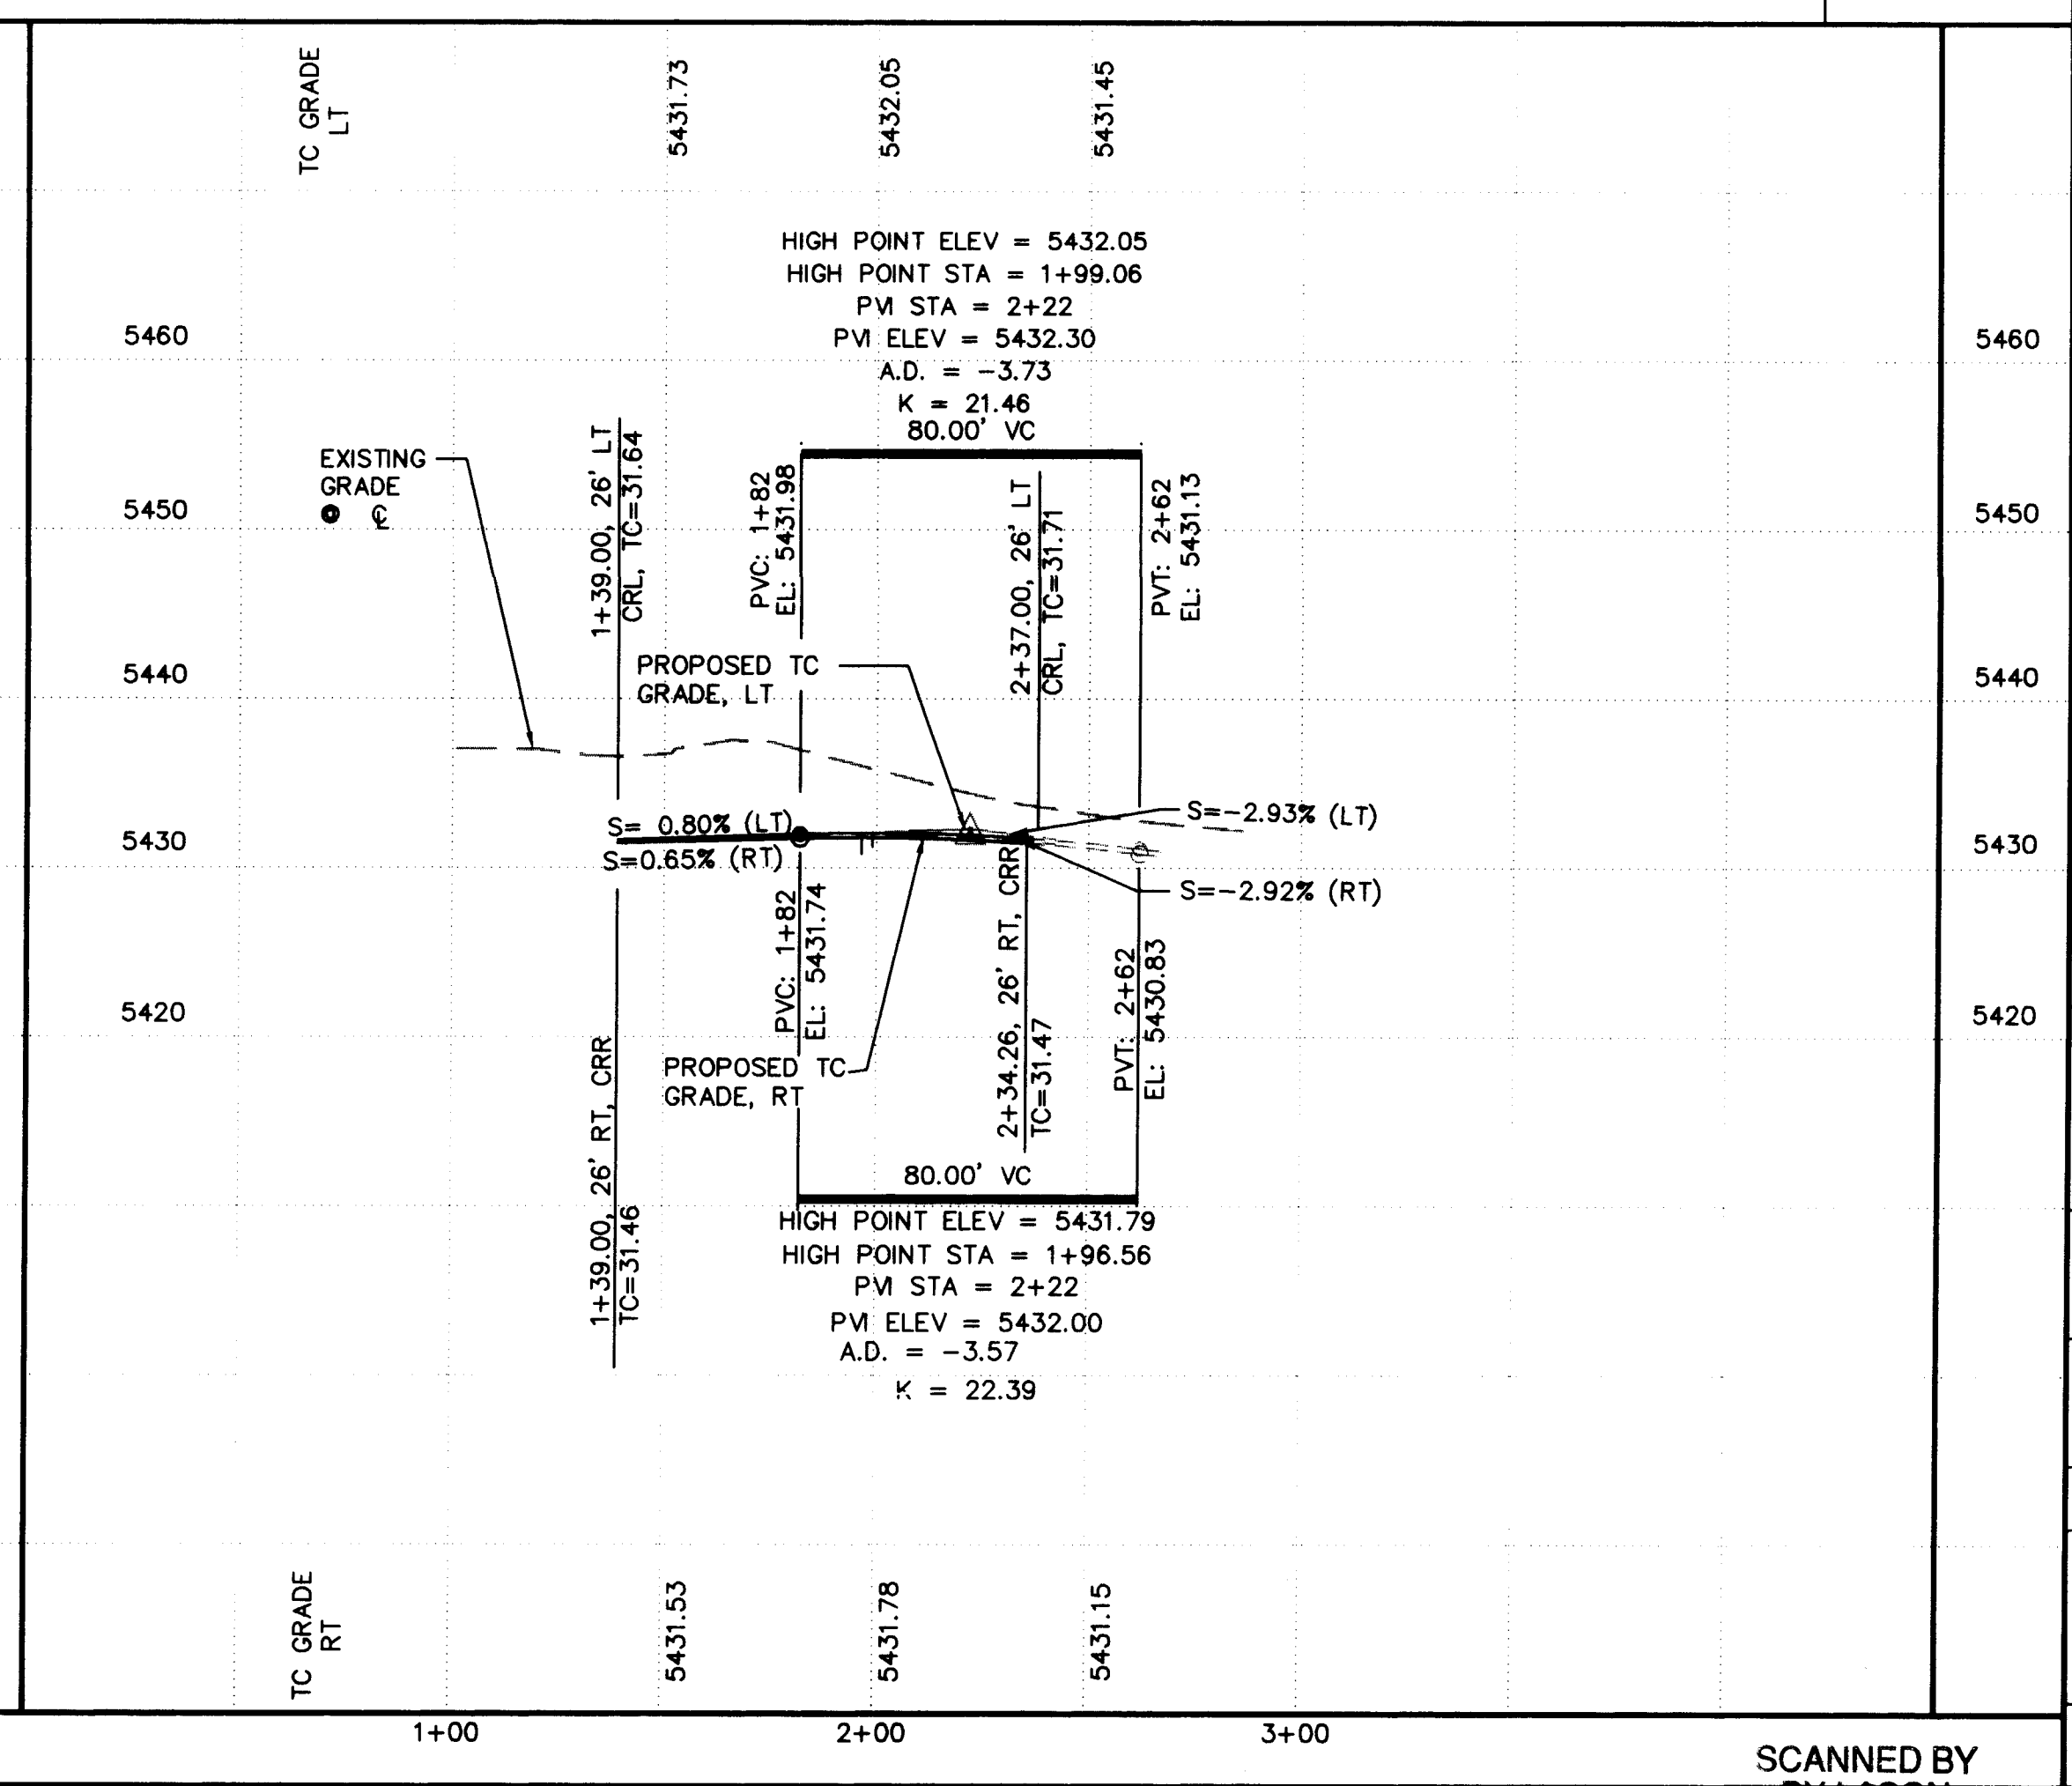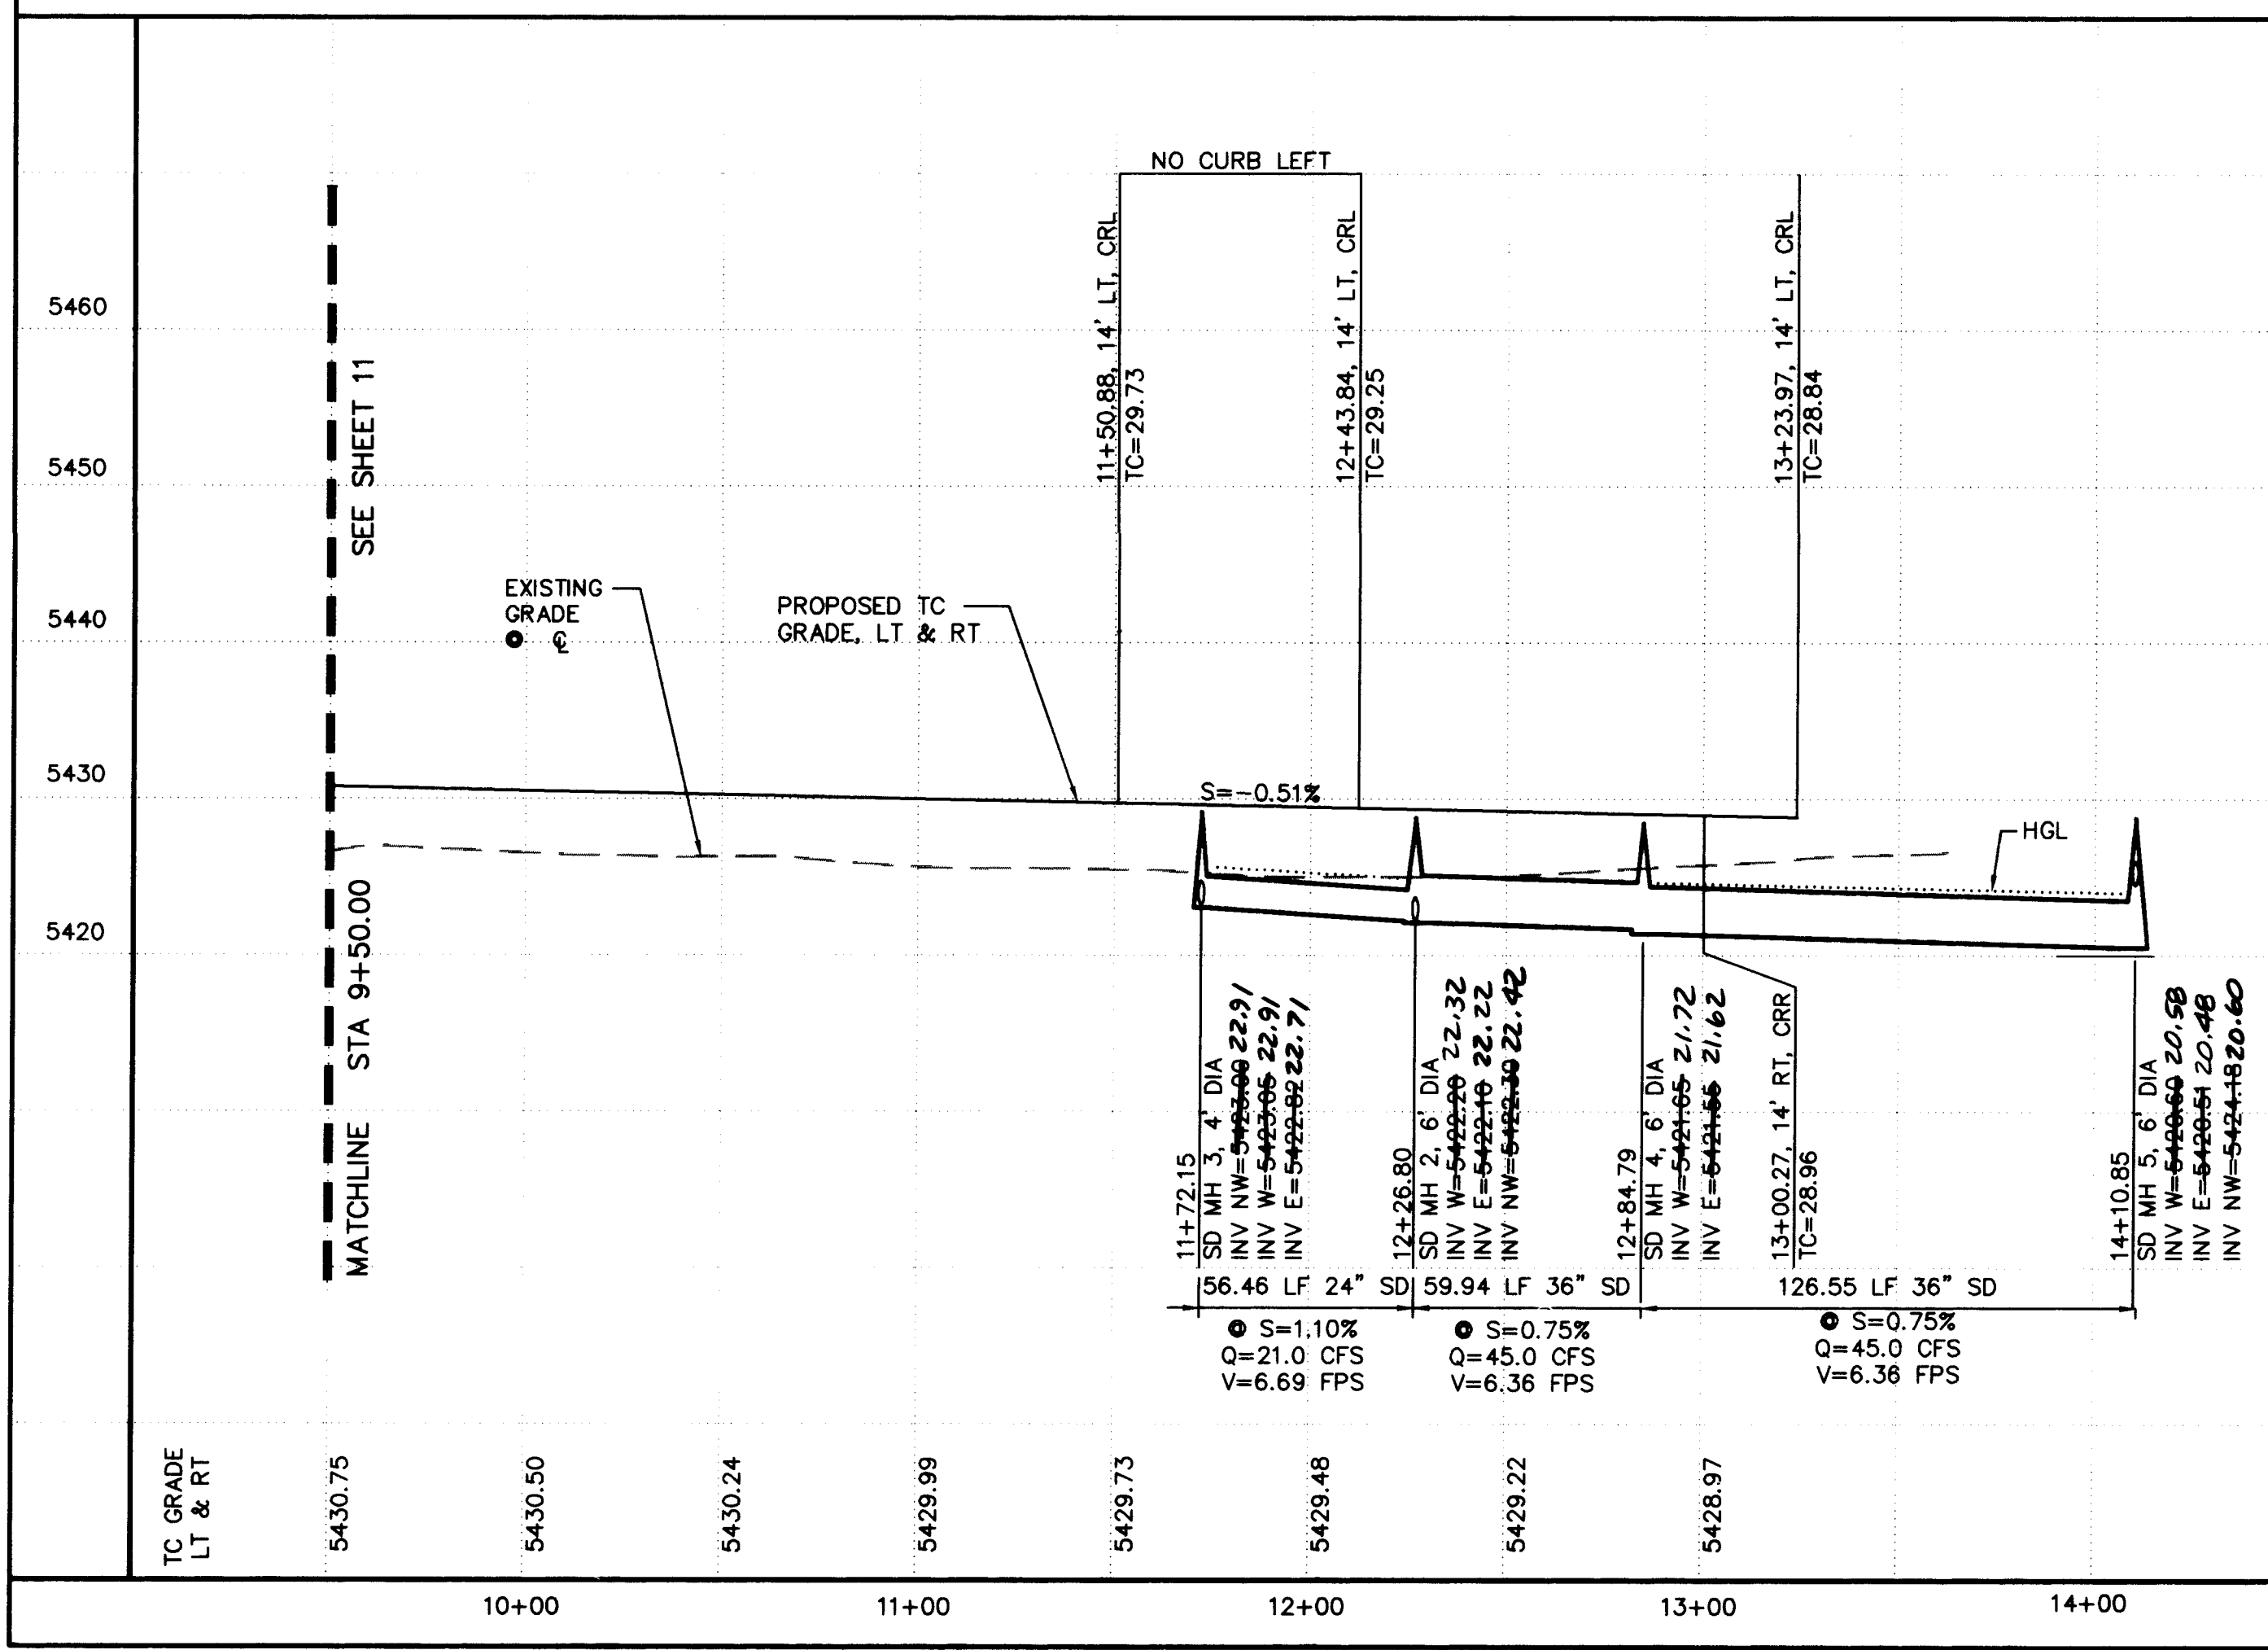

SCANNED BY
BY: LASON

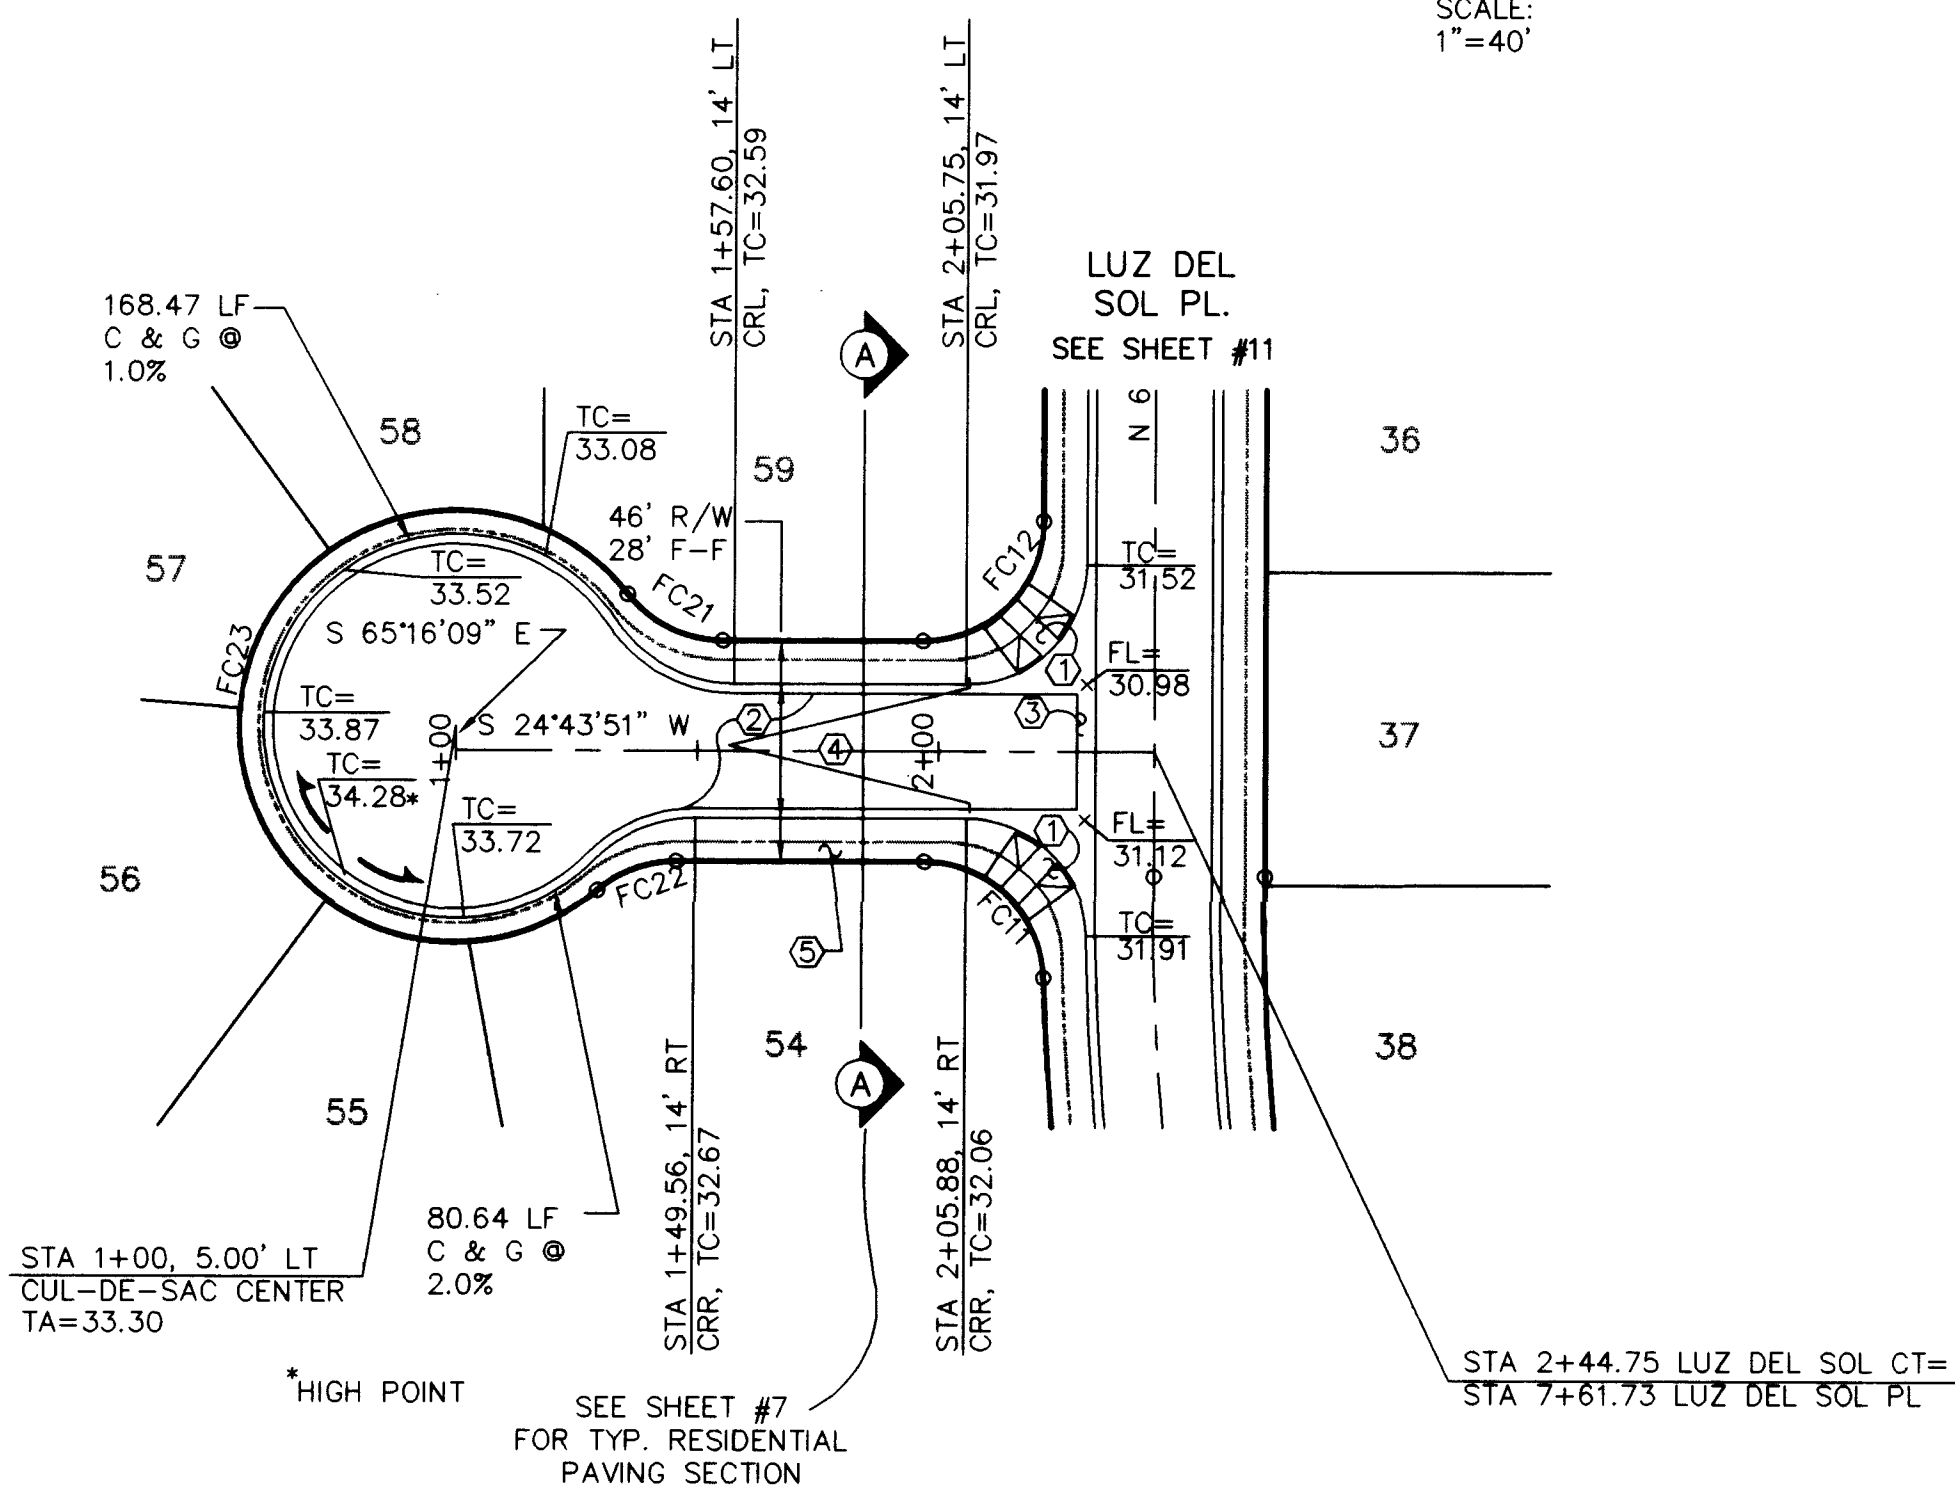

LUZ DEL SOL COURT

NOTE: INFORMATION FOR IMPROVEMENTS SHOWN
WITHIN VENTANA VILLAGE RD NW PER
CITY PROJECT NO. 5316.95

SCALES:
1"=40' HOR.
1"=10' VERT.

KEYED CONSTRUCTION NOTES

1. CONSTRUCT HANDICAP RAMP PER
DETAIL ON SHEET #7.
2. STANDARD CURB & GUTTER PER COA
STD DWG #2415.
3. CONSTRUCT PCC VALLEY GUTTER
4' WIDE, 1 1/2" INVERT PER COA STD
DWG #2421.
4. CROWN TO NO CROWN TRANSITION
50' MIN. LENGTH.
5. FUTURE 4' SIDEWALK PER STD DWG #2430.
6. CONSTRUCT PCC VALLEY GUTTER
6' WIDE, 1 1/2" INVERT PER COA STD
DWG #2420. REMOVE & DISPOSE OF
100 LF ASPHALT CURB.
7. MEDIAN CURB & GUTTER PER COA
STD DWG #2415.
8. REMOVE & DISPOSE OF 105 LF TEMP. ASPHALT
CURB AND AN ADJACENT 1' STRIP OF EXST.
ASPHALT.
9. PLACE 2 30"x4" PVC CONDUITS @ 36" COVER
AS SHOWN.

MEDIAN INFORMATION			
POINT	STATION, OFFSET	TC	DISTANCE
a	4+33.83, 4' LT	33.75	FROM a-b
b	5+41.86, 4' LT	35.90	108.03'
c	5+41.86, 2' RT	35.93	FROM c-d
d	4+33.83, 2' RT	33.78	108.03'

CURVE	RADIUS	LENGTH	DELTA
MC1*	3.00'	9.42'	180°00'00"

*PAINT MEDIAN NOSES YELLOW--INCIDENTAL TO CURB & GUTTER COST.

CURVE	RADIUS	LENGTH	DELTA
FC4	25.00'	40.74'	93'22.35"
FC5	25.00'	37.80'	86'37.25"
FC11	25.00'	38.75'	88'48.14"
FC12	25.00'	39.27'	90'00.00"
FC13	25.00'	35.92'	82'19.14"
FC14	25.00'	37.75'	86'30.31"
FC15	25.00'	41.56'	95'15.15"
FC16	25.00'	41.65'	95'27.54"
FC21	29.00'	28.64'	56'35.14"
FC22	29.00'	23.24'	45'54.58"
FC23	49.00'	197.22'	282'30.12"
FC24	30.00'	42.01'	80'14.15"
FC25	30.00'	44.82'	85'36.28"

AS-BUILT INFORMATION	
CONTRACTOR	SUN-DANCE MECH
WORK	STAND BY
INSPECTOR'S NAME	ALV, INC
DATE	97
FIELD	VERIFICATION BY
DRAWINGS	C.O.A.
CORRECTED BY	ALV, INC
DATE	97
MICRO-FILM INFORMATION	
RECORDED BY	DATE
NO.	

STAMPED "1-B10", SET IN
WITH GROUND UNDER NORTH-
Y. Y. 0.90 MILES WEST OF
E. NW.

	BENCH MARKS
16	A STANDARD ACS BRASS TABLET, TOP OF A CONCRETE POST FLUSH SOUTH POWER LINES APPROXIMATELY PARADISE BLVD NW AND PARK LANE
	ELEVATION: 5419.522

[illegible][illegible]


 **ISAACSON & ARFMAN, P.A.**
Consulting Engineering Associates
128 Monroe Street N.E.
Albuquerque New Mexico
945PV5.DWGanw 6/12/97



CITY OF ALBUQUERQUE
PUBLIC WORKS DEPARTMENT
ENGINEERING GROUP

TITLE: LUZ EN LA VENTANA AT VENTANA RANCH
LUZ DE AMANECER DR & LUZ DEL SOL CT
PAVING PLAN & PROFILE

City Engineer Approval 	Last Design Update	Mo./Day/Yr.	Mo./Day/Yr.

City Project No. 5316.97	Zone Map No. B-9	Sheet 13 Of 18
------------------------------------	----------------------------	------------------------------

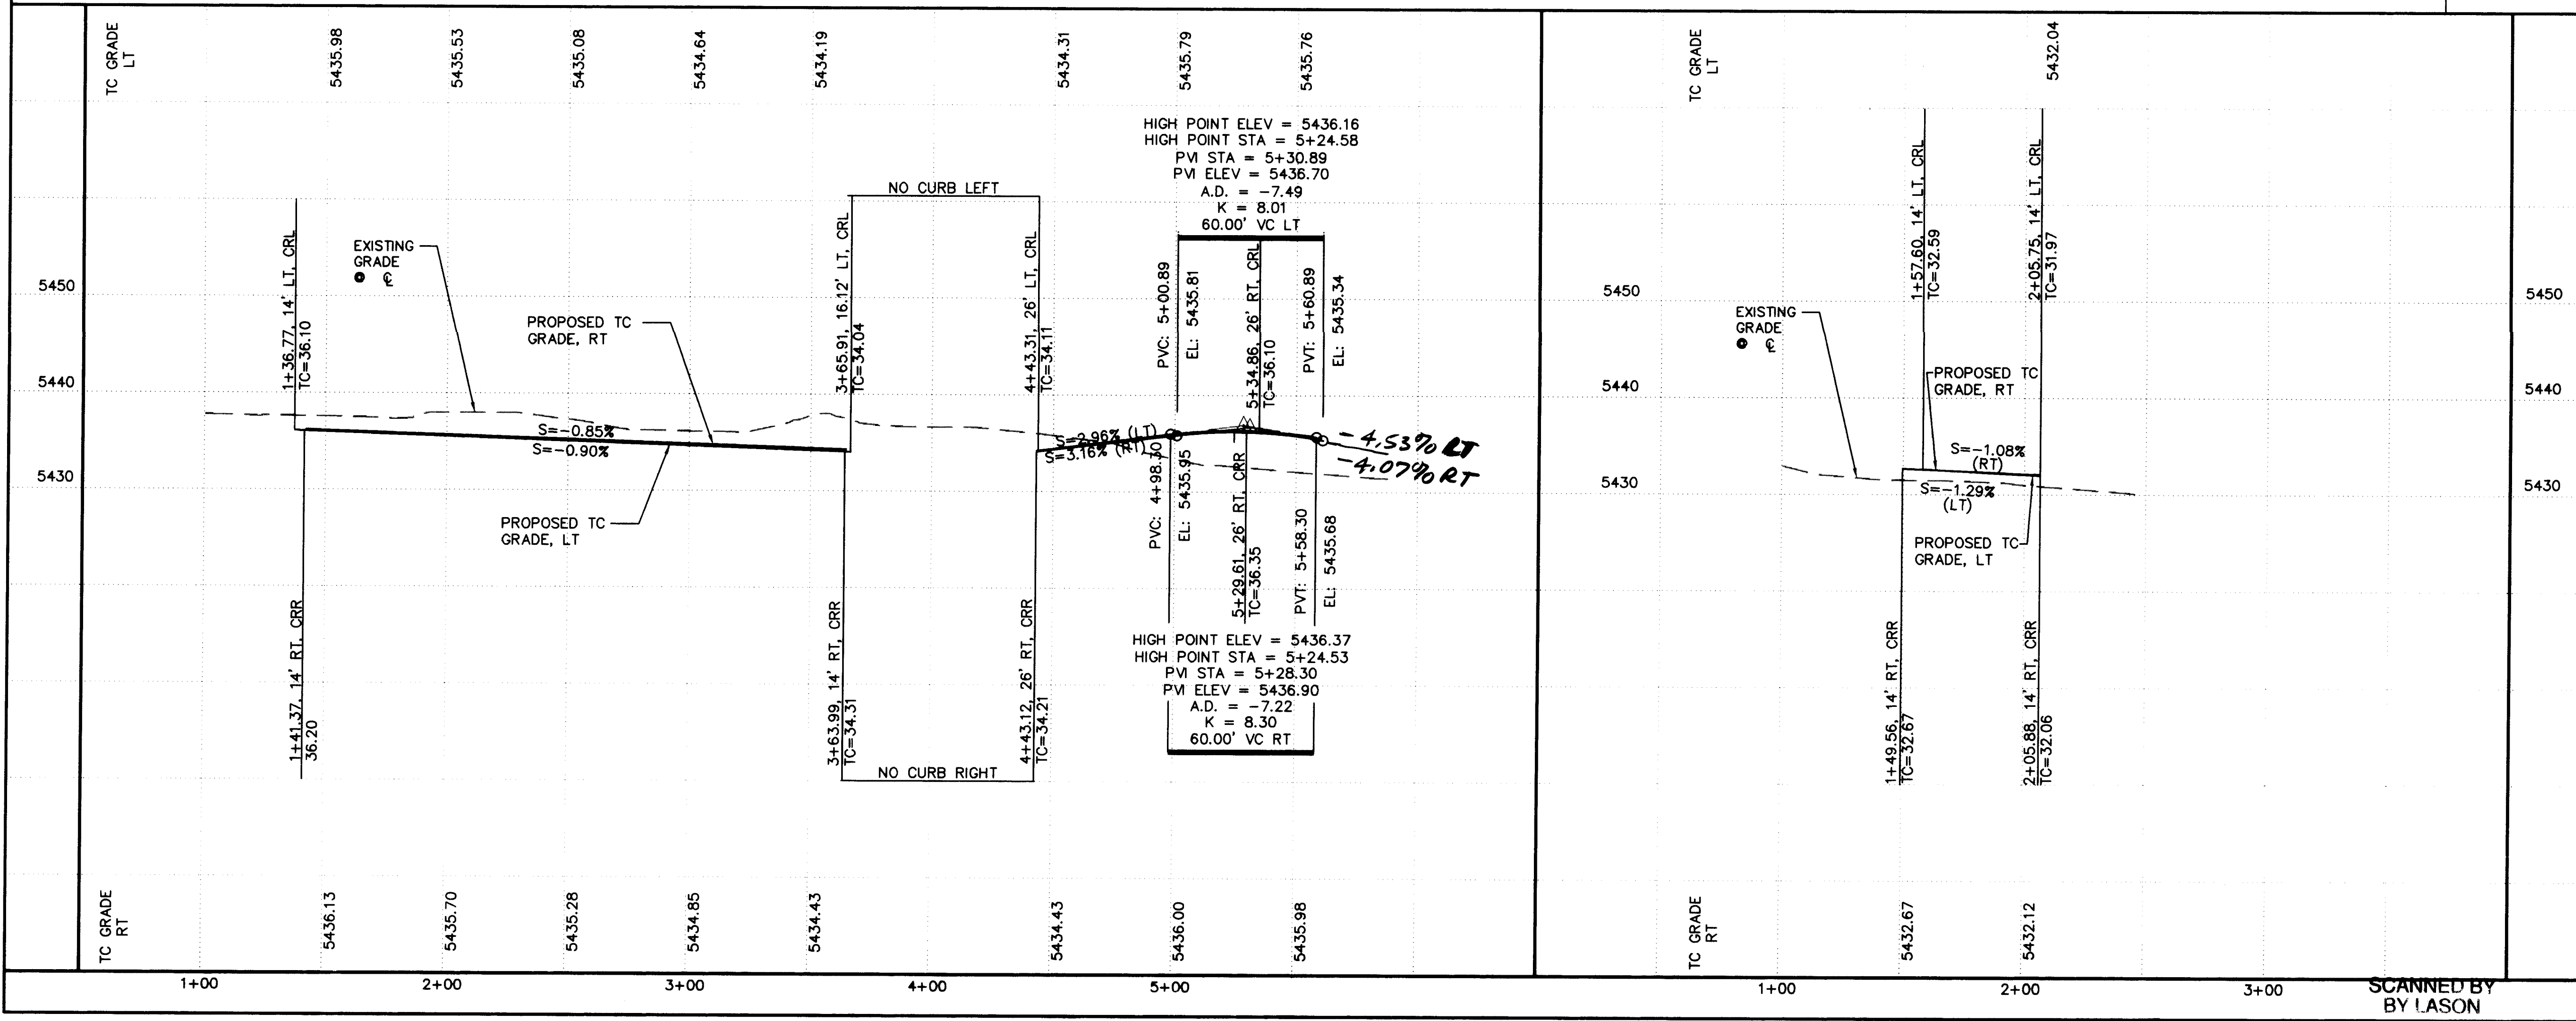

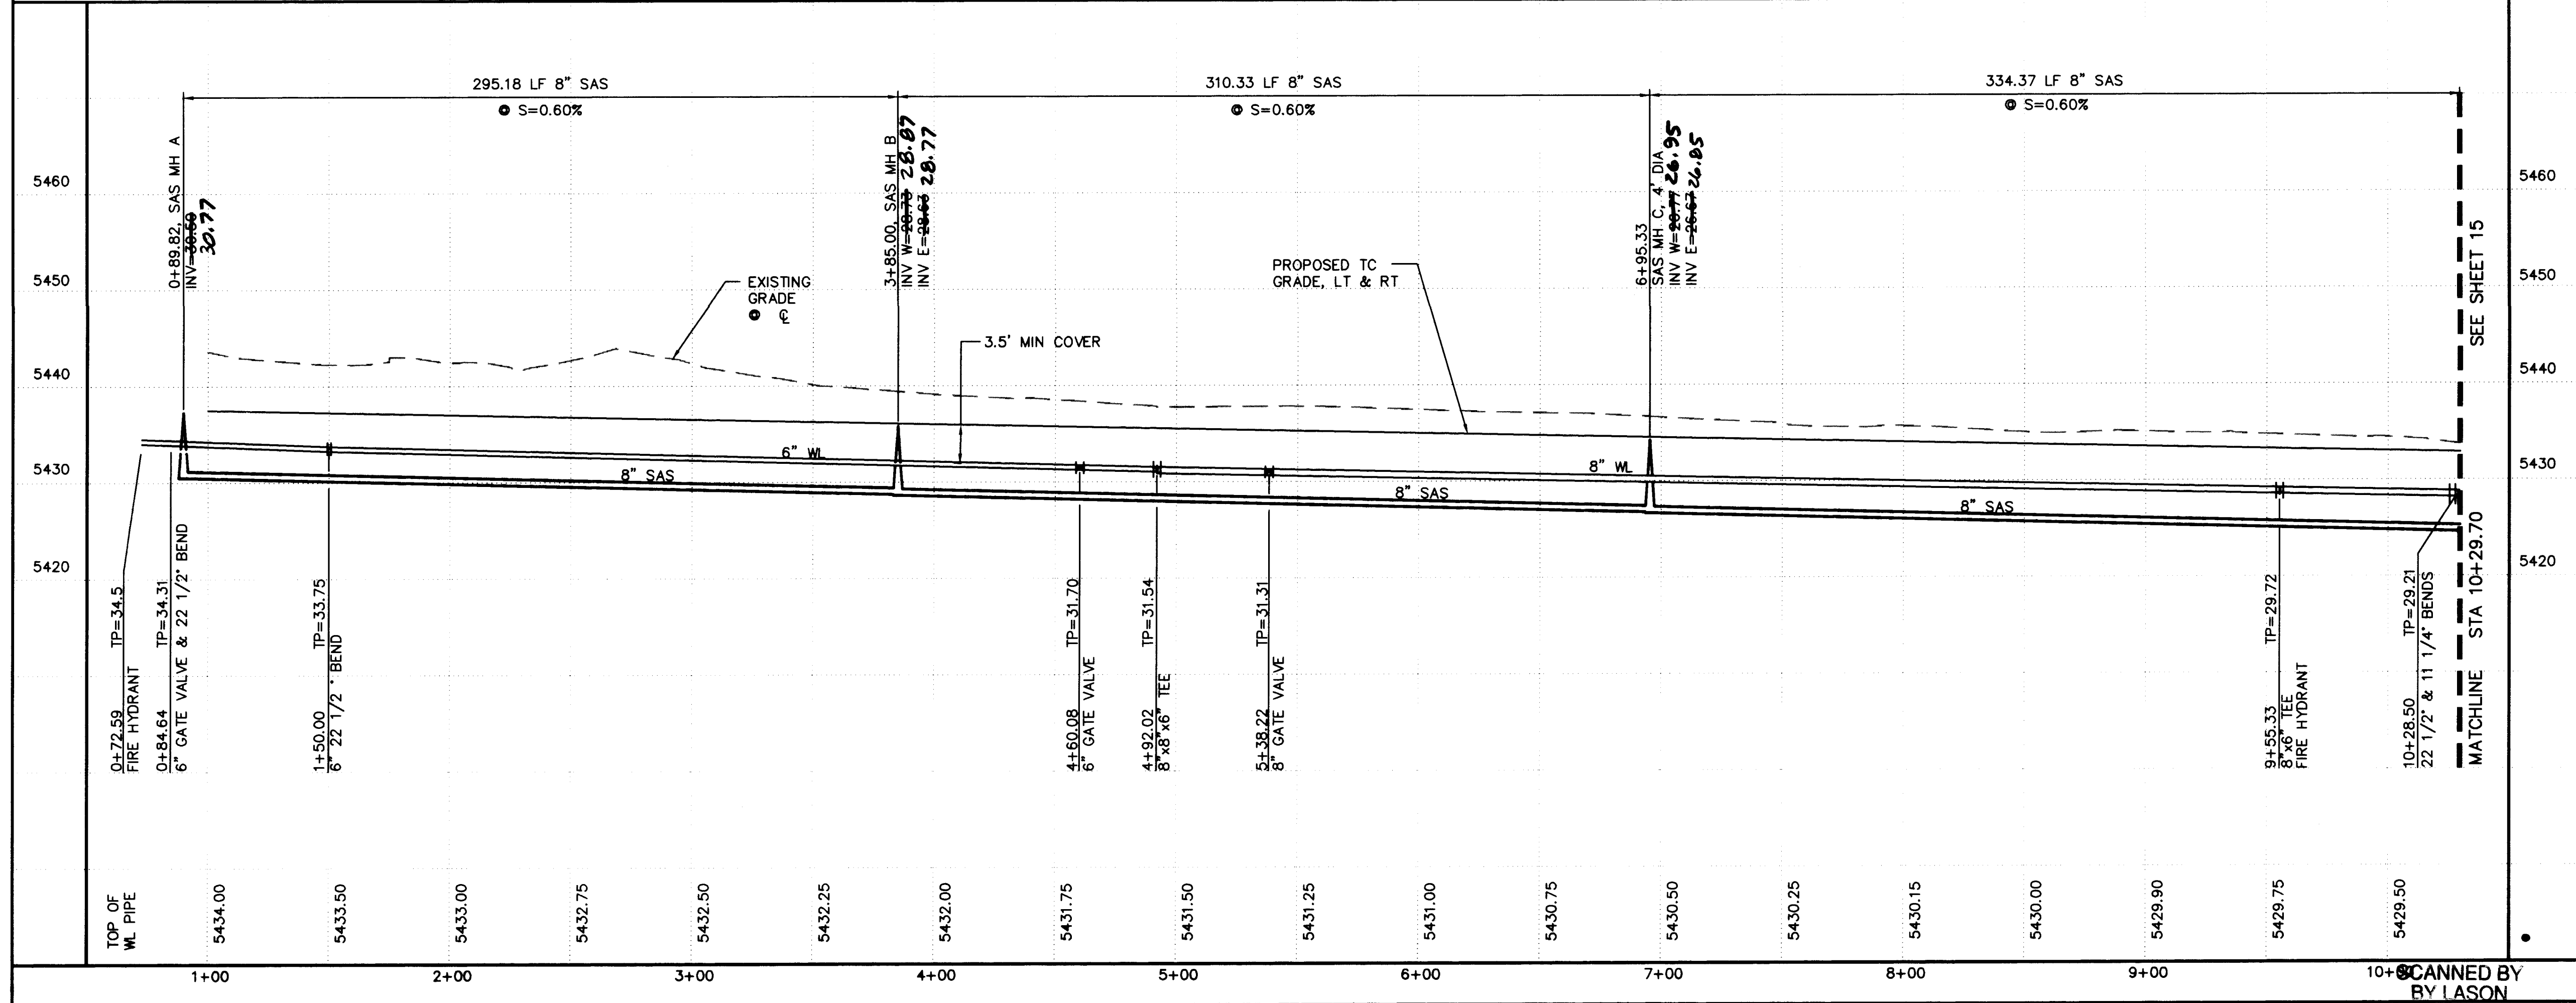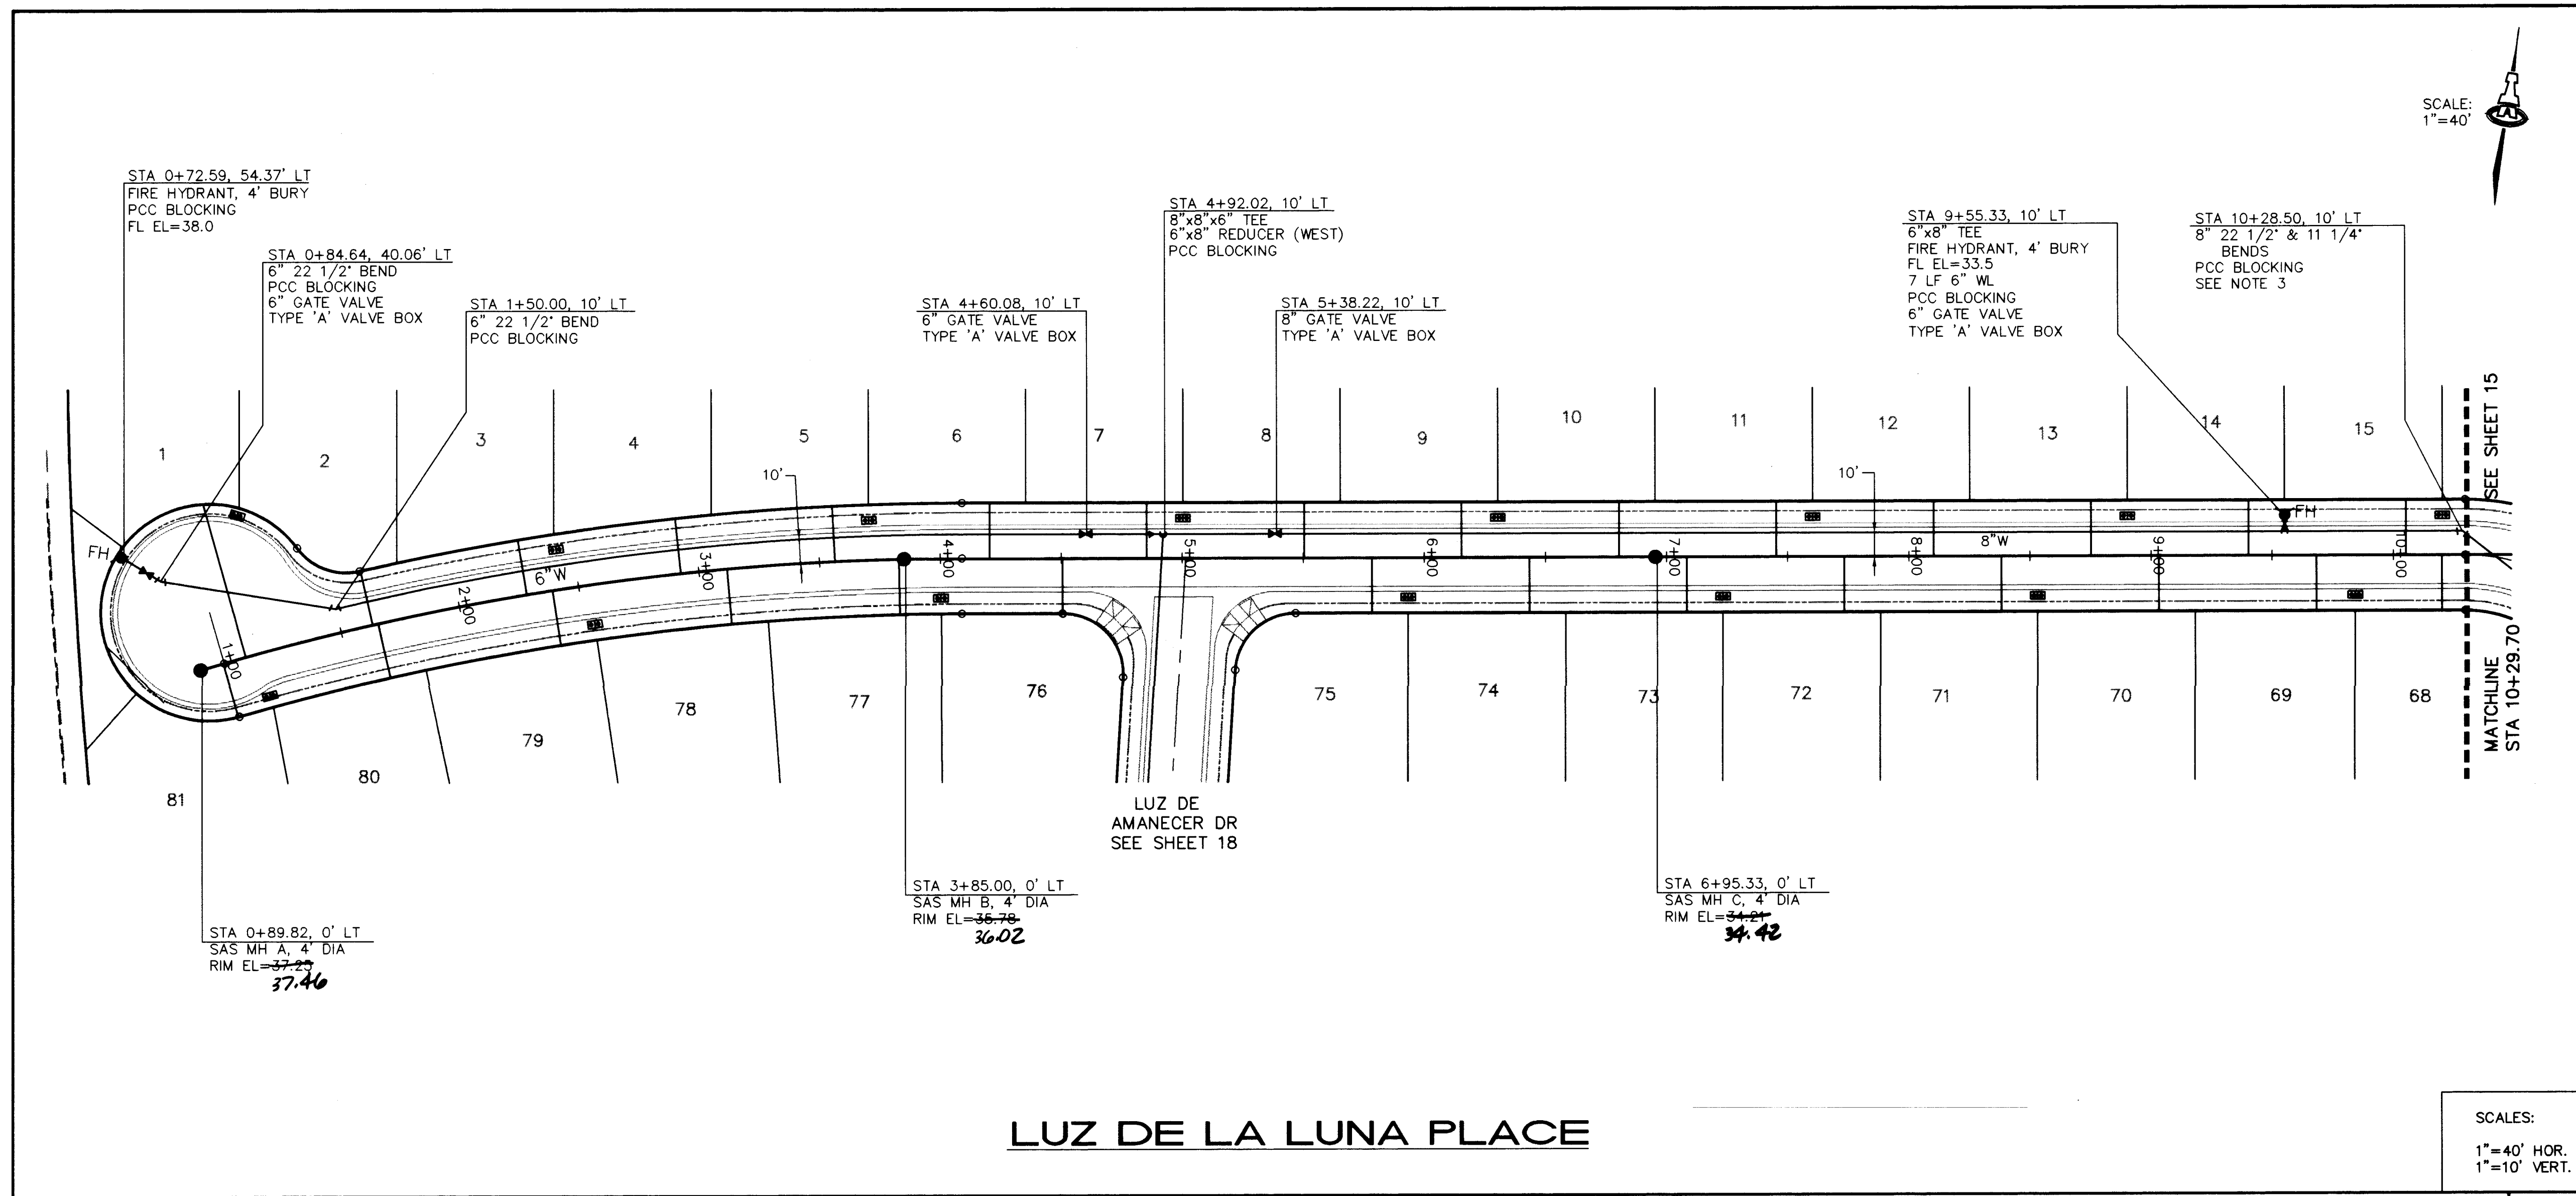

- GENERAL NOTES**
1. CONSTRUCT SAS SERVICES PER COA STD DWG #2125 & NMUI SPECIFICATIONS FOR MATERIALS.
 2. CONSTRUCT FIRE HYDRANTS PER DESIGNATED DEPTHS & LENGTHS PER COA STD DWG #2340.
 3. DEFLECT WATERLINE 4"16"34" RIGHT BETWEEN STA 10+28.50 AND 10+70.

UTILITY SERVICE TABLE

LOT NO.	STATION		SAS INV @ R/W
	WATER, LENGTH	SAS, LENGTH	
1	1+22.65, 48'	1+09.38, 66'	37.8 33.2
2		1+63.39, 23'	36.7 32.5
3	2+43.16, 7'	2+28.28, 23'	36.4 32.6
4		2+92.54, 23'	36.6 32.3
5	3+71.11, 7'	3+56.41, 23'	36.7 32.0
6		4+20.33, 23'	36.1 31.6
7		4+85.33, 23'	36.1 31.6
8	5+00.33, 7'	5+50.33, 23'	34.7 30.2
9		6+15.33, 23'	34.1 29.9
10	6+30.33, 7'	6+80.33, 23'	34.1 29.4
11		7+45.33, 23'	33.8 29.3
12	7+60.33, 7'	8+10.33, 23'	33.4 29.0
13		8+75.33, 23'	33.1 28.6
14	8+90.33, 7'	9+40.33, 23'	32.6 28.5
15		10+05.33, 23'	32.6 28.5
16	10+20.33, 7'	10+47.34, 23'	32.3 28.5
68		10+20.00, 23'	32.4 29.7
69	9+84.27, 26'	9+68.30, 23'	32.7 29.1
70		9+03.30, 23'	32.6 28.4
71	8+53.30, 26'	8+38.30, 23'	32.5 28.1
72		7+73.30, 23'	32.6 29.1
73	7+23.30, 26'	7+08.30, 23'	31.8 29.5
74		6+43.30, 23'	31.3 29.8
75	5+93.30, 26'	5+78.30, 23'	31.6 30.0
76		4+50.54, 23'	32.2 31.7
77	4+00.15, 26'	3+82.79, 23'	32.6 31.9
78		3+11.69, 23'	32.9 32.5
79	2+54.44, 26'	2+39.12, 23'	32.9 32.5
80		1+65.70, 23'	32.8 32.8
81	1+14.94, 28'	0+99.57, 23'	32.8 33.0

LEGEND


- SINGLE WATER METER & BOX
- DOUBLE WATER METER & BOX
- GATE VALVE W/ TYPE 'A' VALVE BOX
- FIRE HYDRANT W/ VALVED LEG
- SAS MANHOLE
- WATER LINE W/ FITTING



ISAACSON & ARFMAN, P.A.
Consulting Engineering Associates
128 Monroe Street, N.E.
Albuquerque, New Mexico 87102
945UTL1.DWGanw 6/9/97



CITY OF ALBUQUERQUE
PUBLIC WORKS DEPARTMENT
ENGINEERING GROUP

TITLE: **LUZ EN LA VENTANA AT VENTANA RANCH**
LUZ DE LA LUNA PL
UTILITY PLAN & PROFILE

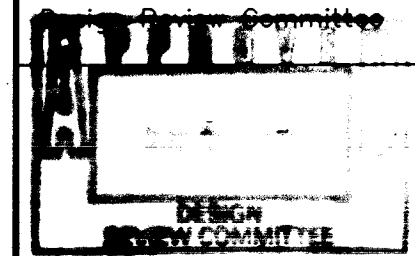

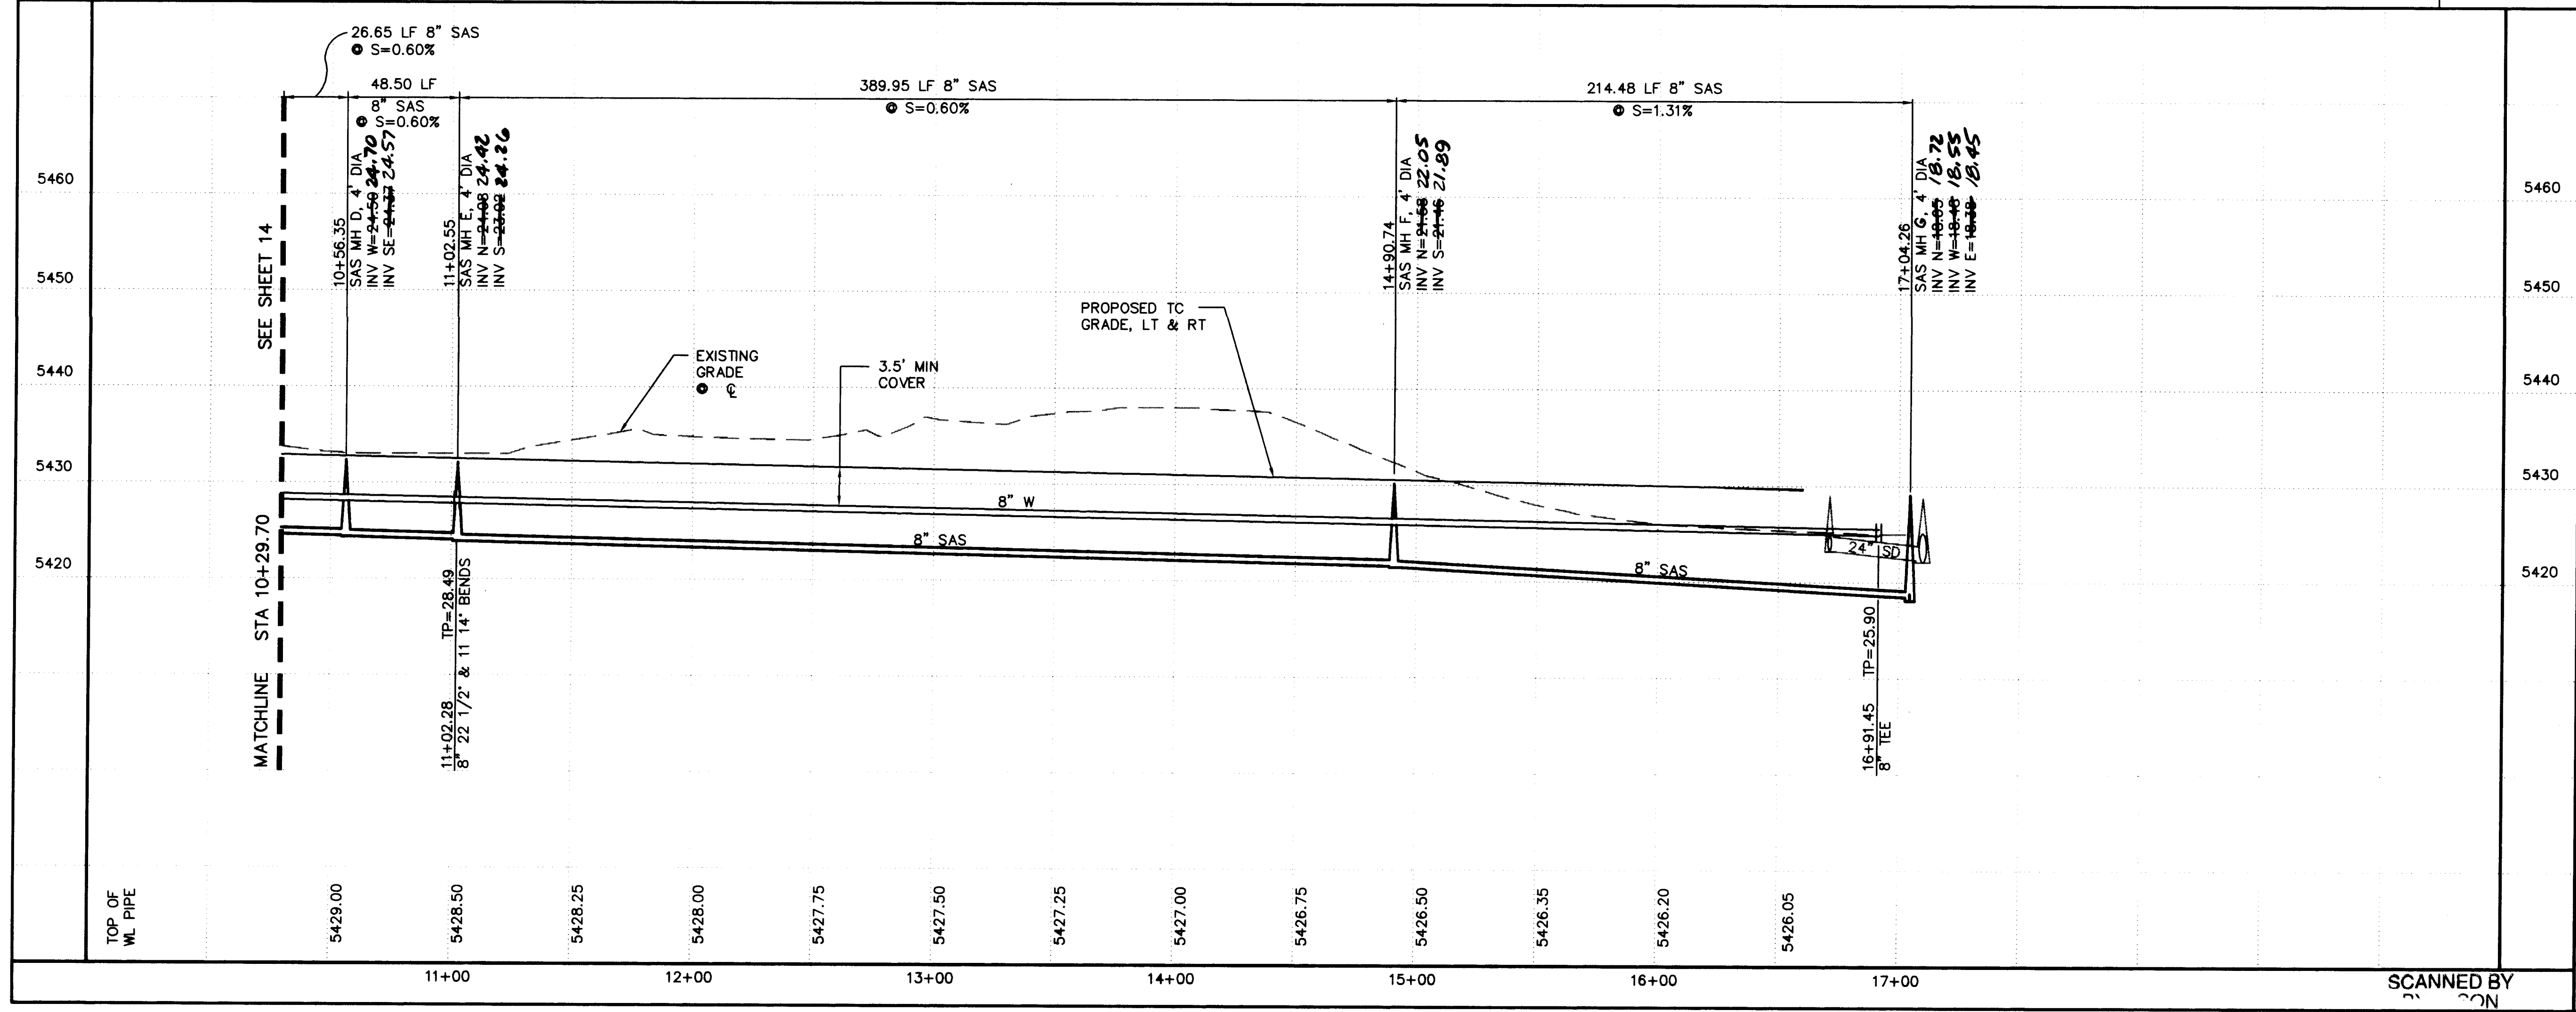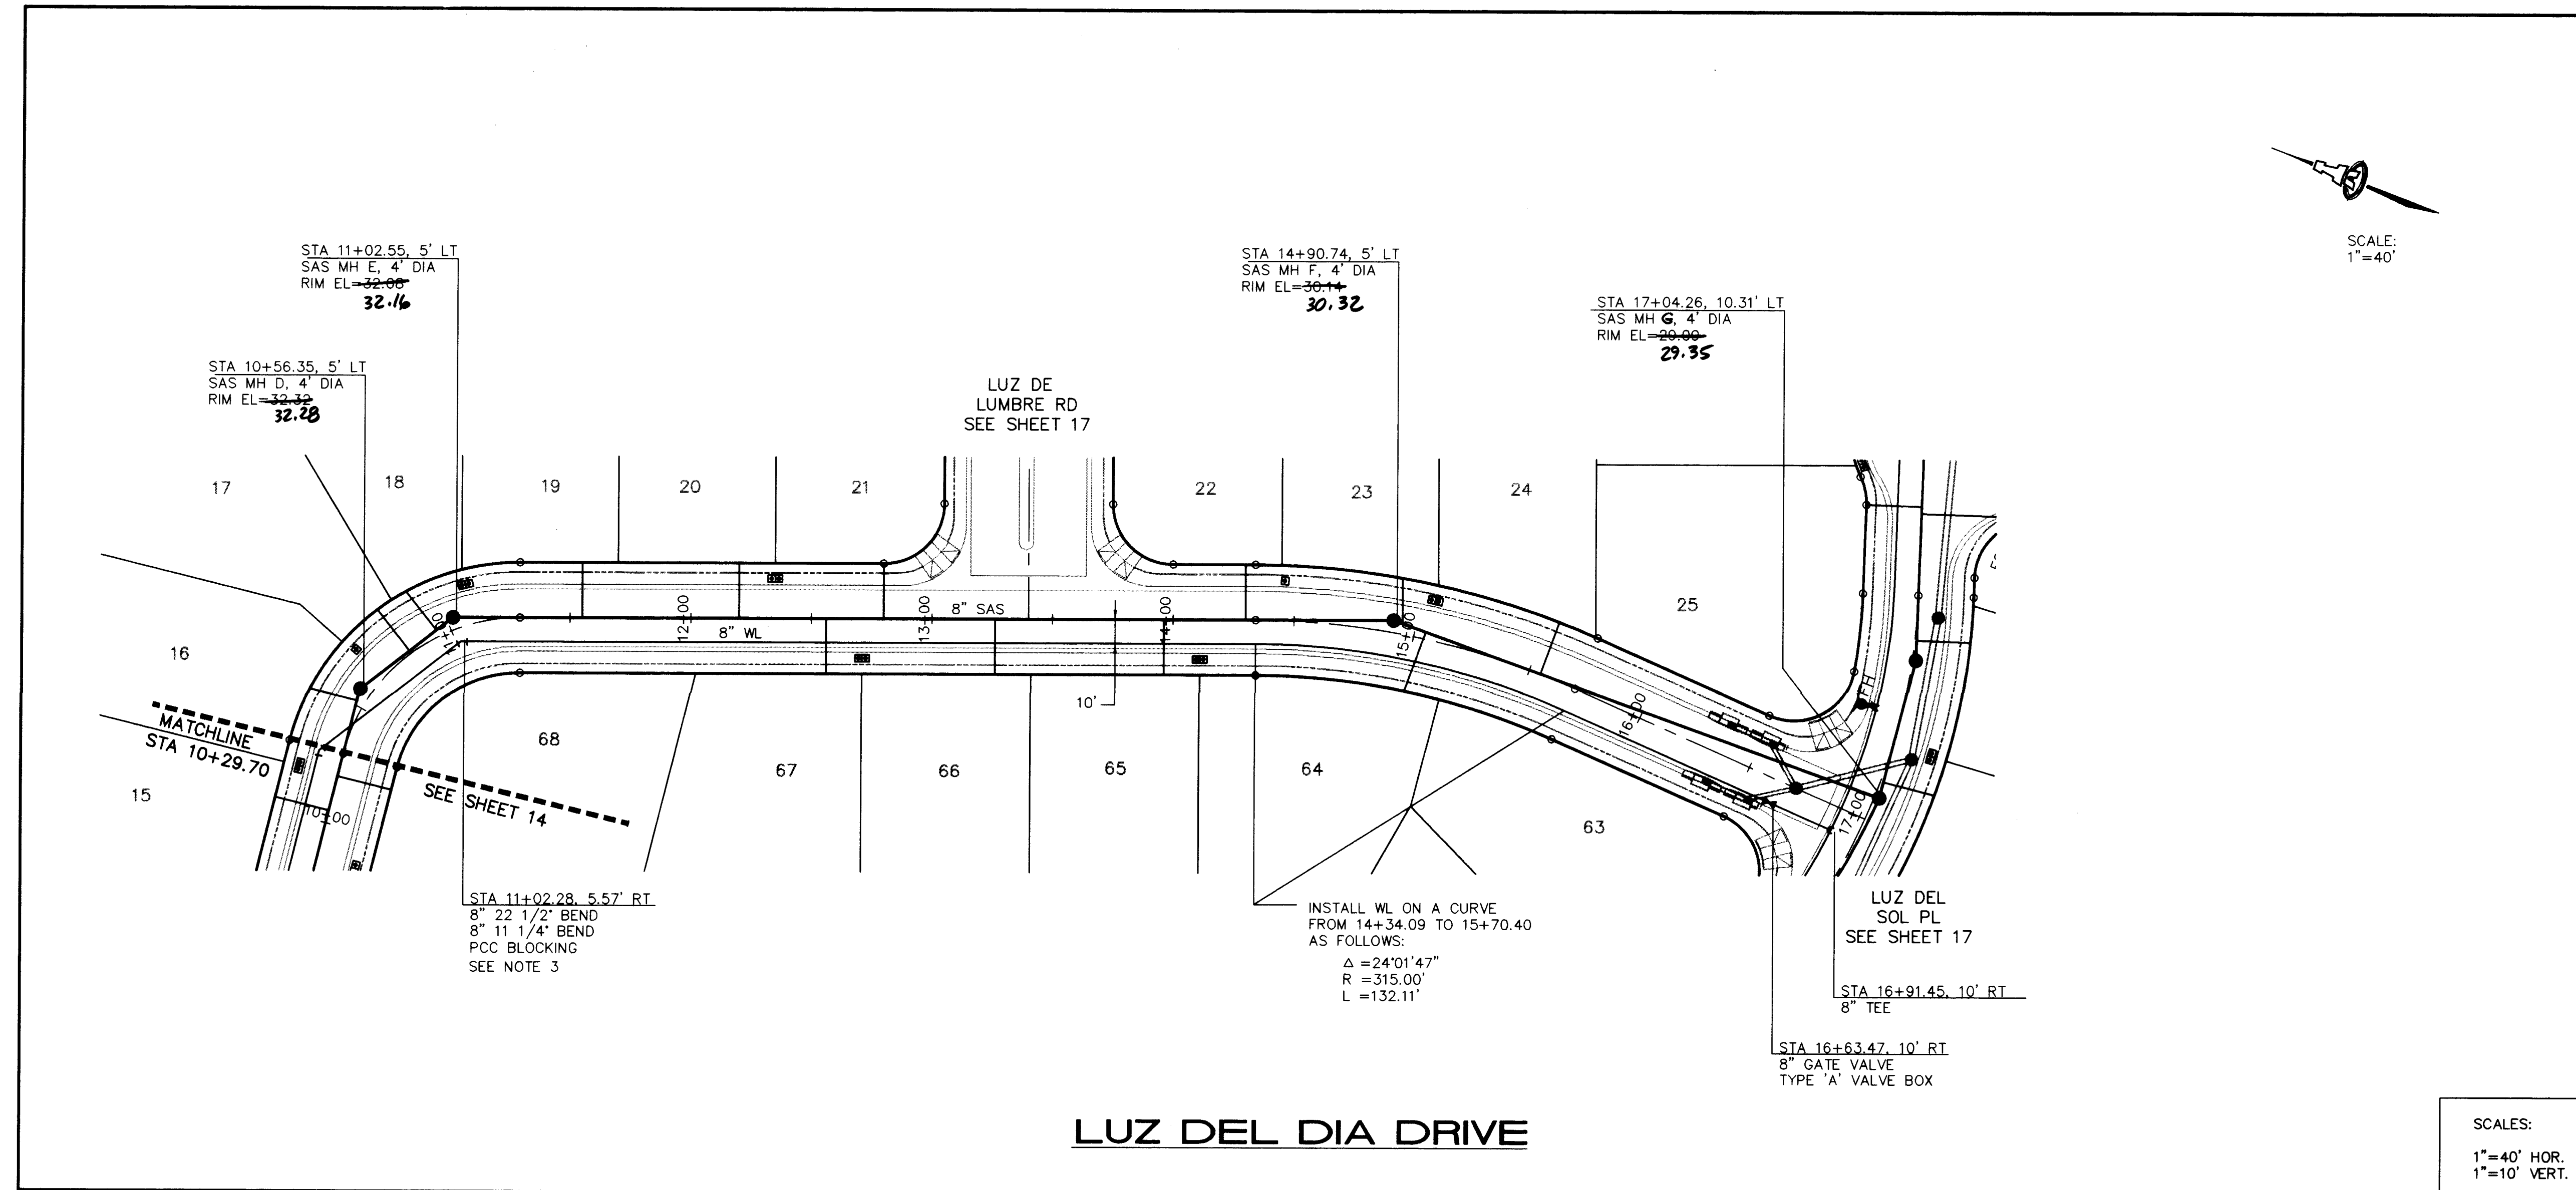

GENERAL NOTES

- CONSTRUCT SAS SERVICES PER COA STD DWG #2125 & NMUI SPECIFICATIONS FOR MATERIALS.
- CONSTRUCT FIRE HYDRANTS PER DESIGNATED DEPTHS & LENGTHS PER COA STD DWG #2340.
- DEFLECT WATERLINE 4"16"34" RIGHT BETWEEN STA 10+70 AND 11+20.

UTILITY SERVICE TABLE

LOT NO.	STATION		SAS INV @ R/W
	WATER, LENGTH	SAS, LENGTH	
16	SEE SHT 14	10+47.34, 20'	32.3 28.2
17	(S) 10+65.45, 24'	10+80.66, 22'	32.1 27.4
18		10+91.39, 21'	32.0 27.3
19	11+10.45, 24'	11+54.96, 23'	31.7 27.0
20		12+19.96, 23'	31.4 26.8
21	12+34.96, 26'	12+79.96, 23'	31.1 26.4
22	(S) 14+44.24, 26'	14+29.96, 23'	30.3 25.6
23		14+01.23, 19'	30.0 25.4
24	15+05.52, 26'	15+54.36, 23'	29.7 25.0
64		13+96.04, 23'	30.8 25.3
65	14+11.04, 7'	15+00.90, 26'	30.8 25.3
66		13+26.04, 23'	30.0 26.0
67	12+71.04, 7'	12+56.04, 23'	31.2 26.6

ALL WATER SERVICES ARE DOUBLE EXCEPT WHERE NOTED AS (S) SINGLE.

LEGEND

- SINGLE WATER METER & BOX
- DOUBLE WATER METER & BOX
- GATE VALVE W/ TYPE 'A' VALVE BOX
- FIRE HYDRANT W/ VALVED LEG
- SAS MANHOLE
- WATER LINE W/ FITTING

SCALES:

1"=40' HOR.
1"=10' VERT.

AS-BUILT INFORMATION

CONTRACTOR: **SUNSHINE MESA**
STARTED BY: **ALS, INC.** DATE: **9/97**
INSPECTOR'S: **C.O.A.** DATE: **9/98**
FIELD REVISION BY: **ALS, INC.** DATE: **9/98**
CORRECTED BY: **ALS, INC.** DATE: **10/98**
MICRO-FILM INFORMATION
RECORDED BY: **ALS, INC.** DATE: **10/98**

BENCH MARKS

1996 A STANDARD ACS BRASS TABLET, STAMPED "1-B10", SET IN TOP OF A CONCRETE POST FLUSH WITH GROUND UNDER NORTH-SOUTH POWER LINES APPROXIMATELY 0.90 MILES WEST OF PARADISE BLVD NW AND PARK LANE NW.
ELEVATION: 5419.522

ENGINEER'S SEAL

SCOTT M. MOORE
NEW MEXICO
10519
PROFESSIONAL ENGINEER
6-24-97

REVISIONS

NO.	DATE	REMARKS
1	4/97	DESIGN

ISAACSON & ARFMAN, P.A.
Consulting Engineering Associates
128 Monroe Street N.E.
Albuquerque New Mexico
945UTL2.DWGanw 6/9/97



**CITY OF ALBUQUERQUE
PUBLIC WORKS DEPARTMENT
ENGINEERING GROUP**

**TITLE: LUZ EN LA VENTANA AT VENTANA RANCH
LUZ DEL DIA DR
UTILITY PLAN & PROFILE**

City Project No. 5316.97

Zone Map No. B-9

Sheet 15 Of 18

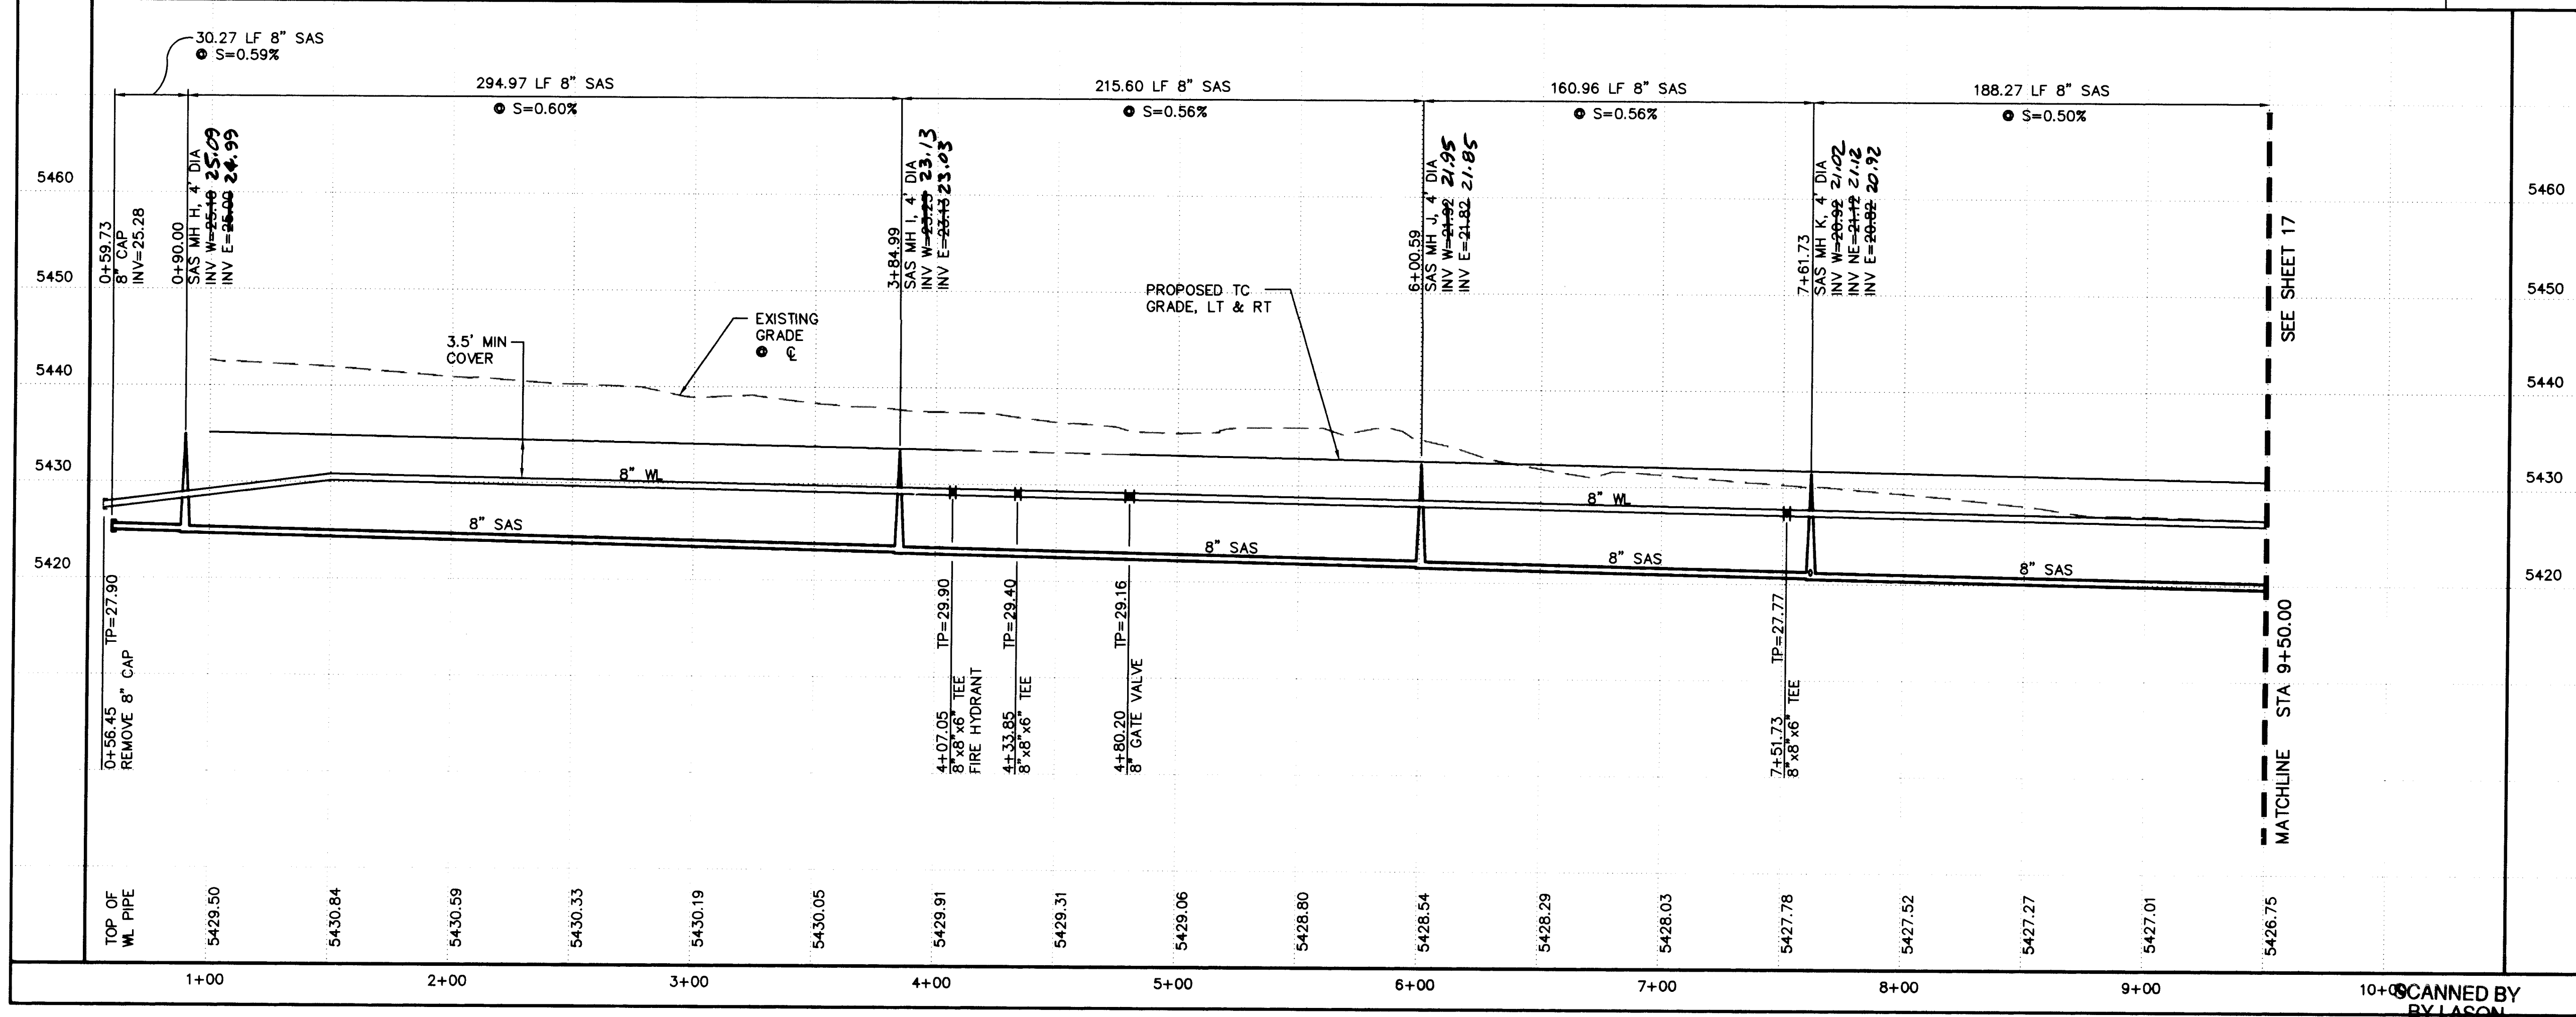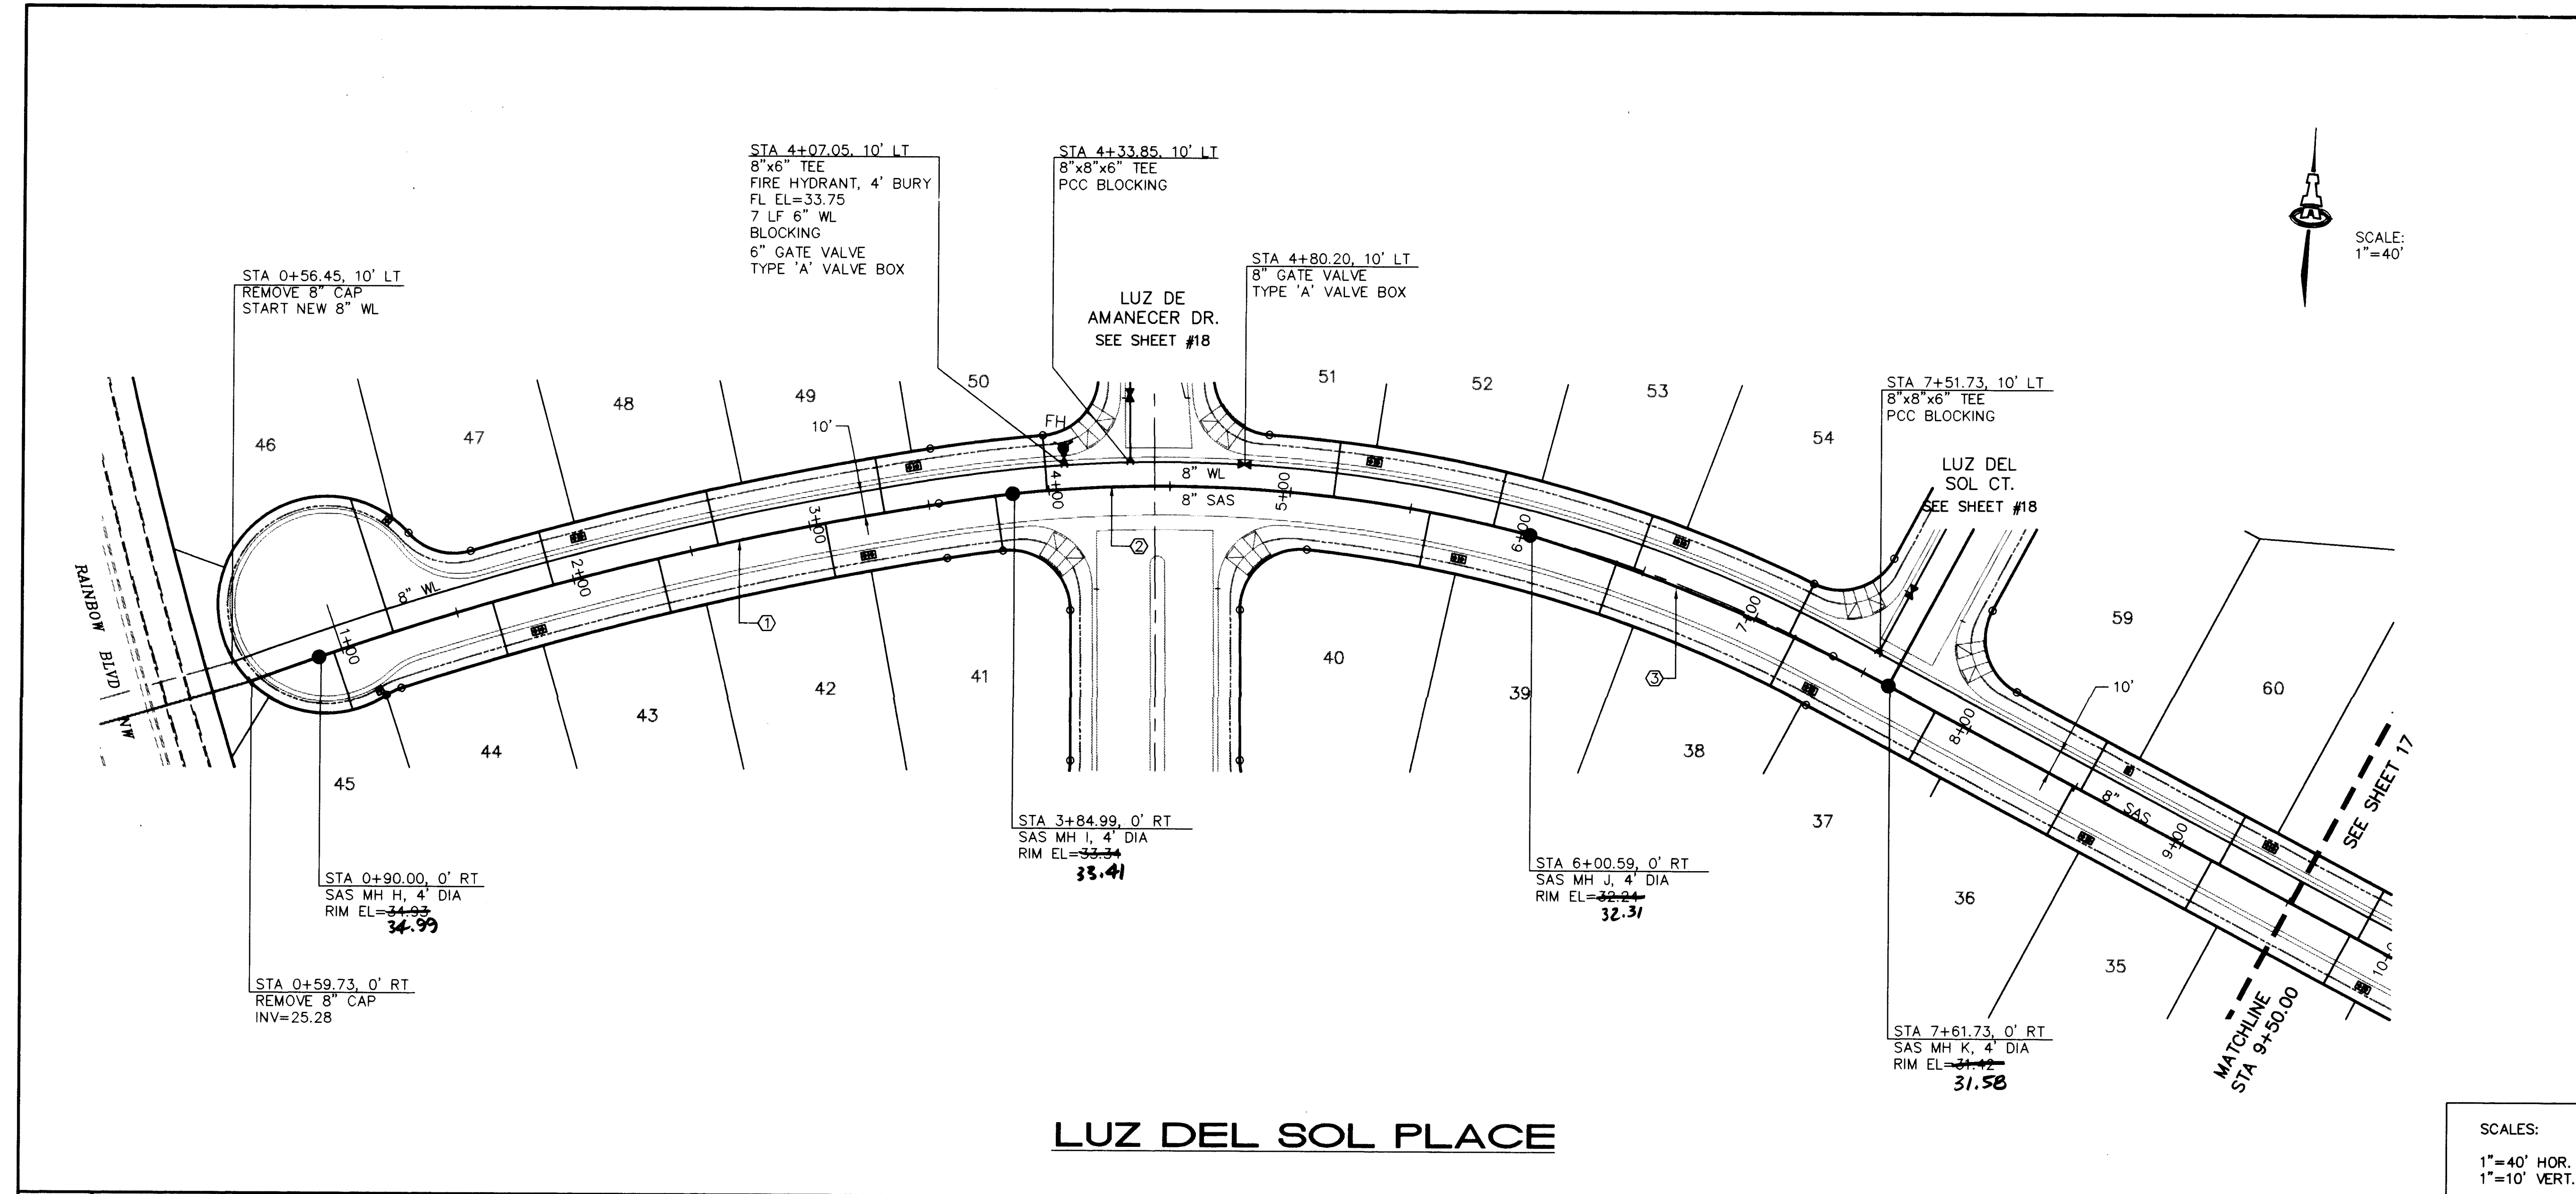

GENERAL NOTES

- CONSTRUCT SAS SERVICES PER COA STD DWG #2125 & NMUI SPECIFICATIONS FOR MATERIALS.
- CONSTRUCT FIRE HYDRANTS PER DESIGNATED DEPTHS & LENGTHS PER COA STD DWG #2340.

KEYED NOTES

- INSTALL SANITARY SEWER FROM MH H TO MH I AS FOLLOWS:
 $\Delta = 11'39.09"$
 $R = 1450.36'$
 $L = 294.97'$
- INSTALL SANITARY SEWER ALONG ROAD CENTERLINE FROM MH I TO MH J AS FOLLOWS:
 $\Delta = 21'06.58"$
 $R = 585.00'$
 $L = 215.60'$
- INSTALL SANITARY SEWER FROM MH J TO MH K AS FOLLOWS:
 $\Delta = 11'31.41"$
 $R = 800.00'$
 $L = 160.96'$

UTILITY SERVICE TABLE

LOT NO.	STATION		SAS INV @ R/W
	WATER, LENGTH	SAS, LENGTH	
35	8+64.10, 26'	9+14.10, 23'	30.4 25.9
36	8+49.10, 23'	8+49.10, 23'	30.8 26.3
37	7+84.10, 23'	7+84.10, 23'	31.1 26.6
38	7+18.11, 23'	7+18.11, 23'	31.4 26.9
39	6+38.14, 23'	6+38.14, 23'	31.8 27.3
40	5+58.18, 23'	5+58.18, 23'	32.2 27.6
41	3+78.29, 23'	3+78.29, 23'	32.6 28.0
42	3+21.76, 26'	3+21.76, 26'	33.0 28.4
43	2+35.96, 23'	2+35.96, 23'	33.4 28.8
44	1+65.30, 23'	1+65.30, 23'	33.8 29.2
45	(S) 1+11.71, 31'	0+96.43, 25'	34.2 30.0
46	(S) 1+36.23, 35'	1+22.40, 58'	34.6 30.0
47	1+91.38, 23'	1+91.38, 23'	34.9 29.4
48	2+61.40, 23'	2+61.40, 23'	35.3 29.7
49	3+31.42, 23'	3+31.42, 23'	35.7 29.7
50	4+99.22, 23'	4+99.22, 23'	36.1 28.4
51	5+17.91, 23'	5+17.91, 23'	36.5 27.9
52	5+84.98, 23'	5+84.98, 23'	36.9 27.4
53	6+45.65, 23'	6+45.65, 23'	37.3 27.1
54	6+60.08, 7'	7+15.39, 23'	37.7 26.8
59	(S) 8+67.65, 7'	8+52.65, 23'	38.1 26.4
60	9+17.65, 23'	9+17.65, 23'	38.5 26.0
61	9+32.65, 7'	9+82.65, 23'	38.9 25.4

LEGEND


- SINGLE WATER METER & BOX
- DOUBLE WATER METER & BOX
- GATE VALVE W/ TYPE 'A' VALVE BOX
- FIRE HYDRANT W/ VALVED LEG
- SAS MANHOLE
- WATER LINE W/ FITTING

ISAACSON & ARFMAN, P.A.
Consulting Engineering Associates
128 Monroe Street N.E.
Albuquerque New Mexico 87102
6/9/97

CITY OF ALBUQUERQUE
PUBLIC WORKS DEPARTMENT
ENGINEERING GROUP

TITLE: LUZ EN LA VENTANA AT VENTANA RANCH
LUZ DEL SOL PL
UTILITY PLAN & PROFILE

City Project No. **5316.97** Zone Map No. **B-9** Sheet **16** Of **18**

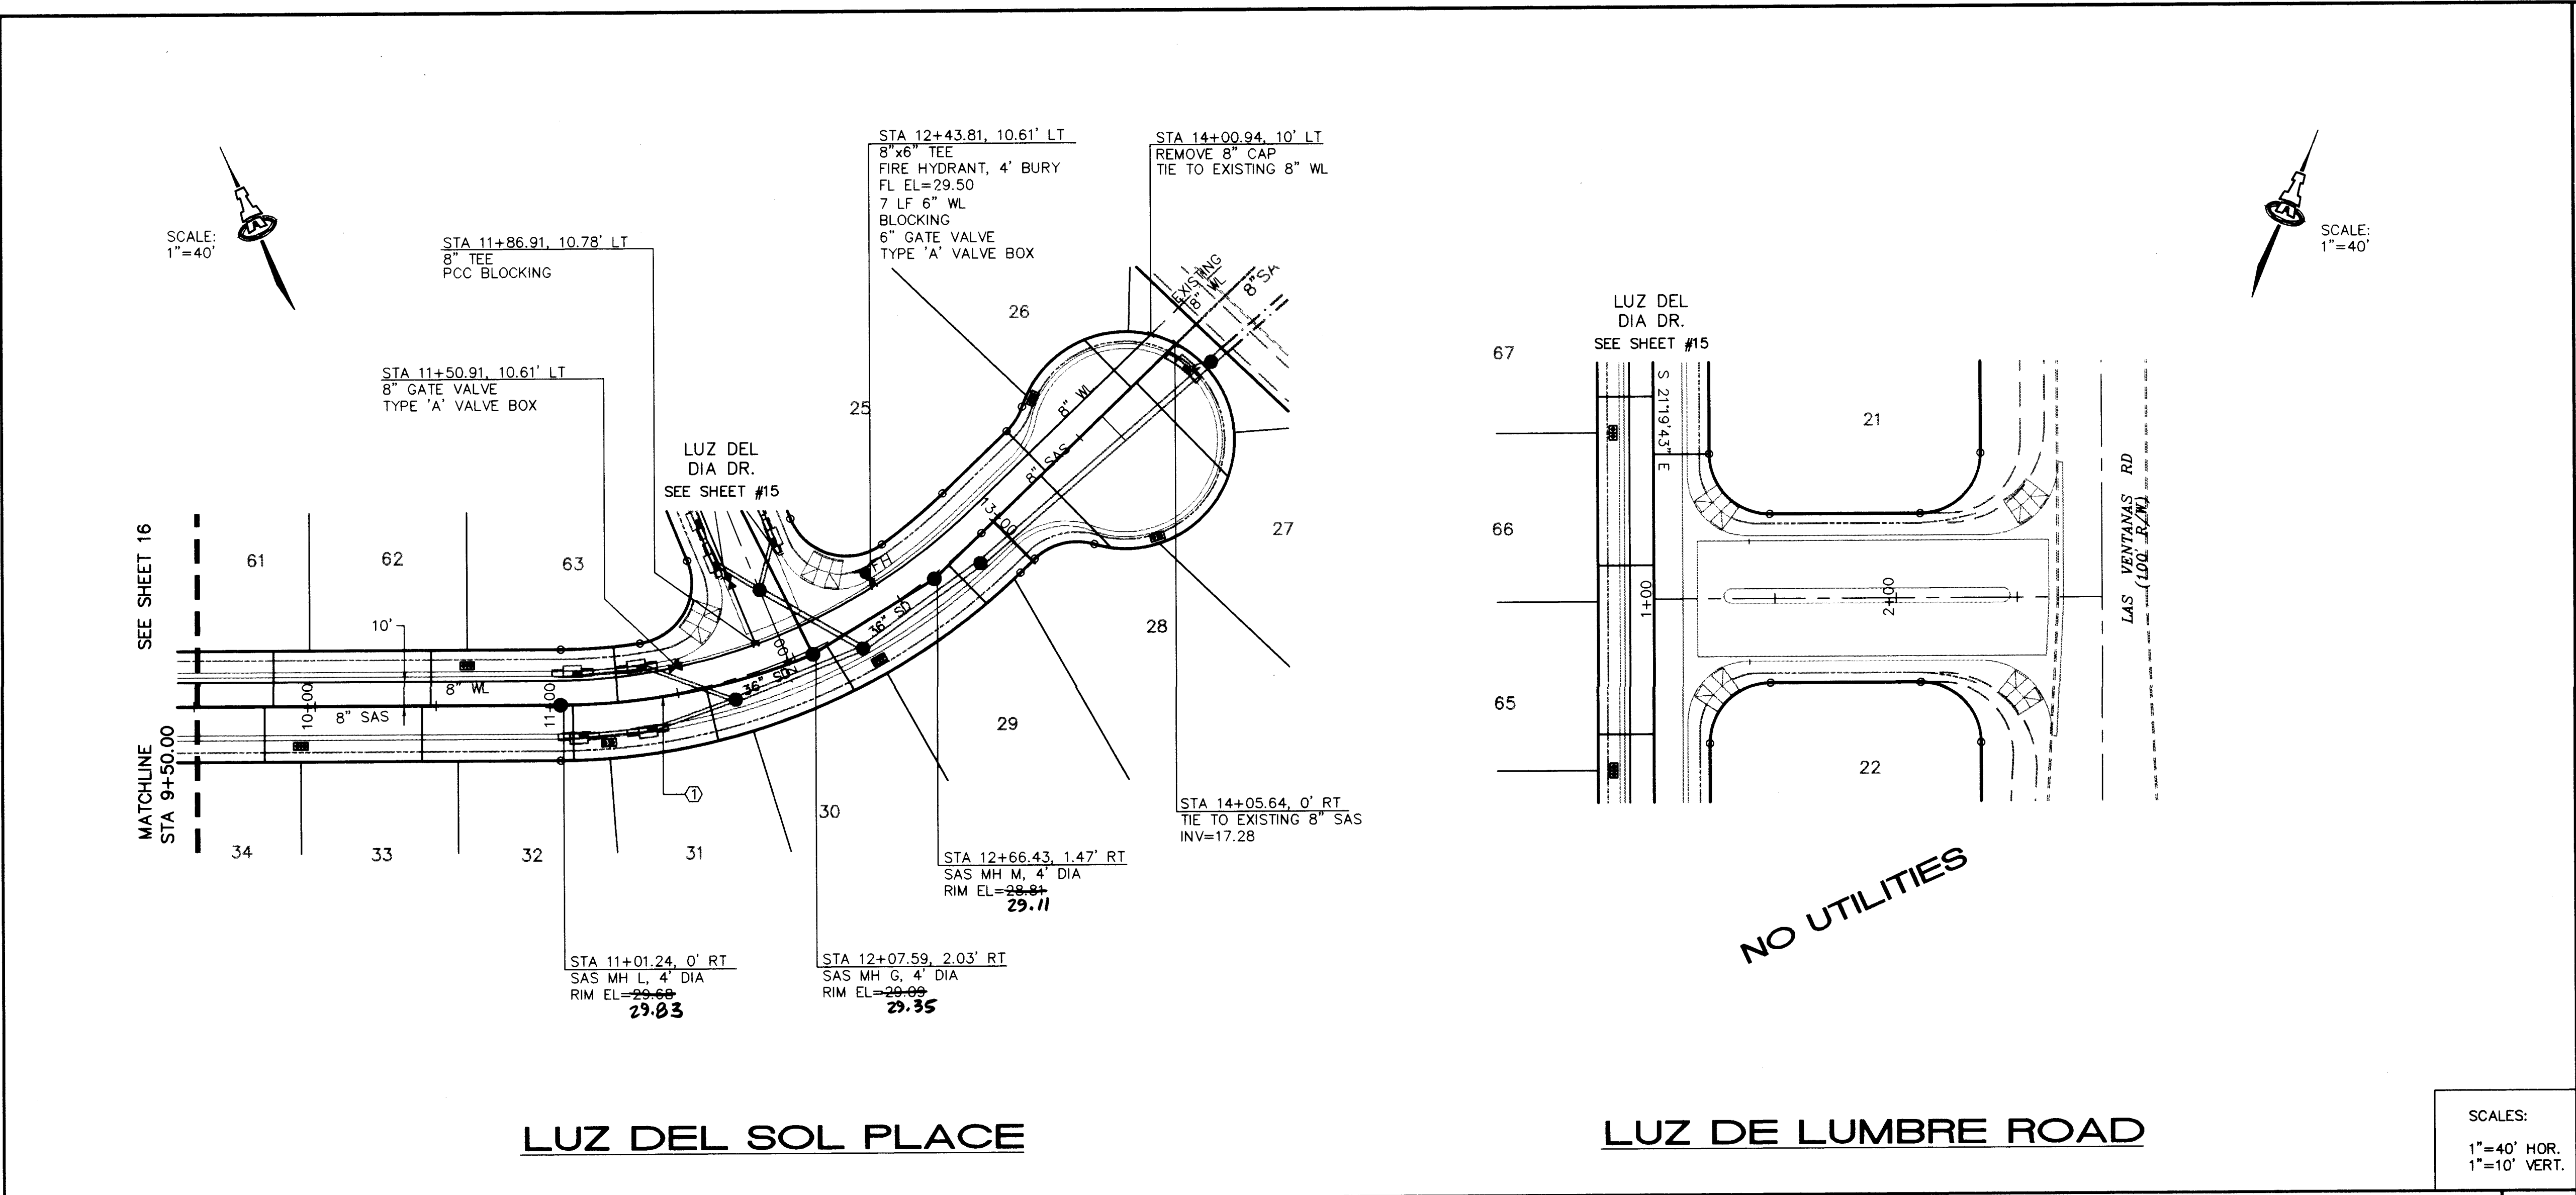

GENERAL NOTES

- CONSTRUCT SAS SERVICES PER COA STD DWG #2125 & NMUI SPECIFICATIONS FOR MATERIALS.
- CONSTRUCT FIRE HYDRANTS PER DESIGNATED DEPTHS & LENGTHS PER COA STD DWG #2340.

KEYED NOTES

- INSTALL SANITARY SEWER FROM MH L TO MH G AS FOLLOWS:
 $\Delta = 22'13.27"$
 $R = 275.00'$
 $L = 106.67'$

LOT NO.	STATION		SAS INV @ R/W
	WATER, LENGTH	SAS, LENGTH	
25	13+46.40, 15'	13+30.36, 23'	28-324.0
26		13+79.72, 28'	28-523.8
27	13+42.94, 62'	13+82.59, 54'	28-023.6
28		13+27.49, 42'	28-323.0
29	12+30.09, 27'	12+76.14, 22'	28-624.0
30		12+16.35, 22'	28-924.3
31	11+19.93, 27'	11+61.45, 22'	28-924.3
32		11+06.19, 23'	28-625.0
33	9+94.10, 26'	10+44.10, 23'	28-625.5
34		9+79.10, 23'	28-125.4
61	(SEE SHEET 16)	9+82.65, 23'	28-125.4
62		10+47.65, 23'	28-025.1
63	10+62.65, 7'	11+25.00, 23'	28-424.7


ALL WATER SERVICES ARE DOUBLE EXCEPT WHERE NOTED AS (S) SINGLE.

LEGEND

- SINGLE WATER METER & BOX
- DOUBLE WATER METER & BOX
- GATE VALVE W/ TYPE 'A' VALVE BOX
- FIRE HYDRANT W/ VALVED LEG
- SAS MANHOLE
- WATER LINE W/ FITTING

ENGINEER'S SEAL

SCOTT M. MCGEE
NEW MEXICO
10510
Professional Engineer
6-24-97

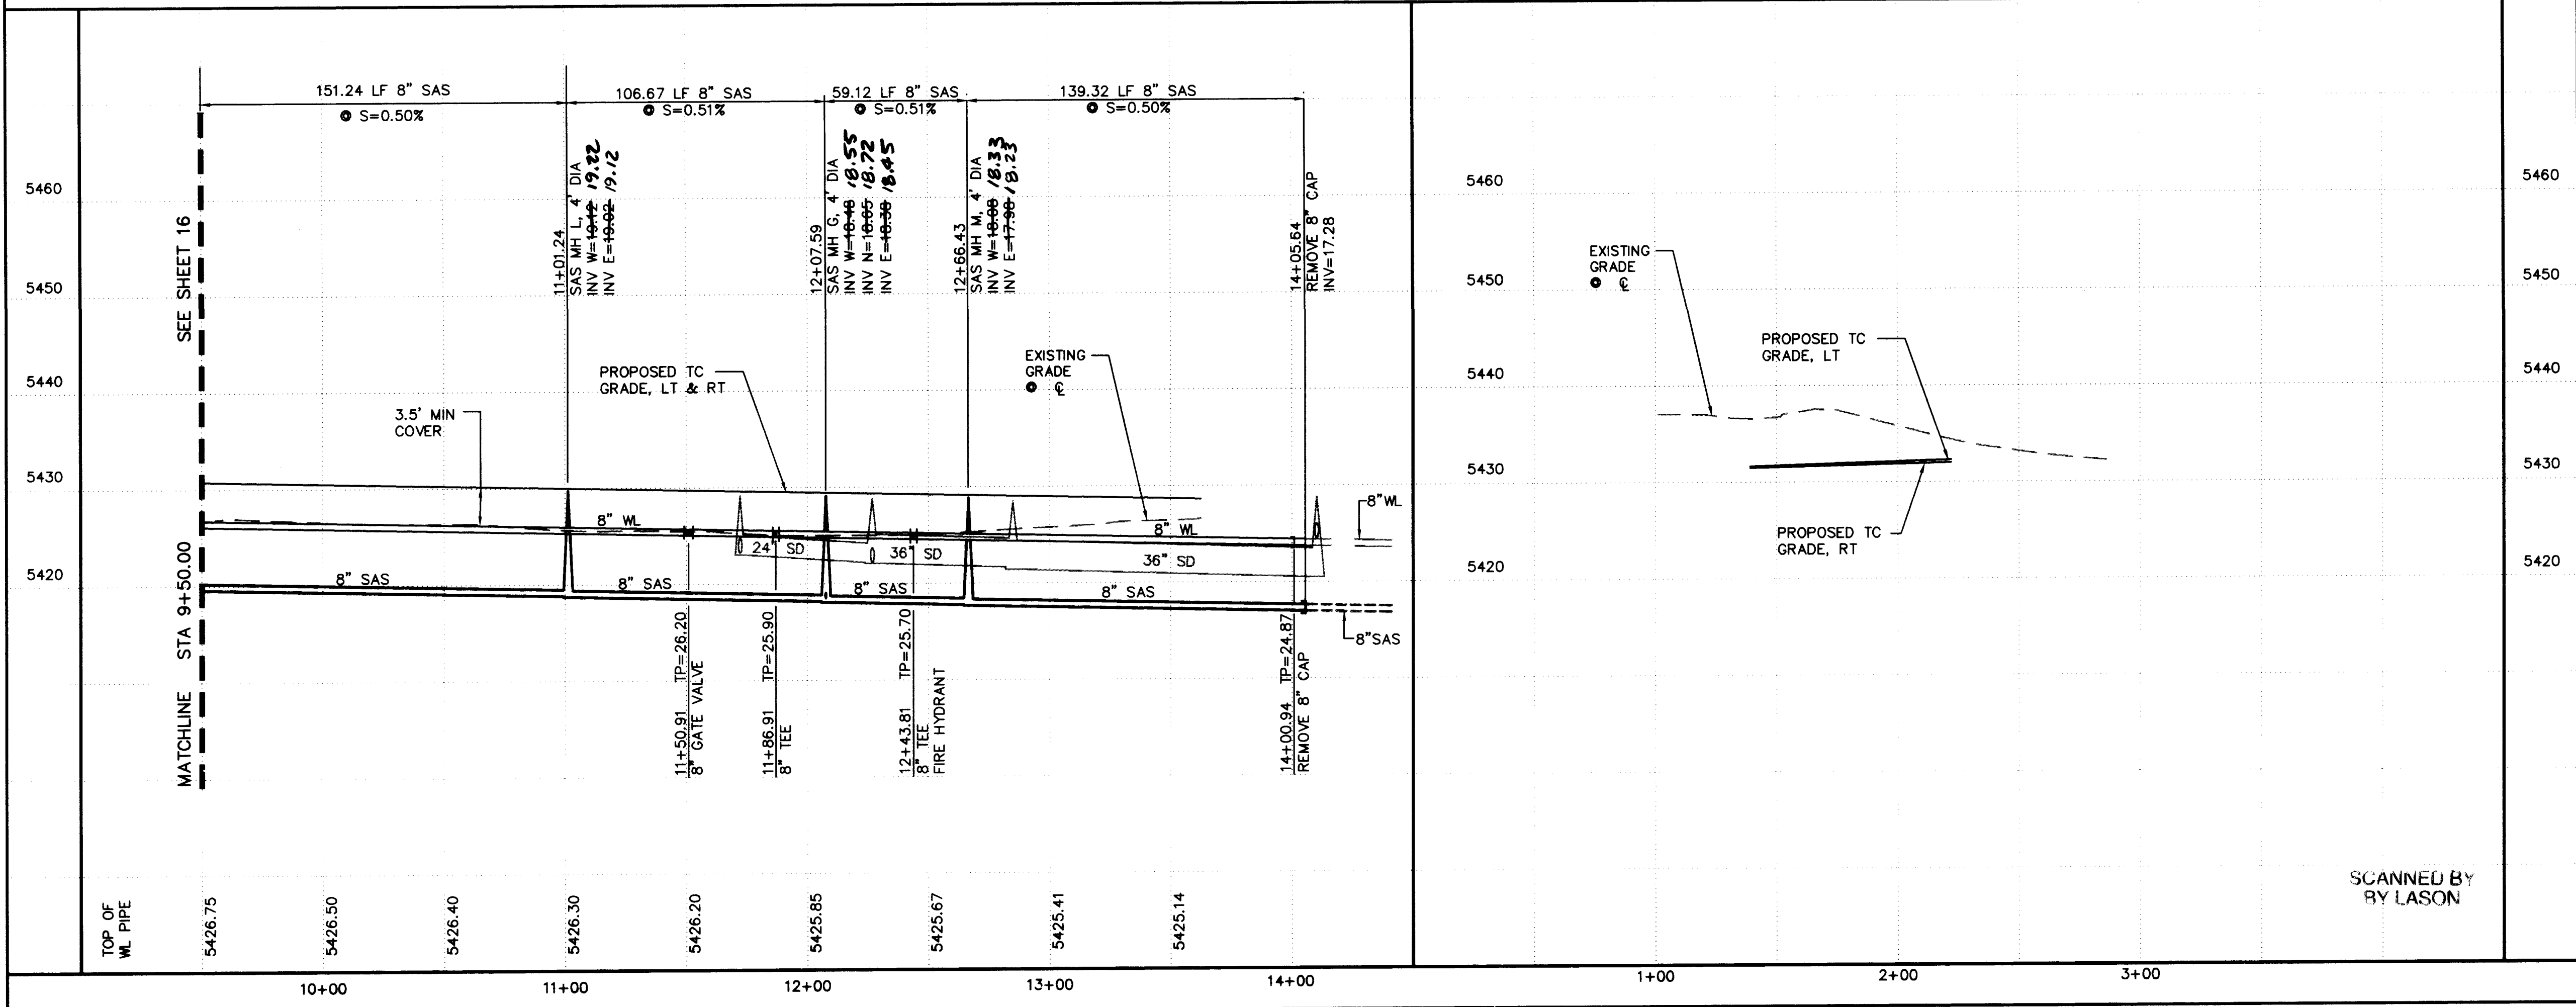

ISAACSON & ARFMAN, P.A.
Consulting Engineering Associates
128 Monroe Street N.E.
Albuquerque New Mexico
945UTL4.DWGonw 6/9/97

**CITY OF ALBUQUERQUE
PUBLIC WORKS DEPARTMENT
ENGINEERING GROUP**

**TITLE: LUZ EN LA VENTANA AT VENTANA RANCH
LUZ DEL SOL PL & LUZ DE LUMBRE RD
UTILITY PLAN & PROFILE**

Design Review Committee

City Engineer Approval



Mo./Day/Yr.

Mo./Day/Yr.

City Project No. 5316.97

Zone Map No. B-9

Sheet 17 Of 18

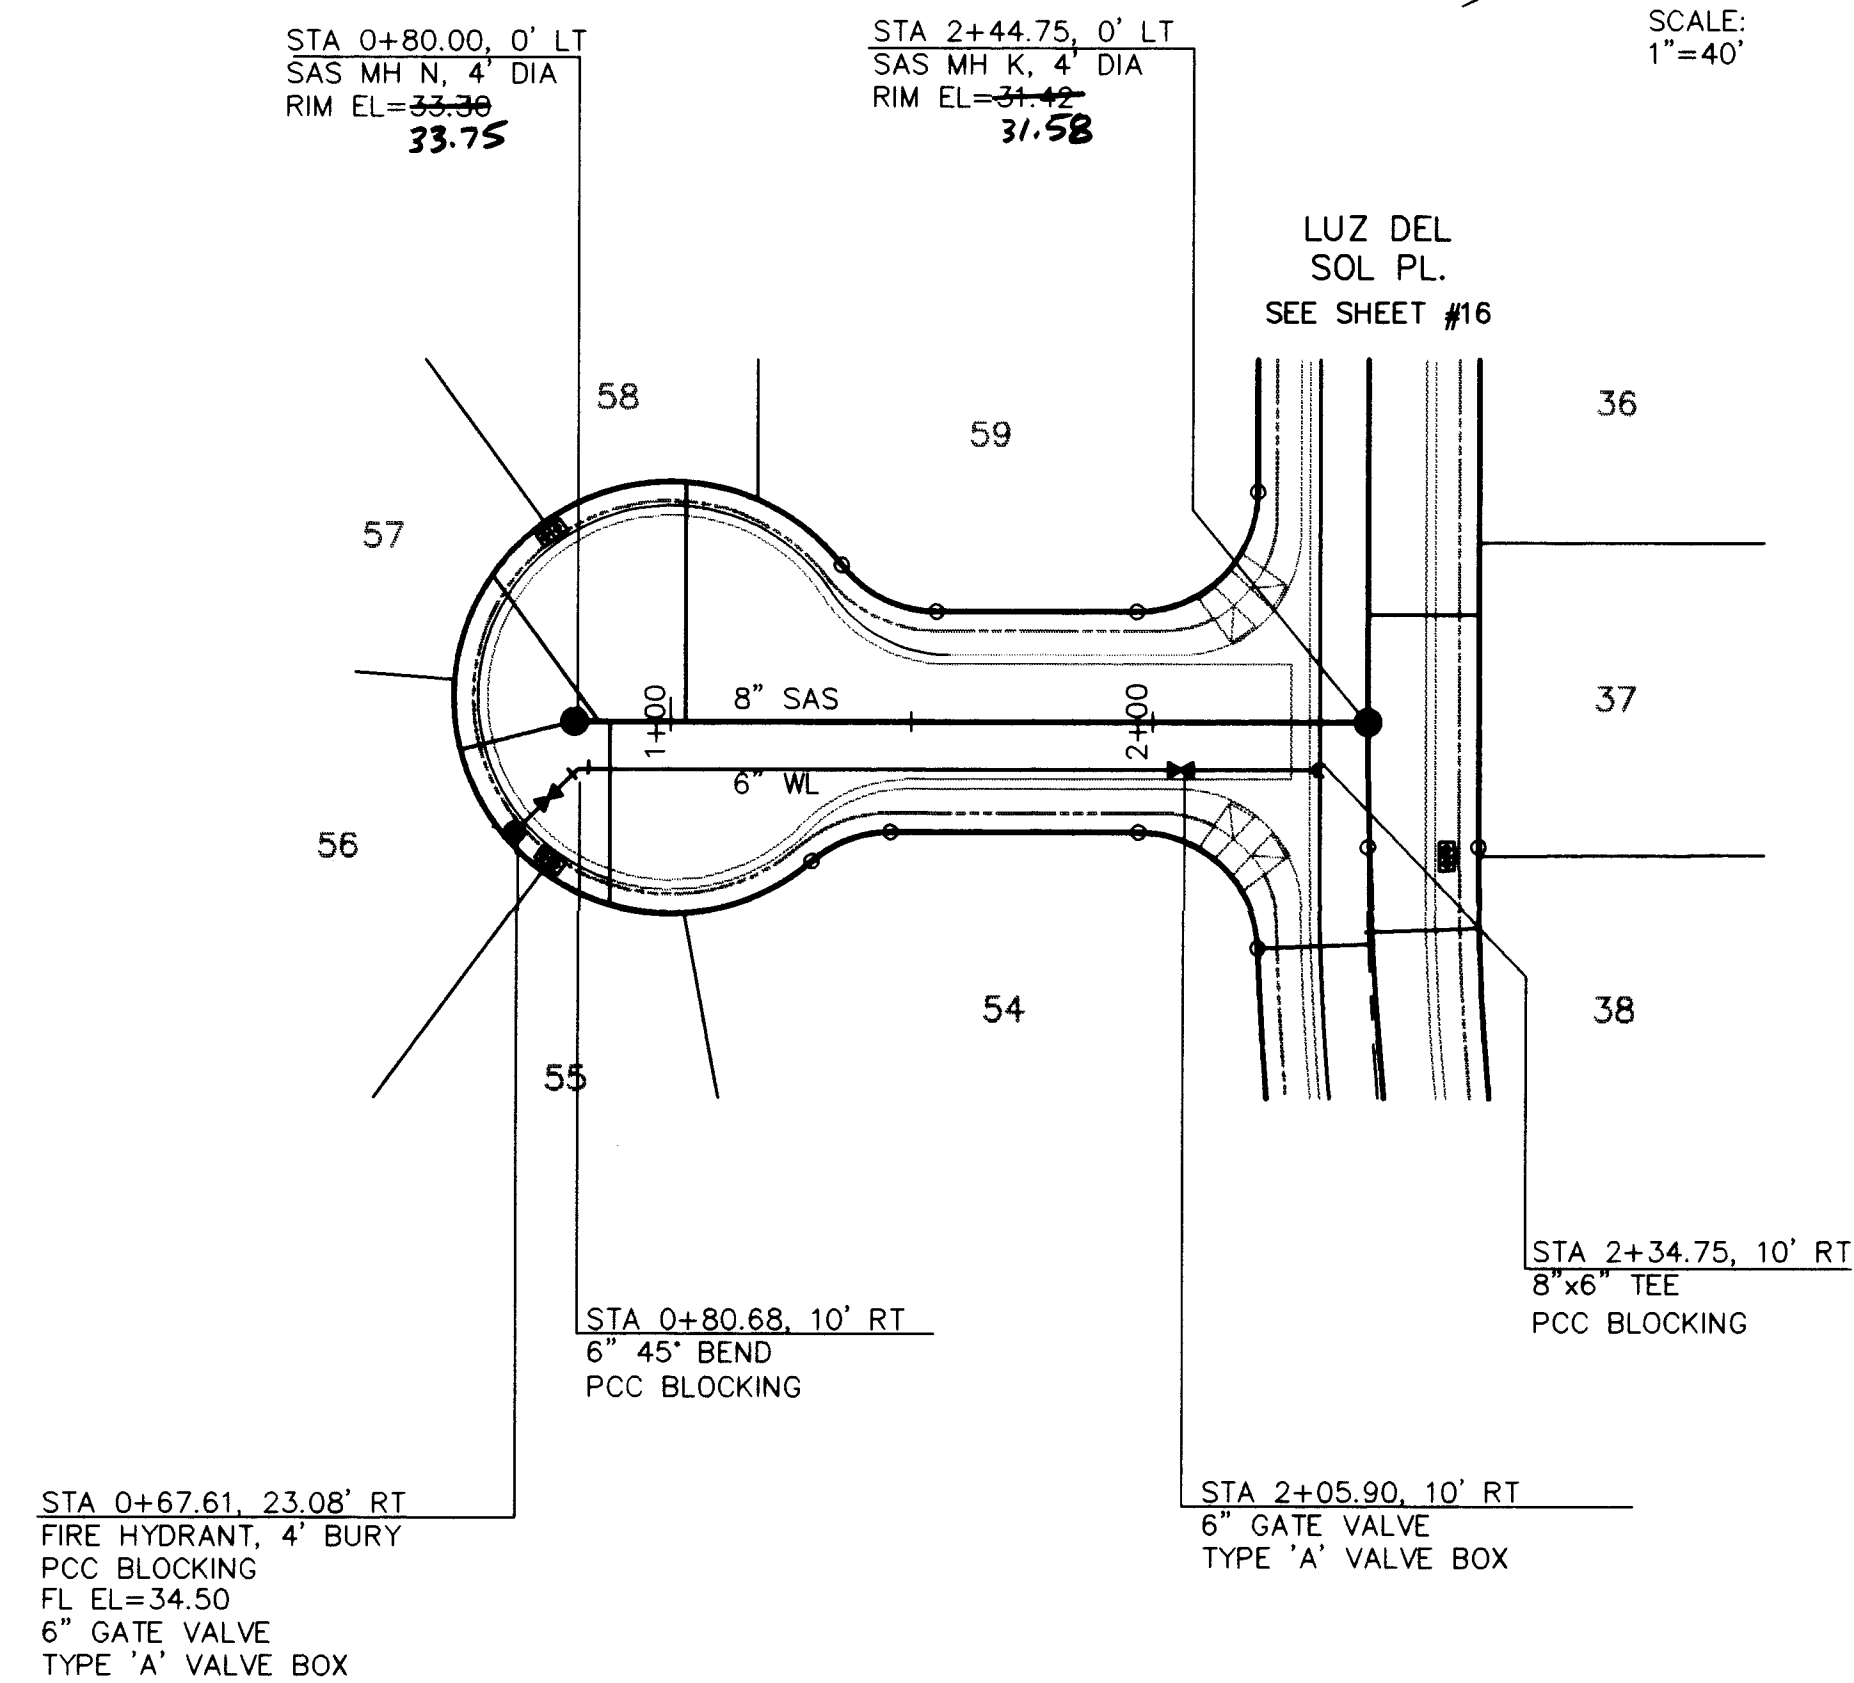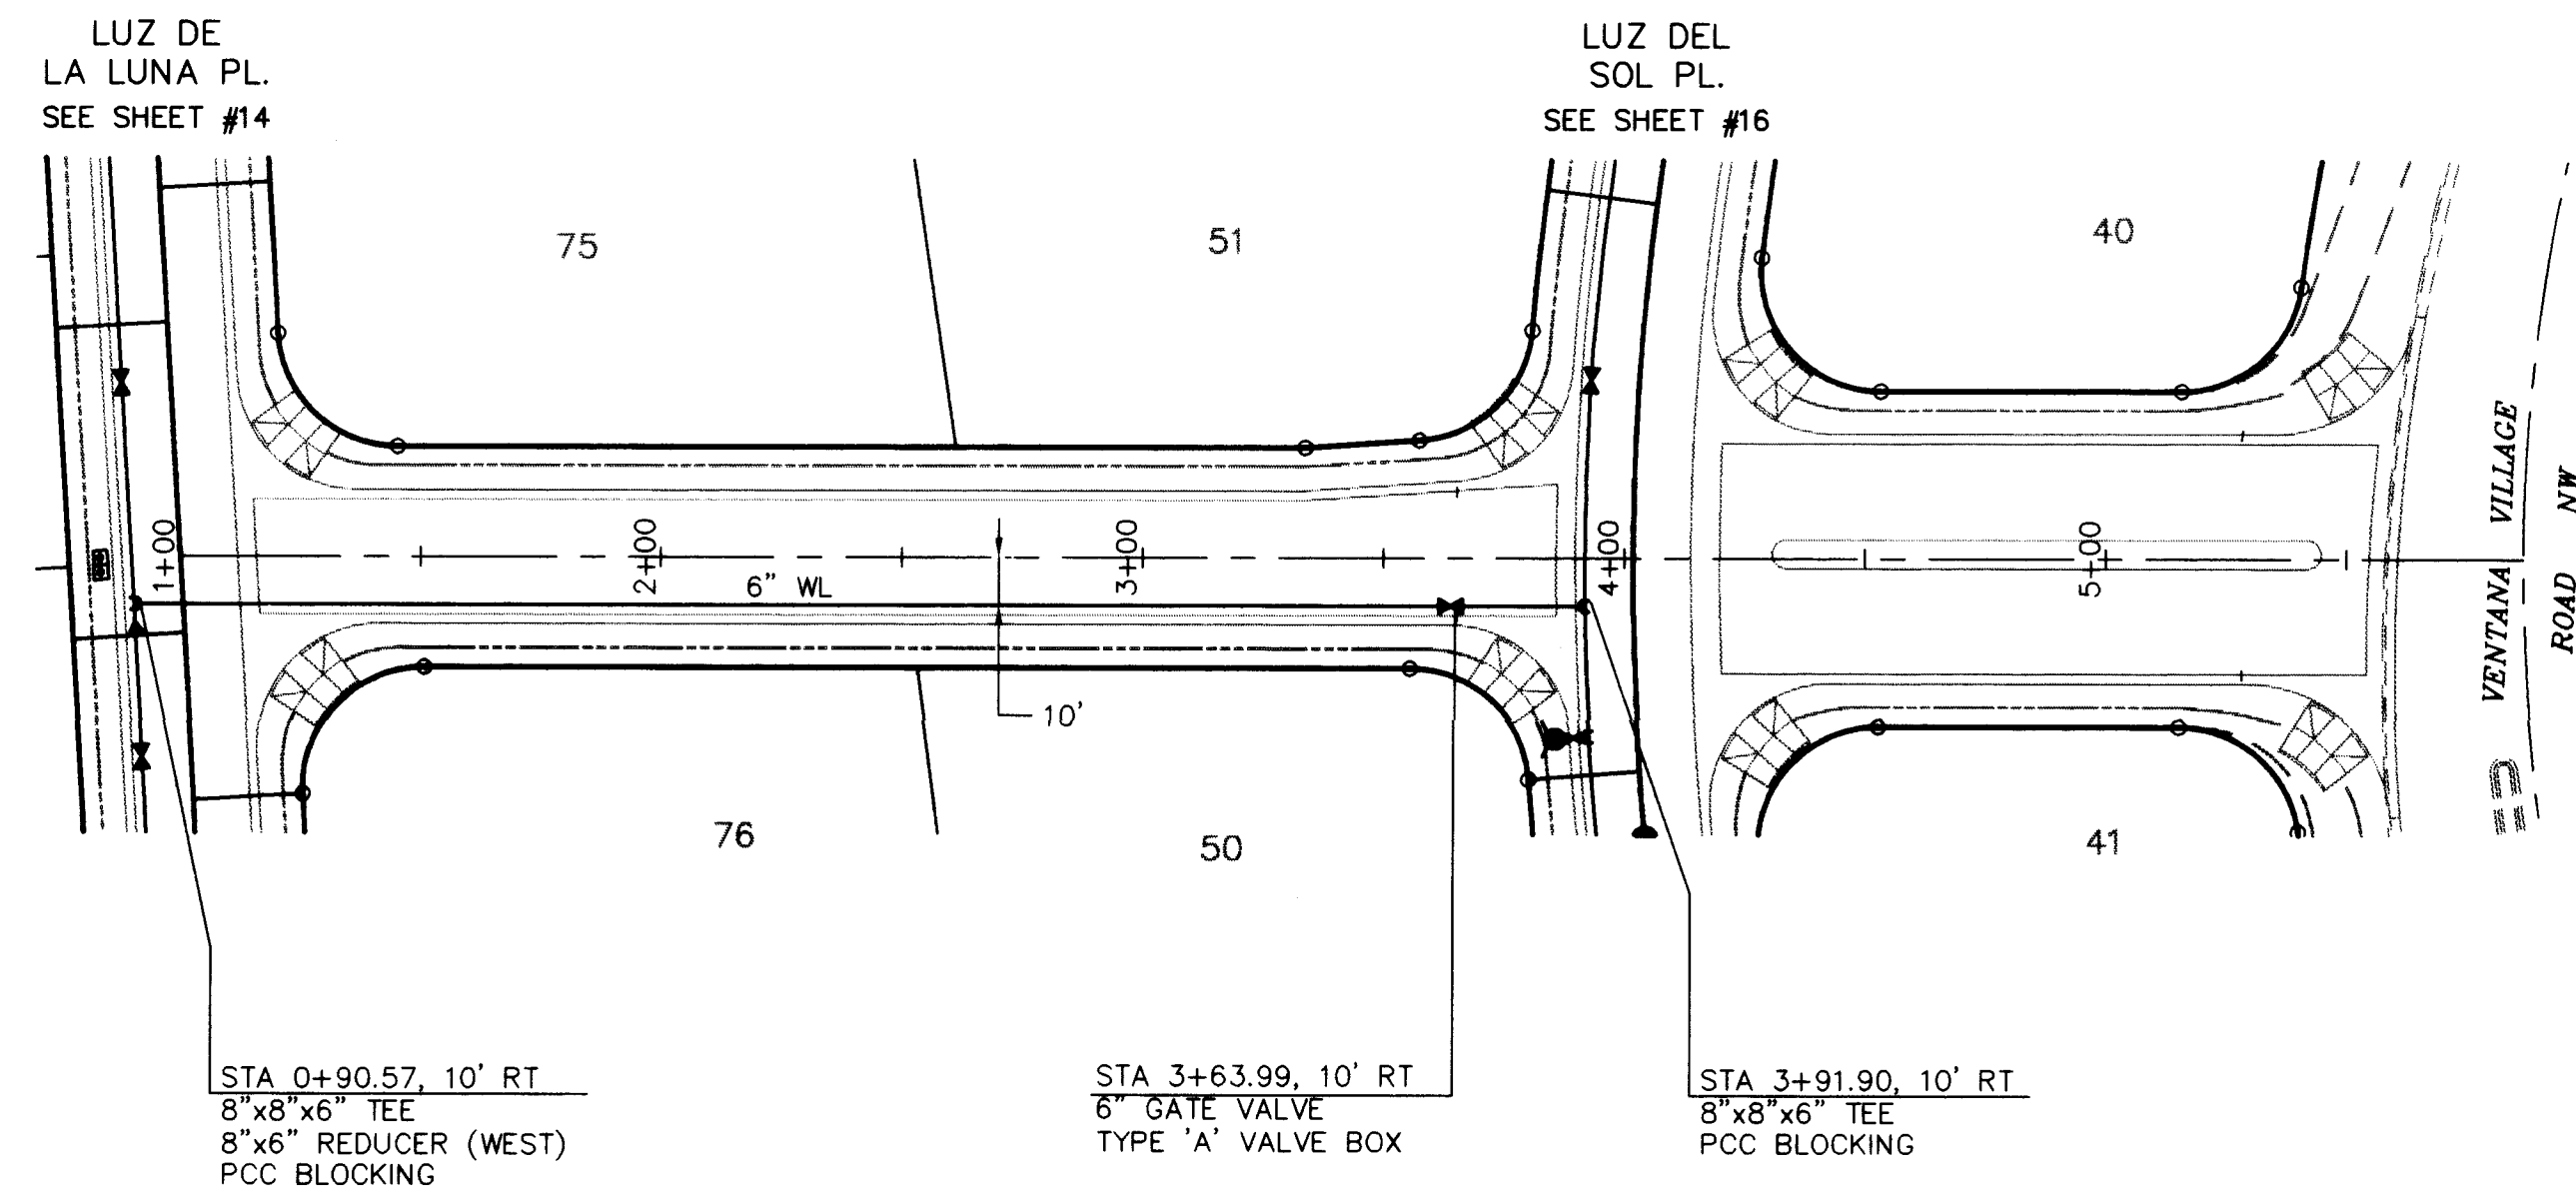

GENERAL NOTES

- CONSTRUCT SAS SERVICES PER COA STD DWG #2125 & NMUI SPECIFICATIONS FOR MATERIALS.
- CONSTRUCT FIRE HYDRANTS PER DESIGNATED DEPTHS & LENGTHS PER COA STD DWG #2340.

UTILITY SERVICE TABLE

LOT NO.	STATION		SAS INV @ R/W
	WATER, LENGTH	SAS, LENGTH	
55	0+73.36, 19'	0+87.36, 38'	29.0335
56		MH N. 24'	29.0335
57	0+73.62, 49'	0+85.10, 38'	28.6332
58		1+03.02, 50'	28.6332

ALL WATER SERVICES ARE DOUBLE EXCEPT WHERE NOTED AS (S) SINGLE.

SCALES:
1"=40' HOR.
1"=10' VERT.

LEGEND

- SINGLE WATER METER & BOX
- DOUBLE WATER METER & BOX
- GATE VALVE W/ TYPE 'A' VALVE BOX
- FIRE HYDRANT W/ VALVED LEG
- SAS MANHOLE
- WATER LINE W/ FITTING

ISAACSON & ARFMAN, P.A.
Consulting Engineering Associates
128 Morvue Street N.E.
Albuquerque New Mexico
945UTLS.DWGanw 6/9/97

CITY OF ALBUQUERQUE
PUBLIC WORKS DEPARTMENT
ENGINEERING GROUP

TITLE: LUZ EN LA VENTANA AT VENTANA RANCH
LUZ DE AMANECER DR & LUZ DEL SOL CT
UTILITY PLAN & PROFILE

DESIGNED BY	DRAWN BY	CHECKED BY	DATE	REVISIONS	DATE
SMM	ANW	SMM	4/97	DESIGN	6/97

City Project No. **5316.97** Zone Map No. **B-9** Sheet **18** Of **18**

ENGINEER'S SEAL
SCOTT M. MCGEE
NEW MEXICO
10510
6-24-97

NO.	DATE	REMARKS	BY

DESIGNED BY	DRAWN BY	CHECKED BY	DATE
SMM	ANW	SMM	4/97

City Project No. **5316.97** Zone Map No. **B-9** Sheet **18** Of **18**