


CONSTRUCTION PLANS
FOR
MONTANO ROAD AND CULTURE DRIVE
INTERSECTION IMPROVEMENTS
ALBUQUERQUE, NEW MEXICO

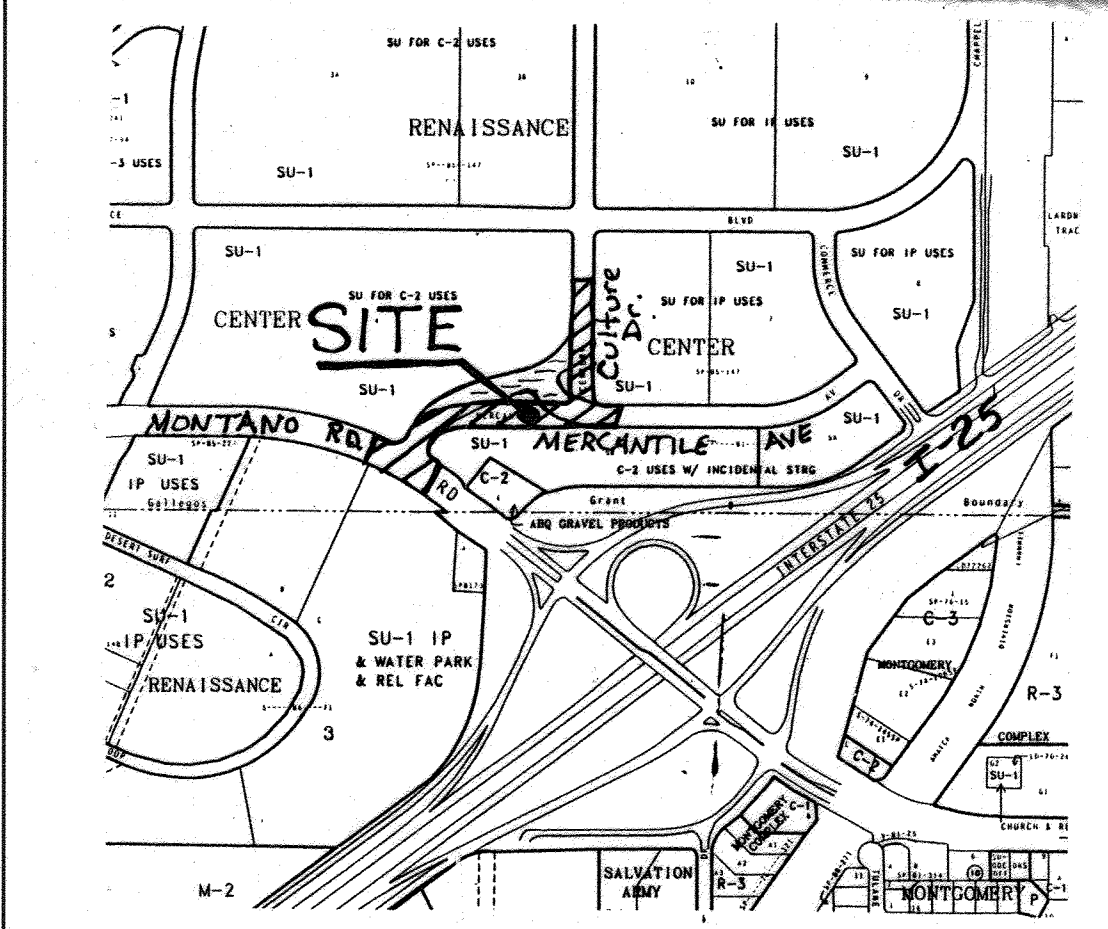

VICINITY MAP
ZONE ATLAS F-16-2
SCALE: NONE

GENERAL NOTES

- NOTICE TO CONTRACTORS
- CITY OF ALBUQUERQUE SPECIFICATIONS FOR PUBLIC WORKS CONSTRUCTION, 1986 EDITION AS AMENDED THROUGH UPDATE 6, WILL BE REFERRED TO HEREIN AS THE "STANDARD SPECIFICATIONS".
 - TWO WORKING DAYS PRIOR TO ANY EXCAVATION, CONTRACTOR MUST CONTACT NEW MEXICO ONE CALL SYSTEM (260-1990) AND DETERMINE LOCATION OF EXISTING UTILITIES.
 - PRIOR TO ANY CONSTRUCTION, THE CONTRACTOR SHALL EXCAVATE AND VERIFY THE HORIZONTAL AND VERTICAL LOCATIONS OF ALL OBSTRUCTIONS. SHOULD A CONFLICT EXIST, THE CONTRACTOR SHALL NOTIFY THE ENGINEER OR THE SURVEYOR SO THAT THE CONFLICT CAN BE RESOLVED WITHOUT DELAY.
 - ALL EXISTING SIGNS, MARKERS, DELINEATORS, ETC., WITHIN THE CONSTRUCTION LIMITS SHALL BE REMOVED, STORED AND RE-SET BY THE CONTRACTOR.
 - THE CONTRACTOR SHALL NOTIFY THE ENGINEER NOT LESS THAN SEVEN (7) PRIOR TO STARTING WORK IN ORDER THAT THE ENGINEER MAY TAKE NECESSARY MEASURES TO INSURE THE PRESERVATION OF SURVEY MONUMENTS. CONTRACTOR SHALL NOT DISTURB PERMANENT SURVEY MONUMENTS WITHOUT THE CONSENT OF THE ENGINEER AND SHALL NOTIFY THE ENGINEER AND BEAR THE EXPENSE OF REPLACING ANY THAT MAY BE DISTURBED WITHOUT PERMISSION. REPLACEMENT SHALL BE DONE ONLY BY THE CITY SURVEYOR. WHEN A CHANGE IS MADE IN THE FINISHED ELEVATIONS OF THE PAVEMENT OF ANY ROADWAY IN WHICH A PERMANENT SURVEY MONUMENT IS LOCATED, CONTRACTOR SHALL, AT HIS OWN EXPENSE, ADJUST THE MONUMENT COVER TO THE NEW GRADE UNLESS OTHERWISE SPECIFIED. REFER TO SECTION 4.4 OF THE GENERAL CONDITIONS OF THE STANDARD SPECIFICATIONS.
 - THREE (3) WORKING DAYS PRIOR TO BEGINNING CONSTRUCTION THE CONTRACTOR SHALL SUBMIT TO THE CONSTRUCTION CO-ORDINATION DIVISION A DETAILED CONSTRUCTION SCHEDULE. TWO (2) WORKING DAYS PRIOR TO CONSTRUCTION THE CONTRACTOR SHALL OBTAIN A BARRICADING PERMIT FROM THE CONSTRUCTION CO-ORDINATION DIVISION. CONTRACTOR SHALL NOTIFY BARRICADE ENGINEER (768-2551) PRIOR TO OCCUPYING AN INTERSECTION.
 - ANY WORK OCCURRING WITHIN AN ARTERIAL ROADWAY REQUIRES 24 HOURS CONSTRUCTION.

THE FOLLOWING NOTES ALSO APPLY WHEN CHECKED

- ☒ ALL UTILITIES AND UTILITY SERVICE LINES SHALL BE INSTALLED PRIOR TO PAVING.
- ☒ BACKFILL COMPACTION SHALL BE ACCORDING TO SPECIFIED STREET USE.
- ☐ TACK COAT REQUIREMENTS SHALL BE DETERMINED BY THE CITY ENGINEER.
- ☒ SIDEWALK AND WHEELCHAIR RAMPS WITHIN THE CURB RETURNS SHALL BE CONSTRUCTED WHEREVER A NEW CURB RETURN IS CONSTRUCTED.
- ☐ IF CURB IS DEPRESSED FOR A DRIVEPAD, THE DRIVEPAD SHALL BE CONSTRUCTED PRIOR TO ACCEPTANCE OF CURB AND GUTTER.
- ☒ ALL STORM DRAINAGE FACILITIES SHALL BE COMPLETED PRIOR TO FINAL ACCEPTANCE.
- ☒ THE REQUESTOR OR DEVELOPER SHALL BE RESPONSIBLE FOR REPAIR OR REPLACEMENT OF ALL CURB AND GUTTER OR SIDEWALK DAMAGE AFTER APPROVAL BY THE CITY ENGINEER OR WORK COMPLETED BY THE CONTRACTOR.

CAUTION:
NOTE THAT ALL EXISTING UTILITIES MAY NOT BE SHOWN. ALL EXISTING SERVICE CONNECTIONS ARE NOT SHOWN. ANY EXISTING UTILITIES THAT ARE SHOWN ARE APPROXIMATE LOCATION ONLY. IT SHALL BE THE SOLE RESPONSIBILITY OF THE CONTRACTOR TO CONTACT ALL THE UTILITY OWNERS AND TO CONDUCT ALL NECESSARY FIELD INVESTIGATIONS PRIOR TO ANY EXCAVATIONS TO DETERMINE THE ACTUAL LOCATION OF UTILITIES AND OTHER IMPROVEMENTS.

LEGEND

- | | | | |
|---|------------------------|---|-------------------|
| — | CURB AND GUTTER | □ | WATER METER |
| — | CONCRETE | ○ | CABLE T.V. |
| □ | ELECTRIC TRANSFORMER | □ | POWER POLE |
| □ | ELECTRIC PANEL | → | ANCHOR |
| ○ | SANITARY SEWER MANHOLE | □ | LIGHT POLE |
| ○ | TELEPHONE MANHOLE | □ | TRAFFIC LIGHT |
| ○ | ELECTRIC MANHOLE | □ | CROSSWALK SIGNAL |
| ○ | STORM SEWER MANHOLE | □ | SPRINKLER CONTROL |
| □ | WATER VALVE | □ | TRAFFIC CONTROL |
| □ | FIRE HYDRANT | □ | LIGHTING BOX |
| □ | TELEPHONE BOX | □ | SIGN |
| — | SPOT ELEVATION | □ | GRATE |

INDEX TO DRAWINGS

SHEET NO.	SHEET
1	TITLE SHEET
2-4	PAVING IMPROVEMENTS
5	INTERSECTION LAYOUT & DETAILS
6	TRAFFIC STRIPING PLAN
7	TRAFFIC SIGNAL PLAN
8	CONDUIT & CABLE REQUIREMENT CHARTS
9-17	TRAFFIC SIGNAL DETAILS
18	TRAFFIC SIGNAL & DETECTOR FUNCTION CHARTS
19	ESTIMATED QUANTITIES

26-5358.90 01 97

APPROVAL OF AS BUILT DRAWINGS
CHIEF CONSTRUCTION ENGINEER
DATE 5-7-97

SURVEYOR'S CERTIFICATION


"I, Timothy Aldrich, a duly qualified Registered Professional Land Surveyor under the laws of the State of New Mexico, do hereby certify that the 'as-built' information shown on these drawings was obtained from field construction and 'as-built' surveys performed by me or under my supervision, that the 'as-built' information shown on these drawings was added by me or under my supervision, and that this 'as-built' information is true and correct to the best of my knowledge and belief." Aldrich Land Surveying is not responsible for any of the design concepts, calculations, engineering, or intent of the record drawings.





Timothy Aldrich, P.S. No. 7719

12-21-96
Date


dmg D. MARK GOODWIN & ASSOCIATES, P.A.
CONSULTING ENGINEERS & SURVEYORS
P.O. BOX 90606
ALBUQUERQUE, NEW MEXICO 87199
(505) 345-2010

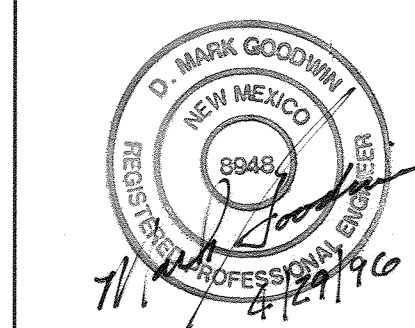

REV.	SHEETS	CITY ENGINEER	DATE	USER DEPARTMENT	DATE	USER DEPARTMENT	DATE
ENGINEERS STAMP & SIGNATURE		APPROVALS	ENGINEER	DATE	*****		
		DRC CHAIRMAN	Bill G. Goodwin	6-25-96	APPROVED FOR CONSTRUCTION		
		TRANSPORTATION	John G. Goodwin	4-30-96			
		WATER/WASTEWATER	John G. Goodwin	5-15-96			
		HYDROLOGY	John G. Goodwin	5-19-96			
		PARKS	John G. Goodwin	5-19-96			
CONSTR. MGMT.							
CITY PROJECT NO.				SHEET OF			
5358.90				1		19	

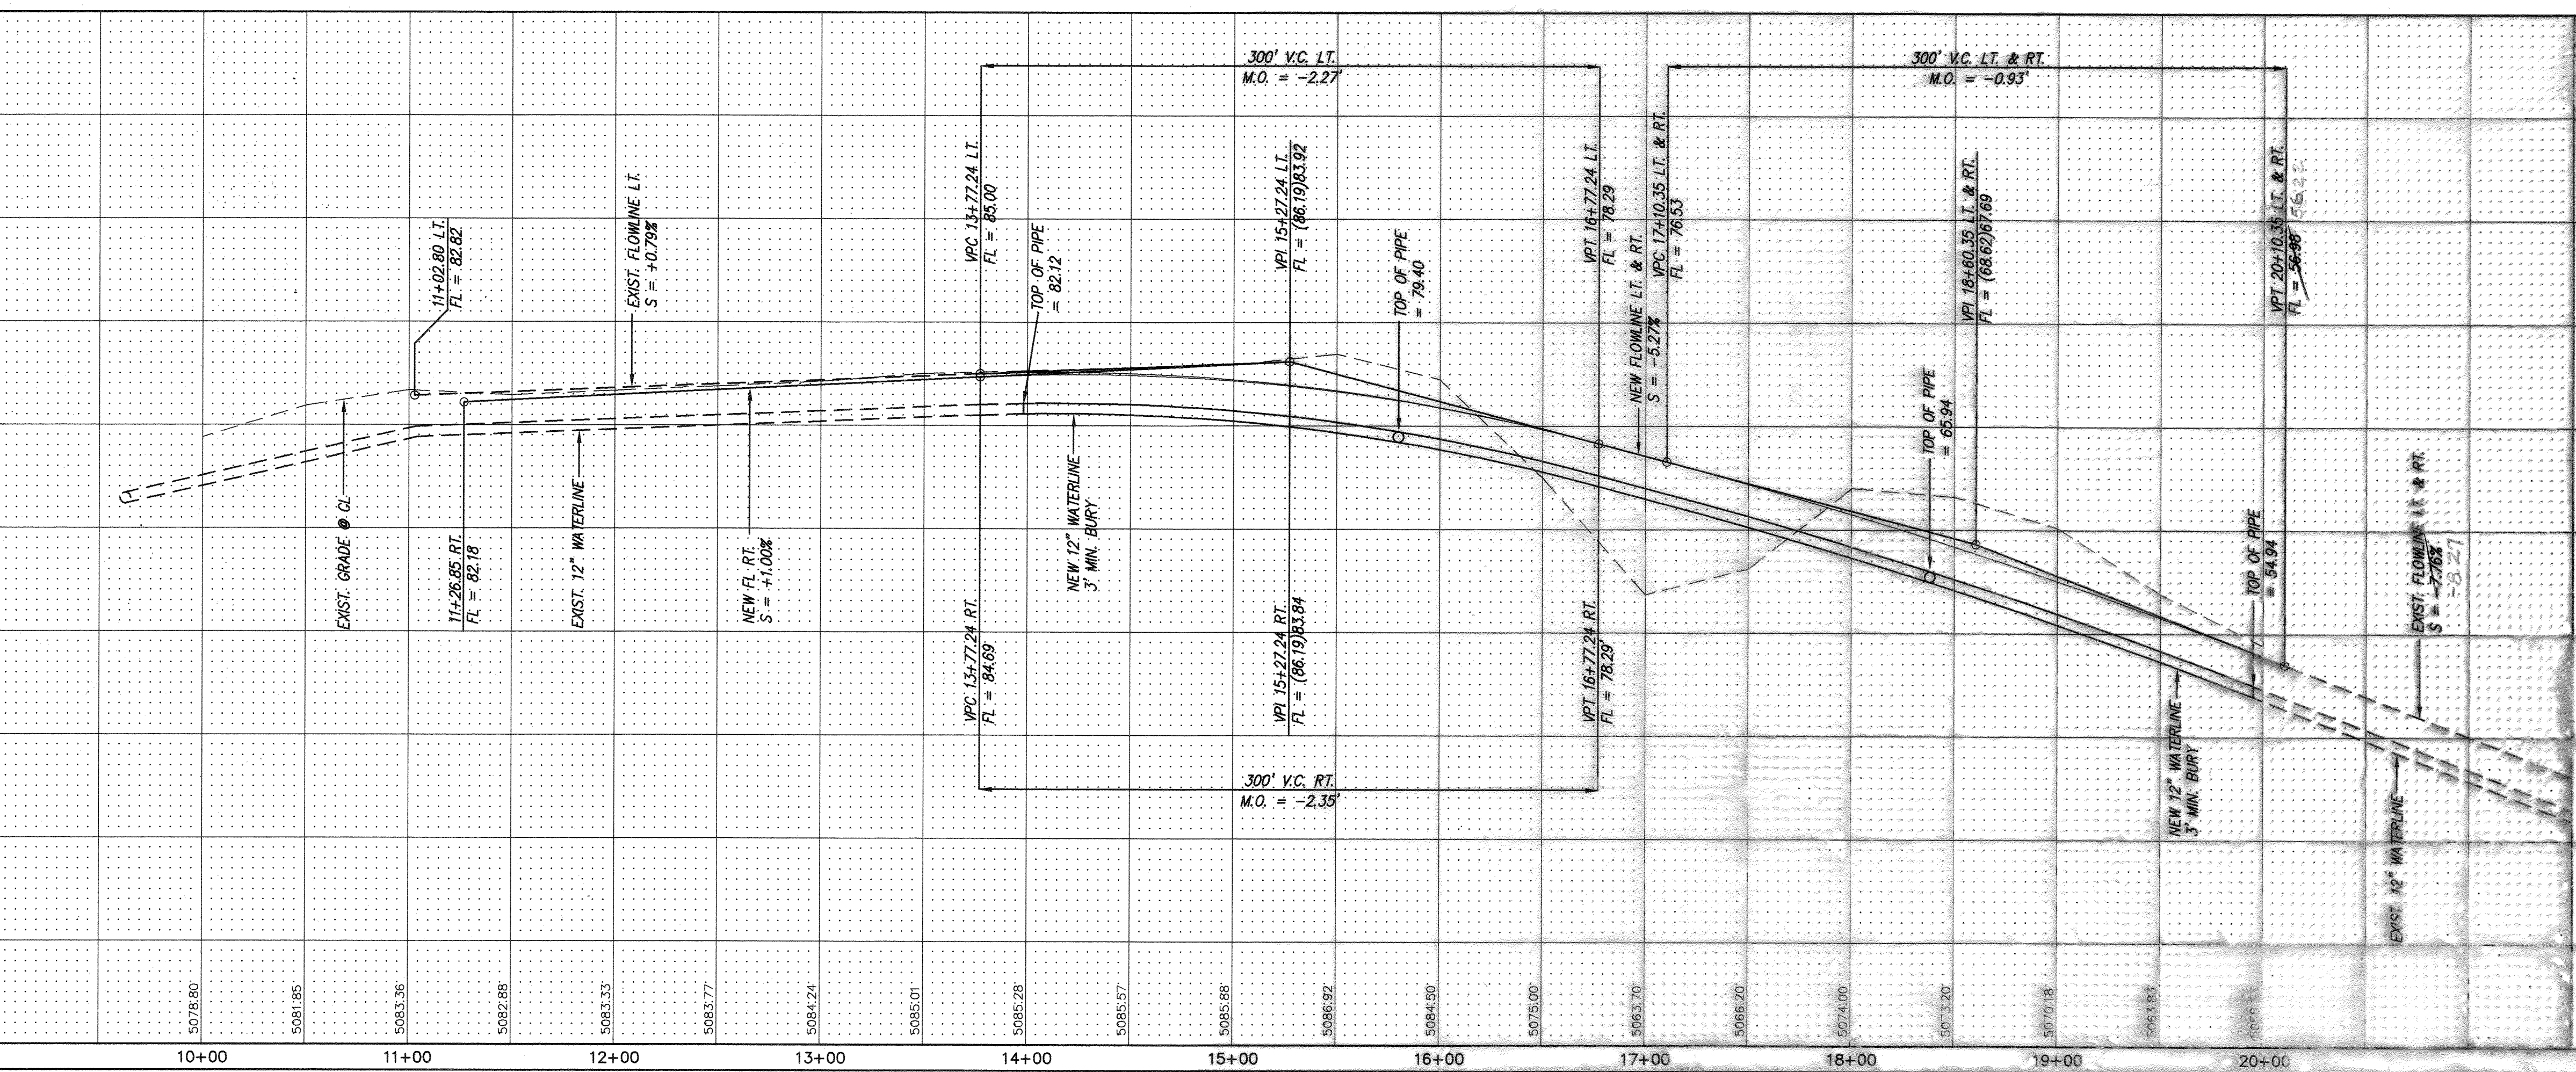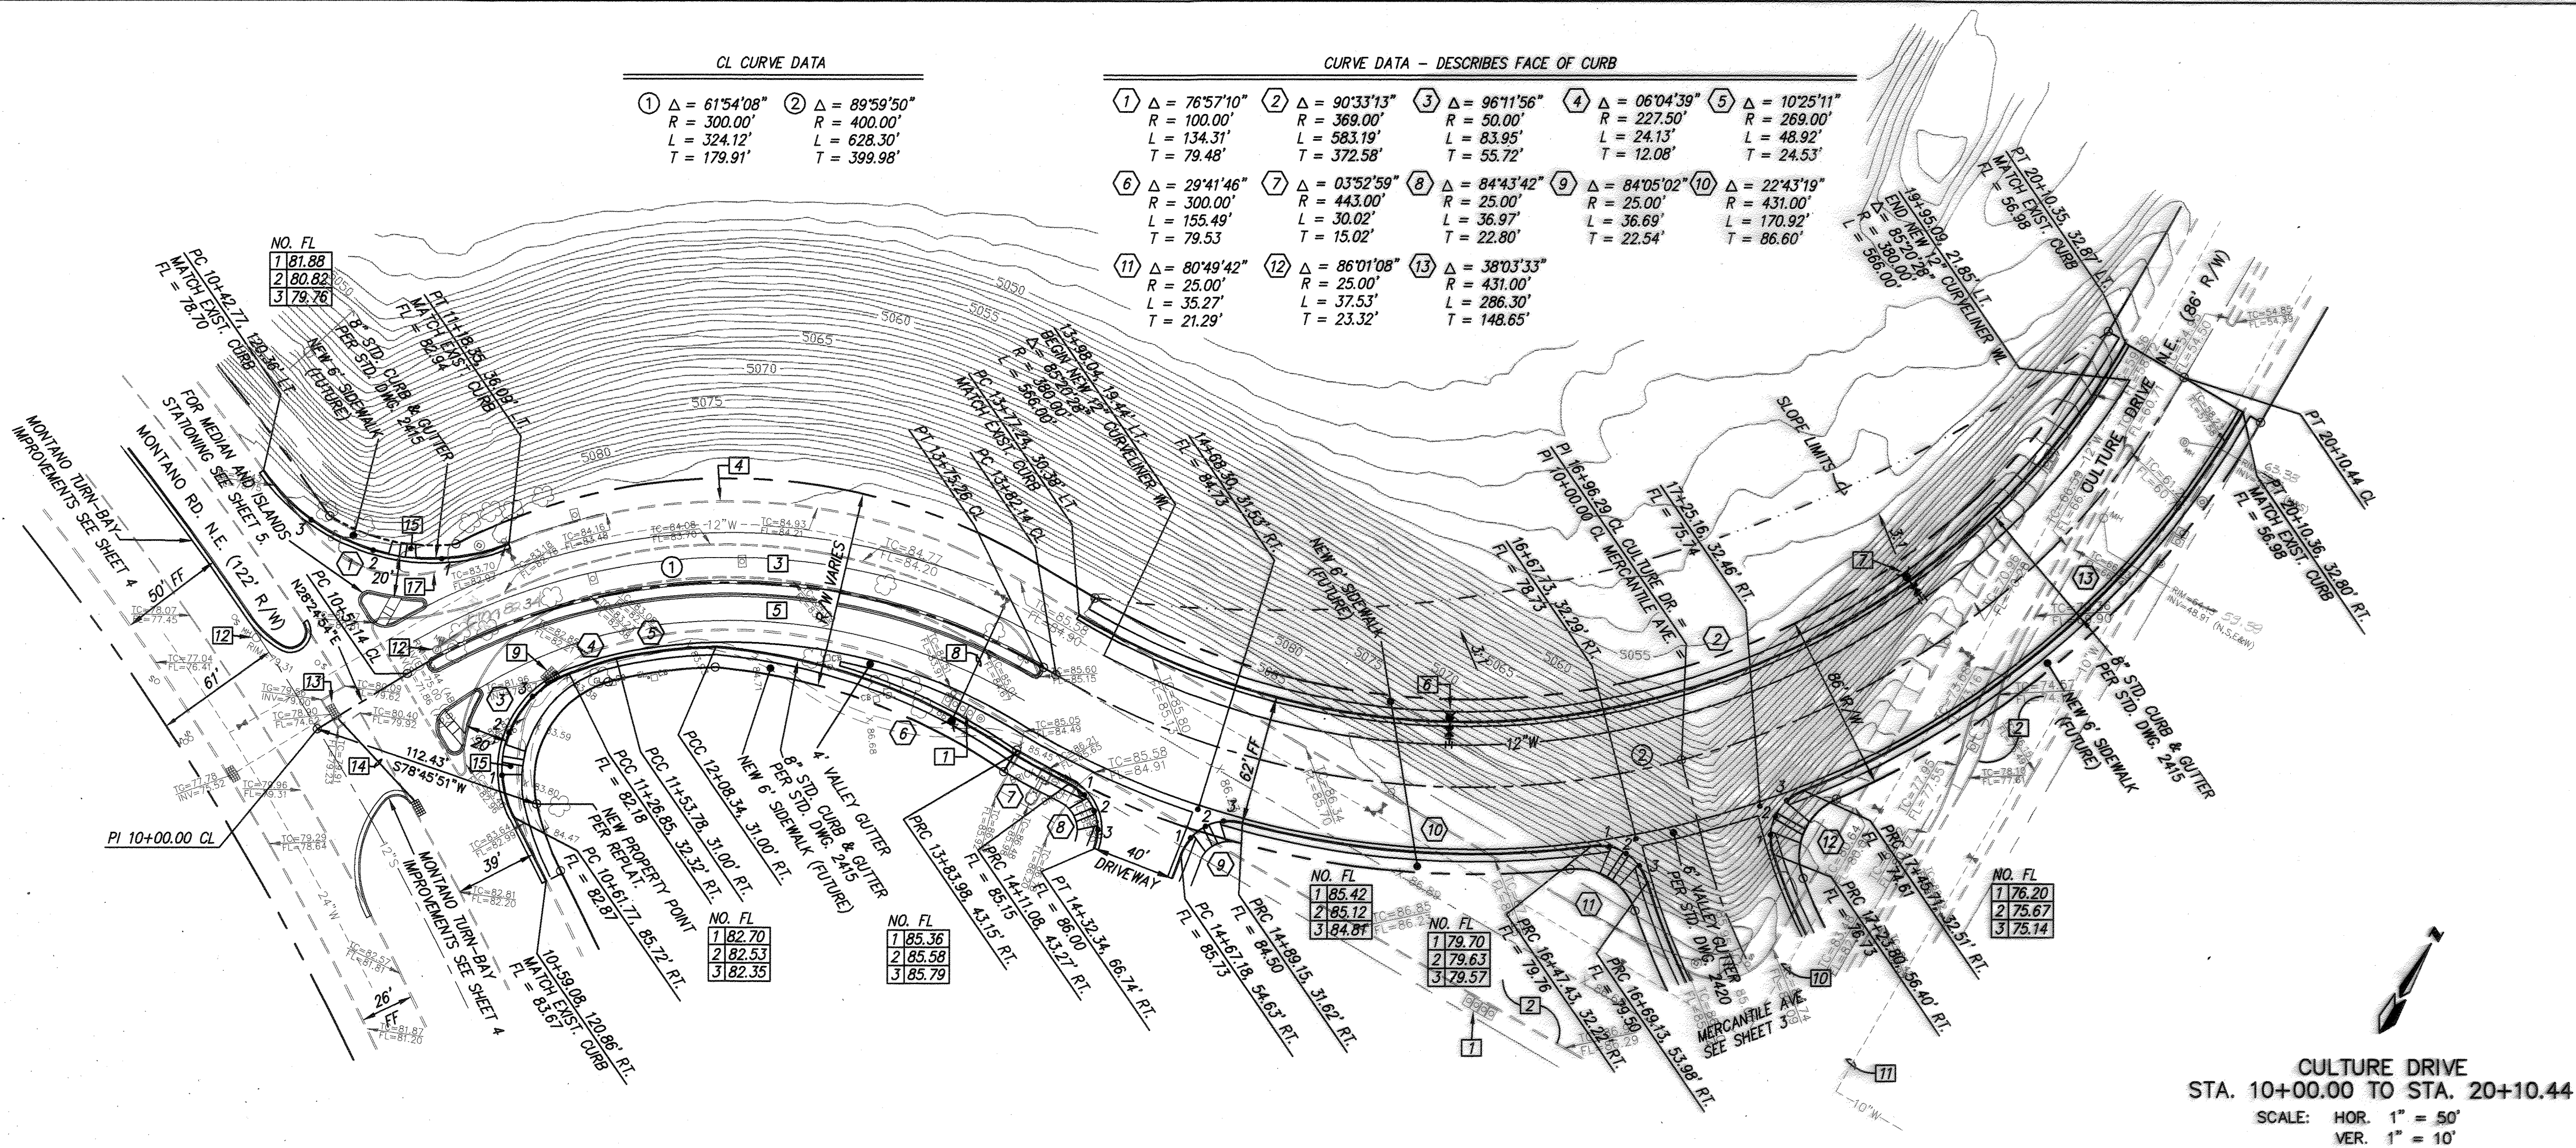

- KEYED NOTES
- 4 water meters with boxes for existing landscaping to be removed.
 - Remove all curb and gutter and paving where existing street falls behind new street. All irrigation to be removed and capped outside new paving area.
 - Remove existing median and all landscaping. Remove all irrigation system and lines, and cap outside of new paving areas.
 - Existing curb and gutter and paving west side of existing median is to remain.
 - Existing curb and gutter and paving east side of existing median is to be removed.
 - Relocate existing fire hydrant to centerline station 15+80. Flange = 83.60. Provide 6" gate valve with type "A" valve box.
 - Relocate existing fire hydrant to centerline station 18+38. Flange = 70.20. Provide 6" gate valve with type "A" valve box.
 - Relocate existing fire hydrant to centerline station 13+36. Flange = 85.63. Adjust valve boxes as necessary.
 - Relocate existing drop inlet to new curb. Extend service line to new inlet.
 - Existing 12" PVC waterline to be relocated 11 ft. off new west face of curb.
 - Existing 10" PVC waterline to remain.
 - Adjust manhole rims as necessary.
 - Remove existing inlet and build new 4' manhole type E. Rim = 80.05 "inv" = 74.62
 - New 56 L.F. 18" Class III RCP from new inlet to new manhole. New Grate = 81.06 New Inv. = 78.06. Slope = 6.14%
 - All wheelchair ramps per city standard drawing 2441.
 - All new sidewalks per city standard drawing 2430.
 - Remove existing curb & gutter outside of new curb & gutter.
- GENERAL NOTES
- All stationing is centerline stationing.
 - Adjust all manhole ring and valve boxes as necessary.
 - All water meter boxes to be removed and lines capped behind new paving.
 - For typical street section, see sht.

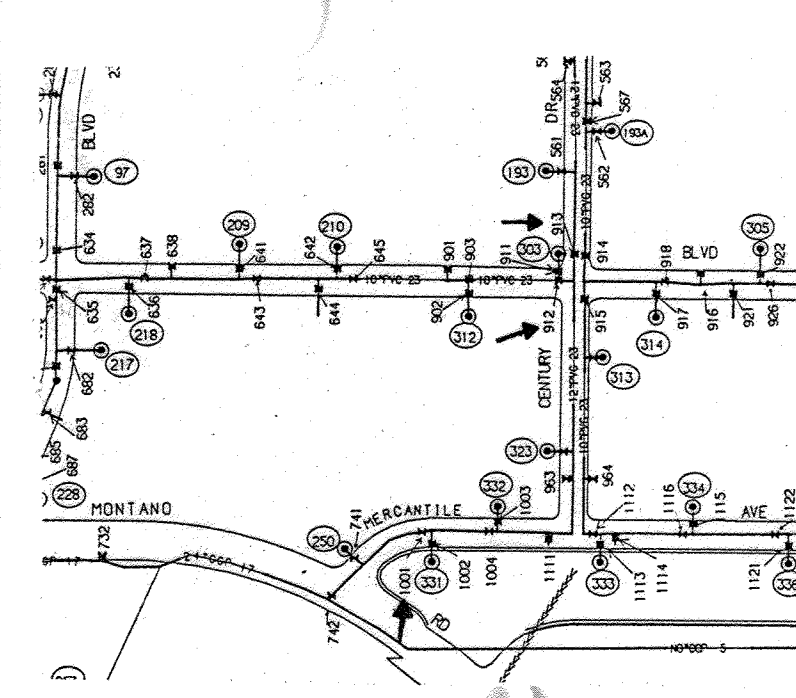

AS BUILT INFORMATION

CONTRACTOR: HANCOCK

WORK STARTED BY: JCS

DATE: 6/1/96

FIELD ACCEPTANCE BY: JCS

DATE: 6/1/96

FIELD REVISION BY: JCS

DATE: 6/1/96

DRAWINGS CORRECTED BY: JCS

DATE: 6/1/96

MICRO-FILM INFORMATION

RECORDED BY: JCS

DATE: 6/1/96

NO. 1

GENERAL NOTES


1. All stationing is centerline stationing.

CURVE DATA - DESCRIBES FACE OF CURB

① $\Delta = 16'11'32''$ $R = 150.00'$ $L = 42.39'$ $T = 21.34'$	② $\Delta = 16'11'32''$ $R = 150.00'$ $L = 42.39'$ $T = 21.34'$	③ $\Delta = 06'22'05''$ $R = 1420.14'$ $L = 157.84'$ $T = 79.00'$	④ $\Delta = 16'07'30''$ $R = 150.00'$ $L = 42.22'$ $T = 21.25'$	⑤ $\Delta = 16'16'00''$ $R = 150.00'$ $L = 42.59'$ $T = 21.44'$
⑥ $\Delta = 04'09'52''$ $R = 1376.14'$ $L = 100.02'$ $T = 50.03'$	⑦ $\Delta = 25'04'27''$ $R = 50.00'$ $L = 21.88'$ $T = 11.12'$	⑧ $\Delta = 154'24'46''$ $R = 8.00'$ $L = 21.56'$ $T = 35.23'$	⑨ $\Delta = 109'38'04''$ $R = 8.00'$ $L = 15.31'$ $T = 11.35'$	⑩ $\Delta = 68'44'50''$ $R = 50.00'$ $L = 59.99'$ $T = 34.20'$


CL CURVE DATA

① $\Delta = 23'36'01''$ $R = 1432.40'$ $L = 590.01'$ $T = 299.25'$

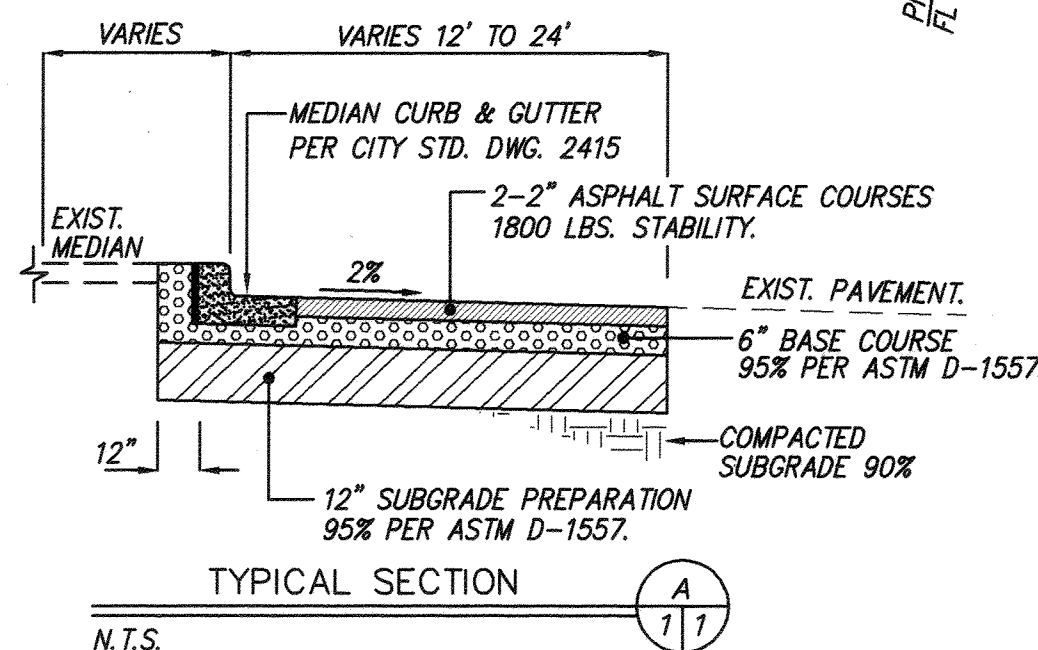

NOTE: PAVEMENT SECTION MATCHES EXISTING MONTANO RD. PAVING.

MONTANO RD. TURN-BAY
STA. 10+00.00 TO STA. 16+09.88
SCALE: HOR. 1" = 50'
VER. 1" = 10'

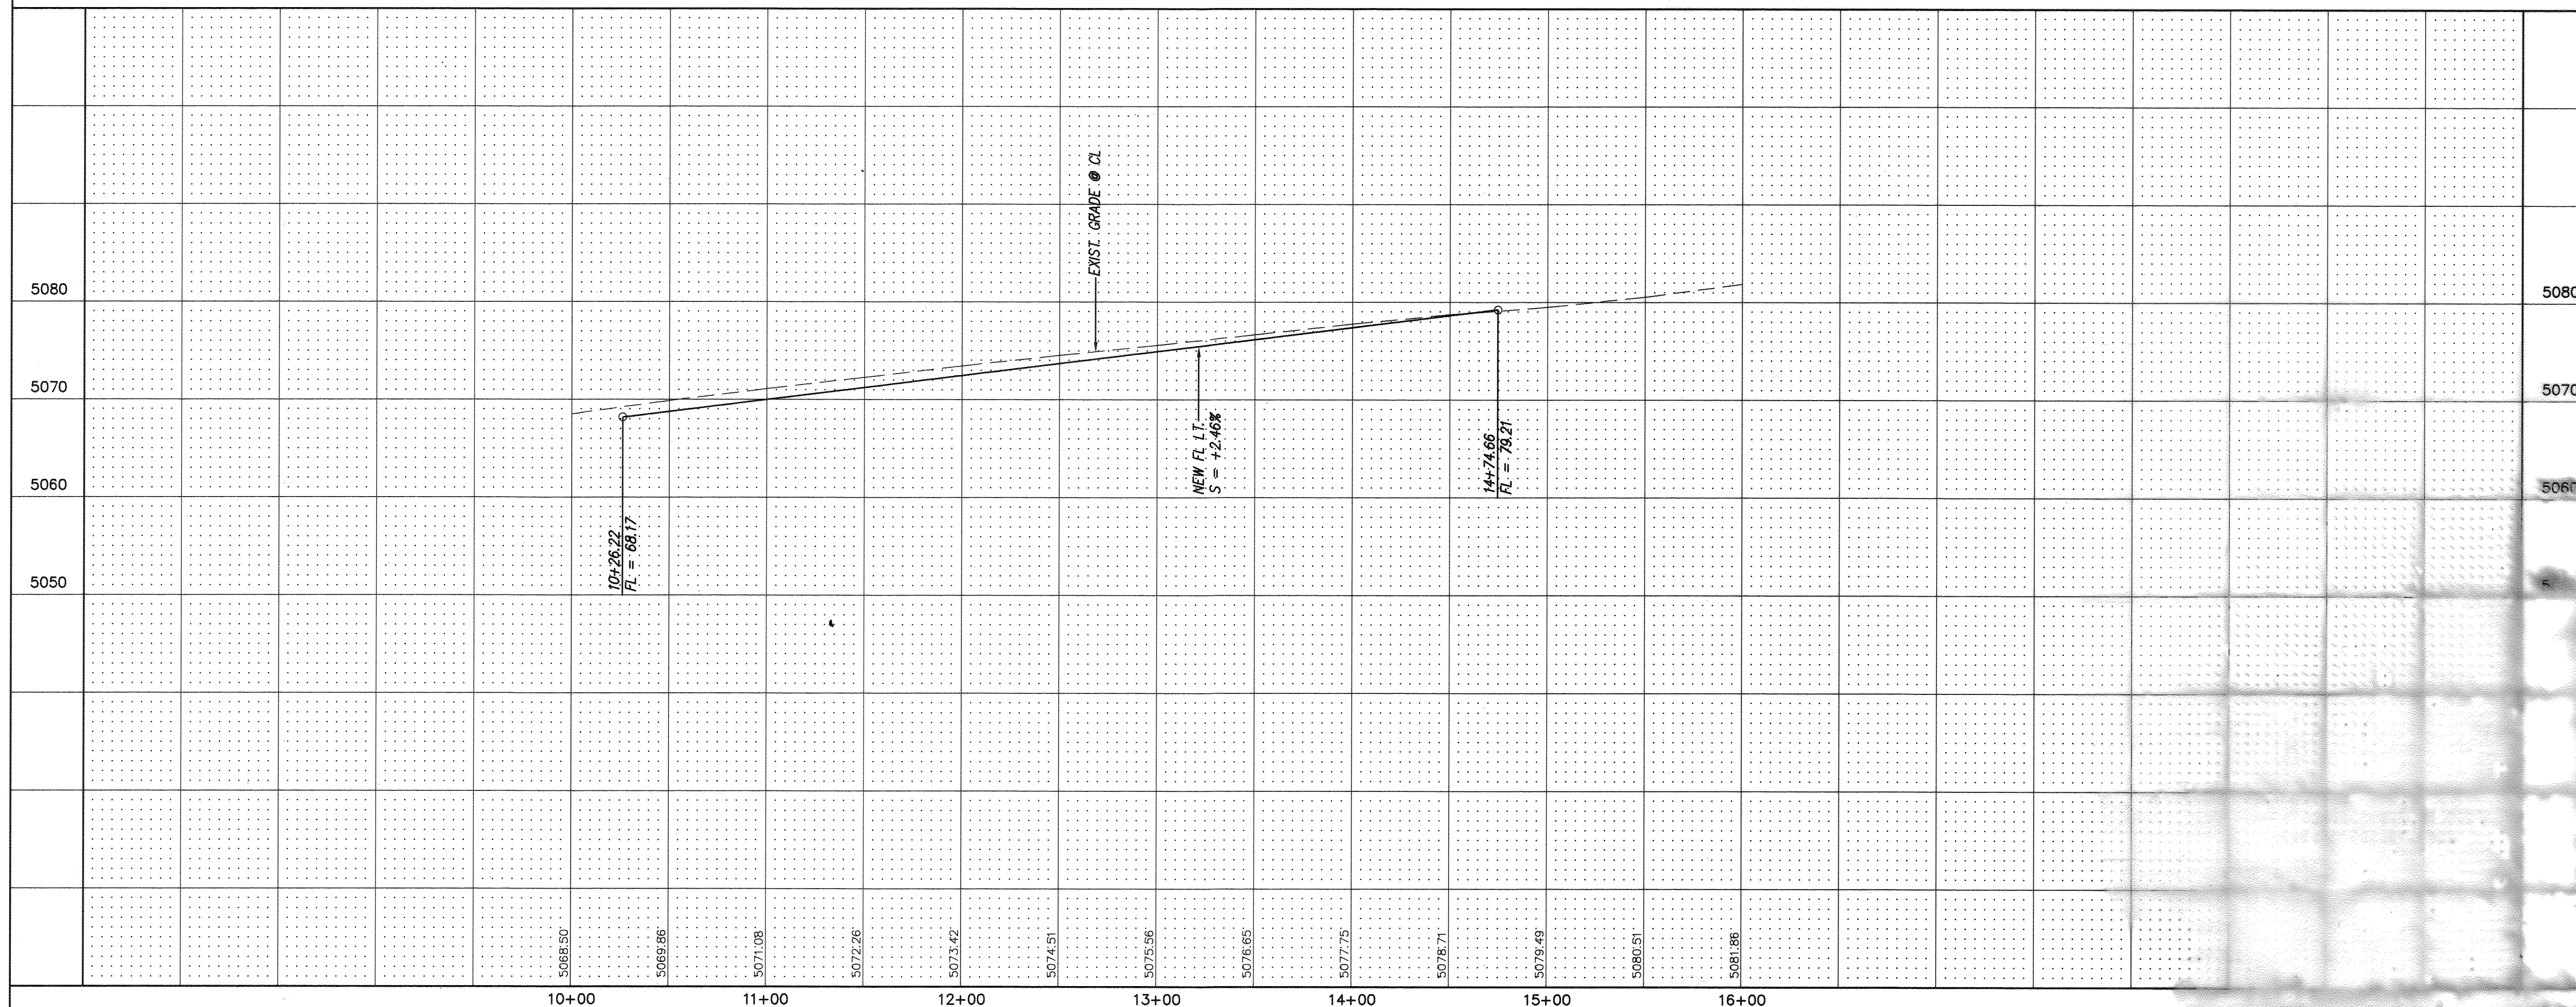

AS BUILT INFORMATION		BENCH MARKS		SURVEY INFORMATION		ENGINEER'S SEAL													
CONTRACTOR	44001115	BRASS TABLET STAMPED	STA. 1-25-207, IN TOP OF CONCRETE POST, LOCATED 0.50 MILES SOUTH OF MONTANO RD. ON WEST FRONTAGE RD. TO THE RIGHT.	DATE	BY		<table border="1"> <tr> <th>NO.</th> <th>DATE</th> <th>BY</th> </tr> <tr> <td>DESIGNED BY</td> <td>DATE</td> <td>02/96</td> </tr> <tr> <td>DRAWN UP</td> <td>DATE</td> <td>02/96</td> </tr> <tr> <td>CHECKED BY</td> <td>DATE</td> <td>02/96</td> </tr> </table>	NO.	DATE	BY	DESIGNED BY	DATE	02/96	DRAWN UP	DATE	02/96	CHECKED BY	DATE	02/96
NO.	DATE	BY																	
DESIGNED BY	DATE	02/96																	
DRAWN UP	DATE	02/96																	
CHECKED BY	DATE	02/96																	
INSPECTED	DATE	VERIFICATION BY	DATE	DATE	DATE														
FIELD	DATE	CORRECTED BY	DATE	DATE	DATE														
MICRO-FILM INFORMATION																			
RECORDED BY	DATE																		
NO.																			

26-5358.00 0497


APPROVE
JUN 25 1996
DESIGN REVIEW COMMITTEE

MONTANO RD. AND CULTURE POINT INTERSECTION
PAVING IMPROVEMENTS
MONTANO RD. TURN-BAY

CITY PROJECT NO. 5358.90

ZONE MAP NO. F16

SHEET 4 OF 19


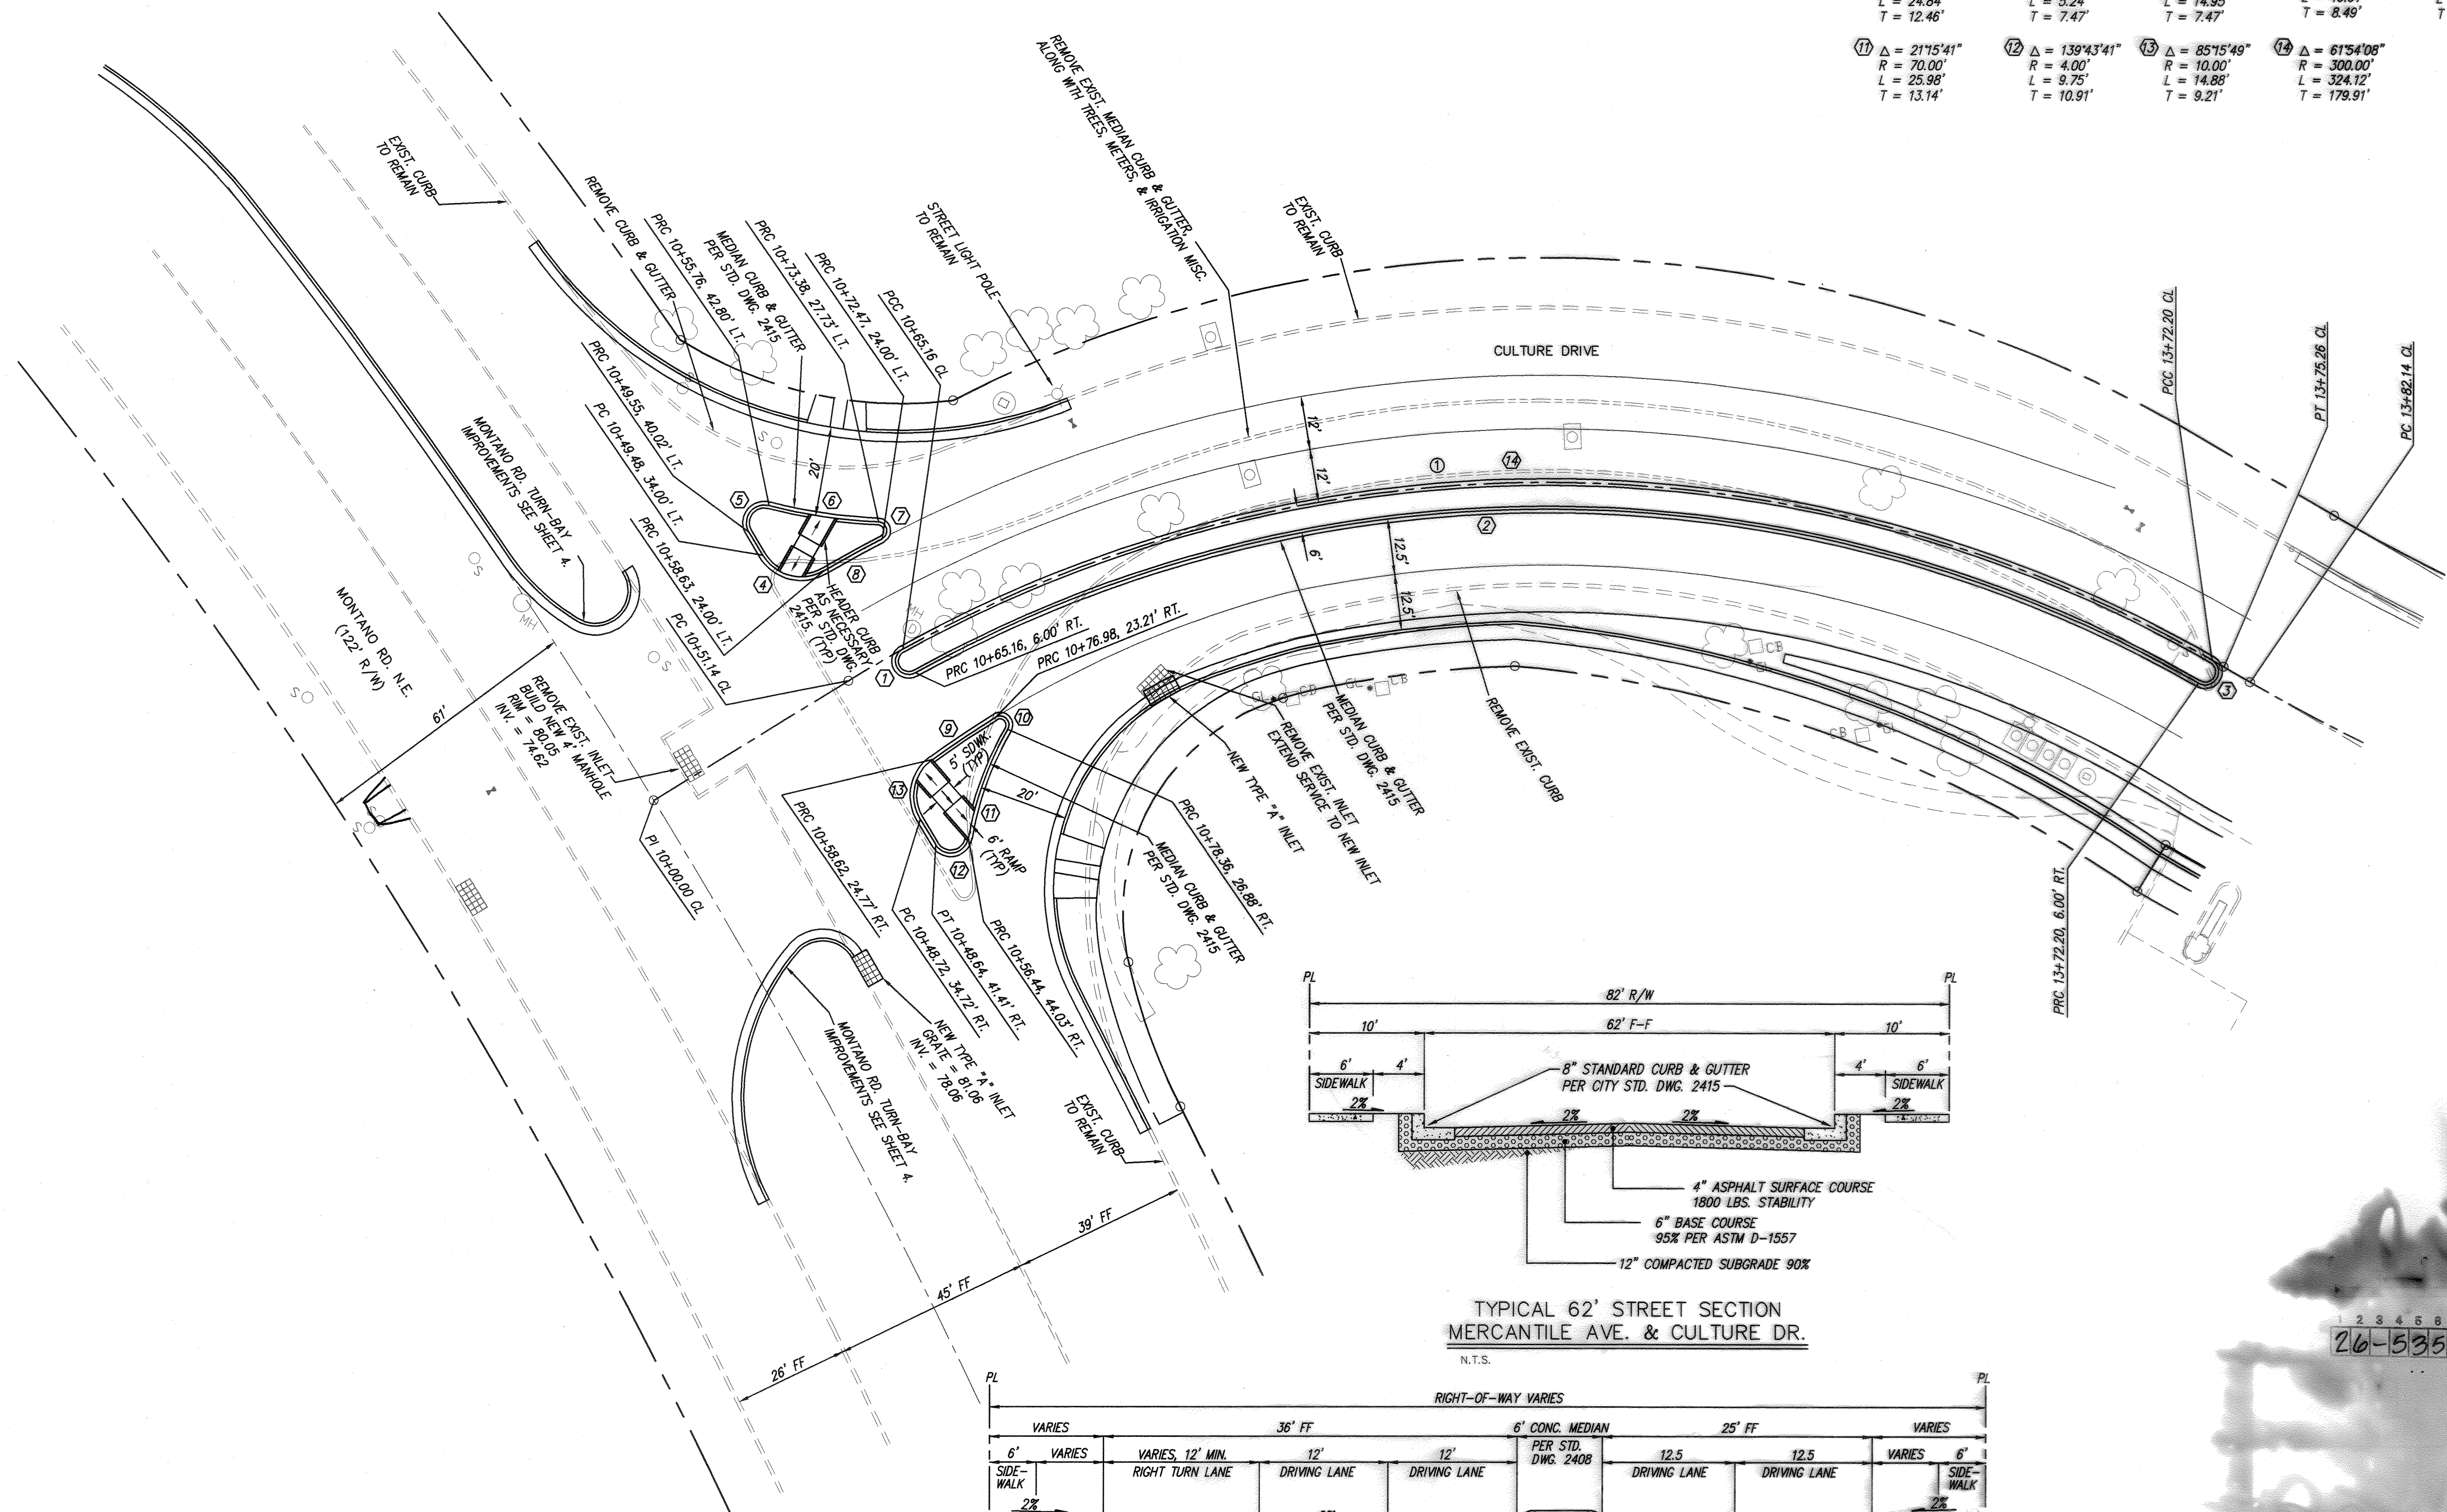


CL CURVE DATA

① $\Delta = 61^\circ 54' 08''$ $R = 300.00'$ $L = 324.12'$ $T = 179.91'$

CURVE DATA - DESCRIBES FACE OF CURB

① $\Delta = 178^\circ 31' 20''$ $R = 3.00'$ $L = 9.90'$ $T = 232.62'$	② $\Delta = 59^\circ 33' 33''$ $R = 294.00'$ $L = 305.61'$ $T = 168.24'$	③ $\Delta = 178^\circ 50' 33''$ $R = 3.00'$ $L = 9.49'$ $T = 296.99'$	④ $\Delta = 89^\circ 12' 20''$ $R = 10.00'$ $L = 15.57'$ $T = 9.86'$	⑤ $\Delta = 135^\circ 15' 45''$ $R = 4.00'$ $L = 9.44'$ $T = 9.72'$
⑥ $\Delta = 11^\circ 51' 30''$ $R = 120.00'$ $L = 24.84'$ $T = 12.46'$	⑦ $\Delta = 150^\circ 02' 00''$ $R = 2.00'$ $L = 5.24'$ $T = 7.47'$	⑧ $\Delta = 02^\circ 38' 35''$ $R = 324.00'$ $L = 14.95'$ $T = 7.47'$	⑨ $\Delta = 04^\circ 03' 02''$ $R = 240.00'$ $L = 16.97'$ $T = 8.49'$	⑩ $\Delta = 152^\circ 13' 10''$ $R = 2.00'$ $L = 5.31'$ $T = 8.09'$
⑪ $\Delta = 21^\circ 15' 41''$ $R = 70.00'$ $L = 25.98'$ $T = 13.14'$	⑫ $\Delta = 139^\circ 43' 41''$ $R = 4.00'$ $L = 9.75'$ $T = 10.91'$	⑬ $\Delta = 85^\circ 15' 49''$ $R = 10.00'$ $L = 14.88'$ $T = 9.21'$	⑭ $\Delta = 61^\circ 54' 08''$ $R = 300.00'$ $L = 324.12'$ $T = 179.91'$	

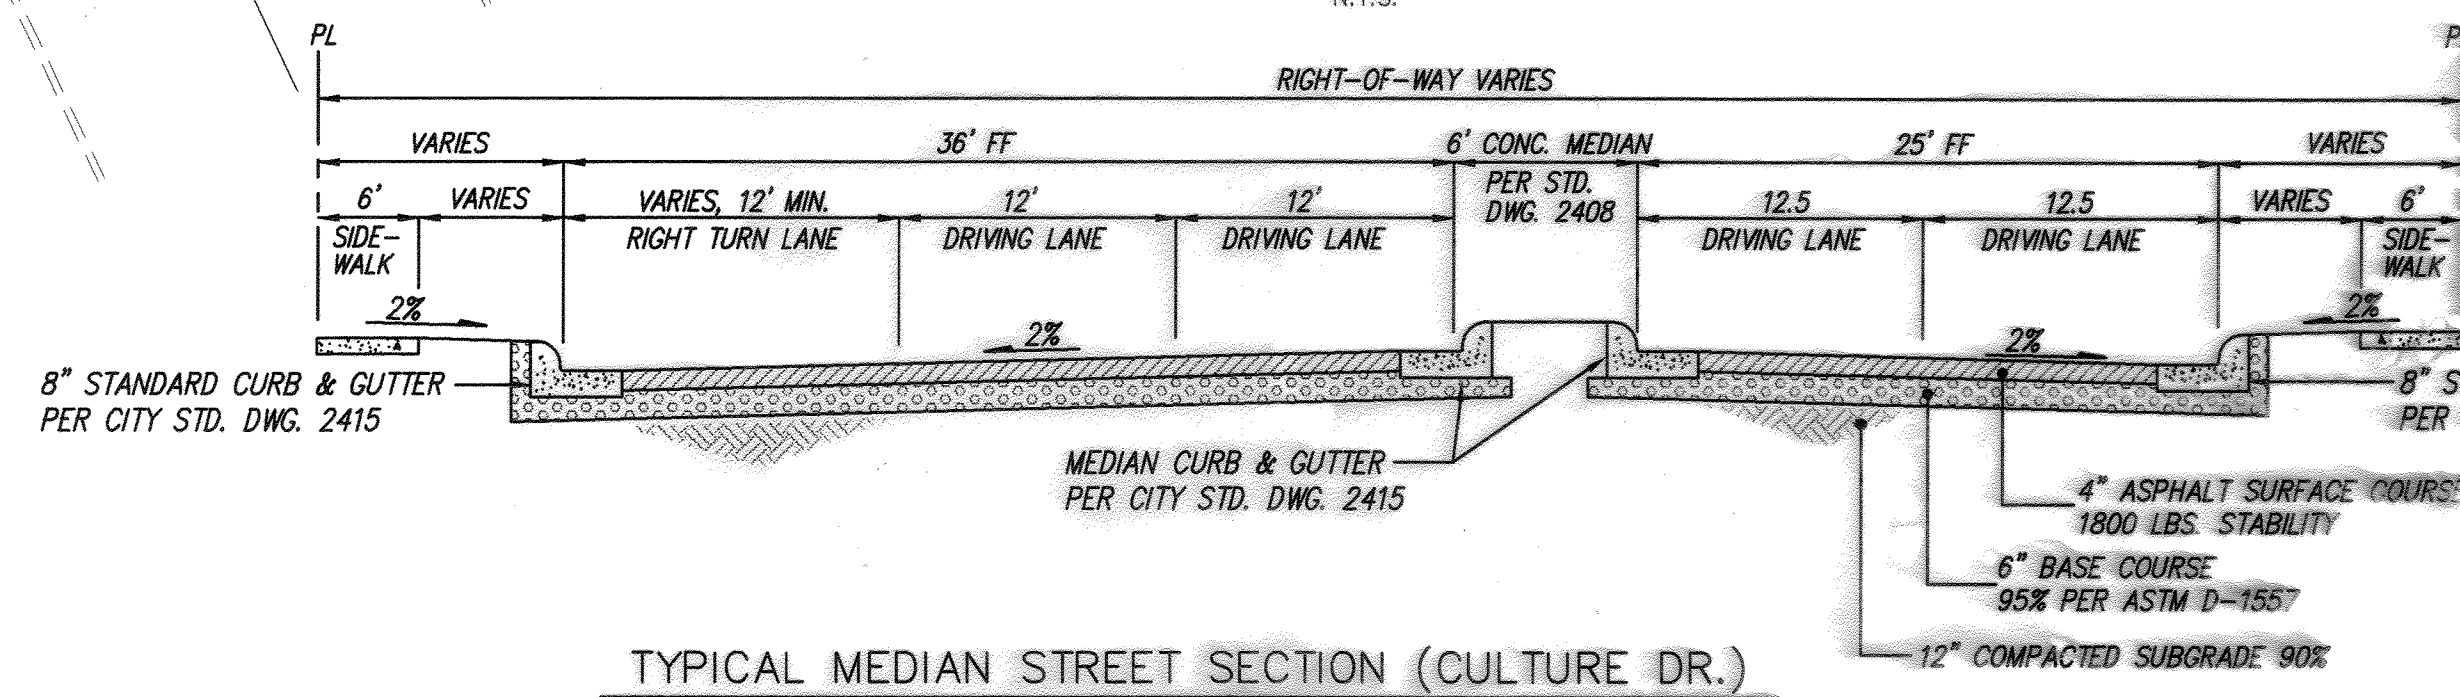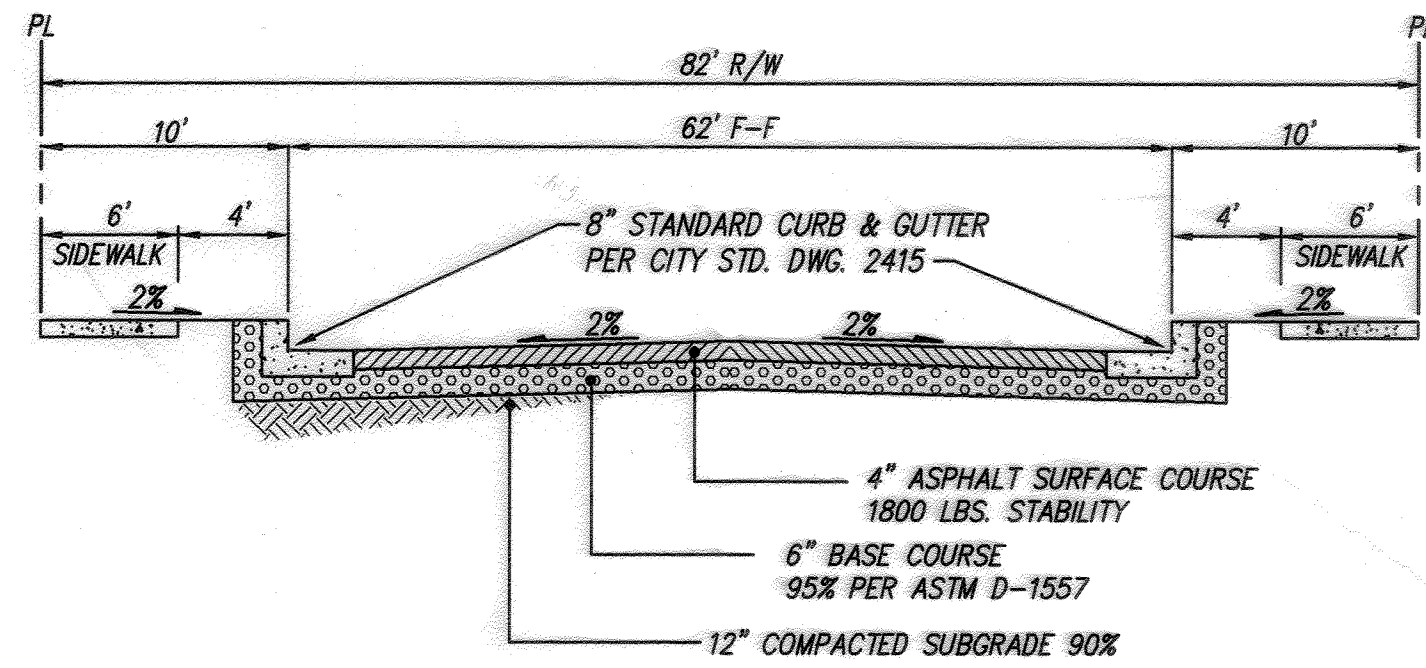

AS BUILT INFORMATION		BENCH MARKS		SURVEY INFORMATION		ENGINEER'S SEAL		DESIGN GROUP	
CONTRACTOR	DATE	BRASS TABLET STAMPED	DATE	FIELD NOTES	DATE	ENGINEER'S SEAL	DESIGN GROUP	CITY DR. INTERSECTION	CITY ENGINEER APPROVAL
WORK STATIONED BY	DATE	POST. LOCATED 0.50 MILES SOUTH OF MONTANO RD. ON WEST FRONTAGE RD. TO THE RIGHT.	DATE	NO.	BY				
FIELD ACCEPTANCE BY	DATE								
DRAWINGS	DATE								
CORRECTED BY	DATE								
MICRO-FILM INFORMATION	DATE								
RECORDED BY	DATE								
NO.									

26-5358.90 0537


APPROVED

DESIGN REVIEW COMMITTEE

CITY PROJECT NO. 5358.90

ZONE MAP NO. 6

SHEET 5 OF 19

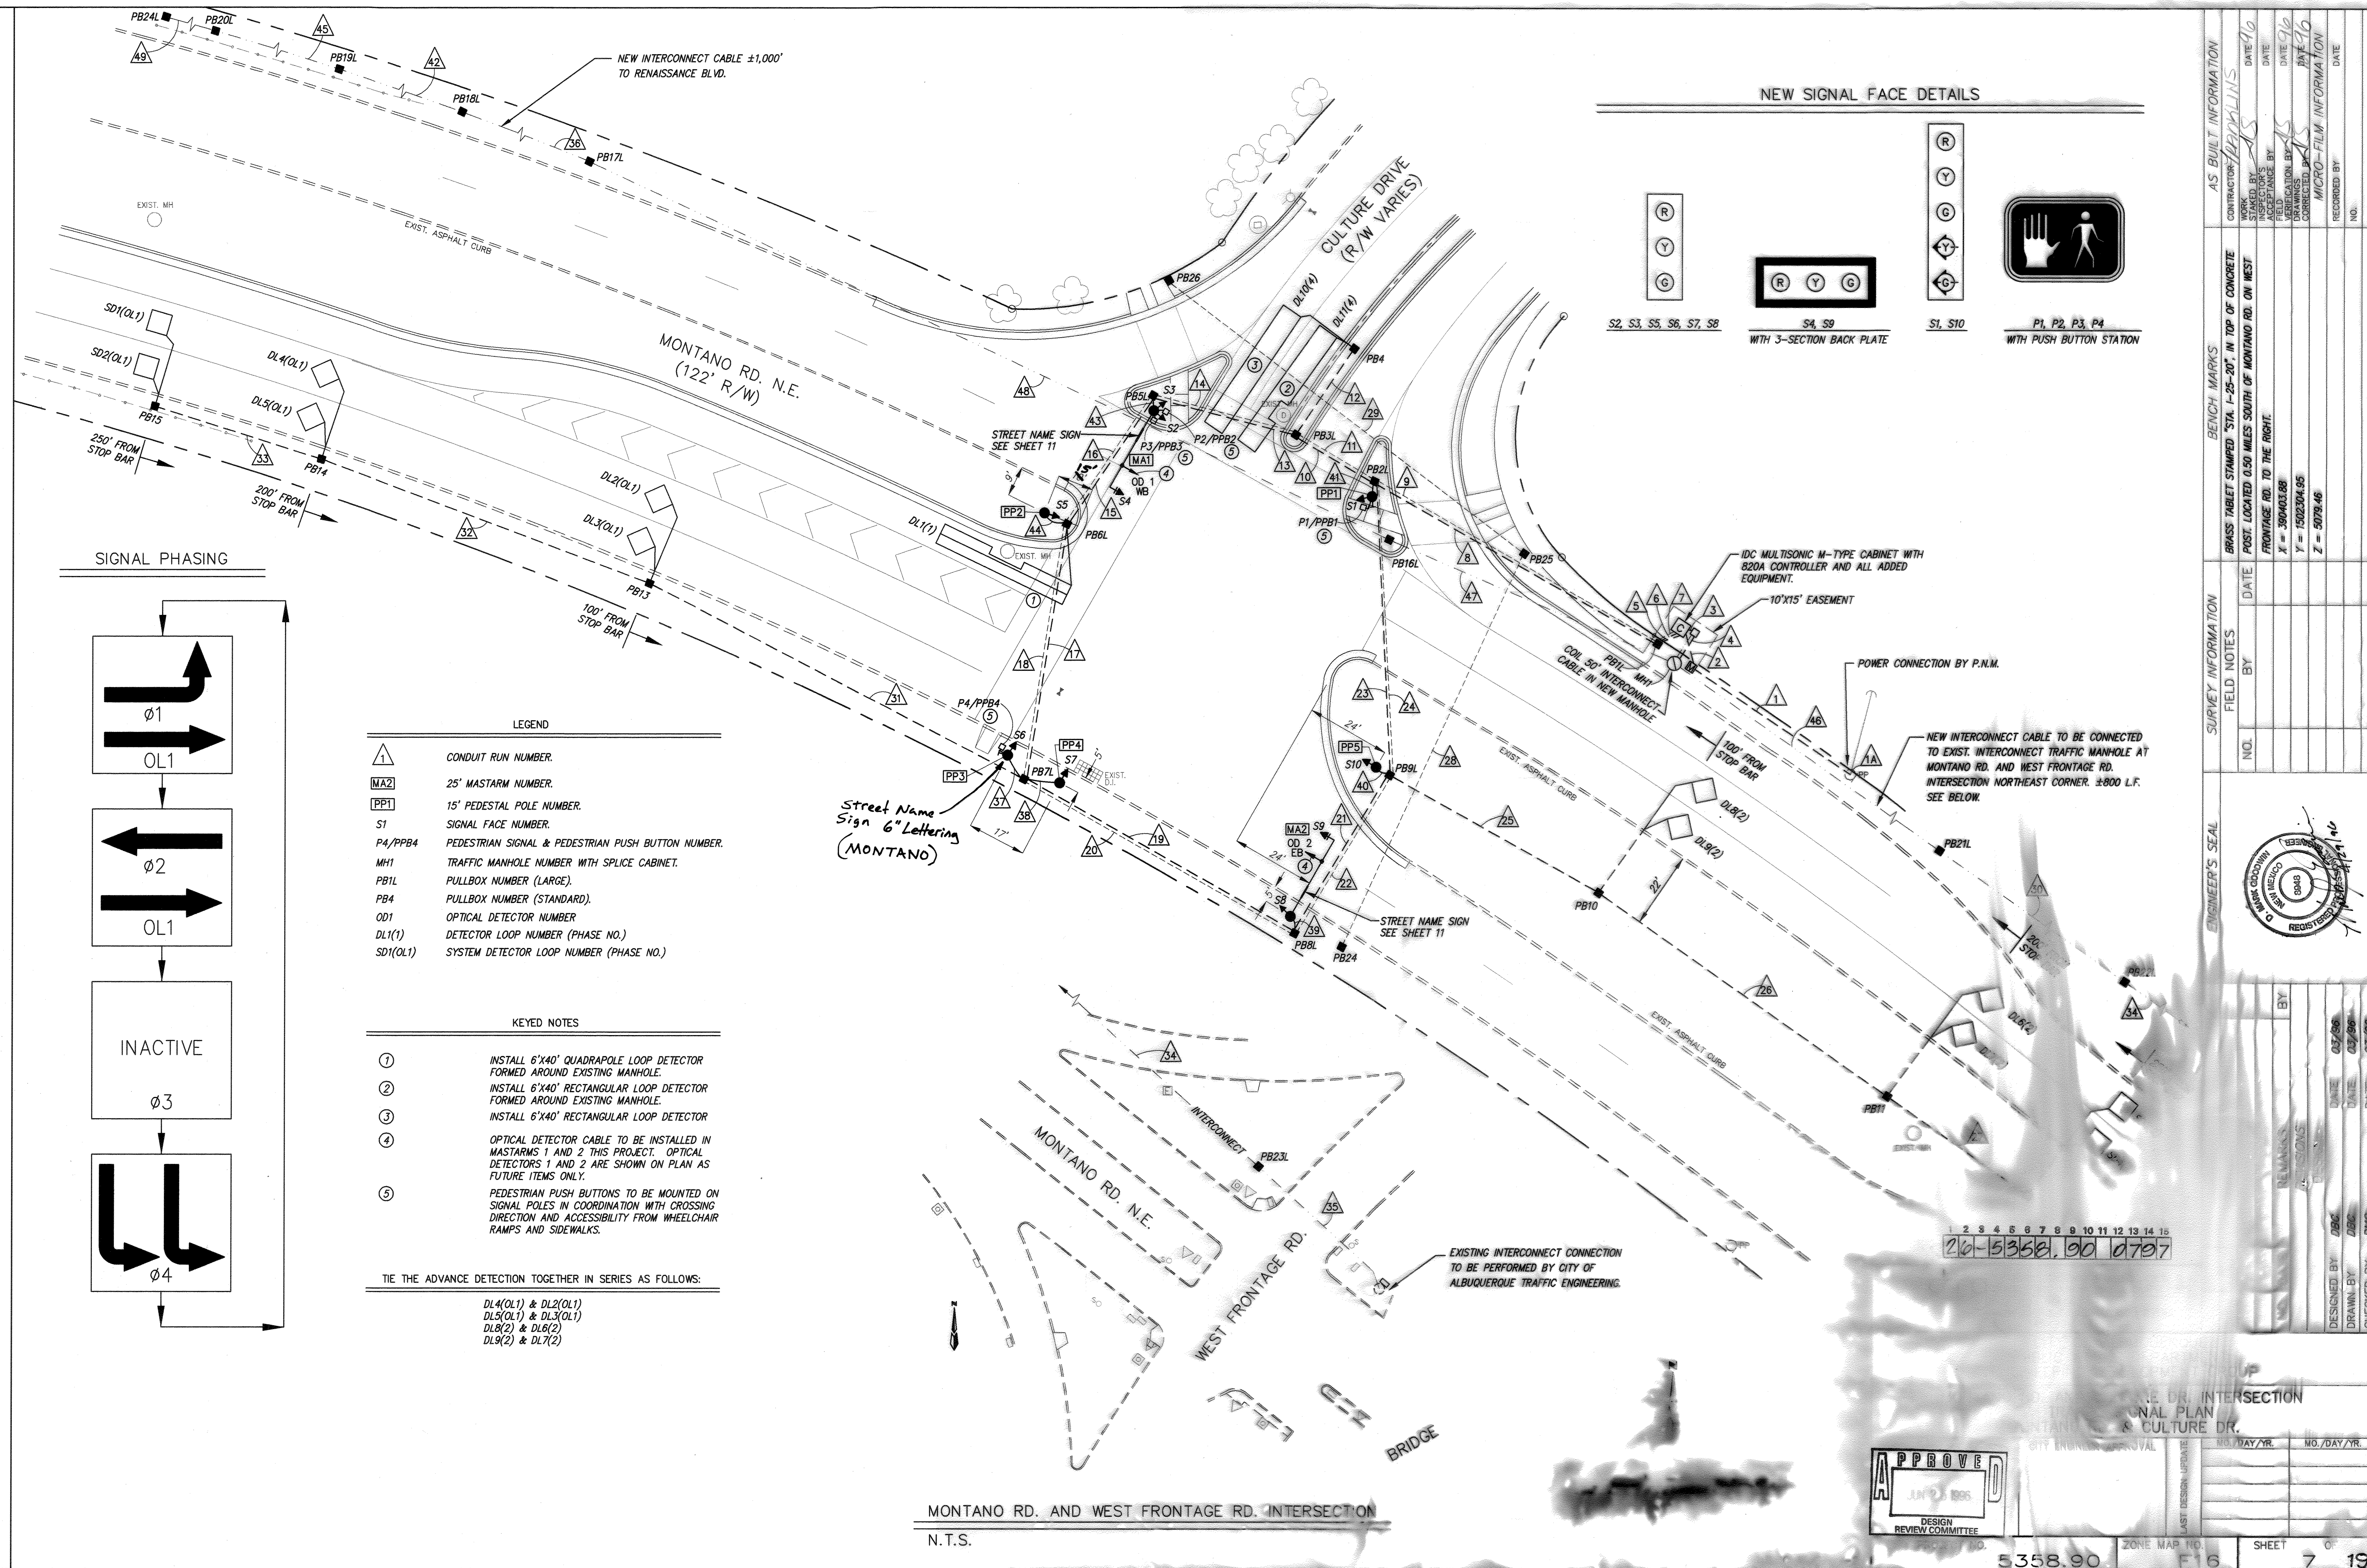


CONDUIT AND CONDUCTOR REQUIREMENTS														
CONDUIT LENGTH, SIZE, AND TYPE					CONDUIT FILL BY CONDUCTOR LENGTH AND TYPE									
RUN I.D. ▲	SIZE/LENGTH			TYPE	REMARKS	MCC 5 (# @ FT.)	MCC 7 (# @ FT.)	MCC 20 (# @ FT.)	SCC #8 (# @ FT.)	SCC #2 (# @ FT.)	NEW DLIC (# @ FT.)	CC 12 (# @ FT.)	OPTICOM (# @ FT.)	SCC #6 (# @ FT.)
	1"	2"	3"											
1		60'		REC	POWER FROM P.N.M. RISER					3 @ 70				
1A		30'		REC	P.N.M. RISER UP POWER POLE					3 @ 40				
2		10'		REC	METER TO CONTROLLER					3 @ 20				
3			2'	REC	SPLICE CABINET TO CONTROLLER							1 @ 15		
4			10'	REC	M.H. TO SPLICE CABINET							2 @ 20		
5			10'	REC	CONTROLLER TO PB1L			1 @ 20	1 @ 20				2 @ 20	
6			10'	REC	CONTROLLER TO PB1L									
7		10'		REC	CONTROLLER TO PB1L	1 @ 20					10 @ 20			
8			95'	REC	PB1L TO PB2L			1 @ 105	1 @ 105				2 @ 105	
9			95'	REC	PB1L TO PB2L	1 @ 105					10 @ 105			
10			25'	REC	PB2L TO PB3L			1 @ 35	1 @ 35				1 @ 35	
11			25'	REC	PB2L TO PB3L	1 @ 35					6 @ 35			
12			30'	REC	PB3L TO PB4						1 @ 40			
13			45'	REC	PB3L TO PB5L			1 @ 55	1 @ 55				1 @ 55	
14			45'	REC	PB3L TO PB5L	1 @ 55					5 @ 55			
15			45'	REC	PB5L TO PB6L			1 @ 55	1 @ 55					
16			45'	REC	PB5L TO PB6L	1 @ 55					5 @ 55			
17			75'	REC	PB6L TO PB7L			1 @ 85	1 @ 85					
18			75'	REC	PB6L TO PB7L	1 @ 85					4 @ 85			
19			90'	REC	PB7L TO PB8L			1 @ 100	1 @ 100					
20			90'	REC	PB7L TO PB8L	1 @ 100								
21			55'	REC	PB8L TO PB9L			1 @ 65	1 @ 65				1 @ 65	
22			55'	REC	PB8L TO PB9L	1 @ 65								
23			85'	REC	PB9L TO PB2L			1 @ 95	1 @ 95				1 @ 95	
24			85'	REC	PB9L TO PB2L	1 @ 95					4 @ 95			
25			70'	REC	PB9L TO PB10						4 @ 80			
26			100'	REC	PB10 TO PB11						4 @ 110			
27			50'	REC	PB11 TO PB12						2 @ 60			
28		125'		REC	PB24 TO PB25									
29		130'		REC	PB25 TO PB26									
30			250'	REC	PB21L TO PB22L							1 @ 260		
31			120'	REC	PB7L TO PB13L						4 @ 130			
32			100'	REC	PB13L TO PB14L						4 @ 110			
33			50'	REC	PB14L TO PB15						2 @ 60			
34			250'	REC	PB22L TO PB23L							1 @ 260		
35			50'	REC	PB23L TO EXIST. INTERCONNECT MH							1 @ 60		
36			250'	REC	PB17L TO PB18L							1 @ 260		
37			10'	REC	PB7L TO PP3	3 @ 20								
38			10'	REC	PB7L TO PP4	1 @ 20								
39			6'	REC	PB8L TO MA2	2 @ 16						1 @ 16		
40			6'	REC	PB9L TO PP5		1 @ 16							
41			6'	REC	PB2L TO PP1	2 @ 16	1 @ 16							
42			250'	REC	PB18L TO PB19L						1 @ 260			
43			6'	REC	PB5L TO MA1	7 @ 16						1 @ 16		
44			10'	REC	PB6L TO PP2	1 @ 20								
45			250'	REC	PB19L TO PB20L							1 @ 260		
46			250'	REC	MH1 TO PB21L							1 @ 305		
47			90'	REC	MH1 TO PB16L							1 @ 100		
48			200'	REC	PB16L TO PB17L							1 @ 210		
49			250'	REC	PB20L TO PB24L							1 @ 260		


CONDUIT AND CONDUCTOR REQUIREMENTS (CONTINUED)														
CONDUIT LENGTH, SIZE, AND TYPE					CONDUIT FILL BY CONDUCTOR LENGTH AND TYPE									
RUN I.D. ▲	SIZE/LENGTH			TYPE	REMARKS	MCC 5 (# @ FT.)	MCC 7 (# @ FT.)	MCC 20 (# @ FT.)	SCC #8 (# @ FT.)	SCC #2 (# @ FT.)	NEW DLIC (# @ FT.)	CC 12 (# @ FT.)	OPTICOM (# @ FT.)	SCC #6 (# @ FT.)
	1"	2"	3"											
PP1					BASE TO S1		1 @ 20							
"					BASE TO P1	1 @ 16								
"					BASE TO PPB1	1 @ 11								
PP2					BASE TO S5	1 @ 25								
PP3					BASE TO S6	1 @ 25								
"					BASE TO P4	1 @ 16								
"					BASE TO PPB4	1 @ 11								
PP4					BASE TO S7	1 @ 25								
PP5					BASE TO S10		1 @ 20							
MA1					BASE TO S2	1 @ 30								
"					BASE TO S3	1 @ 30								
"					BASE TO S4	1 @ 55								
"					BASE TO P2	1 @ 16								
"					BASE TO PPB2	1 @ 11								
"					BASE TO P3	1 @ 16								
"					BASE TO PPB3	1 @ 11								
"					BASE TO OD1								1 @ 50	
MA2					BASE TO S8	1 @ 30								
"					BASE TO S9	1 @ 55								
"					BASE TO OD2								1 @ 50	
TOTALS		880	3,211				72	615	615	390	4,730	2,290	632	

1,274


AS-BUILT INFORMATION		CONTRACTOR: <u>HAUHLIS</u>		DATE: <u>9/6</u>	
WORK STARTED BY: <u>AS</u>		INSPECTOR: <u>AS</u>		DATE: <u>9/6</u>	
FIELD ENGINEER: <u>AS</u>		FIELD CORRECTOR: <u>AS</u>		DATE: <u>9/6</u>	
VERIFICATION BY: <u>AS</u>		CORRECTION BY: <u>AS</u>		DATE: <u>9/6</u>	
MICRO-FILM INFORMATION		RECORDED BY: <u>AS</u>		DATE: <u>9/6</u>	
NO.		NO.		NO.	
BENCH MARKS					
BRASS TABLE STAMPED "STA. 1-25-20" IN TOP OF CONCRETE					
POST LOCATED 0.50 MILES SOUTH OF MONTANO RD. ON WEST					
FRONTAGE RD. TO THE RIGHT.					
X = 389403.88					
Y = 1502304.95					
Z = 5079.46					
SURVEY INFORMATION					
FIELD NOTES		DATE		BY	
NO.		NO.		NO.	
ENGINEER'S SEAL					
DESIGNED BY: <u>DBC</u> DATE: <u>04/98</u>					
DRAWN BY: <u>DBC</u> DATE: <u>04/98</u>					
CHECKED BY: <u>DWG</u> DATE: <u>04/98</u>					
NON-CONFORMANCE GROUP					
REVISIONS					
APPROVED					
DESIGN REVIEW COMMITTEE					
CITY PROJECT NO. <u>5358.90</u>					
ZONE MAP NO. <u>F-16</u>					
SHEET <u>8</u> OF <u>19</u>					

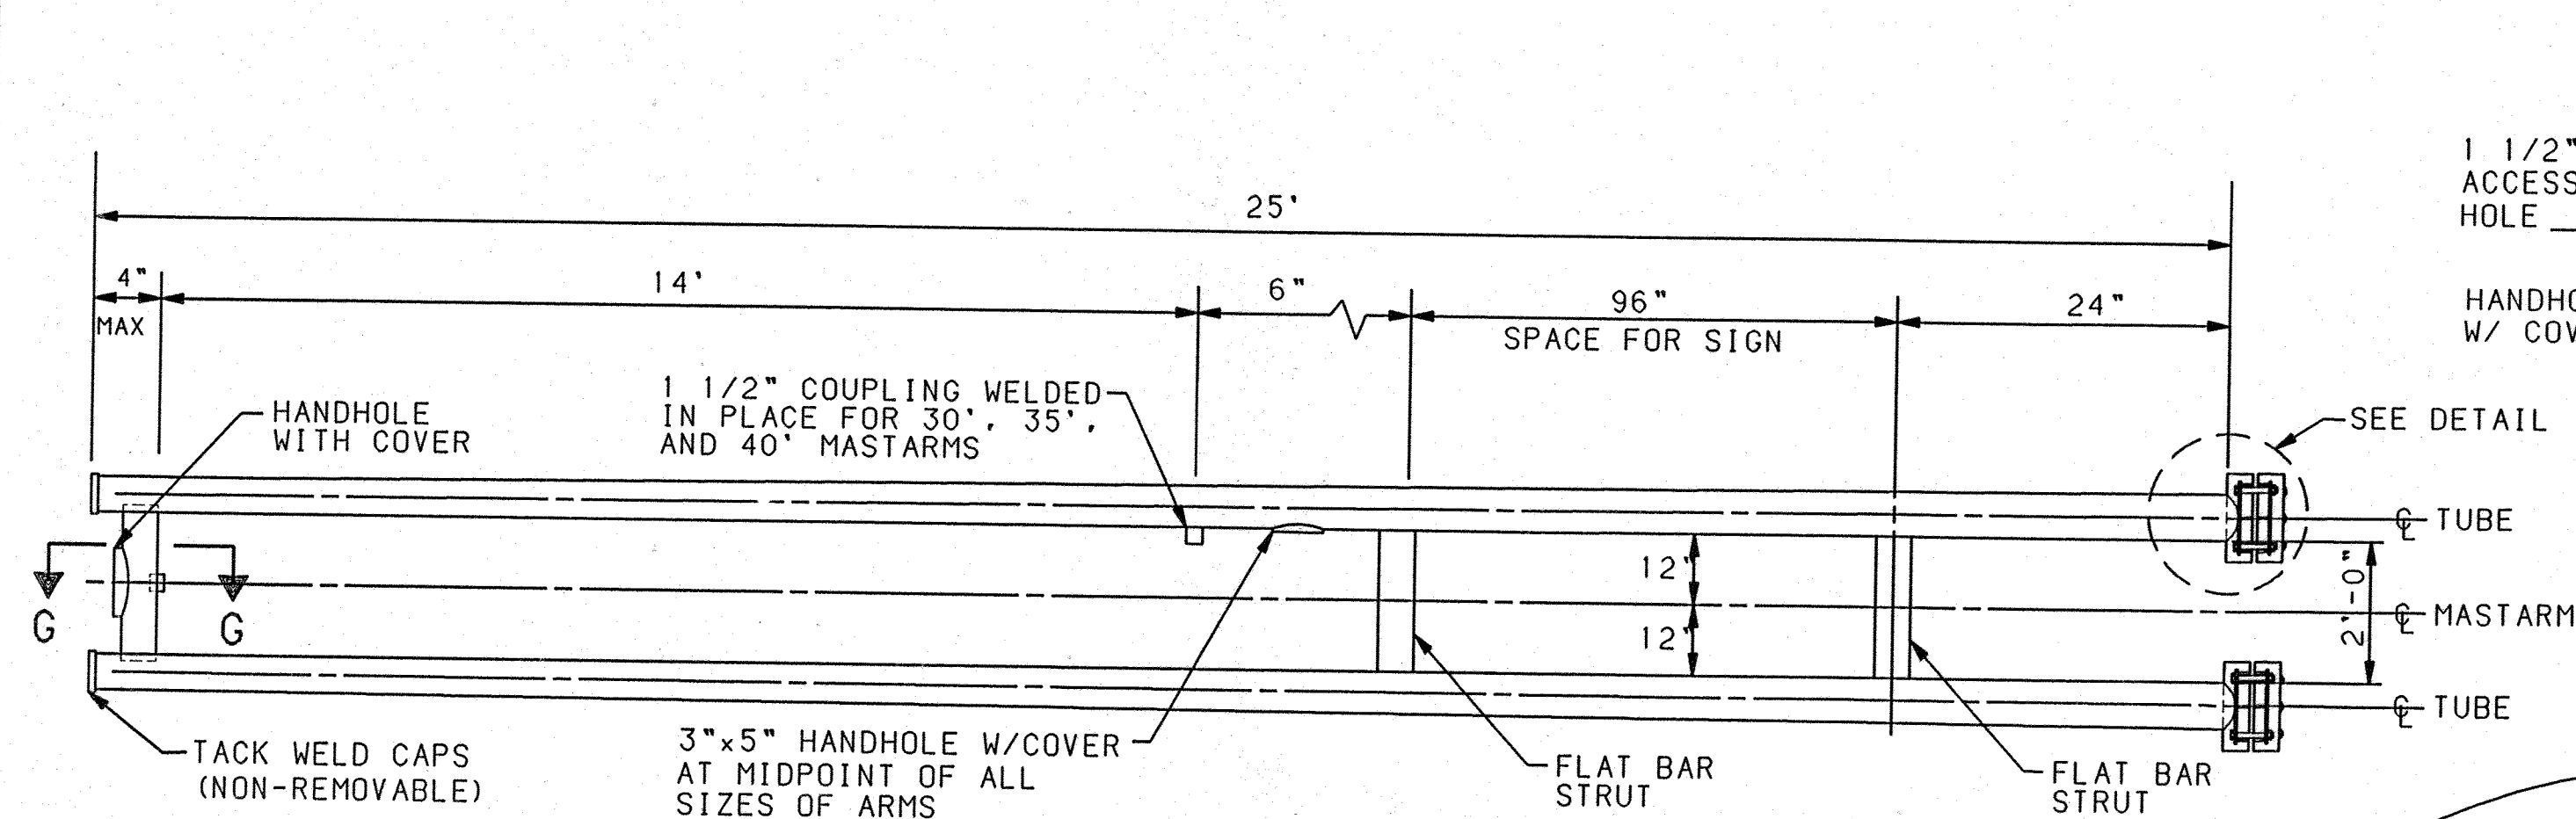

TYPICAL MASTARM DETAIL

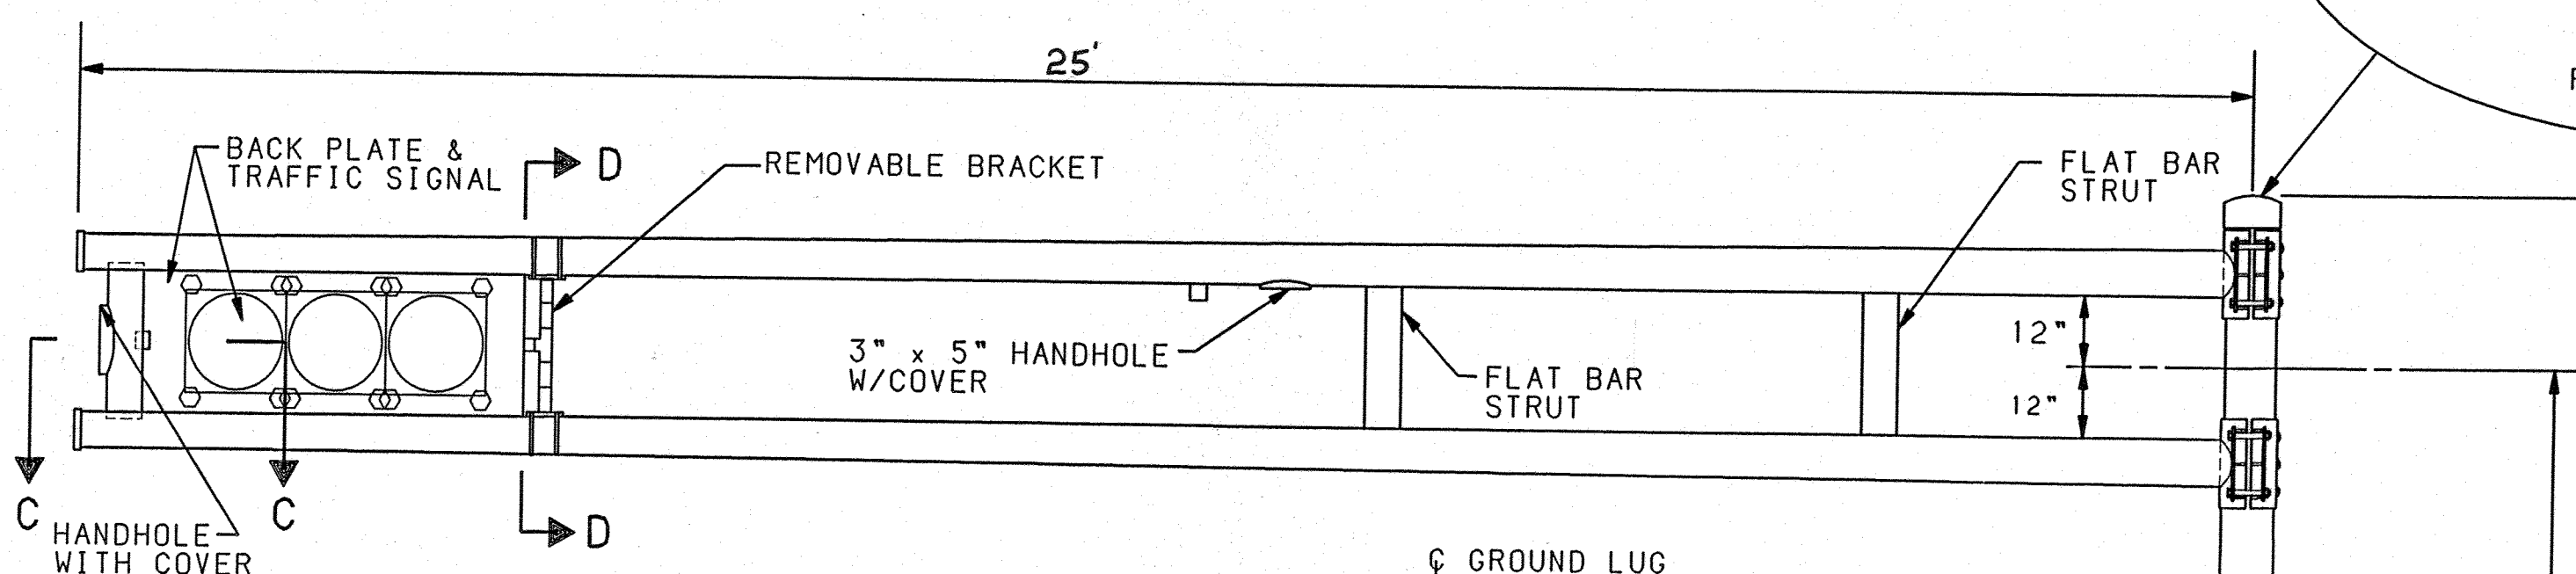


3-SECTION TRAFFIC SIGNAL

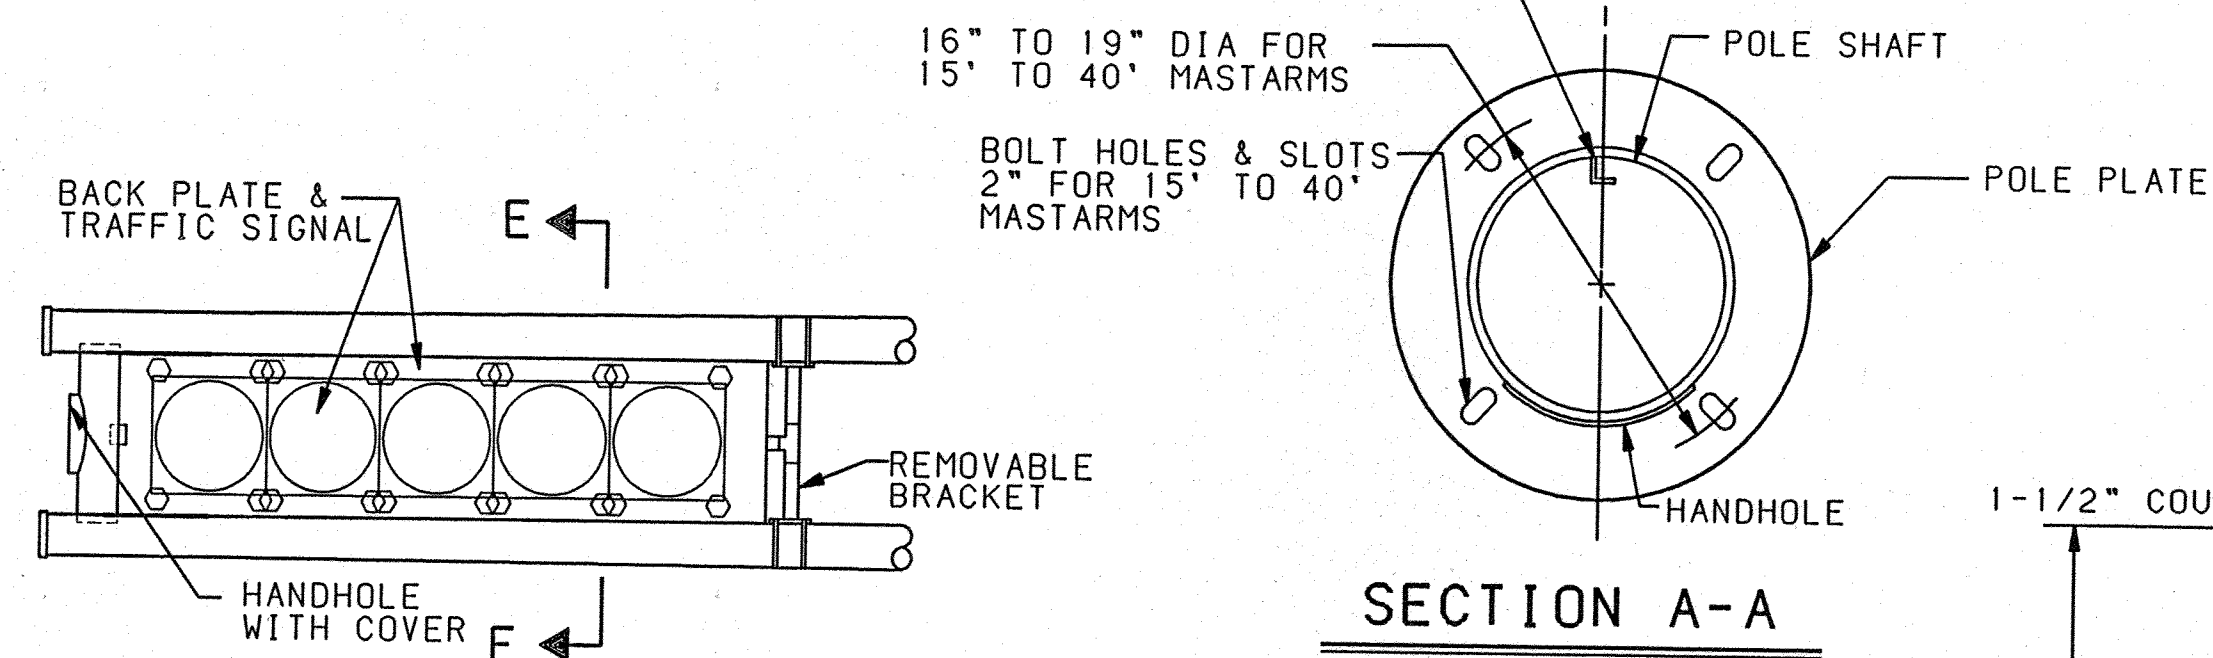


5-SECTION TRAFFIC SIGNAL

SECTION A-A


MITERED ARM END (OPTIONAL)

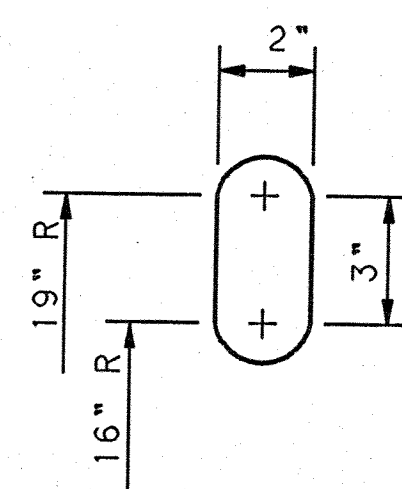

POLE PLATE SLOT DETAIL

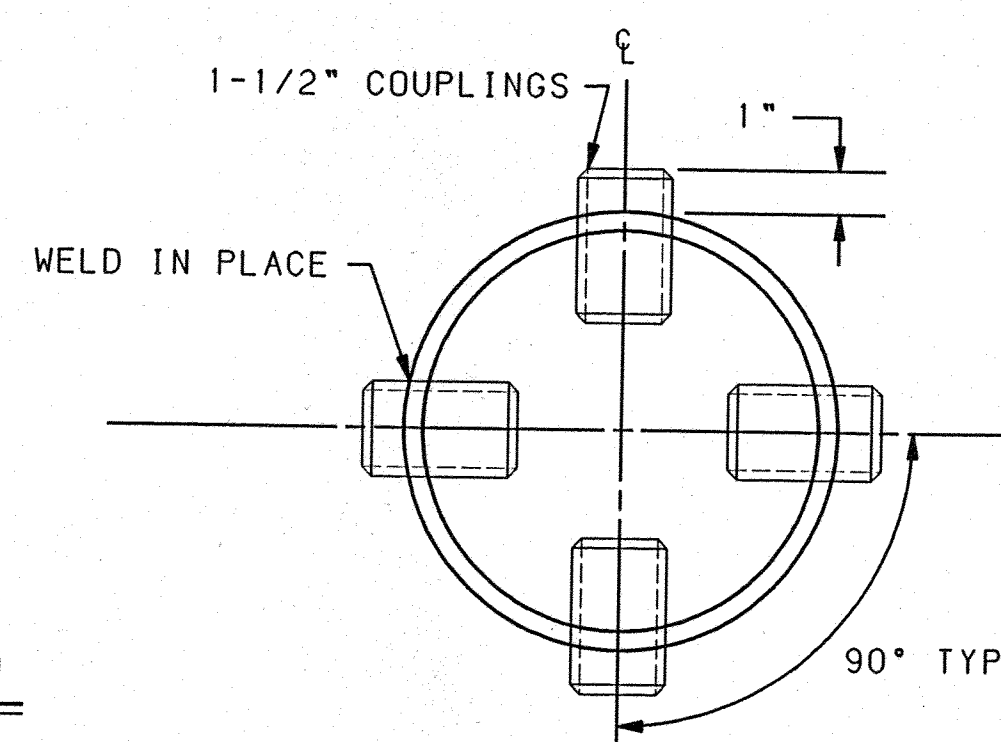


SECTION B-B

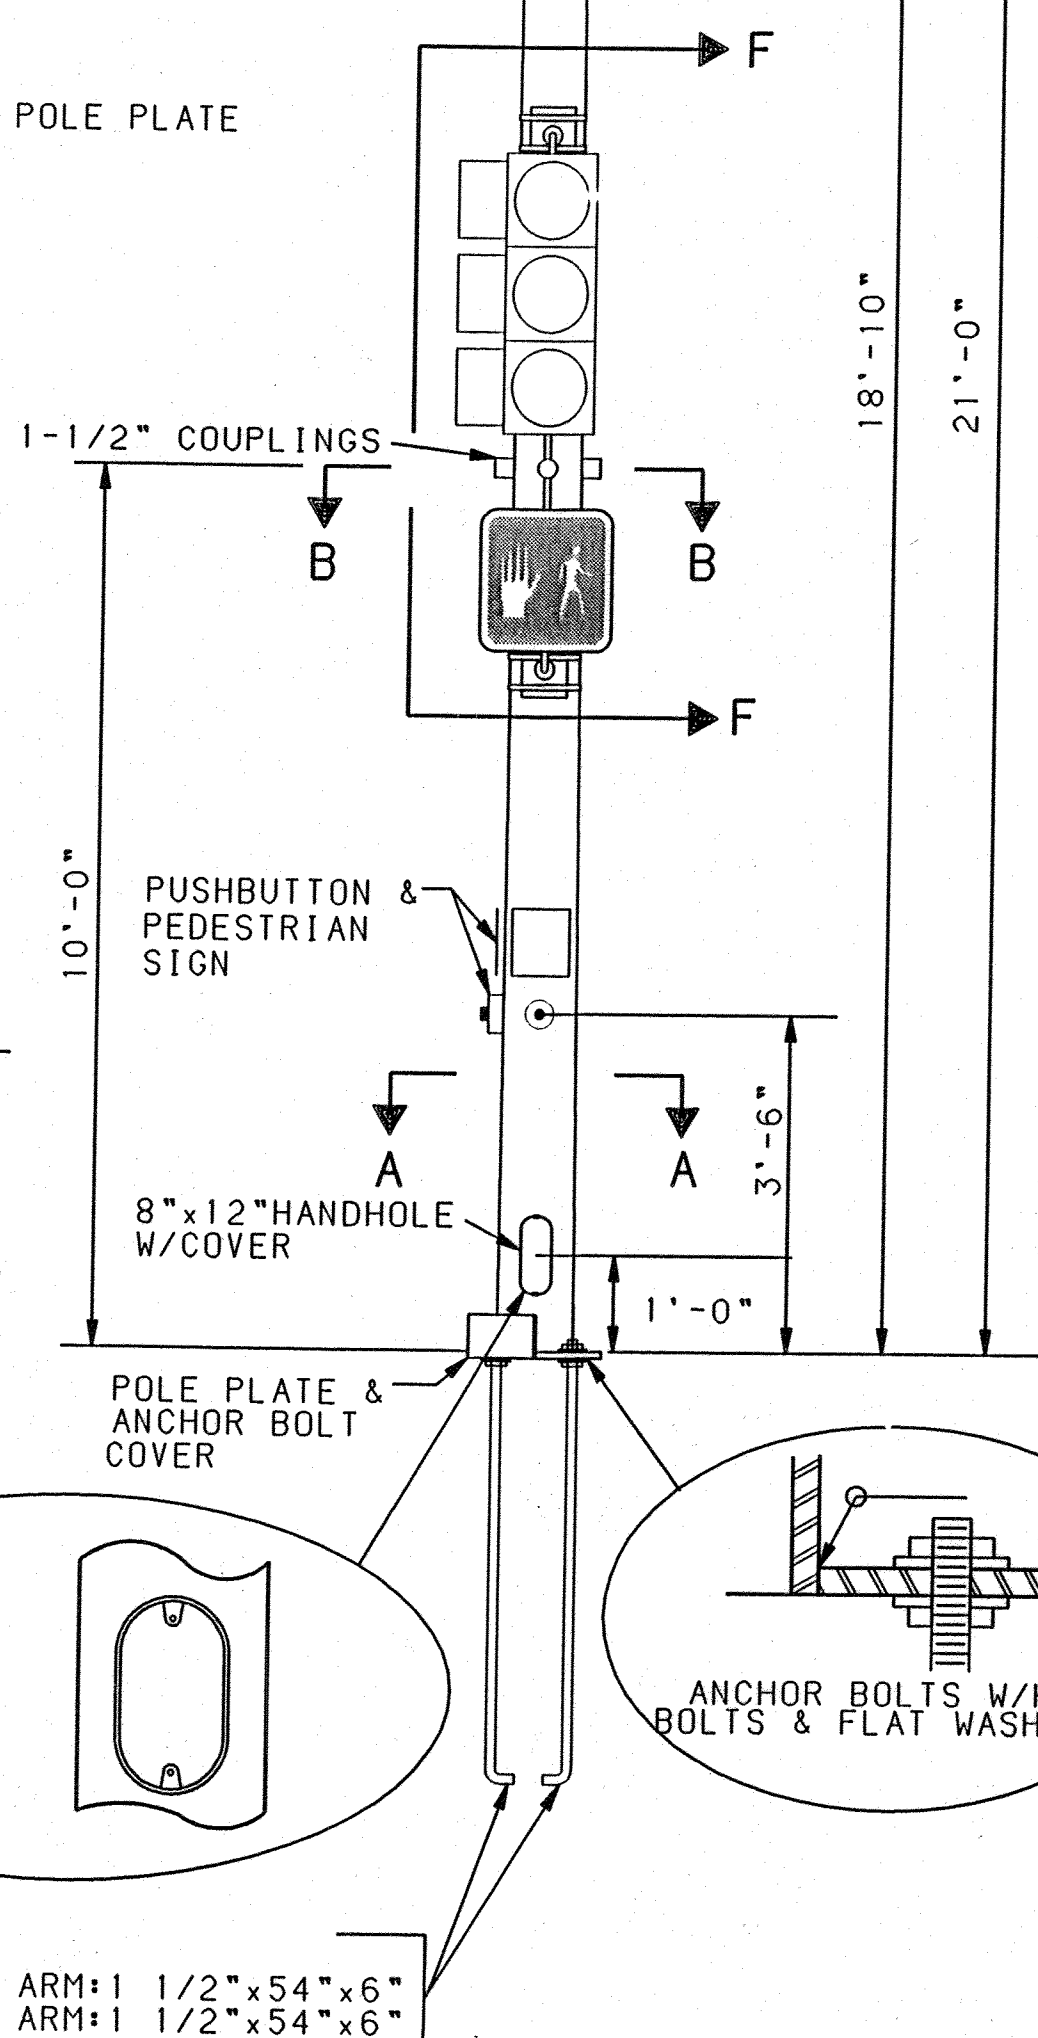


SECTION C-C

SECTION F-F

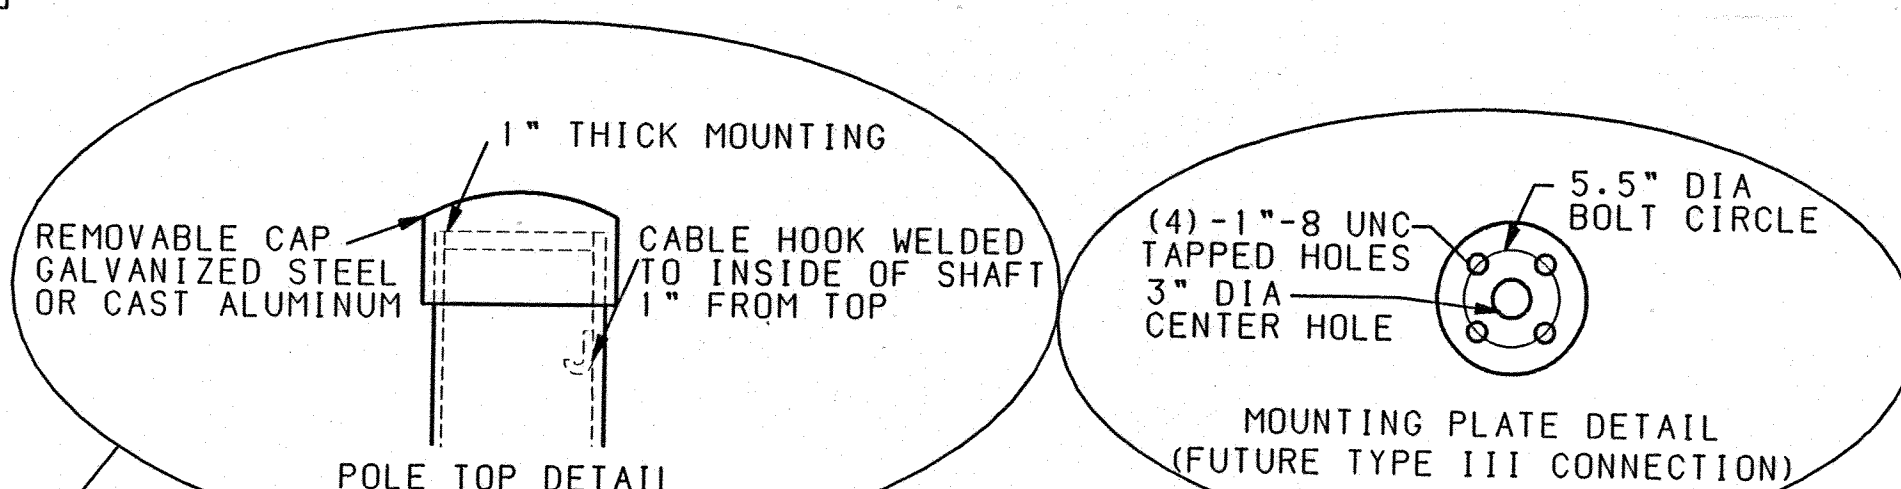


POLE TOP DETAIL

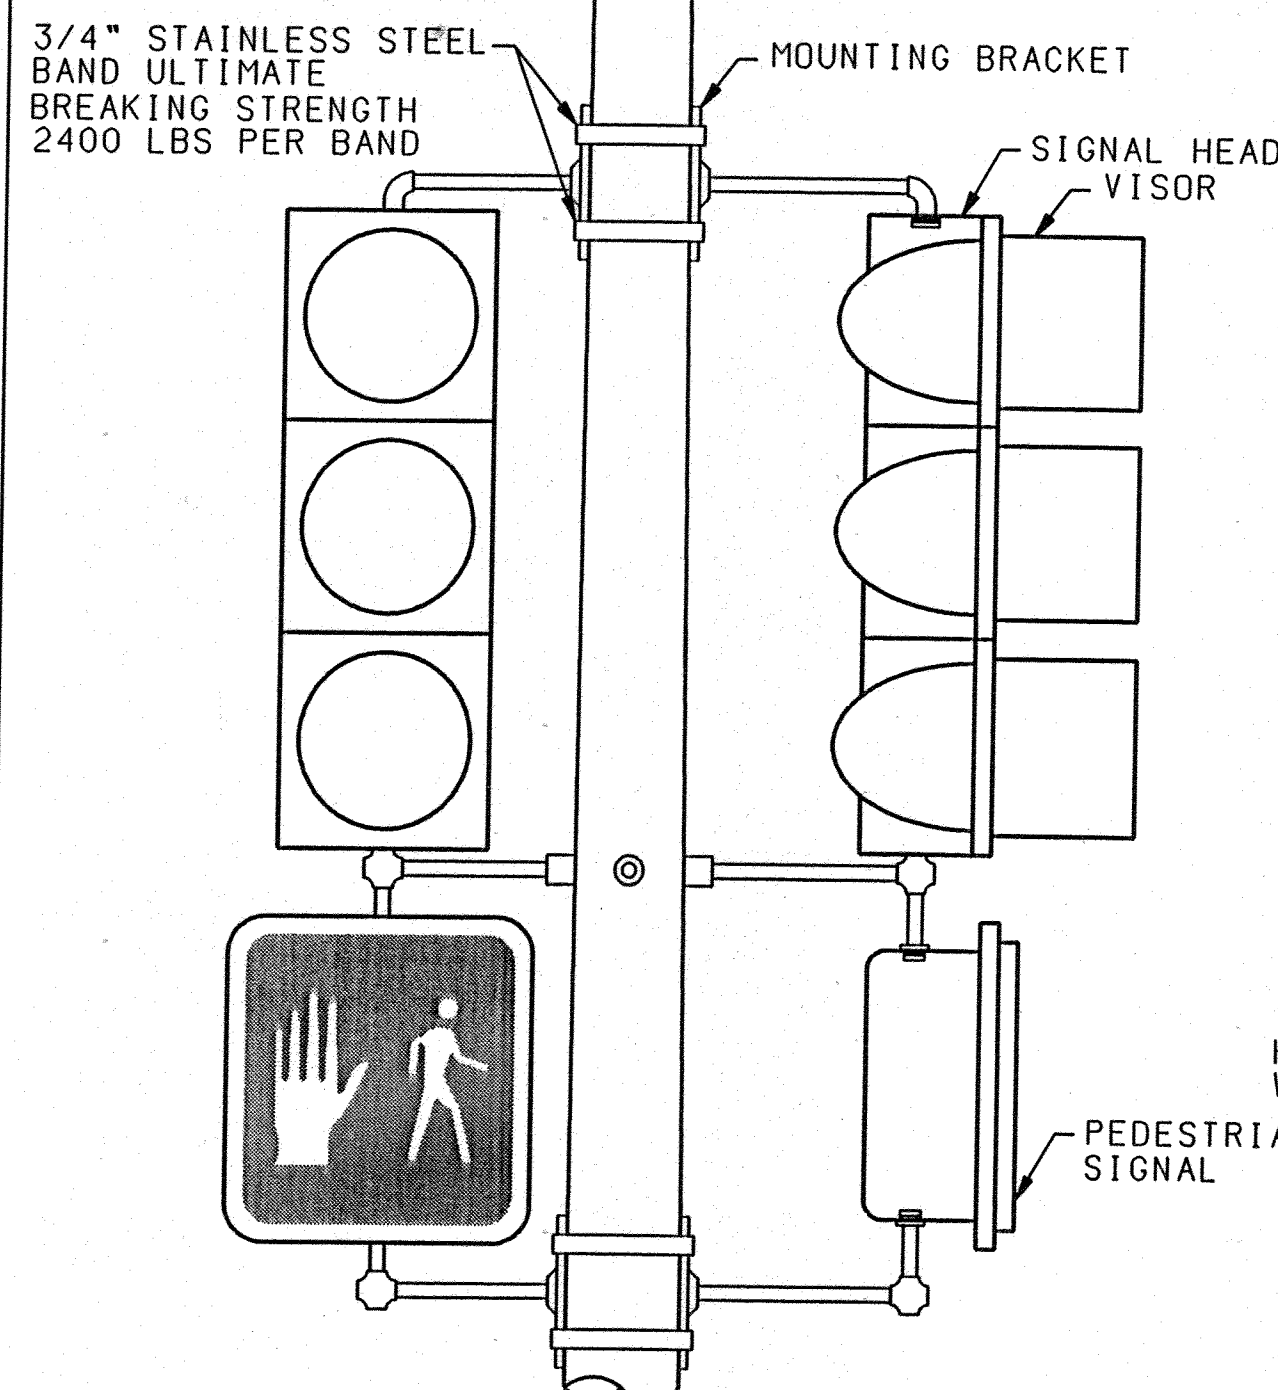


SECTION D-D

SECTION E-E


SECTION G-G

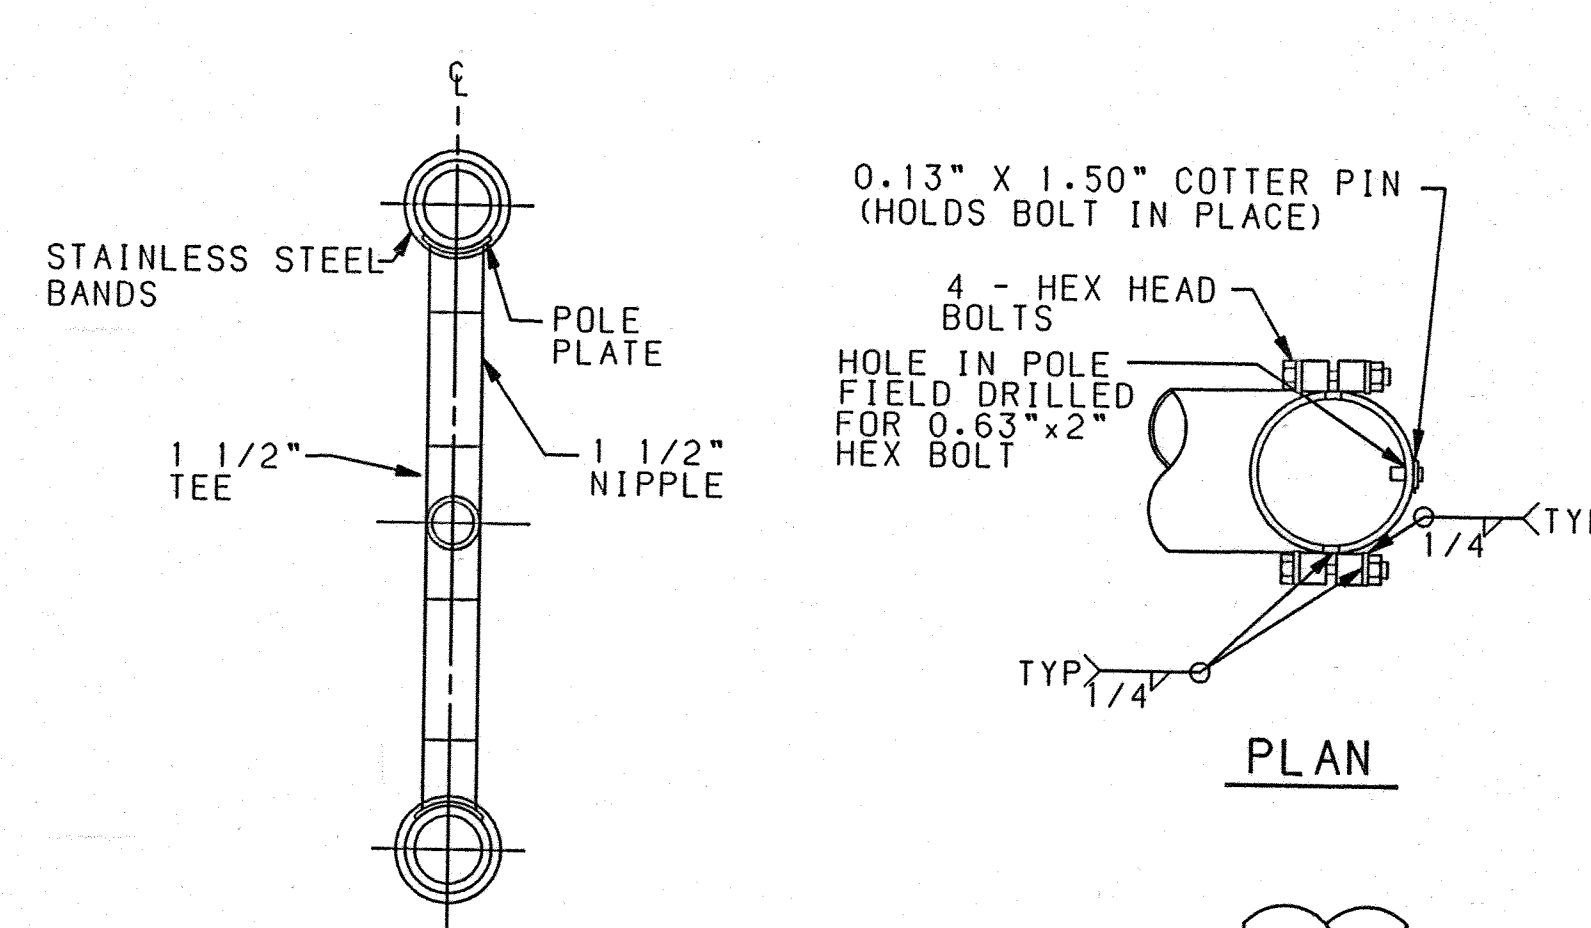


PLAN

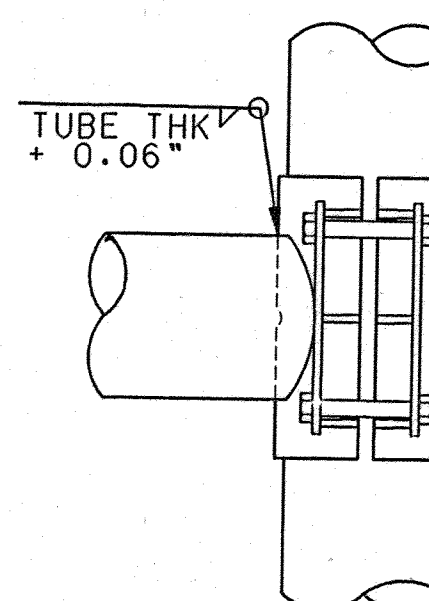

ELEVATION

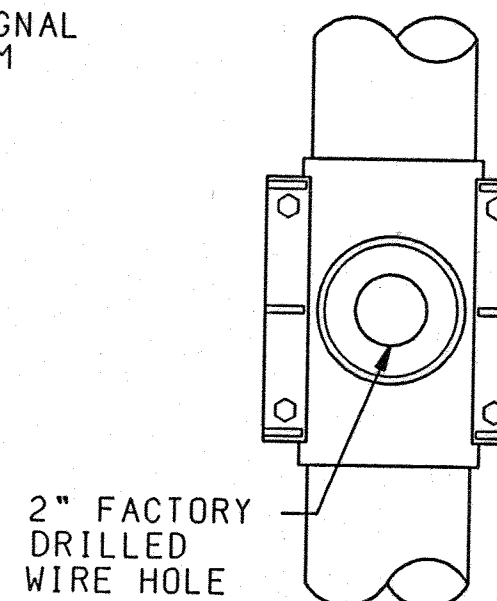

SECTION

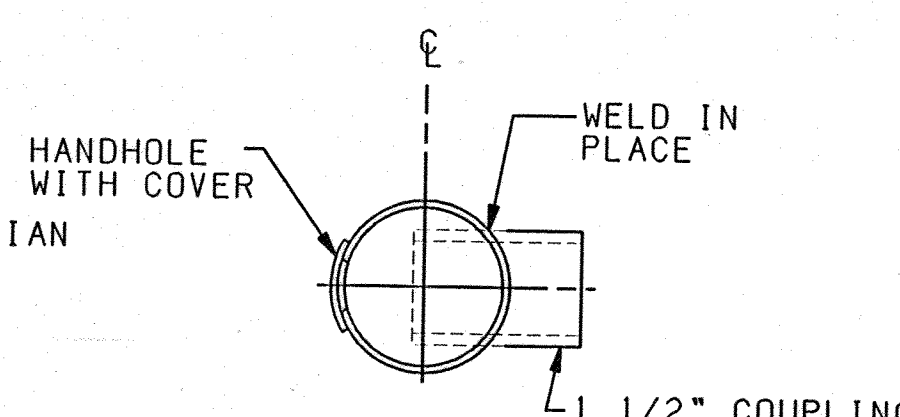

DETAIL I

NOTE:
ONE SIZE ARM CLAMP FOR
15' TO 25' MASTARMS AND
ONE SIZE FOR 30' TO 40'
MASTARMS WILL BE ALLOWED

TRAFFIC SIGNAL MASTARM NOTES

- DESIGN IN ACCORDANCE WITH 1985 AASHTO SPECIFICATIONS FOR STRUCTURAL SUPPORTS FOR HIGHWAY SIGNS, LUMINARIES, AND TRAFFIC SIGNALS FOR AN 80 MPH WIND ZONE.
- POLES AND MASTARM SHAFTS SHALL CONFORM TO ASTM A-595 GRADE A (MIN YIELD 55 KSI).
- BASE PLATE AND SIGNAL ARM CLAMP SHALL BE ASTM A-36 (MIN YIELD 36 KSI).
- ANCHOR BOLTS SHALL BE ASTM A-36 MOD 55 (MIN. YIELD 55 KSI).
- SIGNAL ARM CONNECTING BOLTS SHALL BE ASTM A-325.
- WELDING SHALL CONFORM TO THE REQUIREMENTS OF THE AMERICAN WELDING SOCIETY SPECIFICATION AWS D1.1, LATEST EDITION. ALL WELDS SHALL BE FREE FROM CRACKS, EXCESSIVE UNDERCUT, AND POROSITY. ANY WELDING DEFECTS SHALL BE REPAIRED BY REMOVING THE DEFECTIVE MATERIAL AND REPLACING IT WITH SOUND WELD MATERIAL.
- ALL HOLES SHALL BE DRILLED AND DEBURRED.
- ALL POLES, MASTARMS, AND BOLTS SHALL BE GALVANIZED TO ASTM A-123 AND A-153.
- MASTARMS SHALL BE MARKED TO DESCRIBE WHICH IS TOP AND WHICH IS BOTTOM. POLE PLATE COVERS SHALL BE MARKED IN MATED PAIRS. POLE SHAFTS SHALL BE MARKED "ALB" "15-25" OR "30-40", AND DATE OF FABRICATION (MONTH/YEAR).

26-5358.90 0997

dmg D. MARK GOODWIN & ASSOCIATES, P.A.
CONSULTING ENGINEERS & SURVEYORS
P.O. BOX 60606
ALBUQUERQUE, NEW MEXICO 87199
(505) 345-2010

CITY OF ALBUQUERQUE
PUBLIC WORKS DEPARTMENT
ENGINEERING DEVELOPMENT GROUP

TITLE: TRAFFIC SIGNAL MASTARM DETAILS
TYPE II STANDARD
GALVANIZED STEEL

DESIGN REVIEW COMMITTEE
APPROVED
DATE 02/96


LAST DESIGN UPDATE
MO./DAY/YR.
SHEET 9 OF 19

CITY PROJECT NO. 5358.90






ZONE MAP NO. F16

REVISIONS
NO. DATE BY
1 02/96 BHI/COA
2 02/96 BHI/COA
3 02/96 BHI/COA


AS BUILT INFORMATION			
CONTRACTOR	DATE	INSPECTED BY	DATE
WORK ORDER NO.	DATE	ACCEPTANCE BY	DATE
REVISIONS	DATE	REVISIONS	DATE
DESIGNED BY	DATE	CHECKED BY	DATE
DRAWN BY	DATE	RECORDED BY	DATE
MICRO-FILM INFORMATION			
NO.	DATE	NO.	DATE

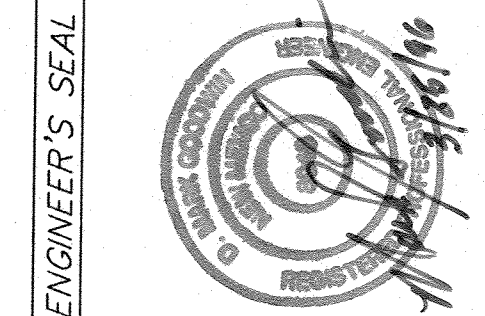


SURVEY INFORMATION			
FIELD NOTES	DATE	BY	NO.
BRASS TABLE STAMPED	DATE	BY	NO.
POST. LOCATED 0.50 MILES SOUTH OF MONTANO RD. ON WEST	DATE	BY	NO.
FRONTAGE RD. TO THE RIGHT.	DATE	BY	NO.
X = 390403.88	DATE	BY	NO.
Y = 1502304.85	DATE	BY	NO.
Z = 5079.46	DATE	BY	NO.

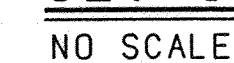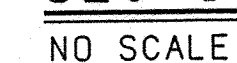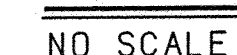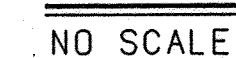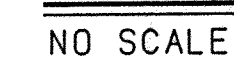


MERCH\TDTL2

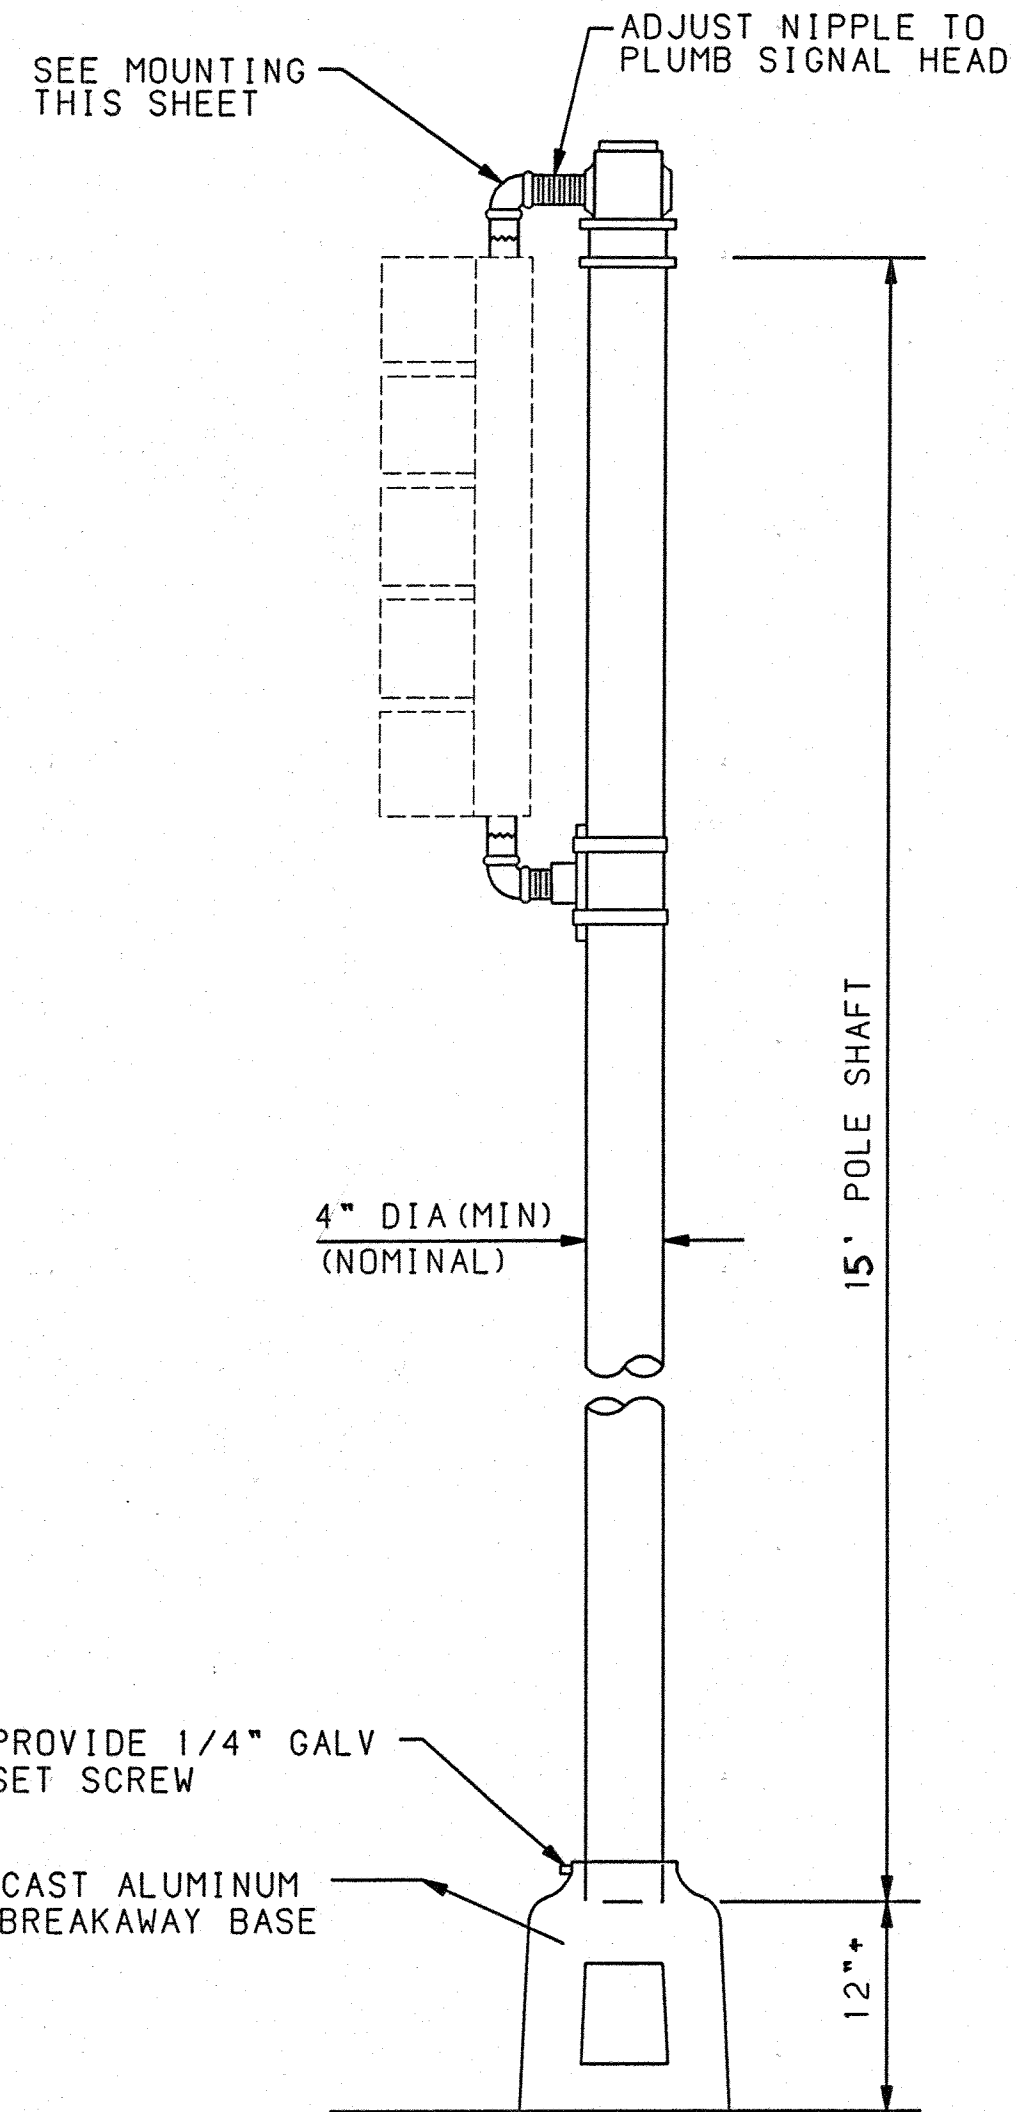


MOUNTING DETAIL

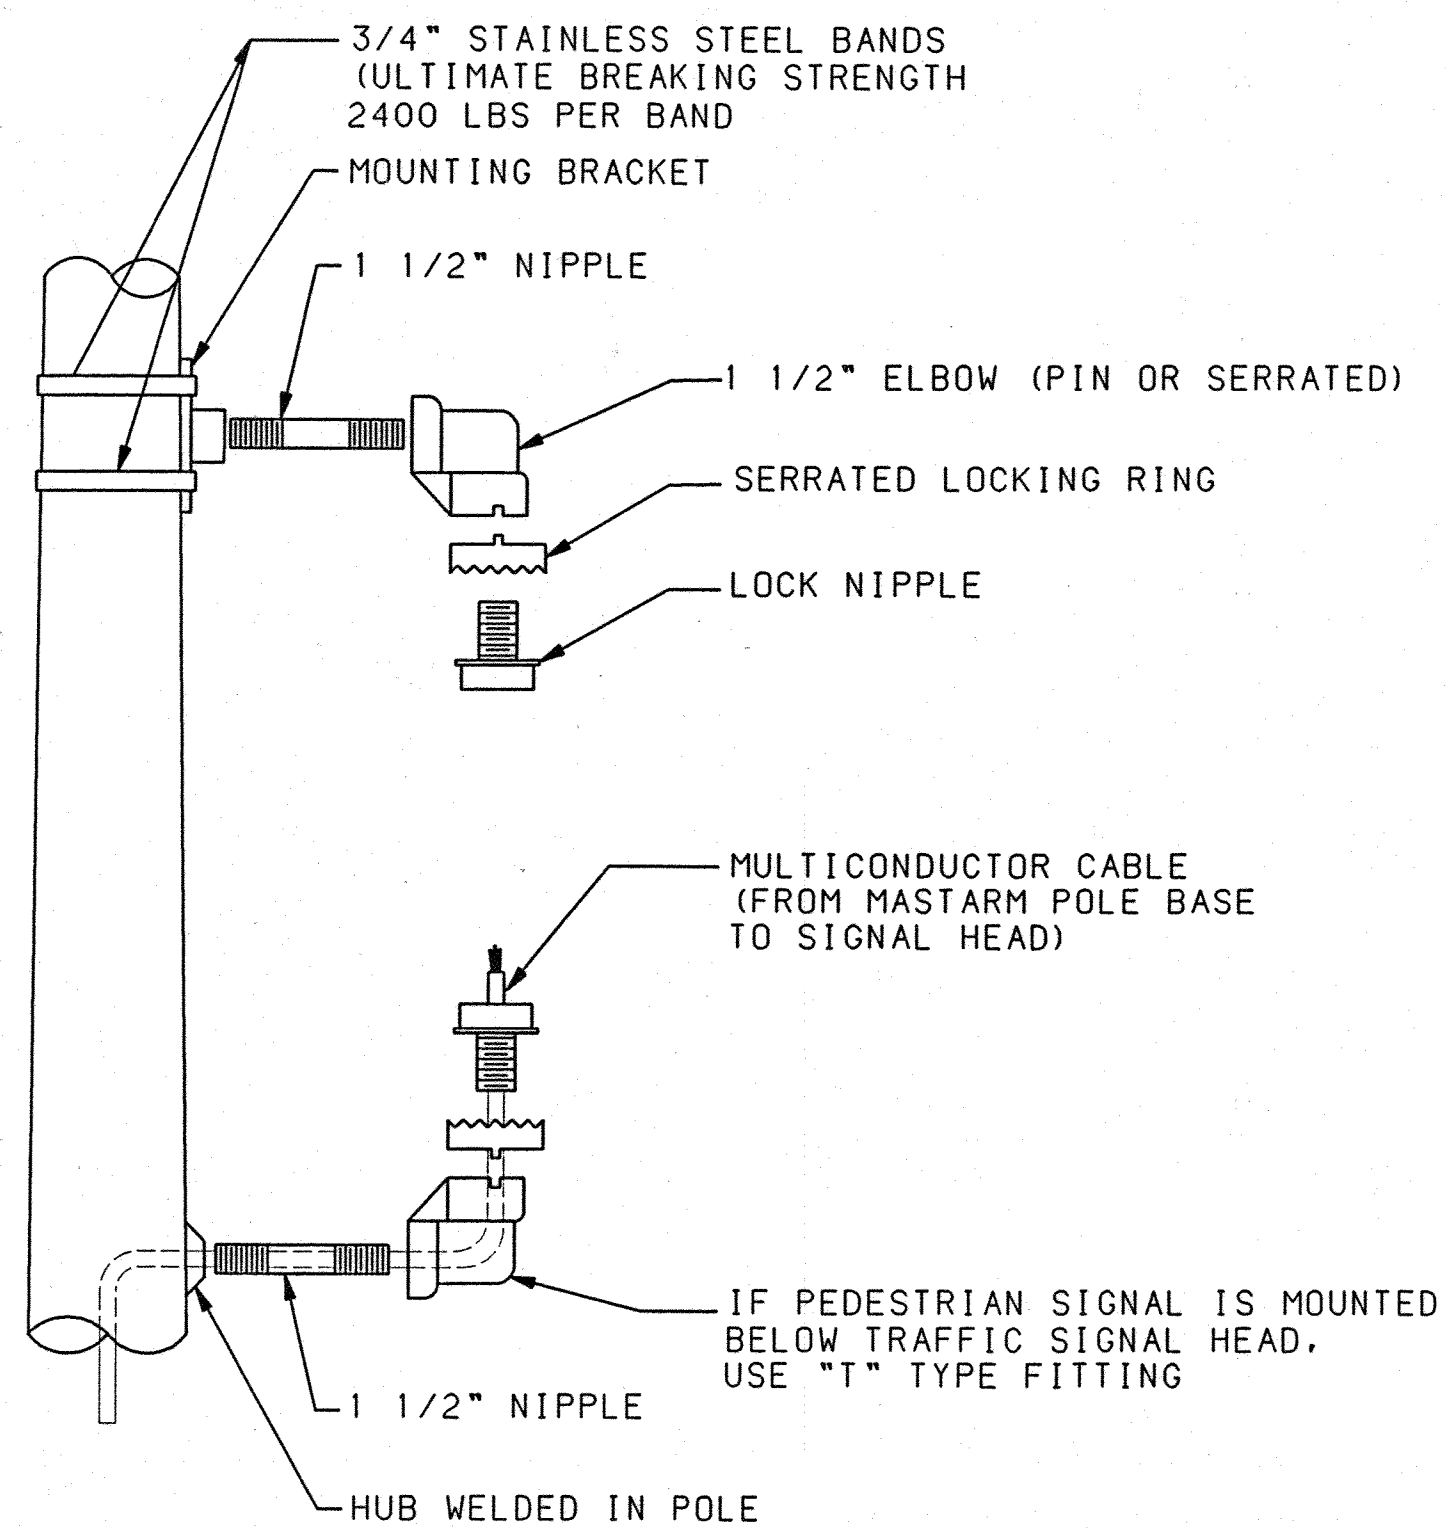


MOUNTING DETAIL
(SIDE OF SHAFT)

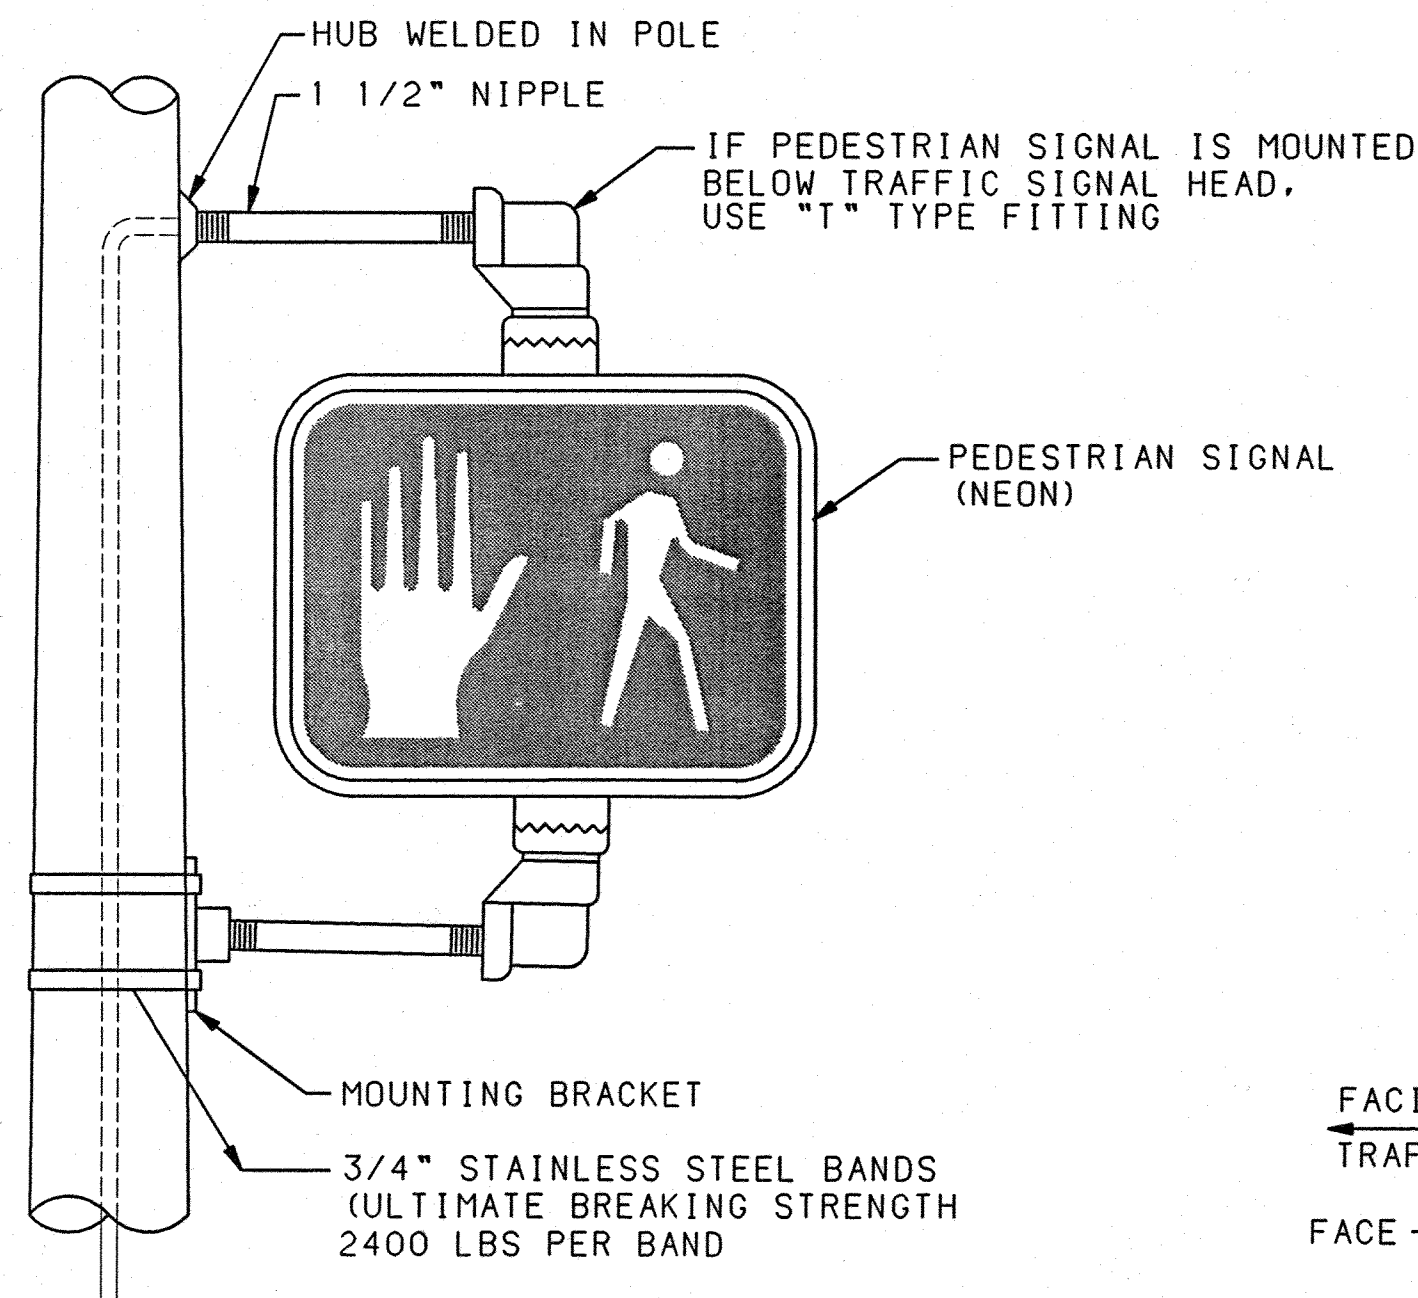


PEDESTRIAN SIGNAL

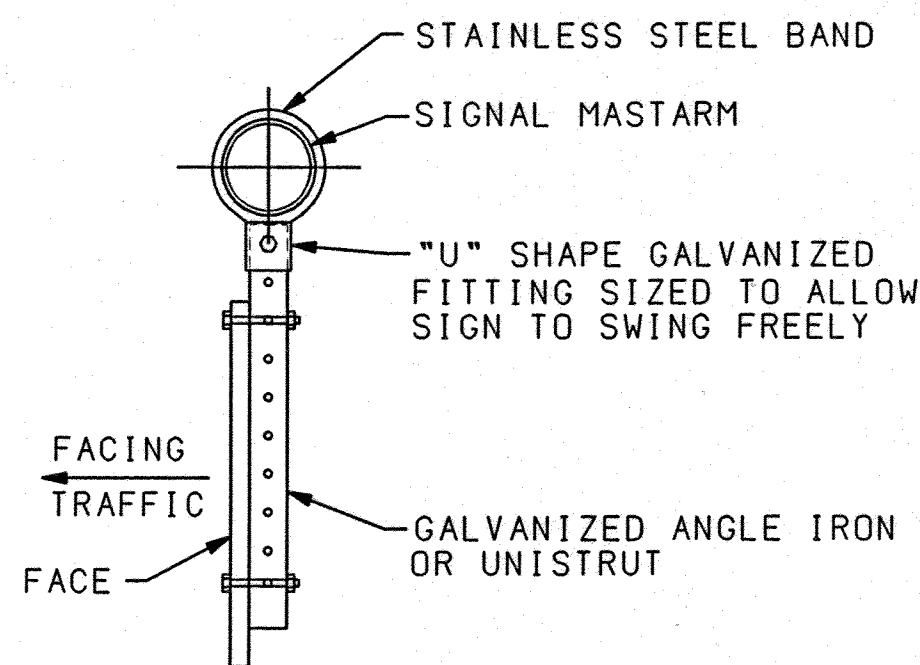

SECTION "A-A"

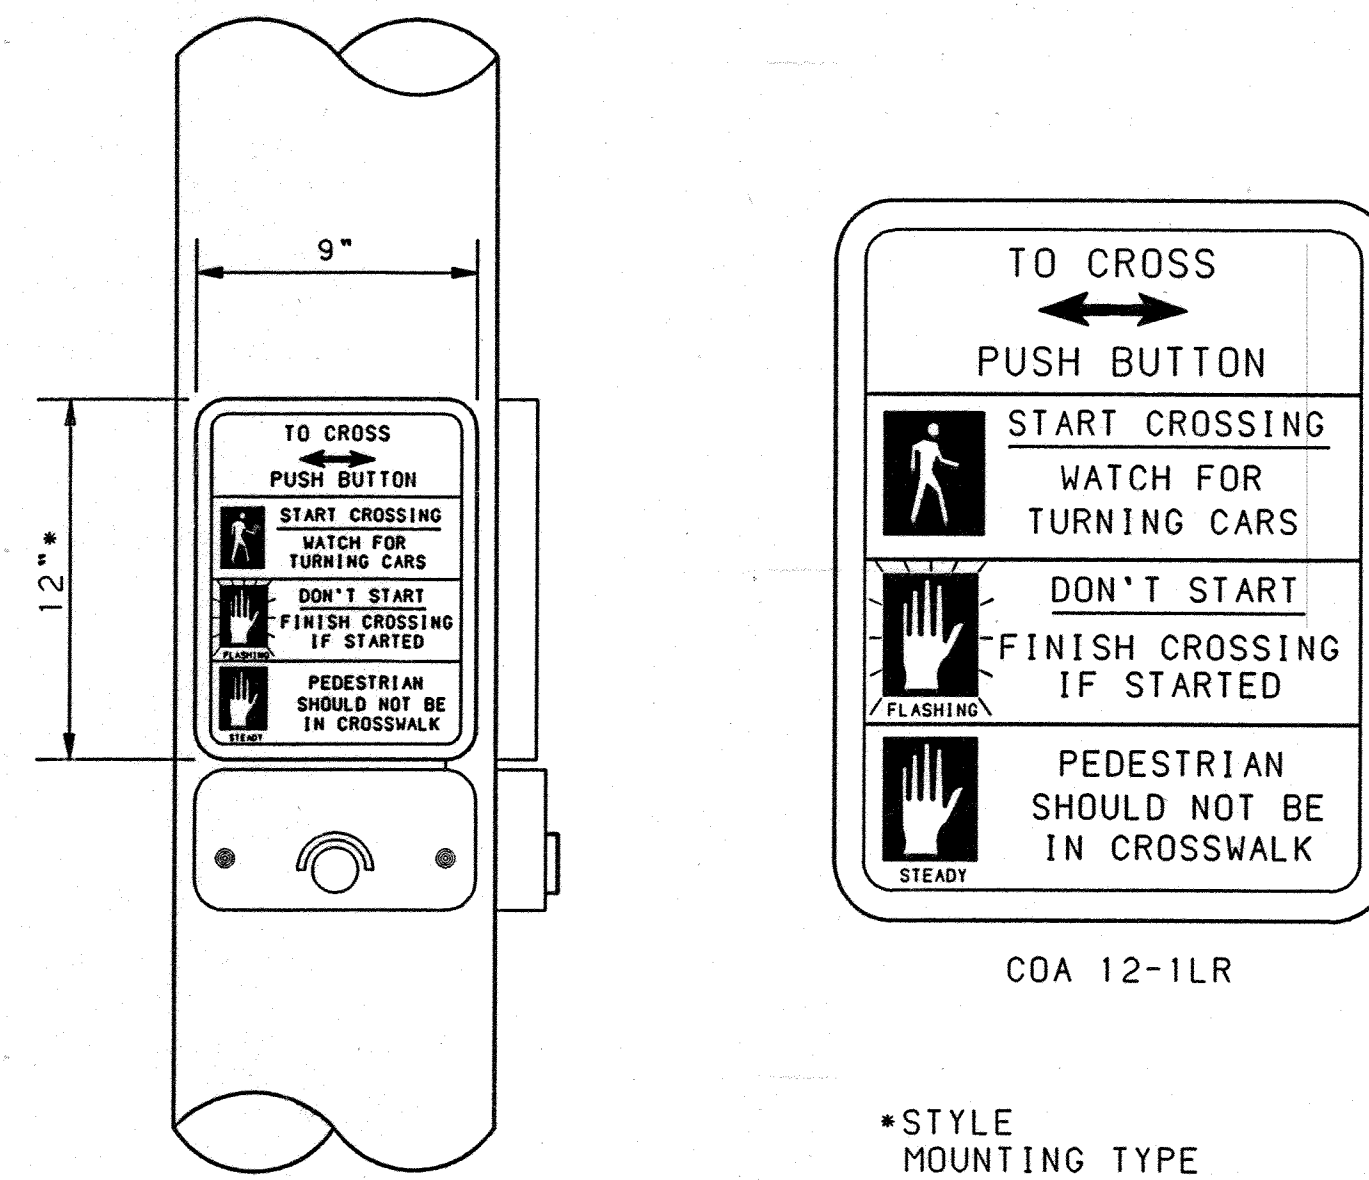

PEDESTRIAN PUSH BUTTON DETAIL

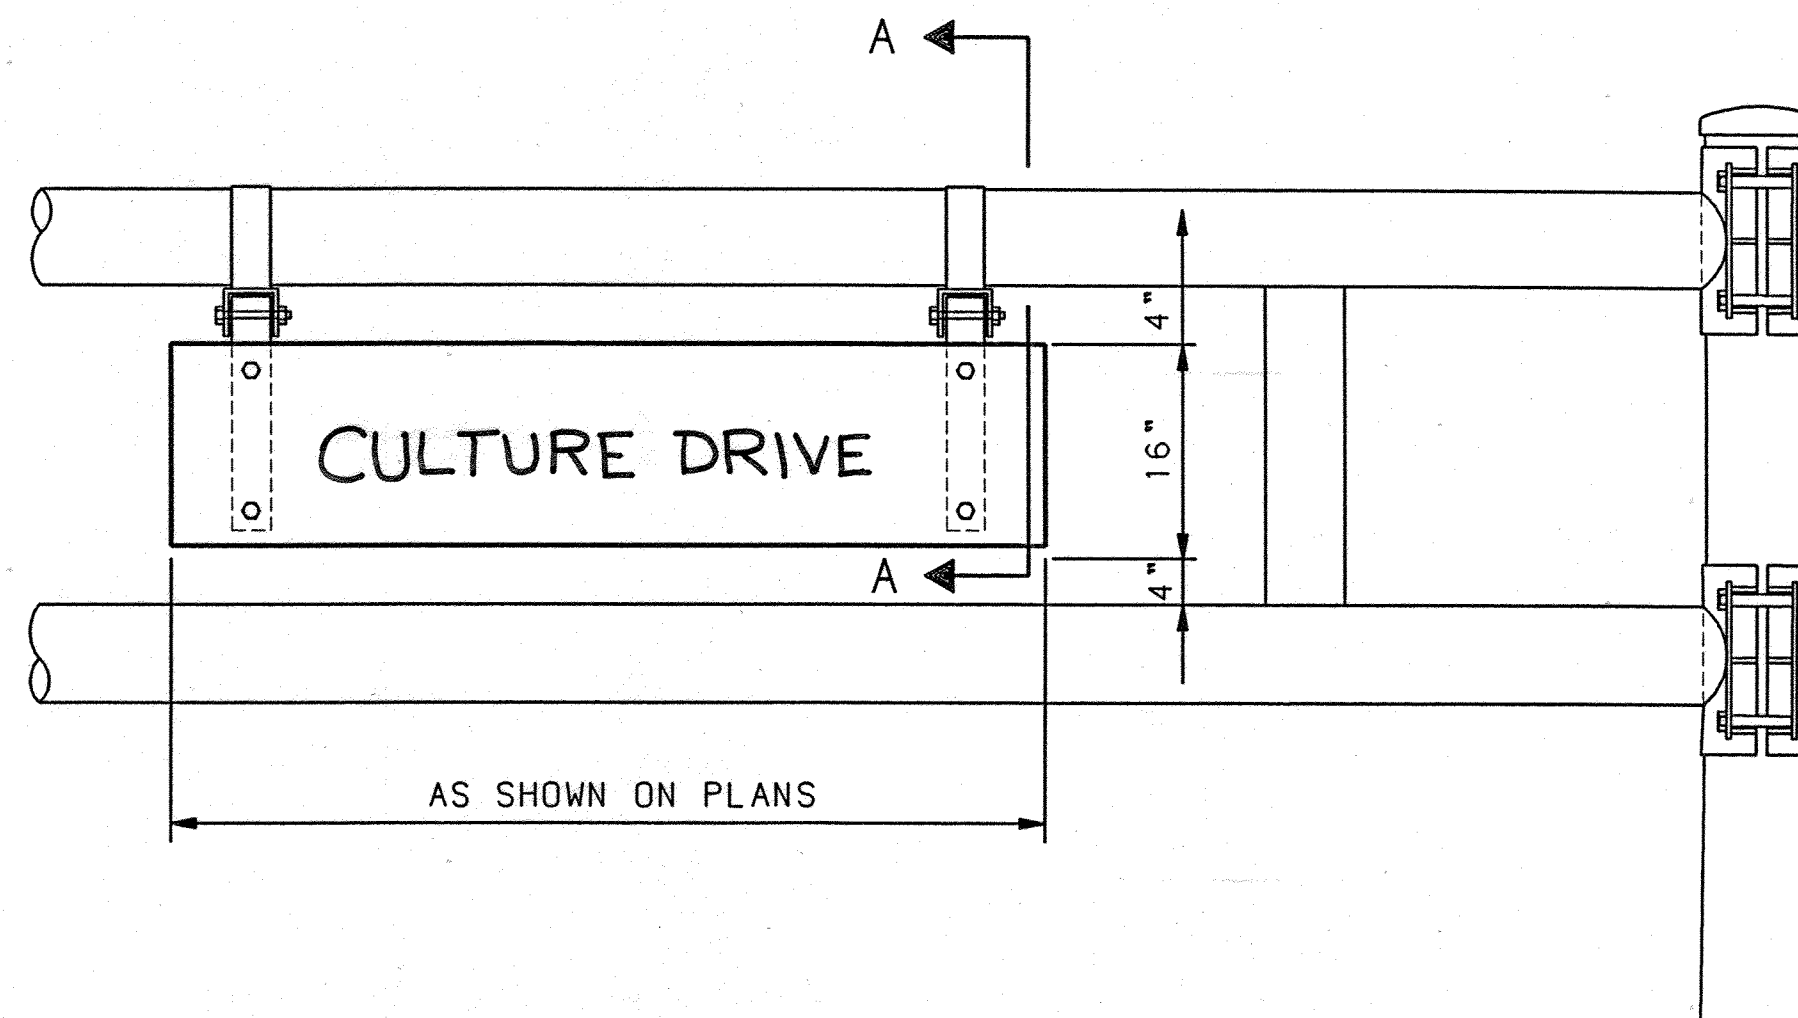

NOTES:


1. STREET NAMES SIGNS REQUIRED AS SHOWN ON SIGNAL PLAN SHEETS.
2. SIGN SHALL BE 16" WIDE WITH 8" SERIES "C" LETTERS UP TO 12 SQUARE FEET TOTAL AREA AND SHALL HAVE HIGH INTENSITY REFLECTIVE LEGEND, BORDER AND BACKGROUND COLORS: WHITE ON GREEN. SIGN PANELS SHALL BE SINGLE SHEET 6061-T6 ALUMINUM .120 MINIMUM THICKNESS.

STREET NAME SIGN DETAIL



D. MARK GOODWIN & ASSOCIATES, P.A. CONSULTING ENGINEERS & SURVEYORS P.O. BOX 90606 ALBUQUERQUE, NEW MEXICO 87199 (505) 345-2010	
CITY OF ALBUQUERQUE PUBLIC WORKS DEPARTMENT ENGINEERING DEVELOPMENT GROUP	
TITLE: TRAFFIC SIGNAL MISCELLANEOUS DETAILS - GALVANIZED STEEL	
DESIGN REVIEW COMMITTEE 	NO. / DAY / YR. 26-5358.90 11/97
CITY PROJECT NO. 5358.90	ZONE MAP NO. F16
SHEET 11	OF 19

AS BUILT INFORMATION			
CONTRACTOR	THAN LINS	DATE	9/6
WORK	INSPECTION	DATE	9/6
ACCEPTANCE BY	DATE	DATE	9/6
REVISIONS	DATE	DATE	9/6
DESIGNED BY	BHJ/COA	DATE	02/96
DRAWN BY	BHJ/COA	DATE	02/96
CHECKED BY	BHJ/COA	DATE	02/96
MICRO-FILM INFORMATION			
RECORDED BY		DATE	
NO.			

SURVEY INFORMATION	
FIELD NOTES	DATE
BY	
NO.	

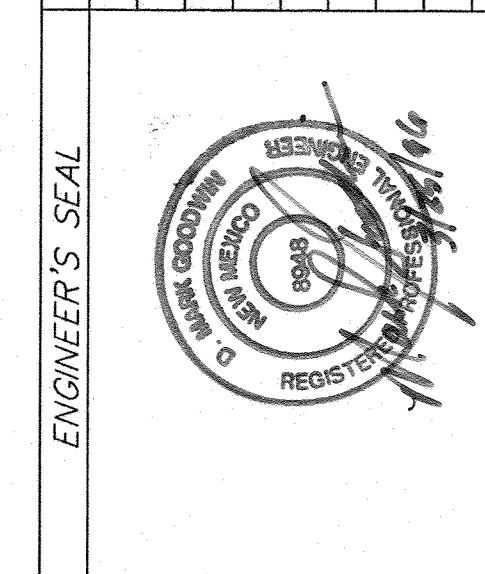

ENGINEER'S SEAL	
REMARKS	BY
NO.	DATE
DESIGN	DATE
REVISIONS	DATE
NO.	DATE
DATE	02/96
DATE	02/96
DATE	02/96

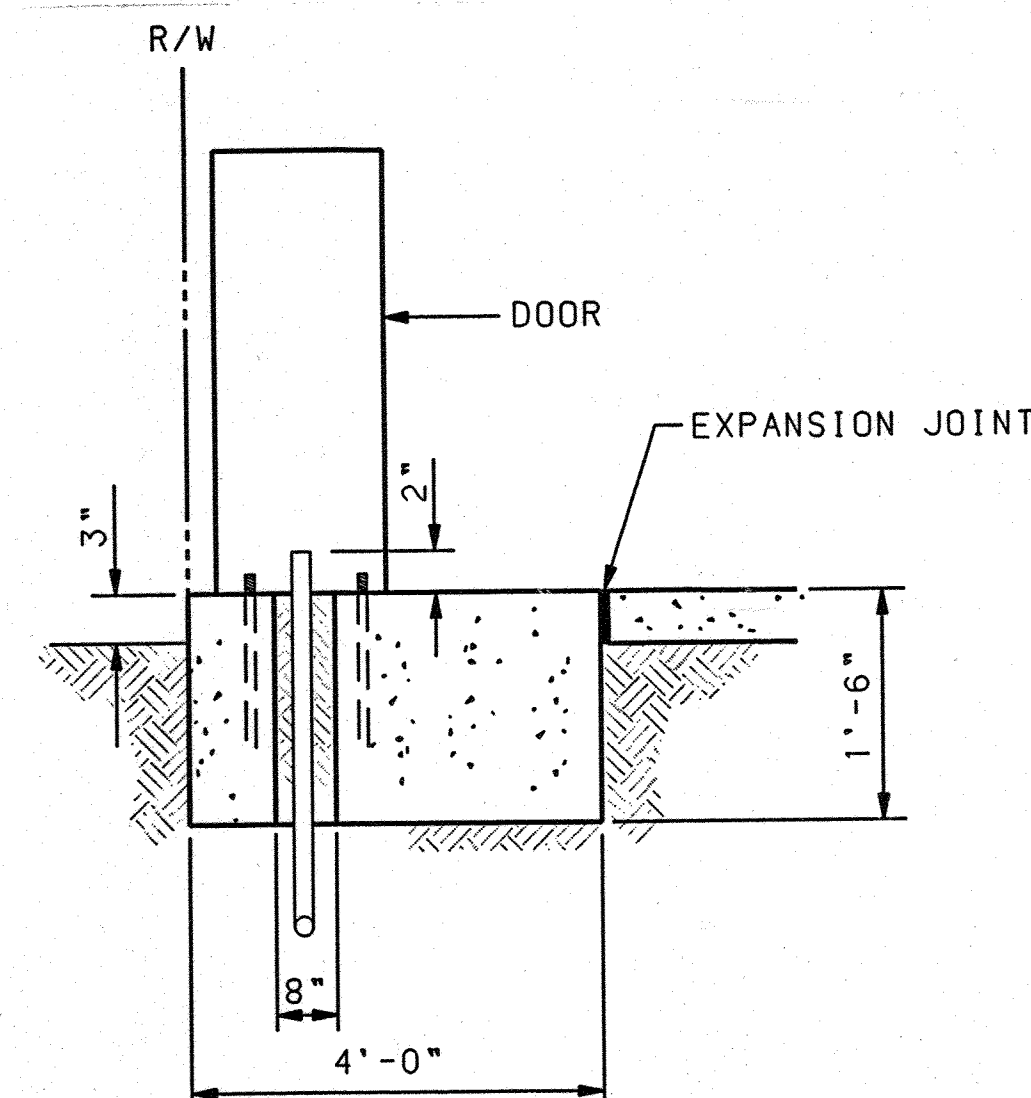
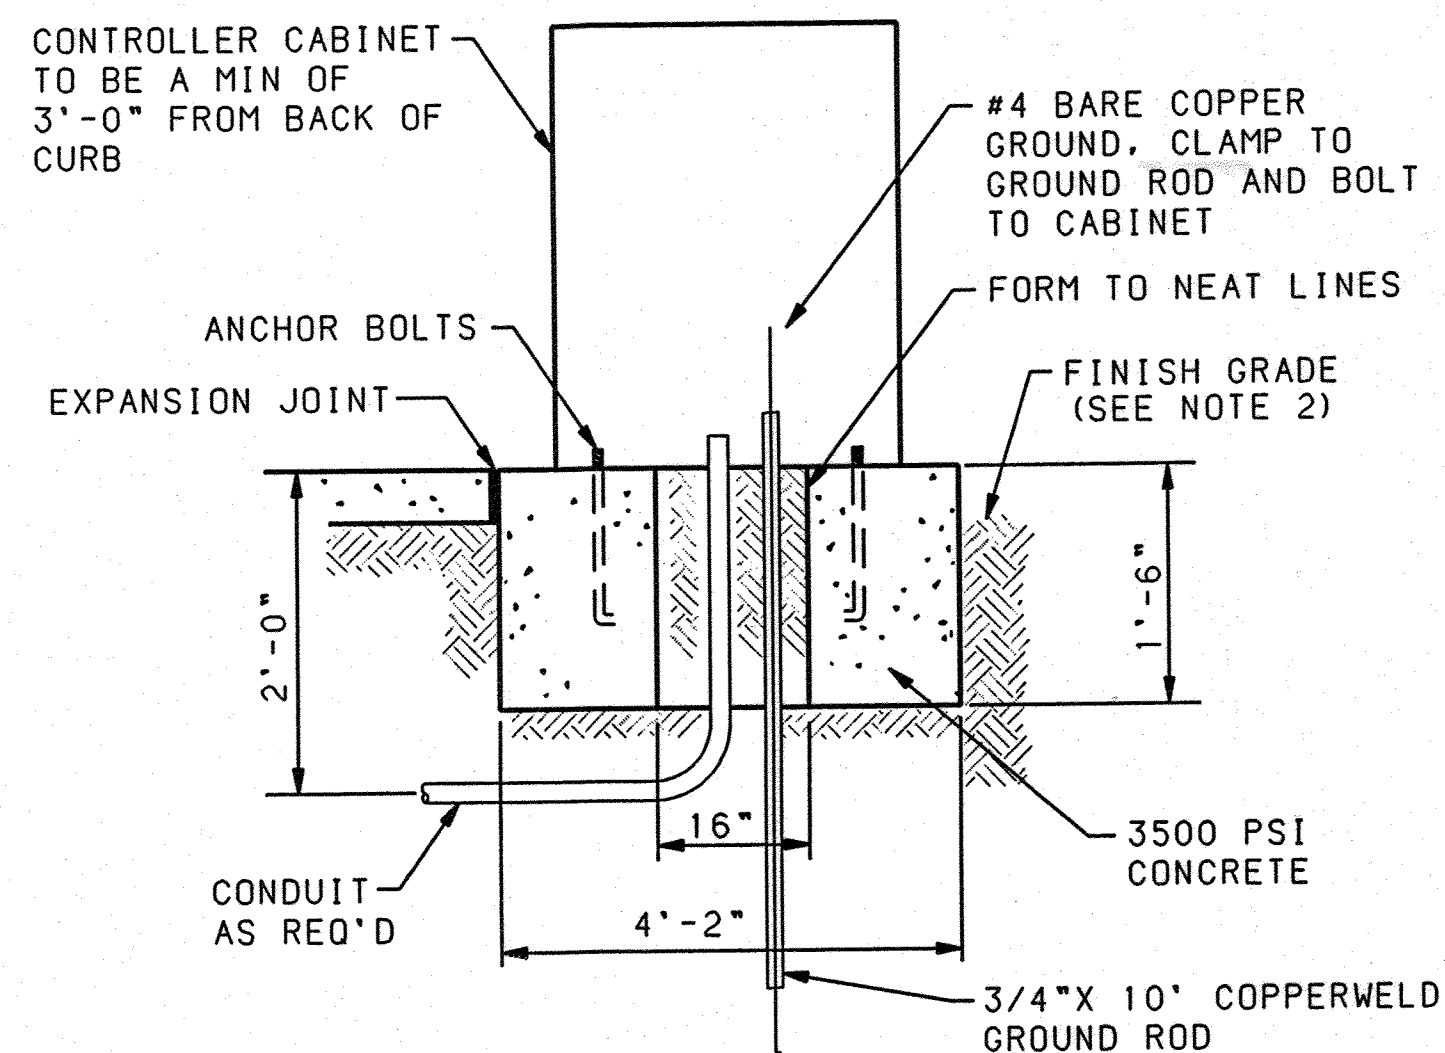


SECTION B


SECTION A

CONTROLLER FOUNDATION DETAIL

IN THE EVENT THE SUPPLIED CABINET WOULD OVERLAP THE SIDES OF ABOVE FOUNDATION. THE FOUNDATION SHALL BE INCREASED IN SIZE AS DIRECTED BY THE ENGINEER.

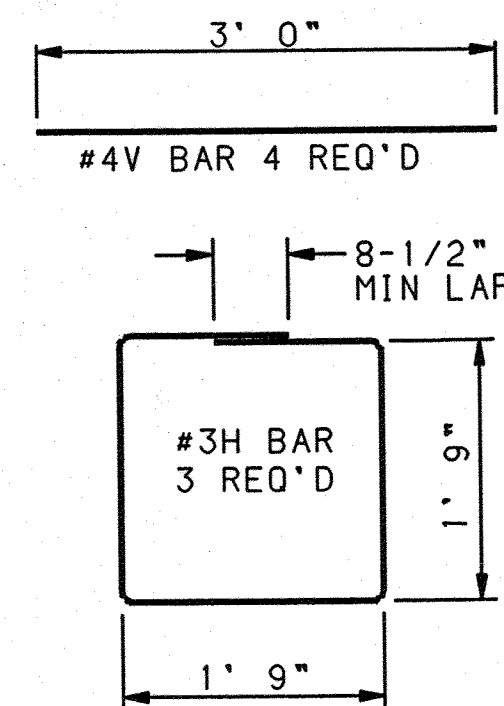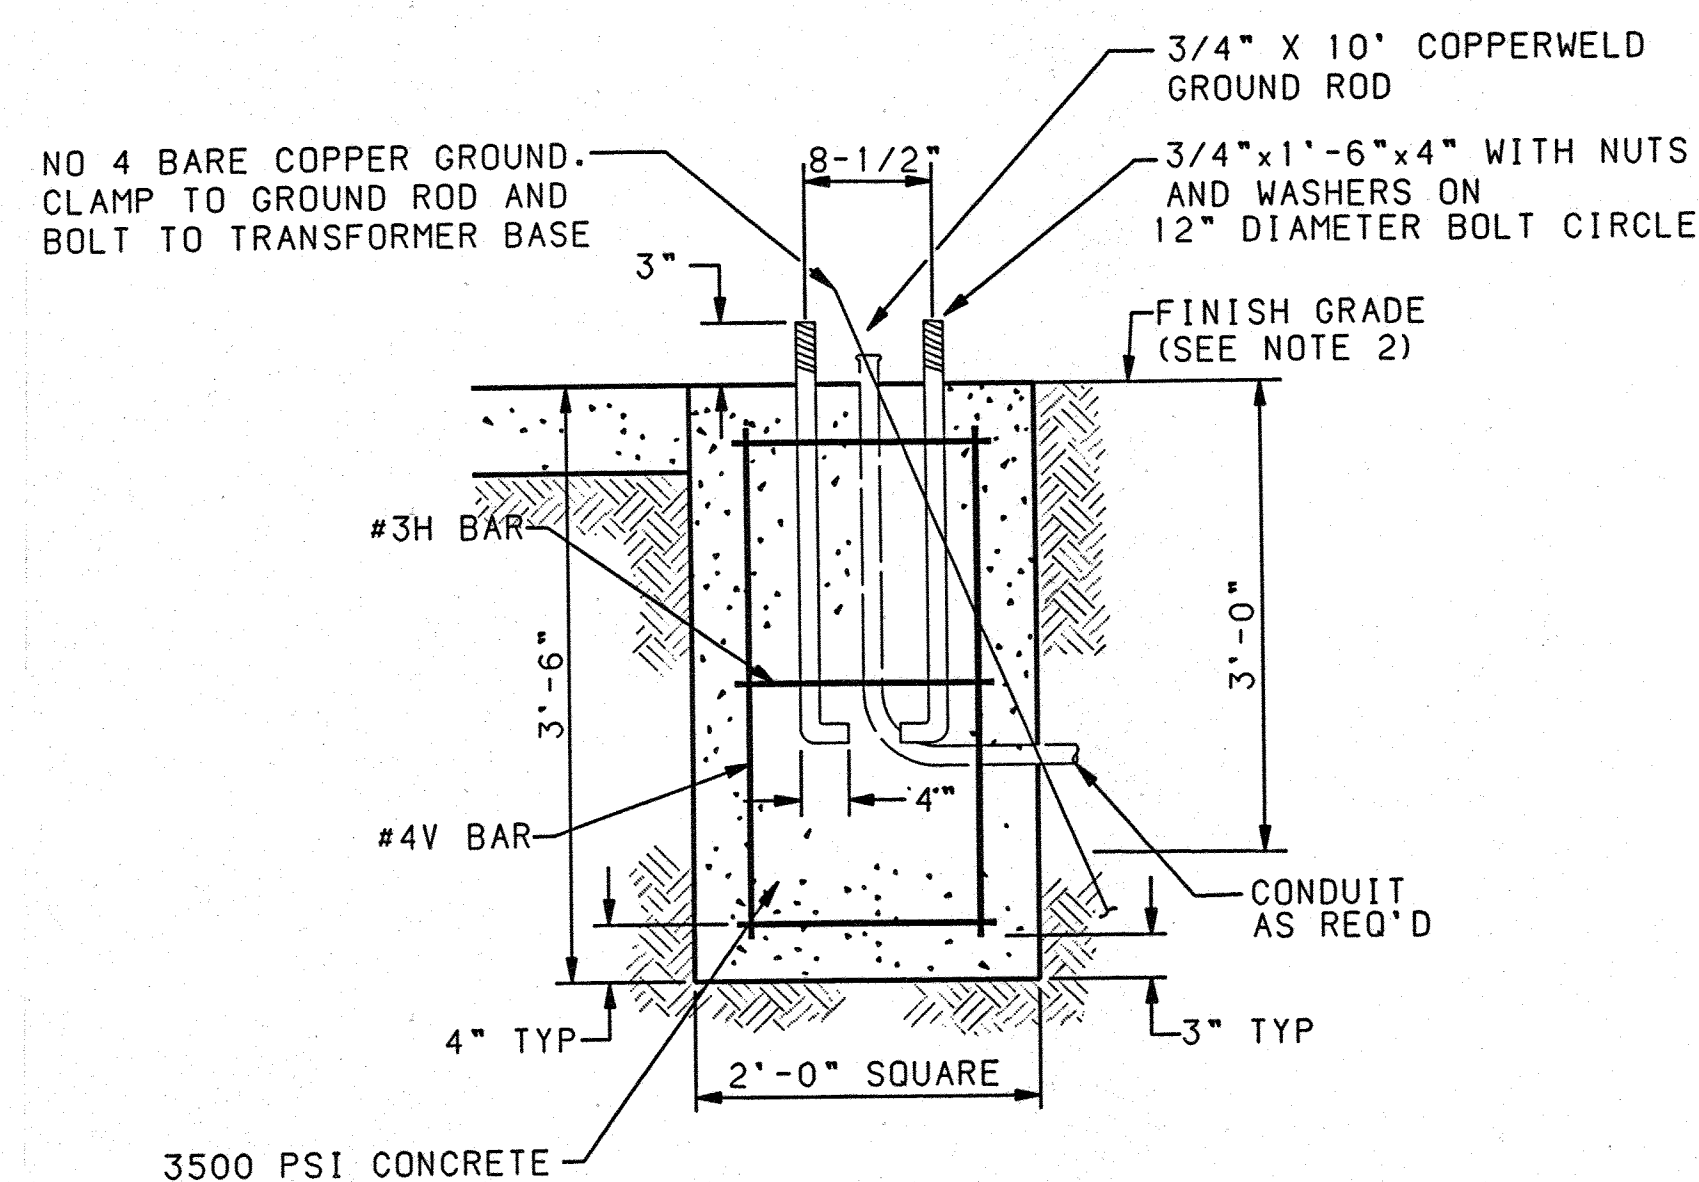

REINFORCING STEEL

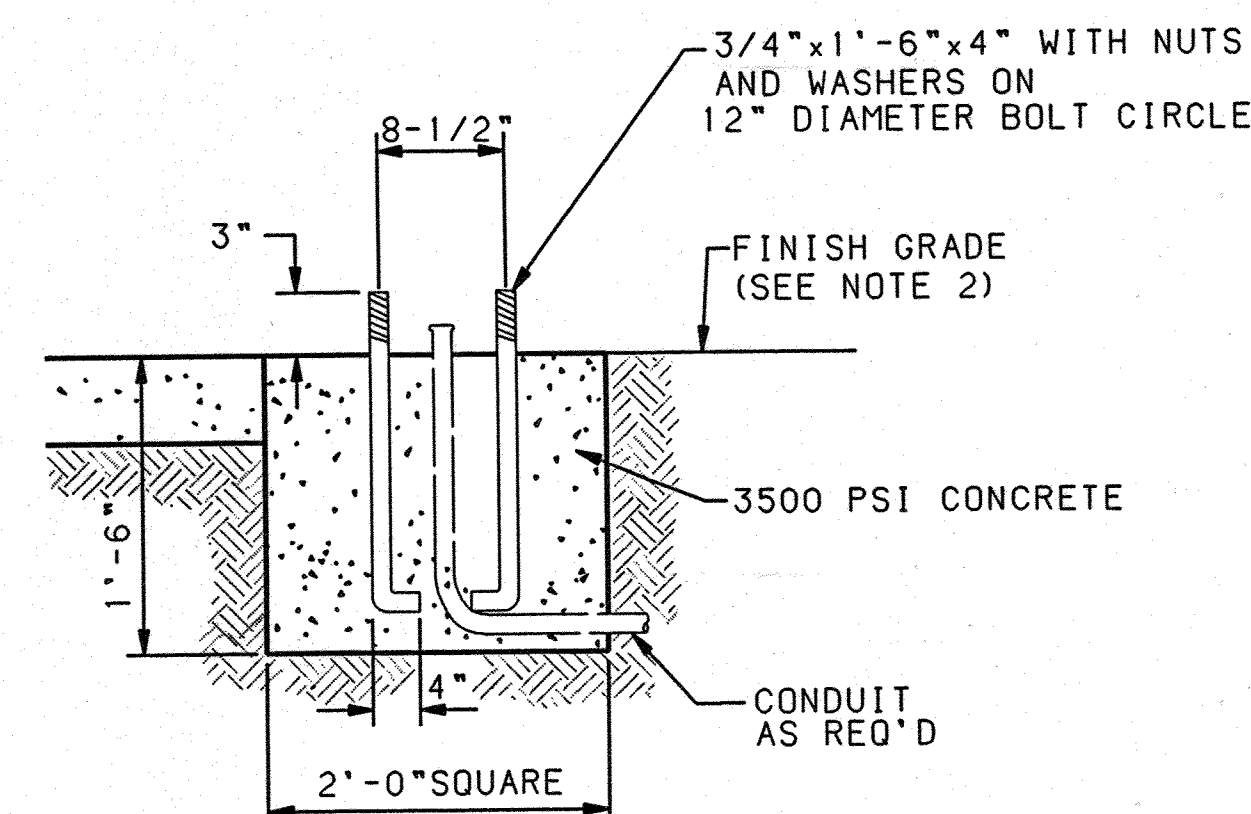

SPLICE CABINET FOUNDATION DETAIL

PEDESTAL FOUNDATION DETAIL


FOUNDATION TYPE	3500 PSI CONCRETE CU YD	REINFORCING BARS POUNDS
PEDESTAL FOUNDATION	0.52	17
CONTROLLER FOUNDATION (TYPE M & P)	0.88	--
SPLICE CABINET FOUNDATION	0.13	--

(FOR CONTRACTORS INFORMATION ONLY)

TRAFFIC SIGNAL FOUNDATION NOTES


1. ALL FOUNDATIONS SHALL INCLUDE COPPERWELD GROUND RODS. ALL GROUND RODS SHALL BE 3/4" Øx10'-0" AND WILL BE CONSIDERED INCIDENTAL TO THE FOUNDATION BID ITEMS.
2. FINISHED GRADE FOR ALL FOUNDATIONS TO BE DETERMINED IN THE FIELD BY THE PROJECT ENGINEER. FOUNDATIONS MAY BE SLOPED TO MATCH SIDEWALKS. SLOPES SHALL CONFORM TO THE AMERICANS WITH DISABILITIES ACT REQUIREMENTS.

	D. MARK GOODWIN & ASSOCIATES, P.A. CONSULTING ENGINEERS & SURVEYORS P.O. BOX 90606 ALBUQUERQUE, NEW MEXICO 87199 (505) 345-2010							DATE			No.		DESIGNED BY	DRAWN BY	CHECKED BY
CITY OF ALBUQUERQUE PUBLIC WORKS DEPARTMENT ENGINEERING DEVELOPMENT GROUP															
TITLE: TRAFFIC SIGNAL CONTROLLER CABINET & PEDESTAL FOUNDATION DETAILS															
DESIGN REVIEW COMMITTEE				LAST DESIGN UPDATE								MO./DAY/YR.			
CITY PROJECT NO.		5358.90		ZONE MAP NO.		F16		SHEET		OF		12		19	

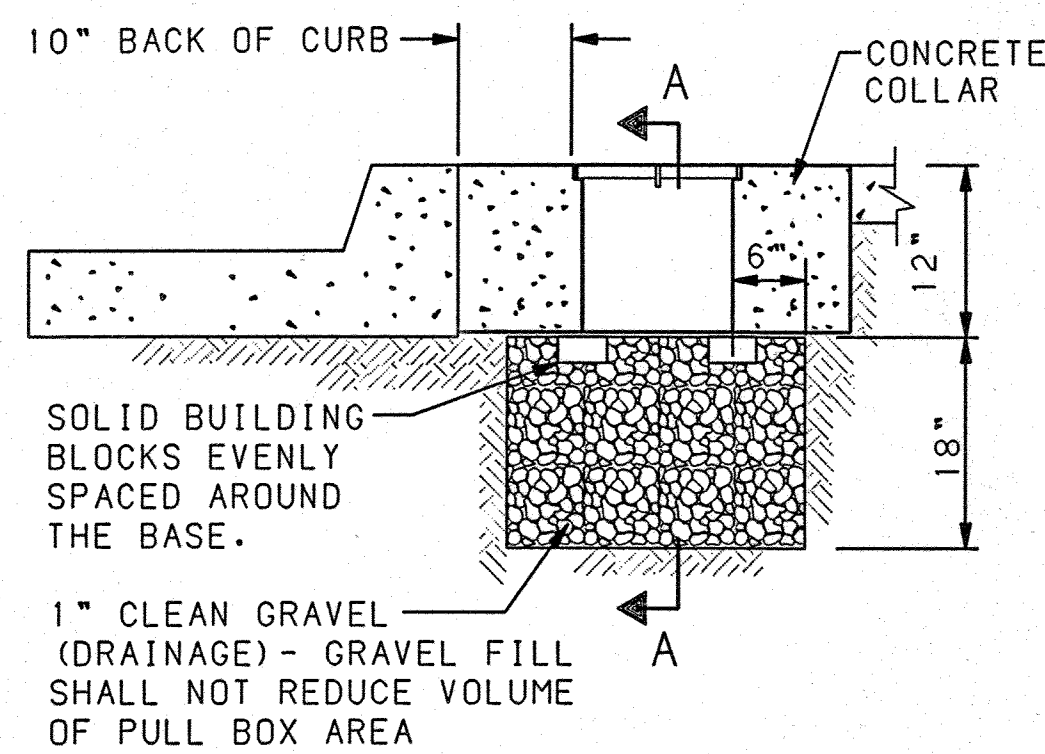


TYPICAL PULLBOX INSTALLATION


NOTE: SEE "CONCRETE COLLAR DETAILS"

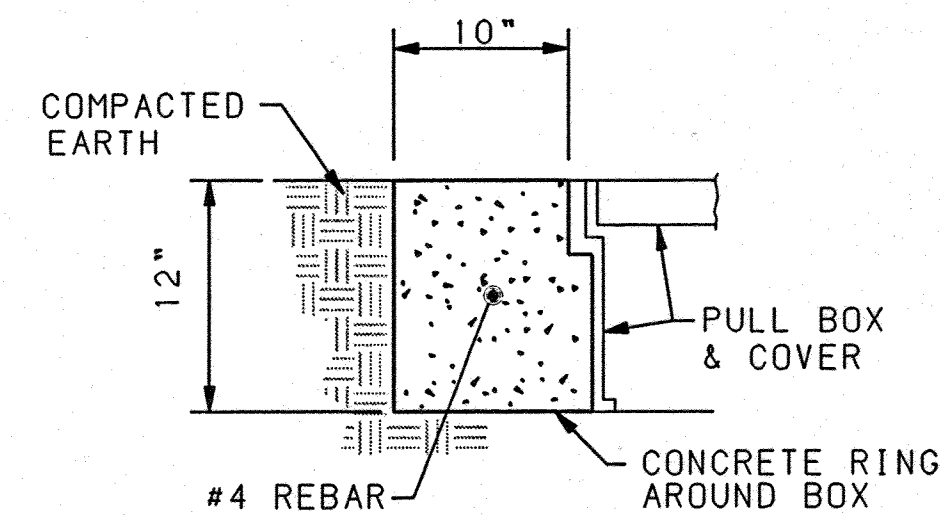

IN COMPACTED EARTH

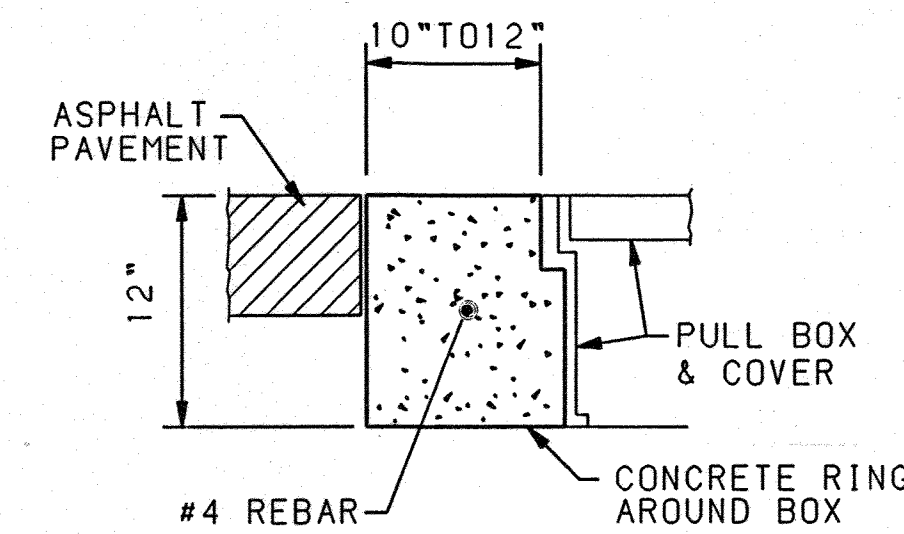


IN ASPHALT PAVEMENTS

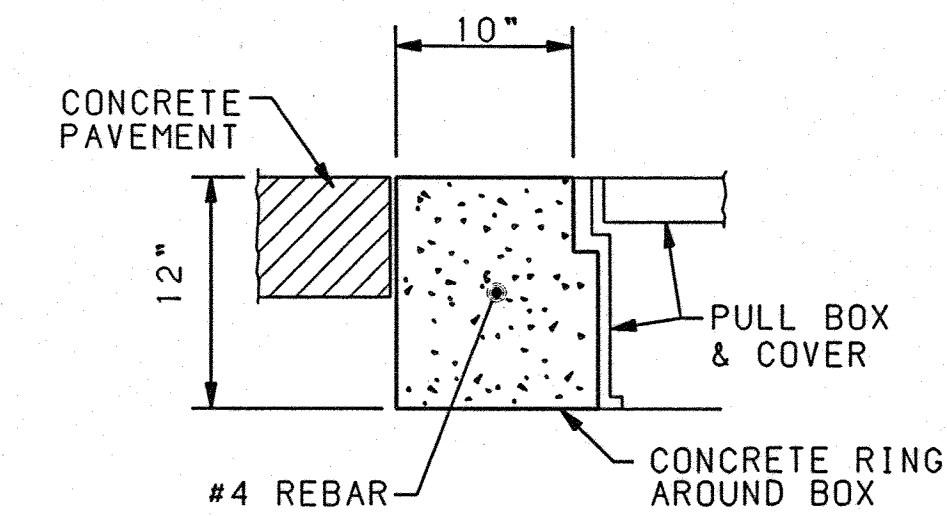

IN CONCRETE PAVEMENTS


CONCRETE COLLAR DETAILS

NOTE: THE CONCRETE COLLAR FOR THE PULL BOXES WILL BE CONSIDERED INCIDENTAL TO THE TO THE PULL BOX BID ITEMS.

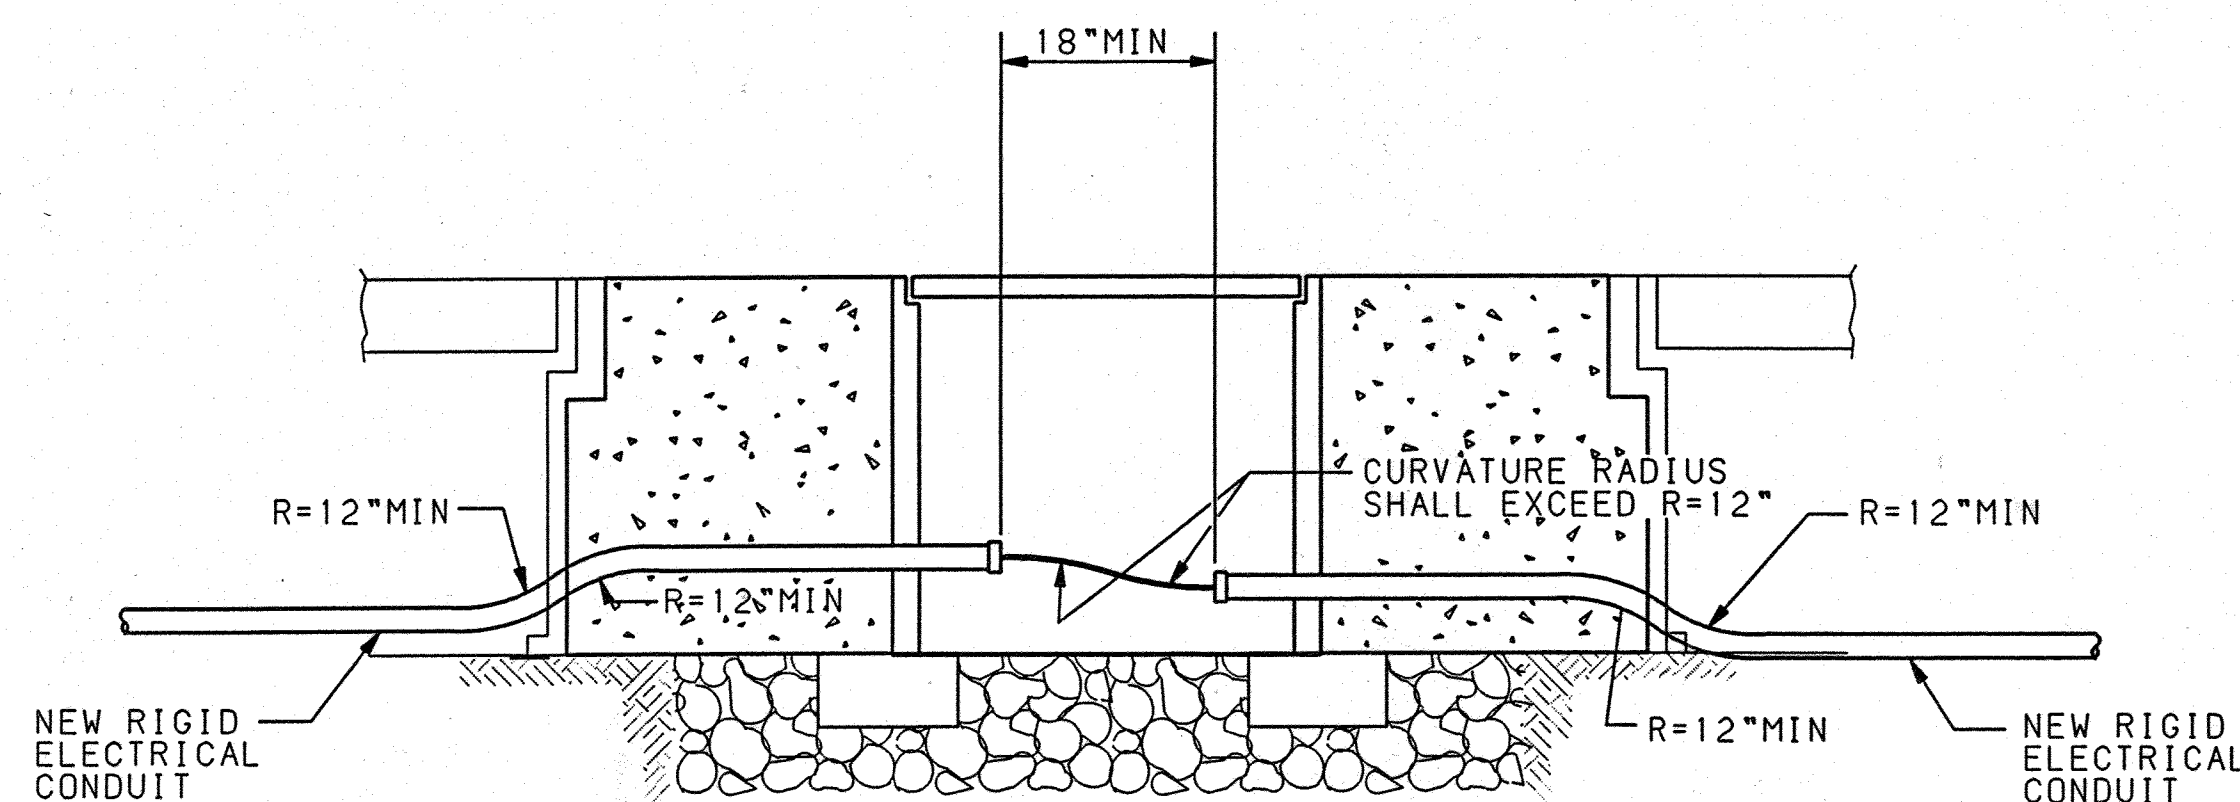


SECTION A-A


**TRAFFIC SIGNAL PULLBOX (TYPICAL)
NEW CONDUIT INSTALLATION**

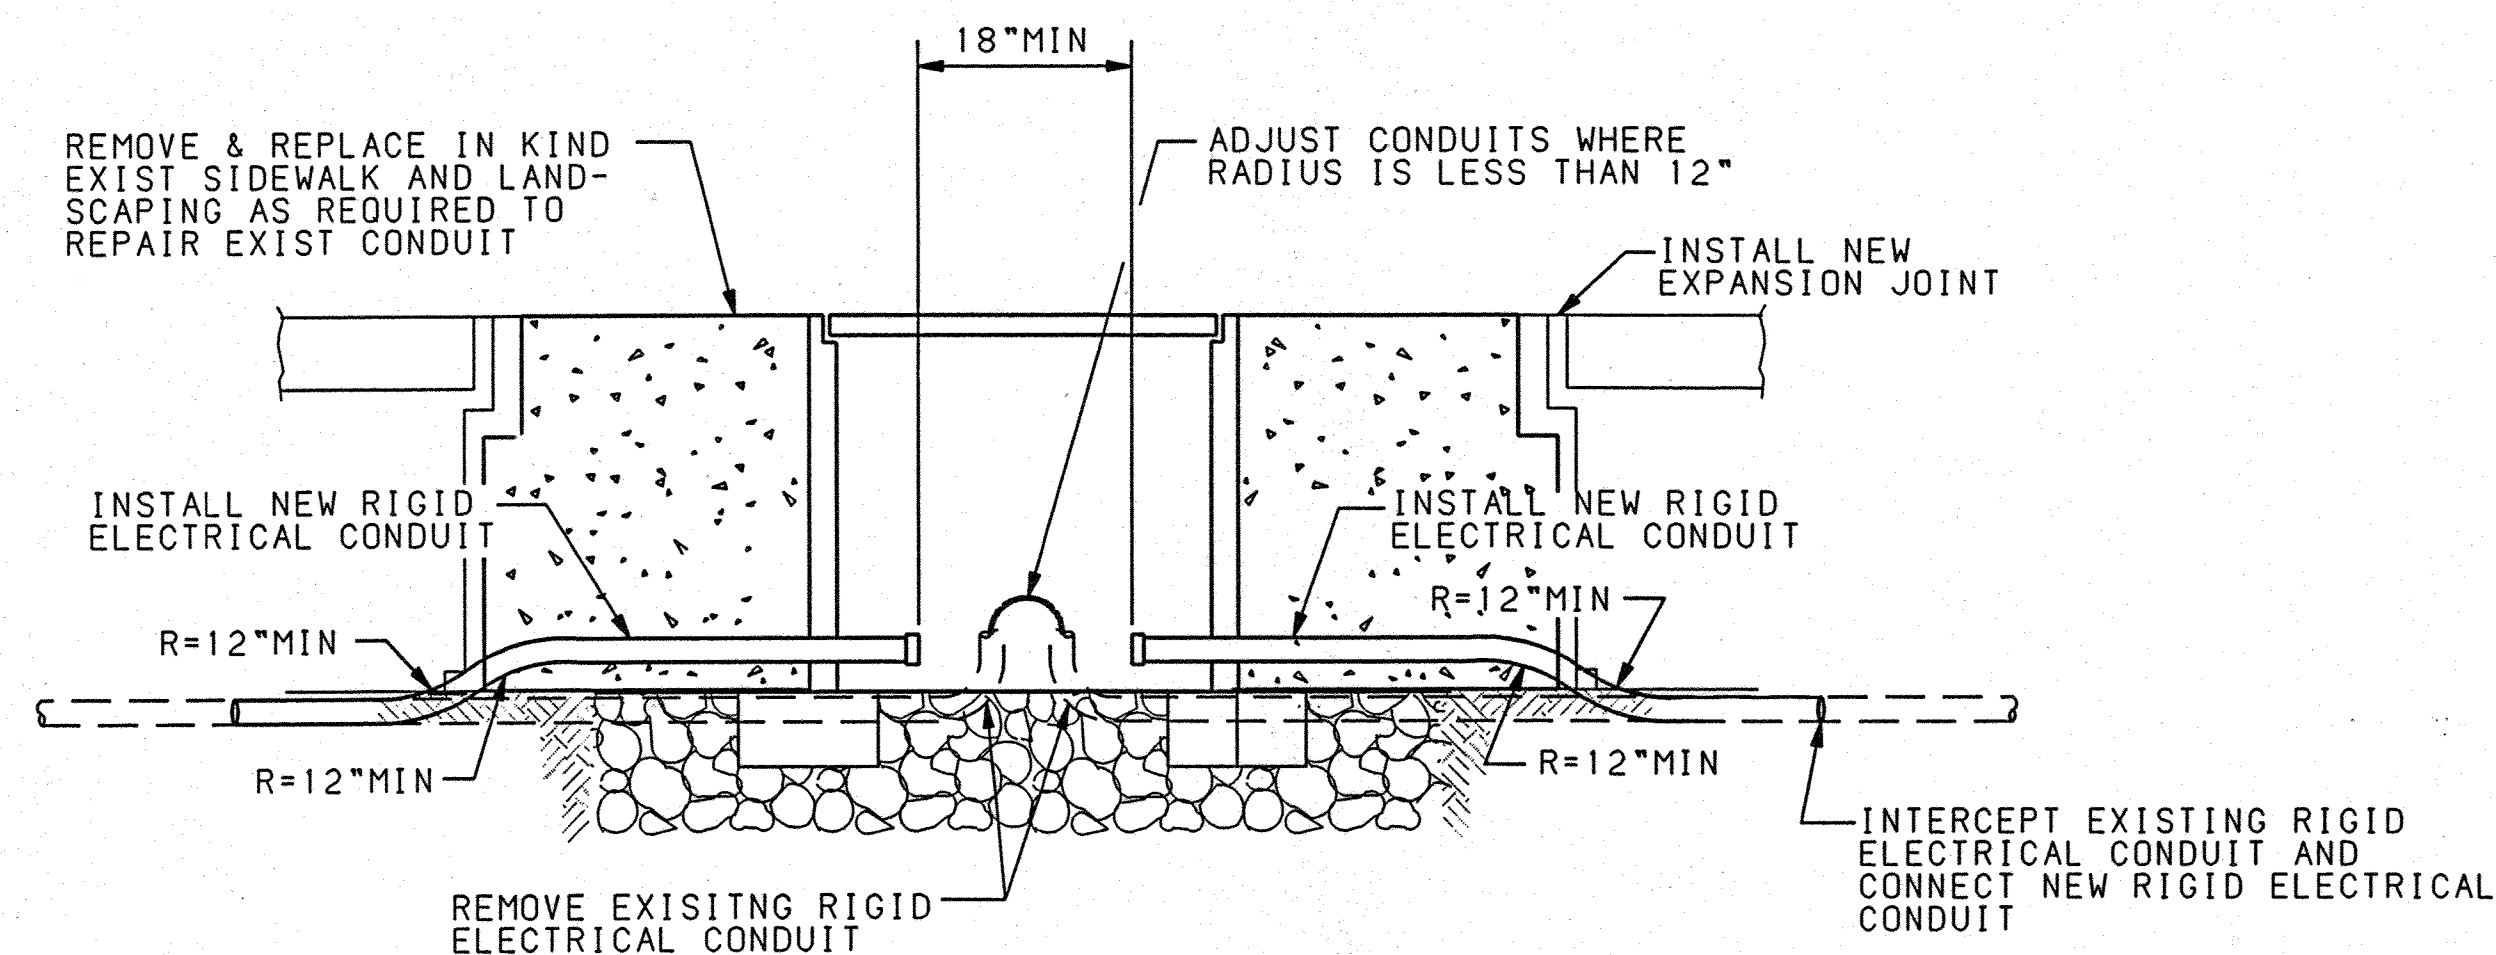

**TRAFFIC SIGNAL PULLBOX (TYPICAL)
RETROFIT INSTALLATION**

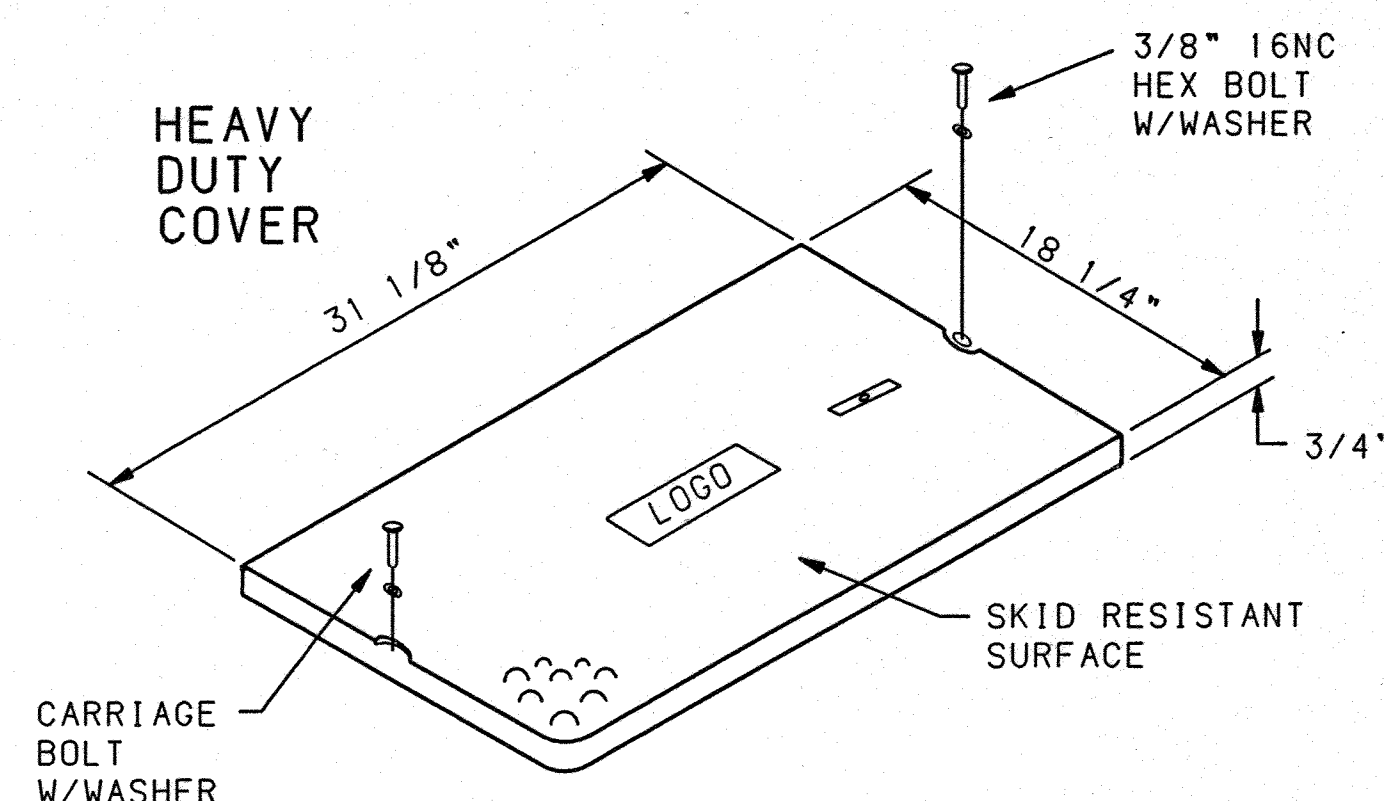

LARGE PULL BOX

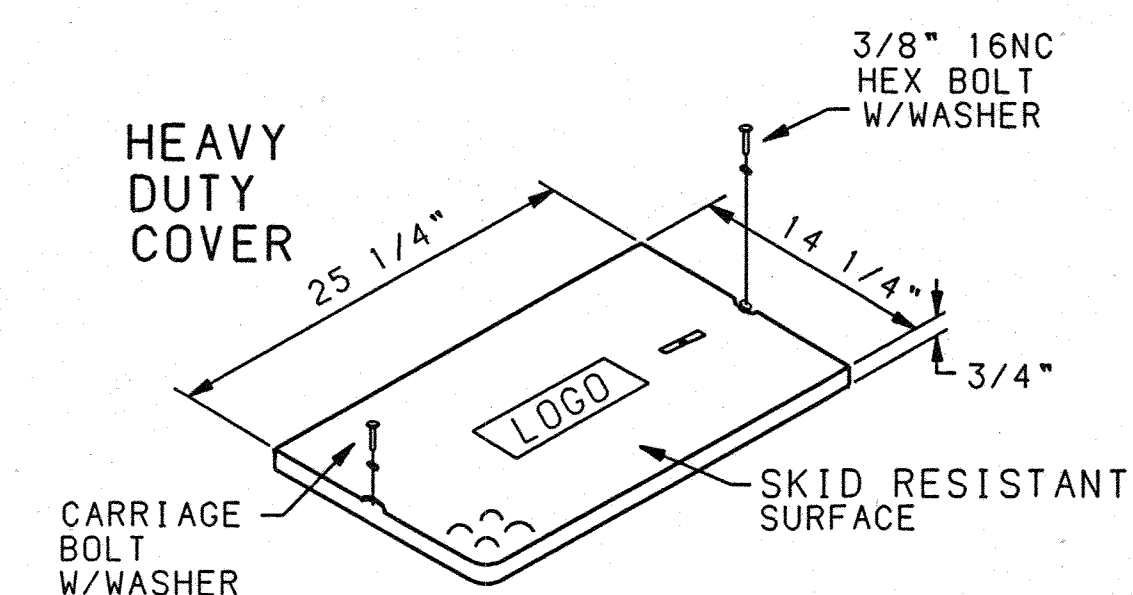

STANDARD PULL BOX

PULL BOX DETAILS

NOTES FOR HEAVY DUTY REINFORCED POLYMER MORTAR PULL BOXES AND COVERS

1. MATERIAL TO BE AN AGGREGATE CONSISTING OF SAND AND GRAVEL BOUND TOGETHER WITH A POLYMER AND REINFORCED WITH A HEAVY WEAVE FIBERGLASS. THE MATERIAL MUST HAVE THE FOLLOWING MECHANICAL PROPERTIES: COMPRESSIVE STRENGTH-11,000 PSI. TENSILE STRENGTH-1700 PSI. FLEXURAL STRENGTH-7500 PSI.
2. ALL PULL BOX COVERS SHALL BE HEAVY DUTY REINFORCED POLYMER MORTAR, HAVING A SERVICE LOAD OF 15,000 LBS. OVER A 10" SQUARE (150 PSI). NO CONCRETE OR STEEL COVERS WILL BE ACCEPTABLE.
3. ELECTRICAL PULL BOX (SMALL) SHALL BE A HEAVY DUTY REINFORCED POLYMER MORTAR PULL BOX AND COVER MEASURING 12-7/8"x12-7/8"x3/4".

dmg
D. MARK GOODWIN & ASSOCIATES, P.A.
CONSULTING ENGINEERS & SURVEYORS
P.O. BOX 90606
ALBUQUERQUE, NEW MEXICO 87199
(505) 345-2010

CITY OF ALBUQUERQUE
PUBLIC WORKS DEPARTMENT
ENGINEERING DEVELOPMENT GROUP

TITLE: **TRAFFIC SIGNAL
PULL BOX DETAILS**

DESIGN REVIEW COMMITTEE
APPROVED
JAN 25 1996
DESIGN REVIEW COMMITTEE

CITY PROJECT NO.

5358.90


ZONE MAP NO.

F16

SHEET OF


13 19

AS BUILT INFORMATION				BENCH MARKS				SURVEY INFORMATION				ENGINEER'S SEAL			
CONTRACTOR	DATE	INSPECTOR	DATE	BRASS TABLET STAMPED	DATE	BY	NO.	DATE	BY	NO.	DATE	DATE	DATE	DATE	DATE
TRAVELLINS	96	ALS	96	POST. LOCATED 0.50 MILES SOUTH OF MONTANO RD. ON WEST											
ACCEPTANCE BY	DATE	VERIFICATION BY	DATE	FRONTAGE RD. TO THE RIGHT.											
ALS	96	ALS	96	X = 390403.88											
DRAWN BY	DATE	CHECKED BY	DATE	Y = 1502304.95											
BHJ/COA	96	BHJ/COA	96	Z = 5079.46											
MICRO-FILM INFORMATION															
RECORDED BY	DATE	NO.													

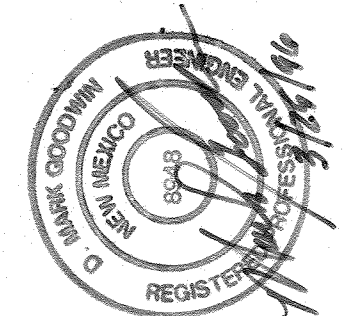


1 2 3 4 5 6 7 8 9 10 11 12 13 14 15
26-5358.90 1397


MERCH\DTLS

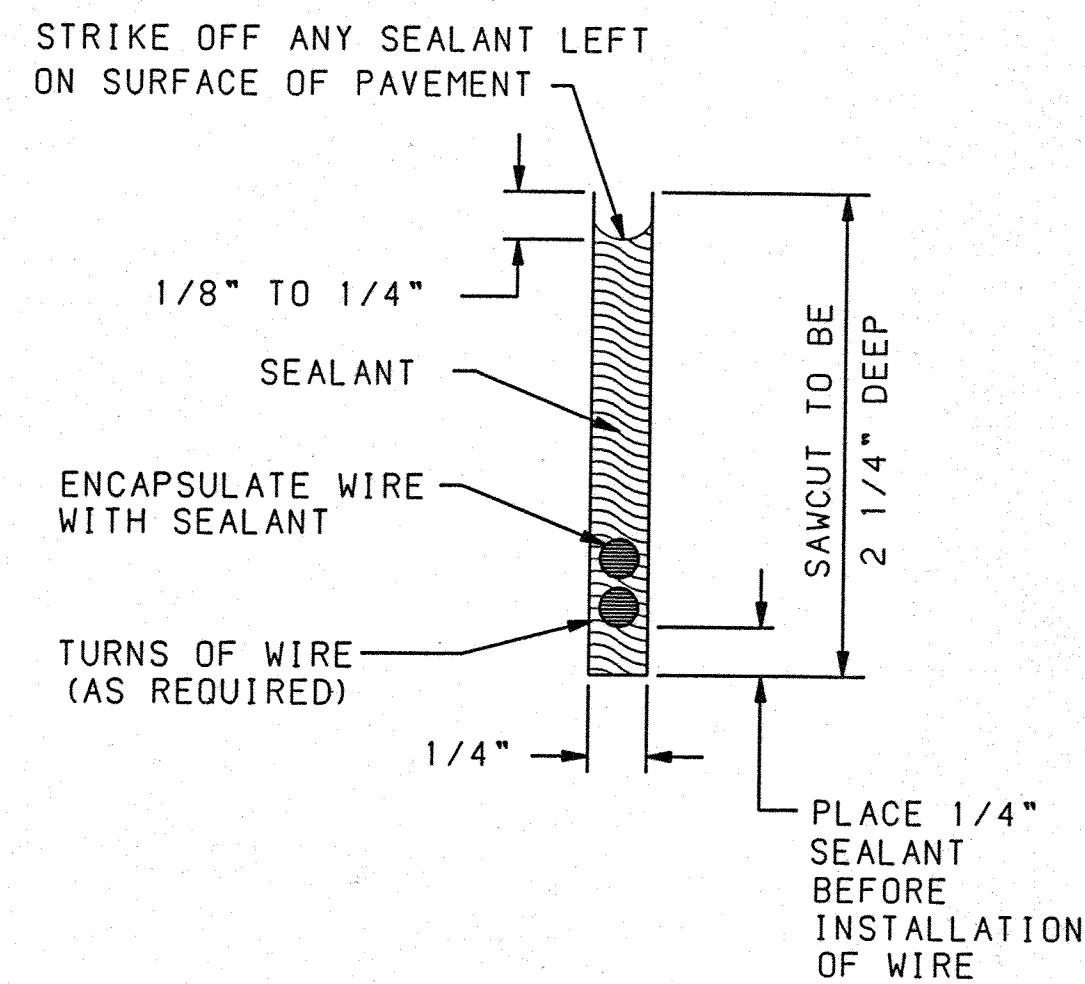


SECTION A-A

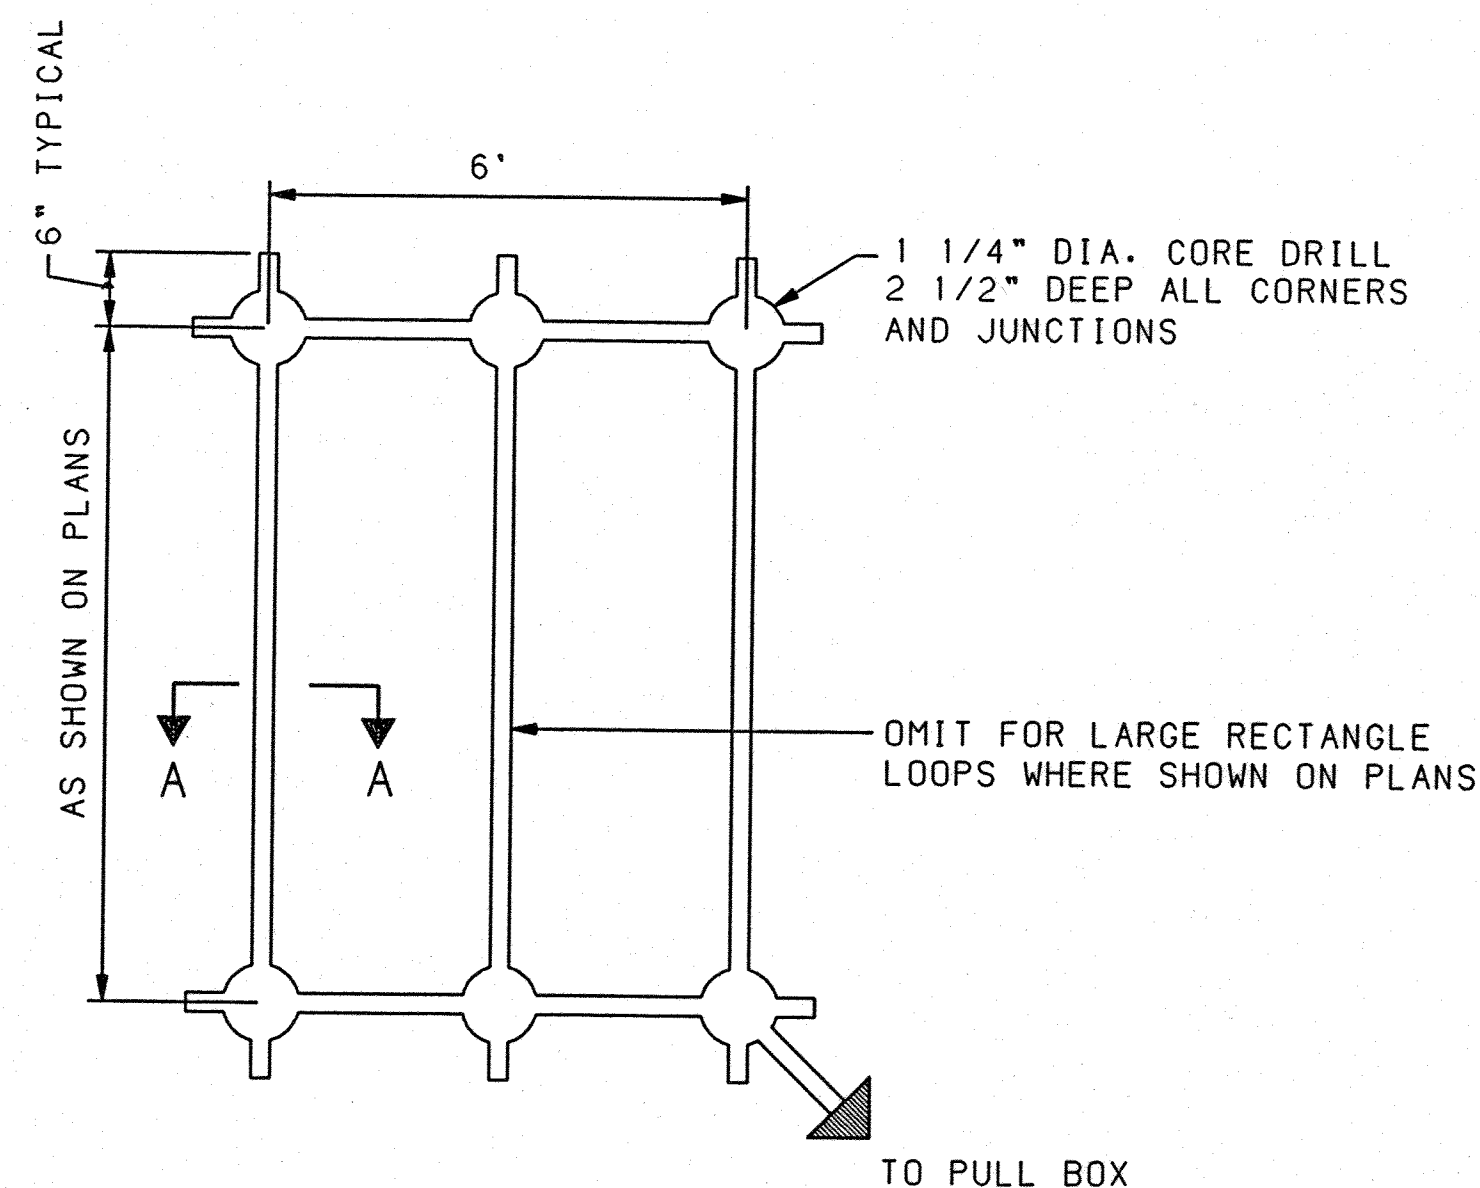


PLAN VIEW

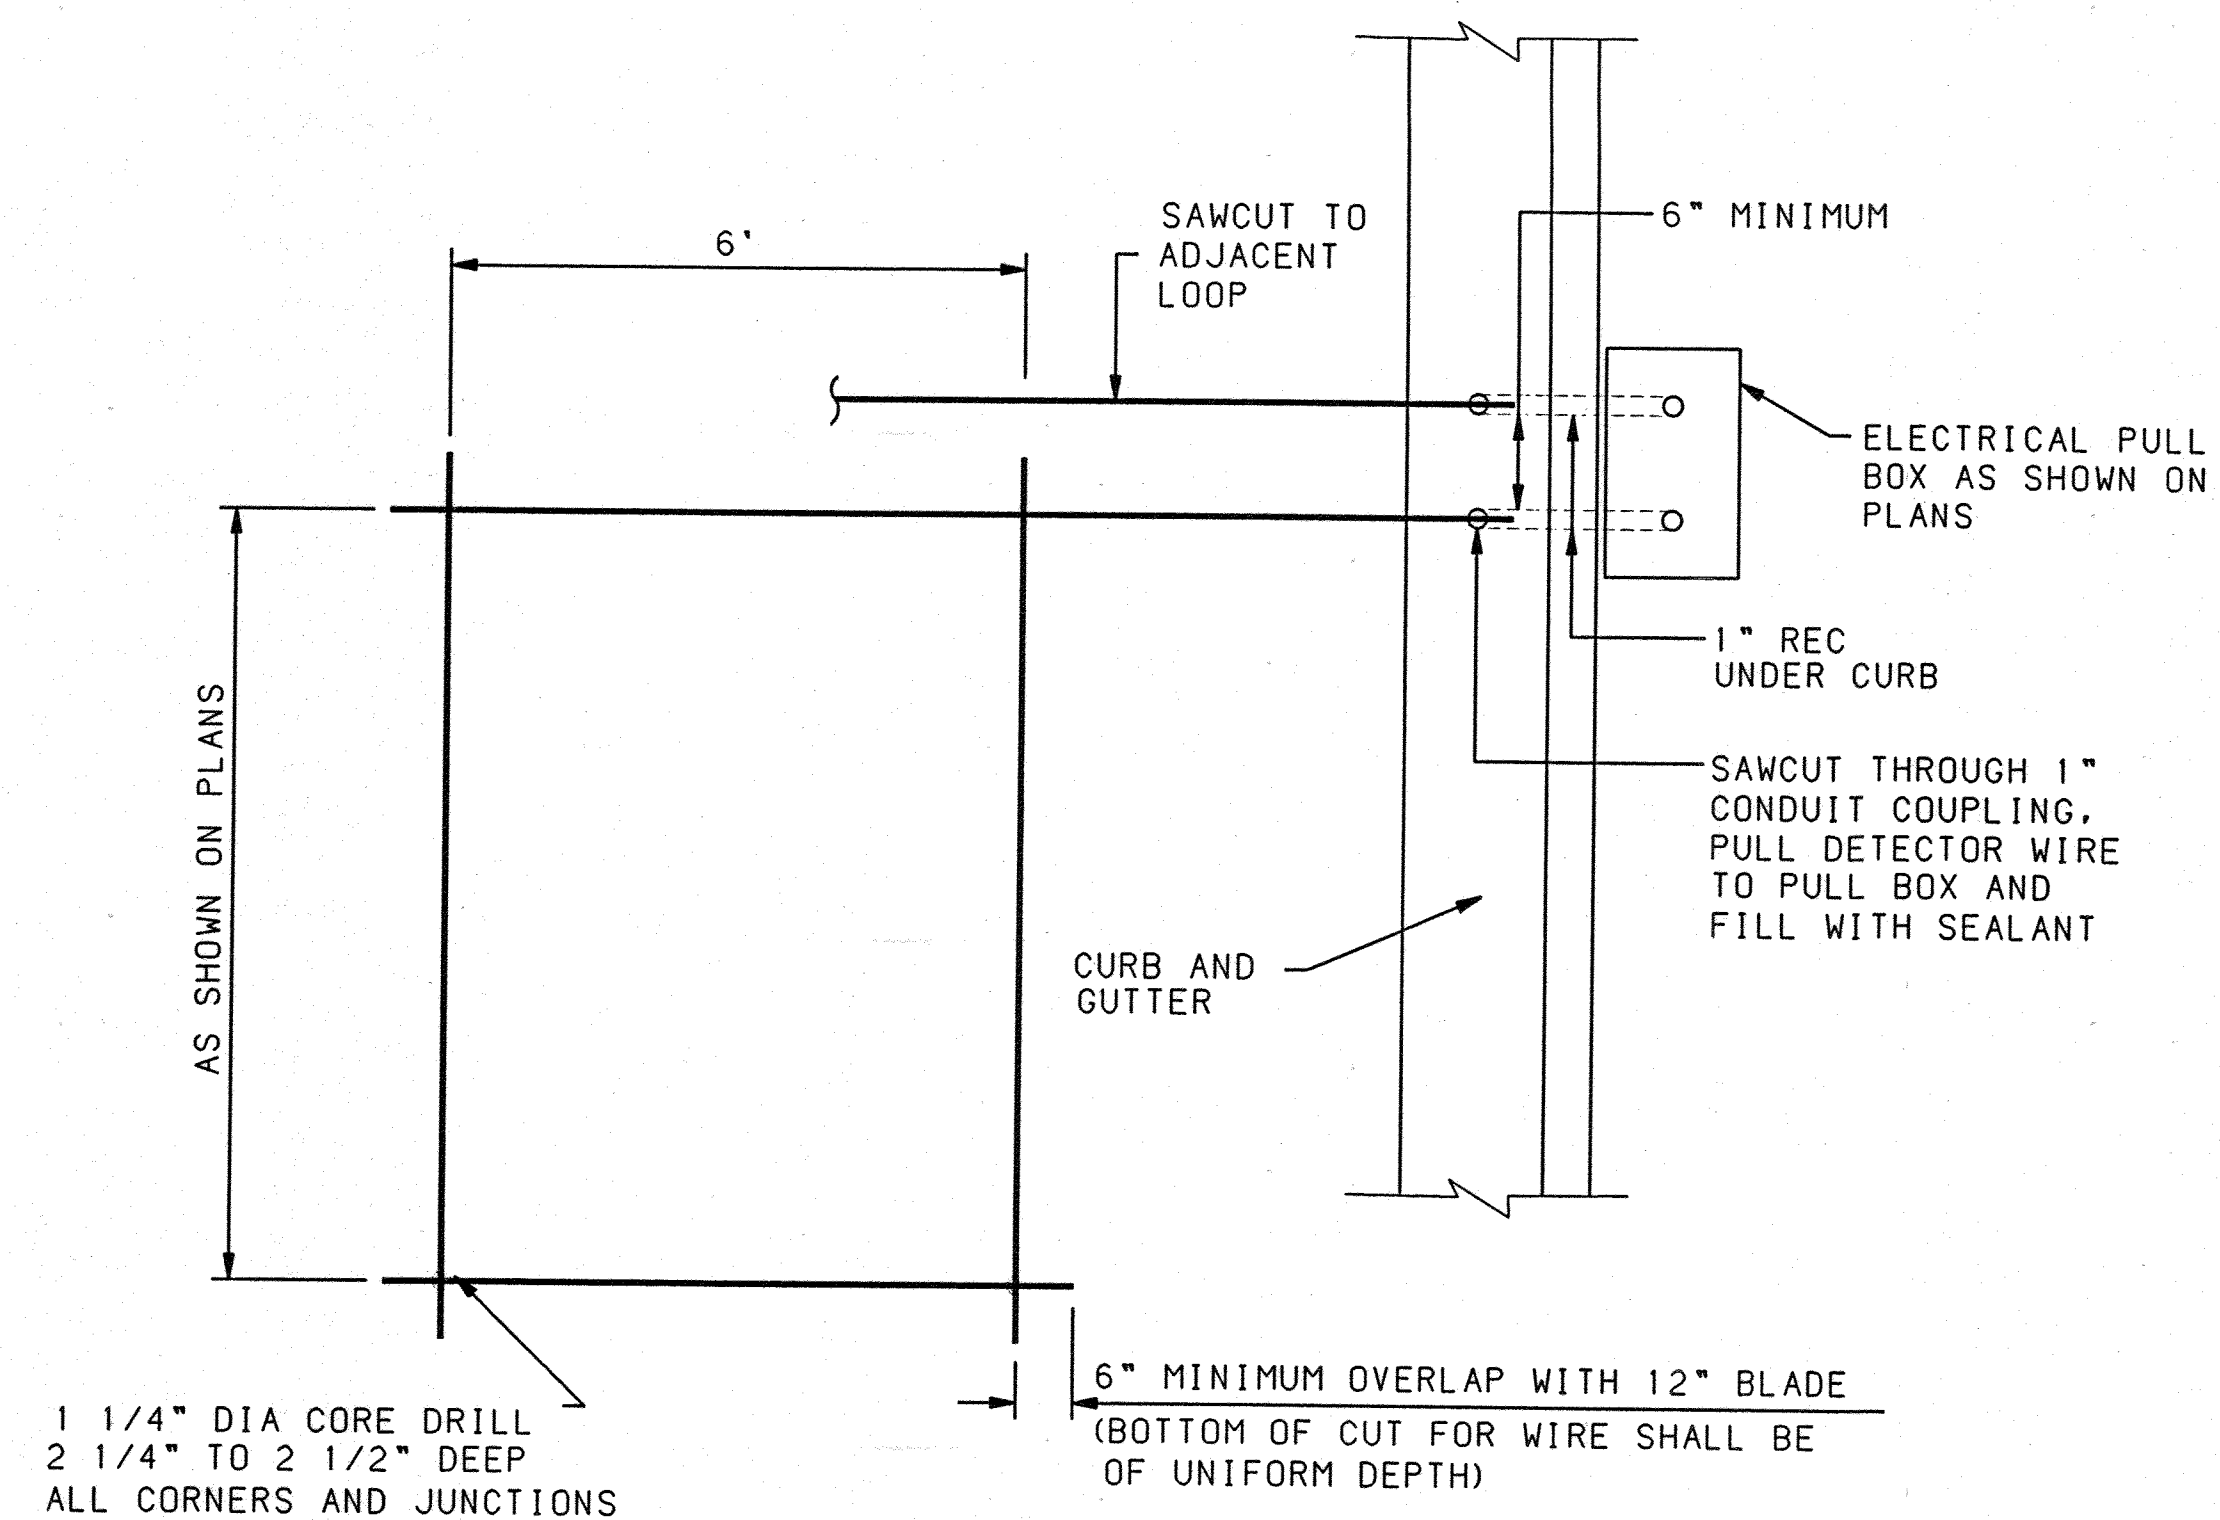


PLAN VIEW

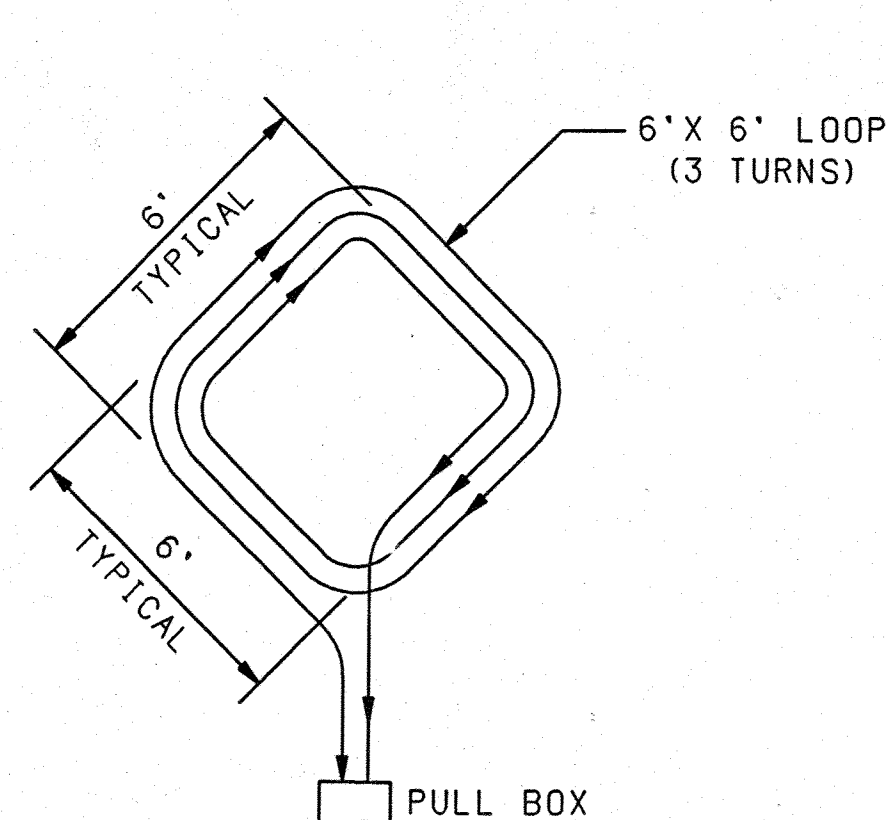


EXTEND CALL LOOP WIRING DETAIL

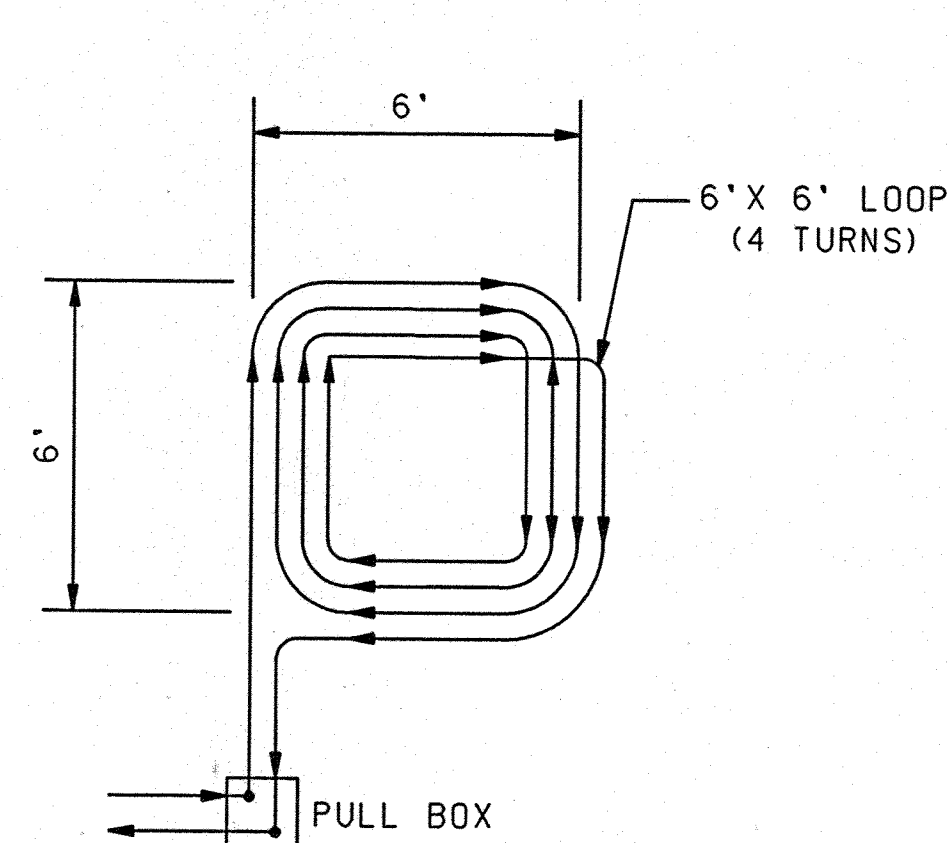


SYSTEM LOOP WIRING DETAIL

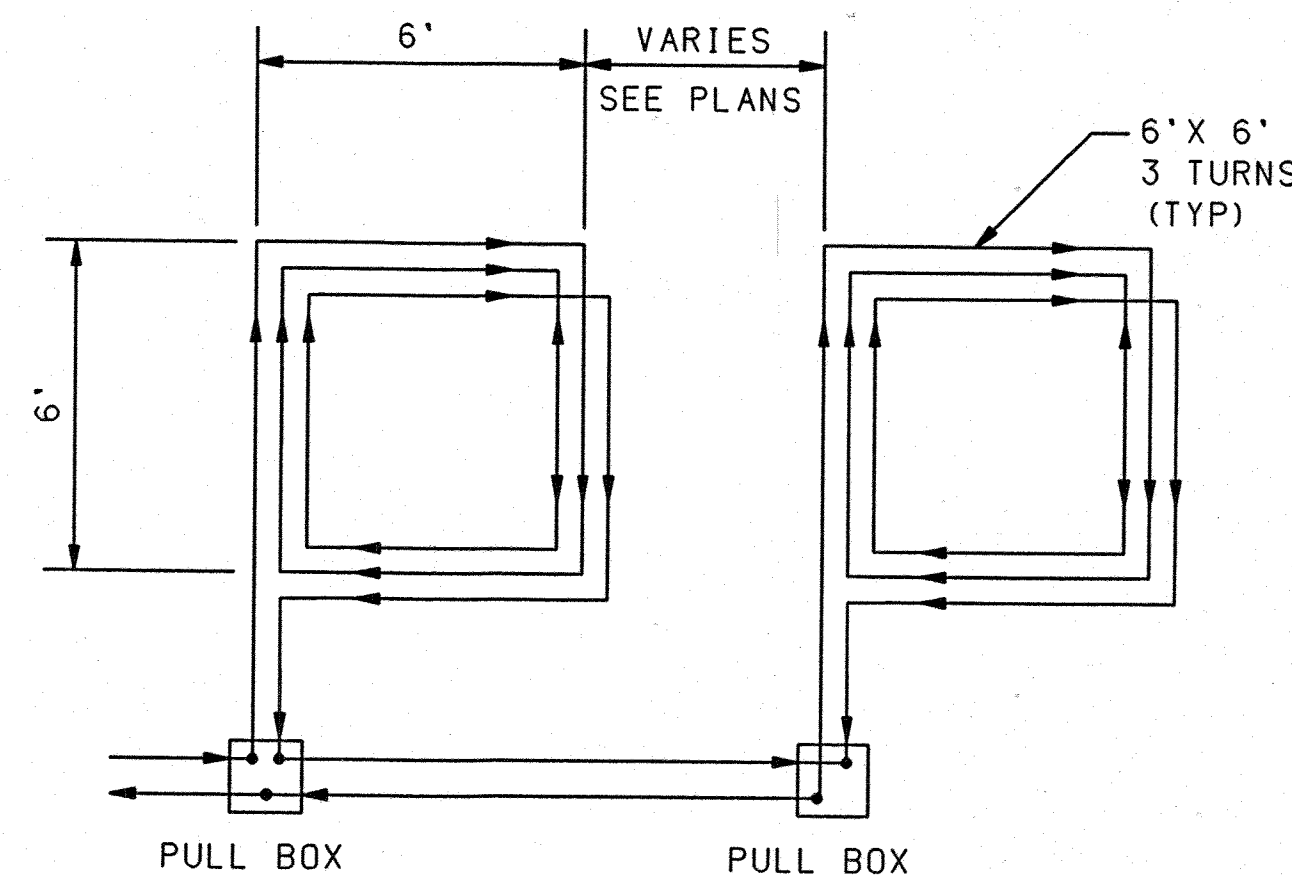


SERIES LOOP WIRING DETAIL

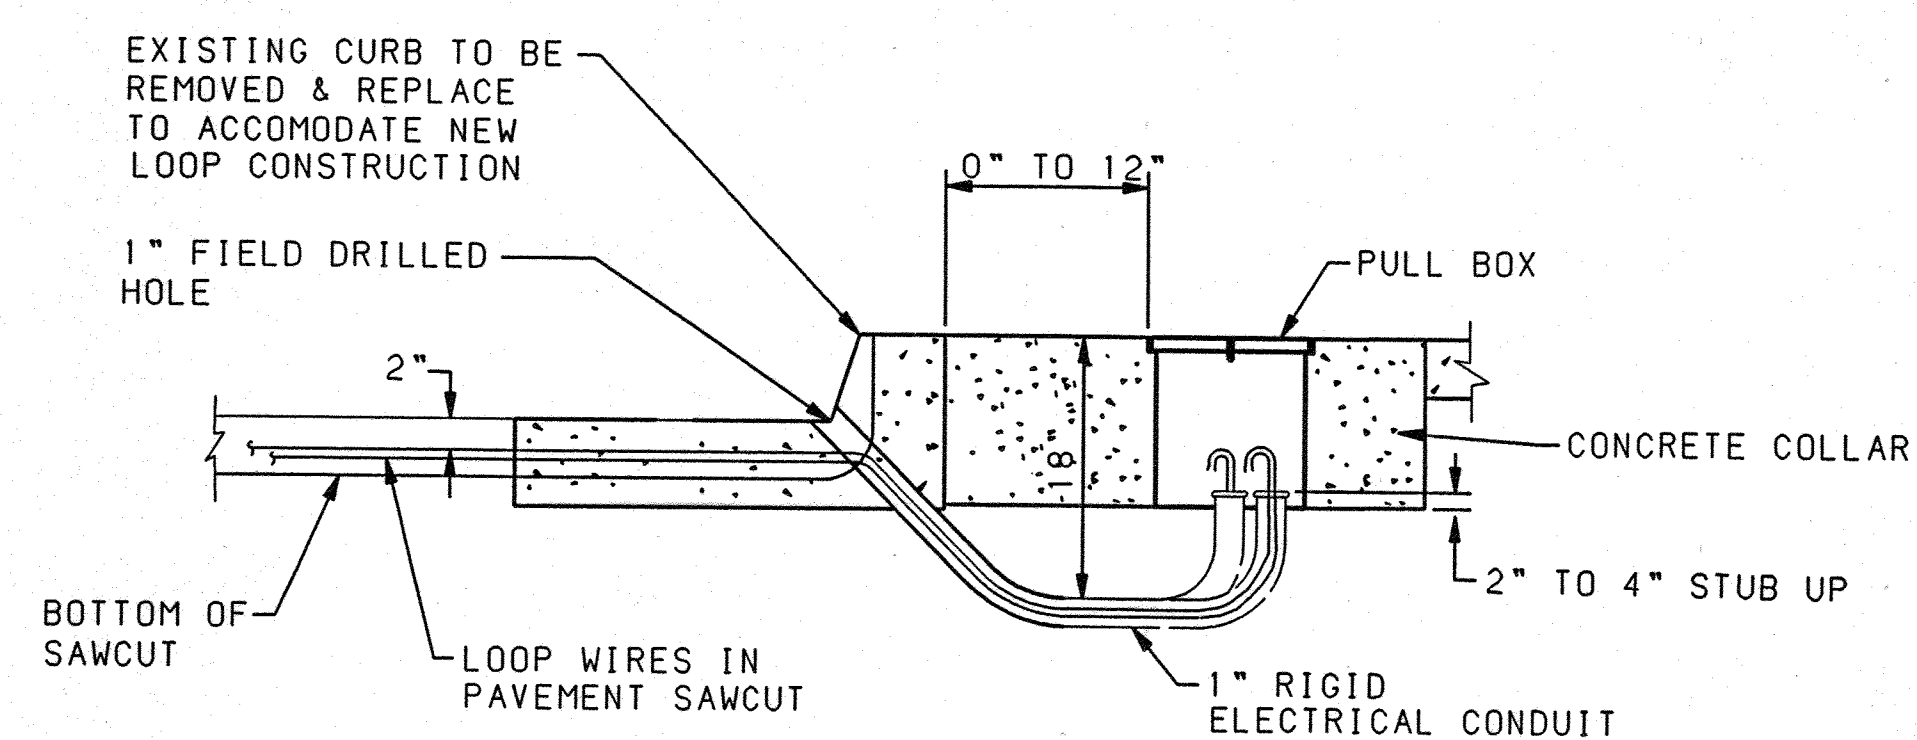

SECTION

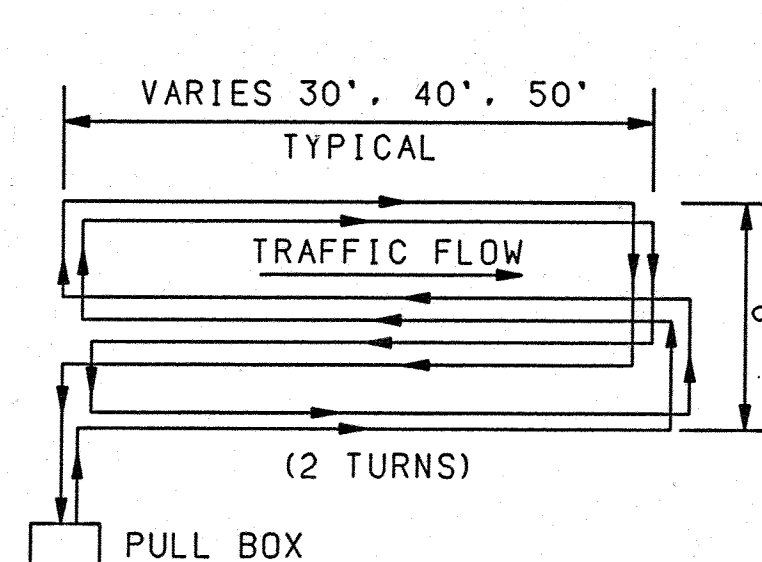

QUADRUPOLE LOOP WIRING DETAIL

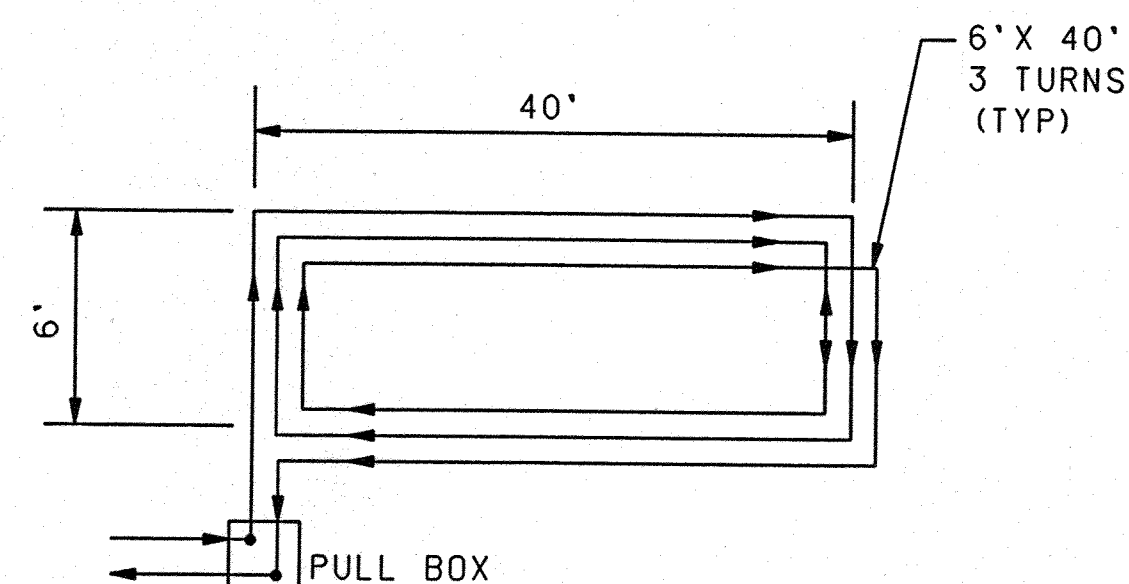

LARGE RECTANGULAR LOOP WIRING DETAIL

NOTES

1. WIRES MUST BE WOUND IN THE DIRECTION SHOWN.
2. QUADRUPOLE LOOPS SHALL HAVE 2 TURNS.
3. EXTEND CALL LOOPS SHALL HAVE 3 TURNS.
4. SYSTEM DETECTOR LOOPS SHALL HAVE 4 TURNS.
5. LARGE RECTANGLE LOOPS SHALL HAVE 3 TURNS

TYPICAL LOOP WIRE PLACEMENT DETAILS

LOOP DETECTOR NOTES

1. ALL LOOP DETECTOR WIRE SHALL BE NO. 14 AWG STRANDED COPPER WIRE WITH CROSSLINKED POLYETHYLENE INSULATION (INDUSTRY TYPE XHHW) CONFORMING TO THE REQUIREMENTS OF I.M.S.A. SPECIFICATIONS NO 51-3 1984. BACKER ROD SHALL NOT BE USED IN THE INSTALLATION OF LOOP (EXCEPT PIECES LESS THAN 12\"/>
2. ALL LOOP LEAD IN CABLES SHALL BE TAGGED AT CABINET TO IDENTIFY EACH CABLE BY LOOP AND AND PHASE NUMBER.
3. GROUND LOOP LEAD IN CABLE SHIELDING IN CONTROL CABINET.
4. SEPARATE 1\"/>


20-5358.90 1497

dmg D. MARK GOODWIN & ASSOCIATES, P.A.
CONSULTING ENGINEERS & SURVEYORS
P.O. BOX 90608
ALBUQUERQUE, NEW MEXICO 87199
(505) 345-2010

CITY OF ALBUQUERQUE
PUBLIC WORKS DEPARTMENT
ENGINEERING DEVELOPMENT GROUP
TITLE: TRAFFIC SIGNAL
LOOP DETECTOR DETAILS

DESIGN REVIEW COMMITTEE
APPROVED
JAN 25 1997


CITY PROJECT NO. 5358.90 ZONE MAP NO. F16 SHEET 14 OF 19

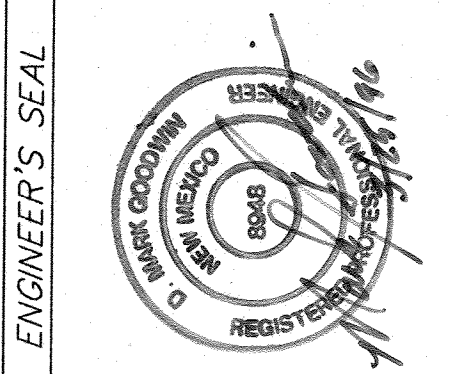


REVISIONS		REVISIONS	
NO.	DATE	BY	DATE

LAST DESIGN UPDATE		NO./DAY/YR.	
DATE	BY	DATE	BY

SURVEY INFORMATION			BENCH MARKS		AS BUILT INFORMATION	
NO.	BY	DATE	BRASS TABLE STAMPED	CONTRACTOR	WORK	DATE
			POST. LOCATED 0.50 MILES SOUTH OF MONTANO RD. ON WEST FRONTAGE RD. TO THE RIGHT.	THANKS	INSPECTED BY	DATE
			X = 390403.89		ACCEPTANCE BY	DATE
			Y = 1502304.95		VERIFICATION BY	DATE
			Z = 5079.46		DRAWINGS	DATE
					CORRECTED BY	DATE
					MICRO-FILM INFORMATION	DATE
					RECORDED BY	DATE
					NO.	DATE

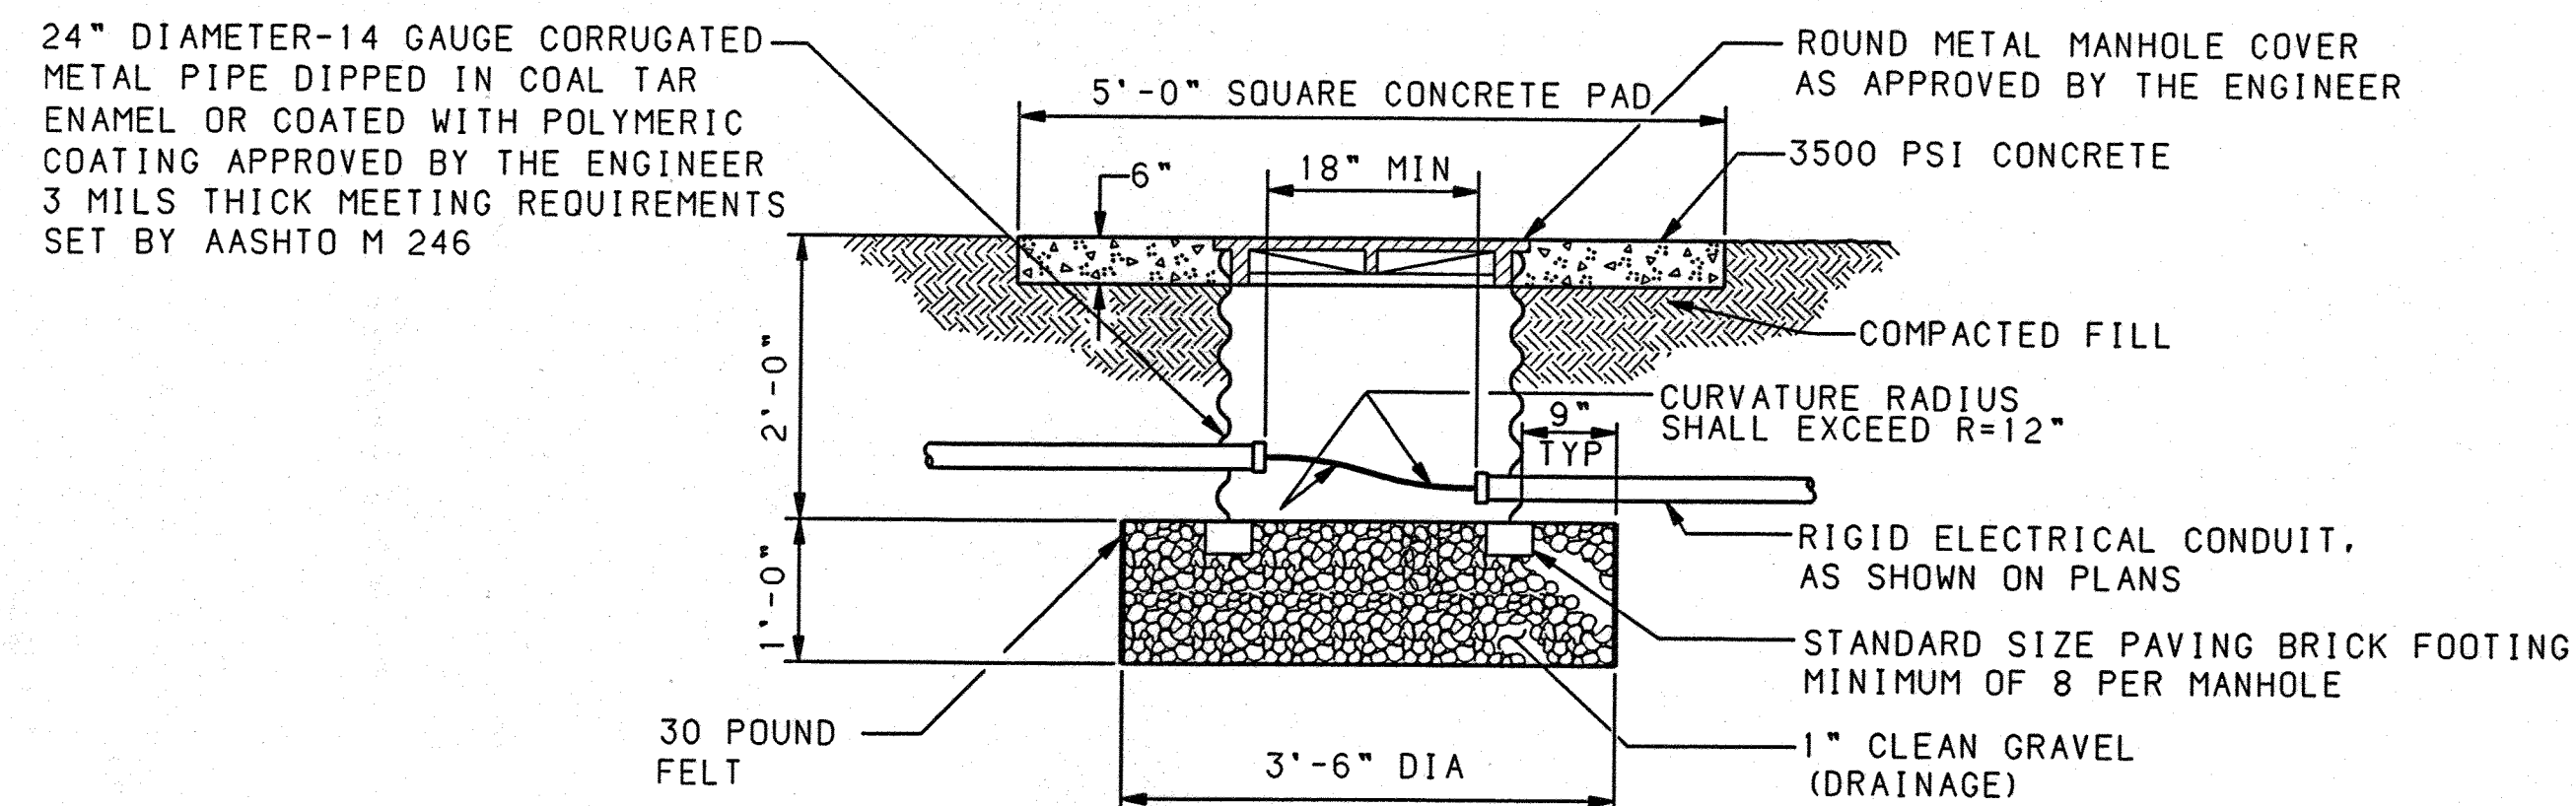


TRAFFIC SIGNAL MANHOLE (TYPICAL)
NEW CONDUIT INSTALLATION

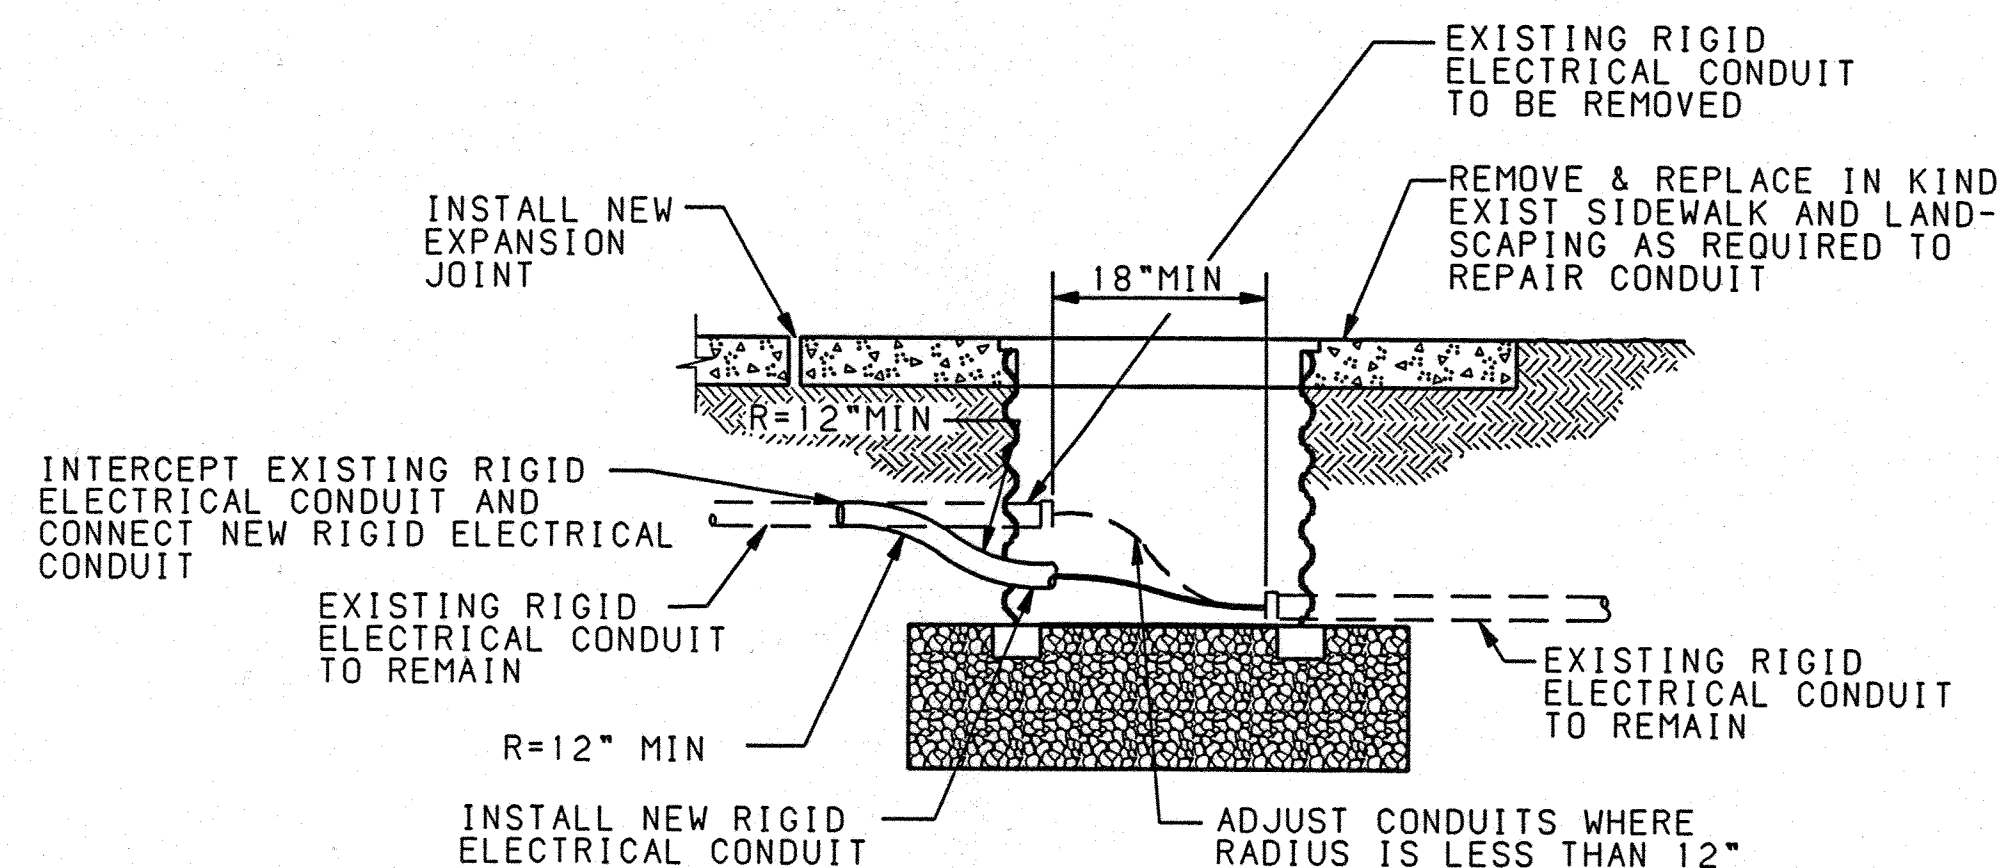


TRAFFIC SIGNAL MANHOLE (TYPICAL)
RETROFIT INSTALLATION


NOTES:
1. TRAFFIC SIGNAL MANHOLE TO BE CONSTRUCTED IN AREAS NOT NORMALLY ACCESSIBLE TO VEHICULAR TRAFFIC.

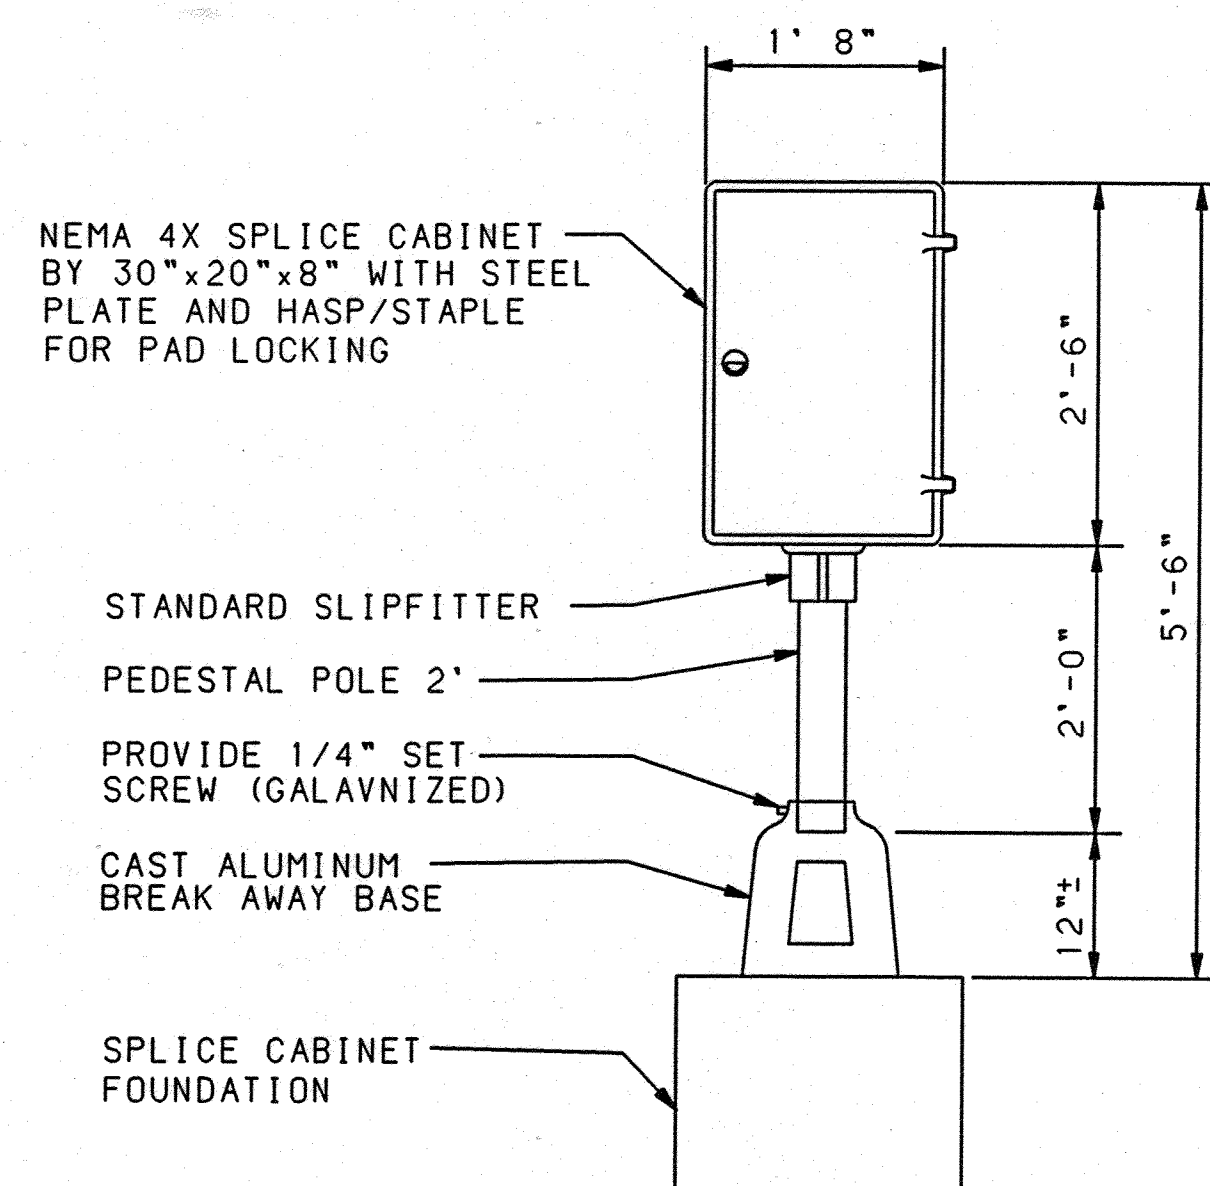

TRAFFIC SIGNAL
SPLICE CABINET DETAIL

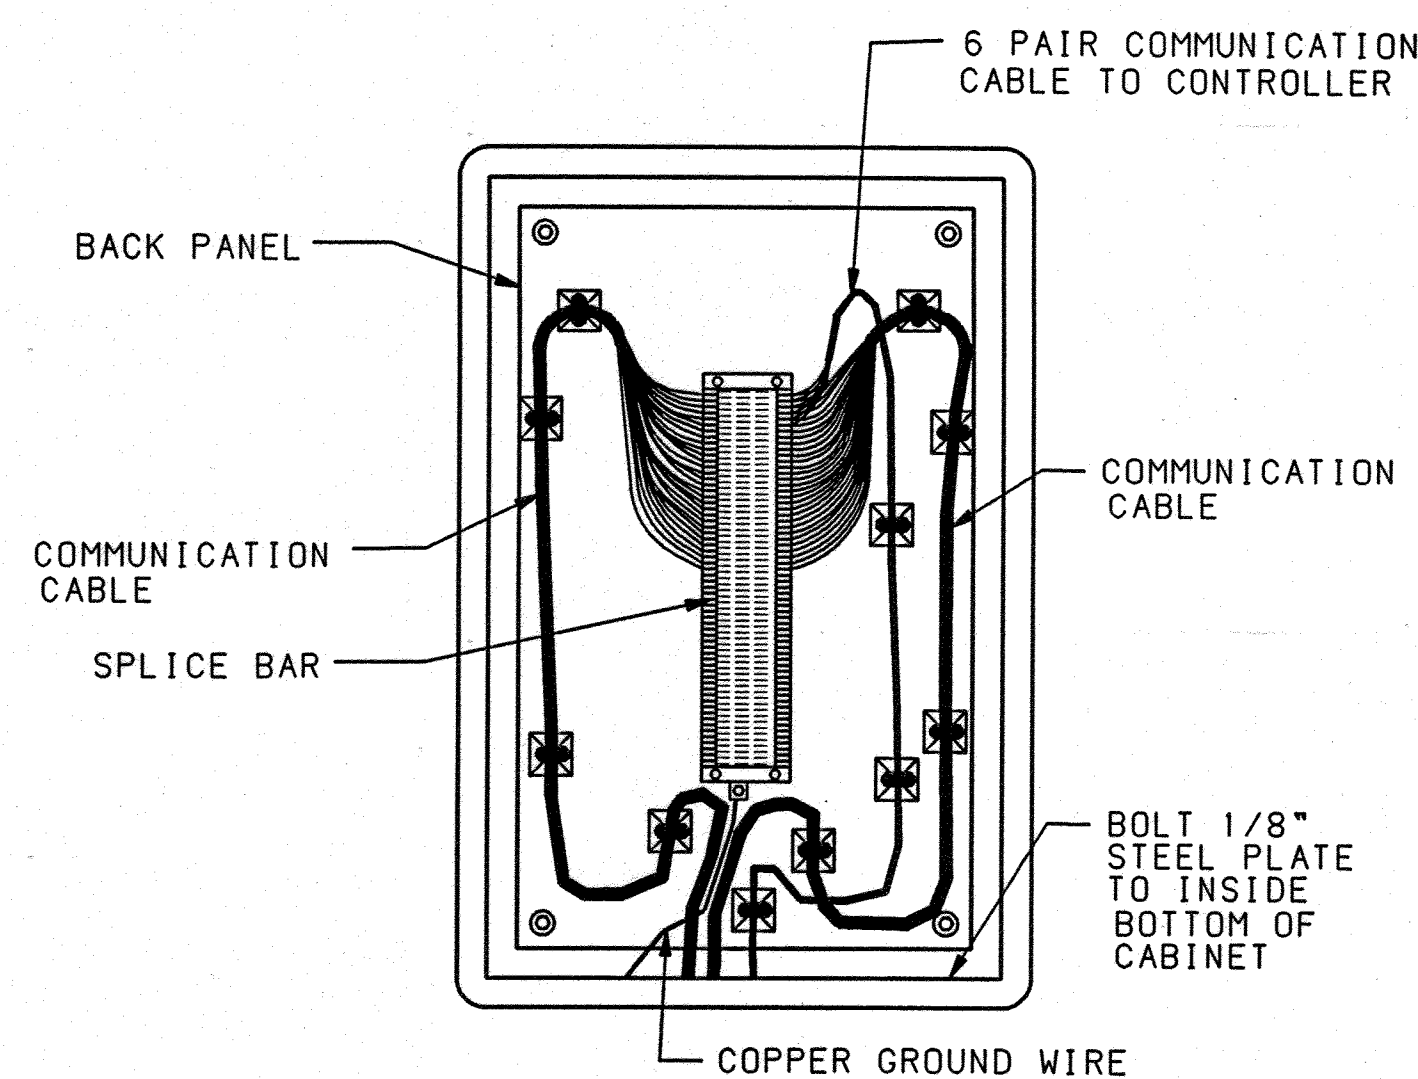


TRAFFIC SIGNAL
SPLICE CABINET WIRING DETAIL

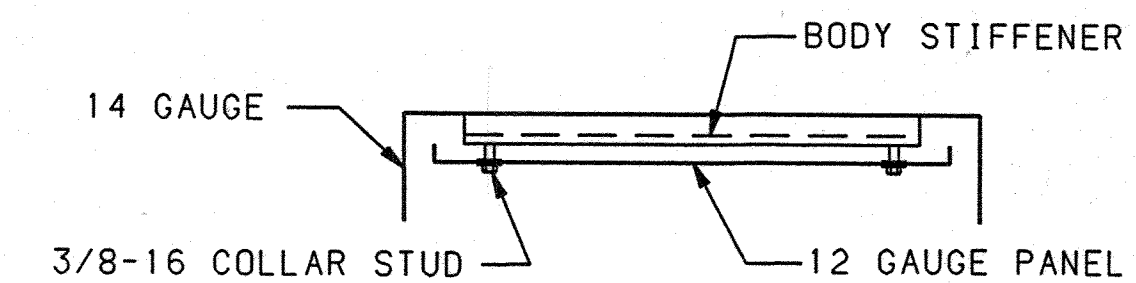


SPLICE CABINET PANEL DETAIL

D. MARK GOODWIN & ASSOCIATES, P.A. CONSULTING ENGINEERS & SURVEYORS P.O. BOX 90806 ALBUQUERQUE, NEW MEXICO 87199 (505) 345-2010		CITY OF ALBUQUERQUE PUBLIC WORKS DEPARTMENT ENGINEERING DEVELOPMENT GROUP	
TITLE: TRAFFIC SIGNAL TRAFFIC MANHOLE & SPLICE CABINET DETAILS			
DESIGNED BY	DATE	NO. / DAY / YR.	
DRAWN BY	DATE		
CHECKED BY	DATE		
CITY PROJECT NO. 5358.90		ZONE MAP NO. F16	SHEET 15 OF 19

SURVEY INFORMATION		BENCH MARKS		AS BUILT INFORMATION	
NO.	BY	DATE	FIELD NOTES	CONTRACTOR	DATE
				WORK STAKED BY	DATE
				ACCEPTANCE BY	DATE
				FIELD DRAWINGS	DATE
				CORRECTED BY	DATE
				RECORDED BY	DATE
				NO.	

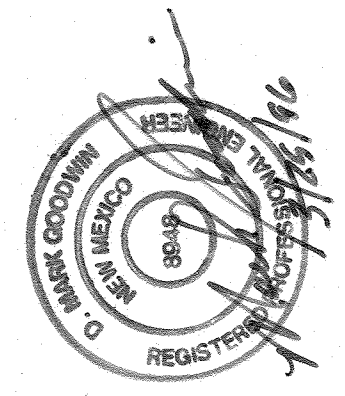

26-5358.90 11597

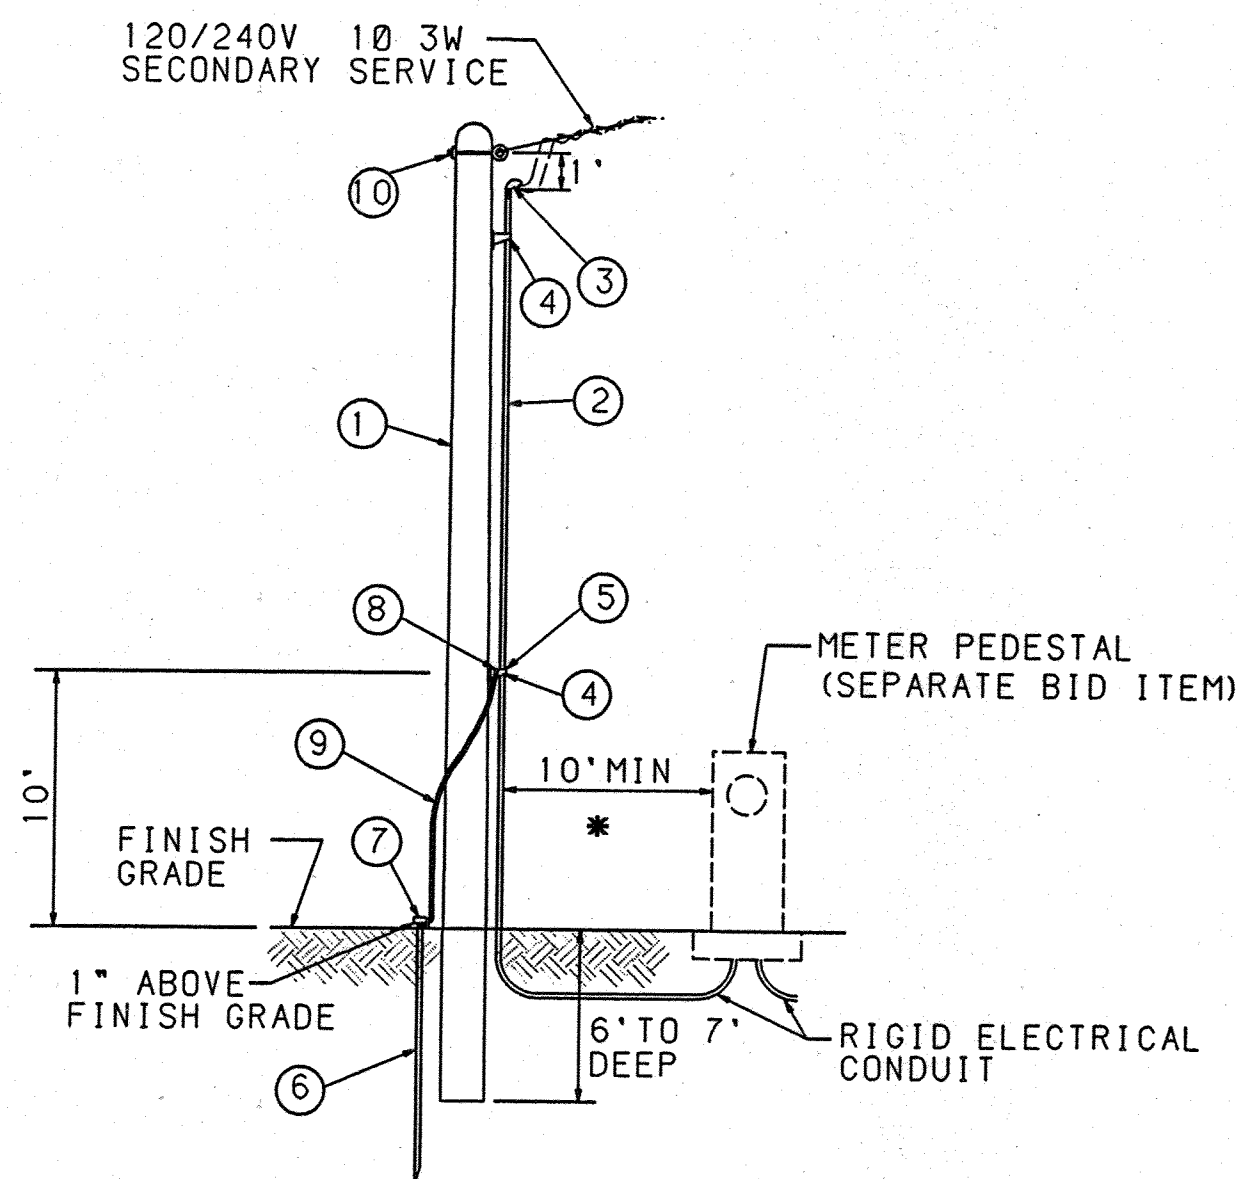

MATERIAL LIST


- ① 1 25' TREATED POLE
- ② 30' 2" GALVANIZED CONDUIT
- ③ 1 2" WEATHER HEAD
- ④ 2 UNIVERSAL SUPPORT BRACKET
- ⑤ 2 2" PIPE STRAP KIT
- ⑥ 1 COPPERWELD 3/4"x10'-0" GROUND ROD
- ⑦ 1 GROUND ROD CLAMP
- ⑧ 1 GROUND LUG
- ⑨ 10' #6 BARE COPPER GROUND WIRE
- ⑩ 1 5/8" EYE BOLT
- 40' 1/C #2 THW BLACK
- 40' 1/C #2 THW WHITE
- 40' 1/C #2 THW RED

SERVICE POLE (SIGNAL)

*CONDUIT AND WIRE EXTENDING MORE THAN 10' FROM POLE WILL BE MEASURED AND PAID PER ACTUAL FOOTAGE USED.

SIGNAL SERVICE NOTES

1. ALL SIGNAL SERVICE DETAILS, MATERIALS, & INSTALLATION SHALL CONFORM TO THE LOCAL POWER COMPANY REQUIREMENTS.
2. CONTACT LOCAL POWER COMPANY CUSTOMER SERVICES FOR POLE QUADRANT FOR RISERS.
3. ALL ABOVE GRADE CONDUIT SHALL BE GALVANIZED.
4. RISER BRACKET ASSEMBLY MUST BE GROUNDED PER LOCAL POWER COMPANY REQUIREMENTS.
5. CONDUIT AND WIRE EXTENDING MORE THAN 10' FROM POLE WILL BE MEASURED AND PAID PER ACTUAL FOOTAGE USED.
6. UNIVERSAL SUPPORT BRACKETS WILL BE CONSIDERED INCIDENTAL TO THE SERVICE RISER.
7. DRILLING HOLES IN EXISTING STEEL POLES FOR UNIVERSAL SUPPORT BRACKETS WILL NOT BE PERMITTED. BRACKETS SHALL BE MOUNTED ON STEEL POLES WITH STAINLESS STEEL BANDS.
8. PROVIDE ONE 50A, SINGLE POLE, 120V CIRCUIT FOR CONTROLLER SIGNALS.

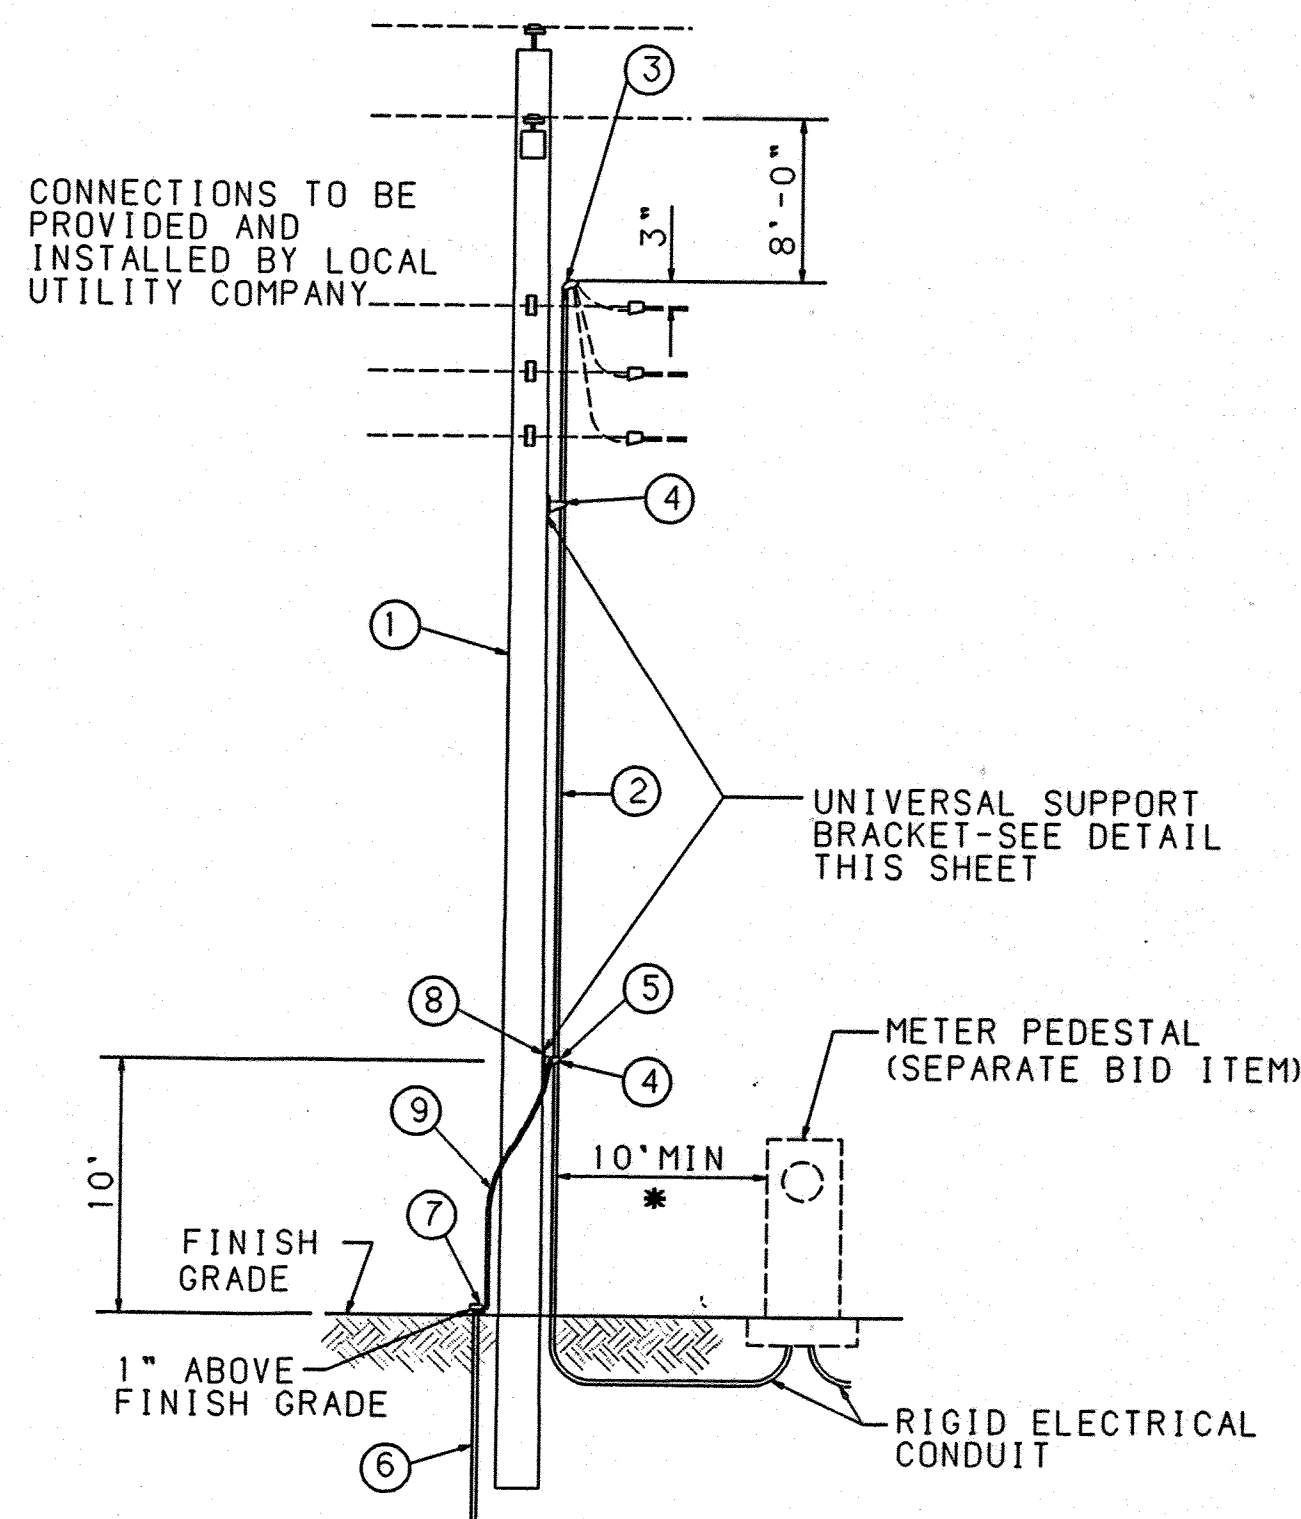


MATERIAL LIST

- ① 1 EXISTING POLE
- ② 40' 2" GALVANIZED CONDUIT
- ③ 1 2" WEATHER HEAD
- ④ 2 UNIVERSAL SUPPORT BRACKET
- ⑤ 2 2" PIPE STRAP KIT
- ⑥ 1 COPPERWELD 3/4"x10'-0" GROUND ROD
- ⑦ 1 GROUND ROD CLAMP
- ⑧ 1 GROUND LUG
- ⑨ 10' #6 BARE COPPER GROUND WIRE
- 50' 1/C #2 THW BLACK
- 50' 1/C #2 THW WHITE
- 50' 1/C #2 THW RED

SERVICE RISER (SIGNAL)

*CONDUIT AND WIRE EXTENDING MORE THAN 10' FROM POLE WILL BE MEASURED AND PAID PER ACTUAL FOOTAGE USED.

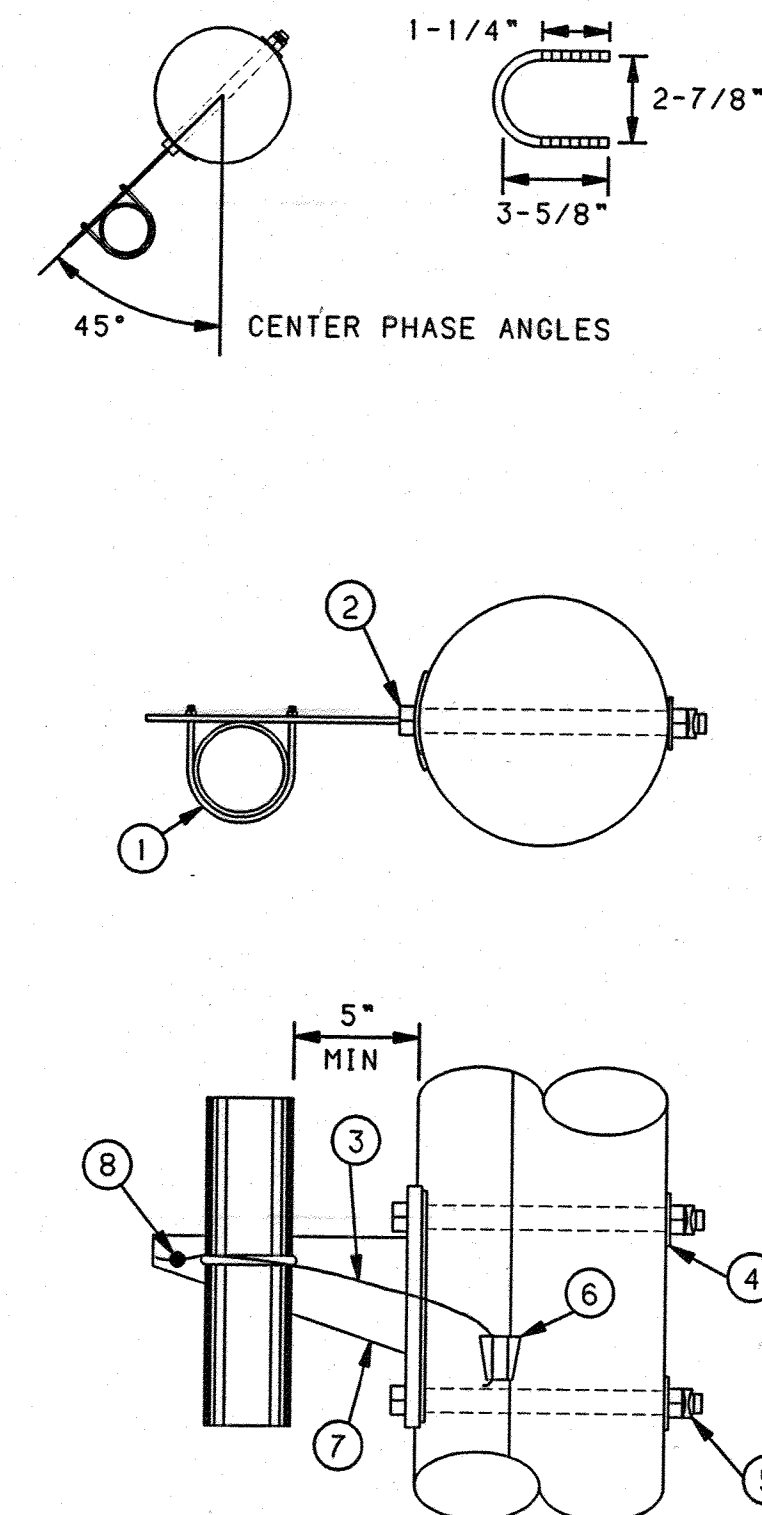

MATERIAL LIST

- ① 1 U BOLT
- ② 2 5/8" MACHINE BOLTS
- ③ 3' #4 SOL CU WIRE
- ④ 2 2-1/4" SQUARE WASHER
- ⑤ 2 5/8" MF LOCKNUT
- ⑥ 1 LINE TAP
- ⑦ 1 SUPPORT BRACKET
- ⑧ 1 GROUNDING LUG

UNIVERSAL SUPPORT BRACKET NOTES:

1. BRACKET TO BE FASTENED TO POLE WITH 5/8" GALVANIZED MACHINE BOLTS.
2. BRACKET SUITABLE FOR TWO 2" CONDUITS.
3. TWO HOLE STRAPS ATTACHED AT 30" INTERVALS WITH 2" LAG SCREWS MAY BE USED INSTEAD OF THE SUPPORT BRACKET WHEN THE CONDUIT IS 1" OR LESS. A MAXIMUM OF TWO CONDUITS MAY BE STRAPPED DIRECTLY TO THE POLE.

UNIVERSAL SUPPORT BRACKET

dmg D. MARK GOODWIN & ASSOCIATES, P.A.
CONSULTING ENGINEERS & SURVEYORS
P.O. BOX 90606
ALBUQUERQUE, NEW MEXICO 87199
(505) 345-2010


CITY OF ALBUQUERQUE
PUBLIC WORKS DEPARTMENT
ENGINEERING DEVELOPMENT GROUP

TITLE: TRAFFIC SIGNAL
ELECTRICAL SERVICE DETAILS
FOR SIGNALS

DESIGN-REVIEW COMMITTEE
LAST DESIGN UPDATE
NO./DAY/YR.


CITY PROJECT NO. 5358.90 ZONE MAP NO. F16 SHEET 16 OF 19

AS BUILT INFORMATION		BENCH MARKS		SURVEY INFORMATION		ENGINEER'S SEAL		REVISIONS		DESIGN	
CONTRACTOR	DATE	BRASS TABLET STAMPED	DATE	FIELD NOTES	DATE	REGISTERED	DATE	NO.	DATE	NO.	DATE
WORK BY	DATE	POST. LOCATED 0.50 MILES SOUTH OF MONTANA RD. ON WEST	DATE	NO.	DATE	REGISTERED	DATE	NO.	DATE	NO.	DATE
INSPECTED BY	DATE	FRONTAGE RD. TO THE RIGHT.	DATE	NO.	DATE	REGISTERED	DATE	NO.	DATE	NO.	DATE
ACCEPTANCE BY	DATE	X = 380403.88	DATE	NO.	DATE	REGISTERED	DATE	NO.	DATE	NO.	DATE
VERIFICATION BY	DATE	Y = 1502304.95	DATE	NO.	DATE	REGISTERED	DATE	NO.	DATE	NO.	DATE
DRAWINGS	DATE	Z = 50739.46	DATE	NO.	DATE	REGISTERED	DATE	NO.	DATE	NO.	DATE
CORRECTED BY	DATE		DATE	NO.	DATE	REGISTERED	DATE	NO.	DATE	NO.	DATE
MICRO-FILM INFORMATION	DATE		DATE	NO.	DATE	REGISTERED	DATE	NO.	DATE	NO.	DATE
RECORDED BY	DATE		DATE	NO.	DATE	REGISTERED	DATE	NO.	DATE	NO.	DATE
NO.	DATE		DATE	NO.	DATE	REGISTERED	DATE	NO.	DATE	NO.	DATE

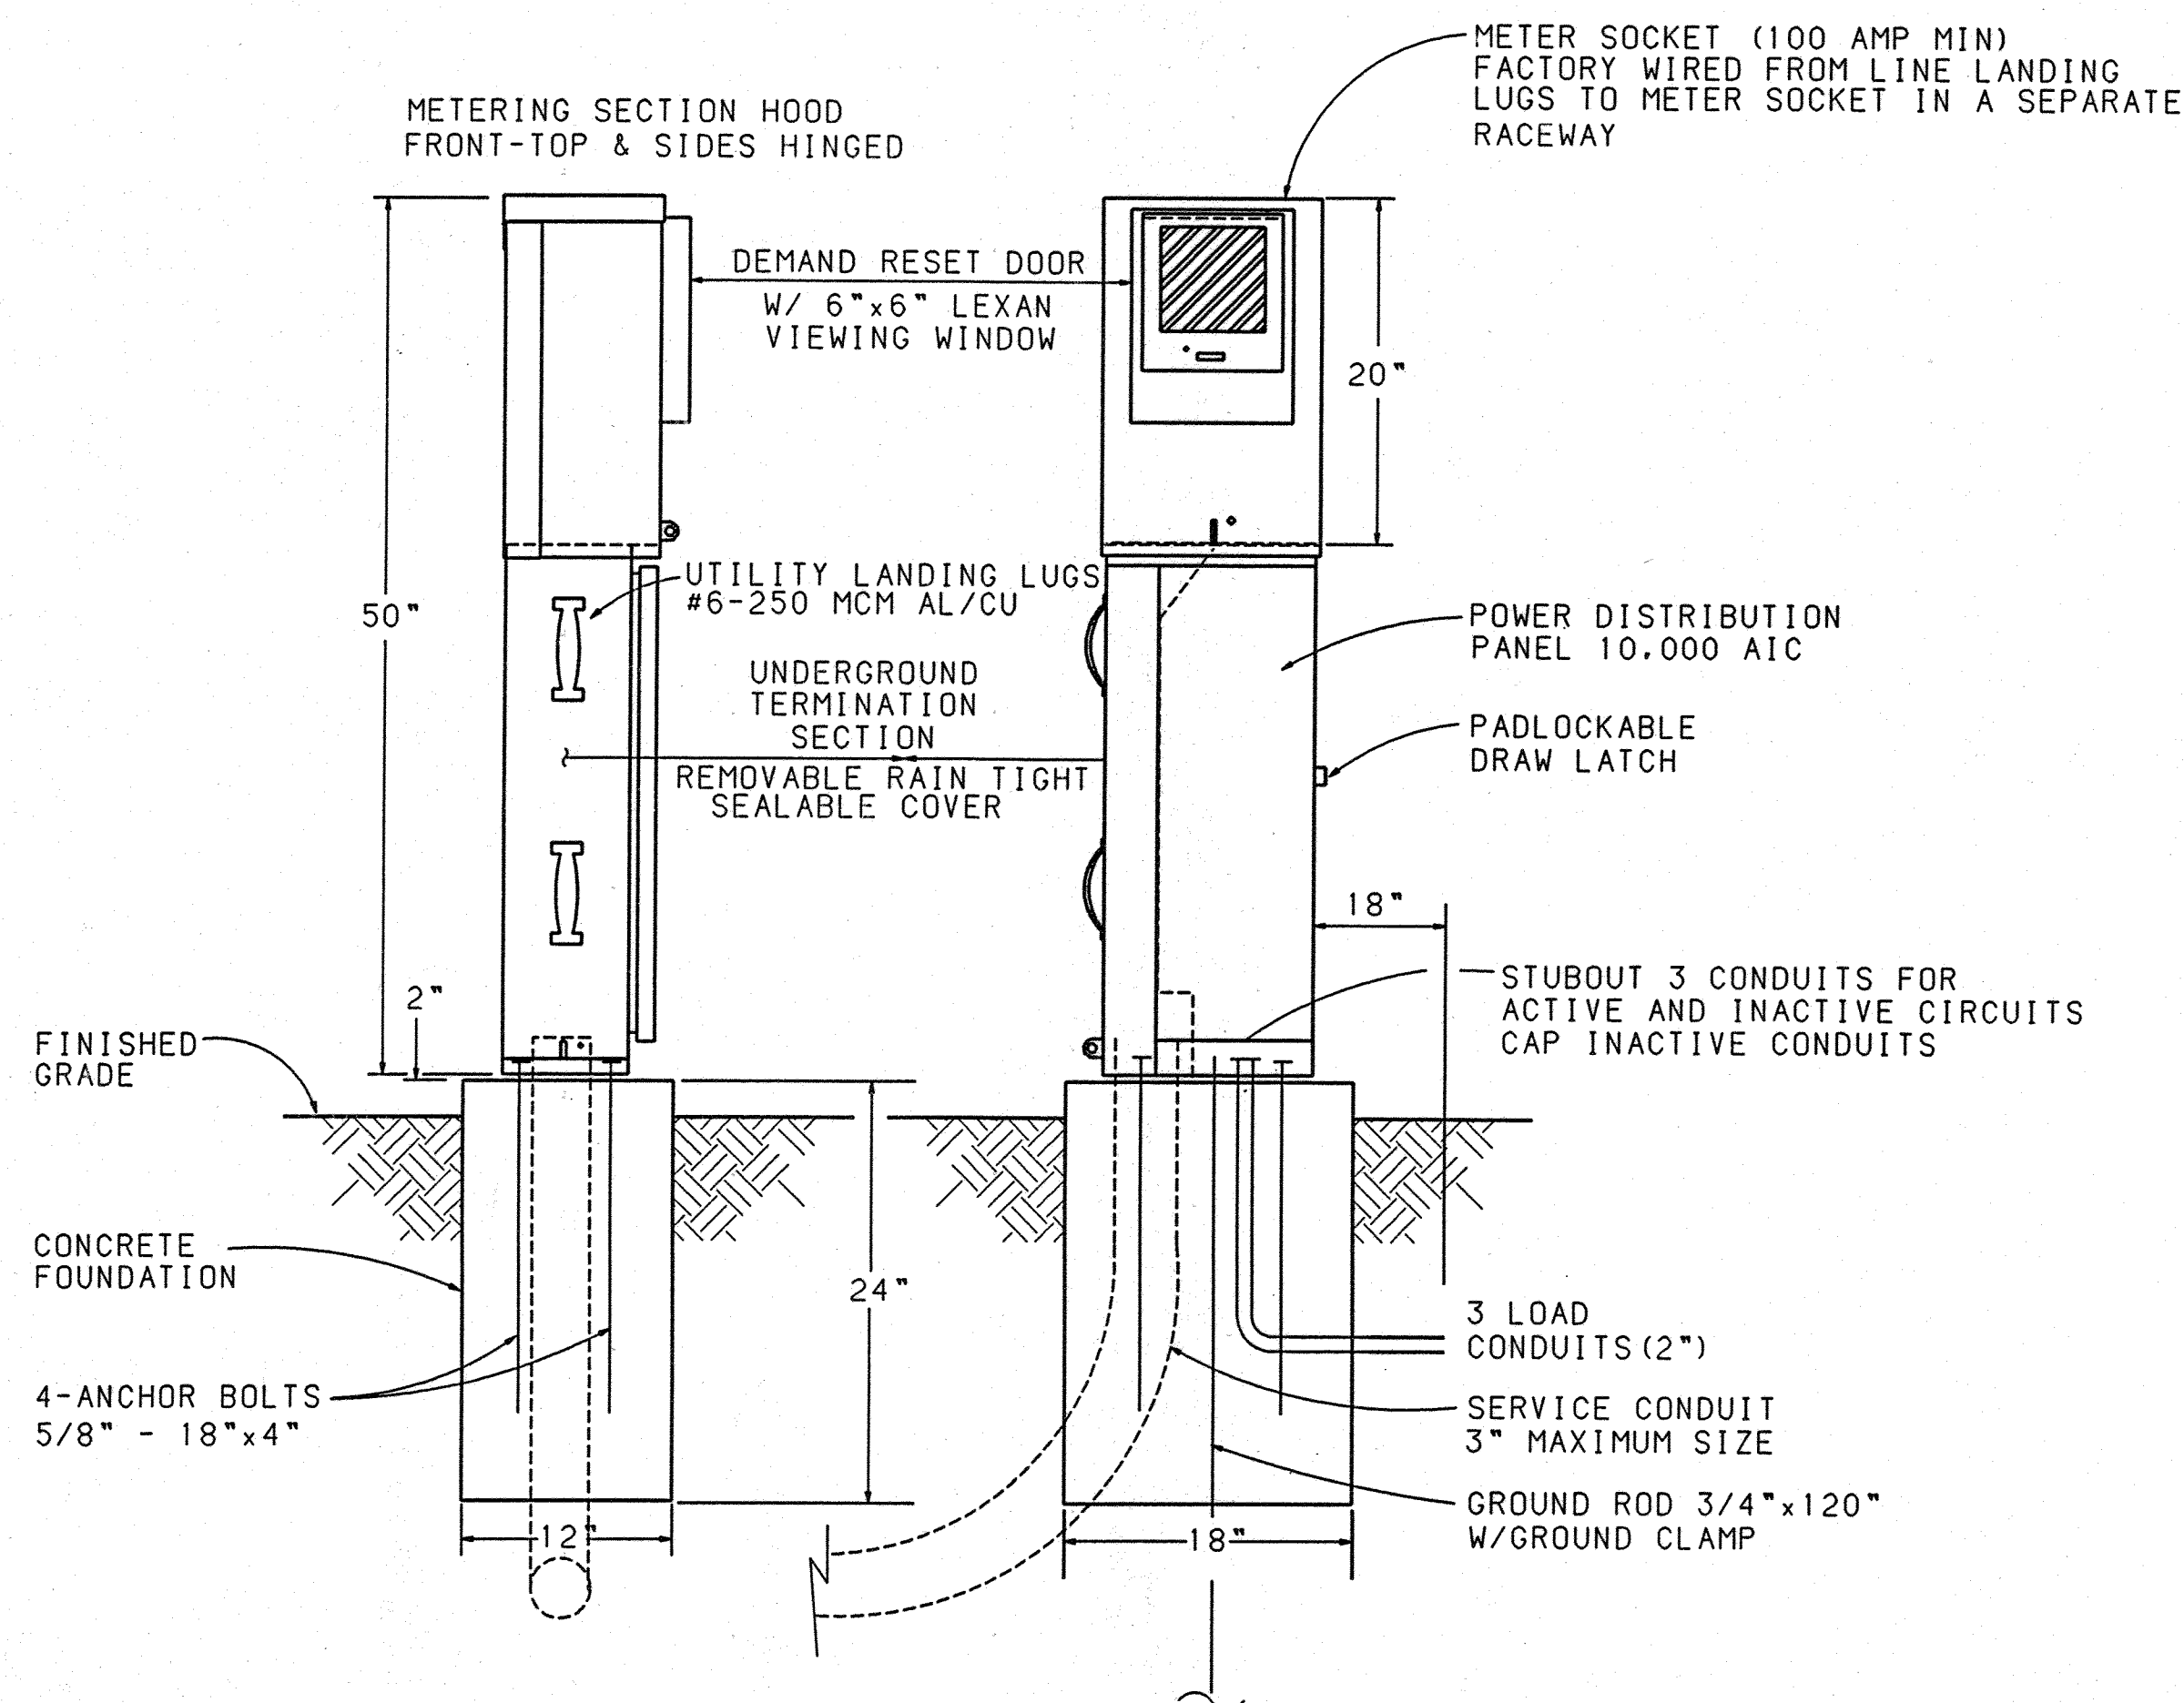


LEFT SIDE

FRONT VIEW

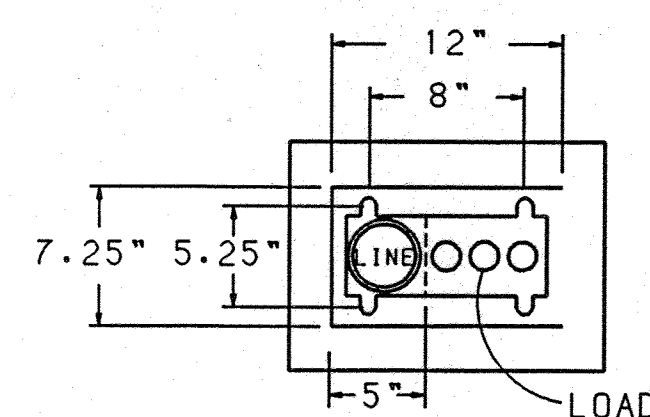

BASE PLAN

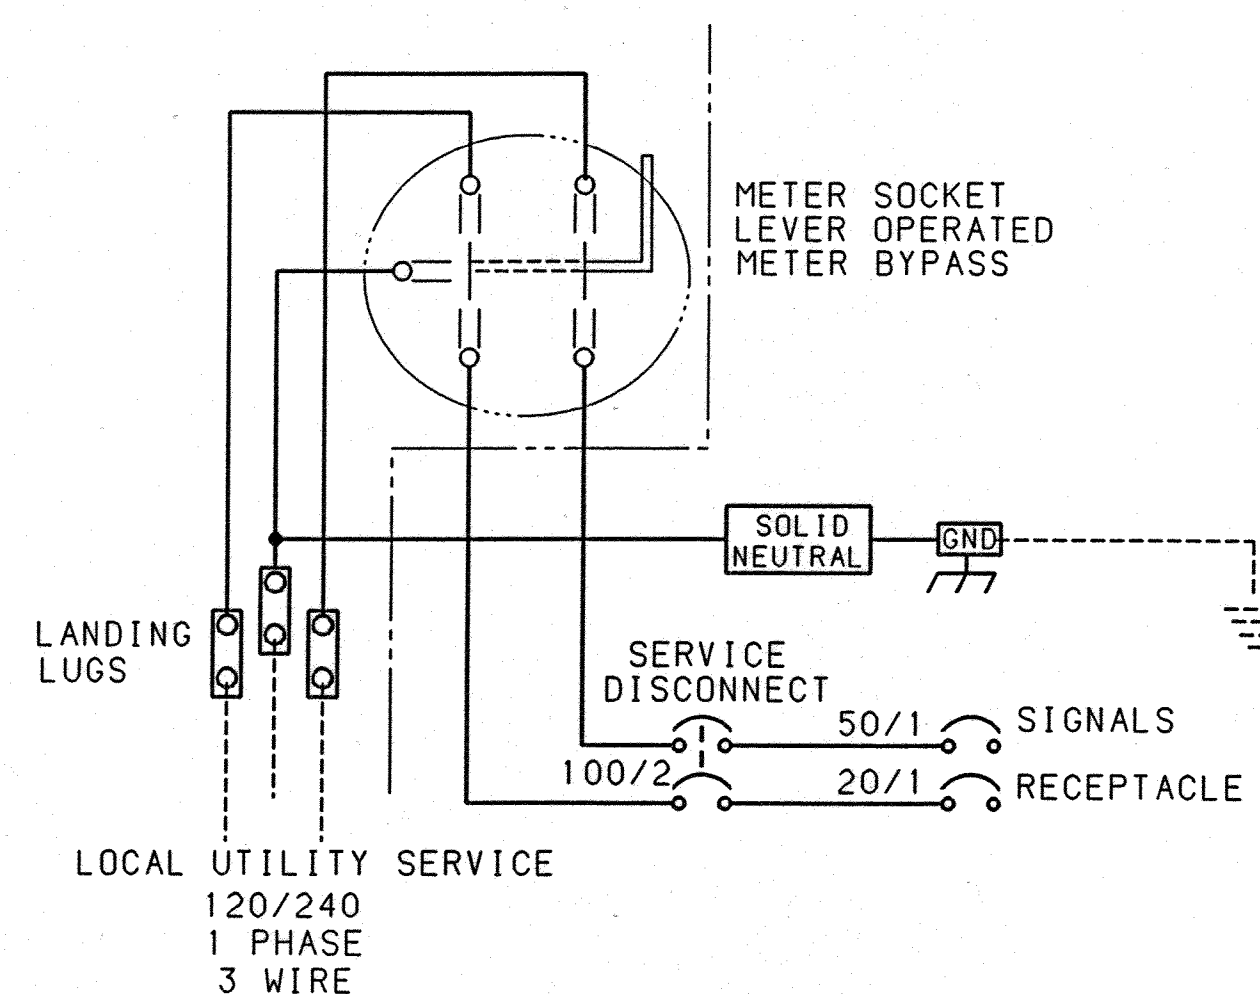

SERVICE EQUIPMENT
WIRING DIAGRAM "A"

CONSTRUCTION MATERIALS AND FINISH

☐	12 GA HD GALV STEEL
☐	POWDER COATED
☐	14 GA #304 S/S SHEET
☐	POWDER COATED COLOR:
☐	NATURAL
☐	0.125" ALUMINUM SHEET
☐	POWDER COATED COLOR:
☐	NATURAL
☐	ANODIZED

POWDER COAT COLORS

☐ WHITE	☐ RANCH GREEN
☐ MINT GREEN	☐ OTHER
☐ CAMEL	

ENCLOSURE CONSTRUCTION NOTES

- SERVICE PEDESTAL SHALL BE UL LISTED "INDUSTRIAL CONTROL PANEL" PER UL 508.
- SERVICE PEDESTAL SHALL MEET THE ELECTRIC UTILITY SERVICE EQUIPMENT REQUIREMENTS COMMITTEE ((EUSERC) GUIDELINES.
- CONSTRUCTION SHALL BE NEMA 3R AND 12. RAIN TIGHT AND DUST TIGHT. ELECTRICALLY WELDED AND REINFORCED WHERE REQUIRED.
- ALL NUTS, BOLTS, SCREWS AND HINGES SHALL BE STAINLESS STEEL.
- NUTS, BOLTS & SCREWS SHALL NOT BE VISIBLE FROM OUTSIDE OF ENCLOSURE.
- PHENOLIC NAME PLATES SHALL BE PROVIDED AS REQUIRED.
- CIRCUIT BREAKERS SHALL BE CABLE IN-CABLE OUT WITH LINE ON TOP & LOAD ON THE BOTTOM. HANDLE POSITION UP="ON", MIDDLE="TRIPPED", DOWN="OFF".
- A PLASTIC COVERED WIRING DIAGRAM SHALL BE ATTACHED TO THE INSIDE OF THE FRONT DOOR.
- ENCLOSURE SHALL BE FACTORY WIRED AND CONFORM TO REQUIRED NEMA STANDARDS.
- ALL POWDER COATED CABINETS SHALL HAVE A CORROSION RESISTANT COATING WHICH INCLUDES A FIVE STEP DIP TANK METAL PREPARATION PROCESS:
 - ALKALINE CLEANER 160°F.
 - CLEAR WATER RINSE.
 - IRON PHOSPHATE APPLICATION 150°F.
 - CLEAR WATER RINSE.
 - INHIBITIVE RINSE TO SEAL PHOSPHATED SURFACES 120°F.
 FINISHED WITH AN ELECTROSTATICALLY APPLIED DRY POLYESTER POWDER COATING THEN BAKED @ 380°F TO CURE.
- CONCRETE FOUNDATIONS INCLUDING EXCAVATION AND BACKFILL, CONCRETE, AND ANCHOR BOLTS, COMPLETE IN PLACE, WILL BE CONSIDERED INCIDENTAL TO THE METER PEDESTAL.

dmg

D. MARK GOODWIN & ASSOCIATES, P.A.
CONSULTING ENGINEERS & SURVEYORS
P.O. BOX 90606
ALBUQUERQUE, NEW MEXICO 87199
(505) 345-2010

CITY OF ALBUQUERQUE
PUBLIC WORKS DEPARTMENT
ENGINEERING DEVELOPMENT GROUP

TITLE: METER PEDESTAL DETAILS
FOR SIGNALS

DESIGN REVIEW COMMITTEE
JAN 25 1996
DESIGN REVIEW COMMITTEE

MO./DAY/YR.
LAST DESIGN UPDATE

CITY PROJECT NO. 5358.90 ZONE MAP NO. F16 SHEET 17 OF 19

MERCH\TDTL9

AS BUILT INFORMATION	
CONTRACTOR <i>FRANKLIN'S</i>	DATE <i>9/6</i>
INSPECTOR'S NAME <i>ALS</i>	DATE <i>9/6</i>
FIELD REPRESENTATIVE BY <i>ALS</i>	DATE <i>9/6</i>
VERIFICATION BY <i>ALS</i>	DATE <i>12/16</i>
CORRECTED BY <i>ALS</i>	DATE <i>12/16</i>
MICRO-FILM INFORMATION	
RECORDED BY	DATE
NO.	

BENCH MARKS	
BRASS TABLET STAMPED "STA. 1-25-20" IN TOP OF CONCRETE POST LOCATED 0.50 MILES SOUTH OF MONTANO RD. ON WEST FRONTAGE RD. TO THE RIGHT.	
X = 39403.88	Y = 150204.95
Z = 5079.46	

ENGINEER'S SEAL	
NO.	DATE
BY	DATE
REMARKS	DATE
DESIGN	DATE
DRAWN BY <i>BHJ/COA</i>	DATE <i>02/96</i>
CHECKED BY <i>BHJ/COA</i>	DATE <i>02/96</i>

FUNCTION CHART -- 115 VOLT CIRCUIT				
CONDUCTOR			RING 1 -- MULTI CONDUCTOR CABLE 20	
CONDUCTOR NUMBER	BASE COLOR	TRACER	FUNCTION	FIELD CONNECTION
1	BLACK	—	SPARE	
2	WHITE	—	SPARE	
3	RED	—	PHASE 1 RED	
4	GREEN	—	PHASE 1 GREEN	S1,S10,LEFT TURN
5	ORANGE	—	PHASE 1 YELLOW	S1,S10,LEFT TURN
6	BLUE	—	PHASE 2 WALK	
7	WHITE	BLACK	PHASE 2 DONT WLK.	
8	RED	BLACK	PHASE 2 RED	
9	GREEN	BLACK	PHASE 2 GREEN	S1,S2,S4,S8,S9,S10
10	ORANGE	BLACK	PHASE 2 YELLOW	S1,S2,S4,S8,S9,S10
11	BLUE	BLACK	SPARE	
12	BLACK	WHITE	SPARE	
13	RED	WHITE	OVER LAY 1 RED	
14	GREEN	WHITE	OVER LAY 1 GREEN	S1,S8,S9,S10
15	BLUE	WHITE	OVER LAY 1 YELLOW	S1,S8,S9,S10
16	BLACK	RED	PHASE 4 WALK	
17	WHITE	RED	PHASE 4 DONT WALK	
18	ORANGE	RED	PHASE 4 RED	
19	BLUE	RED	PHASE 4 GREEN	S3,S6,S7
20	RED	GREEN	PHASE 4 YELLOW	S3,S6,S7

FUNCTION CHART -- 24 VOLT CIRCUIT			
MULTI CONDUCTOR CABLE 5			
CONDUIT NUMBER	BASE COLOR	FUNCTION	FIELD CONNECTION
1	BLACK	PHASE 2 PPB	PPB1, PPB2
2	WHITE	COMMON	
3	RED	PHASE 4 PPB	PPB3, PPB4
4	GREEN		
5	ORANGE		

SIGNAL NOTES

- ALL WORK ON THESE PLANS TO BE PERFORMED UNDER THIS CONTRACT SHALL CONFORM TO THE CURRENT NATIONAL ELECTRIC CODE, AND THE STANDARDS OF THE NATIONAL BOARD OF FIRE UNDERWRITERS FOR ELECTRICAL WIRING AND APPARATUS.
- ALL WORK ON THESE PLANS TO BE PERFORMED UNDER THIS CONTRACT SHALL CONFORM TO THE "THIRD DRAFT SPECIFICATIONS AND CONTRACT ITEM LISTING" TRAFFIC ENGINEERING OPERATIONS, CITY OF ALBUQUERQUE, JUNE 1994. COPIES OF THESE SPECIFICATIONS AREA AVAILABLE FROM THE ENGINEER AT THE COST OF REPRODUCTION.
- LOCATIONS OF CONDUITS, FOUNDATIONS, CONTROL CABINETS, POLES, PULL BOXES, MANHOLES AND SPLICE CABINETS SHOWN ON THE PLANS ARE SCHEMATIC AND SHALL BE ADJUSTED IN THE FIELD TO MAXIMIZE CLEAR SPACE AVAILABLE FOR PEDESTRIANS AND WHEELCHAIRS TO COMPLY WITH THE AMERICANS WITH DISABILITIES ACT. THE CONTRACTOR SHALL MEET WITH THE CITY TRAFFIC ENGINEERING OPERATIONS PERSONNEL IN THE FIELD AT ALL LOCATIONS TO SPOT EQUIPMENT BEFORE BEGINNING THE WORK. ALL SUCH EQUIPMENT SHALL BE INSTALLED WITHIN THE RIGHT-OF-WAY.
- THE CONTRACTOR IS WARNED THAT EXISTING CONDUITS MAY CONTAIN AC POWER AND CAUTION SHALL BE EXERCISED IN INTERCEPTING OR INSTALLING CABLE IN EXISTING CONDUIT.
- THE CONTRACTOR SHALL BORE, DRILL OR PUSH WHEN CROSSING EXISTING PAVEMENTS AND ANY DRIVEWAYS FOR STREET CROSSINGS. BEFORE CONDUIT CAN BE BORED, DRILLED OR PUSHED THE CONTRACTOR SHALL LOCATE ALL EXISTING UTILITIES. THE CONTRACTOR SHALL LOCATE AND EXPOSE GAS LINES WHICH CROSS ANY PROPOSED BORES. THESE EXCAVATIONS SHALL REMAIN OPEN UNTIL AFTER THE BORE IS COMPLETE. CONTRACTOR SHALL REMOVE AND REPLACE IN KIND ANY SIDEWALK OR PAVEMENT REQUIRED TO EXPOSE SUCH LINES. THE CONTRACTOR MAY CUT, TRENCH AND REPLACE EXISTING PAVEMENT ONLY WHEN APPROVED BY THE PROJECT MANAGER.
- SPLICING FOR TRAFFIC SIGNALS MCC WILL BE PERMITTED IN LARGE PULL BOXES INCLUDING LARGE MEDIAN PULL BOXES.
- ALL LOOP LEAD-IN CABLES SHALL BE TAGGED AT CABINET TO IDENTIFY EACH CABLE BY PHASE AND LOOP NUMBER.
- ALL PULL BOXES SHALL BE REINFORCED POLYMER MORTAR HEAVY DUTY TYPE WITH REINFORCED POLYMER MORTAR HEAVY DUTY COVERS. CONCRETE COVERS, STEEL COVERS AND CONCRETE PULL BOXES WILL NOT BE ACCEPTABLE.
- THE CONTRACTOR SHALL REMOVE ALL CONFLICTING SIGNING AND DELIVER TO THE CITY YARDS WHEN TRAFFIC SIGNALS ARE PUT INTO OPERATION.
- LIVE UNUSED CONDUCTORS WILL NOT BE ALLOWED AT MASTARM POLES AND PEDESTAL POLES. ALL SUCH UNUSED CONDUCTORS SHALL BE DISCONNECTED AT THE LARGE PULL BOX ADJACENT TO THE POLE.
- IF TRENCH WIDTHS LESS THAN 12" ARE PROPOSED BY THE CONTRACTOR, APPROVED COMPACTION METHODS SHALL BE USED DURING BACKFILL TO PREVENT LATENT TRENCH FAILURES. THE CONTRACTOR SHALL USE GROUT OR LEAN FILL AS APPROVED BY THE PROJECT MANAGER IN LIEU OF EARTH BACKFILL.
- THE CITY OF ALBUQUERQUE TRAFFIC ENGINEERING OPERATIONS PERSONNEL WILL PROVIDE TRAFFIC SIGNAL TIMING PLANS AND WILL PROGRAM TRAFFIC SIGNAL CONTROLLER.
- ALL DATA SHOWN HEREIN CONCERNING EXISTING UTILITIES HAS BEEN OBTAINED FROM A TOPOGRAPHIC SURVEY WHICH MAY OR MAY NOT BE ACCURATE. THE CONTRACTOR WILL BE RESPONSIBLE FOR EXPLORATORY TRENCHING, IF NECESSARY TO MORE SPECIFICALLY LOCATE UTILITY LINES. COST OF LOCATING UTILITY LINES INCLUDING EXPLORATORY TRENCHING WILL BE CONSIDERED INCIDENTAL TO CONSTRUCTION.

DETECTOR LOOPS											
LOOP I.D.	VEHICLE DETECTOR				LOOP TYPE	VEHICLE DIMENSIONS				LOOP WIRE	PAVEMENT SAWCUT
	MODE	CALL	UNIT NO.	CHANNEL		L	W	S	T		
DL1(1)	PRESS		2	1	QP	40'	6'	15'	5'	389	147
DL2(OL1)	PRESS	EXT2	4	1	EC	6'	6'	22'	3'	127	46
DL3(OL1)	PRESS	EXT2	4	1	EC	6'	6'	7'	3'	97	31
DL4(OL1)	PRESS	EXT2	4	1	EC	6'	6'	22'	3'	127	46
DL5(OL1)	PRESS	EXT2	4	1	EC	6'	6'	7'	3'	97	31
DL6(2)	PRESS	EXT2	4	2	EC	6'	6'	22'	20'	161	46
DL7(2)	PRESS	EXT2	4	2	EC	6'	6'	7'	20'	131	31
DL8(2)	PRESS	EXT2	4	2	EC	6'	6'	22'	22'	165	46
DL9(2)	PRESS	EXT2	4	2	EC	6'	6'	7'	22'	135	31
DL10(4)	PRESS		3	1	QP	40'	6'	16'	3'	387	148
DL11(4)	PRESS		3	2	QP	40'	6'	4'	3'	363	136
SD1(OL1)	PULSE		7	1	SD-4TURN	6'	6'	18'	3'	138	42
SD2(OL1)	PULSE		7	2	SD-4TURN	6'	6'	5'	3'	112	29
SD3(2)	PULSE		6	1	SD-4TURN	6'	6'	17'	20'	170	41
SD4(2)	PULSE		6	2	SD-4TURN	6'	6'	5'	20'	146	29
TOTALS										2,745	880

DETECTOR RACK ASSIGNMENTS												
UNIT NO.	→	POWER SUPPLY	1	2	3	4	5	6	7	8	9	10
CHANNEL 1	→		1	2	4	2EC	4EC	SD1	SD3	SD5	ISOLATION	OPT1
CHANNEL 2	→		3	2	4	2EC	4EC	SD2	SD4	SD6		OPT2
DETECTOR MODULE	REQ.	✓*		✓	✓	✓		✓	✓		✓*	

* INCIDENTAL TO CONSTRUCTION.

QUANTITY ESTIMATING ASSUMPTIONS

LOOP WIRE
6' X 30' QP LOOP = (8*L) + (4*W) + (2*S) + (2*T) + 5 = 269 + 2(S+T)
6' X 40' QP LOOP = (8*L) + (4*W) + (2*S) + (2*T) + 5 = 349 + 2(S+T)
6' X 50' QP LOOP = (8*L) + (4*W) + (2*S) + (2*T) + 5 = 429 + 2(S+T)
6' X 6' EC LOOP = (6*L) + (6*W) + (2*S) + (2*T) + 5 = 77 + 2(S+T)
6' X 6' SYS LOOP = (8*L) + (8*W) + (2*S) + (2*T) + 5 = 96 + 2(S+T)

PAVEMENT SAWCUT
6' X 30' QP LOOP = (3*L) + (2*W) + S = 102 + S
6' X 40' QP LOOP = (3*L) + (2*W) + S = 132 + S
6' X 50' QP LOOP = (3*L) + (2*W) + S = 162 + S
6' X 6' EC LOOP = (2*L) + (2*W) + S = 24 + S
6' X 6' SYS LOOP = (2*L) + (2*W) + S = 24 + S

WHERE:
L = DETECTOR LOOP LENGTH (FROM PLAN).
W = DETECTOR LOOP WIDTH (FROM PLAN).
S = SAWCUT LENGTH FROM DETECTOR LOOP TO FACE OF CURB (FROM PLAN).
T = LOOP WIRE TERMINAL LENGTH FROM FACE OF CURB TO PULL BOX (FROM PLAN).

NOTES:

- IDENTIFY CONDUCTORS LISTED AS "115 VOLTS"
- WRAP RING 2 CABLE AT EACH SPLICE POINT WITH COLORED ELECTRICAL TAPE. THE IDENTIFICATION MARKING SHALL BE PROVIDED ON EACH RING 2 CABLE AT EACH SPLICE BOX AND LOCATED 6" BACK FROM THE END.
- IDENTIFY CONDUCTORS LISTED AS "PPB - LOW VOLTAGE" AT EACH SPLICE POINT. FIVE (5) CONDUCTOR CABLE SHALL BE 24 VOLTS AND USED FOR PUSH BUTTONS ONLY.
- CONDUCTOR CABLE RUNS TO TRAFFIC SIGNALS, PEDESTRIAN SIGNALS, AND PEDESTRIAN PUSH BUTTONS SHALL BE SPLICED INTO THE MAIN CONDUCTORS AT THE NEAREST LARGE PULL BOX AND RUN WITHOUT ADDITIONAL SPLICES INTO EACH SIGNAL HEAD OR PUSH BUTTON ASSEMBLY.

ABBREVIATIONS

DL DETECTOR LOOP
EC EXTENDED CALL LOOP
L DETECTOR LOOP LENGTH
W DETECTOR LOOP WIDTH
S SAWCUT LOOP TO CURB
T TERMINAL LENGTH
QP QUADRAPOLE LOOP

LEGEND

- NEW 3" PVC CONDUIT.
- NEW 6'X40' RECTANGULAR DETECTOR.
- NEW 6'X40' QUADRAPOLE LOOP DETECTOR.
- TRAFFIC ELECTRICAL PULL BOX NO. 1
- NEW ELECTRIC METER.
- NEW CONTROLLER CABINET &
- NEW TRAFFIC SIGNAL
- NEW TRAFFIC SIGNAL MANHOLE.
- TRAFFIC SIGNAL NO. 1.
- NEW 25' TRAFFIC SIGNAL MASTARM.
TYPE II FOUNDATION.
(SUSPENDED SIGNAL TO HAVE BACKPLATE)
- NEW TRAFFIC SIGNAL WITH MOUNTED PEDESTRIAN SIGNAL.

dmg D. MARK GOODWIN & ASSOCIATES, P.A.
CONSULTING ENGINEERS & SURVEYORS
P.O. BOX 90606
ALBUQUERQUE, NEW MEXICO 87199
(505) 345-2010

CITY OF ALBUQUERQUE
PUBLIC WORKS DEPARTMENT
ENGINEERING DEVELOPMENT GROUP

TITLE: TRAFFIC SIGNAL FUNCTIONS & DETECTORS
MONTANO RD. AND CULTURE DR. INTERSECTION

APPROVED
JUN 25 1996
DESIGN REVIEW COMMITTEE

CITY PROJECT NO.

5358.90

ZONE MAP NO.

F16

SHEET OF

18 19

