


CONSTRUCTION PLANS

FOR

CLARA VISTA SUBDIVISION

ALBUQUERQUE, NEW MEXICO

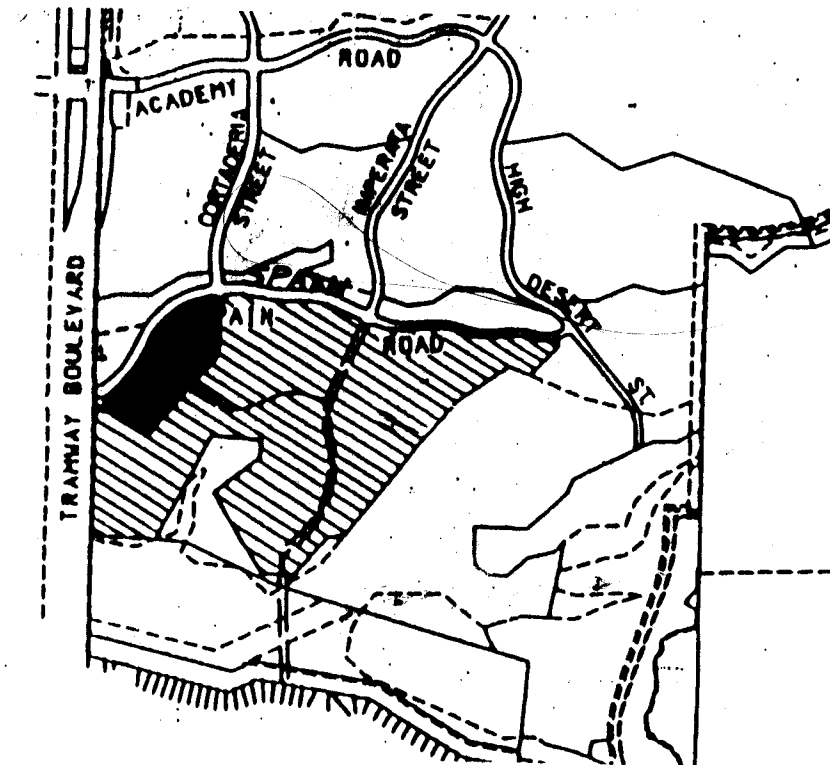

VICINITY MAP

ZONE ATLAS E-23-Z

SCALE: NONE

GENERAL NOTES

NOTICE TO CONTRACTORS

1. CITY OF ALBUQUERQUE SPECIFICATIONS FOR PUBLIC WORKS CONSTRUCTION, 1986 EDITION AS AMENDED THROUGH UPDATE 6, WILL BE REFERRED TO HEREIN AS THE "STANDARD SPECIFICATIONS".
2. TWO WORKING DAYS PRIOR TO ANY EXCAVATION, CONTRACTOR MUST CONTACT NEW MEXICO ONLY CALL SYSTEM (260-1990) AND DETERMINE LOCATION OF EXISTING UTILITIES.
3. PRIOR TO ANY CONSTRUCTION, THE CONTRACTOR SHALL EXCAVATE AND VERIFY THE HORIZONTAL AND VERTICAL LOCATIONS OF ALL OBSTRUCTIONS. SHOULD A CONFLICT EXIST, THE CONTRACTOR SHALL NOTIFY THE ENGINEER OR THE SURVEYOR SO THAT THE CONFLICT CAN BE RESOLVED WITHOUT DELAY.
4. ALL EXISTING SIGNS, MARKERS, DELINEATORS, ETC., WITHIN THE CONSTRUCTION LIMITS SHALL BE REMOVED, STORED AND RE-SET BY THE CONTRACTOR.
5. THE CONTRACTOR SHALL NOTIFY THE ENGINEER NOT LESS THAN SEVEN (7) PRIOR TO STARTING WORK IN ORDER THAT THE ENGINEER MAY TAKE NECESSARY MEASURES TO INSURE THE PRESERVATION OF SURVEY MONUMENTS. CONTRACTOR SHALL NOT DISTURB PERMANENT SURVEY MONUMENTS WITHOUT THE CONSENT OF THE ENGINEER AND SHALL NOTIFY THE ENGINEER AND BEAR THE EXPENSE OF REPLACING ANY THAT MAY BE DISTURBED WITHOUT PERMISSION. REPLACEMENT SHALL BE DONE ONLY BY THE CITY SURVEYOR, WHEN A CHANGE IS MADE IN THE FINISHED ELEVATIONS OF THE PAVEMENT OF ANY ROADWAY IN WHICH A PERMANENT SURVEY MONUMENT IS LOCATED, CONTRACTOR SHALL, AT HIS OWN EXPENSE, ADJUST THE MONUMENT COVER TO THE NEW GRADE UNLESS OTHERWISE SPECIFIED. REFER TO SECTION 4.4 OF THE GENERAL CONDITIONS OF THE STANDARD SPECIFICATIONS.
6. THREE (3) WORKING DAYS PRIOR TO BEGINNING CONSTRUCTION THE CONTRACTOR SHALL SUBMIT TO THE CONSTRUCTION CO-ORDINATION DIVISION A DETAILED CONSTRUCTION SCHEDULE. TWO (2) WORKING DAYS PRIOR TO CONSTRUCTION THE CONTRACTOR SHALL OBTAIN A BARRICADING PERMIT FROM THE CONSTRUCTION CO-ORDINATION DIVISION. CONTRACTOR SHALL NOTIFY BARRICADE ENGINEER (788-2551) PRIOR TO OCCUPYING AN INTERSECTION.
7. ANY WORK OCCURRING WITHIN AN ARTERIAL ROADWAY REQUIRES 24 HOURS CONSTRUCTION.

THE FOLLOWING NOTES ALSO APPLY WHEN CHECKED

- ☒ ALL UTILITIES AND UTILITY SERVICE LINES SHALL BE INSTALLED PRIOR TO PAVING.
- ☒ BACKFILL COMPACTION SHALL BE ACCORDING TO SPECIFIED STREET USE.
- ☐ TACK COAT REQUIREMENTS SHALL BE DETERMINED BY THE CITY ENGINEER.
- ☒ SIDEWALKS AND WHEELCHAIR RAMPS WITHIN THE CURB RETURN SHALL BE CONSTRUCTED WHEREVER A NEW CURB RETURN IS CONSTRUCTED.
- ☐ IF CURB IS DEPRESSIONED FOR A DRIVEPAD, THE DRIVEPAD SHALL BE CONSTRUCTED PRIOR TO ACCEPTANCE OF CURB AND GUTTER.
- ☐ ALL STORM DRAINAGE FACILITIES SHALL BE COMPLETED PRIOR TO FINAL ACCEPTANCE.
- ☒ THE REQUESTOR OR DEVELOPER SHALL BE RESPONSIBLE FOR REPAIR OR REPLACEMENT OF ALL CURB AND GUTTER OR SIDEWALK DAMAGE AFTER APPROVAL BY THE CITY ENGINEER OR WORK COMPLETED BY THE CONTRACTOR.

26-5364 . 90 019

CAUTION:
NOTE THAT ALL EXISTING UTILITIES MAY NOT BE SHOWN. ALL EXISTING SERVICE CONNECTIONS ARE NOT SHOWN. ANY EXISTING UTILITIES THAT ARE SHOWN ARE APPROXIMATE LOCATION ONLY. IT SHALL BE THE SOLE RESPONSIBILITY OF THE CONTRACTOR TO CONTACT ALL THE UTILITY OWNERS AND TO CONDUCT ALL NECESSARY FIELD INVESTIGATIONS PRIOR TO ANY EXCAVATION TO DETERMINE THE LOCATION OF ALL UTILITIES AND OTHER OBSTRUCTIONS.

dmg D. MARK GOODWIN & ASSOCIATES, P.
CONSULTING ENGINEERS & SURVEYOR
P. O. BOX 90606
ALBUQUERQUE, NEW MEXICO 87199
(505) 345-2010

REV.	SHEETS	CITY ENGINEER	DATE	USER DEPARTMENT	DATE	USER DEPARTMENT	DATE				
ENGINEERS STAMP & SIGNATURE			APPROVALS	ENGINEER	DATE	*****					
			DRC CHAIRMAN	<i>[Signature]</i>	4-7-90	APPROVED FOR CONSTRUCTION					
			TRANSPORTATION	<i>[Signature]</i>	4-2-90						
			WATER/WASTE WATER	<i>A.W. Kane</i>	3-18-90						
			HYDROLOGY	<i>[Signature]</i>	4-2-90						
			PARKS			<i>[Signature]</i>					
			CONSTR. MNGMT.			CITY ENGINEER DATE					
			CITY PROJECT NO.	5364.90		SHEET OF 1 13					

LEGEND

	CURB AND GUTTER		WATER METER
	CONCRETE		CABLE T.V.
	ELECTRIC TRANSFORMER		POWER POLE
	ELECTRIC PANEL		ANCHOR
	SANITARY SEWER MANHOLE		LIGHT POLE
	TELEPHONE MANHOLE		TRAFFIC LIGHT
	ELECTRIC MANHOLE		CROSSWALK SIGNAL
	STORM SEWER MANHOLE		SPRINKLER CONTROL
	WATER VALVE		TRAFFIC CONTROL
	FIRE HYDRANT		LIGHTING BOX
	TELEPHONE BOX		SIGN
	SPOT ELEVATION		GRATE



INDEX TO DRAWINGS

SHEET NO.	SHEET
1	TITLE SHEET
2-3	PLAT
4	GRADING PLAN
5	MASTER PAVING PLAN
6-8	PAVING IMPROVEMENTS
9	MASTER UTILITY PLAN
10	STORM DRAIN IMPROVEMENTS
11-13	UTILITY IMPROVEMENTS


RECORD DRAWING - UNIT I

I hereby certify that the information contained on this drawing has been revised in accordance with information furnished by the Contractor, CCM, Inc., and by the Surveyor, ALS, Inc. Surveying, and reflects the construction as actually accomplished. This plan as constructed is in substantial compliance with the Approved Plan.

Mark Goodwin 8/12/96
Mark Goodwin NMPE 8948

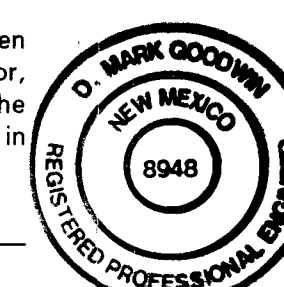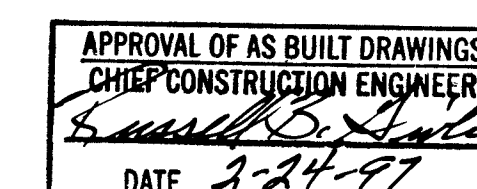

SCANNED BY
BY LASON

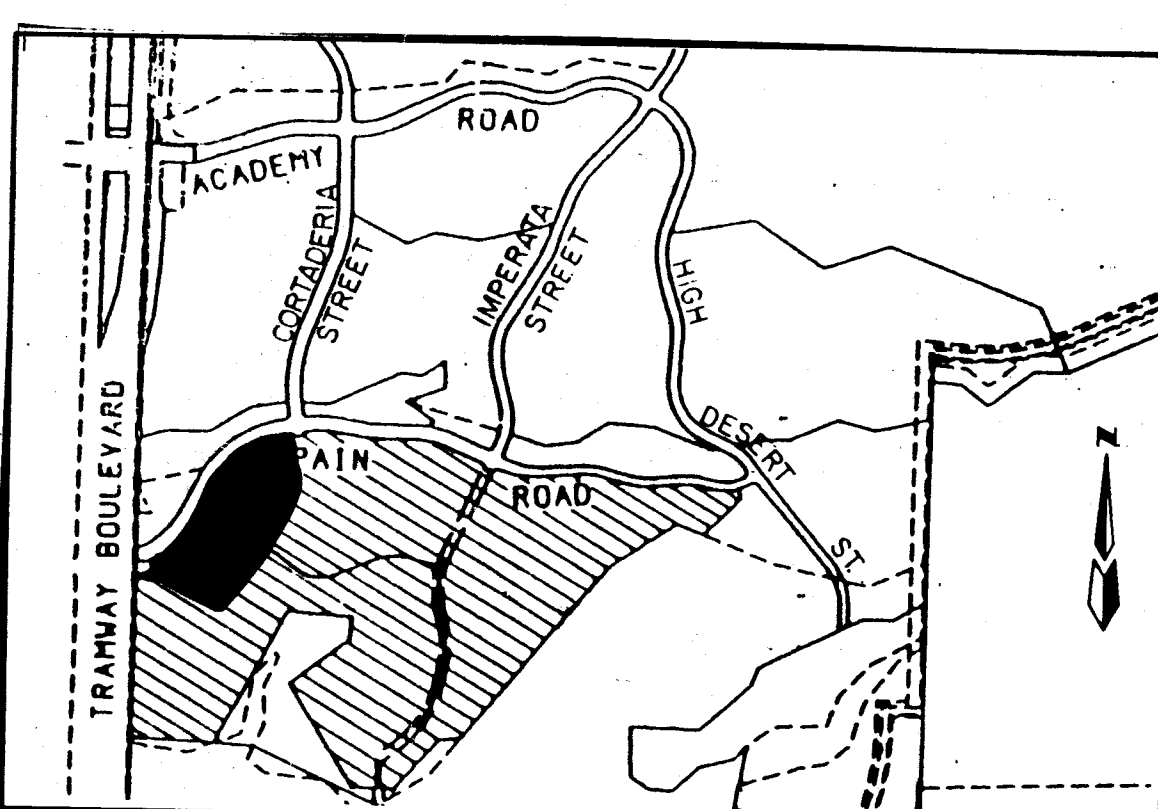

LOCATION MAP

ZONE ATLAS E-23 & F23

NOT TO SCALE

SUBDIVISION DATA

PLAT CASE NOS. DRB.95-401, SP. V.
 GROSS ACREAGE 6.1154
 ZONE ATLAS NO. E-23 & F-23
 NO. OF EXISTING TRACTS/LOTS 1 TRACT
 NO. OF TRACTS/LOTS CREATED 43 LOTS
 NO. OF TRACTS/LOTS ELIMINATED 1 TRACT
 MILES OF FULL WIDTH STREETS CREATED 0.2568
 AREA DEDICATED TO CITY OF ALBUQUERQUE 1.5013
 DATE OF SURVEY 7/95
 UTILITY CONTROL LOCATION SYSTEM LOG NUMBER: 9508112570382

PURPOSE OF PLAT

1. Subdivide the existing Tract 2A-1A-2, HIGH DESERT, into 43 residential lots.
2. Dedicate public drainage right-of-way and public right-of-way for residential streets.
3. Grant public utility, public drainage, pedestrian access and waterline easements.

NOTES

(See Sheet 2 for additional notes)

1. Prior to development, City of Albuquerque Water and Sanitary Sewer Service to THE AERIE AT HIGH DESERT must be verified and coordinated with the Public Works Department, City of Albuquerque, via a request for a water and sanitary sewer availability statement.

SURVEYOR'S CERTIFICATION

"I, Timothy Aldrich, a duly qualified Registered Professional Land Surveyor under the laws of the State of New Mexico, do hereby certify that this plat and description were prepared by me or under my supervision, shows all easements as shown on the plat of record or made known to me by the owners and/or proprietors of the subdivision shown hereon, utility companies and other parties expressing an interest and meets the minimum requirements for monumentation and surveys of the Albuquerque Subdivision Ordinance, and further meets the Minimum Standards for Land Surveying in the State of New Mexico (Effective November 1, 1989 and revisions effective December 25, 1991 and February 2, 1994), and is true and correct to the best of my knowledge and belief."



Timothy Aldrich, P.S. No. 7719

Date

11-17-95


FREE CONSENT AND DEDICATION

The subdivision hereon described is with the free consent and in accordance with the desires of the undersigned owner(s) and/or proprietor(s) thereof and said owner(s) and/or proprietor(s) do hereby dedicate all streets and public right-of-ways shown hereon to the City of Albuquerque in fee simple with warranty covenants and do hereby grant: all access, utility and drainage easements shown hereon including the right to construct, operate, inspect, and maintain facilities therein; and all public utility easements shown hereon for the common and joint use of gas, electrical power and communication services for buried distribution lines, conduits, and pipes for underground utilities where shown or indicated, and including the right of ingress and egress for construction and maintenance, and the right to trim interfering trees and shrubs. Said owner(s) and/or proprietor(s) do hereby consent to all of the foregoing and do hereby certify that this subdivision is their free act and deed.

SCOTT GARRETT, General Partner, Clara Vista Limited Liability Co., Owner

OWNER'S ACKNOWLEDGMENT

STATE OF NEW MEXICO } ss
 COUNTY OF BERNALILLO }
 This instrument was acknowledged before me on 11-14-95
 NOTARY PUBLIC 6-9-98
 MY COMMISSION EXPIRES

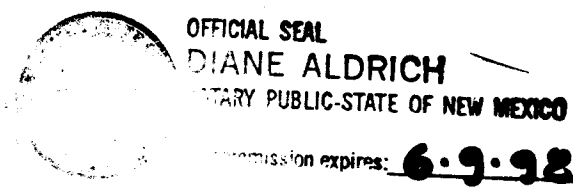PLAT OF
THE AERIE AT HIGH DESERT
UNIT I

PROJECTED SECTIONS 26 & 35
 T 11 N, R 4 E, NMPM
 ELENA GALLEGOS GRANT
 CITY OF ALBUQUERQUE
 BERNALILLO COUNTY, NEW MEXICO
 NOVEMBER 1995

APPROVED AND ACCEPTED BY:

APPROVAL AND CONDITIONAL ACCEPTANCE as specified by the Albuquerque Subdivision Ordinance, Article XI of Chapter 7 of the Revised Ordinances of Albuquerque, New Mexico.

Planning Director, City of Albuquerque, N.M. Date

City Engineer, City of Albuquerque, N.M. Date

Albuquerque Metropolitan Arroyo Flood Control Authority Date

Traffic Division, City of Albuquerque, N.M. Date

Utility Development Division, City of Albuquerque, N.M. Date

Parks and General Services, City of Albuquerque, N.M. Date

City Surveyor, City of Albuquerque, N.M. Date

Property Management, City of Albuquerque, N.M. Date

P.N.M. GAS SERVICES DIVISION Date

U.S. West Telecommunications Date

P.N.M. ELECTRIC SERVICES DIVISION Date

Jones Intercable, Inc. Date

THE AERIE AT HIGH DESERT
UNIT I

D. MARK GOODWIN & ASSOC., P.A.
 CONSULTING ENGINEERS & SURVEYORS
 P.O. BOX 90606
 ALBUQUERQUE, NEW MEXICO 87199
 (505) 345-2010

Designed: SLNB Drawn: BJC Ch'd: ALS Sheet of
 Scale: 1"=50' Date: 11/13/95 Job: 95080 1 3

5080LEGI

CURVE DATA

NO.	RADIUS	DELTA	LENGTH	CHORD BEARING & DISTANCE
13	25.00	90-00-01	39.27	N 75-53-22 E 35.36
14	25.00	89-59-59	39.27	N 14-06-38 W 35.36
15	25.00	90-00-01	39.27	N 75-53-22 E 35.36
16	25.00	89-59-59	39.27	N 14-06-38 W 35.36
17	52.00	78-02-54	70.83	N 69-54-49 E 65.48
18	75.00	78-02-54	102.17	N 69-54-49 E 94.45
19	98.00	56-49-12	97.19	N 60-31-40 E 93.25
20	98.00	21-13-42	36.31	N 41-30-13 E 36.10
21	98.00	32-36-26	55.77	N 54-45-31 W 55.02
22	25.00	47-52-56	20.89	N 62-23-46 W 20.29
23	40.00	59-39-08	41.65	N 56-30-40 W 39.79
24	40.00	28-57-18	20.21	N 12-12-27 W 20.00
25	40.00	50-32-58	35.29	N 27-32-41 E 34.16
26	40.00	19-08-18	13.36	N 62-23-20 E 13.30
27	25.00	47-52-56	20.89	N 48-01-01 E 20.29
28	98.00	5-37-02	9.61	N 26-53-04 E 9.60
29	98.00	12-05-31	20.68	N 35-44-21 E 20.64
30	75.00	48-58-29	64.11	N 17-17-52 E 78.35
31	75.00	63-52-21	83.61	N 39-07-33 W 81.80
32	52.00	103-43-07	94.13	N 19-12-11 W 81.80
33	52.00	9-07-44	8.29	N 37-13-15 E 8.28
34	833.12	2-21-24	34.27	N 40-36-24 E 34.27
35	833.12	3-11-14	46.35	N 37-50-05 E 46.34
36	833.12	2-33-04	37.10	N 34-57-56 E 37.09
37	833.12	2-35-34	37.70	N 32-23-36 E 37.70
38	833.12	2-53-22	42.01	N 29-39-09 E 42.01
39	833.12	2-39-19	38.61	N 26-52-48 E 38.60
40	787.12	0-02-14	0.51	N 25-34-16 E 0.51
41	787.12	3-13-19	44.26	N 27-12-02 E 44.26
42	787.12	3-37-09	49.72	N 30-37-17 E 49.71
43	787.12	3-24-12	46.75	N 34-07-57 E 46.75
44	787.12	3-43-06	51.08	N 37-41-35 E 51.07
45	787.12	3-13-58	30.67	N 40-40-07 E 30.67
46	810.12	16-13-57	228.52	N 33-40-08 E 228.75

CURVE DATA

NO.	RADIUS	DELTA	LENGTH	CHORD BEARING & DISTANCE
113	688.12	3-04-32	36.94	N 27-16-26 E 36.93
114	688.12	3-37-09	43.47	N 30-37-17 E 43.46
115	688.12	3-24-11	40.87	N 34-07-57 E 40.87
116	688.12	3-43-06	44.66	N 37-41-36 E 44.65
117	688.12	3-43-22	44.71	N 41-24-49 E 44.70
118	688.12	3-29-57	42.03	N 45-01-29 E 42.02
119	688.12	3-50-53	46.22	N 48-41-54 E 46.21
120	688.12	6-06-25	73.34	N 53-40-33 E 73.31
121	688.12	4-33-30	54.75	N 59-00-30 E 54.73

SCANNED BY
BVLASOM

NOTES

1. Bearings are New Mexico State Plane Grid Bearings (Central Zone).
2. Distances are ground distances.
3. Bearings and distances are field and record.
4. Basis of boundary are the following plats (and documents) of record entitled:
 PLAT OF HIGH DESERT (11-23-93, 93C-325)
 PLAT OF TRACTS 2A-1A, 2A-1B, 2A-1C AND 5A, HIGH DESERT (06-06-94, 94C-185)
 PLAT OF TRACTS 2A-1A-1, 2A-1A-2, 2A-1B-1, 2A-1C-1, 2A-1C-2 AND 5A-1, HIGH DESERT ()
 all being records of Bernalillo County, New Mexico.

5. Field Survey performed July 27, 1995.

6. Centerline (in lieu of R/W) monumentation to be installed at all centerline PC's, PT's, angle points and street intersections as shown hereon, and will consist of a four inch (4") aluminum alloy cap stamped "City of Albuquerque", "Centerline Monument", "Do Not Disturb", "PLS # 7719".

7. Utility Council Location System Log No. 9508112570382

8. Title Report: Rio Grande Title Co., Inc., No. CC 320022 10 22343, 09-951584 - r

9. This property is apparently affected by reservations, restrictions and agreements contained within easements, documents and memorandums as listed within the above mentioned Title Report.

LEGAL DESCRIPTION

A tract of land situate within the Elena Gallegos Grant, projected Sections 26 and 35, Township 11 North, Range 4 East, New Mexico Principal Meridian, Bernalillo County, New Mexico, being all of TRACT 2A-1A-2, HIGH DESERT as the same is shown and designated on said plat filed for record in the office of County Clerk of Bernalillo County, New Mexico, on

in Volume , Folio , and being more particularly described as follows:

Beginning at the southwest corner of the herein described tract, said point being on the southerly right-of-way line of Spain Road N.E. from whence City of Albuquerque Control Survey Monument "TUMBLE" bears N 09°59'20" W, 5385.49 feet;

Thence along said southerly right-of-way line 426.98 feet along a curve to the left whose radius is 688.12 feet through a central angle of 35°33'07" and whose chord bears N 43°30'44" E, 420.16 feet to a point of non-tangency;

Thence continuing N 25°33'09" E, 196.69 feet to the northwest corner;

Thence leaving said southerly right-of-way line S 64°26'51" E, 99.01 feet to a point;

Thence S 61°45'08" E, 46.05 feet to a point;

Thence S 59°06'39" E, 212.67 feet to a point;

Thence N 30°53'22" E, 22.14 feet to a point;

Thence S 59°06'38" E, 145.99 feet to the northeast corner, said point being on the westerly right-of-way line of Cortaderia Street N.E.;

Thence along said westerly right-of-way line S 30°53'21" W, 492.08 feet to the southeast corner;

Thence leaving said westerly right-of-way line N 71°03'44" W, 505.08 feet to a point;

Thence S 89°56'38" W, 36.51 feet to the point of beginning and containing 6.2298 more or less.

PLAT OF
THE AERIE AT HIGH DESERT
UNIT I

PROJECTED SECTIONS 26 & 35
 T 11 N, R 4 E, NMPM
 ELENA GALLEGOS GRANT
 CITY OF ALBUQUERQUE
 BERNALILLO COUNTY, NEW MEXICO
 NOVEMBER 1995


PUBLIC UTILITY EASEMENTS

PUBLIC UTILITY EASEMENTS shown on this plat are granted for the common and joint use of:

1. The PNM Electric Services Division for the installation, maintenance and service of overhead and underground electrical lines, transformers, poles and any other equipment, fixtures, structures and related facilities reasonably necessary to provide electrical services.
2. The PNM Gas Services Division for installation, maintenance and services of natural gas lines, valves and other equipment and facilities reasonably necessary to provide natural gas.
3. U.S. West for installation, maintenance and service of all buried and aerial communication lines and other related equipment and facilities reasonably necessary to provide communication services, including but not limited to above ground pedestals and closures.
4. Jones Intercable for installation, maintenance and service of such lines, cable and other related equipment and facilities reasonably necessary to provide Cable TV service.

Included, is the right to build, rebuild, construct, reconstruct, locate, relocate, change, remove, modify, renew, operate and maintain facilities for the purposes described above, together with free access to, from and over said easement, including sufficient working area space for electric transformers, with the right and privilege to trim and remove trees, shrubs or bushes which interfere with the purposes set forth herein. No building, sign, pool (above ground or subsurface), hot tub, concrete or wood pool decking, or other structure shall be erected or constructed on said easements, nor shall any well be drilled or operated thereon. Property owners shall be solely responsible for correcting any violations of National Electrical Safety Code caused by construction of pools, decking or any structures adjacent to within or near easements shown on this plat.

In approving this plat, the utility companies did not conduct a Title Search of the properties shown hereon. Consequently, the utility companies do not waive or release any easement or easement rights which may have been granted by prior plat, replat or other document and which are not shown on this plat.

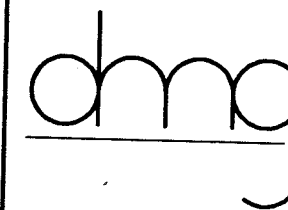THE AERIE AT HIGH DESERT
UNIT I

D. MARK GOODWIN & ASSOC., P.A.
 CONSULTING ENGINEERS & SURVEYORS
 P.O. BOX 90606
 ALBUQUERQUE, NEW MEXICO 87199
 (505) 345-2010

Designed: SLNB Drawn: BJC Ch'd: ALS Sheet of
 Scale: 1"=50' Date: 11/16/95 Job: 95080 2 3

5080DAT1

SETBACKS

Setbacks shall be per the R-T zone:

1. Front yard setback of not less than 15 feet except driveways shall be not less than 20 feet long.
2. There shall be no required side-yard setback except:
 - a. There shall be ten feet on the street side of corner lots.
 - b. There shall be five feet from a side lot line that separates the R-T zone from another zone.
3. There shall be a rear-yard setback of:
 - a. Not less than 15 feet, or
 - b. For houses with offset rear lot lines, lot less than five feet, provided that the average rear yard setback is not less than 15 feet. Such reduced setbacks are allowed only when approved by the Planning Director and specified on a subdivision plat for not less than two back-to-back lots.

A 60' RECIPROCAL FLOATING PUBLIC DRAINAGE AND PUBLIC SANITARY SEWER EASEMENT (6-6-94, 94C-185) VACATED BY V-

30' DRAINAGE EASEMENT GRANTED BY THIS PLAT

EXISTING 10' PUBLIC UTILITY EASEMENT (6-6-94, 94C-185)

30' DRAINAGE, PEDESTRIAN ACCESS AND UTILITY EASEMENT GRANTED BY THIS PLAT

NOTE:
ALL POINTS ARE FOUND REBAR WITH CAP "LS 6544".

△ CENTERLINE MONUMENTATION
Centerline (in lieu of R/W monumentation) to be installed at all centerline PC's, PT's, angle points, and street intersections as shown hereon, and will consist of a four inch (4") aluminum alloy cap stamped: CITY OF ALBUQUERQUE CENTERLINE MONUMENT DO NOT DISTURB PLS #7719

TRACT 2A-1A-2

PLAT OF
THE AERIE AT HIGH DESERT
UNIT I
PROJECTED SECTIONS 26 & 35
T 11 N, R 4 E, NMPM
ELENA GALLEGOS GRANT
CITY OF ALBUQUERQUE
BERNALILLO COUNTY, NEW MEXICO
NOVEMBER 1995

TEMPORARY DRAINAGE & TURNAROUND EASEMENT GRANTED TO THE CITY OF ALBUQUERQUE BY THIS PLAT (TO BE DISSOLVED WITH THE FILING OF THE PLAT OF "CLARA VISTA UNIT II")

HIGH DESERT TRACT 2A-1C-1

HIGH DESERT TRACT 5A-1

50' 25' 0 50' 100'
SCALE: 1" = 50'



THE AERIE AT HIGH DESERT
UNIT I

dmg

D. MARK GOODWIN & ASSOC., P.A.
CONSULTING ENGINEERS & SURVEYORS
P.O. BOX 90606
ALBUQUERQUE, NEW MEXICO 87199
(505) 345-2010

Designed: SLNB	Drawn: BJG	Ch'd: ALS	Sheet of
Scale: 1"=50'	Date: 11/16/95	Job: 95080	3 3

5080M-UI

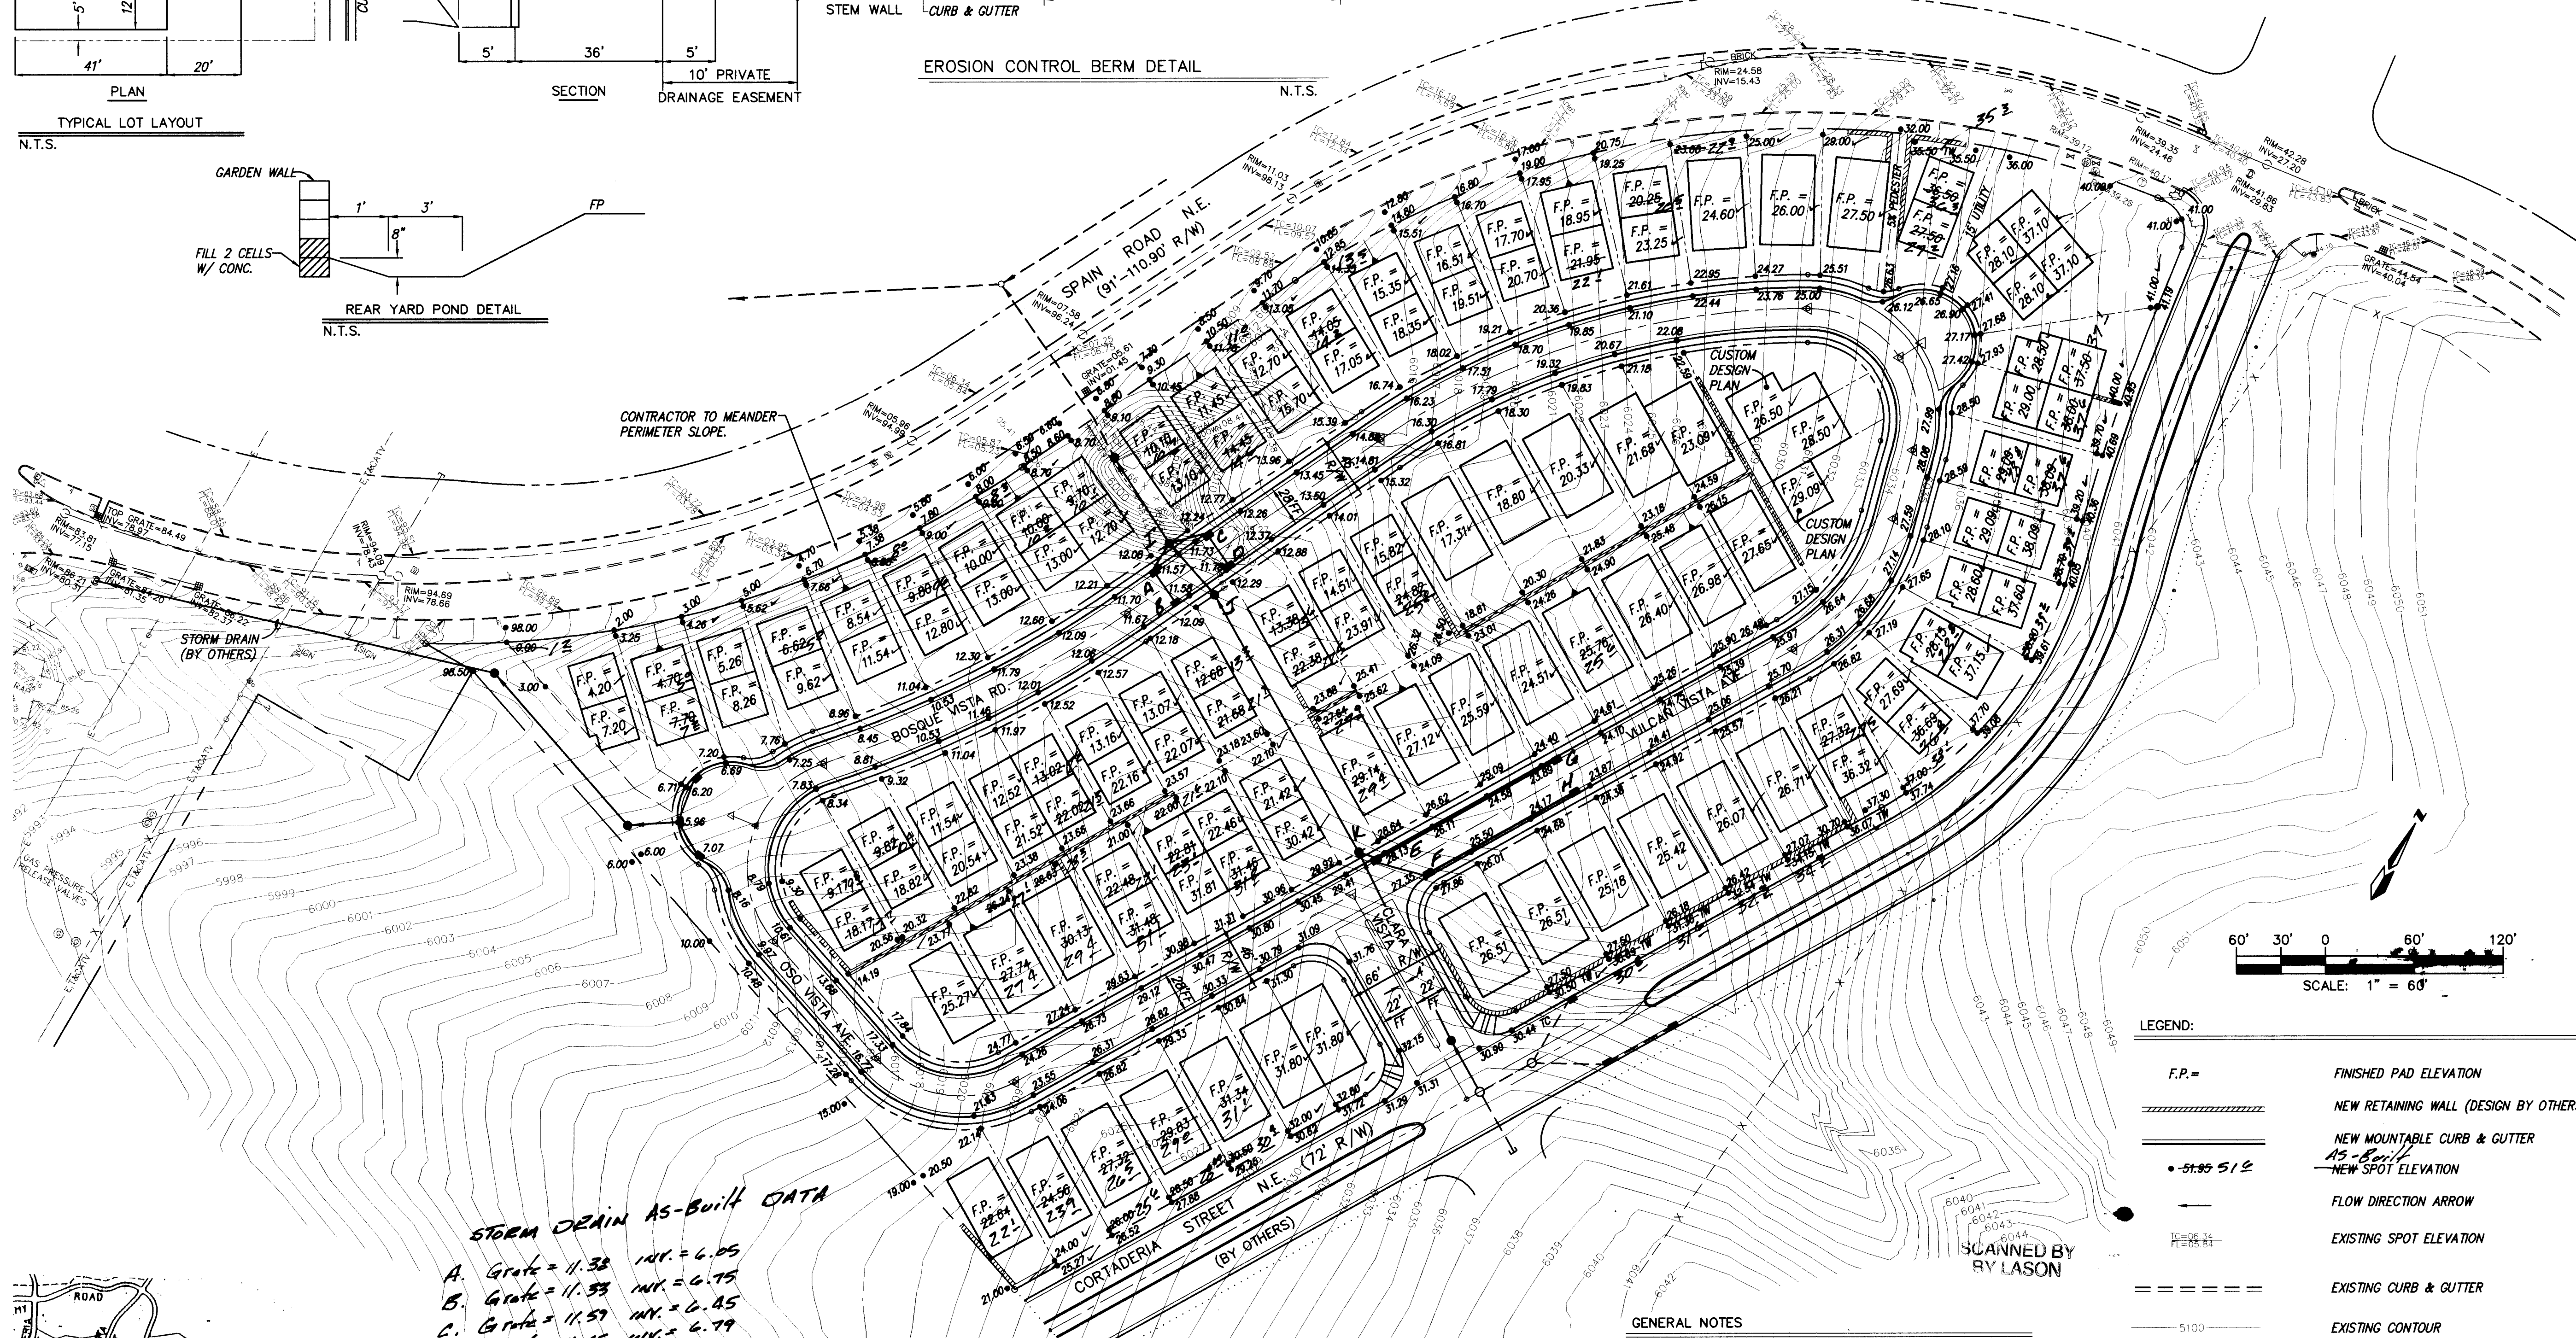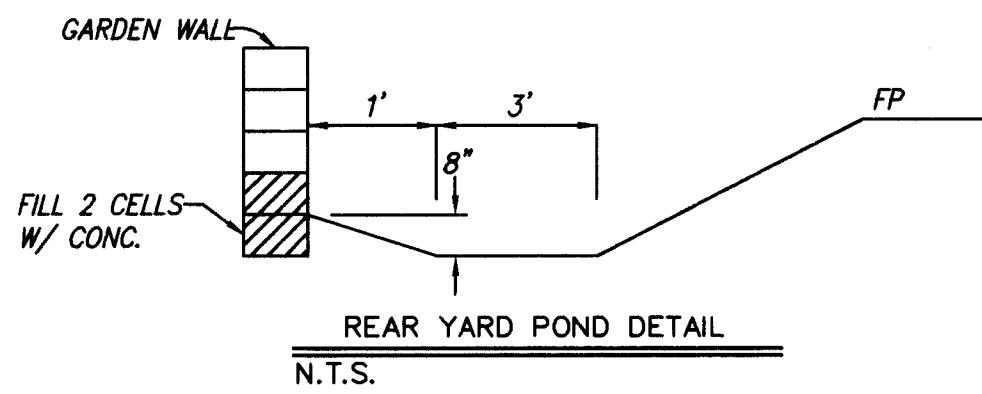


STORM DRAIN AS-BUILT DATA

- A. Grate = 11.38 INV. = 6.05
 B. Grate = 11.33 INV. = 6.75
 C. Grate = 11.53 INV. = 6.45
 D. Grate = 11.05 INV. = 6.79
 E. Grate = 27.92 INV. = 19.49
 F. Grate = 27.60 INV. = 19.61
 G. Grate = 23.71 INV. = 20.31
 H. Grate = 23.61 INV. = 20.31
 I. Rim = 12.34
 J. Rim = 12.53
 K. Rim = 29.48

RECORD DRAWING

I hereby certify that the information contained on this drawing has been revised in accordance with information furnished by the Contractor, CCM, Inc., and by the Surveyor, ALS, Inc. Surveying, and reflects the construction as actually accomplished. This plan as constructed is in substantial compliance with the Approved Plan.

Mark Goodwin
Mark Goodwin, NMPE 8948

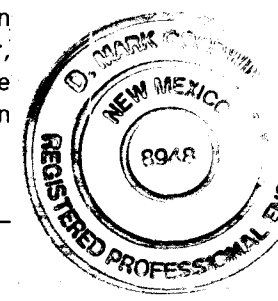

EROSION CONTROL NOTES

1. EROSION CONTROL BERMS ARE REQUIRED AROUND THE ENTIRE SITE.
2. ALL EROSION CONTROL BERMS MUST BE IN PLACE AND ENGINEER CERTIFIED PRIOR TO BUILDING PERMIT RELEASE.

GENERAL NOTES

1. CONTRACTOR MUST OBTAIN A TOPSOIL DISTURBANCE PERMIT FROM THE ENVIRONMENTAL HEALTH DIVISION PRIOR TO CONSTRUCTION.
2. CITY OF ALBUQUERQUE STANDARD SPECIFICATIONS FOR PUBLIC WORKS CONSTRUCTION, LATEST EDITION SHALL GOVERN ALL WORK.
3. THE CONTRACTOR SHALL CONFORM TO ALL CITY, COUNTY, STATE, AND FEDERAL DUST CONTROL MEASURES AND REQUIREMENTS AND WILL BE RESPONSIBLE FOR PREPARING AND OBTAINING ALL NECESSARY APPLICATIONS AND APPROVALS.
4. THE CONTRACTOR SHALL ENSURE THAT NO SOIL ERODES FROM THE LOTS INTO PUBLIC RIGHT-OF-WAY. THIS CAN BE ACHIEVED BY CONSTRUCTING TEMPORARY BERMS AS PER DETAIL THIS SHEET AND METTING THE SOIL TO KEEP IT FROM BLOWING.
5. THE EARTHWORK CONTRACTOR SHALL STOCKPILE ENOUGH MATERIALS ADJACENT TO RETAINING WALL LOCATIONS TO BE UTILIZED FOR WALL BACKFILL.
6. SITE DOES NOT LIE WITHIN A 100 YEAR FLOOD ZONE.

1	2	3	4	5	6	7	8	9	10	11	12	13	14	15
2			5	3	1		8	0		6	4	0	7	

APPROVED FOR ROUGH GRADING $\pm 1'$

CV\GD60\4-1

LEGEND:

F.P. =

FINISHED PAD ELEVATION

NEW RETAINING WALL (DESIGN BY OTHERS)

NEW MOUNTABLE CURB & GUTTER
AS-BUILT
NEW SPOT ELEVATION

FLOW DIRECTION ARROW

EXISTING SPOT ELEVATION

EXISTING CURB & GUTTER

EXISTING CONTOUR

dmg D. MARK GOODWIN & ASSOCIATES, P.A.
CONSULTING ENGINEERS & SURVEYORS
P.O. BOX 90606
ALBUQUERQUE, NEW MEXICO 87199
(505) 345-2010

CITY OF ALBUQUERQUE
PUBLIC WORKS DEPARTMENT
ENGINEERING DEVELOPMENT GROUP

TITLE: CLARA VISTA SUBDIVISION
GRADING PLAN

DESIGN REVIEW COMMITTEE

CITY PROJECT NO.	5364.90
------------------	---------

ZONE MAP NO.
E23

SHEET 4 OF 13


[illegible]

CURVE DATA - DESCRIBES FACE OF CURB

1 $\Delta = 78^{\circ}02'54''$ R = 61.00' L = 83.09' T = 49.44'	2 $\Delta = 46^{\circ}19'24''$ R = 128.00' L = 103.49' T = 54.76'	3 $\Delta = 46^{\circ}19'24''$ R = 156.00' L = 128.12' T = 66.74'
4 $\Delta = 90^{\circ}00'00''$ R = 25.00' L = 39.27' T = 25.00'	5 $\Delta = 90^{\circ}00'00''$ R = 25.00' L = 39.27' T = 25.00'	6 $\Delta = 78^{\circ}02'54''$ R = 89.00' L = 121.24' T = 72.13'


CL CURVE DATA

1 $\Delta = 78^{\circ}02'54''$ R = 75.00' L = 102.17' T = 60.79'	2 $\Delta = 46^{\circ}19'24''$ R = 142.00' L = 114.81' T = 60.75'
---	--

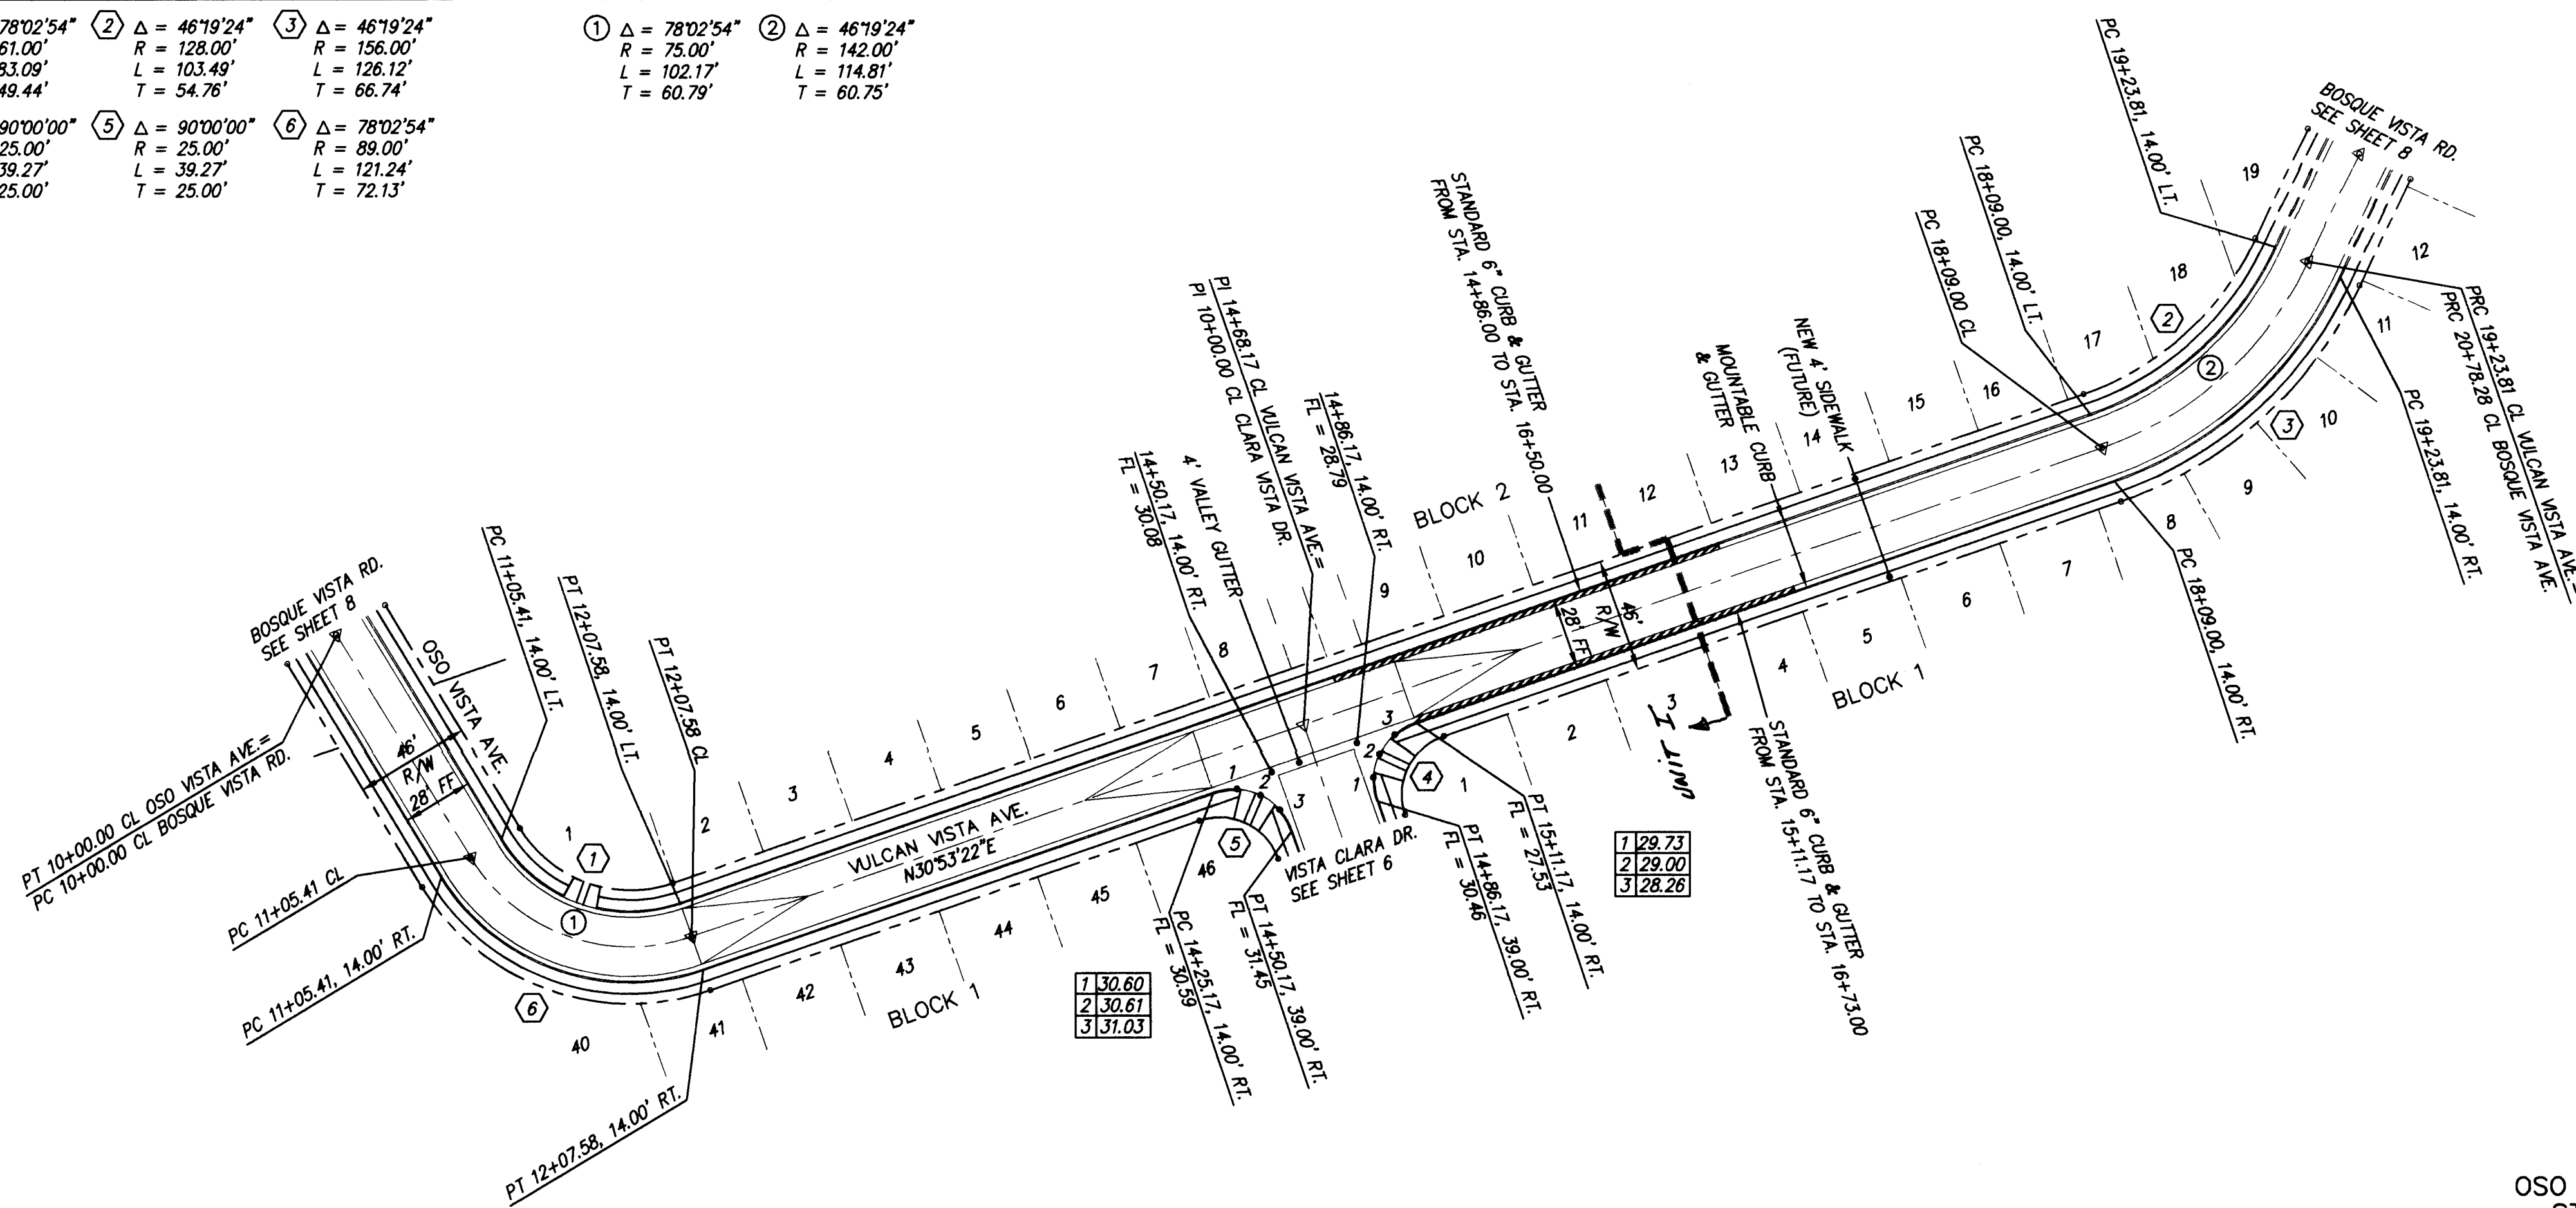


OSO VISTA AVE. & VULCAN VISTA AVE.
STA. 10+00.00 TO STA. 19+23.81

SCALE: HOR. 1" = 50'
VER. 1" = 10'

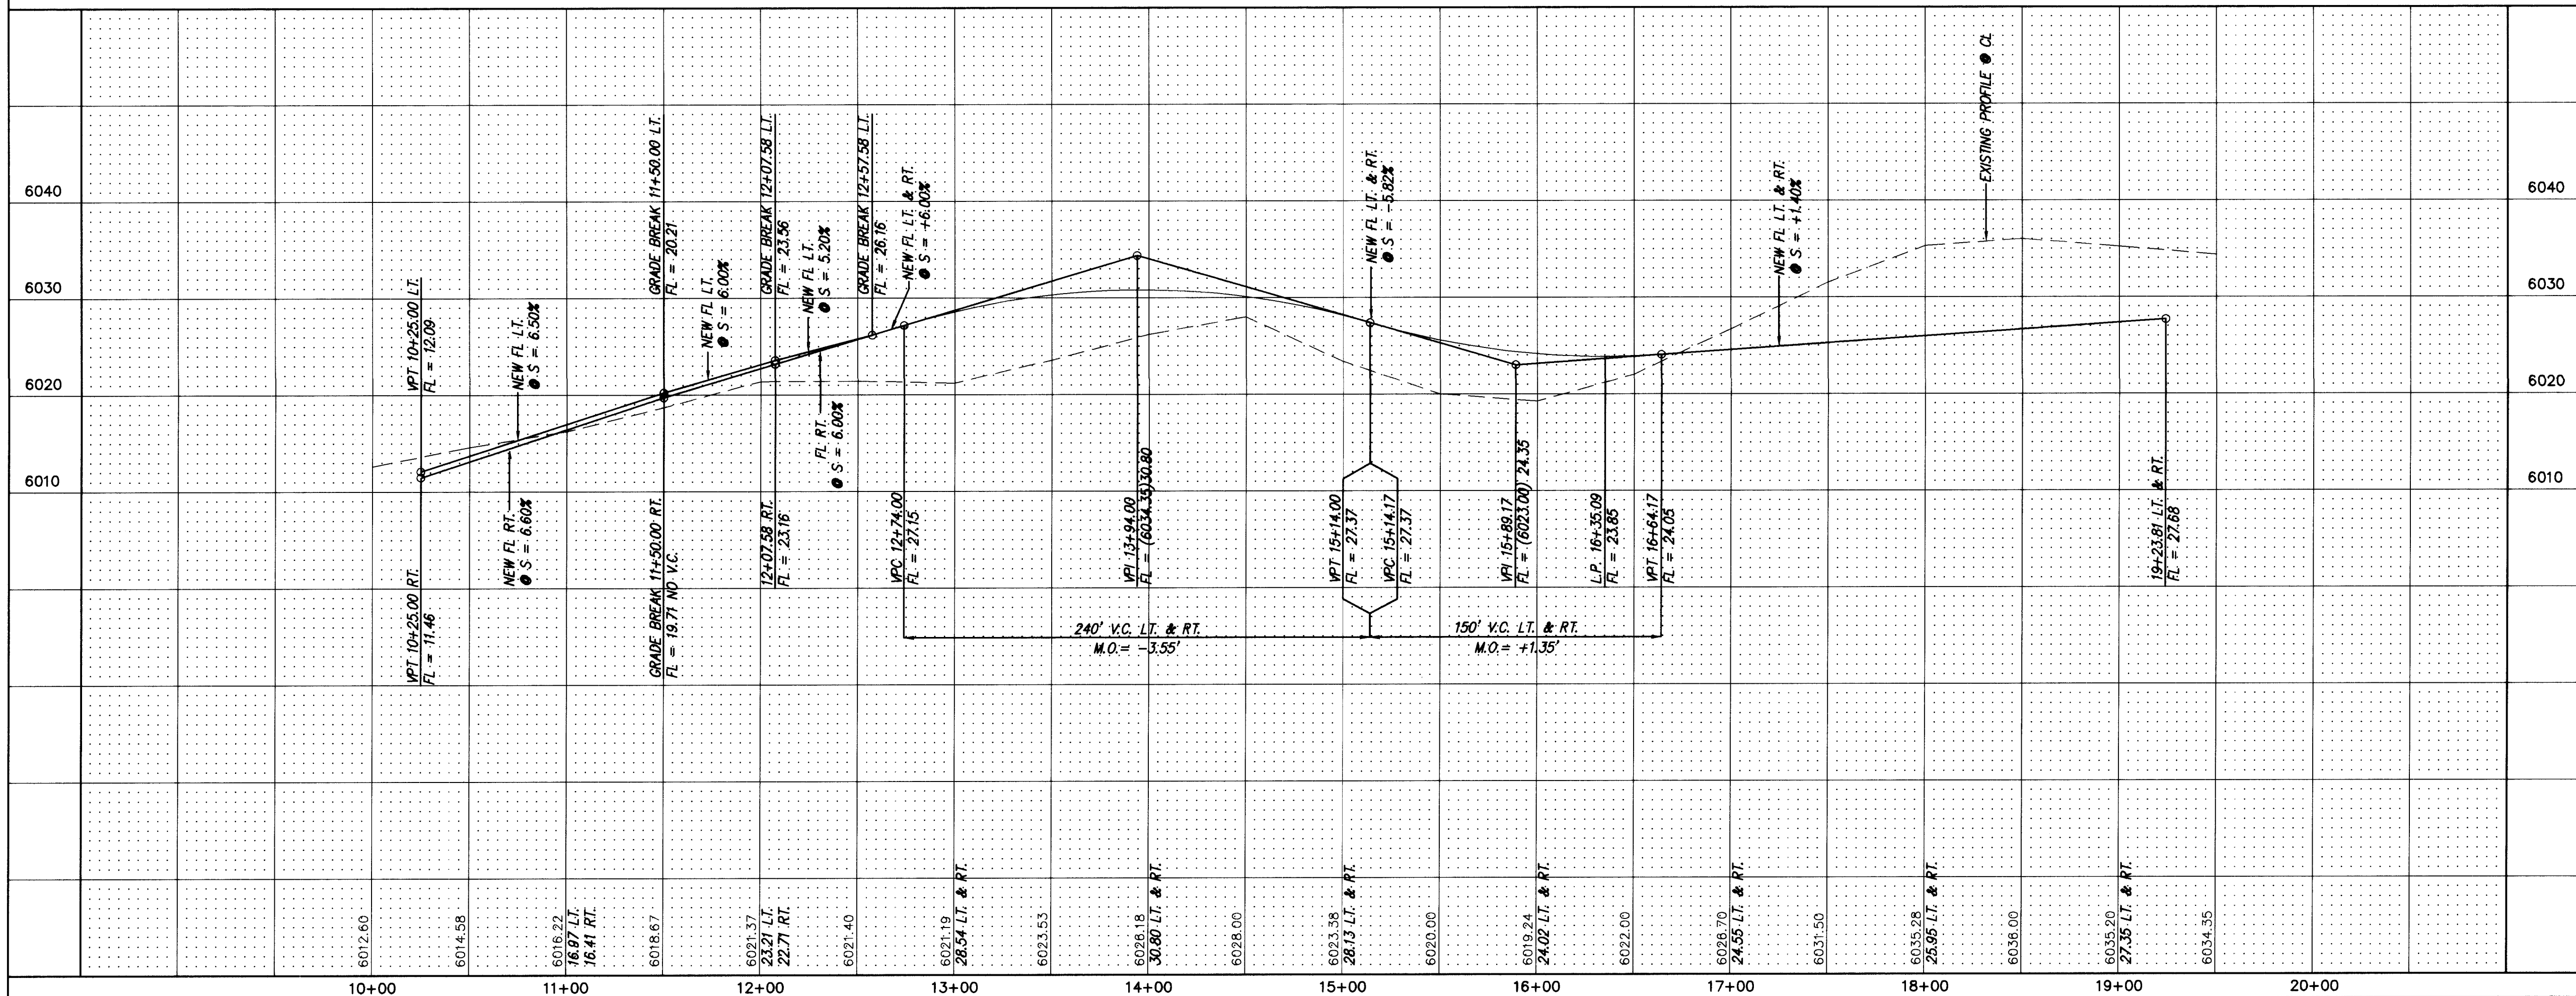

NOTES

- ALL STATIONING IS CENTERLINE STATIONING.
- TRANSITION FROM MOUNTABLE CURB TO STANDARD CURB PER C.O.A. STD. DWG. 2418.

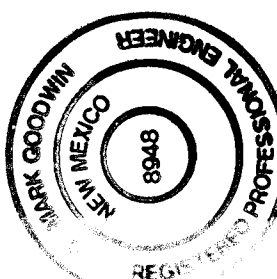

I hereby certify that the information contained on this drawing has been revised in accordance with information furnished by the Contractor, CCM, Inc., and by the Surveyor, ALS, Inc. Surveying, and reflects the construction as actually accomplished. This plan as constructed is in substantial compliance with the Approved Plan.

Mark Goodwin, N.M.P.E. 8848

26-5364-90 0799

dmg D. MARK GOODWIN & ASSOCIATES, P.A.
CONSULTING ENGINEERS & SURVEYORS
P.O. BOX 90606
ALBUQUERQUE, NEW MEXICO 87199
(505) 345-2010

CITY OF ALBUQUERQUE
PUBLIC WORKS DEPARTMENT
ENGINEERING DEVELOPMENT GROUP

TITLE: CLARA VISTA SUBDIVISION
PAVING IMPROVEMENTS
OSO VISTA AVE. & VULCAN VISTA AVE.



DESIGN REVIEW COMMITTEE	CITY ENGINEER APPROVAL	LAST DESIGN UPDATE	NO./DAY/YR.	MO./DAY/YR.
6.4.4 4-12-96				

CITY PROJECT NO. 5364.90 ZONE MAP NO. E23 SHEET 7 OF 13

SCANNED BY LASON

LENGTH OF RESTRAINED PIPE (FEET)						
PIPE SIZE	90	45	22.5	11.25	TEE	VALVE
6"	18'	7'	4'	2'	*	55'
10"	27'	11'	5'	3'	*	72'

LENGTH OF RESTRAINED PIPE ON EACH SIDE OF THE BEND. RESTRAIN BRANCH AT FITTING ONLY. MINIMUM ATTACHED PIPE LENGTH, RUN SIDE OF TEE: 10.00 FEET.

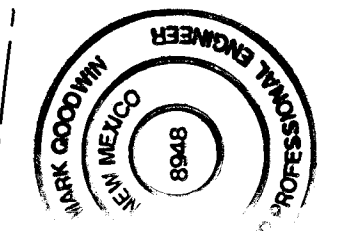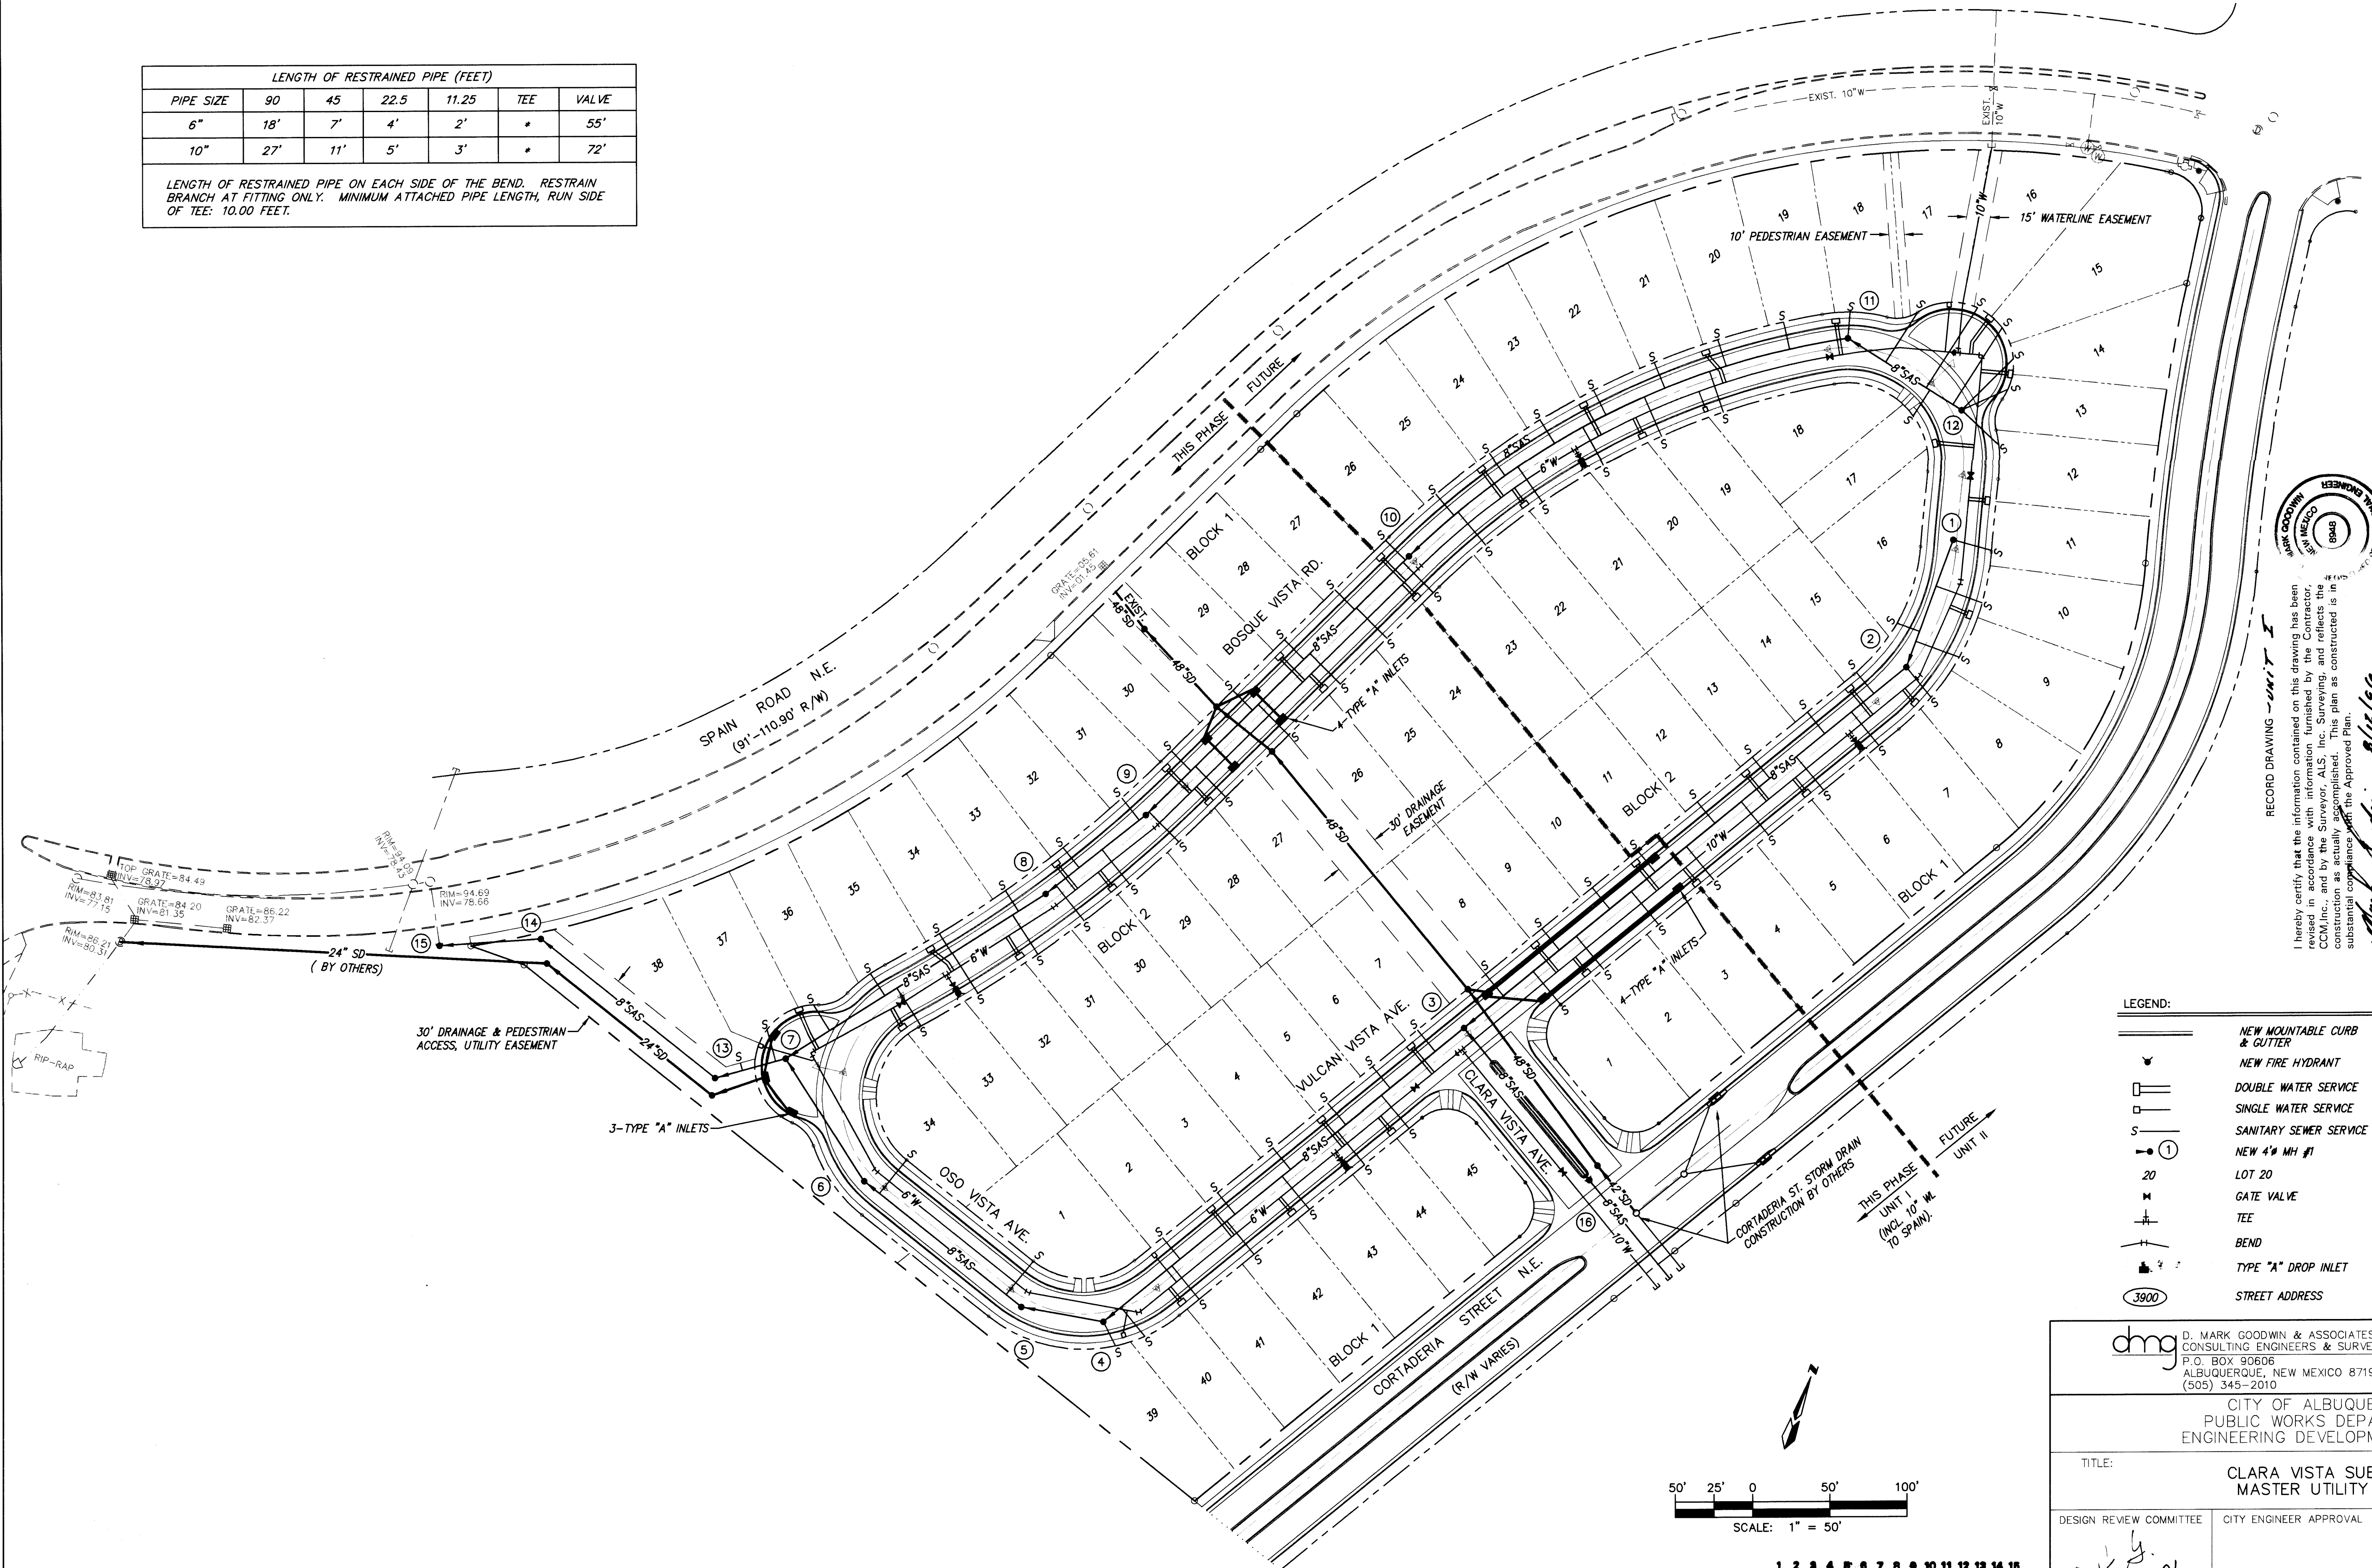

RECORD DRAWING - UNIT I
 I hereby certify that the information contained on this drawing has been prepared by me or under my direct supervision and that I am a duly Licensed Professional Engineer in the State of New Mexico. This plan as constructed is in substantial compliance with the Approved Plan.
 Mark Goodwin, P.E.
 No. 8948

- LEGEND:
- NEW MOUNTABLE CURB & GUTTER
 - NEW FIRE HYDRANT
 - DOUBLE WATER SERVICE
 - SINGLE WATER SERVICE
 - SANITARY SEWER SERVICE
 - NEW 4" MH #1
 - LOT 20
 - GATE VALVE
 - TEE
 - BEND
 - TYPE "A" DROP INLET
 - STREET ADDRESS

dmg D. MARK GOODWIN & ASSOCIATES, P.A.
 CONSULTING ENGINEERS & SURVEYORS
 P.O. BOX 90606
 ALBUQUERQUE, NEW MEXICO 87199
 (505) 345-2010


CITY OF ALBUQUERQUE
 PUBLIC WORKS DEPARTMENT
 ENGINEERING DEVELOPMENT GROUP

TITLE: CLARA VISTA SUBDIVISION
 MASTER UTILITY PLAN

DESIGN REVIEW COMMITTEE	CITY ENGINEER APPROVAL	LAST DESIGN UPDATE	MO./DAY/YR.	MO./DAY/YR.
2. Y. G. 4-12-96				


CITY PROJECT NO. 5364.90 ZONE MAP NO. E23 SHEET 9 OF 13

SURVEY INFORMATION			
NO.	DATE	BY	DATE

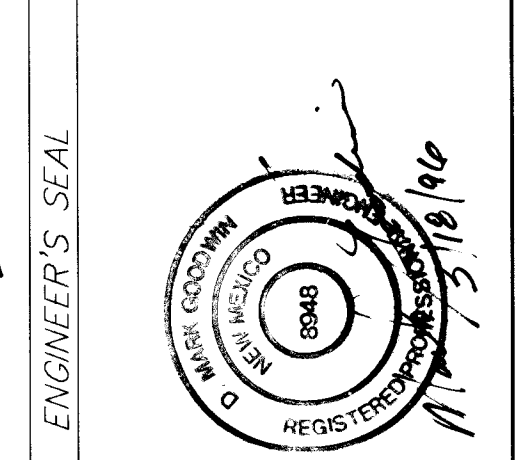

AS-BUILT INFORMATION			
CONTRACTOR	CCM, Inc.	DATE	5/1/96
WORK	STAKED BY	DATE	4/25/96
FIELD	ACCEPTANCE BY	DATE	4/25/96
DRAWINGS	FIELD ACTION BY	DATE	4/25/96
CORRECTED BY	DATE		

SCANNED BY LASON

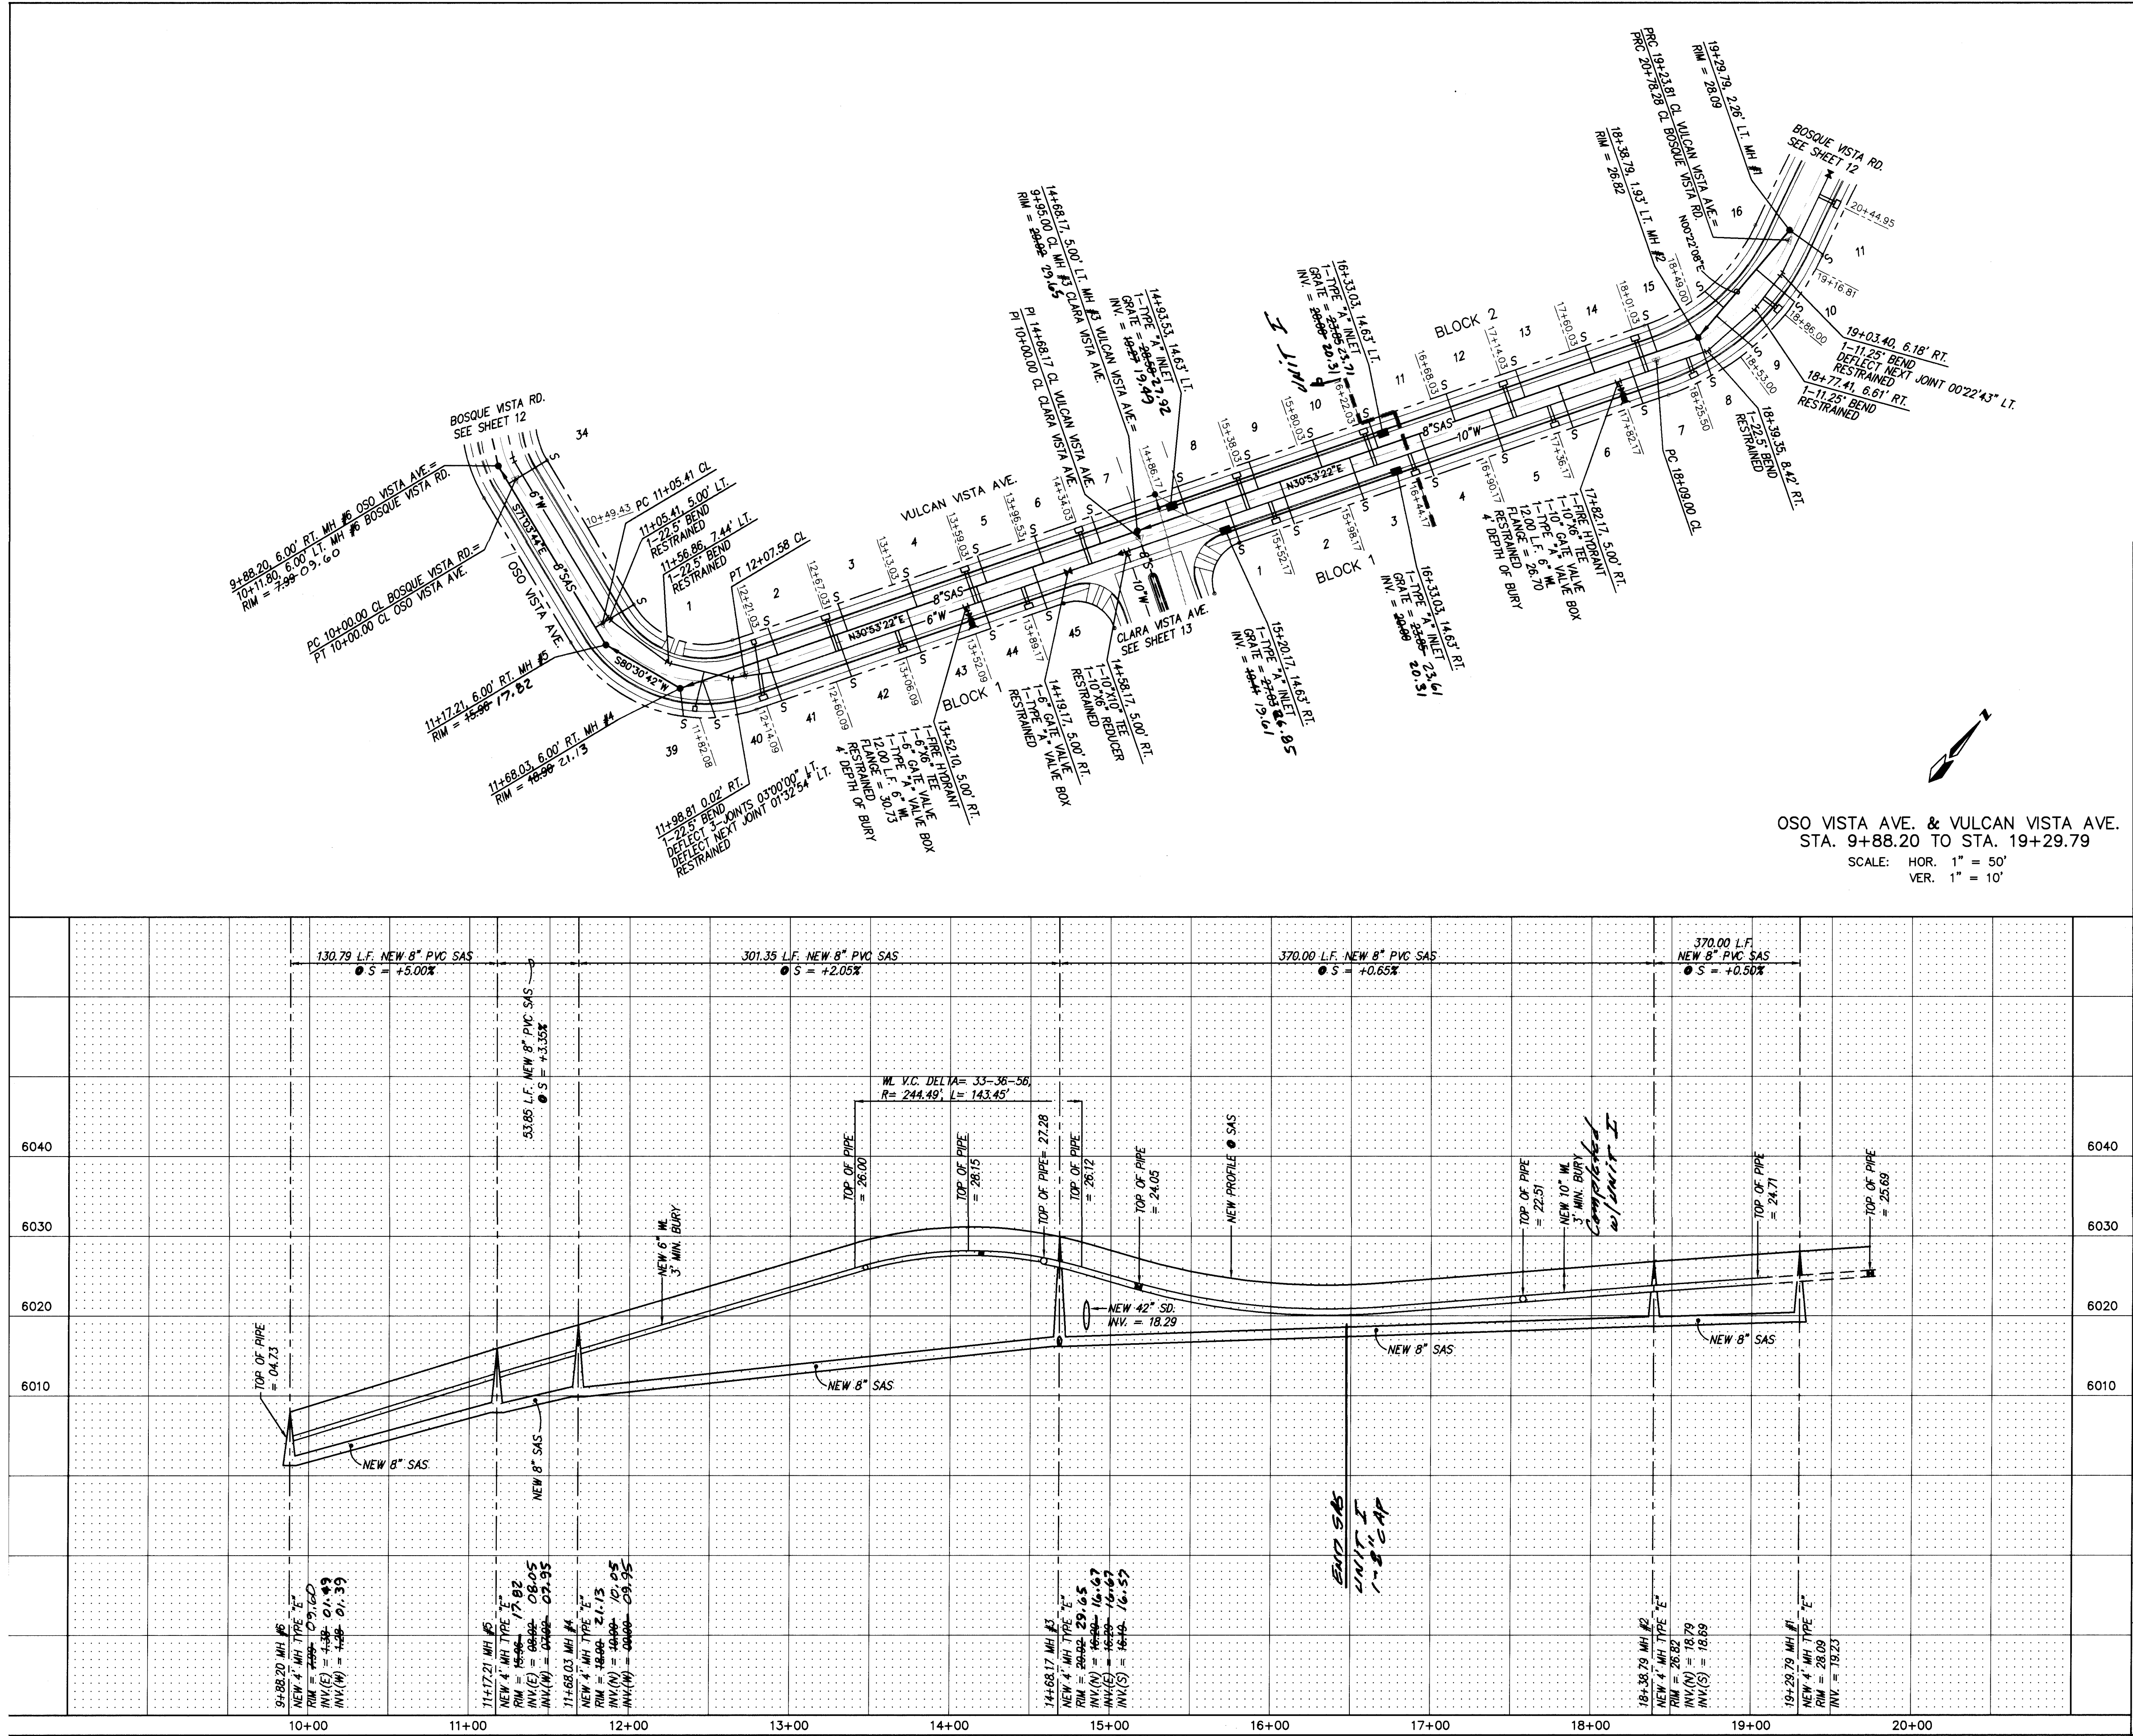

NOTES

1. ALL STATIONING IS CENTERLINE STATIONING.

SANITARY SEWER SERVICES				
LOT	STA.	INV. ELEV. PL	LENGTH PL	INV. ELEV. M.H.
BLK. 2				
34	10+00	04.00	30'	N/A
1	11+05	11.00	30'	N/A
2	12+31	18.00	20'	N/A
3	12+77	21.00	20'	N/A
4	13+23	17.00	20'	N/A
5	13+69	18.00	20'	N/A
6	14+06	18.00	20'	N/A
7	14+44	18.00	20'	N/A
8	15+01	24.00	20'	N/A
9	15+48	22.00	20'	N/A
10	15+90	20.00	20'	N/A
11	16+27	20.00	20'	N/A
12	16+78	20.00	20'	N/A
13	17+24	21.00	20'	N/A
14	17+70	22.00	20'	N/A
15	18+11	22.00	20'	N/A
16	18+59	23.00	20'	N/A
BLK. 1				
39	11+72	15.00	20'	10.20
40	11+92	16.00	25'	N/A
41	12+24	18.00	30'	N/A
42	12+70	21.00	30'	N/A
43	13+16	24.00	30'	N/A
44	13+62	26.00	30'	N/A
45	13+99	27.00	30'	N/A
1	15+27	23.00	30'	N/A
2	15+62	21.00	30'	N/A
3	16+08	20.00	30'	N/A
4	16+54	20.00	30'	N/A
5	17+00	20.00	30'	N/A
6	17+46	21.00	30'	N/A
7	17+92	22.00	30'	N/A
8	18+35	23.00	25'	19.01
9	18+62	23.00	30'	N/A
10	18+95	23.00	35'	N/A
11	19+27	24.00	30'	N/A

CONTRACTOR: CCN, Inc.

DATE: 01/06

INSPECTOR: ALS, Inc.

DATE: 01/06

FIELD ENGINEER: MGB

DATE: 01/06

VERIFICATION BY: MGB

DATE: 01/06

CORRECTED BY: MGB

DATE: 01/06

RECORDED BY: MGB

DATE: 01/06

NO.:

STATION MARK IS A STANDARD US&GS BRASS TABLET STAMPED

DATE: 01/06

LOCATED APPROXIMATELY 500' NORTHWEST OF THE INTERSECTION

DATE: 01/06

OF TENNYSON ST. AND SAN ANTONIO DR.

DATE: 01/06

X = 425,465.55

DATE: 01/06

Y = 1513,470.01

DATE: 01/06

Z = 6008.155

DATE: 01/06

RECORD DRAWING - UNIT I

DATE: 01/06

MARK GOODWIN, NMPE 8948

REVISIONS

DATE: 03/06

DESIGNED BY: DMG

DATE: 03/06

DRAWN BY: DBC

DATE: 03/06

CHECKED BY: DMG

DATE: 03/06

CITY OF ALBUQUERQUE

PUBLIC WORKS DEPARTMENT

ENGINEERING DEVELOPMENT GROUP

TITLE: CLARA VISTA SUBDIVISION

UTILITY IMPROVEMENTS

OSO VISTA AVE. & VULCAN VISTA AVE.


DESIGN REVIEW COMMITTEE: CITY ENGINEER APPROVAL

LAST DESIGN UPDATE: 01/06

CITY PROJECT NO. 5364.90

ZONE MAP NO. E23

SHEET 11 OF 13

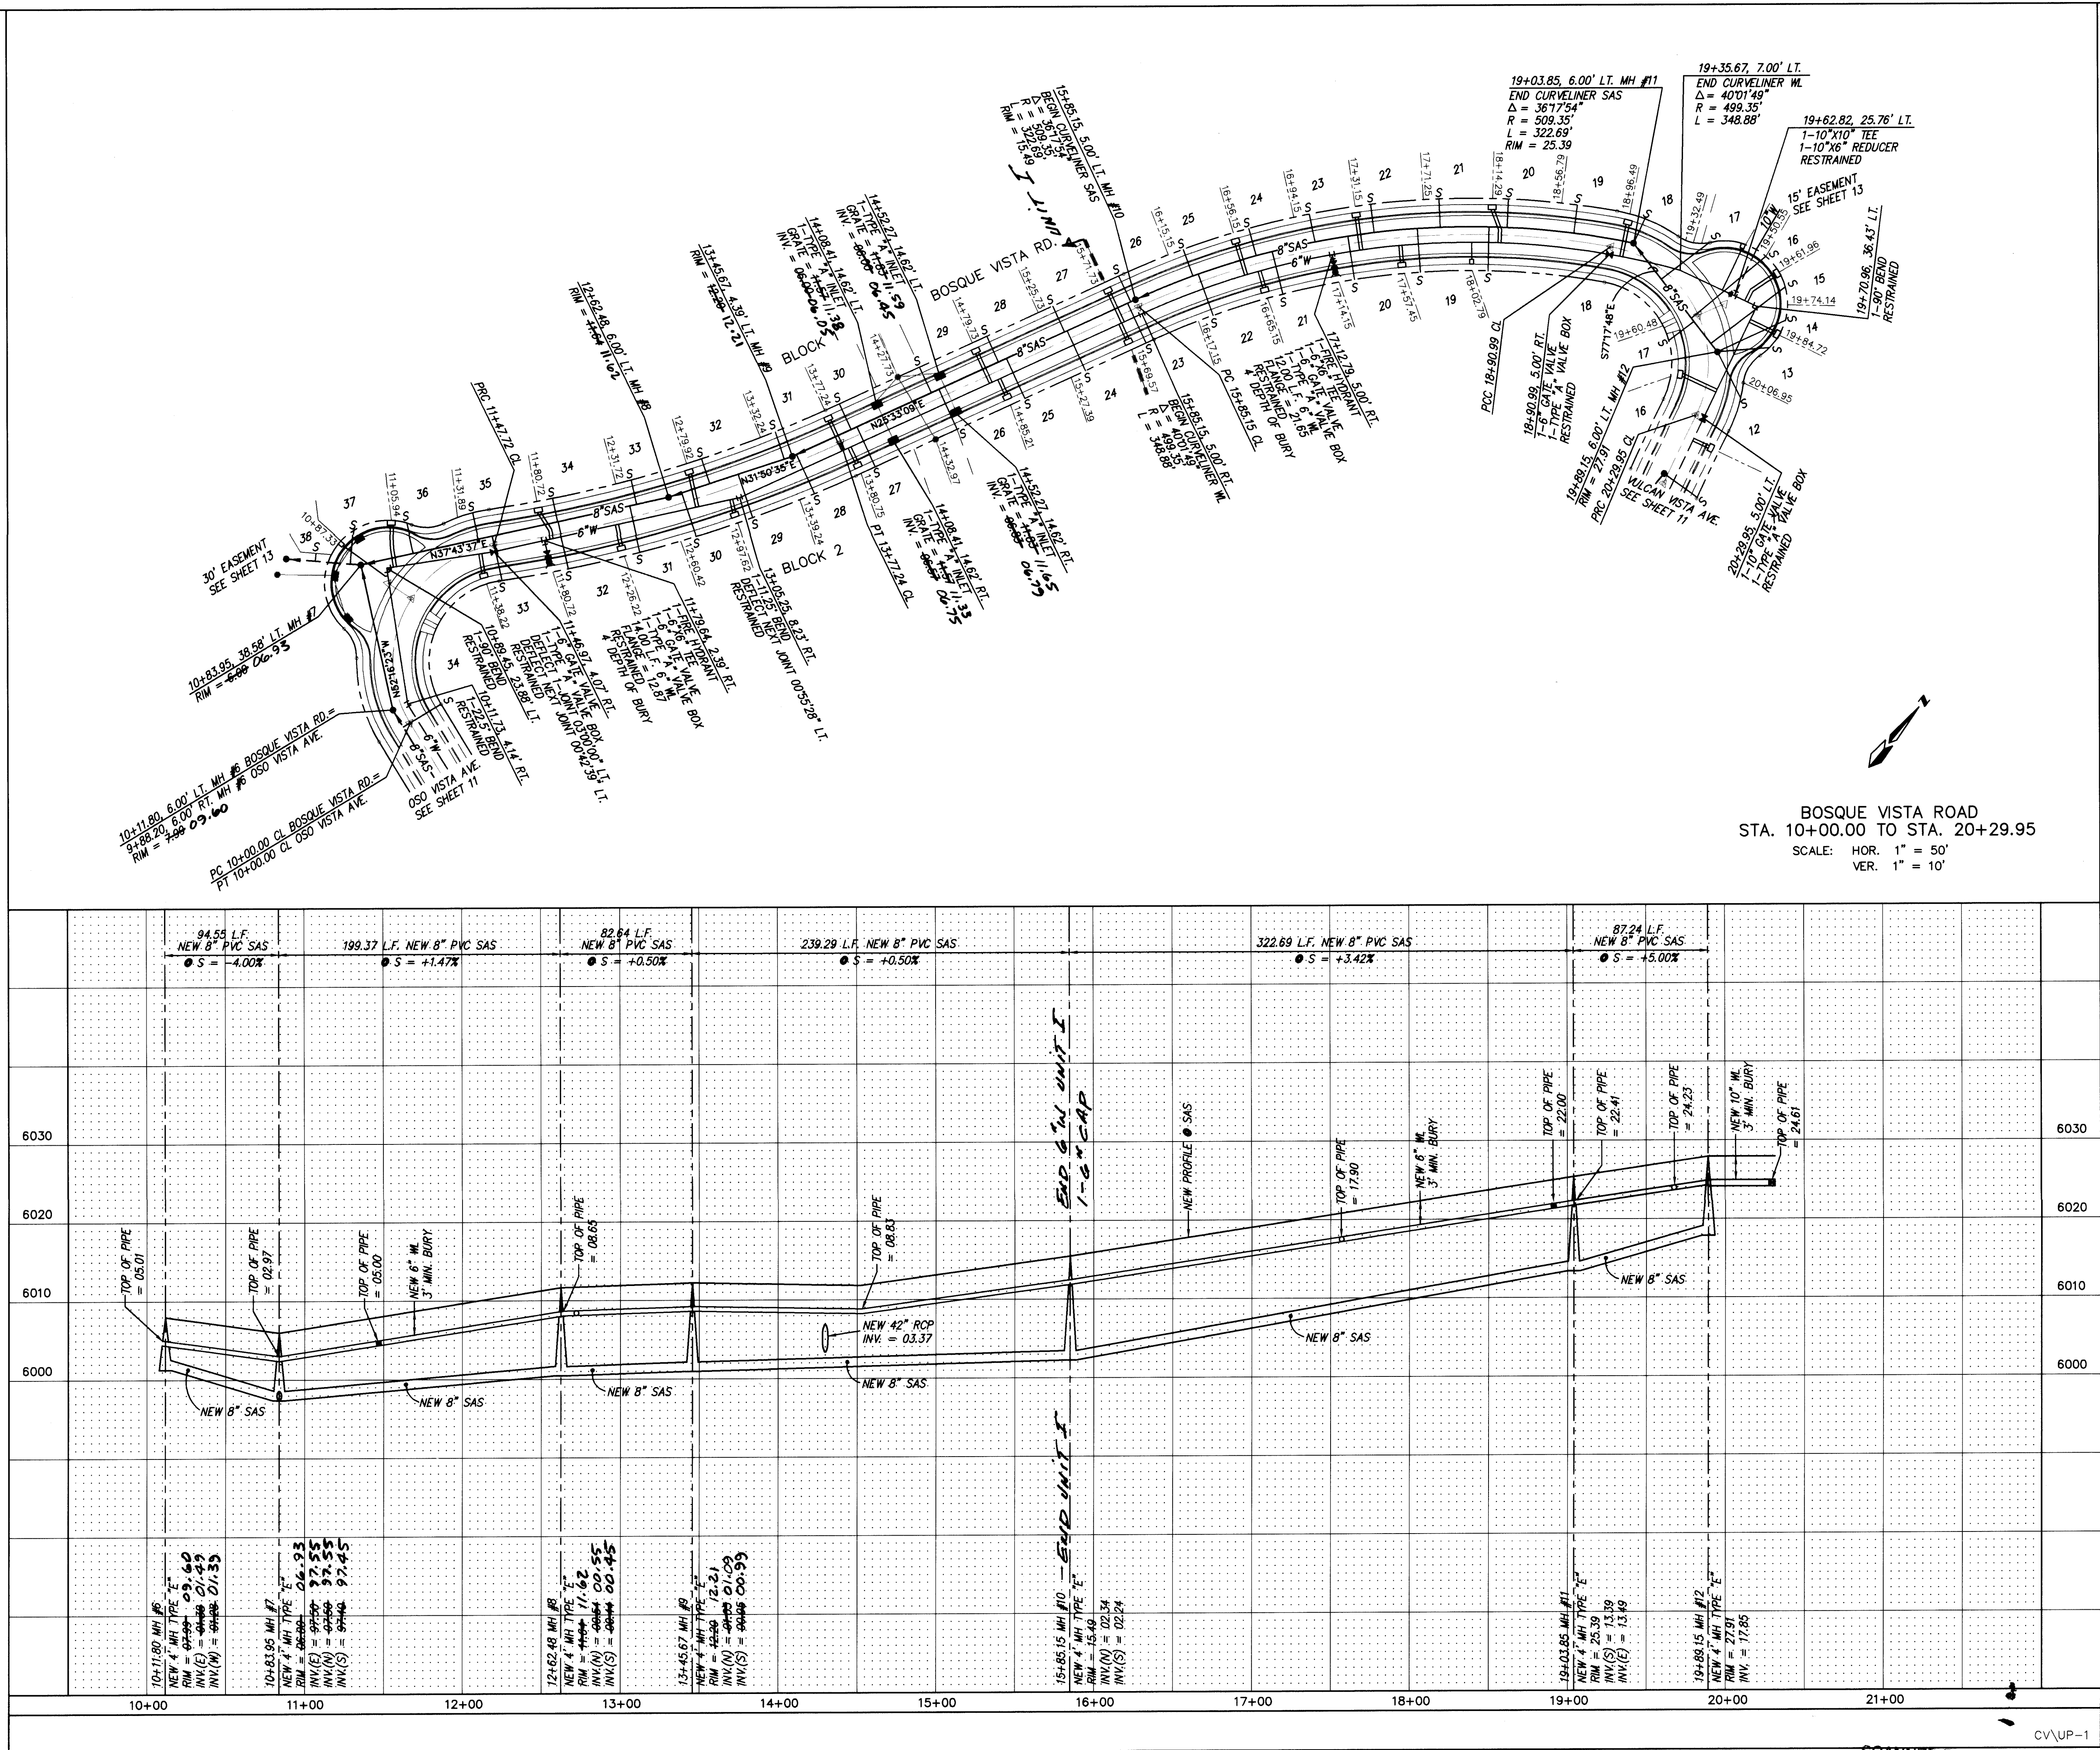

NOTES

1. ALL STATIONING IS CENTERLINE STATIONING.

SANITARY SEWER SERVICES				
LOT	STA.	INV. ELEV. PL	LENGTH PL	INV. ELEV. M.H.
BLK. 1	36	11+16	02.00	N/A
	35	11+41	02.00	N/A
	34	11+91	03.00	N/A
	33	12+42	04.00	N/A
	32	12+90	05.00	N/A
	31	13+42	05.00	N/A
	30	13+87	04.00	N/A
	29	14+43	05.00	N/A
	28	14+90	06.00	N/A
	27	15+36	07.00	N/A
	26	15+82	09.00	N/A
	25	16+25	10.00	N/A
BLK. 2	24	16+66	11.00	N/A
	23	17+04	12.00	N/A
	22	17+41	13.00	N/A
	21	17+81	15.00	N/A
	20	18+24	19.00	N/A
	19	18+67	20.00	N/A
	18	19+06	21.00	13.69
	17	19+42	22.00	N/A
	16	19+59	23.00	N/A
	15	19+72	23.00	N/A
	14	19+84	23.00	18.05
	13	19+95	24.00	18.05
12	20+17	24.00	18.05	

AS BUILT INFORMATION

CONTRACTOR: CCM, Inc.

WORK: SANITARY SEWER SERVICES

DATE: 03/96

STATIONED BY: M.D.

DATE: 03/96

FIELD: M.D.

DATE: 03/96

DRAWINGS: M.D.

DATE: 03/96

CORRECTED BY: M.D.

DATE: 03/96

RECORDED BY: M.D.

DATE: 03/96

NO.

BENCH MARKS

STATION MARK IS A STANDARD USCS BRASS TABLET STAMPED

"TUMBLE 1969" SET IN CONCRETE PROJECTING 0.2' ABOVE GROUND.

LOCATED APPROXIMATELY 500' NORTHWEST OF THE INTERSECTION

OF TENNYSON ST. AND SAN ANTONIO DR.

X = 425,405.55

Y = 1513,470.01

Z = 6009.155

SURVEY INFORMATION

FIELD NOTES

NO.

DATE

BY

ENGINEER'S SEAL

RECORD DRAWING - UNIT I

Mark Goodwin, MPE 8948

03/96

REMARKS

DESIGN

NO.

DATE

BY

DESIGNED BY

DWG

DATE

03/96

DRAWN BY

DBC

DATE

03/96

CHECKED BY

DWG

DATE

03/96

CITY OF ALBUQUERQUE

PUBLIC WORKS DEPARTMENT

ENGINEERING DEVELOPMENT GROUP

TITLE:

CLARA VISTA SUBDIVISION

UTILITY IMPROVEMENTS

BOSQUE VISTA ROAD

DESIGN REVIEW COMMITTEE

CITY ENGINEER APPROVAL

LAST DESIGN UPDATE

NO./DAY/YR.

NO./DAY/YR.

CITY PROJECT NO.

5364.90

ZONE MAP NO.

E23


SHEET

12


OF

13


SANITARY SEWER SERVICES				
LOT	STA.	INV. ELEV. PL	LENGTH PL	INV. ELEV. M.H.
BLK. 1				
38	12+29	00.00	5'	N/A
37	12+51	01.00	20'	N/A

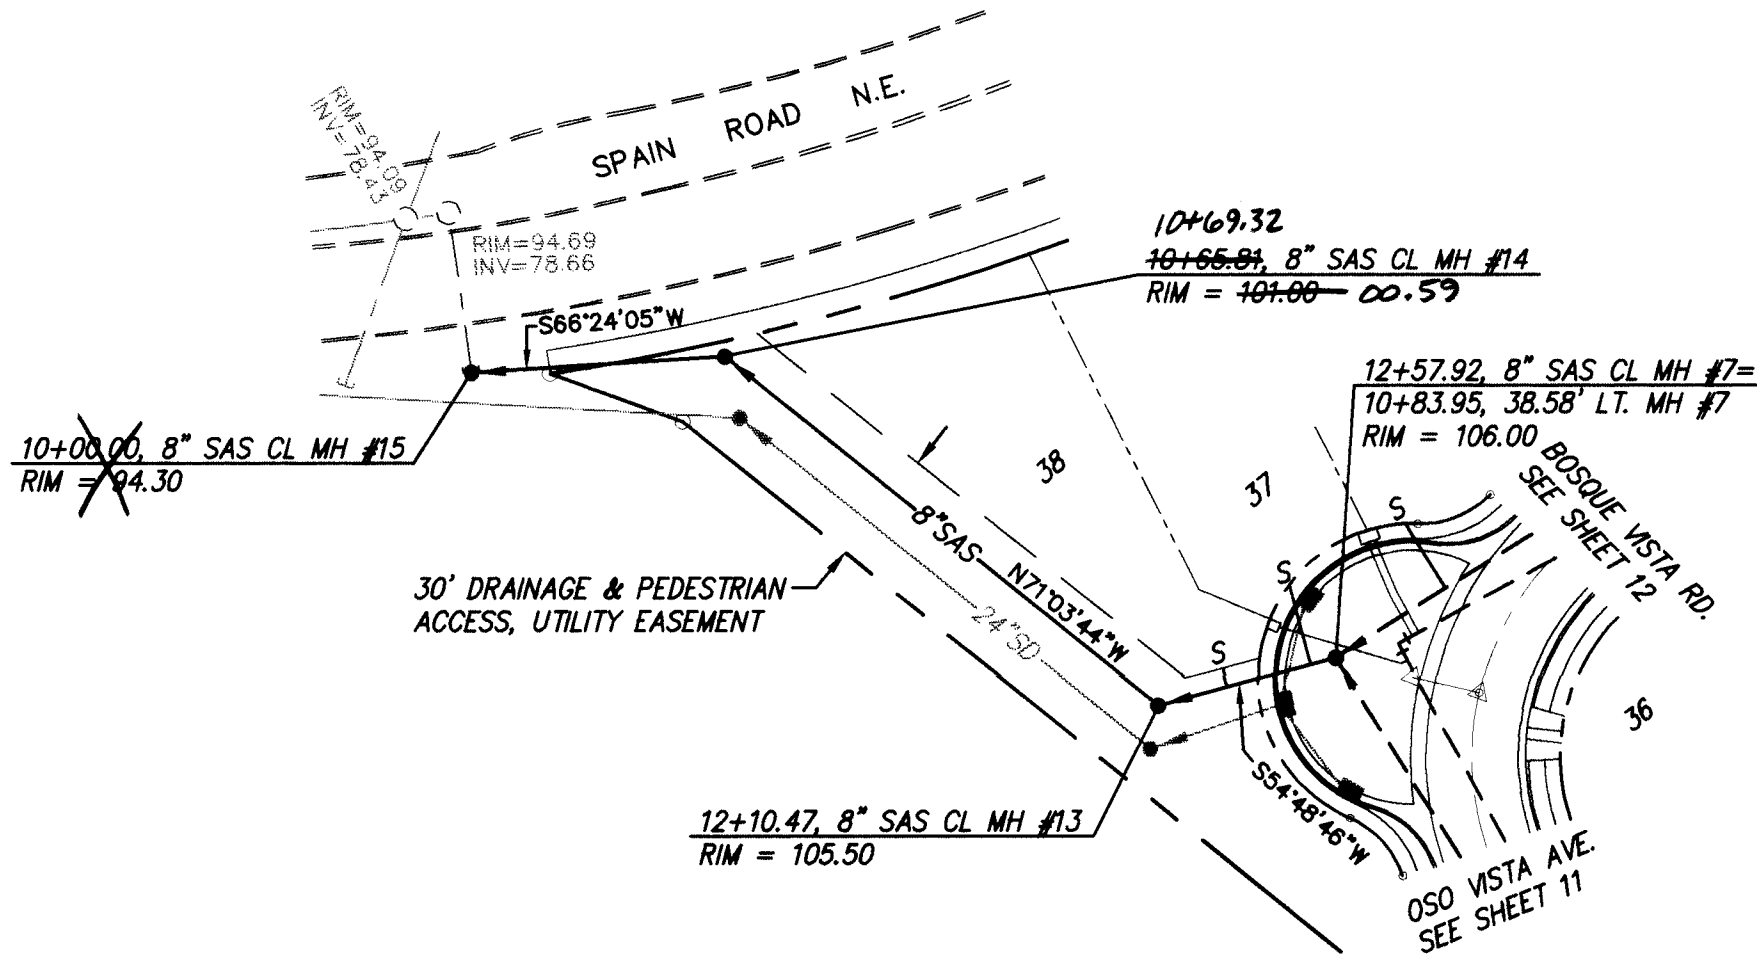


30' UTILITY EASEMENT
STA. 10+00.00 TO STA. 12+57.92
SCALE: HOR. 1" = 50'
VER. 1" = 10'

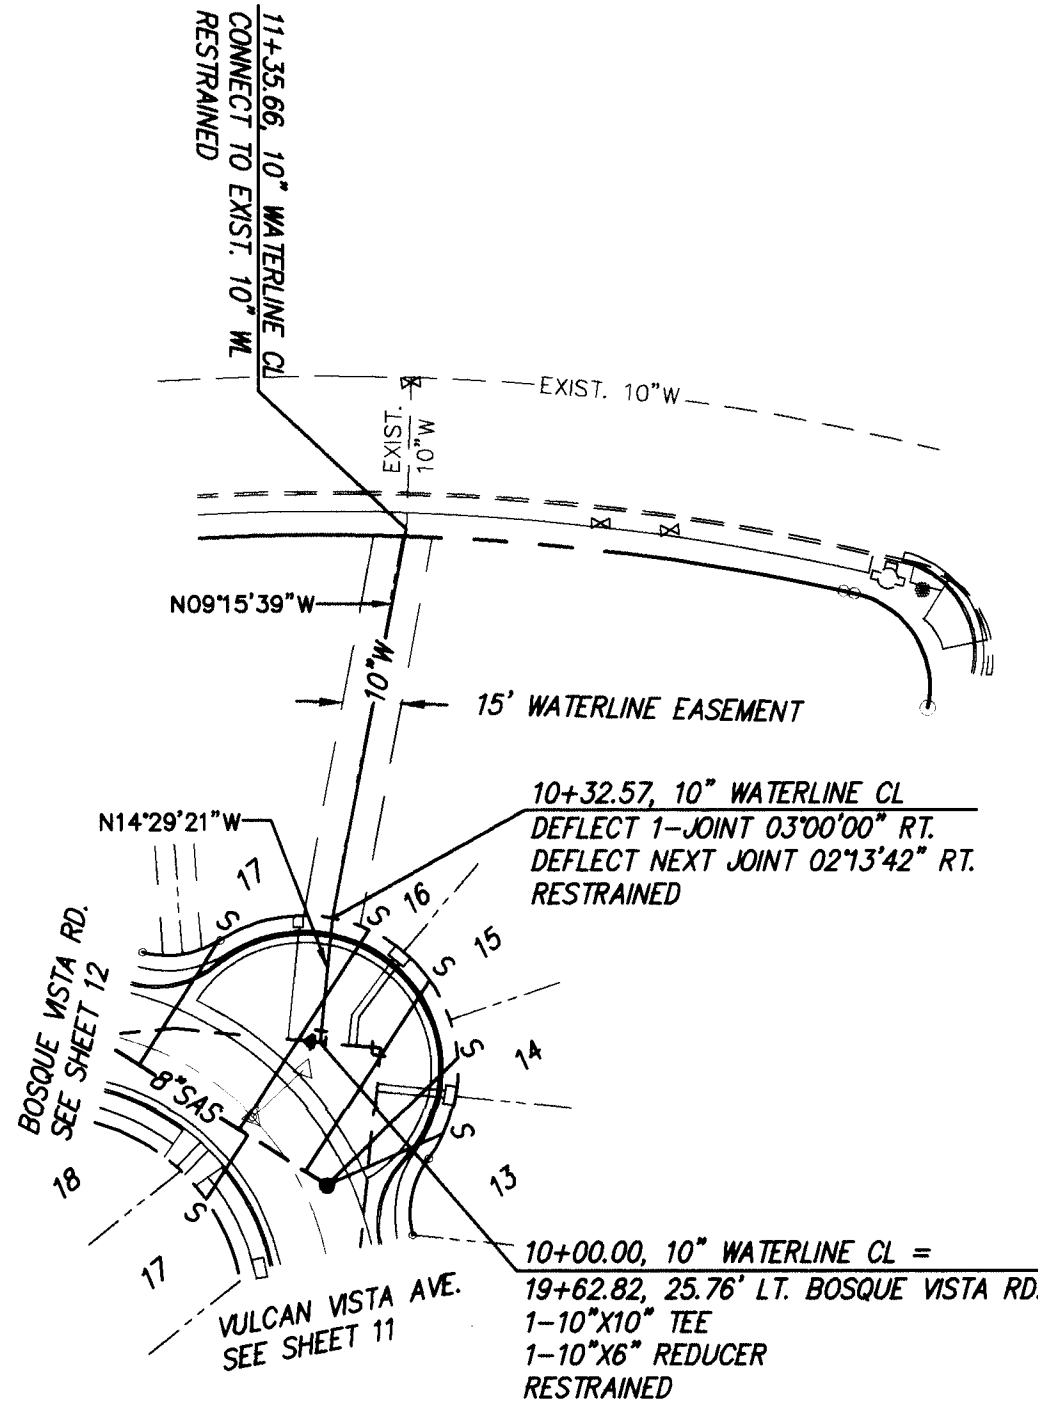

15' WATERLINE EASEMENT
STA. 10+00.00 TO STA. 11+34.60
SCALE: HOR. 1" = 50'
VER. 1" = 10'

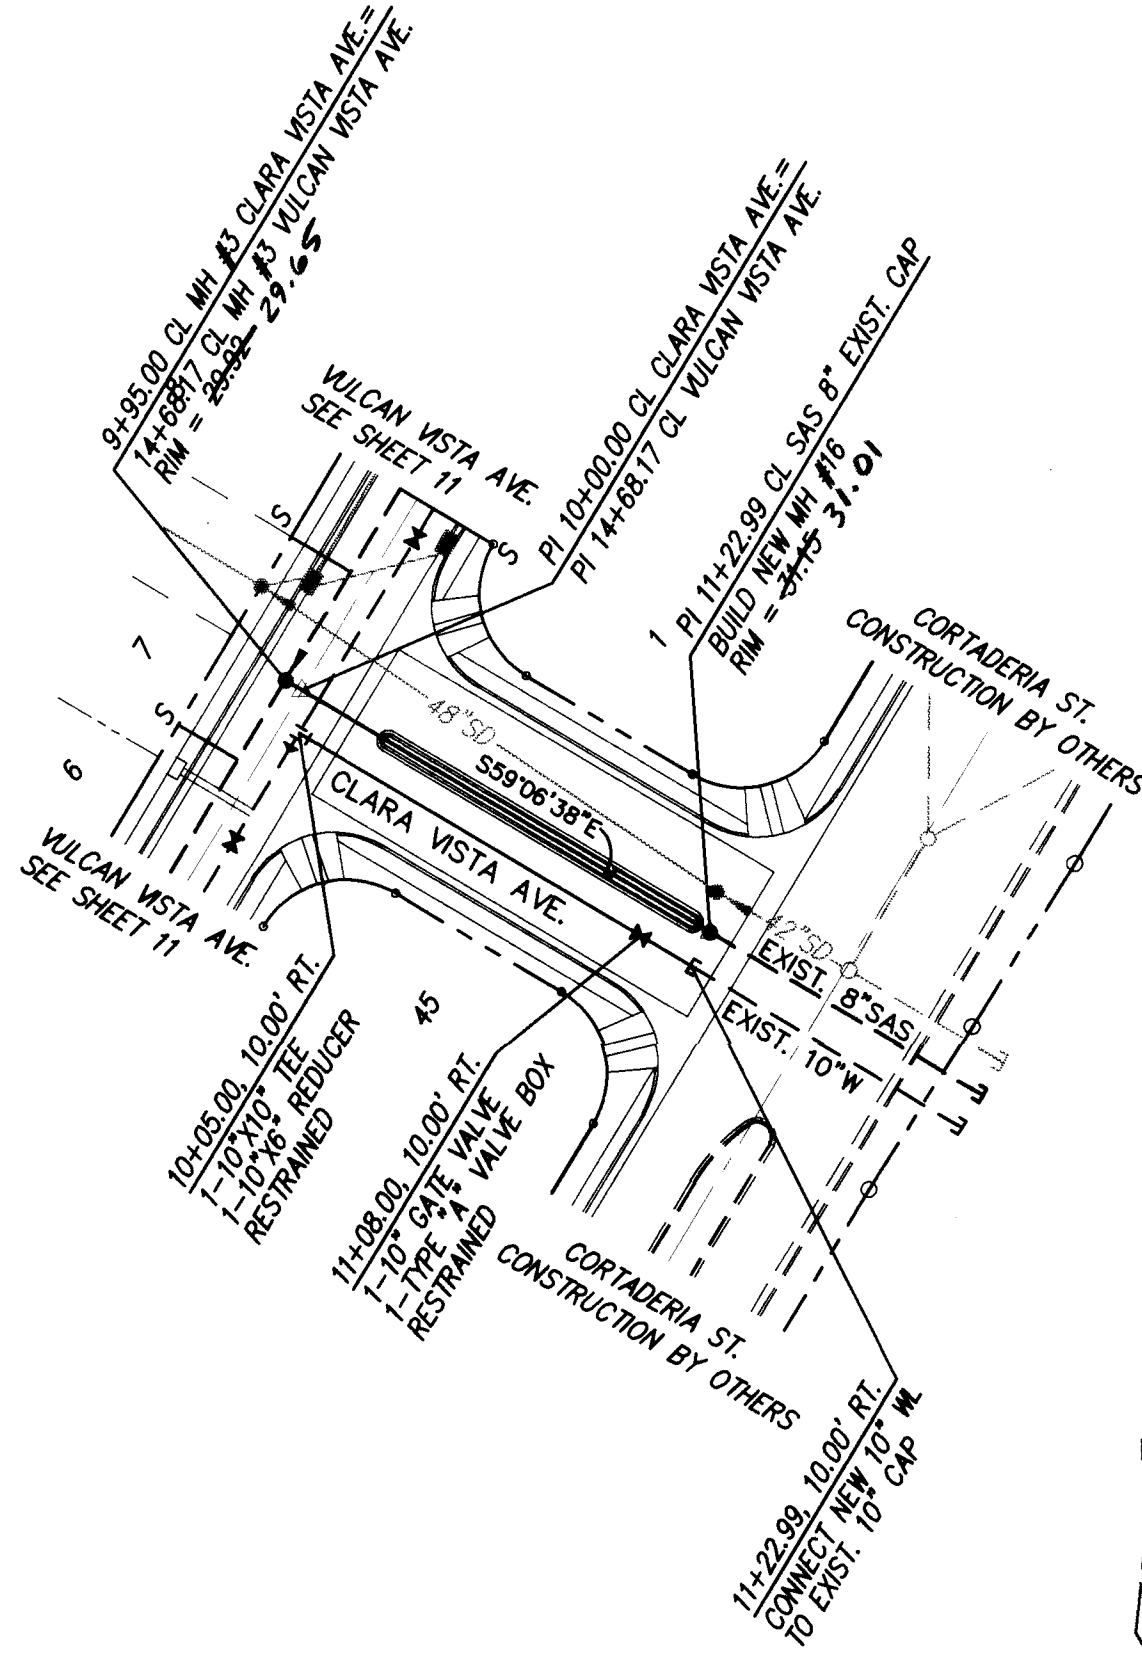

CLARA VISTA AVE.
STA. 9+95.00 TO STA. 11+22.99
SCALE: HOR. 1" = 50'
VER. 1" = 10'

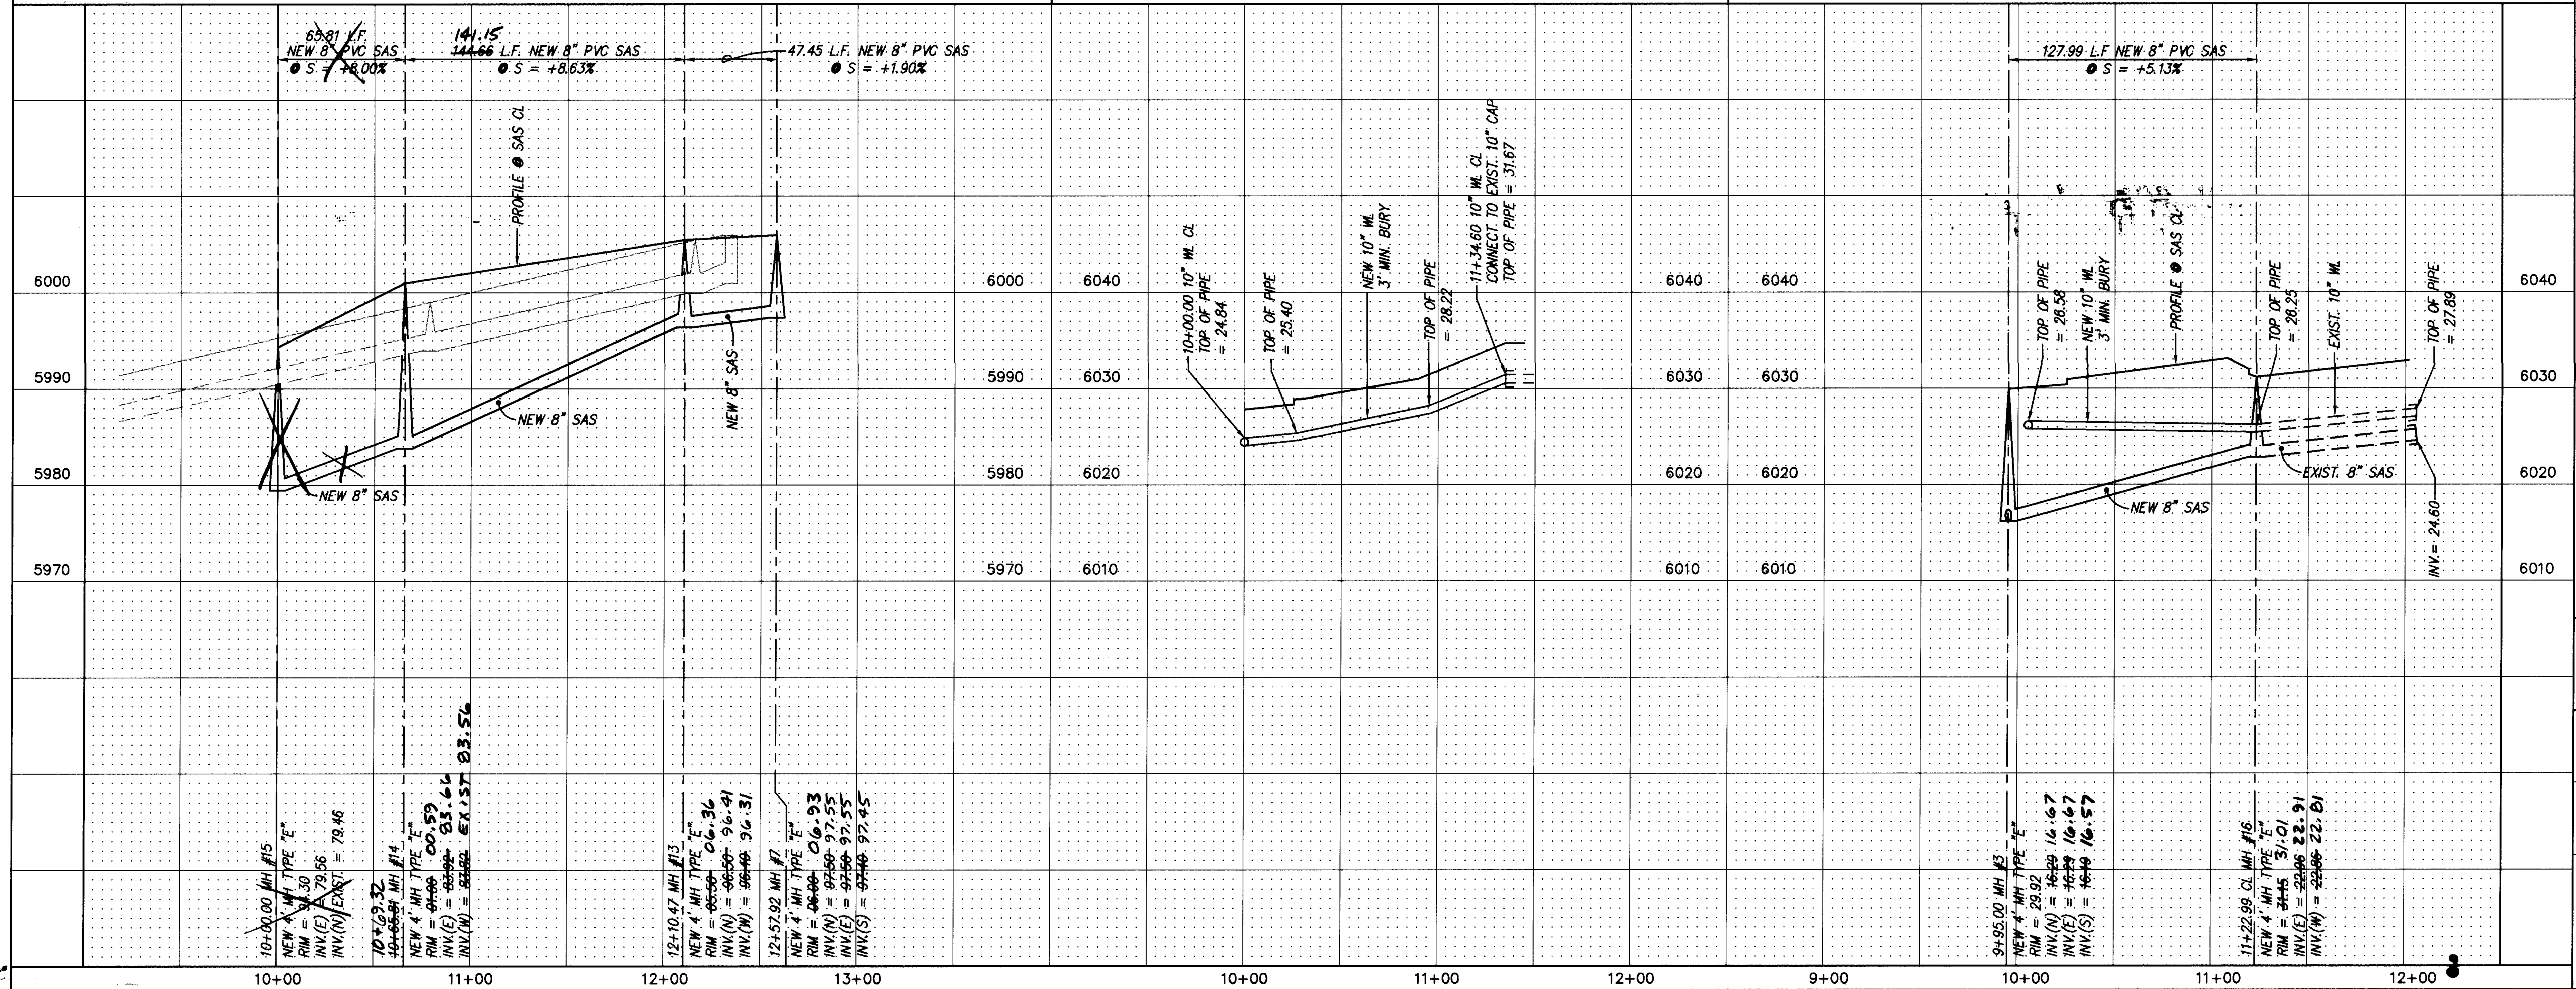

1	2	3	4	5	6	7	8	9	10	11	12	13	14	15
2	6	1	5	3	6	4	1	9	C	1	3	9	7	

dmg D. MARK GOODWIN & ASSOCIATES, P.A.
CONSULTING ENGINEERS & SURVEYORS
P.O. BOX 90606
ALBUQUERQUE, NEW MEXICO 87199
(505) 345-2010

CITY OF ALBUQUERQUE
PUBLIC WORKS DEPARTMENT
ENGINEERING DEVELOPMENT GROUP

TITLE: CLARA VISTA SUBDIVISION
UTILITY IMPROVEMENTS
CLARA VISTA AVE. & UTILITY EASEMENTS

DESIGN REVIEW COMMITTEE

CITY ENGINEER APPROVAL

DATE

MO./DAY/YR.

LAST DESIGN UPDATE

DATE

MO./DAY/YR.

CITY PROJECT NO.

ZONE MAP NO.

SHEET OF


5364.90

E23

13 OF 13


SCANNED BY LASON

CVUP-3

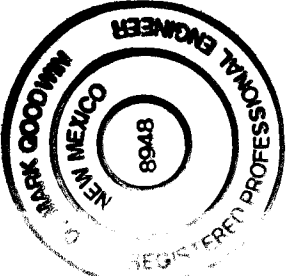

I hereby certify that the information contained on this drawing has been reviewed in accordance with information furnished by the Contractor, CCM, Inc., and by the Surveyor, ALS, Inc., and reflects the substantial compliance with the Approved Plan.

Mark Goodwin, NMPE 8948

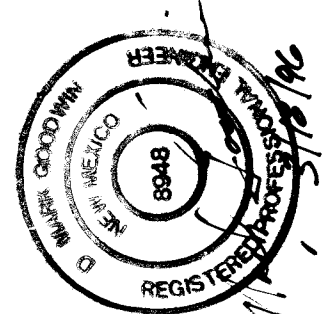

REVISIONS

NO.	DATE	REMARKS
1	03/96	DESIGN
2	03/96	DESIGN
3	03/96	DESIGN

SURVEY INFORMATION	
FIELD NOTES	DATE
NO.	BY

BENCH MARKS	
STATION MARK IS A STANDARD USAGS BRASS TABLET STAMPED	DATE
"TUMBLE 1969" SET IN CONCRETE PROJECTING 0.2' ABOVE GROUND.	DATE
LOCATED APPROXIMATELY 500' NORTHWEST OF THE INTERSECTION	DATE
OF TENNISON ST. AND SAN ANTONIO DR.	DATE
X = 425,465.55	DATE
Y = 1513,470.01	DATE
Z = 6008.155	DATE

AS BUILT INFORMATION	
CONTRACTOR	CCM, Inc.
WORK	DATE
INSPECTOR'S	DATE
FIELD	DATE
VERIFICATION	DATE
CORRECTED BY	DATE
MICRO-FILM INFORMATION	DATE
RECORDED BY	DATE
NO.	DATE