

CONSTRUCTION PLANS FOR LARRY R. & DYLIA C. VIGIL SUBDIVISION ALBUQUERQUE, NEW MEXICO

SCANNED BY
MESA REPRO

INDEX

SHEET NO.	SHEET TITLE
1	TITLE SHEET
2	PLATS
3	DRAINAGE CALCULATIONS
4	GRADING IMPROVEMENTS
5	MASTER UTILITY PLAN
6	SAS & WATER PLAN & PROFILE - LARRY & DYLIA VIGIL STREET
7	SAS & WATER PLAN & PROFILE - LARRY & DYLIA VIGIL STREET
8	SAS & WATER PLAN & PROFILE - ROADWAY "B" & ROADWAY "C"
9	MISCELLANEOUS UTILITY DETAILS
10	MASTER STREET PAVING IMPROVEMENTS PLAN & NEW SIGNAGE
11	PAVING PLAN & PROFILE - LARRY & DYLIA VIGIL STREET
12	PAVING PLAN & PROFILE - LARRY & DYLIA VIGIL STREET & VIGIL LANE
13	PAVING PLAN & PROFILE - VIGIL LANE
14	SIGNING AND CONSTRUCTION TRAFFIC CONTROL STANDARDS (BERNALILLO COUNTY)
15	TYPICAL TRAFFIC CONTROL AND SIGNING EXAMPLES (REF. M.U.T.C.D.)


APPROVED AS RECORD DRAWINGS
DESIGN REVIEW SECTION
CITY OF ALBUQUERQUE
DATE: 11/2/03



RECORD DRAWINGS

I, Gilbert Aldaz of the firm of Applied Engineering & Surveying, Inc., a Registered Professional Engineer in the State of New Mexico, do hereby certify, to the best of my knowledge and belief, that the infrastructure installed as part of this project has been inspected by me or by a qualified person under my direct supervision and has been constructed in accordance with the plans and specifications approved by the City Engineer and Bernalillo County Public Works, that the original design intent of the approved plans has been met, except as noted by me on the as-built construction drawings. This certification is based on site inspections by me or personnel under my direction.

Roxanne Blake Blatz 10/06/03
BERNALILLO COUNTY PUBLIC
WORKS DEPT. APPROVAL

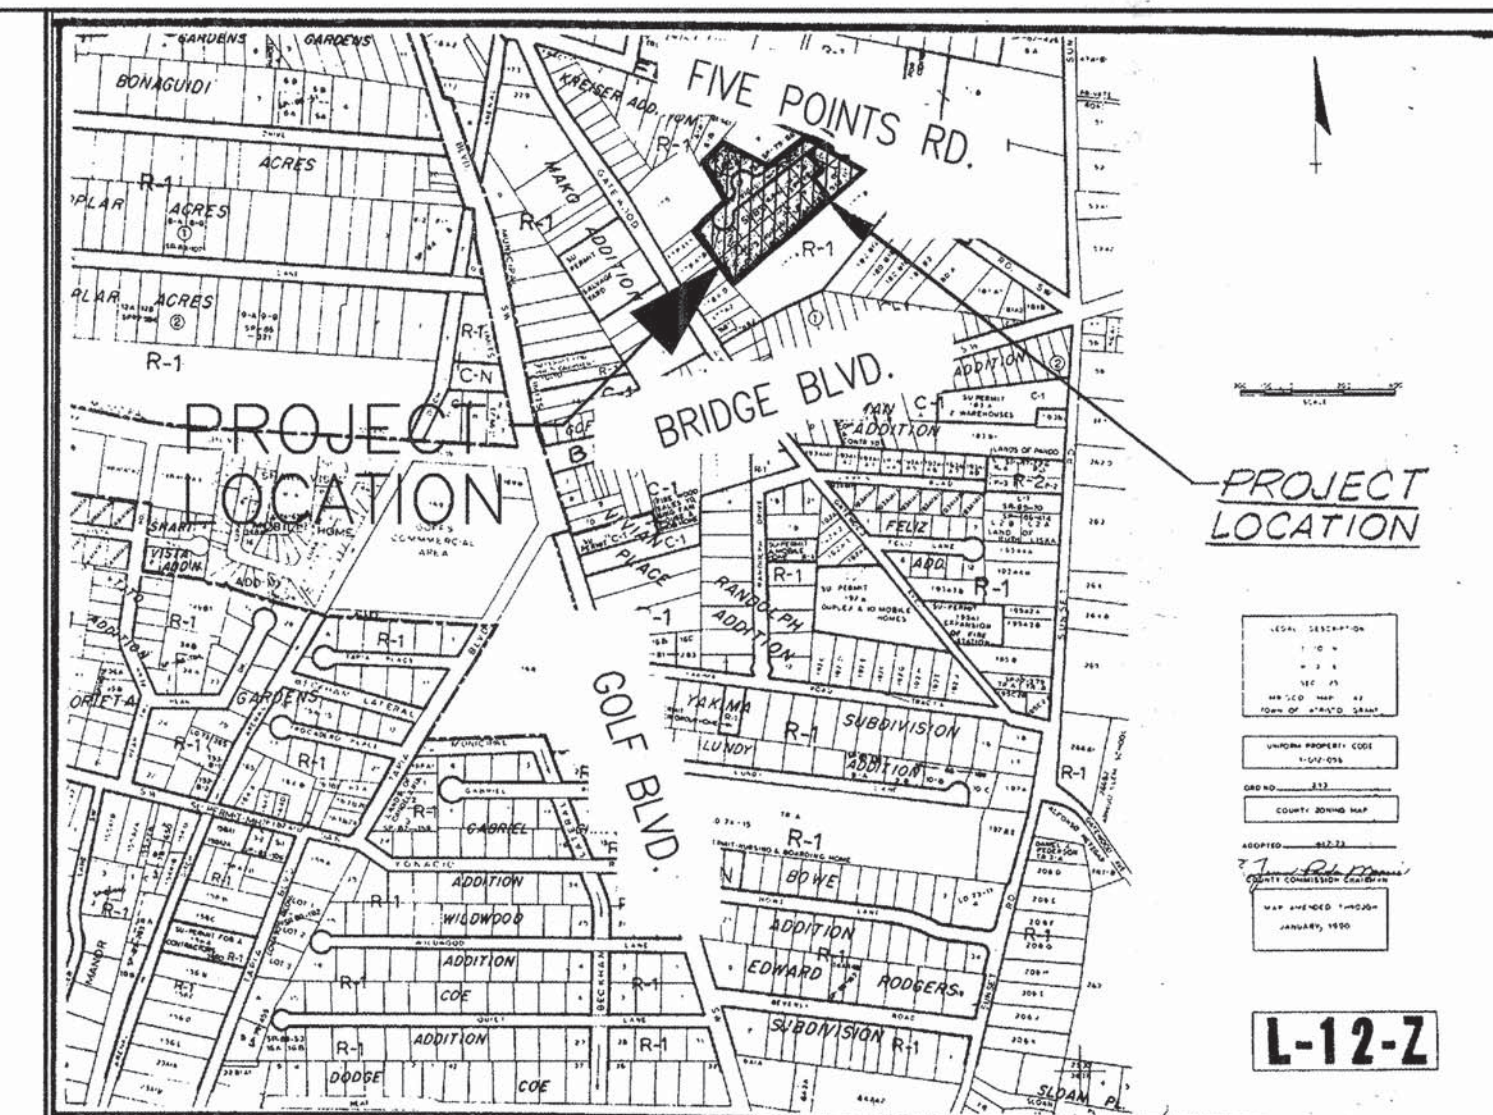

VICINITY MAP (L - 12)

GENERAL NOTES NOTICE TO CONTRACTORS

- CITY OF ALBUQUERQUE SPECIFICATIONS FOR PUBLIC WORKS CONSTRUCTION, 1986 EDITION AS AMENDED THROUGH UPDATE 6, WILL BE REFERRED TO HEREIN AS THE "STANDARD SPECIFICATIONS" FOR ALL UTILITY WORK. BERNALILLO COUNTY PUBLIC WORKS DEPARTMENT STANDARDS AND SPECIFICATIONS SHALL APPLY TO ALL ROADWORK AND SIGNAGE.
- TWO WORKING DAYS PRIOR TO ANY EXCAVATION, CONTRACTOR MUST CONTACT NEW MEXICO ONE CALL SYSTEM (260-1990) AND DETERMINE LOCATION OF EXISTING UTILITIES.
- PRIOR TO ANY CONSTRUCTION, THE CONTRACTOR SHALL EXCAVATE AND VERIFY THE HORIZONTAL AND VERTICAL LOCATIONS OF ALL OBSTRUCTIONS. SHOULD A CONFLICT EXIST, THE CONTRACTOR SHALL NOTIFY THE ENGINEER OR THE SURVEYOR SO THAT THE CONFLICT CAN BE RESOLVED WITHOUT DELAY.
- ALL EXISTING SIGNS, MARKERS, DELINEATORS, ETC. WITHIN THE CONSTRUCTION LIMITS SHALL BE REMOVED, STORED AND RE-SET BY THE CONTRACTOR.
- THE CONTRACTOR SHALL NOTIFY THE ENGINEER NOT LESS THAN SEVEN (7) DAYS PRIOR TO STARTING WORK IN ORDER THAT THE ENGINEER MAY TAKE NECESSARY MEASURES TO INSURE THE PRESERVATION OF SURVEY MONUMENTS. CONTRACTOR SHALL NOT DISTURB PERMANENT SURVEY MONUMENTS WITHOUT THE CONSENT OF THE ENGINEER AND SHALL NOTIFY THE ENGINEER AND BEAR THE EXPENSE OF REPLACING ANY THAT MAY BE DISTURBED WITHOUT PERMISSION. REPLACEMENT SHALL BE DONE ONLY BY THE CITY SURVEYOR. WHEN A CHANGE IS MADE IN THE FINISHED ELEVATIONS OF THE PAVEMENT OF ANY ROADWAY IN WHICH A PERMANENT SURVEY MONUMENT IS LOCATED, CONTRACTOR SHALL, AT HIS OWN EXPENSE, ADJUST THE MONUMENT COVER TO THE NEW GRADE UNLESS OTHERWISE SPECIFIED. REFER TO SECTION 4.4 OF THE GENERAL CONDITIONS OF THE STANDARD SPECIFICATIONS.
- THESE PLANS ARE SUBJECT TO THE REQUIREMENTS OF COUNTY ORDINANCE NO 95-12 AND RESOLUTION NO. AR120-95. THREE (3) WORKING DAYS PRIOR TO BEGINNING CONSTRUCTION THE CONTRACTOR SHALL SUBMIT A TRAFFIC CONTROL PLAN AND BARRICADING PERMIT APPLICATION TO BERNALILLO COUNTY TRAFFIC ENGINEERING (848-1504).
- ALL STREET STRIPING ALTERED OR DESTROYED SHALL BE REPLACED WITH PLASTIC REFLECTORIZED BY CONTRACTOR TO LOCATION AS EXISTING OR AS INDICATED BY THIS PLAN SET.
- WATER SHUTOFF REQUIREMENTS: THE CONTRACTOR SHALL BE RESPONSIBLE FOR TIMING AND COORDINATION OF WATER SHUTOFF. AT LEAST SEVEN (7) WORKING DAYS PRIOR TO CONSTRUCTION, CONTRACTOR SHALL CONTACT THE WATER SYSTEMS DIVISION, 857-8200, TO INITIATE IMPLEMENTATION OF THE NON-PRESSURIZED CONNECTION PLAN. IN ORDER TO COMPLETE THIS CONNECTION, THE FOLLOWING VALVES MUST BE CLOSED BY WATER SYSTEM PERSONNEL: VALVE NO. 471 AND VALVE NO. 541 SHOWN ON SHEET 3.
- BERNALILLO COUNTY INSPECTOR TO VERIFY EXISTING PAVEMENT THICKNESS PRIOR TO PATCHING UTILITY CUT ON FIVE POINT ROAD.

1 2 3 4 5 6 7 8 9 10 11 12 13 14 15
26 5365.90 90 05

APPLIED ENGINEERING AND
SURVEYING, INC.
ENGINEERS AND PLANNERS
1000 Blue Circle NE
Albuquerque, New Mexico 87112
Office (505) 237-1455
Facsimile (505) 237-1455

REV.	SHEETS	CITY ENGINEER	DATE	USER DEPARTMENT	DATE	USER DEPARTMENT	DATE
ENGINEERS STAMP & SIGNATURE	APPROVALS	ENGINEER	DATE	*****			
	DRC Chairman	<i>[Signature]</i>	10-23-03	APPROVED FOR CONSTRUCTION			
	Transportation	<i>[Signature]</i>	11-20-03				
	Water/Wastewater	<i>[Signature]</i>	8/1/03				
	Hydrology	<i>[Signature]</i>	7/30/03				
	Parks	<i>[Signature]</i>	10-23-03				
Constr.	<i>[Signature]</i>						
CITY PROJECT No.				5365.90	Sheet 1 of 15		

THE FOLLOWING ITEMS CONCERNING THE VIGIL SUBDIVISION GRADING AND DRAINAGE PLAN ARE CONTAINED HEREON:

- ### EXISTING CONDITIONS

ACCORDING TO THE FLOOD INSURANCE RATE MAP, PANEL 35001C0333 D, DATED SEPTEMBER 20, 1996, THIS SITE DOES NOT LIE IN A DESIGNATED 100-YEAR FLOOD PLAIN.

PROPOSED CONDITIONS

CURRENTLY THERE ARE NO EXISTING PUBLIC DRAINAGE IMPROVEMENTS ADJACENT TO THIS SITE. IT IS THE INTENT OF THIS PLAN TO PROVIDE A FLAT GRADING SCHEME BY PROVIDING A POND WITHIN EACH LOT. THIS POND WOULD ACCEPT DRAINAGE FLOWS FROM THE NEW PAVED STREET FRONTAGE AND ACCOMMODATE THE IMPERVIOUS AREA WITHIN EACH LOT. THE FINISH FLOOR FOR EACH LOT WILL BE ELEVATED ONE FOOT ABOVE THE 10-DAY, 100-YEAR WATER SURFACE ELEVATION. A FLOODWALL WILL BE CONSTRUCTED AT THE PERIMETER OF THE EXISTING 16-LOT SUBDIVISION TO CONTAIN THE 10-DAY, 100-YEAR WATER SURFACE ELEVATION. THE ASPHALT PAVING WILL BE ELEVATED ABOVE THE 10-DAY, 100-YEAR WATER SURFACE ELEVATION IN ORDER TO MINIMIZE DRAINAGE PONDING WITHIN THE ASPHALT PAVING.

DOWNSTREAM CAPACITY

EROSION CONTROL

OFFSITE FLOWS

THERE ARE NO OFFSITE FLOWS THAT ENTER THIS PROPERTY, SINCE THE SURROUNDING PROPERTY IS RELATIVELY FLAT.

DRAINAGE CALCULATIONS

- | TREATMENT | AREA (ACRES) |
|-----------|--------------|
| A | 4.13 |
| B | 0.18 |
| C | 0.18 |
| D | 0.17 |

$$Q(\text{EXISTING}) = (1.29 \times 4.13) + (2.03 \times 0.18) + (2.87 \times 0.18) + (4.37 \times 0.17) \\ = 6.9 \text{ CFS ENTIRE SUBDIVISION}$$

$$V(\text{EXISTING-6HR}) = (0.44 \times 4.13) + (0.67 \times 0.18) + (0.99 \times 0.18) + (1.97 \times 0.17) / 12$$

$$= 0.20 \text{ AC-FT ENTIRE SUBDIVISION}$$

<u>TREATMENT</u>	<u>AREA(ACRES)</u>
A	0
B	1.12
C	1.12
D	1.61

$$V(\text{PROPOSED-6HR}) = (0.67 \times 1.12) + (0.99 \times 1.12) + (1.97 \times 1.61)/12$$

$$= 0.42 \text{ AC-FT}$$

$$V(\text{PROPOSED}-10\text{DAY}) = 0.42\text{AC-FT} + 1.61\text{AC} \times ((3.67 - 2.20)/12) \\ = 0.62\text{AC-FT}$$

WATER SURFACE DEPTH (PROPOSED 6HR) = (6HR VOLUME / AREA OF TREATMENT "B" + TREATMENT "C")

$$\text{WATER SURFACE DEPTH (PROPOSED 6HR)} = (0.42\text{AC-FT} \times 43,560\text{SF/AC}) / 2 \times 48,787\text{SF} = 0.19\text{FEET OF DEPTH} = 2.25\text{INCHES}$$

WATER SURFACE DEPTH (PROPOSED 10DAY) = (10DAY VOLUME / AREA OF TREATMENT "B" + TREATMENT "C")

WATER SURFACE DEPTH (PROPOSED 10DAY) = $(0.62\text{AC-FT} \times 43,560\text{SF/AC} / 2 \times 48,787\text{SF}) = 0.28\text{FEET OF DEPTH, USE } 0.30 \text{ FEET OF DEPTH}$
= 3.60INCHES

USE POND BOTTOM ELEVATION = 4942.70

MINIMUM TOP OF WALL ELEVATION TO CONTAIN 10DAY VOLUME
= 4942.70 FEET + 0.30FEET = 4943.00FEET

MINIMUM FINISH FLOOR ELEVATION TO BE 1FOOT ABOVE 10DAY VOLUME = 4943.00FEET + 1FOOT = 4944.00

MINIMUM TOP OF PAVED AREA ELEVATION TO MINIMIZE ENCROACHMENT OF 10DAY VOLUME = 4943.00




TOPOGRAPHIC SURVEY

THE EXISTING TOPOGRAPHY SHOWN ON THIS SHEET WAS DEVELOPED FROM A FIELD SURVEY PERFORMED JULY 21, 1995 BY MARCUS SURVEYING CO., INC. A FIELD REVIEW OF THE SITE WAS PERFORMED ON JUNE 8, 1996. THIS REVIEW REVEALED THAT ALL THE INFORMATION SHOWN ON THIS PLAN IS CONSISTENT WITH THE ACTUAL CONDITIONS THAT EXIST IN THE FIELD AND, TO THE BEST OF MY KNOWLEDGE TO DATE, THERE HAS BEEN NO GRADING ACTIVITY.

APPLIED ENGINEERING AND SURVEYING, INC.						No.	Date	DESIGNED BY	DRAWN BY	CHECKED
ENGINEERS AND PLANNERS										
1805 Blair Drive NE Office: (505) 237-1456		Albuquerque, New Mexico 87113 Facsimile: (505) 237-1456								
CITY OF ALBUQUERQUE PUBLIC WORKS DEPARTMENT ENGINEERING DEVELOPMENT GROUP										
TITLE: DRAINAGE CALCULATIONS										
Design Review Committee _____ City Engineer Approval _____ For Information Only				Lent Design Update	Mo./Day/Yr. 		Mo./Day/Yr. 			
City Project No. 5365.90					Zone Map No. L-12	Sheet 3		Of 15		

SCANNED BY
MESA REPRO

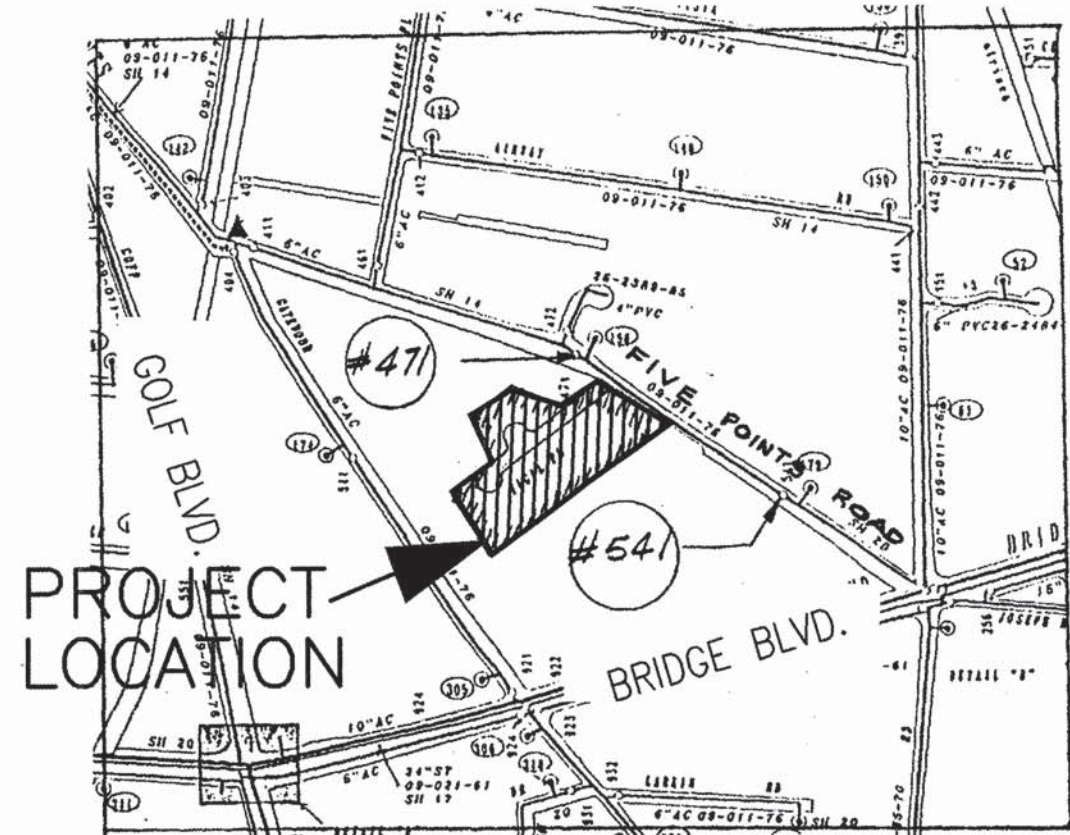

VICINITY MAP (L - 12)

TO ISOLATE THE WATER LINE IN FIVE POINTS ROAD, IT IS NECESSARY TO CLOSE THE FOLLOWING VALVES SHOWN ON THE ABOVE PLAN AS CIRCLED:

VALVE No. 471
VALVE No. 541


Water Shutoff Requirements: The Contractor shall be responsible for timing and coordination of water shutoff. At least seven (7) working days prior to construction, Contractor shall contact the Water Systems Division, 857-8200, to initiate implementation of the non-pressurized connection plan. In order to complete this connection, the following valves must be closed by Water Systems personnel: Valve No. 471 and Valve No. 541 shown on this sheet.

MECHANICAL RESTRAINT NOTES:

- MECHANICALLY RESTRAINED JOINTS WILL TYPICALLY BE USED FOR RESTRAINING NEW WATER LINES.
- CONCRETE THRUST BLOCKING WILL ONLY BE USED WHERE SPECIFICALLY IDENTIFIED ON THE PLANS.
- CONCRETE THRUST BLOCKS SHALL NOT BE USED TOGETHER WITH MECHANICALLY RESTRAINED JOINTS FOR RESTRAINT OF A SINGLE FITTING.
- IN NO CASE SHALL DRY CONCRETE THRUST BLOCKING BE USED FOR JOINT RESTRAINT.
- MECHANICALLY RESTRAINED PIPE LENGTHS WERE CALCULATED USING EBAA IRON'S THRUST RESTRAINING SYSTEM.
- SPECIAL CONSIDERATION MAY BE NEEDED TO MEET CERTAIN FIELD CONDITIONS. RESTRAINT LENGTHS MAY EXTEND INTO EXISTING WATER MAINS, REQUIRING RESTRAINED FITTINGS TO BE PLACED AT EXISTING WATERLINE JOINTS FOR THE LENGTH SPECIFIED IN THE TABLES ON THIS SHEET. LENGTHS OF MECHANICALLY RESTRAINED PIPE MAY OVERLAP TO DETERMINE GREATEST RESTRAINT LENGTH IN ANY ONE DIRECTION.
- ALL JOINTS AT FITTINGS SHALL BE RESTRAINED.
- DESIGN ASSUMPTIONS FOR MECHANICALLY RESTRAINED JOINTS:
SAFETY FACTOR: 1.5
PRESSURE: 150 psi (1034 kPa) (FIRELINES REQUIRE)
SOIL TYPE: GM - SILTY GRAVELS
PIPE: AS NOTED
TRENCH TYPE: 3 (PIPE BEDDED IN 4 INCHES (102 mm) 200 psi (1379 kPa))
BURIAL DEPTH: 3' (0.9 m) TO TOP OF PIPE
MINIMUM LOOSE SOIL BACKFILL LIGHTLY CONSOLIDATED TO TOP OF THE PIPE.)
- FOR SITUATIONS DIFFERING FROM THOSE SHOWN OR NOTED IN NOTE 9 CONSULT THE DESIGN ENGINEER OR EBAA IRON SALES, INC. AT 1-800-433-1716.

GENERAL NOTES:

- ALL WATER SERVICE - INSTALL HEAVY WEIGHT BOX COVER & LID PER STD. DWG. SHOWN ON SHEET 7.

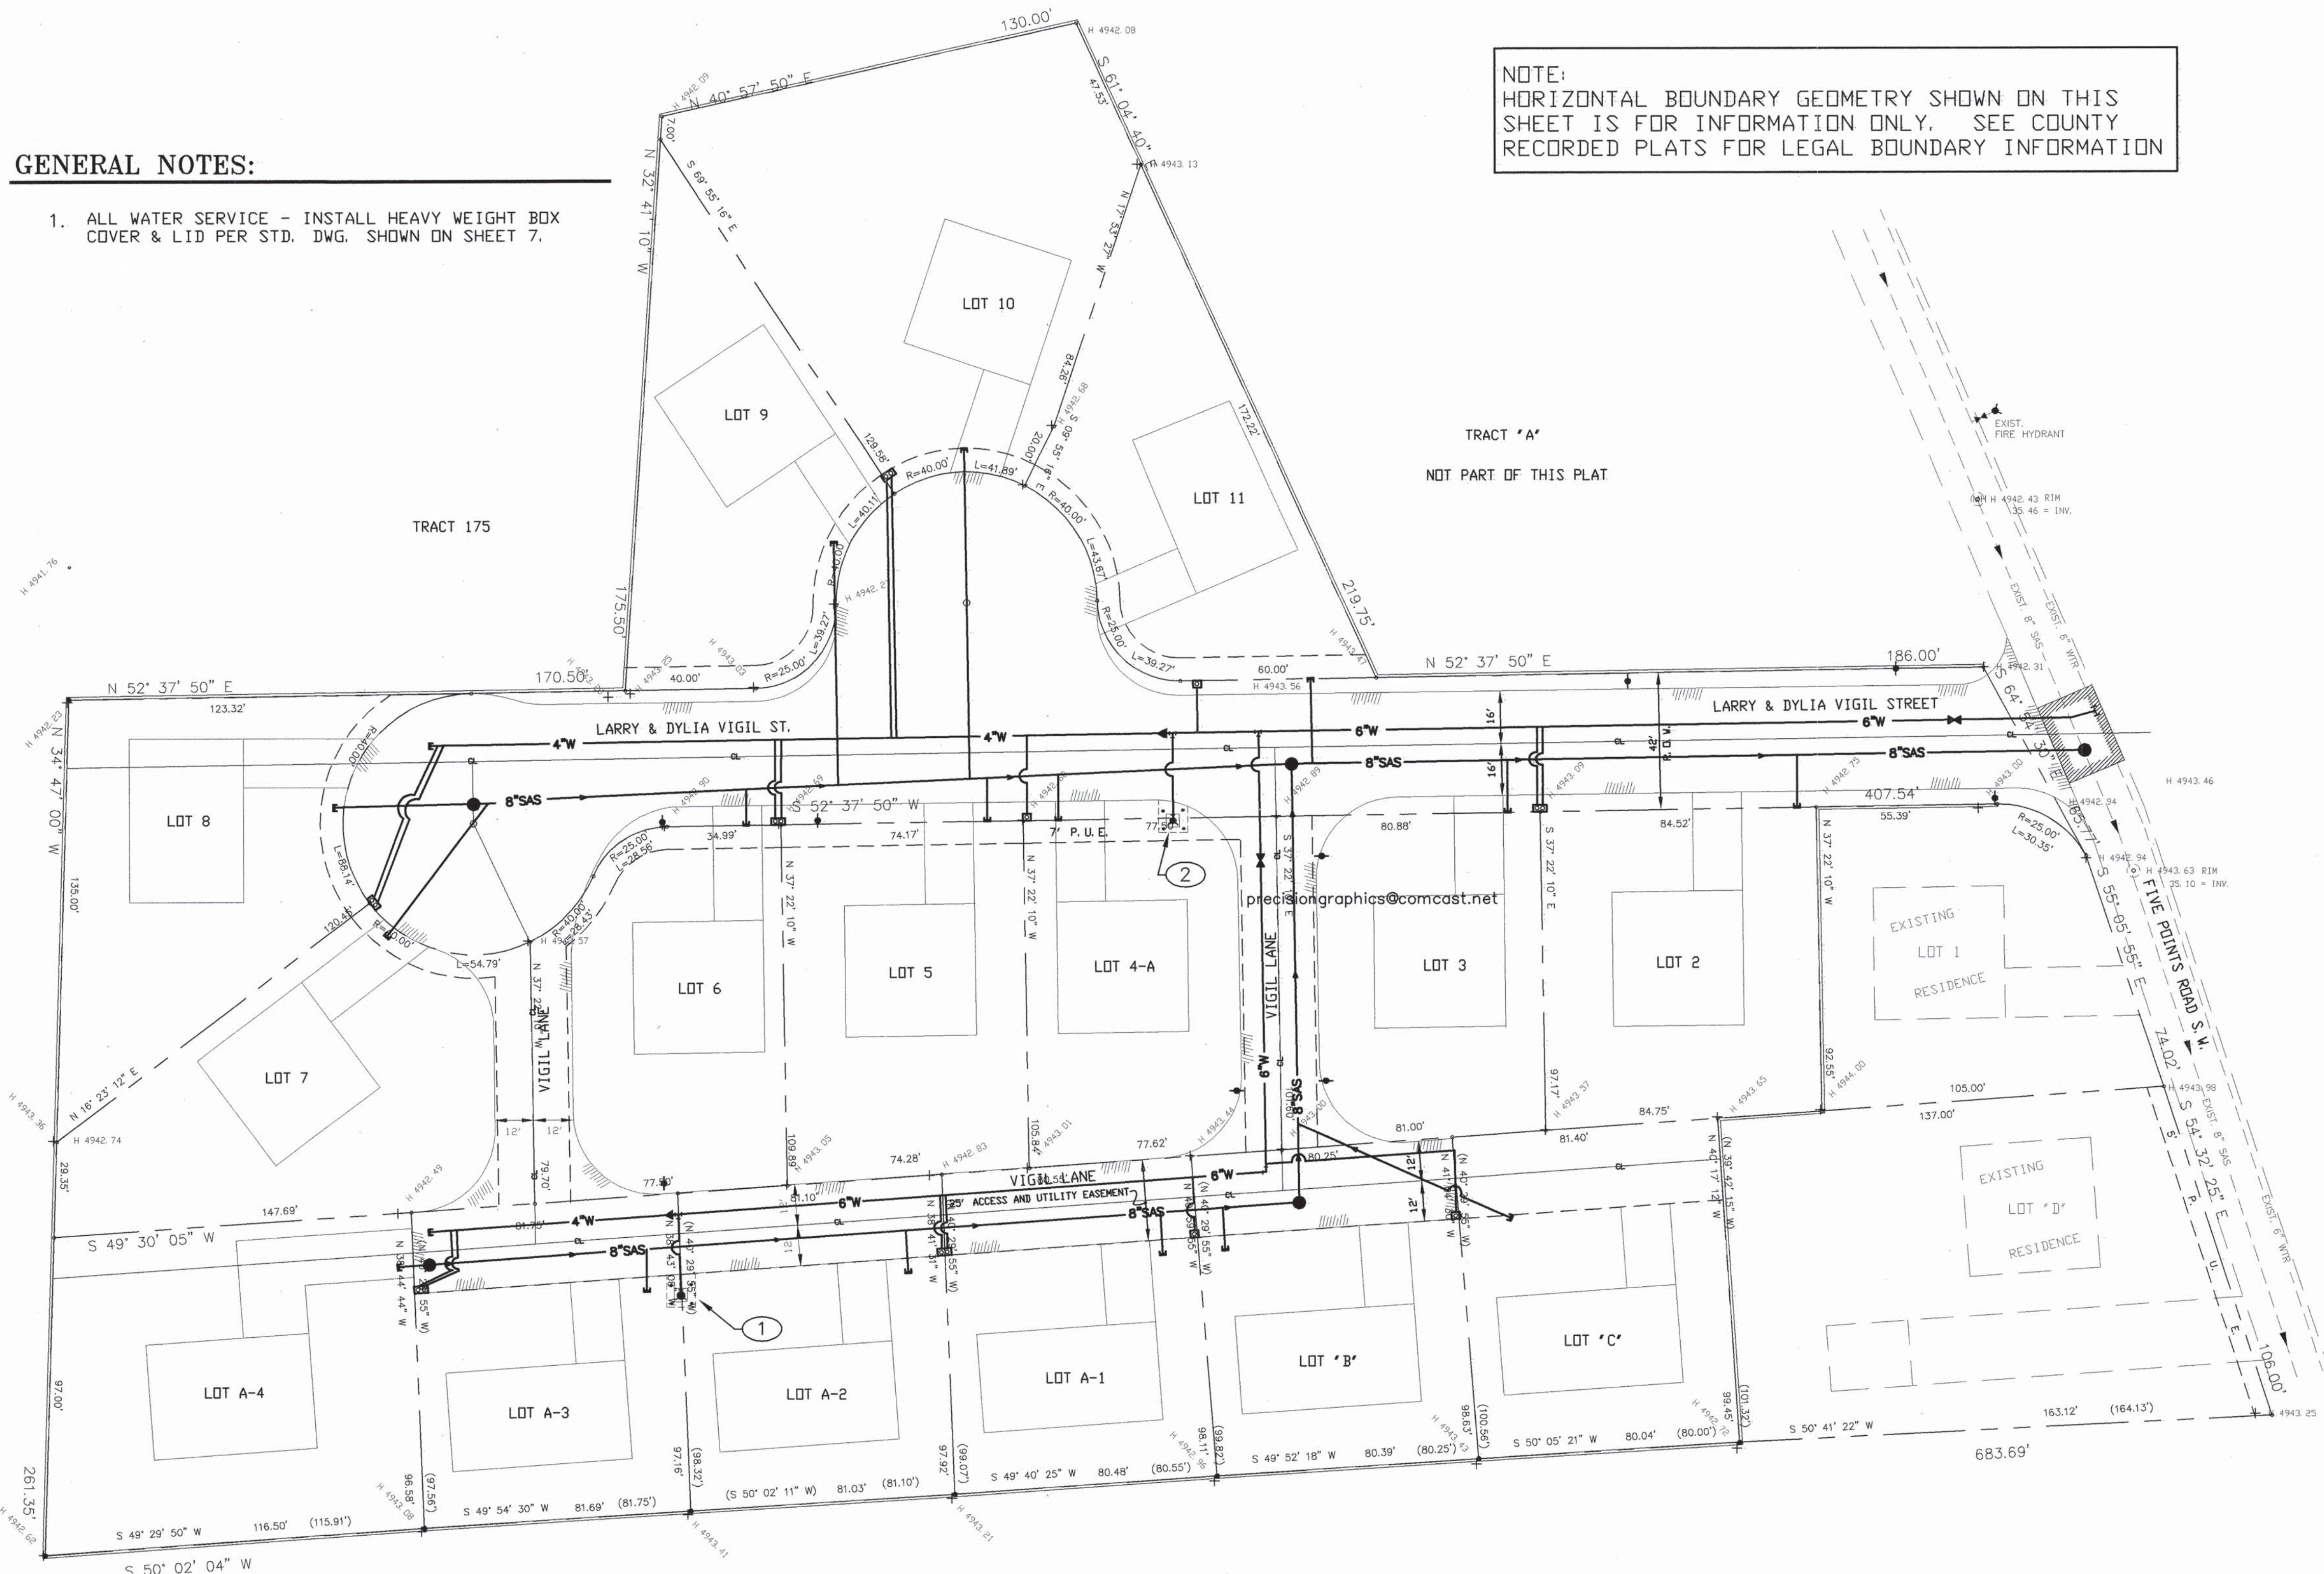

MASTER UTILITY PLAN

SCALE: 1" = 30'

FIRE HYDRANT NOTES:

- A 10'x10' EASEMENT TO BE DEDICATED TO CITY OF ALBUQUERQUE HAS PART OF THIS DEVELOPMENT FOR THE NEW FIRE HYDRANT. INSTALL 4 FIRE HYDRANT GUARD POSTS AS PER BERNALILLO COUNTY DETAIL SHOWN ON SHEET 9.
- A 10'x6' EASEMENT TO BE DEDICATED TO CITY OF ALBUQUERQUE HAS PART OF THIS DEVELOPMENT FOR THE NEW FIRE HYDRANT. INSTALL 4 FIRE HYDRANT GUARD POSTS AS PER BERNALILLO COUNTY DETAIL SHOWN ON SHEET 9.


TEES - PVC PIPE				
Nom. Pipe Size	Branch Size 6"			
	L _r =5'	L _r =10'	L _r =15'	L _r =20'
Restrained Length L, Feet for a Specified L				
6"	43'	21'	FJO	FJO

FJO: RESTRAINT REQUIRED AT FITTING JOINT ONLY
L_r = LENGTH OF PIPE ALONG THE RUN THAT IS FREE OF JOINTS.

HORIZONTAL BENDS - PVC PIPE				
Nom. Pipe Size	Bend Angle			
	11°	22°	45°	90°
Restrained Length, L, Feet				
6"	3'	5'	11'	26'

REDUCER PVC PIPE		
Nominal Pipe Size	Unobstructed Straight Run Length, Feet Restrained	
	(L _s) Small Pipe Side	(L _L) Large Pipe Side
6" X 4"	OPTIONAL	33'

DEAD ENDS GATE VALVES OR END CAPS PVC PIPE	
Nom. Pipe Size	Restrained Length L
4"	46'
6"	65'

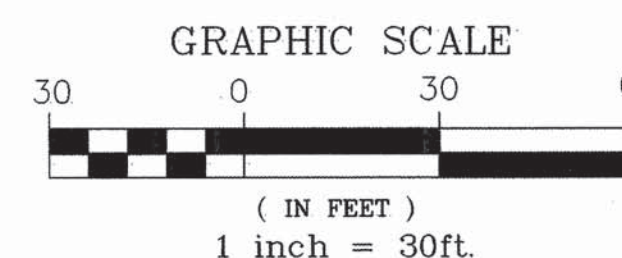

APPLIED ENGINEERING AND SURVEYING, INC.
ENGINEERS AND PLANNERS
1605 West 11th St. Suite 100
Albuquerque, New Mexico 87102
Office: (505) 237-1454 Fax: (505) 237-1454

CITY OF ALBUQUERQUE
PUBLIC WORKS DEPARTMENT
ENGINEERING DEVELOPMENT GROUP

MASTER UTILITY PLAN

Design Review Committee	City Engineer Approval	Mo./Day/Yr.	Mo./Day/Yr.
OCT 23 2008			

City Project No. 5365.90 Zone Map No. L-12 Sheet 5 Of 15

AS BUILT INFORMATION			
CONTRACTOR	STAR PAVING	DATE	09/04
WORK STARTED BY	WATSON	DATE	09/04
INSPECTOR	APPLIED	DATE	09/04
FIELD ENGINEER	APPLIED	DATE	09/04
VERIFICATION BY	APPLIED	DATE	09/04
CORRECTED BY	APPLIED	DATE	09/04
MICRO-FILM INFORMATION			
RECORDED BY		DATE	
NO.			
DATUM=N. G. V. D. =1929			


BENCH MARKS	
SITE BENCHMARK IS AN A. C. S. MONUMENT # 16-L12A, ELEVATION=4945.073, ALUMINUM DISK SET IN THE TOP OF A CONCRETE CURB AT THE E. S. E. CURB RETURN, S. E. QUADRANT OF BRIDGE BLVD. AND SUNSET ROAD S. W. VERTICAL	

SURVEY INFORMATION	
FIELD NOTES	DATE
NO.	

ENGINEER'S SEAL	
APPLIED ENGINEERING AND SURVEYING, INC.	

REVISIONS	
NO.	DATE
1	07-01-03
2	07-07-03

SCANNED BY
MESA REPRO


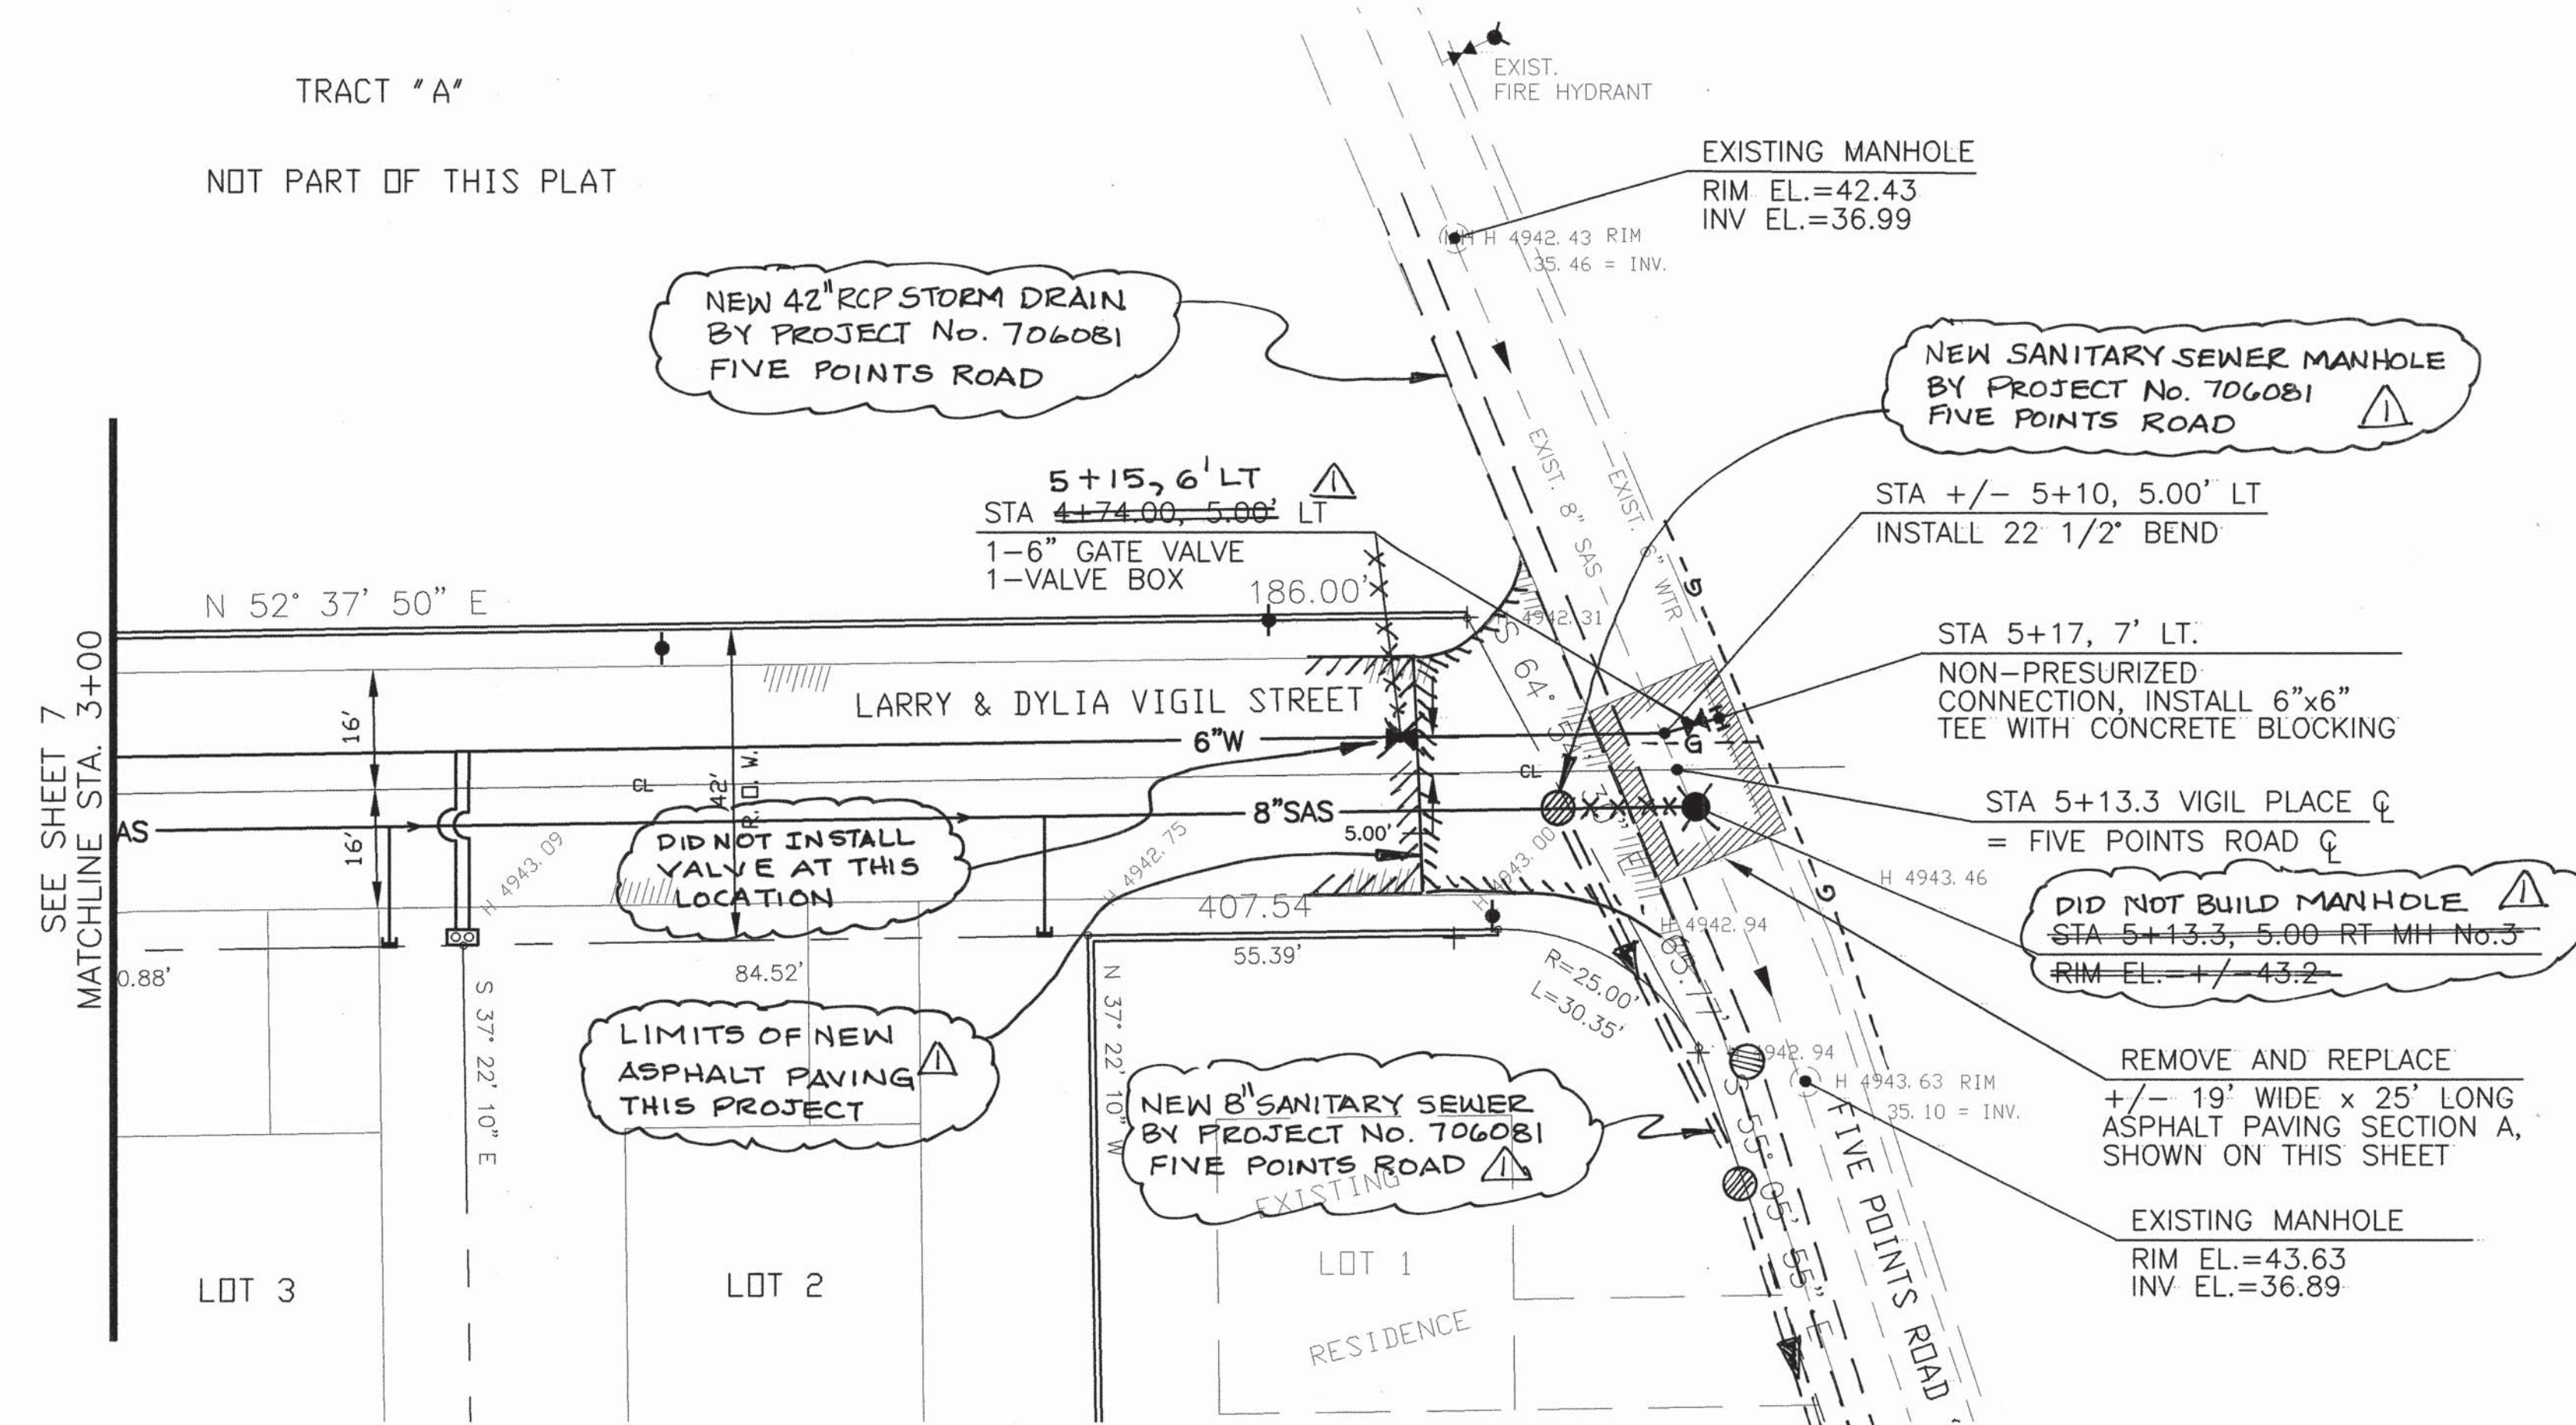


WATER METER SERVICES		
LOT NO.	STATION	OFFSET
2	3+46.66	21' RT
3	3+46.66	21' RT

SANITARY SEWER SERVICES				
LOT NO.	STATION	OFFSET	LENGTH OF SERVICE TO STUB	INVERT AT STUB
2	4+21.18	21' RT	16'	38.83
3	3+36.66	21' RT	16'	39.16

SAS & WATER PLAN - LARRY & DYLIA VIGIL STREET - STA 3+00 TO STA. 5+11

SCALE: 1" = 20'

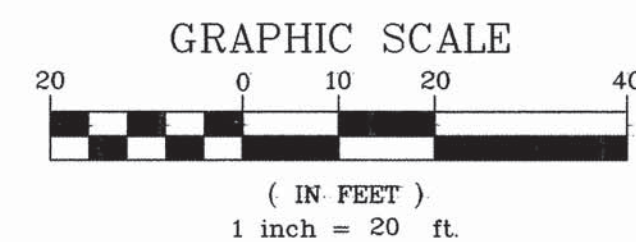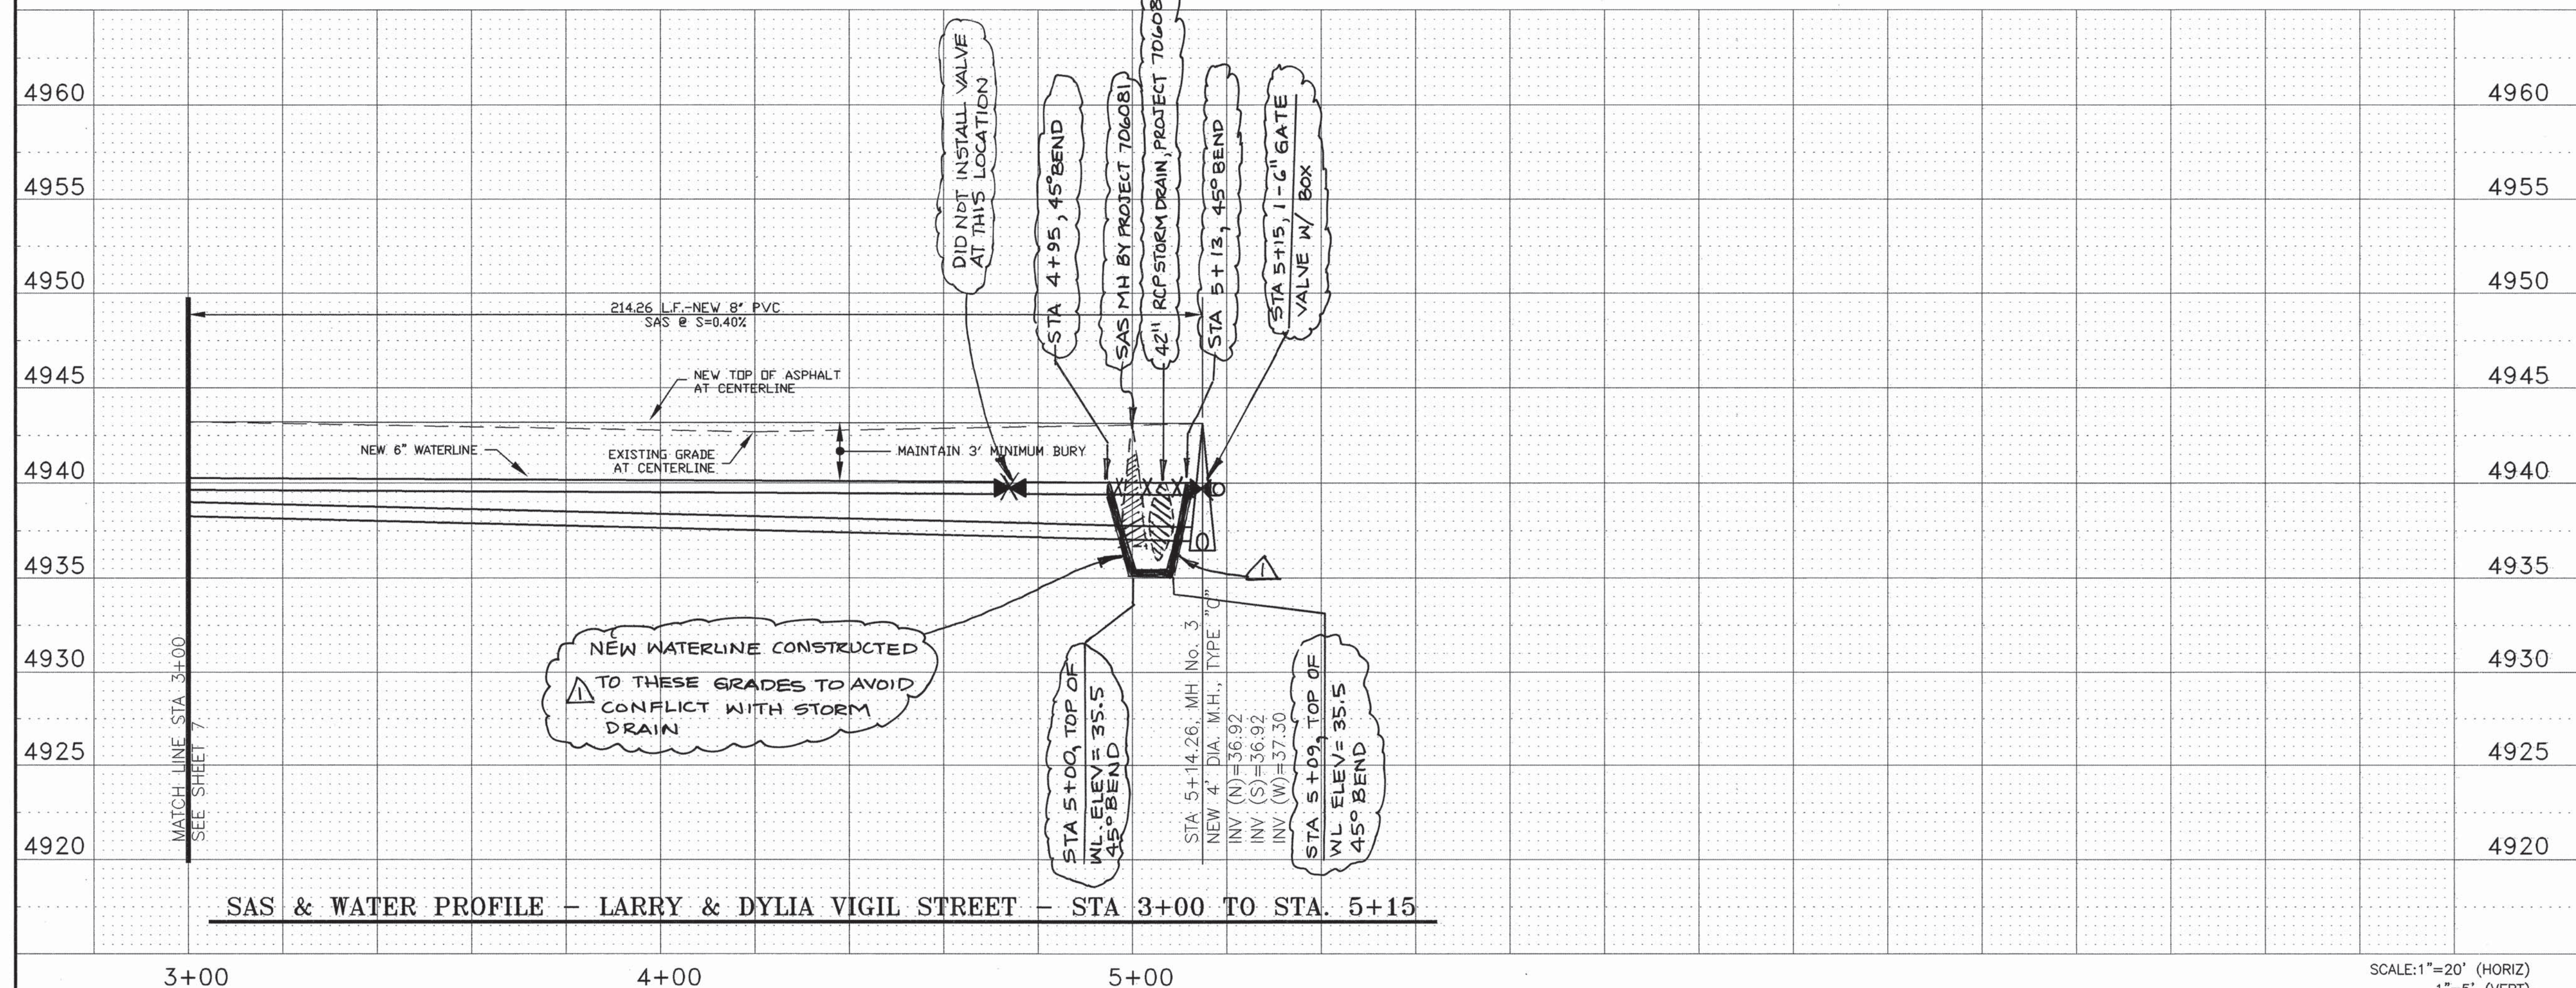


APPLIED ENGINEERING AND SURVEYING, INC.
ENGINEERS AND PLANNERS
1400 Blue Cross NE
Albuquerque, New Mexico 87112
Office (505) 233-1406
Facsimile (505) 237-1406

CITY OF ALBUQUERQUE
PUBLIC WORKS DEPARTMENT
ENGINEERING DEVELOPMENT GROUP

TITLE:
**LARRY & DYLIA VIGIL STREET
SAS & WATER PLAN & PROFILE**

Design Review Committee	City Engineer Approval	Mo./Day/Yr.	Mo./Day/Yr.
OCT 23 2003			
Sheet	Of	6	15


AS BUILT INFORMATION		BENCH MARKS		SURVEY INFORMATION		ENGINEER'S SEAL	
CONTRACTOR	STAR PAVING	SITE BENCHMARK IS AN A.C.S.	MONUMENT "16-L12A"	FIELD NOTES	DATE	NO.	BY
INSPECTOR	WATSON	ELEVATION=4945.073, ALUMINUM	DISK SET IN THE TOP OF A				
VERIFICATION BY	APPLIED ENG	CONCRETE CURB AT THE E.S.E.	CURB RETURN, S.E. QUADRANT				
CORRECTED BY	APPLIED ENG	OF BRIDGE BLVD AND SUNSET	ROAD S.W. VERTICAL				
MICRO-FILM INFORMATION		DATUM=N.G.V.D.=1929					
RECORDED BY							
NO.							

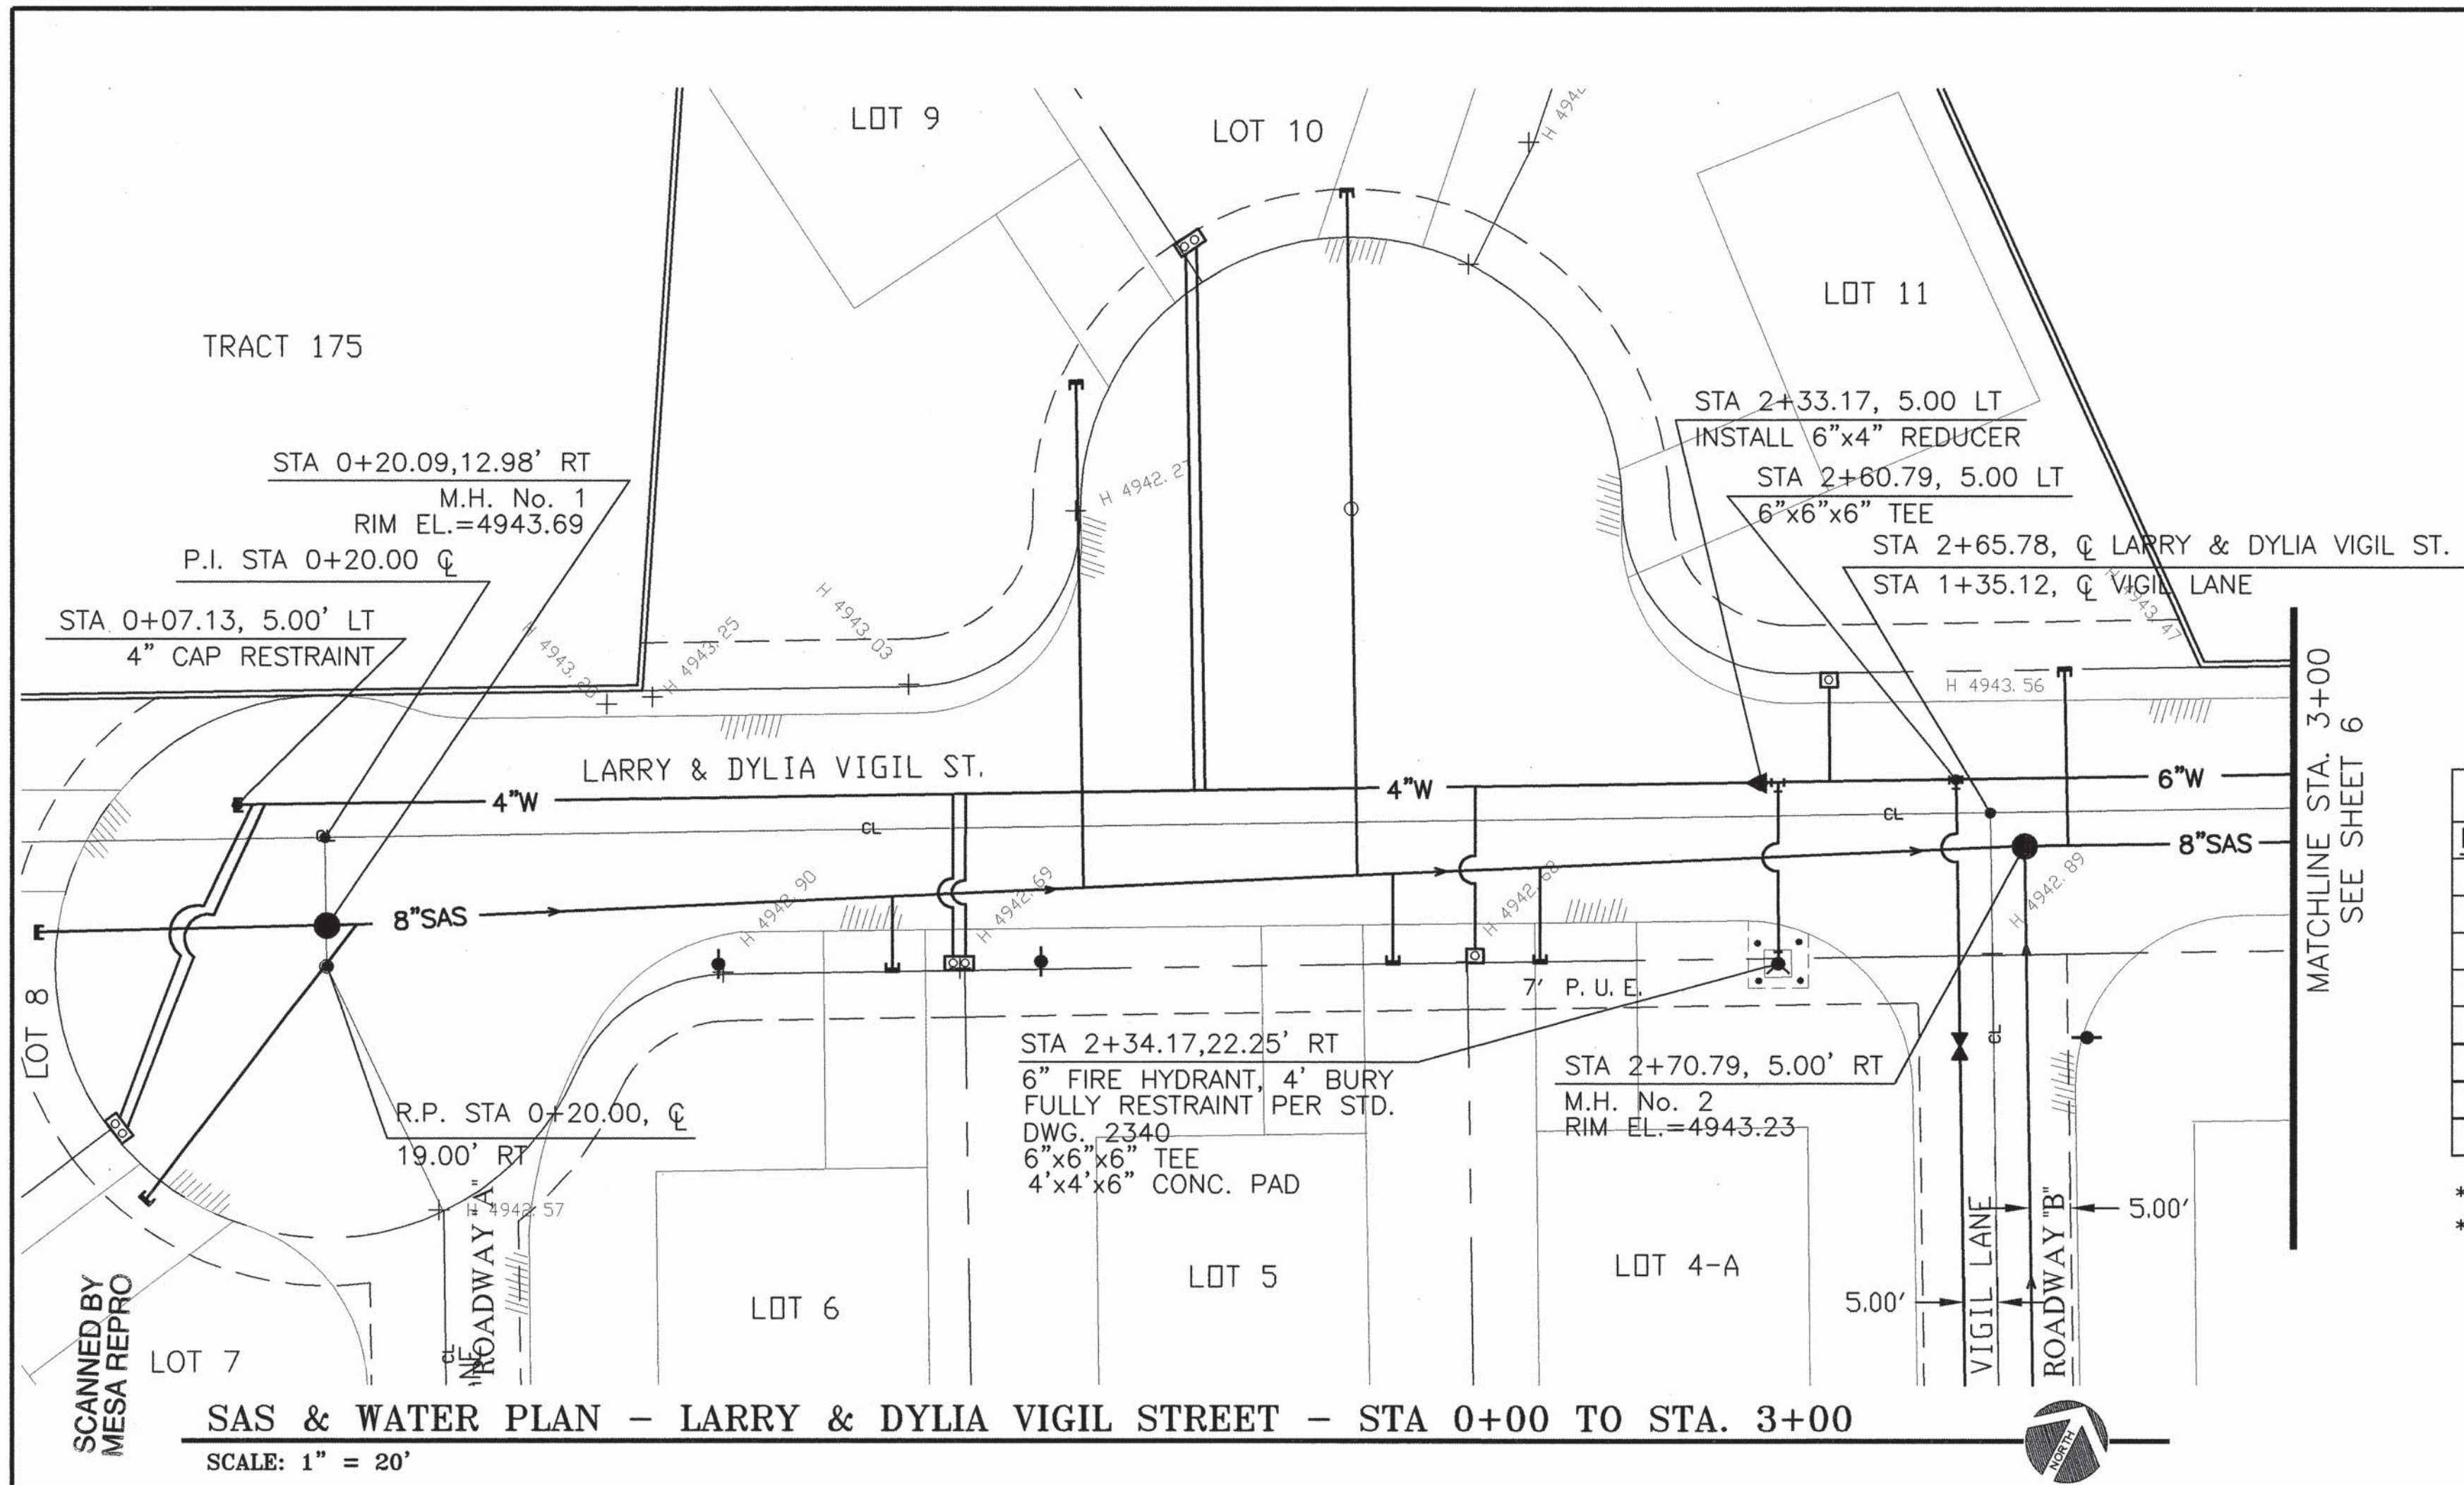

WATER METER SERVICES		
LOT NO.	STATION	OFFSET TO BACK OF METER
4-A	1+88.29	21.00'RT
5	1+14.12	21.00'RT
6	1+14.12	21.00'RT
7	-0+12.27	42.64'RT
8	-0+12.27	42.64'RT
9	1+50.66	79.72'LT
10	1+50.66	79.72'LT
11	2+42.27	21.00'LT

4" SANITARY SEWER SERVICES				
LOT NO.	STATION	OFFSET	LENGTH OF SERVICE TO STUB	INVERT AT STUB
4-A	1+98.29	21.00'RT	14'	39.77
5	1+78.29	21.00'RT	13'	39.99
6	1+04.12	21.00'RT	11'	40.09
**7	-0+07.16	52.92'RT	49'	40.67
*8	-0+22.54	13.34'RT	43'	40.56
9	1+31.80	65.00'LT	74.5'	41.24
10	1+72.19	92.62'LT	100.5'	41.44
11	2+77.16	21.00'LT	26'	39.49

*INSTALL SAS SERVICE INTO MANHOLE PER STANDARD DRAWING 2118.
**INSTALL 8"x4" DIRECTIONAL WYE AT SAS MAIN INTO 4" SEWER SERVICE FOR LOT 7.

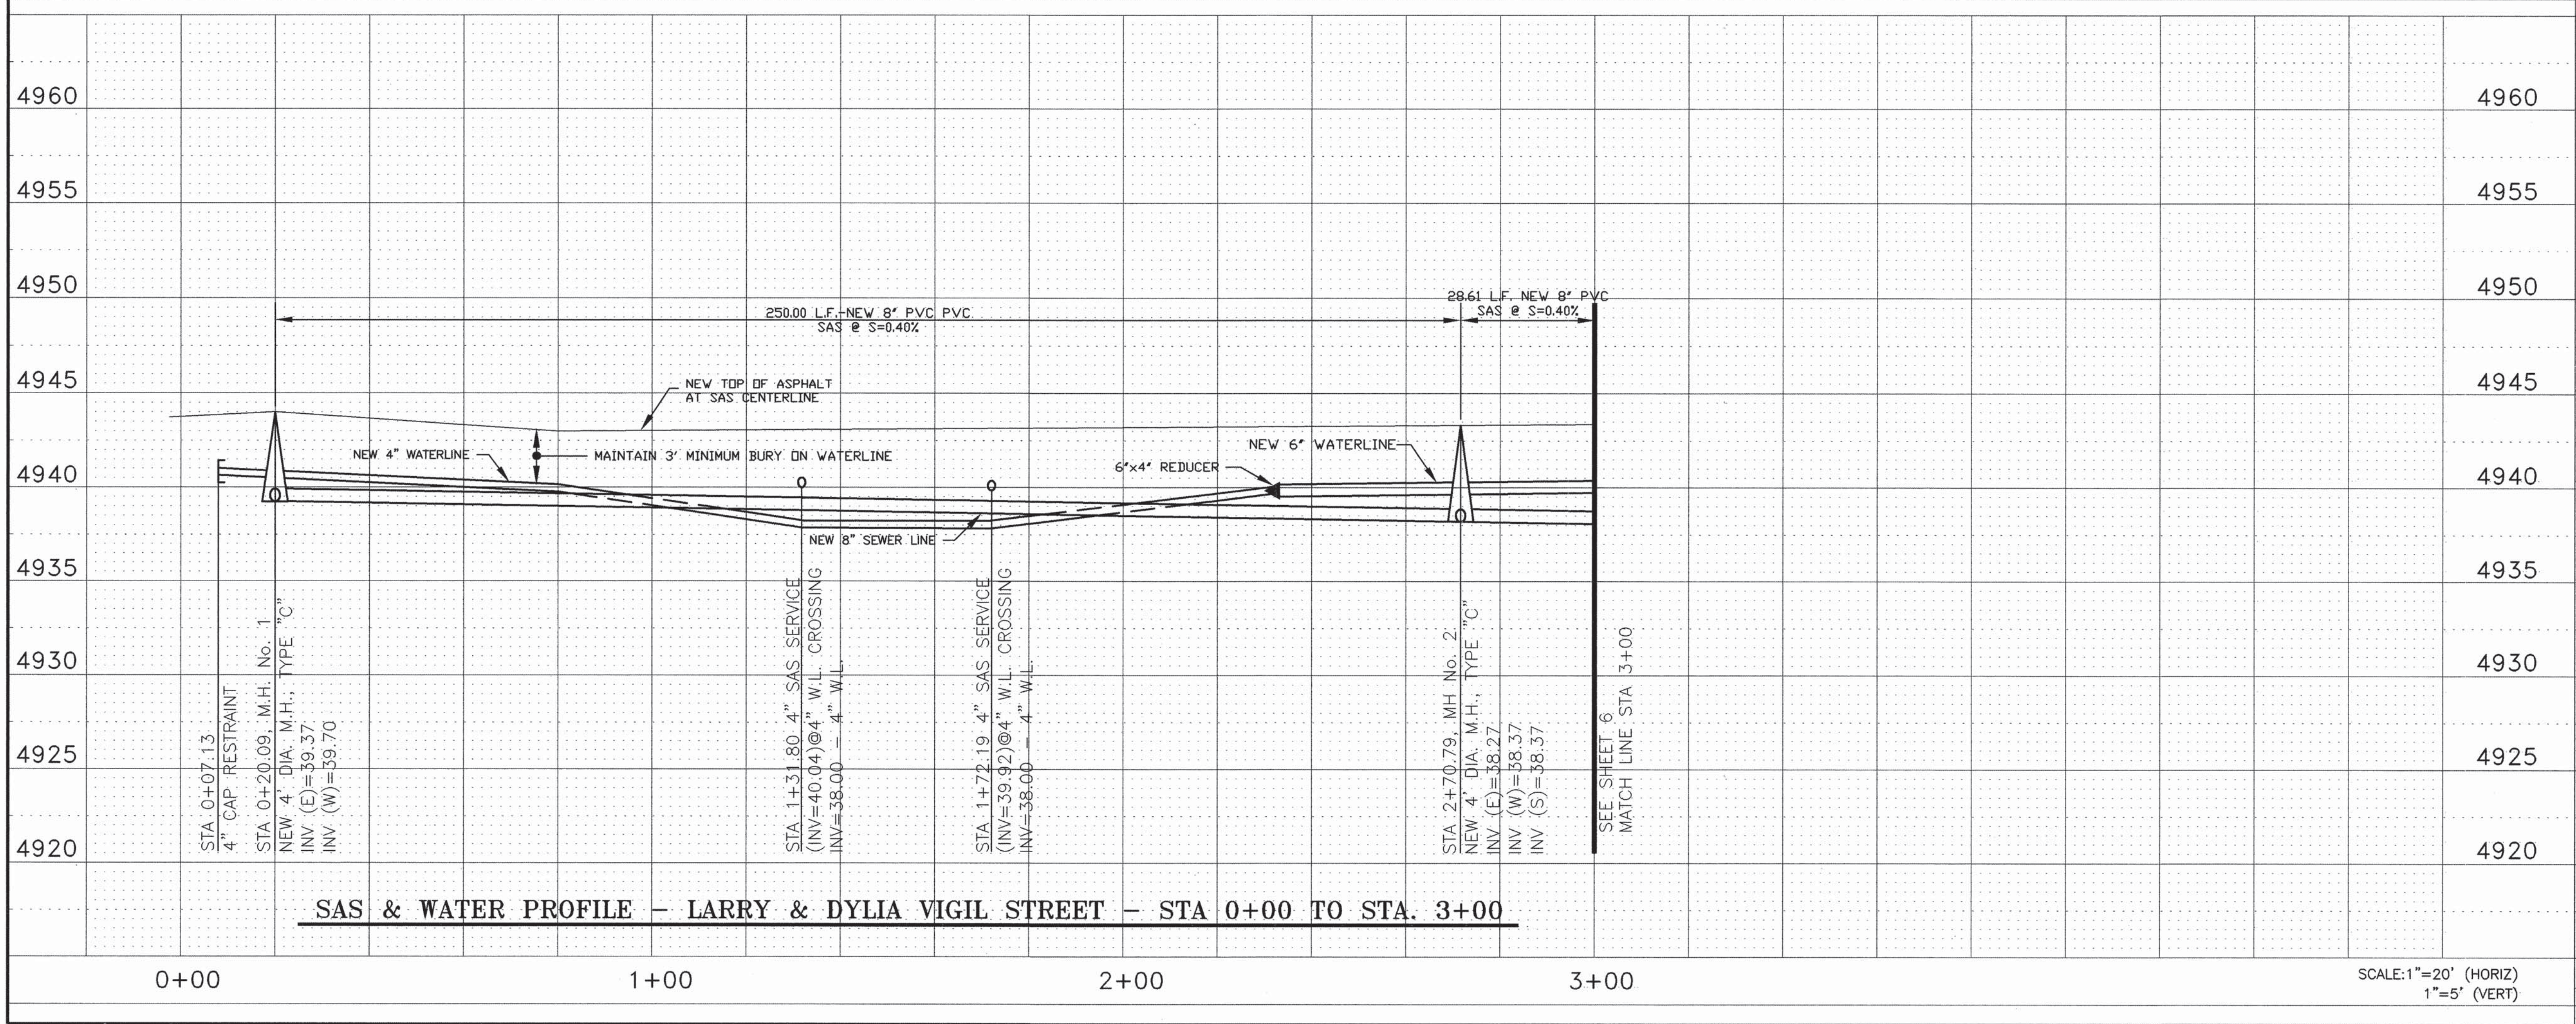

ENGINEER'S SEAL

APPLIED ENGINEERING AND SURVEYING, INC.
ENGINEERS AND PLANNERS
1000 Blue Drive NE
Albuquerque, New Mexico 87112
Office: (505) 233-1456
Fax: (505) 233-1456

GRAPHIC SCALE
(IN FEET)
1 inch = 20 ft.

TITLE:
LARRY & DYLIA VIGIL STREET
SAS & WATER PLAN & PROFILE

Design Review Committee
City Engineer Approval
Last Design Update
OCT 23 2003

Zone Map No.
L-12

Sheet
7

Of
15

AS BUILT INFORMATION

CONTRACTOR: STAR PAVING
WORK: WATER METER SERVICES
INSPECTED BY: [Signature]
ACCEPTANCE BY: [Signature]
DATE: 08/04/03
DRAWINGS: [Signature]
CORRECTED BY: [Signature]
DATE: 09/04/03
MICRO-FILM INFORMATION
RECORDED BY: [Signature]
DATE: [Signature]
NO. [Signature]


BENCH MARKS

SITE BENCHMARK IS AN A.C.S. MONUMENT "16-L12A" ELEVATION=4945.073, ALUMINUM DISK SET IN THE TOP OF A CONCRETE CURB AT THE E.S.E. CURB RETURN, S.E. QUADRANT OF BRIDGE BLVD. AND SUNSET ROAD S.W. VERTICAL DATUM=N.G.V.D.=1929

SURVEY INFORMATION

FIELD NOTES
NO. [Signature]
BY [Signature]
DATE [Signature]

REVISIONS
NO. DATE
1. 07-07-03
DESIGNED BY G. ALDAB
DRAWN BY [Signature]
CHECKED BY G. ALDAB
DATE 07-07-03

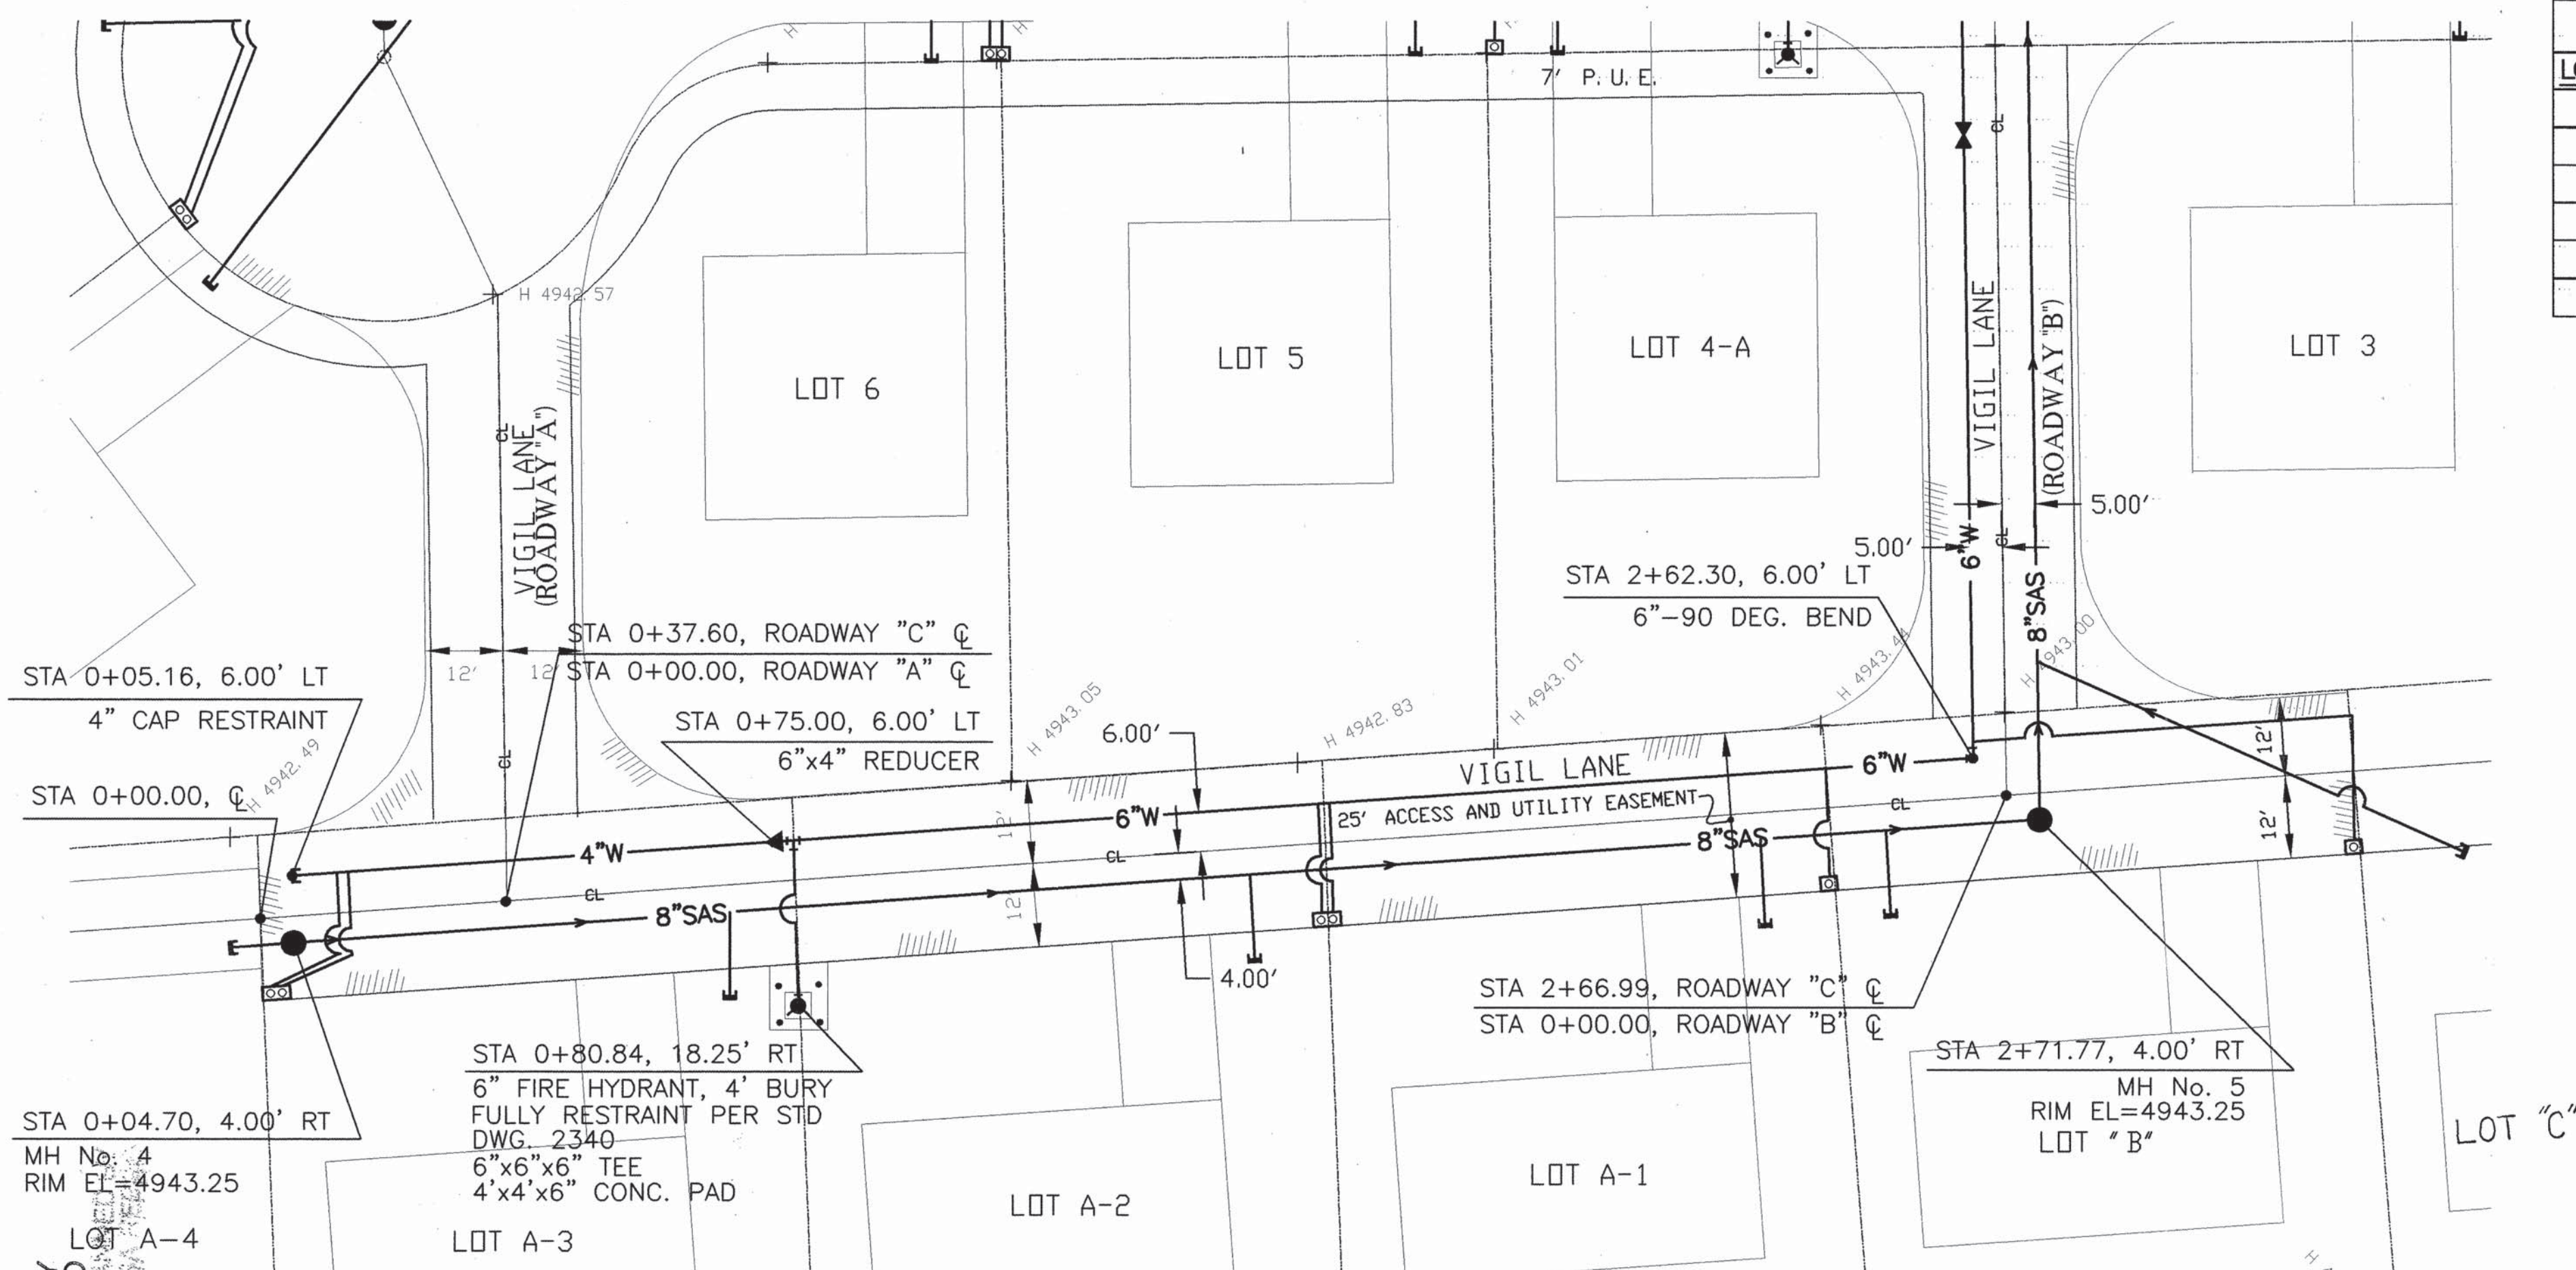


SAS & WATER PLAN - VIGIL LANE (ROADWAY "C")
SCALE: 1" = 20'


SANTARY SEWER SERVICES				
LOT NO.	STATION	OFFSET	LENGTH OF SERVICE TO STUB	INVERT AT STUB
*A-4	0+05.00	4.00 RT	10.0	40.57
A-3	0+70.84	17 RT	13.5	40.87
A-2	1+52.44	17 RT	13.5	40.55
A-1	2+29.99	17 RT	13.5	40.24
B	2+49.99	17 RT	13.5	40.16
**C	3+35.93	13.34 RT	71.0	40.54

*INSTALL SAS SERVICE INTO MANHOLE PER STANDARD DRAWING 2118.
**INSTALL 8"x4" DIRECTIONAL WYE AT SAS MAIN INTO 4" SEWER SERVICE FOR LOT C.

WATER METER SERVICES		
LOT NO.	STATION	OFFSET TO BACK OF METER
A-4	0+01.29	12.50' RT
A-3	0+01.29	12.50' RT
A-2	1+62.44	12.50' RT
A-1	1+62.44	12.50' RT
B	2+39.99	12.50' RT
C	3+20.27	12.50' RT

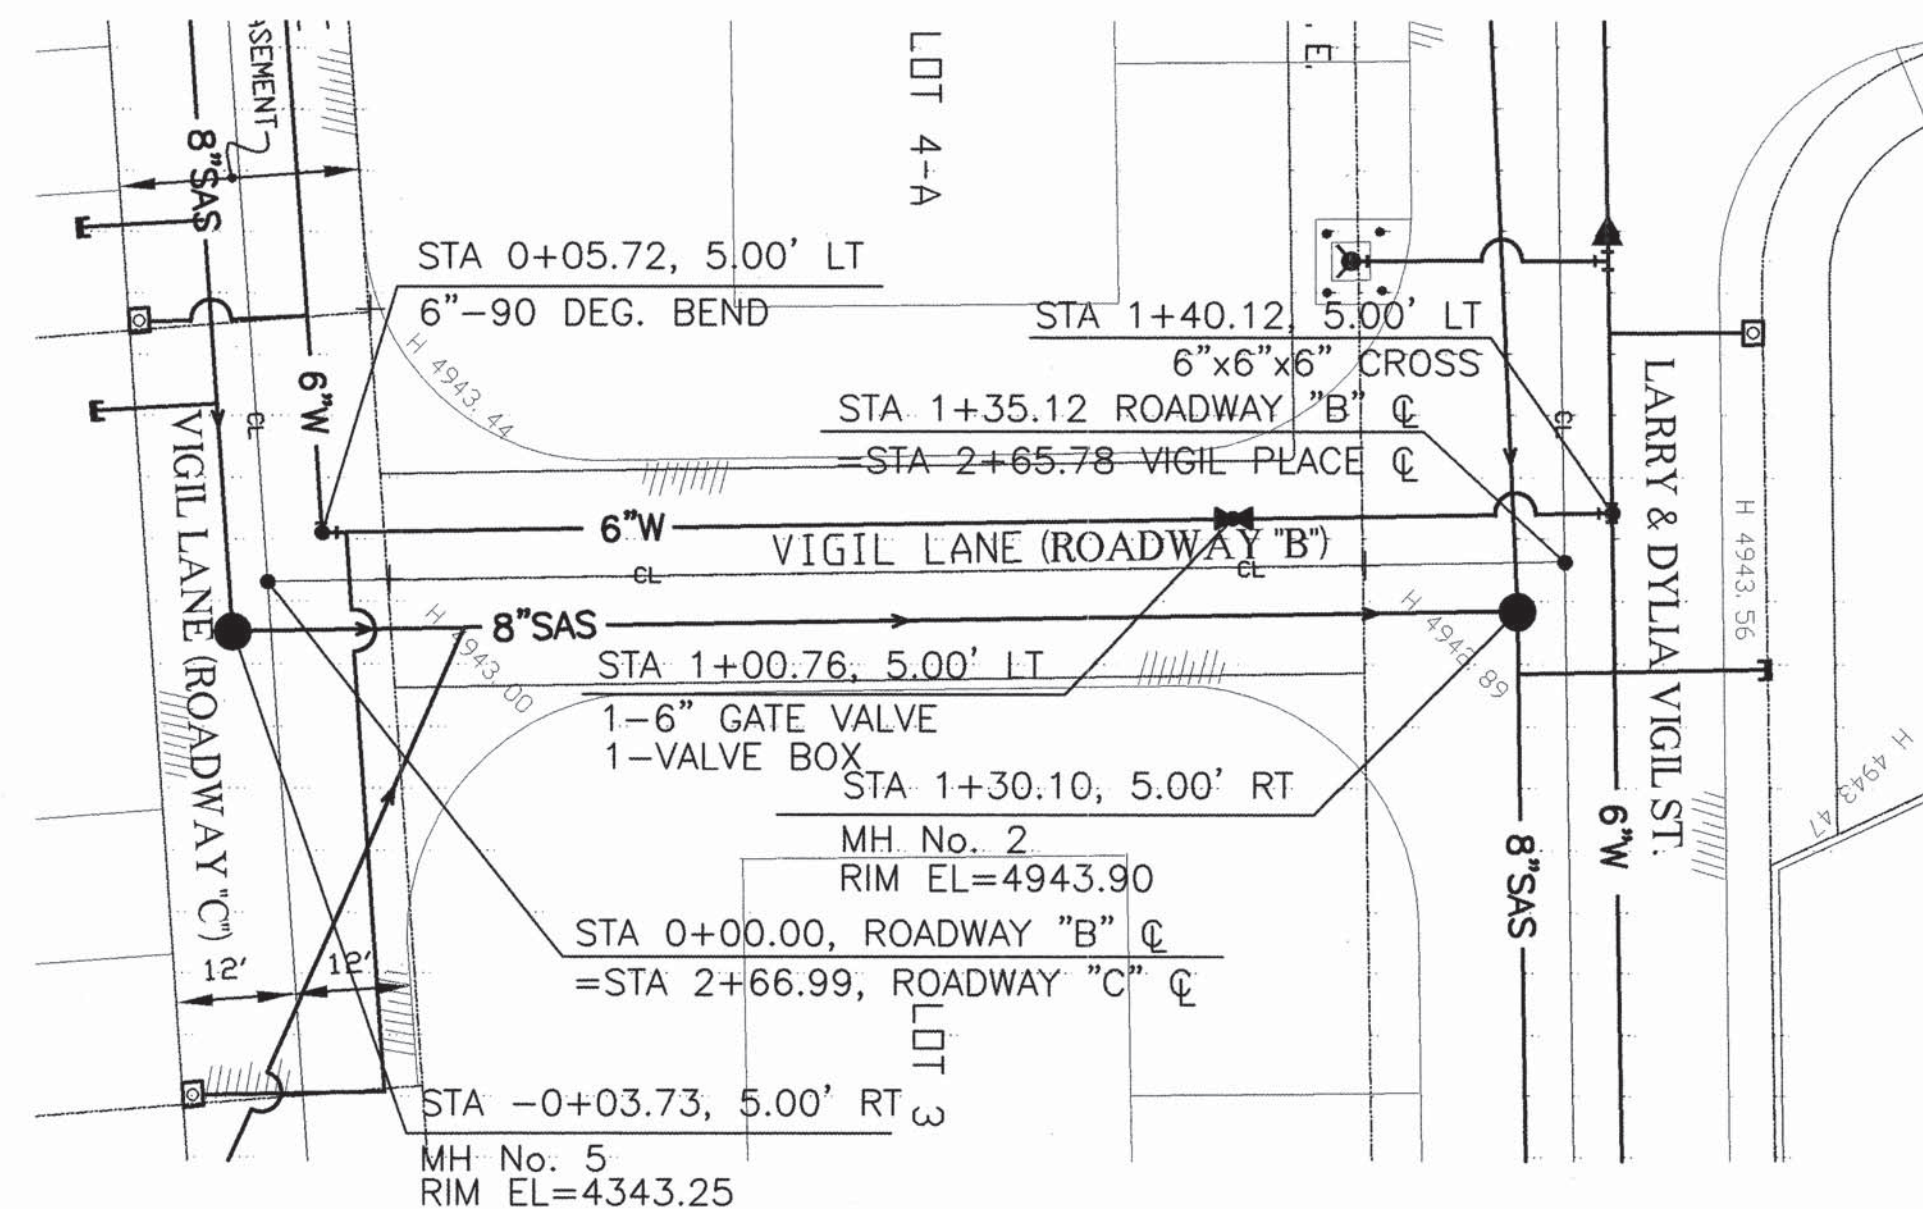


SAS & WATER PLAN - VIGIL LANE (ROADWAY "B")
SCALE: 1" = 20'

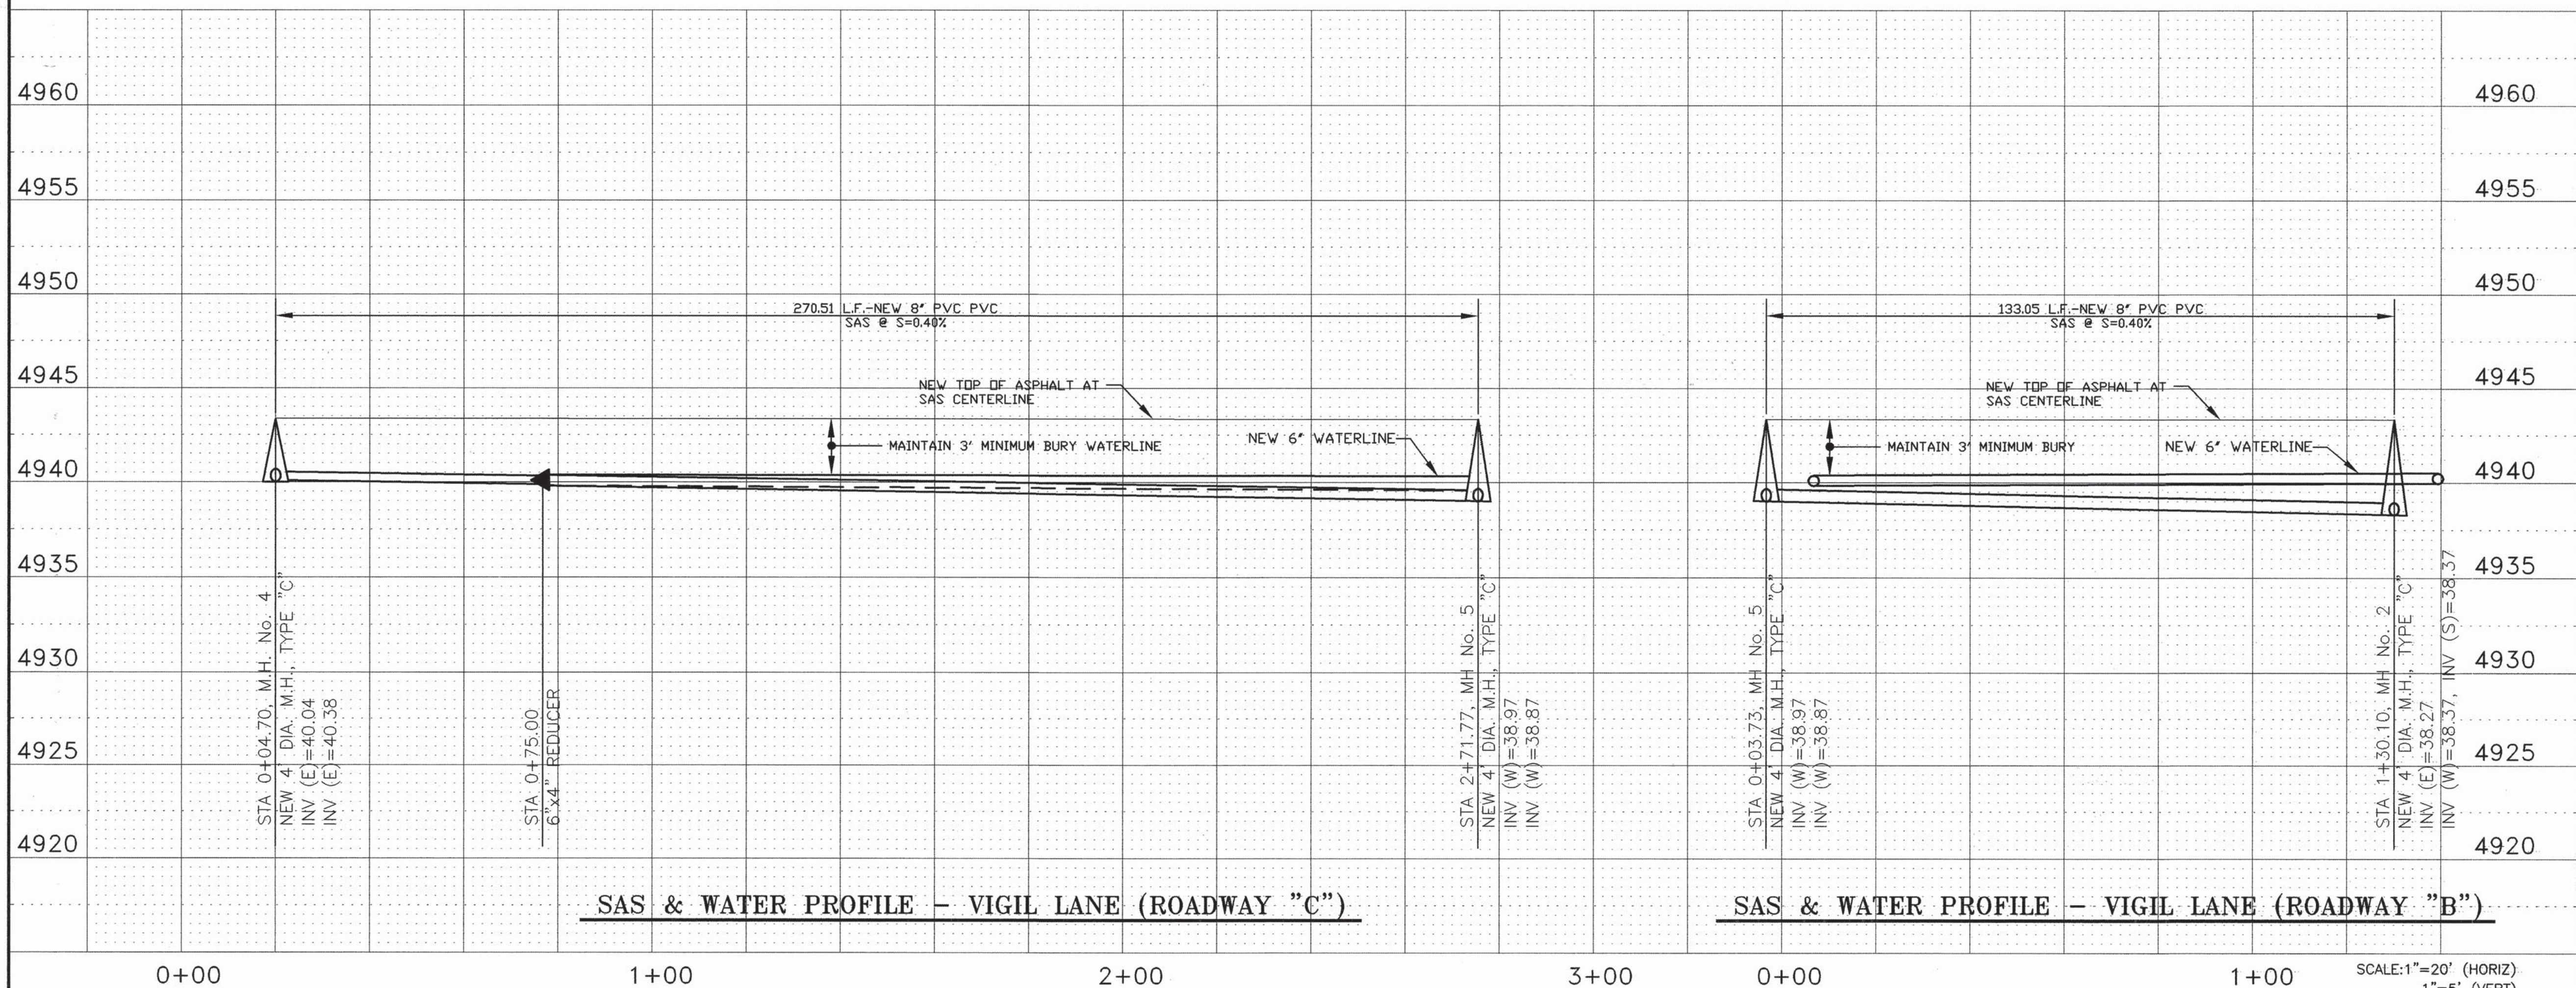

SAS & WATER PROFILE - VIGIL LANE (ROADWAY "C")

SAS & WATER PROFILE - VIGIL LANE (ROADWAY "B")

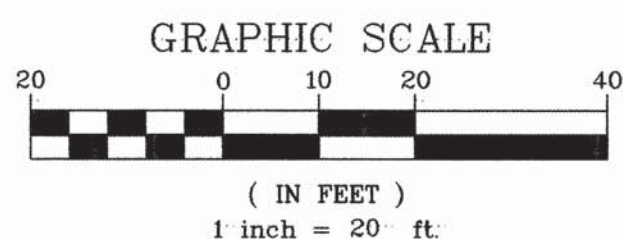

APPLIED ENGINEERING AND SURVEYING, INC.
ENGINEERS AND PLANNERS
1605 Bos Drive NE
Albuquerque, New Mexico 87112
Phone: (505) 233-1400

CITY OF ALBUQUERQUE
PUBLIC WORKS DEPARTMENT
ENGINEERING DEVELOPMENT GROUP

TITLE: **VIGIL LANE ROADWAY "B" & ROADWAY "C" SAS & WATER PLAN & PROFILE**





Design Review Committee	City Engineer Approval	Mo./Day/Yr.	Mo./Day/Yr.
OCT 23 2003			
REVIEW COMMITTEE			
City Project No.	Zone Map No.	Sheet	Of
5365.90	L-12	8	15

AS BUILT INFORMATION		BENCH MARKS		SURVEY INFORMATION		ENGINEER'S SEAL	
CONTRACTOR	DATE	SITE BENCHMARK	DATE	FIELD NOTES	DATE	NO.	BY
STAP PAVING	10/24/03	MONUMENT "16-L12A"	10/24/03				
WAT GSH	10/24/03	ELEVATION=4945.073, ALUMINUM	10/24/03				
APPLIED ENGR.	10/24/03	DISK SET IN THE TOP OF A	10/24/03				
FIELD	10/24/03	CONCRETE CURB AT THE E.S.E.	10/24/03				
REVISION BY	DATE	CURB RETURN, S.E. QUADRANT	DATE				
CORRECTED BY	DATE	OF BRIDGE BLVD AND SUNSET	DATE				
MICRO-FILM INFORMATION	DATE	ROAD S.W. VERTICAL	DATE				
RECORDED BY	DATE	DATUM=N.G.V.D.=1929	DATE				



NO.	DATE	REMARKS	BY
		DESIGN	
		REVISIONS	
		DESIGN	
		DATE	07-07-03
		DATE	07-07-03

SCANNED BY
MESA REPRO

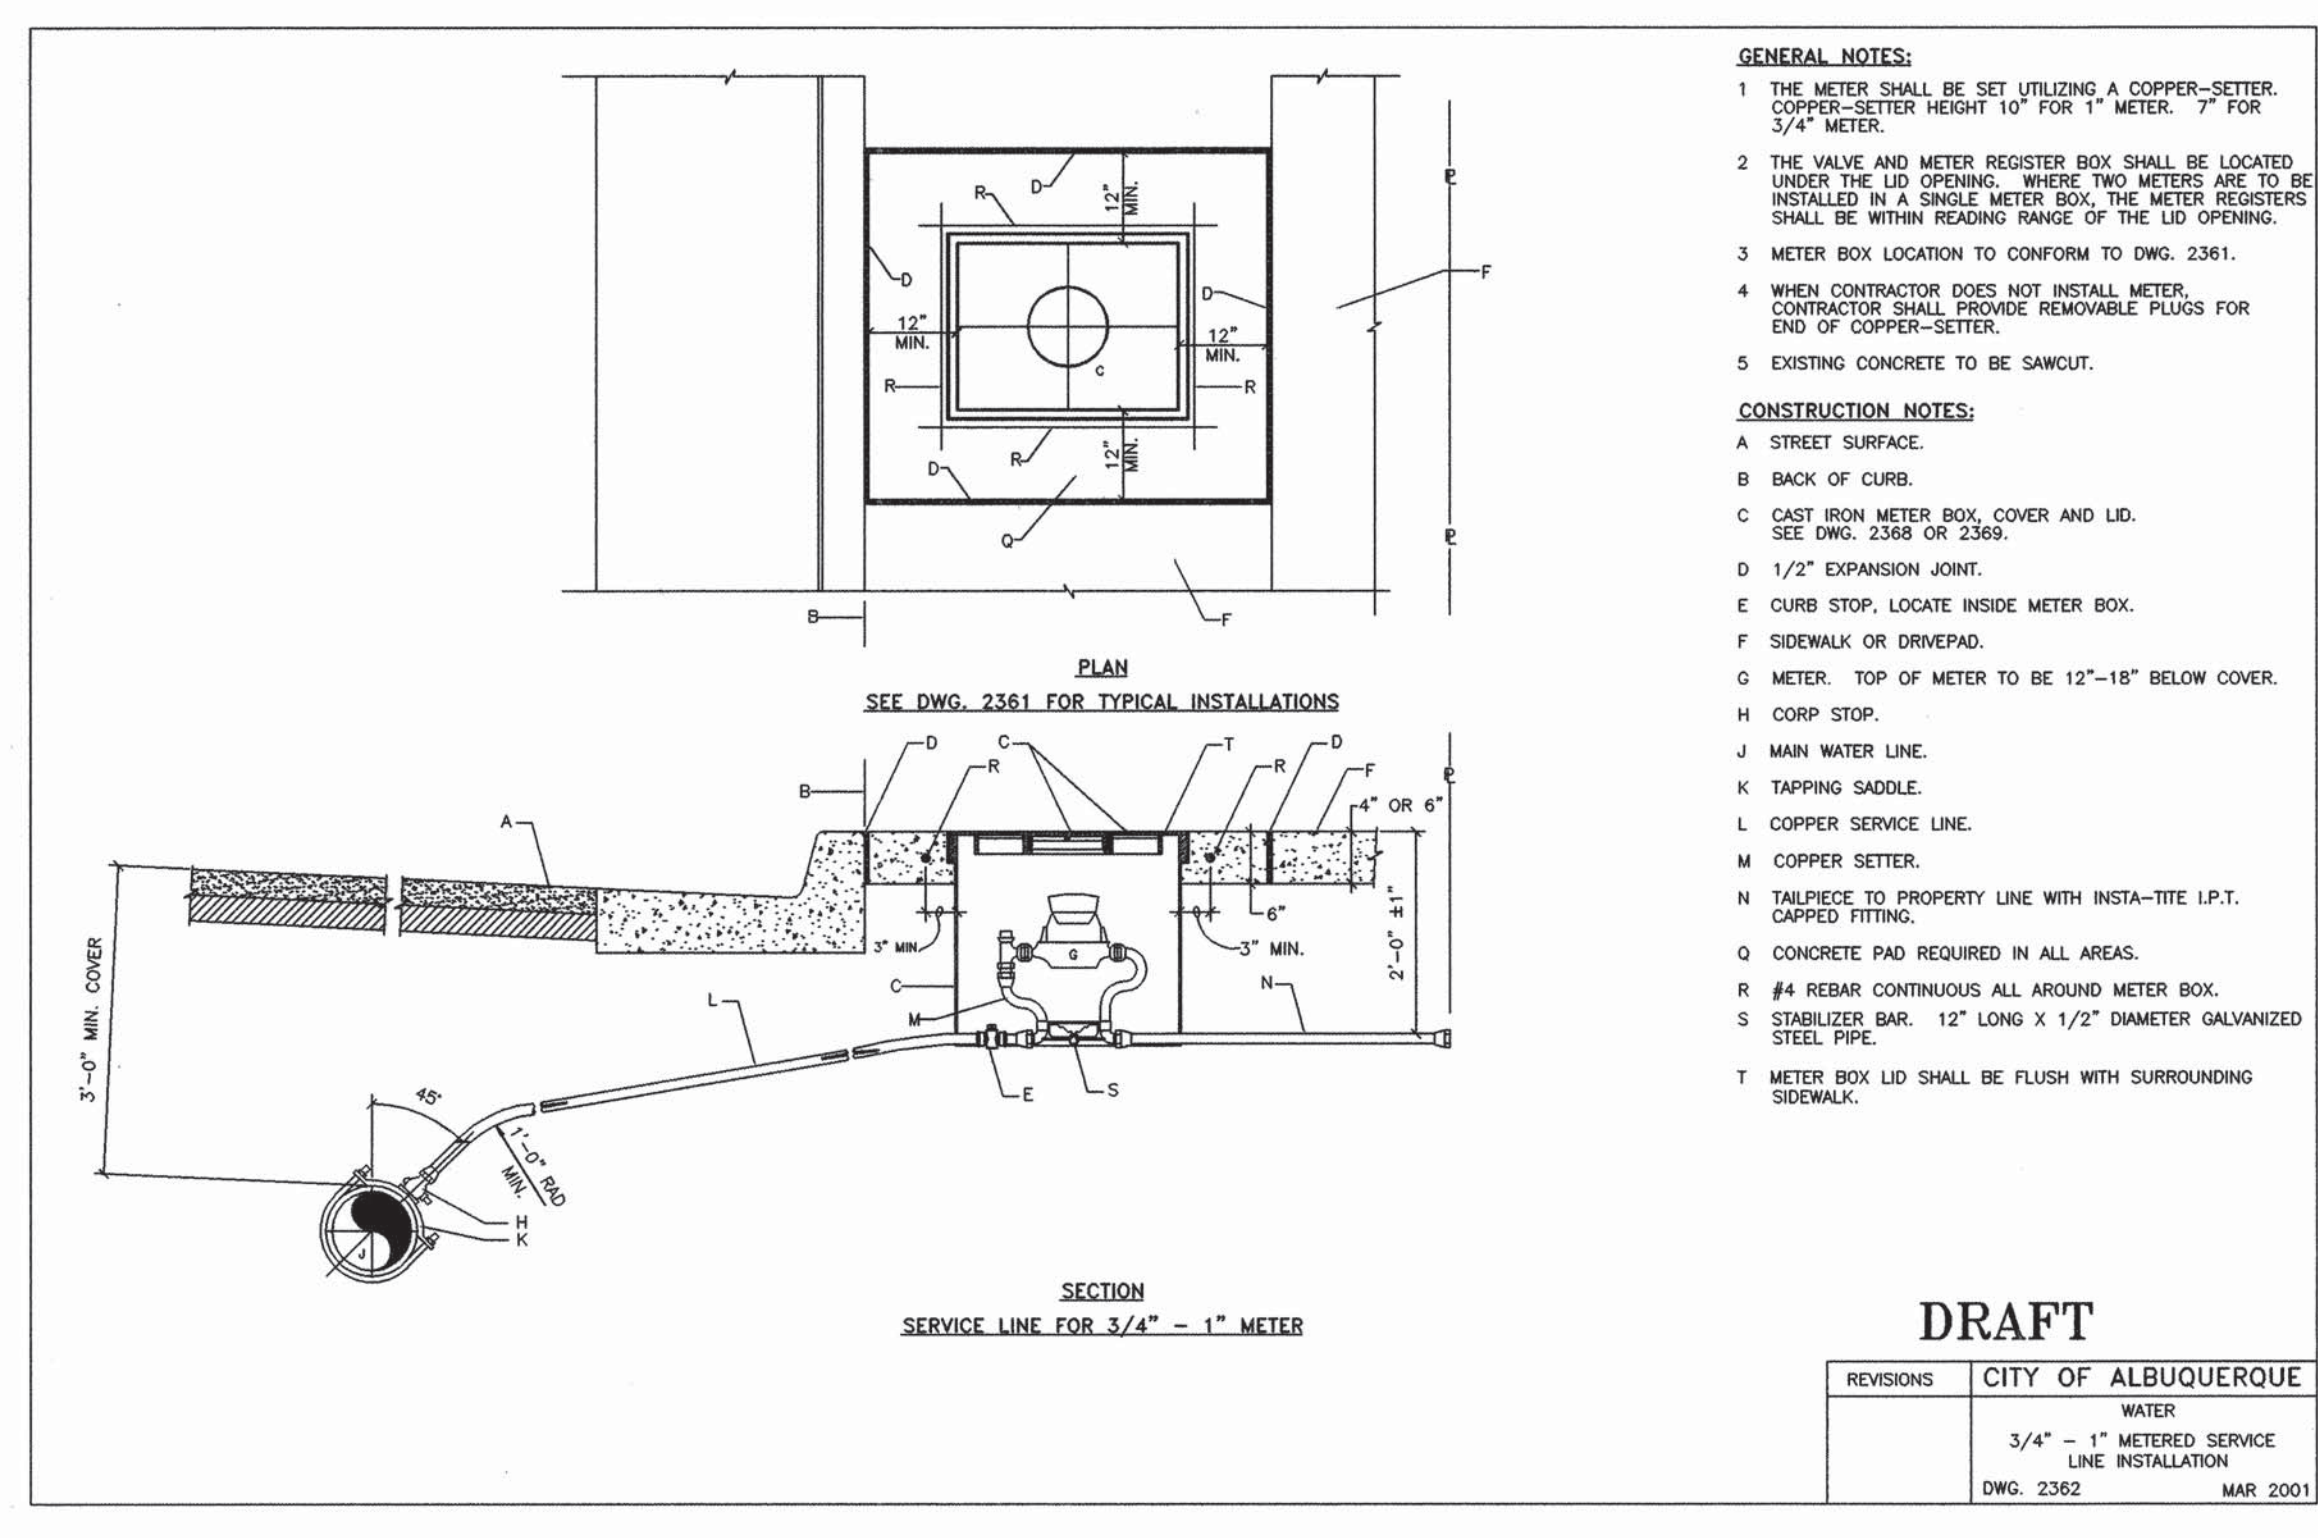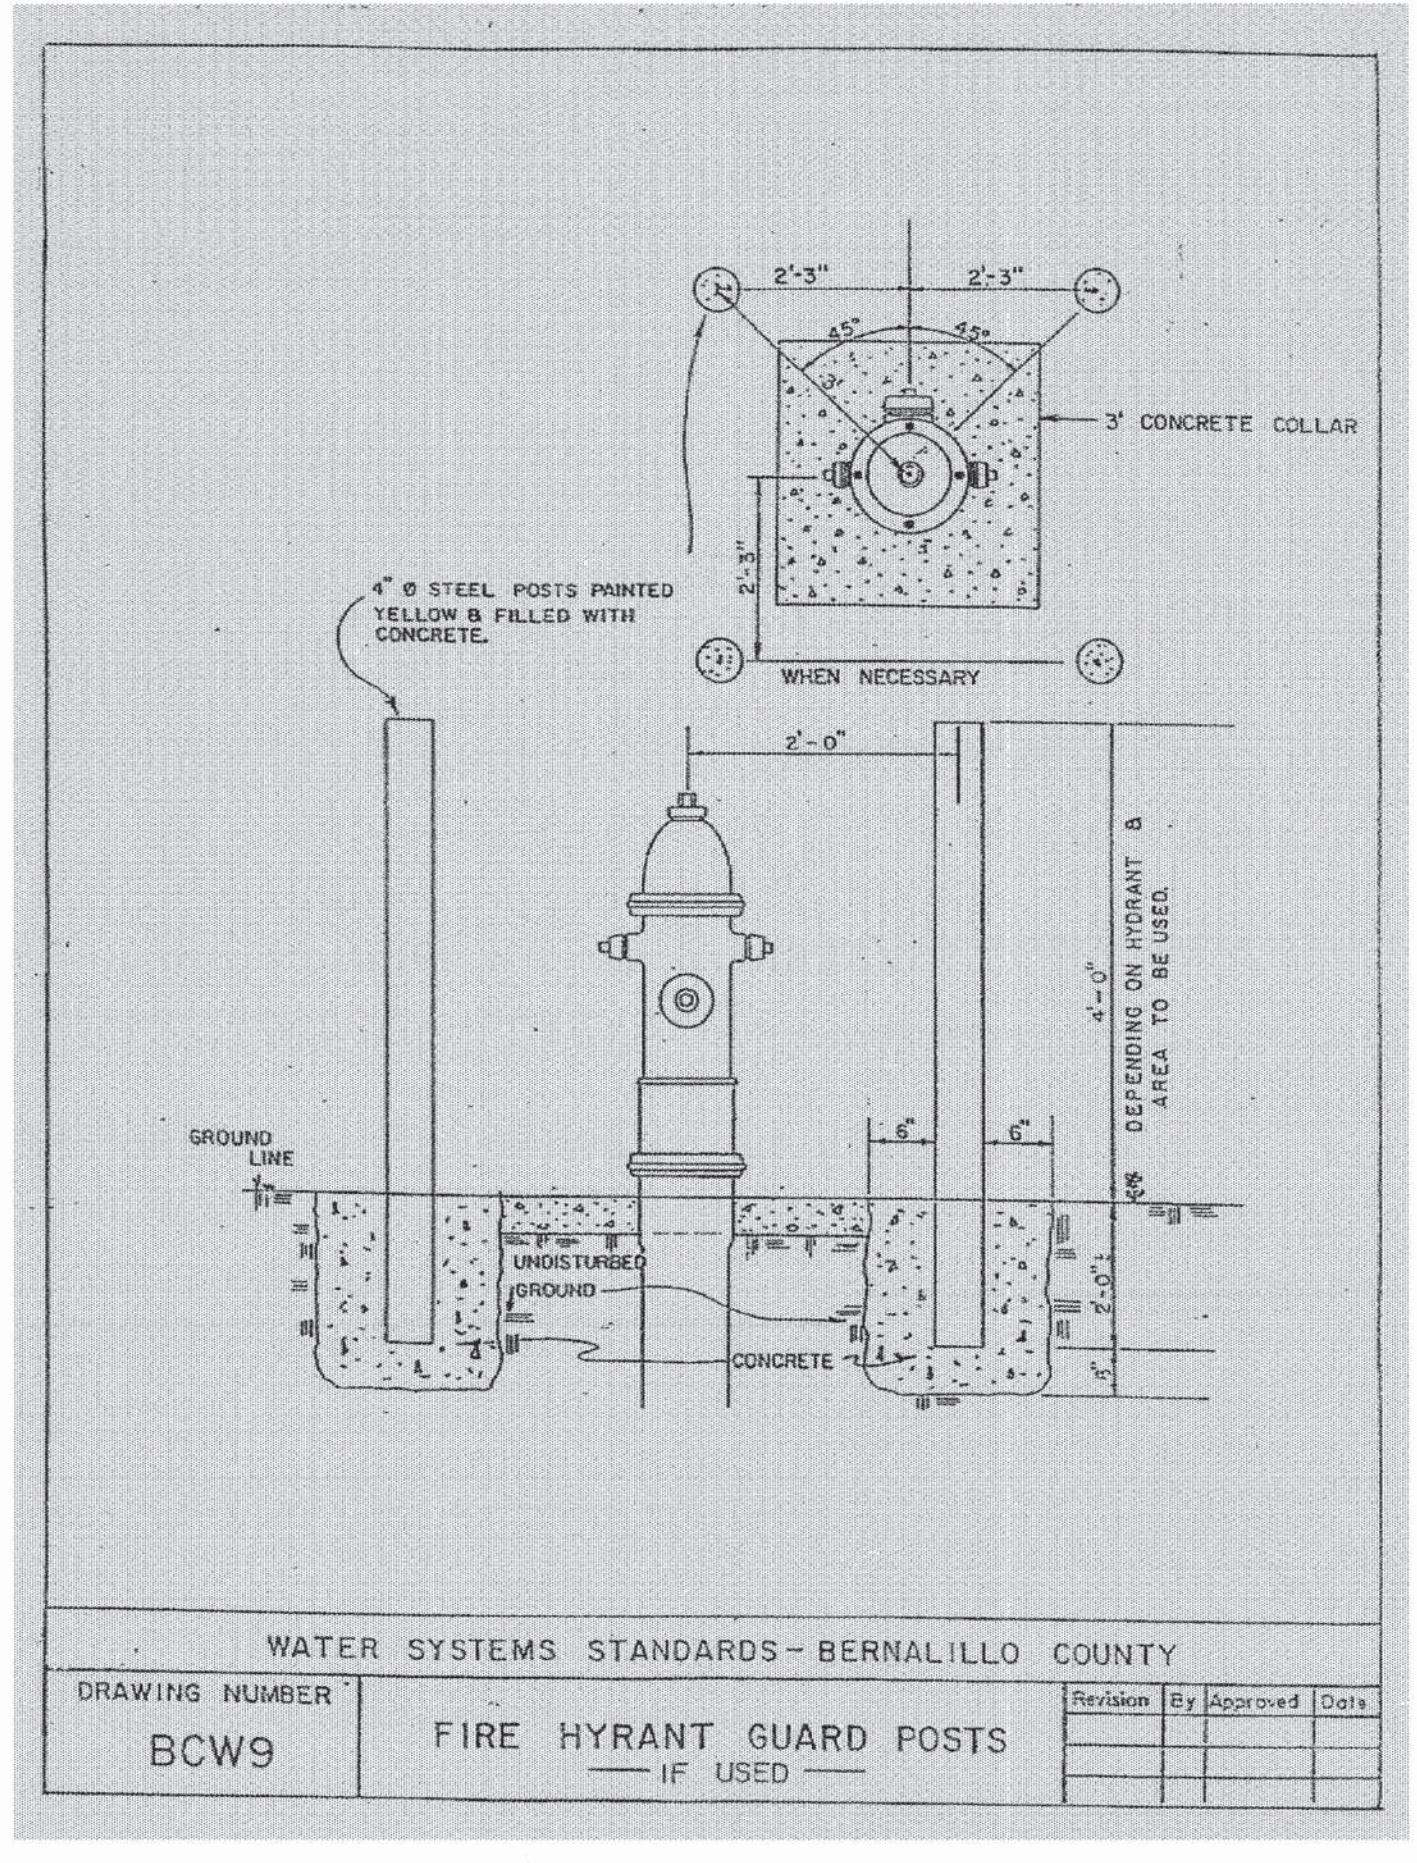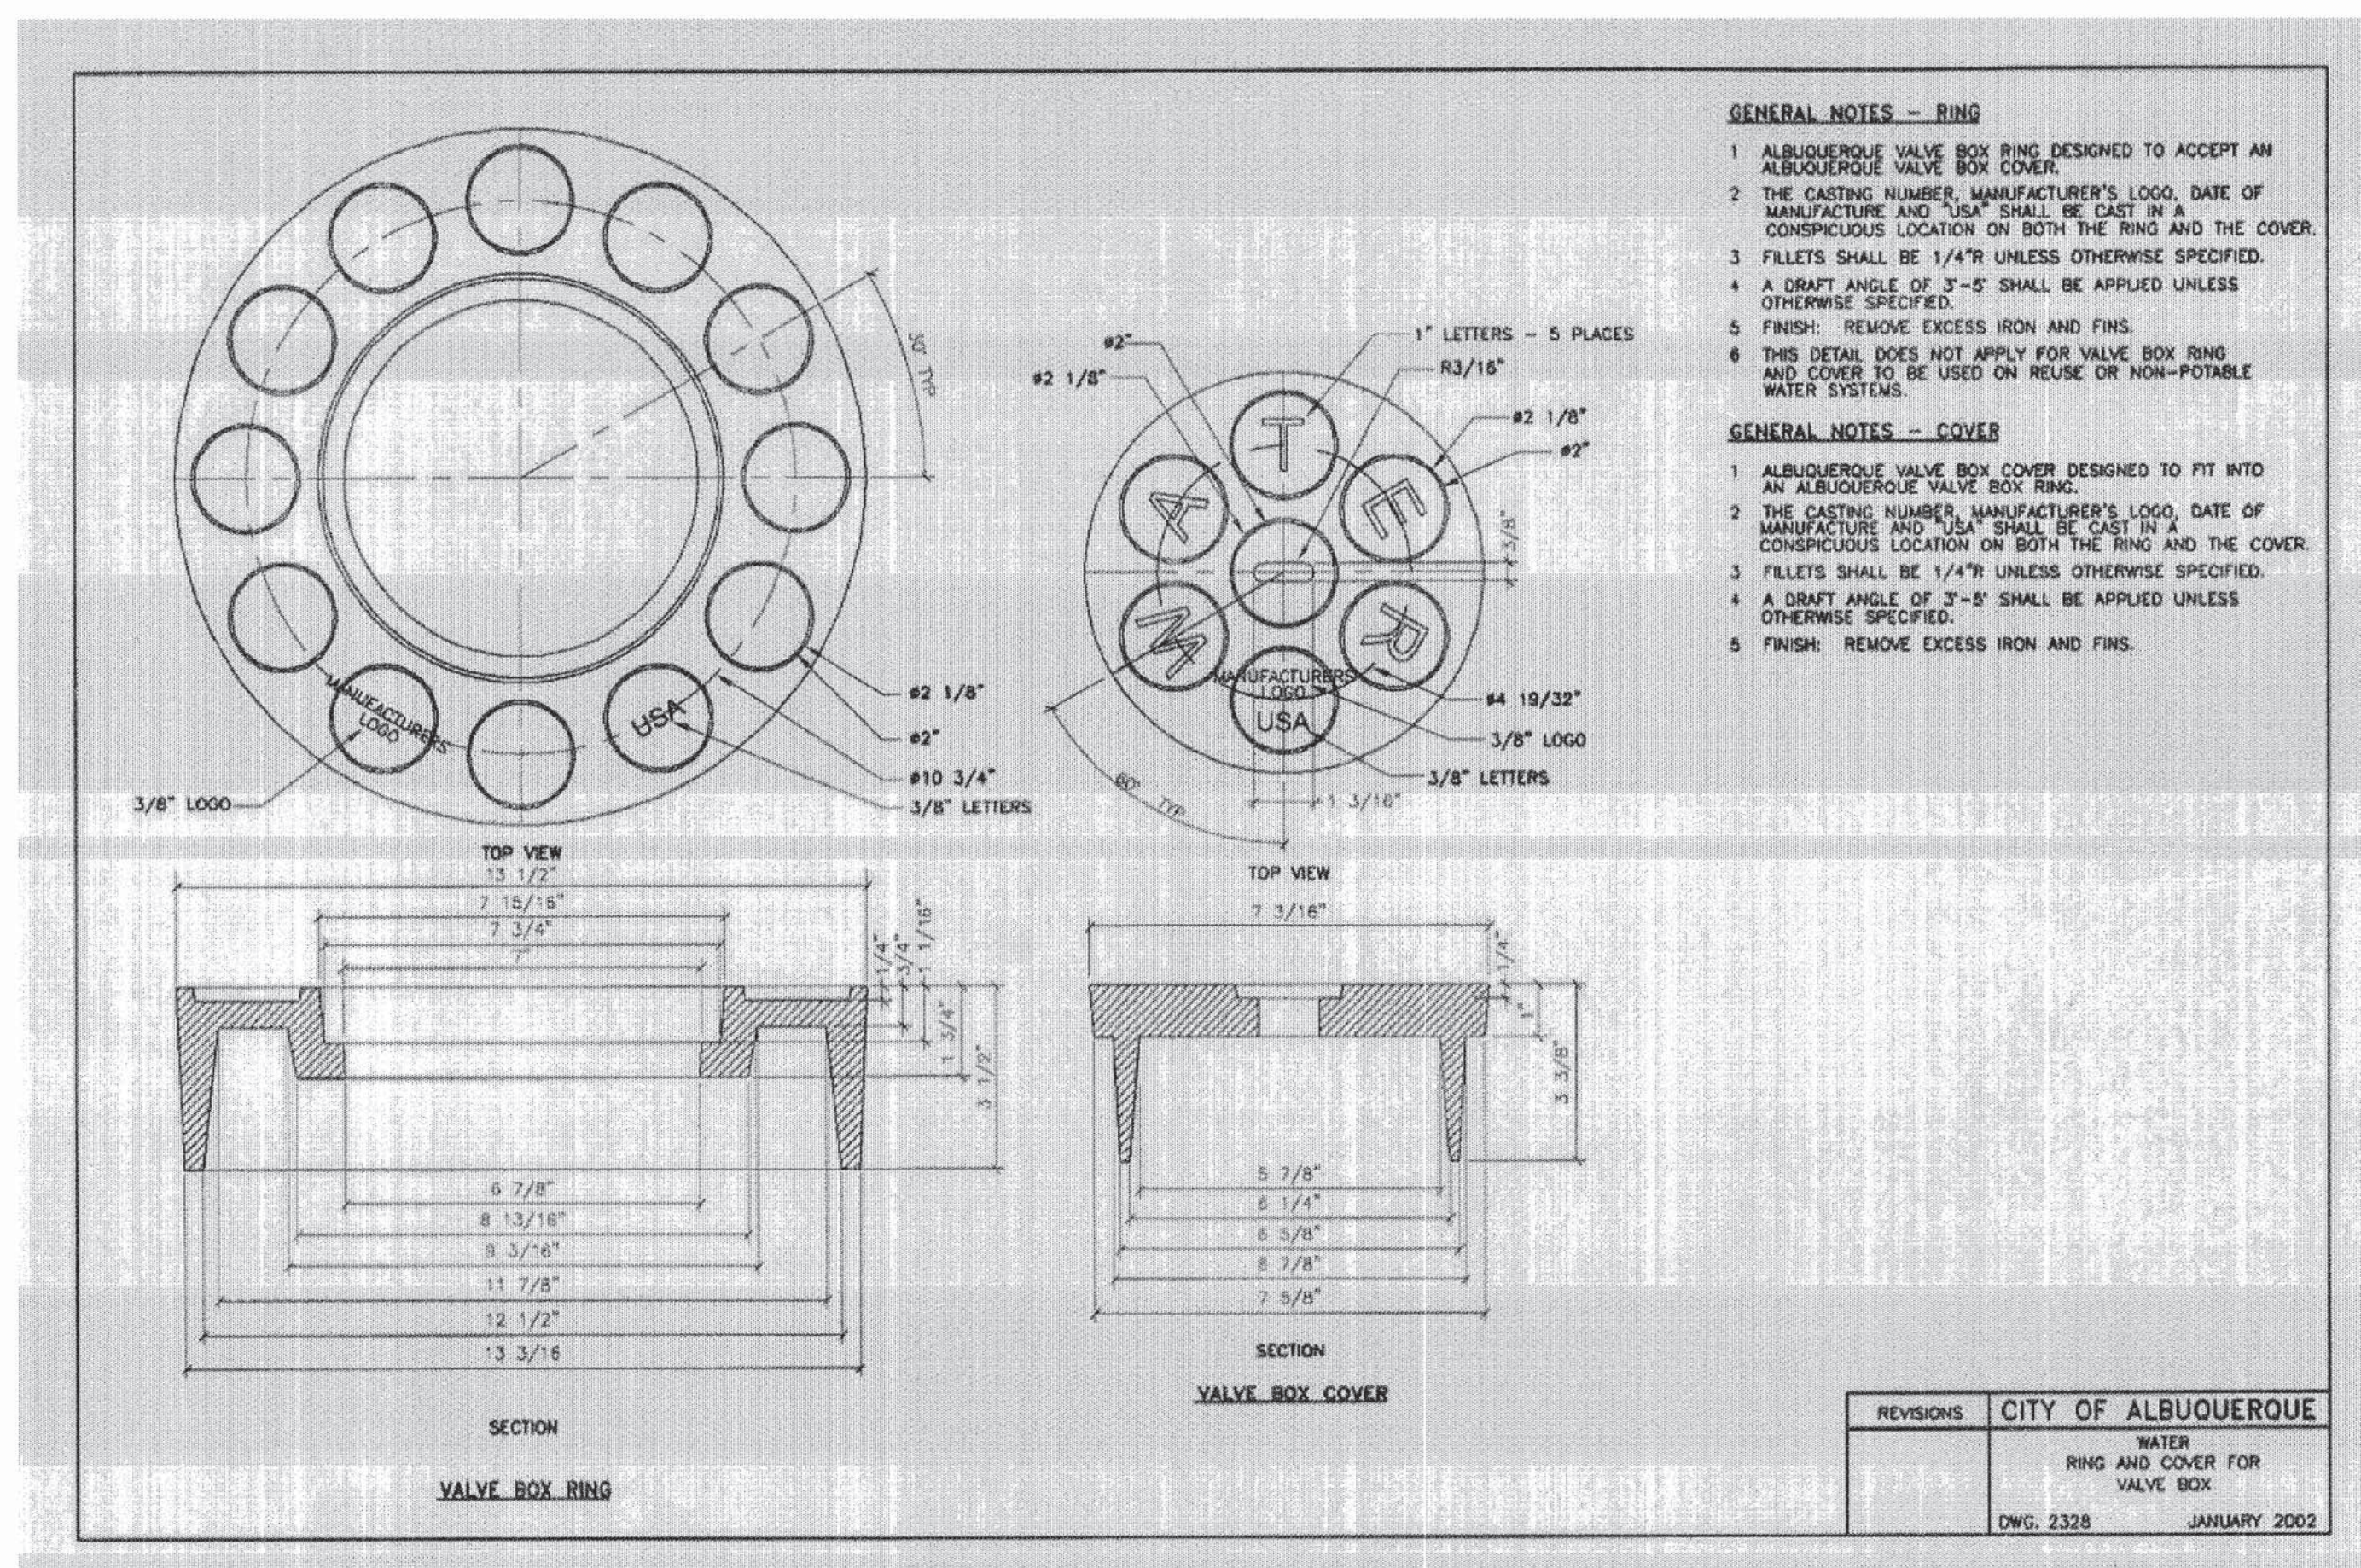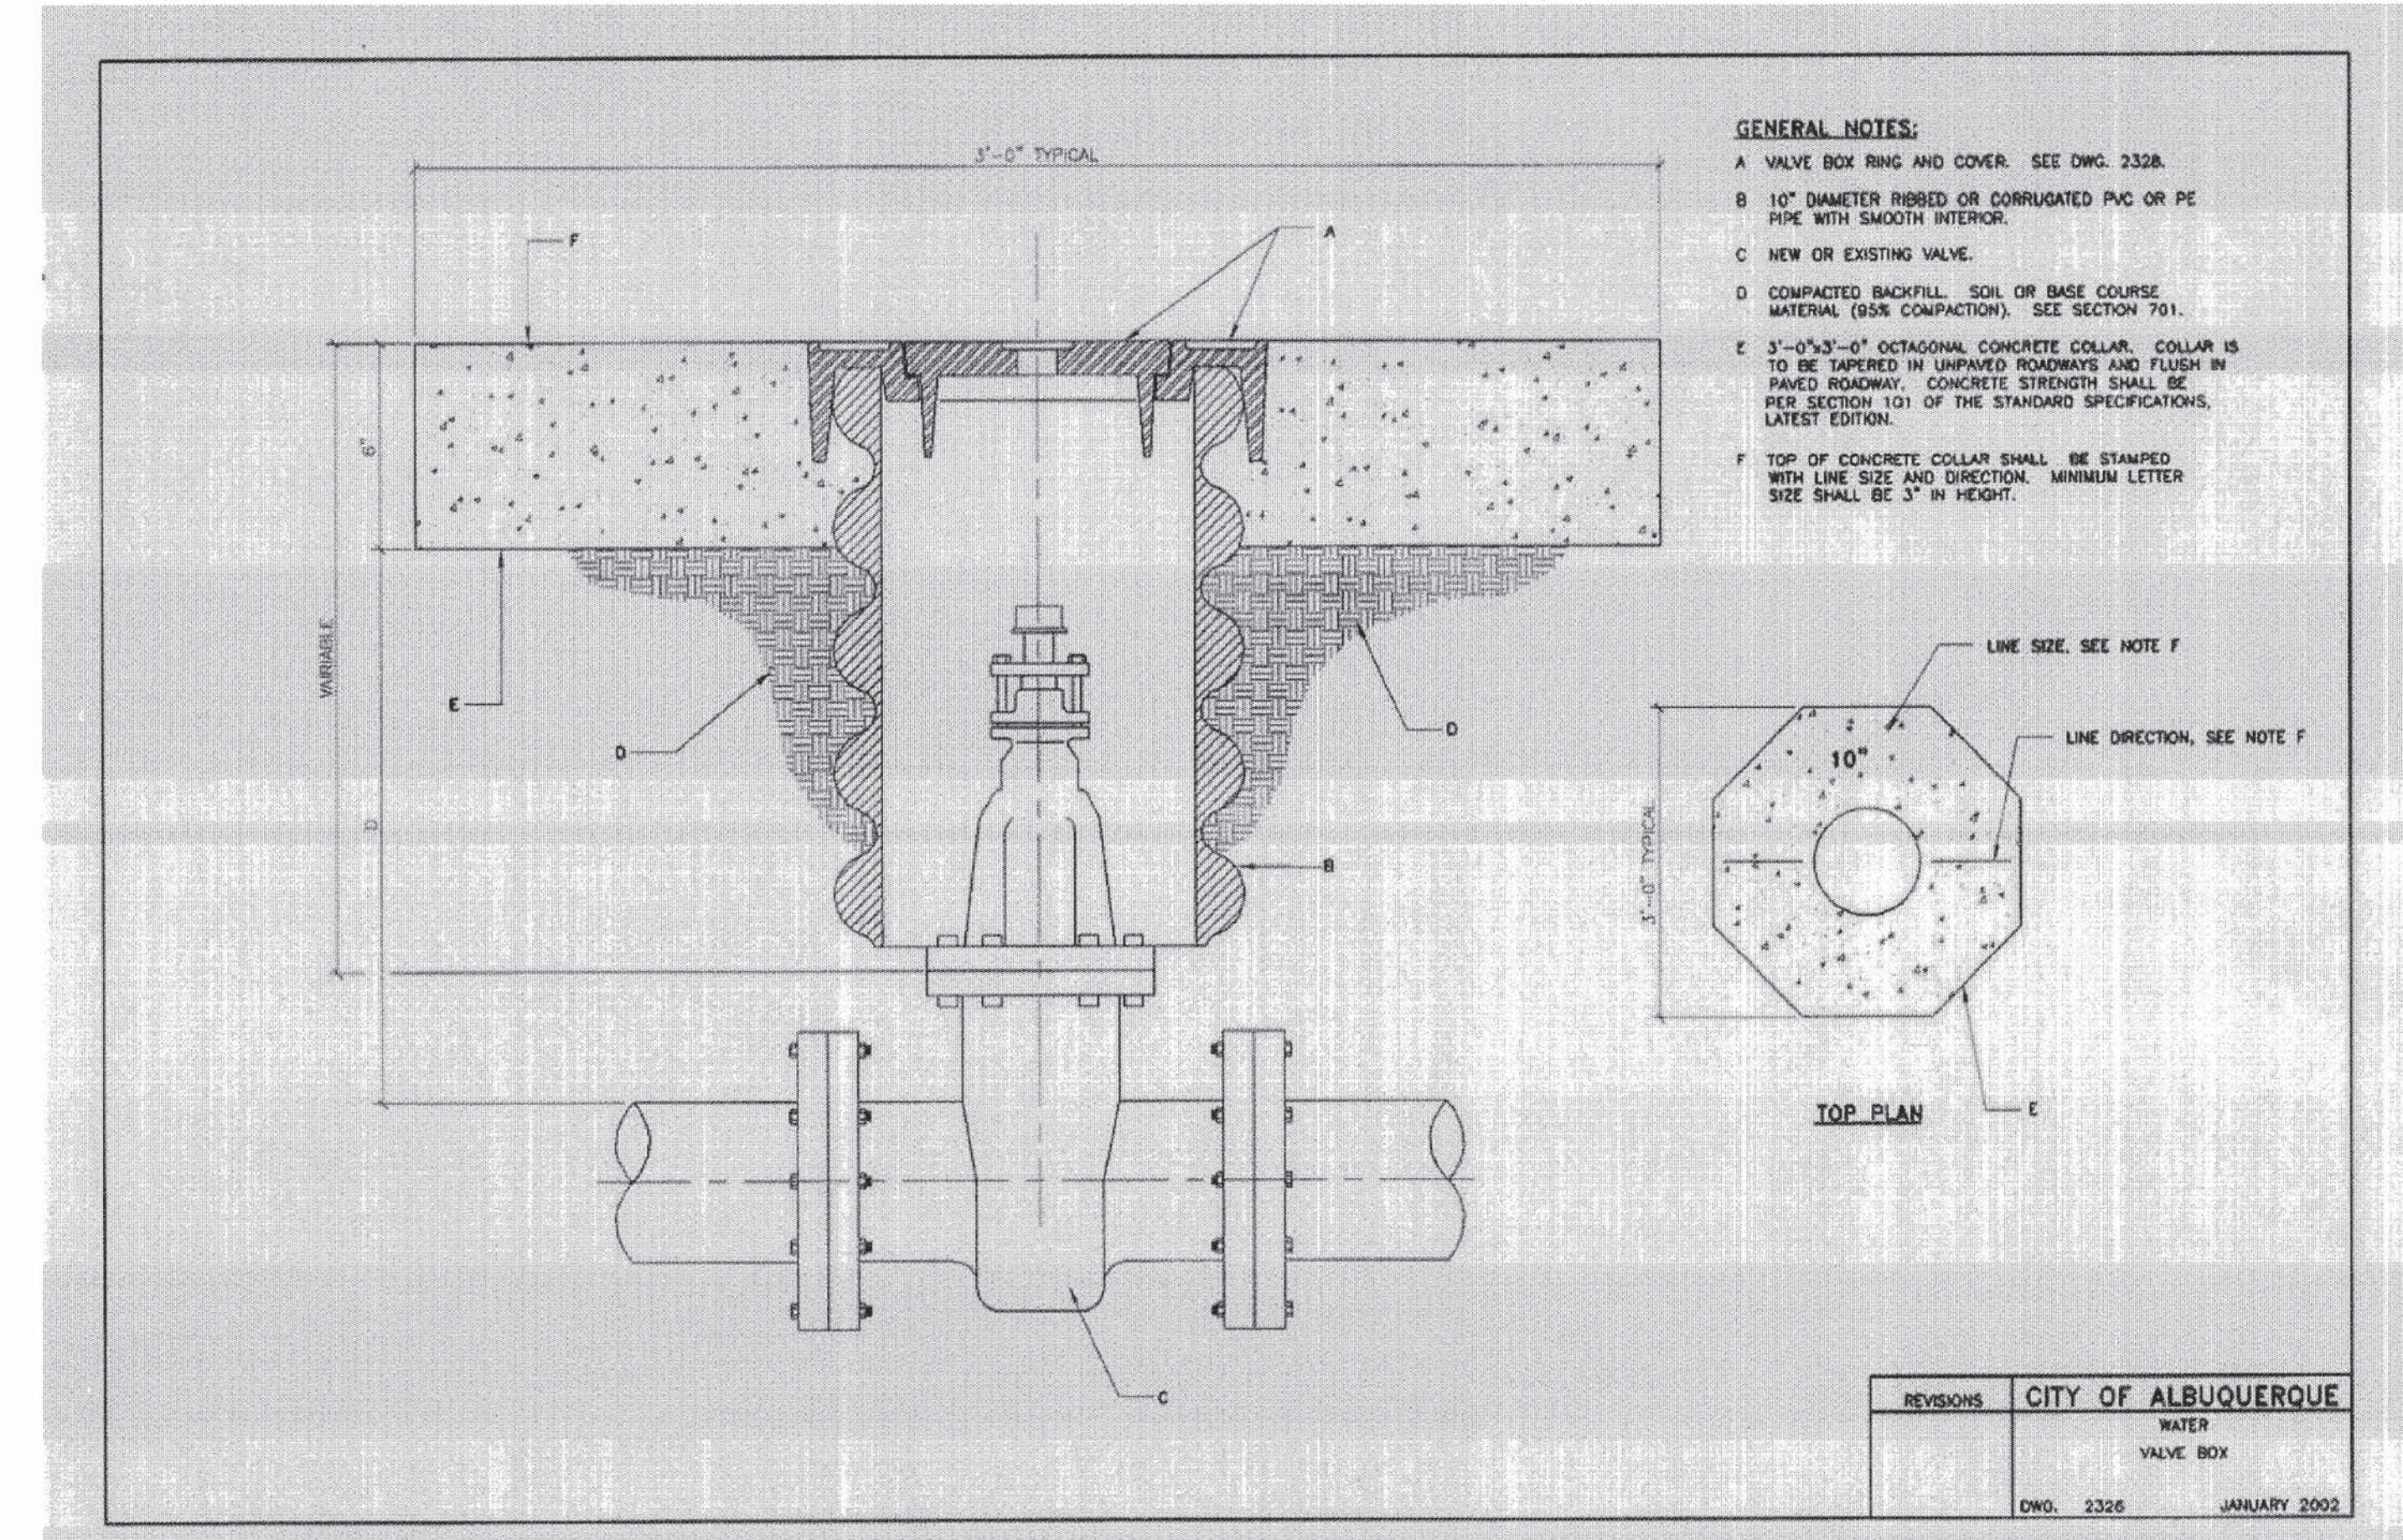

APPLIED ENGINEERING AND SURVEYING, INC.
ENGINEERS AND PLANNERS
1605 Blvd Drive NE
Albuquerque, New Mexico 87112
Phone: (505) 237-1456 Fax: (505) 237-1456

CITY OF ALBUQUERQUE
PUBLIC WORKS DEPARTMENT
ENGINEERING DEVELOPMENT GROUP

TITLE: MISCELLANEOUS UTILITY DETAILS

Design Review Committee: City Engineer Approval:

City Project No. 5365.90 Zone Map No. L-12 Sheet 9 Of 15

DESIGNED BY G. ALDAZ DATE 07-07-03
DRAWN BY G. ALDAZ DATE 07-07-03
CHECKED BY G. ALDAZ DATE 07-07-03


AS BUILT INFORMATION			
CONTRACTOR	STAR PAVING	DATE	07/04/03
WORK	WATER	DATE	07/04/03
STATION	16-L12A	DATE	07/04/03
ACCEPTANCE BY	APPLIED ENR	DATE	07/04/03
FIELD	WATER	DATE	07/04/03
REVISION	BY	DATE	07/04/03
CORRECTED BY	BY	DATE	07/04/03
MICRO-FILM INFORMATION			
RECORDED BY	DATE	DATE	DATE
NO.	DATE	DATE	DATE

SURVEY INFORMATION			
SITE	BENCHMARK	DATE	DATE
MONUMENT	16-L12A	DATE	DATE
ELEVATION	4945.073	DATE	DATE
DISK SET	IN THE TOP OF A	DATE	DATE
CONCRETE CURB	AT THE E. S. E.	DATE	DATE
CURB RETURN	S. E. QUADRANT	DATE	DATE
OF BRIDGE	BLVD. AND SUNSET	DATE	DATE
ROAD	S. W. VERTICAL	DATE	DATE
DATUM	N. G. V. D. = 1929	DATE	DATE




ENGINEER'S SEAL

50-90-80


APPLIED ENGINEERING AND SURVEYING, INC.

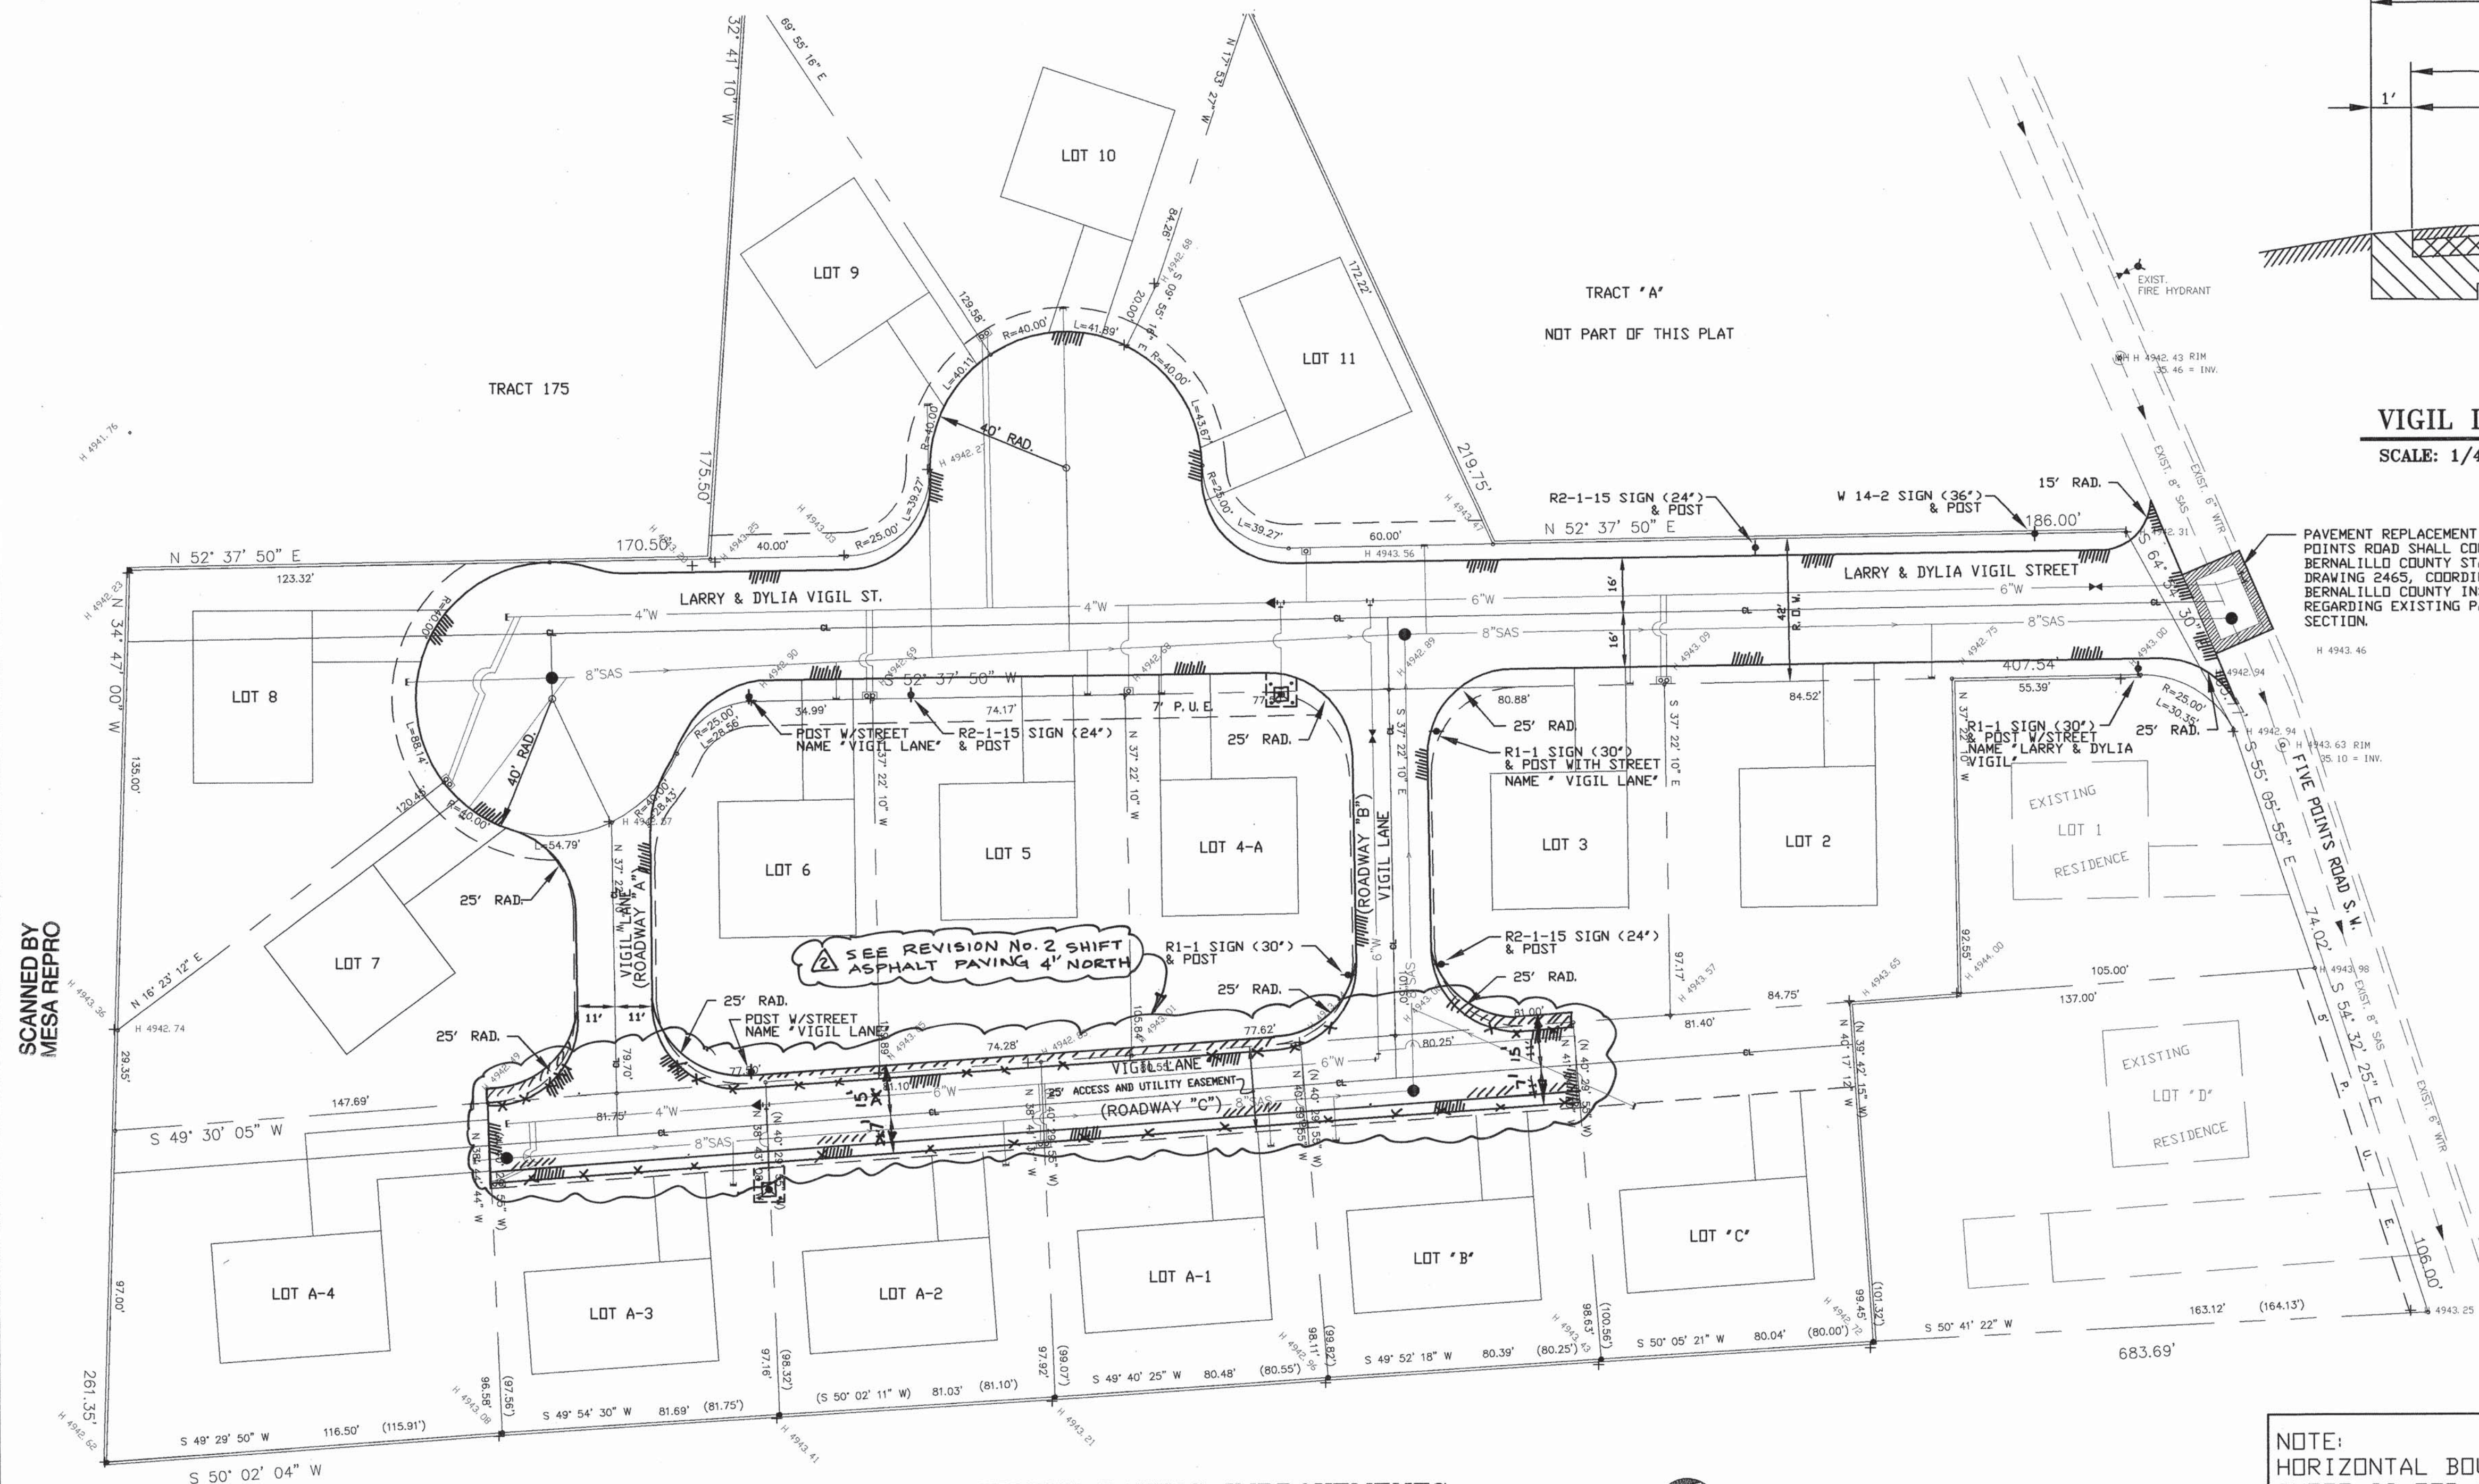

SCALE: 1" = 30'

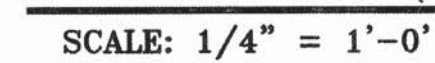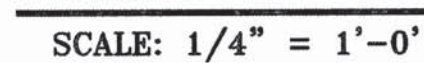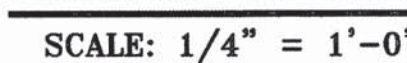

NOTE:
ADDITIONAL ROADWAY EASEMENT TO
BERNALILLO COUNTY WILL BE
DEDICATED FOR VIGIL LANE
(ROADWAY 'A' & 'B') IN ORDER TO
INCREASE WIDTH FROM 22 FEET TO
24 FEET TO INCLUDE 25' RADII AT
ALL RETURNS AS PART OF THIS
SUBDIVISION DEVELOPMENT BY OWNER

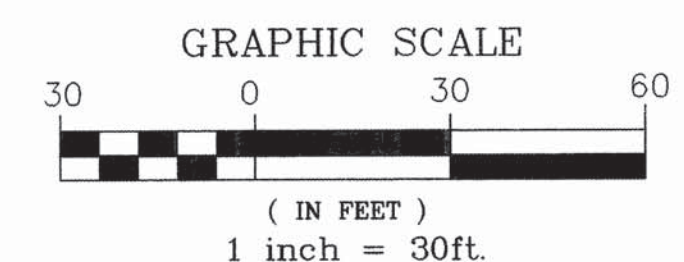

**APPLIED ENGINEERING AND
SURVEYING, INC.
ENGINEERS AND PLANNERS**

CITY OF ALBUQUERQUE
PUBLIC WORKS DEPARTMENT
ENGINEERING DEVELOPMENT GROUP

TITLE: MASTER STREET PAVING IMPROVEMENTS
PLAN & NEW SIGNAGE

Design Review Committee	City Engineer Approval	Mo./Day/Yr.	Mo./Day/Yr.
-------------------------	------------------------	-------------	-------------

For Information	Update		

design		

Only	Last D		

City Project No.	Zone Map No.	Sheet	Of
------------------	--------------	-------	----

5365.90	L-12	10	15
---------	------	----	----

AS BUILT INFORMATION			
CONTRACTOR	STAR PAVING	DATE 06/04	DATE 06/04
WORK	WAY JOHN	DATE 11	DATE 06/04
INSPECTED BY	APPLIED ENGR	DATE 11	DATE 06/04
FIELD OFFICE BY	" "	DATE 11	DATE 06/04
VERIFICATION BY	" "	DATE 11	DATE 06/04
DRAWINGS	" "	DATE 11	DATE 06/04
CORRECTED BY	" "	DATE 11	DATE 06/04
MICRO-FILM INFORMATION			
RECORDED BY		DATE	
NO.			

BENCH MARKS
HWMK IS AN A. C. S. # 16-L12A, =4945.073, ALUMINUM CURB AT THE E. S. E. RN, S. E. QUADRANT BLVD. AND SUNSET


SURVEY INFORMATION		FIELD NOTES		SITE BENCH- MONUMENT
NO.	BY	DATE		ELEVATION
				DISK SET
				CONCRETE
				CURB RETU
				OF BRIDGE
				ROAD S. W.

Professional Engineer Seal for New York State, No. 10027, signed by Robert J. M. and dated 5/16/00.

[illegible]



Mo./Day/Yr.		Mo./Day/Yr.	
Sheet	Of		
10	15		

SCANNED BY
MESA REPRO

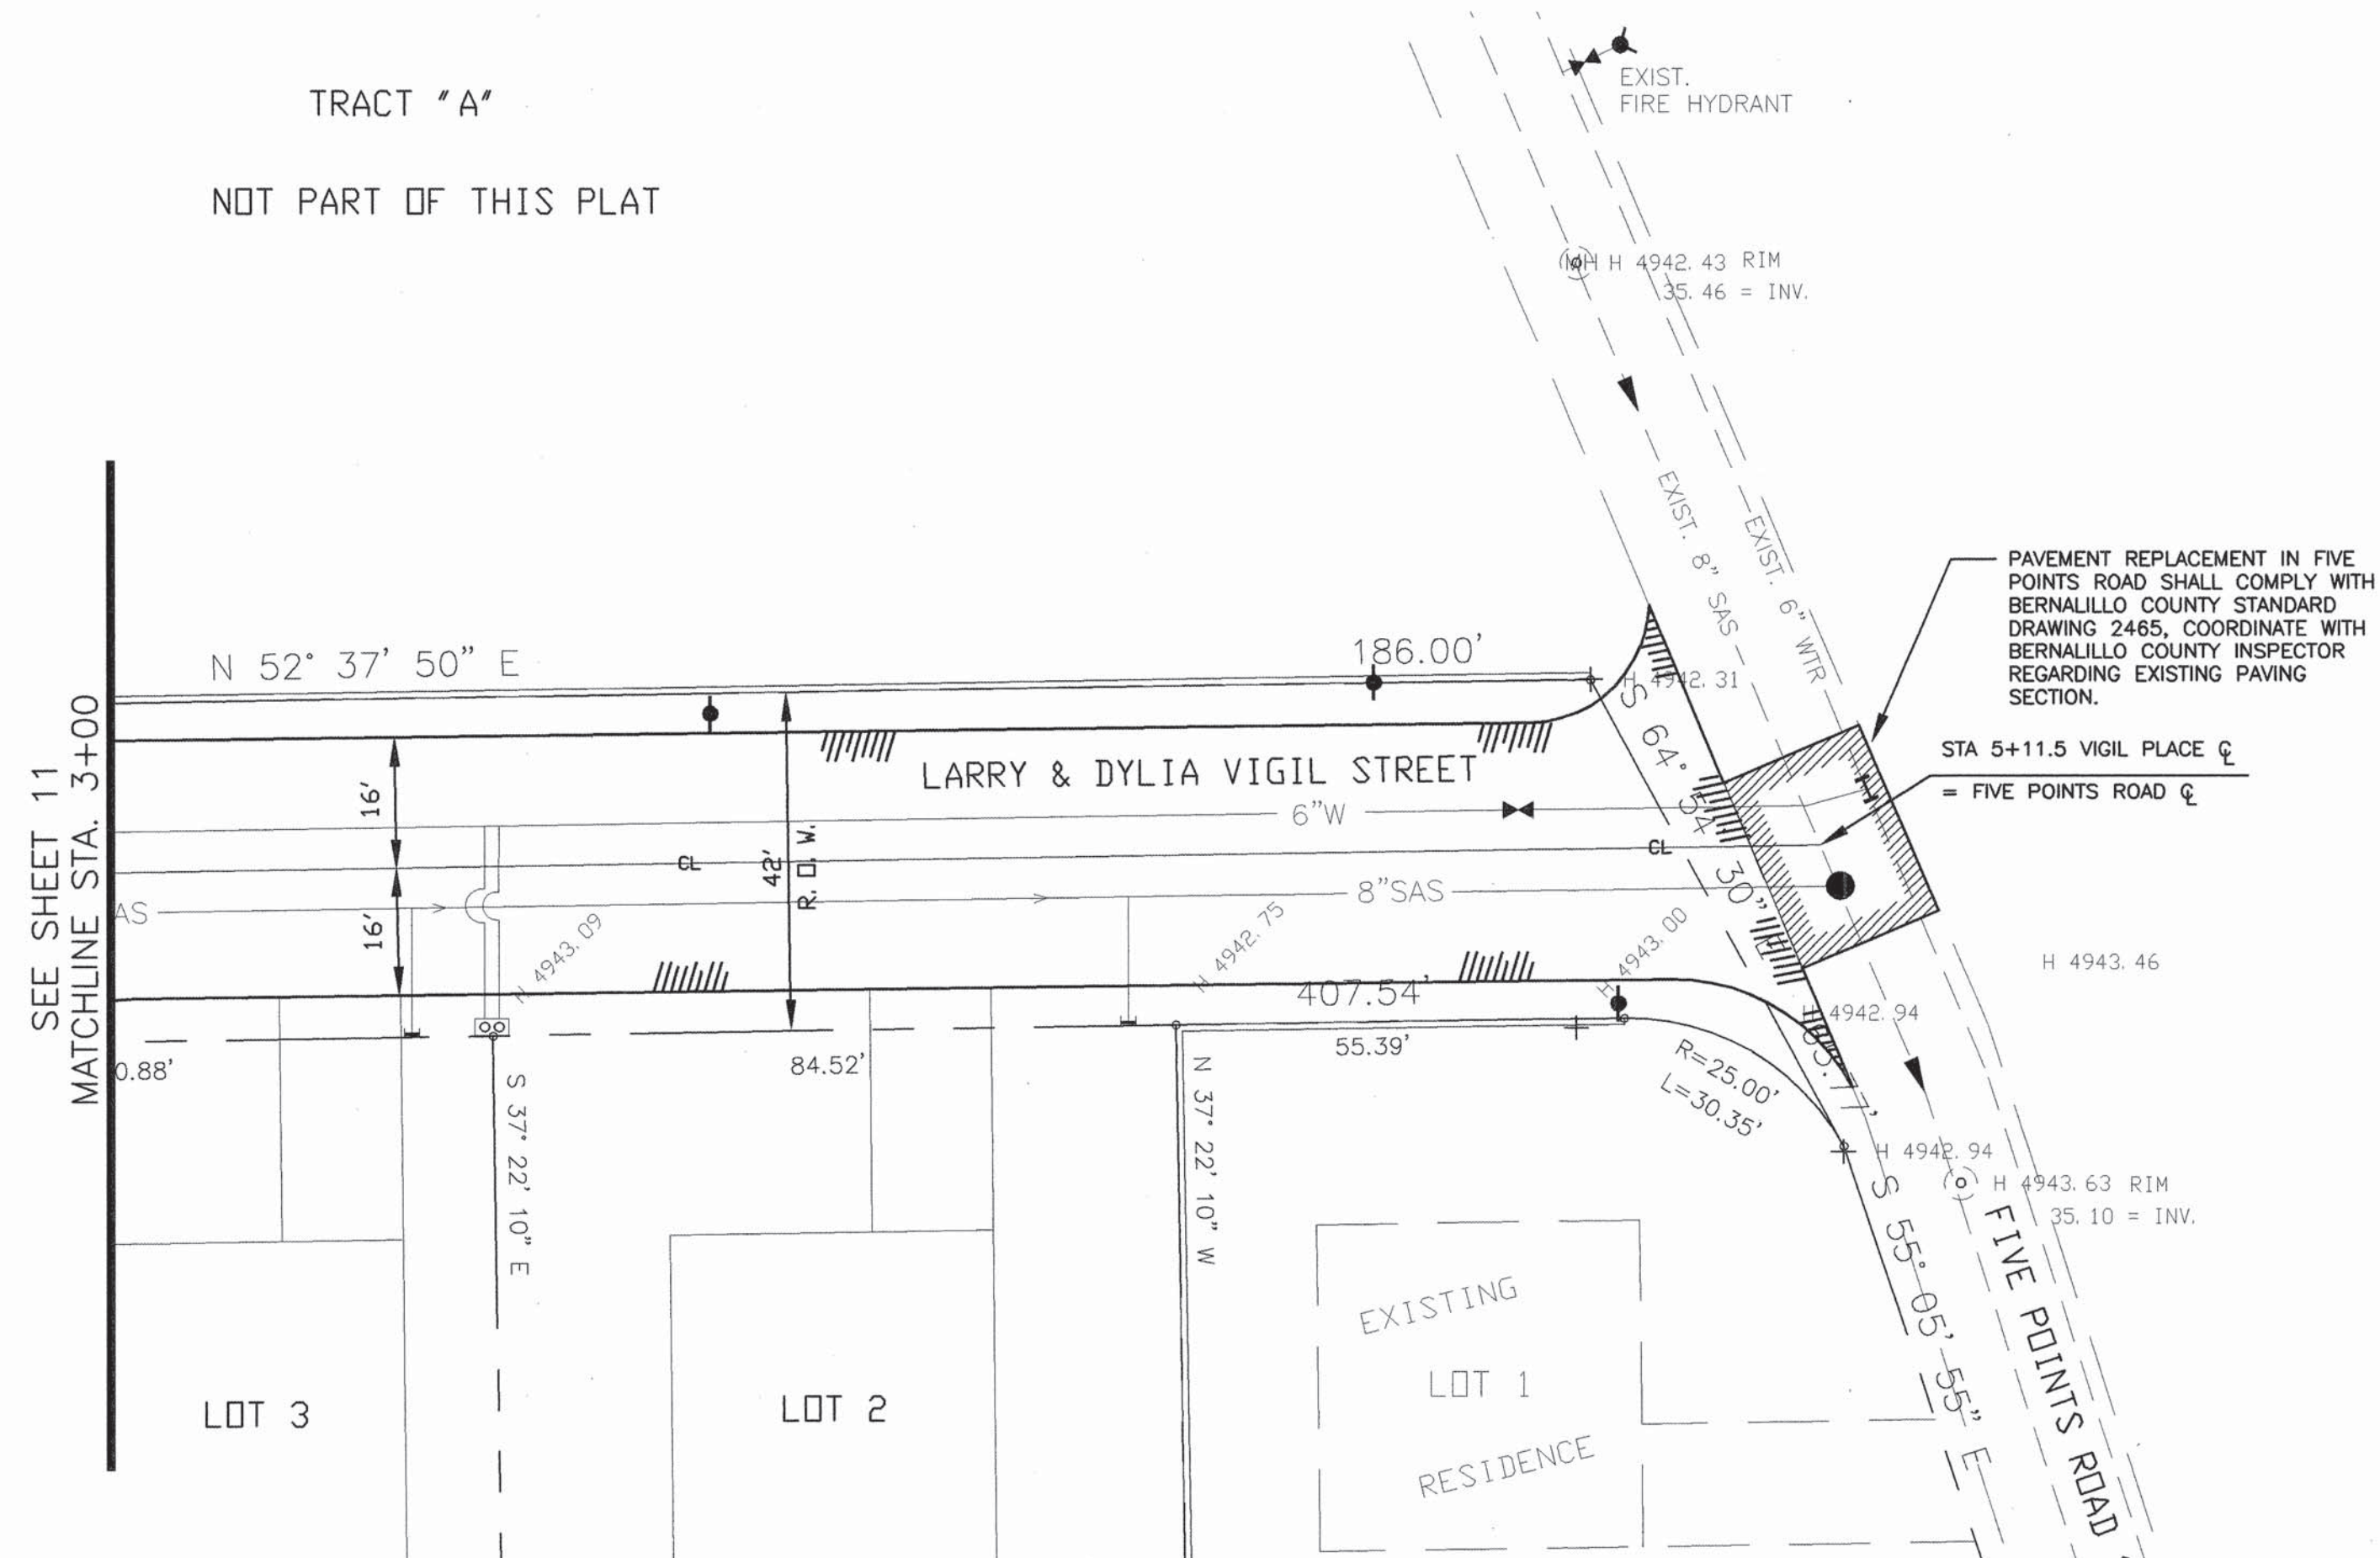

PAVING PLAN - LARRY & DYLIA VIGIL STREET - STA 3+00 TO STA. 5+11

SCALE: 1" = 20'

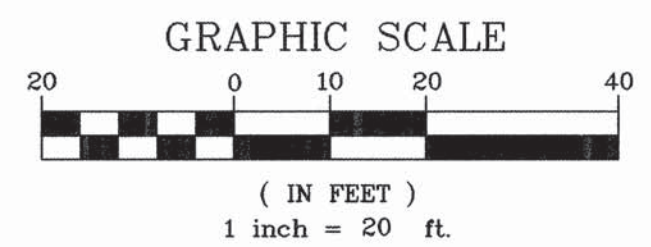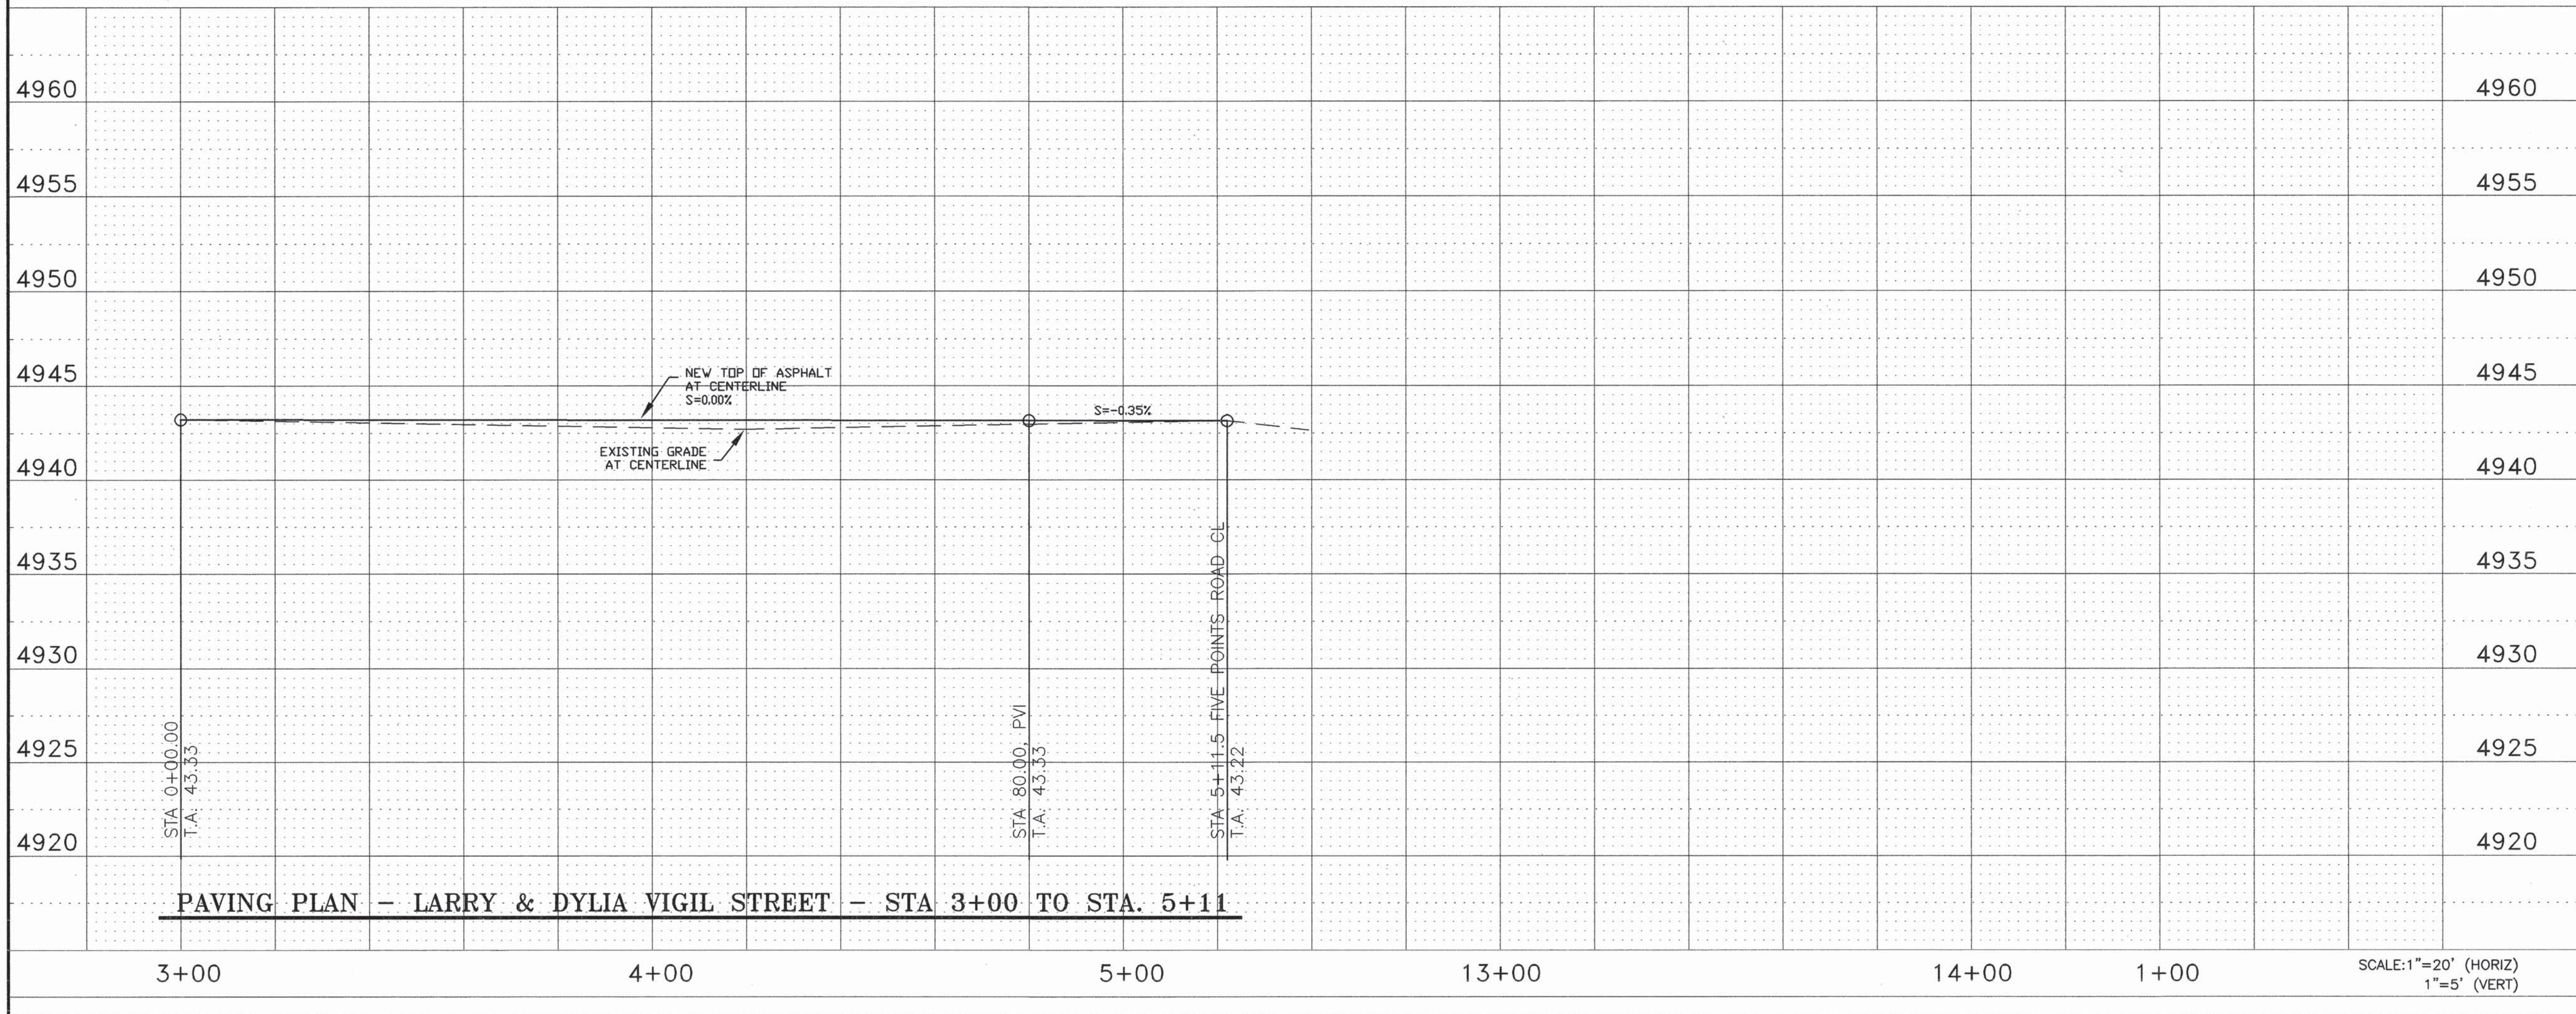

APPLIED ENGINEERING AND
SURVEYING, INC.
ENGINEERS AND PLANNERS
1805 Blair Drive NE
Albuquerque, New Mexico 87112
Office: (505) 233-1406 Fax: (505) 237-1450

CITY OF ALBUQUERQUE
PUBLIC WORKS DEPARTMENT
ENGINEERING DEVELOPMENT GROUP




TITLE: LARRY & DYLIA VIGIL STREET
PAVING PLAN & PROFILE

Design Review Committee City Engineer Approval

For Information Only

City Project No. 5365.90 Zone Map No. L-12 Sheet 11 Of 15

AS BUILT INFORMATION		BENCH MARKS		SURVEY INFORMATION		ENGINEER'S SEAL	
CONTRACTOR	STAR PAVING	DATE	07/04	FIELD NOTES	NO.		
INSPECTOR	W.A. JOHNSON	DATE	07/04	BY	DATE		
ACCEPTANCE BY	APPLIED ENGINEERING AND PLANNERS	DATE	07/04	REVISIONS	BY		
DESIGNED BY	G. ALDAB	DATE	07-07-03	DESIGN	DATE		
RECORDED BY		DATE		CHECKED BY	DATE		
MICRO-FILM INFORMATION		ROAD S.W.					

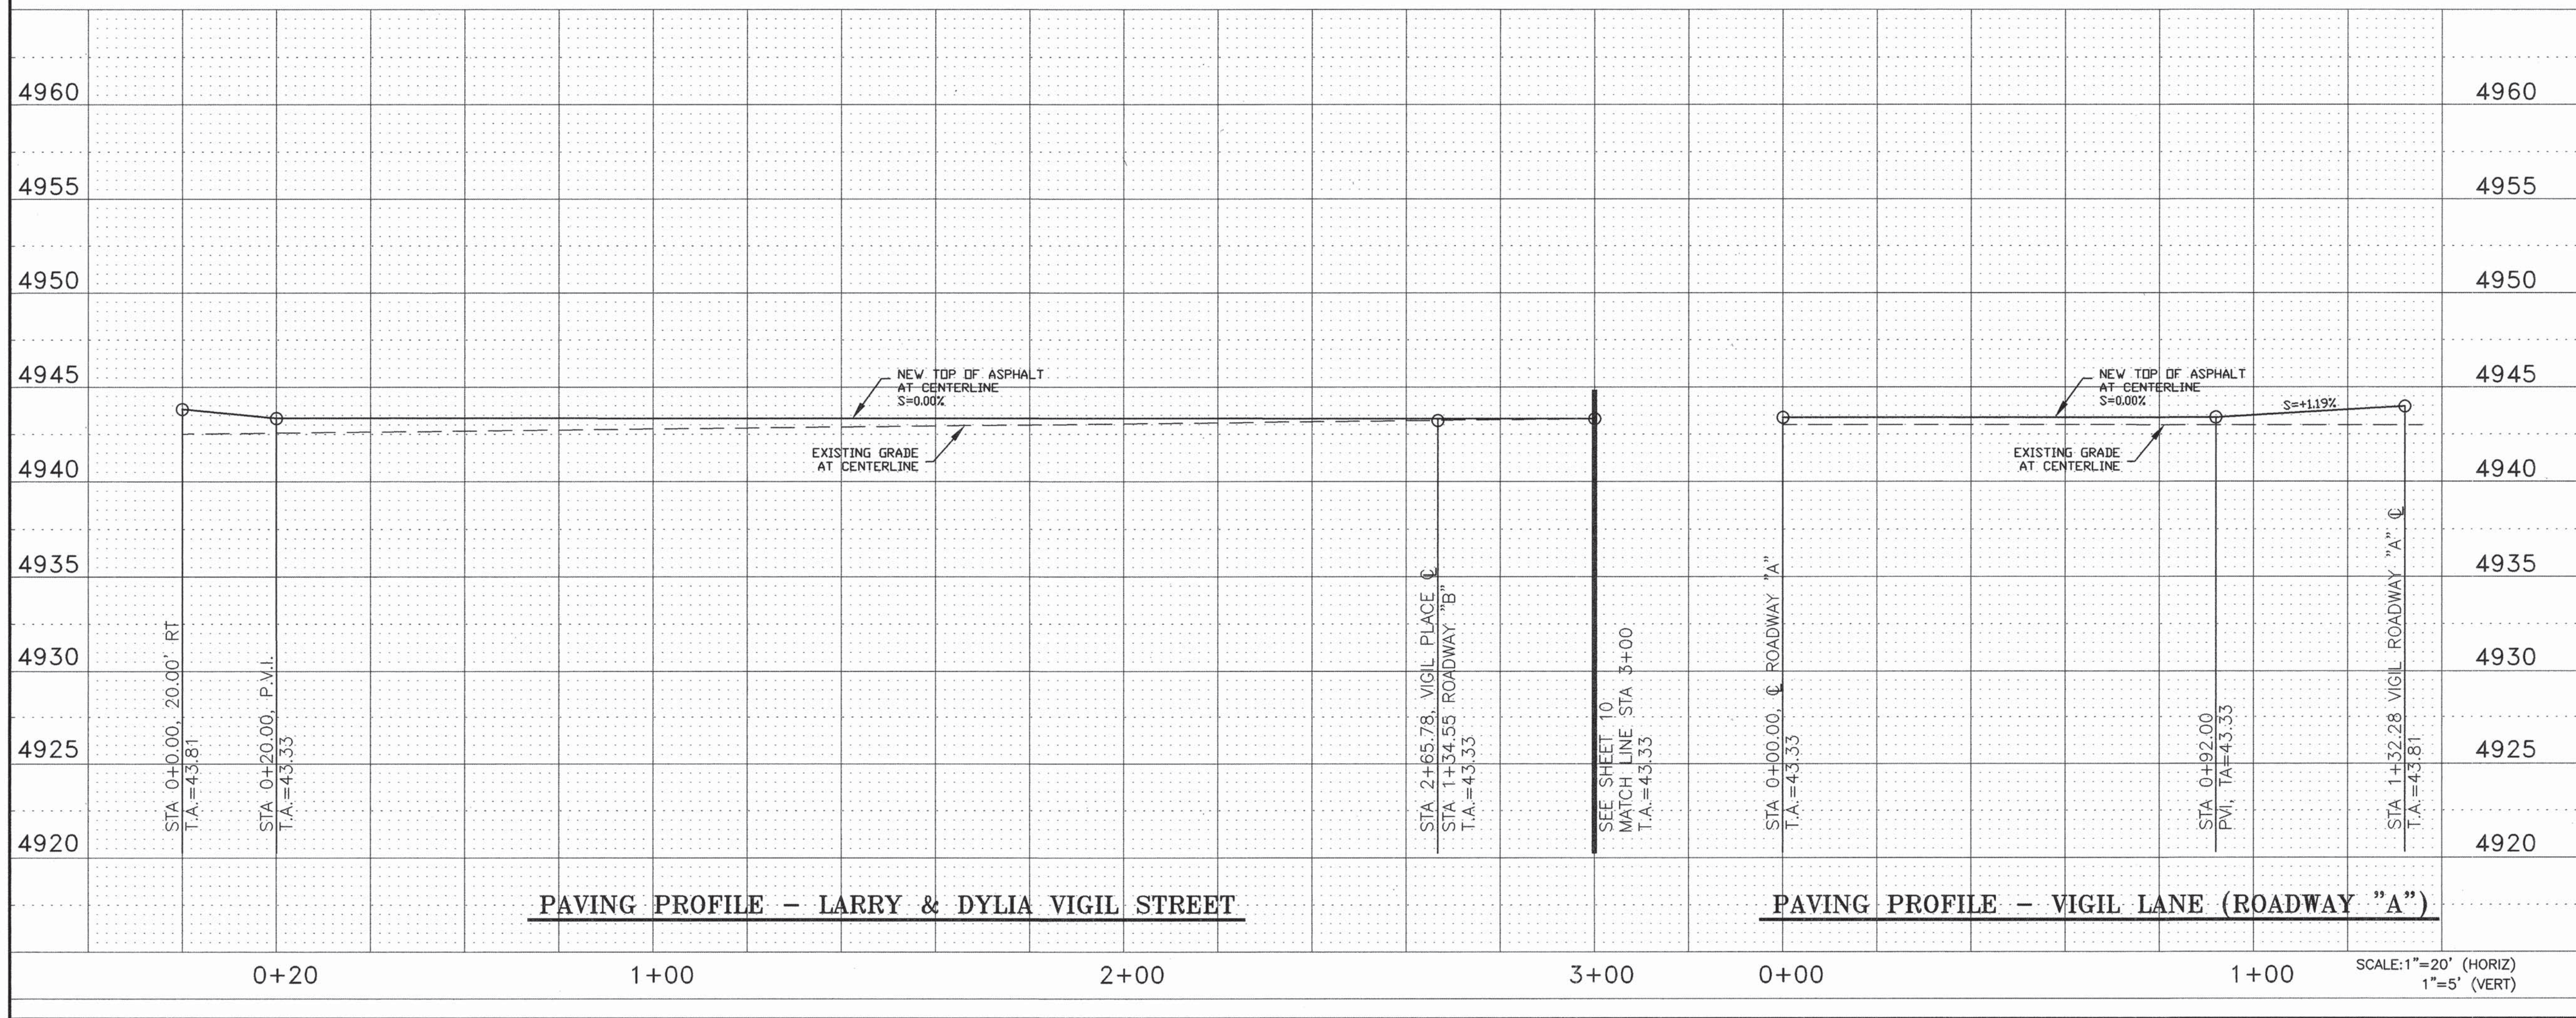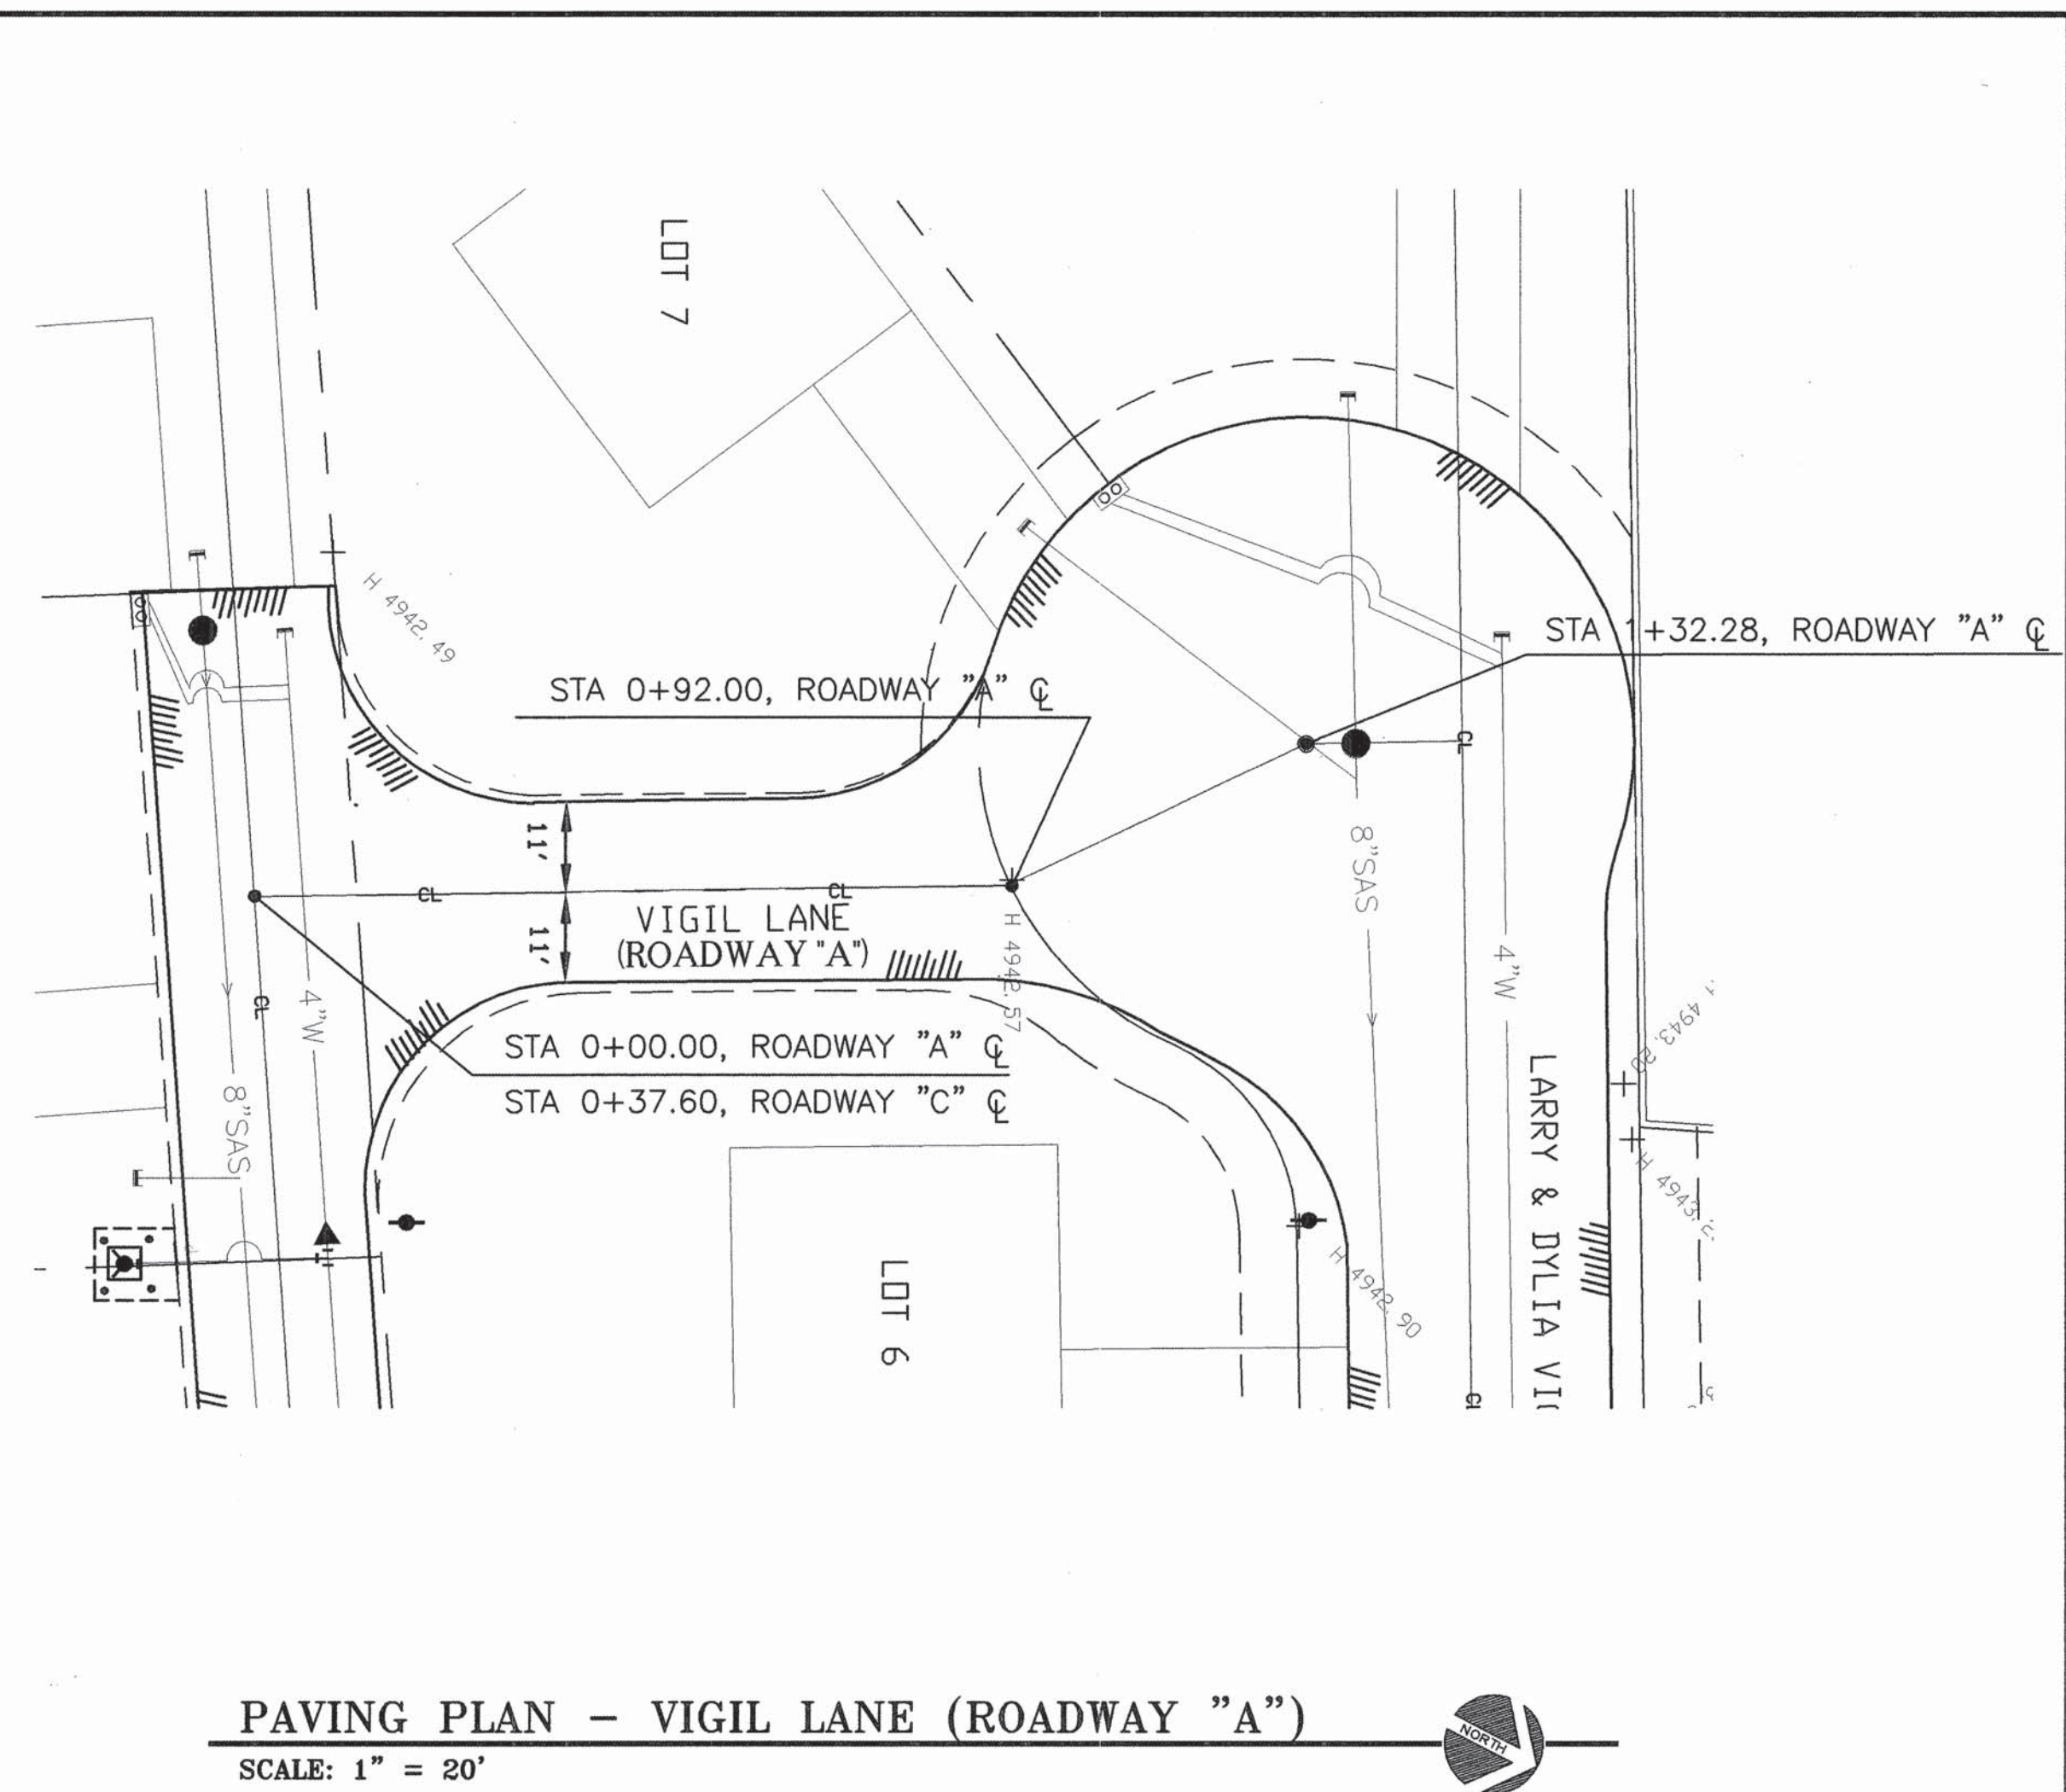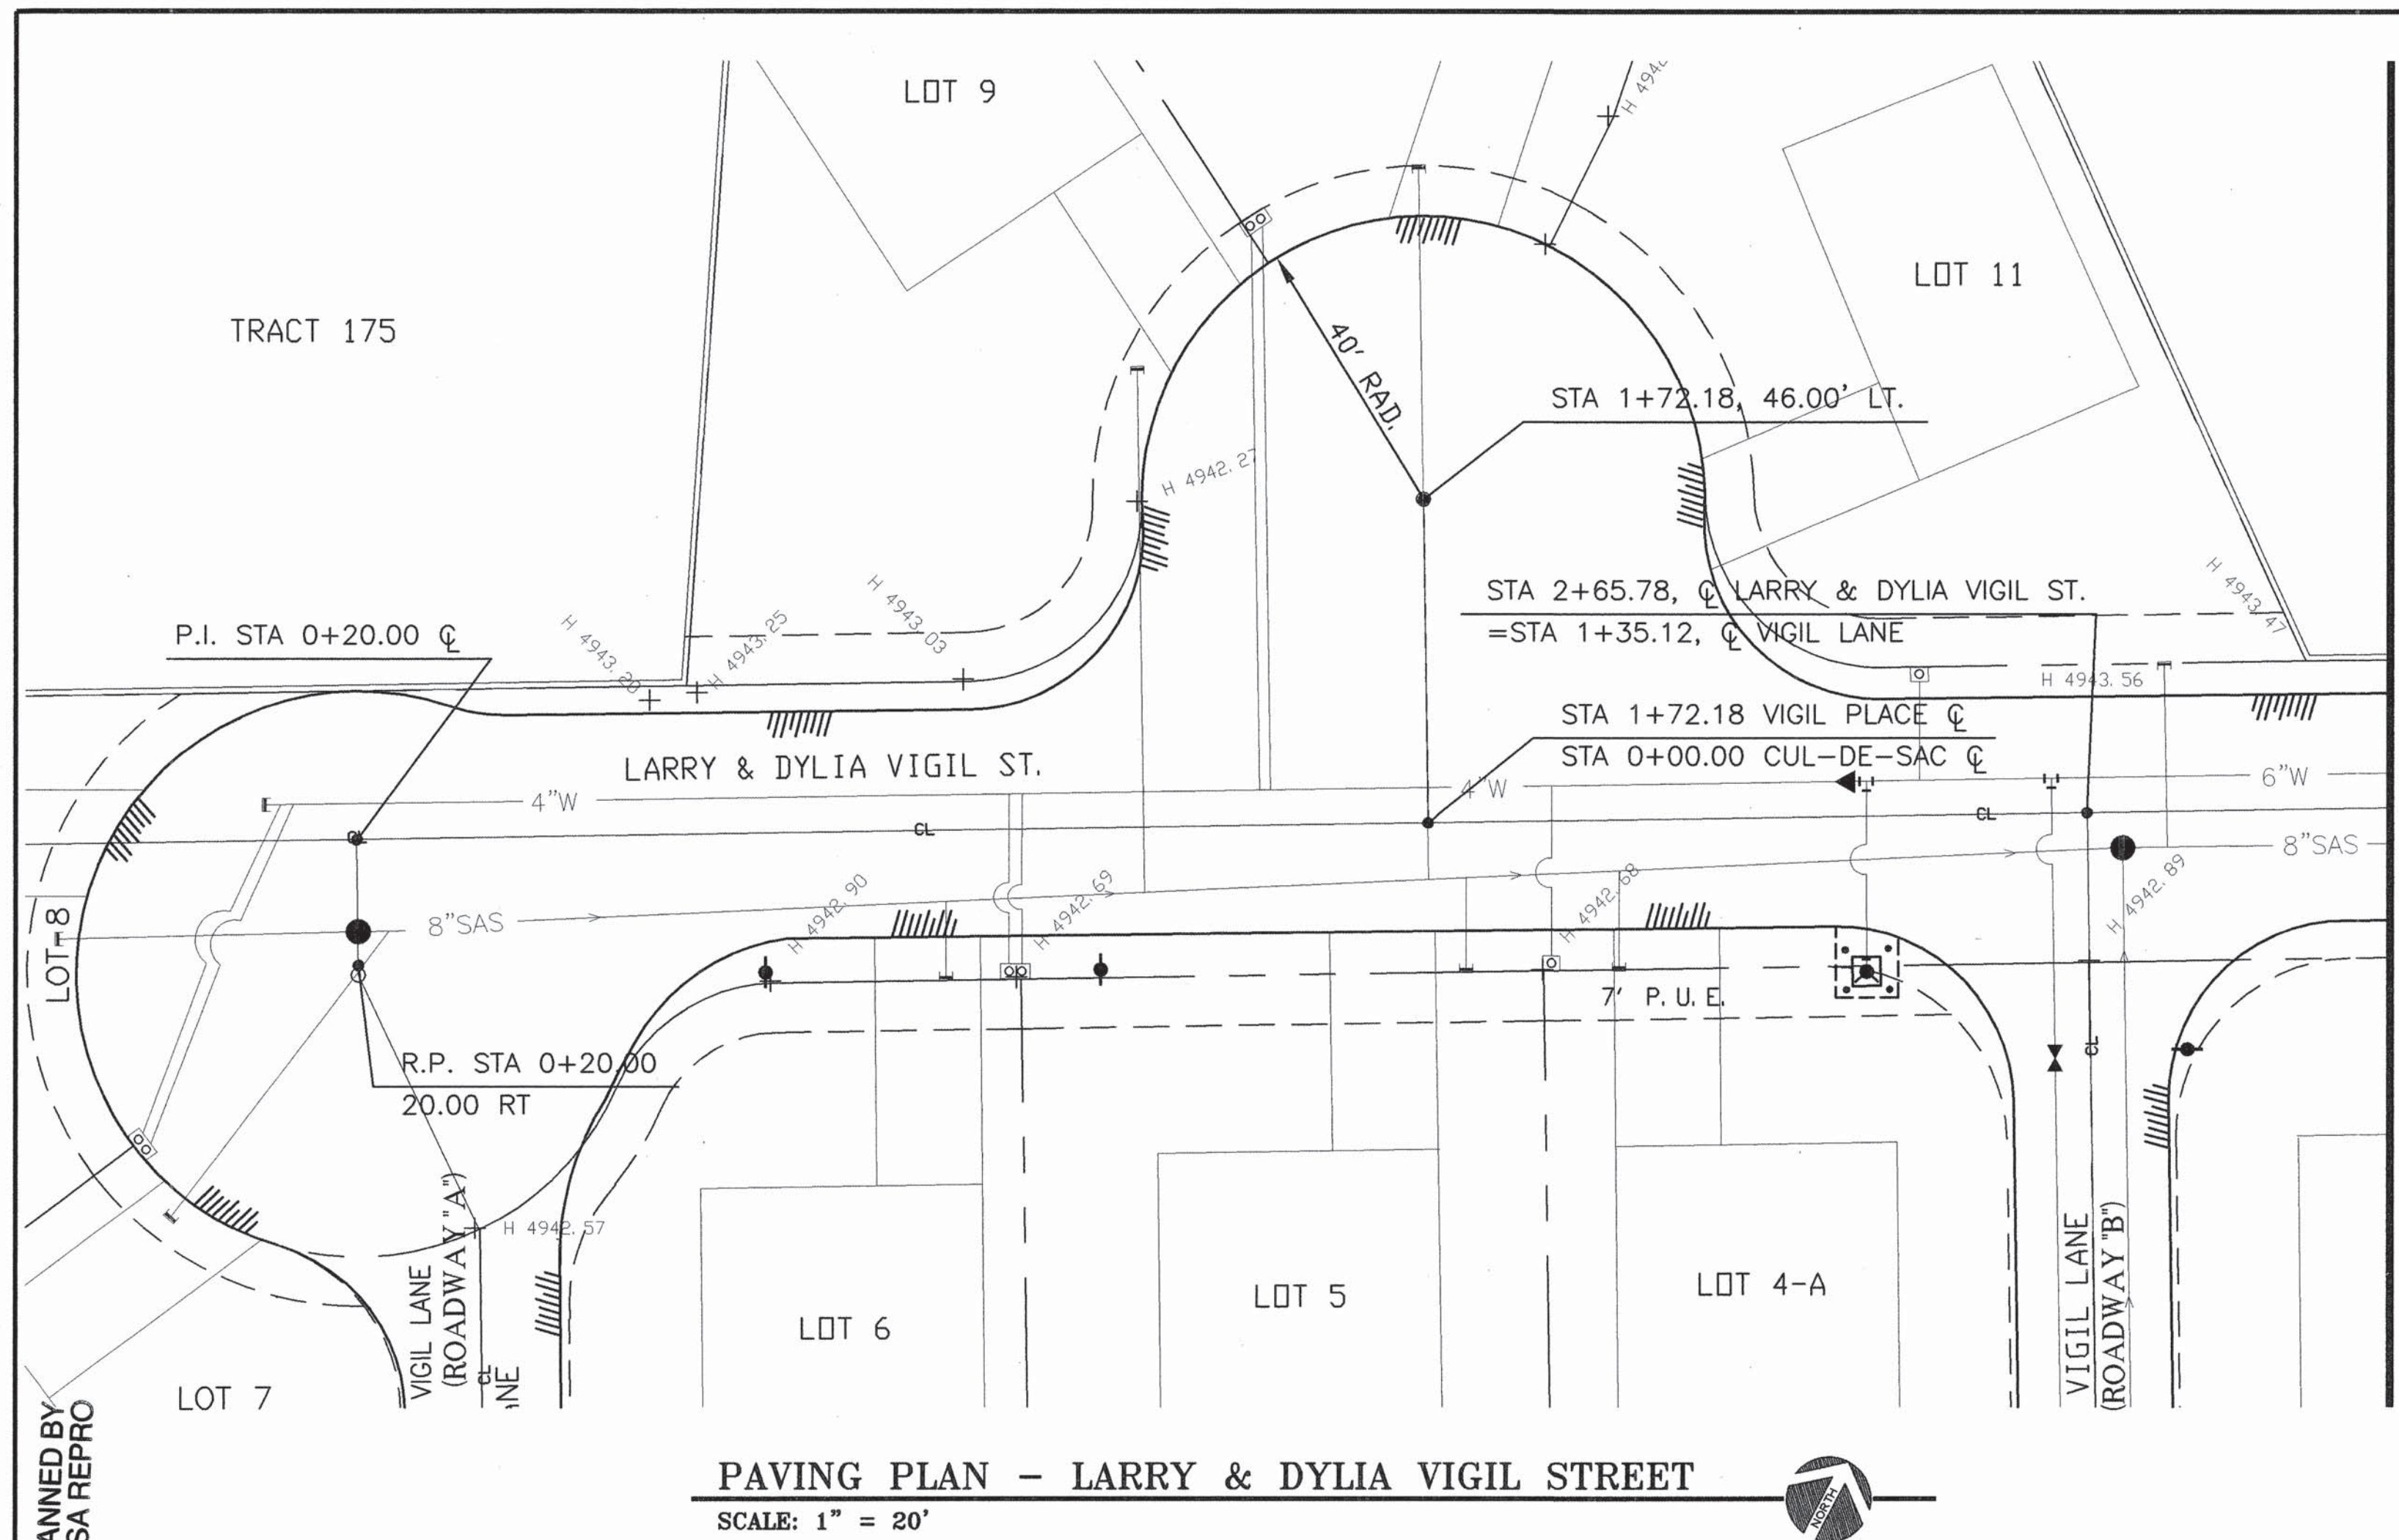

AS BUILT INFORMATION

CONTRACTOR	DATE
INSPECTOR'S	DATE
FIELD	DATE
APPLIED ENGINEERING AND SURVEYING, INC.	DATE
DESIGNED BY	DATE
CHECKED BY	DATE
RECORDED BY	DATE
NO.	DATE

SURVEY INFORMATION

NO.	DATE
BY	DATE
REMARKS	DATE
REVISIONS	DATE
DESIGN	DATE
DESIGNED BY	DATE
DRAWN BY	DATE
CHECKED BY	DATE

ENGINEER'S SEAL

GRAPHIC SCALE

(IN FEET)
1 inch = 20 ft.

APPLIED ENGINEERING AND SURVEYING, INC.
ENGINEERS AND PLANNERS
1600 Main Street NE
Albuquerque, New Mexico 87112
Office: (505) 237-1406 Fax: (505) 237-1406

CITY OF ALBUQUERQUE
PUBLIC WORKS DEPARTMENT
ENGINEERING DEVELOPMENT GROUP

TITLE: LARRY & DYLIA VIGIL STREET & VIGIL LANE (ROADWAY "A") PLAN & PROFILE

Design Review Committee

City Engineer Approval

Mo./Day/Yr.

Mo./Day/Yr.

For Information Only

City Project No.

5365.90





Zone Map No.

L-12

Sheet Of

12 15

SCANNED BY
MESA REPRO

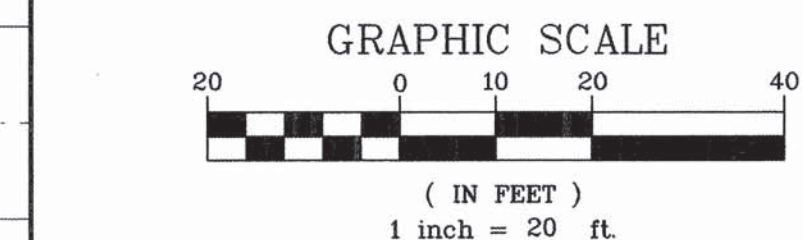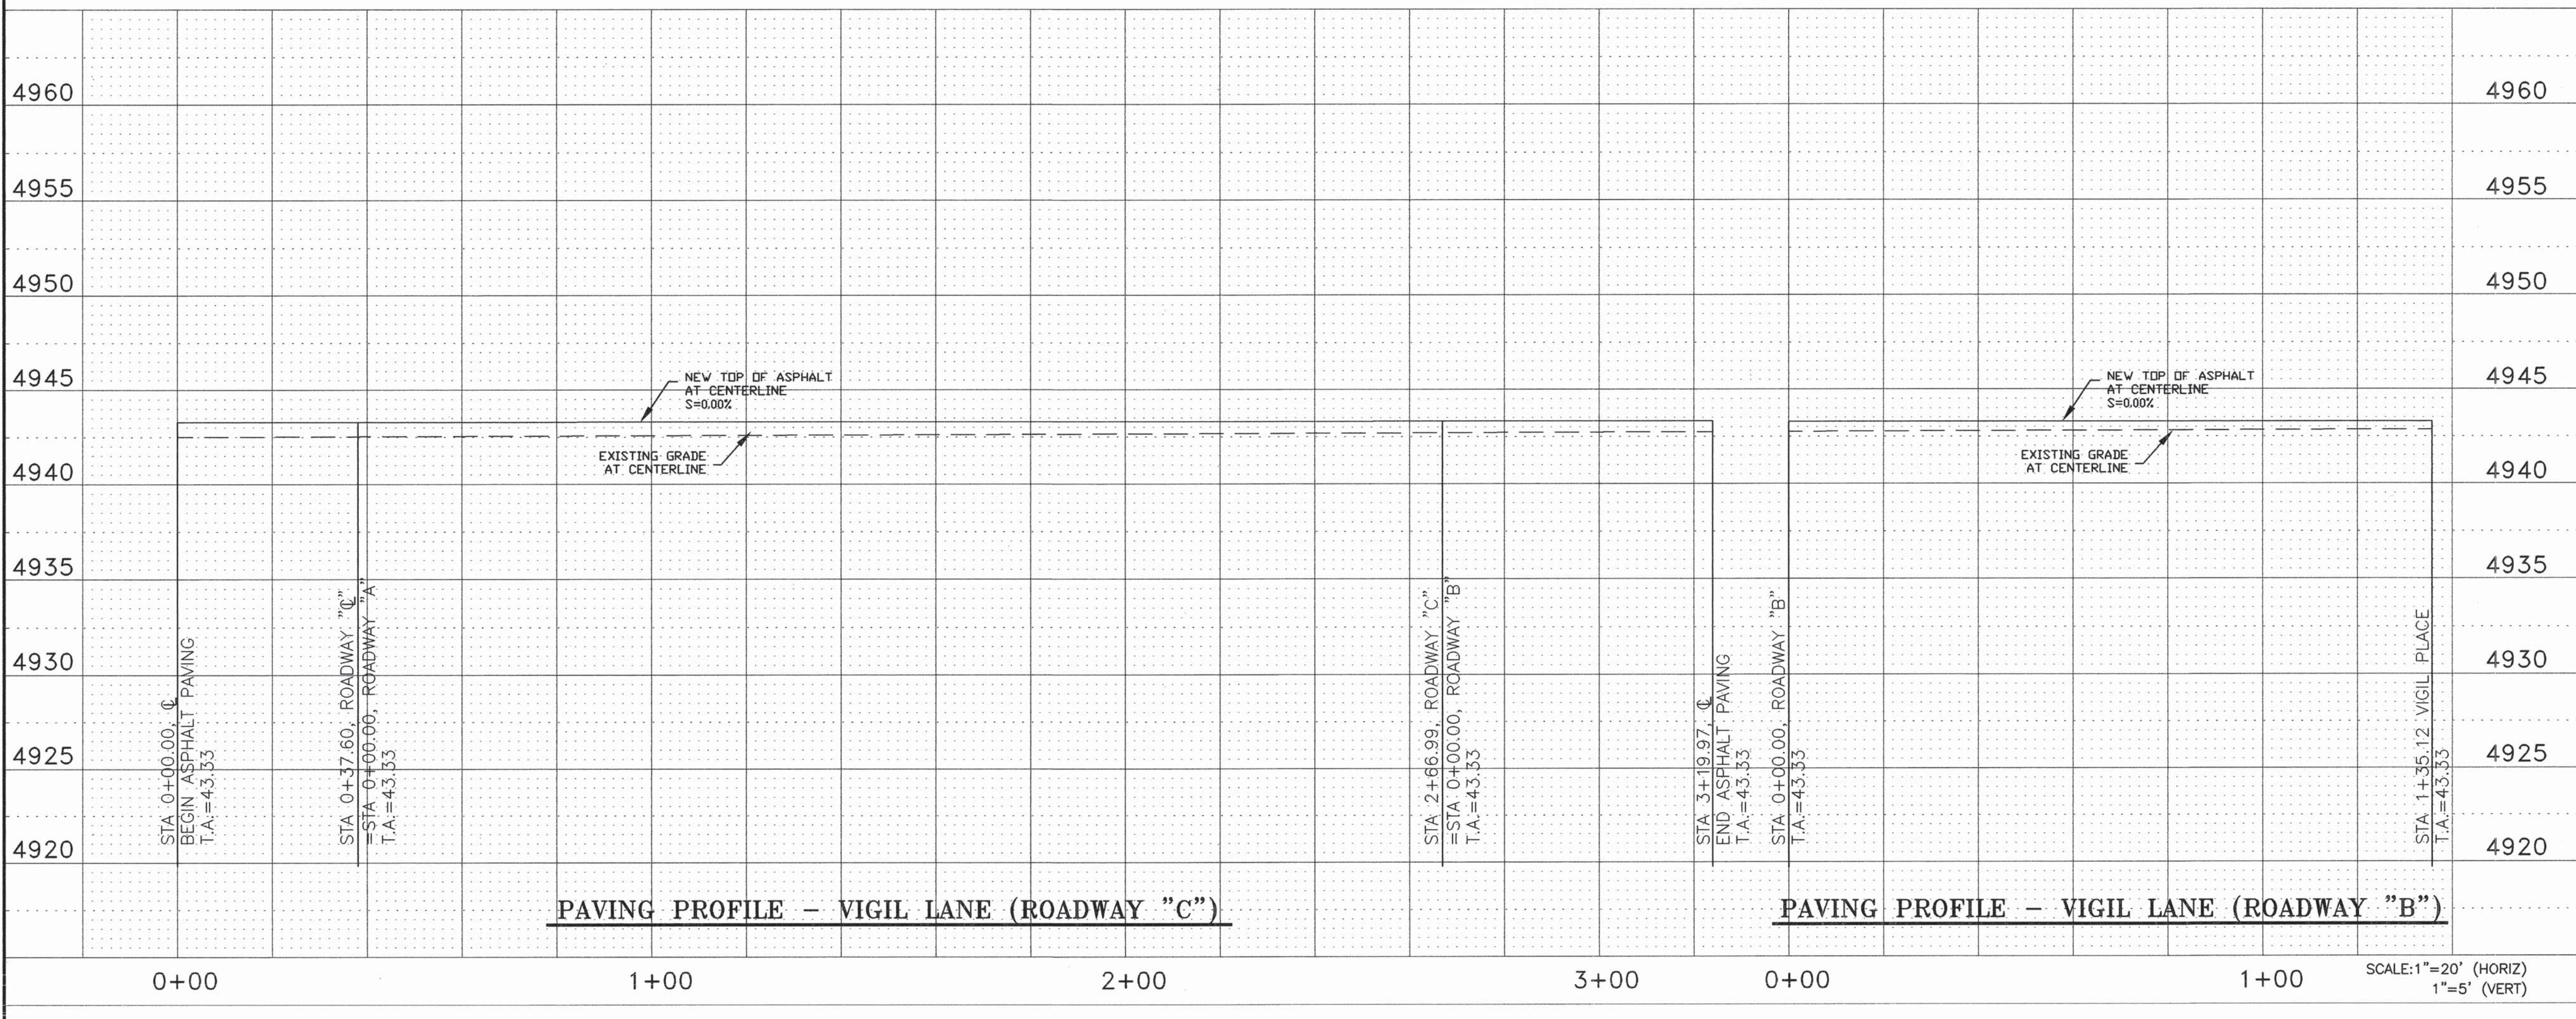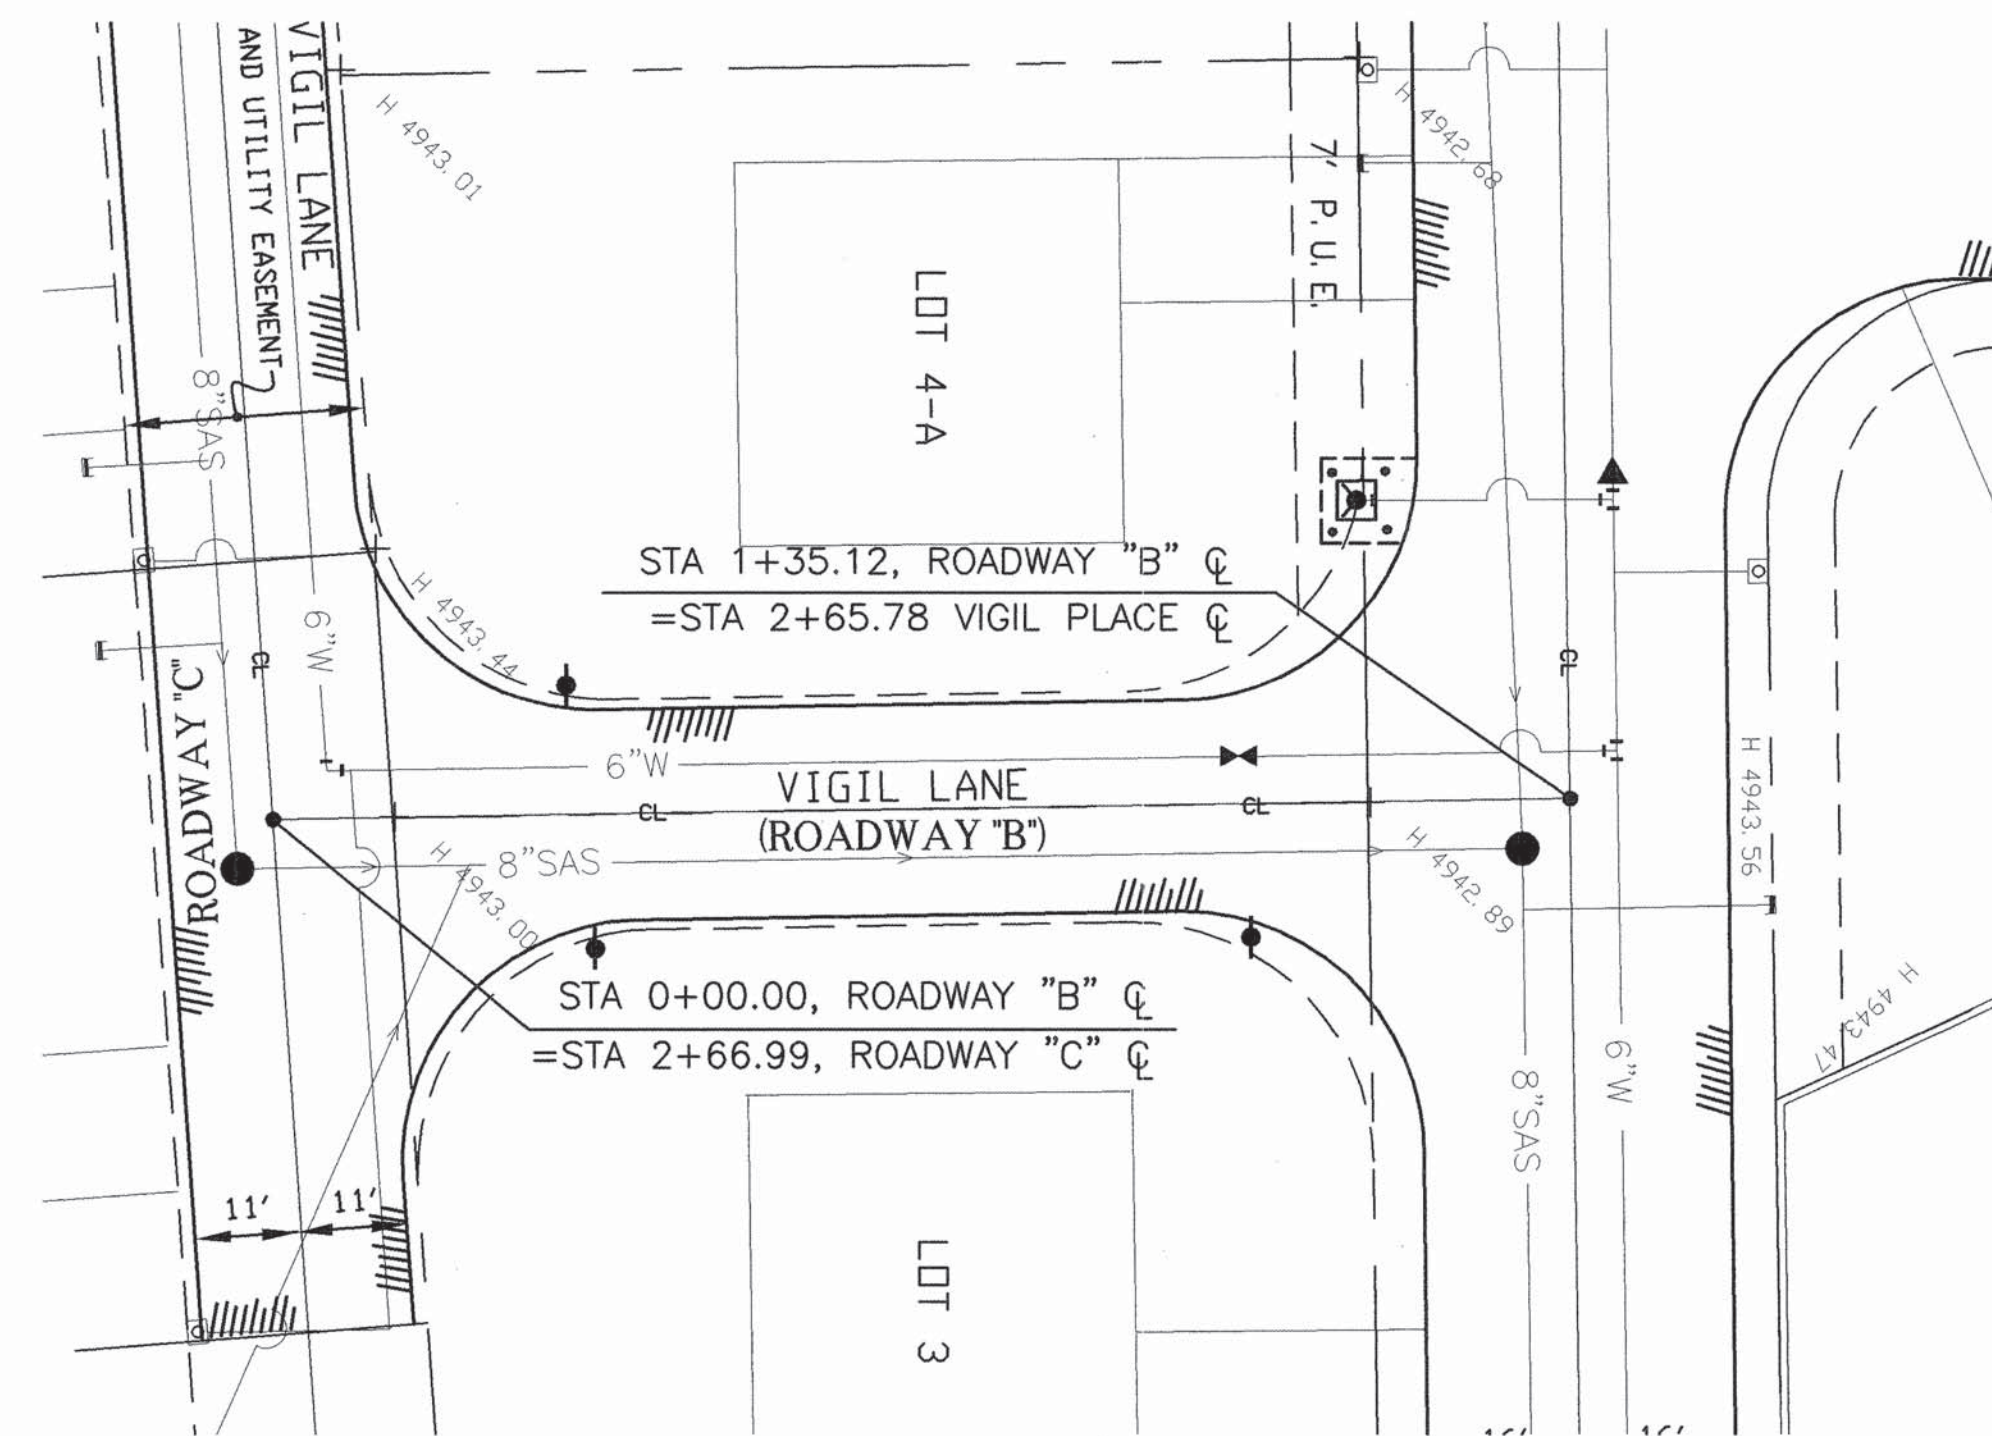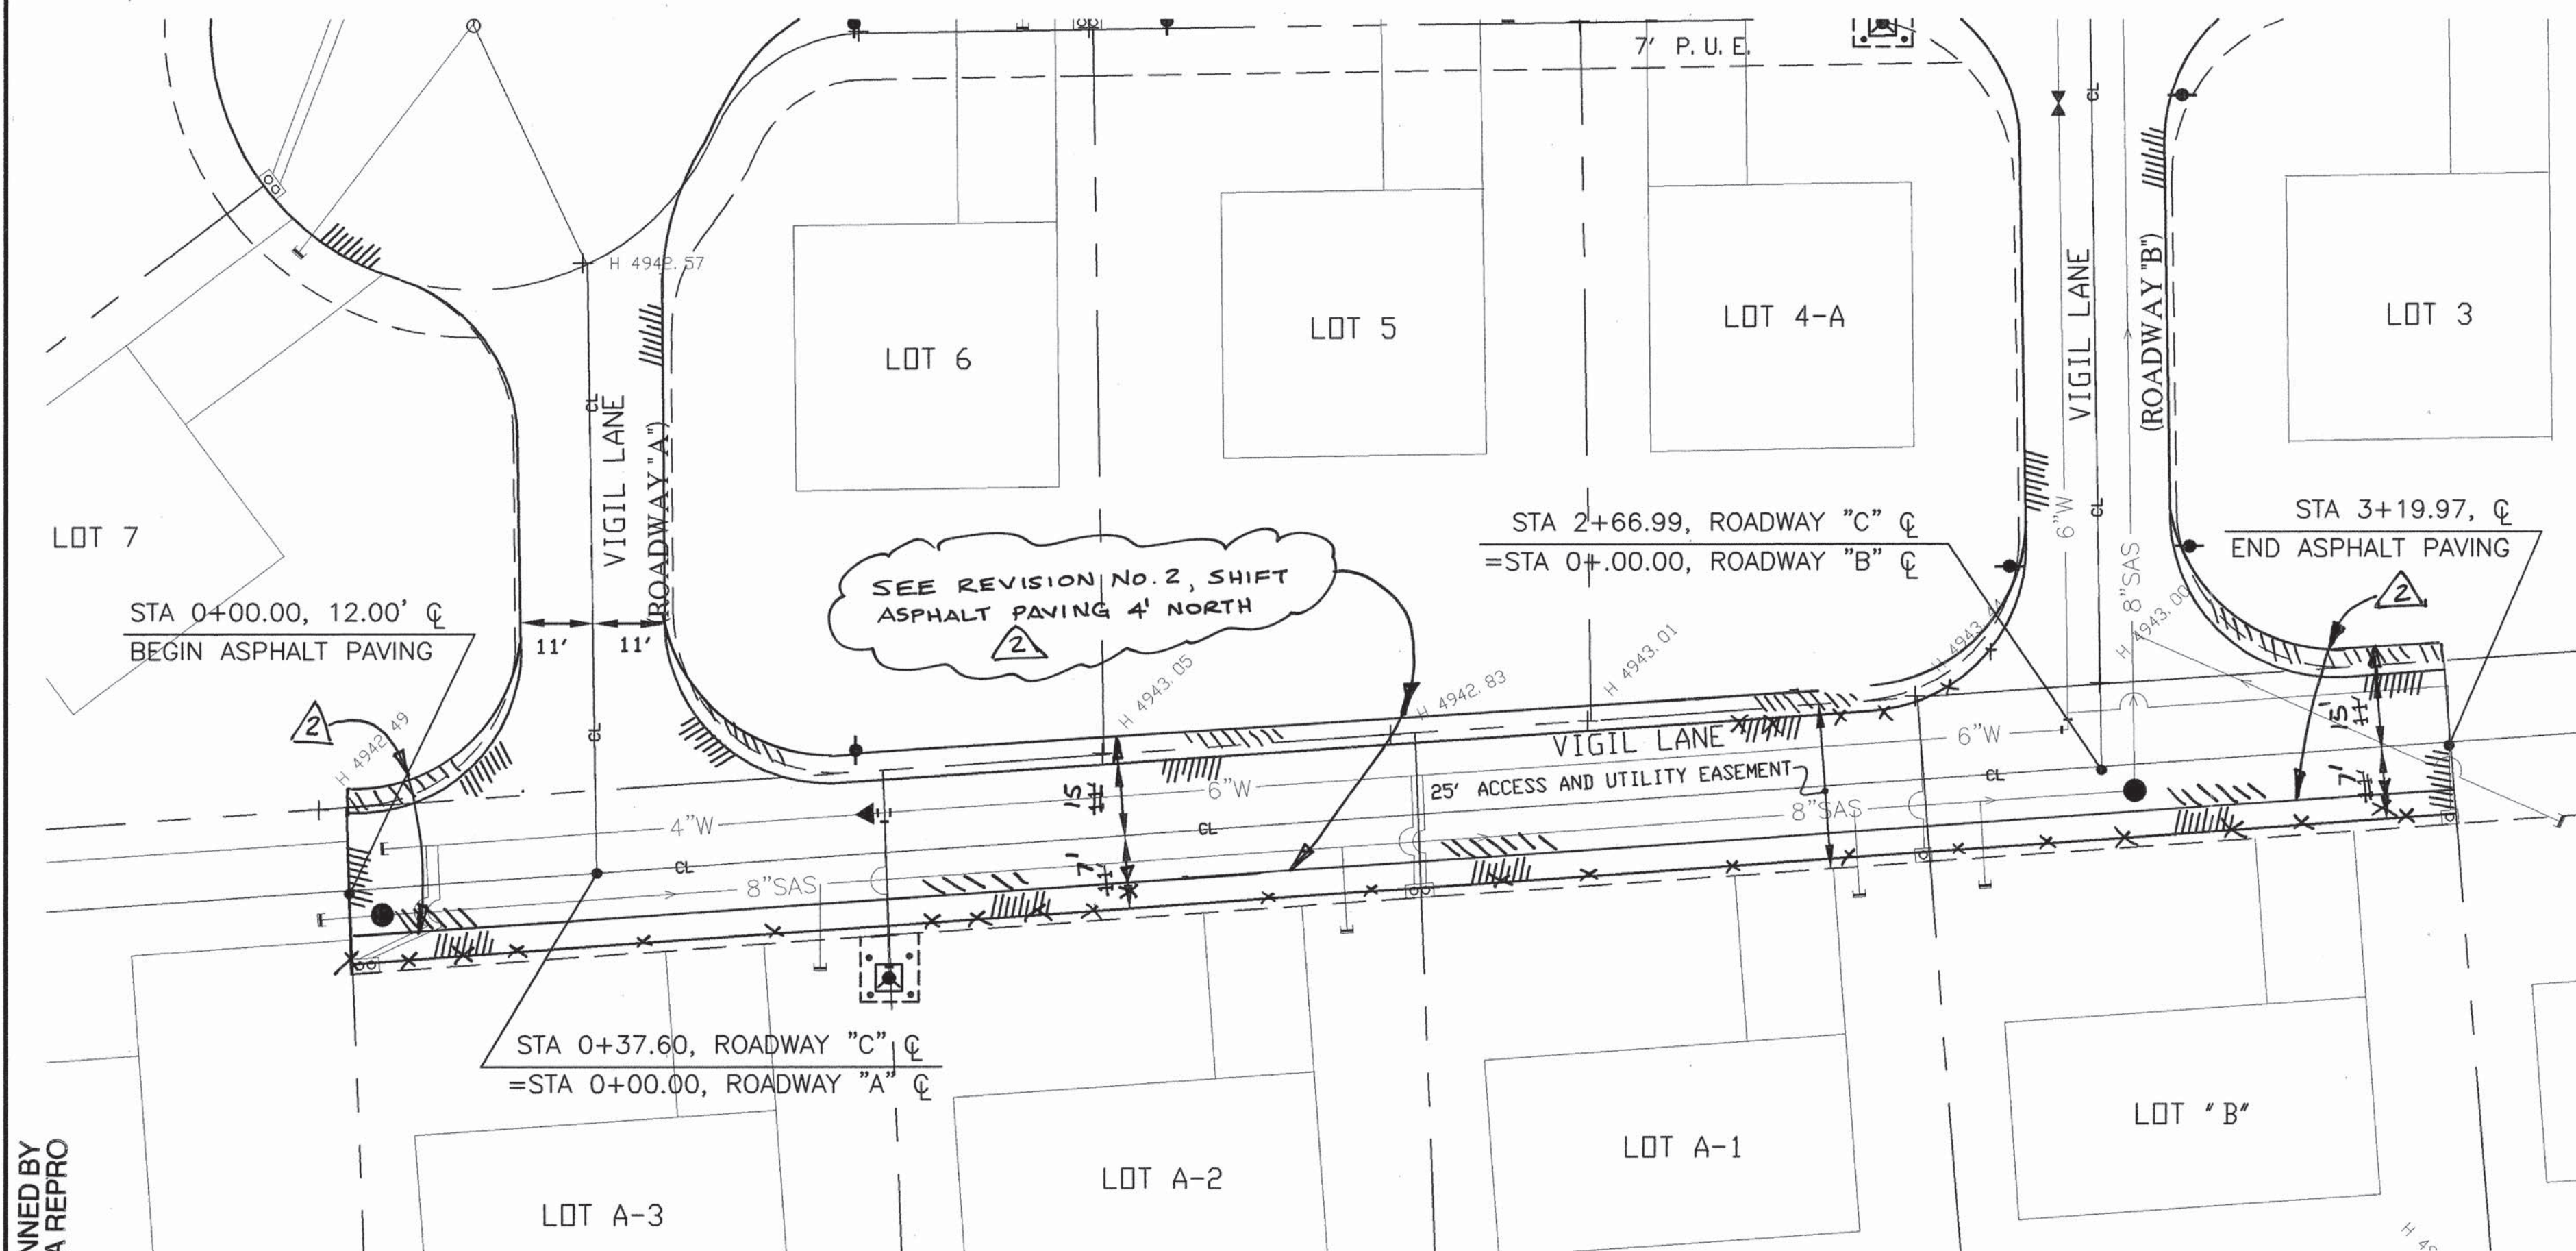

APPLIED ENGINEERING AND SURVEYING, INC.
ENGINEERS AND PLANNERS
1605 Blair Drive NE
Albuquerque, New Mexico 87112
Phone: (505) 233-1456

CITY OF ALBUQUERQUE
PUBLIC WORKS DEPARTMENT
ENGINEERING DEVELOPMENT GROUP

TITLE: **VIGIL LANE (ROADWAY "B" & ROADWAY "C") PAVING PLAN & PROFILE**

Design Review Committee: _____ City Engineer Approval: _____

City Project No. 5365.90 Zone Map No. L-12 Sheet 13 of 15

AS BUILT INFORMATION		BENCH MARKS		SURVEY INFORMATION		ENGINEER'S SEAL	
CONTRACTOR	START DATE	SITE BENCHMARK IS AN A.C.S. MONUMENT	DATE	FIELD NOTES	NO.	NO. DATE	REMARKS
WATSON	07/04	"16-L12A"					
INSPECTOR'S	DATE	ELEVATION=4945.073, ALUMINUM DISK SET IN THE TOP OF A CONCRETE CURB AT THE E.S.E. CURB RETURN, S.E. QUADRANT OF BRIDGE BLVD. AND SUNSET ROAD S.W. VERTICAL					
APPLIED ENGINEER	DATE						
VERIFICATION BY	DATE						
CORRECTED BY	DATE						
MICRO-FILM INFORMATION							
RECORDED BY	NO.						
DATE							

07/04 SHIFTED ASPHALT PAVEMENT 4' NORTH TO ADJUST PNM UTILITIES, DEDICATED ADD'L 4' EASEMENT


DESIGNED BY G. ALDAZ DATE 07-07-03
DRAWN BY DATE
CHECKED BY G. ALDAZ DATE 07-07-03

CONSTRUCTION TRAFFIC CONTROL GENERAL NOTES


1. PROJECT IS SUBJECT TO THE REQUIREMENTS OF COUNTY ORDINANCE NO. 95-12 AND COUNTY ORDINANCE NO. 96-3. THE CONTRACTOR IS RESPONSIBLE FOR ACQUIRING ALL PERMITS NECESSARY. CONTRACTOR SHALL CALL 848-1504 FOR MORE INFORMATION.
2. THE CONTRACTOR SHALL SUBMIT A TRAFFIC CONTROL PLAN TO THE COUNTY TRAFFIC CONTROL ADMINISTRATOR AT LEAST 72 HOURS PRIOR TO COMMENCEMENT OF WORK. TRAFFIC CONTROL PLANS SHALL BE PREPARED IN ACCORDANCE WITH THE MANUAL ON UNIFORM TRAFFIC CONTROL DEVICES (MUTCD), LATEST EDITION AND BY CERTIFIED PERSONNEL AND MUST BE APPROVED PRIOR TO COMMENCEMENT OF WORK ON THE PROJECT. CALL 848-1504 FOR FURTHER INFORMATION.
3. A DAILY TRAFFIC CONTROL LOG SHALL BE MAINTAINED BY THE CONTRACTOR REFLECTING THE TYPES AND LOCATIONS OF ALL TRAFFIC CONTROL DEVICES, SIGNS, BARRICADES, ETC. BEING USED ON THE PROJECT IN COMPLIANCE WITH THE APPROVED TRAFFIC CONTROL PLAN. THIS LOG SHALL BE SUBMITTED TO THE BERNALILLO COUNTY TRAFFIC CONTROL ADMINISTRATOR UPON COMPLETION OF THE PROJECT CONSTRUCTION OR WHEN SO REQUESTED BY THE PROJECT MANAGER OR THE BERNALILLO COUNTY TRAFFIC CONTROL ADMINISTRATOR.
4. CONTRACTOR SHALL PROVIDE A WEEKLY CONSTRUCTION ACTIVITY SCHEDULE TO BERNALILLO COUNTY PUBLIC WORKS DIVISION ATTN: PROJECT MANAGER
5. THE CONTRACTOR SHALL FILE A WEEKLY WRITTEN REPORT TO THE TRAFFIC CONTROL ADMINISTRATOR DESCRIBING THE TRAFFIC CONTROL PLAN THAT WILL BE IN EFFECT FOR THE FOLLOWING WEEK.
6. SUBJECT TO THE APPROVED TRAFFIC CONTROL PLAN, AT LEAST ONE LANE SHALL BE OPEN TO TRAFFIC AT ALL TIMES. CONTRACTOR SHALL PROVIDE PROPER SIGNAGE AND FLAGMAN AND SHALL MAINTAIN THE TRAFFIC LANE IN SUCH A MANNER AS TO ASSURE PROPER SAFETY TO THE TRAVELING PUBLIC AT ALL TIMES, EXCEPT WHEN GRADING, EXCAVATION AND BACKFILL OPERATIONS ARE BEING CONDUCTED IMMEDIATELY IN FRONT OF THE PROPERTY, IN WHICH CASE ACCESS WILL NOT BE DENIED FOR MORE THAN 4 HOURS WITHOUT APPROVAL BY THE COUNTY.
7. TRAFFIC LANES PROVIDED DURING CONSTRUCTION SHALL BE MAINTAINED, IN SUCH A CONDITION UNDER ALL WEATHER CONDITIONS, SO AS TO PERMIT THE REASONABLE PASSAGE OF PASSENGER VEHICLES, AND SHALL BE KEPT GRADED AND SMOOTH, AND WATERED SEVERAL TIMES DAILY TO CONTROL DUST.
8. TYPICAL TRAFFIC CONTROL PLANS DO NOT REFLECT THE EXISTING TOPOGRAPHY SUCH AS DRIVEWAYS, LANE WIDTHS, AND BUSINESS/RESIDENTIAL ACCESSES. EVERY LOCATION THAT REQUIRES CONSTRUCTION TRAFFIC CONTROL SHALL HAVE A DETAILED TRAFFIC CONTROL PLAN SHOWING ALL EXISTING TOPOGRAPHY.
9. CONSTRUCTION SHALL NOT BEGIN UNLESS A TRAFFIC CONTROL PLAN HAS BEEN APPROVED AND VERIFIED BY BERNALILLO COUNTY TRAFFIC ENGINEERING.
10. ALL CONSTRUCTION TRAFFIC CONTROL DEVICES SHALL COMPLY WITH THE MANUAL ON UNIFORM TRAFFIC CONTROL DEVICES (MUTCD), LATEST EDITION. IT IS THE RESPONSIBILITY OF THE CONTRACTOR TO INSTALL, SERVICE AND MAINTAIN ALL TRAFFIC CONTROL DEVICES. TRAFFIC CONTROL DEVICES SHALL NOT BE REMOVED OR ALTERED IN ANY WAY WITHOUT THE APPROVAL OF THE COUNTY TRAFFIC CONTROL ADMINISTRATOR, PER SECTION 6A-4 OF THE MUTCD, LATEST EDITION.
11. THE CONSTRUCTION TRAFFIC CONTROL INITIAL SET-UP FOR EACH PHASE SHALL BE BY AN AMERICAN TRAFFIC SAFETY SERVICES ASSOCIATION (ATSSA) CERTIFIED WORKSITE TRAFFIC SUPERVISOR. THE MAINTENANCE AND SERVICING SHALL ALSO BE DONE BY AN ATSSA CERTIFIED WORKSITE TRAFFIC SUPERVISOR OR EQUIVALENT.
12. CONTRACTOR IS RESPONSIBLE TO MAINTAIN AND SERVICE ALL TRAFFIC CONTROL DEVICES 24 HOURS A DAY, 7 DAYS A WEEK THROUGHOUT LENGTH OF PROJECT. CONTRACTOR IS RESPONSIBLE THAT ALL TRAFFIC CONTROL DEVICES COMPLY WITH THE MUTCD, LATEST EDITION.
13. ALL ADVANCE WARNING SIGNS SHALL BE DOUBLE INDICATED WHENEVER THERE ARE MULTI-LANE TRAFFIC IN ANY ONE GIVEN DIRECTION AND THERE IS SUFFICIENT MEDIAN SPACE.

14. ALL BARRICADES IN ALL TAPERS AND TANGENTS SHALL BE PLACED APART, A DISTANCE MEASURED IN FEET, EQUAL TO THAT OF THE POSTED SPEED LIMIT. NO EXCEPTIONS UNLESS APPROVED BY BERNALILLO COUNTY TRAFFIC ENGINEERING PER MUTCD SECTION 6A-4.
15. ALL WORK IN ARTERIAL ROADWAYS SHALL BE ON A CONTINUOUS 24 HOUR PER DAY BASIS UNTIL COMPLETED.
16. EQUIPMENT OR MATERIALS SHALL NOT BE STORED WITHIN 15 FEET OF A TRAVELED TRAFFIC LANE DURING NON-WORKING HOURS WITHOUT THE APPROVAL OF BERNALILLO COUNTY TRAFFIC ENGINEERING.
17. CONTRACTOR SHALL PROVIDE AND MAINTAIN A SAFE AND ADEQUATE MEANS OF CHANNELIZING PEDESTRIAN TRAFFIC AROUND AND THROUGH THE CONSTRUCTION AREA.
18. CONTRACTOR IS RESPONSIBLE FOR OBLITERATION OF ANY CONFLICTING STRIPING AND RESPONSIBLE FOR ALL TEMPORARY STRIPING.
19. CONTRACTOR SHALL MAINTAIN ACCESS TO ALL FACILITIES, BUSINESSES AND/OR RESIDENTS AT ALL TIMES.
20. CONTRACTOR SHALL PROVIDE ACCESS SIGNS FOR BUSINESSES LOCATED WITHIN THE CONSTRUCTION AREA UNDER THE SUPERVISION OF BERNALILLO COUNTY TRAFFIC ENGINEERING. EACH ACCESS SIGN SHALL HAVE 5 INCH, WHITE LETTERING ON BLUE BACKGROUND. SHOPPING CENTERS AND MALLS SHALL BE LISTED AS SUCH.
21. 48 HOURS PRIOR TO OCCUPYING OR CLOSING OF A RIGHT-OF-WAY, CONTRACTOR SHALL NOTIFY: POLICE, FIRE DEPARTMENT, SCHOOLS, HOSPITALS, TRANSIT AUTHORITY, BUSINESSES AND/OR RESIDENTS THAT WILL BE AFFECTED BY THE CONSTRUCTION.
22. ANY FIELD ADJUSTMENTS SHALL BE APPROVED BY BERNALILLO COUNTY TRAFFIC ENGINEERING.
23. EXCAVATIONS SHALL BE PLATED, TEMPORARILY PATCHED OR RESURFACED PRIOR TO OPENING OF TRAFFIC. A MINIMUM OF 11 FEET, SHALL BE PROVIDED FOR TRAFFIC IN ANY GIVEN DIRECTION. CONTRACTOR IS RESPONSIBLE FOR ANY WORK INVOLVED IN SATISFYING THESE REQUIREMENTS.

SIGN FACE DETAILS

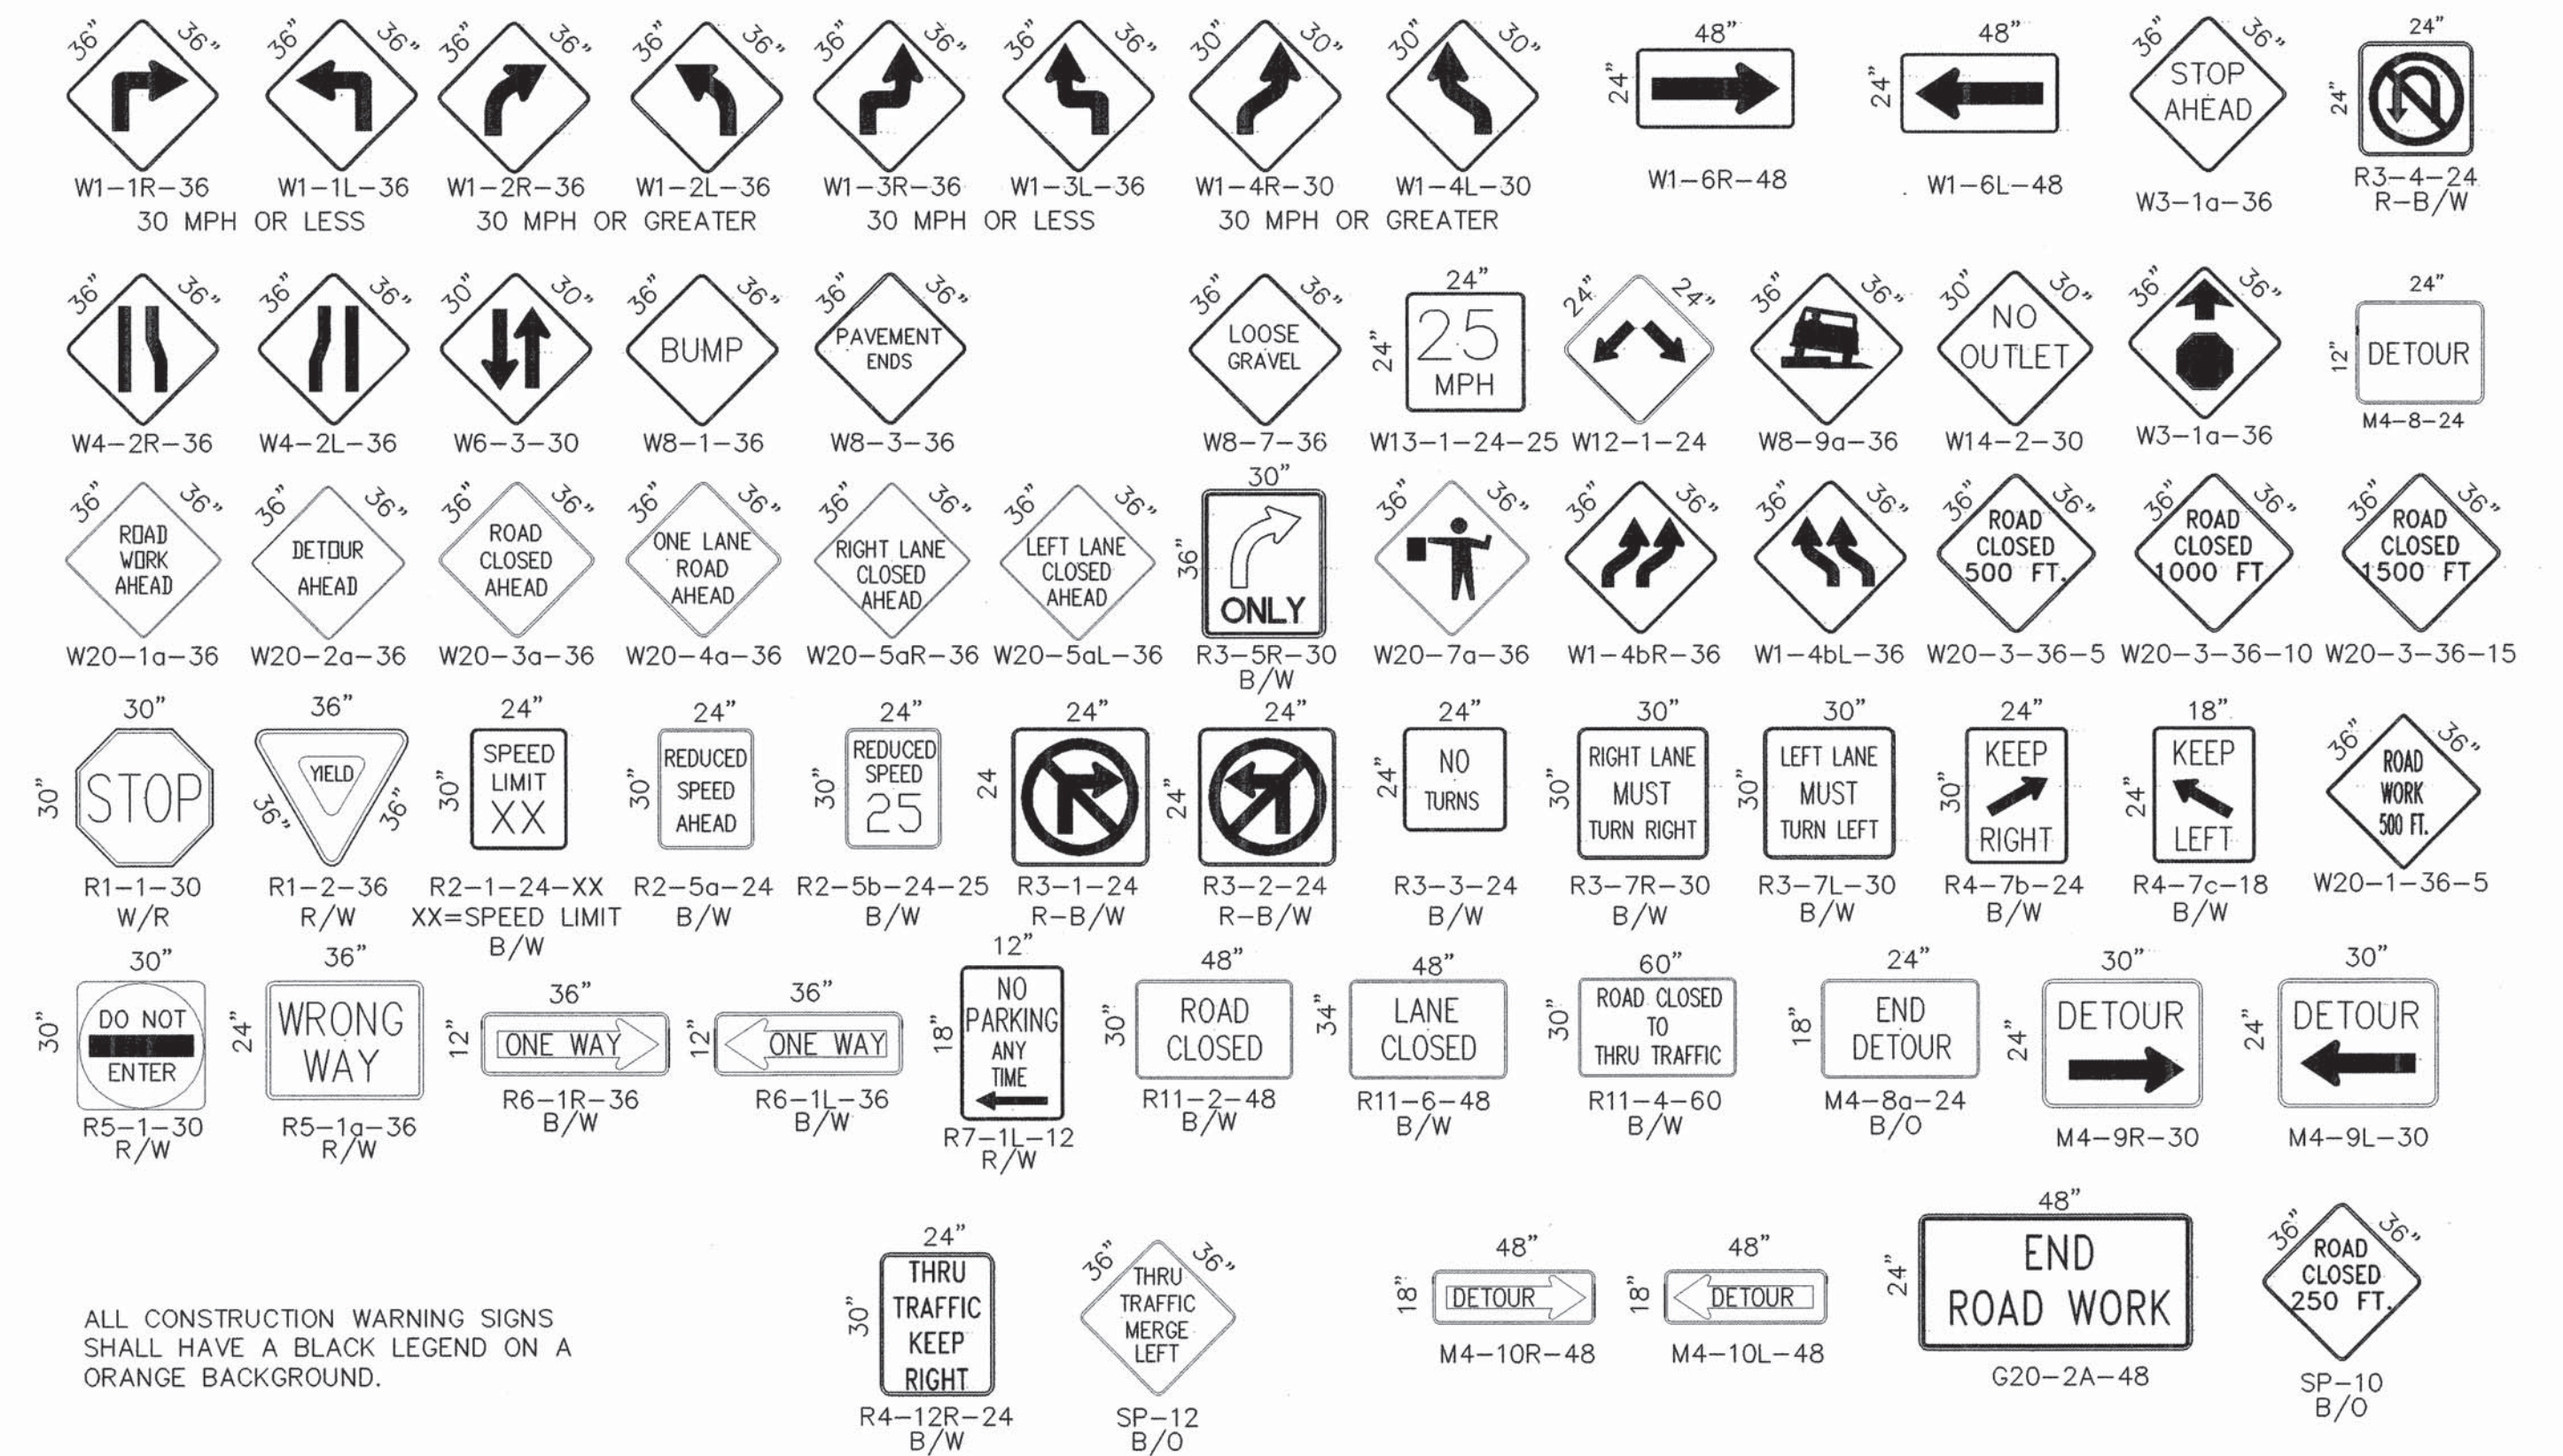

ALL CONSTRUCTION WARNING SIGNS SHALL HAVE A BLACK LEGEND ON A ORANGE BACKGROUND.

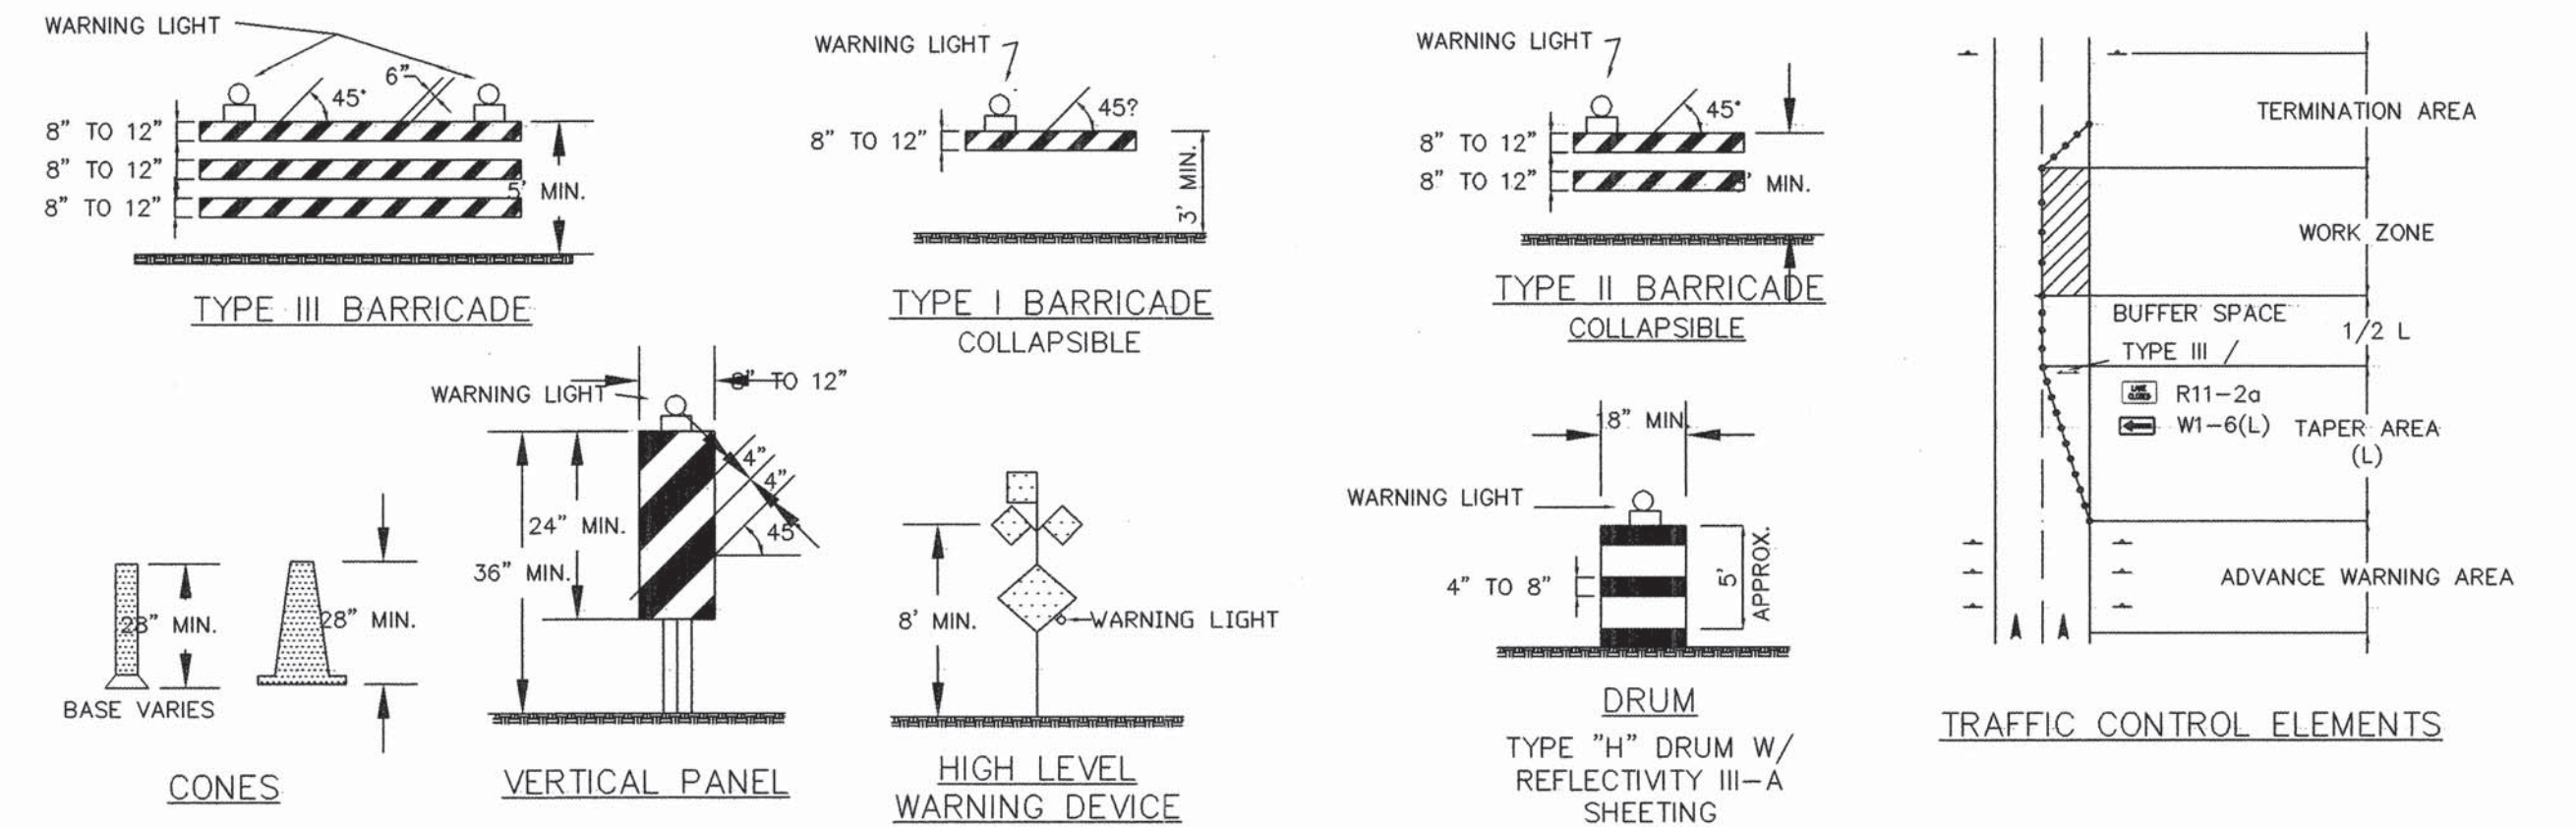






LEGEND

- WORK AREA
 - BARRICADE - TYPE I, TYPE II, OR TYPE "H" DRUM W/ REFLECTIVITY III-A SHEETING
 - BARRICADE - TYPE III
 - VERTICAL PANEL
 - WARNING SIGN
 - DISTANCE BETWEEN SIGNS - A DISTANCE MEASURED IN FEET EQUAL TO A VALUE OF TEN TIMES THE SPEED LIMIT OF THE STREET
 - FLAGMAN POSITION
 - SPACING BETWEEN BARRICADES- A DISTANCE MEASURED IN FEET EQUAL TO THE SPEED LIMIT OF THE STREET
 - L TAPER LENGTH - SEE CHART BELOW
- THE TANGENT LENGTH IS EQUAL TO THE TAPER LENGTH FOR A GIVEN STREET.


Bern. County
STD.

NO.	DESCRIPTION	DATE	BY
REVISIONS			
COUNTY OF BERNALILLO			
LARRY VIGIL SUBD. SIGNING & CONSTRUCTION TRAFFIC CONTROL STANDARDS			
PROJECT NO. 5365.90			
DRAWN: XXX			
CHECKED: XXX			
DATE: 05-30-03			
SCALE:			

SCANNED BY
MESA REPRO

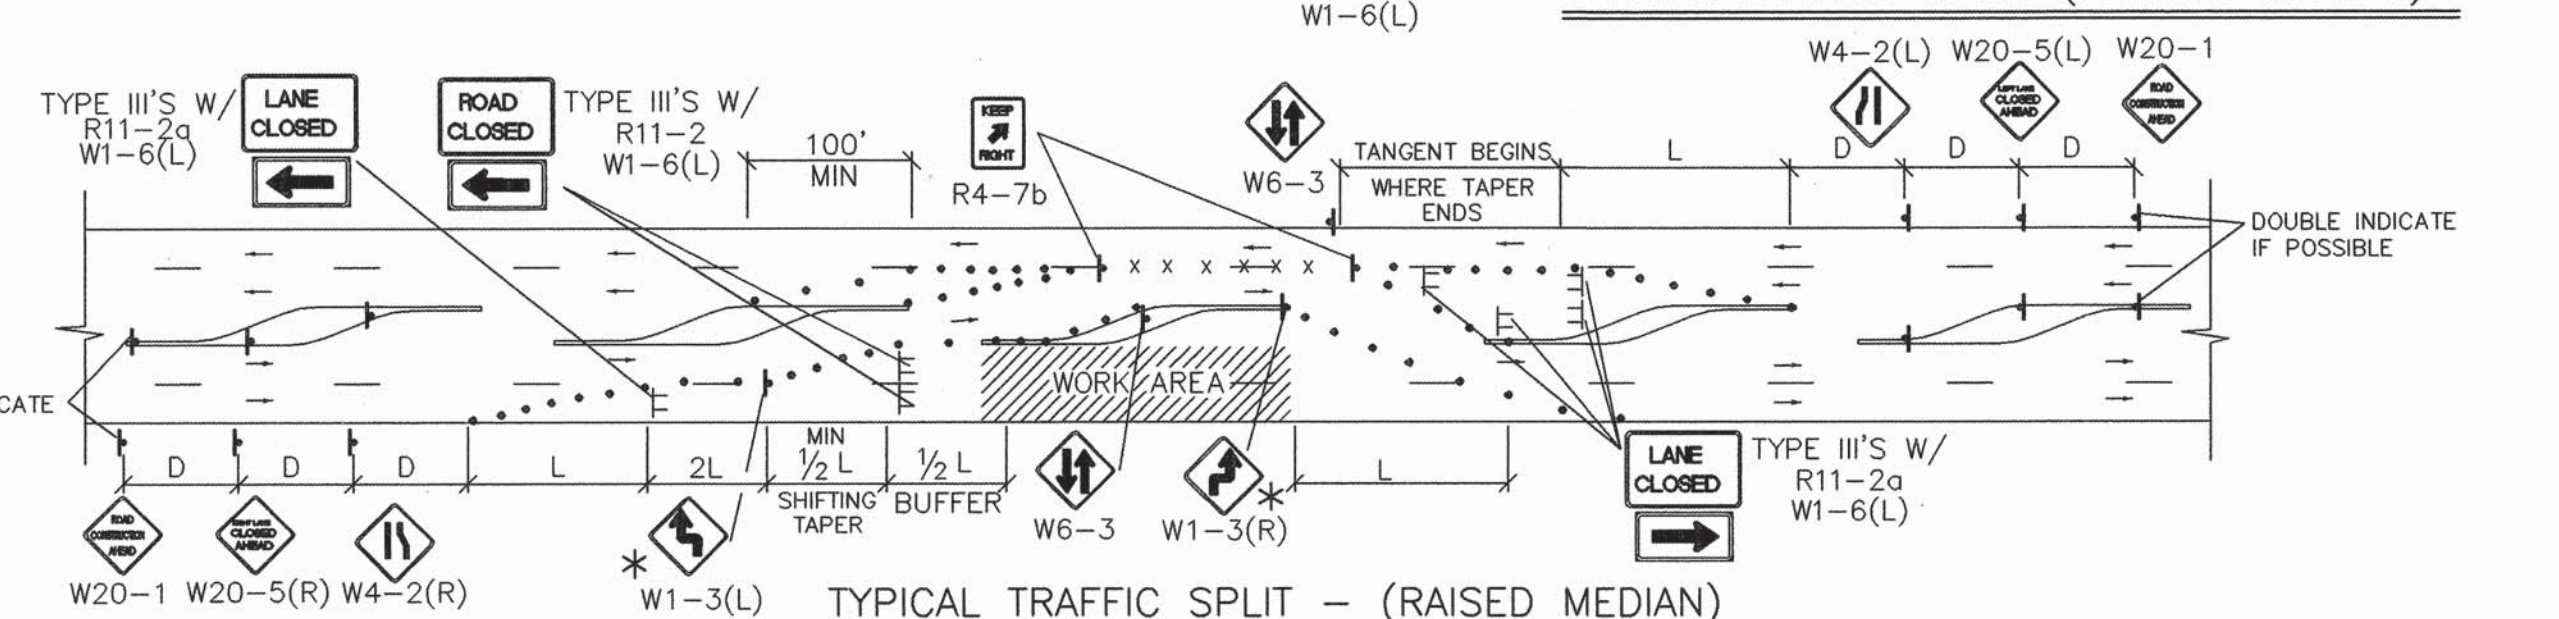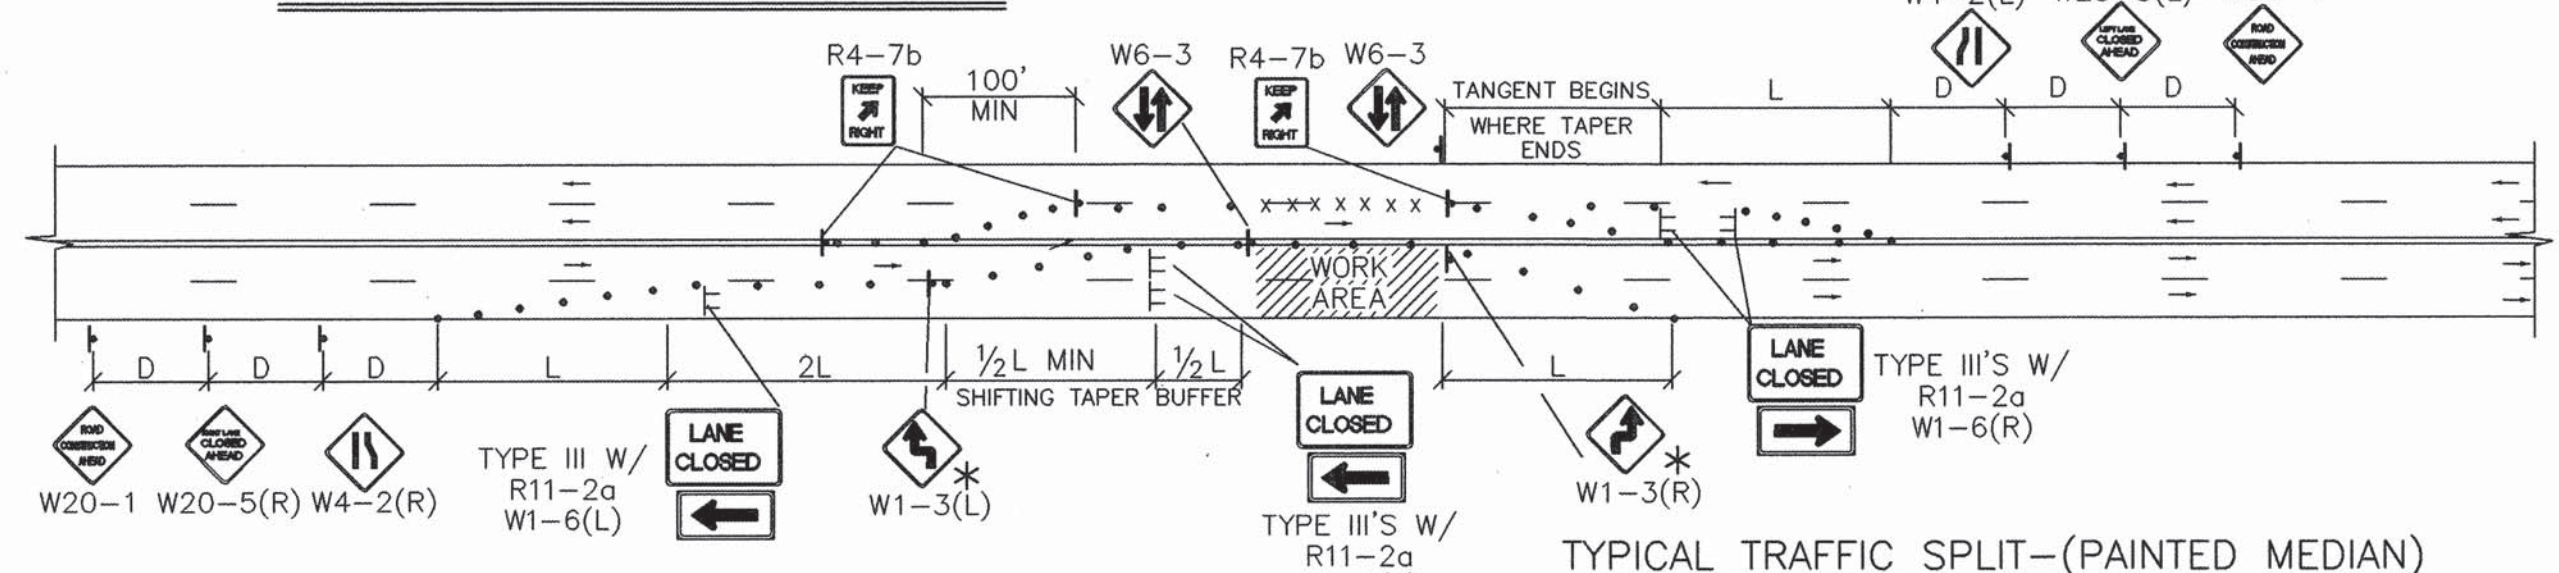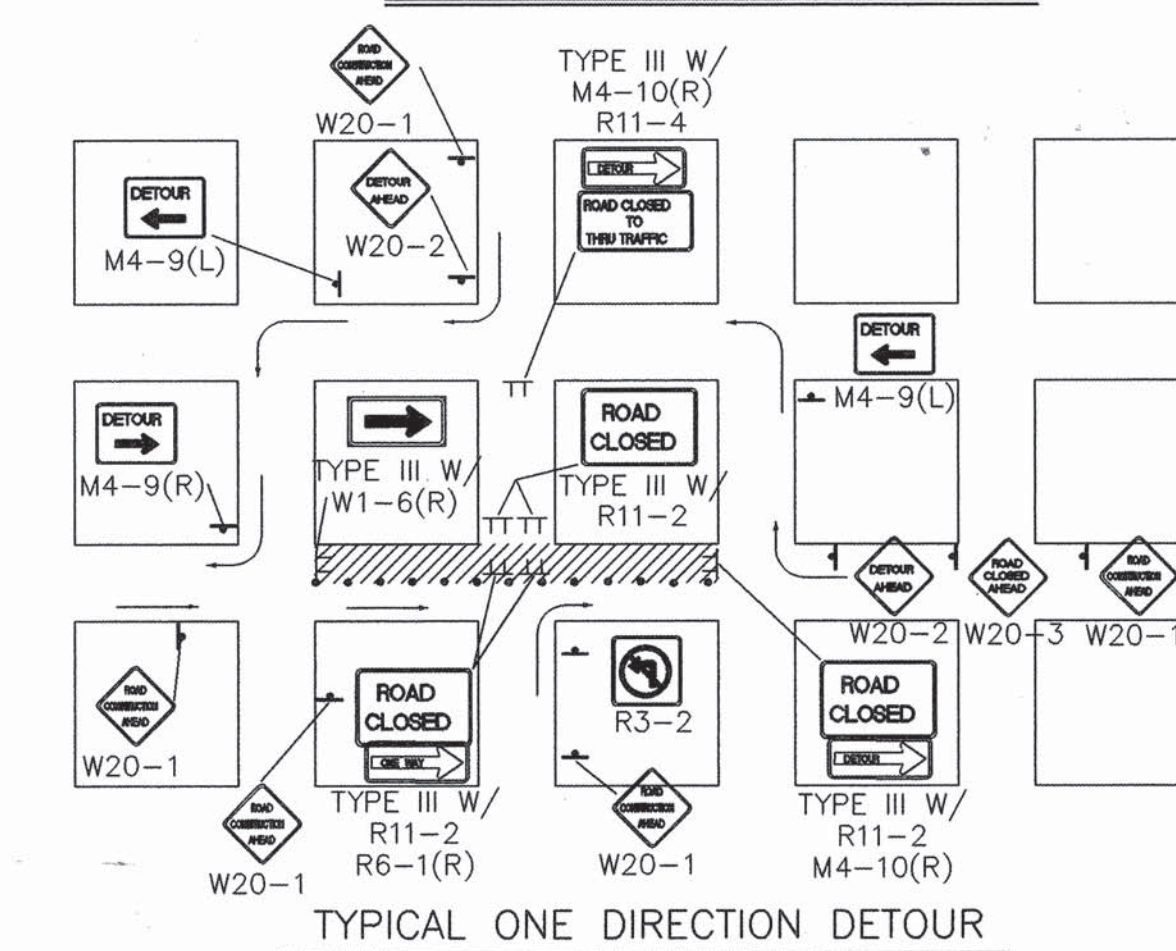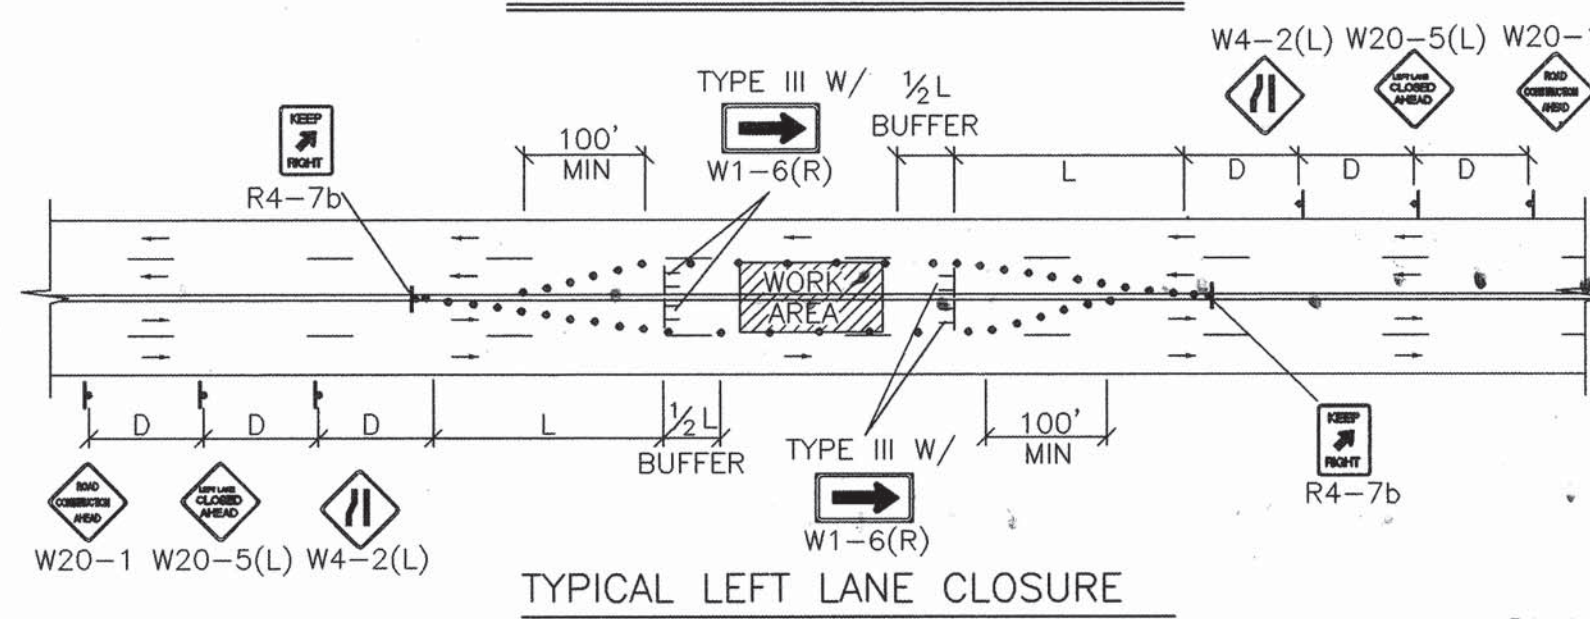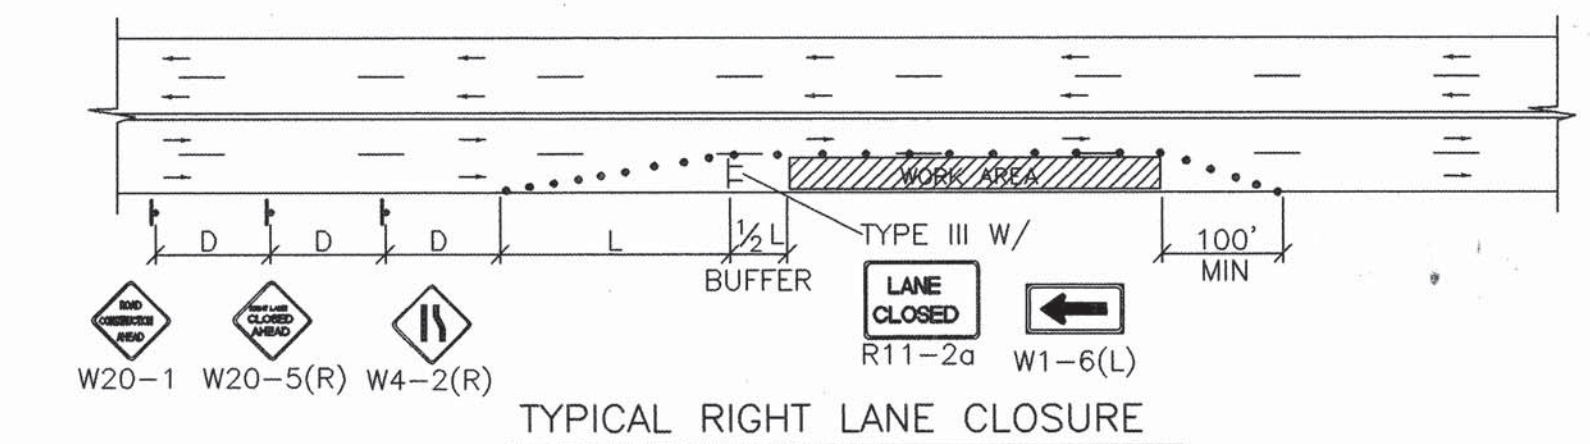


- TRAFFIC SPLIT NOTES:**
1. THE OFFSET DISTANCE MUST BE CALCULATED IN ALL SHIFTING TAPERS. THE OFFSET DISTANCES SHALL INCLUDE LANE WIDTHS PLUS MEDIAN WIDTHS.
 2. 1/2 L IS THE MINIMUM DISTANCE FOR SHIFTING TAPERS.
 3. REVERSE CURVES MAY BE IMPLEMENTED. ALL CURVE DATA SHALL BE CALCULATED.
 4. MEDIAN REMOVAL SHALL BE REQUIRED IF 1/2 L OR REVERSE CURVE IS NOT SUFFICIENT. MEDIAN REMOVAL SHALL TAKE PLACE BEFORE SPLITS.
 5. REDUCED SPEED MAY BE CONSIDERED.
 6. * USE W1-3 FOR 30 MPH OR LESS, W1-4 FOR SPEED 35 MPH OR GREATER.

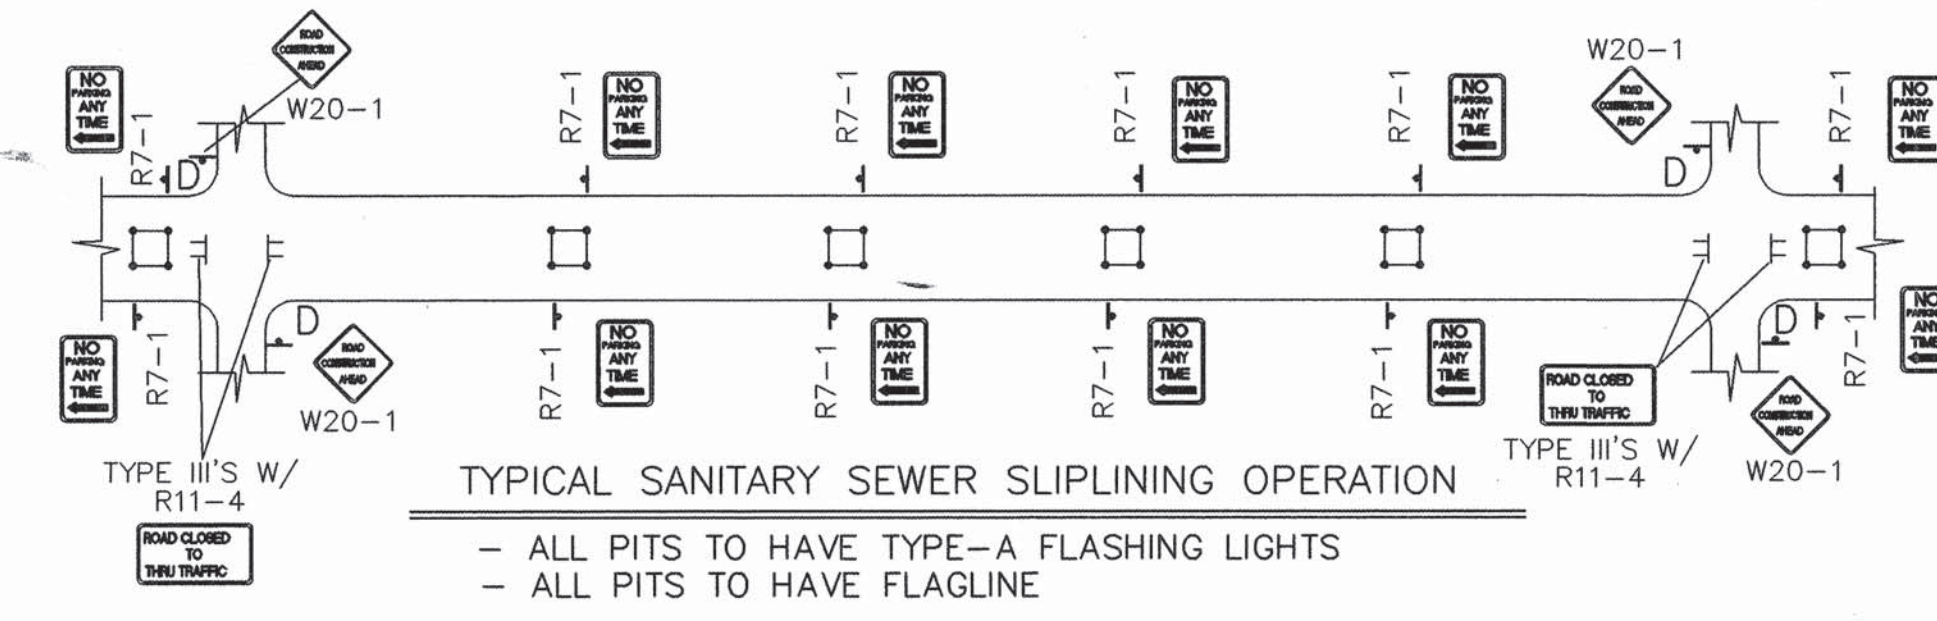


- ALL PITS TO HAVE TYPE-A FLASHING LIGHTS
ALL PITS TO HAVE FLAGLINE

GENERAL NOTE:
ALL CONSTRUCTION WARNING SIGNS SHALL HAVE A BLACK LEGEND ON AN ORANGE BACKGROUND.
ALL ADVANCE WARNING SIGNS SHALL BE A MINIMUM OF 36" THIRTY SIX INCHES BY 36" THIRTY SIX INCHES IN SIZE AND SHALL HAVE ONE WARNING LIGHT.


NOTE:
MAY REQUIRE LEFT LANE CLOSURE DEPENDING ON FIELD CONDITIONS.

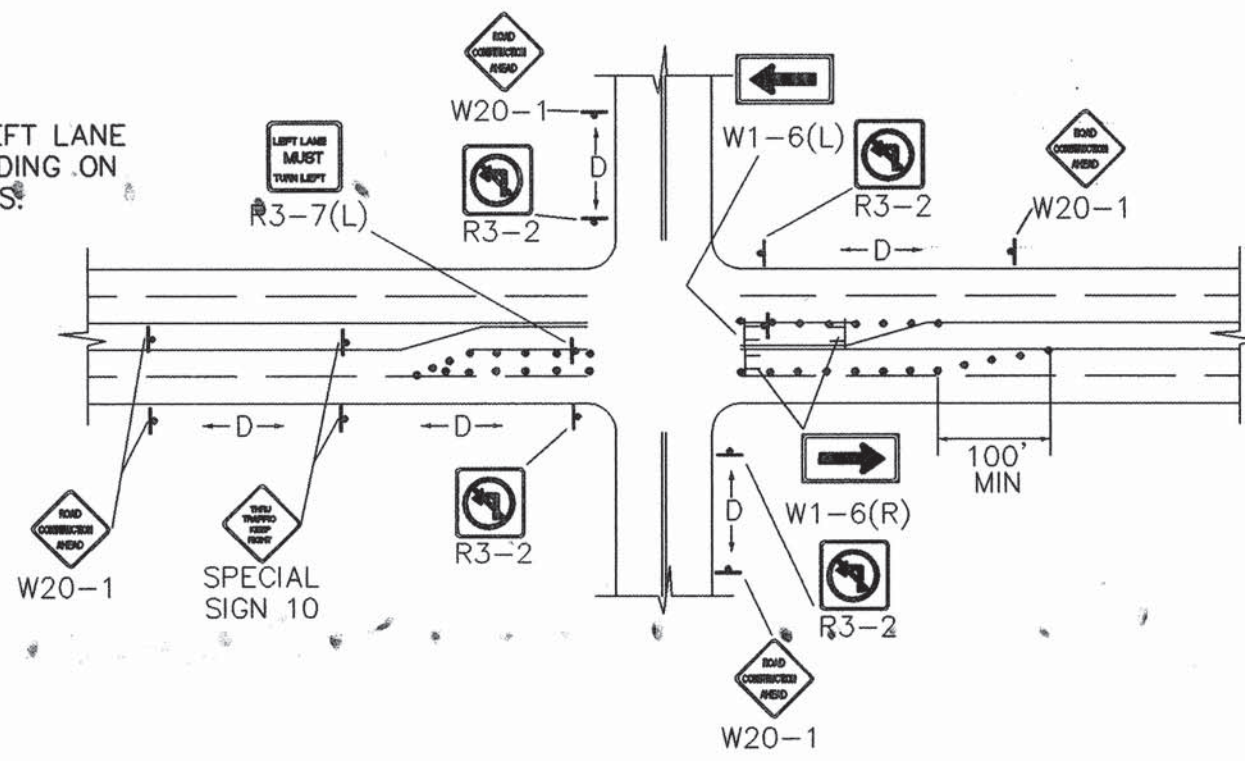





NOTE: DEPENDING ON WORK ZONE LOCATION.

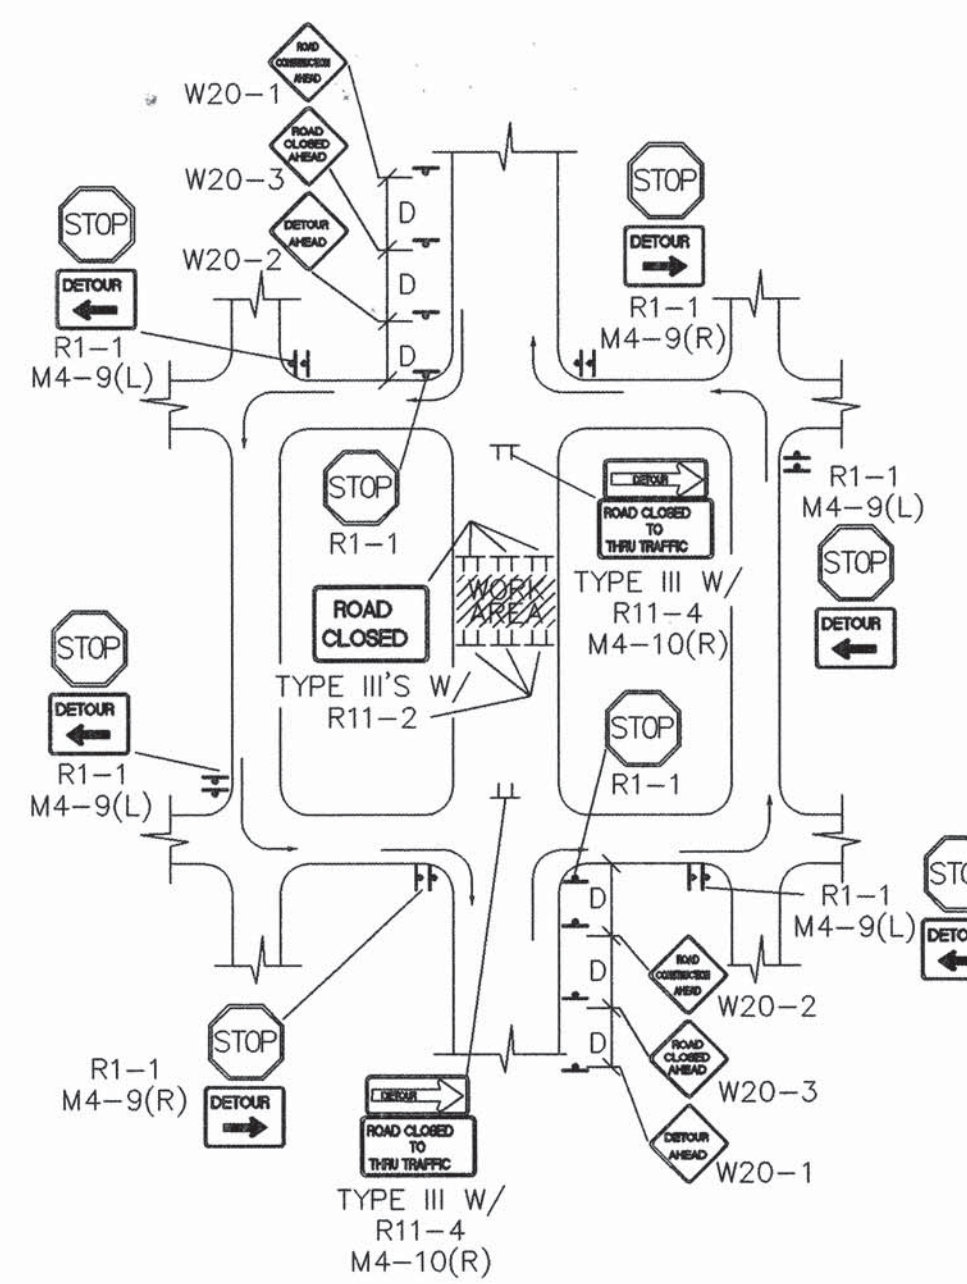

NOTE: (R1-1) BASED ON FIELD CONDITIONS.

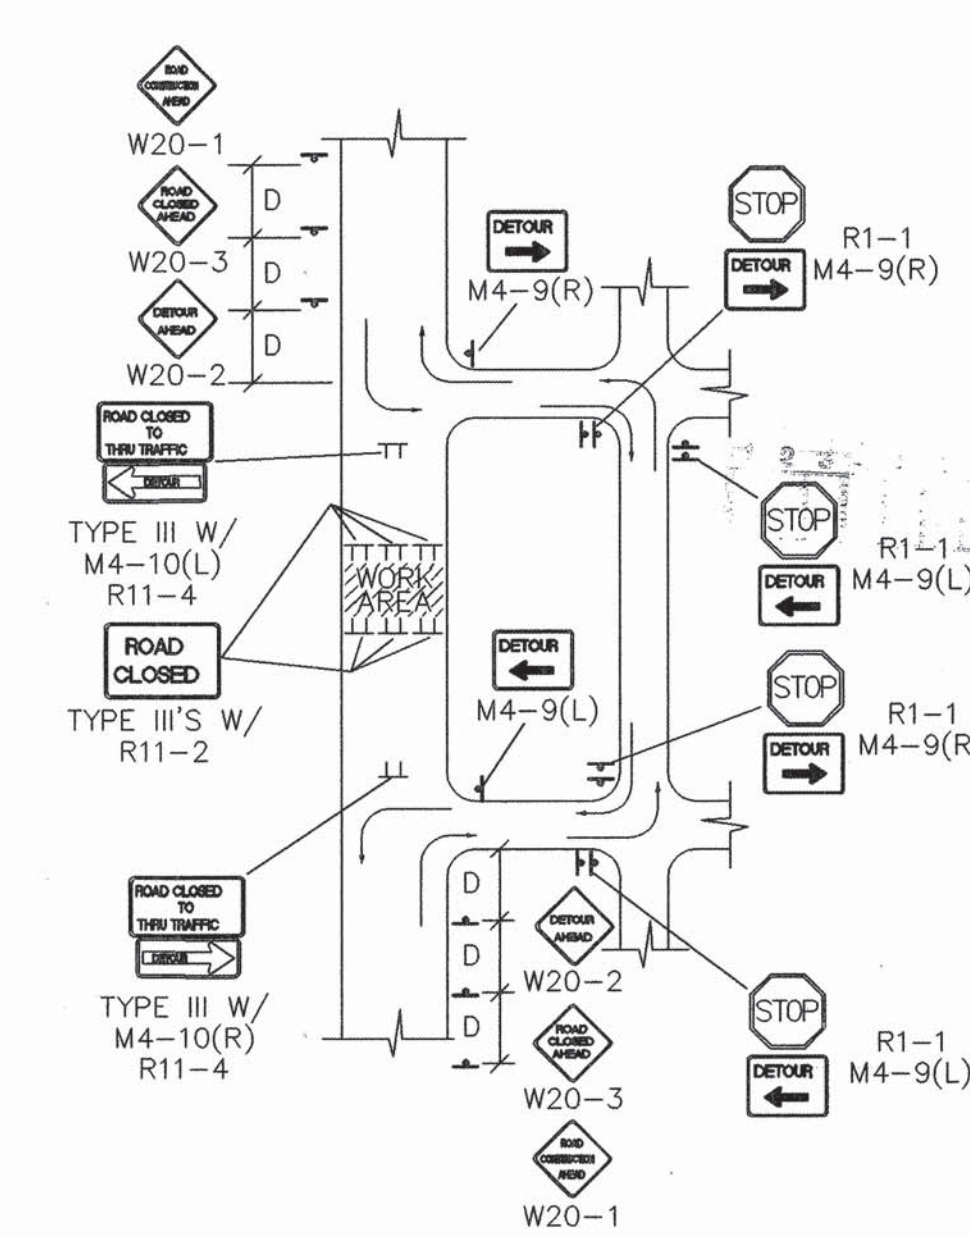

NOTE: (R1-1) BASED ON FIELD CONDITIONS.

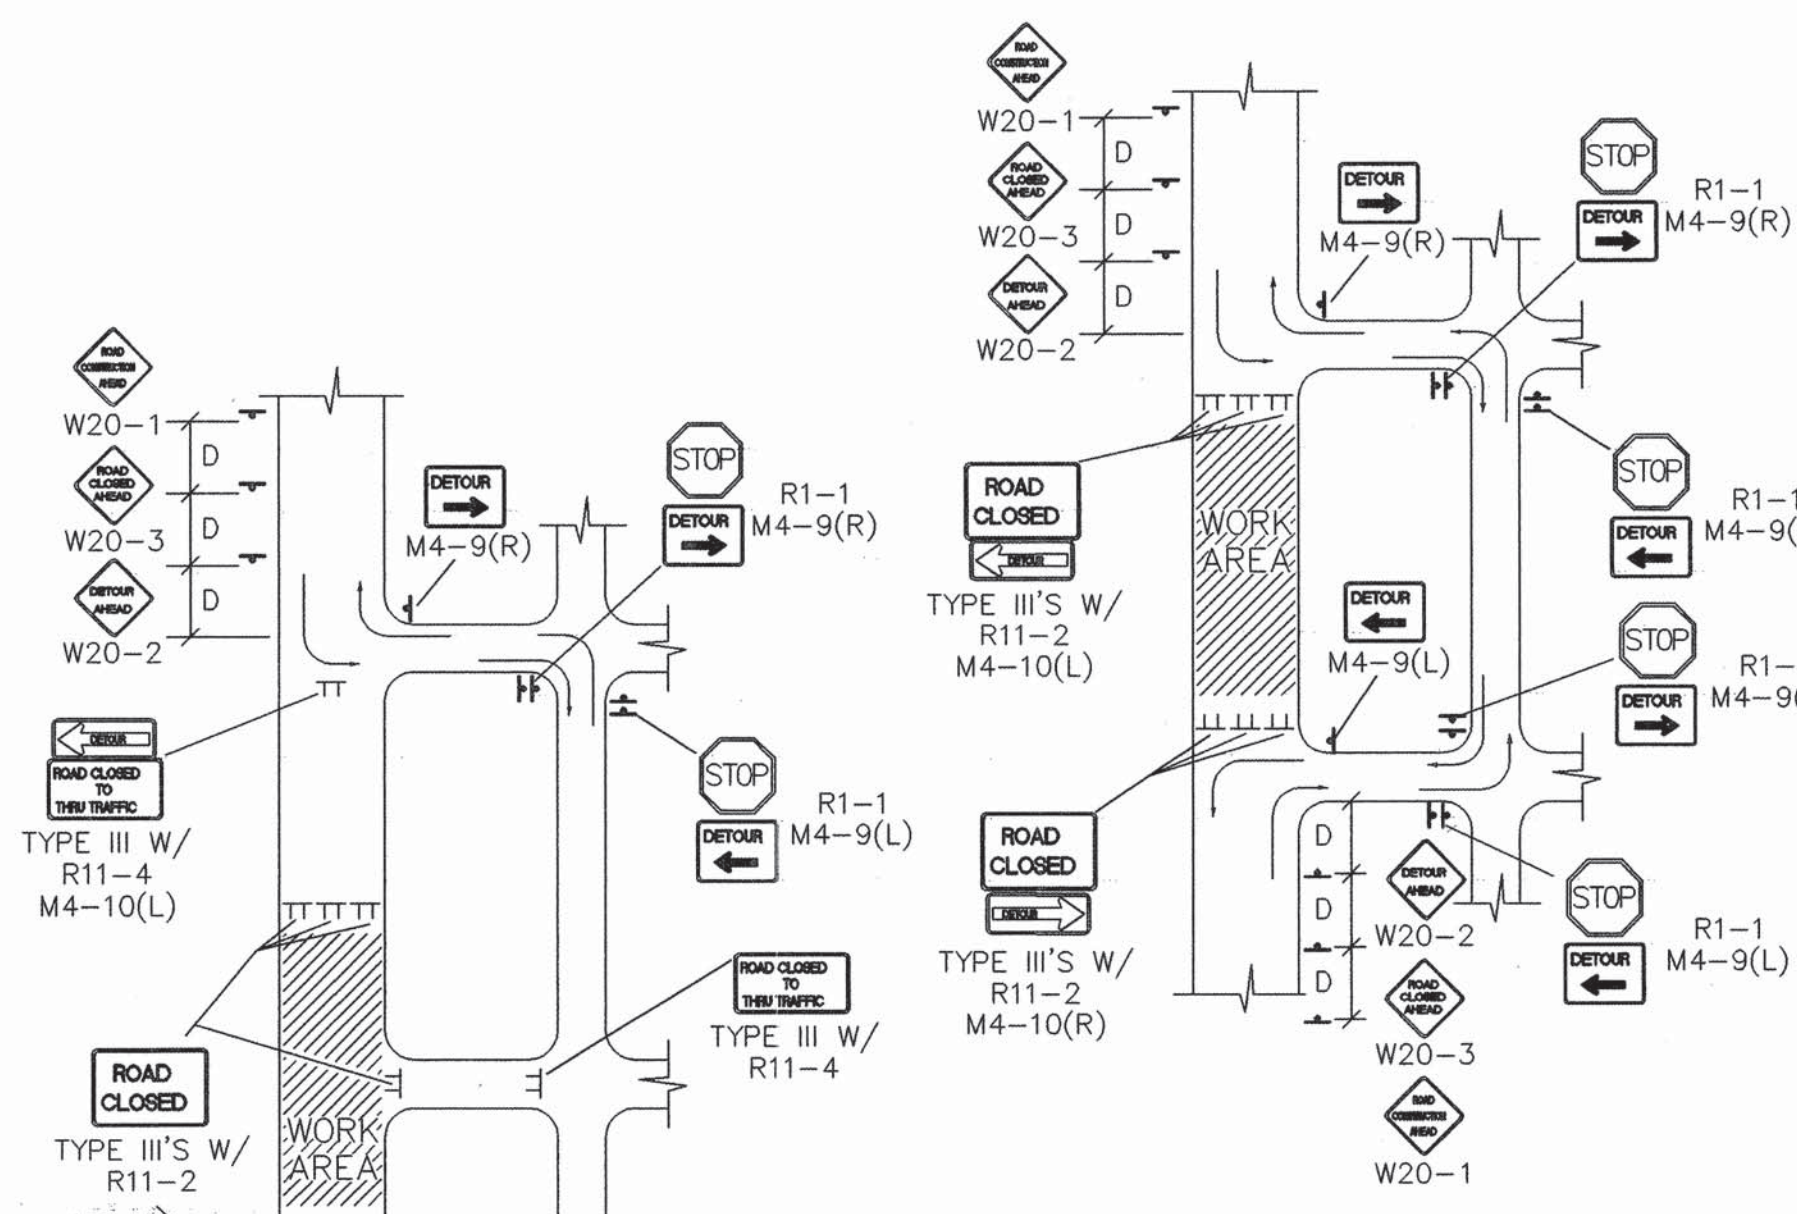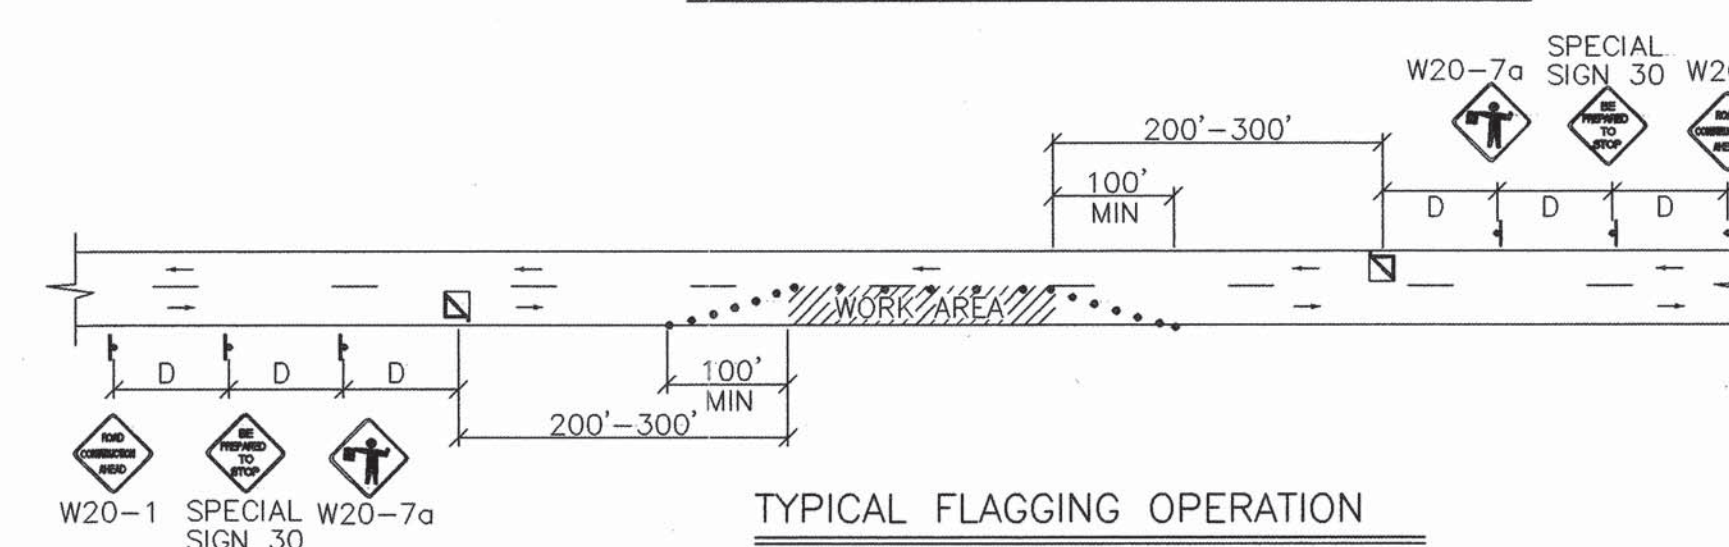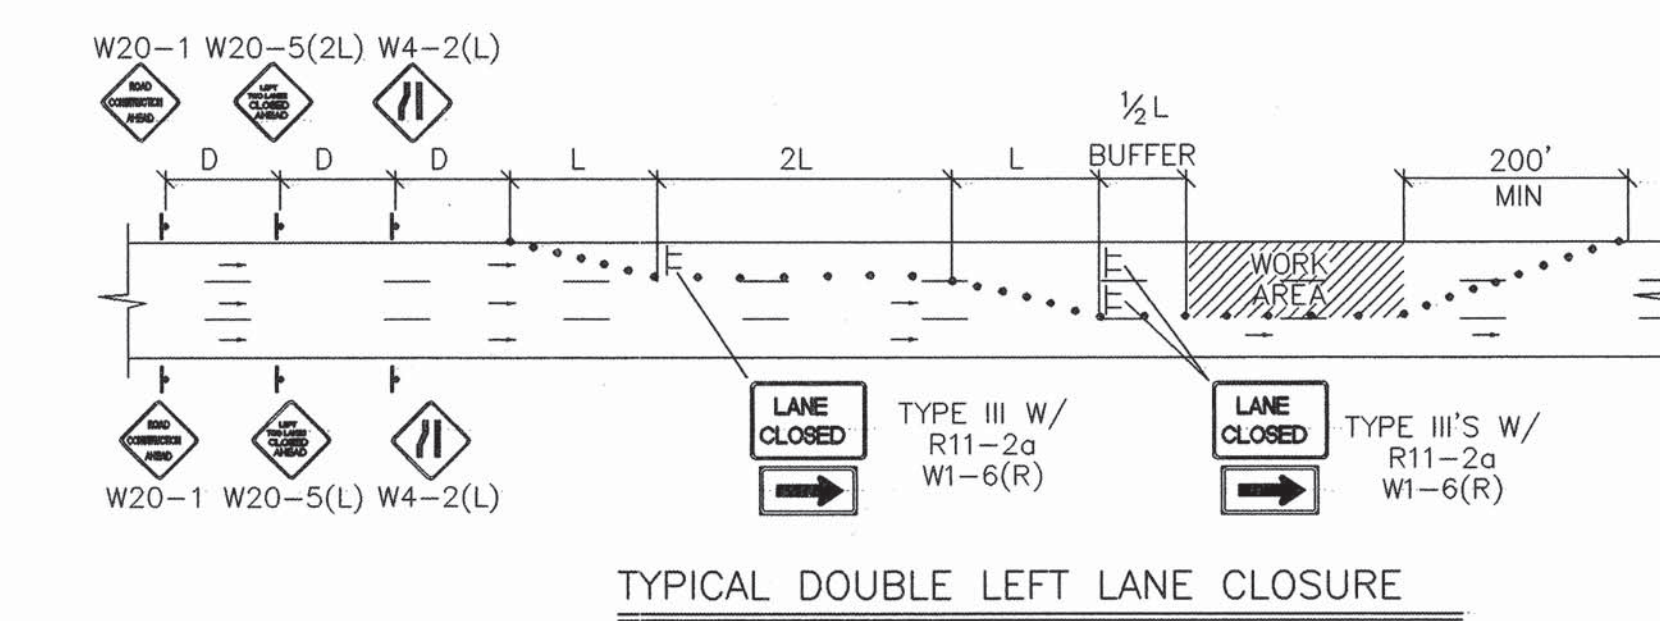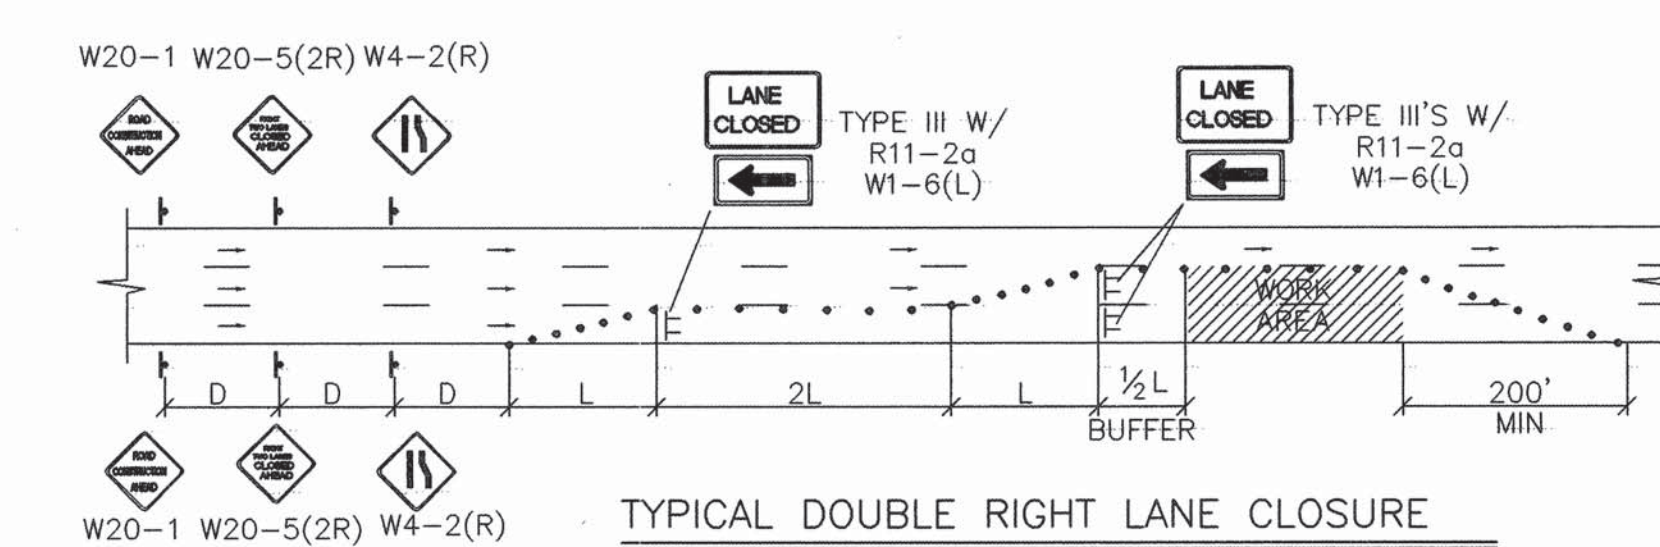

NOTE: (R1-1) BASED ON FIELD CONDITIONS.

NOTE: (R1-1) BASED ON FIELD CONDITIONS.

AS-BUILT INFORMATION		BENCH MARKS		SURVEY INFORMATION		ENGINEER'S SEAL	
CONTRACTOR	DATE	SITE BENCHMARK IS AN A.C.S.	DATE	NO.	BY	DATE	REVISIONS
		MONUMENT "16-L12A"					
		ELEVATION=4945.073, ALUMINUM					
		DISK SET IN THE TOP OF A					
		CONCRETE CURB AT THE E.S.E.					
		CURB RETURN, S.E. QUADRANT					
		OF BRIDGE BLVD. AND SUNSET					
		ROAD, S.W. VERTICAL					
		DATUM=N.G.V.D.=1929					

Prepared by

NO.	DATE	REVISIONS

DESIGNED BY BOHANNAN HUSTON
DRAWN BY BOHANNAN HUSTON
CHECKED BY BOHANNAN HUSTON

CITY OF ALBUQUERQUE
PUBLIC WORKS DEPARTMENT
ENGINEERING DEVELOPMENT GROUP

TITLE:
TYPICAL TRAFFIC CONTROL
& SIGNING EXAMPLES (REF MUTCD)

DESIGN REVIEW COMMITTEE	CITY ENGINEER APPROVAL	MO./DAY/YR.	MO./DAY/YR.

CITY PROJECT NO. 5365.90
ZONE MAP NO. L-12
SHEET 15 OF 15