

PLANS FOR CONSTRUCTION OF

WESTERN ESTATES SUBDIVISION

MARCH, 1996

INDEX TO DRAWINGS

SHEET	TITLE
1	TITLE SHEET
2	SUBDIVISION PLAT
3	GRADING, DRAINAGE AND EROSION CONTROL PLAN
4	GRADING, DRAINAGE AND EROSION CONTROL PLAN DETAILS

STREET PAVING PLAN & PROFILE

5	CHRIS COURT NW
6	ALAMOGORDO DRIVE NW, (CURB AND GUTTER ONLY)

WATER & SANITARY SEWER PLAN & PROFILE


7	CHRIS COURT NW
---	----------------

STORM DRAINAGE IMPROVEMENTS

8	CHANNEL "A"
---	-------------

THESE DRAWINGS DO NOT INCLUDE NECESSARY COMPONENTS FOR THE CONSTRUCTION SAFETY WHICH SHALL REMAIN THE RESPONSIBILITY OF THE CONTRACTOR.

ALL IDEAS, DESIGNS, ARRANGEMENTS, AND PLANS INDICATED OR REPRESENTED BY THIS INSTRUMENT ARE OWNED BY AND THE PROPERTY OF BRASHER & LORENZ, INC., AND WERE CREATED AND DEVELOPED FOR USE ON AND IN CONNECTION WITH THE SPECIFIED PROJECT. THESE IDEAS, DESIGNS, ARRANGEMENTS OR PLANS SHALL NOT BE USED BY ANY PERSON, FIRM OR CORPORATION FOR ANY PURPOSE WHATSOEVER WITHOUT THE WRITTEN CONSENT OF BRASHER & LORENZ, INC.

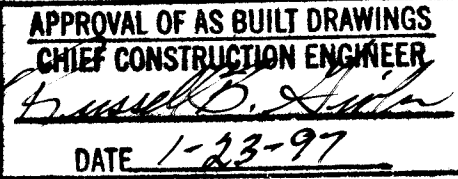

SCANNED BY
BY LASON

DRB No. 95-260

© COPYRIGHT



VICINITY MAP: H-11 SCALE: 1"=750'

GENERAL NOTES:

- ALL WORK DETAILED ON THESE PLANS TO BE PERFORMED UNDER CONTRACT SHALL, EXCEPT AS OTHERWISE STATED OR PROVIDED FOR HEREON, BE CONSTRUCTED IN ACCORDANCE WITH THE "CITY OF ALBUQUERQUE, STANDARD SPECIFICATIONS FOR PUBLIC WORKS CONSTRUCTION, 1986" (COSA STDN). THROUGH UPDATE NO. 6.
- TWO (2) WORKING DAYS PRIOR TO ANY EXCAVATION, CONTRACTOR MUST CONTACT NEW MEXICO ONE CALL SYSTEM, 260-1990, FOR LOCATION OF EXISTING UTILITIES.
- PRIOR TO CONSTRUCTION, THE CONTRACTOR SHALL EXCAVATE AND VERIFY THE HORIZONTAL AND VERTICAL LOCATIONS OF ALL OBSTRUCTIONS. SHOULD A CONFLICT EXIST, THE CONTRACTOR SHALL NOTIFY THE ENGINEER OR SURVEYOR SO THAT THE CONFLICT CAN BE RESOLVED WITH MINIMUM AMOUNT OF DELAY.
- IF ANY UTILITY LINES, PIPELINES, OR UNDERGROUND UTILITY LINES ARE SHOWN ON THESE DRAWINGS, THEY ARE SHOWN IN AN APPROXIMATE MANNER ONLY, AND SUCH LINES MAY EXIST WHERE NONE ARE SHOWN. IF ANY SUCH EXISTING LINES ARE SHOWN, THE LOCATION IS BASED UPON INFORMATION PROVIDED BY THE OWNER OF SAID UTILITY, AND THE INFORMATION MAY BE INCOMPLETE, OR MAY BE OBSOLETE BY THE TIME CONSTRUCTION COMMENCES. THE ENGINEER HAS UNDERTAKEN NO FIELD VERIFICATION OF THE LOCATION, DEPTH, SIZE, OR TYPE OF EXISTING UTILITY LINES, PIPELINES, OR UNDERGROUND UTILITY LINES. THE CONTRACTOR SHALL INFORM HIMSELF OF THE LOCATION OF ANY UTILITY LINE, PIPELINE, OR UNDERGROUND UTILITY LINE IN OR NEAR THE AREA OF THE WORK IN ADVANCE OF AND DURING EXCAVATION WORK. THE CONTRACTOR IS FULLY RESPONSIBLE FOR ANY AND ALL DAMAGE CAUSED BY HIS FAILURE TO LOCATE, IDENTIFY AND PRESERVE ANY AND ALL EXISTING UTILITIES, PIPELINES, AND UNDERGROUND UTILITY LINES. IN PLANNING AND CONDUCTING EXCAVATION, THE CONTRACTOR SHALL COMPLY WITH STATE STATUTES, MUNICIPAL AND LOCAL ORDINANCES, RULES AND REGULATIONS, IF ANY, PERTAINING TO THE LOCATION OF THESE LINES AND FACILITIES.
- THE CONTRACTOR SHALL SECURE A "TOPSOIL DISTURBANCE PERMIT" PRIOR TO BEGINNING CONSTRUCTION.
- THE CONTRACTOR SHALL ASSIST THE ENGINEER/INSPECTOR IN THE RECORDING OF DATA ON ALL UTILITY LINES AND ACCESSORIES AS REQUIRED BY THE OWNERS FOR THE PREPARATION OF "RECORD DRAWINGS". THE CONTRACTOR SHALL NOT COVER UTILITY LINES AND ACCESSORIES UNTIL ALL DATA HAS BEEN RECORDED.
- REFERENCE MADE TO STANDARD DRAWINGS REFER TO ALBUQUERQUE STANDARD DRAWINGS.
- ELECTRONIC MARKER DISCS SHALL BE PLACED IN ACCORDANCE WITH SECTION 170 OF THE CITY OF ALBUQUERQUE, STANDARD SPECIFICATIONS, PUBLIC WORKS CONSTRUCTION.
- WATERLINE CONNECTIONS SHALL BE CONSTRUCTED IN ACCORDANCE WITH CITY STD. DWG. 2301.
- WATER METERS ARE TO BE INSTALLED AT ALL SERVICES IN ACCORDANCE WITH CITY STD. DWG. 2362 AND 2363.
- ALL CONSTRUCTION WITHIN CITY RIGHT-OF-WAY OR EASEMENTS MUST BE DONE FROM APPROVED WORK ORDER DOCUMENTS FROM THE CITY OF ALBUQUERQUE AND PREPARED BY BRASHER & LORENZ, INC.
- AN EXCAVATION/CONSTRUCTION PERMIT WILL BE REQUIRED BEFORE BEGINNING ANY WORK WITHIN CITY RIGHT-OF-WAY. AN APPROVED COPY OF THESE PLANS MUST BE SUBMITTED AT THE TIME OF APPLICATION FOR THIS PERMIT.
- THE CONTRACTOR SHALL BE RESPONSIBLE FOR DETERMINING, IN ADVANCE OF HIS CONSTRUCTION, IF OVERHEAD UTILITY LINES SUPPORT STRUCTURES, POLES, GUYS, ETC. ARE AN OBSTRUCTION TO CONSTRUCTION OPERATIONS. IF ANY OBSTRUCTION TO CONSTRUCTION OPERATIONS IS EVIDENT, THE CONTRACTOR SHALL BE RESPONSIBLE FOR COORDINATING WITH THE APPROPRIATE UTILITY OWNER TO REMOVE OR SUPPORT THE UTILITY OBSTRUCTION. ANY COST ASSOCIATED WITH THIS EFFORT SHALL BE THE RESPONSIBILITY OF THE CONTRACTOR.
- CONTRACTOR IS TO SUPPORT AND MAINTAIN THE INTEGRITY OF ALL UNDERGROUND TELEPHONE, ELECTRIC CABLES, AND CABLE TELEVISION UTILITIES AT NO ADDITIONAL COST TO THE OWNER. CABLE IS TO BE SUPPORTED EVERY 15' (MINIMUM). CONTRACTOR SHALL COORDINATE WITH AND MAKE NECESSARY PAYMENT (IF ANY) TO UTILITY OWNER FOR DE-ENERGIZATION OF CABLES OR SUPPORT OF CABLES BY THE UTILITY OWNER.
- THREE (3) WORKING DAYS PRIOR TO BEGINNING CONSTRUCTION THE CONTRACTOR SHALL SUBMIT TO THE CONSTRUCTION COORDINATION DIVISION A DETAILED CONSTRUCTION SCHEDULE. TWO (2) WORKING DAYS PRIOR TO CONSTRUCTION THE CONTRACTOR SHALL OBTAIN A BARRICADING PERMIT FROM THE CONSTRUCTION COORDINATION DIVISION. THE CONTRACTOR SHALL NOTIFY THE BARRICADE ENGINEER (768-2551) PRIOR TO OCCUPYING AN INTERSECTION. SEE SECTION 19 OF THE SPECIFICATIONS.
- ALL STREET STRIPING ALTERED OR DESTROYED SHALL BE REPLACED IN KIND BY THE CONTRACTOR TO LOCATION, AND IN KIND AS EXISTING OR AS INDICATED ON THE PLANSET.
- ANY WORK OCCURRING IN AN ARTERIAL ROADWAY REQUIRES TWENTY-FOUR HOUR CONSTRUCTION.

1 2 3 4 5 6 7 8 9 10 11 12 13 14 15
26-5369-90 0197




BL BRASHER & LORENZ, INC.
Consulting Engineers
4425 Juan Tabo Blvd. NE, Suite 202
Albuquerque, New Mexico 87111
Ph: 505-298-0422 Fax: 505-296-0466

REV.	SHEETS	CITY	ENGINEER	DATE	USER	DEPARTMENT	DATE	USER	DEPARTMENT	DATE
ENGINEERS STAMP & SIGNATURE		APPROVALS		ENGINEER		DATE		*****		
		DRC Chairman		<i>Billy G. Goodale</i>		5-30-96		APPROVED FOR CONSTRUCTION		
		Transportation		<i>R. W. Kone</i>		4-25-96				
		Water/Wastewater		<i>R. W. Kone</i>		7-22-96				
		Hydrology		<i>John C. Austin</i>		4-29-96				
		Parks								
Constr. Mngmt.										
CITY PROJECT NO.		5369.90		SHEET		OF				
				1		8				

I, the undersigned, being a Professional Engineer in the State of New Mexico, do hereby certify that this drawing was prepared by me or under my supervision, and that the as-built information shown hereon is based on actual field measurements and inspections performed by Brasher & Lorenz, Inc. I further certify that the as-built condition of the site is in substantial compliance with the approved Grading and Drainage Plan prepared by Brasher & Lorenz, Inc., dated March 12, 1996.


Dennis A. Lorenz, NMPE/9647

Date: _____

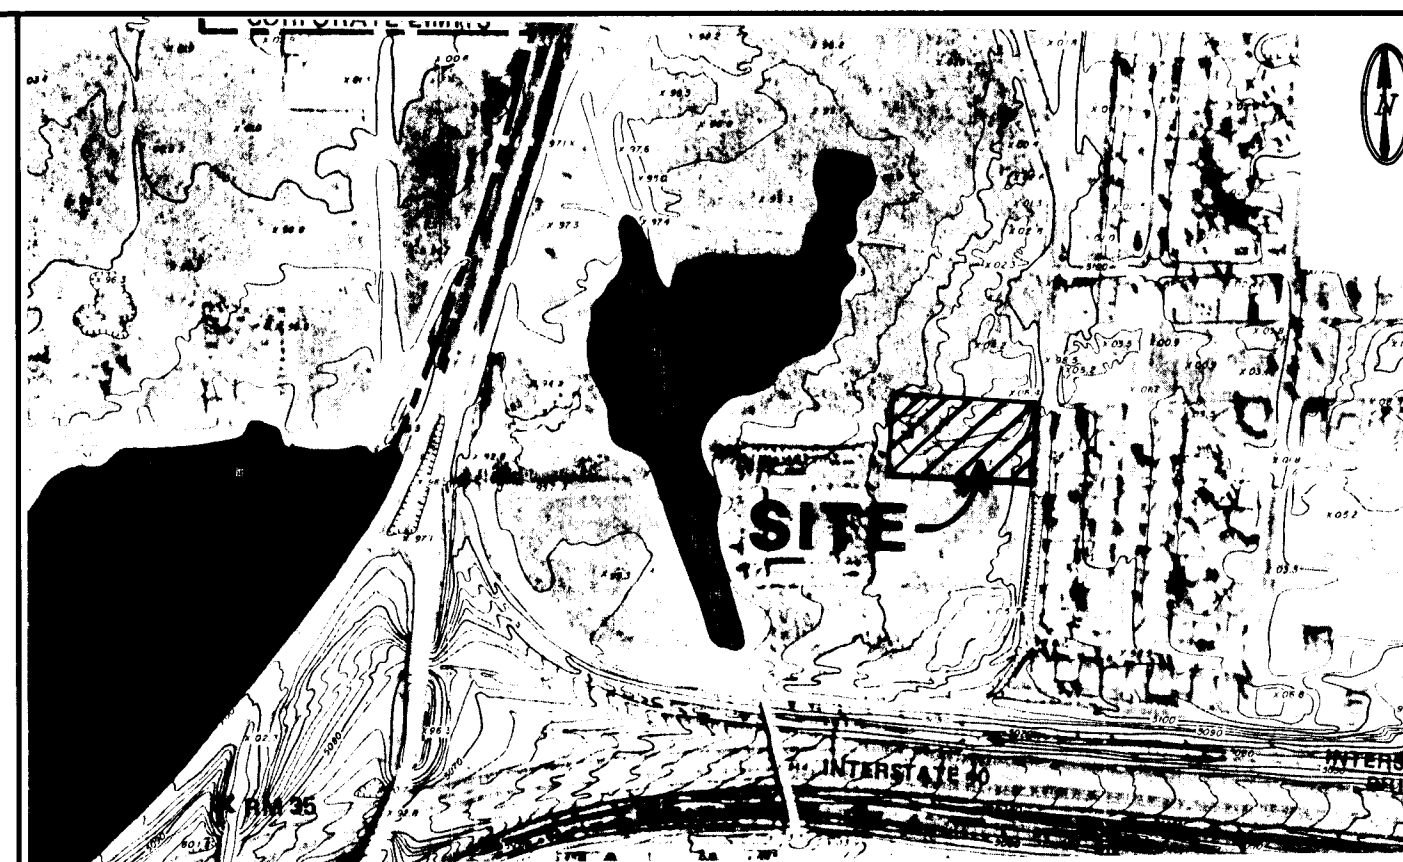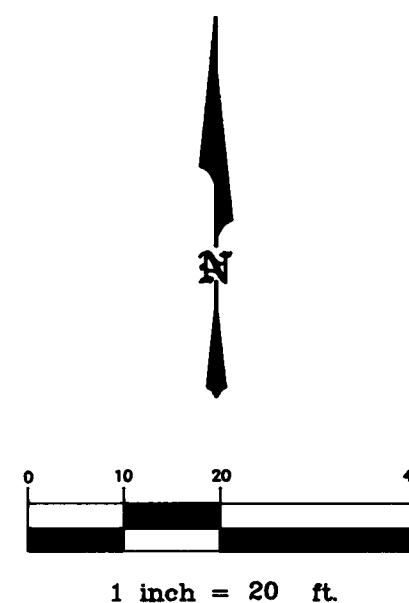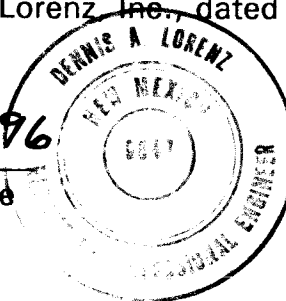

ALTHOUGH THE TOPOGRAPHY SHOWN HEREON DOES NOT REFLECT RECENT DEVELOPMENT
THE DRAINAGE BASINS REMAIN ESSENTIALLY UNCHANGED

FLOODWAY & OFFSITE DRAINAGE MAP
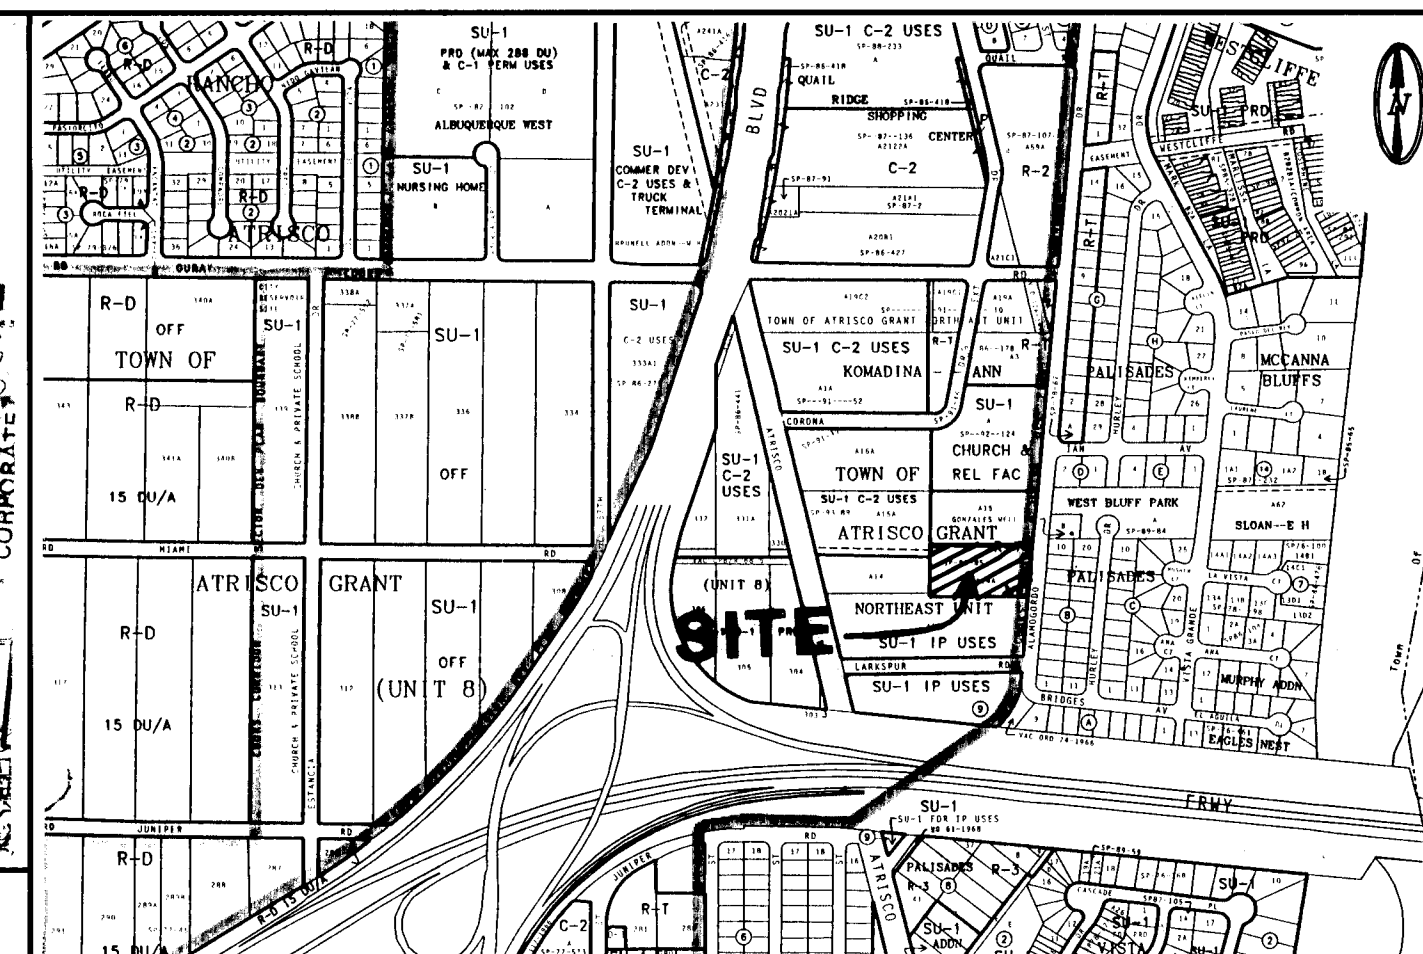
$$1'' = 500'$$


LOCATION MAP

$$1'' = 800'$$

—— 6001 ——	EXISTING CONTOUR ELEVATION
02.5 ×	EXISTING SPOT ELEVATION
—— 01 ——	PROPOSED CONTOUR ELEVATION
— · — · —	PROPERTY LINE
01.5 ♦	PROPOSED SPOT ELEVATION
← — — —	DIRECTION OF FLOW
← — — —	DRAINAGE SWALE
— - - - —	DRAINAGE BASIN DIVIDE
—————	RETAINING WALL
—————	STANDARD CURB
—————	MOUNTABLE CURB
—————	GARDEN WALL
01.5 ♦	AS BUILT ELEV.

Alamogordo Drive, N.W.

LEGAL DESCRIPTION

LEGAL DESCRIPTION


Tract A-14-A, Town of Atrisco Grant

PROJECT BENCHMARK

TBM: NE property corner, a 1/2" rebar with cap marked LS 6446. Elevation 5100.10 feet

SURVEY

Topographic and Field Measurement by
Precision Surveys. Dated August 1995

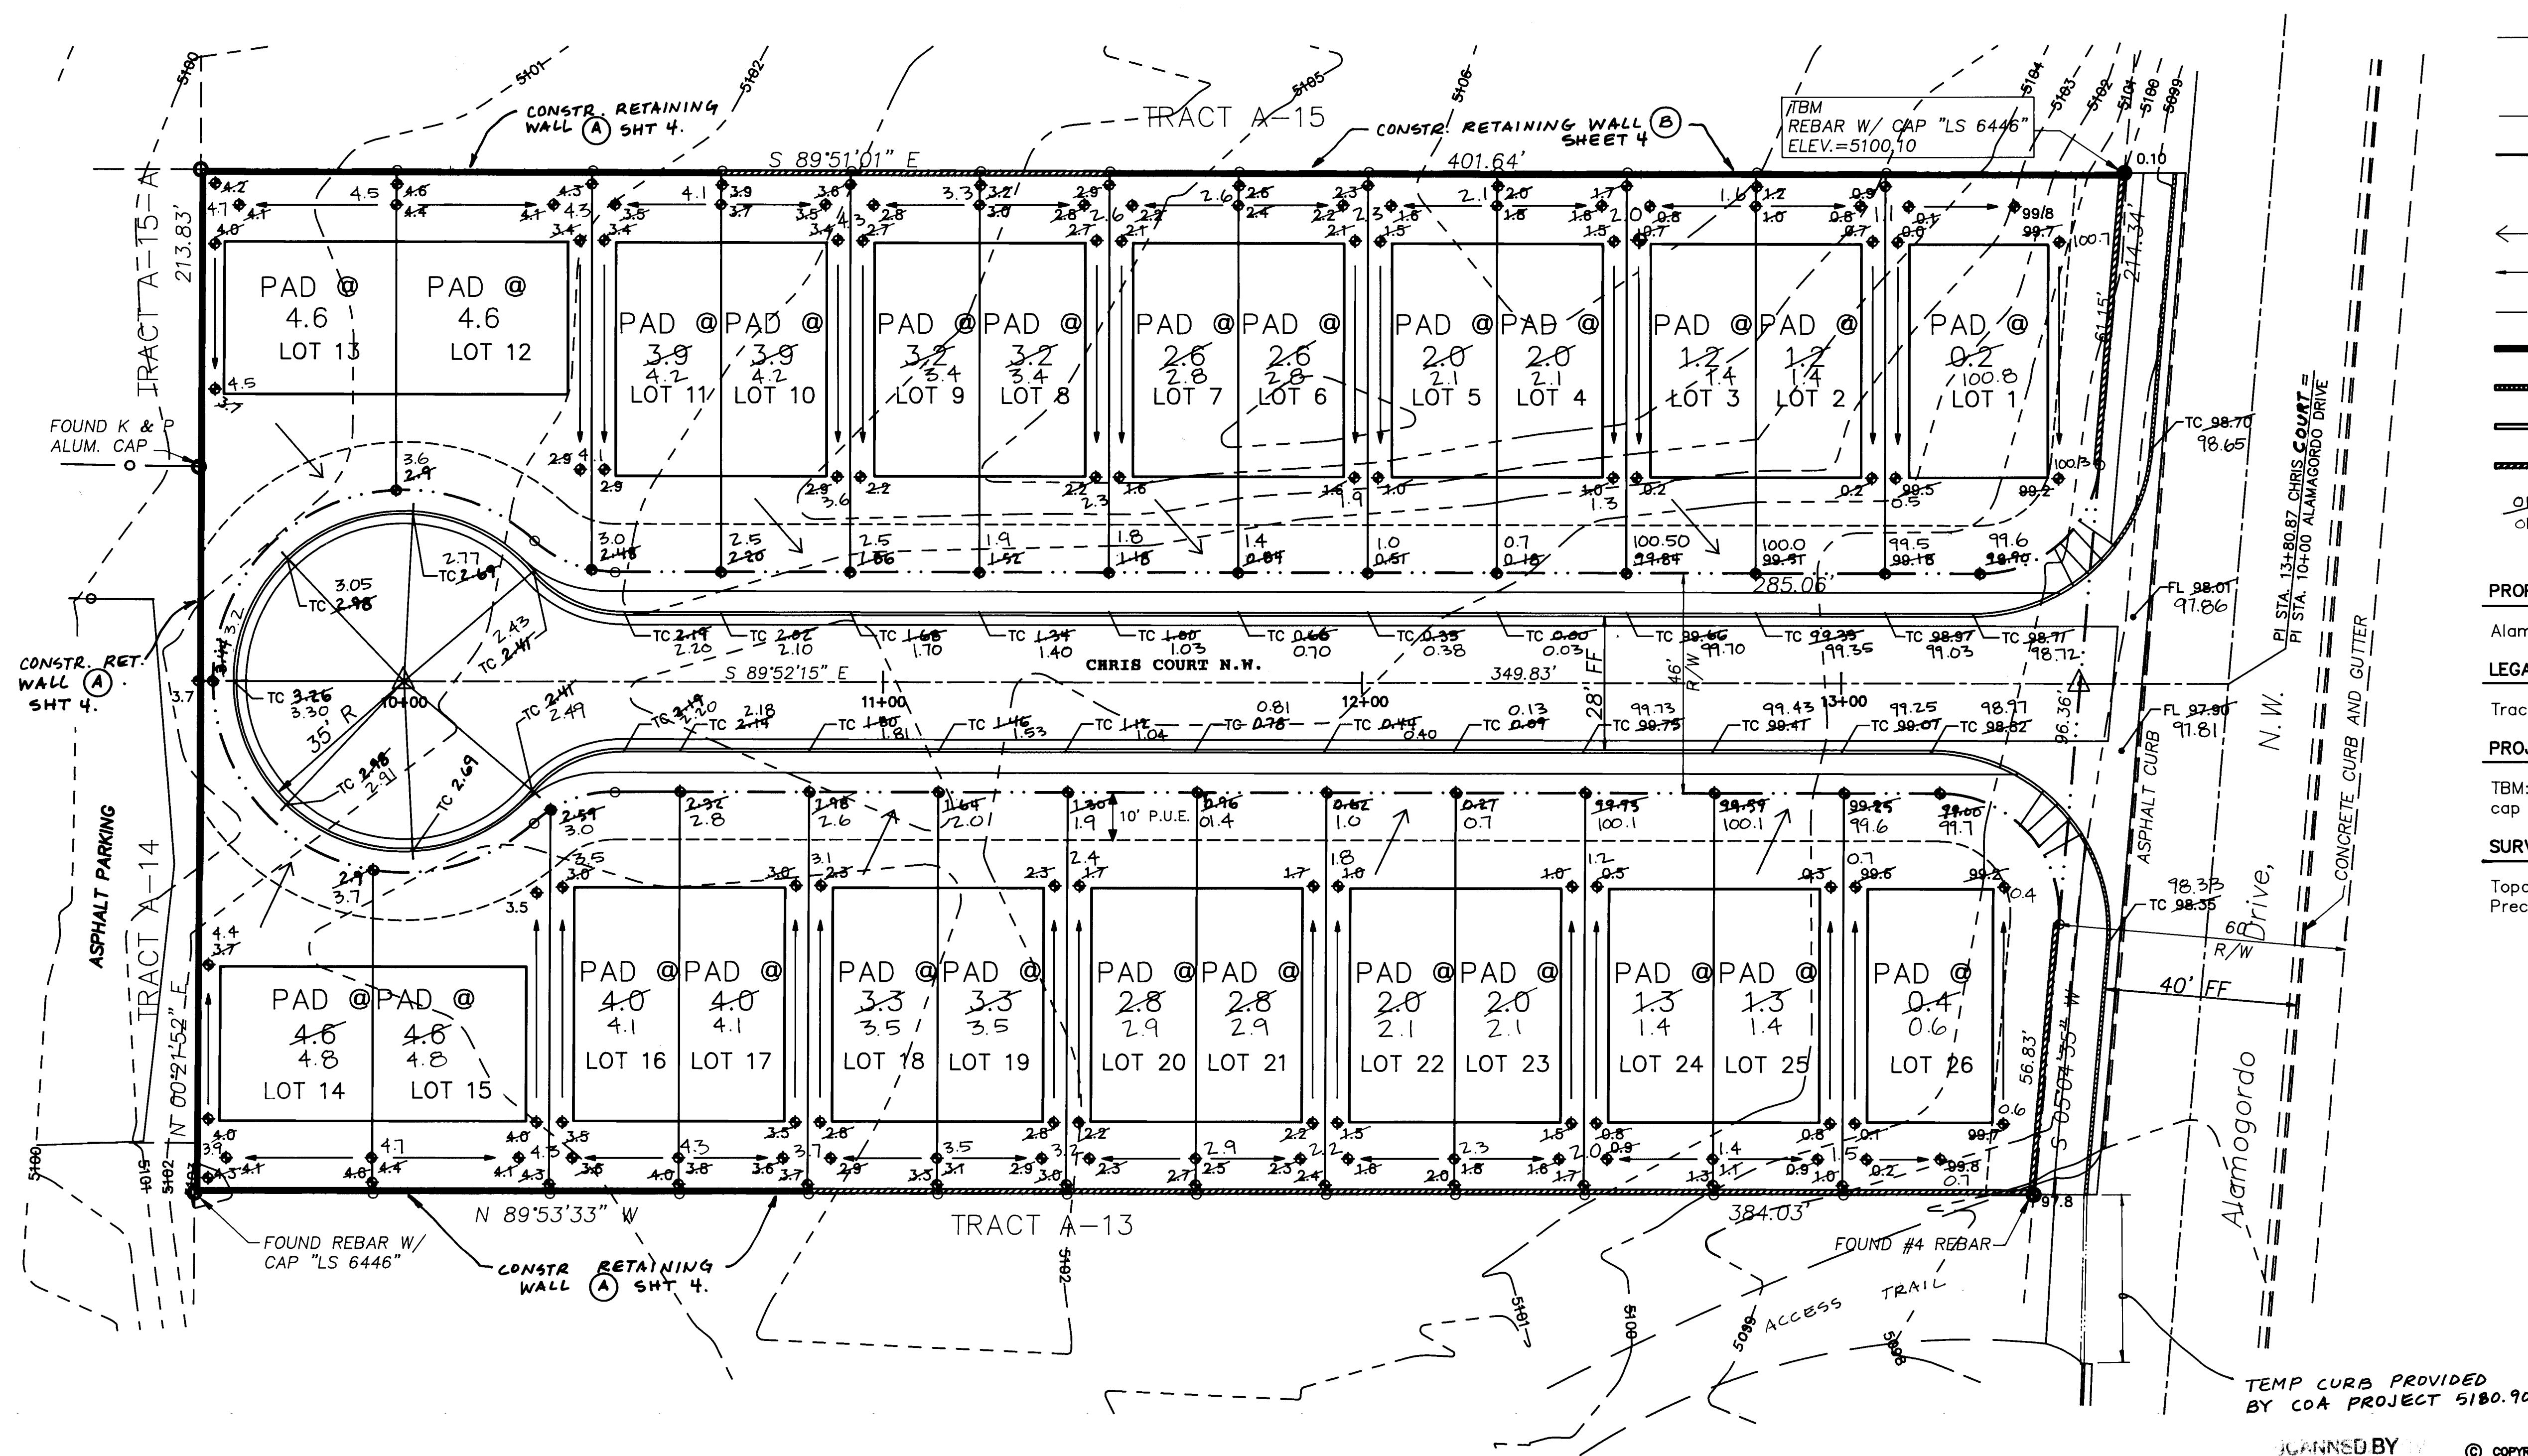

TEMP CURB PROVIDED
BY COA PROJECT 5180.90

SCANNED BY
FBI/DOJ

© COPYRIGHT

© COPYRIGHT

STANDARD CURB
MOUNTABLE CURB
GARDEN WALL
AS BUILT ELEV.

PROPERTY ADDRESS

Cardo Drive, N.W.

[illegible]

-14-A, Town of Atrisco Grant				B		0-95
						0-95

[illegible][illegible]

ARKS
NS
N

Photographic and Field Measurement by
Aerial Surveys, Dated August 1995

[illegible][illegible][illegible]

BRASHER & LORENZ, INC.				DA	GNEED OWN BY
4425 JUAN TABO BLVD. NE., SUITE 202					

[illegible]CITY OF ALBUQUERQUE
PUBLIC WORKS DEPARTMENT

ENGINEERING GROUP
TITLE: WESTERN ESTATES SUBDIVISION

GRADING, DRAINAGE AND EROSION CONTROL PLAN

APPROVALS	ENGINEER	DATE	APPROVALS	ENGINEER	DATE
D.R.C. CHAIR			WATER		


TRANS. DEV.		WASTEWATER	
HYDROLOGY			


Year	Percentage (%)
1970	10
1975	15
1980	12
1985	18
1990	15
1995	22
2000	20

PROJECT NO. 5369.90	MAP NO. H-11	SHEET 3 OF 8
-------------------------------	------------------------	----------------------------

For Information Only

For Information Only

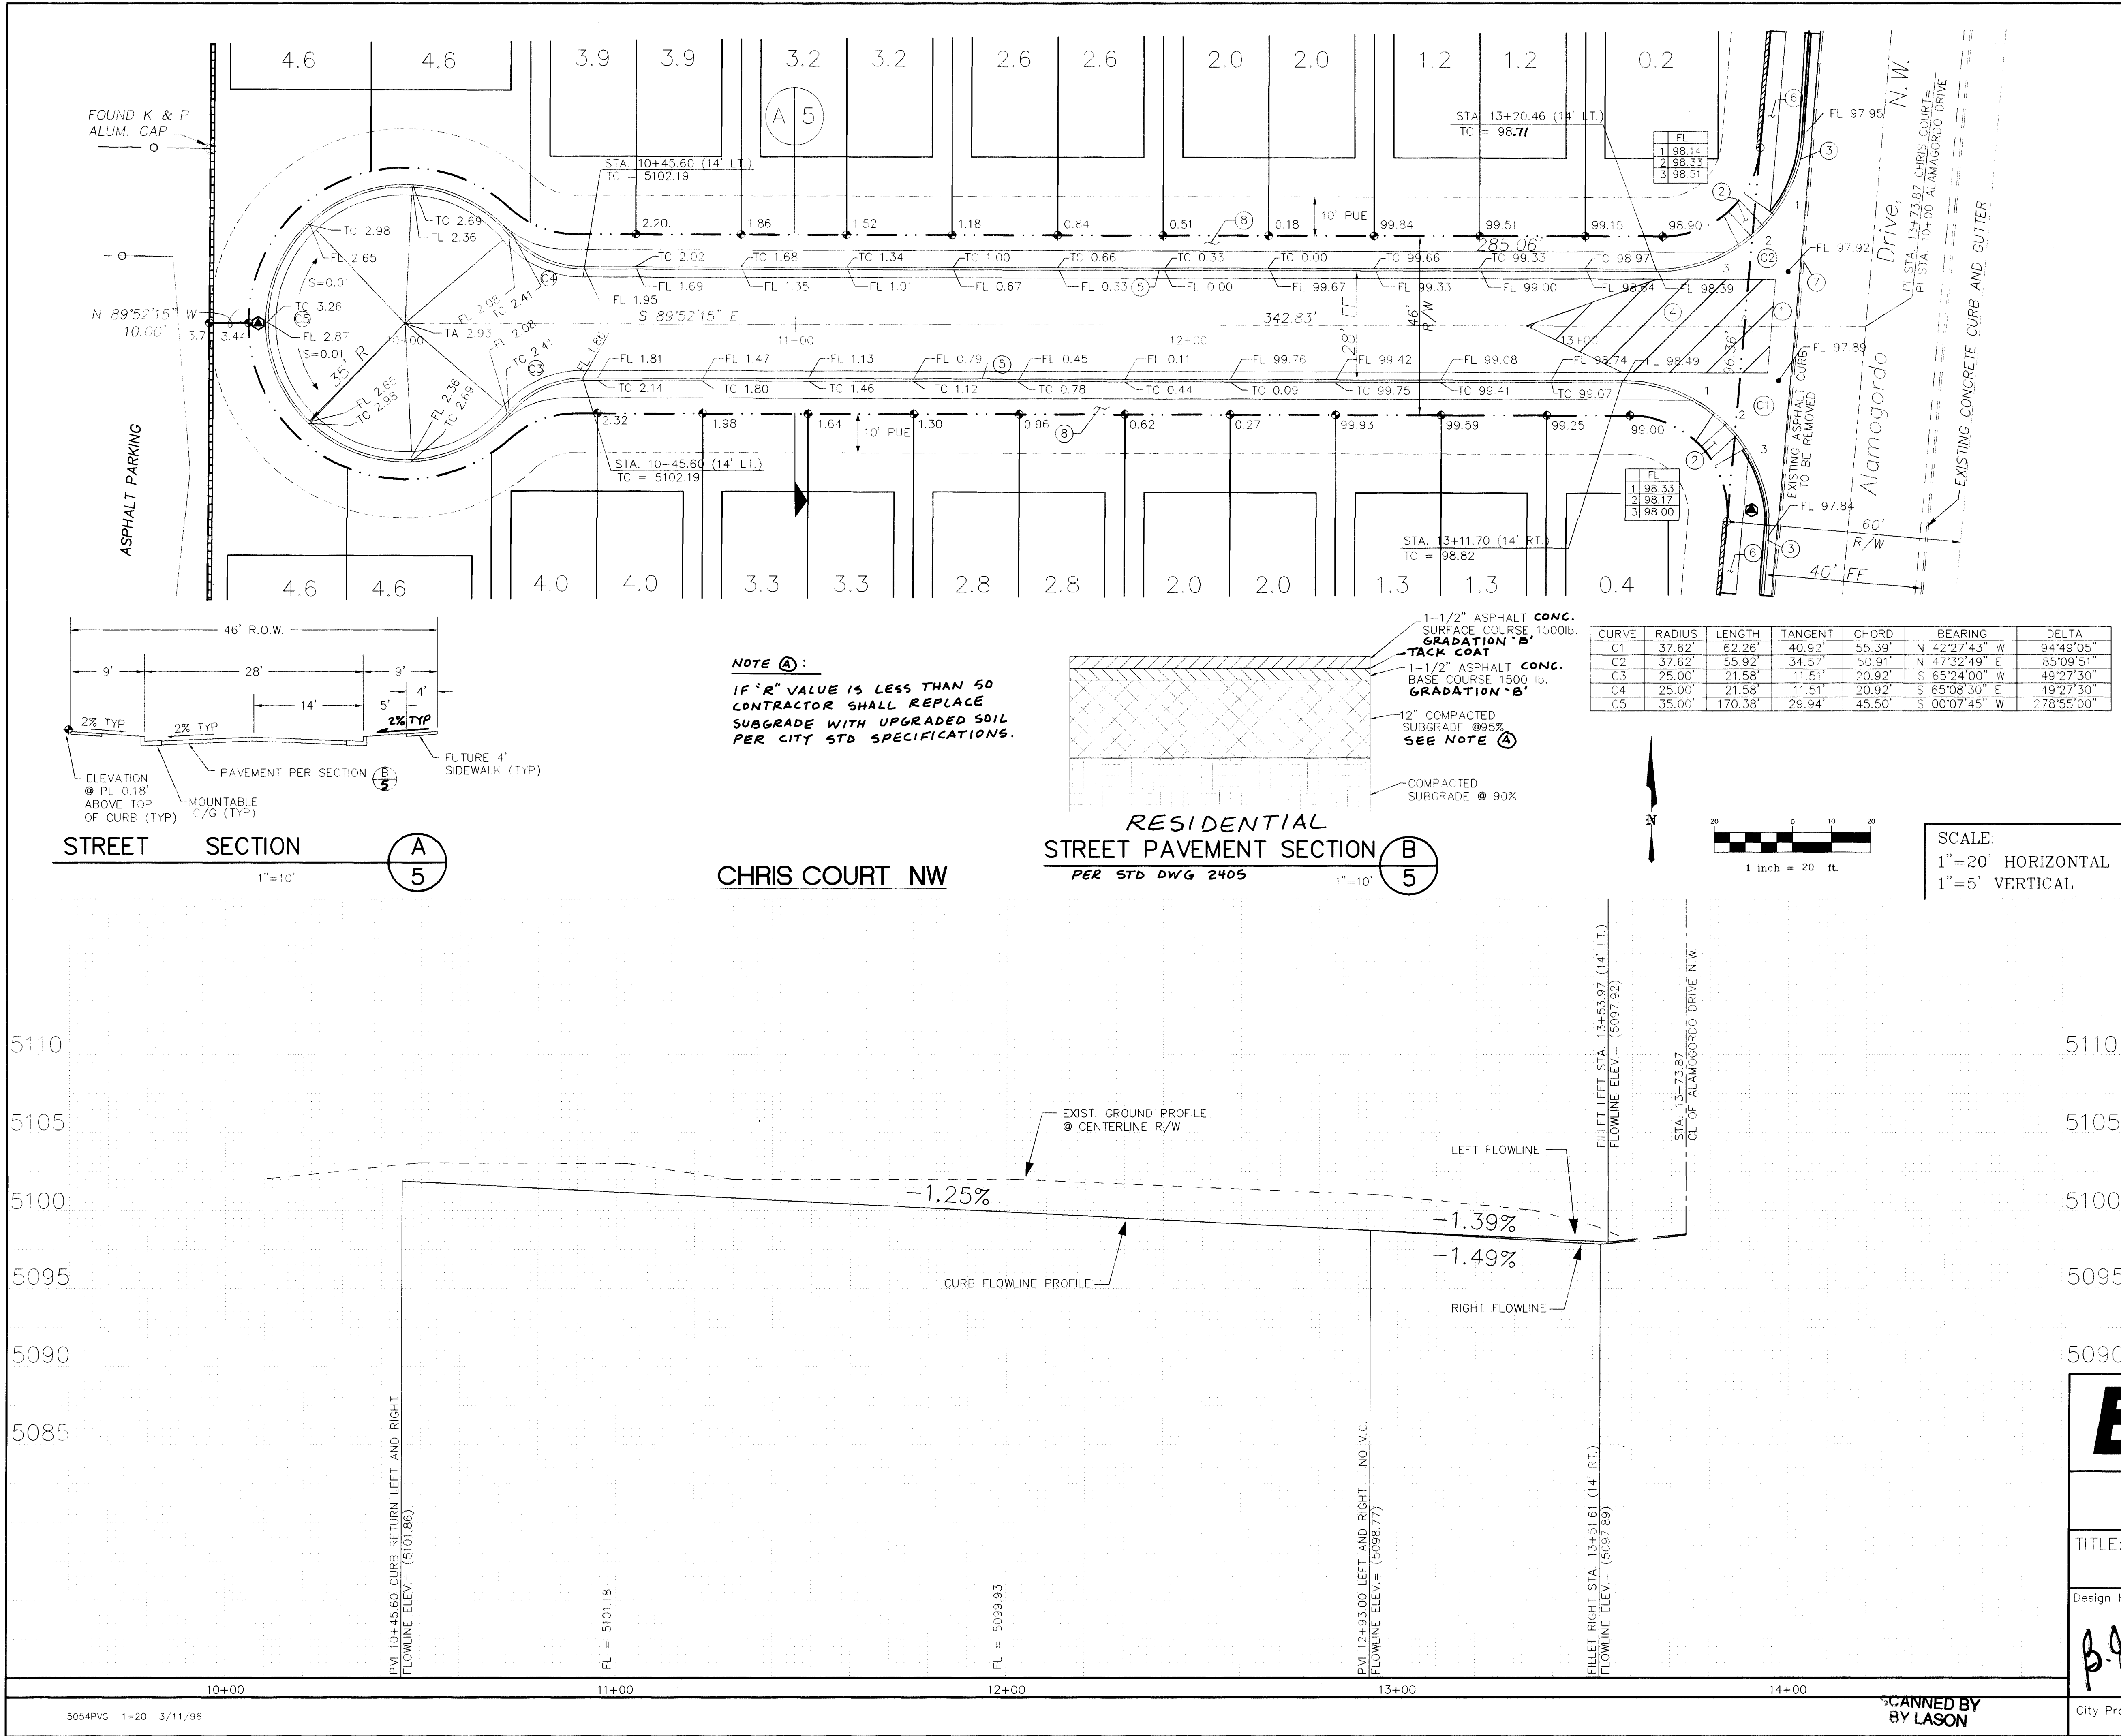


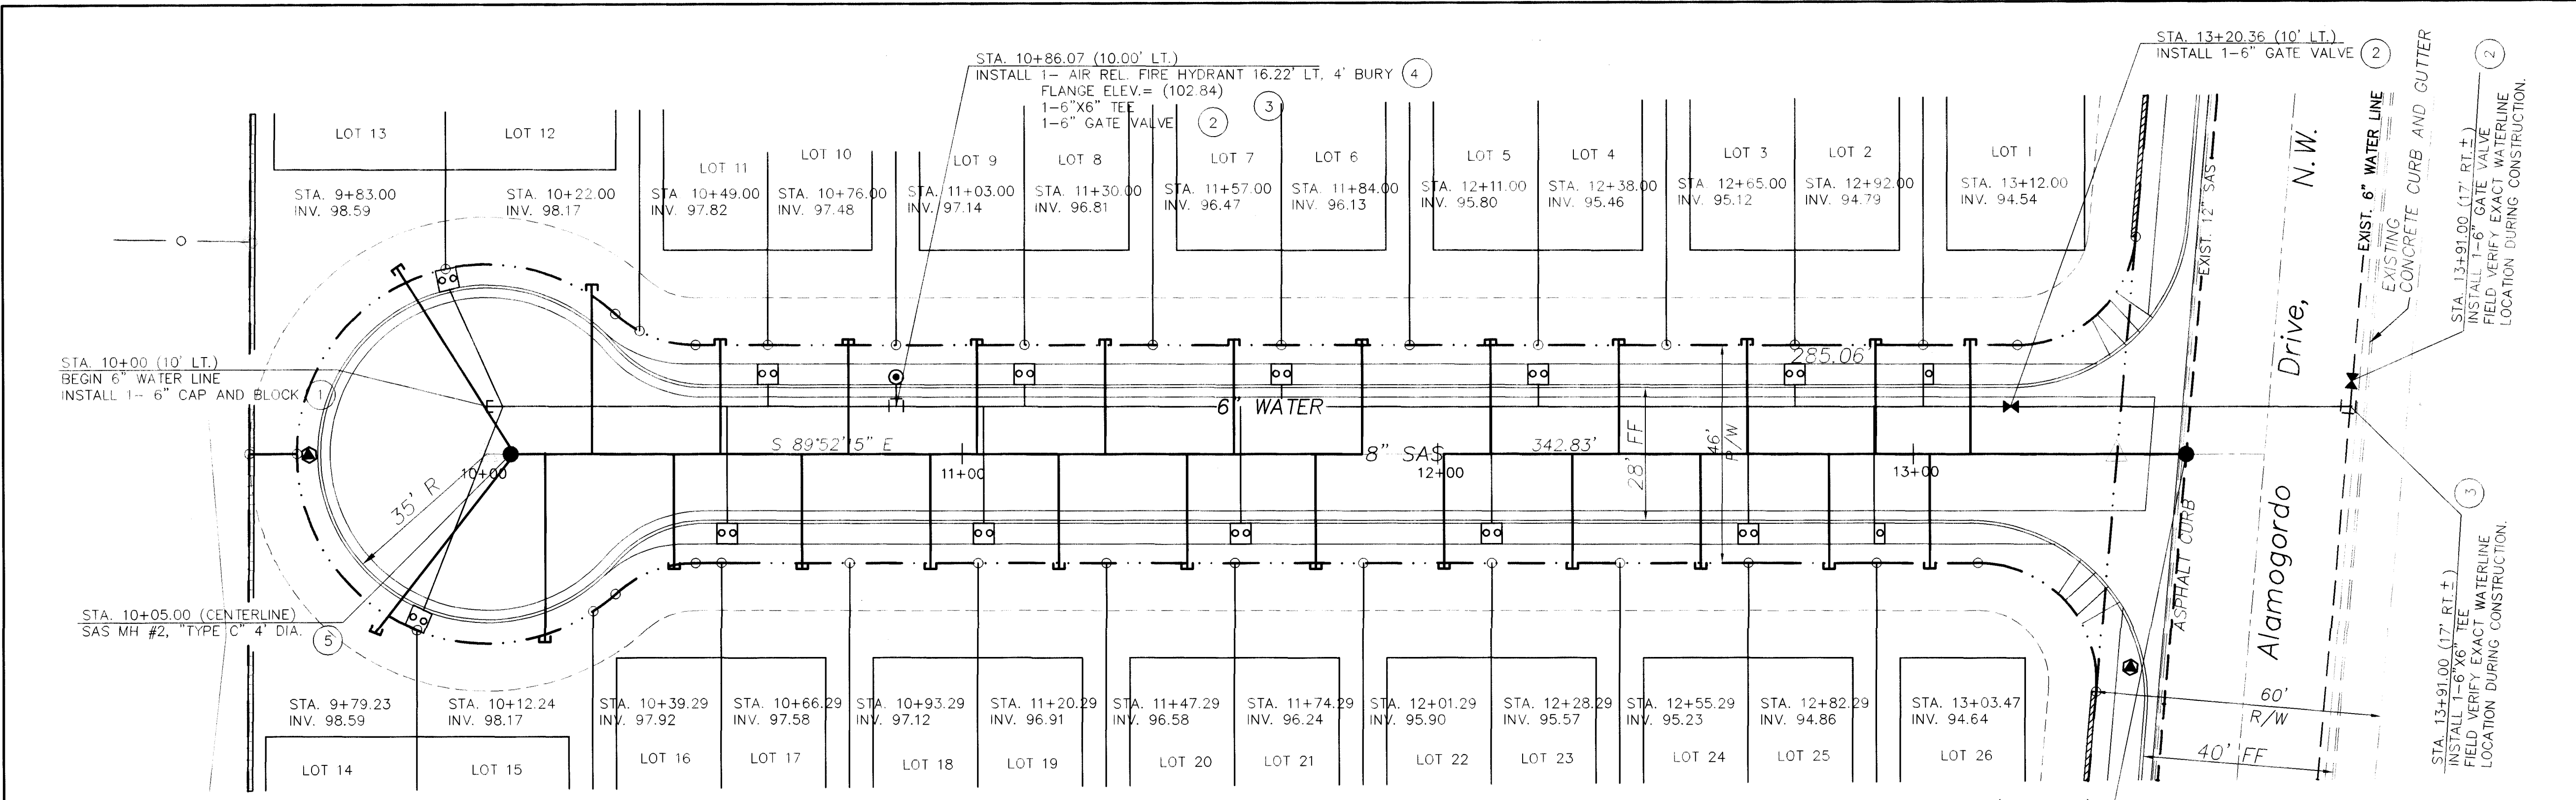

WATER SHUT-OFF PLAN

1. VALVES, HYDRANTS AND APPURTENANCES OF THE CITY WATER SYSTEM SHALL BE OPERATED BY CITY PERSONNEL ONLY.
2. THE CONTRACTOR SHALL PROVIDE THE CITY 48 HOURS ADVANCE NOTICE OF NEED FOR SYSTEM SHUTDOWN.
3. SYSTEM SHUTDOWN SHALL BE ACCOMPLISHED BY CLOSING VALVES 512, 962 AND 963.
4. ANTICIPATED SHUTDOWN DURATION IS 8 HOURS.

CHRIS COURT NW

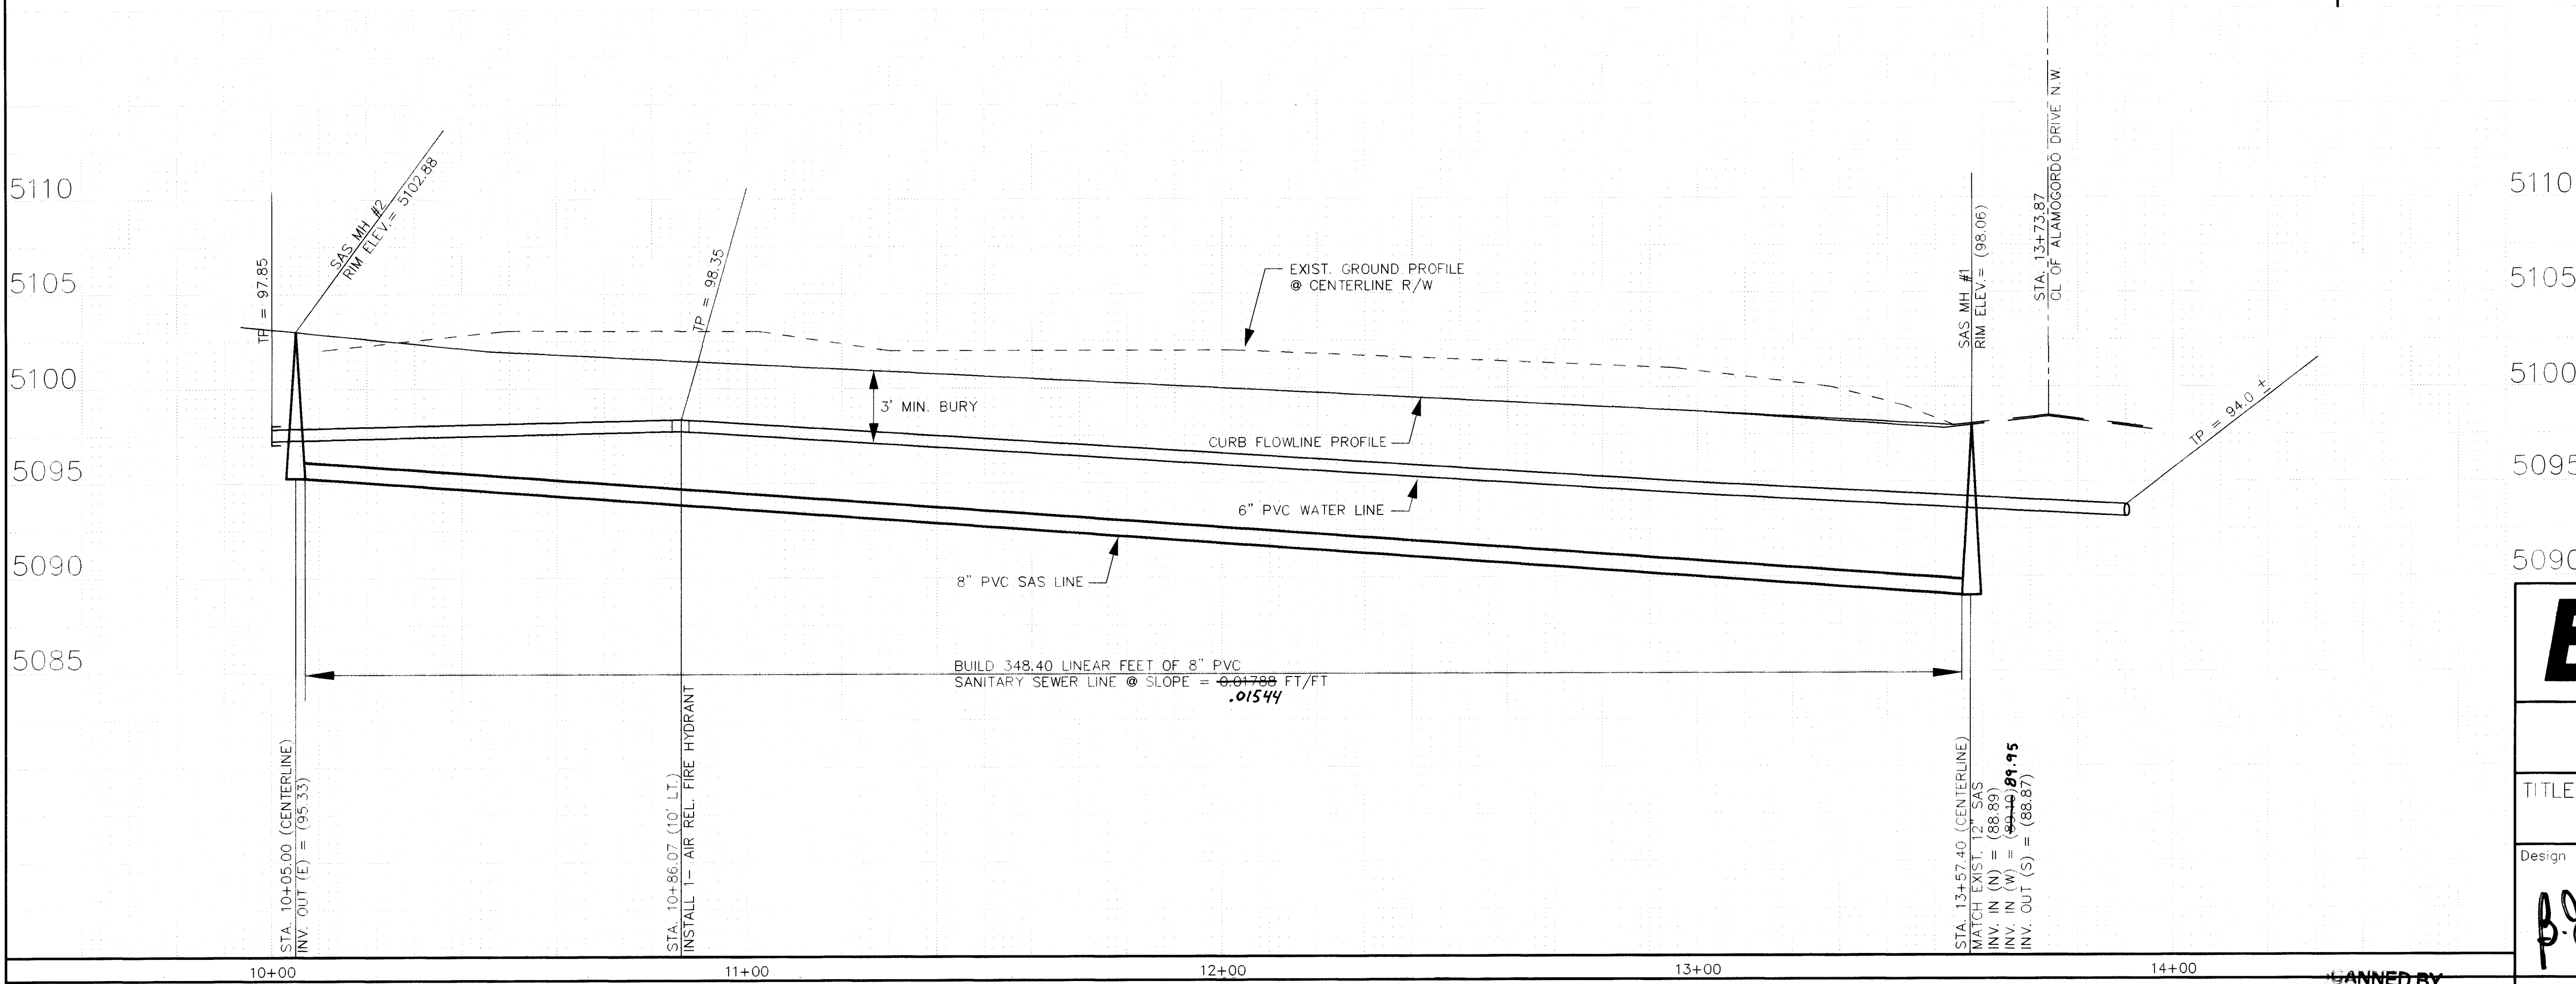

LEGEND

ITEM	EXISTING	PROPOSED
WATERLINE	6" W	6" W
SANITARY SEWER	8" SAS	8" SAS
STORM SEWER	36" SD	24" SD
FIRE HYDRANT		
VALVE		
WATER SERVICE (SINGLE)		
WATER SERVICE (DOUBLE)		
MANHOLE		
CURB		
DROP INLET		
OVERHEAD ELEC	OHE	
UNDERGROUND ELEC.	UGT	
GAS, TEL, TV		
FLOWLINE ELEV.	FL 0.14	FL 0.14
TOP OF CURB ELEV.	TC 99.3	TC 99.31
SPOT ELEV	x 16.7	16.7
SEWER SERVICE		
RIGHT OF WAY		
POWER POLE (GUYYED)	PP	
CHAIN LINK FENCE		
CENTERLINE		
RETAINING WALL		
TOP OF ASPHALT ELEV.	TA 16.2	TA 16.2
CROWN TRANSITION (50' LENGTH - TYPICAL)		
PROPOSED STREET LIGHT		

NOTE:
1. ALL STATIONING IS BASED ON CENTERLINE OF RIGHT-OF-WAY UNLESS OTHERWISE NOTED.

UTILITY BUILD NOTES

1. BUILD 6" CAP & CONCRETE BLOCKING PER COA DRAWING # 2320.
2. BUILD 6" GATE VALVE & BOX PER COA DRAWING #S 2325, 2328 & 2333.
3. BUILD 6"x6" TEE PER COA DRAWING # 2301.
4. BUILD 6" AIR REL. FIRE HYDRANT PER COA DRAWING # 2340.
5. BUILD SAS MANHOLE, "TYPE C", 4' DIA. PER COA DRAWING # 2101.

AS BUILT INFORMATION

CONTRACTOR: CCM

INSPECTED BY: C.O.A.

DATE: 12/24

APPROVED BY: Ray Bica

DATE: 12/16

DESIGNED BY: C.O.A.

DATE: 1/97

DRAWN BY: MICRO-FILM INFORMATION

RECORDED BY: NO

DATE: NO

BENCH MARKS

LOCATED AT THE NORTHEAST CORNER OF THE PROPERTY CORNER A REBAR WITH CAP MARKED "I.S. 6446" THE ELEVATION IS 5100.10 FEET

SURVEY INFORMATION

FIELD NOTES

NO. BY DATE

ENGINEER'S SEAL

03-12-96

REVISIONS

NO.	DATE	REMARKS
1	2/6	1
2	3	2
3	3	3
4	3	4
5	3	5
6	3	6
7	3	7
8	3	8
9	3	9
10	3	10
11	3	11
12	3	12
13	3	13
14	3	14

BRASHER & LORENZ, INC.

Consulting Engineers

4425 Juan Tabo Blvd. NE Suite 202

Albuquerque, New Mexico 87111

Ph: 505-296-0422 Fax: 505-296-0466

CITY OF ALBUQUERQUE

PUBLIC WORKS DEPARTMENT

ENGINEERING DEVELOPMENT GROUP

TITLE: WESTERN ESTATES SUBDIVISION

WATER & SEWER PLAN & PROFILE

CHRIS COURT NW

Design Review Committee

City Engineer Approval



Mo./Day/Yr.

Mo./Day/Yr.


City Project No. 5369.90

Zone Map No. H-11


Sheet 7 Of 8

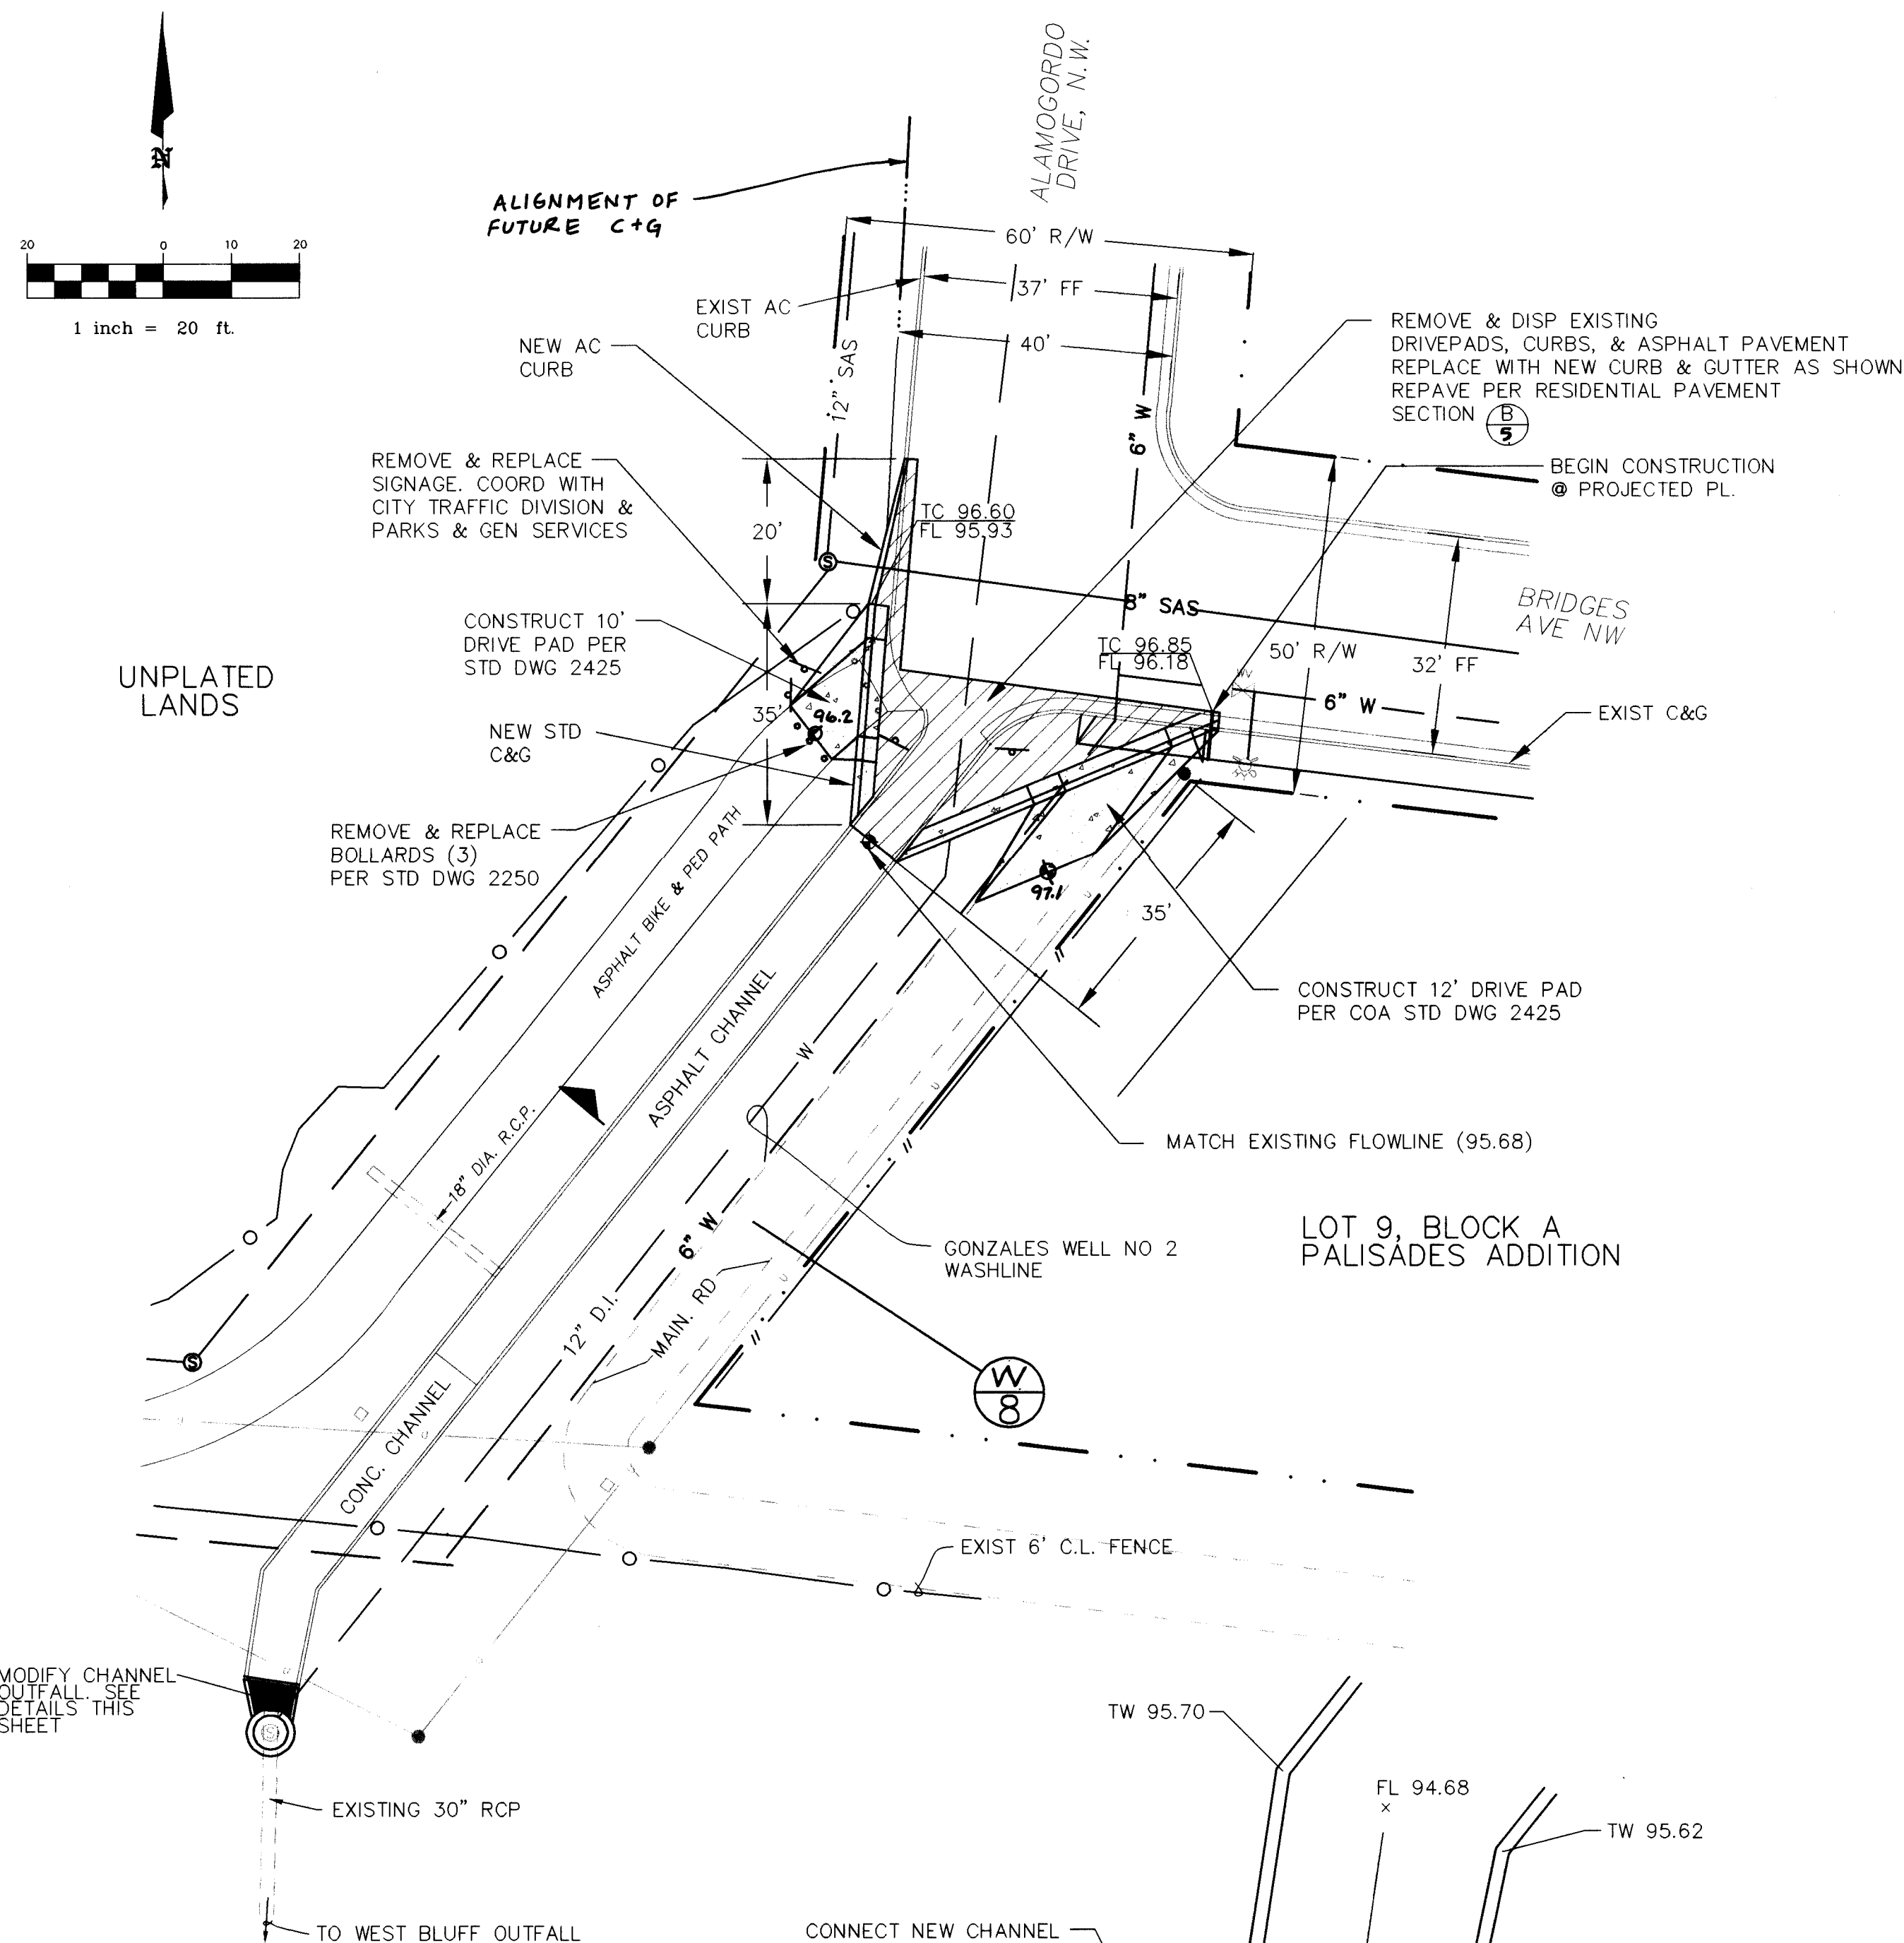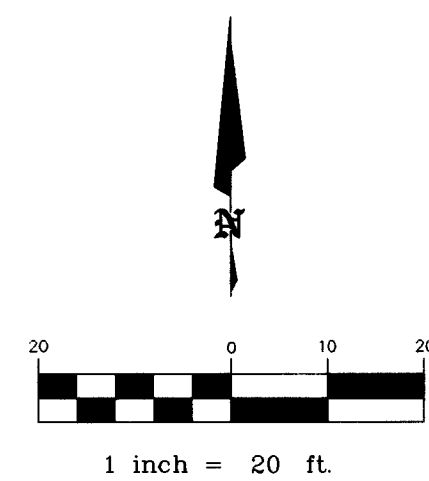


EXISTING CHANNEL - PLAN
1"= 20'

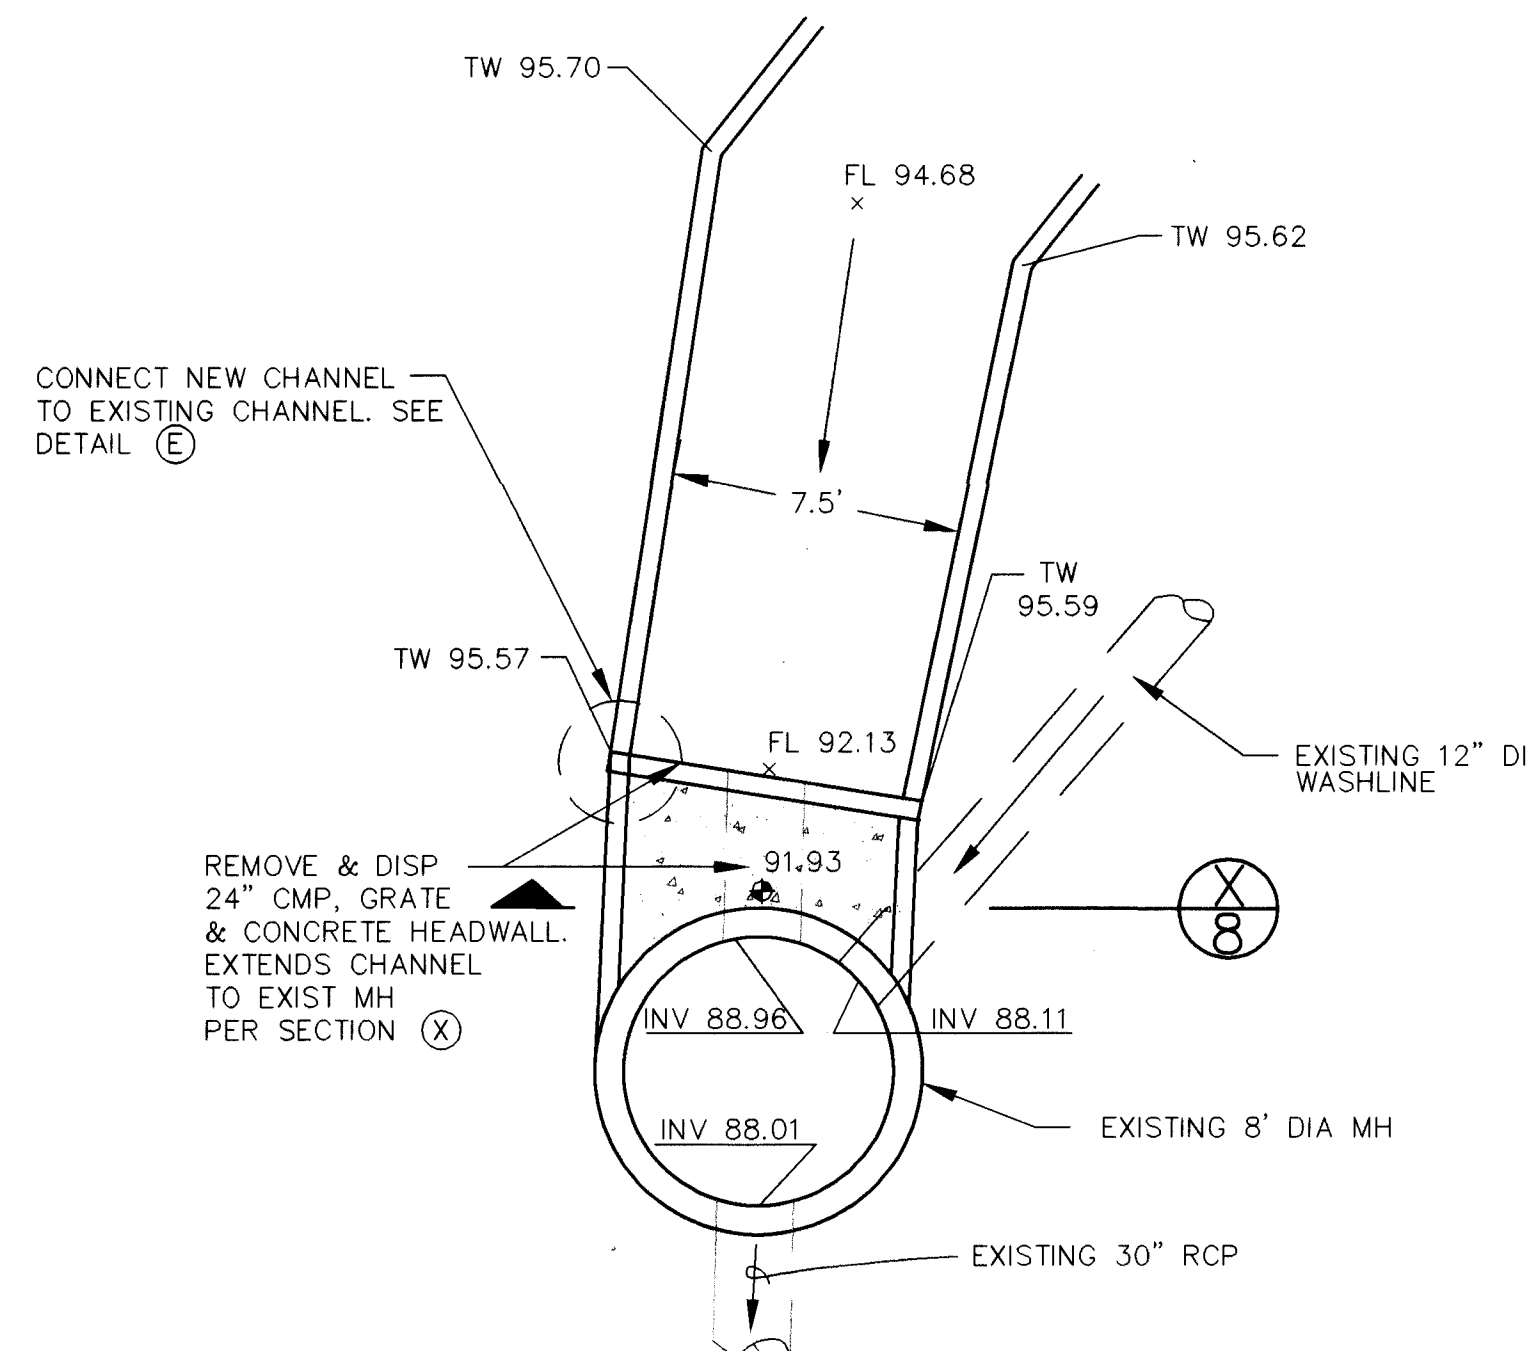


CHANNEL OUTFALL - PLAN
1" = 5'

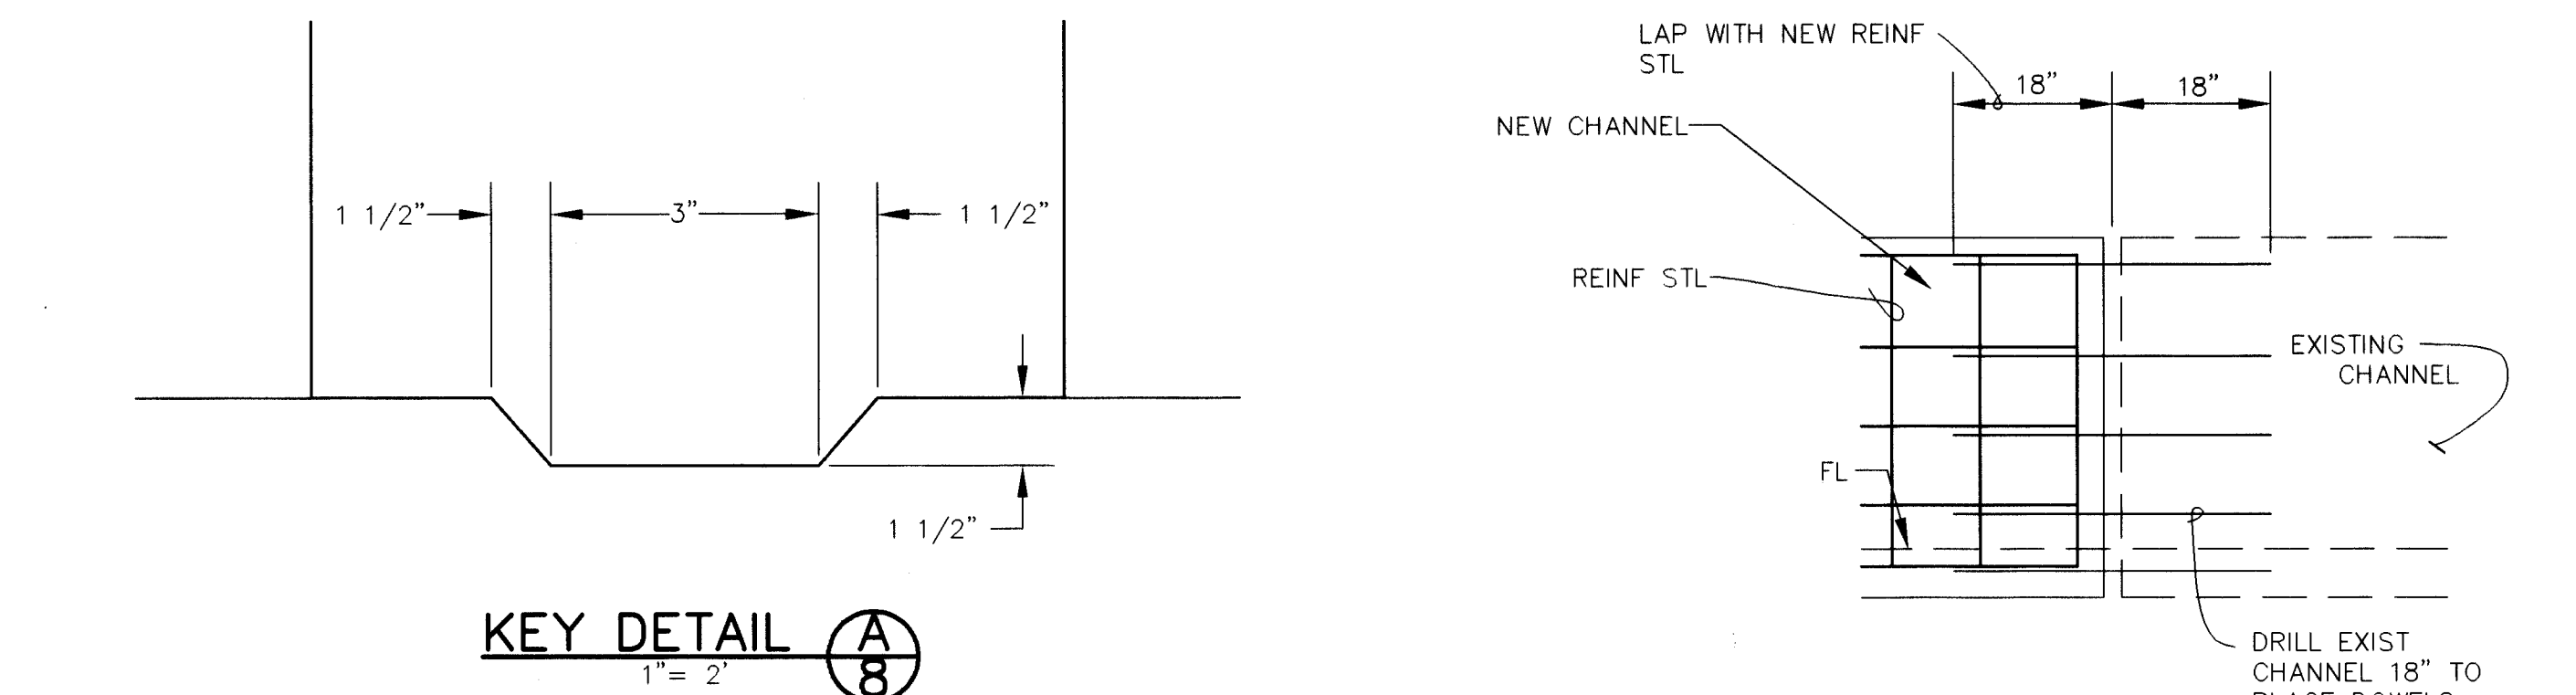


CHANNEL CONNECTION DETAIL (E)
NTS 8

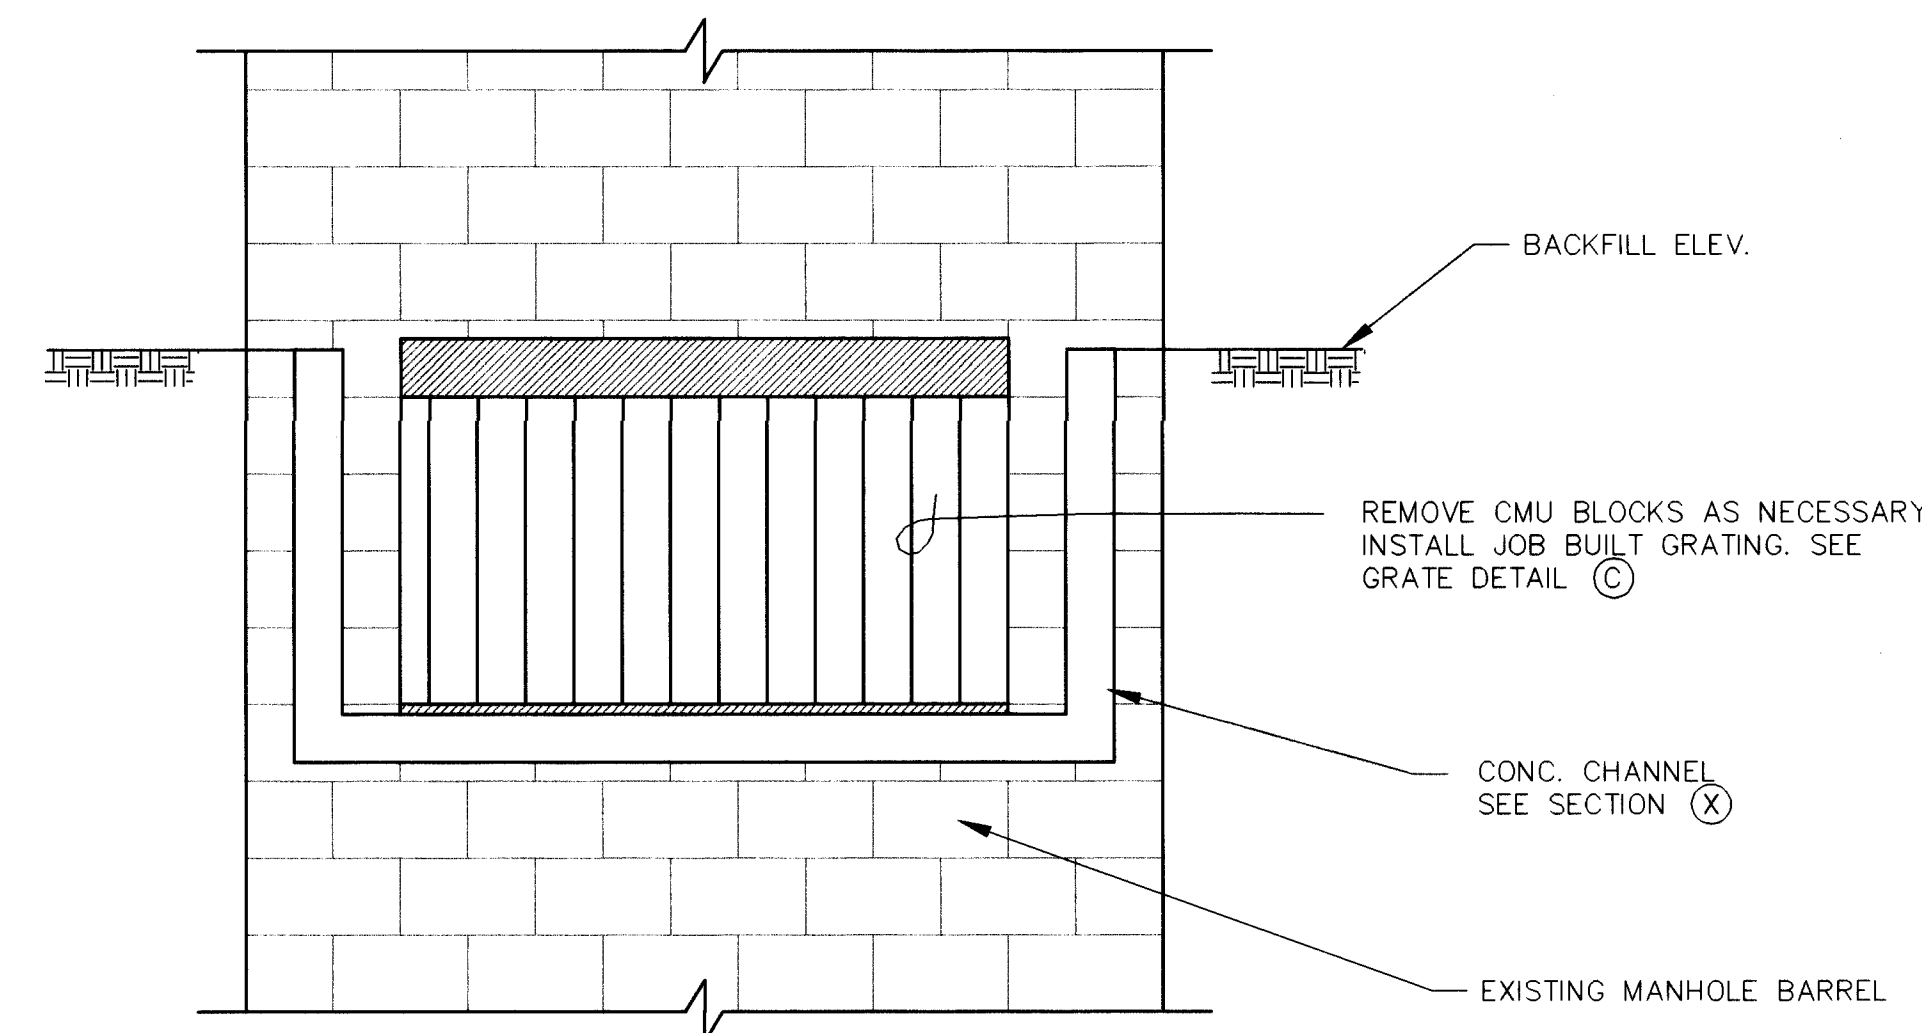


MANHOLE INLET DETAIL (B)
1" = 2'

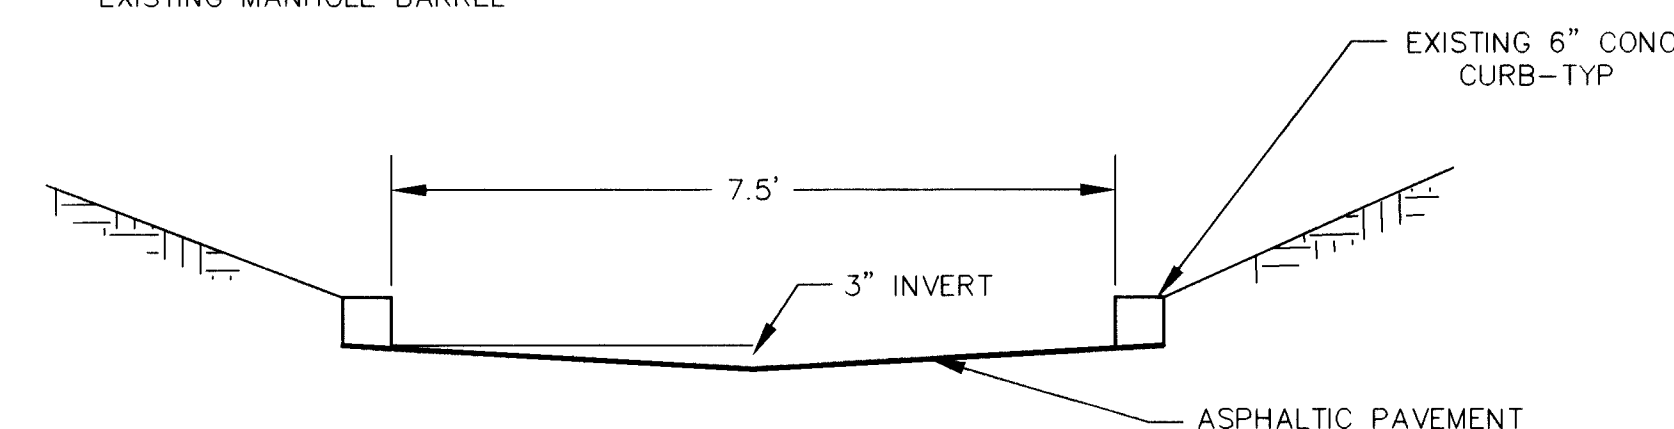


EXISTING CHANNEL SECTION $\text{W} = 8'$
1" = 2'

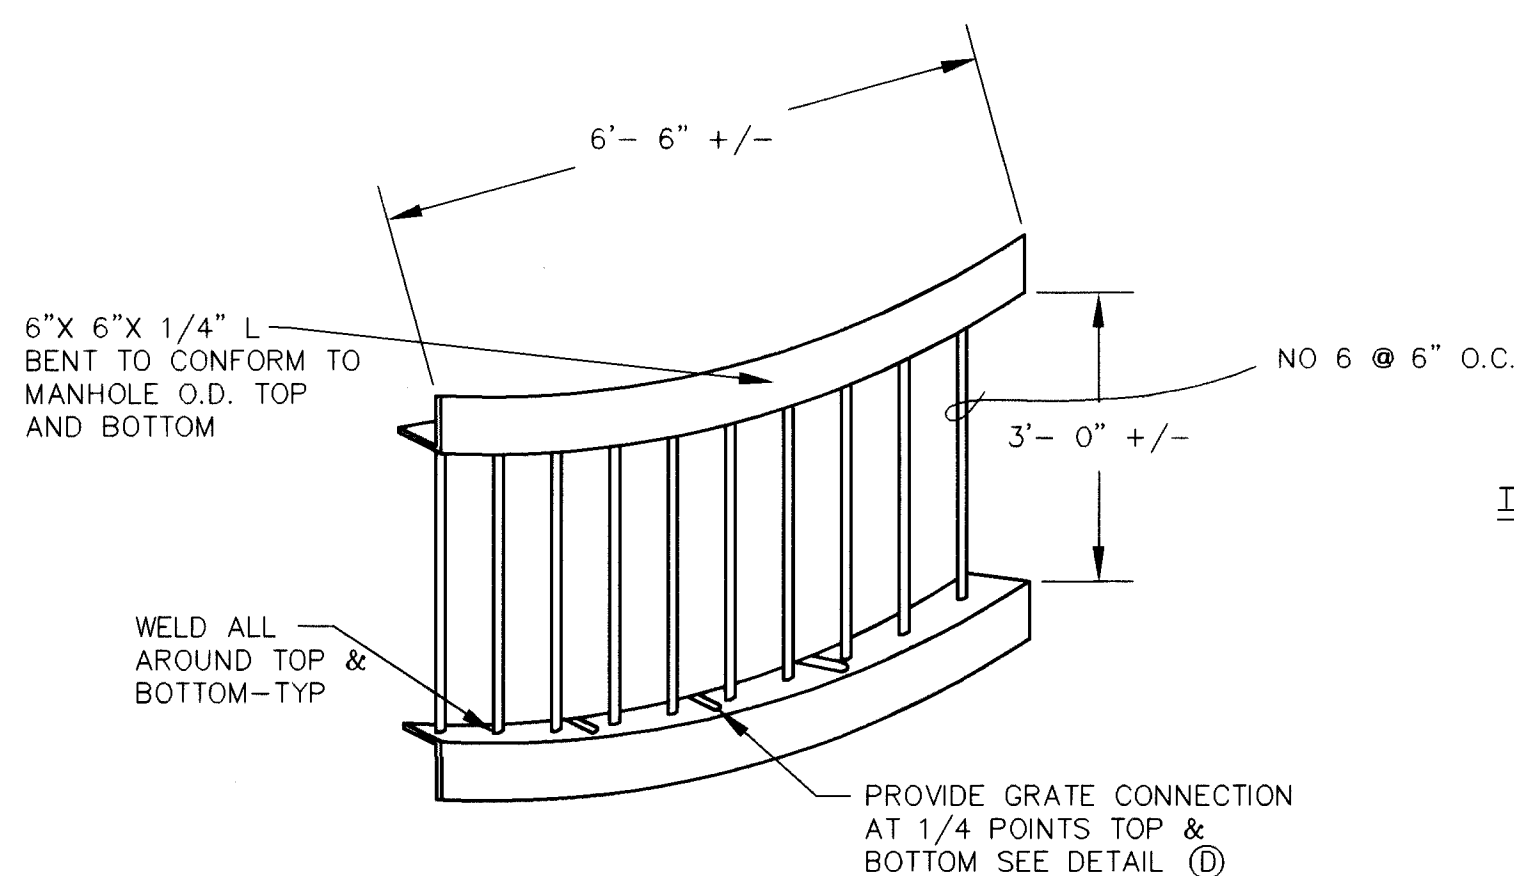

GRATE DETAIL C
8

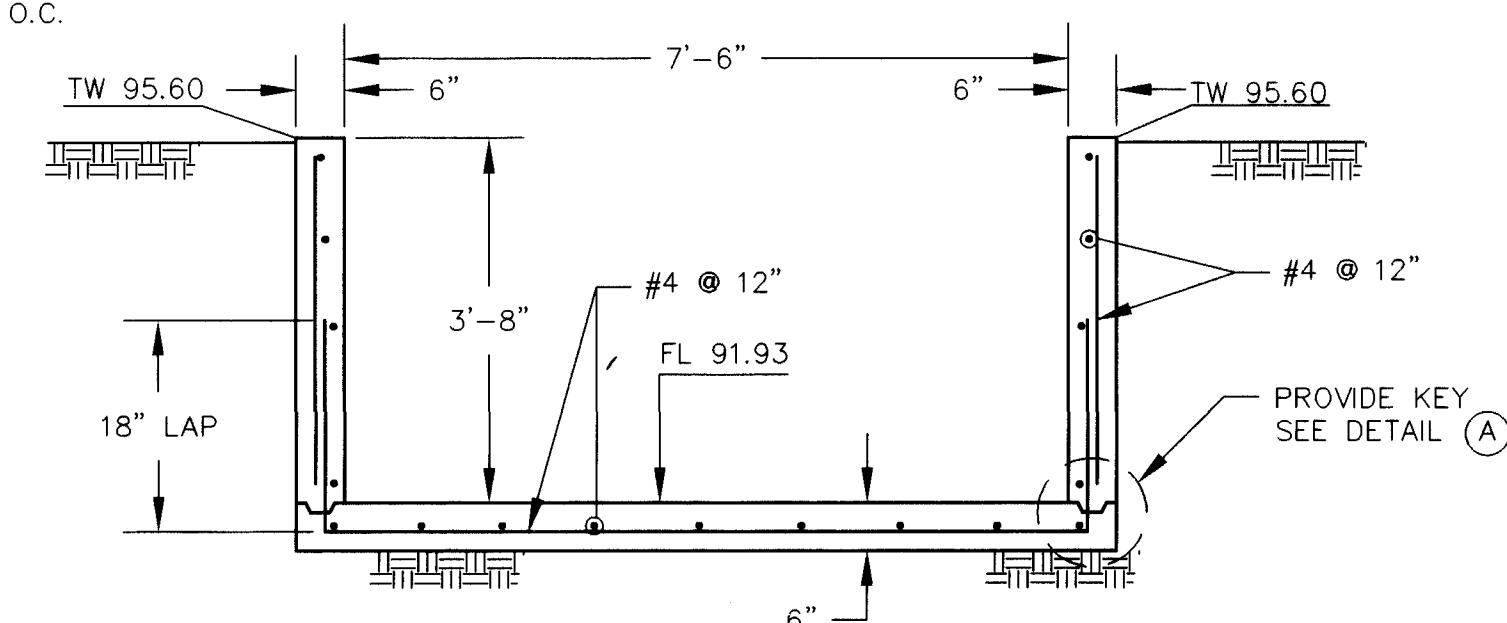

CHANNEL SECTION X
8
1" = 2'

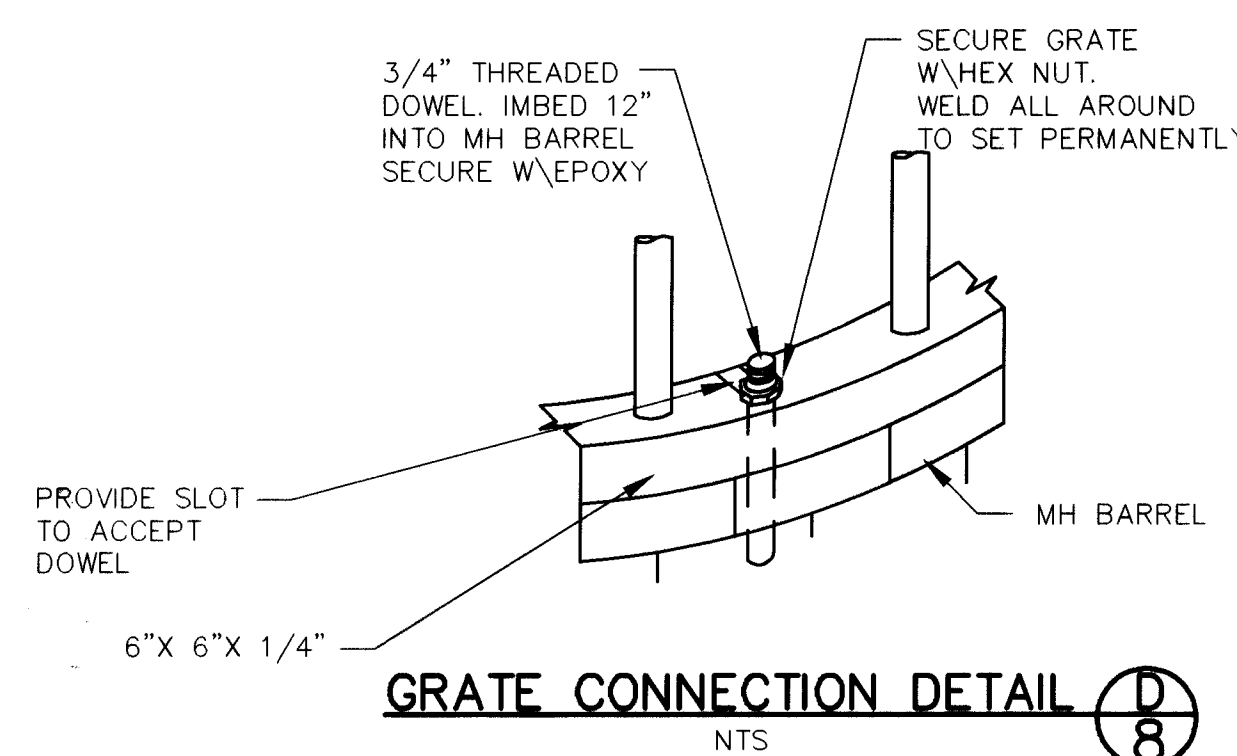

GRATE CONNECTION DETAIL (D
8)

ENGINEER'S SEAL		SURVEY INFORMATION		BENCH MARKS		AS BUILT INFORMATION	
		FIELD NOTES		LOCATED AT THE NORTHEAST CORNER OF THE PROPERTY		CONTRACTOR CCM	
		NO.	BY	DATE	CORNER A REBAR WITH CAP MARKED "LS 6446"	STARTED BY C.O.A.	DATE 12/96
NO.		DATE	REMARKS	BY	INSPECTOR'S FIELD VERIFICATION BY Ray Buca	DATE 12/96	
NO.		DATE	REVISIONS	BY	DRAWN BY C.O.A.	DATE 1/97	
DESIGNED BY		DAL	DATE	3/96	MICRO-FILM INFORMATION		
DRAWN BY		DDE	DATE	3/96	RECORDED BY		
CHECKED BY		SA	DATE	3/96	NO.		

BLI BRASHER & LORENZ, INC.
Consulting Engineers

4425 Juan Tabo Blvd. NE Suite 202
Albuquerque, New Mexico 87111
Ph: 505-296-0422 Fax: 505-296-0466

CITY OF ALBUQUERQUE
PUBLIC WORKS DEPARTMENT
ENGINEERING DEVELOPMENT GROUP

TITLE: WESTERN ESTATES SUBDIVISION
STORM DRAINAGE IMPROVEMENTS CHANNEL "A"

Design Review Committee	City Engineer Approval	Last Design Update	Mo./Day/Yr.	Mo./Day/Yr.
B.G. H. 5/30/96				

City Project No.	5369.90	Zone Map No.	H-11	Sheet	8	Of	8
------------------	---------	--------------	------	-------	---	----	---

SCANNED BY
BY LASON

© COPYRIGHT

© COPYRIGHT	5369.90	H-11	8	8
-------------	---------	------	---	---